


569

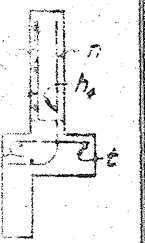

VIEW W1


(1957)  
 14' BPR  
 Loading for  
 vehicles  
 specifications  
 100 lbs. per sq. ft.  
 100 lbs. per sq. ft.  
 100 lbs. per sq. ft.

and wings  
 4" and 4" of  
 concrete  
 set to  
 portions of  
 measured in one  
 roadways.  
 poured  
 initial set to


the length of  
 to make  
 the

built  
 pier


ION

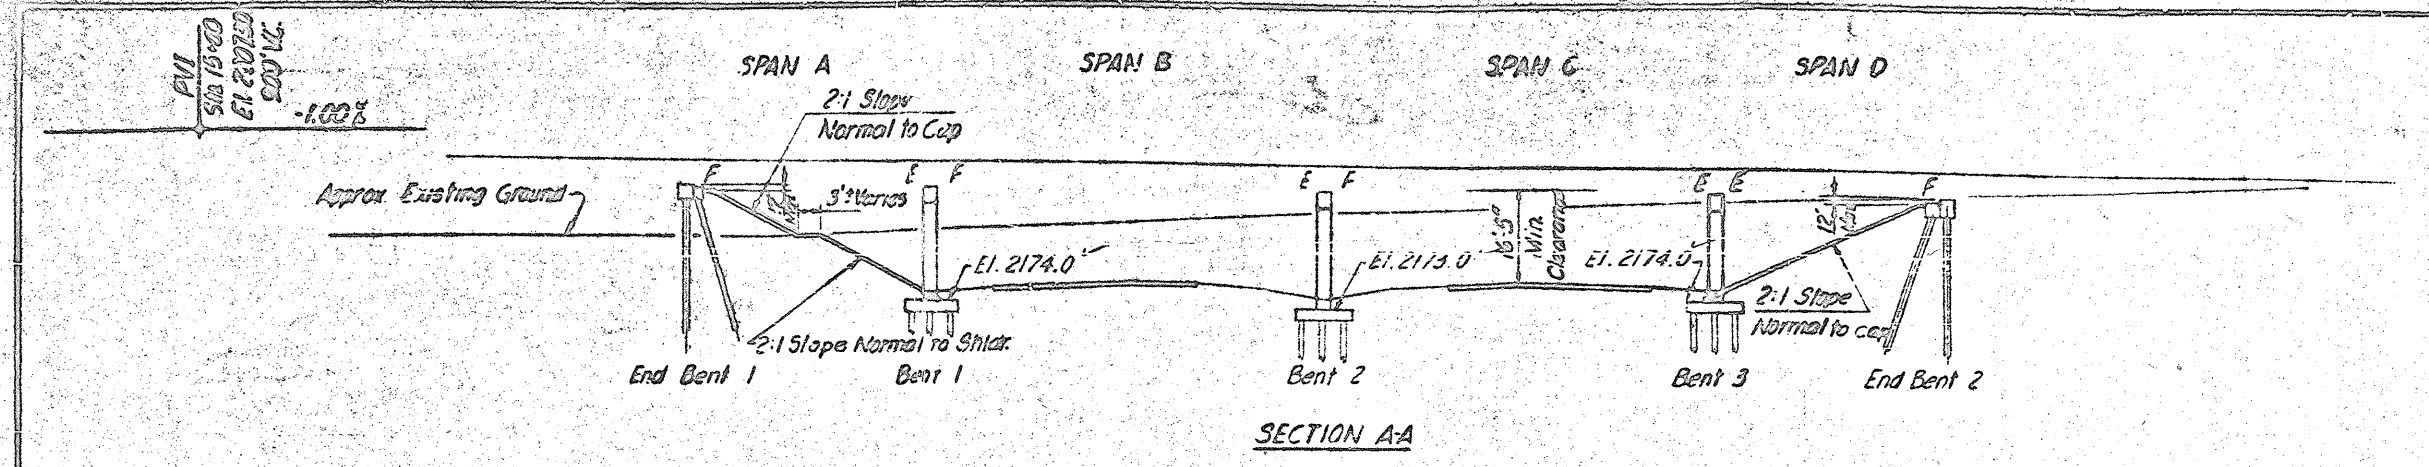

SECTION AA

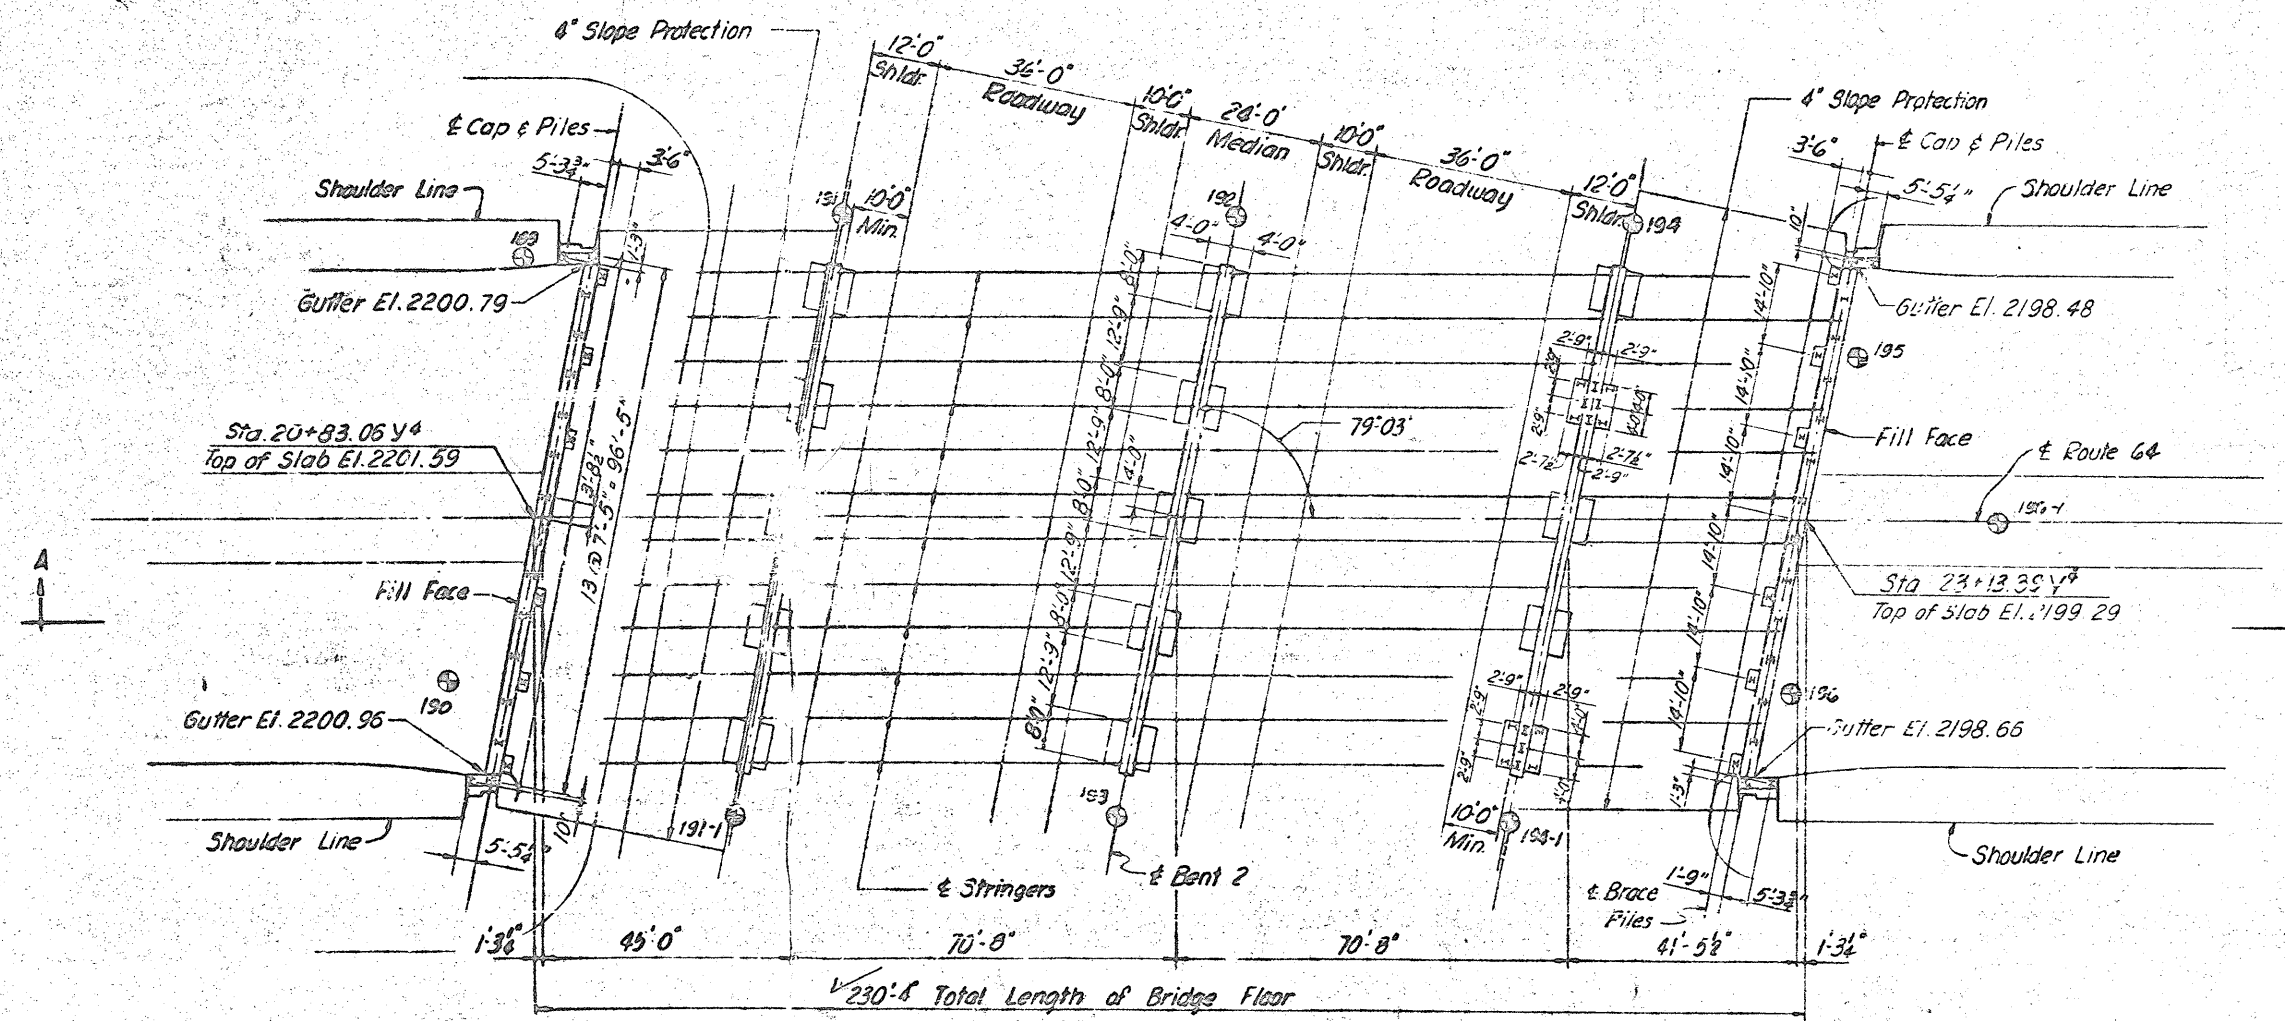

PLAN

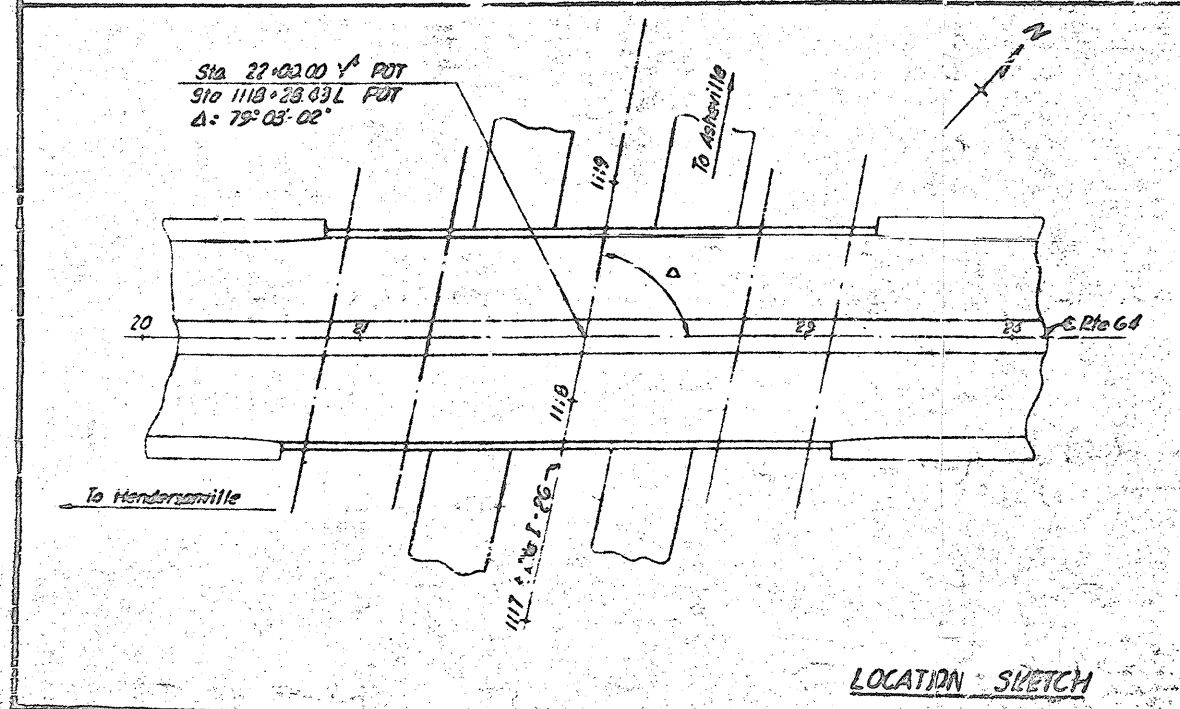

LOCATION SKETCH

Total Bill of Material						
	Class 2 <sup>a</sup> Concrete Cu. Yds.	Reinforcing Steel Lbs.	12 BP53 Steel Piles Lbs.	Unclass. Str. Excav. Cu. Yds.	4' One Slope Protect. Sq. Yds.	Mo. Pal. Rails Lin. Ft.
Superstructure	685.0	120,111				467.88
End Bent #1	89.4	7,391	225,210			667
Bent #1	95.7	15,689	30			
Bent #2	100.1	14,397	39			
Bent #3	94.0	13,414	33			
End Bent #2	98.4	7,991	22			553
Approach Curbs	3.2	76				
Totals:	1056.8	227,978	287			1070.378

Revision No. 2. To change length of metal rail.  
 Revision No. 3. To change Reinforcing Steel Quantities.

DATE	BY	CHKD	APP'D
11/12/57			
11/12/57			
11/12/57			

NOTES


- Loading: AASHTO H 20-316-44 and BPR modified loading for Military Vehicles.
- Future Surfacing: 20 lbs. per sq. ft.
- Roadway Width: 2 roadways at 38'-0" curb to curb.
- For other design data and general notes, see General Notes sheet.
- Concrete surfaces shall be given a surface finish in accordance with the specifications.
- The Contractor will be required to drive one 12 BP53 steel test pile in place of Bents 1 & 3. The test piles shall be paid for as linear foot of 12 BP53 Steel Piles. The order lengths for all piles shall be given after the test piles have been driven. Test Piles for Bents 1 & 3 shall be 25' long.
- All piles at End Bent 1 shall be driven through the roadway fill.
- Piles for all Bents and End Bents shall be driven to a minimum bearing capacity of 30 tons.
- Work is not to be started on Bents 1, 2, 3 and End Bent until after roadway section has been excavated.
- Unclassified Structure Excavation shall be measured from surface of roadway cut.
- Traffic on U.S. 64 will be detoured over ramps and adjacent roads during construction of the proposed structure.
- Benchmark: P.P. Spike in pole at intersection of Hendersonville Rd. & U.S. 64 - 30' At top of 4" dia. 2" dia. Cast Iron GROUND
- ⊕ Indicates 2 1/2" cased hole boring. See Boring Log Sheet
- Benchmark: Nail in slope protection on E.B. #2 at side L. Line. Elev. 2179.46.
- I certify that this structure was built according to Plans.  
 RESIDENT ENGINEER

PROJECT NO. 818293  
 HENDERSON COUNTY  
 STATION 1118 + 23 L  
 22 + 00 V4

STATE OF NORTH CAROLINA  
 STATE HIGHWAY COMMISSION  
 GENERAL DRAWING  
 BRIDGE OVER PROPOSED  
 INTERSTATE ROUTE 23  
 ON U.S. ROUTE 64

64-95-70



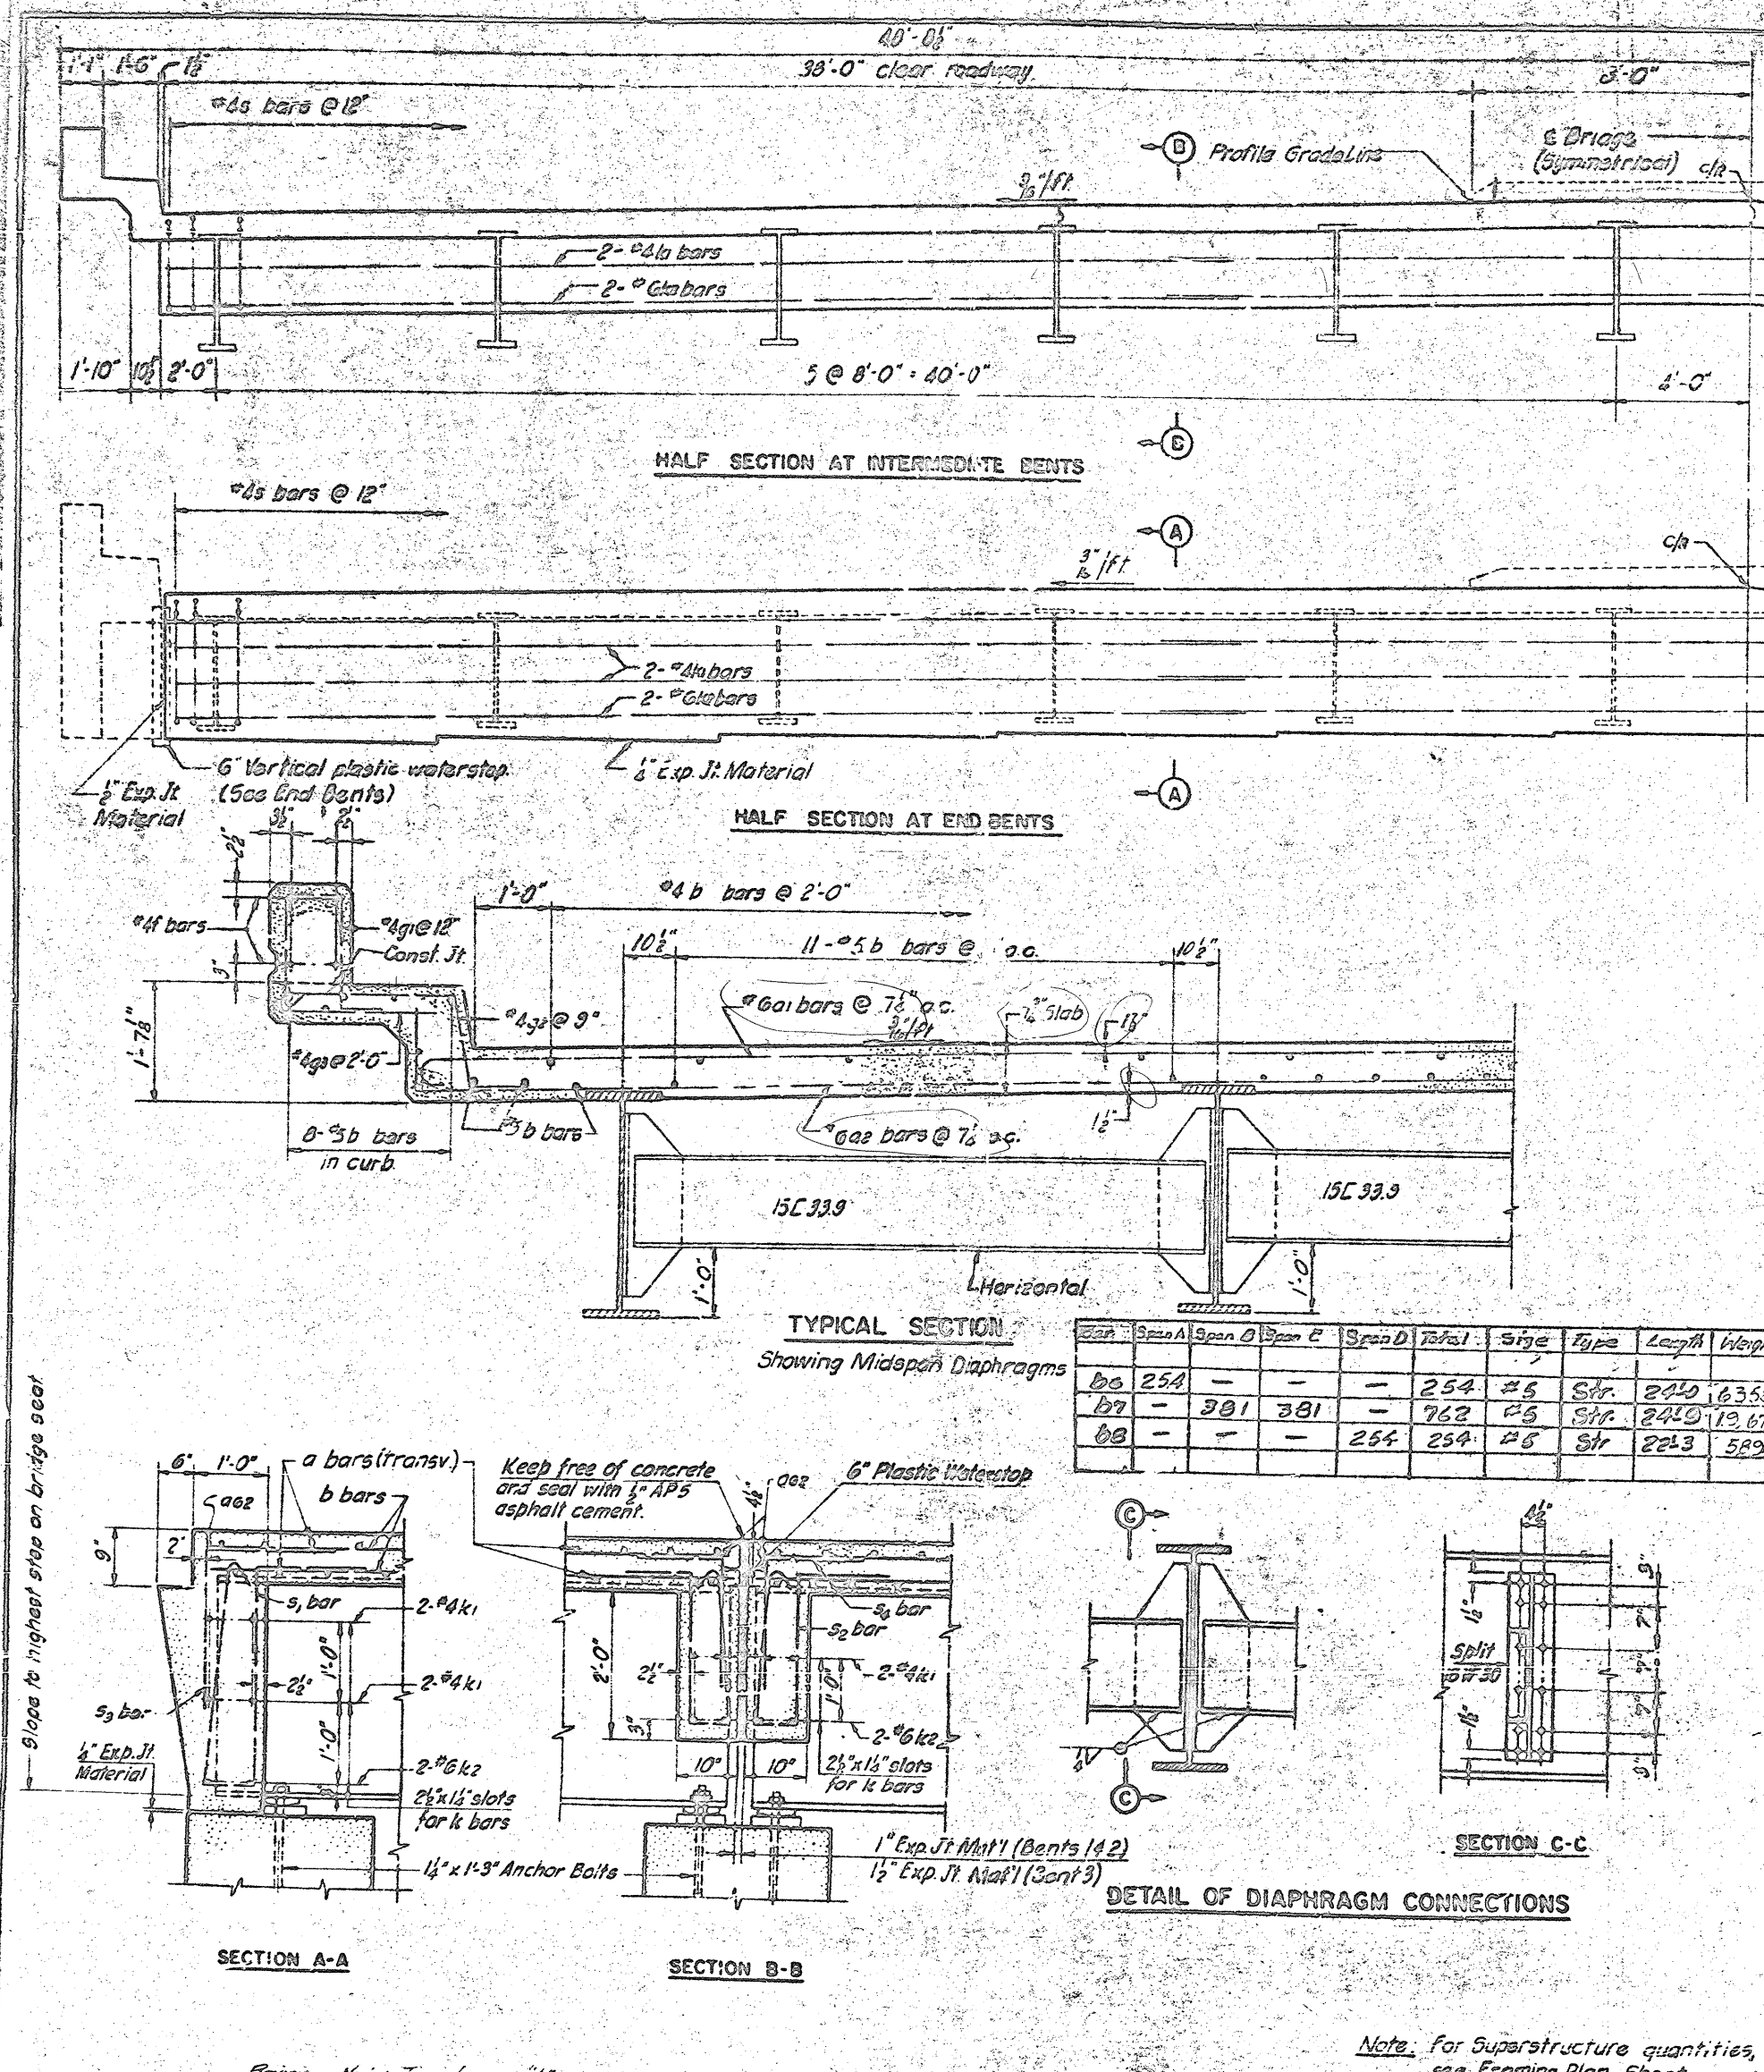

**BILL OF MATERIALS - 4 SPANS**

BAR	NUMBER OF BARS				TOTAL	SIZE	TYPE	LENGTH	WEIGHT
	SPAN A	SPAN B	SPAN C	SPAN D					
a1	126	210	210	115	661	G	32-9	22019	
a2	124	208	208	113	653	G	29-9	21719	
a3	2	2	2	2	8	G	12-1	145	
a4						G	15-3	183	
a5						G	18-5	221	
a6						G	21-7	259	
a7						G	24-9	297	
a8						G	27-11	335	
a9						G	31-1	373	
a10						G	32-3	388	
a11						G	15-10	190	
a12						G	19-0	228	
a13						G	22-2	266	
a14						G	25-4	304	
a15						G	28-6	342	
a16	2	2	2	2	8	G	29-9	357	
a17	4	4	4	4	16	G	29-9	75	
a18	2	2	2	2	8	G	5-6	66	
a19						G	8-8	104	
a20						G	11-9	141	
a21						G	14-10	178	
a22						G	18-0	216	
a23						G	21-1	253	
a24						G	24-3	291	
a25						G	27-5	329	
a26						G	2-0	24	
a27						G	5-0	60	
a28						G	8-1	97	
a29						G	11-3	135	
a30						G	14-4	172	
a31						G	17-5	209	
a32						G	20-7	247	
a33						G	23-9	285	
a34	2	2	2	2	8	G	30-10	403	
a35	5			5	10	G	7-11	404	
a36	5			5	10	G	9-11	16506	
a37	102	102	57	324		G	46-0	19226	
a38	2	2	2	2	8	G	4-9	57	
a39						G	7-0	84	
a40						G	10-2	122	
a41						G	13-3	159	
a42						G	16-5	197	
a43						G	19-7	235	
a44						G	22-9	273	
a45						G	26-10	310	
a46						G	28-11	347	
a47						G	32-0	385	
a48						G	34-0	409	
a49						G	9-3	111	
a50						G	12-4	148	
a51						G	15-5	185	
a52						G	18-6	222	
a53						G	21-8	260	
a54						G	24-10	298	
a55						G	28-0	336	
a56						G	31-2	375	
a57						G	34-5	414	
a58						G	36-7	440	
a59	2	2	2	2	8	G	39-9	478	
a60	6	6	6	6	24	G	31-10	1148	
a61	2	4	4	2	12	G	2-7	47	
a62	32				32	G	23-11	1470	
a63						G	22-6	481	
a64		196	126		322	G	24-3	6226	
a65						G	21-10	1342	
a66						G	20-8	442	
a67						G	22-6	240	
a68		24	24		48	G	24-3	778	
a69						G	20-8	221	
a70	90	142	142	82	456	G	5-7	1701	
a71	120	180	180	103	609	G	5-5	2204	
a72	46	72	72	42	232	G	2-4	362	
a73	18		12	18	60	G	31-10	1276	
a74	12	12	12	12	60	G	31-10	2869	
a75	73			73	158	G	8-7	506	
a76	73	158	158	73	474	G	6-5	2032	
a77	94			94	188	G	3-5	423	
a78	94	188	188	94	566	G	4-4	1162	

PROJECT NO. 810293  
 HENDERSON COUNTY  
 STATION 118+201  
 22+00'±

**STATE OF NORTH CAROLINA  
 STATE HIGHWAY COMMISSION  
 RALEIGH**

**SUPERSTRUCTURE  
 CROSS SECTIONS**


**BENT BAR TYPES**  
 (All dimensions are cut-to-out of bar)

236  
 236  
 66  
 02



DATE	BY	NO.
0	D. C.	81223
FED. AID PROJ. 1-63-1012		

DATE	PROJECT NO.	DATE	NO.
	115	539	
I. A. P. O. NO.			

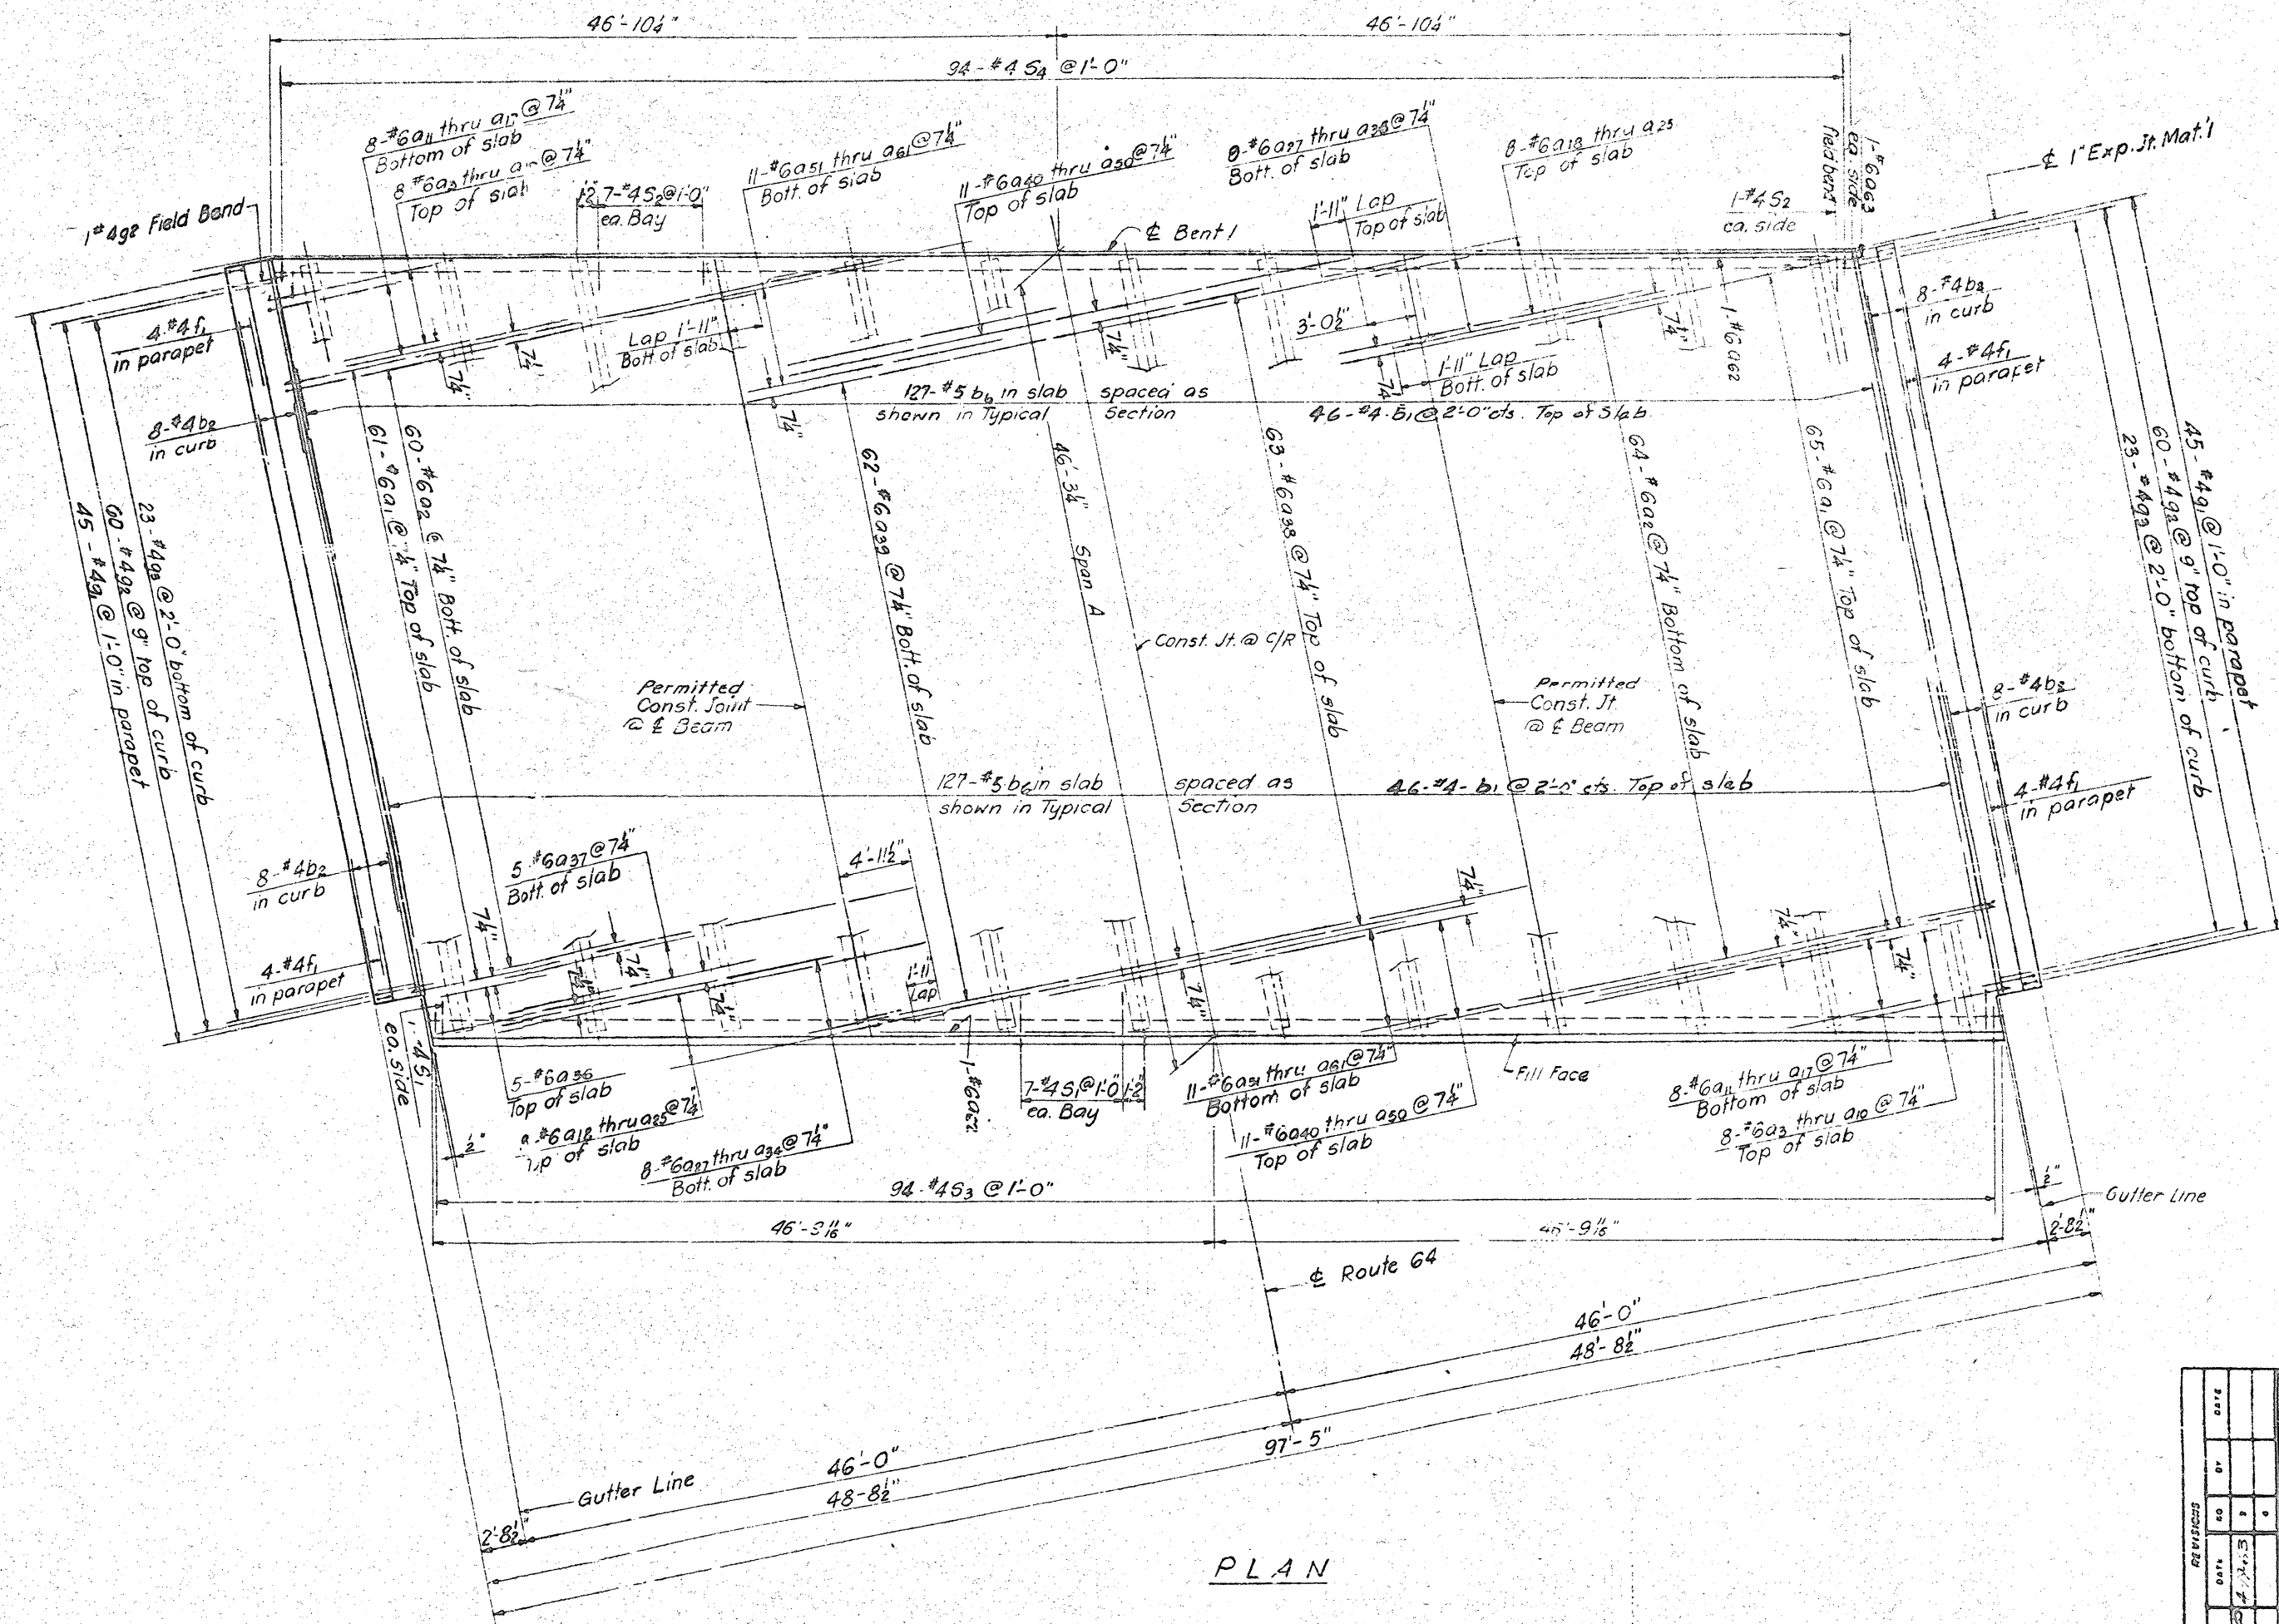

PLAN


Revision No. 1: To change 'b' bars in bottom of slab - JCP

PROJECT NO. 81223  
 HENDERSON COUNTY  
 STATION 1118+294  
 22+00 to 22+00 1/2

STATE OF NORTH CAROLINA	
STATE HIGHWAY COMMISSION	
DESIGN	
SUPERSTRUCTURE	
SPAN "A"	

FILE NO.	STATE	REVISION
5	N.C.	010223
FILE AND PROJ. NO. 416 569		

DATE	MO	YEAR
4/16		569
I.A. PROJ. NO.		

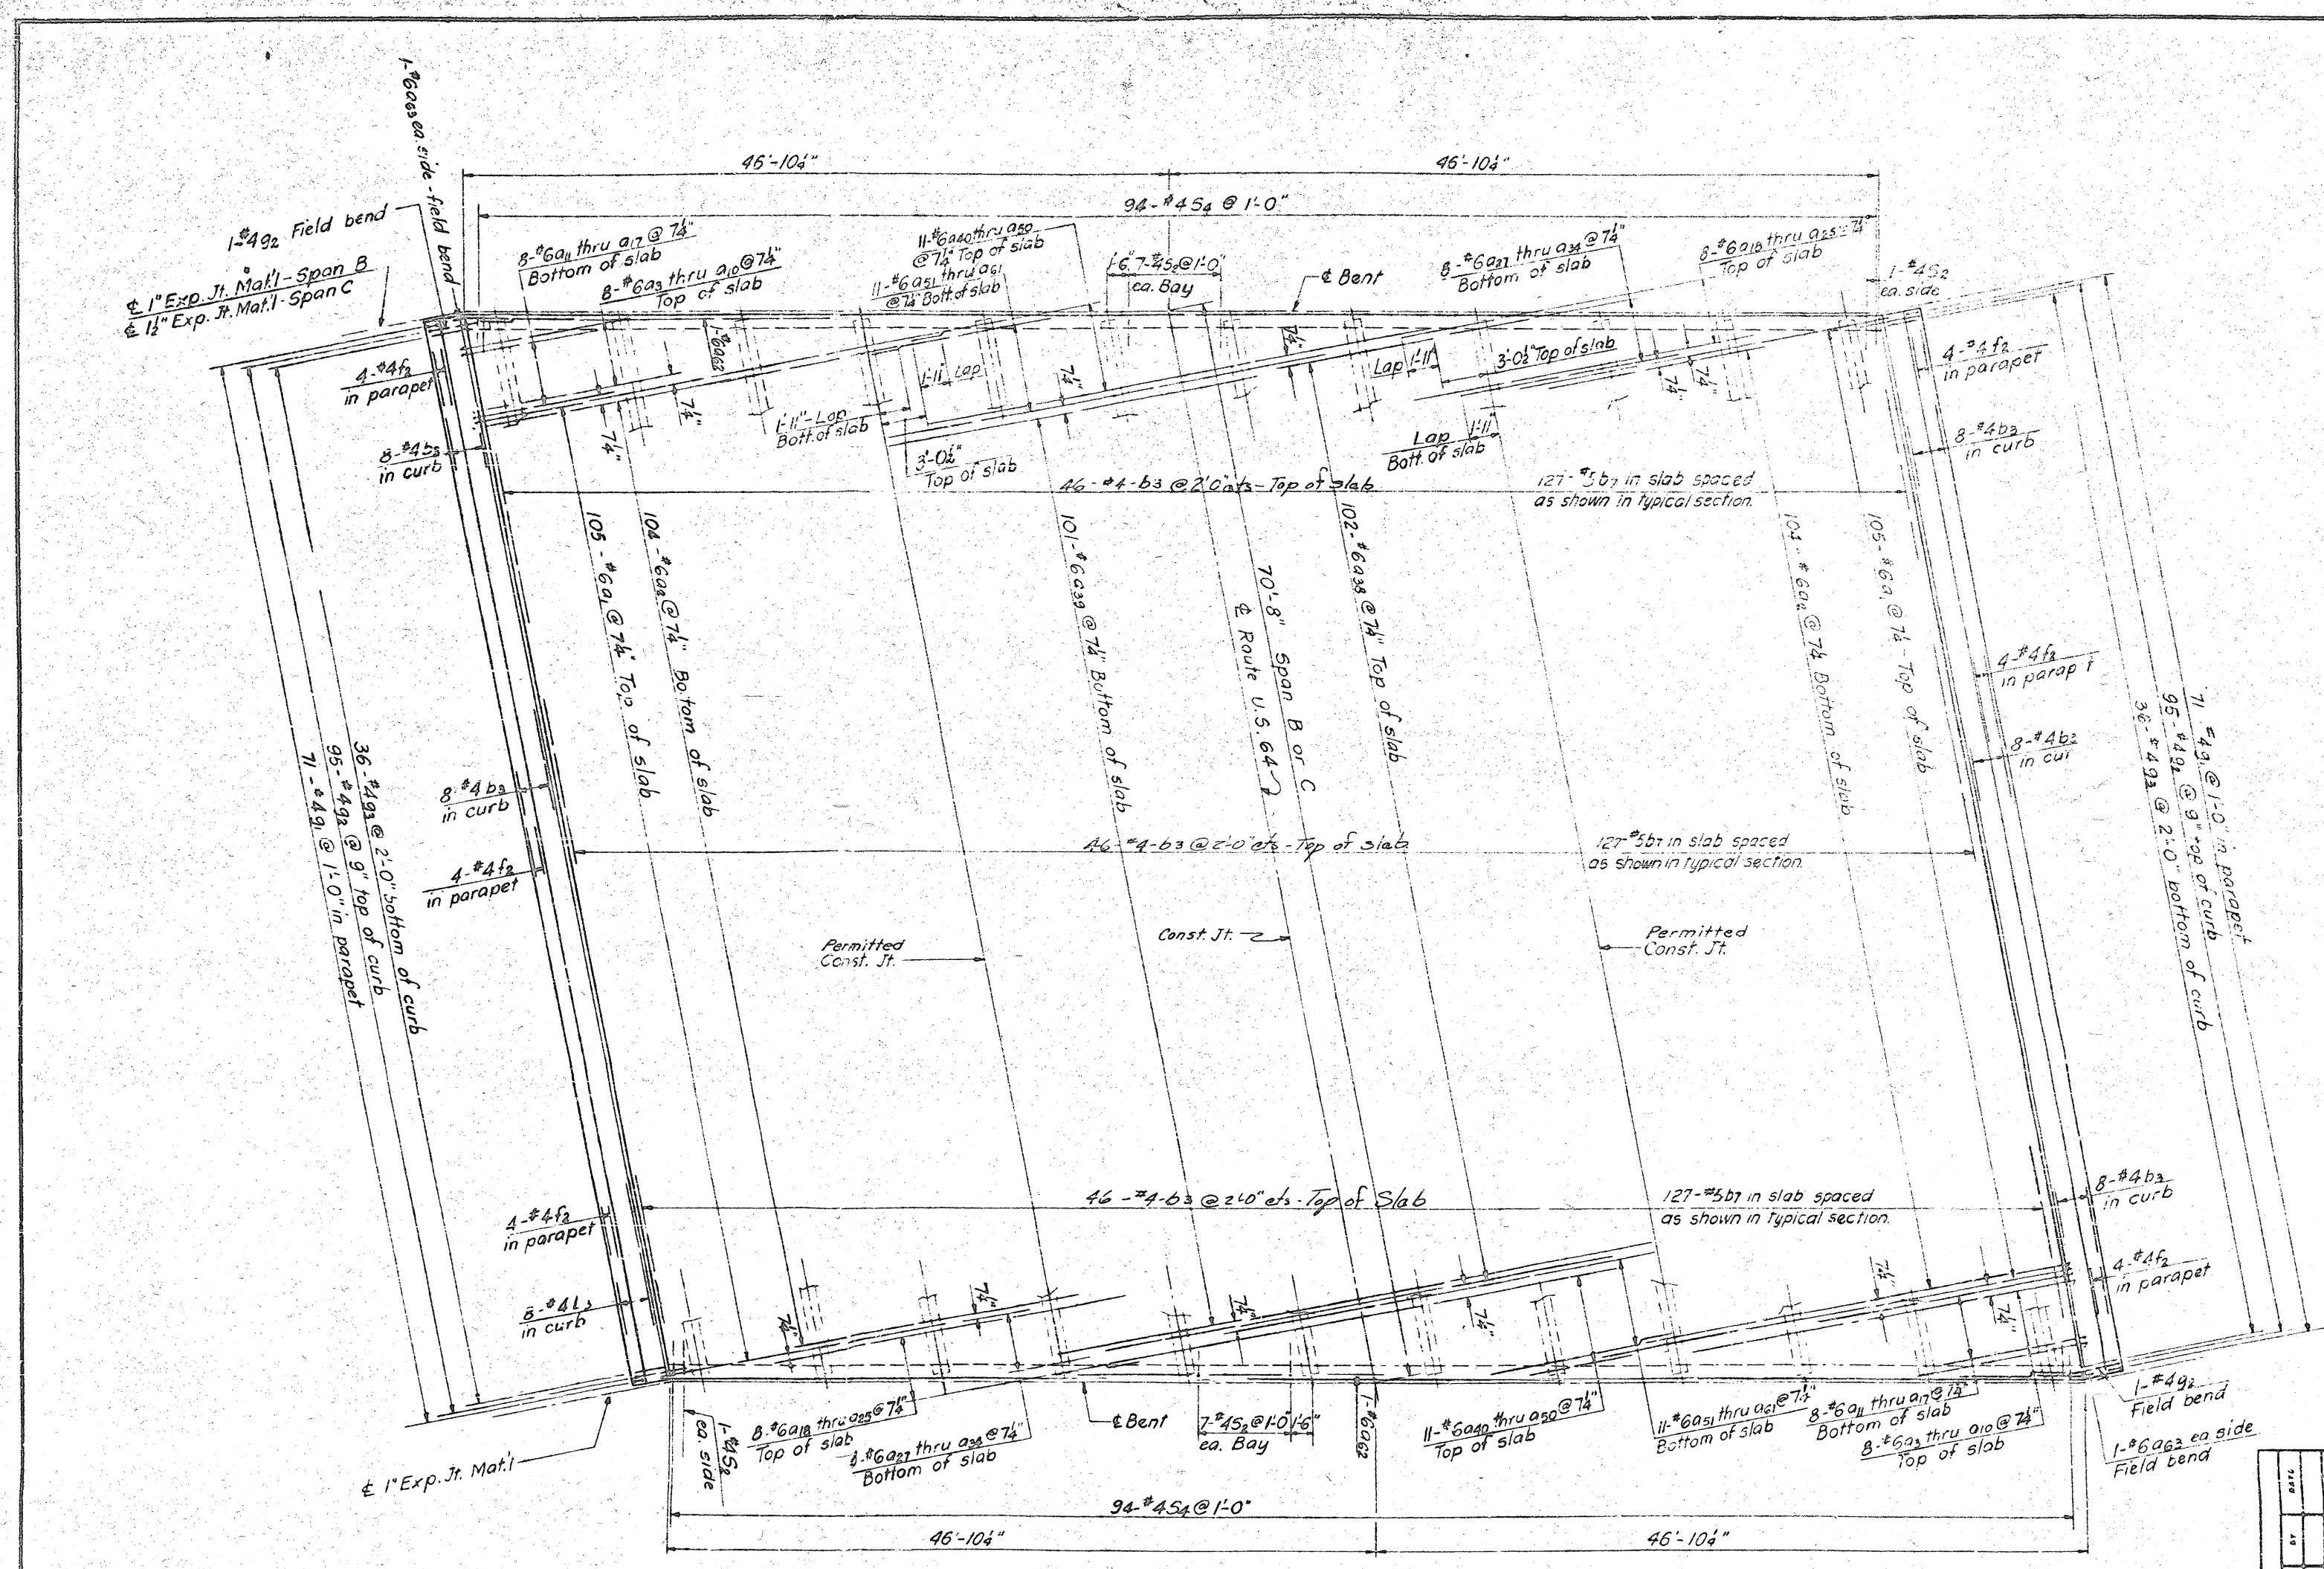

PLAN

PROJECT NO. 810223  
 HENDERSON COUNTY  
 STATION 1118+28L  
 22+00Y4

STATE OF NORTH CAROLINA	
STATE HIGHWAY COMMISSION	
SUPERSTRUCTURE	
SPANS "B" or "C"	
DATE	BY
4/16	...
DATE	BY
...	...


Revision 161: To change 'b' bars in bottom of slab 'c'



569

NO. 100	DATE	BY	REVISION
117	5/69		

SCALE	PROJECT NO.	SECTION NO.	DATE
	117	569	

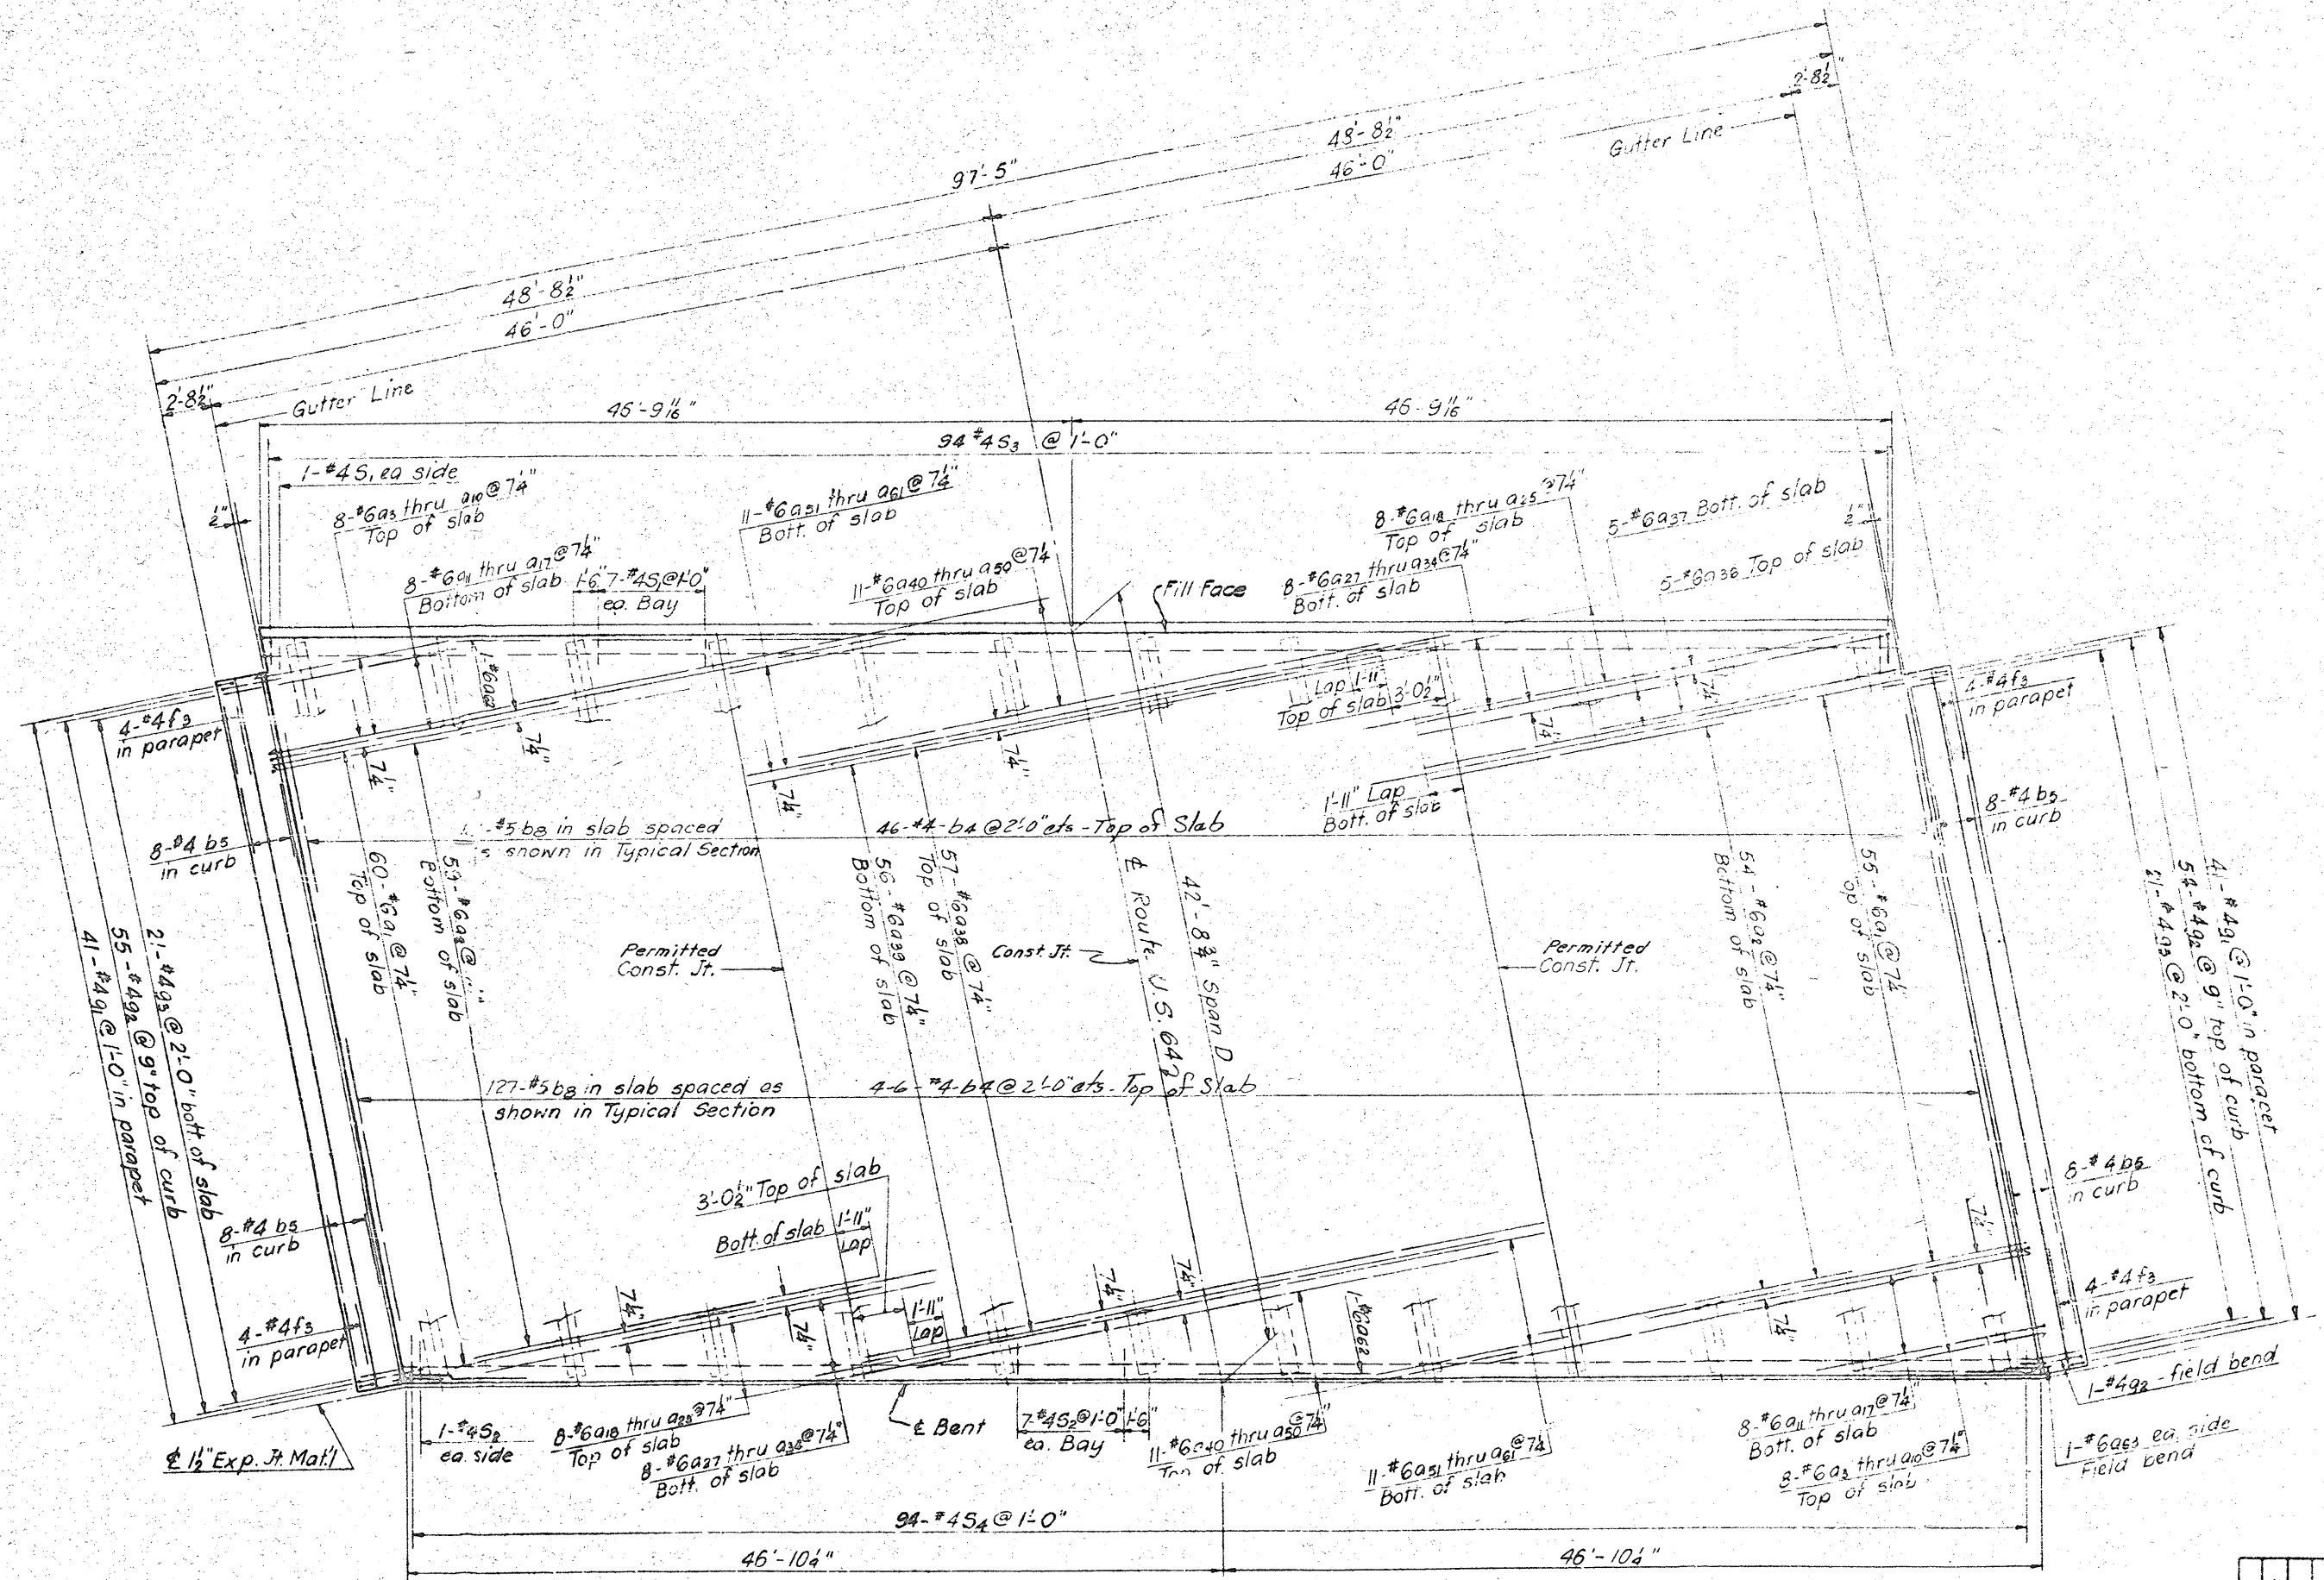

PLAN

PROJECT NO. 8 10293  
 HENDERSON COUNTY  
 STATION 1118 + 28L  
 22-0074

STATE OF NORTH CAROLINA STATE HIGHWAY COMMISSION	
SUPERSTRUCTURE SPAN "D"	
REVISIONS	
NO.	DATE
1	5/69
2	5/69
3	5/69
4	5/69
5	5/69


Revision #1 To change 5" bars in bottom of slab 'B&P'



17 569

REVISED DATE BY  
 0 0 0 0.10.2013  
 Fed Aid Proj. T-26-1151R

DATE REVISION SHEET NO. DATE  
 11/17/13 569

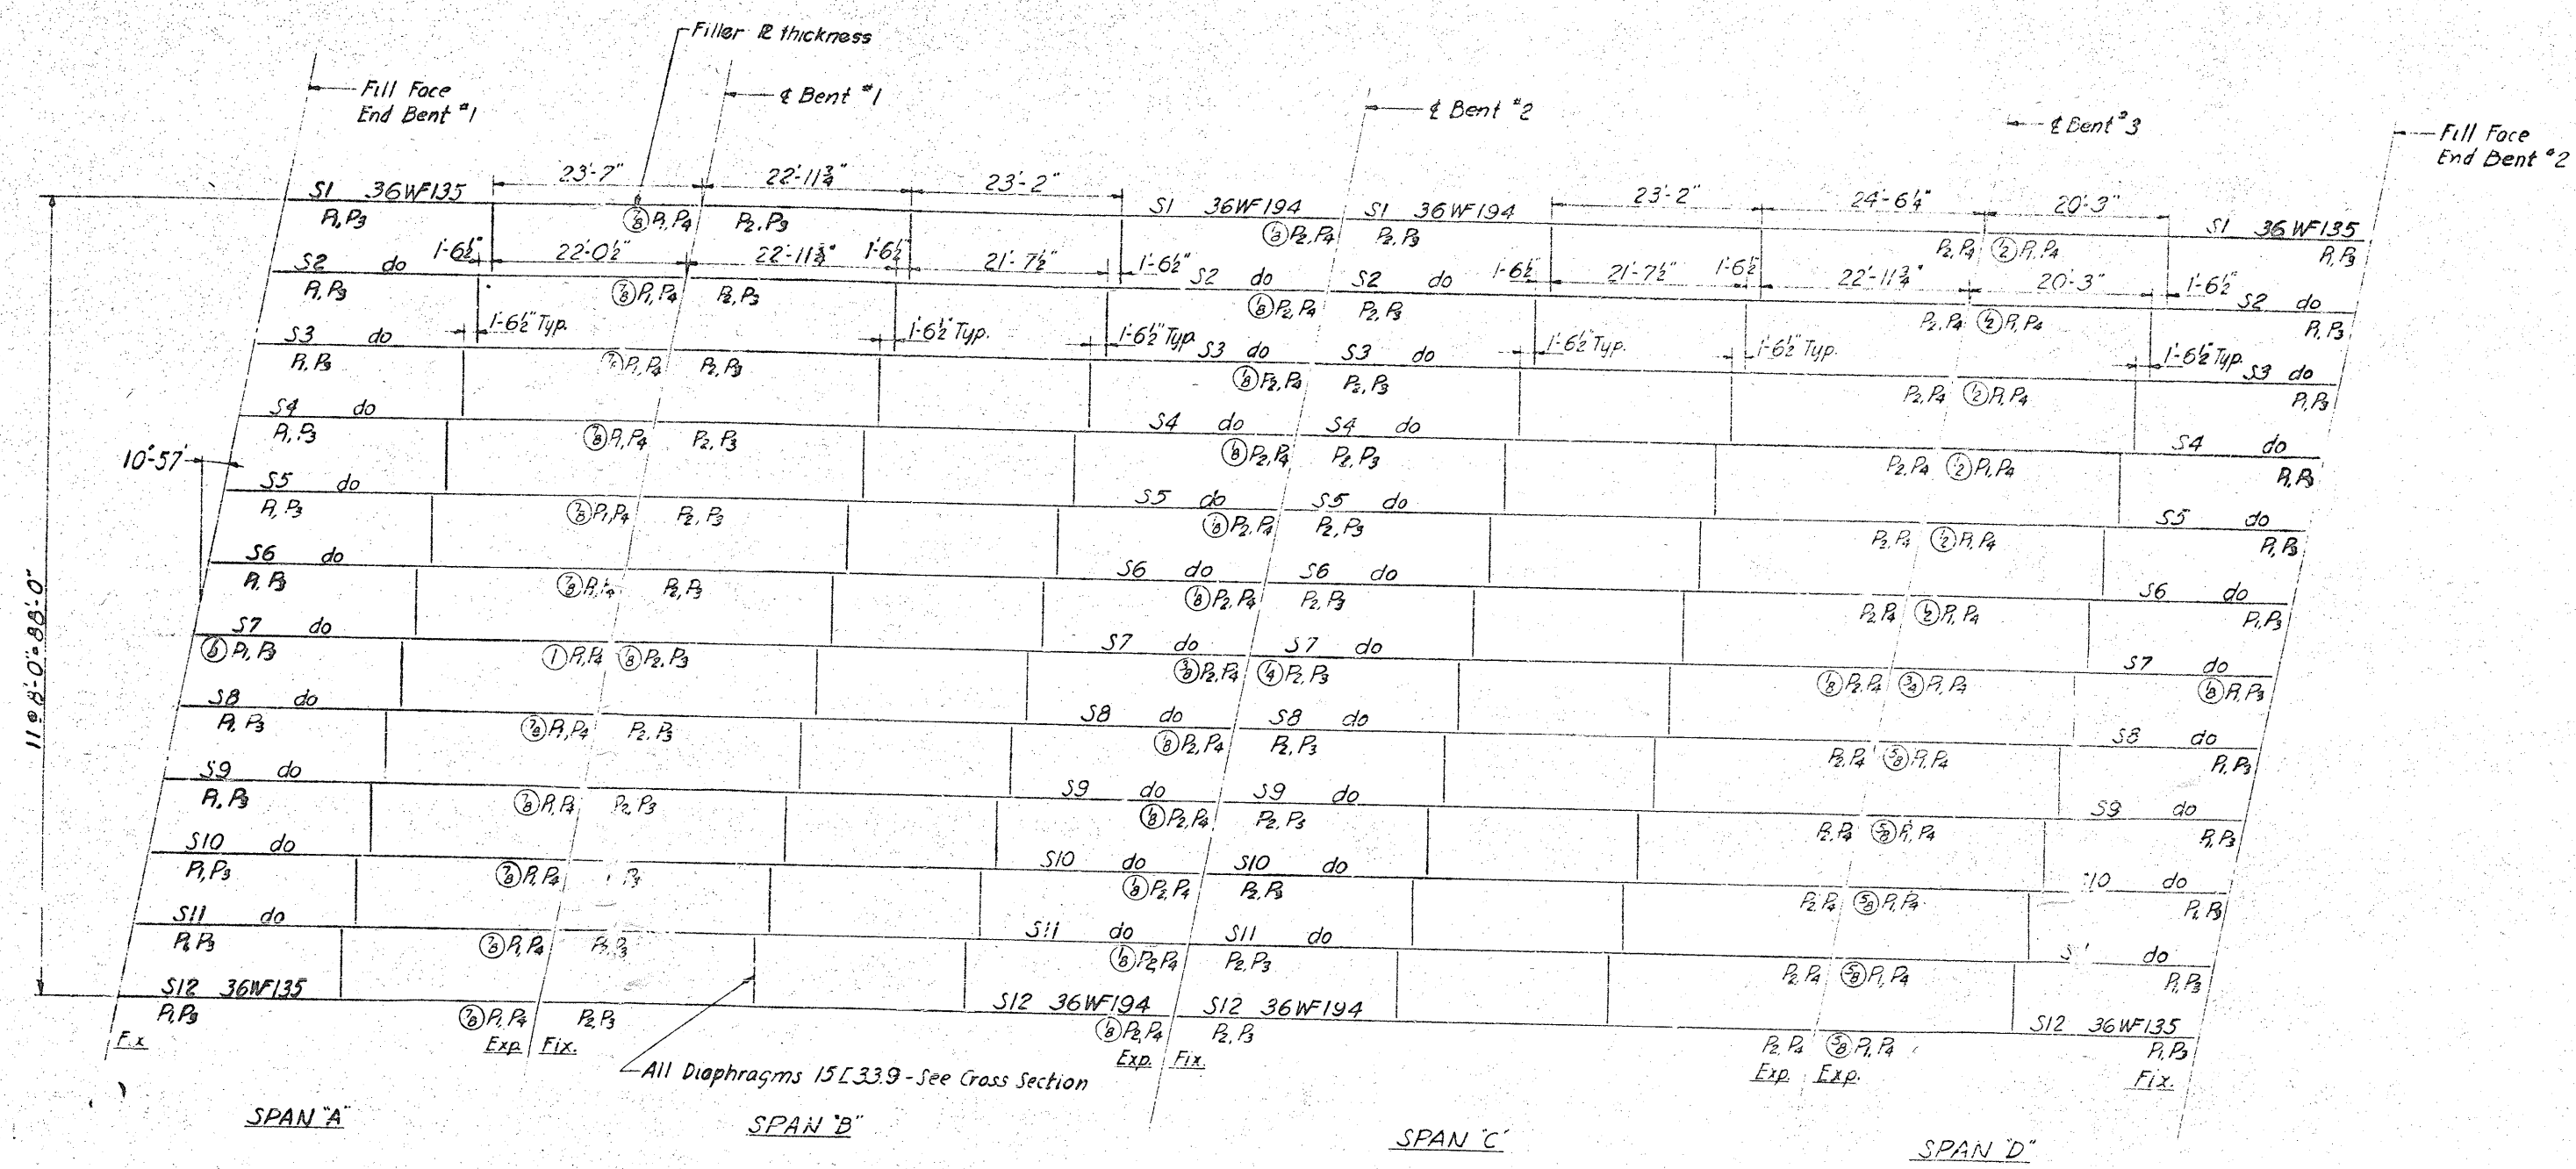

**FRAMING PLAN**

Note: Diaphragm Spacing measured along Beam Grade.

COUNTY

MISSION

TURE




PROJECT NO. 8-18293  
 Henderson COUNTY  
 STATION 1118+28L  
 22+00.94

Total Superstructure Quantities	
Class "A" Concrete	685.0 Cu Yds
Reinforcing Steel	168,111 lbs
Structural Steel	366,300 lbs
Single Bar Metal Railing	467.88 Lin. Ft.


STATE OF NORTH CAROLINA STATE HIGHWAY COMMISSION DALLAS	
STRUCTURAL STEEL	

Revision No 2. To change length of metal rail.  
 Rev. 11/17/13. To change reinf. steel quantity ✓





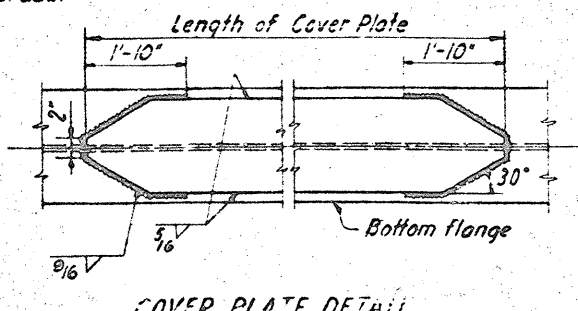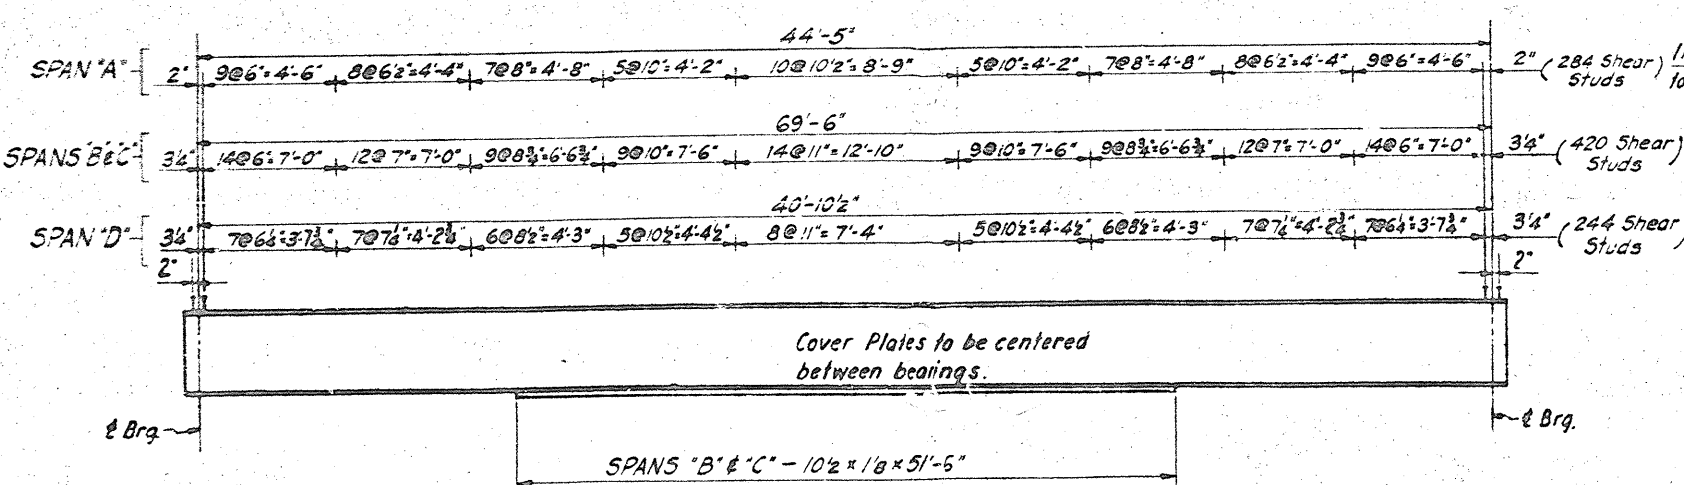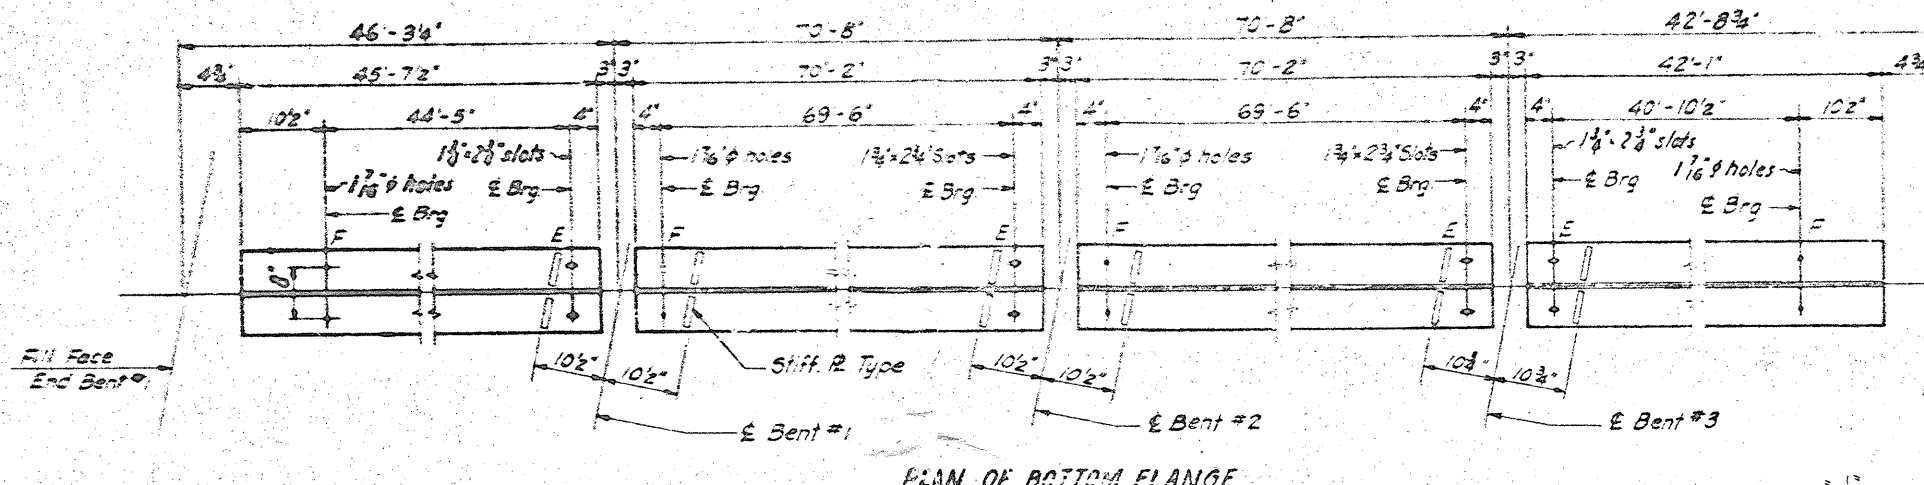

Note: At the Contractor's option, 316 may be substituted for the studs shown. See Sheet S-N

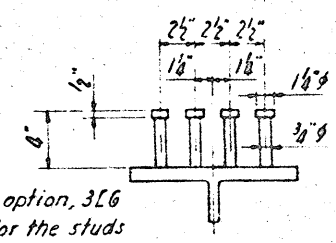

**BEARING PLATE DETAILS**  
For Filler R thickness see Framing Plan

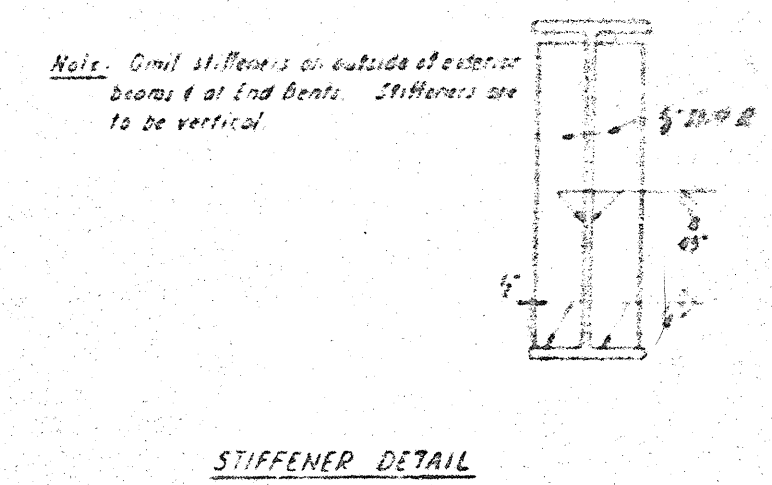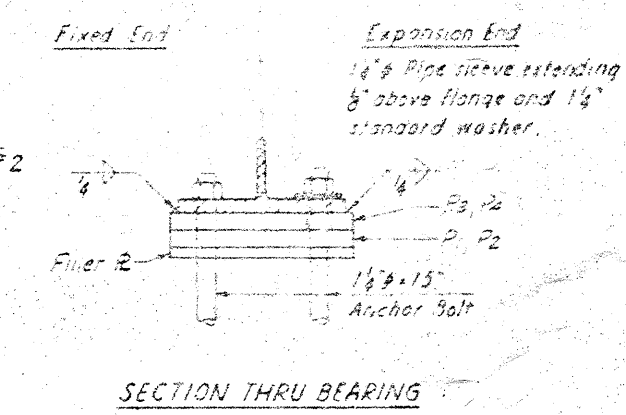

**DEFLECTION TABLE**

	SPAN A		SPAN B		SPAN C		SPAN D	
	STEEL	CONCRETE	STEEL	CONCRETE	STEEL	CONCRETE	STEEL	CONCRETE
Steel	1/8	6	5/16	2 1/8	5/16	1 1/2	1/8	1/8
Concrete	7/16	5/16	1/2	1/2	1/2	1/2	1/2	1/2
Total Defl	2	2 1/8	1 1/8	1 1/8	1 1/8	1 1/8	1 1/8	1 1/8
Vertical Curve	-	-	-	-	-	-	-	-
Total Camber	2	2 1/8	1 1/8	1 1/8	1 1/8	1 1/8	1 1/8	1 1/8

NOTE: All beams, cover plates and channel shear connectors shall be of either ASTM A36 or A313 grade structural steel. See sheet S-N. Stress in extreme fiber of structural steel = 18,000 lbs per sq in.

A375 (33ksi) used in Rating

PROJECT NO. 218293  
HENDESON COUNTY  
STATION 11B+28L  
22-00 Y4


STATE OF NORTH CAROLINA  
STATE HIGHWAY COMMISSION  
CLASSIFICATION

STRUCTURAL STEEL




PROJECT NO.	818293
DATE	11/18/28
BY	559

NO.	REV.	DATE	BY
1			
2			

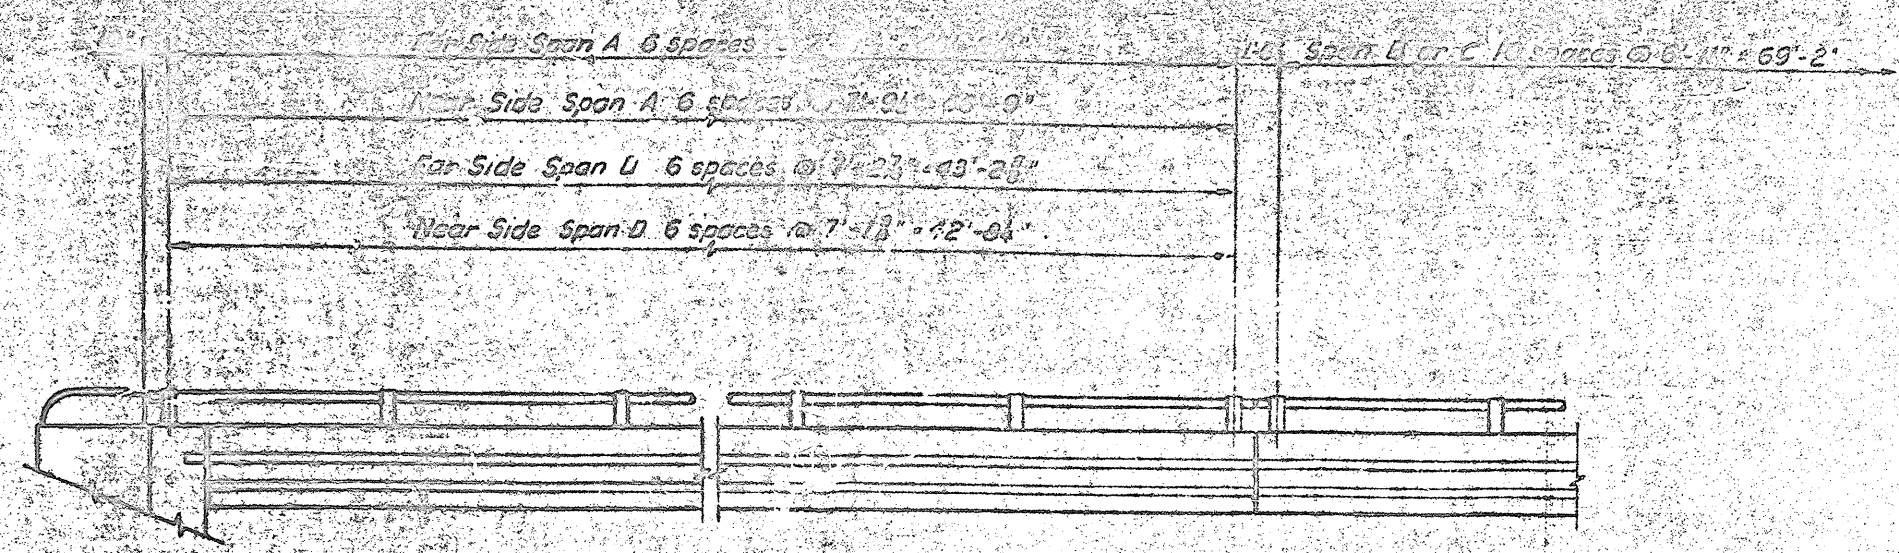

PARAPET AND RAILING ELEVATION

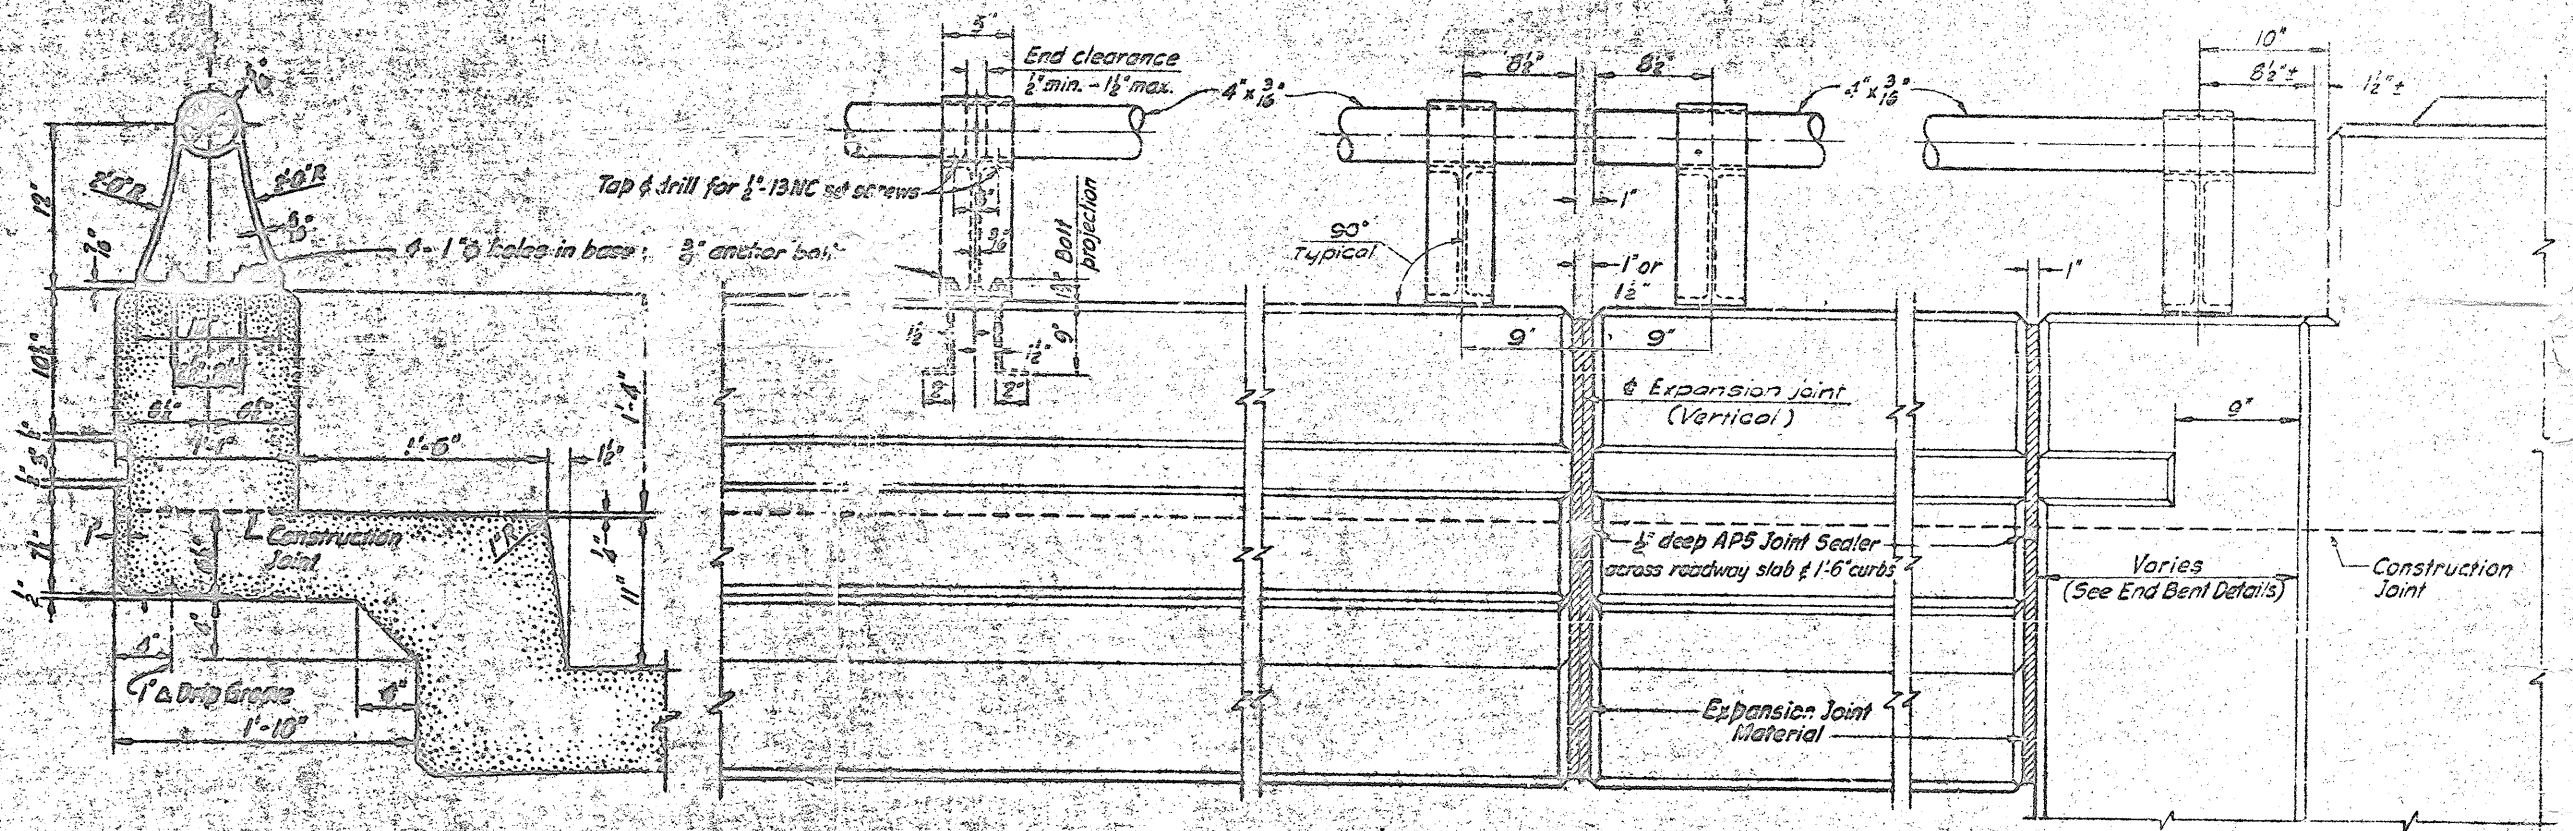

TYPICAL SECTION


ELEVATION

JOINT DETAILS AT BENTS

JOINT DETAILS AT END BENTS

PARAPET AND RAILING DETAILS

At the contractor's option, metal rail may be either Aluminum or Galvanized Steel in accordance with the requirements of the general notes and the following specifications for the alternate materials. However, the contractor will be required to use the same rail material on all structures. (1) Detail for which metal rail is designated.

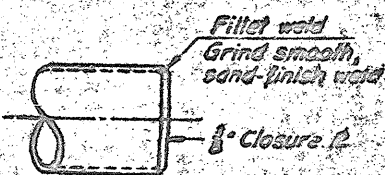

DETAIL END CLOSURE

- Aluminum Alloy to be as follows:  
 Cast Rail Posts: A356-T6  
 Rail: 6061-T6 or 6062-T6  
 Set Screws: 2024-T4  
 Closure Plates: 6061-T6 or 6062-T6
- Round Tubing Posts are to be of 6" O.D. with 1/2" minimum wall thickness.
- The base of rail posts on aluminum surface to contact with concrete shall be surface treated with an aluminum impregnated epoxy.

- Steel and galvanizing are to conform to the following specifications:  
 Cast Rail Post: Steel to cast iron, ASTM A157  
 Grade 50, Galvanized to ASTM A153  
 Rail: Steel A36, Galvanized to ASTM A153  
 Closure Plate: Steel ASTM A-235 Grade C, Galvanized to ASTM A-153  
 Set Screws: Galvanized Steel Set Screws, Galvanized to ASTM A-153

ends of galvanized steel railing and closure plates shall be ground smooth and sanded adjacent to the weld where spalls exist. It has been found by testing that thorough cleaning by wire brushing to remove all traces of welding flux and slag or cracked spatter after which metal cleaned areas shall be given two coats of zinc paint meeting the requirements of Federal Specification MIL-PRC-17300 (USAF) Type I.

**NOTES:**  
 Unless noted on the plans, maximum length of rail section to be two panels plus 'stick thru'.  
 End of rail to clear face of concrete End Post by 1/8".  
 For double panel runs of rail, set screws shall be set tight at center post and snug at ends to allow for expansion.  
 For single panel runs, set screw to be tight at one end and snug at other end.  
 3/8" Anchor bolts, hex nuts and washers to be steel galvanized in accordance with ASTM A-153 and painted with 2 coats of aluminum paint after erection.  
 Cast posts to be as shown or an approved equal.  
 Certified Mill reports are required for rails and posts. Shop inspection is not required.  
 Metal Rail Posts to be set normal to curb grade.  
 Method of measurement for Metal Rails: Unless otherwise stated, the length of Metal rails to be paid for shall be the continuous horizontal length measured from end to end of rail, excepting concrete posts, but without deductions for spaces between rail sections.

PROJECT NO. 818293  
 Henderson COUNTY  
 STATION 1118 + 28 L  
 22 + 00 Y

STATE OF NORTH CAROLINA	
STATE HIGHWAY COMMISSION	
RALEIGH	
PARAPET AND RAILING DETAILS	
DATE	
BY	
DATE	
BY	