
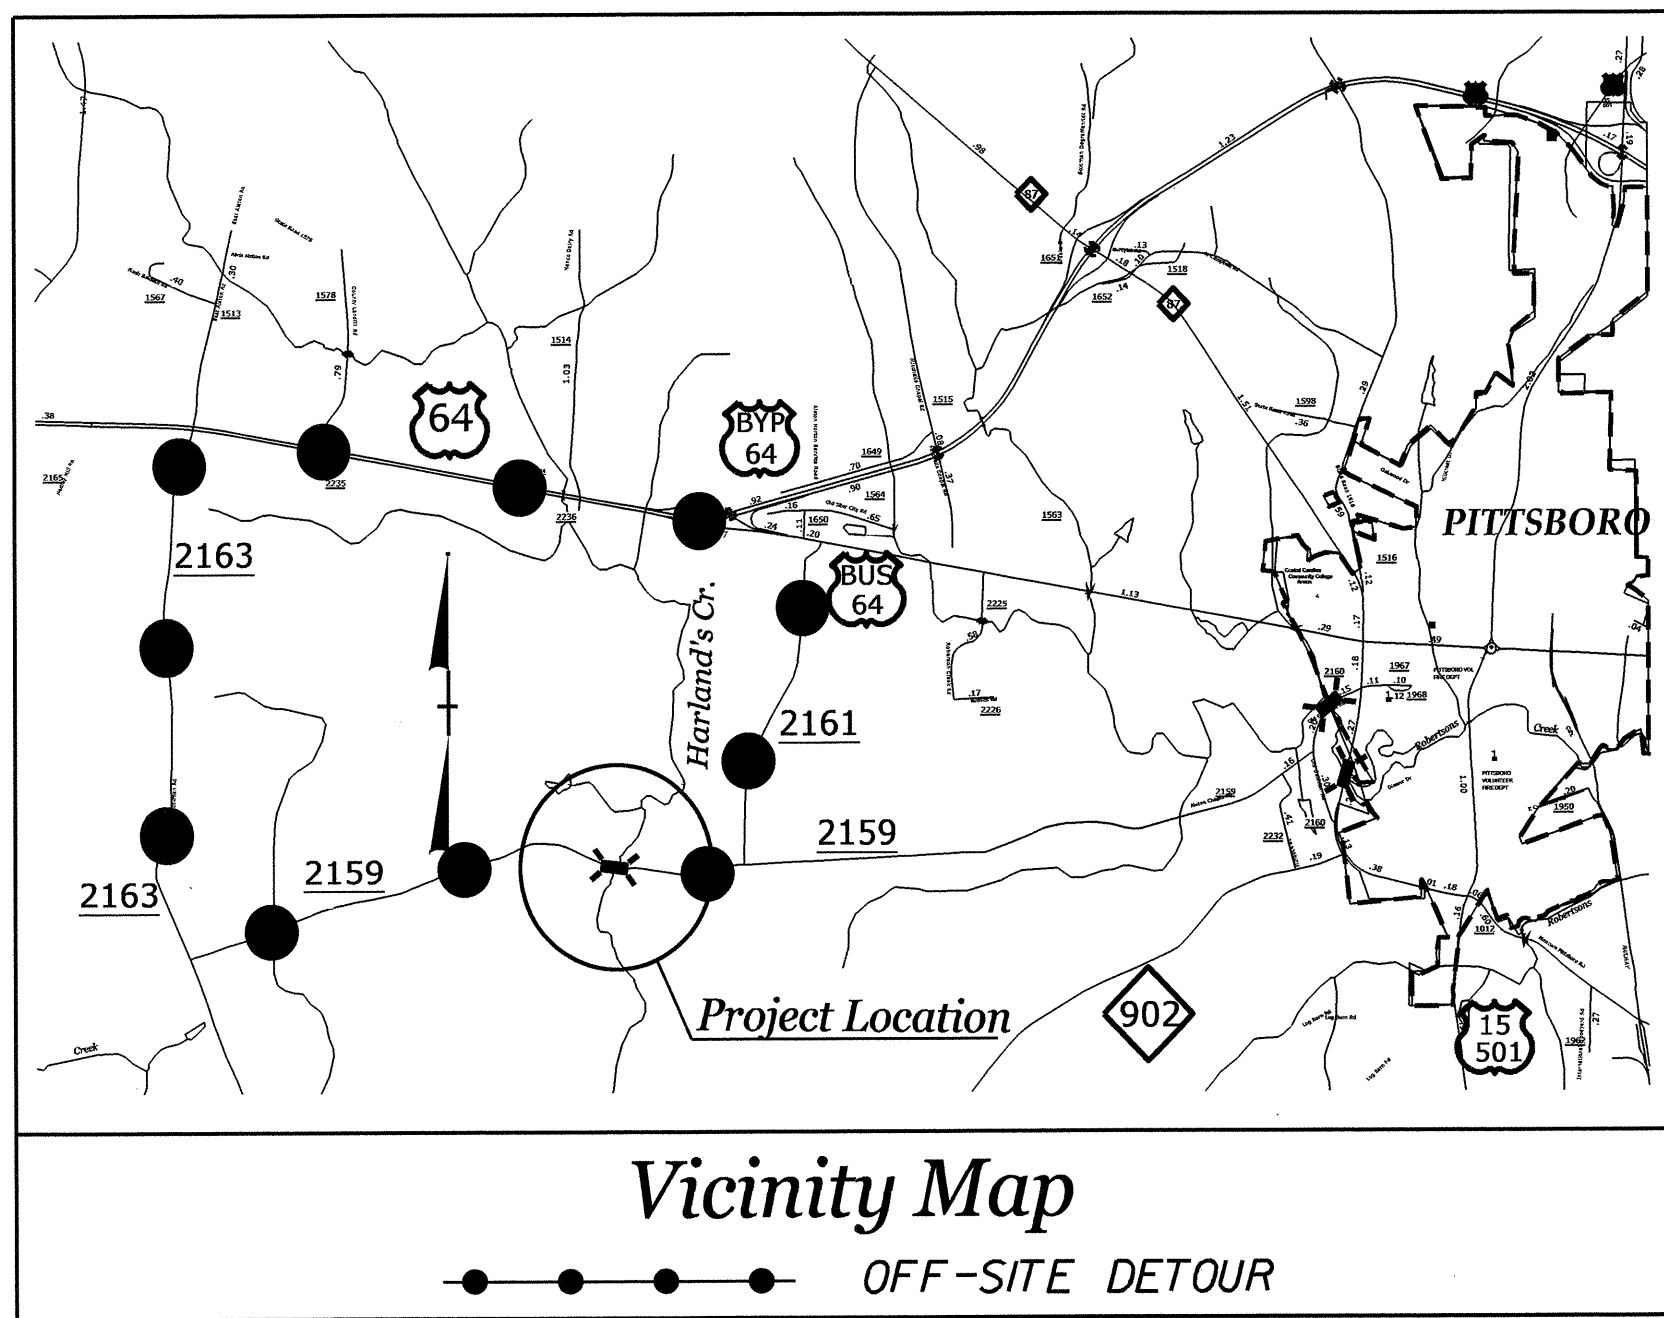


CONTRACT: C203297 TIP NO: B-4731


STATE	STATE PROJECT REFERENCE NO.	SHEET NO.	TOTAL SHEETS
N.C.	B-4731		
STATE PROJ. NO.	F.A. PROJ. NO.	DESCRIPTION	
38504.1.1	BRZ-2159(1)	P. E.	
38504.2.1	BRZ-2159(1)	RW, UTL.	
38504.3.FD1	BRZ-2159(1)	CONST.	

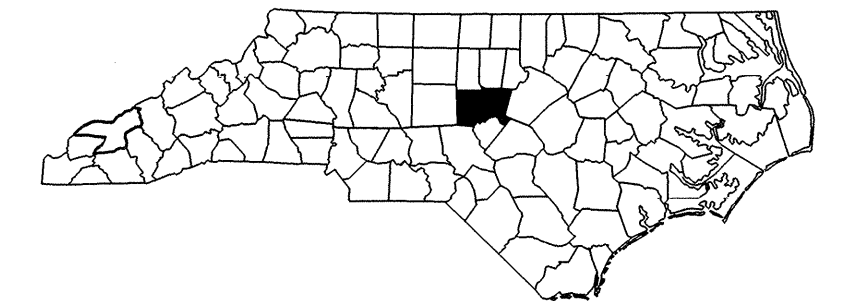


STATE OF NORTH CAROLINA
 DIVISION OF HIGHWAYS
CHATHAM COUNTY

**LOCATION: BRIDGE #129 OVER HARLAND'S CREEK ON
 SR 2159 (ALSTON CHAPEL ROAD)**

**TYPE OF WORK: GRADING, PAVING, DRAINAGE AND
 STRUCTURE**

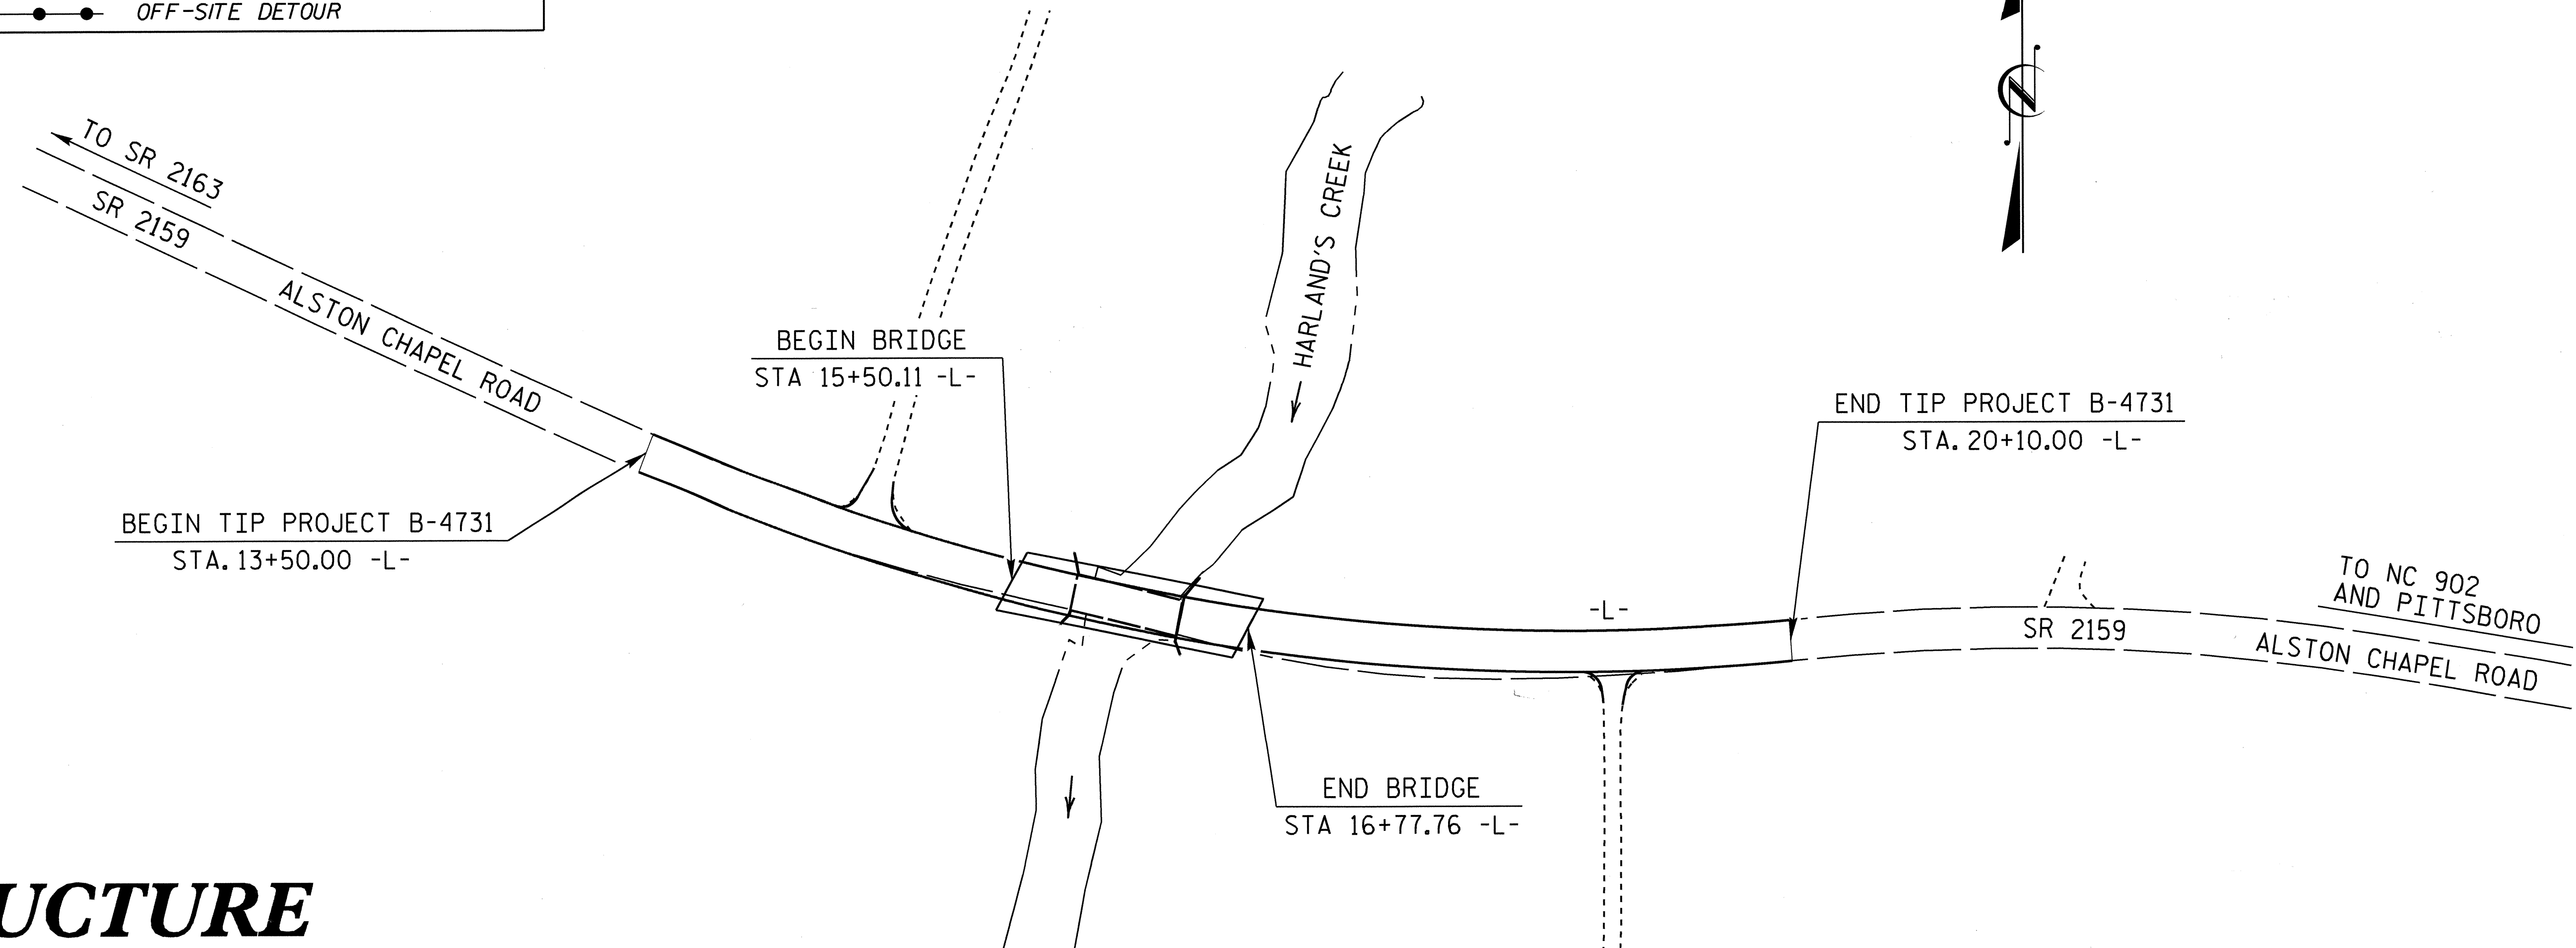

STRUCTURE

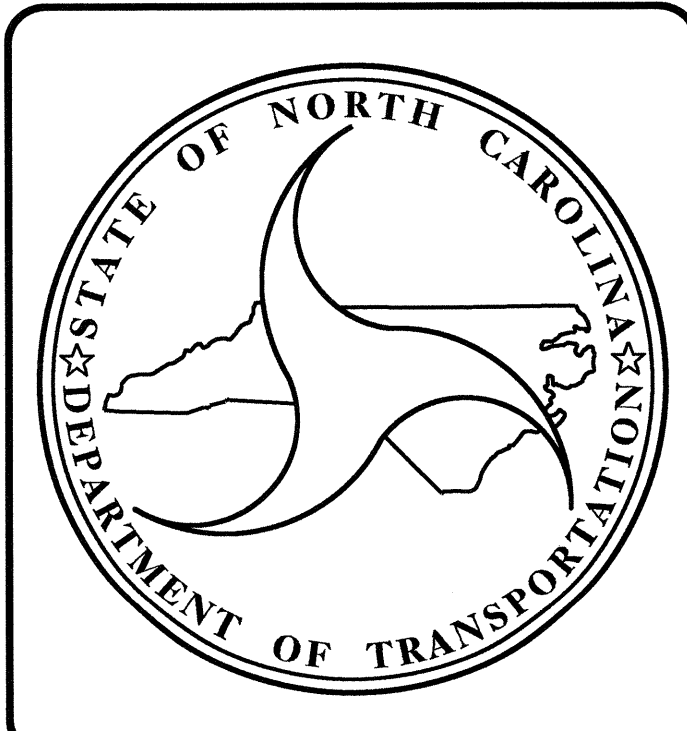

DESIGN DATA

ADT 2014 =	280
ADT 2035 =	400
DHV =	10 %
D =	60 %
T =	5 % *
V =	30 MPH**
* TTST 2	DUAL 3
SUB REGIONAL TIER	

PROJECT LENGTH

LENGTH ROADWAY OF F.A. PROJECT B-4731 =	0.101 MILE
LENGTH STRUCTURE OF F.A. PROJECT B-4731 =	0.024 MILE
TOTAL LENGTH OF STATE PROJECT B-4731 =	0.125 MILE

Prepared in the Office of:
DIVISION OF HIGHWAYS
 STRUCTURES MANAGEMENT UNIT
 1000 BIRCH RIDGE DR.
 RALEIGH, N.C. 27610

LETTING DATE :
 JANUARY 21, 2014

2012 STANDARD SPECIFICATIONS

J. M. BAILEY, P.E.
PROJECT ENGINEER

D. R. CALHOUN, P.E.
PROJECT DESIGN ENGINEER

-4.4159% -0.3011%

GRADE DATA

P.I. STA. = 14+63.00 -L-
EL. = 409.60
VC = 152.000

15+50

16+00



16+50

17+00

SPAN A

SPAN B

SPAN C

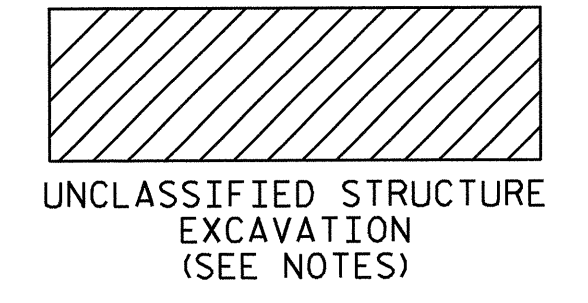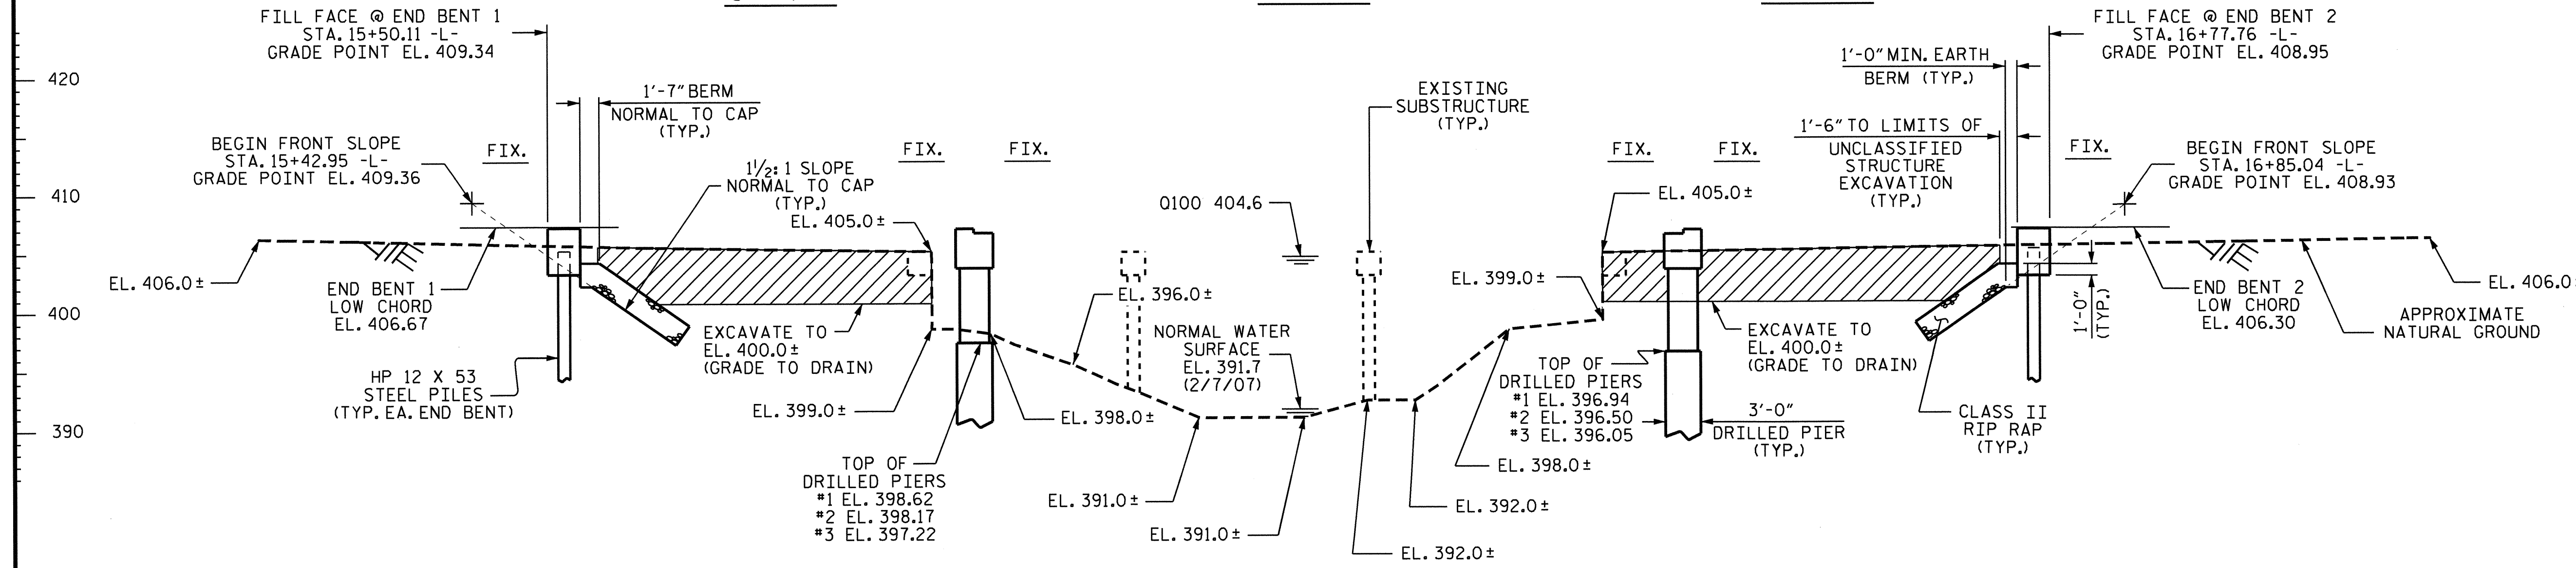

HORIZONTAL CURVE DATA
 PI STA. = 16+66.77 -L-
 Δ = 26°-04'-48.3" (LT.)
 D = 4°-38'-21.6"
 L = 562.15'
 T = 286.03'
 R = 1235'
 S = .04

END BENT 1


BENT 1

BENT 2

END BENT 2

SECTION ALONG -L-

(SECTIONS AT END BENTS AND BENTS ARE TAKEN AT RIGHT ANGLES)

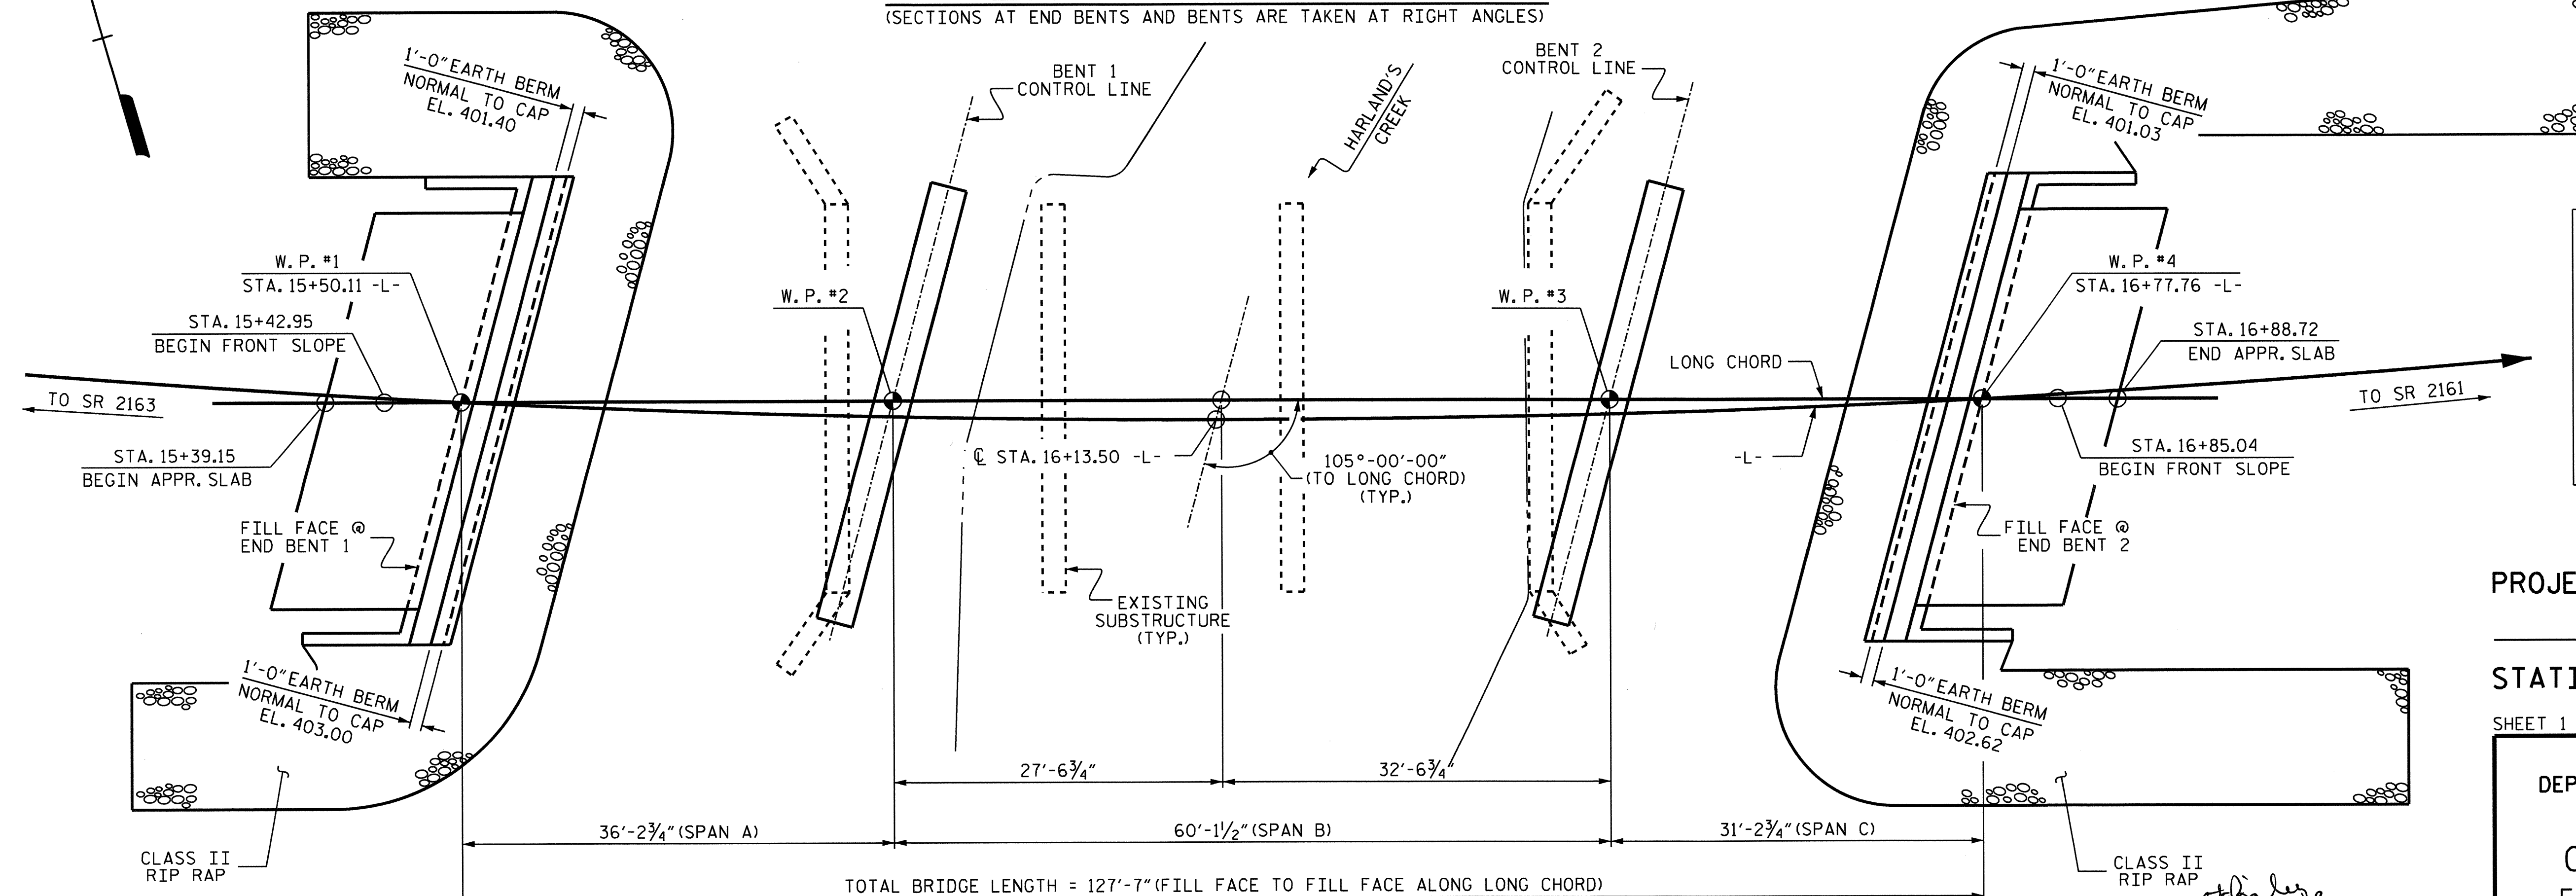


I HEREBY CERTIFY THAT THESE PLANS ARE THE AS-BUILT PLANS.

PROJECT NO. B-4731
 CHATHAM COUNTY
 STATION: 16+13.50 -L-

SHEET 1 OF 3 REPLACES BRIDGE #129

STATE OF NORTH CAROLINA
 DEPARTMENT OF TRANSPORTATION
 RALEIGH
 GENERAL DRAWING
 FOR BRIDGE ON SR 2159
 OVER HARLAND'S CREEK
 BETWEEN SR 2163 AND SR 2161

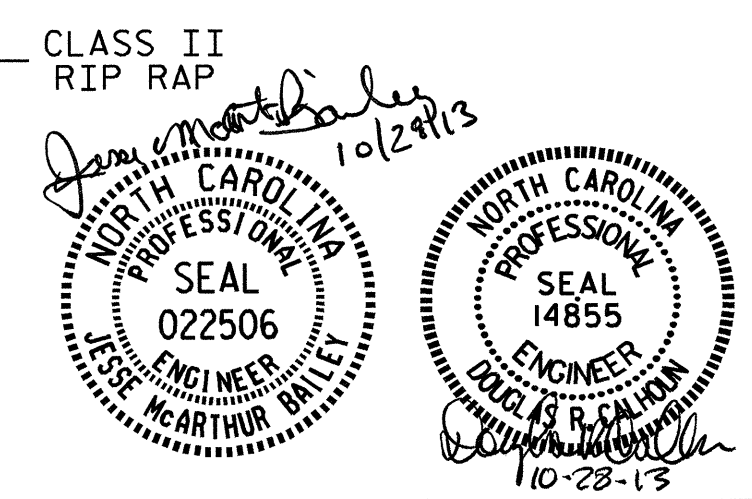


PLAN

FOUNDATION NOT SHOWN FOR CLARITY

DRAWN BY: A. SORSENGINH/DCE DATE: 2-12/10-13
 CHECKED BY: D. R. CALHOUN DATE: 10/13

REVISIONS						SHEET NO.
NO.	BY	DATE	NO.	BY	DATE	S-1
1			3			TOTAL SHEETS
2			4			28

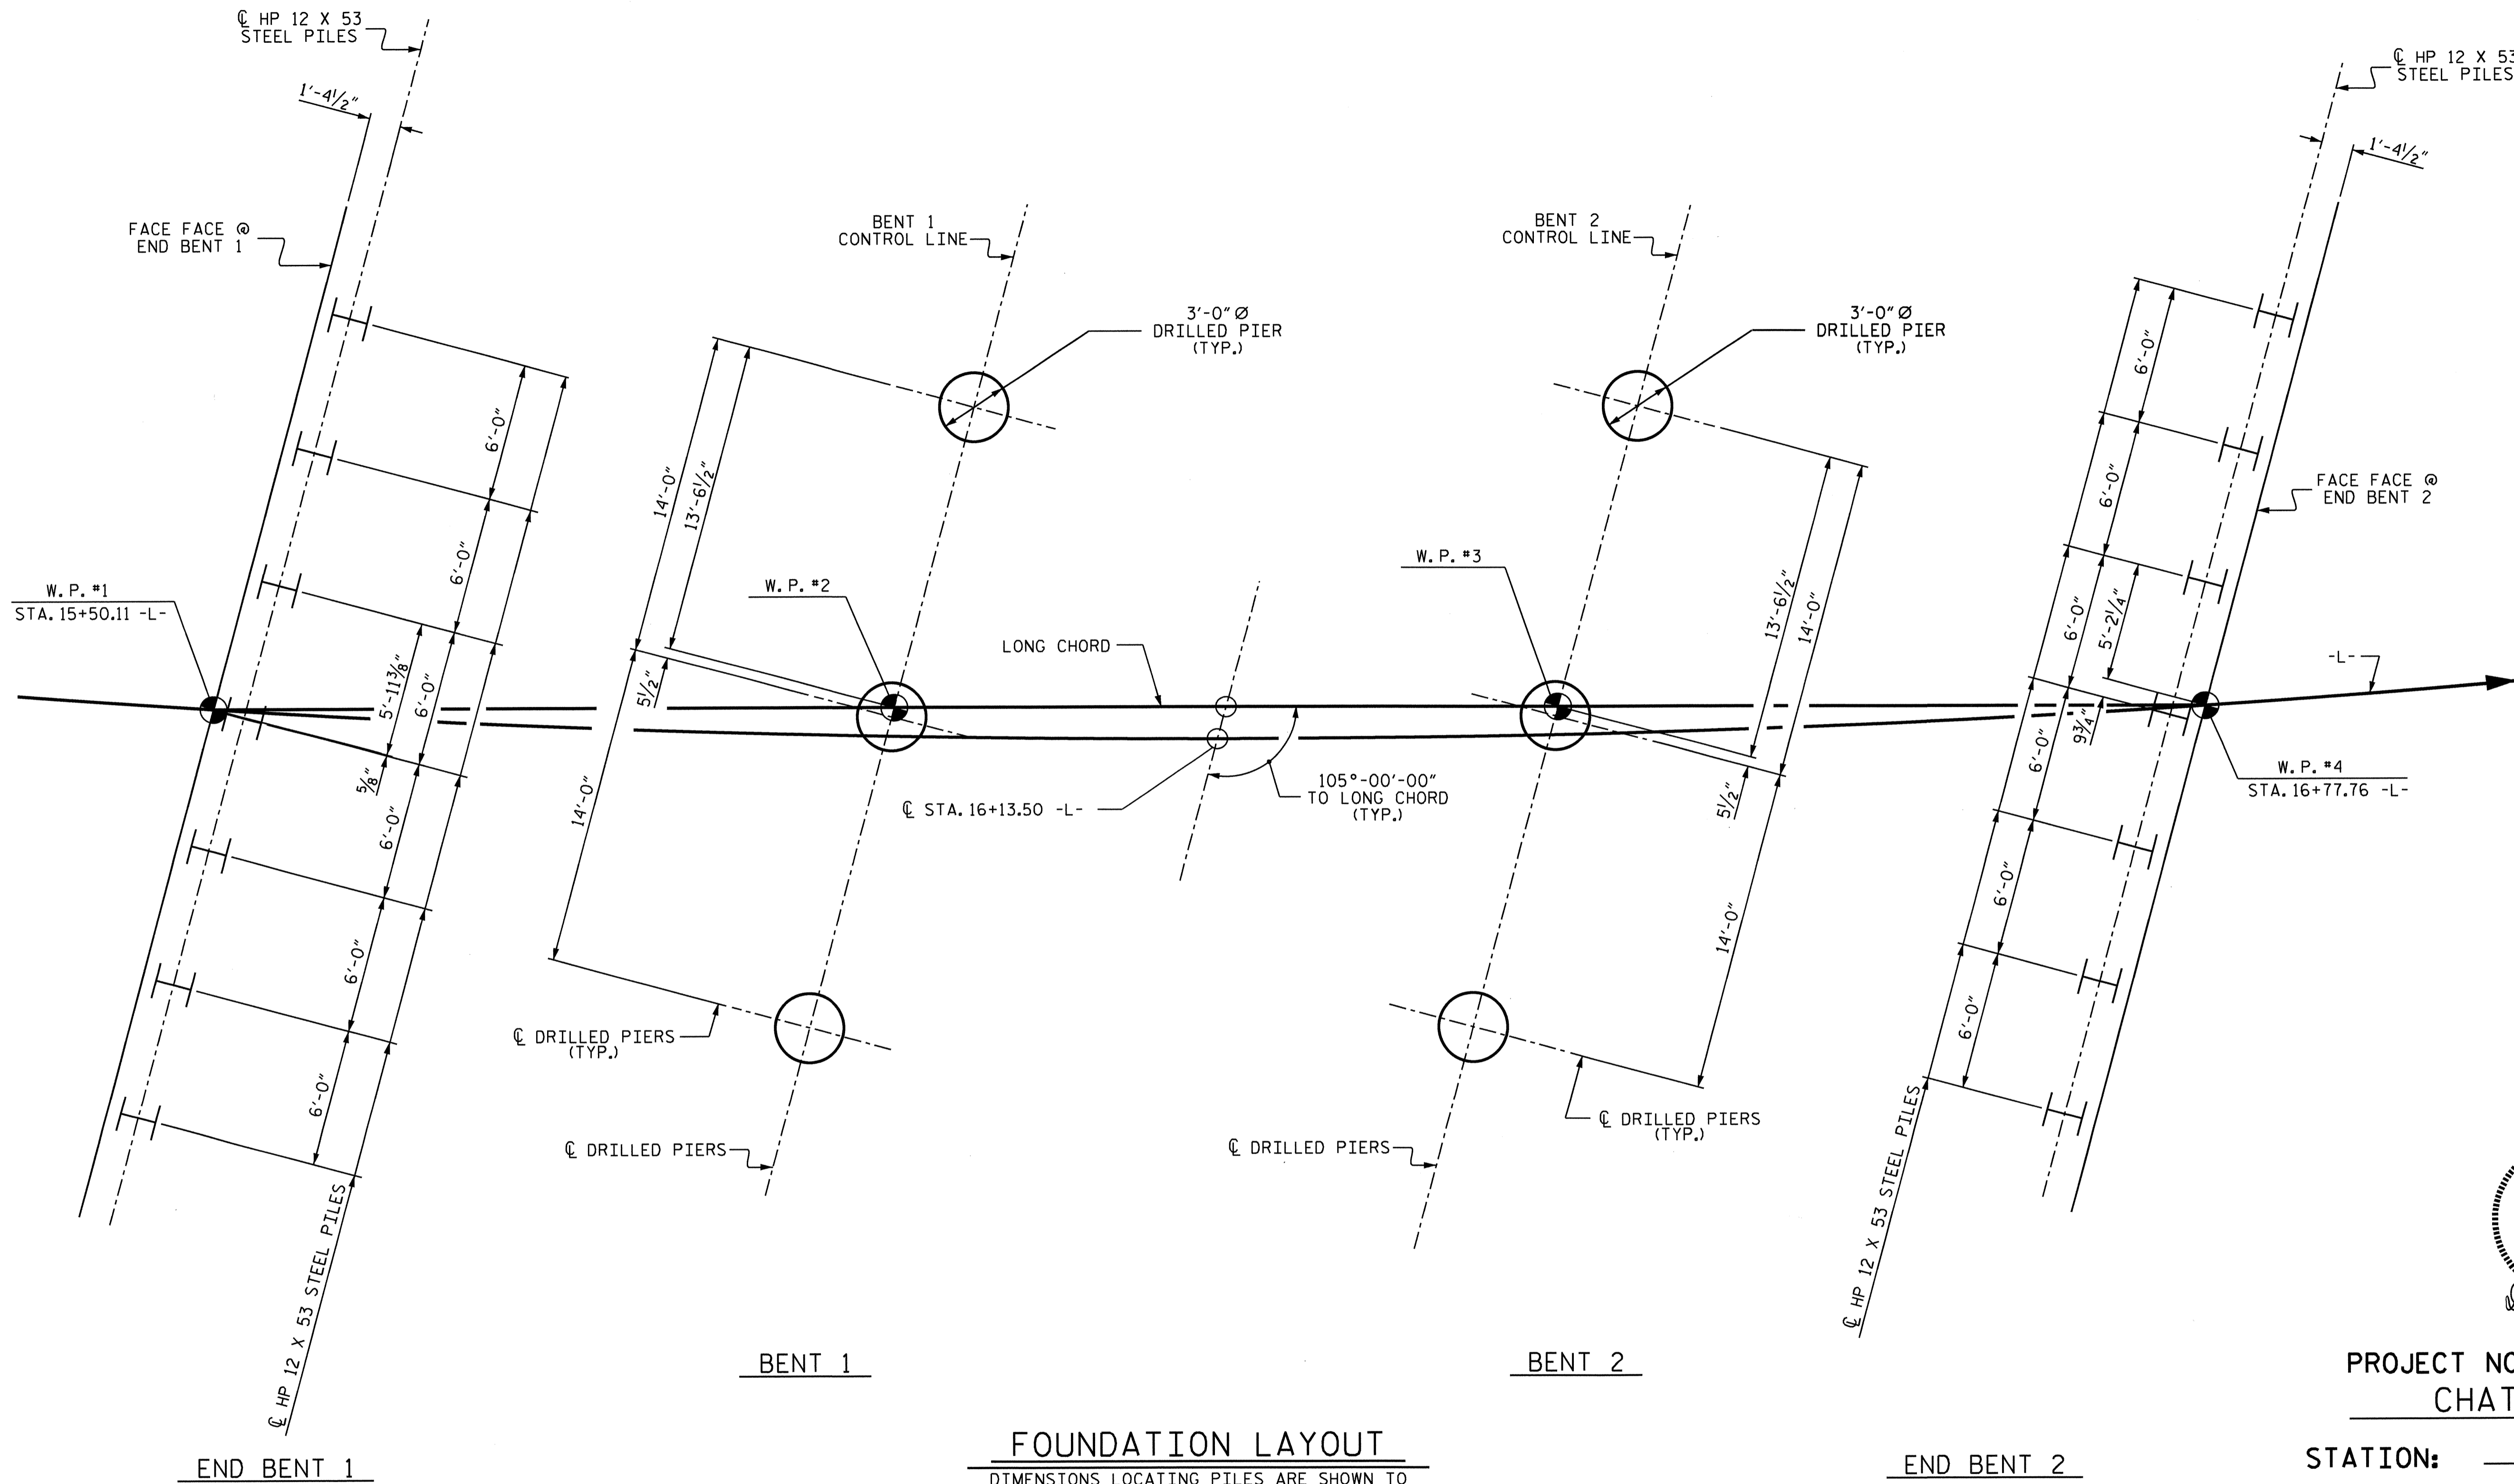

FOUNDATION LAYOUT

DIMENSIONS LOCATING PILES ARE SHOWN TO THE PILE CENTERLINE AT BOTTOM OF CAP

NOTES

FOR DRILLED PIERS, SEE SECTION 411 OF THE STANDARD SPECIFICATIONS.
 DRILLED PIERS AT BENTS 1 AND 2 ARE DESIGNED FOR A FACTORED RESISTANCE OF 360 TONS PER PIER. CHECK FIELD CONDITIONS FOR THE REQUIRED TIP RESISTANCE OF 30 TSF.

PERMANENT STEEL CASINGS MAY BE REQUIRED FOR DRILLED PIERS AT BENT 1 AND 2. IF REQUIRED, DO NOT EXTEND PERMANENT CASINGS BELOW ELEVATION 388 FEET WITHOUT PRIOR APPROVAL FROM THE ENGINEER. THE ENGINEER WILL DETERMINE THE NEED FOR PERMANENT CASINGS.

INSTALL DRILLED PIERS AT BENT 1 THAT EXTEND TO AN ELEVATION NO HIGHER THAN 380.5 FEET, AND WITH THE REQUIRED TIP RESISTANCE.

INSTALL DRILLED PIERS AT BENT 2 THAT EXTEND TO AN ELEVATION NO HIGHER THAN 380 FEET, AND WITH THE REQUIRED TIP RESISTANCE.

THE SCOUR CRITICAL ELEVATION FOR BENT 1 IS ELEVATION 387 FEET. SCOUR CRITICAL ELEVATIONS ARE USED TO MONITOR POSSIBLE SCOUR PROBLEMS DURING THE LIFE OF THE STRUCTURE.

THE SCOUR CRITICAL ELEVATION FOR BENT 2 IS ELEVATION 386 FEET. SCOUR CRITICAL ELEVATIONS ARE USED TO MONITOR POSSIBLE SCOUR PROBLEMS DURING THE LIFE OF THE STRUCTURE.


SID INSPECTIONS MAY BE REQUIRED FOR DRILLED PIERS. THE ENGINEER WILL DETERMINE THE NEED FOR SID INSPECTIONS. FOR SID INSPECTIONS, SEE SECTION 411 OF THE STANDARD SPECIFICATIONS.

CSL TUBES ARE REQUIRED AND CSL TESTING MAY BE REQUIRED FOR DRILLED PIERS. THE ENGINEER WILL DETERMINE THE NEED FOR CSL TESTING. FOR CSL TESTING, SEE SECTION 411 OF THE STANDARD SPECIFICATIONS.

FOR PILES, SEE SECTION 450 OF THE STANDARD SPECIFICATIONS.

PILES AT END BENTS 1 AND 2 ARE DESIGNED FOR A FACTORED RESISTANCE OF 55 TONS.

DRIVE PILES AT END BENTS 1 AND 2 TO A REQUIRED DRIVING RESISTANCE OF 95 TONS PER PILE.

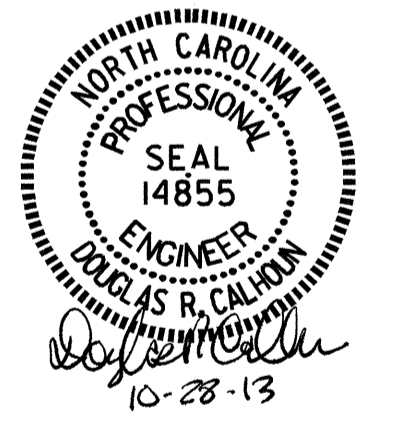

PROJECT NO. B-4731
CHATHAM COUNTY
 STATION: 16+13.50 -L-

SHEET 2 OF 3


STATE OF NORTH CAROLINA
 DEPARTMENT OF TRANSPORTATION
 RALEIGH

GENERAL DRAWING
 FOR BRIDGE ON SR 2159
 OVER HARLAND'S CREEK
 BETWEEN SR 2163 AND SR 2161

REVISIONS						SHEET NO. S-2
NO.	BY:	DATE:	NO.	BY:	DATE:	
1			3			TOTAL SHEETS 28
2			4			

DRAWN BY : A. SORSENGINH/DGE DATE : 2-12/10-13
 CHECKED BY : D. R. CALHOUN DATE : 10/13

BENCH MARK #1: RR SPIKE IN BASE OF 15" ELM 59' LEFT OF STA. 16+88 -L-, EL. 402.09

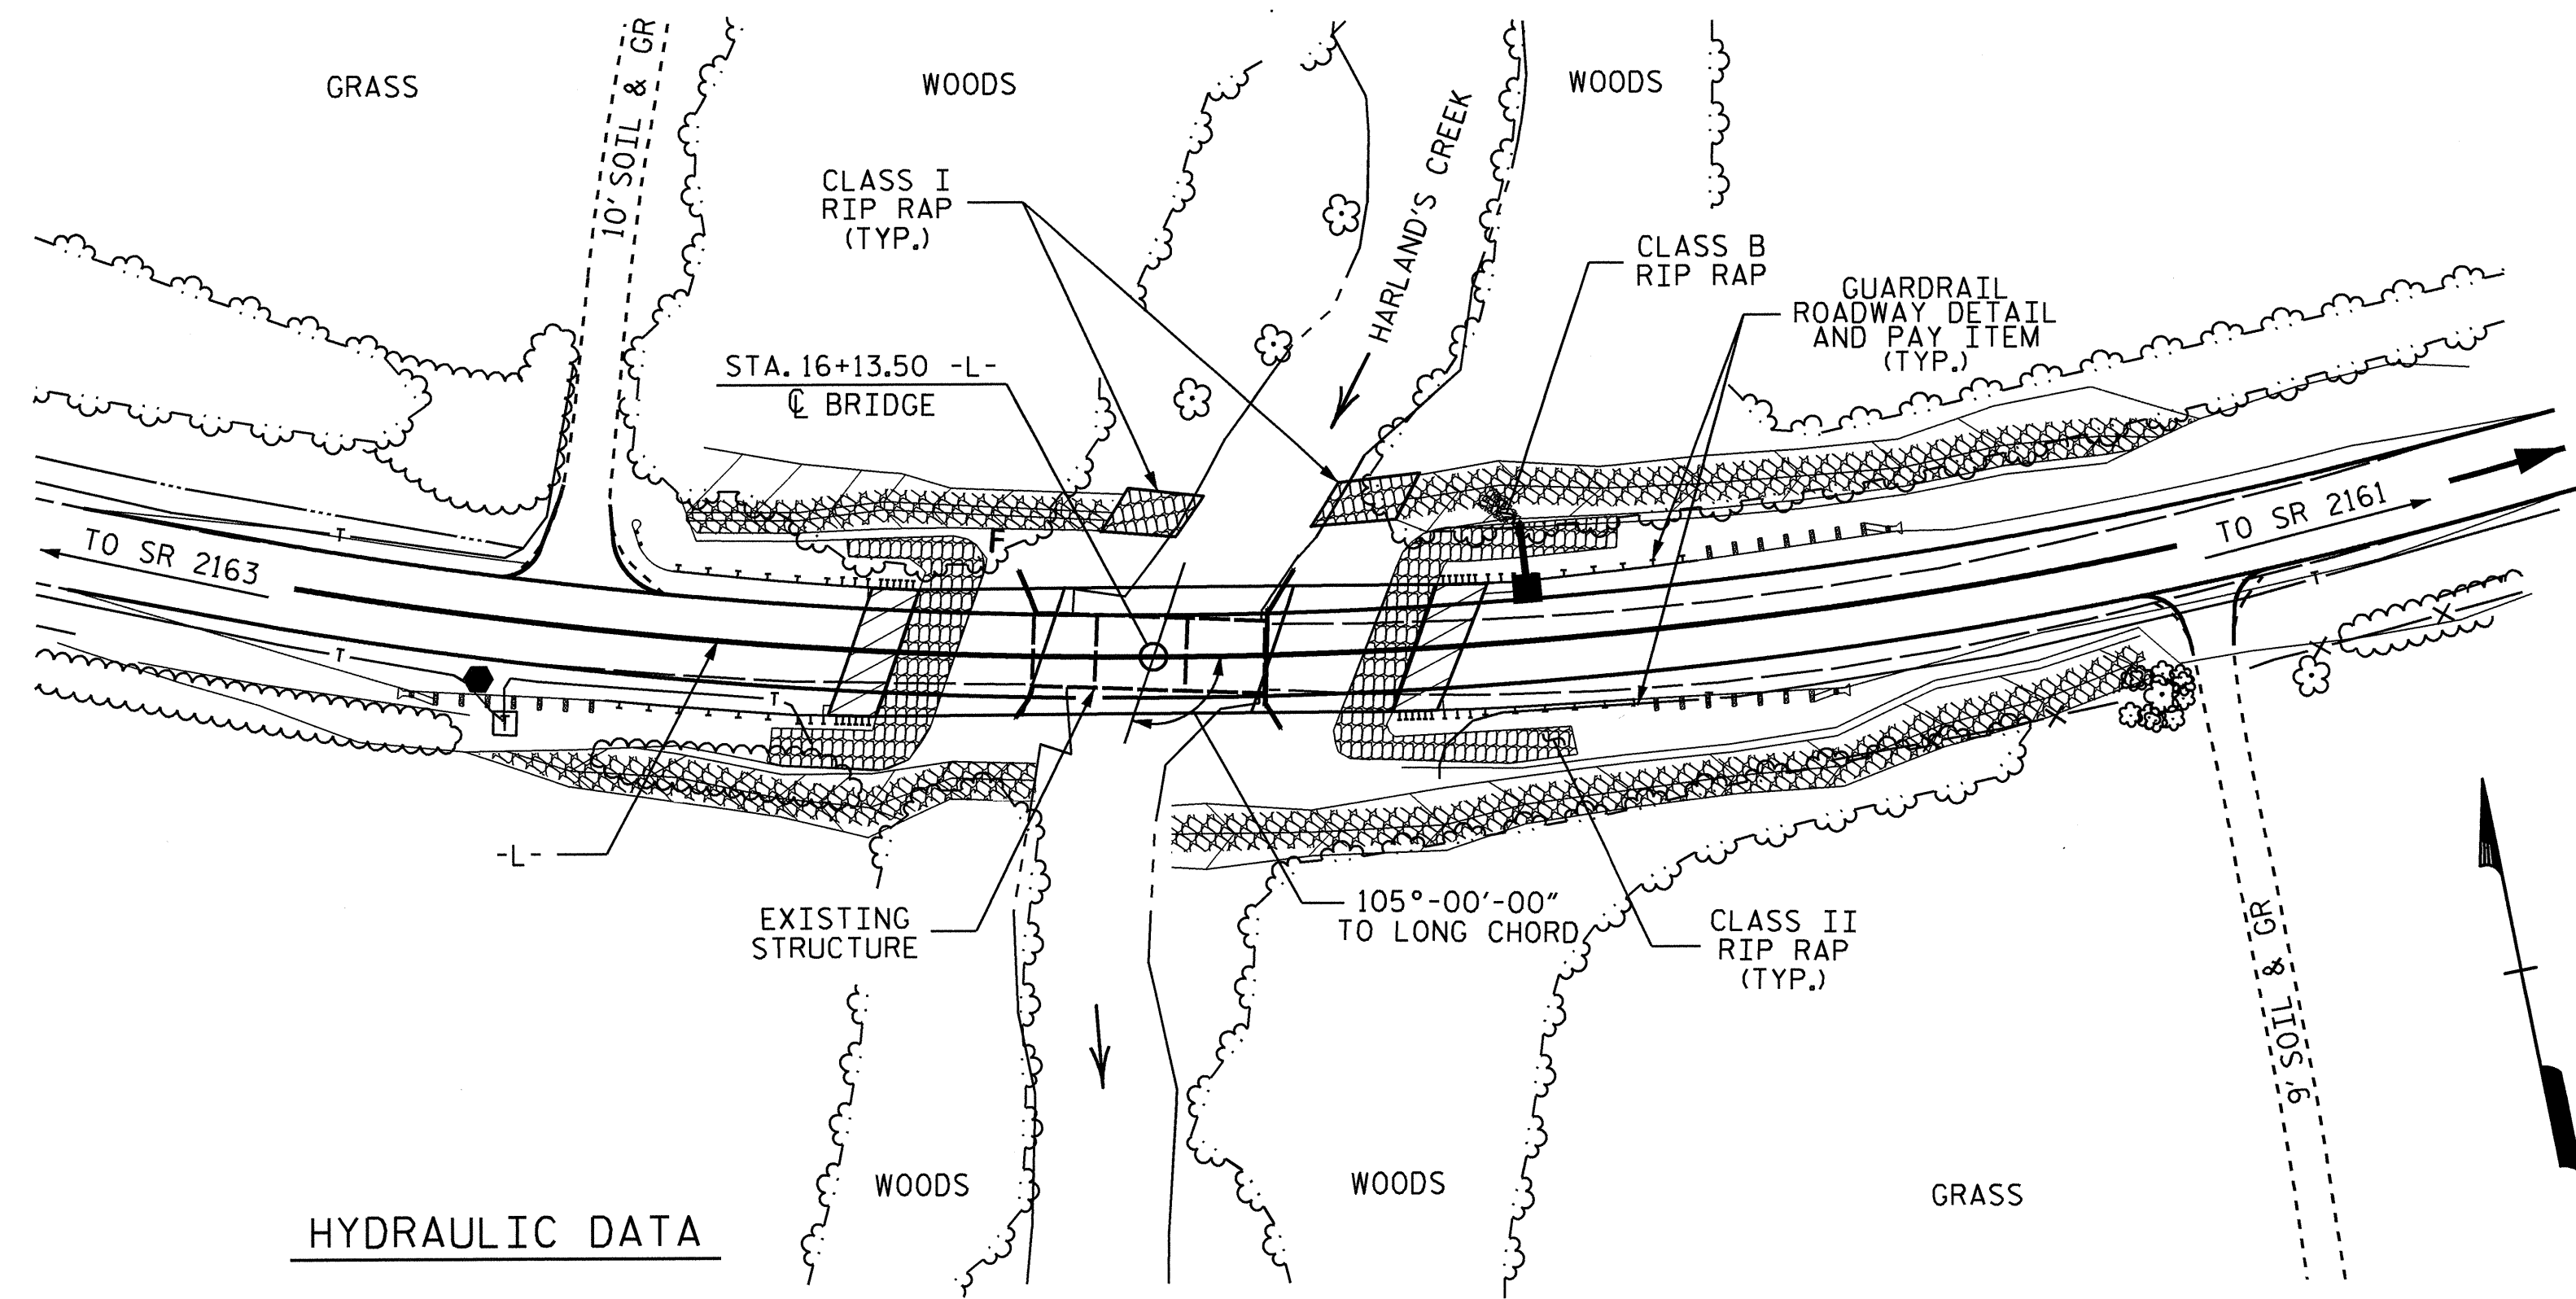

HYDRAULIC DATA

DESIGN DISCHARGE	=	2,400 CFS.
FREQUENCY OF DESIGN FLOOD	=	25 YRS.
DESIGN HIGH WATER ELEVATION	=	403.3
DRAINAGE AREA	=	11.4 SQ. MI.
BASE DISCHARGE (Q100)	=	3,424 CFS.
BASE HIGH WATER ELEVATION	=	404.60

OVERTOPPING FLOOD DATA

OVERTOPPING DISCHARGE	=	8,900 CFS.
FREQUENCY OF OVERTOPPING FLOOD	=	500 YRS.+
OVERTOPPING FLOOD ELEVATION	=	409.6

FOR UTILITY INFORMATION, SEE UTILITY PLANS AND SPECIAL PROVISIONS.

LOCATION SKETCH

NOTES

ASSUMED LIVE LOAD = HL 93 OR ALTERNATE LOADING.
 FOR OTHER DESIGN DATA AND GENERAL NOTES, SEE SHEET SN.
 FOR EROSION CONTROL MEASURES, SEE EROSION CONTROL PLANS.

THIS BRIDGE HAS BEEN DESIGNED IN ACCORDANCE WITH THE AASHTO LRFD BRIDGE DESIGN SPECIFICATIONS.

THE EXISTING STRUCTURE CONSISTING OF 3 SPANS 1 @ 17'-3", 1 @ 19'-8", 1 @ 20'-8" WITH A 2" ASPHALT WEARING SURFACE OVER A TIMBER DECK ON STEEL GIRDER OR FLOOR BEAM SYSTEM SUPERSTRUCTURE AND A CLEAR ROADWAY WIDTH OF 17'-8" ON A SUBSTRUCTURE CONSISTING OF TIMBER CAPS AND PILE FOR END BENTS AND BENT 1 AND STEEL CAP AND PILE FOR BENT 2 AND LOCATED AT THE PROPOSED STRUCTURE LOCATION SHALL BE REMOVED. THE EXISTING BRIDGE IS PRESENTLY POSTED FOR LOAD LIMIT.

REMOVAL OF THE EXISTING BRIDGE SHALL BE PERFORMED SO AS NOT TO ALLOW DEBRIS TO FALL INTO THE WATER. THE CONTRACTOR SHALL REMOVE THE BRIDGE AND SUBMIT PLANS FOR DEMOLITION IN ACCORDANCE WITH ARTICLE 402-2 OF THE STANDARD SPECIFICATIONS.

THE MATERIAL SHOWN IN THE CROSS-HATCHED AREA ON SHEET S-1 SHALL BE EXCAVATED FOR A DISTANCE OF 25 FEET EACH SIDE OF CENTERLINE ROADWAY AS DIRECTED BY THE ENGINEER. THIS WORK WILL BE PAID FOR AT THE CONTRACT LUMP SUM PRICE FOR UNCLASSIFIED STRUCTURE EXCAVATION. SEE SECTION 412 OF THE STANDARD SPECIFICATIONS.

THE SUBSTRUCTURE OF THE EXISTING BRIDGE INDICATED ON THE PLANS IS FROM THE BEST INFORMATION AVAILABLE. SINCE THIS INFORMATION IS SHOWN FOR THE CONVENIENCE OF THE CONTRACTOR, THE CONTRACTOR SHALL HAVE NO CLAIM WHATSOEVER AGAINST THE DEPARTMENT OF TRANSPORTATION FOR ANY DELAYS OR ADDITIONAL COST INCURRED BASED ON DIFFERENCES BETWEEN THE EXISTING BRIDGE SUBSTRUCTURE SHOWN ON THE PLANS AND THE ACTUAL CONDITIONS AT THE PROJECT SITE.

THE CONTRACTOR SHALL PROVIDE INDEPENDENT ASSURANCE SAMPLES OF REINFORCING STEEL AS FOLLOWS: FOR PROJECTS REQUIRING UP TO 400 TONS OF REINFORCING STEEL, ONE 30 INCH SAMPLE OF EACH SIZE BAR USED, AND FOR PROJECTS REQUIRING OVER 400 TONS OF REINFORCING STEEL, TWO 30 INCH SAMPLES OF EACH SIZE BAR USED. THE BARS FROM WHICH THE SAMPLES ARE TAKEN MUST THEN BE SPLICED WITH REPLACEMENT BARS OF THE SIZE AND LENGTH OF THE SAMPLE PLUS A MINIMUM LAP SPLICE OF THIRTY BAR DIAMETERS. PAYMENT FOR THE SAMPLES OF REINFORCING STEEL SHALL BE CONSIDERED INCIDENTAL TO VARIOUS PAY ITEM.

INASMUCH AS THE PAINT SYSTEM ON THE EXISTING STRUCTURAL STEEL CONTAINS LEAD, THE CONTRACTOR'S ATTENTION IS DIRECTED TO ARTICLE 107-1 OF THE STANDARD SPECIFICATIONS. ANY COSTS RESULTING FROM COMPLIANCE WITH APPLICABLE STATE OR FEDERAL REGULATIONS PERTAINING TO HANDLING OF MATERIALS CONTAINING LEAD BASED PAINT SHALL BE INCLUDED IN THE BID PRICE FOR "REMOVAL OF EXISTING STRUCTURE AT STATION 16+13.50 -L-".

FOR SUBMITTAL OF WORKING DRAWINGS, SEE SPECIAL PROVISIONS.

FOR FALSEWORK AND FORMWORK, SEE SPECIAL PROVISIONS.

FOR CRANE SAFETY, SEE SPECIAL PROVISIONS.


FOR GROUT FOR STRUCTURES, SEE SPECIAL PROVISIONS.

THIS STRUCTURE HAS BEEN DESIGNED IN ACCORDANCE WITH "HEC 18-EVALUATING SCOUR AT BRIDGES."

THIS BRIDGE IS LOCATED IN SEISMIC ZONE 1.

ASPHALT WEARING SURFACE IS INCLUDED IN ROADWAY QUANTITY ON ROADWAY PLANS.

THE LOCATION OF THE CONSTRUCTION JOINT IN THE DRILLED PIERS IS BASED ON AN APPROXIMATE GROUND LINE ELEVATION. IF THE CONSTRUCTION JOINT IS ABOVE THE ACTUAL GROUND ELEVATION, THE CONTRACTOR SHALL PLACE THE CONSTRUCTION JOINT 1 FT. BELOW THE GROUND LINE.

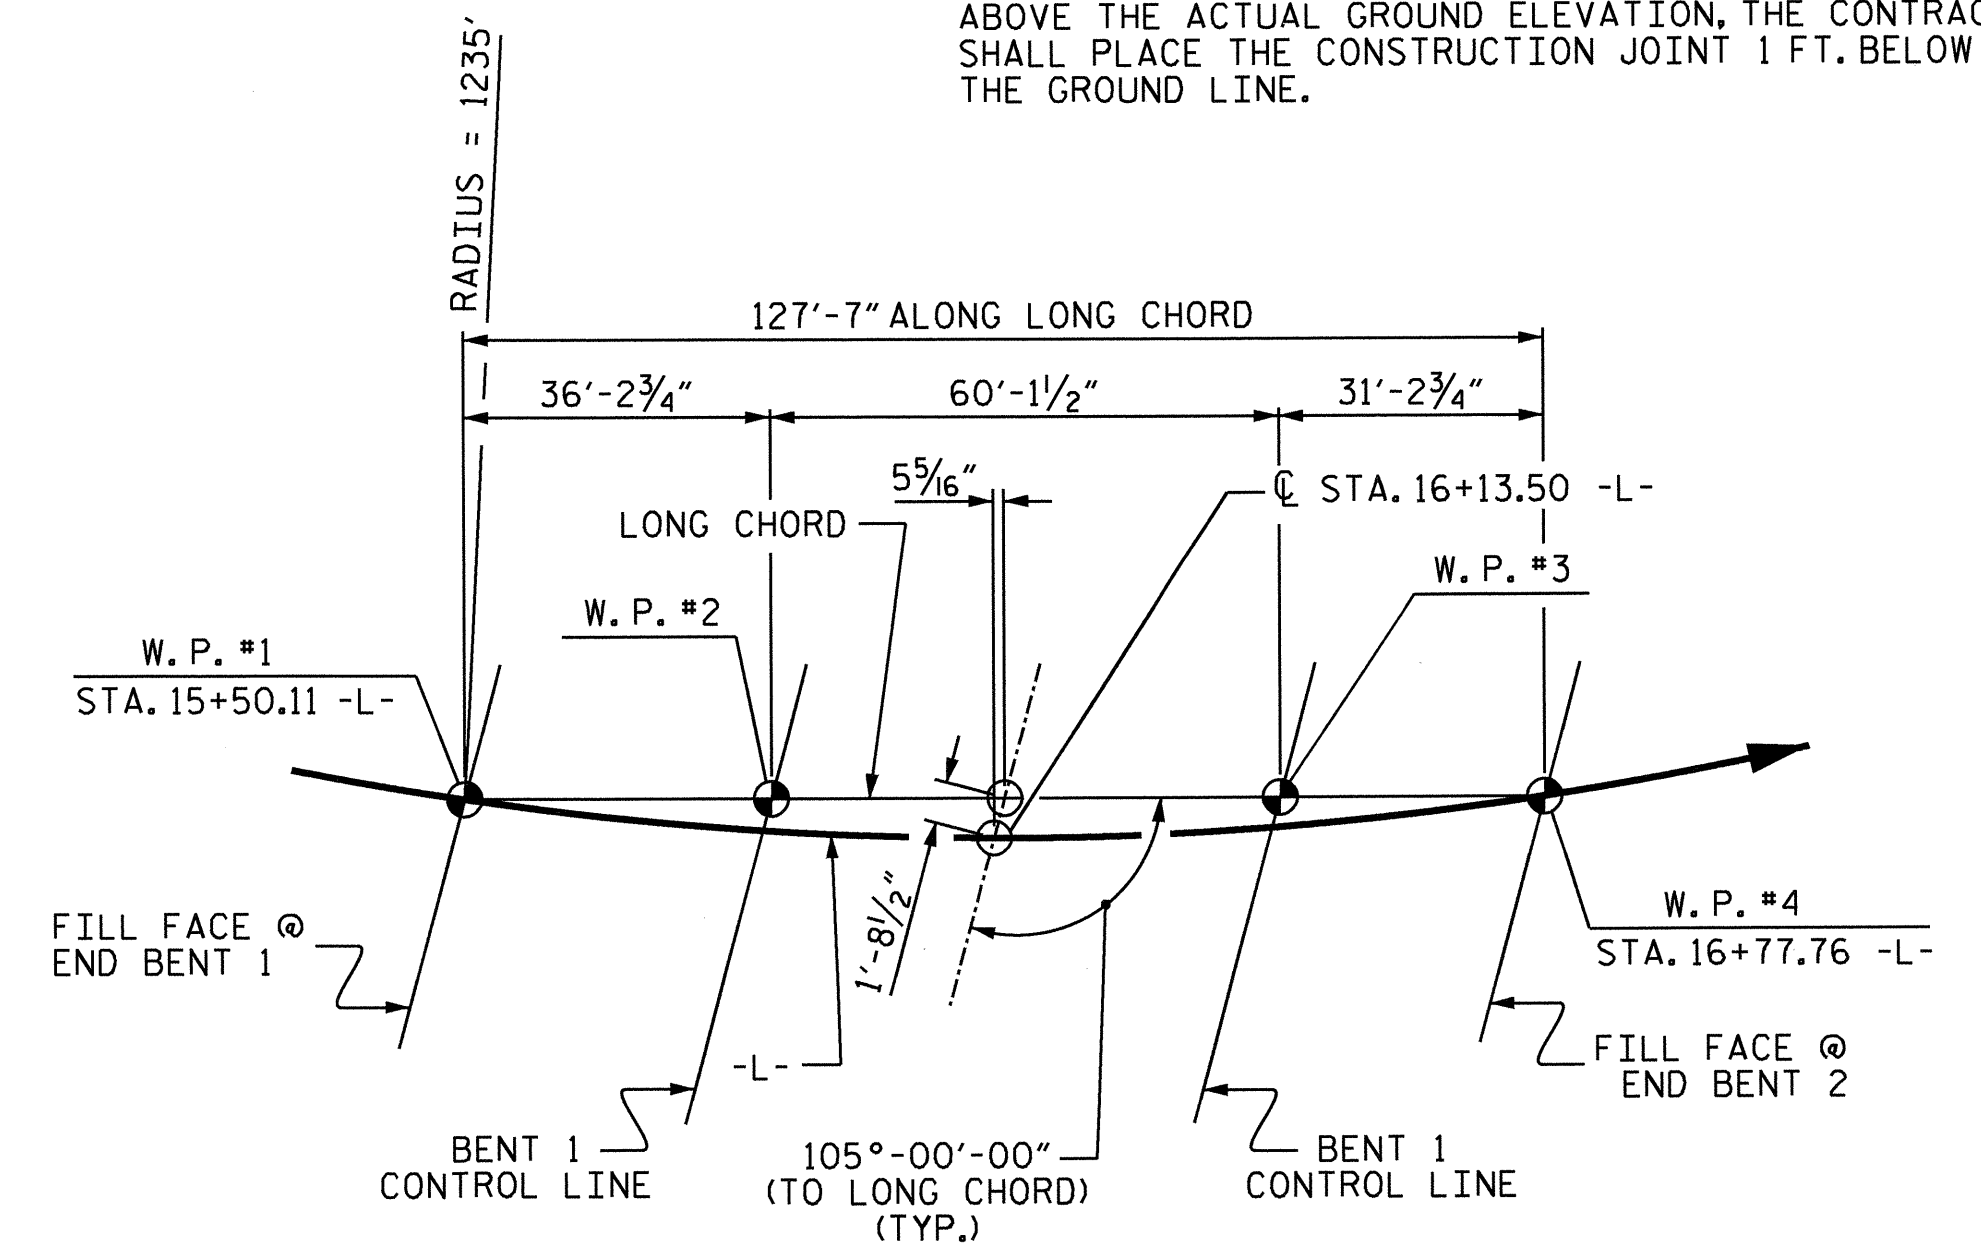

LONG CHORD LAYOUT

PROJECT NO. B-4731
 CHATHAM COUNTY
 STATION: 16+13.50 -L-

SHEET 3 OF 3


TOTAL BILL OF MATERIAL

	REMOVAL OF EXISTING STRUCTURE	3'-0" Ø DRILLED PIER IN SOIL	3'-0" Ø DRILLED PIER NOT IN SOIL	PERMANENT STEEL CASING FOR 3'-0" Ø DRILLED PIER	SID INSPECTION	CSL TESTING	UNCLASSIFIED STRUCTURE EXCAVATION	CLASS A CONCRETE	BRIDGE APPROACH SLABS	REINFORCING STEEL
	LUMP SUM	LIN. FT.	LIN. FT.	LIN. FT.	EA.	EA.	LUMP SUM	CU. YDS.	LUMP SUM	LBS.
SUPERSTRUCTURE									LUMP SUM	
END BENT 1							LUMP SUM	22.2		2716
BENT 1		35.5	18.0	30.0				17.4		8071
BENT 2		31.75	18.0	25.5				18.1		8084
END BENT 2							LUMP SUM	22.2		2716
TOTAL	LUMP SUM	67.25	36.0	55.5	1	1	LUMP SUM	79.9	LUMP SUM	21,587

TOTAL BILL OF MATERIAL

	SPIRAL COLUMN REINFORCING STEEL	HP 12 X 53 STEEL PILES	2 BAR METAL RAIL	1'-2" x 2'-10" CONCRETE PARAPET	RIP RAP CLASS II (2'-0" THICK)	GEOTEXTILE FOR DRAINAGE	ELASTOMERIC BEARINGS	3'-0" X 1'-9" PRESTRESSED CONCRETE CORED SLABS	3'-0" X 2'-0" PRESTRESSED CONCRETE CORED SLABS			
	LBS.	NO.	LIN. FT.	LIN. FT.	LIN. FT.	TONS	SQ. YDS	LUMP SUM	NO.	LIN. FT.	NO.	LIN. FT.
SUPERSTRUCTURE				234.90	250.52			LUMP SUM	22	715.0	11	660.0
END BENT 1		7	140			163	181					
BENT 1	1233											
BENT 2	1245											
END BENT 2		7	175			253	281					
TOTAL	2478	14	315	234.90	250.52	416	462	LUMP SUM	22	715.0	11	660.0

DRAWN BY : A. SORSENGINH/DGE DATE : 2-12-10-13
 CHECKED BY : D. R. CALHOUN DATE : 10/13

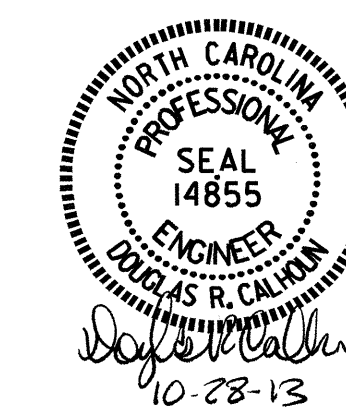

STATE OF NORTH CAROLINA
 DEPARTMENT OF TRANSPORTATION
 RALEIGH

GENERAL DRAWING
 FOR BRIDGE ON SR 2159
 OVER HARLAND'S CREEK
 BETWEEN SR 2163 AND SR 2161

REVISIONS						SHEET NO.
NO.	BY:	DATE:	NO.	BY:	DATE:	S-3
1			3			TOTAL SHEETS
2			4			28

LOAD FACTORS:

DESIGN LOAD RATING FACTORS	LIMIT STATE	γ_{DC}	γ_{DW}
	STRENGTH I	1.25	1.50
	SERVICE III	1.00	1.00


LOAD AND RESISTANCE FACTOR RATING (LRFD) SUMMARY FOR PRESTRESSED CONCRETE GIRDERS																								
LEVEL	VEHICLE	WEIGHT (W) (TONS)	CONTROLLING LOAD RATING	MINIMUM RATING FACTORS (RF)	TONS = W X RF	STRENGTH I LIMIT STATE										SERVICE III LIMIT STATE								COMMENT NUMBER
						LIVELOAD FACTORS	MOMENT					SHEAR					LIVELOAD FACTORS	MOMENT						
							DISTRIBUTION FACTORS (DF)	RATING FACTOR	SPAN	GIRDER LOCATION	DISTANCE FROM LEFT END OF SPAN (ft)	DISTRIBUTION FACTORS (DF)	RATING FACTOR	SPAN	GIRDER LOCATION	DISTANCE FROM LEFT END OF SPAN (ft)		DISTRIBUTION FACTORS (DF)	RATING FACTOR	SPAN	GIRDER LOCATION	DISTANCE FROM LEFT END OF SPAN (ft)		
DESIGN LOAD RATING	HL-93(Inv)	N/A	1	1.06	--	1.75	0.275	1.38	35'	EL	16.982	0.623	1.2	35'	EL	1.698	0.80	0.275	1.06	35'	EL	16.982		
	HL-93(0pr)	N/A	--	1.549	--	1.35	0.275	1.79	35'	EL	16.982	0.623	1.55	35'	EL	1.698	N/A	--	--	--	--	--		
	HS-20(Inv)	36.000	2	1.377	49.573	1.75	0.275	1.82	35'	EL	13.586	0.623	1.38	35'	EL	1.698	0.80	0.275	1.41	35'	EL	16.982		
	HS-20(0pr)	36.000	--	1.785	64.262	1.35	0.275	2.36	35'	EL	13.586	0.623	1.79	35'	EL	1.698	N/A	--	--	--	--	--		
LEGAL LOAD RATING	SV	SNSH	13.500	--	2.424	32.72	1.4	0.275	3.95	35'	EL	16.982	0.623	3.55	35'	EL	1.698	0.80	0.275	2.42	35'	EL	16.982	
		SNGARBS2	20.000	--	2.082	41.635	1.4	0.275	3.34	35'	EL	13.586	0.623	2.68	35'	EL	1.698	0.80	0.275	2.08	35'	EL	13.586	
		SNAGRIS2	22.000	--	2.076	45.668	1.4	0.275	3.31	35'	EL	13.586	0.623	2.56	35'	EL	1.698	0.80	0.275	2.08	35'	EL	13.586	
		SNCOTTS3	27.250	--	1.213	33.066	1.4	0.275	1.98	35'	EL	16.982	0.623	1.79	35'	EL	1.698	0.80	0.275	1.21	35'	EL	16.982	
		SNAGGRS4	34.925	--	1.123	39.207	1.4	0.275	1.83	35'	EL	16.982	0.623	1.6	35'	EL	1.698	0.80	0.275	1.12	35'	EL	16.982	
		SNS5A	35.550	--	1.09	38.739	1.4	0.275	1.77	35'	EL	16.982	0.623	1.69	35'	EL	1.698	0.80	0.275	1.09	35'	EL	16.982	
		SNS6A	39.950	--	1.052	42.014	1.4	0.275	1.71	35'	EL	16.982	0.623	1.58	35'	EL	1.698	0.80	0.275	1.05	35'	EL	16.982	
	SNS7B	42.000	3	1.004	42.153	1.4	0.275	1.63	35'	EL	16.982	0.623	1.62	35'	EL	1.698	0.80	0.275	1.00	35'	EL	16.982		
	TTST	TNAGRIT3	33.000	--	1.299	42.872	1.4	0.275	2.11	35'	EL	16.982	0.623	1.85	35'	EL	1.698	0.80	0.275	1.30	35'	EL	16.982	
		TNT4A	33.075	--	1.298	42.933	1.4	0.275	2.11	35'	EL	16.982	0.623	1.75	35'	EL	1.698	0.80	0.275	1.30	35'	EL	16.982	
		TNT6A	41.600	--	1.137	47.314	1.4	0.275	1.85	35'	EL	16.982	0.623	1.71	35'	EL	1.698	0.80	0.275	1.14	35'	EL	16.982	
		TNT7A	42.000	--	1.175	49.358	1.4	0.275	1.92	35'	EL	16.982	0.623	1.59	35'	EL	1.698	0.80	0.275	1.18	35'	EL	16.982	
		TNT7B	42.000	--	1.156	48.536	1.4	0.275	1.88	35'	EL	16.982	0.623	1.54	35'	EL	1.698	0.80	0.275	1.16	35'	EL	16.982	
		TNAGRIT4	43.000	--	1.17	50.308	1.4	0.275	1.89	35'	EL	13.586	0.623	1.48	35'	EL	1.698	0.80	0.275	1.17	35'	EL	16.982	
TNAGT5A		45.000	--	1.079	48.572	1.4	0.275	1.76	35'	EL	16.982	0.623	1.56	35'	EL	1.698	0.80	0.275	1.08	35'	EL	16.982		
TNAGT5B	45.000	--	1.041	46.853	1.4	0.275	1.69	35'	EL	16.982	0.623	1.4	35'	EL	1.698	0.80	0.275	1.04	35'	EL	16.982			

NOTES:

MINIMUM RATING FACTORS ARE BASED ON THE STRENGTH I AND SERVICE III LIMIT STATES.


ALLOWABLE STRESSES FOR SERVICE III LIMIT STATE ARE AS REQUIRED FOR DESIGN.

#	CONTROLLING LOAD RATING
1	DESIGN LOAD RATING (HL-93)
2	DESIGN LOAD RATING (HS-20)
3	LEGAL LOAD RATING **
** SEE CHART FOR VEHICLE TYPE	
GIRDER LOCATION	
I - INTERIOR GIRDER	
EL - EXTERIOR LEFT GIRDER	
ER - EXTERIOR RIGHT GIRDER	

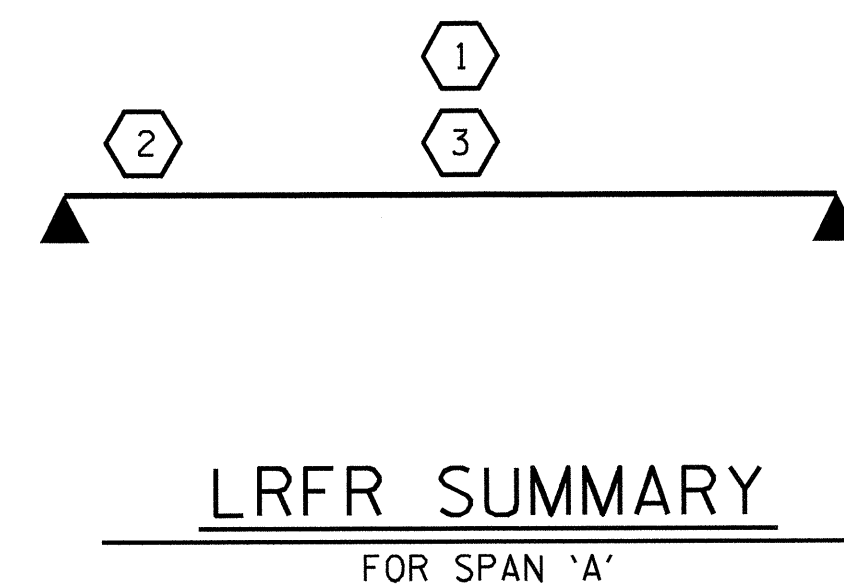

PROJECT NO. B-4731
CHATHAM COUNTY
 STATION: 16+13.50 -L-

SHEET 1 OF 3

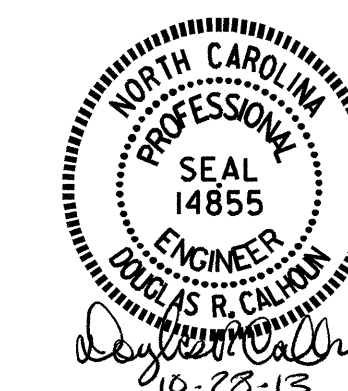

STATE OF NORTH CAROLINA
 DEPARTMENT OF TRANSPORTATION
 RALEIGH
 STANDARD
 LRFR SUMMARY FOR
 35' CORED SLAB UNIT
 105° SKEW
 (NON-INTERSTATE TRAFFIC)

REVISIONS						SHEET NO.
NO.	BY:	DATE:	NO.	BY:	DATE:	S-4
1			3			TOTAL SHEETS 28
2			4			

ASSEMBLED BY : A.C. OUTLAW DATE : 5/21/12
 CHECKED BY : D. R. CALHOUN DATE : 10/13
 DRAWN BY : CVC 6/10
 CHECKED BY : DNS 6/10

LOAD AND RESISTANCE FACTOR RATING (LRFD) SUMMARY FOR PRESTRESSED CONCRETE GIRDERS

LEVEL	VEHICLE	WEIGHT (W) (TONS)	CONTROLLING LOAD RATING	MINIMUM RATING FACTORS (RF)	TONS = W X RF	STRENGTH I LIMIT STATE										SERVICE III LIMIT STATE					COMMENT NUMBER			
						MOMENT					SHEAR					MOMENT								
						LIVELOAD FACTORS	DISTRIBUTION FACTORS (DF)	RATING FACTOR	SPAN	GIRDER LOCATION	DISTANCE FROM LEFT END OF SPAN (FT)	DISTRIBUTION FACTORS (DF)	RATING FACTOR	SPAN	GIRDER LOCATION	DISTANCE FROM LEFT END OF SPAN (FT)	LIVELOAD FACTORS	DISTRIBUTION FACTORS (DF)	RATING FACTOR	SPAN		GIRDER LOCATION	DISTANCE FROM LEFT END OF SPAN (FT)	
DESIGN LOAD RATING	HL-93(Inv)	N/A	1	1.128	--	1.75	0.27	1.35	60'	EL	29.482	0.608	1.13	60'	EL	2.948	0.80	0.27	1.39	60'	EL	29.482		
	HL-93(0pr)	N/A	--	1.463	--	1.35	0.27	1.76	60'	EL	29.482	0.608	1.46	60'	EL	2.948	N/A	--	--	--	--	--		
	HS-20(Inv)	36.000	2	1.381	49.722	1.75	0.27	1.72	60'	EL	29.482	0.608	1.38	60'	EL	2.948	0.80	0.27	1.76	60'	EL	29.482		
	HS-20(0pr)	36.000	--	1.79	64.455	1.35	0.27	2.22	60'	EL	29.482	0.608	1.79	60'	EL	2.948	N/A	--	--	--	--	--		
LEGAL LOAD RATING	SV	SNSH	13.500	--	3.791	51.185	1.4	0.27	4.62	60'	EL	29.482	0.608	4.02	60'	EL	2.948	0.80	0.27	3.79	60'	EL	29.482	
		SNGARBS2	20.000	--	2.888	57.751	1.4	0.27	3.53	60'	EL	29.482	0.608	2.89	60'	EL	2.948	0.80	0.27	2.90	60'	EL	29.482	
		SNAGRIS2	22.000	--	2.691	59.194	1.4	0.27	3.39	60'	EL	29.482	0.608	2.69	60'	EL	2.948	0.80	0.27	2.78	60'	EL	29.482	
		SNCOTTS3	27.250	--	1.889	51.473	1.4	0.27	2.3	60'	EL	29.482	0.608	2.01	60'	EL	2.948	0.80	0.27	1.89	60'	EL	29.482	
		SNAGGRS4	34.925	--	1.608	56.157	1.4	0.27	1.96	60'	EL	29.482	0.608	1.69	60'	EL	2.948	0.80	0.27	1.61	60'	EL	29.482	
		SNS5A	35.550	--	1.57	55.826	1.4	0.27	1.91	60'	EL	29.482	0.608	1.72	60'	EL	2.948	0.80	0.27	1.57	60'	EL	29.482	
		SNS6A	39.950	--	1.453	58.064	1.4	0.27	1.77	60'	EL	29.482	0.608	1.58	60'	EL	2.948	0.80	0.27	1.45	60'	EL	29.482	
	SNS7B	42.000	--	1.385	58.152	1.4	0.27	1.69	60'	EL	29.482	0.608	1.56	60'	EL	2.948	0.80	0.27	1.38	60'	EL	29.482		
	TTST	TNAGRIT3	33.000	--	1.776	58.612	1.4	0.27	2.16	60'	EL	29.482	0.608	1.87	60'	EL	2.948	0.80	0.27	1.78	60'	EL	29.482	
		TNT4A	33.075	--	1.787	59.12	1.4	0.27	2.18	60'	EL	29.482	0.608	1.81	60'	EL	2.948	0.80	0.27	1.79	60'	EL	29.482	
		TNT6A	41.600	--	1.474	61.31	1.4	0.27	1.79	60'	EL	29.482	0.608	1.68	60'	EL	2.948	0.80	0.27	1.47	60'	EL	29.482	
		TNT7A	42.000	--	1.488	62.489	1.4	0.27	1.81	60'	EL	29.482	0.608	1.62	60'	EL	2.948	0.80	0.27	1.49	60'	EL	29.482	
		TNT7B	42.000	--	1.515	63.636	1.4	0.27	1.89	60'	EL	29.482	0.608	1.52	60'	EL	2.948	0.80	0.27	1.55	60'	EL	29.482	
TNAGRIT4		43.000	--	1.464	62.958	1.4	0.27	1.79	60'	EL	29.482	0.608	1.46	60'	EL	2.948	0.80	0.27	1.47	60'	EL	29.482		
TNAGT5A	45.000	--	1.378	62.016	1.4	0.27	1.68	60'	EL	29.482	0.608	1.47	60'	EL	2.948	0.80	0.27	1.38	60'	EL	29.482			
TNAGT5B	45.000	3	1.356	61.038	1.4	0.27	1.65	60'	EL	29.482	0.608	1.39	60'	EL	2.948	0.80	0.27	1.36	60'	EL	29.482			

LOAD FACTORS:


DESIGN LOAD RATING FACTORS	LIMIT STATE	γ_{DC}	γ_{DW}
	STRENGTH I	1.25	1.50
	SERVICE III	1.00	1.00

NOTES:

MINIMUM RATING FACTORS ARE BASED ON THE STRENGTH I AND SERVICE III LIMIT STATES.


ALLOWABLE STRESSES FOR SERVICE III LIMIT STATE ARE AS REQUIRED FOR DESIGN.

#	CONTROLLING LOAD RATING
1	DESIGN LOAD RATING (HL-93)
2	DESIGN LOAD RATING (HS-20)
3	LEGAL LOAD RATING **
** SEE CHART FOR VEHICLE TYPE	
GIRDER LOCATION	
I - INTERIOR GIRDER EL - EXTERIOR LEFT GIRDER ER - EXTERIOR RIGHT GIRDER	

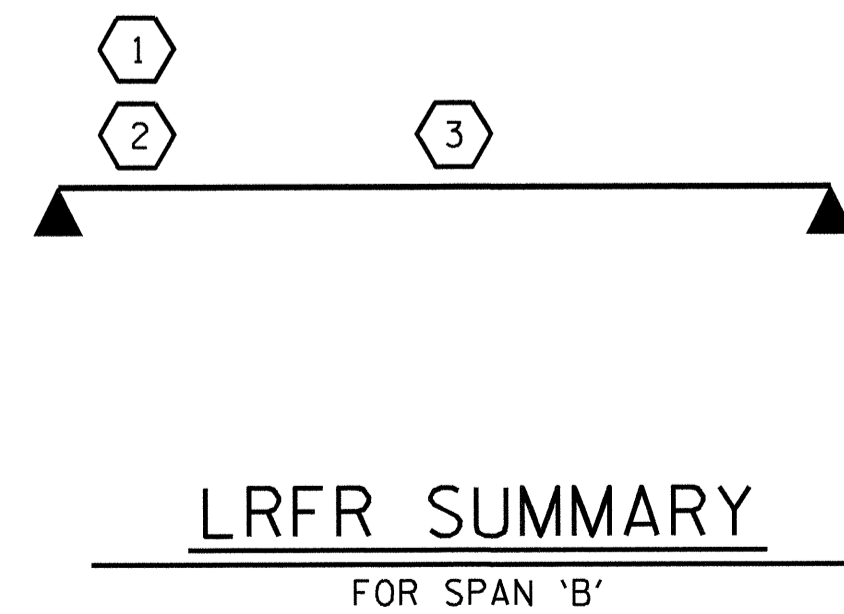

PROJECT NO. B-4731
CHATHAM COUNTY
 STATION: 16+13.50 -L-

SHEET 2 OF 3

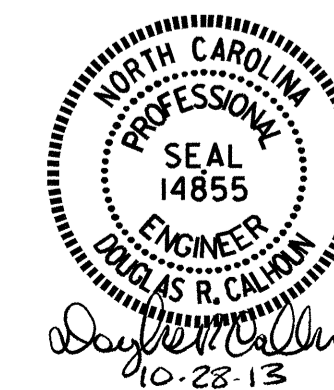

STATE OF NORTH CAROLINA
 DEPARTMENT OF TRANSPORTATION
 RALEIGH

STANDARD
 LRFR SUMMARY FOR
 60' CORED SLAB UNIT
 105° SKEW
 (NON-INTERSTATE TRAFFIC)

REVISIONS						SHEET NO.
NO.	BY:	DATE:	NO.	BY:	DATE:	S-5
1			3			TOTAL SHEETS
2			4			28

ASSEMBLED BY : A.C. OUTLAW DATE : 5/21/12
 CHECKED BY : D. R. CALHOUN DATE : 10/13
 DRAWN BY : CVC 6/10
 CHECKED BY : DNS 6/10

LOAD FACTORS:

DESIGN LOAD RATING FACTORS	LIMIT STATE	γ_{DC}	γ_{DW}
	STRENGTH I	1.25	1.50
	SERVICE III	1.00	1.00


NOTES:

MINIMUM RATING FACTORS ARE BASED ON THE STRENGTH I AND SERVICE III LIMIT STATES.

ALLOWABLE STRESSES FOR SERVICE III LIMIT STATE ARE AS REQUIRED FOR DESIGN.


LOAD AND RESISTANCE FACTOR RATING (LRFD) SUMMARY FOR PRESTRESSED CONCRETE GIRDERS																								
LEVEL	VEHICLE	WEIGHT (W) (TONS)	CONTROLLING LOAD RATING	MINIMUM RATING FACTORS (RF)	TONS = W X RF	STRENGTH I LIMIT STATE										SERVICE III LIMIT STATE								COMMENT NUMBER
						LIVELOAD FACTORS	MOMENT					SHEAR					LIVELOAD FACTORS	MOMENT						
							DISTRIBUTION FACTORS (DF)	RATING FACTOR	SPAN	GIRDER LOCATION	DISTANCE FROM LEFT END OF SPAN (ft)	DISTRIBUTION FACTORS (DF)	RATING FACTOR	SPAN	GIRDER LOCATION	DISTANCE FROM LEFT END OF SPAN (ft)		DISTRIBUTION FACTORS (DF)	RATING FACTOR	SPAN	GIRDER LOCATION	DISTANCE FROM LEFT END OF SPAN (ft)		
DESIGN LOAD RATING	HL-93(Inv)	N/A	1	1.223	--	1.75	0.278	1.87	30'	EL	14.482	0.629	1.22	30'	EL	1.448	0.80	0.278	1.60	30'	EL	14.482		
	HL-93(0pr)	N/A	--	1.586	--	1.35	0.278	2.42	30'	EL	14.482	0.629	1.59	30'	EL	1.448	N/A	--	--	--	--	--		
	HS-20(Inv)	36.000	2	1.396	50.263	1.75	0.278	2.57	30'	EL	11.586	0.629	1.4	30'	EL	1.448	0.80	0.278	2.23	30'	EL	11.586		
	HS-20(0pr)	36.000	--	1.81	65.156	1.35	0.278	3.34	30'	EL	11.586	0.629	1.81	30'	EL	1.448	N/A	--	--	--	--	--		
LEGAL LOAD RATING	SV	SNSH	13,500	--	3.415	46.108	1.4	0.278	5.27	30'	EL	14.482	0.629	3.42	30'	EL	1.448	0.80	0.278	3.61	30'	EL	14.482	
		SNGARBS2	20.000	--	2.643	52.856	1.4	0.278	4.6	30'	EL	11.586	0.629	2.64	30'	EL	1.448	0.80	0.278	3.19	30'	EL	11.586	
		SNAGRIS2	22.000	--	2.546	56.012	1.4	0.278	4.68	30'	EL	11.586	0.629	2.55	30'	EL	1.448	0.80	0.278	3.25	30'	EL	11.586	
		SNCOTTS3	27.250	--	1.725	47.014	1.4	0.278	2.64	30'	EL	14.482	0.629	1.73	30'	EL	1.448	0.80	0.278	1.81	30'	EL	14.482	
		SNAGGRS4	34.925	--	1.588	55.465	1.4	0.278	2.55	30'	EL	14.482	0.629	1.59	30'	EL	1.448	0.80	0.278	1.74	30'	EL	14.482	
		SNS5A	35.550	--	1.684	59.866	1.4	0.278	2.46	30'	EL	14.482	0.629	1.68	30'	EL	1.448	0.80	0.278	1.69	30'	EL	14.482	
		SNS6A	39.950	--	1.583	63.244	1.4	0.278	2.33	30'	EL	14.482	0.629	1.58	30'	EL	1.448	0.80	0.278	1.60	30'	EL	14.482	
	TTST	SNS7B	42.000	--	1.552	65.191	1.4	0.278	2.26	30'	EL	14.482	0.629	1.62	30'	EL	1.448	0.80	0.278	1.55	30'	EL	14.482	
		TNAGRIT3	33.000	--	1.881	62.062	1.4	0.278	3.02	30'	EL	14.482	0.629	1.88	30'	EL	1.448	0.80	0.278	2.07	30'	EL	14.482	
		TNT4A	33.075	--	1.75	57.88	1.4	0.278	2.86	30'	EL	14.482	0.629	1.75	30'	EL	1.448	0.80	0.278	1.97	30'	EL	14.482	
		TNT6A	41.600	--	1.691	70.356	1.4	0.278	2.6	30'	EL	14.482	0.629	1.69	30'	EL	1.448	0.80	0.278	1.78	30'	EL	14.482	
		TNT7A	42.000	--	1.609	67.589	1.4	0.278	2.69	30'	EL	14.482	0.629	1.61	30'	EL	1.448	0.80	0.278	1.84	30'	EL	14.482	
		TNT7B	42.000	--	1.571	66.001	1.4	0.278	2.53	30'	EL	14.482	0.629	1.57	30'	EL	1.448	0.80	0.278	1.74	30'	EL	14.482	
		TNAGRIT4	43.000	--	1.52	65.345	1.4	0.278	2.62	30'	EL	14.482	0.629	1.52	30'	EL	1.448	0.80	0.278	1.80	30'	EL	14.482	
TNAGT5A	45.000	--	1.63	73.366	1.4	0.278	2.55	30'	EL	14.482	0.629	1.63	30'	EL	1.448	0.80	0.278	1.75	30'	EL	14.482			
TNAGT5B	45.000	3	1.431	64.38	1.4	0.278	2.45	30'	EL	11.586	0.629	1.43	30'	EL	1.448	0.80	0.278	1.69	30'	EL	11.586			

#	CONTROLLING LOAD RATING
1	DESIGN LOAD RATING (HL-93)
2	DESIGN LOAD RATING (HS-20)
3	LEGAL LOAD RATING **
** SEE CHART FOR VEHICLE TYPE	
GIRDER LOCATION	
I - INTERIOR GIRDER EL - EXTERIOR LEFT GIRDER ER - EXTERIOR RIGHT GIRDER	

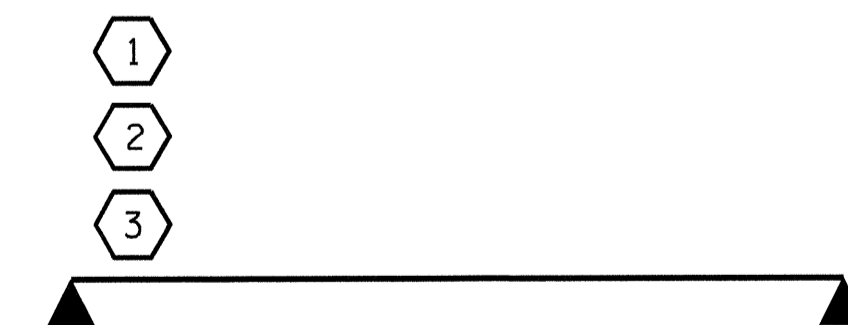

LRFR SUMMARY
FOR SPAN 'C'

PROJECT NO. B-4731
CHATHAM COUNTY
 STATION: 16+13.50 -L-
 SHEET 3 OF 3

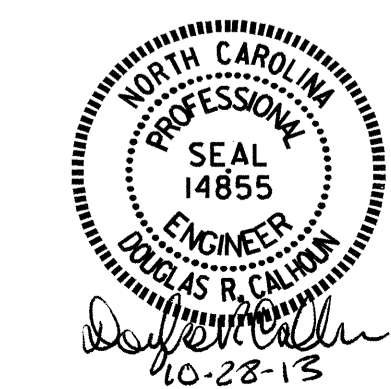


STATE OF NORTH CAROLINA
 DEPARTMENT OF TRANSPORTATION
 RALEIGH

STANDARD
 LRFR SUMMARY FOR
 30' CORED SLAB UNIT
 105° SKEW
 (NON-INTERSTATE TRAFFIC)



REVISIONS						SHEET NO.
NO.	BY:	DATE:	NO.	BY:	DATE:	S-6
1			3			TOTAL SHEETS 28
2			4			

ASSEMBLED BY : A.C. OUTLAW DATE : 5/21/12
 CHECKED BY : D. R. CALHOUN DATE : 10/13
 DRAWN BY : CVC 6/10
 CHECKED BY : DNS 6/10

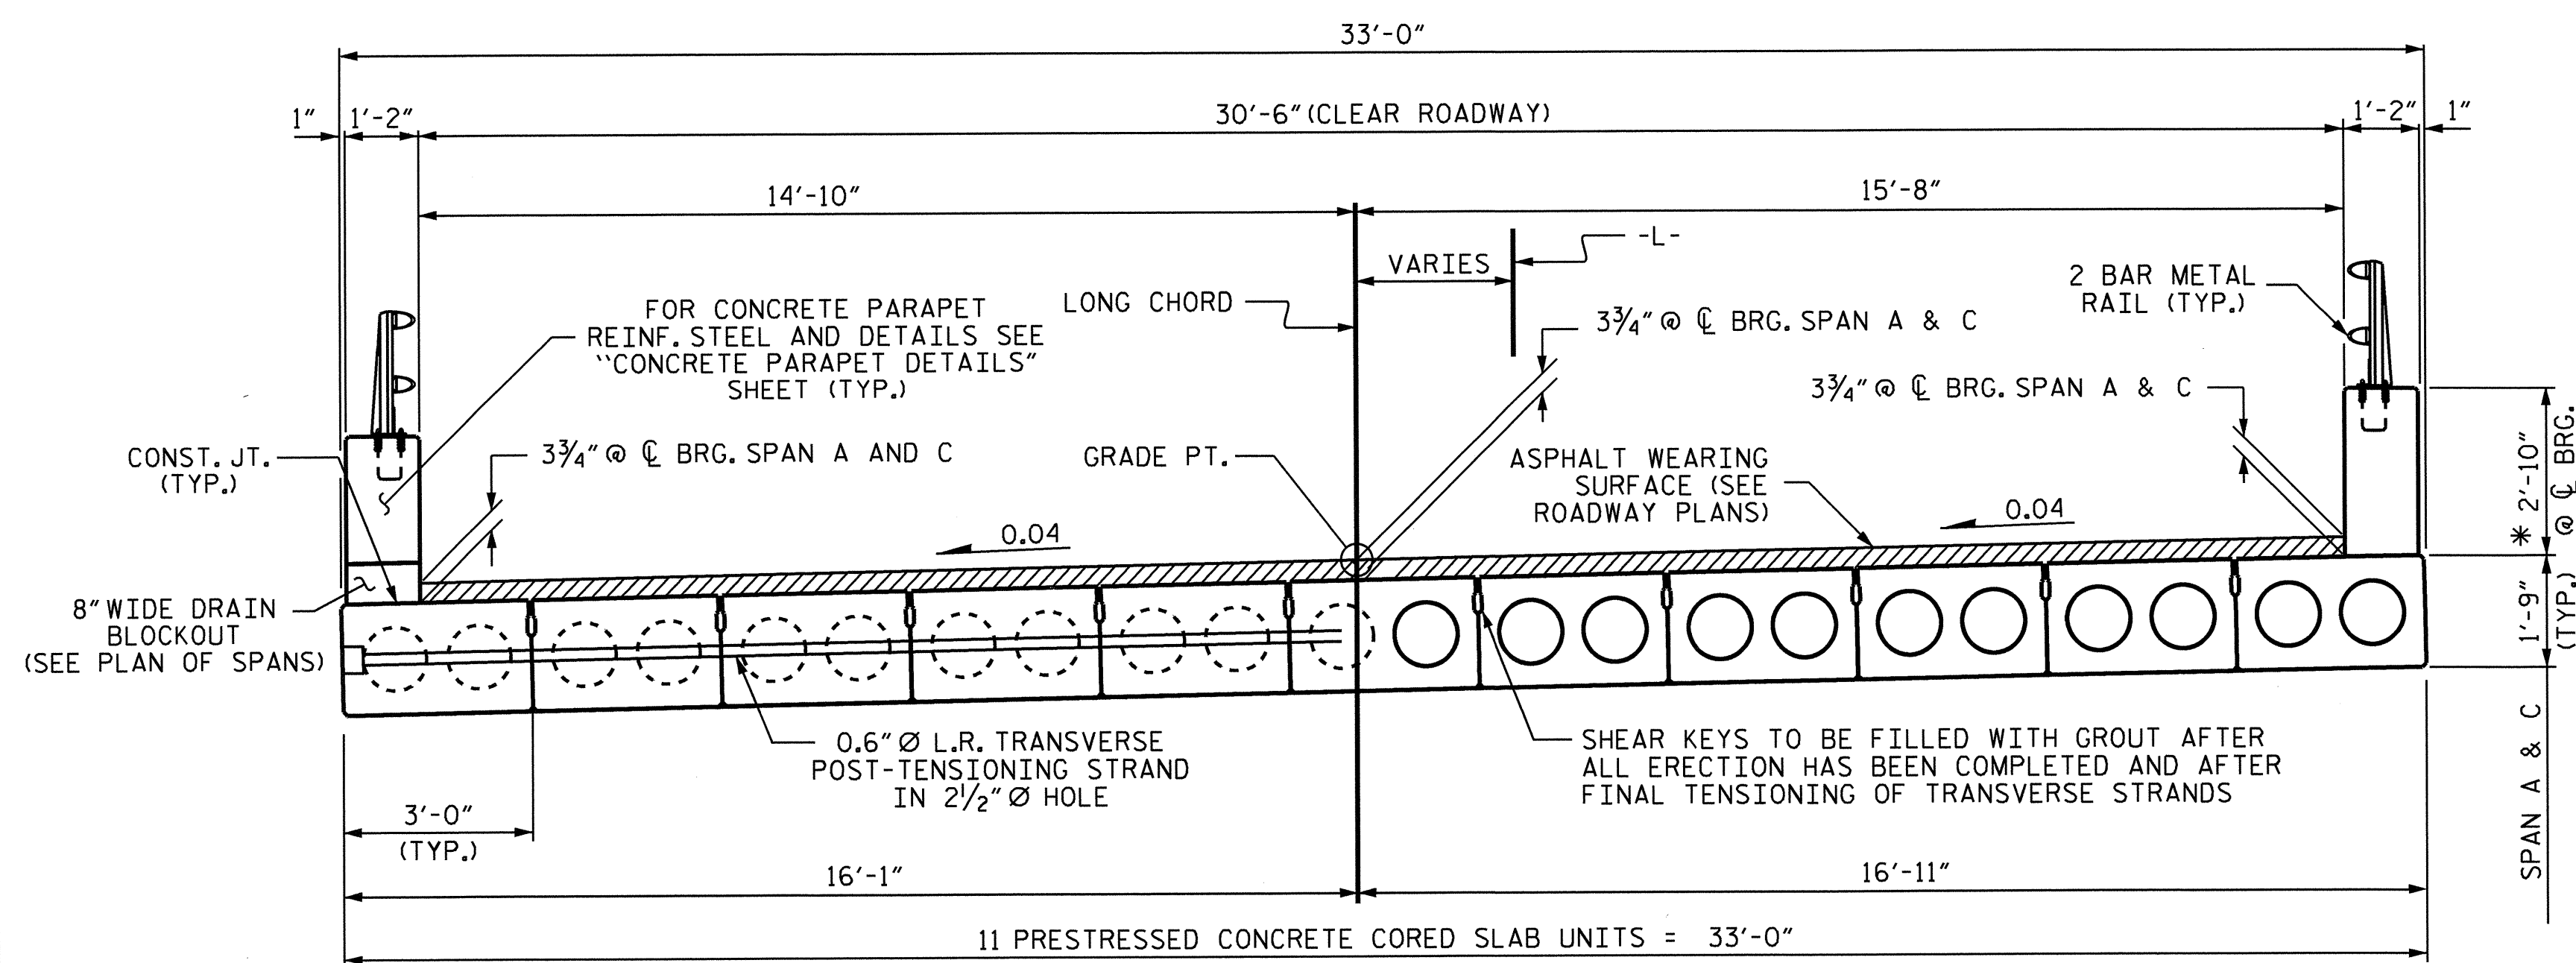


HALF SECTION AT INTERMEDIATE DIAPHRAGMS
TYPICAL SECTION
 HALF SECTION THROUGH VOIDS


* - THE MAXIMUM PARAPET HEIGHT AND ASPHALT THICKNESS IS SHOWN. THE HEIGHT OF THE PARAPET AND ASPHALT THICKNESS VARIES WHILE THE TOP OF THE PARAPET FOLLOWS THE PROFILE OF THE GUTTERLINE.

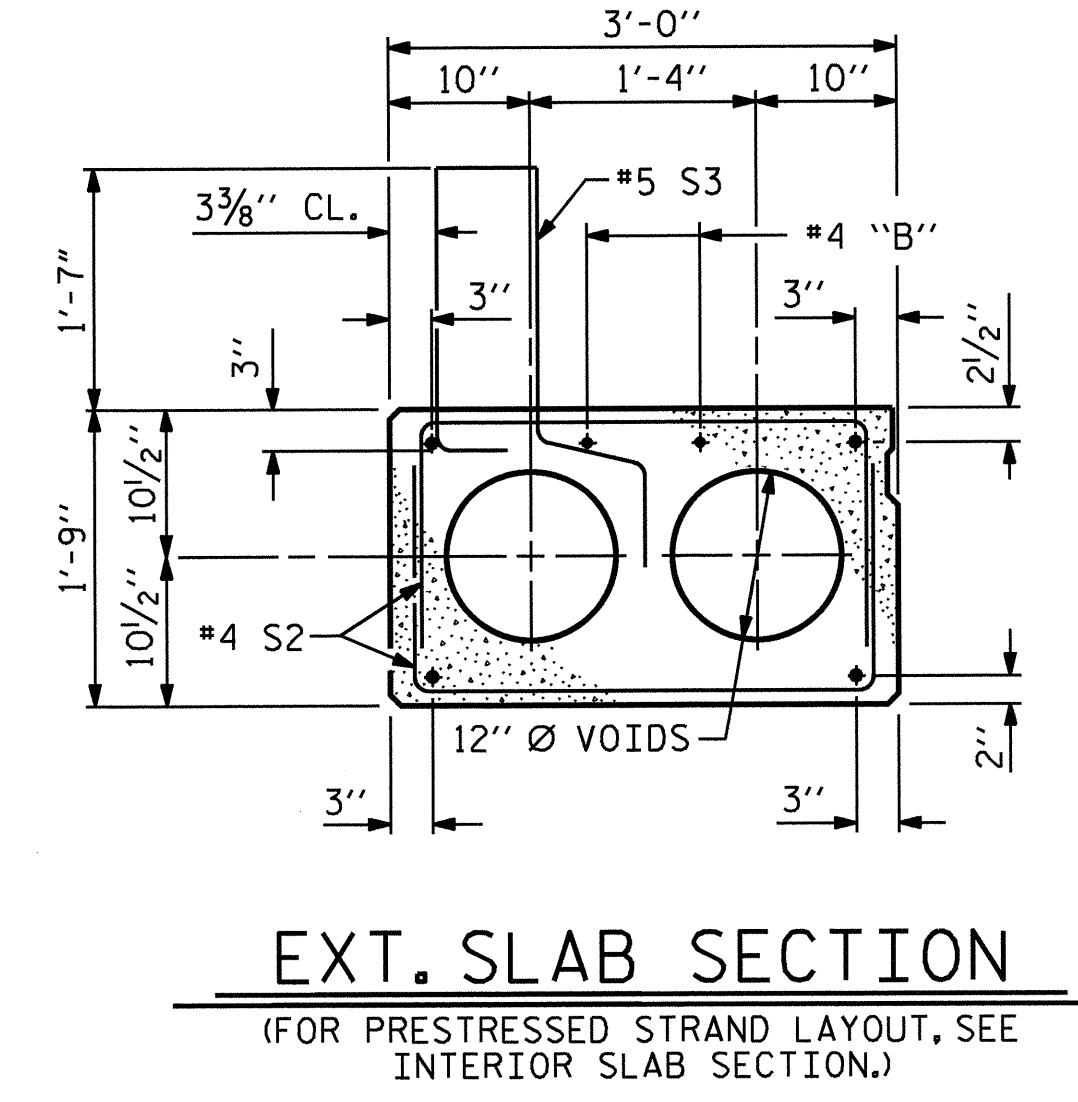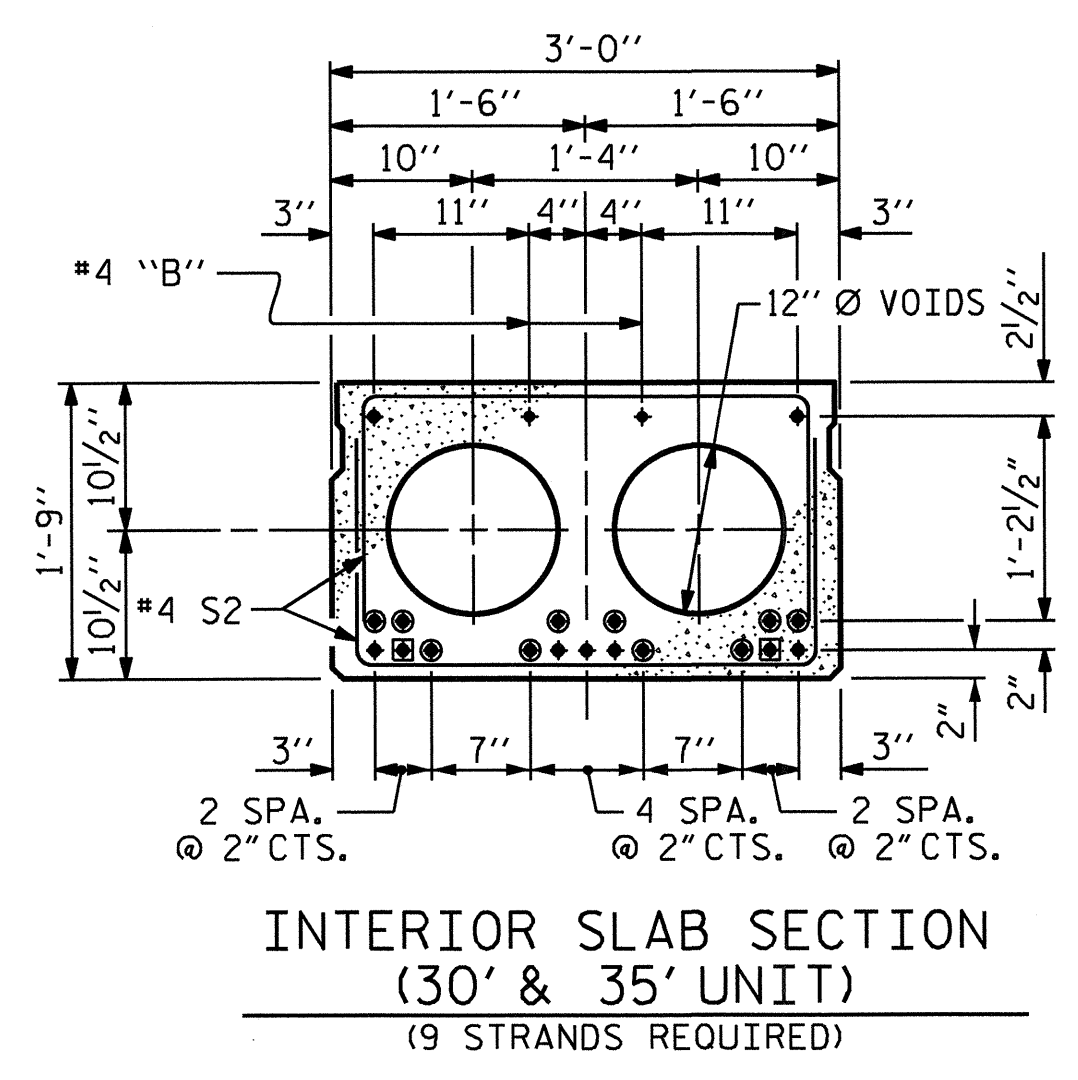


0.6" Ø LOW RELAXATION STRAND LAYOUT

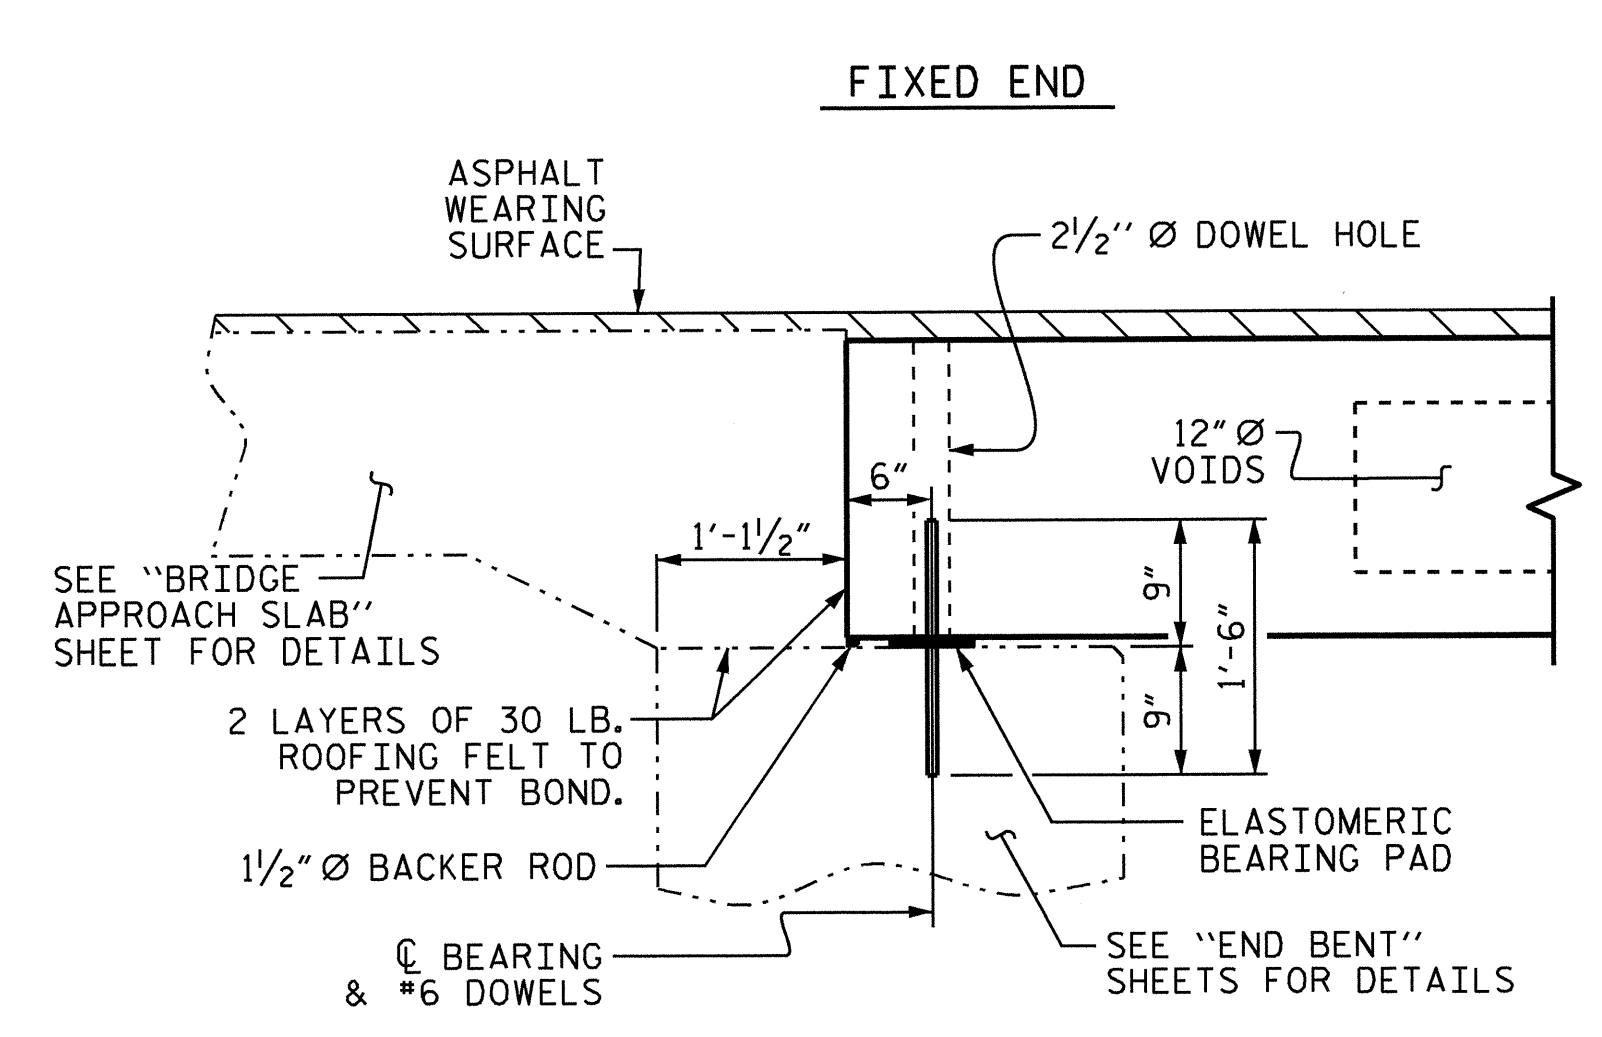

SECTION AT END BENT

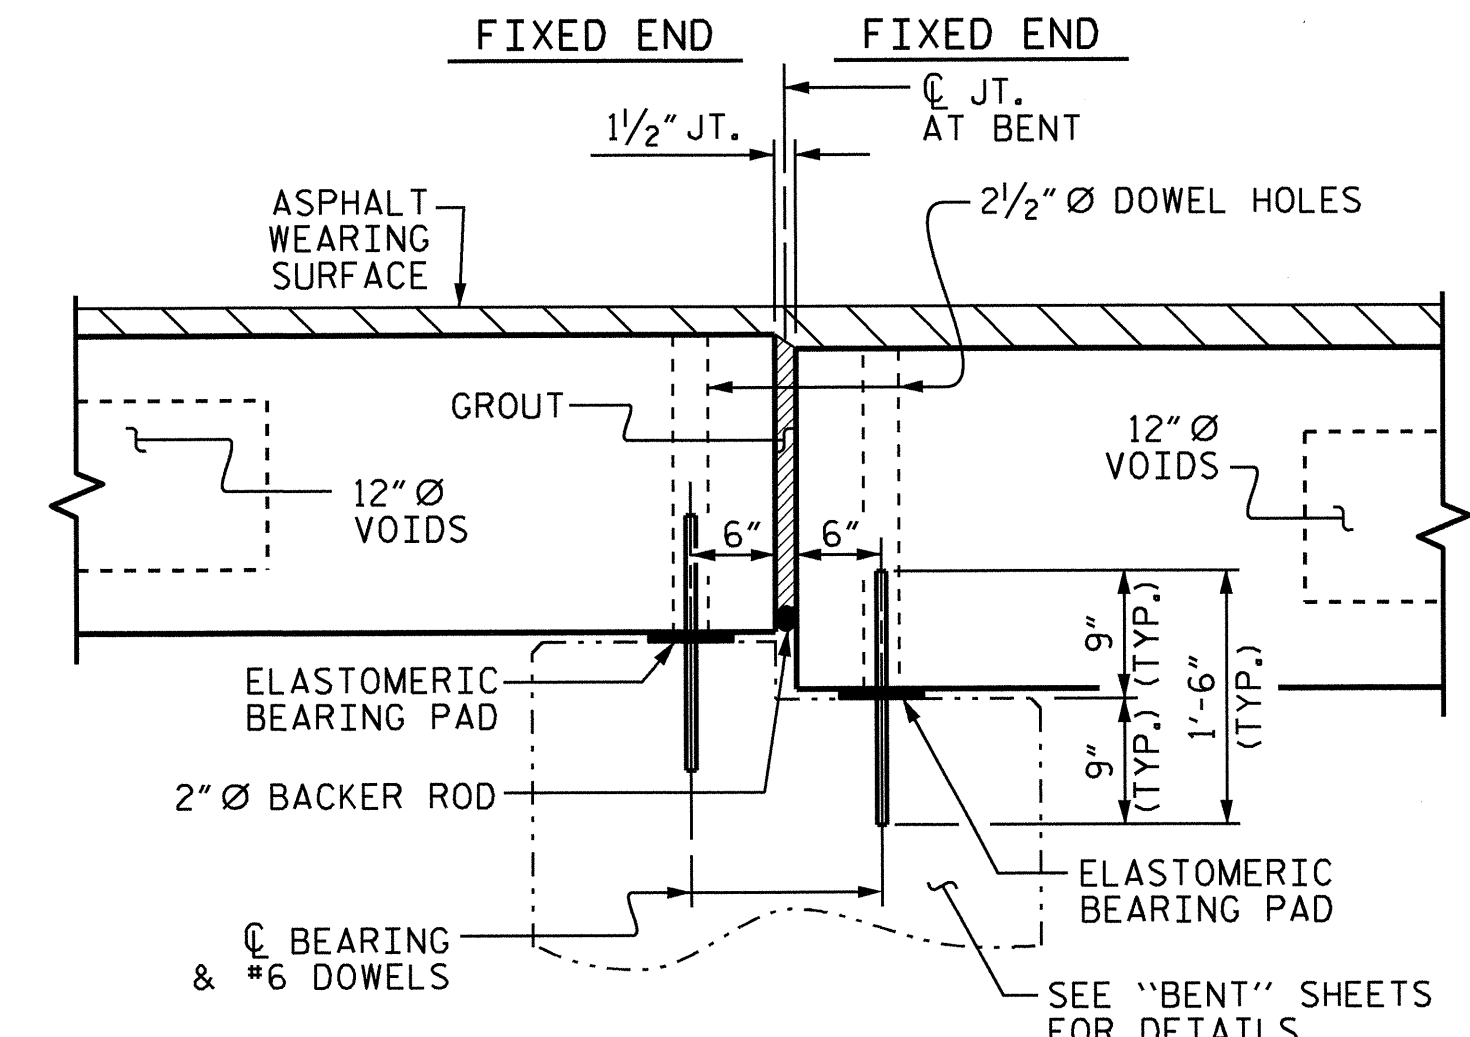


SECTION AT BENT 1
 (BENT 2 SIMILAR)

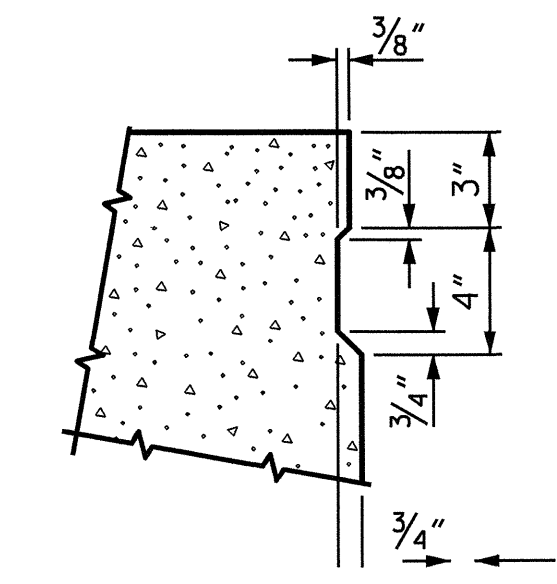


SHEAR KEY DETAIL
 NOTE: OMIT SHEAR KEY ON OUTSIDE FACE OF EXTERIOR CORED SLABS.

- DEBONDING LEGEND**
- BOND SHALL BE BROKEN ON THESE STRANDS FOR A DISTANCE OF 2'-0" FROM END OF CORED SLAB UNIT. SEE STANDARD SPECIFICATIONS, ARTICLE 1078-7.
 - OPTIONAL FULL LENGTH DEBONDED STRANDS. THESE STRANDS ARE NOT REQUIRED. IF THE FABRICATOR CHOOSES TO INCLUDE THESE STRANDS IN THE CORED SLAB UNIT, THE STRANDS SHALL BE DEBONDED FOR THE FULL LENGTH OF THE UNIT AT NO ADDITIONAL COST. SEE STANDARD SPECIFICATIONS, ARTICLE 1078-7.

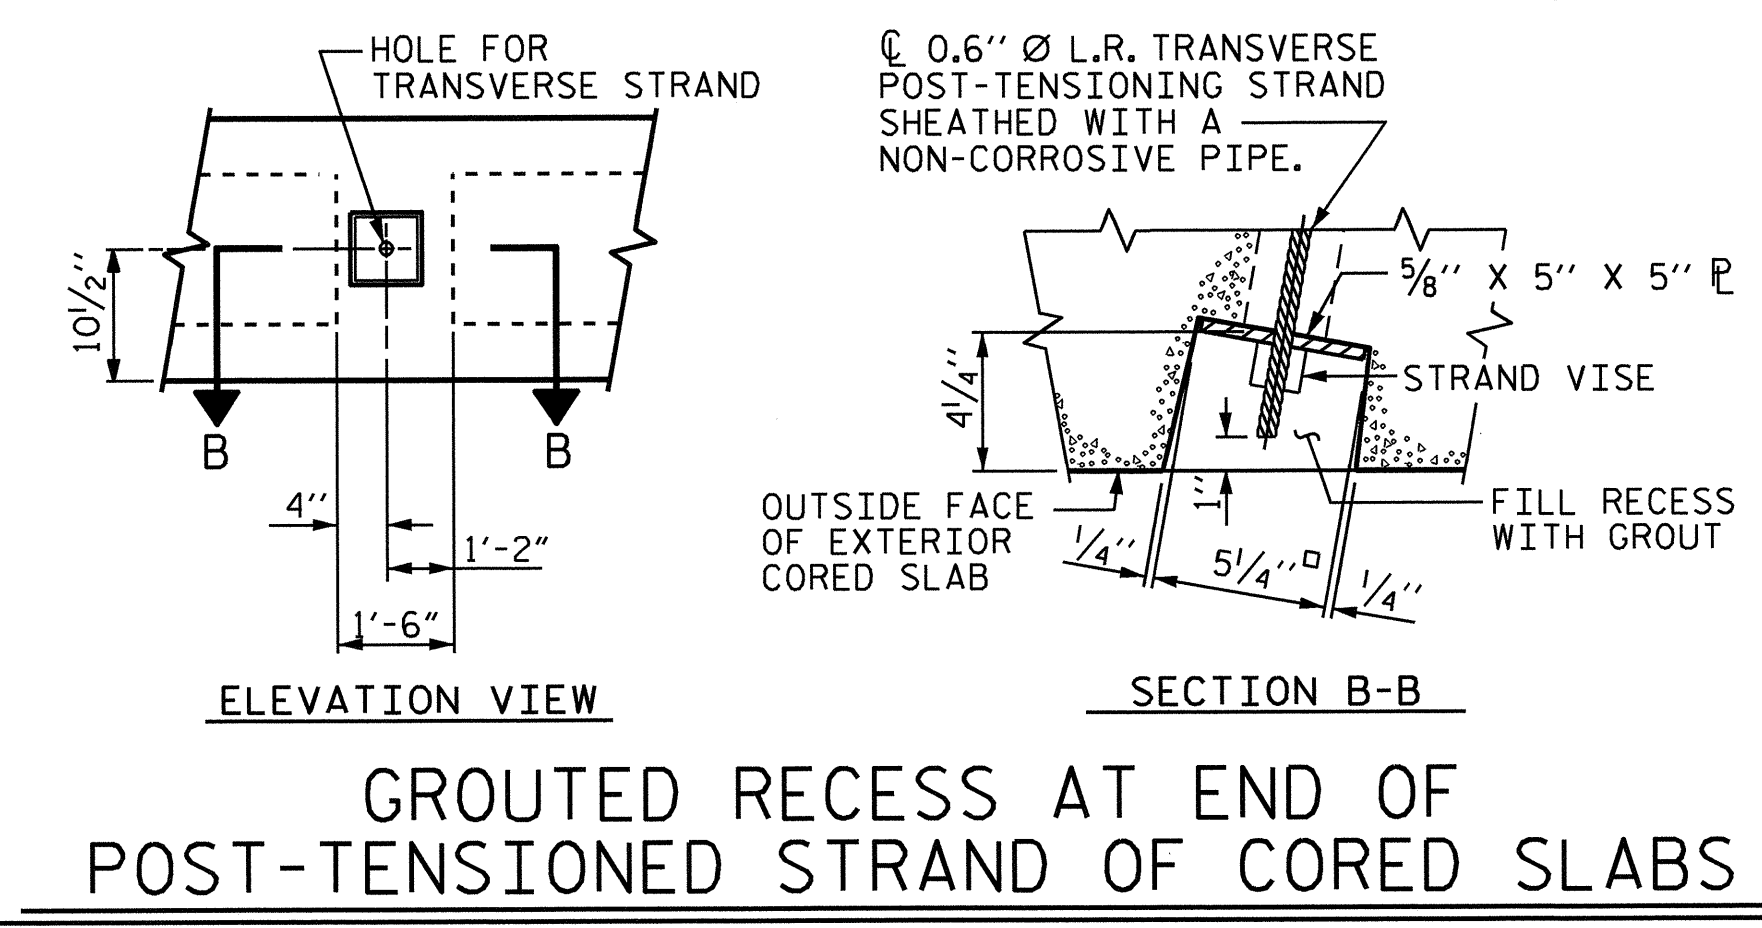

GROUTED RECESS AT END OF POST-TENSIONED STRAND OF CORED SLABS

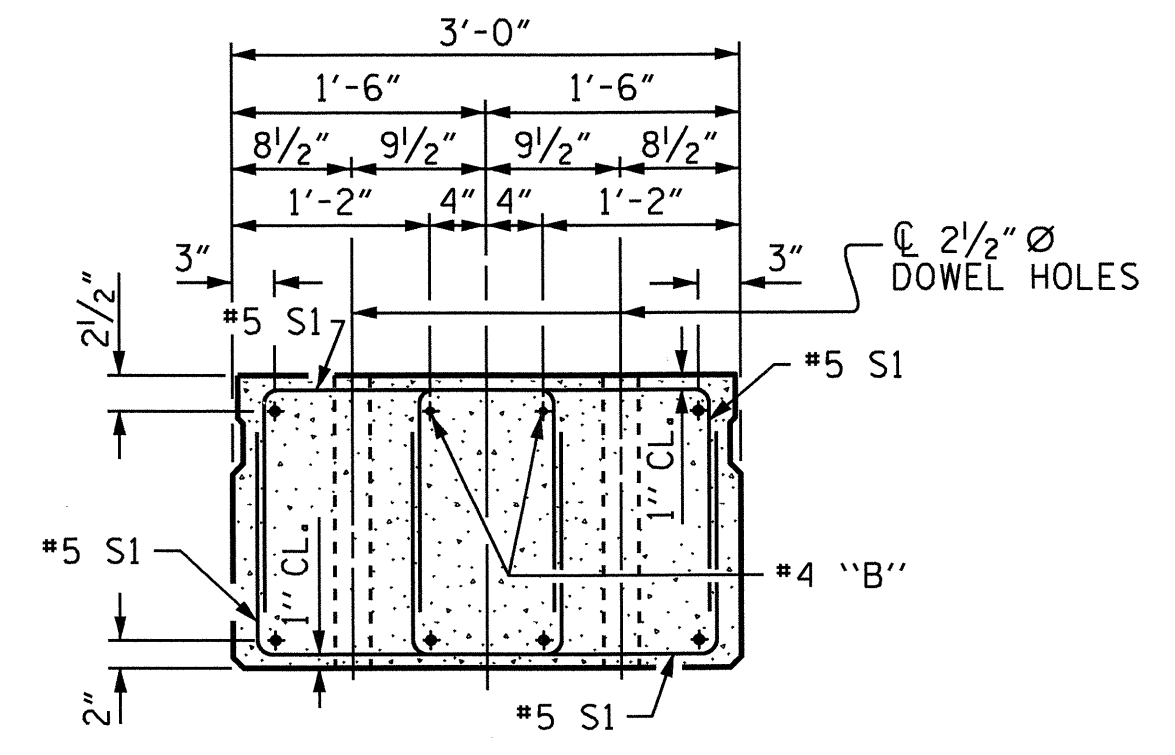

END ELEVATION
 SHOWING PLACEMENT OF DOUBLE STIRRUPS AND LOCATION OF DOWEL HOLES. (STRAND LAYOUT NOT SHOWN.) INTERIOR SLAB UNIT SHOWN-EXTERIOR SLAB UNIT SIMILAR EXCEPT SHEAR KEY LOCATION.

PROJECT NO. B-4731
CHATHAM COUNTY
 STATION: 16+13.50 -L-




SHEET 1 OF 7

STATE OF NORTH CAROLINA DEPARTMENT OF TRANSPORTATION RALEIGH					
STANDARD 3'-0" X 1'-9" PRESTRESSED CONCRETE CORED SLAB UNIT 105° SKEW					
REVISIONS					
NO.	BY:	DATE:	NO.	BY:	DATE:
1			3		
2			4		

SHEET NO. S-7
 TOTAL SHEETS 28






ASSEMBLED BY : A.C. OUTLAW DATE : 5/21/12
 CHECKED BY : A. SORSENGINH DATE : 9/13
 DRAWN BY : DGE 5/09 REV. 12/11 MAA/AAC
 CHECKED BY : BCH 6/09

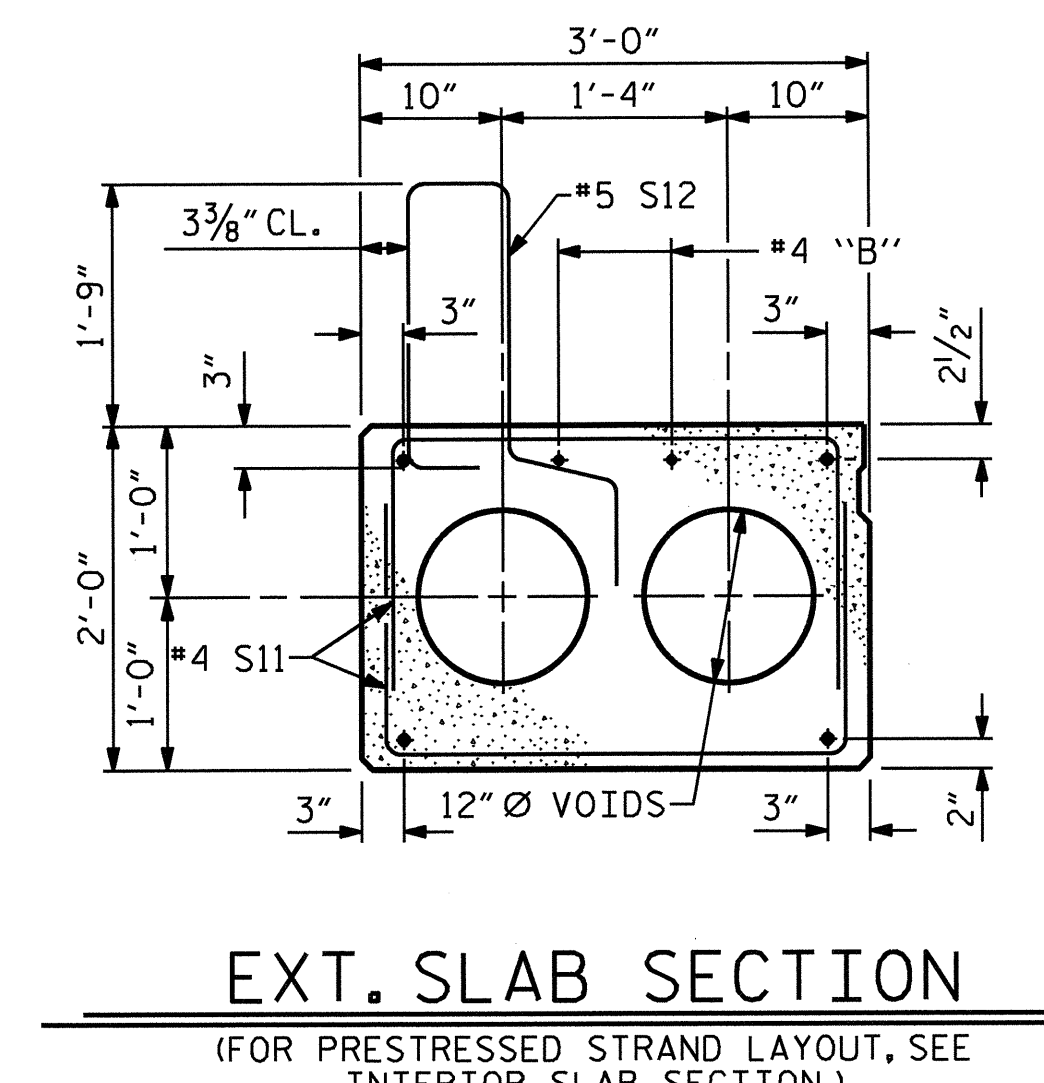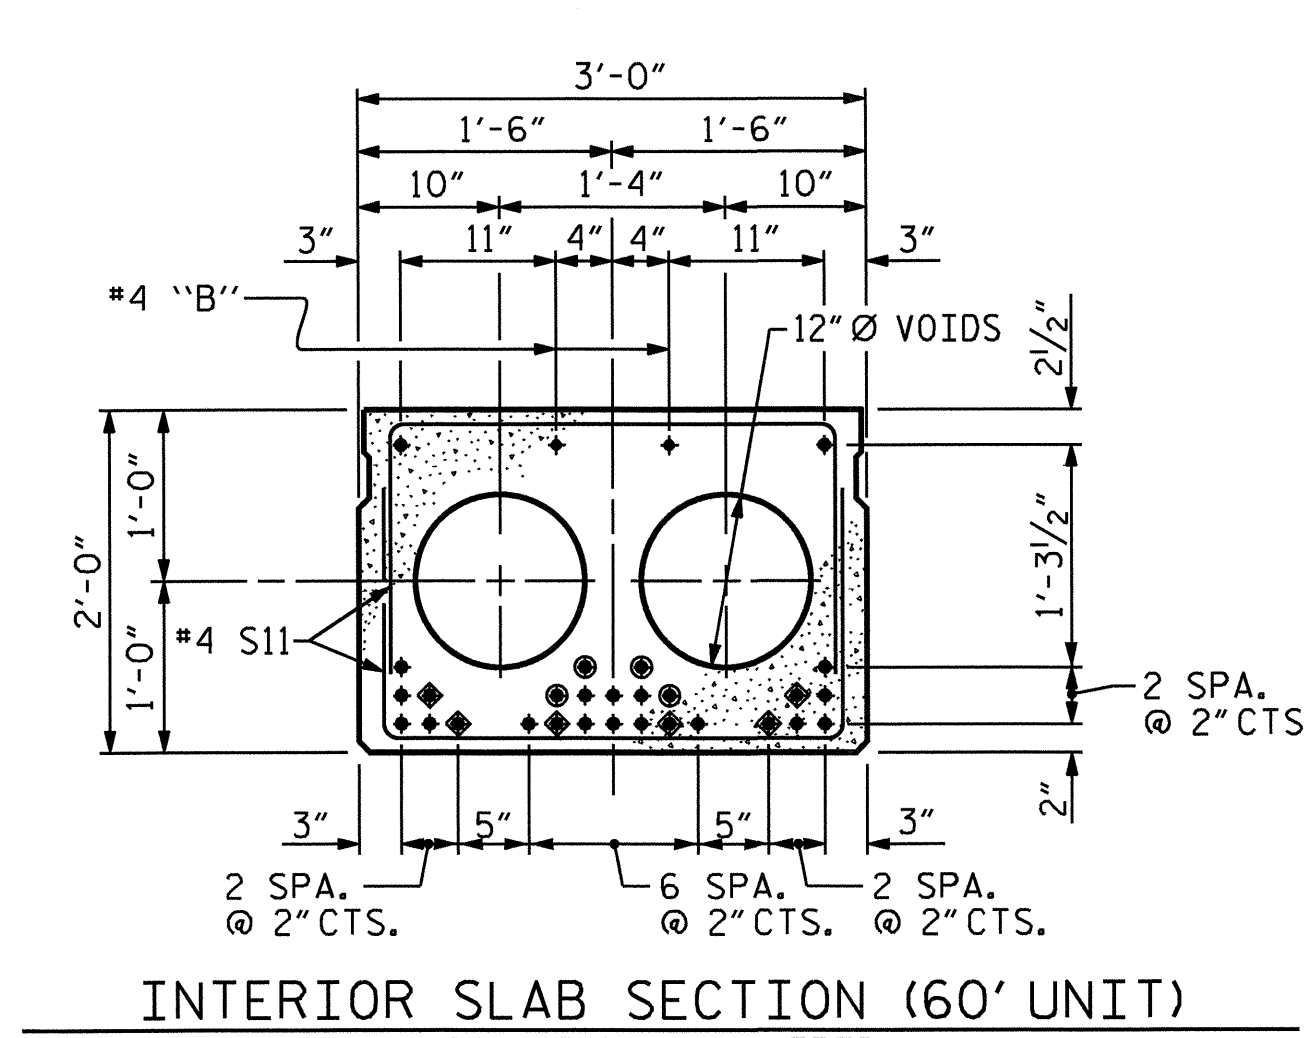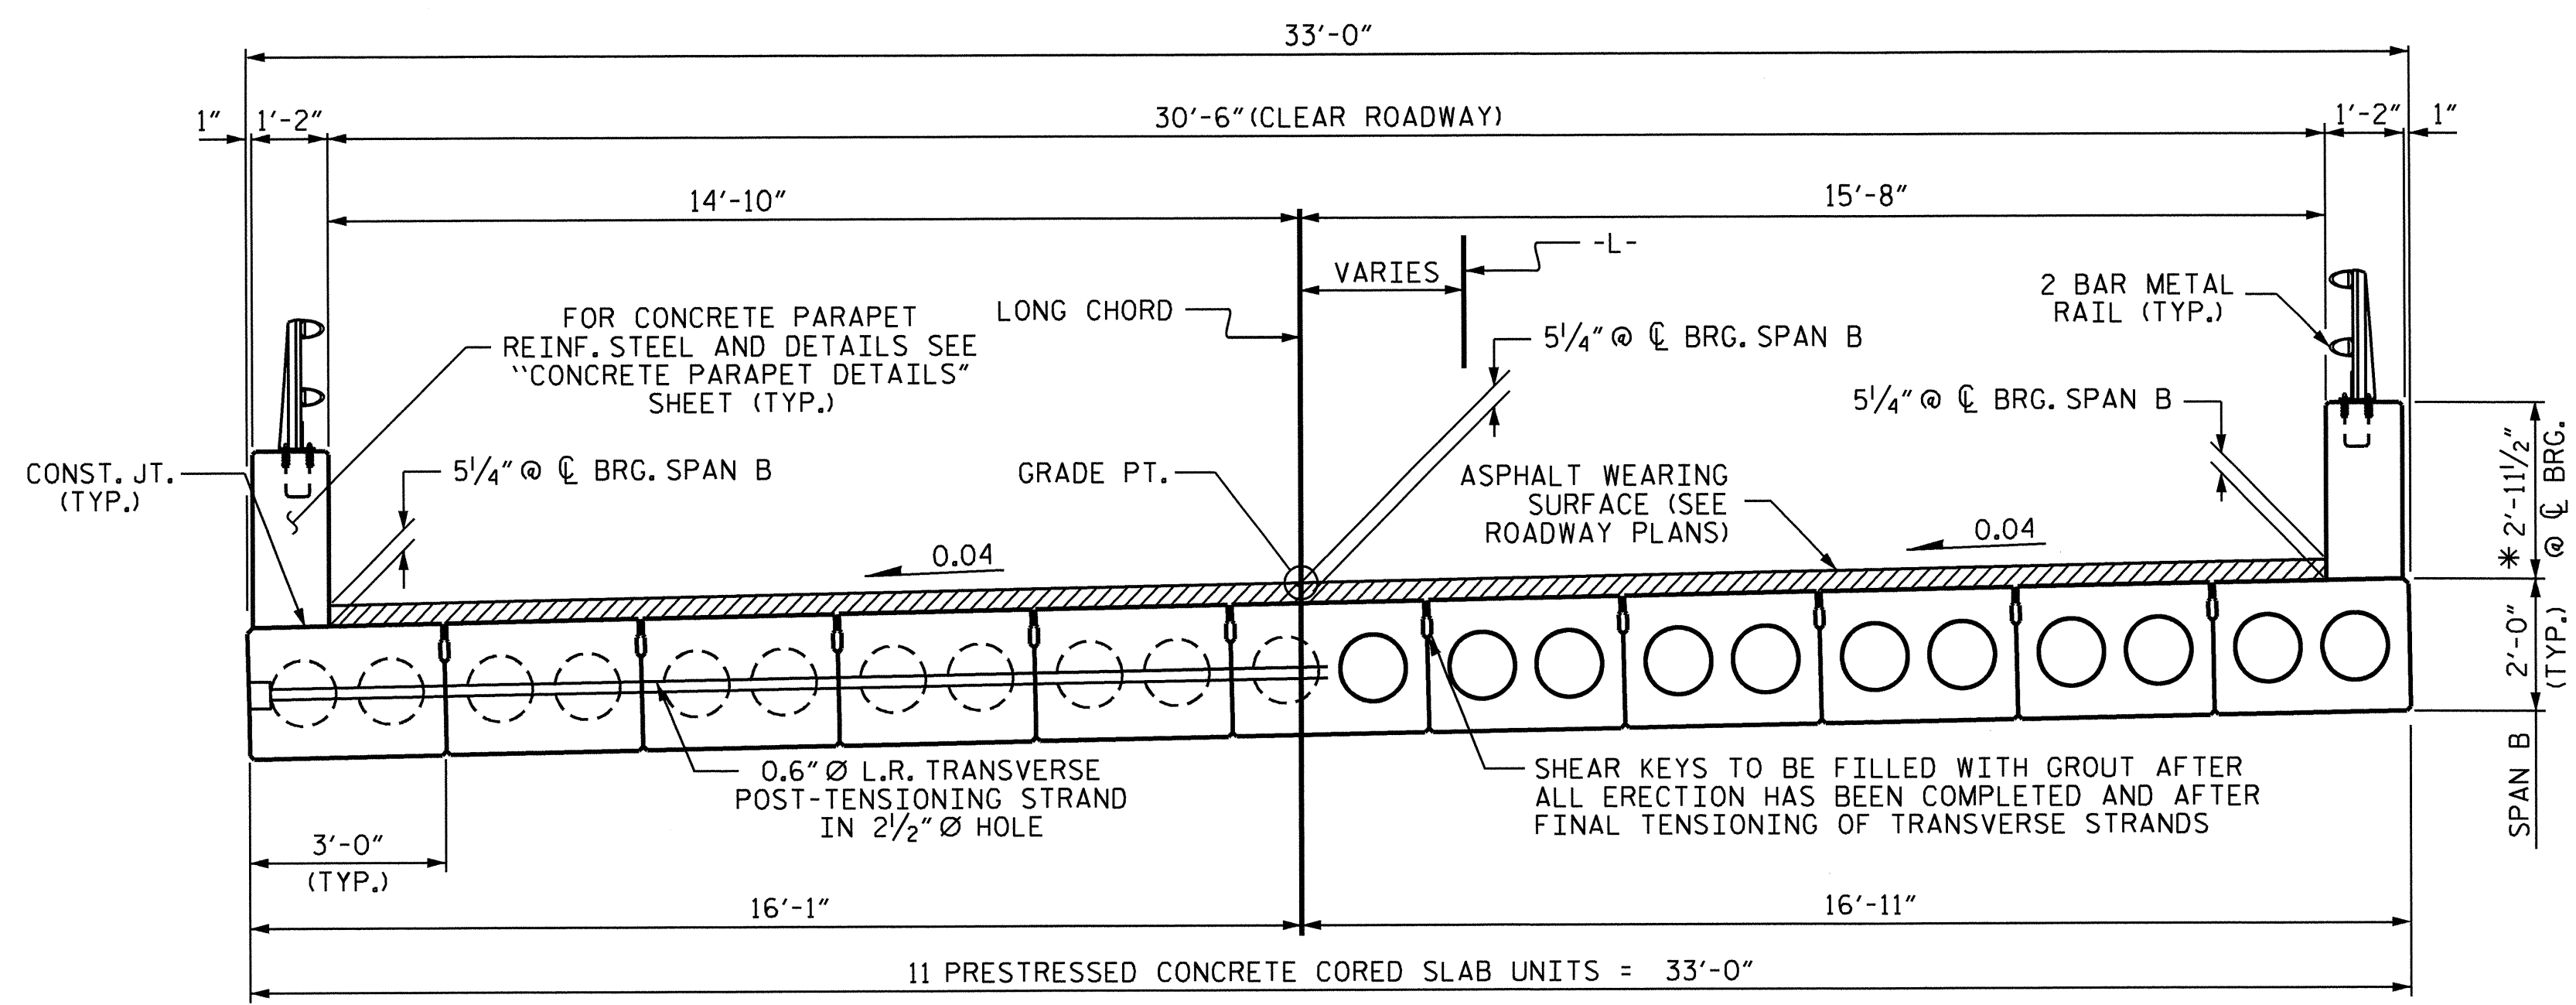

0.6" Ø LOW RELAXATION STRAND LAYOUT

HALF SECTION AT INTERMEDIATE DIAPHRAGMS
TYPICAL SECTION
HALF SECTION THROUGH VOIDS

* - THE MAXIMUM PARAPET HEIGHT AND ASPHALT THICKNESS IS SHOWN. THE HEIGHT OF THE PARAPET AND ASPHALT THICKNESS VARIES WHILE THE TOP OF THE PARAPET FOLLOWS THE PROFILE OF THE GUTTERLINE.

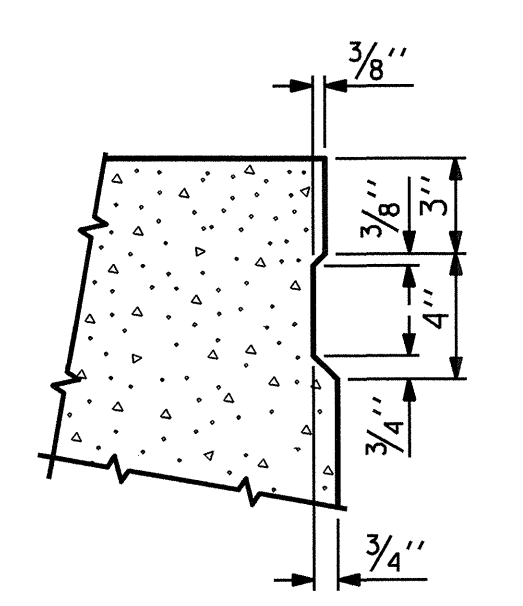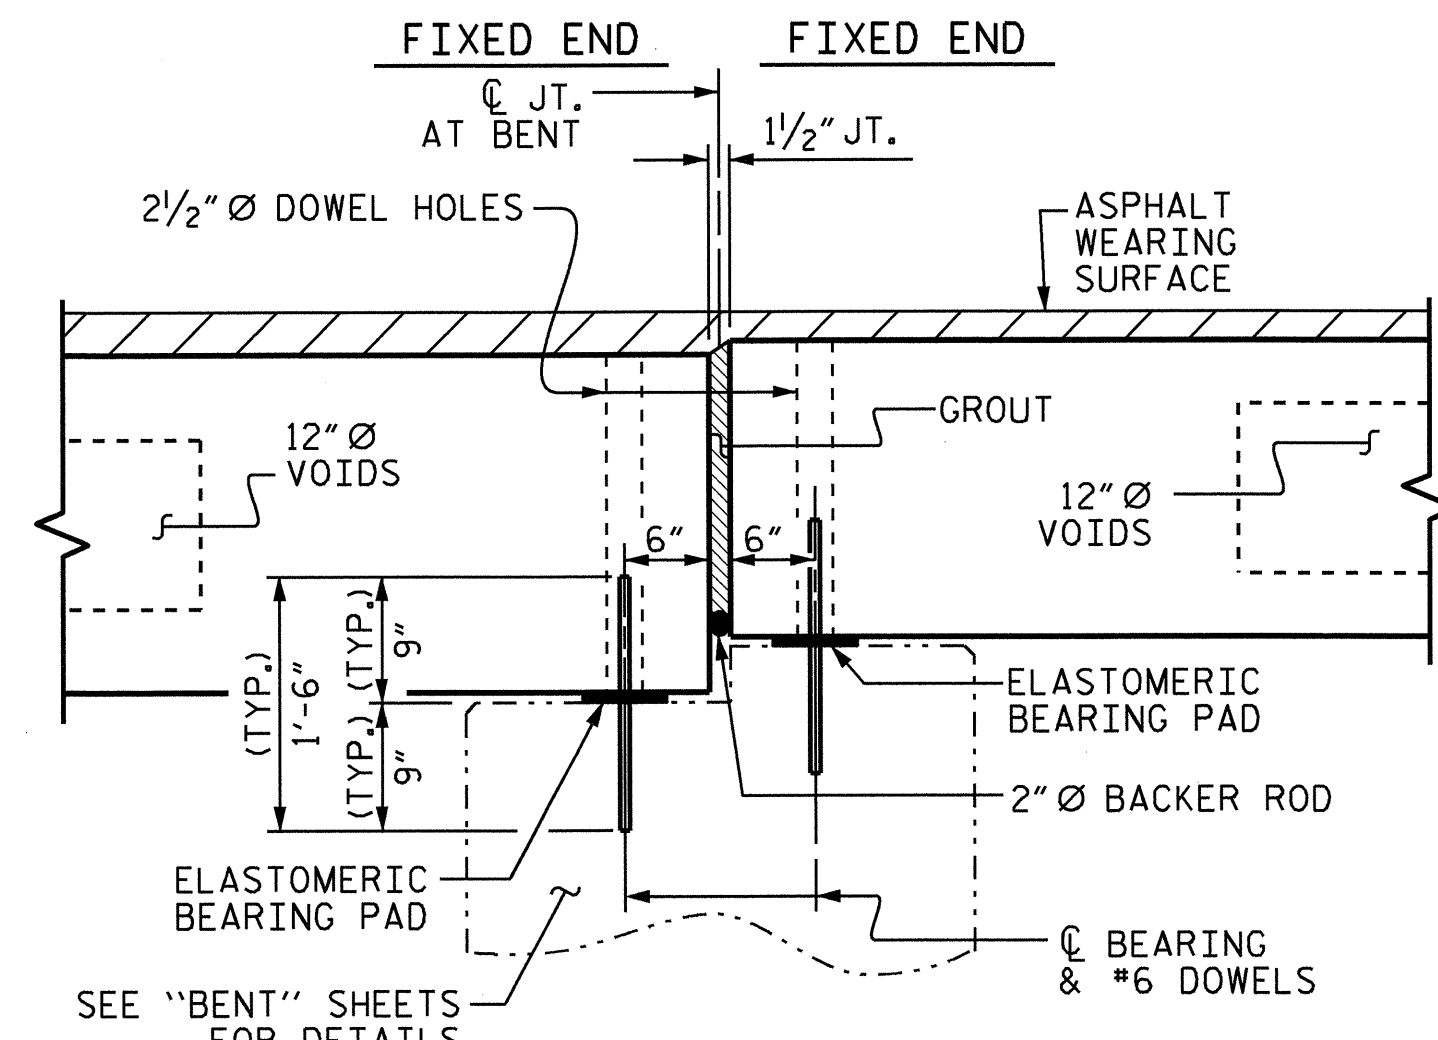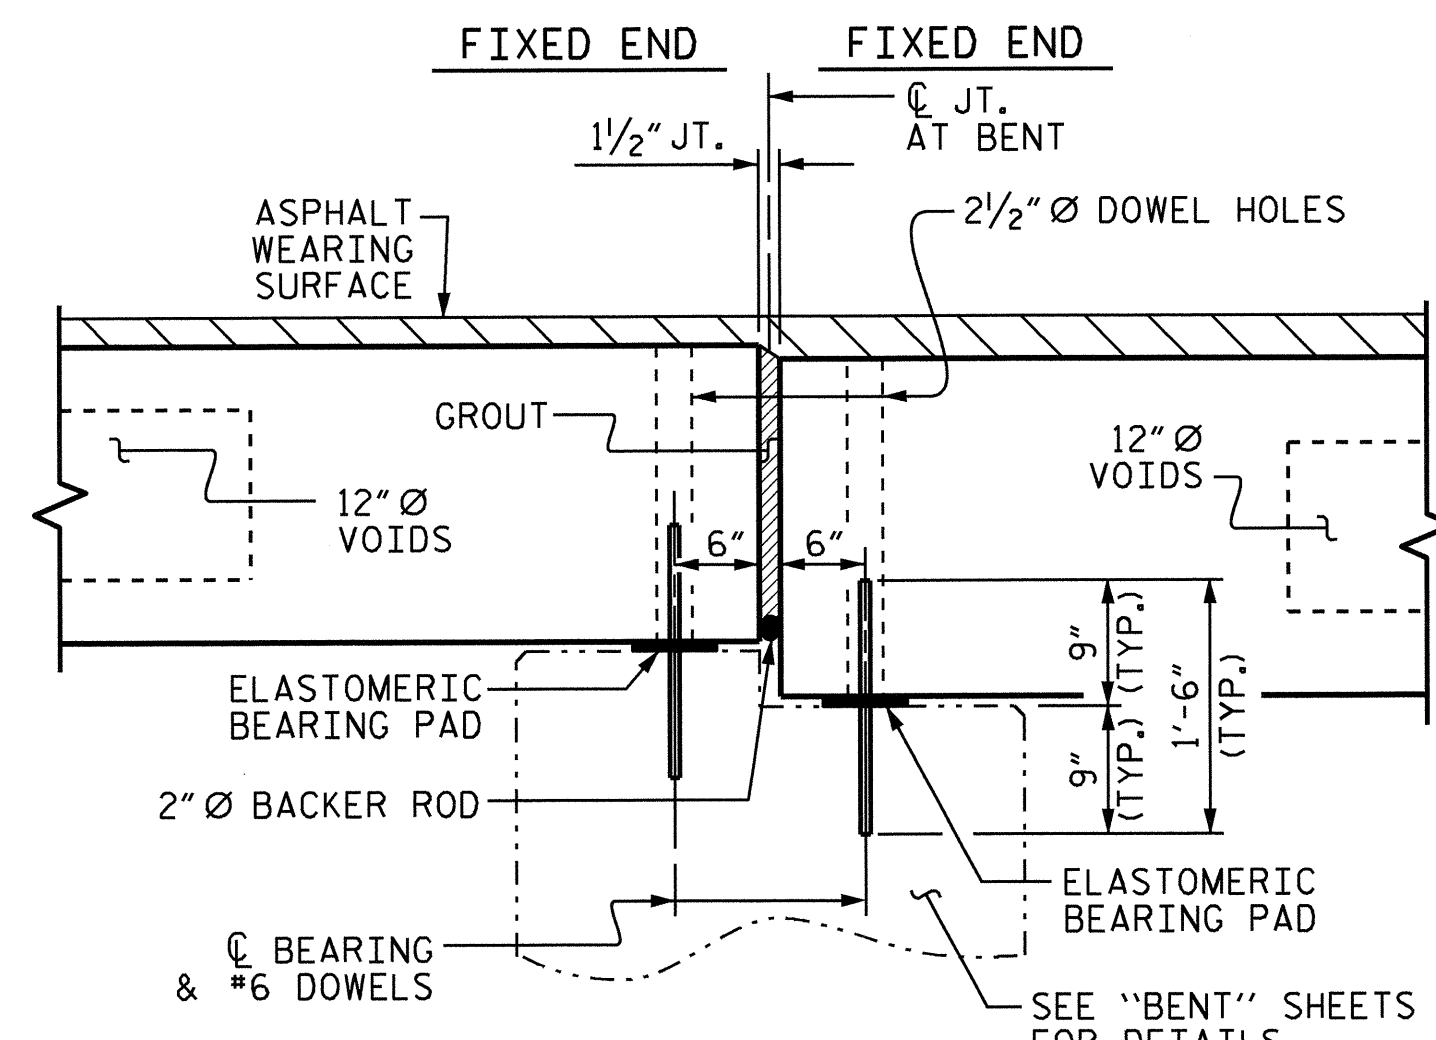


SHEAR KEY DETAIL
NOTE: OMIT SHEAR KEY ON OUTSIDE FACE OF EXTERIOR CORED SLABS.

- ◆ BOND SHALL BE BROKEN ON THESE STRANDS FOR A DISTANCE OF 12'-0" FROM END OF CORED SLAB UNIT. SEE STANDARD SPECIFICATIONS, ARTICLE 1078-7.
- OPTIONAL FULL LENGTH DEBONDED STRANDS. THESE STRANDS ARE NOT REQUIRED. IF THE FABRICATOR CHOOSES TO INCLUDE THESE STRANDS IN THE CORED SLAB UNIT, THE STRANDS SHALL BE DEBONDED FOR THE FULL LENGTH OF THE UNIT AT NO ADDITIONAL COST. SEE STANDARD SPECIFICATIONS, ARTICLE 1078-7.


DEBONDING LEGEND

SECTION AT BENT 1

SECTION AT BENT 2

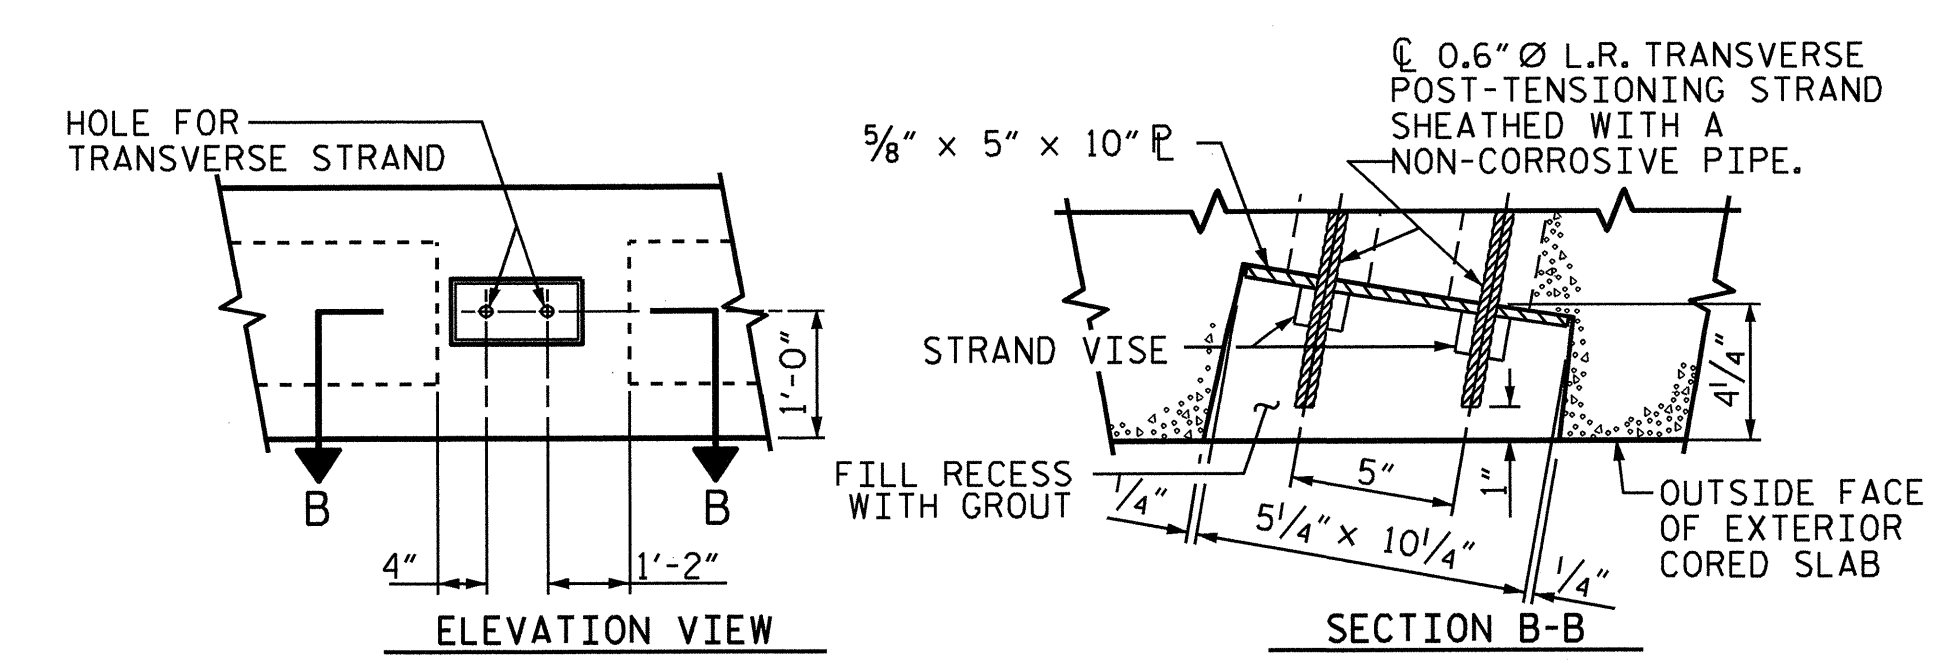


GROUTED RECESS AT END OF POST-TENSIONED STRAND-CORED SLABS

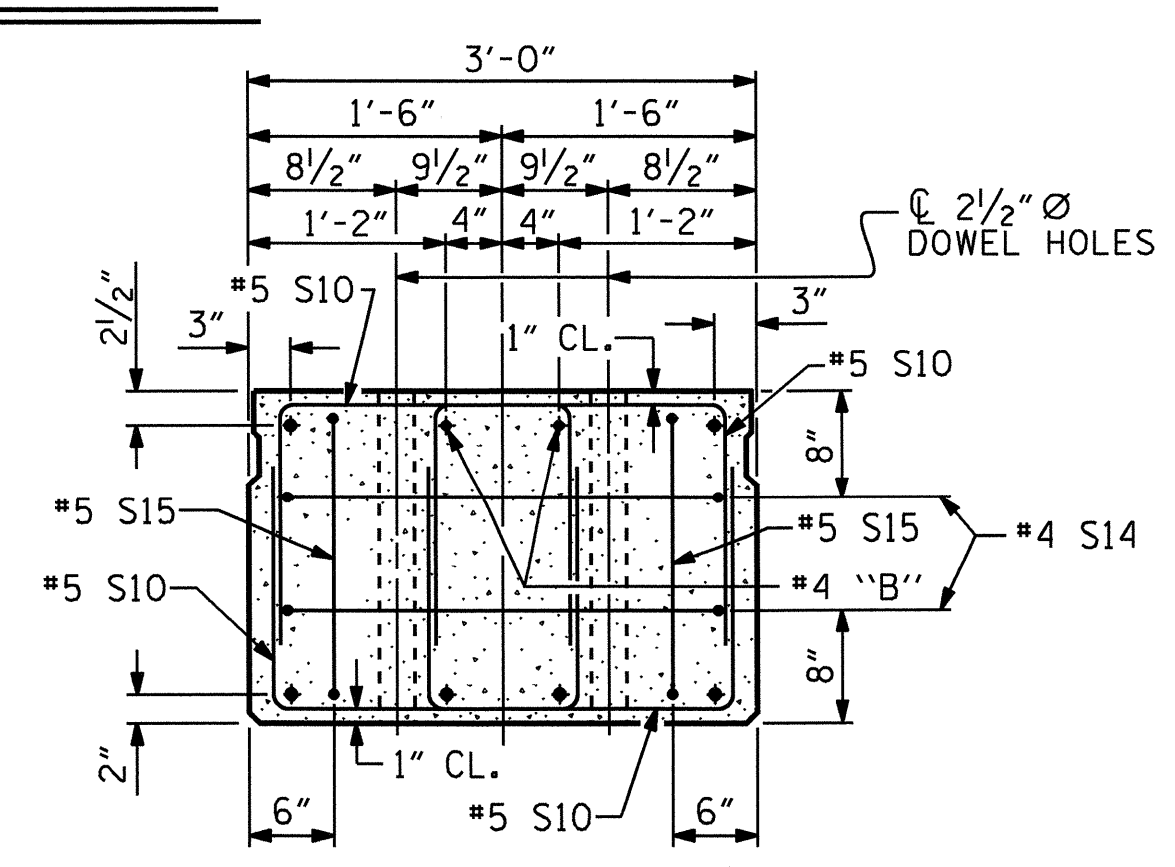

END ELEVATION
SHOWING PLACEMENT OF DOUBLE STIRRUPS AND LOCATION OF DOWEL HOLES. (STRAND LAYOUT NOT SHOWN).
INTERIOR SLAB UNIT SHOWN-EXTERIOR SLAB UNIT SIMILAR EXCEPT SHEAR KEY LOCATION.

ASSEMBLED BY : A.C. OUTLAW DATE : 5/21/12
CHECKED BY : A. SORSENGINH DATE : 9/13
DRAWN BY : MAA 6/10 REV. 12/11 MAA/AAC
CHECKED BY : MKT 7/10


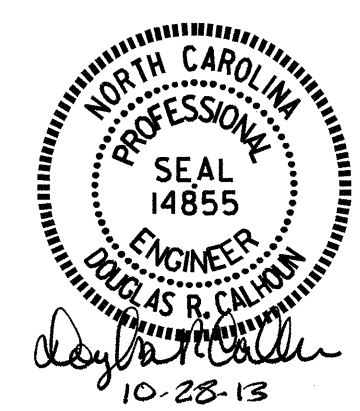


PROJECT NO. B-4731
CHATHAM COUNTY
STATION: 16+13.50 -L-

SHEET 2 OF 7

REVISIONS						SHEET NO.
NO.	BY:	DATE:	NO.	BY:	DATE:	TOTAL SHEETS
1			3			28
2			4			

STATE OF NORTH CAROLINA
DEPARTMENT OF TRANSPORTATION
RALEIGH
STANDARD
3'-0" X 2'-0"
PRESTRESSED CONCRETE
CORED SLAB UNIT
105° SKEW

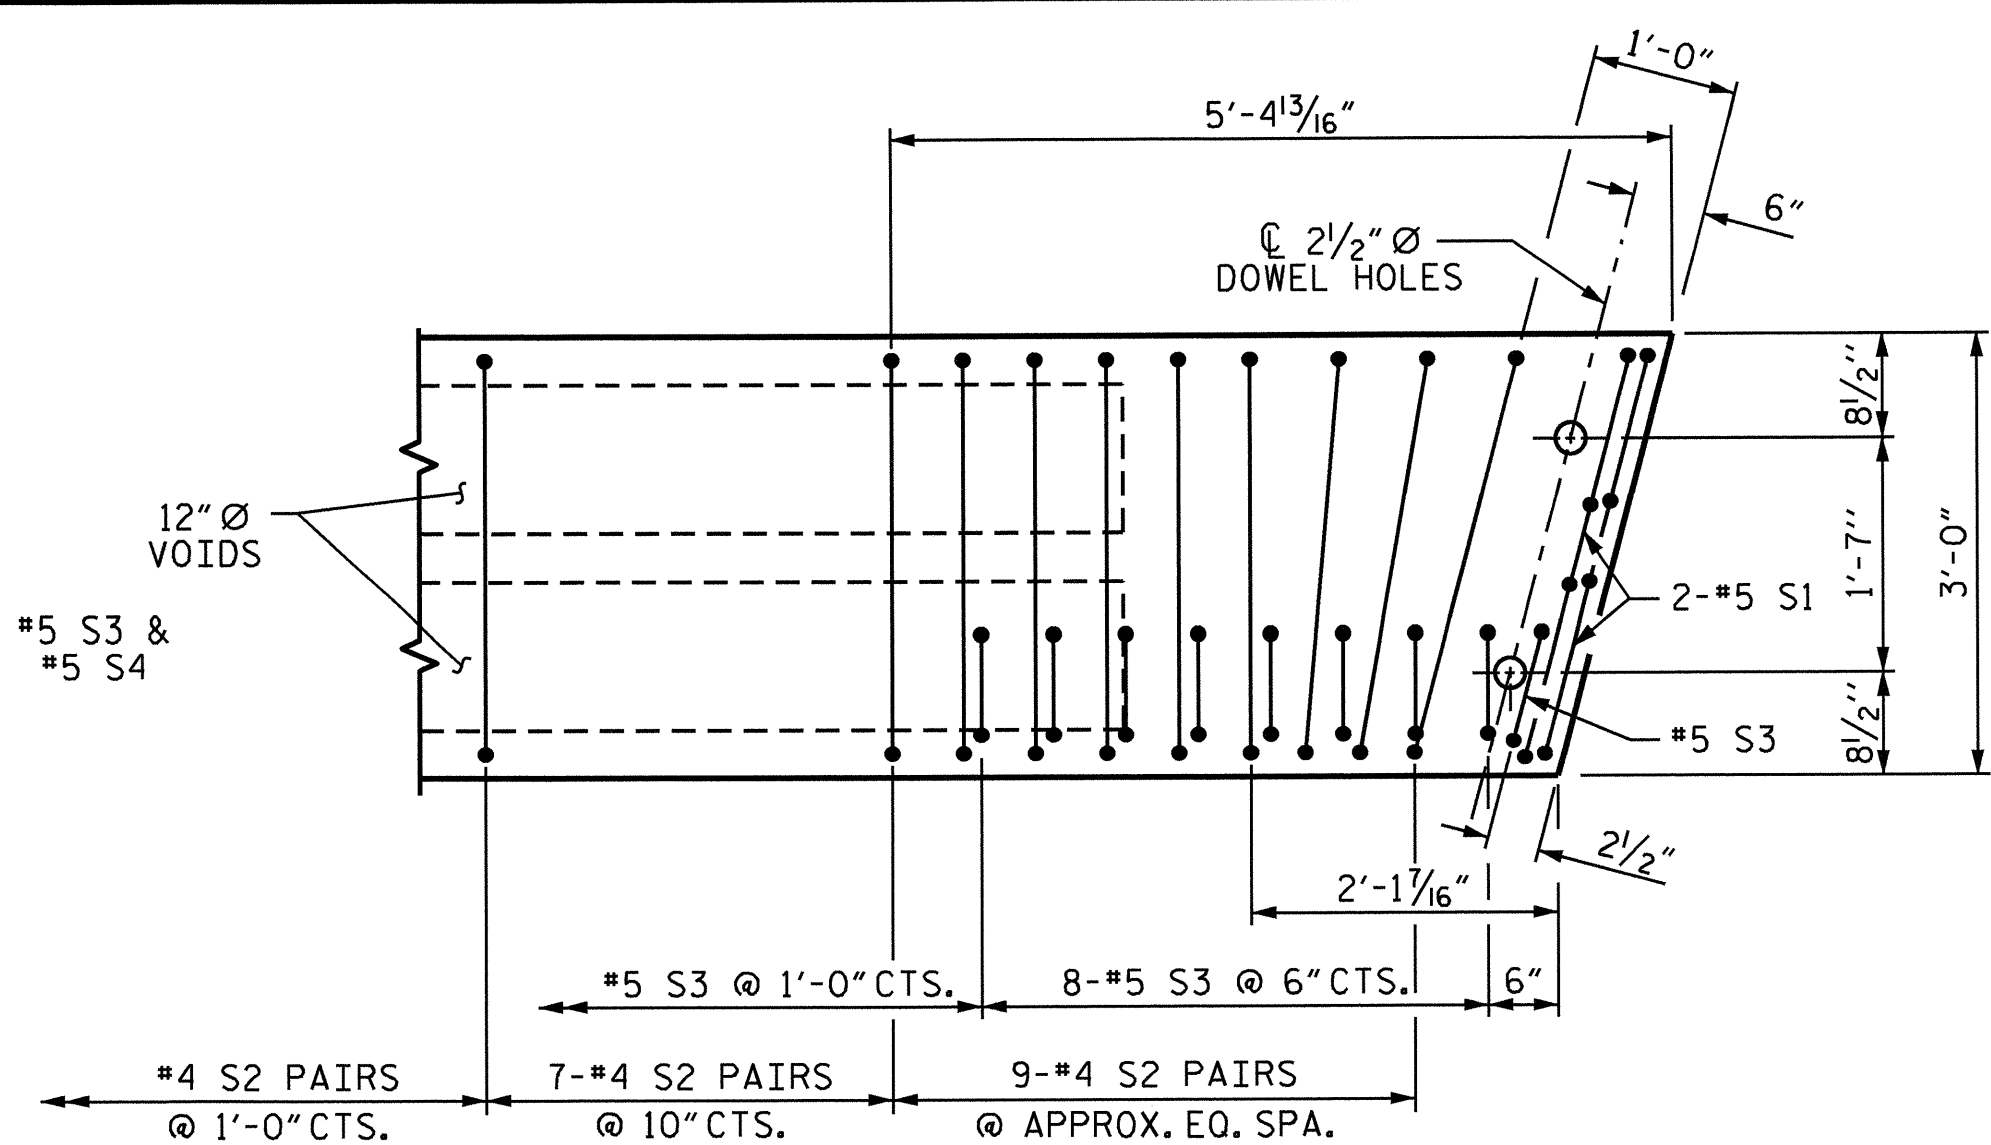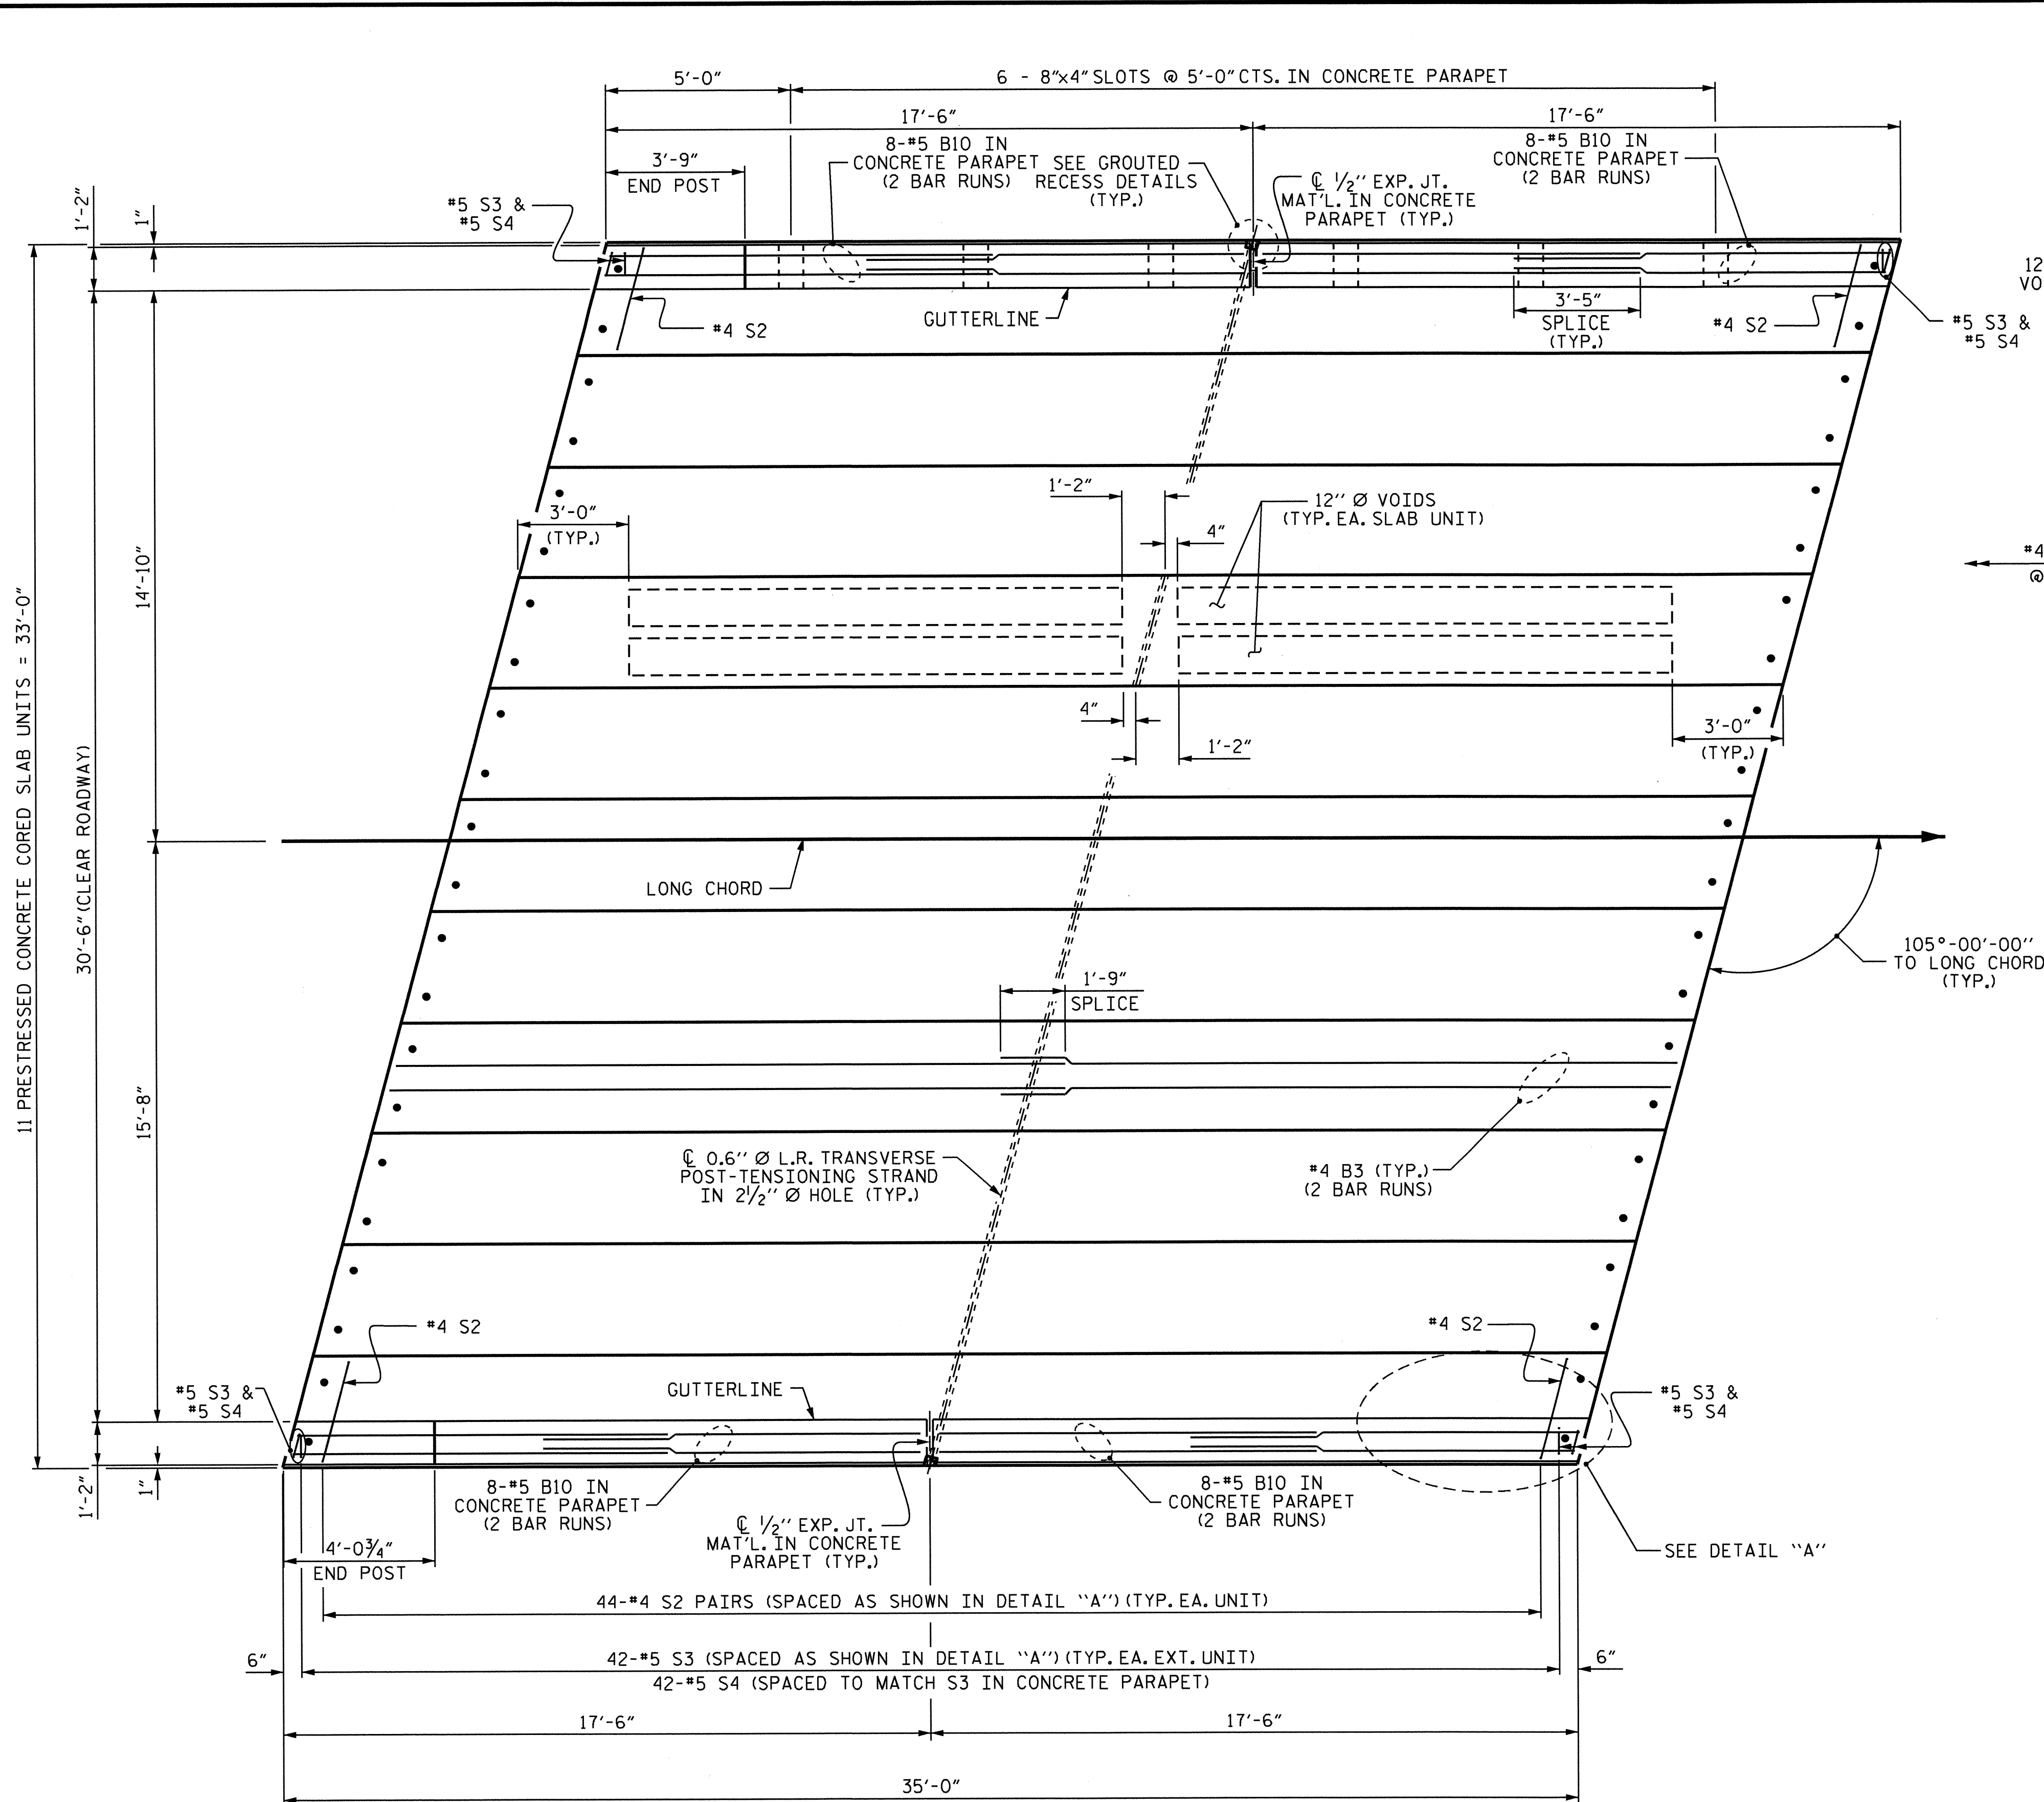

DETAIL "A"
 NOTE: EXTERIOR UNIT SHOWN - INTERIOR UNIT SIMILAR EXCEPT OMIT #5 S3 BARS.


PLAN OF SPAN A

PROJECT NO. B-4731
CHATHAM COUNTY
 STATION: 16+13.50 -L-
 SHEET 3 OF 7


STATE OF NORTH CAROLINA
 DEPARTMENT OF TRANSPORTATION
 RALEIGH

**PLAN OF 35' UNIT
 30'-6" CLEAR ROADWAY
 105° SKEW**


REVISIONS						SHEET NO.	
NO.	BY:	DATE:	NO.	BY:	DATE:	S-9	
1			3			TOTAL SHEETS 28	
2			4				

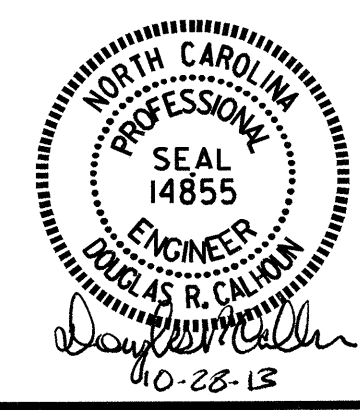

ASSEMBLED BY : A.C. OUTLAW DATE : 5/21/12
 CHECKED BY : A. SORSENGINH DATE : 9/13
 DRAWN BY : DCE 3/09 REV. 12/5/11 MAA/AAC
 CHECKED BY : BCH 3/09

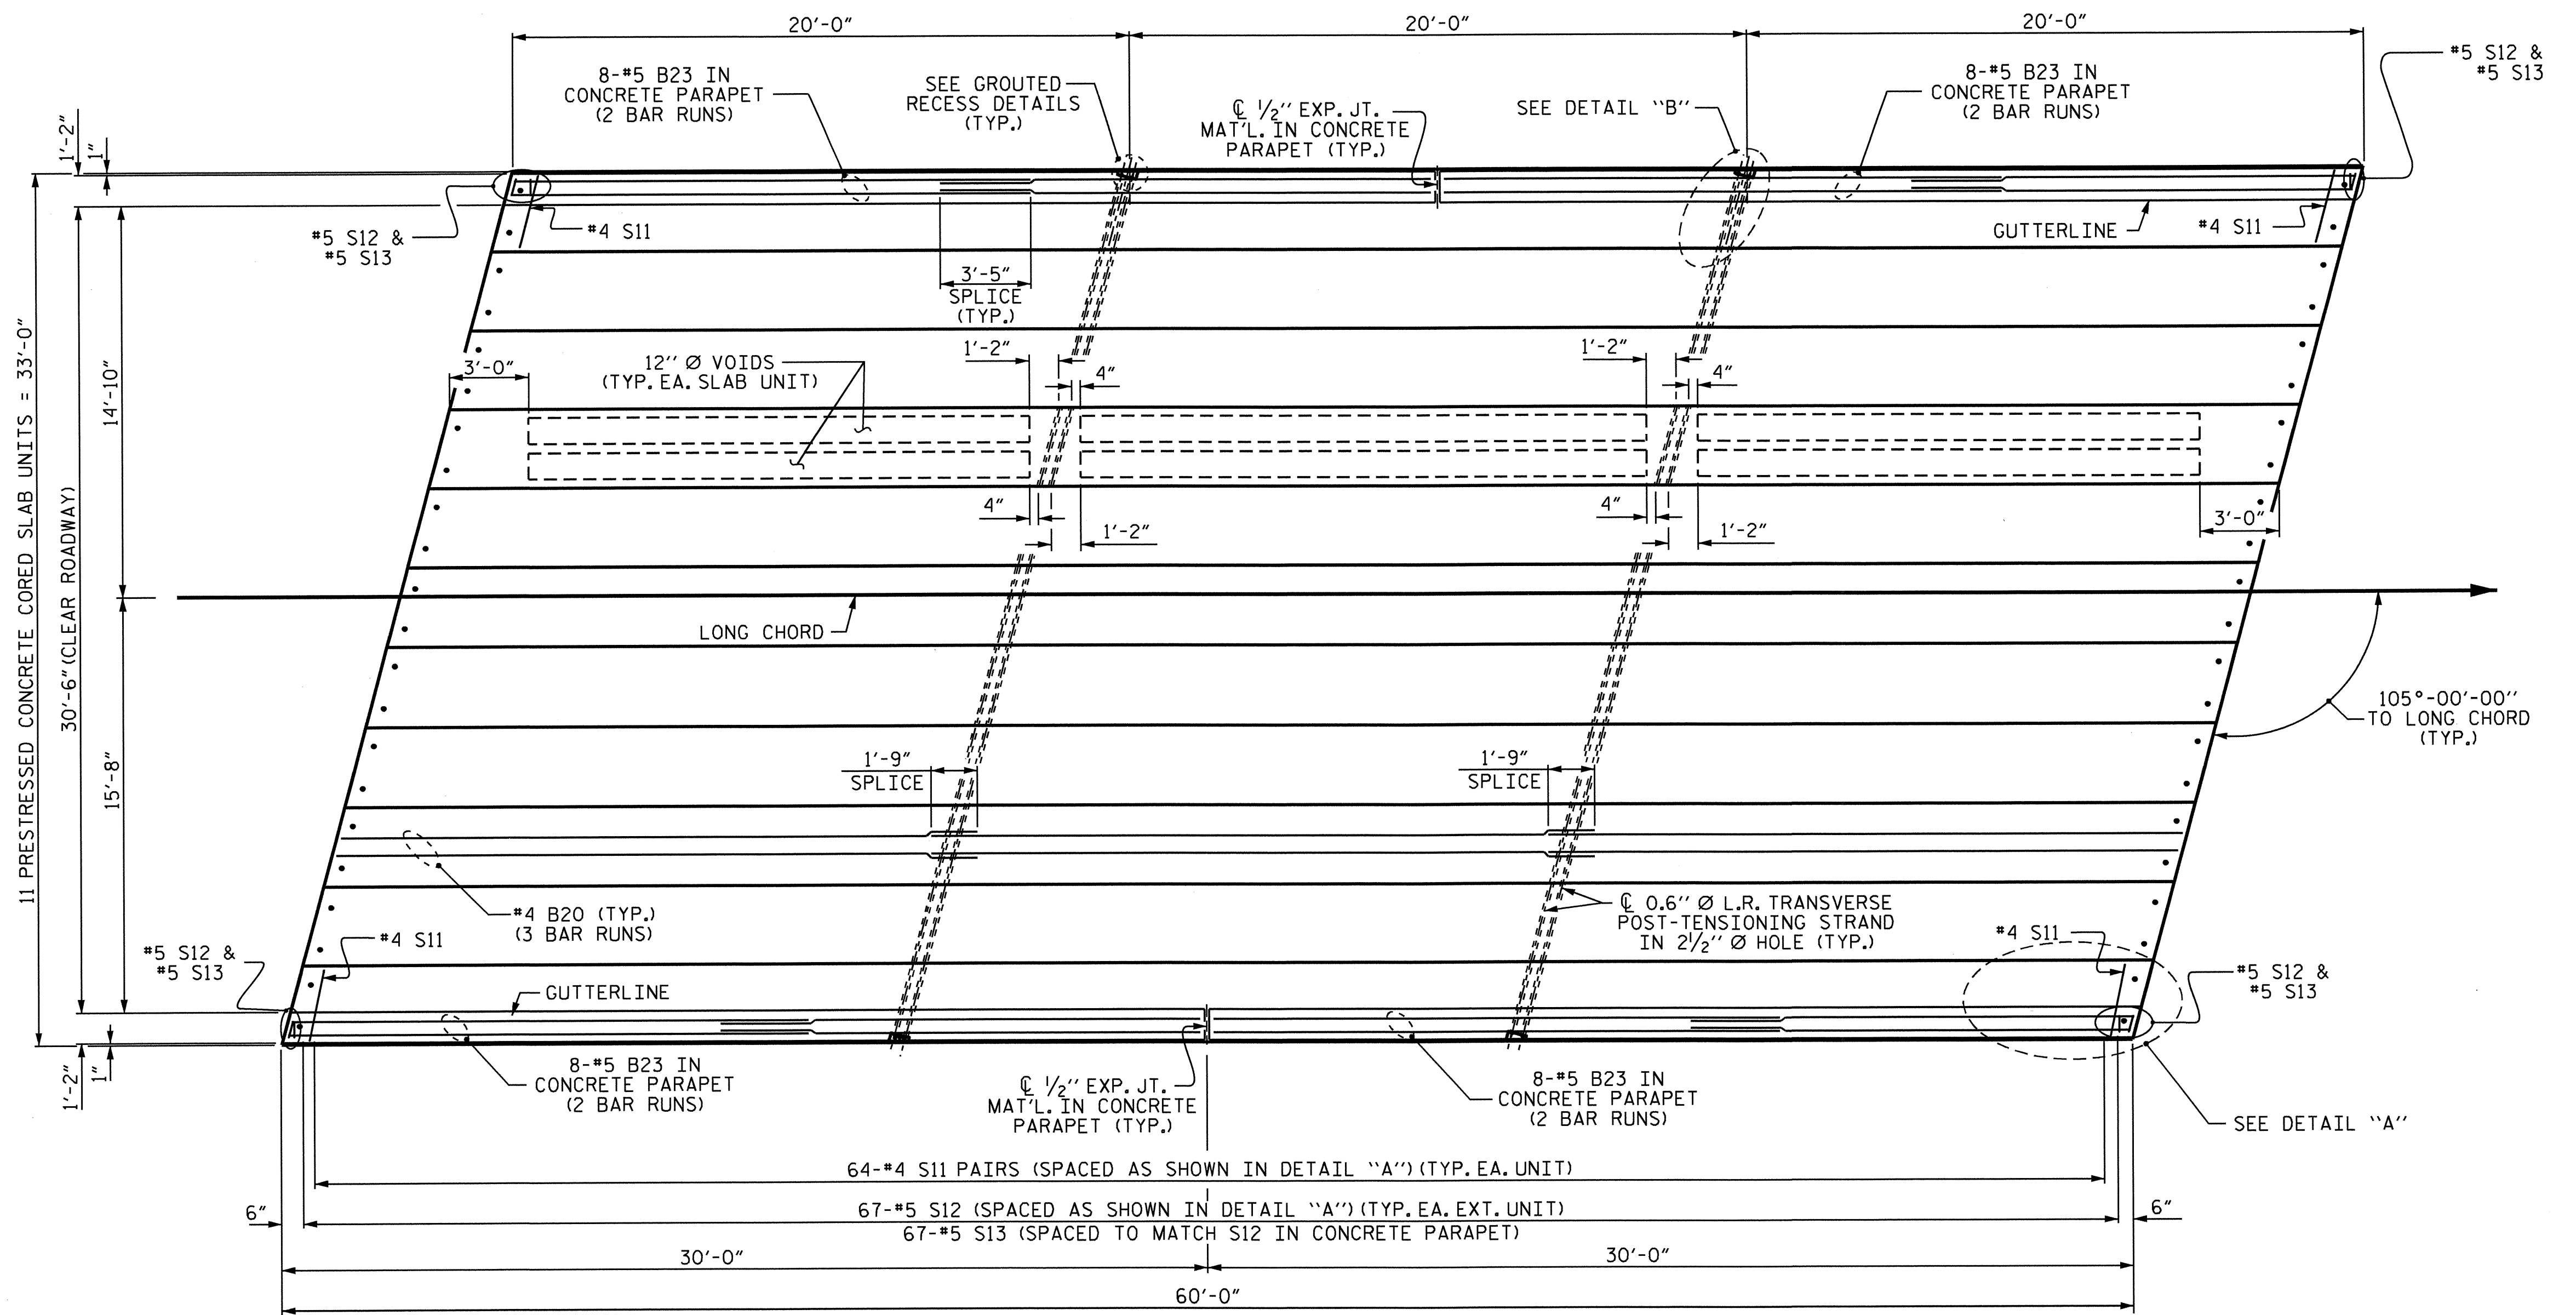


PLAN OF SPAN B

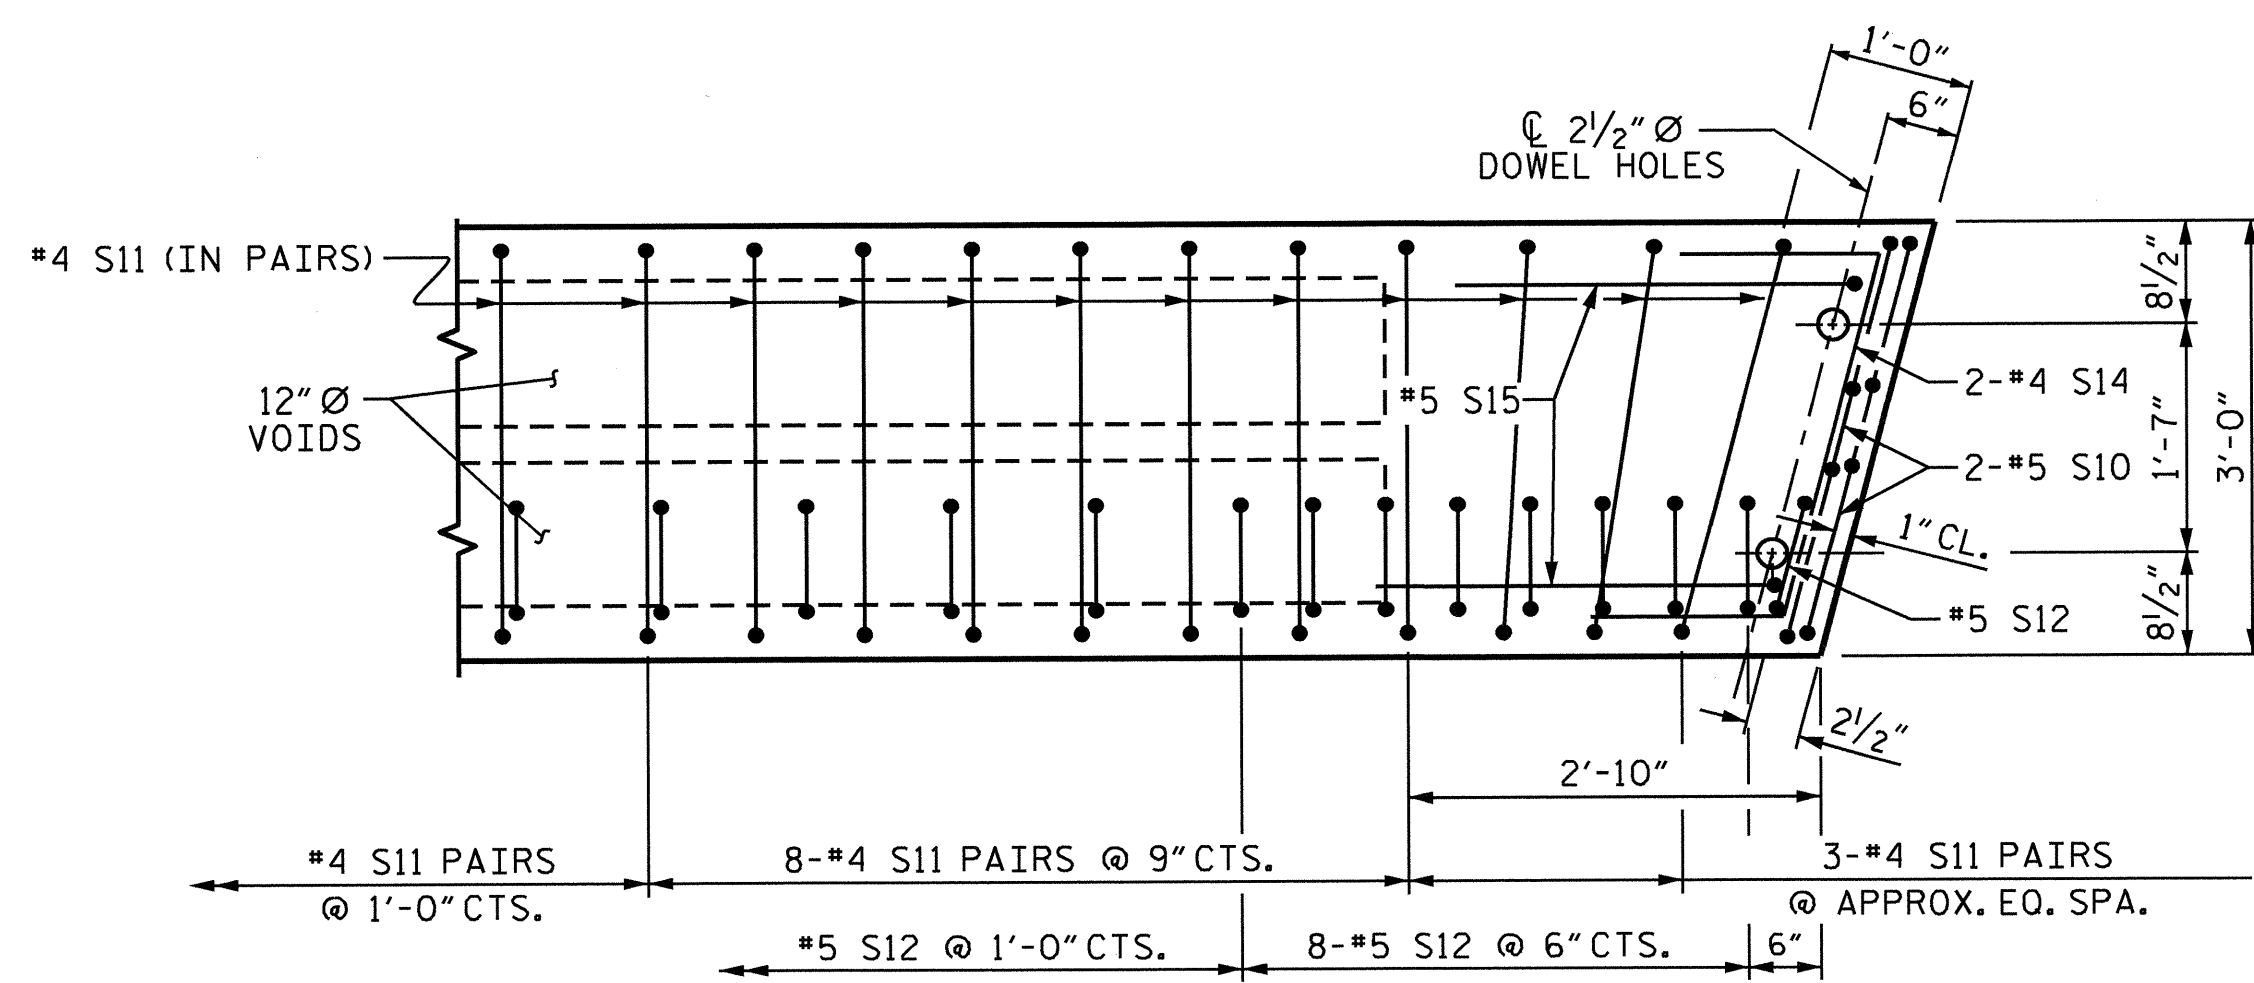

DETAIL "A"

NOTE: EXTERIOR UNIT SHOWN - INTERIOR UNIT SIMILAR EXCEPT OMIT #5 S12 BARS.

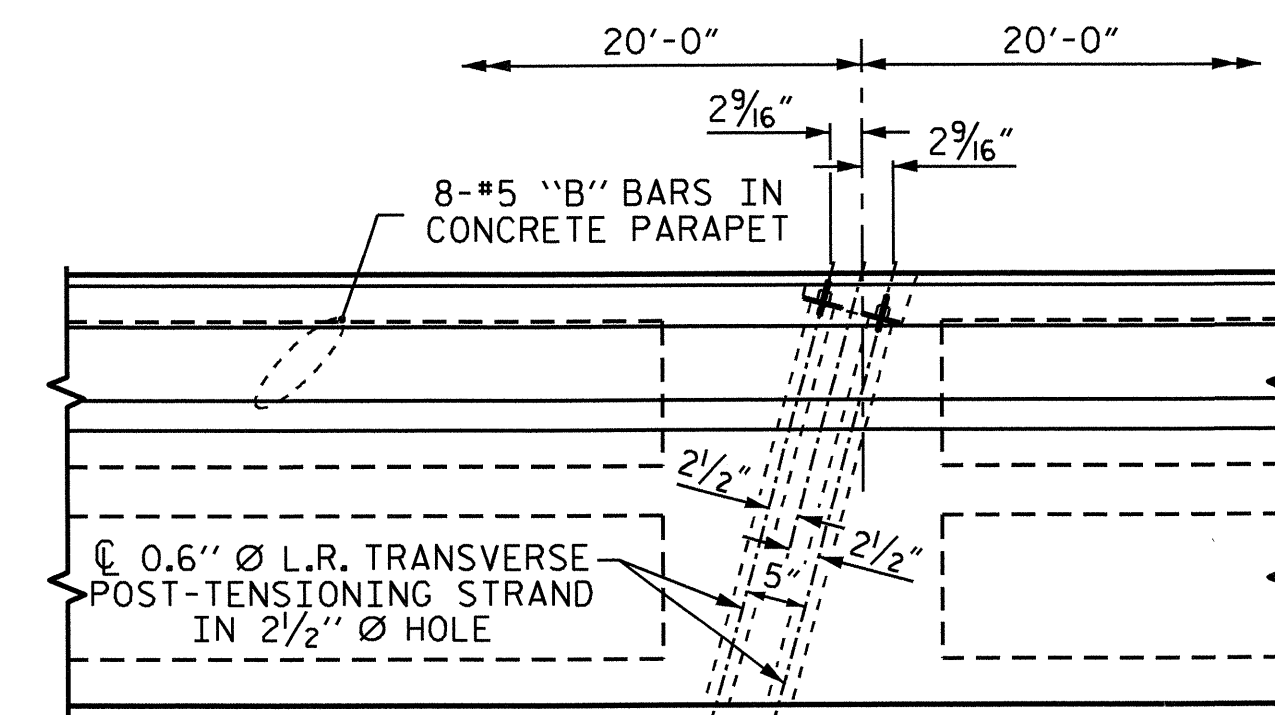


DETAIL "B"

#4 S11 BARS MAY BE SHIFTED AS NECESSARY TO MAINTAIN 1" CLEAR TO GROUDED RECESS AND 2 1/2" Ø TRANSVERSE POST-TENSIONING STRAND HOLES


PROJECT NO. B-4731
CHATHAM COUNTY
 STATION: 16+13.50 -L-

SHEET 4 OF 7
 STATE OF NORTH CAROLINA
 DEPARTMENT OF TRANSPORTATION
 RALEIGH
 PLAN OF 60' UNIT
 30'-6" CLEAR ROADWAY
 105° SKEW

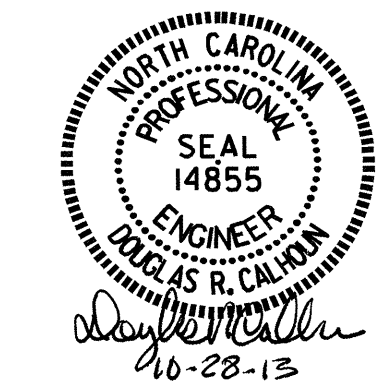


ASSEMBLED BY : A.C. OUTLAW DATE : 5/21/12
 CHECKED BY : A. SORSENGINH DATE : 9/13
 DRAWN BY : MAA 6/10 REV. 12/5/11 MAA/AAC
 CHECKED BY : MKT 7/10

REVISIONS						SHEET NO.
NO.	BY:	DATE:	NO.	BY:	DATE:	TOTAL SHEETS
1			3			28
2			4			

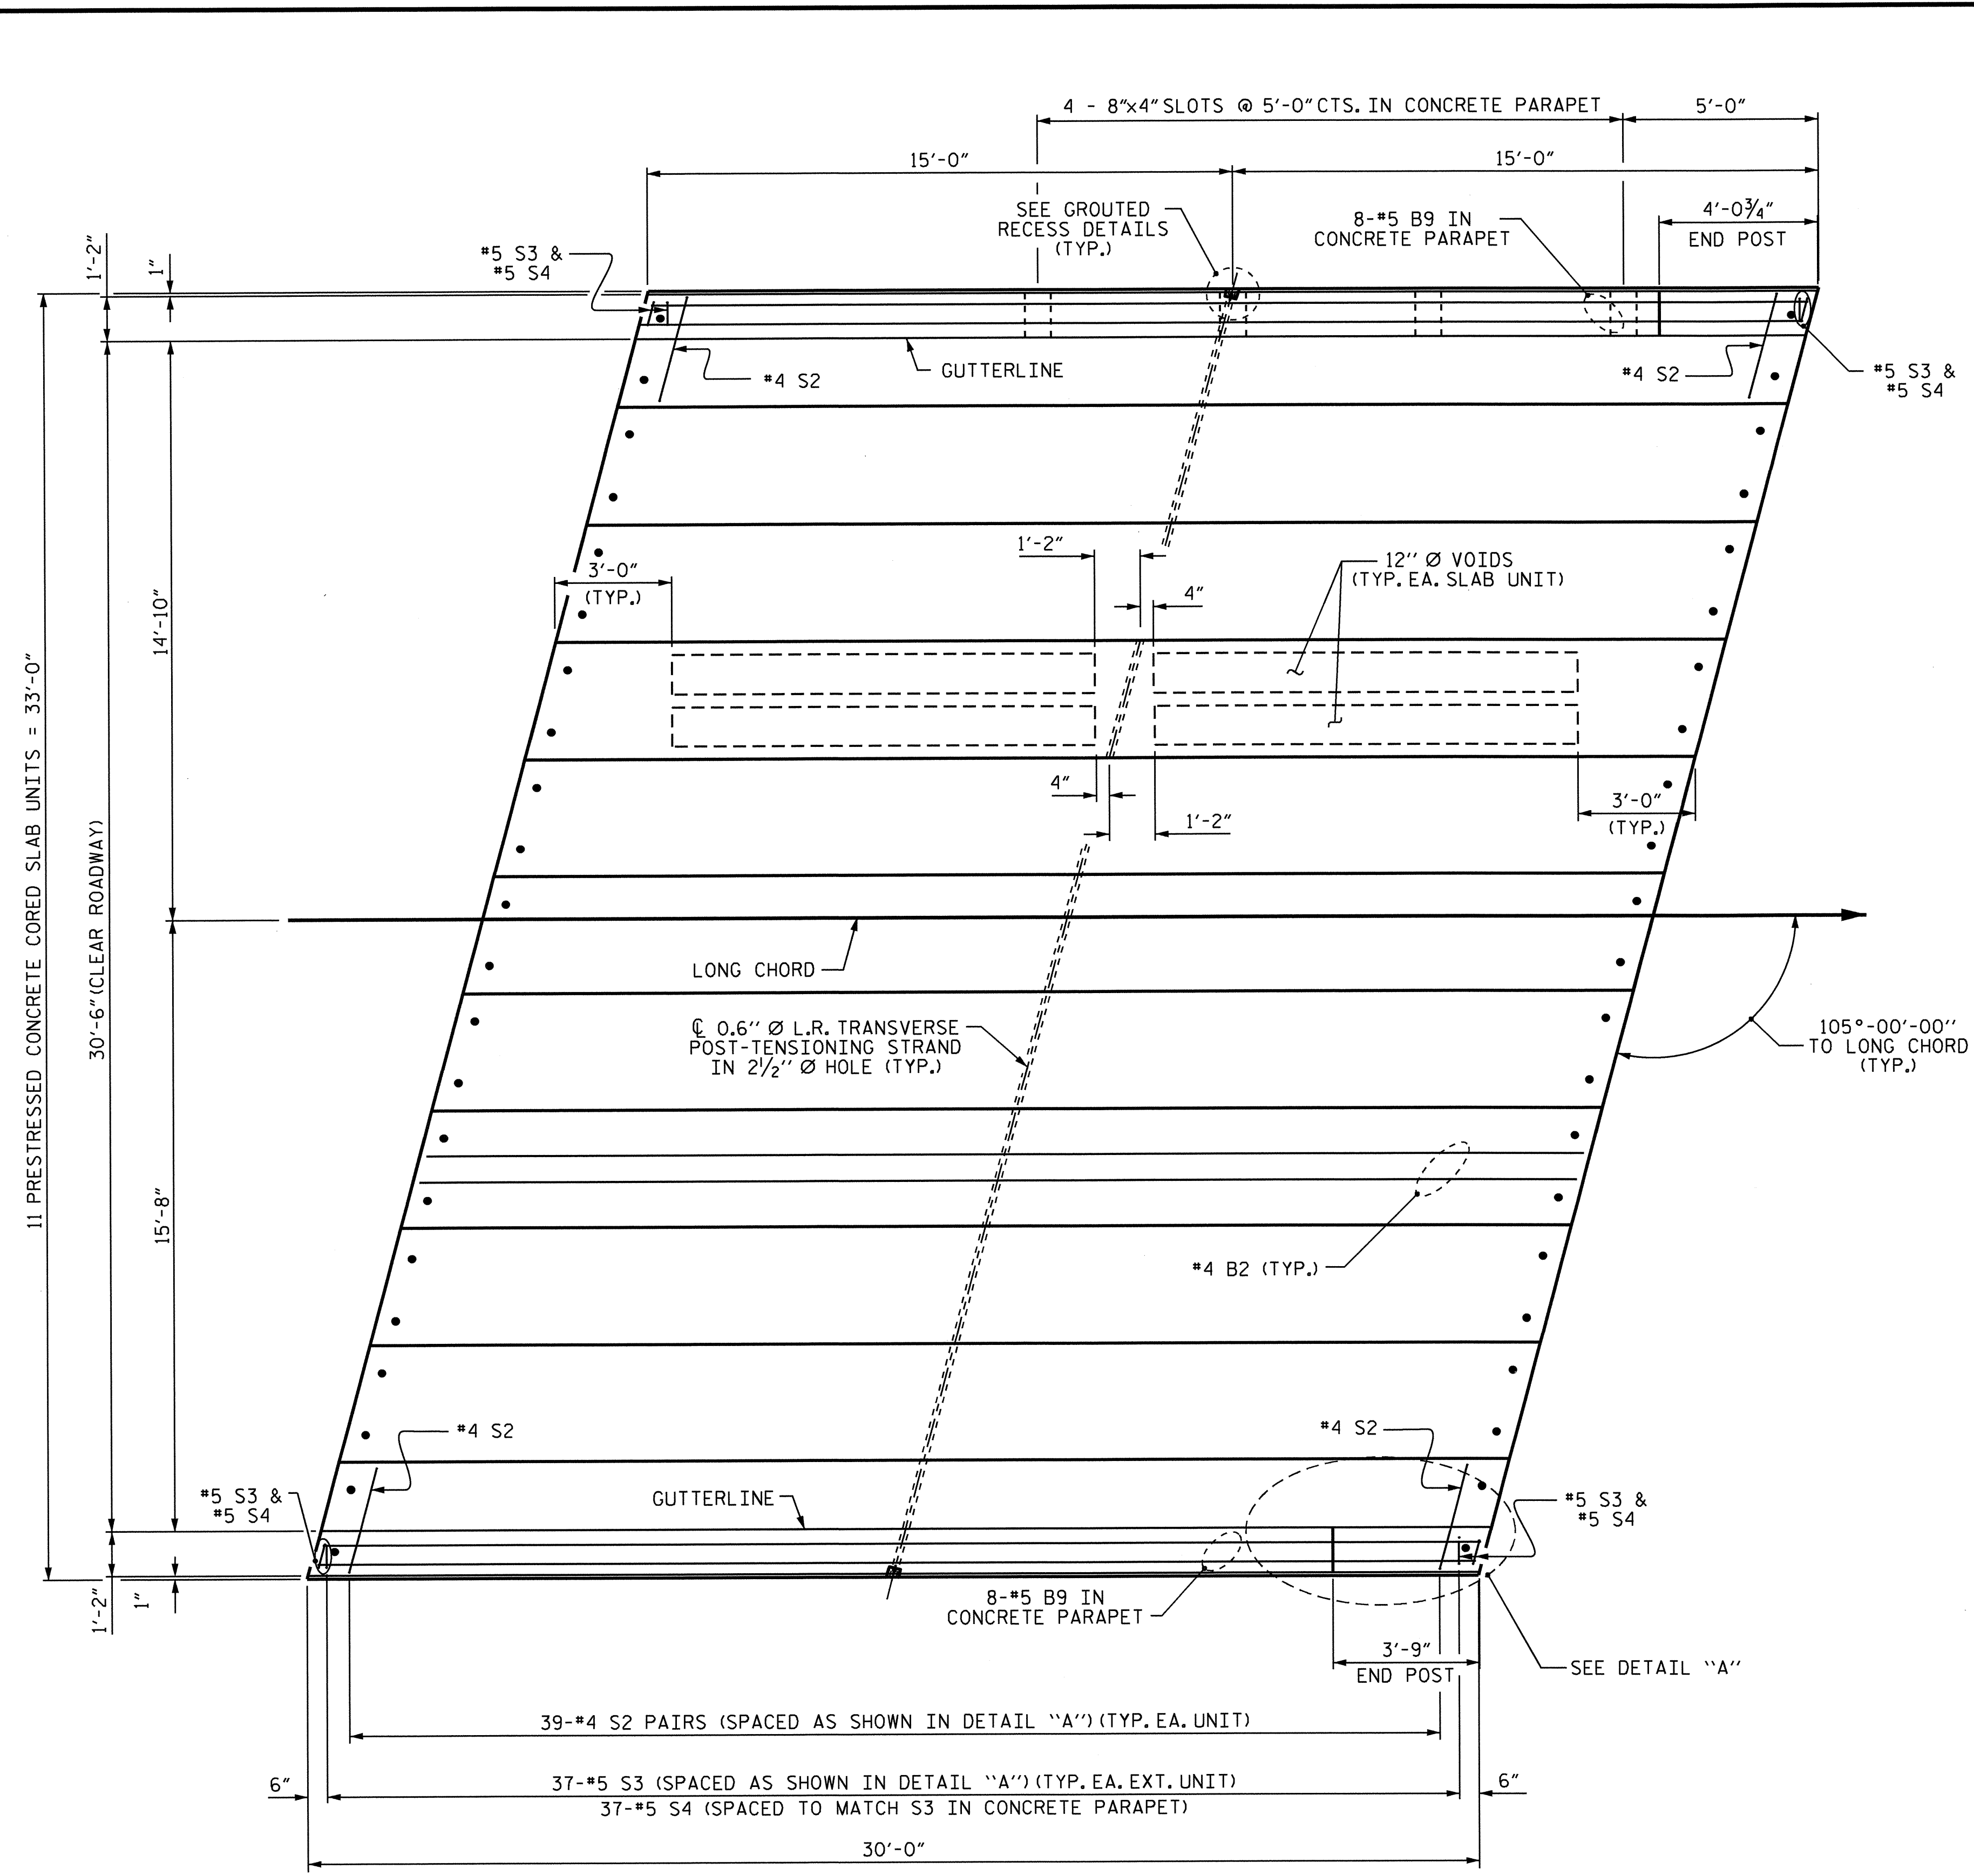

PLAN OF SPAN C

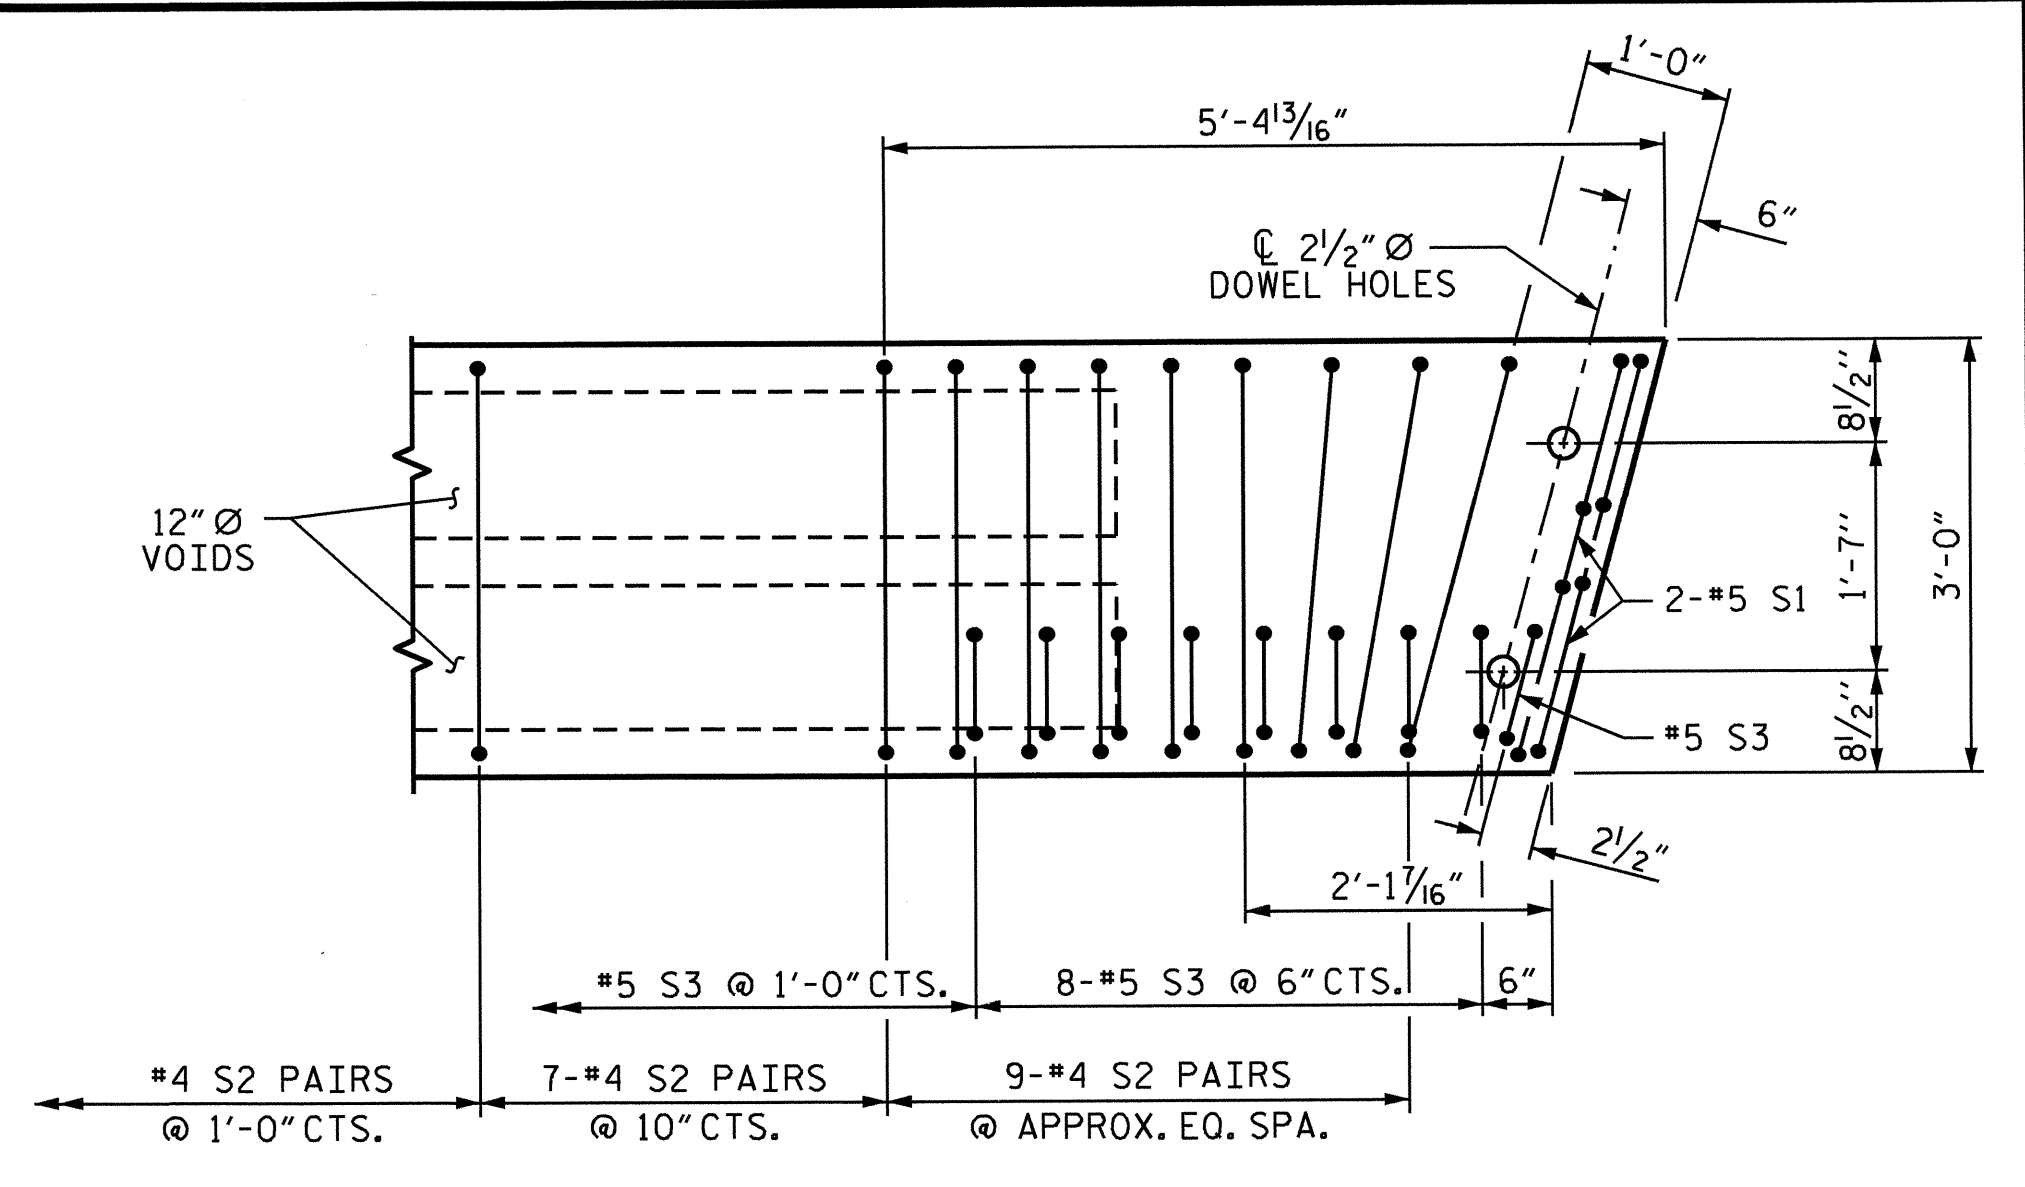

DETAIL "A"
 NOTE: EXTERIOR UNIT SHOWN - INTERIOR UNIT SIMILAR EXCEPT OMIT #5 S3 BARS.

PROJECT NO. B-4731
CHATHAM COUNTY
 STATION: 16+13.50 -L-
 SHEET 5 OF 7

STATE OF NORTH CAROLINA
 DEPARTMENT OF TRANSPORTATION
 RALEIGH
 PLAN OF 30' UNIT
 30'-6" CLEAR ROADWAY
 105° SKEW



ASSEMBLED BY : A.C. OUTLAW DATE : 5/21/12
 CHECKED BY : A. SORSENGINH DATE : 9/13
 DRAWN BY : DGE 3/09 REV. 12/5/11 MAA/AAC
 CHECKED BY : BCH 3/09

REVISIONS						SHEET NO.	
NO.	BY:	DATE:	NO.	BY:	DATE:	S-11	
1			3			TOTAL SHEETS 28	
2			4				

GRADE 270 STRANDS	
AREA (SQUARE INCHES)	0.217
ULTIMATE STRENGTH (LBS. PER STRAND)	58,600
APPLIED PRESTRESS (LBS. PER STRAND)	43,950


CONCRETE RELEASE STRENGTH	
UNIT	PSI
30' & 35' UNITS	4000
60' UNITS	4800

DEAD LOAD DEFLECTION AND CAMBER	
30' & 35' CORED SLAB UNIT	3'-0" x 1'-9"
CAMBER (SLAB ALONE IN PLACE)	0.6" Ø L.R. STRAND
DEFLECTION DUE TO SUPERIMPOSED DEAD LOAD**	1/2" ↑
FINAL CAMBER	1/8" ↓

** INCLUDES FUTURE WEARING SURFACE

DEAD LOAD DEFLECTION AND CAMBER	
60' CORED SLAB UNIT	3'-0" x 2'-0"
CAMBER (SLAB ALONE IN PLACE)	0.6" Ø L.R. STRAND
DEFLECTION DUE TO SUPERIMPOSED DEAD LOAD**	3/8" ↑
FINAL CAMBER	1/2" ↓

** INCLUDES FUTURE WEARING SURFACE

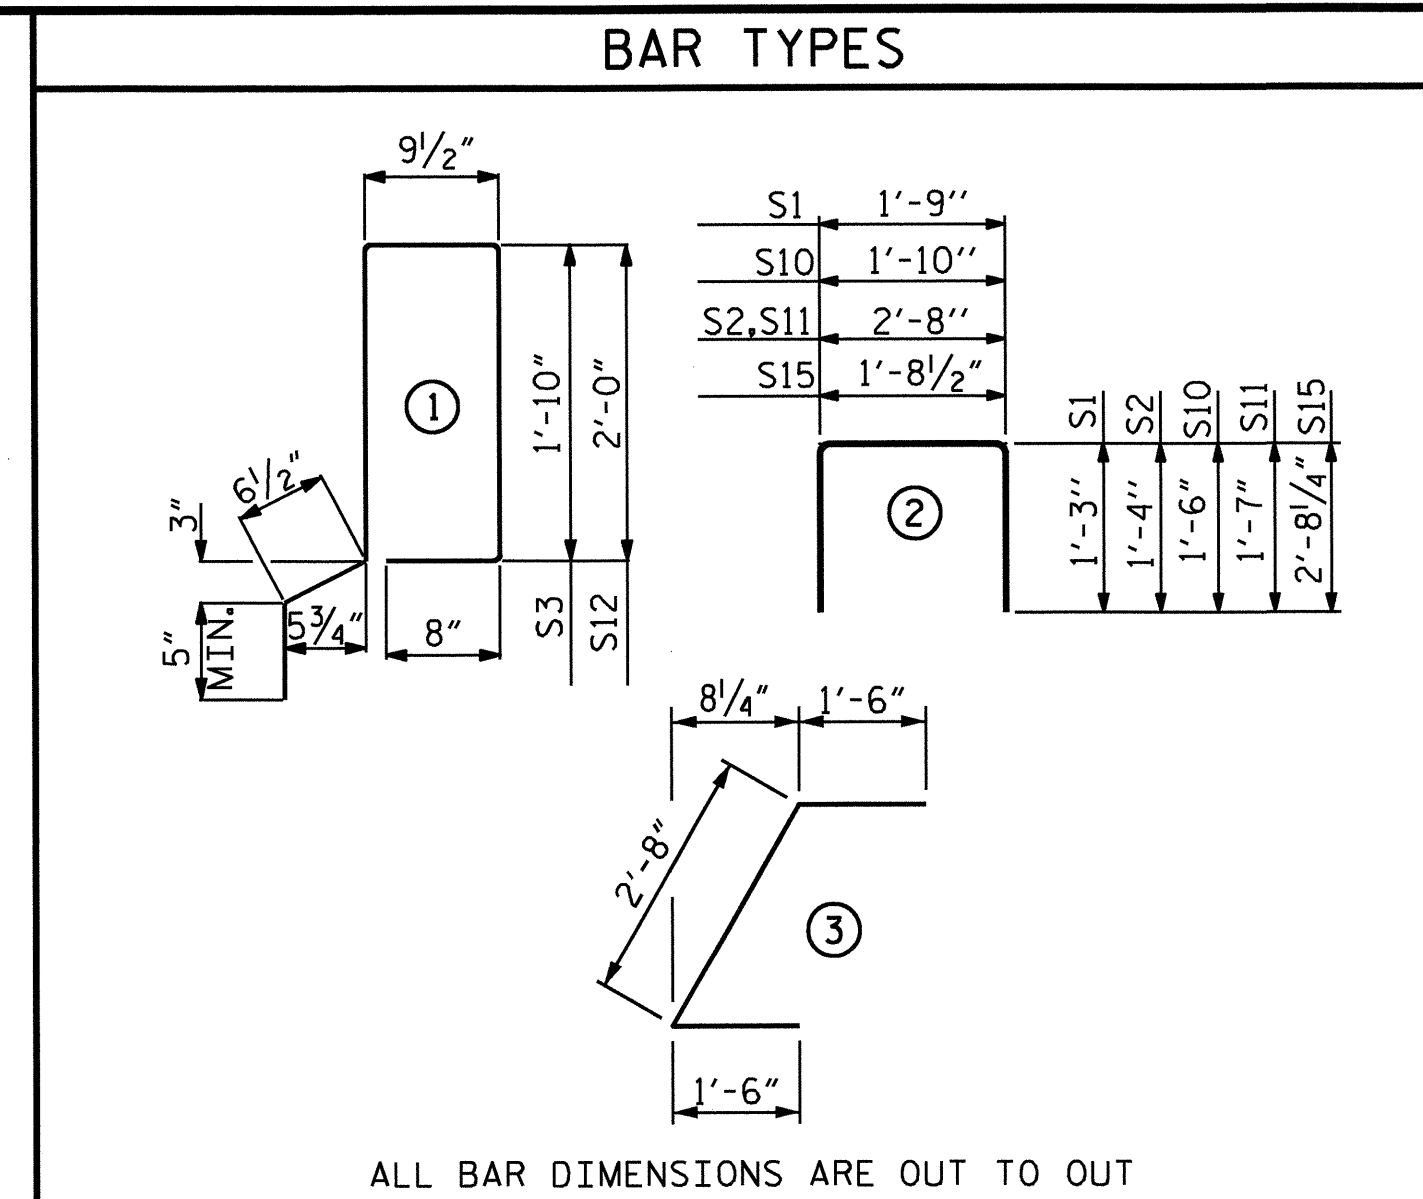

BILL OF MATERIAL FOR ONE 35' CORED SLAB UNIT							
BAR	NUMBER	SIZE	TYPE	EXTERIOR UNIT		INTERIOR UNIT	
				LENGTH	WEIGHT	LENGTH	WEIGHT
B3	4	#4	STR	18'-3"	49	18'-3"	49
S1	8	#5	2	4'-3"	35	4'-3"	35
S2	88	#4	2	5'-4"	314	5'-4"	314
* S3	44	#5	1	6'-1"	279		
REINFORCING STEEL				LBS.	398		398
* EPOXY COATED REINFORCING STEEL				LBS.	279		
5000 P.S.I. CONCRETE				CU. YDS.	5.2		5.2
0.6" Ø L.R. STRANDS				No.	9		9

BILL OF MATERIAL FOR ONE 60' CORED SLAB UNIT							
BAR	NUMBER	SIZE	TYPE	EXTERIOR UNIT		INTERIOR UNIT	
				LENGTH	WEIGHT	LENGTH	WEIGHT
B20	6	#4	STR	21'-2"	85	21'-2"	85
S10	8	#5	2	4'-10"	40	4'-10"	40
S11	128	#4	2	5'-10"	499	5'-10"	499
* S12	69	#5	1	6'-5"	462		
S14	4	#4	3	5'-8"	15	5'-8"	15
S15	4	#5	2	7'-1"	30	7'-1"	30
REINFORCING STEEL				LBS.	669		669
* EPOXY COATED REINFORCING STEEL				LBS.	462		
6000 P.S.I. CONCRETE				CU. YDS.	10.3		10.3
0.6" Ø L.R. STRANDS				No.	24		24

BILL OF MATERIAL FOR ONE 30' CORED SLAB UNIT							
BAR	NUMBER	SIZE	TYPE	EXTERIOR UNIT		INTERIOR UNIT	
				LENGTH	WEIGHT	LENGTH	WEIGHT
B2	2	#4	STR	29'-7"	40	29'-7"	40
S1	8	#5	2	4'-3"	35	4'-3"	35
S2	78	#4	2	5'-4"	278	5'-4"	278
* S3	39	#5	1	6'-1"	247		
REINFORCING STEEL				LBS.	353		353
* EPOXY COATED REINFORCING STEEL				LBS.	247		
5000 P.S.I. CONCRETE				CU. YDS.	4.5		4.5
0.6" Ø L.R. STRANDS				No.	9		9

NOTES

ALL PRESTRESSING STRANDS SHALL BE 7-WIRE LOW RELAXATION GRADE 270 STRANDS AND SHALL CONFORM TO AASHTO M203 EXCEPT FOR SAMPLING REQUIREMENTS WHICH SHALL BE IN ACCORDANCE WITH THE STANDARD SPECIFICATIONS.

ALL REINFORCING STEEL CAST WITH THE CORED SLAB SECTIONS SHALL BE GRADE 60 AND SHALL BE INCLUDED IN THE UNIT PRICE BID FOR PRESTRESSED CONCRETE CORED SLABS.

RECESSES FOR TRANSVERSE STRANDS SHALL BE GROUTED AFTER THE TENSIONING OF THE STRANDS.

THE 2 1/2" Ø DOWEL HOLES AT FIXED ENDS OF SLAB SECTIONS SHALL BE FILLED WITH NON-SHRINK GROUT.

THE BACKER RODS SHALL CONFORM TO THE REQUIREMENTS OF TYPE M BOND BREAKER. SEE SECTION 1028 OF THE STANDARD SPECIFICATIONS.

WHEN CORED SLABS ARE CAST, AN INTERNAL HOLD-DOWN SYSTEM SHALL BE EMPLOYED TO PREVENT VOIDS FROM RISING OR MOVING SIDEWAYS. AT LEAST SIX WEEKS PRIOR TO CASTING CORED SLABS, THE CONTRACTOR SHALL SUBMIT TO THE ENGINEER FOR REVIEW AND COMMENT, DETAILED DRAWINGS OF THE PROPOSED HOLD-DOWN SYSTEM. IN ADDITION TO STRUCTURAL DETAILS, LOCATION AND SPACING OF THE HOLD-DOWNS SHALL BE INDICATED.

THE TRANSFER OF LOAD FROM THE ANCHORAGES TO THE CORED SLAB UNIT SHALL BE DONE WHEN THE CONCRETE HAS REACHED A COMPRESSIVE STRENGTH OF NOT LESS THAN THE REQUIRED STRENGTH SHOWN IN THE "CONCRETE RELEASE STRENGTH" TABLE.

ALL REINFORCING STEEL IN CONCRETE PARAPET SHALL BE EPOXY COATED. PRESTRESSING STRANDS SHALL BE CUT FLUSH WITH THE CORED SLAB UNIT ENDS.

APPLY EPOXY PROTECTIVE COATING TO CORED SLAB UNIT ENDS.

GROOVED CONTRACTION JOINTS, 1/2" IN DEPTH, SHALL BE TOOLED IN ALL EXPOSED FACES OF THE BARRIER RAIL AND IN ACCORDANCE WITH ARTICLE 825-10(B) OF THE STANDARD SPECIFICATIONS. A CONTRACTION JOINT SHALL BE LOCATED AT EACH THIRD POINT BETWEEN BARRIER RAIL EXPANSION JOINTS. ONLY ONE CONTRACTION JOINT IS REQUIRED AT MIDPOINT OF BARRIER RAIL SEGMENTS LESS THAN 20 FEET IN LENGTH AND NO CONTRACTION JOINTS ARE REQUIRED FOR THOSE SEGMENTS LESS THAN 10 FEET IN LENGTH.

TRANSVERSE POST TENSIONING OF THE CORED SLAB UNITS SHALL BE DONE IN ACCORDANCE WITH THE STANDARD SPECIFICATIONS.

MAINTAIN A SYMMETRIC TENSION FORCE BETWEEN EACH PAIR OF TRANSVERSE POST TENSIONING STRANDS IN THE DIAPHRAGM.

THE #4 S11 STIRRUPS MAY BE SHIFTED AS NECESSARY TO MAINTAIN 1" CLEAR TO THE GROUTED RECESS.

FOR GROUT FOR STRUCTURES, SEE SPECIAL PROVISIONS.

THE DRAIN OPENING AT THE GUTTERLINE SHALL BE 4" X 8". THE HEIGHT OF THE BLOCKOUT IN THE CONCRETE PARAPET SHALL EXTEND FROM THE TOP OF THE CORED SLAB UNIT TO THE TOP OF THE DRAIN OPENING.

APPLY EPOXY PROTECTIVE COATING TO EXTERIOR FACE OF THE EXTERIOR CORED SLAB UNITS THAT REQUIRE DRAINS IN THE CONCRETE PARAPET.

GUTTERLINE ASPHALT THICKNESS & PARAPET HEIGHT		
30'-6" CLEAR ROADWAY	ASPHALT OVERLAY THICKNESS	PARAPET HEIGHT
	@ MID-SPAN	@ MID-SPAN
30' & 35' UNITS	3 3/8"	2'-9 5/8"
60' UNITS	2 3/8"	2'-8 5/8"

PROJECT NO. B-4731
CHATHAM COUNTY
 STATION: 16+13.50 -L-


SHEET 6 OF 7

STATE OF NORTH CAROLINA
 DEPARTMENT OF TRANSPORTATION
 RALEIGH




STANDARD
 3'-0" X 1'-9" &
 3'-0" X 2'-0"
 PRESTRESSED CONCRETE
 CORED SLAB UNIT
 105° SKEW

REVISIONS						SHEET NO.
NO.	BY:	DATE:	NO.	BY:	DATE:	S-12
1			3			TOTAL SHEETS 28
2			4			

10-28-13

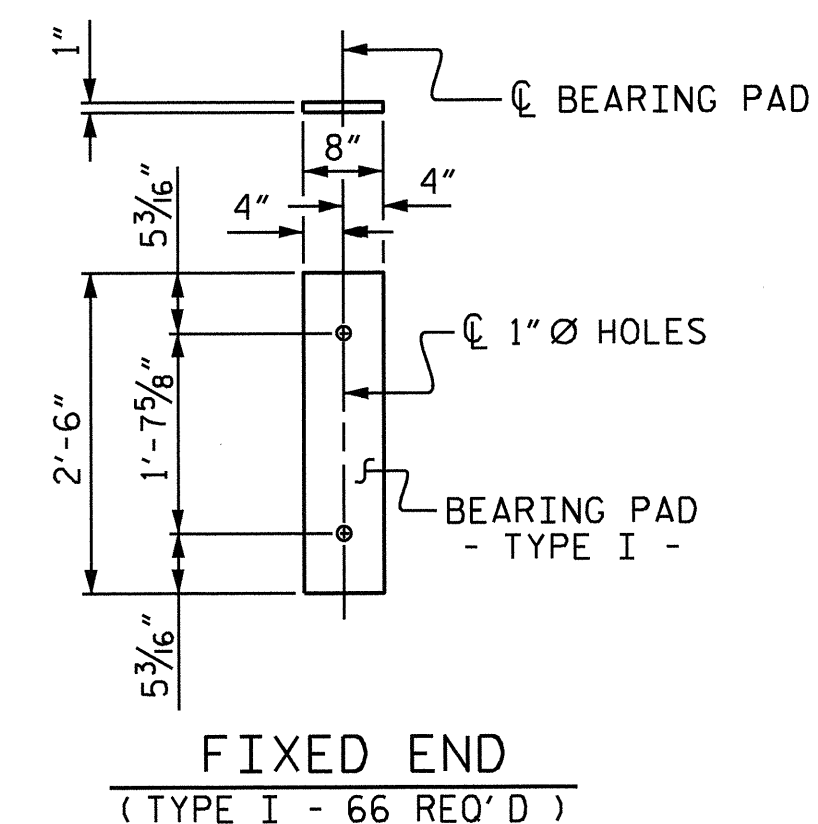

ELASTOMERIC BEARING DETAILS
 ELASTOMER IN ALL BEARINGS SHALL BE 60 DUROMETER HARDNESS.

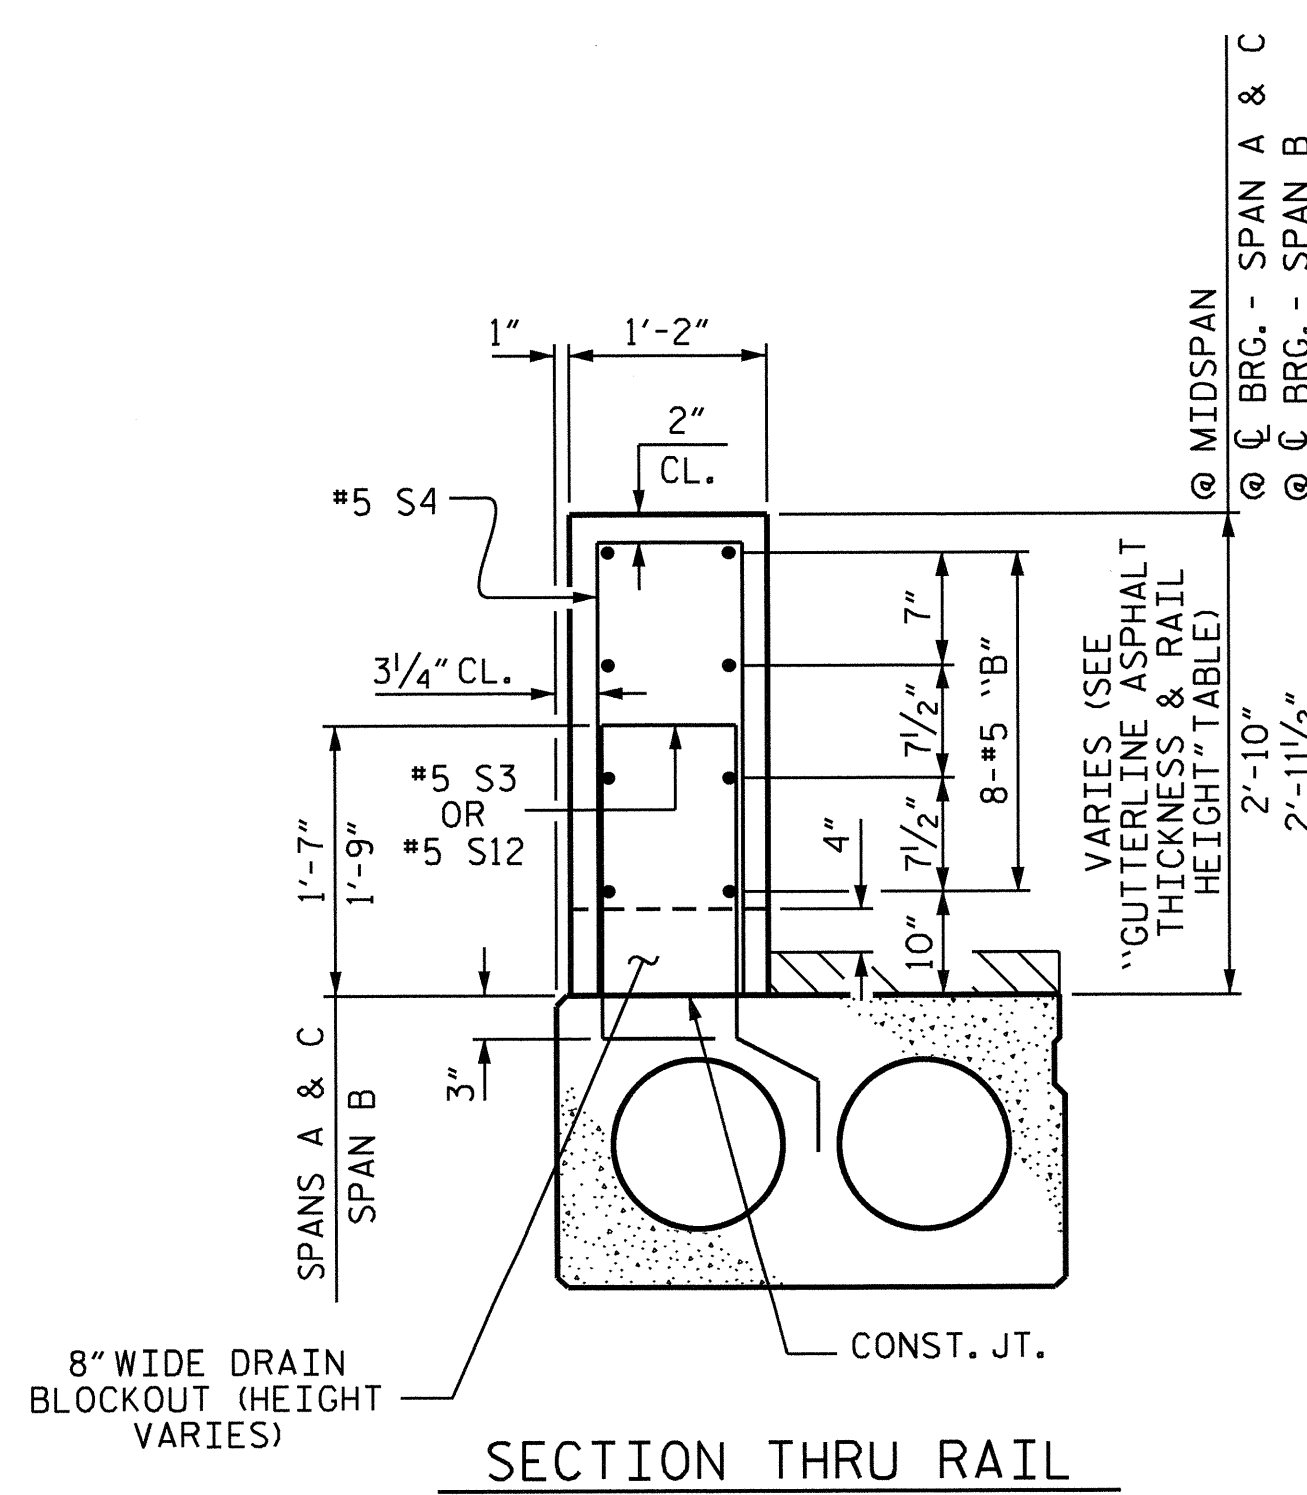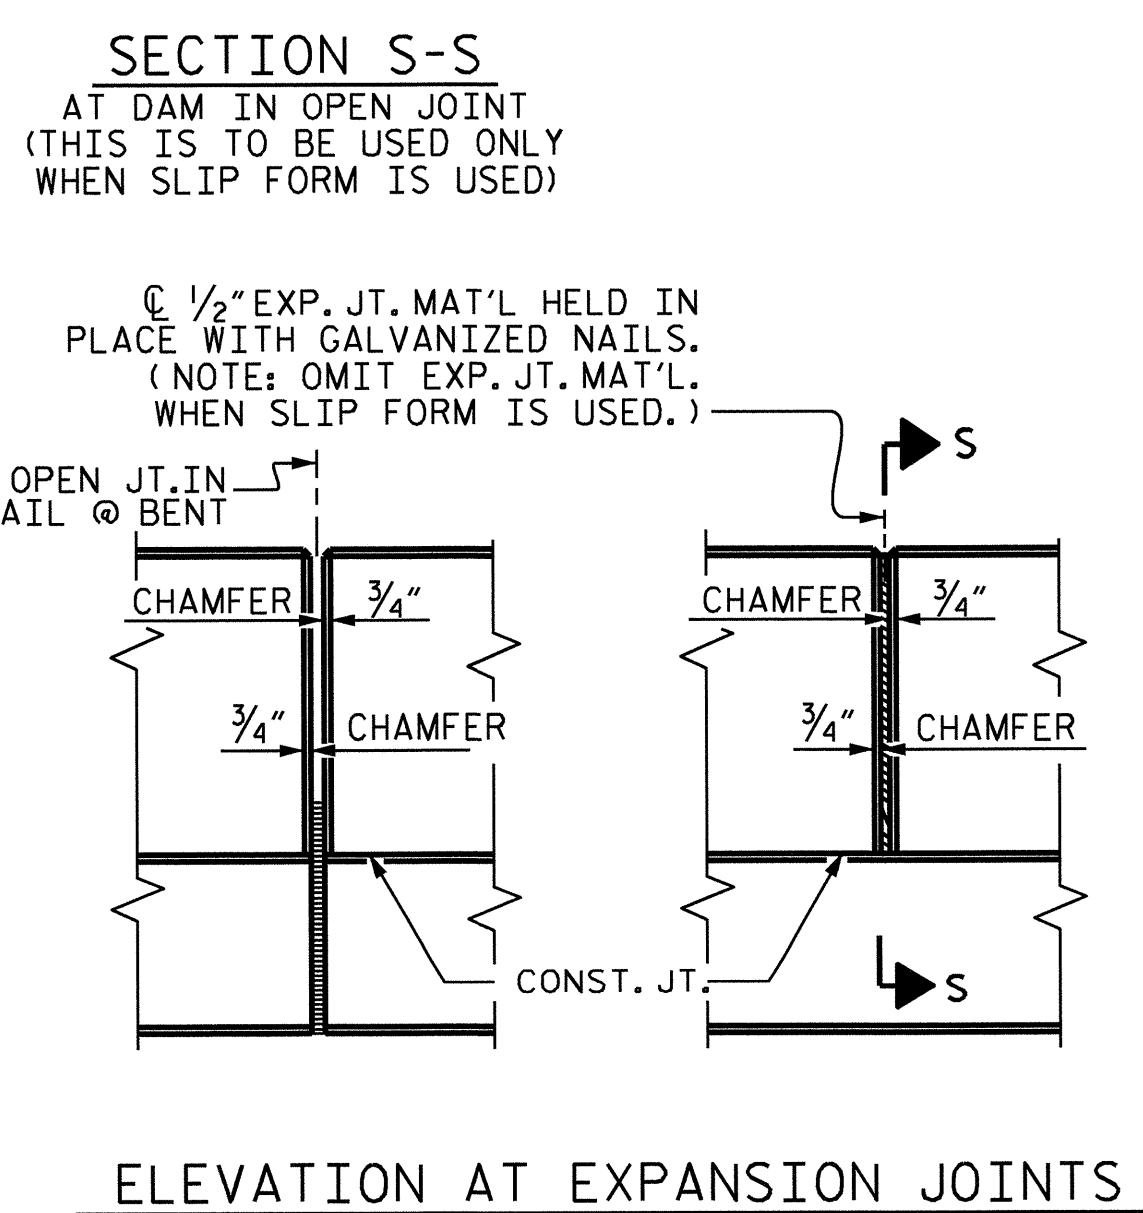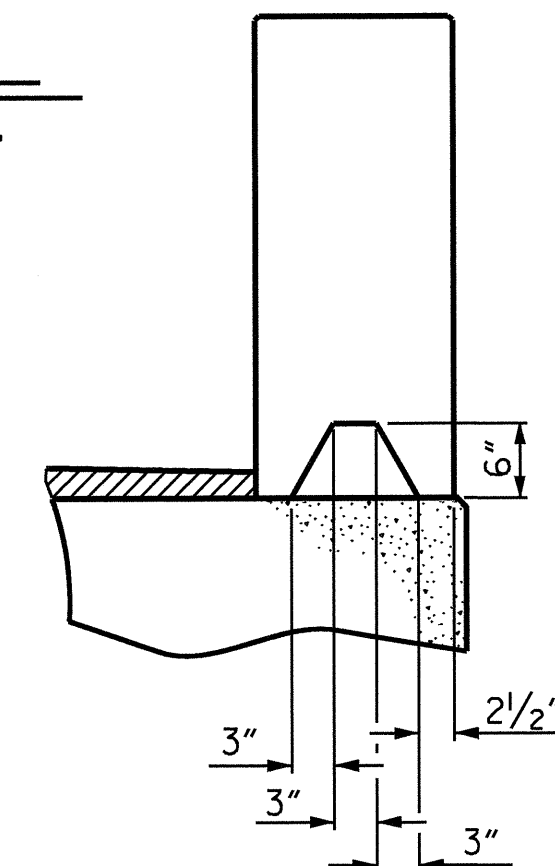

PARAPET FOR TWO BAR METAL RAIL ON CORED SLABS

ASSEMBLED BY: A.C. OUTLAW DATE: 5/21/12
 CHECKED BY: A. SORSENGINH DATE: 9/13
 DRAWN BY: MAA 6/10 REV. 12/11 MAA/AAC
 CHECKED BY: MKT 7/10

NOTES


FOR DETAILS FOR CONCRETE INSERTS IN END POSTS, SEE "RAIL POST SPACINGS AND END OF RAIL DETAILS" SHEETS.

FOR DETAILS OF GUARDRAIL ANCHOR ASSEMBLIES, SEE "GUARDRAIL ANCHORAGE DETAILS FOR METAL RAIL" SHEET.

GROOVED CONTRACTION JOINTS, 1/2" IN DEPTH, SHALL BE TOOLED IN ALL EXPOSED FACES OF THE PARAPET AND IN ACCORDANCE WITH ARTICLE 825-10(B) OF THE STANDARD SPECIFICATIONS. A CONTRACTION JOINT SHALL BE LOCATED AT EACH THIRD POINT BETWEEN PARAPET EXPANSION JOINTS. ONLY ONE CONTRACTION JOINT IS REQUIRED AT MIDPOINT OF PARAPET SEGMENTS LESS THAN 20 FEET IN LENGTH AND NO CONTRACTION JOINTS ARE REQUIRED FOR THOSE SEGMENTS LESS THAN 10 FEET IN LENGTH.

** #5 S3 BARS INCLUDED IN BILL OF MATERIAL FOR CORED SLAB UNIT.

ALL REINFORCING STEEL IN CONCRETE PARAPET SHALL BE EPOXY COATED.

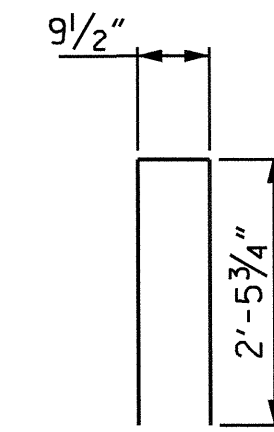


①

BAR TYPE


BAR DIMENSIONS ARE OUT TO OUT

BILL OF MATERIAL FOR PARAPETS AND END POSTS


BAR	NO.	SIZE	TYPE	LENGTH	WEIGHT
* B9	16	#5	STR	29'-8"	495
* B10	64	#5	STR	10'-4"	690
* B23	64	#5	STR	16'-7"	1040
* E1	8	#7	STR	3'-0"	49
* E2	8	#7	STR	3'-5"	56
* E3	8	#7	STR	3'-11"	64
* E4	8	#7	STR	4'-4"	71
* E5	8	#7	STR	4'-8"	76
* F1	8	#6	STR	2'-0"	24
* F2	4	#6	STR	3'-0"	18
* F3	4	#6	STR	3'-4"	20
* F4	4	#6	STR	3'-3"	20
* F5	4	#6	STR	4'-1"	25
* S4	304	#5	1	5'-9"	1823
* EPOXY COATED REINF. STEEL				LBS.	4471
CLASS AA CONCRETE				CU. YDS.	31.6
TOTAL LIN. FT. OF CONC. PARAPET					250.52

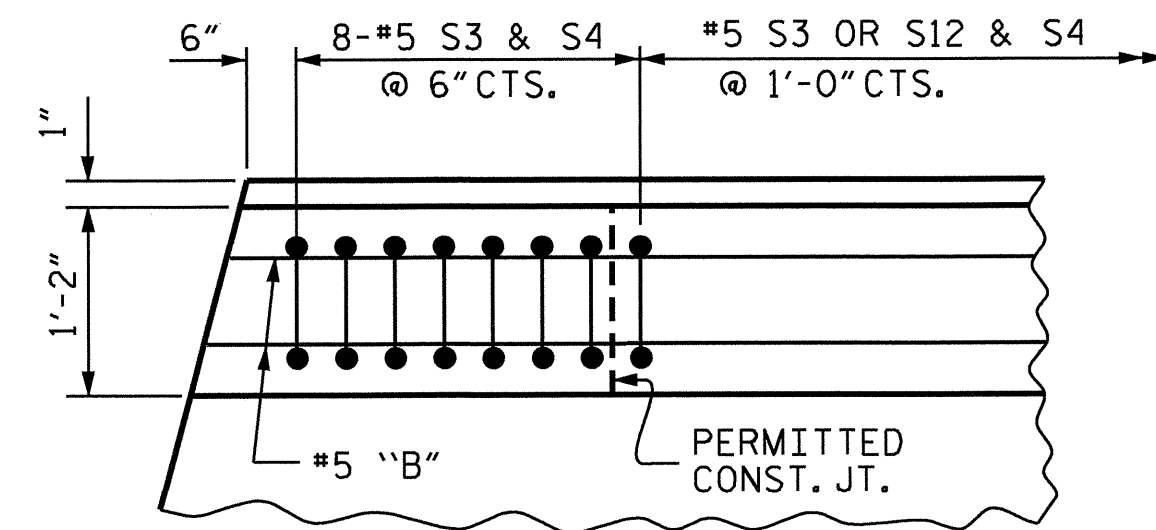


PLAN OF PARAPET

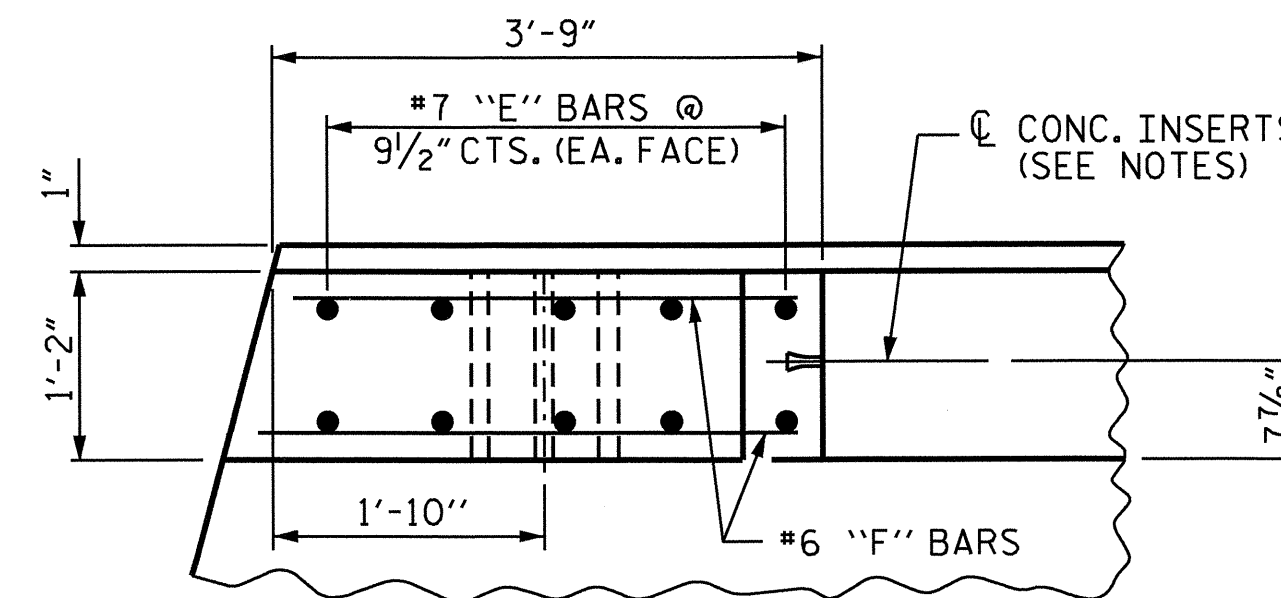

PLAN OF END POST

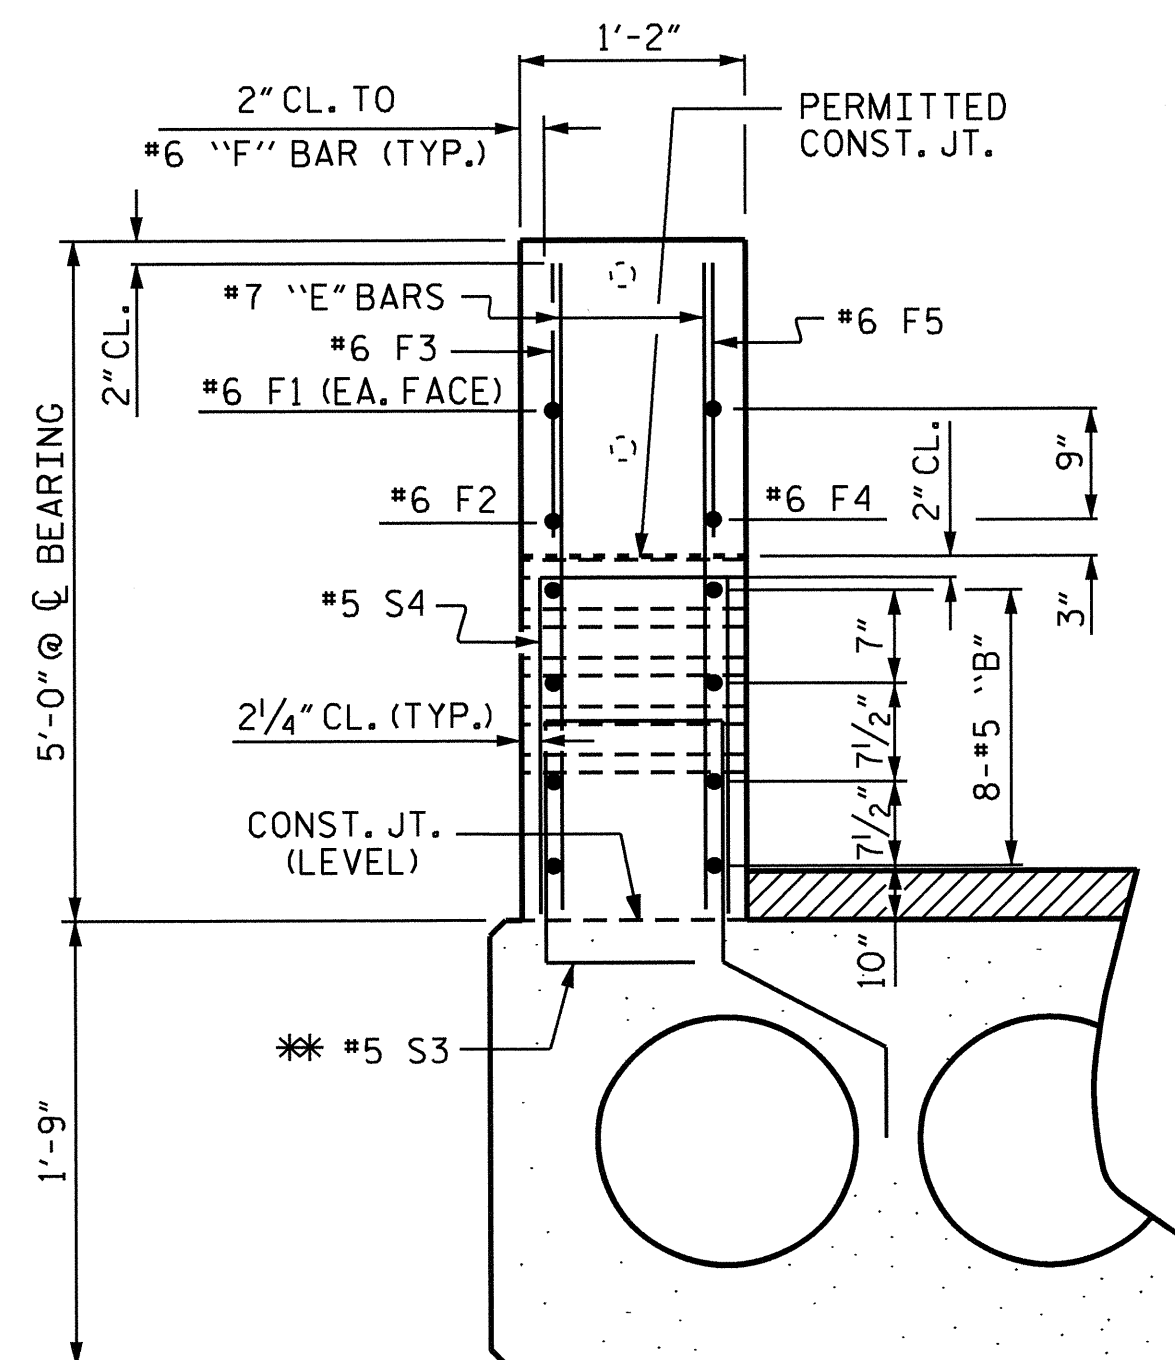

END VIEW

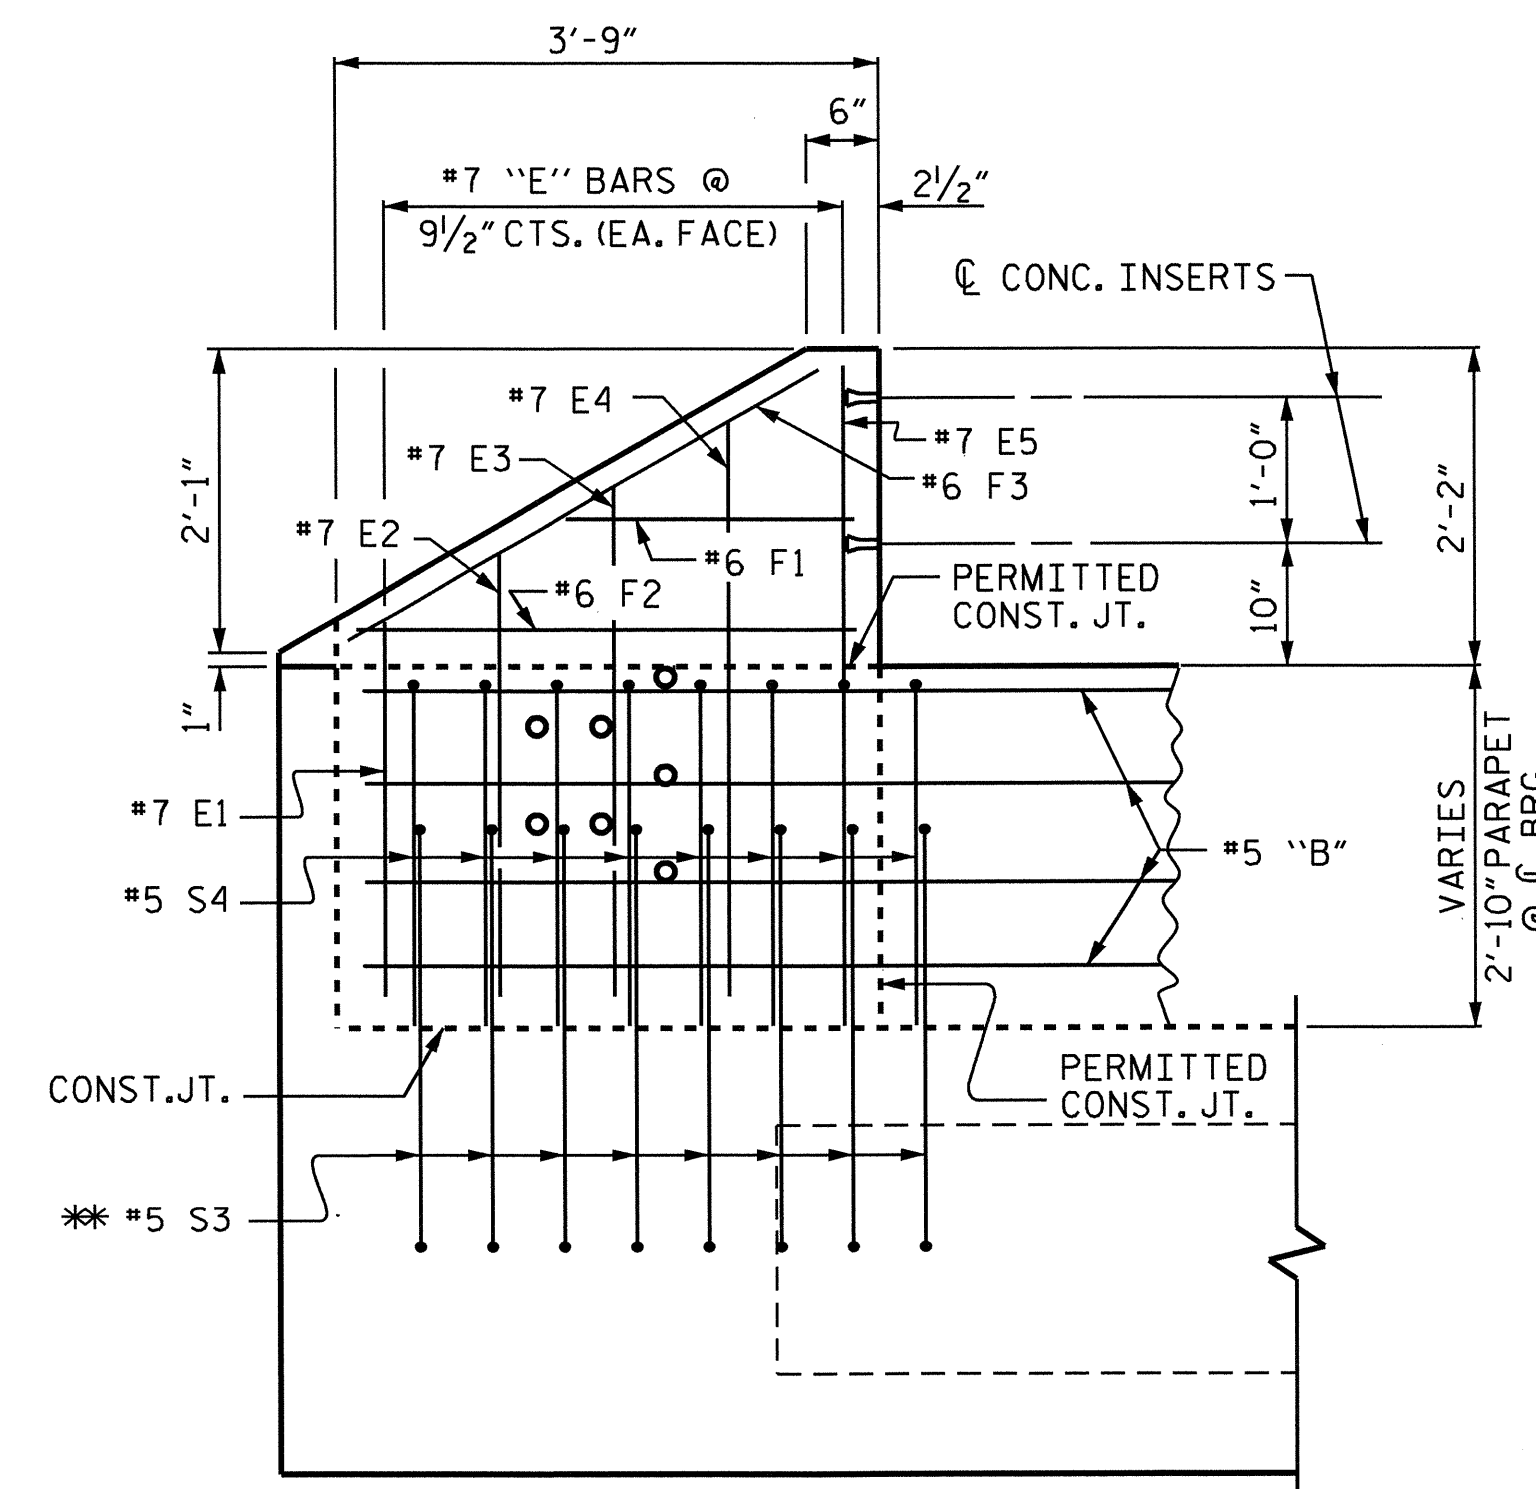

ELEVATION

PARAPET AND END POST FOR TWO BAR RAIL

PROJECT NO. B-4731
CHATHAM COUNTY
 STATION: 16+13.50 -L-

SHEET 7 OF 7

STATE OF NORTH CAROLINA
 DEPARTMENT OF TRANSPORTATION
 RALEIGH
 SUPERSTRUCTURE
 CONCRETE PARAPET
 DETAILS



REVISIONS				SHEET NO.
NO.	BY:	DATE:	NO.	DATE:
1			3	
2			4	

TOTAL SHEETS: 28

DRAWN BY: A.C. OUTLAW DATE: 5/21/12
 CHECKED BY: A. SORSENGINH DATE: 9/13

NOTES

AT THE CONTRACTOR'S OPTION, METAL RAIL MAY BE EITHER ALUMINUM OR GALVANIZED STEEL IN ACCORDANCE WITH THE REQUIREMENTS OF THE GENERAL NOTES AND THE FOLLOWING SPECIFICATIONS FOR THE ALTERNATE MATERIALS; HOWEVER, THE CONTRACTOR WILL BE REQUIRED TO USE THE SAME RAIL MATERIAL ON ALL STRUCTURES ON THE PROJECT FOR WHICH METAL RAIL IS DESIGNATED.

UNLESS OTHERWISE REQUIRED IN THE CONTRACT DOCUMENTS, THE CONTRACTOR HAS THE OPTION TO USE AN ALTERNATE TO THE 2 BAR METAL RAIL. THE ALTERNATE RAIL SHALL MEET THE REQUIREMENTS OF THE AASHTO LRFD BRIDGE DESIGN SPECIFICATIONS AND MUST BE LISTED ON THE DEPARTMENT'S APPROVED PRODUCTS LIST (APL) UNDER "2 BAR METAL RAIL ALTERNATE". ADJUSTMENTS TO THE CONCRETE PARAPET WILL NOT BE ALLOWED.

ALUMINUM RAILS

MATERIAL FOR POSTS, BASES AND RAILS, EXPANSION BARS AND CLAMP BARS SHALL BE ASTM B-221 ALLOY 6061-T6. MATERIAL FOR RIVETS SHALL BE ASTM B316 ALLOY 6061-T6. RIVETS SHALL BE STANDARD BUTTON HEAD AND CONE POINT COLD DRIVEN AS PER DRAWING.

THE BASE OF RAIL POSTS, OR ANY OTHER ALUMINUM SURFACE IN CONTACT WITH CONCRETE SHALL BE THOROUGHLY COATED WITH AN ALUMINUM IMPREGNATED CAULKING COMPOUND OF APPROVED QUALITY.

MATERIAL FOR SHIMS TO BE ASTM B209 ALLOY 6061-T6.

GALVANIZED STEEL RAILS

MATERIAL AND GALVANIZING ARE TO CONFORM TO THE FOLLOWING SPECIFICATIONS:

POST, POST BASES, RAILS, EXPANSION BARS AND CLAMP BARS: AASHTO M270 GRADE 36 STRUCTURAL STEEL - GALVANIZED TO AASHTO M111.

RIVETS: RIVETS SHALL MEET THE REQUIREMENTS OF ASTM A502 FOR GRADE 1 RIVETS.

THE CUT ENDS OF GALVANIZED STEEL RAILING, AFTER GRINDING SMOOTH SHALL BE GIVEN TWO COATS OF ZINC RICH PAINT MEETING THE REQUIREMENTS OF FEDERAL SPECIFICATION MIL-P-26915 USAF TYPE 1, OR OF FEDERAL SPECIFICATIONS TT-P-641.

SHIMS: SHIMS SHALL MEET THE REQUIREMENTS OF ASTM A570 FOR GRADE 33 OR A611 FOR GRADE C AND SHALL BE GALVANIZED IN ACCORDANCE WITH AASHTO M111.

RAIL CAPS: RAIL CAPS SHALL MEET THE REQUIREMENTS OF ASTM A570 FOR GRADE 33 OR A611 FOR GRADE C AND SHALL BE GALVANIZED IN ACCORDANCE WITH AASHTO M111.

GENERAL NOTES

RAILING SHALL BE CONTINUOUS FROM END POST TO END POST OF BRIDGE. EACH JOINT IN RAIL LENGTH SHALL BE SPLICED AS DETAILED. PANEL LENGTHS OF RAIL SHALL BE ATTACHED TO A MINIMUM OF THREE POSTS.

FOR END OF RAIL TO CLEAR FACE OF CONCRETE END POST DIMENSION, SEE STANDARD NO. BMR2.

CAP SCREWS SHALL BE ASTM F593 ALLOY 305 STAINLESS STEEL. WASHERS SHALL MEET THE REQUIREMENTS OF ASTM F844 EXCEPT THEY SHALL BE MADE FROM ALLOY 304 STAINLESS STEEL.

CERTIFIED MILL REPORTS ARE REQUIRED FOR RAILS AND POSTS. SHOP INSPECTION IS NOT REQUIRED.

METAL RAIL POSTS SHALL BE SET NORMAL TO CURB GRADE.

METHOD OF MEASUREMENT FOR METAL RAILS: FOR LENGTH OF METAL RAILS TO BE PAID FOR, SEE THE STANDARD SPECIFICATIONS.

CURVED RAIL USAGE: WHERE RAILS ARE TO BE USED ON BRIDGES ON HORIZONTAL AND/OR VERTICAL CURVATURE THE CONTRACTOR MAY, AT HIS OPTION, HAVE THE REQUIRED CURVATURE IN THE RAIL FORMED IN THE SHOP OR IN THE FIELD. IN EITHER EVENT, THE RAIL SHALL CONFORM WITHOUT BUCKLING OR KINKING TO THE REQUIRED CURVATURE IN A UNIFORM MANNER ACCEPTABLE TO THE ENGINEER.

TO INSURE FUTURE IDENTIFICATION OF THE FABRICATOR, A PERMANENT IDENTIFYING MARK SHALL BE PLACED ON EACH POST. THE METHOD OF MARKING AND LOCATION SHALL BE SUCH THAT IT DOES NOT DETRACT FROM THE APPEARANCE OF THE POST, BUT REMAINS VISIBLE AFTER RAIL PLACEMENT.

SHIMS SHALL BE USED AS NECESSARY FOR POST ALIGNMENT.

ALLOY 6351-T5 MAY BE SUBSTITUTED FOR ALLOY 6061-T6 WHERE APPLICABLE.

MINOR VARIATIONS IN DETAILS OF METAL RAIL WILL BE CONSIDERED. DETAILS OF SUCH VARIATIONS, IF DESIRED, SHALL BE SUBMITTED FOR APPROVAL.






GROOVED CONTRACTION JOINTS, 1/2" IN DEPTH, SHALL BE TOOLED IN ALL EXPOSED FACES OF THE PARAPET AND IN ACCORDANCE WITH ARTICLE 825-10(B) OF THE STANDARD SPECIFICATIONS. A CONTRACTION JOINT SHALL BE LOCATED AT EACH THIRD POINT BETWEEN PARAPET EXPANSION JOINTS. ONLY ONE CONTRACTION JOINT IS REQUIRED AT MIDPOINT OF PARAPET SEGMENTS LESS THAN 20 FEET IN LENGTH AND NO CONTRACTION JOINTS ARE REQUIRED FOR THOSE SEGMENTS LESS THAN 10 FEET IN LENGTH.

PAY LENGTH = 234.90 LIN. FT.



PROJECT NO. B-4731
CHATHAM COUNTY
 STATION: 16+13.50 -L-

SHEET 1 OF 2

STATE OF NORTH CAROLINA
 DEPARTMENT OF TRANSPORTATION
 RALEIGH
 STANDARD
2 BAR METAL RAIL

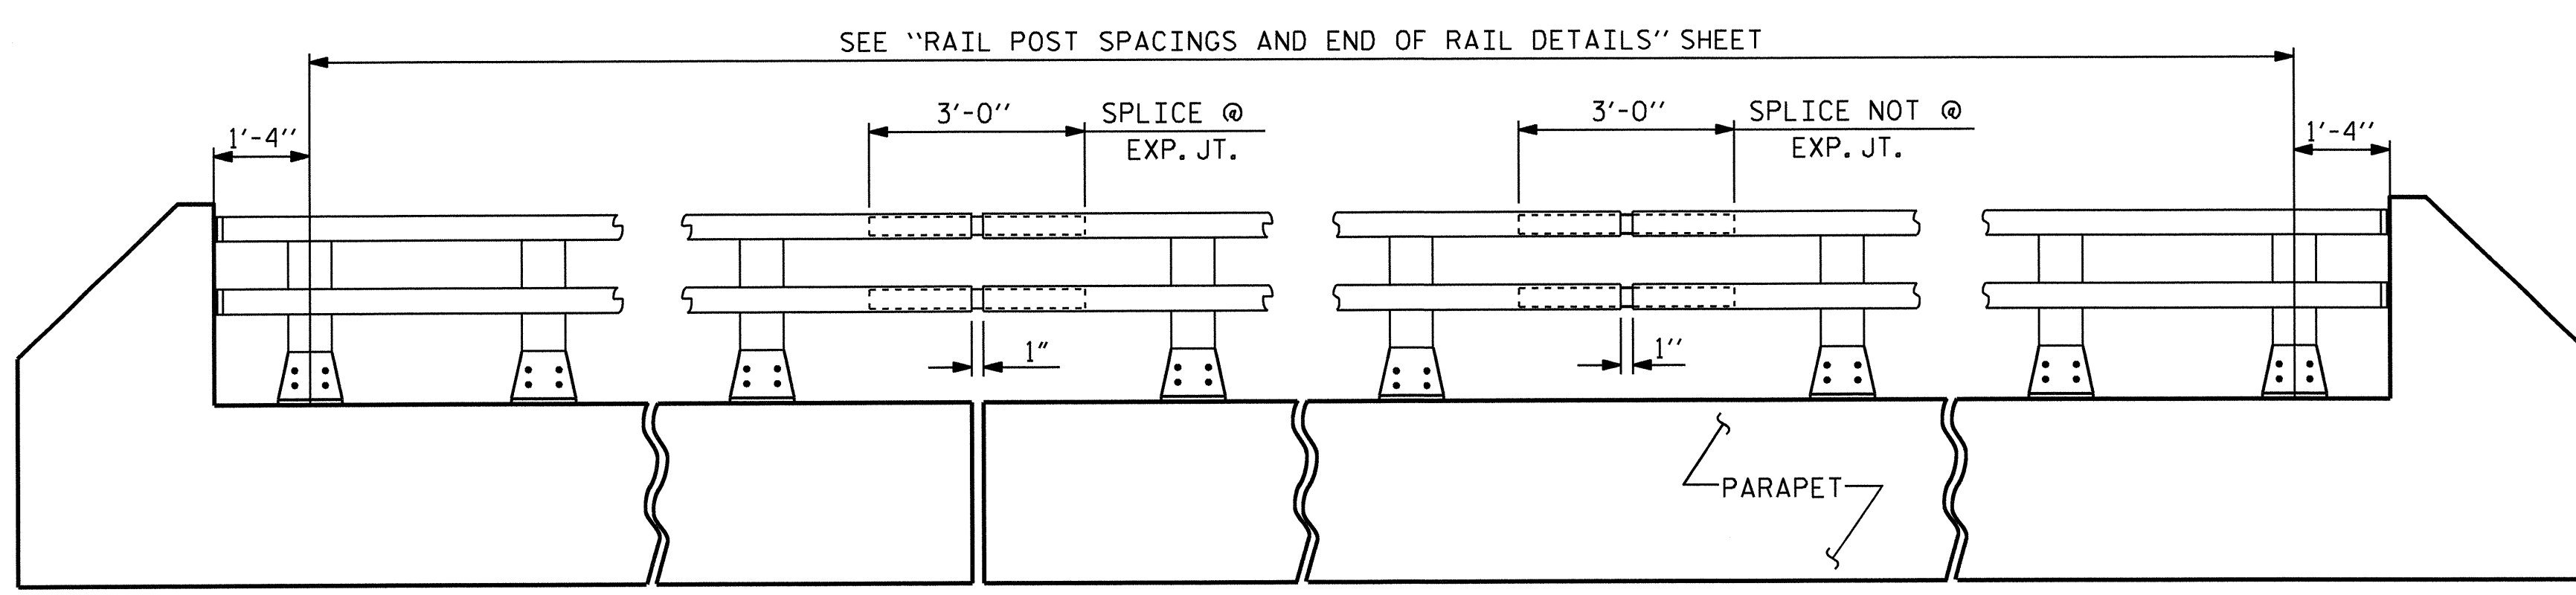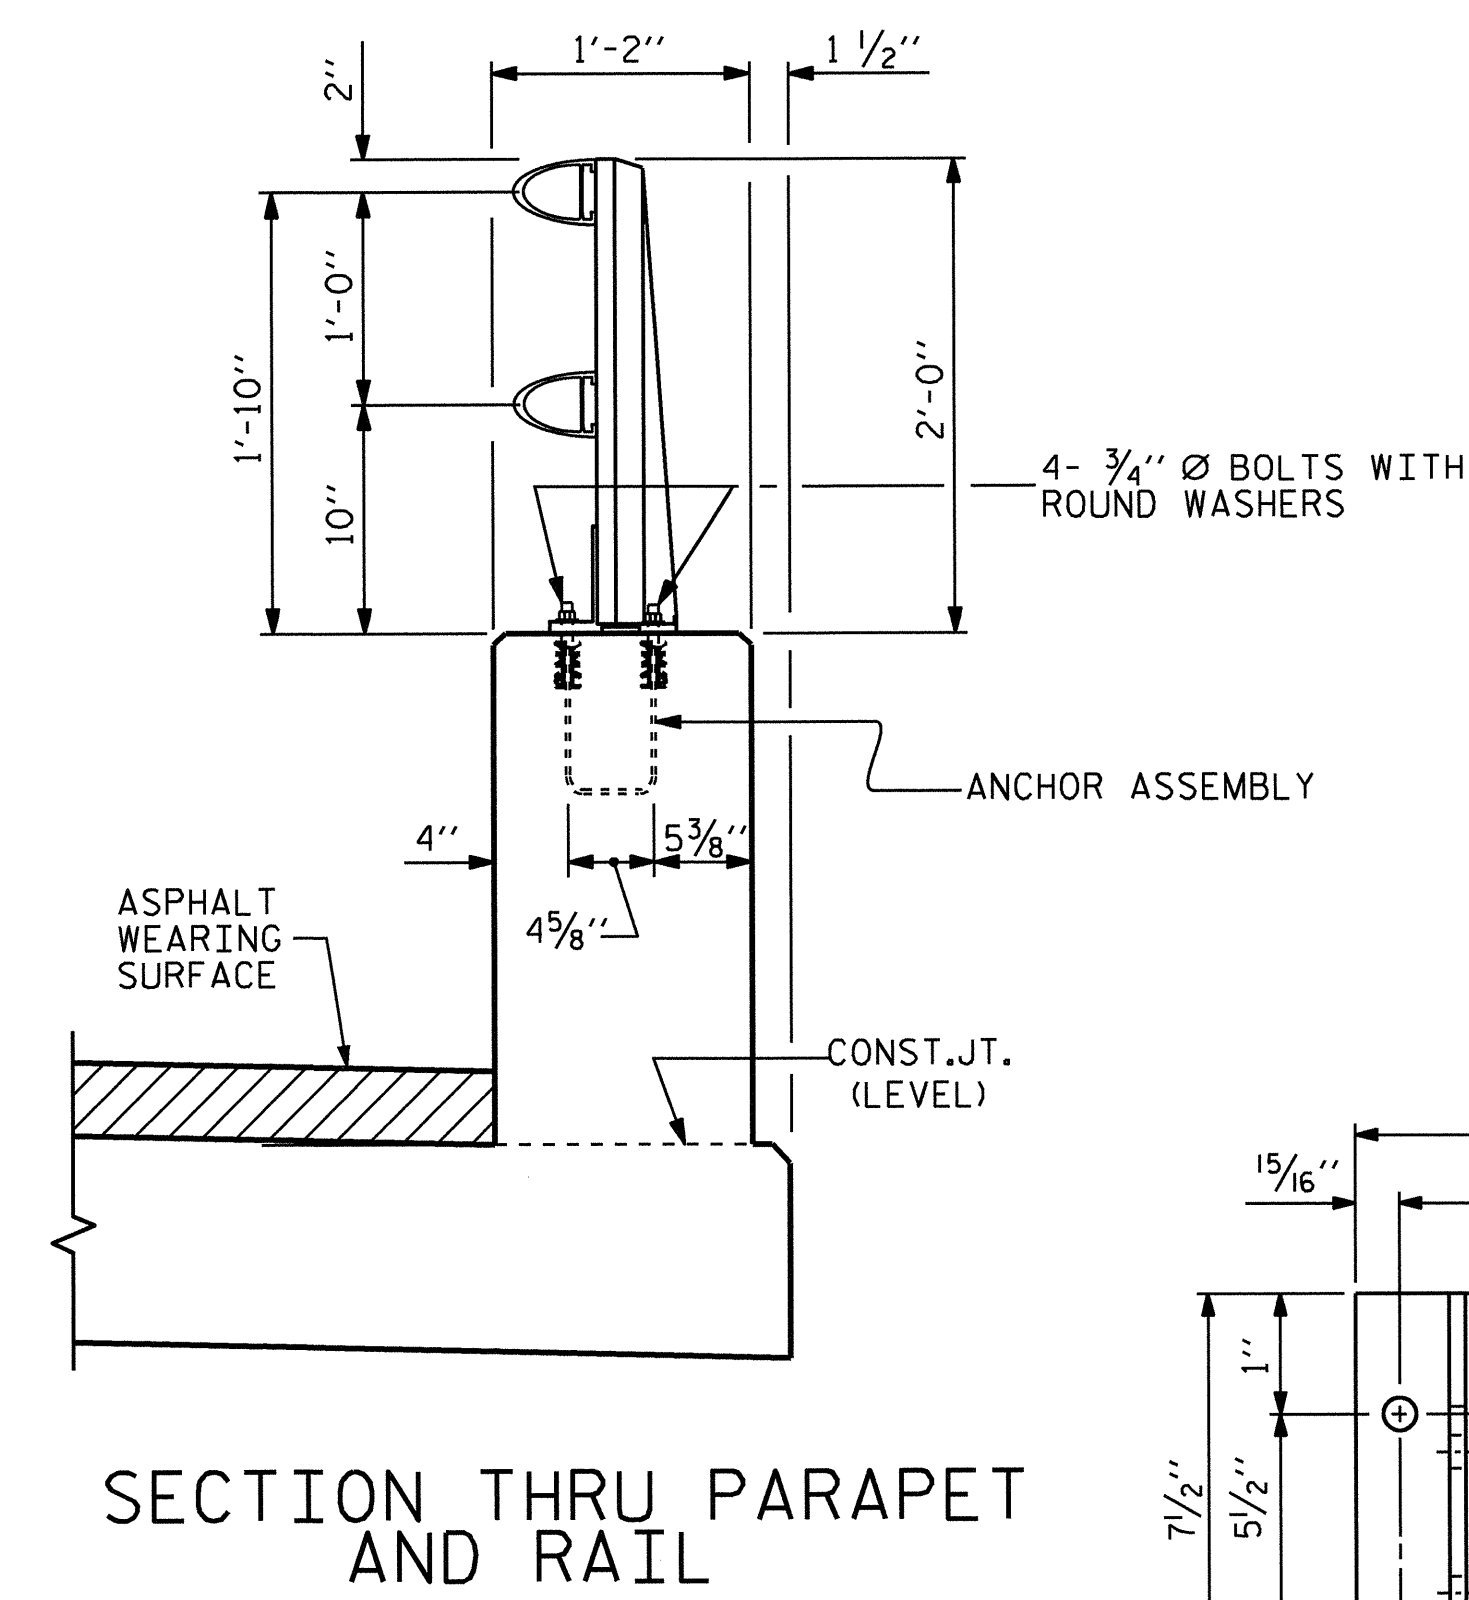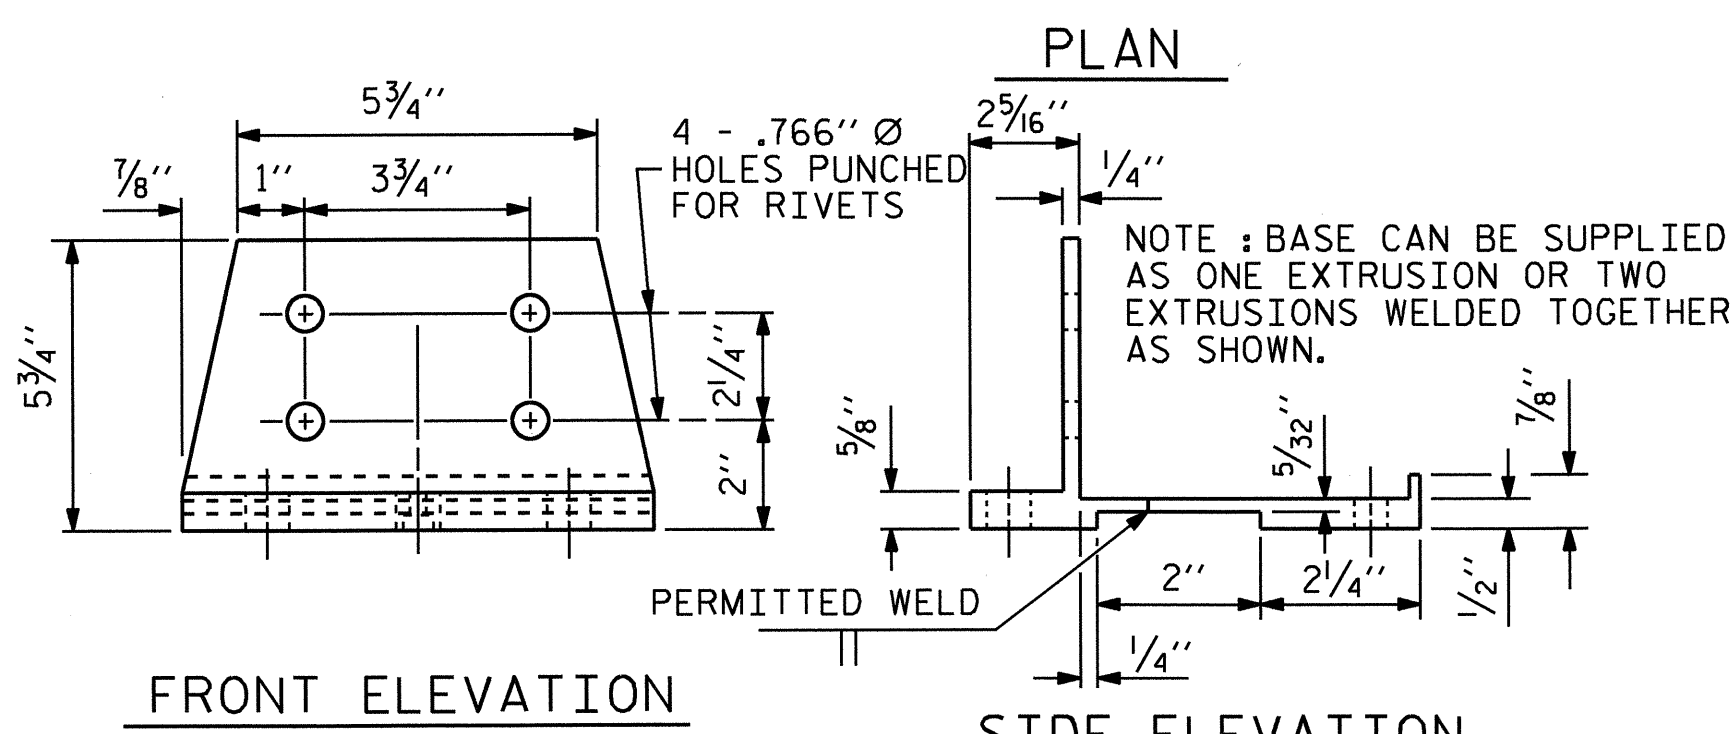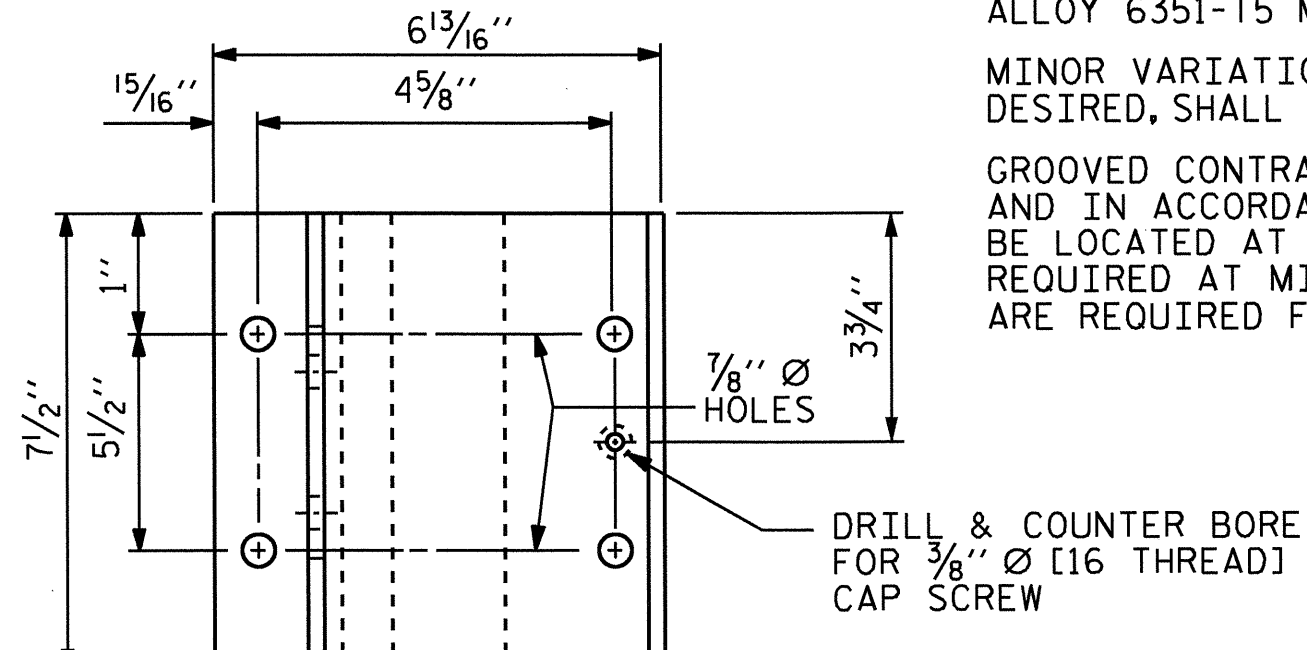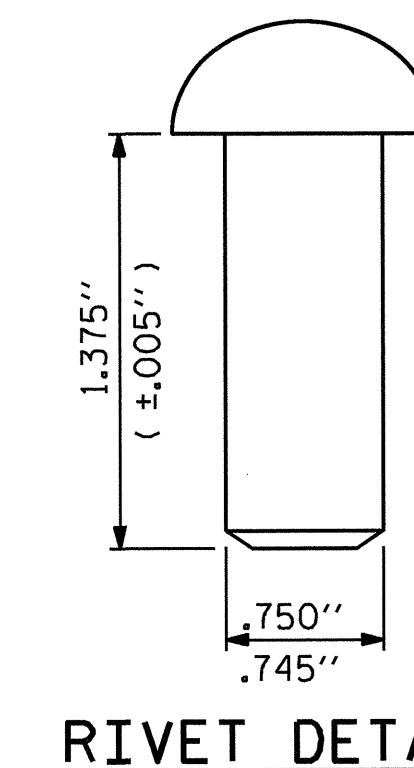

ELEVATION
 NOTE: FOR ATTACHMENT OF METAL RAIL TO END POST, SEE STANDARD NO. BMR2.

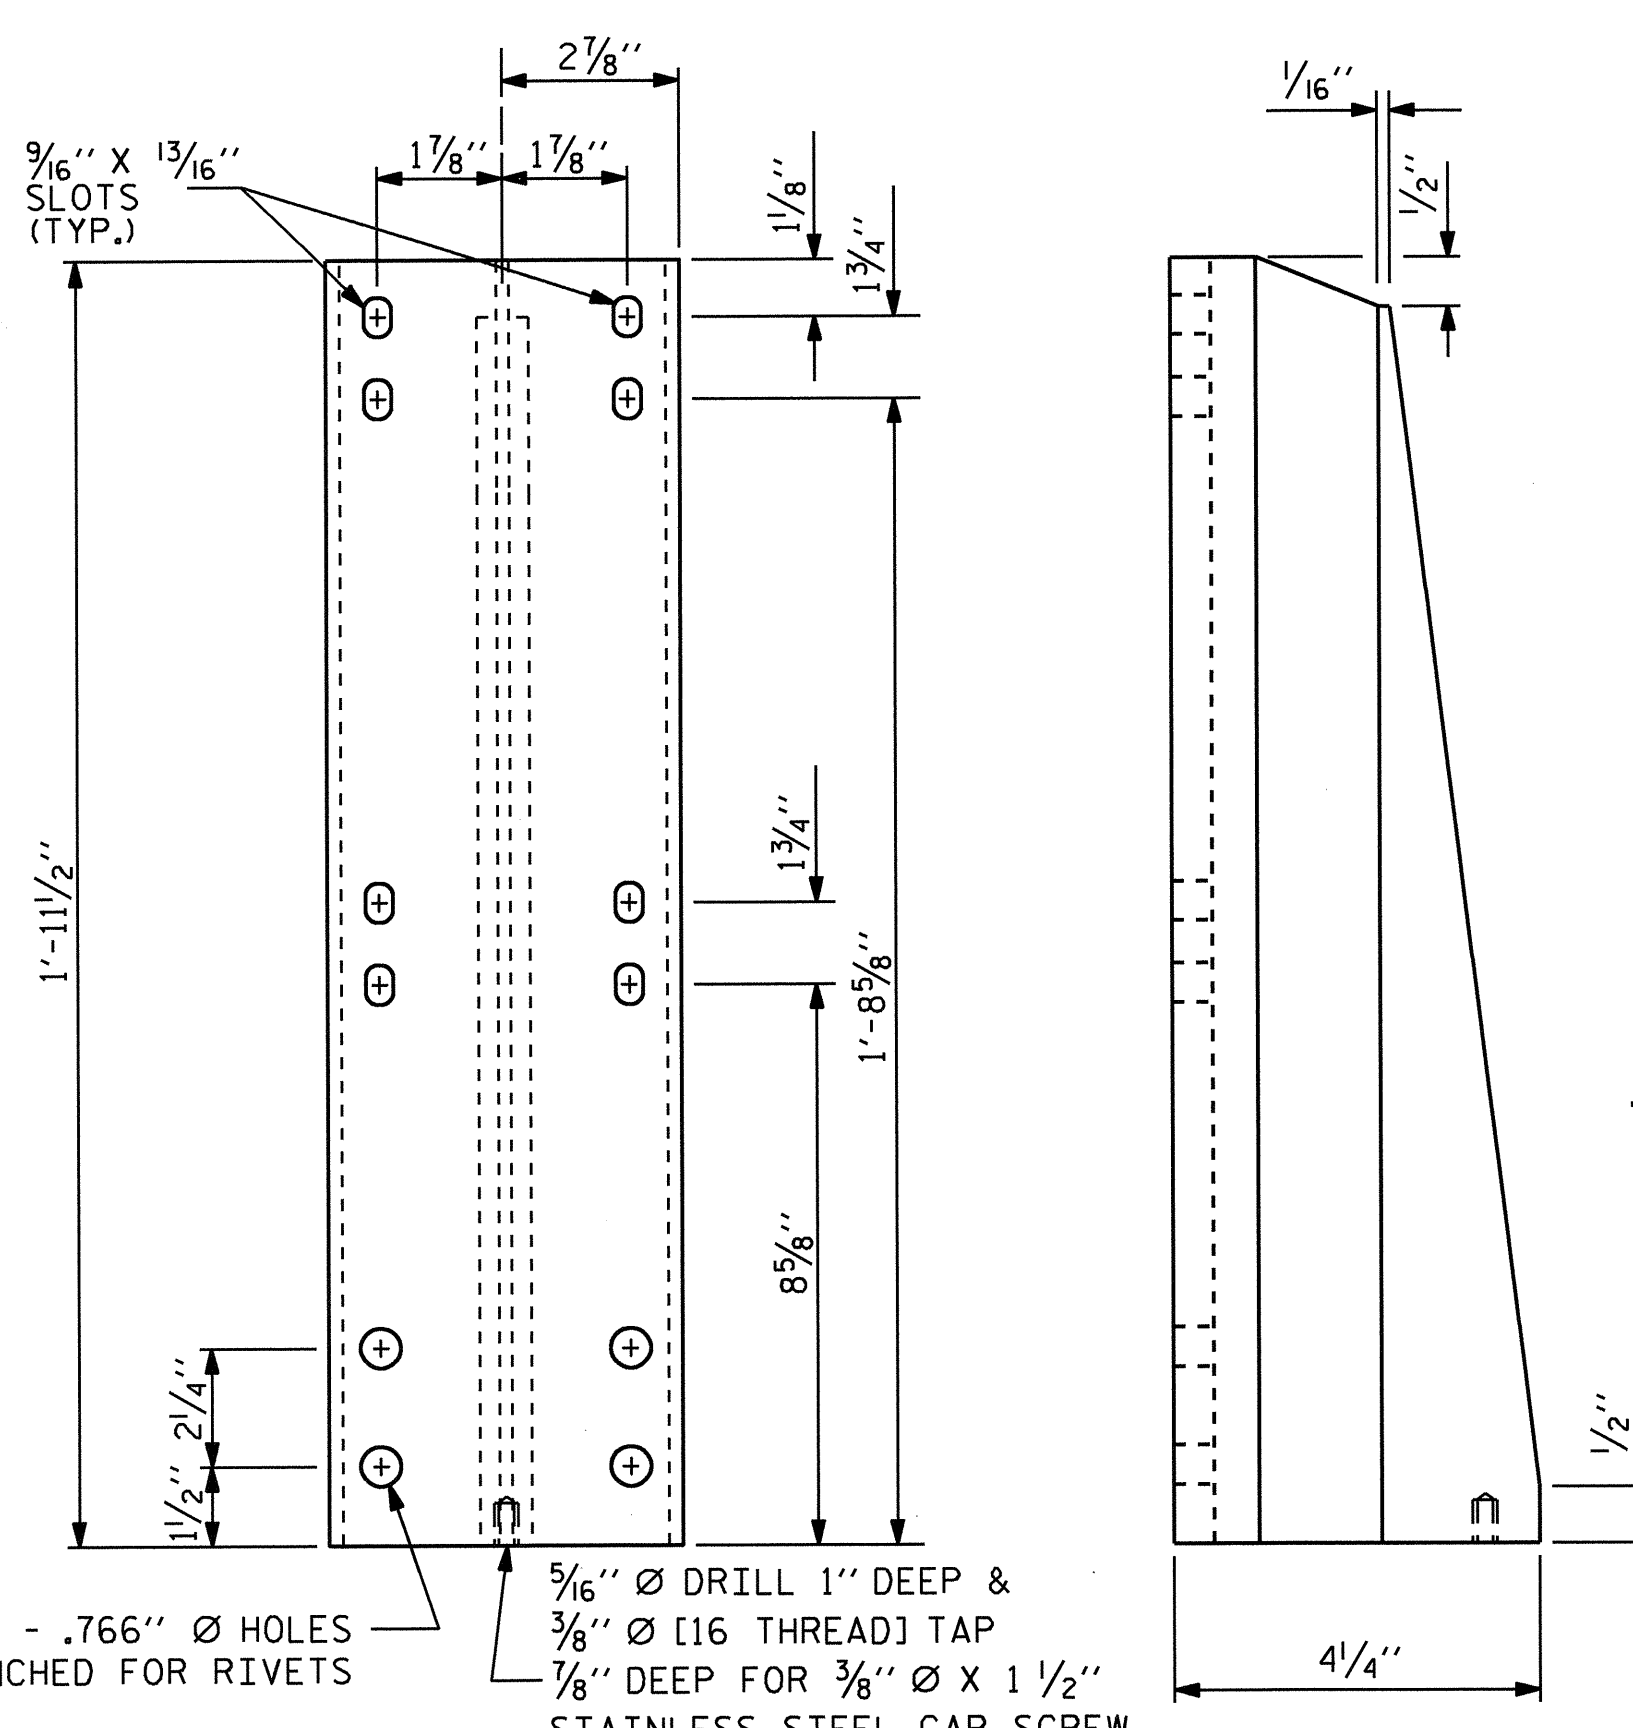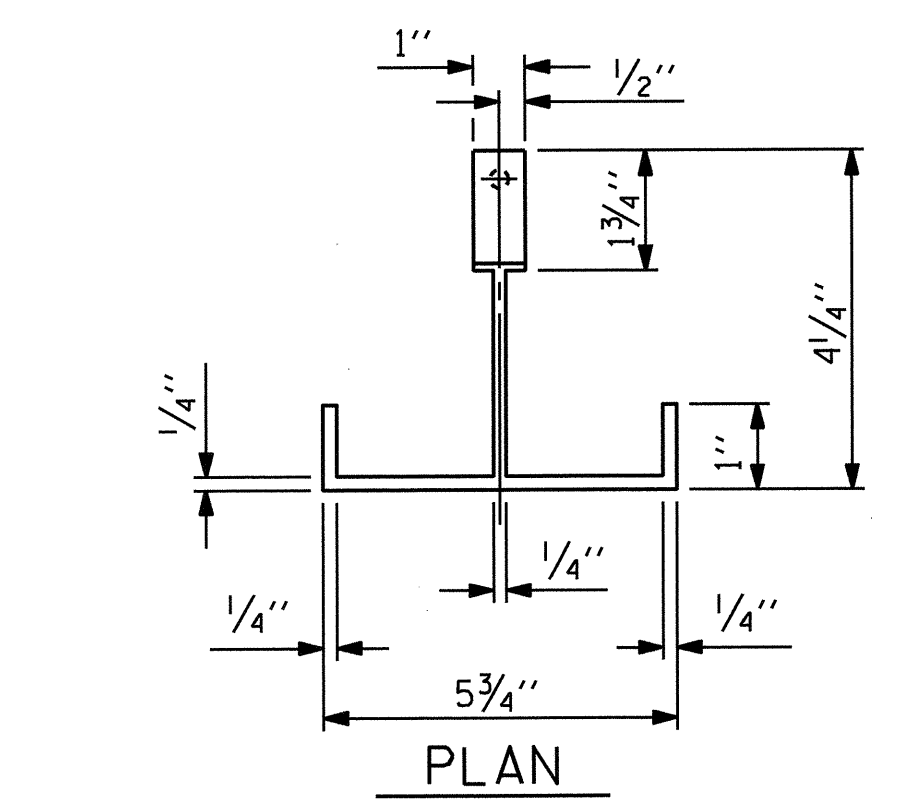

DETAILS OF POST
 FRONT ELEVATION SIDE ELEVATION

ASSEMBLED BY : A.C. OUTLAW	DATE : 5/21/12
CHECKED BY : A. SORSENGINH	DATE : 9/13
DRAWN BY : EEM 6/94	REV. 5/1/06 TLA/GM
CHECKED BY : RCW 6/94	REV. 10/1/11 MAA/GM
	REV. 6/13 MAA/GM

NOTES


STRUCTURAL CONCRETE ANCHOR ASSEMBLY

THE STRUCTURAL CONCRETE ANCHOR ASSEMBLY SHALL CONSIST OF THE FOLLOWING COMPONENTS :


- A. FERRULES SHALL BE MADE FROM STEEL MEETING THE REQUIREMENTS OF AASHTO M169, GRADE 12L14 AND SHALL HAVE A MINIMUM LENGTH OF THREADS OF 2" FOR 3/4" FERRULES.
- B. 4 - 3/4" Ø X 2 1/2" BOLTS WITH WASHERS. BOLTS SHALL CONFORM TO THE REQUIREMENTS OF ASTM A307. BOLTS AND WASHERS SHALL BE GALVANIZED. AT THE CONTRACTOR'S OPTION, STAINLESS STEEL BOLTS AND WASHERS MAY BE USED AS AN ALTERNATE FOR THE 3/4" Ø X 2 1/2" GALVANIZED BOLTS AND WASHERS. THEY SHALL CONFORM TO OR EXCEED THE MECHANICAL REQUIREMENTS OF ASTM A307. THE USE OF THIS ALTERNATE SHALL BE APPROVED BY THE ENGINEER.
- C. WIRE STRUT SHOWN IN THE CONCRETE ANCHOR ASSEMBLY DETAIL IS THE MINIMUM ALLOWABLE SIZE AND SHALL HAVE A MINIMUM TENSILE STRENGTH OF 100,000 PSI. AS AN OPTION, A 1/6" Ø WIRE STRUT WITH A MINIMUM TENSILE STRENGTH OF 90,000 PSI IS ACCEPTABLE.
- D. THE METAL RAIL ANCHOR ASSEMBLIES TO BE HOT DIPPED GALVANIZED TO CONFORM TO REQUIREMENTS OF AASHTO M111.
- E. THE COST OF THE METAL RAIL ANCHOR ASSEMBLY WITH BOLTS AND WASHERS COMPLETE IN PLACE SHALL BE INCLUDED IN THE PRICE BID FOR LINEAR FEET OF METAL RAIL.
- F. BOLTS TO BE TIGHTENED ONE-HALF TURN WITH A WRENCH FROM A FINGER-TIGHT POSITION.

THE CONTRACTOR MAY USE ADHESIVELY ANCHORED ANCHOR BOLTS IN PLACE OF THE METAL RAIL ANCHOR ASSEMBLY. LEVEL ONE FIELD TESTING IS REQUIRED, AND THE YIELD LOAD OF THE 3/4" Ø BOLT IS 10 KIPS. FOR ADHESIVELY ANCHORED ANCHOR BOLTS OR DOWELS, SEE THE STANDARD SPECIFICATIONS.

WHEN ADHESIVELY ANCHORED ANCHOR BOLTS ARE USED, BOLTS SHALL MEET THE REQUIREMENTS OF ASTM F593 ALLOY 304 STAINLESS STEEL WITH MINIMUM 75,000 PSI ULTIMATE STRENGTH. NUTS SHALL MEET THE REQUIREMENTS OF ASTM F594 ALLOY 304 STAINLESS STEEL AND WASHERS SHALL MEET THE REQUIREMENTS OF ASTM F844 EXCEPT THEY SHALL BE MADE FROM ALLOY 304 STAINLESS STEEL.

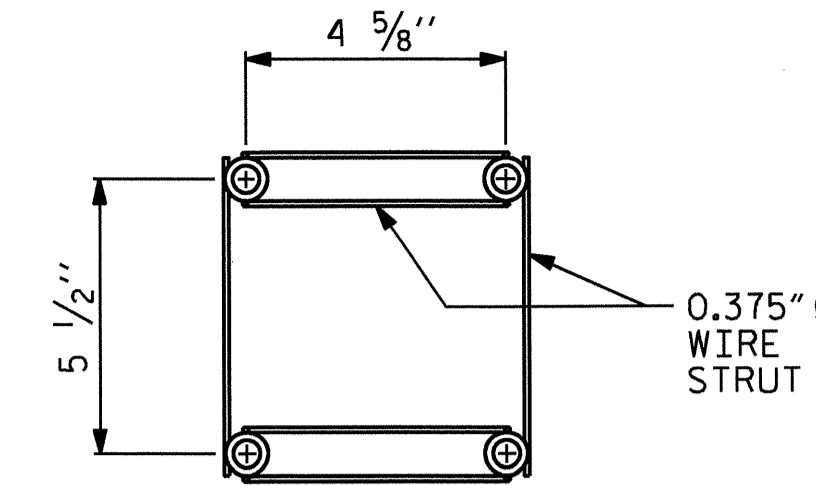

PLAN

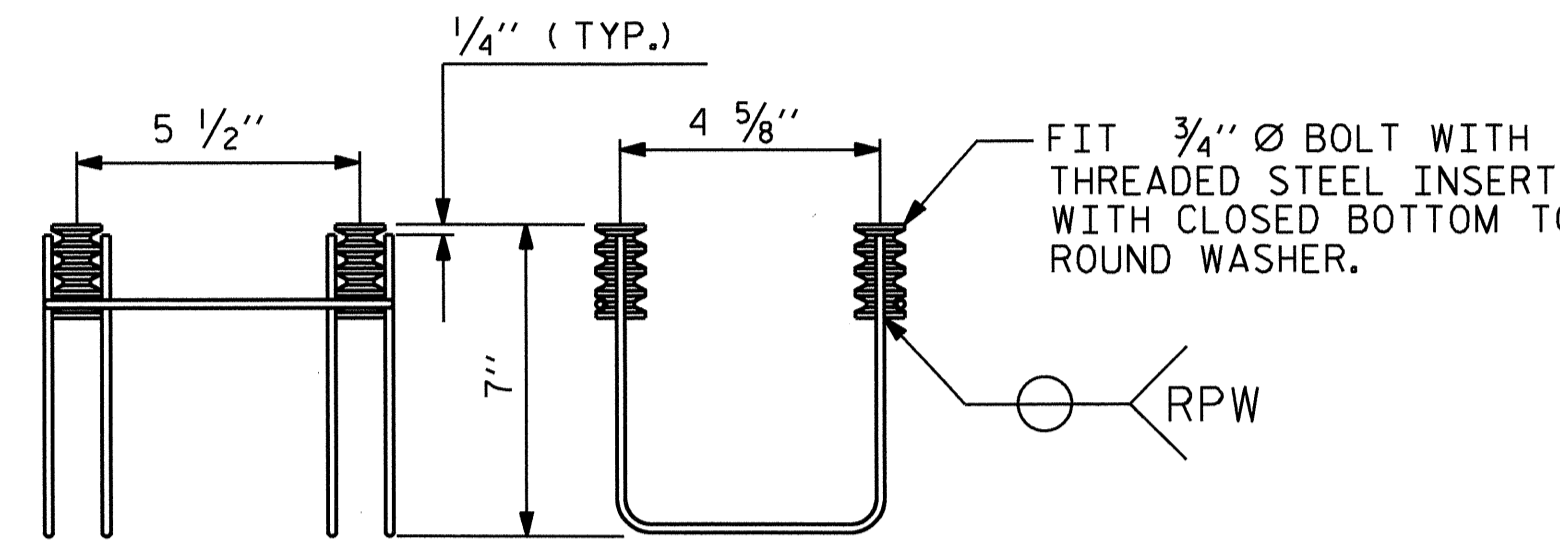


SIDE VIEW


ELEVATION

4-BOLT METAL RAIL ANCHOR ASSEMBLY


(46 ASSEMBLIES REQUIRED)

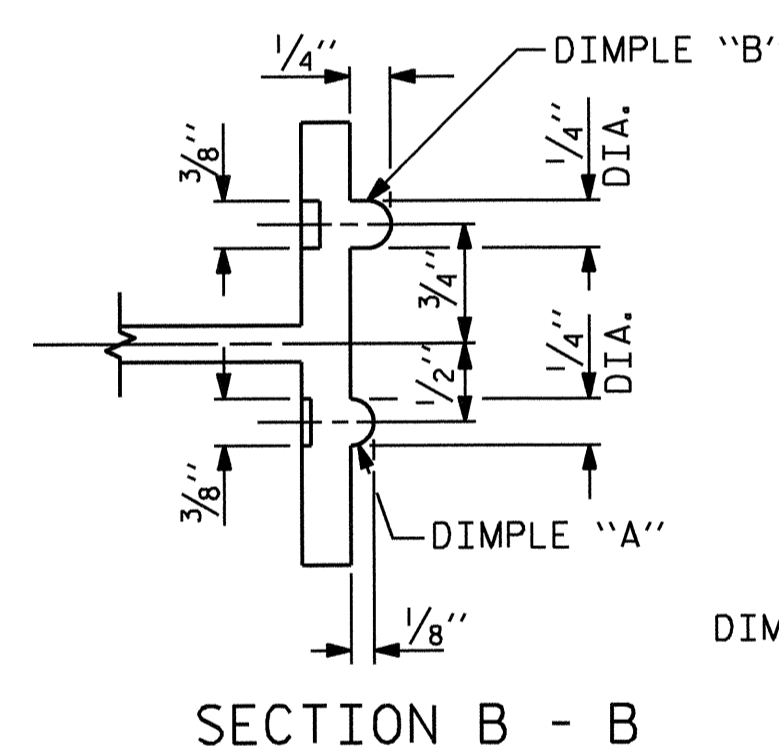


SECTION B - B

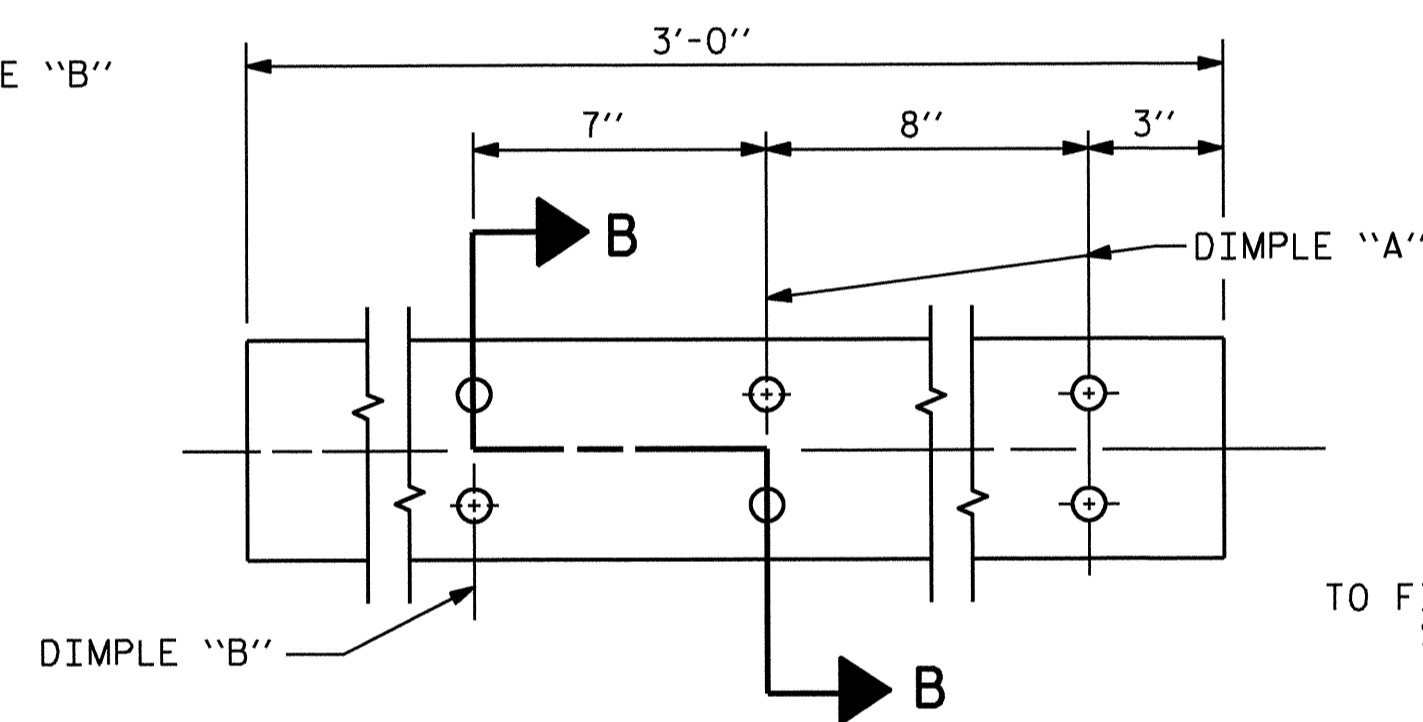


EXPANSION BAR DETAILS

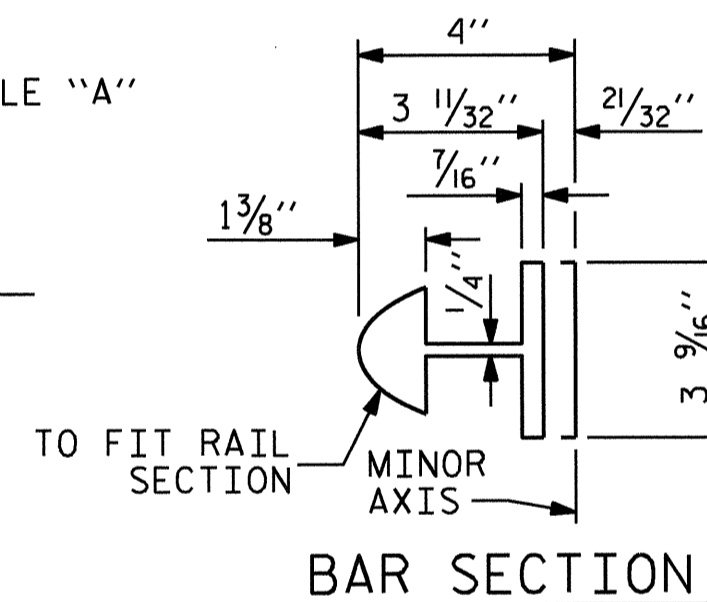

BAR SECTION

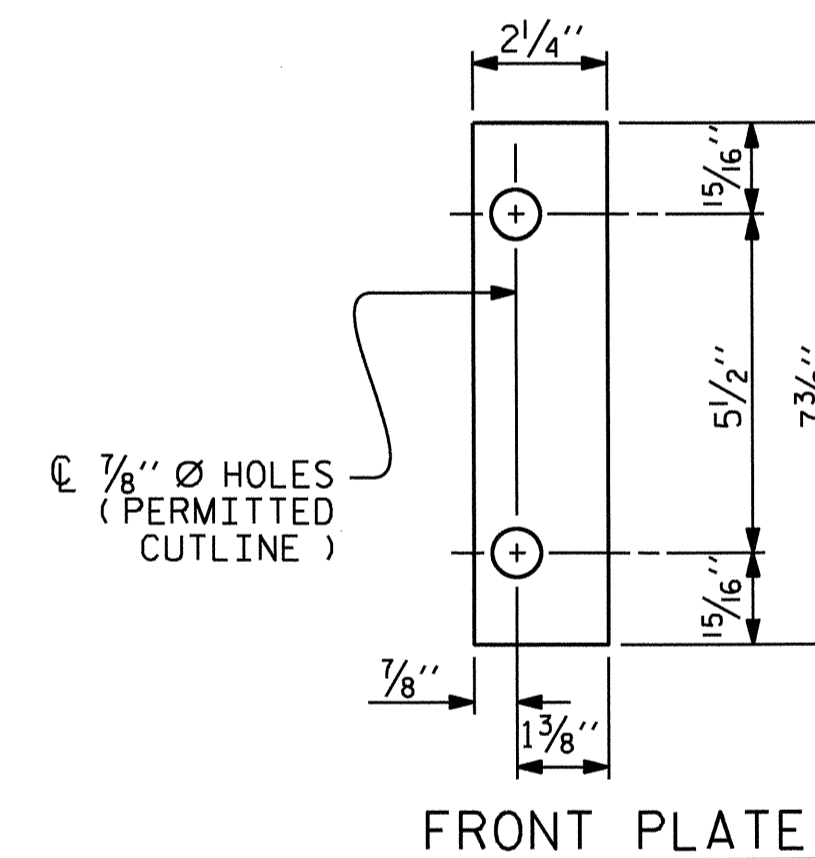


FRONT PLATE

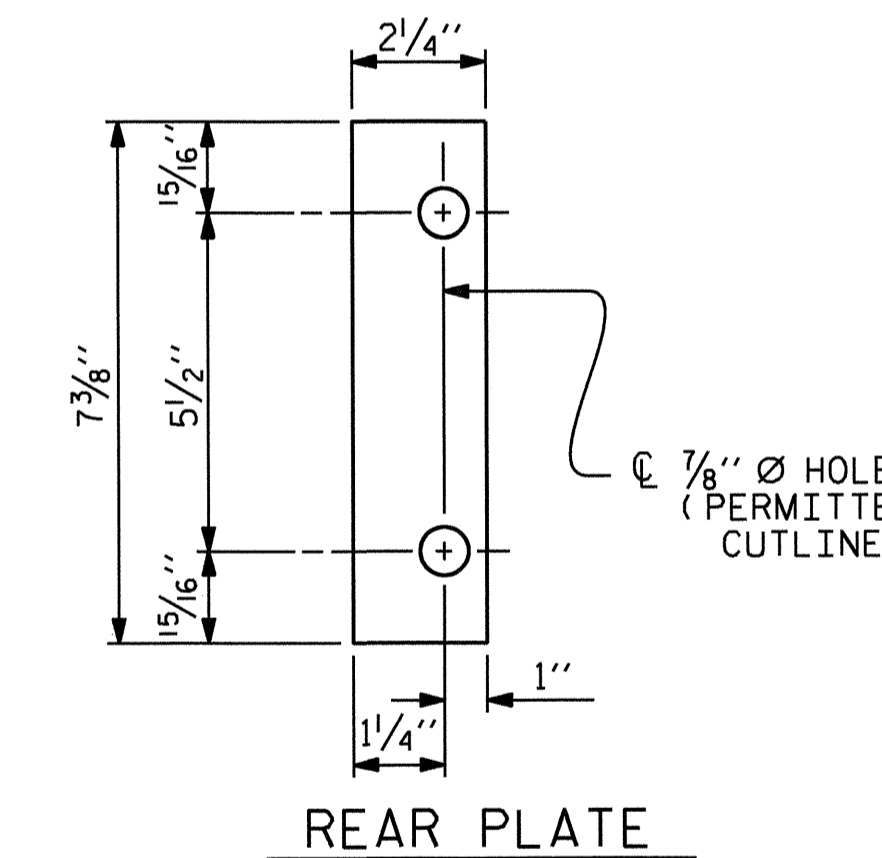


REAR PLATE

SHIM DETAILS

NOTE : SHIMS MAY BE CUT ALONG PERMITTED CUTLINE OR SLOTTED TO EDGE OF PLATE TO FACILITATE PLACEMENT.

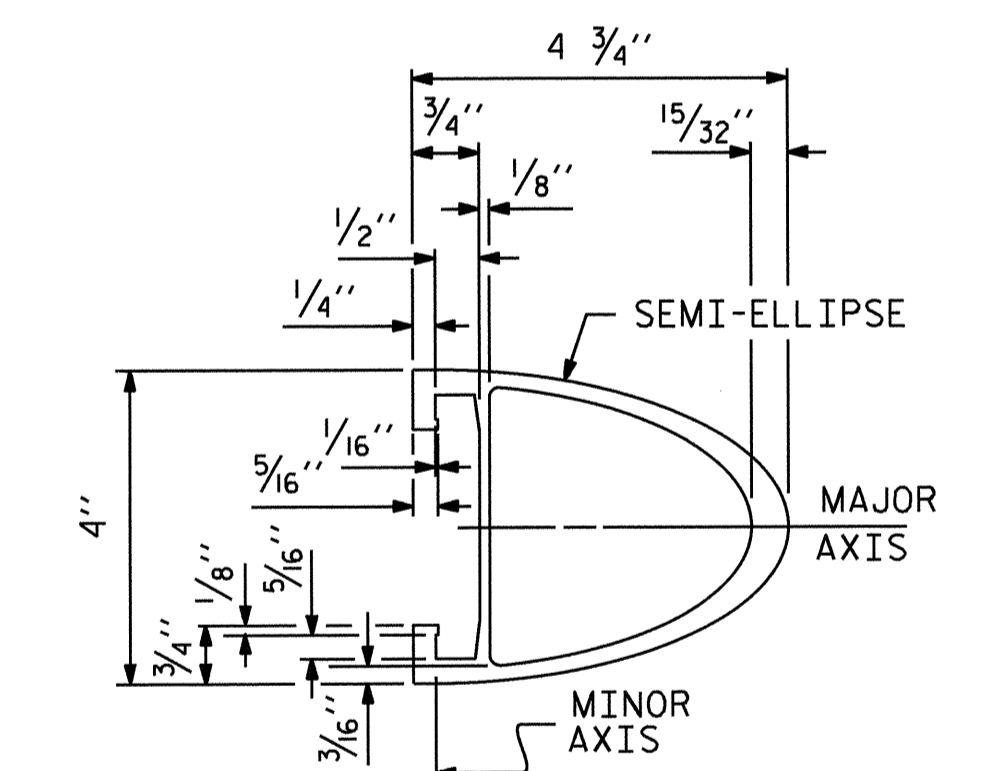


RAIL SECTION

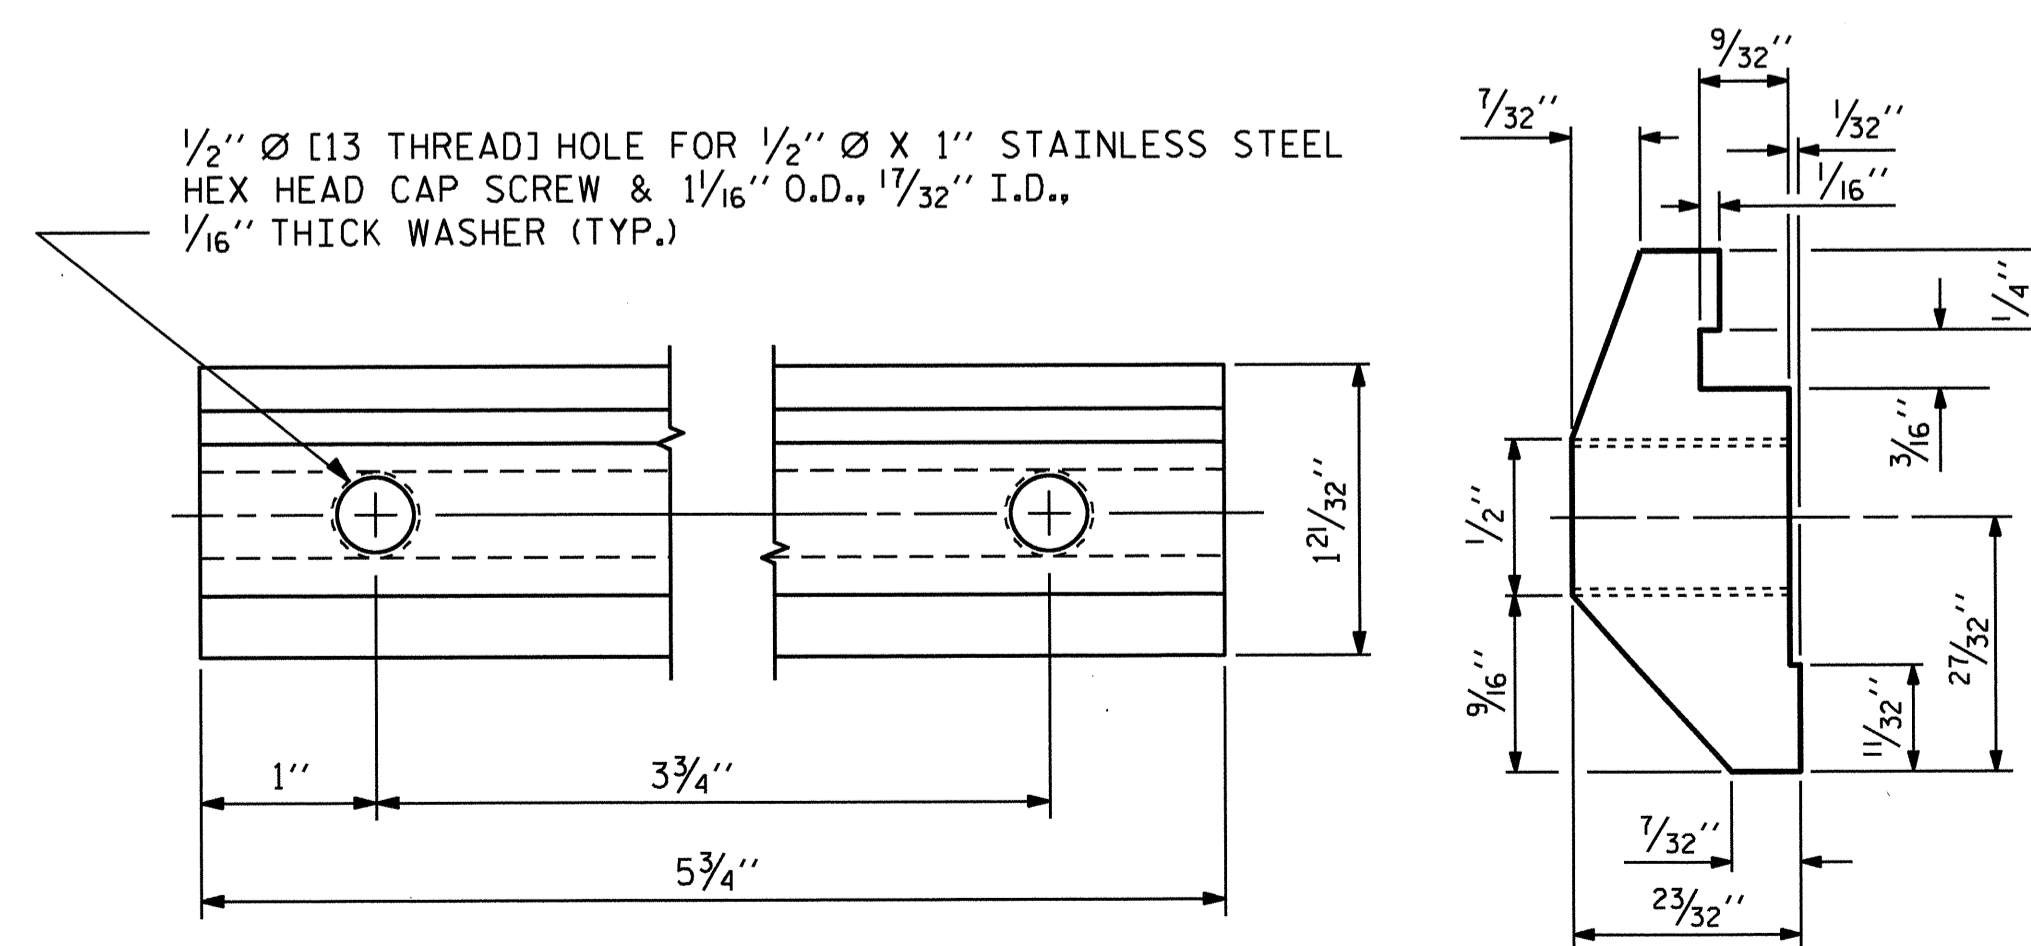


CLAMP BAR DETAIL

(4 REQUIRED PER POST)

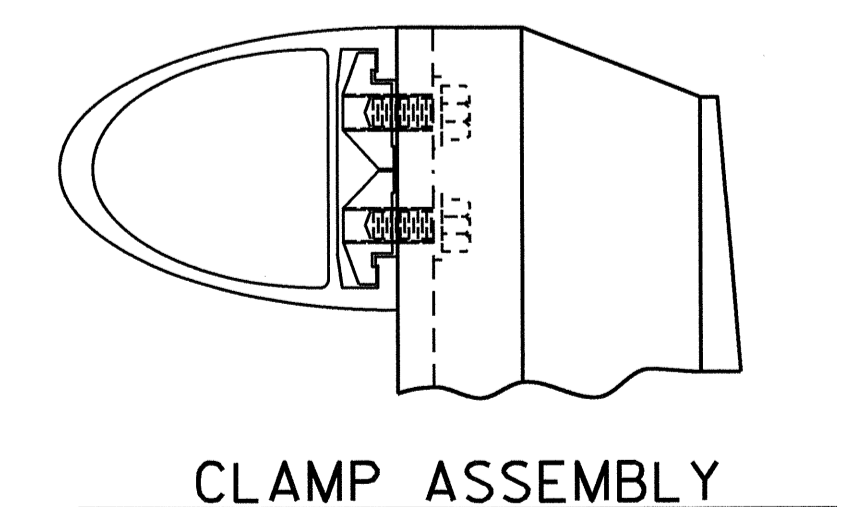

CLAMP ASSEMBLY

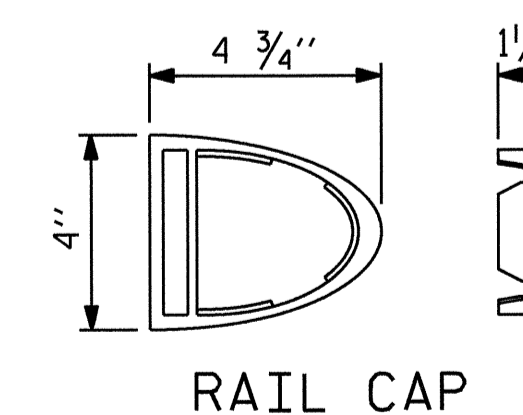


RAIL CAP

PROJECT NO. B-4731
CHATHAM COUNTY
STATION: 16+13.50 -L-

SHEET 2 OF 2

STATE OF NORTH CAROLINA
DEPARTMENT OF TRANSPORTATION
RALEIGH
STANDARD
2 BAR METAL RAIL

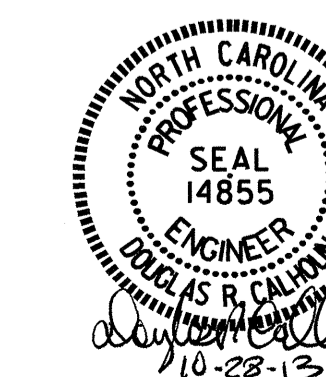

REVISIONS						SHEET NO.
NO.	BY:	DATE:	NO.	BY:	DATE:	S-15
1			3			TOTAL SHEETS 28
2			4			

ASSEMBLED BY : A.C. OUTLAW DATE : 5/21/12
CHECKED BY : A. SORSENGINH DATE : 9/13
DRAWN BY : EEM 6/94 REV. 8/16/99 MAB/LES
CHECKED BY : RGW 6/94 REV. 5/1/06R KMM/GM
REV. 10/1/11 MAA/GM

NOTES

THE GUARDRAIL ANCHOR ASSEMBLY SHALL CONSIST OF A 1/4" HOLD DOWN PLATE AND 7 - 7/8" Ø BOLTS WITH NUTS AND WASHERS.

THE HOLD-DOWN PLATE SHALL CONFORM TO AASHTO M270 GRADE 36. AFTER FABRICATION, THE HOLD-DOWN PLATE SHALL BE HOT-DIP GALVANIZED IN ACCORDANCE WITH AASHTO M111.

BOLTS SHALL CONFORM TO THE REQUIREMENTS OF ASTM A307 AND NUTS SHALL CONFORM TO THE REQUIREMENTS OF AASHTO M291. BOLTS, NUTS AND WASHERS SHALL BE GALVANIZED. AT THE CONTRACTOR'S OPTION, STAINLESS STEEL BOLTS, NUTS AND WASHERS MAY BE USED AS AN ALTERNATE FOR THE 7/8" Ø GALVANIZED BOLTS, NUTS AND WASHERS. THEY SHALL CONFORM TO OR EXCEED THE MECHANICAL REQUIREMENTS OF ASTM A307. THE USE OF THIS ALTERNATE SHALL BE APPROVED BY THE ENGINEER.


THE GUARDRAIL ANCHOR ASSEMBLY IS REQUIRED AT ALL POINTS WHERE APPROACH GUARDRAIL IS TO BE ATTACHED TO THE END OF THE PARAPET. FOR POINTS OF ATTACHMENT, SEE SKETCH.

AFTER INSTALLATION, THE EXPOSED THREAD OF THE BOLT SHALL BE BURRED WITH A SHARP POINTED TOOL.


THE COST OF THE GUARDRAIL ANCHOR ASSEMBLIES WITH BOLTS, NUTS AND WASHERS COMPLETE IN PLACE, SHALL BE INCLUDED IN THE VARIOUS PAY ITEMS.

THE VERTICAL REINFORCING BARS MAY BE SHIFTED SLIGHTLY IN THE END POST TO CLEAR ASSEMBLY BOLTS.

THE 1 1/4" Ø HOLES SHALL BE FORMED OR DRILLED WITH A CORE BIT. IMPACT TOOLS WILL NOT BE PERMITTED. ANY CONCRETE DAMAGED BY THIS WORK SHALL BE REPAIRED TO THE SATISFACTION OF THE ENGINEER.

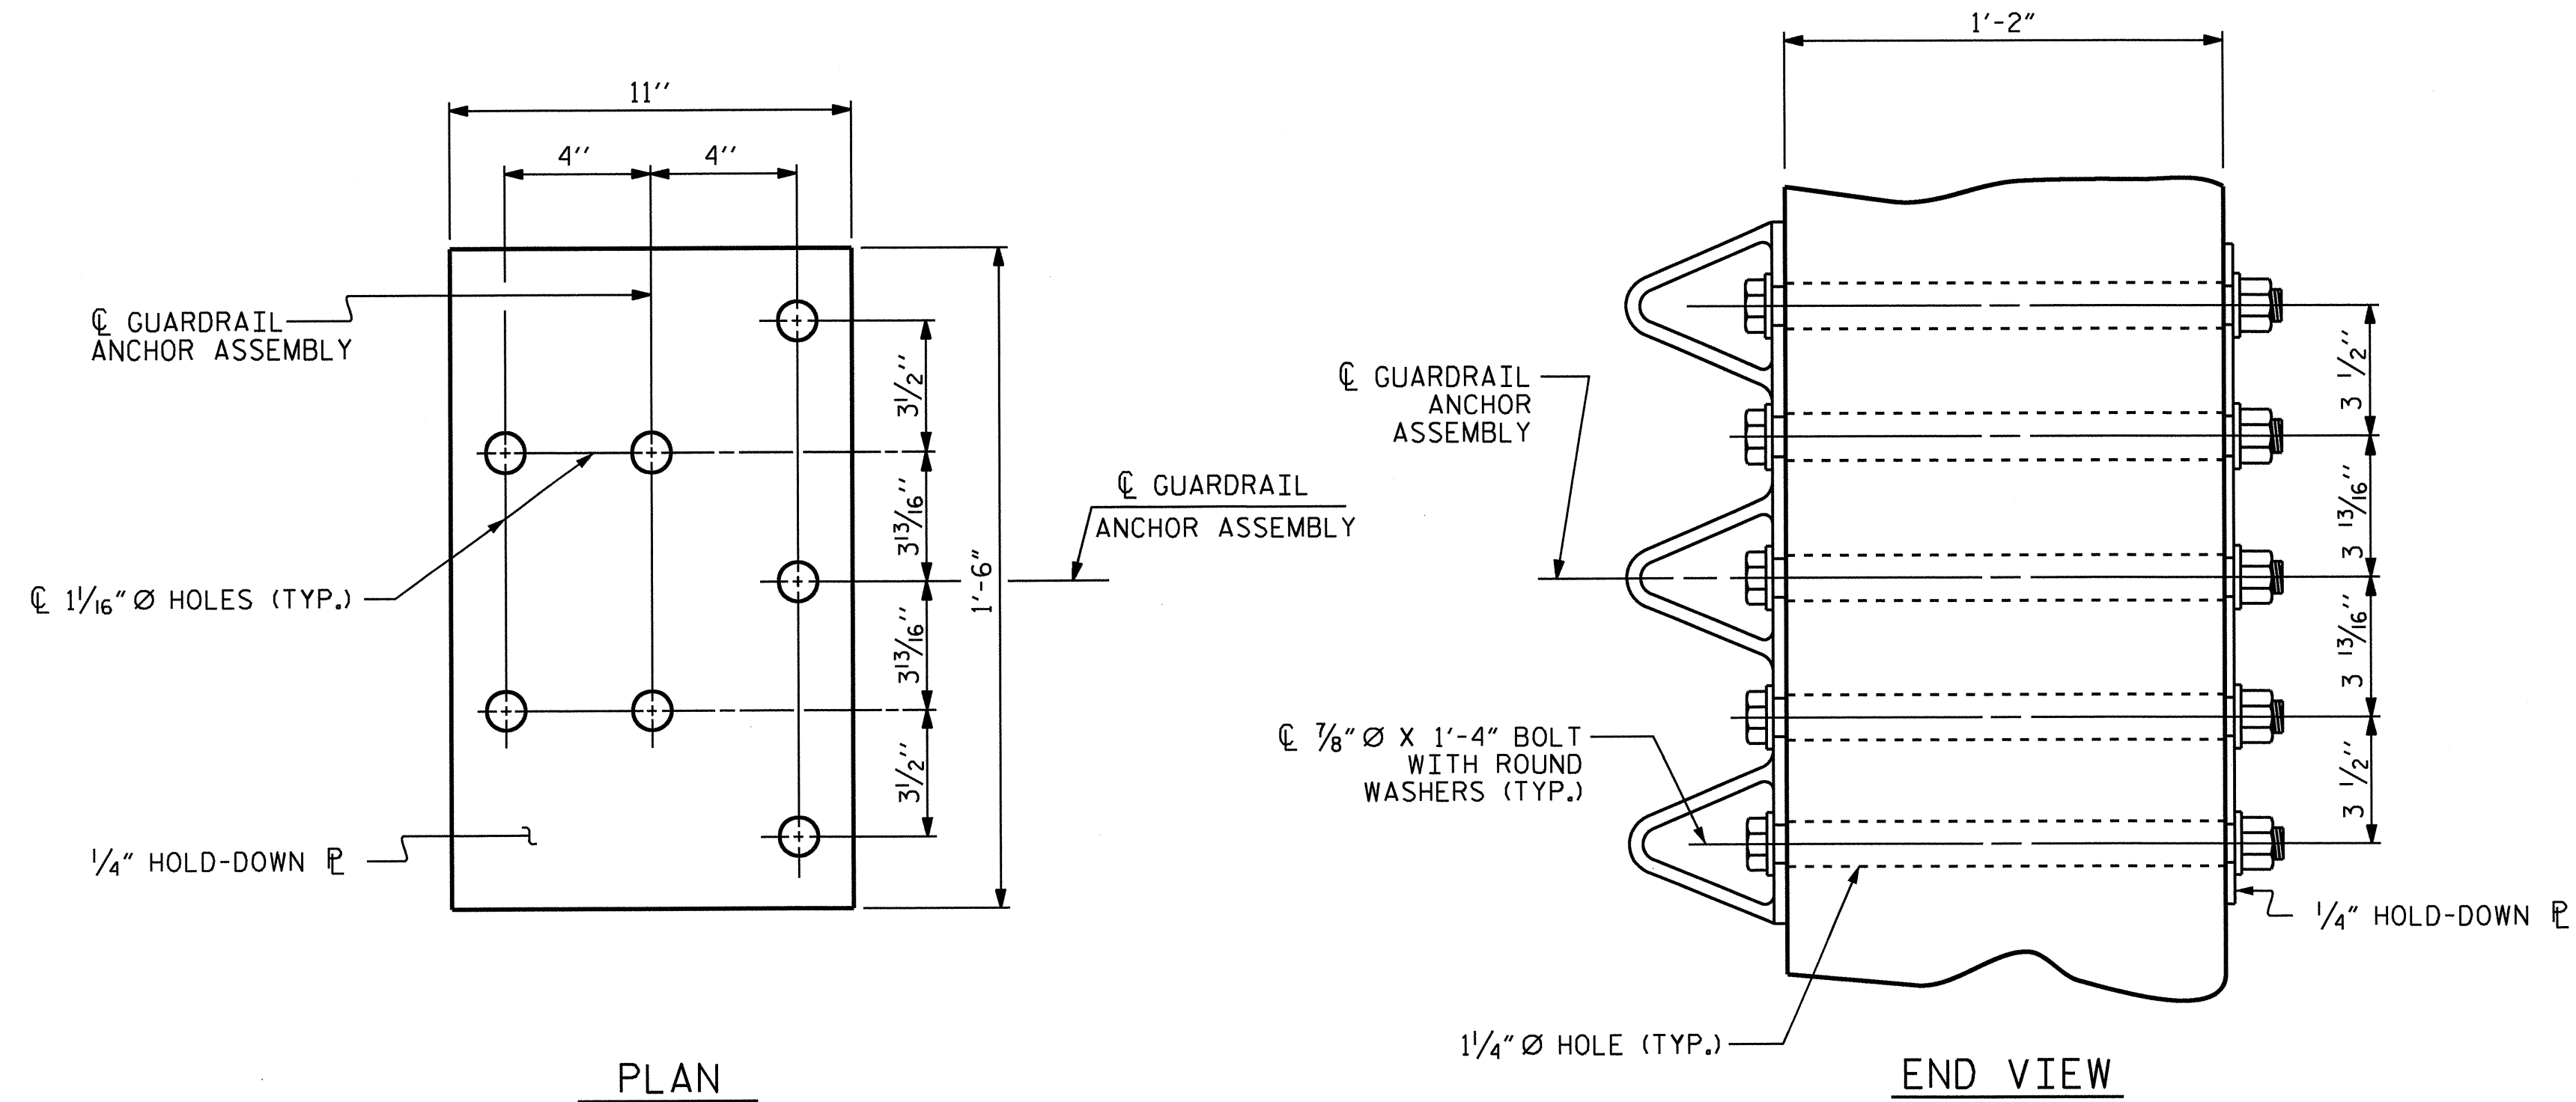


GUARDRAIL ANCHOR ASSEMBLY DETAILS

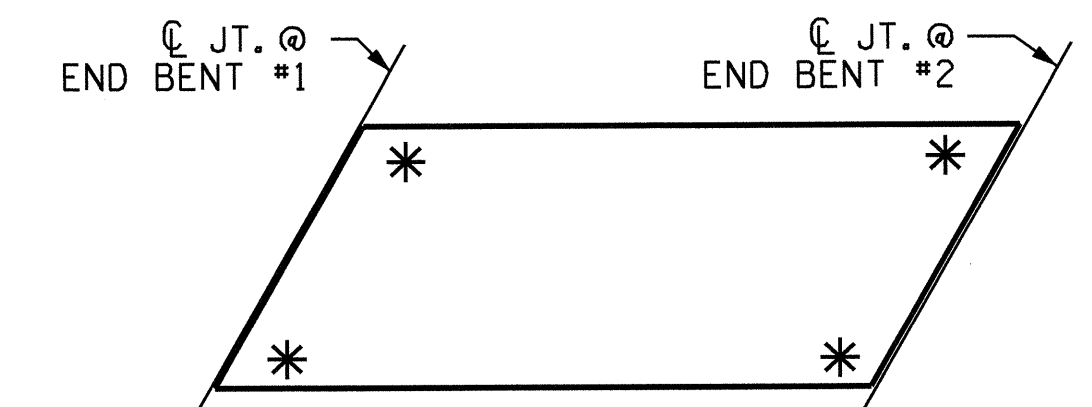

SKETCH SHOWING POINTS OF ATTACHMENT

* LOCATION OF GUARDRAIL ATTACHMENT

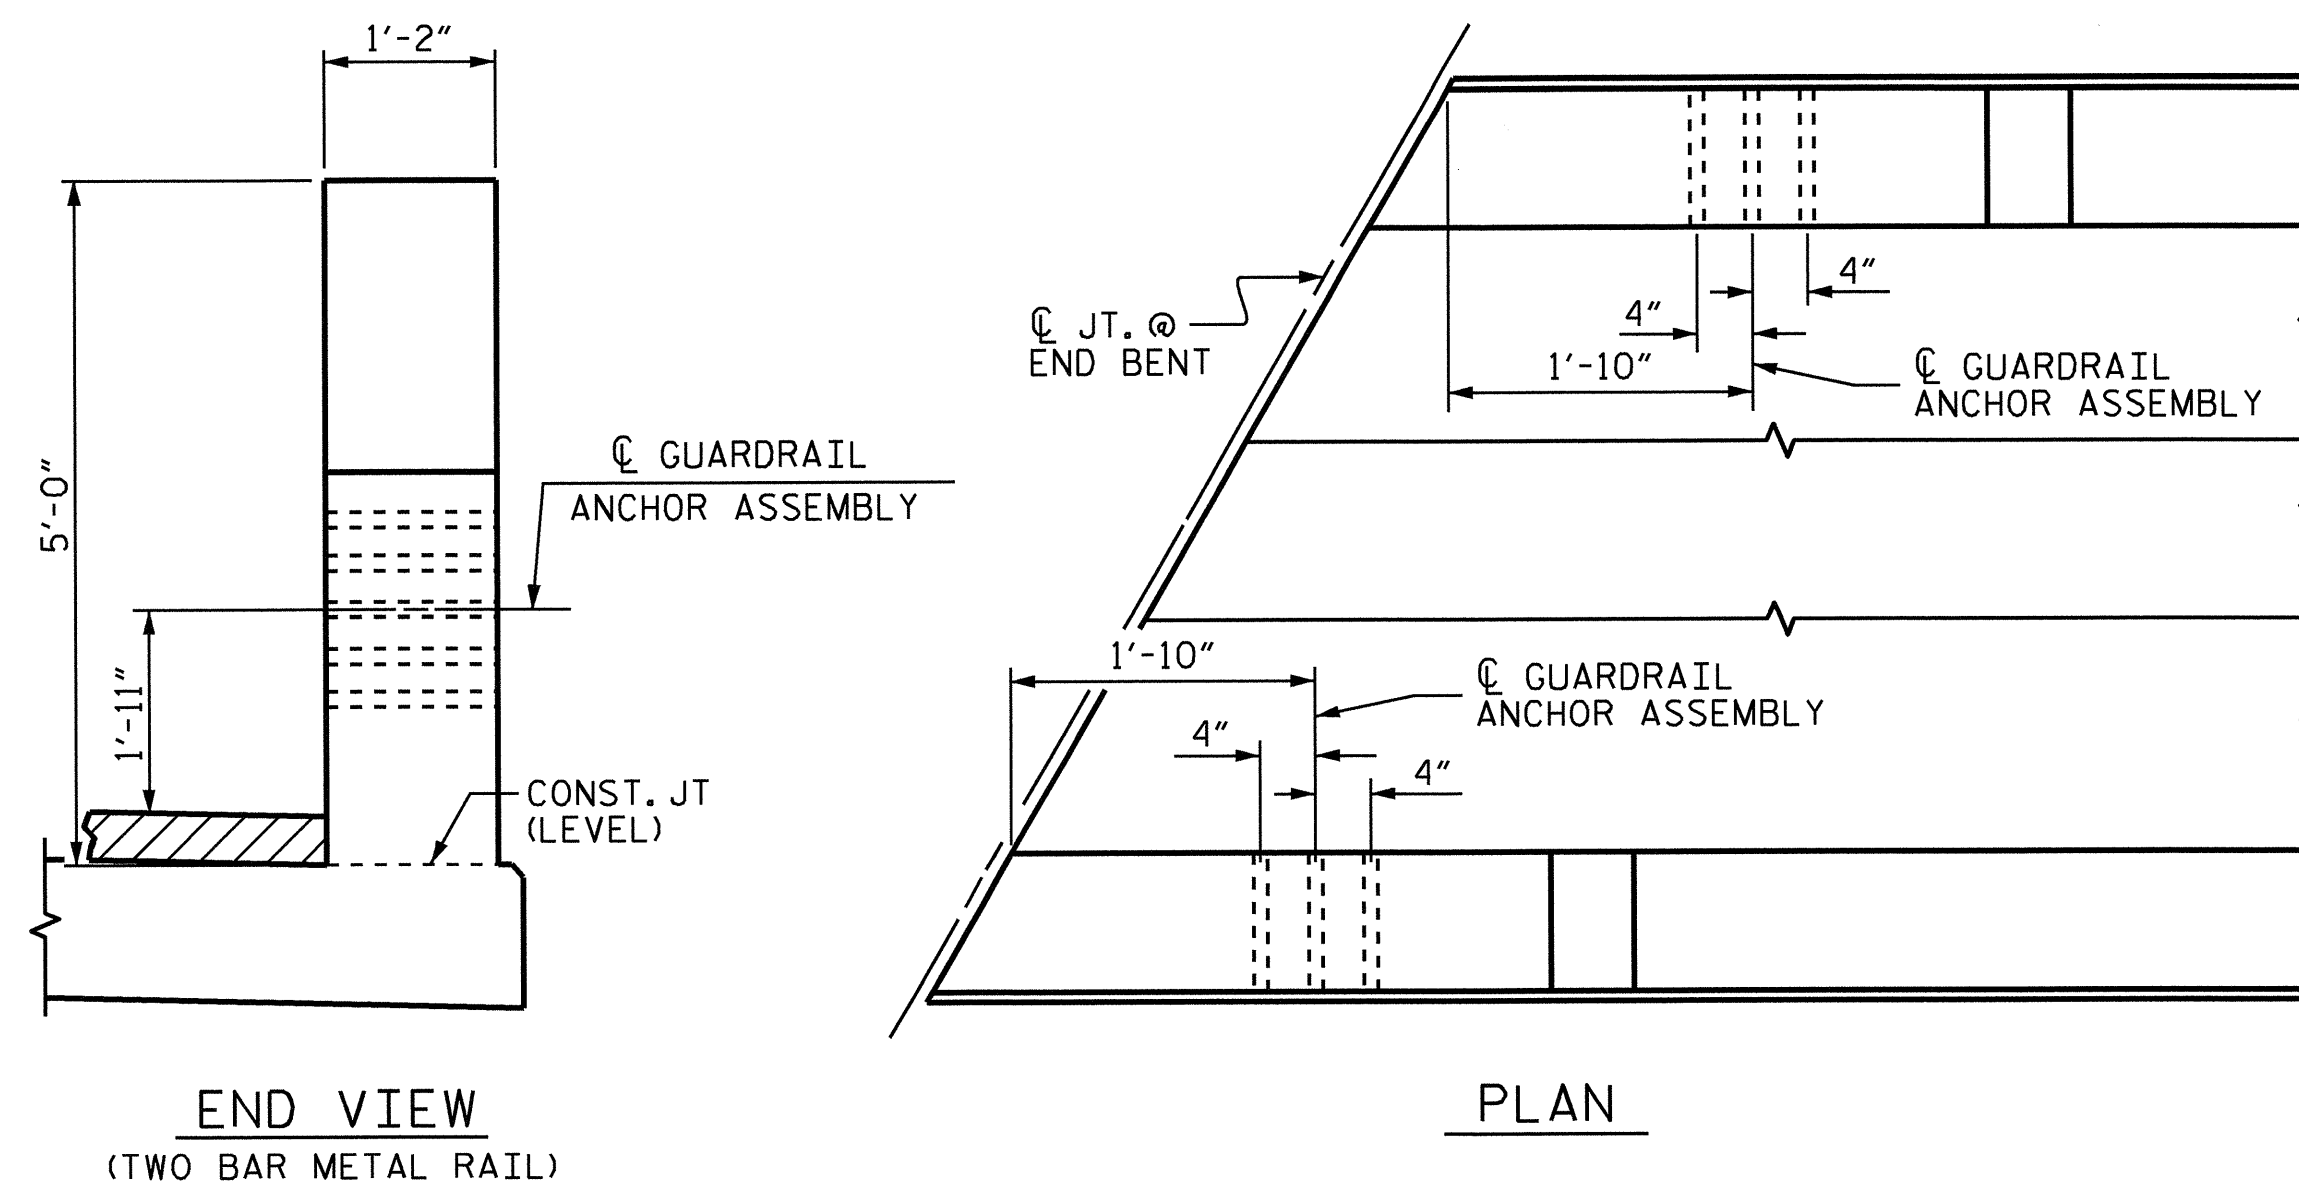

LOCATION OF GUARDRAIL ANCHOR AT END POST

PROJECT NO. B-4731
CHATHAM COUNTY
 STATION: 16+13.50 -L-



STATE OF NORTH CAROLINA
 DEPARTMENT OF TRANSPORTATION
 RALEIGH
 STANDARD
 GUARDRAIL ANCHORAGE
 DETAILS
 FOR METAL RAILS

REVISIONS						SHEET NO.
NO.	BY:	DATE:	NO.	BY:	DATE:	TOTAL SHEETS
1			3			5-17
2			4			28

ASSEMBLED BY : A.C. OUTLAW	DATE : 5/21/12
CHECKED BY : A. SORSENGINH	DATE : 9/13
DRAWN BY : MAA 5/10	REV. 10/1/11 MAA/GM
CHECKED BY : GM 5/10	REV. 12/5/11 MAA/GM
	REV. 6/13 MAA/GM


NOTES

STIRRUPS IN CAP MAY BE SHIFTED AS NECESSARY TO CLEAR DOWELS.

THE CONCRETE IN THE SHADED AREA OF THE WING SHALL BE POURED AFTER THE CONCRETE PARAPET IS CAST IF SLIP FORMING IS USED.

FOR PILE SPLICE DETAILS, SEE SHEET 5 OF 5.

FOR WING DETAILS, SEE SHEET 3 OF 5.

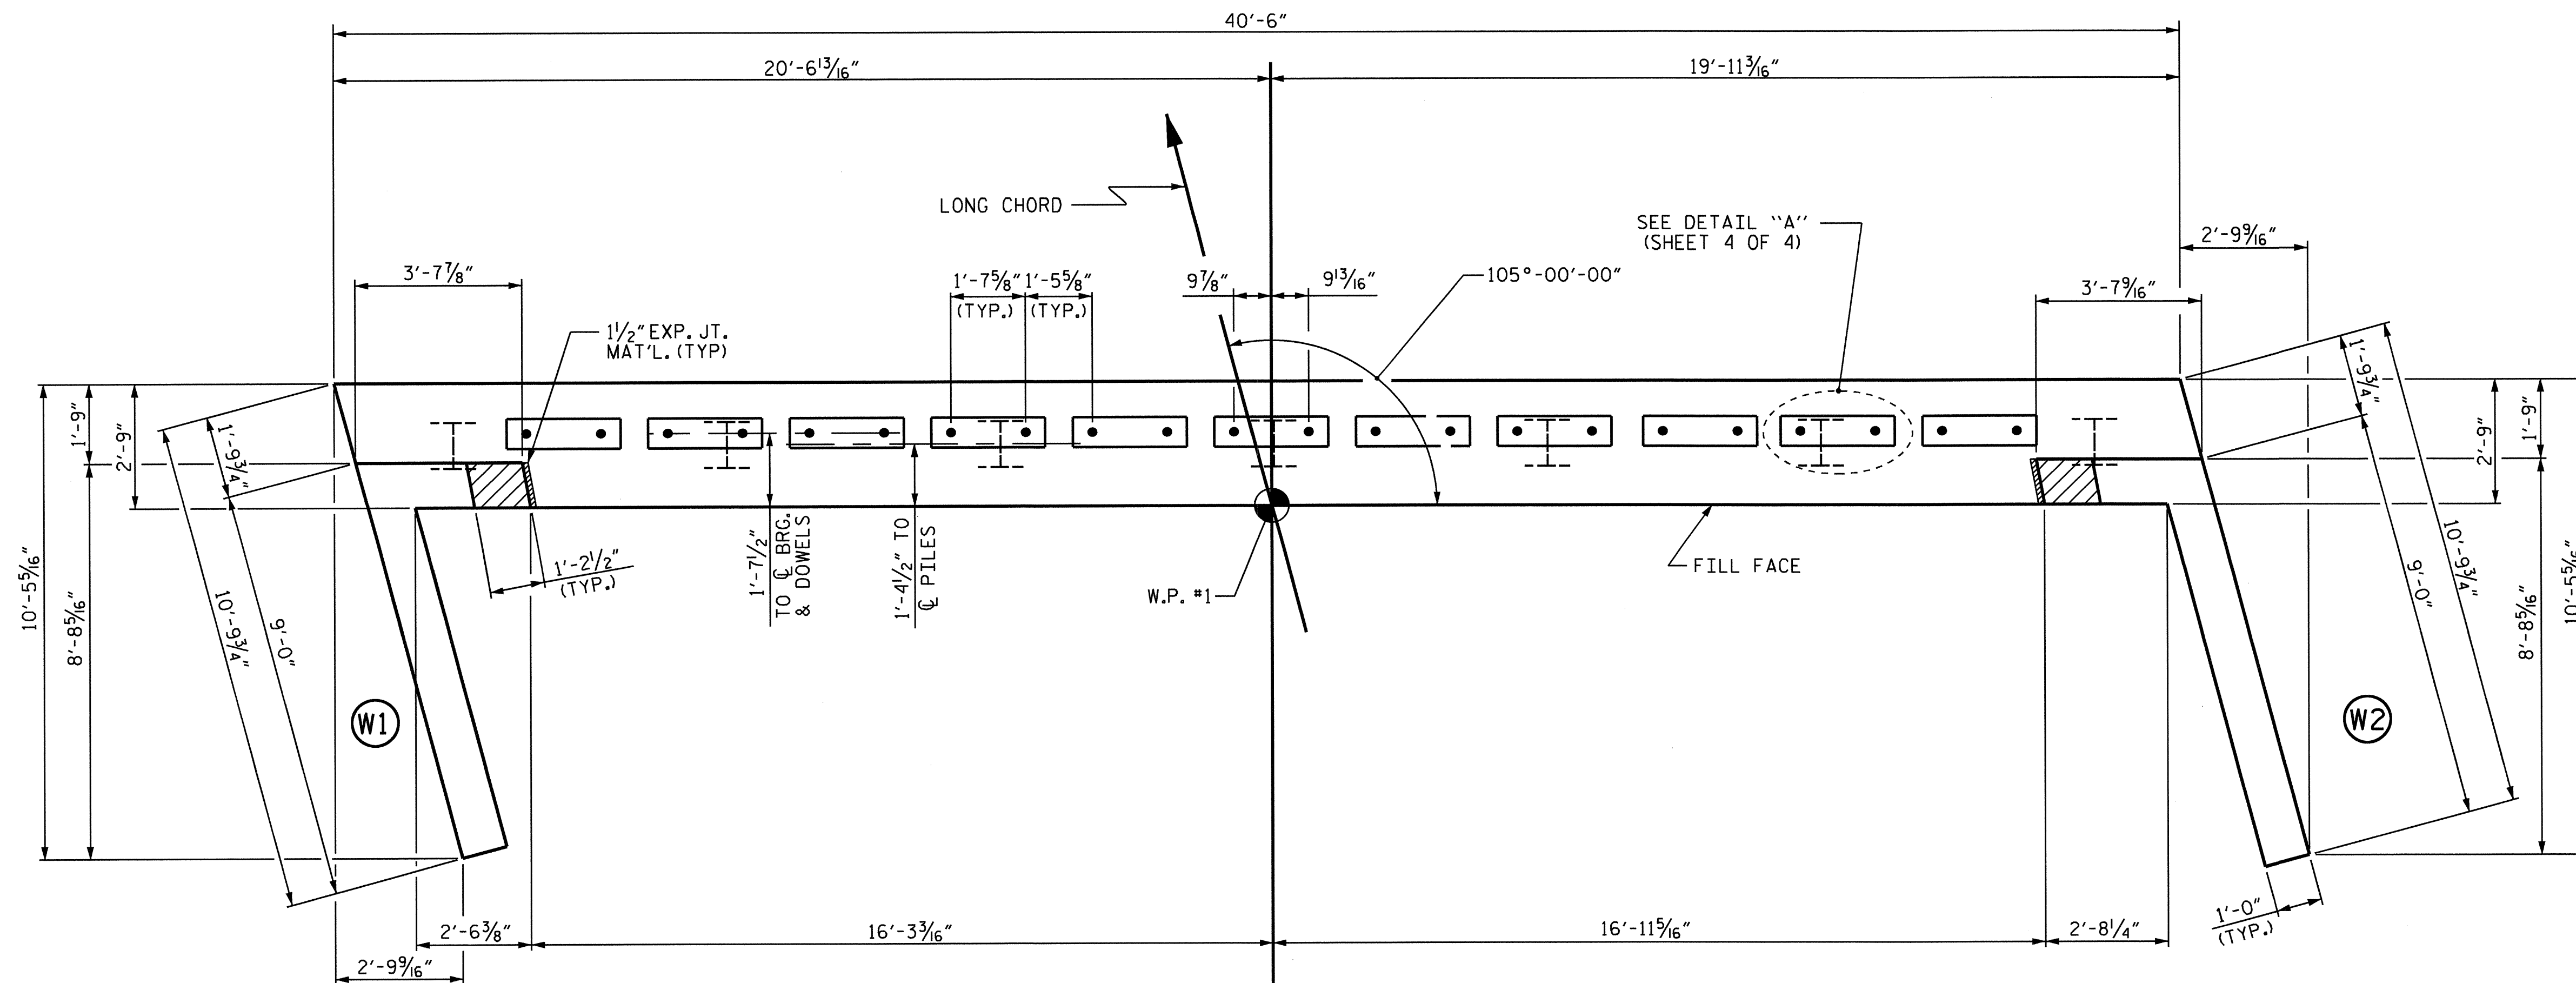


PLAN

WORKLINE

A

A

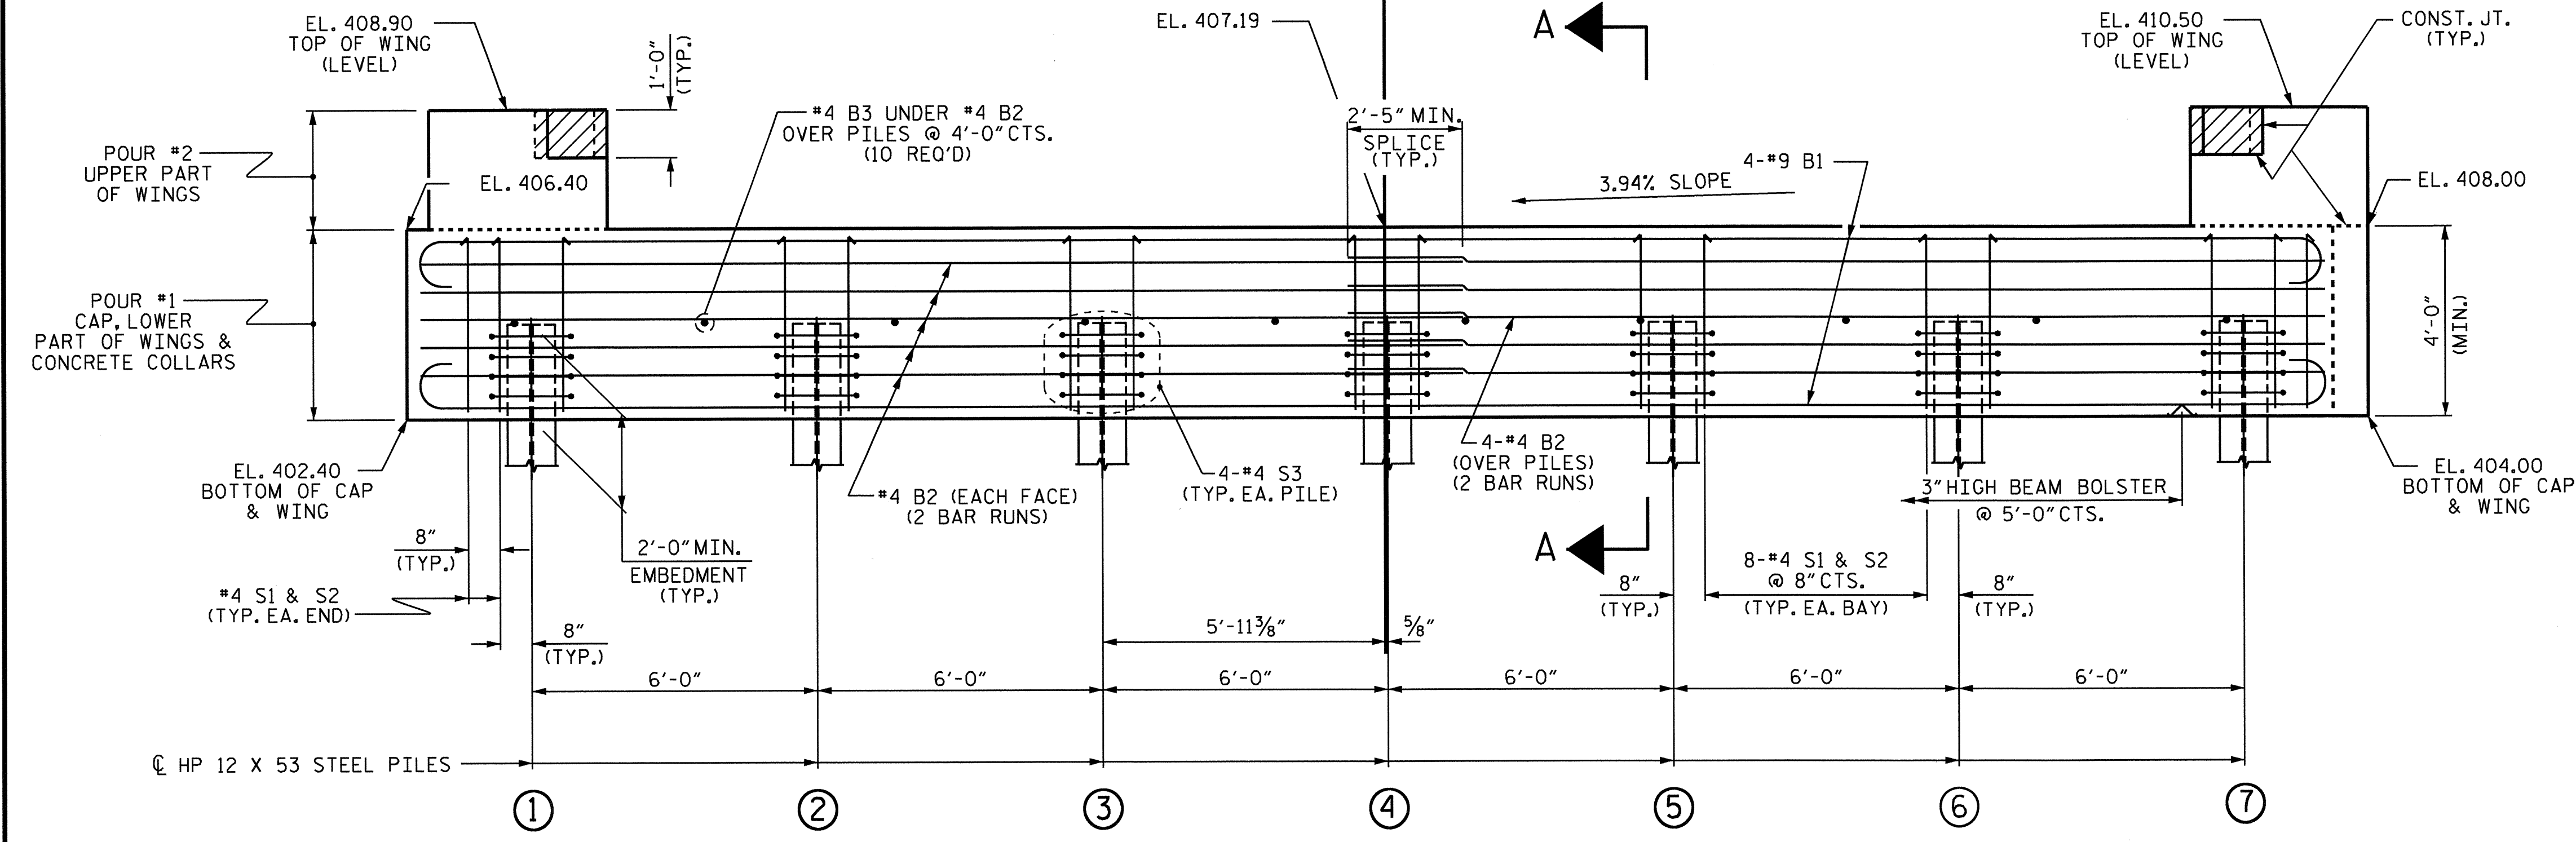

ELEVATION

TOP OF PILE ELEVATIONS	
①	404.51
②	404.75
③	404.98
④	405.22
⑤	405.46
⑥	405.69
⑦	405.93


PROJECT NO. B-4731
CHATHAM COUNTY
 STATION: 16+13.50 -L-

SHEET 1 OF 5

STATE OF NORTH CAROLINA
 DEPARTMENT OF TRANSPORTATION
 RALEIGH

SUBSTRUCTURE
 END BENT 1

REVISIONS						SHEET NO.
NO.	BY:	DATE:	NO.	BY:	DATE:	TOTAL SHEETS
1			3			5-18
2			4			28

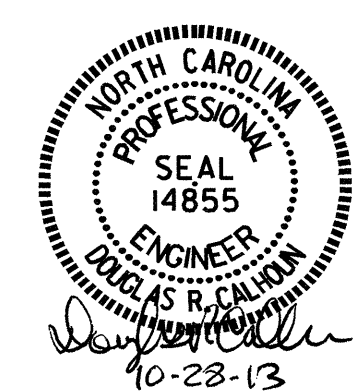

ASSEMBLED BY : A.C. OUTLAW DATE : 5/31/12
 CHECKED BY : A. SORSENGIN DATE : 9/13
 DRAWN BY : WJH 12/11
 CHECKED BY : AAC 12/11

WINGS NOT SHOWN FOR CLARITY.
 FOR SECTION A-A, SEE SHEET 5 OF 5.
 CONCRETE COLLARS FOR STEEL PILES NOT SHOWN IN PLAN AND ELEVATION VIEWS FOR CLARITY.
 SEE "CORROSION PROTECTION FOR STEEL PILES DETAIL", SHEET 5 OF 5.


NOTES

STIRRUPS IN CAP MAY BE SHIFTED AS NECESSARY TO CLEAR DOWELS.


THE CONCRETE IN THE SHADED AREA OF THE WING SHALL BE POURED AFTER THE CONCRETE PARAPET IS CAST IF SLIP FORMING IS USED.

FOR PILE SPLICE DETAILS, SEE SHEET 5 OF 5.

FOR WING DETAILS, SEE SHEET 4 OF 5.

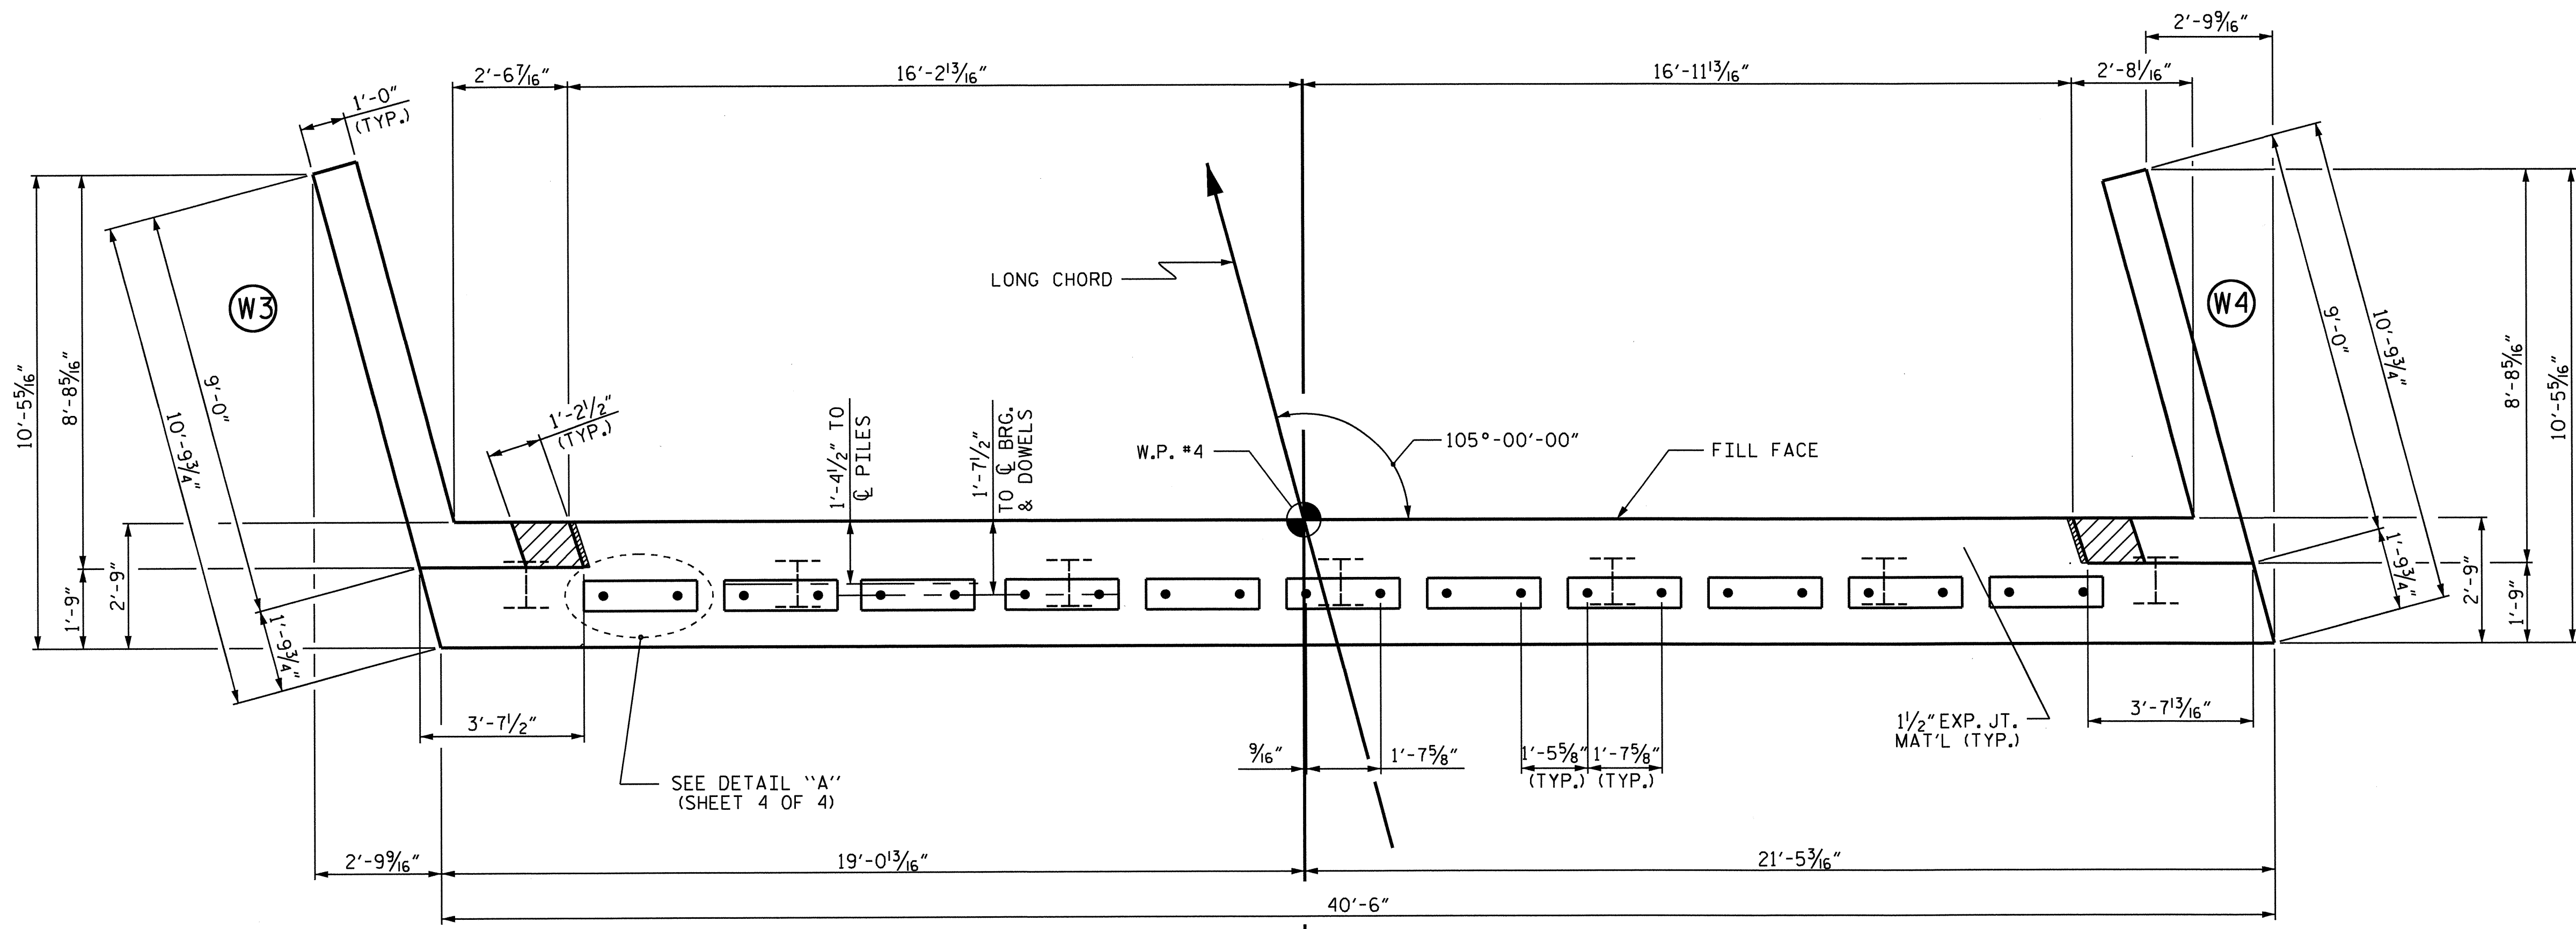

PLAN

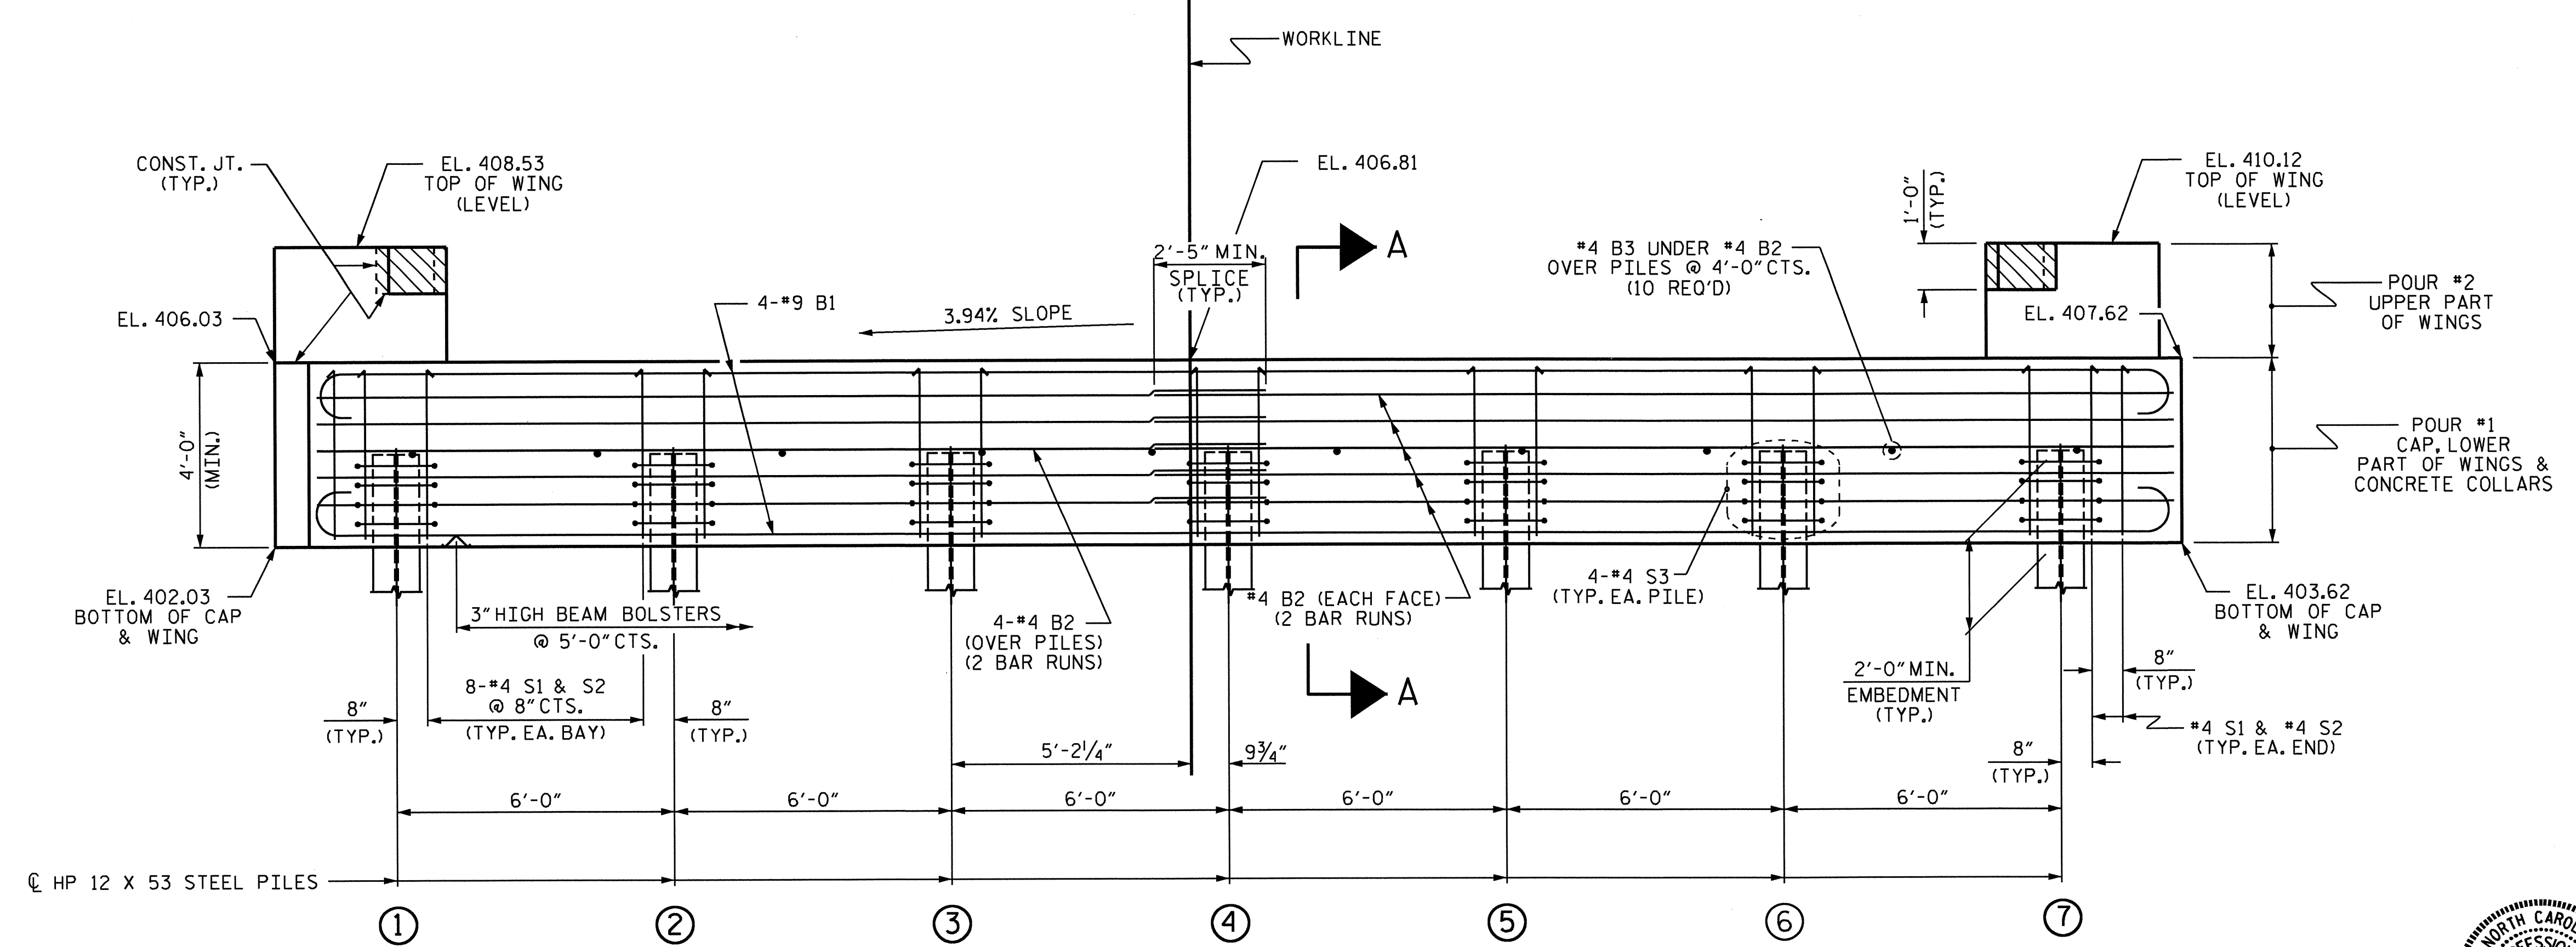

ELEVATION

TOP OF PILE ELEVATIONS	
①	404.14
②	404.37
③	404.61
④	404.84
⑤	405.08
⑥	405.32
⑦	405.55


PROJECT NO. B-4731
CHATHAM COUNTY
 STATION: 16+13.50 -L-

SHEET 2 OF 5

STATE OF NORTH CAROLINA
 DEPARTMENT OF TRANSPORTATION
 RALEIGH


SUBSTRUCTURE
 END BENT 2

REVISIONS						SHEET NO.
NO.	BY:	DATE:	NO.	BY:	DATE:	S-19
1			3			TOTAL SHEETS 28
2			4			

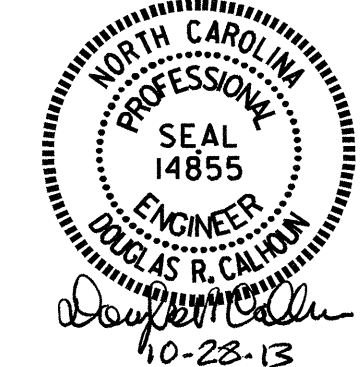


ASSEMBLED BY : A.C. OUTLAW DATE : 5/31/12
 CHECKED BY : A. SORSENGINH DATE : 9/13
 DRAWN BY : WJH 12/11
 CHECKED BY : AAC 12/11


WINGS NOT SHOWN FOR CLARITY.
 FOR SECTION A-A, SEE SHEET 5 OF 5.
 CONCRETE COLLARS FOR STEEL PILES NOT SHOWN IN PLAN AND ELEVATION VIEWS FOR CLARITY.
 SEE "CORROSION PROTECTION FOR STEEL PILES DETAIL", SHEET 5 OF 5.

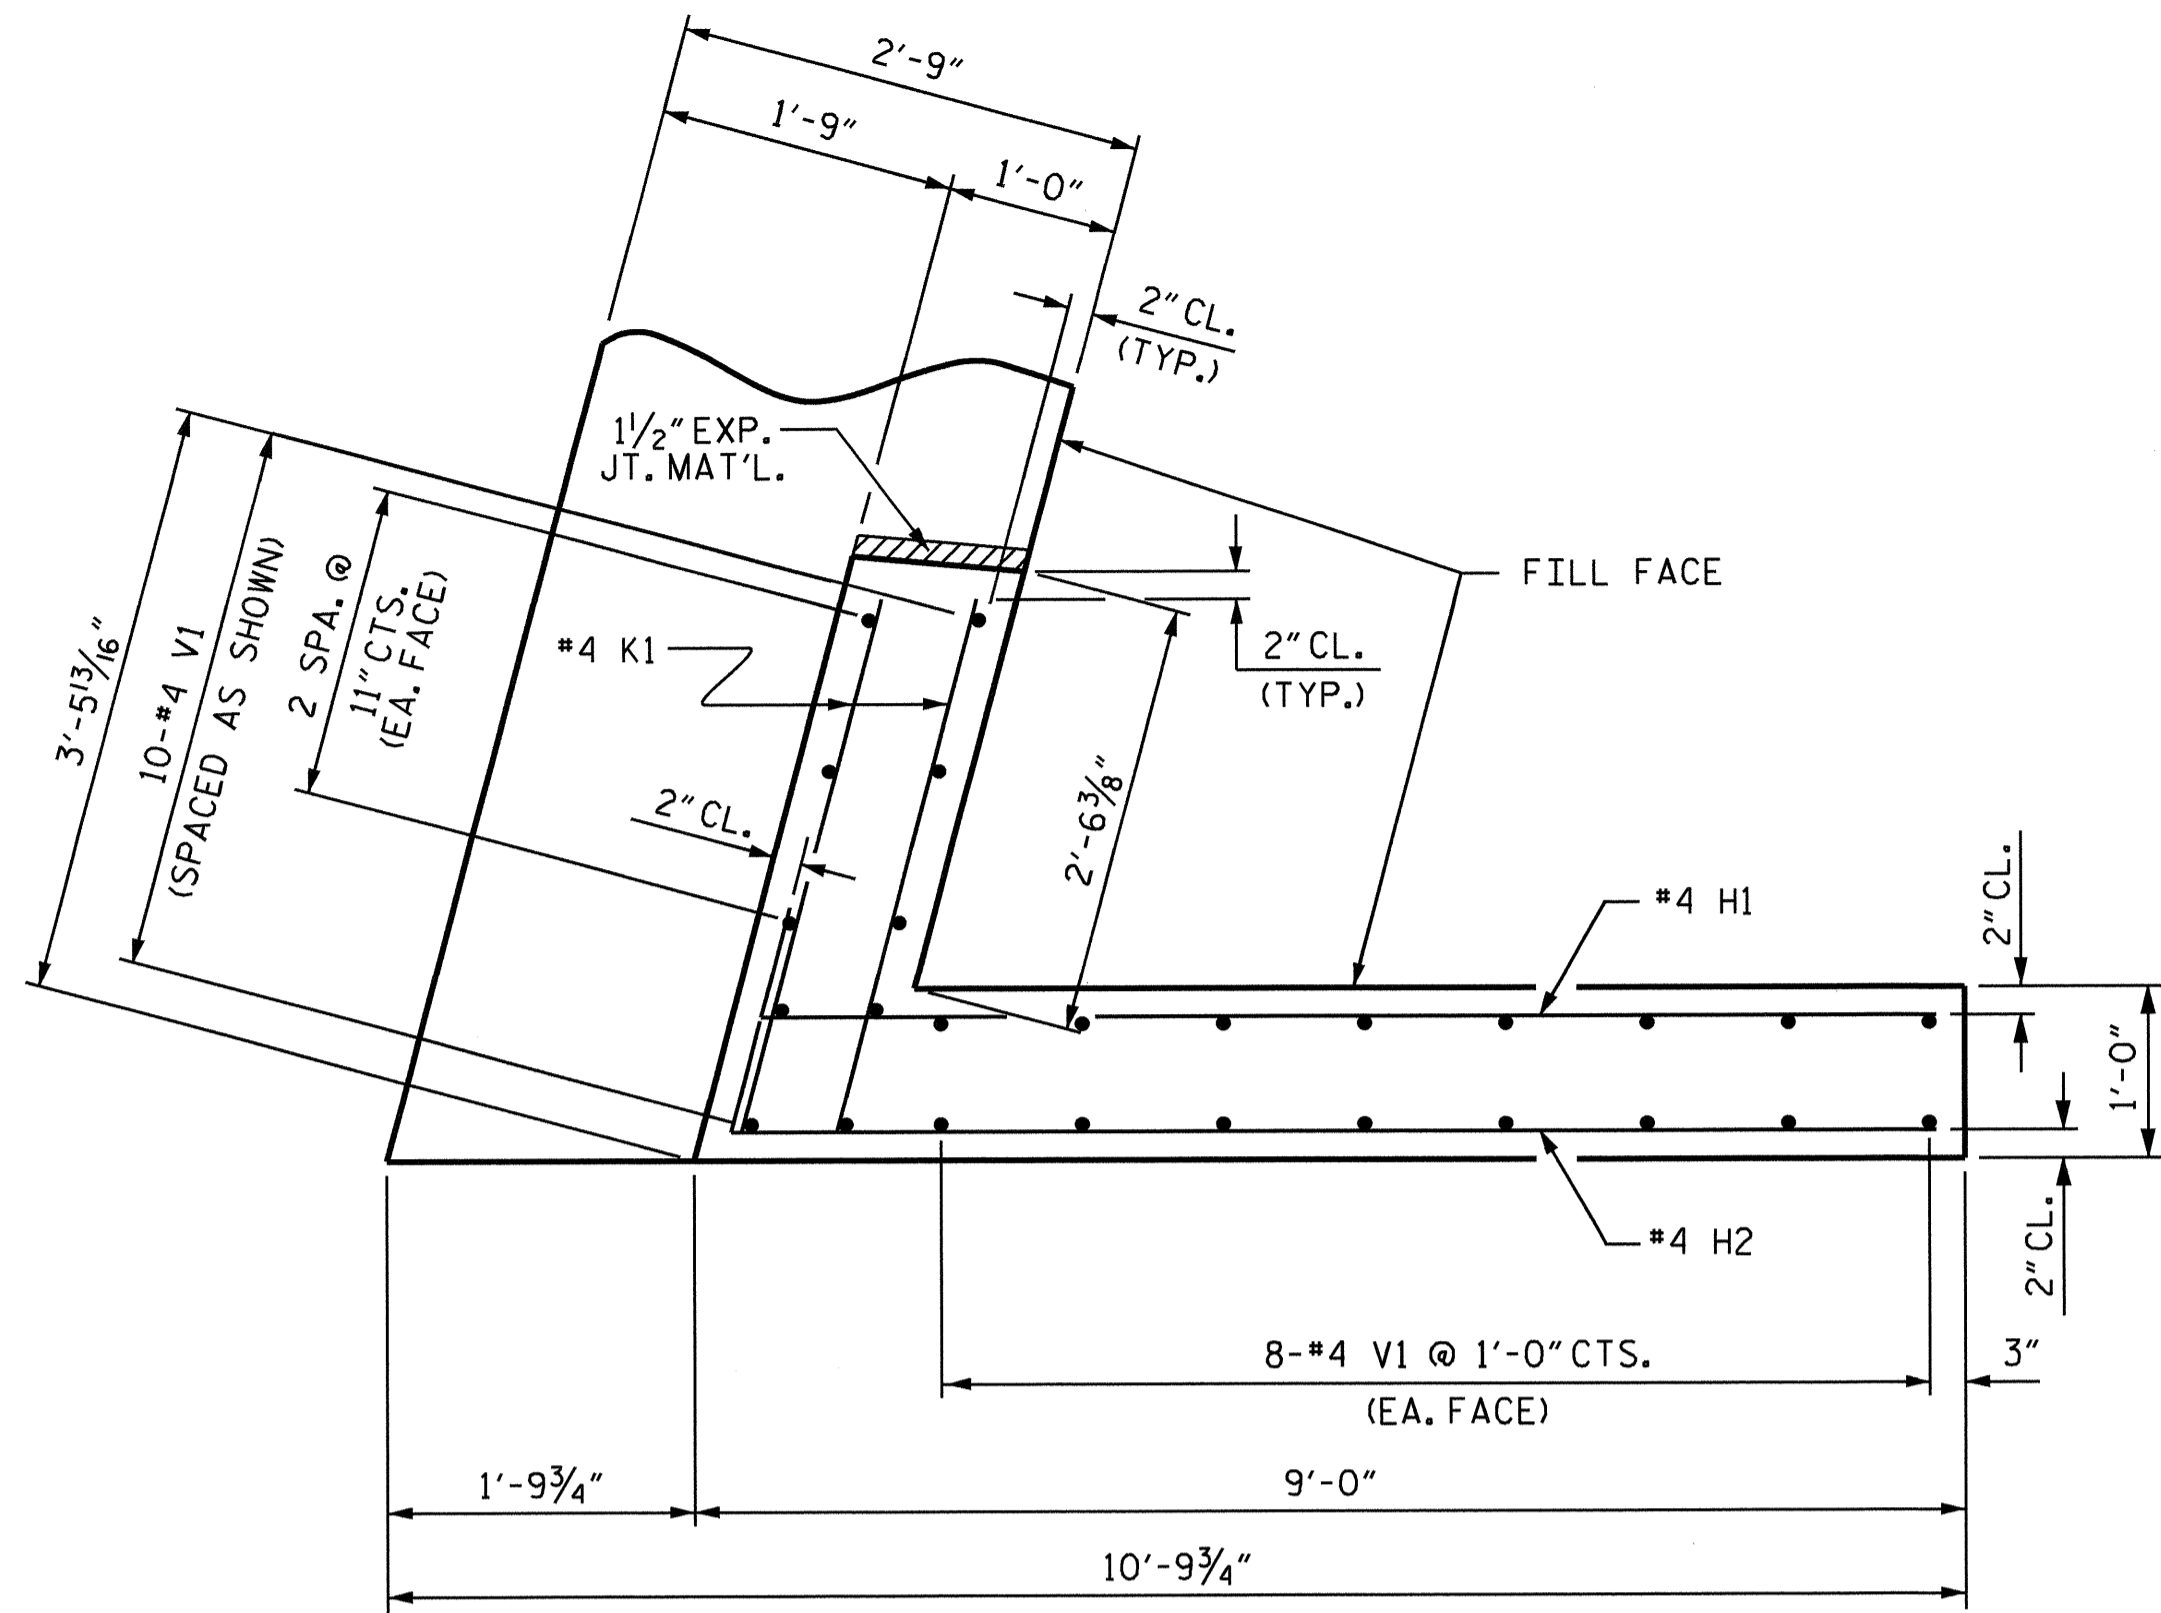


PLAN OF WING (W1)

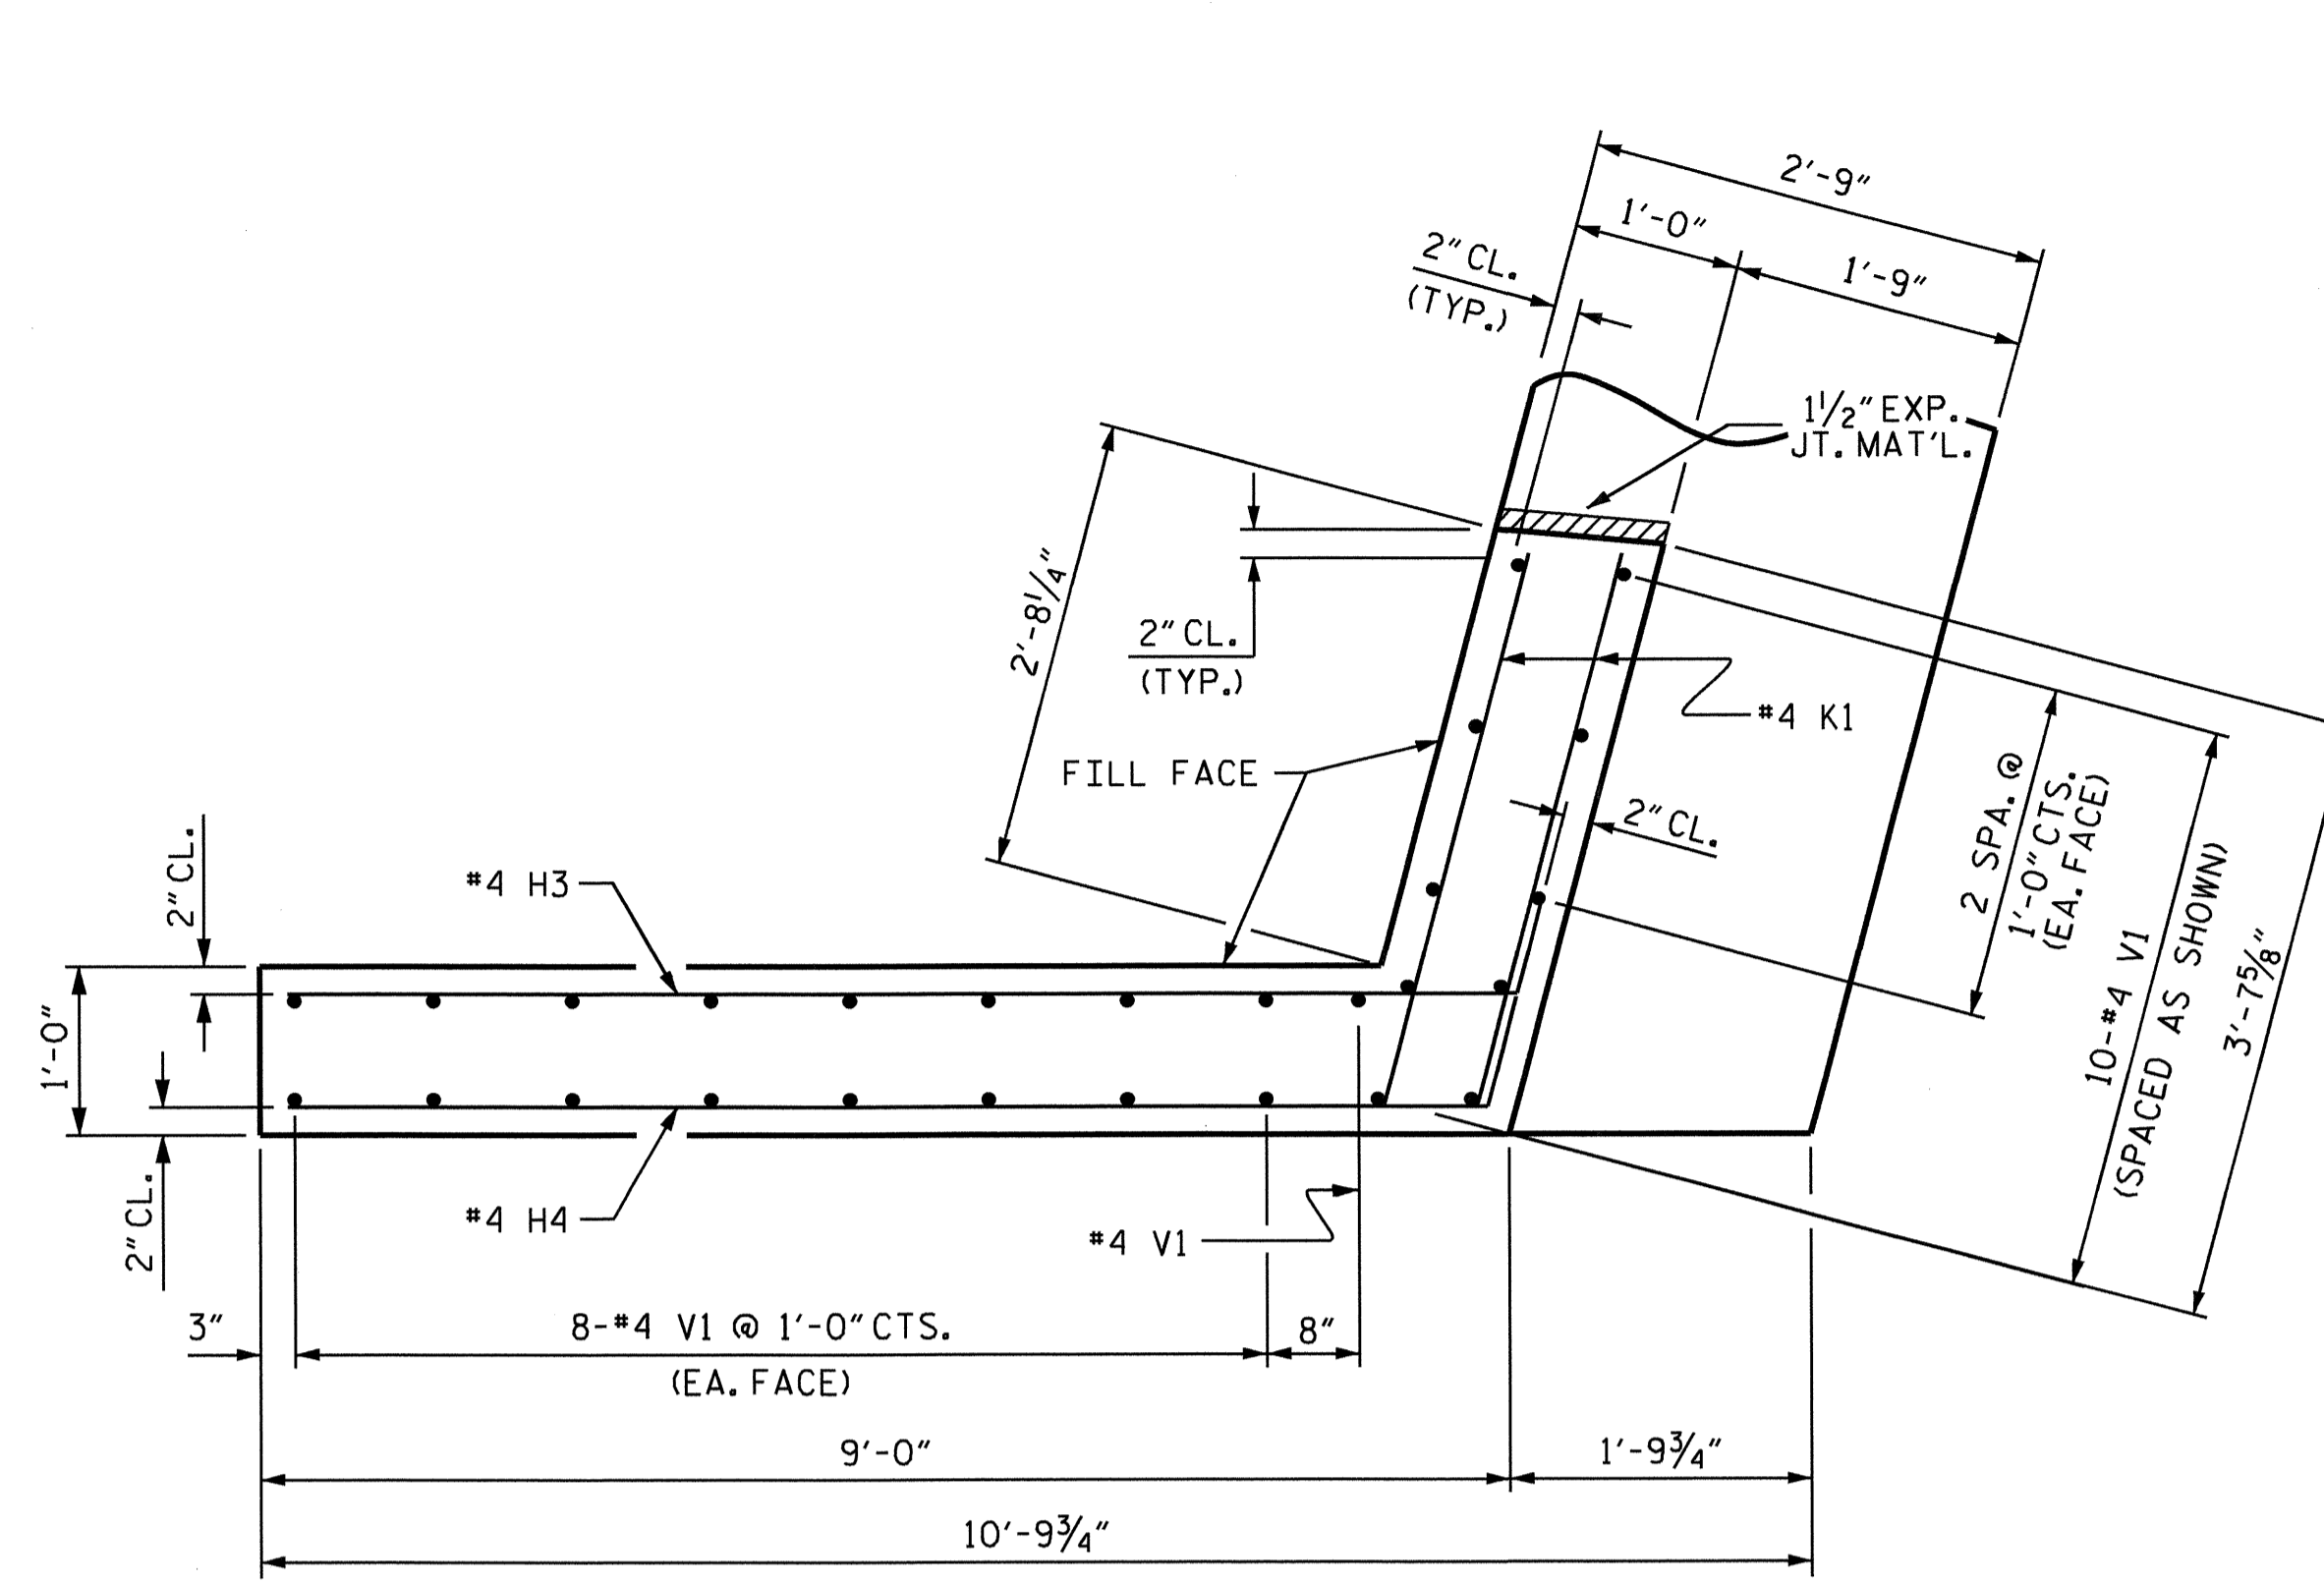


PLAN OF WING (W2)

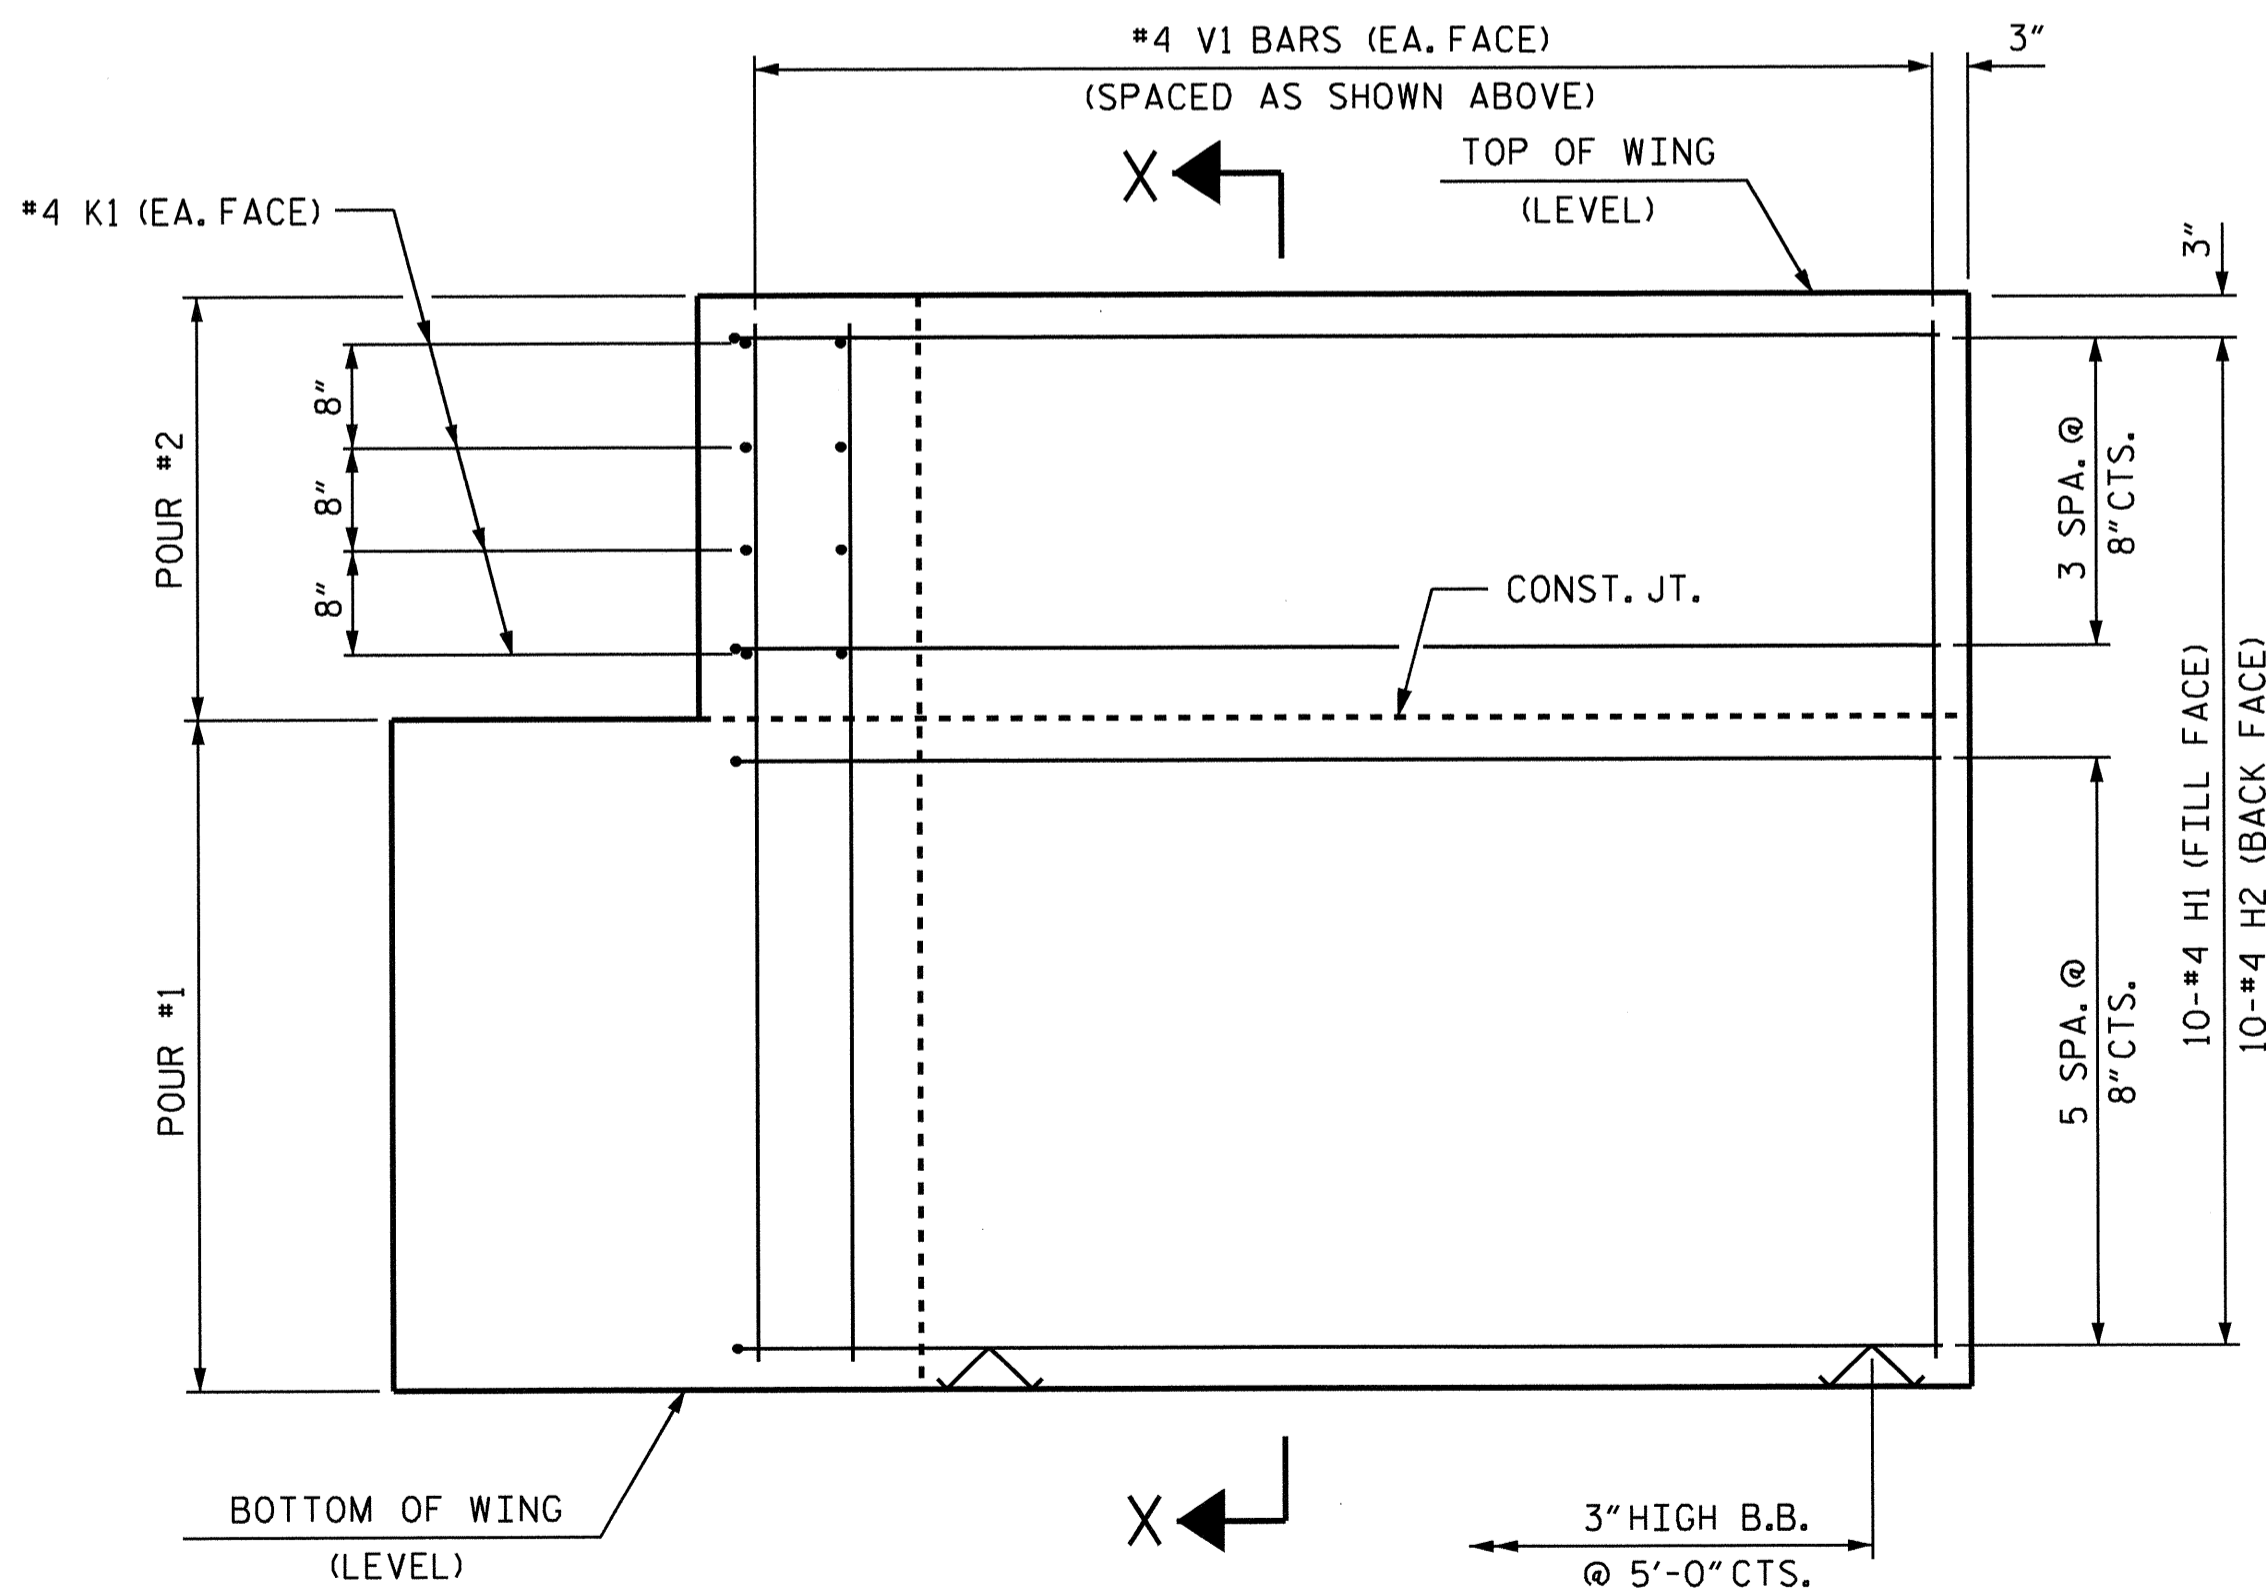


ELEVATION OF WING (W1)

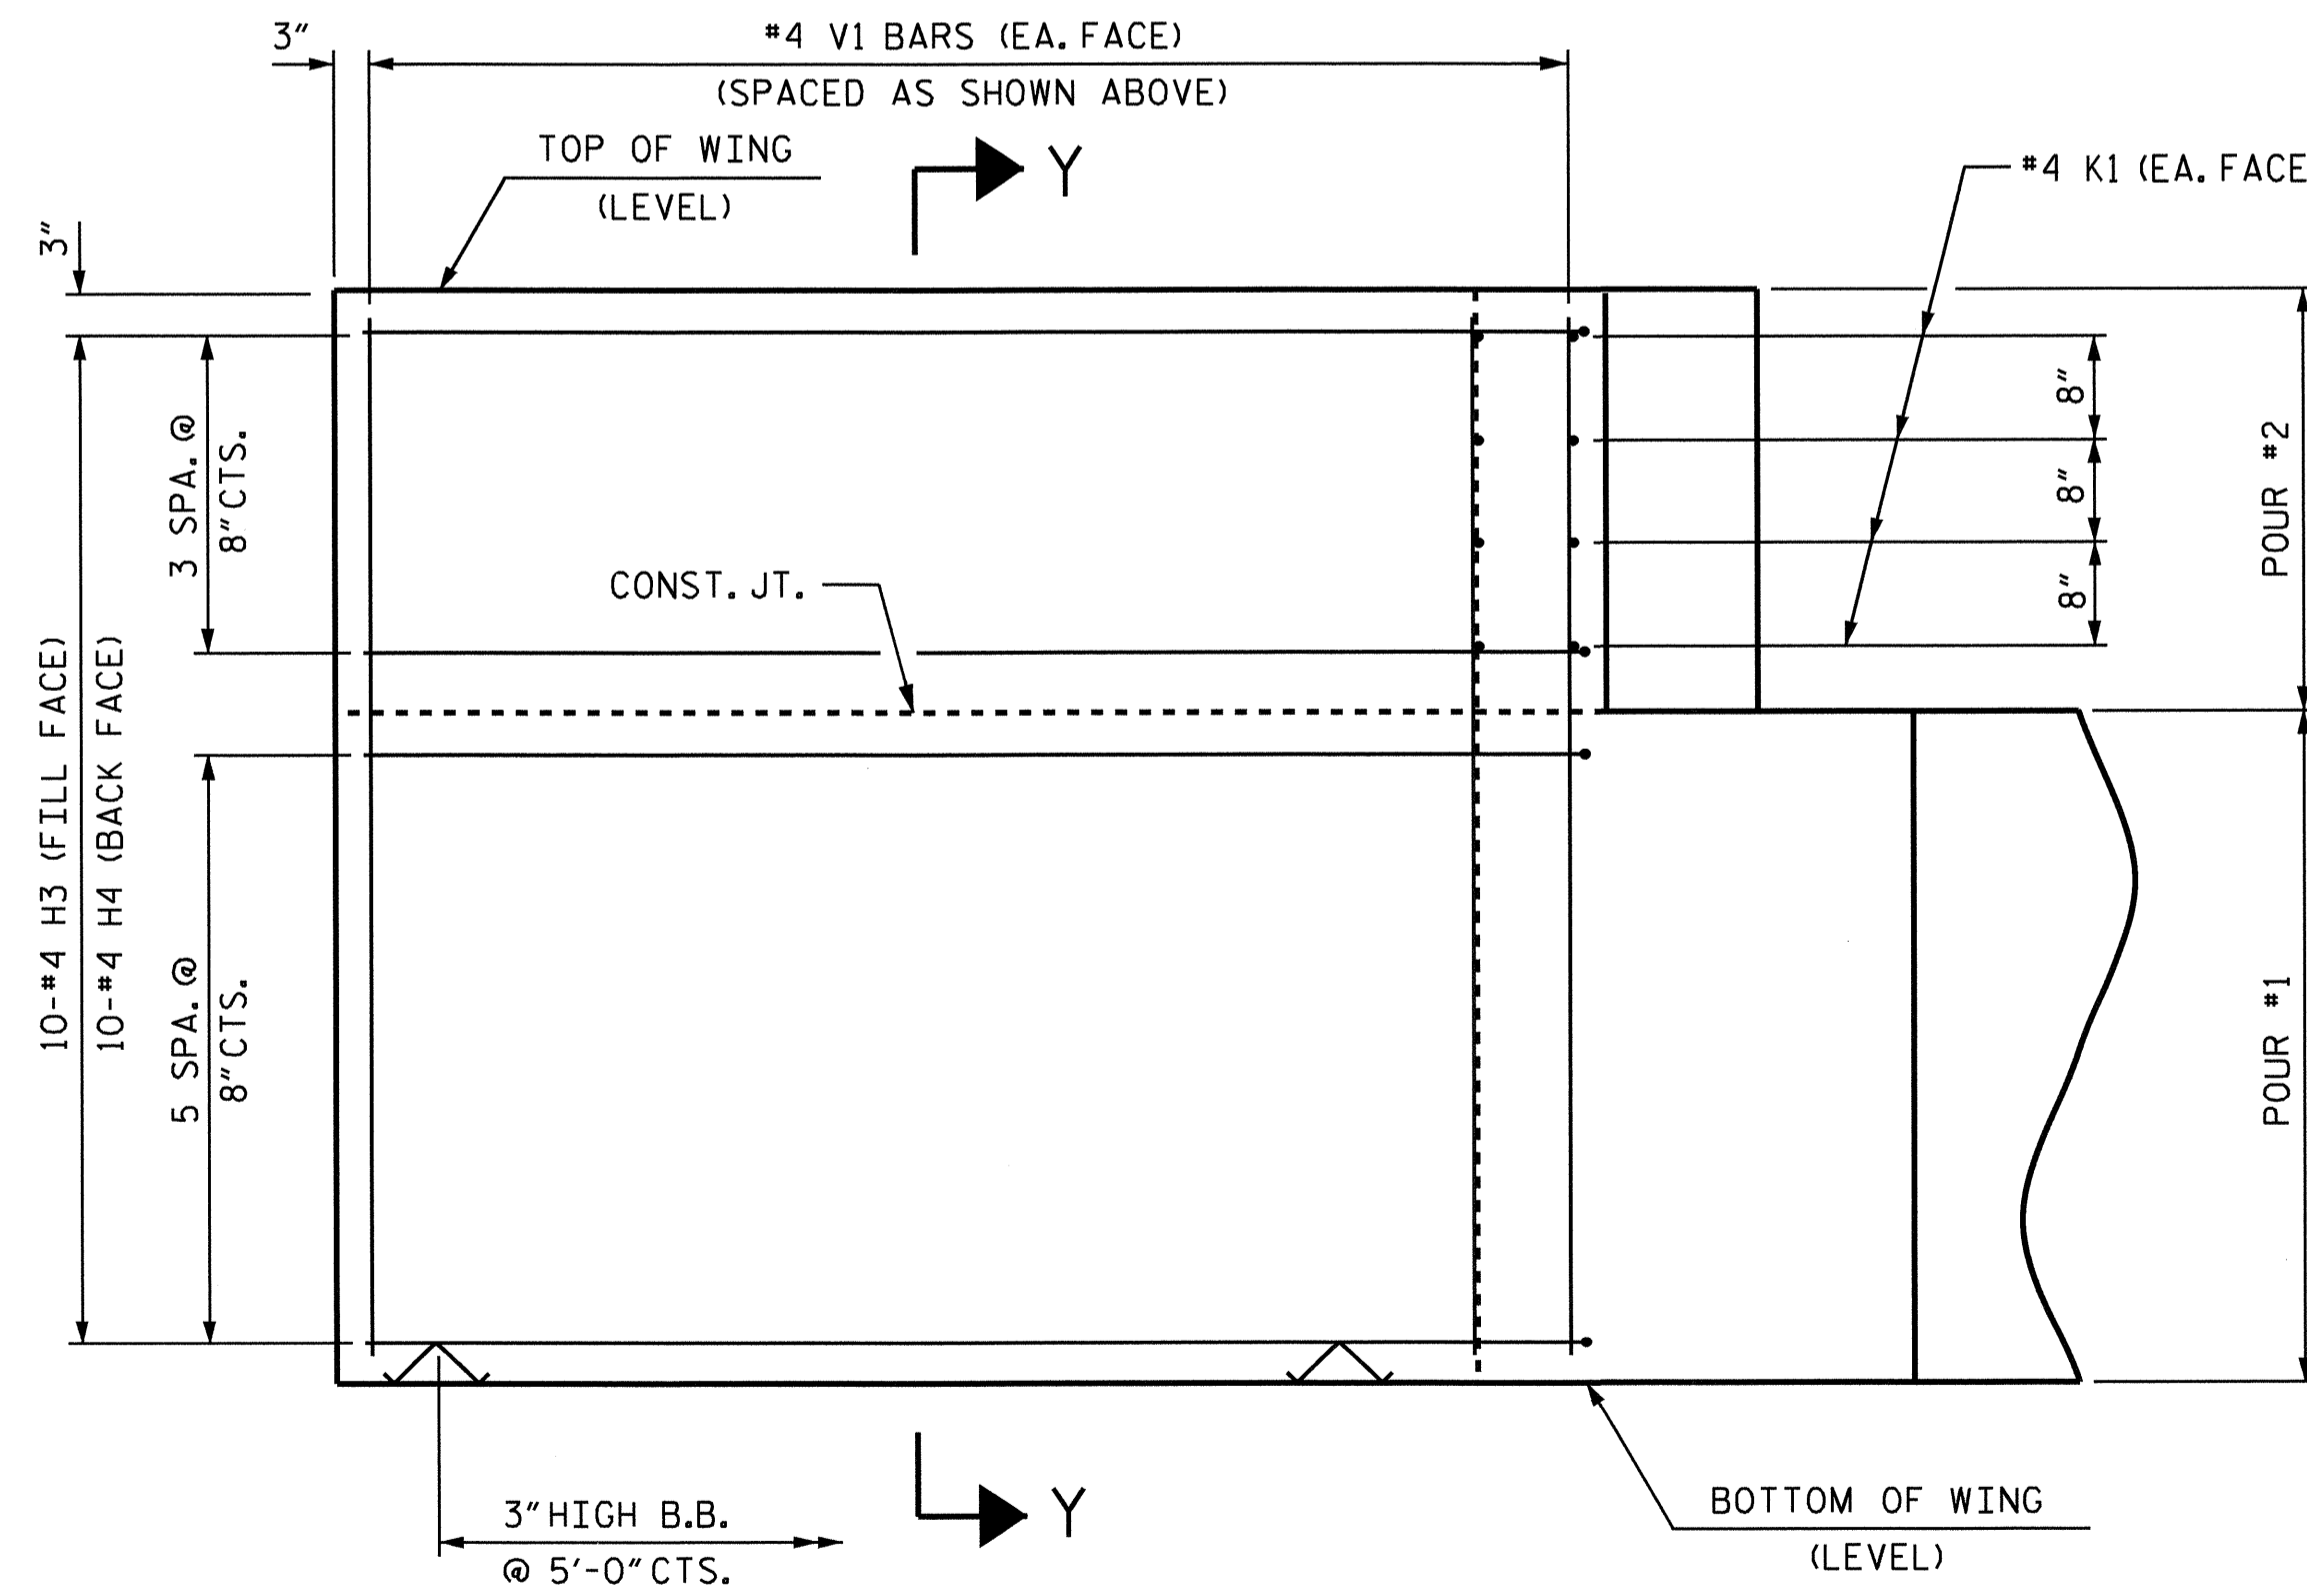

ELEVATION OF WING (W2)

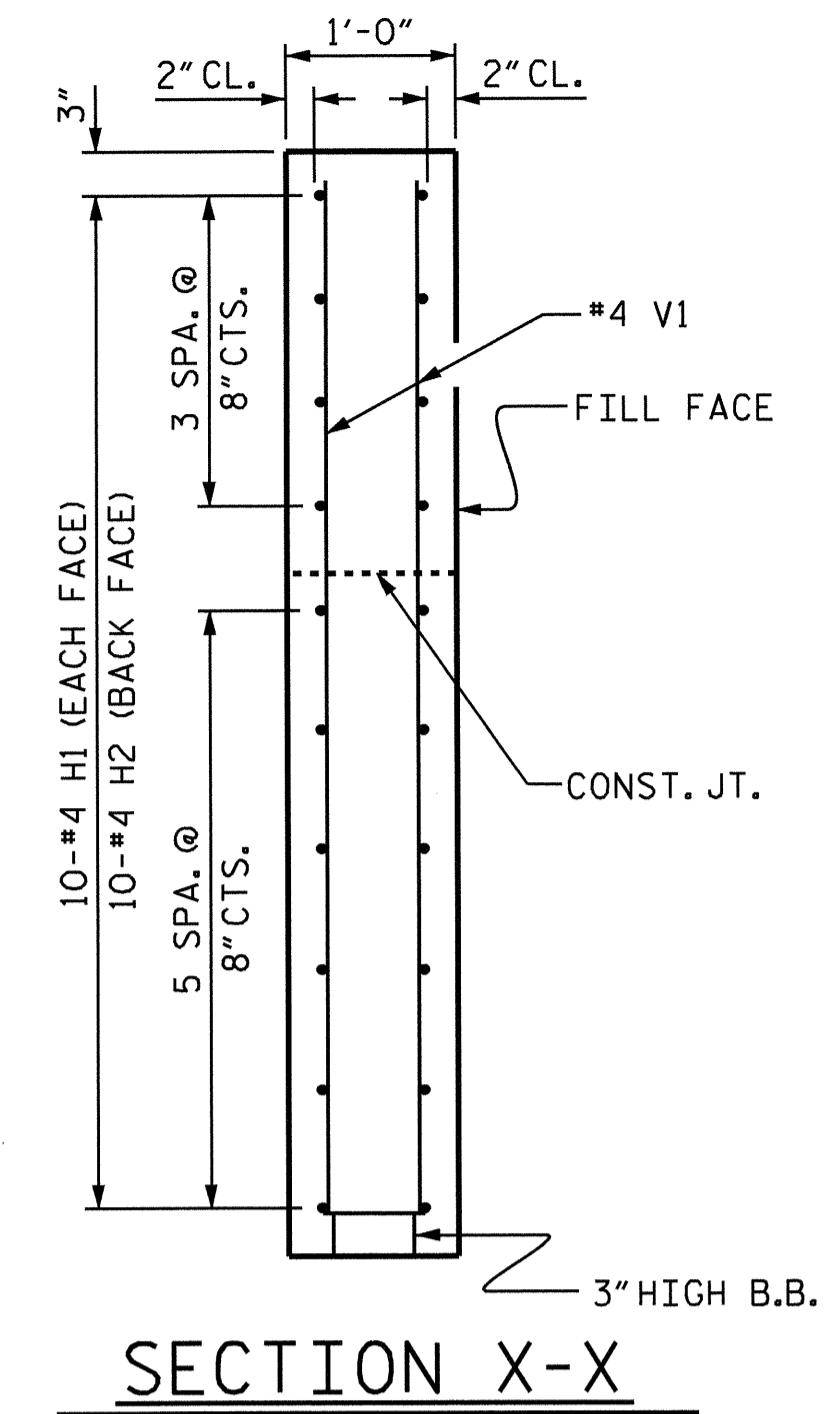

SECTION X-X

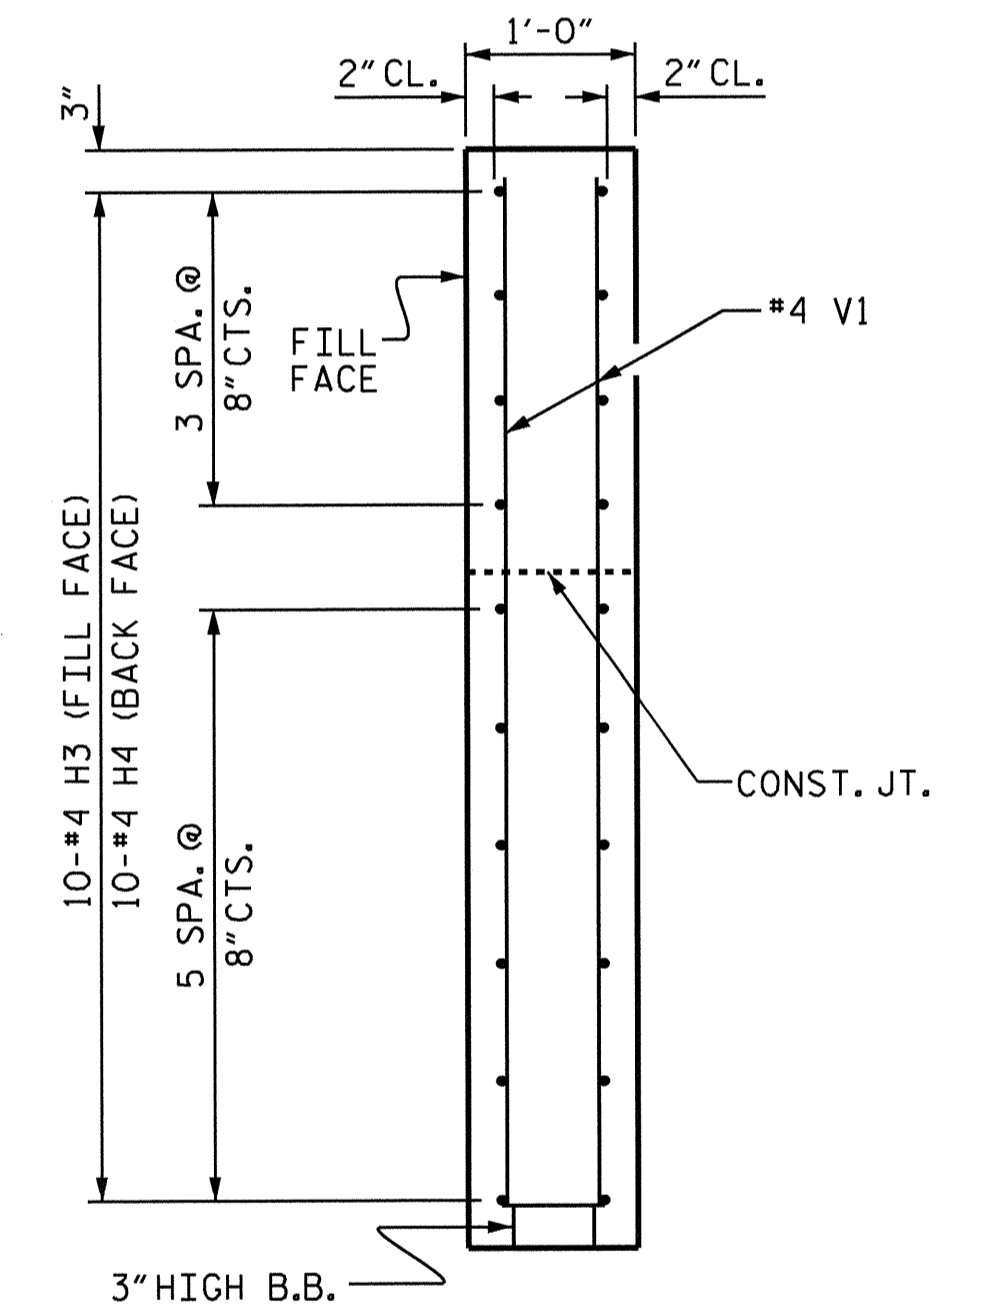


SECTION Y-Y

PROJECT NO. B-4731
 CHATHAM COUNTY
 STATION: 16+13.50 -L-

SHEET 3 OF 5

STATE OF NORTH CAROLINA
 DEPARTMENT OF TRANSPORTATION
 RALEIGH


SUBSTRUCTURE
 END BENT 1
 WING DETAILS

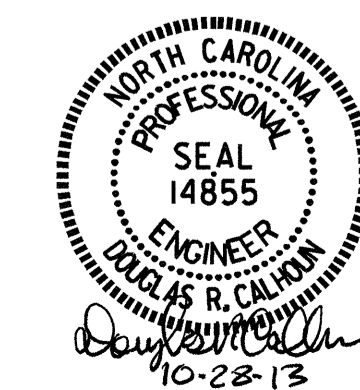


ASSEMBLED BY : A.C. OUTLAW DATE : 5/31/12
 CHECKED BY : A. SORSENGINH DATE : 9/13
 DRAWN BY : WJH 12/11
 CHECKED BY : AAC 12/11

WING DETAILS


REVISIONS						SHEET NO.
NO.	BY	DATE	NO.	BY	DATE	S-20
1			3			TOTAL SHEETS
2			4			28

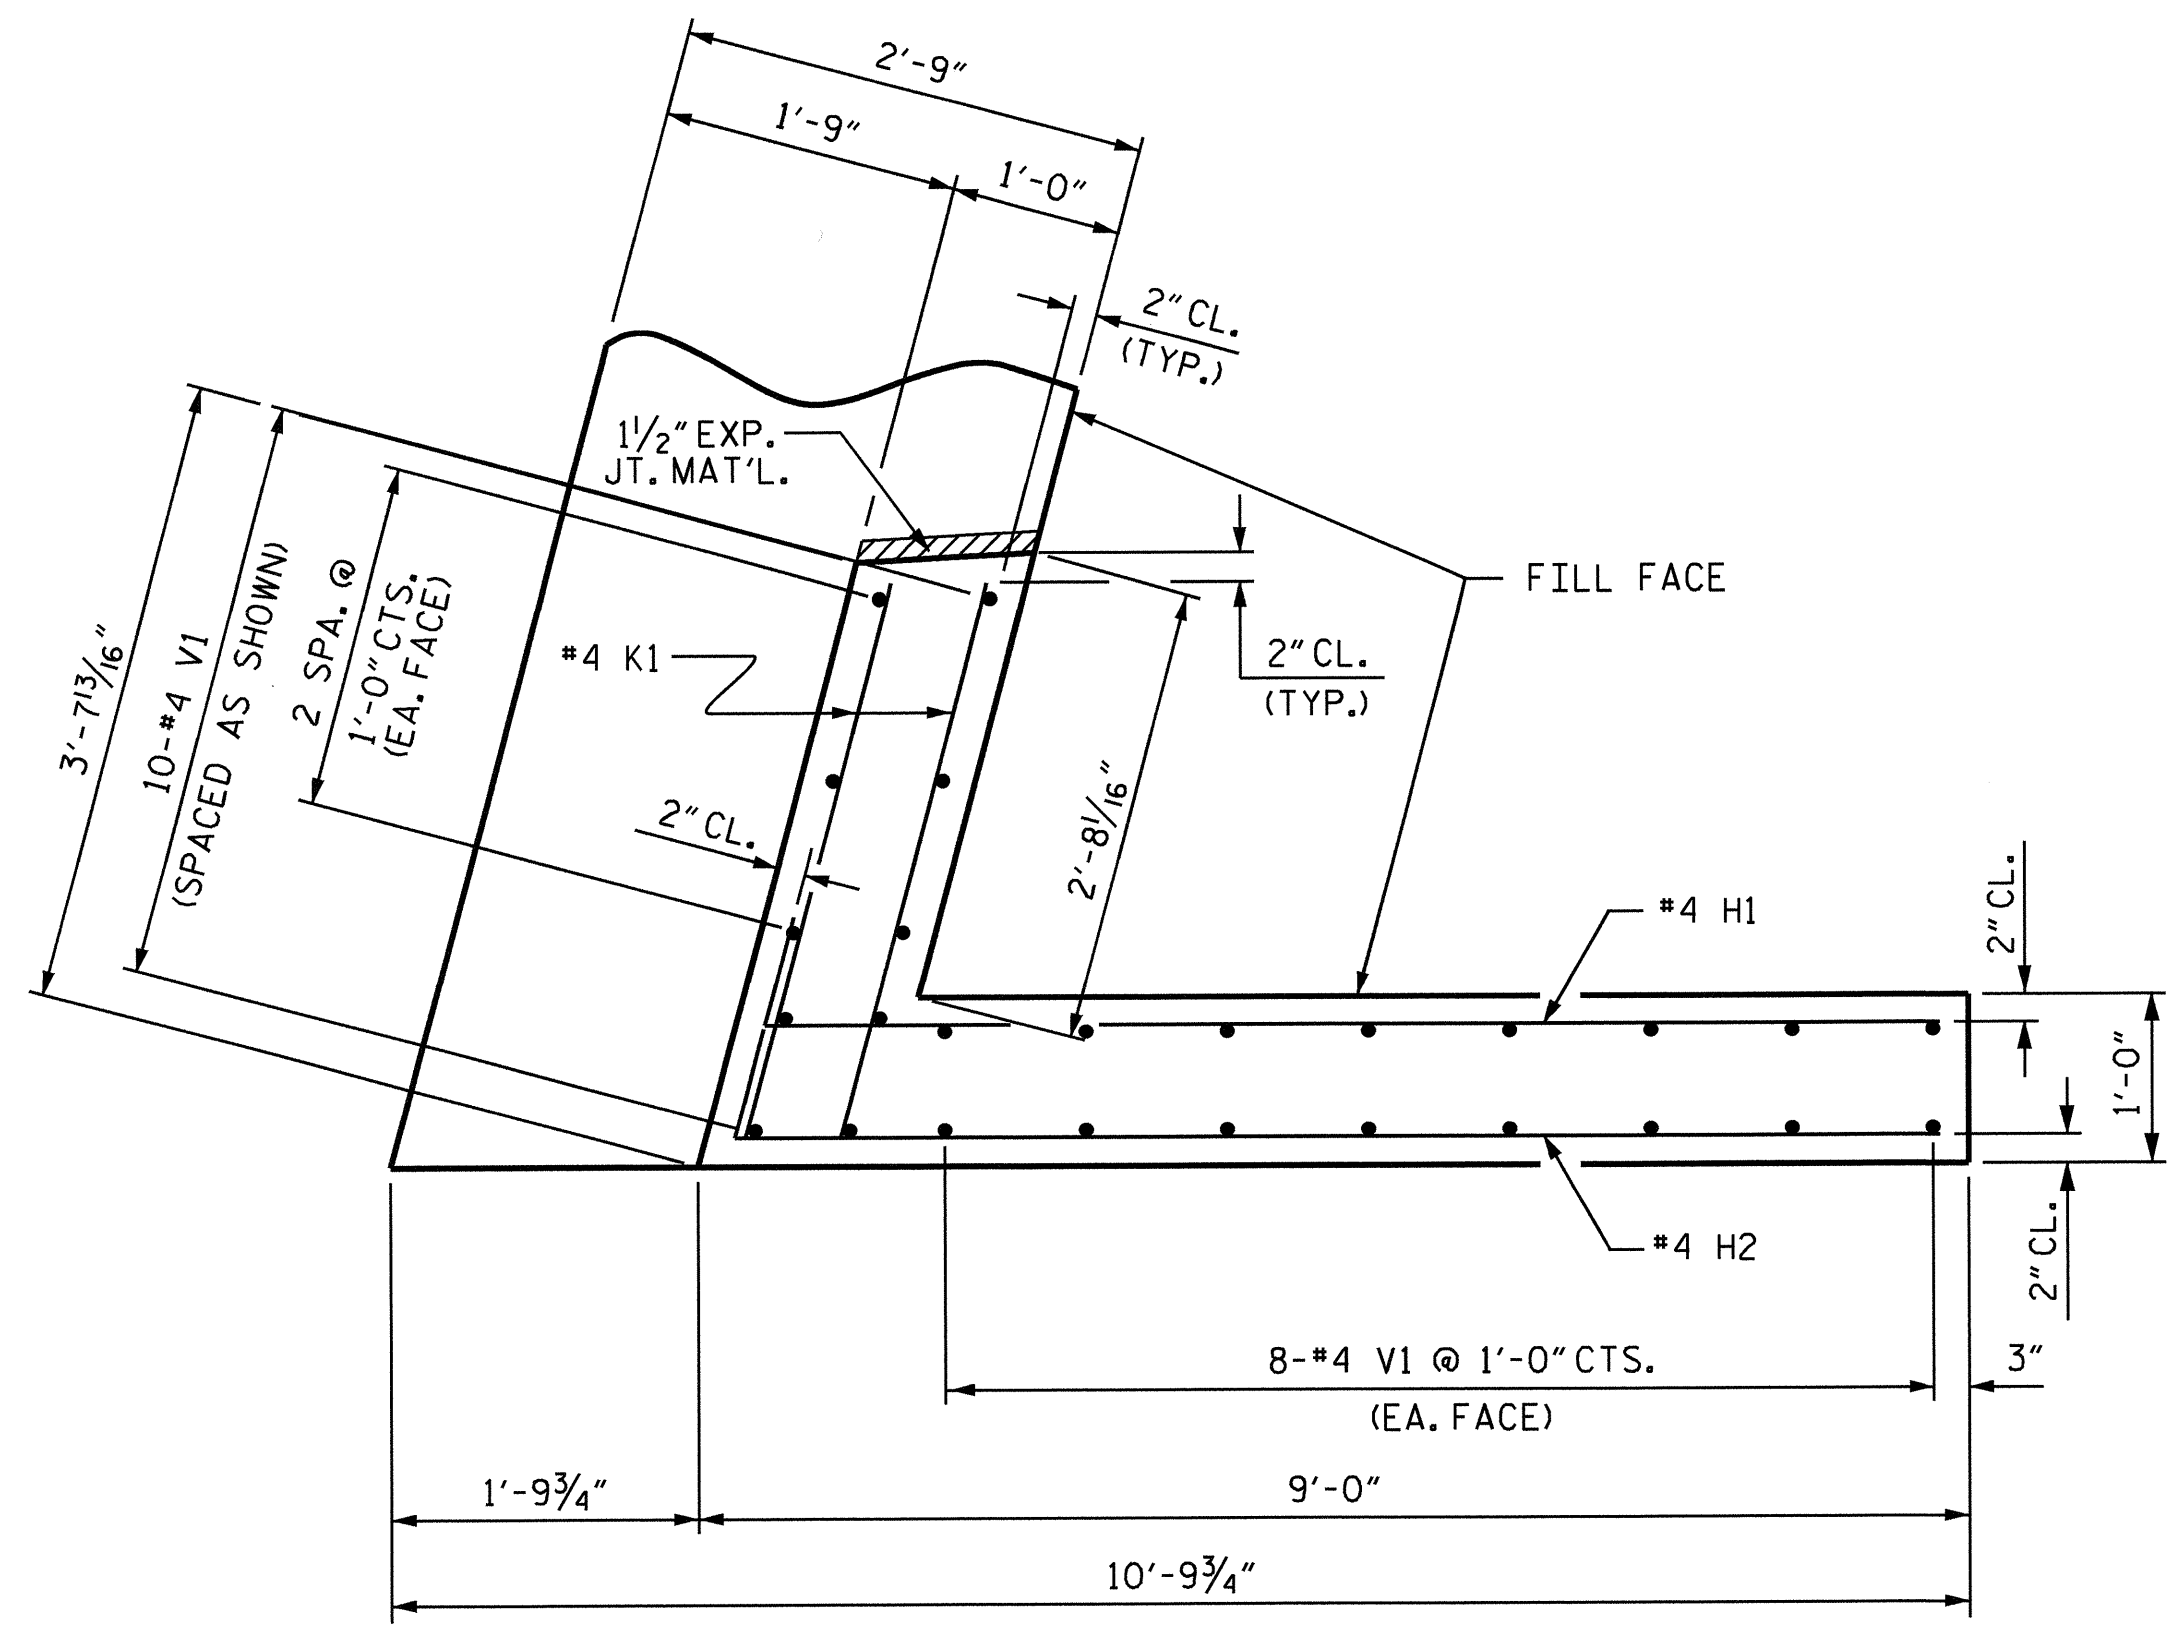


PLAN OF WING (W4)

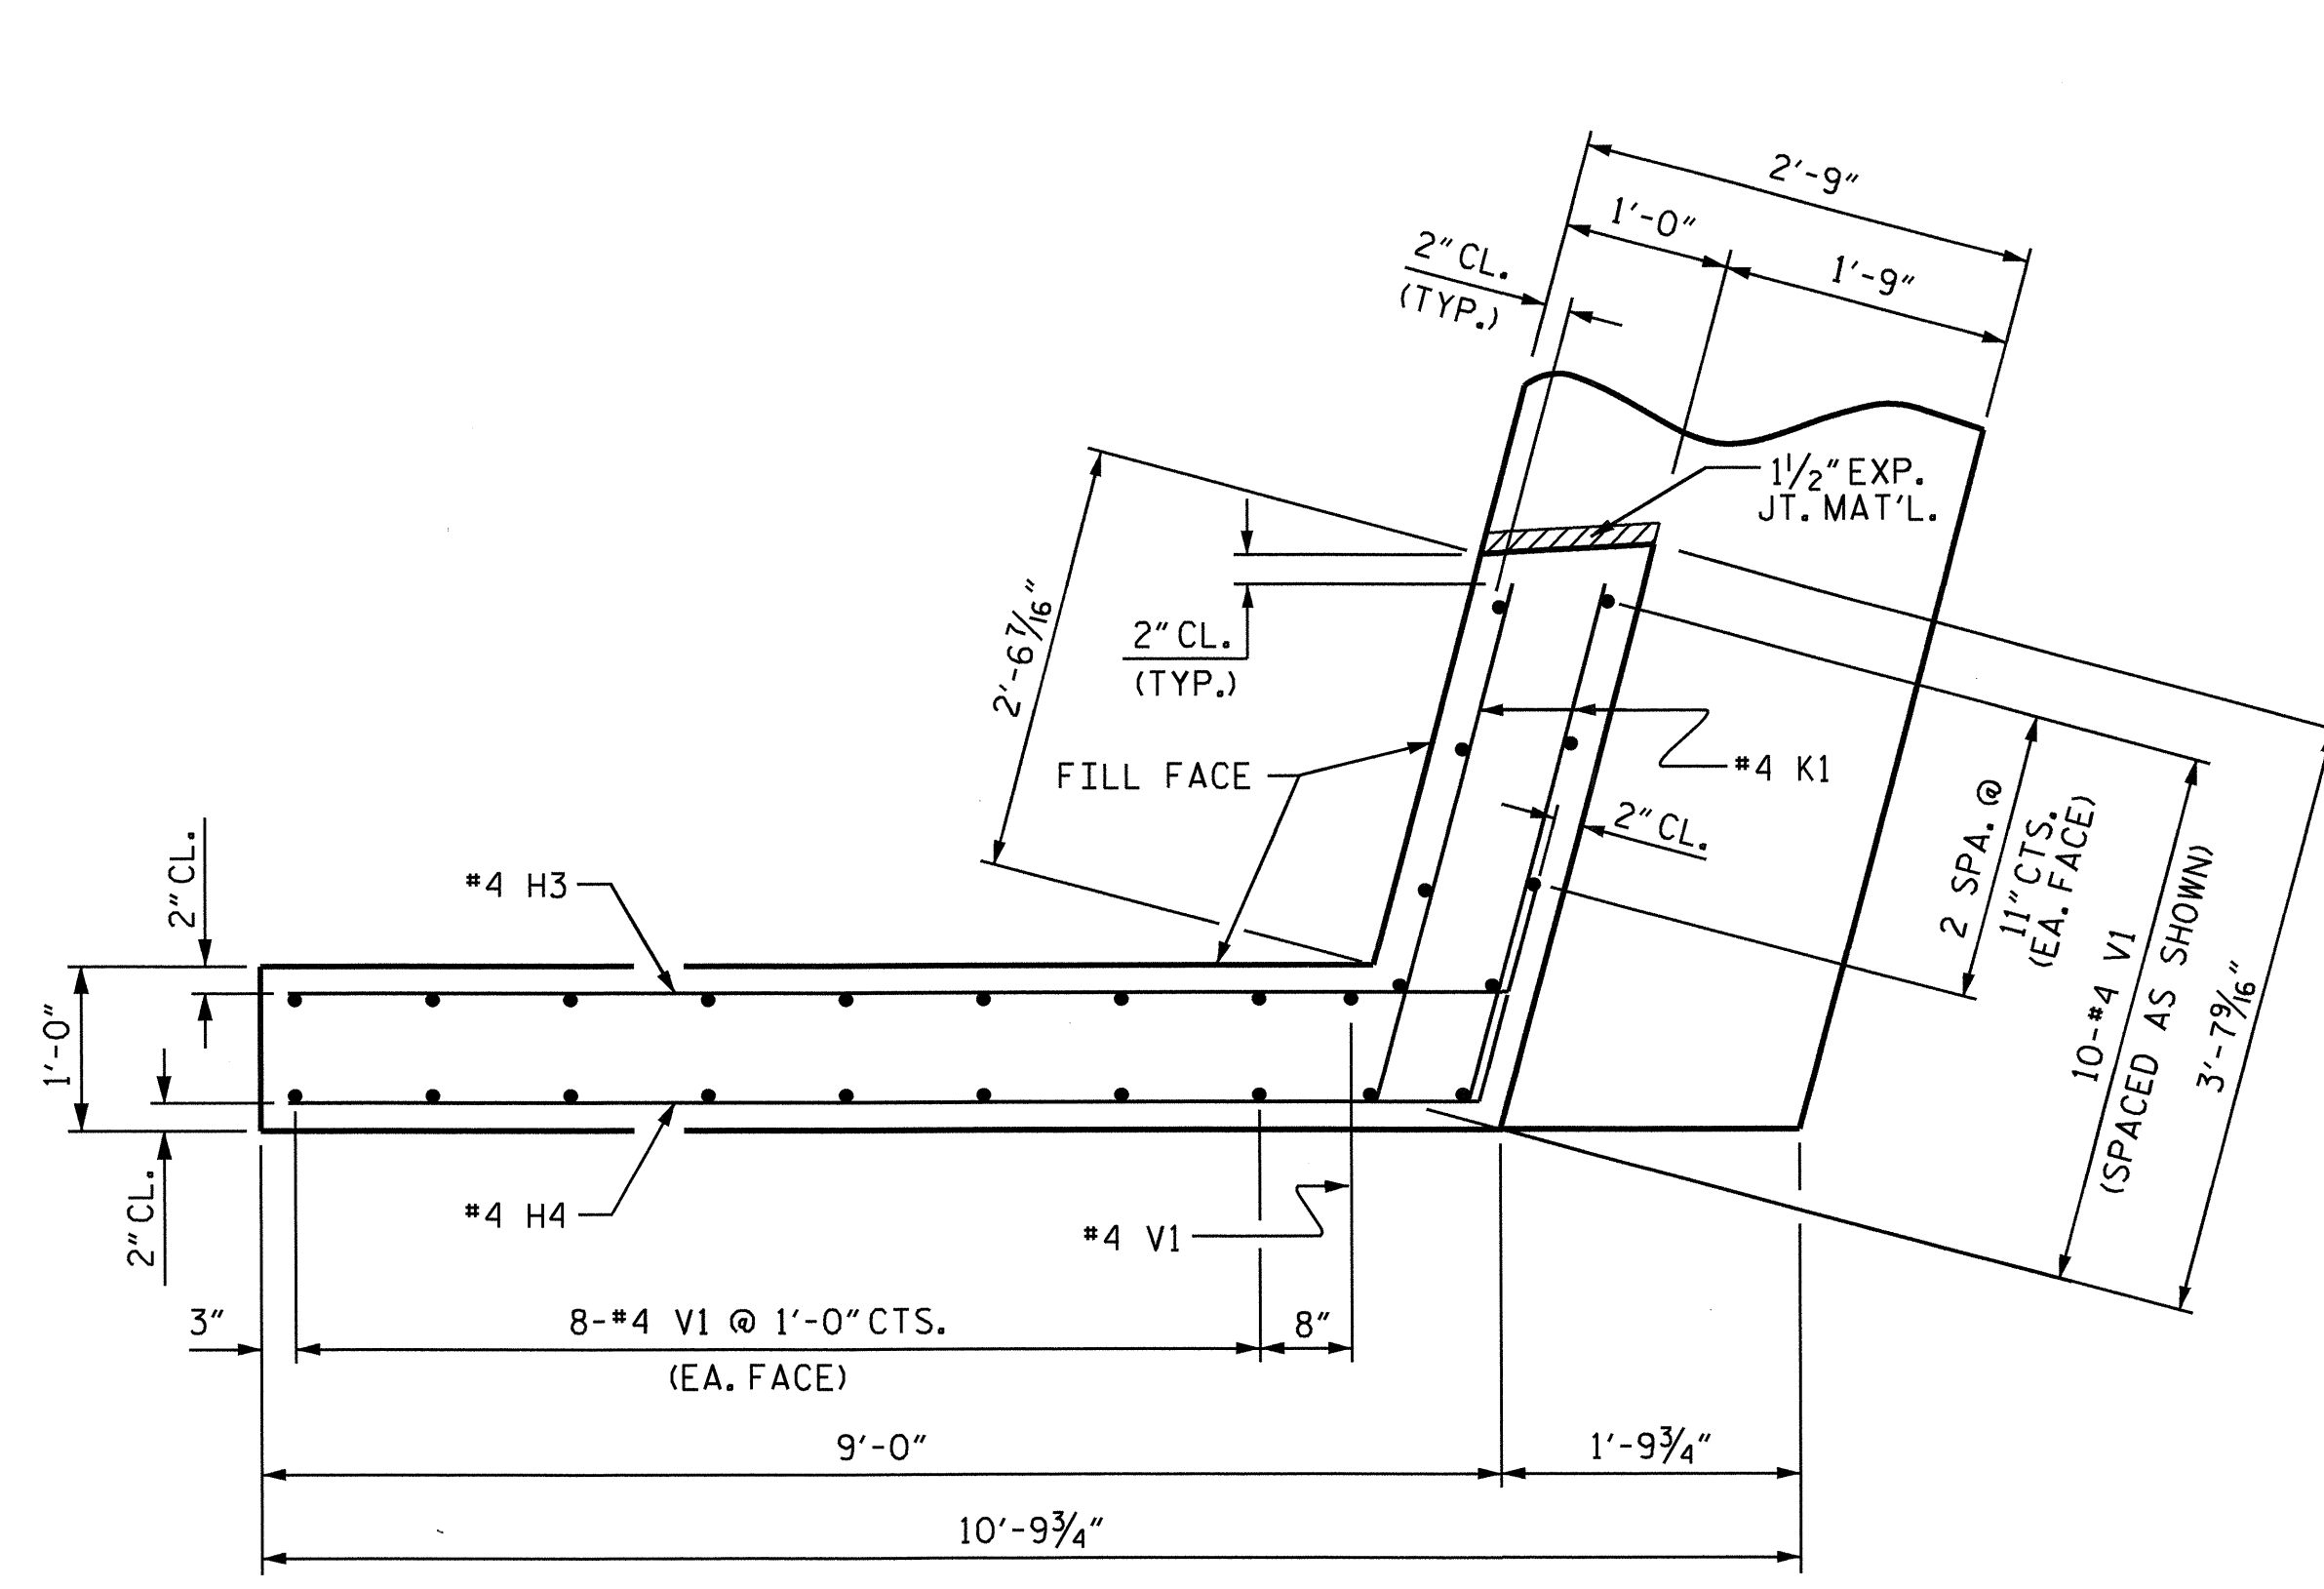


PLAN OF WING (W3)

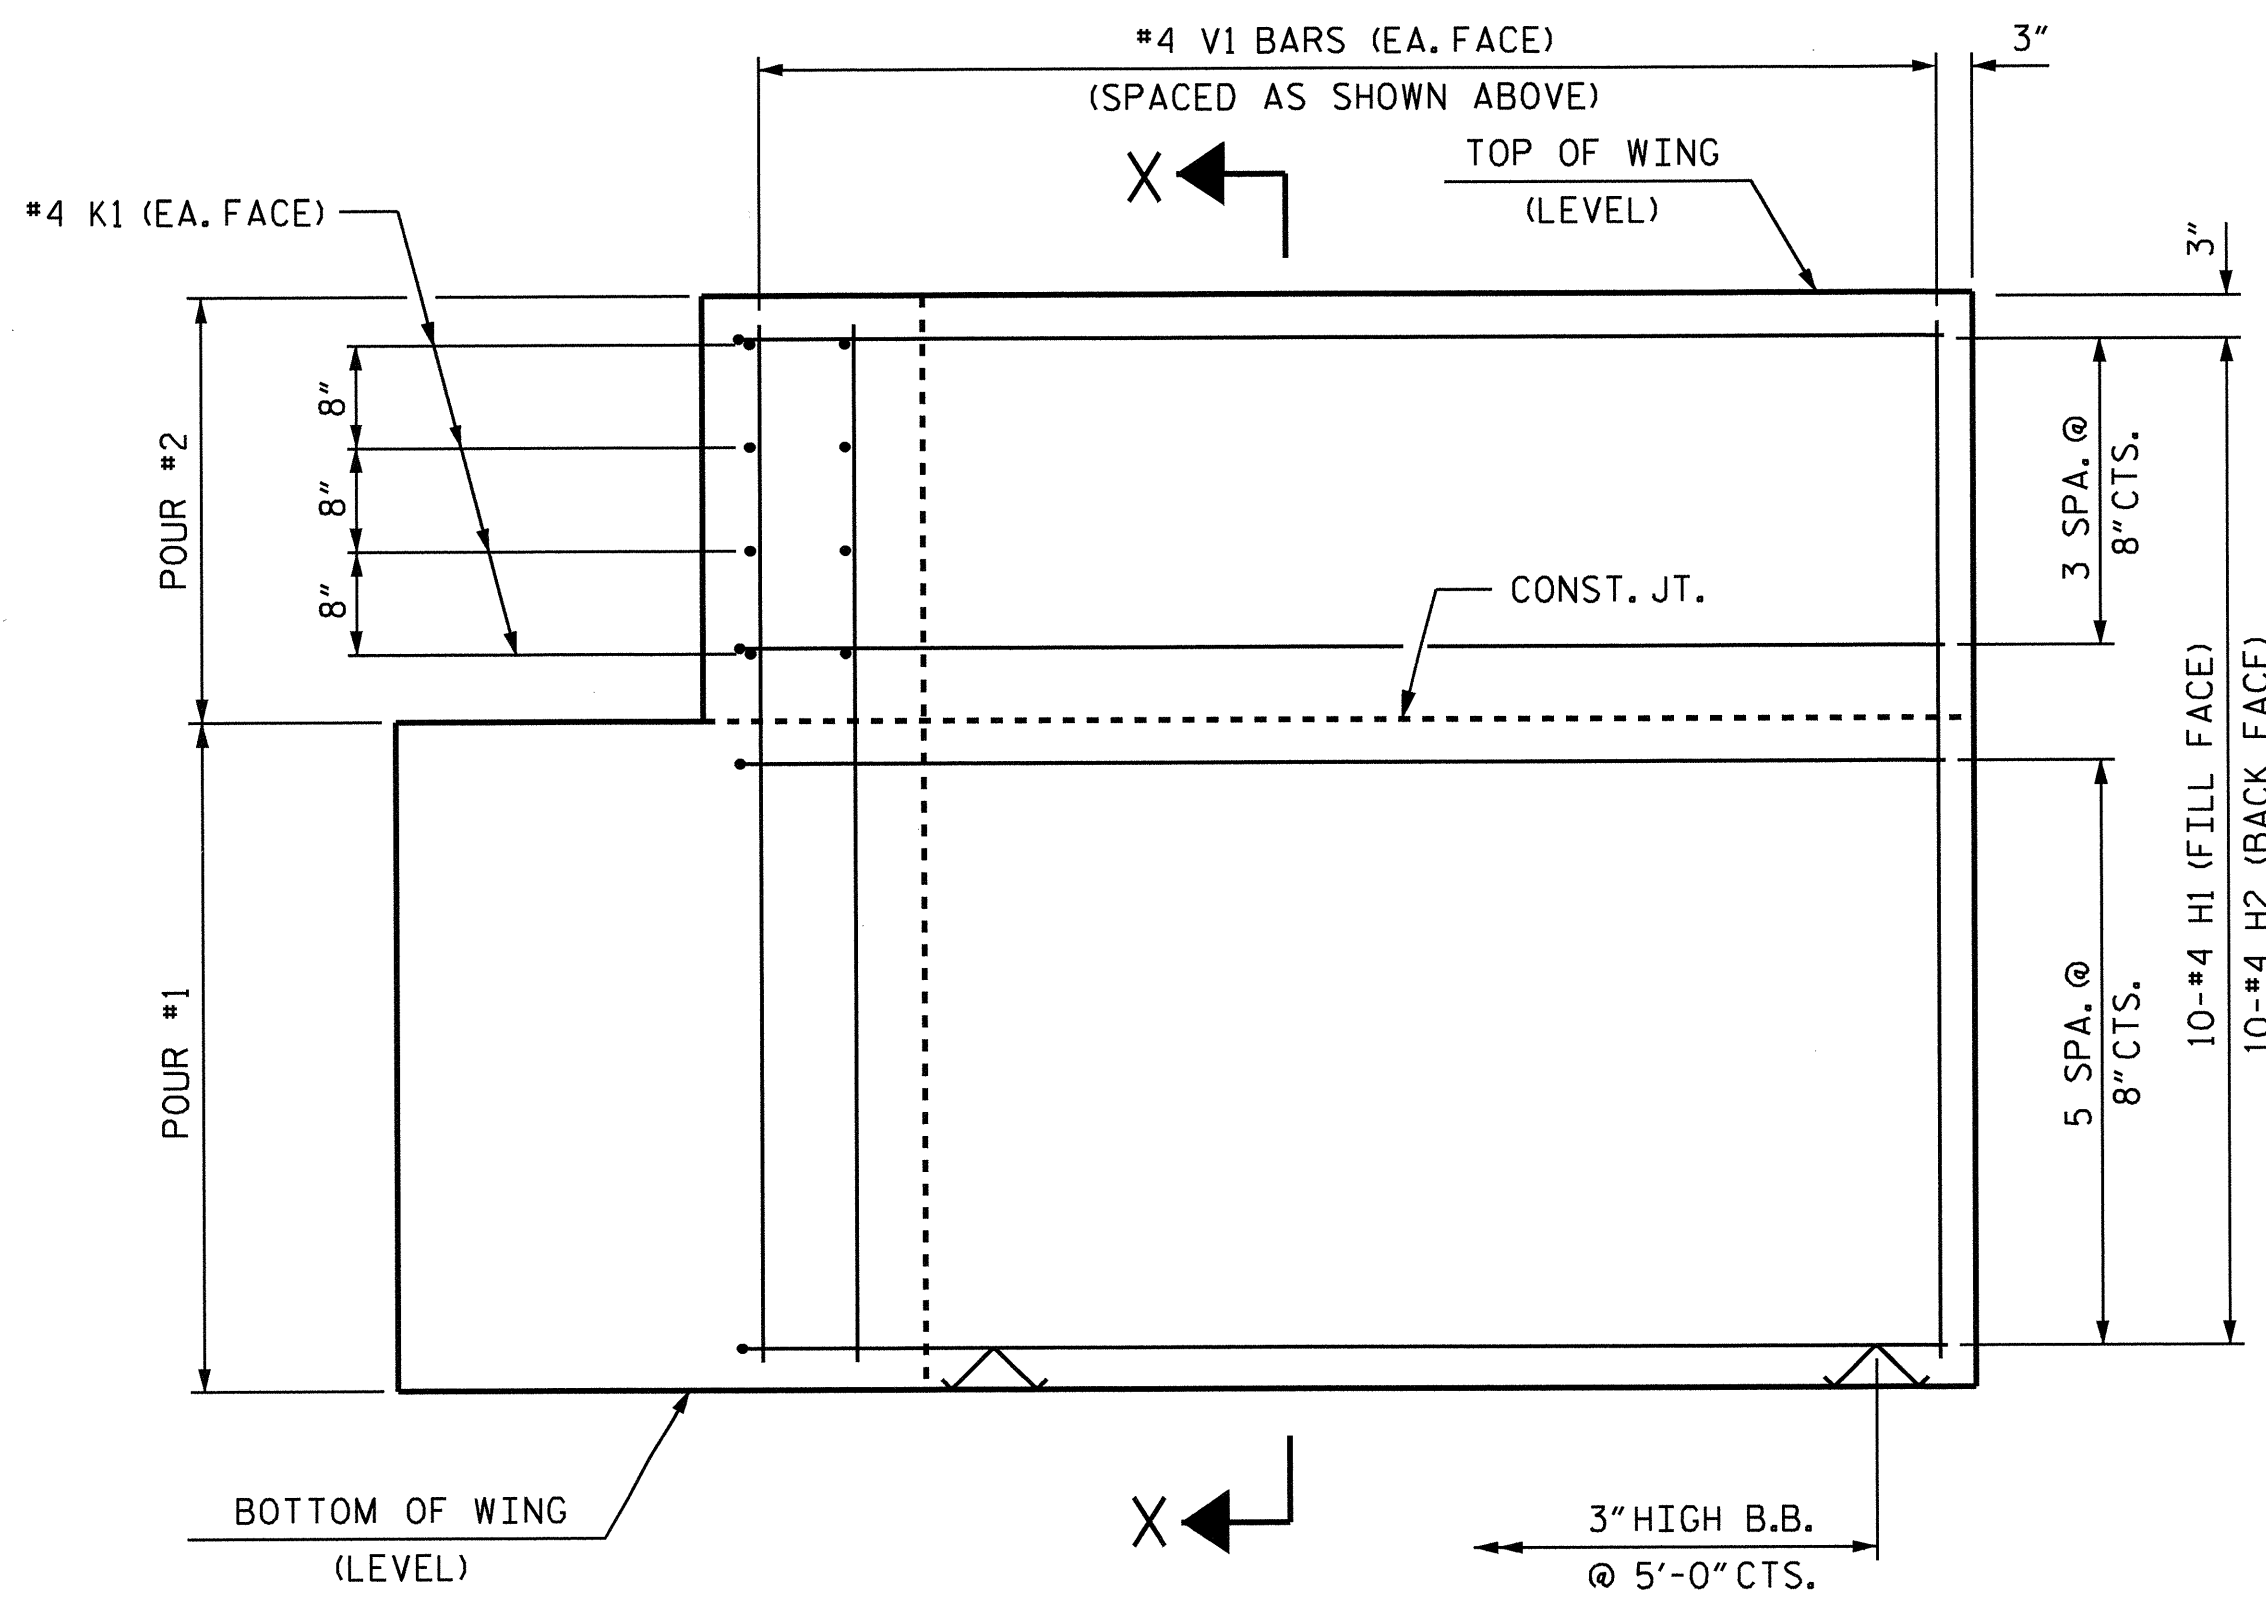


ELEVATION OF WING (W4)

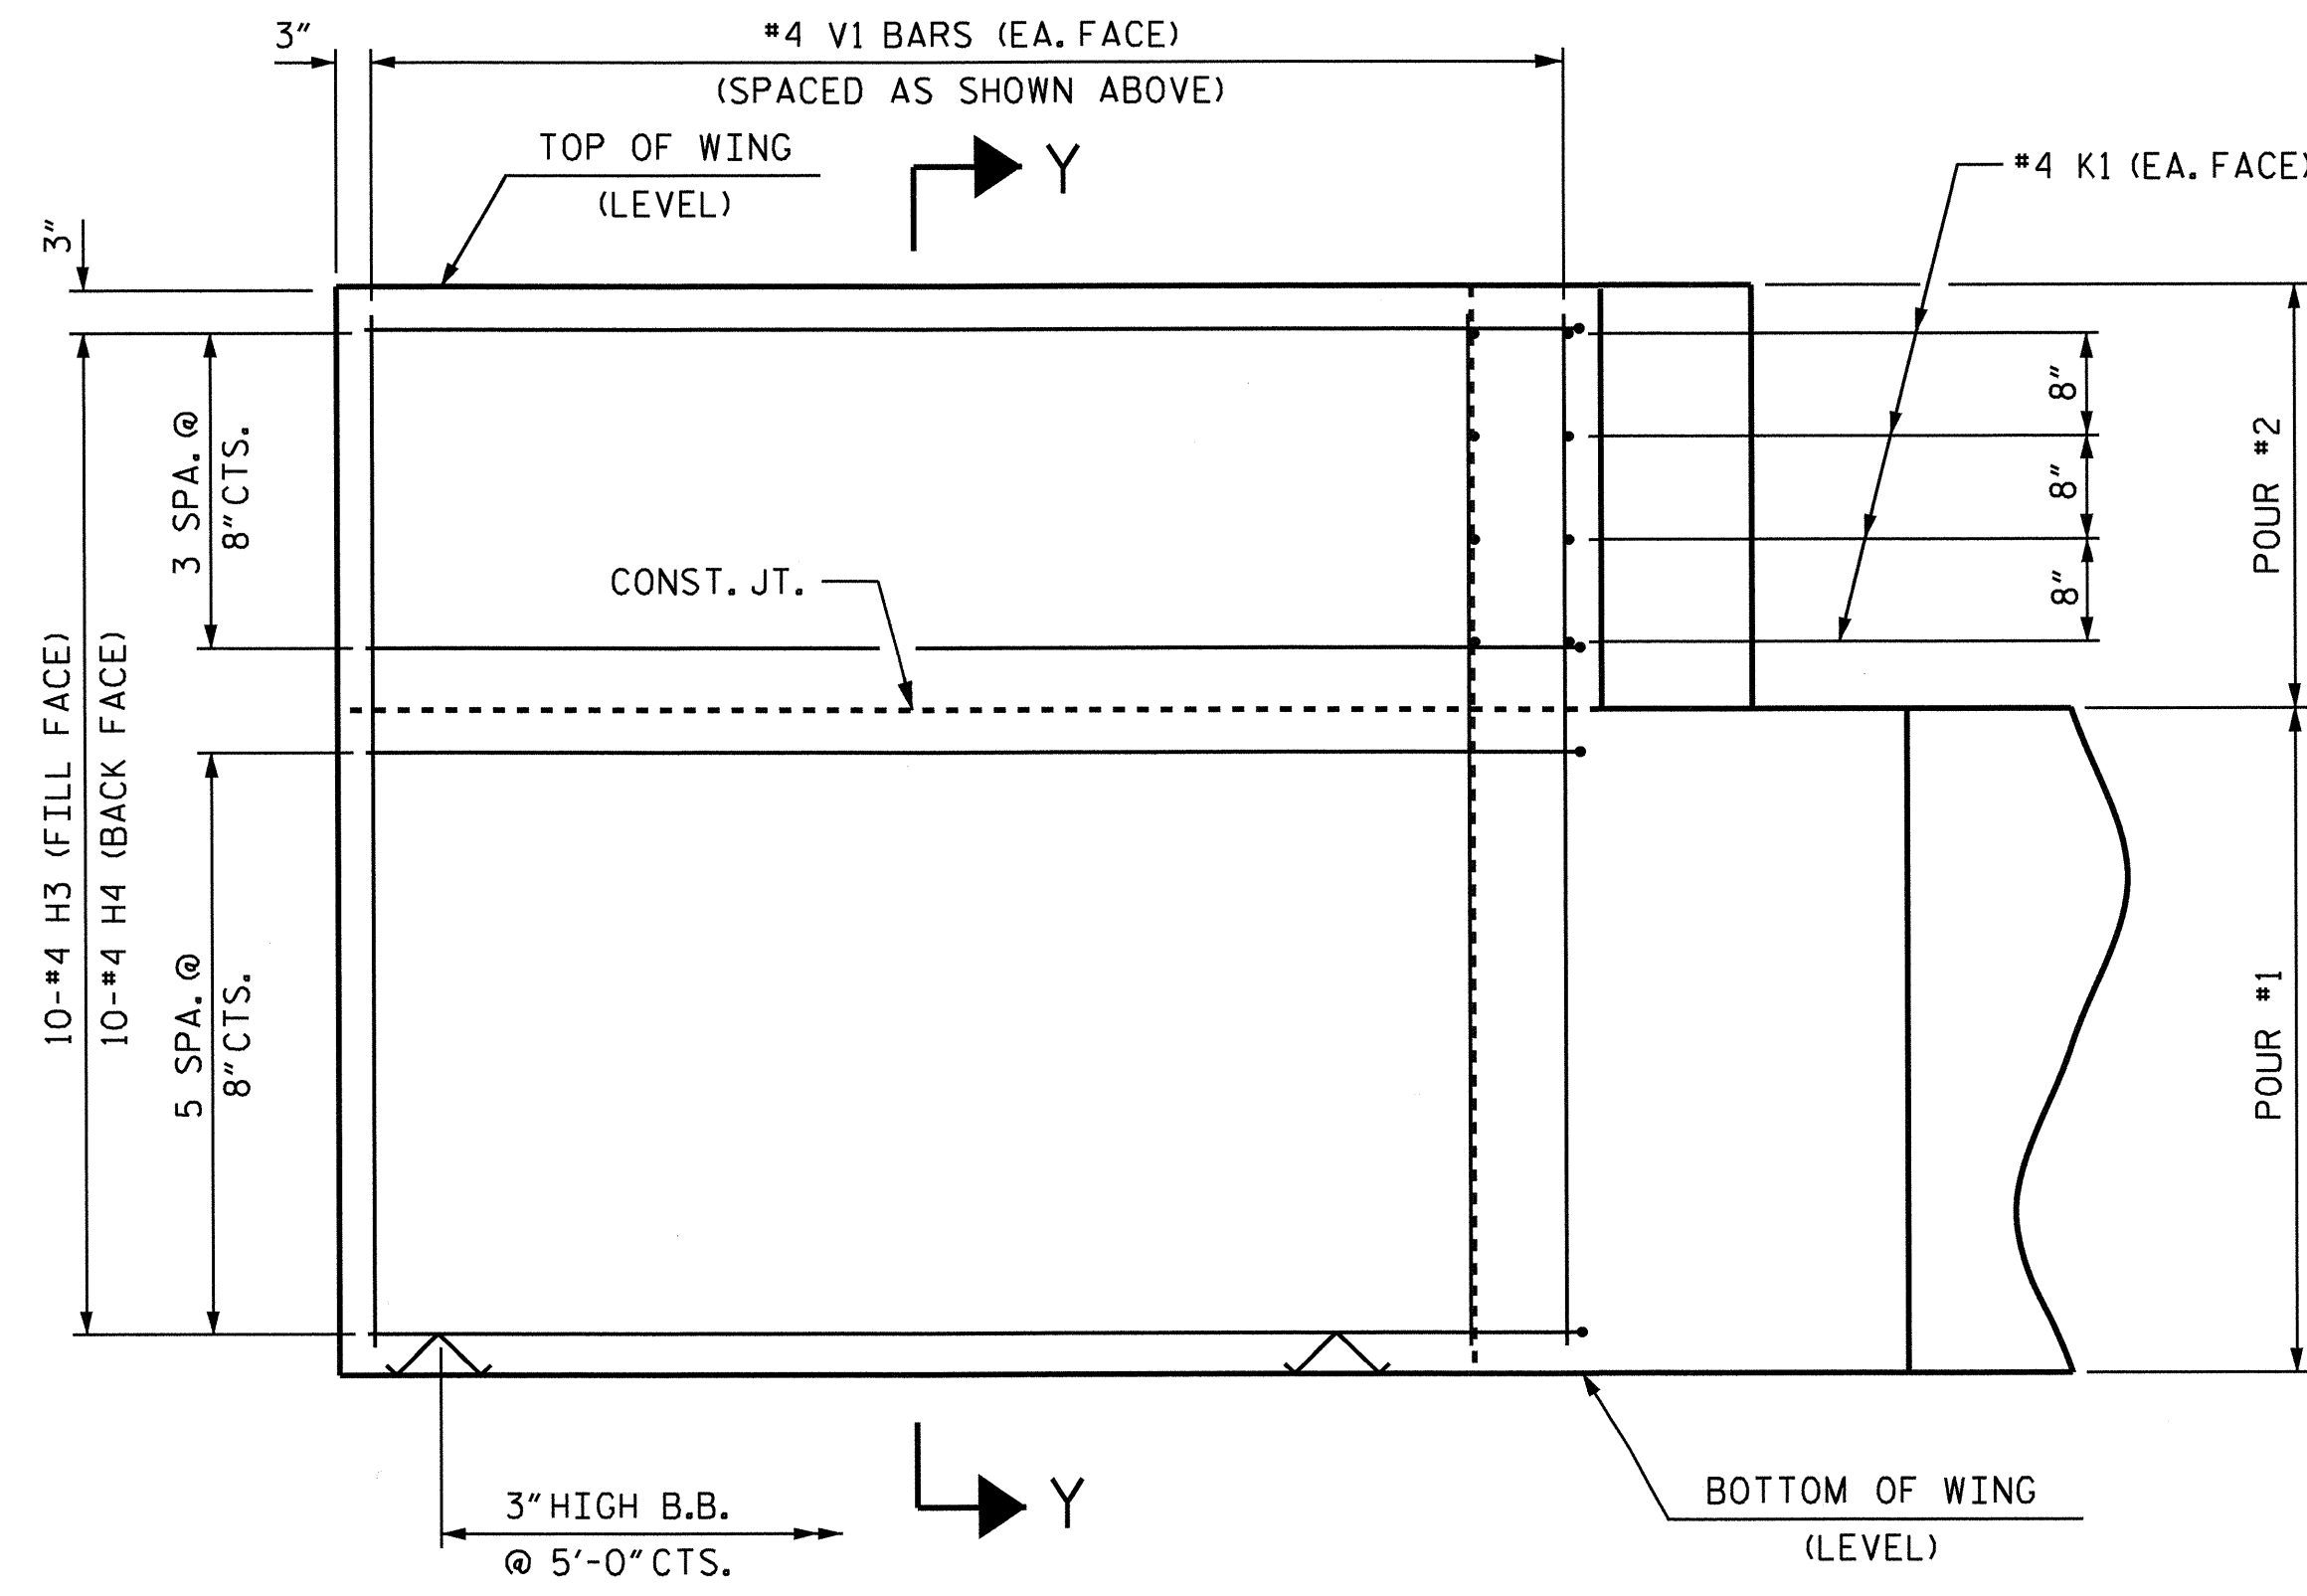

ELEVATION OF WING (W3)

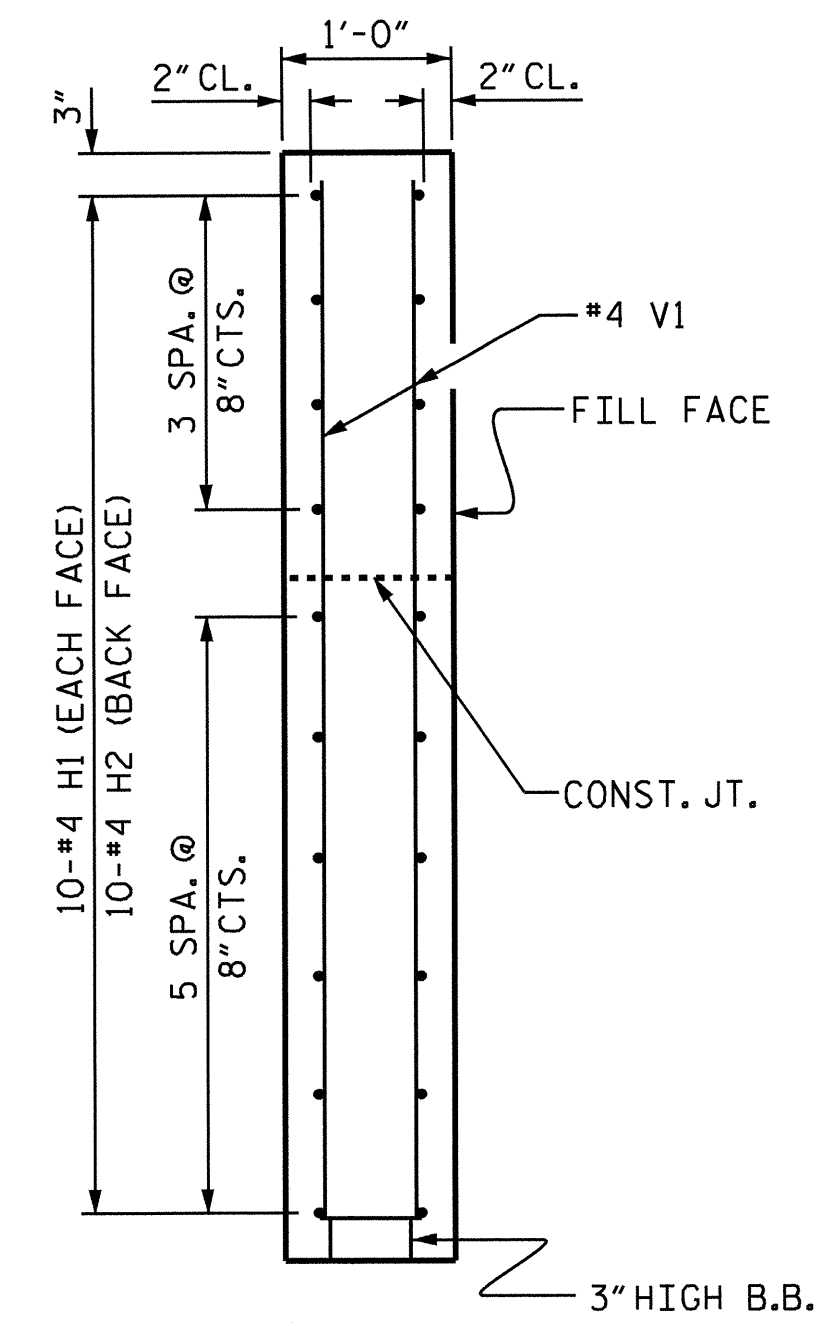

SECTION X-X

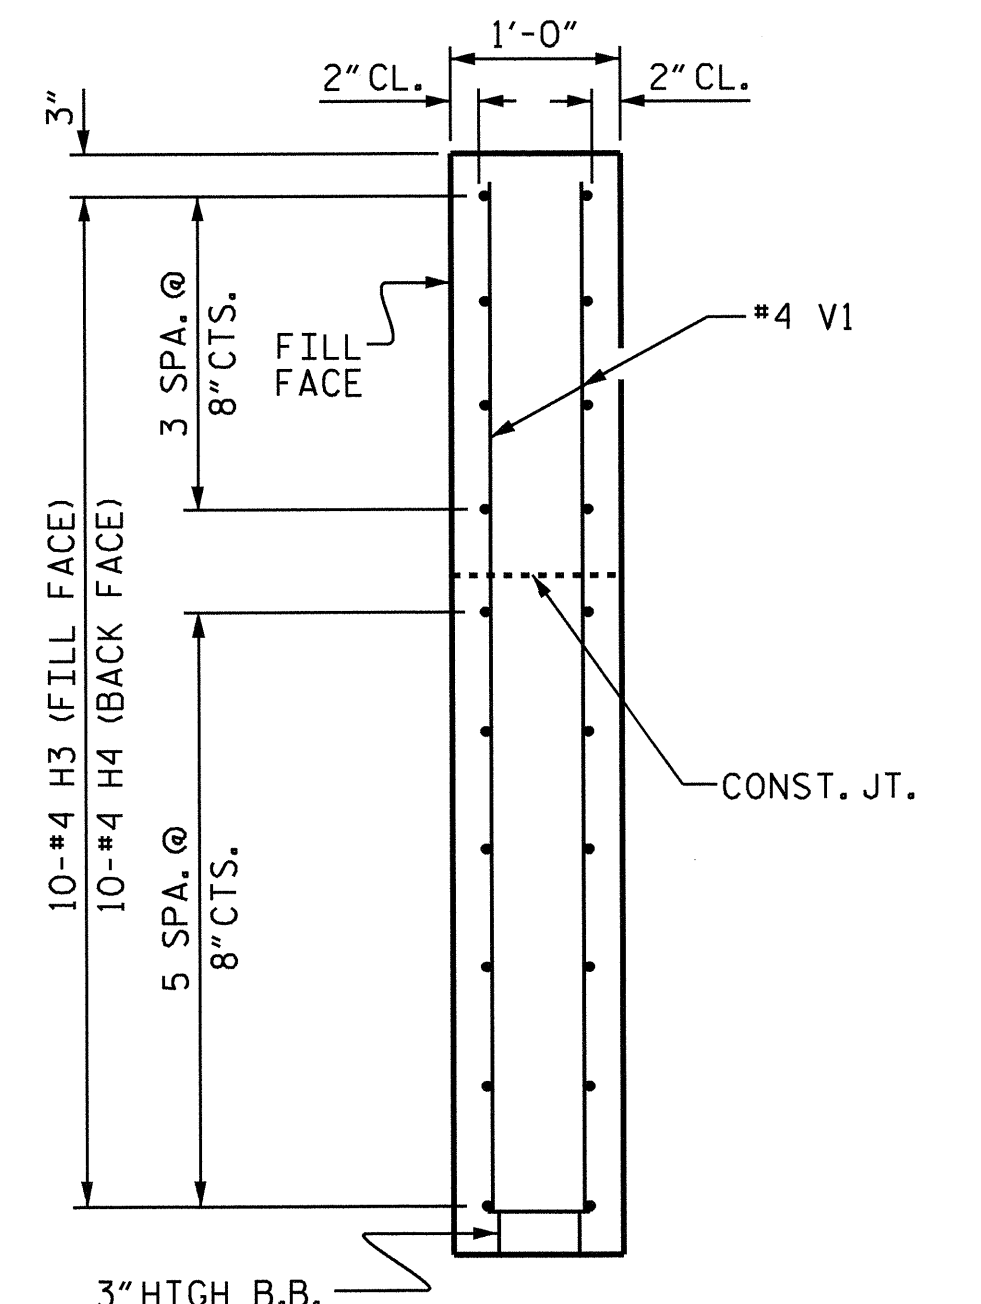


SECTION Y-Y

WING DETAILS

ASSEMBLED BY : A.C. OUTLAW DATE : 5/31/12
 CHECKED BY : A. SORSENGINH DATE : 9/13
 DRAWN BY : WJH 12/11
 CHECKED BY : AAC 12/11


15-OCT-2013 14:20
 R:\Structures\Plans\Revised Drawings\Substructure\B4731.SD.E*.01.dgn
 acoutlaw

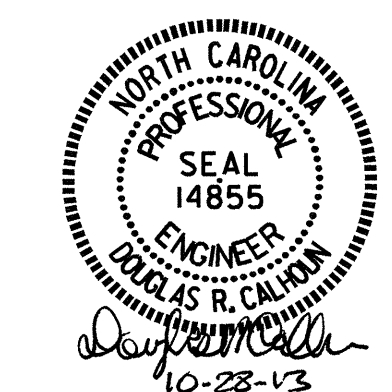

PROJECT NO. B-4731
 CHATHAM COUNTY
 STATION: 16+13.50 -L-

SHEET 4 OF 5

REVISIONS						SHEET NO. S-21
NO.	BY:	DATE:	NO.	BY:	DATE:	
1			3			TOTAL SHEETS 28
2			4			

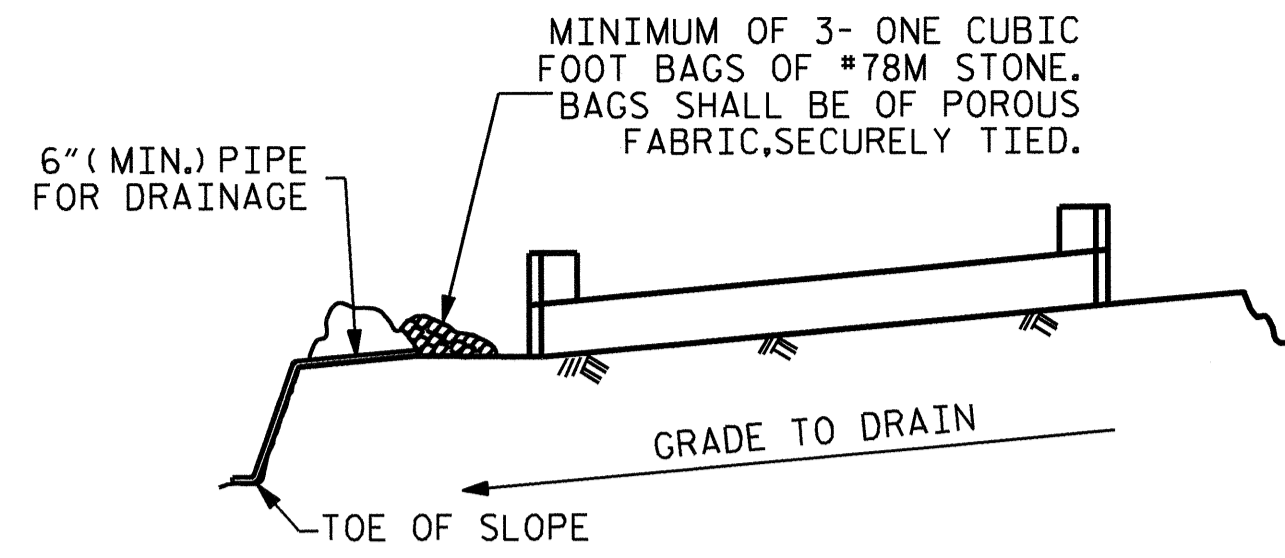

MINIMUM OF 3- ONE CUBIC FOOT BAGS OF #78M STONE. BAGS SHALL BE OF POROUS FABRIC, SECURELY TIED.

6" (MIN.) PIPE FOR DRAINAGE

GRADE TO DRAIN


TOE OF SLOPE

BAGGED STONE AND PIPE SHALL BE PLACED IMMEDIATELY AFTER COMPLETION OF END BENT EXCAVATION. PIPE MAY BE EITHER CONCRETE, CORRUGATED STEEL, CORRUGATED ALUMINUM ALLOY, OR CORRUGATED PLASTIC. PERFORATED PIPE WILL NOT BE ALLOWED.

BAGGED STONE SHALL REMAIN IN PLACE UNTIL THE ENGINEER DIRECTS THAT IT BE REMOVED. THE CONTRACTOR SHALL REMOVE AND DISPOSE OF SILT ACCUMULATIONS AT BAGGED STONE WHEN SO DIRECTED BY THE ENGINEER. BAGS SHALL BE REMOVED AND REPLACED WHENEVER THE ENGINEER DETERMINES THAT THEY HAVE DETERIORATED AND LOST THEIR EFFECTIVENESS.


NO SEPARATE PAYMENT WILL BE MADE FOR THIS WORK AND THE ENTIRE COST OF THIS WORK SHALL BE INCLUDED IN THE UNIT CONTRACT PRICE BID FOR THE SEVERAL PAY ITEMS.

TEMPORARY DRAINAGE AT END BENT

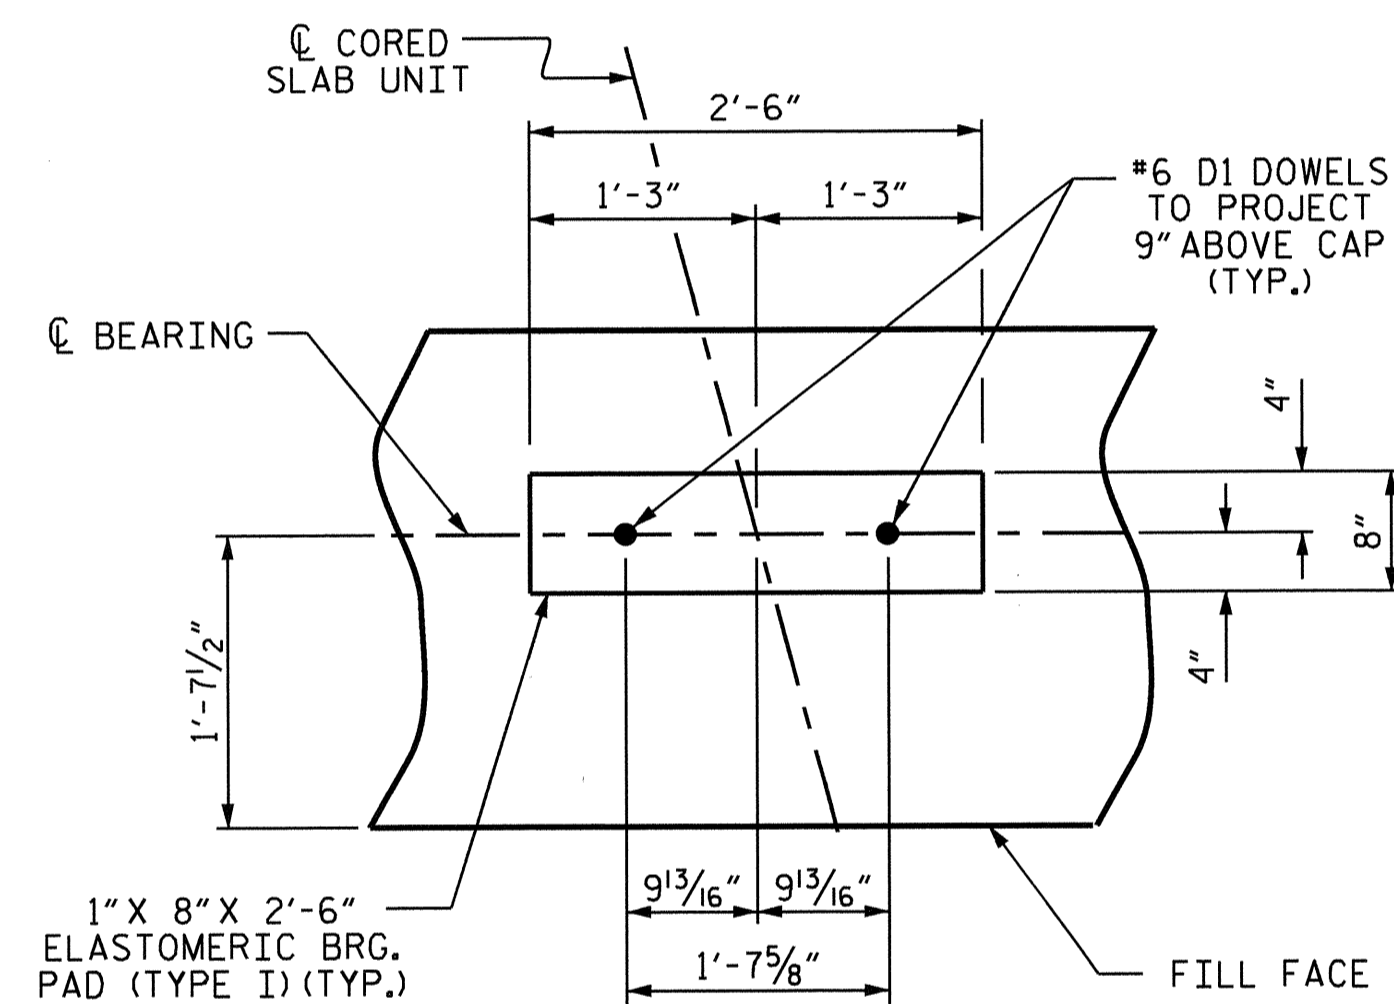

DETAIL "A"


(END BENT No. 1 SHOWN, END BENT No. 2 SIMILAR BY ROTATION)

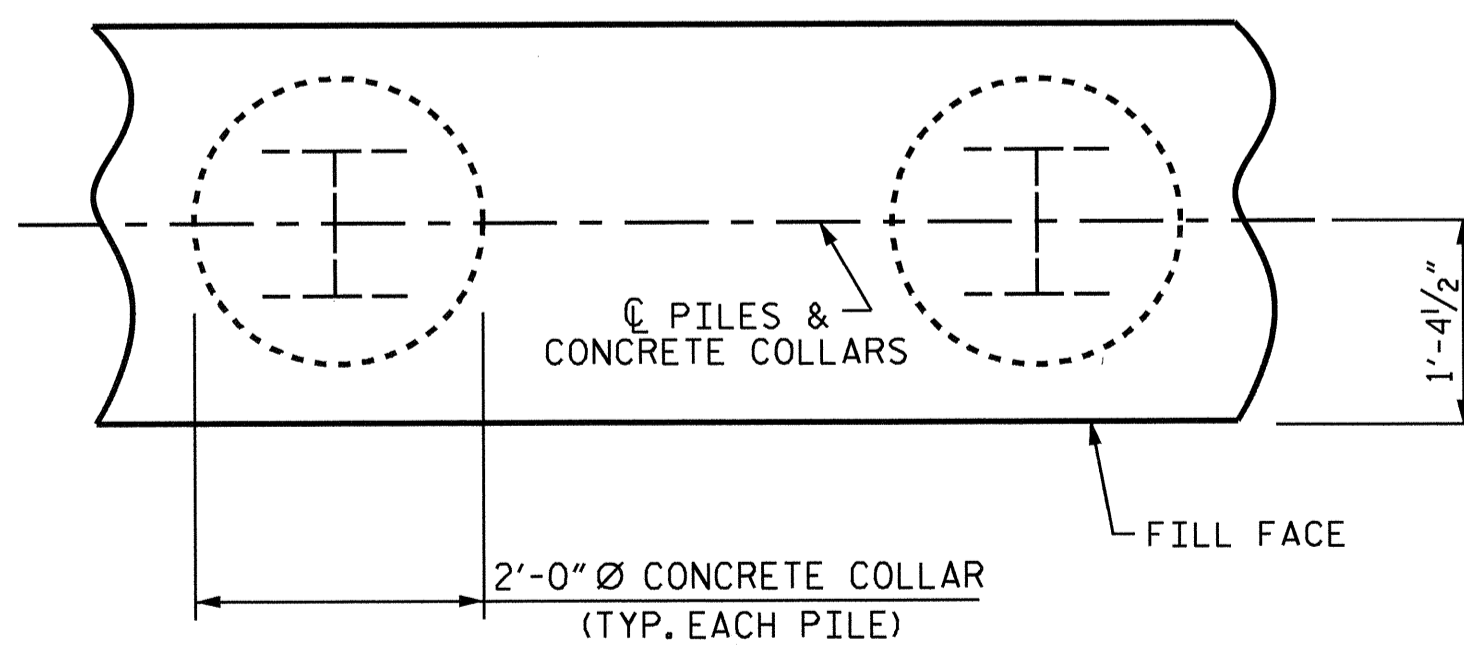


PLAN

CORROSION PROTECTION FOR STEEL PILES DETAIL

(END BENT No. 1 SHOWN, END BENT No. 2 SIMILAR BY ROTATION)

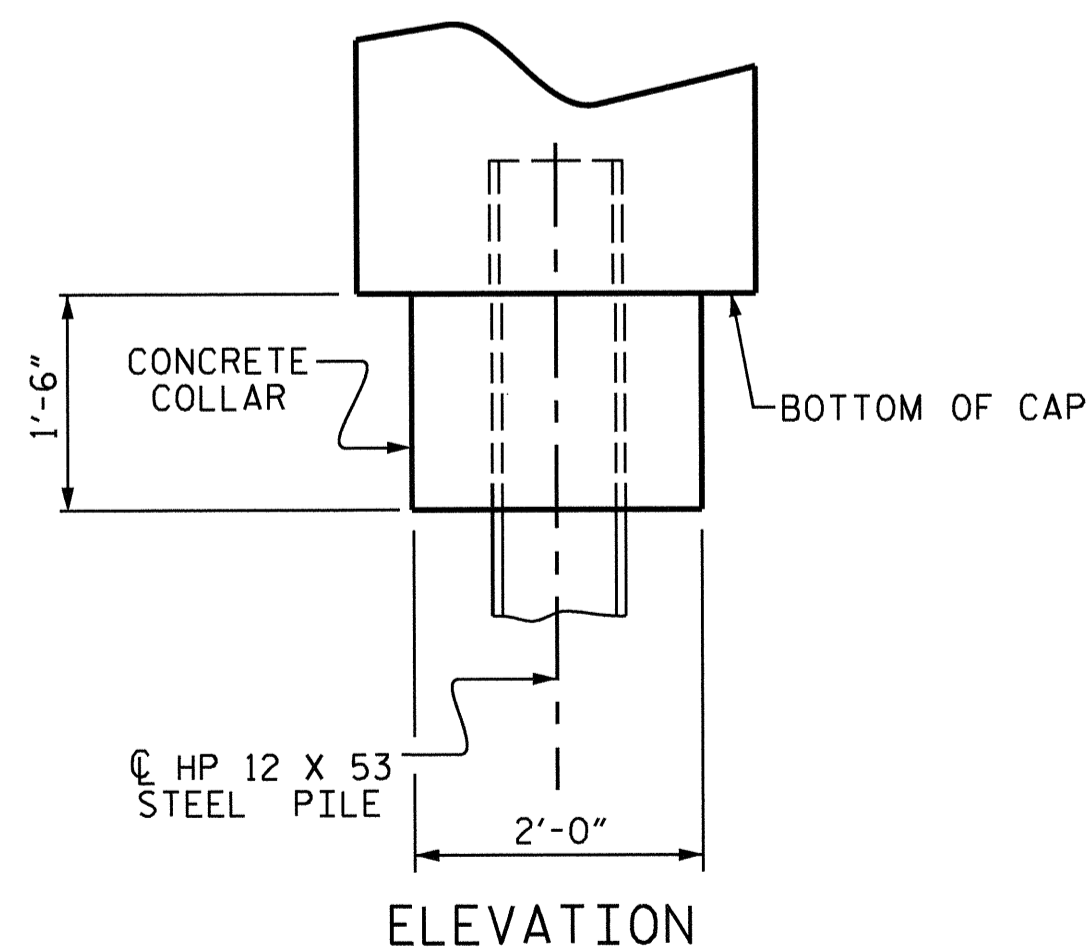


ELEVATION

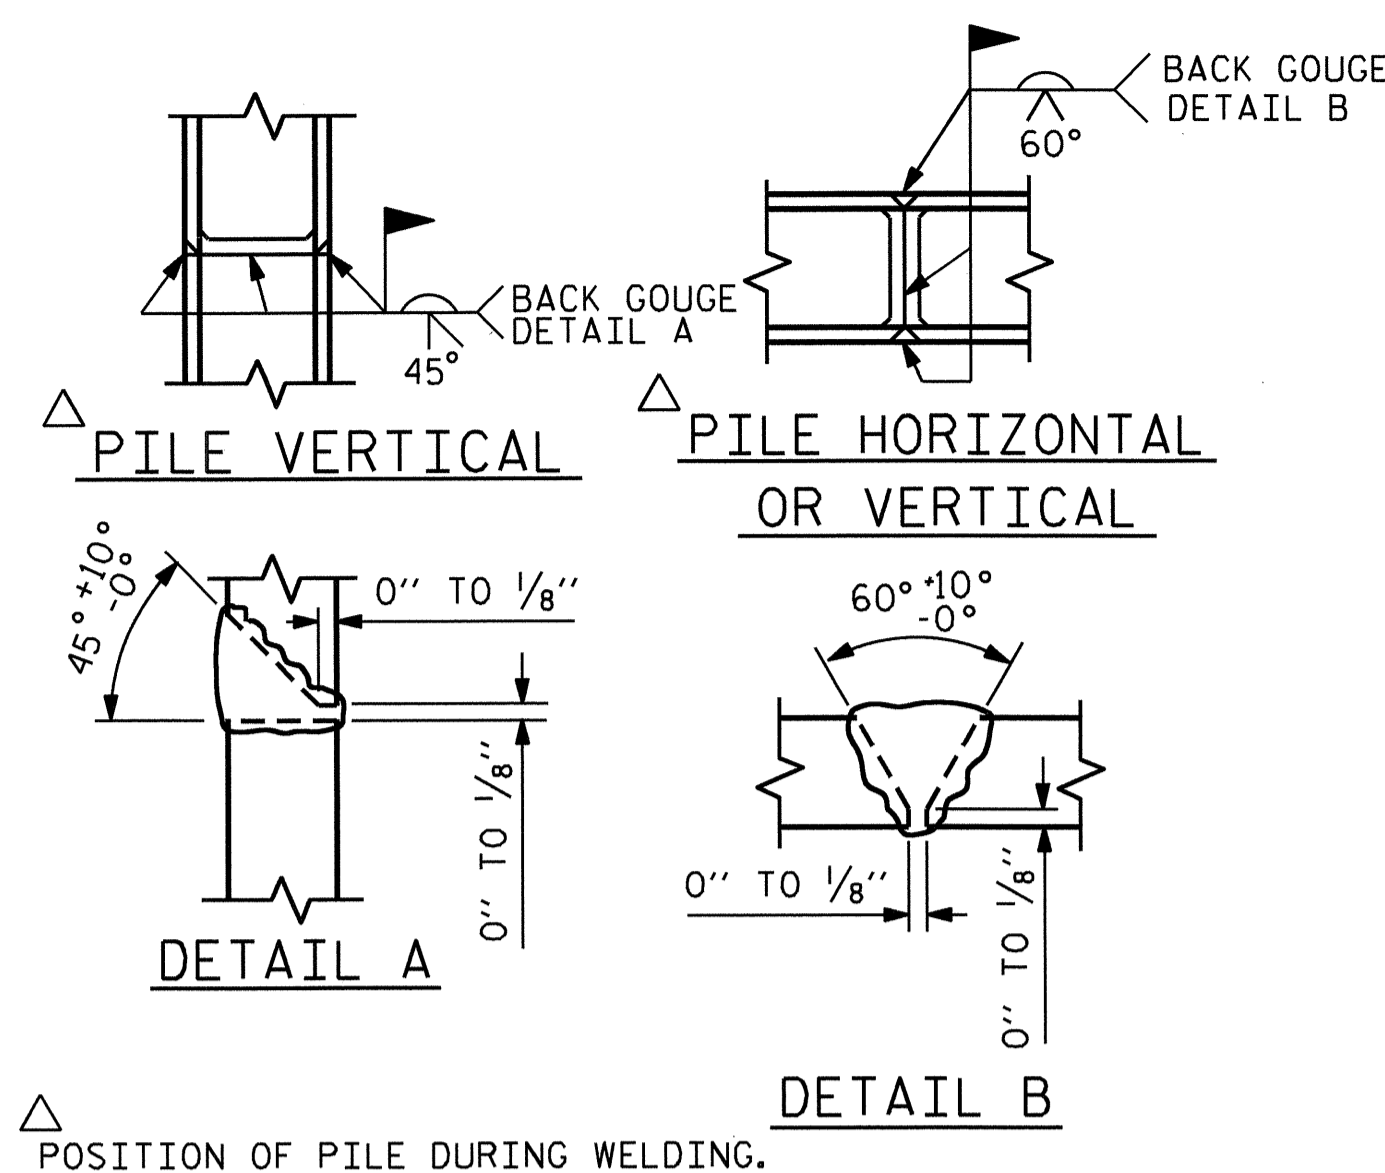


PILE SPLICE DETAILS

BILL OF MATERIAL					
FOR ONE END BENT					
BAR	NO.	SIZE	TYPE	LENGTH	WEIGHT
B1	8	#9	1	42'-6"	1156
B2	28	#4	STR	21'-4"	399
B3	10	#4	STR	2'-5"	16
D1	22	#6	STR	1'-6"	50
H1	10	#4	2	9'-1"	61
H2	10	#4	2	9'-3"	62
H3	10	#4	3	9'-6"	63
H4	10	#4	3	9'-4"	62
K1	16	#4	STR	3'-3"	35
S1	52	#4	4	10'-5"	362
S2	52	#4	5	3'-2"	110
S3	28	#4	6	6'-6"	122
V1	53	#4	STR	6'-2"	218
REINFORCING STEEL (FOR ONE END BENT)					2716 LBS.
CLASS A CONCRETE BREAKDOWN (FOR ONE END BENT)					
POUR #1 CAP, LOWER PART OF WINGS & COLLARS				20.1 C.Y.	
POUR #2 UPPER PART OF WINGS				2.1 C.Y.	
TOTAL CLASS A CONCRETE				22.2 C.Y.	

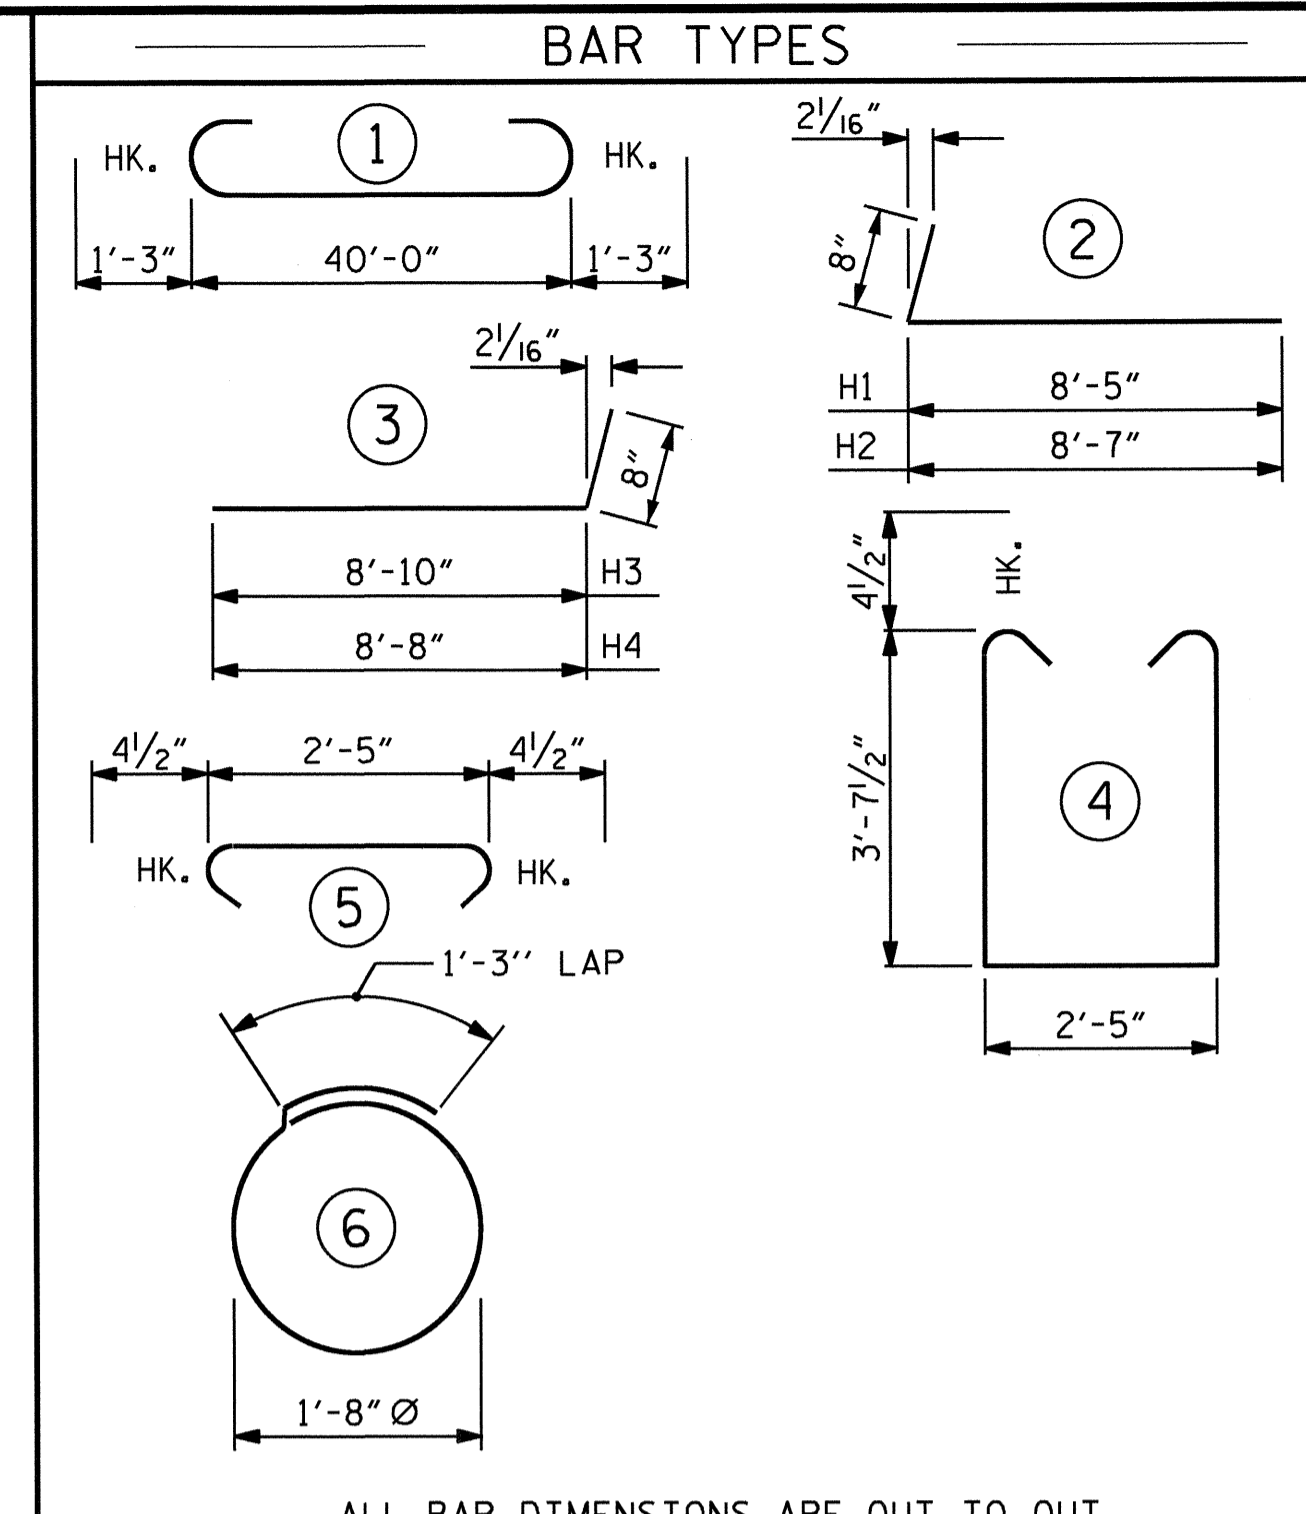

ALL BAR DIMENSIONS ARE OUT TO OUT.

END BENT No. 1	END BENT No. 2
HP 12 X 53 STEEL PILES	HP 12 X 53 STEEL PILES
NO: 7	NO: 7
LIN. FT.= 140	LIN. FT.= 175

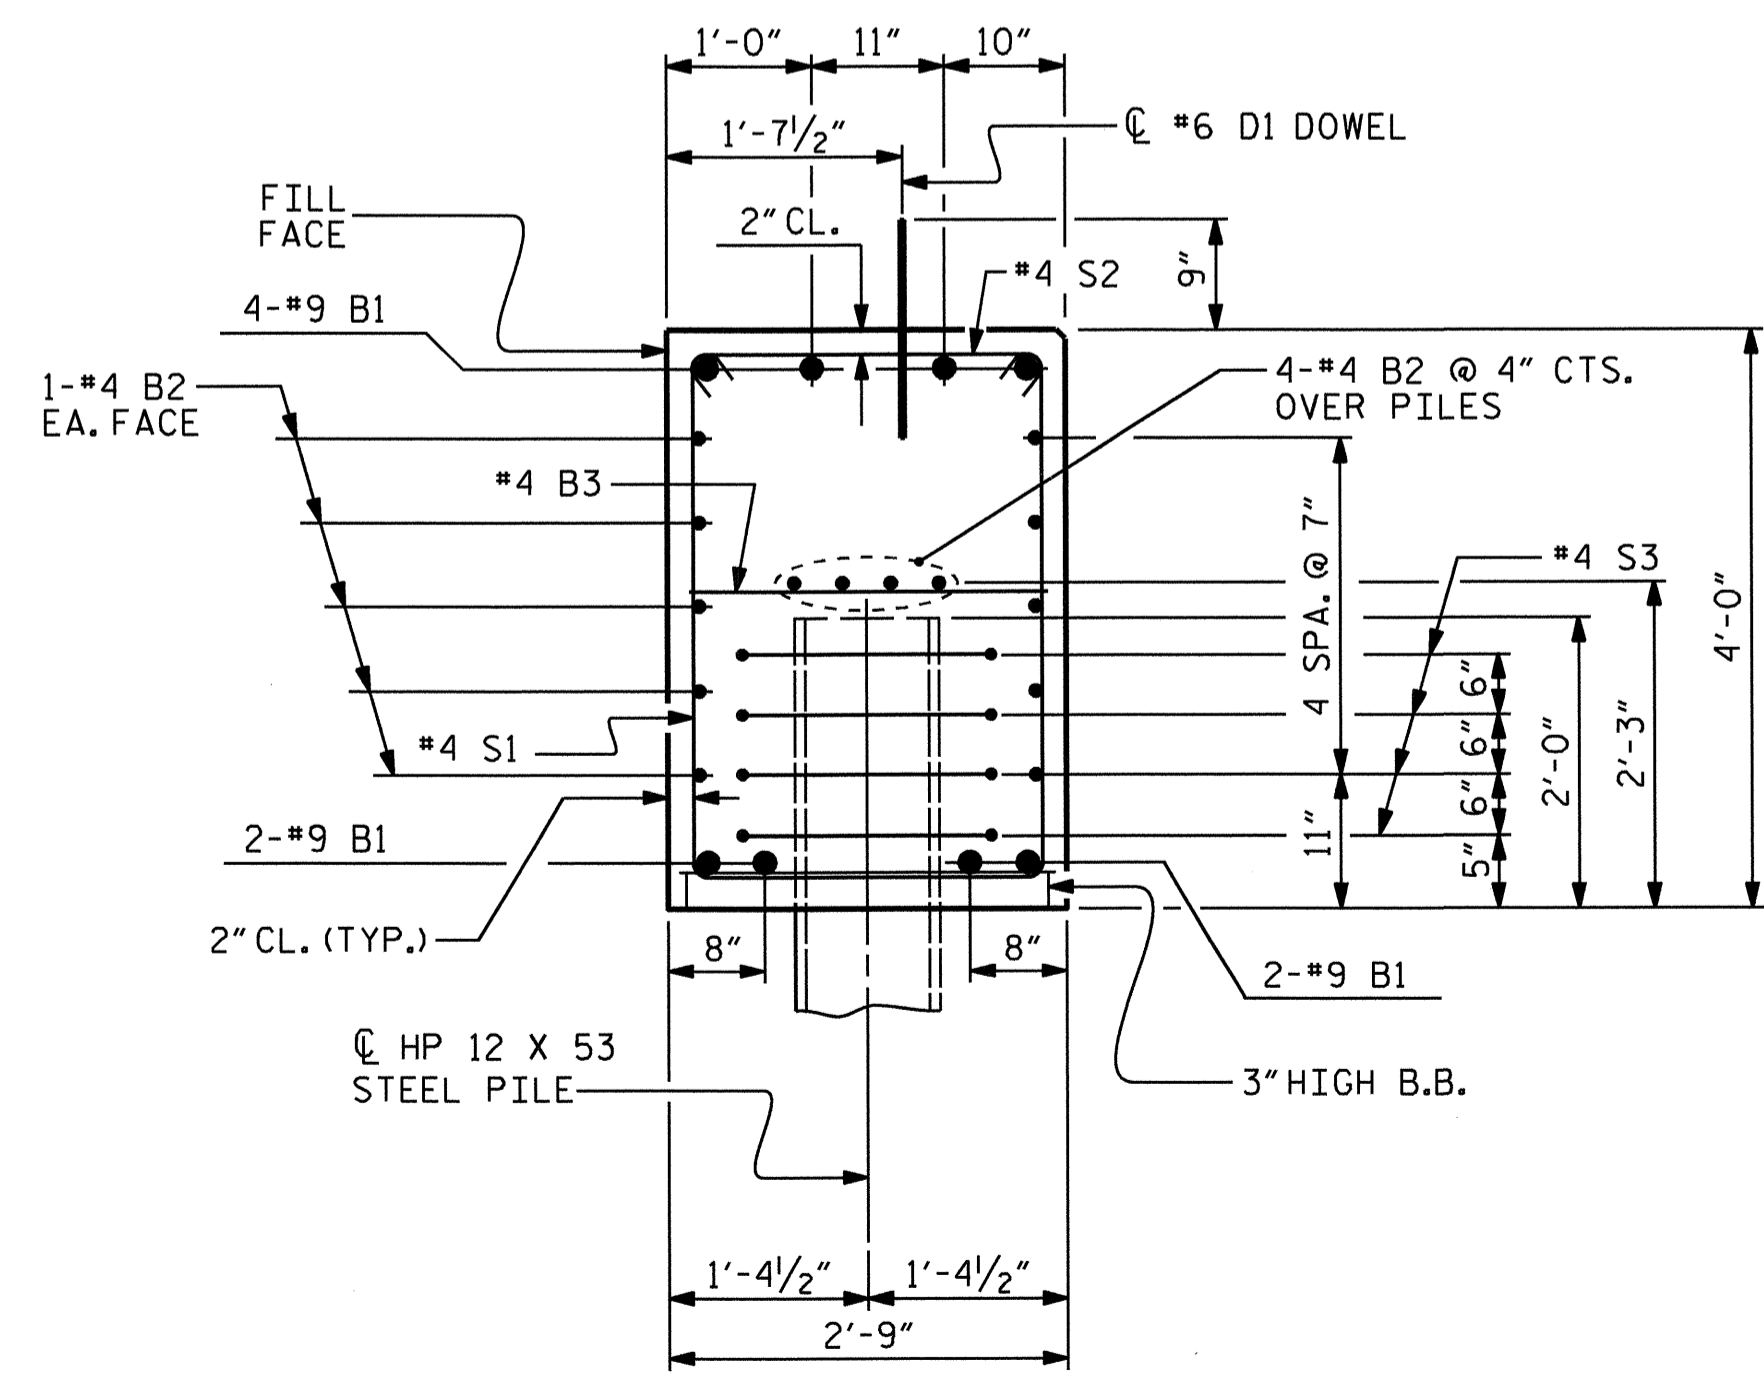

SECTION A-A


(CONCRETE COLLAR NOT SHOWN FOR CLARITY. SEE "CORROSION PROTECTION FOR STEEL PILES DETAIL.")

PROJECT NO. B-4731
 CHATHAM COUNTY
 STATION: 16+13.50 -L-

SHEET 5 OF 5

STATE OF NORTH CAROLINA DEPARTMENT OF TRANSPORTATION RALEIGH					
SUBSTRUCTURE					
END BENT 1 & 2 DETAILS					
REVISIONS					
NO.	BY:	DATE:	NO.	BY:	DATE:
1			3		
2			4		

SHEET NO. S-22
 TOTAL SHEETS 28

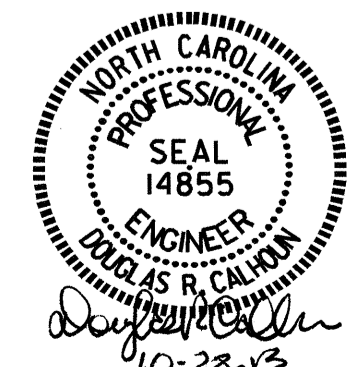

ASSEMBLED BY: A.C. OUTLAW DATE: 5/31/12
 CHECKED BY: A. SORSENGINH DATE: 9/13
 DRAWN BY: WJH 12/11
 CHECKED BY: AAC 12/11

NOTES

STIRRUPS IN CAP MAY BE SHIFTED AS NECESSARY TO CLEAR DOWELS.

HOOKS ON "M" BARS MAY BE TURNED AS NECESSARY FOR PLACING REINFORCING STEEL.


FOR DRILLED PIERS, SEE SECTION 411 OF THE STANDARD SPECIFICATIONS.

ALL STEEL IN THE DRILLED PIERS IS INCLUDED IN THE PAY ITEMS FOR "REINFORCING STEEL" AND "SPIRAL COLUMN REINFORCING STEEL."


★ INVERT ALTERNATE STIRRUPS.

THE LOCATION OF THE CONSTRUCTION JOINT IN THE DRILLED PIERS IS BASED ON AN APPROXIMATE GROUND LINE ELEVATION. IF THE CONSTRUCTION JOINT IS ABOVE THE ACTUAL GROUND LINE ELEVATION, THE CONTRACTOR SHALL PLACE THE CONSTRUCTION JOINT ONE FOOT BELOW THE GROUND LINE.

THE CONTRACTOR'S ATTENTION IS CALLED TO THE FACT THAT THE LONGITUDINAL REINFORCEMENT FOR DRILLED PIERS IS DETAILED WITH 3 FEET OF EXTRA LENGTH.

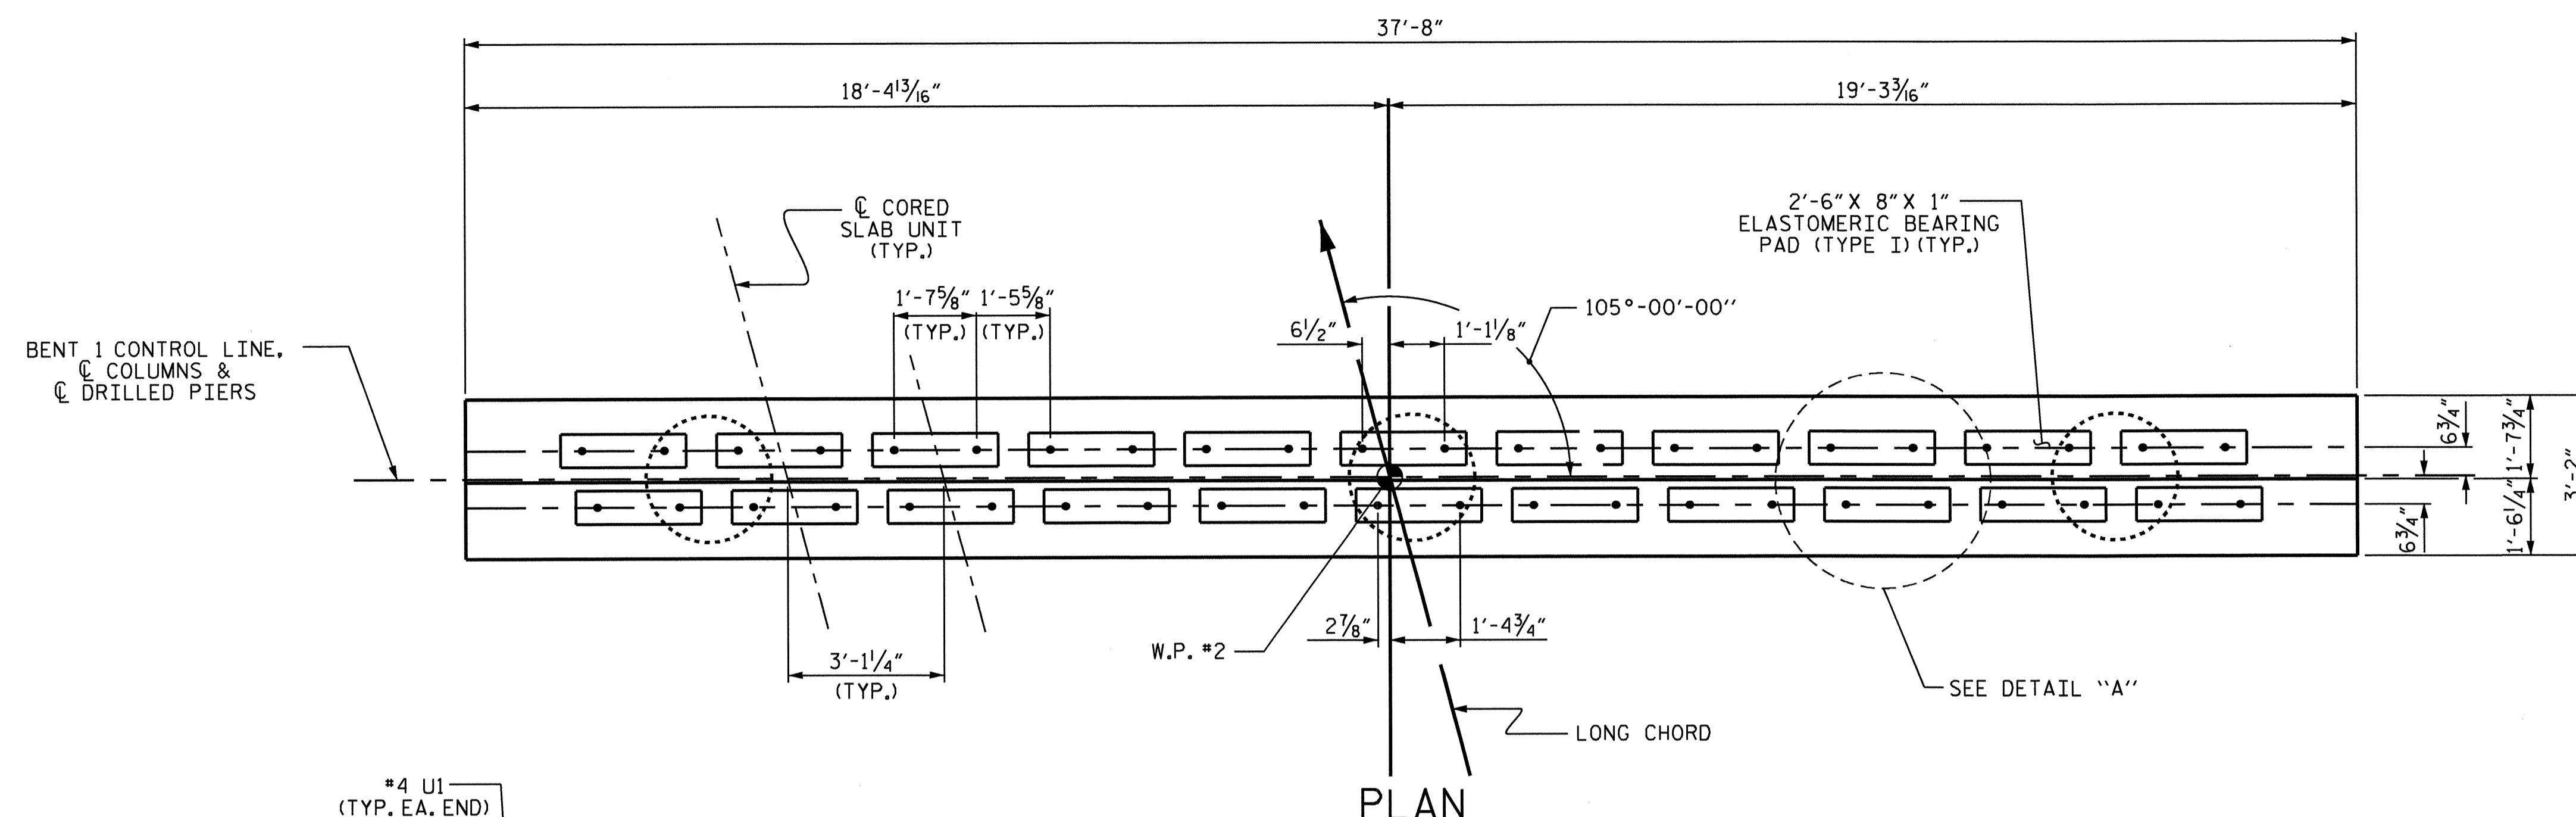


PLAN

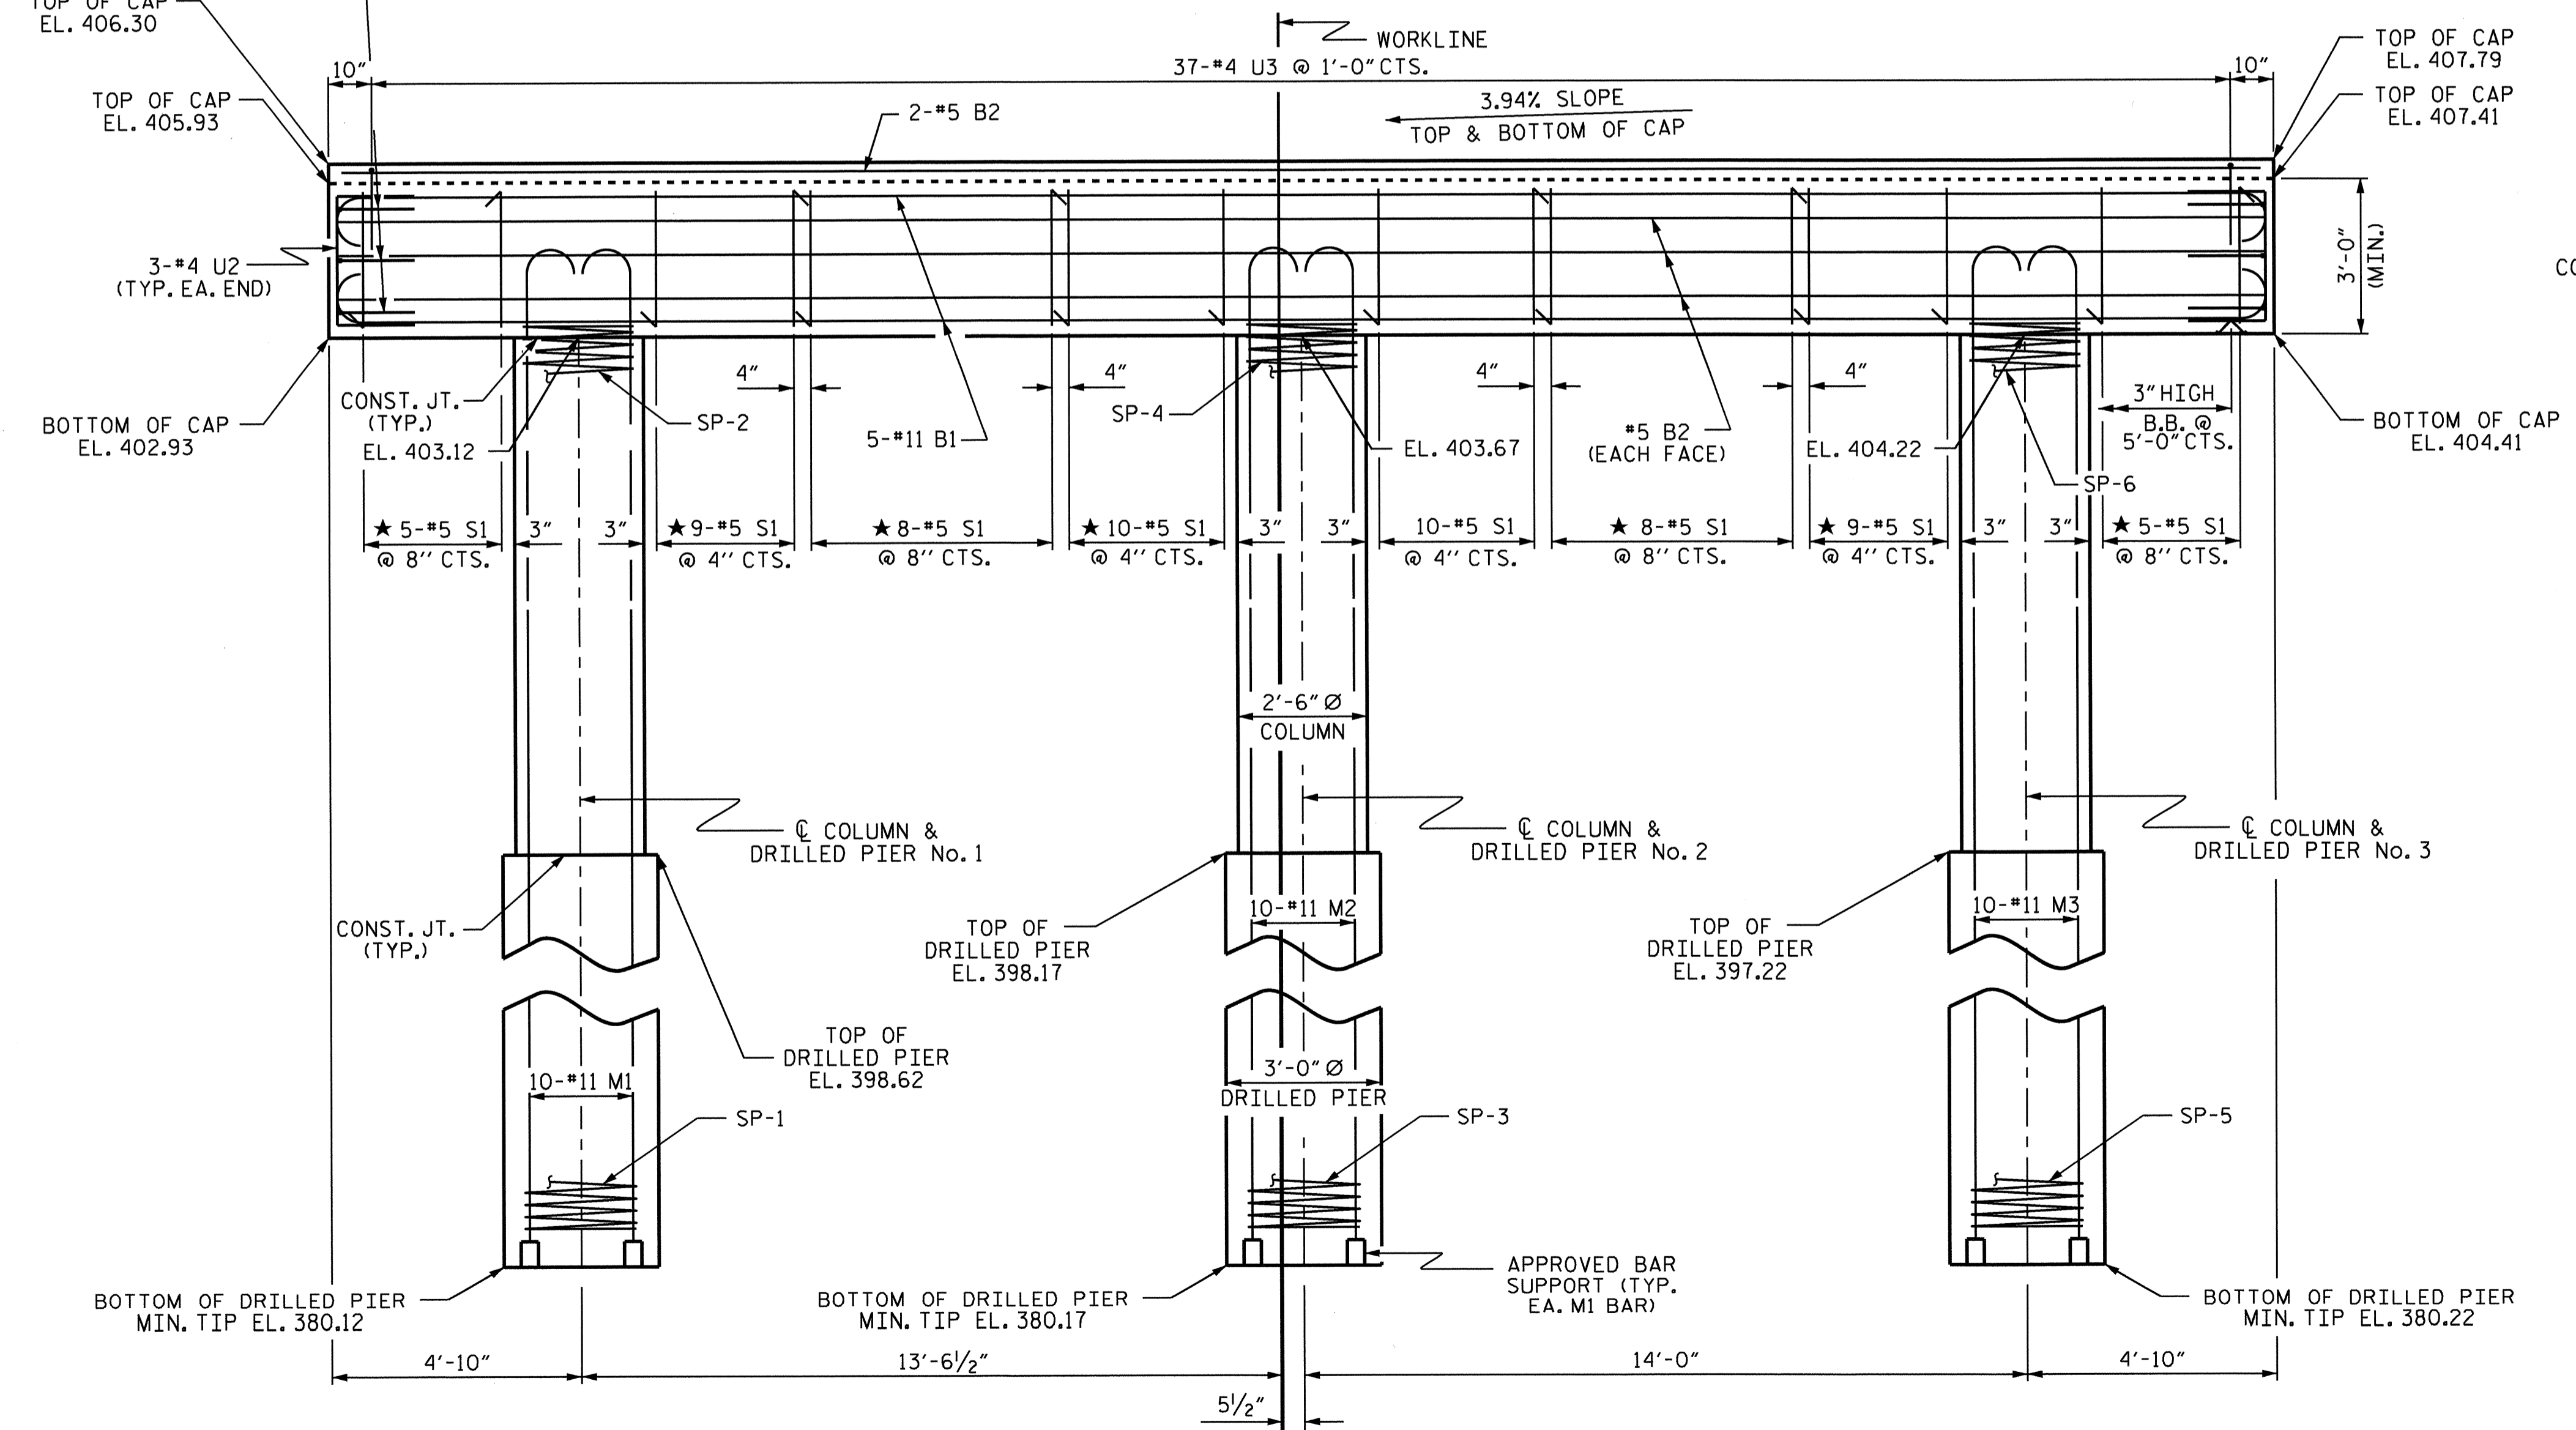

ELEVATION

DIMENSIONS & REINFORCING STEEL ARE TYPICAL FOR EACH COLUMN & DRILLED PIER UNLESS OTHERWISE NOTED.

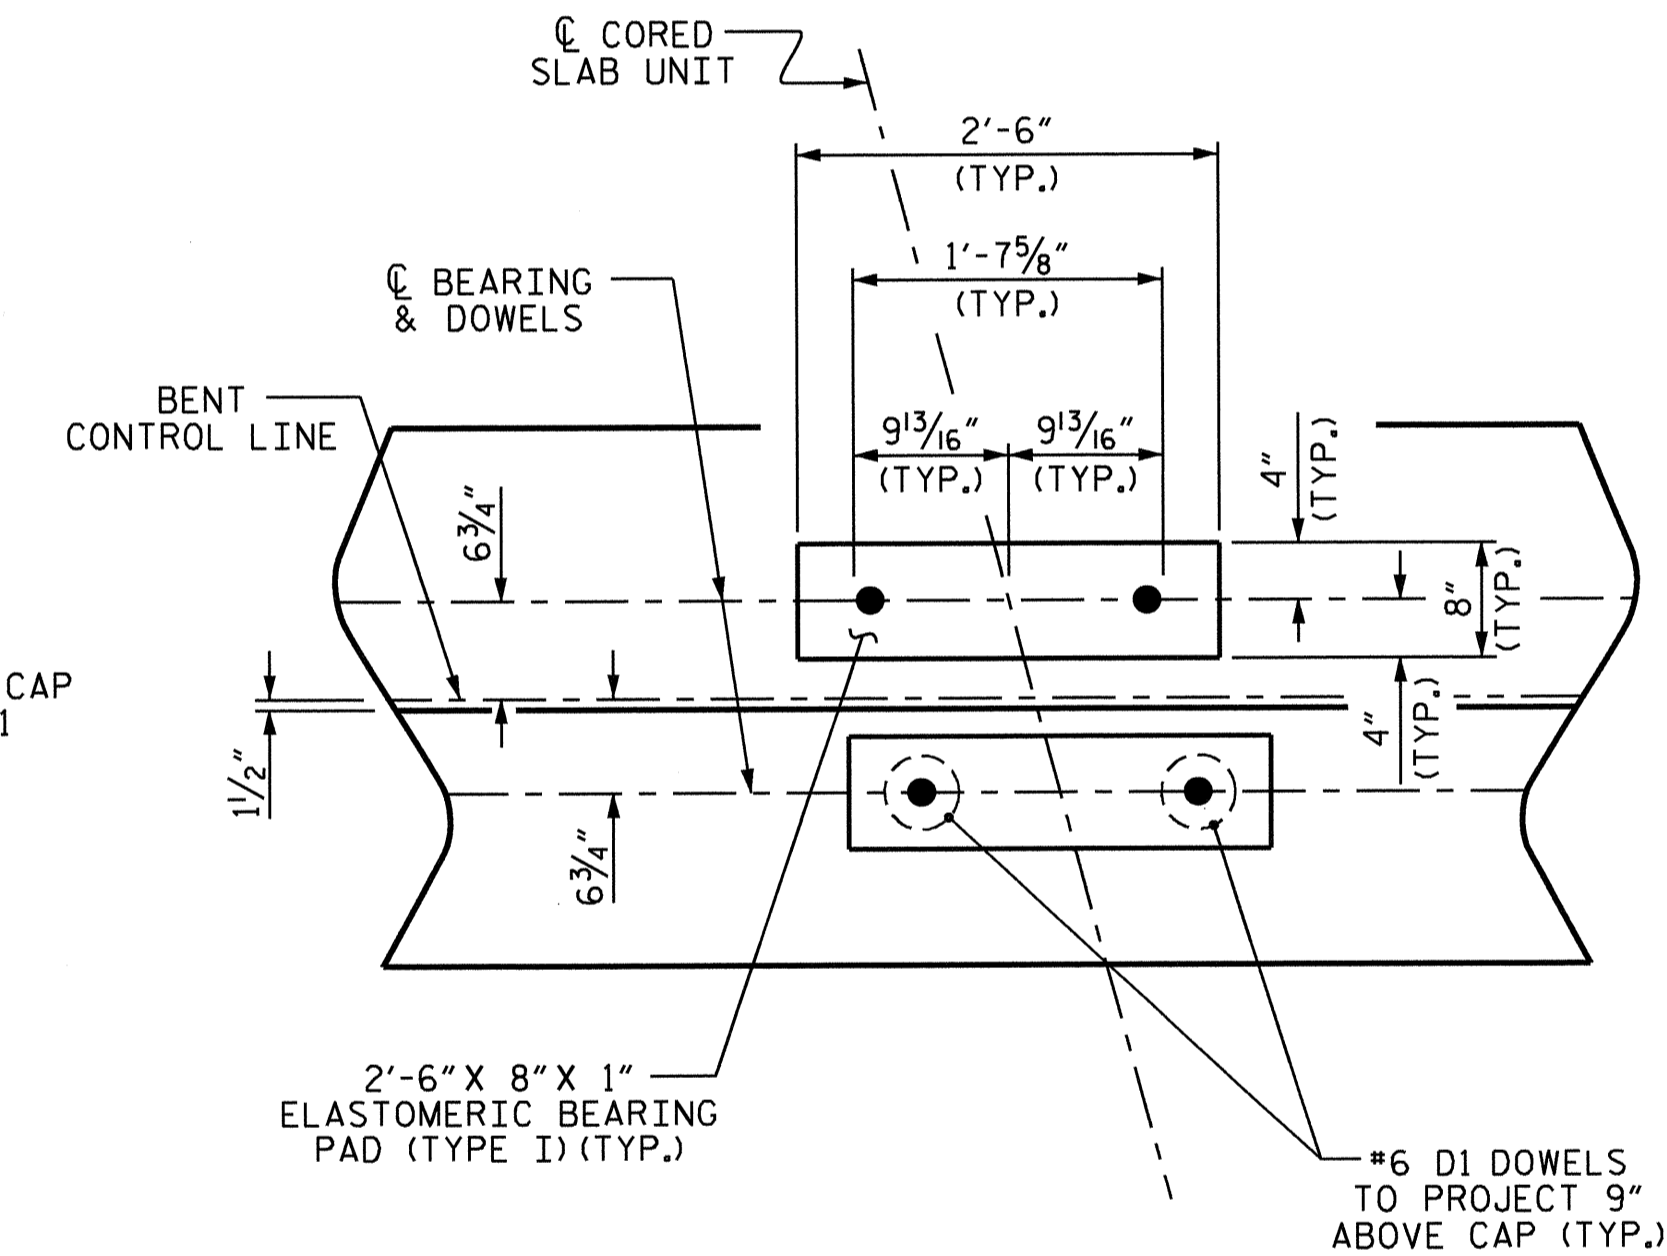

DETAIL "A"


(DIMENSIONS ARE TYPICAL EACH BEARING)

PROJECT NO. B-4731
CHATHAM COUNTY
 STATION: 16+13.50 -L-

SHEET 1 OF 2



STATE OF NORTH CAROLINA
 DEPARTMENT OF TRANSPORTATION
 RALEIGH

SUBSTRUCTURE
BENT 1



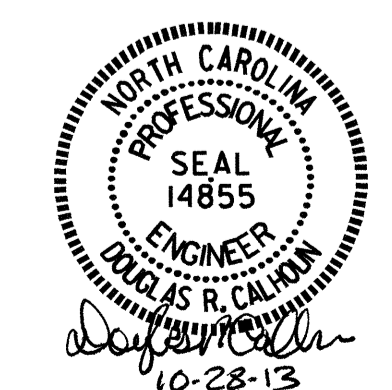


REVISIONS						SHEET NO.	
NO.	BY:	DATE:	NO.	BY:	DATE:	S-23	
1			3			TOTAL SHEETS 28	
2			4				

ASSEMBLED BY : A.C. OUTLAW DATE : 9/03/13
 CHECKED BY : A. SORSENGINH DATE : 9/13
 DRAWN BY : DGE 04/10
 CHECKED BY : MKT 04/10

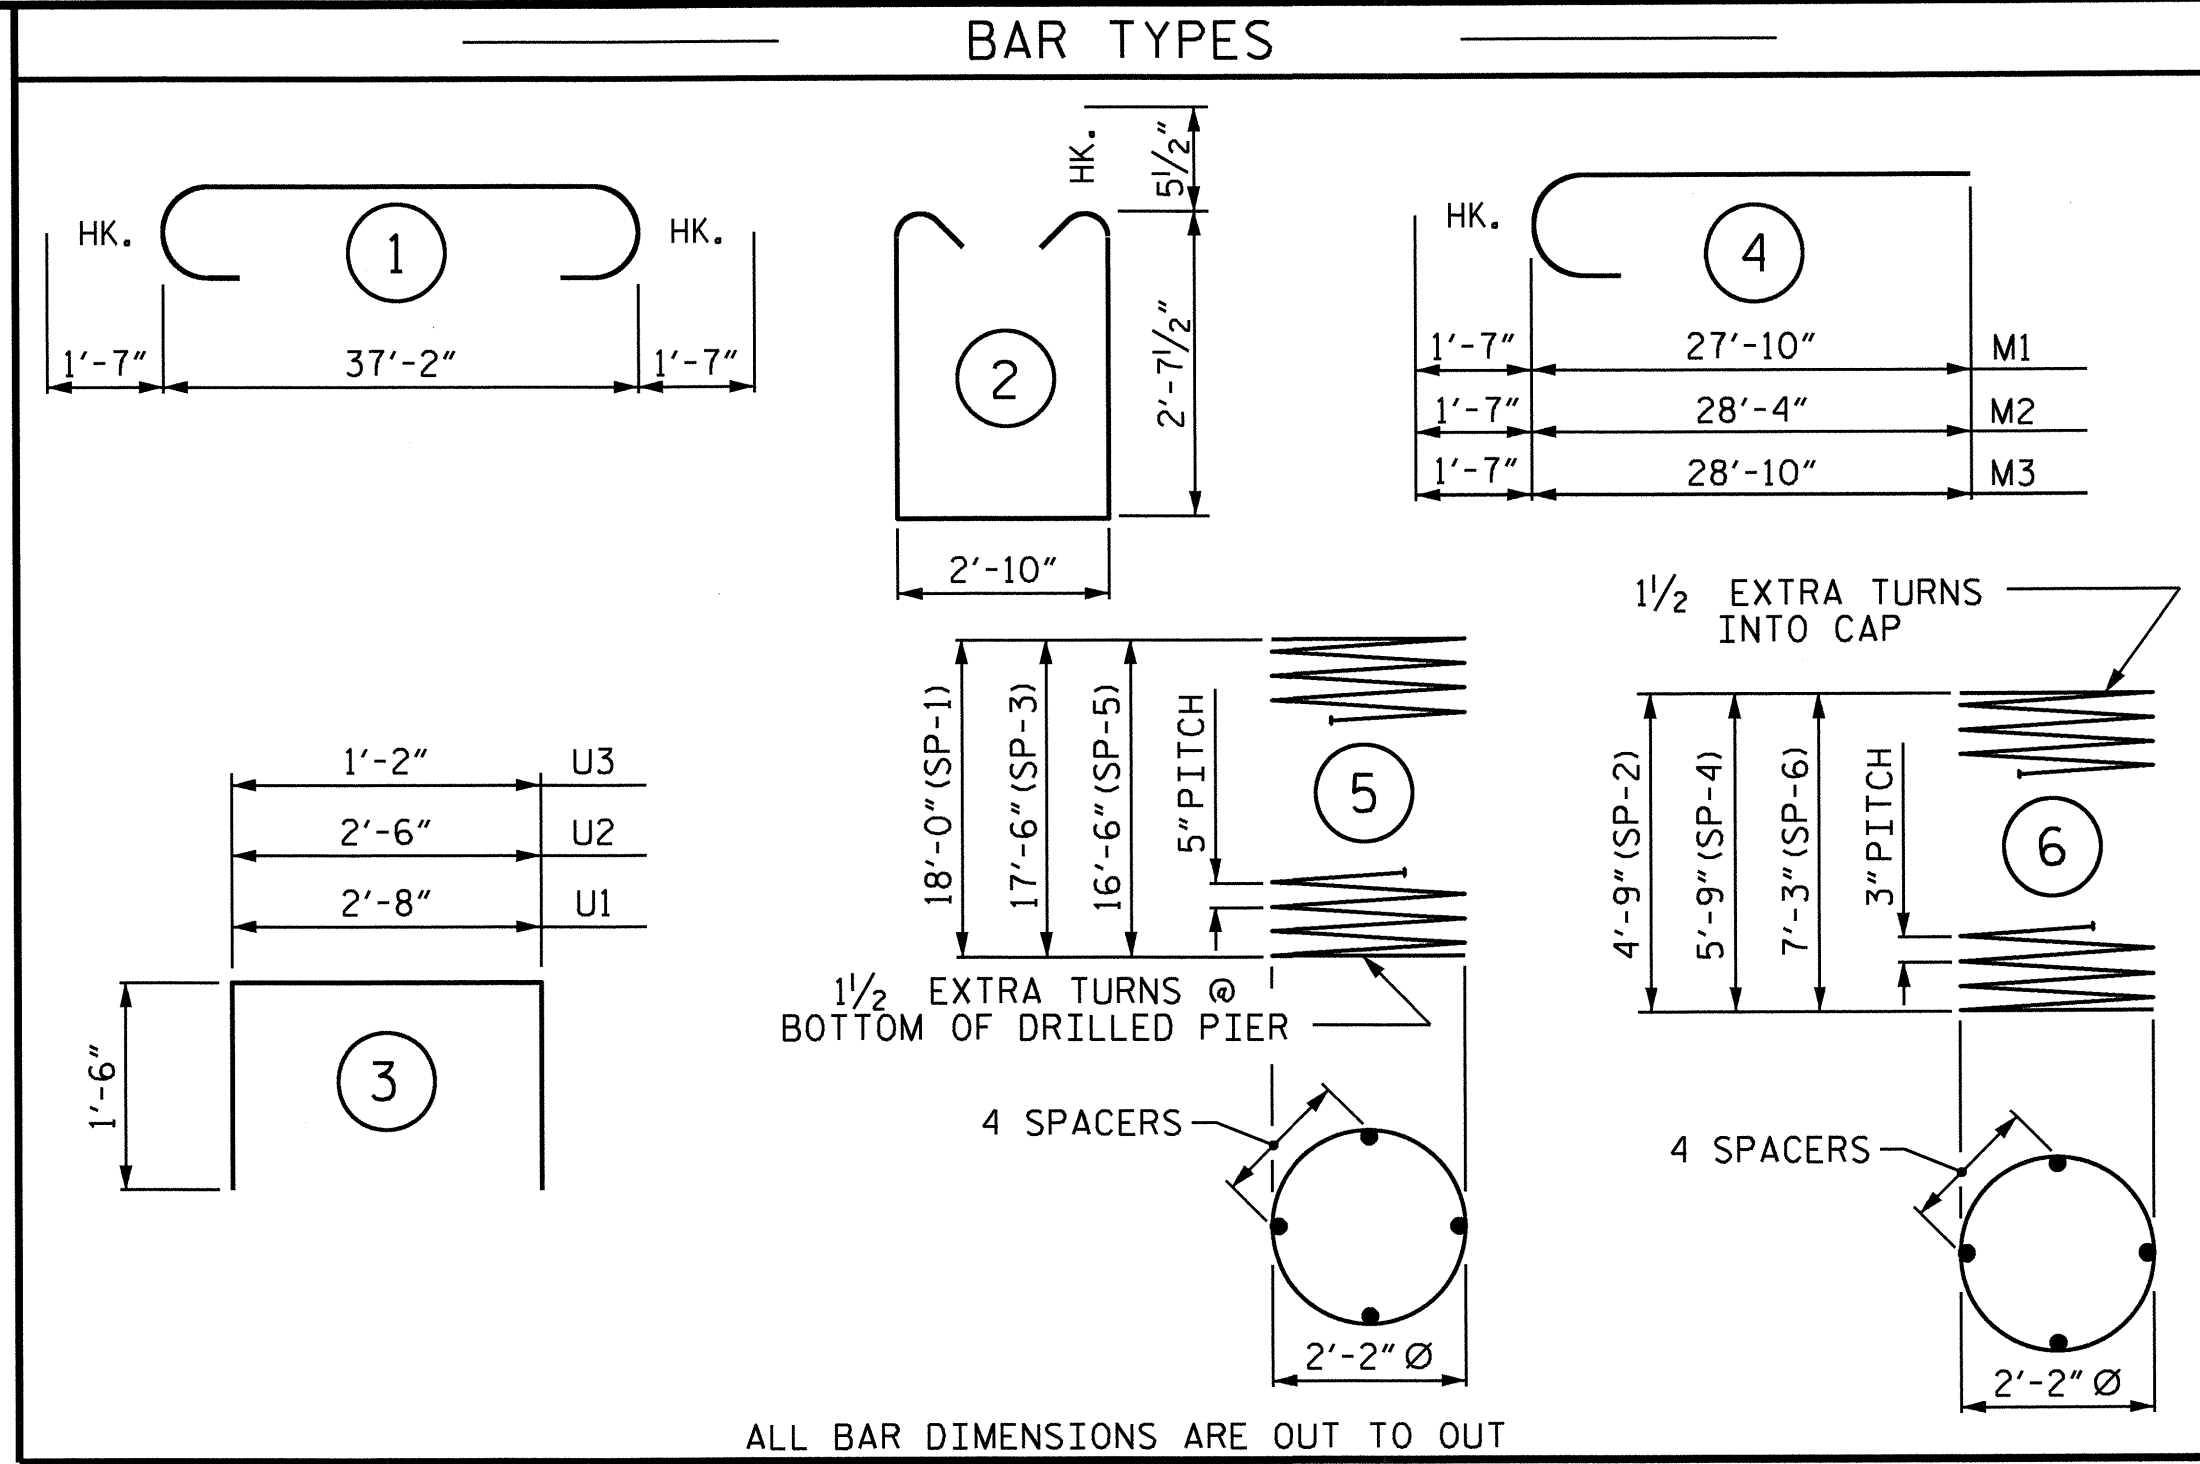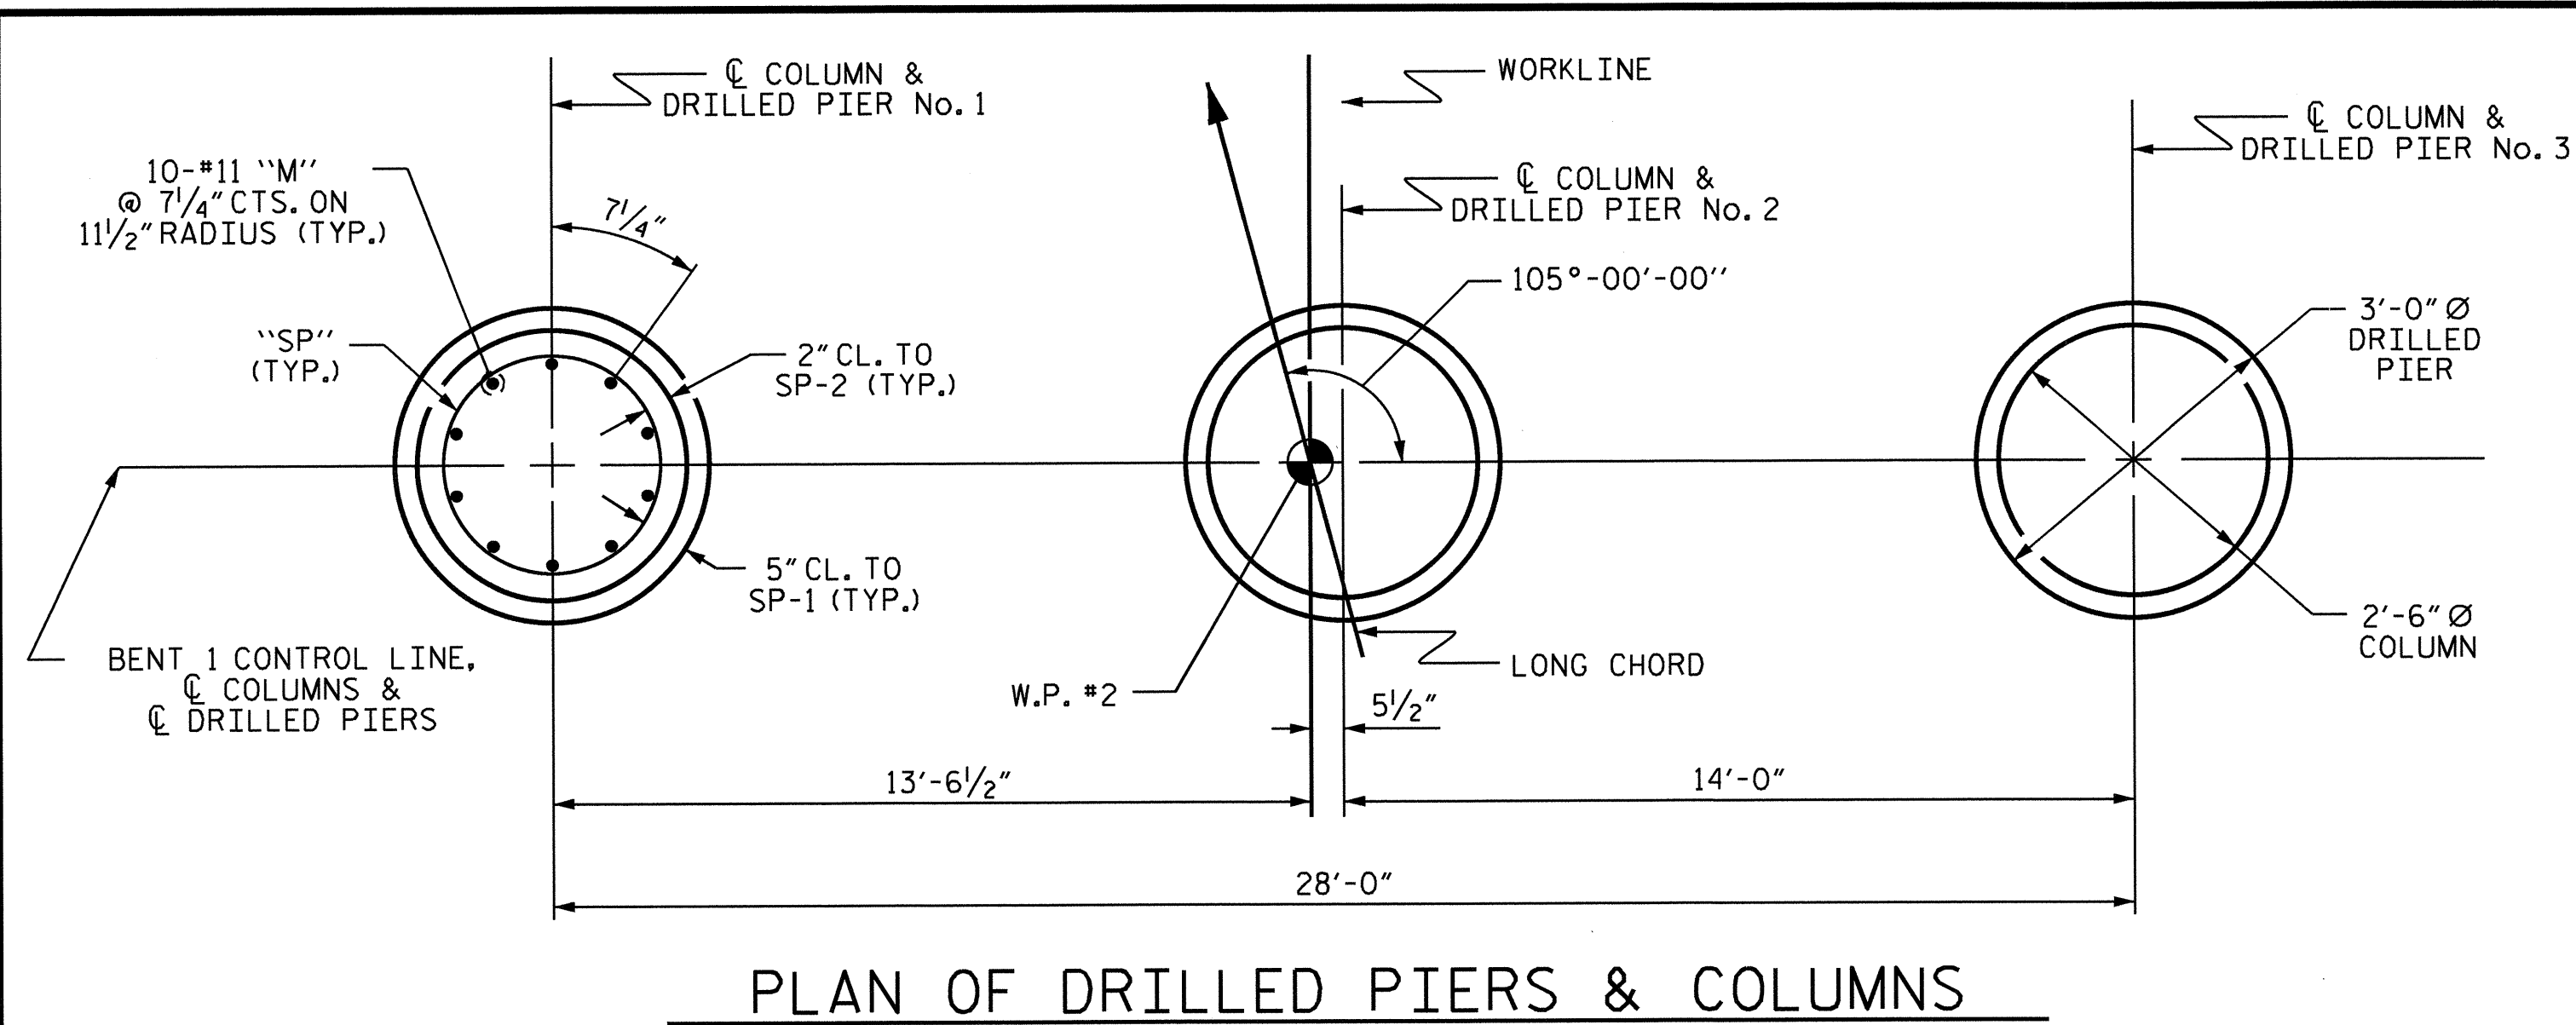


BILL OF MATERIAL FOR ONE BENT					
BAR NO.	SIZE	TYPE	LENGTH	WEIGHT	
B1	#11	1	40'-4"	2143	
B2	#5	STR	37'-4"	312	
D1	#6	STR	1'-6"	99	
M1	#11	4	29'-5"	1563	
M2	#11	4	29'-11"	1589	
M3	#11	4	30'-5"	1616	
S1	#5	2	9'-0"	601	
U1	#4	3	5'-8"	23	
U2	#4	3	5'-6"	22	
U3	#4	3	4'-2"	103	
REINFORCING STEEL (FOR ONE BENT)				8071 LBS.	
SP-1	1	*	5	297'-2"	310
SP-2	1	**	6	136'-8"	91
SP-3	1	*	5	288'-11"	301
SP-4	1	**	6	163'-4"	109
SP-5	1	*	5	273'-11"	286
SP-6	1	**	6	203'-4"	136
SPIRAL COLUMN REINFORCING STEEL (FOR ONE BENT)				1233 LBS.	
* THE SP-1, SP-3, OR SP-5 SPIRAL REINFORCING STEEL SHALL BE W31 OR D-31 COLD DRAWN WIRE OR #5 PLAIN OR DEFORMED BAR					
* THE SP-2, SP-4, OR SP-6 SPIRAL REINFORCING STEEL SHALL BE W20 OR D-20 COLD DRAWN WIRE OR #4 PLAIN OR DEFORMED BAR					
CLASS A CONCRETE BREAKDOWN (FOR ONE BENT)					
POUR #2 (COLUMNS)				3.1 C.Y.	
POUR #3 (CAP)				14.3 C.Y.	
TOTAL CLASS A CONCRETE				17.4 C.Y.	
DRILLED PIERS; (FOR ONE BENT)					
DRILLED PIER CONCRETE POUR #1 (DRILLED PIERS)				14.0 C.Y.	
3'-0" Ø DRILLED PIER NOT IN SOIL				18.0 LIN. FT.	
3'-0" Ø DRILLED PIER IN SOIL				35.5 LIN. FT.	
PERMANENT STEEL CASING FOR 3'-0" Ø DRILLED PIER				30.0 LIN. FT.	
CSL TUBES				232.0 LIN. FT.	

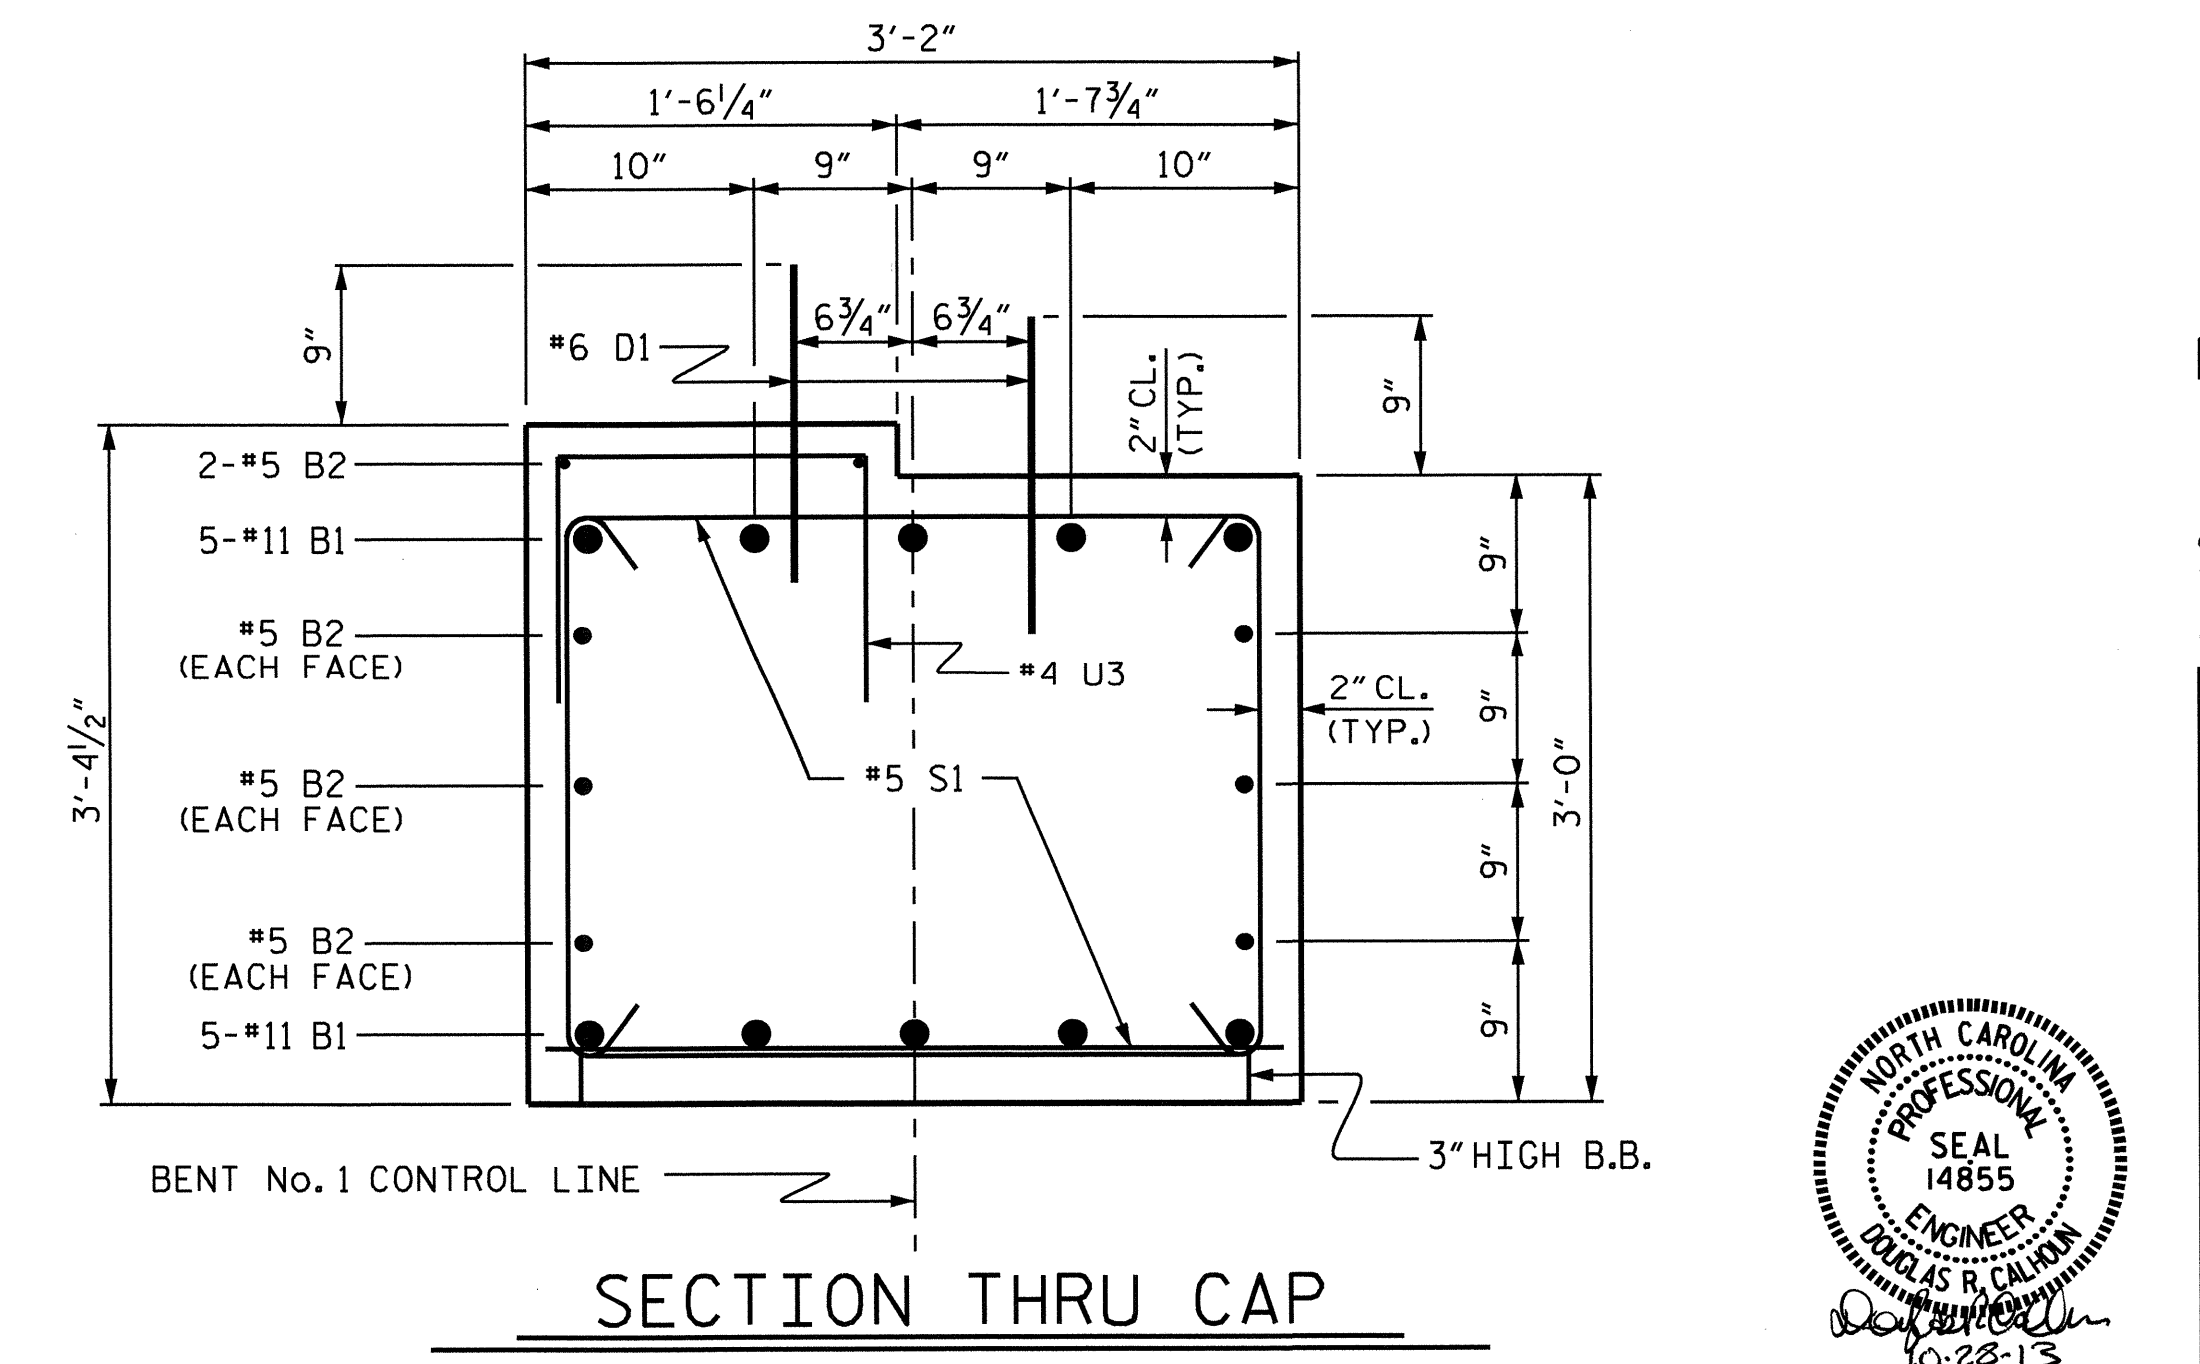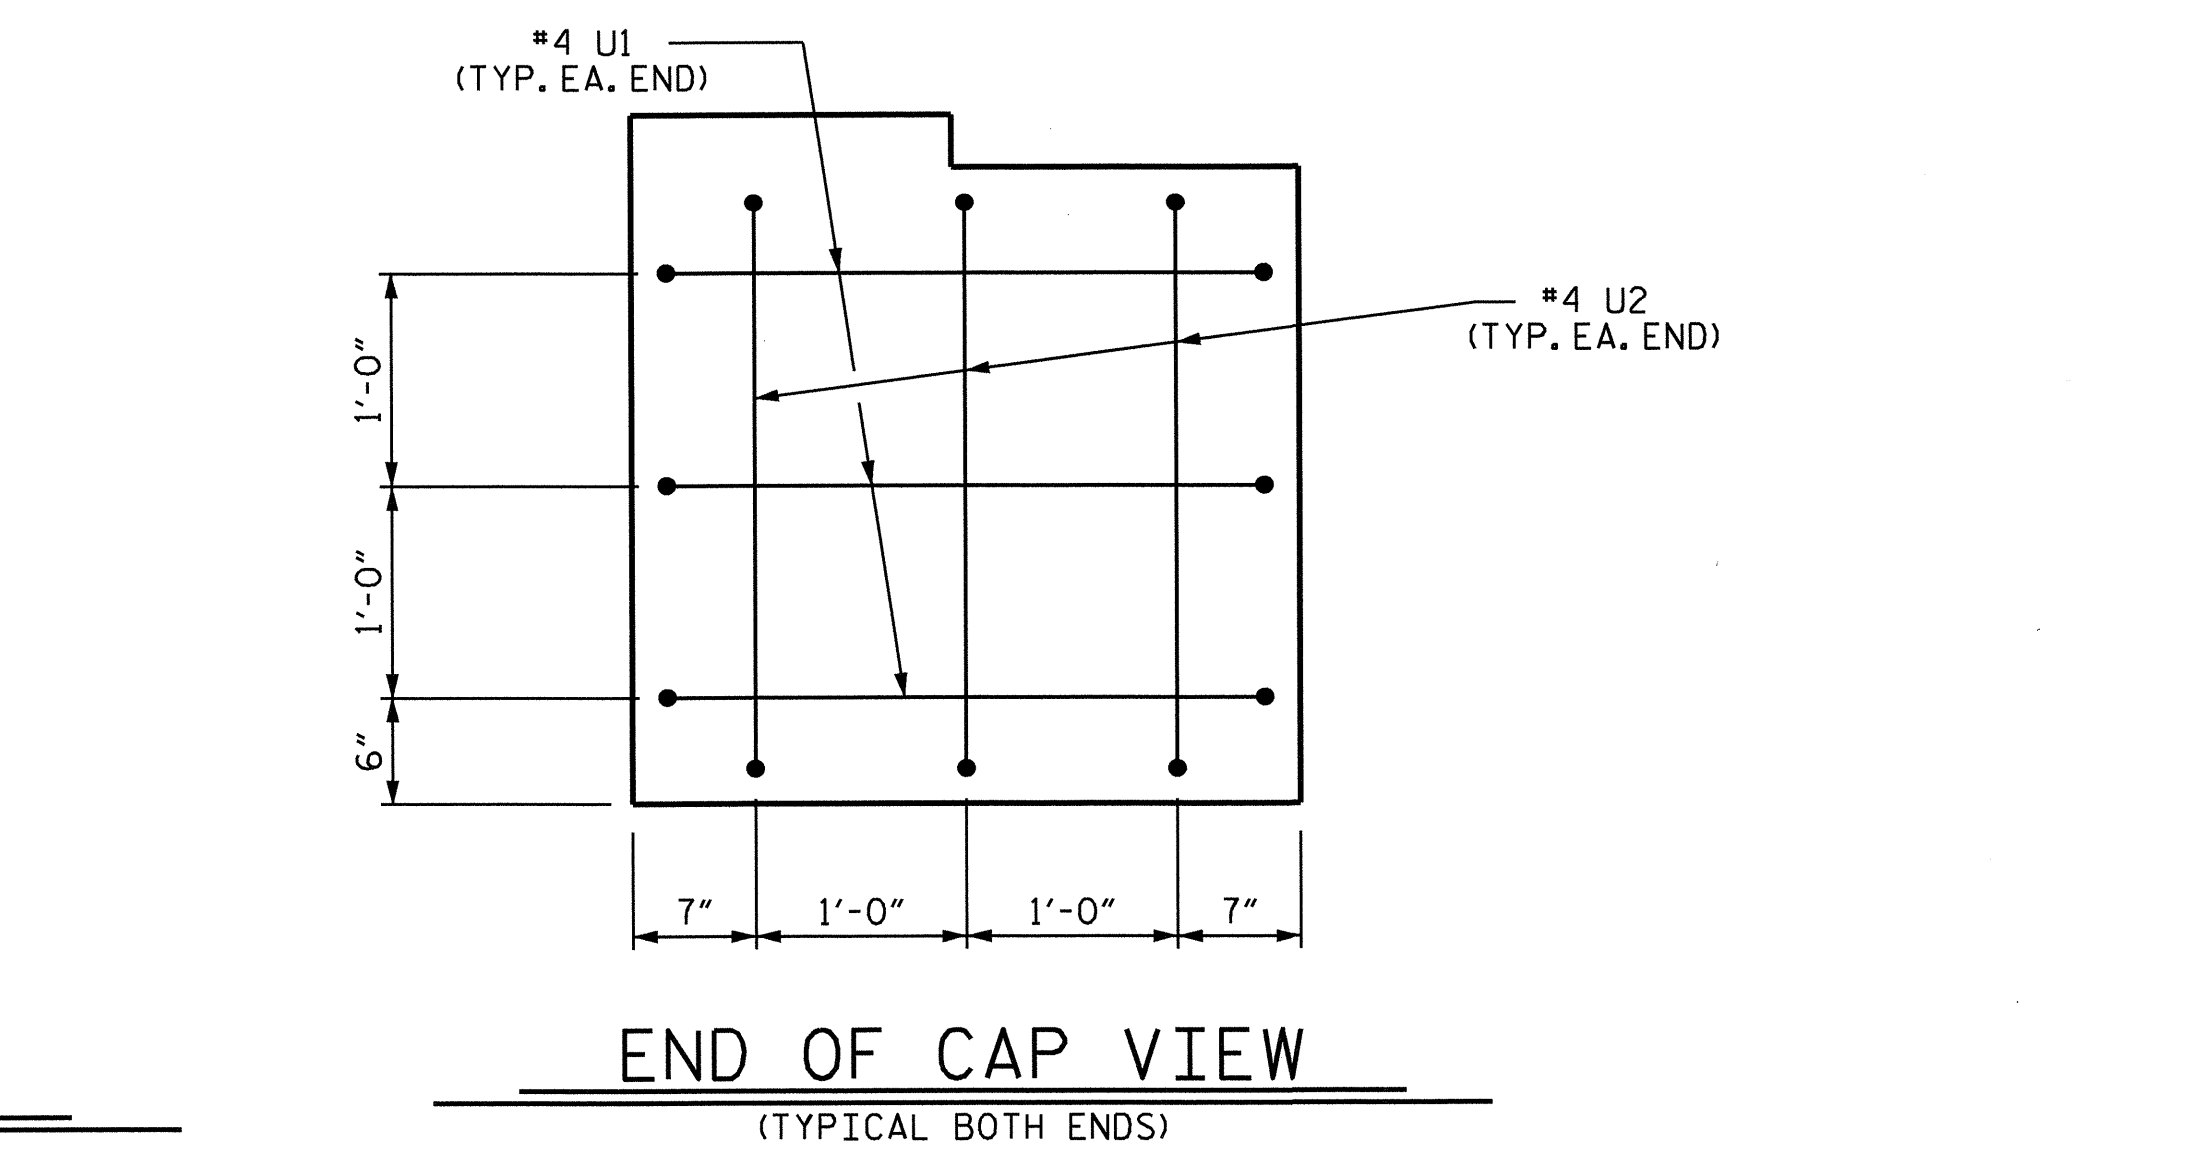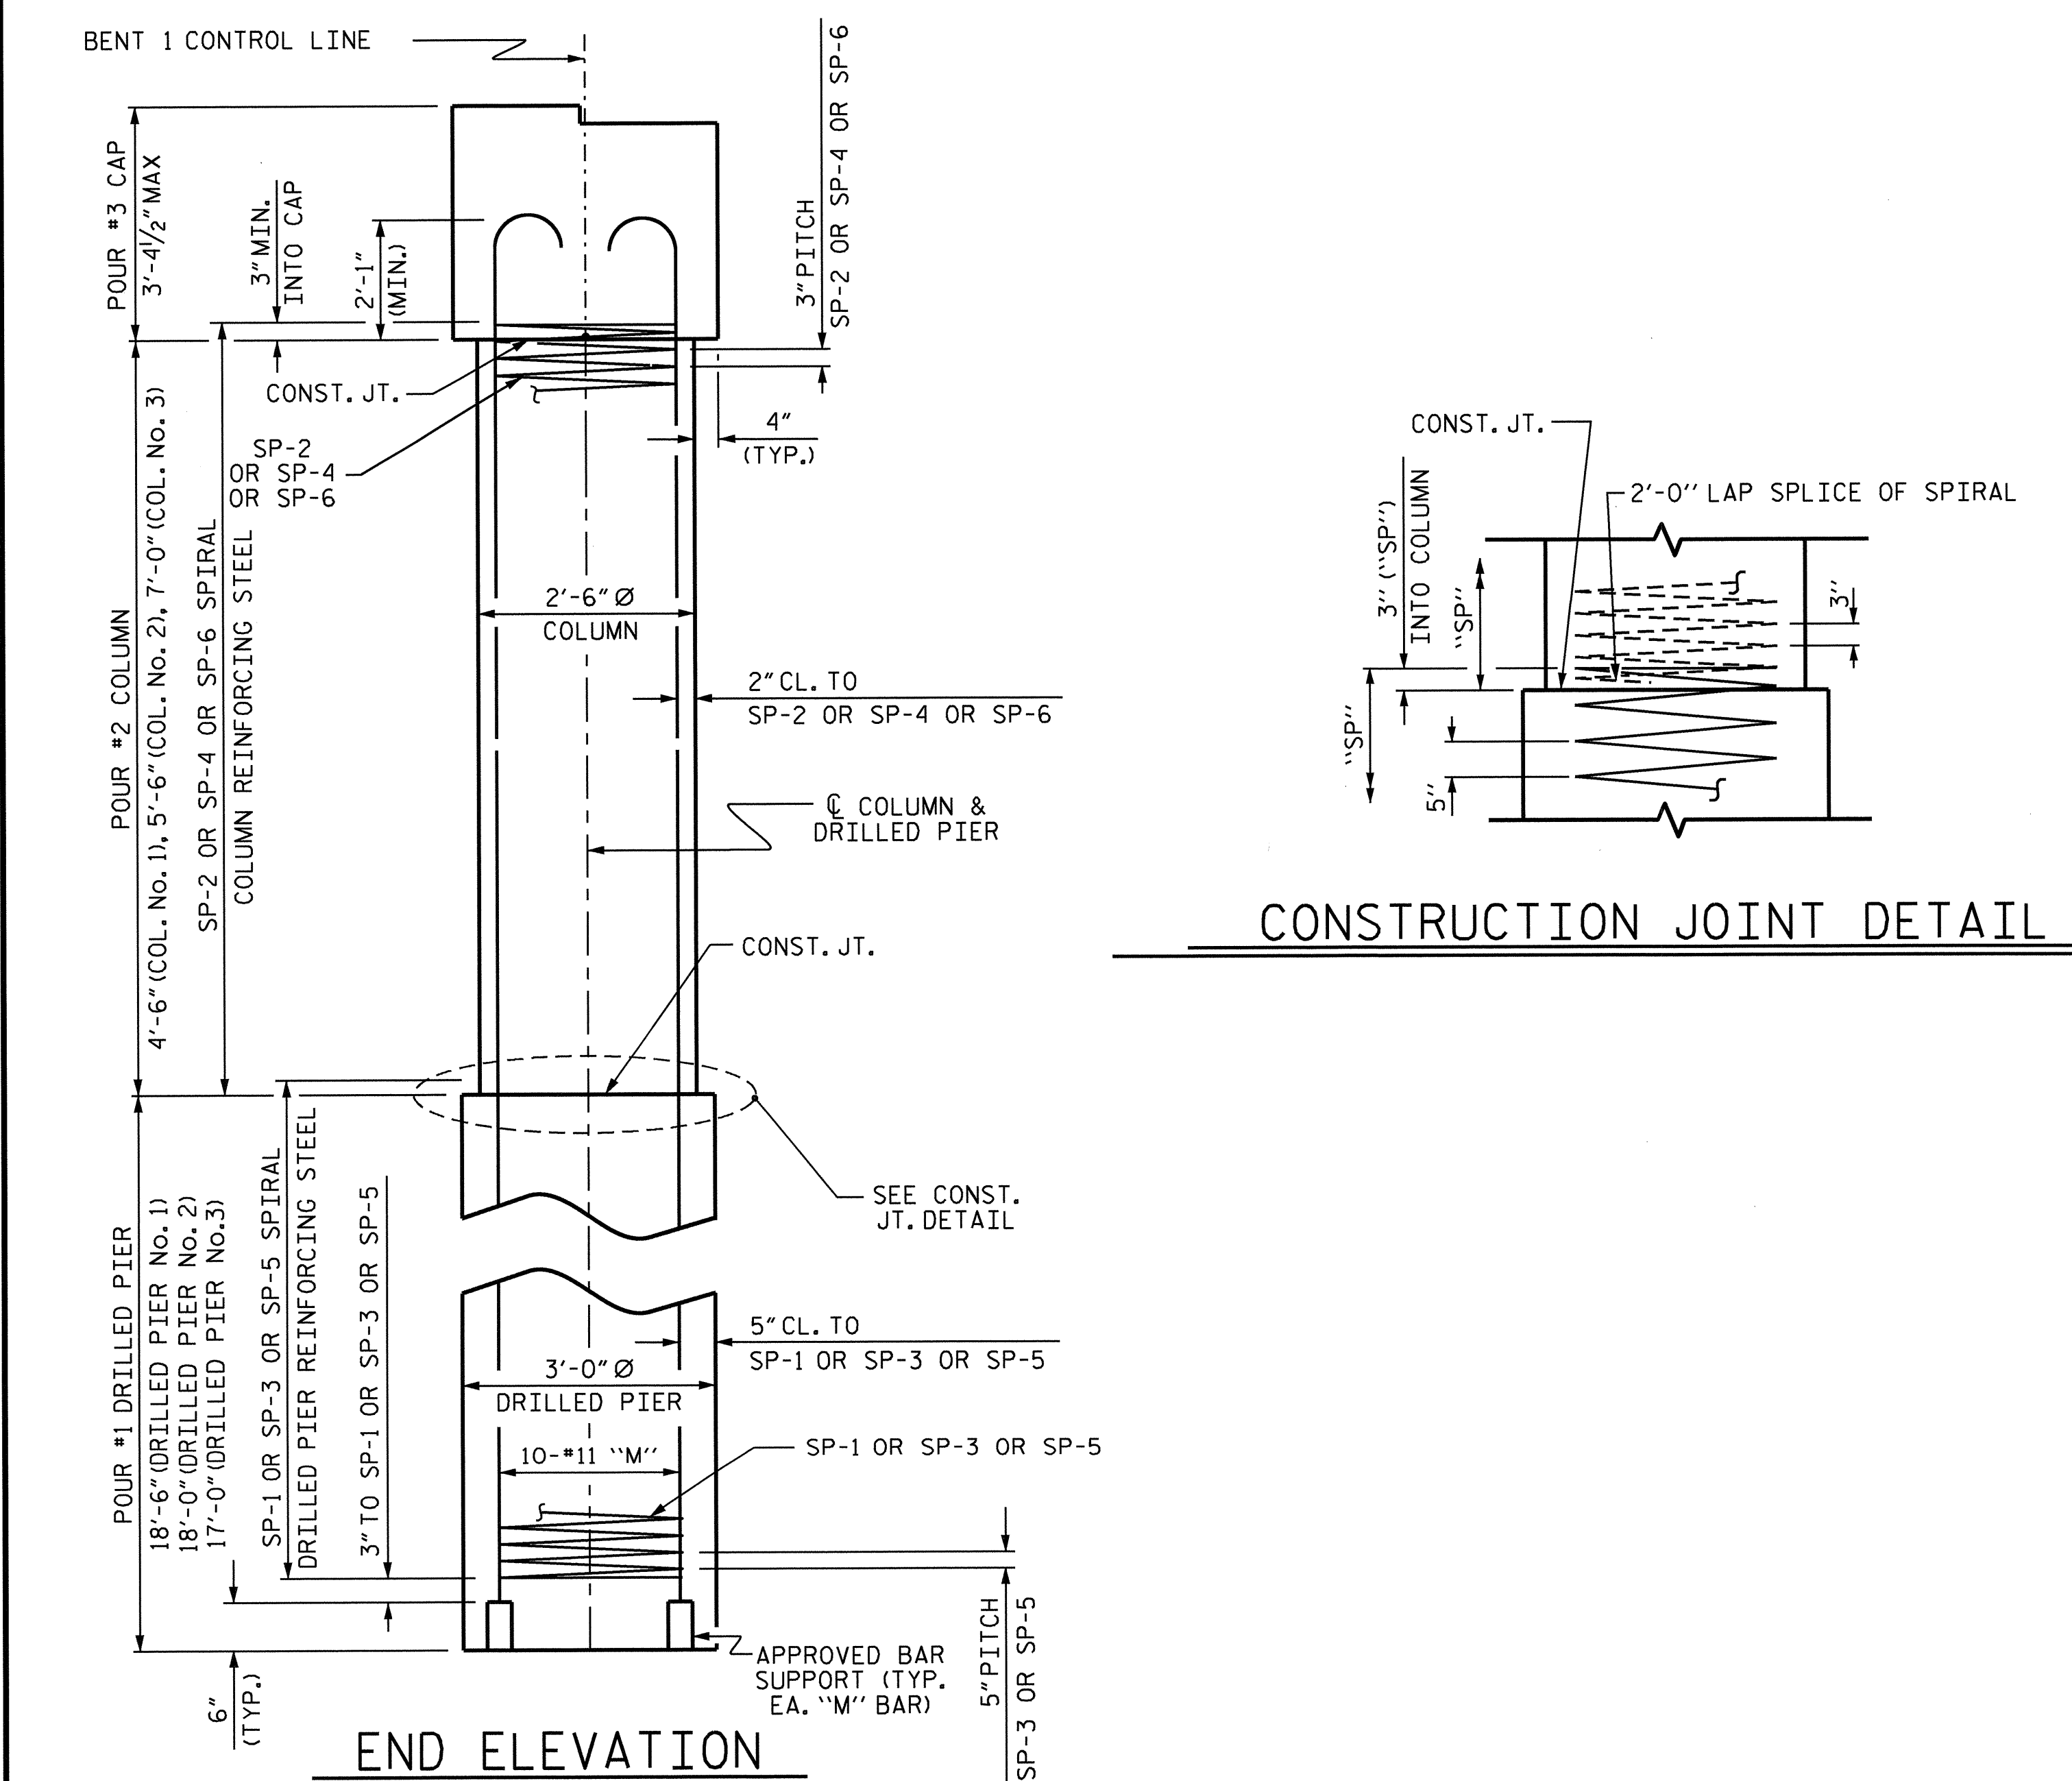

ASSEMBLED BY : A.C. OUTLAW DATE : 9/03/13
 CHECKED BY : A. SORSENGINH DATE : 9/13
 DRAWN BY : DGE 03/10
 CHECKED BY : MKT 03/10

23-OCT-2013 10:02
 R:\Structures\Plans\Revised Drawings\Substructure\B4731.50.B*.01.dgn

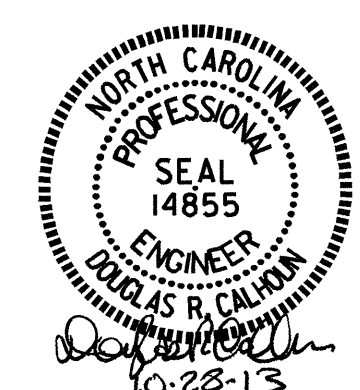

PROJECT NO. B-4731
 CHATHAM COUNTY
 STATION: 16+13.50 -L-

REVISIONS						SHEET NO.
NO.	BY:	DATE:	NO.	BY:	DATE:	S-24
1			3			TOTAL SHEETS 28
2			4			

STD. NO. DP_BT_33.105S_<50'

NOTES

STIRRUPS IN CAP MAY BE SHIFTED AS NECESSARY TO CLEAR DOWELS.

HOOKS ON "M" BARS MAY BE TURNED AS NECESSARY FOR PLACING REINFORCING STEEL.


FOR DRILLED PIERS, SEE SECTION 411 OF THE STANDARD SPECIFICATIONS.

ALL STEEL IN THE DRILLED PIERS IS INCLUDED IN THE PAY ITEMS FOR "REINFORCING STEEL" AND "SPIRAL COLUMN REINFORCING STEEL."


★ INVERT ALTERNATE STIRRUPS.

THE LOCATION OF THE CONSTRUCTION JOINT IN THE DRILLED PIERS IS BASED ON AN APPROXIMATE GROUND LINE ELEVATION. IF THE CONSTRUCTION JOINT IS ABOVE THE ACTUAL GROUND LINE ELEVATION, THE CONTRACTOR SHALL PLACE THE CONSTRUCTION JOINT ONE FOOT BELOW THE GROUND LINE.

THE CONTRACTOR'S ATTENTION IS CALLED TO THE FACT THAT THE LONGITUDINAL REINFORCEMENT FOR DRILLED PIERS IS DETAILED WITH 3 FEET OF EXTRA LENGTH.

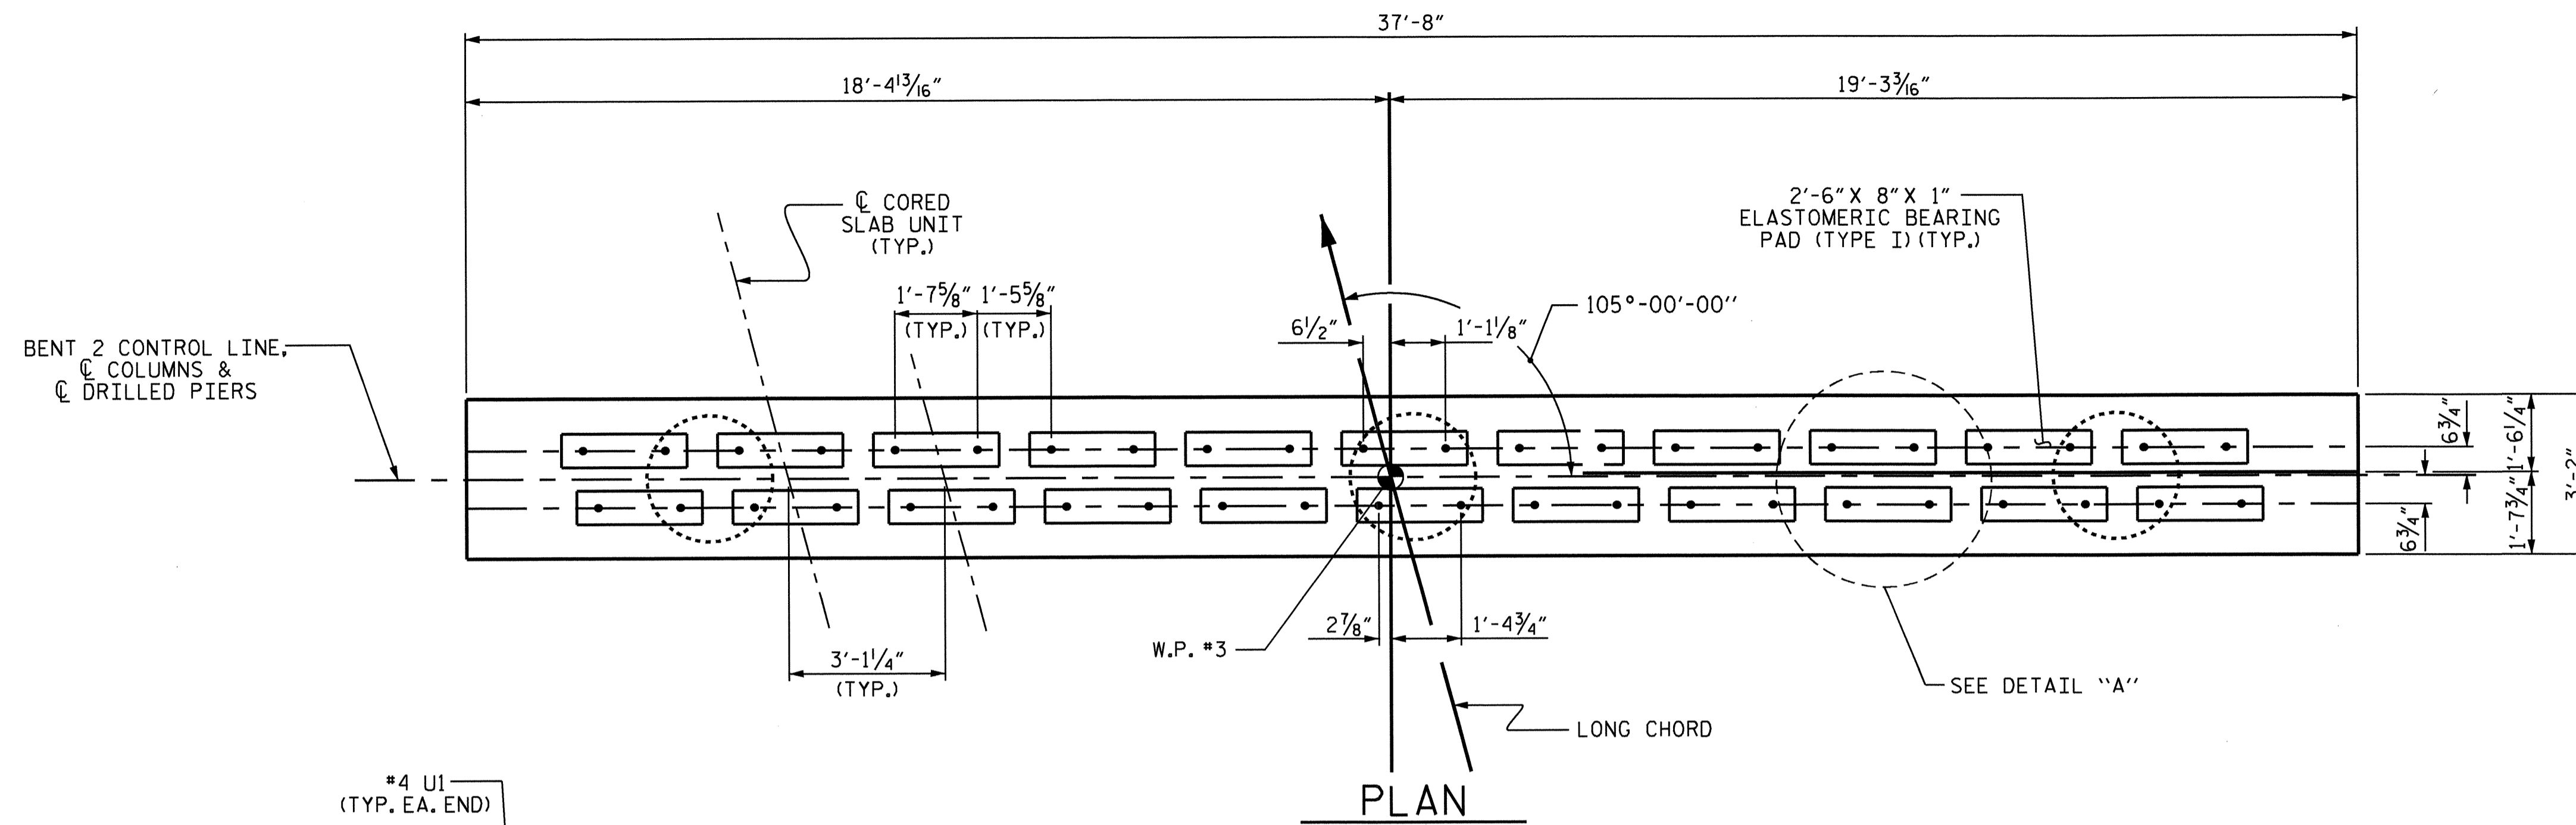


PLAN

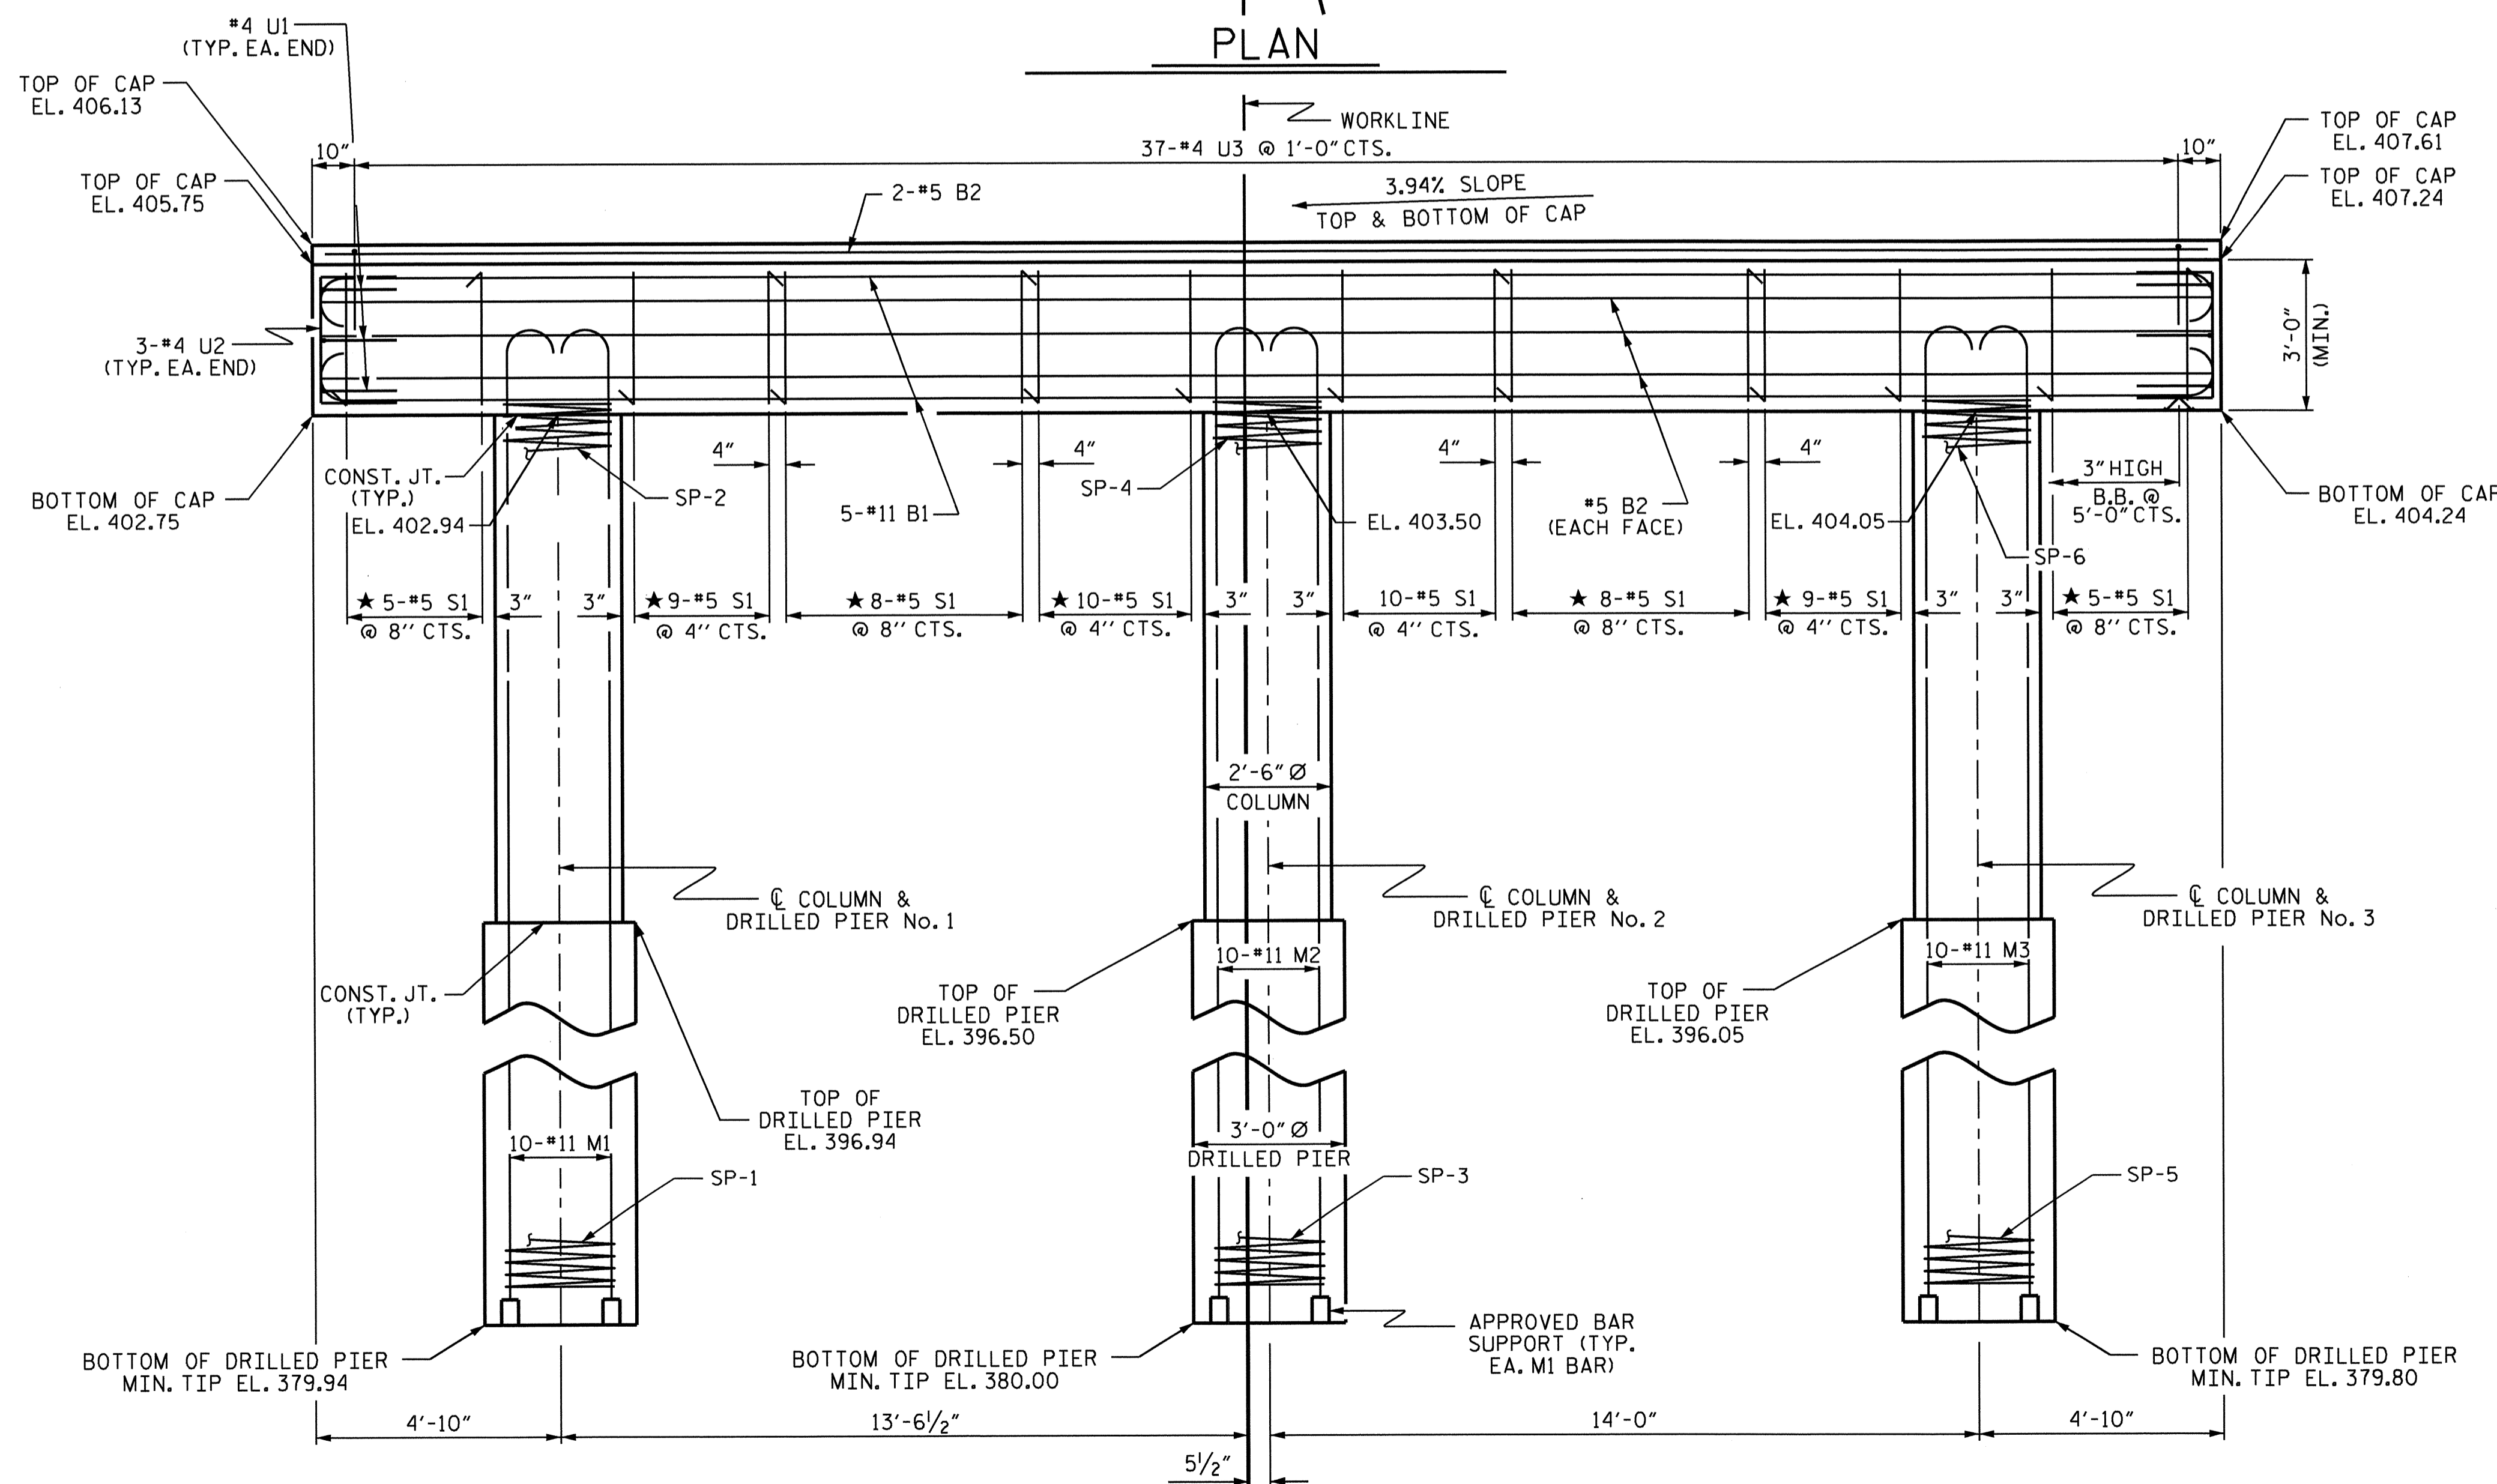

ELEVATION

DIMENSIONS & REINFORCING STEEL ARE TYPICAL FOR EACH COLUMN & DRILLED PIER UNLESS OTHERWISE NOTED.

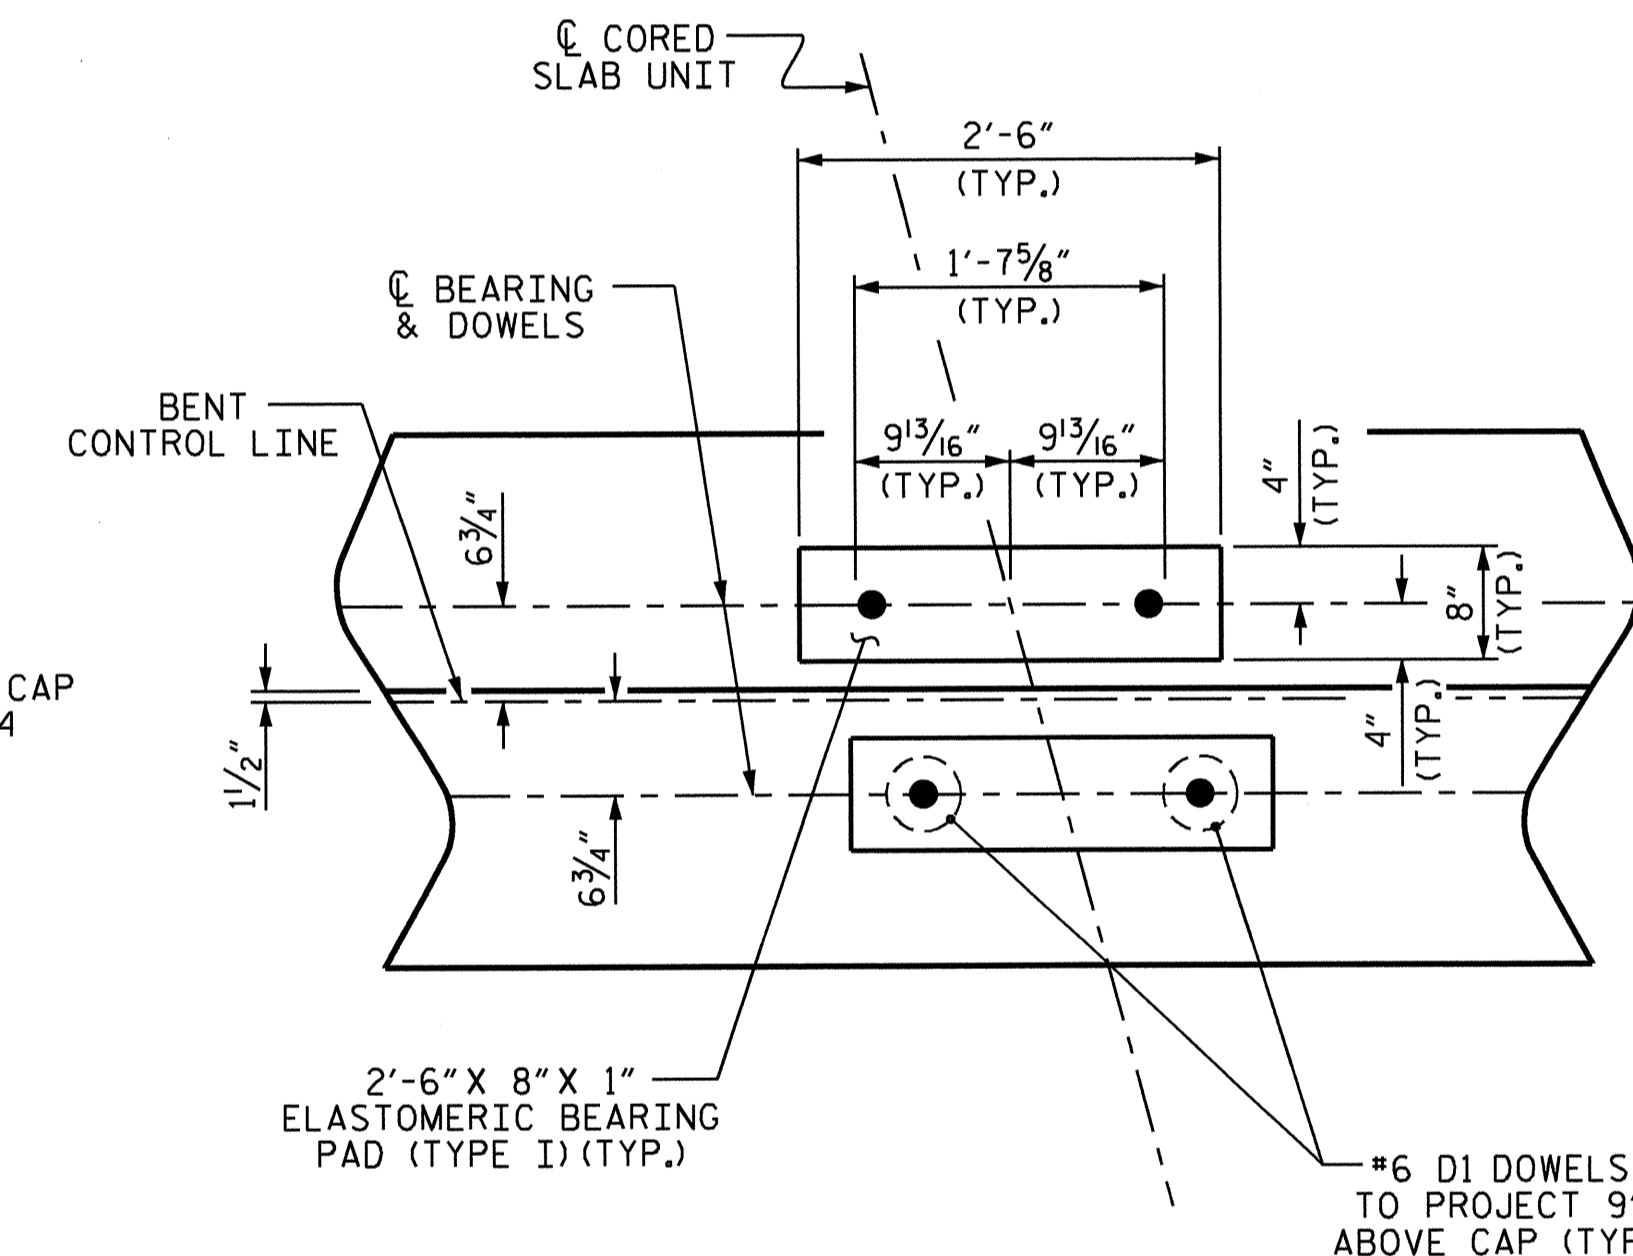

DETAIL "A"


(DIMENSIONS ARE TYPICAL EACH BEARING)

PROJECT NO. B-4731
CHATHAM COUNTY
 STATION: 16+13.50 -L-

SHEET 1 OF 2



STATE OF NORTH CAROLINA
 DEPARTMENT OF TRANSPORTATION
 RALEIGH

SUBSTRUCTURE
BENT 2




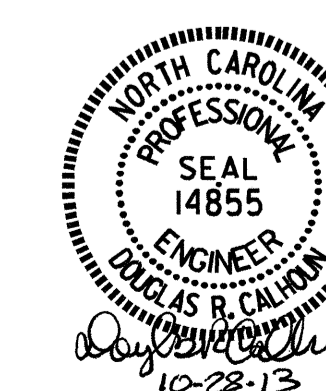


REVISIONS						SHEET NO.
NO.	BY:	DATE:	NO.	BY:	DATE:	S-25
1			3			TOTAL SHEETS
2			4			28

ASSEMBLED BY : A.C. OUTLAW DATE : 9/03/13
 CHECKED BY : A. SORSENGINH DATE : 9/13
 DRAWN BY : DGE 04/10
 CHECKED BY : MKT 04/10

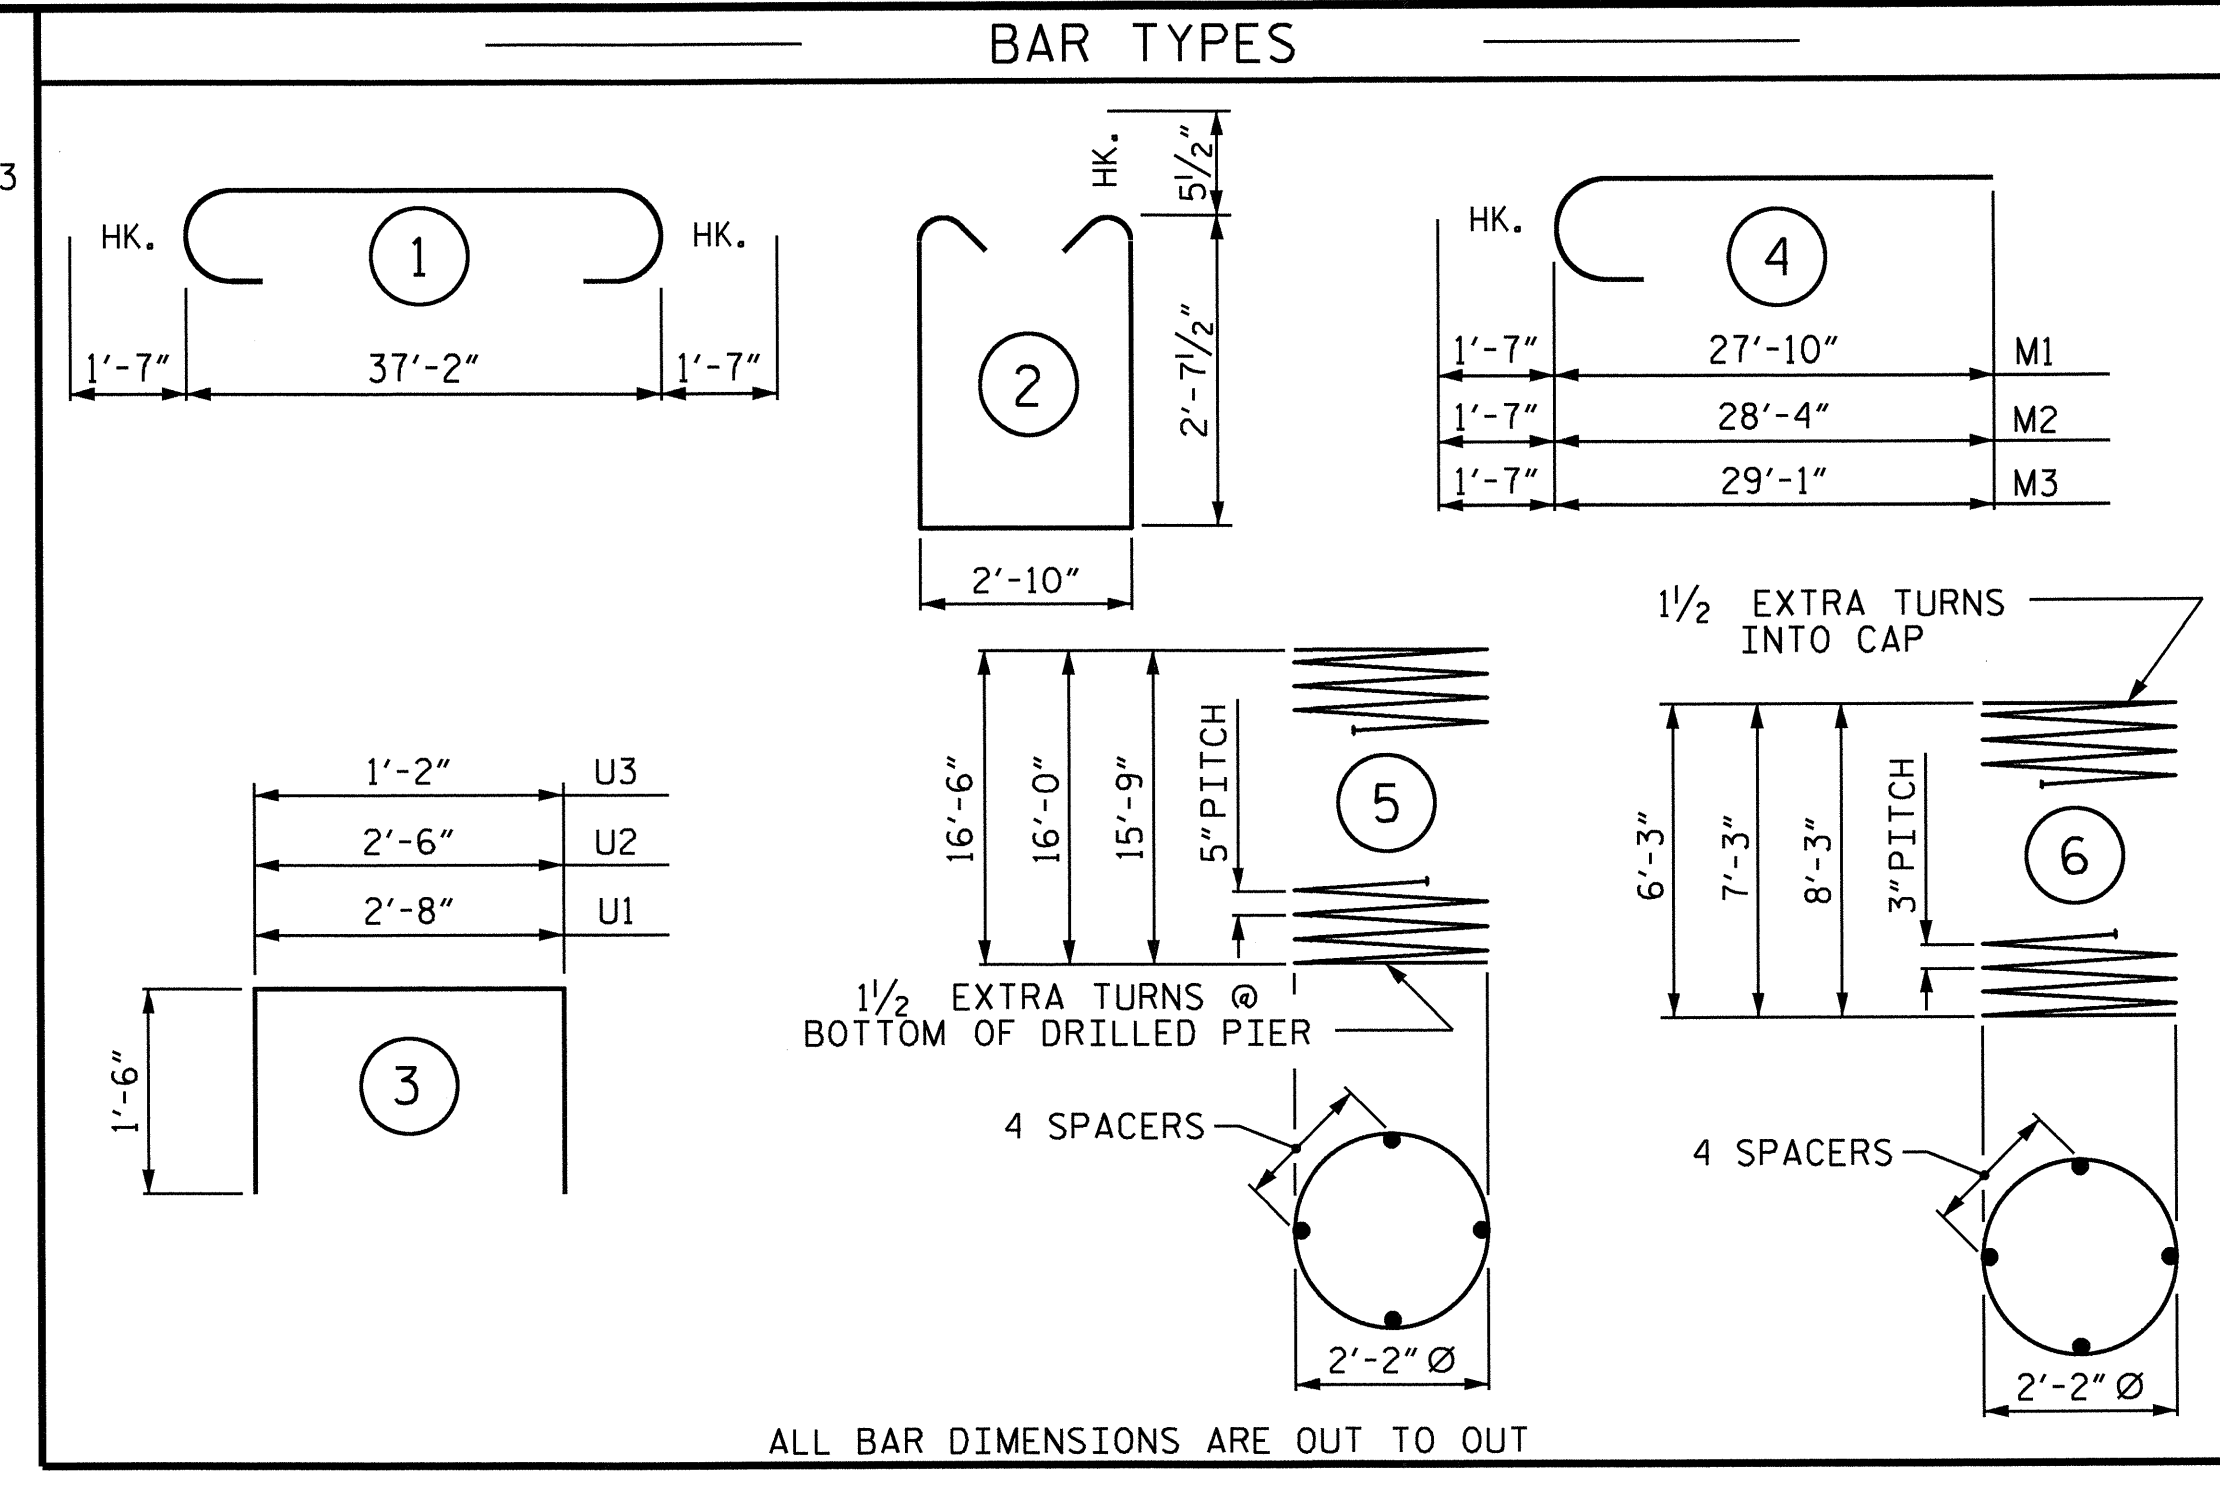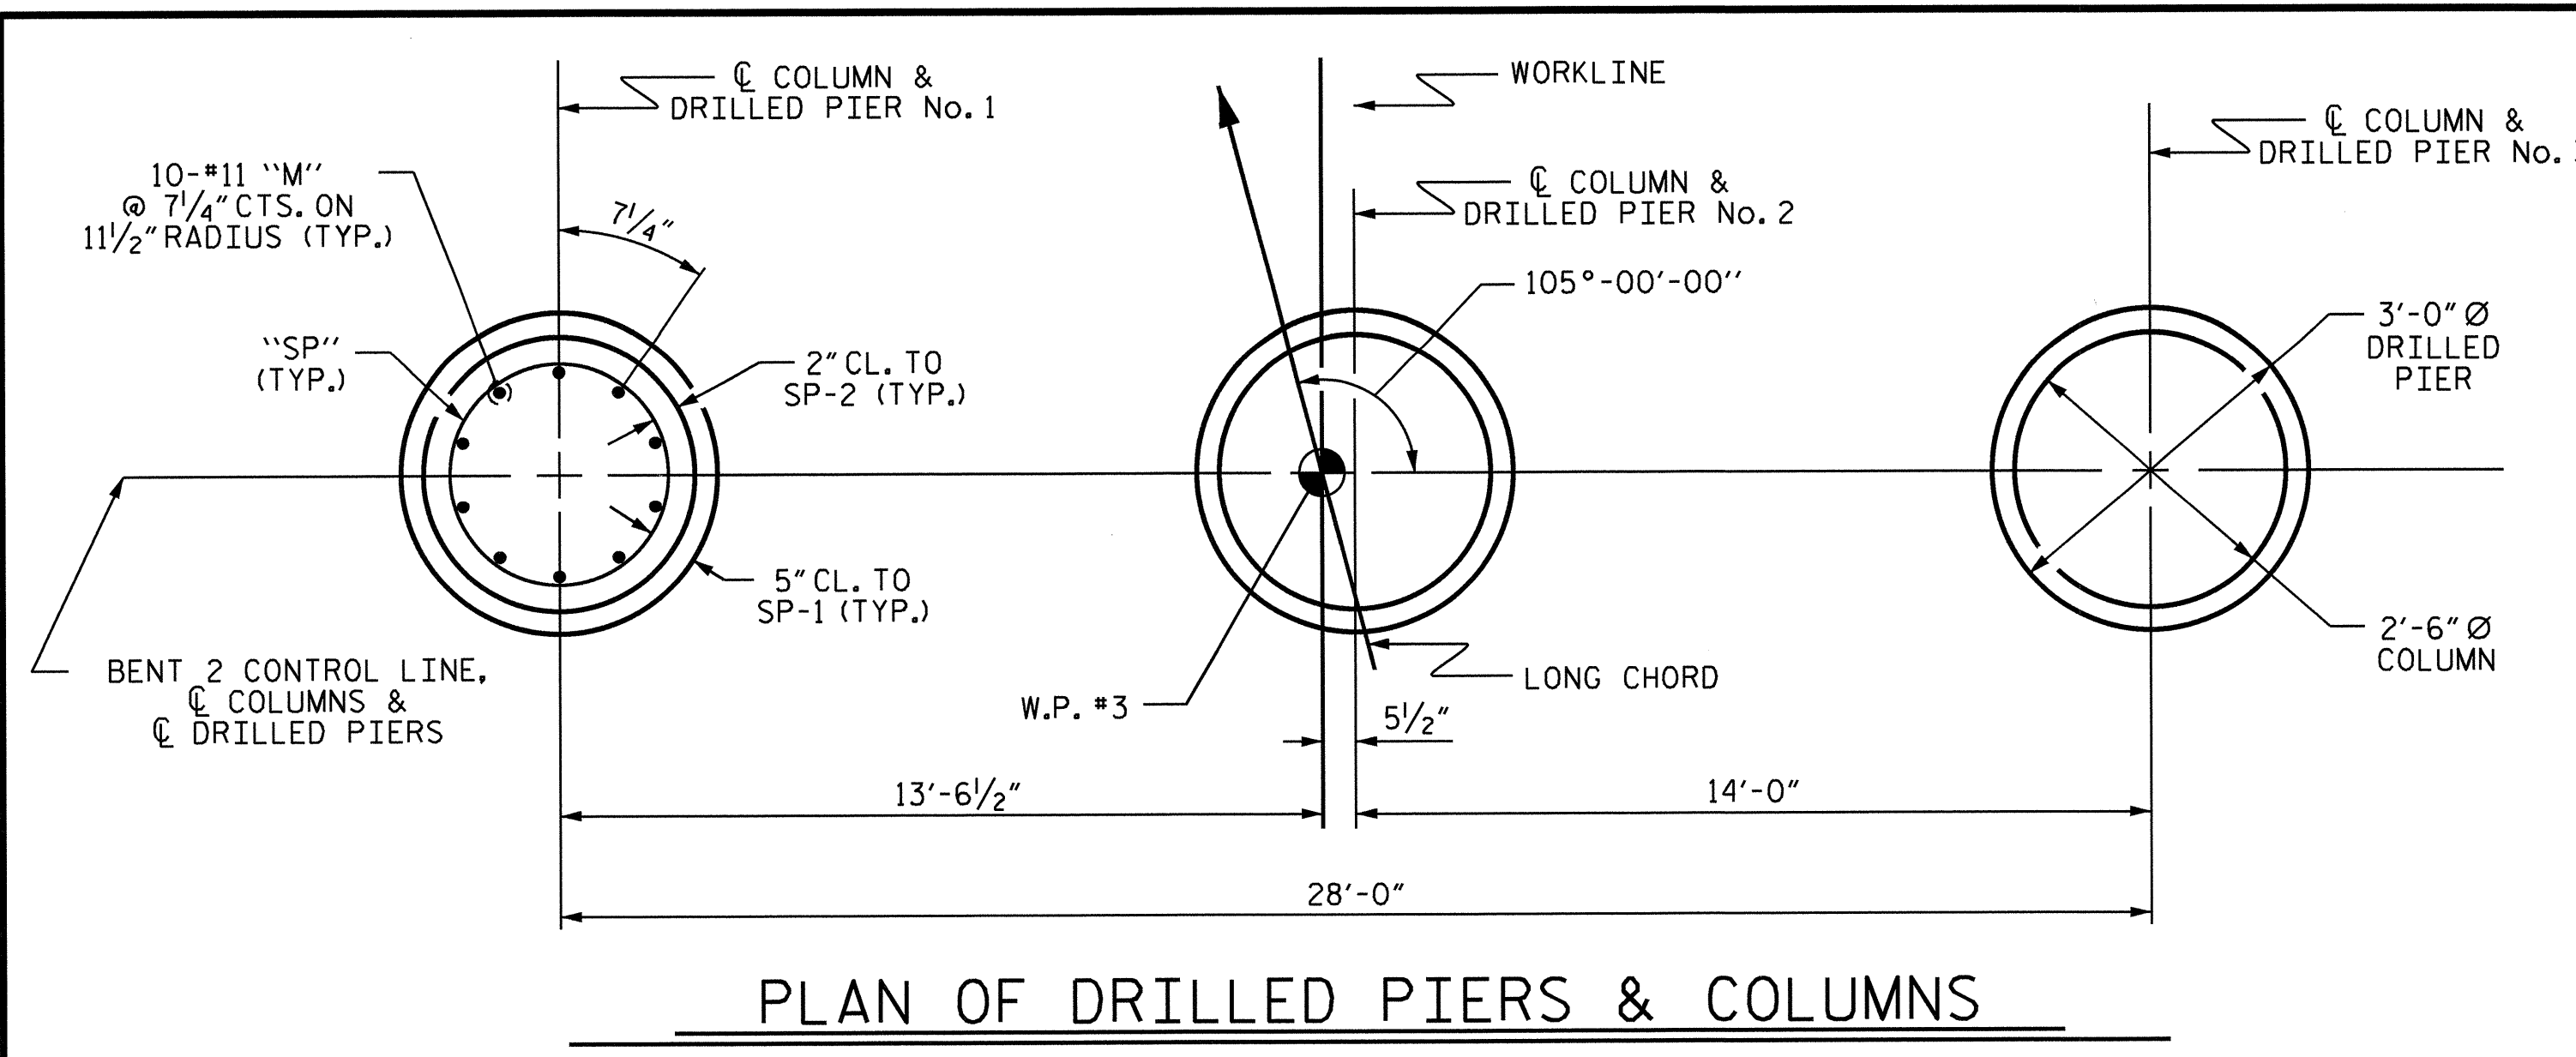


BILL OF MATERIAL FOR ONE BENT					
BAR	NO.	SIZE	TYPE	LENGTH	WEIGHT
B1	10	#11	1	40'-4"	2143
B2	8	#5	STR	37'-4"	312
D1	44	#6	STR	1'-6"	99
M1	10	#11	4	29'-5"	1563
M2	10	#11	4	29'-11"	1589
M3	10	#11	4	30'-8"	1629
S1	64	#5	2	9'-0"	601
U1	6	#4	3	5'-8"	23
U2	6	#4	3	5'-6"	22
U3	37	#4	3	4'-2"	103
REINFORCING STEEL (FOR ONE BENT)					8084 LBS.
SP-1	1	*	5	273'-11"	286
SP-2	1	**	6	176'-8"	118
SP-3	1	*	5	265'-8"	277
SP-4	1	**	6	203'-4"	136
SP-5	1	*	5	262'-4"	274
SP-6	1	**	6	229'-11"	154
SPIRAL COLUMN REINFORCING STEEL (FOR ONE BENT)					1245 LBS.
* THE SP-1, SP-3, OR SP-5 SPIRAL REINFORCING STEEL SHALL BE W31 OR D-31 COLD DRAWN WIRE OR #5 PLAIN OR DEFORMED BAR					
** THE SP-2, SP-4, OR SP-6 SPIRAL REINFORCING STEEL SHALL BE W20 OR D-20 COLD DRAWN WIRE OR #4 PLAIN OR DEFORMED BAR					
CLASS A CONCRETE BREAKDOWN (FOR ONE BENT)					
POUR #2 (COLUMNS)					3.8 C.Y.
POUR #3 (CAP)					14.3 C.Y.
TOTAL CLASS A CONCRETE					18.1 C.Y.
DRILLED PIERS: (FOR ONE BENT)					
DRILLED PIER CONCRETE POUR #1 (DRILLED PIERS)					13.0 C.Y.
3'-0" Ø DRILLED PIER NOT IN SOIL					18.0 LIN. FT.
3'-0" Ø DRILLED PIER IN SOIL					31.75 LIN. FT.
PERMANENT STEEL CASING FOR 3'-0" Ø DRILLED PIER					25.5 LIN. FT.
CSL TUBES					217.0 LIN. FT.

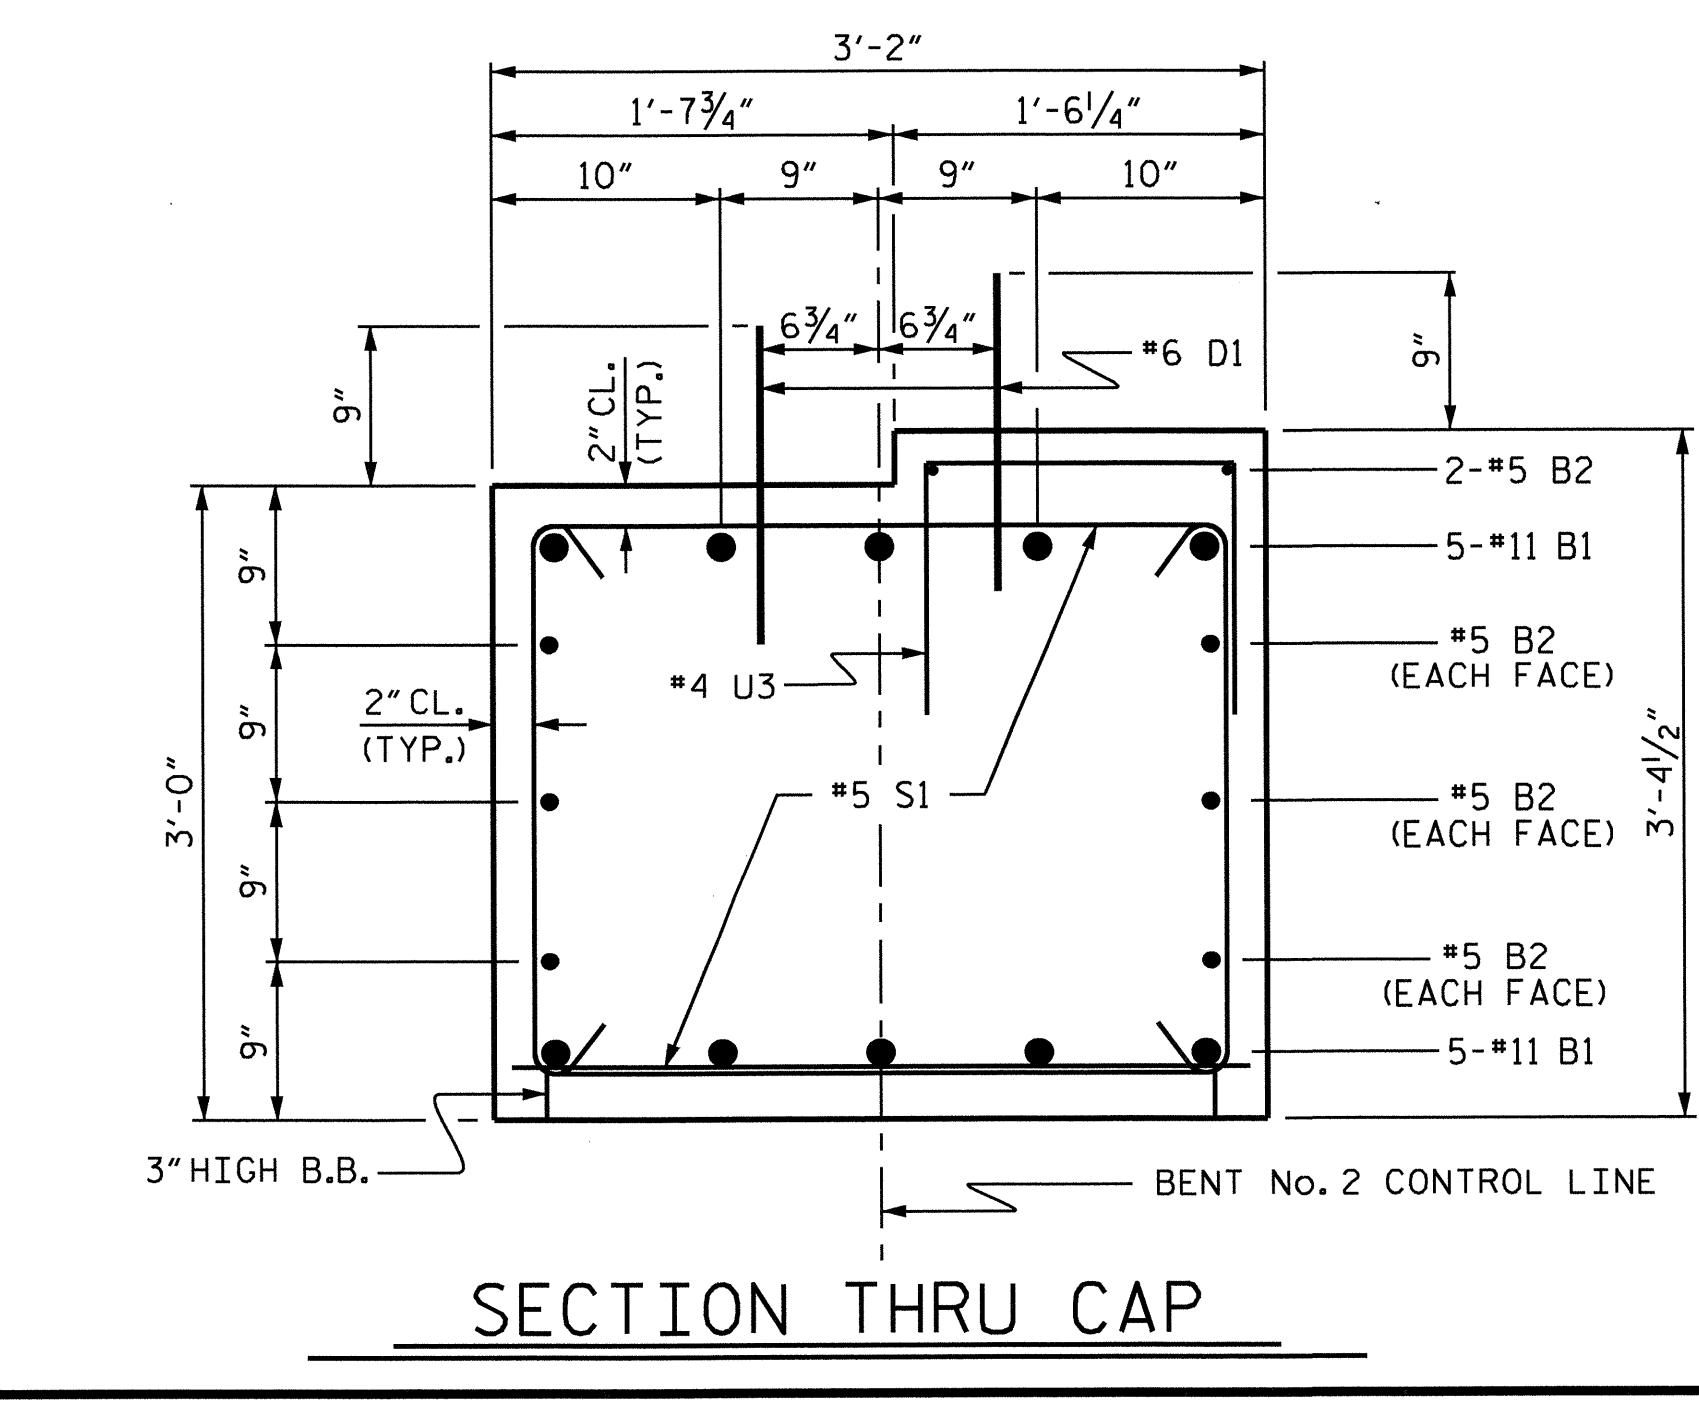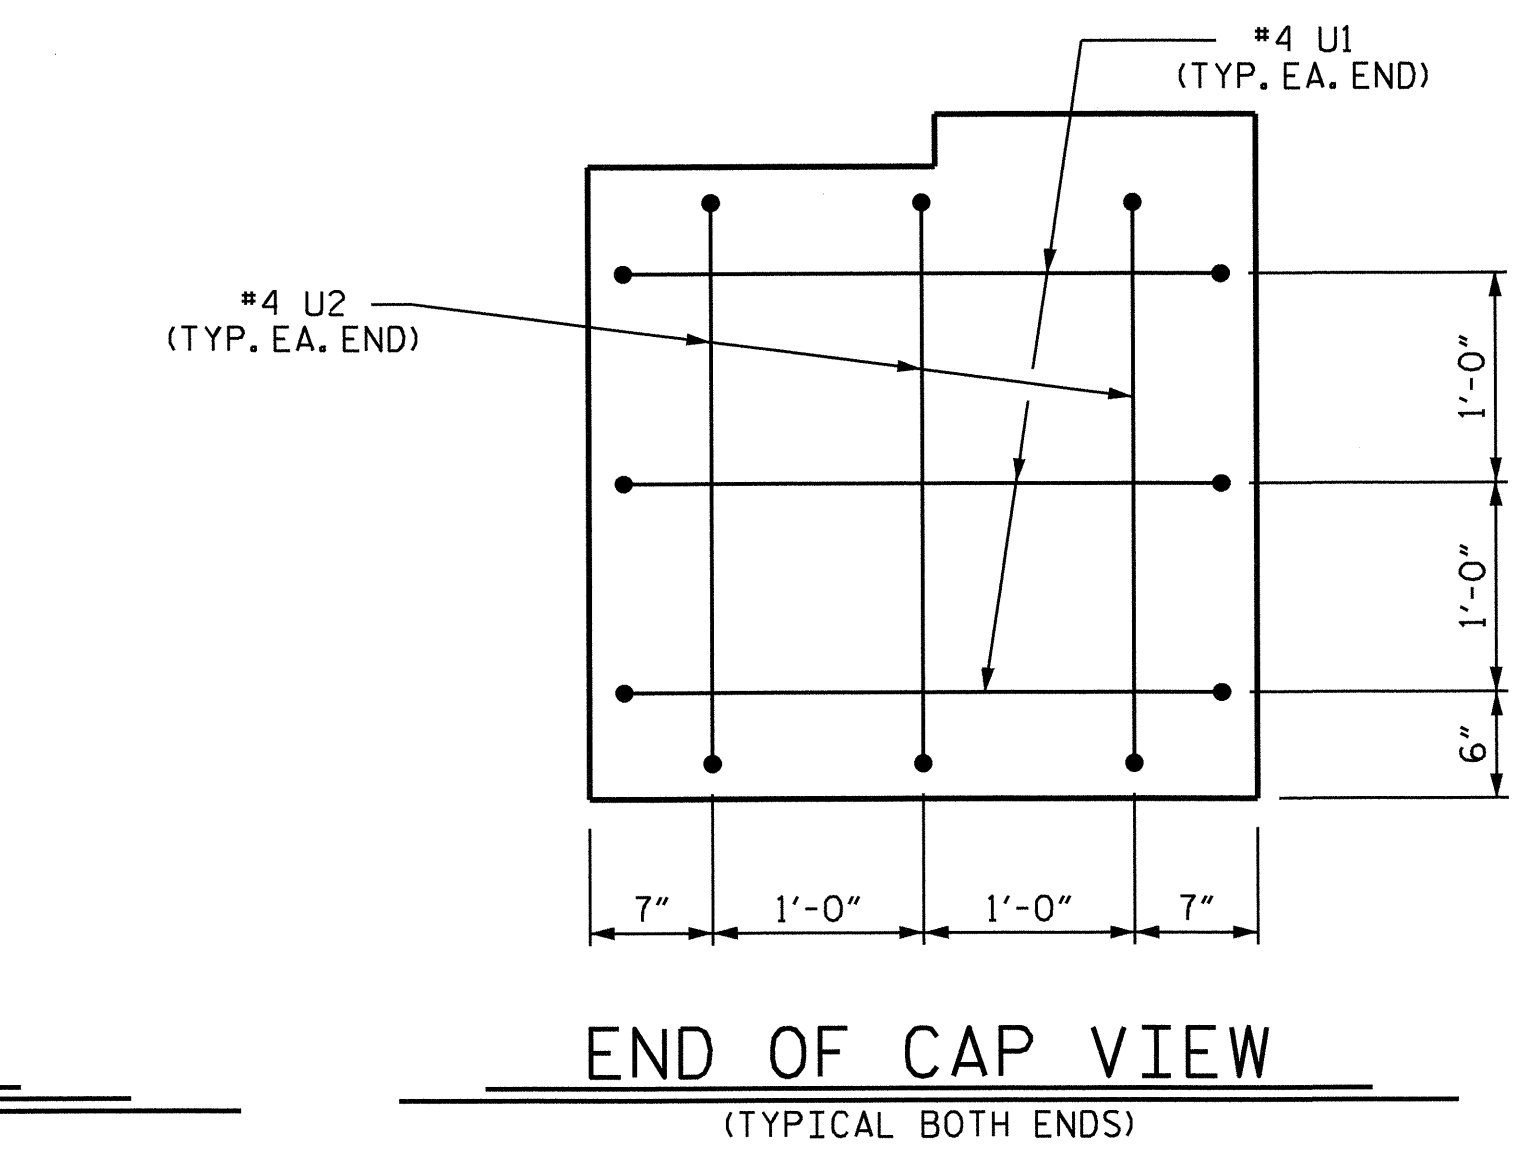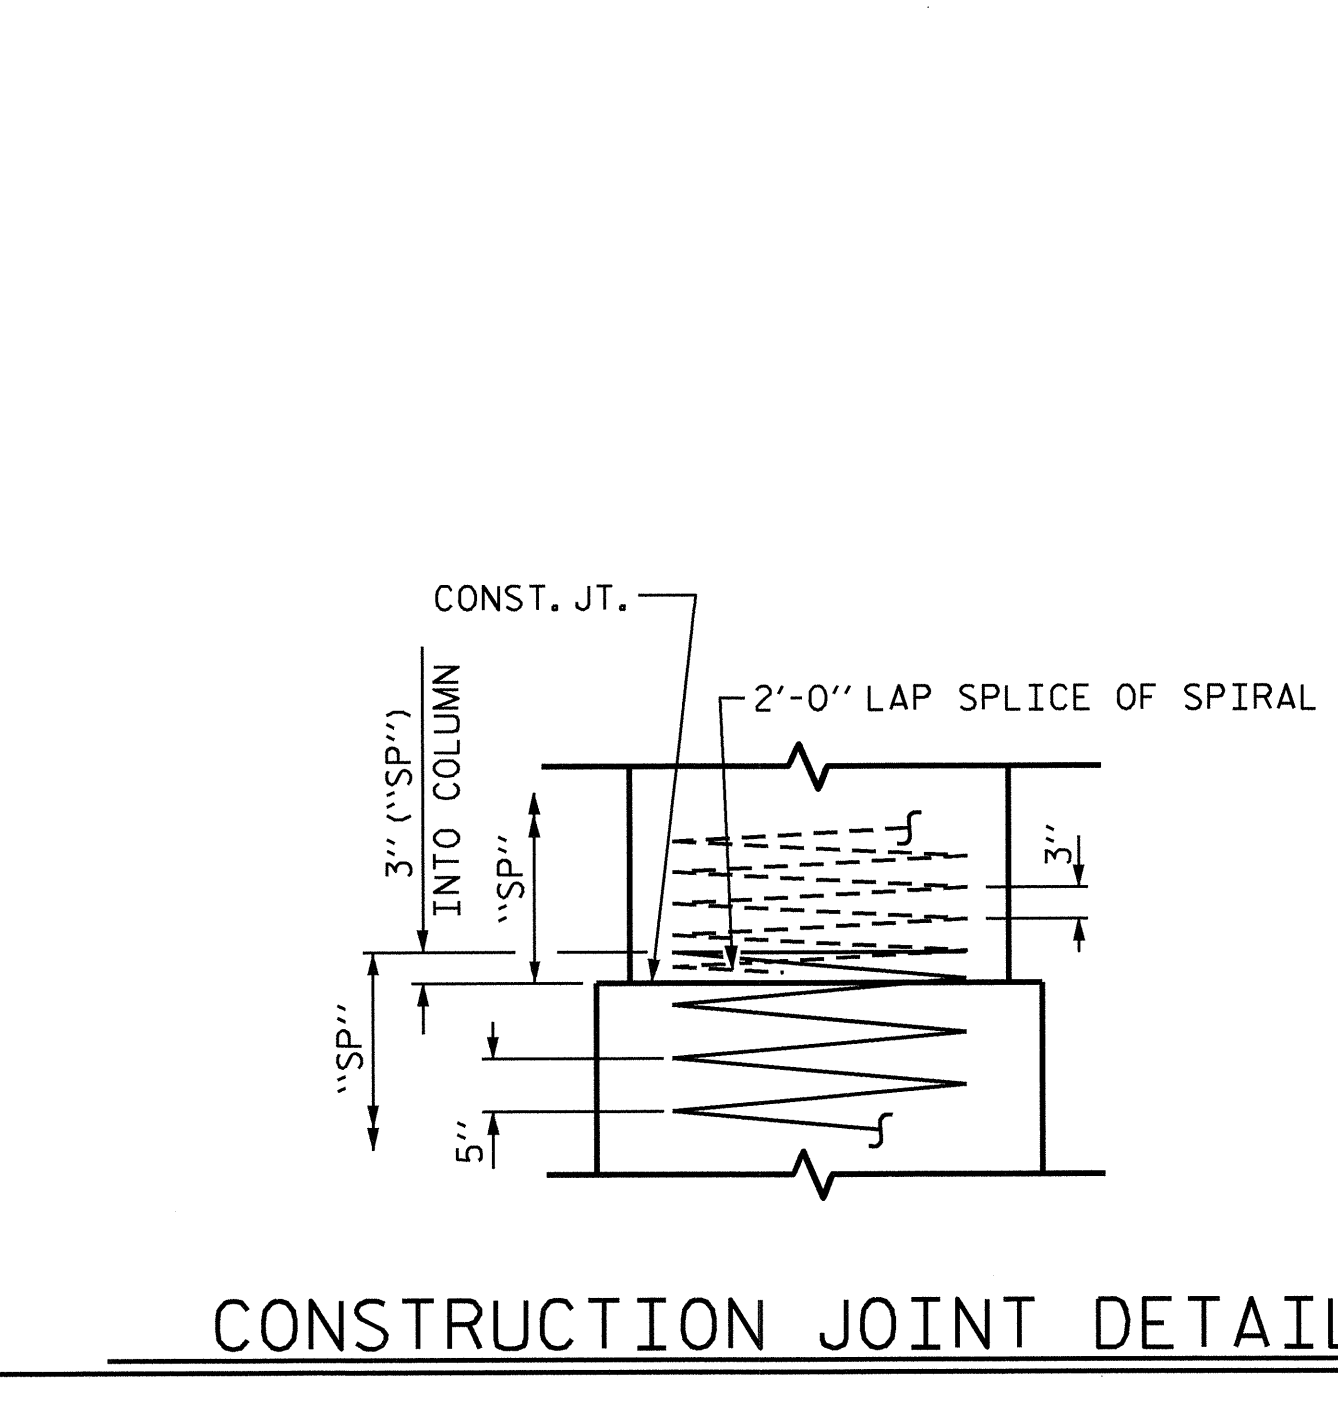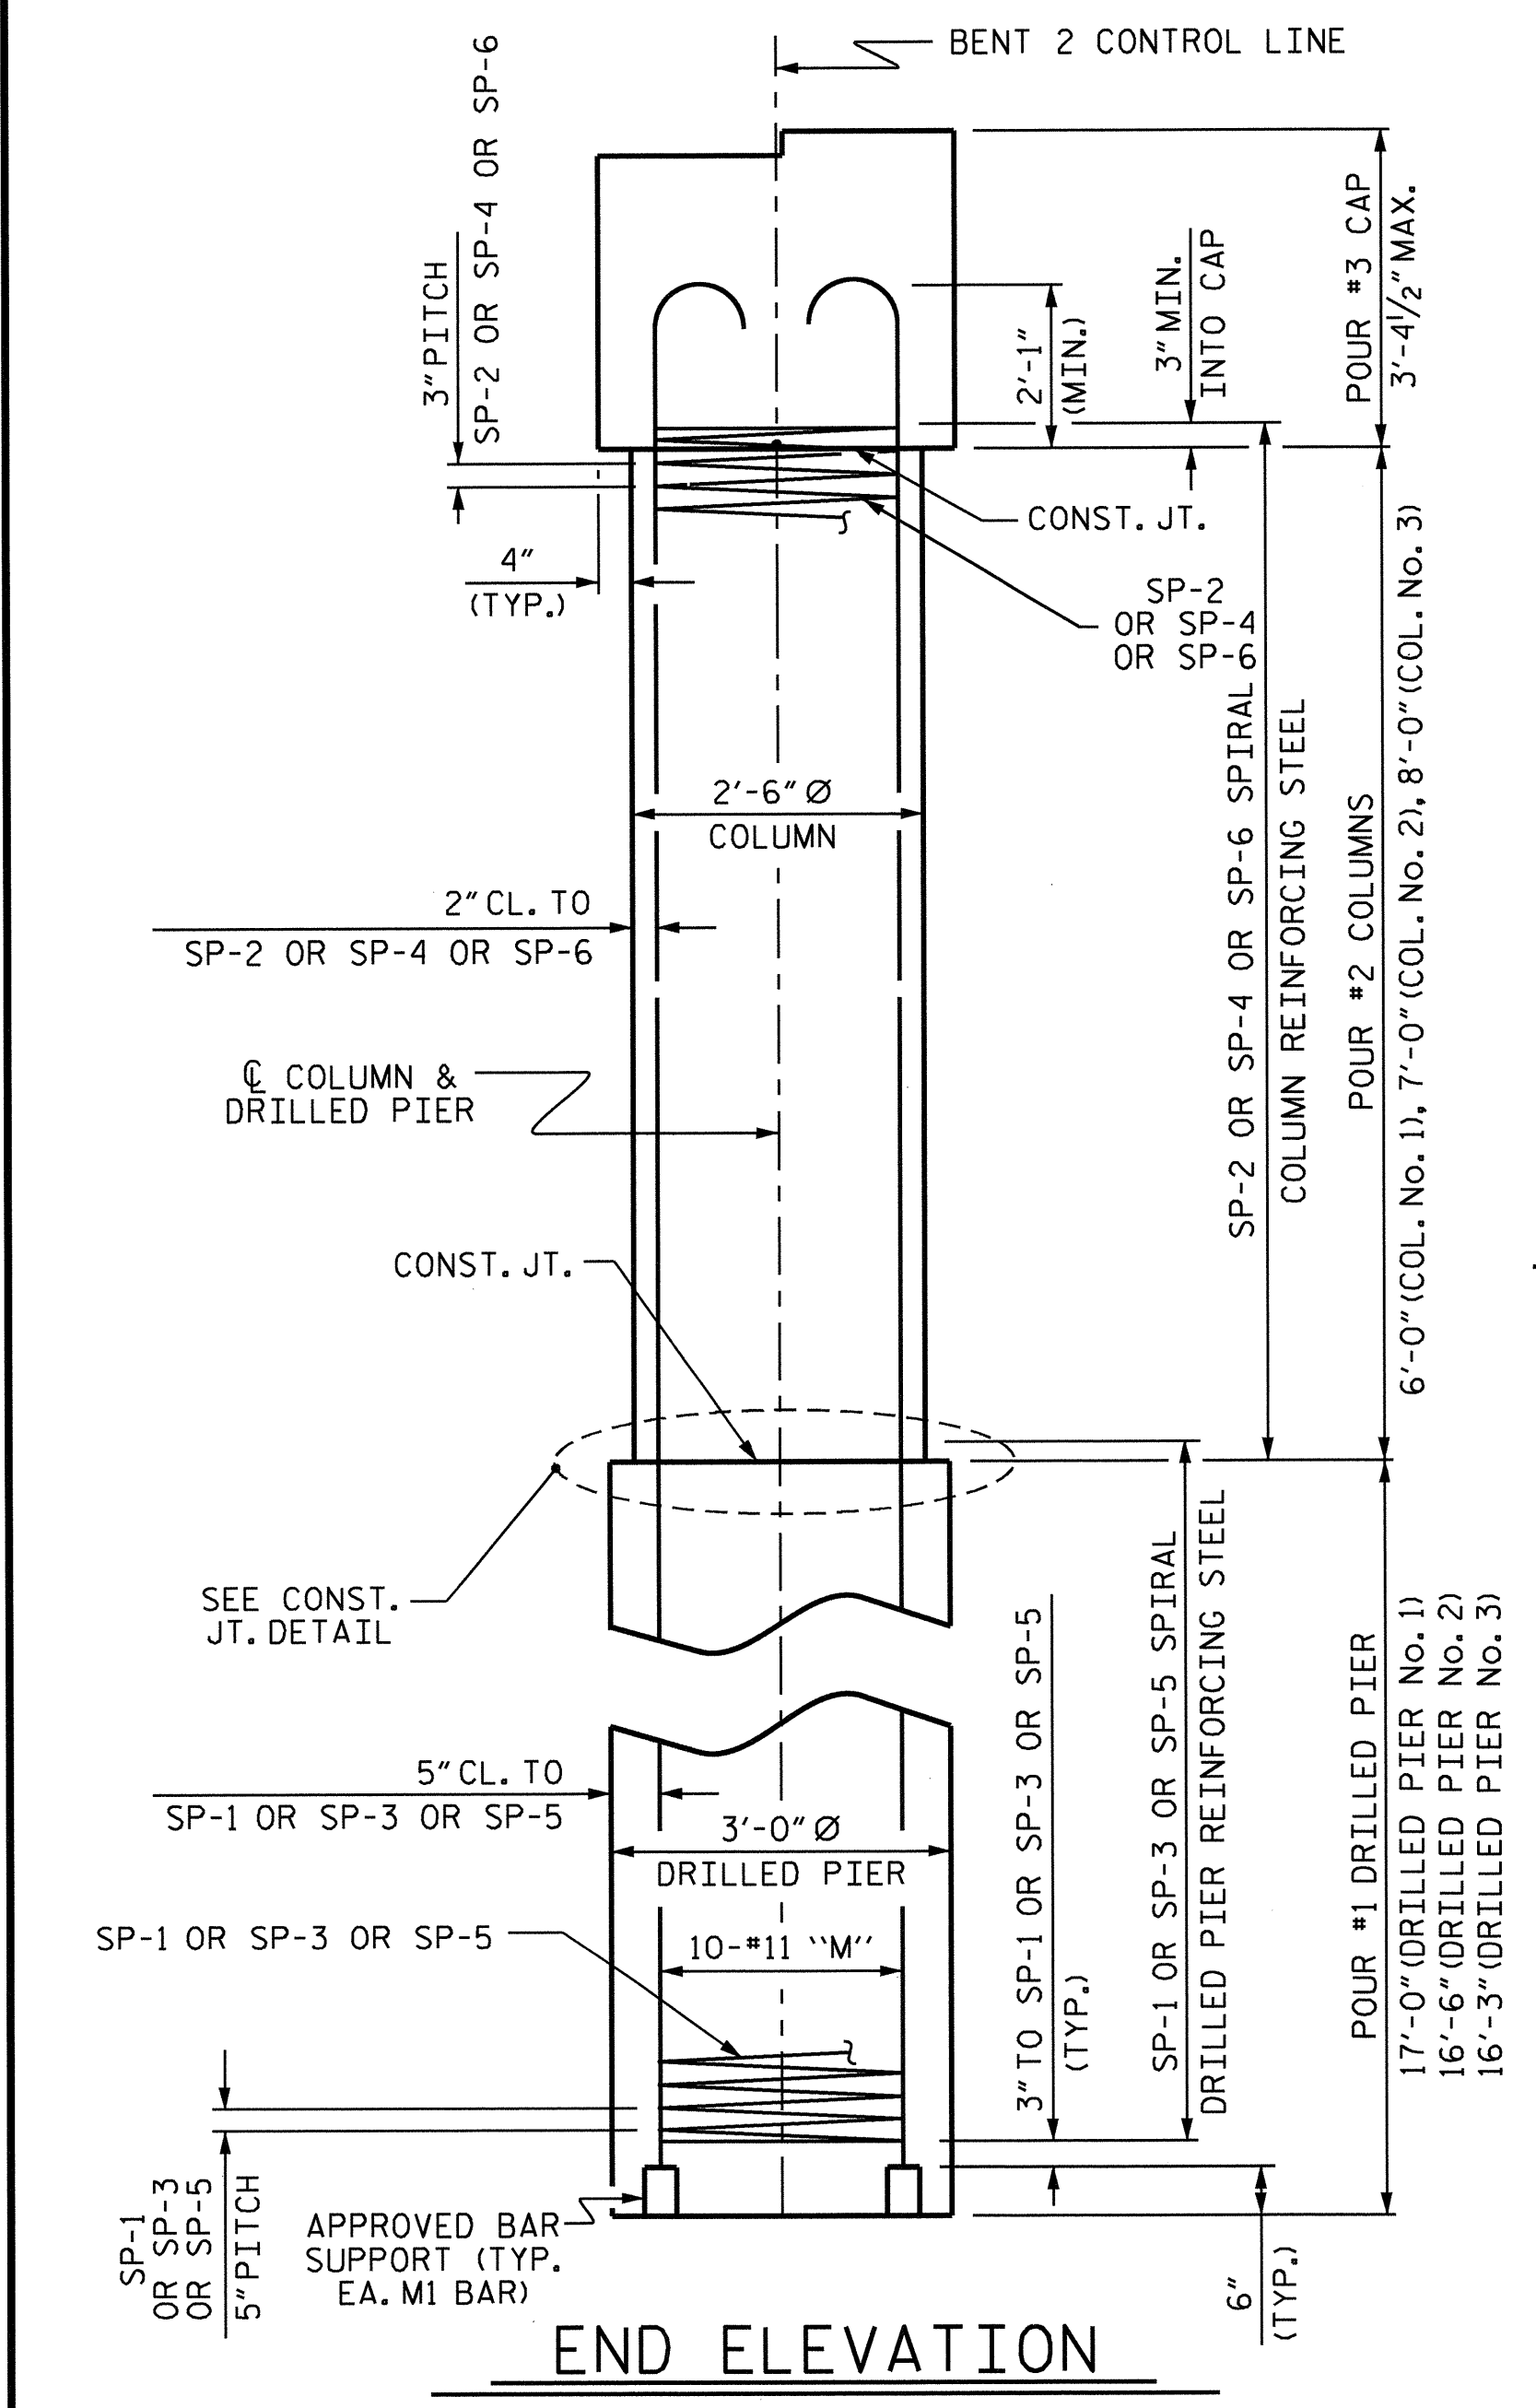

ASSEMBLED BY : A.C. OUTLAW DATE : 9/03/13
 CHECKED BY : A. SORSENGTINH DATE : 9/13
 DRAWN BY : DGE 03/10
 CHECKED BY : MKT 03/10


23-OCT-2013 10:01
 R:\Structures\Plans\Revised Drawings\Substructure\B4731.S0.B*.01.dgn
 dely

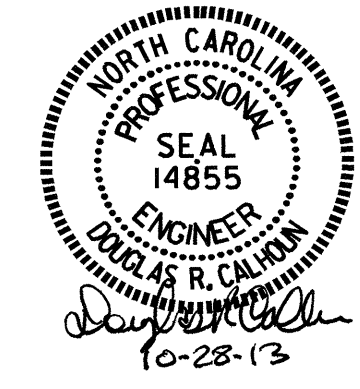


PROJECT NO. B-4731
 CHATHAM COUNTY
 STATION: 16+13.50 -L-
 SHEET 2 OF 2

STATE OF NORTH CAROLINA DEPARTMENT OF TRANSPORTATION RALEIGH					
SUBSTRUCTURE BENT 2					
REVISIONS					SHEET NO.
NO.	BY:	DATE:	NO.	BY:	DATE:
1			3		
2			4		
					S-26
					TOTAL SHEETS 28

STD. NO. DP_BT_33.105S_<50'

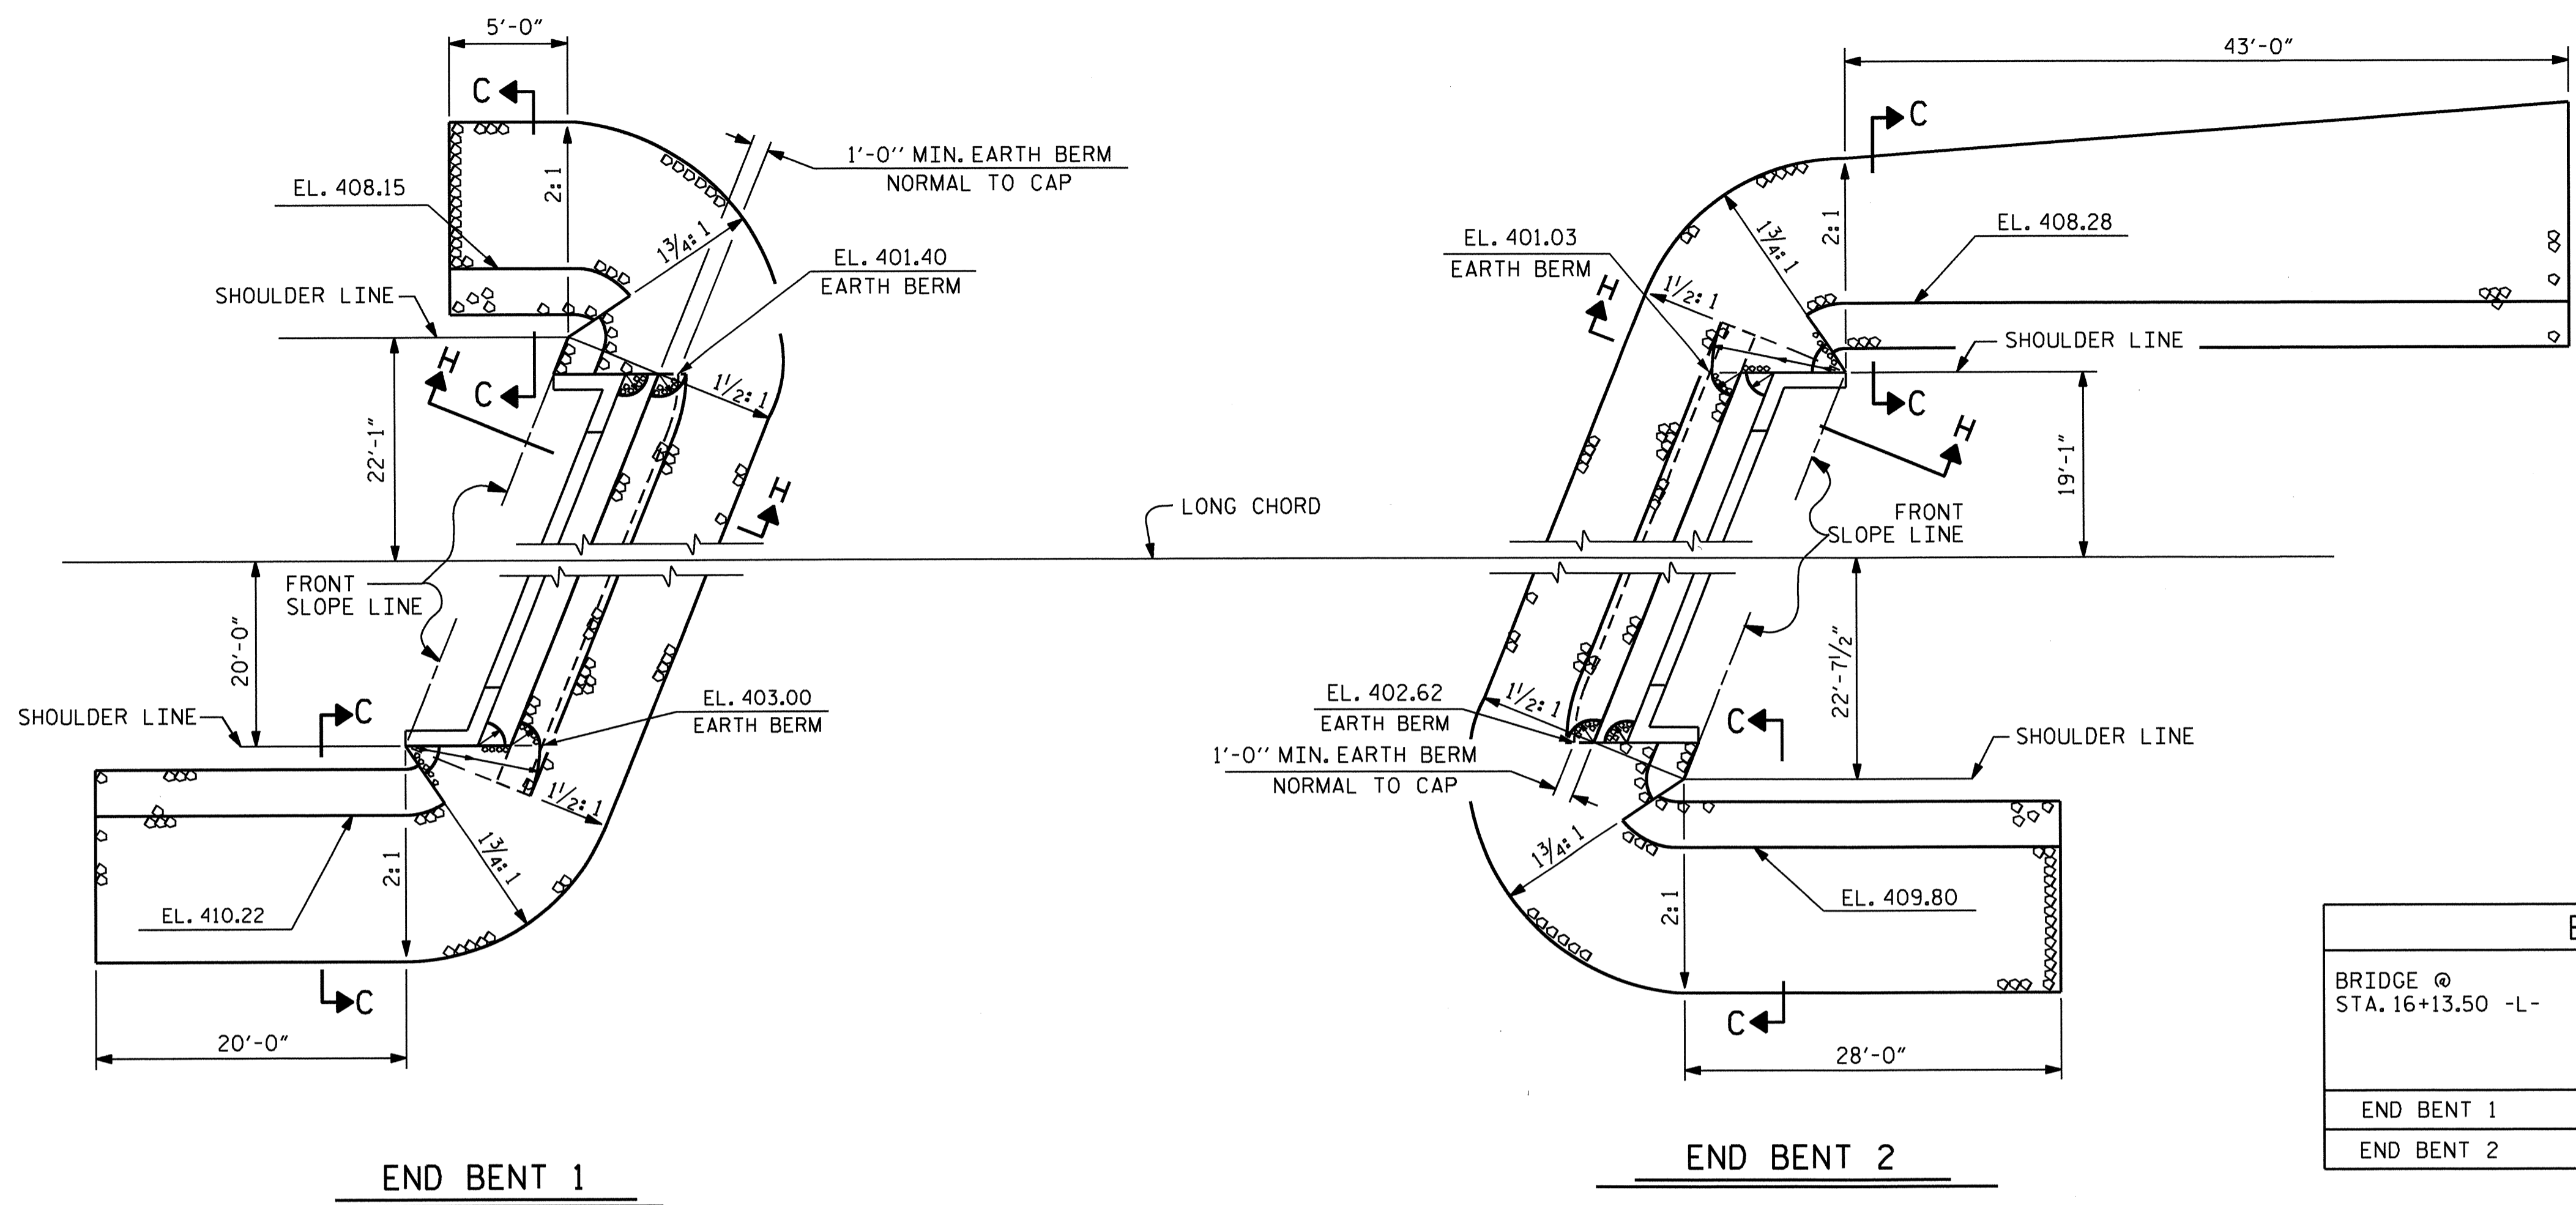


ESTIMATED QUANTITIES		
BRIDGE @ STA. 16+13.50 -L-	RIP RAP CLASS II (2'-0" THICK)	GEOTEXTILE FOR DRAINAGE
	TONS	SQUARE YARDS
END BENT 1	163	181
END BENT 2	253	281

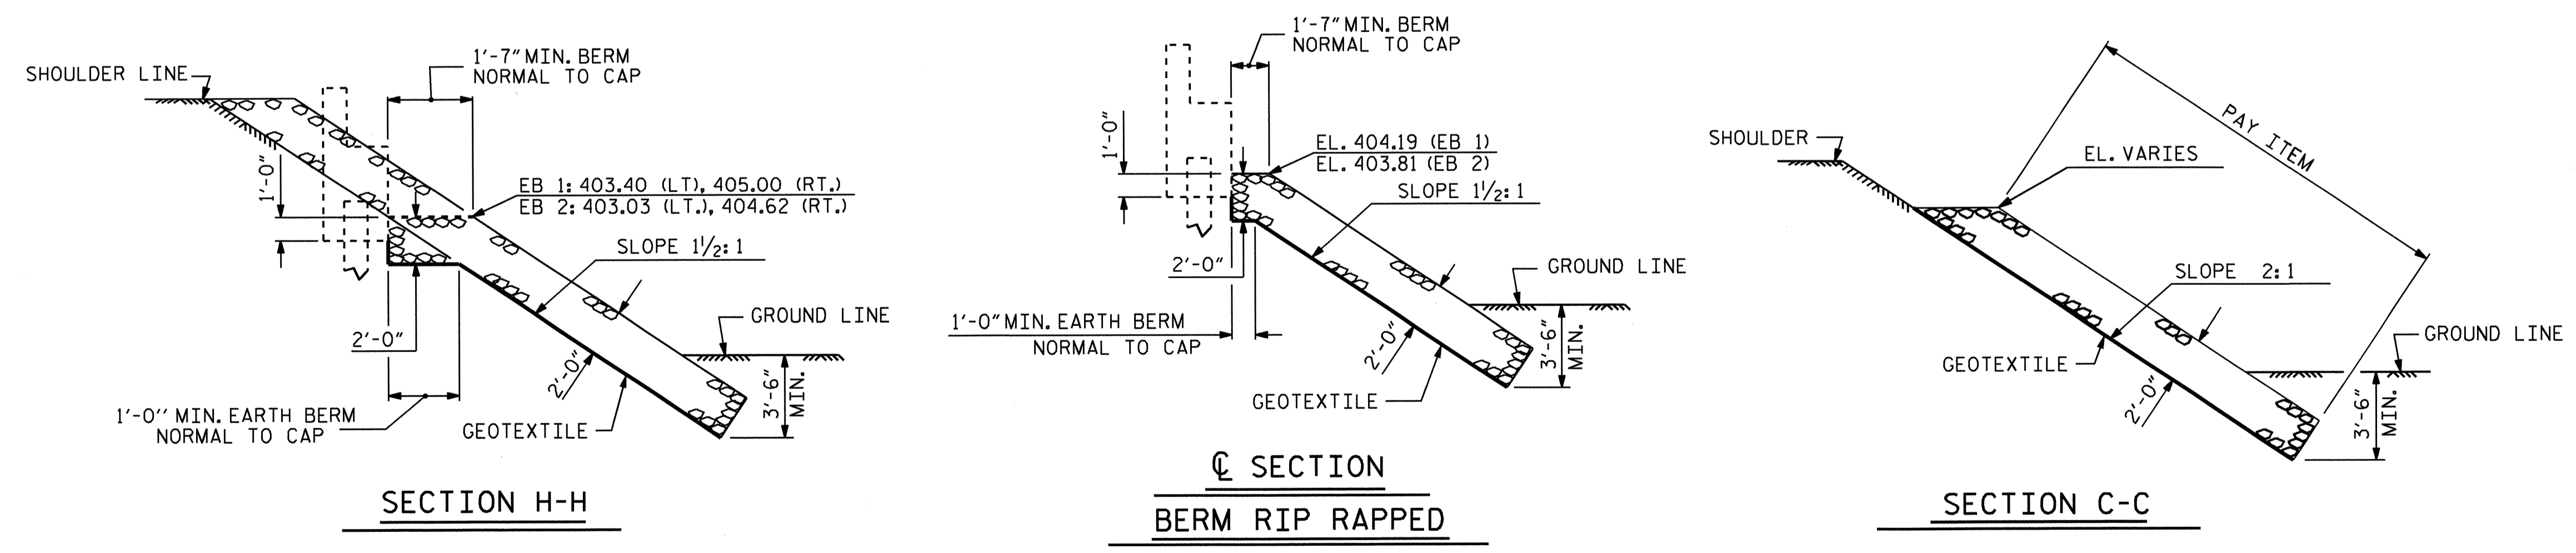

PROJECT NO. B-4731
CHATHAM COUNTY
 STATION: 16+13.50 -L-


STATE OF NORTH CAROLINA
 DEPARTMENT OF TRANSPORTATION
 RALEIGH

—RIP RAP DETAILS—

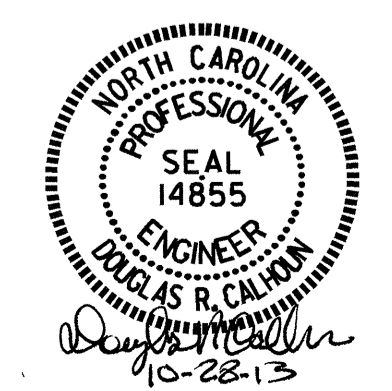


ASSEMBLED BY : A.C. OUTLAW DATE : 9/05/13
 CHECKED BY : A. SORSENGINH DATE : 9/13
 DRAWN BY : REK 1/84 REV. 8/16/99 RWW/LES
 CHECKED BY : RDU 1/84 REV. 10/17/00 RWW/LES
 REV. 5/1/06R TLA/GM

REVISIONS						SHEET NO.
NO.	BY:	DATE:	NO.	BY:	DATE:	S-27
1			3			TOTAL SHEETS
2			4			28

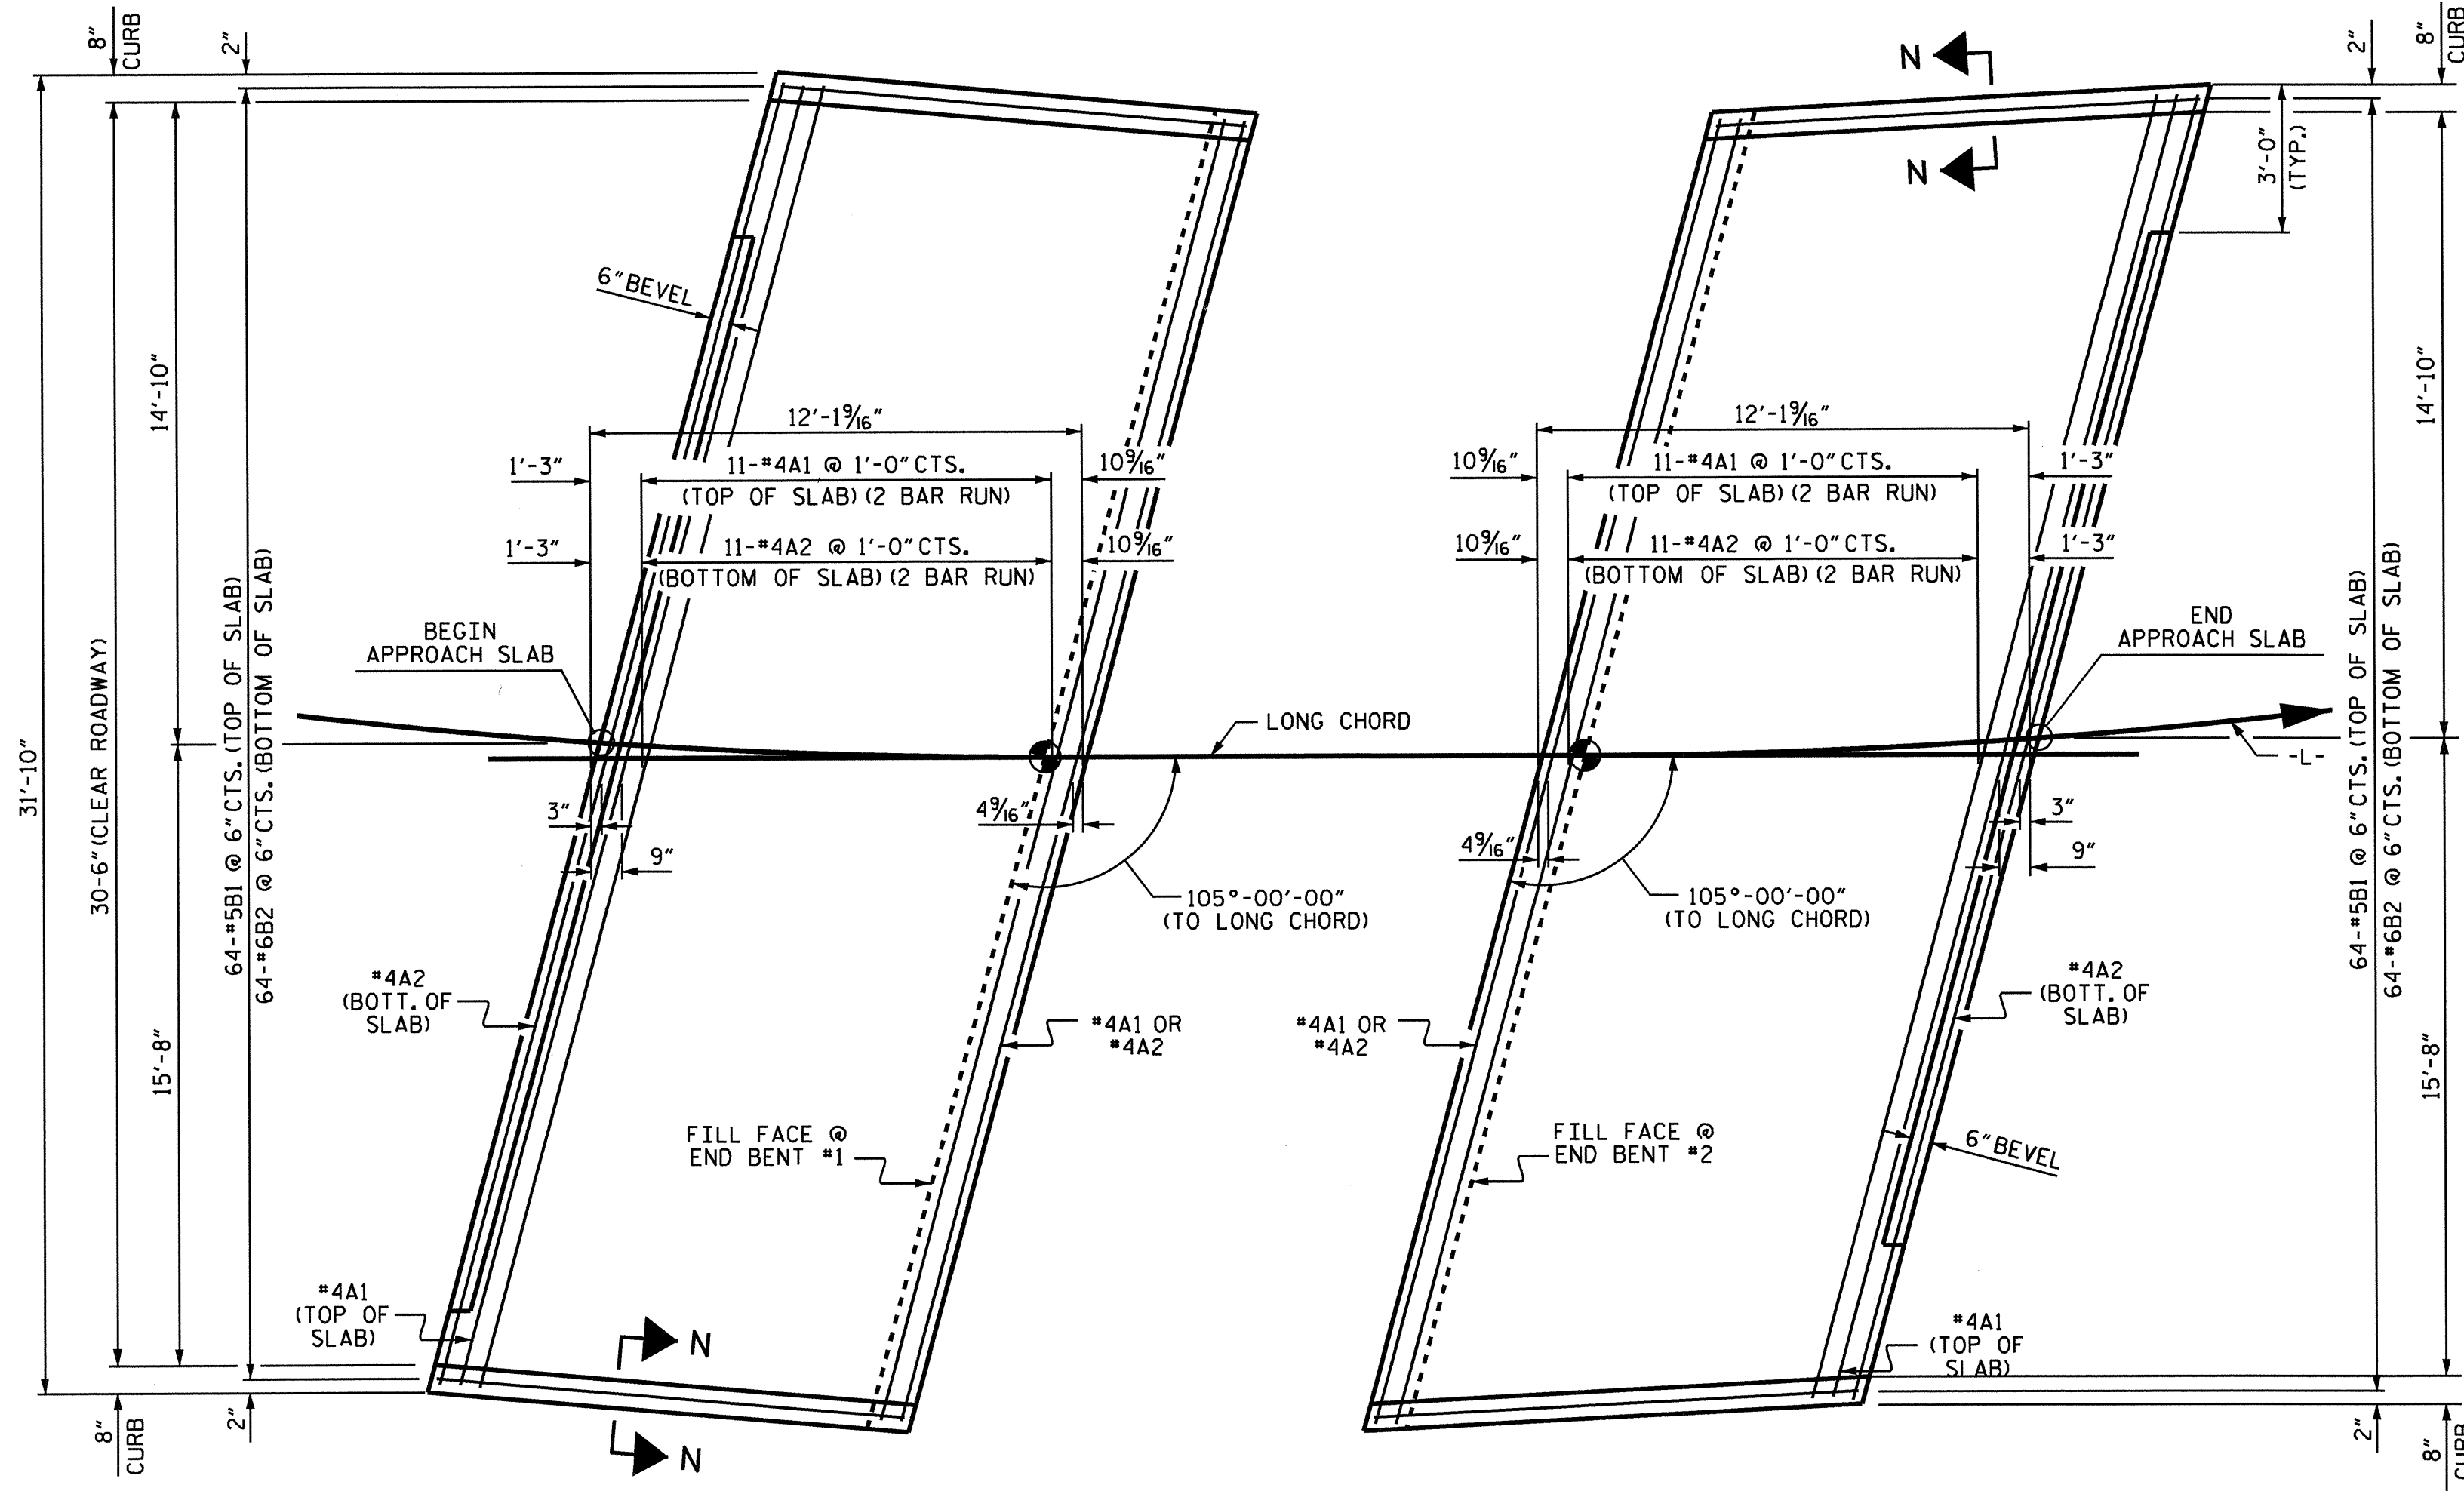

PLAN @ END BENT #1 **PLAN @ END BENT #2**
 DIMENSIONS SHOWN ARE TYPICAL FOR BOTH APPROACH SLABS

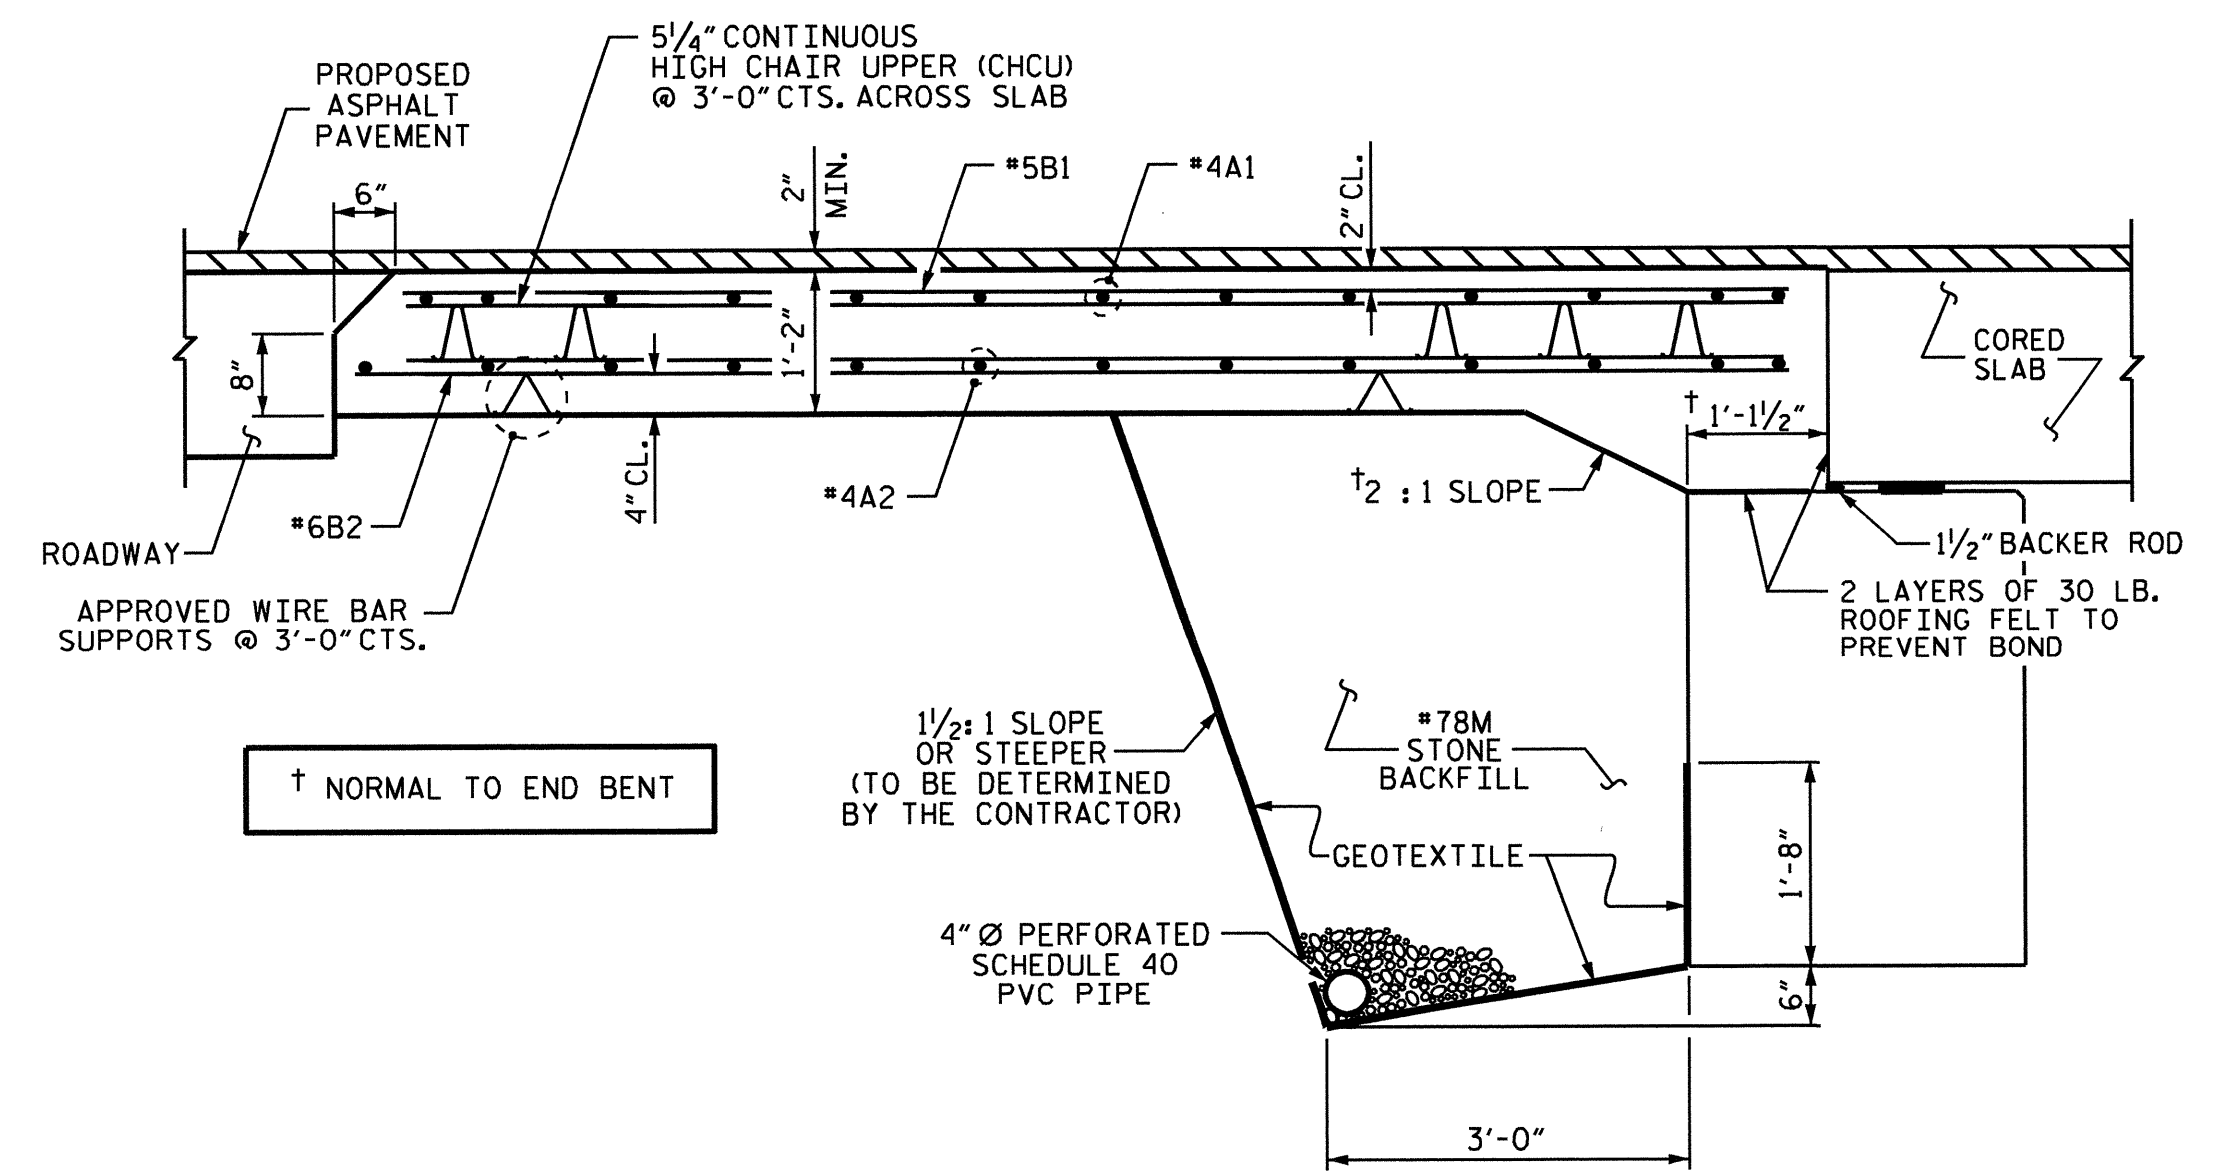

SECTION THRU SLAB

ASSEMBLED BY: A.C. OUTLAW DATE: 9/05/13
 CHECKED BY: A. SORSENGINH DATE: 9/13
 DRAWN BY: SHS/MAA 5-09 REV. 12-11 MAA/AAC
 CHECKED BY: BCH 5-09

15-001-2013 15x24
 RA\Structures\Plans\Revised Drawings\Miscellaneous\B4731.SD.AS.01.dgn
 acoutlaw

NOTES

FOR BRIDGE APPROACH FILL INCLUDING GEOTEXTILE, 4" Ø DRAINAGE PIPE, AND #78M STONE BACKFILL, SEE ROADWAY PLANS.

GEOTEXTILE SHALL BE TYPE 1 IN ACCORDANCE WITH THE STANDARD SPECIFICATIONS SECTION 1056.


#78M STONE BACKFILL (CLASS V SELECT MATERIAL) SHALL BE IN ACCORDANCE WITH STANDARD SPECIFICATIONS SECTION 1016.

#78M STONE BACKFILL IS TO BE CONTINUOUS ALONG FILL FACE OF BACKWALL FROM OUTSIDE EDGE TO OUTSIDE EDGE OF APPROACH SLAB.

FOR THE 4" Ø DRAINAGE PIPE OUTLET(S), SEE ROADWAY STANDARD DRAWINGS.


AREA BETWEEN THE WINGWALL AND APPROACH SLAB SHALL BE GRADED TO DRAIN THE WATER AWAY FROM THE FILL FACE OF THE BRIDGE AND SHALL BE PAVED. SEE ROADWAY PLANS.

APPROACH SLAB GROOVING IS NOT REQUIRED.

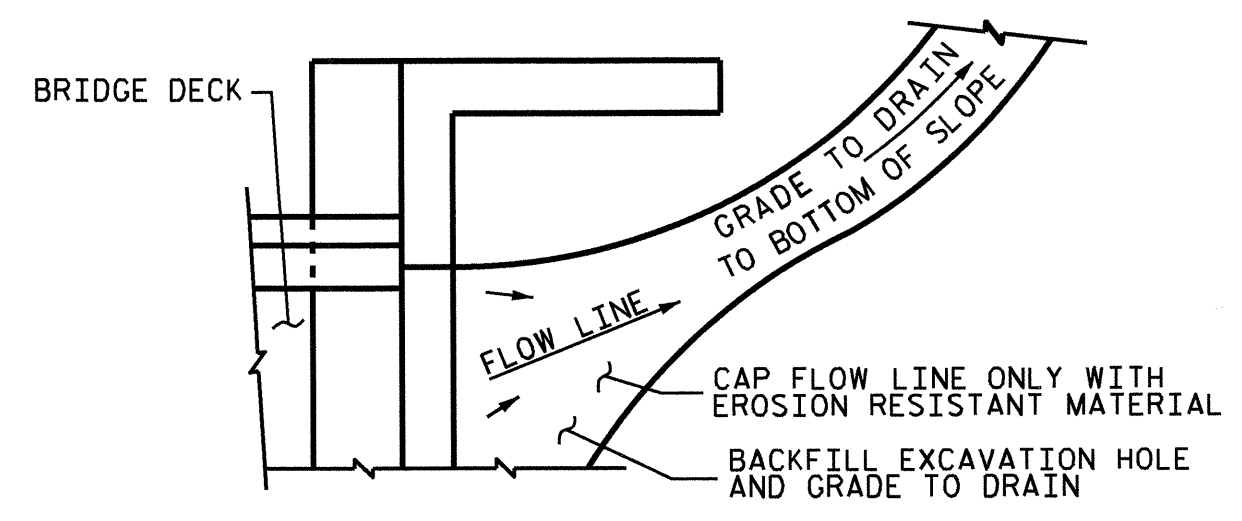


NOTE: IF THE APPROACH SLAB IS NOT CONSTRUCTED IMMEDIATELY AFTER THE BACKFILLING OF THE END BENT EXCAVATION, GRADE TO DRAIN TO THE BOTTOM OF THE SLOPE AND PROVIDE EROSION RESISTANT MATERIAL, SUCH AS FIBERGLASS ROVING OR AS DIRECTED BY THE ENGINEER TO PREVENT SOIL EROSION AND TO PROTECT THE AREA ADJACENT TO THE STRUCTURE. THE CONTRACTOR WILL BE REQUIRED TO REMOVE THESE MATERIALS PRIOR TO CONSTRUCTION OF THE APPROACH SLAB.

TEMPORARY DRAINAGE DETAIL

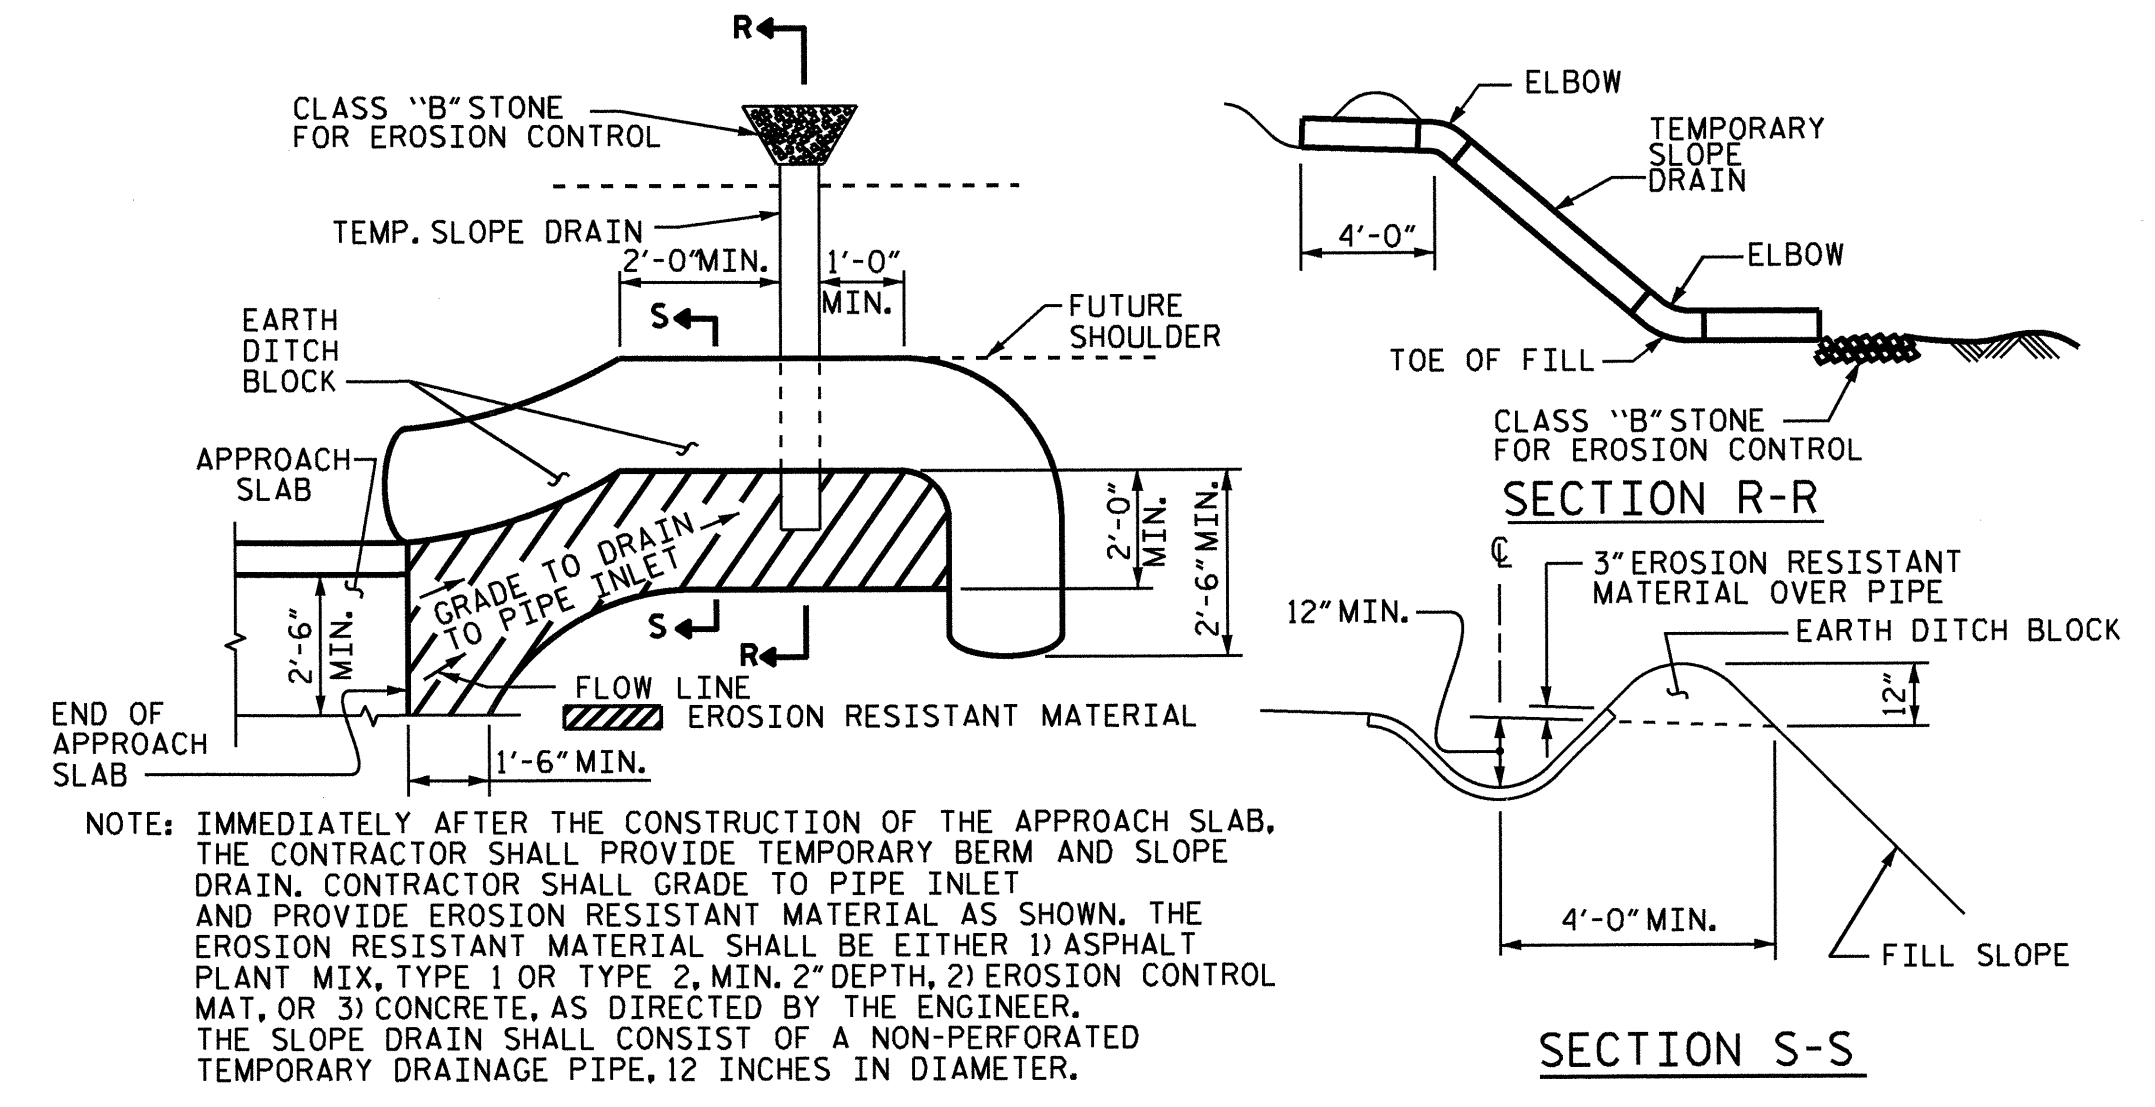


TEMPORARY BERM AND SLOPE DRAIN DETAILS
 (TO BE USED WHEN SHOULDER BERM GUTTER IS REQUIRED)

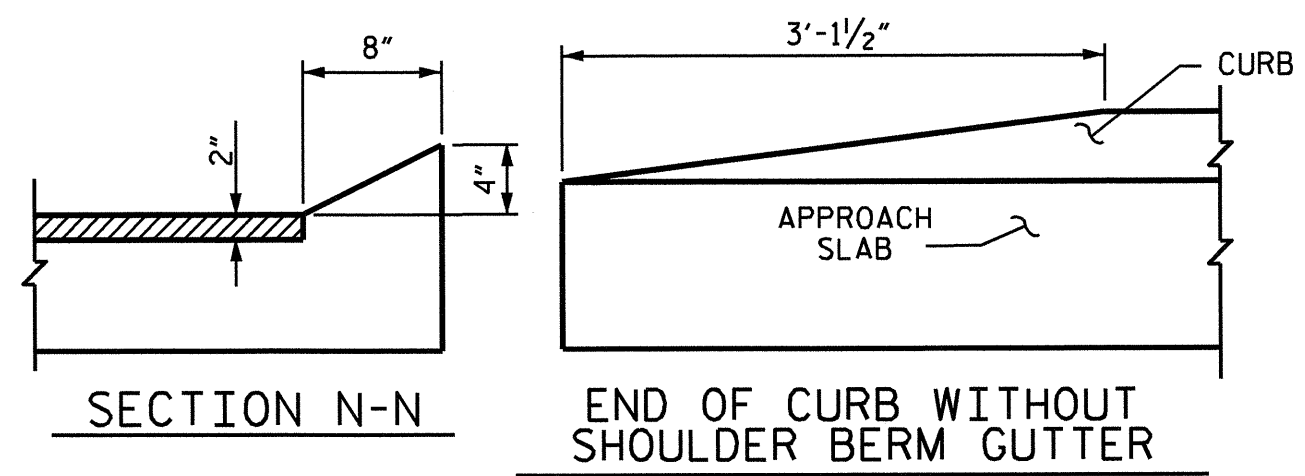

SPLICE LENGTHS

BAR SIZE	EPOXY COATED	UNCOATED
#4	2'-0"	1'-9"
#5	2'-6"	2'-2"
#6	3'-10"	2'-7"

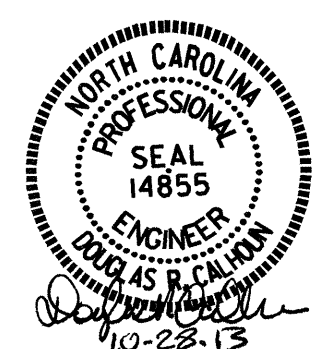

BILL OF MATERIAL

APPROACH SLAB AT EB #1						
BAR	NO.	SIZE	TYPE	LENGTH	WEIGHT	
*A1	26	#4	STR	17'-6"	304	
A2	26	#4	STR	17'-5"	302	
*B1	64	#5	STR	11'-1"	740	
B2	64	#6	STR	11'-7"	1113	
REINFORCING STEEL					LBS.	1415
*EPOXY COATED REINFORCING STEEL					LBS.	1044
CLASS AA CONCRETE					C. Y.	18.7

APPROACH SLAB AT EB #2						
BAR	NO.	SIZE	TYPE	LENGTH	WEIGHT	
*A1	26	#4	STR	17'-6"	304	
A2	26	#4	STR	17'-5"	302	
*B1	64	#5	STR	11'-1"	740	
B2	64	#6	STR	11'-7"	1113	
REINFORCING STEEL					LBS.	1415
*EPOXY COATED REINFORCING STEEL					LBS.	1044
CLASS AA CONCRETE					C. Y.	18.7

PROJECT NO. B-4731
 CHATHAM COUNTY
 STATION: 16+13.50 -L-

STATE OF NORTH CAROLINA
 DEPARTMENT OF TRANSPORTATION
 RALEIGH
 STANDARD
 BRIDGE APPROACH SLAB
 FOR PRESTRESSED CONCRETE
 CORED SLAB UNIT
 (SUB-REGIONAL TIER)
 105° SKEW

REVISIONS				SHEET NO.	
NO.	BY:	DATE:	NO.	BY:	DATE:
1			3		
2			4		

TOTAL SHEETS: 28

STANDARD NOTES

DESIGN DATA:

SPECIFICATIONS	-----	A.A.S.H.T.O. (CURRENT)
LIVE LOAD	-----	SEE PLANS
IMPACT ALLOWANCE	-----	SEE A.A.S.H.T.O.
STRESS IN EXTREME FIBER OF		
STRUCTURAL STEEL - AASHTO M270 GRADE 36	-	20,000 LBS. PER SQ. IN.
- AASHTO M270 GRADE 50W	-	27,000 LBS. PER SQ. IN.
- AASHTO M270 GRADE 50	-	27,000 LBS. PER SQ. IN.
REINFORCING STEEL IN TENSION		
GRADE 60	--	24,000 LBS. PER SQ. IN.
CONCRETE IN COMPRESSION	-----	1,200 LBS. PER SQ. IN.
CONCRETE IN SHEAR	-----	SEE A.A.S.H.T.O.
STRUCTURAL TIMBER - TREATED OR		
UNTREATED - EXTREME FIBER STRESS	-----	1,800 LBS. PER SQ. IN.
COMPRESSION PERPENDICULAR TO GRAIN OF TIMBER	-----	375 LBS. PER SQ. IN.
EQUIVALENT FLUID PRESSURE OF EARTH	-----	30 LBS. PER CU. FT. (MINIMUM)

MATERIAL AND WORKMANSHIP:

EXCEPT AS MAY OTHERWISE BE SPECIFIED ON PLANS OR IN THE SPECIAL PROVISIONS, ALL MATERIAL AND WORKMANSHIP SHALL BE IN ACCORDANCE WITH THE 2012 "STANDARD SPECIFICATIONS FOR ROADS AND STRUCTURES" OF THE N.C. DEPARTMENT OF TRANSPORTATION.

STEEL SHEET PILING FOR PERMANENT OR TEMPORARY APPLICATIONS SHALL BE HOT ROLLED.

CONCRETE:

UNLESS OTHERWISE REQUIRED ON PLANS, CLASS A CONCRETE SHALL BE USED FOR ALL PORTIONS OF ALL STRUCTURES WITH THE EXCEPTION THAT: CLASS AA CONCRETE SHALL BE USED IN BRIDGE SUPERSTRUCTURES, ABUTMENT BACKWALLS, AND APPROACH SLABS; AND CLASS B CONCRETE SHALL BE USED FOR SLOPE PROTECTION AND RIP RAP.

CONCRETE CHAMFERS:

UNLESS OTHERWISE NOTED ON THE PLANS, ALL EXPOSED CORNERS ON STRUCTURES SHALL BE CHAMFERED 3/4" WITH THE FOLLOWING EXCEPTIONS: TOP CORNERS OF CURBS MAY BE ROUNDED TO 1-1/2" RADIUS WHICH IS BUILT INTO CURB FORMS; CORNERS OF TRANSVERSE FLOOR EXPANSION JOINTS SHALL BE ROUNDED WITH A 1/4" FINISHING TOOL UNLESS OTHERWISE REQUIRED ON PLANS; AND CORNERS OF EXPANSION JOINTS IN THE ROADWAY FACES AND TOPS OF CURBS AND SIDEWALKS SHALL BE ROUNDED TO A 1/4" RADIUS WITH A FINISHING STONE OR TOOL UNLESS OTHERWISE REQUIRED ON PLANS.

DOWELS:

DOWELS WHEN INDICATED ON PLANS AS FOR CULVERT EXTENSIONS, SHALL BE EMBEDDED AT LEAST 12" INTO THE OLD CONCRETE AND GROUTED INTO PLACE WITH 1:2 CEMENT MORTAR.

ALLOWANCE FOR DEAD LOAD DEFLECTION, SETTLEMENT, ETC. IN CASTING SUPERSTRUCTURES:

BRIDGES SHALL BE BUILT ON THE GRADE OR VERTICAL CURVE SHOWN ON PLANS. SLABS, CURBS AND PARAPETS SHALL CONFORM TO THE GRADE OR CURVE.

ALL DIMENSIONS WHICH ARE GIVEN IN SECTION AND ARE AFFECTED BY DEAD LOAD DEFLECTIONS ARE DIMENSIONS AT CENTER LINE OF BEARING UNLESS OTHERWISE NOTED ON PLANS. IN SETTING FORMS FOR STEEL BEAM BRIDGES AND PRESTRESSED CONCRETE GIRDER BRIDGES, ADJUSTMENTS SHALL BE MADE DUE TO THE DEAD LOAD DEFLECTIONS FOR THE ELEVATIONS SHOWN. WHERE BLOCKS ARE SHOWN OVER BEAMS FOR BUILDING UP TO THE SLAB, THE VERTICAL DIMENSIONS OF THE BLOCKS SHALL BE ADJUSTED BETWEEN BEARINGS TO COMPENSATE FOR DEAD LOAD DEFLECTIONS, VERTICAL CURVE ORDINATE, AND ACTUAL BEAM CAMBER. WHERE BOTTOM OF SLAB IS IN LINE WITH BOTTOM OF TOP FLANGES, DEPTH OF SLAB BETWEEN BEARINGS SHALL BE ADJUSTED TO COMPENSATE FOR DEAD LOAD DEFLECTION, VERTICAL CURVE ORDINATE, AND ACTUAL BEAM CAMBER.

IN SETTING FALSEWORK AND FORMS FOR REINFORCED CONCRETE SPANS, AN ALLOWANCE SHALL BE MADE FOR DEAD LOAD DEFLECTIONS, SETTLEMENT OF FALSEWORK, AND PERMANENT CAMBER WHICH SHALL BE PROVIDED FOR IN ADDITION TO THE ELEVATIONS SHOWN. AFTER REMOVAL OF THE FALSEWORK, THE FINISHED STRUCTURES SHALL CONFORM TO THE PROFILE AND ELEVATIONS SHOWN ON THE PLANS AND CONSTRUCTION ELEVATIONS FURNISHED BY THE ENGINEER.

DETAILED DRAWINGS FOR FALSEWORK OR FORMS FOR BRIDGE SUPERSTRUCTURE AND ANY STRUCTURE OR PARTS OF A STRUCTURE AS NOTED ON THE PLANS SHALL BE SUBMITTED TO THE ENGINEER FOR APPROVAL BEFORE CONSTRUCTION OF THE FALSEWORK OR FORMS IS STARTED.

REINFORCING STEEL:

ALL REINFORCING STEEL SHALL BE DEFORMED. DIMENSIONS RELATIVE TO PLACEMENT OF REINFORCING ARE TO CENTERS OF BARS UNLESS OTHERWISE INDICATED IN THE PLANS. DIMENSIONS ON BAR DETAILS ARE TO CENTERS OF BARS OR ARE OUT TO OUT AS INDICATED ON PLANS.

WIRE BAR SUPPORTS SHALL BE PROVIDED FOR REINFORCING STEEL WHERE INDICATED ON THE PLANS. WHEN BAR SUPPORT PIECES ARE PLACED IN CONTINUOUS LINES, THEY SHALL BE SO PLACED THAT THE ENDS OF THE SUPPORTING WIRES SHALL BE LAPPED TO LOCK LEGS ON ADJOINING PIECES.

STRUCTURAL STEEL:

AT THE CONTRACTOR'S OPTION, HE MAY SUBSTITUTE 7/8" Ø SHEAR STUDS FOR THE 3/4" Ø STUDS SPECIFIED ON THE PLANS. THIS SUBSTITUTION SHALL BE MADE AT THE RATE OF 3 - 7/8" Ø STUDS FOR 4 - 3/4" Ø STUDS, AND STUD SPACING CHANGES SHALL BE MADE AS NECESSARY TO PROVIDE THE SAME EQUIVALENT NUMBER OF 7/8" Ø STUDS ALONG THE BEAM AS SHOWN FOR 3/4" Ø STUDS BASED ON THE RATIO OF 3 - 7/8" Ø STUDS FOR 4 - 3/4" Ø STUDS. STUDS OF THE LENGTH SPECIFIED ON THE PLANS MUST BE PROVIDED. THE MAXIMUM SPACING SHALL BE 2'-0".

EXCEPT AT THE INTERIOR SUPPORTS OF CONTINUOUS BEAMS WHERE THE COVER PLATE IS IN CONTACT WITH BEARING PLATE, THE CONTRACTOR MAY, AT HIS OPTION, SUBSTITUTE FOR THE COVER PLATES DESIGNATED ON THE PLANS COVER PLATES OF THE EQUIVALENT AREA PROVIDED THESE PLATES ARE AT LEAST 5/16" IN THICKNESS AND DO NOT EXCEED A WIDTH EQUAL TO THE FLANGE WIDTH LESS 2" OR A THICKNESS EQUAL TO 2 TIMES THE FLANGE THICKNESS. THE SIZE OF FILLET WELDS SHALL CONFORM TO THE REQUIREMENTS OF THE CURRENT ANSI/AASHTO/AWS "BRIDGE WELDING CODE". ELECTROSLAG WELDING WILL NOT BE PERMITTED.

WITH THE SOLE EXCEPTION OF EDGES AT SURFACES WHICH BEAR ON OTHER SURFACES, ALL SHARP EDGES AND ENDS OF SHAPES AND PLATES SHALL BE SLIGHTLY ROUNDED BY SUITABLE MEANS TO A RADIUS OF APPROXIMATELY 1/16 INCH OR EQUIVALENT FLAT SURFACE AT A SUITABLE ANGLE PRIOR TO PAINTING, GALVANIZING, OR METALLIZING.

HANDRAILS AND POSTS:

METAL STANDARDS AND FACES OF THE CONCRETE END POSTS FOR THE METAL RAIL SHALL BE SET NORMAL TO THE GRADE OF THE CURB, UNLESS OTHERWISE SHOWN ON PLANS. THE METAL RAIL AND TOPS OF CONCRETE POSTS USED WITH THE ALUMINUM RAIL SHALL BE BUILT PARALLEL TO THE GRADE OF THE CURB.

METAL HANDRAILS SHALL BE IN ACCORDANCE WITH THE PLANS. RAILS SHALL BE AS MANUFACTURED FOR BRIDGE RAILING. CASTINGS SHALL BE OF A UNIFORM APPEARANCE. FINS AND OTHER DEFORMATIONS RESULTING FROM CASTING OR OTHERWISE SHALL BE REMOVED IN A MANNER SO THAT A UNIFORM COLORING OF THE COMPLETED CASTING SHALL BE OBTAINED. CASTINGS WITH DISCOLORATIONS OR OF NON-UNIFORM COLORING WILL NOT BE ACCEPTED. CERTIFIED MILL REPORTS ARE REQUIRED FOR METAL RAILS AND POSTS.

SPECIAL NOTES:

GENERALLY, IN CASE OF DISCREPANCY, THIS STANDARD SHEET OF NOTES SHALL GOVERN OVER THE SPECIFICATIONS, BUT THE REMAINDER OF THE PLANS SHALL GOVERN OVER NOTES HEREON, AND SPECIAL PROVISIONS SHALL GOVERN OVER ALL. SEE SPECIFICATIONS ARTICLE 105-4.

ENGLISH

JANUARY, 1990