


-6.4752% -0.3000%
GRADE DATA -L-


PI = 15+29.00
 EL. = 308.12
 VC = 169'

-0.3000% +6.6265%
GRADE DATA -L-

PI = 18+25.00
 EL. = 307.23
 VC = 120'

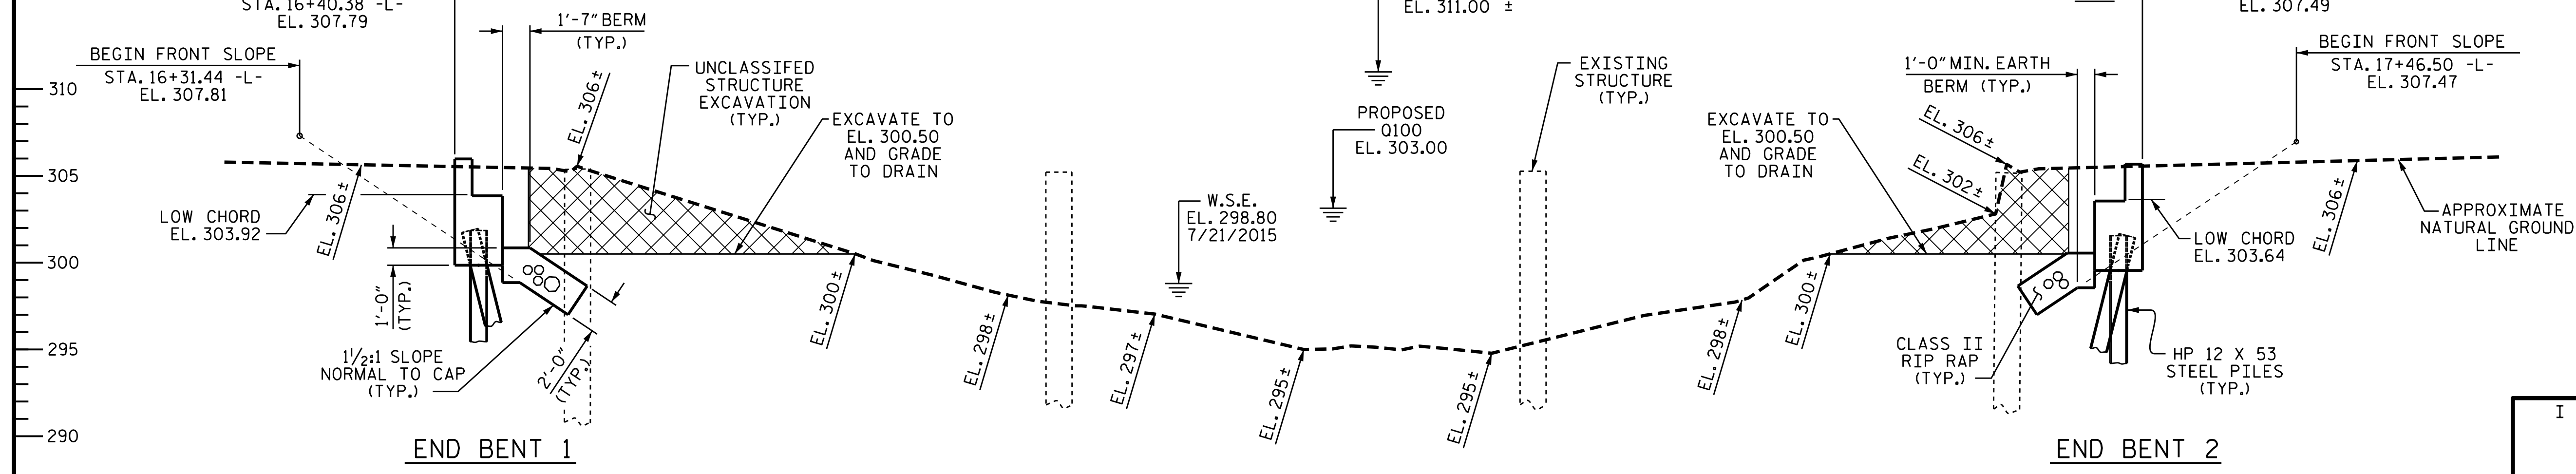

SECTION ALONG -L-

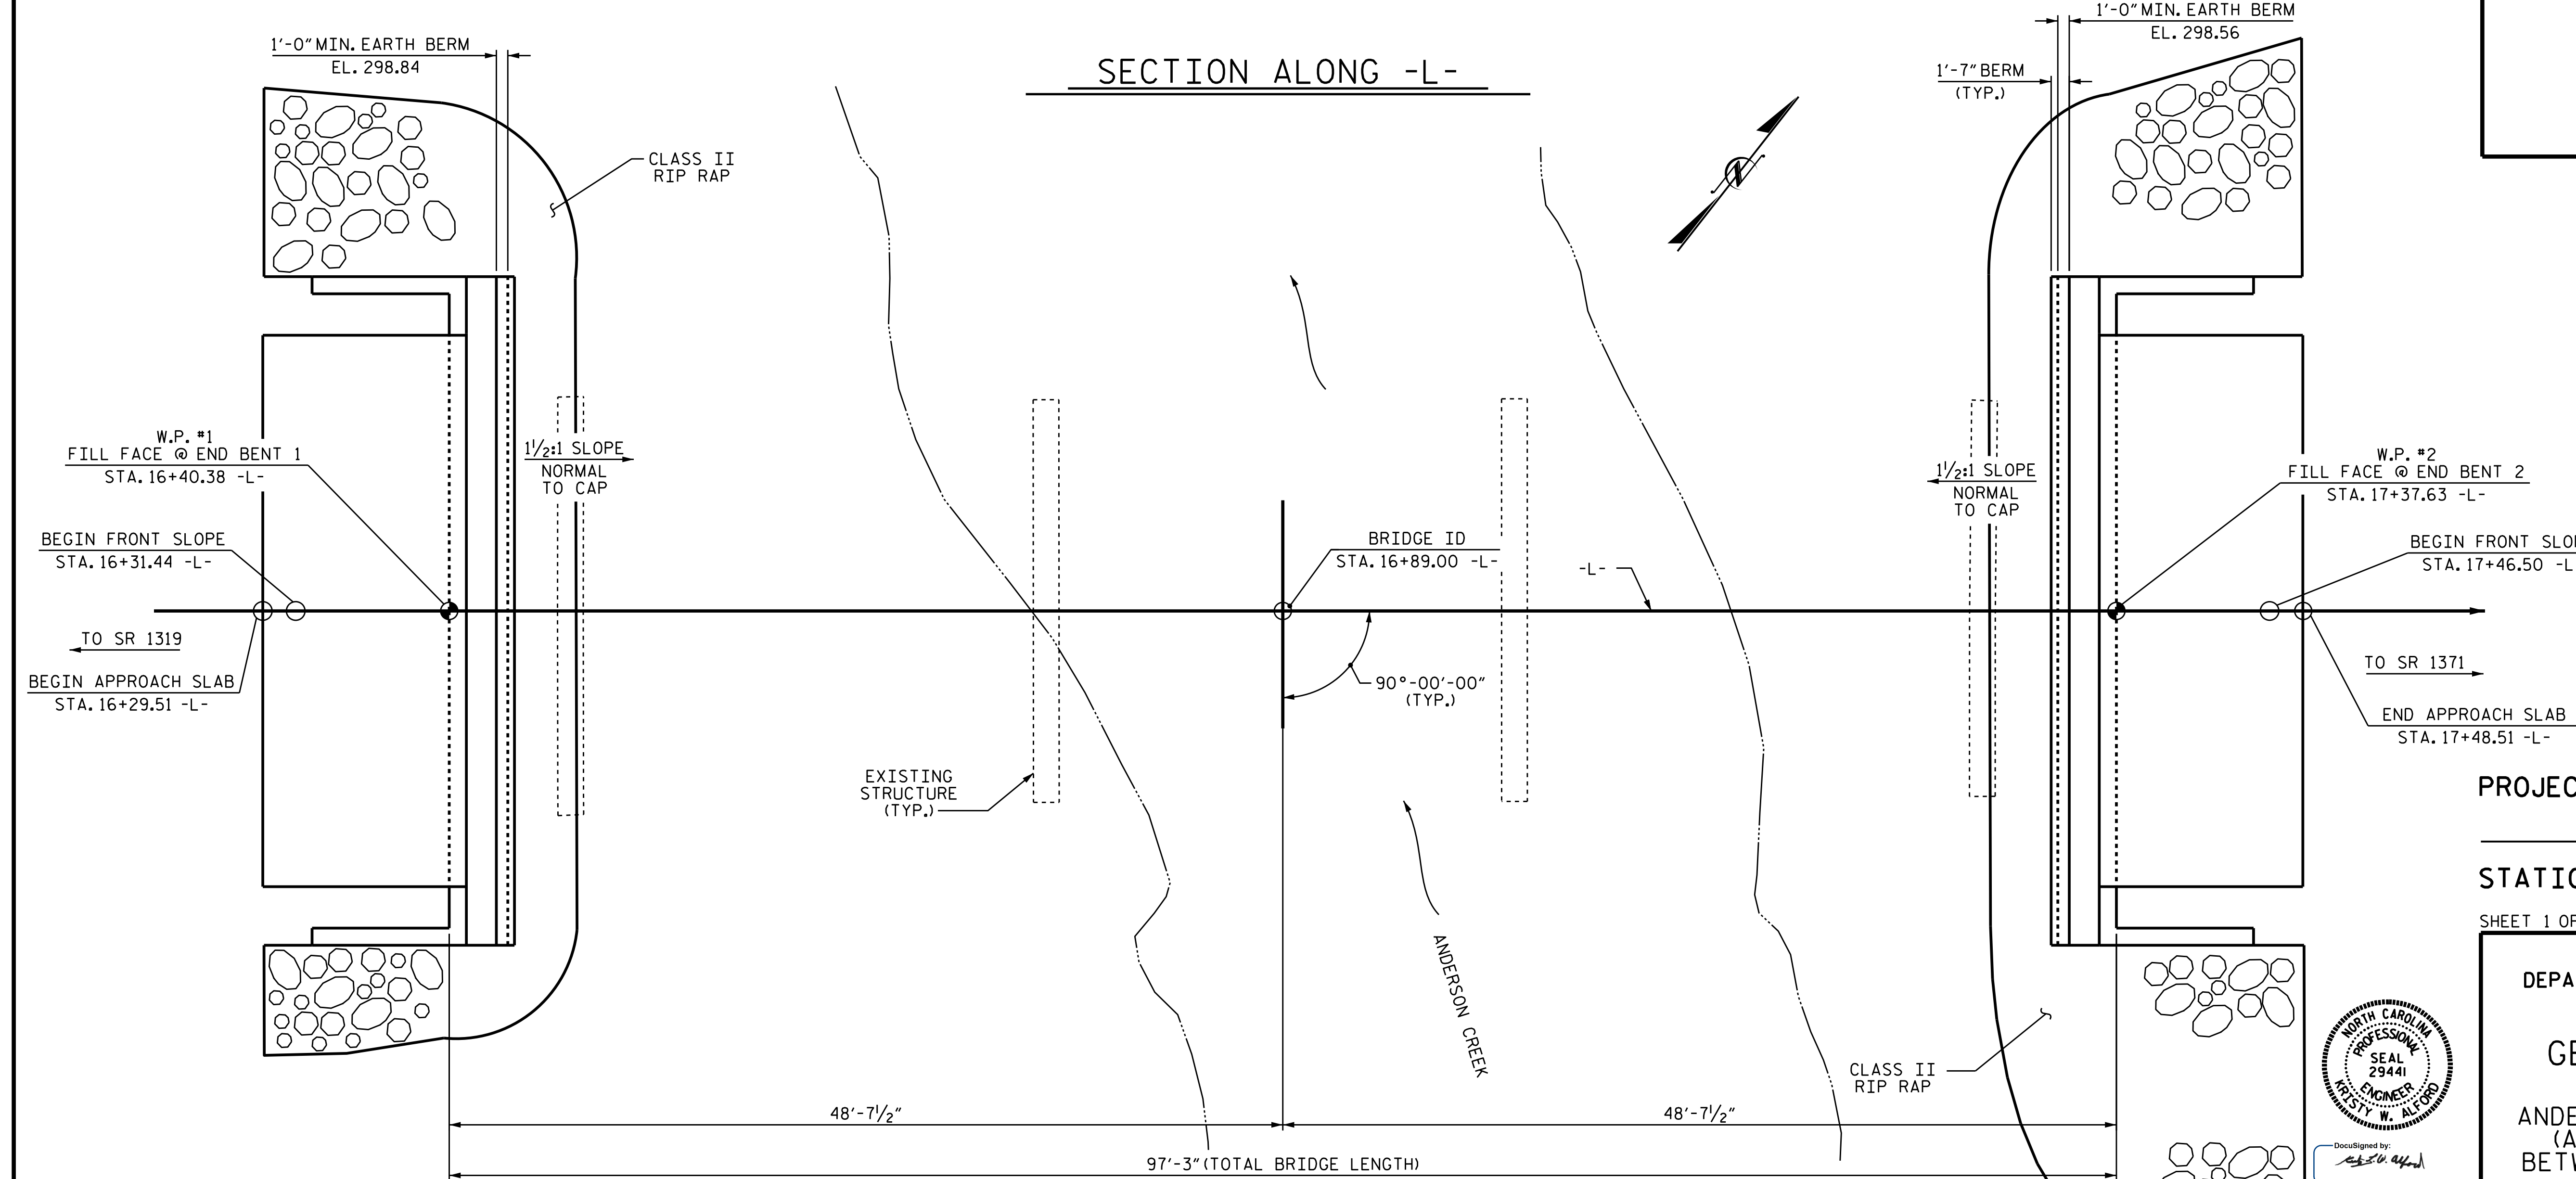

PLAN
 PILES NOT SHOWN FOR CLARITY

I HEREBY CERTIFY THESE PLANS
 ARE THE AS-BUILT PLANS

DOCUMENT NOT CONSIDERED
 FINAL UNLESS ALL
 SIGNATURES COMPLETED

PROJECT NO. B-4945
VANCE COUNTY
 STATION: 16+89.00 -L-

SHEET 1 OF 2 REPLACES BRIDGE #36



STATE OF NORTH CAROLINA
 DEPARTMENT OF TRANSPORTATION
 RALEIGH
GENERAL DRAWING
 FOR BRIDGE OVER
 ANDERSON CREEK ON SR 1374
 (ANDERSON CREEK ROAD)
 BETWEEN SR 1319 & SR 1371

REVISIONS						SHEET NO.
NO.	BY:	DATE:	NO.	BY:	DATE:	S-1
1			3			TOTAL SHEETS
2			4			15

DRAWN BY: J.P. ADAMS DATE: 8/2016
 CHECKED BY: T.L. AVERETTE DATE: 8/2016

07-SEP-2016 11:21
 R:\Structures\Plans\B-4945.SD.BB.dgn
 jpadams