


BENCH MARK #6: RAILROAD SPIKE IN BASE OF 18" POPLAR, 208' LEFT STA 103+58, EL. 593.11

F.A. PROJECT NO.: STP-0119(9)

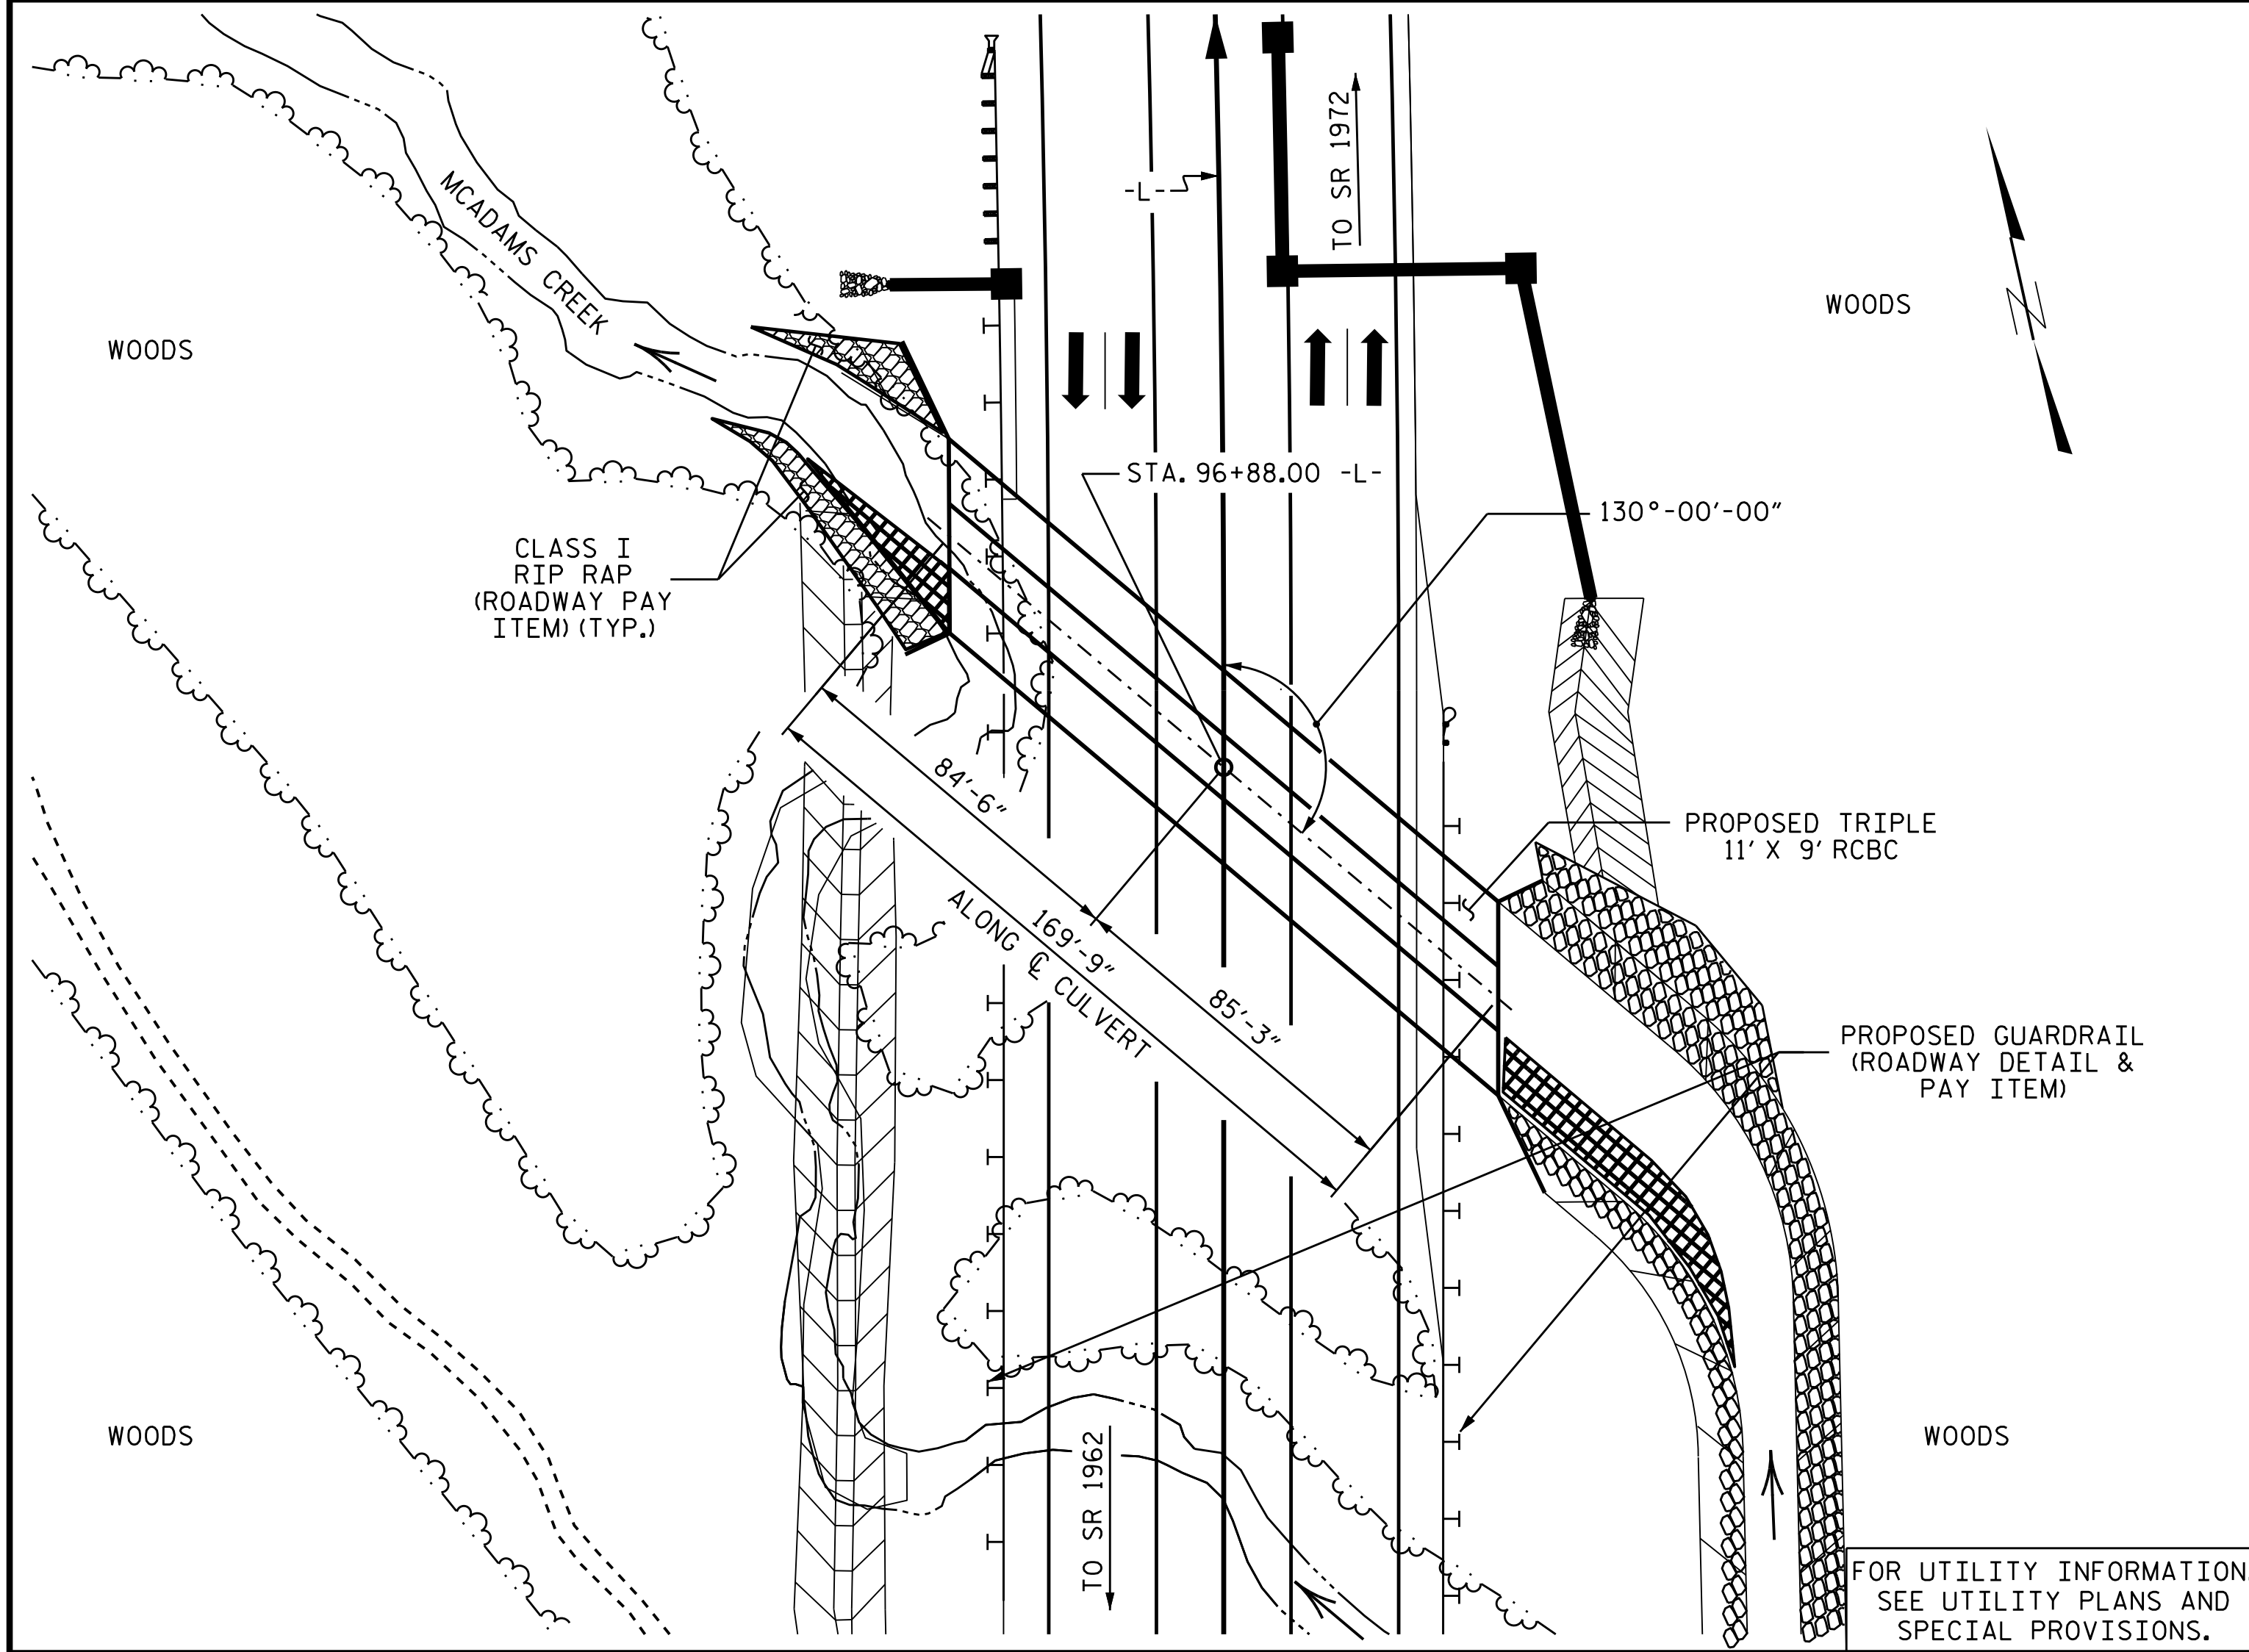

LOCATION SKETCH

NOTES

ASSUMED LIVE LOAD -----HL-93 OR ALTERNATE LOADING.
 DESIGN FILL----- 6.42'
 FOR OTHER DESIGN DATA AND NOTES, SEE STANDARD NOTE SHEET.
 3"Ø WEEP HOLES INDICATED TO BE IN ACCORDANCE WITH THE SPECIFICATIONS.
 CONCRETE IN CULVERTS TO BE POURED IN THE FOLLOWING ORDER:
 1. WING FOOTINGS AND FLOOR SLAB INCLUDING 4" OF ALL VERTICAL WALLS.
 2. THE REMAINING PORTIONS OF THE WALLS AND WINGS FULL HEIGHT FOLLOWED BY ROOF SLAB AND HEADWALLS.
 THE RESIDENT ENGINEER SHALL CHECK THE LENGTH OF CULVERT BEFORE STAKING IT OUT TO MAKE CERTAIN THAT IT WILL PROPERLY TAKE CARE OF THE FILL.
 DIMENSIONS FOR WING LAYOUT AS WELL AS ADDITIONAL REINFORCING STEEL EMBEDDED IN BARREL ARE SHOWN ON WING SHEET.
 TRANSVERSE CONSTRUCTION JOINTS SHALL BE USED IN THE BARREL, SPACED TO LIMIT THE POURS TO A MAXIMUM OF 70 FT. LOCATION OF JOINTS SHALL BE SUBJECT TO APPROVAL OF THE ENGINEER.
 AT THE CONTRACTOR'S OPTION, HE MAY SPLICE THE VERTICAL REINFORCING STEEL IN THE INTERIOR FACE OF EXTERIOR WALL ABOVE LOWER WALL CONSTRUCTION JOINT. THE SPLICE LENGTH SHALL BE AS PROVIDED IN THE SPLICE LENGTH CHART SHOWN ON THE PLANS. EXTRA WEIGHT OF STEEL DUE TO THE SPLICES SHALL BE PAID FOR BY THE CONTRACTOR.
 AT THE CONTRACTOR'S OPTION HE MAY SUBMIT, TO THE ENGINEER FOR APPROVAL, DESIGN AND DETAIL DRAWINGS FOR A PRECAST REINFORCED CONCRETE BOX CULVERT IN LIEU OF THE CAST-IN-PLACE CULVERT SHOWN ON THE PLANS. THE DESIGN SHALL PROVIDE THE SAME SIZE OF BARREL AS USED ON THE CAST-IN-PLACE DESIGN. FOR OPTIONAL PRECAST REINFORCED CONCRETE BOX CULVERT, SEE SPECIAL PROVISIONS.
 STEEL IN THE BOTTOM SLAB MAY BE SPLICED AT THE PERMITTED CONSTRUCTION JOINT AT THE CONTRACTOR'S OPTION. EXTRA WEIGHT OF STEEL DUE TO THE SPLICES WILL BE PAID FOR BY THE CONTRACTOR.

THE CONTRACTOR SHALL PROVIDE INDEPENDENT ASSURANCE SAMPLES OF REINFORCING STEEL AS FOLLOWS: FOR PROJECTS REQUIRING UP TO 400 TONS OF REINFORCING STEEL, ONE 30 INCH SAMPLE OF EACH SIZE BAR USED, AND FOR PROJECTS REQUIRING OVER 400 TONS OF REINFORCING STEEL, TWO 30 INCH SAMPLES OF EACH SIZE BAR USED. THE BARS FROM WHICH THE SAMPLES ARE TAKEN MUST THEN BE SPLICED WITH REPLACEMENT BARS OF THE SIZE AND LENGTH OF THE SAMPLE, PLUS A MINIMUM LAP SPLICE OF THIRTY BAR DIAMETERS. PAYMENT FOR THE SAMPLES OF REINFORCING STEEL SHALL BE CONSIDERED INCIDENTAL TO VARIOUS PAY ITEMS.
 A 3 FOOT STRIP OF FILTER FABRIC SHALL BE ATTACHED TO THE FILL FACE OF THE WING COVERING THE ENTIRE LENGTH OF THE EXPANSION JOINT.
 FOR SUBMITTAL OF WORKING DRAWINGS, SEE SPECIAL PROVISIONS.
 FOR CRANE SAFETY, SEE SPECIAL PROVISIONS.
 FOR FALSEWORK AND FORMWORK, SEE SPECIAL PROVISIONS.
 FOR CULVERT DIVERSION DETAILS AND PAY ITEM, SEE EROSION CONTROL PLANS.
 FOR CONSTRUCTION SEQUENCE, SEE EROSION CONTROL PLANS.
 FOR GROUT FOR STRUCTURES, SEE SPECIAL PROVISIONS.
 NATIVE MATERIAL CONSISTS OF MATERIAL THAT IS EXCAVATED FROM THE STREAM OR FLOOD PLAIN AT THE PROJECT SITE DURING CONSTRUCTION. RIP RAP MAY BE USED TO SUPPLEMENT THE NATIVE MATERIAL IN THE HIGH FLOW CULVERT BARREL(S). IF RIP RAP IS USED TO LINE THE HIGH FLOW CULVERT BARREL(S), NATIVE MATERIAL SHOULD BE PLACED ON TOP TO FILL VOIDS AND PROVIDE A FLAT SURFACE FOR ANIMAL PASSAGE. NATIVE MATERIAL IS SUBJECT TO APPROVAL BY THE ENGINEER AND MAY BE SUBJECT TO PERMIT CONDITIONS.
 DO NOT SET ELEVATION OF HIGH SILL ABOVE BANK FULL.

TOTAL STRUCTURE QUANTITIES	
CLASS A CONCRETE	
BARREL @ 3.378 CY/FT	573.4 C.Y.
WINGS, ETC.	46.5 C.Y.
SILLS	1.6 C.Y.
TOTAL	621.5 C.Y.
REINFORCING STEEL	
BARREL	71,561 LBS.
WINGS, ETC.	2,516 LBS.
TOTAL	74,077 LBS.
FOUNDATION CONDITIONING MATERIAL	475 TONS
CULVERT EXCAVATION	LUMP SUM

HYDRAULIC DATA


DESIGN DISCHARGE = 1420 CFS
 FREQUENCY OF DESIGN FLOOD = 50 YRS.
 DESIGN HIGH WATER ELEVATION = 582.40
 DRAINAGE AREA = 2.08 SQ. MI.
 BASE DISCHARGE (Q100) = 1700 CFS
 BASE HIGH WATER ELEVATION = 583.39

OVERTOPPING FLOOD DATA

OVERTOPPING DISCHARGE = 2570+ CFS
 FREQUENCY OF OVERTOPPING FLOOD = 500+ YRS.
 OVERTOPPING FLOOD ELEVATION = 586.80 *
 * OVERTOPS PROPOSED ROADWAY AT STA. 98+00 -L-


GRADE DATA

GRADE POINT ELEVATION @ STA. 96+88.00 -L- = 587.39'
 BED ELEVATION @ STA. 96+88.00 -L- = 571.43'
 ROADWAY FILL SLOPES = 2:1

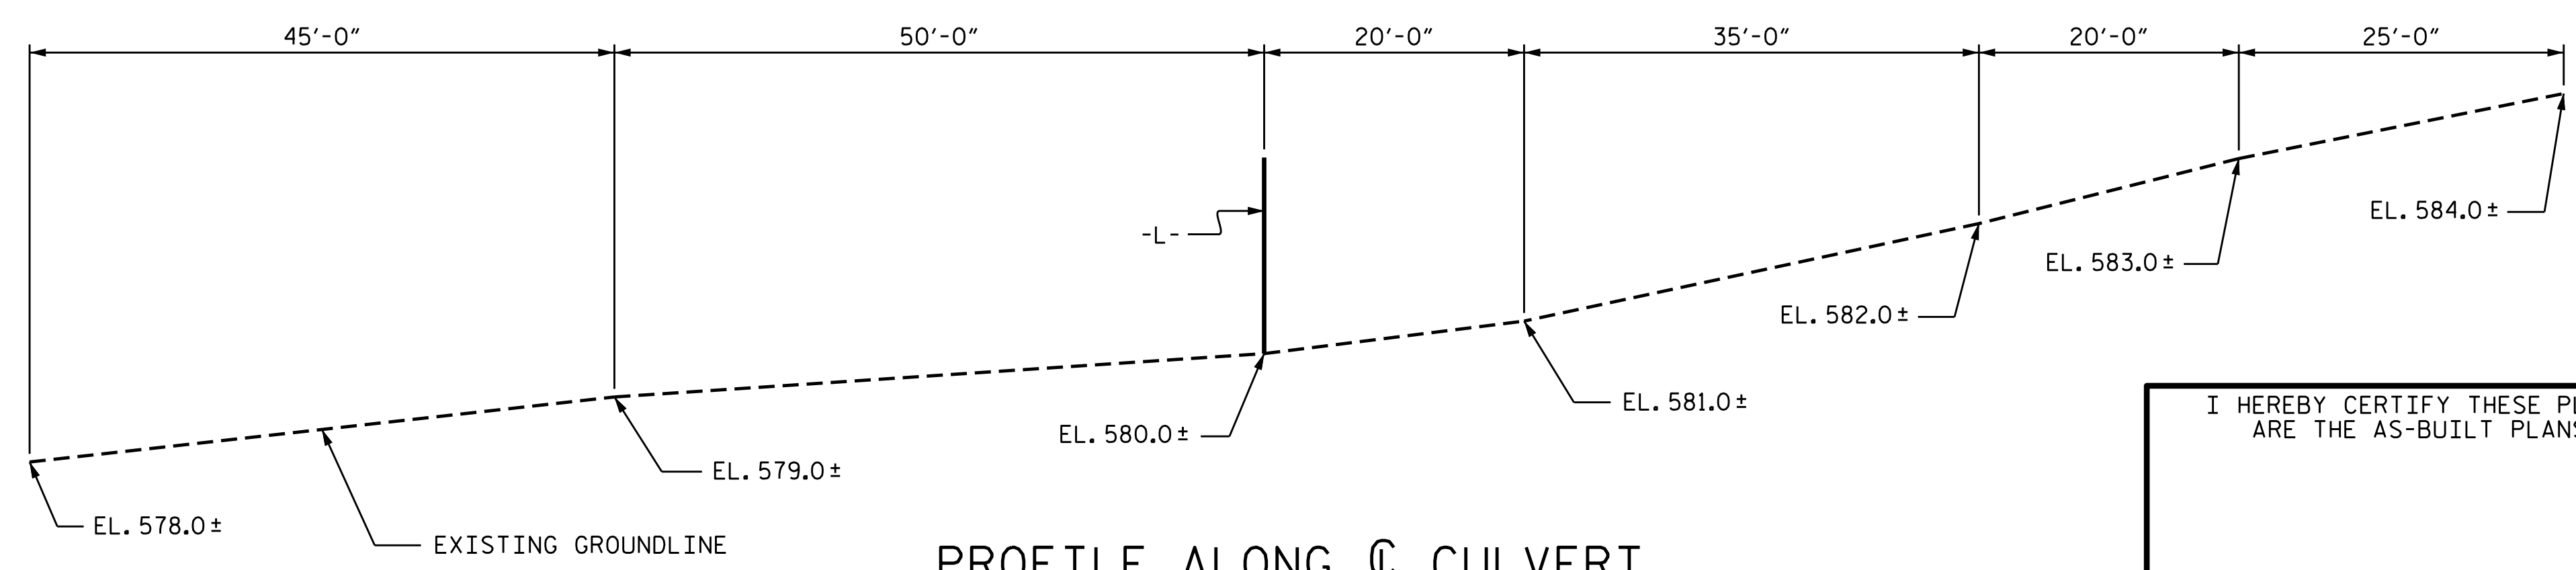

PROFILE ALONG CULVERT

I HEREBY CERTIFY THESE PLANS ARE THE AS-BUILT PLANS

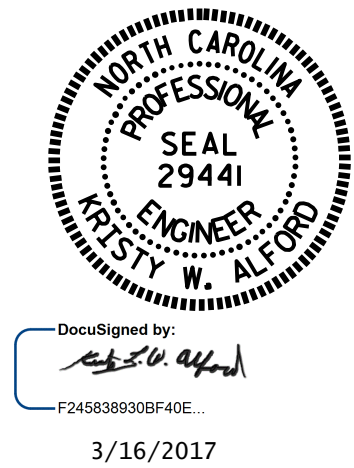


PROJECT NO. U-3109A
 ALAMANCE COUNTY
 STATION: 96+88.00 -L-
 SHEET 1 OF 5 CULVERT NO. 437

STATE OF NORTH CAROLINA
 DEPARTMENT OF TRANSPORTATION
 RALEIGH
 TRIPLE 11 FT. X 9 FT. CONCRETE BOX CULVERT
 130° SKEW


ASSEMBLED BY : A. SORSENGINH DATE : 4/2014
 CHECKED BY : S. B. WILLIAMS DATE : 4/2014
 DESIGN ENGINEER OF RECORD: A. SORSENGINH DATE : 4/2014

DOCUMENT NOT CONSIDERED FINAL UNLESS ALL SIGNATURES COMPLETED


REVISIONS				SHEET NO.		
NO.	BY:	DATE:	NO.	BY:	DATE:	TOTAL SHEETS
1			3			5
2			4			

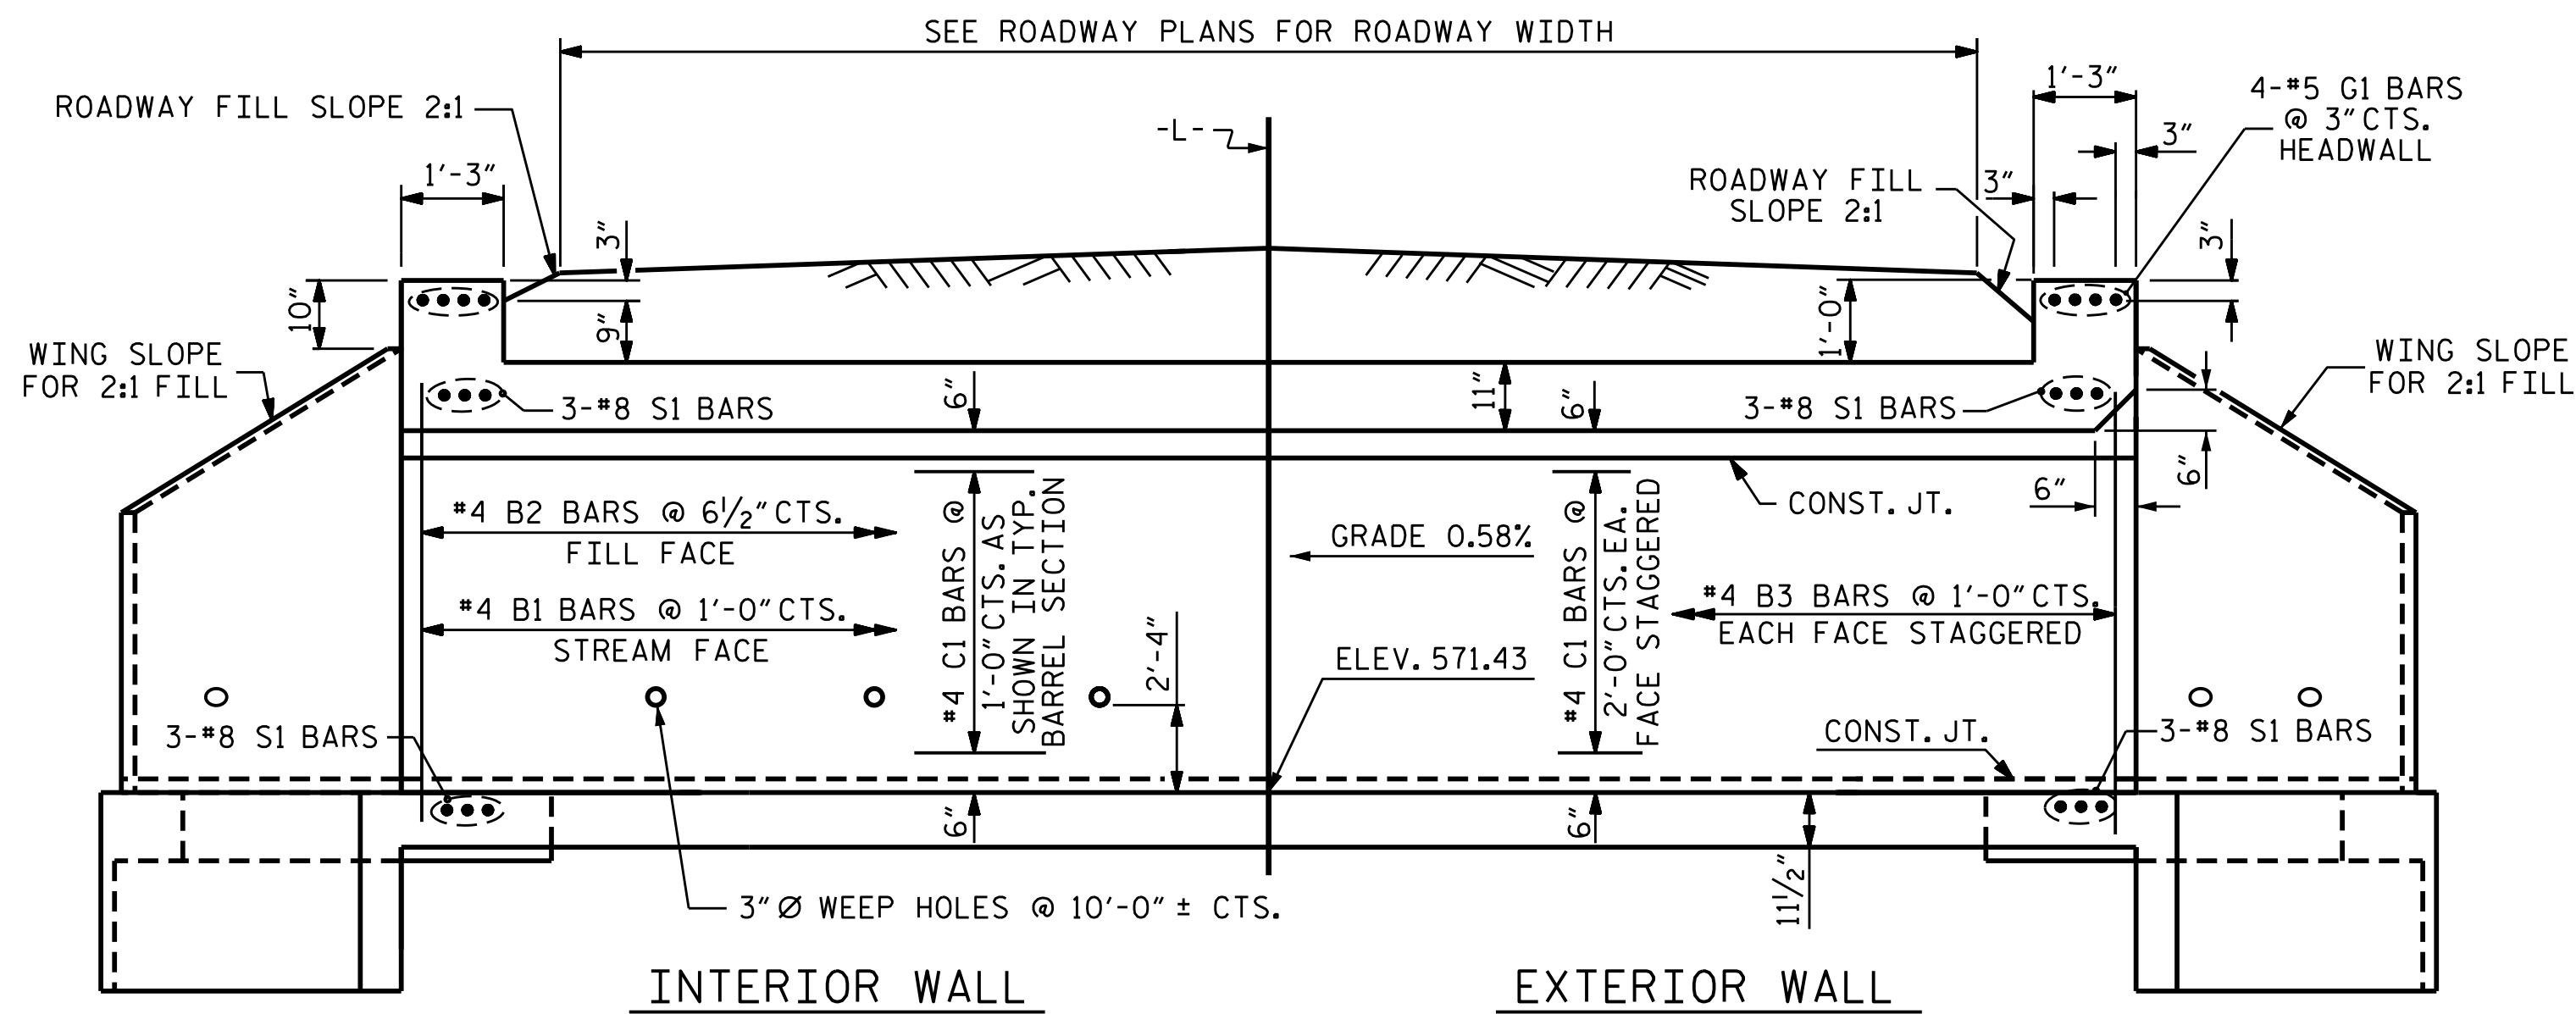

INTERIOR WALL
 EXTERIOR WALL
CULVERT SECTION NORMAL TO ROADWAY

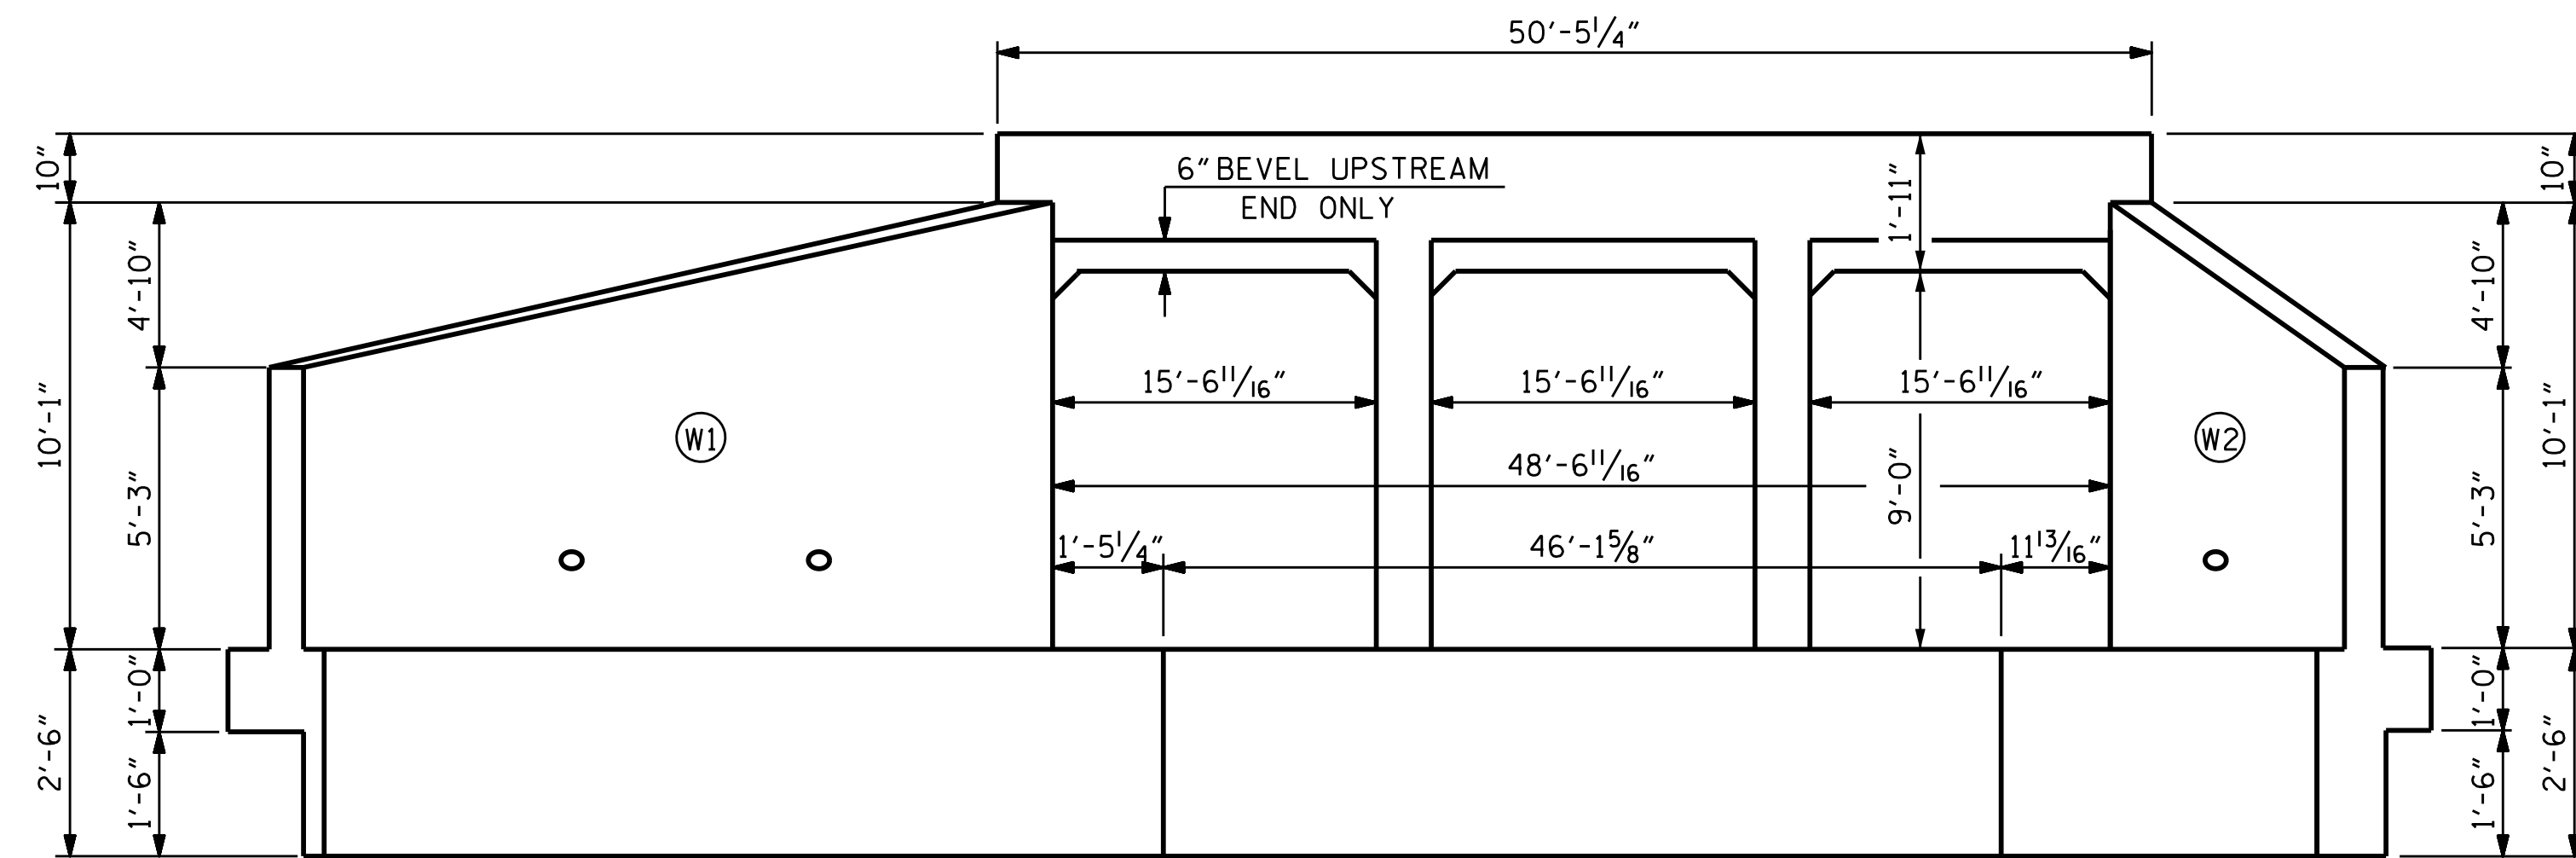

INLET END ELEVATION NORMAL TO SKEW

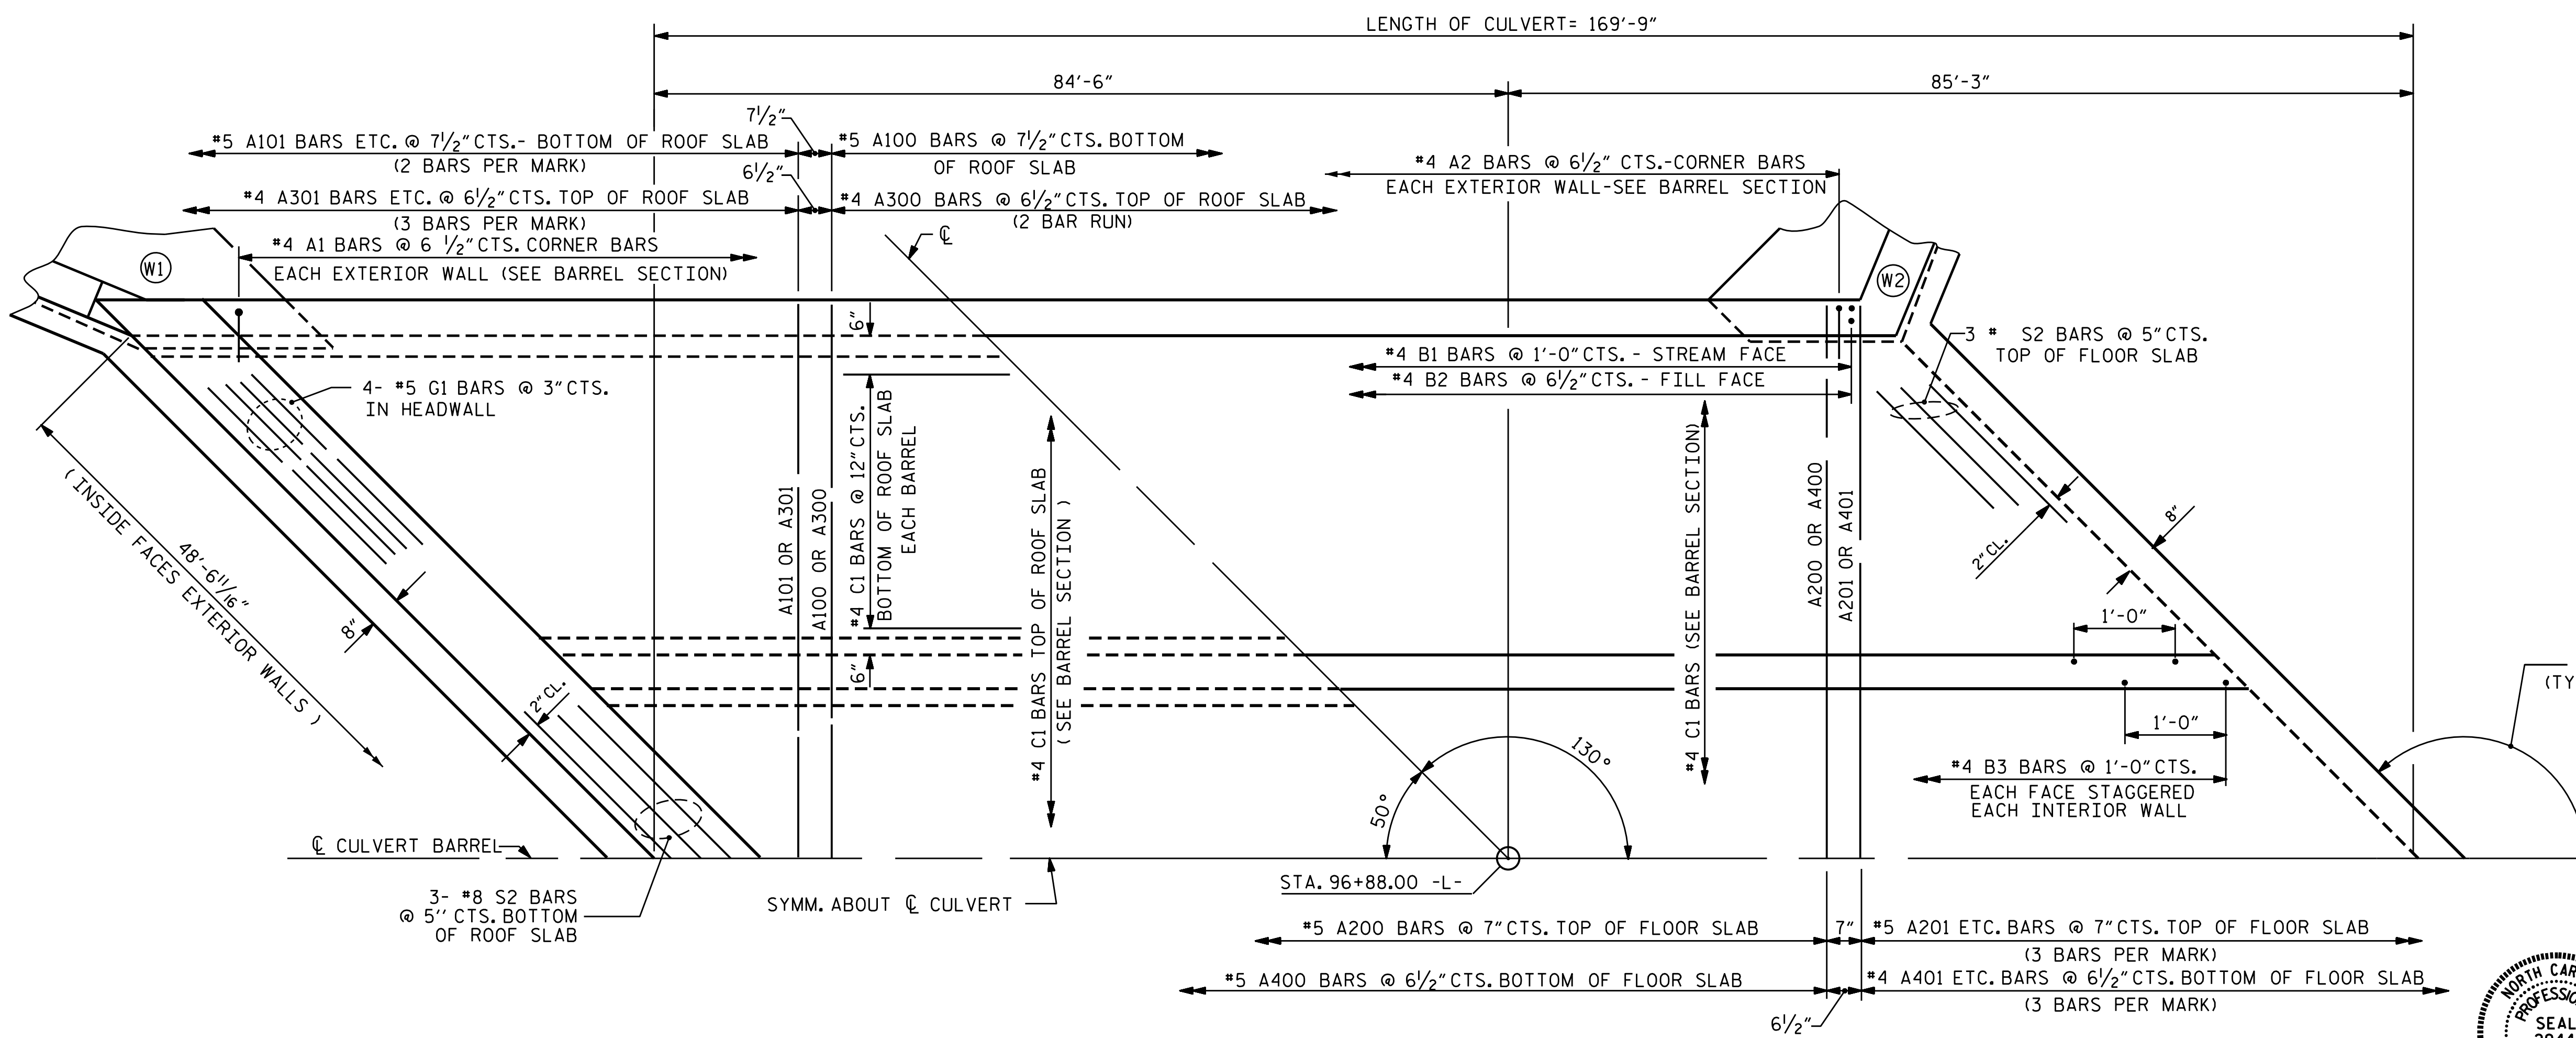

PART PLAN - ROOF SLAB

PART PLAN - FLOOR SLAB

I HEREBY CERTIFY THESE PLANS
 ARE THE AS-BUILT PLANS

PROJECT NO. U-3109A
ALAMANCE COUNTY
 STATION: 96+88.00 -L-

SHEET 2 OF 5




STATE OF NORTH CAROLINA
 DEPARTMENT OF TRANSPORTATION
 RALEIGH
 TRIPLE 11 FT. X 9 FT.
 CONCRETE BOX CULVERT
 130° SKEW

REVISED 11-19-99 BY M.M. CHECKED BY R.W.W.
 REDRAWN NOV.1990 BY D.P.D. CHECKED BY M.A.J.


ASSEMBLED BY : <u>A. SORSENGINH</u> DATE : <u>4/2014</u>	SPECIAL
CHECKED BY : <u>S. B. WILLIAMS</u> DATE : <u>4/2014</u>	
DRAWN BY : <u>H. A. JUDEH</u> DATE : <u>4/12/72</u>	STANDARD
CHECKED BY : <u>RALPH D. UNDERWOOD</u> DATE : <u>APR. 1972</u>	

DOCUMENT NOT CONSIDERED FINAL
 UNLESS ALL SIGNATURES COMPLETED


REVISIONS						SHEET NO.
NO.	BY:	DATE:	NO.	BY:	DATE:	C1-2
1			3			TOTAL SHEETS
2			4			5

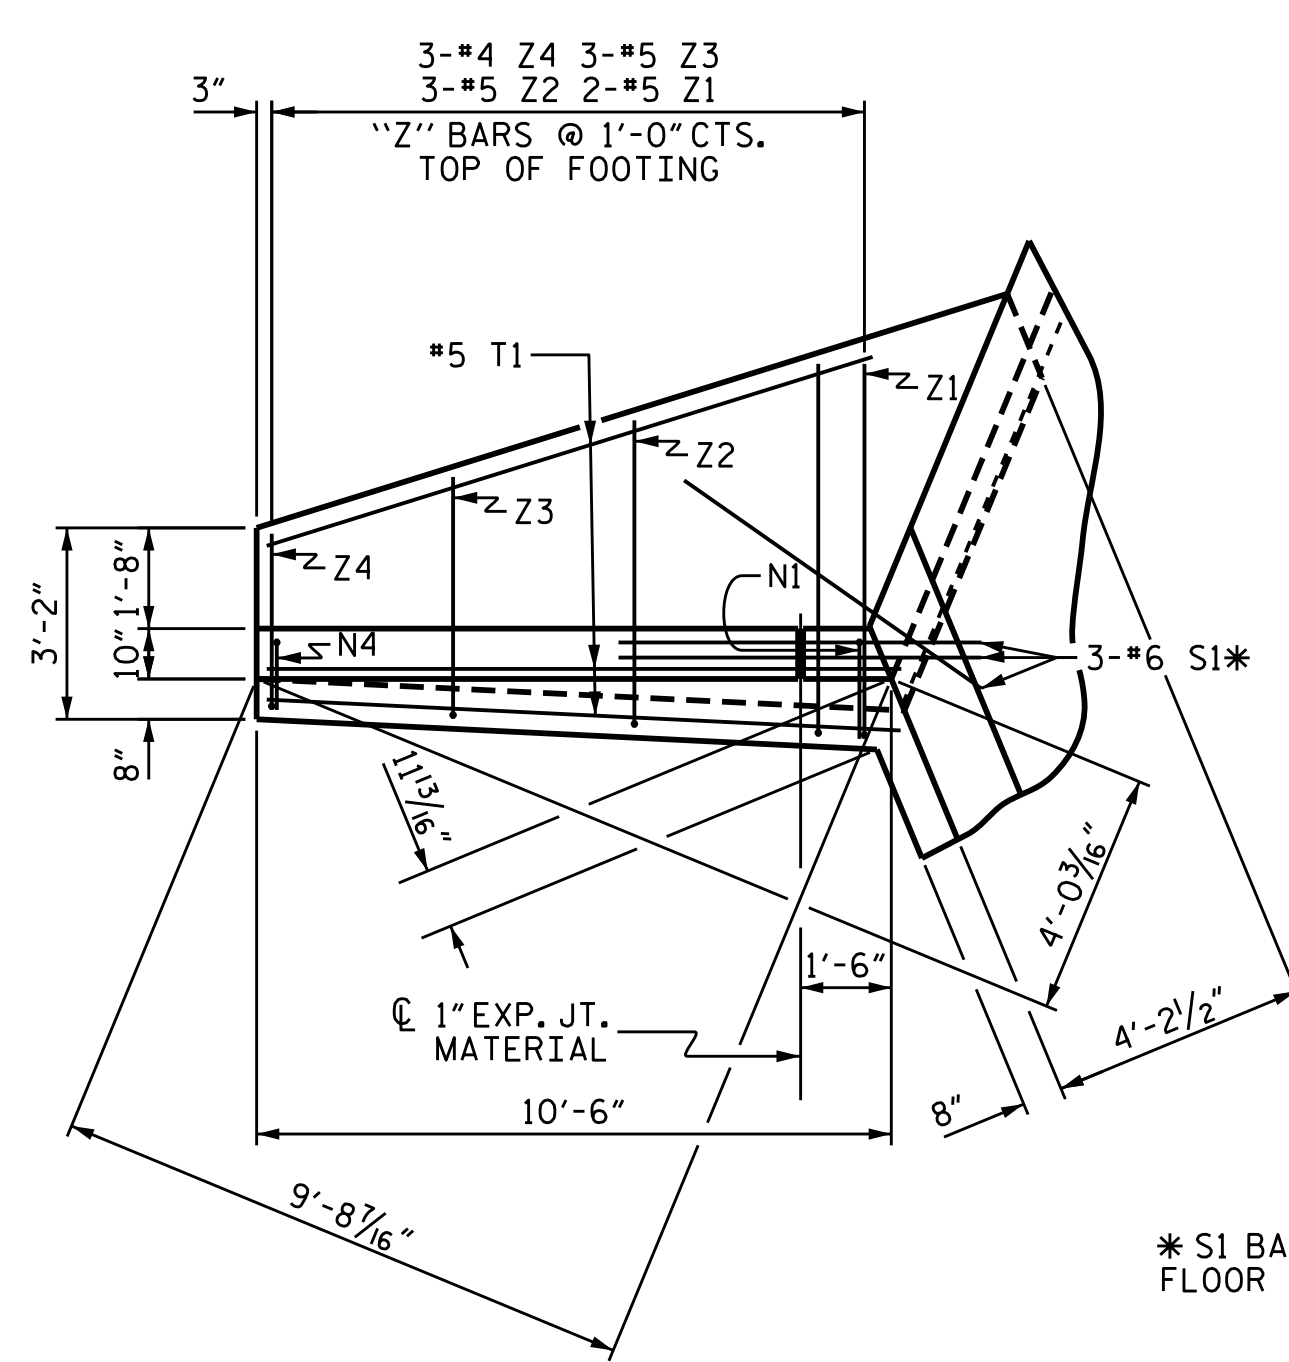


PLAN W2

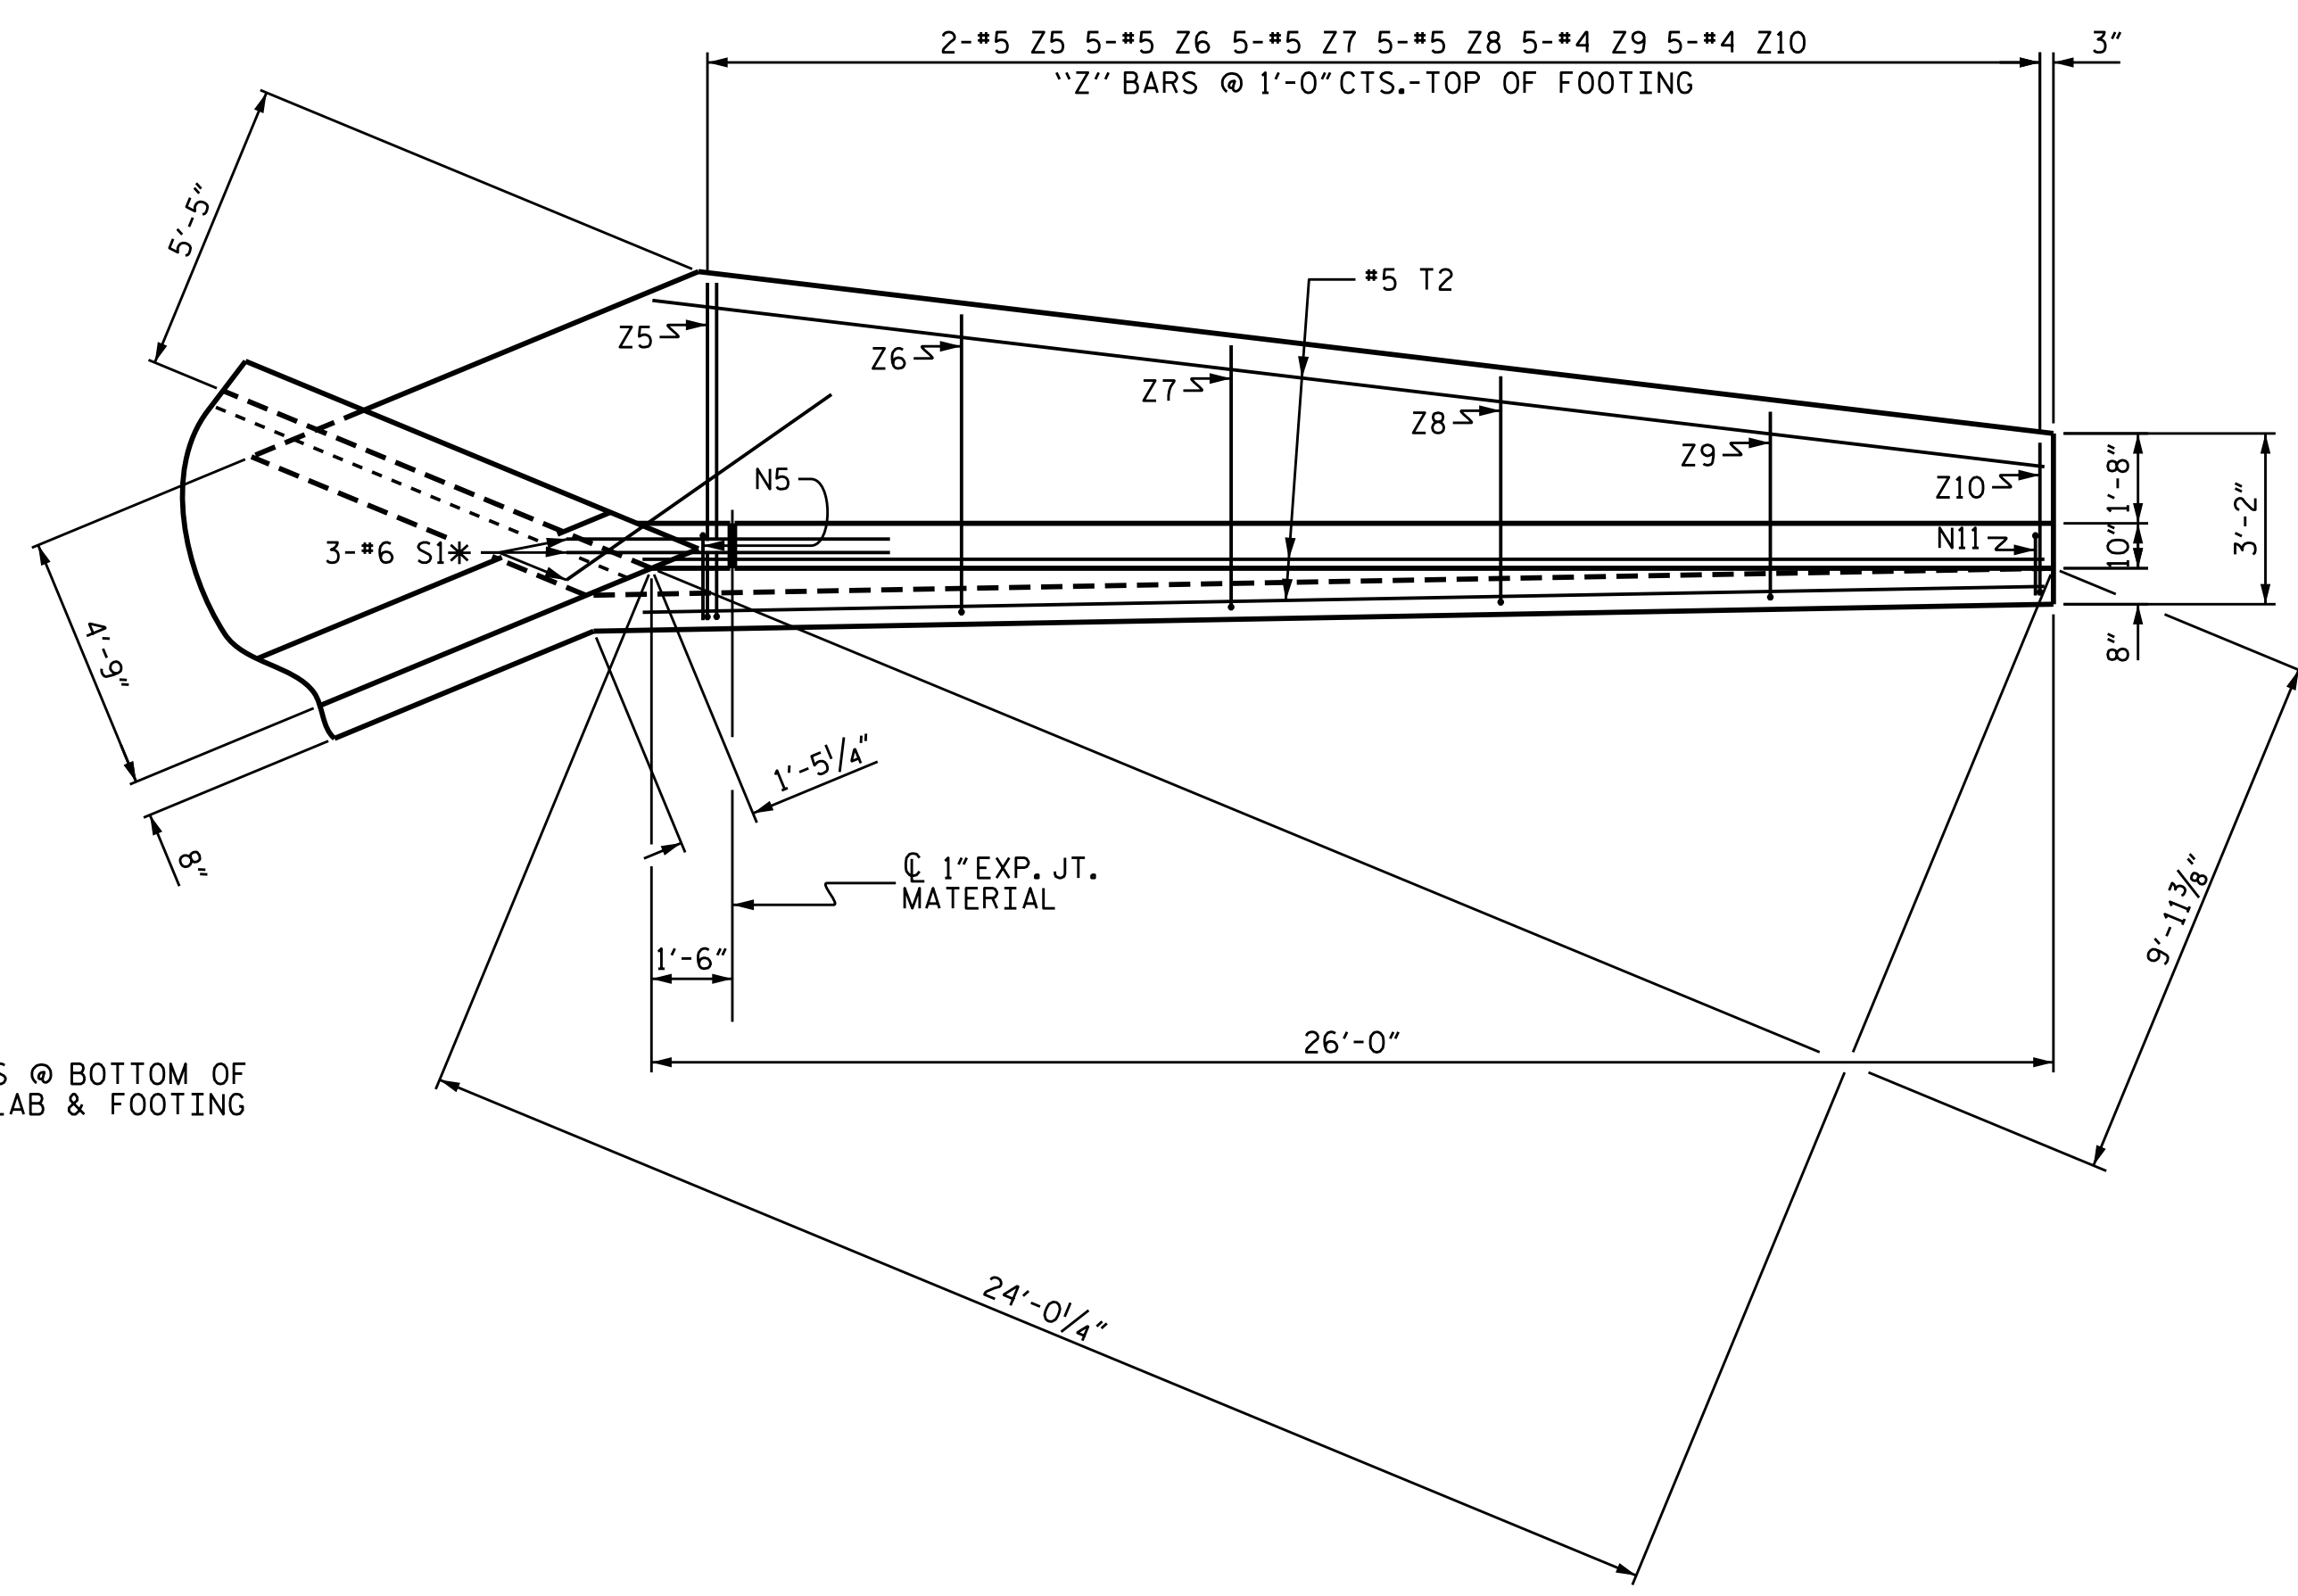

PLAN W1

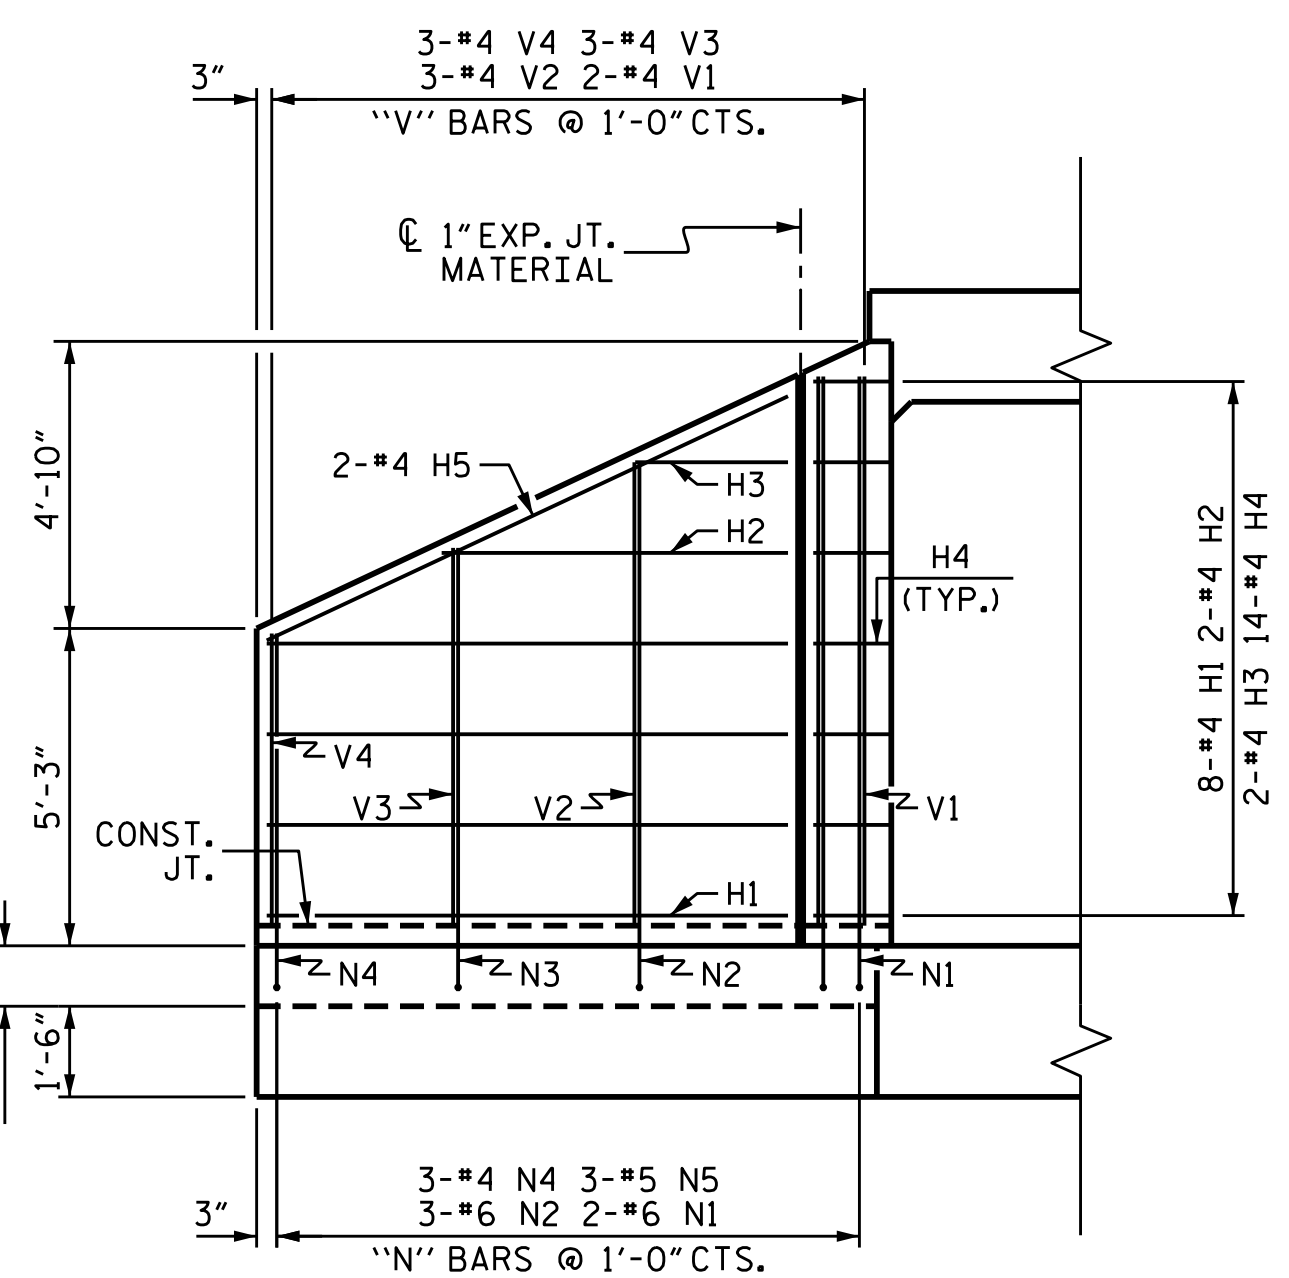

ELEVATION W2

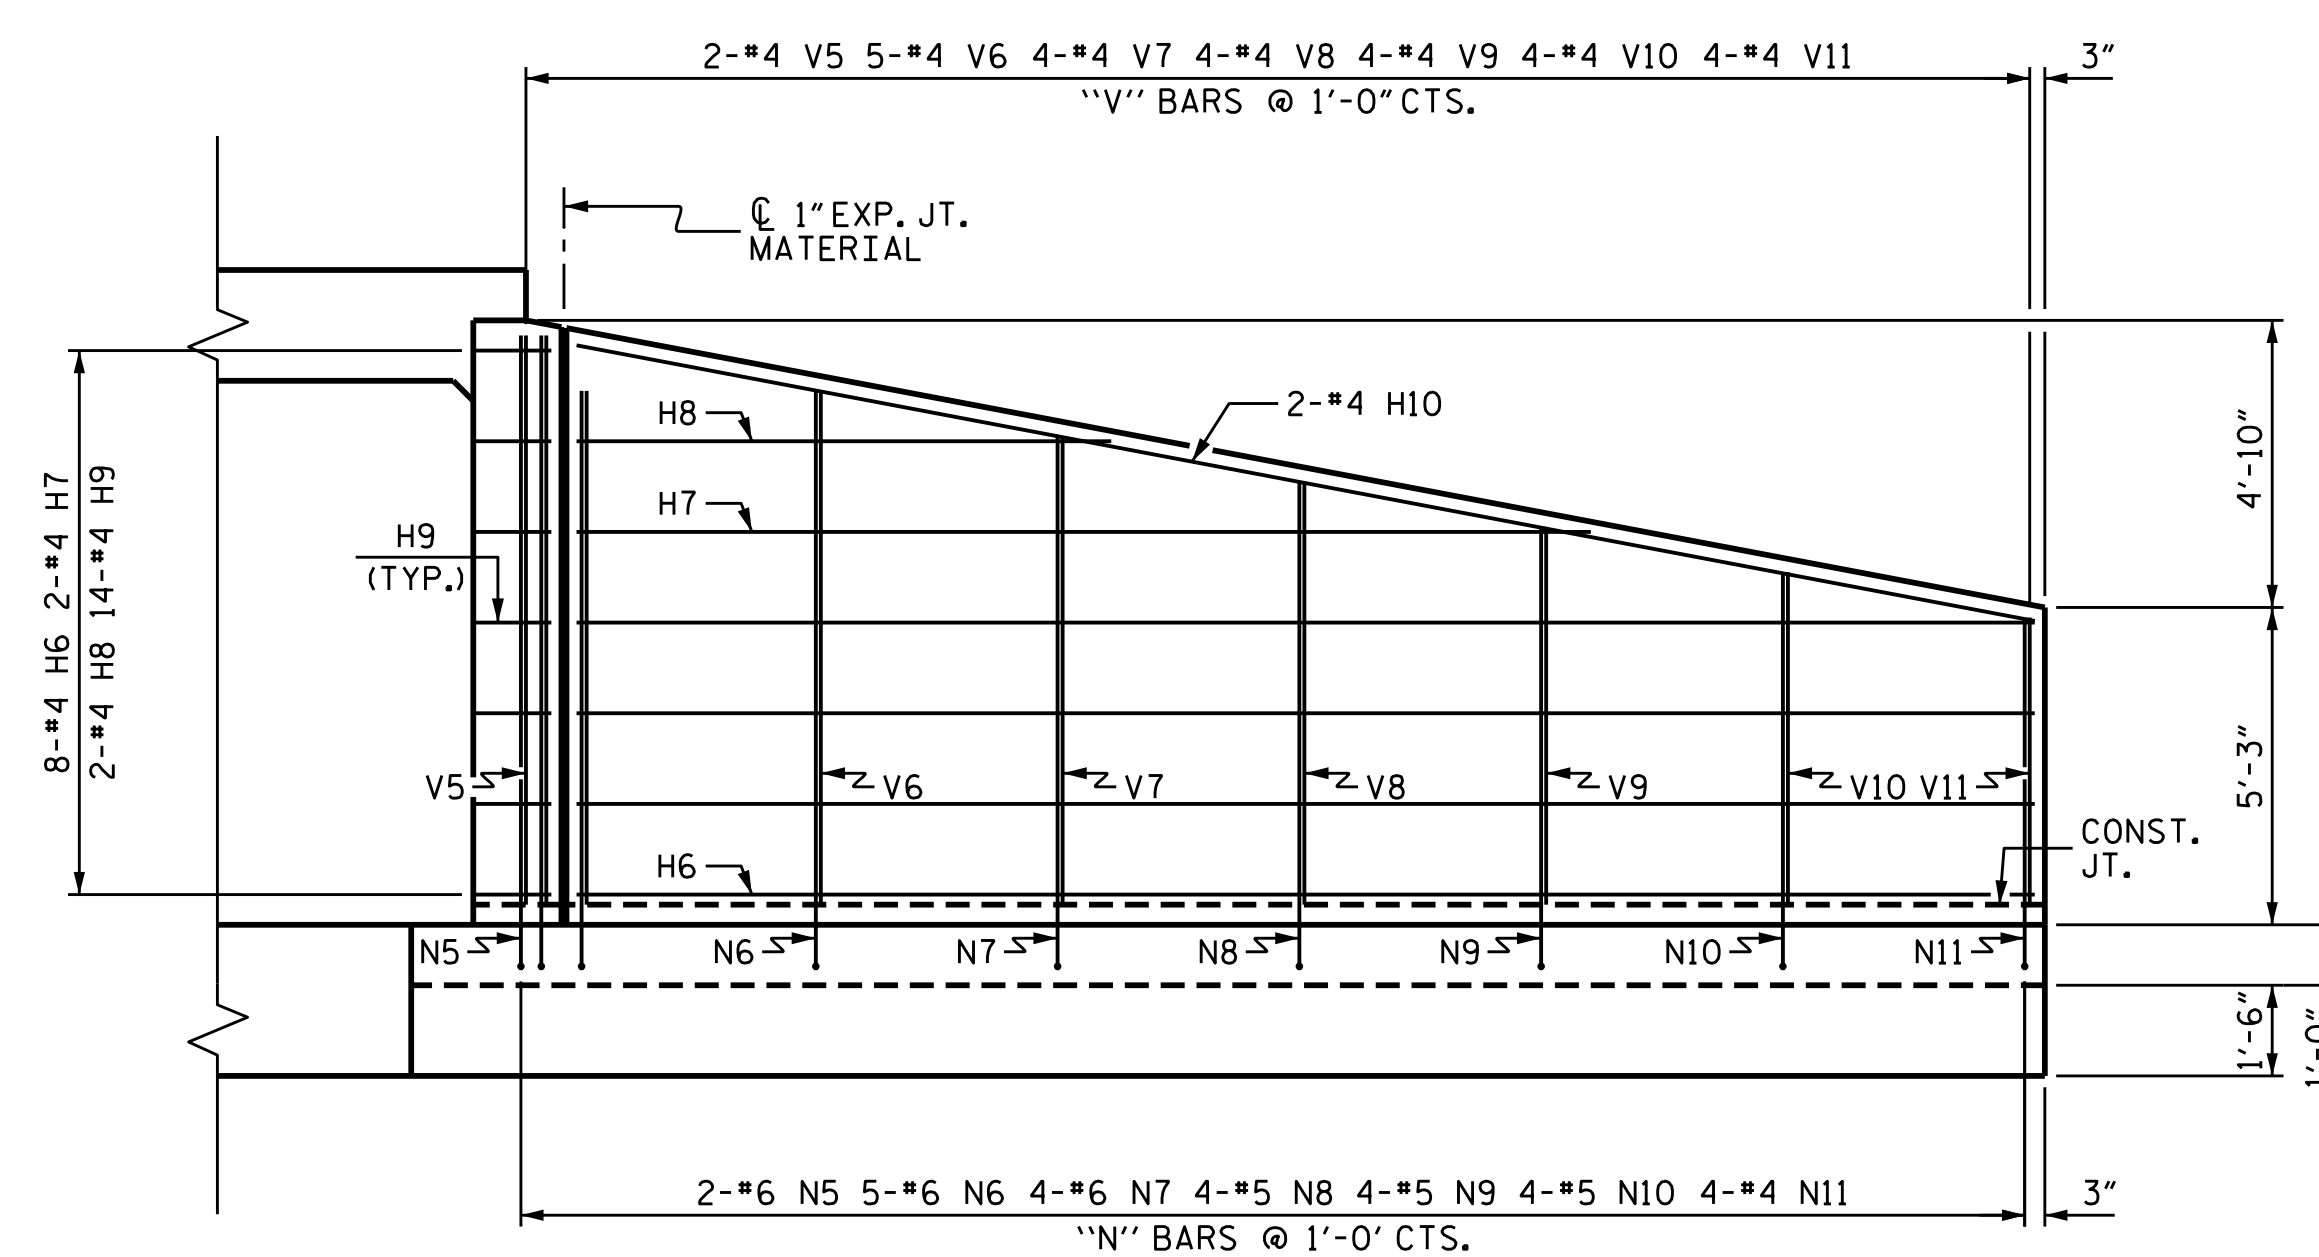

ELEVATION W1


BAR TYPES

ALL BAR DIMENSIONS ARE OUT TO OUT.

BAR NO.	SIZE	TYPE	LENGTH	WEIGHT
H1	#4	STR	8'-7"	92
H2	#4	STR	5'-8"	15
H3	#4	STR	2'-6"	7
H4	#4	1	3'-3"	61
H5	#4	STR	9'-6"	25
H6	#4	STR	24'-1"	257
H7	#4	STR	16'-9"	45
H8	#4	STR	8'-10"	24
H9	#4	2	3'-3"	61
H10	#4	STR	24'-6"	65
N1	#6	3	11'-1"	67
N2	#6	3	9'-8"	87
N3	#5	3	8'-3"	52
N4	#4	3	6'-11"	28
N5	#6	3	11'-5"	69
N6	#6	3	10'-7"	159
N7	#6	3	9'-10"	118
N8	#5	3	9'-1"	76
N9	#5	3	8'-4"	70
N10	#5	3	7'-7"	63
N11	#4	3	6'-10"	37
S1	#6	STR	6'-0"	108
T1	#5	STR	10'-6"	66
T2	#5	STR	26'-0"	163
V1	#4	STR	9'-1"	24
V2	#4	STR	7'-8"	31
V3	#4	STR	6'-3"	25
V4	#4	STR	4'-10"	19
V5	#4	STR	9'-5"	25
V6	#4	STR	8'-6"	57
V7	#4	STR	7'-9"	41
V8	#4	STR	7'-0"	37
V9	#4	STR	6'-3"	33
V10	#4	STR	5'-6"	29
V11	#4	STR	4'-9"	25
Z1	#5	4	6'-9"	28
Z2	#5	4	5'-8"	35
Z3	#5	4	4'-7"	29
Z4	#4	4	3'-5"	14
Z5	#5	4	6'-10"	29
Z6	#5	4	6'-2"	64
Z7	#5	4	5'-6"	57
Z8	#5	4	4'-10"	50
Z9	#4	4	4'-0"	27
Z10	#4	4	3'-4"	22

REINFORCING STEEL 2516 LBS
FOR 4 WINGS

CLASS A CONCRETE 36.1 CY
4 WINGS 4.7 CY
2 HEADWALLS 5.7 CY
2 END CURTAIN WALLS 46.5 CY

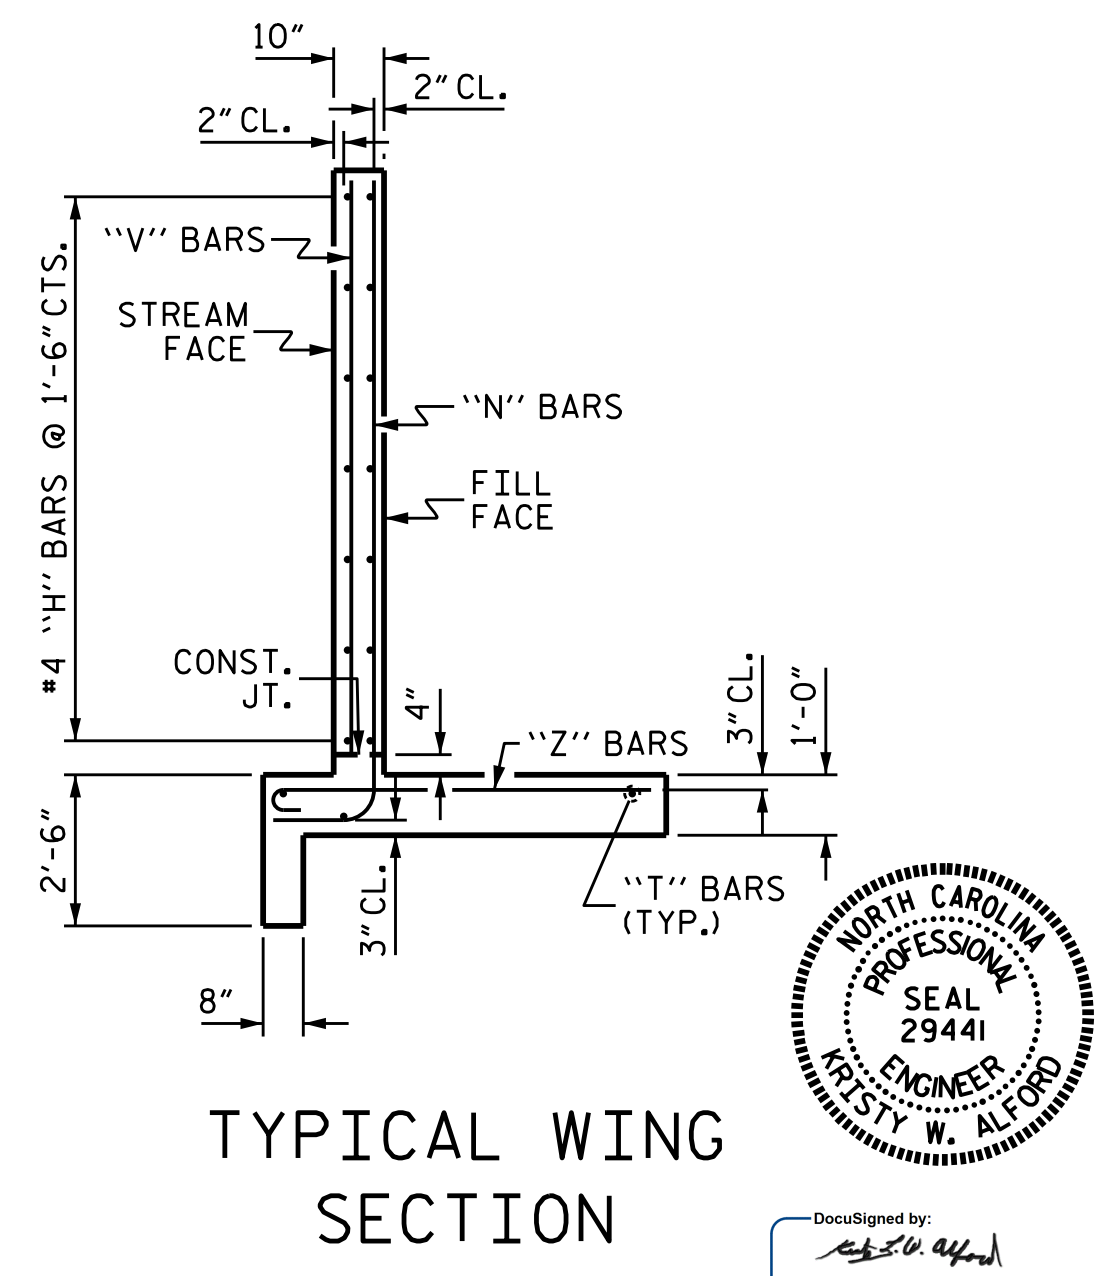

TYPICAL WING SECTION

PROJECT NO. U-3109A
ALAMANCE COUNTY
STATION: 96+88.00 -L-

SHEET 4 OF 5

STATE OF NORTH CAROLINA
DEPARTMENT OF TRANSPORTATION
RALEIGH

STANDARD WINGS FOR CONCRETE BOX CULVERT
H = 9'-0" SLOPE = 2:1
135° SKEW

ASSEMBLED BY: A. SORSENGINH DATE: 4/2014
CHECKED BY: S. B. WILLIAMS DATE: 4/2014
DRAWN BY: CCJ 01/00
CHECKED BY: RWW 03/00

REVISIONS

NO.	BY:	DATE:	NO.	BY:	DATE:
1			3		
2			4		

Desigined by: [Signature]
F249383008F4GE
3/16/2017

DOCUMENT NOT CONSIDERED FINAL
UNLESS ALL SIGNATURES COMPLETED

SHEET NO. C1-4
TOTAL SHEETS 5

**LOAD AND RESISTANCE FACTOR RATING (LRFR)
SUMMARY FOR REINFORCED CONCRETE BOX CULVERTS**

LEVEL	VEHICLE	WEIGHT (W) (TONS)	CONTROLLING LOAD RATING #	MINIMUM RATING FACTORS (RF)	TONS = W x RF	STRENGTH I LIMIT STATE								COMMENT NUMBER		
						MOMENT				SHEAR						
						LIVE-LOAD FACTORS (LL)	RATING FACTOR	BOX NO.	ELEMENT TYPE	DISTANCE FROM LEFT END OF ELEMENT (ft)	RATING FACTOR	BOX NO.	ELEMENT TYPE		DISTANCE FROM LEFT END OF ELEMENT (ft)	
DESIGN LOAD RATING	HL-93 (INVENTORY)	N/A	①	1.16	--	1.75	1.16	1	TOP SLAB	5.25	1.26	1	TOP SLAB	10.67		
	HL-93 (OPERATING)	N/A		1.50	--	1.35	1.50	1	TOP SLAB	5.25	1.63	1	TOP SLAB	10.67		
	HS-20 (INVENTORY)	36.000	②	1.46	52.64	1.75	1.55	1	TOP SLAB	5.25	1.46	1	TOP SLAB	10.67		
	HS-20 (OPERATING)	36.000		1.90	68.23	1.35	2.01	1	TOP SLAB	5.25	1.90	1	TOP SLAB	10.67		
LEGAL LOAD RATING	SINGLE VEHICLE (SV)	SNSH	13.500		2.76	37.20	1.40	2.82	1	TOP SLAB	5.25	2.76	1	TOP SLAB	10.67	
		SNGARBS2	20.000		2.51	50.15	1.40	2.63	1	TOP SLAB	5.25	2.51	1	TOP SLAB	10.67	
		SNAGRIS2	22.000		2.60	57.25	1.40	2.60	1	BOT CORNER WALL	9.69	2.64	1	TOP SLAB	10.67	
		SNCOTTS3	27.250	③	1.45	39.41	1.40	1.45	1	TOP SLAB	5.25	1.56	1	TOP SLAB	10.67	
		SNAGGRS4	34.925		1.66	57.82	1.40	1.71	1	TOP SLAB	5.25	1.66	1	TOP SLAB	10.67	
		SNS5A	35.550		1.63	57.82	1.40	1.63	1	TOP SLAB	5.25	1.63	1	TOP SLAB	10.67	
		SNS6A	39.950		1.62	64.71	1.40	1.63	1	TOP SLAB	5.25	1.62	1	TOP SLAB	10.67	
		SNS7B	42.000		1.57	66.05	1.40	1.69	1	TOP SLAB	5.25	1.57	1	TOP SLAB	10.67	
	TRUCK TRACTOR SEMI-TRAILER (TTST)	TNAGRIT3	33.000		2.30	75.76	1.40	2.30	1	BOT CORNER WALL	9.69	2.48	1	TOP SLAB	10.67	
		TNT4A	33.075		1.72	56.81	1.40	1.72	1	TOP SLAB	5.25	1.85	1	TOP SLAB	10.67	
		TNT6A	41.600		1.59	66.35	1.40	1.72	1	TOP SLAB	5.25	1.59	1	TOP SLAB	10.67	
		TNT7A	42.000		1.72	72.26	1.40	1.80	1	TOP SLAB	5.25	1.72	1	TOP SLAB	10.67	
		TNT7B	42.000		1.65	69.33	1.40	1.65	1	TOP SLAB	5.25	1.67	1	TOP SLAB	10.67	
		TNAGRIT4	43.000		1.64	70.66	1.40	1.64	1	TOP SLAB	5.25	1.77	1	TOP SLAB	10.67	
TNAGT5A	45.000		1.68	75.58	1.40	1.68	1	TOP SLAB	5.25	1.77	1	TOP SLAB	10.67			
TNAGT5B	45.000		1.70	76.72	1.40	1.72	1	TOP SLAB	5.25	1.73	1	TOP SLAB	10.67			

LOAD FACTORS:

DESIGN LOAD RATING FACTORS		
LOAD TYPE	MAX FACTOR	MIN FACTOR
DC	1.25	0.90
DW	1.50	0.65
EV	1.30	0.90
EH	1.35	0.50 OR 0.90
ES	1.35	0.50 OR 0.90
LS	1.75	--
WA	1.00	--


NOTE:

RATING FACTORS ARE BASED ON THE STRENGTH I LIMIT STATE.

COMMENTS:

- 1.
- 2.
- 3.
- 4.


#	CONTROLLING LOAD RATING
①	DESIGN LOAD RATING (HL-93)
②	DESIGN LOAD RATING (HS-20)
③	LEGAL LOAD RATING **
** SEE CHART FOR VEHICLE TYPE	

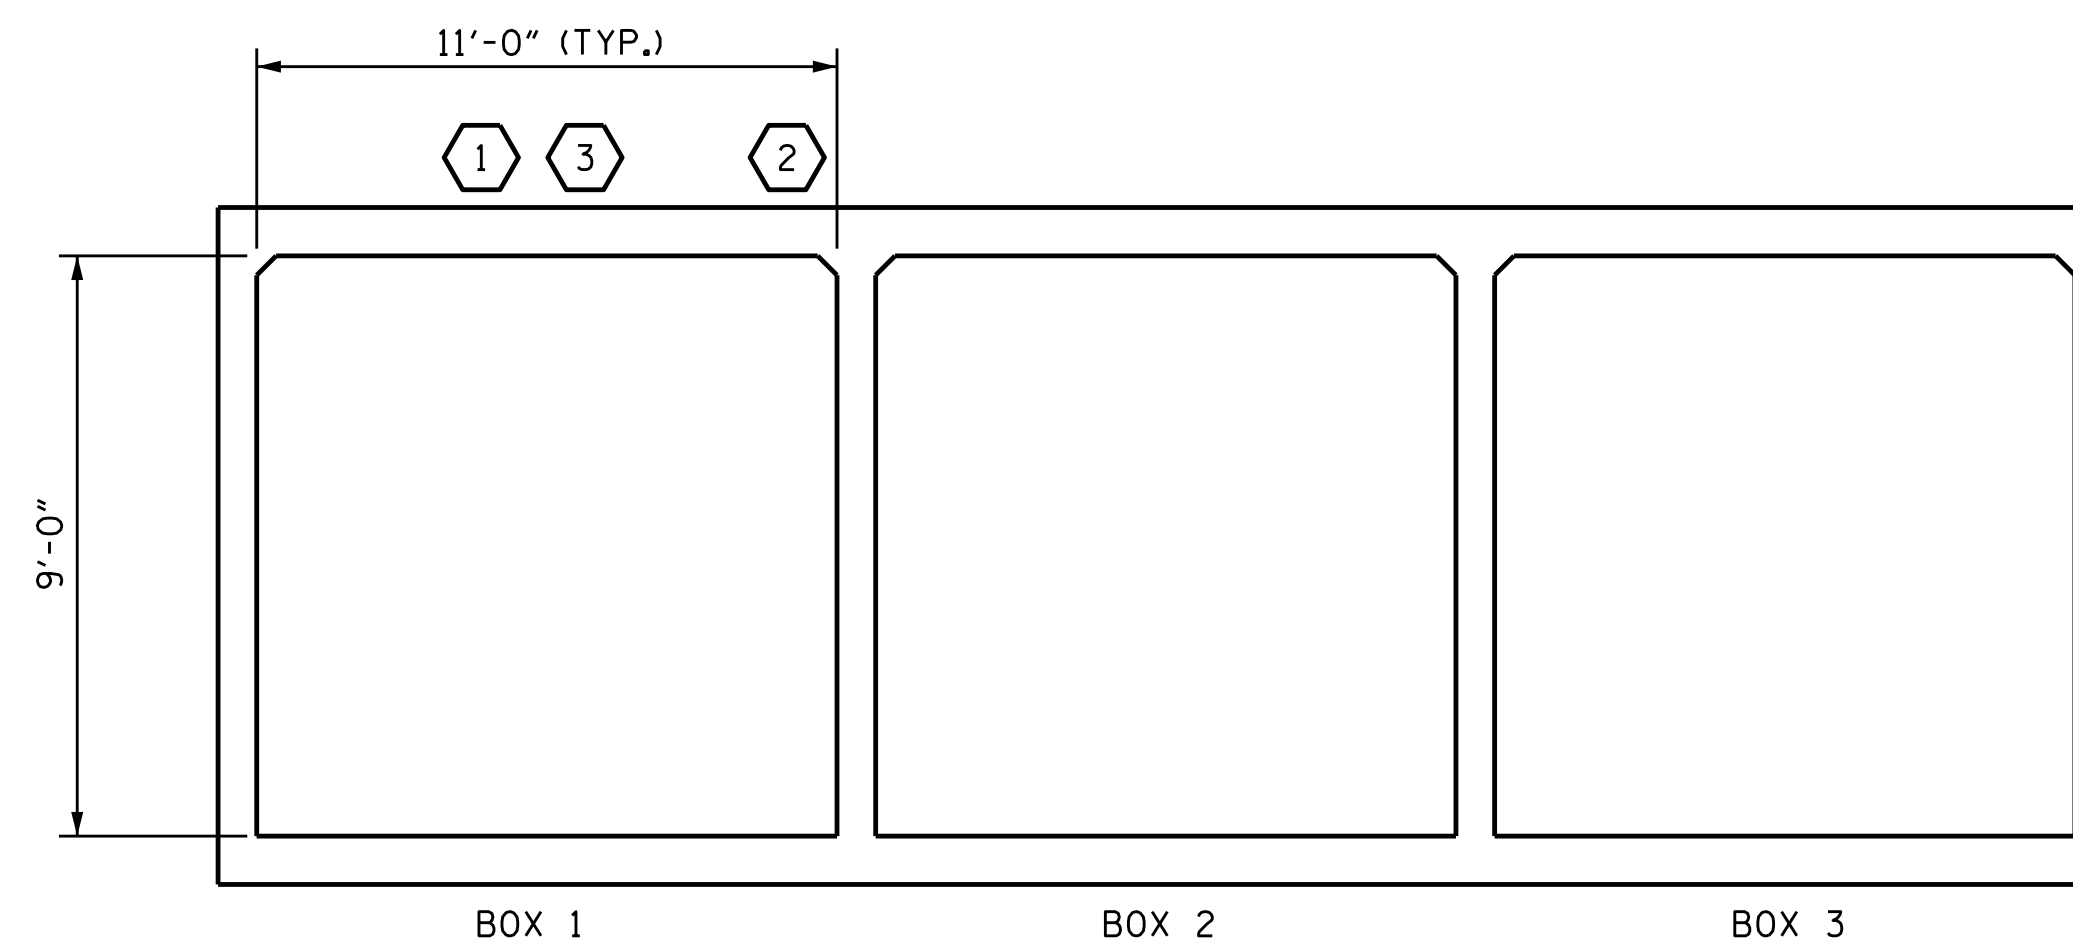

LRFR SUMMARY

PROJECT NO. U-3109A
ALAMANCE COUNTY
 STATION: 96+88.00 -L-

SHEET 5 OF 5

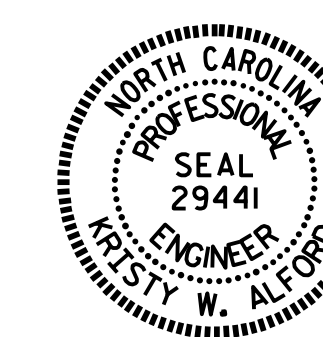

STATE OF NORTH CAROLINA
 DEPARTMENT OF TRANSPORTATION
 RALEIGH
 STANDARD
 LRFR SUMMARY FOR
 REINFORCED CONCRETE
 BOX CULVERTS
 (NON-INTERSTATE TRAFFIC)


ASSEMBLED BY : A. SORSENCINH	DATE : 4/2014
CHECKED BY : S. B. WILLIAMS	DATE : 4/2014
DRAWN BY : WMC	7/11
CHECKED BY : GM	7/11
REV. 10/1/11	MAA/GM

DOCUMENT NOT CONSIDERED FINAL
 UNLESS ALL SIGNATURES COMPLETED

REVISIONS						SHEET NO.
NO.	BY:	DATE:	NO.	BY:	DATE:	C1-5
1			3			TOTAL SHEETS
2			4			5

BENCHMARK #10: RAIL ROAD SPIKE IN BASE OF 15" MAPLE, STA. 184+72.00 -L-, 214' RIGHT, EL. 627.17

F.A. PROJECT NO.: STP-0119(9)

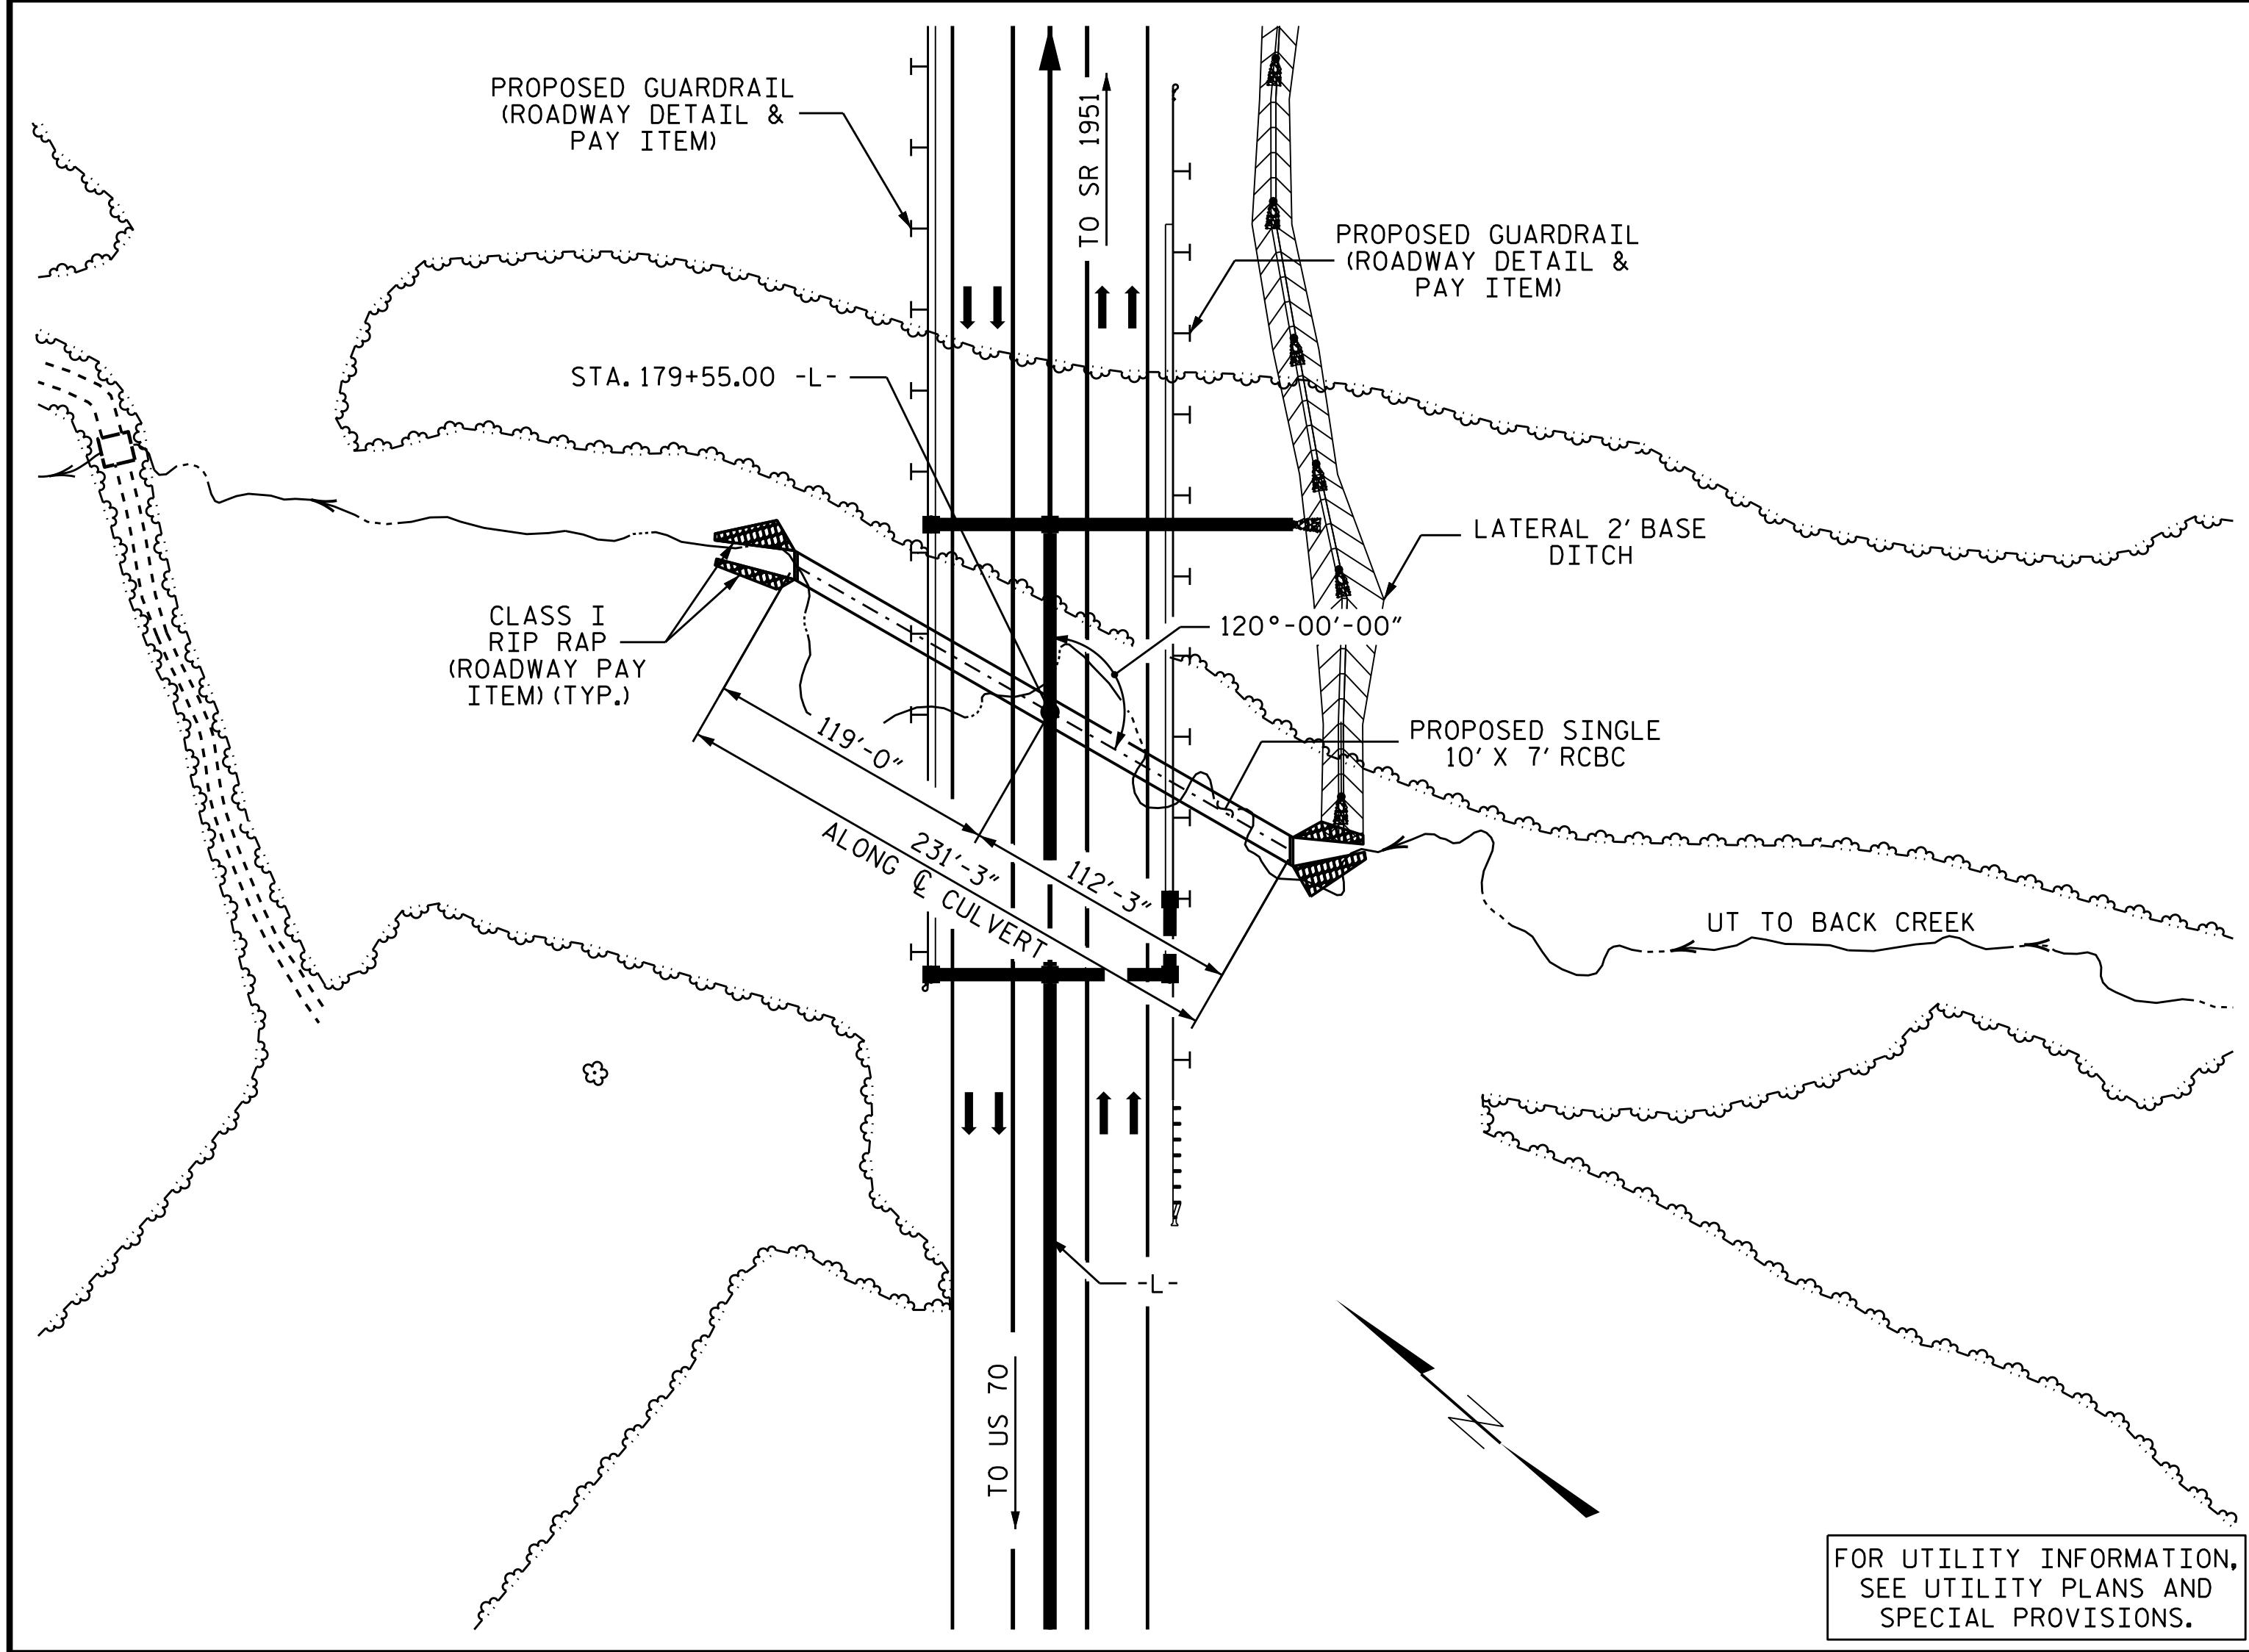

LOCATION SKETCH

NOTES

ASSUMED LIVE LOAD -----HL-93 OR ALTERNATE LOADING.
 DESIGN FILL-----26.90'
 FOR OTHER DESIGN DATA AND NOTES, SEE STANDARD NOTE SHEET.
 3" Ø WEEP HOLES INDICATED TO BE IN ACCORDANCE WITH THE SPECIFICATIONS.
 CONCRETE IN CULVERTS TO BE POURED IN THE FOLLOWING ORDER:
 1. WING FOOTINGS AND FLOOR SLAB INCLUDING 4" OF ALL VERTICAL WALLS.
 2. THE REMAINING PORTIONS OF THE WALLS AND WINGS FULL HEIGHT FOLLOWED BY ROOF SLAB AND HEADWALLS.
 THE RESIDENT ENGINEER SHALL CHECK THE LENGTH OF CULVERT BEFORE STAKING IT OUT TO MAKE CERTAIN THAT IT WILL PROPERLY TAKE CARE OF THE FILL.
 DIMENSIONS FOR WING LAYOUT AS WELL AS ADDITIONAL REINFORCING STEEL EMBEDDED IN BARREL ARE SHOWN ON WING SHEET.
 TRANSVERSE CONSTRUCTION JOINTS SHALL BE USED IN THE BARREL, SPACED TO LIMIT THE POURS TO A MAXIMUM OF 70 FT. LOCATION OF JOINTS SHALL BE SUBJECT TO APPROVAL OF THE ENGINEER.
 AT THE CONTRACTOR'S OPTION, HE MAY SPLICE THE VERTICAL REINFORCING STEEL IN THE INTERIOR FACE OF EXTERIOR WALL ABOVE LOWER WALL CONSTRUCTION JOINT. THE SPLICE LENGTH SHALL BE AS PROVIDED IN THE SPLICE LENGTH CHART SHOWN ON THE PLANS. EXTRA WEIGHT OF STEEL DUE TO THE SPLICES SHALL BE PAID FOR BY THE CONTRACTOR.
 AT THE CONTRACTOR'S OPTION HE MAY SUBMIT, TO THE ENGINEER FOR APPROVAL, DESIGN AND DETAIL DRAWINGS FOR A PRECAST REINFORCED CONCRETE BOX CULVERT IN LIEU OF THE CAST-IN-PLACE CULVERT SHOWN ON THE PLANS. THE DESIGN SHALL PROVIDE THE SAME SIZE OF BARREL AS USED ON THE CAST-IN-PLACE DESIGN. FOR OPTIONAL PRECAST REINFORCED CONCRETE BOX CULVERT, SEE SPECIAL PROVISIONS.

THE CONTRACTOR SHALL PROVIDE INDEPENDENT ASSURANCE SAMPLES OF REINFORCING STEEL AS FOLLOWS: FOR PROJECTS REQUIRING UP TO 400 TONS OF REINFORCING STEEL, ONE 30 INCH SAMPLE OF EACH SIZE BAR USED, AND FOR PROJECTS REQUIRING OVER 400 TONS OF REINFORCING STEEL, TWO 30 INCH SAMPLES OF EACH SIZE BAR USED. THE BARS FROM WHICH THE SAMPLES ARE TAKEN MUST THEN BE SPLICED WITH REPLACEMENT BARS OF THE SIZE AND LENGTH OF THE SAMPLE, PLUS A MINIMUM LAP SPLICE OF THIRTY BAR DIAMETERS. PAYMENT FOR THE SAMPLES OF REINFORCING STEEL SHALL BE CONSIDERED INCIDENTAL TO VARIOUS PAY ITEMS.
 A 3 FOOT STRIP OF FILTER FABRIC SHALL BE ATTACHED TO THE FILL FACE OF THE WING COVERING THE ENTIRE LENGTH OF THE EXPANSION JOINT.
 FOR SUBMITTAL OF WORKING DRAWINGS, SEE SPECIAL PROVISIONS.
 FOR CRANE SAFETY, SEE SPECIAL PROVISIONS.
 FOR FALSEWORK AND FORMWORK, SEE SPECIAL PROVISIONS.
 FOR CULVERT DIVERSION DETAILS AND PAY ITEM, SEE EROSION CONTROL PLANS.
 FOR CONSTRUCTION SEQUENCE, SEE EROSION CONTROL PLANS.
 FOR GROUT FOR STRUCTURES, SEE SPECIAL PROVISIONS.

TOTAL STRUCTURE QUANTITIES		
CLASS A CONCRETE		
BARREL @ 1.458 CY/FT	337.2	C.Y.
WINGS, ETC.	22.3	C.Y.
SILLS AND BAFFLES	3.4	C.Y.
TOTAL	362.9	C.Y.
REINFORCING STEEL		
BARREL	41,436	LBS.
WINGS, ETC.	1,321	LBS.
TOTAL	42,757	LBS.
FOUNDATION CONDITIONING MATERIAL	253	TONS
CULVERT EXCAVATION		LUMP SUM

HYDRAULIC DATA


DESIGN DISCHARGE	= 350 CFS
FREQUENCY OF DESIGN FLOOD	= 50 YRS.
DESIGN HIGH WATER ELEVATION	= 602.50
DRAINAGE AREA	= 0.19 SQ. MI.
BASE DISCHARGE (Q100)	= 400 CFS
BASE HIGH WATER ELEVATION	= 603.09

OVERTOPPING FLOOD DATA

OVERTOPPING DISCHARGE	= 1100 CFS
FREQUENCY OF OVERTOPPING FLOOD	= 500+ YRS.
OVERTOPPING FLOOD ELEVATION	= 621.80*


*OVERTOPS ROADWAY DITCH AT 177+00 -L- RT GRADE DATA

GRADE POINT ELEVATION @ STA. 179+55.00 -L-	= 627.83'
BED ELEVATION @ STA. 179+55.00 -L-	= 594.73'
ROADWAY FILL SLOPES	= 2:1

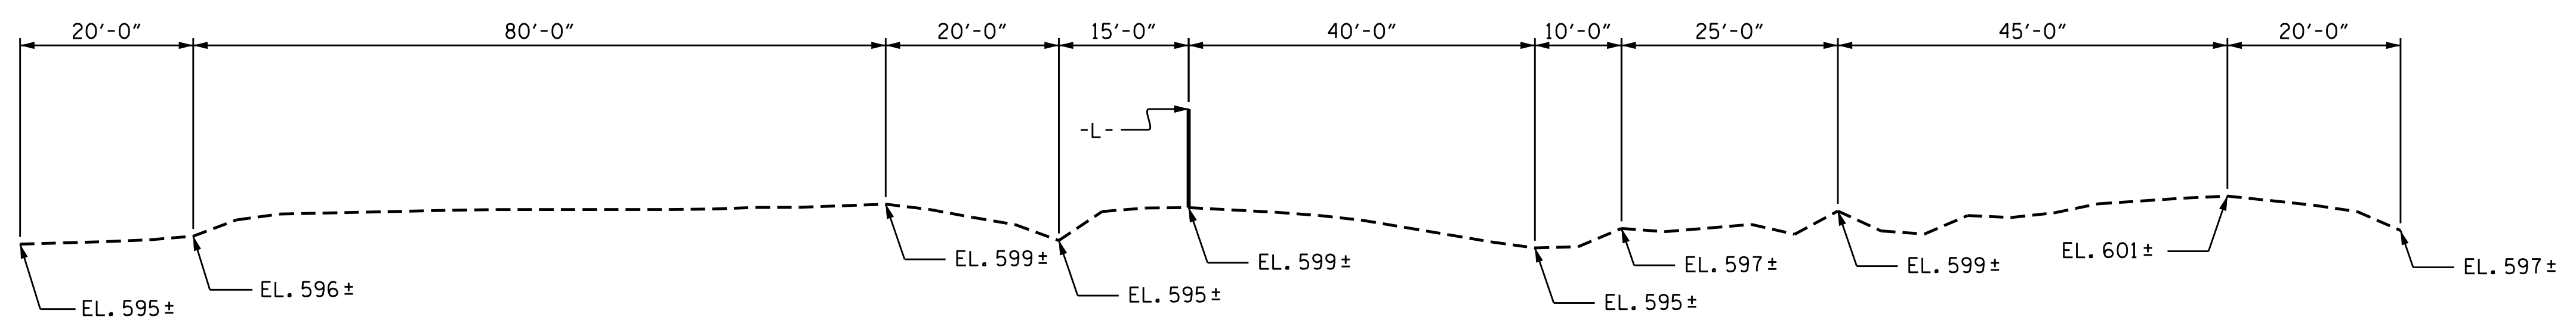

PROFILE ALONG CULVERT

ASSEMBLED BY : A. SORSENGINH DATE : 4/2014
 CHECKED BY : K.W. ALFORD DATE : 2/2017
 DESIGN ENGINEER OF RECORD: A. SORSENGINH DATE : 4/2014

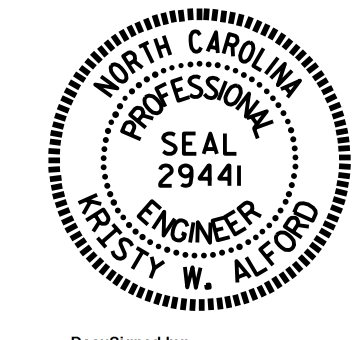

DocuSigned by:
 Kristy W. Alford
 3/16/2017

PROJECT NO. U-3109A
 ALAMANCE COUNTY
 STATION: 179+55.00 -L-


SHEET 1 OF 5

STATE OF NORTH CAROLINA
 DEPARTMENT OF TRANSPORTATION
 RALEIGH


SINGLE 10 FT. X 7 FT. CONCRETE BOX CULVERT
 120° SKEW

REVISIONS						SHEET NO.
NO.	BY:	DATE:	NO.	BY:	DATE:	C2-1
1			3			TOTAL SHEETS
2			4			5


DOCUMENT NOT CONSIDERED FINAL UNLESS ALL SIGNATURES COMPLETED

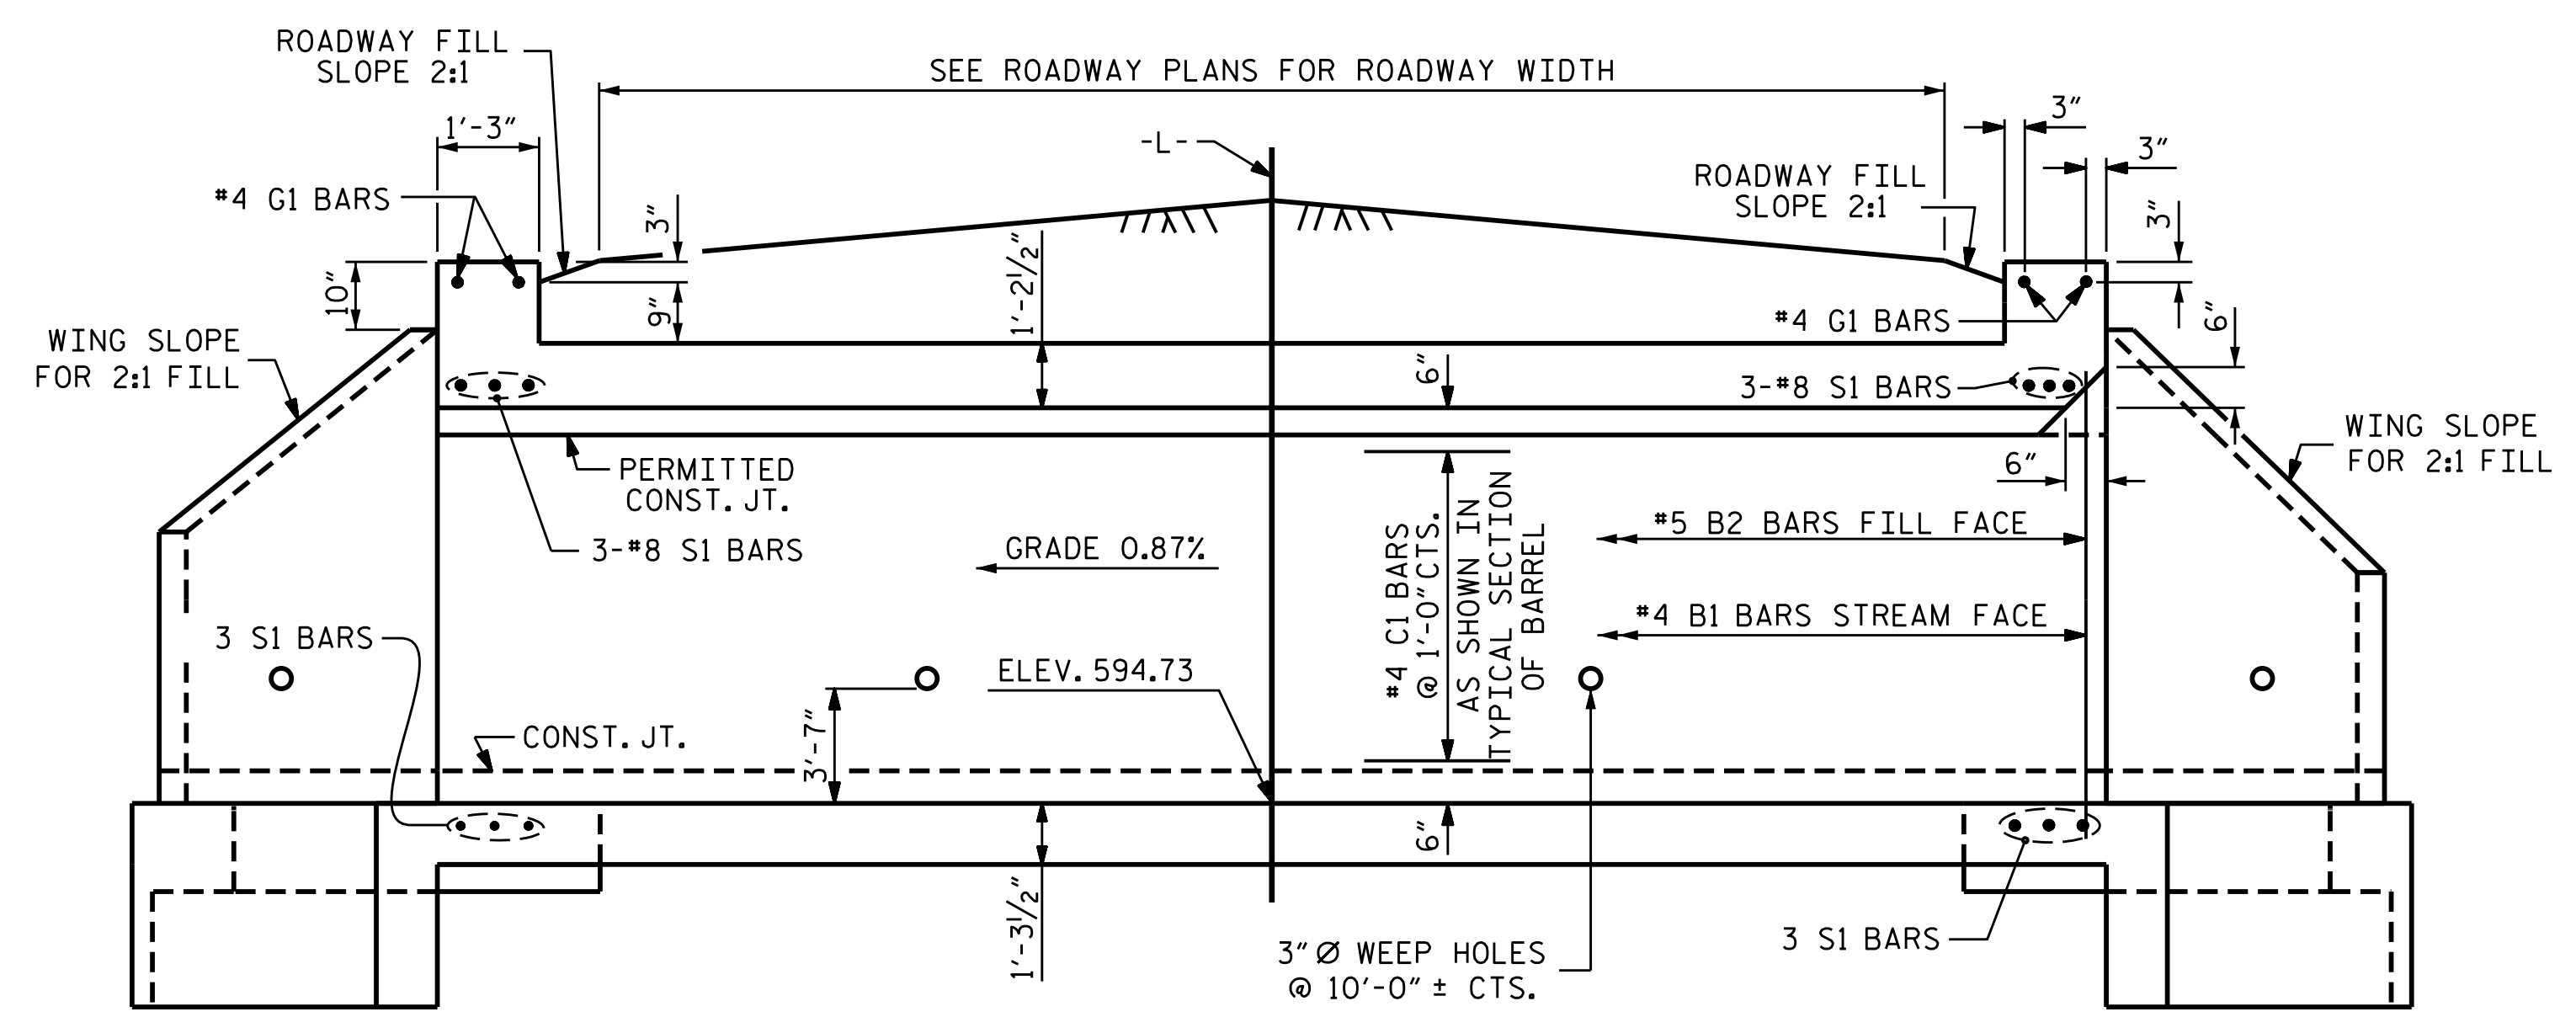

CULVERT SECTION NORMAL TO ROADWAY

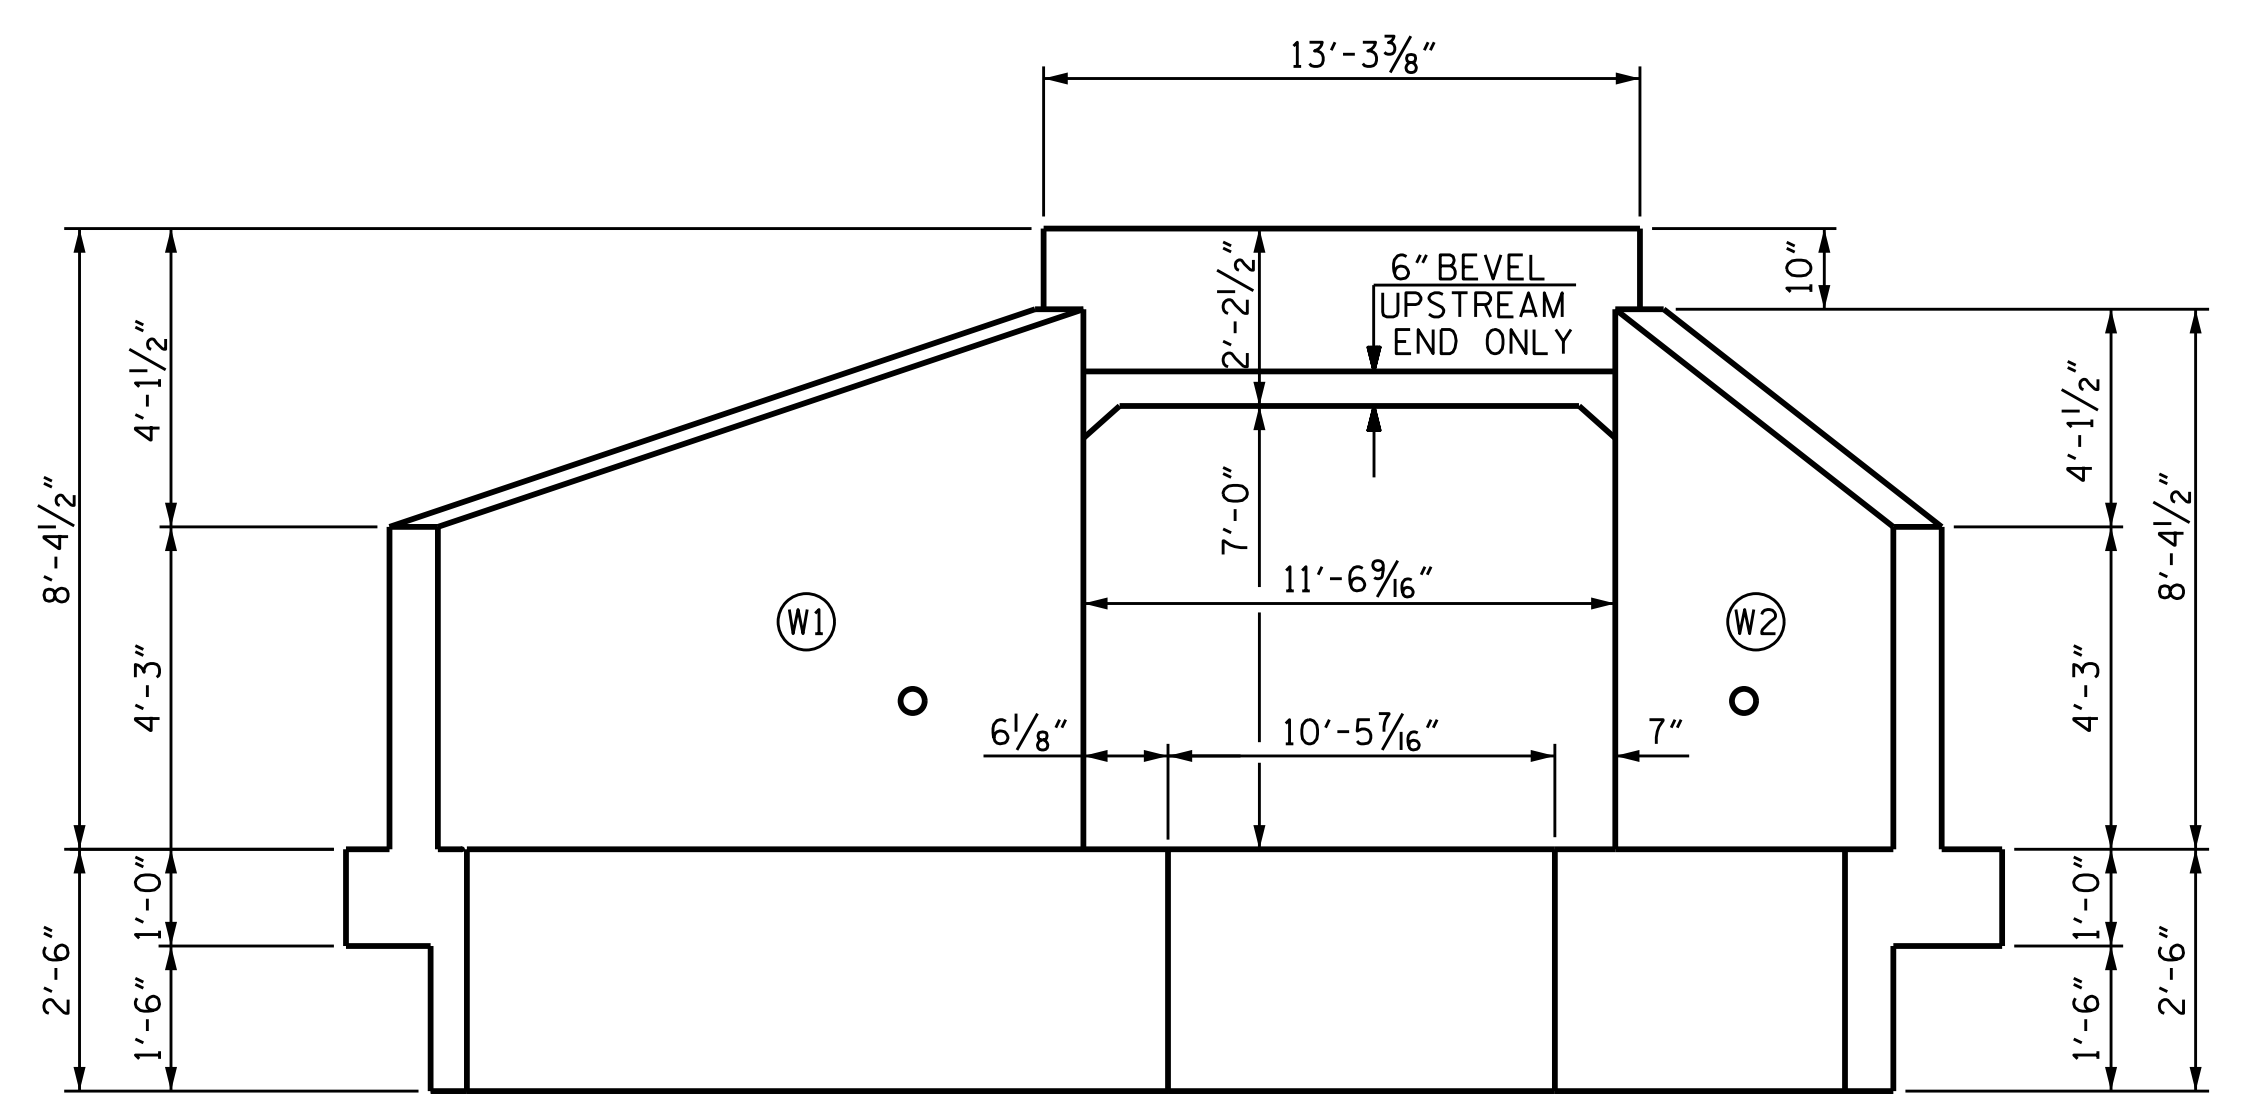


INLET END ELEVATION NORMAL TO SKEW

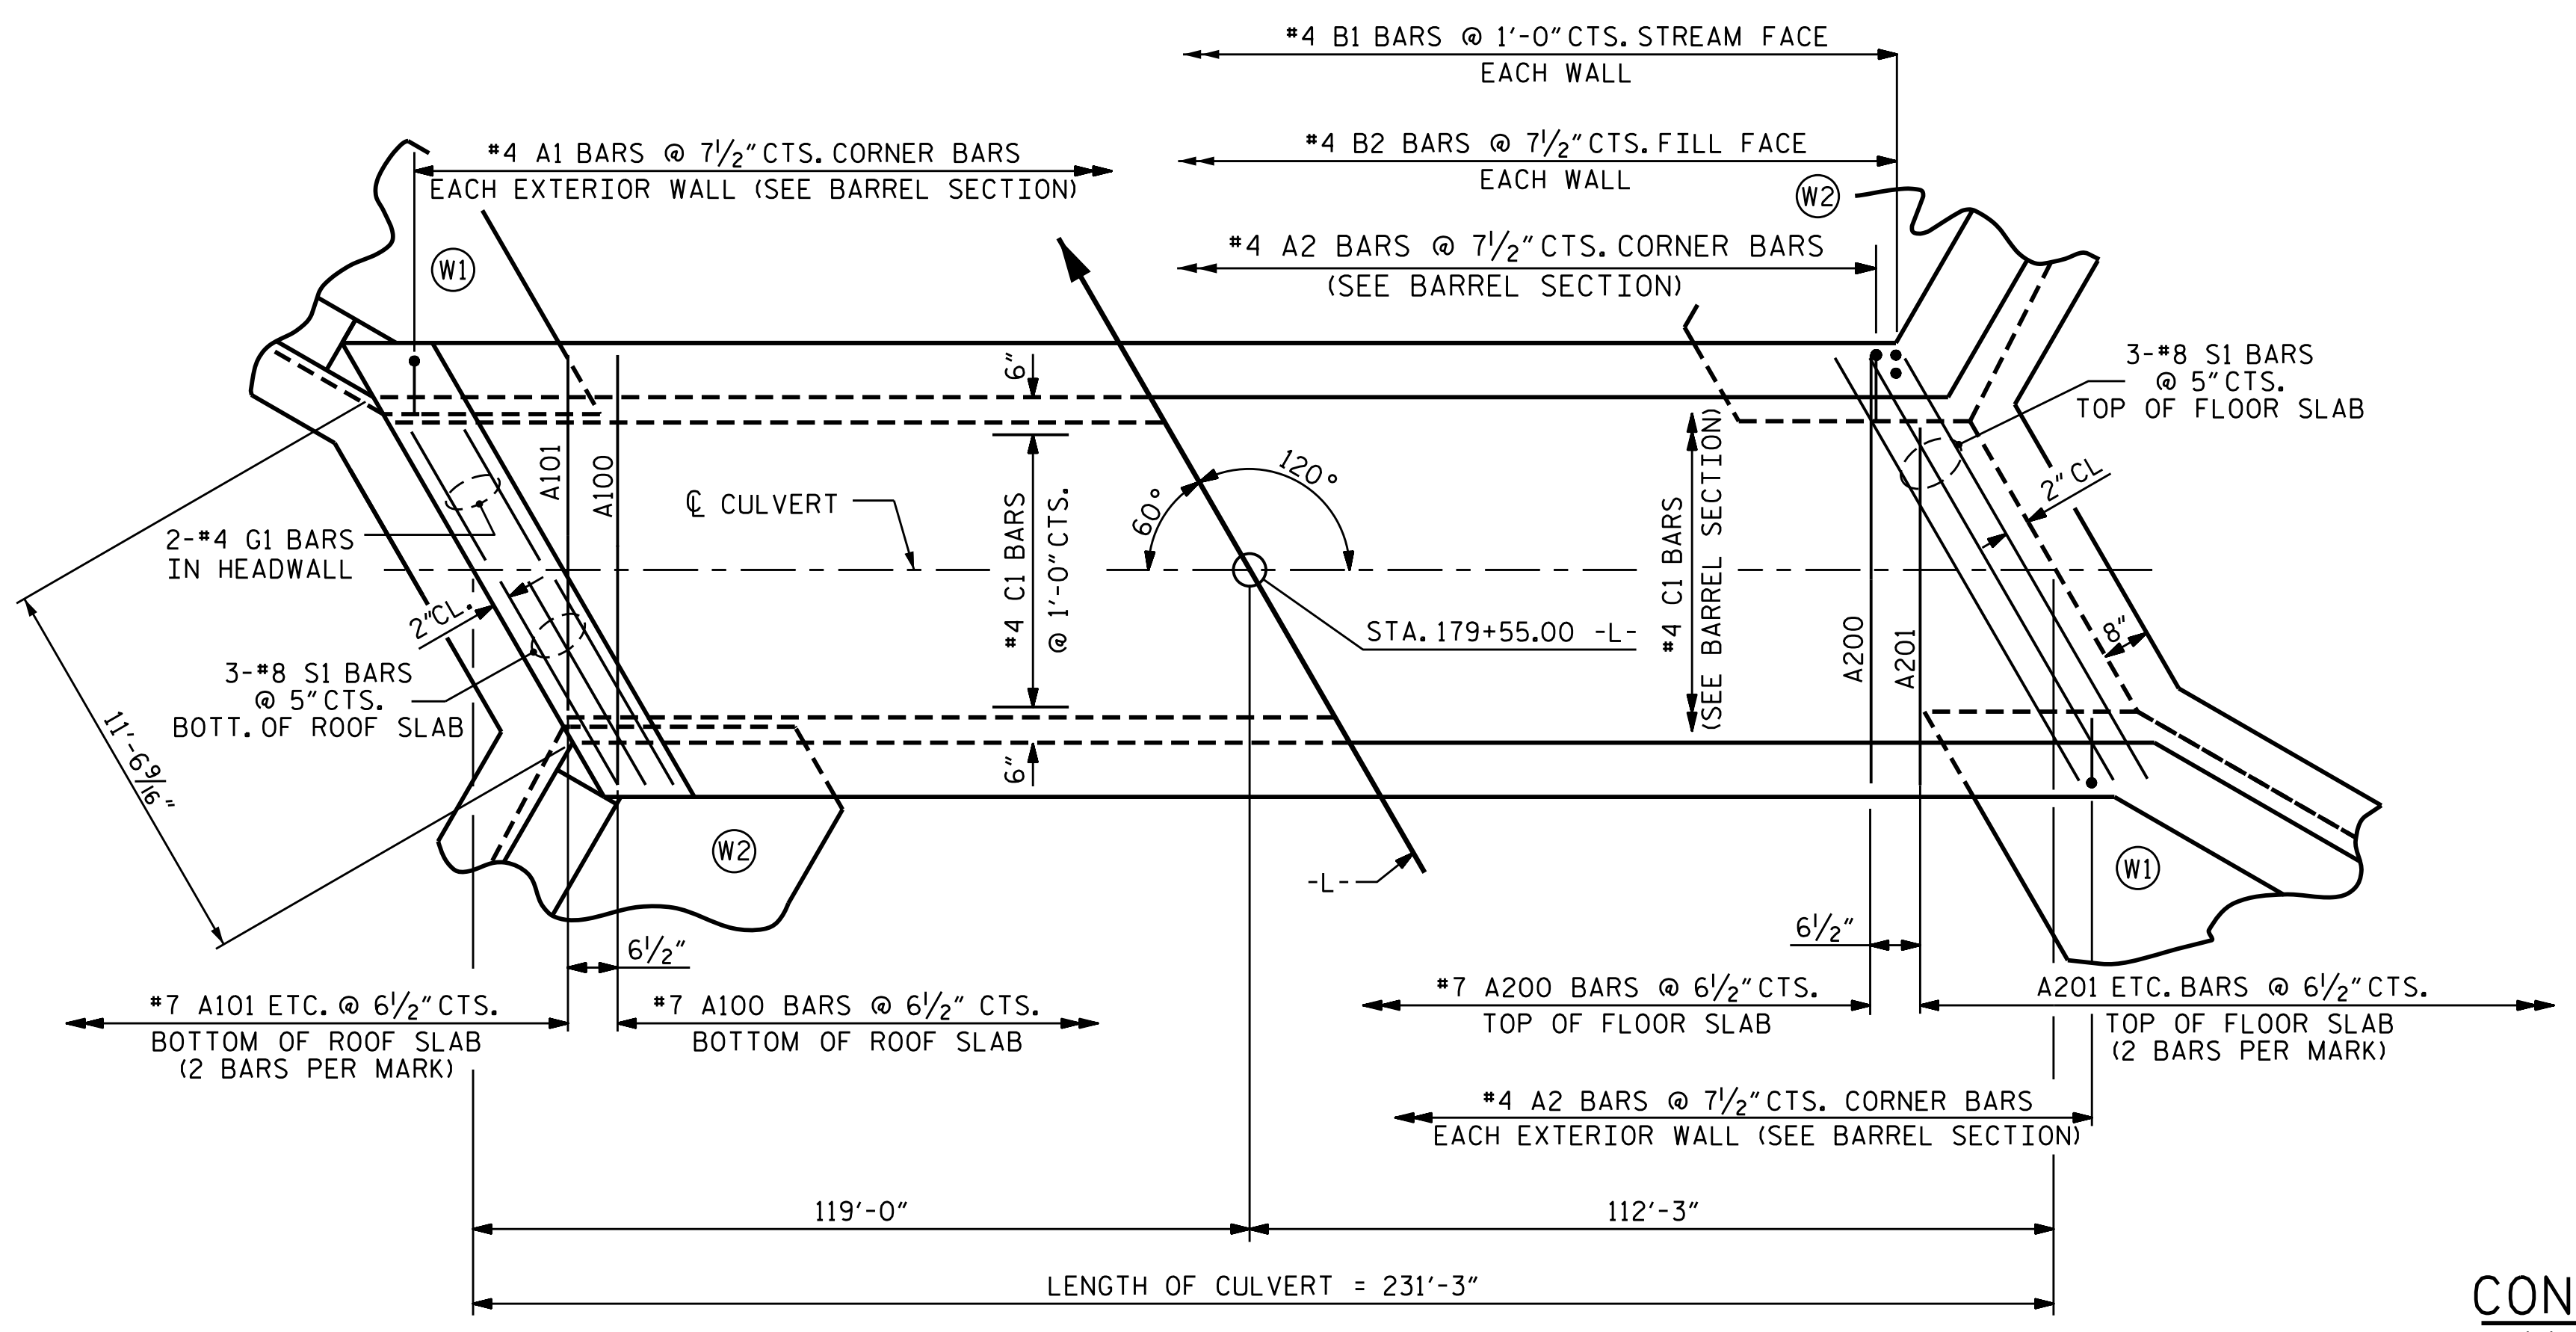

PART PLAN - ROOF SLAB

PART PLAN - FLOOR SLAB

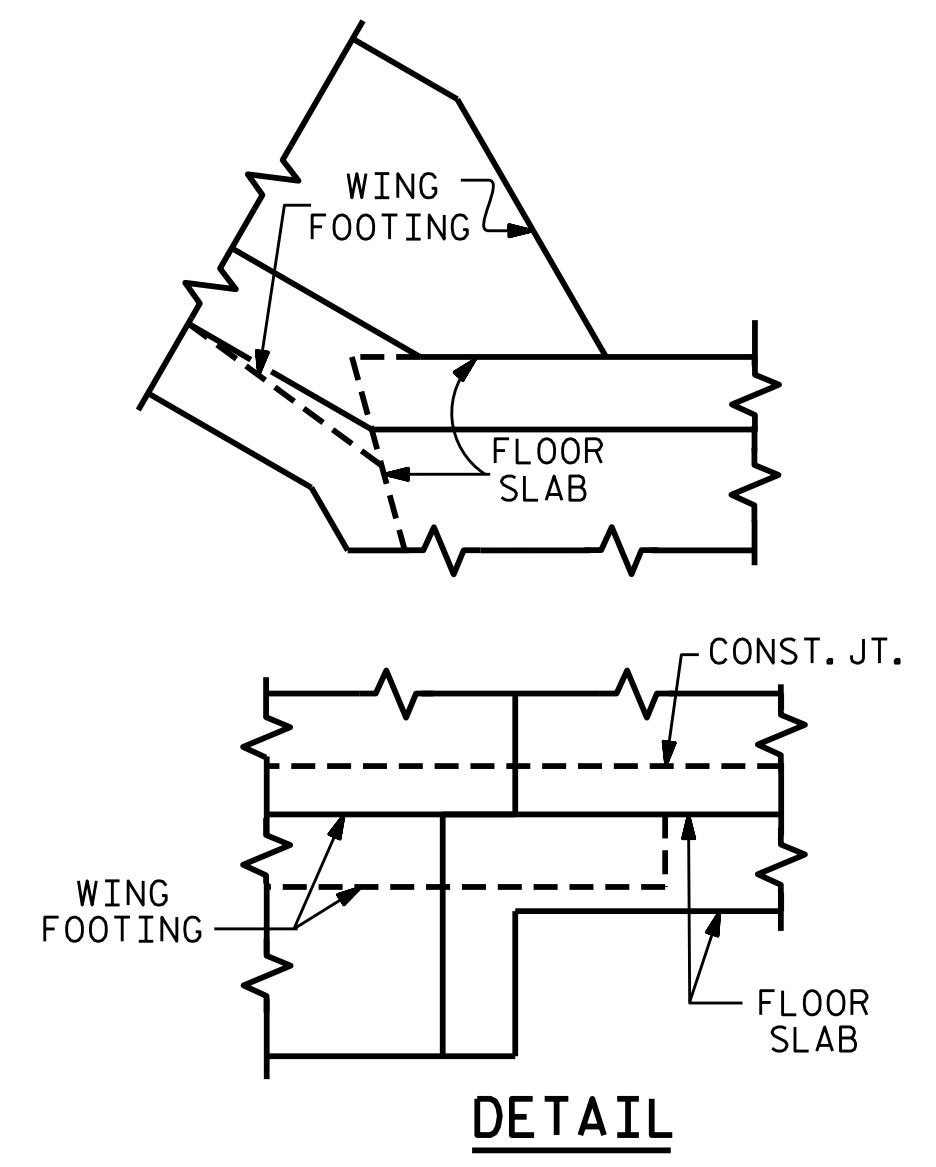

CONNECTION OF WING FOOTING AND FLOOR SLAB WHEN SLAB IS THICKER THAN FOOTING



DocuSigned by:
 Kristy W. Alford
 3/16/2017

PROJECT NO. U-3109A
ALAMANCE COUNTY
 STATION: 179+55.00 -L-
 SHEET 2 OF 5


STATE OF NORTH CAROLINA
 DEPARTMENT OF TRANSPORTATION
 RALEIGH
 BARREL STANDARD
 SINGLE 10 FT. X 7 FT.
 CONCRETE BOX CULVERT
 120° SKEW

REVISIONS						SHEET NO.
NO.	BY:	DATE:	NO.	BY:	DATE:	C2-2
1			3			TOTAL SHEETS
2			4			5

DOCUMENT NOT CONSIDERED FINAL
 UNLESS ALL SIGNATURES COMPLETED


REVISED 8-28-92 BY E.L.R. CHECKED BY G.R.P.
 REVISED 8-22-89 BY A.R.B. CHECKED BY C.R.K.
 REDRAWN 8-22-89
 REVISED 11-19-99 BY M.M. CHECKED BY R.W.W.

ASSEMBLED BY : <u>A. SORSENGINH</u>	DATE : <u>4/2014</u>	SPECIAL
CHECKED BY : <u>K.W. ALFORD</u>	DATE : <u>2/2017</u>	
DRAWN BY : <u>J.W. ROUSE</u>	DATE : <u>SEPT. 1989</u>	STANDARD
CHECKED BY : <u>A.R. BISSETTE</u>	DATE : <u>AUG. 1989</u>	

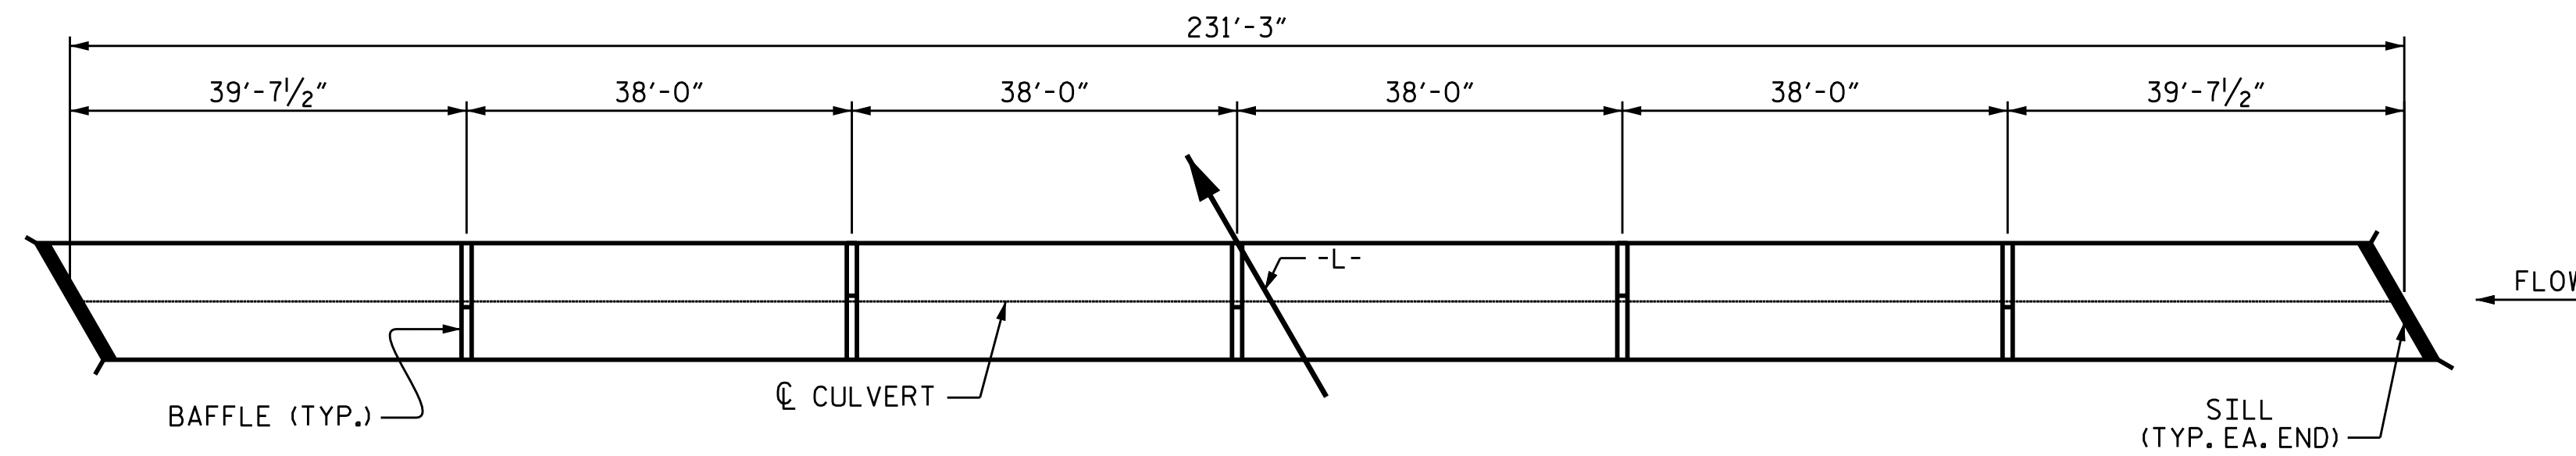


PLAN OF SILL LOCATION

BAR TYPE		BAR SCHEDULE				
BAR	NO.	SIZE	TYPE	LENGTH	WEIGHT	
A100	415	#7	STR	11'-1"	9402	
A101	4	#7	STR	9'-1"	74	
A102	4	#7	STR	7'-2"	59	
A103	4	#7	STR	5'-4"	44	
A104	4	#7	STR	3'-5"	28	
A200	415	#7	STR	11'-1"	9402	
A201	4	#7	STR	9'-1"	74	
A202	4	#7	STR	7'-2"	59	
A203	4	#7	STR	5'-4"	44	
A204	4	#7	STR	3'-5"	28	
SPLICE LENGTH CHART						
BAR	SIZE	LENGTH				
A1	#7	11'-1"	1	7'-1"	3501	
A2	#7	11'-1"	1	6'-9"	3337	
C1	#4	1'-11"				
B1	464	#4	STR	9'-0"	2790	
B2	740	#4	STR	6'-4"	3131	
C1	477	#4	STR	27'-7"	8789	
D1	16	#6	STR	1'-10"	44	
D2	10	#6	STR	2'-7"	39	
F1	46	#4	STR	4'-9"	146	
G1	4	#4	STR	12'-10"	34	
S1	12	#8	STR	12'-10"	411	
REINFORCING STEEL					= 41,436 LBS	

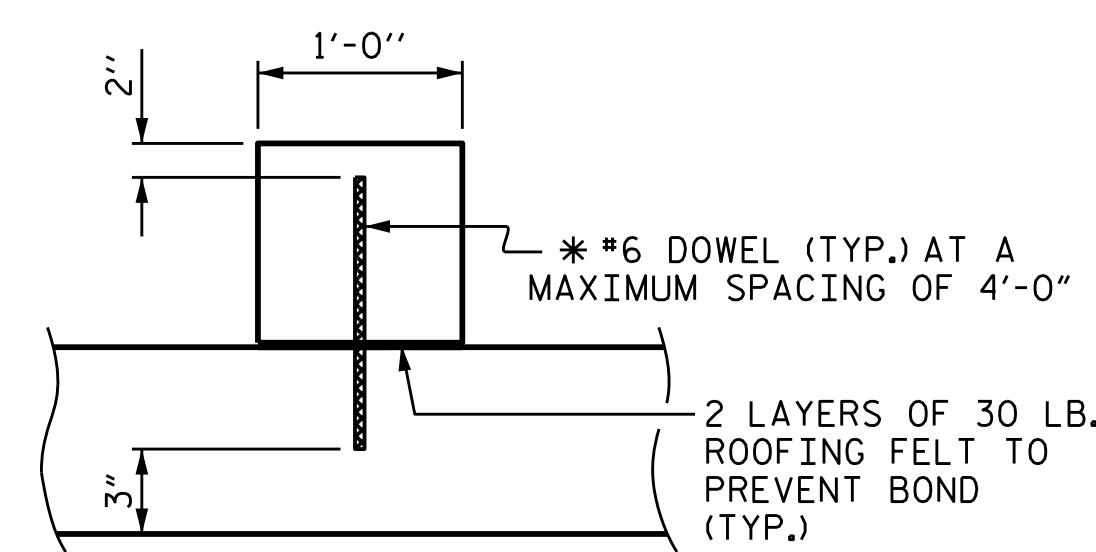


SECTION THROUGH SILL AND BAFFLE

* DOWELS MAY BE PUSHED INTO GREEN CONCRETE AFTER SLAB HAS BEEN FLOAT FINISHED.

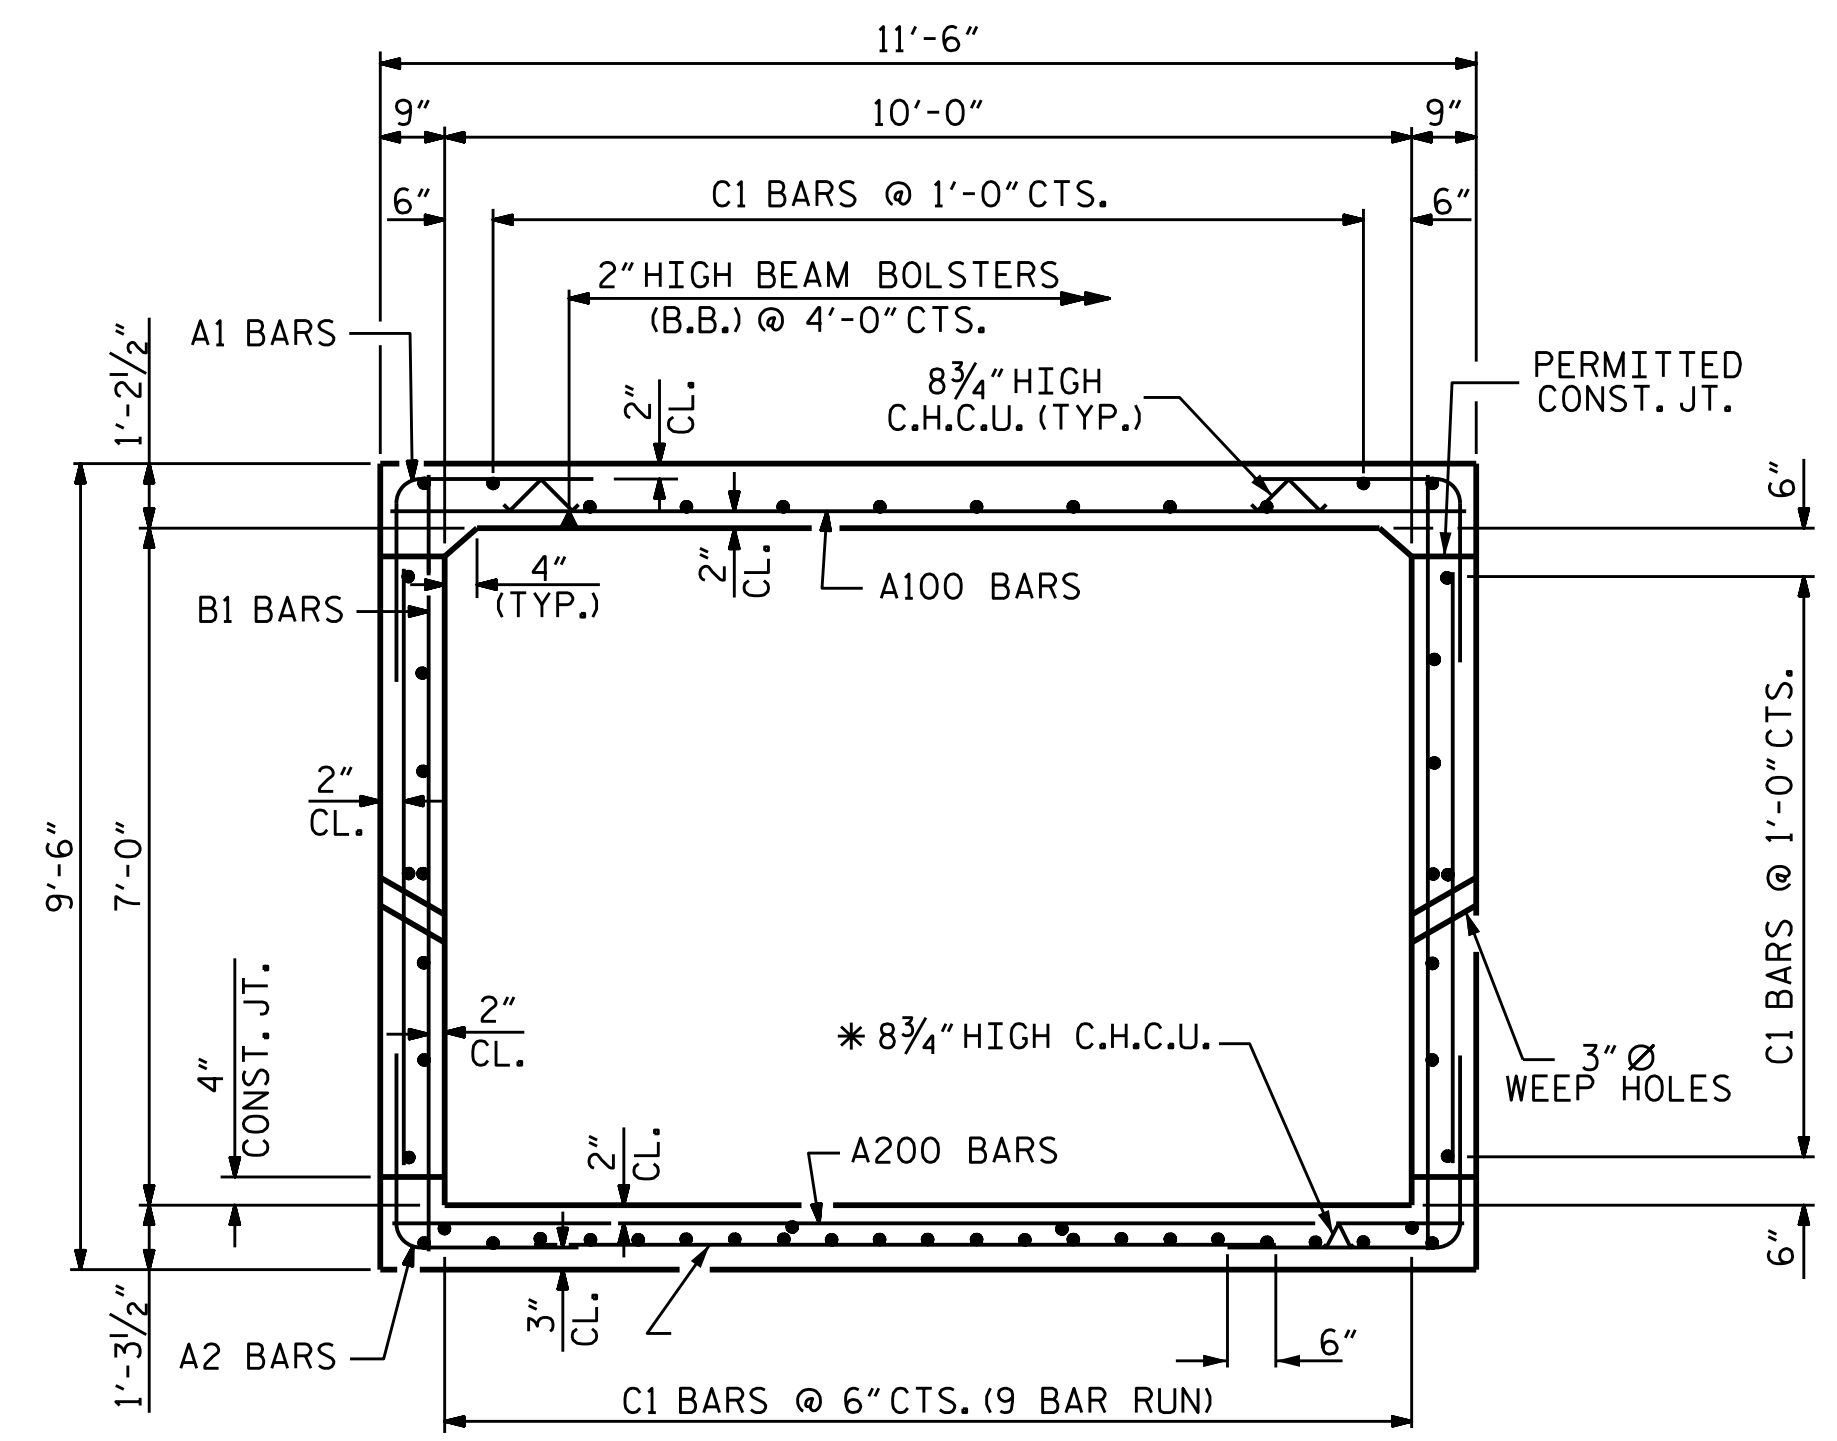


RIGHT ANGLE SECTION OF BARREL

THERE ARE 53 C1 BARS IN SECTION OF BARREL (9 BAR RUN)

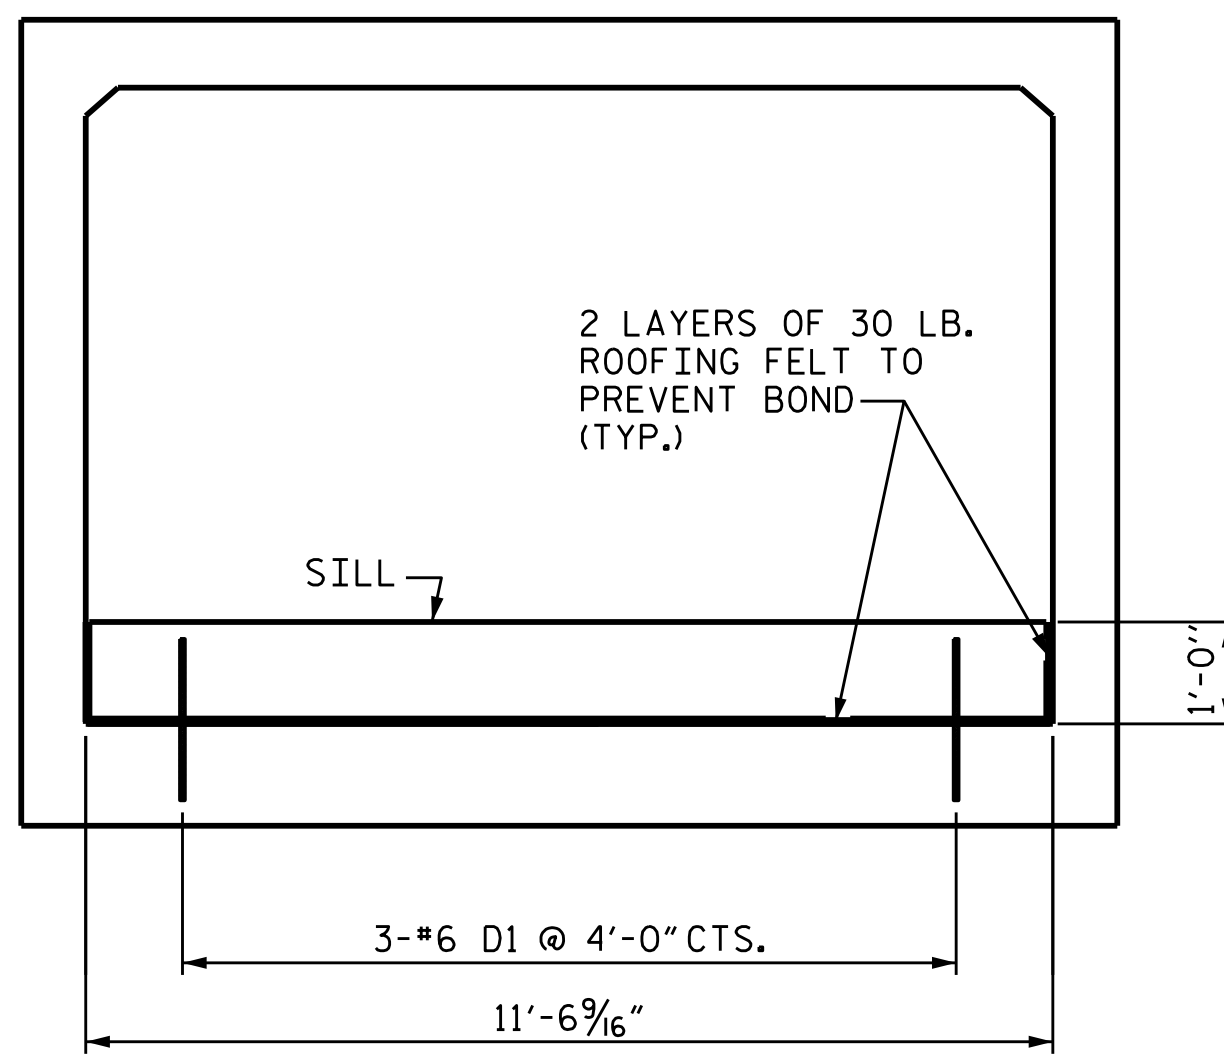

ELEVATION

CULVERT SILL DETAILS

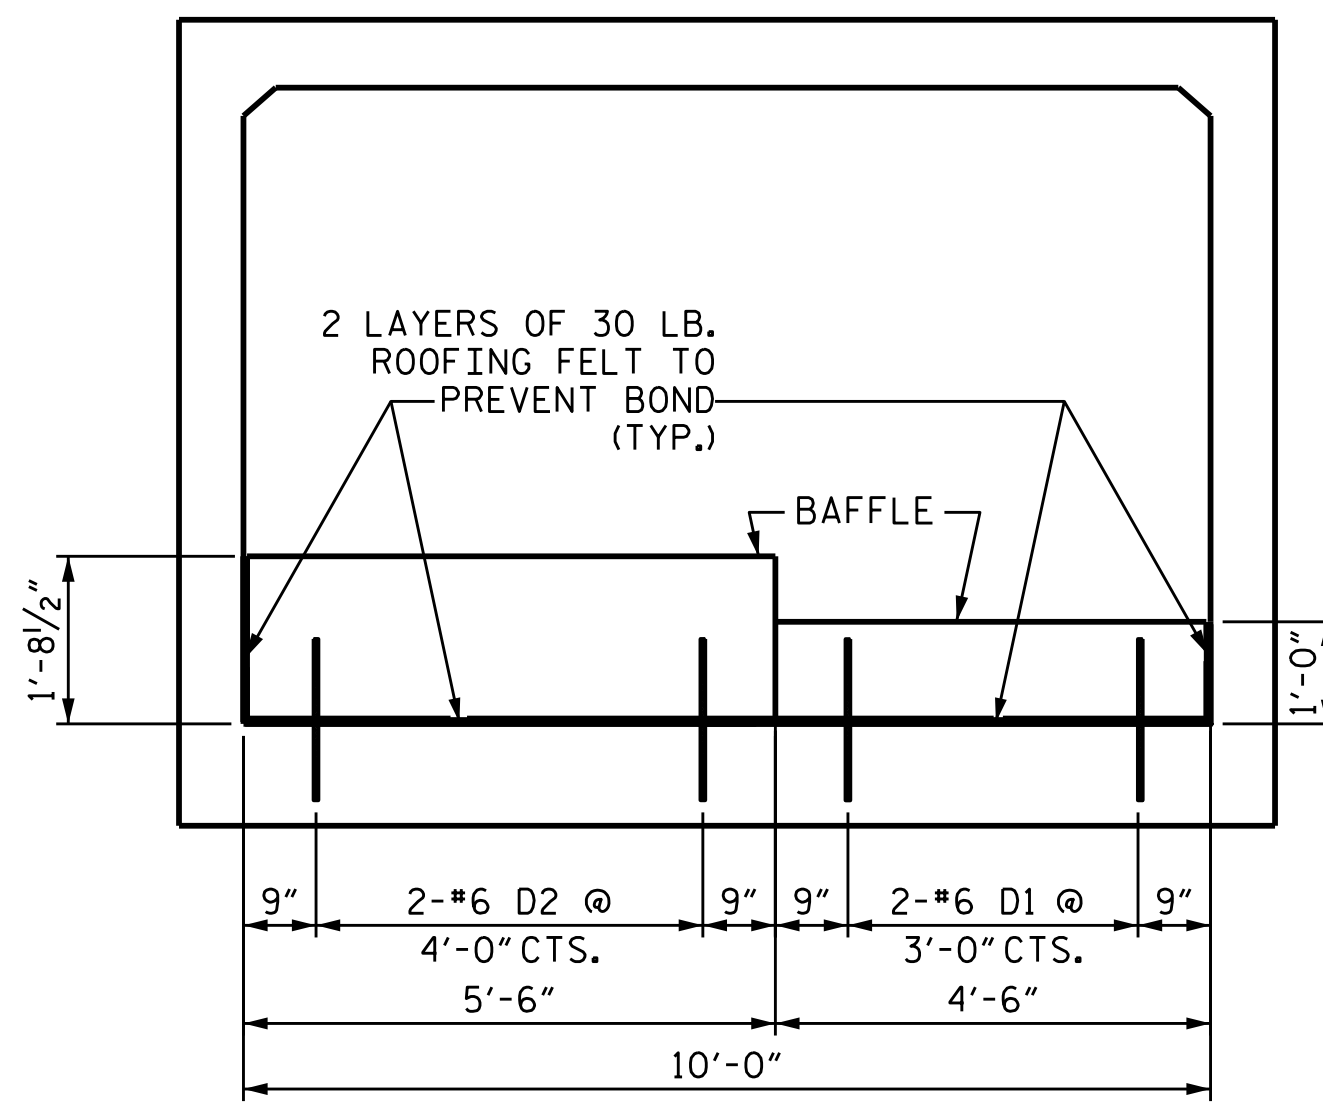

ELEVATION

CULVERT BAFFLE DETAILS

ALTERNATE HIGH SIDE OF BATTLE ALONG CULVERT LENGTH

NOTES:

BED MATERIAL BETWEEN BAFFLES IN THE CULVERT SHALL PROVIDE A CONTINUOUS LOW FLOW CHANNEL.


THE BED MATERIAL SHALL BE NATIVE MATERIAL, WHICH CONSISTS OF MATERIAL THAT IS EXCAVATED FROM THE STREAM BED AT THE PROJECT SITE DURING CULVERT CONSTRUCTION. NATIVE MATERIAL IS SUBJECT TO APPROVAL BY THE ENGINEER AND MAYBE SUBJECT TO PERMIT CONDITIONS.

TOP OF SILLS SHOULD MATCH STREAM BED ELEVATION IN LOW FLOW CHANNEL OF STREAM.

CLASS B RIP RAP MAY BE USED TO SUPPLEMENT NATIVE MATERIAL. NATIVE MATERIAL SHOULD BE PLACED ON TOP TO FILL VOIDS AND PROVIDE A FLAT SURFACE FOR ANIMAL PASSAGE.

PROJECT NO. U-3109A
ALAMANCE COUNTY
 STATION: 179+55.00 -L-

SHEET 3 OF 5

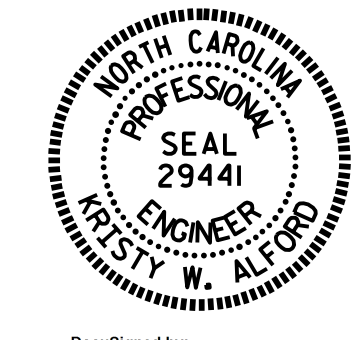


DocuSigned by:
 Kristy W. Alford
 3/16/2017

STATE OF NORTH CAROLINA
 DEPARTMENT OF TRANSPORTATION
 RALEIGH
 SINGLE 10 FT. X 7 FT.
 CONCRETE BOX CULVERT
 120° SKEW


ASSEMBLED BY: A. SORSENGINH DATE: 4/2014
 CHECKED BY: K.W. ALFORD DATE: 2/2017
 DESIGN ENGINEER OF RECORD:
A. SORSENGINH DATE: 4/2014

DOCUMENT NOT CONSIDERED FINAL
 UNLESS ALL SIGNATURES COMPLETED


REVISIONS						SHEET NO.
NO.	BY:	DATE:	NO.	BY:	DATE:	C2-3
1			3			TOTAL SHEETS
2			4			5

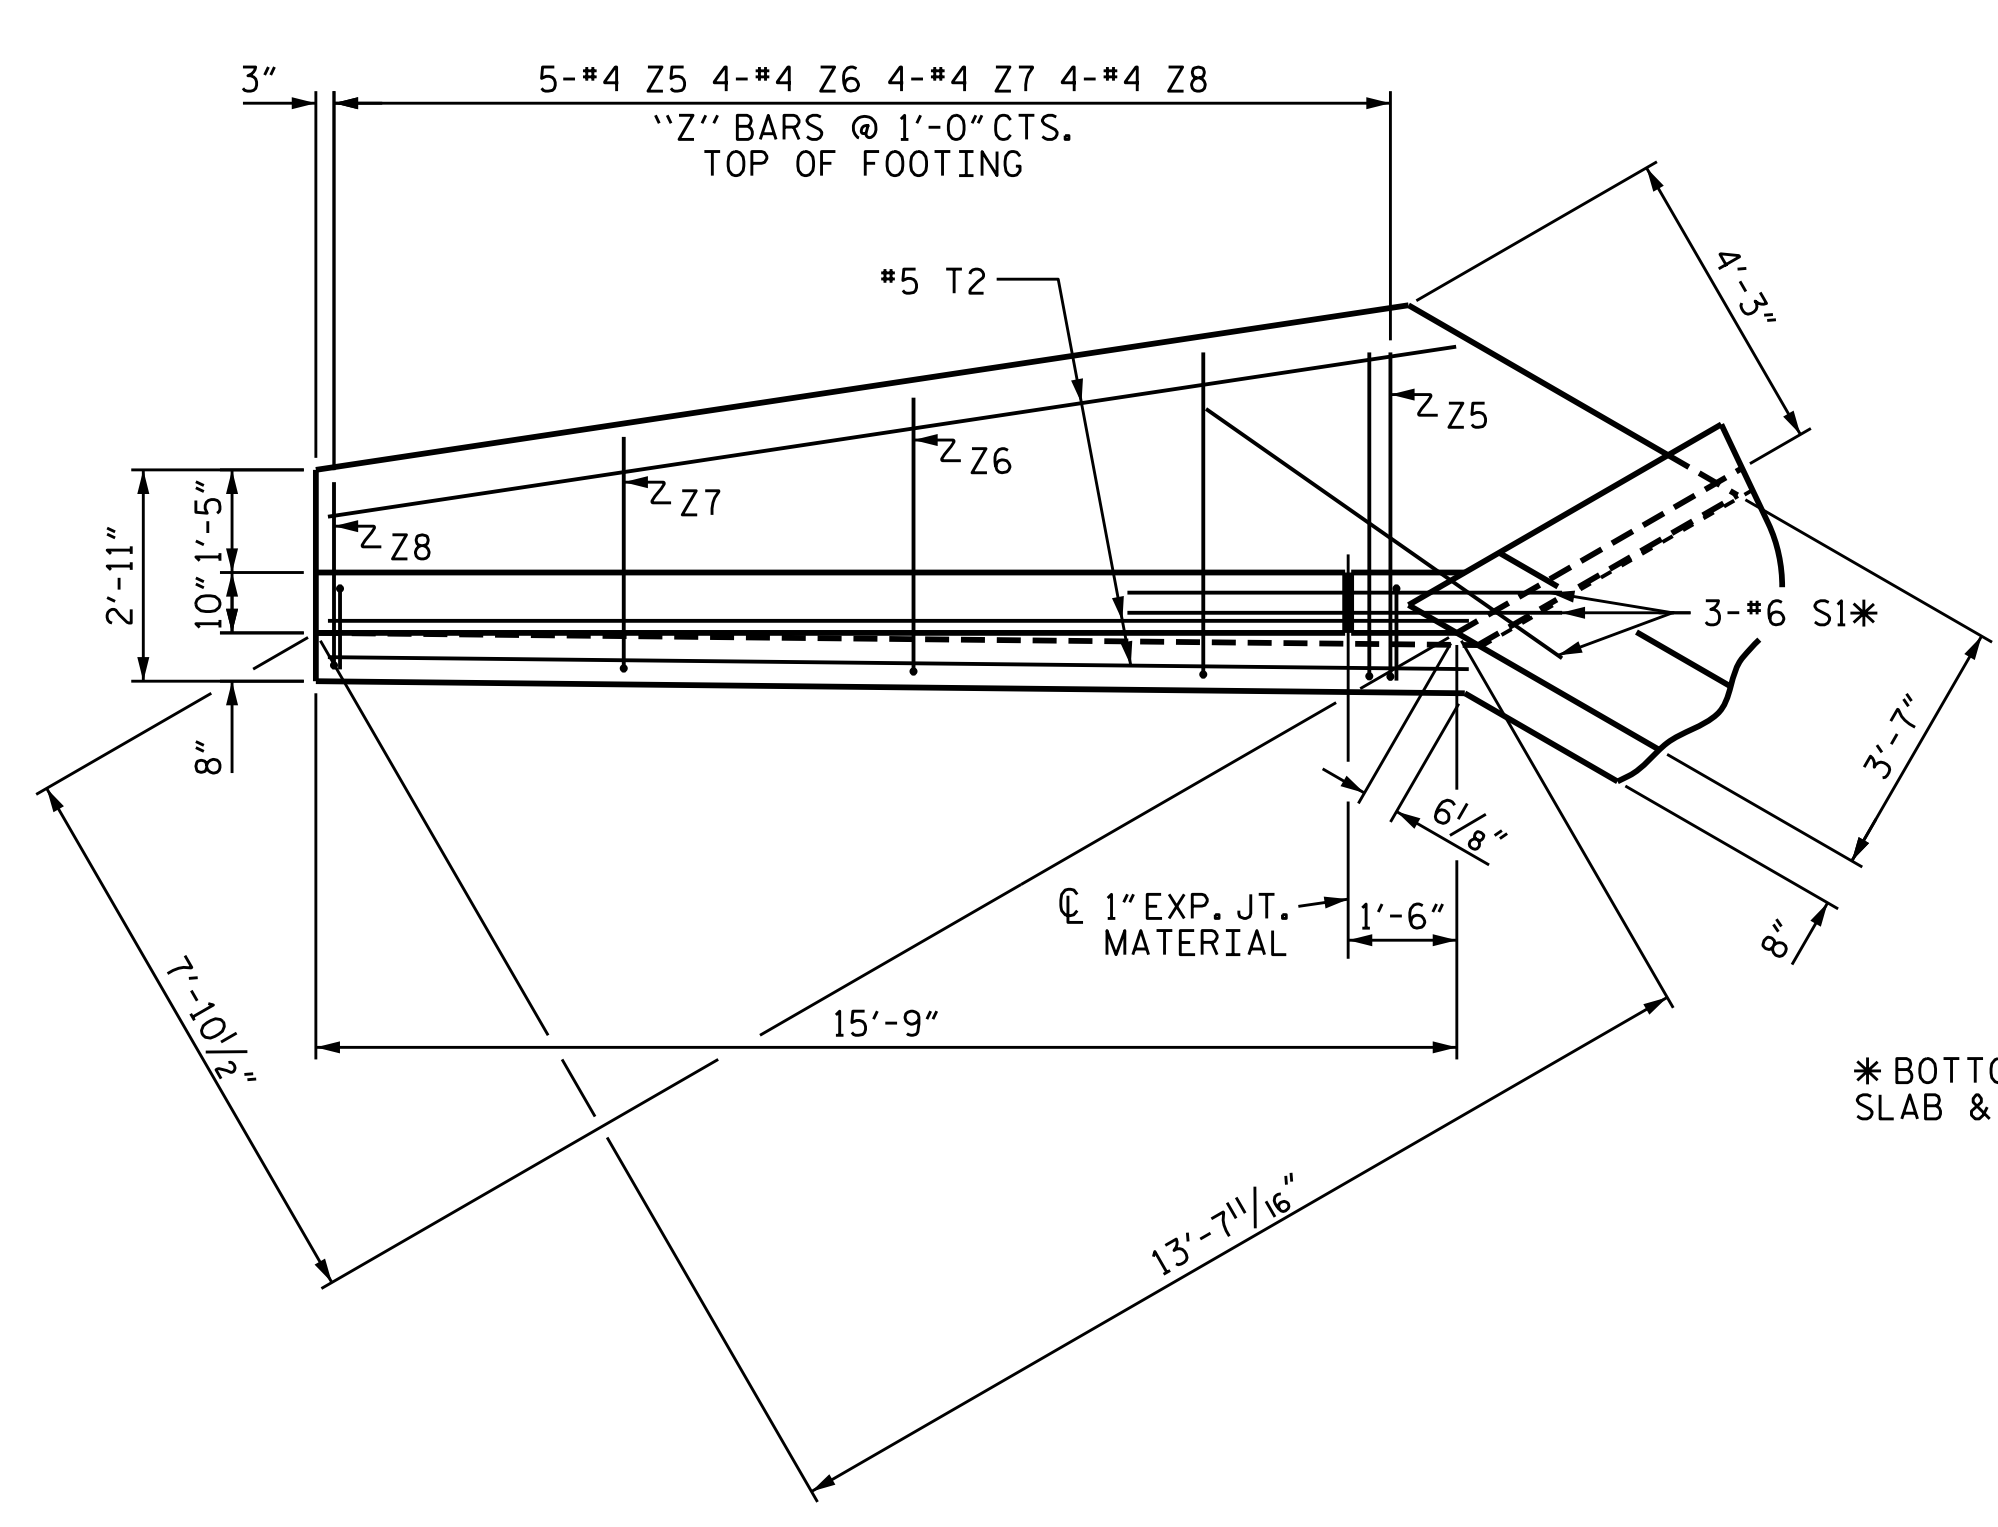


PLAN W1

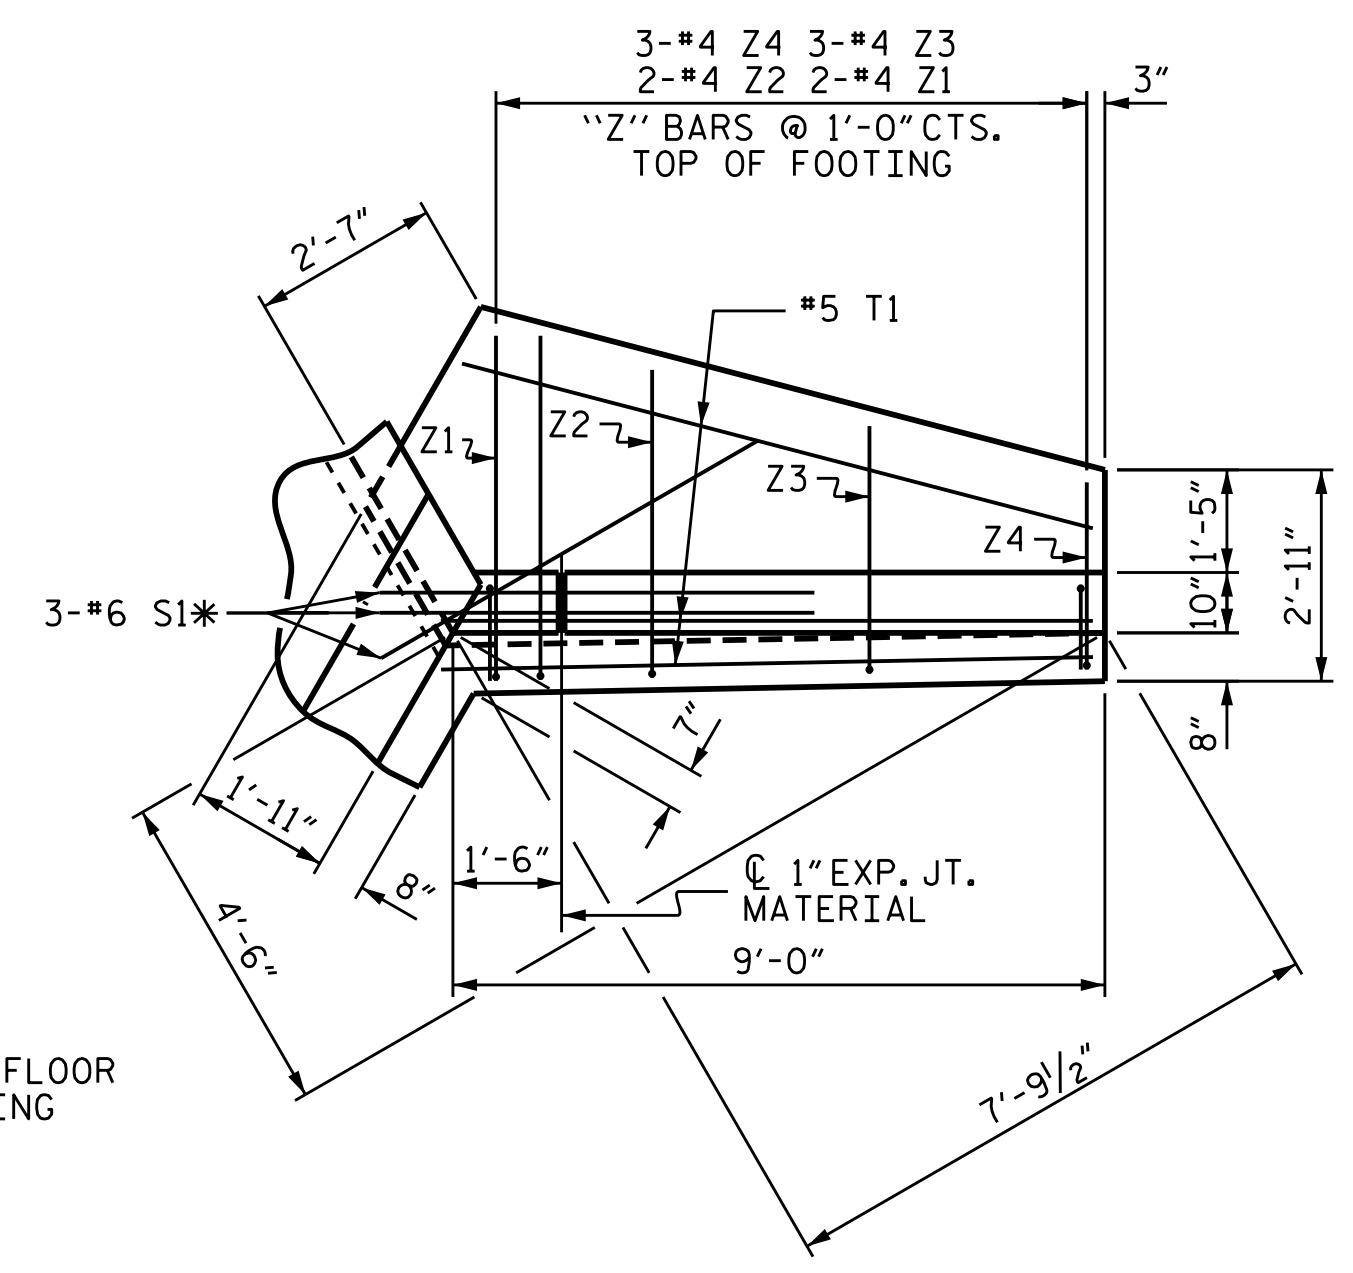


PLAN W2

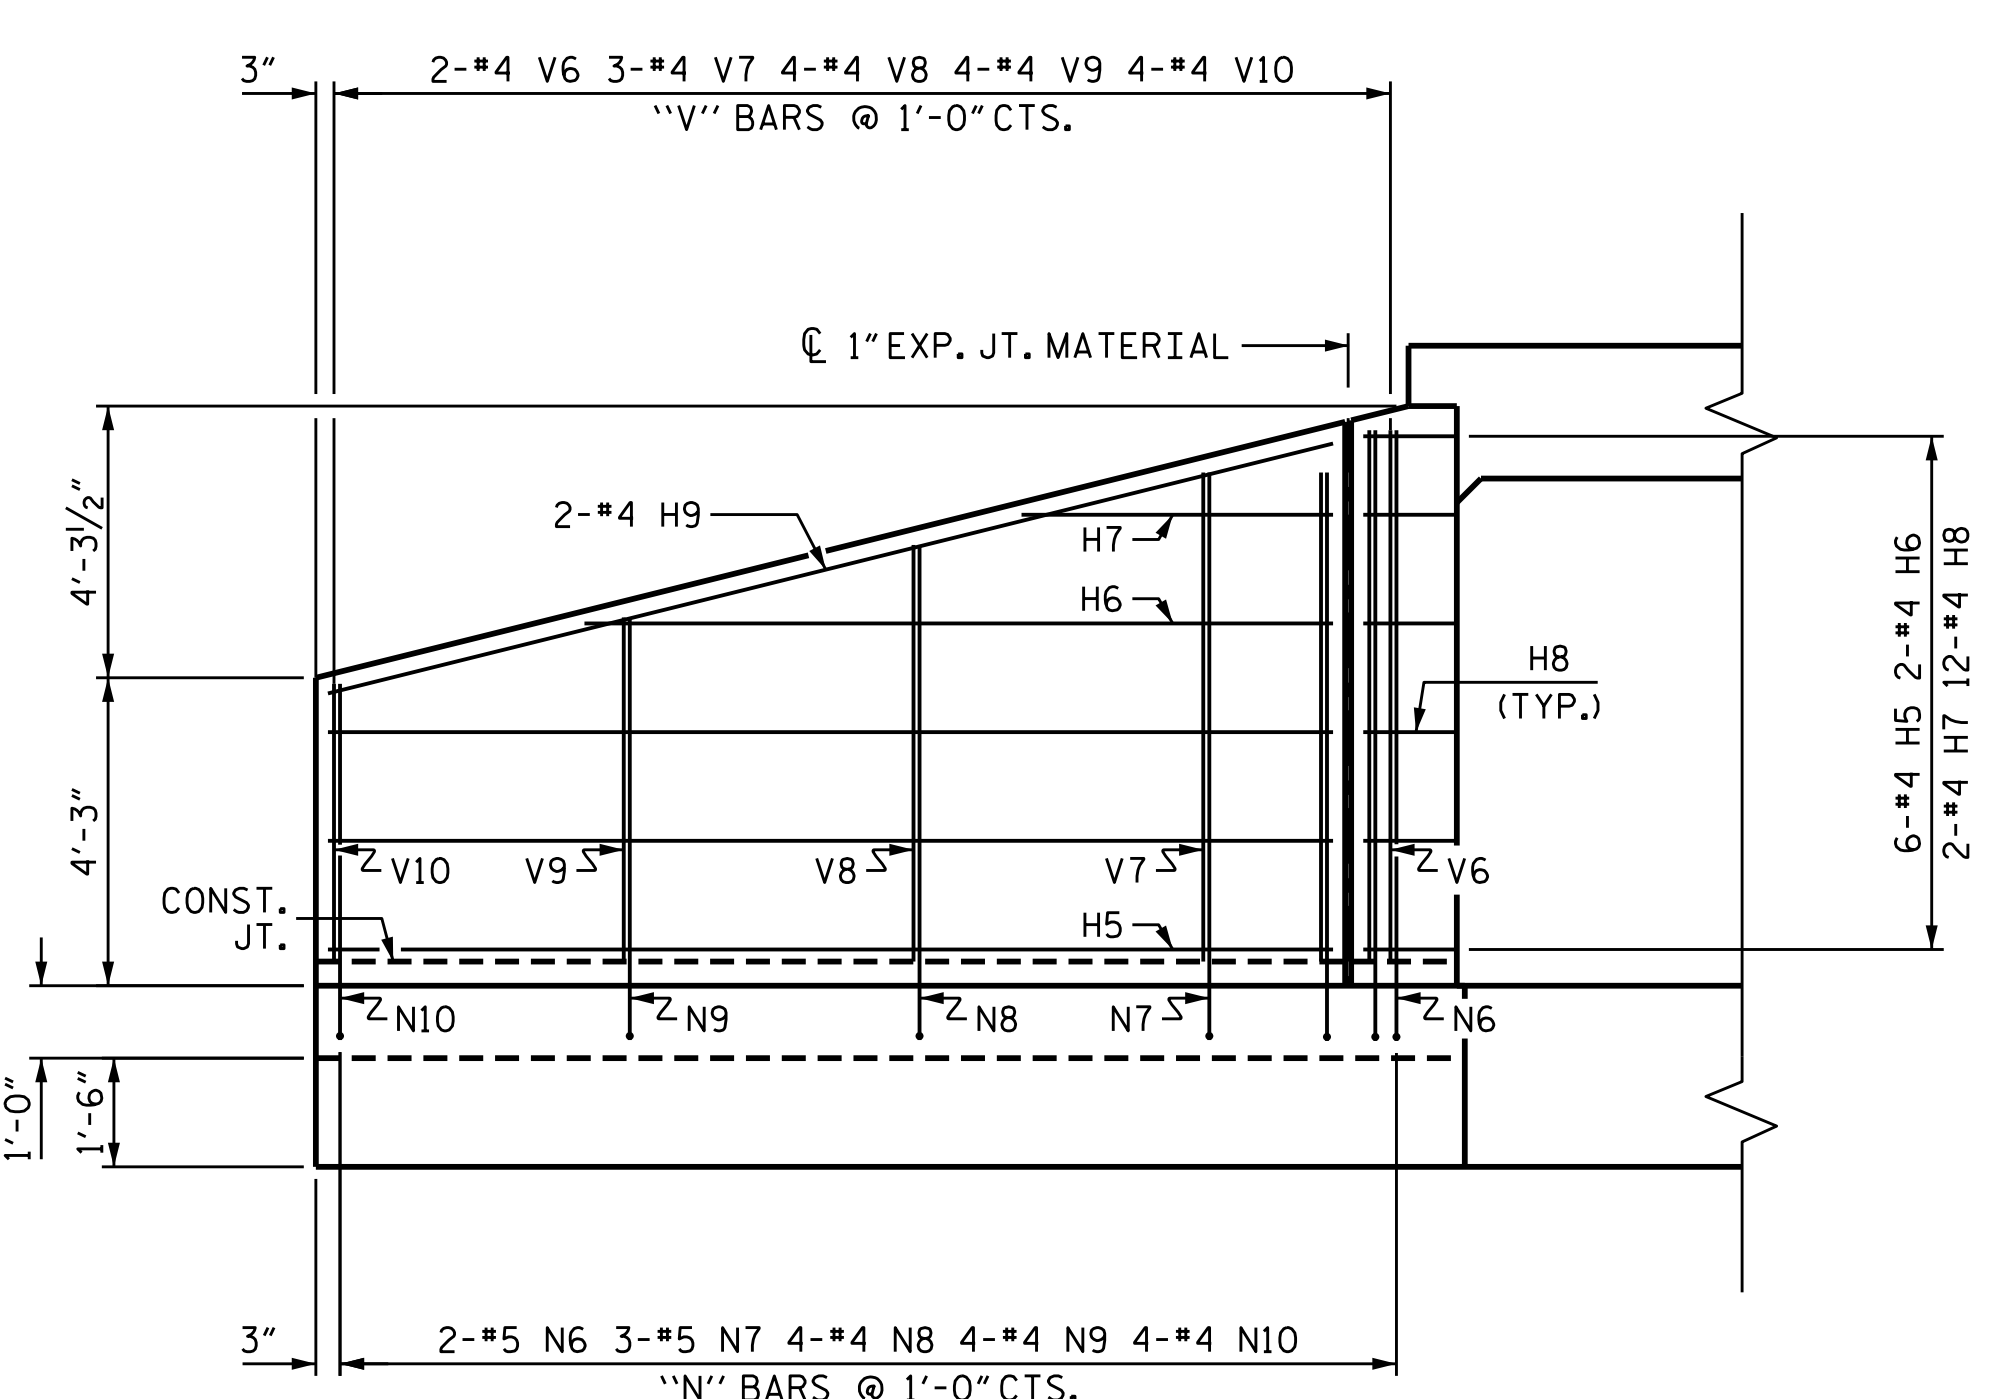

ELEVATION W1

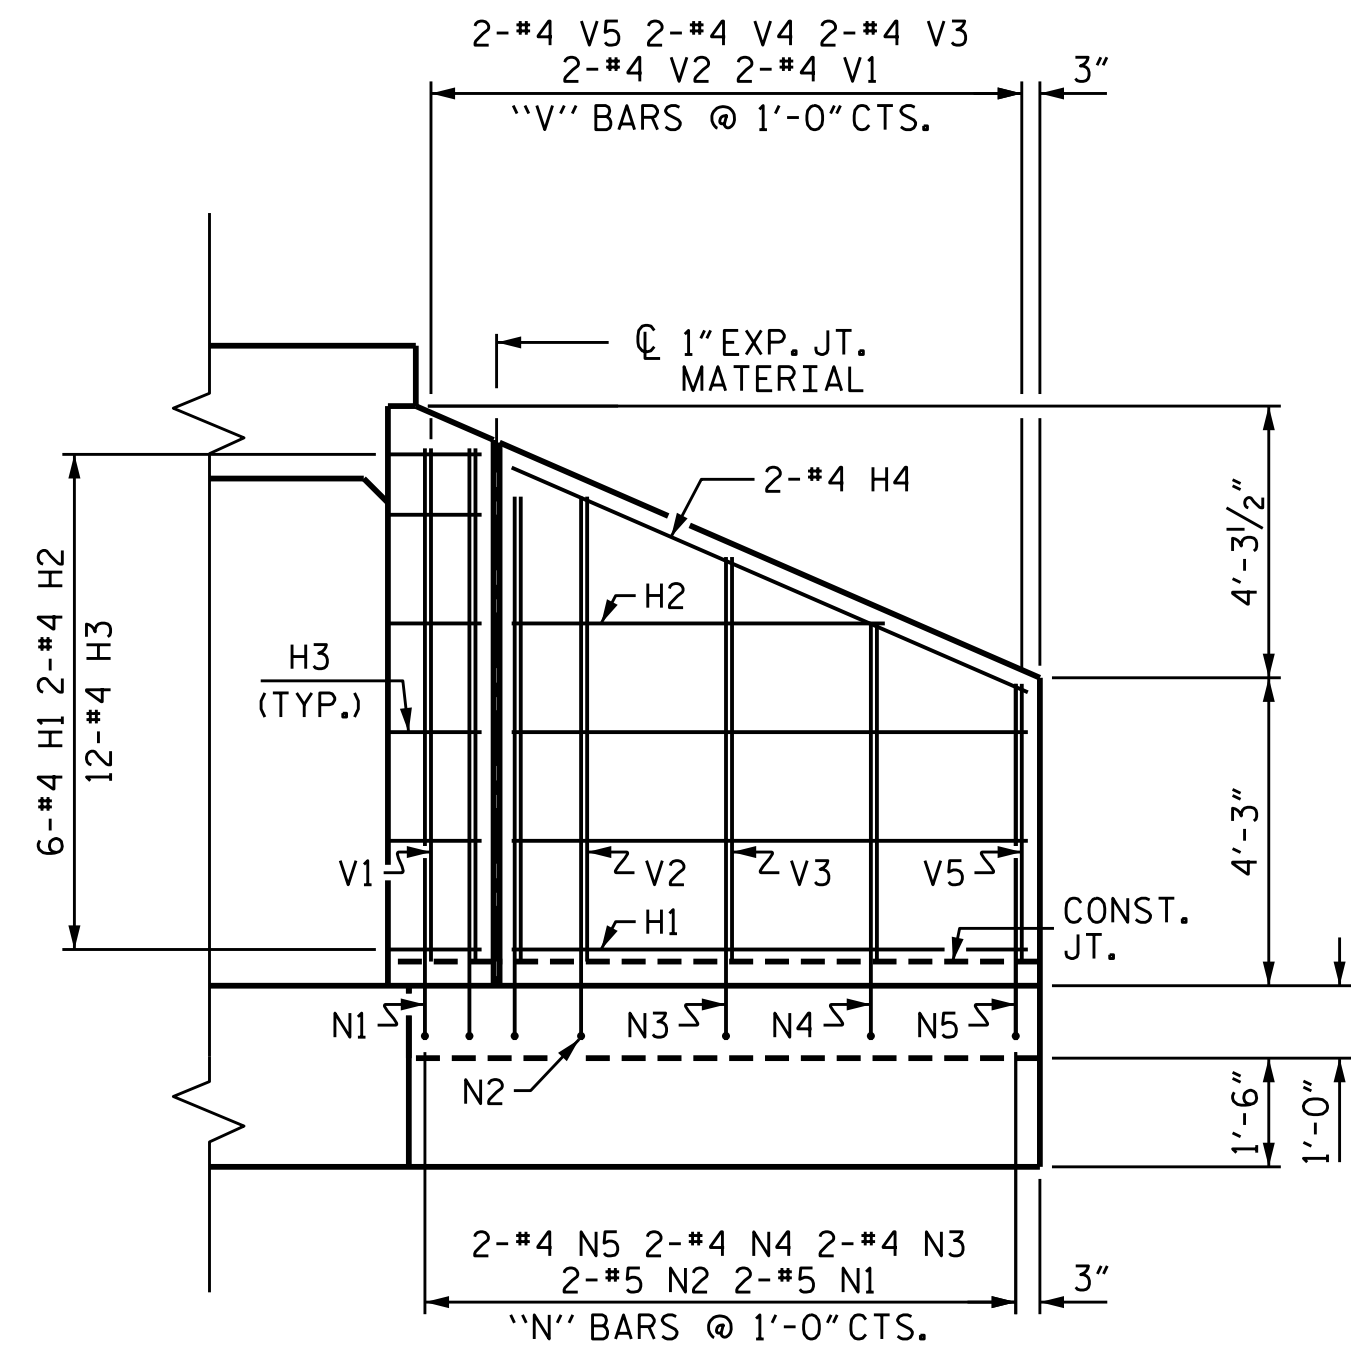


ELEVATION W2

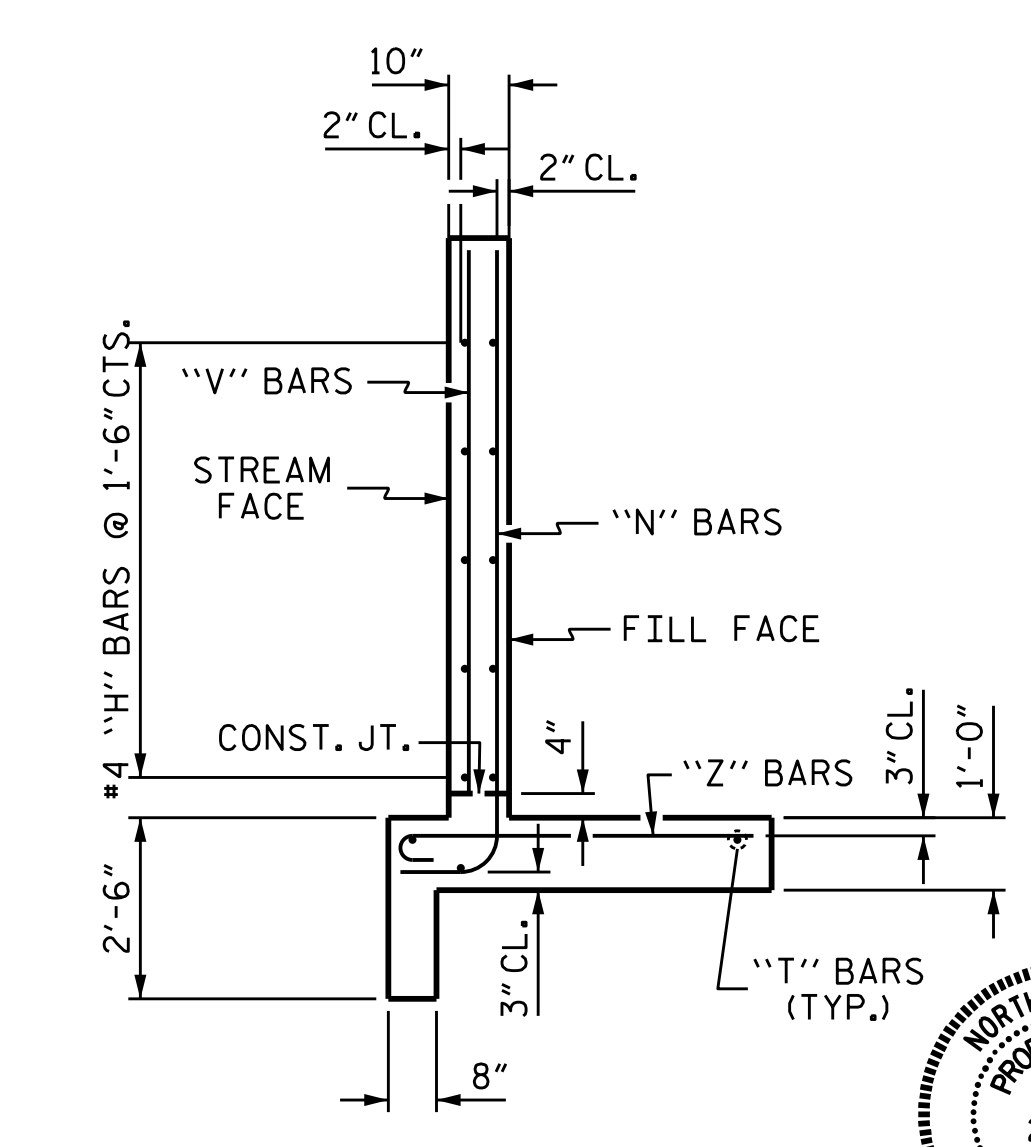

TYPICAL WING SECTION

BAR TYPES

ALL BAR DIMENSIONS ARE OUT TO OUT.

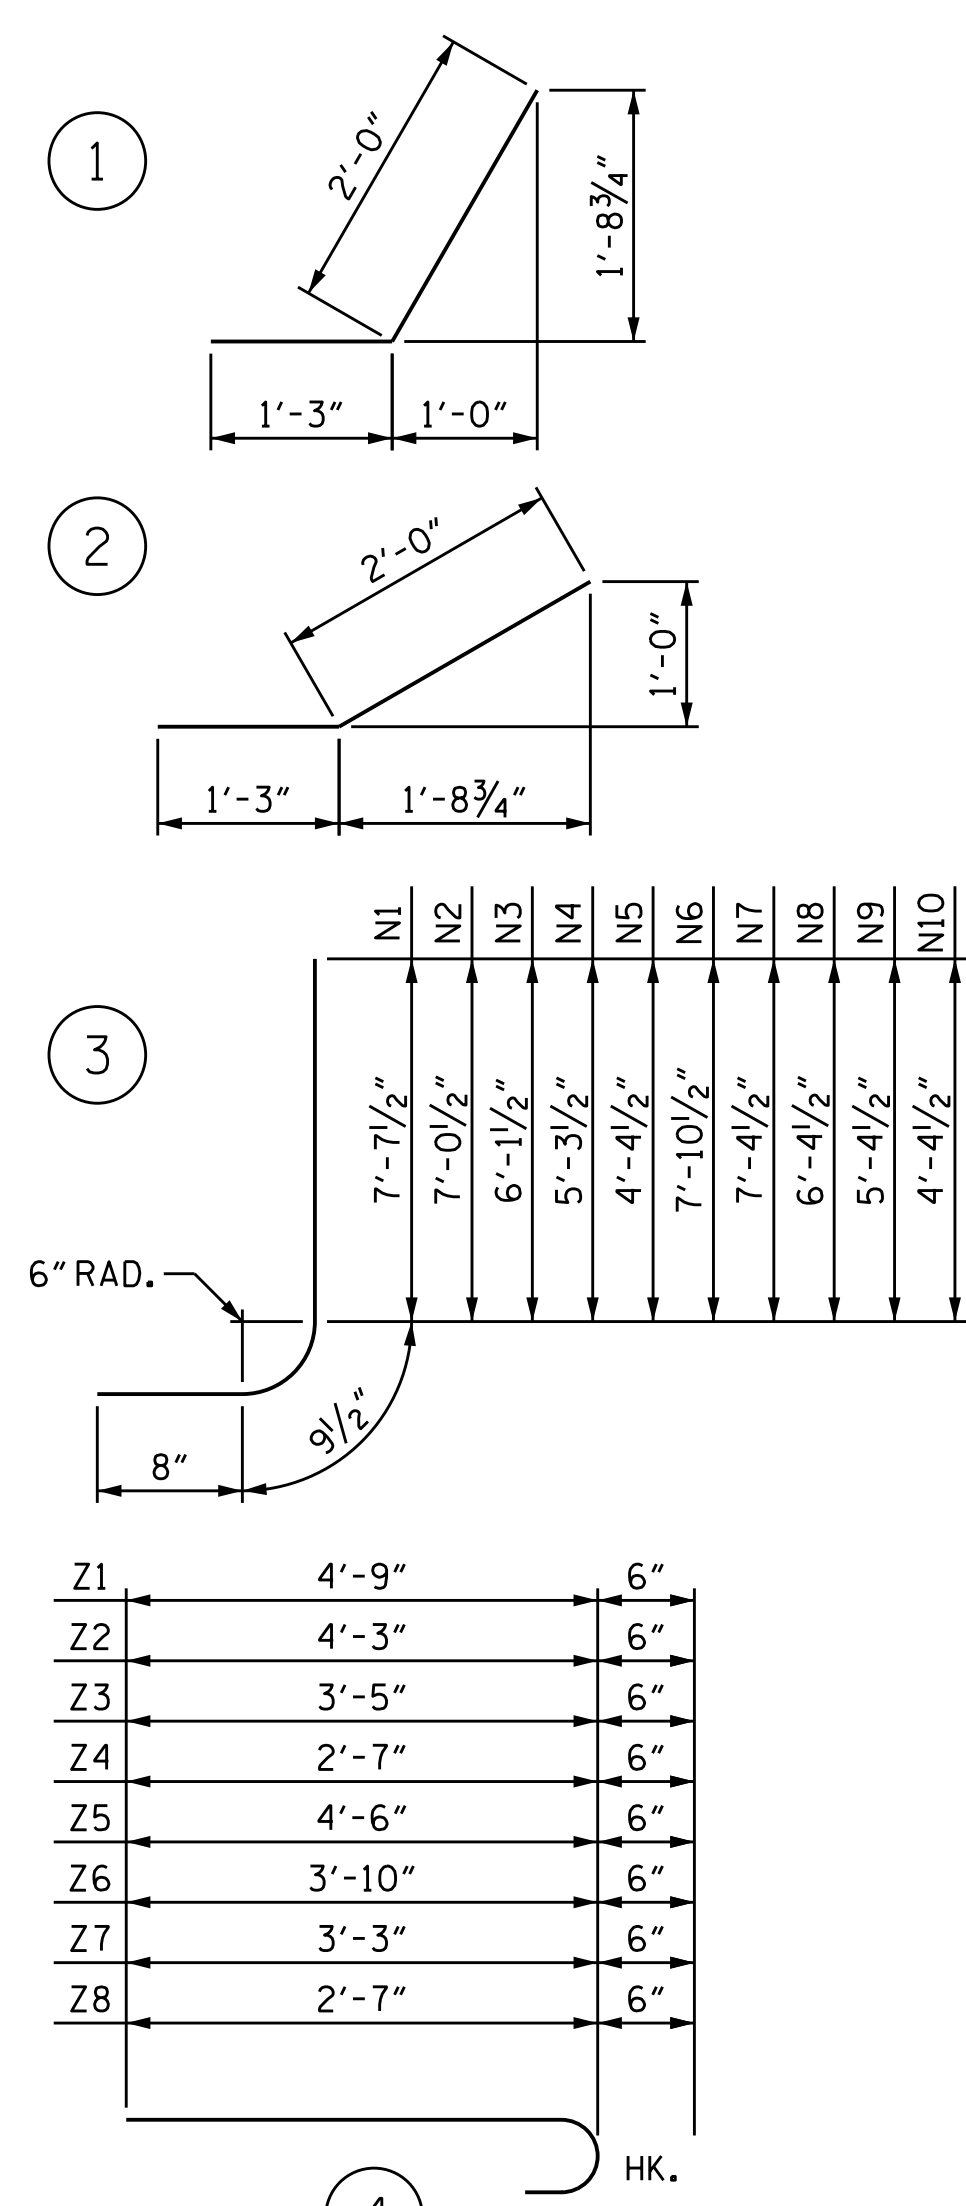

BILL OF MATERIAL


BAR NO.	SIZE	TYPE	LENGTH	WEIGHT
H1	12	#4	STR 7'-1"	57
H2	4	#4	STR 5'-2"	14
H3	24	#4	1 3'-3"	52
H4	4	#4	STR 7'-9"	21
H5	12	#4	STR 13'-10"	111
H6	4	#4	STR 10'-4"	28
H7	4	#4	STR 4'-3"	11
H8	24	#4	2 3'-3"	52
H9	4	#4	STR 14'-3"	38
N1	4	#5	3 9'-1"	38
N2	4	#5	3 8'-6"	35
N3	4	#4	3 7'-7"	20
N4	4	#4	3 6'-9"	18
N5	4	#4	3 5'-10"	16
N6	4	#5	3 9'-4"	39
N7	6	#5	3 8'-10"	55
N8	8	#4	3 7'-10"	42
N9	8	#4	3 6'-10"	37
N10	8	#4	3 5'-10"	31
S1	12	#6	STR 6'-0"	108
T1	6	#5	STR 9'-0"	56
T2	6	#5	STR 15'-9"	99
V1	4	#4	STR 7'-1"	19
V2	4	#4	STR 6'-5"	17
V3	4	#4	STR 5'-7"	15
V4	4	#4	STR 4'-8"	12
V5	4	#4	STR 3'-10"	10
V6	4	#4	STR 7'-4"	20
V7	6	#4	STR 6'-9"	27
V8	8	#4	STR 5'-9"	31
V9	8	#4	STR 4'-9"	25
V10	8	#4	STR 3'-10"	20
Z1	4	#4	4 5'-3"	14
Z2	4	#4	4 4'-9"	13
Z3	6	#4	4 3'-11"	16
Z4	6	#4	4 3'-1"	12
Z5	10	#4	4 5'-0"	33
Z6	8	#4	4 4'-4"	23
Z7	8	#4	4 3'-9"	20
Z8	8	#4	4 3'-1"	16

REINFORCING STEEL 1321 LBS
 FOR 4 WINGS
 CLASS A CONCRETE
 4 WINGS 19.8 CY
 2 HEADWALLS 1.2 CY
 2 END CURTAIN WALLS 1.3 CY
 TOTAL 22.3 CY

PROJECT NO. U-3109A
ALAMANCE COUNTY
 STATION: 179+55.00 -L-

SHEET 4 OF 5

STATE OF NORTH CAROLINA
 DEPARTMENT OF TRANSPORTATION
 RALEIGH
**STANDARD WINGS
 FOR
 CONCRETE BOX CULVERT**
 H = 7'-0" SLOPE = 2:1
 120° SKEW

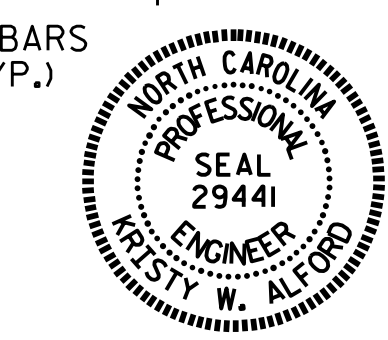

DocuSigned by:
 W. ALFORD
 3/16/2017

REVISIONS				SHEET NO.	
NO.	BY:	DATE:	NO.	BY:	DATE:
1			3		
2			4		

TOTAL SHEETS 5

ASSEMBLED BY : A. SORSENGIH DATE : 4/2014
 CHECKED BY : K.W. ALFORD DATE : 2/2017
 DRAWN BY : CCJ 11/99
 CHECKED BY : RWW 03/00

DOCUMENT NOT CONSIDERED FINAL
 UNLESS ALL SIGNATURES COMPLETED

**LOAD AND RESISTANCE FACTOR RATING (LRFR)
SUMMARY FOR REINFORCED CONCRETE BOX CULVERTS**

LEVEL	VEHICLE	WEIGHT (W) (TONS)	CONTROLLING LOAD RATING #	MINIMUM RATING FACTORS (RF)	TONS = W x RF	STRENGTH I LIMIT STATE								COMMENT NUMBER		
						MOMENT				SHEAR						
						LIVE-LOAD FACTORS (γ _{LL})	RATING FACTOR	BOX NO.	ELEMENT TYPE	DISTANCE FROM LEFT END OF ELEMENT (ft)	RATING FACTOR	BOX NO.	ELEMENT TYPE		DISTANCE FROM LEFT END OF ELEMENT (ft)	
DESIGN LOAD RATING	HL-93 (INVENTORY)	N/A	①	4.34	--	1.75	4.34	1	BOT. CORNER WALL	7.63	6.52	1	EXTERIOR WALL	7.06		
	HL-93 (OPERATING)	N/A		5.62	--	1.35	5.62	1	BOT. CORNER WALL	7.63	8.45	1	EXTERIOR WALL	7.06		
	HS-20 (INVENTORY)	36.000	②	4.34	156.08	1.75	4.34	1	BOT. CORNER WALL	7.63	6.52	1	EXTERIOR WALL	7.06		
	HS-20 (OPERATING)	36.000		5.62	202.32	1.35	5.62	1	BOT. CORNER WALL	7.63	8.45	1	EXTERIOR WALL	7.06		
LEGAL LOAD RATING	SINGLE VEHICLE (SV)	SNSH	13.500	③	5.42	73.16	1.40	5.42	1	BOT. CORNER WALL	7.63	8.15	1	EXTERIOR WALL	7.06	
		SNGARBS2	20.000		5.42	108.39	1.40	5.42	1	BOT. CORNER WALL	7.63	8.15	1	EXTERIOR WALL	7.06	
		SNAGRIS2	22.000		5.42	119.22	1.40	5.42	1	BOT. CORNER WALL	7.63	8.15	1	EXTERIOR WALL	7.06	
		SNCOTTS3	27.250		5.42	147.68	1.40	5.42	1	BOT. CORNER WALL	7.63	8.15	1	EXTERIOR WALL	7.06	
		SNAGGRS4	34.925		5.42	189.27	1.40	5.42	1	BOT. CORNER WALL	7.63	8.15	1	EXTERIOR WALL	7.06	
		SNS5A	35.550		5.42	192.66	1.40	5.42	1	BOT. CORNER WALL	7.63	8.15	1	EXTERIOR WALL	7.06	
		SNS6A	39.950		5.42	216.50	1.40	5.42	1	BOT. CORNER WALL	7.63	8.15	1	EXTERIOR WALL	7.06	
		SNS7B	42.000		5.42	227.61	1.40	5.42	1	BOT. CORNER WALL	7.63	8.15	1	EXTERIOR WALL	7.06	
	TRUCK TRACTOR SEMI-TRAILER (TTST)	TNAGRIT3	33.000		5.42	178.84	1.40	5.42	1	BOT. CORNER WALL	7.63	8.15	1	EXTERIOR WALL	7.06	
		TNT4A	33.075		5.42	179.24	1.40	5.42	1	BOT. CORNER WALL	7.63	8.15	1	EXTERIOR WALL	7.06	
		TNT6A	41.600		5.42	225.44	1.40	5.42	1	BOT. CORNER WALL	7.63	8.15	1	EXTERIOR WALL	7.06	
		TNT7A	42.000		5.42	227.61	1.40	5.42	1	BOT. CORNER WALL	7.63	8.15	1	EXTERIOR WALL	7.06	
		TNT7B	42.000		5.42	227.61	1.40	5.42	1	BOT. CORNER WALL	7.63	8.15	1	EXTERIOR WALL	7.06	
		TNAGRIT4	43.000		5.42	233.03	1.40	5.42	1	BOT. CORNER WALL	7.63	8.15	1	EXTERIOR WALL	7.06	
TNAGT5A	45.000		5.42	243.87	1.40	5.42	1	BOT. CORNER WALL	7.63	8.15	1	EXTERIOR WALL	7.06			
TNAGT5B	45.000		5.42	243.87	1.40	5.42	1	BOT. CORNER WALL	7.63	8.15	1	EXTERIOR WALL	7.06			

LOAD FACTORS:

DESIGN LOAD RATING FACTORS		
LOAD TYPE	MAX FACTOR	MIN FACTOR
DC	1.25	0.90
DW	1.50	0.65
EV	1.30	0.90
EH	1.35	0.50 OR 0.90
ES	1.35	0.50 OR 0.90
LS	1.75	--
WA	1.00	--


NOTE:

RATING FACTORS ARE BASED ON THE STRENGTH I LIMIT STATE.

COMMENTS:

- 1.
- 2.
- 3.
- 4.

#	CONTROLLING LOAD RATING
①	DESIGN LOAD RATING (HL-93)
②	DESIGN LOAD RATING (HS-20)
③	LEGAL LOAD RATING **
** SEE CHART FOR VEHICLE TYPE	

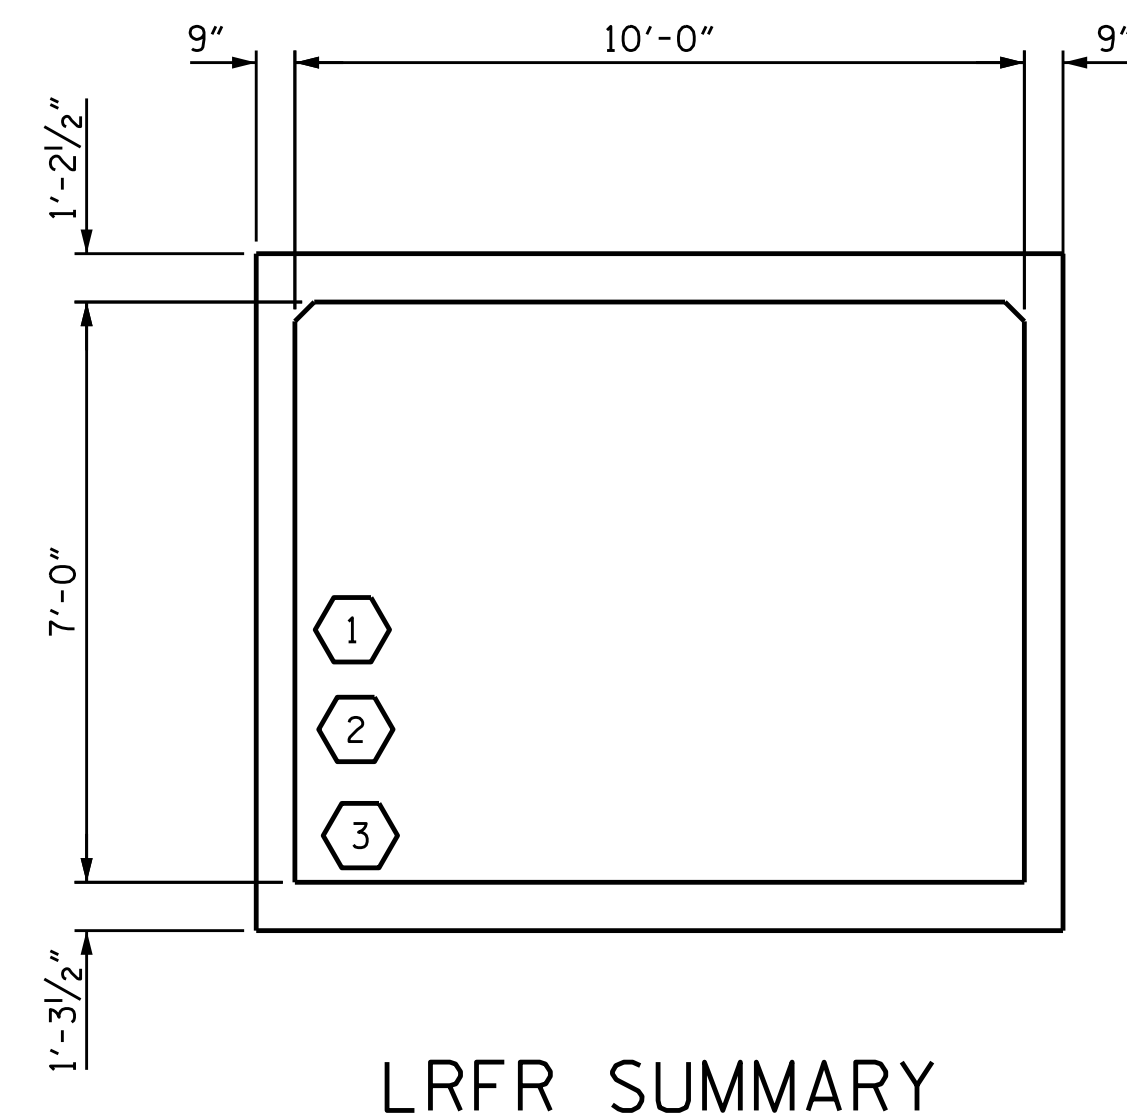

PROJECT NO. U-3109A
ALAMANCE COUNTY
 STATION: 179+55.00 -L-

SHEET 5 OF 5



STATE OF NORTH CAROLINA
 DEPARTMENT OF TRANSPORTATION
 RALEIGH
 STANDARD
 LRFR SUMMARY FOR
 REINFORCED CONCRETE
 BOX CULVERTS
 (NON-INTERSTATE TRAFFIC)

ASSEMBLED BY : A. SORSENCINH	DATE : 4/2014
CHECKED BY : K.W. ALFORD	DATE : 2/2017
DRAWN BY : WMC	7/11
CHECKED BY : GM	7/11

16-MAR-2017 11:36
 K:\Structures\Plans\Culver+3\U3109A.SD.CU.dgn
 kaiford


DOCUMENT NOT CONSIDERED FINAL
 UNLESS ALL SIGNATURES COMPLETED

REVISIONS						SHEET NO.
NO.	BY:	DATE:	NO.	BY:	DATE:	C2-5
1			3			TOTAL SHEETS
2			4			5

STD. NO. LRFR5

BENCHMARK #22, RAILROAD SPIKE IN BASE OF 18" SWEETGUM,
STA. 23+31.00 -Y10-, 120' RIGHT, EL. 607.62

F.A. PROJECT NO.: STP-0119(9)

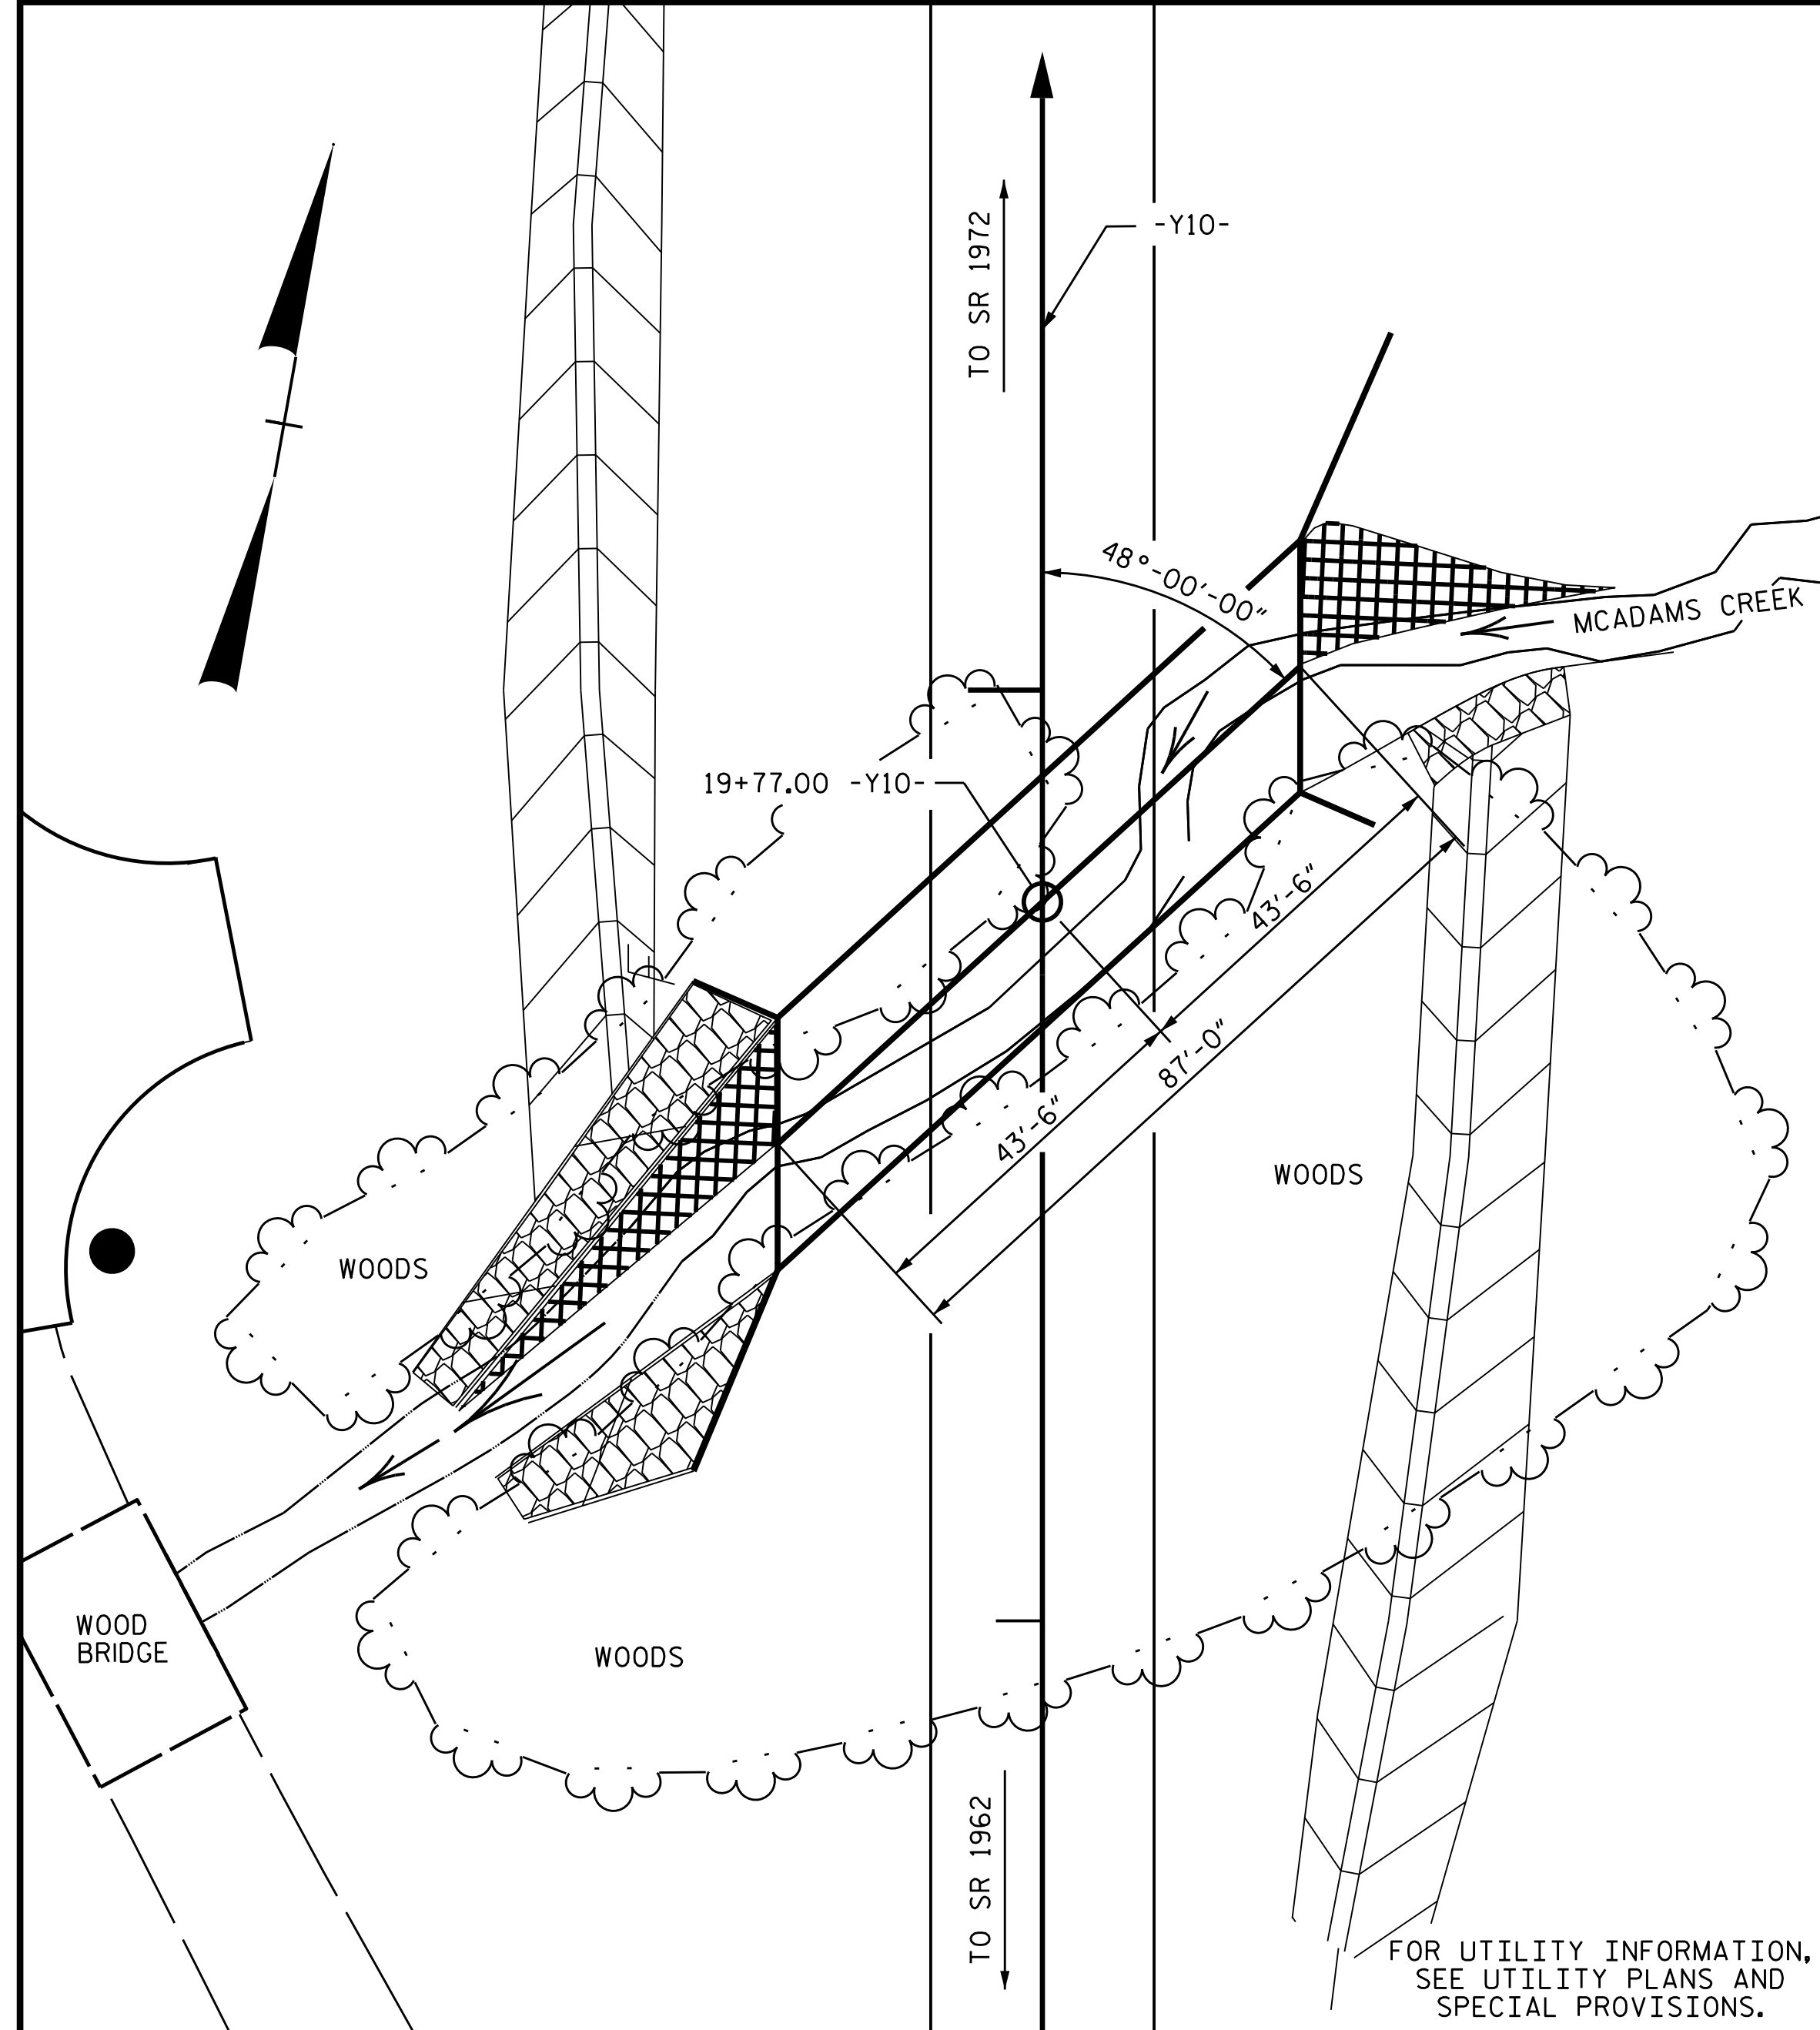

LOCATION SKETCH

TOTAL STRUCTURE QUANTITIES		
CLASS A CONCRETE		
BARREL @	2.061 CY/FT	179.3 C.Y.
SILLS		1.5 C.Y.
WING ETC.		35.4 C.Y.
TOTAL		216.2 C.Y.
REINFORCING STEEL		
BARREL		23735 LBS.
WINGS ETC.		1876 LBS.
TOTAL		25611 LBS.
FOUNDATION CONDITIONING MATERIAL		160 TONS
CULVERT EXCAVATION		LUMP SUM
REMOVAL OF EXISTING STRUCTURE		LUMP SUM

HYDRAULIC DATA

DESIGN DISCHARGE	= 800 CFS
FREQUENCY OF DESIGN FLOOD	= 25 YRS.
DESIGN HIGH WATER ELEVATION	= 605.4
DRAINAGE AREA	= 0.94 SQ. MI.
BASE DISCHARGE (Q100)	= 1220 CFS
BASE HIGH WATER ELEVATION	= 607.6

OVERTOPPING FLOOD DATA

OVERTOPPING DISCHARGE	= 1720 + CFS
FREQUENCY OF OVERTOPPING FLOOD	= 500 + YRS.
OVERTOPPING FLOOD ELEVATION	= 611.0 *

GRADE DATA

GRADE POINT ELEVATION @ STA. 19+77.00 -Y10-	= 612.02'
BED ELEVATION @ STA. 19+77.00 -Y10-	= 597.74'
ROADWAY FILL SLOPES	= 2:1

* OVERTOPS PROP. ROADWAY @ STA. 18+40 -Y10-

I HEREBY CERTIFY THESE PLANS ARE THE AS-BUILT PLANS

NOTES

ASSUMED LIVE LOAD ----- HL-93 OR ALTERNATE LOADING.
MINIMUM DESIGN FILL----- 5.94'
FOR OTHER DESIGN DATA AND NOTES SEE STANDARD NOTE SHEET.
3" Ø WEEP HOLES INDICATED TO BE IN ACCORDANCE WITH THE SPECIFICATIONS.
CONCRETE IN CULVERTS TO BE POURED IN THE FOLLOWING ORDER:

1. WING FOOTINGS AND FLOOR SLAB INCLUDING 4" OF ALL VERTICAL WALLS.
2. THE REMAINING PORTIONS OF THE WALLS AND WINGS FULL HEIGHT FOLLOWED BY ROOF SLAB AND HEADWALLS.

THE RESIDENT ENGINEER SHALL CHECK THE LENGTH OF CULVERT BEFORE STAKING IT OUT TO MAKE CERTAIN THAT IT WILL PROPERLY TAKE CARE OF THE FILL.

DIMENSIONS FOR WING LAYOUT AS WELL AS ADDITIONAL REINFORCING STEEL EMBEDDED IN BARREL ARE SHOWN ON WING SHEET.

TRANSVERSE CONSTRUCTION JOINTS SHALL BE USED IN THE BARREL, SPACED TO LIMIT THE POURS TO A MAXIMUM OF 70 FT. LOCATION OF JOINTS SHALL BE SUBJECT TO APPROVAL OF THE ENGINEER.

STEEL IN THE BOTTOM SLAB MAY BE SPLICED AT THE PERMITTED CONSTRUCTION JOINT AT THE CONTRACTOR'S OPTION, EXTRA WEIGHT OF STEEL DUE TO THE SPLICES SHALL BE PAID FOR BY THE CONTRACTOR.

AT THE CONTRACTOR'S OPTION, HE MAY SPLICE THE VERTICAL REINFORCING STEEL IN THE INTERIOR FACE OF EXTERIOR WALL AND BOTH FACES OF INTERIOR WALLS ABOVE LOWER WALL CONSTRUCTION JOINT. THE SPLICE LENGTH SHALL BE AS PROVIDED IN THE SPLICE LENGTH CHART SHOWN ON THE PLANS. EXTRA WEIGHT OF STEEL DUE TO THE SPLICES SHALL BE PAID FOR BY THE CONTRACTOR.

AT THE CONTRACTOR'S OPTION HE MAY SUBMIT, TO THE ENGINEER FOR APPROVAL, DESIGN AND DETAIL DRAWINGS FOR A PRECAST REINFORCED CONCRETE BOX CULVERT IN LIEU OF THE CAST-IN-PLACE CULVERT SHOWN ON THE PLANS. THE DESIGN SHALL PROVIDE THE SAME SIZE AND NUMBER OF BARRELS AS USED ON THE CAST-IN-PLACE DESIGN. FOR OPTIONAL PRECAST REINFORCED CONCRETE BOX CULVERT, SEE SPECIAL

A 3 FOOT STRIP OF FILTER FABRIC SHALL BE ATTACHED TO THE FILL FACE OF THE WING COVERING THE ENTIRE LENGTH OF THE EXPANSION JOINT.

FOR SUBMITTAL OF WORKING DRAWINGS, SEE SPECIAL PROVISIONS.

FOR CONSTRUCTION SEQUENCE, SEE EROSION CONTROL PLANS.

FOR FALSEWORK AND FORMWORK, SEE SPECIAL PROVISIONS.

FOR CRANE SAFETY, SEE SPECIAL PROVISIONS.


FOR GROUT FOR STRUCTURES, SEE SPECIAL PROVISIONS.

THE CONTRACTOR SHALL PROVIDE INDEPENDENT ASSURANCE SAMPLES OF REINFORCING STEEL AS FOLLOWS: FOR PROJECTS REQUIRING 400 TONS OF REINFORCING STEEL, ONE 30 INCH SAMPLE OF EACH SIZE BAR USED, AND FOR PROJECTS REQUIRING OVER 400 TONS OF REINFORCING STEEL, TWO 30 INCH SAMPLES OF EACH SIZE BAR USED. THE BARS FROM WHICH THE SAMPLES ARE TAKEN MUST THEN BE SPLICED WITH REPLACEMENT BARS OF THE SIZE AND LENGTH OF THE SAMPLE, PLUS A MINIMUM LAP SPLICE OF THIRTY BAR DIAMETERS. PAYMENT FOR THE SAMPLES OF REINFORCING STEEL SHALL BE CONSIDERED INCIDENTAL TO VARIOUS PAY ITEMS.

FOR CULVERT DIVERSION DETAILS AND PAY ITEM, SEE EROSION CONTROL PLANS.

THE EXISTING WOODEN BRIDGE LOCATED 125' DOWNSTREAM FROM THE PROPOSED STRUCTURE SHALL BE REMOVED.

REMOVAL OF THE EXISTING BRIDGE SHALL BE PERFORMED IN A MANNER THAT PREVENTS DEBRIS FROM FALLING INTO THE WATER. THE CONTRACTOR SHALL SUBMIT DEMOLITION PLANS FOR REVIEW AND REMOVE THE BRIDGE IN ACCORDANCE WITH ARTICLE 402-2 OF THE STANDARD SPECIFICATIONS.

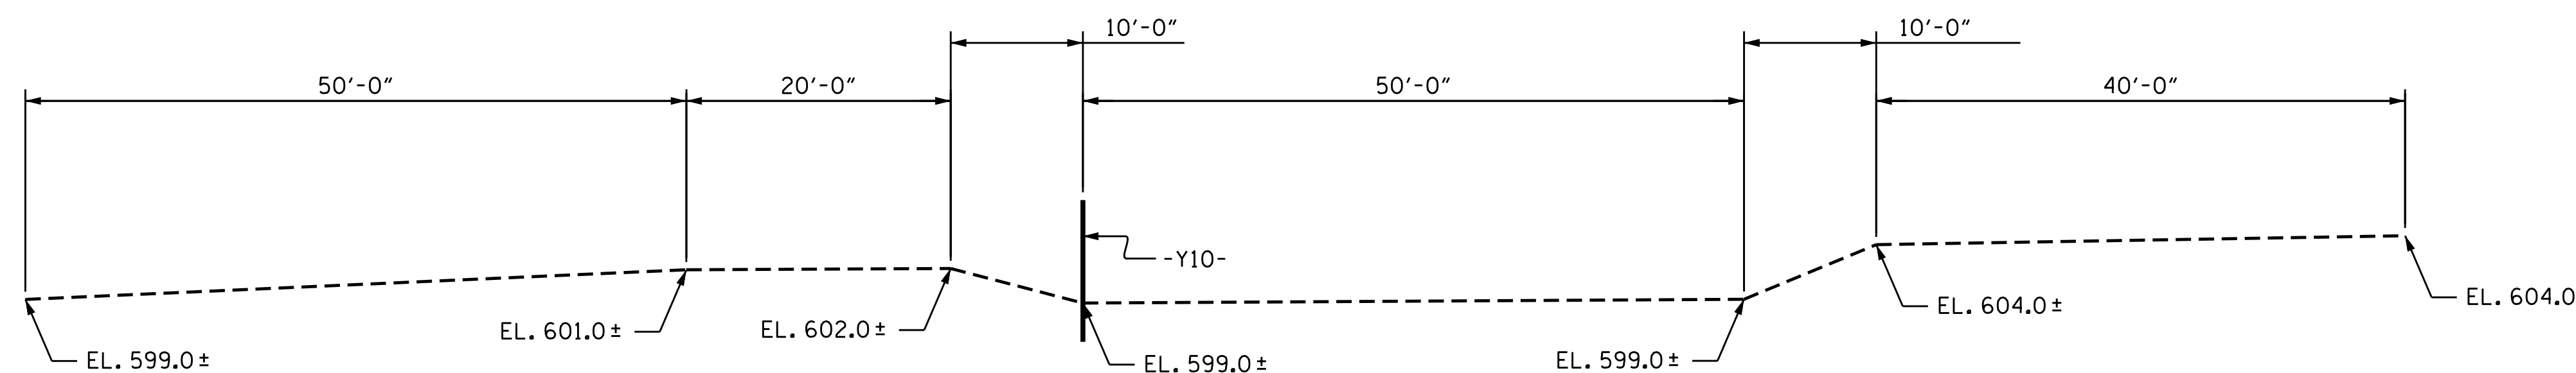

PROFILE ALONG CULVERT

PROJECT NO. U-3109A
ALAMANCE COUNTY
STATION: 19+77.00 -Y10-

SHEET 1 OF 5 CULVERT #438

STATE OF NORTH CAROLINA
DEPARTMENT OF TRANSPORTATION
RALEIGH
BARREL STANDARD
DOUBLE 10 FT. X 8 FT.
CONCRETE BOX CULVERT

48° SKEW





DocuSigned by:
Tristy W. Alford
3/16/2017

REVISIONS						SHEET NO.
NO.	BY:	DATE:	NO.	BY:	DATE:	C3-1
1			3			TOTAL SHEETS
2			4			5


DOCUMENT NOT CONSIDERED FINAL UNLESS ALL SIGNATURES COMPLETED

ASSEMBLED BY : A.C. OUTLAW	DATE : 4/25/14	SPECIAL
CHECKED BY : W.F. PARKER	DATE : 5/14	
DRAWN BY : C.O. CUEVAS	DATE : 8-28-90	STANDARD
CHECKED BY : M.A.J.	DATE : 10-2-90	

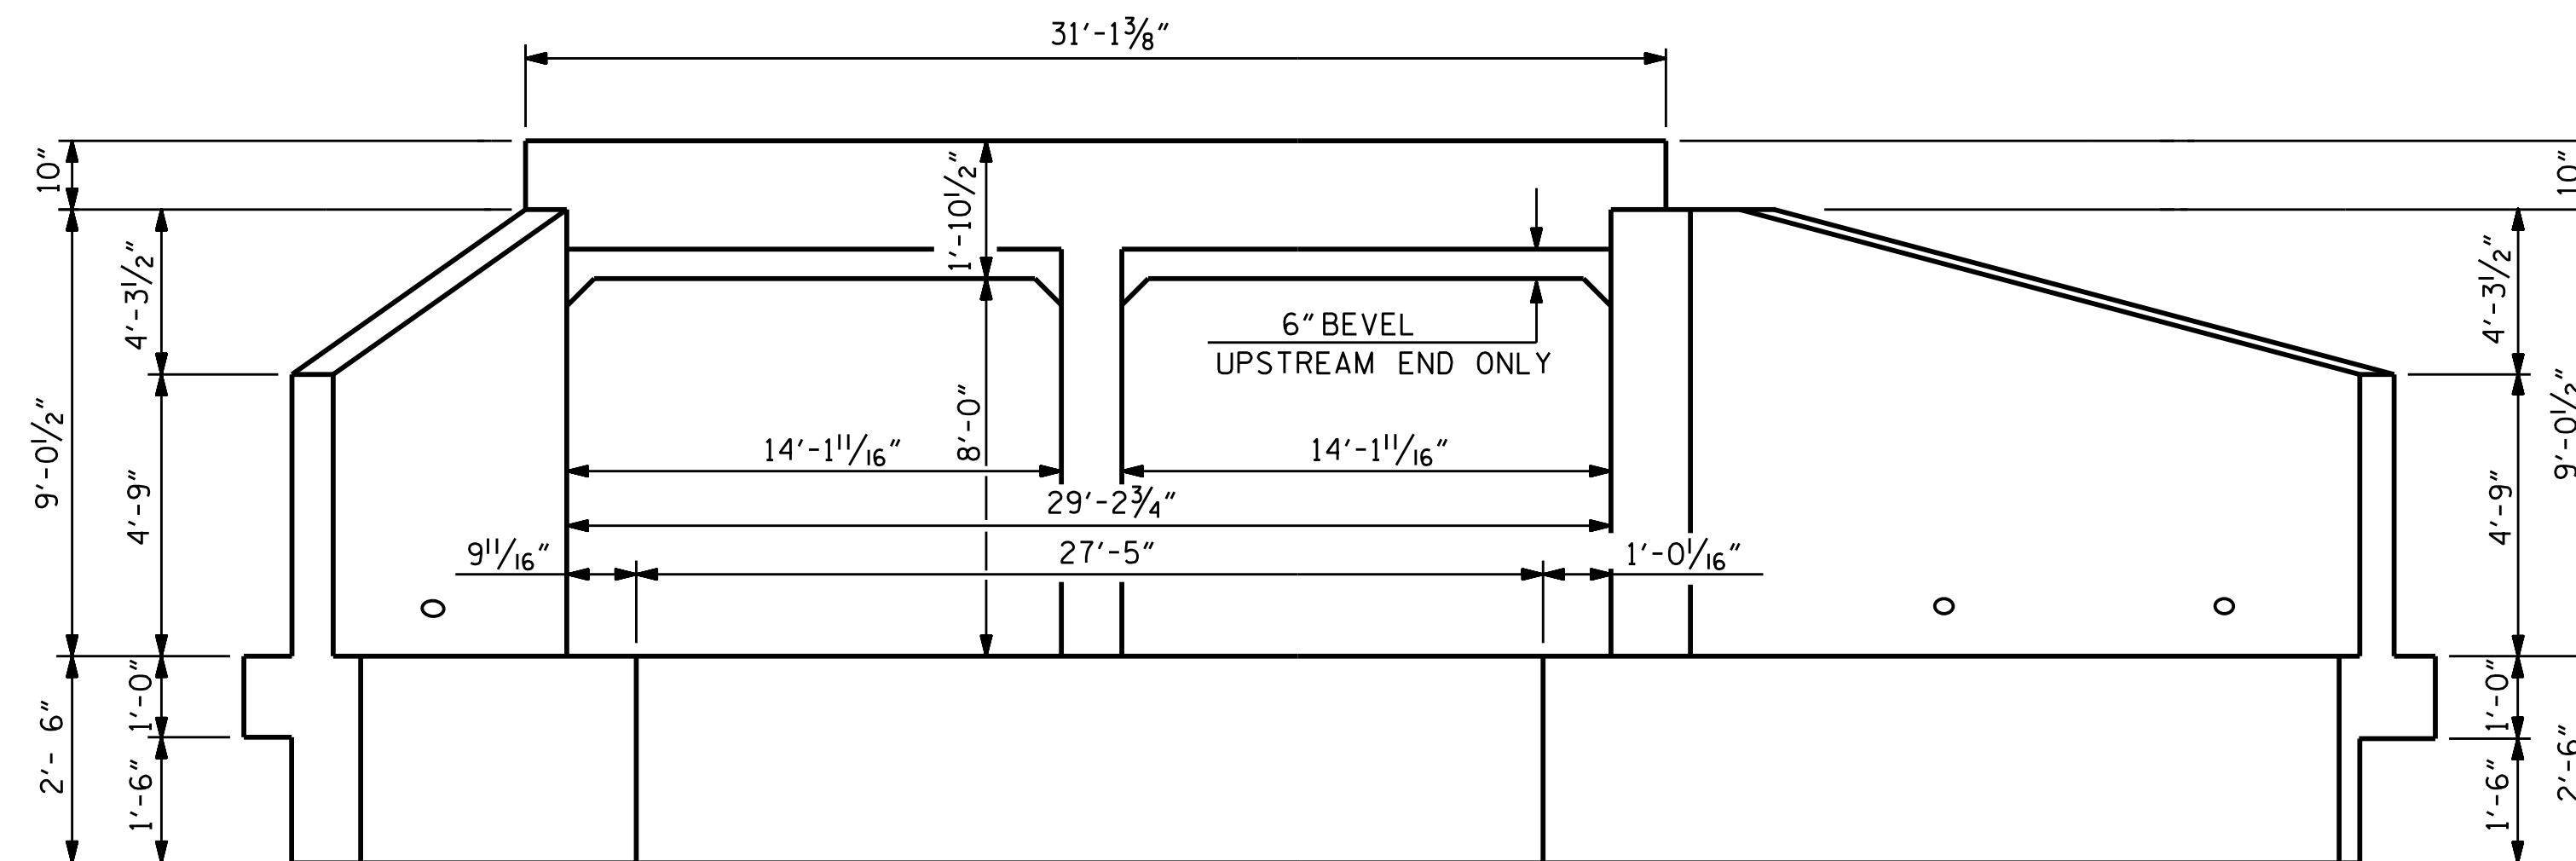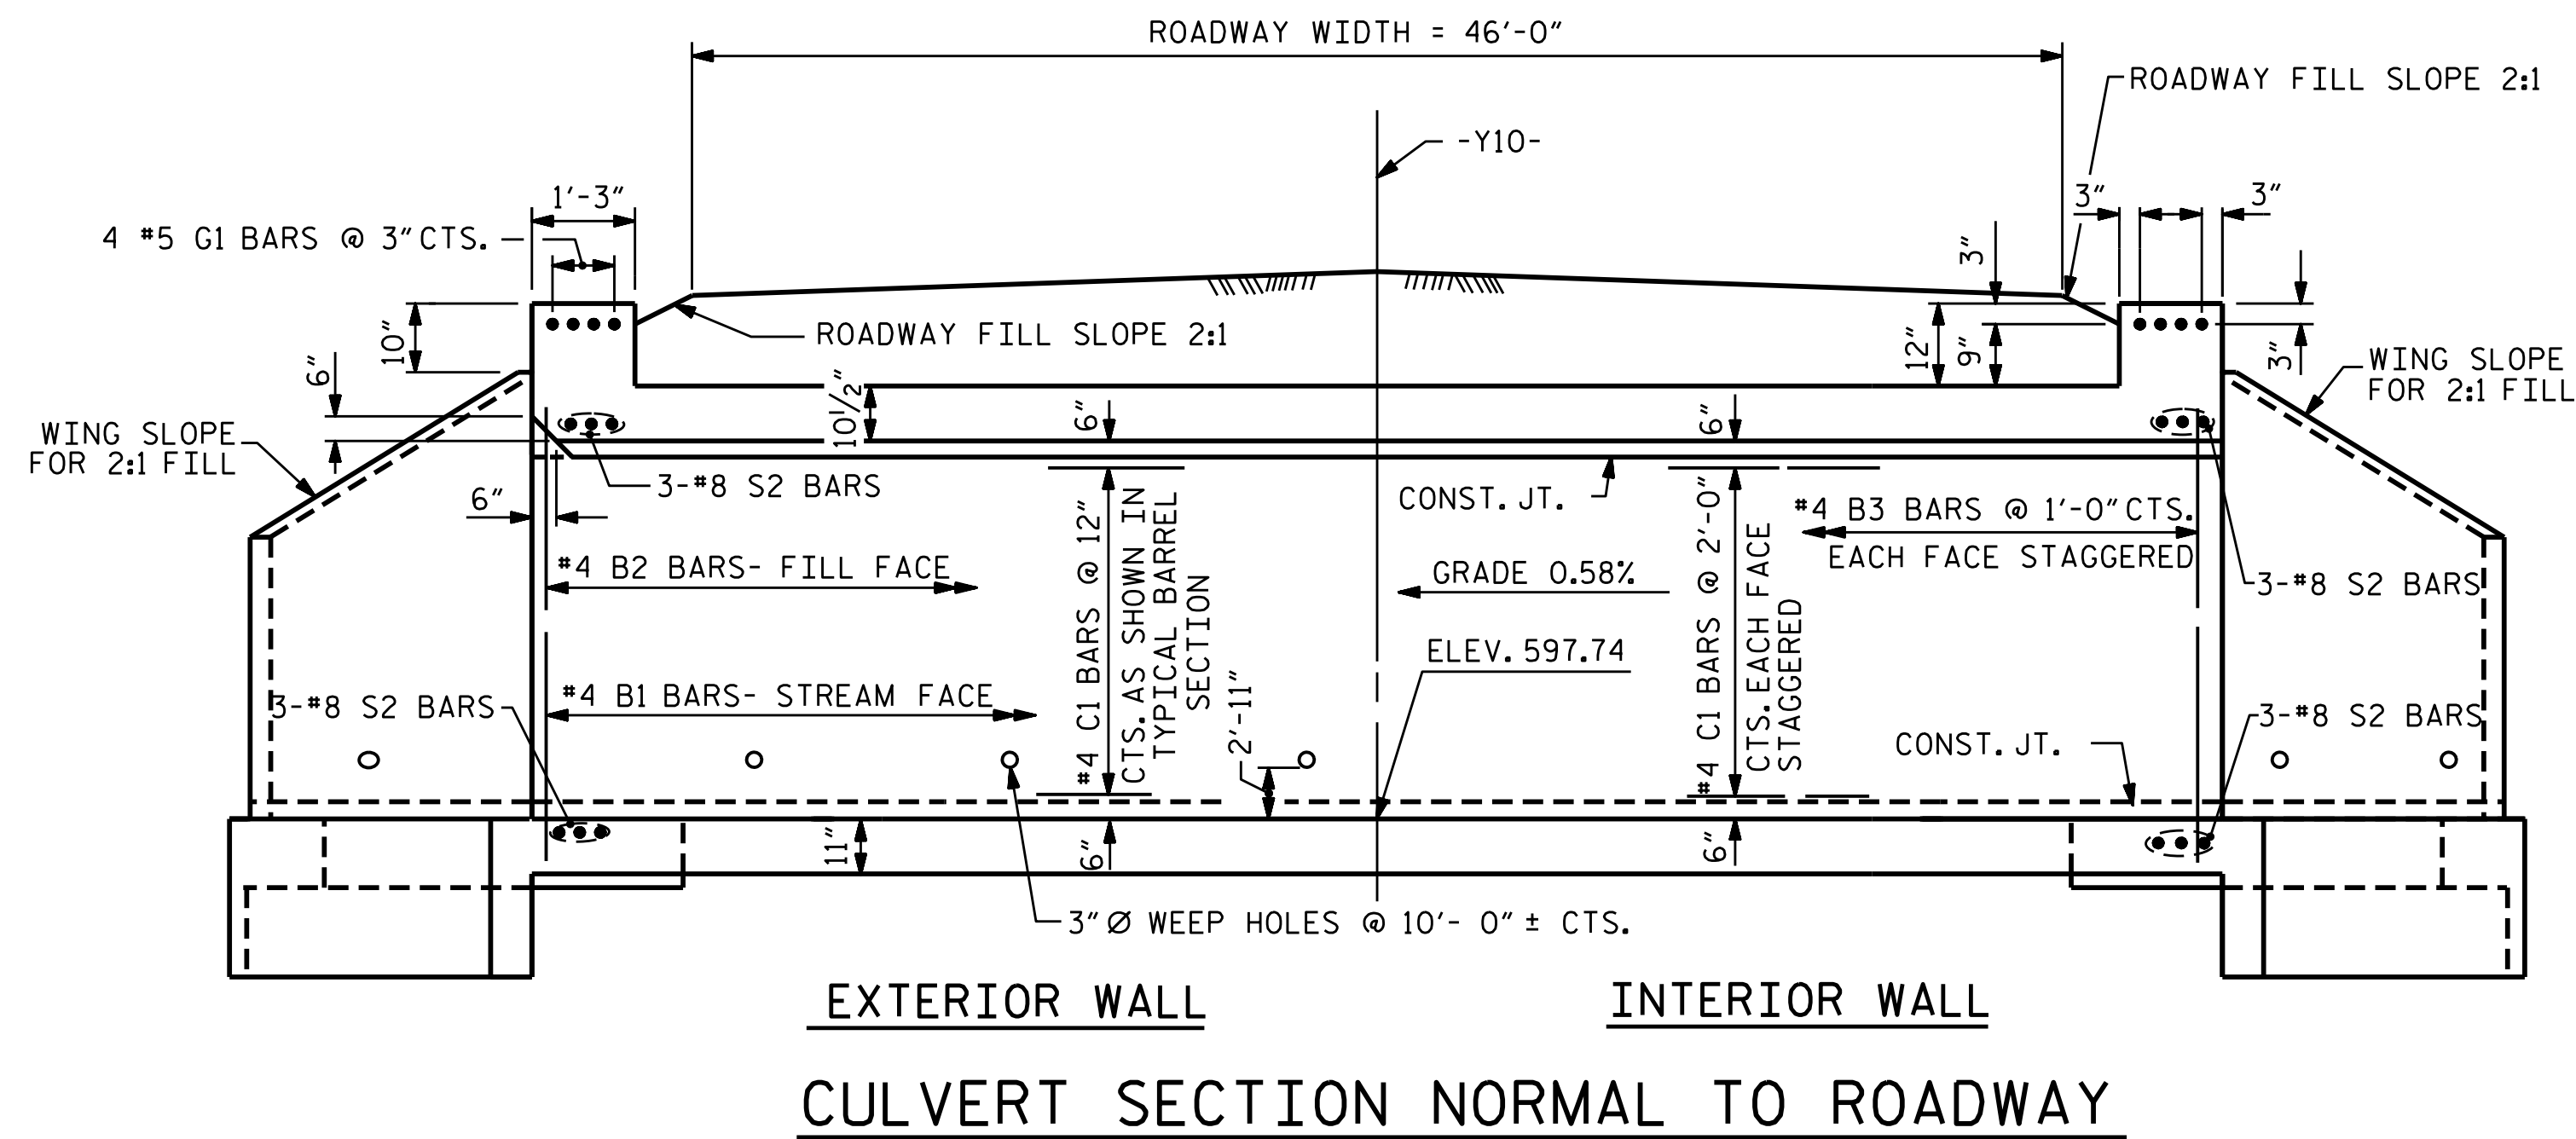

EXTERIOR WALL INTERIOR WALL
CULVERT SECTION NORMAL TO ROADWAY

END ELEVATION NORMAL TO SKEW

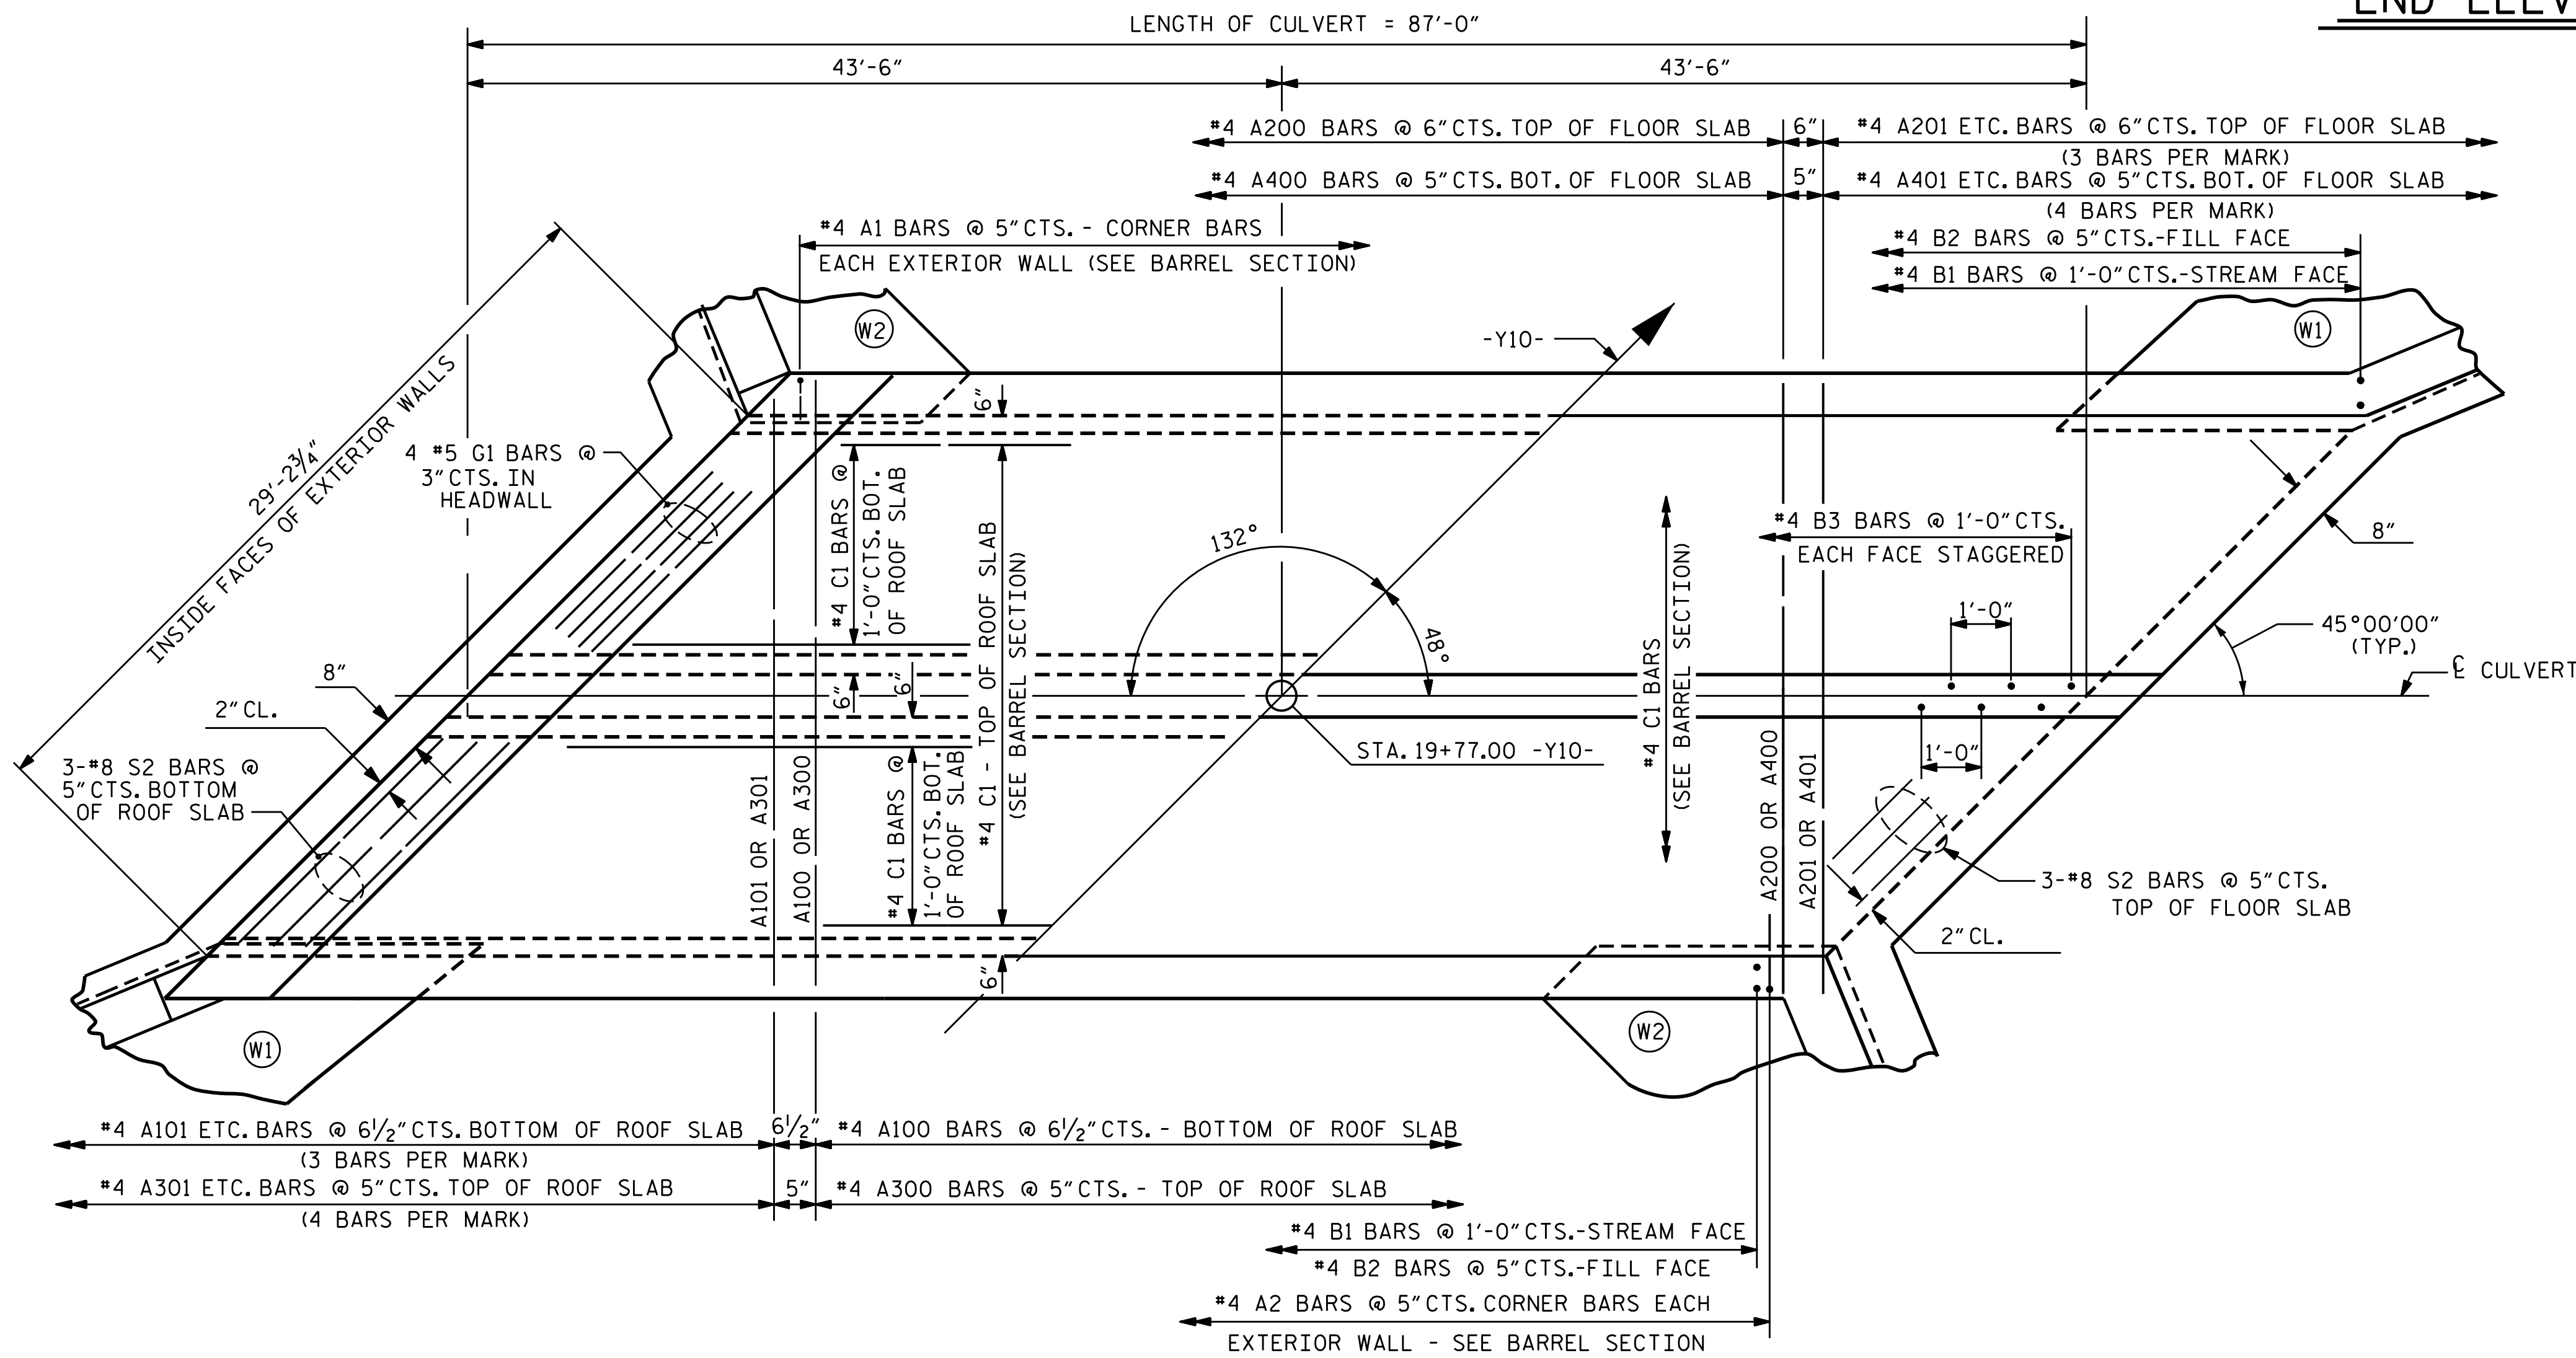

I HEREBY CERTIFY THESE PLANS ARE THE AS-BUILT PLANS



PROJECT NO. U-3109A
ALAMANCE COUNTY
STATION: 19+77.00 -Y10-

SHEET 2 OF 5

STATE OF NORTH CAROLINA
DEPARTMENT OF TRANSPORTATION
RALEIGH
BARREL STANDARD
DOUBLE 10 FT. X 8 FT.
CONCRETE BOX CULVERT
48° SKEW

REVISIONS						SHEET NO.
NO.	BY:	DATE:	NO.	BY:	DATE:	C3-2
1			3			TOTAL SHEETS
2			4			5


DOCUMENT NOT CONSIDERED FINAL UNLESS ALL SIGNATURES COMPLETED

REVISED 11-19-99 BY M.M. CHECKED BY R.W.W.
REDRAWN 11-90 BY C.O.C. CHECKED BY M.A.J.

ASSEMBLED BY: A.C. OUTLAW DATE: 4/25/14
CHECKED BY: W.F. PARKER DATE: 5/14
DRAWN BY: DANNY SHERRED DATE: 4-11-72
CHECKED BY: HASON A. JUDEH DATE: 4-17-72

SPECIAL STANDARD


PART PLAN - FLOOR SLAB
SILLS NOT SHOWN FOR CLARITY
SEE SHEET 3 OF 5 FOR SILL DETAILS

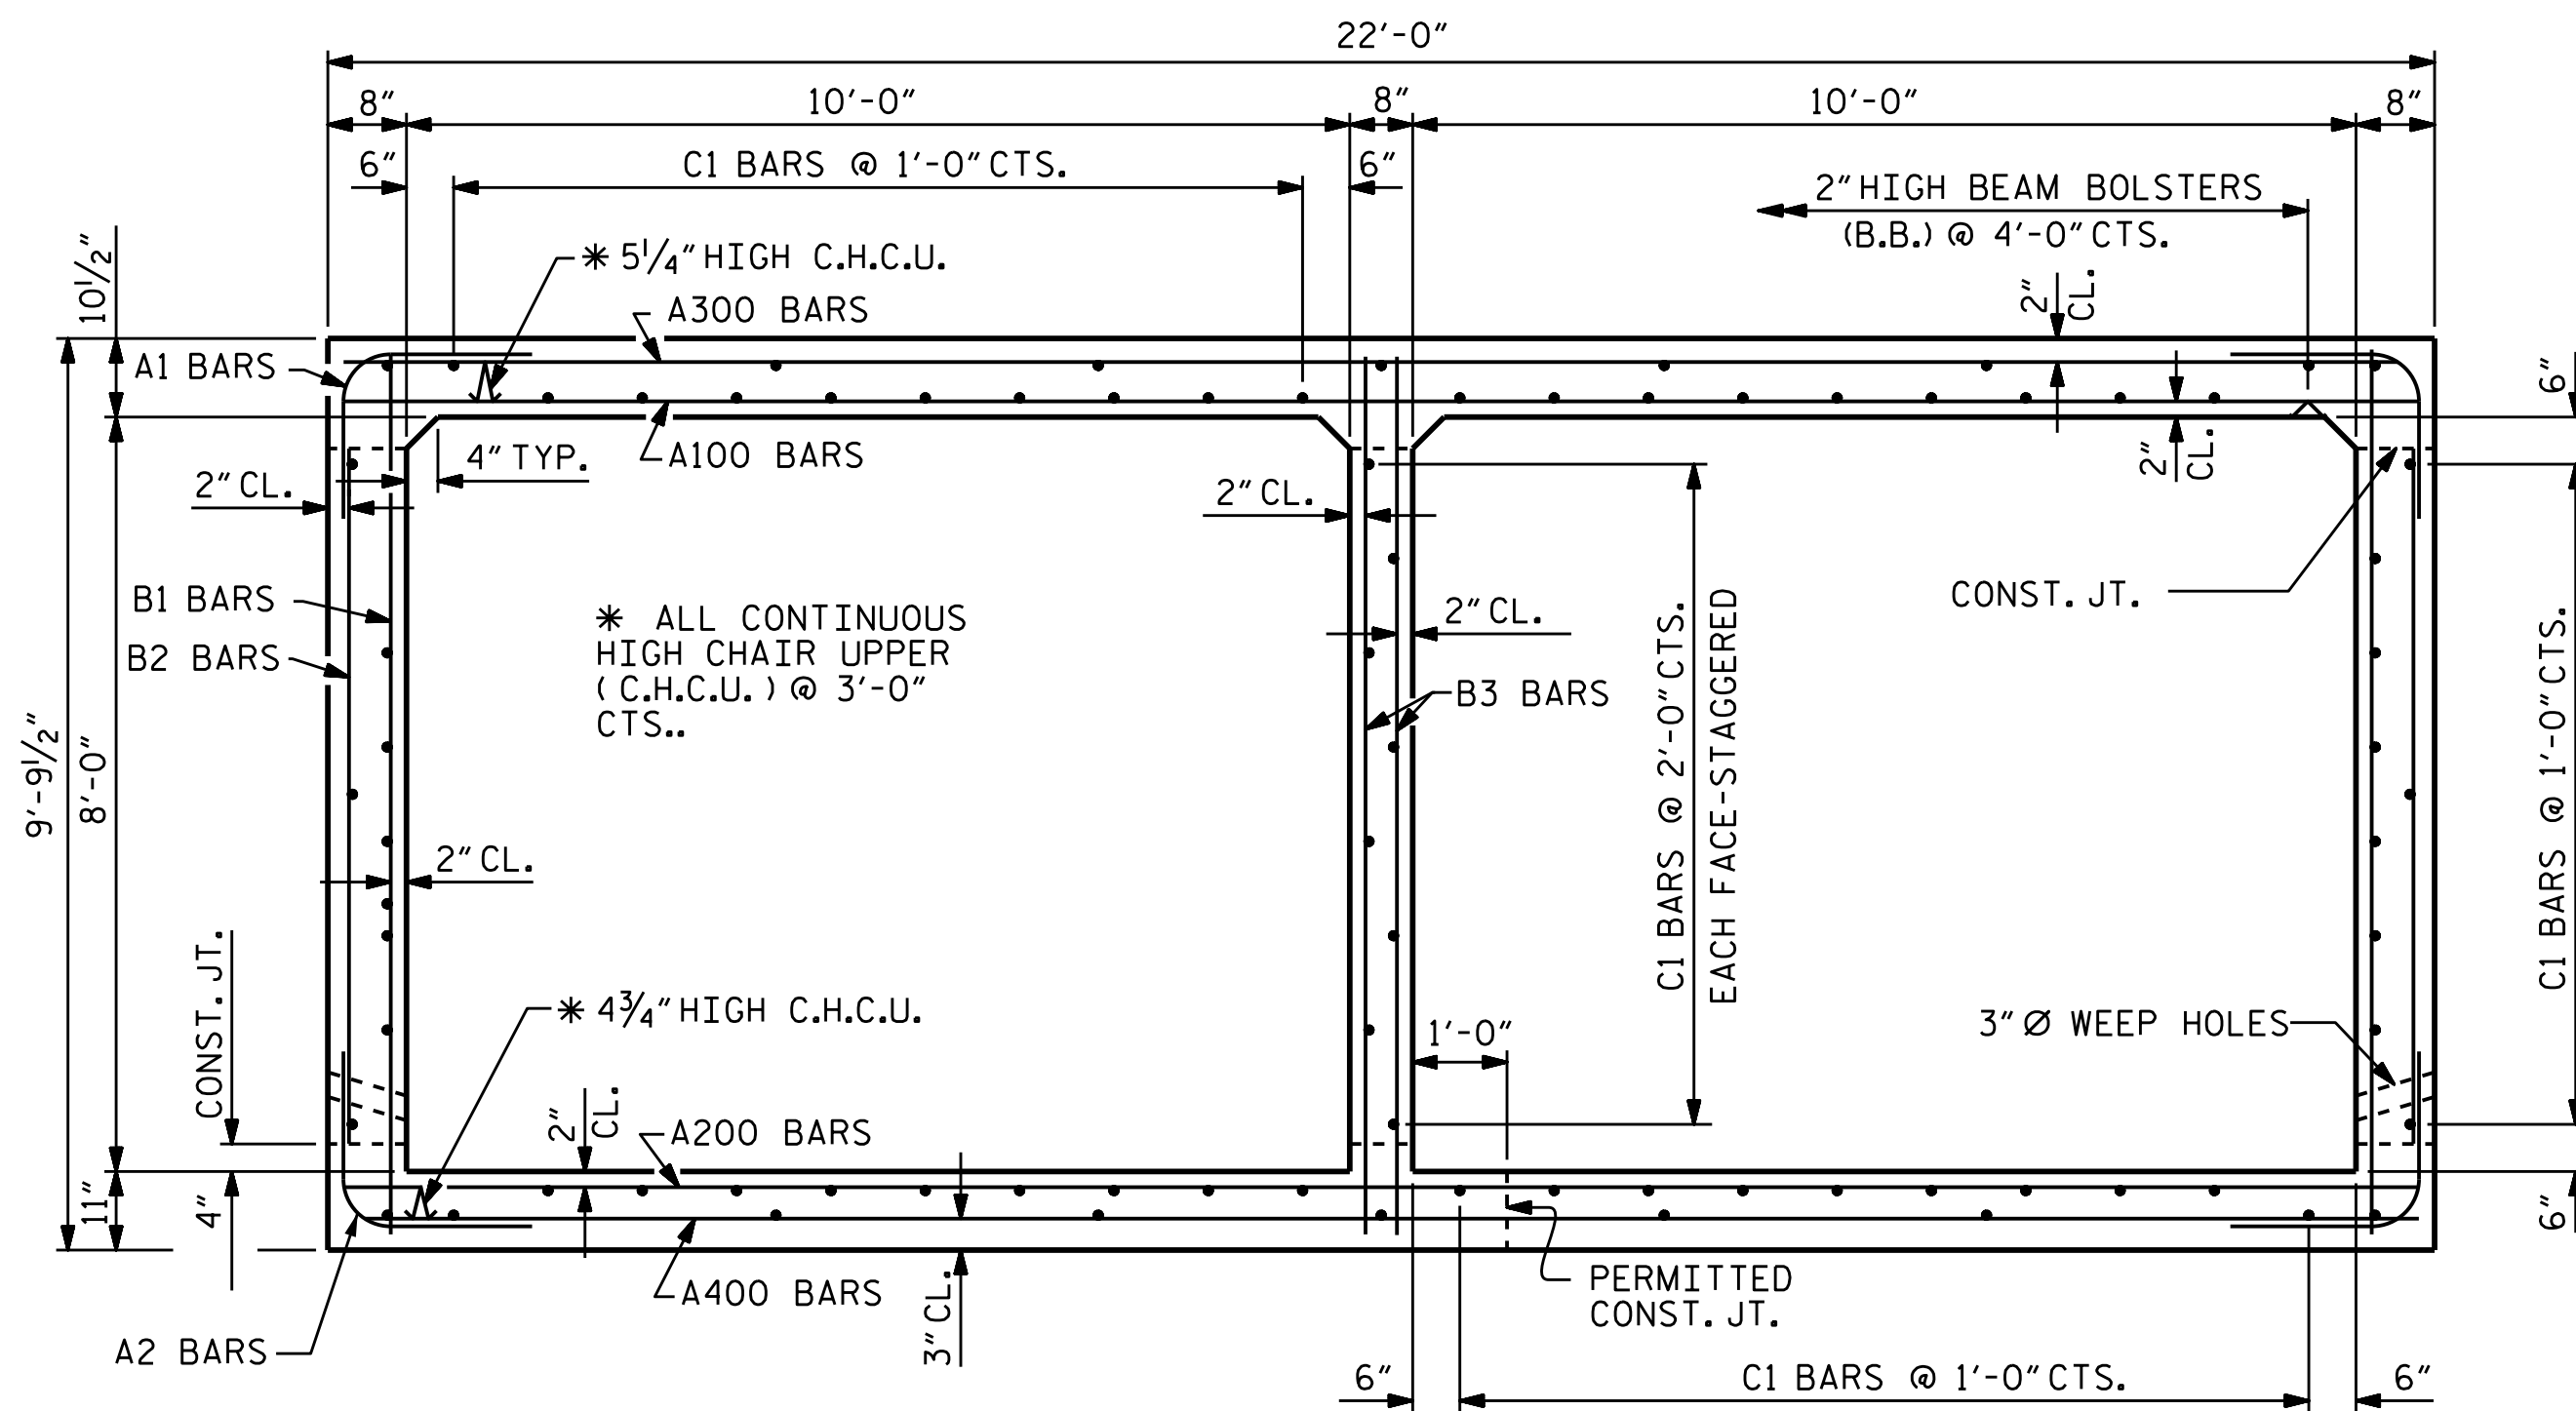

RIGHT ANGLE SECTION OF BARREL

THERE ARE 80 "C" BARS IN SECTION OF BARREL.
(4 BAR RUNS)


BAR TYPE		REINFORCING STEEL BAR SCHEDULE															
BAR	NO.	SIZE	TYPE	LENGTH	WEIGHT	BAR	NO.	SIZE	TYPE	LENGTH	WEIGHT						
A100	120	4	STR	21'-7"	1730	A400	156	4	STR	21'-7"	2249						
A101	6	4	STR	19'-11"	80	A401	8	4	STR	19'-11"	106						
A102	6	4	STR	18'-4"	73	A402	8	4	STR	18'-3"	98						
A103	6	4	STR	16'-8"	67	A403	8	4	STR	16'-7"	89						
A104	6	4	STR	15'-1"	60	A404	8	4	STR	14'-11"	80						
A105	6	4	STR	13'-5"	54	A405	8	4	STR	13'-3"	71						
A106	6	4	STR	11'-10"	47	A406	8	4	STR	11'-7"	62						
A107	6	4	STR	10'-2"	41	A407	8	4	STR	9'-11"	53						
A108	6	4	STR	8'-7"	34	A408	8	4	STR	8'-3"	44						
A109	6	4	STR	6'-11"	28	A409	8	4	STR	6'-7"	35						
A110	6	4	STR	5'-4"	21	A410	8	4	STR	4'-11"	26						
A111	6	4	STR	3'-8"	15	A411	8	4	STR	3'-3"	17						
A112	6	4	STR	2'-1"	8												
						A1	418	4	1	5'-1"	1419						
						A2	418	4	1	4'-9"	1326						
						A200	130	4	STR	21'-7"	1874						
						A201	6	4	STR	20'-1"	80						
						A202	6	4	STR	18'-7"	74	B1	174	4	STR	9'-3"	1075
						A203	6	4	STR	17'-1"	68	B2	418	4	STR	7'-4"	2048
						A204	6	4	STR	15'-7"	62	B3	174	4	STR	9'-3"	1075
						A205	6	4	STR	14'-1"	56						
						A206	6	4	STR	12'-7"	50	C1	320	4	STR	23'-3"	4970
						A207	6	4	STR	11'-1"	44						
						A208	6	4	STR	9'-7"	38	D1	6	6	STR	2'-6"	23
						A209	6	4	STR	8'-1"	32						
						A210	6	4	STR	6'-7"	26	G1	8	5	STR	30'-7"	255
						A211	6	4	STR	5'-1"	20						
						A212	6	4	STR	3'-7"	14	S2	12	8	STR	30'-7"	980
						A213	6	4	STR	2'-1"	8						
											REINFORCING STEEL		LBS.	23735			
A300	156	4	STR	21'-7"	2249												
A301	8	4	STR	19'-11"	106												
A302	8	4	STR	18'-3"	98												
A303	8	4	STR	16'-7"	89												
A304	8	4	STR	14'-11"	80												
A305	8	4	STR	13'-3"	71												
A306	8	4	STR	11'-7"	62												
A307	8	4	STR	9'-11"	53												
A308	8	4	STR	8'-3"	44												
A309	8	4	STR	6'-7"	35												
A310	8	4	STR	4'-11"	26												
A311	8	4	STR	3'-3"	17												

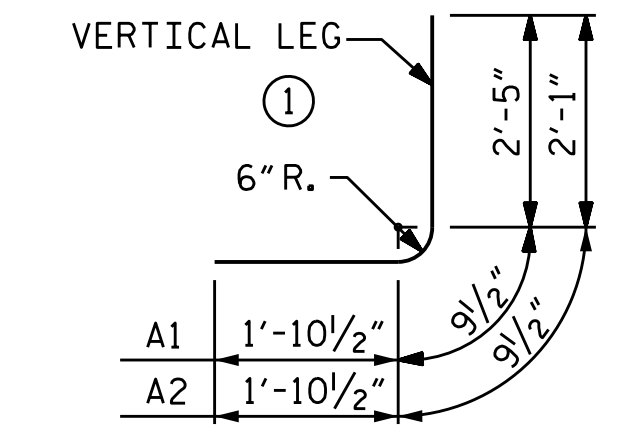

NOTES


NATIVE MATERIAL CONSISTS OF MATERIAL THAT IS EXCAVATED FROM THE STREAM OR FLOODPLAIN AT THE PROJECT SITE DURING CONSTRUCTION. RIP-RAP MAY BE USED TO SUPPLEMENT THE NATIVE MATERIAL IN THE HIGH FLOW CULVERT BARREL(S). NATIVE MATERIAL SHOULD BE PLACED ON TOP TO FILL VOIDS AND PROVIDE A FLAT SURFACE FOR ANIMAL PASSAGE. NATIVE MATERIAL IS SUBJECT TO APPROVAL BY THE ENGINEER AND MAY BE SUBJECT TO PERMIT CONDITIONS.

DO NOT SET ELEVATION OF HIGH SILL ABOVE THE BANK FULL.

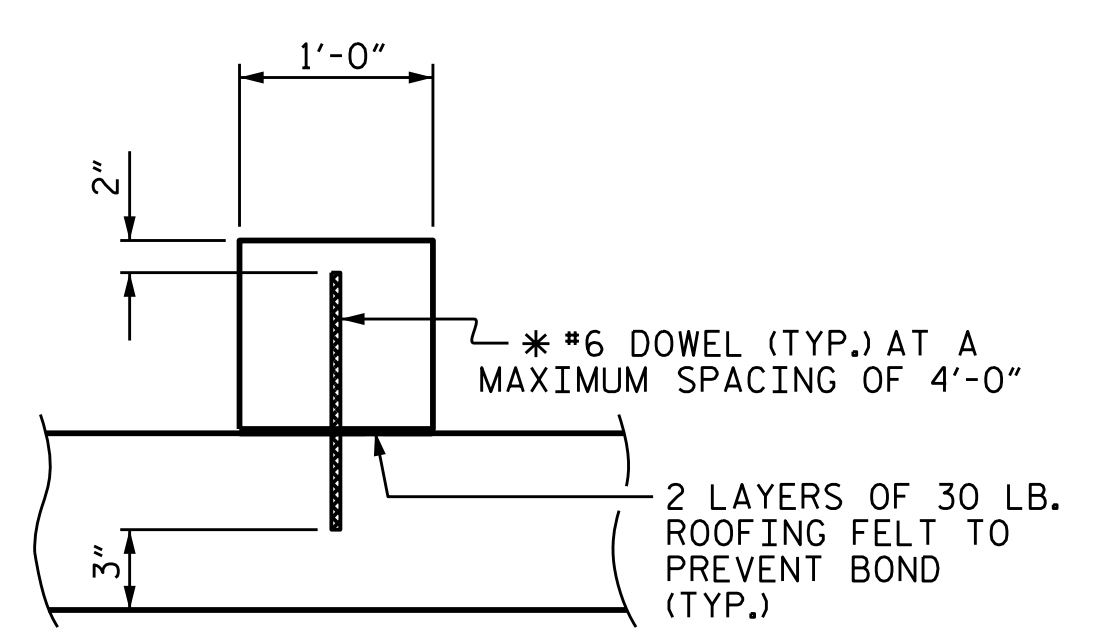


SECTION THROUGH SILL

* DOWELS MAY BE PUSHED INTO GREEN CONCRETE AFTER SLAB HAS BEEN FLOAT FINISHED.

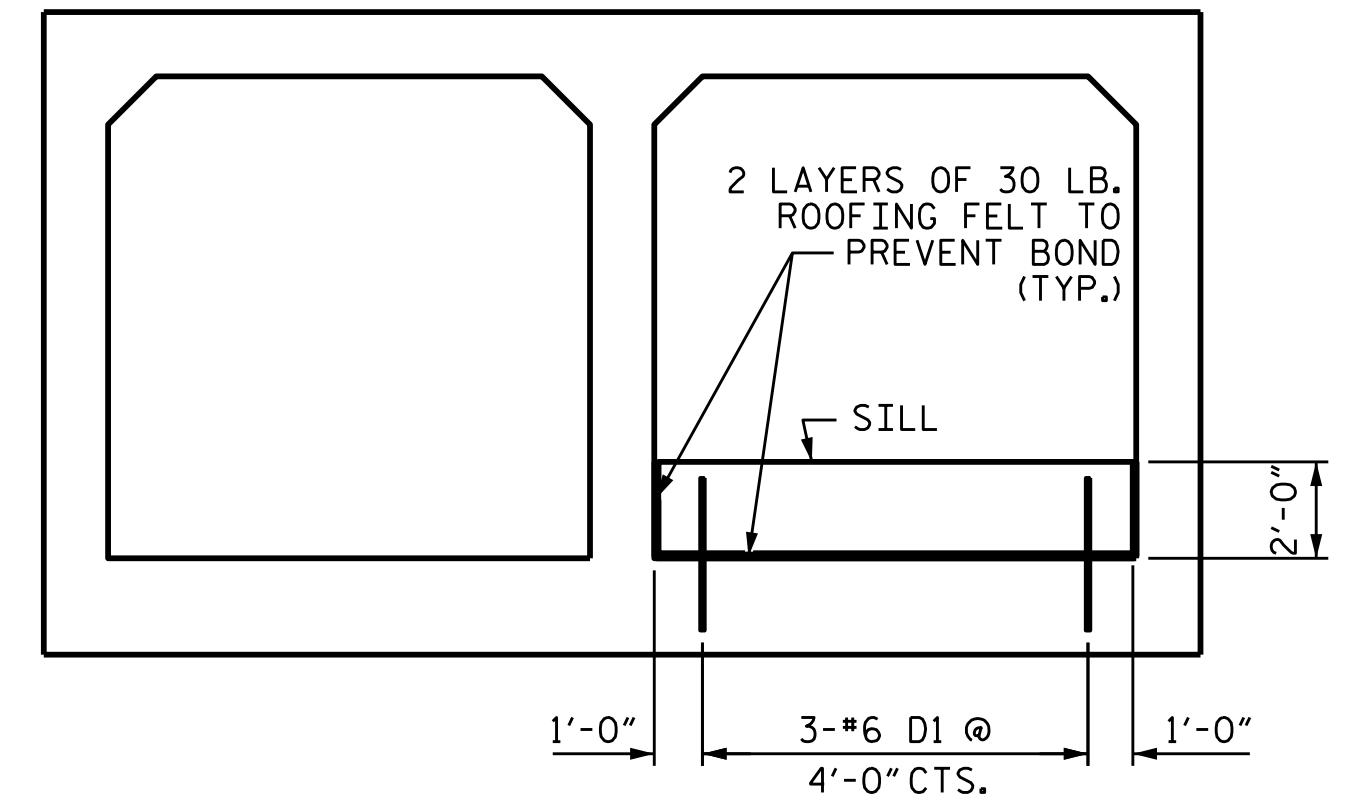

ELEVATION


CULVERT SILL DETAILS

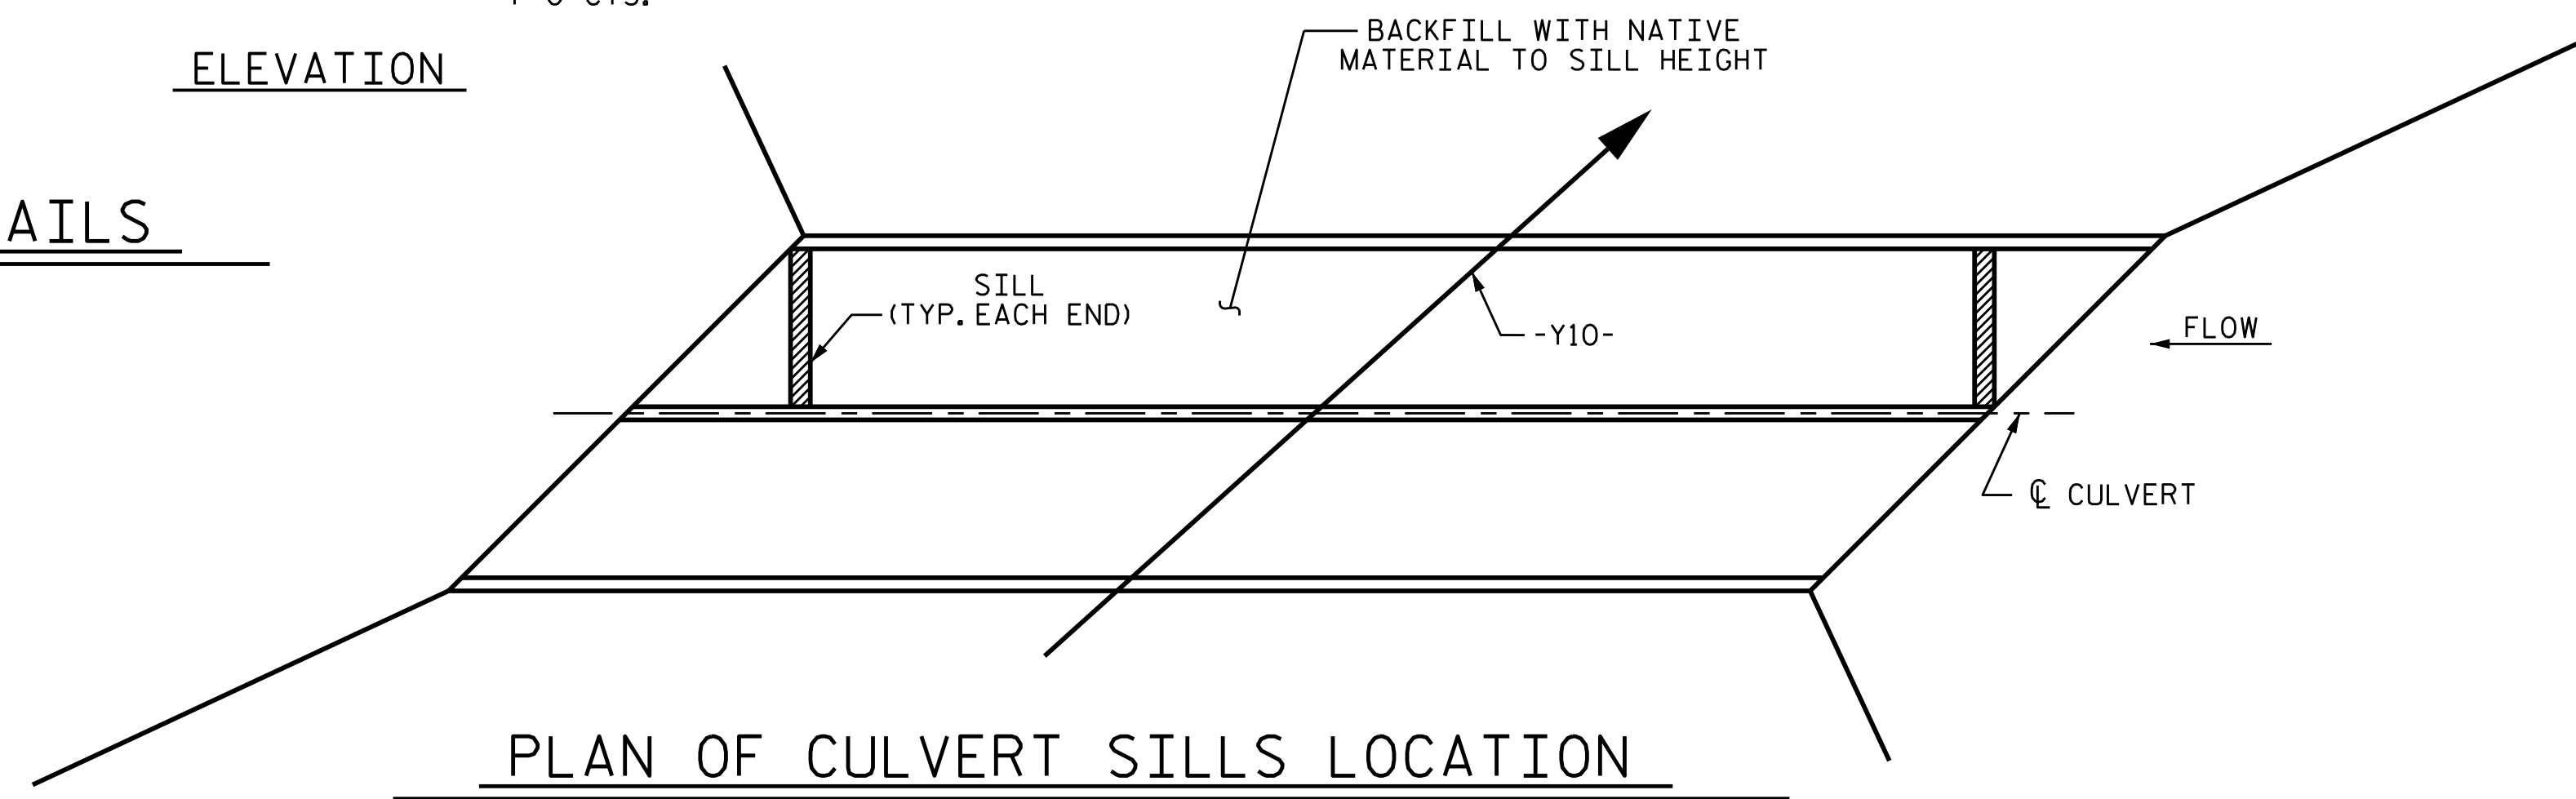

PLAN OF CULVERT SILLS LOCATION

PROJECT NO. U-3109A
ALAMANCE COUNTY
 STATION: 19+77.00 -Y10-

SHEET 3 OF 5

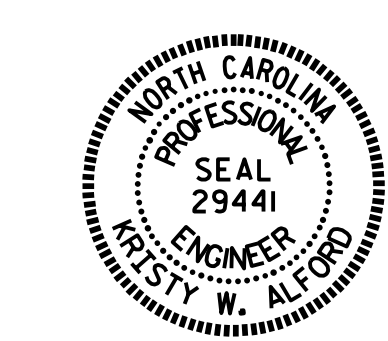


STATE OF NORTH CAROLINA
 DEPARTMENT OF TRANSPORTATION
 RALEIGH

CULVERT DETAILS


DRAWN BY : A.C. OUTLAW DATE : 4/25/14
 CHECKED BY : W.F. PARKER DATE : 5/14
 DESIGN ENGINEER OF RECORD: K.W. ALFORD DATE : 2/17

DOCUMENT NOT CONSIDERED FINAL
 UNLESS ALL SIGNATURES COMPLETED


REVISIONS						SHEET NO.
NO.	BY:	DATE:	NO.	BY:	DATE:	C3-3
1			3			TOTAL SHEETS
2			4			5

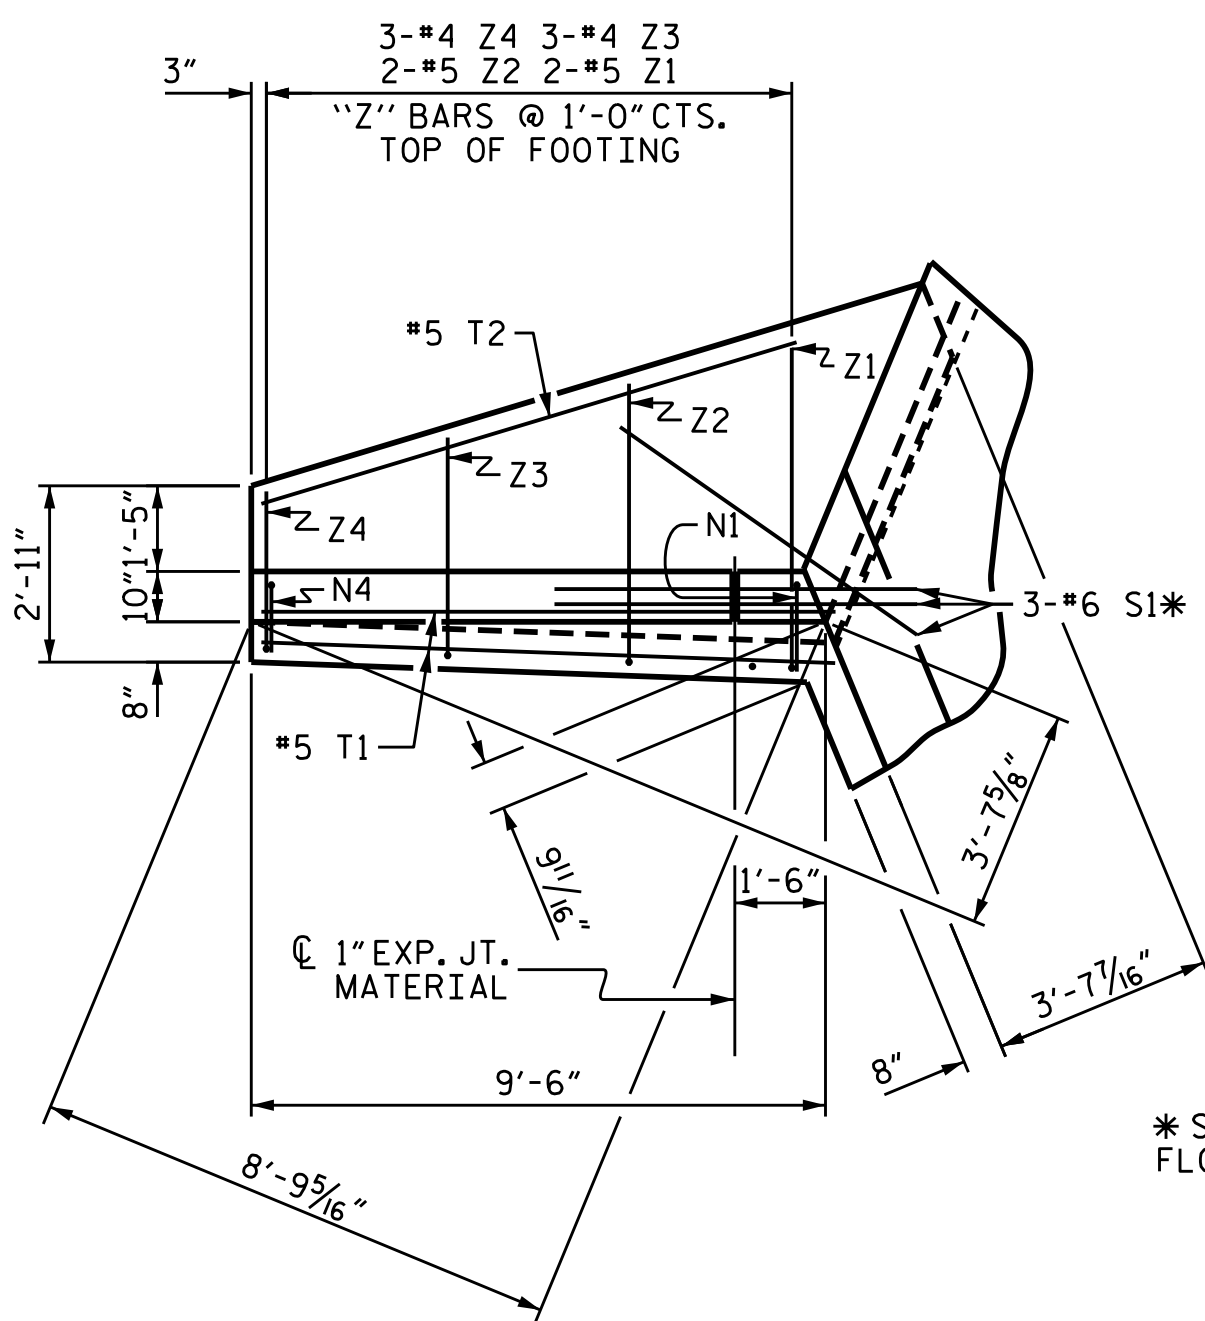


PLAN W2

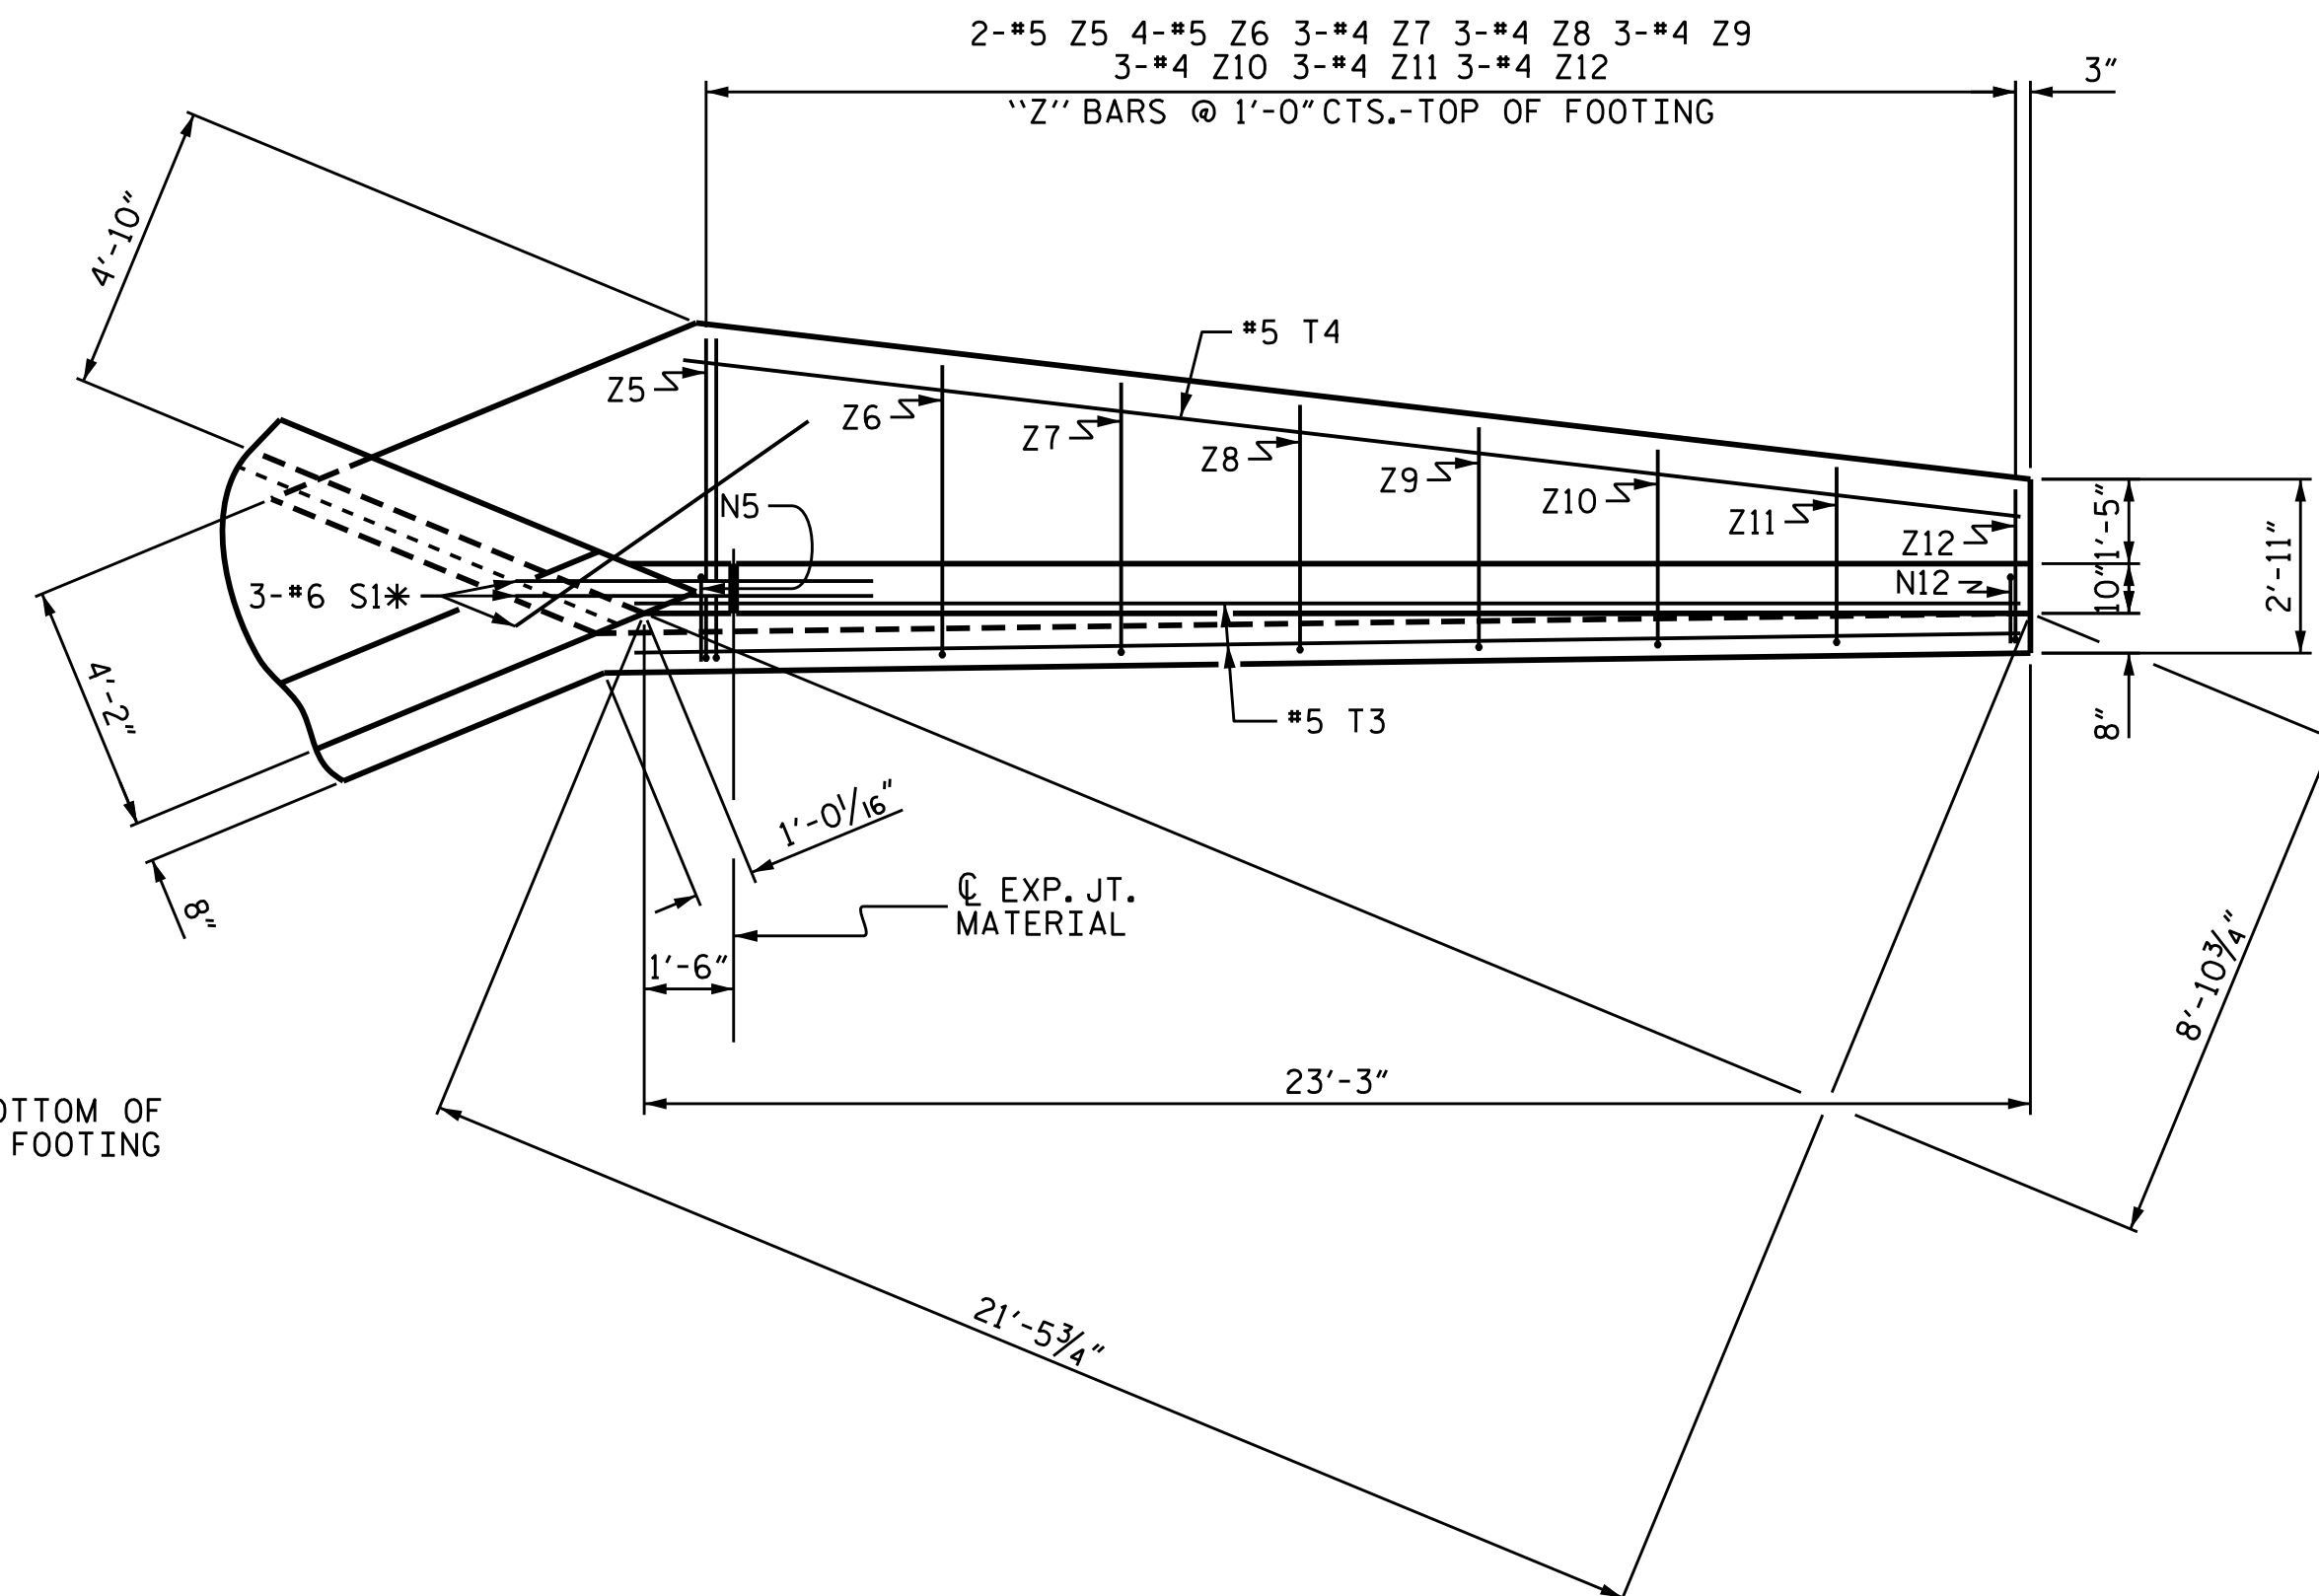


PLAN W1

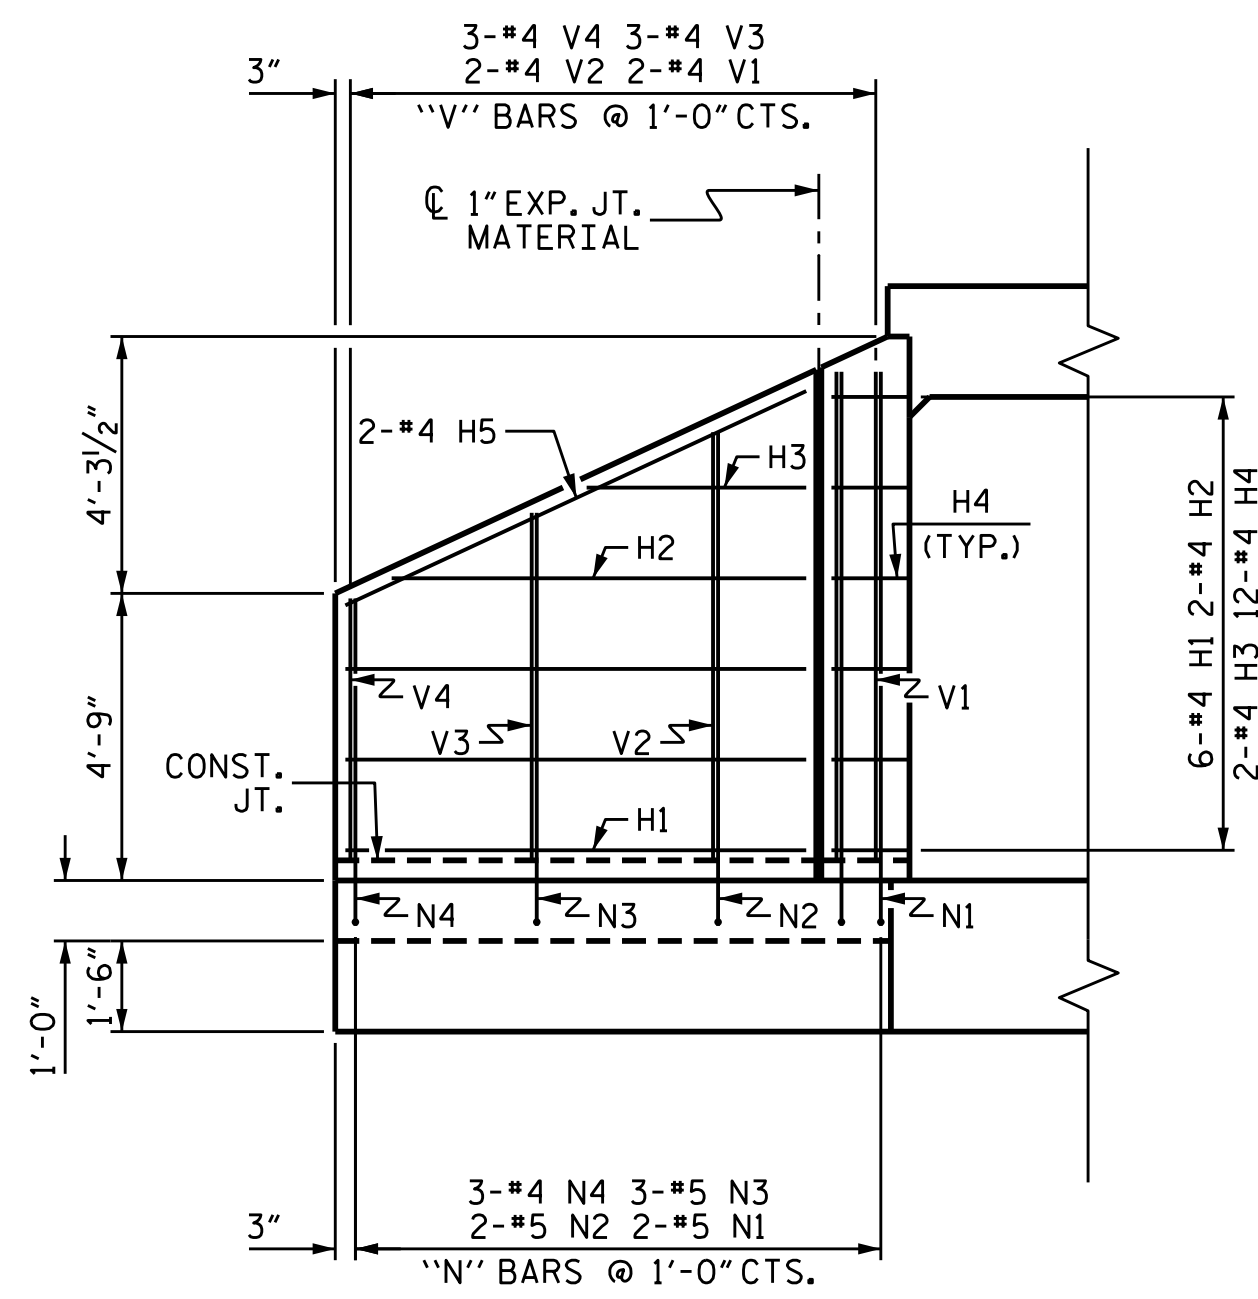


ELEVATION W2

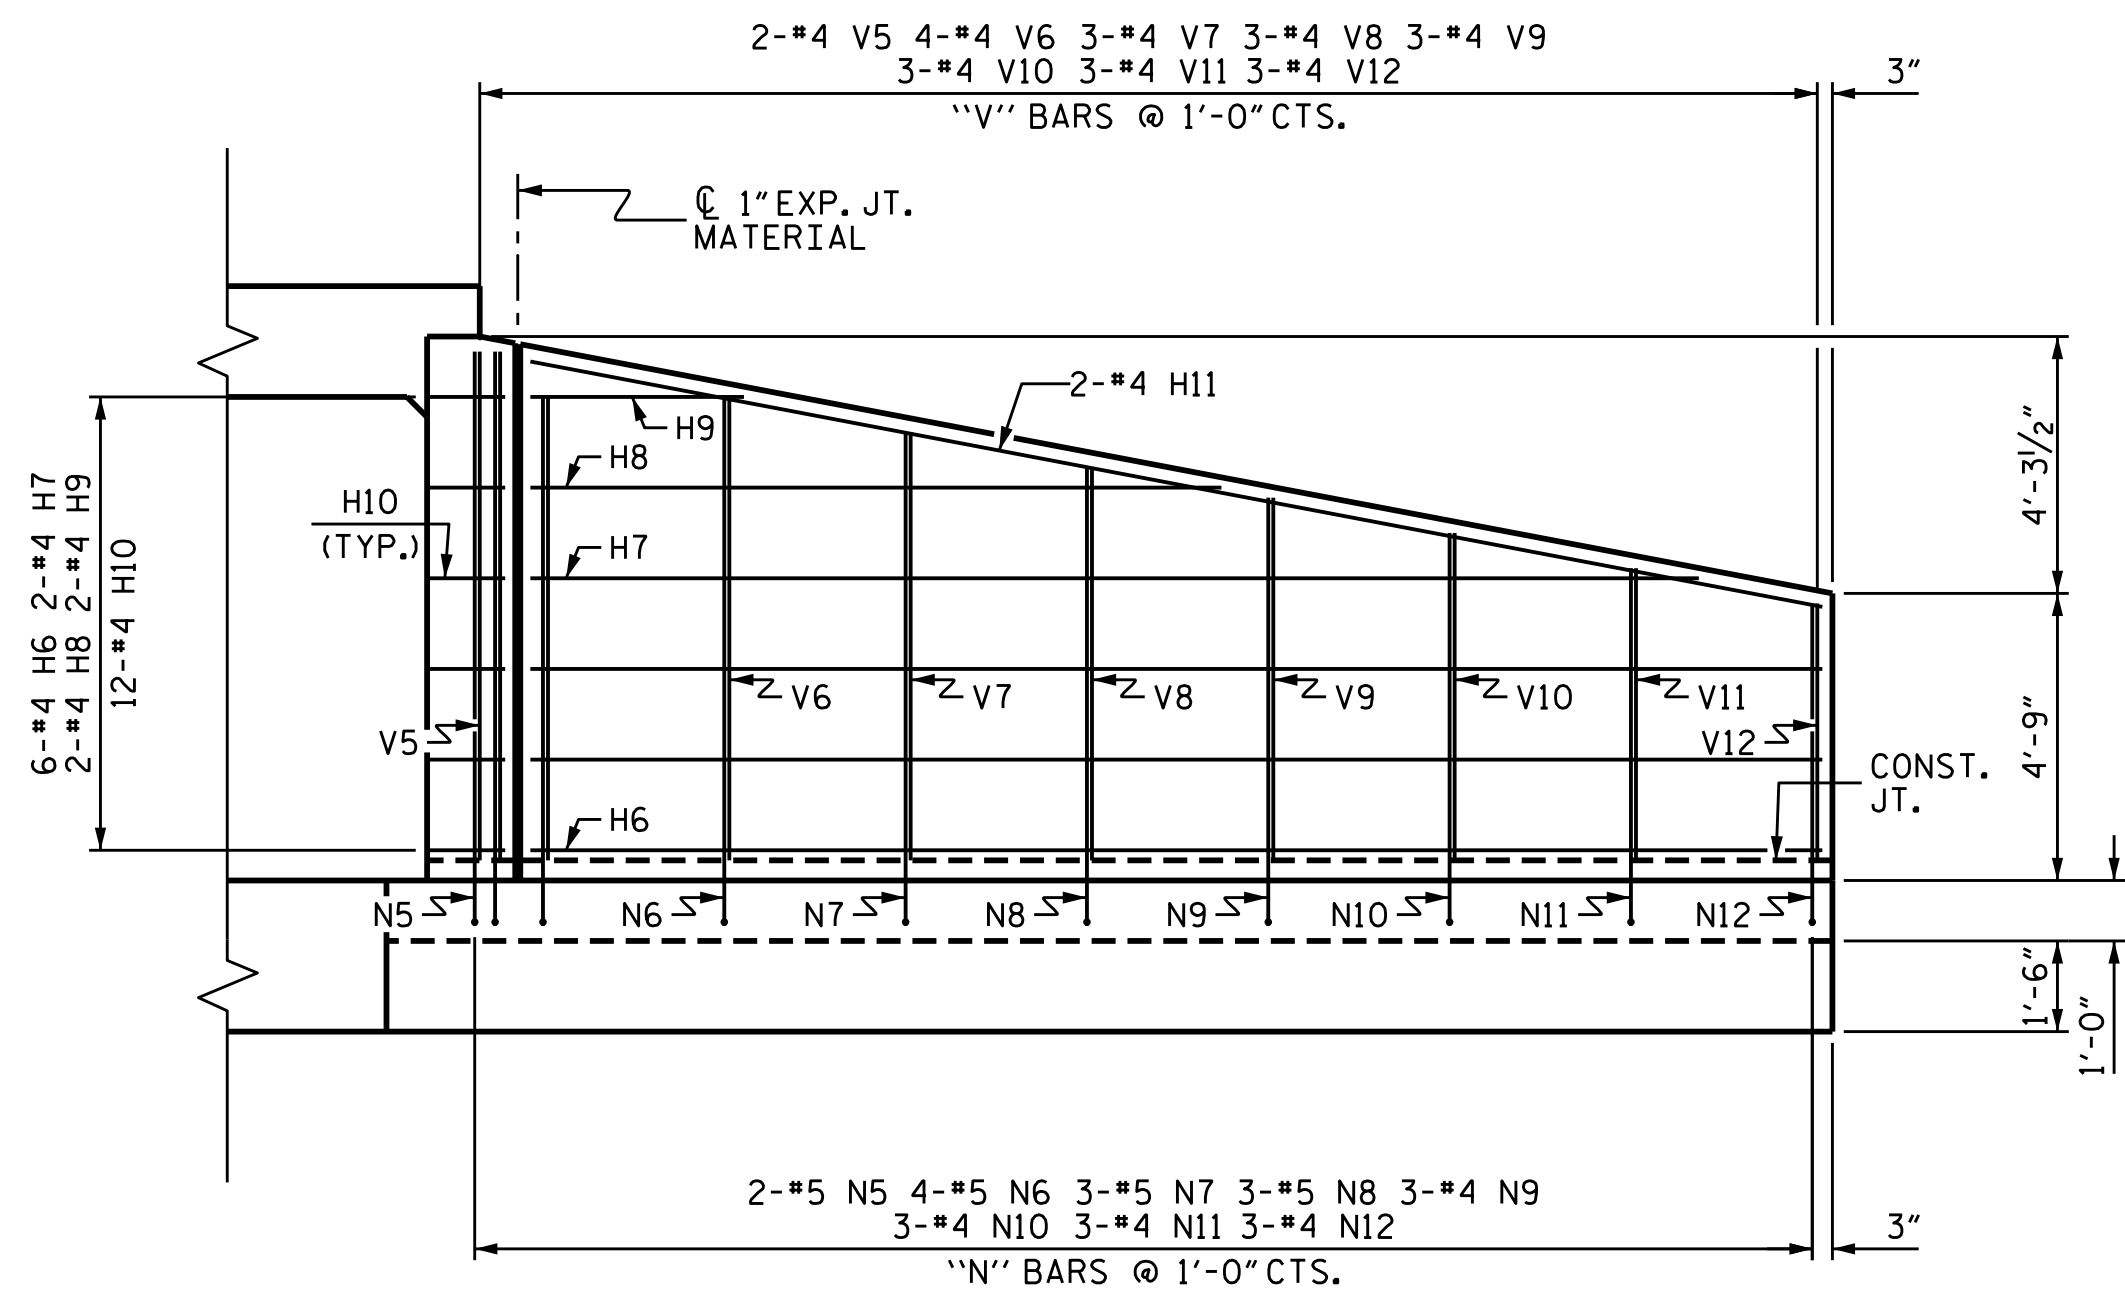

ELEVATION W1

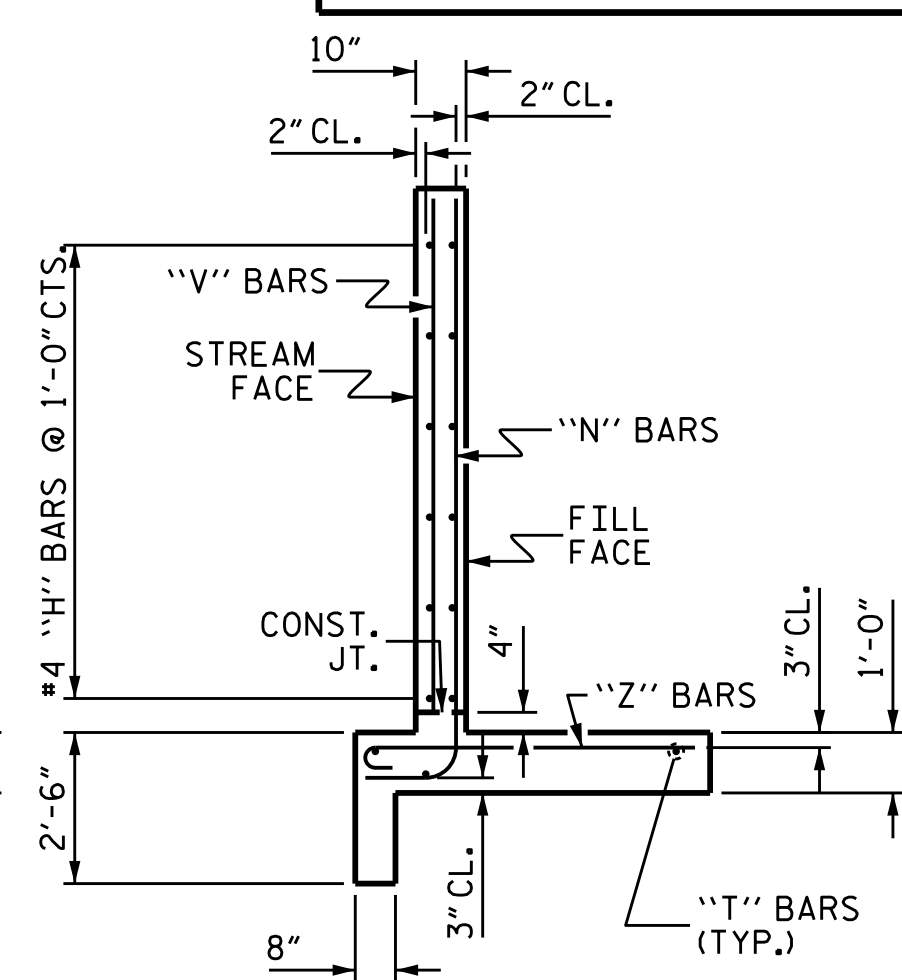

TYPICAL WING SECTION

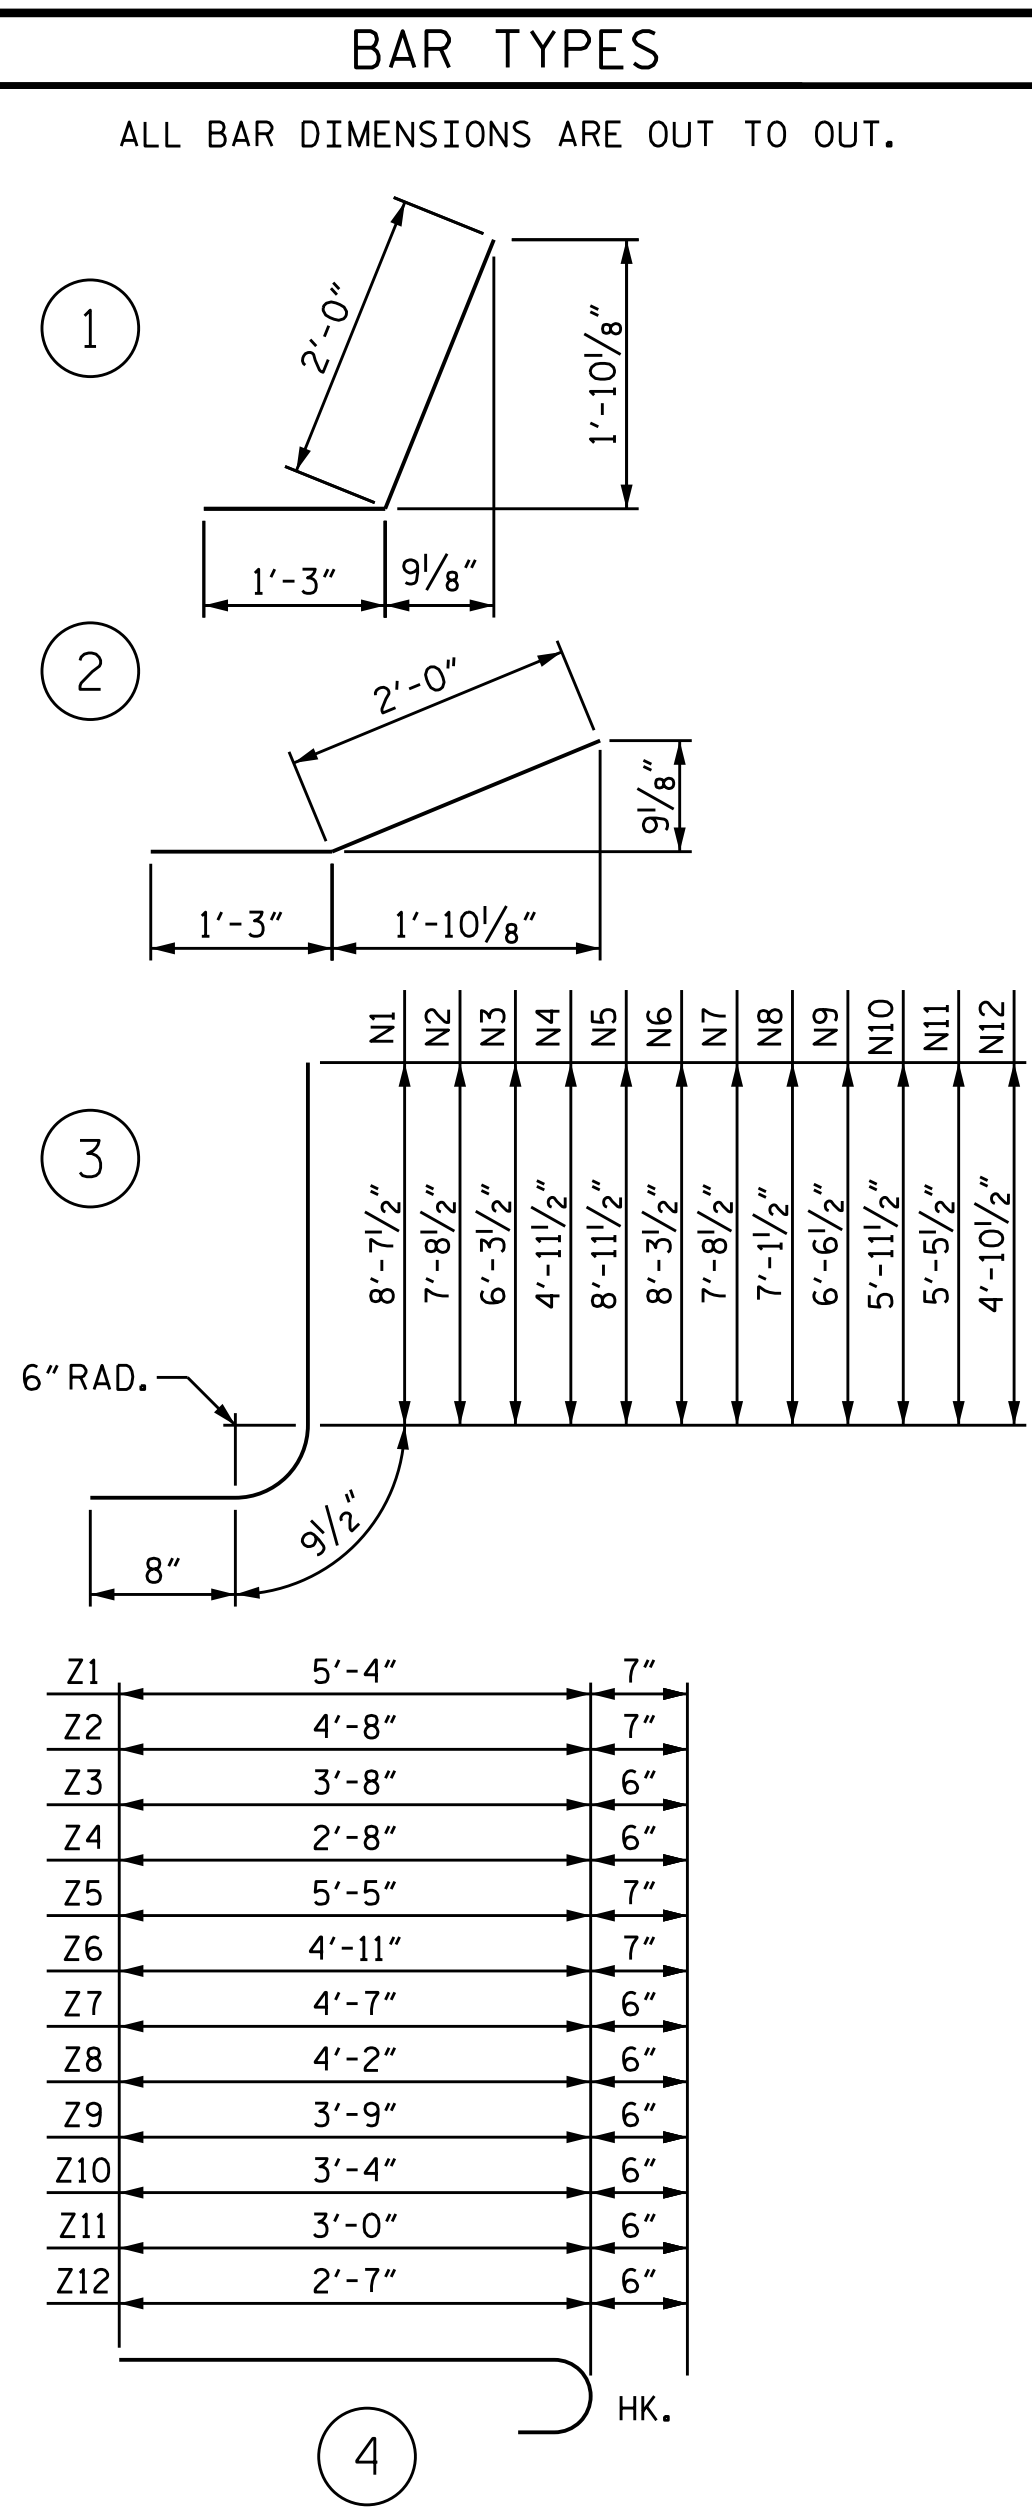


Z1	5'-4"	7"
Z2	4'-8"	7"
Z3	3'-8"	6"
Z4	2'-8"	6"
Z5	5'-5"	7"
Z6	4'-11"	7"
Z7	4'-7"	6"
Z8	4'-2"	6"
Z9	3'-9"	6"
Z10	3'-4"	6"
Z11	3'-0"	6"
Z12	2'-7"	6"

BILL OF MATERIAL					
BAR NO.	SIZE	TYPE	LENGTH	WEIGHT	
H1	12	#4	STR	7'-7"	61
H2	4	#4	STR	6'-10"	18
H3	4	#4	STR	3'-7"	10
H4	24	#4	1	3'-3"	52
H5	4	#4	STR	8'-5"	22
H6	12	#4	STR	21'-4"	171
H7	4	#4	STR	19'-4"	52
H8	4	#4	STR	11'-5"	31
H9	4	#4	STR	3'-6"	9
H10	24	#4	2	3'-3"	52
H11	4	#4	STR	21'-9"	58
N1	4	#5	3	10'-1"	42
N2	4	#5	3	9'-2"	38
N3	6	#5	3	7'-9"	48
N4	6	#4	3	6'-5"	26
N5	4	#5	3	10'-5"	43
N6	8	#5	3	9'-9"	81
N7	6	#5	3	9'-2"	57
N8	6	#5	3	8'-7"	54
N9	6	#4	3	8'-0"	32
N10	6	#4	3	7'-5"	30
N11	6	#4	3	6'-11"	28
N12	6	#4	3	6'-4"	25
S1	12	#6	STR	6'-0"	108
T1	4	#5	STR	9'-6"	40
T2	2	#5	STR	9'-3"	19
T3	4	#5	STR	23'-3"	97
T4	2	#5	STR	22'-7"	47
V1	4	#4	STR	8'-1"	22
V2	4	#4	STR	7'-1"	19
V3	6	#4	STR	5'-9"	23
V4	6	#4	STR	4'-4"	17
V5	4	#4	STR	8'-5"	22
V6	8	#4	STR	7'-8"	41
V7	6	#4	STR	7'-1"	28
V8	6	#4	STR	6'-6"	26
V9	6	#4	STR	6'-0"	24
V10	6	#4	STR	5'-5"	22
V11	6	#4	STR	4'-10"	19
V12	6	#4	STR	4'-3"	17
Z1	4	#5	4	5'-11"	25
Z2	4	#5	4	5'-3"	22
Z3	6	#4	4	4'-2"	17
Z4	6	#4	4	3'-2"	13
Z5	4	#5	4	6'-0"	25
Z6	8	#5	4	5'-6"	46
Z7	6	#4	4	5'-1"	20
Z8	6	#4	4	4'-8"	19
Z9	6	#4	4	4'-3"	17
Z10	6	#4	4	3'-10"	15
Z11	6	#4	4	3'-6"	14
Z12	6	#4	4	3'-1"	12

REINFORCING STEEL FOR 4 WINGS	1876 LBS
CLASS A CONCRETE 4 WINGS	29.1 CY
2 HEADWALLS	2.9 CY
2 END CURTAIN WALLS	3.4 CY
TOTAL	35.4 CY

PROJECT NO. U-3109A
 ALAMANCE COUNTY
 STATION: 19+77.00 -Y10-

SHEET 4 OF 5
 STATE OF NORTH CAROLINA
 DEPARTMENT OF TRANSPORTATION
 RALEIGH
 STANDARD WINGS
 FOR
 CONCRETE BOX CULVERT
 H = 8'-0" SLOPE = 2:1
 45° OR 135° SKEW

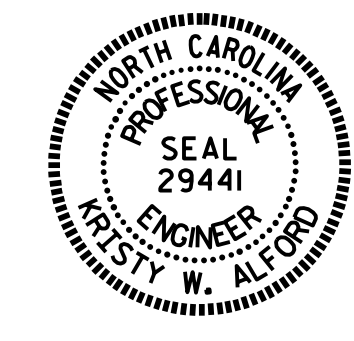

ASSEMBLED BY: A.C. OUTLAW DATE: 4/25/14
 CHECKED BY: W.F. PARKER DATE: 5/14
 DRAWN BY: CCJ 01/00
 CHECKED BY: RWW 03/00

DOCUMENT NOT CONSIDERED FINAL
 UNLESS ALL SIGNATURES COMPLETED

REVISIONS						SHEET NO.
NO.	BY:	DATE:	NO.	BY:	DATE:	C3-4
1			3			TOTAL SHEETS
2			4			5

**LOAD AND RESISTANCE FACTOR RATING (LRFR)
SUMMARY FOR REINFORCED CONCRETE BOX CULVERTS**

LEVEL	VEHICLE	WEIGHT (W) (TONS)	CONTROLLING LOAD RATING #	MINIMUM RATING FACTORS (RF)	TONS = W x RF	STRENGTH I LIMIT STATE								COMMENT NUMBER		
						MOMENT				SHEAR						
						LIVE-LOAD FACTORS (LL)	RATING FACTOR	BOX NO.	ELEMENT TYPE	DISTANCE FROM LEFT END OF ELEMENT (ft)	RATING FACTOR	BOX NO.	ELEMENT TYPE		DISTANCE FROM LEFT END OF ELEMENT (ft)	
DESIGN LOAD RATING	HL-93 (INVENTORY)	N/A	①	1.02	--	1.75	1.02	1	TOP SLAB	4.80	1.34	1	TOP SLAB	9.70		
	HL-93 (OPERATING)	N/A		1.32	--	1.35	1.32	1	TOP SLAB	4.80	1.74	1	TOP SLAB	9.70		
	HS-20 (INVENTORY)	36.000	②	1.33	47.70	1.75	1.33	1	TOP SLAB	4.53	1.44	1	BOTTOM SLAB	9.67		
	HS-20 (OPERATING)	36.000		1.72	61.84	1.35	1.72	1	TOP SLAB	4.53	1.86	1	BOTTOM SLAB	9.67		
LEGAL LOAD RATING	SINGLE VEHICLE (SV)	SNSH	13.500		2.40	32.40	1.40	2.40	1	TOP SLAB	4.53	2.87	1	TOP SLAB	9.70	
		SNGARBS2	20.000		2.25	44.96	1.40	2.25	1	TOP SLAB	4.53	2.64	1	TOP SLAB	9.70	
		SNAGRIS2	22.000		2.40	52.79	1.40	2.40	1	TOP SLAB	4.53	2.63	1	BOTTOM SLAB	9.67	
		SNCOTTS3	27.250	③	1.27	34.67	1.40	1.27	1	TOP SLAB	4.53	1.66	1	TOP SLAB	9.70	
		SNAGGRS4	34.925		1.57	54.73	1.40	1.57	1	TOP SLAB	4.80	1.80	1	BOTTOM SLAB	9.67	
		SNS5A	35.550		1.47	52.32	1.40	1.47	1	TOP SLAB	4.53	1.73	1	TOP SLAB	9.70	
		SNS6A	39.950		1.47	58.80	1.40	1.47	1	TOP SLAB	4.53	1.71	1	BOTTOM SLAB	9.67	
		SNS7B	42.000		1.53	64.10	1.40	1.53	1	TOP SLAB	4.53	1.68	1	BOTTOM SLAB	9.67	
	TRUCK TRACTOR SEMI-TRAILER (TTST)	TNAGRIT3	33.000		2.12	69.92	1.40	2.40	1	TOP SLAB	4.53	2.12	1	BOTTOM SLAB	9.67	
		TNT4A	33.075		1.51	50.04	1.40	1.51	1	TOP SLAB	4.53	1.97	1	TOP OF SLAB	9.70	
		TNT6A	41.600		1.57	65.13	1.40	1.57	1	TOP SLAB	4.80	1.73	1	TOP OF SLAB	9.70	
		TNT7A	42.000		1.63	68.58	1.40	1.63	1	TOP SLAB	4.53	1.84	1	TOP OF SLAB	9.70	
		TNT7B	42.000		1.51	63.54	1.40	1.51	1	TOP SLAB	4.53	1.80	1	TOP OF SLAB	9.70	
		TNAGRIT4	43.000		1.44	62.11	1.40	1.44	1	TOP SLAB	4.53	1.77	1	BOTTOM SLAB	9.67	
TNAGT5A	45.000		1.48	66.42	1.40	1.48	1	TOP SLAB	4.53	1.60	1	BOTTOM SLAB	9.67			
TNAGT5B	45.000		1.51	67.74	1.40	1.51	1	TOP SLAB	4.53	1.51	1	BOTTOM SLAB	9.67			

LOAD FACTORS:


DESIGN LOAD RATING FACTORS

LOAD TYPE	MAX FACTOR	MIN FACTOR
DC	1.25	0.90
DW	1.50	0.65
EV	1.30	0.90
EH	1.35	0.90
ES	1.35	0.90
LS	1.75	--
WA	1.00	--

NOTE:

RATING FACTORS ARE BASED ON THE STRENGTH I LIMIT STATE.

#	CONTROLLING LOAD RATING
①	DESIGN LOAD RATING (HL-93)
②	DESIGN LOAD RATING (HS-20)
③	LEGAL LOAD RATING **
** SEE CHART FOR VEHICLE TYPE	

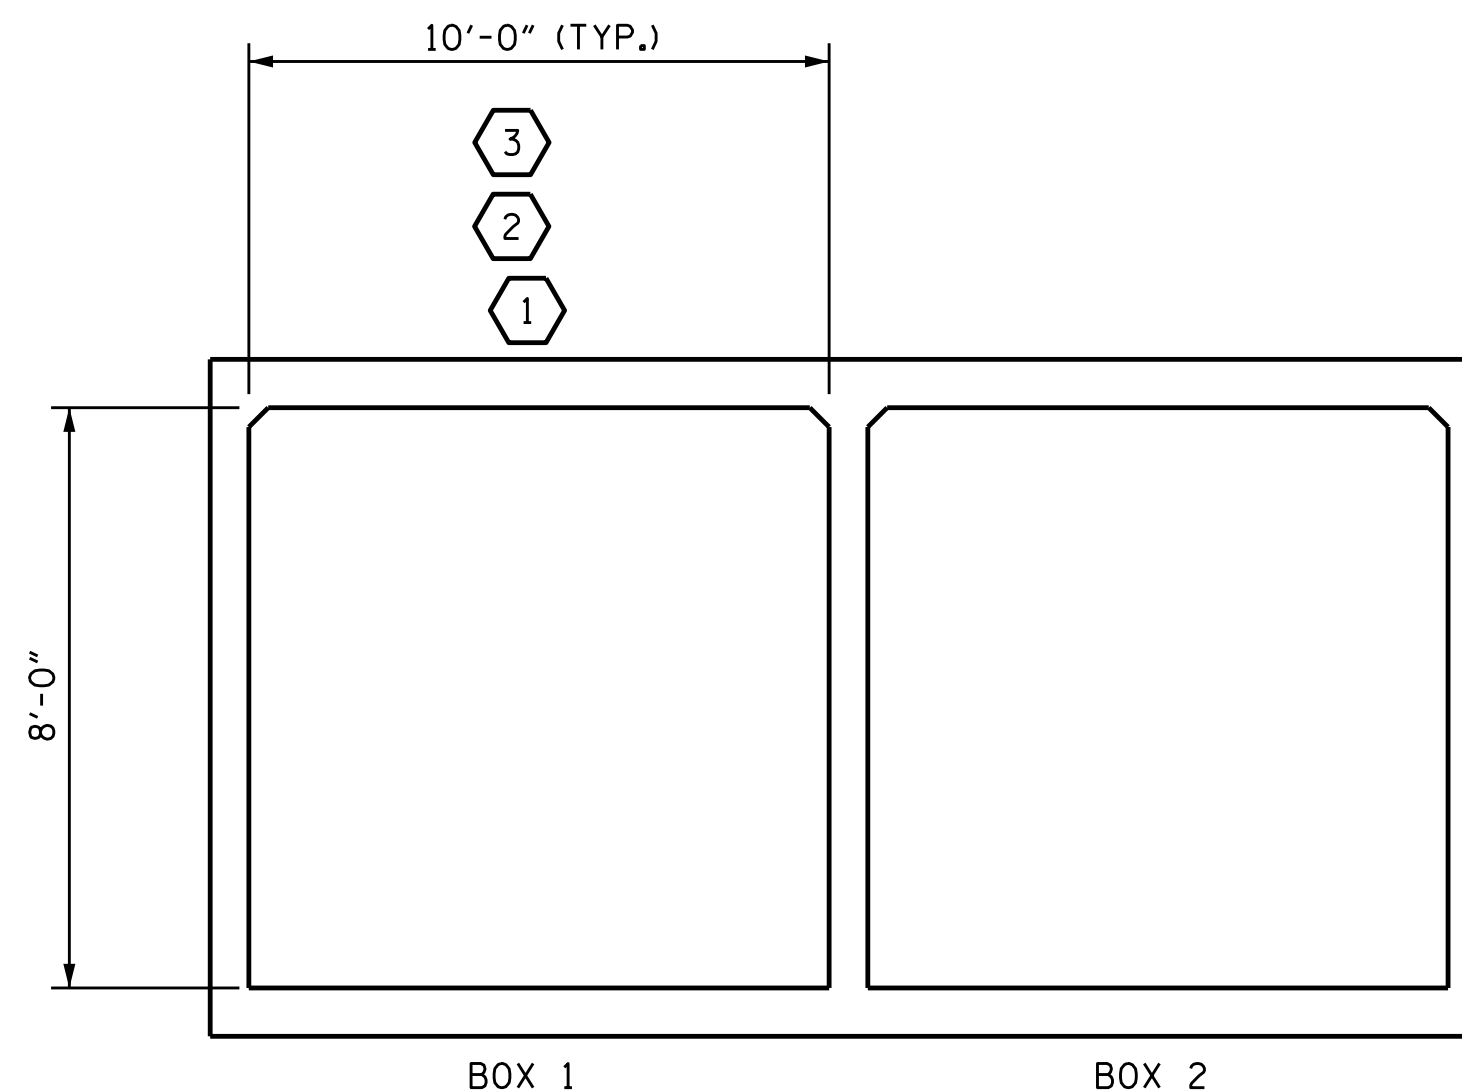

LRFR SUMMARY
(LOOKING DOWNSTREAM)

PROJECT NO. U-3109A
ALAMANCE COUNTY
STATION: 19+77.00 -Y10-

SHEET 5 OF 5



STATE OF NORTH CAROLINA
DEPARTMENT OF TRANSPORTATION
RALEIGH
STANDARD
LRFR SUMMARY FOR
REINFORCED CONCRETE
BOX CULVERTS
(NON-INTERSTATE TRAFFIC)

Designed by: *Kristy W. Alford*
F2458389308F40E
3/16/2017

REVISIONS						SHEET NO.
NO.	BY:	DATE:	NO.	BY:	DATE:	TOTAL SHEETS
1			3			C3-5
2			4			5

DOCUMENT NOT CONSIDERED FINAL
UNLESS ALL SIGNATURES COMPLETED

ASSEMBLED BY : A.C. OUTLAW	DATE : 4/24/14
CHECKED BY : K.W. ALFORD	DATE : 2/17
DRAWN BY : WMC	7/11
CHECKED BY : GM	7/11
REV. 10/1/11	MAA/GM