



STATE OF NORTH CAROLINA  
DEPARTMENT OF TRANSPORTATION

ROY COOPER  
GOVERNOR

JAMES H. TROGDON, III  
SECRETARY

February 27, 2019

**Addendum No. 2**

RE: Contract # C204177

WBS # 34360.3.4

F. A. # NHF-0070 (049)

**Carteret-Craven Counties (R-1015)**

US-70 (Havelock Bypass) From North of Pine Grove To North  
Of Carteret County Line

**March 19, 2019 Letting**

To Whom It May Concern:

Reference is made to the plans and proposal form furnished to you on this project.

The following revisions have been made to the Structure plans:

Sheet No.	Revision
S03-4	Revised TOTAL BILL OF MATERIAL to adjust quantities for HP 12x53 Steel Piles and Pile Driving Equipment Setup for HP 12x53 Steel Piles
S03-32	Revised quantities for HP 12x53 Steel Piles and Pile Driving Equipment Setup for HP 12x53 Steel Piles
S9-20	Revised to show the correct amount of Epoxy Coated Reinforcing Steel in SUPERSTRUCTURE BILL OF MATERIAL
S12-13	Revised to add anchor bolt length in SECTION E-E

Please void the above listed existing Sheets in your plans and staple the revised Sheets thereto.

Mailing Address:  
NC DEPARTMENT OF TRANSPORTATION  
CONTRACT STANDARDS AND DEVELOPMENT  
1591 MAIL SERVICE CENTER  
RALEIGH, NC 27699-1591

Telephone: (919) 707-6900  
Fax: (919) 250-4127  
Customer Service: 1-877-368-4968

Location:  
1020 BIRCH RIDGE DR.  
RALEIGH, NC 27610

Website: [www.ncdot.gov](http://www.ncdot.gov)

The following revisions have been made to the Roadway plans:

Sheet No.	Revision
3B-2	Revised to separate the earthwork for service road (SERVEXT) from the Mainline (L).
New EC-17C thru EC-17E	Sheets added for Sta. 244+09 -L- pipe culvert construction sequence.
New EC-36A and EC-36B	Sheets added for Sta. 509+41 -L- pipe culvert construction sequence.
UO-5, UO-9, UO-10, UO-17, UO-18, UO-19, UO-22, UO-23	Revised to add Piedmont Natural Gas and Duke Energy Progress utilities.

Please void the above listed existing Sheets in your plans and staple the revised Sheets thereto. Please staple the new Sheets EC-17C thru EC-17E after existing Sheet EC-17B in your plans. Please staple the new Sheets EC-36A and EC-36B after existing Sheet EC-36 in your plans.

The following revisions have been made to the Cross Sections:

Sheet No.	Revision
Cross Section Index Sheet	Revised to reflect the separation of earthwork for service road (SERVEXT) from the Mainline (L)
X-1E, X-1F, X-1J	Revised to separate the earthwork for service road (SERVEXT) from the Mainline (L)

Please void the above listed existing Sheets in your plans and staple the revised Sheets thereto.

The following revisions have been made to the proposal:

Page No.	Revisions
Proposal Cover	Note added that reads "Includes Addendum No. 2 Dated 02-27-2019"
UoO-3	Revised I.2. to read, "Utility location unknown"
EC-33 thru EC-39 and new pages EC-40 thru EC-42	Revised and added pages to add project special provisions entitled TEMPORARY PIPE FOR CULVERT CONSTRUCTION and COMPOST BLANKET
ST-46	Revised section 8. A.

Please void the above listed existing Pages in your proposal and staple the revised Pages thereto. Please staple the new Pages EC-40 thru EC-42 after existing Page EC-39 in your proposal.

On the item sheets the following pay items revisions have been made:

<u>Item</u>	<u>Description</u>	<u>Old Quantity</u>	<u>New Quantity</u>
0028-0196000000-E-270	GEOTEXTILE FOR SOIL STABILIZATION	72,500 SY	74,600 SY
0084-1491000000-E-610	ASPHALT CONC BASE COURSE, TYPE B25.0C	53,560 TON	20,880 TON
0085-1503000000-E-610	ASPHALT CONC INTERMEDIATE COURSE, TYPE I19.0C	156,730	139,880 TON
0086-1519000000-E-610	ASPHALT CONC SURFACE COURSE, TYPE S9.5B	28,470 TON	13,100 TON
0087-1523000000-E-610	ASPHALT CONC SURFACE COURSE, TYPE S9.5C	109,310 TON	98,960 TON
0088-1575000000-E-620	ASPHALT BINDER FOR PLANT MIX	18,400 TON	14,470 TON
0226-6069000000-E-1638	STILLING BASINS	700 CY	1,250 CY
0227-6070000000-N-1639	SPECIAL STILLING BASINS	26 EA	38 EA
0230-6071030000-E-1640	COIR FIBER BAFFLE	20,000 LF	20,100 LF
0239-6111000000-E-SP	IMPERVIOUS DIKE	1,275 LF	2,100 LF
0243-6120000000-E-SP	CULVERT DIVERSION CHANNEL PILE DRIVING	3,132 CY	4,175 CY
0360-8328200000-E-450	EQUIPMENT SETUP FOR *** STEEL PILES (HP12X53)	575 EA	576 EA
0364-8364000000-E-450	HP12X53 STEEL PILES	43,865 LF	43,970 EA
0383-0015000000-N-205	SEALING ABANDONED WELLS	New Item	25 EA
0384-6045000000-E-SP	72" TEMPORARY PIPE	New Item	85 LF
0385-6135000000-E-SP	COMPOST BLANKET	New Item	5 ACR

The Contractor's bid must include these pay item revisions and additions.

The electronic bidding file has been updated to reflect these revisions. Please download the Addendum File and follow the instructions for applying the addendum. Bid Express will not accept your bid unless the addendum has been applied.

The contract will be prepared accordingly.

Sincerely,

DocuSigned by:  
*Ronald E. Davenport, Jr.*  
F81B6038A47A442...

Ronald E. Davenport, Jr., PE  
State Contract Officer

RED/jjr  
Attachments

cc: Mr. Lamar Sylvester, PE  
Mr. Preston Hunter, PE  
Mr. Ron Hancock, PE  
Mr. Jon Weathersbee, PE  
Mr. Ken Kennedy, PE  
Ms. Lori Strickland  
Project File (2)

Mr. Ray Arnold, PE  
Mr. Jamie Lancaster, PE  
Ms. Jaci Kincaid  
Mr. Mike Gwyn  
Mr. Alex J. Foster, PE  
Ms. Penny Higgins  
Mr. Mitchell Dixon

STATE OF NORTH CAROLINA  
DEPARTMENT OF TRANSPORTATION  
RALEIGH, N.C.

PROPOSAL

**INCLUDES ADDENDUM No. 2 DATED 02-27-2019**

DATE AND TIME OF BID OPENING: **MARCH 19, 2019 AT 2:00 PM**

CONTRACT ID C204177  
WBS 34360.3.4

FEDERAL-AID NO. NHF-0070(049)  
COUNTY CARTERET, CRAVEN  
T.I.P. NO. R-1015  
MILES 10.353  
ROUTE NO. US 70  
LOCATION US-70 (HAVELOCK BYPASS) FROM NORTH OF PINE GROVE TO NORTH OF  
CARTERET COUNTY LINE.

TYPE OF WORK GRADING, DRAINAGE, PAVING, SIGNALS & STRUCTURES.

**NOTICE:**

ALL BIDDERS SHALL COMPLY WITH ALL APPLICABLE LAWS REGULATING THE PRACTICE OF GENERAL CONTRACTING AS CONTAINED IN CHAPTER 87 OF THE GENERAL STATUTES OF NORTH CAROLINA WHICH REQUIRES THE BIDDER TO BE LICENSED BY THE N.C. LICENSING BOARD FOR CONTRACTORS WHEN BIDDING ON ANY NON-FEDERAL AID PROJECT WHERE THE BID IS \$30,000 OR MORE, EXCEPT FOR CERTAIN SPECIALTY WORK AS DETERMINED BY THE LICENSING BOARD. BIDDERS SHALL ALSO COMPLY WITH ALL OTHER APPLICABLE LAWS REGULATING THE PRACTICES OF ELECTRICAL, PLUMBING, HEATING AND AIR CONDITIONING AND REFRIGERATION CONTRACTING AS CONTAINED IN CHAPTER 87 OF THE GENERAL STATUTES OF NORTH CAROLINA. NOTWITHSTANDING THESE LIMITATIONS ON BIDDING, THE BIDDER WHO IS AWARDED ANY FEDERAL - AID FUNDED PROJECT SHALL COMPLY WITH CHAPTER 87 OF THE GENERAL STATUTES OF NORTH CAROLINA FOR LICENSING REQUIREMENTS WITHIN 60 CALENDAR DAYS OF BID OPENING.

BIDS WILL BE RECEIVED AS SHOWN BELOW:

THIS IS A ROADWAY & STRUCTURE PROPOSAL

**5% BID BOND OR BID DEPOSIT REQUIRED**

---

PROJECT SPECIAL PROVISIONS

Utilities by Others

F. Telecommunications – Charter Communications

1. Charter Communications will relocate facilities by April 30, 2020.
2. See UbO plan for details
3. Contact person: Jason Stone (252).514-5893

G. Telecommunications – Spirit Communications

1. Spirit Communications will relocate facilities by April 30, 2020.
2. See UbO plan for details
3. Contact person: Scott Williford (336).937-1743

H. Telecommunications – MCNC

1. MCNC will relocate facilities by April 30, 2020.
2. See UbO plan for details
3. Contact person: Scott Williford (336).937-1743

I. Telecommunications – City of New Bern (Fiber)

1. City of New Bern will relocate facilities by April 30, 2020.
2. Utility location unknown
3. Contact person: Mike Harper (252).639-2840

J. Gas – Piedmont Natural Gas (PNG)

1. Piedmont Natural Gas will relocate their facilities by October 31, 2020.
2. Piedmont Natural Gas will cooperate with contractor to sequence work ahead of construction. PNG inspectors must be on-site to during any work over the PNG lines. Contact Joe Keily to request inspectors. Allow a two (2) week notice when requesting inspectors.
3. See UbO plan for details
4. Contact person: Joe Keily (910).358-0537

**Measurement and Payment**

*Impervious Dike* will be measured and paid as the actual number of linear feet of impervious dike(s) constructed, measured in place from end to end of each separate installation that has been completed and accepted. Such price and payment will be full compensation for all work including but not limited to furnishing materials, construction, maintenance, and removal of the impervious dike.

Payment will be made under:

Pay Item	Pay Unit
Impervious Dike	Linear Foot

**TEMPORARY PIPE FOR CULVERT CONSTRUCTION:****Description**

This work consists of furnishing, installing, maintaining and removing any and all temporary pipe used on this project in conjunction with the culvert construction.

**Construction Methods**

The Contractor shall install temporary pipe in locations shown on the plans in such a manner approved by the Engineer. The temporary pipe shall provide a passageway for the stream through the work-site. The minimum size requirements will be as stated on the erosion control plans.

**Measurement and Payment**

   " *Temporary Pipe* will be measured and paid for at the contract unit price per linear foot of temporary pipe approved by the Engineer and measured in place from end to end. Such price and payment will be full compensation for all work covered by this section including but not limited to furnishing all materials required for installation, construction, maintenance, and removal of temporary pipe.

Payment will be made under:

Pay Item	Pay Unit
<u>   </u> " Temporary Pipe	Linear Foot

**COIR FIBER MAT:****Description**

Furnish material, install and maintain coir fiber mat in locations shown on the plans or in locations as directed. Work includes providing all materials, excavating and backfilling, and placing and securing coir fiber mat with stakes, steel reinforcement bars or staples as directed.

**Materials**

<b>Item</b>	<b>Section</b>
Coir Fiber Mat	1060-14

Anchors: Stakes, reinforcement bars, or staples shall be used as anchors.

**Wooden Stakes:**

Provide hardwood stakes 12"- 24" long with a 2" x 2" nominal square cross section. One end of the stake must be sharpened or beveled to facilitate driving through the coir fiber mat and down into the underlying soil. The other end of the stake needs to have a 1"- 2" long head at the top with a 1"- 2" notch following to catch and secure the coir fiber mat.

**Steel Reinforcement Bars:**

Provide uncoated #10 steel reinforcement bars 24" nominal length. The bars shall have a 4" diameter bend at one end with a 4" straight section at the tip to catch and secure the coir fiber mat.

**Staples:**

Provide staples made of 0.125" diameter new steel wire formed into a *u* shape not less than 12" in length with a throat of 1" in width.

**Construction Methods**

Place the coir fiber mat immediately upon final grading. Provide a smooth soil surface free from stones, clods, or debris that will prevent the contact of the mat with the soil. Unroll the mat and apply without stretching such that it will lie smoothly but loosely on the soil surface.

For stream relocation applications, take care to preserve the required line, grade, and cross section of the area covered. Bury the top slope end of each piece of mat in a narrow trench at least 6 in. deep and tamp firmly. Where one roll of matting ends and a second roll begins, overlap the end of the upper roll over the buried end of the second roll so there is a 6 in. overlap. Construct check trenches at least 12 in. deep every 50 ft. longitudinally along the edges of the mat or as directed. Fold over and bury mat to the full depth of the trench, close and tamp firmly. Overlap mat at least 6 in. where 2 or more widths of mat are installed side by side.

Place anchors across the mat at the ends approximately 1 ft. apart. Place anchors along the outer edges and down the center of the mat 3 ft. apart.

Adjustments in the trenching or anchoring requirements to fit individual site conditions may be required.



**Measurement and Payment**

*Coir Fiber Mat* will be measured and paid for as the actual number of square yards measured along the surface of the ground over which coir fiber mat is installed and accepted.

No measurement will be made for anchor items.

Payment will be made under:

<b>Pay Item</b>	<b>Pay Unit</b>
Coir Fiber Mat	Square Yard

**CONCRETE WASHOUT STRUCTURE:**

(09-07-18)

**Description**

Concrete washout structures are enclosures above or below grade to contain concrete waste water and associated concrete mix from washing out ready-mix trucks, drums, pumps, or other equipment. Concrete washouts must collect and retain all the concrete washout water and solids, so that this material does not migrate to surface waters or into the ground water. These enclosures are not intended for concrete waste not associated with wash out operations.

The concrete washout structure may include constructed devices above or below ground and or commercially available devices designed specifically to capture concrete wash water.

**Materials**

<b>Item</b>	<b>Section</b>
Temporary Silt Fence	1605

*Safety Fence* shall meet the specifications as provided elsewhere in this contract.

Geomembrane basin liner shall meet the following minimum physical properties for low permeability; it shall consist of a polypropylene or polyethylene 10 mil thick geomembrane. If the minimum setback dimensions can be achieved the liner is not required. (5 feet above groundwater, 50 feet from top of bank of perennial stream, other surface water body, or wetland.)

**Construction Methods**

Build an enclosed earthen berm or excavate to form an enclosure in accordance with the details and as directed.

Install temporary silt fence around the perimeter of the enclosure in accordance with the details and as directed if structure is not located in an area where existing erosion and sedimentation control devices are capable to containing any loss of sediment.

Post a sign with the words "Concrete Washout" in close proximity of the concrete washout area, so it is clearly visible to site personnel. Install safety fence as directed for visibility to construction traffic.

The construction details for the above grade and below grade concrete washout structures can be found on the following web page link:

<https://inside.ncdot.gov/stage/connect/resources/roadside/SoilWaterDocuments/ConcreteWashoutStructuredetail.pdf>

Alternate details for accommodating concrete washout may be submitted for review and approval. The alternate details shall include the method used to retain and dispose of the concrete waste water within the project limits and in accordance with the minimum setback requirements. (5 feet above groundwater, 50 feet from top of bank of perennial stream, other surface water body, or wetland.)

**Maintenance and Removal**

Maintain the concrete washout structure(s) to provide adequate holding capacity plus a minimum freeboard of 12 inches. Remove and dispose of hardened concrete and return the structure to a functional condition after reaching 75% capacity.

Inspect concrete washout structures for damage and maintain for effectiveness.

Remove the concrete washout structures and sign upon project completion. Grade the earth material to match the existing contours and permanently seed and mulch area.

**Measurement and Payment**

*Concrete Washout Structure* will be paid for per each enclosure installed in accordance with the details. If alternate details are approved then those details will also be paid for per each approved and installed device.

*Temporary Silt Fence* will be measured and paid for in accordance with Article 1605-5 of the *Standard Specifications*.

No measurement will be made for other items or for over excavation or stockpiling.

Payment will be made under:

<b>Pay Item</b>	<b>Pay Unit</b>
Concrete Washout Structure	Each

**COMPOST BLANKET:**

(8-23-17)

**Description**

This work shall consist of furnishing, installing, maintaining, and seeding a water permeable *Compost Blanket* to reduce soil erosion and sediment by promoting the establishment of vegetation on sandy soils where vegetation is difficult to establish. Compost Blanket will not be shown on the plans but it will be installed on fill slopes 2:1 or steeper or as directed.

**Materials****Compost:**

Compost used for Compost Blankets shall be weed free and derived from a well-decomposed source of organic matter. The compost shall be produced using an aerobic composting process meeting CFR 503 regulations, including time and temperature data indicating effective weed seed, pathogen, and insect larvae kill. The compost shall be free of any refuse, contaminants or other materials toxic to plant growth. Non-composted products will not be accepted. Test methods for the items below should follow USCC TMECC guidelines for laboratory procedures:

1. pH between 5.0-8.0 in accordance with TMECC 04.11-A, "Electrometric pH Determinations for Compost".
2. For seeded Compost Blankets, seed should be incorporated at the time of application in the entire depth of the compost blanket, at rates per foot, per square yard, or per acre, as acceptable to the engineer. The following particle sizes shall also be followed: 100% passing a 2" sieve; 99% passing a 1" sieve; minimum of 60% passing a ½" sieve. All other testing parameters remain the same. The seeding rates are generally similar or slightly higher than those used when considering application of seed via hydroseeding or other seeding methods.
3. Moisture content of less than 60% in accordance with standardized test methods for moisture determination.
4. Material shall be relatively free (<1% by dry weight) of inert or foreign man made materials.
5. A sample shall be submitted to the engineer for approval prior to being used and must comply with all local, state and federal regulations.

**Construction Methods**

1. Compost Blankets will be placed as directed. Unless otherwise specified, Compost Blankets should be installed at a minimum depth of 1".
2. The Compost Blanket shall be seeded at time of installation for establishment of permanent vegetation. The Engineer will specify seeding requirements.
3. Compost Blankets are not to be used in direct flow situations or in runoff channels.
4. The type and rate of seed, fertilizer and lime shall be in accordance with the Seeding and Mulching provisions of this contract and as directed.

**Maintenance**

1. The Contractor shall perform routine inspections and maintain the Compost Blanket in a functional condition at all times.
2. Where the Compost Blanket fails, it will be routinely repaired.
3. The Compost Blanket will be seeded on site, at rates and seed types as determined by the Engineer. Once vegetation is established, final seeding is not required.

**Performance**

1. The Contractor is responsible for establishing a working erosion control system and may, with approval of the Engineer, work outside the minimum construction requirements as needed.
2. Where the Compost Blanket deteriorates or fails, it will be repaired or replaced with a more effective approved alternative.

**Measurement and Payment**

The Contractor shall provide the Engineer with proof that a minimum 1" thick Compost Blanket has been applied after settling. This rate equals approximately 270 cubic yards of compost material per acre of application area. The Contractor shall supply satisfactory evidence that the specified amount of material has been effectively placed (i.e., truck load tickets).

*Compost Blanket* will be measured and paid for as the actual number of acres measured along the surface of the ground over which the Compost Blanket is installed and accepted.

Payment will be made under:

<b>Pay Item</b>	<b>Pay Unit</b>
Compost Blanket	Acre

**EQUIPMENT CLEANING FOR NATIONAL FOREST SERVICE LANDS**

(2-4-19)

All construction equipment, including but not limited to cranes, graders, pans, excavators, loaders, and dump trucks, shall be cleaned prior to being brought into the National Forest Service (NFS) lands construction areas to ensure they are free of seeds, rhizomes, or other propagules. Cleaning may be done with pressure washing or other acceptable methods sufficient to remove this material. Equipment shall be visually inspected for vegetation when moving from delineated non-native invasive species sites to ensure that seeds or other propagules are not transported outside of those areas. No direct payment will be made for Equipment Cleaning for National Forest Service Lands.

**MANAGEMENT OF NON-NATIVE INVASIVE SPECIES**

(11-6-18)

Minimize removal of native vegetation within NCDOT right-of-way within Nation Forest System (NFS) lands to prevent the encroachment of non-native invasive species (NNIS) onto NFS lands. To control the spread of NNIS on NFS lands, areas will be identified and delineated with flagging at the direction of USFS for targeted removal of NNIS. NNIS delineated areas within the proposed fill shall be cleared and grubbed and the material disposed of outside the limits of the NFS land. Within identified areas of NNIS in proposed cuts, excavation of material should include the actual thickness of root mat or other defined amount and shall be disposed of outside the limits of the NFS land.

Use of mowing as a control method for NNIS shall be timed to avoid spreading seeds (e.g. before seed set) to the extent possible.

**HERBICIDE APPLICATION ON NATIONAL FOREST LANDS**

(02-04-19)

Herbicide application shall comply with section 1060-13 of NCDOT's *Standard Specification for Roads and Structures* as well as all guidelines and mitigation measures presented in Forest Manual 2150, *Pesticide-Use Management and Coordination*, and Forest Service Handbook 2109.14, *Pesticide Use Management and Coordination Handbook*. United States Forest Service (USFS) approval is required for non-routine maintenance on National Forest Service (NFS) lands or prior to use of herbicides not contained within the manuals. Prior to herbicide application, an herbicide treatment plan shall be submitted for review by forest resource specialists in areas of wildlife biology, botany, aquatics, soils, recreation, and heritage resources.

The use of broadcast sprays for herbicides and pesticides on NFS lands is not permitted. Herbicides and pesticides will only be used in specific areas on NFS lands in consultation with the USFS. Coordination with the USFS on any mechanical methods that would be allowed.

Herbicide application within NFS lands shall also conform to the following:

- A) Along stream edges and banks, wide-angle cone tip nozzle guards shall be used on the end of herbicide applicator wands. All herbicides will be sprayed away from any water in ephemeral and perennial streams, vernal pools, or lakes. Aquatic-labeled herbicides shall be used when within 150 feet of any live water. Only surfactants/adjuvants with low toxicity to aquatic species will be used in these areas.

- B) When conducting chemical control of targeted Non-native Invasive Species (NNIS) within 10 feet of any identified USFS Rare Plant Species populations, the following guidelines apply:
- All the rare plant species occurrences shall be flagged or marked prior to treatment sufficient to avoid any off-target effects and “No Treatment” signs shall be posted at rare plant sites along the roadway.
  - No chemical treatment shall occur within 1 foot of the rare plant. Cover rare plants or place an appropriate barrier adjacent to them prior to applying herbicide within 10 feet of the plants. For vining species, pull the vines outside one foot of adjacent rare plants.
  - For larger woody stems with diameters 1 inch or greater, apply herbicide to cut stem surfaces. Apply herbicides to cut stems with a small wick applicator or with a spray bottle to minimize drift.
  - For smaller woody NNIS stems, broadcast treatment is allowable at the the only feasible treatment if no other viable option is available at the direction of the engineer. Stems shall be cut and herbicide applied only after re-sprouting from 6-inches to 1 foot in height. While spraying the re-sprouting foliage, place a barrier (such as an appropriately sized cardboard sheet) next to the rare plant species or cover the rare plant species with an appropriate container.

#### **Application**

Apply herbicides following approved treatment plan to targeted non-native invasive species at delineated sites in accordance with this provision. Reapply as directed until targeted non-native invasive species have been eliminated.

#### **Measurement and Payment**

*Herbicide Application for Non-Native Invasive Species* shall be measured and paid for as the actual number of man hours worked while applying herbicide treatment, as directed. Where an area has had herbicide applied previously, as directed, separate measurement will also be made for each subsequent application of herbicide.

Payment will be made under:

<b>Pay Item</b>	<b>Pay Unit</b>
Herbicide Application for Non-Native Invasive Species	MHR

#### **REMOVAL OF NNIS VIA MECHANICAL METHODS ON NFS LANDS**

When conducting mechanical control by hand, NNIS capable of starting new plants (seeds, rhizomes, root mats, etc.) require proper disposal outside the limits of the NFS lands. Plants should be bagged and moved off site. Bagged plants will receive standard garbage disposal. For large woody bushes that would be difficult to move, treatments will be scheduled prior to seed

set as practical. Coordination with the USFS on any mechanical methods that would be allowed for NNIS will be needed. No direct payment will be made for Removal of NNIS Via Mechanical Methods on NFS Lands.

**NATURAL FIBER MATTING:**

(11-2-18)

**Description**

This work consists of furnishing, installing and maintaining *Natural Fiber Matting*, of the type specified, in locations shown on the plans or in locations as directed. Work includes providing all materials, placing and securing natural fiber matting with stakes or staples as directed.

**Materials**

The product shall be a temporary erosion control mat and shall be constructed of weed free 100% grain straw, a combination of coir and grain straw, or curled wood excelsior fibers evenly distributed throughout the mat between a biodegradable bottom and top netting made of jute or cotton fibers or other biodegradable organic material. The matting shall be stitched together with a degradable thread. The mat shall meet following physical properties:

- (A) Straw Natural Fiber Matting shall consist of a machine produced mat of 100% grain straw. The straw natural fiber matting shall have a width of at least 48 inches and no more than 90 inches and weighing at least 0.50 lb/sy and no more than 0.75 lb/sy. Evenly distribute the straw over the entire area of the blanket between a woven biodegradable bottom and top netting made of jute, cotton fibers or other biodegradable organic material with a maximum mesh (netting) size of 0.75 inch x 0.75 inch (or maximum opening of 0.60 square inches) sewn together with a degradable thread. The grain straw shall contain no weed seeds.
- (B) Straw-Coir Natural Fiber Matting shall be a blend of no more that 70% grain straw of consistent thickness with the straw and coir evenly distributed over the entire area of the mat. The straw-coir natural fiber matting shall have a width of at least 48 inches and no more than 90 inches and weighing at least 0.50 lb/sy. The blanket shall be covered on the top and bottom sides with a woven biodegradable bottom and top netting made of jute, cotton fibers or other biodegradable organic material with a maximum mesh (netting) size of 0.75 inch x 0.75 inch (or maximum opening of 0.60 square inches) sewn together with a degradable thread. The grain straw shall contain no weed seeds.
- (C) Excelsior Natural Fiber Matting shall be made of weed free, curled wood excelsior fibers with 80% of the fibers six inches or greater length. The excelsior natural fiber matting shall have a width of at least 48 inches and no more than 90 inches and weighing at least 0.975 lb/sy. Evenly distribute the excelsior over the entire area of the blanket between a woven biodegradable netting made of jute, cotton fibers or other biodegradable organic material with a maximum mesh (netting) size of 1.0 inch x 1.0 inch sewn together with a degradable thread. Netless excelsior fiber matting is acceptable for slopes 3:1 or

shallower meeting a minimum weight of 0.70 lb/sy (+/- 10%) with stitch spacing no more than 2 inches on center.

### **Construction Methods**

Matting shall be installed in accordance with Subarticle 1631-3 of the *Standard Specifications*.

All areas to be matted shall be brought to final grade and seeded in accordance with Section 1660 of the *Standard Specifications*. The surface of the soil shall be smooth, firm, stable and free of rocks, clods, roots or other obstructions that would prevent the mat from lying in direct contact with the soil surface. Areas where the mat is to be placed will not need to be mulched.

### **Measurement and Payment**

*Natural Fiber Matting* will be measured and paid for as the actual number of square yards measured along the surface of the ground over which Natural Fiber Matting is installed and accepted. Overlaps will not be included in the measurement and will be considered as incidental to the work. Such payment shall be full compensation for furnishing and installing the mat, including overlaps, and for all required maintenance.

Payment will be made under:

<b>Pay Item</b>	<b>Pay Unit</b>
Natural Fiber Matting	Square Yard



above estimates of flagging costs are provided for information only and are not binding in any way.

**D. Verification:**

1. Railroad's flagman will electronically enter flagging time via Railroad's electronic billing system. Any complaints concerning flagging must be resolved in a timely manner. If the need for flagging is questioned, please contact the Railroad Engineer. All verbal complaints will be confirmed in writing by the Contractor within 5 working days with a copy to the Department Engineer. Address all written correspondence electronically to Railroad Engineer.
  2. The Railroad flagman assigned to the project will be responsible for notifying the Department Engineer upon arrival at the job site on the first day (or as soon thereafter as possible) that flagging services begin and on the last day that he performs such services for each separate period that services are provided. The Department's Engineer will document such notification in the project records. When requested, the Department Engineer will also sign the flagman's diary showing daily time spent and activity at the project site.
- 8. HAUL ACROSS RAILROAD TRACK:**
- A. Where the plans show or imply that materials of any nature must be hauled across tracks of the Company or Railroad, unless the plans clearly show that the Department has included arrangements for such haul in its agreement with the Railroad, the Contractor will be required to make all necessary arrangements with the Railroad regarding means of transporting such materials across the tracks of the Company or Railroad. The Department will be required to bear all railroad costs incidental to such crossings, including flagging, materials and services performed by Railroad personnel. The Contractor shall sequence construction to minimize the duration the crossing(s) remain in-place. Cost of the installation, maintenance and removal of the temporary crossing(s) incurred by the Contractor will be considered incidental to the other pay items.
  - B. No crossing may be established for use of the Contractor for transporting materials or equipment across the tracks of the company or Railroad unless specific authority for its installation, maintenance, necessary watching and flagging thereof and removal, until a temporary private crossing agreement has been executed between the Contractor and Railroad. The approval process for an agreement normally takes 90 days.
- 9. WORK FOR THE BENEFIT OF THE CONTRACTOR:**
- A. All temporary or permanent changes in wire lines or other facilities owned by the Company or Railroad and which are considered necessary to the project are shown on the plans; included in the force account agreement between the Department and the Railroad or will be covered by appropriate revisions to same which will be initiated and approved by the Department and/or the Railroad.
  - B. Should the Contractor desire any changes in addition to the above, then he shall make separate arrangements with the Railroad for same to be accomplished at the Contractor's expense.

County : Carteret, Craven

Line #	Item Number	Sec #	Description	Quantity	Unit Cost	Amount
<b>ROADWAY ITEMS</b>						
0001	0000100000-N	800	MOBILIZATION	Lump Sum	L.S.	
0002	0000400000-N	801	CONSTRUCTION SURVEYING	Lump Sum	L.S.	
0003	0000700000-N	SP	FIELD OFFICE	Lump Sum	L.S.	
0004	0000900000-N	SP	GENERIC MISCELLANEOUS ITEM UTILITY COORDINATOR	Lump Sum	L.S.	
0005	0028000000-N	SP	TYPE I STANDARD APPROACH FILL STATION ***** (138+69.74 -L-)	Lump Sum	L.S.	
0006	0028000000-N	SP	TYPE I STANDARD APPROACH FILL STATION ***** (139+25.54 -L-)	Lump Sum	L.S.	
0007	0028000000-N	SP	TYPE I STANDARD APPROACH FILL STATION ***** (176+32.00 -L- LT)	Lump Sum	L.S.	
0008	0028000000-N	SP	TYPE I STANDARD APPROACH FILL STATION ***** (176+32.00 -L- RT)	Lump Sum	L.S.	
0009	0028000000-N	SP	TYPE I STANDARD APPROACH FILL STATION ***** (227+54.13 -L-)	Lump Sum	L.S.	
0010	0028000000-N	SP	TYPE I STANDARD APPROACH FILL STATION ***** (227+59.99 -L-)	Lump Sum	L.S.	
0011	0028000000-N	SP	TYPE I STANDARD APPROACH FILL STATION ***** (288+29.87 -L- LT)	Lump Sum	L.S.	
0012	0028000000-N	SP	TYPE I STANDARD APPROACH FILL STATION ***** (288+29.87 -L- RT)	Lump Sum	L.S.	
0013	0028000000-N	SP	TYPE I STANDARD APPROACH FILL STATION ***** (44+71.82 -Y4-)	Lump Sum	L.S.	
0014	0028000000-N	SP	TYPE I STANDARD APPROACH FILL STATION ***** (506+32.25 -L-)	Lump Sum	L.S.	

County : Carteret, Craven

Line #	Item Number	Sec #	Description	Quantity	Unit Cost	Amount
0015	0028000000-N	SP	TYPE I STANDARD APPROACH FILL STATION ***** (506+47.11 -L-)	Lump Sum	L.S.	
0016	0028000000-N	SP	TYPE I STANDARD APPROACH FILL STATION ***** (52+32.96 -Y3-)	Lump Sum	L.S.	
0017	0029000000-N	SP	TYPE III REINFORCED APPROACH FILL, STATION ***** (11+50.20 -RP1AB-)	Lump Sum	L.S.	
0018	0029000000-N	SP	TYPE III REINFORCED APPROACH FILL, STATION ***** (12+01.81 -RP1AB-)	Lump Sum	L.S.	
0019	0029000000-N	SP	TYPE III REINFORCED APPROACH FILL, STATION ***** (516+87.37 -L- LT)	Lump Sum	L.S.	
0020	0029000000-N	SP	TYPE III REINFORCED APPROACH FILL, STATION ***** (516+87.37 -L- RT)	Lump Sum	L.S.	
0021	0036000000-E	225	UNDERCUT EXCAVATION	96,000 CY		
0022	0050000000-E	226	SUPPLEMENTARY CLEARING & GRUB- BING	5 ACR		
0023	0063000000-N	SP	GRADING	Lump Sum	L.S.	
0024	0106000000-E	230	BORROW EXCAVATION	5,793,000 CY		
0025	0127000000-N	235	EMBANKMENT SETTLEMENT GAUGES	2 EA		
0026	0134000000-E	240	DRAINAGE DITCH EXCAVATION	9,730 CY		
0027	0194000000-E	265	SELECT GRANULAR MATERIAL, CLASS III	150,000 CY		
0028	0196000000-E	270	GEOTEXTILE FOR SOIL STABILIZA- TION	74,600 SY		
0029	0199000000-E	SP	TEMPORARY SHORING	1,341.2 SF		
0030	0241000000-E	SP	GENERIC GRADING ITEM GEOTEXTILE FOR EMBANKMENT STA- BILIZATION	6,000 SY		

County : Carteret, Craven

Line #	Item Number	Sec #	Description	Quantity	Unit Cost	Amount
0031	0255000000-E	SP	GENERIC GRADING ITEM HAULING & DISPOSAL OF PETROLEUM CONTAMINATED SOIL	100 TON		
0032	0318000000-E	300	FOUNDATION CONDITIONING MATE- RIAL, MINOR STRUCTURES	5,260 TON		
0033	0320000000-E	300	FOUNDATION CONDITIONING GEO- TEXTILE	16,520 SY		
0034	0342000000-E	310	*** SIDE DRAIN PIPE (30")	88 LF		
0035	0342000000-E	310	*** SIDE DRAIN PIPE (36")	52 LF		
0036	0342000000-E	310	*** SIDE DRAIN PIPE (60")	116 LF		
0037	0342000000-E	310	*** SIDE DRAIN PIPE (84")	76 LF		
0038	0343000000-E	310	15" SIDE DRAIN PIPE	524 LF		
0039	0344000000-E	310	18" SIDE DRAIN PIPE	980 LF		
0040	0345000000-E	310	24" SIDE DRAIN PIPE	272 LF		
0041	0354000000-E	310	**** RC PIPE CULVERTS, CLASS ***** (15", V)	548 LF		
0042	0354000000-E	310	**** RC PIPE CULVERTS, CLASS ***** (18", V)	400 LF		
0043	0354000000-E	310	**** RC PIPE CULVERTS, CLASS ***** (24", V)	416 LF		
0044	0354000000-E	310	**** RC PIPE CULVERTS, CLASS ***** (30", V)	548 LF		
0045	0354000000-E	310	**** RC PIPE CULVERTS, CLASS ***** (36", V)	3,064 LF		

County : Carteret, Craven

Line #	Item Number	Sec #	Description	Quantity	Unit Cost	Amount
0046	0354000000-E	310	**** RC PIPE CULVERTS, CLASS ***** (42", V)	388	LF	
0047	0354000000-E	310	**** RC PIPE CULVERTS, CLASS ***** (72", V)	664	LF	
0048	0354000000-E	310	**** RC PIPE CULVERTS, CLASS ***** (84", V)	728	LF	
0049	0366000000-E	310	15" RC PIPE CULVERTS, CLASS III	3,580	LF	
0050	0372000000-E	310	18" RC PIPE CULVERTS, CLASS III	1,664	LF	
0051	0378000000-E	310	24" RC PIPE CULVERTS, CLASS III	684	LF	
0052	0384000000-E	310	30" RC PIPE CULVERTS, CLASS III	732	LF	
0053	0390000000-E	310	36" RC PIPE CULVERTS, CLASS III	1,436	LF	
0054	0396000000-E	310	42" RC PIPE CULVERTS, CLASS III	628	LF	
0055	0402000000-E	310	48" RC PIPE CULVERTS, CLASS III	192	LF	
0056	0414000000-E	310	60" RC PIPE CULVERTS, CLASS III	92	LF	
0057	0426000000-E	310	72" RC PIPE CULVERTS, CLASS III	404	LF	
0058	0448000000-E	310	***** RC PIPE CULVERTS, CLASS IV (48")	720	LF	
0059	0448000000-E	310	***** RC PIPE CULVERTS, CLASS IV (72")	932	LF	
0060	0448000000-E	310	***** RC PIPE CULVERTS, CLASS IV (84")	388	LF	

County : Carteret, Craven

Line #	Item Number	Sec #	Description	Quantity	Unit Cost	Amount
0061	0448200000-E	310	15" RC PIPE CULVERTS, CLASS IV	10,972 LF		
0062	0448300000-E	310	18" RC PIPE CULVERTS, CLASS IV	2,460 LF		
0063	0448400000-E	310	24" RC PIPE CULVERTS, CLASS IV	580 LF		
0064	0448500000-E	310	30" RC PIPE CULVERTS, CLASS IV	388 LF		
0065	0448600000-E	310	36" RC PIPE CULVERTS, CLASS IV	8,212 LF		
0066	0448700000-E	310	42" RC PIPE CULVERTS, CLASS IV	396 LF		
0067	0546000000-E	310	*** CAA PIPE CULVERTS, ***** THICK (15", 0.064")	5,464 LF		
0068	0546000000-E	310	*** CAA PIPE CULVERTS, ***** THICK (18", 0.064")	694 LF		
0069	0546000000-E	310	*** CAA PIPE CULVERTS, ***** THICK (24", 0.064")	76 LF		
0070	0564000000-E	310	*** CAA PIPE ELBOWS, ***** THICK (15", 0.064")	150 EA		
0071	0564000000-E	310	*** CAA PIPE ELBOWS, ***** THICK (18", 0.064")	30 EA		
0072	0564000000-E	310	*** CAA PIPE ELBOWS, ***** THICK (24", 0.064")	4 EA		
0073	0995000000-E	340	PIPE REMOVAL	3,991 LF		
0074	0996000000-N	350	PIPE CLEAN OUT	3 EA		
0075	1000000000-E	462	6" SLOPE PROTECTION	250 SY		
0076	1077000000-E	SP	#57 STONE	400 TON		
0077	1099500000-E	505	SHALLOW UNDERCUT	1,000 CY		

County : Carteret, Craven

Line #	Item Number	Sec #	Description	Quantity	Unit Cost	Amount
0078	1099700000-E	505	CLASS IV SUBGRADE STABILIZATION	2,550 TON		
0079	1111000000-E	SP	CLASS IV AGGREGATE STABILIZATION	50,600 TON		
0080	1121000000-E	520	AGGREGATE BASE COURSE	272,400 TON		
0081	1220000000-E	545	INCIDENTAL STONE BASE	2,500 TON		
0082	1275000000-E	600	PRIME COAT	14,290 GAL		
0083	1330000000-E	607	INCIDENTAL MILLING	1,500 SY		
0084	1491000000-E	610	ASPHALT CONC BASE COURSE, TYPE B25.0C	20,880 TON		
0085	1503000000-E	610	ASPHALT CONC INTERMEDIATE COURSE, TYPE I19.0C	139,880 TON		
0086	1519000000-E	610	ASPHALT CONC SURFACE COURSE, TYPE S9.5B	13,100 TON		
0087	1523000000-E	610	ASPHALT CONC SURFACE COURSE, TYPE S9.5C	98,960 TON		
0088	1575000000-E	620	ASPHALT BINDER FOR PLANT MIX	14,470 TON		
0089	1693000000-E	654	ASPHALT PLANT MIX, PAVEMENT REPAIR	1,300 TON		
0090	1840000000-E	665	MILLED RUMBLE STRIPS (ASPHALT CONCRETE)	215,500 LF		
0091	2000000000-N	806	RIGHT-OF-WAY MARKERS	97 EA		
0092	2020000000-N	806	CONTROL-OF-ACCESS MARKERS	147 EA		
0093	2022000000-E	815	SUBDRAIN EXCAVATION	1,434 CY		
0094	2026000000-E	815	GEOTEXTILE FOR SUBSURFACE DRAINS	6,400 SY		
0095	2036000000-E	815	SUBDRAIN COARSE AGGREGATE	1,075 CY		

County : Carteret, Craven

Line #	Item Number	Sec #	Description	Quantity	Unit Cost	Amount
0096	2044000000-E	815	6" PERFORATED SUBDRAIN PIPE	6,400		
					LF	
0097	2070000000-N	815	SUBDRAIN PIPE OUTLET	13		
					EA	
0098	2077000000-E	815	6" OUTLET PIPE	78		
					LF	
0099	2209000000-E	838	ENDWALLS	134.3		
					CY	
0100	2220000000-E	838	REINFORCED ENDWALLS	101.1		
					CY	
0101	2286000000-N	840	MASONRY DRAINAGE STRUCTURES	331		
					EA	
0102	2297000000-E	840	MASONRY DRAINAGE STRUCTURES	9.2		
					CY	
0103	2308000000-E	840	MASONRY DRAINAGE STRUCTURES	60.1		
					LF	
0104	2364000000-N	840	FRAME WITH TWO GRATES, STD 840.16	13		
					EA	
0105	2364200000-N	840	FRAME WITH TWO GRATES, STD 840.20	137		
					EA	
0106	2365000000-N	840	FRAME WITH TWO GRATES, STD 840.22	133		
					EA	
0107	2366000000-N	840	FRAME WITH TWO GRATES, STD 840.24	11		
					EA	
0108	2367000000-N	840	FRAME WITH TWO GRATES, STD 840.29	31		
					EA	
0109	2374000000-N	840	FRAME WITH GRATE & HOOD, STD 840.03, TYPE ** (E)	3		
					EA	
0110	2374000000-N	840	FRAME WITH GRATE & HOOD, STD 840.03, TYPE ** (F)	2		
					EA	
0111	2374000000-N	840	FRAME WITH GRATE & HOOD, STD 840.03, TYPE ** (G)	2		
					EA	
0112	2396000000-N	840	FRAME WITH COVER, STD 840.54	2		
					EA	



County : Carteret, Craven

Line #	Item Number	Sec #	Description	Quantity	Unit Cost	Amount
0113	2451000000-N	852	CONCRETE TRANSITIONAL SECTION FOR DROP INLET	9 EA		
0114	2542000000-E	846	1'-6" CONCRETE CURB & GUTTER	3,760 LF		
0115	2549000000-E	846	2'-6" CONCRETE CURB & GUTTER	1,780 LF		
0116	2556000000-E	846	SHOULDER BERM GUTTER	29,970 LF		
0117	2577000000-E	846	CONCRETE EXPRESSWAY GUTTER	2,400 LF		
0118	2591000000-E	848	4" CONCRETE SIDEWALK	100 SY		
0119	2612000000-E	848	6" CONCRETE DRIVEWAY	40 SY		
0120	2647000000-E	852	5" MONOLITHIC CONCRETE ISLANDS (SURFACE MOUNTED)	50 SY		
0121	2724000000-E	857	PRECAST REINFORCED CONCRETE BARRIER, SINGLE FACED	1,239 LF		
0122	2752000000-E	SP	GENERIC PAVING ITEM MEDIAN HAZARD PROTECTION	426 LF		
0123	2815000000-N	858	ADJUSTMENT OF DROP INLETS	3 EA		
0124	3001000000-N	SP	IMPACT ATTENUATOR UNITS, TYPE TL-3	8 EA		
0125	3030000000-E	862	STEEL BEAM GUARDRAIL	50,425 LF		
0126	3210000000-N	862	GUARDRAIL END UNITS, TYPE CAT-1	22 EA		
0127	3215000000-N	SP	GUARDRAIL ANCHOR UNITS, TYPE III	8 EA		
0128	3287000000-N	SP	GUARDRAIL END UNITS, TYPE TL-3	53 EA		
0129	3288000000-N	SP	GUARDRAIL END UNITS, TYPE TL-2	2 EA		
0130	3317000000-N	SP	GUARDRAIL ANCHOR UNITS, TYPE B-77	63 EA		
0131	3360000000-E	863	REMOVE EXISTING GUARDRAIL	640 LF		

County : Carteret, Craven

Line #	Item Number	Sec #	Description	Quantity	Unit Cost	Amount
0132	3380000000-E	862	TEMPORARY STEEL BEAM GUARDRAIL	888	LF	
0133	3389150000-N	SP	TEMPORARY GUARDRAIL END UNITS, TYPE ***** (TL-2)	4	EA	
0134	3389200000-E	865	CABLE GUIDERAIL	47,250	LF	
0135	3389500000-N	865	ADDITIONAL GUIDERAIL POSTS	18	EA	
0136	3389600000-N	865	CABLE GUIDERAIL ANCHOR UNITS	36	EA	
0137	3503000000-E	866	WOVEN WIRE FENCE, 47" FABRIC	108,660	LF	
0138	3509000000-E	866	4" TIMBER FENCE POSTS, 7'-6" LONG	6,920	EA	
0139	3515000000-E	866	5" TIMBER FENCE POSTS, 8'-0" LONG	1,550	EA	
0140	3578000000-N	SP	GENERIC FENCING ITEM 16' USFS WELDED PIPE GATES	14	EA	
0141	3628000000-E	876	RIP RAP, CLASS I	2,020	TON	
0142	3649000000-E	876	RIP RAP, CLASS B	900	TON	
0143	3656000000-E	876	GEOTEXTILE FOR DRAINAGE	9,800	SY	
0144	4048000000-E	902	REINFORCED CONCRETE SIGN FOUN- DATIONS	16	CY	
0145	4054000000-E	902	PLAIN CONCRETE SIGN FOUNDA- TIONS	4	CY	
0146	4057000000-E	SP	OVERHEAD FOOTING	148	CY	
0147	4060000000-E	903	SUPPORTS, BREAKAWAY STEEL BEAM	14,533	LB	
0148	4066000000-E	903	SUPPORTS, SIMPLE STEEL BEAM	7,946	LB	
0149	4072000000-E	903	SUPPORTS, 3-LB STEEL U-CHANNEL	306	LF	
0150	4082000000-E	903	SUPPORTS, WOOD	4,474	LF	

County : Carteret, Craven

Line #	Item Number	Sec #	Description	Quantity	Unit Cost	Amount
0151	4082100000-N	906	SUPPORTS, OVERHEAD SIGN STRUCTURE AT STA ***** (22+05 -RP1AB-)	Lump Sum	L.S.	
0152	4082100000-N	906	SUPPORTS, OVERHEAD SIGN STRUCTURE AT STA ***** (42+00 -L-)	Lump Sum	L.S.	
0153	4082100000-N	906	SUPPORTS, OVERHEAD SIGN STRUCTURE AT STA ***** (504+50 -L-)	Lump Sum	L.S.	
0154	4082100000-N	906	SUPPORTS, OVERHEAD SIGN STRUCTURE AT STA ***** (544+00 -L-)	Lump Sum	L.S.	
0155	4082100000-N	906	SUPPORTS, OVERHEAD SIGN STRUCTURE AT STA ***** (57+15 -RP2AC-)	Lump Sum	L.S.	
0156	4082100000-N	906	SUPPORTS, OVERHEAD SIGN STRUCTURE AT STA ***** (58+50 -L-)	Lump Sum	L.S.	
0157	4082100000-N	906	SUPPORTS, OVERHEAD SIGN STRUCTURE AT STA ***** (76+00 -L-)	Lump Sum	L.S.	
0158	4082100000-N	906	SUPPORTS, OVERHEAD SIGN STRUCTURE AT STA ***** (89+84 -L-)	Lump Sum	L.S.	
0159	4096000000-N	904	SIGN ERECTION, TYPE D	12 EA		
0160	4102000000-N	904	SIGN ERECTION, TYPE E	125 EA		
0161	4108000000-N	904	SIGN ERECTION, TYPE F	27 EA		
0162	4109000000-N	904	SIGN ERECTION, TYPE *** (OVERHEAD) (A)	14 EA		
0163	4109000000-N	904	SIGN ERECTION, TYPE *** (OVERHEAD) (B)	7 EA		
0164	4110000000-N	904	SIGN ERECTION, TYPE *** (GROUND MOUNTED) (A)	29 EA		

County : Carteret, Craven

Line #	Item Number	Sec #	Description	Quantity	Unit Cost	Amount
0165	4110000000-N	904	SIGN ERECTION, TYPE *** (GROUND MOUNTED) (B)	22 EA		
0166	4114000000-N	904	SIGN ERECTION, MILEMARKERS	22 EA		
0167	4115000000-N	904	SIGN ERECTION, OVERLAY (OVER- HEAD)	3 EA		
0168	4116100000-N	904	SIGN ERECTION, RELOCATE TYPE **** (GROUND MOUNTED) (E)	8 EA		
0169	4141000000-N	907	DISPOSAL OF SUPPORT, WOOD	8 EA		
0170	4158000000-N	907	DISPOSAL OF SIGN SYSTEM, WOOD	56 EA		
0171	4400000000-E	1110	WORK ZONE SIGNS (STATIONARY)	752 SF		
0172	4405000000-E	1110	WORK ZONE SIGNS (PORTABLE)	832 SF		
0173	4410000000-E	1110	WORK ZONE SIGNS (BARRICADE MOUNTED)	384 SF		
0174	4415000000-N	1115	FLASHING ARROW BOARD	6 EA		
0175	4420000000-N	1120	PORTABLE CHANGEABLE MESSAGE SIGN	4 EA		
0176	4430000000-N	1130	DRUMS	860 EA		
0177	4445000000-E	1145	BARRICADES (TYPE III)	208 LF		
0178	4455000000-N	1150	FLAGGER	60 DAY		
0179	4465000000-N	1160	TEMPORARY CRASH CUSHIONS	3 EA		
0180	4470000000-N	1160	REMOVE & RESET TEMPORARY CRASH CUSHION	1 EA		
0181	4480000000-N	1165	TMA	4 EA		
0182	4485000000-E	1170	PORTABLE CONCRETE BARRIER	5,220 LF		

County : Carteret, Craven

Line #	Item Number	Sec #	Description	Quantity	Unit Cost	Amount
0183	4500000000-E	1170	REMOVE & RESET PORTABLE CONCRETE BARRIER	610 LF		
0184	4510000000-N	1190	LAW ENFORCEMENT	40 HR		
0185	4516000000-N	1180	SKINNY DRUM	500 EA		
0186	4650000000-N	1251	TEMPORARY RAISED PAVEMENT MARKERS	400 EA		
0187	4685000000-E	1205	THERMOPLASTIC PAVEMENT MARKING LINES (4", 90 MILS)	20,359 LF		
0188	4686000000-E	1205	THERMOPLASTIC PAVEMENT MARKING LINES (4", 120 MILS)	24,986 LF		
0189	4688000000-E	1205	THERMOPLASTIC PAVEMENT MARKING LINES (6", 90 MILS)	258,306 LF		
0190	4690000000-E	1205	THERMOPLASTIC PAVEMENT MARKING LINES (6", 120 MILS)	35,807 LF		
0191	4695000000-E	1205	THERMOPLASTIC PAVEMENT MARKING LINES (8", 90 MILS)	249 LF		
0192	4697000000-E	1205	THERMOPLASTIC PAVEMENT MARKING LINES (8", 120 MILS)	465 LF		
0193	4700000000-E	1205	THERMOPLASTIC PAVEMENT MARKING LINES (12", 90 MILS)	9,926 LF		
0194	4702000000-E	1205	THERMOPLASTIC PAVEMENT MARKING LINES (12", 120 MILS)	3,507 LF		
0195	4710000000-E	1205	THERMOPLASTIC PAVEMENT MARKING LINES (24", 120 MILS)	609 LF		
0196	4721000000-E	1205	THERMOPLASTIC PAVEMENT MARKING CHARACTER (120 MILS)	32 EA		
0197	4725000000-E	1205	THERMOPLASTIC PAVEMENT MARKING SYMBOL (90 MILS)	100 EA		
0198	4810000000-E	1205	PAINT PAVEMENT MARKING LINES (4")	51,288 LF		
0199	4815000000-E	1205	PAINT PAVEMENT MARKING LINES (6")	147,366 LF		

County : Carteret, Craven

Line #	Item Number	Sec #	Description	Quantity	Unit Cost	Amount
0200	4835000000-E	1205	PAINT PAVEMENT MARKING LINES (24")	208 LF		
0201	4845000000-N	1205	PAINT PAVEMENT MARKING SYMBOL	10 EA		
0202	4847020000-E	1205	POLYUREA PAVEMENT MARKING LINES (4", 30 MILS)	2,334 LF		
0203	4847040000-E	1205	POLYUREA PAVEMENT MARKING LINES (6", 30 MILS)	18,160 LF		
0204	4847080000-E	1205	POLYUREA PAVEMENT MARKING LINES (12", 30 MILS)	819 LF		
0205	4850000000-E	1205	REMOVAL OF PAVEMENT MARKING LINES (4")	80 LF		
0206	4855000000-E	1205	REMOVAL OF PAVEMENT MARKING LINES (6")	2,500 LF		
0207	4870000000-E	1205	REMOVAL OF PAVEMENT MARKING LINES (24")	20 LF		
0208	4900000000-N	1251	PERMANENT RAISED PAVEMENT MARKERS	147 EA		
0209	4905000000-N	1253	SNOWPLOWABLE PAVEMENT MARKERS	2,693 EA		
0210	6000000000-E	1605	TEMPORARY SILT FENCE	503,715 LF		
0211	6006000000-E	1610	STONE FOR EROSION CONTROL, CLASS A	860 TON		
0212	6009000000-E	1610	STONE FOR EROSION CONTROL, CLASS B	32,100 TON		
0213	6012000000-E	1610	SEDIMENT CONTROL STONE	23,000 TON		
0214	6015000000-E	1615	TEMPORARY MULCHING	560.5 ACR		
0215	6018000000-E	1620	SEED FOR TEMPORARY SEEDING	25,500 LB		
0216	6021000000-E	1620	FERTILIZER FOR TEMPORARY SEEDING	128.5 TON		
0217	6024000000-E	1622	TEMPORARY SLOPE DRAINS	55,000 LF		

County : Carteret, Craven

Line #	Item Number	Sec #	Description	Quantity	Unit Cost	Amount
0218	6029000000-E	SP	SAFETY FENCE	70,000 LF		
0219	6030000000-E	1630	SILT EXCAVATION	65,100 CY		
0220	6036000000-E	1631	MATTING FOR EROSION CONTROL	79,000 SY		
0221	6037000000-E	SP	COIR FIBER MAT	700 SY		
0222	6038000000-E	SP	PERMANENT SOIL REINFORCEMENT MAT	10,550 SY		
0223	6042000000-E	1632	1/4" HARDWARE CLOTH	14,200 LF		
0224	6043000000-E	SP	LOW PERMEABILITY GEOTEXTILE	1,300 SY		
0225	6046000000-E	1636	TEMPORARY PIPE FOR STREAM CROSSING	600 LF		
0226	6069000000-E	1638	STILLING BASINS	1,250 CY		
0227	6070000000-N	1639	SPECIAL STILLING BASINS	38 EA		
0228	6071012000-E	SP	COIR FIBER WATTLE	78,000 LF		
0229	6071020000-E	SP	POLYACRYLAMIDE (PAM)	36,350 LB		
0230	6071030000-E	1640	COIR FIBER BAFFLE	20,100 LF		
0231	6071050000-E	SP	*** SKIMMER (1-1/2")	53 EA		
0232	6071050000-E	SP	*** SKIMMER (2")	4 EA		
0233	6084000000-E	1660	SEEDING & MULCHING	753 ACR		
0234	6087000000-E	1660	MOWING	702 ACR		
0235	6090000000-E	1661	SEED FOR REPAIR SEEDING	5,400 LB		
0236	6093000000-E	1661	FERTILIZER FOR REPAIR SEEDING	30 TON		
0237	6096000000-E	1662	SEED FOR SUPPLEMENTAL SEEDING	18,675 LB		

County : Carteret, Craven

Line #	Item Number	Sec #	Description	Quantity	Unit Cost	Amount
0238	6108000000-E	1665	FERTILIZER TOPDRESSING	560.15	TON	
0239	6111000000-E	SP	IMPERVIOUS DIKE	2,100	LF	
0240	6114500000-N	1667	SPECIALIZED HAND MOWING	450	MHR	
0241	6117000000-N	SP	RESPONSE FOR EROSION CONTROL	100	EA	
0242	6117500000-N	SP	CONCRETE WASHOUT STRUCTURE	12	EA	
0243	6120000000-E	SP	CULVERT DIVERSION CHANNEL	4,175	CY	
0244	6123000000-E	1670	REFORESTATION	0.1	ACR	
0245	6141000000-E	SP	GENERIC EROSION CONTROL ITEM NATURAL FIBER MATTING	445,000	SY	
0246	7060000000-E	1705	SIGNAL CABLE	5,950	LF	
0247	7120000000-E	1705	VEHICLE SIGNAL HEAD (12", 3 SECTION)	33	EA	
0248	7132000000-E	1705	VEHICLE SIGNAL HEAD (12", 4 SECTION)	4	EA	
0249	7144000000-E	1705	VEHICLE SIGNAL HEAD (12", 5 SECTION)	4	EA	
0250	7252000000-E	1710	MESSENGER CABLE (1/4")	14,550	LF	
0251	7264000000-E	1710	MESSENGER CABLE (3/8")	1,360	LF	
0252	7279000000-E	1715	TRACER WIRE	26,630	LF	
0253	7300000000-E	1715	UNPAVED TRENCHING (***** (1, 2")	2,550	LF	
0254	7300000000-E	1715	UNPAVED TRENCHING (***** (2, 2")	13,560	LF	
0255	7300000000-E	1715	UNPAVED TRENCHING (***** (3, 2")	270	LF	
0256	7300000000-E	1715	UNPAVED TRENCHING (***** (4, 2")	30	LF	



County : Carteret, Craven

Line #	Item Number	Sec #	Description	Quantity	Unit Cost	Amount
0257	7300100000-E	1715	UNPAVED TRENCHING FOR TEMPORARY LEAD-IN	10 LF		
0258	7301000000-E	1715	DIRECTIONAL DRILL (*****) (1, 2")	900 LF		
0259	7301000000-E	1715	DIRECTIONAL DRILL (*****) (1, 6")	860 LF		
0260	7301000000-E	1715	DIRECTIONAL DRILL (*****) (2, 2")	5,960 LF		
0261	7301000000-E	1715	DIRECTIONAL DRILL (*****) (3, 2")	50 LF		
0262	7324000000-N	1716	JUNCTION BOX (STANDARD SIZE)	42 EA		
0263	7348000000-N	1716	JUNCTION BOX (OVER-SIZED, HEAVY DUTY)	61 EA		
0264	7372000000-N	1721	GUY ASSEMBLY	35 EA		
0265	7396000000-E	1722	1/2" RISER WITH WEATHERHEAD	1 EA		
0266	7420000000-E	1722	2" RISER WITH WEATHERHEAD	14 EA		
0267	7430000000-N	1722	HEAT SHRINK TUBING RETROFIT KIT	22 EA		
0268	7432000000-E	1722	2" RISER WITH HEAT SHRINK TUBING	16 EA		
0269	7444000000-E	1725	INDUCTIVE LOOP SAWCUT	1,850 LF		
0270	7456000000-E	1726	LEAD-IN CABLE (*****) (14-2)	6,620 LF		
0271	7516000000-E	1730	COMMUNICATIONS CABLE (**FIBER) (24)	72,940 LF		
0272	7528000000-E	1730	DROP CABLE	10,000 LF		
0273	7540000000-N	1731	SPLICE ENCLOSURE	23 EA		
0274	7541000000-N	1731	MODIFY SPLICE ENCLOSURE	1 EA		

County : Carteret, Craven

Line #	Item Number	Sec #	Description	Quantity	Unit Cost	Amount
0275	7552000000-N	1731	INTERCONNECT CENTER	31	EA	
0276	7566000000-N	1733	DELINEATOR MARKER	23	EA	
0277	7575160000-E	1734	REMOVE EXISTING COMMUNICATIONS CABLE	5,190	LF	
0278	7576000000-N	SP	METAL STRAIN SIGNAL POLE	12	EA	
0279	7613000000-N	SP	SOIL TEST	20	EA	
0280	7614100000-E	SP	DRILLED PIER FOUNDATION	72	CY	
0281	7636000000-N	1745	SIGN FOR SIGNALS	15	EA	
0282	7684000000-N	1750	SIGNAL CABINET FOUNDATION	3	EA	
0283	7696000000-N	1751	CONTROLLERS WITH CABINET (.....) (2070E)	17	EA	
0284	7901000000-N	1753	CABINET BASE EXTENDER	3	EA	
0285	7960000000-N	SP	METAL POLE FOUNDATION REMOVAL	4	EA	
0286	7972000000-N	SP	METAL POLE REMOVAL	4	EA	
0287	7980000000-N	SP	GENERIC SIGNAL ITEM CCTV CAMERA ASSEMBLY	7	EA	
0288	7980000000-N	SP	GENERIC SIGNAL ITEM CCTV CAMERA EXTENSION POLE	2	EA	
0289	7980000000-N	SP	GENERIC SIGNAL ITEM CCTV WOOD POLE	5	EA	
0290	7980000000-N	SP	GENERIC SIGNAL ITEM CONTROLLER (TYPE 2070E)	3	EA	
0291	7980000000-N	SP	GENERIC SIGNAL ITEM DETECTOR CARD (TYPE 2070E)	136	EA	
0292	7980000000-N	SP	GENERIC SIGNAL ITEM DMS ACCESS LADDER	2	EA	

County : Carteret, Craven

Line #	Item Number	Sec #	Description	Quantity	Unit Cost	Amount
0293	7980000000-N	SP	GENERIC SIGNAL ITEM DMS TYPE A	2 EA		
0294	7980000000-N	SP	GENERIC SIGNAL ITEM DMS TYPE A STRUCTURE	2 EA		
0295	7980000000-N	SP	GENERIC SIGNAL ITEM DMS TYPE B	6 EA		
0296	7980000000-N	SP	GENERIC SIGNAL ITEM DMS TYPE B STRUCTURE	6 EA		
0297	7980000000-N	SP	GENERIC SIGNAL ITEM ELECTRICAL SERVICE FOR ITS DEVICE	12 EA		
0298	7980000000-N	SP	GENERIC SIGNAL ITEM ETHERNET EDGE SWITCH	20 EA		
0299	7980000000-N	SP	GENERIC SIGNAL ITEM FIELD EQUIPMENT CABINET	6 EA		
0300	7980000000-N	SP	GENERIC SIGNAL ITEM FURNISH CCTV CAMERA ASSEMBLY	7 EA		
0301	7980000000-N	SP	GENERIC SIGNAL ITEM JUNCTION BOX MARKER	37 EA		
0302	7980000000-N	SP	GENERIC SIGNAL ITEM MICROWAVE VEHICLE DETECTION SYSTEM-MULTIPLE ZONES	9 EA		
0303	7980000000-N	SP	GENERIC SIGNAL ITEM WOOD PEDESTAL	2 EA		
0304	7992000000-E	SP	GENERIC SIGNAL ITEM DMS FOUNDATION	48 CY		
0381	0000970000-E	SP	GENERIC MISCELLANEOUS ITEM CLEARING ACCESS FOR DUKE	6.3 ACR		
0382	0000970000-E	SP	GENERIC MISCELLANEOUS ITEM SPECIALIZED CLEARING	14.31 ACR		
0383	0015000000-N	205	SEALING ABANDONED WELLS	25 EA		
0384	6045000000-E	SP	*** TEMPORARY PIPE (72")	85 LF		

County : Carteret, Craven

Line #	Item Number	Sec #	Description	Quantity	Unit Cost	Amount
0385	6135000000-E	SP	GENERIC EROSION CONTROL ITEM COMPOST BLANKET	5 ACR		

---

**CULVERT ITEMS**


---

0305	8126000000-N	414	CULVERT EXCAVATION, STA ***** (44+89.00-RP2AC-)	Lump Sum	L.S.	
0306	8126000000-N	414	CULVERT EXCAVATION, STA ***** (509+41.00-L-)	Lump Sum	L.S.	
0307	8133000000-E	414	FOUNDATION CONDITIONING MATERIAL, BOX CULVERT	1,025 TON		
0308	8196000000-E	420	CLASS A CONCRETE (CULVERT)	2,346.4 CY		
0309	8217000000-E	425	REINFORCING STEEL (BRIDGE)	206,812 LB		

---

**WALL ITEMS**


---

0310	8801000000-E	SP	MSE RETAINING WALL NO ***** (1)	8,200 SF		
0311	8801000000-E	SP	MSE RETAINING WALL NO ***** (2)	4,600 SF		
0312	8801000000-E	SP	MSE RETAINING WALL NO ***** (3)	6,400 SF		
0313	8801000000-E	SP	MSE RETAINING WALL NO ***** (4)	5,400 SF		

---

**STRUCTURE ITEMS**


---

0314	8017000000-N	SP	CONSTRUCTION, MAINTENANCE, & REMOVAL OF TEMP ACCESS AT STA ***** (177+67.00-L-)	Lump Sum	L.S.	
------	--------------	----	--	----------	------	--

---

County : Carteret, Craven

Line #	Item Number	Sec #	Description	Quantity	Unit Cost	Amount
0315	8017000000-N	SP	CONSTRUCTION, MAINTENANCE, & REMOVAL OF TEMP ACCESS AT STA ***** (287+62.50-L-)	Lump Sum	L.S.	
0316	8091000000-N	410	FOUNDATION EXCAVATION FOR BENT ** AT STATION ***** (1, 138+31.09-L-LT)	Lump Sum	L.S.	
0317	8091000000-N	410	FOUNDATION EXCAVATION FOR BENT ** AT STATION ***** (1, 138+31.09-L-RT)	Lump Sum	L.S.	
0318	8091000000-N	410	FOUNDATION EXCAVATION FOR BENT ** AT STATION ***** (1, 227+57.02-L-LT)	Lump Sum	L.S.	
0319	8091000000-N	410	FOUNDATION EXCAVATION FOR BENT ** AT STATION ***** (1, 227+57.02-L-RT)	Lump Sum	L.S.	
0320	8091000000-N	410	FOUNDATION EXCAVATION FOR BENT ** AT STATION ***** (1, 44+71.82-Y4-)	Lump Sum	L.S.	
0321	8091000000-N	410	FOUNDATION EXCAVATION FOR BENT ** AT STATION ***** (1, 506+32.25-L-LT)	Lump Sum	L.S.	
0322	8091000000-N	410	FOUNDATION EXCAVATION FOR BENT ** AT STATION ***** (1, 506+32.25-L-RT)	Lump Sum	L.S.	
0323	8091000000-N	410	FOUNDATION EXCAVATION FOR BENT ** AT STATION ***** (1, 52+32.96-Y3-)	Lump Sum	L.S.	
0324	8091000000-N	410	FOUNDATION EXCAVATION FOR BENT ** AT STATION ***** (2, 138+31.09-L-LT)	Lump Sum	L.S.	
0325	8091000000-N	410	FOUNDATION EXCAVATION FOR BENT ** AT STATION ***** (2, 138+31.09-L-RT)	Lump Sum	L.S.	
0326	8091000000-N	410	FOUNDATION EXCAVATION FOR BENT ** AT STATION ***** (2, 227+57.02-L-LT)	Lump Sum	L.S.	
0327	8091000000-N	410	FOUNDATION EXCAVATION FOR BENT ** AT STATION ***** (2, 227+57.02-L-RT)	Lump Sum	L.S.	

County : Carteret, Craven

Line #	Item Number	Sec #	Description	Quantity	Unit Cost	Amount
0328	8091000000-N	410	FOUNDATION EXCAVATION FOR BENT ** AT STATION ***** (2, 506+32.25-L-LT)	Lump Sum	L.S.	
0329	8091000000-N	410	FOUNDATION EXCAVATION FOR BENT ** AT STATION ***** (2, 506+32.25-L-RT)	Lump Sum	L.S.	
0330	8091000000-N	410	FOUNDATION EXCAVATION FOR BENT ** AT STATION ***** (3, 138+31.09-L-LT)	Lump Sum	L.S.	
0331	8091000000-N	410	FOUNDATION EXCAVATION FOR BENT ** AT STATION ***** (3, 138+31.09-L-RT)	Lump Sum	L.S.	
0332	8112730000-N	450	PDA TESTING	38 EA		
0333	8147000000-E	420	REINFORCED CONCRETE DECK SLAB	340,594 SF		
0334	8161000000-E	420	GROOVING BRIDGE FLOORS	308,222 SF		
0335	8175000000-E	420	CLASS AA CONCRETE (BRIDGE)	1,140.6 CY		
0336	8182000000-E	420	CLASS A CONCRETE (BRIDGE)	4,001.5 CY		
0337	8210000000-N	422	BRIDGE APPROACH SLABS, STATION ***** (11+76.30-RP1AB-LT)	Lump Sum	L.S.	
0338	8210000000-N	422	BRIDGE APPROACH SLABS, STATION ***** (11+76.30-RP1AB-RT)	Lump Sum	L.S.	
0339	8210000000-N	422	BRIDGE APPROACH SLABS, STATION ***** (138+31.09-L-LT)	Lump Sum	L.S.	
0340	8210000000-N	422	BRIDGE APPROACH SLABS, STATION ***** (138+31.09-L-RT)	Lump Sum	L.S.	
0341	8210000000-N	422	BRIDGE APPROACH SLABS, STATION ***** (177+67.00-L-LT)	Lump Sum	L.S.	
0342	8210000000-N	422	BRIDGE APPROACH SLABS, STATION ***** (177+67.00-L-RT)	Lump Sum	L.S.	

County : Carteret, Craven

Line #	Item Number	Sec #	Description	Quantity	Unit Cost	Amount
0343	8210000000-N	422	BRIDGE APPROACH SLABS, STATION ***** (227+57.02-L-LT)	Lump Sum	L.S.	
0344	8210000000-N	422	BRIDGE APPROACH SLABS, STATION ***** (227+57.02-L-RT)	Lump Sum	L.S.	
0345	8210000000-N	422	BRIDGE APPROACH SLABS, STATION ***** (287+62.50-L-LT)	Lump Sum	L.S.	
0346	8210000000-N	422	BRIDGE APPROACH SLABS, STATION ***** (287+62.50-L-RT)	Lump Sum	L.S.	
0347	8210000000-N	422	BRIDGE APPROACH SLABS, STATION ***** (44+71.82-Y4-)	Lump Sum	L.S.	
0348	8210000000-N	422	BRIDGE APPROACH SLABS, STATION ***** (506+32.25-L-LT)	Lump Sum	L.S.	
0349	8210000000-N	422	BRIDGE APPROACH SLABS, STATION ***** (506+32.25-L-RT)	Lump Sum	L.S.	
0350	8210000000-N	422	BRIDGE APPROACH SLABS, STATION ***** (516+87.37-L-LT)	Lump Sum	L.S.	
0351	8210000000-N	422	BRIDGE APPROACH SLABS, STATION ***** (516+87.37-L-RT)	Lump Sum	L.S.	
0352	8210000000-N	422	BRIDGE APPROACH SLABS, STATION ***** (52+32.96-Y3-)	Lump Sum	L.S.	
0353	8217000000-E	425	REINFORCING STEEL (BRIDGE)	605,741 LB		
0354	8224000000-E	425	EPOXY COATED REINFORCING STEEL (BRIDGE)	184,196 LB		
0355	8238000000-E	425	SPIRAL COLUMN REINFORCING STEEL (BRIDGE)	47,027 LB		
0356	8265000000-E	430	54" PRESTRESSED CONCRETE GIR- DERS	8,099.63 LF		

County : Carteret, Craven


Line #	Item Number	Sec #	Description	Quantity	Unit Cost	Amount
0357	8277000000-E	430	MODIFIED 72" PRESTRESSED CONC GIRDERS	1,892.44 LF		
0358	8328000000-E	450	PILE DRIVING EQUIPMENT SETUP FOR *** PRESTRESSED CONCRETE PILES (12")	92 EA		
0359	8328000000-E	450	PILE DRIVING EQUIPMENT SETUP FOR *** PRESTRESSED CONCRETE PILES (20")	84 EA		
0360	8328200000-E	450	PILE DRIVING EQUIPMENT SETUP FOR *** STEEL PILES (HP12X53)	576 EA		
0361	8328400000-E	450	PILE DRIVING EQUIPMENT SETUP FOR *** GALVANIZED STEEL PILES (PP14X0.50)	28 EA		
0362	8329000000-E	450	12" PRESTRESSED CONCRETE PILES	5,020 LF		
0363	8336000000-E	450	20" PRESTRESSED CONCRETE PILES	4,760 LF		
0364	8364000000-E	450	HP12X53 STEEL PILES	43,970 LF		
0365	8385200000-E	450	PP ** X **** GALVANIZED STEEL PILES (14X0.50)	2,510 LF		
0366	8391000000-N	450	STEEL PILE POINTS	34 EA		
0367	8392000000-N	450	PIPE PILE PLATES	28 EA		
0368	8392500000-E	450	PREDRILLING FOR PILES	274 LF		
0369	8393000000-N	450	PILE REDRIVES	801 EA		
0370	8475000000-E	460	TWO BAR METAL RAIL	712.59 LF		
0371	8503000000-E	460	CONCRETE BARRIER RAIL	15,087.36 LF		
0372	8517000000-E	460	1'***X ***** CONCRETE PARA-PET (1'-2" X 2'-6")	744.24 LF		



County : Carteret, Craven

Line #	Item Number	Sec #	Description	Quantity	Unit Cost	Amount
0373	8531000000-E	462	4" SLOPE PROTECTION	12,882.3 SY		
0374	8608000000-E	876	RIP RAP CLASS II (2'-0" THICK)	1,883 TON		
0375	8622000000-E	876	GEOTEXTILE FOR DRAINAGE	2,128 SY		
0376	8657000000-N	430	ELASTOMERIC BEARINGS	Lump Sum	L.S.	
0377	8706000000-N	SP	EXPANSION JOINT SEALS	Lump Sum	L.S.	
0378	8867000000-E	SP	GENERIC STRUCTURE ITEM HP14X73 METALLIZED STEEL PILES	34,740 LF		
0379	8867000000-E	SP	GENERIC STRUCTURE ITEM MODIFIED 74" PRESTRESSED CONCRETE GIRDERS	28,382.49 LF		
0380	8897000000-N	SP	GENERIC STRUCTURE ITEM PILE DRIVING EQUIPMENT SETUP FOR HP14X73 METALIZED STEEL PILES	396 EA		
1433/Feb26/Q11516150.31/D1789204182000/E385			Total Amount Of Bid For Entire Project :			


BM - 3M7-1- STA 140+63.43, 191.75' LT., RR SPIKE IN TREE, EL. 22.75

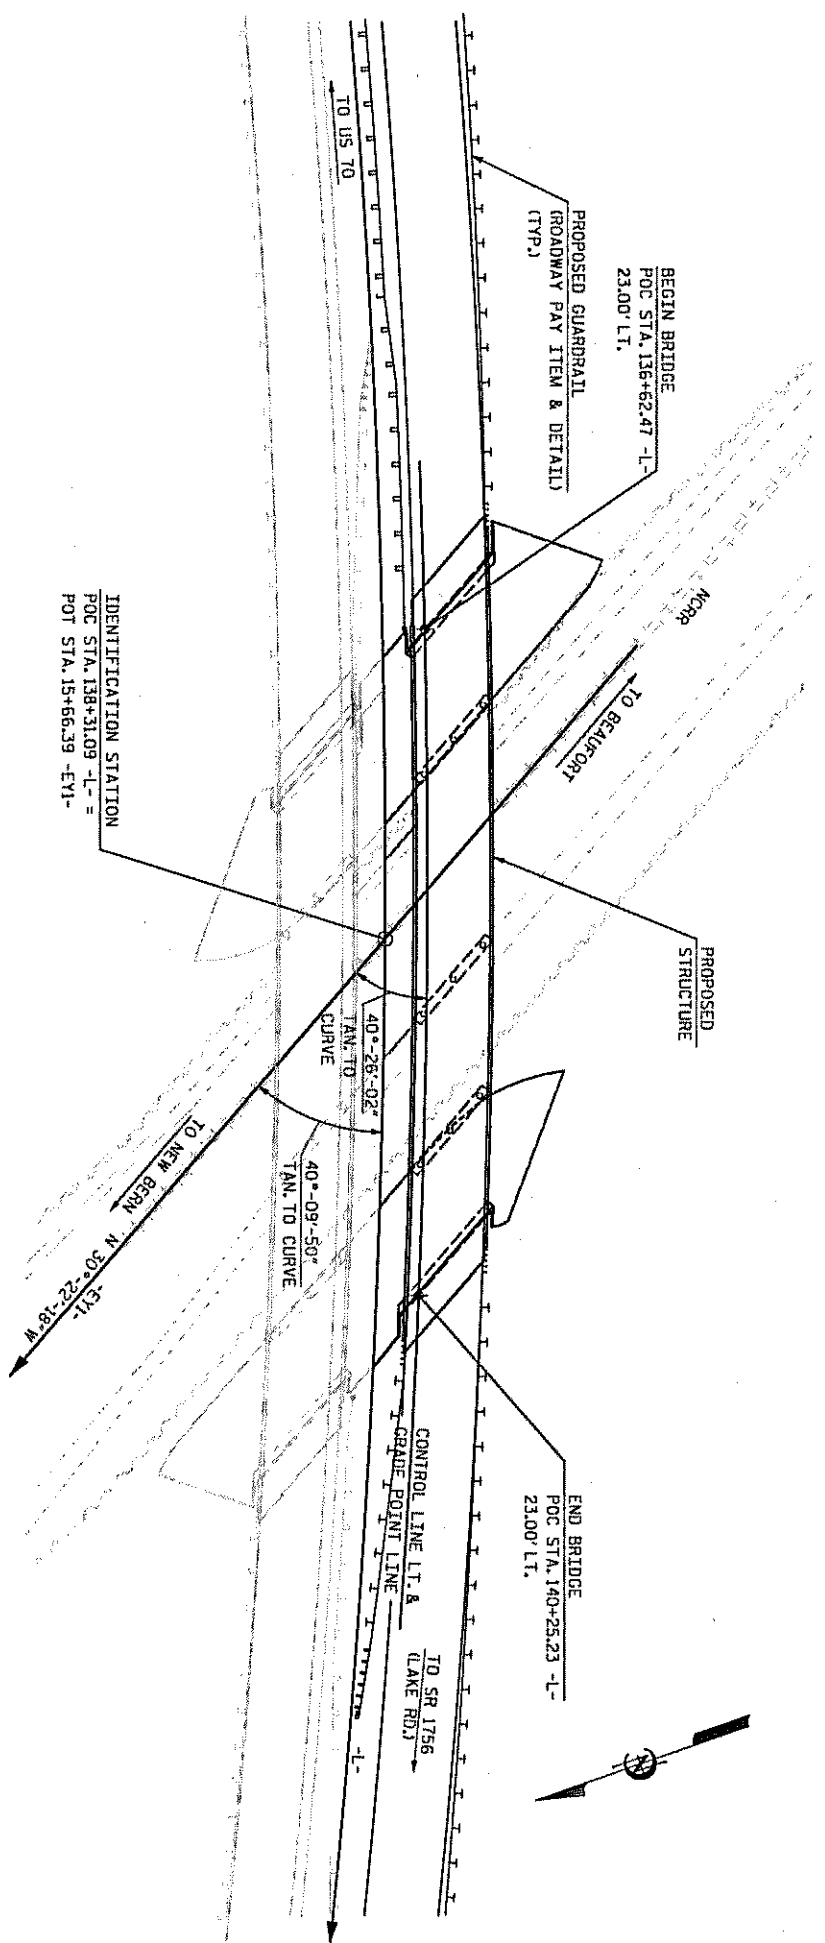

LOCATION SKETCH NOTE: FOR UTILITY INFORMATION, SEE UTILITY PLANS AND SPECIAL PROVISIONS.

TOTAL BILL OF MATERIAL										
FOUNDATION EXCAVATION FOR BENT AT STATION 138+31.09 -1- (LEFT LANE)	PDA TESTING	REINFORCED CONCRETE DECK SLAB	GROOVING BRIDGE FLOORS	CLASS A CONCRETE	BRIDGE APPROACH SLAB AT STATION 138+31.09 -1- (LEFT LANE)	REINFORCING STEEL	SPIRAL COLUMN REINFORCING STEEL			
LUMP SUM	EA.	SQ. FT.	SQ. FT.	CU. YDS.	SQ. YD.	LBS.	LBS.			
SUPERSTRUCTURE		15,549	15,031	86.3	1,392	11,392				
BENT 1		LUMP SUM		150.7		29,787		2,953		
BENT 2		LUMP SUM		164.0		29,749		3,153		
BENT 3		LUMP SUM		153.4		29,088		3,069		
END BENT 2				88.9		11,968				
TOTAL		LUMP SUM	2	15,549	15,031	643.3	111,984	9,175		

TOTAL BILL OF MATERIAL										
MODIFIED 74" PRESTRESSED CONCRETE GIRDERS	PILE DRIVING EQUIPMENT SETUP FOR HP 12X53 STEEL PILES	HP 12X53 STEEL PILES	PILE REDRIEVES	CONCRETE BARRIER RAIL	4' SLOPE PROTECTION	ELASTOMERIC BEARINGS	EXPANSION JOINT SEALS			
NO.	L.F.	EA.	NO.	L.F.	EA.	L.F.	SQ. YD.	LUMP SUM	LUMP SUM	LUMP SUM
SUPERSTRUCTURE	16	1413.54	14	1470	6	763.3	1,616.3			
END BENT 1			18	1,350	9					
BENT 1			24	1,680	12					
BENT 2			18	1,170	9					
BENT 3			13	1,300	6					
END BENT 2										
TOTAL	16	1413.54	87	6,970	42	763.3	2,812.4			

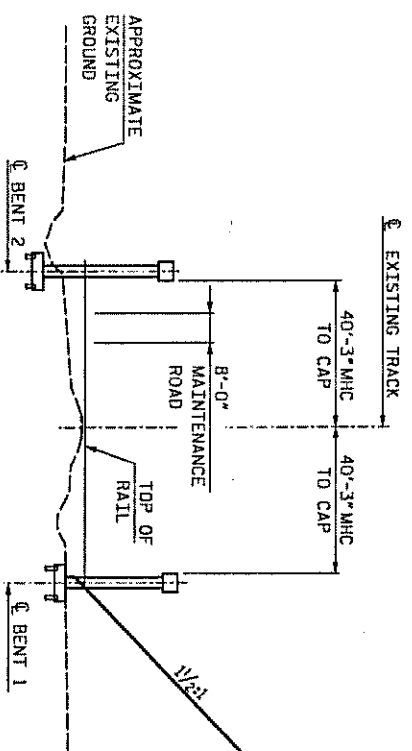

SECTION THRU RAILROAD (LOOKING IN DIRECTION OF INCREASING STATIONS ON RAILROAD) (SPAN LENGTHS BASED ON THIS SECTION) MHC = MINIMUM HORIZONTAL CLEARANCE

SAMPLE BAR REPLACEMENT	SIZE	LENGTH
#3	6'-2"	
#4	7'-4"	
#5	8'-6"	
#6	9'-8"	
#7	10'-10"	
#8	12'-0"	
#9	13'-2"	
#10	14'-6"	
#11	15'-10"	

NOTE: SAMPLE BAR REPLACEMENT LENGTHS BASED ON 30' SAMPLE LENGTH PLUS TWO SPLICE LENGTHS AND FY = 60KSI.

GENERAL NOTES

ASSUMED LIVE LOAD = HL-93 OR ALTERNATE LOADING.  
 THIS BRIDGE HAS BEEN DESIGNED IN ACCORDANCE WITH THE AASHTO LRFD BRIDGE DESIGN SPECIFICATIONS.  
 REMOVABLE FORMS MAY BE USED IN LIEU OF METAL STAY-IN-PLACE FORMS IN ACCORDANCE WITH ARTICLE 420-3 OF THE STANDARD SPECIFICATIONS.  
 THIS BRIDGE IS LOCATED IN SEISMIC ZONE 1.  
 FOR OTHER DESIGN DATA AND GENERAL NOTES, SEE SHEET SN.  
 FOR SUBMITTAL OF WORKING DRAWINGS, SEE SPECIAL PROVISIONS.  
 FOR FALSEWORK AND FORMWORK, SEE SPECIAL PROVISIONS.  
 FOR CRANE SAFETY, SEE SPECIAL PROVISIONS.  
 FOR GROUT FOR STRUCTURES, SEE SPECIAL PROVISIONS.  
 FOR MODIFIED 74" PRESTRESSED CONCRETE GIRDERS, SEE SPECIAL PROVISIONS.  
 NEEDLE BEAMS WILL NOT BE ALLOWED UNLESS OTHERWISE CALLED FOR ON THE PLANS OR APPROVED BY THE ENGINEER.  
 THE CONTRACTOR SHALL PROVIDE INDEPENDENT ASSURANCE SAMPLES OF REINFORCING STEEL AS FOLLOWS: FOR PROJECTS REQUIRING UP TO 400 TONS OF REINFORCING STEEL, ONE 30 INCH SAMPLE OF EACH SIZE BAR USED, AND FOR PROJECTS REQUIRING OVER 400 TONS OF REINFORCING STEEL, TWO 30 INCH SAMPLES OF EACH SIZE BAR USED. THE SAMPLE BARS SHOULD COME FROM STEEL ACTUALLY USED IN THE PROJECT AND THE SAMPLE BARS SHOULD BE REPLACED BY SPLICE BARS AS SPECIFIED IN THE SAMPLE BAR REPLACEMENT CHART. PAYMENT FOR THE SAMPLE BARS AND REPLACEMENT REINFORCING STEEL SHALL BE CONSIDERED INCIDENTAL TO VARIOUS PAY ITEMS.  
 FOR EROSION CONTROL MEASURES, SEE EROSION CONTROL PLANS.  
 THE RAILROAD TRACK TOP OF RAIL ELEVATIONS SHOWN ON THE PLANS ARE FROM THE BEST INFORMATION AVAILABLE. PRIOR TO BEGINNING BRIDGE CONSTRUCTION, VERIFY THE TOP OF RAIL ELEVATIONS AND REPORT ANY VARIATIONS TO THE ENGINEER. ANY PLAN REVISIONS NECESSARY TO ACHIEVE THE REQUIRED MINIMUM VERTICAL CLEARANCE WILL BE PROVIDED BY THE DEPARTMENT.



PROJECT NO. R-1015  
 COUNTY CRAVEN  
 STATION: POC STA. 138+31.09 -1-

DEPARTMENT OF TRANSPORTATION  
 GENERAL DRAWINGS  
 LOCATION SKETCH, GENERAL NOTES, AND TOTAL BILL OF MATERIALS  
 SHEET NO. 46


DOCUMENT NOT CONSIDERED FINAL UNLESS ALL SIGNATURES COMPLETED

**HNTB**  
 HNTB NORTH CAROLINA, P.C.  
 50 E. Main Street, Suite 200, Raleigh, NC 27609  
 DRAWN BY: A. SMITH  
 CHECKED BY: S. W. STINE  
 DATE: 7/8/13  
 DATE: 7/8/13  
 DESIGN NO. 4

NO.	BY	DATE	NO.	BY	DATE
1			3		
2			4		

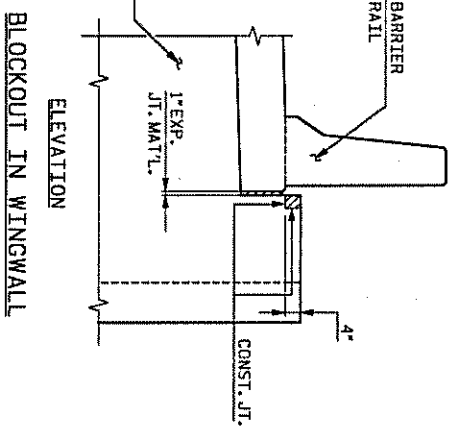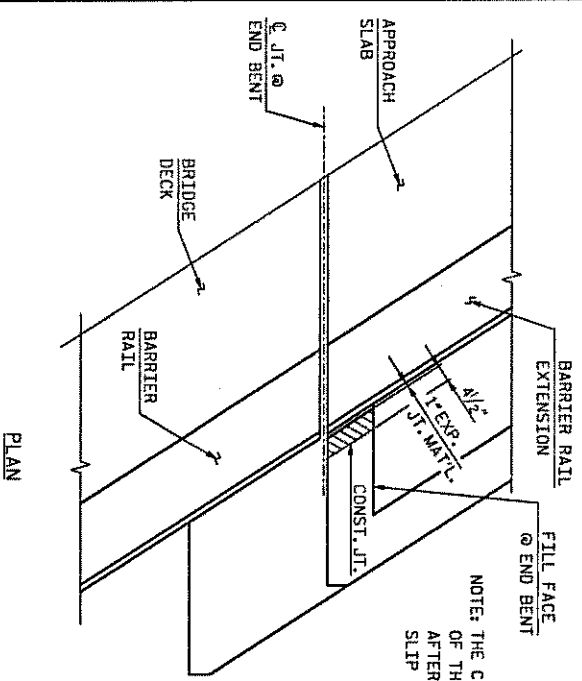


NOTE: THE CONCRETE IN THE SHADED AREA OF THE WING SHALL BE POURED AFTER BARRIER RAILS ARE CAST IF SLIP FORMING IS USED.

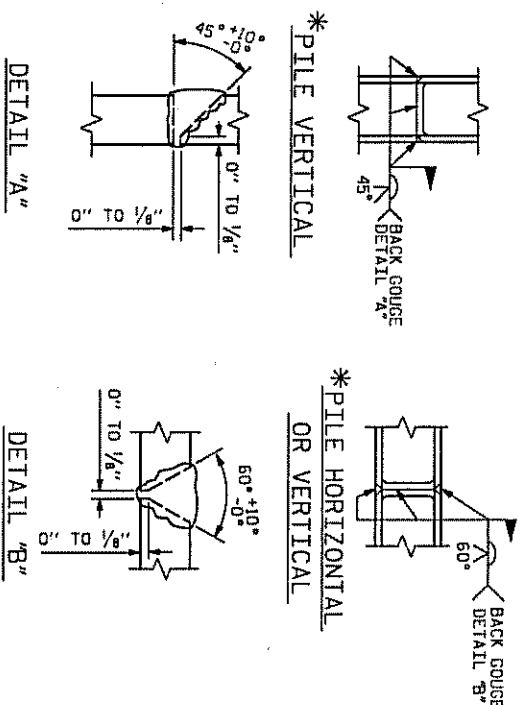

\* POSITION OF PILE DURING WELDING.

NOTES:

STIRRUPS IN CAP MAY BE SHIFTED AS NECESSARY TO CLEAR ANCHOR BOLTS.  
 BACKWALL SHALL BE PLACED BEFORE APPLYING THE EPOXY PROTECTIVE COATING.  
 THE TOP SURFACE AREAS OF THE END BENT CAPS SHALL BE CURED IN ACCORDANCE WITH THE STANDARD SPECIFICATIONS EXCEPT THE MEMBRANE CURING COMPOUND METHOD SHALL NOT BE USED.  
 THE TOP SURFACE OF THE END BENT CAP EXCEPT THE BRIDGE SEAT BUILDUPS SHALL BE SLOPED TRANSVERSELY FROM THE FILL FACE TO THE BACK FACE AT THE RATE OF 2%.

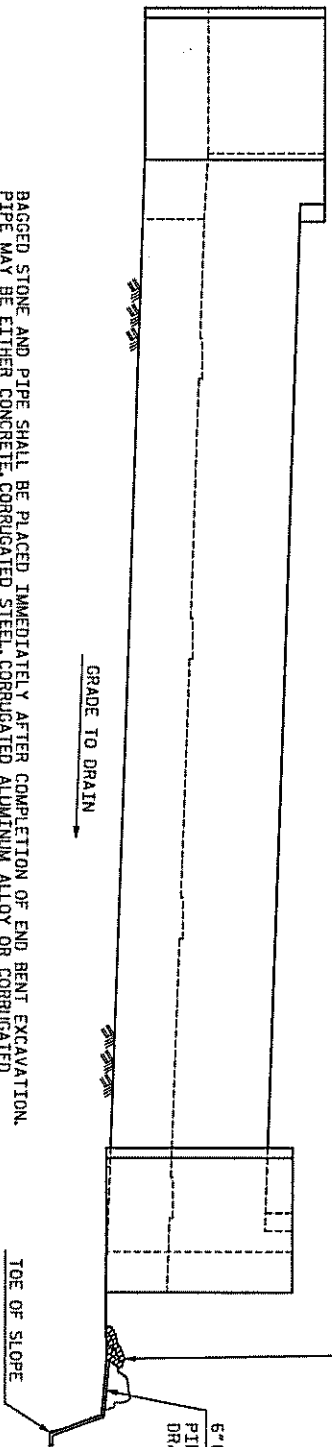


MINIMUM OF 3 - ONE CUBIC FOOT BAGS OF #78M STONE BAGS SHALL BE OF POROUS FABRIC, SECURELY TIED.

BAGGED STONE AND PIPE SHALL BE PLACED IMMEDIATELY AFTER COMPLETION OF END BENT EXCAVATION. PIPE MAY BE EITHER CONCRETE CORRUGATED STEEL, CORRUGATED ALUMINUM ALLOY OR CORRUGATED PLASTIC. PERFORATED PIPE WILL NOT BE ALLOWED.  
 BAGGED STONE SHALL REMAIN IN PLACE UNTIL THE ENGINEER DIRECTS THAT IT BE REMOVED. THE CONTRACTOR SHALL REMOVE AND DISPOSE OF SILT ACCUMULATIONS AT BAGGED STONE WHEN SO DIRECTED BY THE ENGINEER. BAGS SHALL BE REMOVED AND REPLACED WHENEVER THE ENGINEER DETERMINES THAT THEY HAVE DETEIORATED AND LOST THEIR EFFECTIVENESS.

NO SEPARATE PAYMENT WILL BE MADE FOR THIS WORK AND THE ENTIRE COST OF THIS WORK SHALL BE INCLUDED IN THE UNIT CONTRACT PRICE FOR THE SEVERAL PAY ITEMS.

TEMPORARY DRAINAGE AT END BENT 1

BAR TYPES

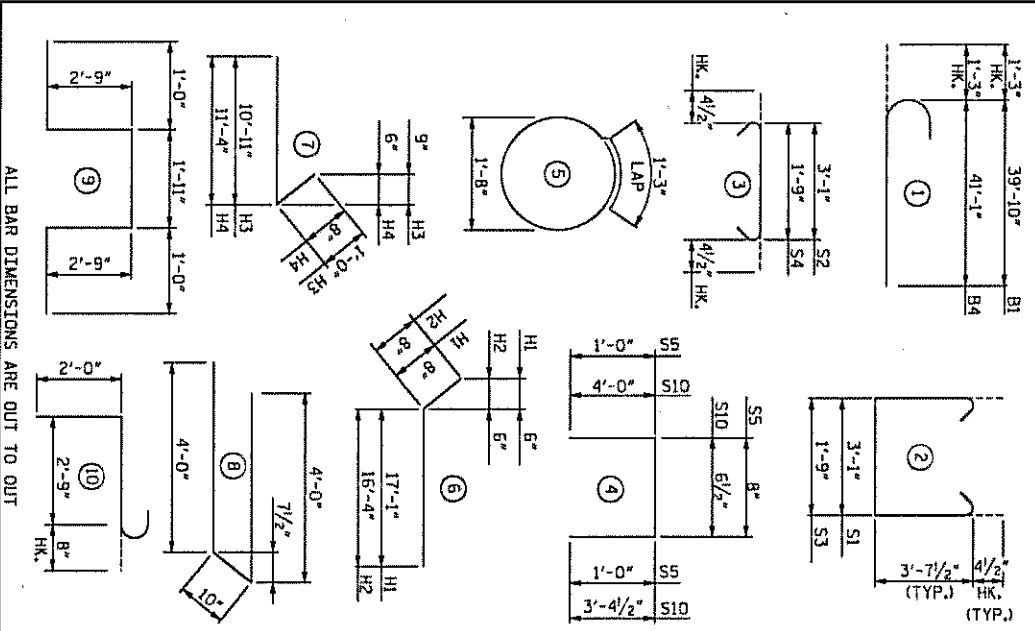

ALL BAR DIMENSIONS ARE OUT TO OUT

BILL OF REINFORCING

BAR	NO.	SIZE	TYPE	LENGTH	WEIGHT
B1	14	9	1	41'-1"	1,956
B2	60	4	STR	26'-2"	1,049
B3	18	4	STR	4'-8"	56
B4	14	9	1	42'-4"	2,015
H1	14	4	6	17'-9"	166
H2	14	4	6	17'-0"	159
H3	25	6	7	11'-11"	447
H4	13	4	7	12'-0"	104
K1	36	4	STR	28'-2"	629
S1	198	4	2	11'-1"	1,466
S2	198	4	3	3'-10"	507
S3	2	4	2	9'-9"	13
S4	2	4	3	2'-6"	3
S5	65	4	4	2'-8"	116
S6	52	4	5	6'-6"	226
S7	3	6	9	9'-5"	42
S8	3	6	10	5'-5"	24
S9	2	4	8	8'-10"	12
S10	2	4	4	7'-11"	11
V1	130	5	STR	9'-10"	1,333
V2	58	5	STR	11'-3"	681
V3	31	5	STR	11'-8"	377

QUANTITIES

REINFORCING STEEL	LBS.	11,392
CLASS "A" CONCRETE BREAKDOWN		
POUR 1 - CAP, COLLARS & BOT. OF WINGS	CU. YDS.	61.0
POUR 2 - TOP OF WINGS & BACKWALL	CU. YDS.	25.3
TOTAL	CU. YDS.	86.3
HP 12X53 STEEL PILES	NO.	14
	LN. FT.	1,470
PILE REDRIVES	EA.	6
PILE DRIVING EQUIPMENT SETUP	EA.	14

PROJECT NO. R-1015  
 CRAVEN COUNTY  
 STATION: POC STA. 138+31.09 -L-

STATE OF NORTH CAROLINA  
 DEPARTMENT OF TRANSPORTATION  
 SUBSTRUCTURE  
 END BENT 1

LEFT LANE

**HNTB**  
 HNTB NORTH CAROLINA, P.C.  
 340 E. SIX FORTS RD., SUITE 200, RANDOLPH, N.C. 28139  
 NC License No. C-554  
 DATE: 12/15/2013  
 SEAL: 12/15/2013  
 DESIGN ENGINEER OF RECORD: J. L. GREGG

NO.	REV.	DATE	NO.	REV.	DATE	SHEET NO.
1			3			503-32
2			4			TOTAL SHEETS 46

**SUPERSTRUCTURE REINFORCING STEEL LENGTHS ARE BASED ON THE FOLLOWING MINIMUM SPlice LENGTHS**

BAR SIZE	SUPERSTRUCTURE EXCEPT APPROACH SLABS, PARAPET, AND BARRIER RAIL	APPROACH SLABS	PARAPET AND BARRIER RAIL
#4	2'-0"	2'-0"	2'-9"
#5	2'-6"	2'-6"	3'-5"
#6	3'-0"	3'-10"	4'-4"
#7	5'-3"	3'-6"	
#8	6'-10"	4'-7"	



**SUPERSTRUCTURE BILL OF MATERIAL**

CLASS AA CONCRETE (CU.YDS.)	EPOXY COATED REINFORCING STEEL (LBS.)
POUR #1	140.3
POUR #2	188.3
POUR #3	88.6
TOTALS	36047

**GROOVING BRIDGE FLOORS**

APPROACH SLABS	2365 SO.FT.
BRIDGE DECK	9413 SO.FT.
TOTAL	11778 SO.FT.

**\* QUANTITIES FOR CONCRETE PARAPET ARE NOT INCLUDED.**

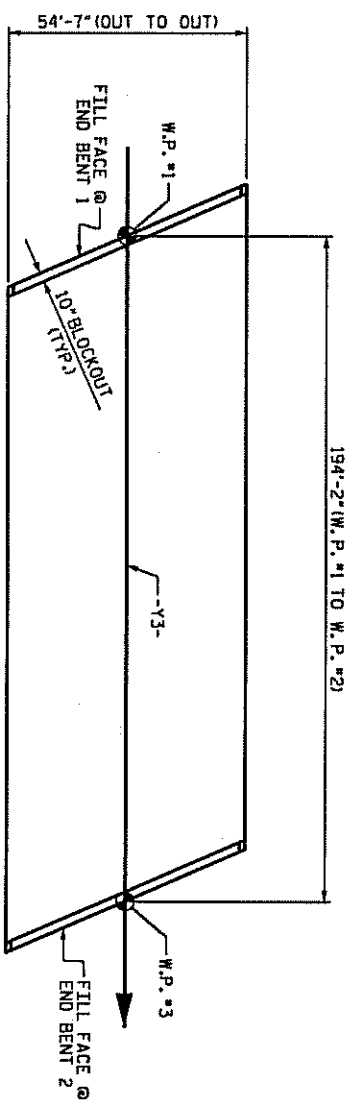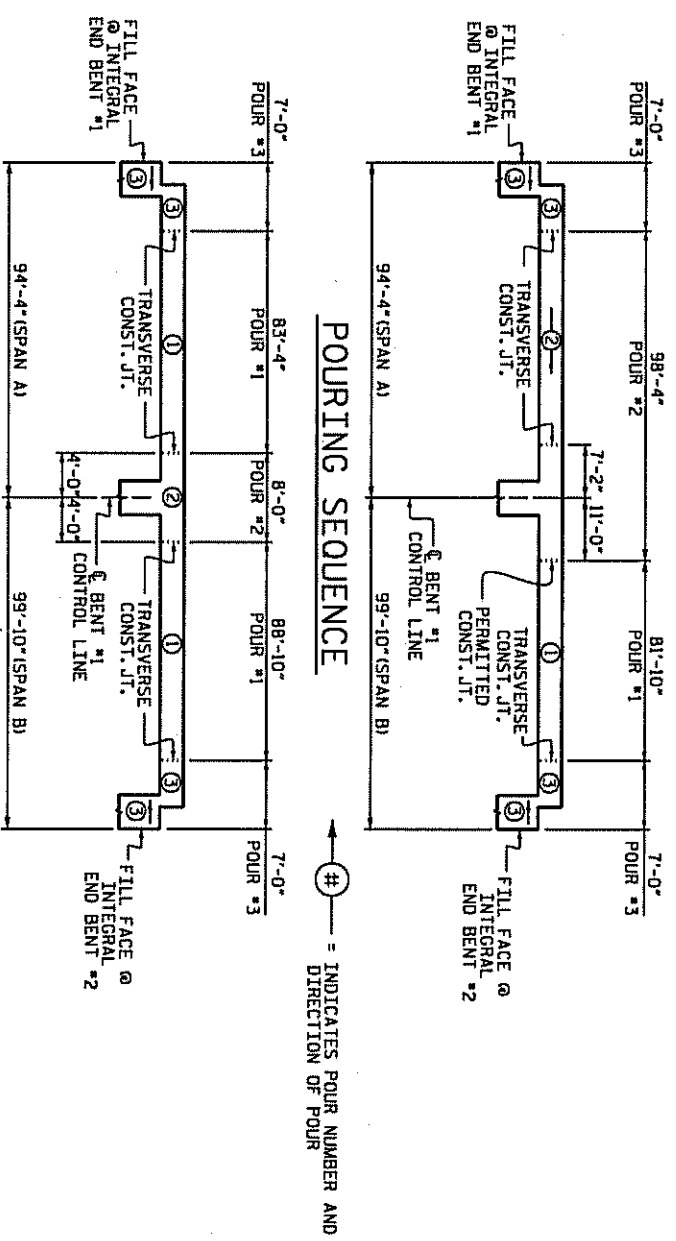

LAYOUT FOR COMPUTING AREA REINFORCED CONCRETE DECK SLAB (SO. FT. = 10598)


DESIGN BY: I.L.B. DATE: 2/20/18  
 CHECKED BY: I.L.B. DATE: 2/20/18  
 DESIGN ENGINEER OF RECORD: I.L.B. DATE: 2/20/18

**BILL OF MATERIAL**


BAR NO.	SIZE	TYPE	LENGTH	WEIGHT	BAR NO.	SIZE	TYPE	LENGTH	WEIGHT
* A1	337	#5	STR	54'-1"	A2	337	#5	STR	54'-1"
* A1D1	2	#5	STR	51'-11"	A2D1	2	#5	STR	51'-11"
* A1D2	2	#5	STR	49'-7"	A2D2	2	#5	STR	49'-7"
* A1D3	2	#5	STR	47'-4"	A2D3	2	#5	STR	47'-4"
* A1D4	2	#5	STR	45'-1"	A2D4	2	#5	STR	45'-1"
* A1D5	2	#5	STR	42'-9"	A2D5	2	#5	STR	42'-9"
* A1D6	2	#5	STR	40'-6"	A2D6	2	#5	STR	40'-6"
* A1D7	2	#5	STR	38'-2"	A2D7	2	#5	STR	38'-2"
* A1D8	2	#5	STR	35'-11"	A2D8	2	#5	STR	35'-11"
* A1D9	2	#5	STR	33'-8"	A2D9	2	#5	STR	33'-8"
* A1D10	2	#5	STR	31'-4"	A2D10	2	#5	STR	31'-4"
* A1D11	2	#5	STR	29'-1"	A2D11	2	#5	STR	29'-1"
* A1D12	2	#5	STR	26'-9"	A2D12	2	#5	STR	26'-9"
* A1D13	2	#5	STR	24'-6"	A2D13	2	#5	STR	24'-6"
* A1D14	2	#5	STR	22'-3"	A2D14	2	#5	STR	22'-3"
* A1D15	2	#5	STR	19'-11"	A2D15	2	#5	STR	19'-11"
* A1D16	2	#5	STR	17'-8"	A2D16	2	#5	STR	17'-8"
* A1D17	2	#5	STR	15'-4"	A2D17	2	#5	STR	15'-4"
* A1D18	2	#5	STR	13'-1"	A2D18	2	#5	STR	13'-1"
* A1D19	2	#5	STR	10'-10"	A2D19	2	#5	STR	10'-10"
* A1D20	2	#5	STR	8'-6"	A2D20	2	#5	STR	8'-6"
* A1D21	2	#5	STR	6'-3"	A2D21	2	#5	STR	6'-3"
* A1D22	2	#5	STR	3'-11"	A2D22	2	#5	STR	3'-11"
* B1	87	#6	STR	18'-6"	B8	252	#5	STR	49'-10"
* B2	88	#4	STR	23'-6"	K1	30	#4	STR	21'-1"
* B3	44	#6	STR	43'-2"	K2	20	#4	STR	8'-2"
* B4	43	#6	STR	29'-1"	K3	40	#4	STR	9'-3"
* B5	44	#6	STR	28'-2"	K4	20	#4	STR	8'-6"
* B6	88	#4	STR	24'-9"	K5	10	#4	STR	7'-7"
* B7	87	#6	STR	19'-9"	K6	4	#4	STR	2'-7"
* S3	35	#4	#4	14'-8"	K7	8	#4	STR	3'-1"
* S4	10	#4	#4	13'-4"	K8	4	#4	STR	2'-8"
				89	K9	4	#4	STR	2'-4"
					K10	10	#4	STR	6'-4"
					K11	10	#4	STR	6'-4"
					K12	20	#4	STR	12'-8"
					S1	92	#4	STR	11'-8"
					S2	88	#4	STR	11'-2"
					S5	170	#4	STR	2'-7"
					U1	92	#4	STR	11'-4"
									697

**\* EPOXY COATED REINFORCING STEEL 36047 LBS.**

**REINFORCING STEEL 36041 LBS.**

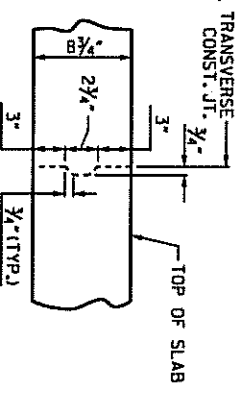

TRANSVERSE CONSTRUCTION JOINT DETAIL  
 NOTE: REINFORCING STEEL IN SLAB NOT SHOWN. LONGITUDINAL REINFORCING STEEL SHALL BE CONTINUOUS THRU JOINT.

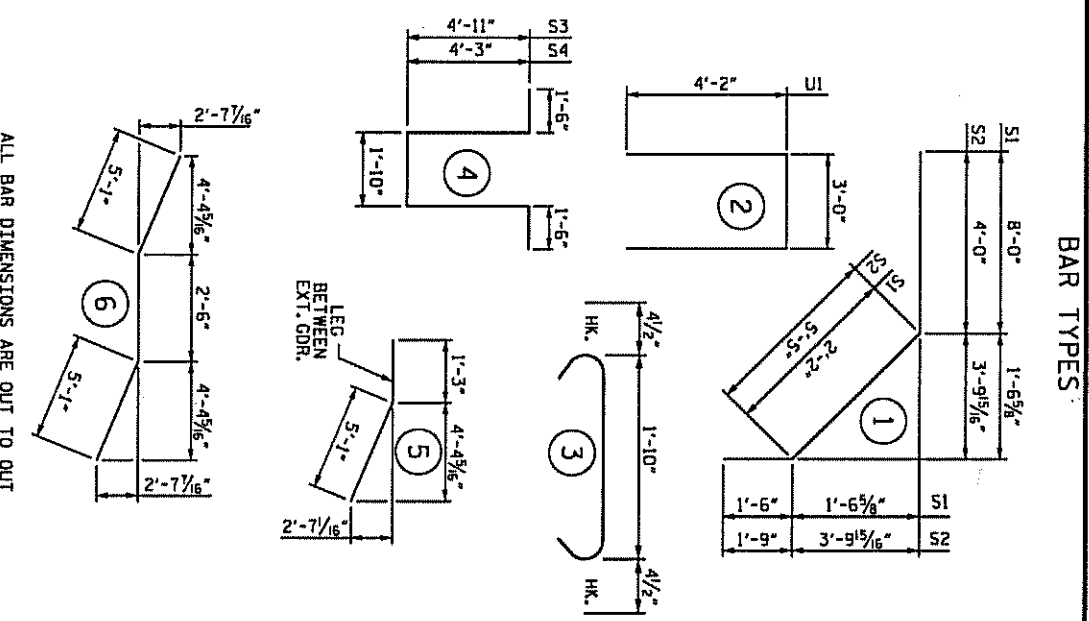

1998 **ALPHA & OMEGA GROUP** 2015  
 CIVIL | STRUCTURAL | WATER RESOURCES  
 400 Lakewood Trail, Suite 3C, Raleigh, NC 27607  
 Phone: 919.981.0310 Fax: 919.981.0451  
 www.alphaomega.com Firm License No. C-1684  
 A&O PROJECT NO. 2015.042

REGISTERED PROFESSIONAL ENGINEER  
 I.L.B. #10000  
 2/17/2018

REFERENCE NO. 9-20  
 DOCUMENT NOT CONSIDERED FINAL UNLESS ALL SIGNATURES COMPLETED

PROJECT NO. R-1015  
 COUNTY CRAVEN  
 STATION: 52+32.96 -Y3-

STATE OF NORTH CAROLINA  
 DEPARTMENT OF TRANSPORTATION  
 STANDARD  
 SUPERSTRUCTURE  
 BILL OF MATERIAL

REVISIONS

NO.	BY	DATE	REV.	DATE
1				
2				
3				
4				

SHEET NO. 32 OF 32



DIVISION OF HIGHWAYS  
 STATE OF NORTH CAROLINA

**SUMMARY OF EARTHWORK**  
 IN CUBIC YARDS

EST. DDE = 1,560 CY  
 TOTAL EST. SHALLOW UNDERCUT = 1,000 CY  
 SELECT GRANULAR MATERIAL = 144,000 CY  
 GEOTEXTILE FOR SOIL STABILIZATION = 62,500 SY

LOCATION	UNCLASSIFIED EXCAVATION	UNDERCUT	EMBT + %	BORROW	WASTE	
-L- 472+50.00 -L- 505+00.00		76	180,835	180,835	76	
-G12- 11+00.00 -G12- 13+47.00			605	605		
SUBTOTAL		76	181,440	181,440	76	
-L- 507+50.00 -L- 515+50.00		6,811	366,176	366,176	6,811	
-RP2C- 5+87.11 -RP2C- 10+71.91		102	74,383	74,383	102	
SUBTOTAL		6,913	440,559	440,559	6,913	
-L- 518+07.32 -L- 548+00.00	2,101	1,083	211,540	209,439	1,083	
-LP2A- 81+29.61 -LP2A- 86+00.00	28	313	5,344	5,316	313	
-RP2A- 79+22.74 -RP2A- 92+00.00	7	17	29,731	29,724	17	
-RP2AC- 38+30.60 -RP2AC- 67+00.00	1,439	18	43,424	42,020	53	
-RP2AC- 67+00.00 -RP2AC- 79+22.74			50,236	50,236		
-RP2CD- 5+39.89 -RP2CD- 15+00.00	1,678		30,272	28,594		
SUBTOTAL		5,253	370,547	365,329	1,466	
-L- 548+00.00 -L- 579+00.00	2,420	475	20,724	18,304	475	
-SERVEXT- 10+00.00 -SERVEXT- 21+64.81	310	378	4,969	4,659	378	
SUBTOTAL		2,730	25,963	22,963	853	
DETOUR REMOVAL						
-Y3DET- 36+50.00 -Y3DET- 69+00.00	14,030				14,030	
-Y4DET- 34+60.97 -Y4DET- 58+70.00	12,827				12,827	
SUBTOTAL		26,857			26,857	
PROJECT TOTAL		84,972	72,361	5,350,612	5,292,736	99,457
MATERIAL FOR SHOULDER CONSTRUCTION			64,776	64,776		
ADDITIONAL UNDERCUT			18,000	21,600	18,000	
GRADE POINT UNDERCUT			2,900	3,480	2,900	
WASTE IN LIEU OF BORROW				-26,966	-26,966	
EST.5% TO REPLACE TOP SOIL ON BORROW PIT				267,781		
GRAND TOTAL		84,972	93,261	5,440,468	5,623,407	93,391
SAY		88,000	96,000		5,793,000	

PAVEMENT STRUCTURE VOLUME  
 L- 6,970 CY  
 R- 35 CY  
 R- 160 CY  
 R- 386 CY  
 R- 37 CY  
 R- 192 CY  
 R- 251 CY  
 R- 72 CY  
 R- 102 CY  
 Y- 62 CY  
 Y- 89 CY  
 Y- 10 CY  
 Y- 112 CY  
 Y- 36 CY  
 Y- 50 CY  
 Y- 380 CY  
 Y- 153 CY  
 Y- 50 CY  
 Y- 74 CY  
 Y- 2 CY  
 Y- 10 CY  
 Y- 4 CY  
 Y- 112 CY  
 Y- 43 CY


NOTE: Earthwork quantities are calculated by the Roadway Design Unit. These earthwork quantities are based in part on subsurface data provided by the Geotechnical Engineering Unit.

# PIPE CULVERT CONSTRUCTION SEQUENCE

## STA. 244+09 -L-

PROJECT REFERENCE NO. E-1015 SHEET NO. EC-170CONSTR17  
 modified & nchou


### PHASE I

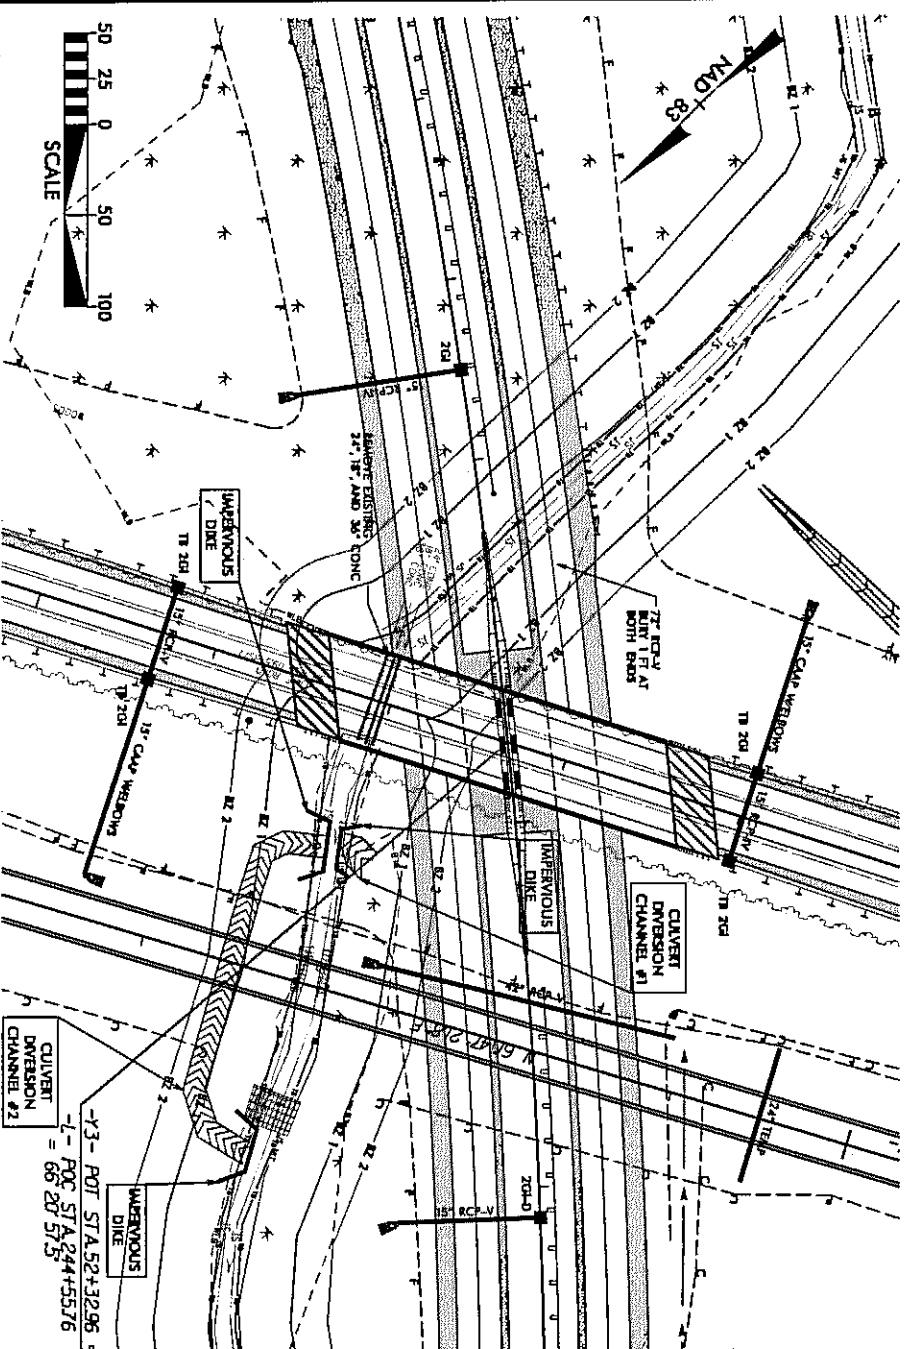

CULVERT CONSTRUCTION SEQUENCE

1. UTILIZE SPECIAL STILLING BASIN AS NEEDED THROUGHOUT THE PIPE CULVERT CONSTRUCTION.
2. INSTALL IMPERVIOUS DIKES AS SHOWN.
3. CONSTRUCT CULVERT DIVERSION CHANNELS WITH 2:1 SIDES, FOR CHANNEL #2, MATCH THE UPSTREAM AND DOWNSTREAM ELEVATIONS TO THE STREAM. FOR CHANNEL #1, THE DOWNSTREAM INVERT SHOULD BE 17.2' AND THE UPSTREAM INVERT SHOULD MATCH THE STREAM INVERT ELEVATION.

### PHASE II

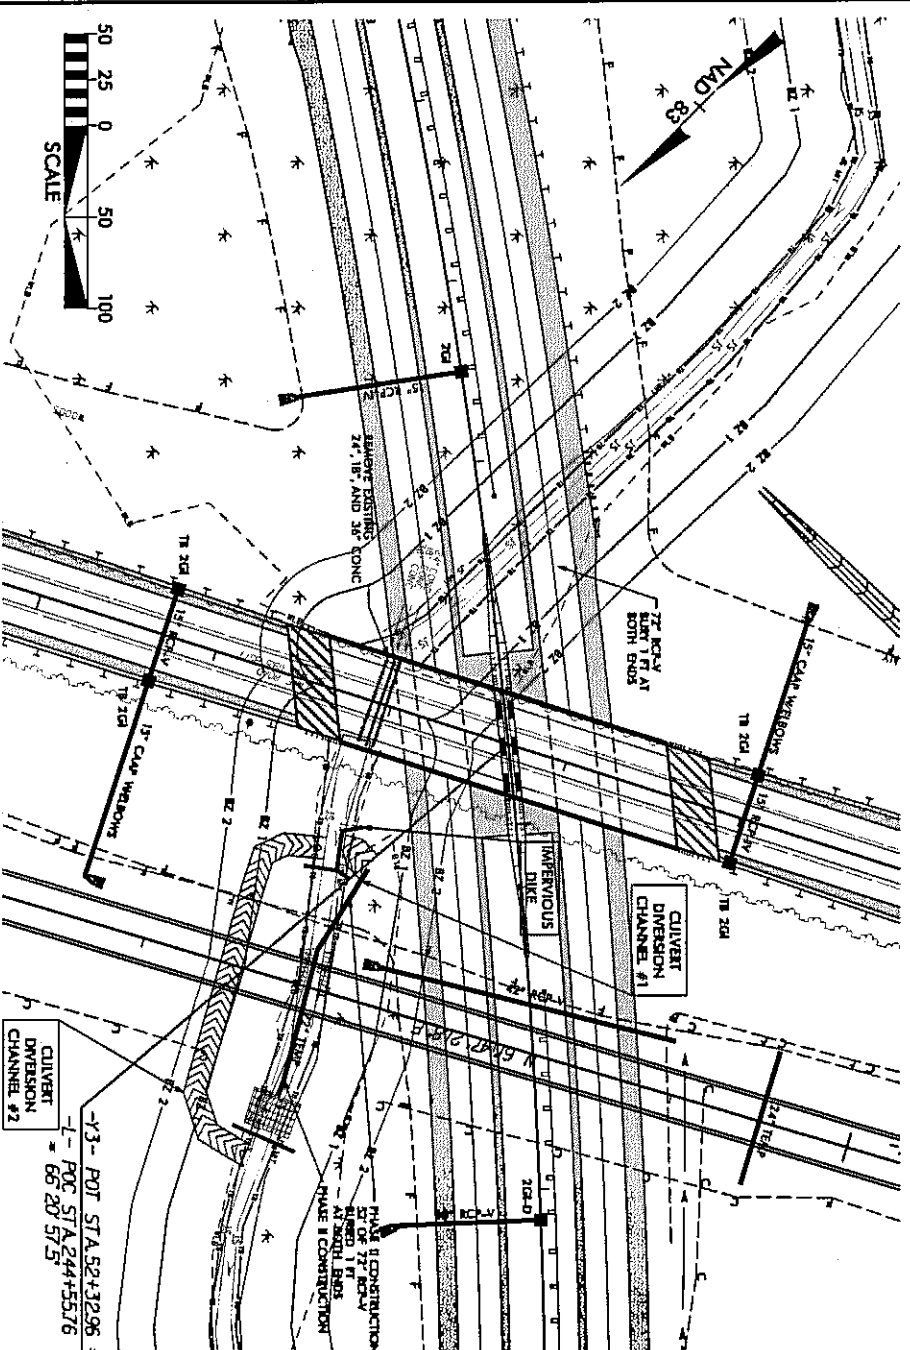

CULVERT CONSTRUCTION SEQUENCE


4. REMOVE THE IMPERVIOUS DIKES BLOCKING CULVERT DIVERSION CHANNEL #2.
5. INSTALL IMPERVIOUS DIKES TO DIVERT FLOW INTO CULVERT DIVERSION CHANNEL #2 INTO SPECIAL STILLING BASINS AS NEEDED.
6. DRY OUT WORK AREA NEEDED TO CONSTRUCT THE 72" RCP-V PIPES. PUMPING EFFLUENT
7. CONSTRUCT THE LAST 52' OF THE PERMANENT 72" RCP-V PIPE AND CONNECT VIA ELBOW TO THE 72" TEMPORARY PIPE. CONSTRUCT THE OUTLET RIP RAP PAD FOR THE TEMPORARY PIPE.

# PIPE CULVERT CONSTRUCTION SEQUENCE

## STA. 244+09 -L-


PHASE III

PHASE IV

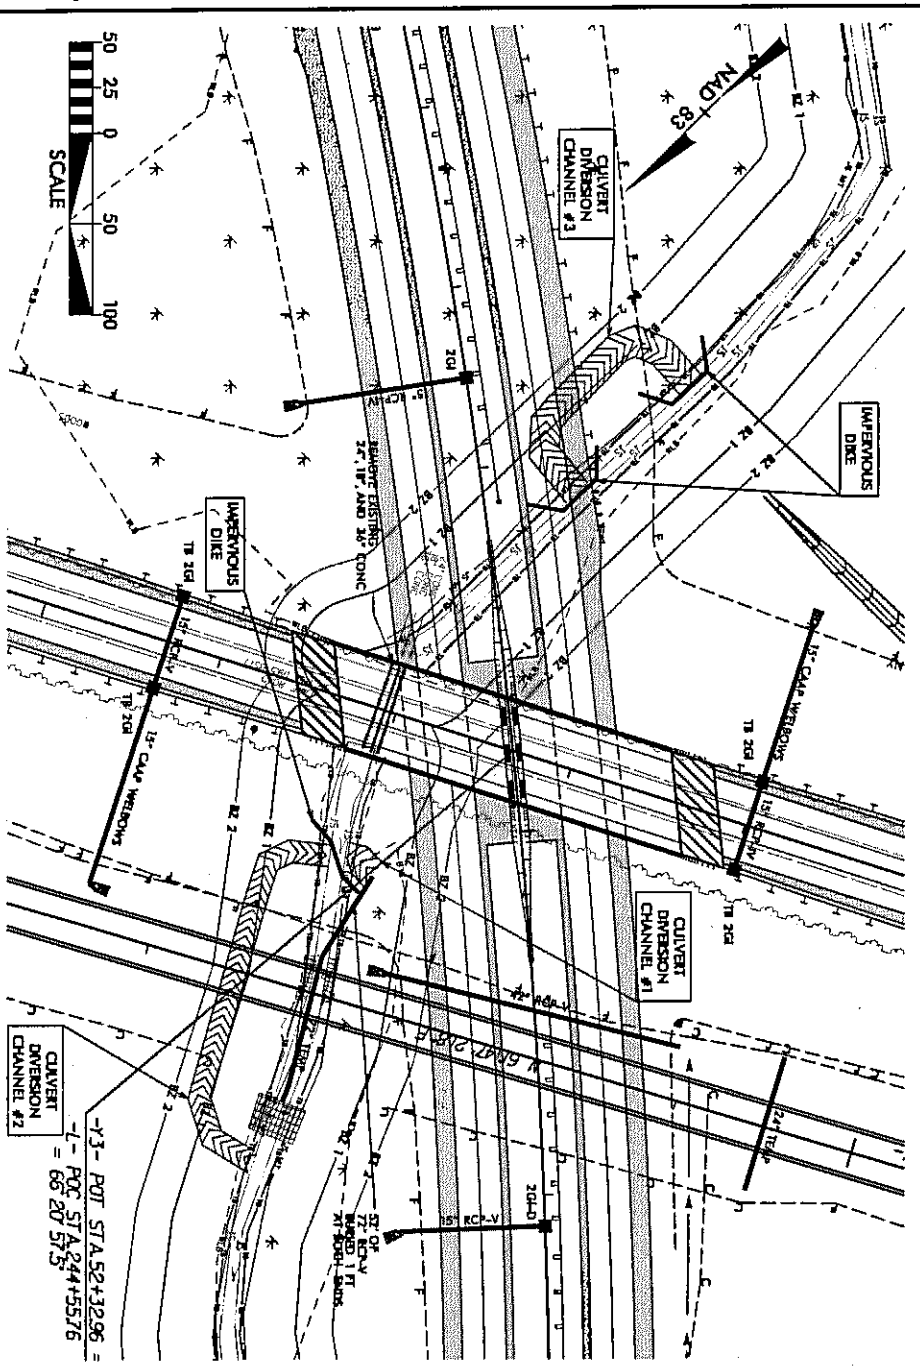

CULVERT CONSTRUCTION SEQUENCE

8. REMOVE THE IMPERVIOUS DIKES FROM PHASE II.
9. INSTALL THE IMPERVIOUS DIKES AS SHOWN ON THE PLANS TO DIVERT FLOW INTO CULVERT DIVERSION CHANNEL #1 AND THE PIPES CONSTRUCTED DURING PHASE II. ALSO INSTALL THE IMPERVIOUS DIKES NEAR CULVERT DIVERSION CHANNEL #3.
10. REMOVE CULVERT DIVERSION CHANNEL #1.
11. CONSTRUCT CULVERT DIVERSION CHANNEL #3.
12. COMPLETE THE DETOUR ROADWAY.

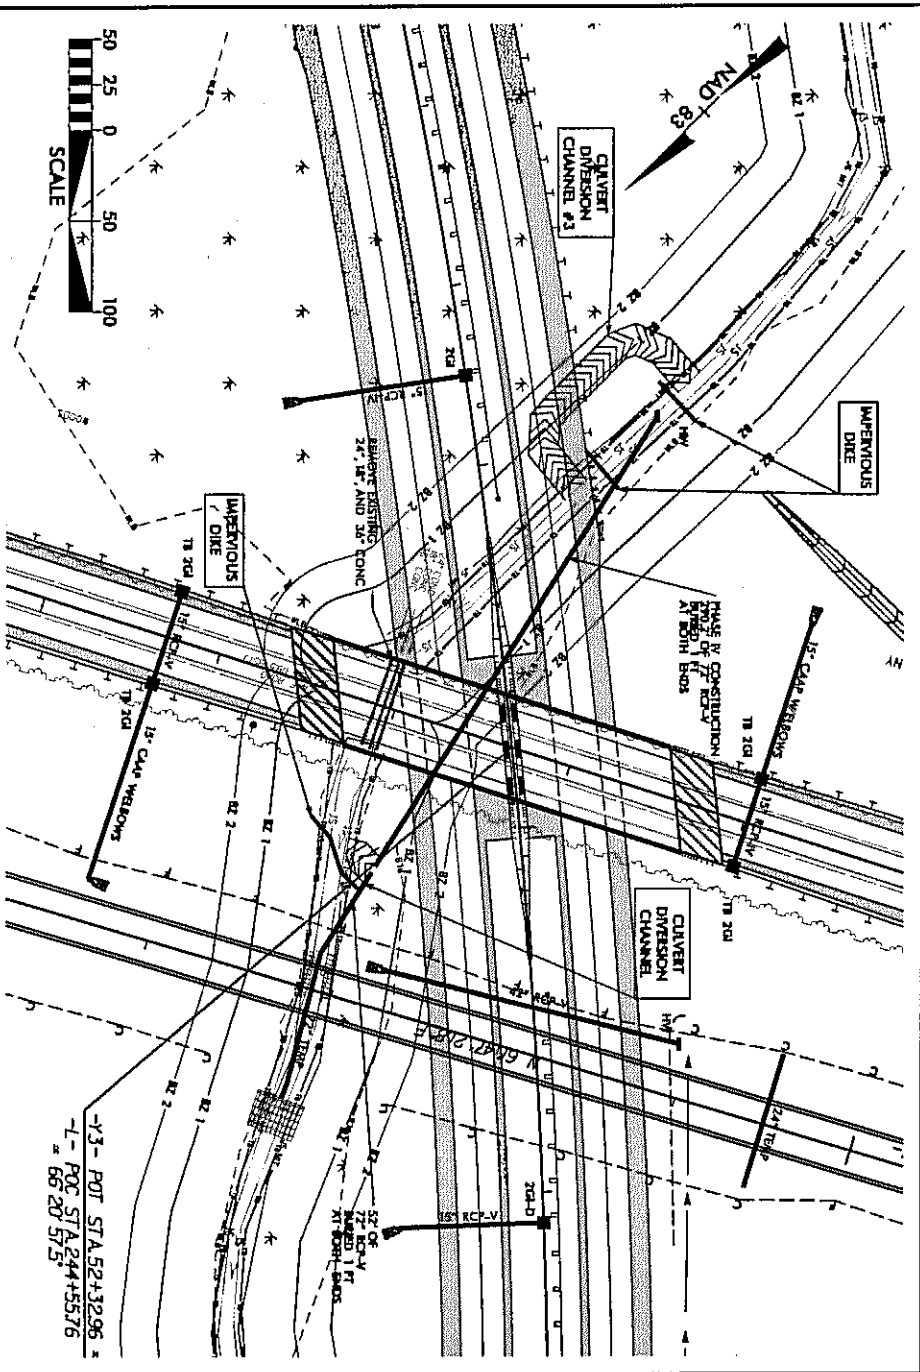

CULVERT CONSTRUCTION SEQUENCE

13. REMOVE IMPERVIOUS DIKES BLOCKING FLOW IN CULVERT DIVERSION CHANNEL #3.
14. INSTALL IMPERVIOUS DIKES TO DIVERT FLOW INTO CULVERT DIVERSION CHANNEL #3.
15. CONSTRUCT THE HEADWALL AND FIRST 290.2' OF THE 72" RCP-V AS SHOWN ON THE PLANS. DO NOT CONNECT TO THE SECTION OF 72" RCP-V CONSTRUCTED DURING PHASE II.

1/16/2009 8:57:04 AM C:\CAD\11015\Roadside\NR 1015\_REV EC-170\_PSH 17D\_EC.dgn




# PIPE CULVERT CONSTRUCTION SEQUENCE

## STA. 244+09 -L-

PROJECT REFERENCE NO.	SHEET NO.
R-2016	RC-178CONSTR17
modified by: michel DATE: 08/14/17 DRAWN BY: michel CHECKED BY: michel PROJECT MANAGER: michel	


### PHASE V

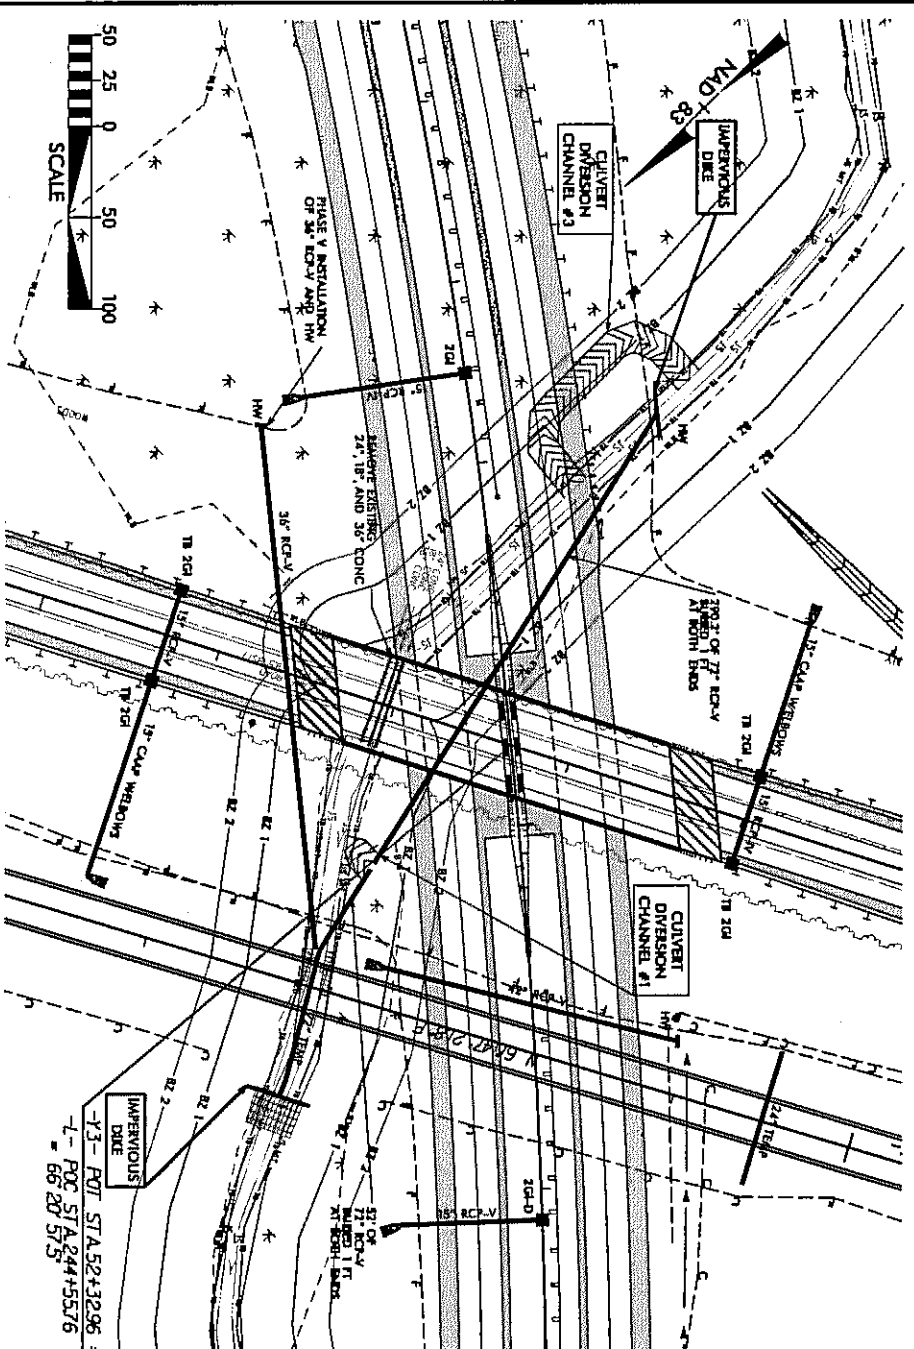

#### CULVERT CONSTRUCTION SEQUENCE

16. REMOVE THE IMPERVIOUS DIKES FROM PHASE IV TO DIVERT FLOW INTO THE 72" RCP-IV SECTION CONSTRUCTED DURING PHASE IV.
17. REMOVE CULVERT DIVERSION CHANNEL #3.
18. PLACE IMPERVIOUS DIKES AS SHOWN ON PLANS.
19. CONNECT THE SECTIONS OF 72" RCP-IV CONSTRUCTED DURING PHASE II AND IV.
20. REMOVE THE IMPERVIOUS DIKES.
21. REMOVE IMPERVIOUS DIKES THAT WERE DIVERTING FLOW INTO CULVERT DIVERSION CHANNEL #1.
22. REMOVE CULVERT DIVERSION CHANNEL #1.
23. INSTALL 36" RCP-V AND HEADWALL.
24. REMOVE THE EXISTING 18" 24" AND 36" CONCRETE PIPES.
25. COMPLETE THE FINAL ROADWAY.

### PHASE VI

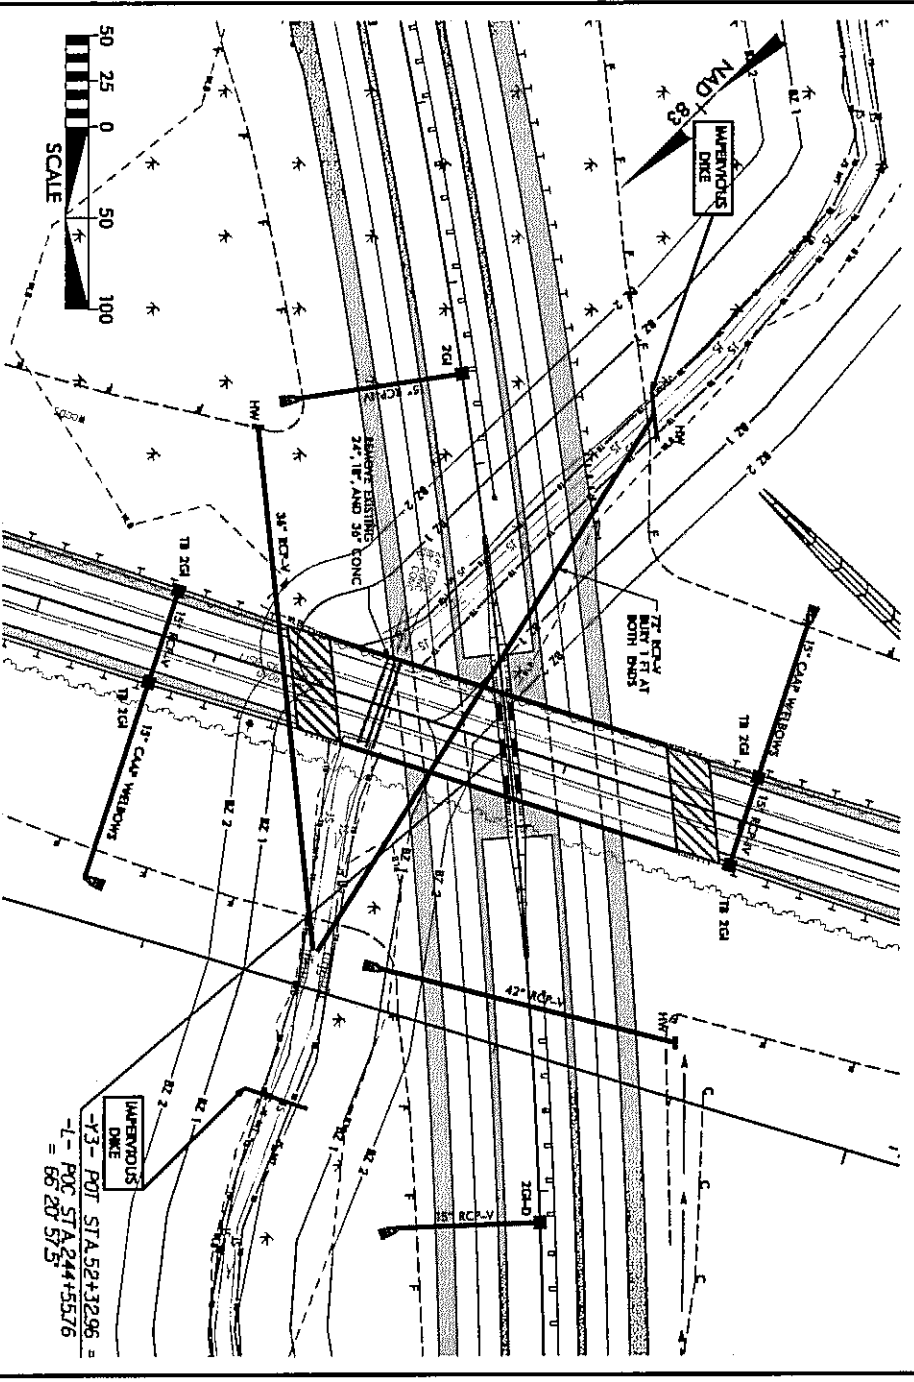

#### CULVERT CONSTRUCTION SEQUENCE


26. REMOVE THE DETOUR ROADWAY AND DRAINAGE.
27. RECONSTRUCT CHANNEL AND CONSTRUCT RIP RAP PAD AT PIPE OUTLET.
28. PLACE IMPERVIOUS DIKES AS SHOWN ON PLANS.
29. REMOVE THE ELBOW AND 72" TEMPORARY PIPE INSTALLED DURING PHASE II.
30. REMOVE THE IMPERVIOUS DIKES.

# CULVERT CONSTRUCTION SEQUENCE

## STA. 509 + 41 -L-


PROJECT REFERENCE NO. R-1015 SHEET NO. EC-S&ACONST-36  
 modified & revised  
 DATE: 11/15/05  
 BY: [Signature]

### PHASE I

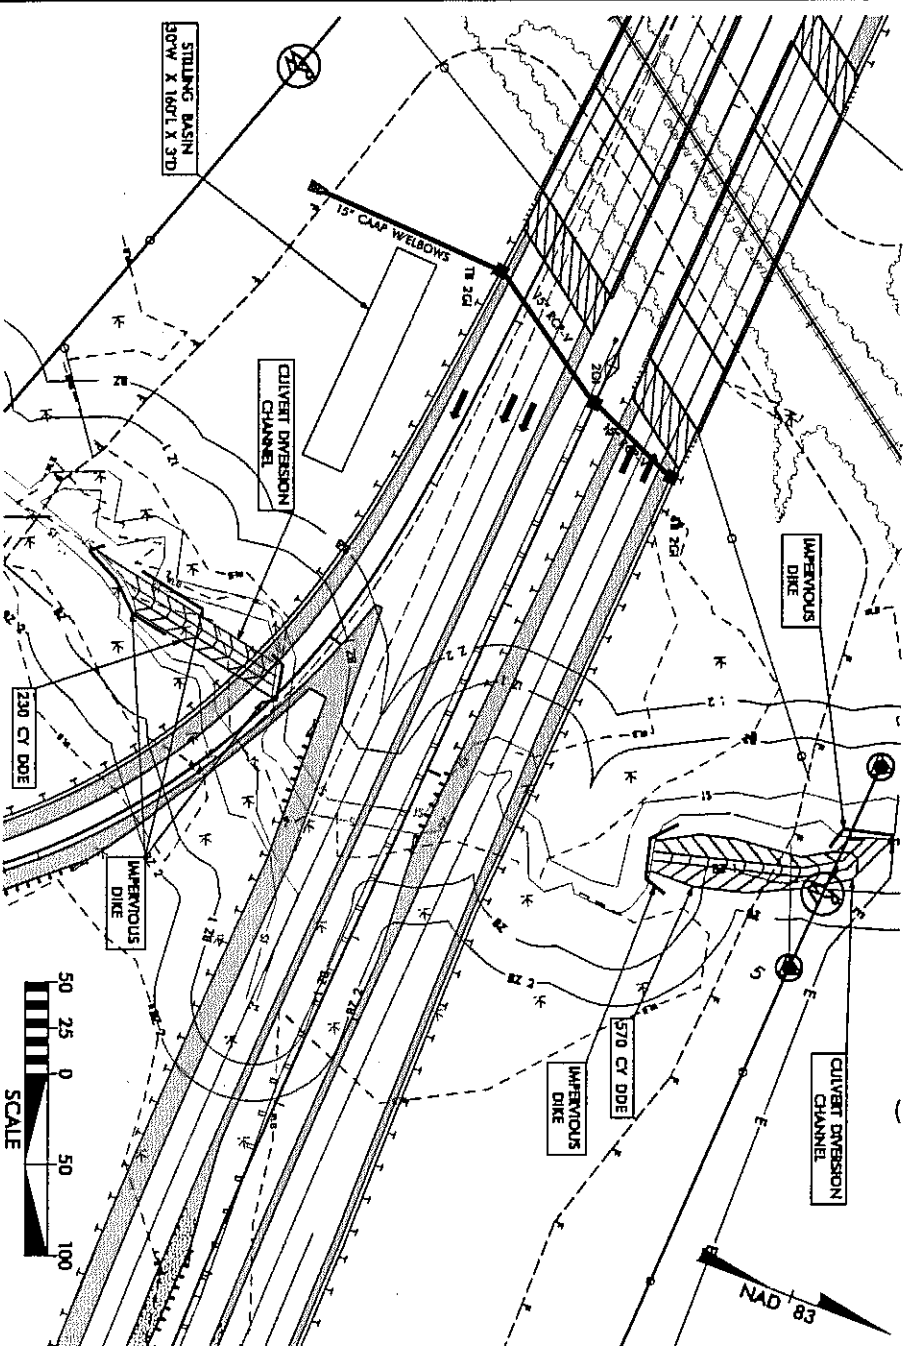


#### CULVERT CONSTRUCTION SEQUENCE

1. INSTALL STILLING BASIN WITH A MINIMUM CAPACITY OF 530 CY.
2. INSTALL IMPERVIOUS DIKES AS SHOWN.
3. DRY OUT WORK AREA NEEDED TO CONSTRUCT THE CULVERT DIVERSION CHANNELS, PUMPING EFFLUENT INTO STILLING BASIN.
4. CONSTRUCT CULVERT DIVERSION CHANNELS.

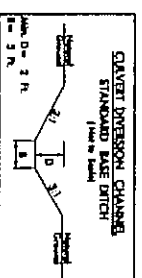

### PHASE II

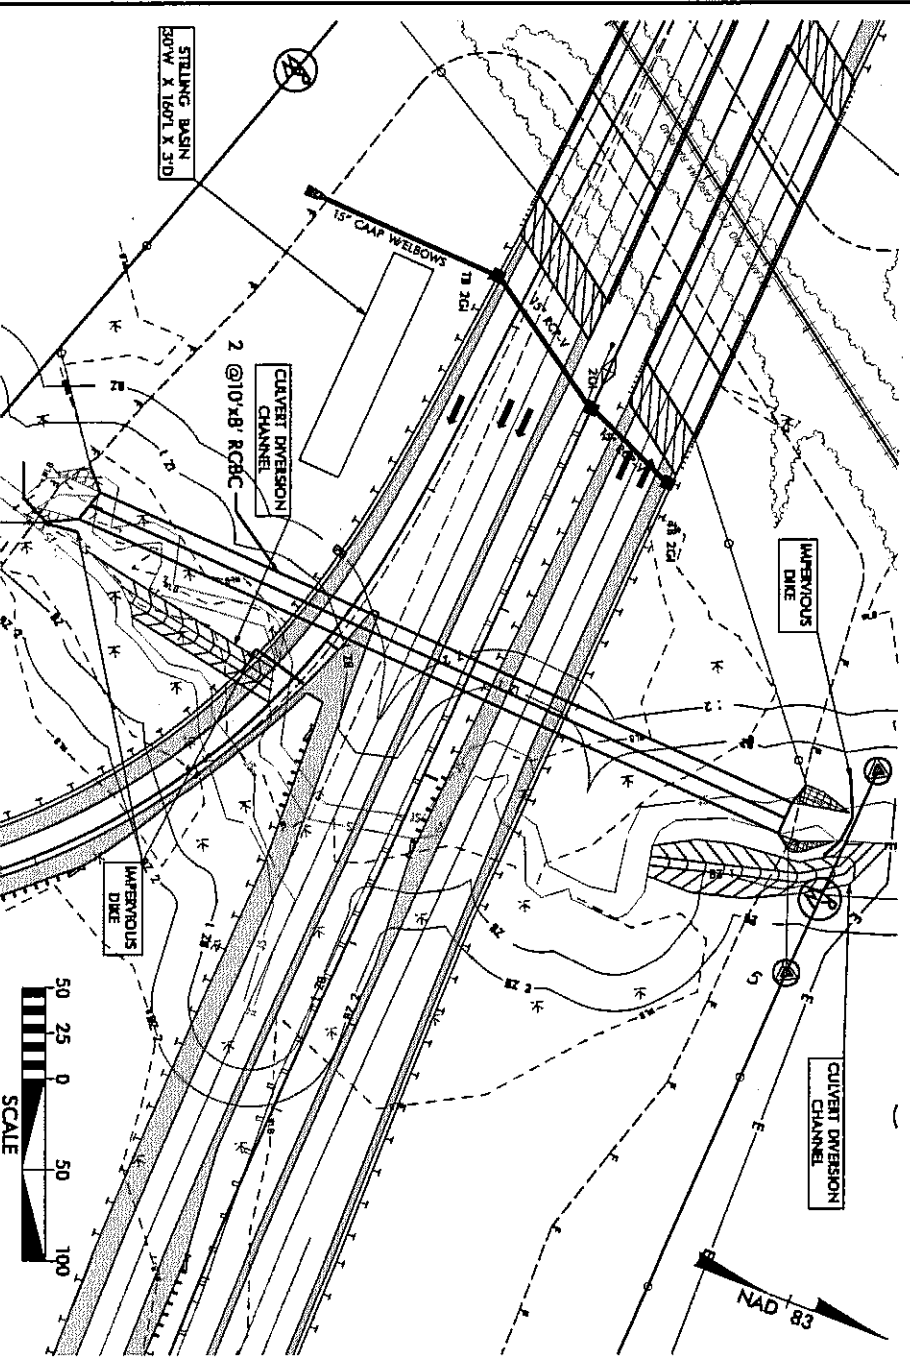

#### CULVERT CONSTRUCTION SEQUENCE

5. REMOVE IMPERVIOUS DIKES CONSTRUCTED IN PHASE I AND DIVERT FLOW INTO CULVERT DIVERSION CHANNELS BY CONSTRUCTING THE IMPERVIOUS DIKES SHOWN IN PHASE II.
6. DRY OUT WORK AREA NEEDED TO CONSTRUCT THE CULVERT, PUMPING EFFLUENT INTO STILLING BASIN.
7. CONSTRUCT THE TWO CULVERTS.
8. CONSTRUCT THE ARMORING TO THE GREATEST EXTENT PRACTICABLE.


# CULVERT CONSTRUCTION SEQUENCE

## STA. 509 + 41 -L-

PROJECT REFERENCE NO.	SHEET NO.
R-1015	EC-588/CONST-38
<small>                 CONSULTING ENGINEER                  MORTON &amp; MORTON                  1000 WEST 10TH AVENUE                  DENVER, COLORADO 80202             </small>	


PHASE III

PHASE IV

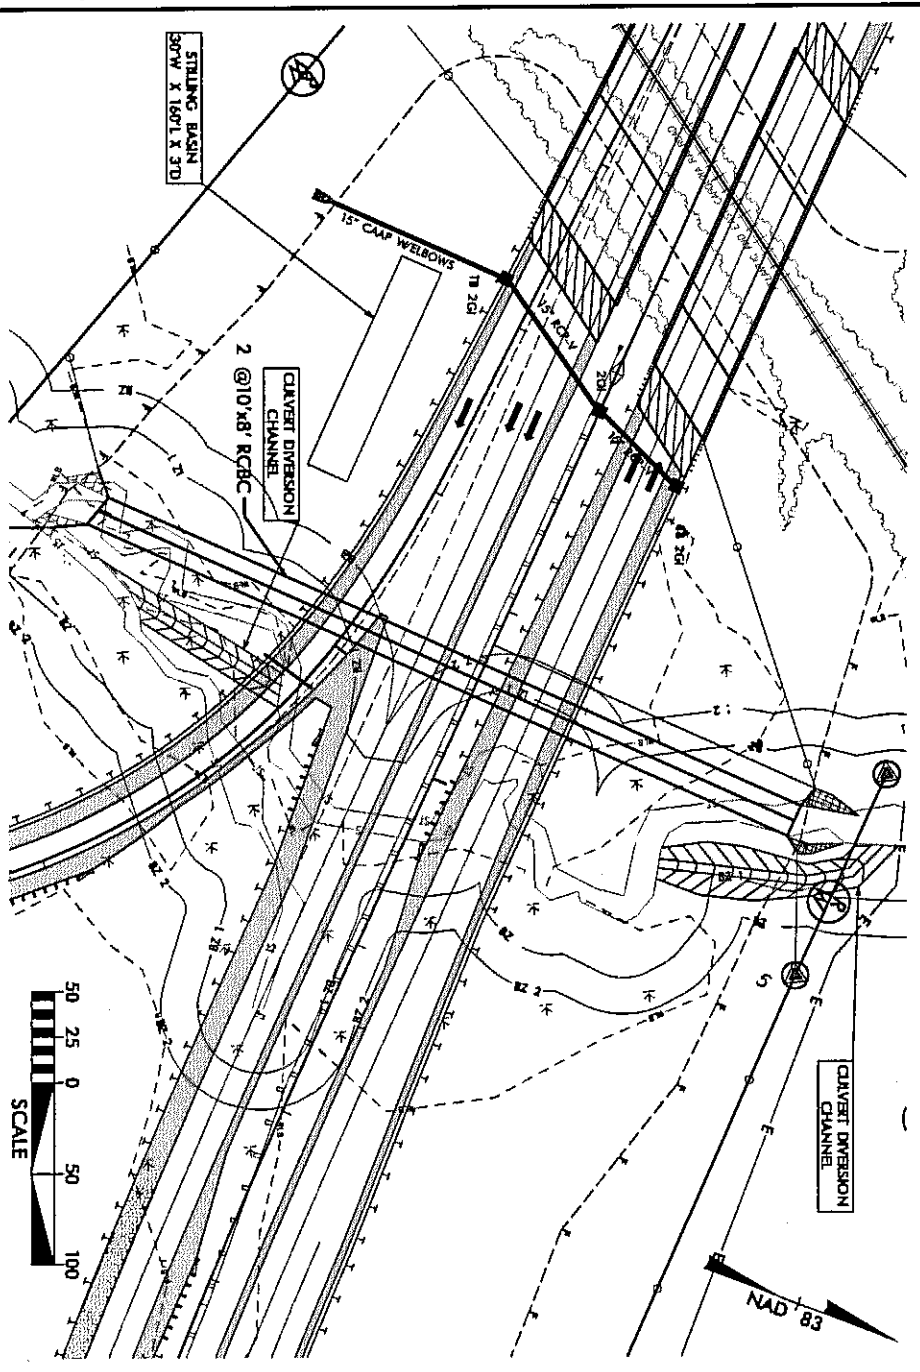

CULVERT CONSTRUCTION SEQUENCE

9. REMOVE IMPERVIOUS DIKS ALLOWING FLOW INTO THE CULVERT.
10. FINISH ARMORING THE BANKS THAT WERE UNABLE TO BE COMPLETED DURING PHASE II
11. REMOVE CULVERT DIVERSION CHANNELS.

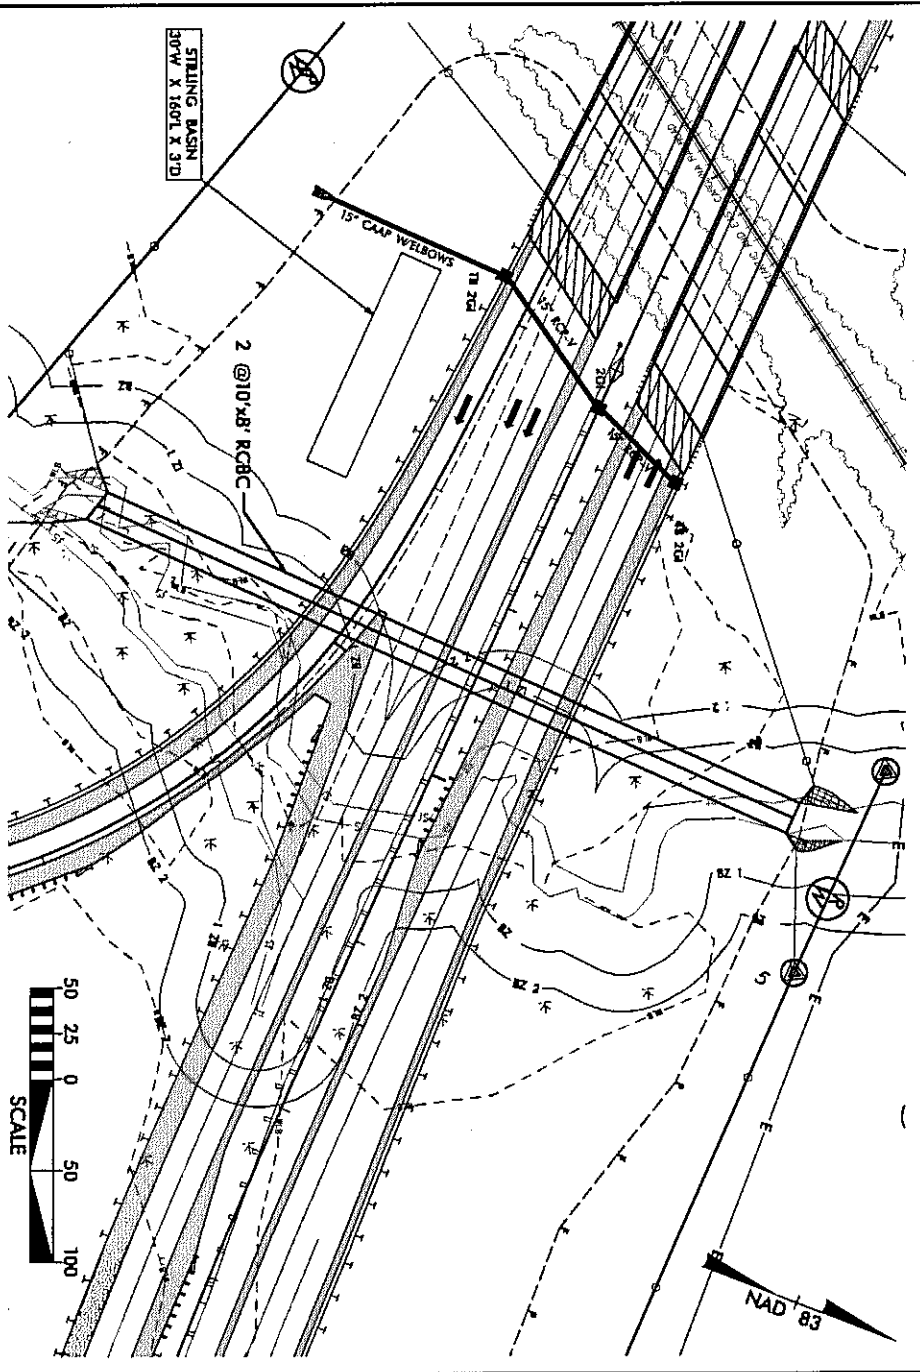


CULVERT CONSTRUCTION SEQUENCE

12. REMOVE STILLING BASIN
13. COMPLETE ROADWAY


PROJECT REFERENCE NO. R-1015 SHEET NO. UO-5

**UTILITIES BY OTHERS**

**NOTE:**  
 ALL UTILITY WORK SHOWN ON THIS SHEET WILL BE DONE BY OTHERS. NO PAYMENT WILL BE MADE TO THE CONTRACTOR FOR UTILITY WORK SHOWN ON THIS SHEET.

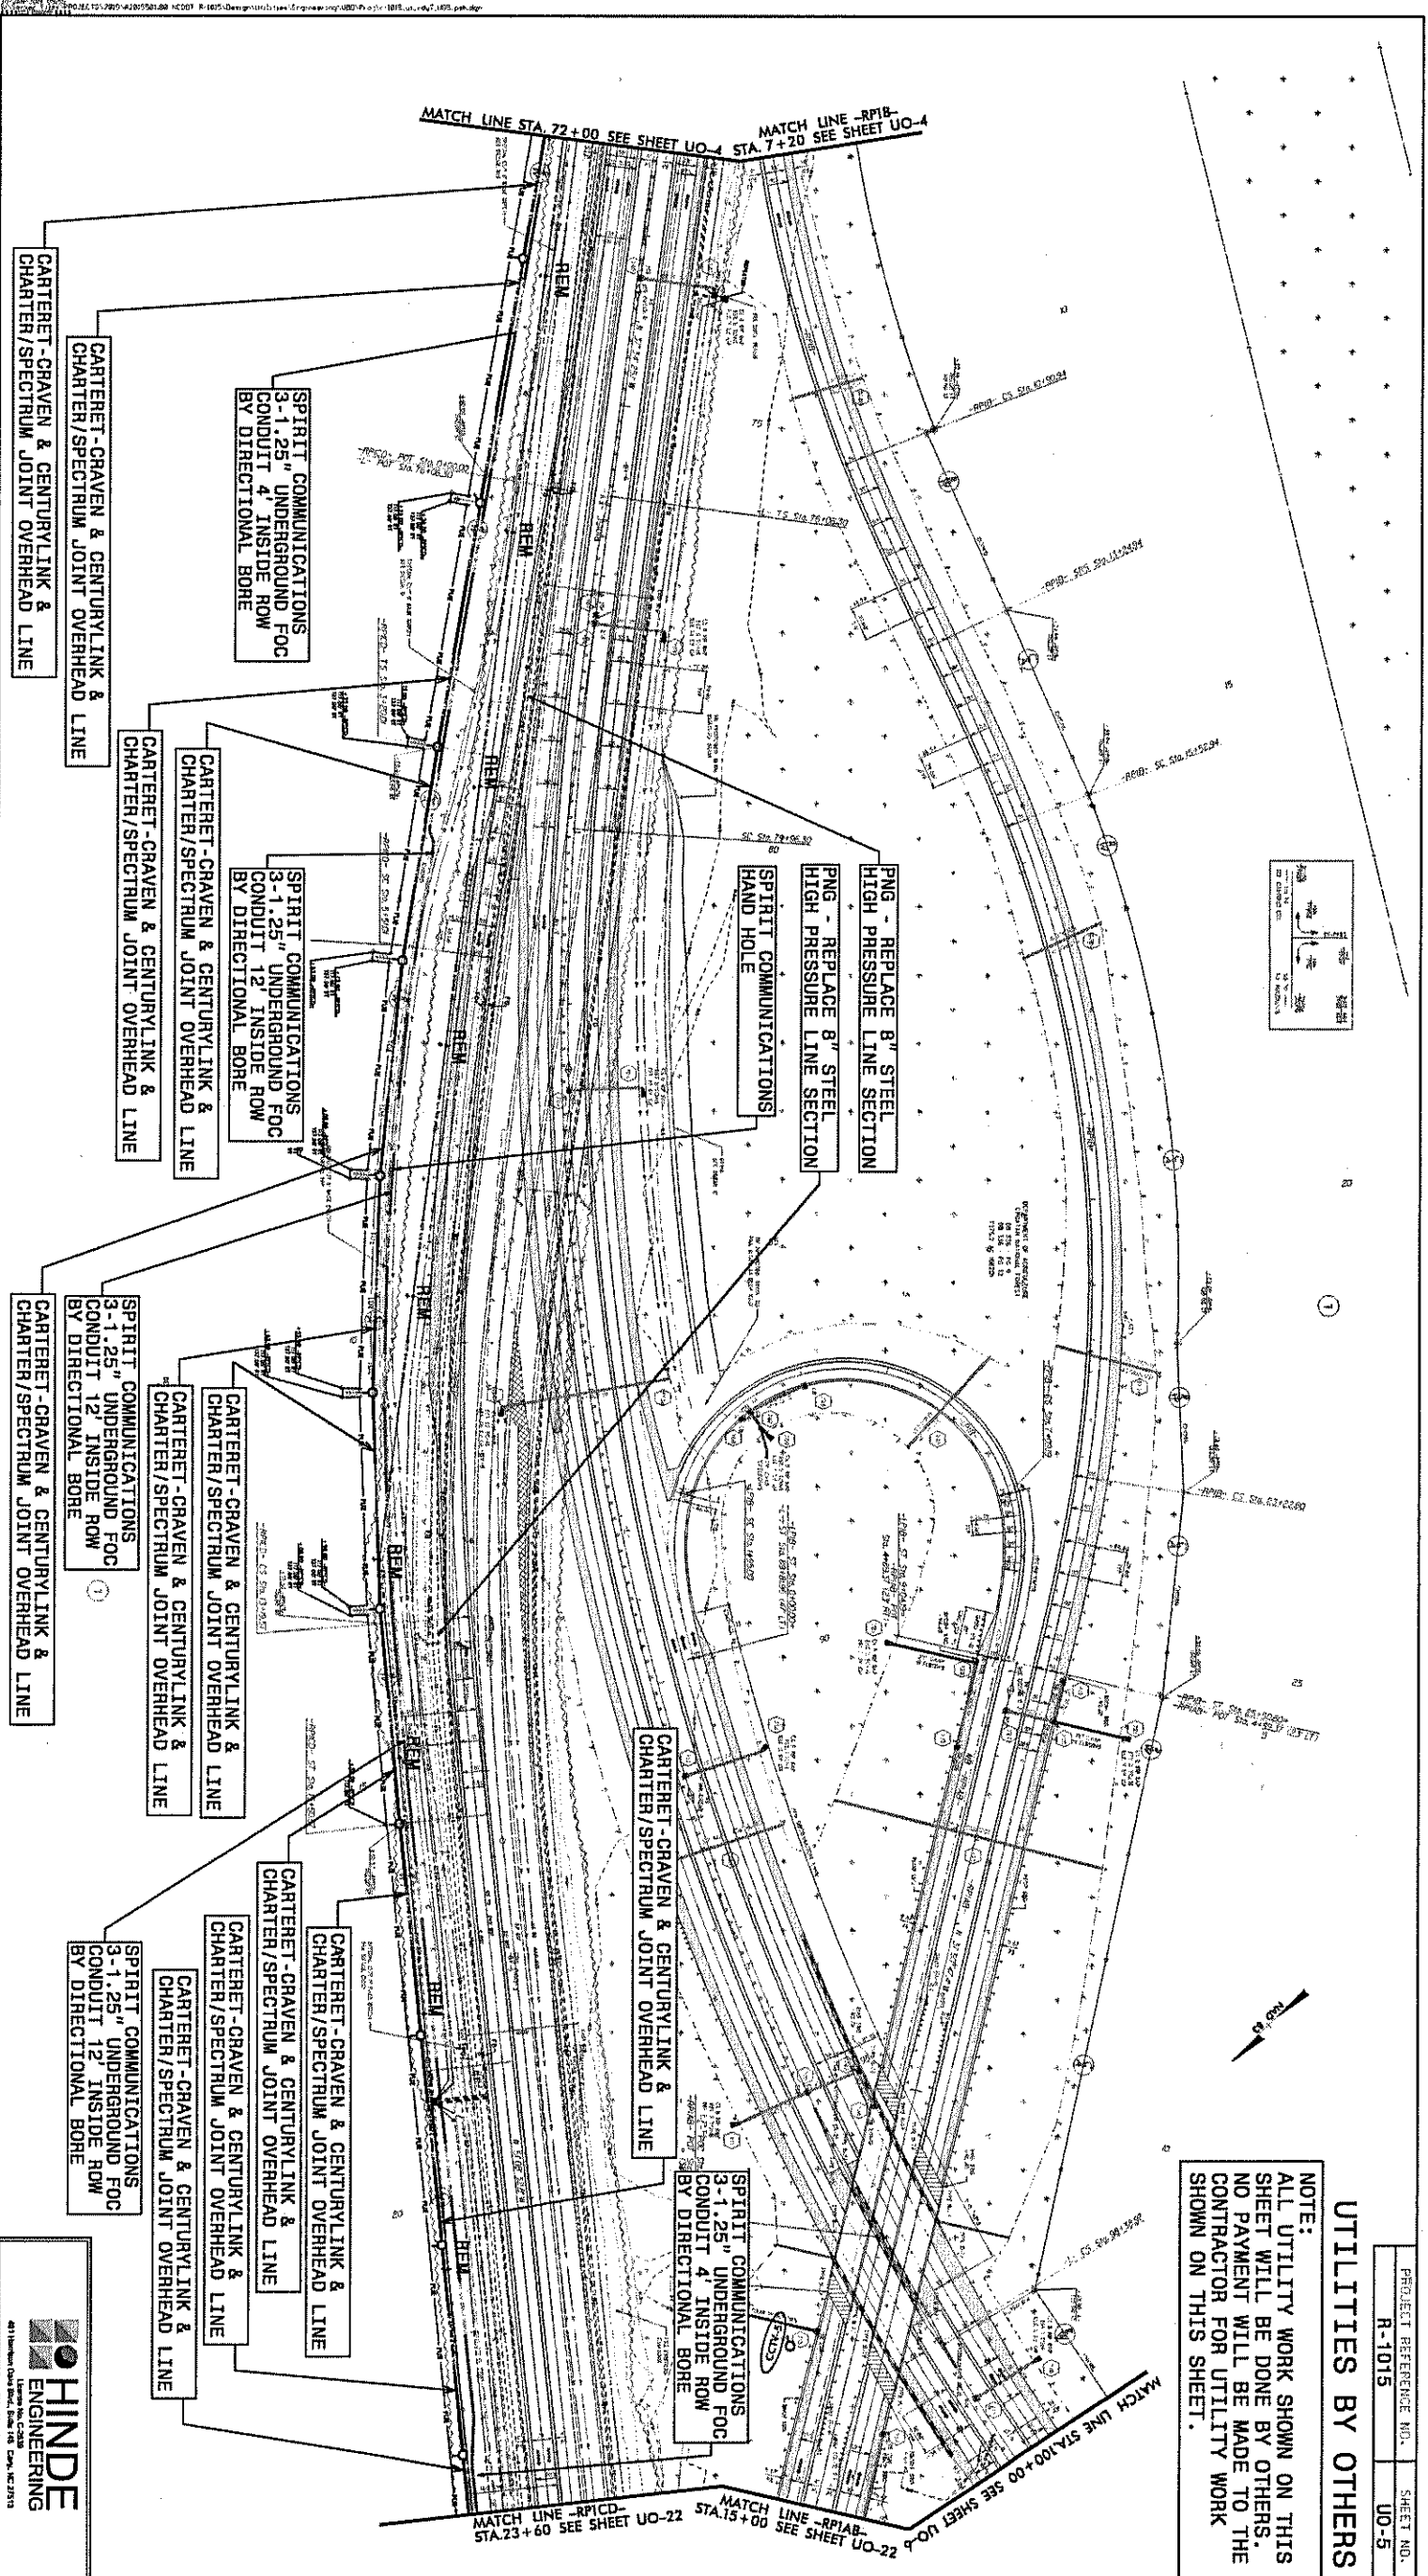

MATCH LINE STA.142+00 SEE SHEET UO-8

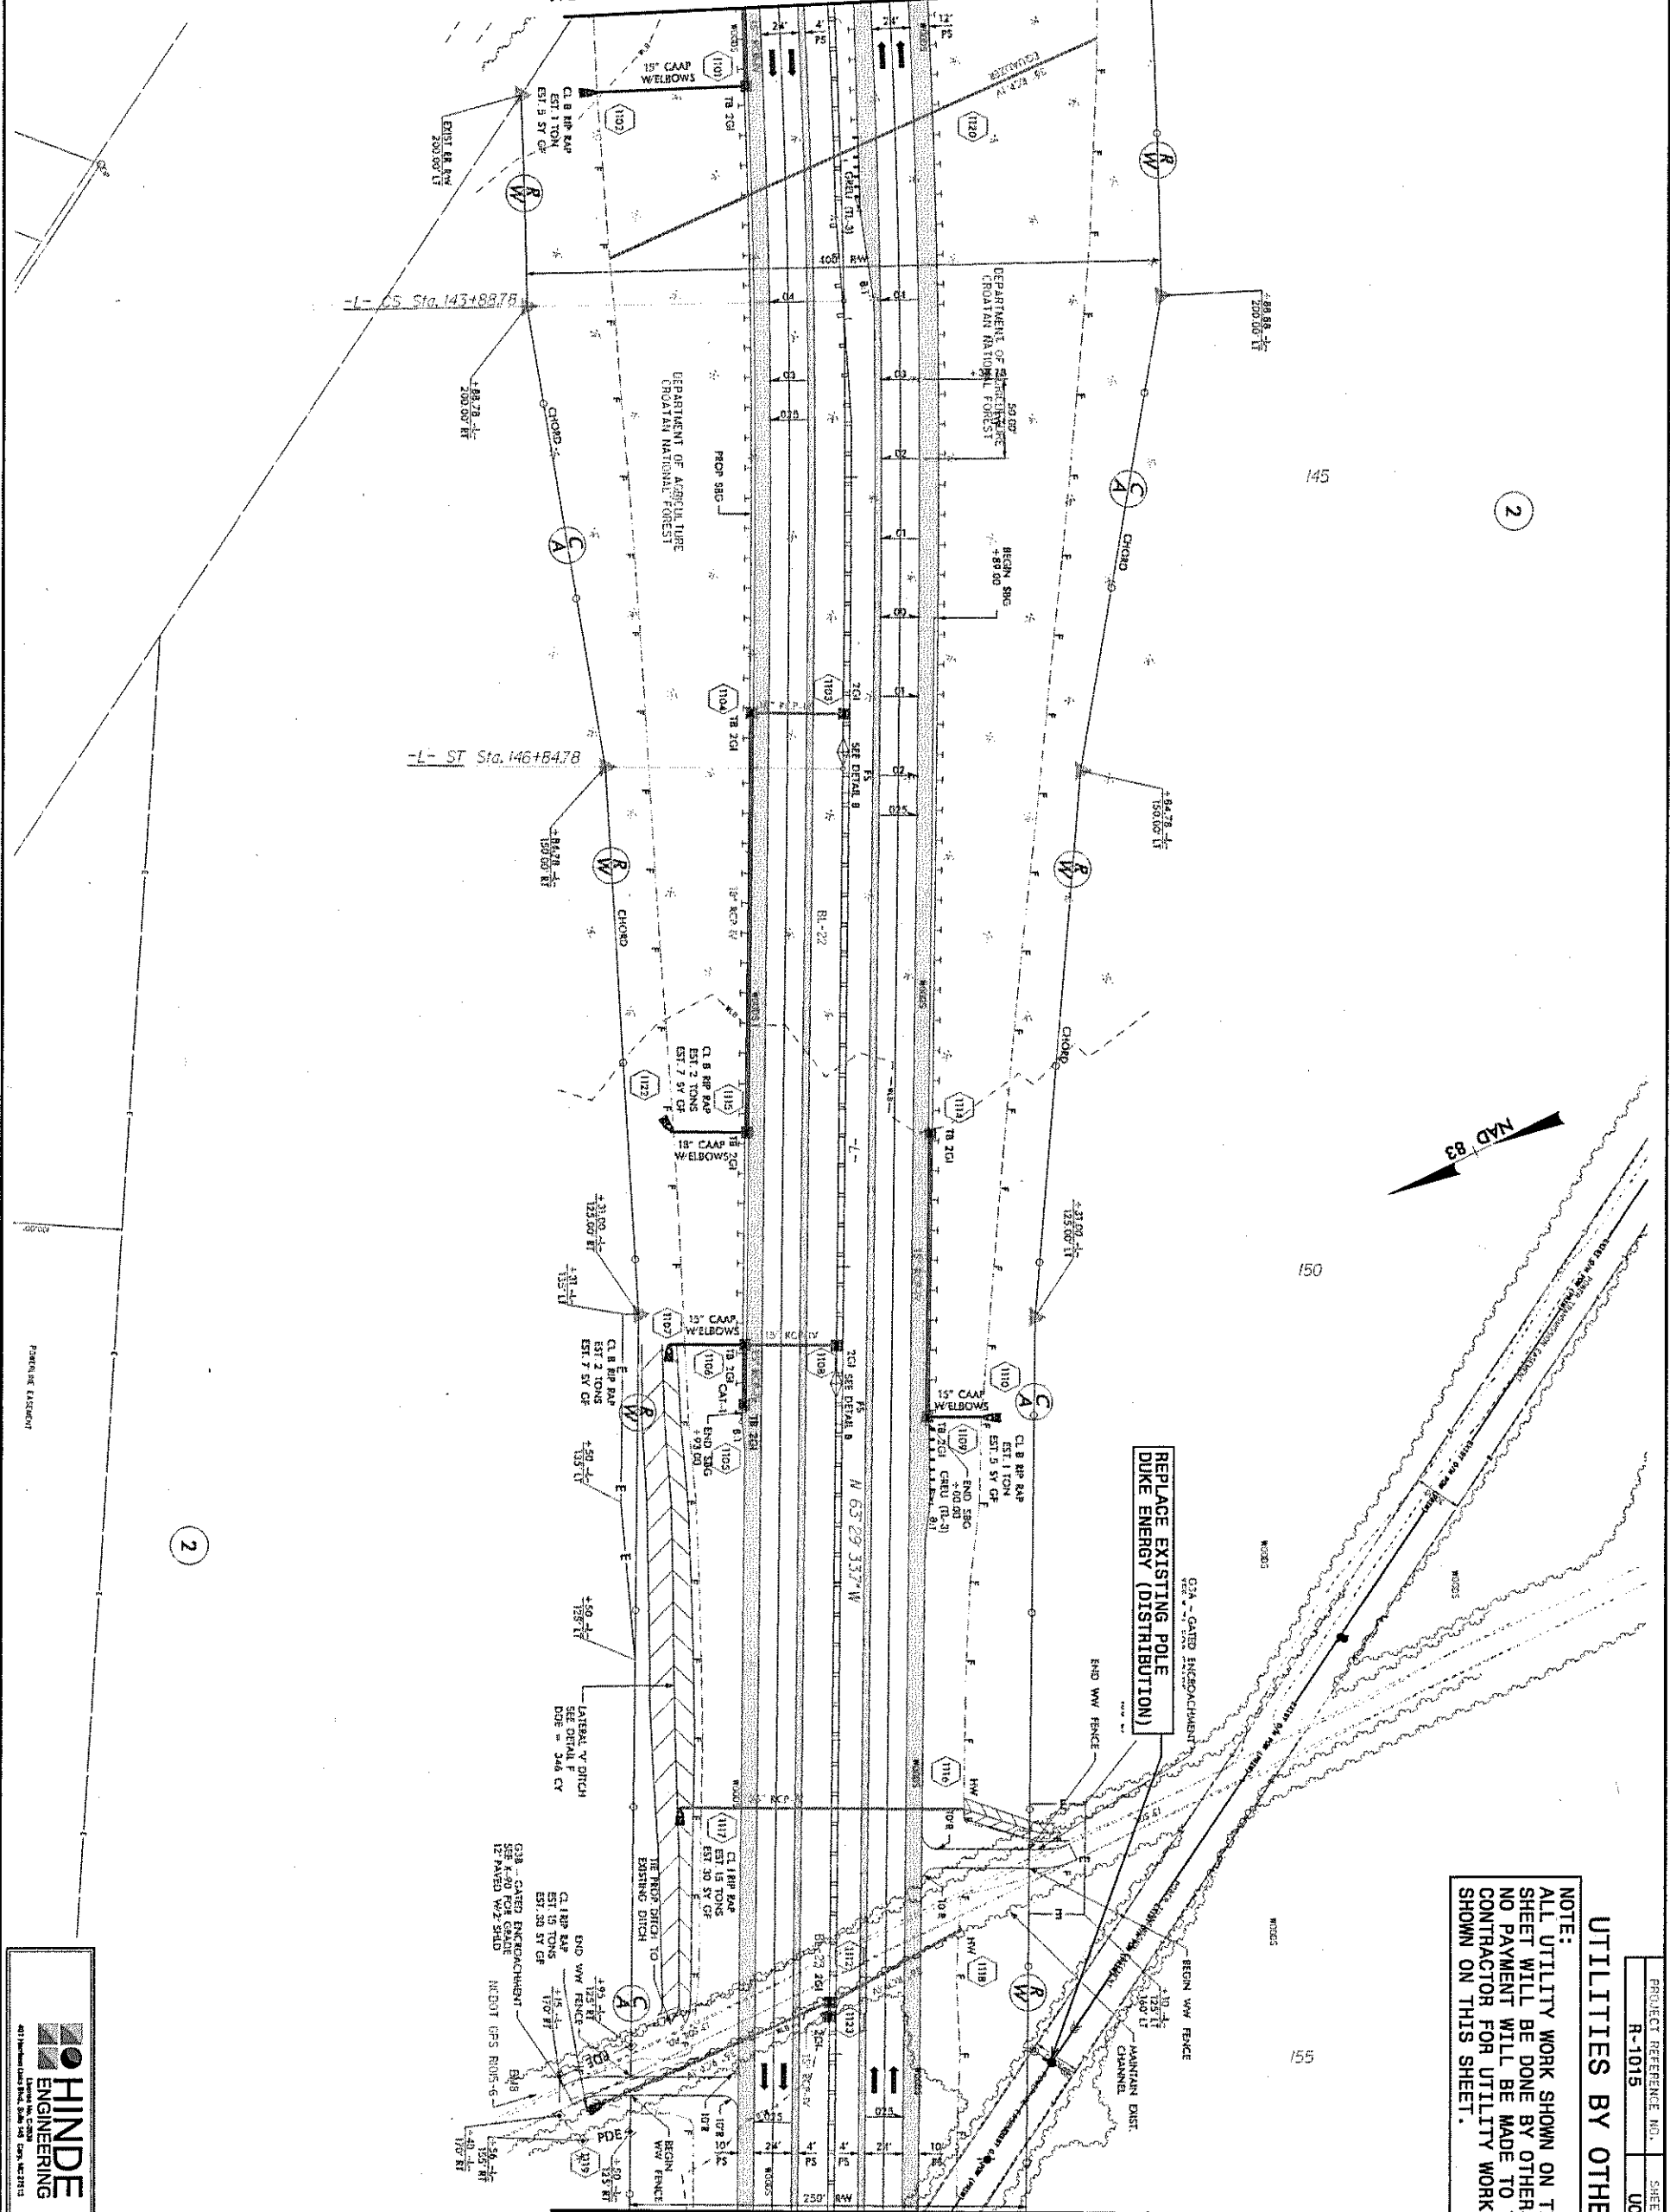

REPLACE EXISTING POLE  
 DUKE ENERGY (DISTRIBUTION)

NOTE:  
 ALL UTILITY WORK SHOWN ON THIS SHEET WILL BE DONE BY OTHERS. NO PAYMENT WILL BE MADE TO THE CONTRACTOR FOR UTILITY WORK SHOWN ON THIS SHEET.

UTILITIES BY OTHERS


PROJECT REFERENCE NO. R-1015 SHEET NO. UO-9

MATCH LINE STA.156+00 SEE SHEET UO-10



MATCH LINE STA.156+00 SEE SHEET UO-9

REPLACE EXISTING POLE  
 DUKE ENERGY (DISTRIBUTION)

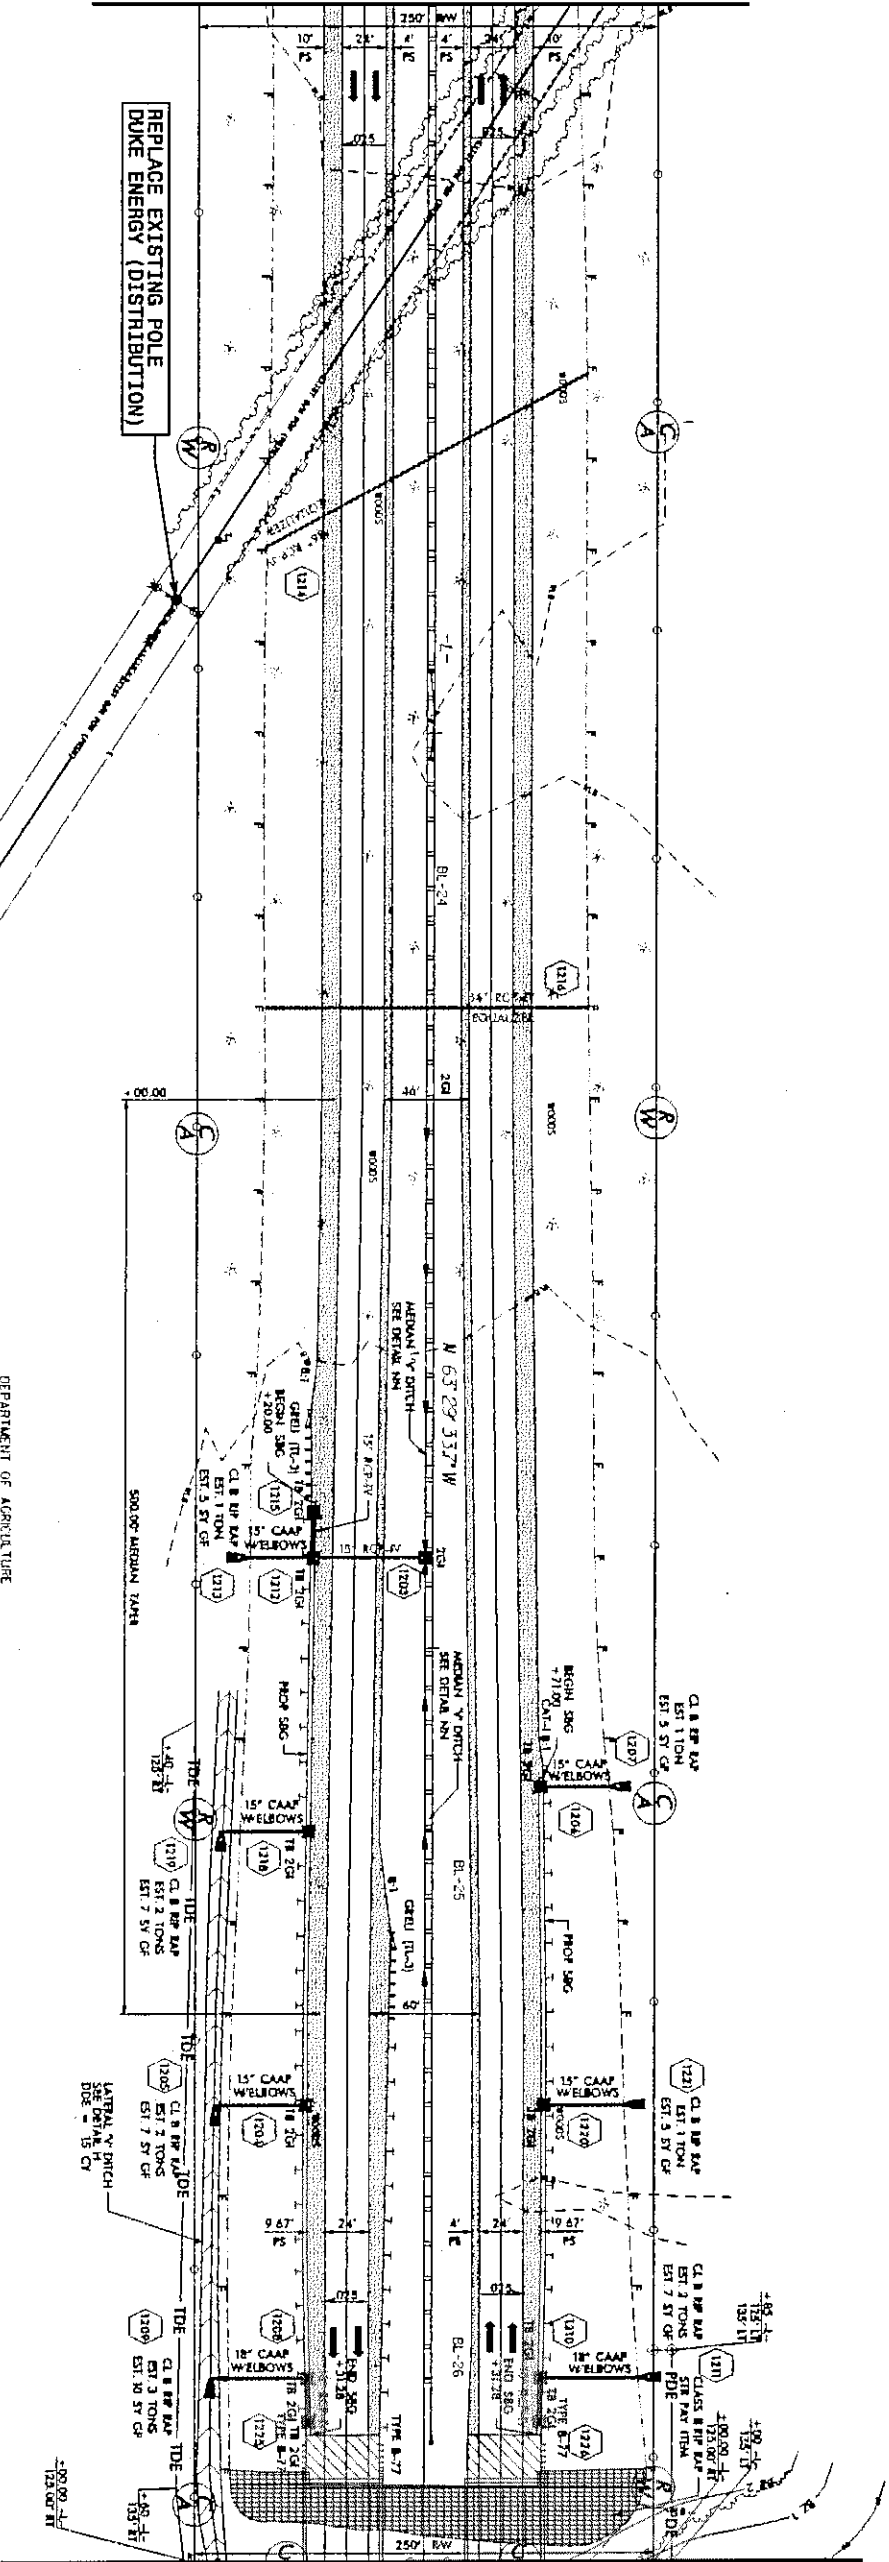

MATCH LINE STA.170+00 SEE SHEET 13



**UTILITIES BY OTHERS**  
 NOTE:  
 ALL UTILITY WORK SHOWN ON THIS SHEET WILL BE DONE BY OTHERS. NO PAYMENT WILL BE MADE TO THE CONTRACTOR FOR UTILITY WORK SHOWN ON THIS SHEET.

PROJECT REFERENCE NO.	R-1015	SHEET NO.	UO-10
-----------------------	--------	-----------	-------



MATCH LINE STA. 492+00 SEE SHEET 34

DEPARTMENT OF AGRICULTURE  
 CROATAN NATIONAL FOREST  
 NO DEED REFERENCE  
 SEE CROATAN PURCHASE TRACT REC

59

-G12- POT Sta. 495+50.000  
 -L- POT Sta. 495+50.000

2

-G12- PC Sta. 10+89296  
 -G12- PT Sta. 11+3984

REPLACE EXISTING POLE  
 DUKE ENERGY (DISTRIBUTION)

REPLACE EXISTING POLE  
 DUKE ENERGY (DISTRIBUTION)

EXIST. TRANSMISSION LINE PROFILE 13  
 SEE SHEET UO-43

REPLACE EXISTING POLE  
 DUKE ENERGY (DISTRIBUTION)

STR. 201

DEPARTMENT OF AGRICULTURE  
 CROATAN NATIONAL FOREST  
 NO DEED REFERENCE  
 SEE CROATAN PURCHASE TRACT REC

**UTILITIES BY OTHERS**  
 NOTE:  
 ALL UTILITY WORK SHOWN ON THIS SHEET WILL BE DONE BY OTHERS. NO PAYMENT WILL BE MADE TO THE CONTRACTOR FOR UTILITY WORK SHOWN ON THIS SHEET.

PROJECT REFERENCE NO. R-1015 SHEET NO. UO-17

MATCH LINE STA. 505+00 SEE SHEET UO-18

-L- POT Sta. 504+56.800  
 -RPPC- POT Sta. 0+00.000 147' RTI  
 = 218.00'

THE PROPOSED PROJECT WILL NOT CHANGE THE QUANTITY OR CHARACTER OF FLOW IN THE RAILWAY'S DITCHES. THE EXISTING RAILWAY DITCHES ARE TO BE MAINTAINED AT ALL HIGH POINTS OF THESE DITCHES OCCUR THE BRIDGE. THE PROPOSED BRIDGE HAS



13


2





MATCH LINE STA. 533+50 SEE SHEET UO-18

MATCH LINE -RP2A  
 STA. 86+80 SEE SHEET UO-18

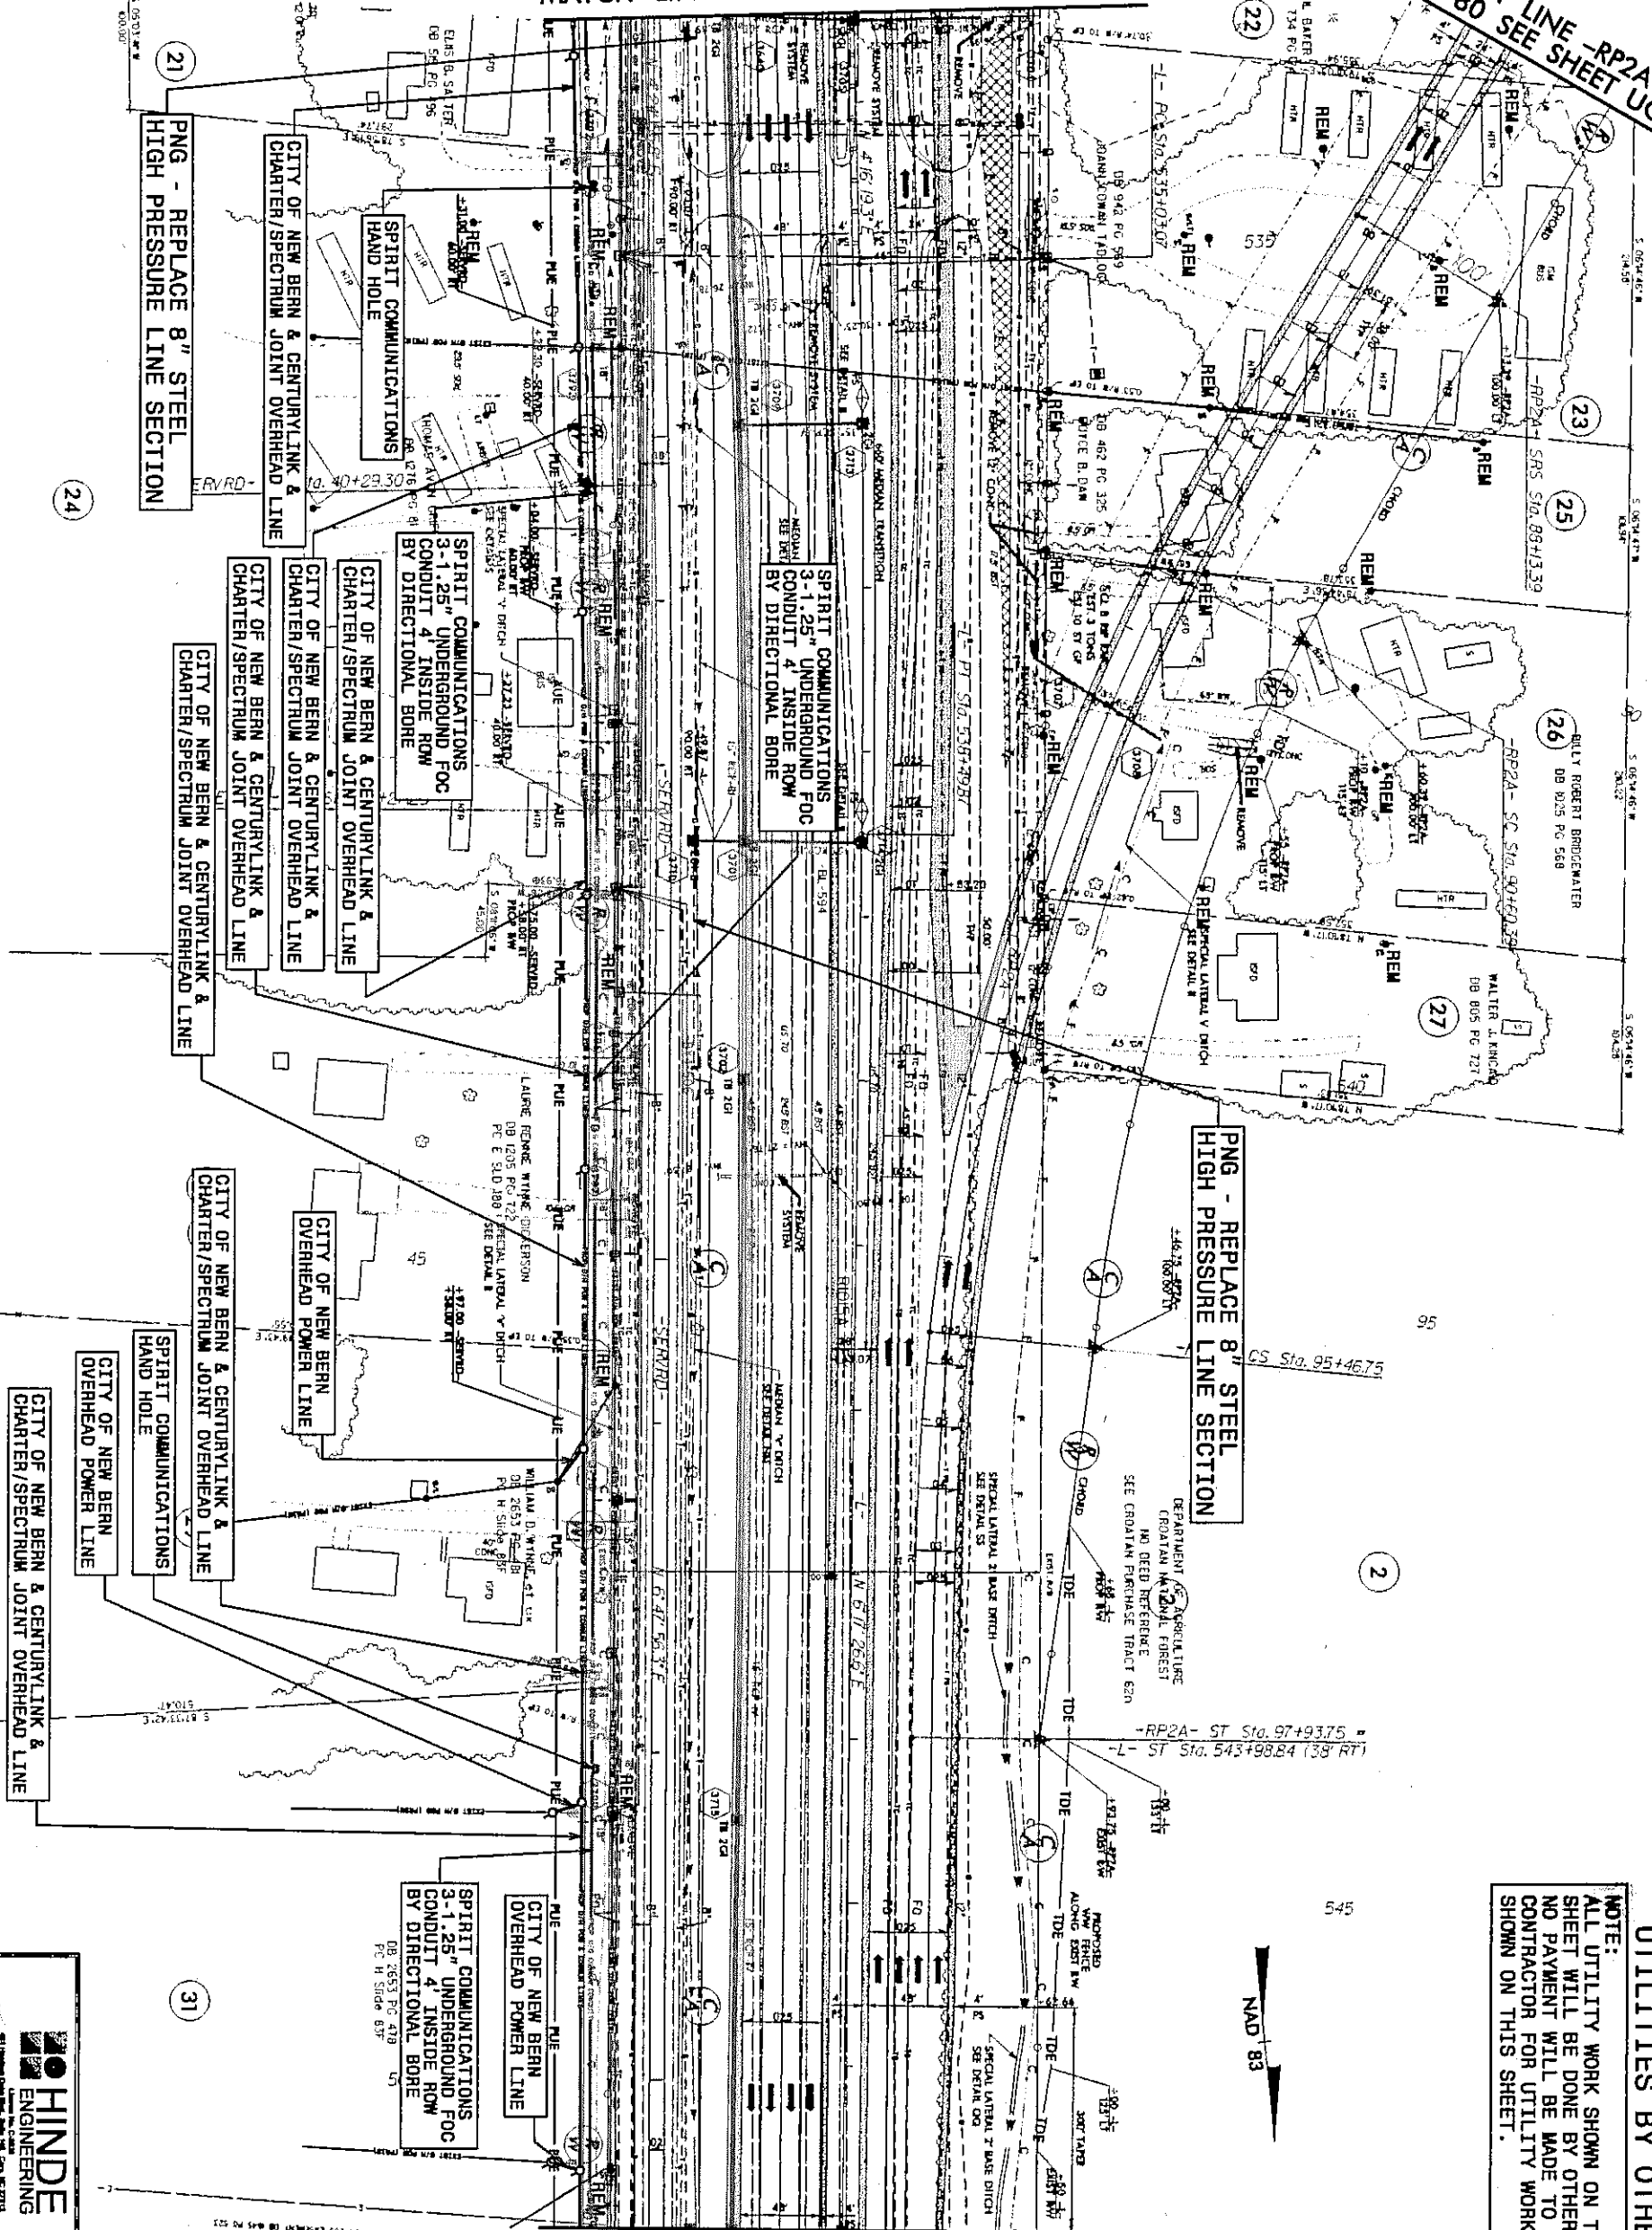

MATCH LINE STA. 547+00 SEE SHEET UO-20

**NOTE:**  
 ALL UTILITY WORK SHOWN ON THIS SHEET WILL BE DONE BY OTHERS. NO PAYMENT WILL BE MADE TO THE CONTRACTOR FOR UTILITY WORK SHOWN ON THIS SHEET.


**UTILITIES BY OTHERS**

PROJECT REFERENCE NO.	R-1015
SHEET NO.	UO-19



MATCH LINE -RPICD- STA. 23+60 SEE SHEET UO-5 MATCH LINE -RPIAB- STA.15+00 SEE SHEET UO-5

MATCH LINE -RPIA- STA. 5+00 SEE SHEET UO-6

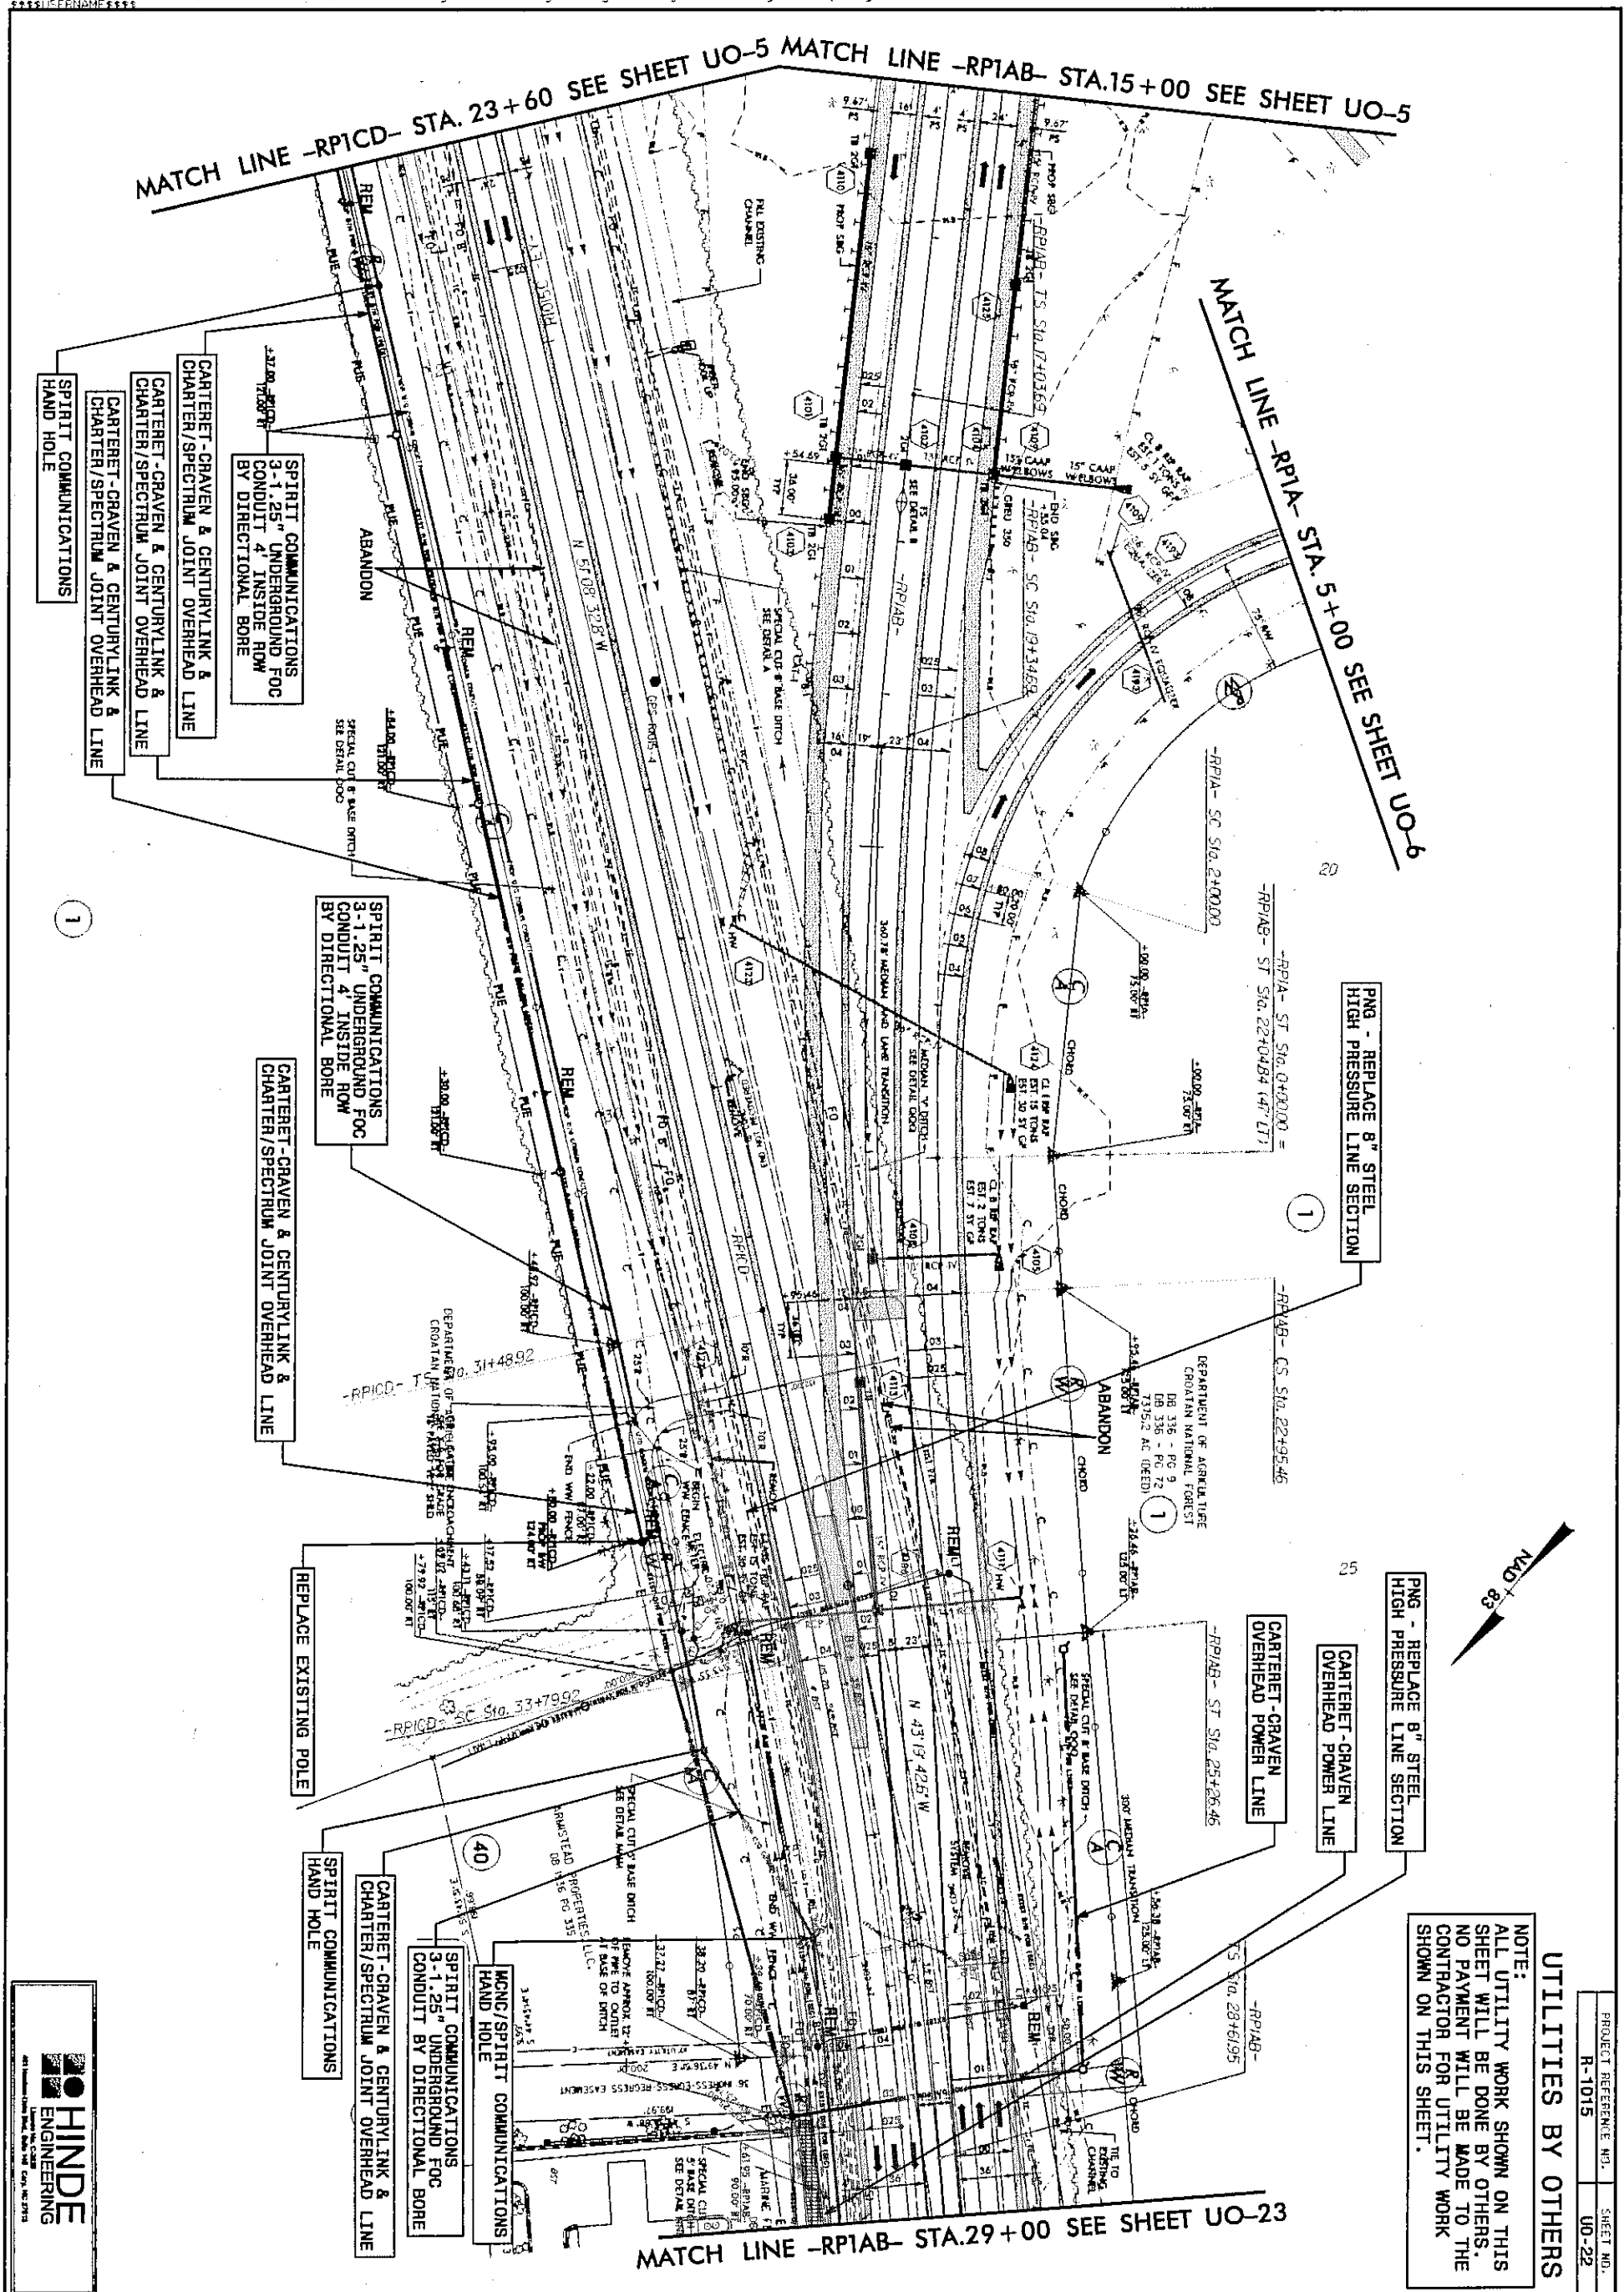

1  
 PNG - REPLACE 8" STEEL HIGH PRESSURE LINE SECTION

25  
 PNG - REPLACE 6" STEEL HIGH PRESSURE LINE SECTION

1  
 CARTERET-GRAVEN OVERHEAD POWER LINE

1  
 CARTERET-GRAVEN OVERHEAD POWER LINE

REPLACE EXISTING POLE

40  
 SPIRIT COMMUNICATIONS HAND HOLE

3-1.25" UNDERGROUND FOC CONDUIT BY DIRECTIONAL BORE

CARTERET-GRAVEN & CENTURYLINK & CHARTER/SPECTRUM JOINT OVERHEAD LINE

SPIRIT COMMUNICATIONS HAND HOLE

CARTERET-GRAVEN & CENTURYLINK & CHARTER/SPECTRUM JOINT OVERHEAD LINE

SPIRIT COMMUNICATIONS 3-1.25" UNDERGROUND FOC CONDUIT BY DIRECTIONAL BORE

CARTERET-GRAVEN & CENTURYLINK & CHARTER/SPECTRUM JOINT OVERHEAD LINE

SPIRIT COMMUNICATIONS 3-1.25" UNDERGROUND FOC CONDUIT BY DIRECTIONAL BORE

CARTERET-GRAVEN & CENTURYLINK & CHARTER/SPECTRUM JOINT OVERHEAD LINE


MATCH LINE -RPIAB- STA.29+00 SEE SHEET UO-23

NOTE:  
 ALL UTILITY WORK SHOWN ON THIS SHEET WILL BE DONE BY OTHERS. NO PAYMENT WILL BE MADE TO THE CONTRACTOR FOR UTILITY WORK SHOWN ON THIS SHEET.

UTILITIES BY OTHERS

PROJECT REFERENCE NO.	R-1015	SHEET NO.	UO-22
-----------------------	--------	-----------	-------



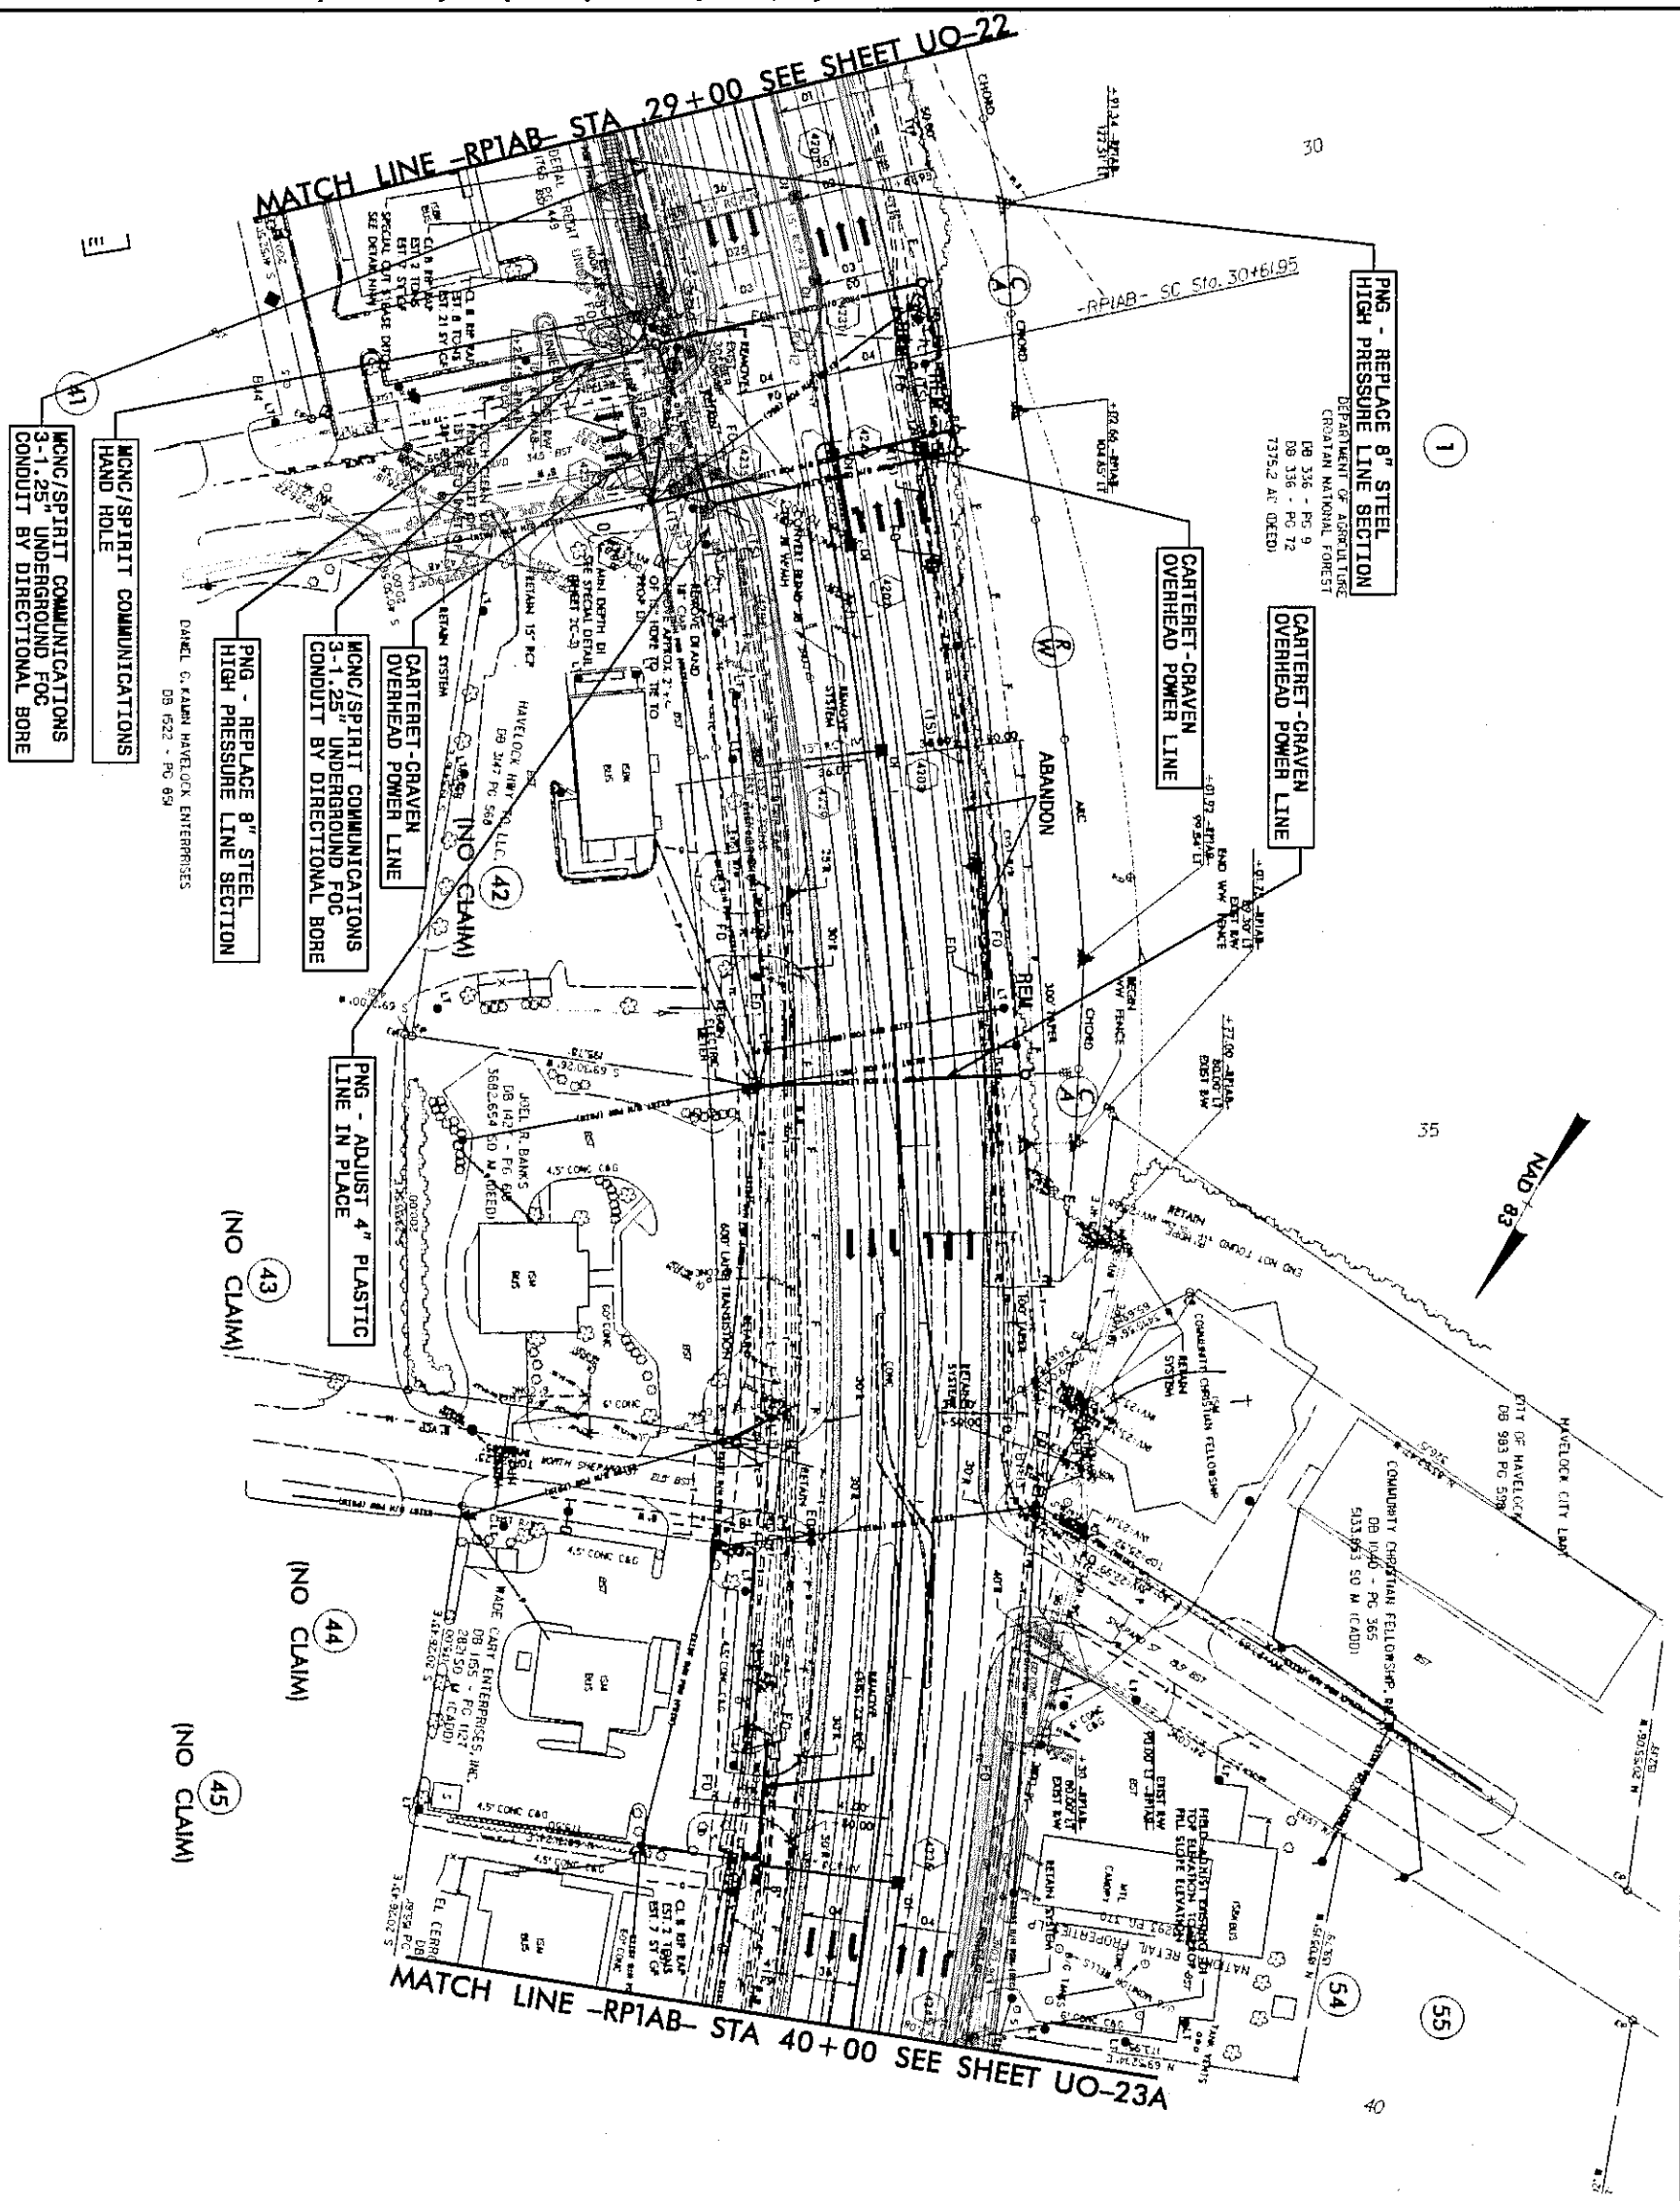

**NOTE:**  
 ALL UTILITY WORK SHOWN ON THIS SHEET WILL BE DONE BY OTHERS. NO PAYMENT WILL BE MADE TO THE CONTRACTOR FOR UTILITY WORK SHOWN ON THIS SHEET.

**UTILITIES BY OTHERS**

PROJECT REFERENCE NO.	SHEET NO.
R-1015	UO-23







## STATE OF NORTH CAROLINA DIVISION OF HIGHWAYS

### CROSS-SECTION SUMMARY

Quantities are approximate only. The Resident Engineer will  
re-cross-section the work accurately when the project is staked  
out. These cross-section notes will be used in computing the  
final quantities for which the contractor will be paid.

PROJ. REFERENCE NO.	SHEET NO.
R-1015	X-1F

Station	Uncl. Exc. (cu. yd.)	Embt (cu. yd.)	Undercut (cu. yd.)	Station	Uncl. Exc. (cu. yd.)	Embt (cu. yd.)	Undercut (cu. yd.)	Station	Uncl. Exc. (cu. yd.)	Embt (cu. yd.)	Undercut (cu. yd.)	Station	Uncl. Exc. (cu. yd.)	Embt (cu. yd.)	Undercut (cu. yd.)
557+50.00	5	563	0	5+50.000000	0	690	0	4+89.37	0	0	0	32+50.00	74	195	0
558+00.00	4	501	0	6+00.000000	0	563	0	5+00.00	0	1730	0	33+00.00	78	200	0
558+50.00	9	457	0	6+50.000000	0	505	0	5+50.00	0	8674	1701	33+50.00	82	196	0
559+00.00	11	444	0	7+07.478548	0	580	0	6+00.00	0	9613	1101	34+00.00	79	188	0
559+50.00	50	369	82	7+54.621890	0	471	0	6+50.00	0	10811	833	34+50.00	59	169	0
560+00.00	62	354	100	Station				7+00.00	0	11619	1366	35+00.00	31	103	0
560+50.00	23	427	92	RP11B				7+50.00	0	12535	1979	35+50.00	15	52	0
561+00.00	18	420	93	Uncl. Exc. (cu. yd.)				8+00.00	0	13270	2659	36+00.00	14	56	0
561+50.00	29	370	0	Embt (cu. yd.)				8+50.00	0	13992	3189	36+50.00	16	77	0
562+00.00	35	321	0	Undercut (cu. yd.)				9+00.00	0	14253	3030	37+00.00	16	102	0
562+50.00	39	281	0	Station				9+50.00	0	13542	2473	37+50.00	11	106	0
563+00.00	51	239	0	RP11A				10+00.00	0	12075	2048	38+00.00	7	107	0
563+50.00	55	231	0	Uncl. Exc. (cu. yd.)				Station		Embt (cu. yd.)		38+50.00	6	111	0
564+00.00	54	206	0	Embt (cu. yd.)				RP11B		Undercut (cu. yd.)		39+00.00	6	115	0
564+50.00	48	194	0	Undercut (cu. yd.)				Uncl. Exc. (cu. yd.)		Embt (cu. yd.)		39+50.00	6	121	0
565+00.00	38	244	0	Station				Embt (cu. yd.)		Undercut (cu. yd.)		40+00.00	7	130	0
565+50.00	28	299	0	Uncl. Exc. (cu. yd.)				Embt (cu. yd.)		Undercut (cu. yd.)		40+50.00	10	125	0
566+00.00	11	313	0	Embt (cu. yd.)				Undercut (cu. yd.)		Embt (cu. yd.)		41+00.00	16	199	0
566+50.00	4	351	0	Undercut (cu. yd.)				Station		Undercut (cu. yd.)		41+50.00	20	94	0
567+00.00	2	414	0	Station				Uncl. Exc. (cu. yd.)		Embt (cu. yd.)		42+00.00	19	126	0
567+50.00	1	406	0	Uncl. Exc. (cu. yd.)				Embt (cu. yd.)		Undercut (cu. yd.)		42+50.00	20	195	0
568+00.00	3	374	0	Embt (cu. yd.)				Undercut (cu. yd.)		Embt (cu. yd.)		43+00.00	19	186	0
568+50.00	4	326	0	Undercut (cu. yd.)				Station		Undercut (cu. yd.)		43+50.00	17	119	0
569+00.00	6	274	0	Uncl. Exc. (cu. yd.)				Embt (cu. yd.)		Undercut (cu. yd.)		44+00.00	27	49	0
569+50.00	9	226	0	Embt (cu. yd.)				Undercut (cu. yd.)		Embt (cu. yd.)		44+50.00	42	20	0
570+00.00	15	176	61	Station				Uncl. Exc. (cu. yd.)		Embt (cu. yd.)		45+00.00	55	19	0
570+50.00	21	140	15	Uncl. Exc. (cu. yd.)				Embt (cu. yd.)		Undercut (cu. yd.)		LP11B			
571+00.00	24	127	0	Embt (cu. yd.)				Undercut (cu. yd.)		Embt (cu. yd.)		Uncl. Exc. (cu. yd.)			
571+50.00	21	137	0	Undercut (cu. yd.)				Station		Undercut (cu. yd.)		Uncl. Exc. (cu. yd.)			
572+00.00	16	178	0	Uncl. Exc. (cu. yd.)				Embt (cu. yd.)		Undercut (cu. yd.)		Embt (cu. yd.)			
572+50.00	13	222	0	Embt (cu. yd.)				Undercut (cu. yd.)		Embt (cu. yd.)		Undercut (cu. yd.)			
573+00.00	15	243	0	Station				Uncl. Exc. (cu. yd.)		Embt (cu. yd.)		Undercut (cu. yd.)			
573+50.00	19	257	0	Uncl. Exc. (cu. yd.)				Embt (cu. yd.)		Undercut (cu. yd.)		Uncl. Exc. (cu. yd.)			
574+00.00	20	268	0	Embt (cu. yd.)				Undercut (cu. yd.)		Embt (cu. yd.)		Embt (cu. yd.)			
574+50.00	19	261	0	Station				Uncl. Exc. (cu. yd.)		Undercut (cu. yd.)		Uncl. Exc. (cu. yd.)			
575+00.00	17	244	0	Uncl. Exc. (cu. yd.)				Embt (cu. yd.)		Undercut (cu. yd.)		Embt (cu. yd.)			
575+50.00	17	221	0	Embt (cu. yd.)				Undercut (cu. yd.)		Embt (cu. yd.)		Undercut (cu. yd.)			
576+00.00	19	197	0	Station				Uncl. Exc. (cu. yd.)		Embt (cu. yd.)		Uncl. Exc. (cu. yd.)			
576+50.00	25	163	0	Uncl. Exc. (cu. yd.)				Embt (cu. yd.)		Undercut (cu. yd.)		Embt (cu. yd.)			
577+00.00	32	128	0	Embt (cu. yd.)				Undercut (cu. yd.)		Embt (cu. yd.)		Undercut (cu. yd.)			
577+50.00	41	102	0	Station				Uncl. Exc. (cu. yd.)		Embt (cu. yd.)		Uncl. Exc. (cu. yd.)			
578+00.00	49	81	0	Uncl. Exc. (cu. yd.)				Embt (cu. yd.)		Undercut (cu. yd.)		Embt (cu. yd.)			
578+50.00	47	70	0	Embt (cu. yd.)				Undercut (cu. yd.)		Embt (cu. yd.)		Undercut (cu. yd.)			
579+00.00	40	67	0	Station				Uncl. Exc. (cu. yd.)		Embt (cu. yd.)		Uncl. Exc. (cu. yd.)			
RP11A	Uncl. Exc. (cu. yd.)	Embt (cu. yd.)	Undercut (cu. yd.)	RP11C	Uncl. Exc. (cu. yd.)	Embt (cu. yd.)	Undercut (cu. yd.)	Station	Uncl. Exc. (cu. yd.)	Embt (cu. yd.)	Undercut (cu. yd.)	Station	Uncl. Exc. (cu. yd.)	Embt (cu. yd.)	Undercut (cu. yd.)
2+99.974043	0	0	0	22+50.000000	1927	1041	0	2+95.593694	0	0	0	3+46.353792	39	676	0
3+46.020745	0	858	0	23+00.000000	3681	1148	0	3+46.353792	259	197	0	3+47.300933	32	825	0
3+92.558332	0	1038	0	23+50.000000	5361	1508	0	4+48.394172	136	136	0	4+48.394172	29	1037	0
4+50.000000	0	1223	0	24+00.000000	5707	1695	0	4+99.333603	143	101	0	4+99.333603	30	1259	0
5+00.000000	0	866	0	24+50.000000	6207	1893	0	5+50.669360	30	94	0	5+50.669360	30	1464	0
				25+00.000000	6771	2038	0	6+02.205765	29	1623	0	6+02.205765	29	1623	0
				25+50.000000	7667	2280	0	7+05.567062	32	115	0	7+05.567062	30	1737	0
								7+50.000000	71	156	0	7+50.000000	33	1737	0
										178	0			1479	0

