
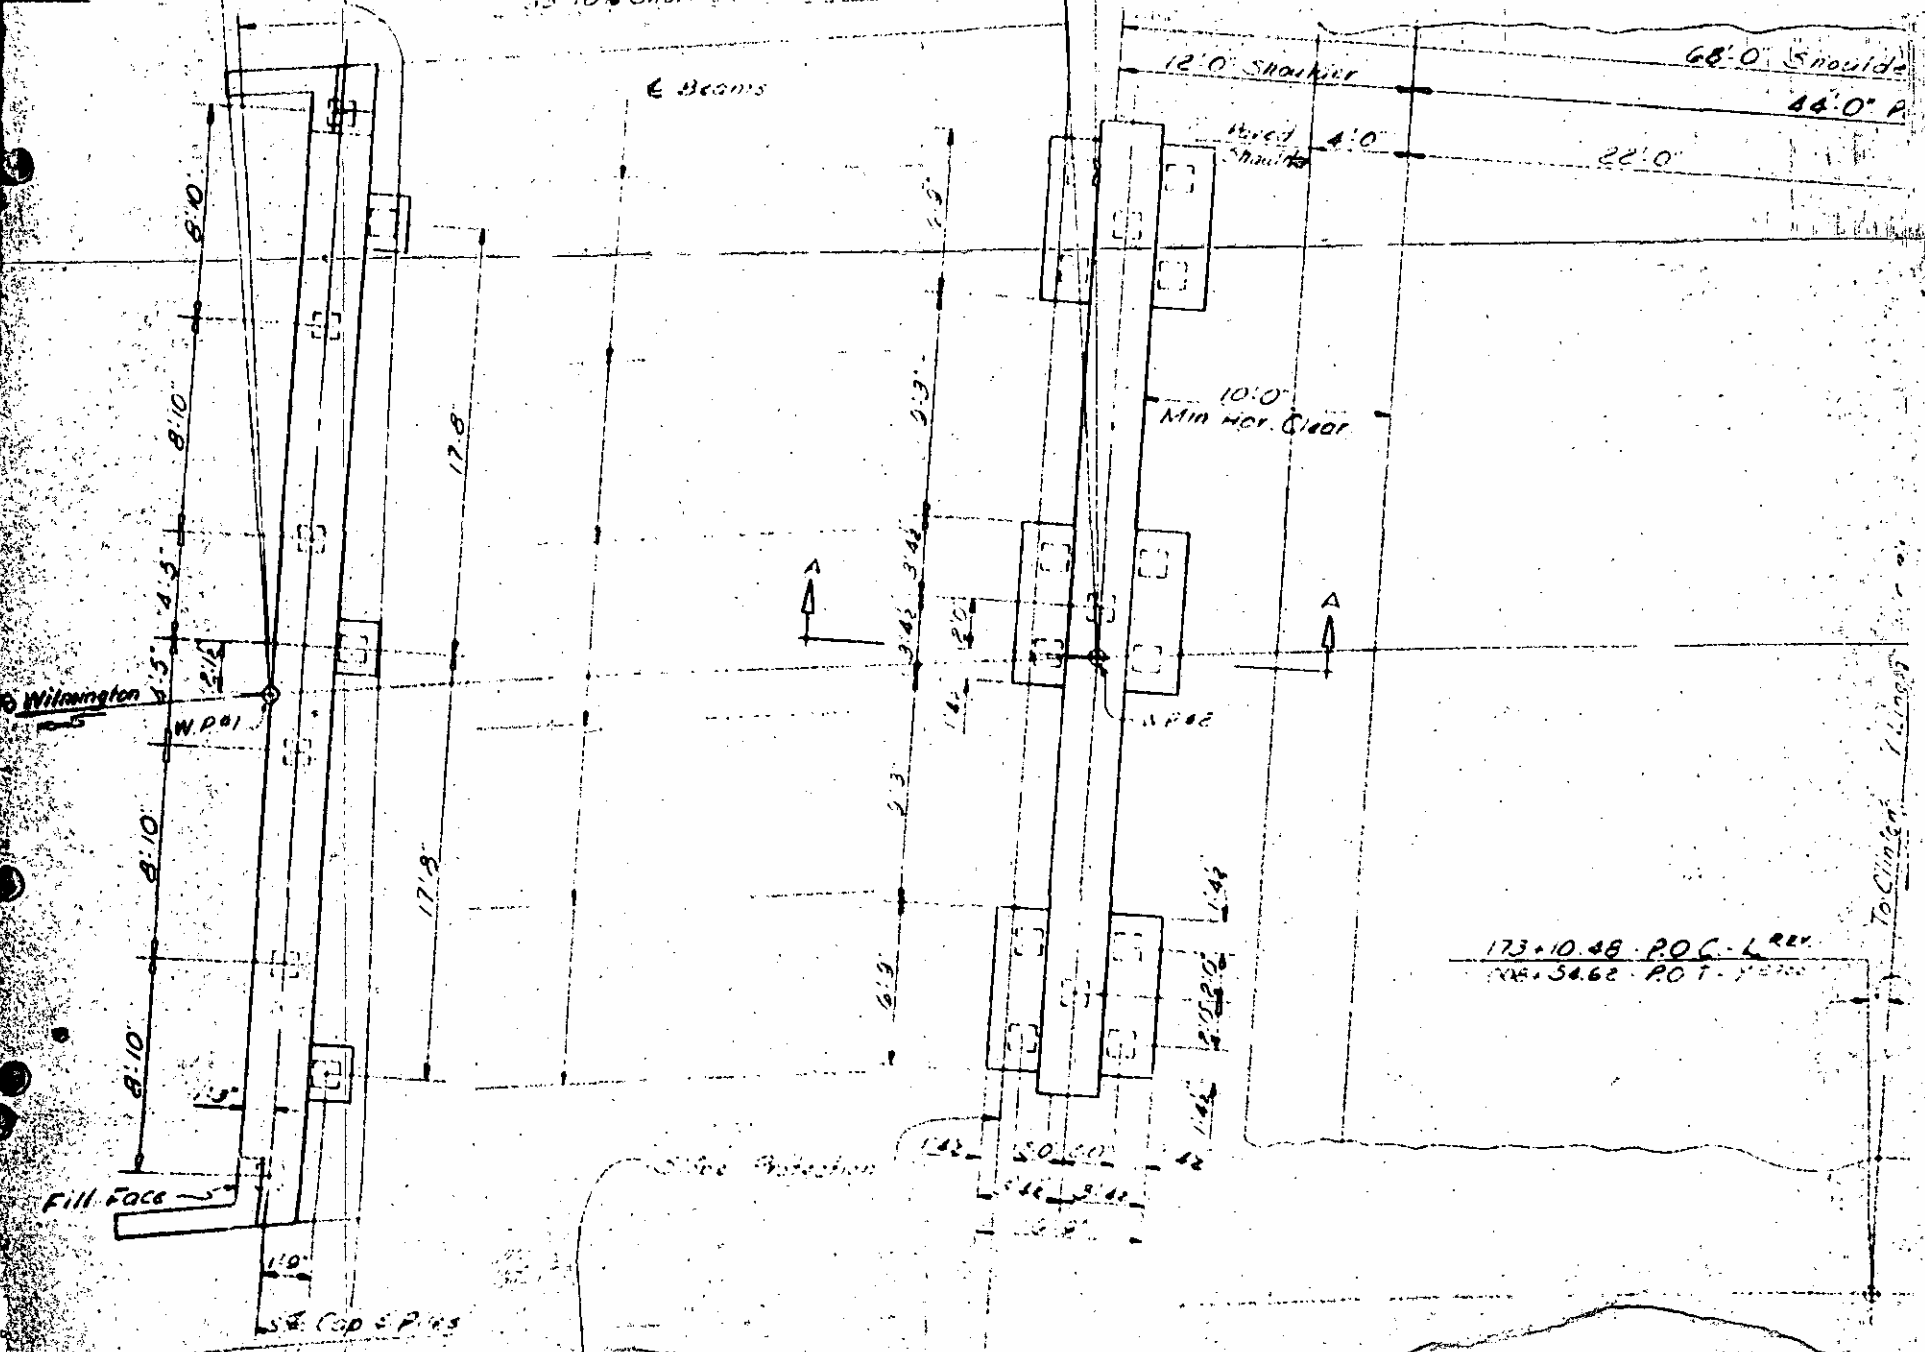


421-28-40 E
SAMPSON

PI 175+00
EI 115.74
VC 880'

+0.825%

Fill Face E.B. 01
10+178+45.82
Ct. EI 113.33

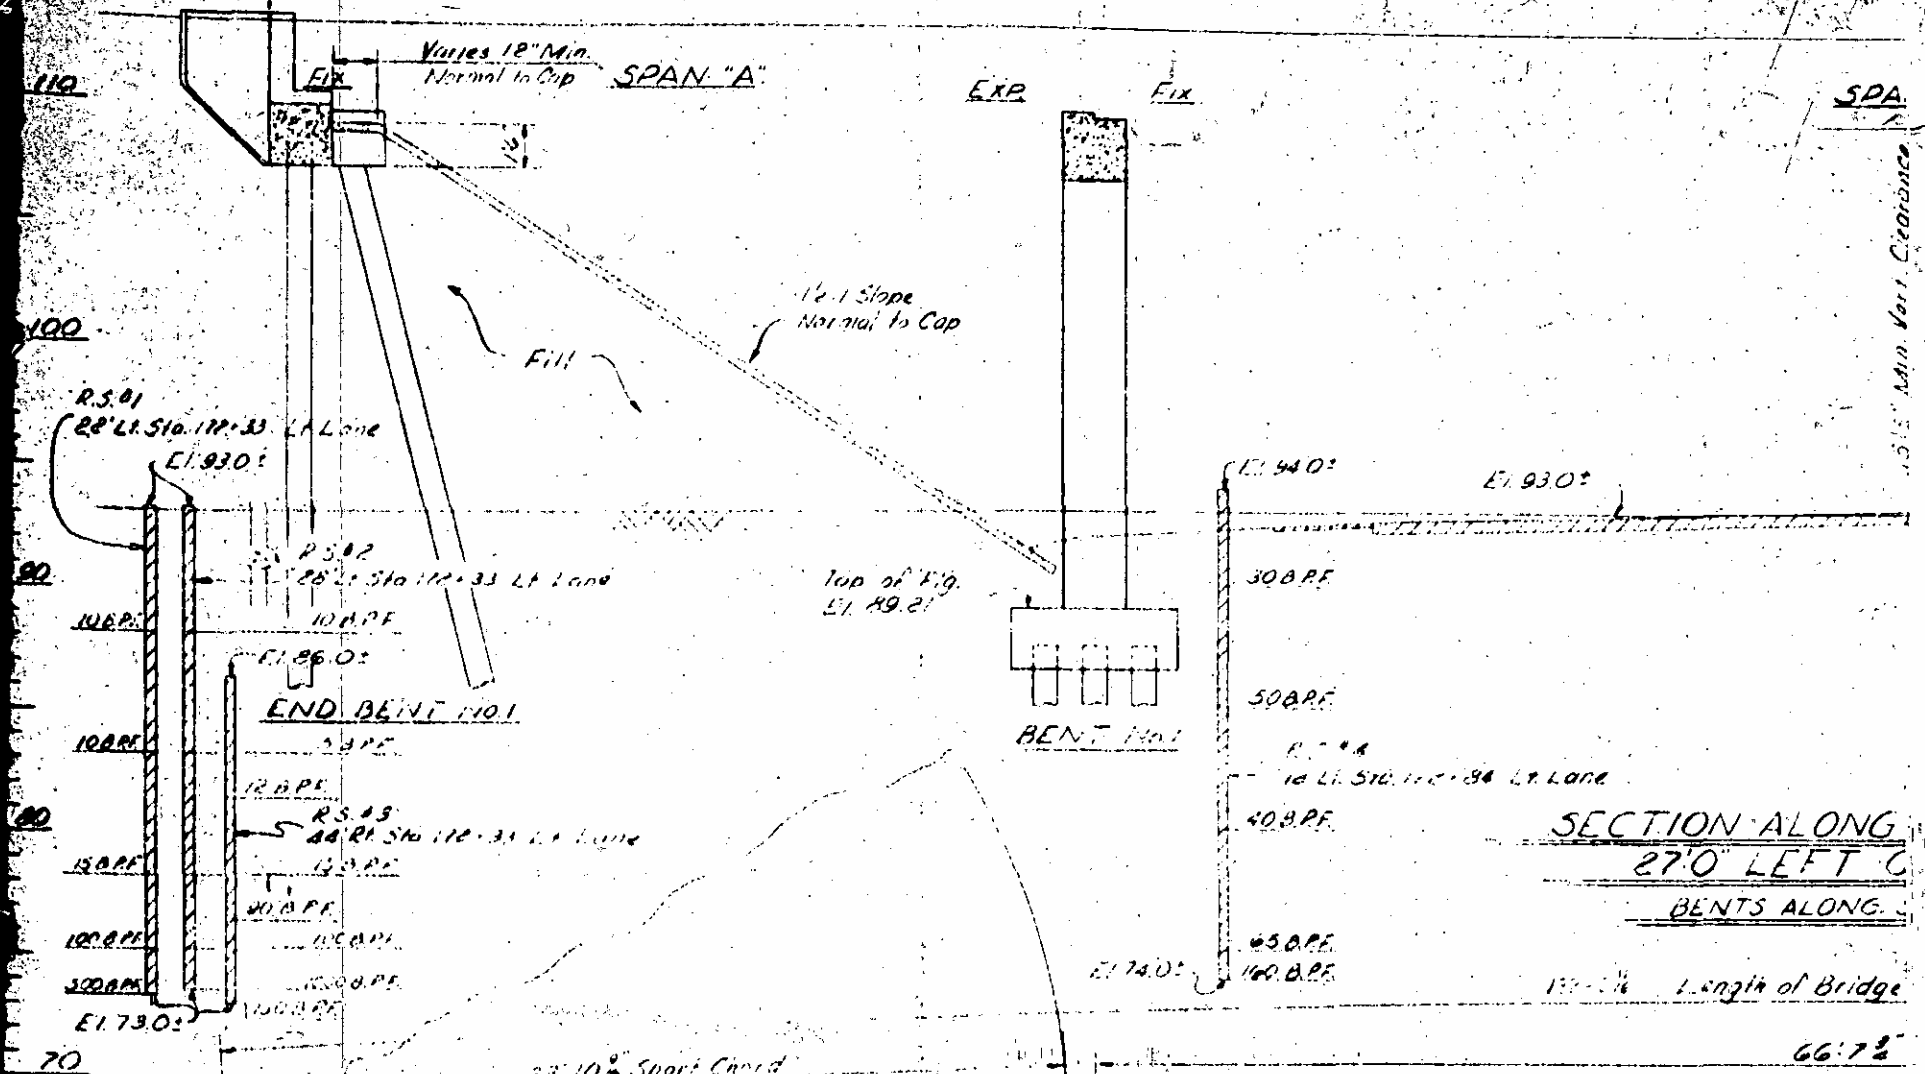


173+10.48 P.O.C. - L.R.V.
108+54.62 P.O.T. - P. 108

15.15' Min. Vert. Clearance


To Clinton 1.1 Miles

Full Face E. 81'
 S. Sta 173+76.94
 C. 81.110.29

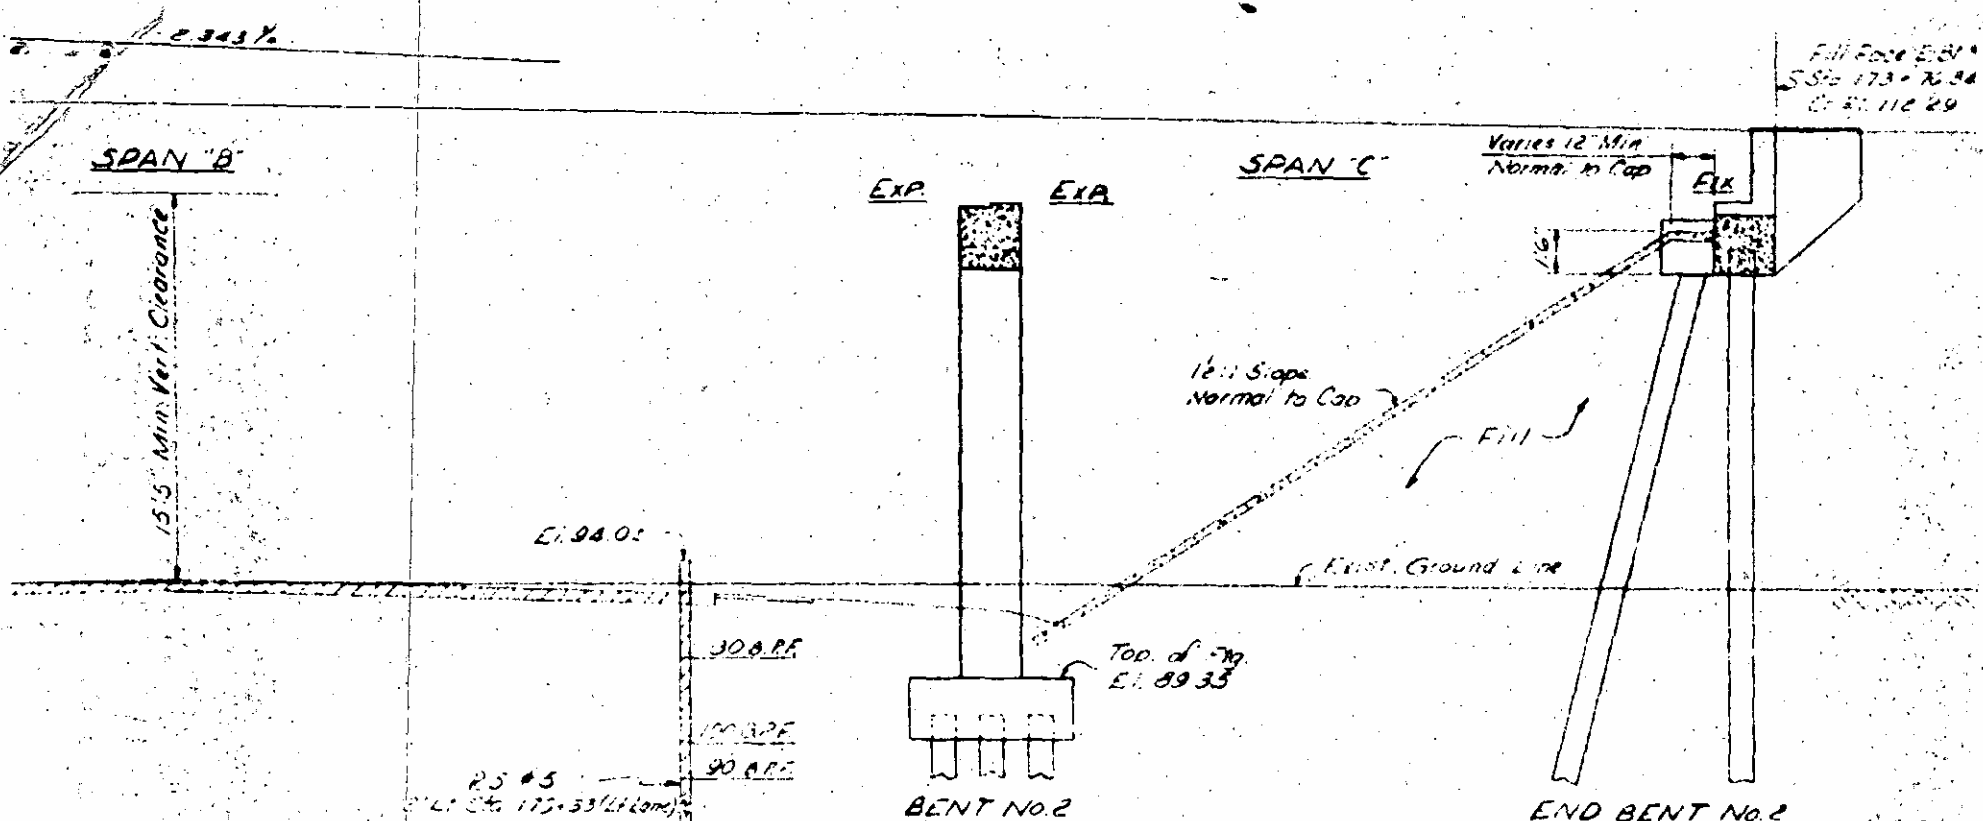


ALONG & OF LEFT LANE
LEFT OF & MEDIAN
'S ALONG SECTION 'A-A'

in of Bridge Floor measured along Arc (Fill Face to Fill Face) (Along & Left Lane)

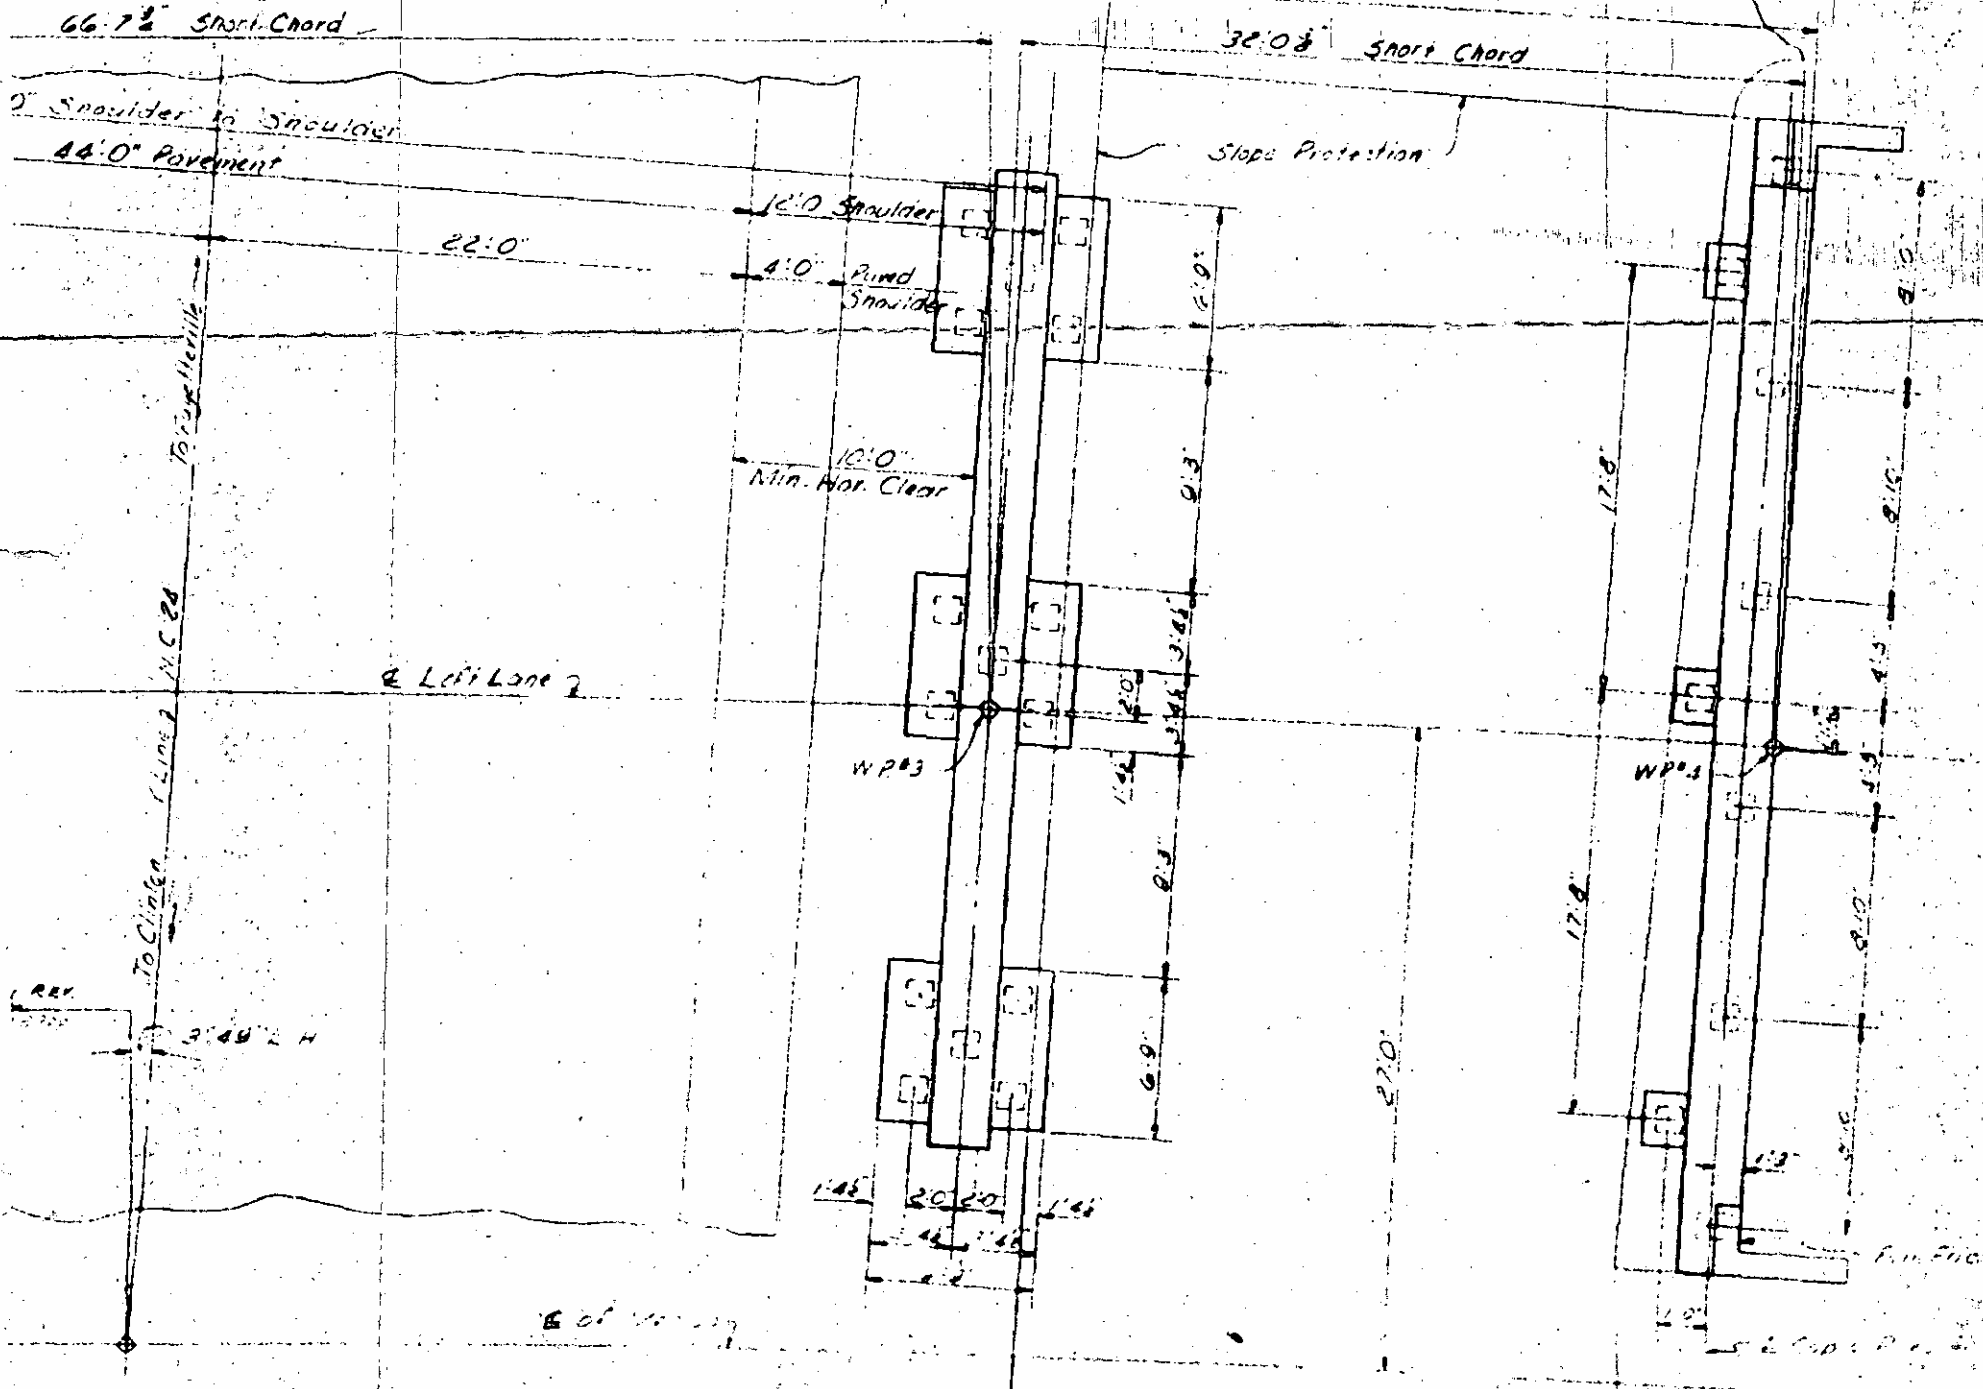

FD. ROAD NO. 8	DATE M. C.	PROJECT NO. 8-1273002
F. A. PROJECT		5-60-1600 (2)
SHEET 104 of 105		

Fill Face E.B. No. 2
S.S. No. 173-10.48
C. R. 110 29

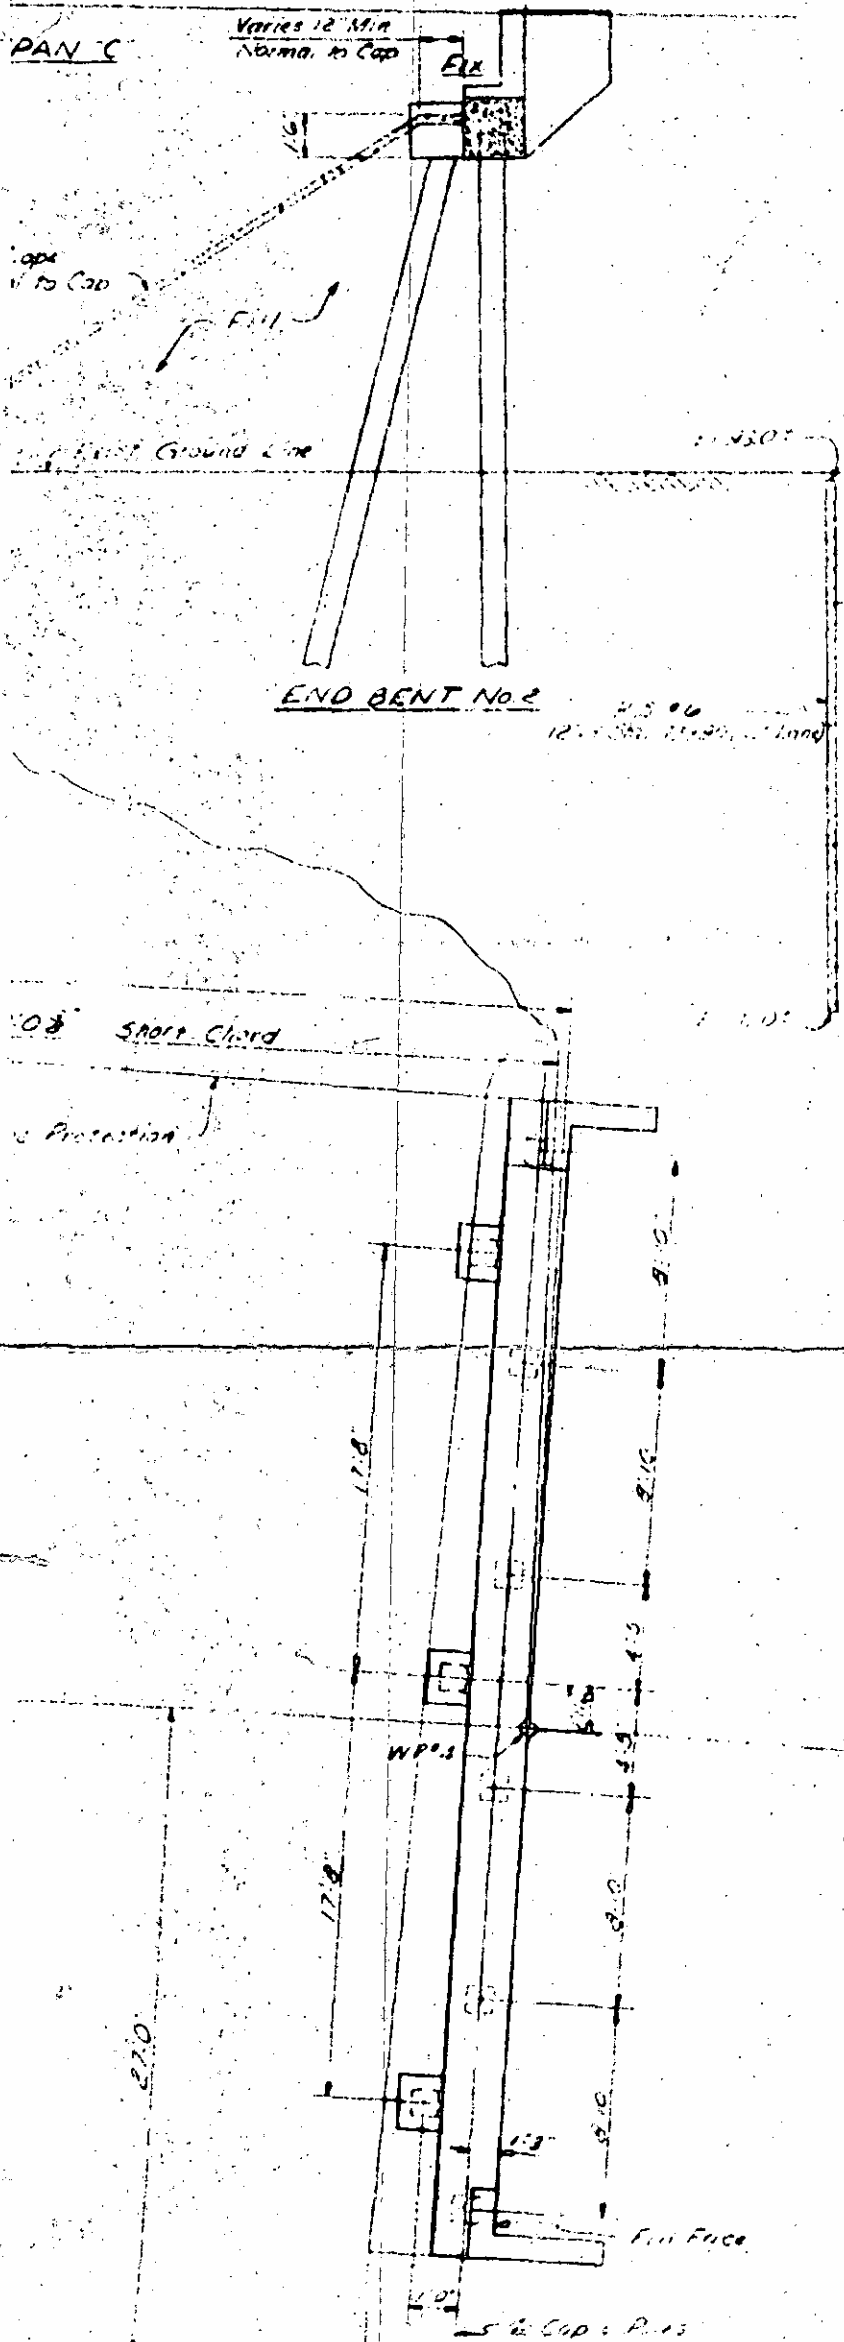


NOTE Stations are measured along the E of Median.

I HEREBY CERTIFY THAT THIS STRUCTURE
WAS BUILT ACCORDING TO DRAWING
SIGNED BY *[Signature]*
RESIDENT ENGINEER.


PROJECT NO. 8-1273002
SAMPSON COUNTY
STATION: 173-10.48 P.O.C. L. R&K
 11778-3462 P.O.T. V. 0000

STATE OF NORTH CAROLINA
STATE HIGHWAY COMMISSION
DESIGNED BY
 GENERAL DRAWING
 FOR DUAL BRIDGES OVER NC 24
 DII PROJECT, CLINTON BY-PASS
 LEFT LANE
 DATE 1965


REVISIONS

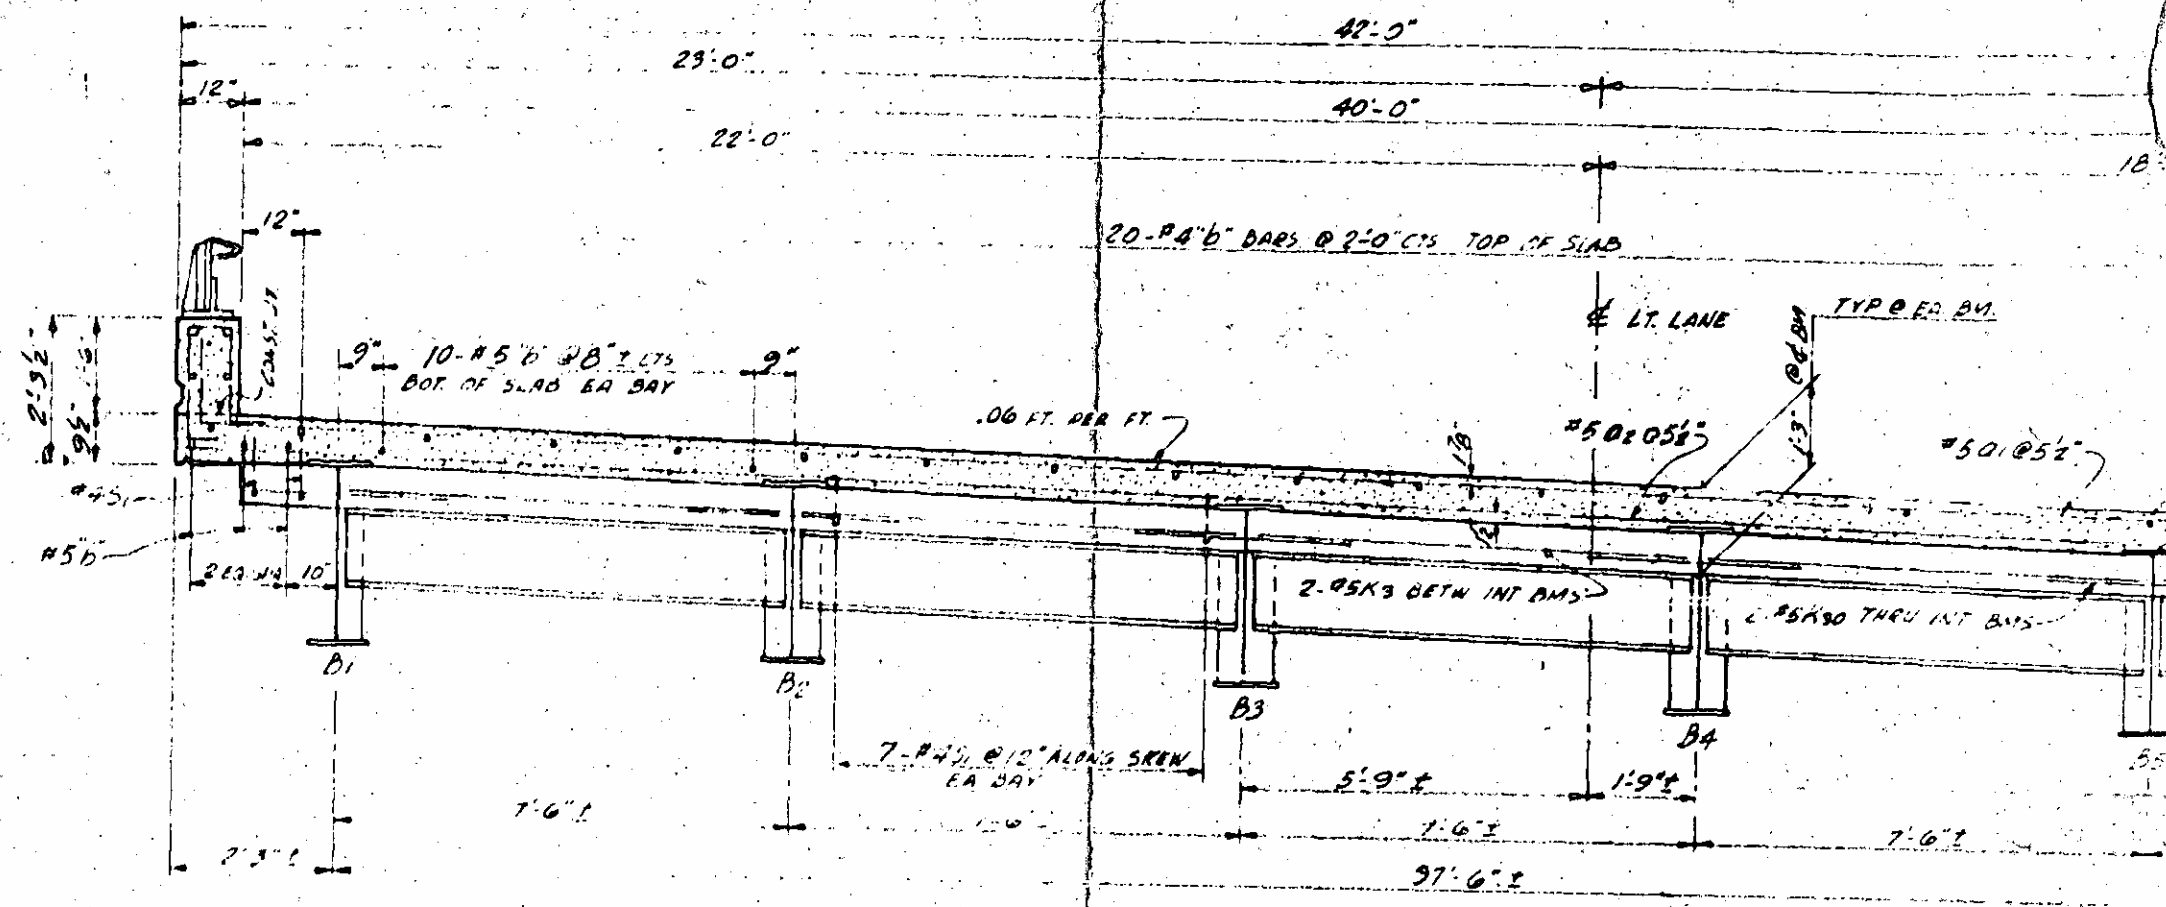


TYPICAL SECTION
(SHOWING DIAPHRAGMS AT BENTS)

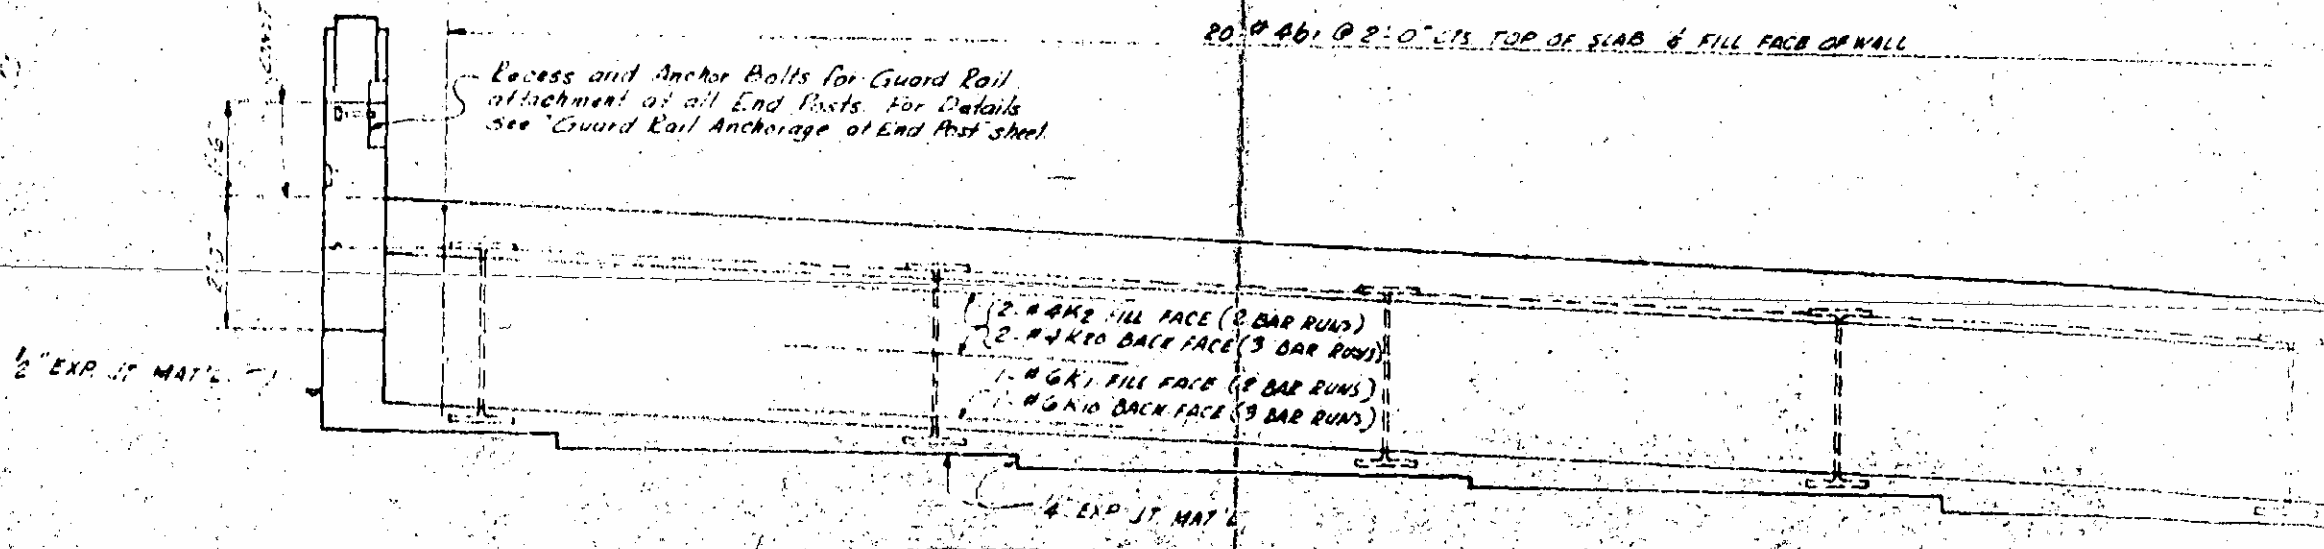

END ELEVATION

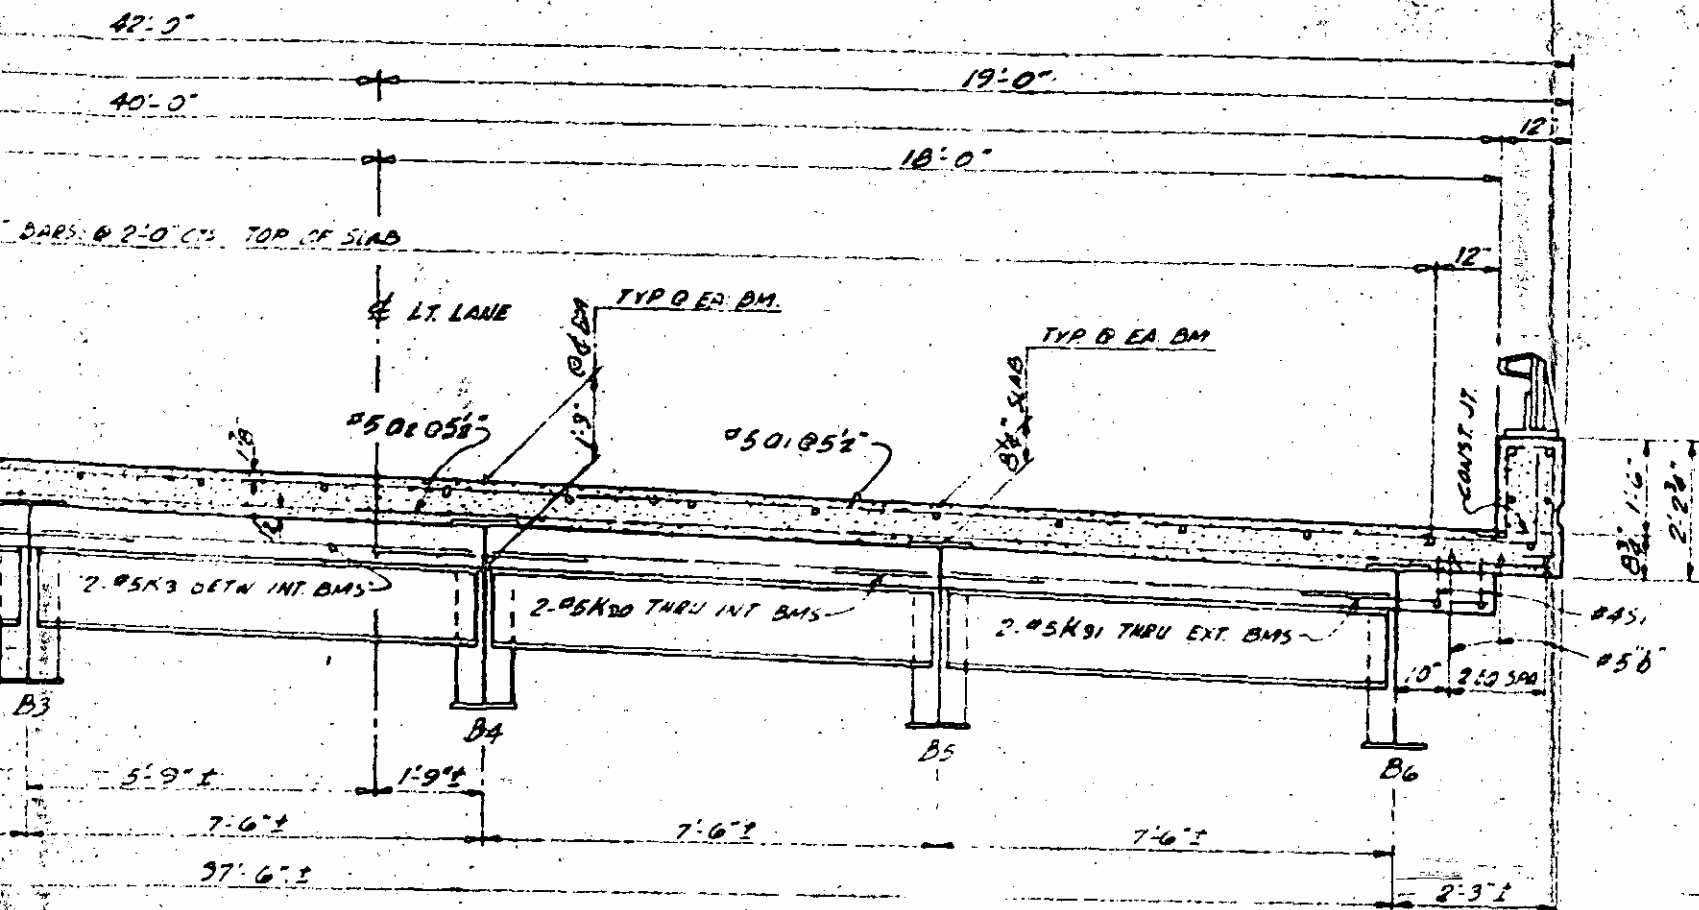

TYPICAL SECTION
(SHOWING DIAPHRAGMS AT BENTS)

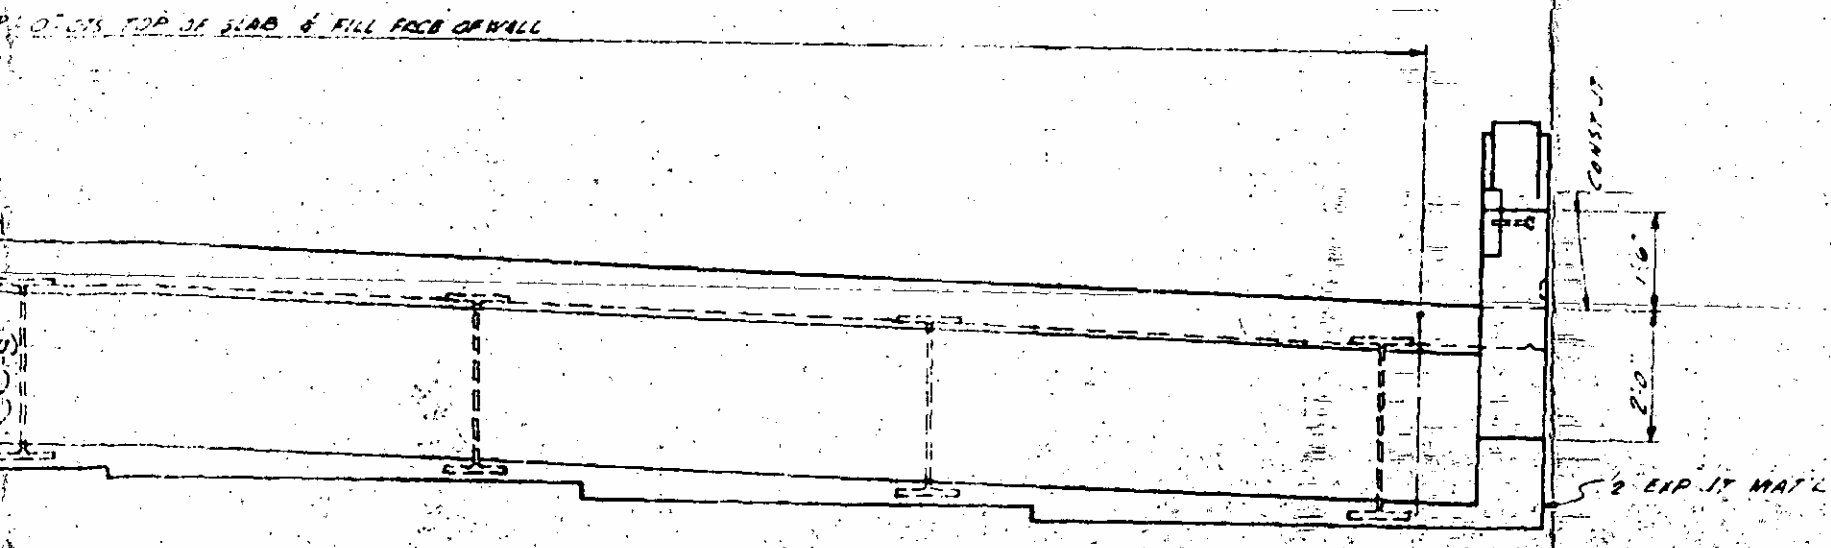

END ELEVATION

1'-0 1/8"

1" JT @ BT #1

2-#5b8 (1 SET)
UNDER PARAPET

4-#404 (2 SETS)
IN PARAPET

34-#5 5/8 @ 12" IN PARAPET

12" CURT
WALL
6" PAR'T.
NOTCH

7-#5 Q121-Q127 @ 5 1/2"
TOP OF SLAB

7-#5 Q131-Q137 @ 5 1/2"
BOT. OF SLAB

2-#4 S1 Q12
FR BAY

33-10 9/16" SHORT CHORD

20-#4 B2 @ 9'-0" TOP OF SLAB (2 SETS)

54-#5 5/8 SPACING SHOWN IN SECT. (1 SET) BOT. OF SLAB



W.P.#1

W.P.#2

LT. LANE
SHORT CHORD

84° 59' 08"

1'-9 3/8" DIAM

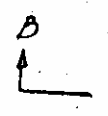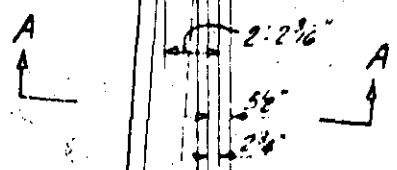

66-#5 Q1 @ 5 1/2" (-) IN TOP OF SLAB

65-#5 Q2 @ 5 1/2" (-) IN BOT. OF SLAB

#4 S1 Q117 @ 5 1/2"
BOT. OF SLAB

#4 S1 Q127 @ 5 1/2"
TOP OF SLAB

2-#5b8 (1 SET)
UNDER PARAPET

4-#404 (2 SETS)
IN PARAPET

34-#5 5/8 @ 12" IN PARAPET

20-#4 B1 @ 2'-0" TOP OF SLAB & FACE OF WALL


22'-08"

40'-1 1/8"

18'-0 1/8"

PLAN


SPAN A - LT. LANE

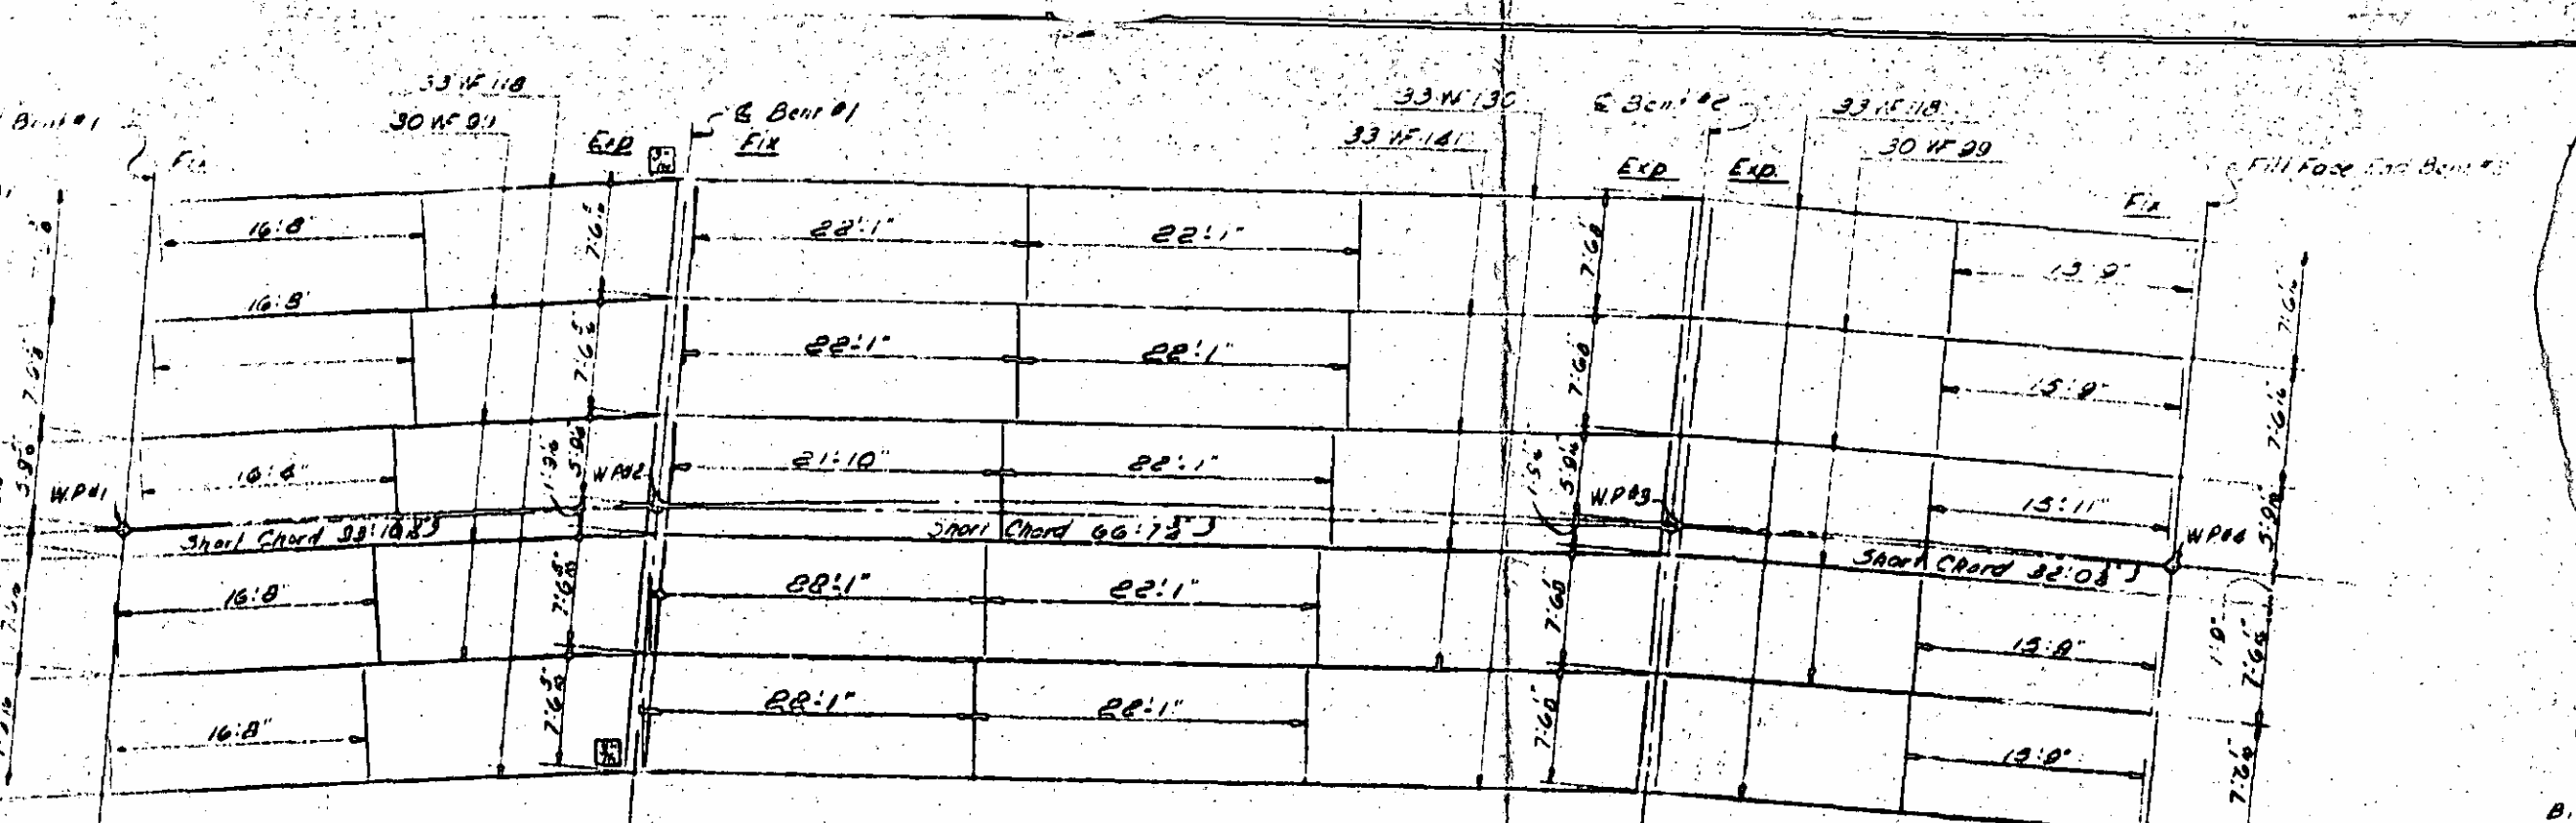

P.P. - Ext. Dms
 P.P. - Int. Dms
 Ext. Dms - P.P.
 Int. Dms - P.P.
 P.P. - All Dms
 All Dms - P.P.
 P.P. - Ext. Dms
 Int. Dms - P.P.
 Ext. Dms - P.P.
 Int. Dms - P.P.

STRUCTURAL STEEL PLAN

LEGEND
 [Symbol] Indicates Fill Plate required

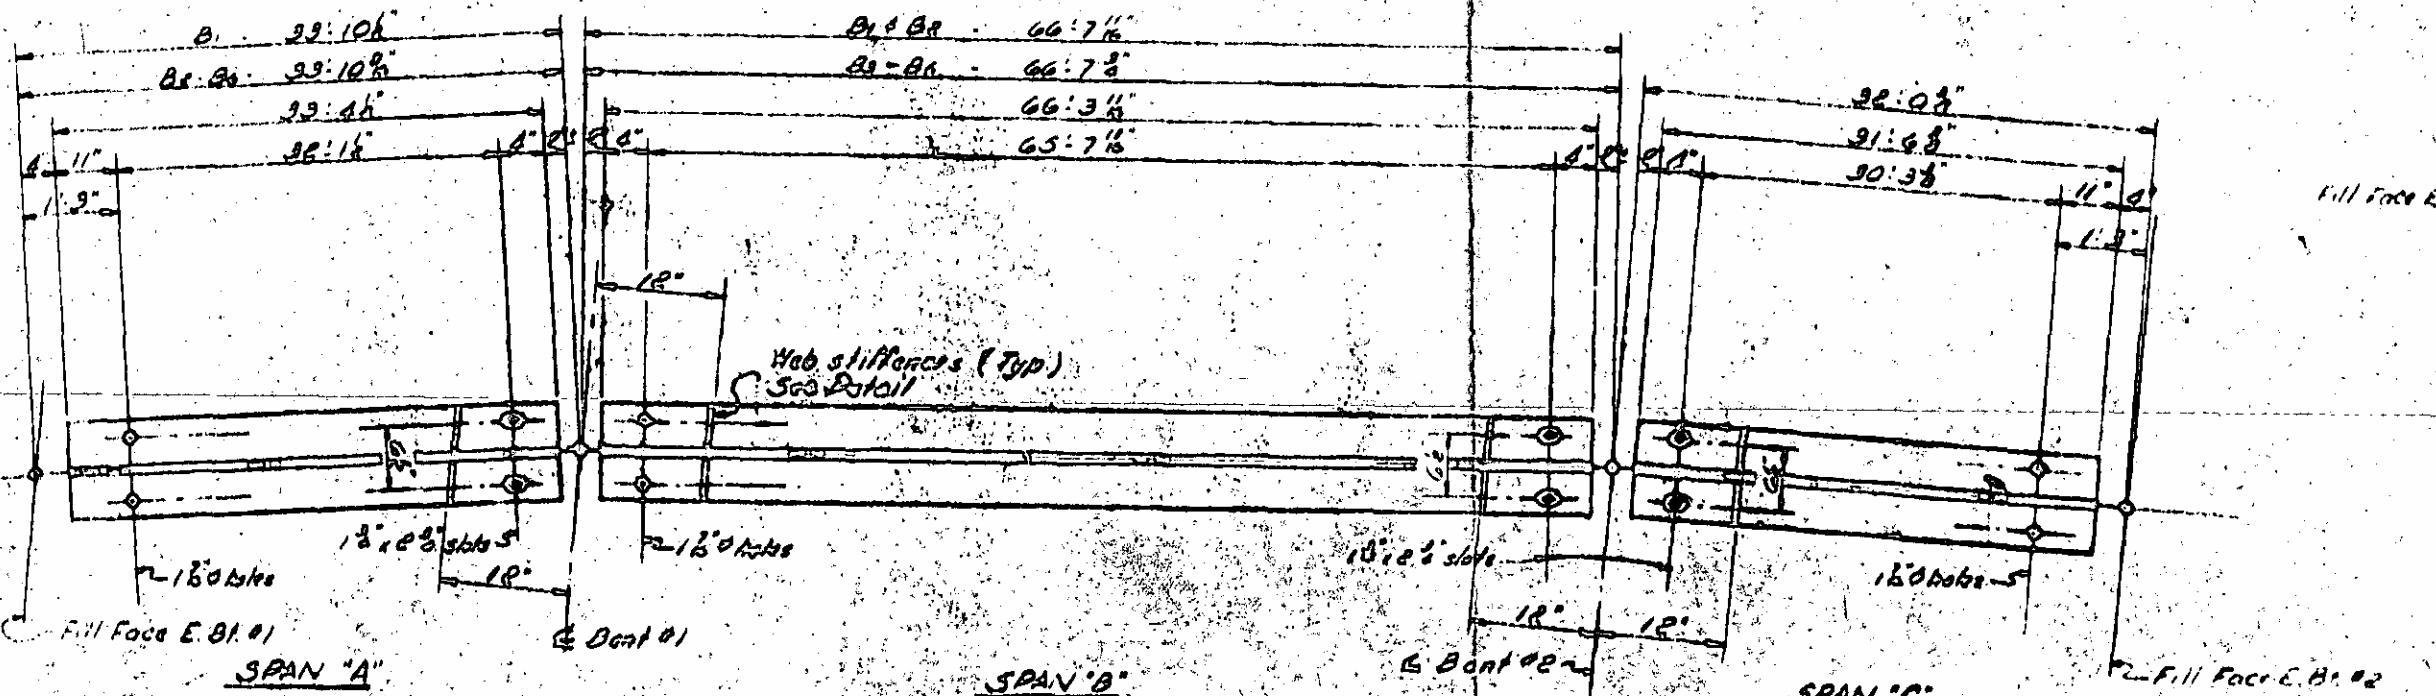

BOTTOM FLANGE DETAIL


Beams B1 & B2
 11.5 rows - 4" x 4" studs each row - 460 studs each beam
 20 sps @ 6" - 10'0" + 10 sps @ 6" - 5'0" + 11 sps @ 7 1/2" - 6'10 1/2" + 7 sps @ 9" - 5'9" + 4 sps @ 10 1/2" - 4'6" // Low - 5 @ 11 1/2" - 4'8 1/2" R/Low - 6 @ 11 1/2" - 6'9 1/2"

Beams B3 & B4
 9 rows - 4" x 4" studs each row - 360 studs each beam
 20 sps @ 6" - 10'0" + 7 sps @ 7 1/2" - 4'4 1/2" + 7 sps @ 9" - 4'7" + 5 sps @ 10 1/2" - 4'6" + 6 sps @ 12" - 6'0" // Low - 2 @ 11 1/2" - 2'9 1/2" R/Low - 2 @ 11 1/2" - 2'9 1/2"


COVER 10' x 10' 27'0"

COVER 8' x 16' 27'0"

BEAM ELEVATION AND STUD SPACING

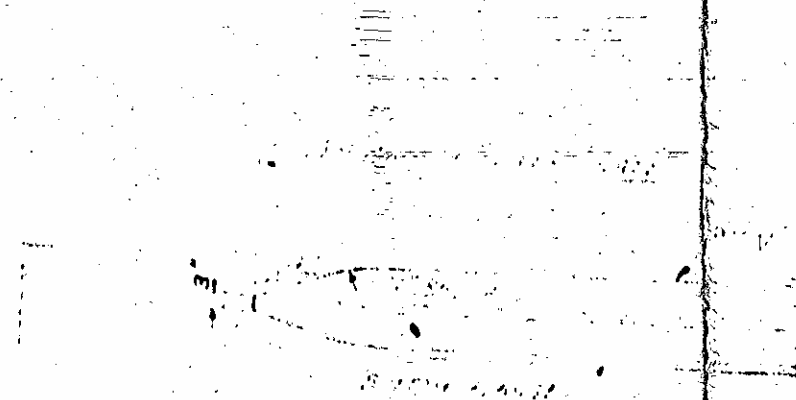



STEEL PLATE WELD DETAIL

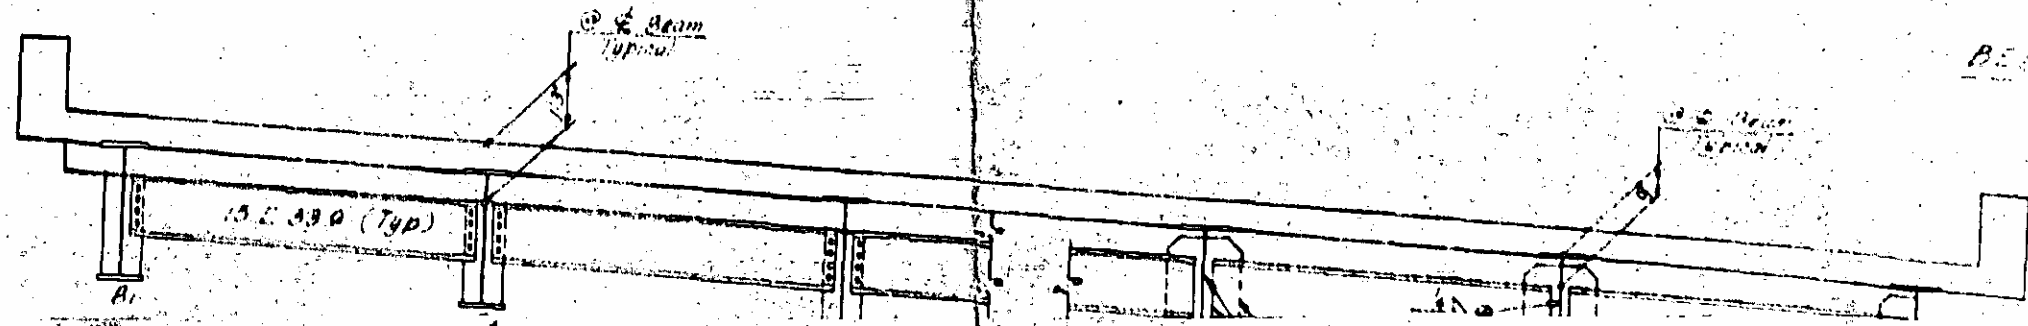

NO FILLING OUT TO BE DONE
 TO BE IN THIS DIRECTION
 NO FILLING REQUIRED
 FOR FILL R/S

Interior Beams
 2'0"
 6'3"

2'66 1/2"

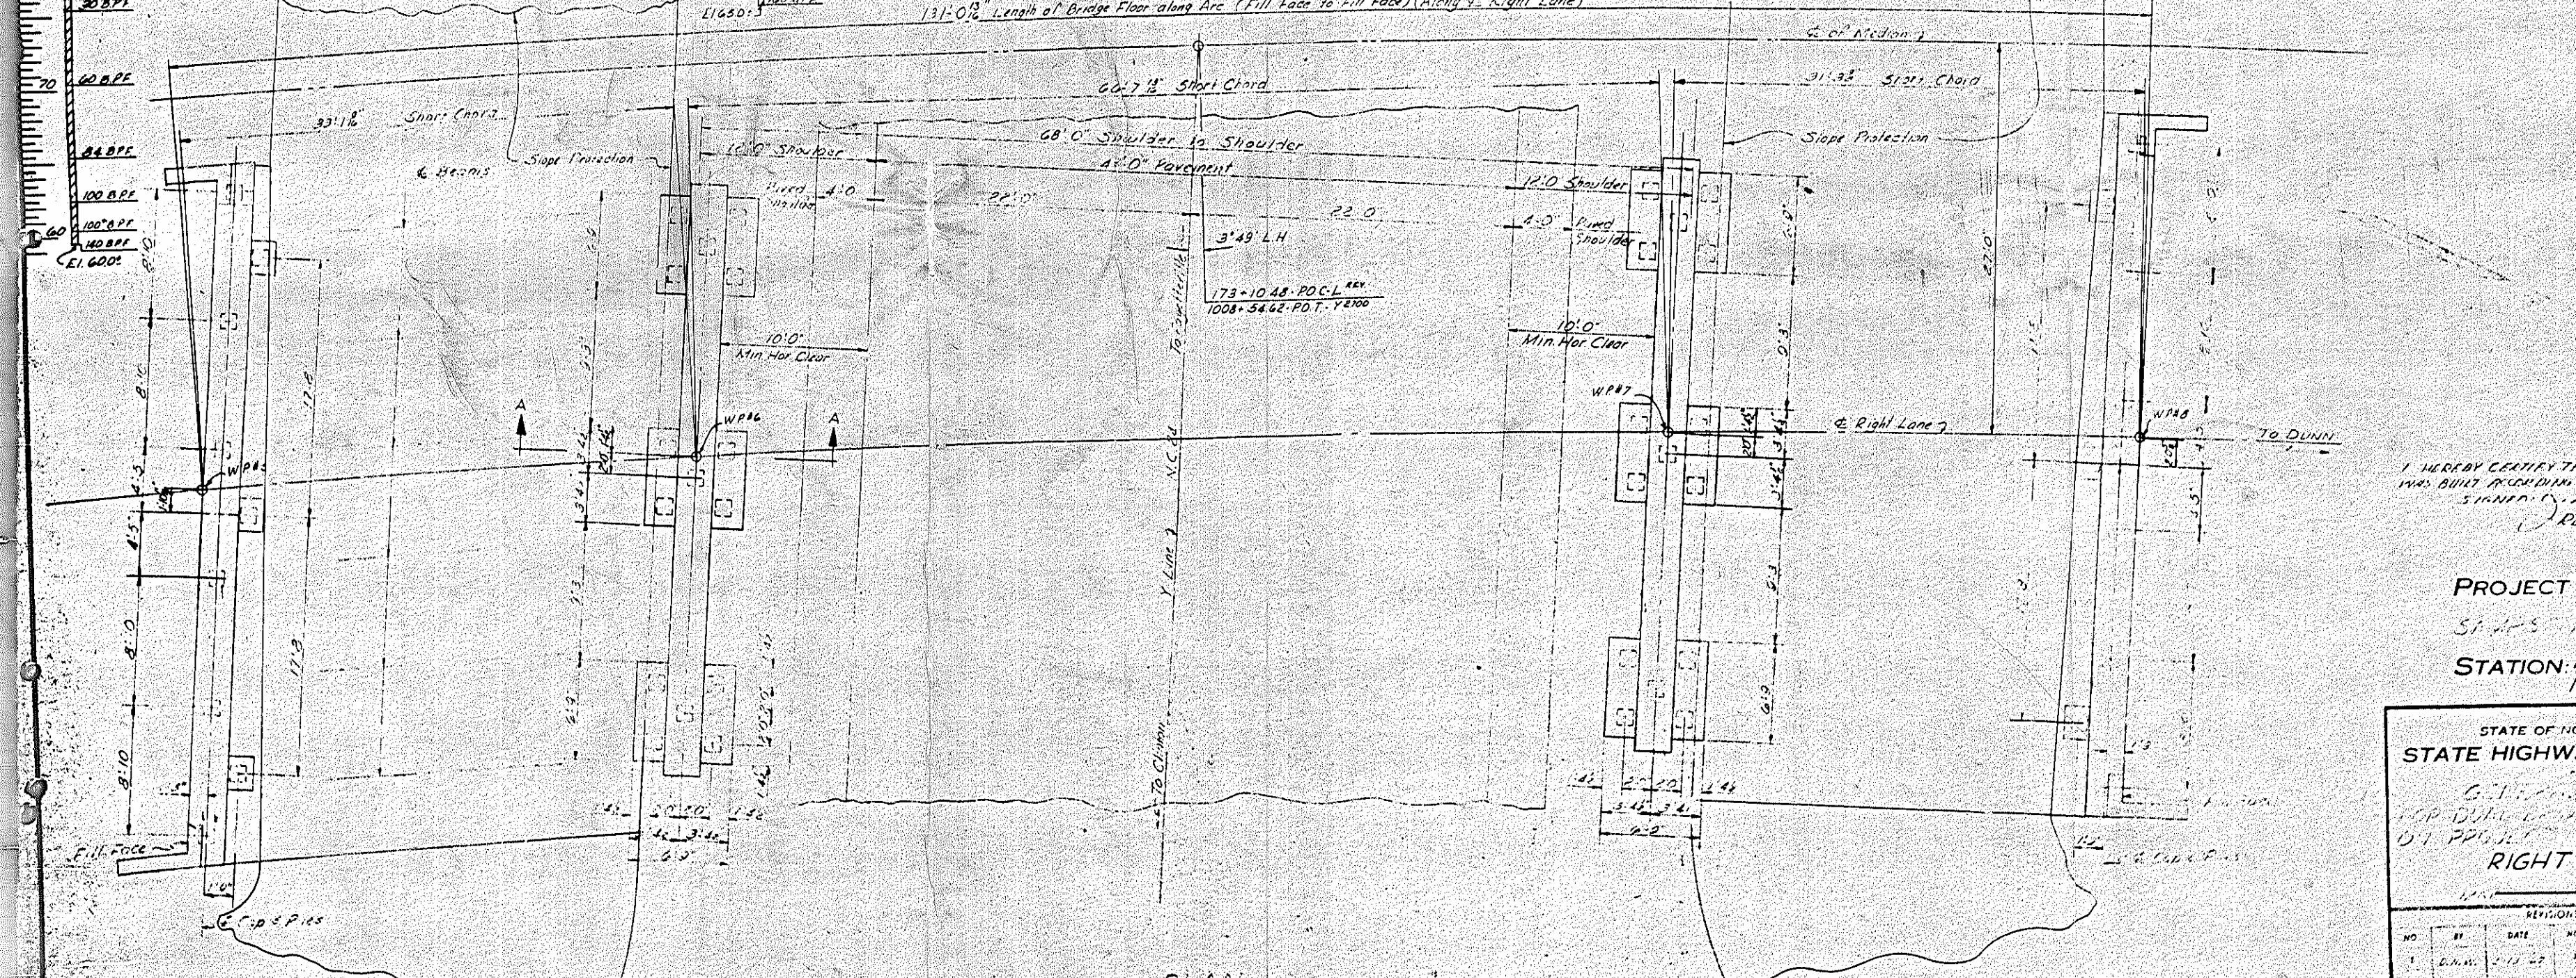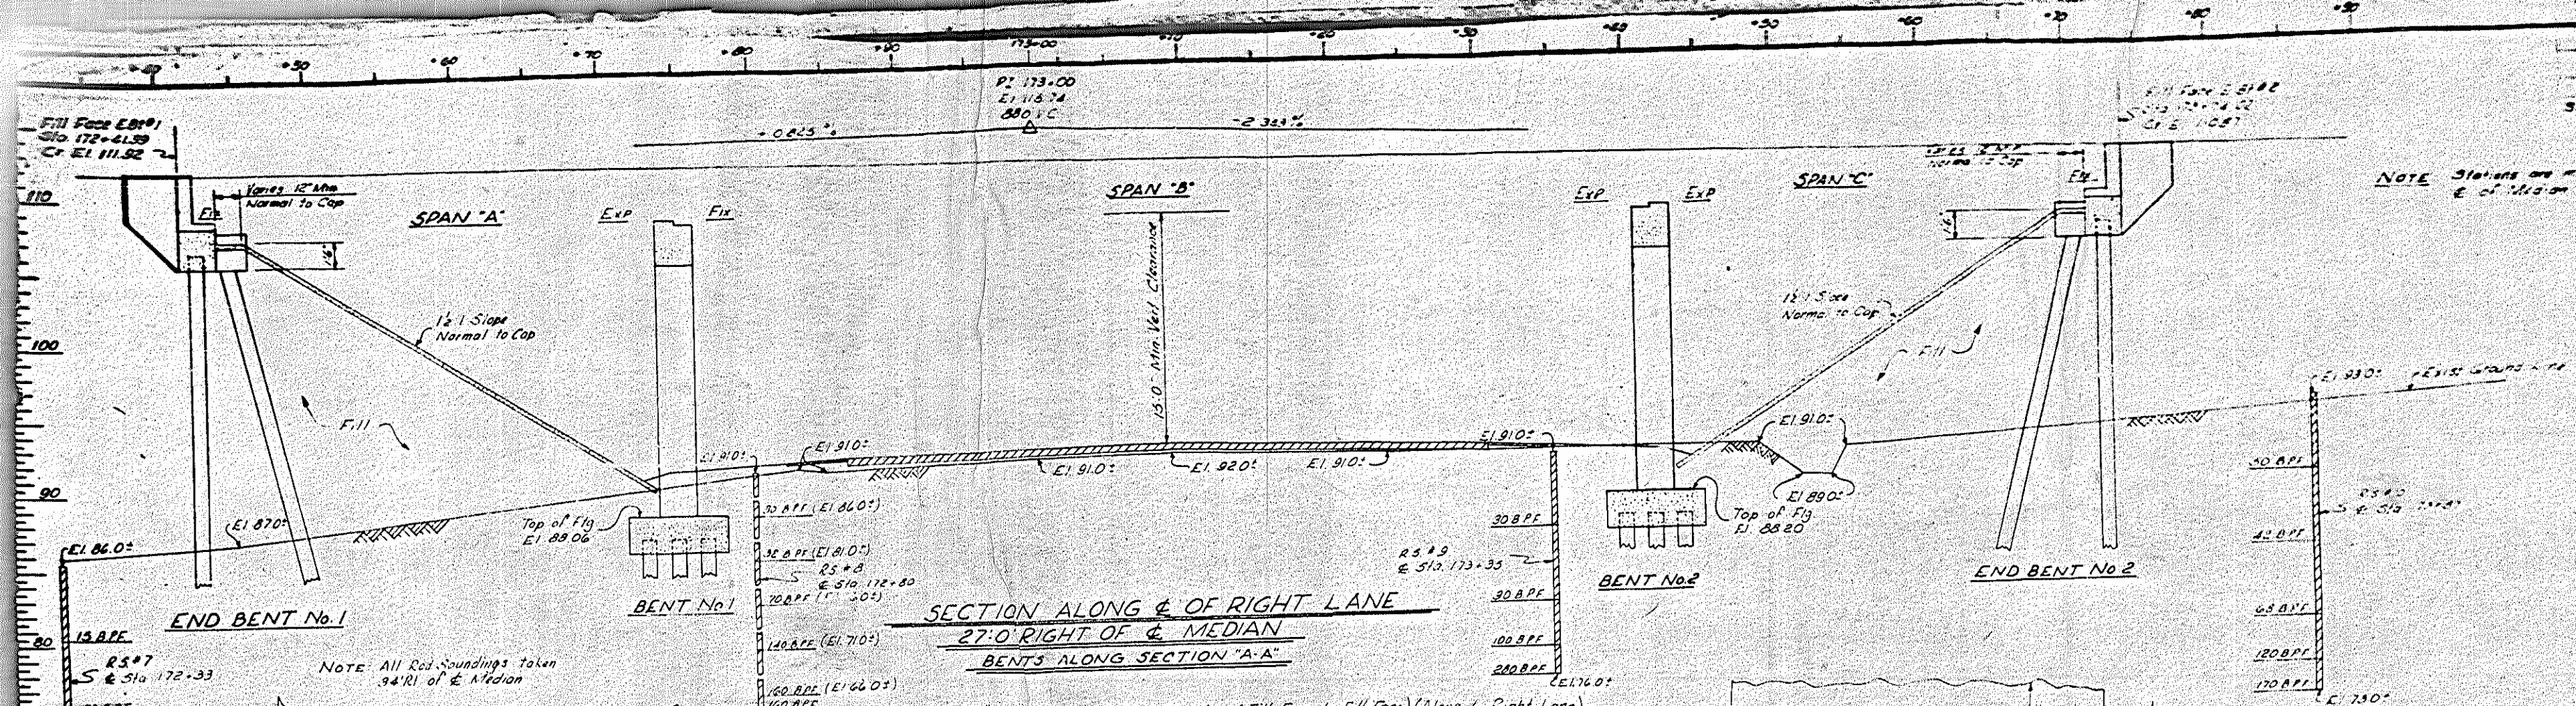

NOTE: Stationing measured along the E. of Median

I HEREBY CERTIFY THAT THIS STRUCTURE WAS BUILT ACCORDING TO PLAN, REVISIONS SIGNED BY ME, AS RESIDENT ENGINEER

PROJECT NO. 5-73002
 ST. ASHTON COUNTY
 STATION: 173+10.48-POC-L REV.
 1008-5462-POT-YE1000

STATE OF NORTH CAROLINA	
STATE HIGHWAY COMMISSION	
ST. ASHTON COUNTY	
RIGHT LANE	
NO.	REVISIONS
1	DATE: 10/25/64
2	DATE: 11/12/64
3	DATE: 11/12/64
4	DATE: 11/12/64
5	DATE: 11/12/64
6	DATE: 11/12/64
7	DATE: 11/12/64
8	DATE: 11/12/64
9	DATE: 11/12/64
10	DATE: 11/12/64


173002
 75002
 VTY
 NBL
 SECTION
 DRAWING
 5.100
 194

DRAWN BY: S. L. SANFORD, TOMAS DATE: 10/25/64
 CHECKED BY: B. J. TAYLOR DATE: 11/12/64

421-28-40 E

NOTES

Assumed Live Load - H20-S16(44) or Alternate Loading
 For other design data and general notes, see Sheet S-11.
 All piles for End Bents and Interior Bents shall be driven to a minimum bearing capacity of 30 tons each. The contractor shall be responsible for determining lengths of piles required. See Special Provisions for note regarding alternate type of piles set by State. The contractor will be required to accurately completely through the fill at End Bents before driving End Bent piles. See Sheet S-11.
 The roadway contractor will be required to remove the existing pavement and curbs, the roadbed to a minimum depth of 6" within the area of the End Bent piles. This note applies to Left Lane Bridge only.
 No work shall be started on Interior Bents for Left Lane Bridge until after roadway section has been excavated by the roadway contractor. Unclassified Structure Excavation for Interior Bents shall be measured from surface of road way cut for Left Lane Bridge and from existing ground line for Right Lane Bridge.
 The length of bridge was computed on the basis of no ditch section with the 5% slope 2:1 outside of shoulder.
 Traffic on U.S. 421 will be detoured and traffic on N.C. 24 will be maintained during construction.
 The existing 10" water main located approximately 4' south of the existing pavement of N.C. 24, the existing 6" water main located approximately 3' north of the existing pavement of N.C. 24, and the existing 2" water main that runs out from the existing 10" water main 2' north of the pavement of the existing U.S. 421 shall be protected during construction. See Location Sketch for note regarding proposed 10" sewer.

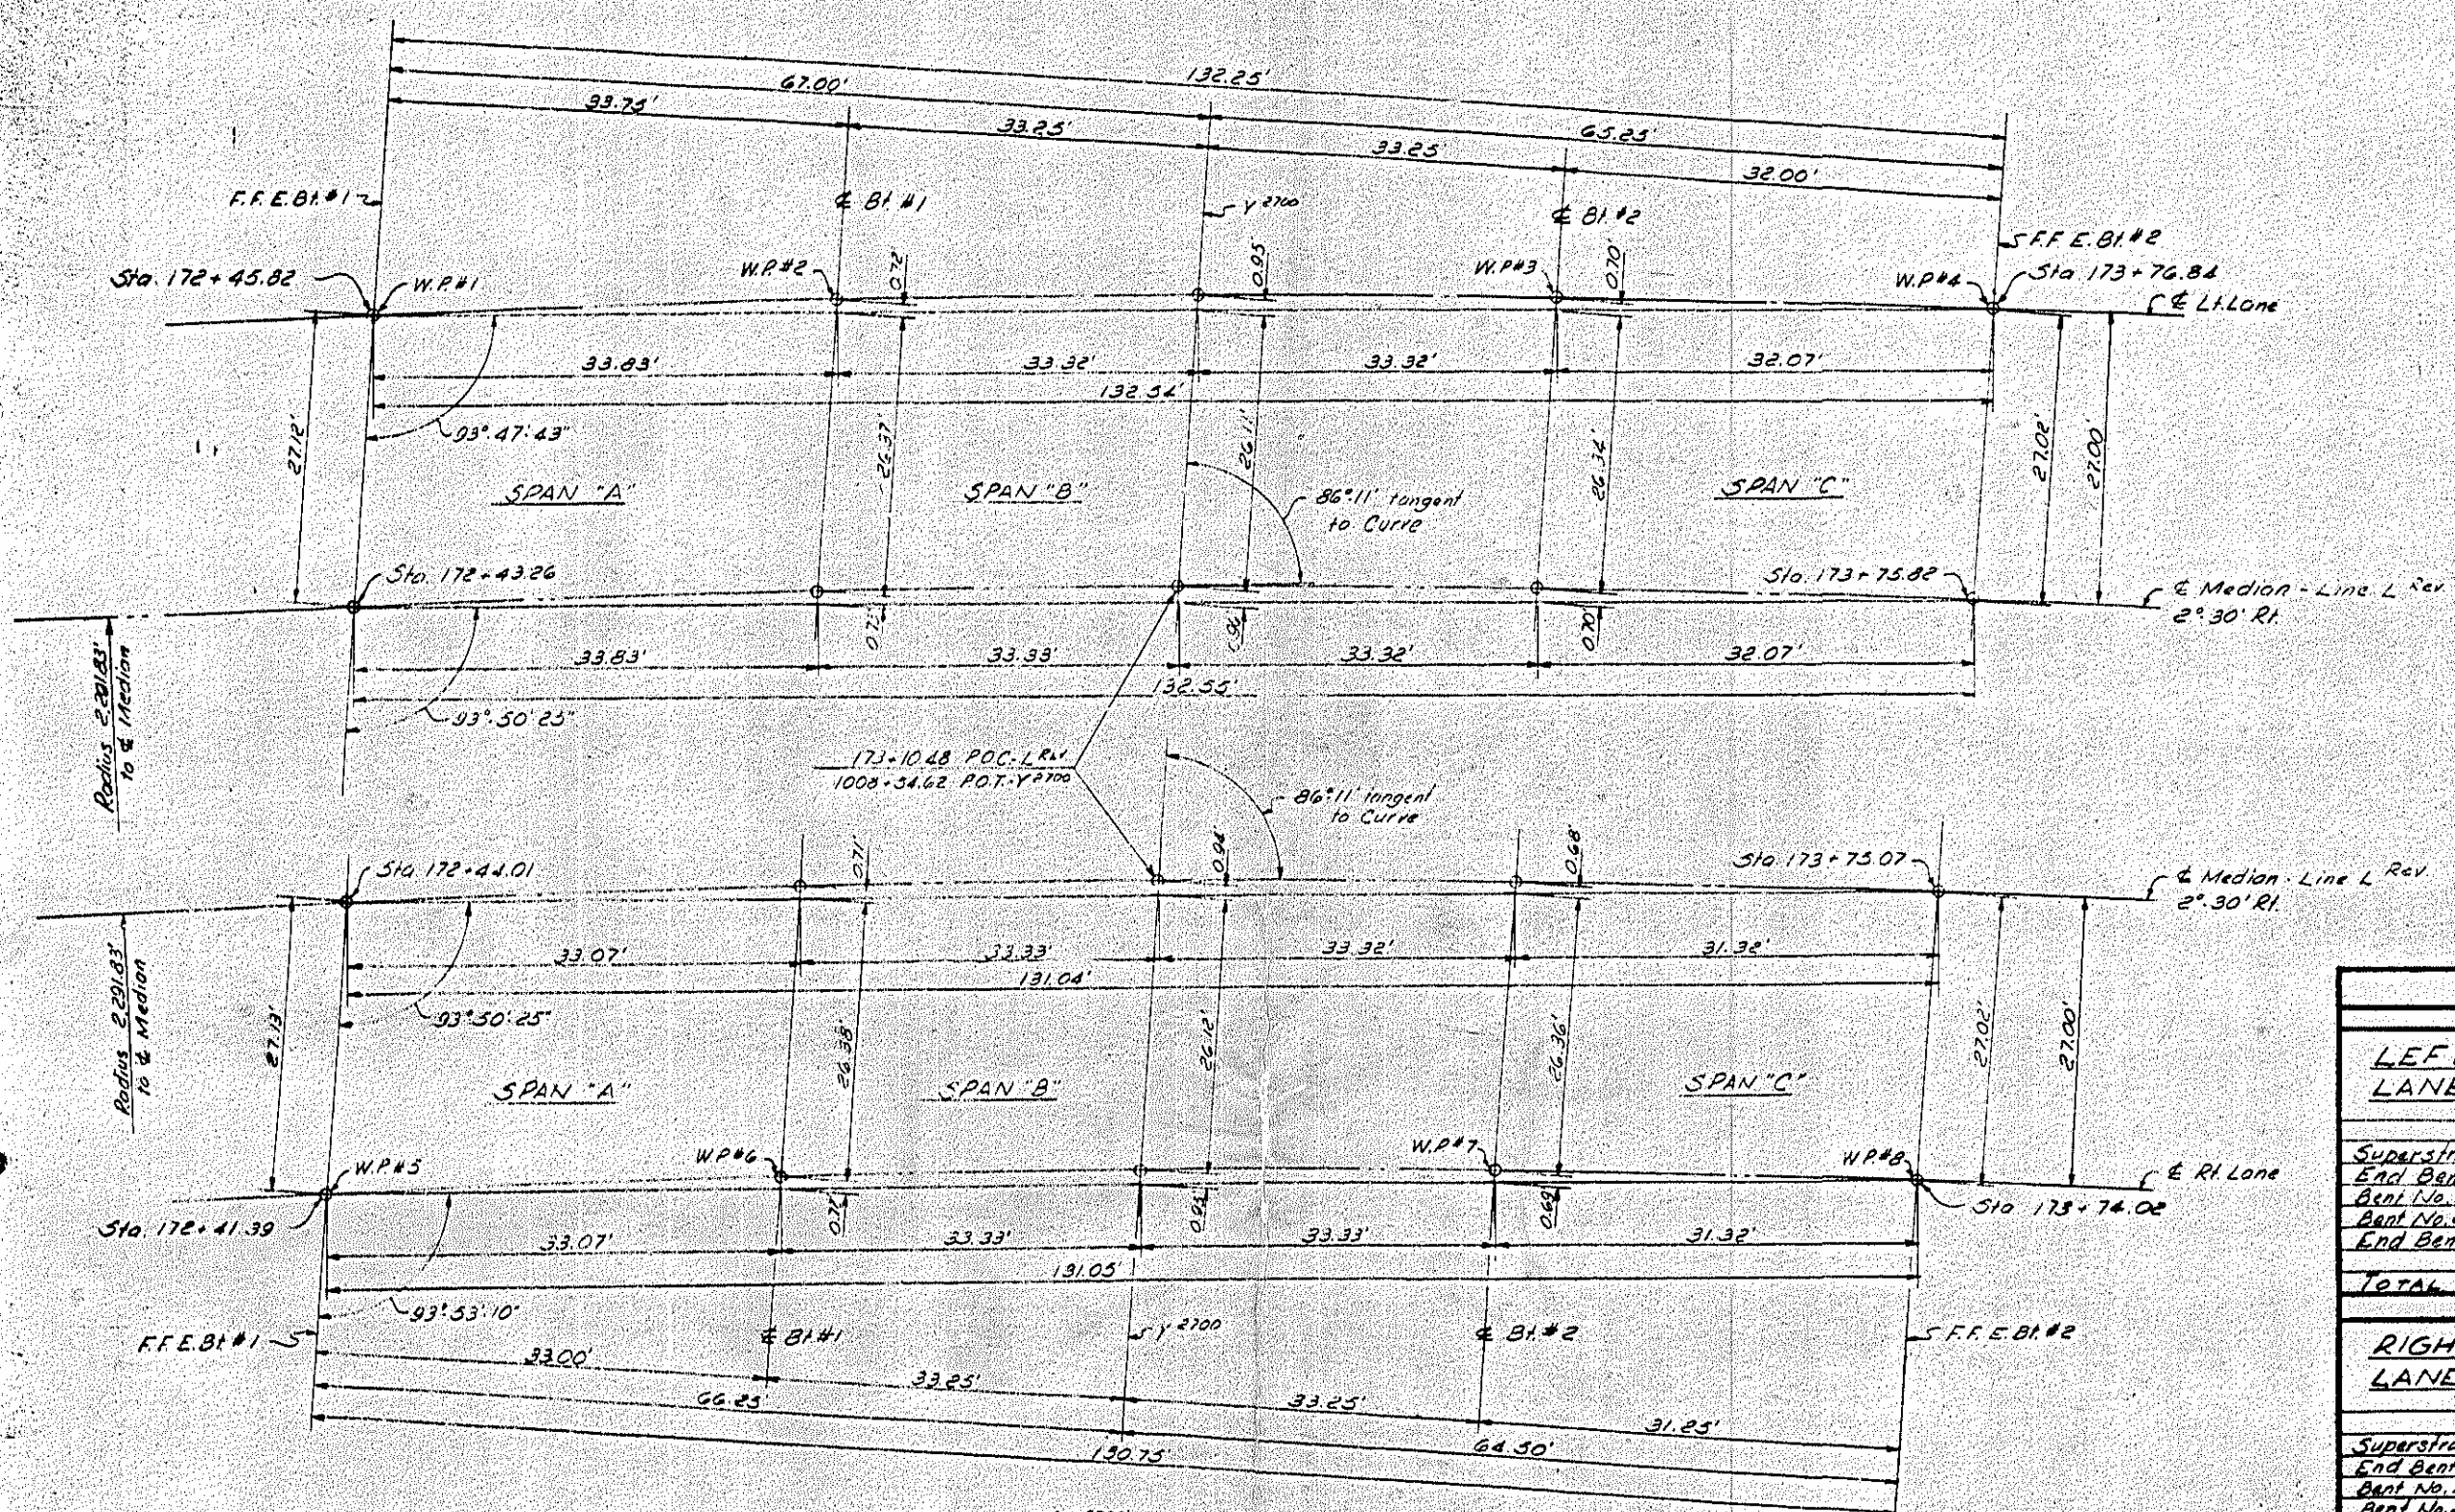

LEFT LANE	9 344'-10"
RIGHT LANE	15 332'-0"
BENT No. 1	15 437'-10"
BENT No. 2	9 353'-0"
TOTAL	48 1501'-58"

TOTAL BILL OF MATERIAL


LEFT LANE	Class 'A' Concrete	Reinforcing Steel	Structural Steel	12" Square Pile	PILES	Unclassified Structure Excavation	Concrete Slope Protection	One Bar Metal Rail
Superstructure	173.3	39,352	12,300	18	1,188	113.53	204.87	249.94
End Bent No. 1	15.8	2,941	1,300	4	252	140	140	140
Bent No. 1	36.3	6,141	1,300	13	819	140	140	140
Bent No. 2	35.9	6,027	1,300	13	819	140	140	140
End Bent No. 2	15.9	2,937	1,300	4	252	140	140	140
TOTAL	277.2	57,497	12,300	18	1,188	113.53	204.87	249.94

RIGHT LANE	Class 'A' Concrete	Reinforcing Steel	Structural Steel	12" Square Pile	PILES	Unclassified Structure Excavation	Concrete Slope Protection	One Bar Metal Rail
Superstructure	171.5	39,002	12,300	18	1,188	113.55	204.87	249.94
End Bent No. 1	13.8	2,853	1,300	4	252	140	140	140
Bent No. 1	36.1	6,101	1,300	13	819	140	140	140
Bent No. 2	36.3	6,027	1,300	13	819	140	140	140
End Bent No. 2	15.7	2,950	1,300	4	252	140	140	140
TOTAL	273.4	57,033	12,300	18	1,188	113.55	204.87	249.94

NOTE: All Bents are parallel to base line (Y=2700)

CURVE LAYOUT

B.M. #13 - Nail in base of 12 Mulberry 247' S. of Sta. 172+79 - Elev. 96.86

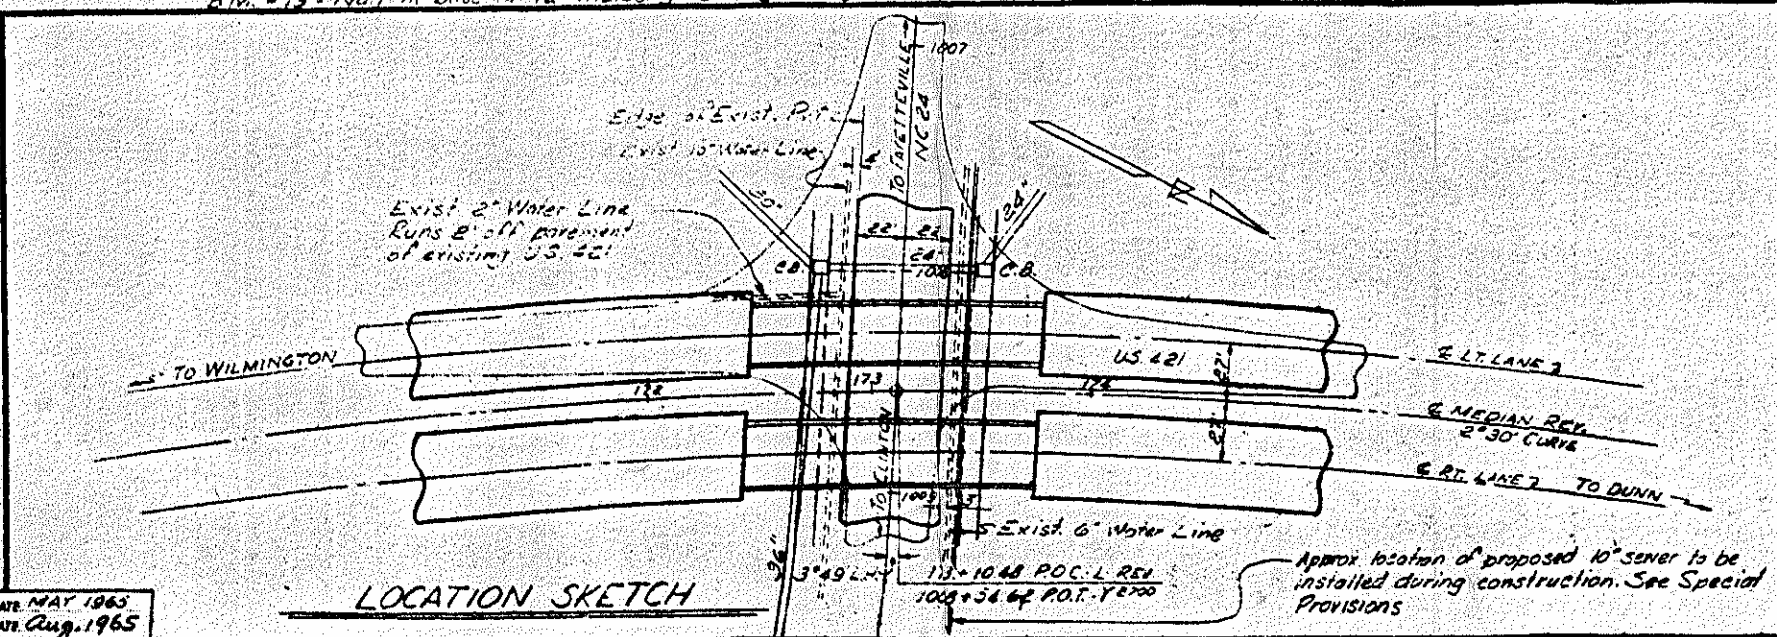

LOCATION SKETCH

PROJECT NO. 81273002

SAMPSON COUNTY

STATION: 173+10.48 P.O.C.L. REV
 1008+34.62 P.O.T. Y=2700

STATE OF NORTH CAROLINA
STATE HIGHWAY COMMISSION
 GENERAL DRAWING
 FOR DUAL BRIDGES OVER NC24
 ON PROJECT CLINTON BY-PASS
 LEFT AND RIGHT LANE
 MAY 1965


REVISIONS			
NO.	BY	DATE	DESCRIPTION
1			
2			

5-103
134


GRADE DATA $+0.85\%$ -2.34%

PI Sta. 173+00
 P.I. Elev. 115.74
 Length of Curve 880'
 G1 = +0.85 % G2 = -2.34 %

Column 1 Bottom of overhang		Column 2 Cut Roadway		Column 3 Bottom of overhang	
Dist.	Elev.	Dist.	Elev.	Dist.	Elev.
112.197	172+43.79	111.919	172+43.79	109.882	172+43.79
136	172+43.79	848	172+43.79	856	172+43.79
136	172+43.79	848	172+43.79	799	172+43.79
075	172+43.79	787	172+43.79	737	172+43.79
112.010	172+73.79	722	172+73.79	679	172+73.79
2'-8 1/2"	172+73.79	1'-1 1/2"	172+73.79	679	172+73.79
7'-3 3/4"	172+83.79	8'-9 1/4"	172+83.79	605	172+73.79
870	173+33.79	581	173+33.79	553	173+33.79
795	173+33.79	506	173+33.79	457	173+33.79
716	173+33.79	427	173+33.79	378	173+33.79
635	173+33.79	345	173+33.79	295	173+33.79
547	173+33.79	258	173+33.79	209	173+33.79
461	173+33.79	181	173+33.79	143	173+33.79
365	173+33.79	104	173+33.79	77	173+33.79
266	173+33.79	27	173+33.79	11	173+33.79
111.155	FILL FACE	110.875	FILL FACE	108.835	FILL FACE

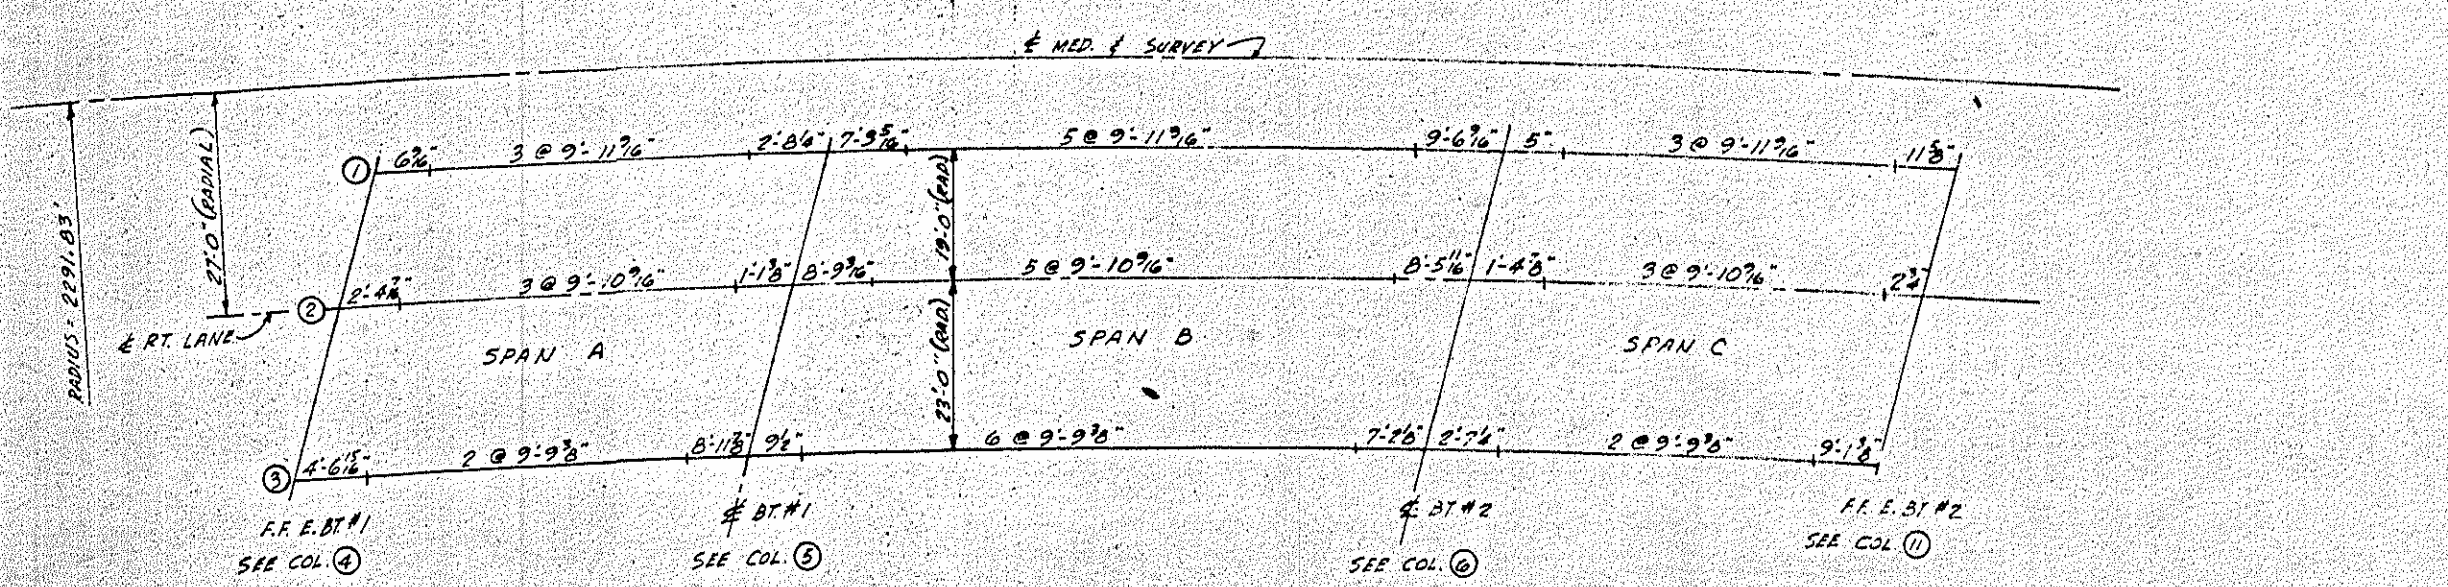

PLAN

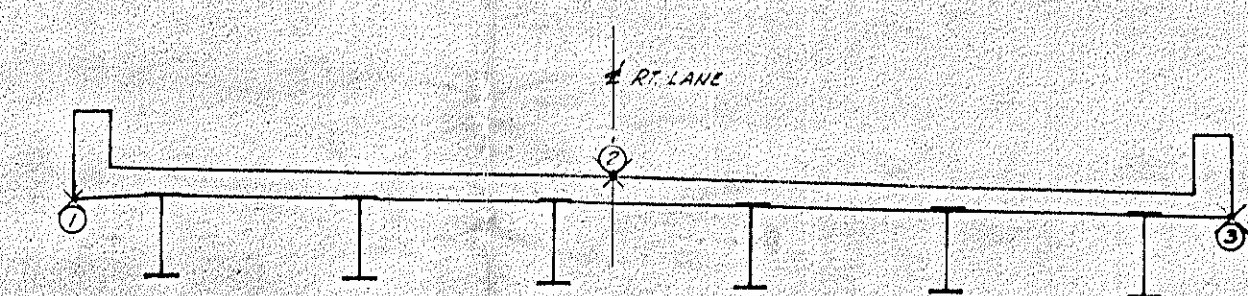

TYPICAL SECTION

HEADERS

Column 1 Fill Face E.B. 1	Column 2 Bent #1	Column 3 Bent #2	Column 4 Bent #3	Column 5 Bent #4	Column 6 Bent #5	Column 7 Bent #6	Column 8 Fill Face E.B. 2
Dist.	Elev.	Dist.	Elev.	Dist.	Elev.	Dist.	Elev.
112.589	172.785	112.785	172.785	112.785	172.785	112.785	172.785
870	172.785	848	172.785	856	172.785	856	172.785
795	172.785	787	172.785	799	172.785	799	172.785
716	172.785	722	172.785	737	172.785	737	172.785
635	172.785	605	172.785	553	172.785	553	172.785
547	172.785	506	172.785	457	172.785	457	172.785
461	172.785	427	172.785	378	172.785	378	172.785
365	172.785	345	172.785	295	172.785	295	172.785
266	172.785	258	172.785	209	172.785	209	172.785
111.155	172.785	181	172.785	143	172.785	143	172.785
	172.785	104	172.785	77	172.785	77	172.785
	172.785	27	172.785	11	172.785	11	172.785
	172.785		172.785		172.785		172.785

Elevations shown in columns 1 thru 8 are final required elevations of the completed structure. In setting up the form and screeds elevations provisions must be made for deflections where required.

For columns 9 thru 11 elevations are to be set radial from the left gutter line to the right gutter line.

PROJECT NO. 8.1273002
 SAMPSON COUNTY
 STATION 173+10.48 - 1

SUPERIMPOSED DEAD LOAD DEFLECTION (inches)

	SPAN A	SPAN B	SPAN C
INT.	1/8"	1/8"	1/8"
EXT.	3/8"	1/2"	3/8"

STATE OF NORTH CAROLINA
STATE HIGHWAY COMMISSION
 RALEIGH
 ELEVATIONS
 FOR
 SETTING UP
 FORMS AND SCREEDS
 RT. LANE
 1962


PROJECT NO. 8.1273002
 SAMPSON COUNTY
 STATION 173+10.48 - 1

DATE: 1/15/62


BY: [Signature]

CHECKED BY: [Signature]

SCALE: 1" = 10'

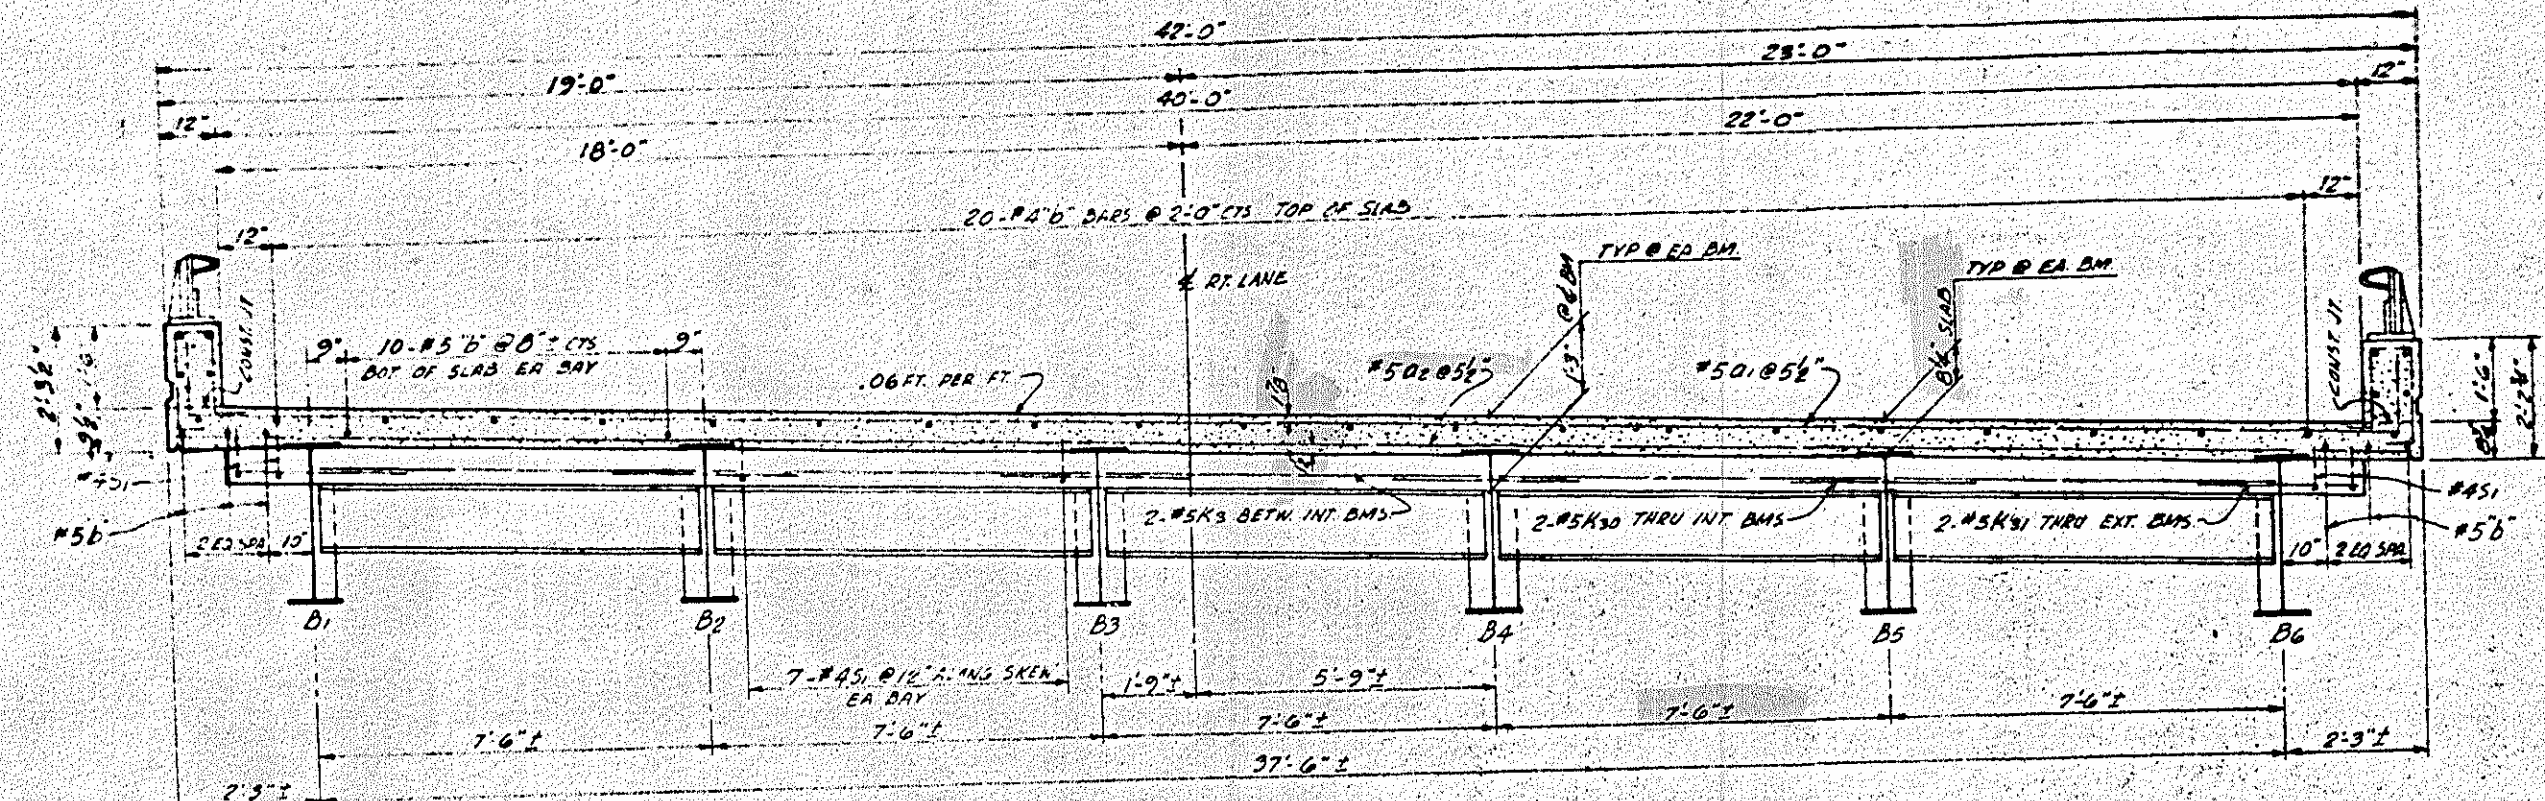

TYPICAL SECTION
(SHOWING DIAPHRAGMS AT BENTS)

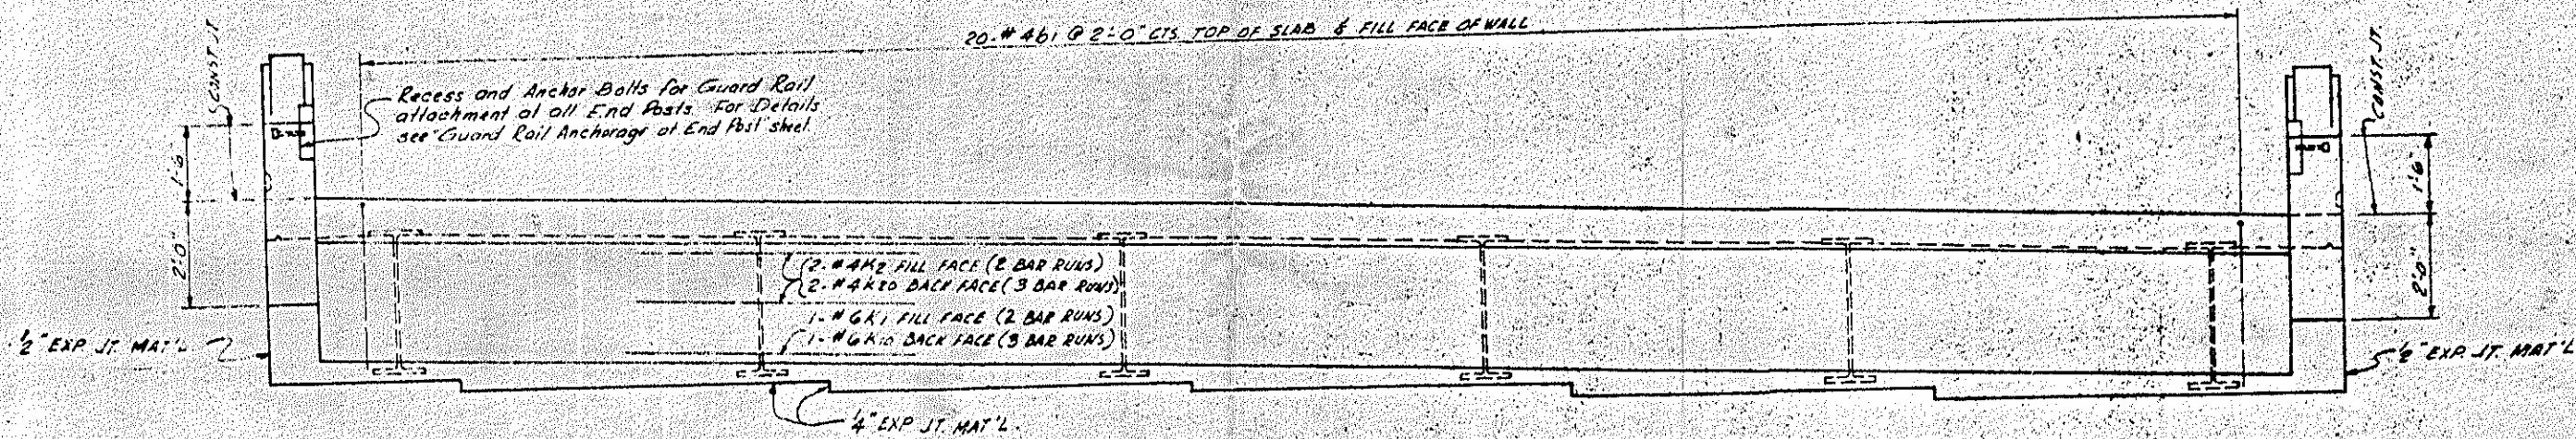

END ELEVATION


PROJECT No. 8.1273002
 SAMPSON COUNTY
 STATION: 173+10.48-L
 RT. LANE

STATE OF NORTH CAROLINA					
STATE HIGHWAY COMMISSION					
SUPERSTRUCTURE					
STANDARD TYPICAL SECTION					
40' ROADWAY - 6 STEEL BEAMS					
MARCH 1965					
REVISIONS					
NO.	BY	DATE	NO.	BY	DATE
1			2		
2			3		
					5-106
					196


DRAWN BY: R. D. ALFORD, JR. DATE: APR '65
 CHECKED BY: GEORGE B. WYNNIE DATE: MAY '65

DESIGNED BY	DATE	NO.	DATE
DRAWN BY	DATE	NO.	DATE
CHECKED BY	DATE	NO.	DATE


DESIGNED FOR LIVE LOAD AEC-56 (44) OR EQUIVALENT LOADING.
 CONCRETE COMPRESSIVE STRENGTH 4,000 PSI PER 1000
 REINFORCING STEEL IN TENSION 20,000 PSI PER 1000
 STRONG IN EXTREME FIBER OF STRUCTURAL STEEL 20,000 PSI PER 1000
 FOR OTHER DESIGN DATA AND GENERAL NOTES SEE SHEET 5-107
 FOR THIS PROJECT AND NO PART THEREOF INCLUDING THIS DRAWING
 PLAN FOR THE DIFFERENT SPANS.
 EXPANSION JOINTS TO BE KEPT FREE OF CONCRETE AND
 SEALED WITH AN ASPHALT CEMENT.

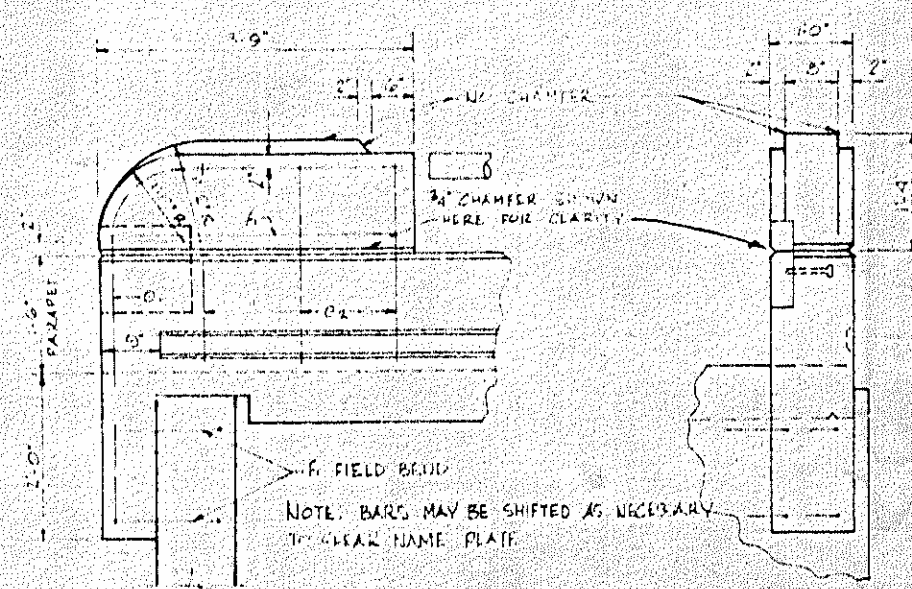


END POST DETAILS

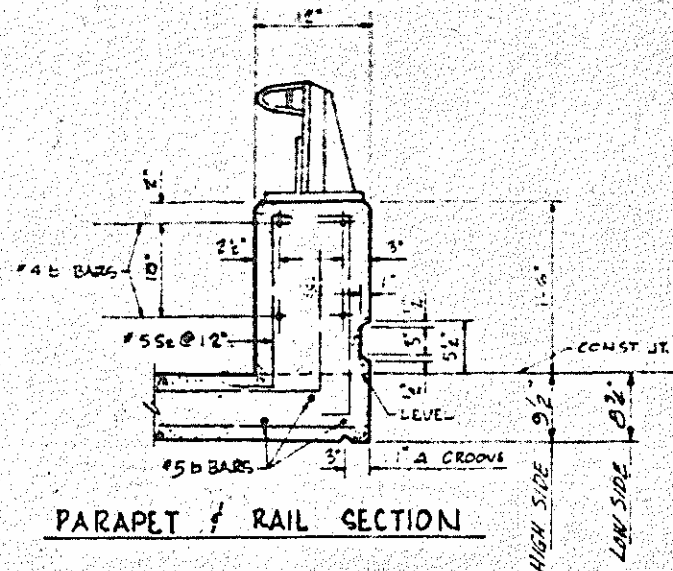


PARAPET / RAIL SECTION

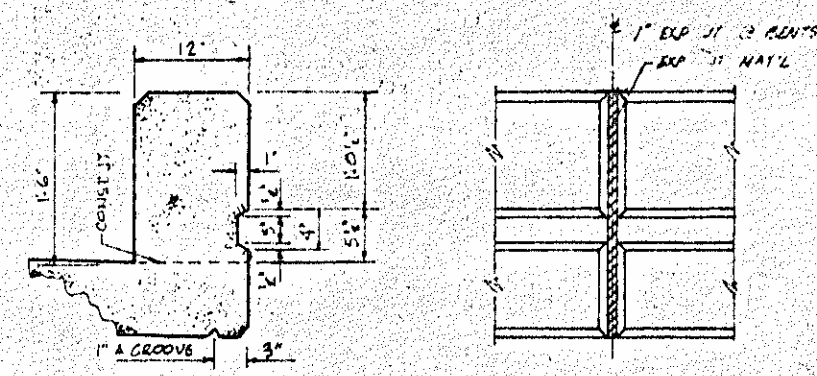


DETAIL RAIL BASE GROOVE

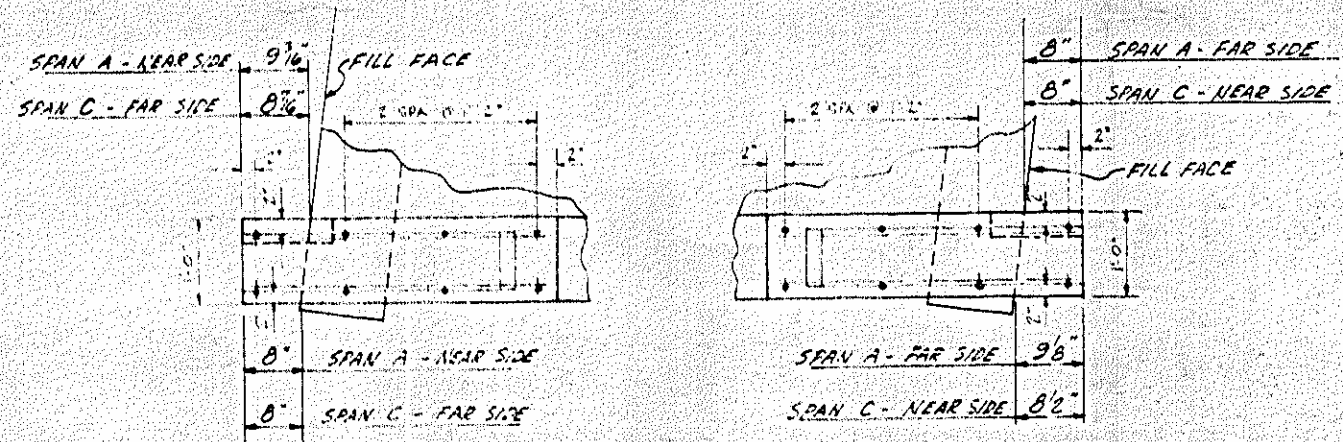

END POST DETAILS

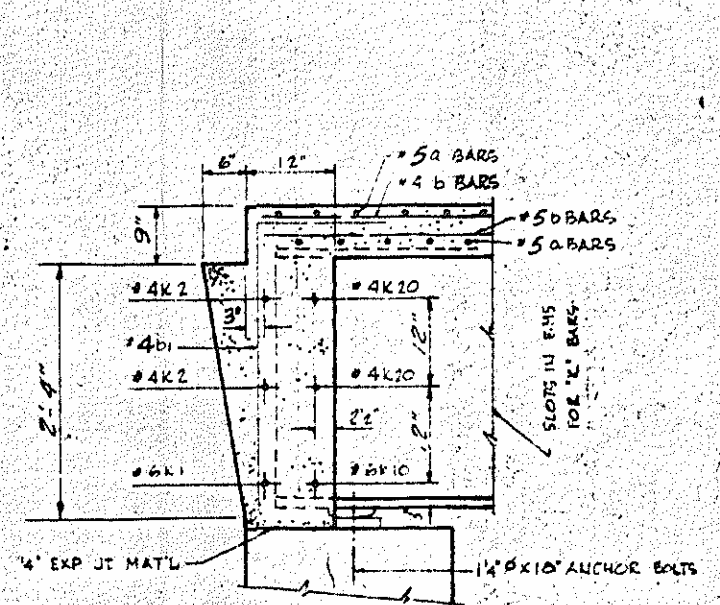

SECTION A-A

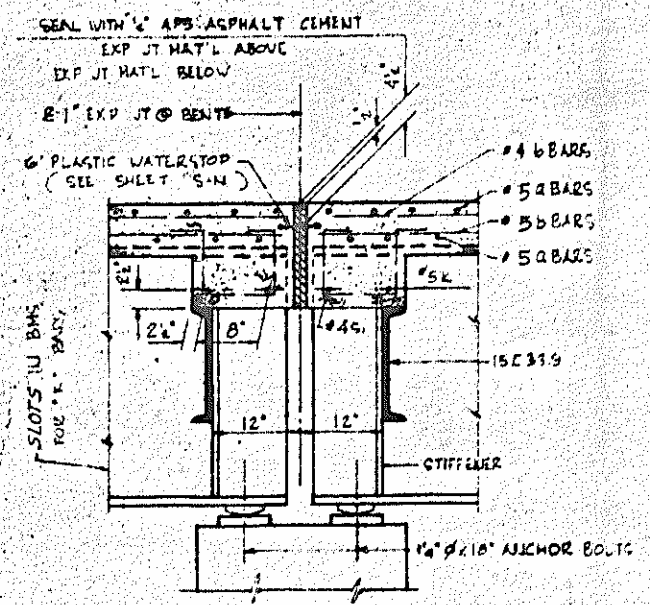

SECTION B-B

PROJECT NO. 8.1273002
 SAMPSON COUNTY
 STATION: 173+10.48-L
 RT. LANE



STATE OF NORTH CAROLINA			
STATE HIGHWAY COMMISSION			
1 BM SUPERSTRUCTURE			
DETAILS FOR ONE BAR METAL			
RAIL			
MARCH		1965	
REVISIONS			
NO.	BY	DATE	NO.
1			1
2			4
SHEET NO.			5-107
TOTAL SHEETS			134

DESIGNED BY F. G. ALFORD, JR. DATE APR. '65
 DRAWN BY FRANK BY 1 DATE
 CHECKED BY GEORGE B. KAYNE DATE MAY '65

002
 ON
 196

173002
 (1)
 185

FED. ROAD DIST. NO.	STATE	PROJECT NO.
3	N.C.	B.1273002
F.A. PROJECT 6-6U-1800(2)		
SHEET 110 of 185		

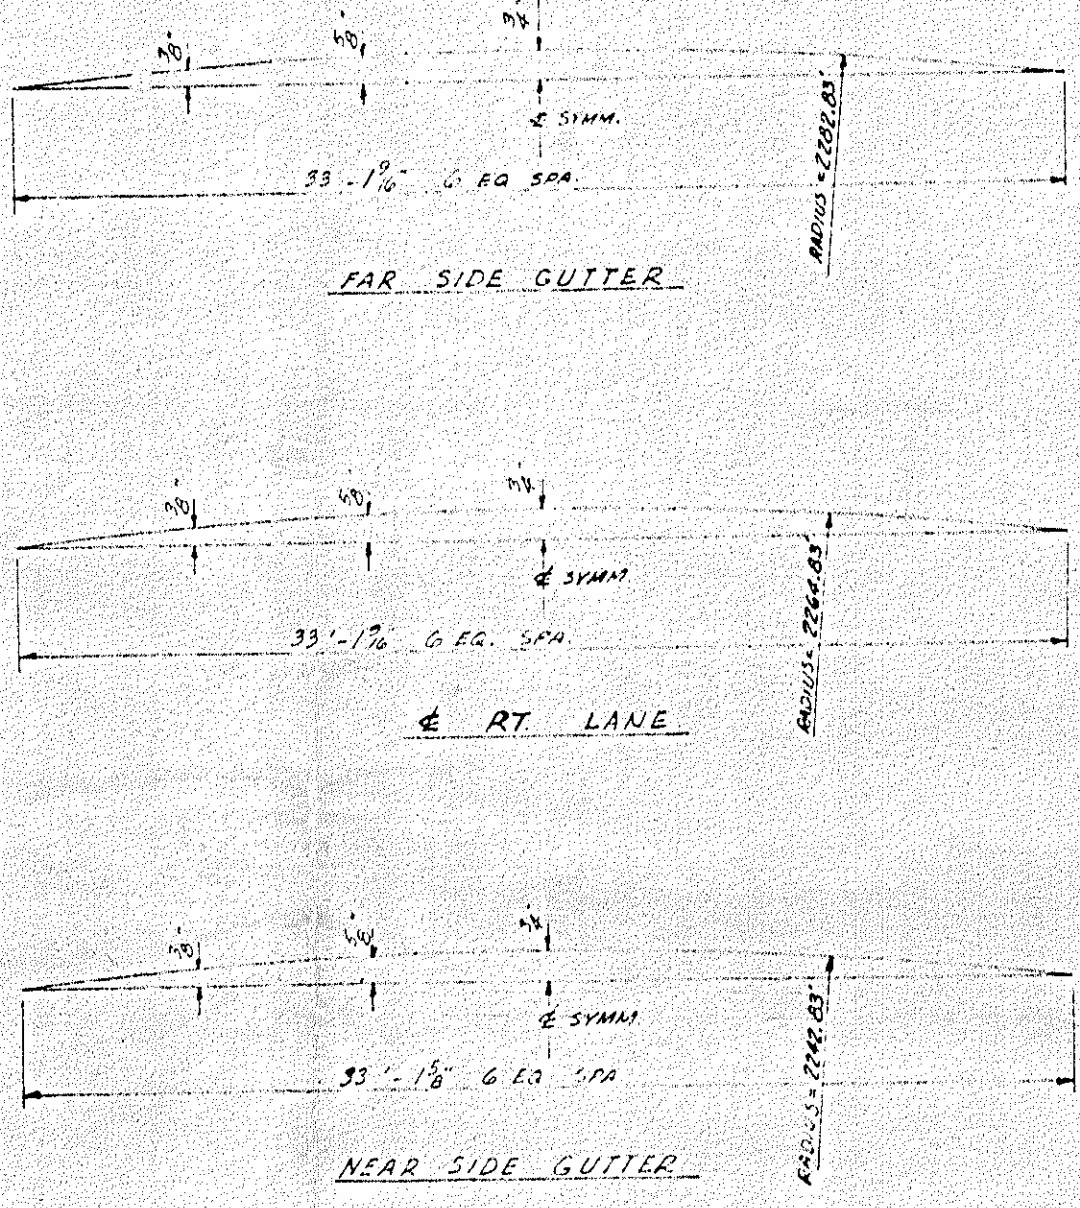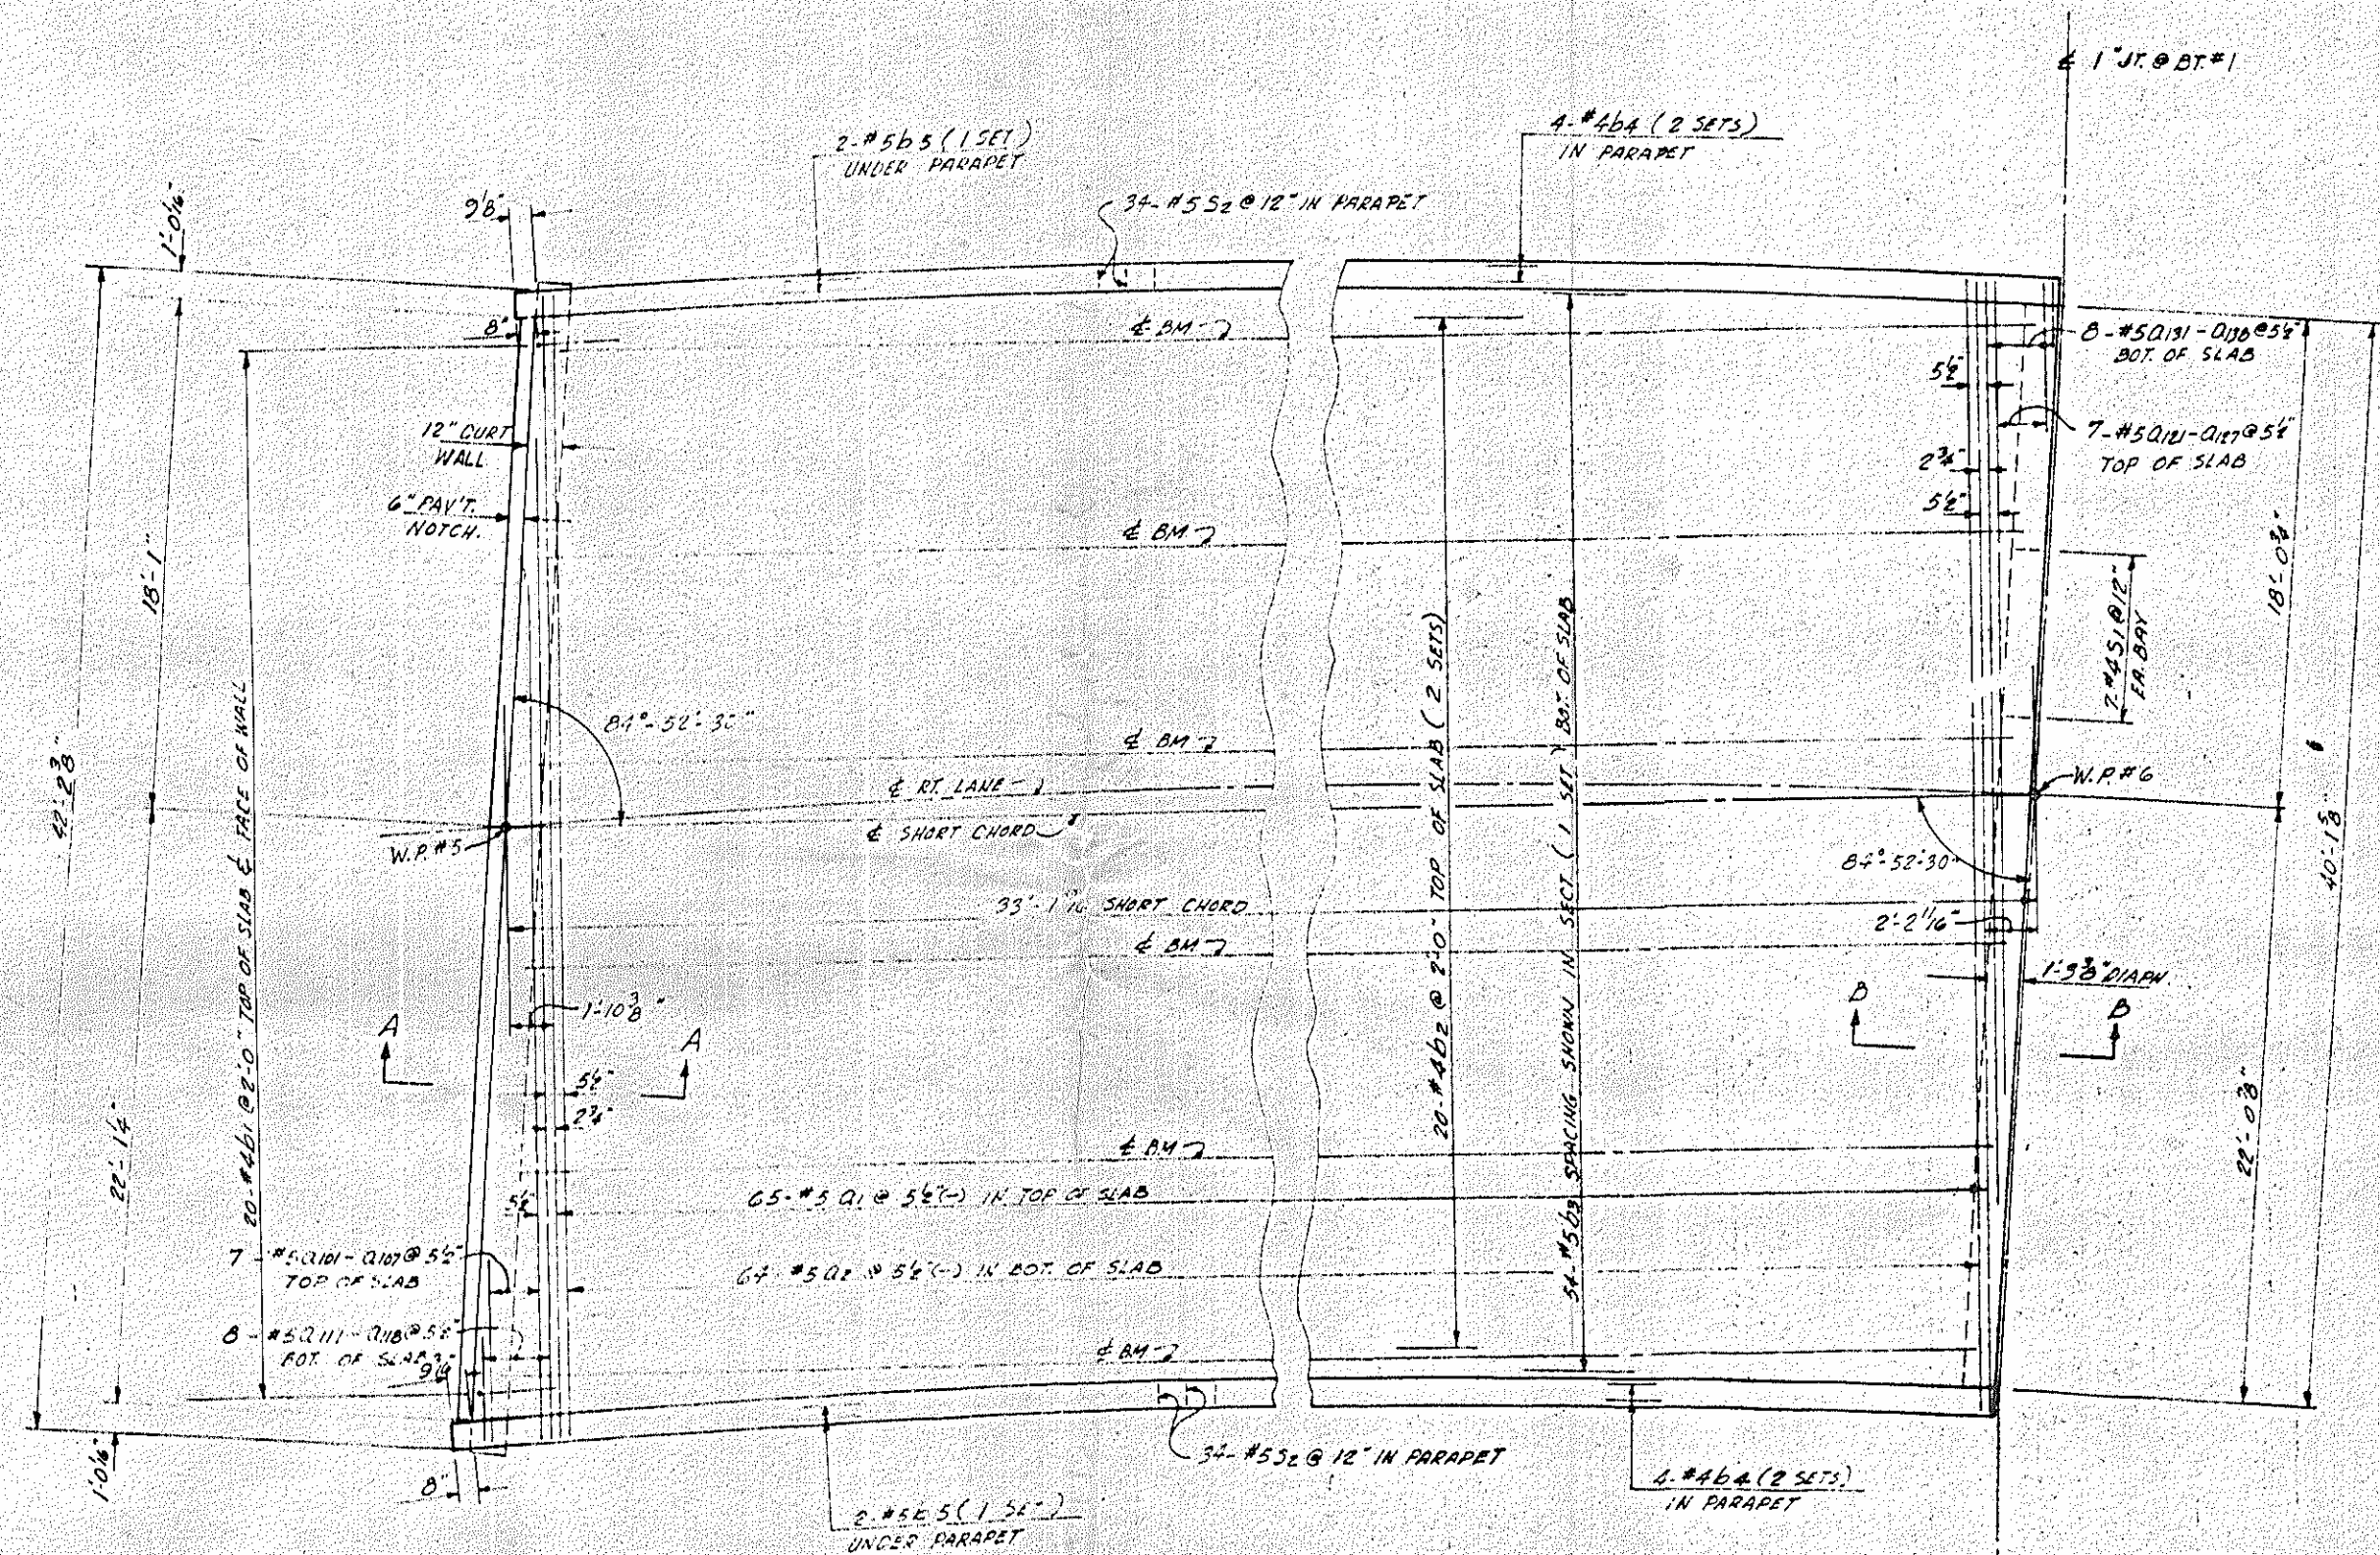

PLAN
SPAN A - RT. LANE
 NOTE: POSTS AND RAIL ARE NOT SHOWN.

CURVE OFFSETS
 NOTE: SHORT CHORD IS MEASURED FROM RILL FACE OF BT #1 TO BT #1.

NOTE: "O" BARS SHALL BE PLACED PERPENDICULAR TO THE RT. LANE SHORT CHORD & SPACED ALONG THE SHORT CHORD.

PROJECT No. B.1273002
 SAMPSON COUNTY
 STATION: 175 + 10.48 - L



STATE OF NORTH CAROLINA	
STATE HIGHWAY COMMISSION	
FRACTION	
SUPERSTRUCTURE	
SPAN A	
RIGHT LANE	
APRIL 1965	
NO.	DATE
1	5-108
2	134

DRAWN BY: G. B. RICE, JR. DATE: APR 65
 CHECKED BY: GEORGE B. LUSVINE DATE: MAY 65

3002
 Y
 L
 SION
 5-107
 134

173002
 134
 7002
 COUNTY
 SIGN

FED. ROAD DIST. NO.	STATE	PROJECT NO.
3	N.C.	B1273002
PROJECT 5-50-100W(3)		
SHEET 111 OF 185		

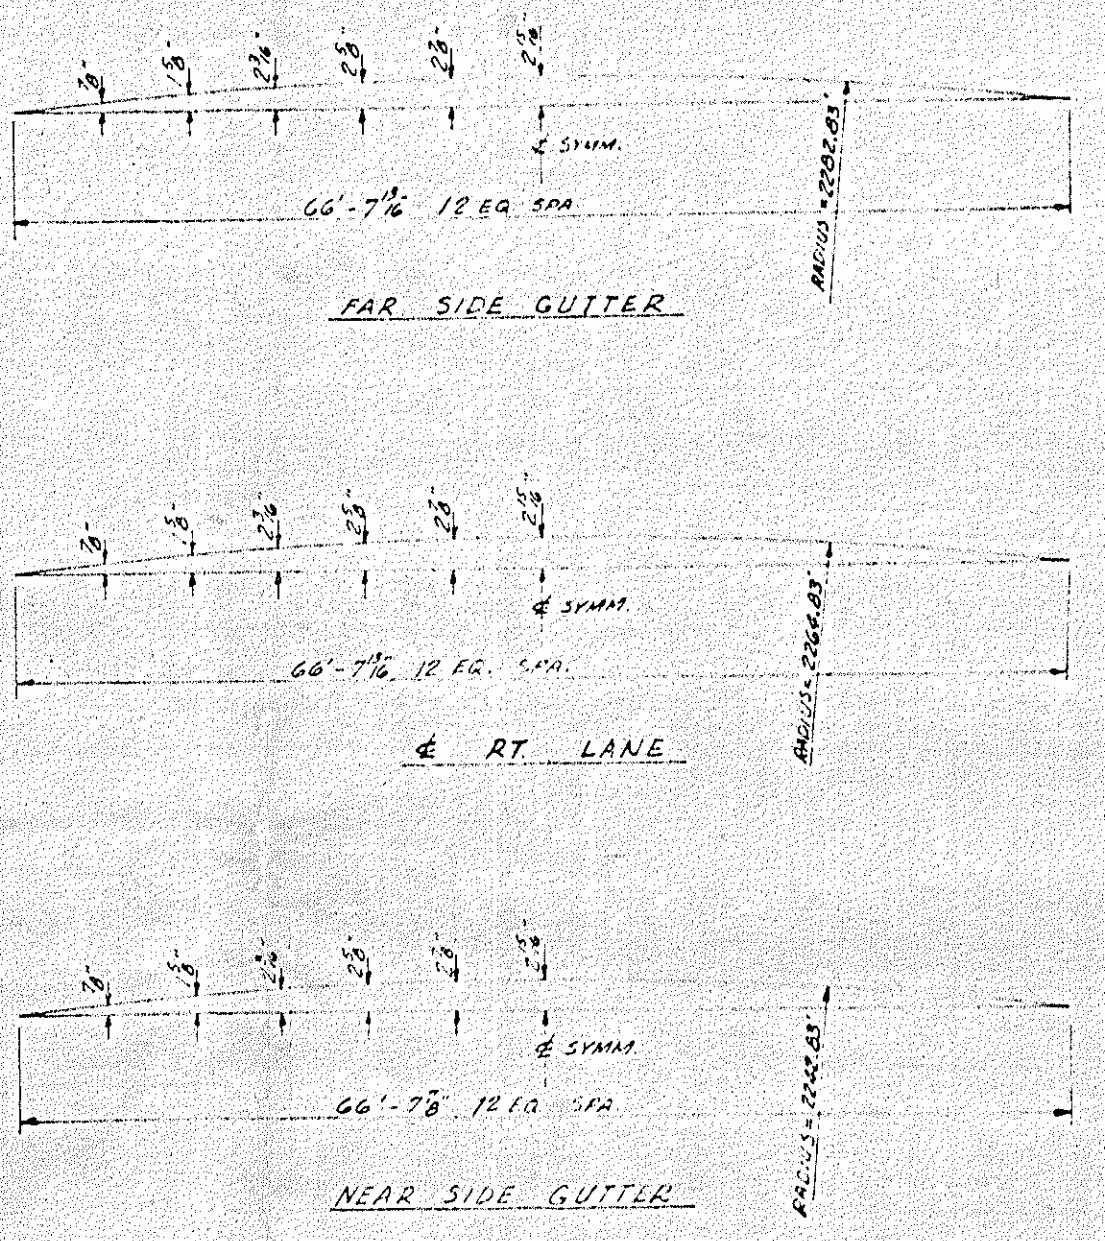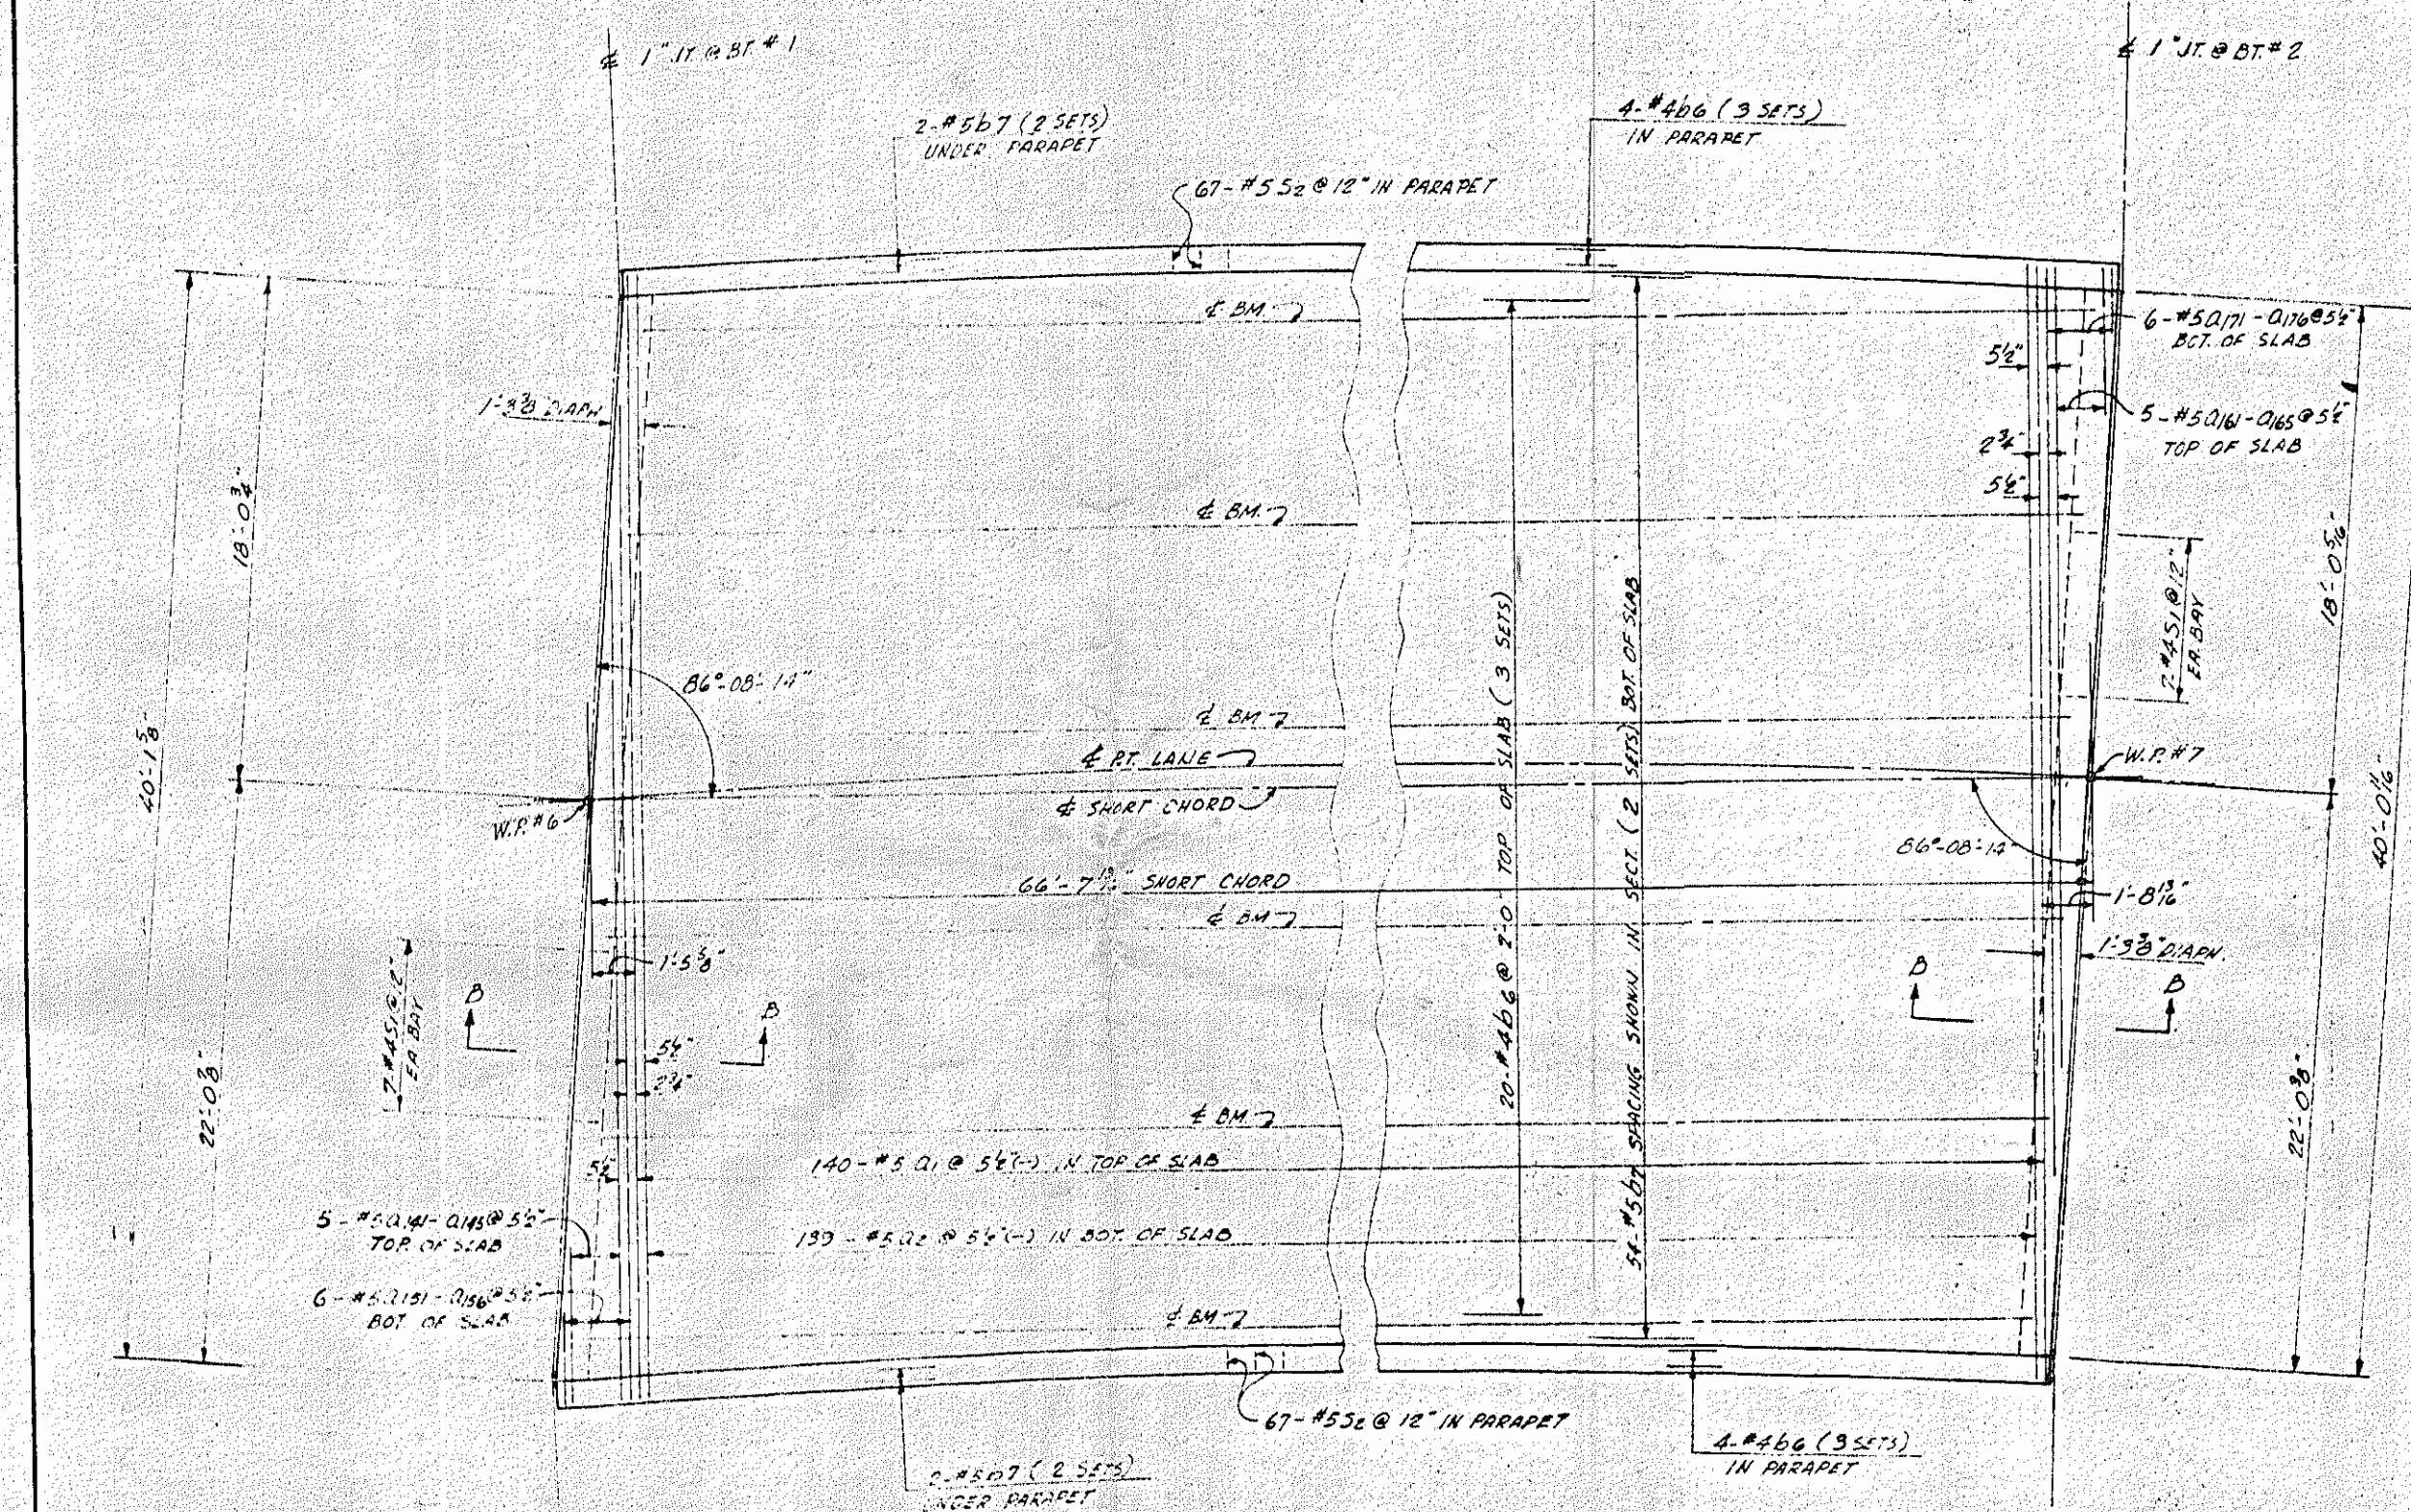

CURVE OFFSETS
 NOTE: SHORT CHORD IS MEASURED FROM
 & OF BT #1 TO & OF BT #2.


PROJECT NO. B.1273002
 SAMPSON COUNTY
 STATION: 173+10.48 -L-

STATE OF NORTH CAROLINA	
STATE HIGHWAY COMMISSION	
RALEIGH	
SUPERSTRUCTURE	
SPAN B	
RIGHT LANE	
APRIL 1965	
NO.	DATE
1	5-109
TOTAL SHEETS	134


DRAWN BY: G.D. A. S. 1965
 CHECKED BY: GEORGE B. WYKANE DATE: 4/1/65

PROJECT NO.
B.1273002

PROJECT NO.	B.1273002
STATE	N.C.
COUNTY	SAMPSON
STATION	173 + 10.48

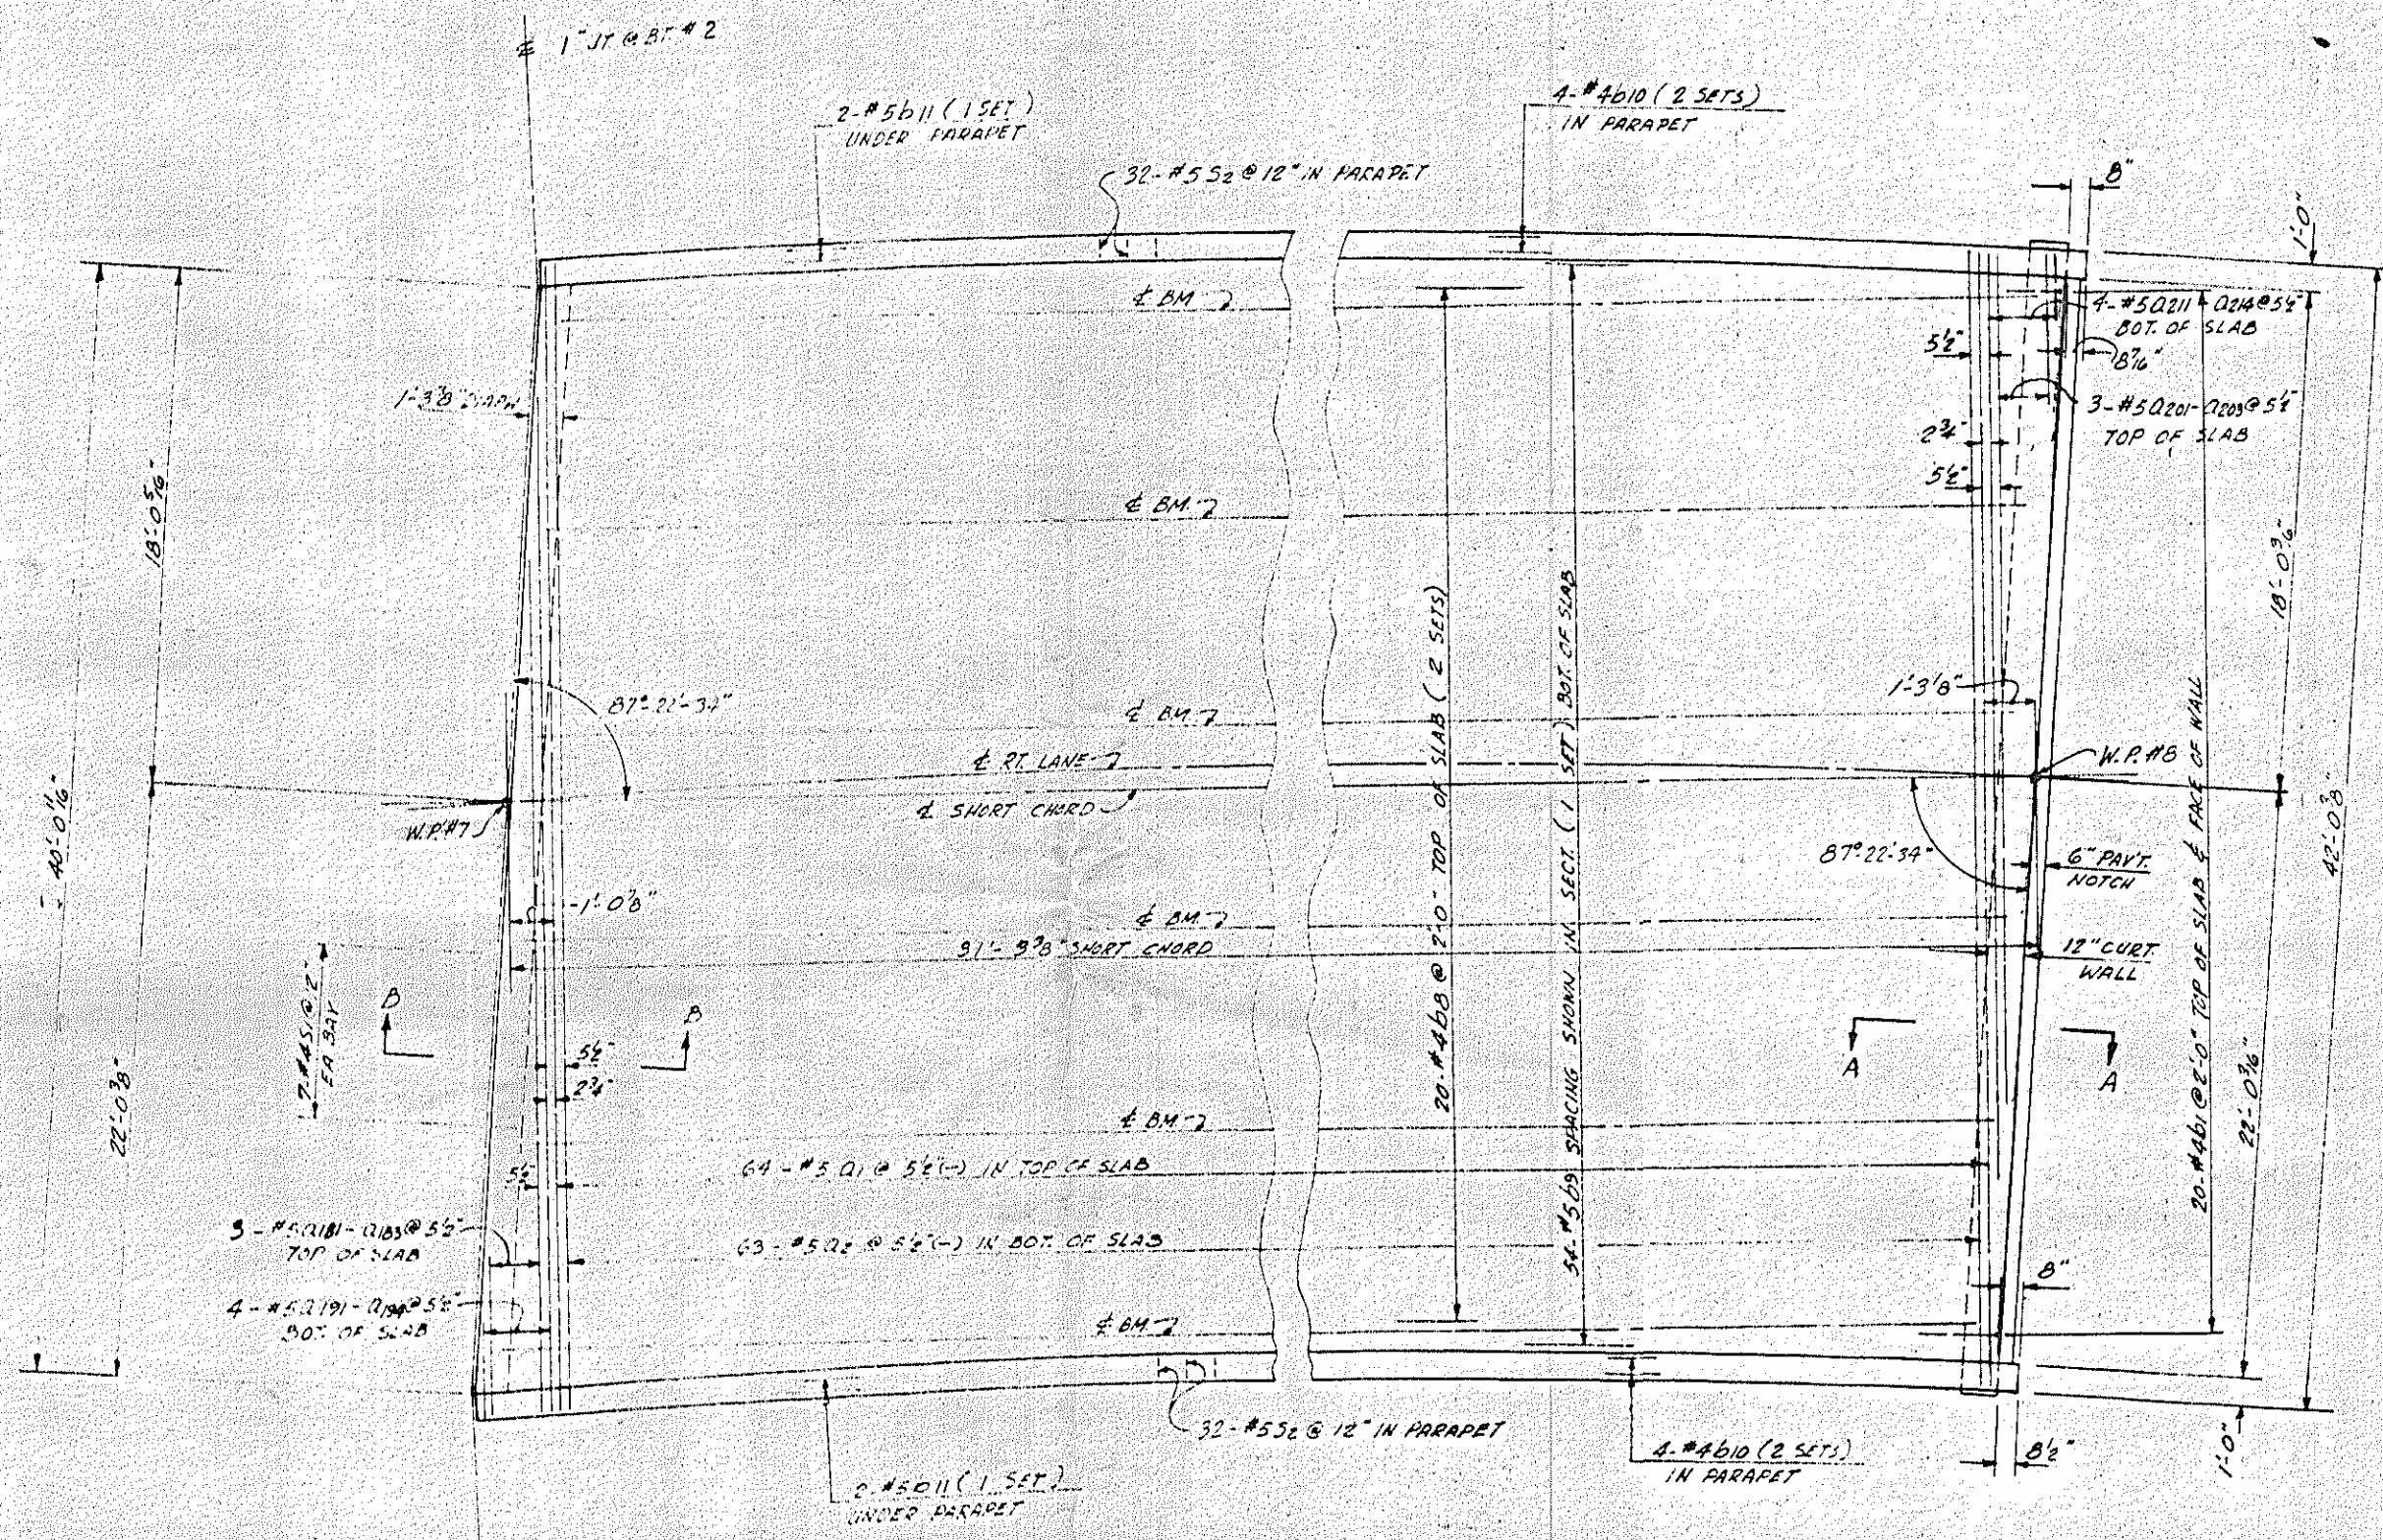

PLAN
SPAN C - RT. LANE
NOTE: POSTS AND RAIL ARE NOT SHOWN.

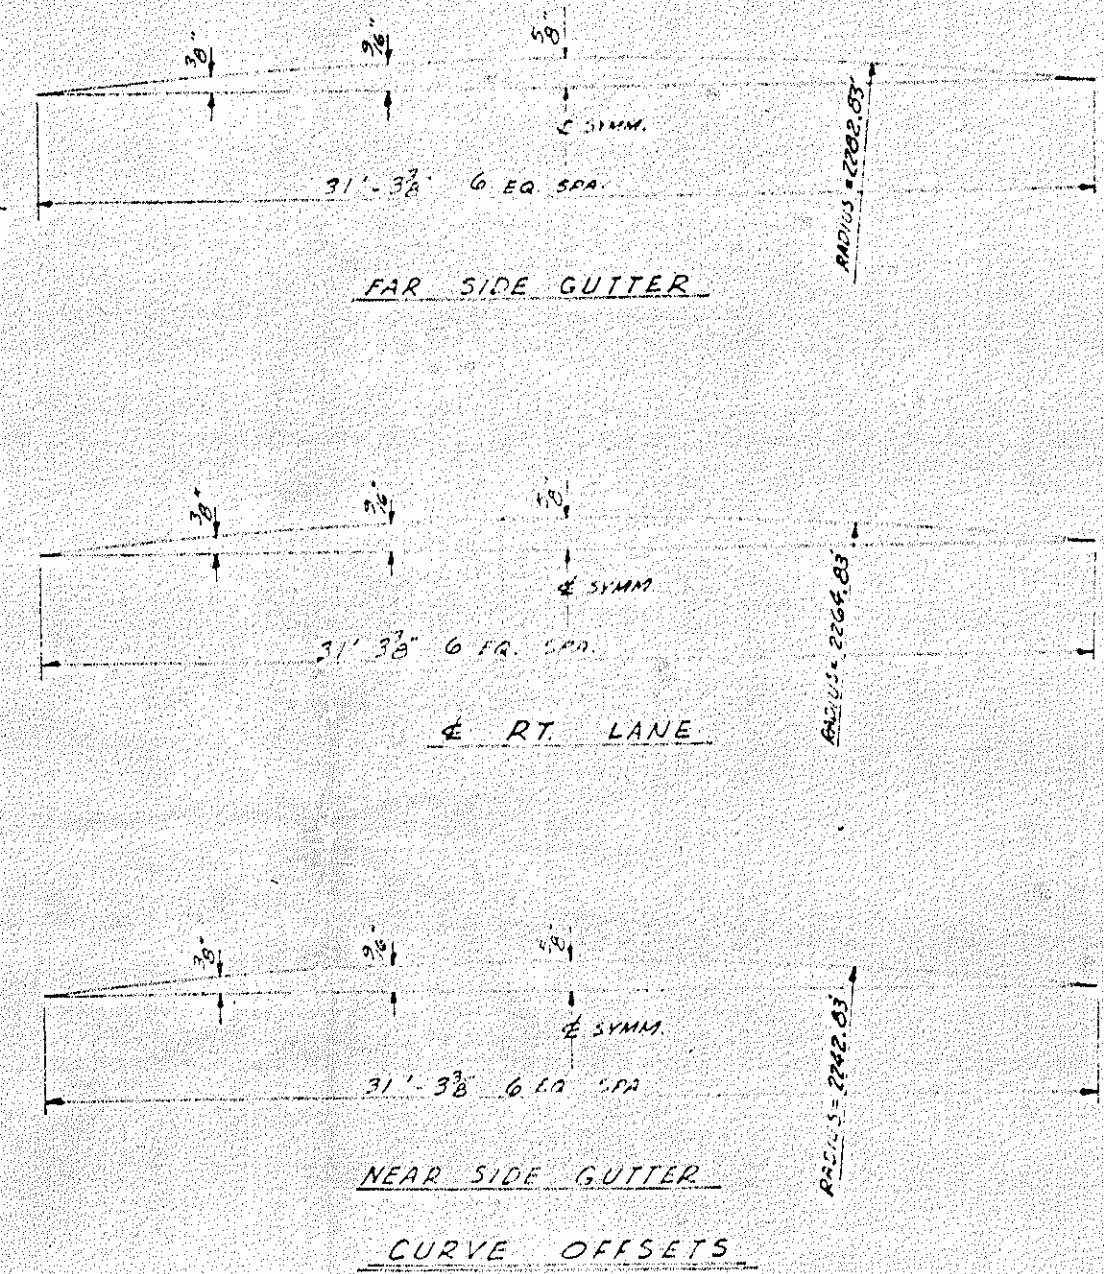

CURVE OFFSETS
NOTE: SHORT CHORD IS MEASURED FROM
BT #2 TO FULL FACE OF E. BT #2.


NOTE: "O" BARS SHALL BE PLACED PERPENDICULAR
TO THE RT. LANE SHORT CHORD & SPACED ALONG
THE SHORT CHORD.

73002
COUNTY
SAMPSON


PROJECT No. B.1273002
SAMPSON COUNTY
STATION 173 + 10.48

STATE OF NORTH CAROLINA			
STATE HIGHWAY COMMISSION			
SUPERSTRUCTURE			
SPAN C			
RIGHT LANE			
APRIL 1965			
NO.	BY	DATE	NO.
1	BY	DATE	NO.
2	BY	DATE	NO.
SHEET NO. 5-110			TOTAL SHEETS 134


DRAWN BY: E. G. ... DATE APR 65
CHECKED BY: GEORGE B. ... DATE MAY 65

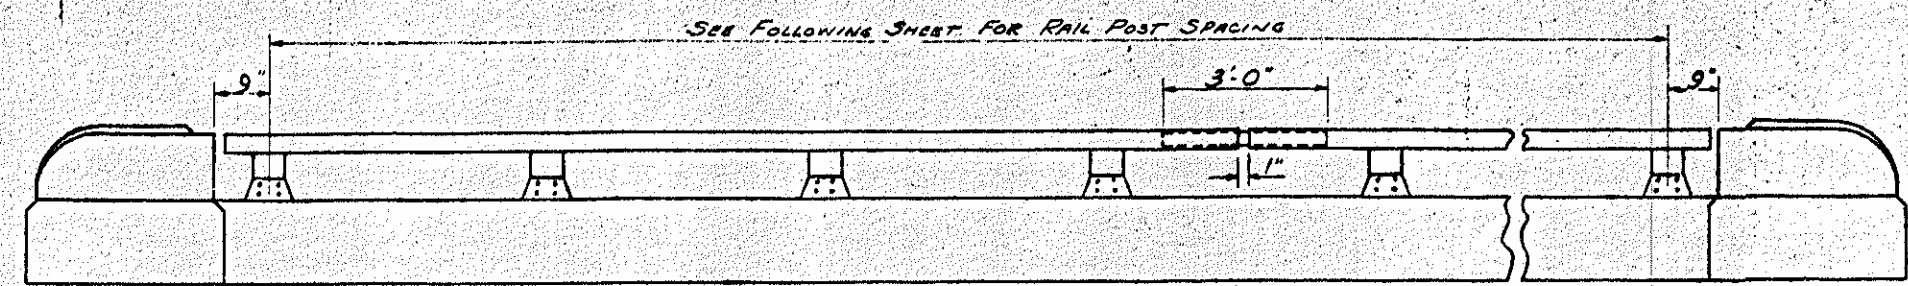


ELEVATION

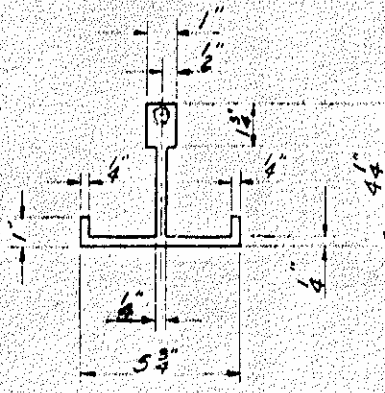


PLAN

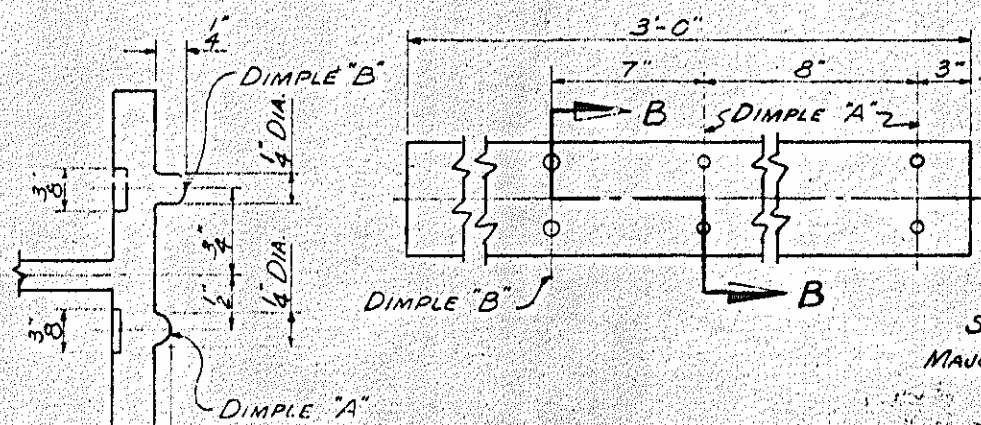

SECTION B-B

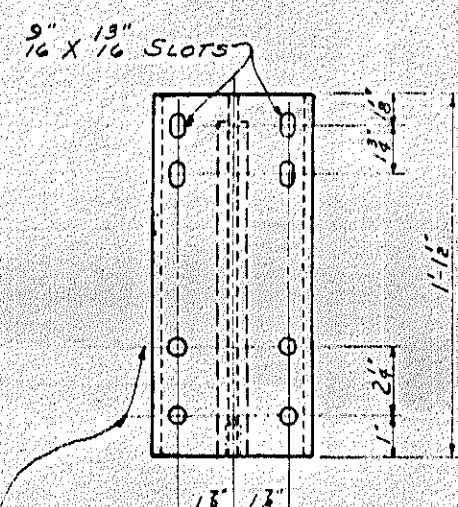


FRONT ELEVATION

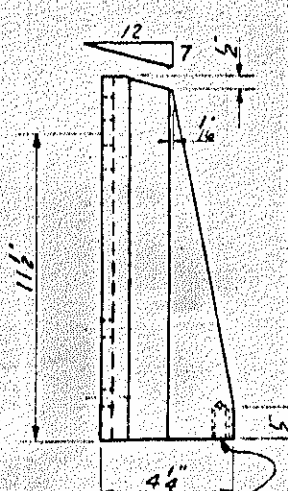


SIDE ELEVATION

DETAILS OF POST

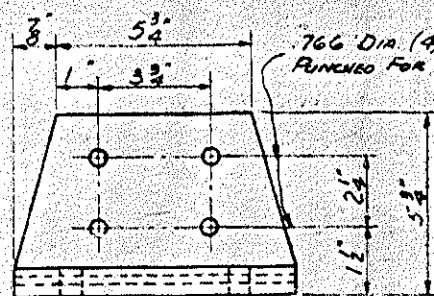


FRONT ELEVATION

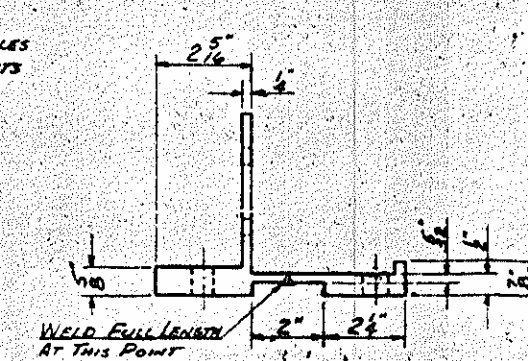


SIDE ELEVATION


POST BASE DETAILS

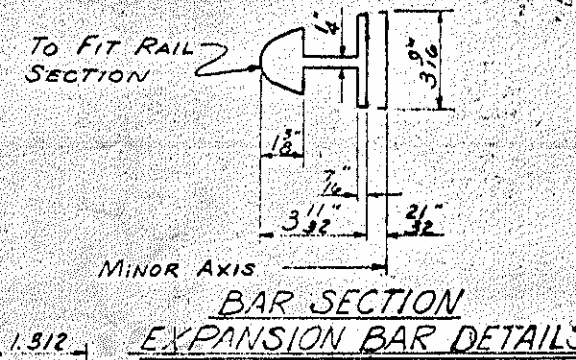

BAR SECTION EXPANSION BAR DETAILS

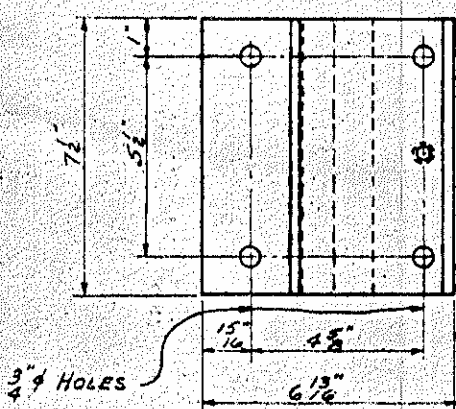


PLAN

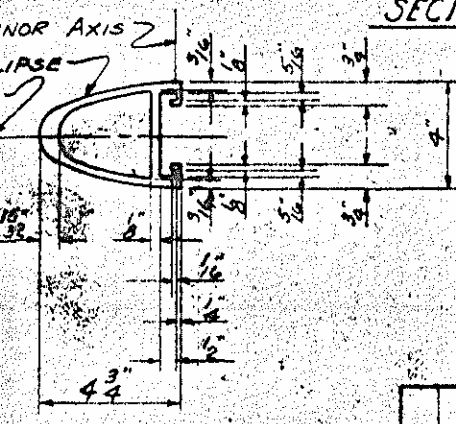


RAIL SECTION


SECTION THRU PARAPET & RAIL

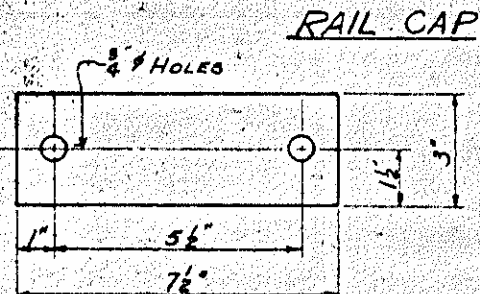


RAIL CAP

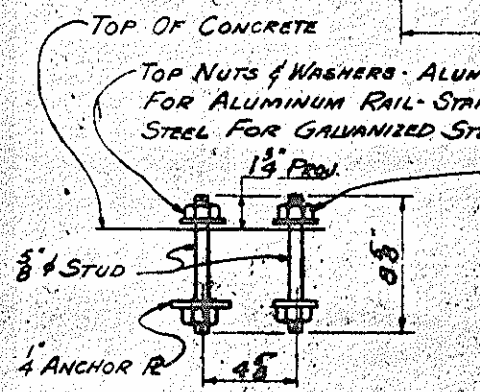


ANCHOR ASSEMBLY

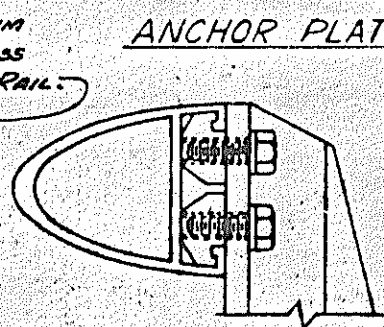

CLAMP & RAIL ASSEMBLY

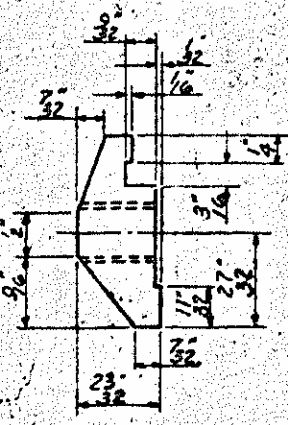

CLAMP BAR DETAIL (2 REQUIRED PER POST)

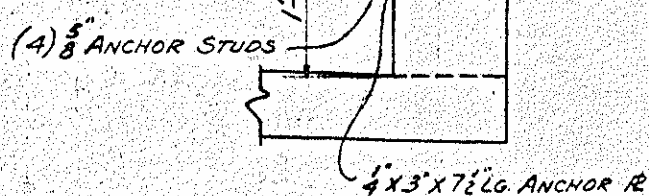

(4) 5/8 ANCHOR STUDS

5/8 X 3 X 7 1/2 LG. ANCHOR R.

AT THE CONTRACTOR'S OPTION METAL RAIL MAY BE EITHER ALUMINUM OR GALVANIZED STEEL IN ACCORDANCE WITH THE REQUIREMENTS OF THE GENERAL NOTES AND THE FOLLOWING SPECIFICATIONS FOR THE ALTERNATE MATERIALS; HOWEVER THE CONTRACTOR WILL BE REQUIRED TO USE THE SAME RAIL MATERIAL ON ALL STRUCTURES ON THE PROJECT FOR WHICH METAL RAIL IS DESIGNATED.

ALUMINUM RAILS

MATERIAL FOR POSTS, BASES & RAILS, EXPANSION BARS, CLAMP BARS & ALUMINUM NUTS SHALL BE A.S.T.M. B 211 ALLOY 6061 OR 6062-T6.
MATERIAL FOR ALUMINUM WASHER SHALL BE A.S.T.M. B 209 ALLOY ALCLAD 2024-T3.
MATERIAL FOR RIVETS SHALL BE A.S.T.M. B 316 ALLOY 6061 OR 6062-T6. RIVETS SHALL BE BUTT HEAD & CONE POINT COLD DRIVEN AS PER DRAWING.

GENERAL NOTES

1. RAILING SHALL BE CONTINUOUS FROM END POST TO END POST OF BRIDGE. EACH JOINT IN RAIL LENGTH SHALL BE SPICED AS DETAILED. PANEL LENGTHS OF RAIL SHALL BE ATTACHED TO A MINIMUM OF FOUR POSTS.
2. END OF RAIL TO CLEAR FACE OF CONCRETE END POST BY 1 1/2".
3. MATERIAL FOR ANCHOR STUDS SHALL BE TYPE 430 STAINLESS STEEL WITH MINIMUM 70,000 P.S.I. ULTIMATE STRENGTH. THREADS TO BE ROLLED & NOT CUT. STUDS TO BE EMBEDDED 7" IN CONCRETE. NUTS SHALL BE AMERICAN STANDARD FINISHED HEXAGON THICK NUTS, CLASS 2B THREAD. ANCHOR PLATES SHALL BE A.S.T.M. A7 OR A36. MACHINE SCREWS FOR RAIL ATTACHMENT SHALL BE STAINLESS STEEL.
4. CERTIFIED MILL REPORTS ARE REQUIRED FOR RAILS & POSTS. SHOP INSPECTION IS NOT REQUIRED.
5. METAL RAIL POSTS TO BE SET NORMAL TO CURB GRADE.
6. METHOD OF MEASUREMENT FOR METAL RAILS: UNLESS OTHERWISE SPECIFIED THE LENGTH OF METAL RAILS TO BE PAID FOR, SHALL BE THE CONTINUOUS HORIZONTAL LENGTH MEASURED FROM INSIDE TO INSIDE OF CONCRETE POSTS ALONG OUTSIDE OF PARAPET.

GALVANIZED STEEL RAILS

MATERIALS AND GALVANIZING ARE TO CONFORM TO THE FOLLOWING SPECIFICATIONS:
RAIL POST & POST BASE: A.S.T.M. A36 GRADE STRUCTURAL STEEL GALVANIZED TO A.S.T.M. A123.
RAIL & EXPANSION BAR: A.S.T.M. A36 GRADE STRUCTURAL STEEL GALVANIZED TO A.S.T.M. A123.
CLOSURE PLATES & SHIMS: STEEL A36 GRADE-C GALVANIZED TO A.S.T.M. A123.
NUTS & WASHERS FOR TOP END OF ANCHOR ASSEMBLY FOR STEEL RAIL SHALL BE TYPE 430 STAINLESS STEEL.

THE CUT ENDS OF GALVANIZED STEEL RAILING, AFTER GRINDING SMOOTH, SHALL BE GIVEN TWO COATS OF ZINC PRIMER MEETING THE REQUIREMENTS OF FEDERAL SPECIFICATION MIL-P-26515 USAF TYPE 1.

PAY LENGTH: 249.94' RT. LANE
PAY LENGTH: 252.92' LT. LANE

PROJECT NO. 8.1273002

SAMPSON COUNTY

STATION: 173 + 10.48

RT. OR LT. LANE


STATE OF NORTH CAROLINA	
STATE HIGHWAY COMMISSION	
STANDARD	
1 BAR	
METAL RAIL	
JULY	1964
	5-118
	134

DRAWN BY: F. G. ALPHEO, JR. DATE: APR. 65
CHECKED BY: GEORGE E. HYMAN DATE: MAY 65

STANDARD R.D.U. 7-23-64 V-26-R.H.

KODAK SAFETY FILM

FED. ROAD DIV. NO.	STATE	PROJECT NO.
3	N. C.	8.1273002
F. A. PROJECT	S. 60-1400 (2)	
SHEET 121 of 185		

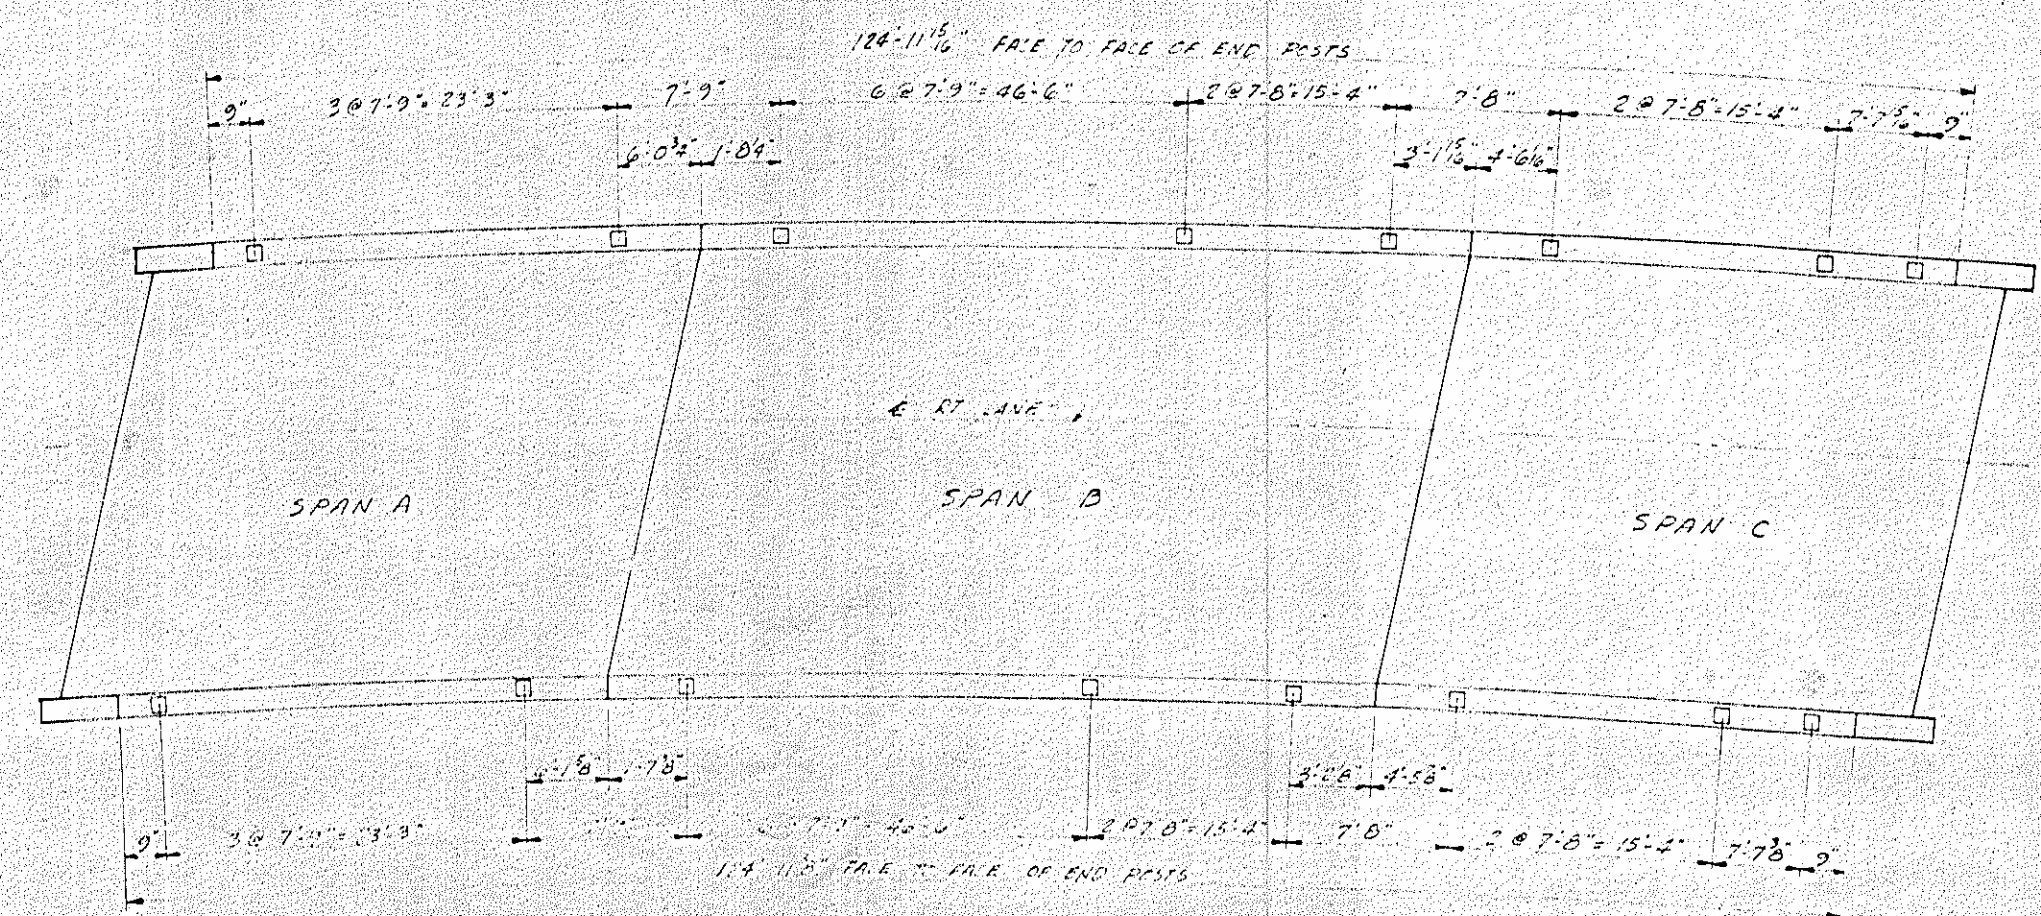

PLAN SHOWING RAIL POST SPACING
 NOTE: DIMENSIONS SHOWN ARE HORIZONTAL ARC LENGTHS
 MEASURED ALONG OUTSIDE OF PARAPET.




PROJECT No. 8.1273002
 SAMPSON COUNTY
 STATION: 173 + 10.48

STATE OF NORTH CAROLINA	
STATE HIGHWAY COMMISSION	
RAIL POST SPACING	
RT LANE	
APRIL 1965	
NO.	BY
1	DATE
2	DATE
3	DATE
REVISIONS	
SHEET NO. 5-199	
TOTAL SHEETS 134	

DRAWN BY: E. B. BILCO, JR. DATE: 4-22-65
 CHECKED BY: W. C. K. D. Y. DATE: 4-22-65

T NO.
002

FED. ROAD DIST. NO.	STATE	PROJECT NO.
3	N. C.	B1973002
I. A. PROJECT 9-50-1600(2)		
SHEET 123 OF 185		

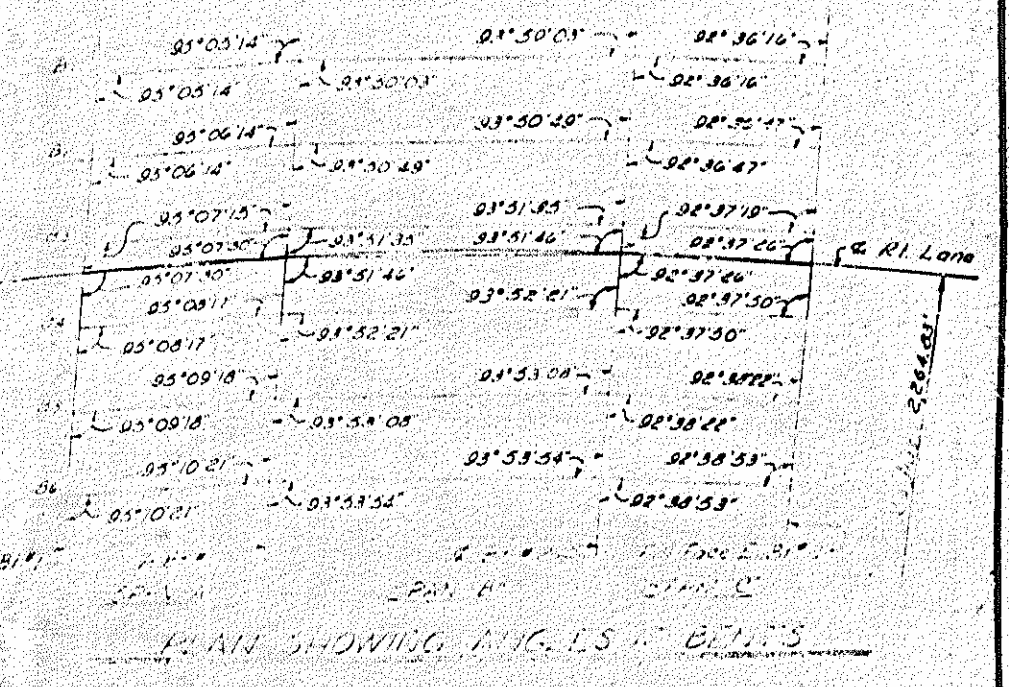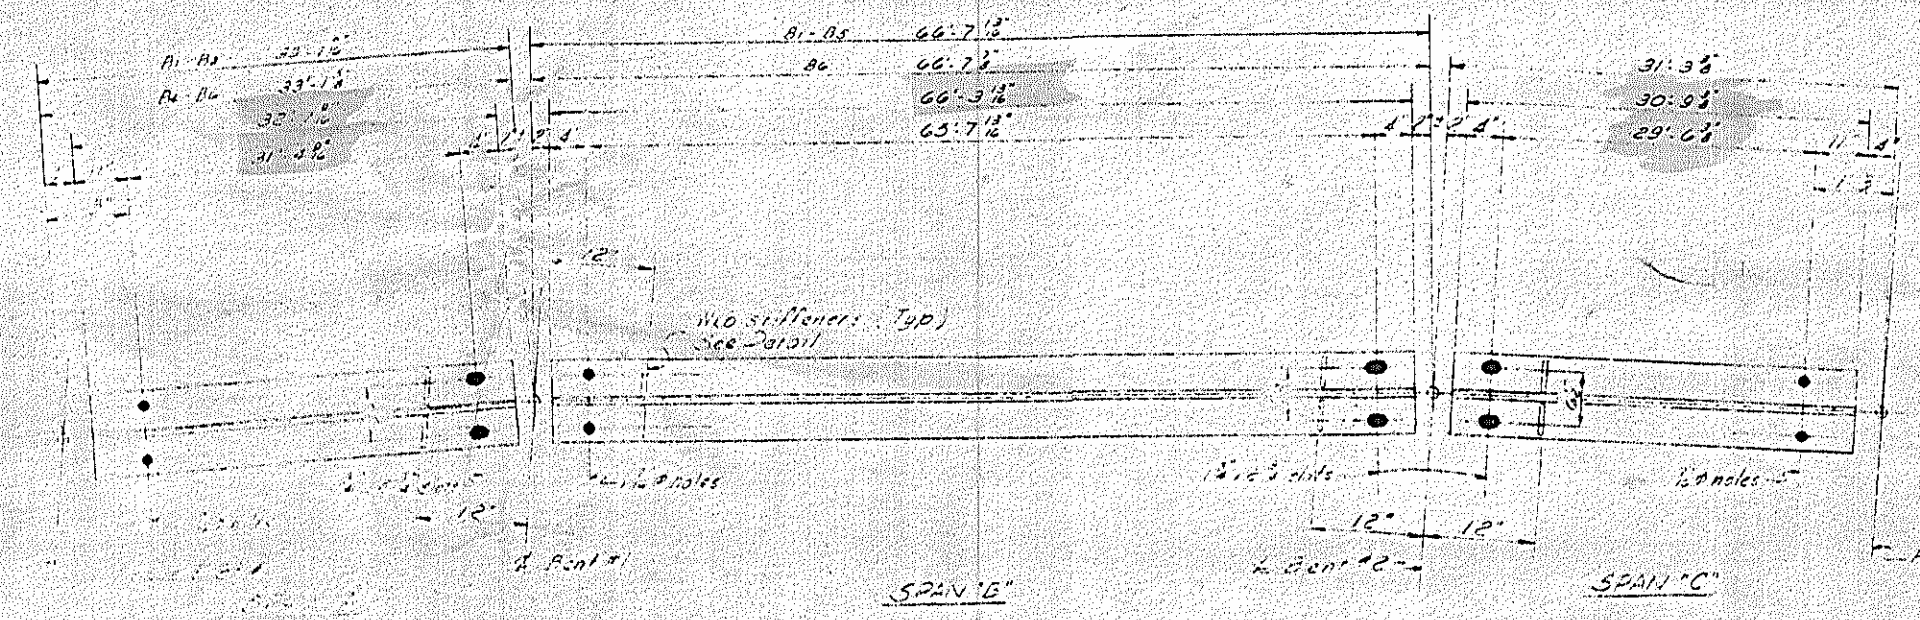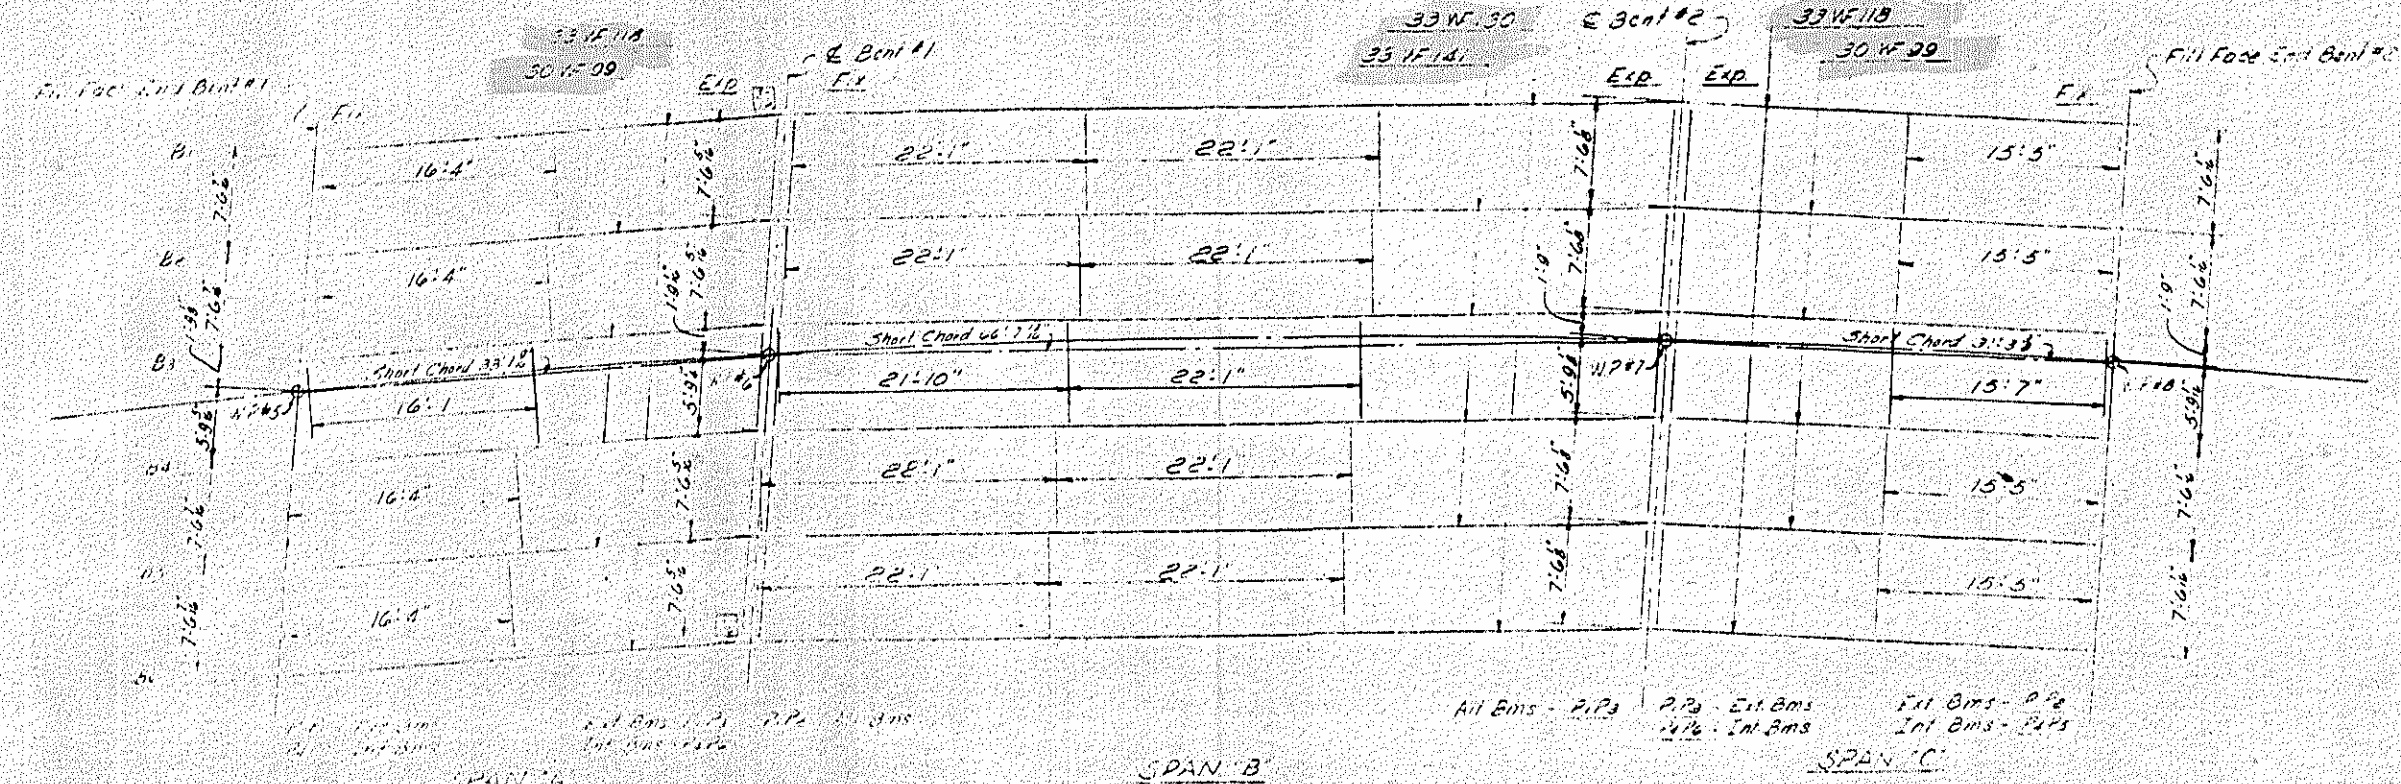

NOTE
In lieu of the welding procedure for shop and field welds indicated for the interior diaphragm connections, the contractor may elect to shop weld the connector plates to the beam webs and field weld the channels to the connector plates. Special care in handling the beams must be observed if connector plates are shop welded to the beam webs.

PROJECT NO. B 1973002
COUNTY
STATION: 173+648-POCL

STATE OF NORTH CAROLINA
STATE HIGHWAY COMMISSION

SUPERSTRUCTURE
STRUCTURAL STEEL
RIGHT LANE


1965

REVISIONS				DATE	
NO.	BY	DATE	NO.	BY	DATE
1			1		5-12-65
2			2		

ATTACHED
NO. 33
OF 85

DATE 04 01 65


Beams B1-C3a
115 rows - 4" x 8" studs each row - 400 studs each beam
Beams B1-B4
115 rows - 4" x 8" studs each row - 400 studs each beam
Beams B1-E4
115 rows - 4" x 8" studs each row - 400 studs each beam

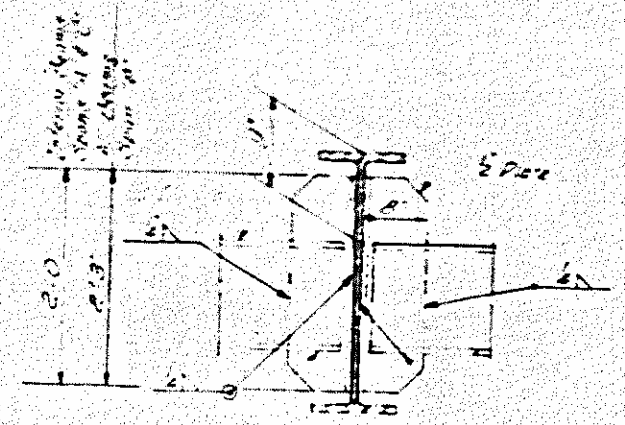

INTERIOR DIAPHRAGM CONNECTION


COVER PLATE WELD DETAIL
COVER PLATE WELD DETAIL

COVER PLATE WELD DETAIL

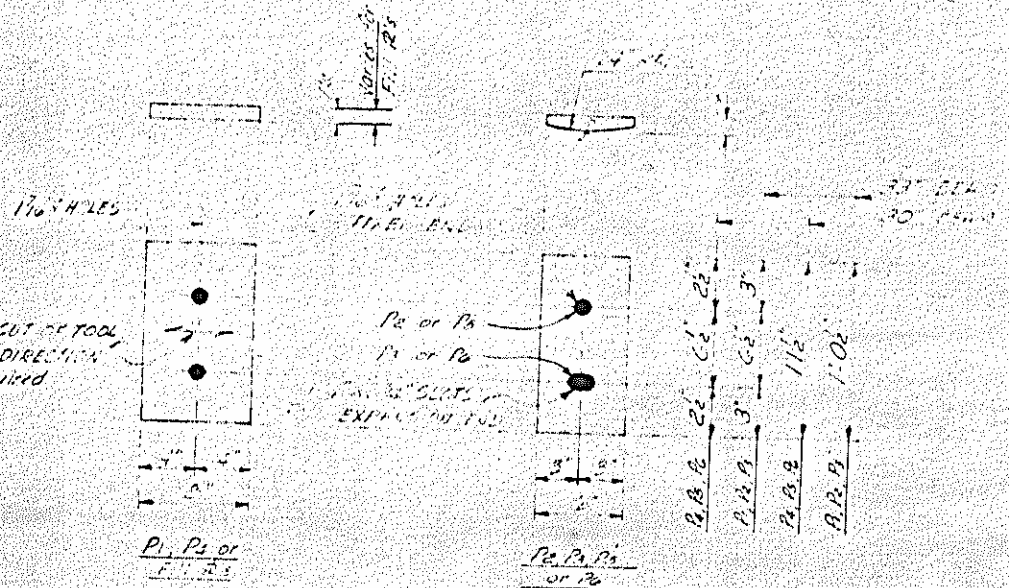


BEARING PLATE DETAILS

STUD DETAILS

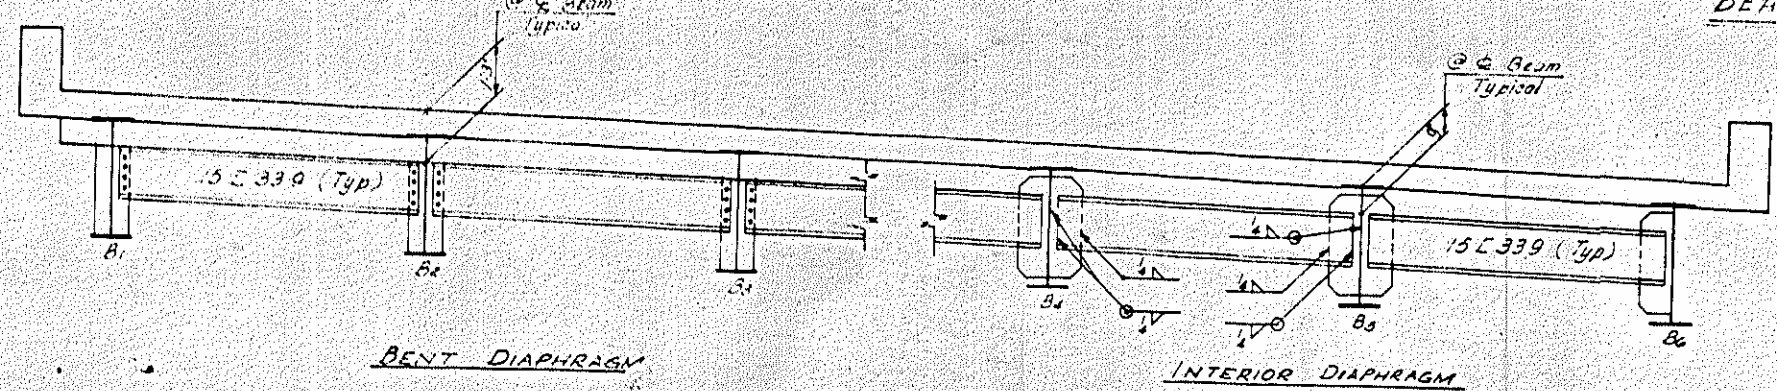

BENT DIAPHRAGM
INTERIOR DIAPHRAGM

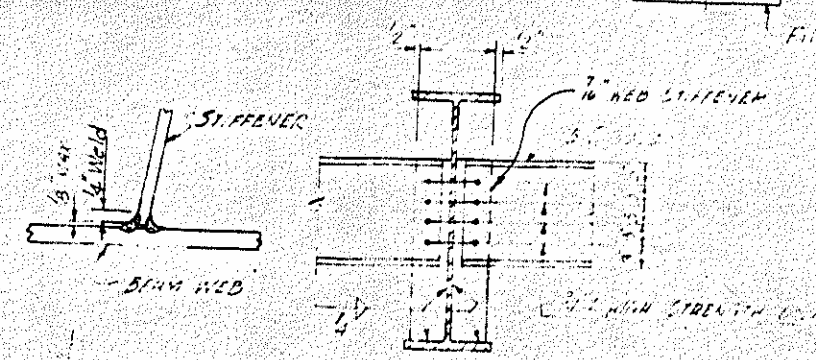

DIAPHRAGM CONNECTION AT BENT AND DETAIL WEB STIFFENER

DETAIL AT BEARINGS

PROJECT No. 81273002
SAMPSON COUNTY
STATION: 173+10.48 - POC - L
LEFT & RIGHT LANE

STATE OF NORTH CAROLINA
STATE HIGHWAY COMMISSION
STRUCTURAL STEEL

BEARING PLATES REQUIRED
20-P1 - 8" x 14" x 1/2" Plate Finish to 1/4"
10-P2 - 6" x 14" x 1/2" As detailed
10-B3 - 6" x 14" x 1/2" As detailed
16-P4 - 8" x 14" x 1/2" Plate Finish to 1/4"
8-P5 - 6" x 14" x 1/2" As detailed
8-P6 - 6" x 14" x 1/2" As detailed
FILL PLATES REQUIRED
2 - 8" x 2" x 1/2"

NOTE: One set of above R's required for each lane.

STRUCTURAL STEEL APPROXIMATE WEIGHT = 121,300 LBS. LT. LANE
DEAD LOAD DEFLECTIONS AND BEAM CAMBER

SPAN	DEFLECTION	DEFLECTION DUE TO WEIGHT OF BEAM		DEFLECTION DUE TO SUPERIMPOSED LOAD		Total dead load deflection	Vertical Curve ordinate	Super elevation	Camber
		LT	RT	LT	RT				
SPAN "A"	EXTERIOR OMS	0"	0"	1/16"	1/16"	1/8"	1/16"	1/16"	0"
	INTERIOR OMS	0"	0"	1/16"	1/16"	1/8"	1/16"	1/16"	0"
SPAN "B"	EXTERIOR OMS	0"	0"	1/16"	1/16"	1/8"	1/16"	1/16"	0"
	INTERIOR OMS	0"	0"	1/16"	1/16"	1/8"	1/16"	1/16"	0"
SPAN "C" LT. LANE	EXTERIOR OMS	0"	0"	1/16"	1/16"	1/8"	1/16"	1/16"	0"
	INTERIOR OMS	0"	0"	1/16"	1/16"	1/8"	1/16"	1/16"	0"
SPAN "C" RT. LANE	EXTERIOR OMS	0"	0"	1/16"	1/16"	1/8"	1/16"	1/16"	0"
	INTERIOR OMS	0"	0"	1/16"	1/16"	1/8"	1/16"	1/16"	0"

DESIGNED BY S. L. SANTO-TOMAS DATE APRIL 1965
DRAWN BY S. L. SANTO-TOMAS DATE APRIL 1965
CHECKED BY GEORGE B. WYNNIE DATE MAY 1965



STATE OF NORTH CAROLINA
STATE HIGHWAY COMMISSION
DATE APRIL 1965
DATE MAY 1965

MAUNCH 1965



REVISIONS		DATE	
NO.	BY	DATE	NO.
1			
2			

DATE 04 01 65



PROJECT NO. 1273002
 SHEET 128 OF 125
 WEIGHT
 1015
 819
 88
 54
 28
 70
 116
 382
 47
 1.46
 736
 154
 620
 696
 0.02
 965
 5-126
 734

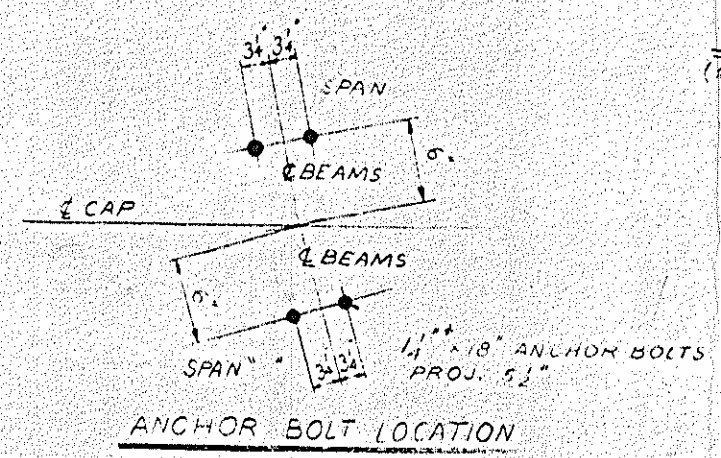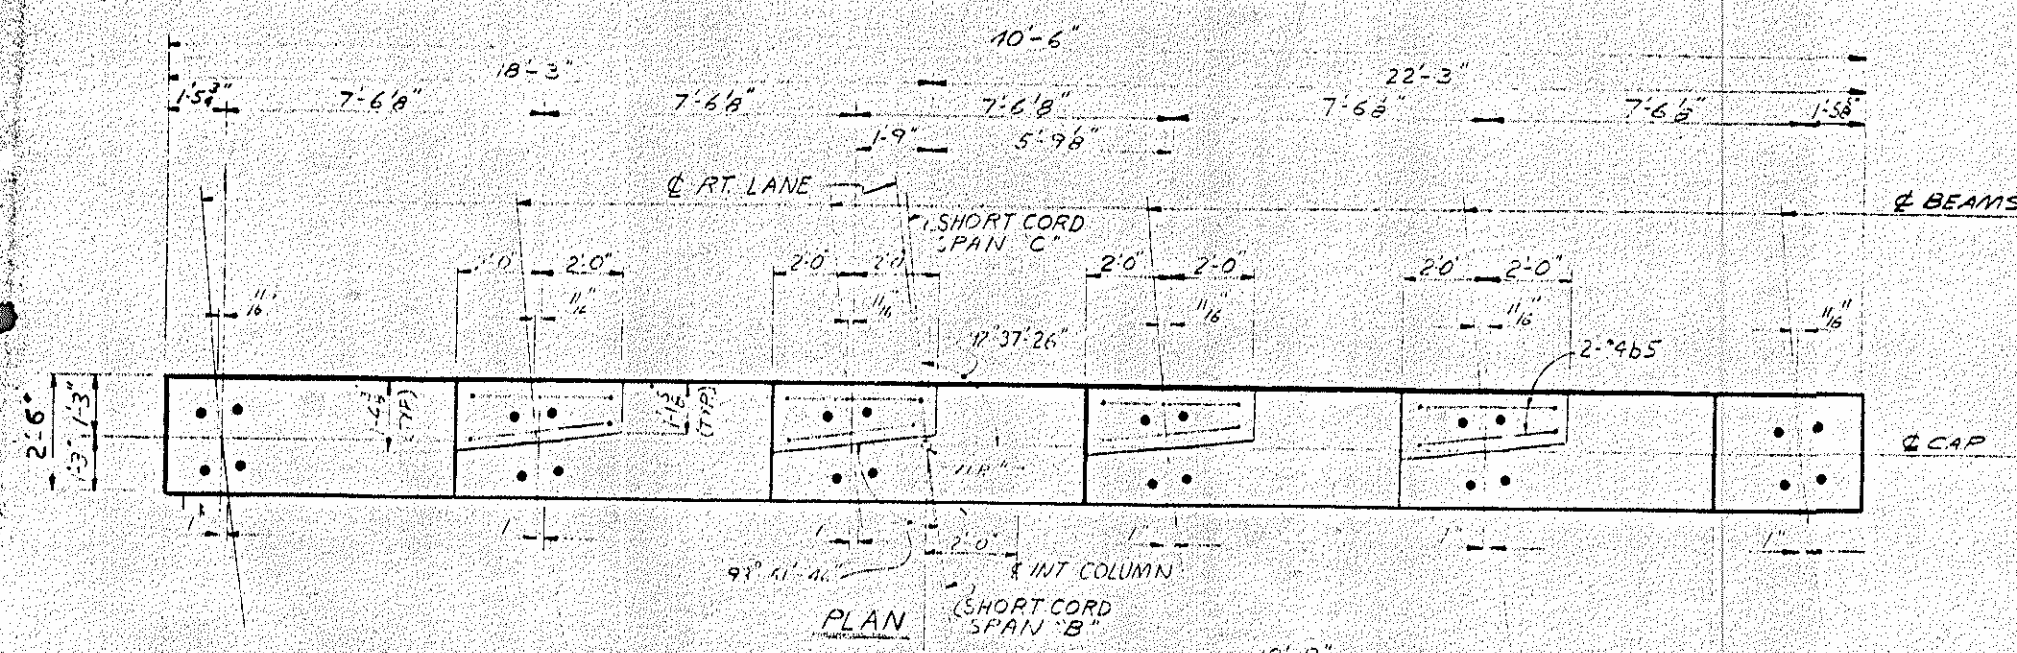


BAR TYPES
 ALL DIMENSIONS ARE OUT TO OUT

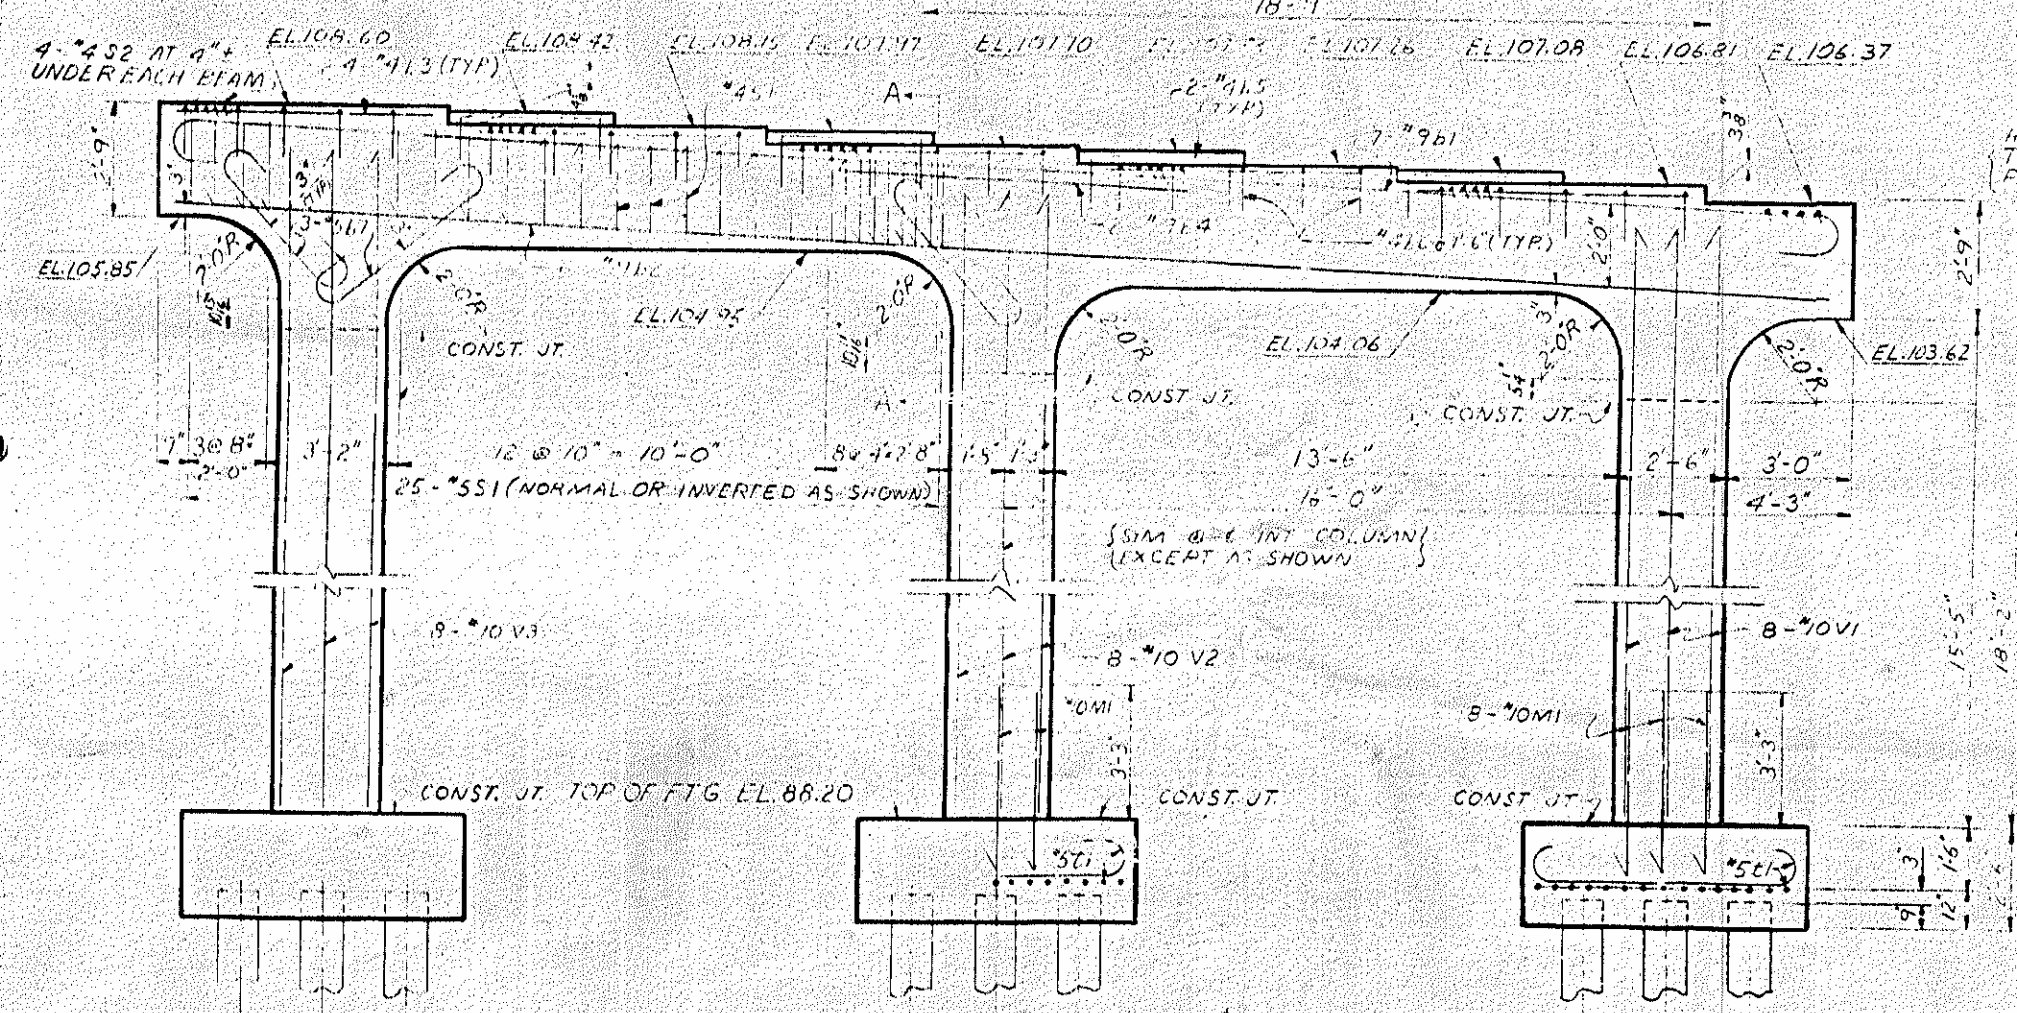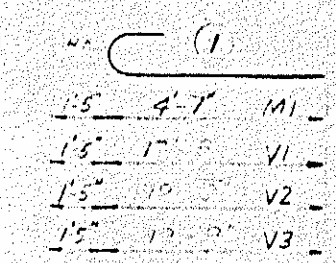

HOOKS OF V1, V2, V3 BARS MAY BE TURNED AS NECESSARY FOR PLACING OF REINFORCING

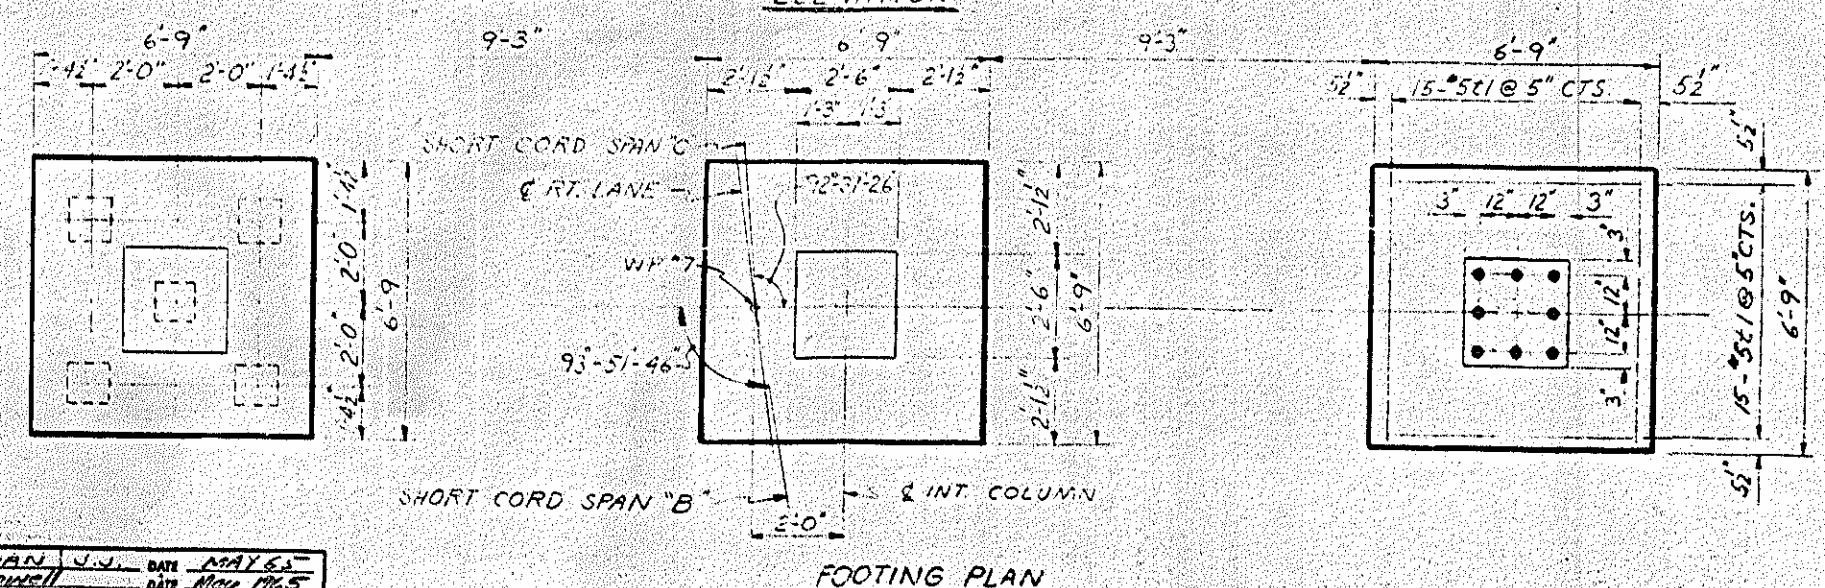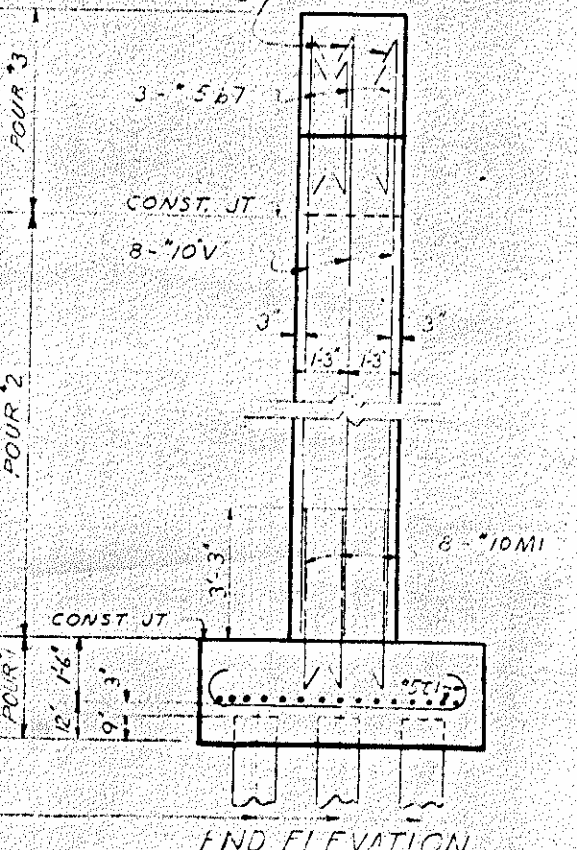

VARIES, SEE EL.

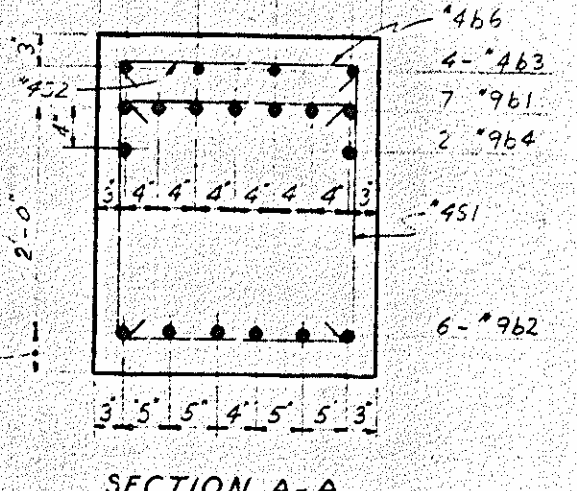

PROJECT NO. 1273002
 SHEET 128 OF 125

BILL OF MATERIAL
 ONE BENT ONLY

BAR NO.	NO.	SIZE	TYPE	LENGTH	WEIGHT
41	1	#9		2'-8"	1.25
42	6	#7	STR.	40'-2"	51.9
43	10	#4	STR.	6'-2"	28
44	2	#9	STR.	8'-0"	54
45	8	#4	S	5'-2"	18
46	25	#4	S	4'-2"	70
47	18	#5	S	5'-2"	116
51	2	#7		7'-1"	29.2
52	24	#8	S	2'-11"	27
V1	8	#10	I	17'-1"	660
V2	8	#10	I	20'-5"	77.3
V3	8	#10	I	2'-1"	77.3
M1	4	#10	I	6'-0"	620
E1	70	#5	S	7'-5"	696

REINFORCING STEEL LBS. 3027

CLASS A CONC. CU. YDS.	FOUR #1	FOUR #2	FOUR #3	TOTAL
	12.2	10.1	13.4	36.3

NO. 15 LIN. FT. 225
 387.1"

NOTE: CONCRETE DISPLACED BY 1/2" DIA. PILE HEADS HAS BEEN DEDUCTED.
 PROJECT NO. 8 1273002
 SAMPSON COUNTY
 STATION: 173+10.48 L.R.V.

STATE OF NORTH CAROLINA
 STATE HIGHWAY COMMISSION
 ALBANY
 BENT #2
 RIGHT LANE
 MAY 1965

NO.	BY	DATE	NO.	BY	DATE
1			1		5-126
2			2		196

FED. ROAD DIST. NO. 3
 STATE 1 N.C.
 PROJECT NO. 8-12730(2)
 S.A. PROJECT 5-51-100B(2)
 SHEET 129 OF 185

BILL OF MATERIAL
ONE BENT ONLY

BAR NO.	NO.	SIZE	TYPE	LENGTH	WEIGHT
11	8	#10	6	50'-6"	1738
12	4	#6	6	3'-3"	71
13	10	#4	STR	2'-2"	14
14	8	#2	STR	24'-6"	130
15	2	#8	STR	47'-8"	255
16	3	#6	3	11'-7"	50
17	7	#4	7	7'-3"	179
18	3	#4	5	2'-11"	72
19	4	#4	4	3'-7"	81
20	14	#4	STR	5'-9"	58
21	15	#4	STR	6'-4"	64
22	7	#4	1	5'-3"	25
23	7	#4	1	6'-7"	31
24	7	#4	2	6'-5"	30
25	7	#4	7	7'-9"	36
26	4	#4	STR	10'-0"	27
27	12	#4	STR	8'-9"	70
28	4	#4	STR	7'-0"	19

REINFORCING STEEL - A501-2950
 CLASS A CONC CU YDS = 15.7
 PILES
 10'-9" LIN FT = 370
 360'-0"





* CONC REPLACED BY SQUARE DILE HEADS
 HAS BEEN DEDUCTED
PROJECT NO. 8-12730(2)
CAMPSON COUNTY
STATION: 173+10.48

STATE OF NORTH CAROLINA
STATE HIGHWAY COMMISSION
END BENT NO2
RIGHT LANE

REVISIONS

NO.	BY	DATE	NO.	BY	DATE
1			1		
2			2		
3			3		

SHEET NO. 127
 TOTAL SHEETS 134

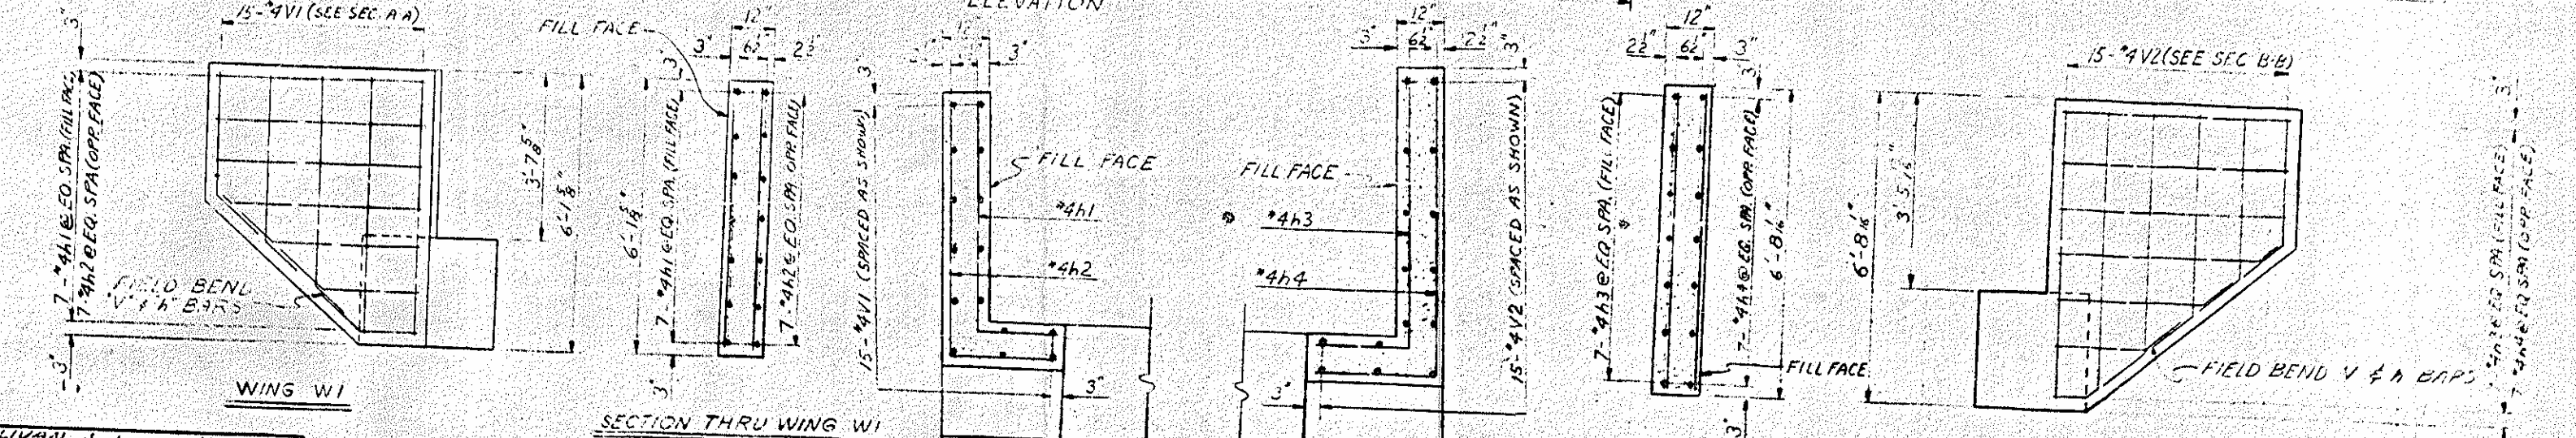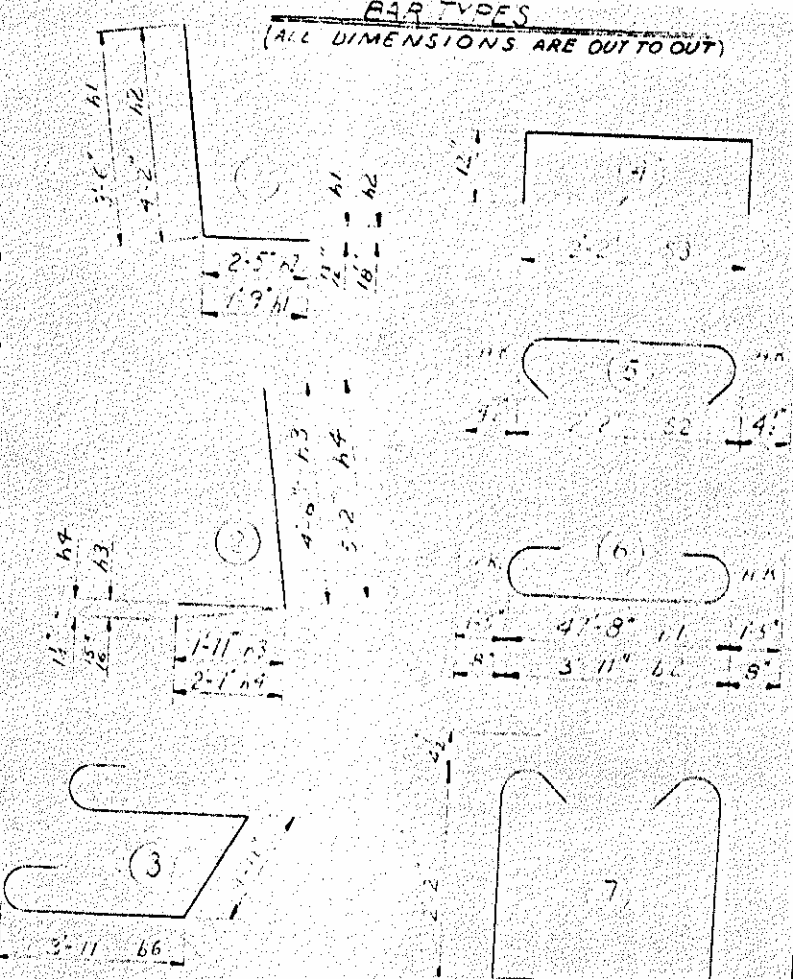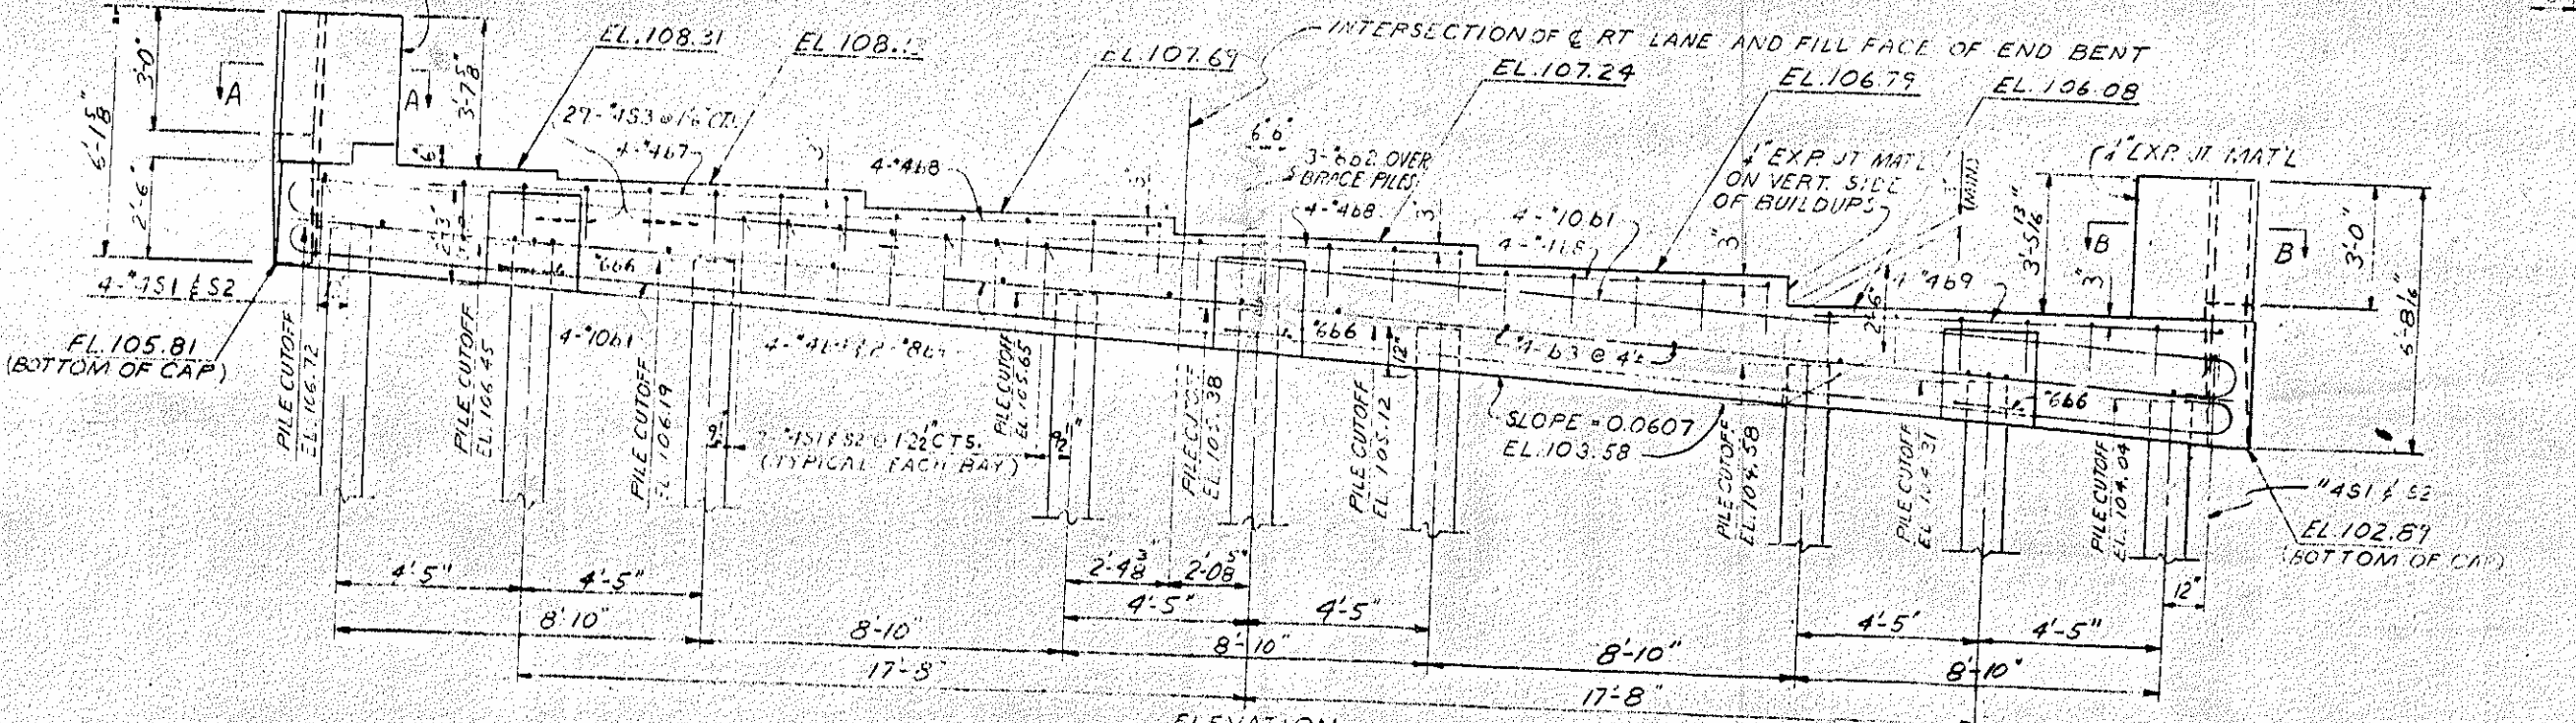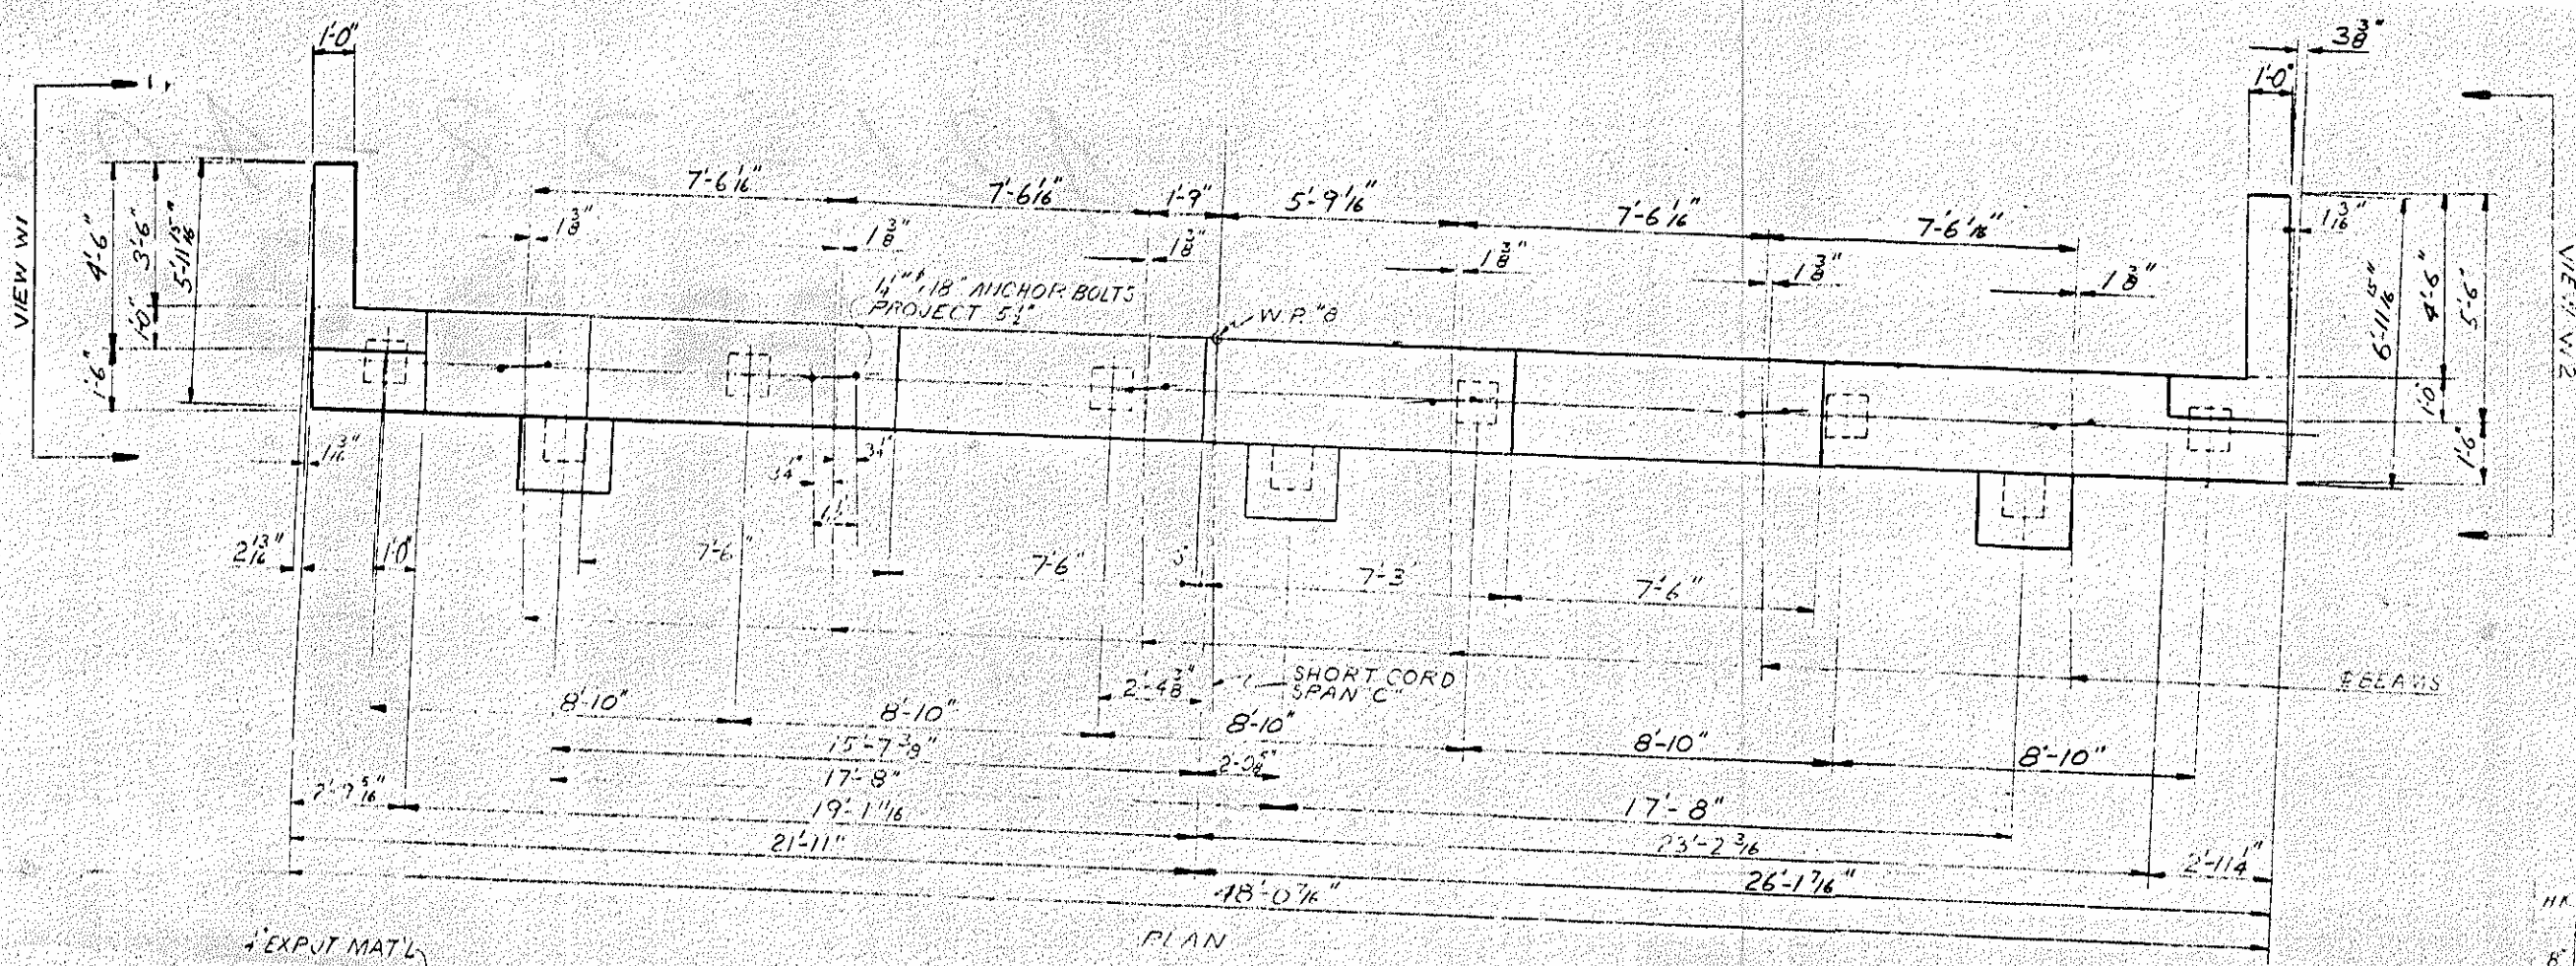

DESIGNED BY SULLIVAN J.V. DATE MAY 63
 CHECKED BY GEORGE R. LITTLE DATE JUNE 63
 L.H. McPHERSON