



LENGTH FOR ALUMINUM BOX CULVERT

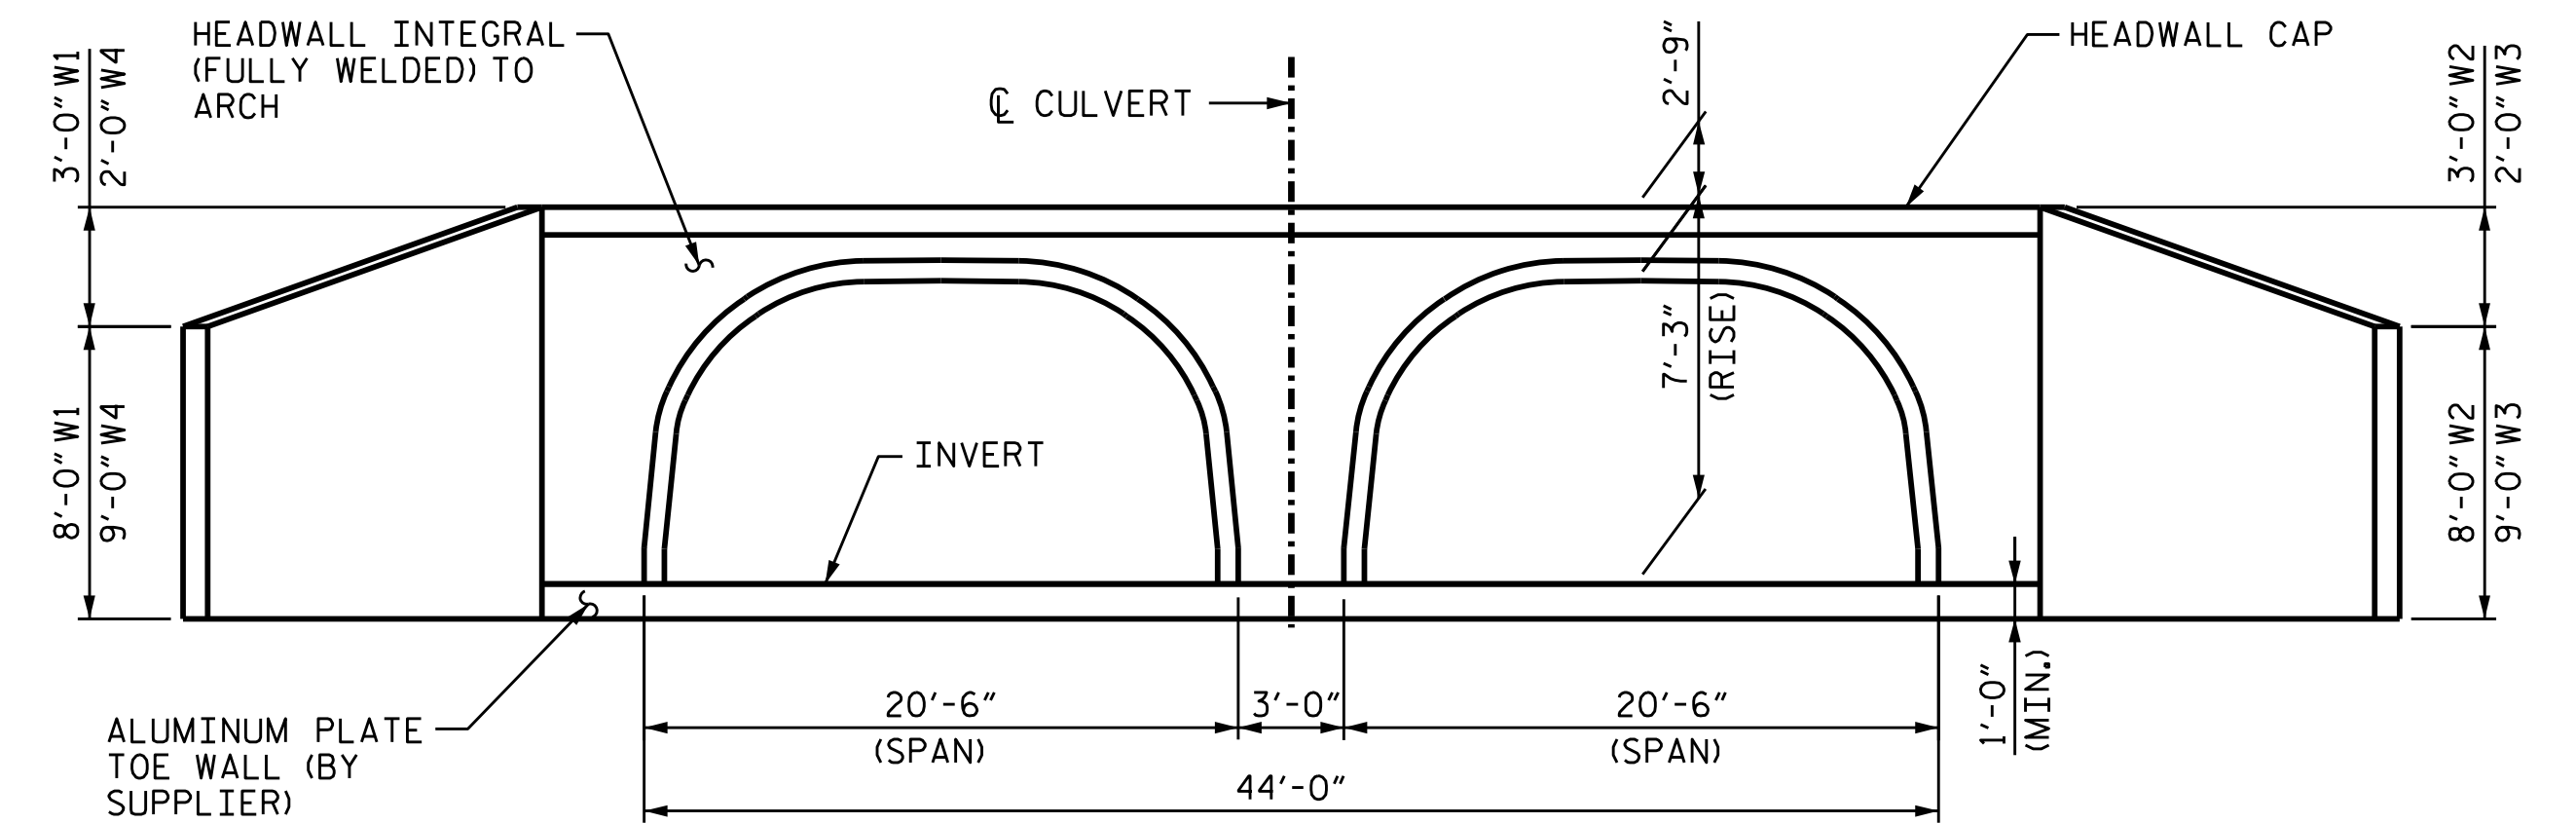

END ELEVATION
INLET SHOWN, OUTLET SIMILAR

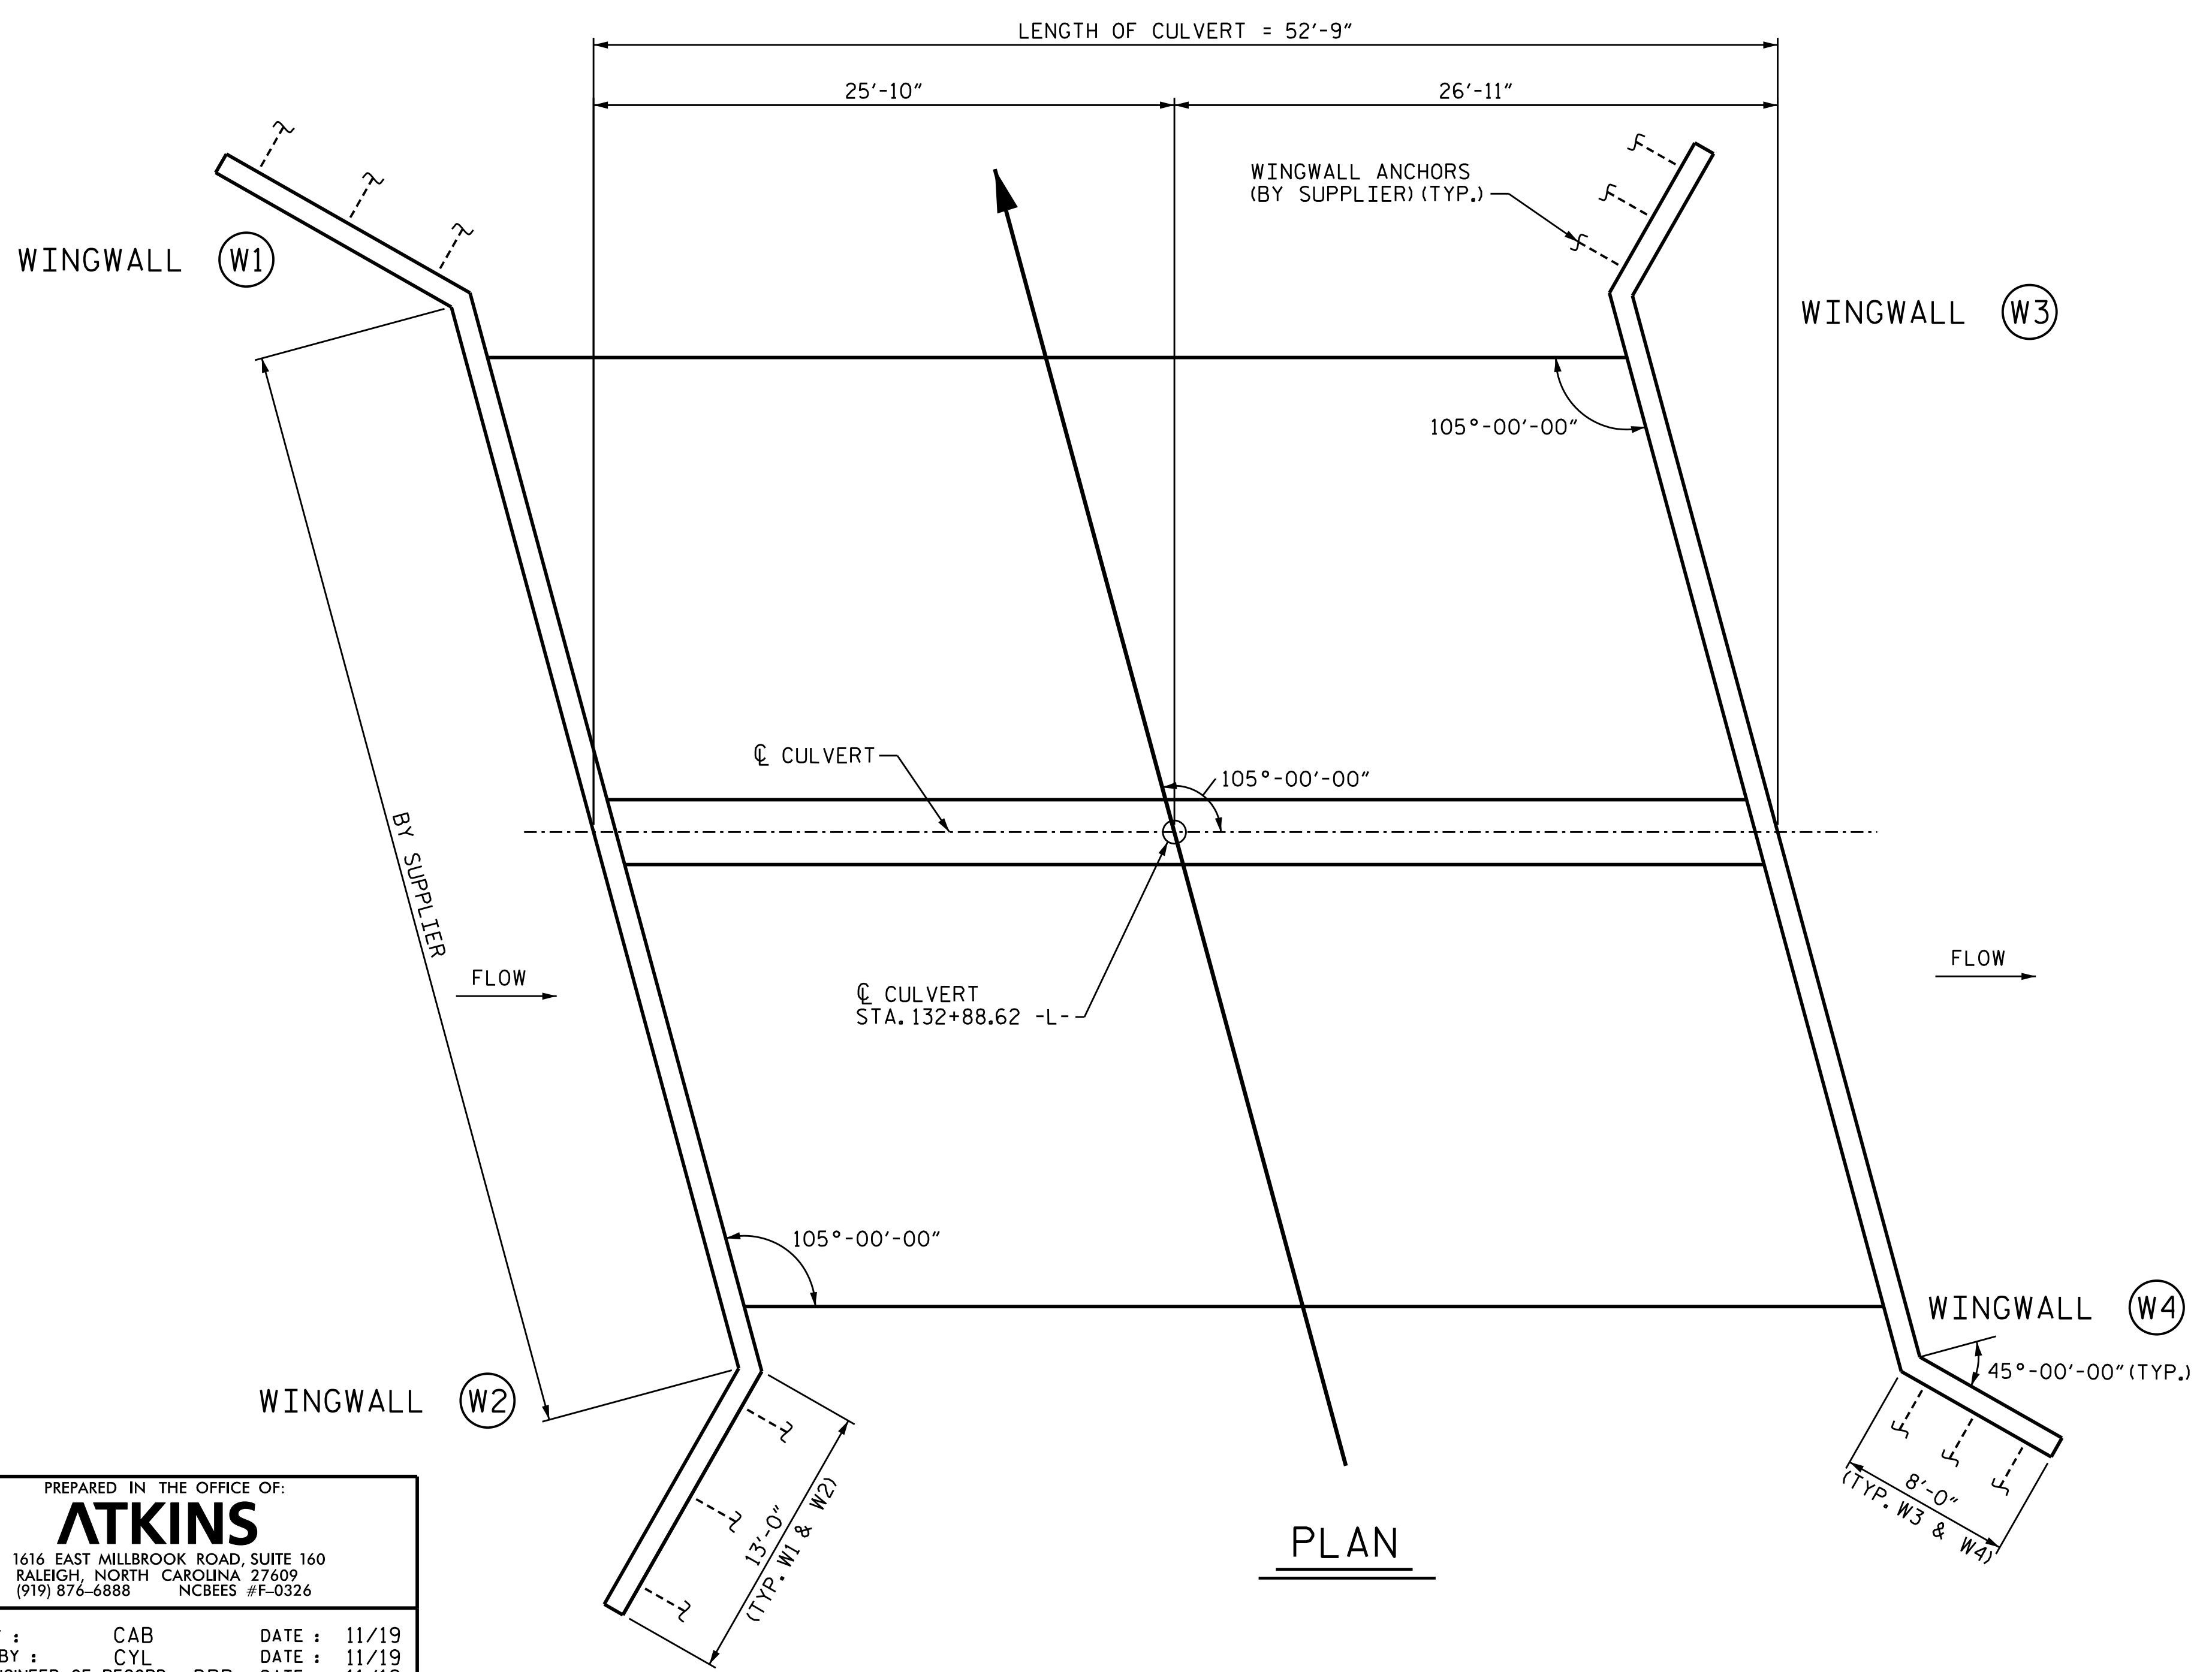

PLAN

I HEREBY CERTIFY THESE PLANS ARE THE AS-BUILT PLANS

PROJECT NO. R-5740
PERQUIMANS COUNTY
 STATION: 132+88.62 -L-

SHEET 2 OF 3

STATE OF NORTH CAROLINA
 DEPARTMENT OF TRANSPORTATION
 RALEIGH
 DANIEL R. BURGUNDY
 11/17/2020

DOUBLE
 20'-6" x 7'-3"
 ALUMINUM BOX CULVERT
 105° SKEW

PREPARED IN THE OFFICE OF:
ATKINS
 1616 EAST MILLBROOK ROAD, SUITE 160
 RALEIGH, NORTH CAROLINA 27609
 (919) 876-6888 NCBES #F-0326

DRAWN BY : CAB DATE : 11/19
 CHECKED BY : CYL DATE : 11/19
 DESIGN ENGINEER OF RECORD : DRB DATE : 11/19

REVISIONS						SHEET NO.
NO.	BY:	DATE:	NO.	BY:	DATE:	C-6
1			3			TOTAL SHEETS
2			4			7