


BM #3: R/R SPIKE IN 32" Ø GUM TREE, 162.15' RT OF STA. 48+52.28 -L-, EL. 747.31

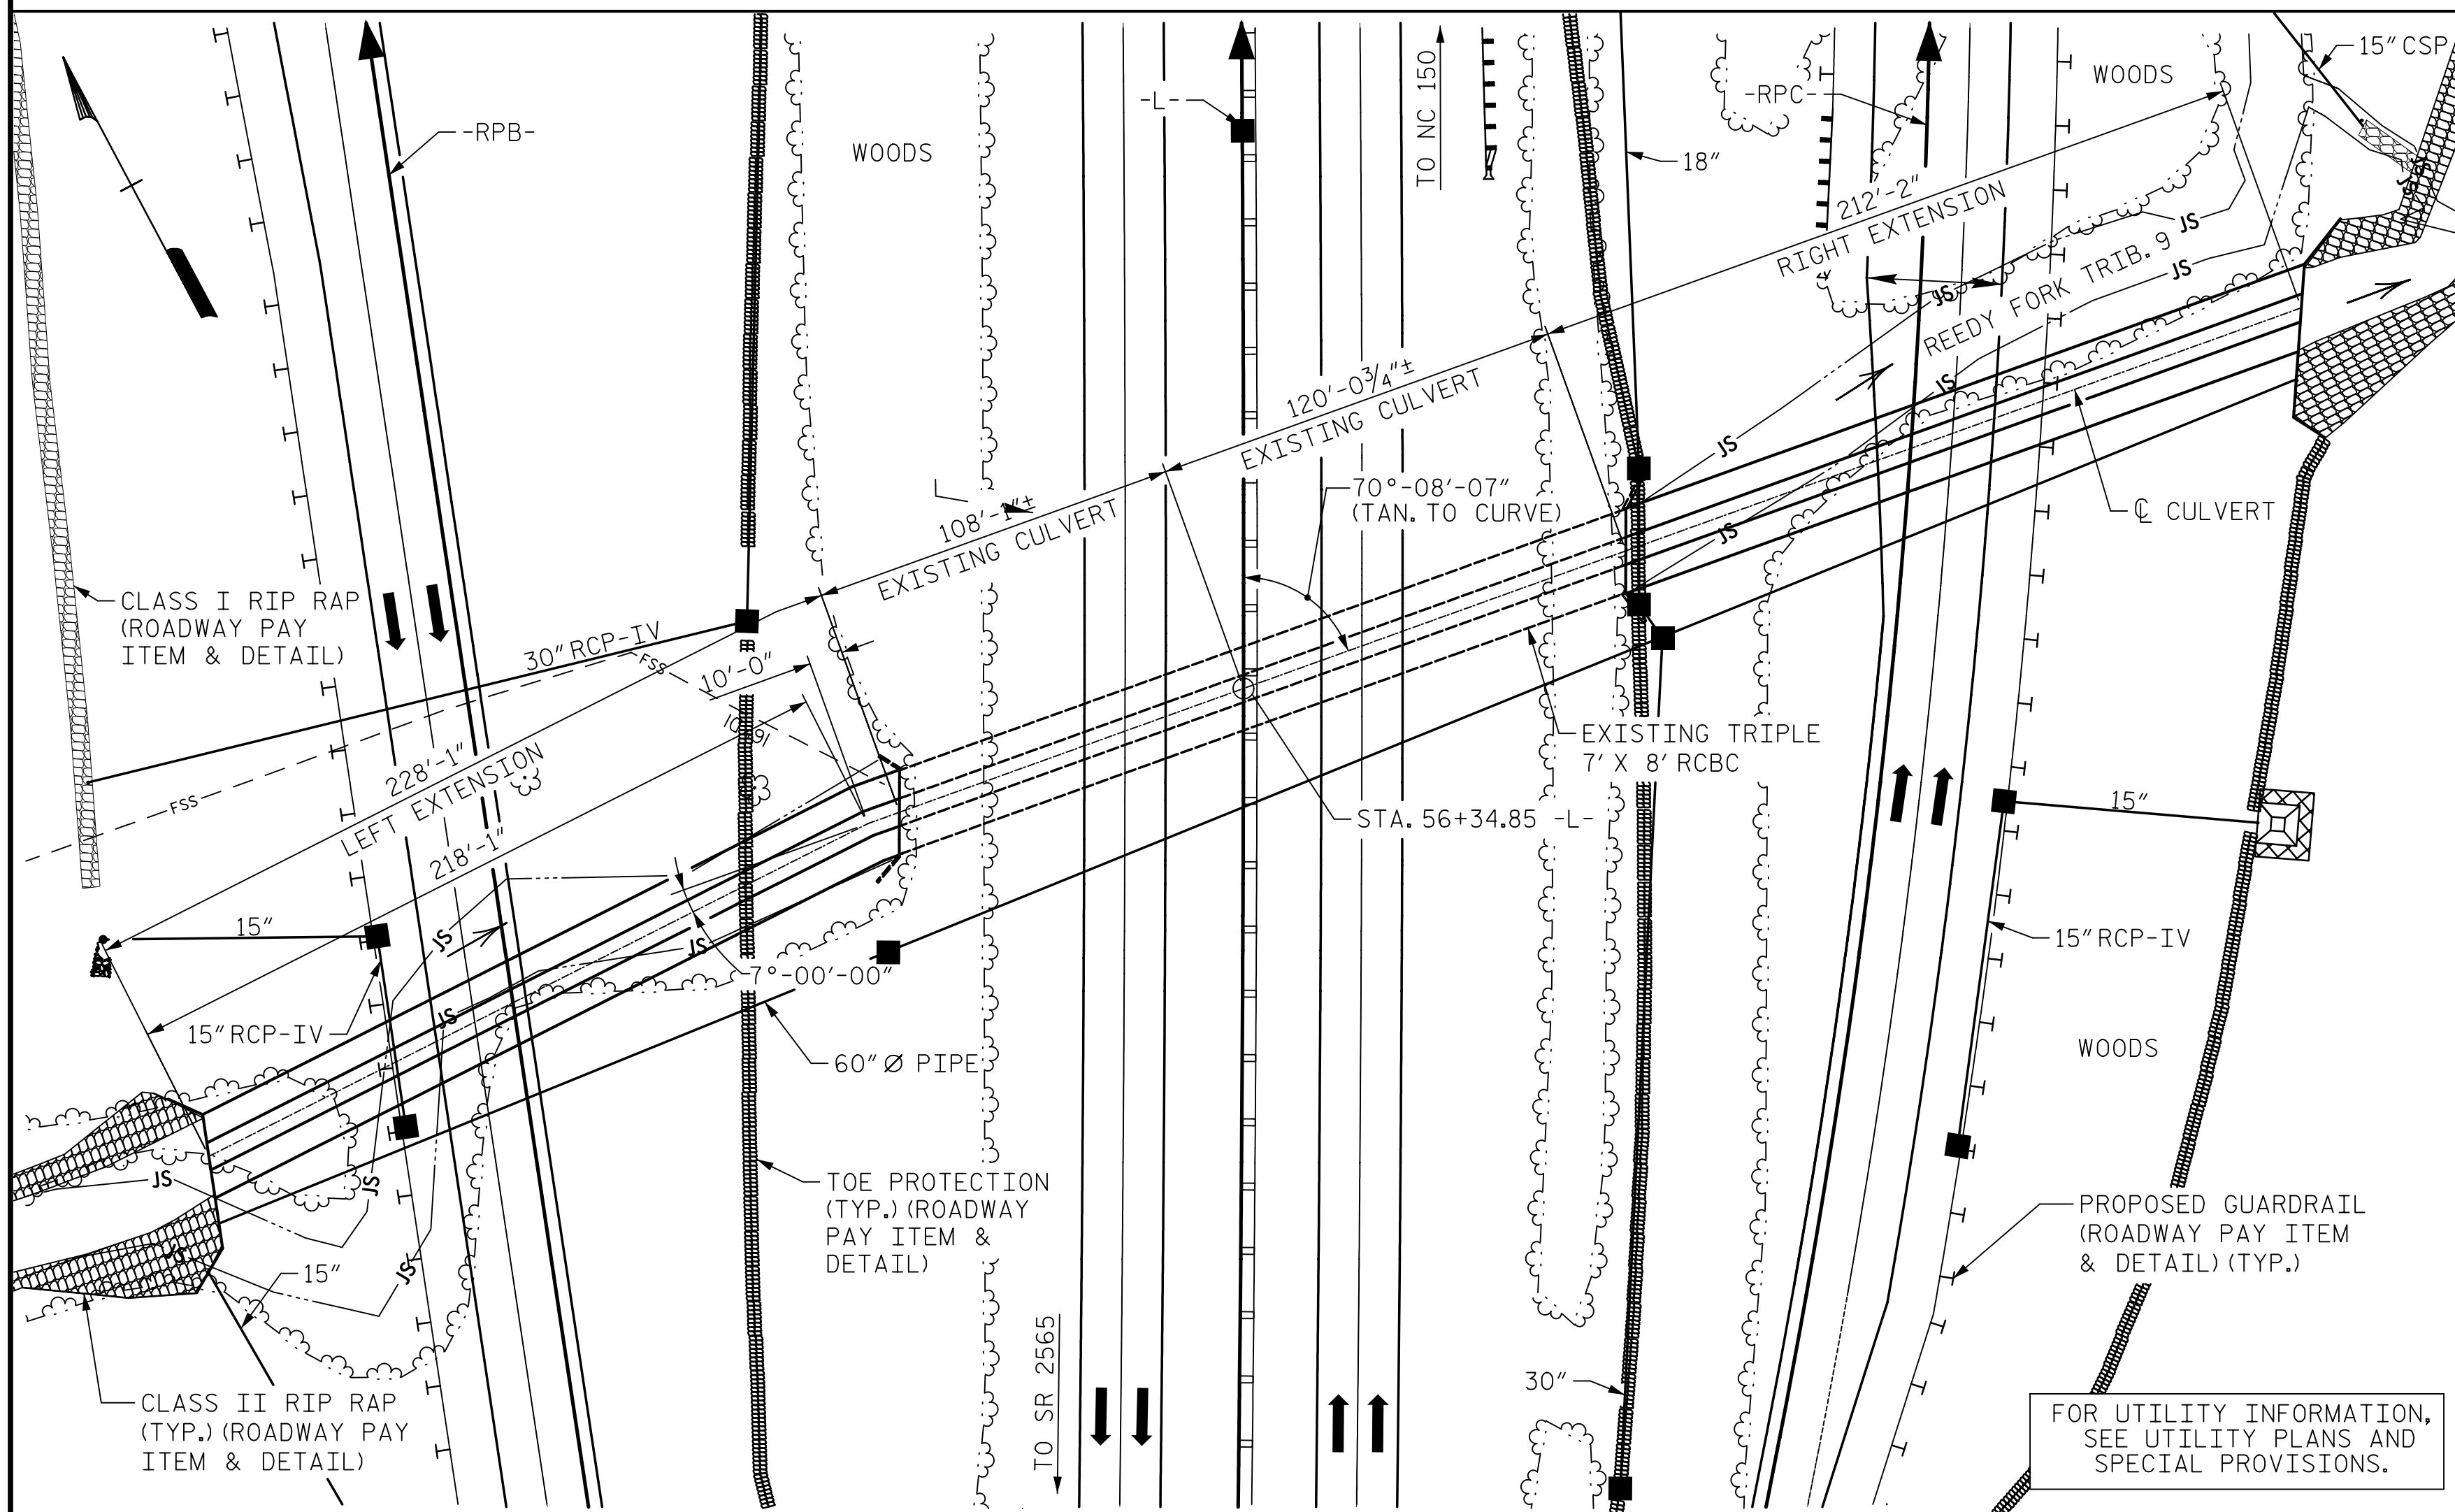

LOCATION SKETCH

HYDRAULIC DATA

DESIGN DISCHARGE = 1,700 C.F.S.
 FREQUENCY OF DESIGN FLOOD = 50 YRS.
 DESIGN HIGH WATER ELEVATION = 691.4'
 DRAINAGE AREA = 3.16 SQ. MI.
 BASE DISCHARGE (Q100) = 2,100 C.F.S.
 BASE HIGH WATER ELEVATION = 695.1

OVERTOPPING FLOOD DATA

OVERTOPPING DISCHARGE = 3,870 C.F.S.
 FREQUENCY OF OVERTOPPING FLOOD = 500+ YRS.
 OVERTOPPING FLOOD ELEVATION = 720.2'

ROADWAY DATA

G.P. ELEV. @ STA. 56+34.85 -L- (-L- SB) = 719.37
 BED ELEV. @ STA. 56+34.85 -L- = 681.7
 ROADWAY FILL SLOPES= 2:1

NOTES

- ASSUMED LIVE LOAD ----- HL-93 OR ALTERNATE LOADING.
 MAX. DESIGN FILL (RIGHT EXTENSION) ----- 36.90 FT.
 MAX. DESIGN FILL (LEFT EXTENSION) ----- 30.22 FT.
 FOR OTHER DESIGN DATA AND NOTES SEE STANDARD NOTE SHEET.
 3" Ø WEEP HOLES INDICATED TO BE IN ACCORDANCE WITH THE SPECIFICATIONS.
 CONCRETE IN CULVERT EXTENSIONS TO BE POURED IN THE FOLLOWING ORDER:
 PHASE I:
 1. WING FOOTINGS AND FLOOR SLAB INCLUDING 4" OF ALL VERTICAL WALLS.
 2. THE REMAINING PORTIONS OF PHASE I WALLS.
 PHASE II:
 3. FLOOR SLAB INCLUDING 4" OF VERTICAL WALL.
 4. THE REMAINING PORTION OF PHASE II WALL FULL HEIGHT FOLLOWED BY ROOF SLAB AND HEADWALL.
 CONCRETE IN 60" Ø PIPE WINGS, FOOTINGS, AND HEADWALL SHALL BE POURED IN THE FOLLOWING ORDER:
 1. WINGS AND HEADWALL FOOTING UP TO CONSTRUCTION JOINT.
 2. REMAINING PORTION OF WINGS AND HEADWALL FULL HEIGHT.

TRANSVERSE CONSTRUCTION JOINTS SHALL BE USED IN THE BARREL, SPACED TO LIMIT THE POURS TO A MAXIMUM OF 70 FT. LOCATION OF JOINTS SHALL BE SUBJECT TO APPROVAL OF THE ENGINEER.
 A 3 FOOT STRIP OF FILTER FABRIC SHALL BE ATTACHED TO THE FILL FACE OF THE WING COVERING THE ENTIRE LENGTH OF THE EXPANSION JOINT.
 AT THE CONTRACTOR'S OPTION, HE MAY SPLICE THE VERTICAL REINFORCING STEEL IN THE INTERIOR FACE OF EXTERIOR WALLS AND BOTH FACES OF INTERIOR WALLS ABOVE LOWER WALL CONSTRUCTION JOINT. THE SPLICE LENGTH SHALL BE AS PROVIDED IN THE SPLICE LENGTH CHART SHOWN ON THE PLANS. EXTRA WEIGHT OF STEEL DUE TO THE SPLICES SHALL BE PAID FOR BY THE CONTRACTOR.
 EXCAVATE A MINIMUM OF 1 FOOT BELOW CULVERT BEARING ELEVATION AND REPLACE WITH FOUNDATION CONDITIONING MATERIAL PER SECTION 414 OF THE STANDARD SPECIFICATIONS.

THE RESIDENT ENGINEER SHALL CHECK THE LENGTH OF CULVERT BEFORE STAKING IT OUT TO MAKE CERTAIN THAT IT WILL PROPERLY TAKE CARE OF THE FILL.

UNDERCUT ANY SOFT/LOOSE ALLUVIAL SOILS THAT MAY BE ENCOUNTERED BENEATH THE BOTTOM OF THE FOUNDATION CONDITIONING MATERIAL. BACKFILL UNDERCUT AREAS WITH FOUNDATION CONDITIONING MATERIAL (SELECT MATERIAL CLASS VI; NO. 57 STONE). INCLUDE 200 CUBIC YARDS OF UNDERCUT AND 300 TONS OF FOUNDATION CONDITIONING MATERIAL AS CONTINGENCY ITEMS IN THE CONTRACT FOR LEFT CULVERT EXTENSION AND 185 CUBIC YARDS OF UNDERCUT AND 275 TONS OF FOUNDATION CONDITIONING MATERIAL FOR RIGHT CULVERT EXTENSION. THE COST OF THE CONTINGENCY QUANTITY OF FOUNDATION CONDITIONING MATERIAL SHALL BE PAID FOR AT THE CONTRACT UNIT BID PRICE. THE COST OF THE CONTINGENCY UNDERCUT SHALL BE CONSIDERED INCIDENTAL TO THE CULVERT EXCAVATION LUMP SUM.

DIMENSIONS FOR WING LAYOUT AS WELL AS ADDITIONAL REINFORCING STEEL EMBEDDED IN BARREL ARE SHOWN ON WING SHEET.


INSTALL TYPE V GEOTEXTILE AT THE BOTTOM OF EXCAVATION PRIOR TO PLACING FOUNDATION CONDITIONING MATERIAL. THE GEOTEXTILE SHOULD BE PLACED AT THE BOTTOM OF THE EXCAVATION AND WRAPPED UP THE SIDE WALLS OF THE EXCAVATION. INCLUDE 1,200 SQ. YDS. OF TYPE V GEOTEXTILE IN THE CONTRACT FOR LEFT CULVERT EXTENSION AND 1,100 SQ. YDS FOR RIGHT CULVERT EXTENSION. THE COST OF TYPE V GEOTEXTILE SHALL BE CONSIDERED INCIDENTAL TO FOUNDATION CONDITIONING MATERIAL.

DOWELS SHALL BE USED TO CONNECT THE CULVERT EXTENSION TO THE EXISTING CULVERT AS SHOWN. FOR NOTE REGARDING SETTING OF DOWELS, SEE SHEET SN.

FOR GROUT FOR STRUCTURES, SEE SPECIAL PROVISIONS.
 FOR FALSEWORK AND FORMWORK, SEE SPECIAL PROVISIONS.
 FOR SUBMITTAL OF WORKING DRAWINGS, SEE SPECIAL PROVISIONS.
 FOR CRANE SAFETY, SEE SPECIAL PROVISIONS.

NO PRECAST REINFORCED BOX CULVERT OPTION WILL BE ALLOWED.
 FOR CULVERT DIVERSION DETAILS AND PAY ITEMS, SEE EROSION CONTROL PLANS.
 FOR EPOXY RESIN INJECTION, SEE SPECIAL PROVISIONS.
 FOR SHOTCRETE REPAIRS, SEE SPECIAL PROVISIONS.
 FOR CONCRETE REPAIRS, SEE SPECIAL PROVISIONS.

I HEREBY CERTIFY THESE PLANS ARE THE AS-BUILT PLANS

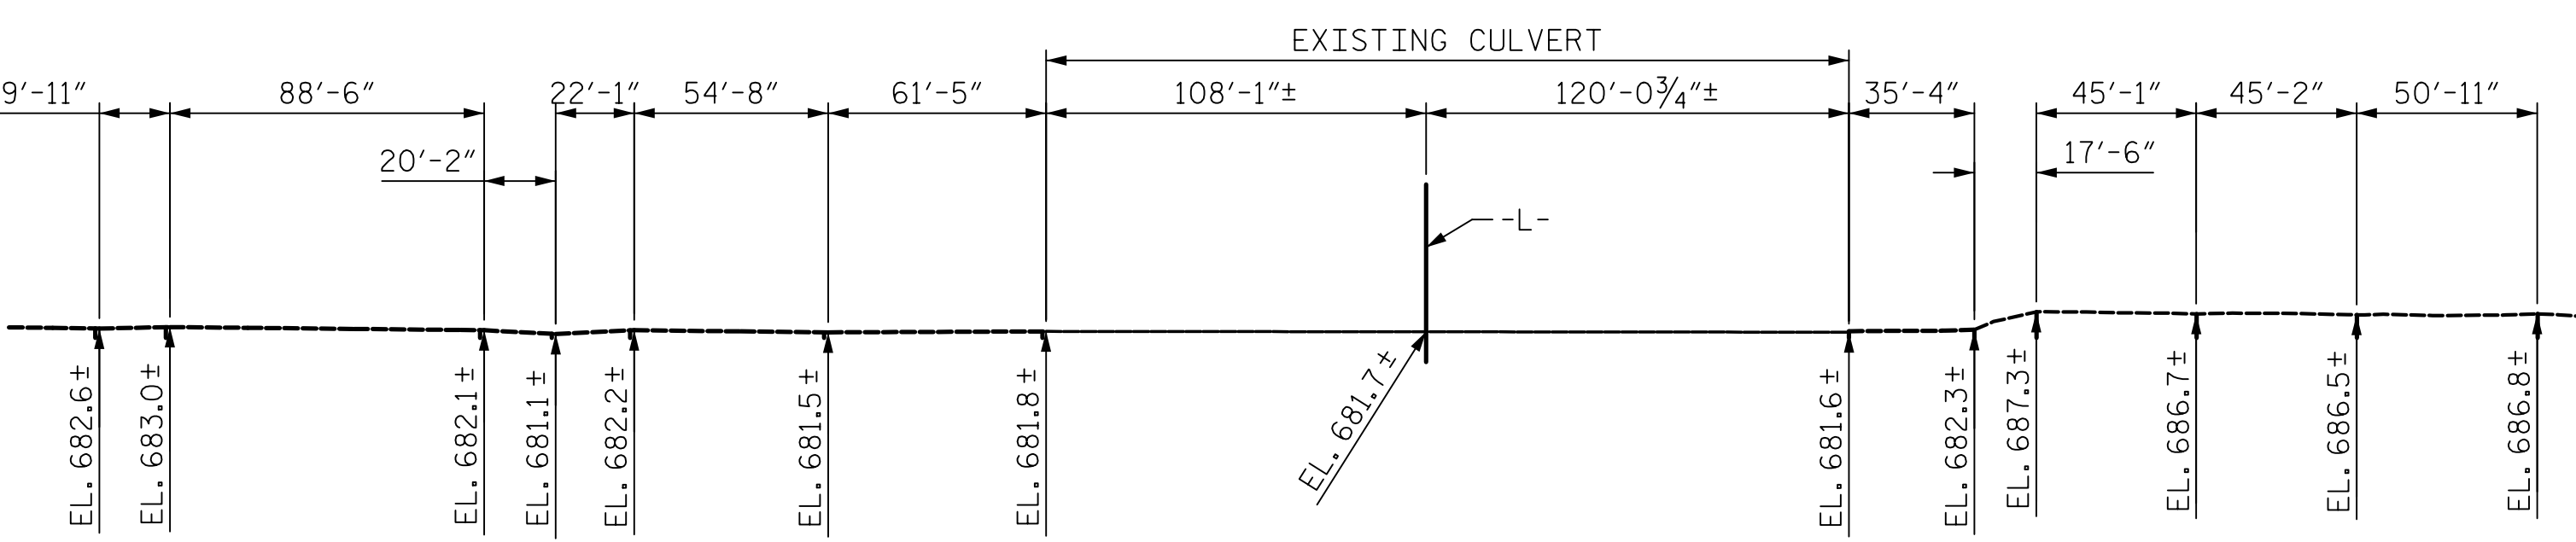

PROFILE ALONG CULVERT

TOTAL STRUCTURE QUANTITIES		
CULVERT EXCAVATION		LUMP SUM
FOUNDATION COND. MAT'L		
LEFT EXTENSION	451	TONS
RIGHT EXTENSION	419	TONS
TOTAL	870	TONS
CLASS A CONCRETE		
LEFT EXTENSION	853.2	C.Y.
RIGHT EXTENSION	877.9	C.Y.
TOTAL	1,731.1	C.Y.
REINFORCING STEEL		
LEFT EXTENSION	102,286	LBS.
RIGHT EXTENSION	96,215	LBS.
TOTAL	198,501	LBS.
CONCRETE REPAIRS	1.2	CU. FT.
SHOTCRETE REPAIRS	11.5	CU. FT.
EPOXY RESIN INJECTION	420.0	LIN. FT.

Mead & Hunt
 111 E. Hargett Street
 Suite 300
 Raleigh, NC 27601
 919-714-8670
 meadhunt.com
 NC License No. F-1235






DOCUMENT NOT CONSIDERED FINAL UNLESS ALL SIGNATURES COMPLETED


PROJECT NO. R-4707
GUILFORD COUNTY
 STATION: 56+34.85 -L-
 EXTENDS CULVERT NO. 355

STATE OF NORTH CAROLINA
 DEPARTMENT OF TRANSPORTATION
 RALEIGH
 TRIPLE 7 FT. x 8 FT. CONCRETE BOX CULVERT
 LEFT EXTENSION AND
 RIGHT EXTENSION WITH
 60" Ø PIPE


DRAWN BY : J.S. HOBSON DATE : 04/12/19
 CHECKED BY : J.A. LEE DATE : 04/24/19
 DESIGN ENGINEER OF RECORD : J.S. HOBSON DATE : 04/26/19

REVISIONS						SHEET NO.
NO.	BY:	DATE:	NO.	BY:	DATE:	C1-01
1			3			TOTAL SHEETS
2			4			24

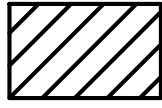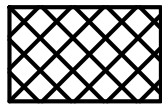
-  = SHOTCRETE REPAIR AREA
-  = CONCRETE REPAIR AREA
-  = EPOXY RESIN INJECTION (ERI)

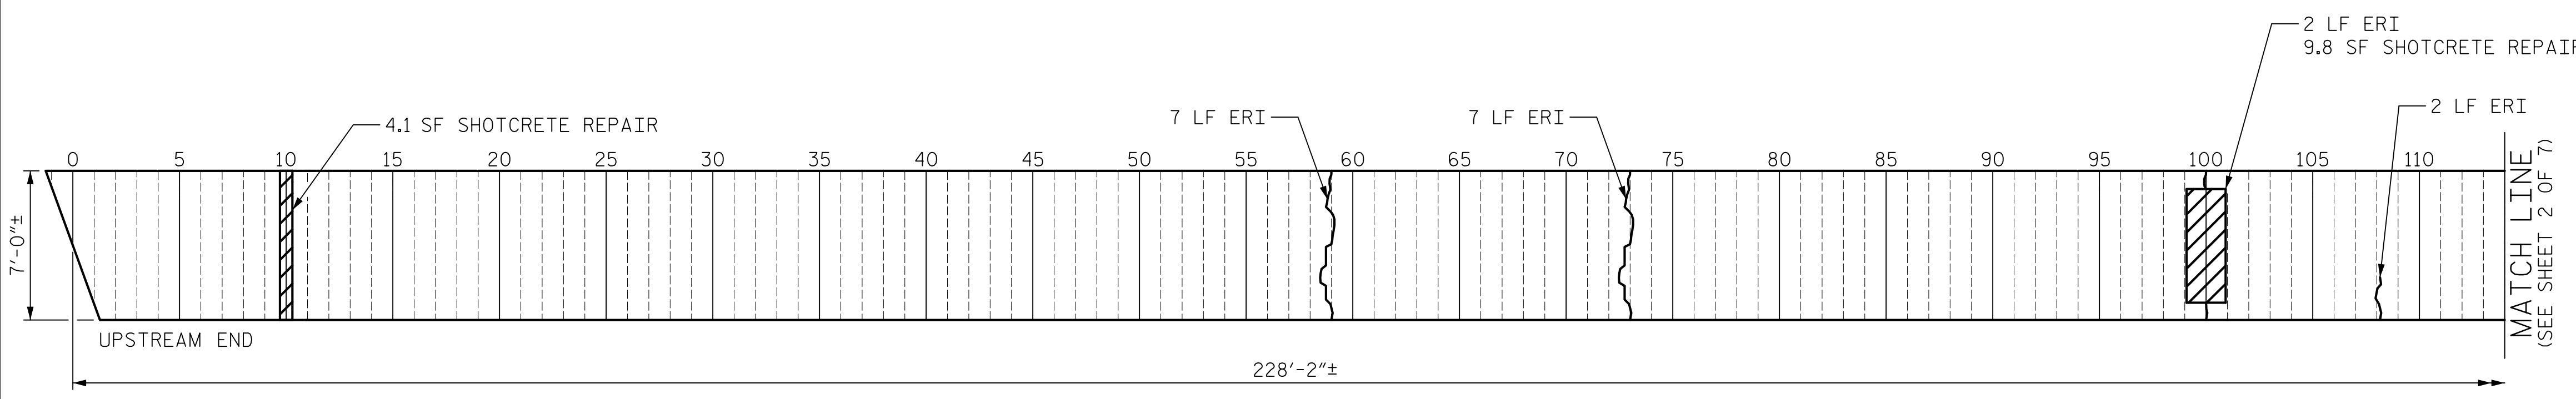


LOOKING UP AT TOP SLAB

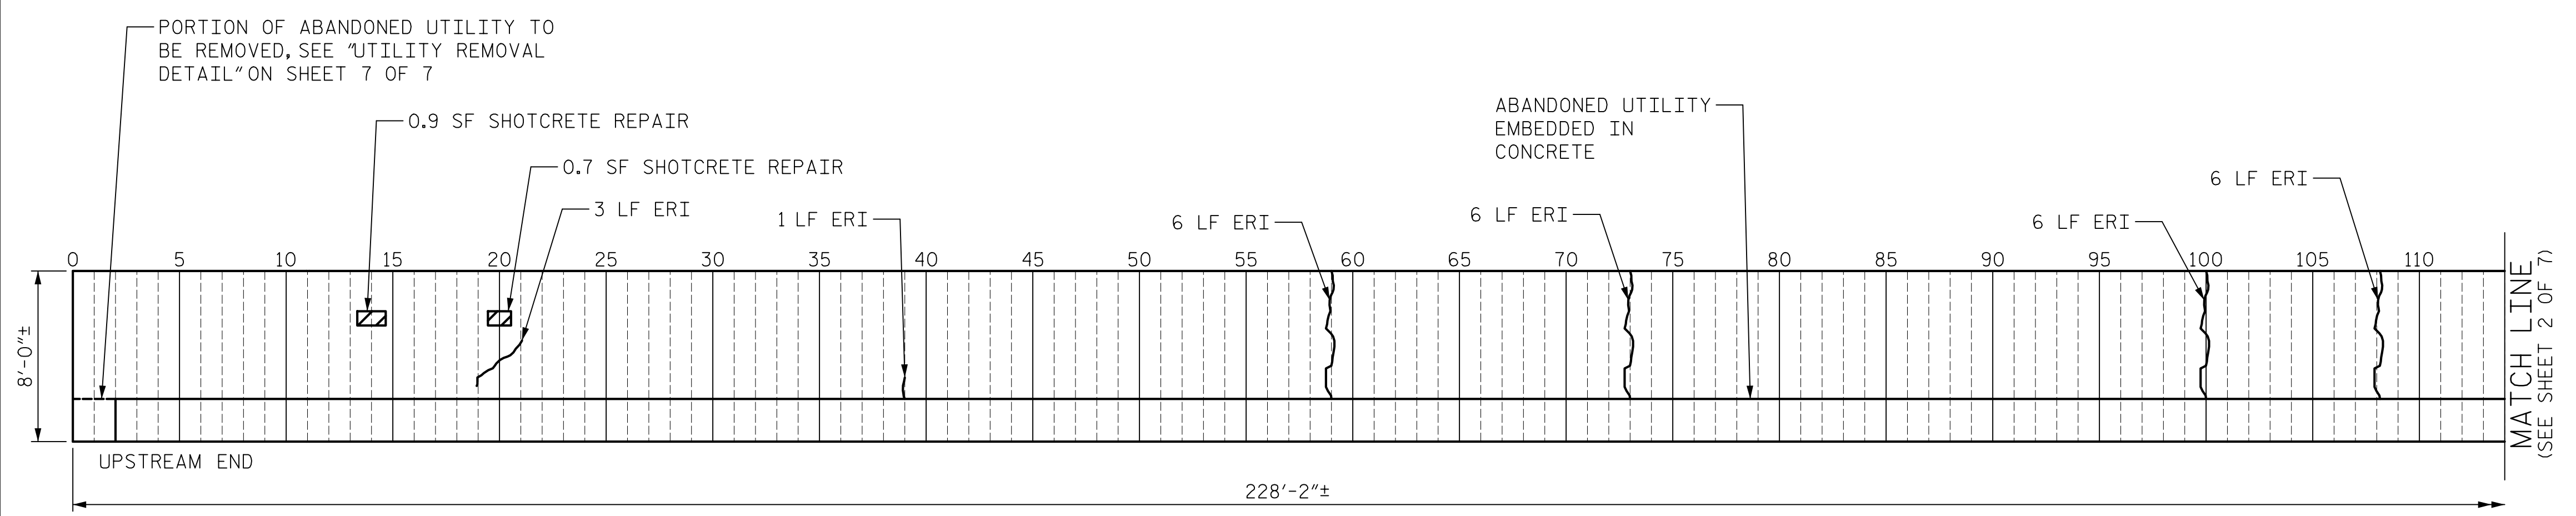

NORTH WALL ELEVATION

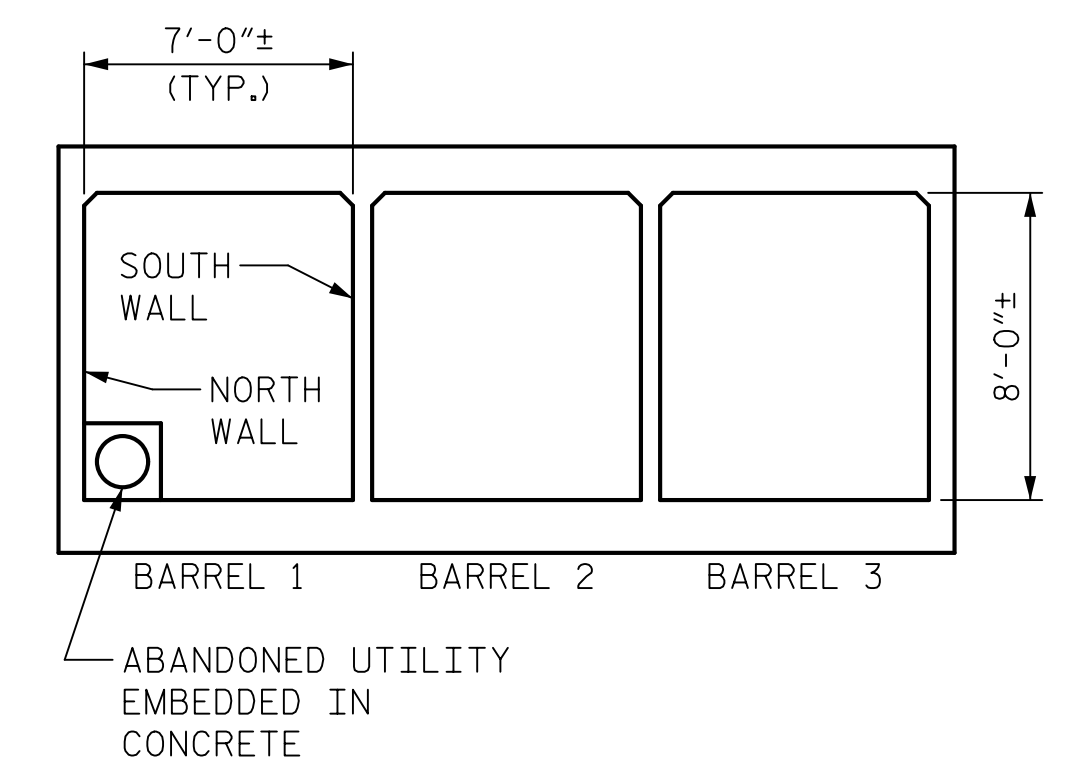


EXISTING CULVERT SECTION
(LOOKING DOWNSTREAM)

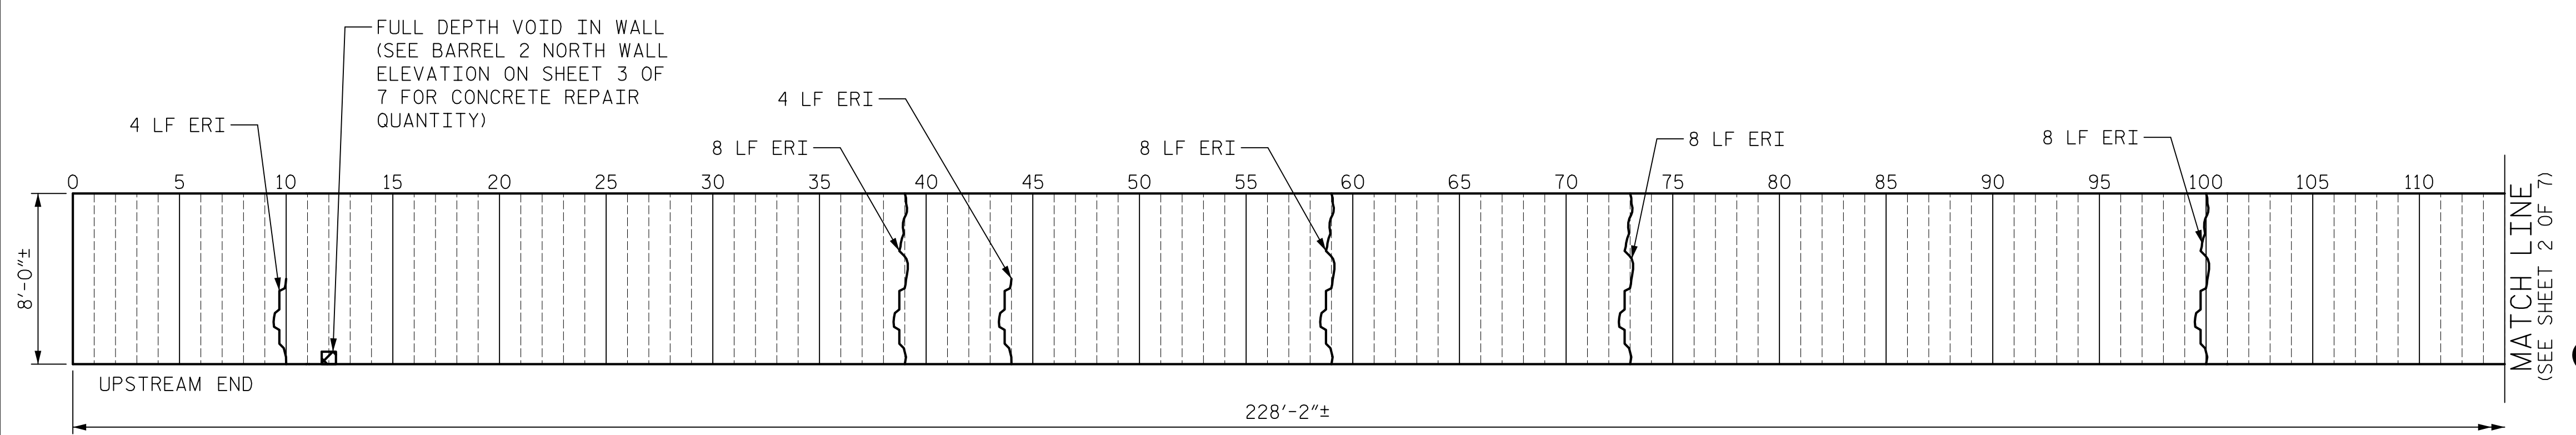

SOUTH WALL ELEVATION

Mead & Hunt
 111 E. Hargett Street
 Suite 300
 Raleigh, NC 27601
 919-714-8670
 meadhunt.com
 NC License No. F-1235

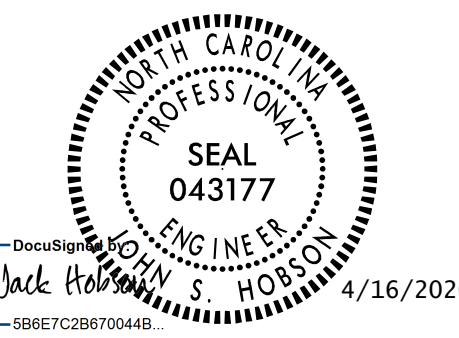

PROJECT NO. R-4707
GUILFORD COUNTY
 STATION: 56+34.85 -L-
 SHEET 1 OF 7

STATE OF NORTH CAROLINA
 DEPARTMENT OF TRANSPORTATION
 RALEIGH

BARREL 1 WALLS AND TOP SLAB REPAIRS

DRAWN BY : A.J. FORFA DATE : 03/06/19
 CHECKED BY : J.S. HOBSON DATE : 04/17/19
 DESIGN ENGINEER OF RECORD : J.S. HOBSON DATE : 04/26/19

DOCUMENT NOT CONSIDERED
 FINAL UNLESS ALL
 SIGNATURES COMPLETED

REVISIONS						SHEET NO.
NO.	BY:	DATE:	NO.	BY:	DATE:	C1-02
1			3			TOTAL SHEETS
2			4			24




AS-BUILT REPAIR QUANTITY TABLE				
	QUANTITIES			
	ESTIMATE		ACTUAL	
SHOTCRETE REPAIRS	AREA SQ. FT.	VOLUME CU. FT.	AREA SQ. FT.	VOLUME CU. FT.
BARREL 1	17.6	4.1		
CONCRETE REPAIRS	AREA SQ. FT.	VOLUME CU. FT.	AREA SQ. FT.	VOLUME CU. FT.
BARREL 1	5.9	1.0		
EPOXY RESIN INJECTION		LIN. FT.		LIN. FT.
BARREL 1		152.0		


NOTES:

VALUES IN CHART REPRESENT ESTIMATED REPAIR TOTALS AFTER REMOVAL OF UNSOUND CONCRETE, MINIMUM OF 1" BEHIND REBAR AND MINIMUM 2" CLEARANCE TO SAWCUT. FOR REPAIR DETAILS, SEE "CULVERT REPAIR DETAILS" SHEET.


REPAIR LOCATIONS AND ESTIMATE OF QUANTITIES ARE BASED ON THE BEST INFORMATION AVAILABLE. IF ADDITIONAL REPAIRS NOT SHOWN ON THE DRAWINGS ARE DEEMED NECESSARY BY THE ENGINEER, THE ENGINEER WILL NOTE ON THE DRAWINGS THE APPROXIMATE LOCATION AND DESCRIPTION OF THE REPAIRS AND ENTER THE ACTUAL QUANTITIES INTO THE AS-BUILT REPAIR QUANTITY TABLE.

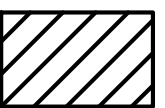CONCRETE REPAIRS MAY BE SUBSTITUTED IN LIEU OF SHOTCRETE REPAIRS WITH THE APPROVAL OF THE ENGINEER.


-  = SHOTCRETE REPAIR AREA
-  = CONCRETE REPAIR AREA
-  = EPOXY RESIN INJECTION (ERI)

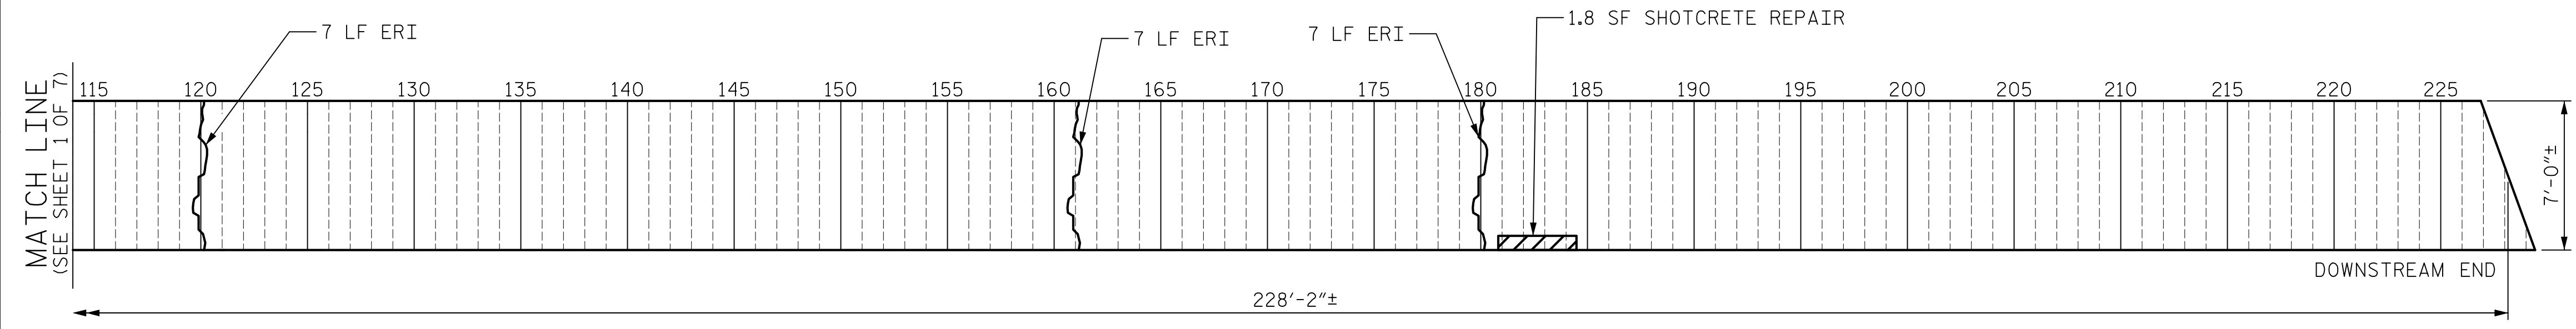

LOOKING UP AT TOP SLAB

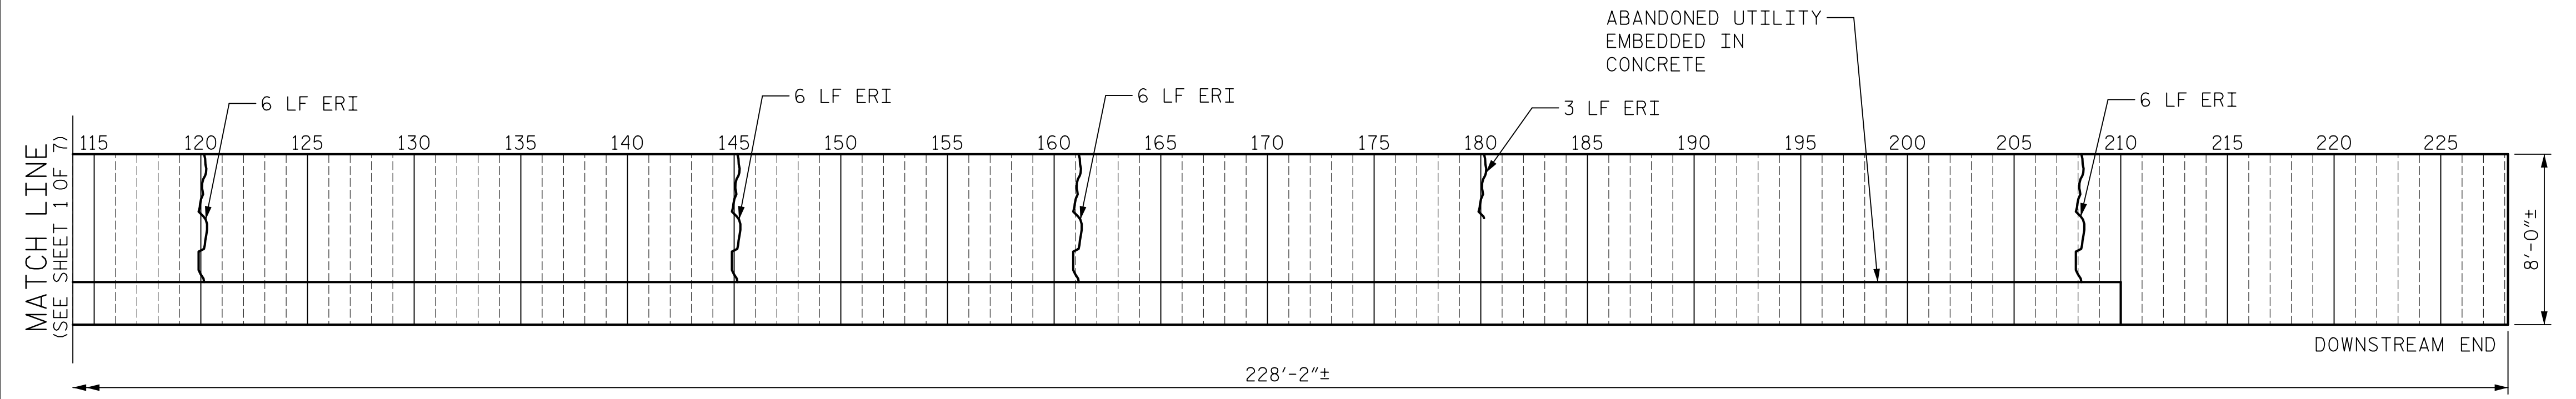

NORTH WALL ELEVATION

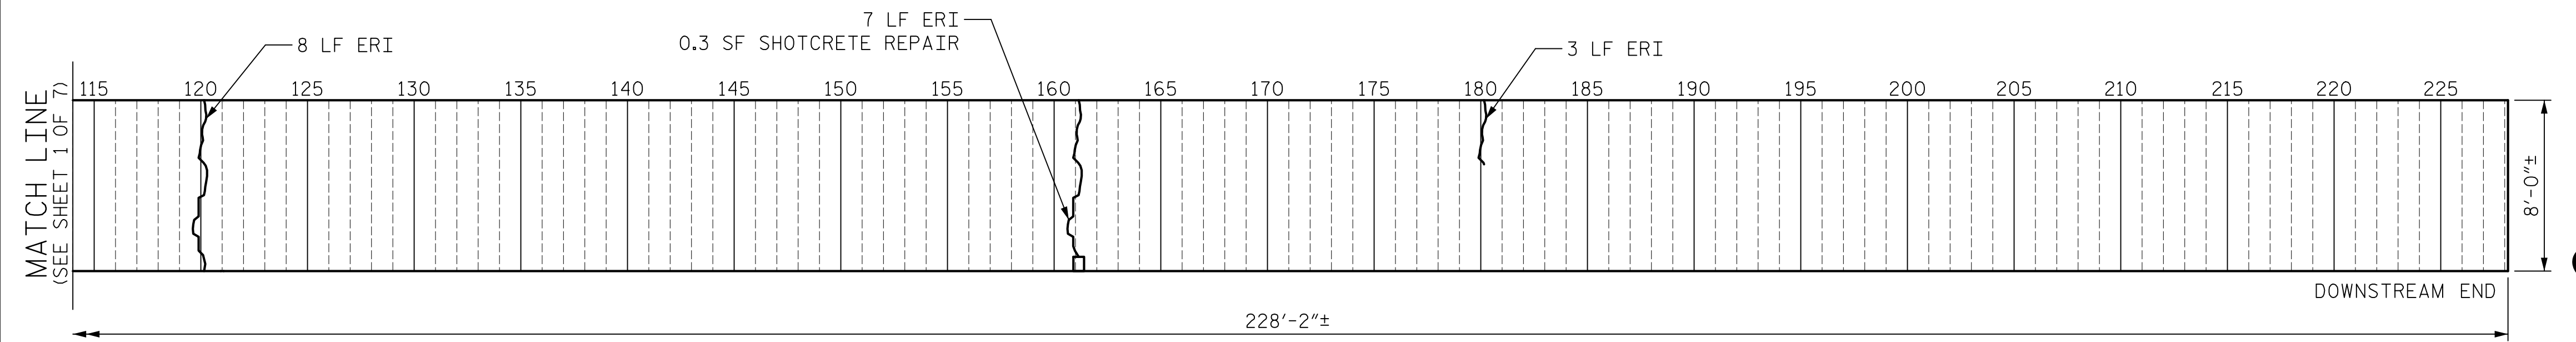

SOUTH WALL ELEVATION



111 E. Hargett Street
Suite 300
Raleigh, NC 27601
919-714-8670
meadhunt.com
NC License No. F-1235



PROJECT NO. R-4707
GUILFORD COUNTY
STATION: 56+34.85 -L-
SHEET 2 OF 7




STATE OF NORTH CAROLINA
DEPARTMENT OF TRANSPORTATION
RALEIGH


**BARREL 1 WALLS AND
TOP SLAB REPAIRS**

DRAWN BY : A.J. FORFA DATE : 03/06/19
CHECKED BY : J.S. HOBSON DATE : 04/17/19
DESIGN ENGINEER OF RECORD : J.S. HOBSON DATE : 04/26/19


DOCUMENT NOT CONSIDERED
FINAL UNLESS ALL
SIGNATURES COMPLETED

REVISIONS						SHEET NO.
NO.	BY:	DATE:	NO.	BY:	DATE:	C1-03
1			3			TOTAL SHEETS
2			4			24

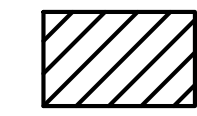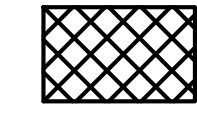
-  = SHOTCRETE REPAIR AREA
-  = CONCRETE REPAIR AREA
-  = EPOXY RESIN INJECTION (ERI)

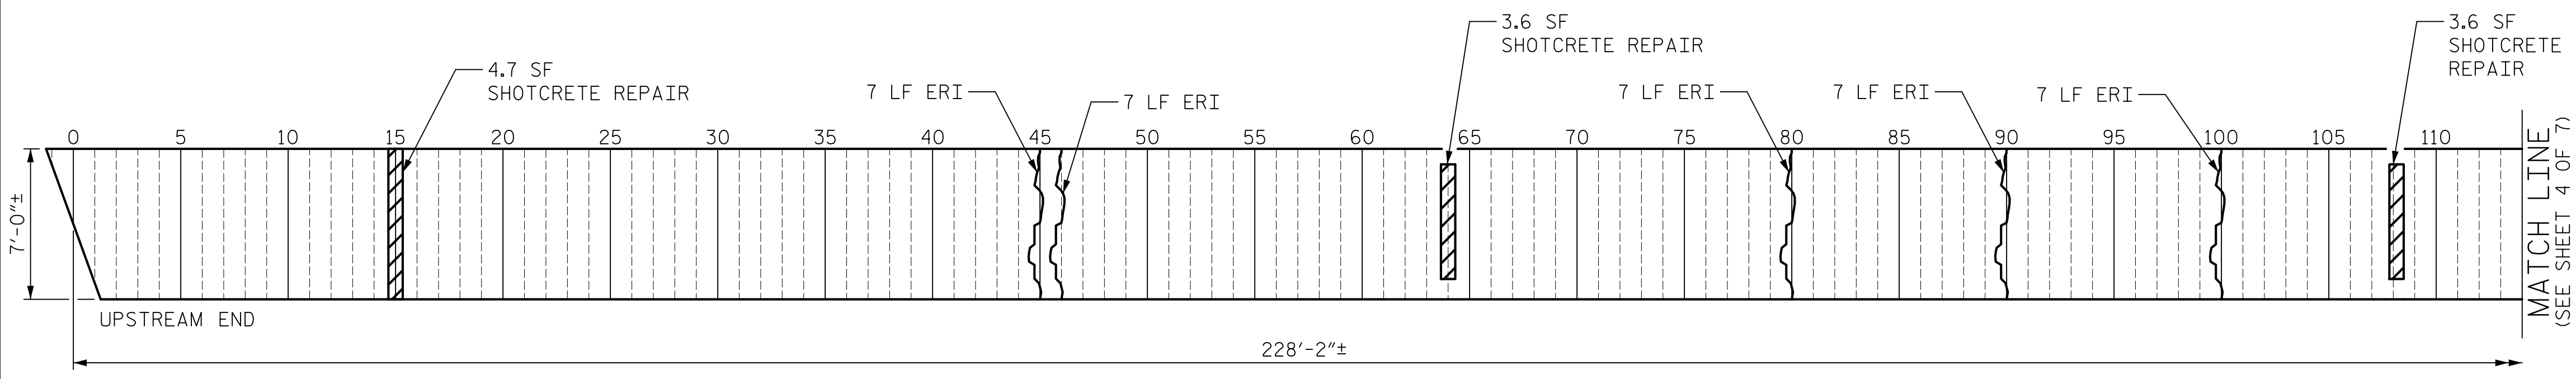

LOOKING UP AT TOP SLAB

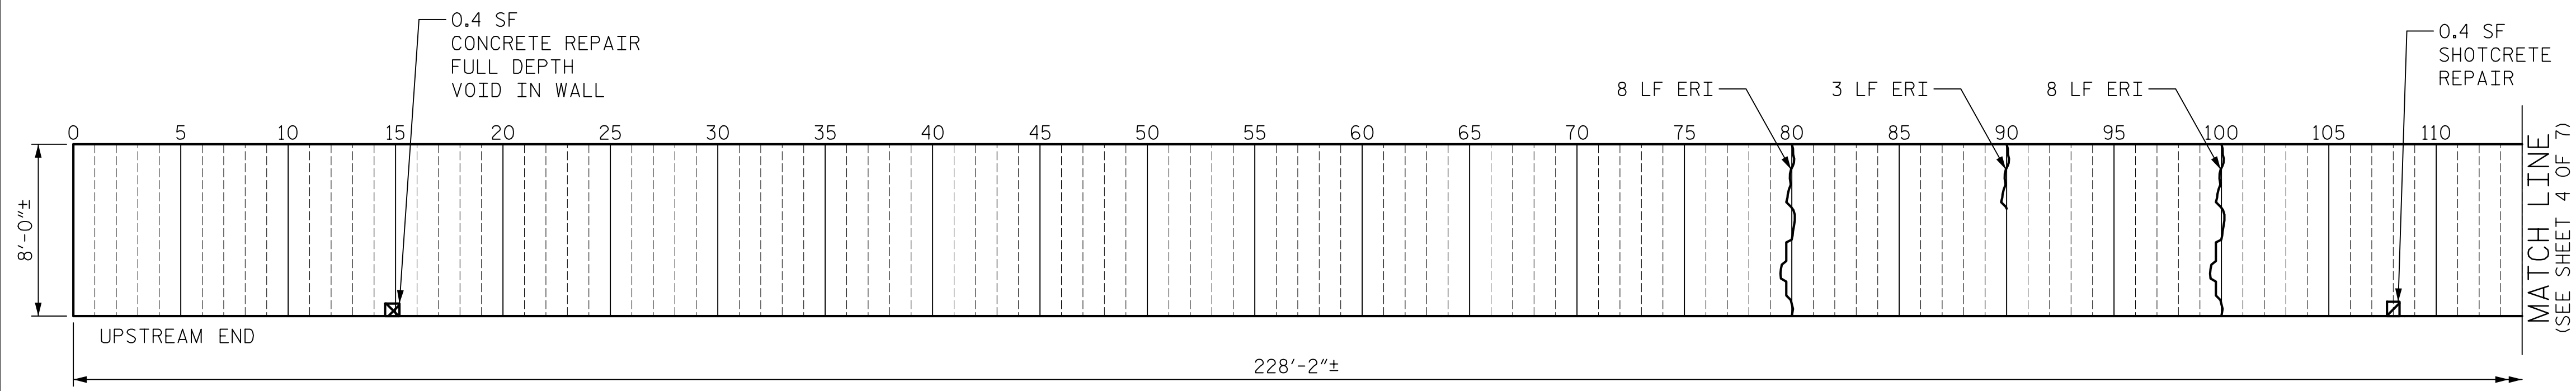


NORTH WALL ELEVATION

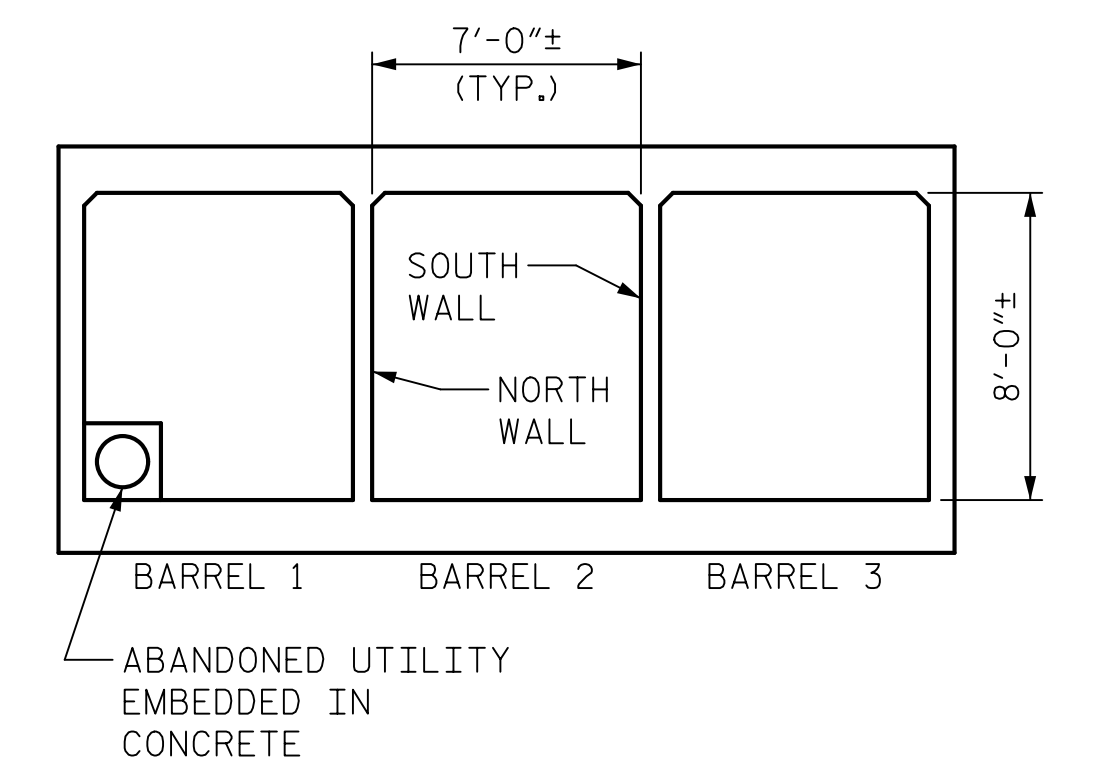

EXISTING CULVERT SECTION


(LOOKING DOWNSTREAM)

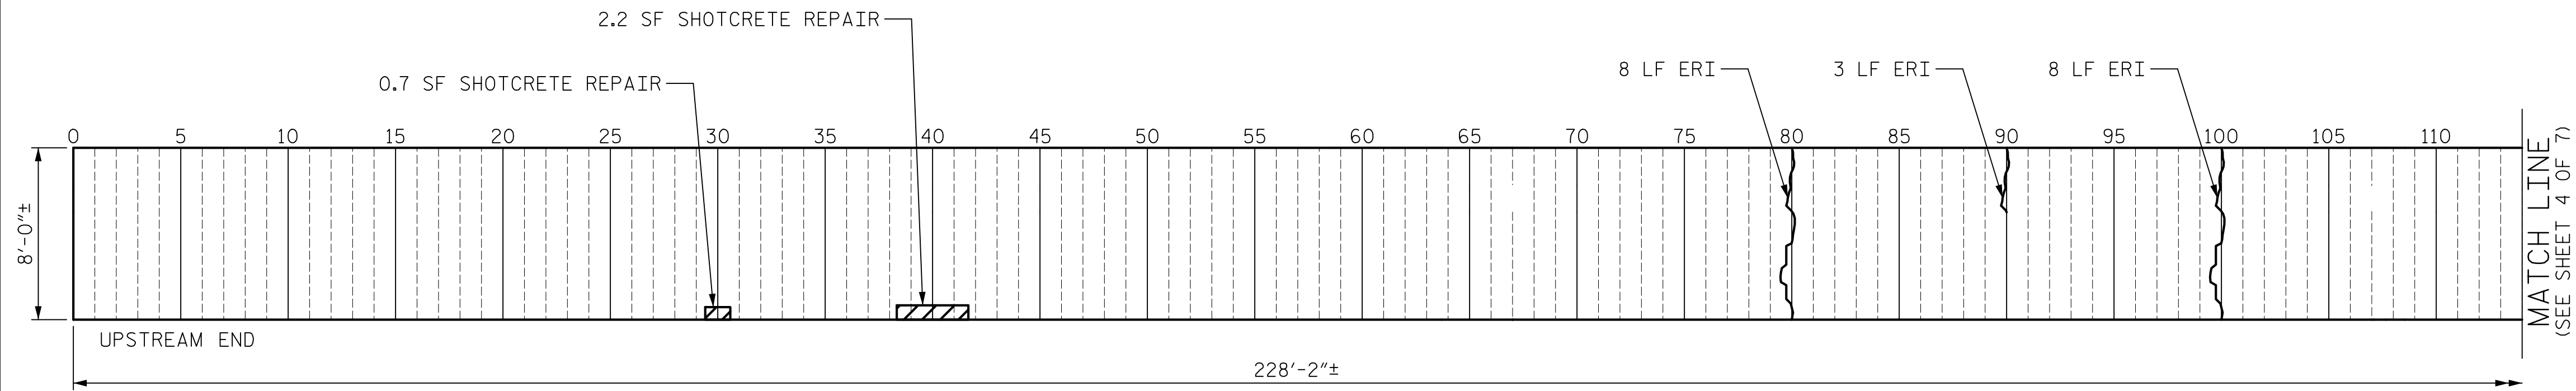

SOUTH WALL ELEVATION



111 E. Hargett Street
Suite 300
Raleigh, NC 27601
919-714-8670
meadhunt.com
NC License No. F-1235

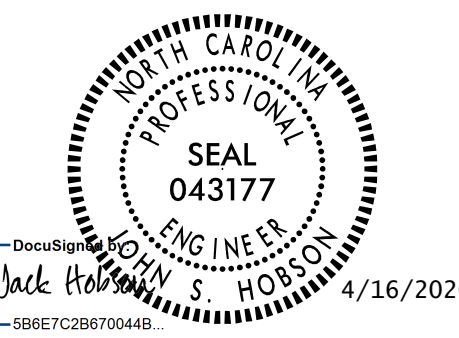

PROJECT NO. R-4707

GUILFORD COUNTY

STATION: 56+34.85 -L-

SHEET 3 OF 7

STATE OF NORTH CAROLINA
DEPARTMENT OF TRANSPORTATION
RALEIGH

**BARREL 2 WALLS AND
TOP SLAB REPAIRS**

DRAWN BY : A.J. FORFA DATE : 03/05/19
 CHECKED BY : J.S. HOBSON DATE : 04/17/19
 DESIGN ENGINEER OF RECORD : J.S. HOBSON DATE : 04/26/19

DOCUMENT NOT CONSIDERED
FINAL UNLESS ALL
SIGNATURES COMPLETED

REVISIONS						SHEET NO.
NO.	BY:	DATE:	NO.	BY:	DATE:	C1-04
1			3			TOTAL SHEETS
2			4			24




AS-BUILT REPAIR QUANTITY TABLE				
	QUANTITIES			
	ESTIMATE		ACTUAL	
SHOTCRETE REPAIRS	AREA SQ. FT.	VOLUME CU. FT.	AREA SQ. FT.	VOLUME CU. FT.
BARREL 2	15.9	4.1		
CONCRETE REPAIRS	AREA SQ. FT.	VOLUME CU. FT.	AREA SQ. FT.	VOLUME CU. FT.
BARREL 2	0.4	0.2		
EPOXY RESIN INJECTION			LIN. FT.	LIN. FT.
BARREL 2			119.0	


NOTES:

VALUES IN CHART REPRESENT ESTIMATED REPAIR TOTALS AFTER REMOVAL OF UNSOUND CONCRETE, MINIMUM OF 1" BEHIND REBAR AND MINIMUM 2" CLEARANCE TO SAWCUT. FOR REPAIR DETAILS, SEE "CULVERT REPAIR DETAILS" SHEET.


REPAIR LOCATIONS AND ESTIMATE OF QUANTITIES ARE BASED ON THE BEST INFORMATION AVAILABLE. IF ADDITIONAL REPAIRS NOT SHOWN ON THE DRAWINGS ARE DEEMED NECESSARY BY THE ENGINEER, THE ENGINEER WILL NOTE ON THE DRAWINGS THE APPROXIMATE LOCATION AND DESCRIPTION OF THE REPAIRS AND ENTER THE ACTUAL QUANTITIES INTO THE AS-BUILT REPAIR QUANTITY TABLE.

CONCRETE REPAIRS MAY BE SUBSTITUTED IN LIEU OF SHOTCRETE REPAIRS WITH THE APPROVAL OF THE ENGINEER.


-  = SHOTCRETE REPAIR AREA
-  = CONCRETE REPAIR AREA
-  = EPOXY RESIN INJECTION (ERI)

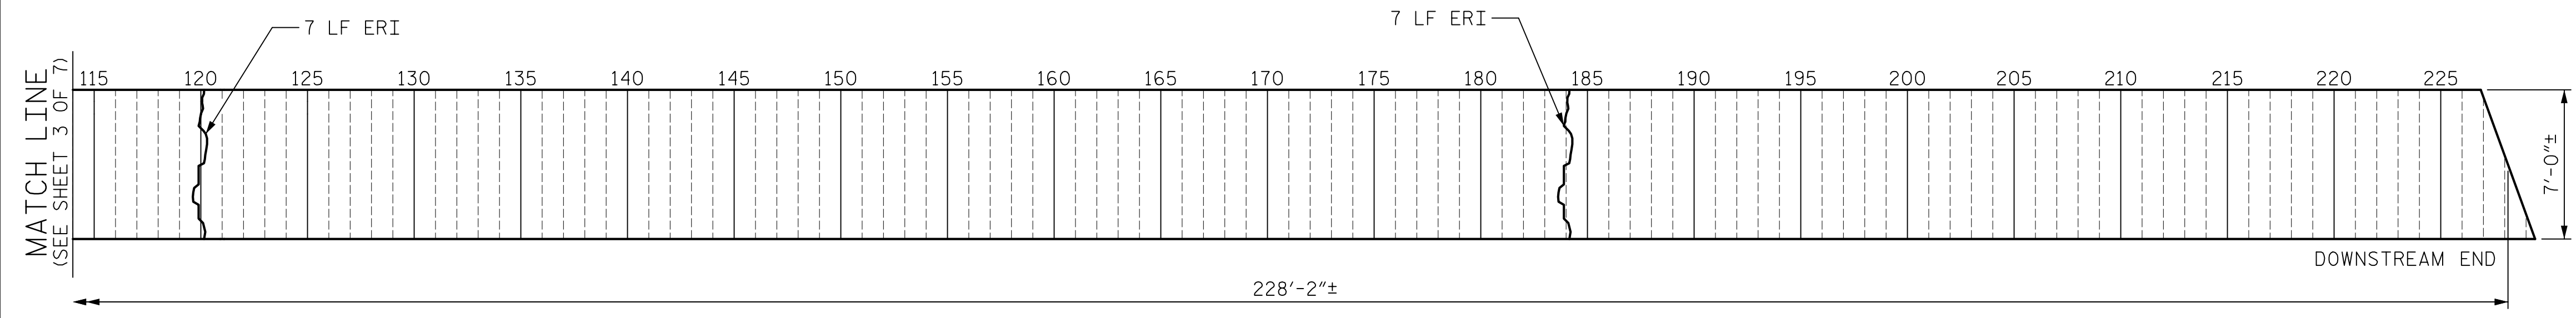

LOOKING UP AT TOP SLAB

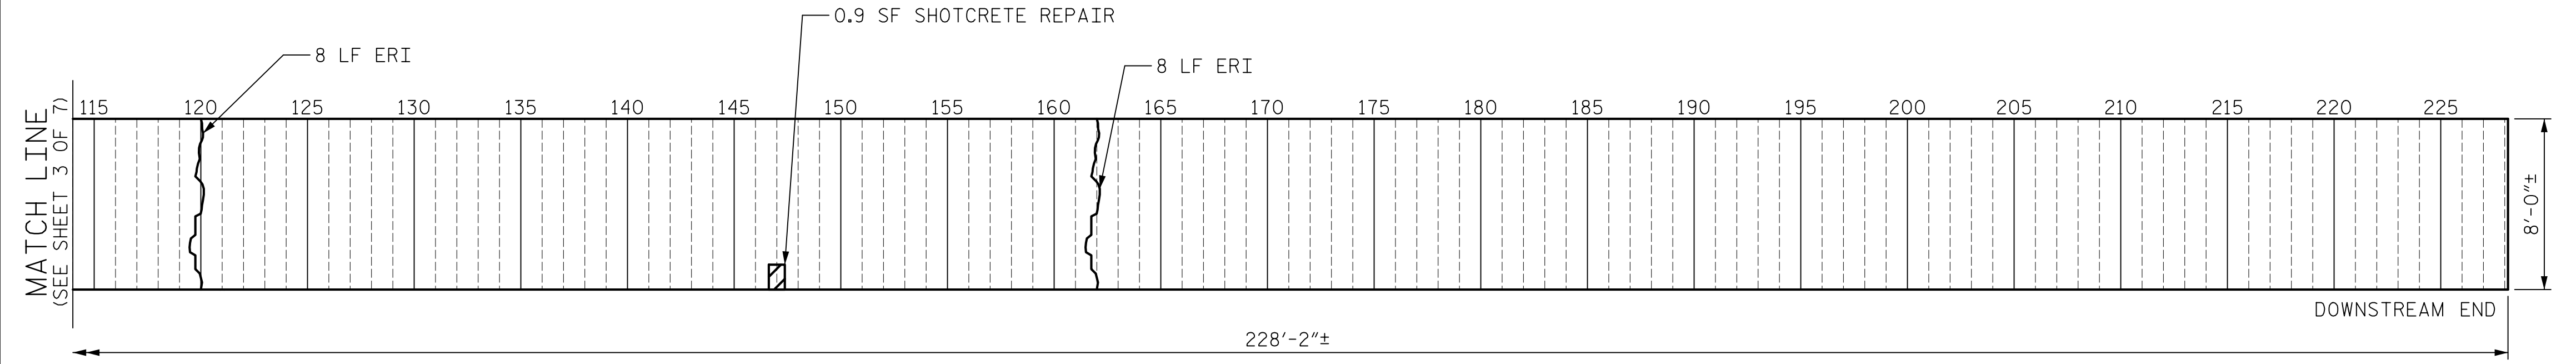


NORTH WALL ELEVATION

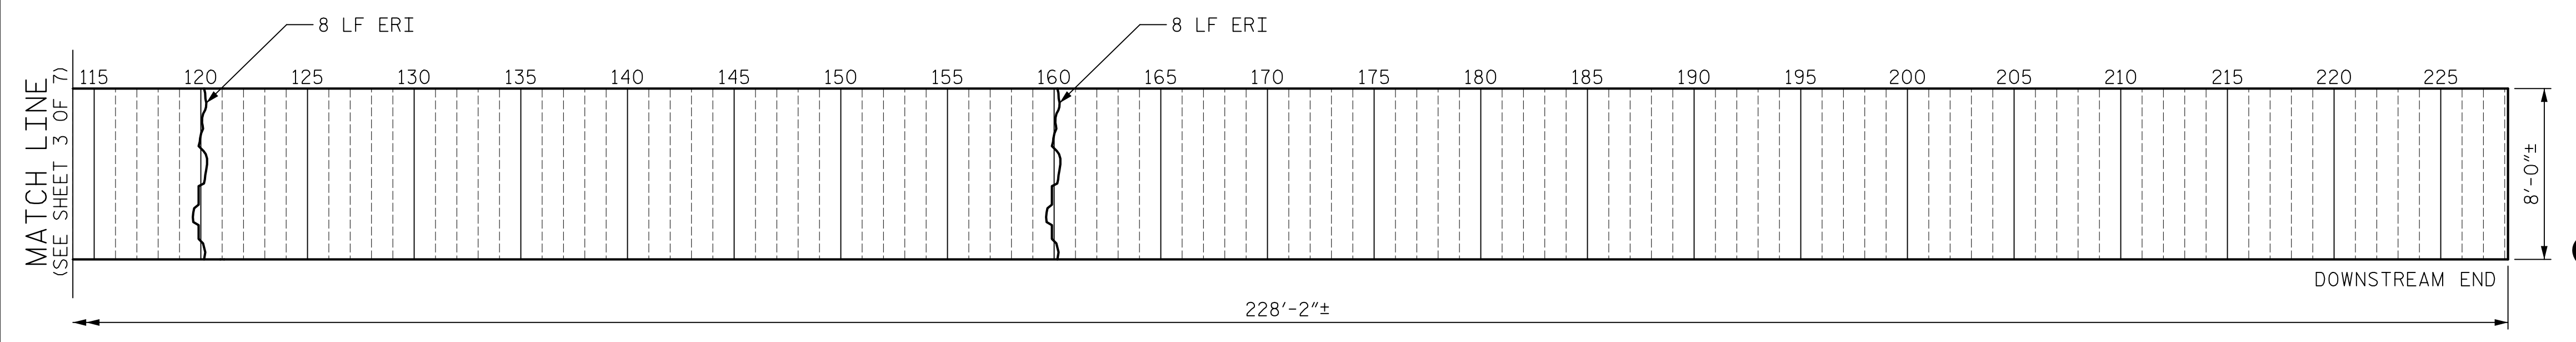

SOUTH WALL ELEVATION

Mead & Hunt
 111 E. Hargett Street
 Suite 300
 Raleigh, NC 27601
 919-714-8670
 meadhunt.com
 NC License No. F-1235

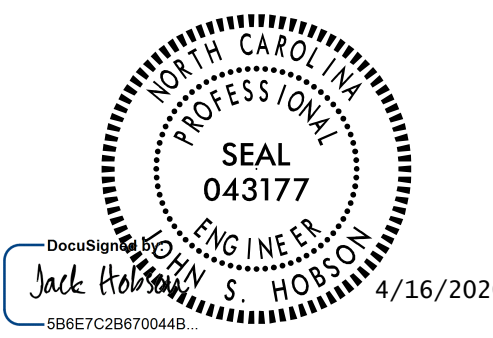

PROJECT NO. R-4707
GUILFORD COUNTY
 STATION: 56+34.85 -L-
 SHEET 4 OF 7




STATE OF NORTH CAROLINA
 DEPARTMENT OF TRANSPORTATION
 RALEIGH


BARREL 2 WALLS AND TOP SLAB REPAIRS

DRAWN BY : A.J. FORFA DATE : 03/06/19
 CHECKED BY : J.S. HOBSON DATE : 04/17/19
 DESIGN ENGINEER OF RECORD : J.S. HOBSON DATE : 04/26/19


DOCUMENT NOT CONSIDERED
 FINAL UNLESS ALL
 SIGNATURES COMPLETED

REVISIONS						SHEET NO.
NO.	BY:	DATE:	NO.	BY:	DATE:	C1-05
1			3			TOTAL SHEETS
2			4			24

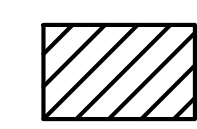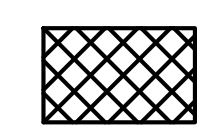
-  = SHOTCRETE REPAIR AREA
-  = CONCRETE REPAIR AREA
-  = EPOXY RESIN INJECTION (ERI)

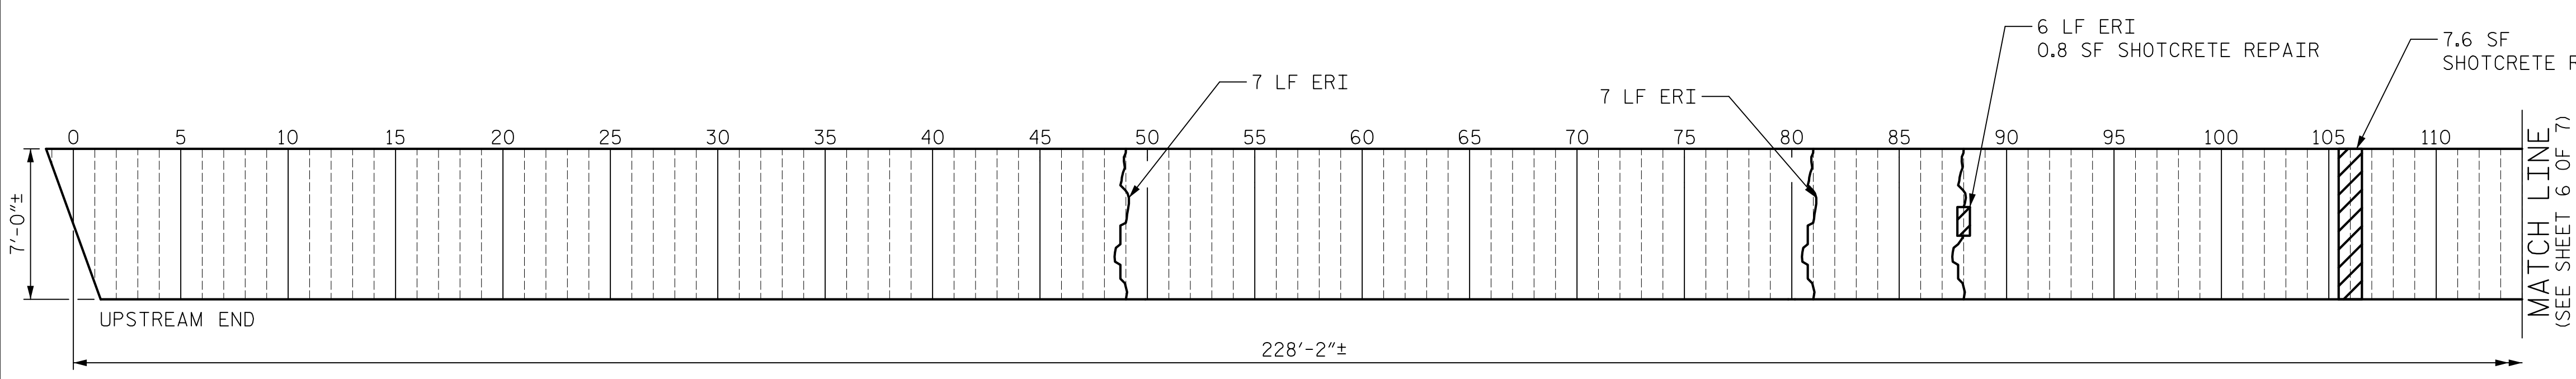


LOOKING UP AT TOP SLAB

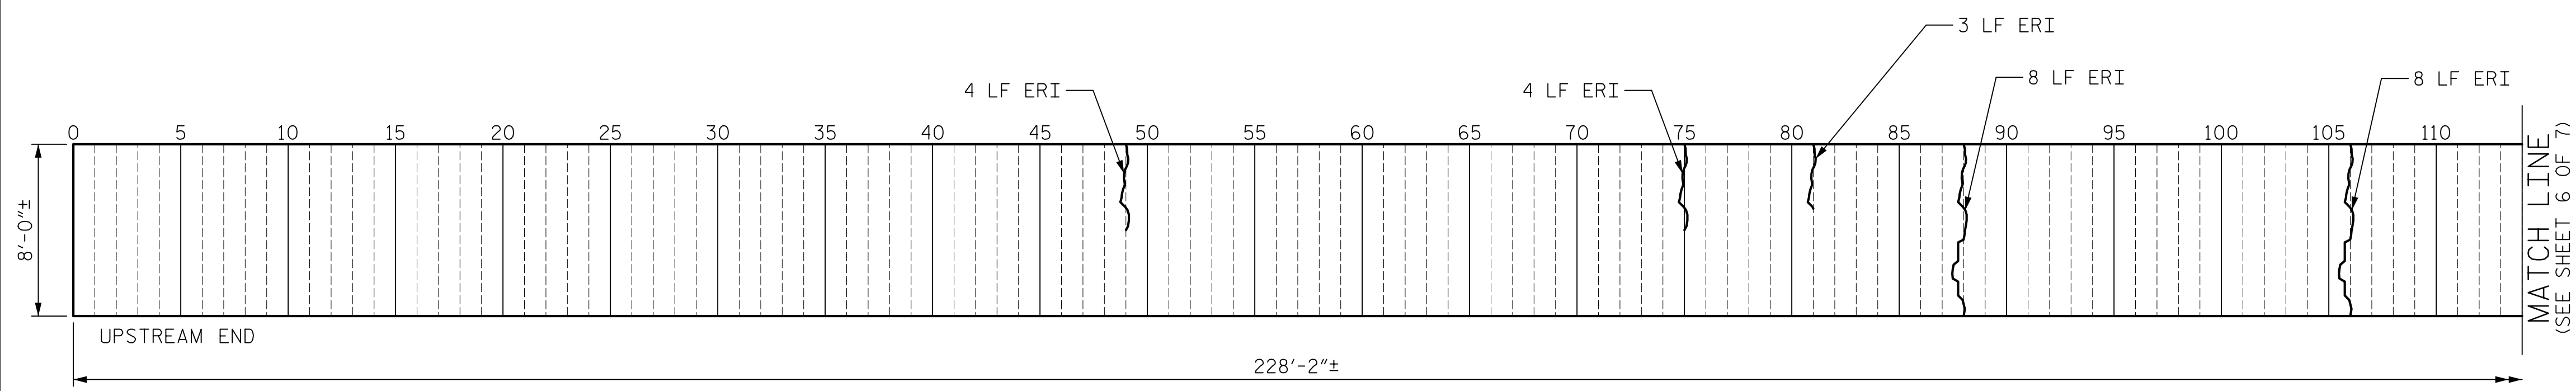

NORTH WALL ELEVATION

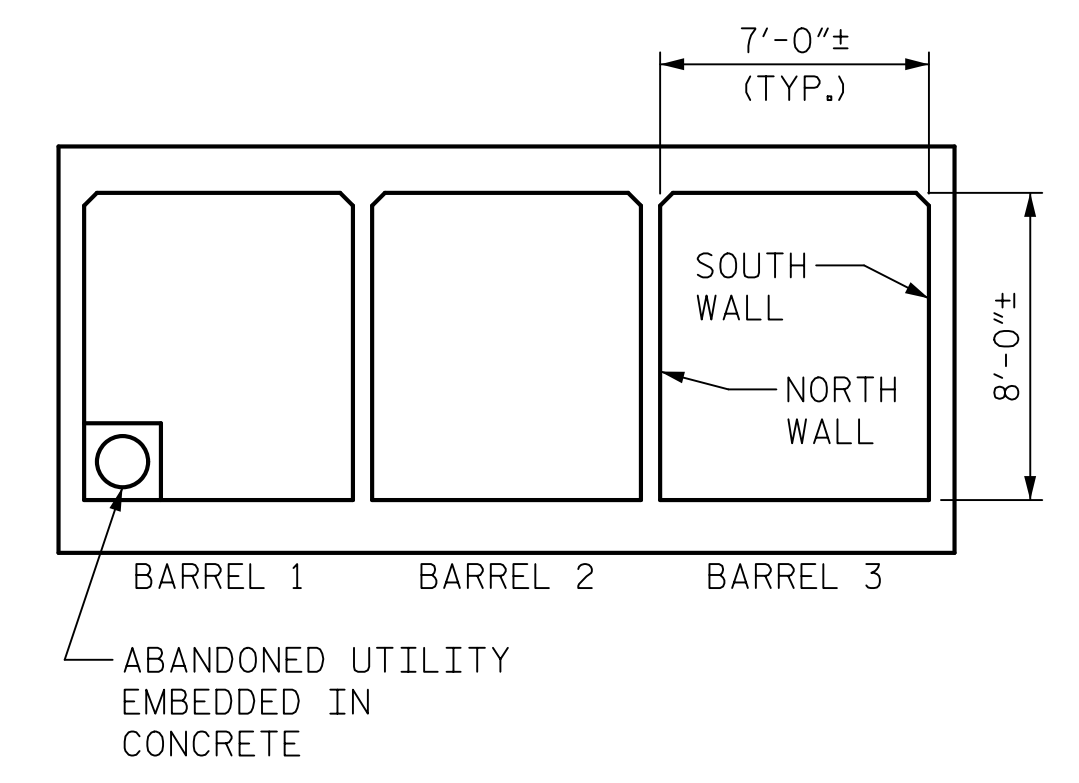


EXISTING CULVERT SECTION
(LOOKING DOWNSTREAM)

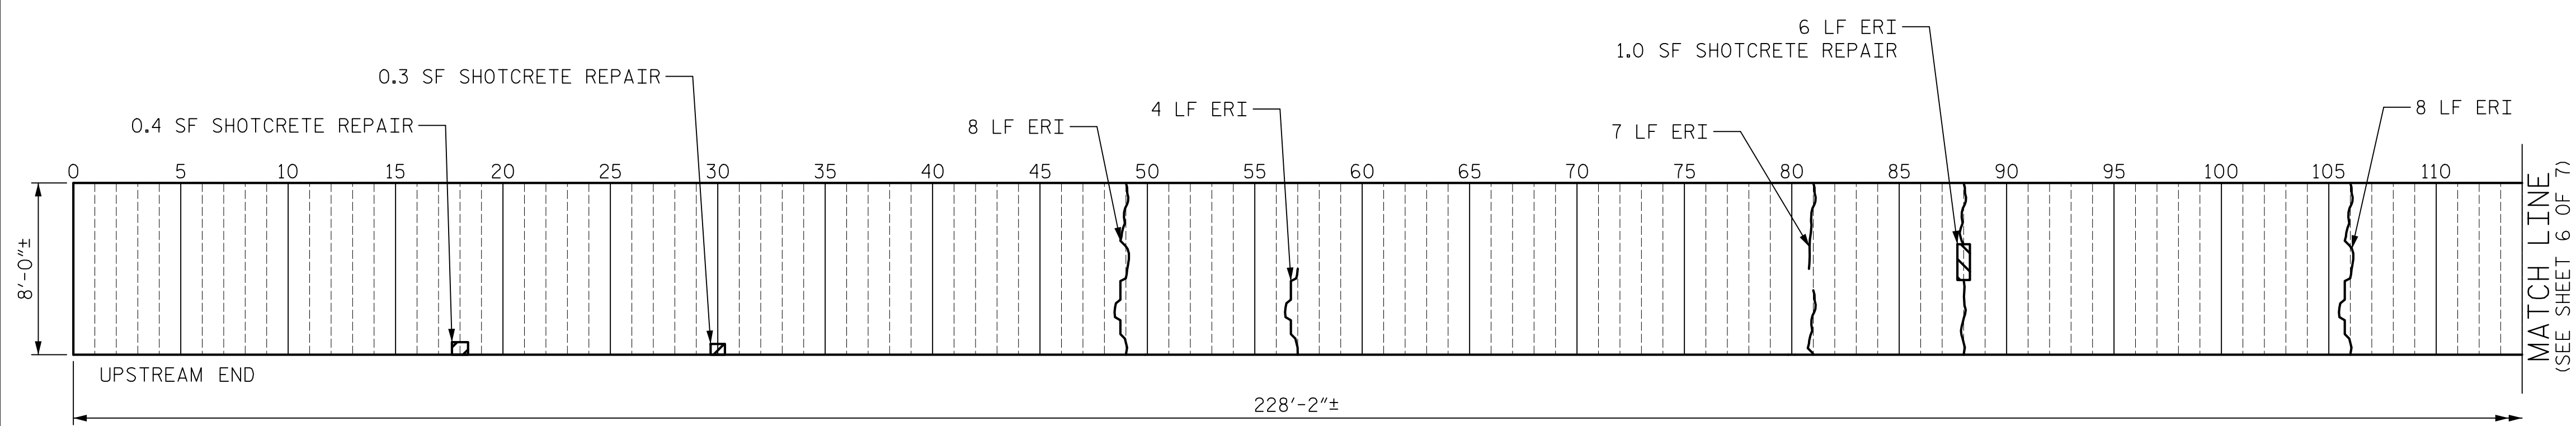

SOUTH WALL ELEVATION

Mead & Hunt
 111 E. Hargett Street
 Suite 300
 Raleigh, NC 27601
 919-714-8670
 meadhunt.com
 NC License No. F-1235

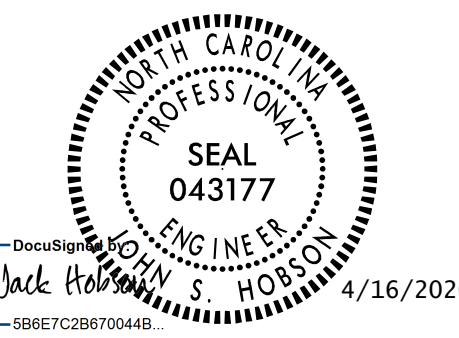

PROJECT NO. R-4707
GUILFORD COUNTY
 STATION: 56+34.85 -L-
 SHEET 5 OF 7

STATE OF NORTH CAROLINA
 DEPARTMENT OF TRANSPORTATION
 RALEIGH

**BARREL 3 WALLS AND
 TOP SLAB REPAIRS**

DRAWN BY : A.J. FORFA DATE : 03/04/19
 CHECKED BY : J.S. HOBSON DATE : 04/17/19
 DESIGN ENGINEER OF RECORD : J.S. HOBSON DATE : 04/26/19

DOCUMENT NOT CONSIDERED
 FINAL UNLESS ALL
 SIGNATURES COMPLETED

REVISIONS						SHEET NO.
NO.	BY:	DATE:	NO.	BY:	DATE:	C1-06
1			3			TOTAL SHEETS
2			4			24




AS-BUILT REPAIR QUANTITY TABLE				
	QUANTITIES			
	ESTIMATE		ACTUAL	
SHOTCRETE REPAIRS	AREA SQ. FT.	VOLUME CU. FT.	AREA SQ. FT.	VOLUME CU. FT.
BARREL 3	11.2	3.3		
CONCRETE REPAIRS	AREA SQ. FT.	VOLUME CU. FT.	AREA SQ. FT.	VOLUME CU. FT.
BARREL 3	0.0	0.0		
EPOXY RESIN INJECTION	LIN. FT.		LIN. FT.	
BARREL 3	149.0			


NOTES:

VALUES IN CHART REPRESENT ESTIMATED REPAIR TOTALS AFTER REMOVAL OF UNSOUND CONCRETE, MINIMUM OF 1" BEHIND REBAR AND MINIMUM 2" CLEARANCE TO SAWCUT. FOR REPAIR DETAILS, SEE "CULVERT REPAIR DETAILS" SHEET.


REPAIR LOCATIONS AND ESTIMATE OF QUANTITIES ARE BASED ON THE BEST INFORMATION AVAILABLE. IF ADDITIONAL REPAIRS NOT SHOWN ON THE DRAWINGS ARE DEEMED NECESSARY BY THE ENGINEER, THE ENGINEER WILL NOTE ON THE DRAWINGS THE APPROXIMATE LOCATION AND DESCRIPTION OF THE REPAIRS AND ENTER THE ACTUAL QUANTITIES INTO THE AS-BUILT REPAIR QUANTITY TABLE.

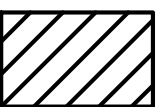CONCRETE REPAIRS MAY BE SUBSTITUTED IN LIEU OF SHOTCRETE REPAIRS WITH THE APPROVAL OF THE ENGINEER.


-  = SHOTCRETE REPAIR AREA
-  = CONCRETE REPAIR AREA
-  = EPOXY RESIN INJECTION (ERI)

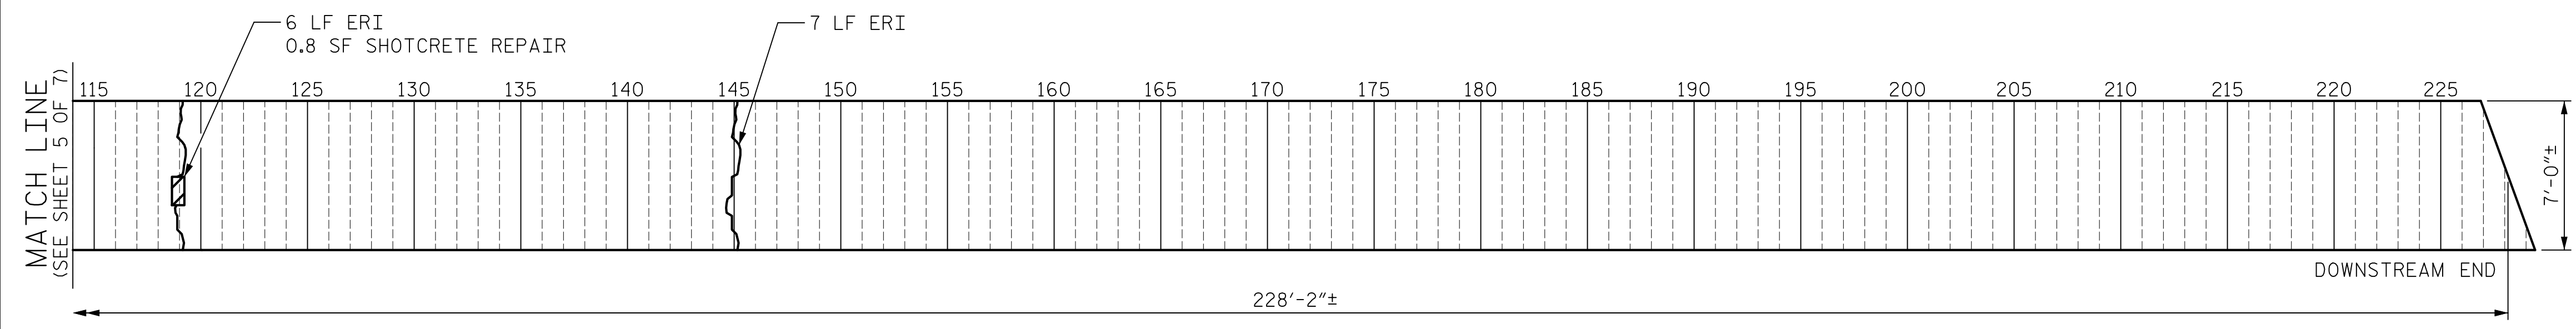

LOOKING UP AT TOP SLAB

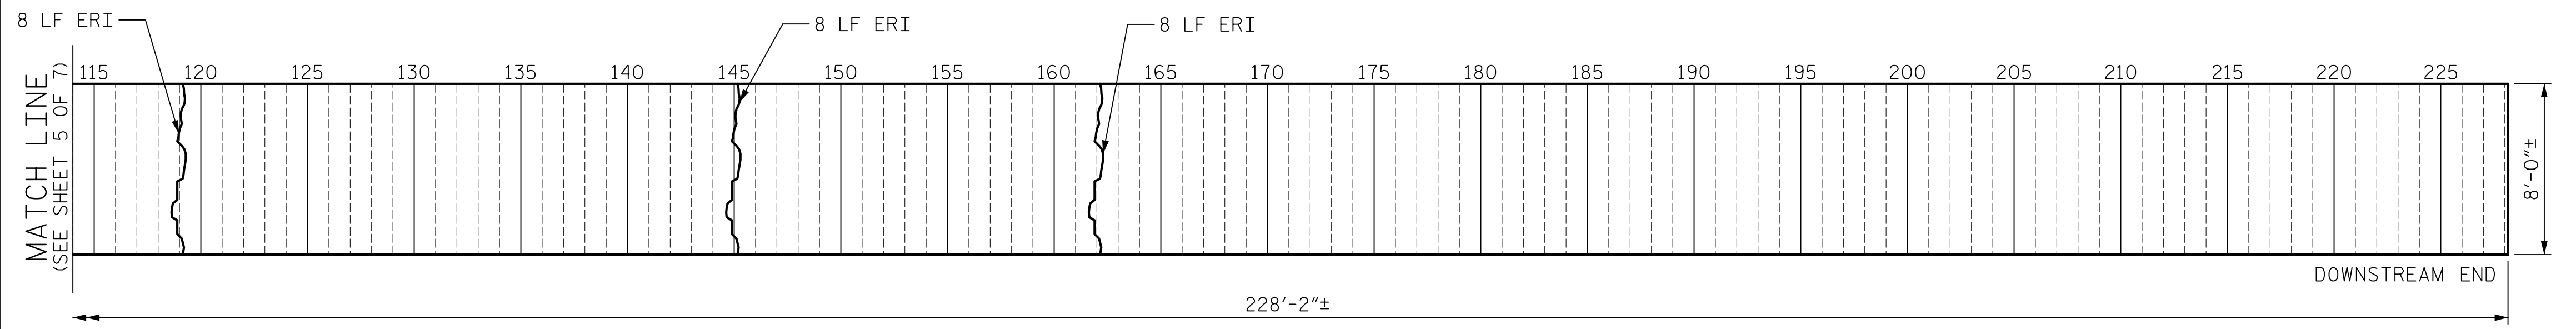


NORTH WALL ELEVATION

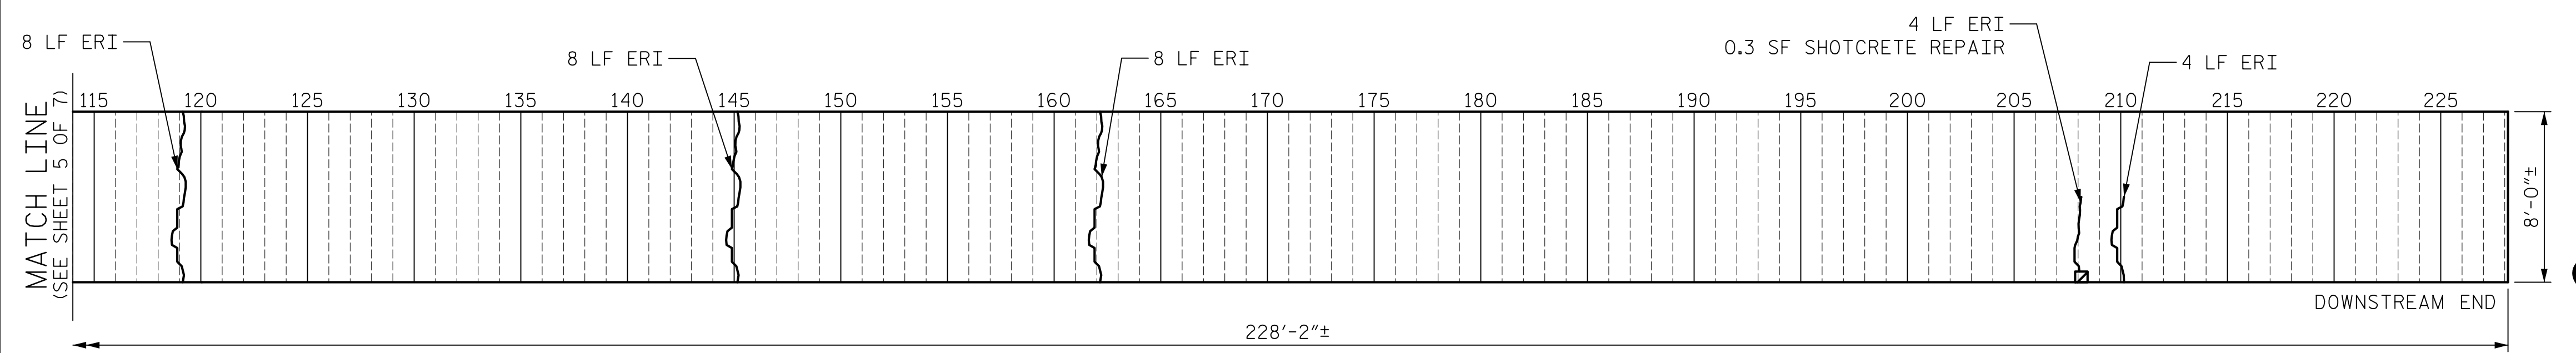

SOUTH WALL ELEVATION

Mead & Hunt
 111 E. Hargett Street
 Suite 300
 Raleigh, NC 27601
 919-714-8670
 meadhunt.com
 NC License No. F-1235

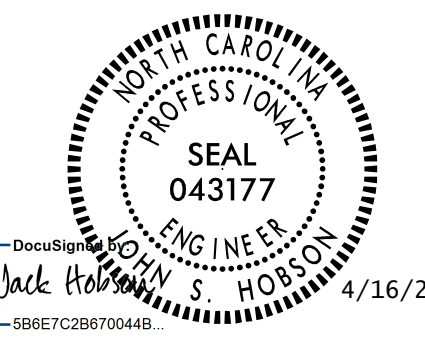

PROJECT NO. R-4707
GUILFORD COUNTY
 STATION: 56+34.85 -L-
 SHEET 6 OF 7


STATE OF NORTH CAROLINA
 DEPARTMENT OF TRANSPORTATION
 RALEIGH

BARREL 3 WALLS AND TOP SLAB REPAIRS


DRAWN BY : A.J. FORFA DATE : 03/05/19
 CHECKED BY : J.S. HOBSON DATE : 04/17/19
 DESIGN ENGINEER OF RECORD : J.S. HOBSON DATE : 04/26/19

DOCUMENT NOT CONSIDERED
 FINAL UNLESS ALL
 SIGNATURES COMPLETED

REVISIONS						SHEET NO.
NO.	BY:	DATE:	NO.	BY:	DATE:	C1-07
1			3			TOTAL SHEETS
2			4			24

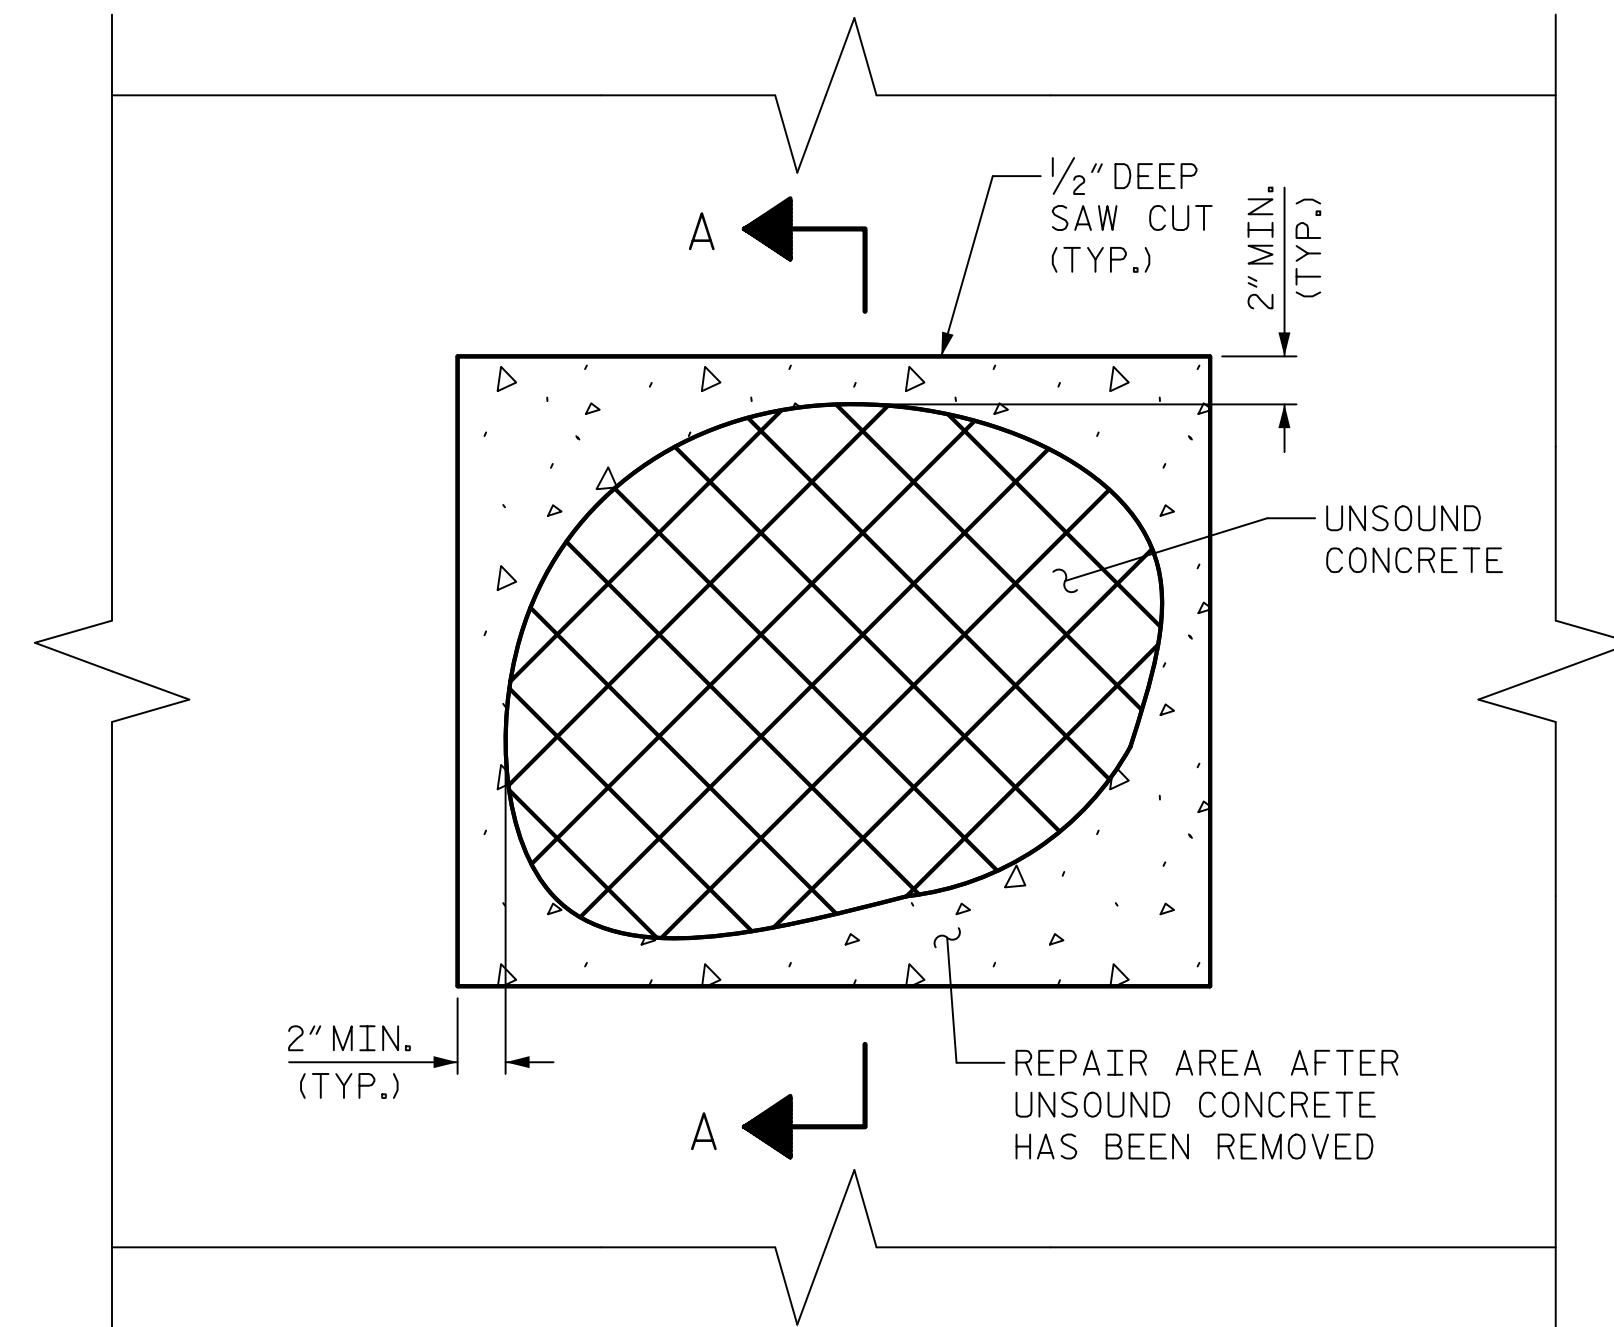

FACE REPAIR

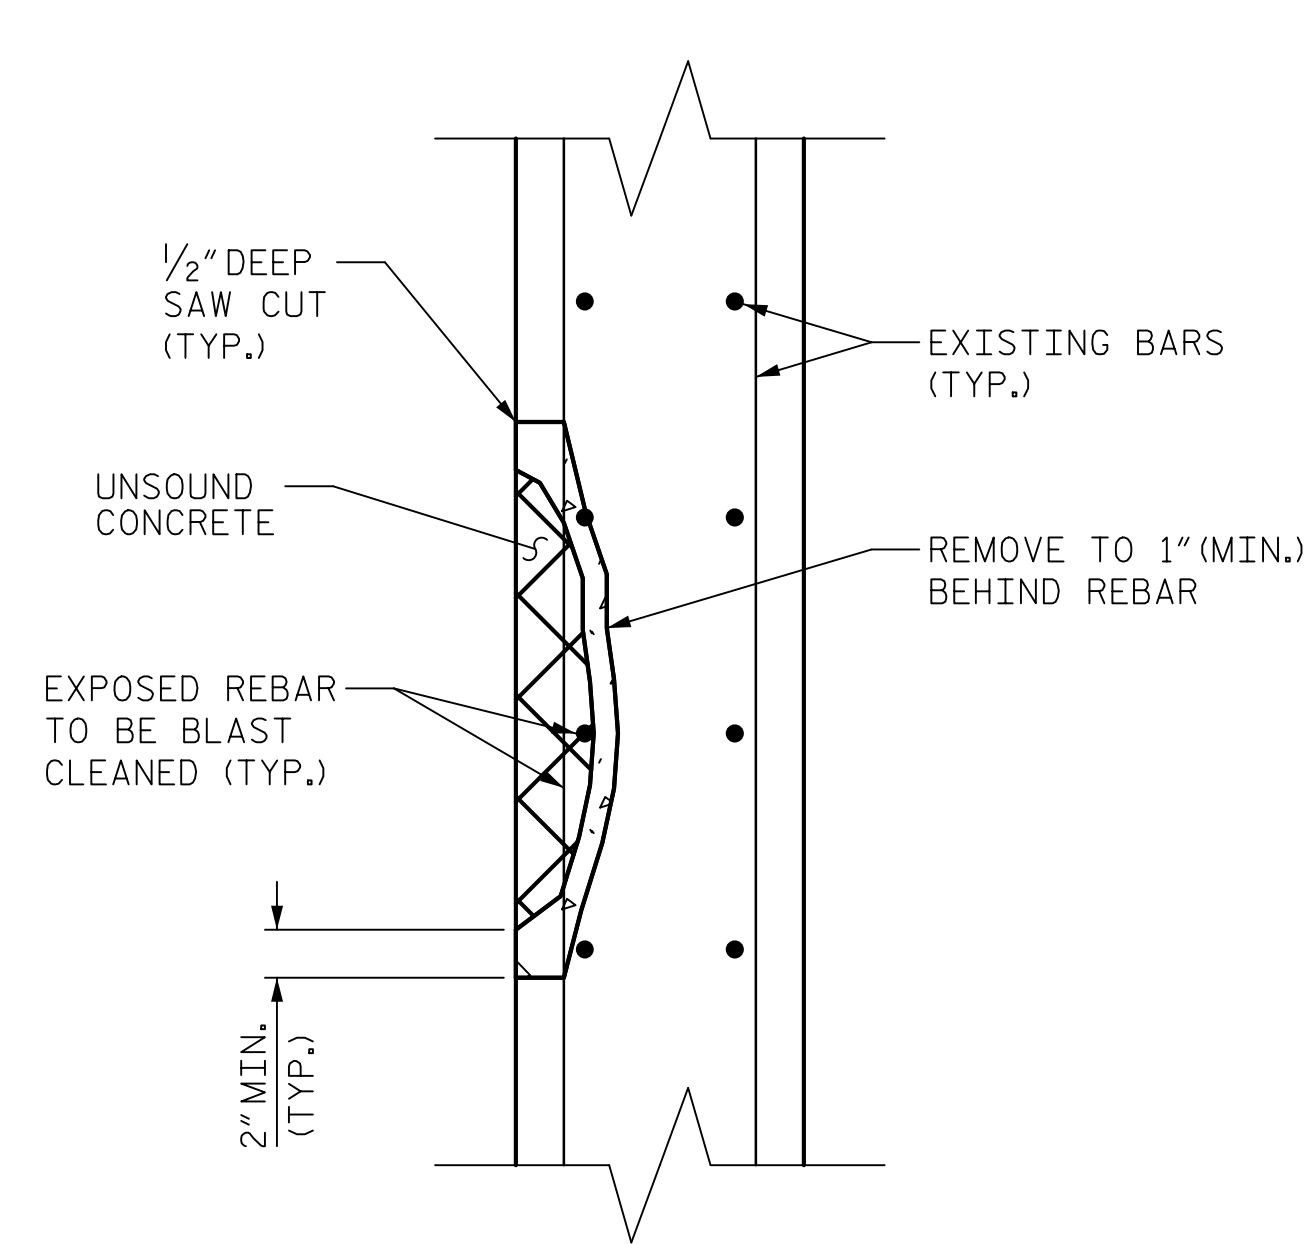

SECTION A-A


CULVERT REPAIR

NOTES:

- FOR SHALLOW REPAIRS THAT DO NOT ENGAGE REINFORCEMENT, ANCHOR PATCH MATERIAL USING 1/4" GALVANIZED BOLTS, EPOXY ANCHORED WITH 2" EMBEDMENT. PLACE IN A 6" GRID. USE A LATEX OR EPOXY PATCH MATERIAL FOR IMPROVED BOND.
- ANY DAMAGE TO EXISTING REINFORCING STEEL, DURING CONTRACTOR'S OPERATIONS, SHALL BE REPAIRED AS DIRECTED BY THE ENGINEER AND PERFORMED AT NO ADDITIONAL COST.
- ENSURE NO CONTENTS INSIDE THE ABANDONED UTILITY PIPE EMPTY INTO THE WATERWAY DURING THE REMOVAL PROCESS.
- PAYMENT FOR REPAIR OF EXISTING CULVERT WALL AND SLAB AT LOCATION OF REMOVAL OF ABANDONED UTILITY EMBEDDED IN CONCRETE SHALL BE MADE UNDER CONCRETE REPAIRS.

REPAIR SEQUENCE:

- SOUND CONCRETE TO DETERMINE EXTENT OF REPAIR LOCATION.
- REMOVE SURFACE CONCRETE TO VERIFY SAWCUT DEPTH WILL NOT DAMAGE EXISTING REINFORCING STEEL. SAW CUT AROUND REPAIR AREA TO A NOMINAL DEPTH OF 1/2".
- REMOVE CONCRETE WITHIN A SAW CUT AREA TO MINIMUM 1/2" DEPTH.
- ABRASIVE BLAST ALL EXPOSED EXISTING REINFORCING STEEL IN REPAIR AREAS TO REMOVE LOOSE CONCRETE, RUST SCALE, ETC. FOR BARS WITH MORE THAN 10% SECTION LOSS, SPLICE AND SECURELY TIE SUPPLEMENTAL REINFORCING BARS AS NEEDED.
- REMOVE ALL LOOSE OR WEAKENED MATERIAL THEN CLEAN THE REPAIR AREA OF DIRT, GREASE, OIL, AND FOREIGN MATTER.
- PREPARE SURFACE AND PLACE APPROVED REPAIR MATERIAL ACCORDING TO MANUFACTURER'S RECOMMENDATIONS.

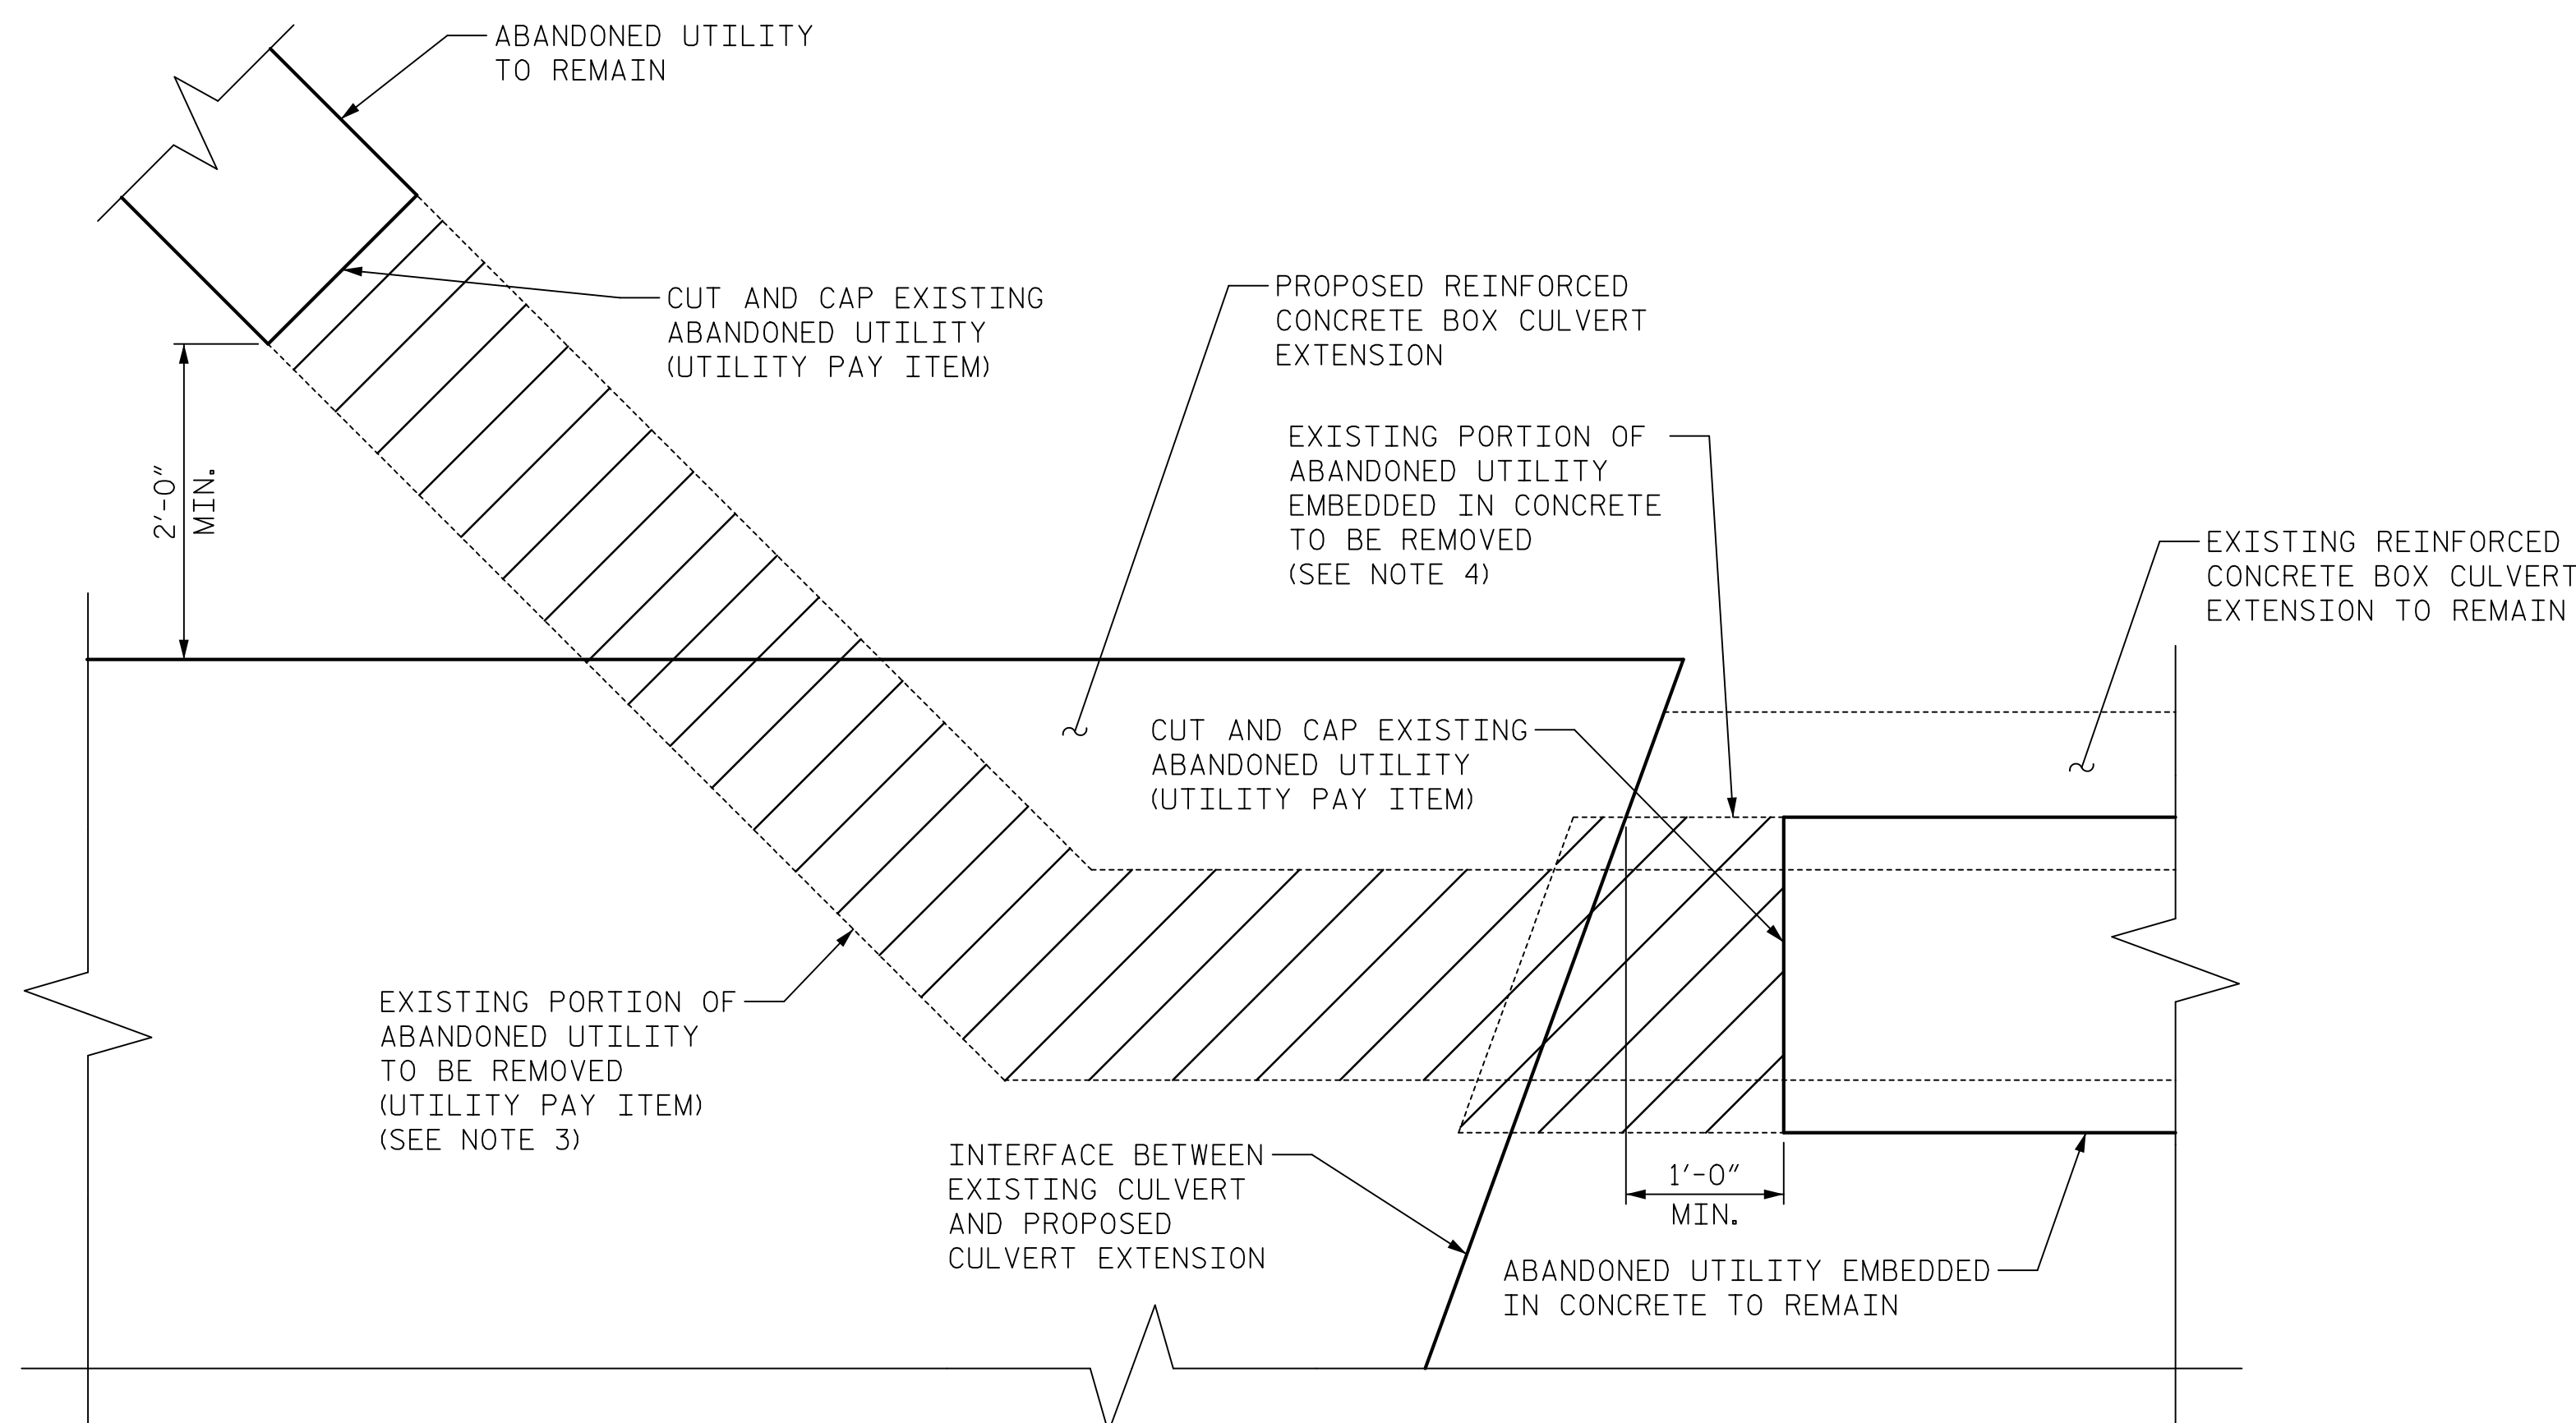


UTILITY REMOVAL DETAIL

(UPSTREAM END OF BARREL 1)



111 E. Hargett Street
Suite 300
Raleigh, NC 27601
919-714-8670
meadhunt.com
NC License No. F-1235

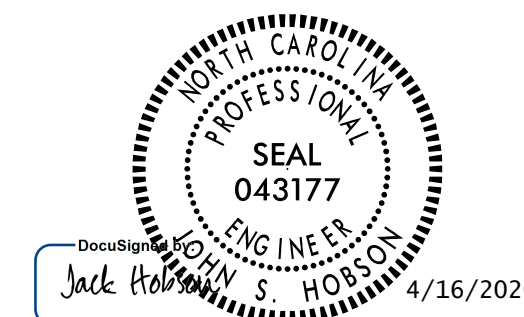

PROJECT NO. R-4707

GUILFORD COUNTY

STATION: 56+34.85 -L-

SHEET 7 OF 7

STATE OF NORTH CAROLINA
DEPARTMENT OF TRANSPORTATION
RALEIGH

**CULVERT REPAIR
DETAILS**

DRAWN BY : A.J. FORFA DATE : 03/06/19
CHECKED BY : J.S. HOBSON DATE : 04/17/19
DESIGN ENGINEER OF RECORD : J.S. HOBSON DATE : 04/26/19

DOCUMENT NOT CONSIDERED
FINAL UNLESS ALL
SIGNATURES COMPLETED

REVISIONS						SHEET NO.
NO.	BY:	DATE:	NO.	BY:	DATE:	C1-08
1			3			TOTAL SHEETS
2			4			24

LOAD FACTORS:

DESIGN LOAD RATING FACTORS

LOAD TYPE	MAX FACTOR	MIN FACTOR
DC	1.25	0.90
DW	1.50	0.65
EV	1.30	0.90
EH	1.35	0.90
ES	1.35	0.90
LS	1.75	--
WA	1.00	--

LOAD AND RESISTANCE FACTOR RATING (LRFR)
SUMMARY FOR REINFORCED CONCRETE BOX CULVERTS


	CONTROLLING LOAD RATING	MINIMUM RATING FACTOR (RF)	STRENGTH I LIMIT STATE							
			MOMENT				SHEAR			
			RATING FACTOR	BOX NO.	ELEMENT TYPE	DISTANCE FROM LEFT END OF ELEMENT (FT)	RATING FACTOR	BOX NO.	ELEMENT TYPE	DISTANCE FROM LEFT END OF ELEMENT (FT)
PERMANENT LOAD RATING	①	1.03	1.09	1	TOP SLAB	3.88	1.03	1	TOP SLAB	2

NOTES:

RATING FACTORS ARE BASED ON THE STRENGTH I LIMIT STATE.

THE EFFECTS OF LIVE LOAD ON DESIGN AND LOAD RATING MAY BE NEGLECTED FOR CULVERTS WITH CERTAIN FILL DEPTHS DESCRIBED IN THE AASHTO LRFD BRIDGE DESIGN SPECIFICATIONS.

CULVERTS WITH NEGLIGIBLE LIVE LOAD SHOULD BE LOAD RATED FOR PERMANENT LOADS ONLY IN ACCORDANCE WITH THE AASHTO MANUAL FOR BRIDGE EVALUATION.

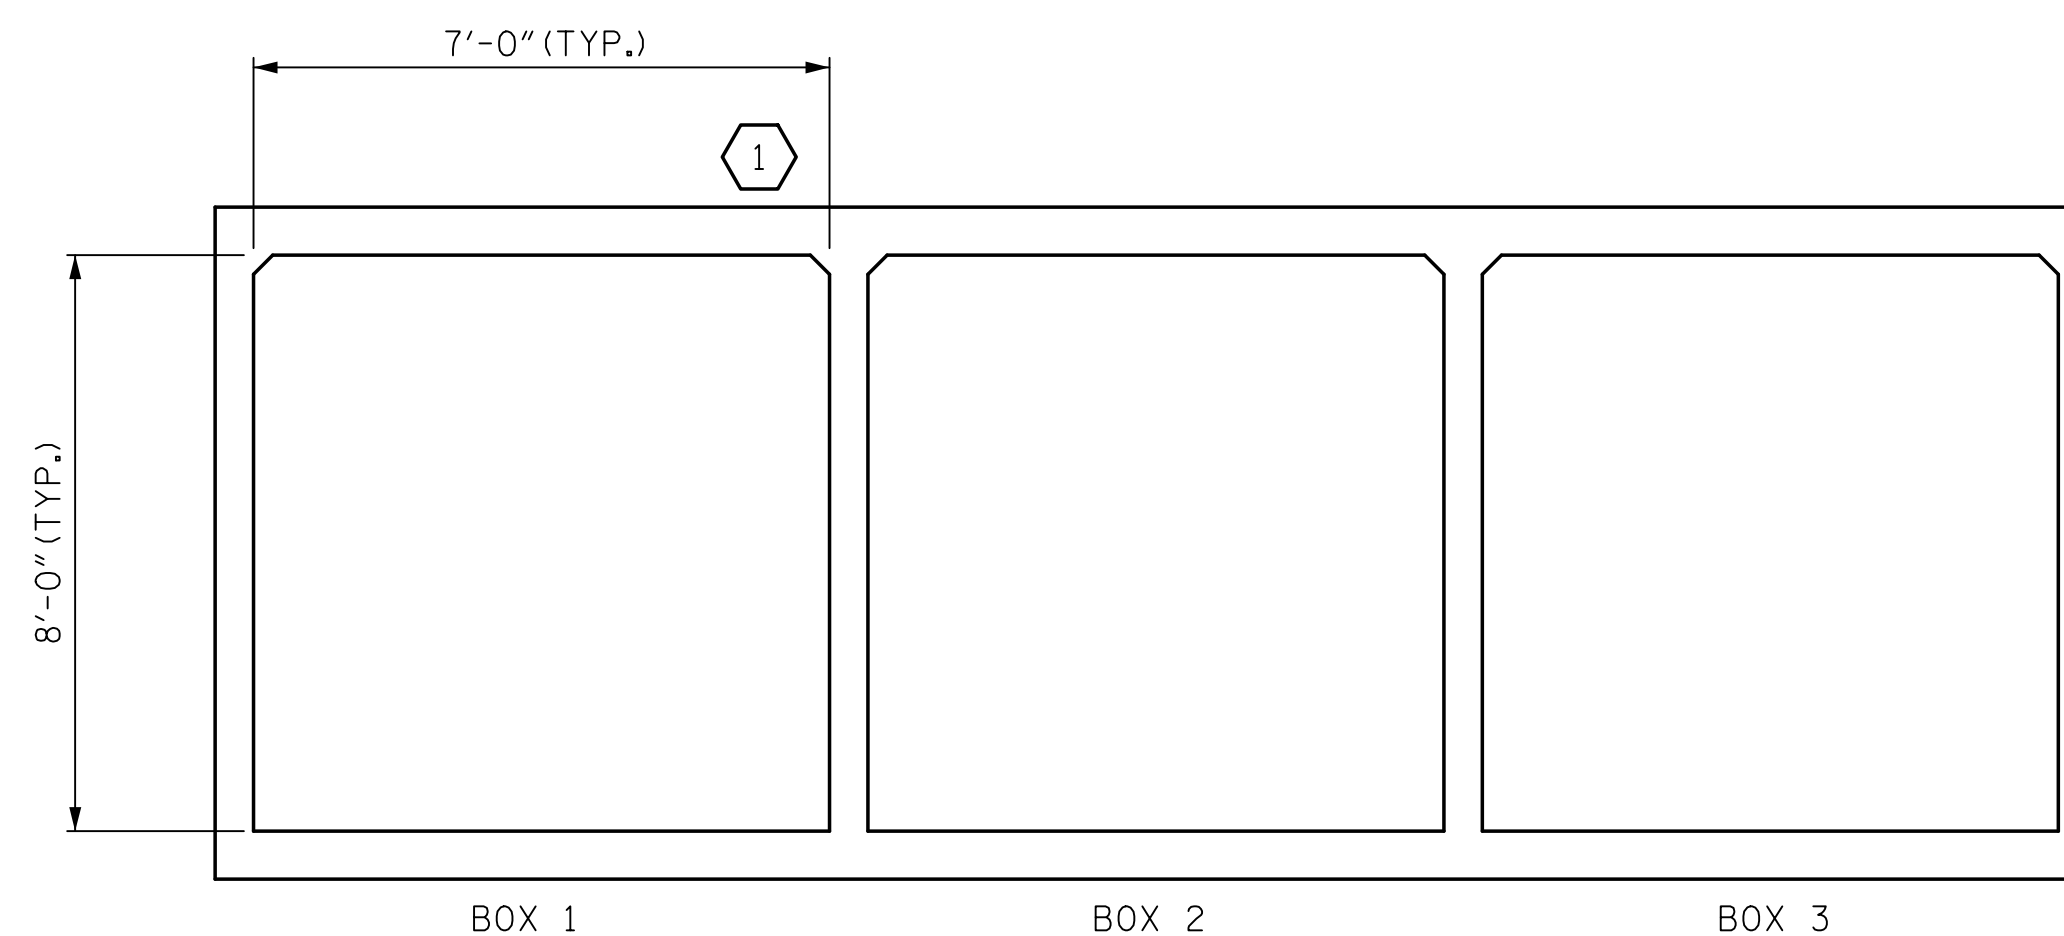


LRFR SUMMARY

(LOOKING DOWNSTREAM)

Mead & Hunt

111 E. Hargett Street
Suite 300
Raleigh, NC 27601
919-714-8670
meadhunt.com
NC License No. F-1235

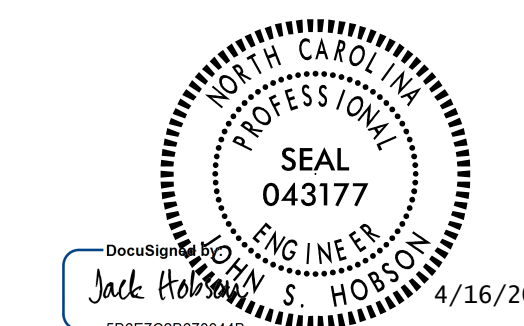

DOCUMENT NOT CONSIDERED
FINAL UNLESS ALL
SIGNATURES COMPLETED

PROJECT NO. R-4707
GUILFORD COUNTY
STATION: 56+34.85 -L-


SHEET 1 OF 16

STATE OF NORTH CAROLINA
DEPARTMENT OF TRANSPORTATION
RALEIGH
STANDARD
LRFR SUMMARY FOR
REINFORCED CONCRETE
BOX CULVERTS
(DEEP FILLS)
(LEFT AND RIGHT EXTENSION)


REVISIONS						SHEET NO.
NO.	BY:	DATE:	NO.	BY:	DATE:	C1-09
1			3			TOTAL SHEETS
2			4			24

STD. NO. LRFR7

ASSEMBLED BY :	J.S. HOBSON	DATE : 03/01/19
CHECKED BY :	J.A. LEE	DATE : 04/15/19
DRAWN BY :	BNB 6/19	
CHECKED BY :	THC 6/19	

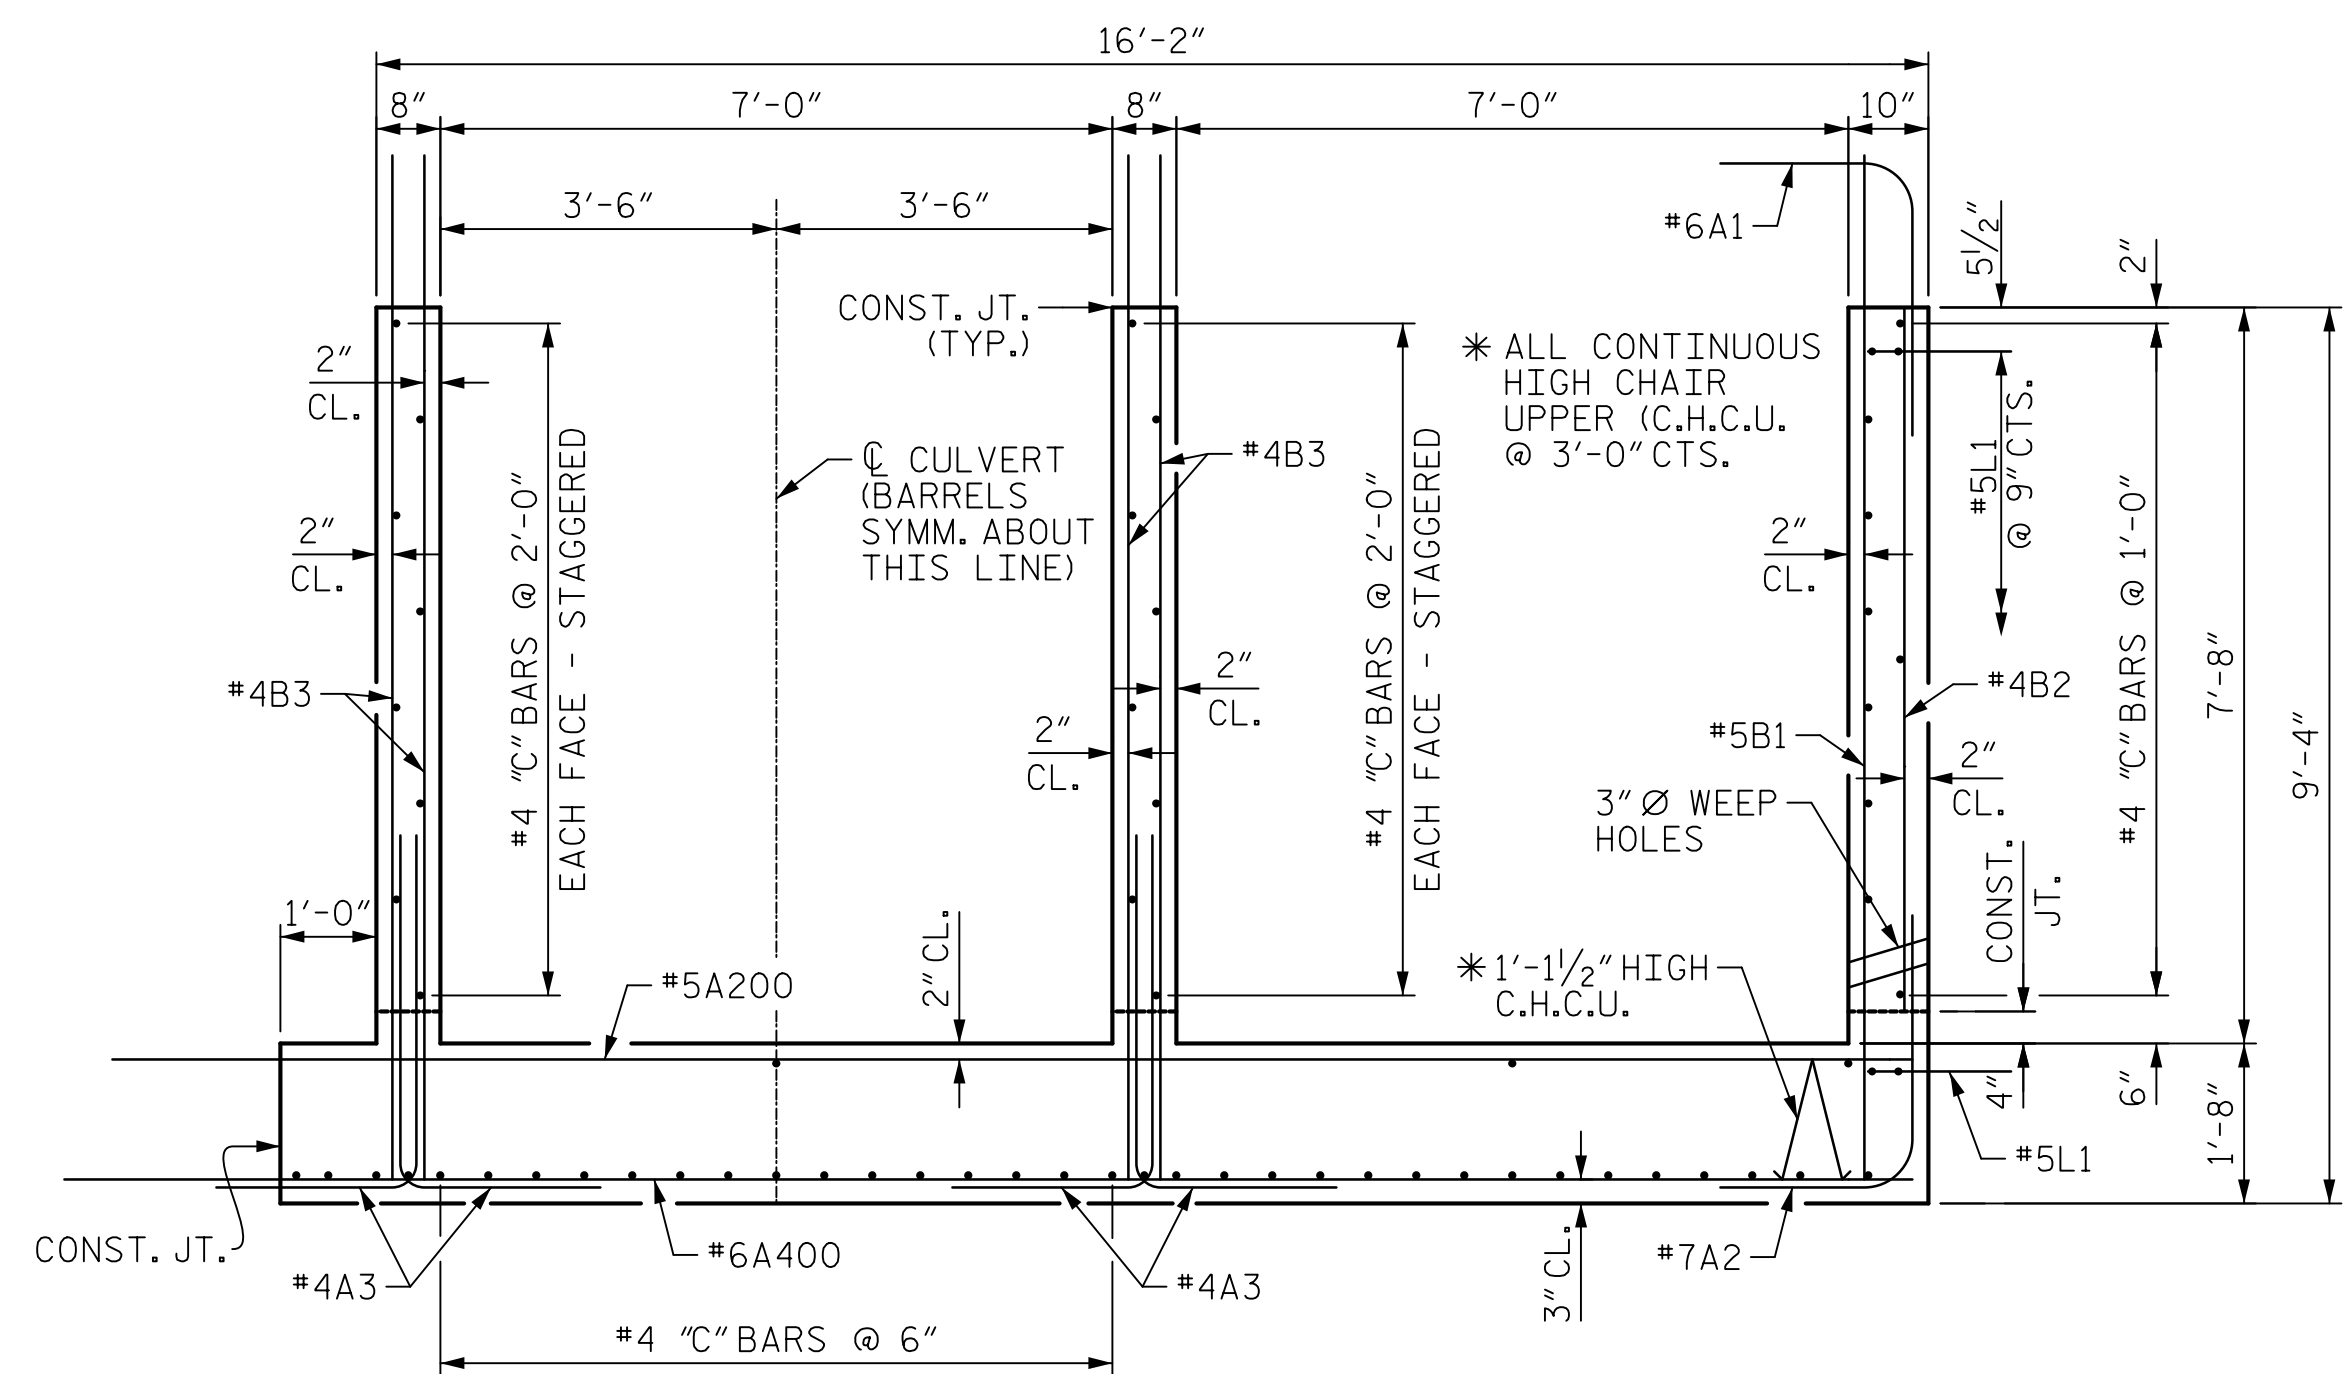


RIGHT ANGLE SECTION OF BARREL
 LEFT EXTENSION - PHASE I (LOOKING DOWNSTREAM)
 THERE ARE 63 "C" BARS IN SECTION OF BARREL

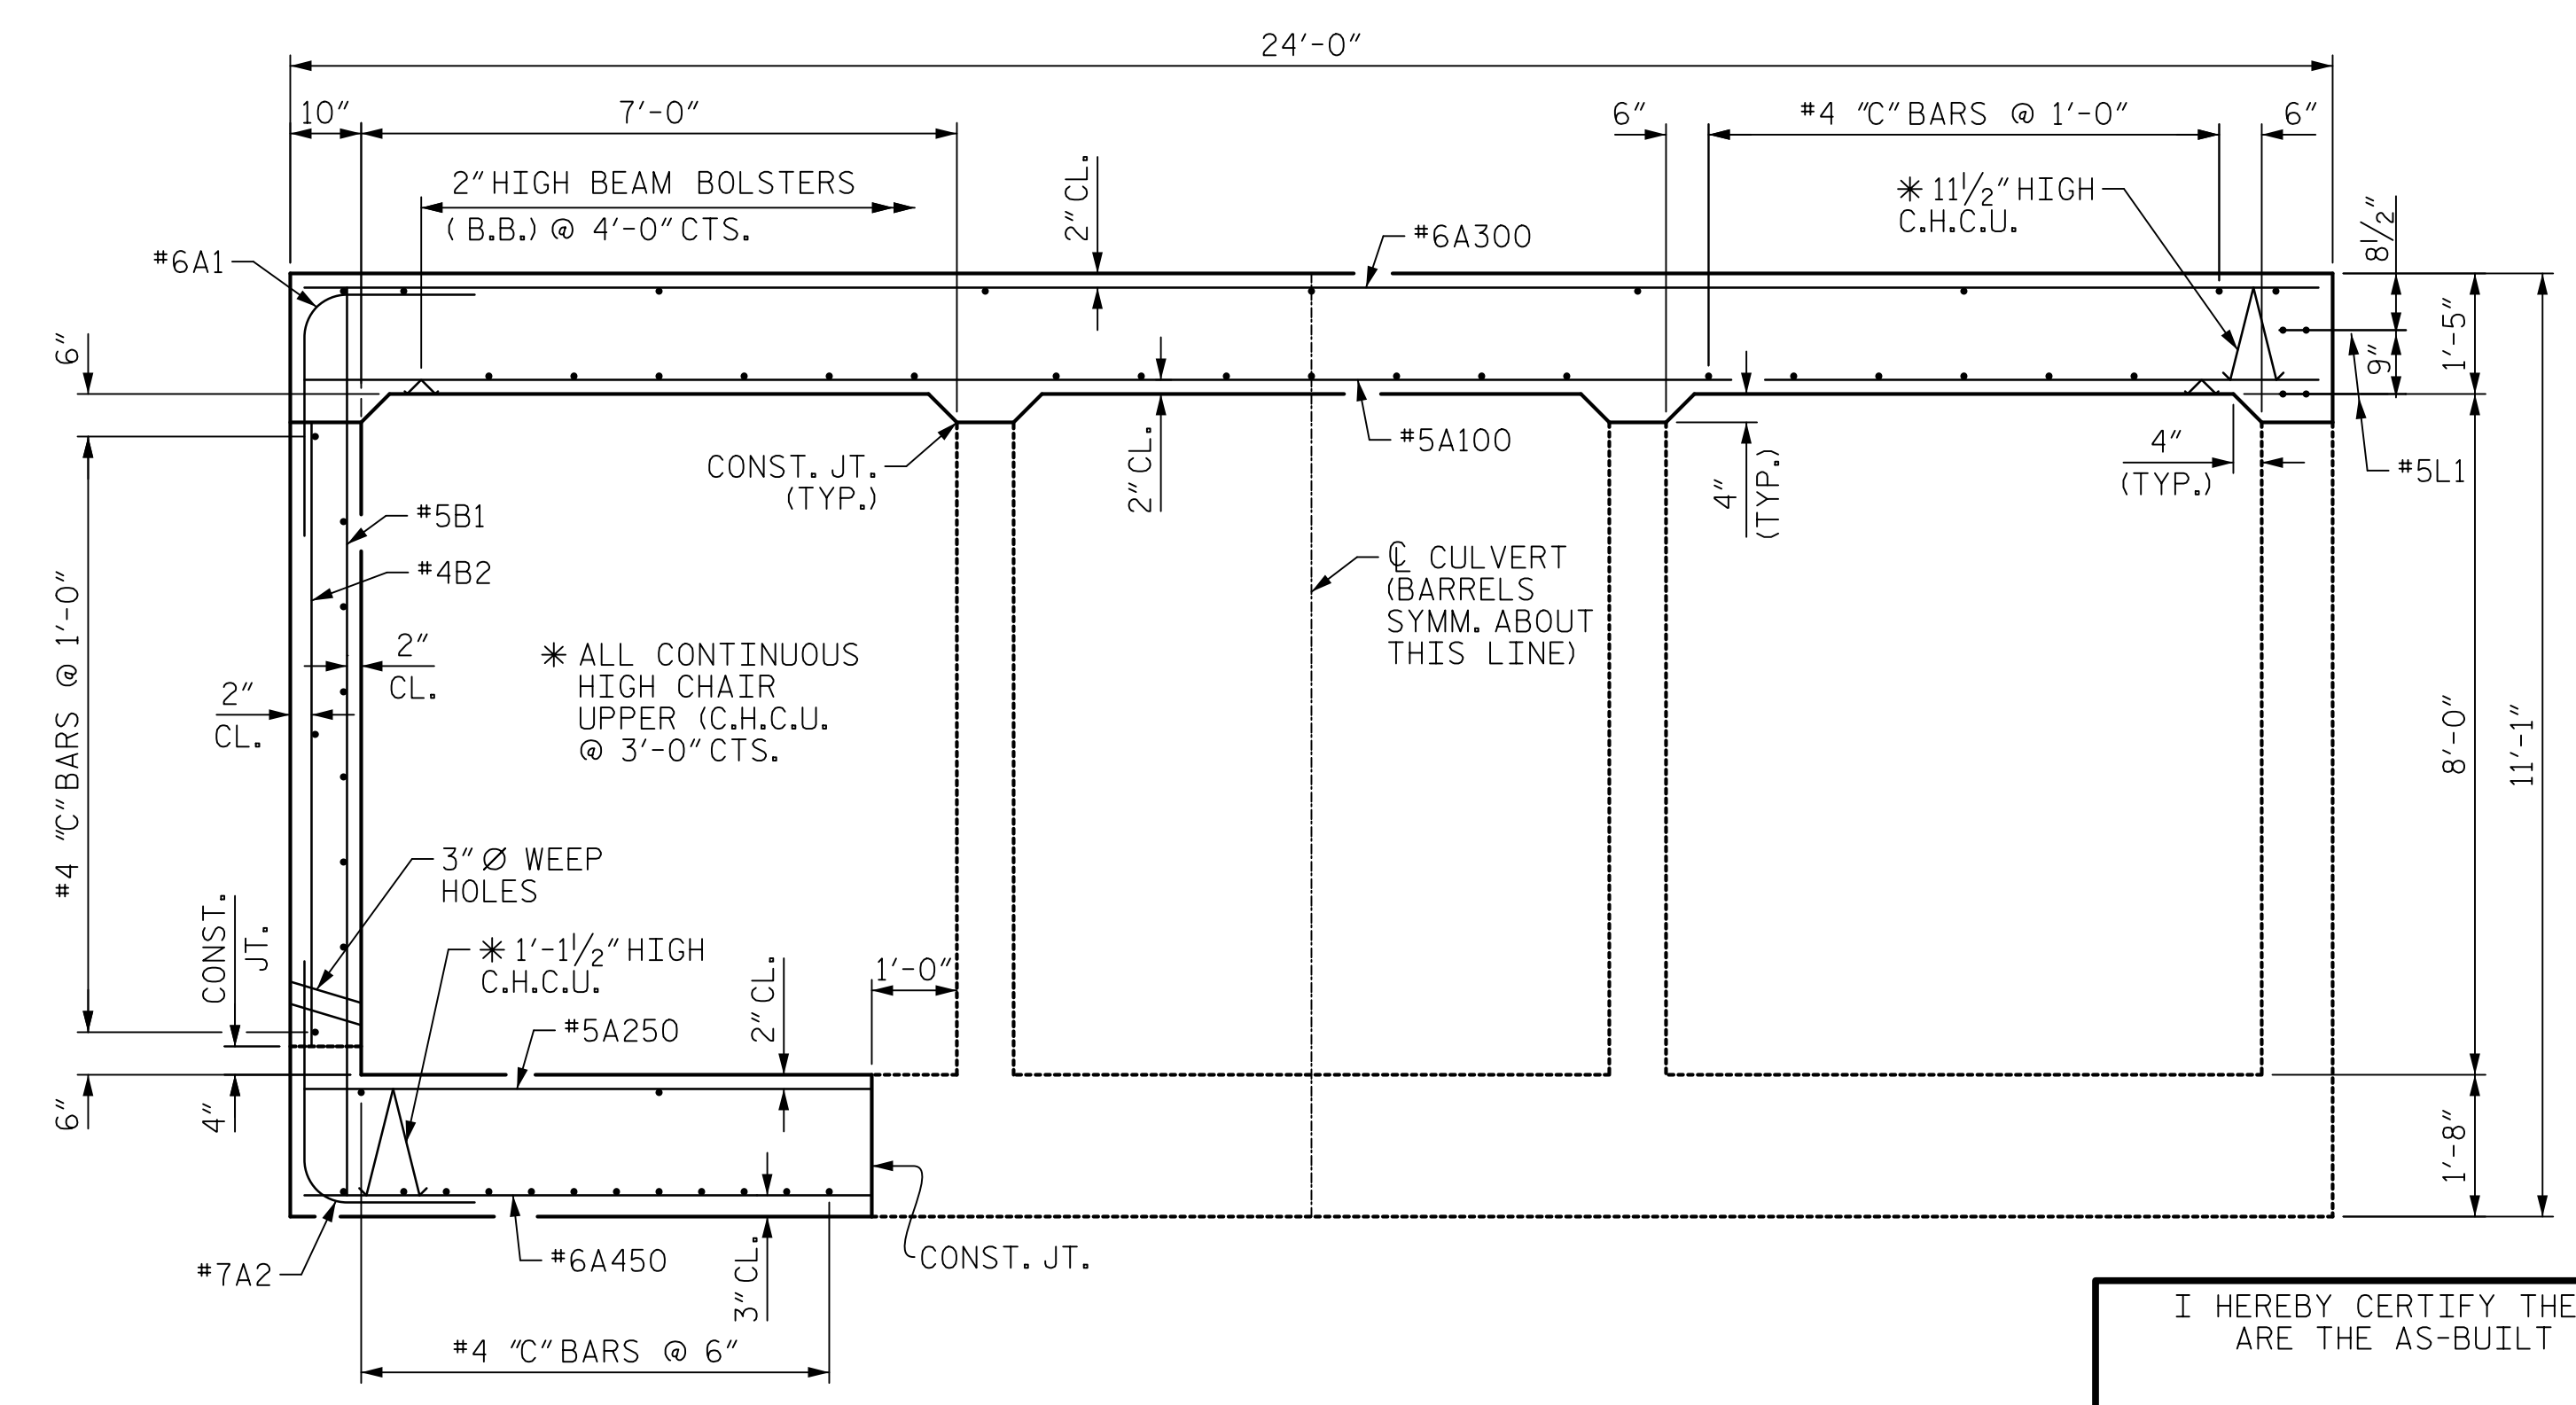


RIGHT ANGLE SECTION OF BARREL
 LEFT EXTENSION - PHASE II (LOOKING DOWNSTREAM)
 THERE ARE 51 "C" BARS IN SECTION OF BARREL

I HEREBY CERTIFY THESE PLANS ARE THE AS-BUILT PLANS

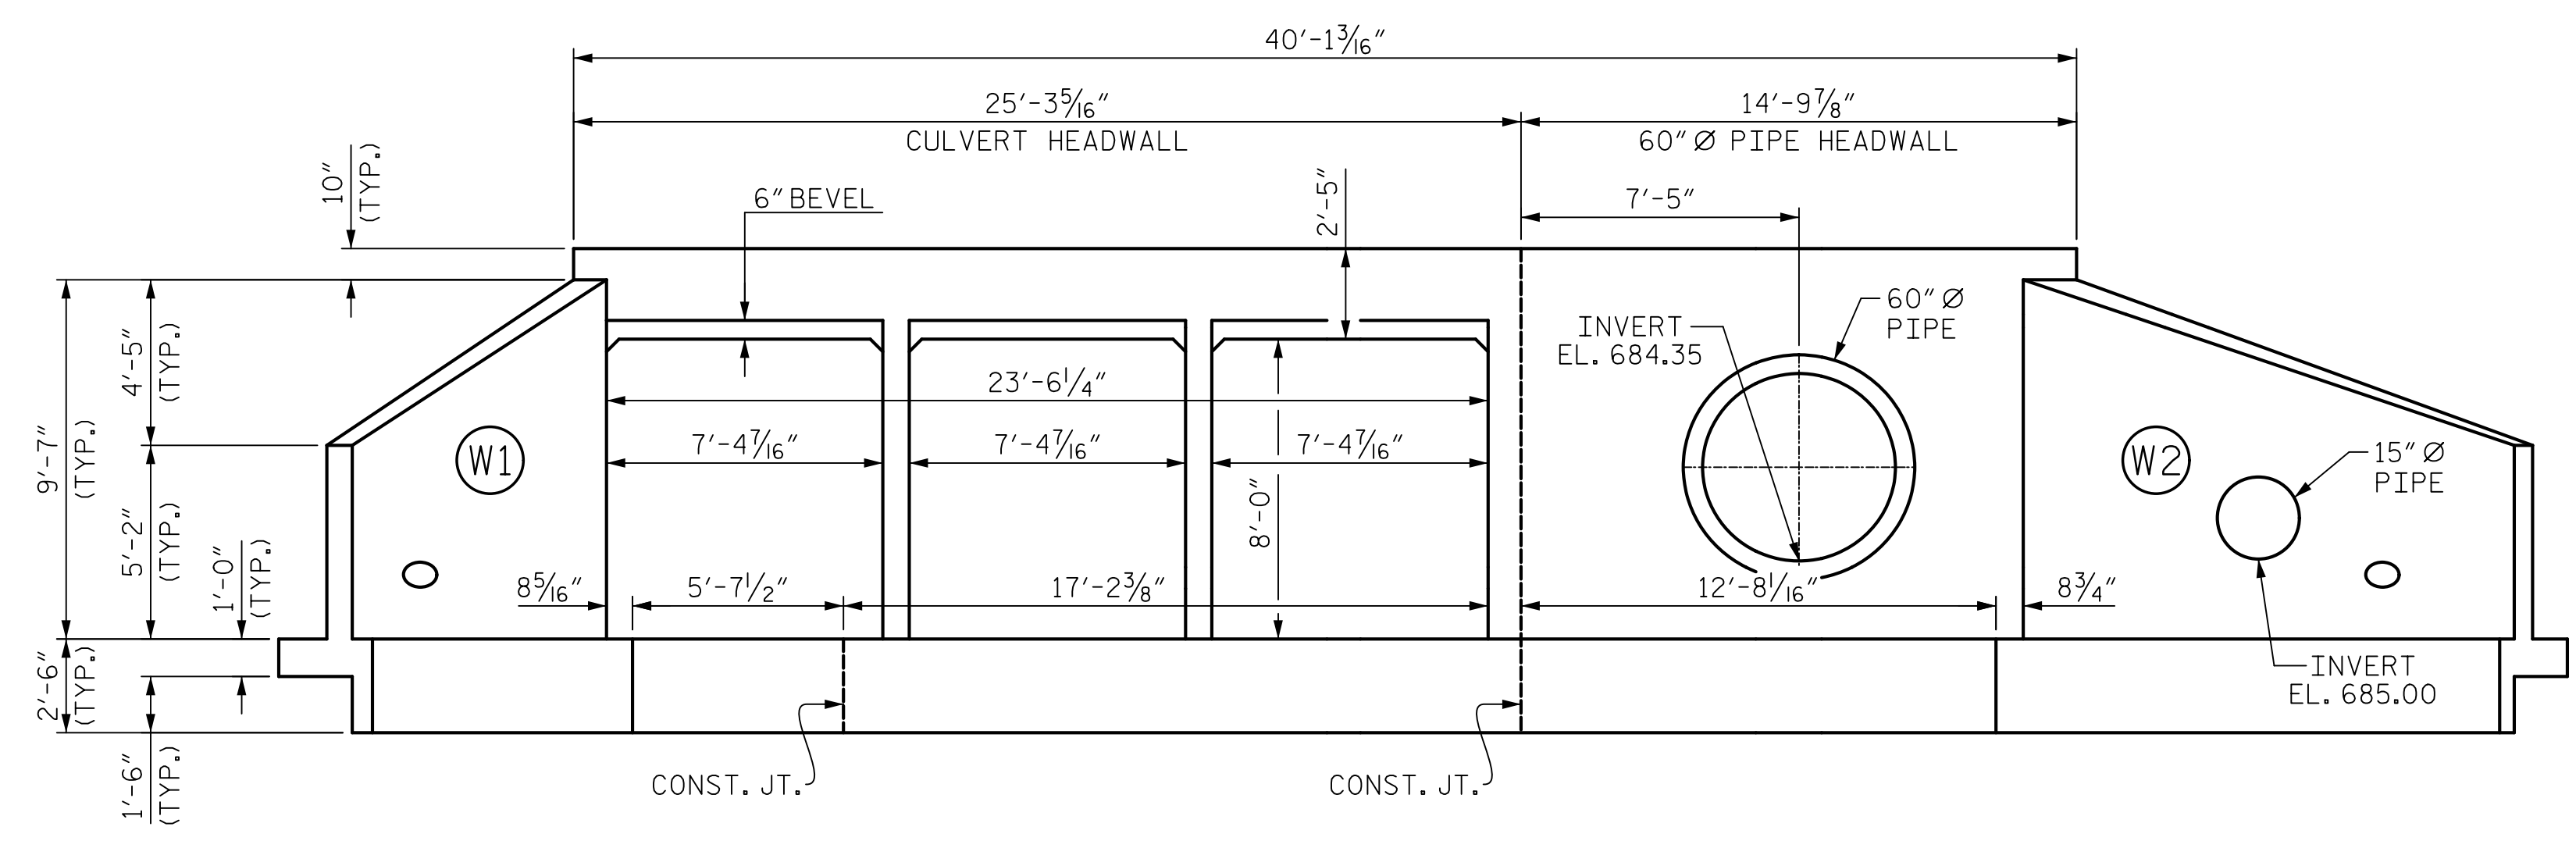

LEFT END ELEVATION NORMAL TO SKEW
 (LOOKING DOWNSTREAM)

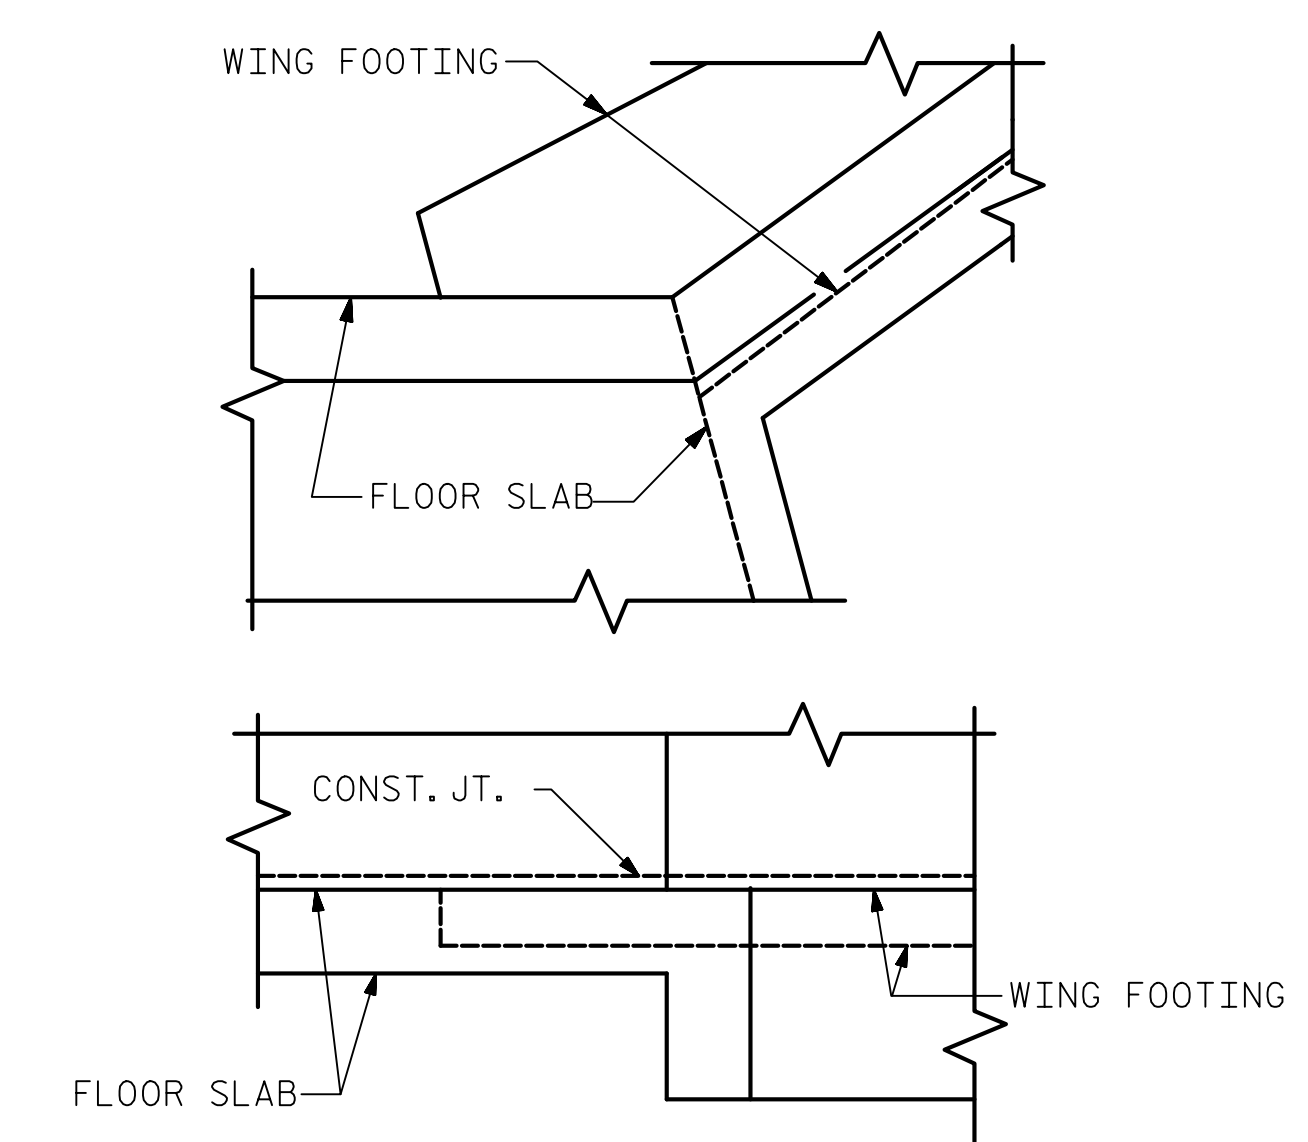

DETAIL
 CONNECTION OF WING FOOTING AND FLOOR SLAB WHEN SLAB IS THICKER THAN FOOTING

Mead & Hunt
 111 E. Hargett Street
 Suite 300
 Raleigh, NC 27601
 919-714-8670
 meadhunt.com
 NC License No. F-1235


SEAL
 043177
 ENGINEER
 JOHN S. HOBSON
 Jack Hobson
 4/16/2020
 DOCUMENT NOT CONSIDERED FINAL UNLESS ALL SIGNATURES COMPLETED

PROJECT NO. R-4707
GUILFORD COUNTY
 STATION: 56+34.85 -L-
 SHEET 2 OF 16


STATE OF NORTH CAROLINA
 DEPARTMENT OF TRANSPORTATION
 RALEIGH
TRIPLE 7 FT. x 8 FT. REINFORCED CONCRETE BOX CULVERT
 (LEFT EXTENSION)

DRAWN BY : J.S. HOBSON DATE : 03/28/19
 CHECKED BY : J.A. LEE DATE : 04/15/19
 DESIGN ENGINEER OF RECORD : J.S. HOBSON DATE : 04/26/19

REVISIONS						SHEET NO.
NO.	BY:	DATE:	NO.	BY:	DATE:	C1-10
1			3			TOTAL SHEETS
2			4			24

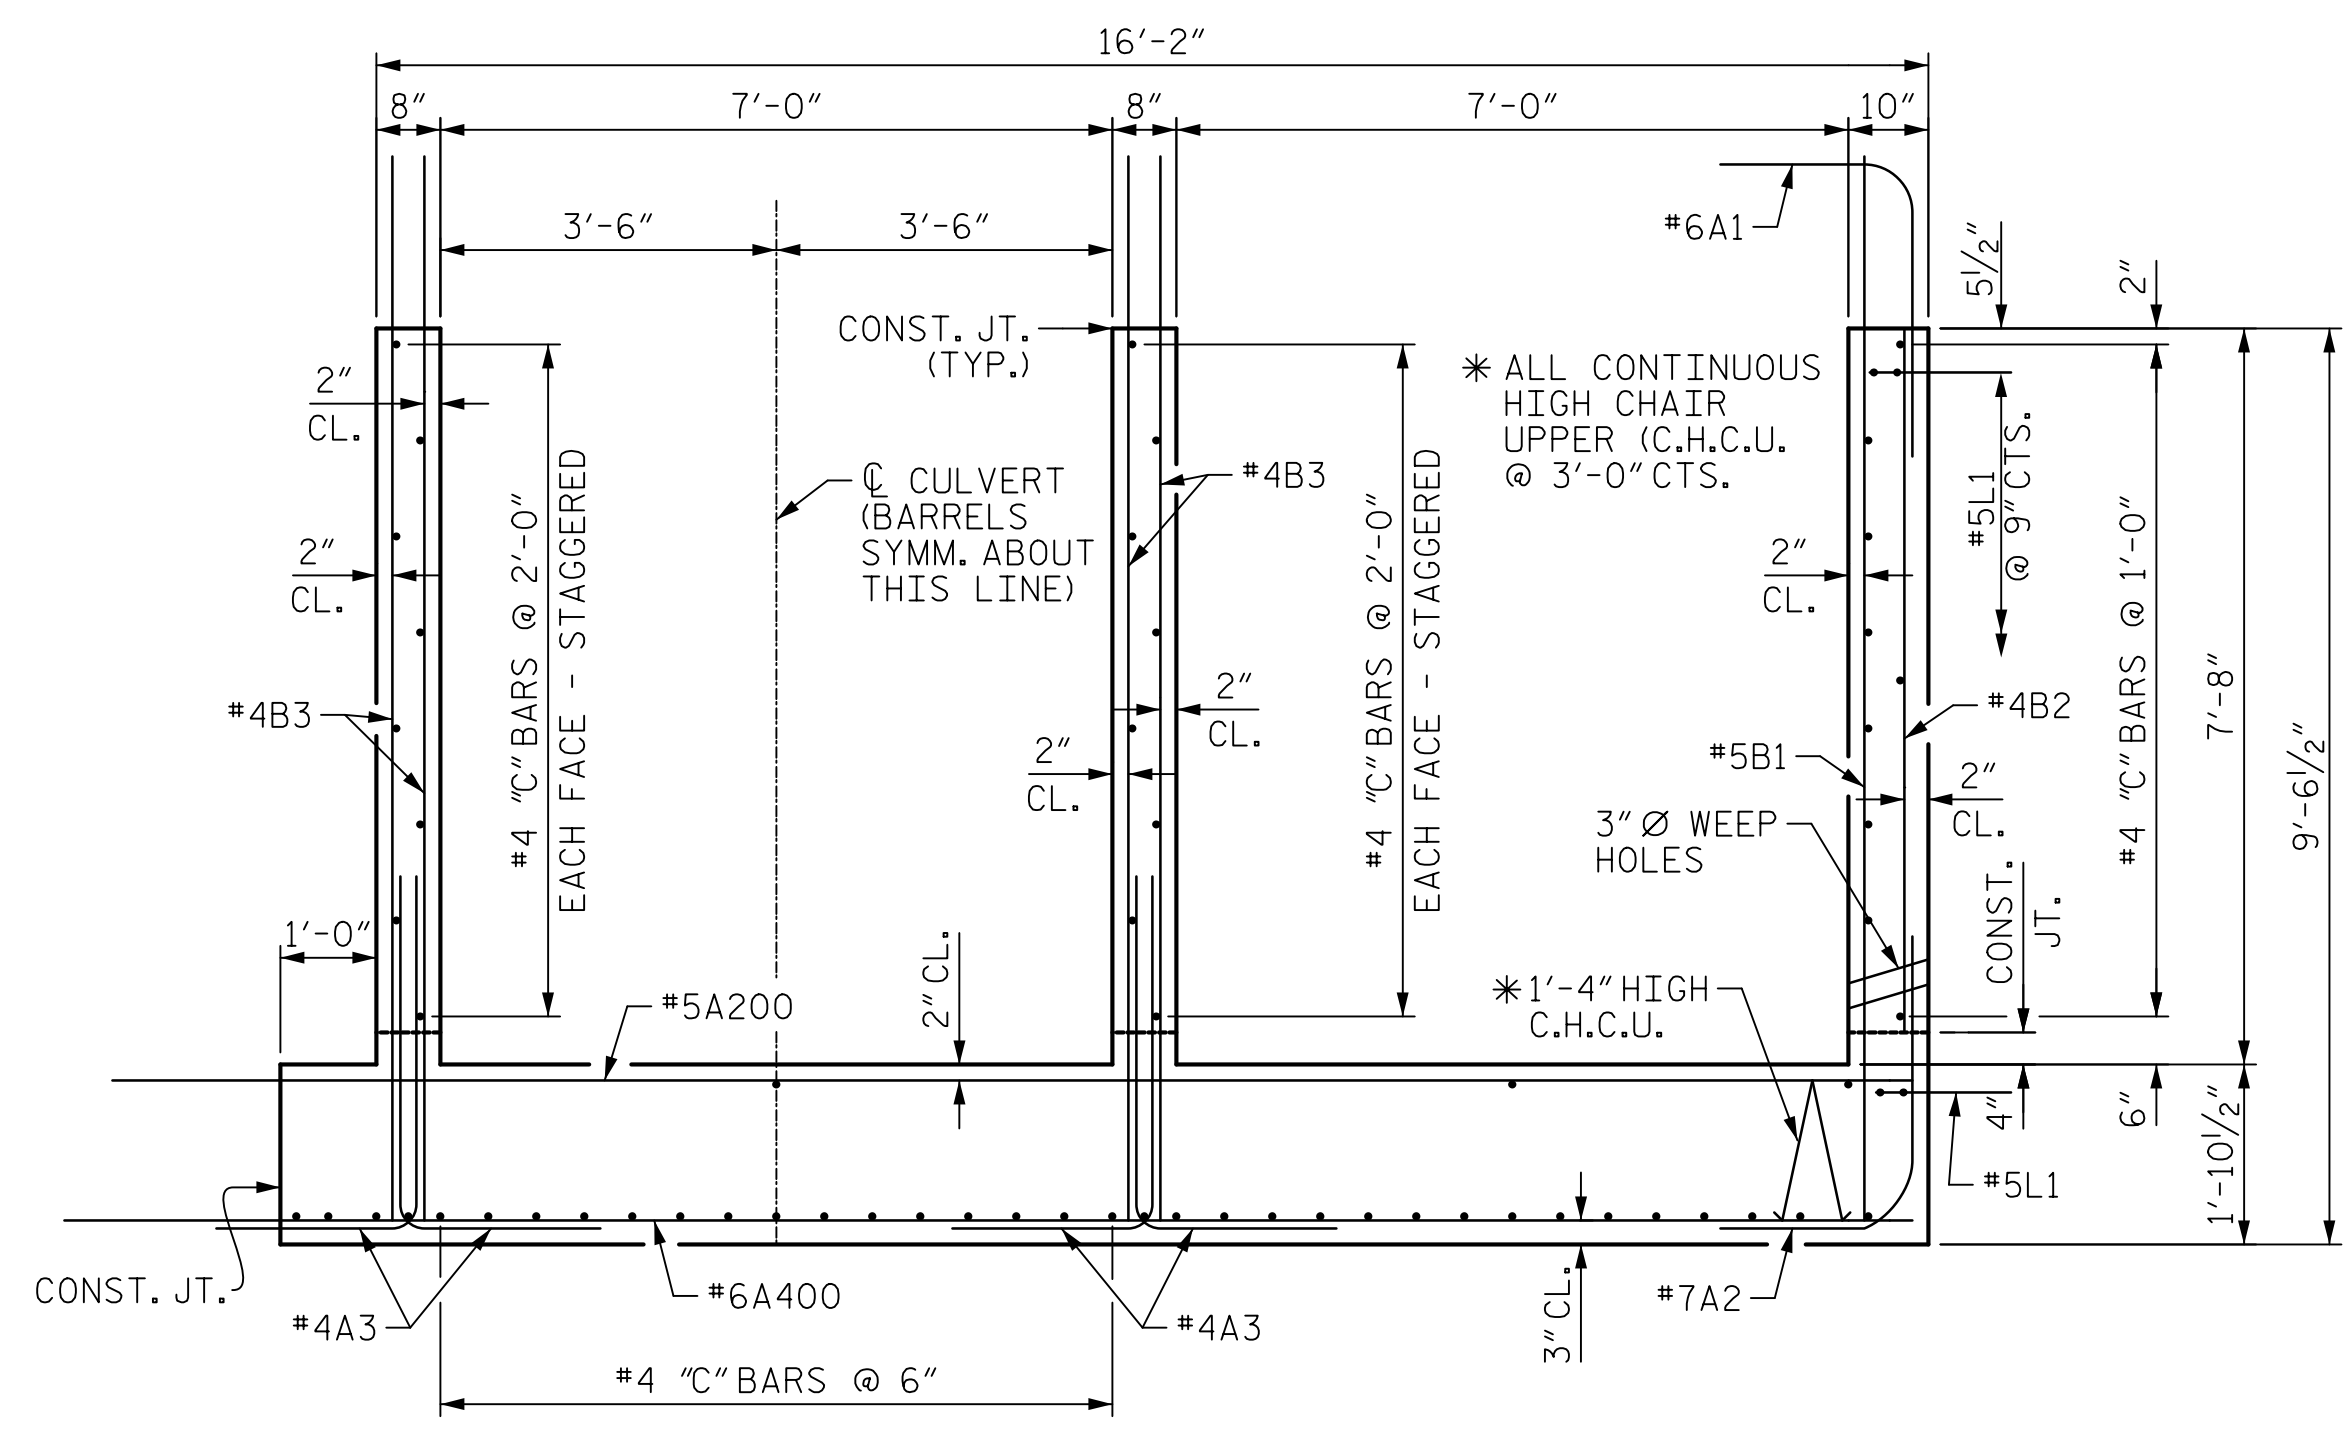


RIGHT ANGLE SECTION OF BARREL
 RIGHT EXTENSION - PHASE I (LOOKING DOWNSTREAM)
 THERE ARE 63 "C" BARS IN SECTION OF BARREL

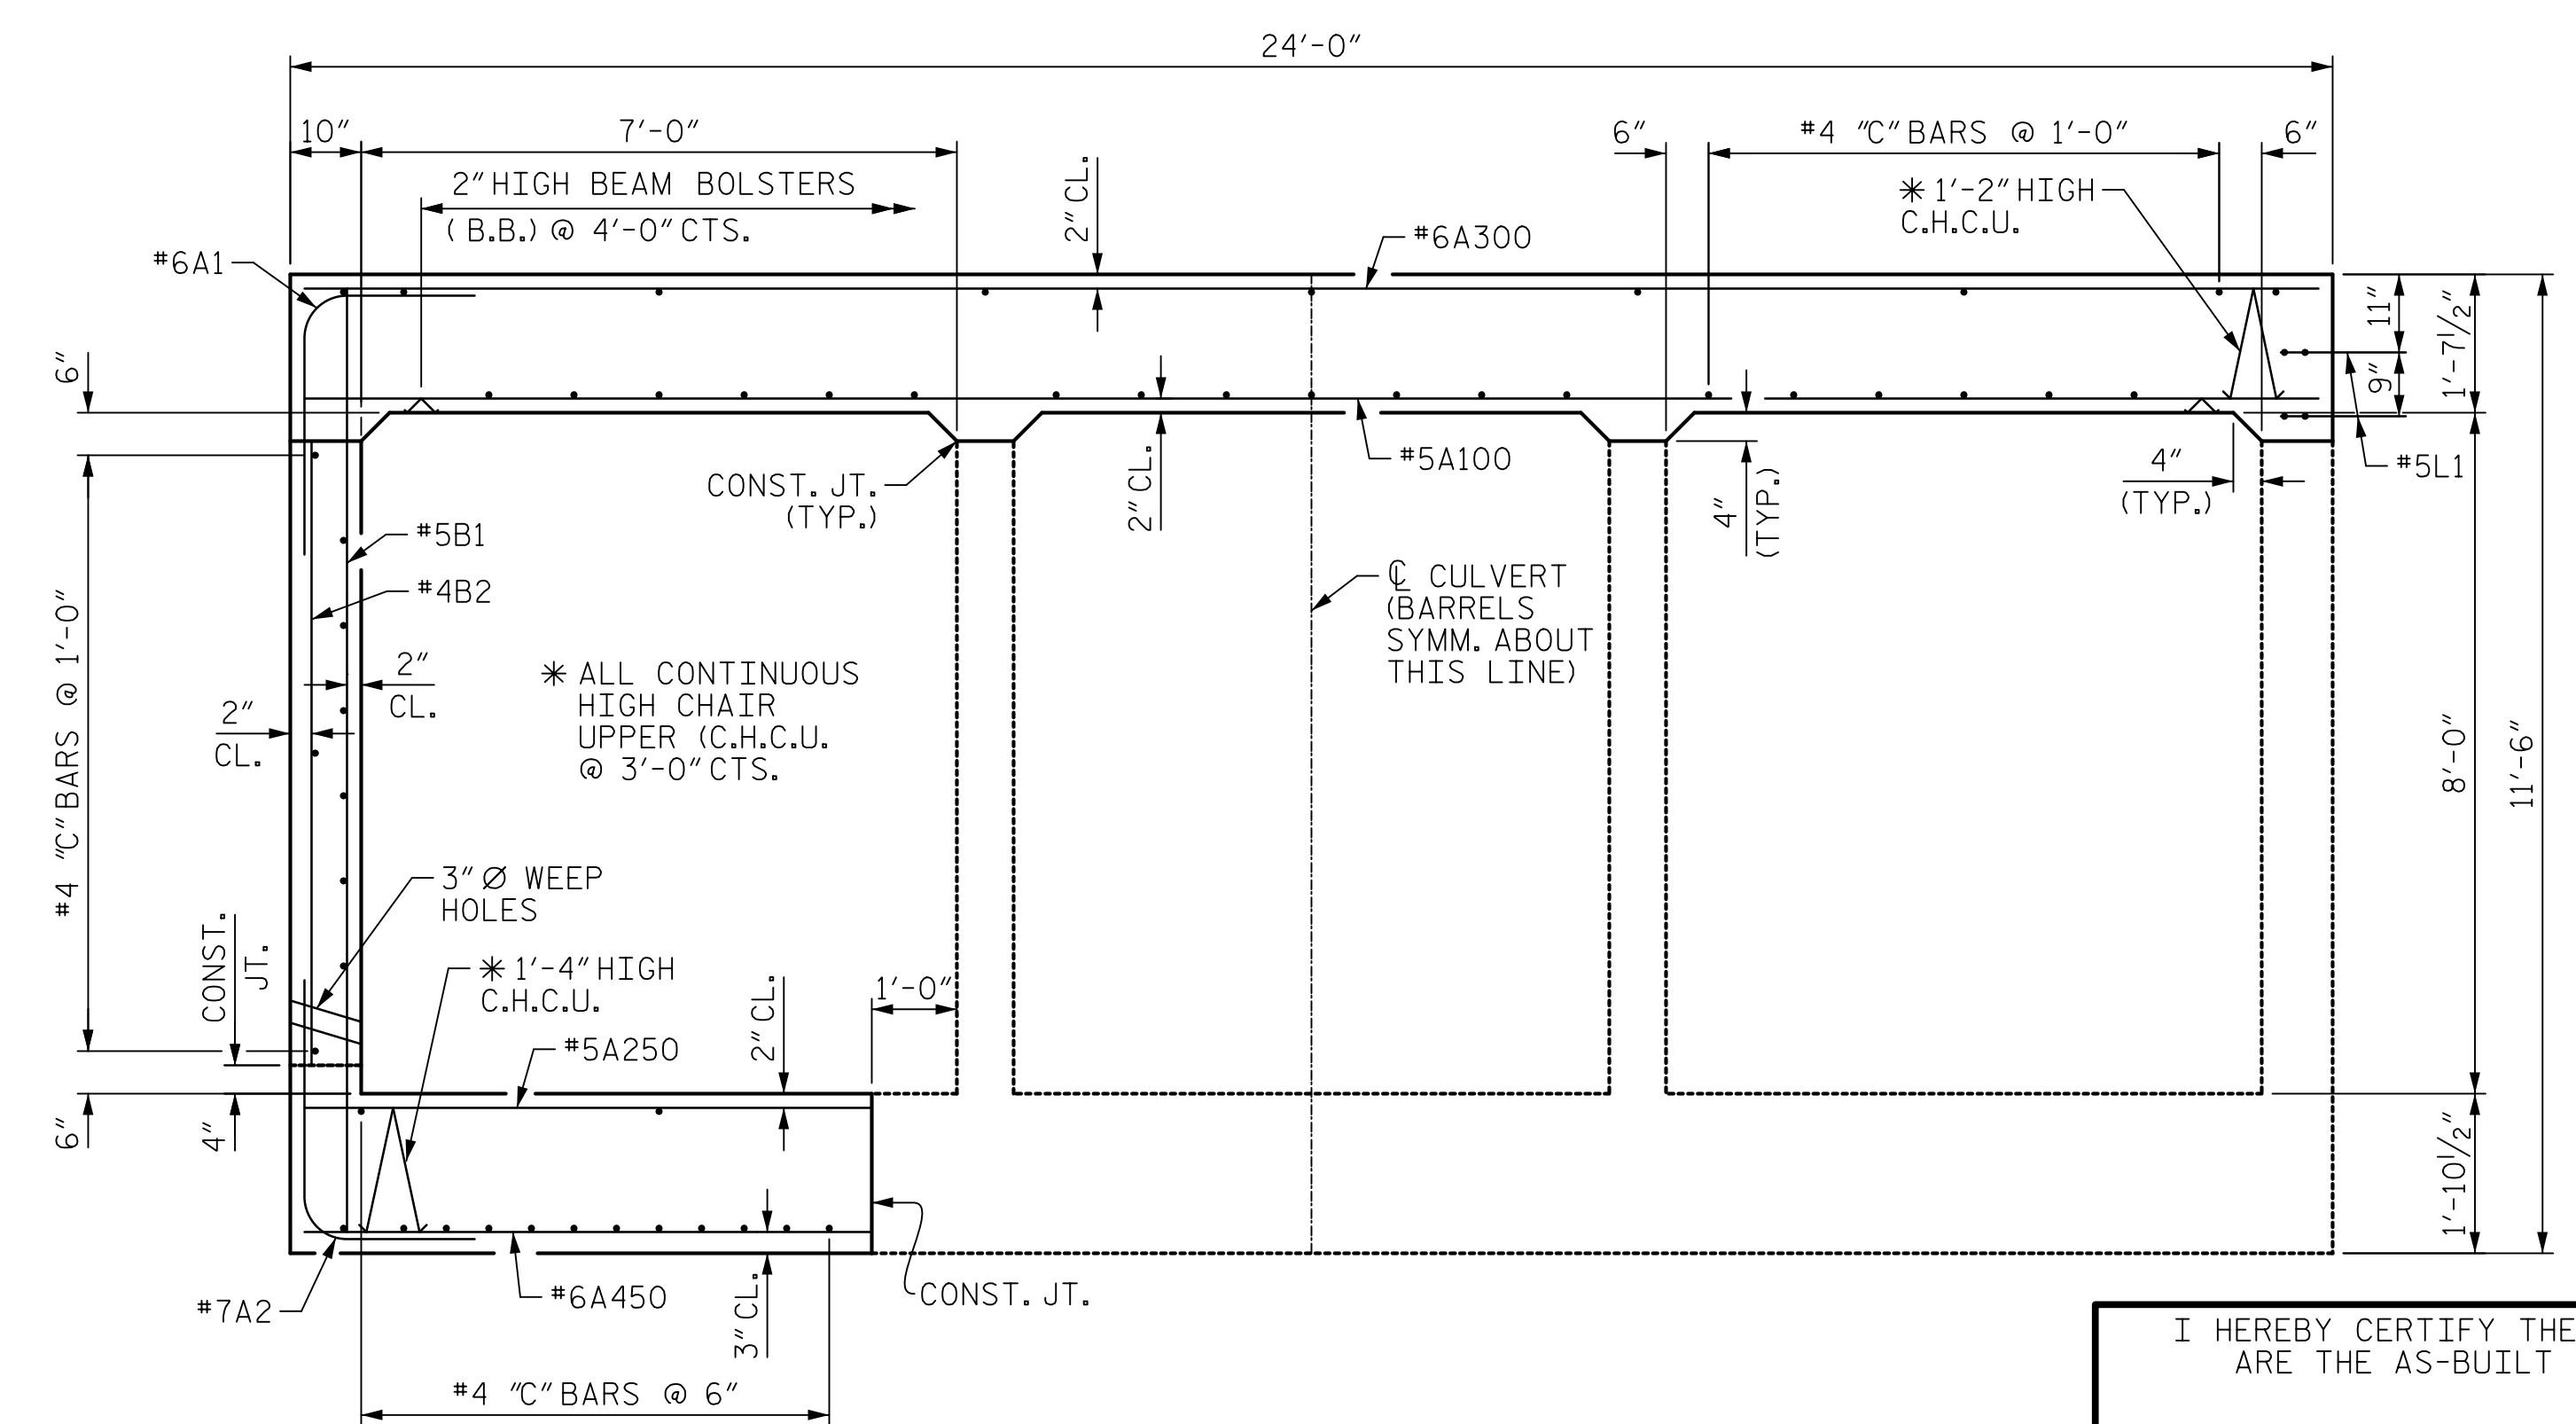


RIGHT ANGLE SECTION OF BARREL
 RIGHT EXTENSION - PHASE II (LOOKING DOWNSTREAM)
 THERE ARE 51 "C" BARS IN SECTION OF BARREL

I HEREBY CERTIFY THESE PLANS ARE THE AS-BUILT PLANS

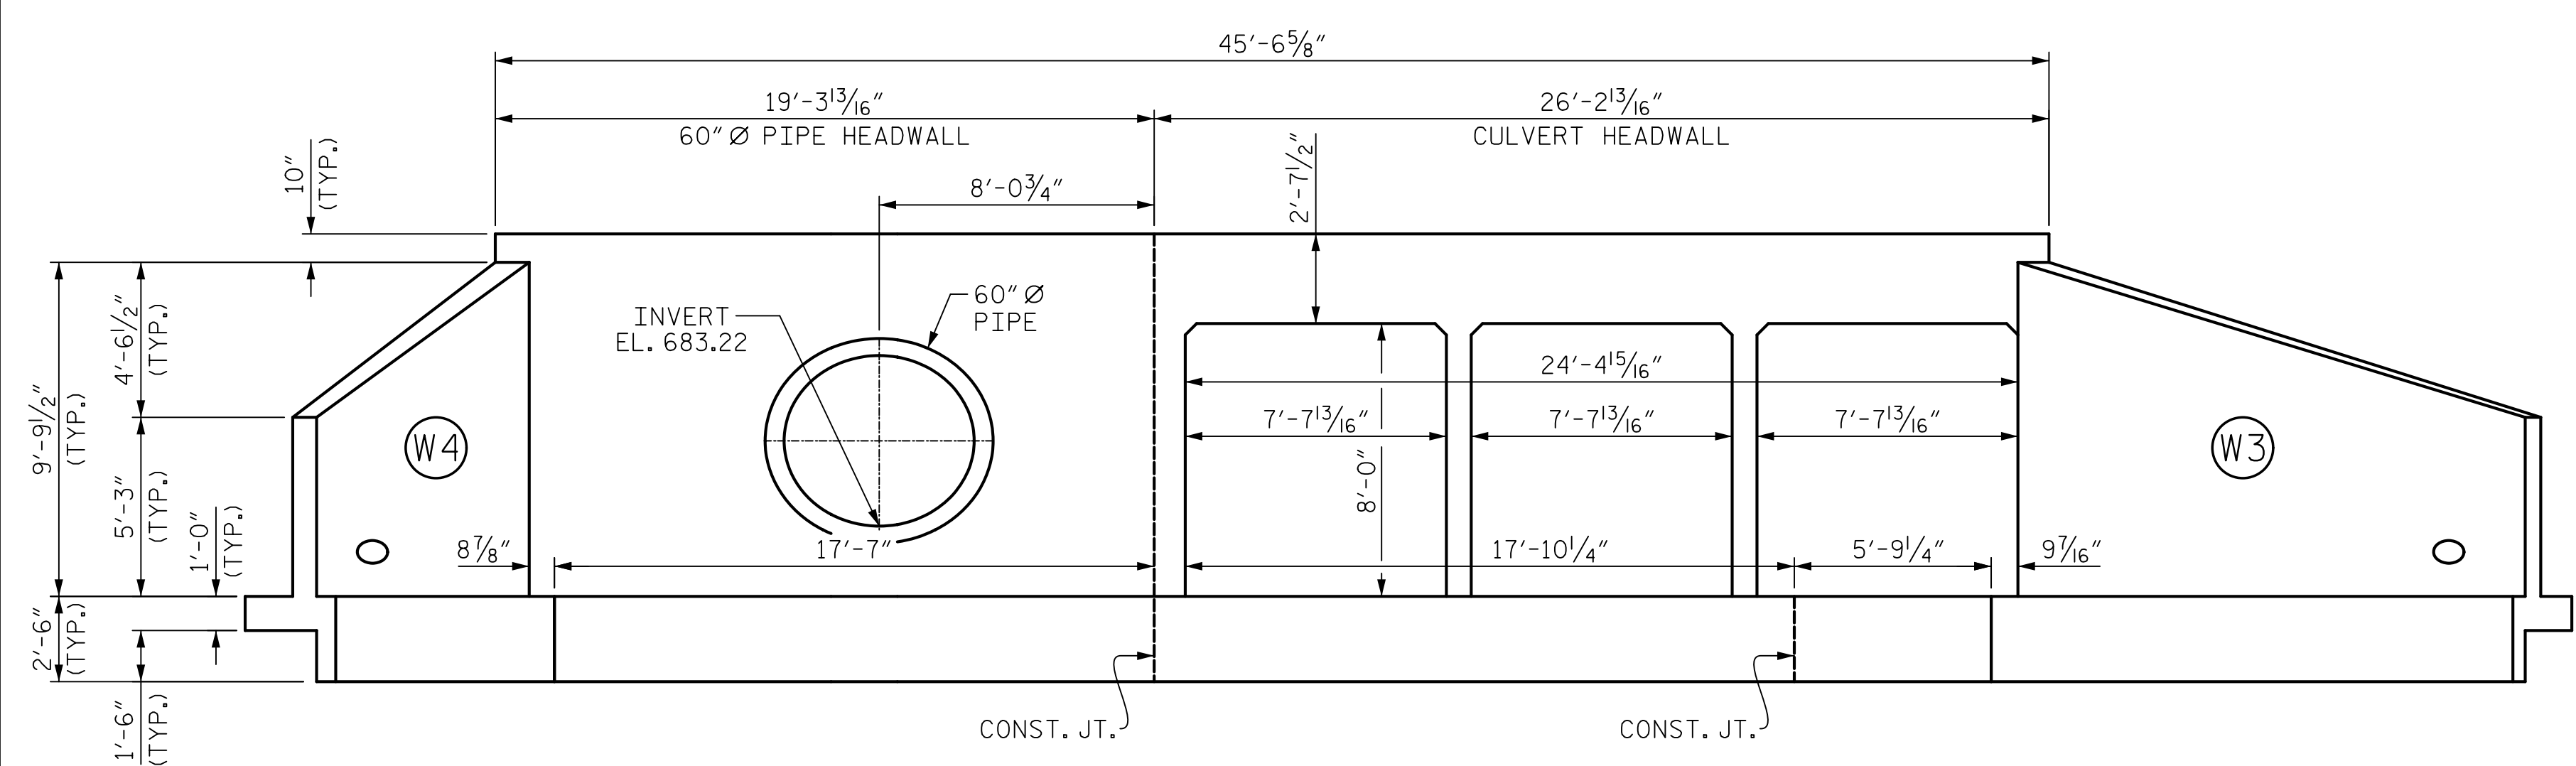

RIGHT END ELEVATION NORMAL TO SKEW
 (LOOKING UPSTREAM)

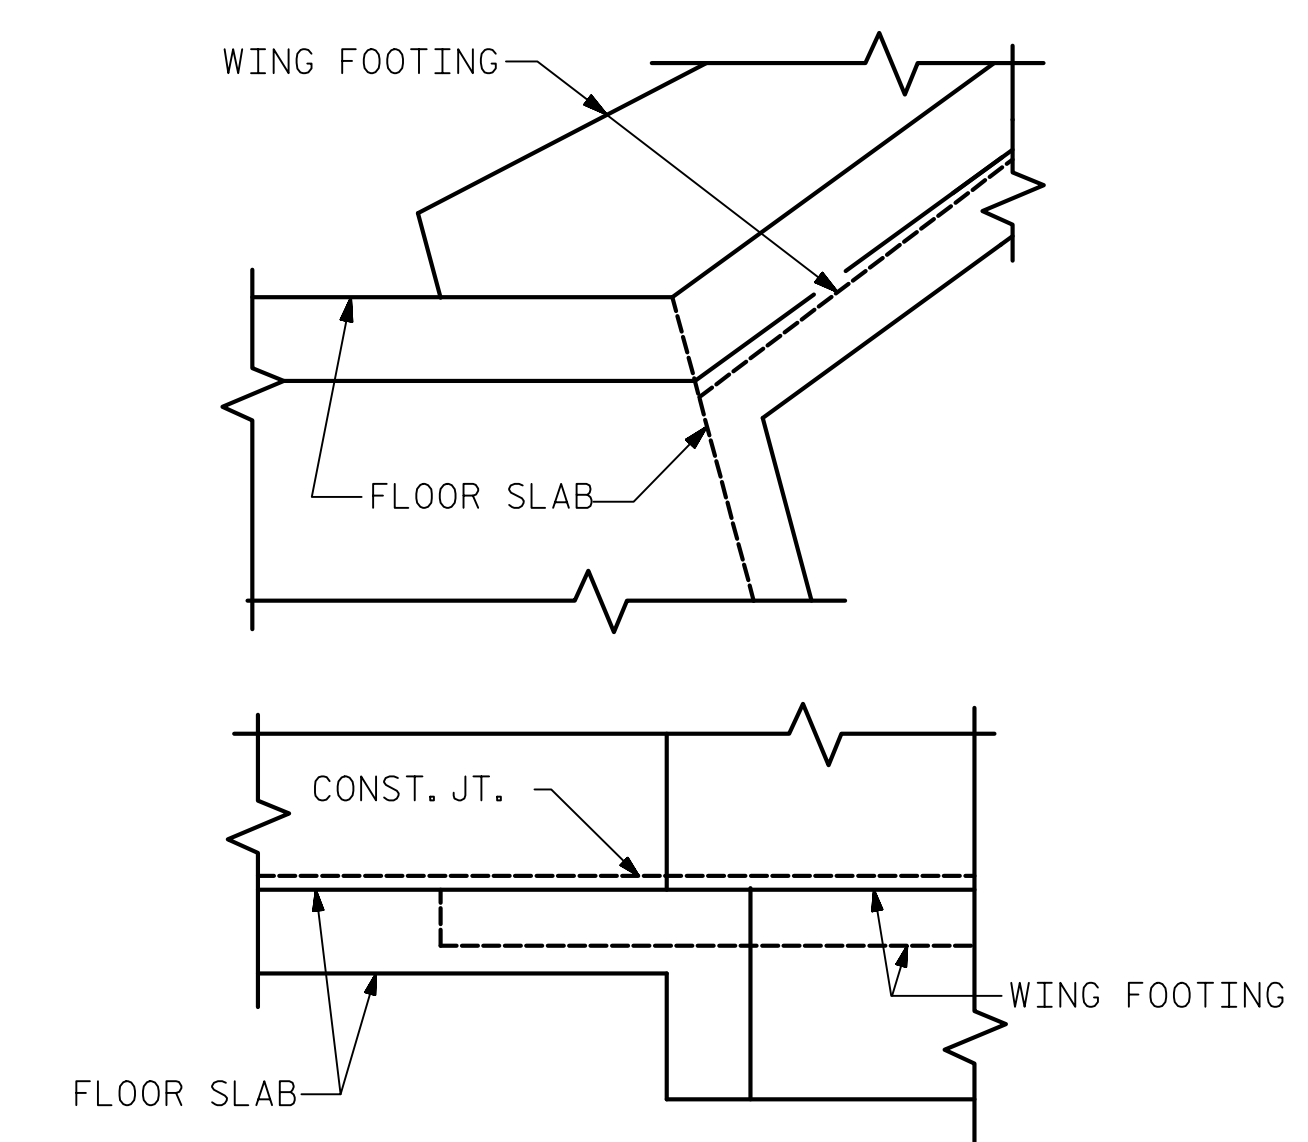

DETAIL
 CONNECTION OF WING FOOTING AND FLOOR SLAB WHEN SLAB IS THICKER THAN FOOTING

Mead & Hunt
 111 E. Hargett Street
 Suite 300
 Raleigh, NC 27601
 919-714-8670
 meadhunt.com
 NC License No. F-1235




DOCUMENT NOT CONSIDERED FINAL UNLESS ALL SIGNATURES COMPLETED

PROJECT NO. R-4707
GUILFORD COUNTY
 STATION: 56+34.85 -L-
 SHEET 3 OF 16

STATE OF NORTH CAROLINA
 DEPARTMENT OF TRANSPORTATION
 RALEIGH
TRIPLE 7 FT. x 8 FT. REINFORCED CONCRETE BOX CULVERT
 (RIGHT EXTENSION)

DRAWN BY : J.S. HOBSON DATE : 03/28/19
 CHECKED BY : J.A. LEE DATE : 04/15/19
 DESIGN ENGINEER OF RECORD : J.S. HOBSON DATE : 04/26/19

REVISIONS						SHEET NO.
NO.	BY:	DATE:	NO.	BY:	DATE:	C1-11
1			3			TOTAL SHEETS
2			4			24

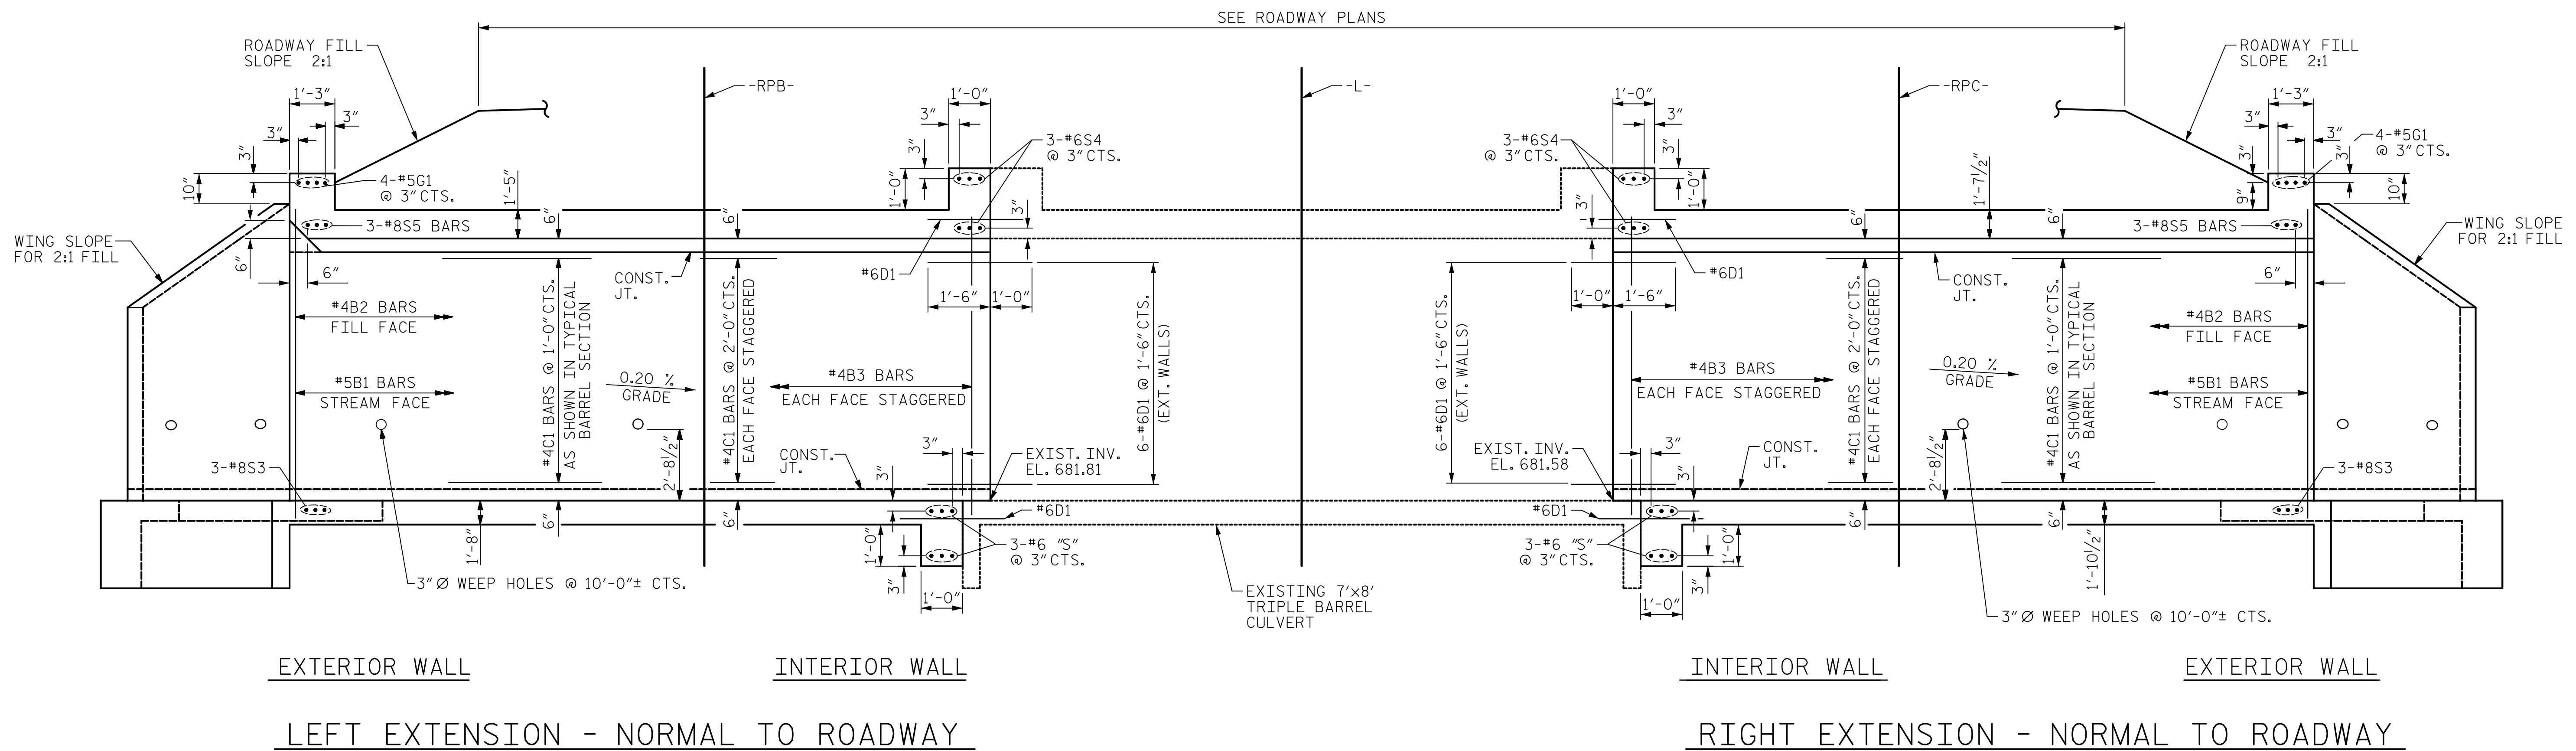

I HEREBY CERTIFY THESE PLANS ARE THE AS-BUILT PLANS

LEFT EXTENSION QUANTITIES	
CULVERT EXCAVATION	LUMP SUM
FOUNDATION COND. MAT'L	451 TONS
CLASS A CONCRETE	
PHASE I BARRELS @ 1.675 CY/FT	381.0 C.Y.
PHASE II BARREL @ 1.967 CY/FT	451.2 C.Y.
60" Ø PIPE HEADWALL	9.4 C.Y.
WING W1, ETC.	4.9 C.Y.
WING W2, ETC.	6.7 C.Y.
TOTAL	853.2 C.Y.
REINFORCING STEEL	
PHASE I BARRELS	53,006 LBS.
PHASE II BARREL	47,683 LBS.
60" Ø PIPE HEADWALL	650 LBS.
WING W1, ETC.	383 LBS.
WING W2, ETC.	564 LBS.
TOTAL	102,286 LBS.

RIGHT EXTENSION QUANTITIES	
CULVERT EXCAVATION	LUMP SUM
FOUNDATION COND. MAT'L	419 TONS
CLASS A CONCRETE	
PHASE I BARRELS @ 1.807 CY/FT	382.6 C.Y.
PHASE II BARREL @ 2.205 CY/FT	470.0 C.Y.
60" Ø PIPE HEADWALL	12.6 C.Y.
WING W3, ETC.	8.0 C.Y.
WING W4, ETC.	4.7 C.Y.
TOTAL	877.9 C.Y.
REINFORCING STEEL	
PHASE I BARRELS	49,853 LBS.
PHASE II BARREL	44,530 LBS.
60" Ø PIPE HEADWALL	853 LBS.
WING W3, ETC.	590 LBS.
WING W4, ETC.	389 LBS.
TOTAL	96,215 LBS.

Mead & Hunt
 111 E. Hargett Street
 Suite 300
 Raleigh, NC 27601
 919-714-8670
 meadhunt.com
 NC License No. F-1235

Seal: Jack Hobson, Professional Engineer, No. 043177, dated 4/16/2020.

PROJECT NO. R-4707
GUILFORD COUNTY
 STATION: 56+34.85 -L-
 SHEET 4 OF 16


STATE OF NORTH CAROLINA
 DEPARTMENT OF TRANSPORTATION
 RALEIGH

TRIPLE 7 FT. x 8 FT. REINFORCED CONCRETE BOX CULVERT
 (LEFT & RIGHT EXTENSION)

DRAWN BY : J.S. HOBSON DATE : 03/28/19
 CHECKED BY : J.A. LEE DATE : 04/15/19
 DESIGN ENGINEER OF RECORD : J.S. HOBSON DATE : 04/26/19


DOCUMENT NOT CONSIDERED FINAL UNLESS ALL SIGNATURES COMPLETED

REVISIONS						SHEET NO.
NO.	BY:	DATE:	NO.	BY:	DATE:	C1-12
1			3			TOTAL SHEETS
2			4			24

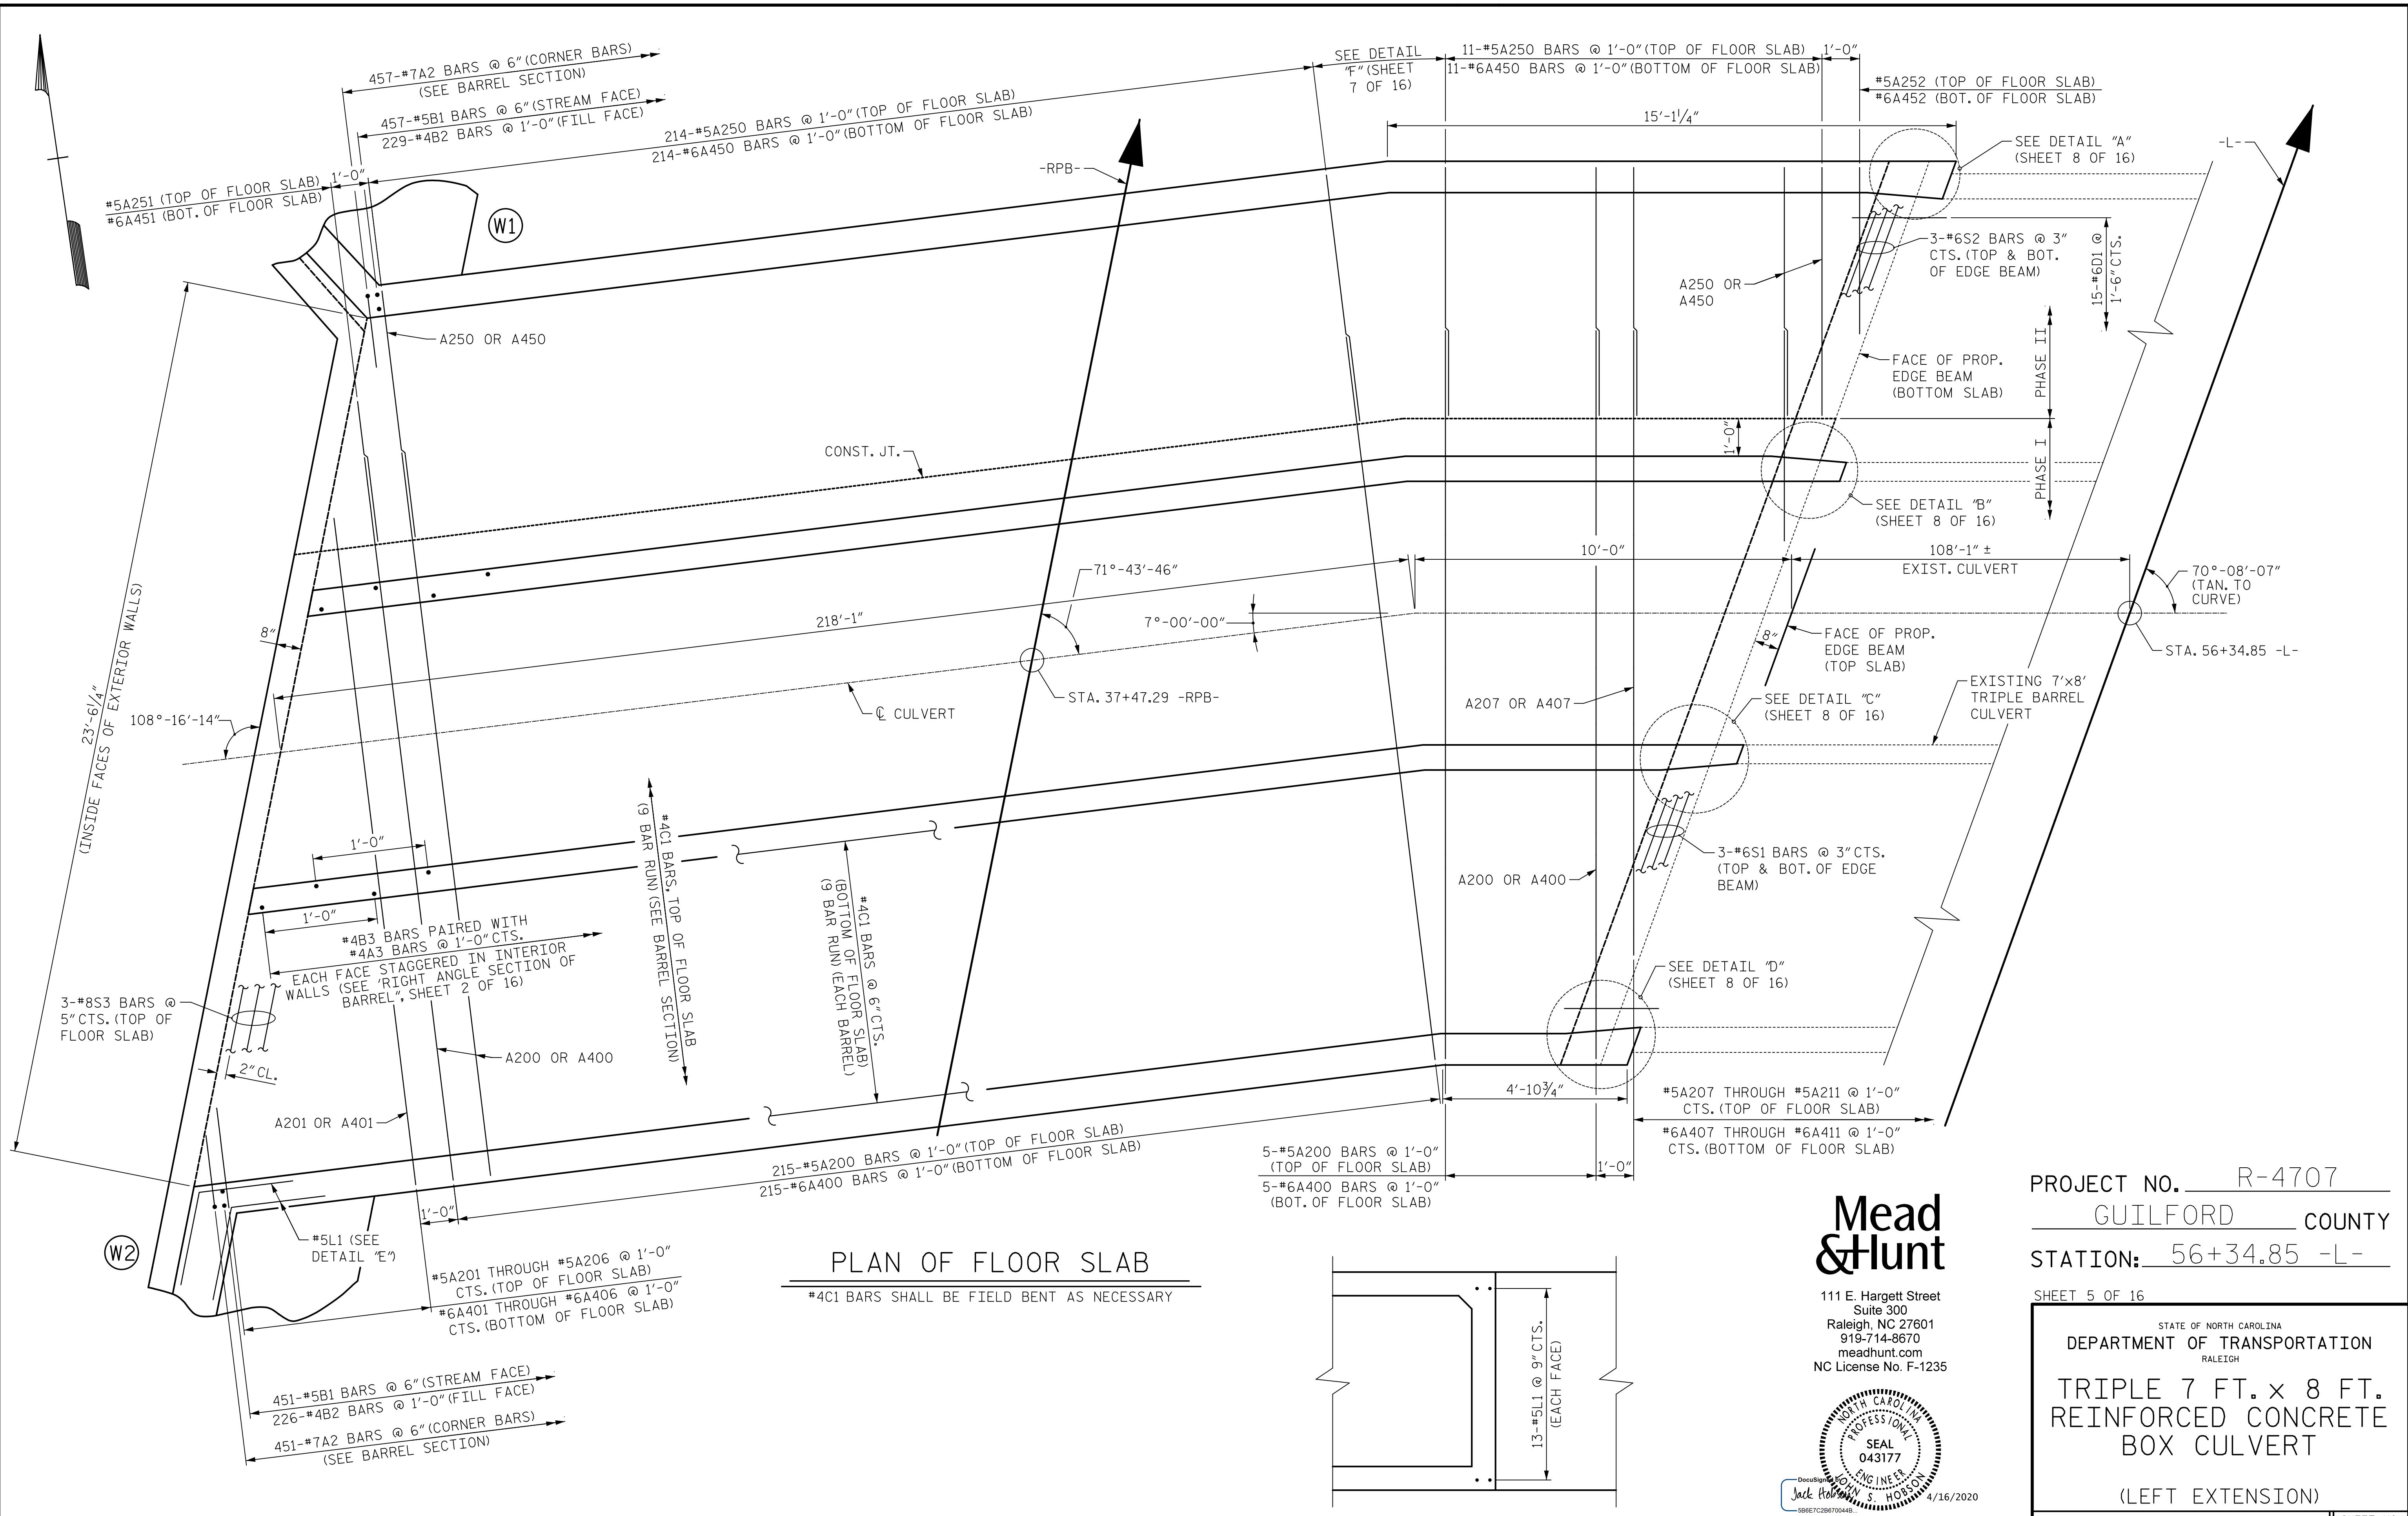


PLAN OF FLOOR SLAB

*4C1 BARS SHALL BE FIELD BENT AS NECESSARY

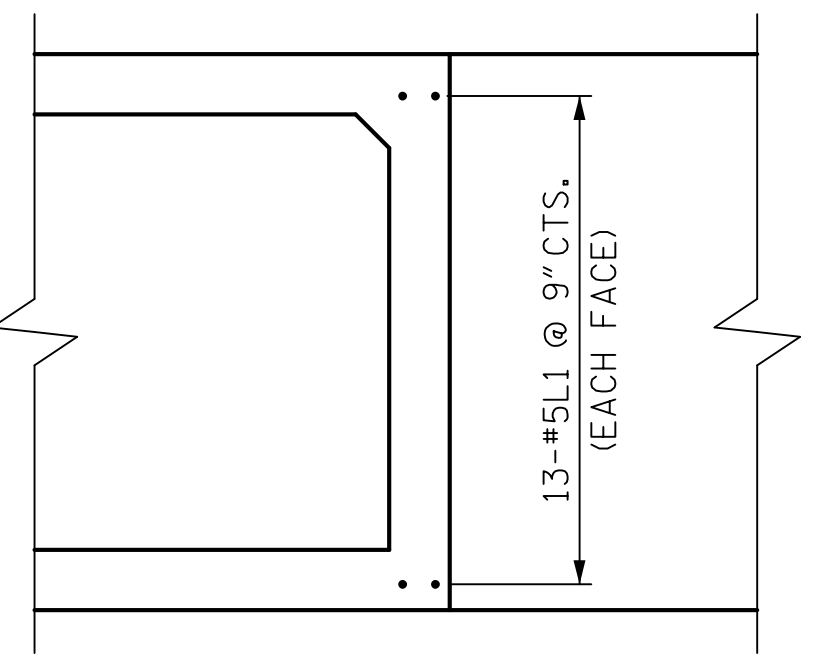

DETAIL "E"

Mead & Hunt
 111 E. Hargett Street
 Suite 300
 Raleigh, NC 27601
 919-714-8670
 meadhunt.com
 NC License No. F-1235

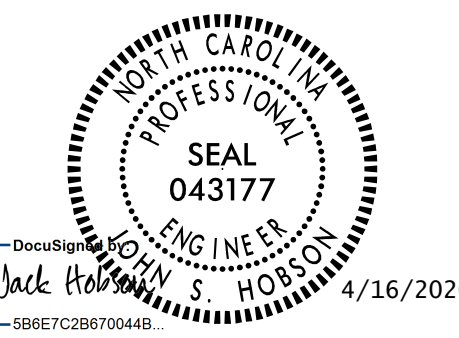


PROJECT NO. R-4707
GUILFORD COUNTY
 STATION: 56+34.85 -L-
 SHEET 5 OF 16

STATE OF NORTH CAROLINA
 DEPARTMENT OF TRANSPORTATION
 RALEIGH
**TRIPLE 7 FT. x 8 FT.
 REINFORCED CONCRETE
 BOX CULVERT**
 (LEFT EXTENSION)

DRAWN BY : J.S. HOBSON DATE : 04/08/19
 CHECKED BY : J.A. LEE DATE : 04/15/19
 DESIGN ENGINEER OF RECORD : J.S. HOBSON DATE : 04/26/19


DOCUMENT NOT CONSIDERED
 FINAL UNLESS ALL
 SIGNATURES COMPLETED

REVISIONS						SHEET NO.
NO.	BY:	DATE:	NO.	BY:	DATE:	C1-13
1			3			TOTAL SHEETS
2			4			24

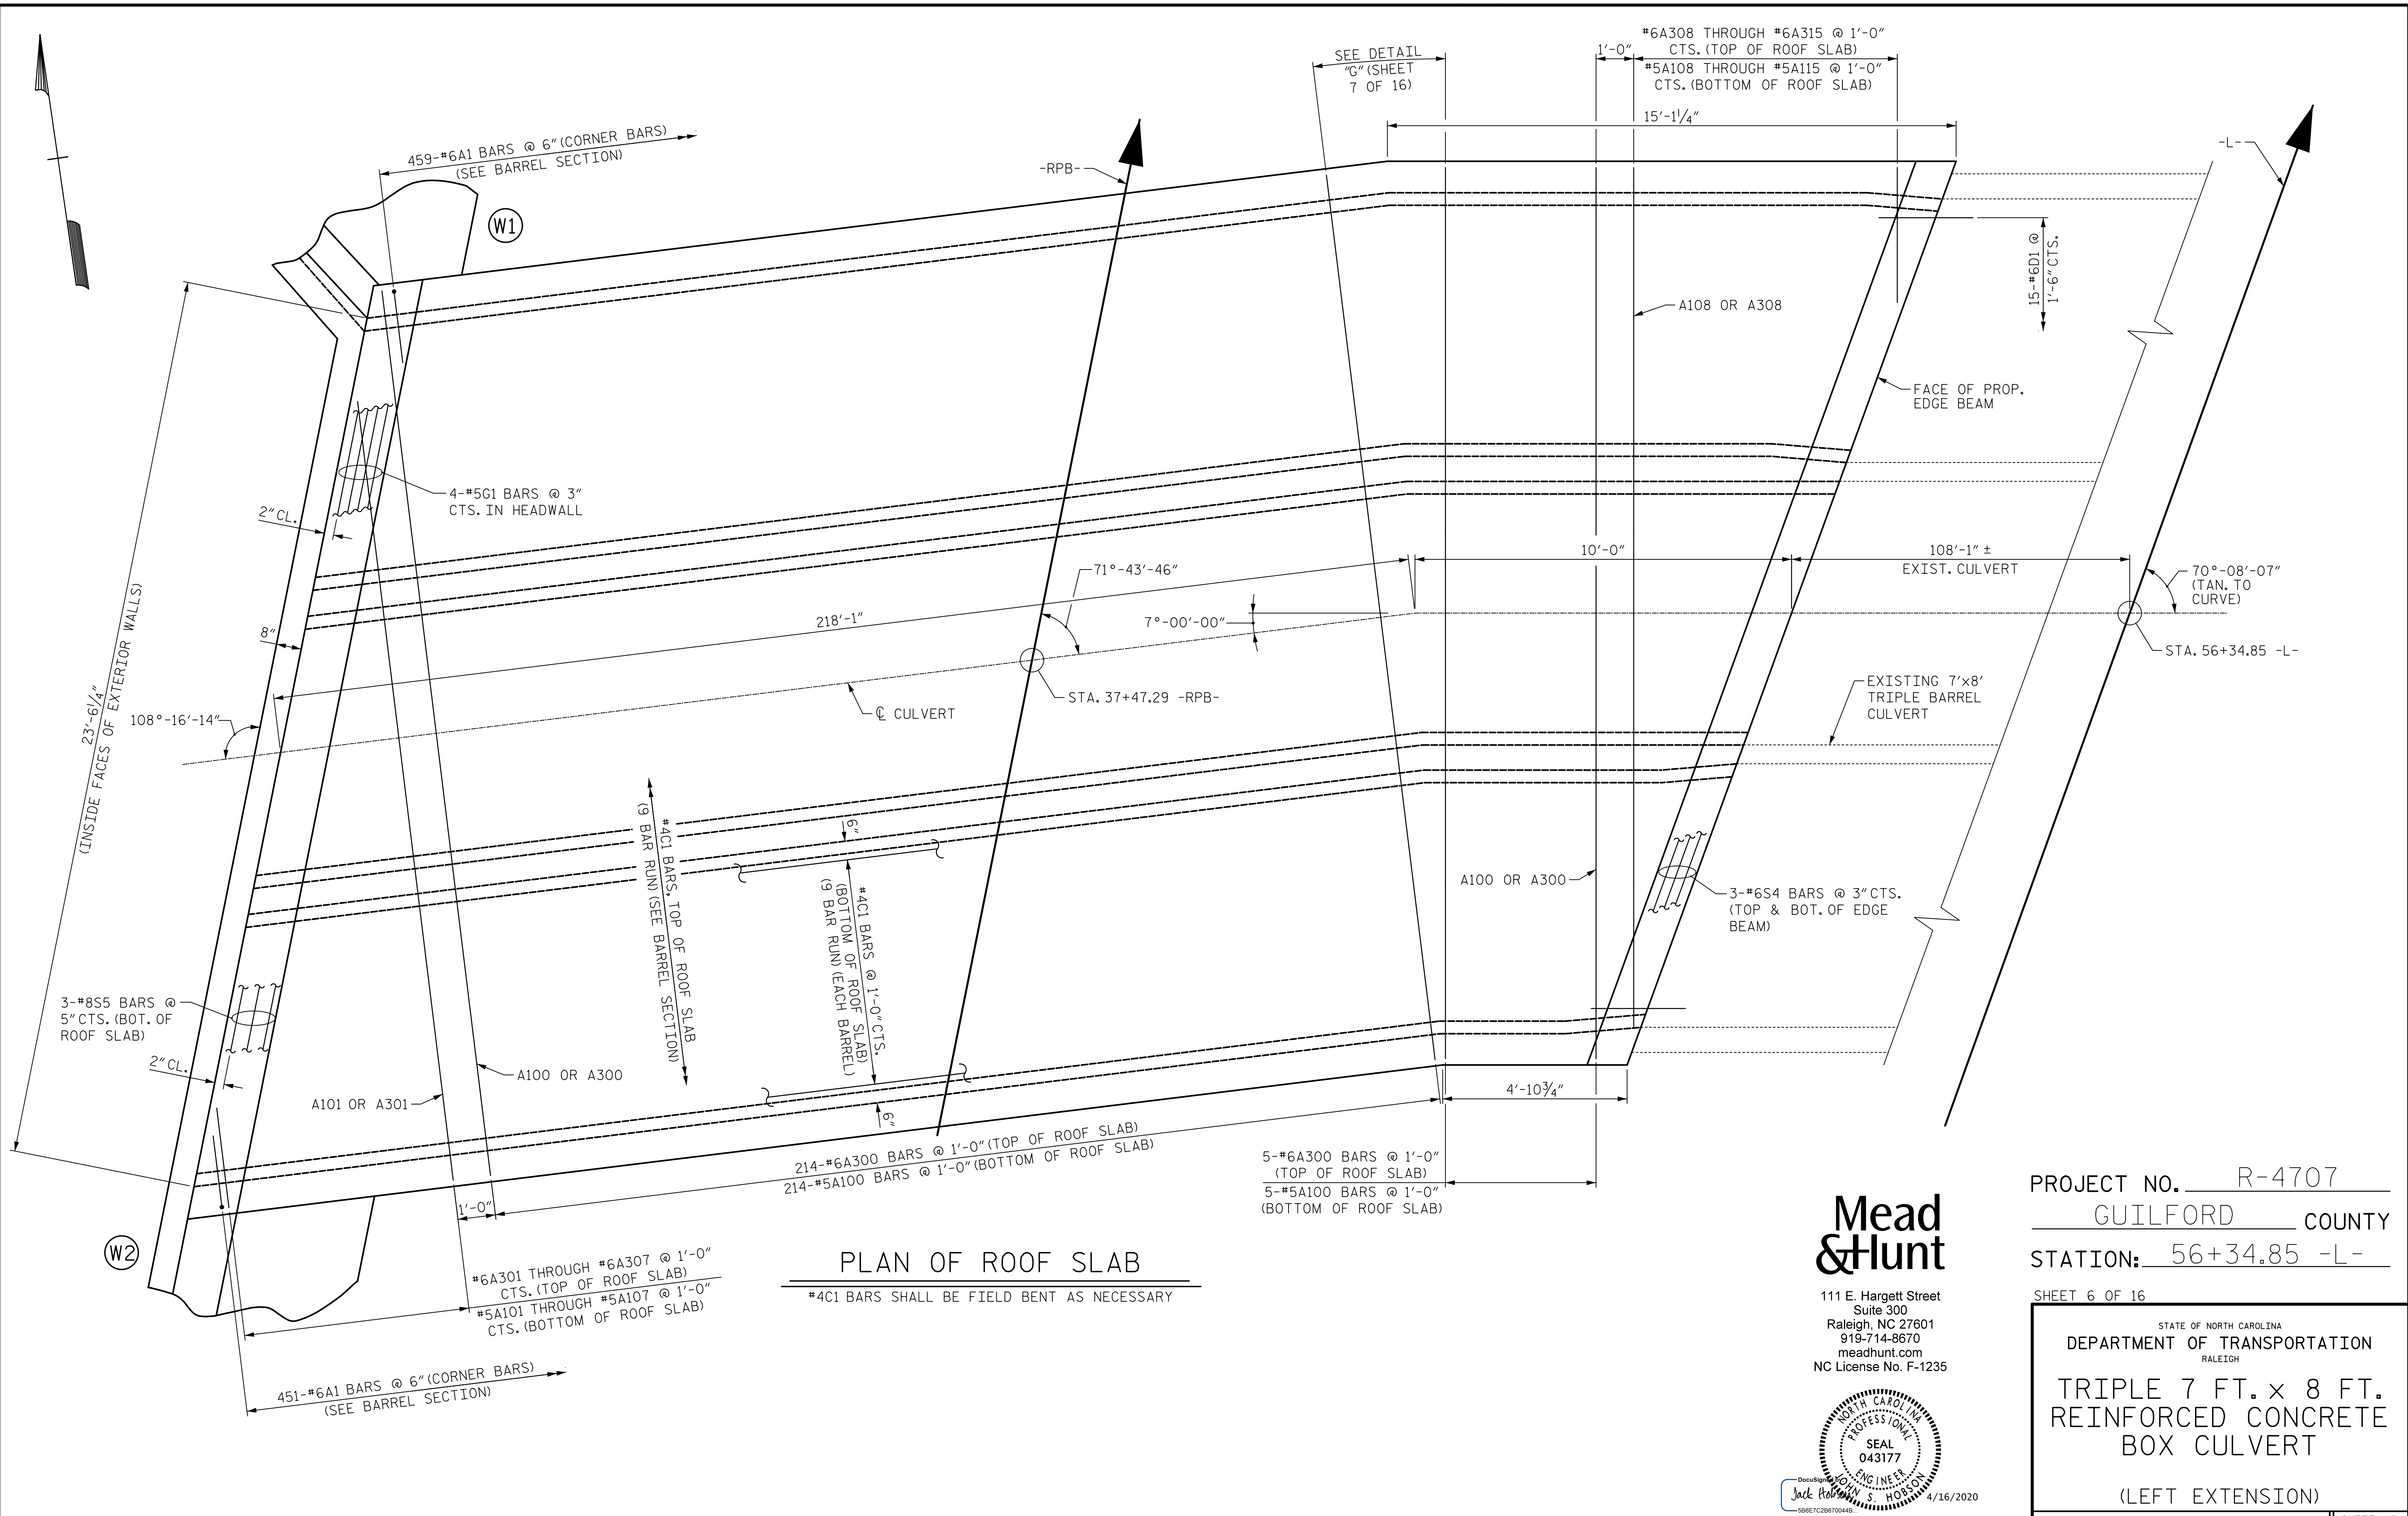

PLAN OF ROOF SLAB
 #4C1 BARS SHALL BE FIELD BENT AS NECESSARY

Mead & Hunt
 111 E. Hargett Street
 Suite 300
 Raleigh, NC 27601
 919-714-8670
 meadhunt.com
 NC License No. F-1235

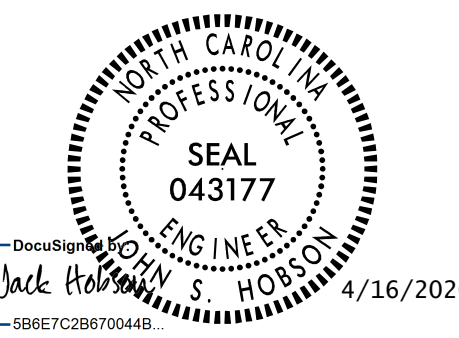


PROJECT NO. R-4707
GUILFORD COUNTY
 STATION: 56+34.85 -L-
 SHEET 6 OF 16

STATE OF NORTH CAROLINA
 DEPARTMENT OF TRANSPORTATION
 RALEIGH
**TRIPLE 7 FT. x 8 FT.
 REINFORCED CONCRETE
 BOX CULVERT**
 (LEFT EXTENSION)

DRAWN BY : J.S. HOBSON DATE : 04/08/19
 CHECKED BY : J.A. LEE DATE : 04/16/19
 DESIGN ENGINEER OF RECORD : J.S. HOBSON DATE : 04/26/19


DOCUMENT NOT CONSIDERED
 FINAL UNLESS ALL
 SIGNATURES COMPLETED

REVISIONS						SHEET NO.
NO.	BY:	DATE:	NO.	BY:	DATE:	C1-14
1			3			TOTAL SHEETS
2			4			24

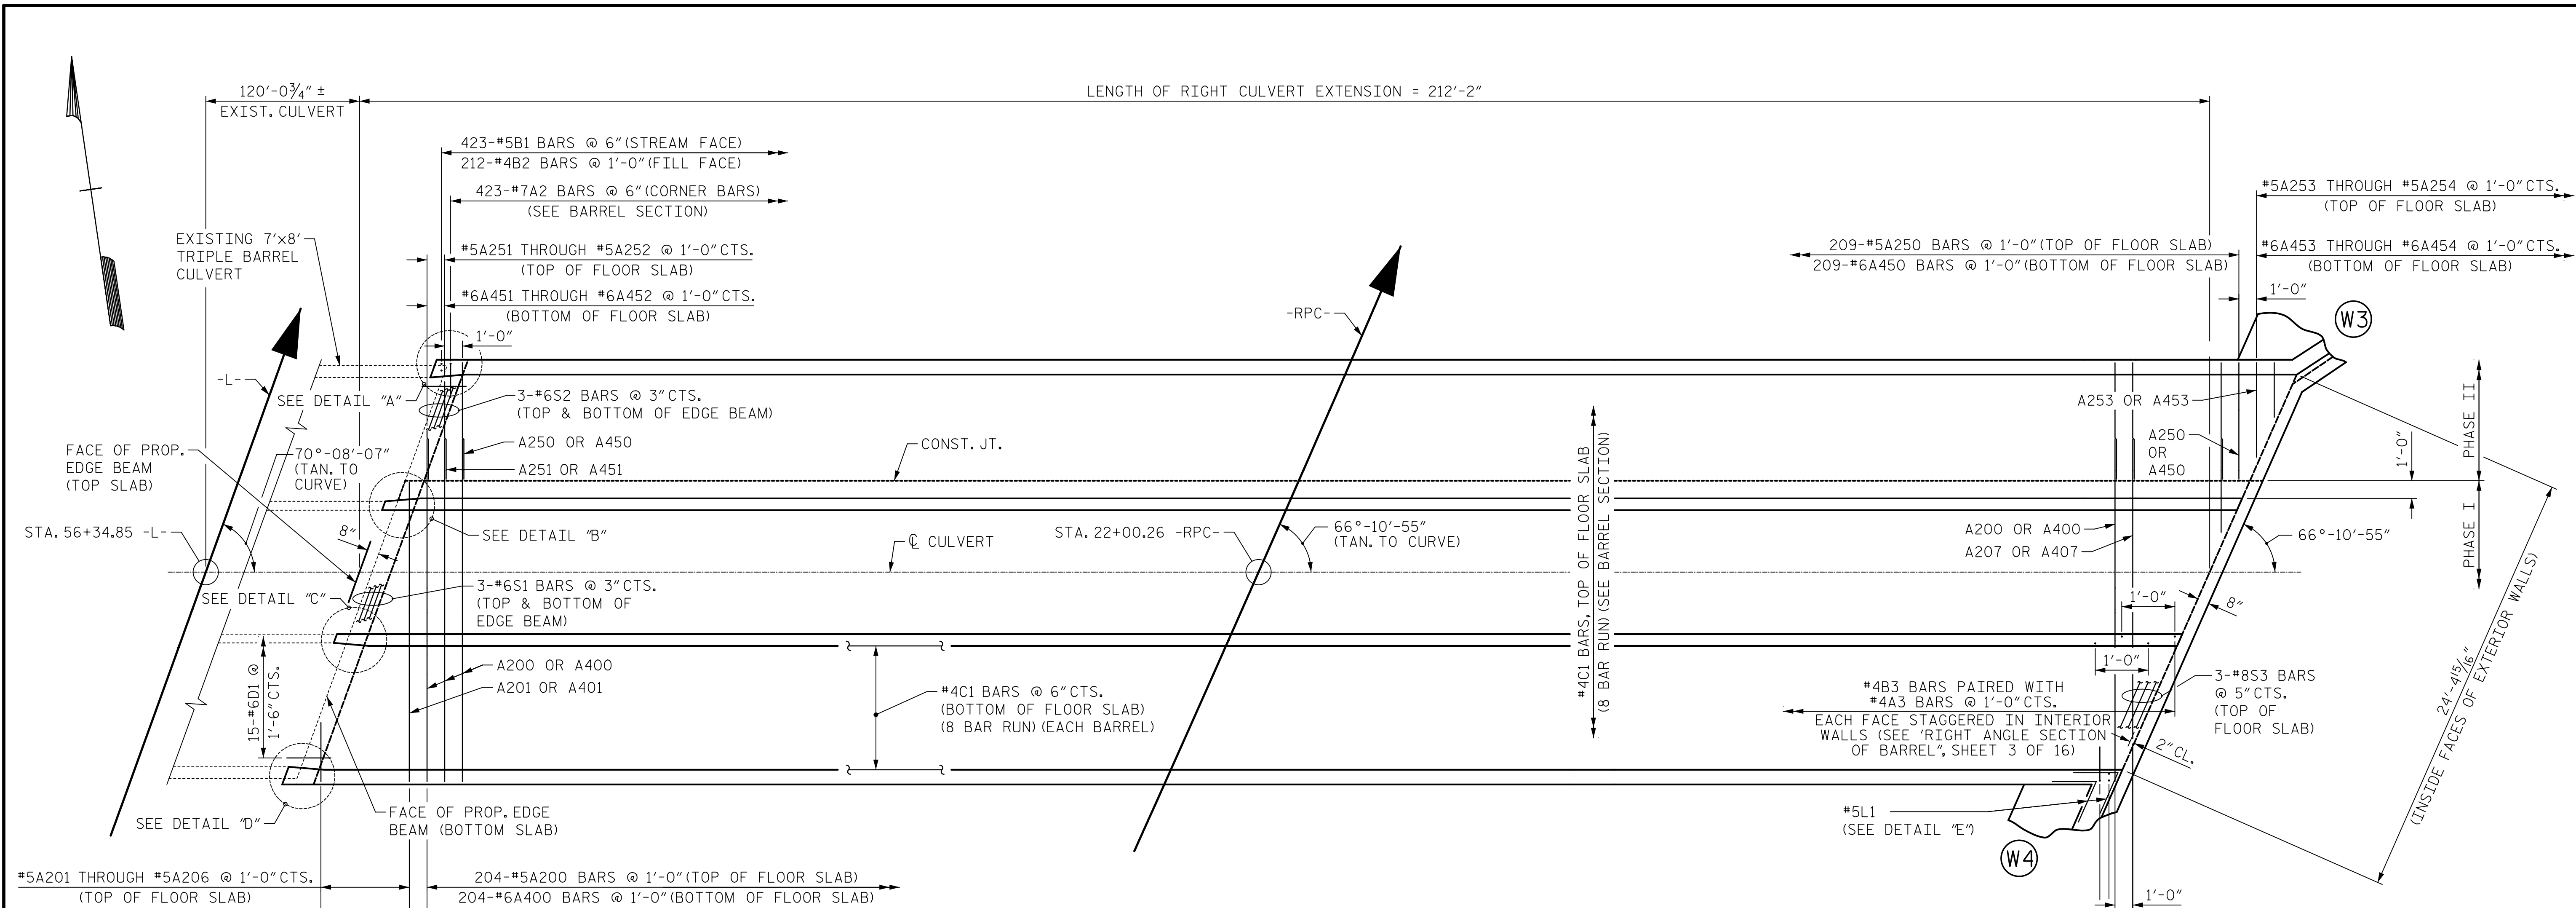


PLAN OF FLOOR SLAB

#4C1 BARS SHALL BE FIELD BENT AS NECESSARY

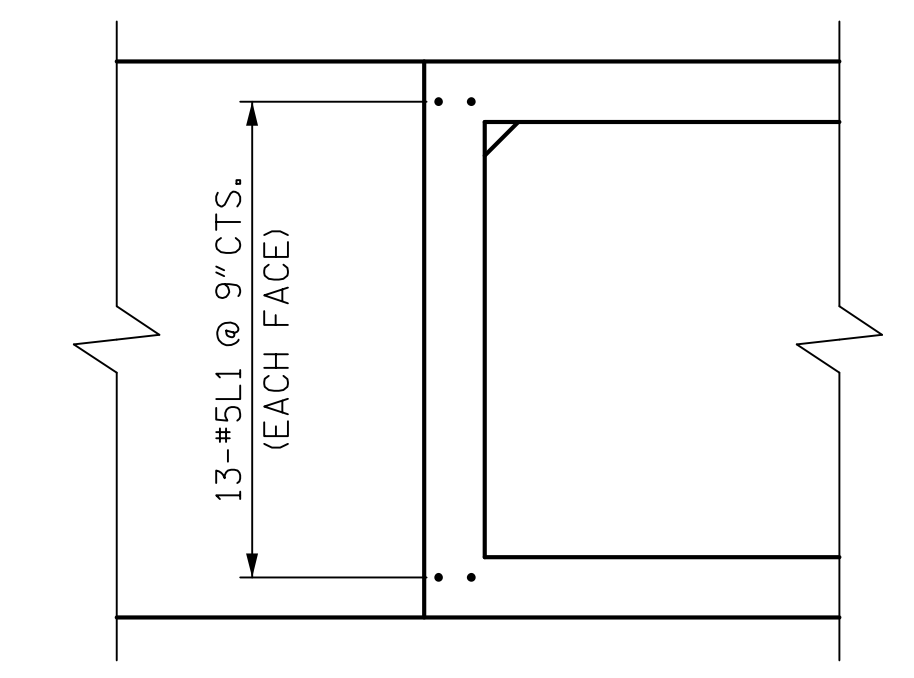


DETAIL "E"

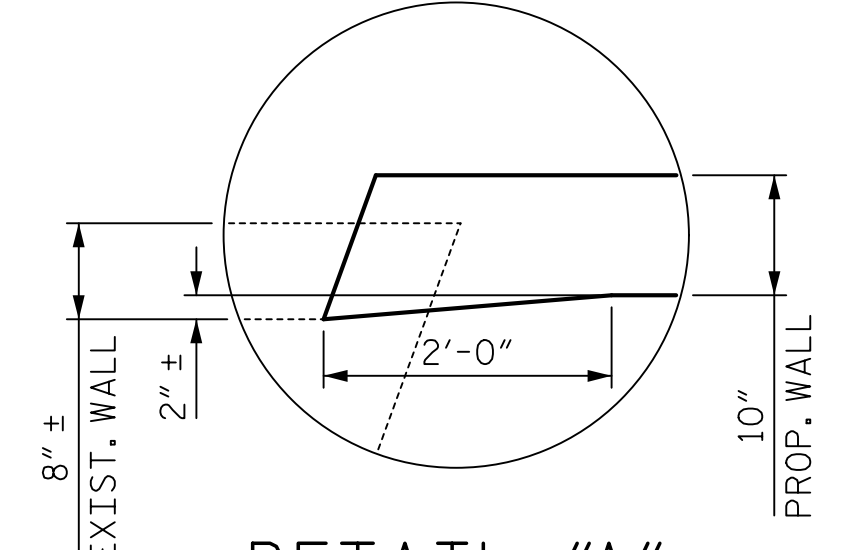


DETAIL "A"

(RIGHT EXT. SHOWN, LEFT EXT. SIMILAR)

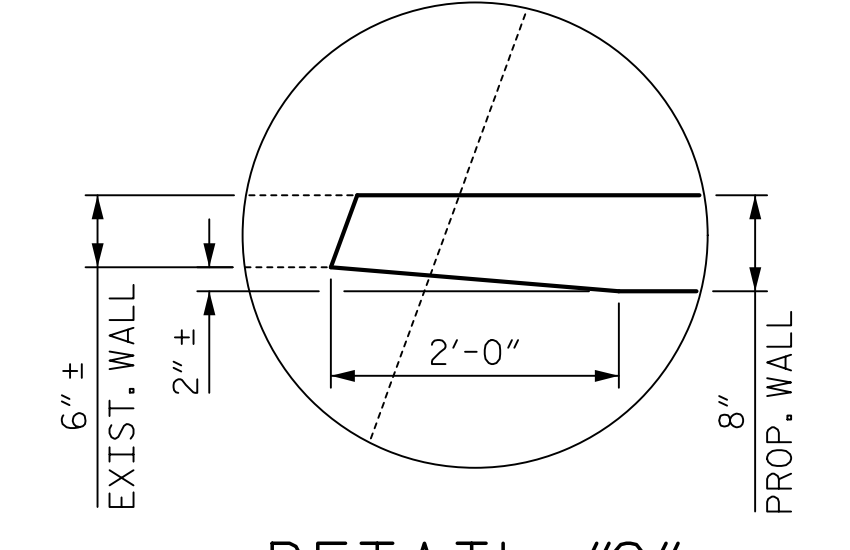


DETAIL "C"

(RIGHT EXT. SHOWN, LEFT EXT. SIMILAR)

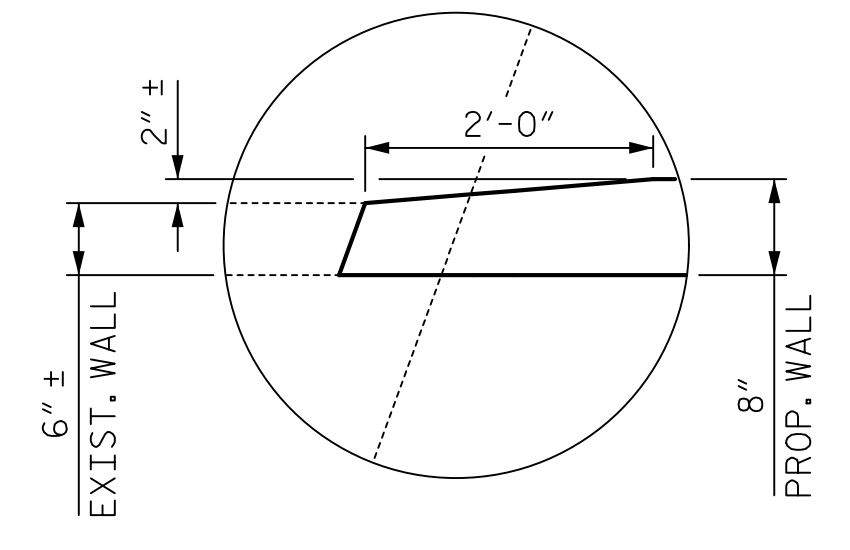

DETAIL "B"

(RIGHT EXT. SHOWN, LEFT EXT. SIMILAR)

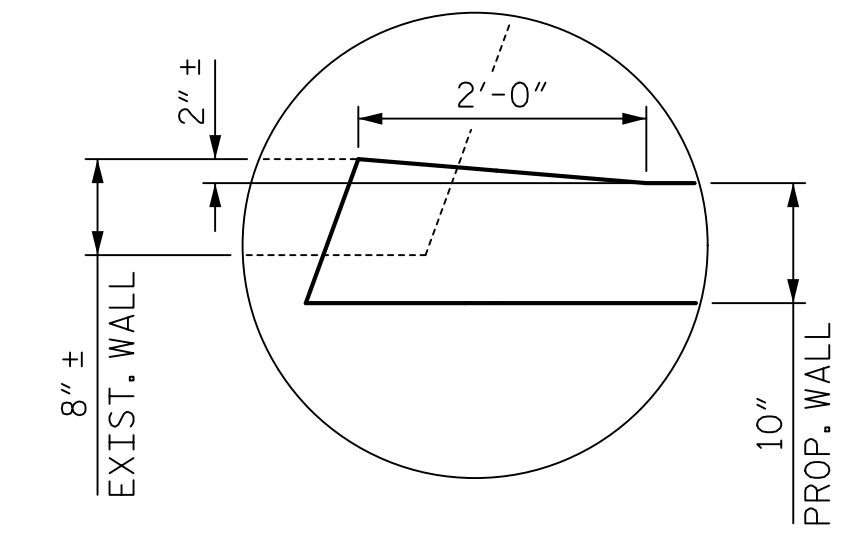


DETAIL "D"

(RIGHT EXT. SHOWN, LEFT EXT. SIMILAR)

Mead & Hunt

111 E. Hargett Street
Suite 300
Raleigh, NC 27601
919-714-8670
meadhunt.com
NC License No. F-1235

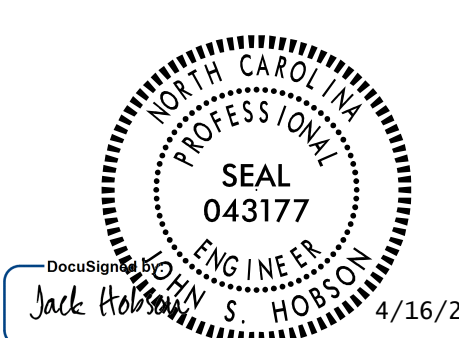

PROJECT NO. R-4707
GUILFORD COUNTY
STATION: 56+34.85 -L-
SHEET 8 OF 16

STATE OF NORTH CAROLINA
DEPARTMENT OF TRANSPORTATION
RALEIGH


TRIPLE 7 FT. x 8 FT. REINFORCED CONCRETE BOX CULVERT

(RIGHT EXTENSION)

DRAWN BY : J.S. HOBSON DATE : 04/01/19
CHECKED BY : J.A. LEE DATE : 04/18/19
DESIGN ENGINEER OF RECORD : J.S. HOBSON DATE : 04/26/19

DOCUMENT NOT CONSIDERED FINAL UNLESS ALL SIGNATURES COMPLETED

REVISIONS						SHEET NO.
NO.	BY:	DATE:	NO.	BY:	DATE:	C1-16
1			3			TOTAL SHEETS
2			4			24

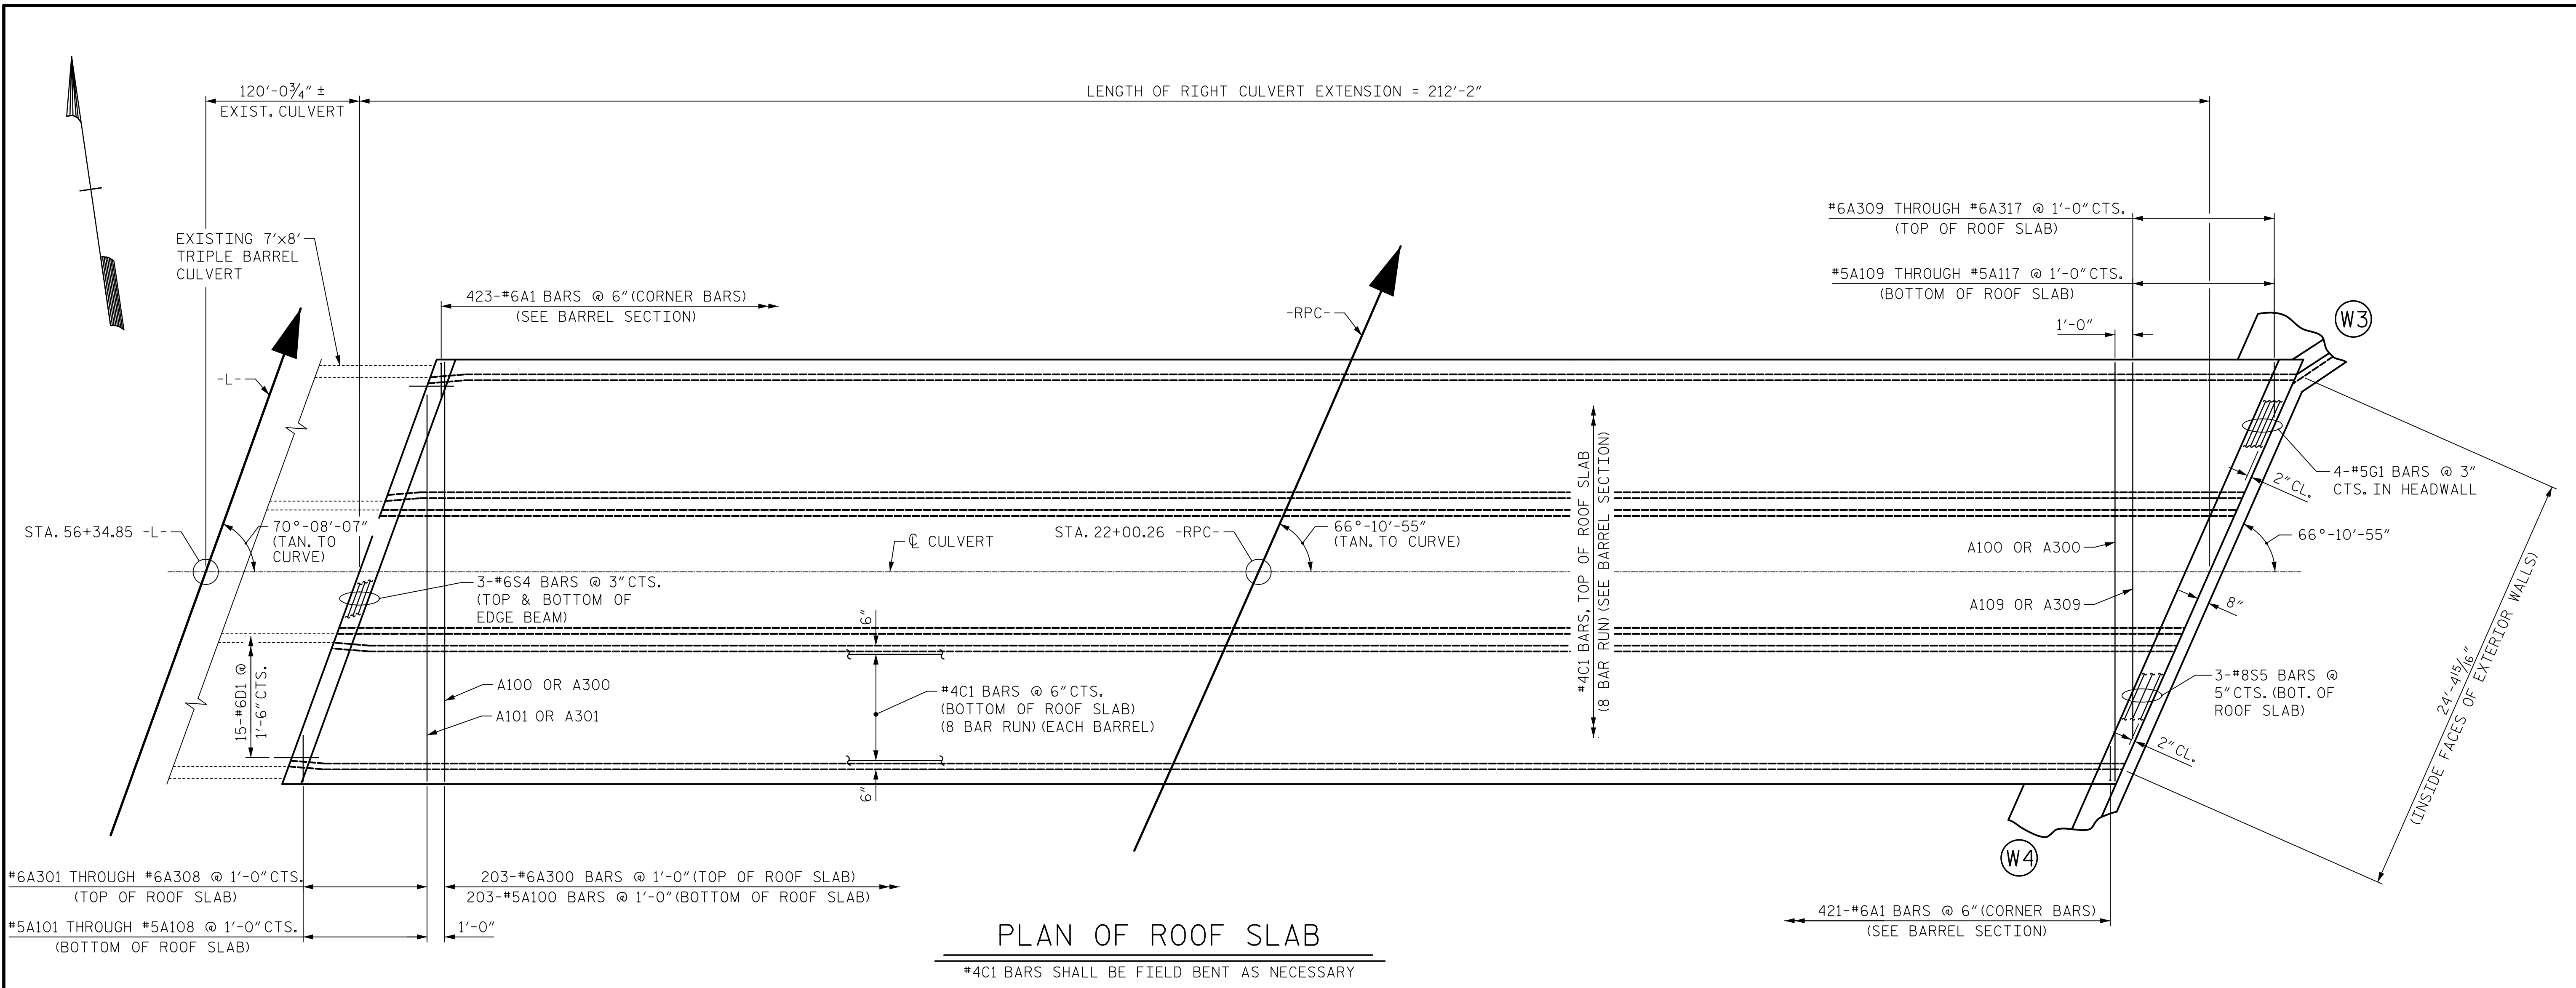

PLAN OF ROOF SLAB
#4C1 BARS SHALL BE FIELD BENT AS NECESSARY

DRAWN BY : J.S. HOBSON DATE : 04/01/19
 CHECKED BY : J.A. LEE DATE : 04/18/19
 DESIGN ENGINEER OF RECORD : J.S. HOBSON DATE : 04/26/19

Mead & Hunt
 111 E. Hargett Street
 Suite 300
 Raleigh, NC 27601
 919-714-8670
 meadhunt.com
 NC License No. F-1235

SEAL
 043177
 ENGINEER
 Jack Hobson
 4/16/2020

DOCUMENT NOT CONSIDERED
 FINAL UNLESS ALL
 SIGNATURES COMPLETED

PROJECT NO. R-4707
GUILFORD COUNTY
 STATION: 56+34.85 -L-
 SHEET 9 OF 16

STATE OF NORTH CAROLINA
 DEPARTMENT OF TRANSPORTATION
 RALEIGH

**TRIPLE 7 FT. x 8 FT.
 REINFORCED CONCRETE
 BOX CULVERT**


(RIGHT EXTENSION)

REVISIONS						SHEET NO.
NO.	BY:	DATE:	NO.	BY:	DATE:	C1-17
1			3			TOTAL SHEETS
2			4			24

BILL OF MATERIAL - RIGHT EXTENSION											
PHASE I						PHASE II					
BAR	NO.	SIZE	TYPE	LENGTH	WEIGHT	BAR	NO.	SIZE	TYPE	LENGTH	WEIGHT
A200	204	#5	STR	20'-1"	4273	A100	203	#5	STR	23'-8"	5011
A201	1	#5	STR	16'-11"	18	A101	1	#5	STR	21'-10"	23
A202	1	#5	STR	14'-4"	15	A102	1	#5	STR	19'-1"	20
A203	1	#5	STR	11'-7"	12	A103	1	#5	STR	16'-4"	17
A204	1	#5	STR	8'-10"	9	A104	1	#5	STR	13'-7"	14
A205	1	#5	STR	6'-1"	6	A105	1	#5	STR	10'-10"	11
A206	1	#5	STR	3'-4"	3	A106	1	#5	STR	8'-1"	8
A207	1	#5	STR	17'-8"	18	A107	1	#5	STR	5'-4"	6
A208	1	#5	STR	15'-4"	16	A108	1	#5	STR	2'-7"	3
A209	1	#5	STR	13'-0"	14	A109	1	#5	STR	21'-3"	22
A210	1	#5	STR	10'-8"	11	A110	1	#5	STR	18'-11"	20
A211	1	#5	STR	8'-4"	9	A111	1	#5	STR	16'-7"	17
A212	1	#5	STR	6'-0"	6	A112	1	#5	STR	14'-3"	15
						A113	1	#5	STR	11'-11"	12
A400	204	#6	STR	19'-10"	6077	A114	1	#5	STR	9'-7"	10
A401	1	#6	STR	16'-11"	25	A115	1	#5	STR	7'-8"	8
A402	1	#6	STR	14'-4"	22	A116	1	#5	STR	5'-4"	6
A403	1	#6	STR	11'-7"	17	A117	1	#5	STR	3'-1"	3
A404	1	#6	STR	8'-10"	13						
A405	1	#6	STR	6'-1"	9	A250	209	#5	STR	6'-7"	1435
A406	1	#6	STR	3'-4"	5	A251	1	#5	STR	5'-6"	6
A407	1	#6	STR	17'-5"	26	A252	1	#5	STR	2'-9"	3
A408	1	#6	STR	15'-1"	23	A253	1	#5	STR	5'-4"	6
A409	1	#6	STR	12'-9"	19	A254	1	#5	STR	3'-1"	3
A410	1	#6	STR	10'-5"	16						
A411	1	#6	STR	8'-1"	12	A300	203	#6	STR	23'-8"	7216
A412	1	#6	STR	5'-9"	9	A301	1	#6	STR	21'-10"	33
						A302	1	#6	STR	19'-1"	29
A1	421	#6	1	8'-8"	481	A303	1	#6	STR	16'-4"	25
A2	419	#7	1	9'-9"	8350	A304	1	#6	STR	13'-7"	20
A3	849	#4	3	5'-6"	3119	A305	1	#6	STR	10'-10"	16
						A306	1	#6	STR	8'-1"	12
B1	419	#5	STR	11'-1"	4844	A307	1	#6	STR	1'-0"	2
B2	210	#4	STR	7'-4"	1029	A308	1	#6	STR	2'-7"	4
B3	849	#4	STR	11'-1"	6286	A309	1	#6	STR	21'-3"	32
						A310	1	#6	STR	18'-11"	28
C1	378	#4	STR	37'-6'	9469	A311	1	#6	STR	16'-7"	25
						A312	1	#6	STR	14'-3"	21
D1	17	#6	STR	2'-6"	64	A313	1	#6	STR	11'-11"	18
						A314	1	#6	STR	9'-7"	14
L1	24	#5	2	5'-0"	125	A315	1	#6	STR	7'-8"	12
						A316	1	#6	STR	5'-4"	8
S1	6	#6	STR	21'-9"	196	A317	1	#6	STR	3'-1"	5
S3	3	#8	STR	25'-10"	207						
REINFORCING STEEL						49,853 LBS.					

BAR	SIZE	SPLICE
A200, A207-A212	#5	3'-0"
A400, A407-A412	#5	2'-9"
B1	#5	2'-4"
B3	#4	1'-10"
C1	#4	2'-5"
S1	#6	3'-7"

A450	209	#6	STR	6'-7"	2067						
A451	1	#6	STR	5'-6"	8						
A452	1	#6	STR	2'-9"	4						
A453	1	#6	STR	5'-4"	8						
A454	1	#6	STR	3'-1"	5						
A1	423	#6	1	8'-8"	5507						
A2	423	#7	1	9'-9"	8430						
B1	423	#5	STR	11'-1"	4890						
B2	212	#4	STR	7'-4"	1038						
C1	306	#4	STR	37'-6"	7665						
D1	25	#6	STR	2'-6"	94						
G1	4	#5	STR	25'-10"	108						
L1	2	#4	3	5'-0"	10						
S2	6	#6	STR	7'-0"	63						
S4	6	#6	STR	25'-2"	227						
S5	3	#8	STR	25'-10"	207						
REINFORCING STEEL						44,530 LBS.					

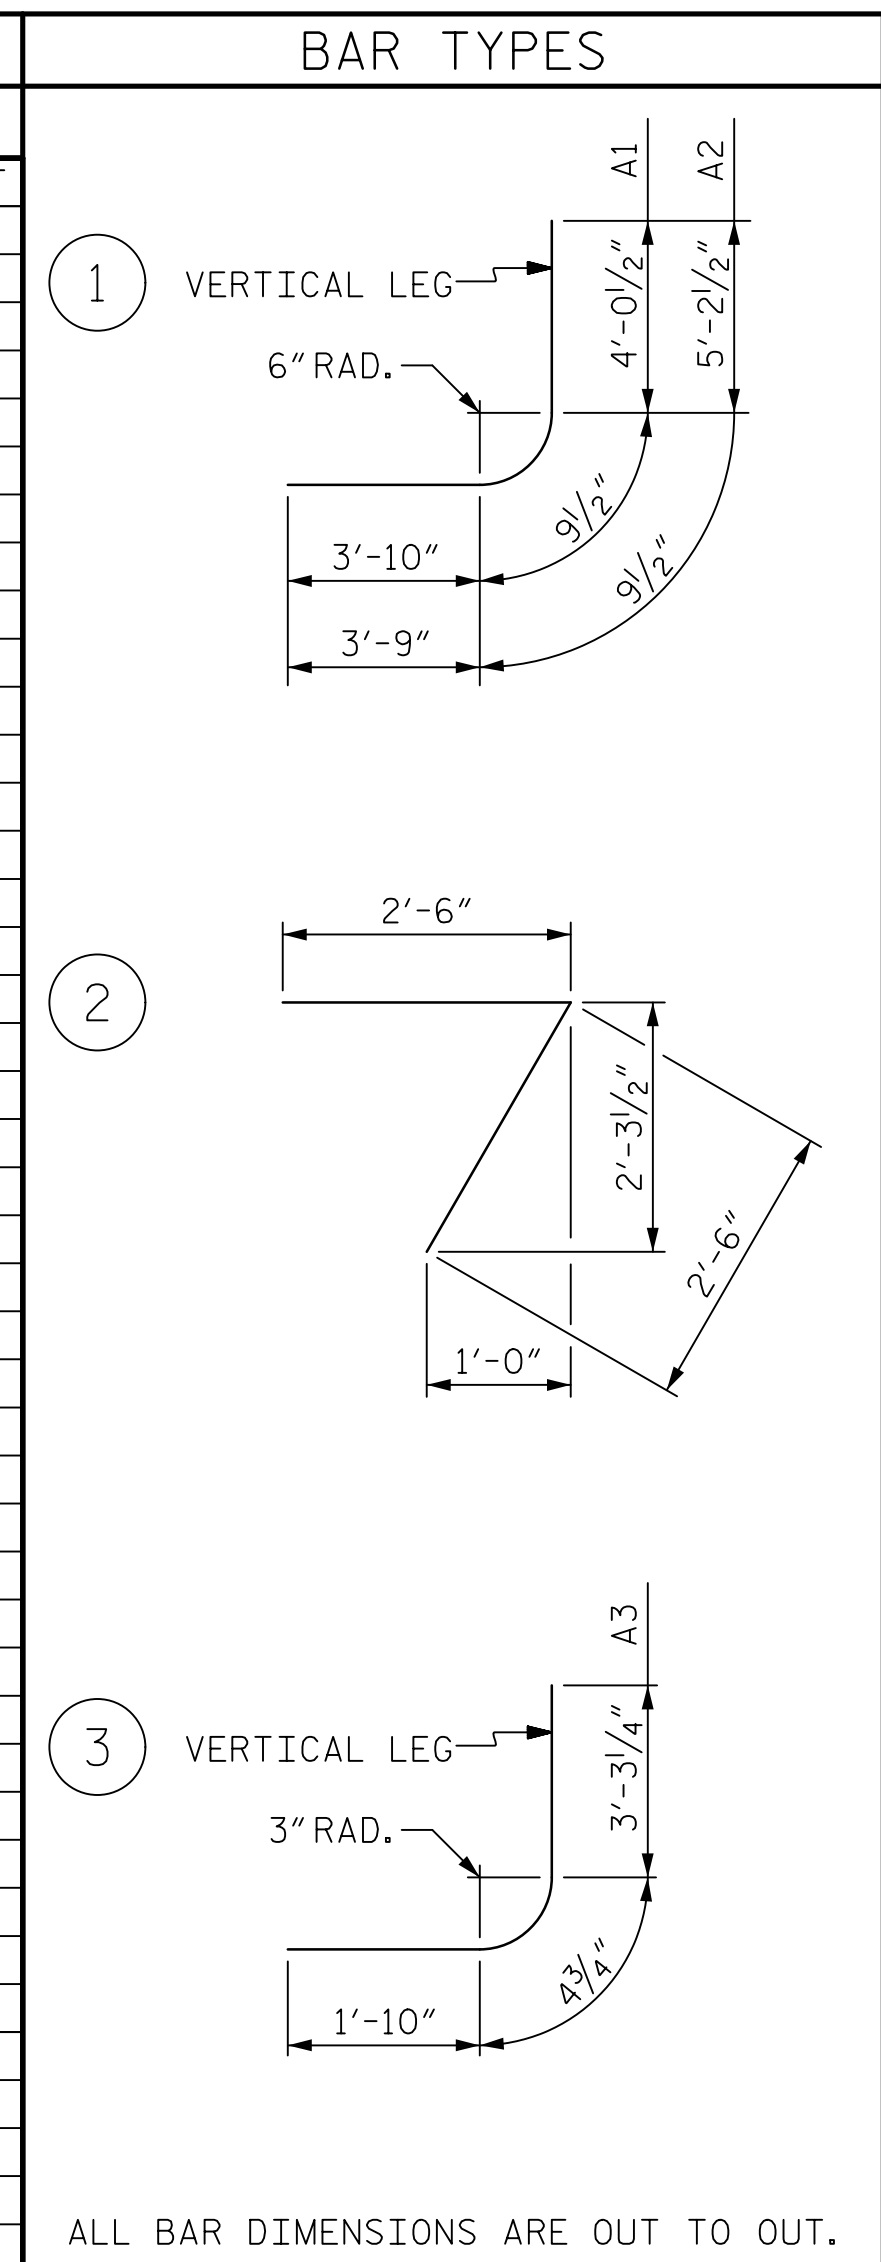

Mead & Hunt
 111 E. Hargett Street
 Suite 300
 Raleigh, NC 27601
 919-714-8670
 meadhunt.com
 NC License No. F-1235



PROJECT NO. R-4707
GUILFORD COUNTY
 STATION: 56+34.85 -L-

SHEET 10 OF 16

STATE OF NORTH CAROLINA
 DEPARTMENT OF TRANSPORTATION
 RALEIGH


TRIPLE 7 FT. x 8 FT.
 REINFORCED CONCRETE
 BOX CULVERT

(RIGHT EXTENSION)


DRAWN BY : J.S. HOBSON DATE : 04/03/19
 CHECKED BY : J.A. LEE DATE : 04/18/19
 DESIGN ENGINEER OF RECORD : J.S. HOBSON DATE : 04/26/19

DOCUMENT NOT CONSIDERED
 FINAL UNLESS ALL
 SIGNATURES COMPLETED


REVISIONS						SHEET NO.
NO.	BY:	DATE:	NO.	BY:	DATE:	C1-18
1			3			TOTAL SHEETS
2			4			24

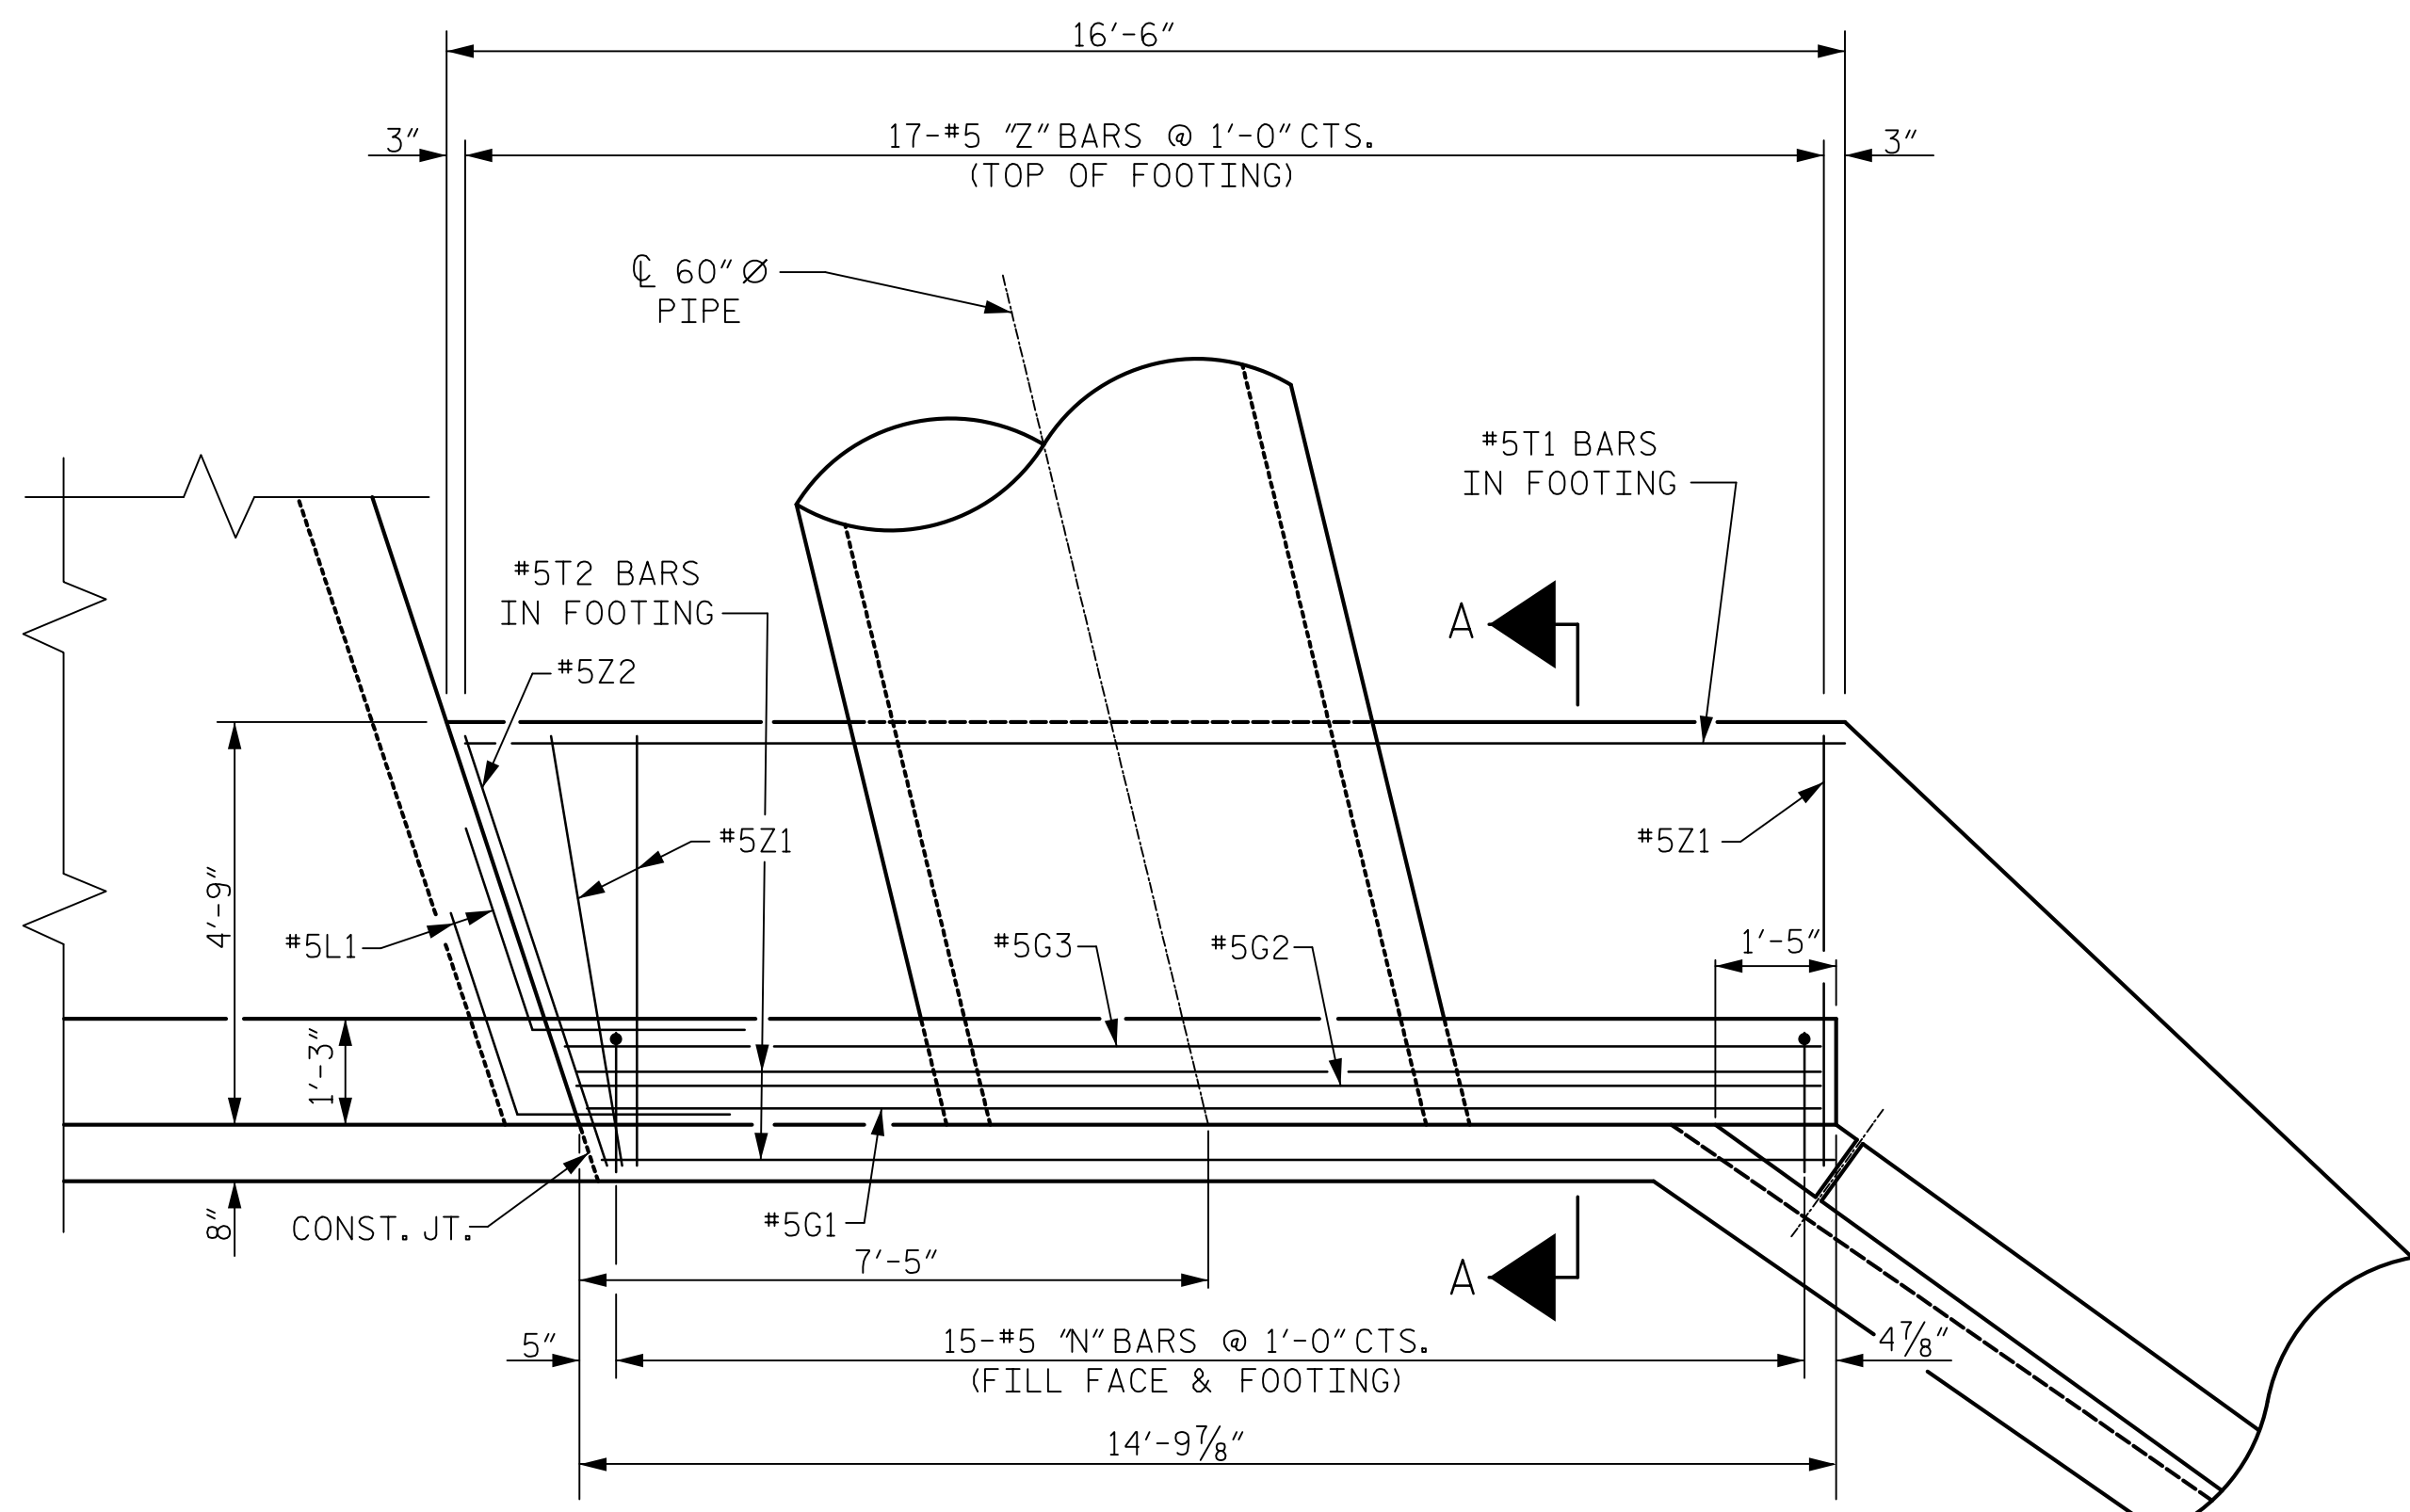

PLAN - 60" Ø PIPE HEADWALL

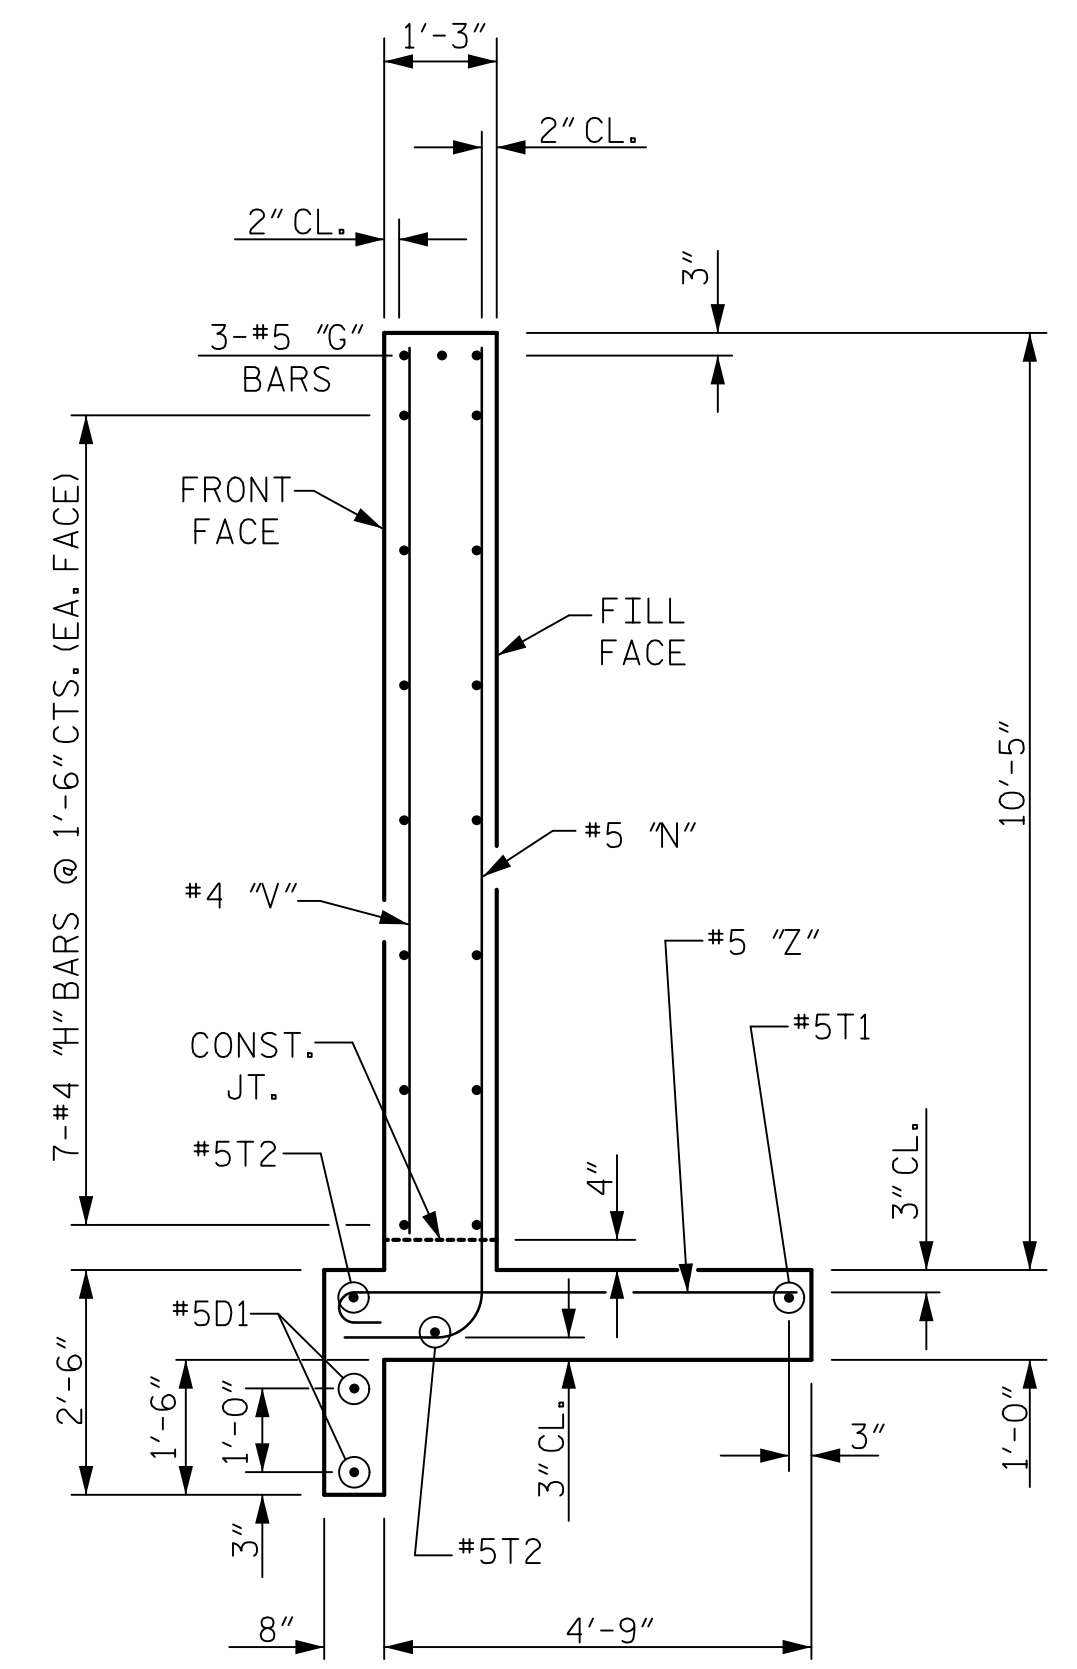


SECTION A-A

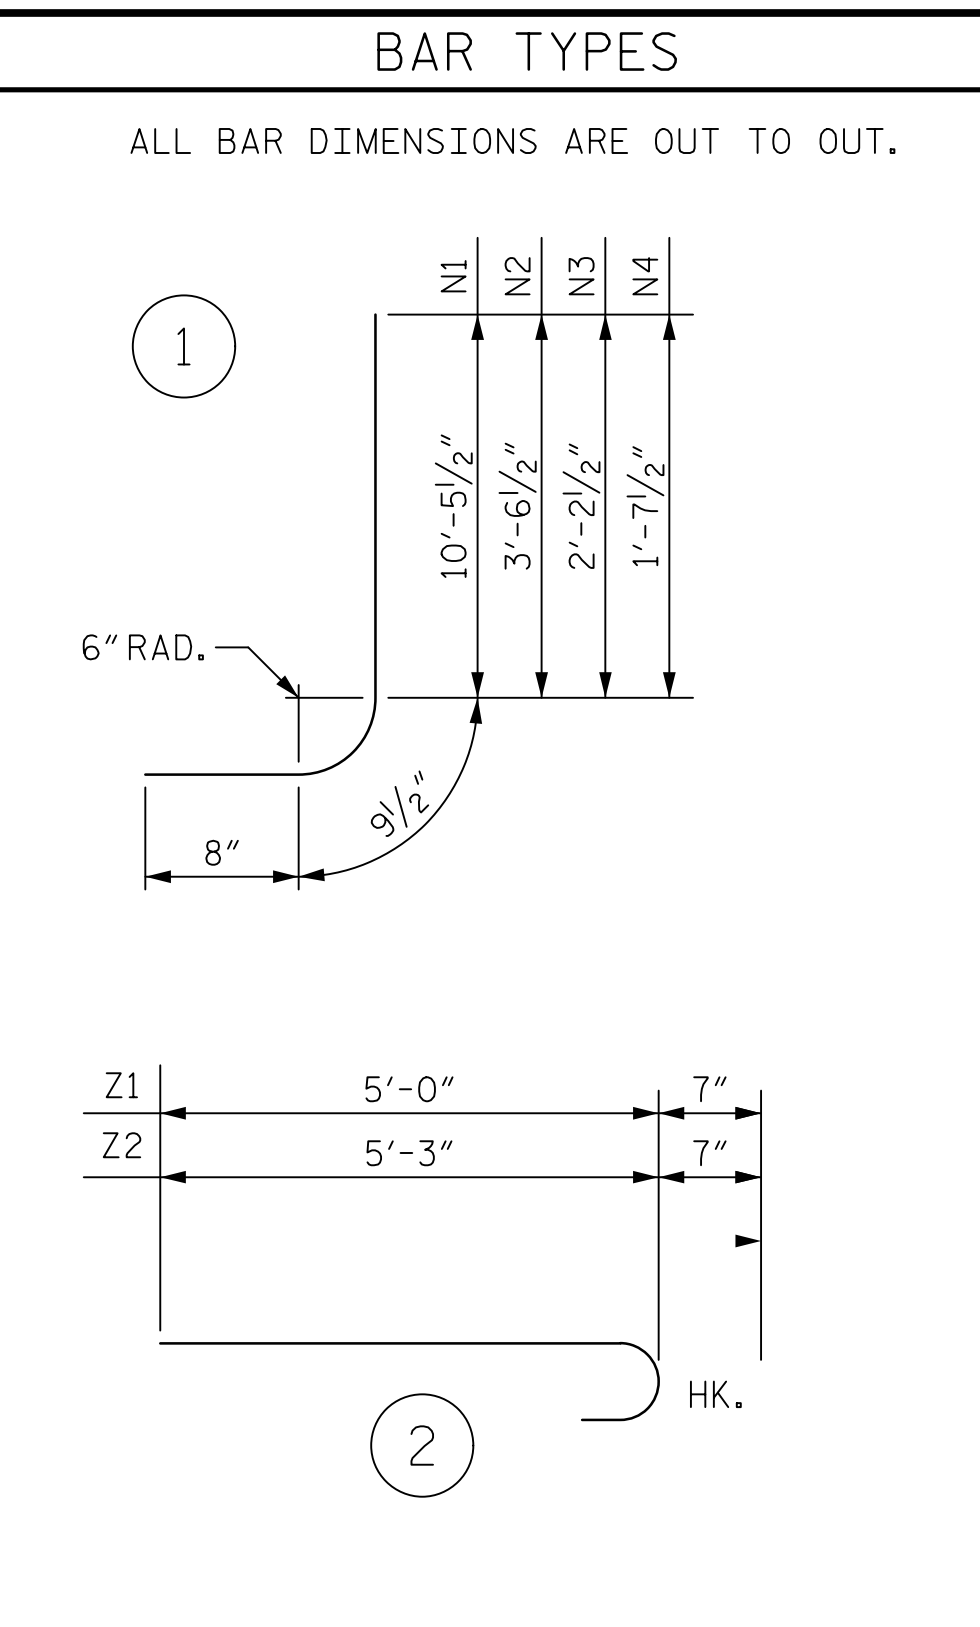

BILL OF MATERIAL					
BAR NO.	SIZE	TYPE	LENGTH	WEIGHT	
D1	2	#5	STR	5'-0"	10
H1	3	#4	STR	14'-6"	29
H2	3	#4	STR	4'-8"	9
H3	3	#4	STR	4'-0"	8
H4	3	#4	STR	4'-3"	9
H5	3	#4	STR	5'-4"	11
H6	3	#4	STR	14'-10"	30
H7	1	#4	STR	4'-10"	3
H8	1	#4	STR	4'-2"	3
H9	1	#4	STR	4'-5"	3
H10	1	#4	STR	5'-6"	4
G1	1	#5	STR	14'-6"	15
G2	1	#5	STR	14'-8"	15
G3	1	#5	STR	14'-10"	15
N1	8	#5	1	11'-11"	99
N2	2	#5	1	5'-0"	10
N3	2	#5	1	3'-8"	8
N4	3	#5	1	3'-1"	10
T1	1	#5	STR	16'-3"	17
T2	2	#5	STR	14'-7"	30
T3	8	#5	STR	7'-4"	61
T4	8	#5	STR	5'-5"	45
T5	4	#5	STR	3'-9"	16
V1	8	#4	STR	9'-11"	53
V2	2	#4	STR	3'-0"	4
V3	2	#4	STR	1'-8"	2
V4	3	#4	STR	1'-1"	2
V5	4	#4	STR	4'-5"	12
V6	4	#4	STR	3'-2"	8
V7	4	#4	STR	2'-8"	7
V8	2	#4	STR	2'-6"	3
Z1	16	#5	2	5'-7"	93
Z2	1	#5	2	5'-10"	6

REINFORCING STEEL (60" Ø PIPE HEADWALL)	650 LBS
CLASS A CONCRETE (60" Ø PIPE HEADWALL)	9.4 CY

I HEREBY CERTIFY THESE PLANS ARE THE AS-BUILT PLANS

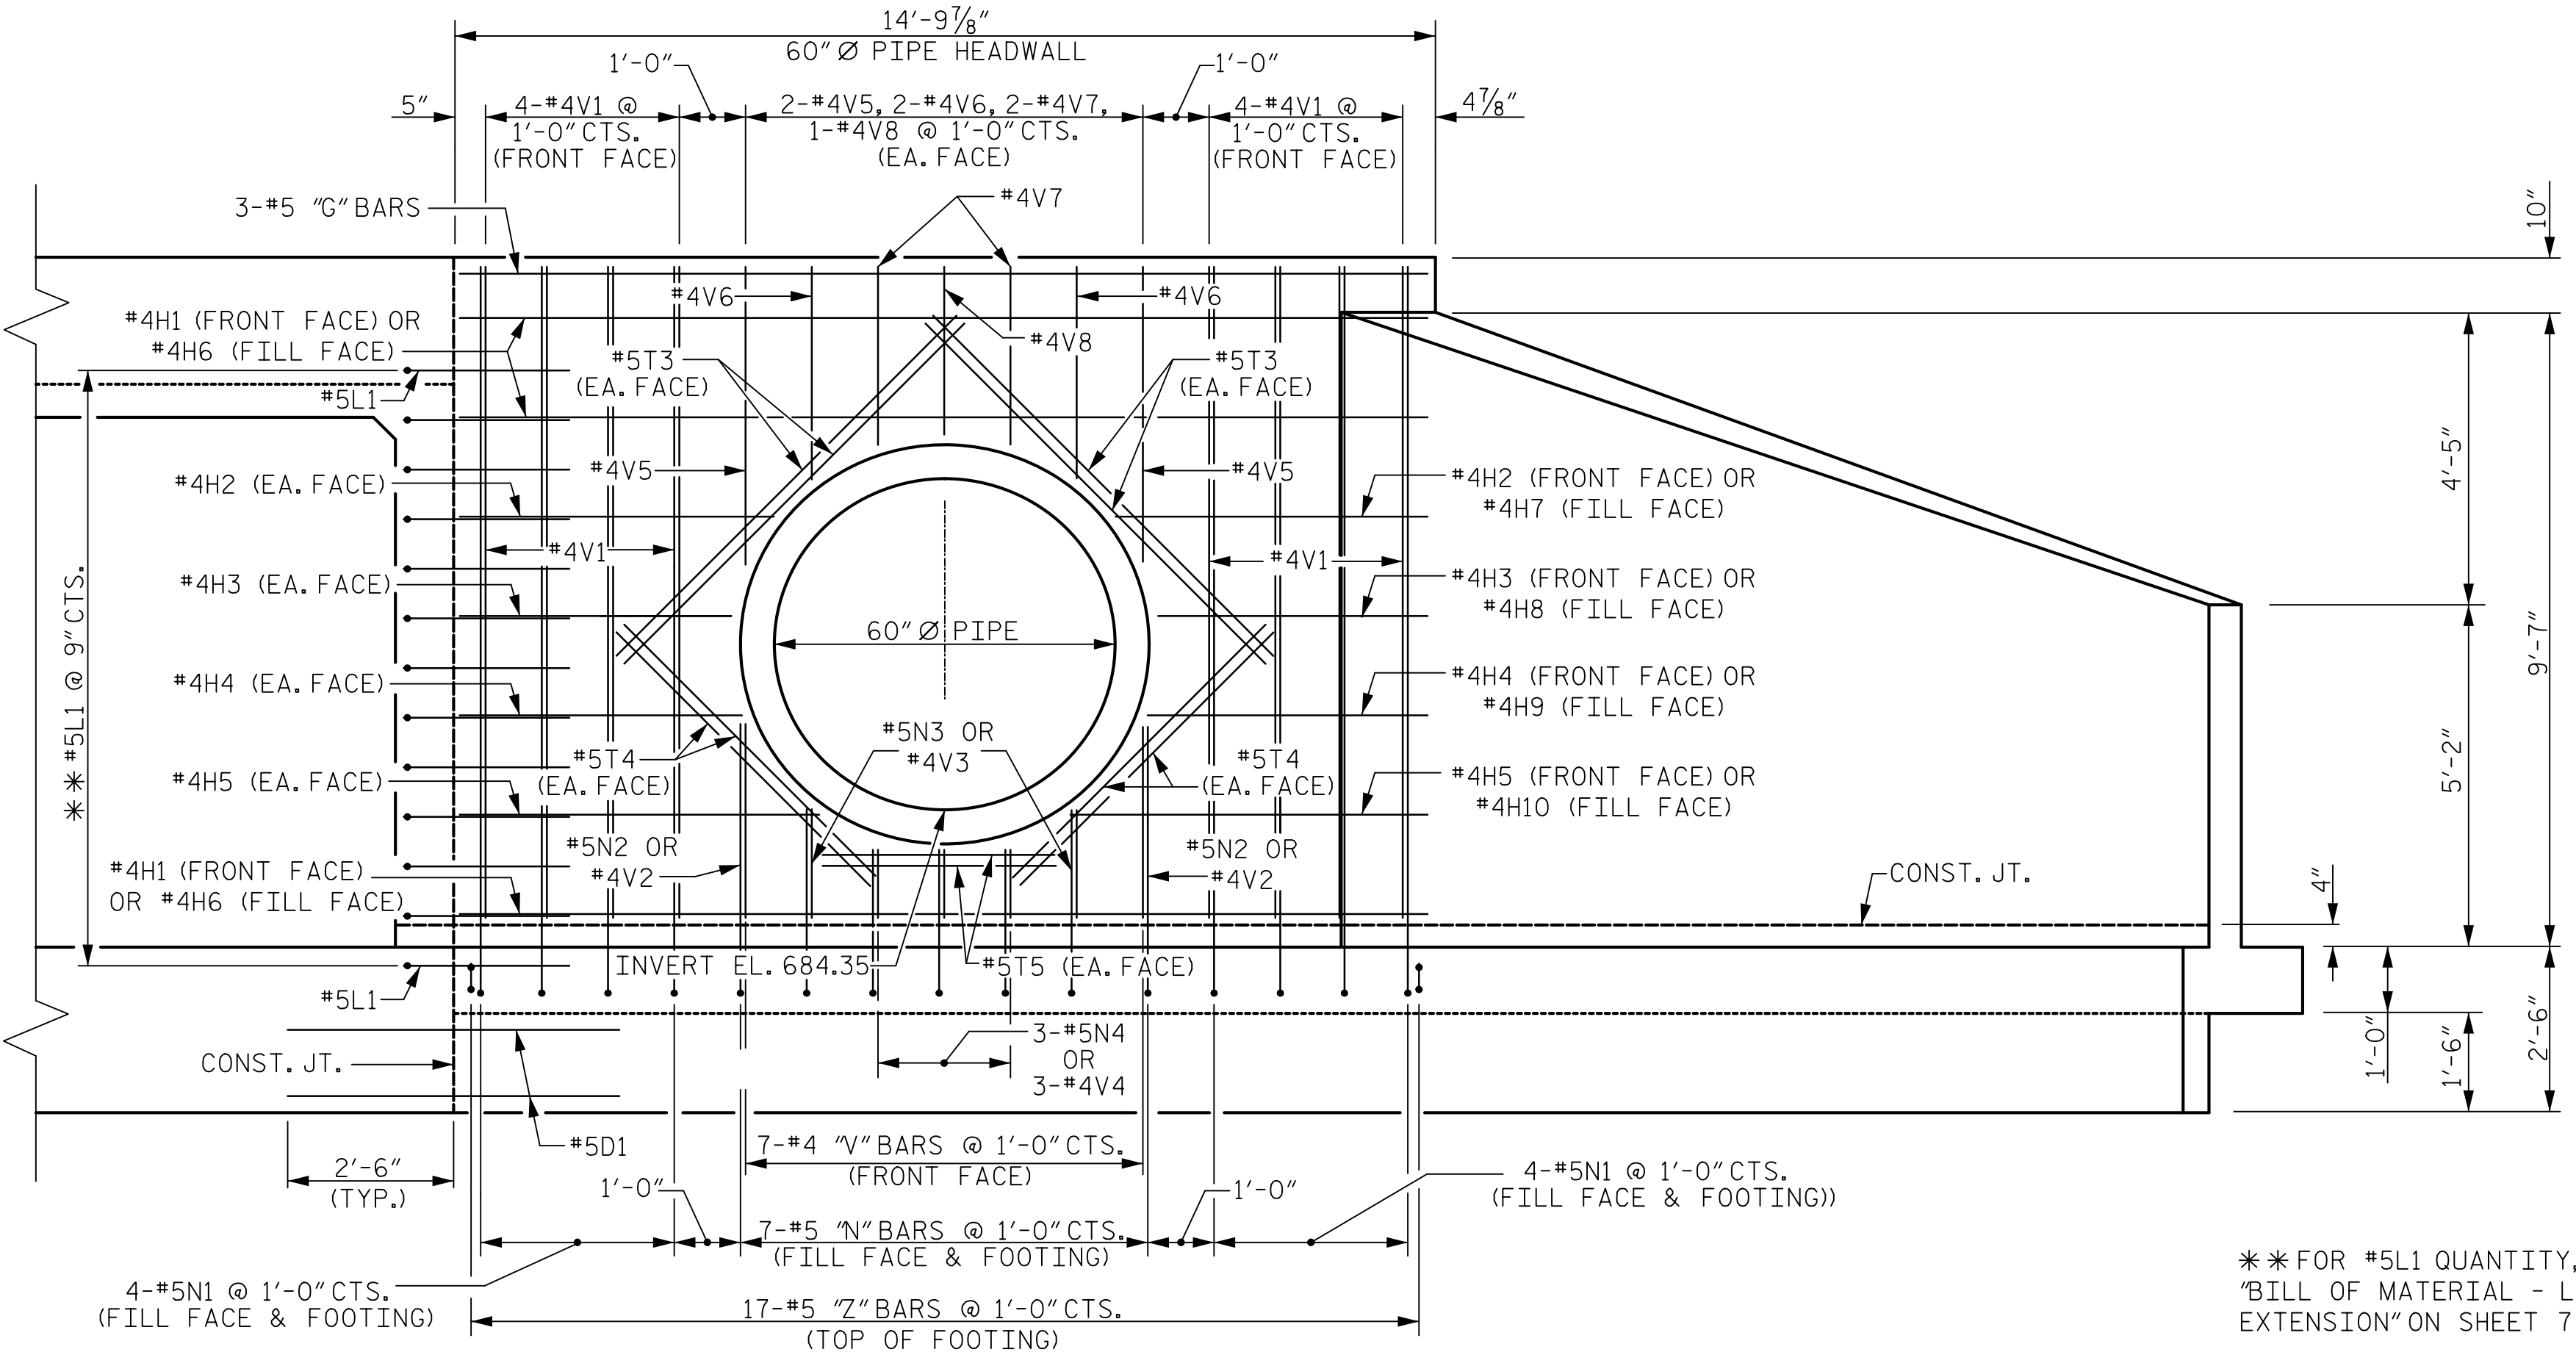

ELEVATION - 60" Ø PIPE HEADWALL

** FOR #5L1 QUANTITY, SEE "BILL OF MATERIAL - LEFT EXTENSION" ON SHEET 7 OF 16

Mead & Hunt
 111 E. Hargett Street
 Suite 300
 Raleigh, NC 27601
 919-714-8670
 meadhunt.com
 NC License No. F-1235



PROJECT NO. R-4707
GUILFORD COUNTY
 STATION: 56+34.85 -L-


SHEET 11 OF 16
 DEPARTMENT OF TRANSPORTATION
 RALEIGH
60" Ø PIPE HEADWALL
 (LEFT EXTENSION)

DRAWN BY : J.A. LEE DATE : 03/18/19
 CHECKED BY : J.S. HOBSON DATE : 04/15/19
 DESIGN ENGINEER OF RECORD : J.S. HOBSON DATE : 04/26/19


DOCUMENT NOT CONSIDERED
 FINAL UNLESS ALL
 SIGNATURES COMPLETED

REVISIONS					
NO.	BY:	DATE:	NO.	BY:	DATE:
1			3		
2			4		


SHEET NO.
 C1-19
 TOTAL SHEETS
 24

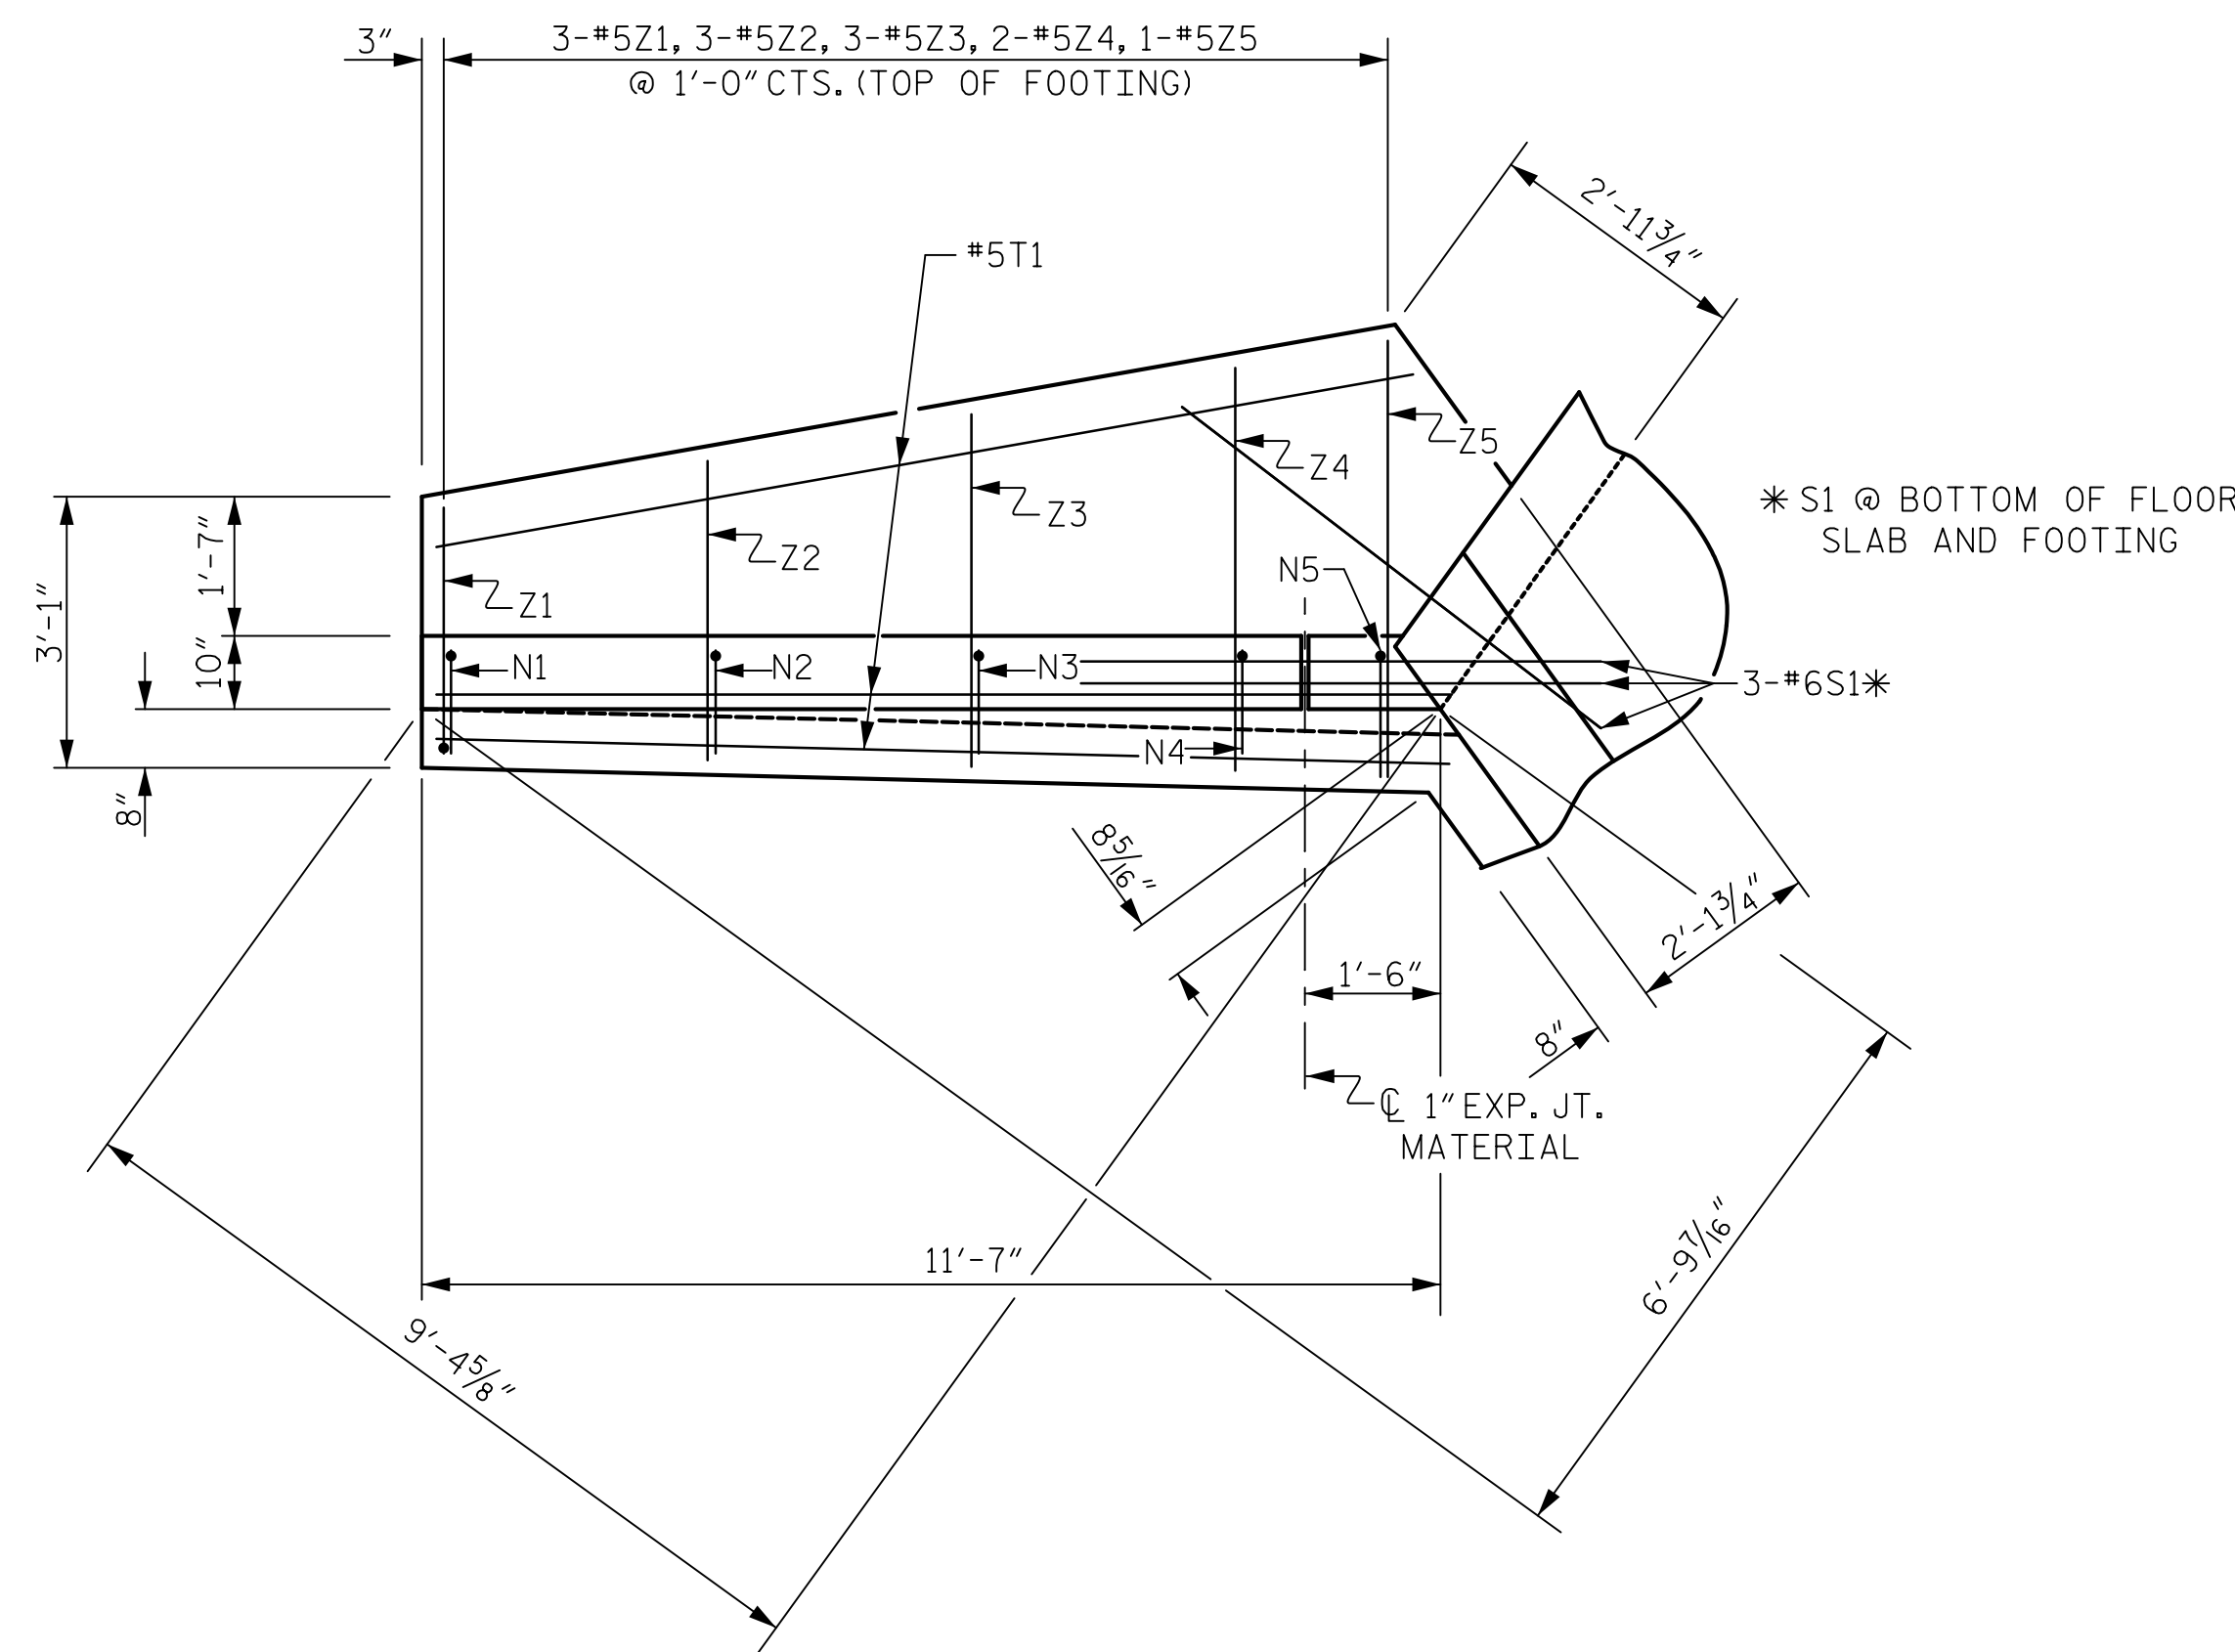

PLAN W1

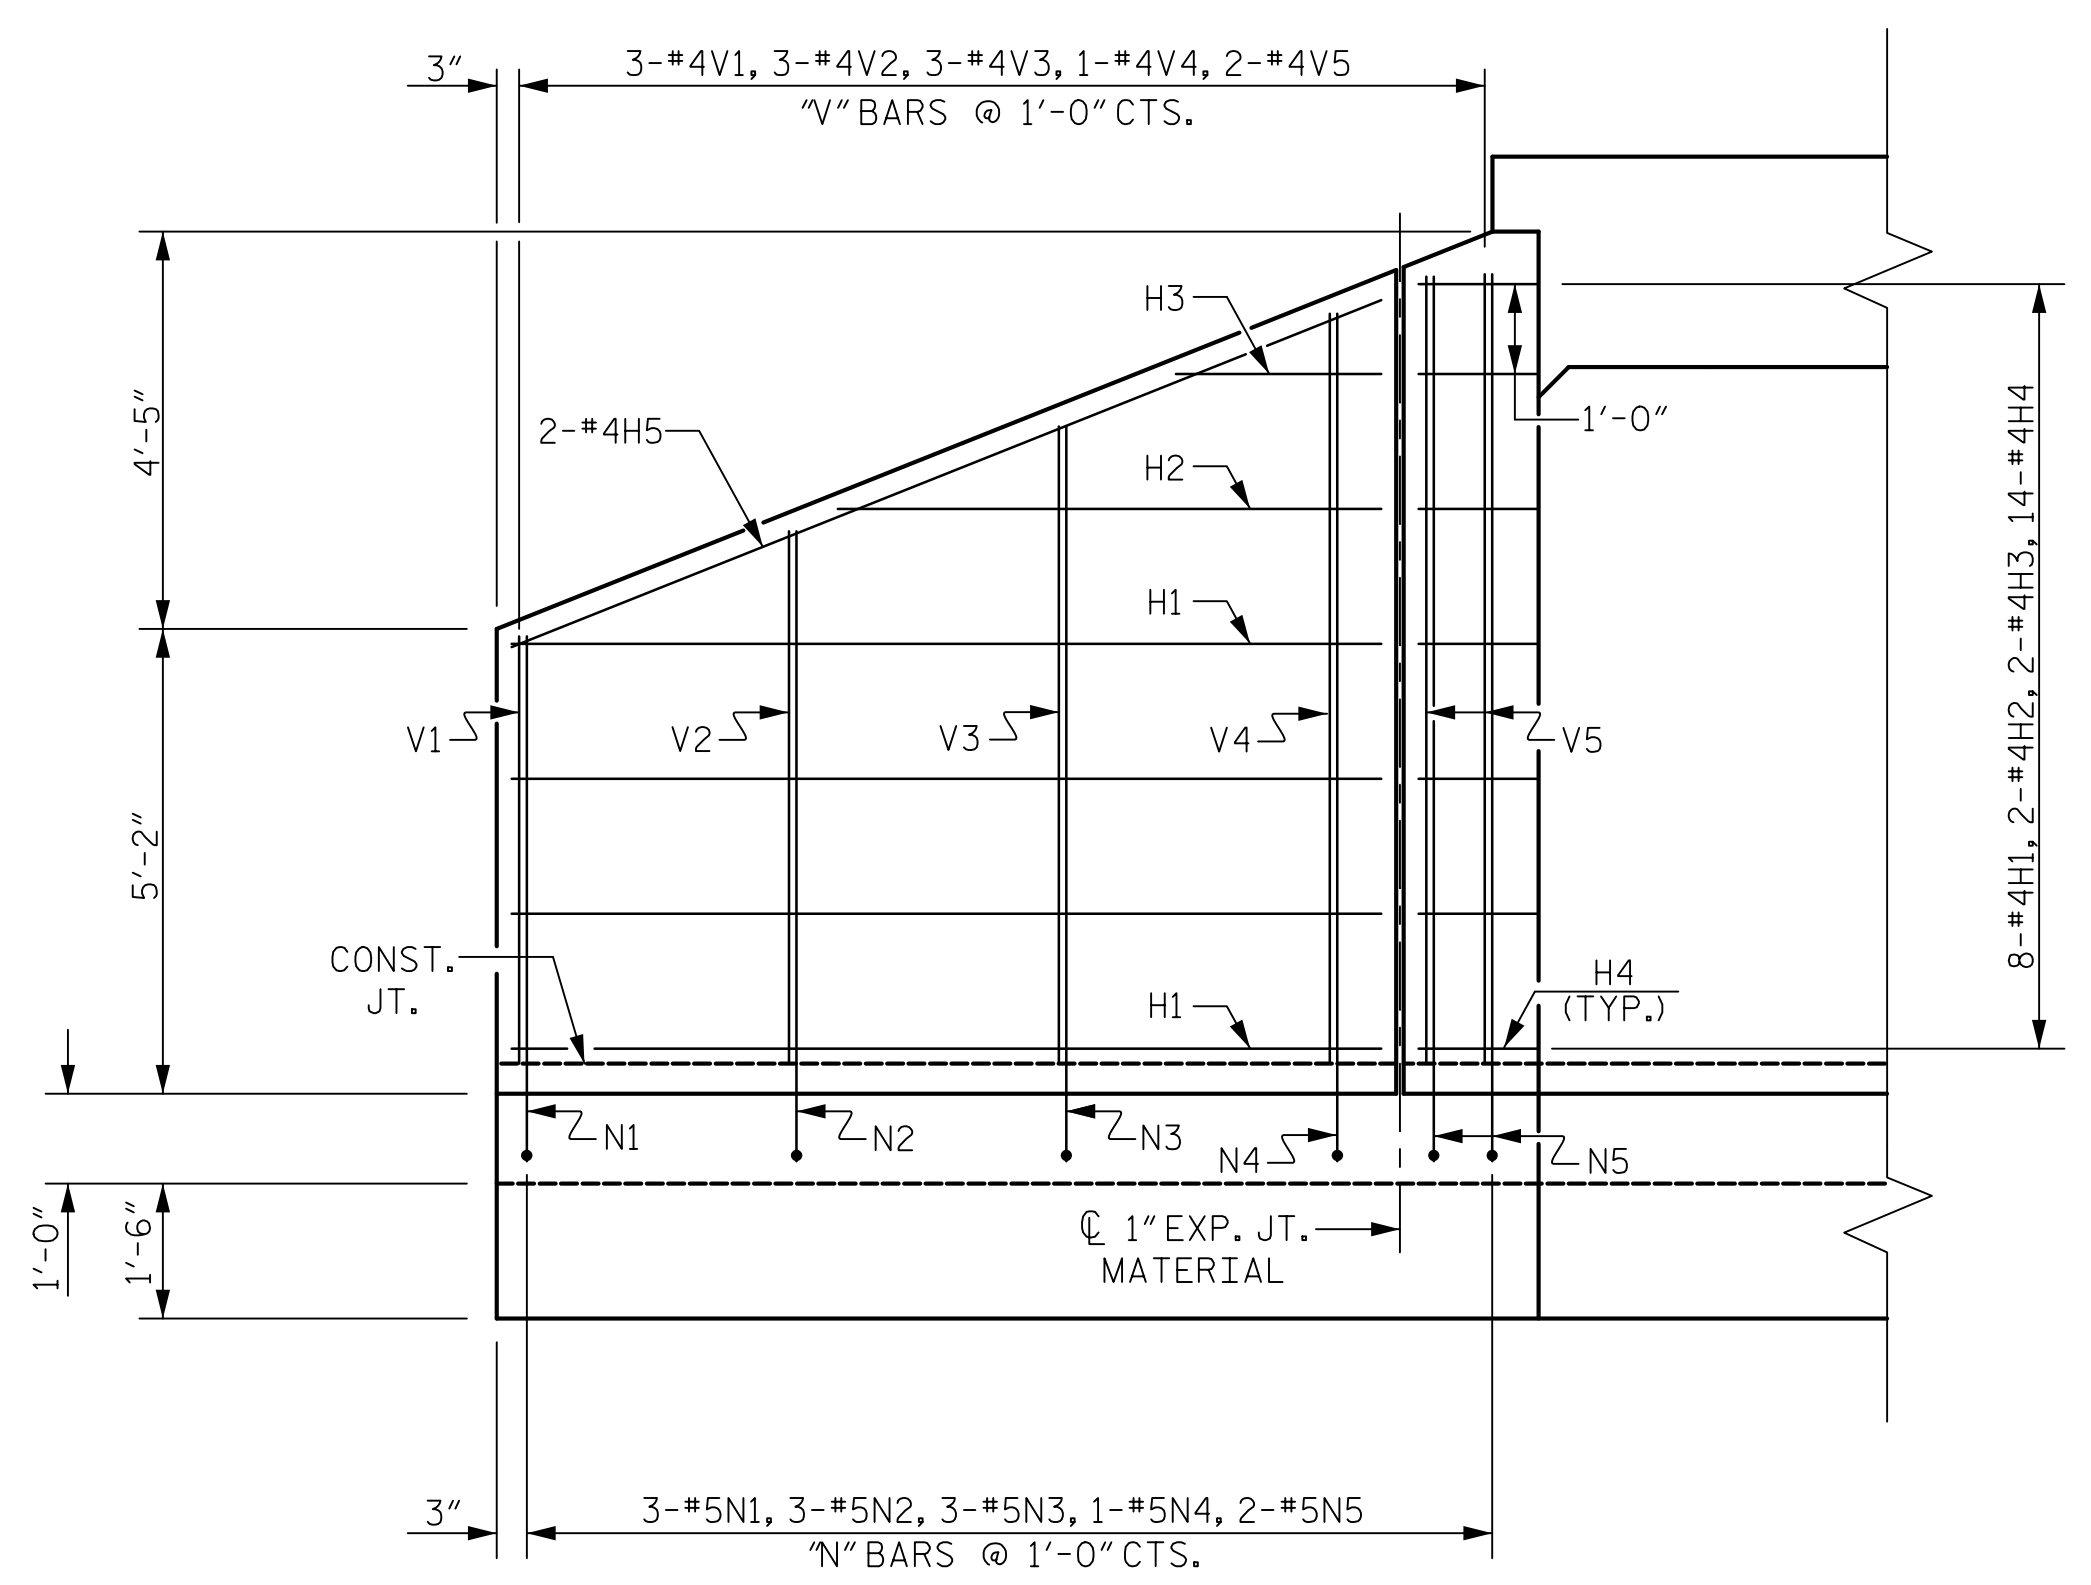

ELEVATION W1

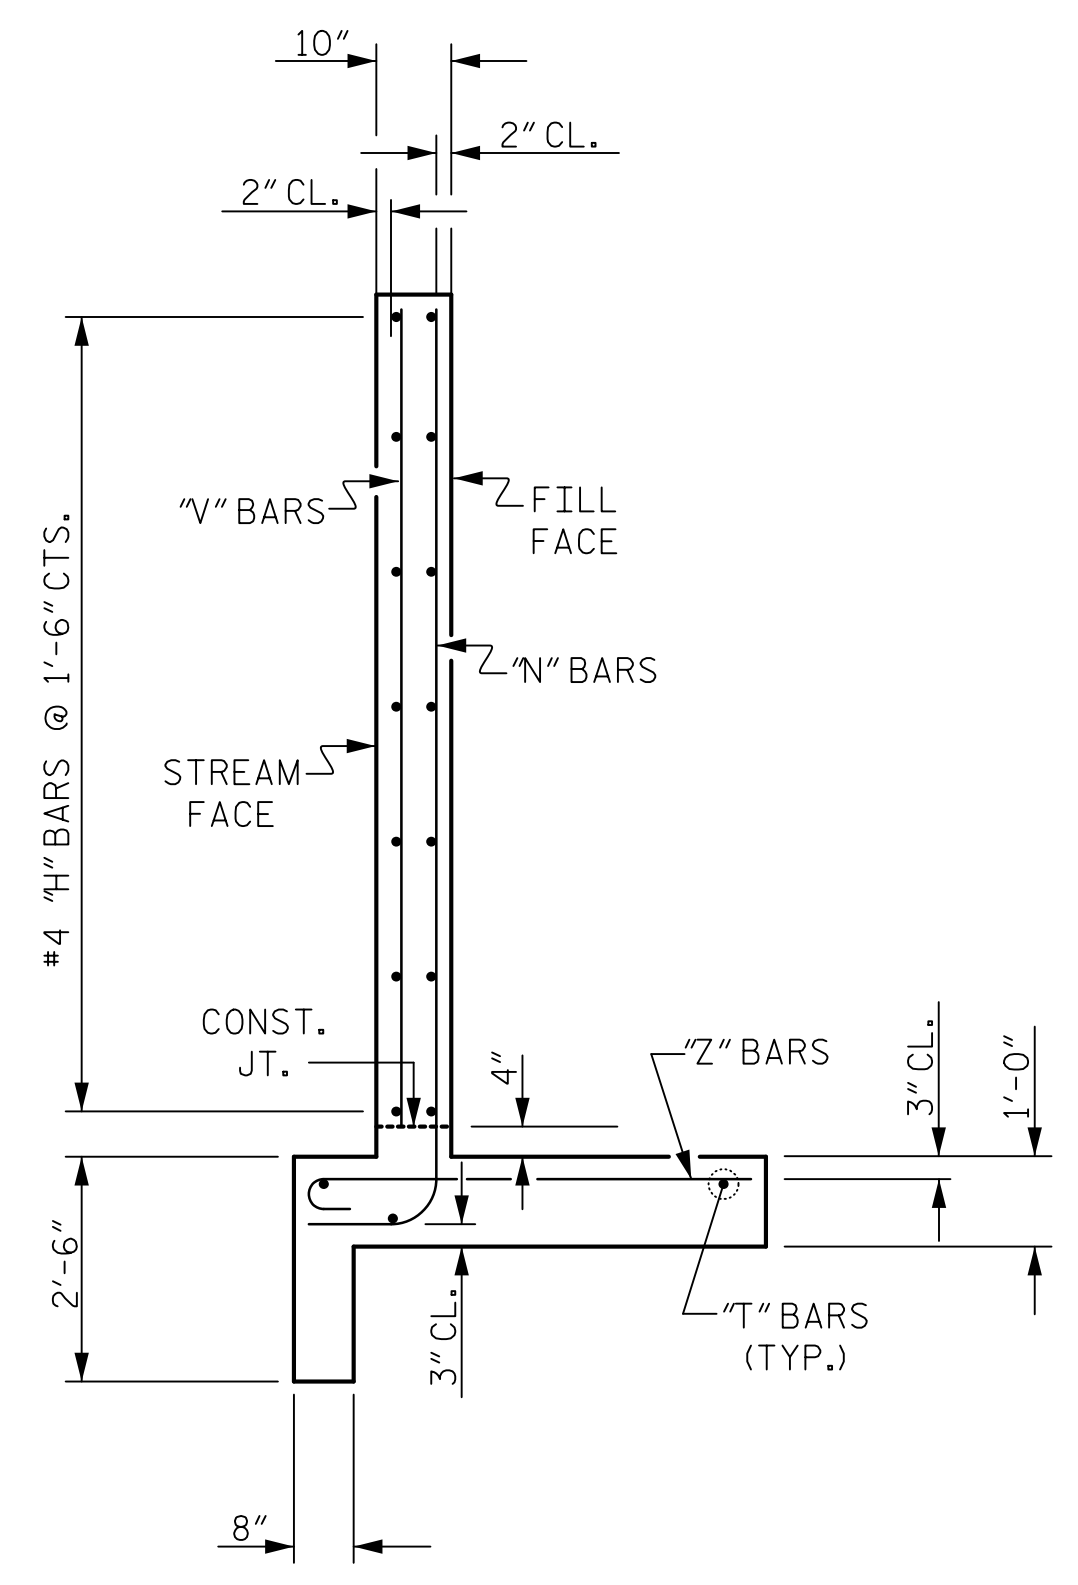

TYPICAL WING SECTION

BAR TYPES

BILL OF MATERIAL

BAR	NO.	SIZE	TYPE	LENGTH	WEIGHT
H1	8	#4	STR	9'-8"	52
H2	2	#4	STR	6'-0"	8
H3	2	#4	STR	2'-3"	3
H4	14	#4	1	3'-3"	30
H5	2	#4	STR	10'-4"	14
N1	3	#5	2	6'-9"	21
N2	3	#5	2	7'-11"	25
N3	3	#5	2	9'-1"	28
N4	1	#5	2	10'-4"	11
N5	2	#5	2	10'-8"	22
S1	3	#6	STR	6'-0"	27
T1	3	#5	STR	11'-3"	35
V1	3	#4	STR	4'-9"	10
V2	3	#4	STR	5'-11"	12
V3	3	#4	STR	7'-1"	14
V4	1	#4	STR	8'-4"	6
V5	2	#4	STR	8'-8"	12
Z1	3	#5	3	3'-4"	10
Z2	3	#5	3	3'-11"	12
Z3	3	#5	3	4'-7"	14
Z4	2	#5	3	5'-2"	11
Z5	1	#5	3	5'-6"	6

REINFORCING STEEL FOR WING W1 383 LBS

CLASS A CONCRETE WING W1 4.5 CY


CURTAIN WALL 0.4 CY

TOTAL 4.9 CY

ALL BAR DIMENSIONS ARE OUT TO OUT.

DRAWN BY : J.A. LEE DATE : 03/25/19
 CHECKED BY : J.S. HOBSON DATE : 04/15/19
 DESIGN ENGINEER OF RECORD : J.S. HOBSON DATE : 04/26/19

Mead & Hunt
 111 E. Hargett Street
 Suite 300
 Raleigh, NC 27601
 919-714-8670
 meadhunt.com
 NC License No. F-1235

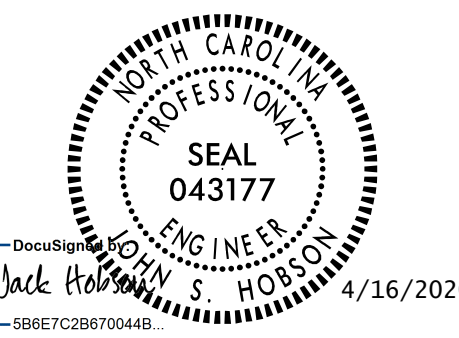

DOCUMENT NOT CONSIDERED FINAL UNLESS ALL SIGNATURES COMPLETED

PROJECT NO. R-4707
 GUILFORD COUNTY
 STATION: 56+34.85 -L-
 SHEET 12 OF 16


STATE OF NORTH CAROLINA
 DEPARTMENT OF TRANSPORTATION
 RALEIGH

**WING W1
 FOR
 CONCRETE BOX CULVERT
 (LEFT EXTENSION)**


H=8'-0" SLOPE=2:1

REVISIONS				SHEET NO.	
NO.	BY:	DATE:	NO.	BY:	DATE:
1			3		
2			4		

C1-20
 TOTAL SHEETS 24

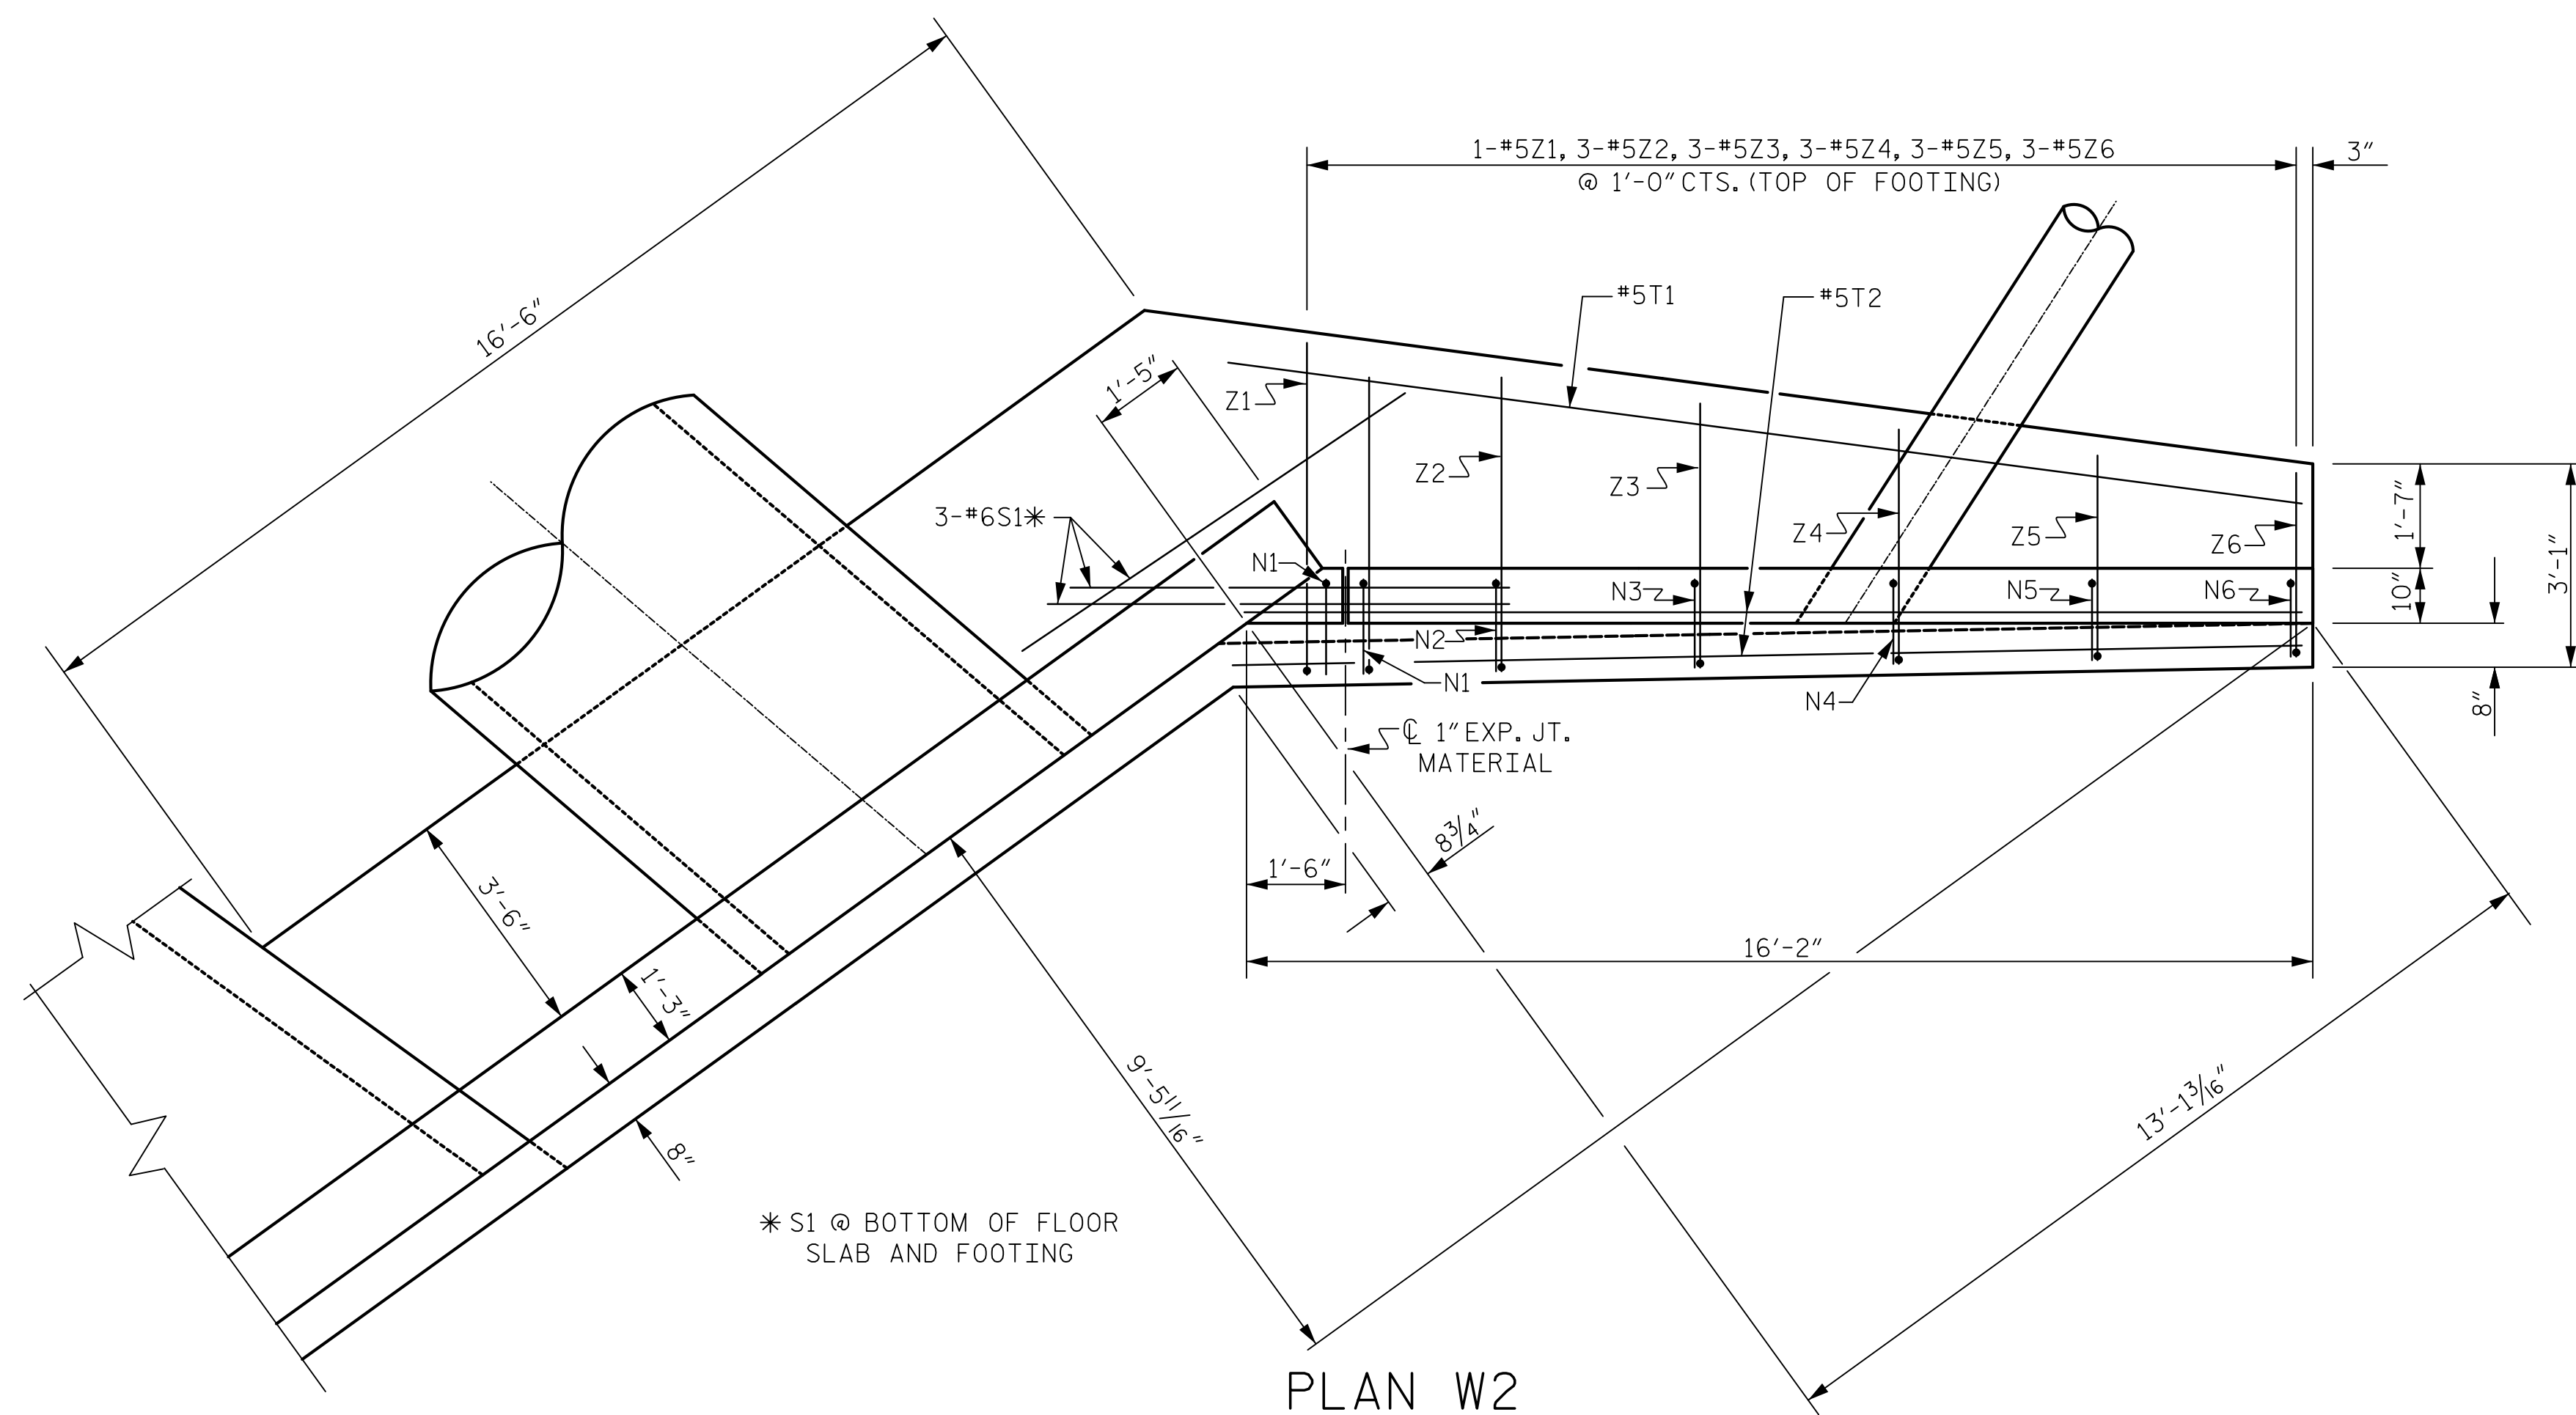


PLAN W2

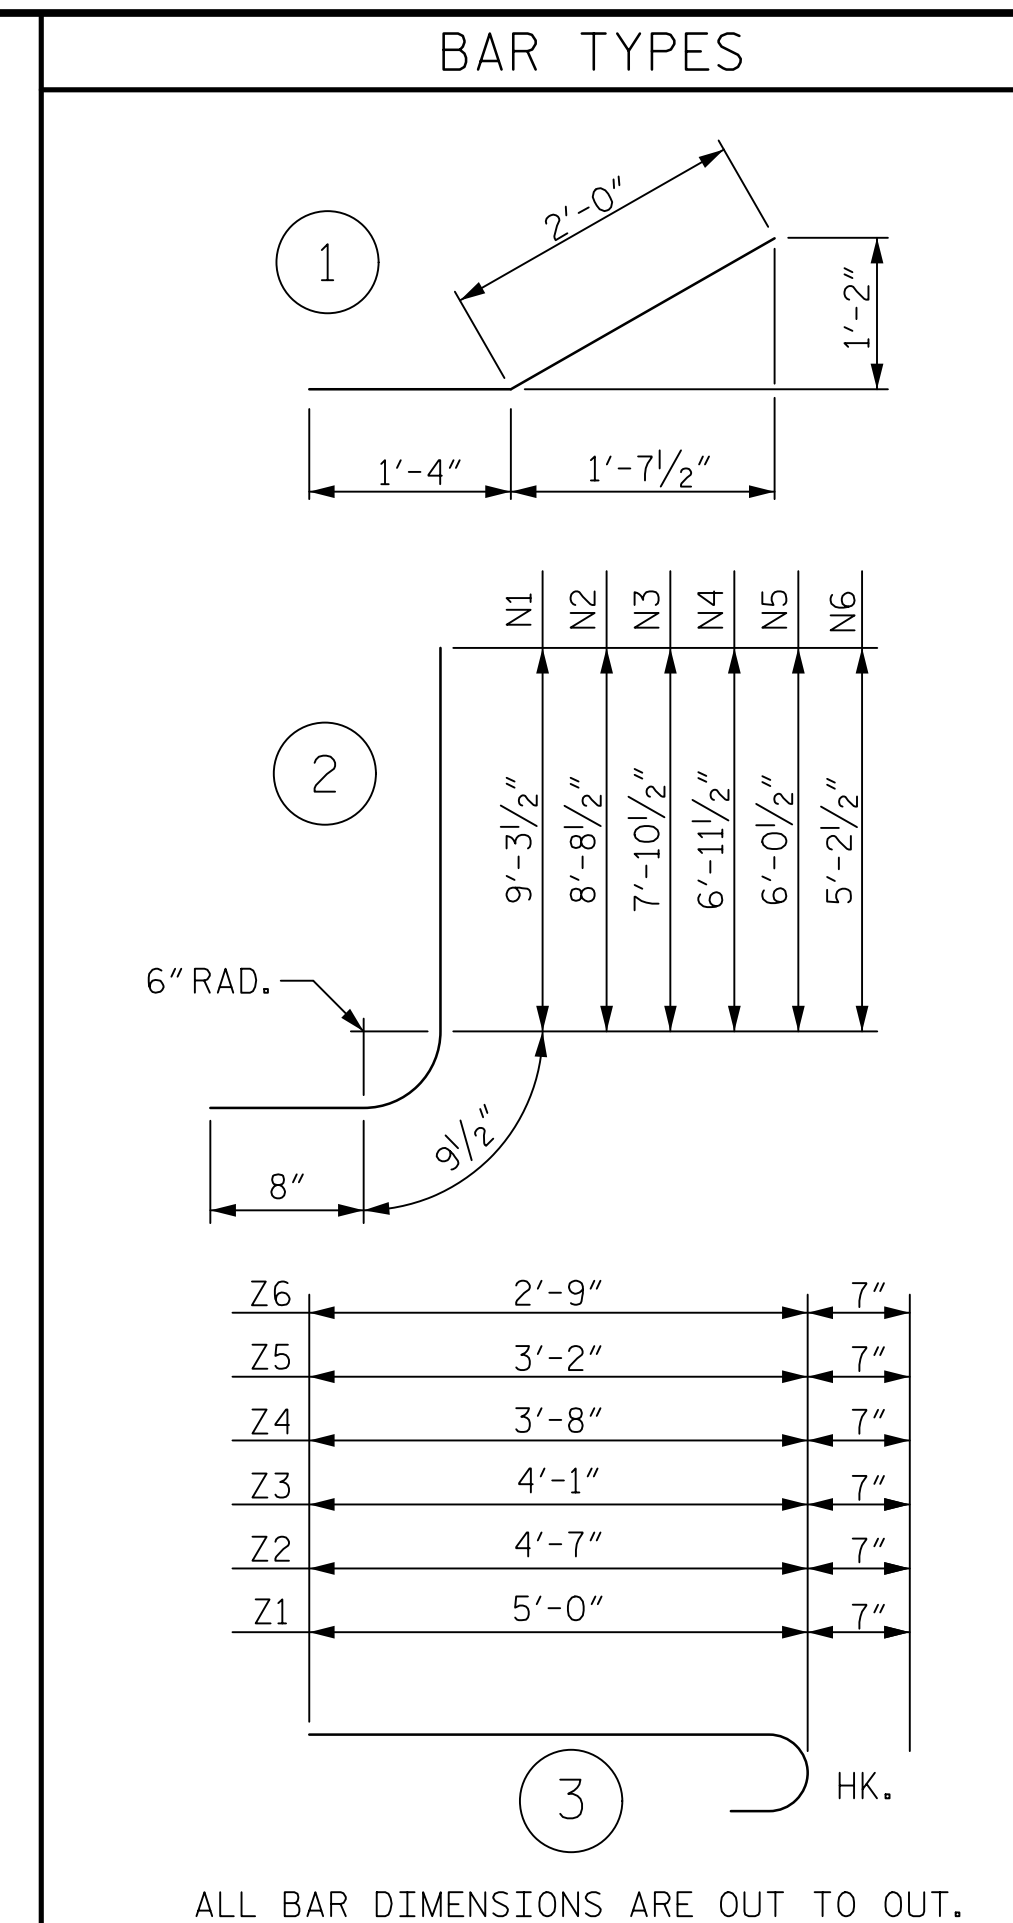


BILL OF MATERIAL					
BAR NO.	NO.	SIZE	TYPE	LENGTH	WEIGHT
E1	16	#5	STR	2'-8"	45
H1	8	#4	STR	14'-3"	76
H2	2	#4	STR	9'-2"	12
H3	2	#4	STR	4'-1"	5
H4	14	#4	1	3'-4"	31
H5	2	#4	STR	14'-10"	20
N1	2	#5	2	10'-9"	22
N2	2	#5	2	10'-2"	21
N3	3	#5	2	9'-4"	29
N4	3	#5	2	8'-5"	26
N5	3	#5	2	7'-6"	23
N6	3	#5	2	6'-8"	21
S1	3	#6	STR	7'-0"	32
T1	1	#5	STR	17'-6"	18
T2	2	#5	STR	16'-1"	34
V1	3	#4	STR	8'-9"	18
V2	2	#4	STR	8'-2"	11
V3	3	#4	STR	7'-4"	15
V4	3	#4	STR	6'-5"	13
V5	3	#4	STR	5'-6"	11
V6	3	#4	STR	4'-8"	9
Z1	1	#5	3	5'-7"	6
Z2	3	#5	3	5'-2"	16
Z3	3	#5	3	4'-8"	15
Z4	3	#5	3	4'-3"	13
Z5	3	#5	3	3'-9"	12
Z6	3	#5	3	3'-4"	10


REINFORCING STEEL FOR WING W2	564	LBS
CLASS A CONCRETE WING W2	6.1	CY
CURTAIN WALL	0.6	CY
TOTAL	6.7	CY

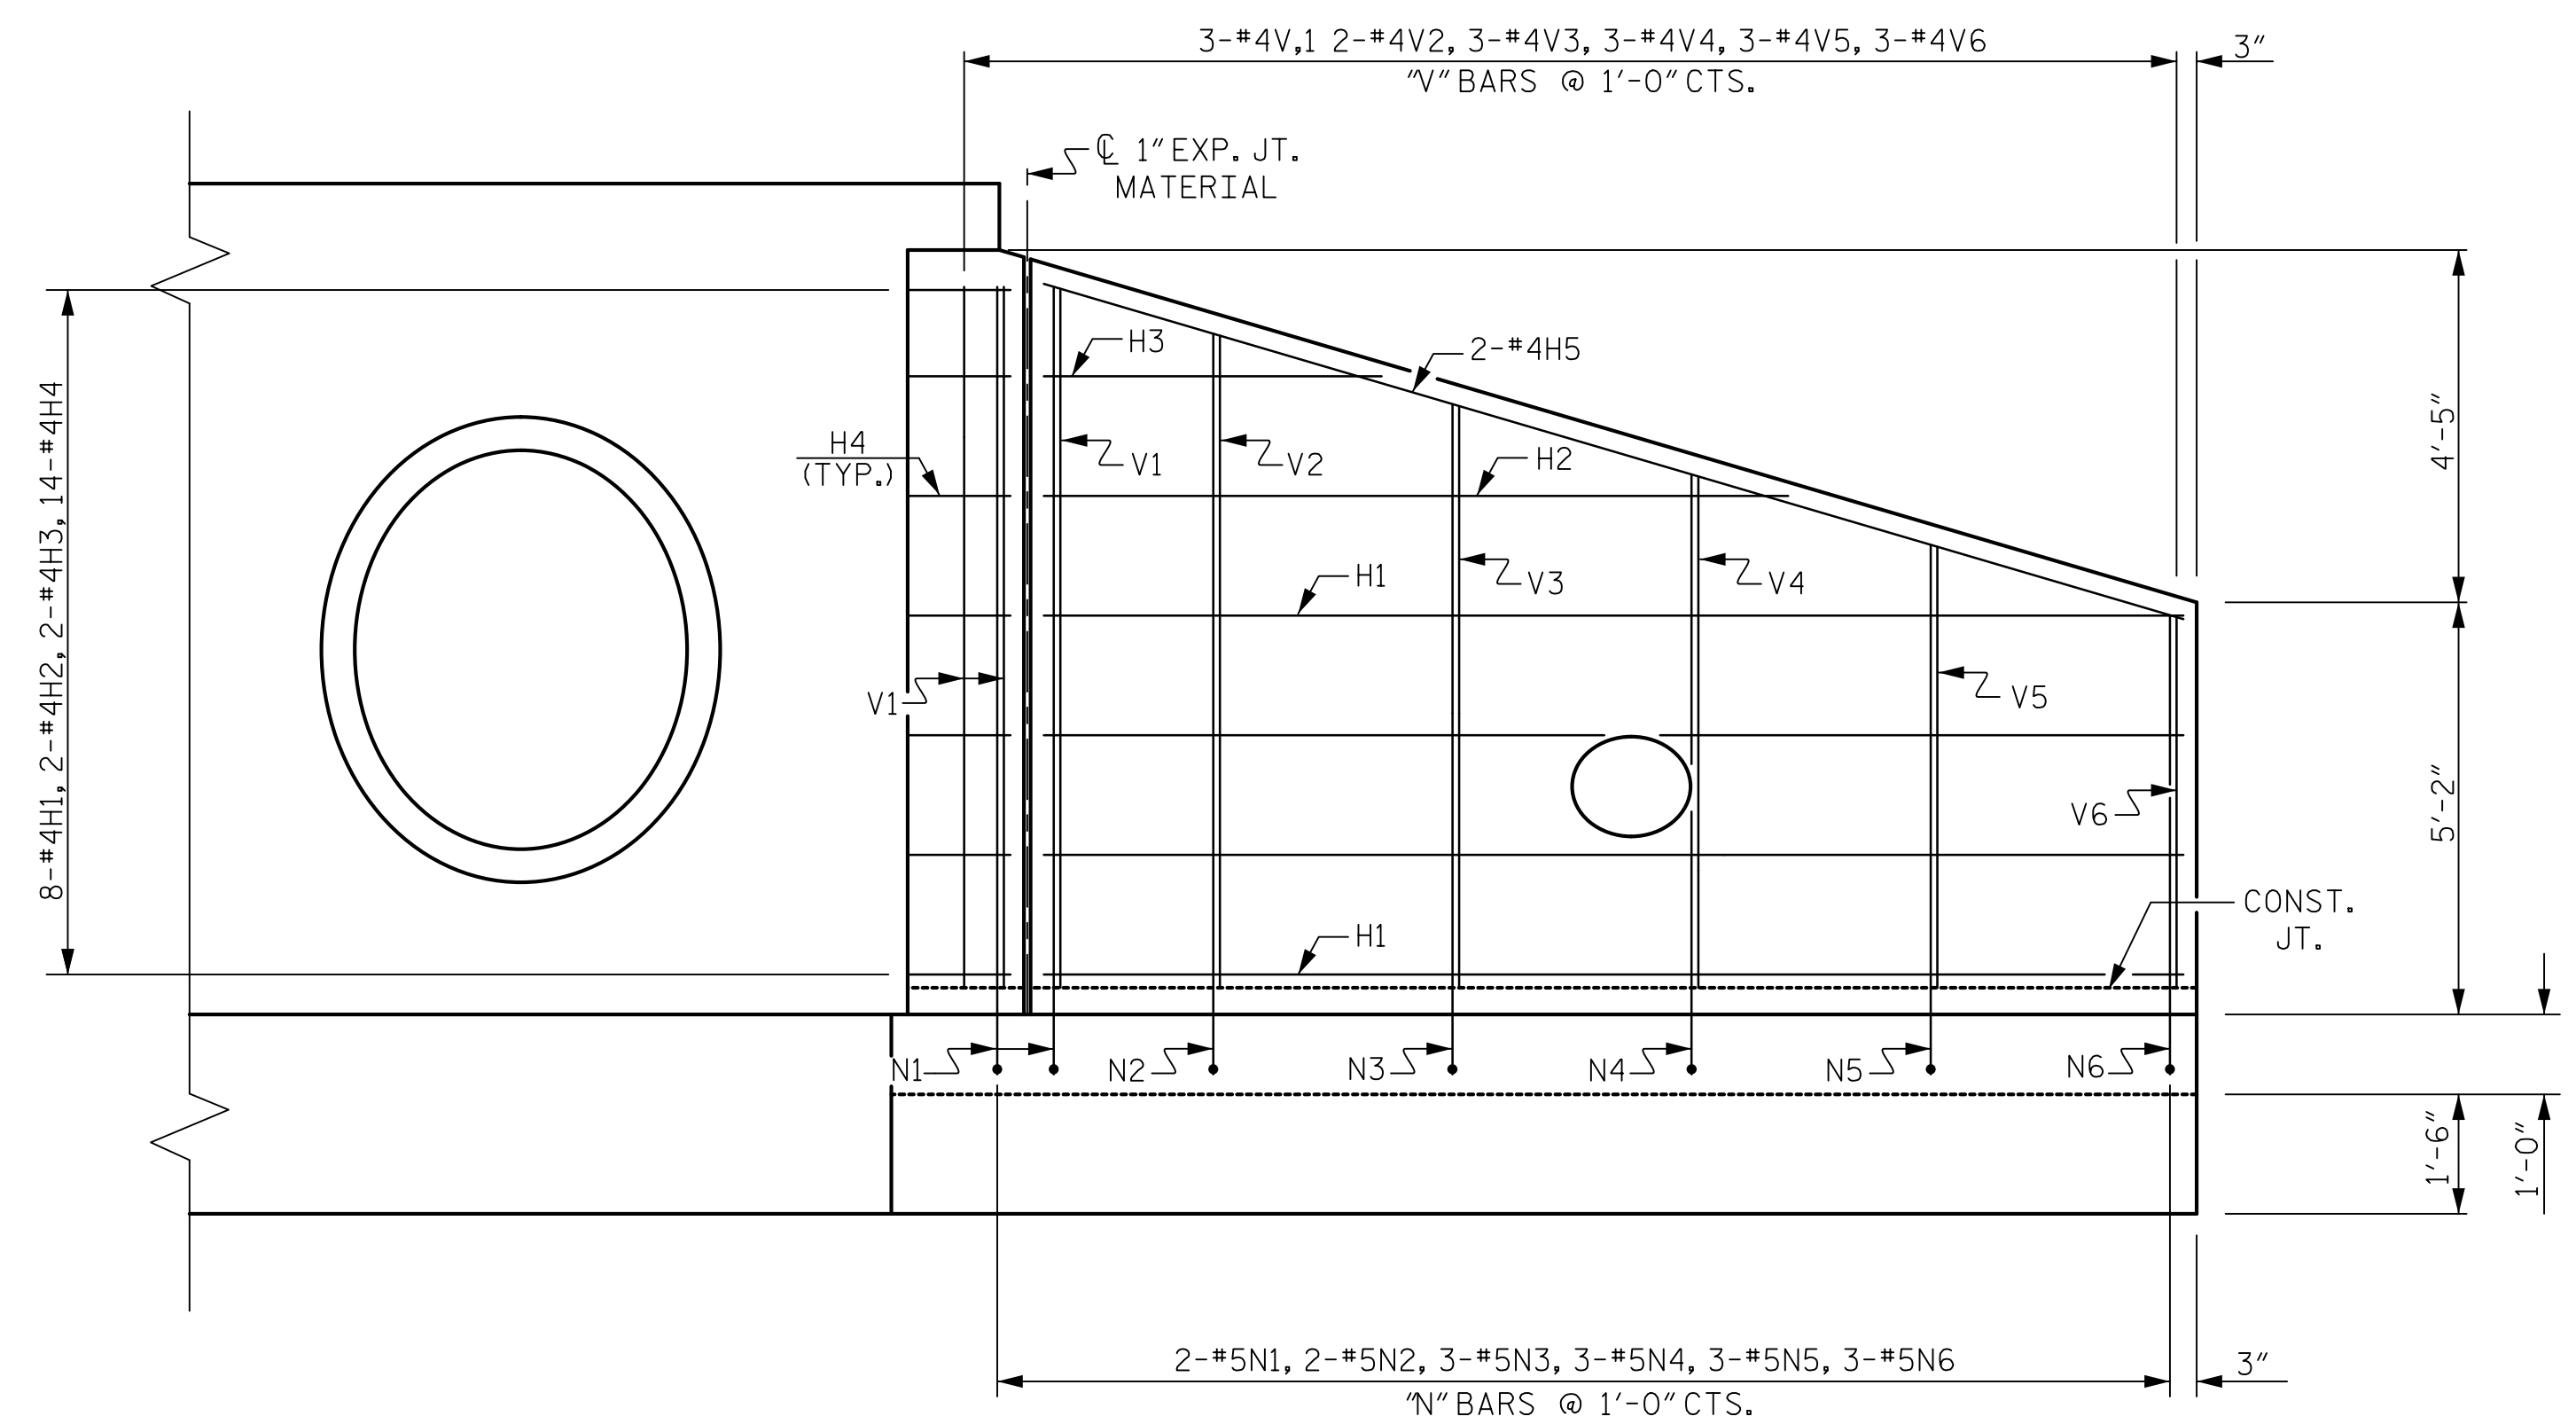

ELEVATION W2

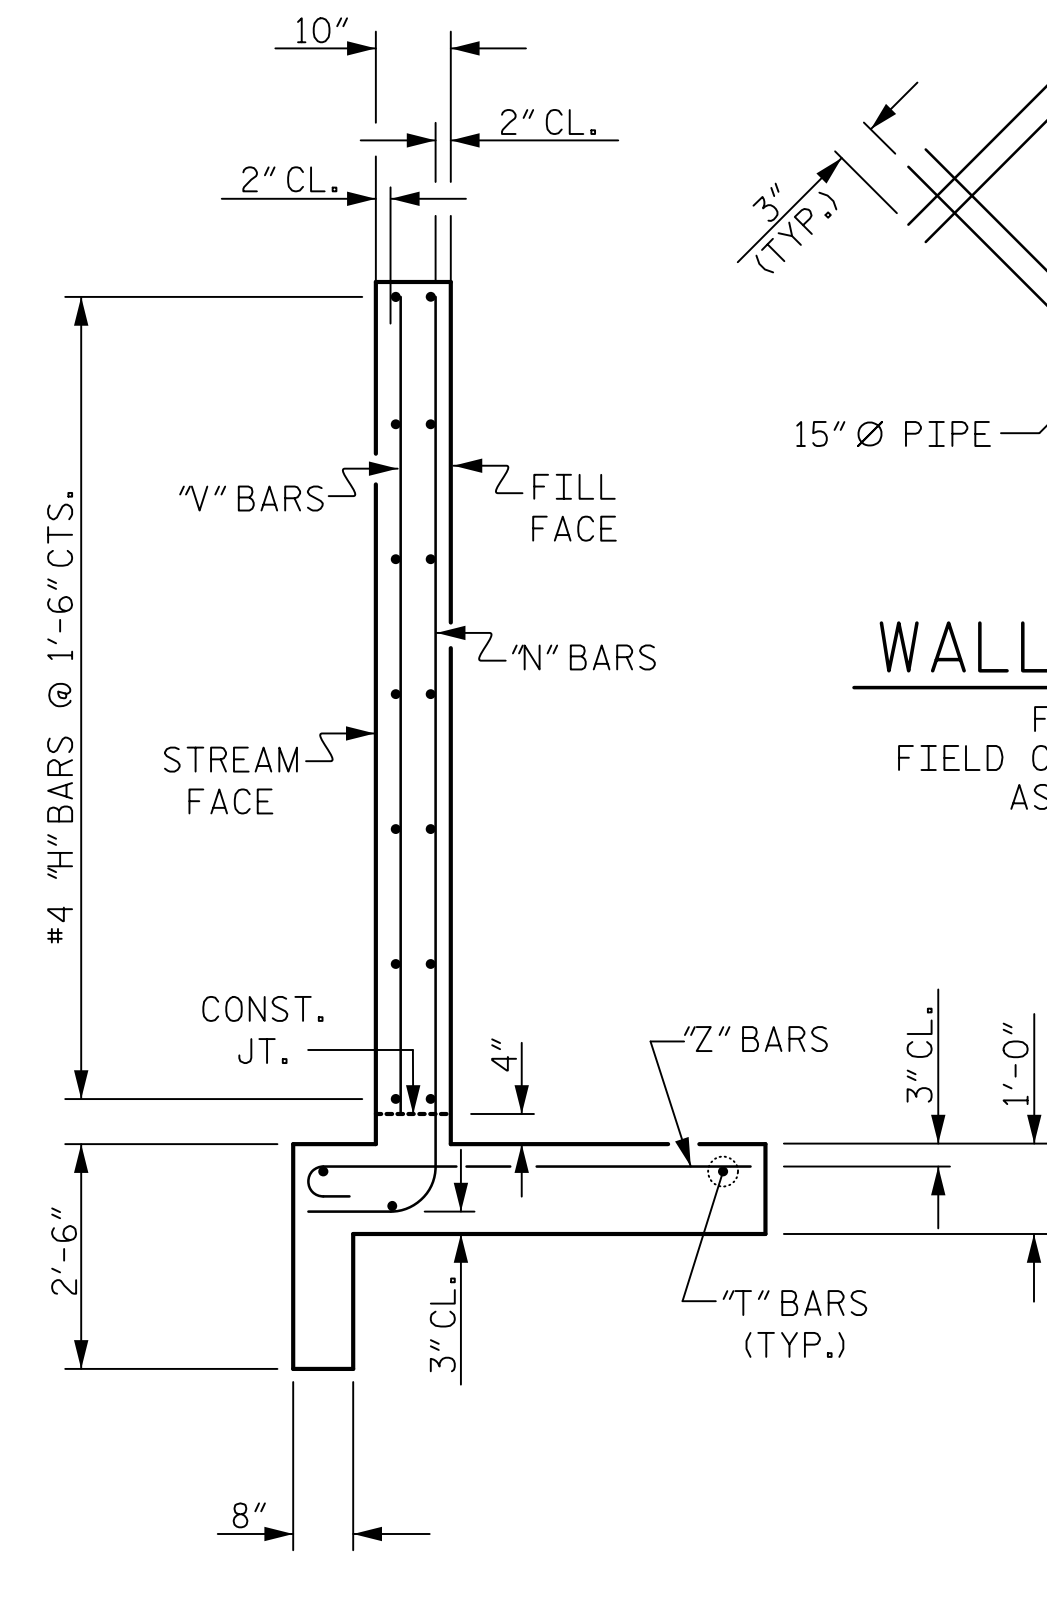


TYPICAL WING SECTION

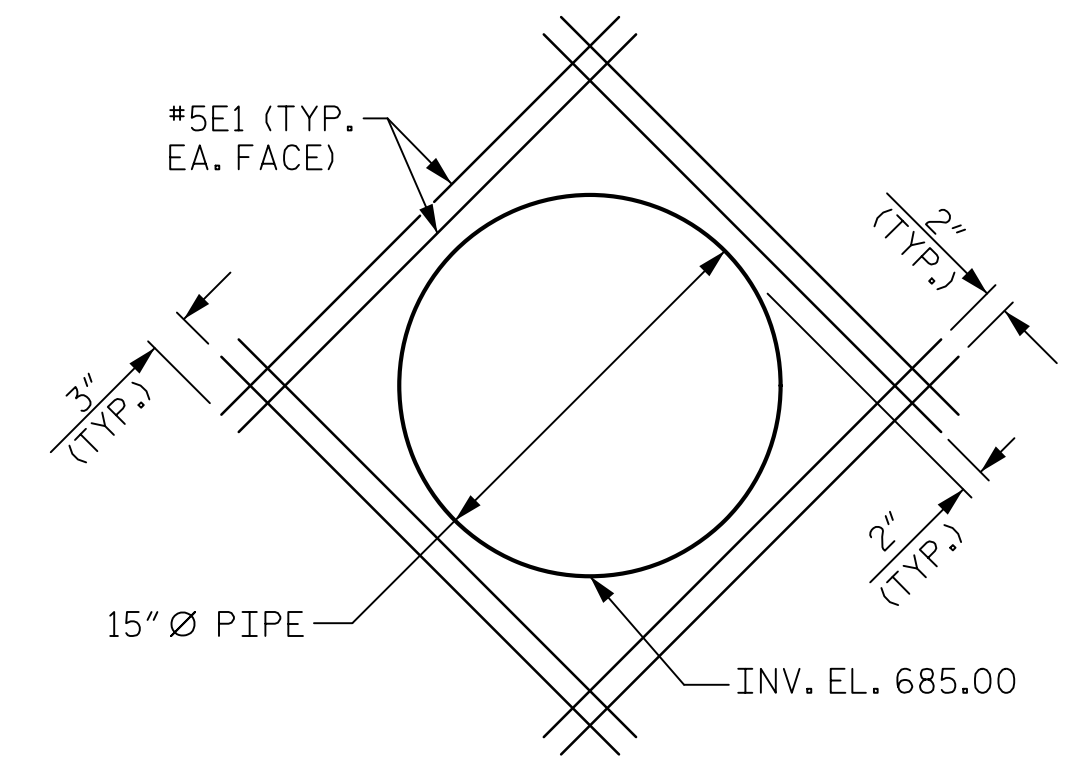

WALL OPENING DETAIL
 FOR PIPE THROUGH W2 WALL.
 FIELD CUT, SHIFT, OR BEND "N", "H", AND "V"
 AS NECESSARY TO CLEAR PIPE.

Mead & Hunt
 111 E. Hargett Street
 Suite 300
 Raleigh, NC 27601
 919-714-8670
 meadhunt.com
 NC License No. F-1235

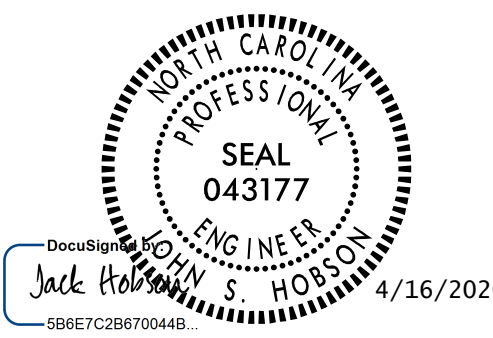

PROJECT NO. R-4707
GUILFORD COUNTY
 STATION: 56+34.85 -L-
 SHEET 13 OF 16


STATE OF NORTH CAROLINA
 DEPARTMENT OF TRANSPORTATION
 RALEIGH
WING W2
 FOR
CONCRETE BOX CULVERT
 (LEFT EXTENSION)
 H=8'-0" SLOPE=2:1

DRAWN BY : J.A. LEE DATE : 03/18/19
 CHECKED BY : J.S. HOBSON DATE : 04/15/19
 DESIGN ENGINEER OF RECORD : J.S. HOBSON DATE : 04/26/19


DOCUMENT NOT CONSIDERED
 FINAL UNLESS ALL
 SIGNATURES COMPLETED

REVISIONS				SHEET NO.	
NO.	BY:	DATE:	NO.	BY:	DATE:
1			3		
2			4		


TOTAL SHEETS: 24

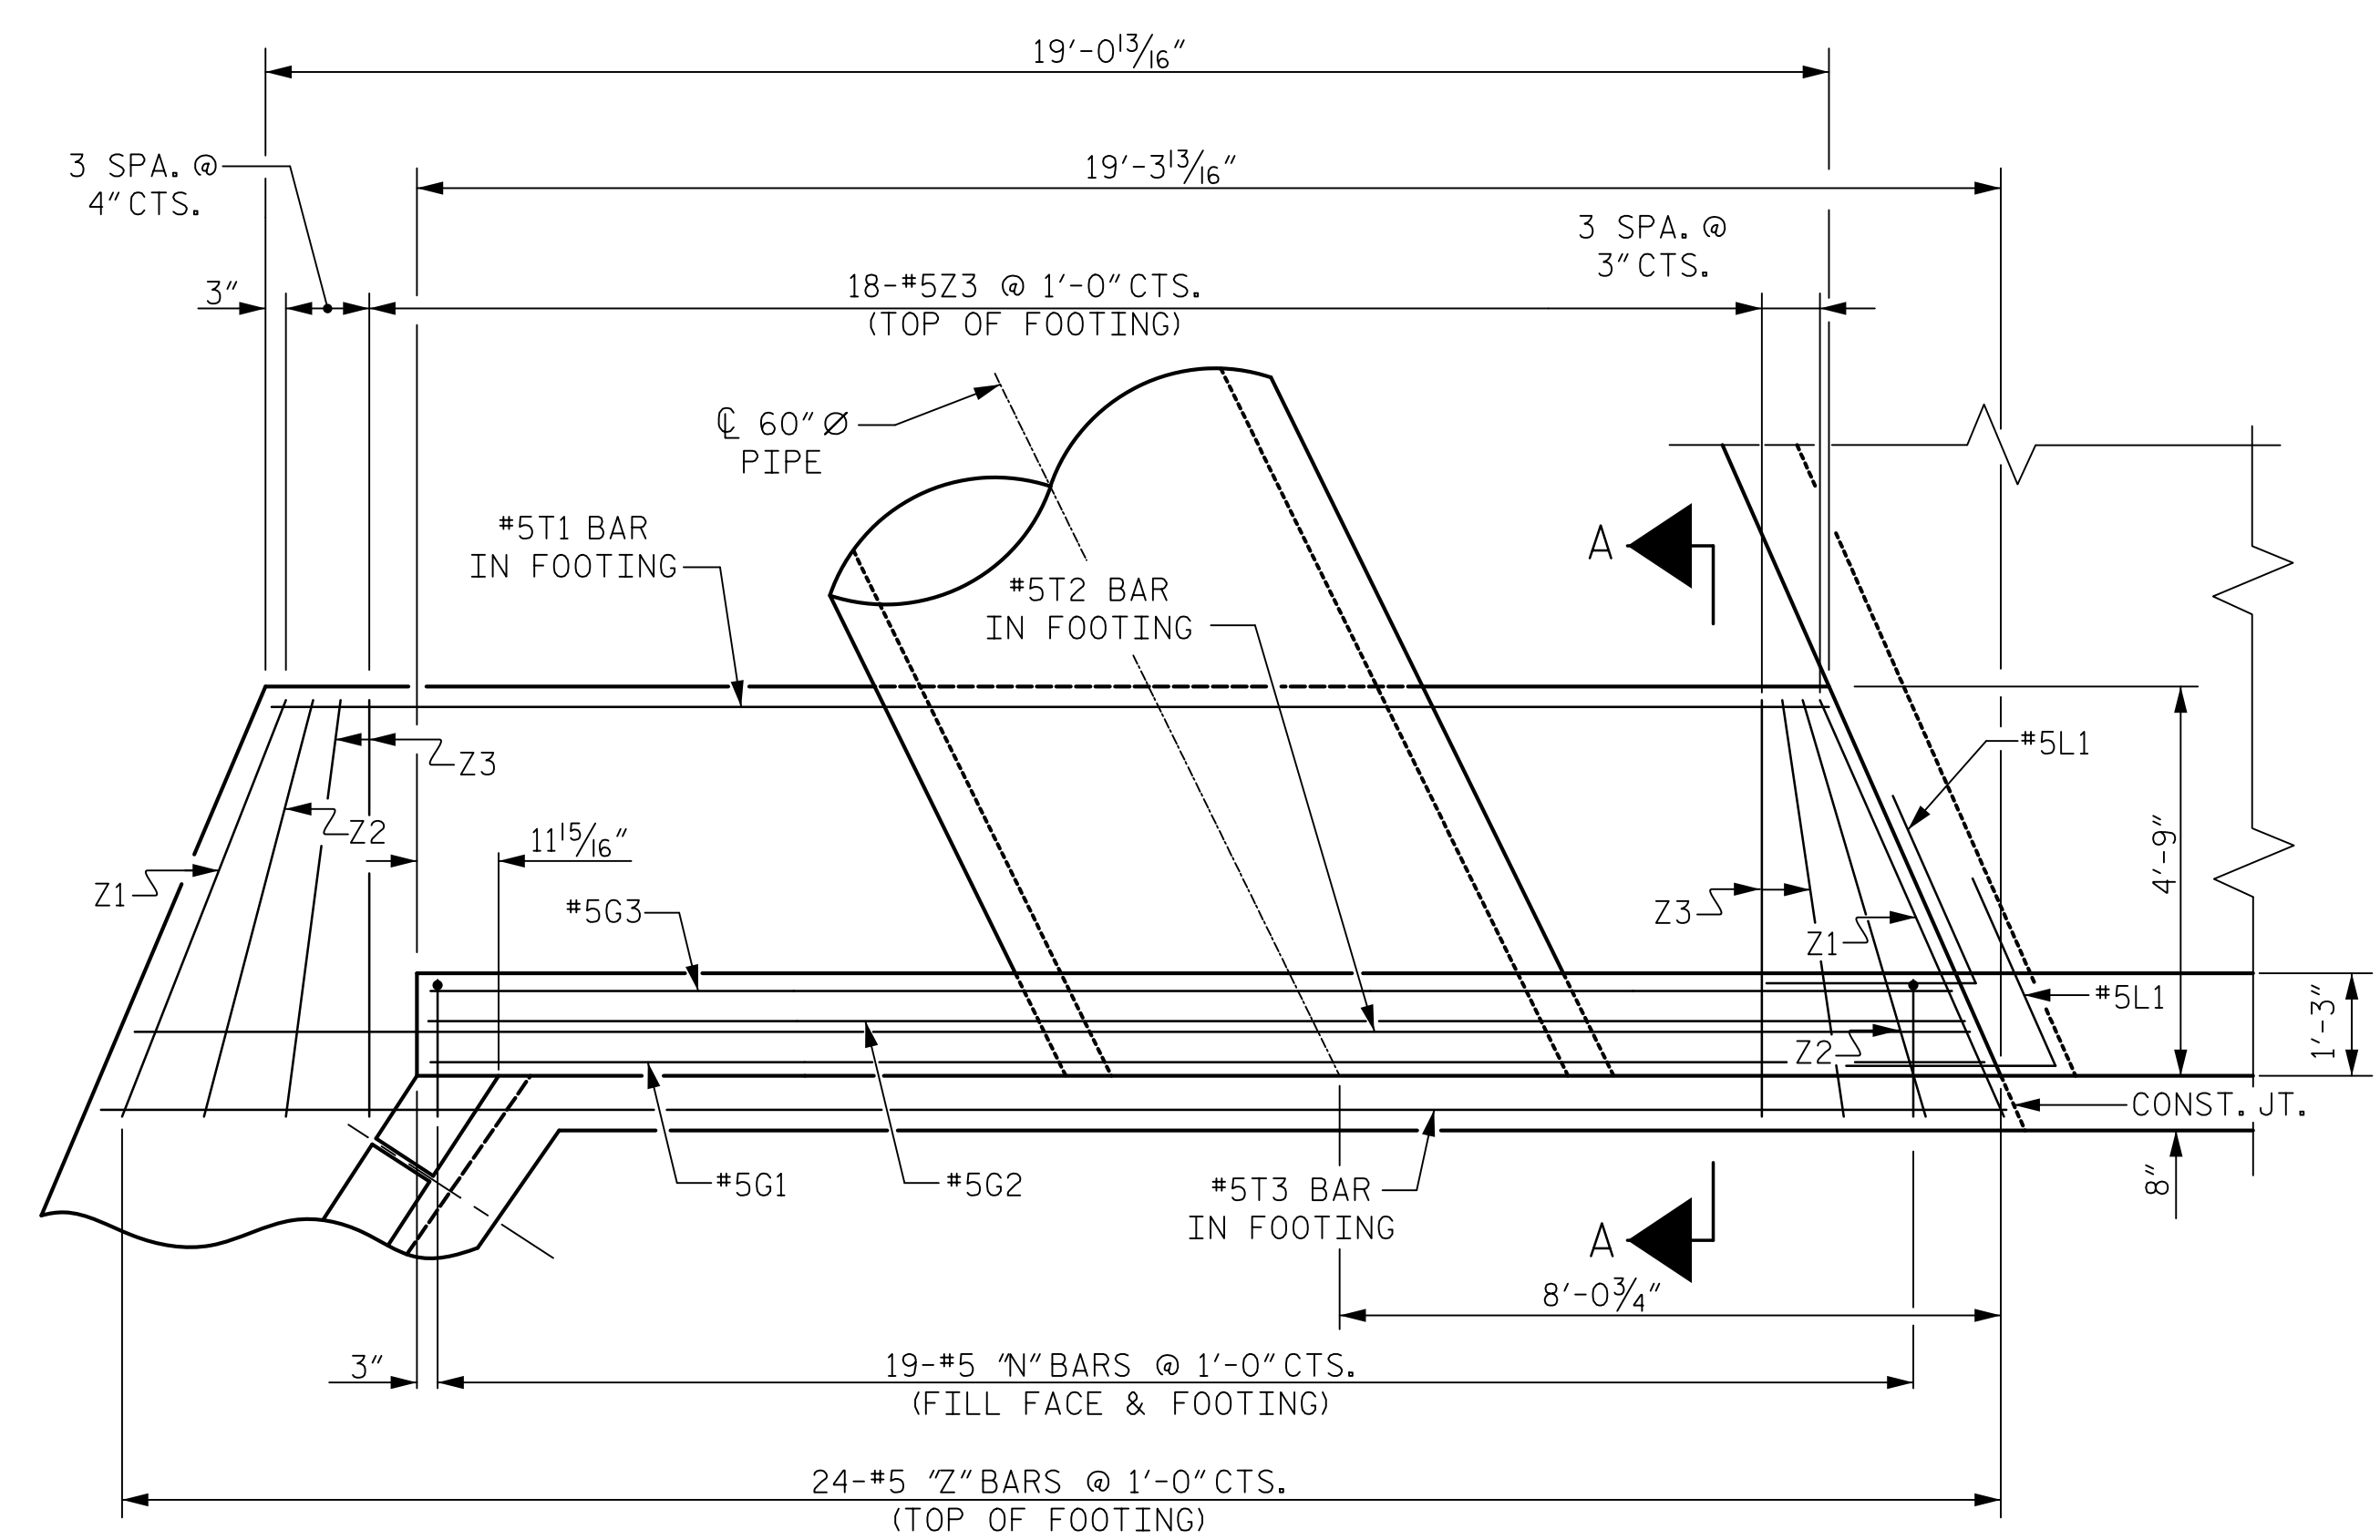


PLAN - 60" Ø PIPE HEADWALL

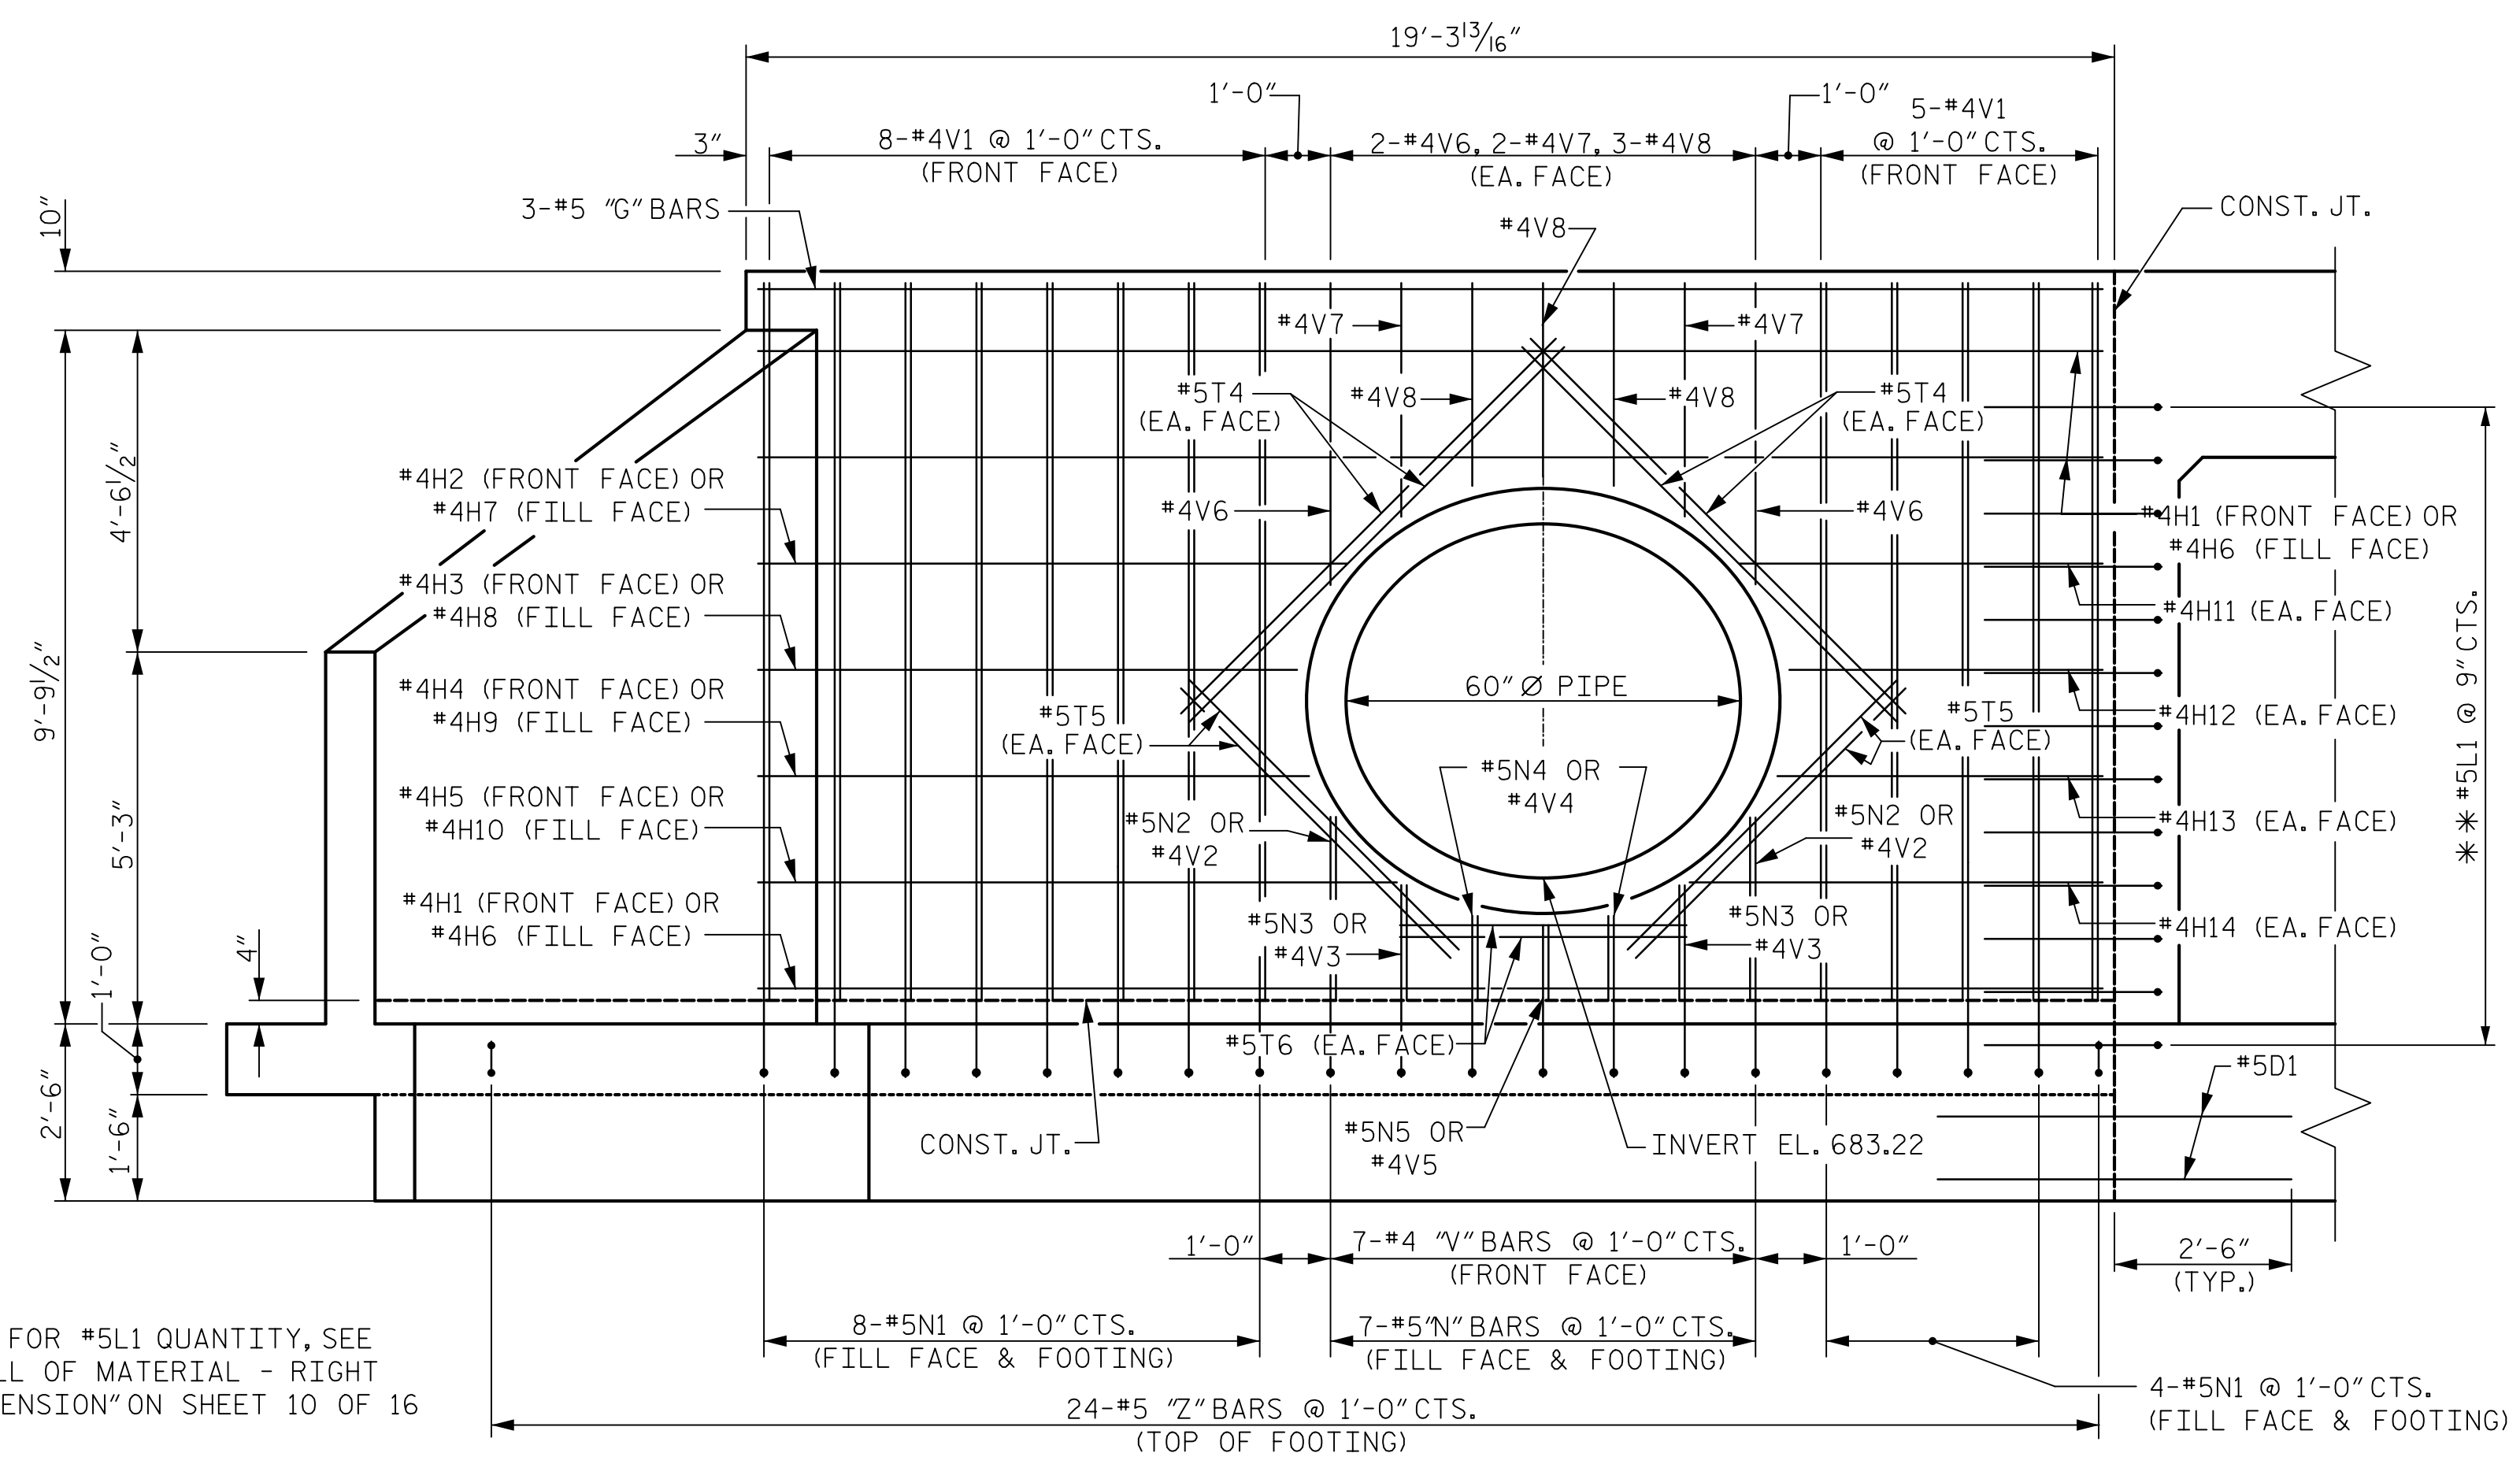

ELEVATION - 60" Ø PIPE HEADWALL

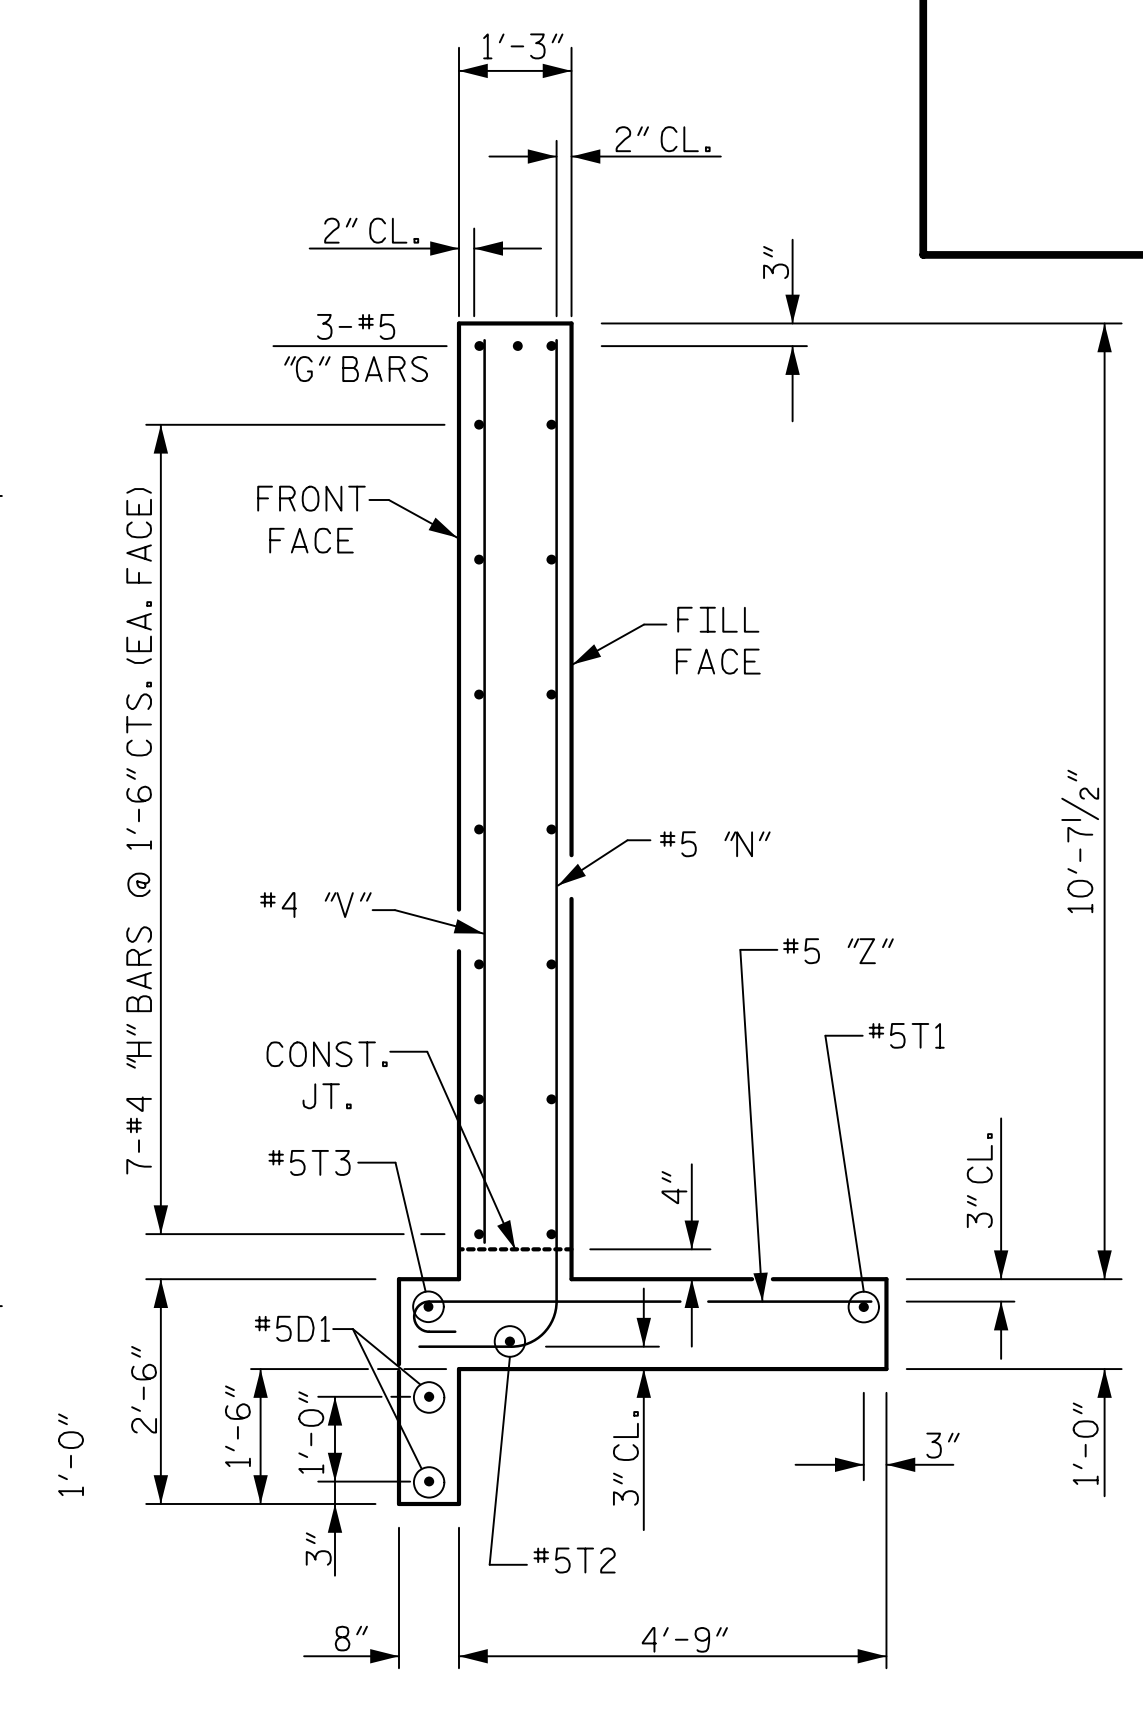

SECTION A-A

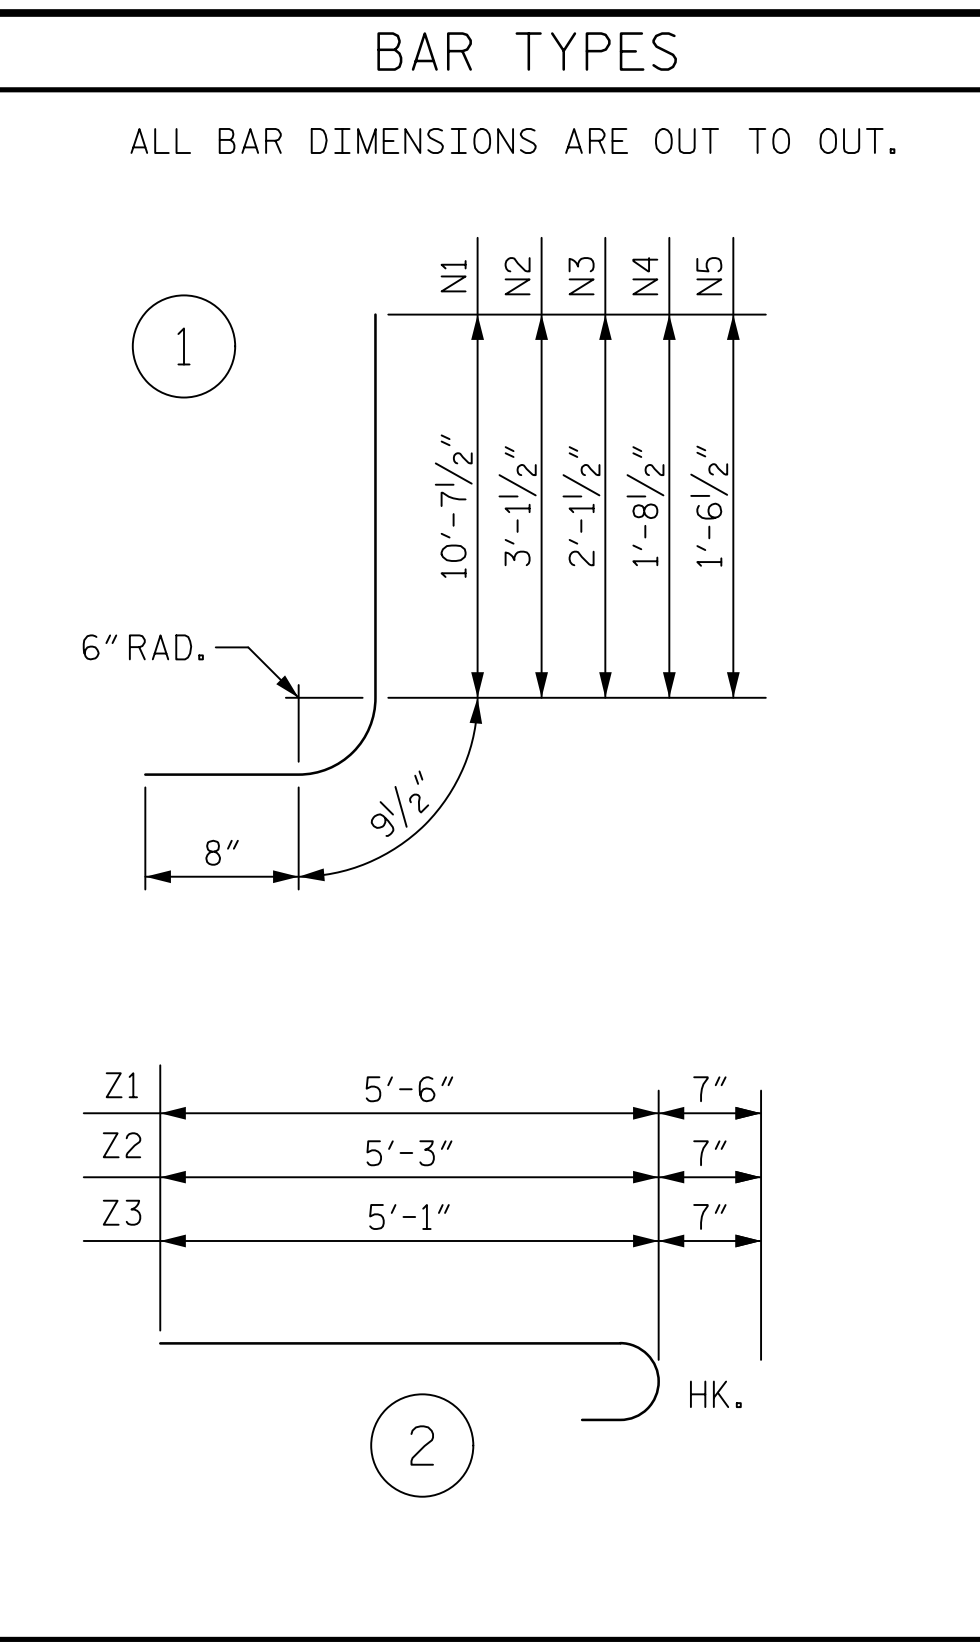


I HEREBY CERTIFY THESE PLANS ARE THE AS-BUILT PLANS

BILL OF MATERIAL					
BAR NO.	NO.	SIZE	TYPE	LENGTH	WEIGHT
D1	2	#5	STR	5'-0"	10
H1	3	#4	STR	18'-10"	38
H2	1	#4	STR	8'-3"	6
H3	1	#4	STR	7'-7"	5
H4	1	#4	STR	7'-9"	5
H5	1	#4	STR	9'-0"	6
H6	3	#4	STR	18'-6"	37
H7	1	#4	STR	7'-10"	5
H8	1	#4	STR	7'-2"	5
H9	1	#4	STR	7'-4"	5
H10	1	#4	STR	8'-7"	6
H11	2	#4	STR	5'-0"	7
H12	2	#4	STR	4'-4"	6
H13	2	#4	STR	4'-6"	6
H14	2	#4	STR	5'-9"	8
G1	1	#5	STR	18'-10"	20
G2	1	#5	STR	18'-8"	19
G3	1	#5	STR	18'-6"	19
N1	12	#5	1	12'-1"	151
N2	2	#5	1	4'-7"	10
N3	2	#5	1	3'-7"	7
N4	2	#5	1	3'-2"	7
N5	1	#5	1	3'-0"	3
T1	1	#5	STR	18'-11"	20
T2	1	#5	STR	22'-3"	23
T3	1	#5	STR	23'-2"	24
T4	8	#5	STR	7'-6"	63
T5	8	#5	STR	5'-5"	45
T6	4	#5	STR	4'-1"	17
V1	13	#4	STR	10'-1"	88
V2	2	#4	STR	2'-7"	3
V3	2	#4	STR	1'-7"	2
V4	2	#4	STR	1'-2"	2
V5	1	#4	STR	1'-0"	1
V6	4	#4	STR	4'-2"	11
V7	4	#4	STR	3'-3"	9
V8	6	#4	STR	2'-8"	11
Z1	2	#5	2	6'-1"	13
Z2	2	#5	2	5'-10"	12
Z3	2	#5	2	5'-8"	118
REINFORCING STEEL (60" Ø PIPE HEADWALL)				853 LBS	
CLASS A CONCRETE (60" Ø PIPE HEADWALL)				12.6 CY	

** FOR #5L1 QUANTITY, SEE "BILL OF MATERIAL - RIGHT EXTENSION" ON SHEET 10 OF 16

Mead & Hunt
 111 E. Hargett Street
 Suite 300
 Raleigh, NC 27601
 919-714-8670
 meadhunt.com
 NC License No. F-1235

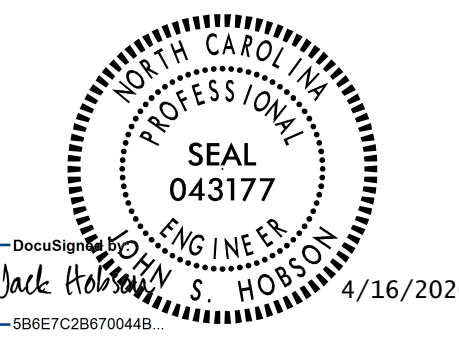


PROJECT NO. R-4707
GUILFORD COUNTY
 STATION: 56+34.85 -L-
 SHEET 14 OF 16

STATE OF NORTH CAROLINA
 DEPARTMENT OF TRANSPORTATION
 RALEIGH
60" Ø PIPE HEADWALL
 (RIGHT EXTENSION)


DRAWN BY : J.A. LEE DATE : 03/26/19
 CHECKED BY : J.S. HOBSON DATE : 04/15/19
 DESIGN ENGINEER OF RECORD : J.S. HOBSON DATE : 04/26/19

DOCUMENT NOT CONSIDERED FINAL UNLESS ALL SIGNATURES COMPLETED


REVISIONS						SHEET NO.	
NO.	BY:	DATE:	NO.	BY:	DATE:	C1-22	
1			3			TOTAL SHEETS	
2			4			24	

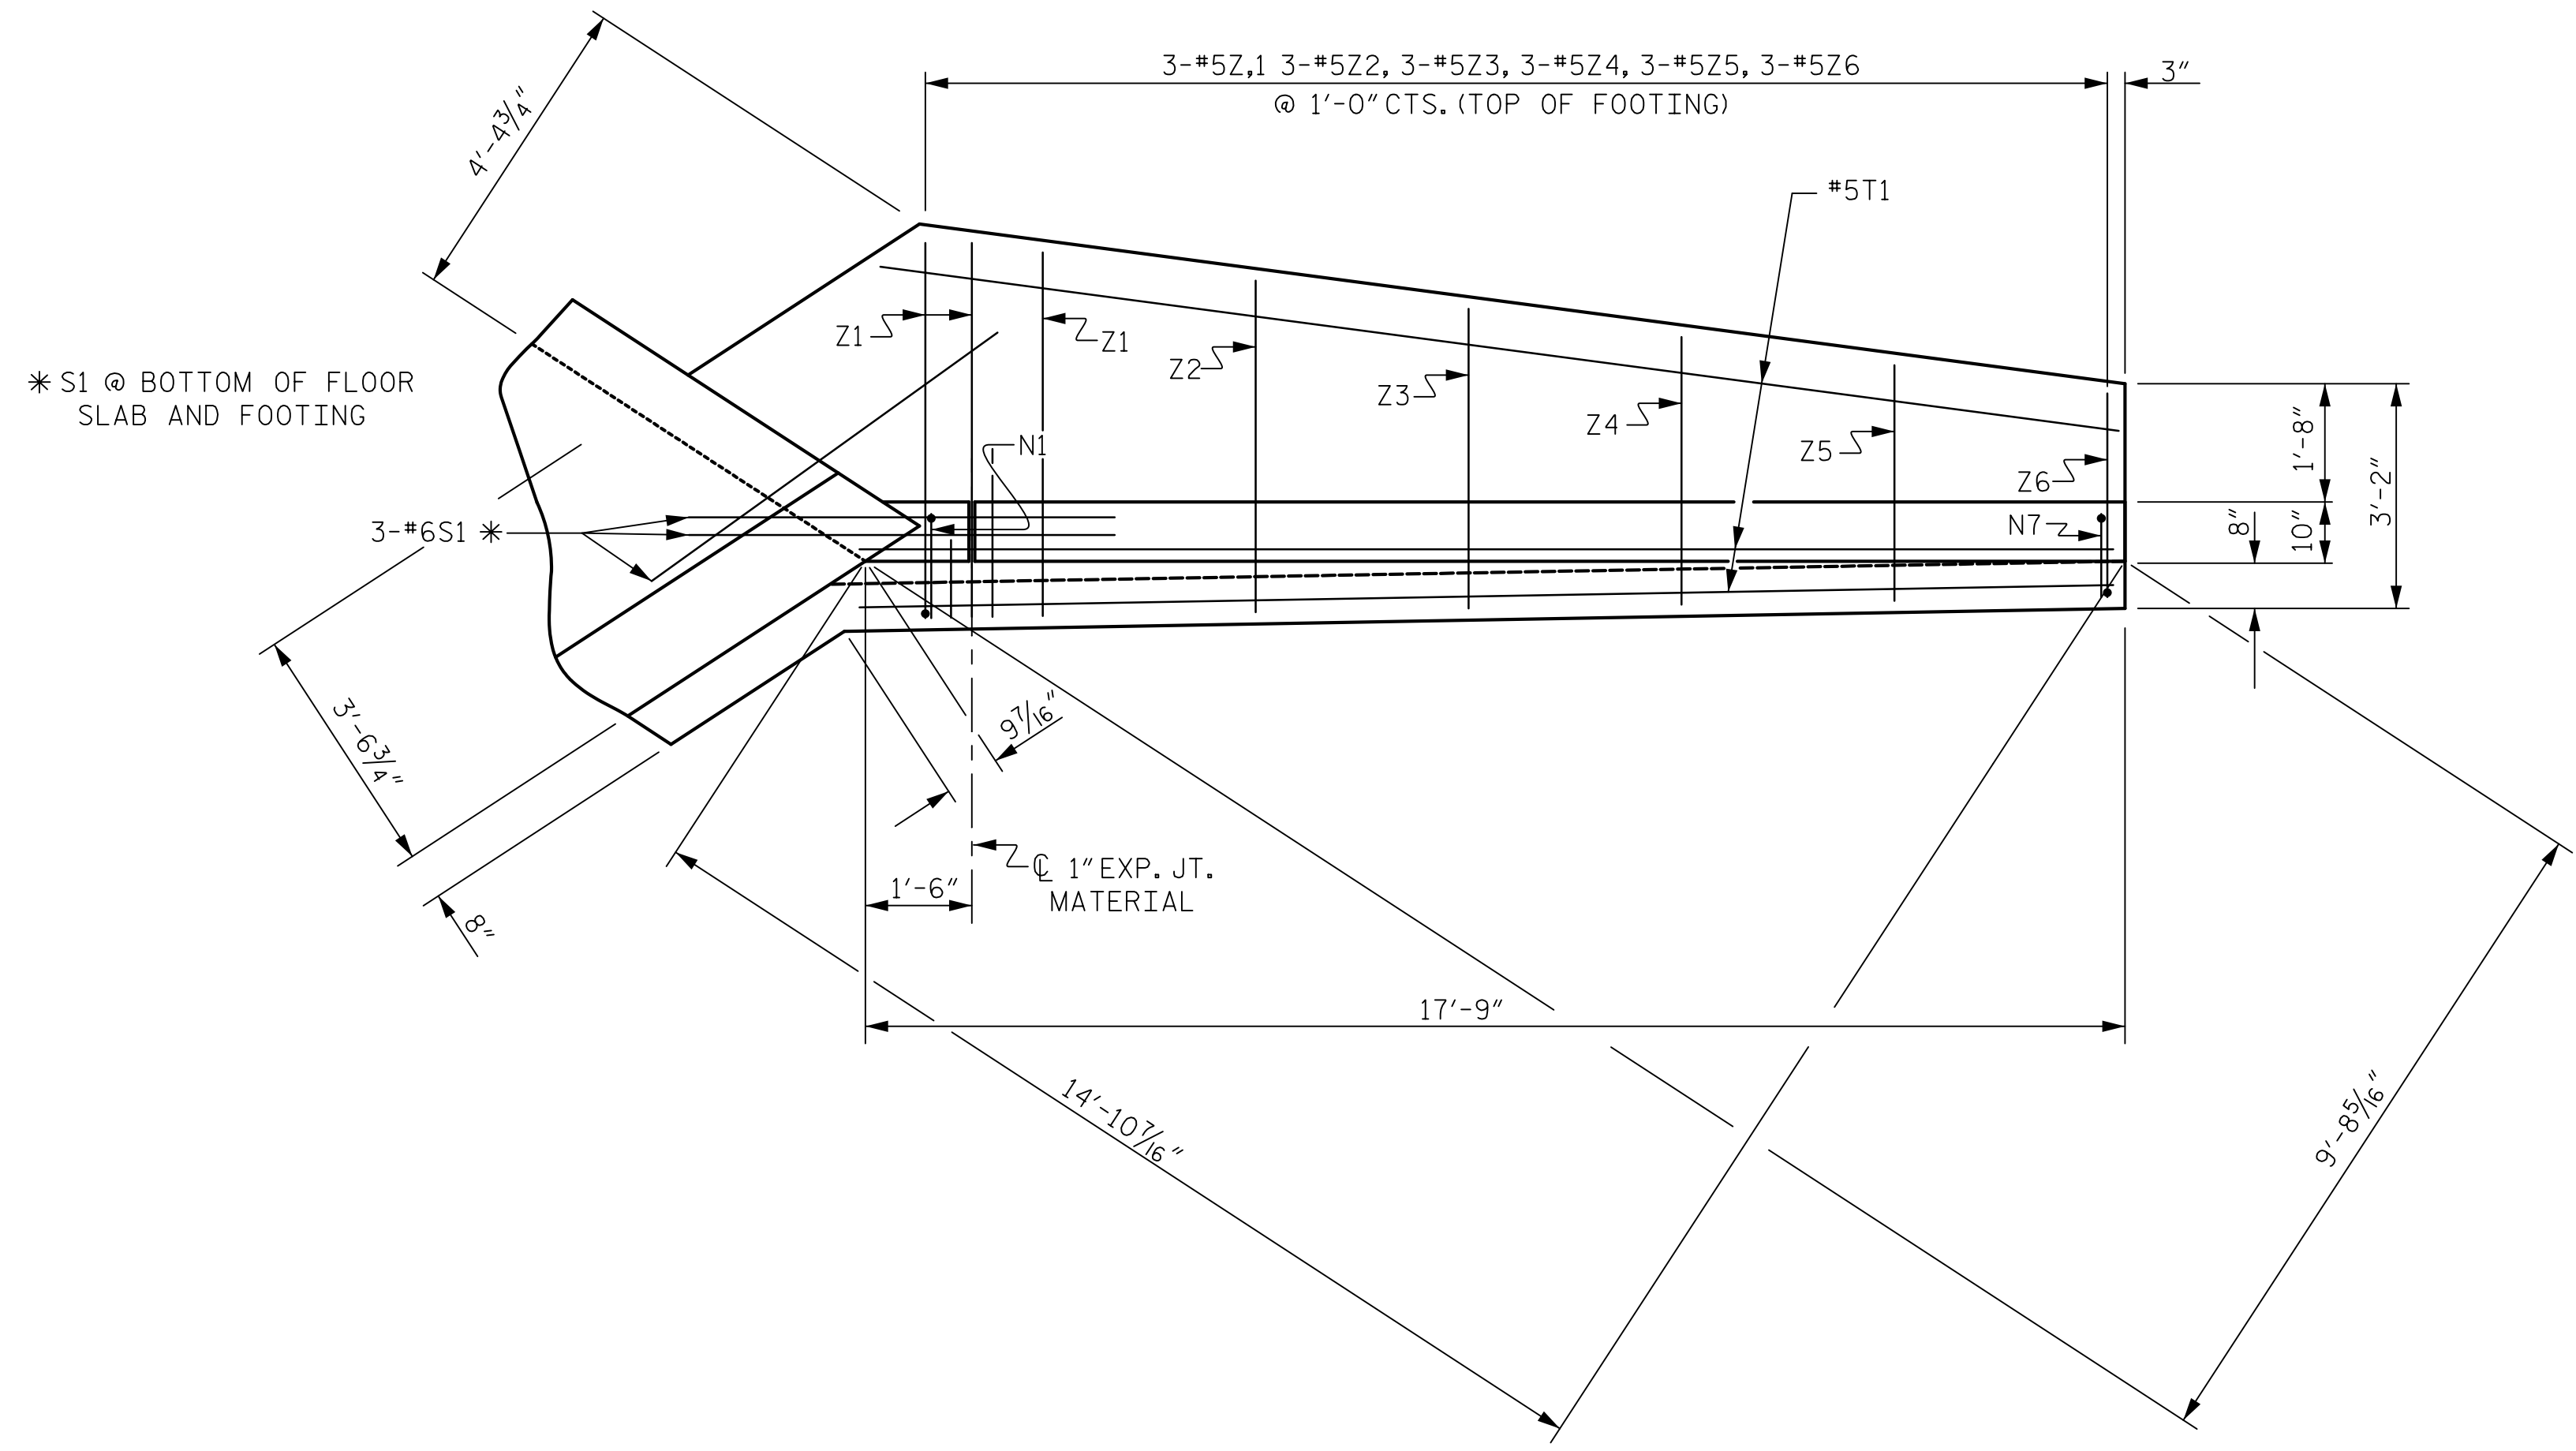


PLAN W3

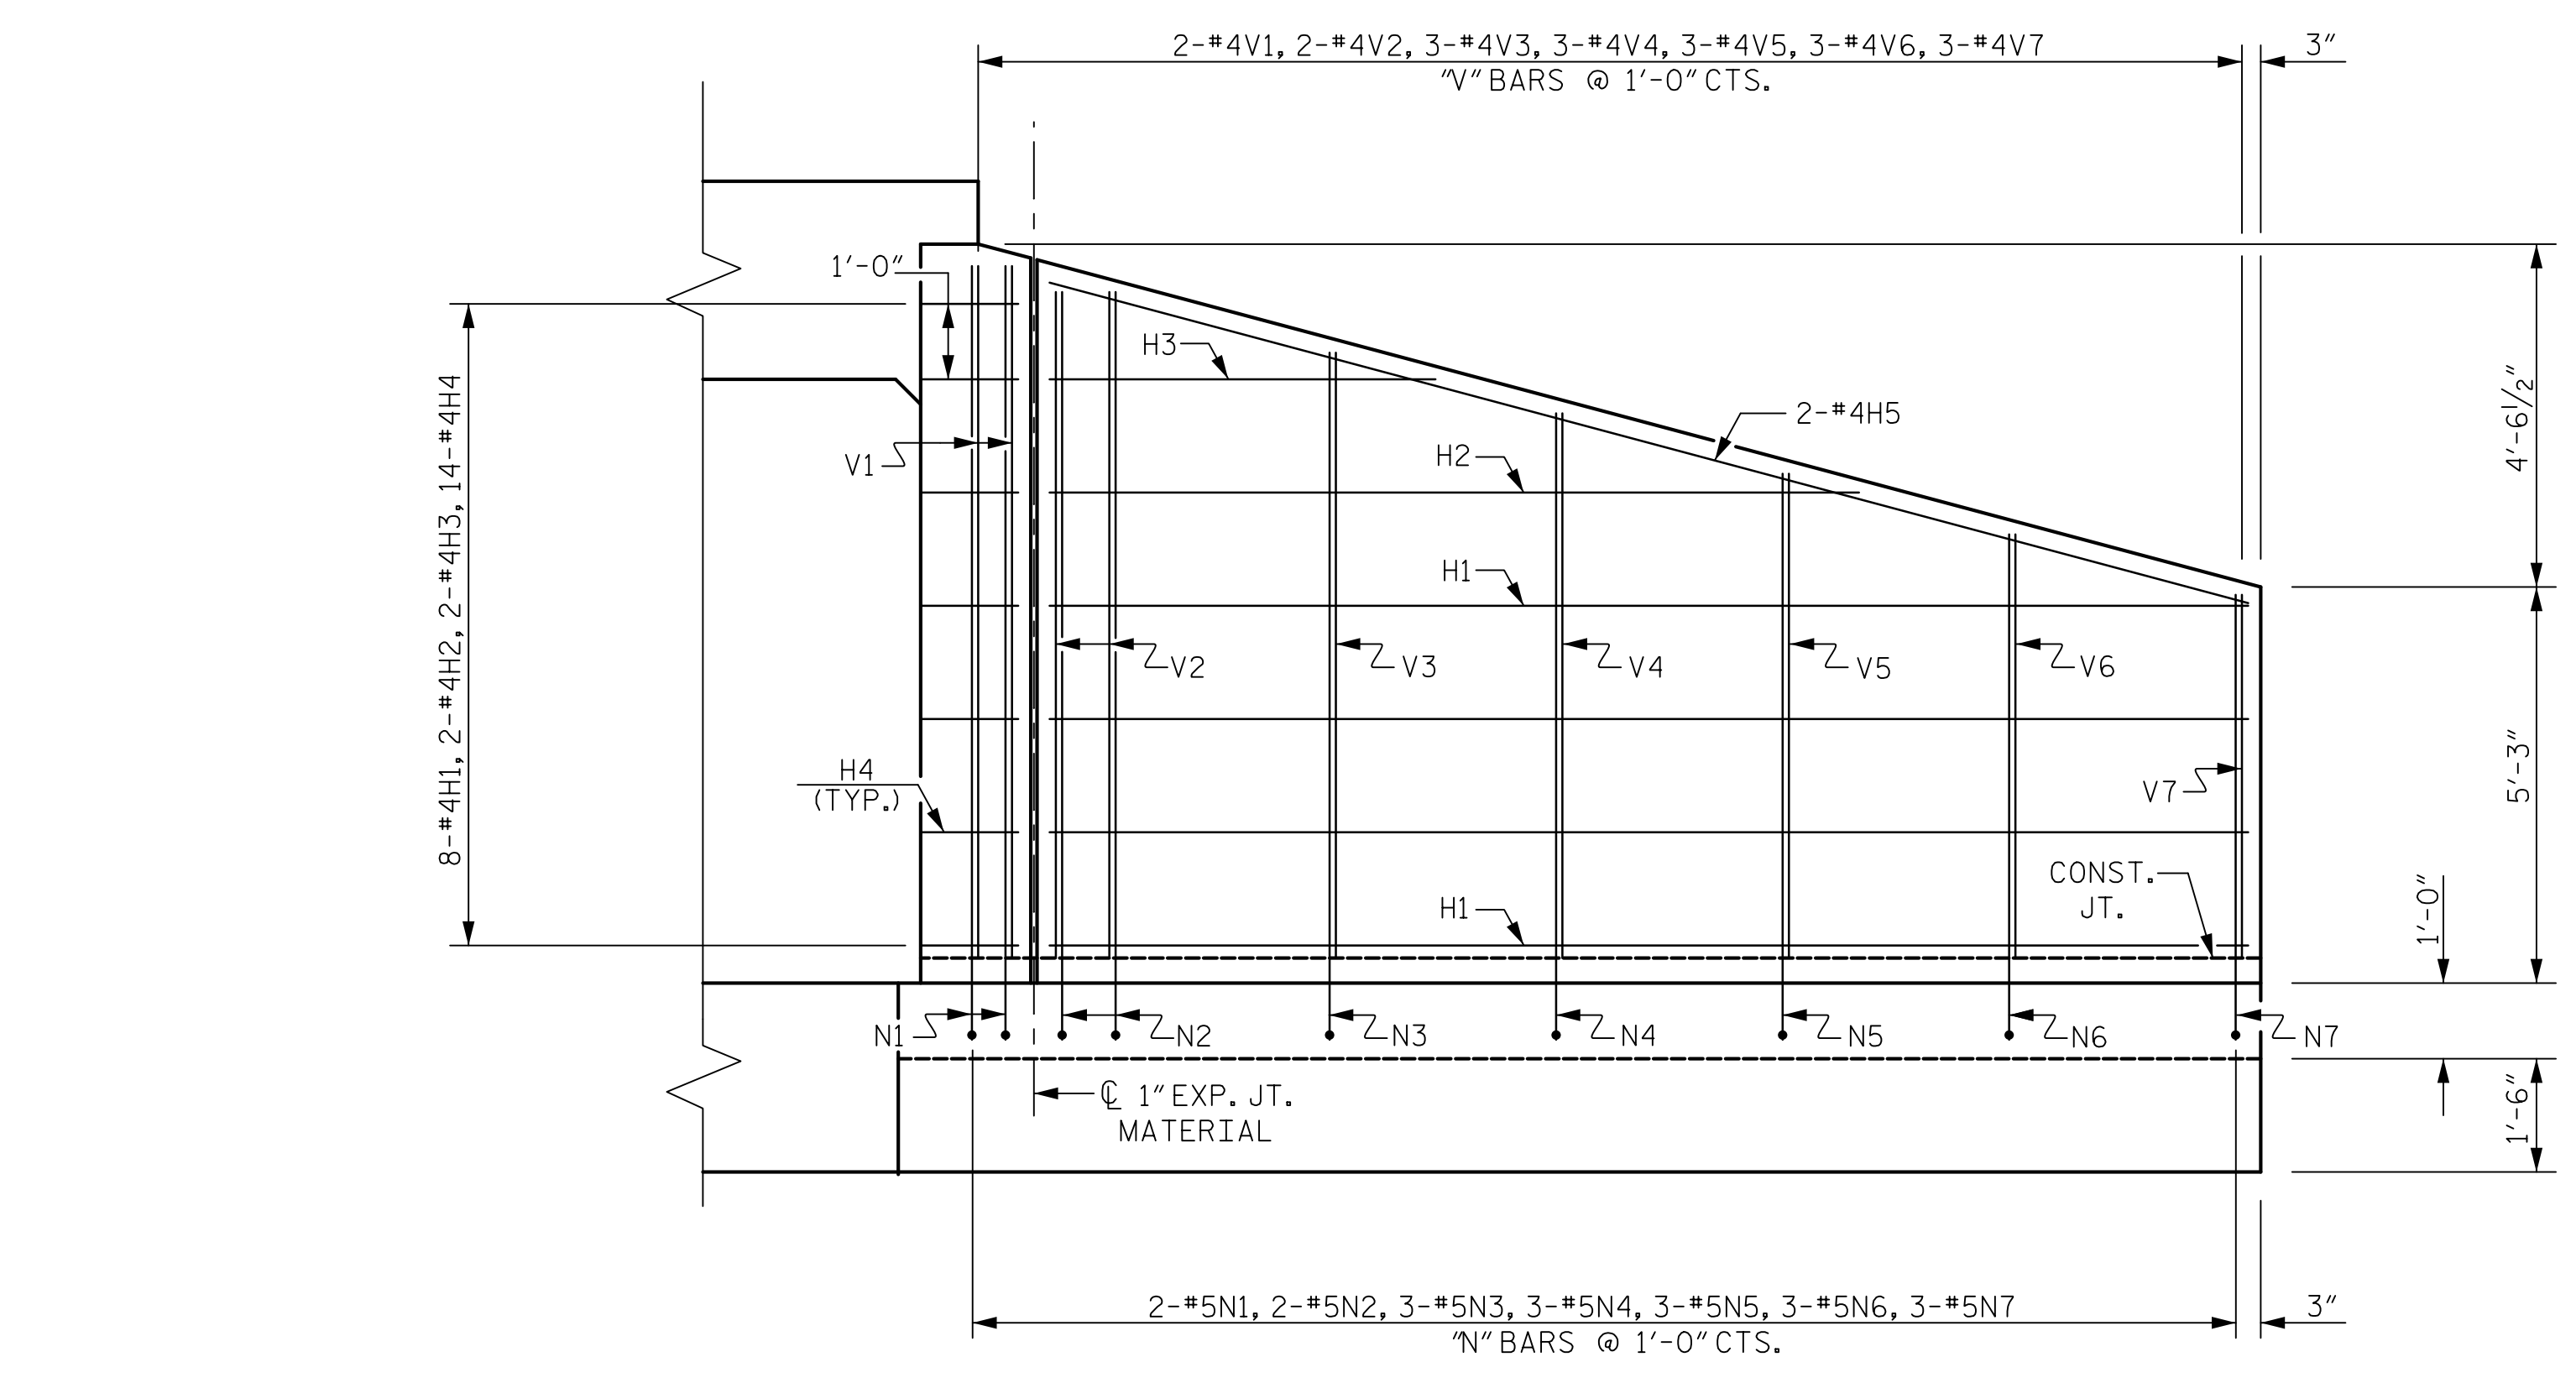

ELEVATION W3

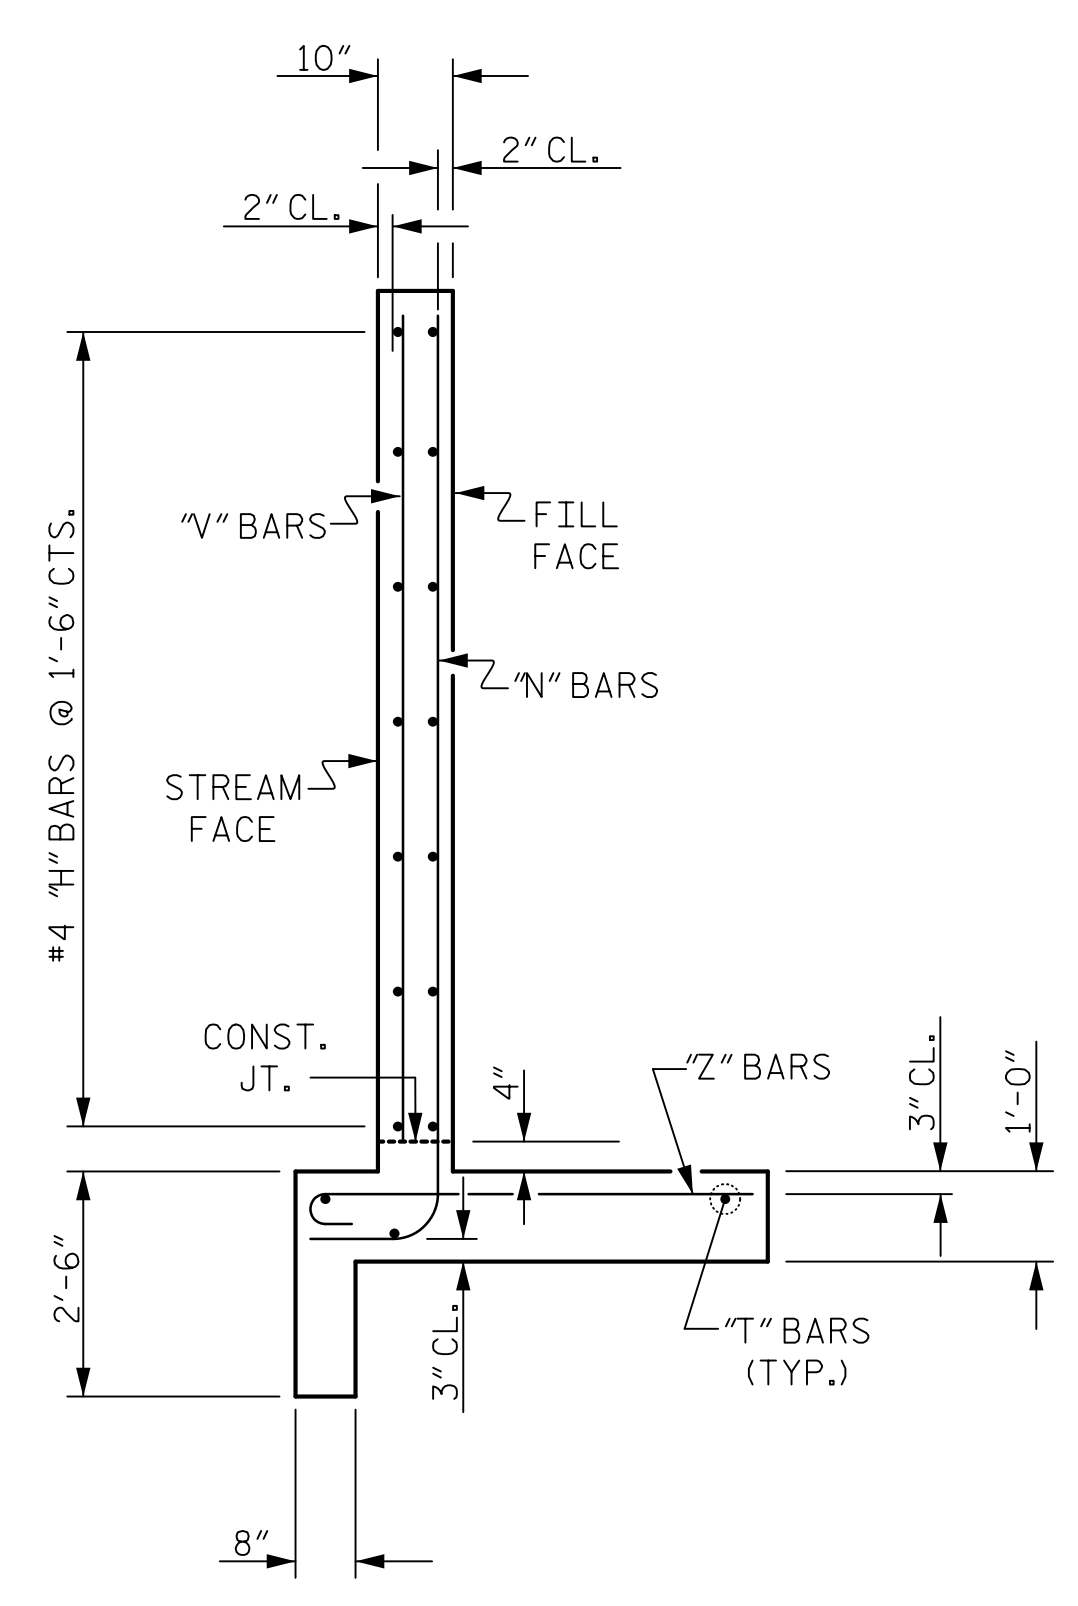

TYPICAL WING SECTION

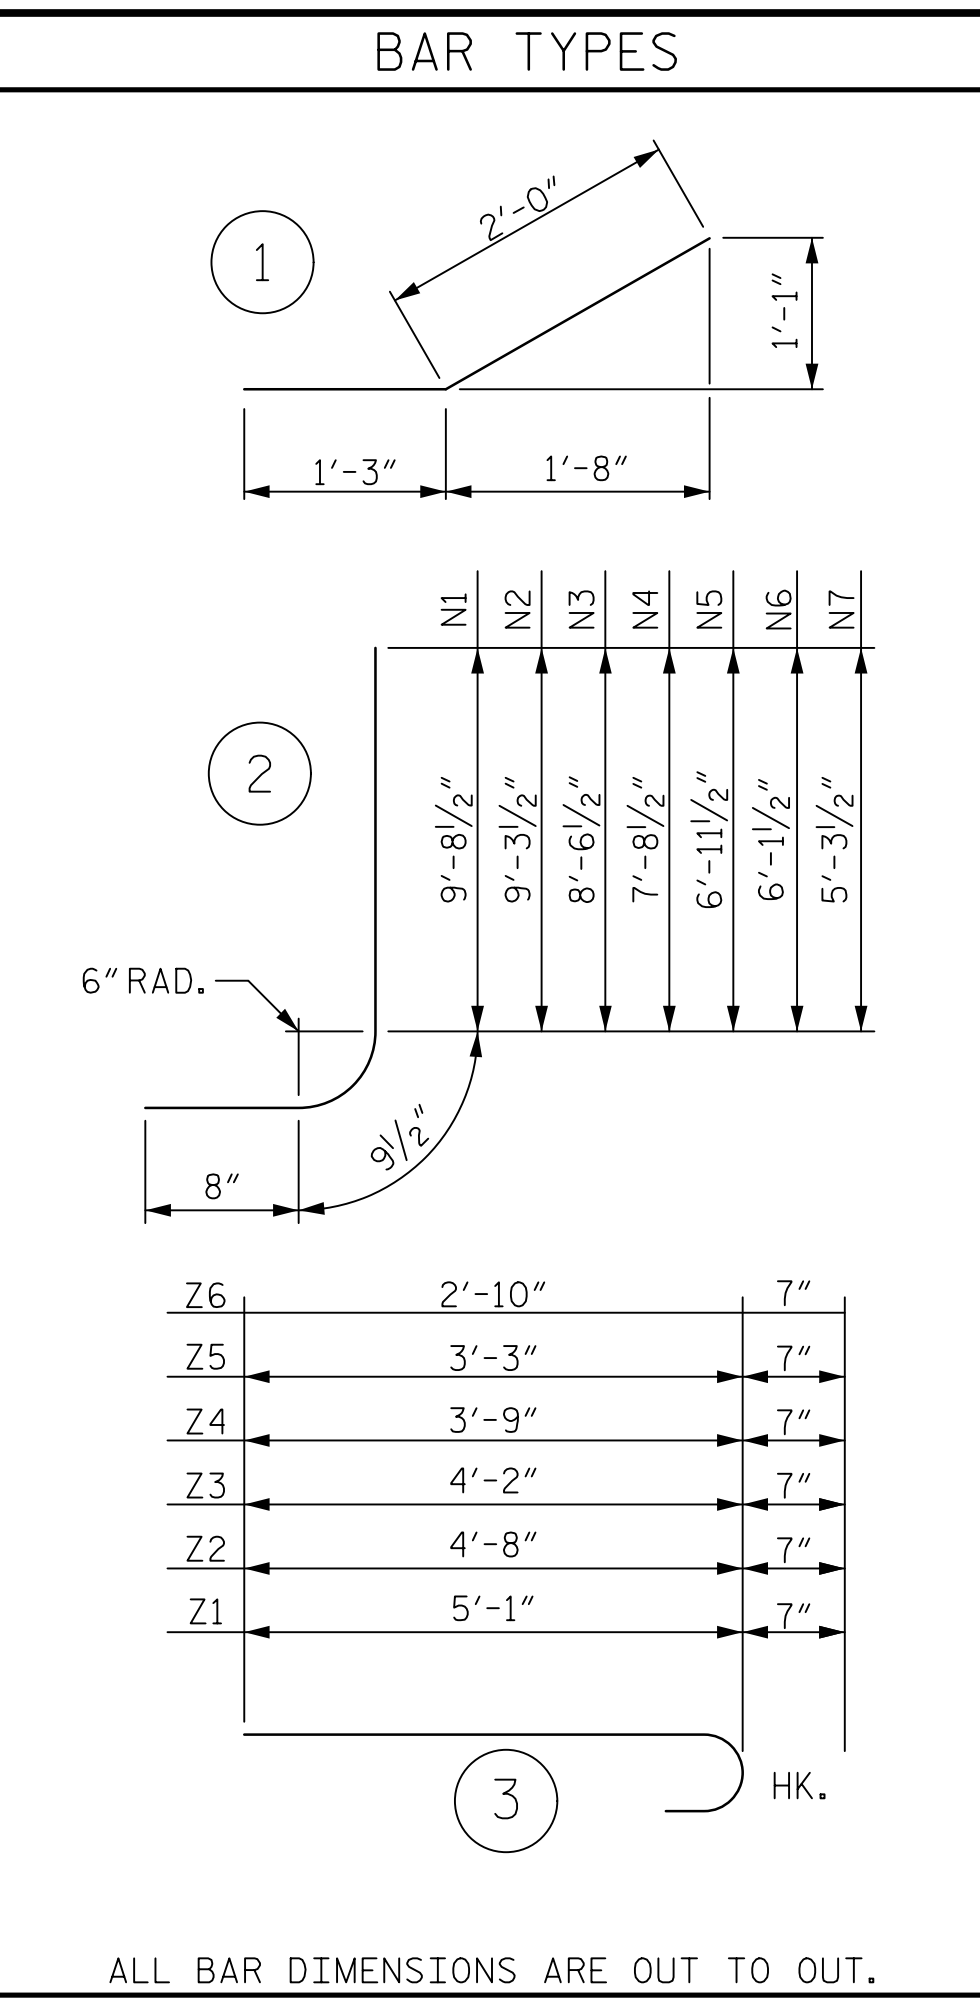

BILL OF MATERIAL					
BAR	NO.	SIZE	TYPE	LENGTH	WEIGHT
H1	8	#4	STR	15'-10"	85
H2	2	#4	STR	10'-8"	14
H3	2	#4	STR	5'-1"	7
H4	14	#4	1	3'-3"	30
H5	2	#4	STR	16'-5"	22
N1	2	#5	2	11'-2"	23
N2	2	#5	2	10'-9"	22
N3	3	#5	2	10'-0"	31
N4	3	#5	2	9'-2"	29
N5	3	#5	2	8'-5"	26
N6	3	#5	2	7'-7"	24
N7	3	#5	2	6'-9"	21
S1	3	#6	STR	6'-0"	27
T1	3	#5	STR	17'-6"	55
V1	2	#4	STR	9'-2"	12
V2	2	#4	STR	8'-9"	12
V3	3	#4	STR	8'-0"	16
V4	3	#4	STR	7'-2"	14
V5	3	#4	STR	6'-5"	13
V6	3	#4	STR	5'-7"	11
V7	3	#4	STR	4'-9"	10
Z1	3	#5	3	5'-8"	18
Z2	3	#5	3	5'-3"	16
Z3	3	#5	3	4'-9"	15
Z4	3	#5	3	4'-4"	14
Z5	3	#5	3	3'-10"	12
Z6	3	#5	3	3'-5"	11

REINFORCING STEEL FOR WING W3	590 LBS
CLASS A CONCRETE WING W3	7.3 CY
CURTAIN WALL	0.7 CY
TOTAL	8.0 CY

ALL BAR DIMENSIONS ARE OUT TO OUT.

DRAWN BY : J.A. LEE DATE : 03/18/19
 CHECKED BY : J.S. HOBSON DATE : 04/15/19
 DESIGN ENGINEER OF RECORD : J.S. HOBSON DATE : 04/26/19


Mead & Hunt
 111 E. Hargett Street
 Suite 300
 Raleigh, NC 27601
 919-714-8670
 meadhunt.com
 NC License No. F-1235

SEAL 043177
 JACK HOBSON S. HOBSON
 4/16/2020


DOCUMENT NOT CONSIDERED FINAL UNLESS ALL SIGNATURES COMPLETED

PROJECT NO. R-4707
 GUILFORD COUNTY
 STATION: 56+34.85 -L-
 SHEET 15 OF 16


STATE OF NORTH CAROLINA DEPARTMENT OF TRANSPORTATION RALEIGH					
WING W3 FOR CONCRETE BOX CULVERT (RIGHT EXTENSION) H=8'-0" SLOPE=2:1					
REVISIONS					
NO.	BY:	DATE:	NO.	BY:	DATE:
1			3		
2			4		
					SHEET NO. C1-23 TOTAL SHEETS 24

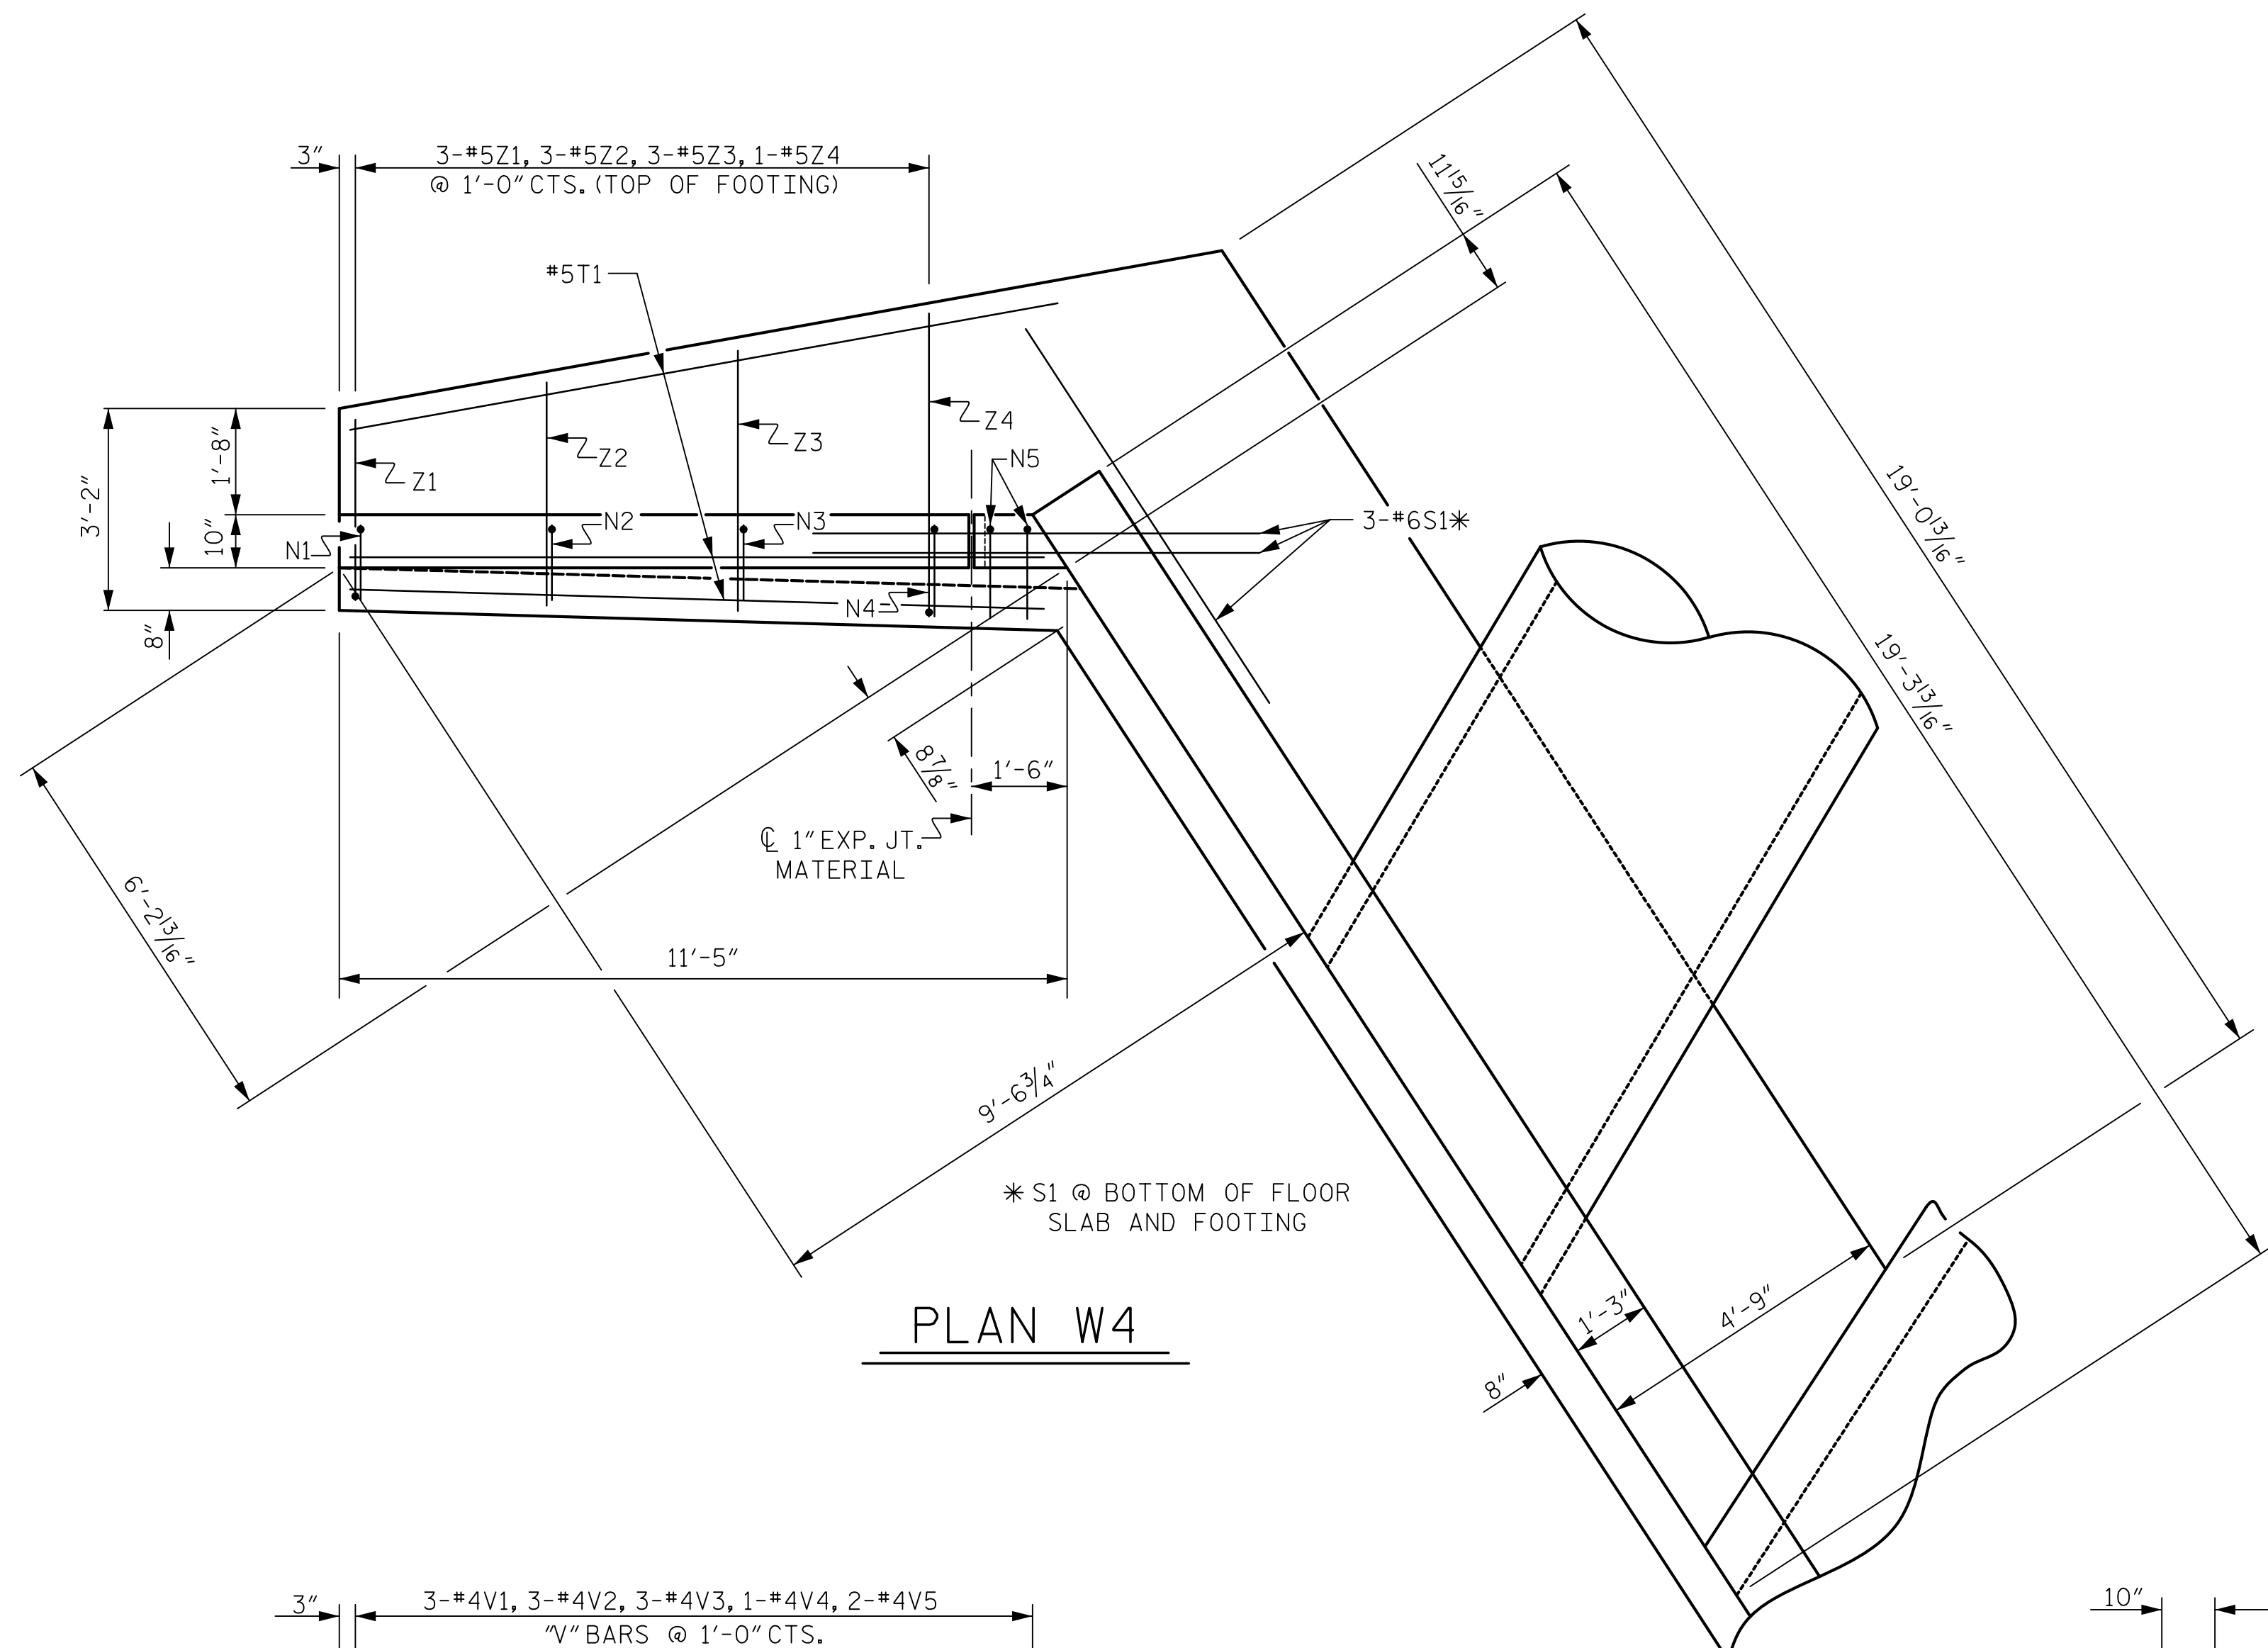


PLAN W4

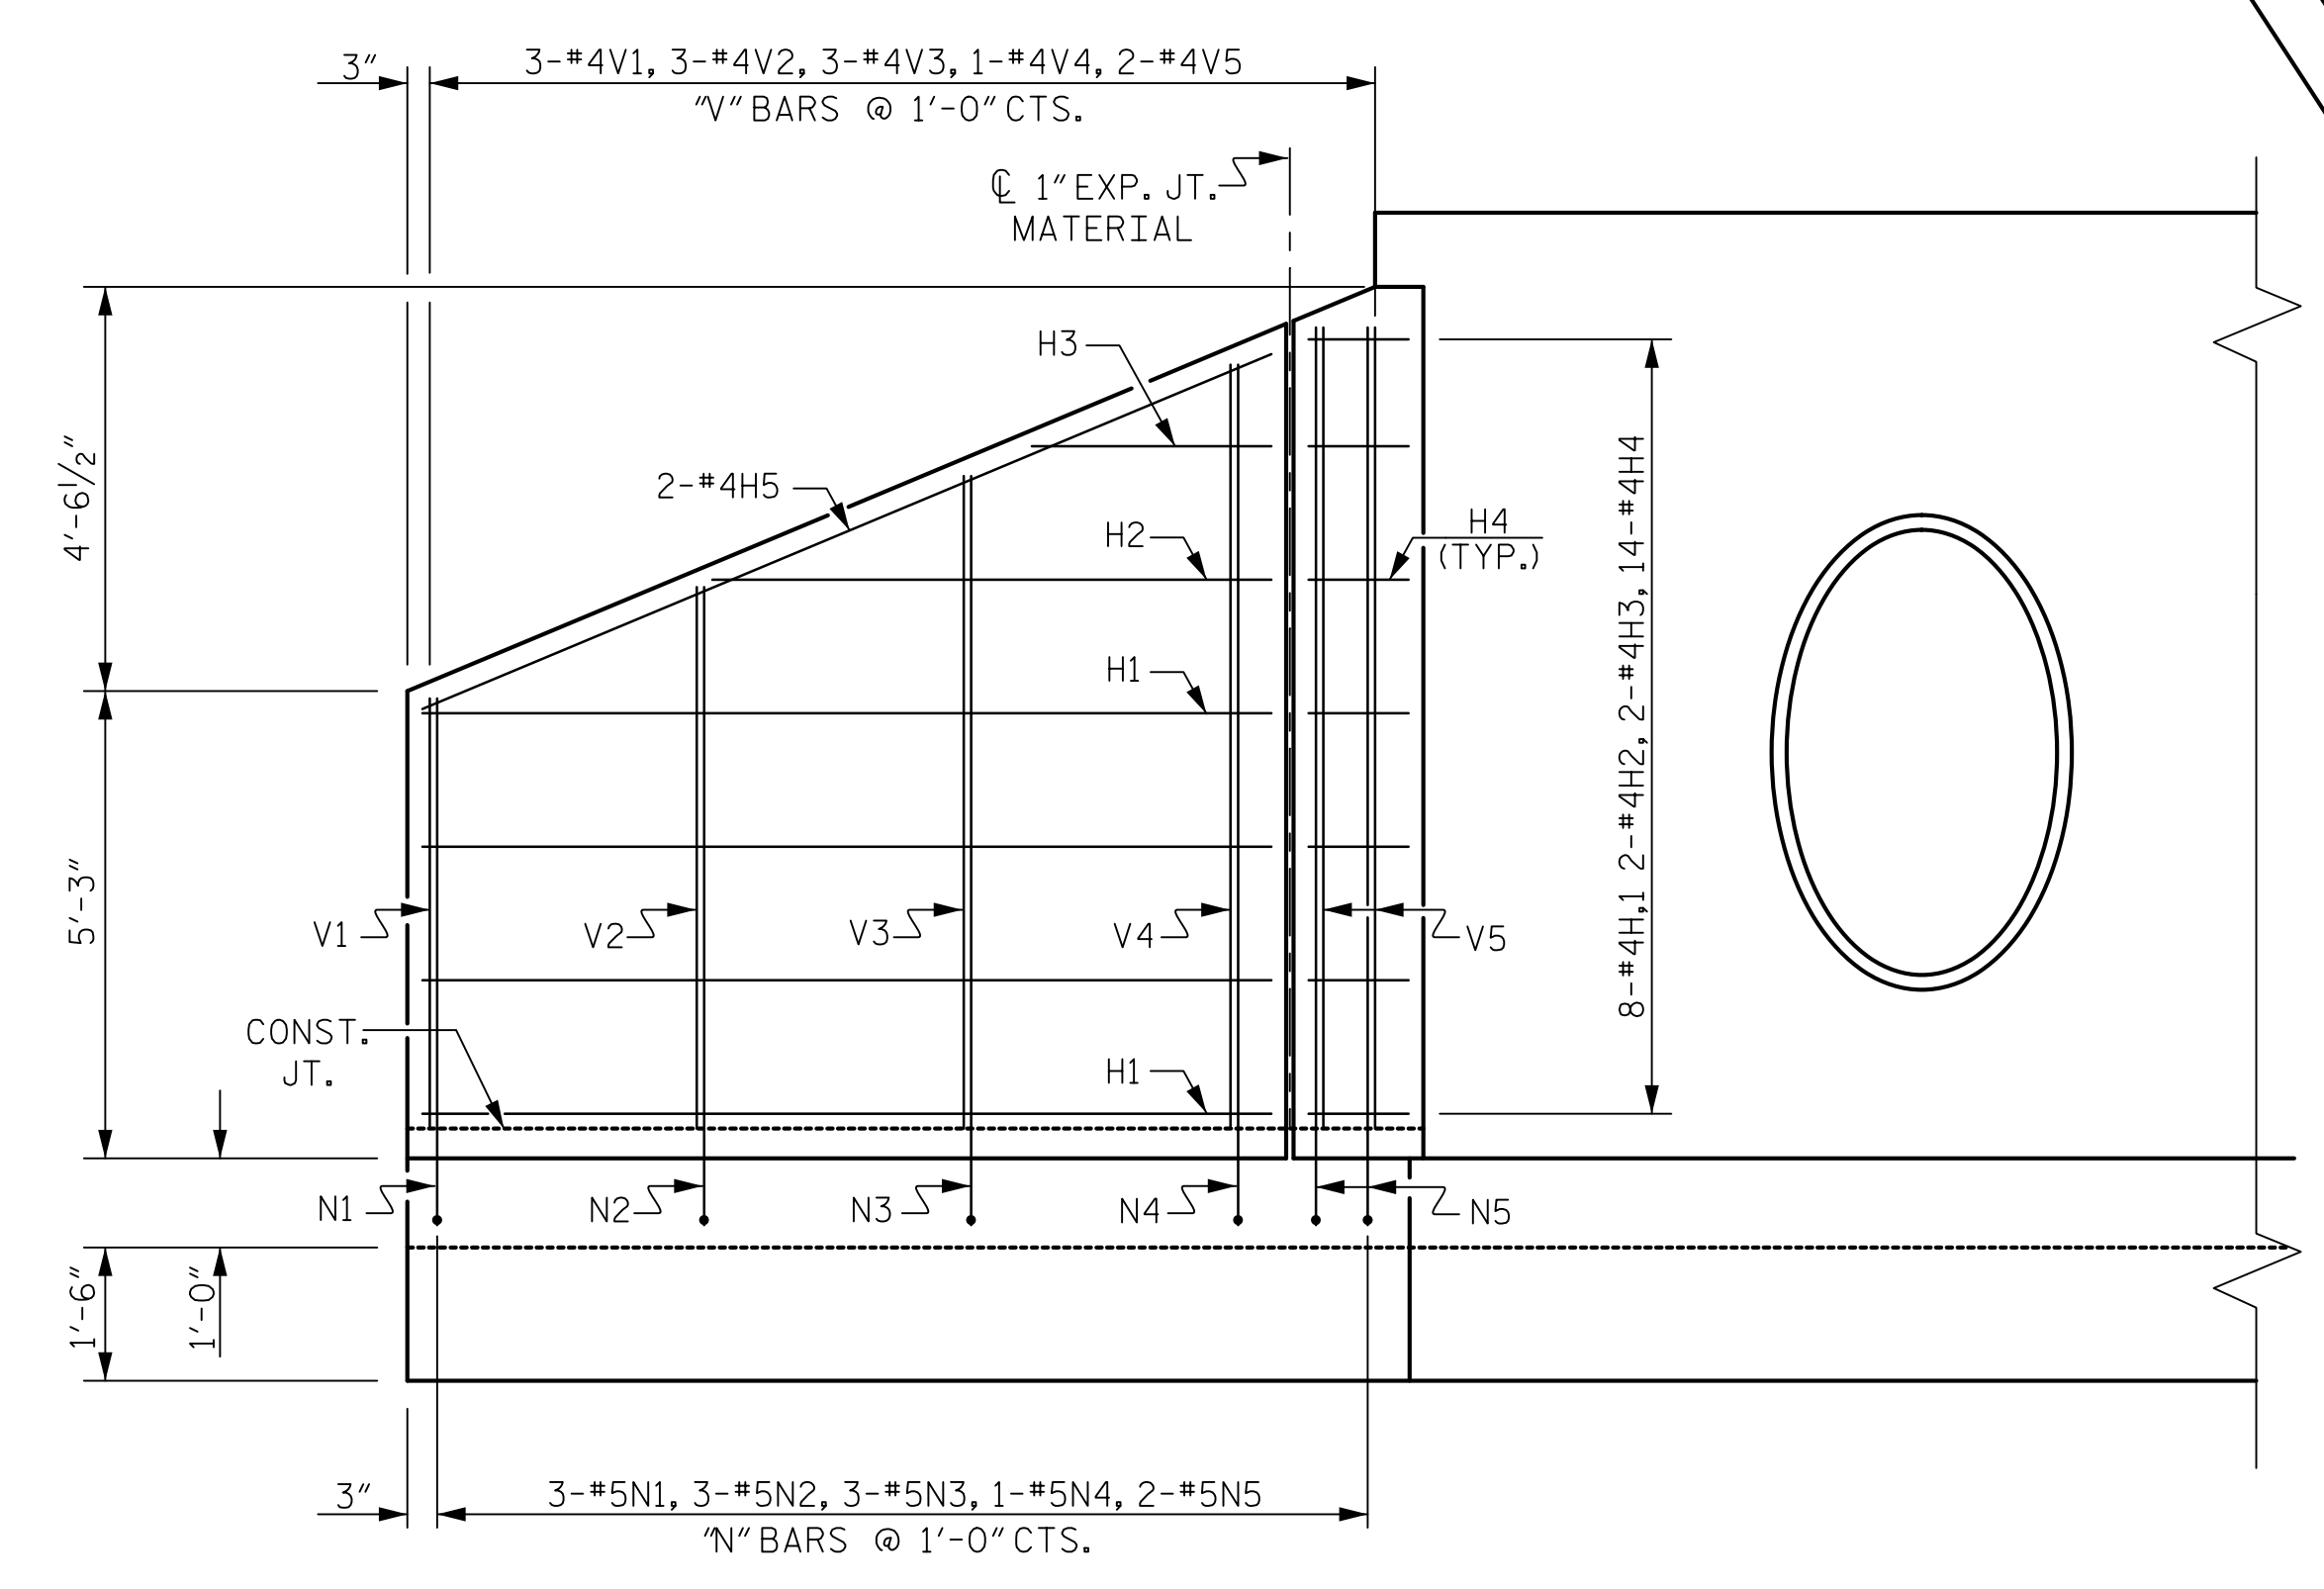

ELEVATION W4

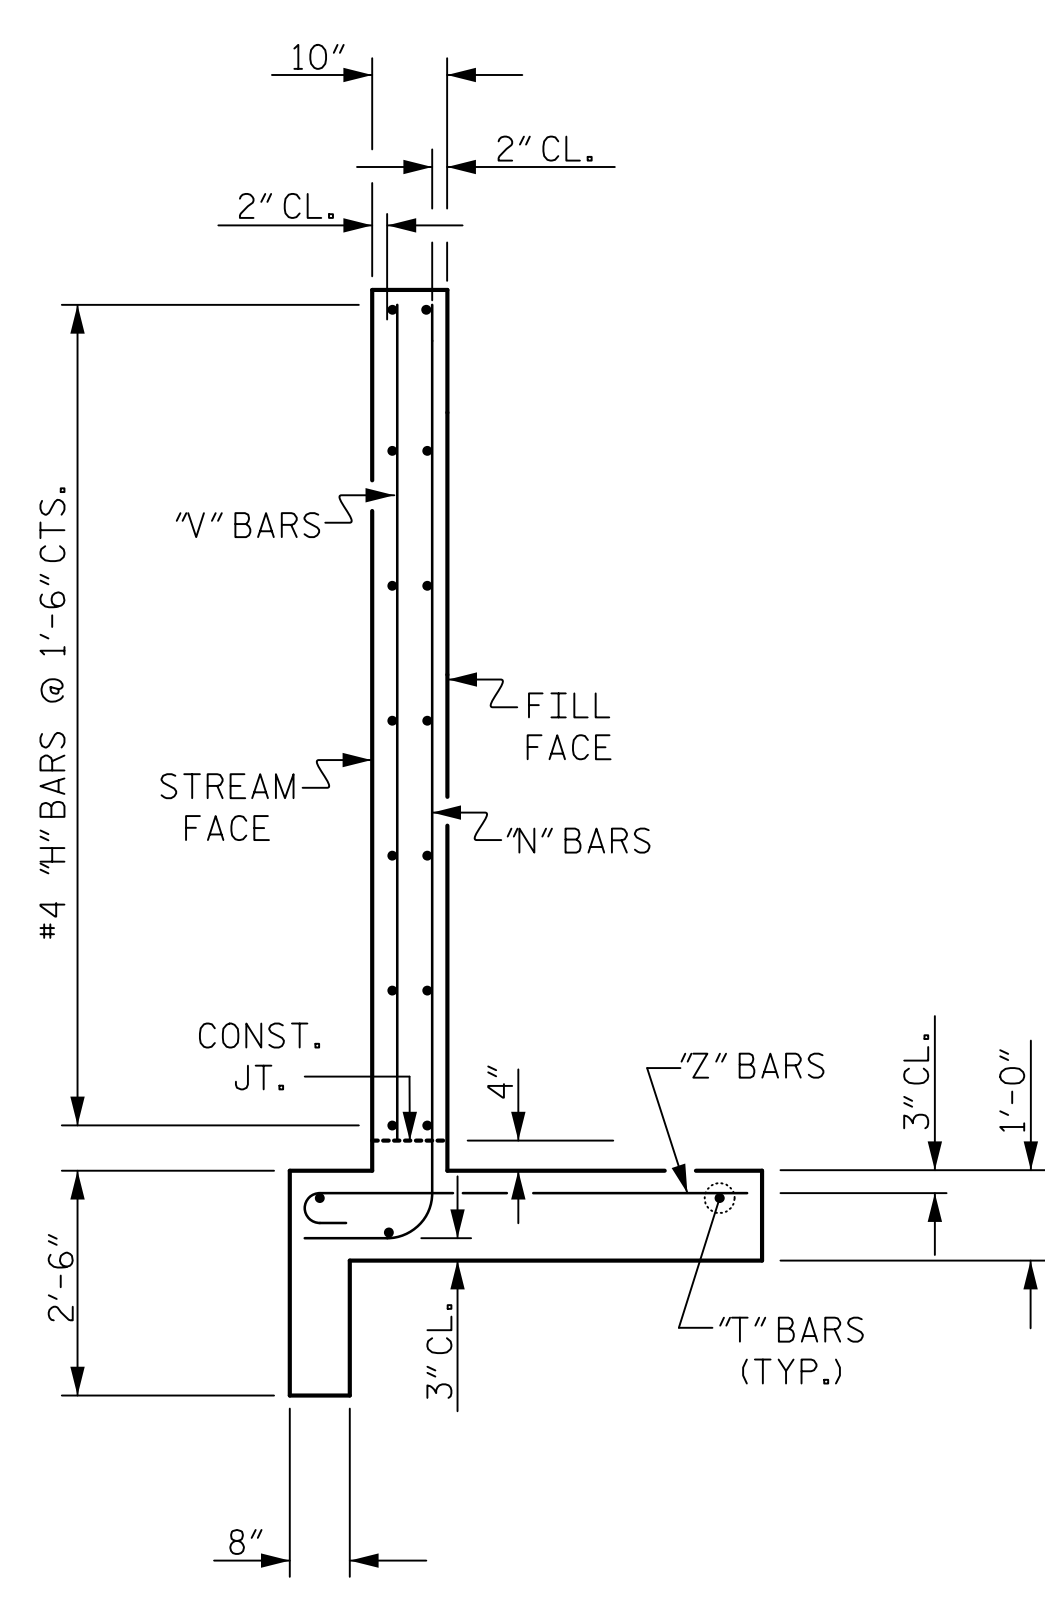

TYPICAL WING SECTION

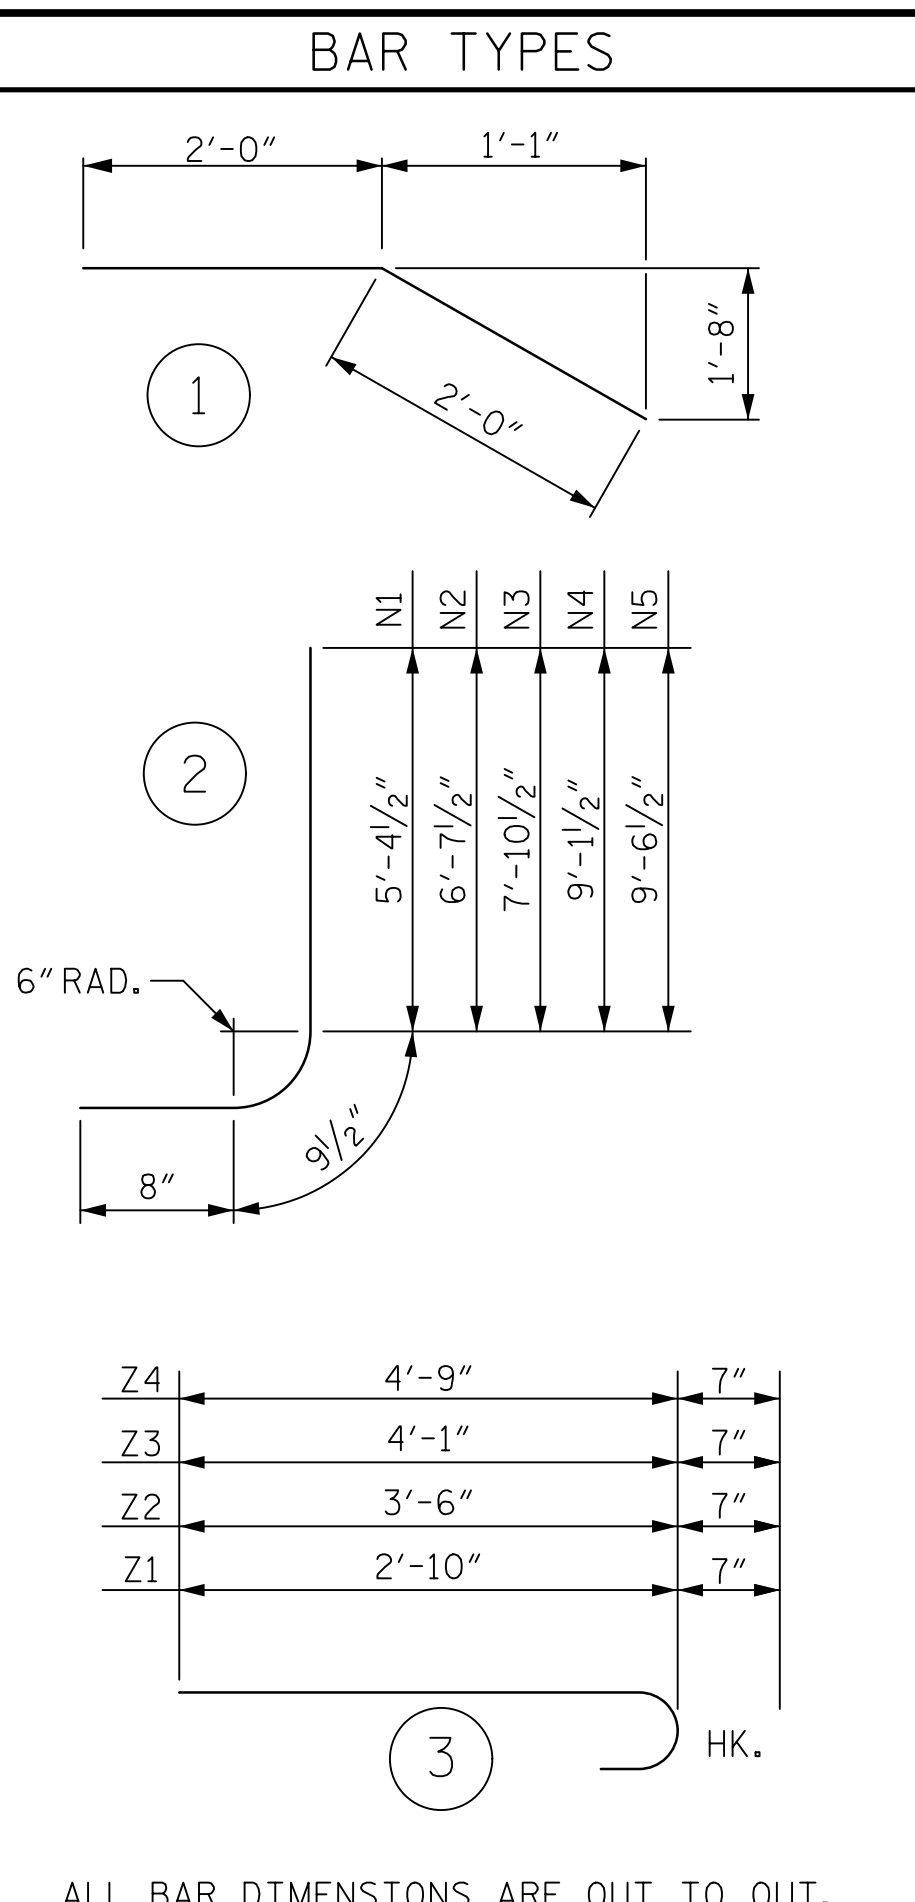

BILL OF MATERIAL					
BAR	NO.	SIZE	TYPE	LENGTH	WEIGHT
H1	8	#4	STR	9'-6"	51
H2	2	#4	STR	6'-3"	8
H3	2	#4	STR	2'-8"	4
H4	14	#4	1	4'-0"	37
H5	2	#4	STR	10'-4"	14
N1	3	#5	2	6'-10"	21
N2	3	#5	2	8'-1"	25
N3	3	#5	2	9'-4"	29
N4	1	#5	2	10'-7"	11
N5	2	#5	2	11'-0"	23
S1	3	#6	STR	7'-0"	32
T1	3	#5	STR	11'-0"	34
V1	3	#4	STR	4'-10"	10
V2	3	#4	STR	6'-1"	12
V3	3	#4	STR	7'-4"	15
V4	1	#4	STR	8'-7"	6
V5	2	#4	STR	9'-0"	12
Z1	3	#5	3	3'-5"	11
Z2	3	#5	3	4'-1"	13
Z3	3	#5	3	4'-8"	15
Z4	1	#5	3	5'-4"	6
REINFORCING STEEL FOR WING W4					389 LBS
CLASS A CONCRETE WING W4					4.3 CY
CURTAIN WALL					0.4 CY
TOTAL					4.7 CY

DRAWN BY : J.A. LEE DATE : 03/27/19
 CHECKED BY : J.S. HOBSON DATE : 04/15/19
 DESIGN ENGINEER OF RECORD : J.S. HOBSON DATE : 04/26/19

Mead & Hunt
 111 E. Hargett Street Suite 300
 Raleigh, NC 27601
 919-714-8670
 meadhunt.com
 NC License No. F-1235

SEAL 043177
 JACK S. HOBSON
 PROFESSIONAL ENGINEER
 4/16/2020


DOCUMENT NOT CONSIDERED FINAL UNLESS ALL SIGNATURES COMPLETED

PROJECT NO. R-4707
 GUILFORD COUNTY
 STATION: 56+34.85 -L-
 SHEET 16 OF 16

REVISIONS						SHEET NO.
NO.	BY:	DATE:	NO.	BY:	DATE:	C1-24
1			3			TOTAL SHEETS
2			4			24

STATE OF NORTH CAROLINA
 DEPARTMENT OF TRANSPORTATION
 RALEIGH
WING W4 FOR CONCRETE BOX CULVERT (RIGHT EXTENSION)
 H=8'-0" SLOPE=2:1

BM #11: R/R SPIKE IN ROOT OF 24" HICKORY TREE, 166.54' LT OF STA. 55+89.32 -Y-, EL. 733.65

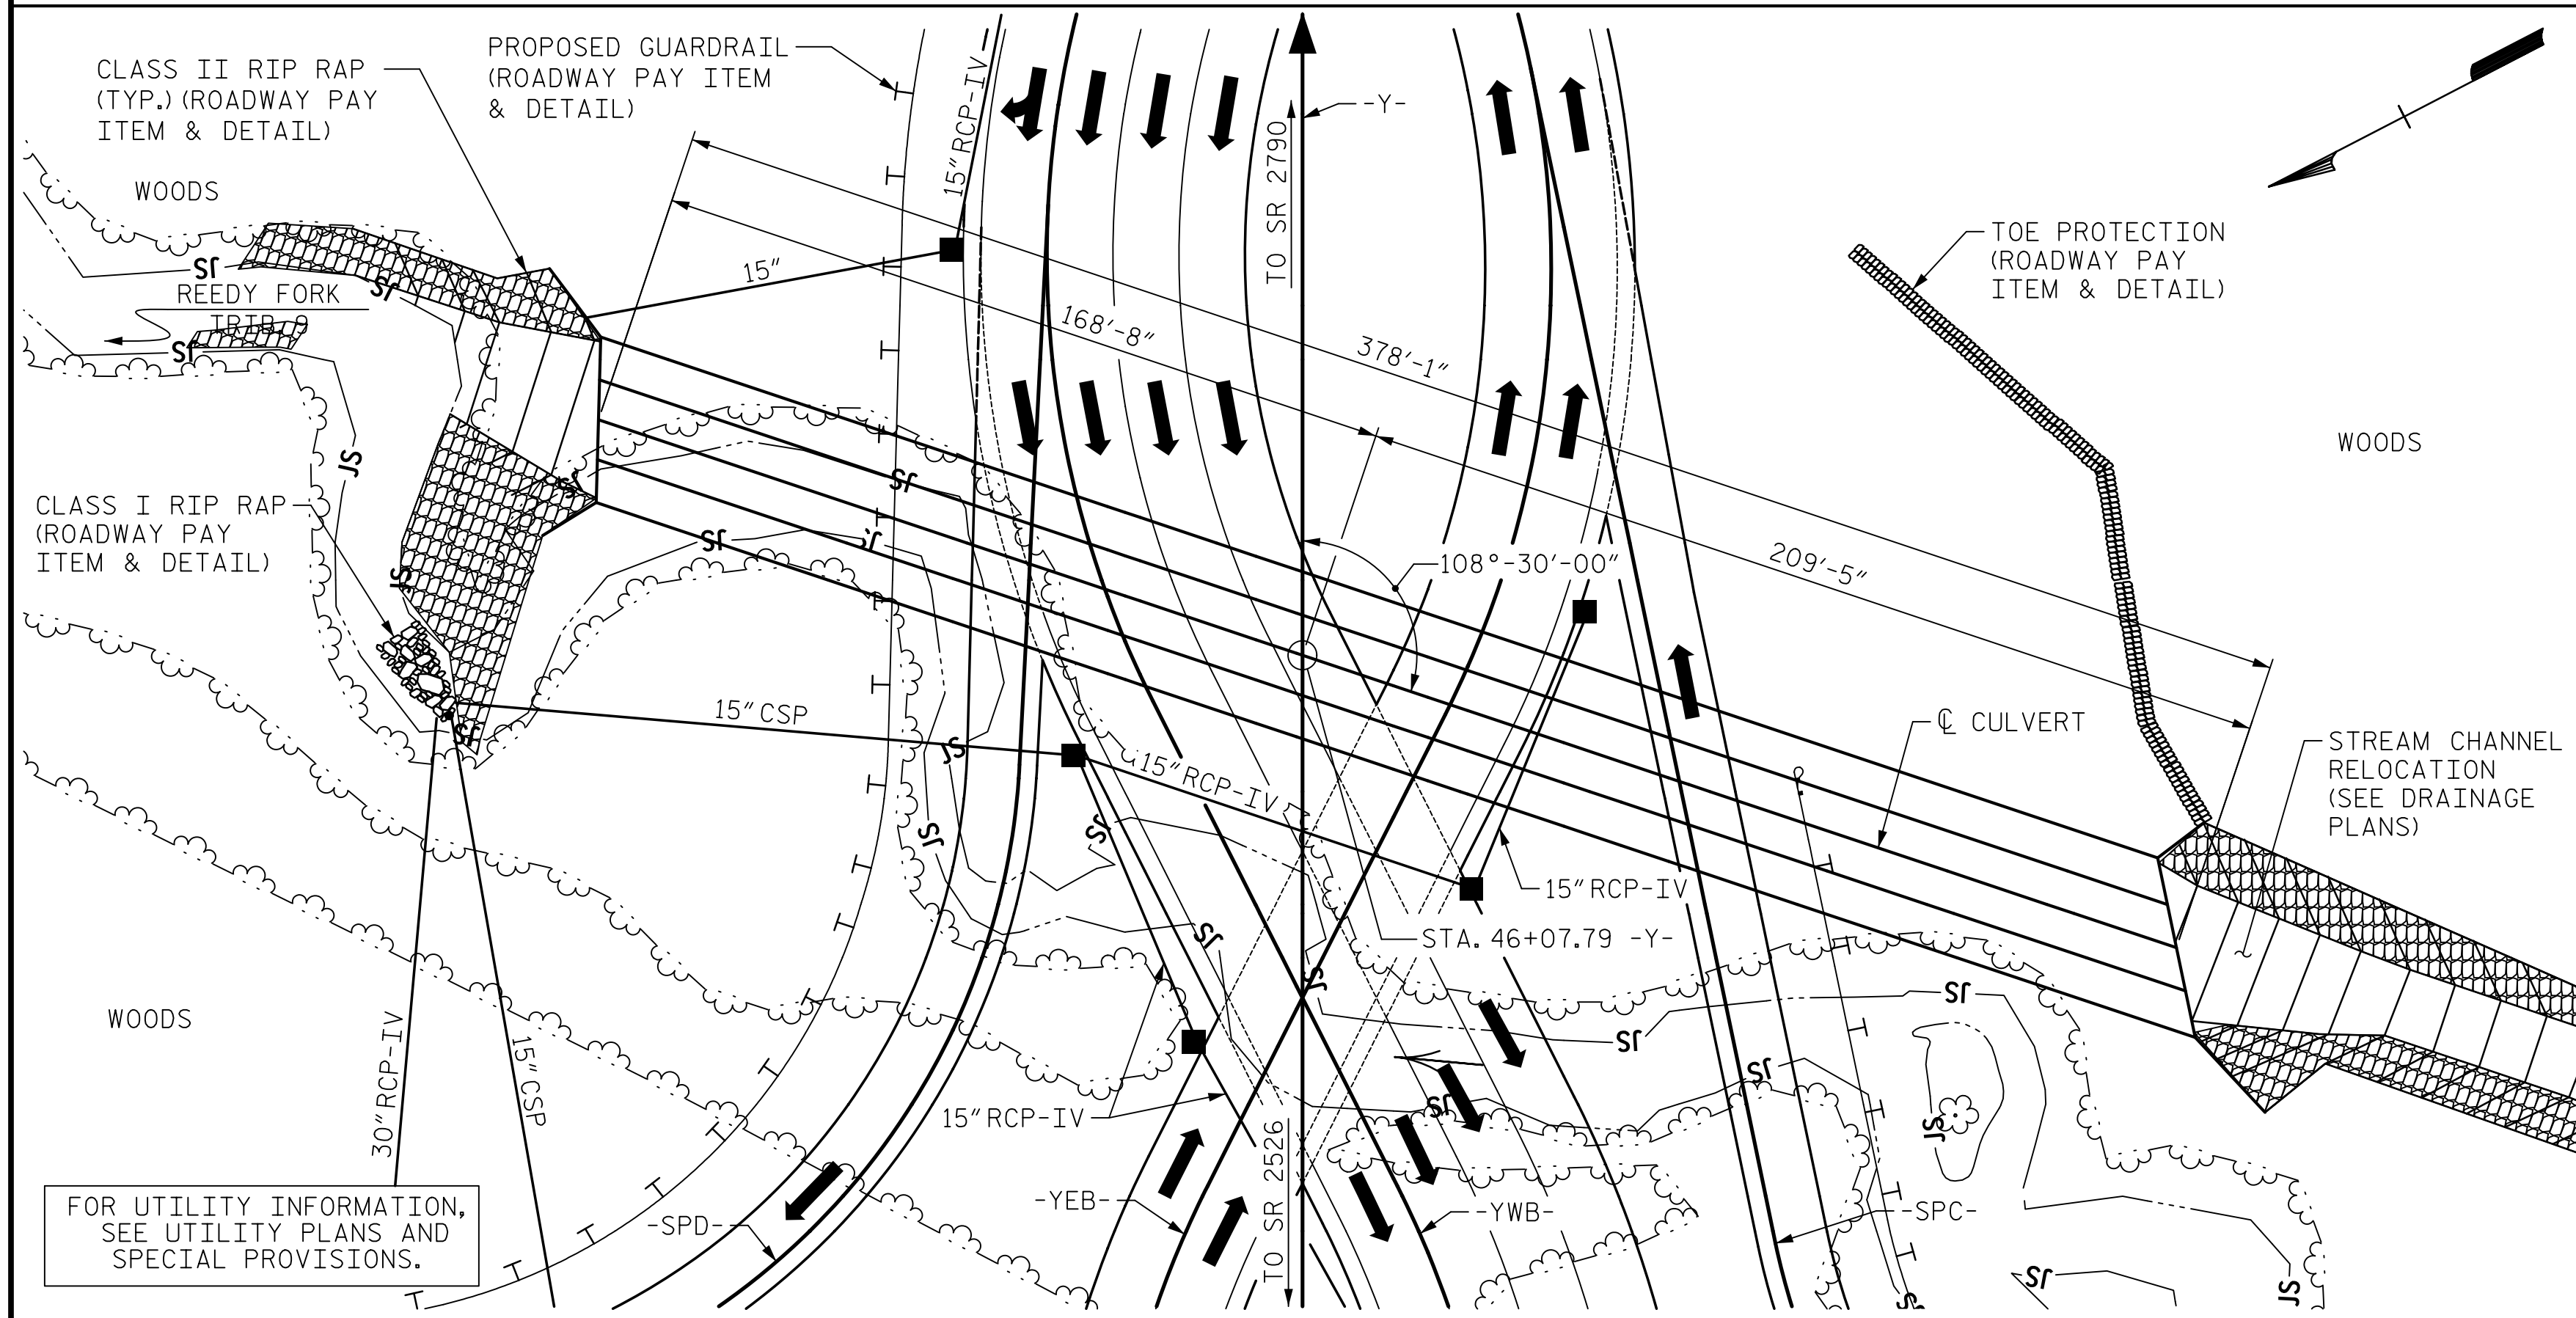

LOCATION SKETCH

HYDRAULIC DATA


DESIGN DISCHARGE = 1,700 C.F.S.
 FREQUENCY OF DESIGN FLOOD = 50 YRS.
 DESIGN HIGH WATER ELEVATION = 687.6'
 DRAINAGE AREA = 3.16 SQ. MI.
 BASE DISCHARGE (Q100) = 2,100 C.F.S.
 BASE HIGH WATER ELEVATION = 689.4'

OVERTOPPING FLOOD DATA

OVERTOPPING DISCHARGE = 8,400 C.F.S.
 FREQUENCY OF OVERTOPPING FLOOD = 500+ YRS.
 OVERTOPPING FLOOD ELEVATION = 719.7'

ROADWAY DATA

GRADE POINT ELEV. @ STA. 46+07.79 -Y- = 726.23
 BED ELEV. @ STA. 46+07.79 -Y- = 679.20
 ROADWAY FILL SLOPES= 2:1

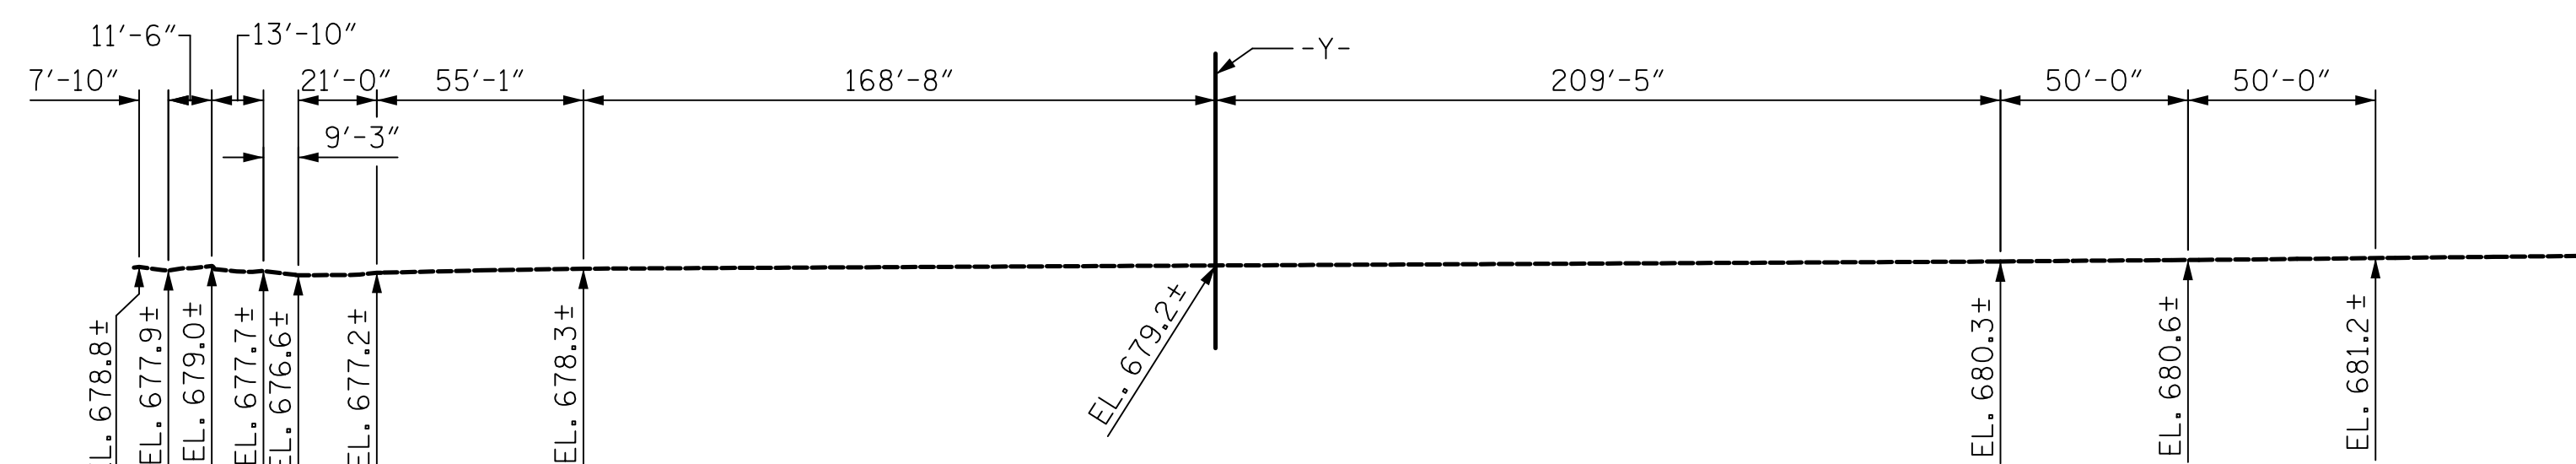

PROFILE ALONG CULVERT

DRAWN BY : J.S. HOBSON DATE : 03/07/19
 CHECKED BY : J.A. LEE DATE : 04/03/19
 DESIGN ENGINEER OF RECORD : J.S. HOBSON DATE : 04/11/19

NOTES

ASSUMED LIVE LOAD ----- HL-93 OR ALTERNATE LOADING.
 MAX. DESIGN FILL----- 37.99 FT.
 MIN. DESIGN FILL----- 33.57 FT.

FOR OTHER DESIGN DATA AND NOTES SEE STANDARD NOTE SHEET.

3" Ø WEEP HOLES INDICATED TO BE IN ACCORDANCE WITH THE SPECIFICATIONS.

CONCRETE IN CULVERTS TO BE POURED IN THE FOLLOWING ORDER:

1. WING FOOTINGS AND FLOOR SLAB INCLUDING 4" OF ALL VERTICAL WALLS.
2. THE REMAINING PORTIONS OF THE WALLS AND WINGS FULL HEIGHT.
3. ROOF SLAB INCLUDING REMAINING PORTION OF WALLS AND HEADWALL.

THE RESIDENT ENGINEER SHALL CHECK THE LENGTH OF CULVERT BEFORE STAKING IT OUT TO MAKE CERTAIN THAT IT WILL PROPERLY TAKE CARE OF THE FILL.

DIMENSIONS FOR WING LAYOUT AS WELL AS ADDITIONAL REINFORCING STEEL EMBEDDED IN BARREL ARE SHOWN ON WING SHEET.

STEEL IN THE BOTTOM SLAB MAY BE SPLICED AT THE PERMITTED CONSTRUCTION JOINT AT THE CONTRACTOR'S OPTION. EXTRA WEIGHT OF STEEL DUE TO SPLICES WILL BE PAID FOR BY THE CONTRACTOR.

TRANSVERSE CONSTRUCTION JOINTS SHALL BE USED IN THE BARREL, SPACED TO LIMIT THE POURS TO A MAXIMUM OF 70 FT. LOCATION OF JOINTS SHALL BE SUBJECT TO APPROVAL OF THE ENGINEER.

A 3 FOOT STRIP OF FILTER FABRIC SHALL BE ATTACHED TO THE FILL FACE OF THE WING COVERING THE ENTIRE LENGTH OF THE EXPANSION JOINT.

AT THE CONTRACTOR'S OPTION, HE MAY SPLICE THE VERTICAL REINFORCING STEEL IN THE INTERIOR FACE OF EXTERIOR WALLS AND BOTH FACES OF INTERIOR WALLS ABOVE LOWER WALL CONSTRUCTION JOINT. THE SPLICE LENGTH SHALL BE AS PROVIDED IN THE SPLICE LENGTH CHART SHOWN ON THE PLANS. EXTRA WEIGHT OF STEEL DUE TO THE SPLICES SHALL BE PAID FOR BY THE CONTRACTOR.

EXCAVATE A MINIMUM OF 1 FOOT BELOW CULVERT BEARING ELEVATION AND REPLACE WITH FOUNDATION CONDITIONING MATERIAL PER SECTION 414 OF THE STANDARD SPECIFICATIONS.

UNDERCUT ANY SOFT/LOOSE ALLUVIAL SOILS THAT MAY BE ENCOUNTERED BENEATH THE BOTTOM OF THE FOUNDATION CONDITIONING MATERIAL. BACKFILL UNDERCUT AREAS WITH FOUNDATION CONDITIONING MATERIAL (SELECT MATERIAL CLASS VI; NO. 57 STONE). INCLUDE 600 CUBIC YARDS OF UNDERCUT AND 875 TONS OF FOUNDATION CONDITIONING MATERIAL AS CONTINGENCY ITEMS IN THE CONTRACT.

NO PRECAST REINFORCED BOX CULVERT OPTION WILL BE ALLOWED.

DETAILED DRAWINGS FOR FALSEWORK AND FORMS FOR THIS BOX CULVERT SHALL BE SUBMITTED. SEE SHEET SN.

FOR CULVERT DIVERSION DETAILS AND PAY ITEMS, SEE EROSION CONTROL PLANS.

FOR GROUT FOR STRUCTURES, SEE SPECIAL PROVISIONS.

FOR FALSEWORK AND FORMWORK, SEE SPECIAL PROVISIONS.

FOR SUBMITTAL OF WORKING DRAWINGS, SEE SPECIAL PROVISIONS.

FOR CRANE SAFETY, SEE SPECIAL PROVISIONS.


TOTAL STRUCTURE QUANTITIES

CLASS A CONCRETE		
BARREL @	7.109	CY/FT 2,668.2 C.Y.
WING ETC.	46.4	C.Y.
TOTAL	2,714.7	C.Y.
REINFORCING STEEL		
BARREL	334,072	LBS.
WINGS ETC.	3,298	LBS.
TOTAL	337,370	LBS.
CULVERT EXCAVATION	LUMP SUM	
FOUNDATION COND. MAT'L	1,067 TONS	

I HEREBY CERTIFY THESE PLANS ARE THE AS-BUILT PLANS



111 E. Hargett Street
 Suite 300
 Raleigh, NC 27601
 919-714-8670
 meadhunt.com
 NC License No. F-1235

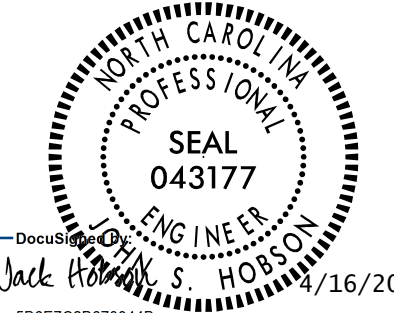

DOCUMENT NOT CONSIDERED FINAL UNLESS ALL SIGNATURES COMPLETED

PROJECT NO. R-4707
 GUILFORD COUNTY
 STATION: 46+07.79 -Y-

SHEET 1 OF 9 CULVERT NO. 1285

STATE OF NORTH CAROLINA
 DEPARTMENT OF TRANSPORTATION
 RALEIGH
 QUADRUPLE
 8 FT. x 10 FT.
 REINFORCED CONCRETE
 BOX CULVERT

REVISIONS						SHEET NO.
NO.	BY:	DATE:	NO.	BY:	DATE:	C2-01
1			3			TOTAL SHEETS
2			4			9

LOAD AND RESISTANCE FACTOR RATING (LRFR) SUMMARY FOR REINFORCED CONCRETE BOX CULVERTS

LEVEL	VEHICLE	WEIGHT (W) (TONS)	CONTROLLING LOAD RATING #	MINIMUM RATING FACTORS (RF)	TONS = W x RF	STRENGTH I LIMIT STATE								COMMENT NUMBER		
						LIVE-LOAD FACTORS (γ _L)	MOMENT				SHEAR					
							RATING FACTOR	BOX NO.	ELEMENT TYPE	DISTANCE FROM LEFT END OF ELEMENT (FT)	RATING FACTOR	BOX NO.	ELEMENT TYPE		DISTANCE FROM LEFT END OF ELEMENT (FT)	
DESIGN LOAD RATING	HL-93 (INVENTORY)	N/A	①	4.21	--	1.75	4.21	1	TOP SLAB	4.17	12.28	1	TOP SLAB	2.31		
	HL-93 (OPERATING)	N/A		5.46	--	1.35	5.46	1	TOP SLAB	4.17	15.91	1	TOP SLAB	2.31		
	HS-20 (INVENTORY)	36.000	②	4.21	151.56	1.75	4.21	1	TOP SLAB	4.17	12.28	1	TOP SLAB	2.31		
	HS-20 (OPERATING)	36.000		5.46	196.56	1.35	5.46	1	TOP SLAB	4.17	15.91	1	TOP SLAB	2.31		
LEGAL LOAD RATING	SINGLE VEHICLE (SV)	SNSH	13.500		20.13	271.76	1.40	20.13	1	TOP SLAB	4.17	58.24	1	TOP SLAB	2.31	
		SNGARBS2	20.000		13.61	272.20	1.40	13.61	1	TOP SLAB	4.17	39.38	1	TOP SLAB	2.31	
		SNAGRIS2	22.000		12.38	272.36	1.40	12.38	1	TOP SLAB	4.17	35.82	1	TOP SLAB	2.31	
		SNCOTTS3	27.250		9.97	271.68	1.40	9.97	1	TOP SLAB	4.17	28.86	1	TOP SLAB	2.31	
		SNAGGRS4	34.925		7.80	272.42	1.40	7.80	1	TOP SLAB	4.17	22.60	1	TOP SLAB	2.31	
		SNS5A	35.550		7.65	271.96	1.40	7.65	1	TOP SLAB	4.17	22.19	1	TOP SLAB	2.31	
		SNS6A	39.950		6.83	272.86	1.40	6.83	1	TOP SLAB	4.17	19.94	1	TOP SLAB	2.31	
		SNS7B	42.000		6.49	272.58	1.40	6.49	1	TOP SLAB	4.17	18.91	1	TOP SLAB	2.31	
	TRUCK TRACTOR SEMI-TRAILER (TTST)	TNAGRIT3	33.000		8.26	272.58	1.40	8.26	1	TOP SLAB	4.17	23.97	1	TOP SLAB	2.31	
		TNT4A	33.075		8.23	272.21	1.40	8.23	1	TOP SLAB	4.17	24.02	1	TOP SLAB	2.31	
		TNT6A	41.600		6.58	273.73	1.40	6.58	1	TOP SLAB	4.17	19.29	1	TOP SLAB	2.31	
		TNT7A	42.000		6.67	280.14	1.40	6.67	1	TOP SLAB	4.17	19.51	1	TOP SLAB	2.31	
		TNT7B	42.000		6.67	280.14	1.40	6.67	1	TOP SLAB	4.17	19.84	1	TOP SLAB	2.31	
		TNAGRIT4	43.000		6.33	272.19	1.40	6.33	1	TOP SLAB	4.17	18.49	1	TOP SLAB	2.31	
TNAGT5A	45.000		6.07	273.15	1.40	6.07	1	TOP SLAB	4.17	17.83	1	TOP SLAB	2.31			
TNAGT5B	45.000		③	6.06	272.70	1.40	6.06	1	TOP SLAB	4.17	17.59	1	TOP SLAB	2.31		

LOAD FACTORS:

DESIGN LOAD RATING FACTORS

LOAD TYPE	MAX FACTOR	MIN FACTOR
DC	1.25	0.90
DW	1.50	0.65
EV	1.30	0.90
EH	1.35	0.90
ES	1.35	0.90
LS	1.75	--
WA	1.00	--

NOTE:

RATING FACTORS ARE BASED ON THE STRENGTH I LIMIT STATE.

COMMENTS:


CONTROLLING LOAD RATING

① DESIGN LOAD RATING (HL-93)

② DESIGN LOAD RATING (HS-20)

③ LEGAL LOAD RATING **

** SEE CHART FOR VEHICLE TYPE

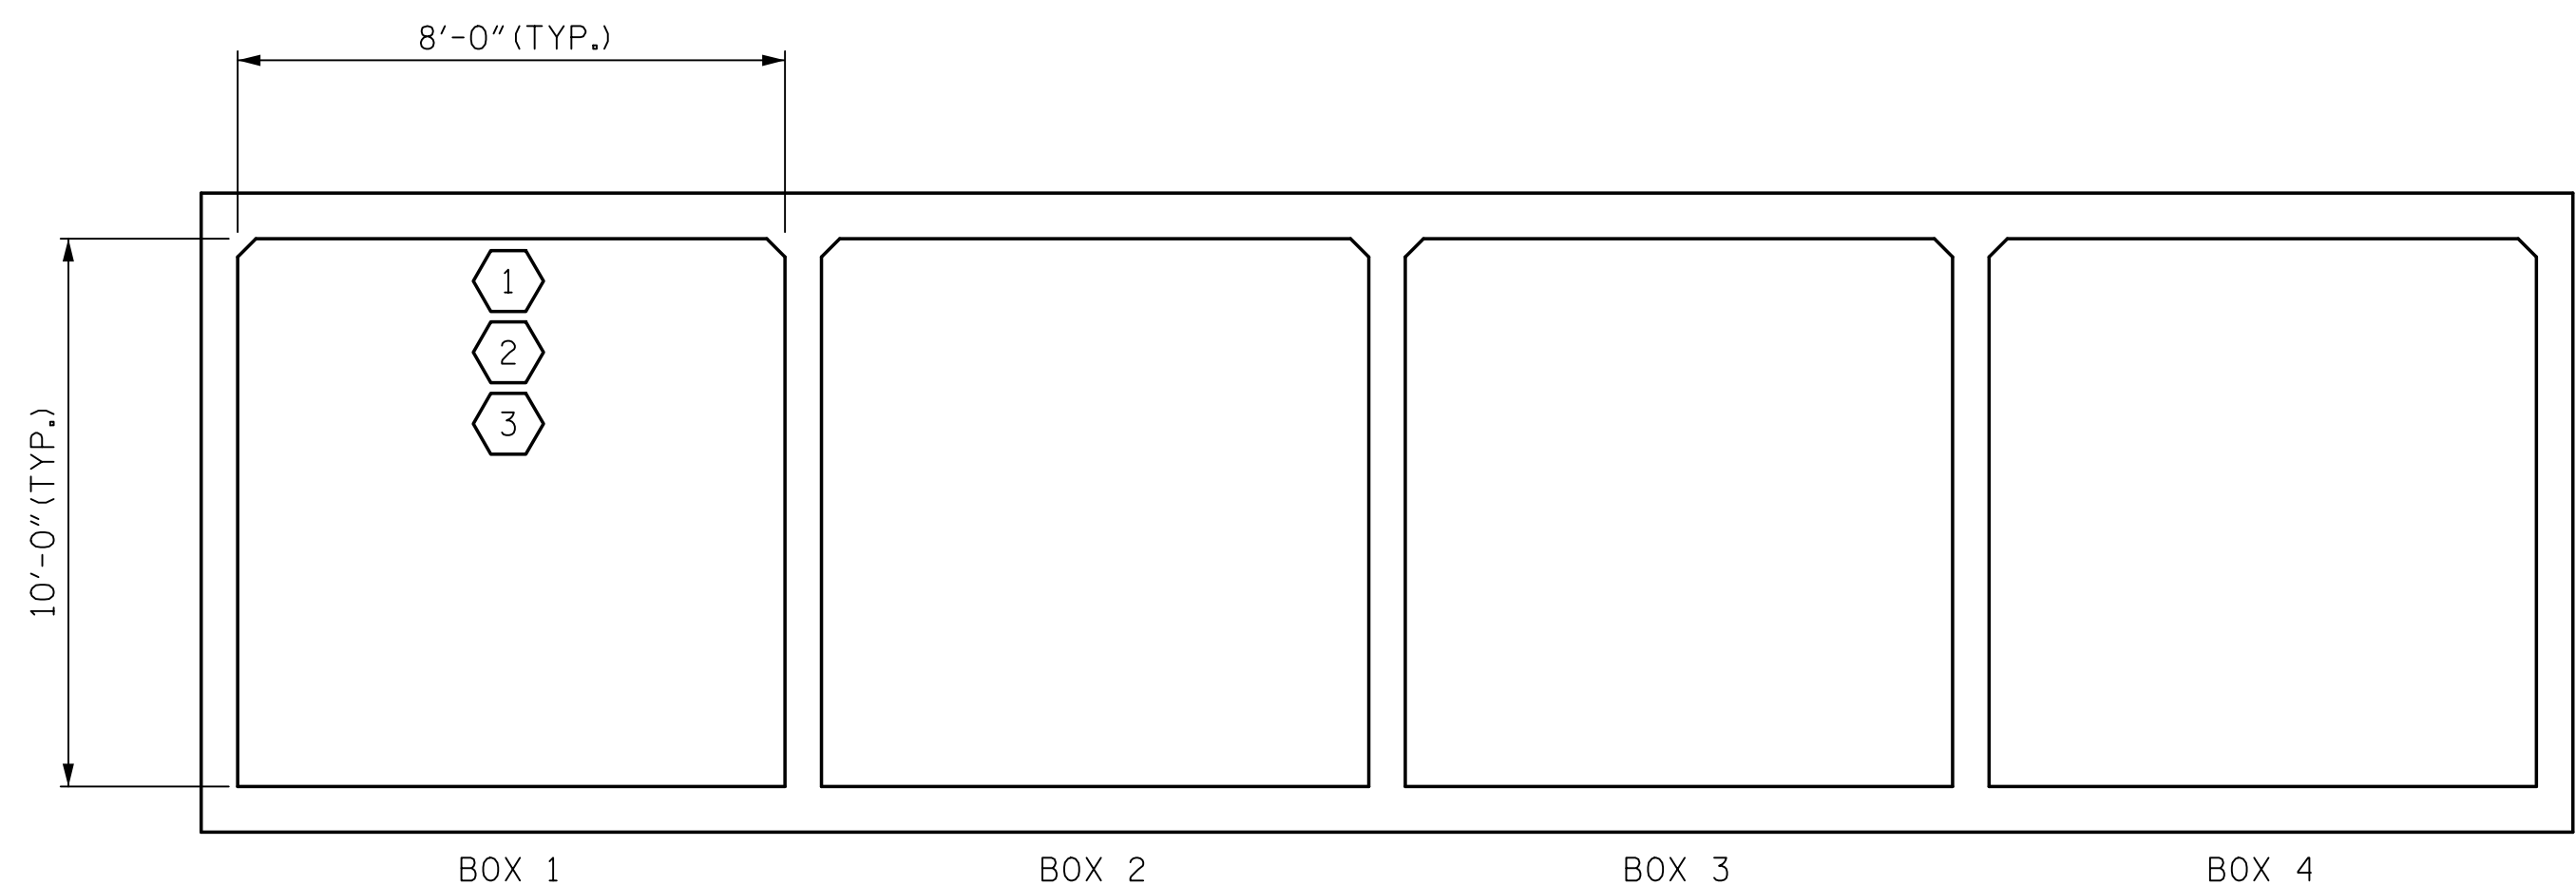

LRFR SUMMARY
(LOOKING DOWNSTREAM)

ASSEMBLED BY : J.S. HOBSON	DATE :03/07/19
CHECKED BY : J.A. LEE	DATE :04/03/19
DRAWN BY : WMC 7/II	REV. 10/1/II MAA/GM
CHECKED BY : GM 7/II	

Mead & Hunt

111 E. Hargett Street
Suite 300
Raleigh, NC 27601
919-714-8670
meadhunt.com
NC License No. F-1235

SEAL
043177
ENGINEER
Jack Hobson, S. HOBSON
4/16/2020


DOCUMENT NOT CONSIDERED
FINAL UNLESS ALL
SIGNATURES COMPLETED

PROJECT NO. R-4707
GUILFORD COUNTY
STATION: 46+07.79 -Y-

STATE OF NORTH CAROLINA
DEPARTMENT OF TRANSPORTATION
RALEIGH


STANDARD
LRFR SUMMARY FOR
REINFORCED CONCRETE
BOX CULVERTS
(NON-INTERSTATE TRAFFIC)

REVISIONS						SHEET NO.
NO.	BY:	DATE:	NO.	BY:	DATE:	C2-02
1			3			TOTAL SHEETS 9
2			4			

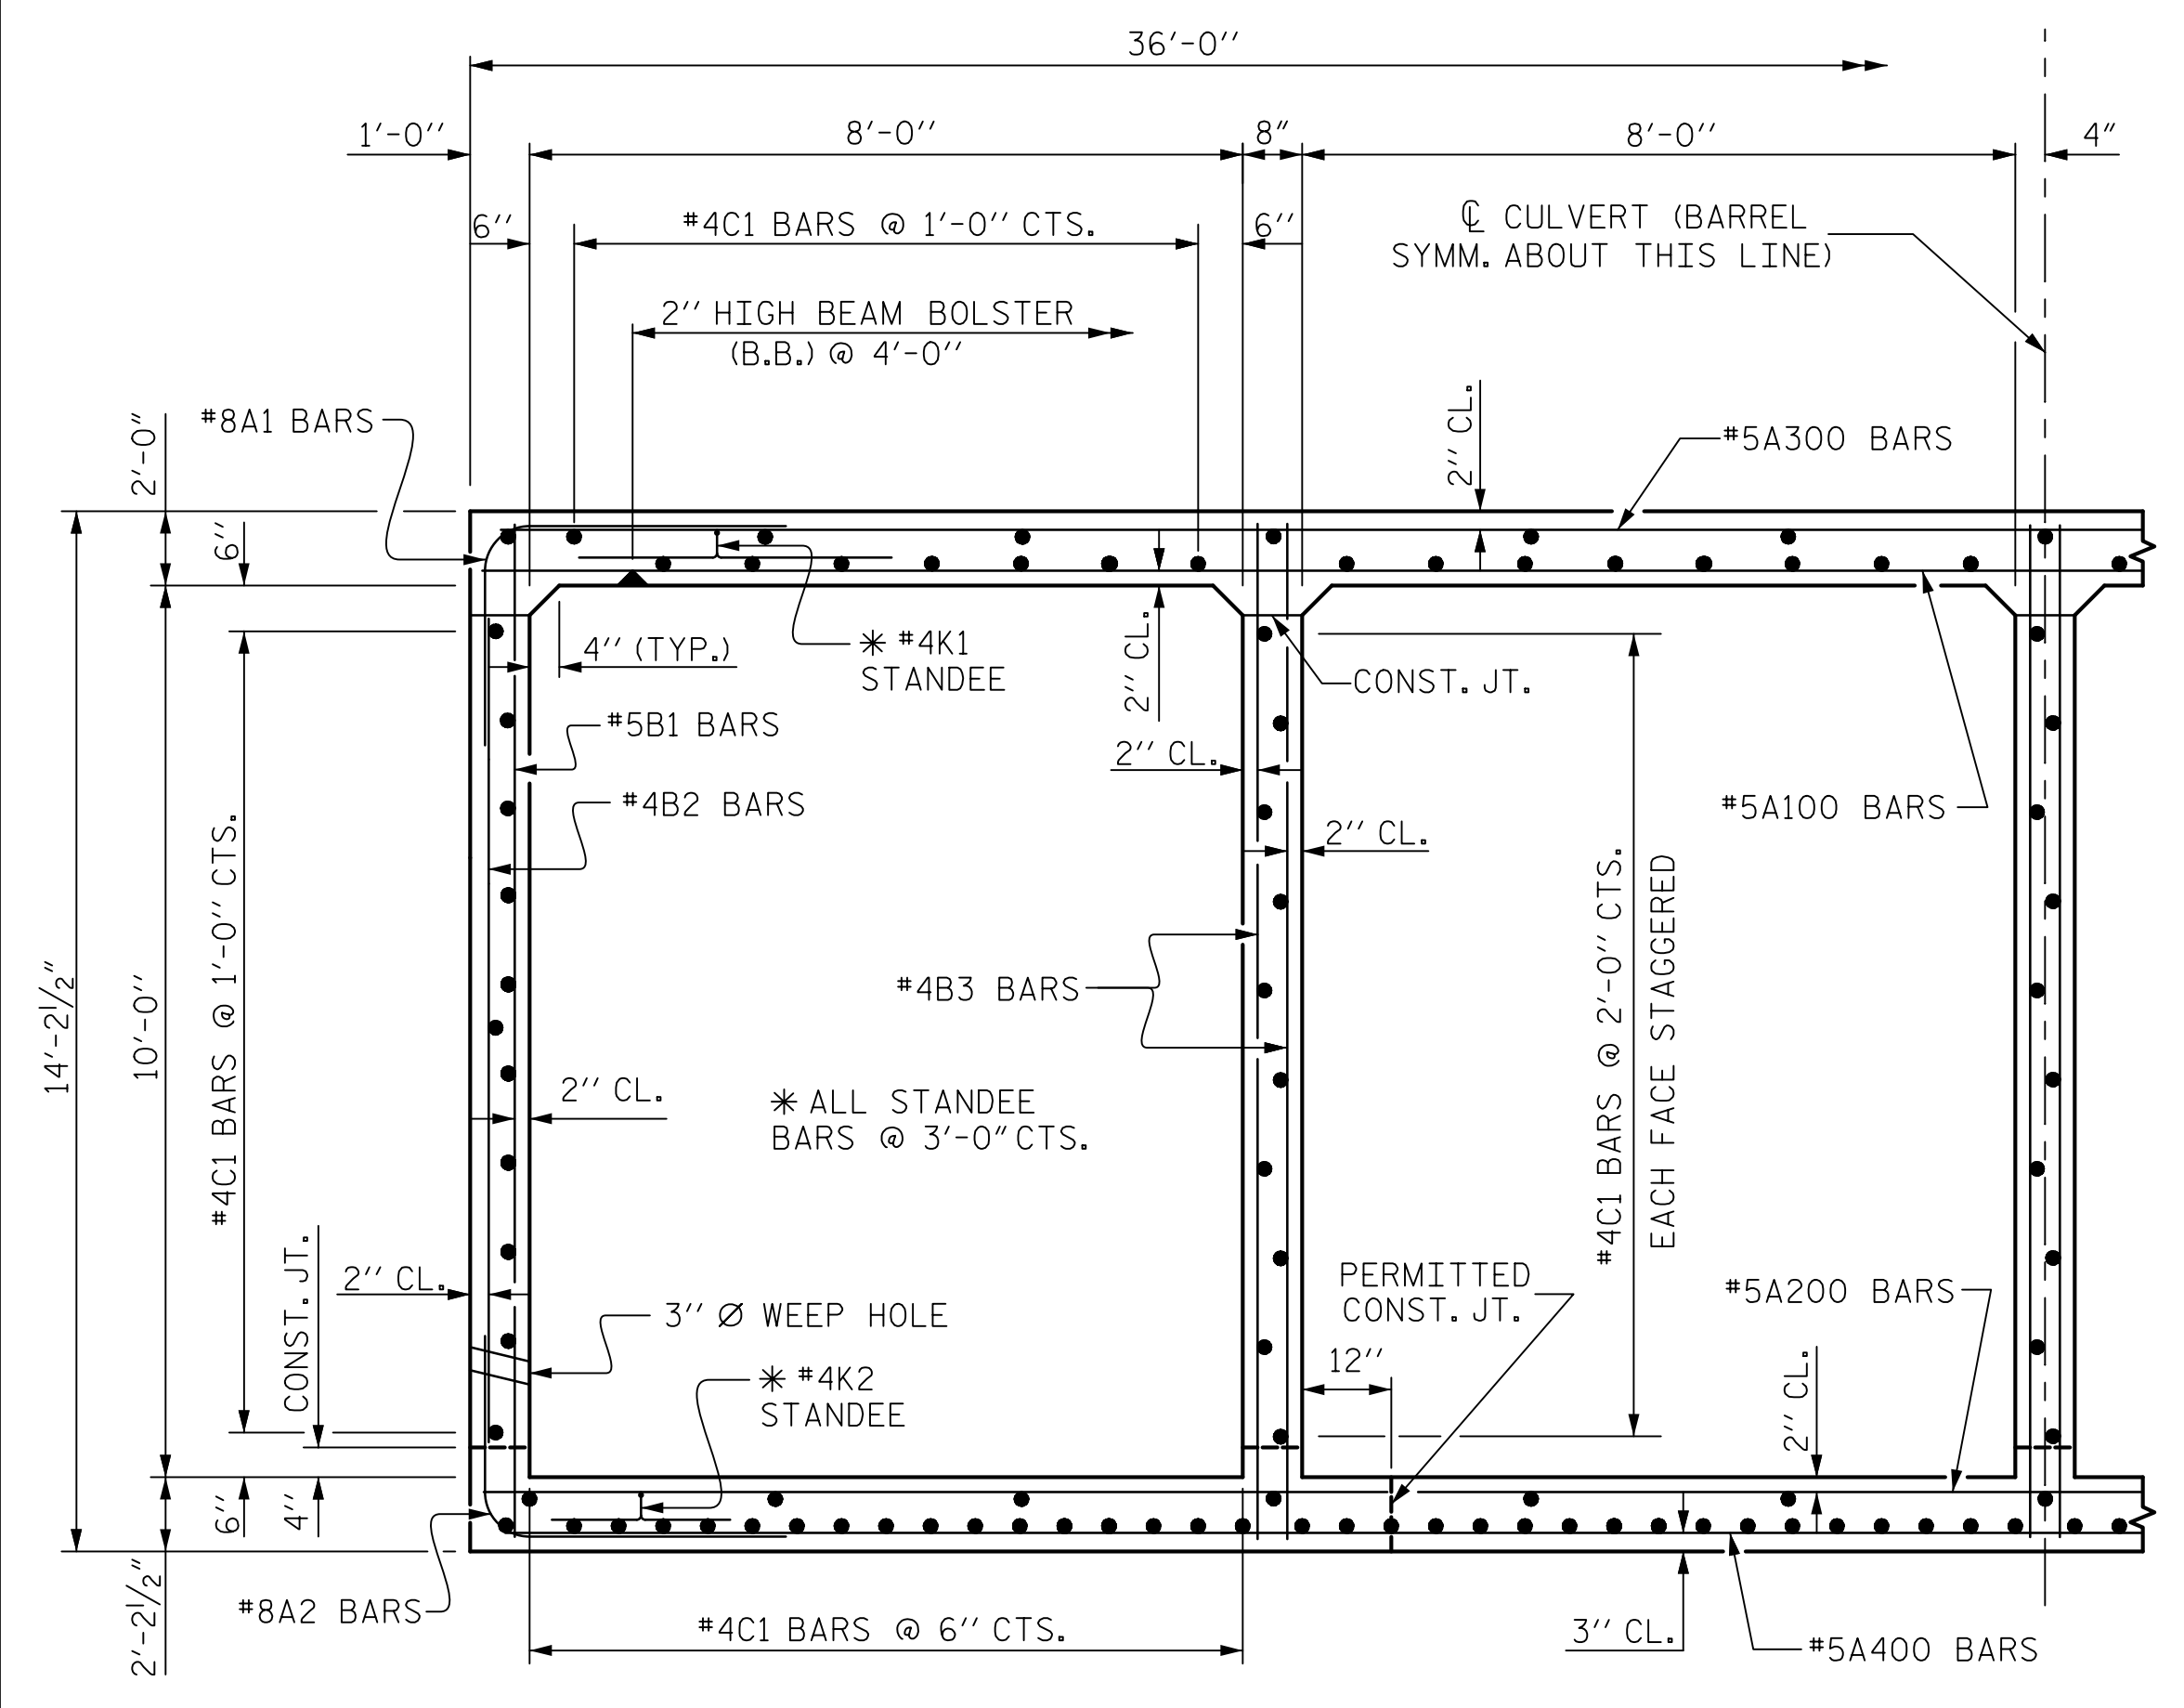


RIGHT ANGLE SECTION OF BARREL


THERE ARE 178 "C" BARS IN SECTION OF BARREL

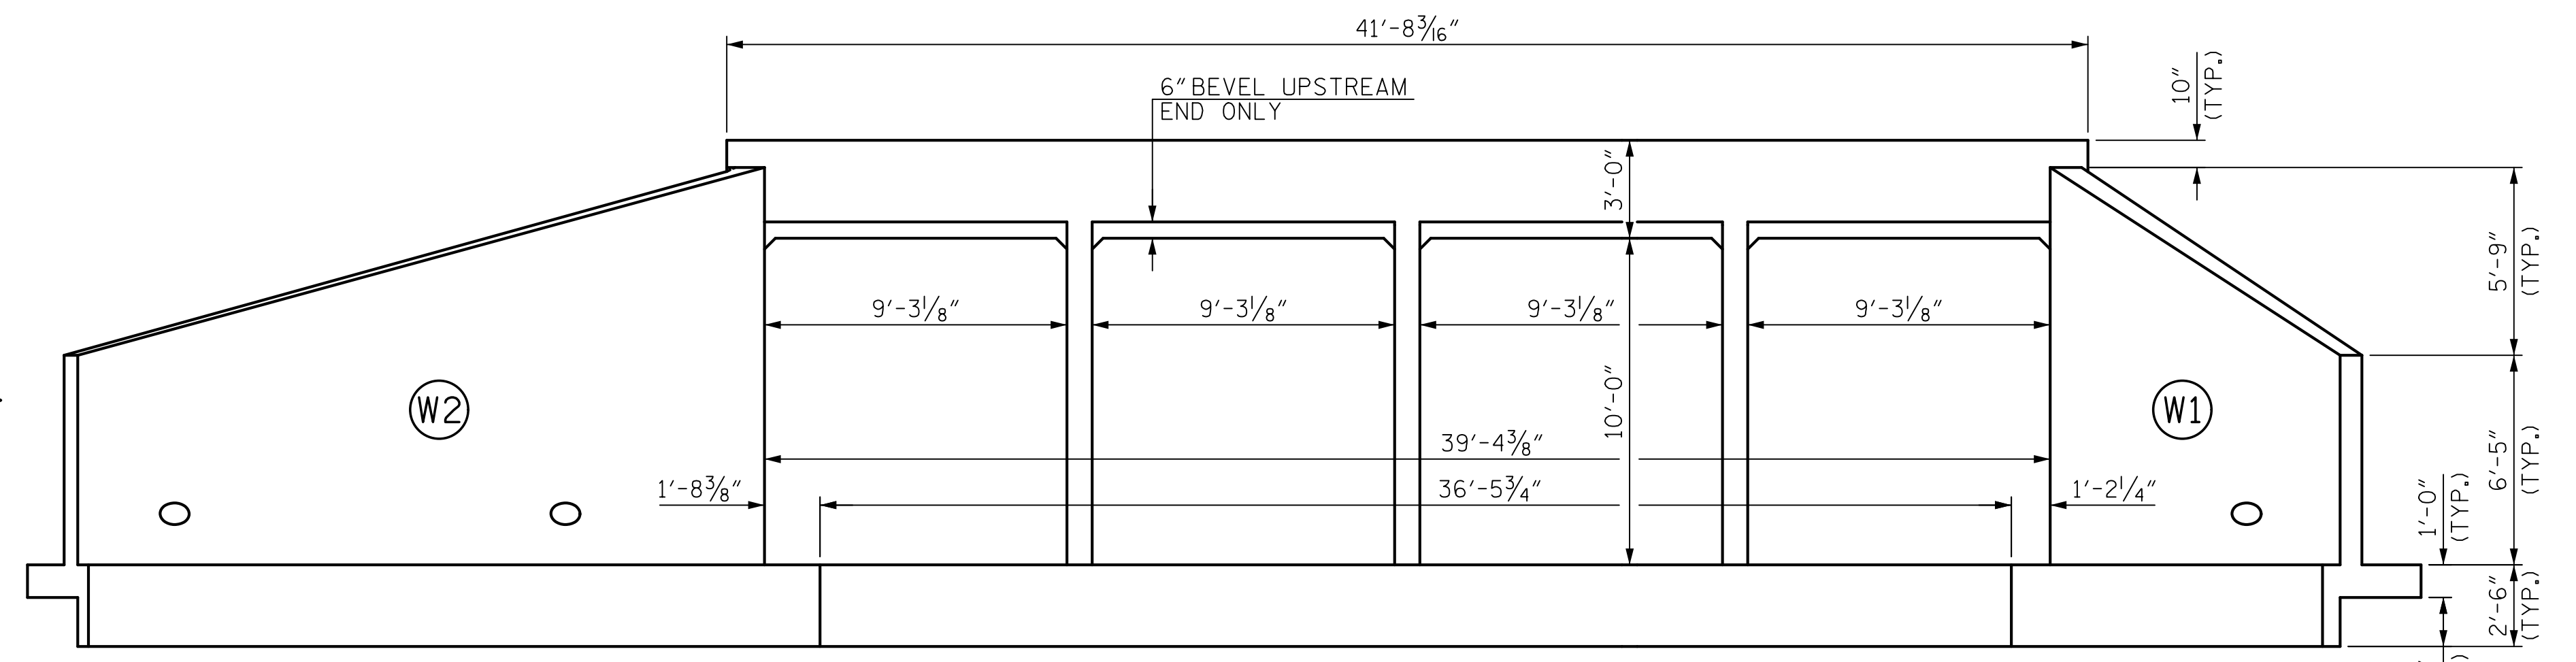


INLET END ELEVATION NORMAL TO SKEW

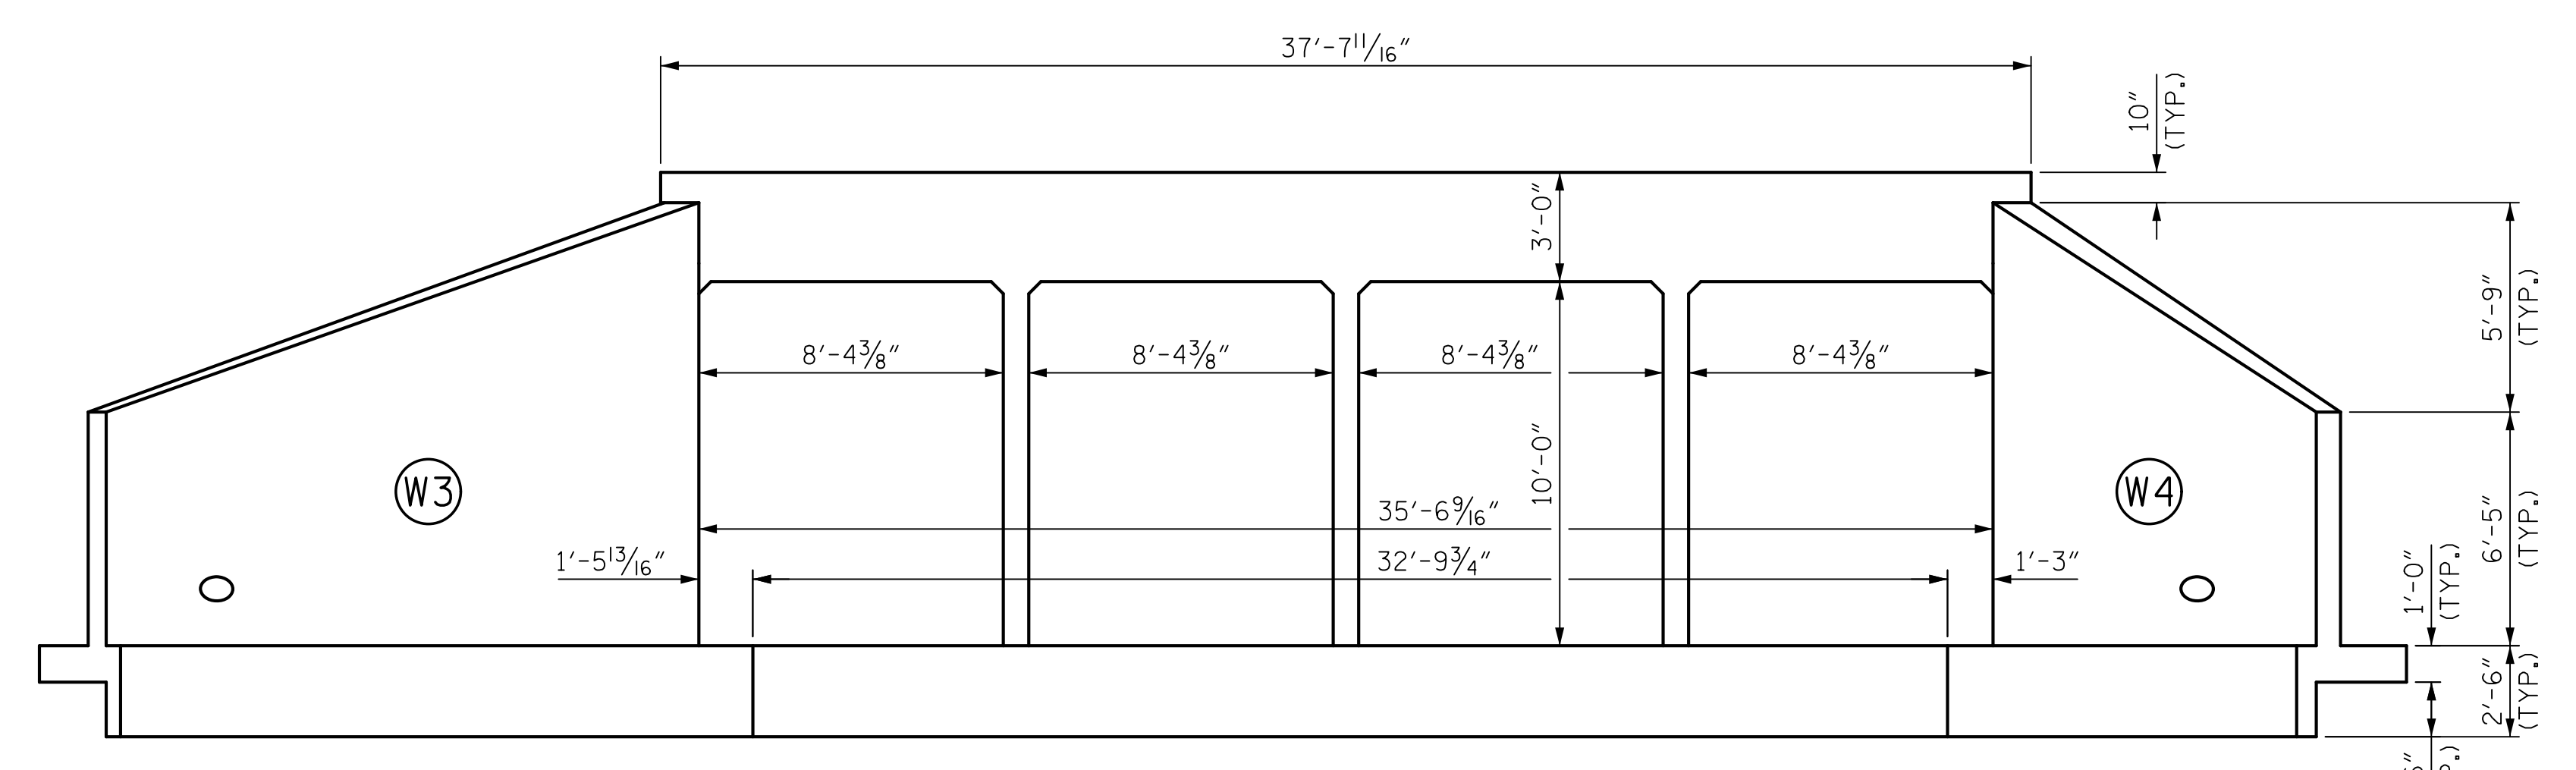

OUTLET END ELEVATION NORMAL TO SKEW

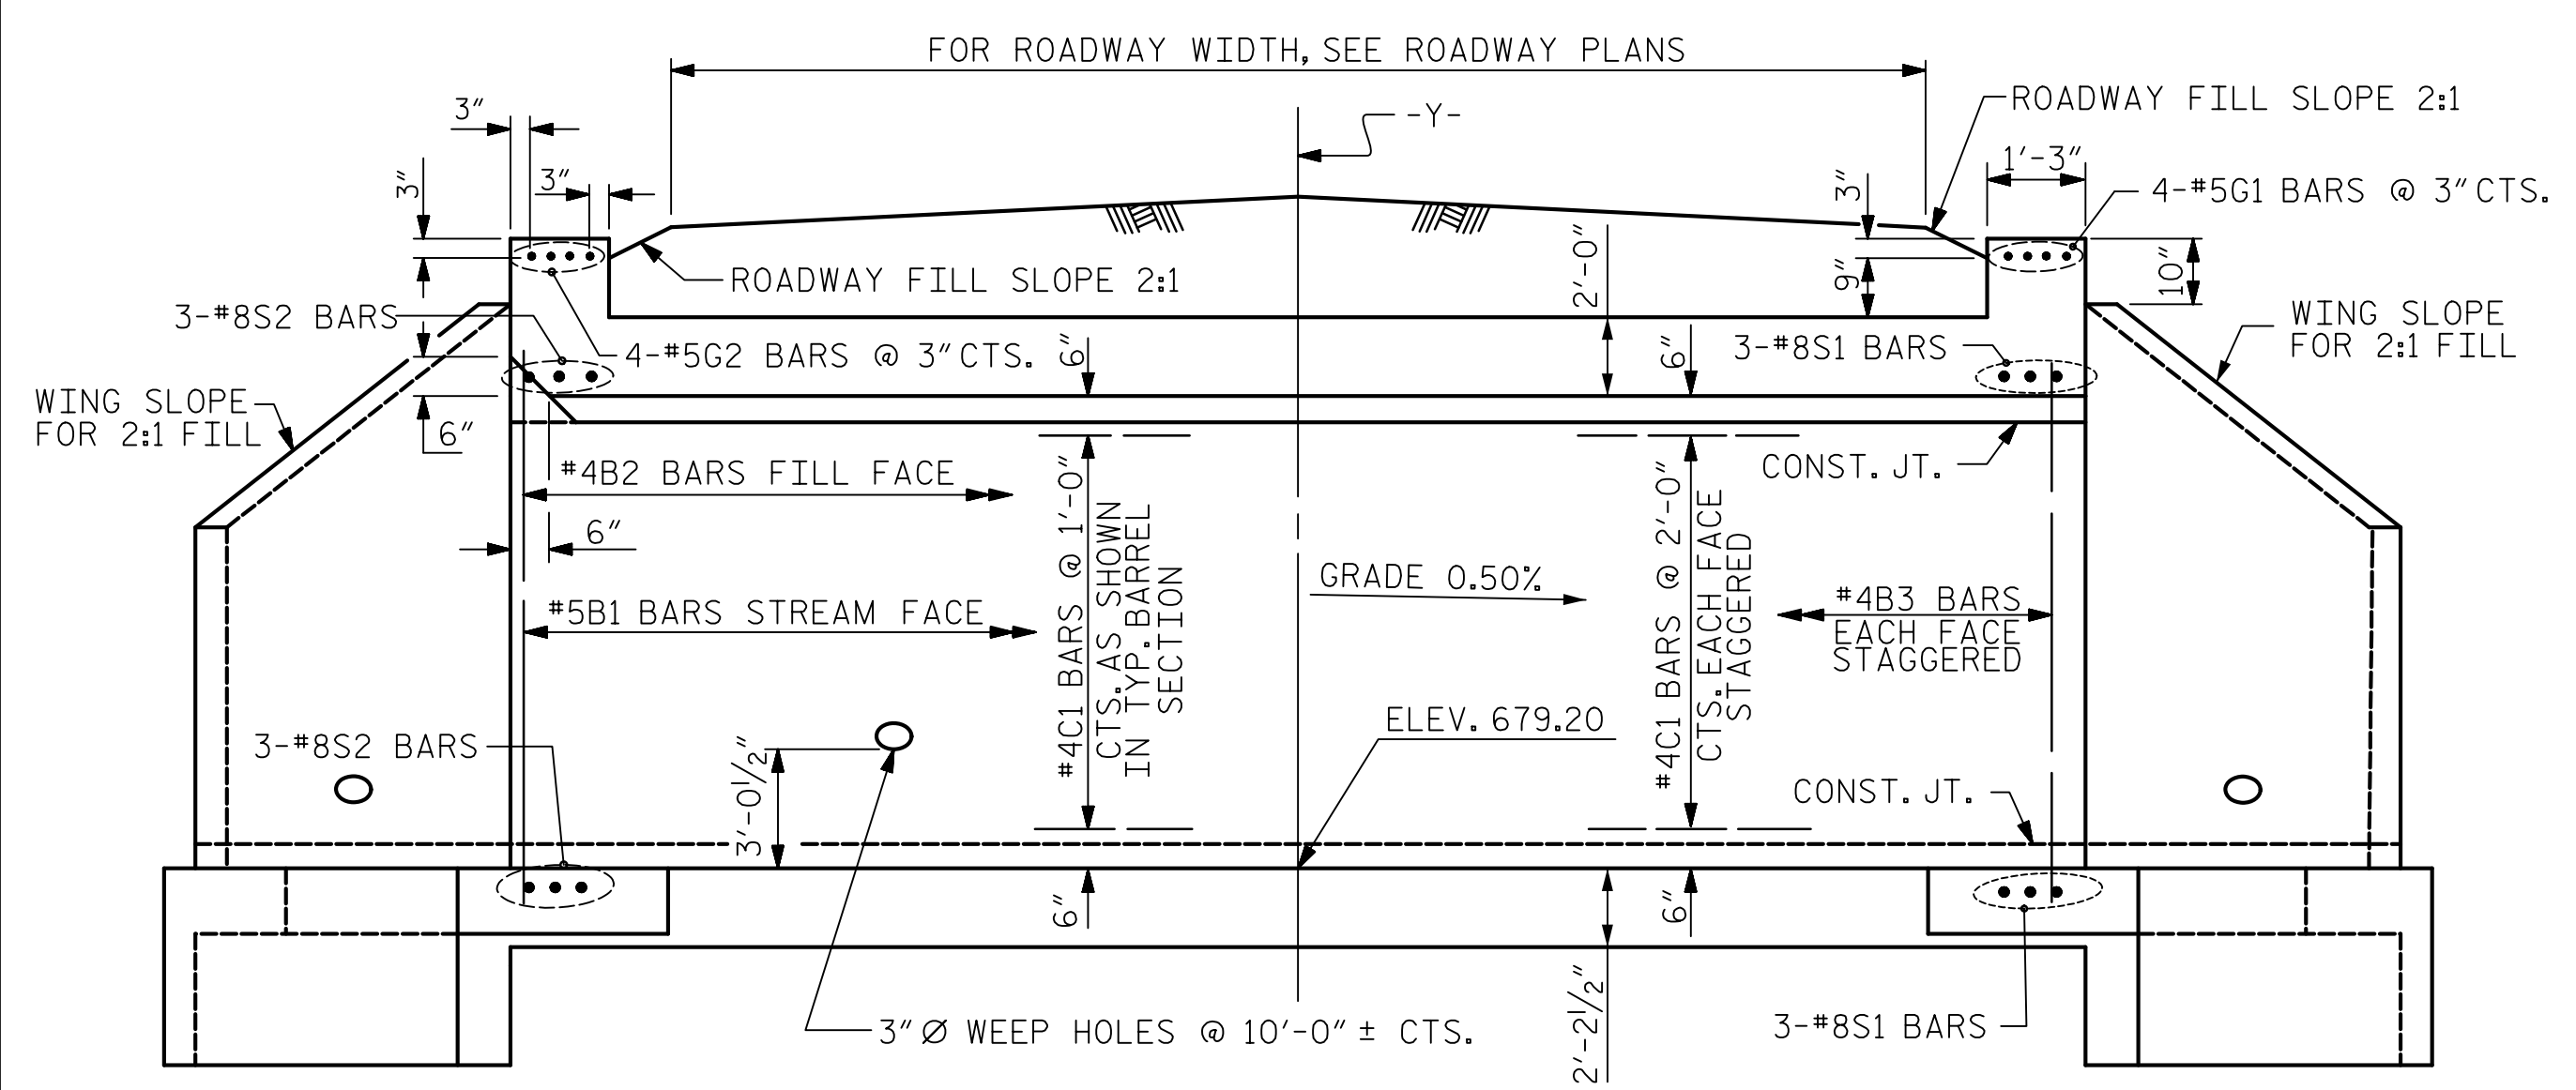


EXTERIOR WALL INTERIOR WALL
CULVERT SECTION NORMAL TO ROADWAY

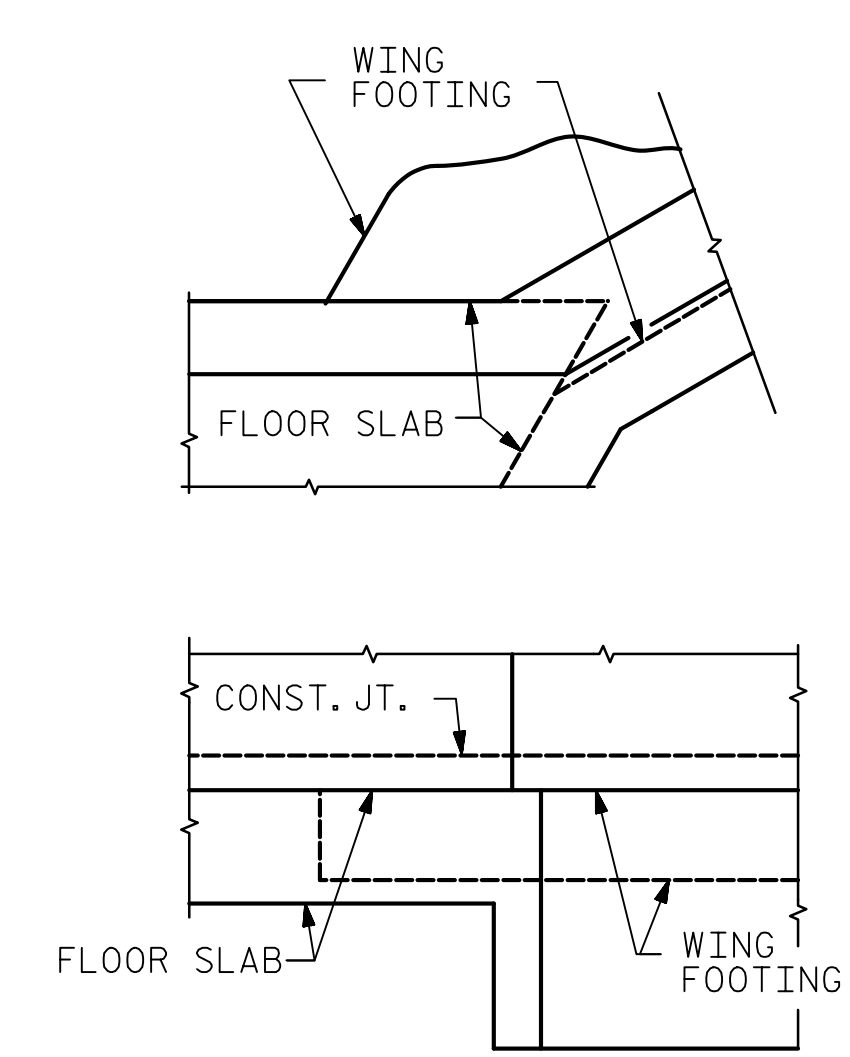

DETAIL
CONNECTION OF WING FOOTING AND FLOOR SLAB WHEN SLAB IS THICKER THAN FOOTING

I HEREBY CERTIFY THESE PLANS ARE THE AS-BUILT PLANS

Mead & Hunt
111 E. Hargett Street
Suite 300
Raleigh, NC 27601
919-714-8670
meadhunt.com
NC License No. F-1235

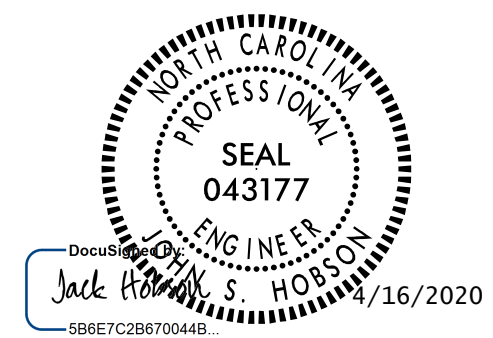


PROJECT NO. R-4707
GUILFORD COUNTY
STATION: 46+07.79 -Y-
SHEET 3 OF 9

STATE OF NORTH CAROLINA
DEPARTMENT OF TRANSPORTATION
RALEIGH
QUADRUPLE
8 FT. x 10 FT.
REINFORCED CONCRETE
BOX CULVERT

DRAWN BY : J.S. HOBSON DATE : 03/07/19
CHECKED BY : J.A. LEE DATE : 04/03/19
DESIGN ENGINEER OF RECORD : J.S. HOBSON DATE : 04/11/19

DOCUMENT NOT CONSIDERED FINAL UNLESS ALL SIGNATURES COMPLETED


REVISIONS						SHEET NO.
NO.	BY:	DATE:	NO.	BY:	DATE:	C2-03
1			3			TOTAL SHEETS
2			4			9

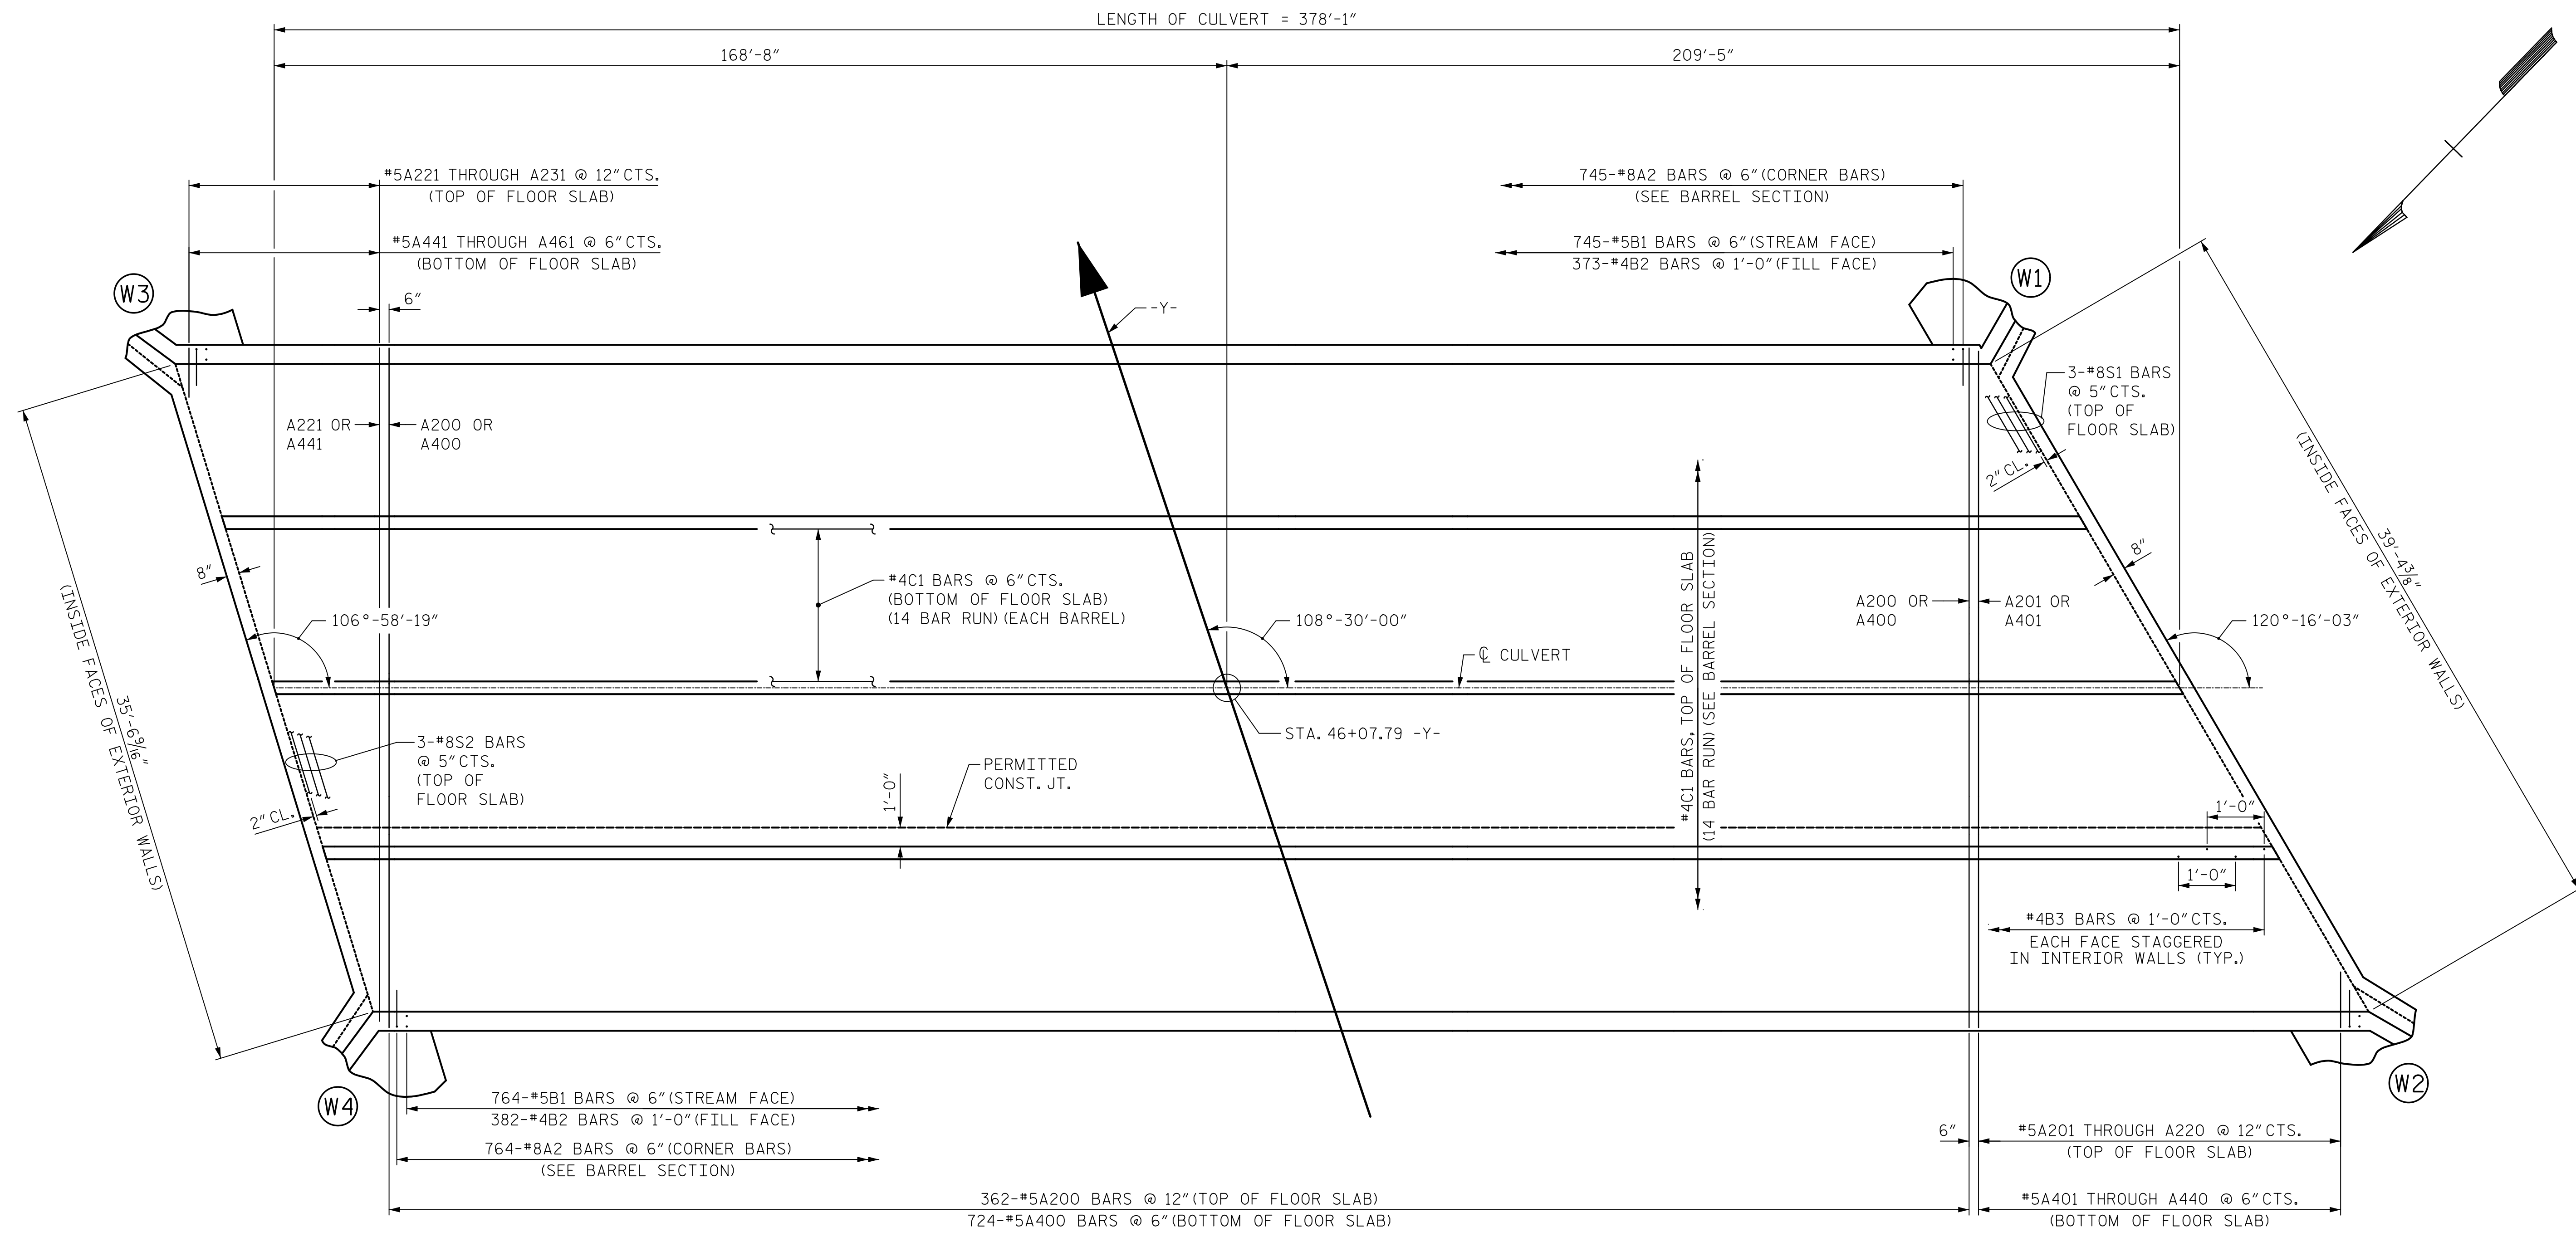

PLAN OF FLOOR SLAB



111 E. Hargett Street
Suite 300
Raleigh, NC 27601
919-714-8670
meadhunt.com
NC License No. F-1235

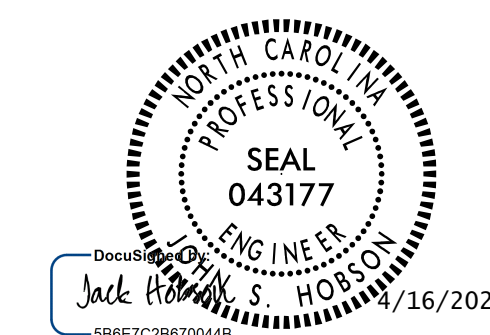

DOCUMENT NOT CONSIDERED
FINAL UNLESS ALL
SIGNATURES COMPLETED

PROJECT NO. R-4707
GUILFORD COUNTY
STATION: 46+07.79 -Y-

SHEET 4 OF 9


STATE OF NORTH CAROLINA
DEPARTMENT OF TRANSPORTATION
RALEIGH

QUADRUPLE
8 FT. x 10 FT.
REINFORCED CONCRETE
BOX CULVERT

DRAWN BY : J.S. HOBSON DATE : 03/15/19
CHECKED BY : J.A. LEE DATE : 04/04/19
DESIGN ENGINEER OF RECORD : J.S. HOBSON DATE : 04/11/19

REVISIONS						SHEET NO.
NO.	BY:	DATE:	NO.	BY:	DATE:	C2-04
1			3			TOTAL SHEETS
2			4			9


LENGTH OF CULVERT = 378'-1"

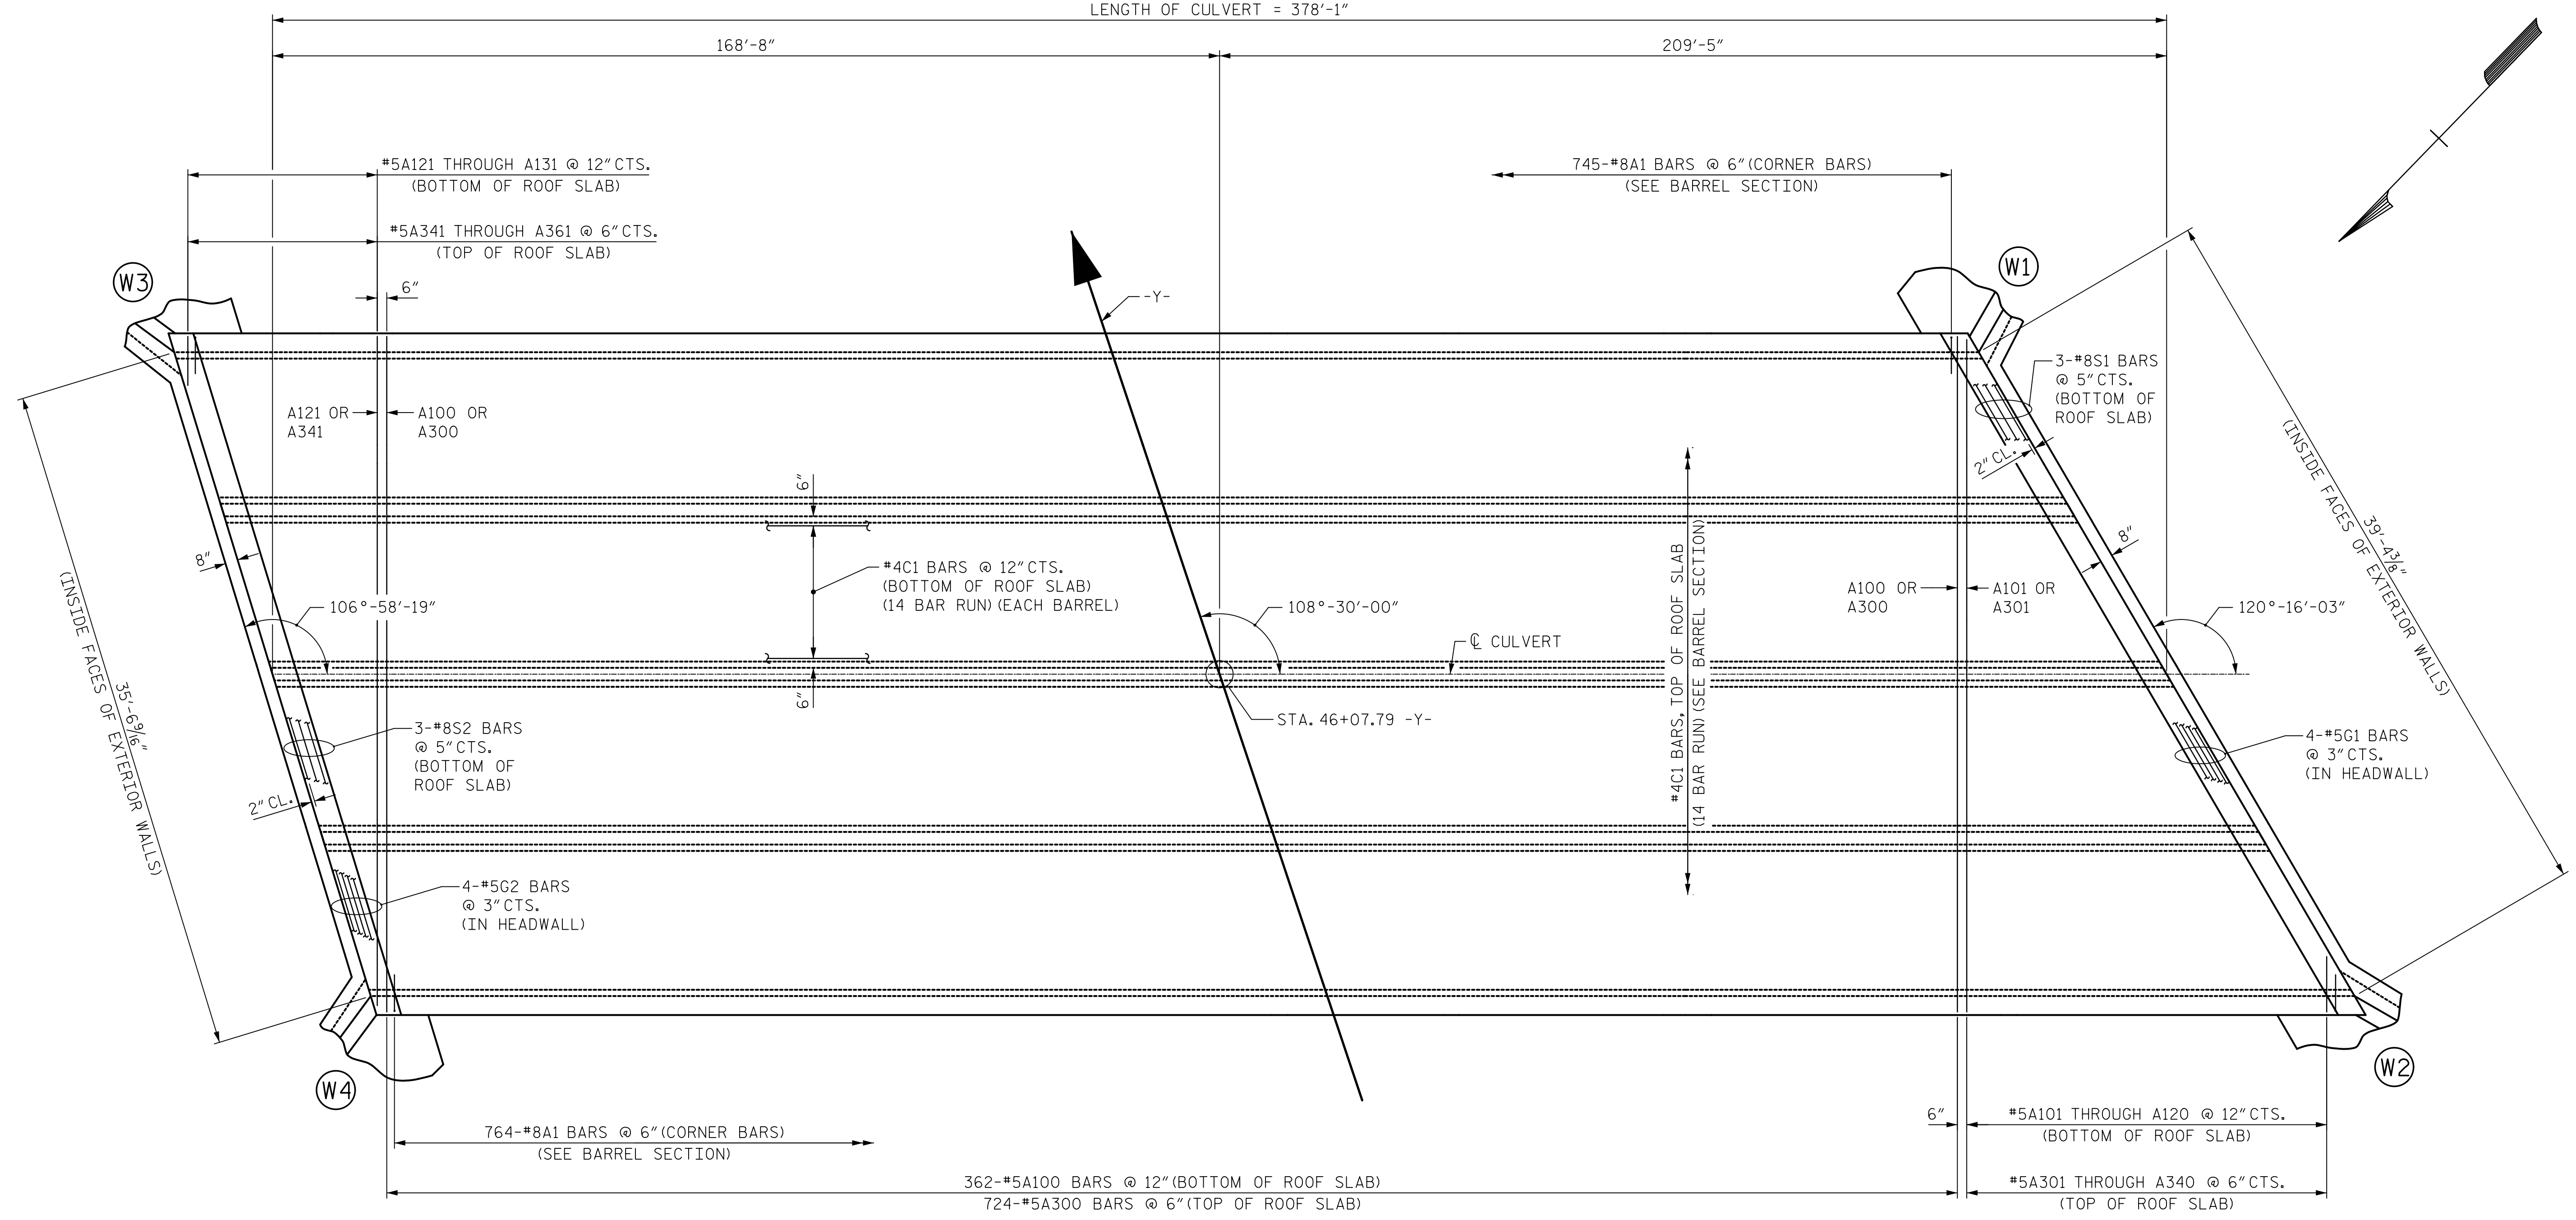

PLAN OF ROOF SLAB



111 E. Hargett Street
Suite 300
Raleigh, NC 27601
919-714-8670
meadhunt.com
NC License No. F-1235

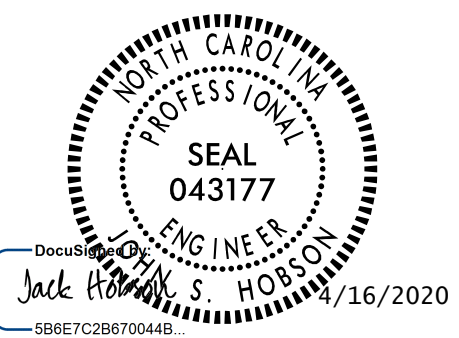

PROJECT NO. R-4707

GUILFORD COUNTY

STATION: 46+07.79 -Y-

SHEET 5 OF 9

STATE OF NORTH CAROLINA
DEPARTMENT OF TRANSPORTATION
RALEIGH

QUADRUPLE
8 FT. x 10 FT.
REINFORCED CONCRETE
BOX CULVERT


DRAWN BY : J.S. HOBSON DATE : 03/15/19
CHECKED BY : J.A. LEE DATE : 04/04/19
DESIGN ENGINEER OF RECORD : J.S. HOBSON DATE : 04/11/19

DOCUMENT NOT CONSIDERED
FINAL UNLESS ALL
SIGNATURES COMPLETED

REVISIONS						SHEET NO.
NO.	BY:	DATE:	NO.	BY:	DATE:	C2-05
1			3			TOTAL SHEETS
2			4			9

BILL OF MATERIAL

BAR	NO.	SIZE	TYPE	LENGTH	WEIGHT	BAR	NO.	SIZE	TYPE	LENGTH	WEIGHT	BAR	NO.	SIZE	TYPE	LENGTH	WEIGHT	BAR	NO.	SIZE	TYPE	LENGTH	WEIGHT
A100	362	#5	STR	35'-8"	13467	A300	724	#5	STR	35'-8"	26933	A400	724	#5	STR	35'-8"	26933	A1	1509	#8	1	12'-8"	51034
A101	1	#5	STR	35'-6"	37	A301	1	#5	STR	35'-6"	37	A401	1	#5	STR	35'-6"	37	A2	1509	#8	1	12'-8"	51034
A102	1	#5	STR	33'-10"	35	A302	1	#5	STR	34'-8"	36	A402	1	#5	STR	34'-8"	36	B1	1509	#5	STR	13'-9"	21641
A103	1	#5	STR	32'-1"	33	A303	1	#5	STR	33'-10"	35	A403	1	#5	STR	33'-10"	35	B2	755	#4	STR	9'-3"	4665
A104	1	#5	STR	30'-4"	32	A304	1	#5	STR	33'-0"	34	A404	1	#5	STR	33'-0"	34	B3	2269	#4	STR	13'-9"	20841
A105	1	#5	STR	28'-7"	30	A305	1	#5	STR	32'-1"	33	A405	1	#5	STR	32'-1"	33						
A106	1	#5	STR	26'-10"	28	A306	1	#5	STR	31'-2"	33	A406	1	#5	STR	31'-2"	33						
A107	1	#5	STR	25'-1"	26	A307	1	#5	STR	30'-4"	32	A407	1	#5	STR	30'-4"	32	C1	1780	#4	STR	40'-0"	47562
A108	1	#5	STR	23'-4"	24	A308	1	#5	STR	29'-6"	31	A408	1	#5	STR	29'-6"	31						
A109	1	#5	STR	21'-10"	23	A309	1	#5	STR	28'-7"	30	A409	1	#5	STR	28'-7"	30	G1	4	#5	STR	41'-3"	172
A110	1	#5	STR	20'-1"	21	A310	1	#5	STR	27'-10"	29	A410	1	#5	STR	27'-10"	29	G2	4	#5	STR	37'-3"	155
A111	1	#5	STR	18'-4"	19	A311	1	#5	STR	26'-10"	28	A411	1	#5	STR	26'-10"	28						
A112	1	#5	STR	16'-7"	17	A312	1	#5	STR	26'-2"	27	A412	1	#5	STR	26'-2"	27	K1	8299	#4	2	6'-5"	35572
A113	1	#5	STR	14'-10"	15	A313	1	#5	STR	25'-1"	26	A413	1	#5	STR	25'-1"	26	K2	4151	#4	2	5'-8"	15714
A114	1	#5	STR	13'-1"	14	A314	1	#5	STR	24'-3"	25	A414	1	#5	STR	24'-3"	25						
A115	1	#5	STR	11'-4"	12	A315	1	#5	STR	23'-4"	24	A415	1	#5	STR	23'-4"	24	S1	6	#8	STR	41'-3"	661
A116	1	#5	STR	9'-10"	10	A316	1	#5	STR	22'-7"	24	A416	1	#5	STR	22'-7"	24	S2	6	#8	STR	37'-3"	597
A117	1	#5	STR	8'-1"	8	A317	1	#5	STR	21'-10"	23	A417	1	#5	STR	21'-10"	23						
A118	1	#5	STR	6'-4"	7	A318	1	#5	STR	20'-11"	22	A418	1	#5	STR	20'-11"	22						
A119	1	#5	STR	4'-8"	5	A319	1	#5	STR	20'-1"	21	A419	1	#5	STR	20'-1"	21						
A120	1	#5	STR	2'-11"	3	A320	1	#5	STR	19'-3"	20	A420	1	#5	STR	19'-3"	20						
A121	1	#5	STR	35'-4"	37	A321	1	#5	STR	18'-4"	19	A421	1	#5	STR	18'-4"	19						
A122	1	#5	STR	32'-1"	33	A322	1	#5	STR	17'-7"	18	A422	1	#5	STR	17'-7"	18						
A123	1	#5	STR	28'-10"	30	A323	1	#5	STR	16'-7"	17	A423	1	#5	STR	16'-7"	17						
A124	1	#5	STR	25'-5"	27	A324	1	#5	STR	15'-8"	16	A424	1	#5	STR	15'-8"	16						
A125	1	#5	STR	22'-2"	23	A325	1	#5	STR	14'-10"	15	A425	1	#5	STR	14'-10"	15						
A126	1	#5	STR	18'-11"	20	A326	1	#5	STR	14'-0"	15	A426	1	#5	STR	14'-0"	15						
A127	1	#5	STR	15'-8"	16	A327	1	#5	STR	13'-1"	14	A427	1	#5	STR	13'-1"	14						
A128	1	#5	STR	12'-5"	13	A328	1	#5	STR	12'-4"	13	A428	1	#5	STR	12'-4"	13						
A129	1	#5	STR	9'-2"	10	A329	1	#5	STR	11'-4"	12	A429	1	#5	STR	11'-4"	12						
A130	1	#5	STR	5'-10"	6	A330	1	#5	STR	10'-8"	11	A430	1	#5	STR	10'-8"	11						
A131	1	#5	STR	2'-7"	3	A331	1	#5	STR	9'-10"	10	A431	1	#5	STR	9'-10"	10						
						A332	1	#5	STR	9'-0"	9	A432	1	#5	STR	9'-0"	9						
A200	362	#5	STR	35'-8"	13467	A333	1	#5	STR	8'-1"	8	A433	1	#5	STR	8'-1"	8						
A201	1	#5	STR	35'-6"	37	A334	1	#5	STR	7'-1"	7	A434	1	#5	STR	7'-1"	7						
A202	1	#5	STR	33'-10"	35	A335	1	#5	STR	6'-4"	7	A435	1	#5	STR	6'-4"	7						
A203	1	#5	STR	32'-1"	33	A336	1	#5	STR	5'-5"	6	A436	1	#5	STR	5'-5"	6						
A204	1	#5	STR	30'-4"	32	A337	1	#5	STR	4'-8"	5	A437	1	#5	STR	4'-8"	5						
A205	1	#5	STR	28'-7"	30	A338	1	#5	STR	3'-9"	4	A438	1	#5	STR	3'-9"	4						
A206	1	#5	STR	26'-10"	28	A339	1	#5	STR	2'-11"	3	A439	1	#5	STR	2'-11"	3						
A207	1	#5	STR	25'-1"	26	A340	1	#5	STR	2'-1"	2	A440	1	#5	STR	2'-1"	2						
A208	1	#5	STR	23'-4"	24	A341	1	#5	STR	35'-4"	37	A441	1	#5	STR	35'-4"	37						
A209	1	#5	STR	21'-10"	23	A342	1	#5	STR	33'-9"	35	A442	1	#5	STR	33'-9"	35						
A210	1	#5	STR	20'-1"	21	A343	1	#5	STR	32'-1"	33	A443	1	#5	STR	32'-1"	33						
A211	1	#5	STR	18'-4"	19	A344	1	#5	STR	30'-5"	32	A444	1	#5	STR	30'-5"	32						
A212	1	#5	STR	16'-7"	17	A345	1	#5	STR	28'-10"	30	A445	1	#5	STR	28'-10"	30						
A213	1	#5	STR	14'-10"	15	A346	1	#5	STR	27'-1"	28	A446	1	#5	STR	27'-1"	28						
A214	1	#5	STR	13'-1"	14	A347	1	#5	STR	25'-5"	27	A447	1	#5	STR	25'-5"	27						
A215	1	#5	STR	11'-4"	12	A348	1	#5	STR	23'-9"	25	A448	1	#5	STR	23'-9"	25						
A216	1	#5	STR	9'-10"	10	A349	1	#5	STR	22'-2"	23	A449	1	#5	STR	22'-2"	23						
A217	1	#5	STR	8'-1"	8	A350	1	#5	STR	20'-5"	21	A450	1	#5	STR	20'-5"	21						
A218	1	#5	STR	6'-4"	7	A351	1	#5	STR	18'-11"	20	A451	1	#5	STR	18'-11"	20						
A219	1	#5	STR	4'-8"	5	A352	1	#5	STR	17'-1"	18	A452	1	#5	STR	17'-1"	18						
A220	1	#5	STR	2'-11"	3	A353	1	#5	STR	15'-8"	16	A453	1	#5	STR	15'-8"	16						
A221	1	#5	STR	35'-4"	37	A354	1	#5	STR	13'-9"	14	A454	1	#5	STR	13'-9"	14						
A222	1	#5	STR	32'-1"	33	A355	1	#5	STR	12'-5"	13	A455	1	#5	STR	12'-5"	13						
A223	1	#5	STR	28'-10"	30	A356	1	#5	STR	10'-7"	11	A456	1	#5	STR	10'-7"	11						
A224	1	#5	STR	25'-5"	27	A357	1	#5	STR	9'-2"	10	A457	1	#5	STR	9'-2"	10						
A225	1	#5	STR	22'-2"	23	A358	1	#5	STR	7'-3"	8	A458	1	#5	STR	7'-3"	8						
A226	1	#5	STR	18'-11"	20	A359	1	#5	STR	5'-10"	6	A459	1	#5	STR	5'-10"	6						
A227	1	#5	STR	15'-8"	16	A360	1	#5	STR	3'-11"	4	A460	1	#5	STR	3'-11"	4						
A228	1	#5	STR	12'-5"	13	A361	1	#5	STR	2'-7"	3	A461	1	#5	STR	2'-7"	3						
A229	1	#5	STR	9'-2"	10																		
A230	1	#5	STR	5'-10"	6																		
A231	1	#5	STR	2'-7"	3																		

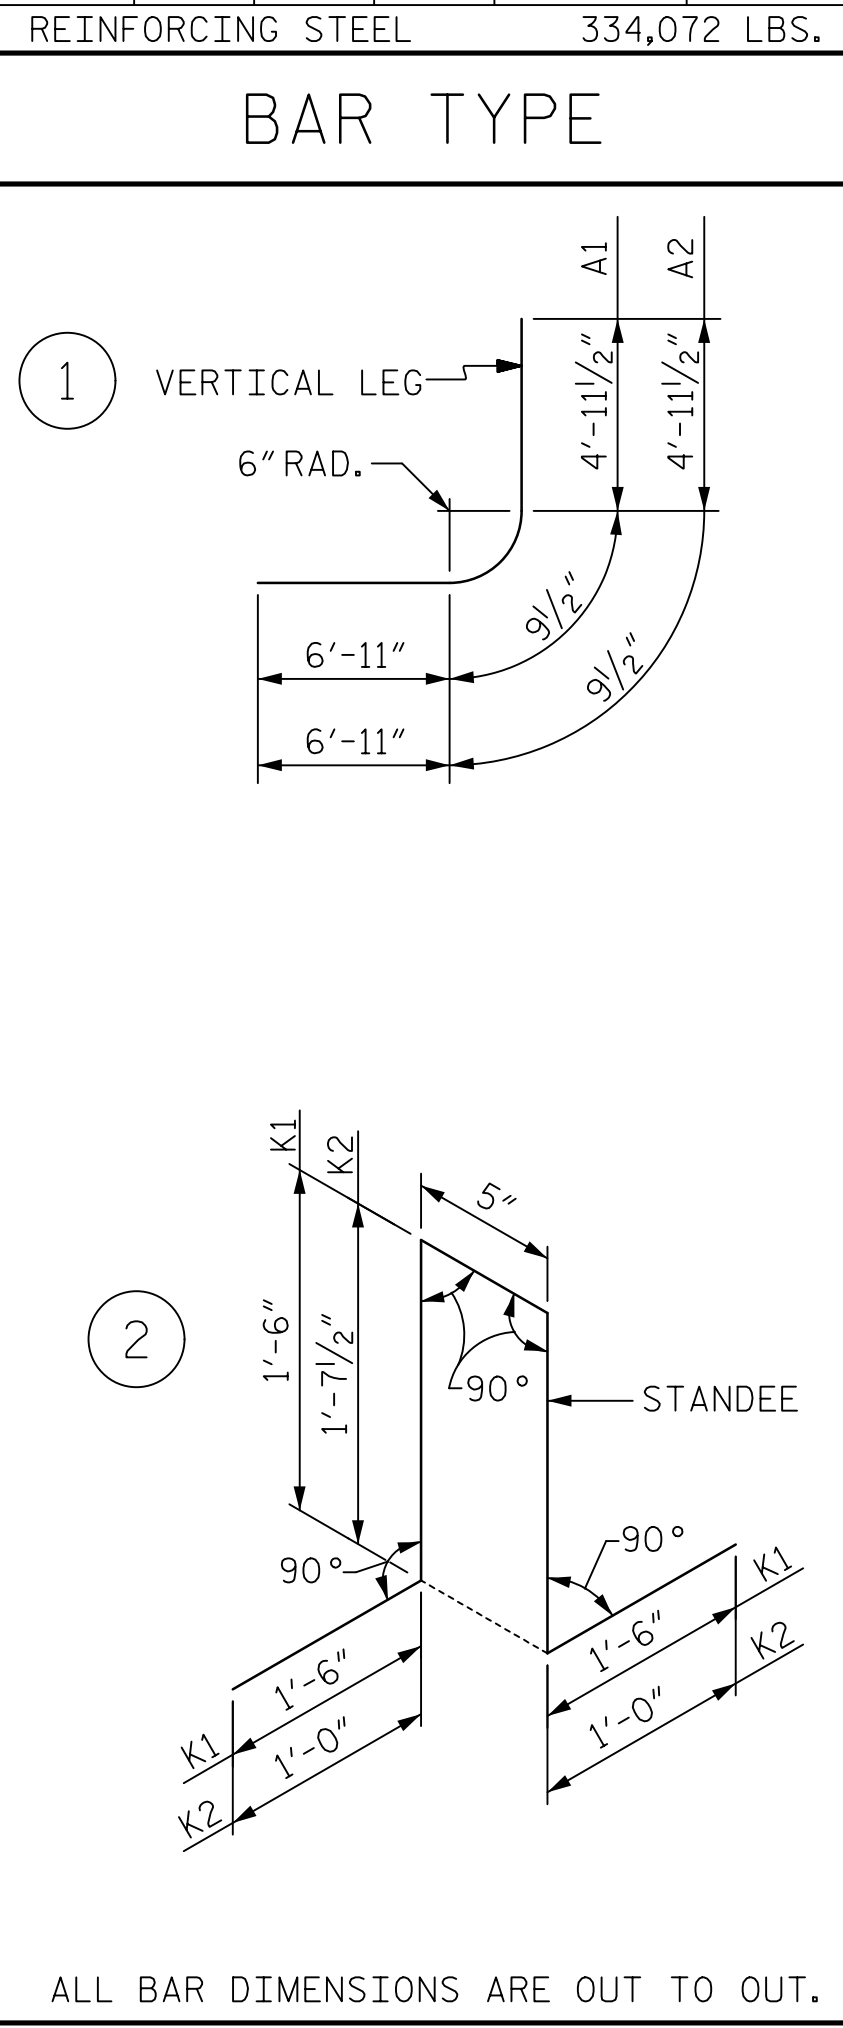

SPLICE LENGTH CHART

BAR	SIZE	SPLICE
B1	#5	2'-4"
B3	#4	1'-10"
C1	#4	2'-5"

DRAWN BY : J.S. HOBSON DATE : 03/15/19
 CHECKED BY : J.A. LEE DATE : 04/08/19
 DESIGN ENGINEER OF RECORD : J.S. HOBSON DATE : 04/11/19

Mead & Hunt
 111 E. Hargett Street
 Suite 300
 Raleigh, NC 27601
 919-714-8670
 meadhunt.com
 NC License No. F-1235

Seal: Jack Hobson, S. HOBSON, ENGINEER, SEAL 043177, 4/16/2020

DOCUMENT NOT CONSIDERED FINAL UNLESS ALL SIGNATURES COMPLETED


PROJECT NO. R-4707
 GUILFORD COUNTY
 STATION: 46+07.79 -Y-

SHEET 6 OF 9


STATE OF NORTH CAROLINA
 DEPARTMENT OF TRANSPORTATION
 RALEIGH

QUADRUPLE
 8 FT. x 10 FT.
 REINFORCED CONCRETE
 BOX CULVERT


REVISIONS						SHEET NO.
NO.	BY:	DATE:	NO.	BY:	DATE:	C2-06
1			3			TOTAL SHEETS
2			4			9

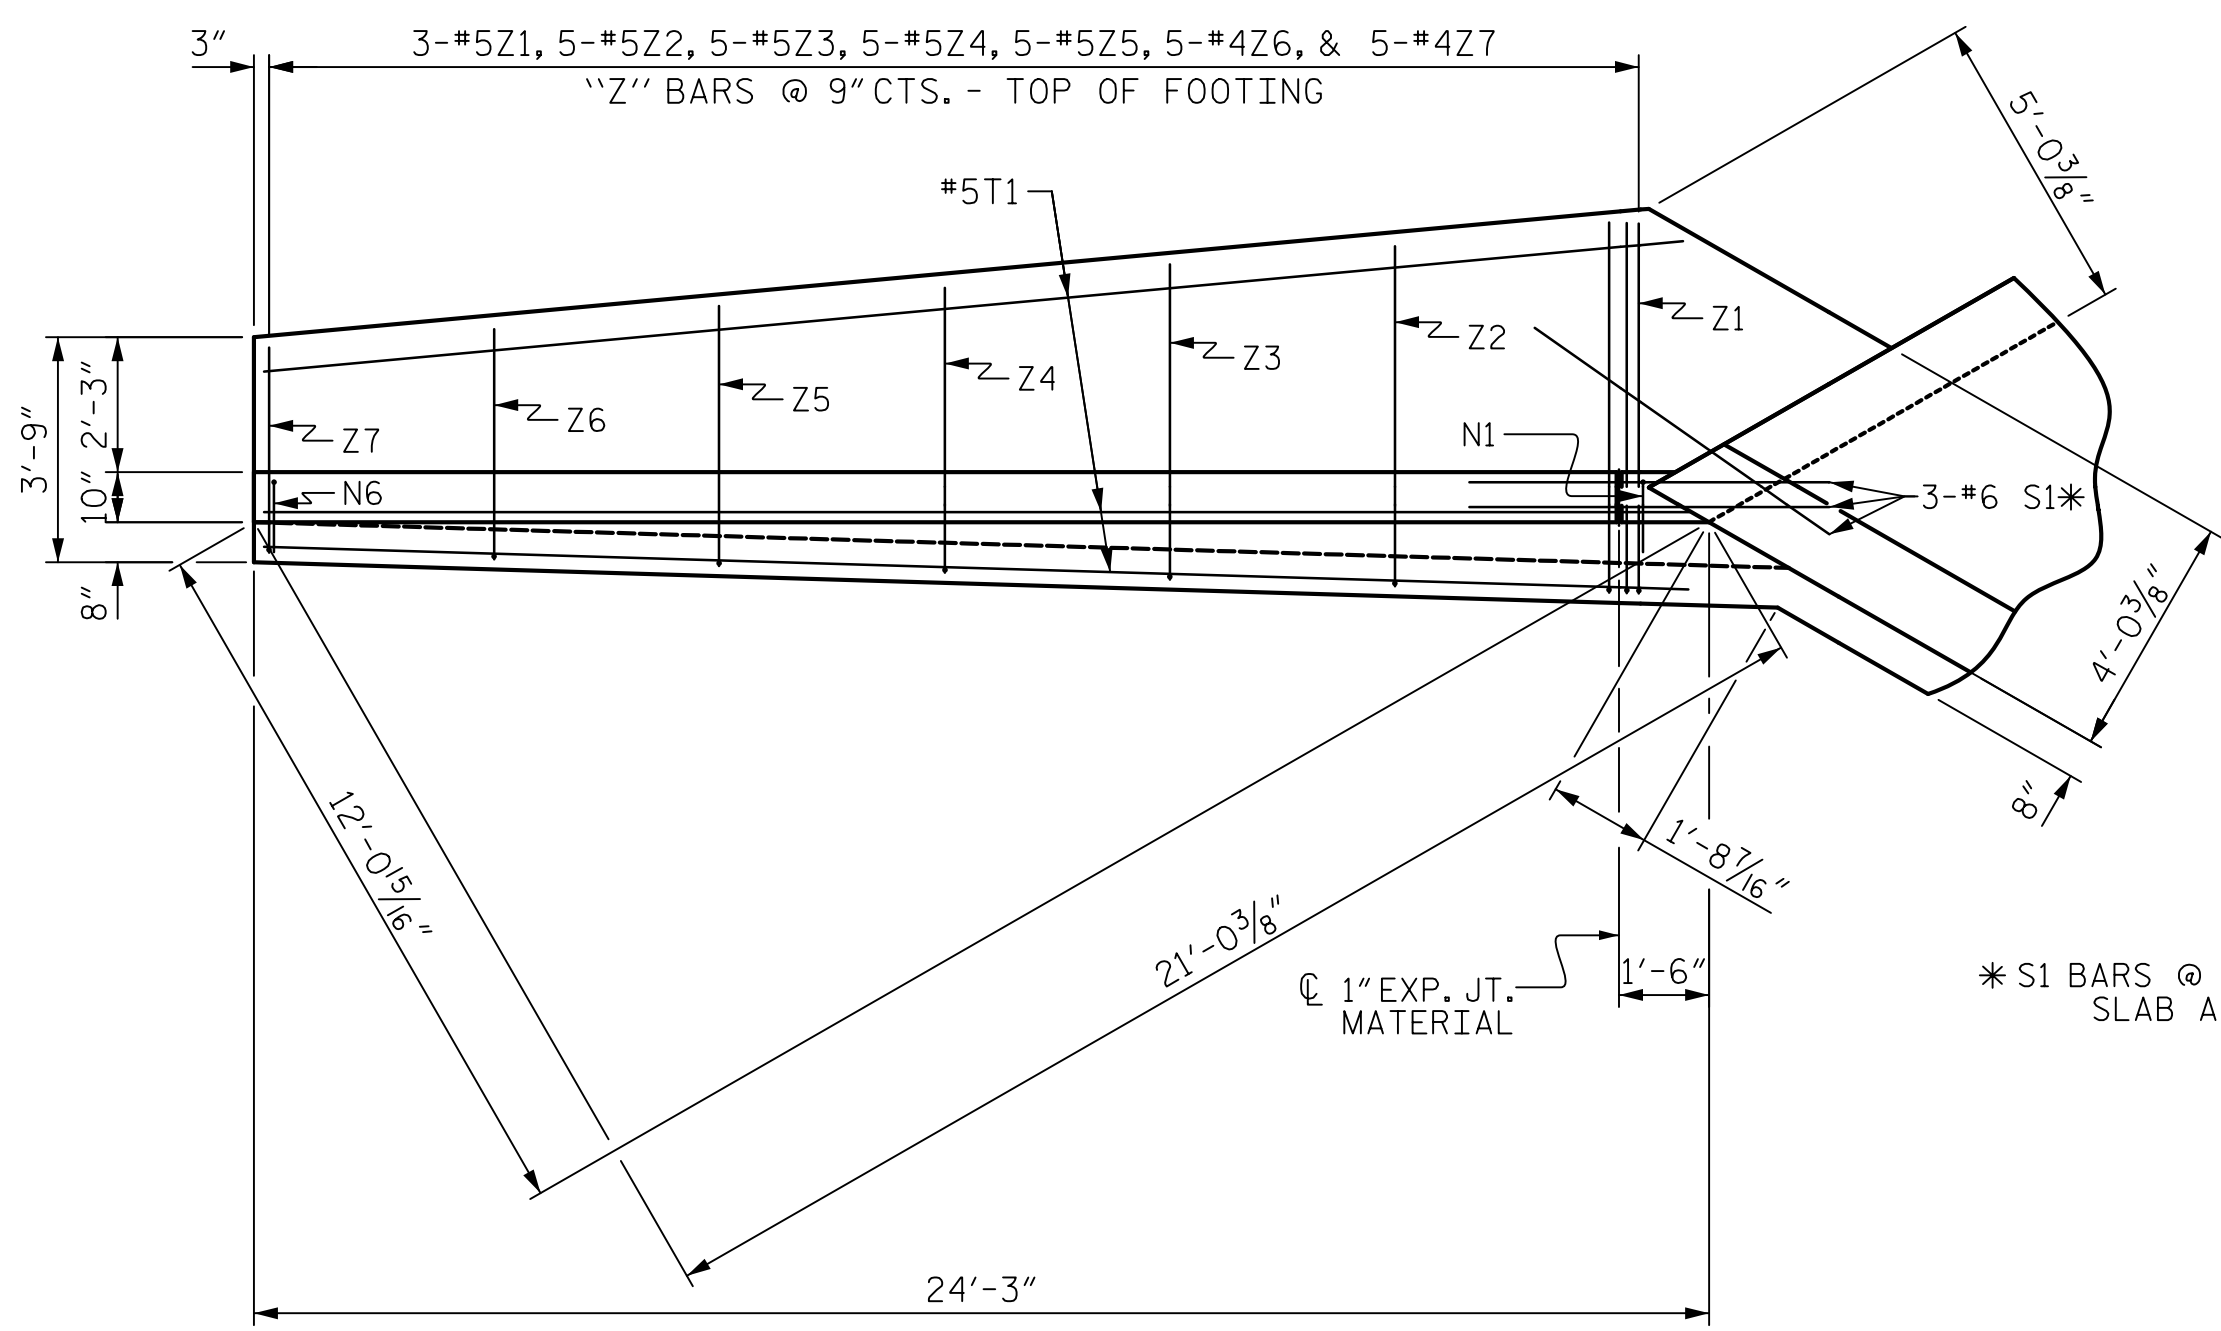


PLAN W2

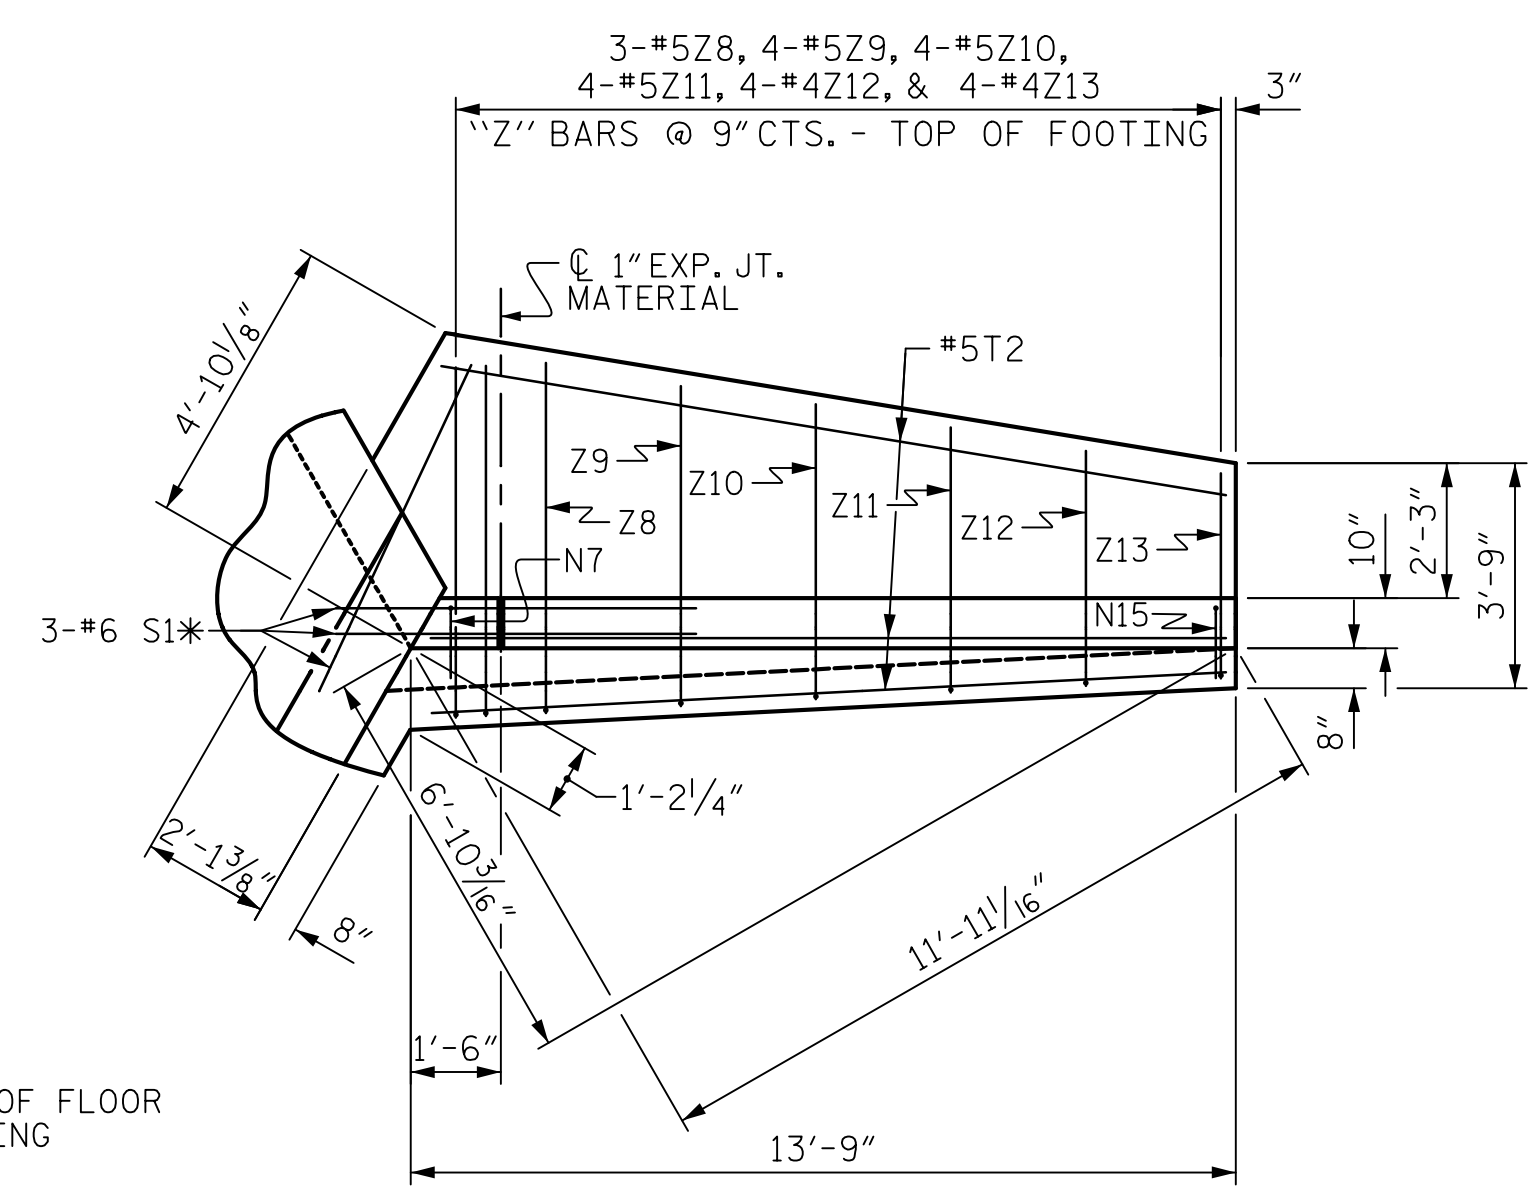


PLAN W1

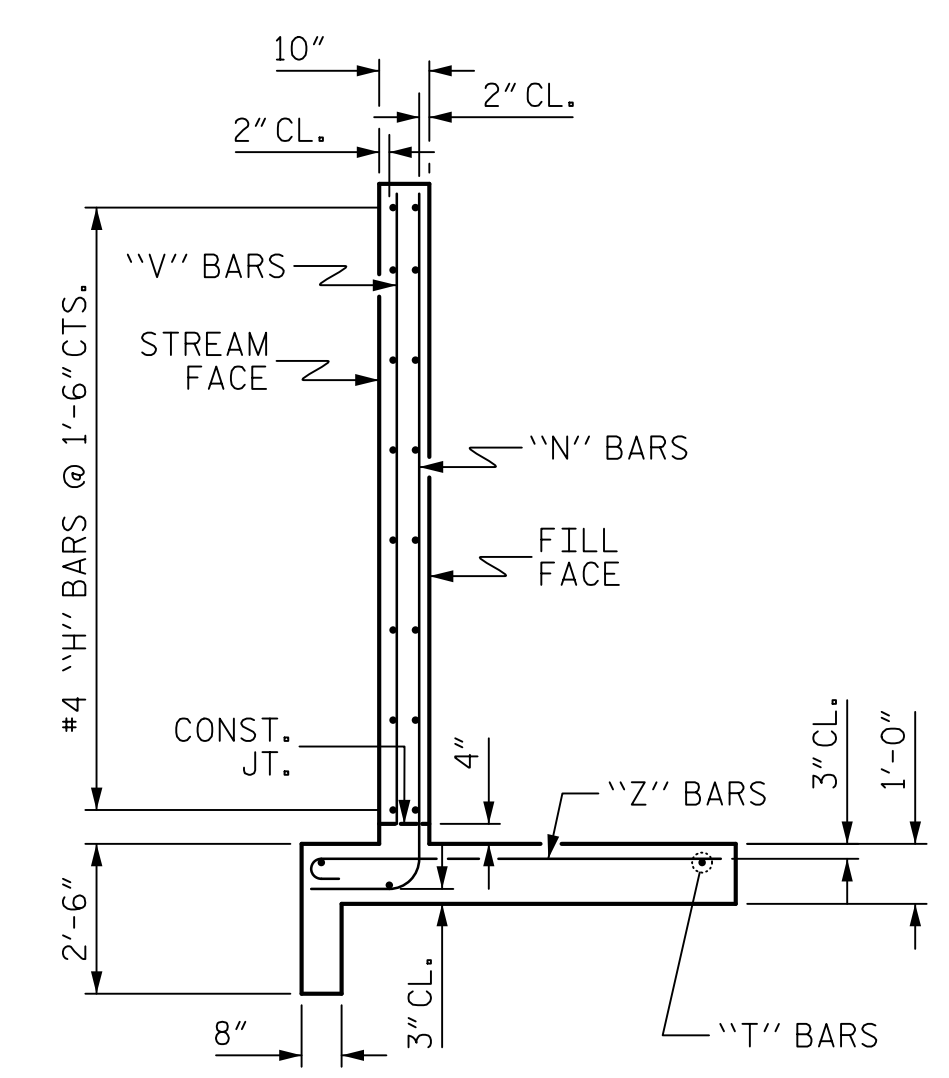

TYPICAL WING SECTION

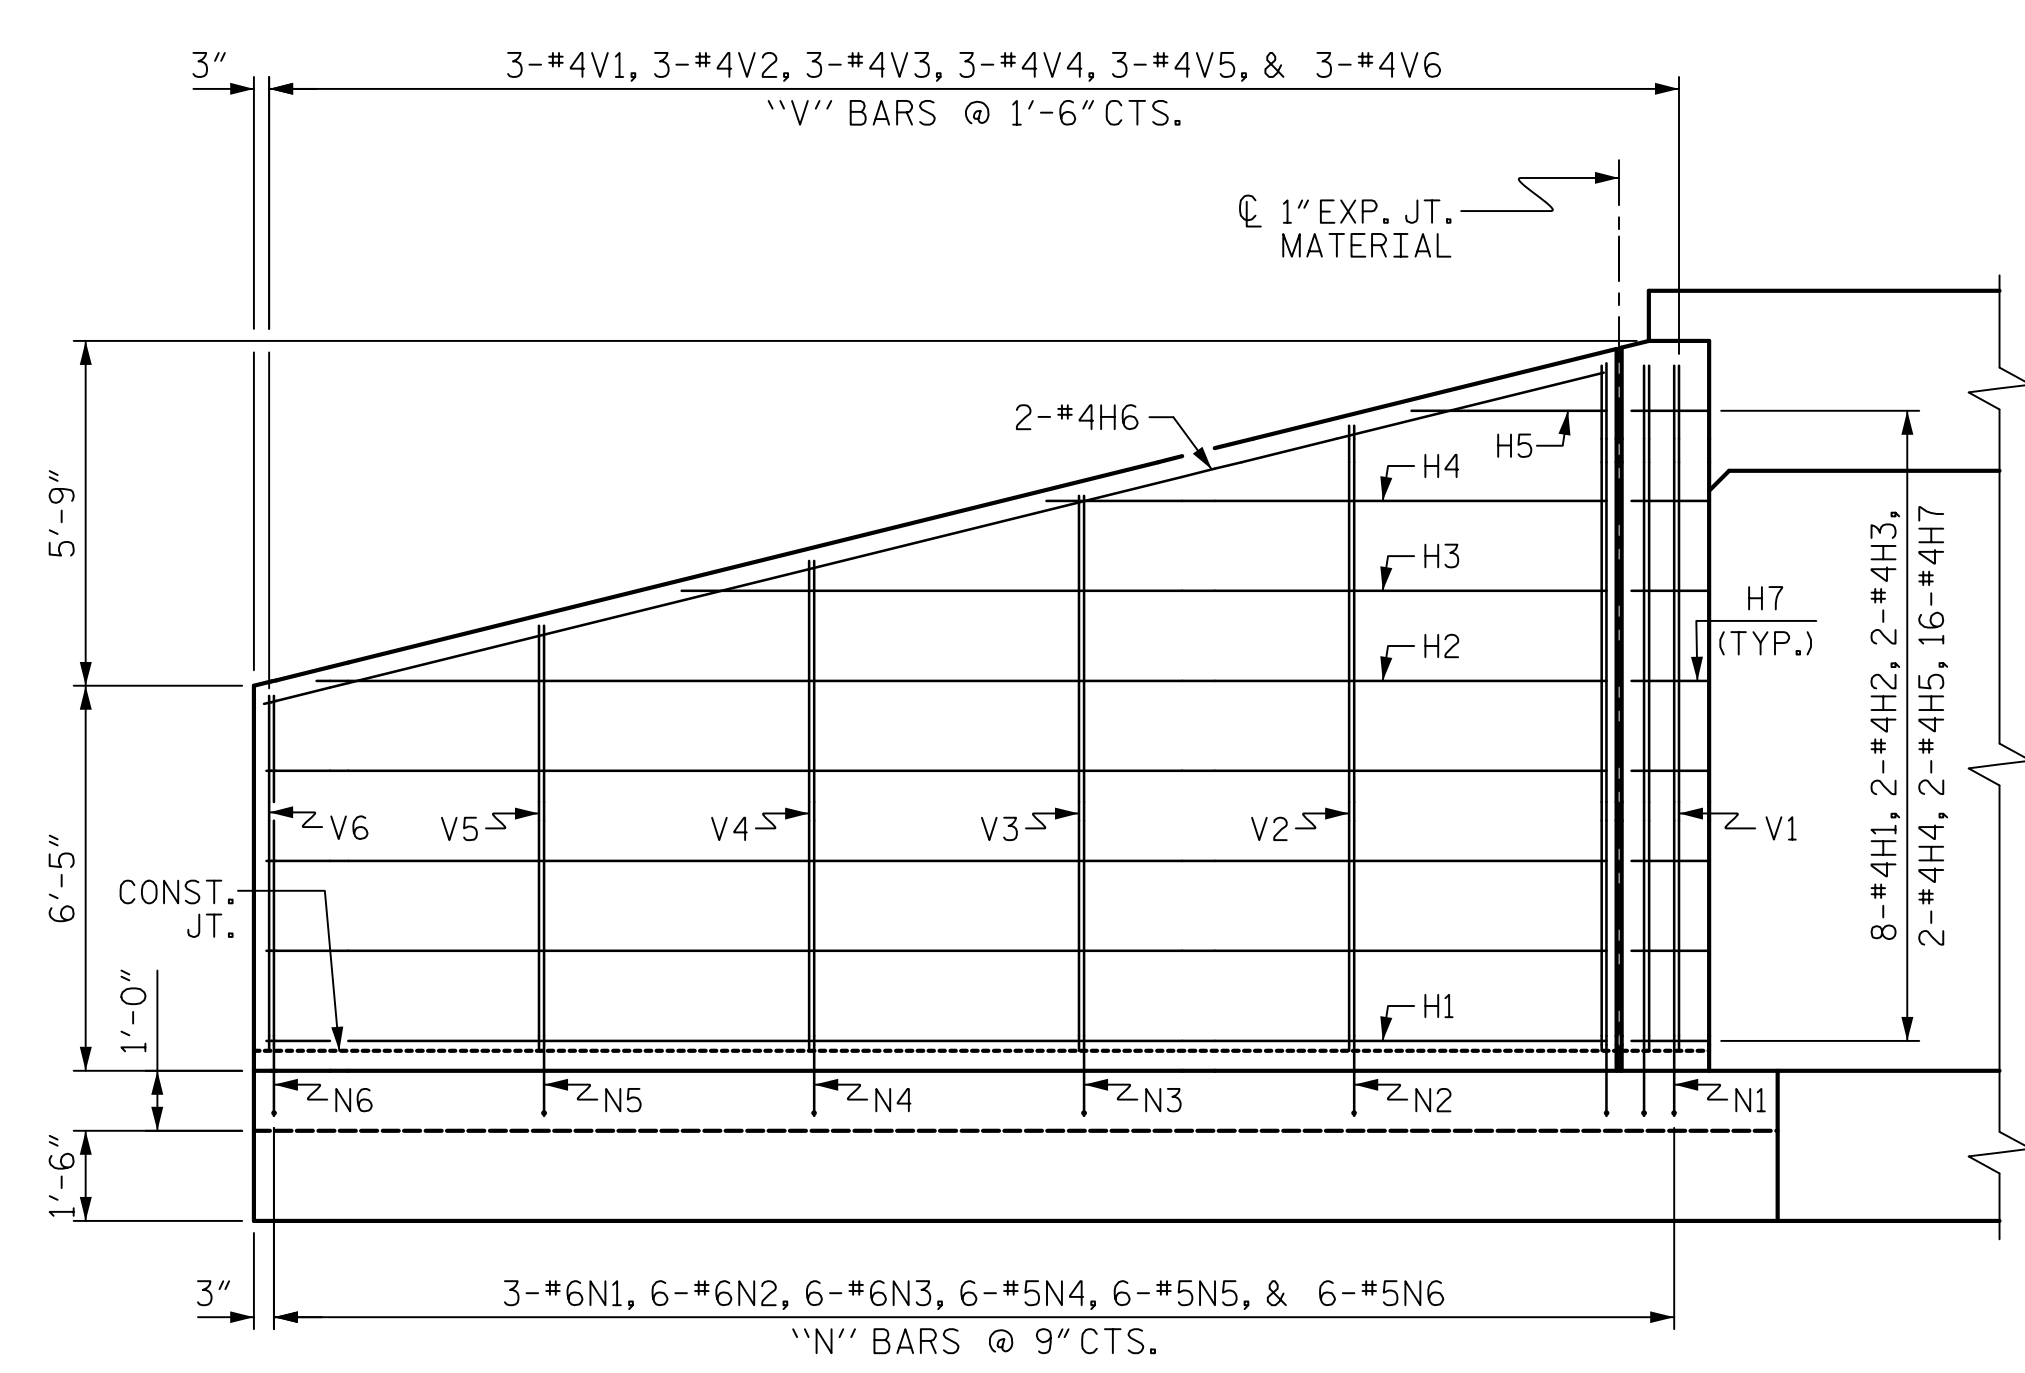


ELEVATION W2

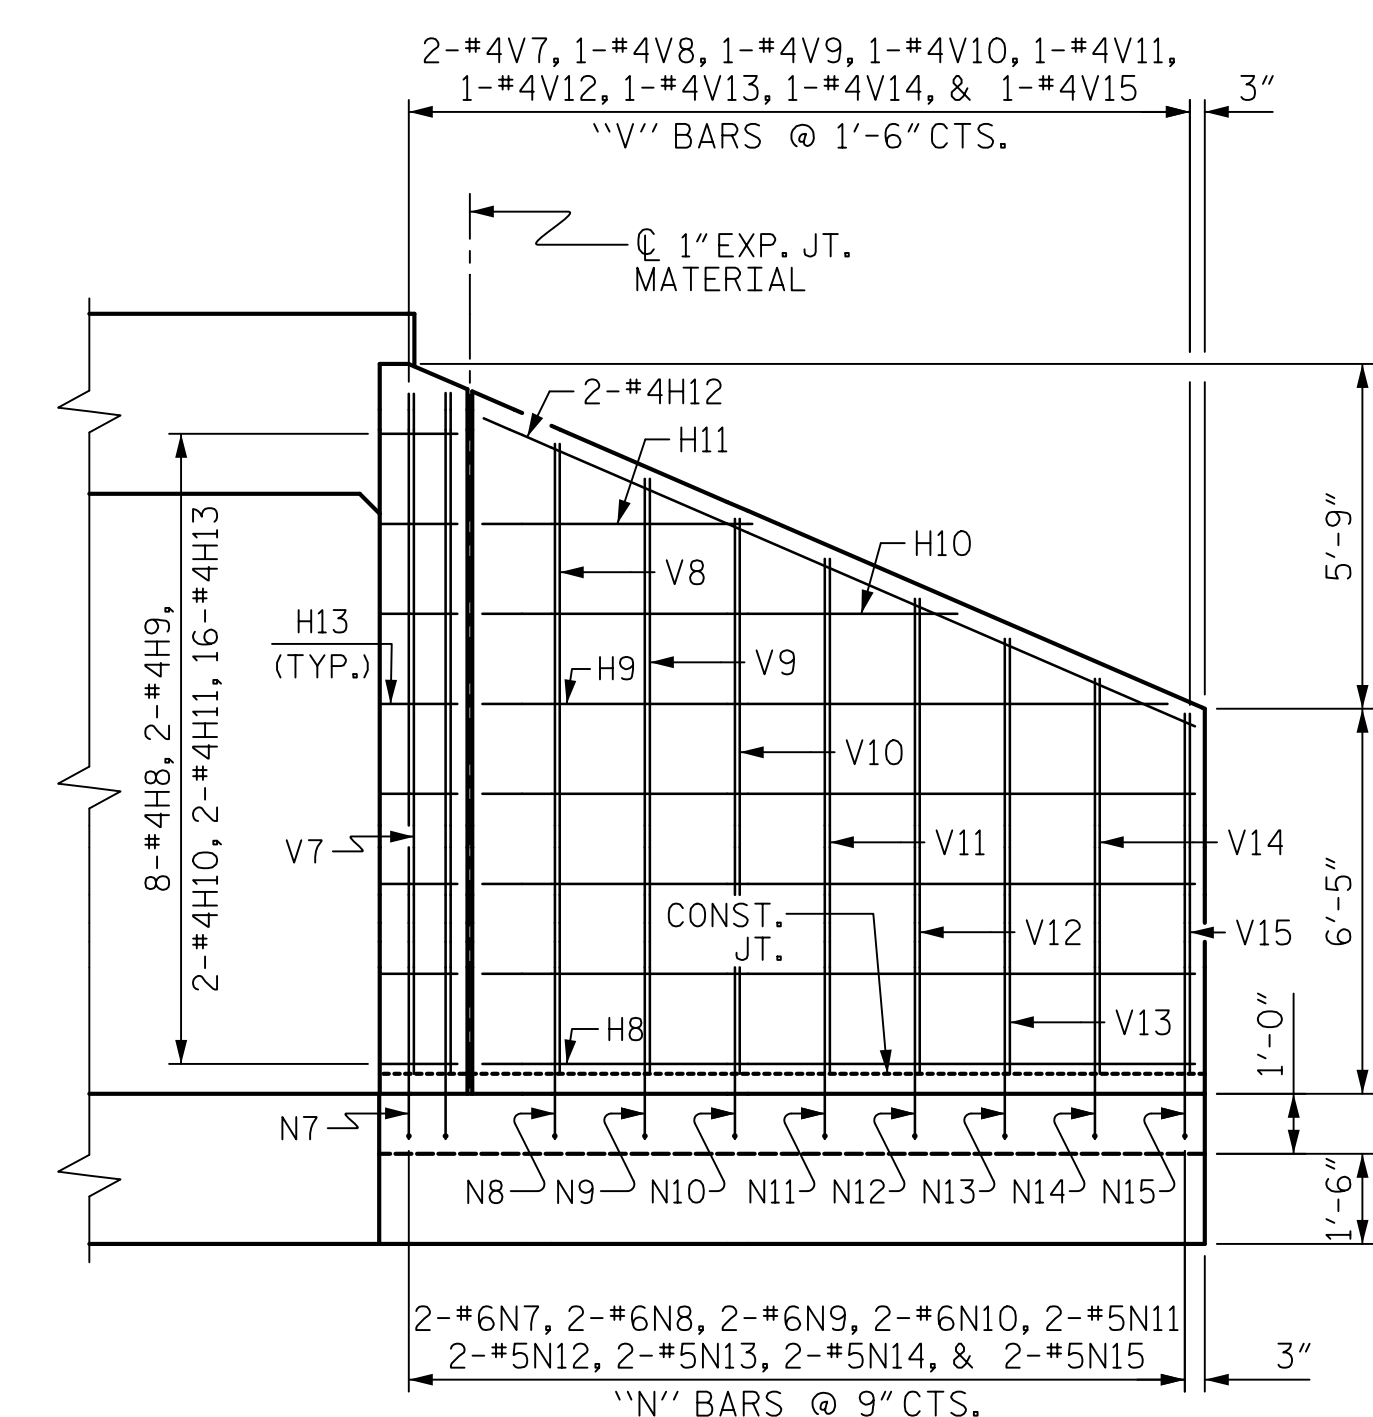

ELEVATION W1

Mead & Hunt
 111 E. Hargett Street
 Suite 300
 Raleigh, NC 27601
 919-714-8670
 meadhunt.com
 NC License No. F-1235

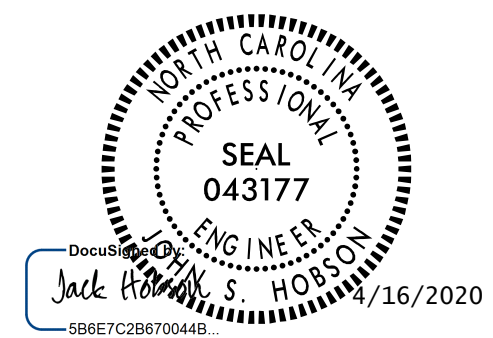


PROJECT NO. R-4707
GUILFORD COUNTY
 STATION: 46+07.79 -Y-
 SHEET 7 OF 9

STATE OF NORTH CAROLINA
 DEPARTMENT OF TRANSPORTATION
 RALEIGH
**RIGHT SIDE WINGS
 FOR
 CONCRETE BOX CULVERT**
 H = 10'-0" SLOPE = 2:1


DRAWN BY : J.S. HOBSON DATE : 03/11/19
 CHECKED BY : J.A. LEE DATE : 04/08/19
 DESIGN ENGINEER OF RECORD : J.S. HOBSON DATE : 04/11/19

DOCUMENT NOT CONSIDERED
 FINAL UNLESS ALL
 SIGNATURES COMPLETED

REVISIONS						SHEET NO.
NO.	BY:	DATE:	NO.	BY:	DATE:	C2-07
1			3			TOTAL SHEETS
2			4			9

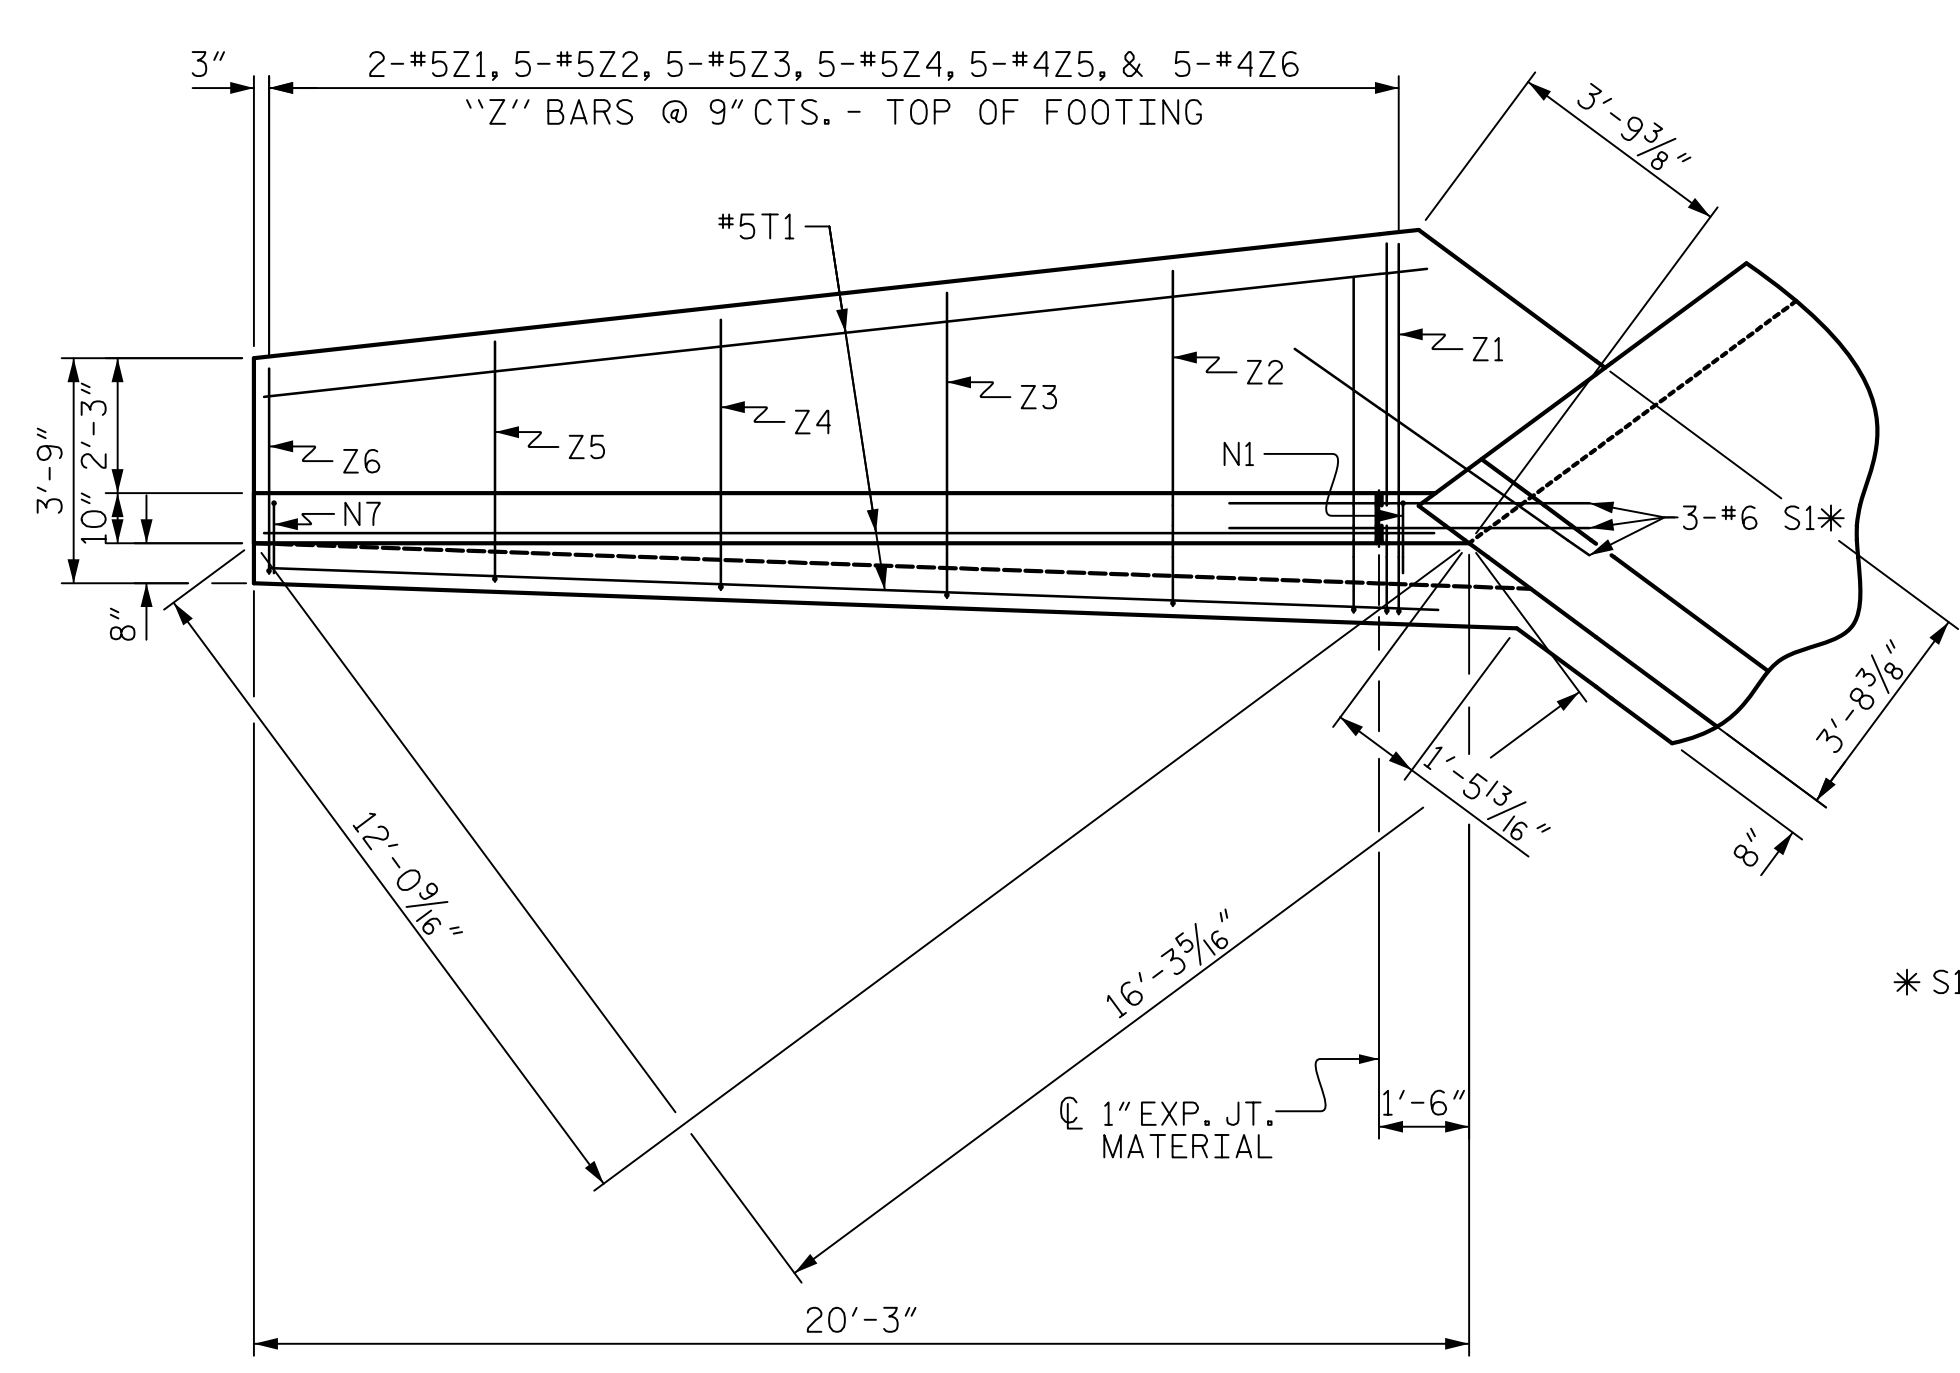


PLAN W3

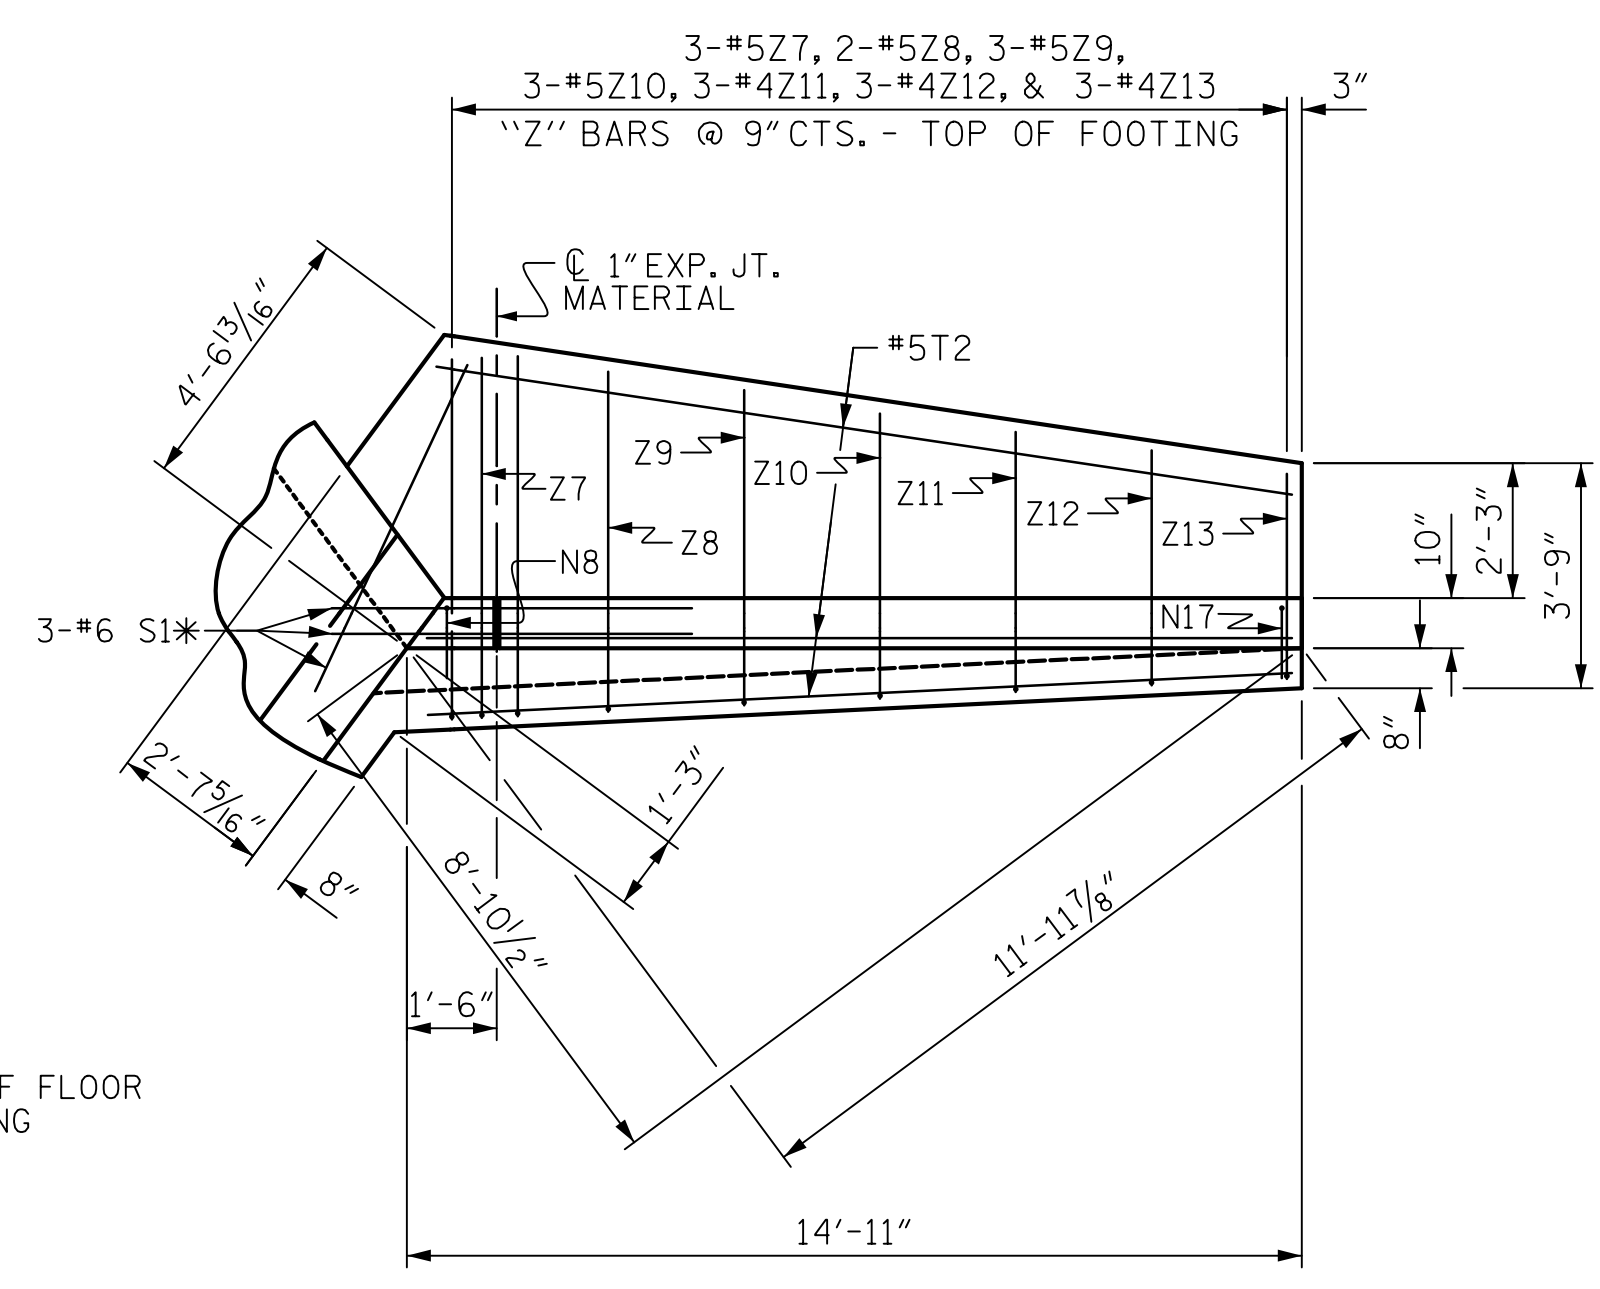


PLAN W4

* S1 BARS @ BOTTOM OF FLOOR SLAB AND FOOTING

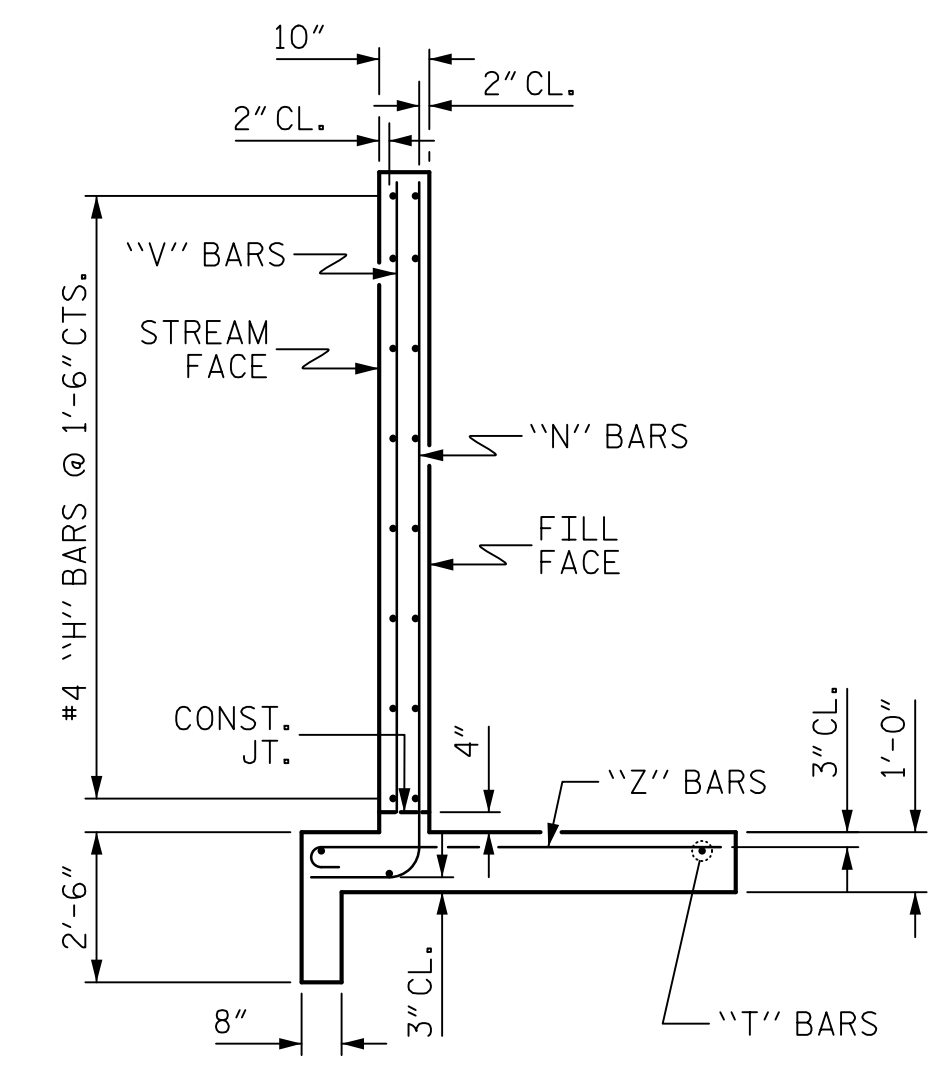


TYPICAL WING SECTION

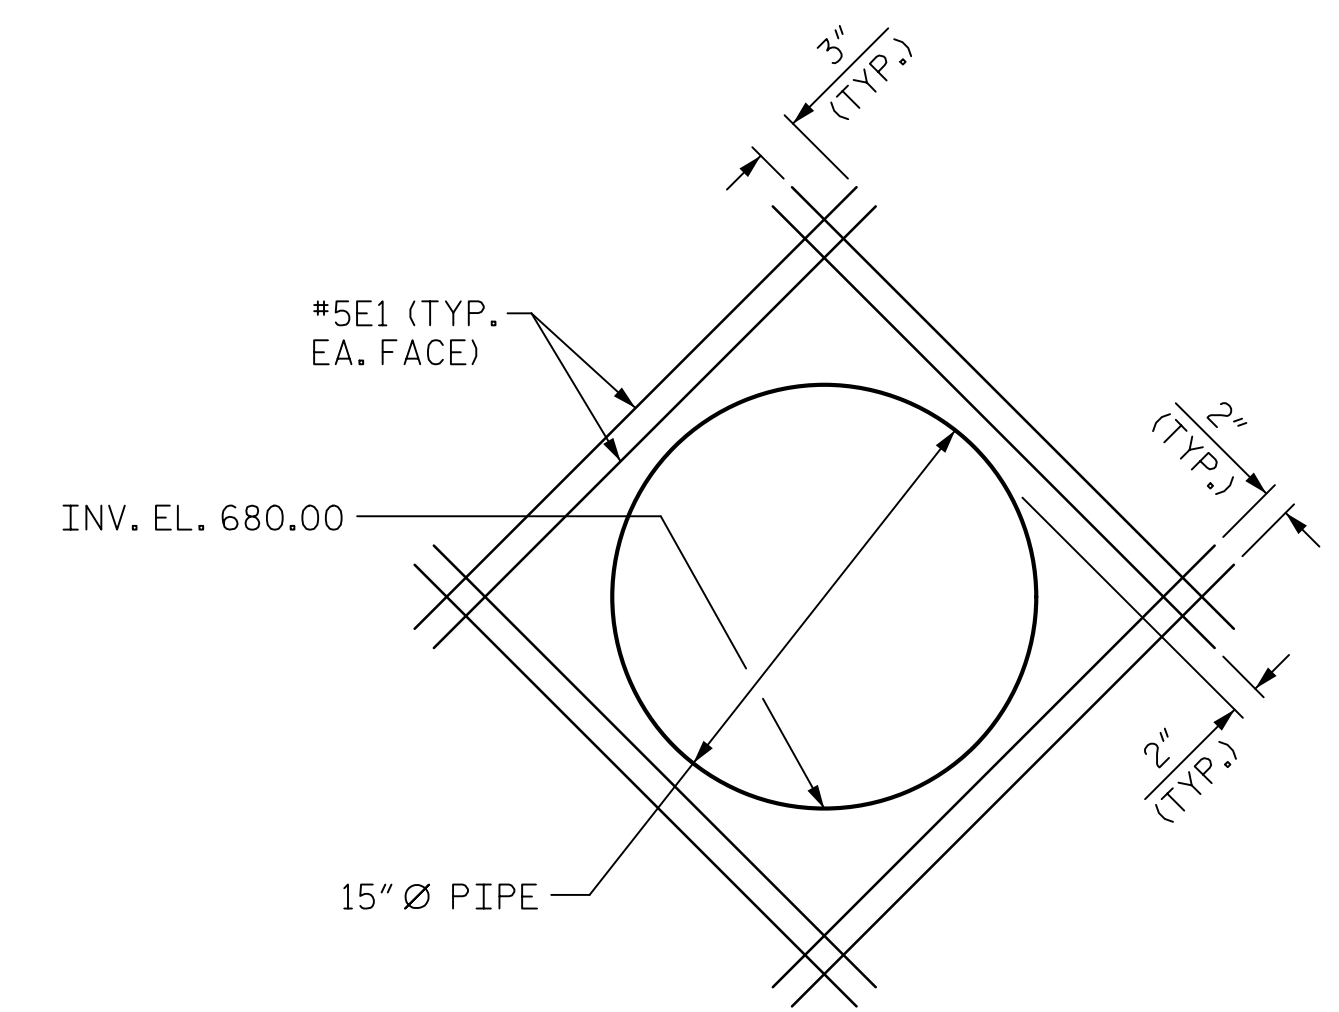


WALL OPENING DETAIL

FOR PIPE THROUGH W3 WALL. FIELD CUT, SHIFT, OR BEND "N", "H", AND "V" AS NECESSARY TO CLEAR PIPE.

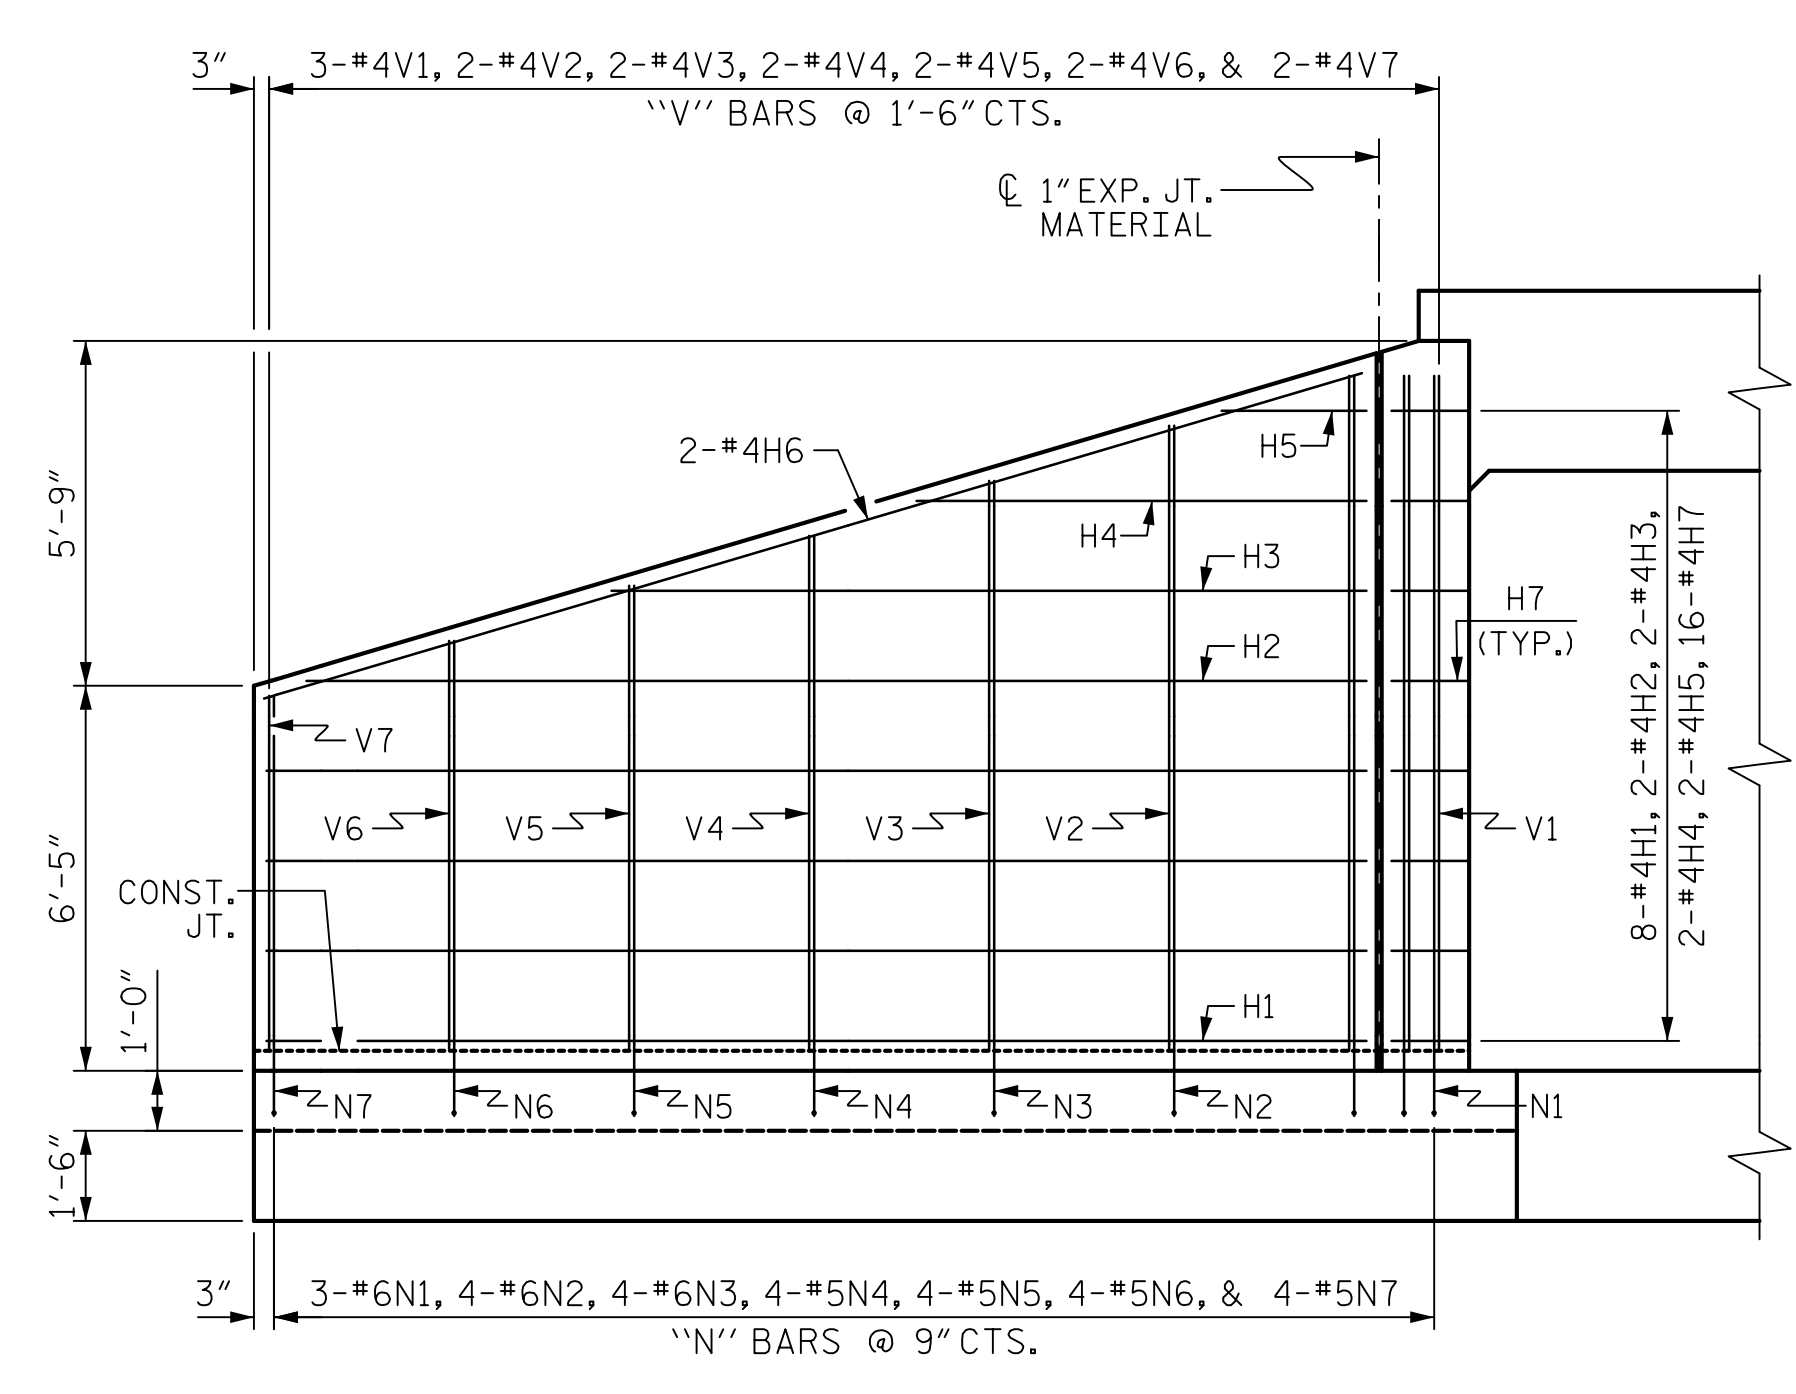


ELEVATION W3

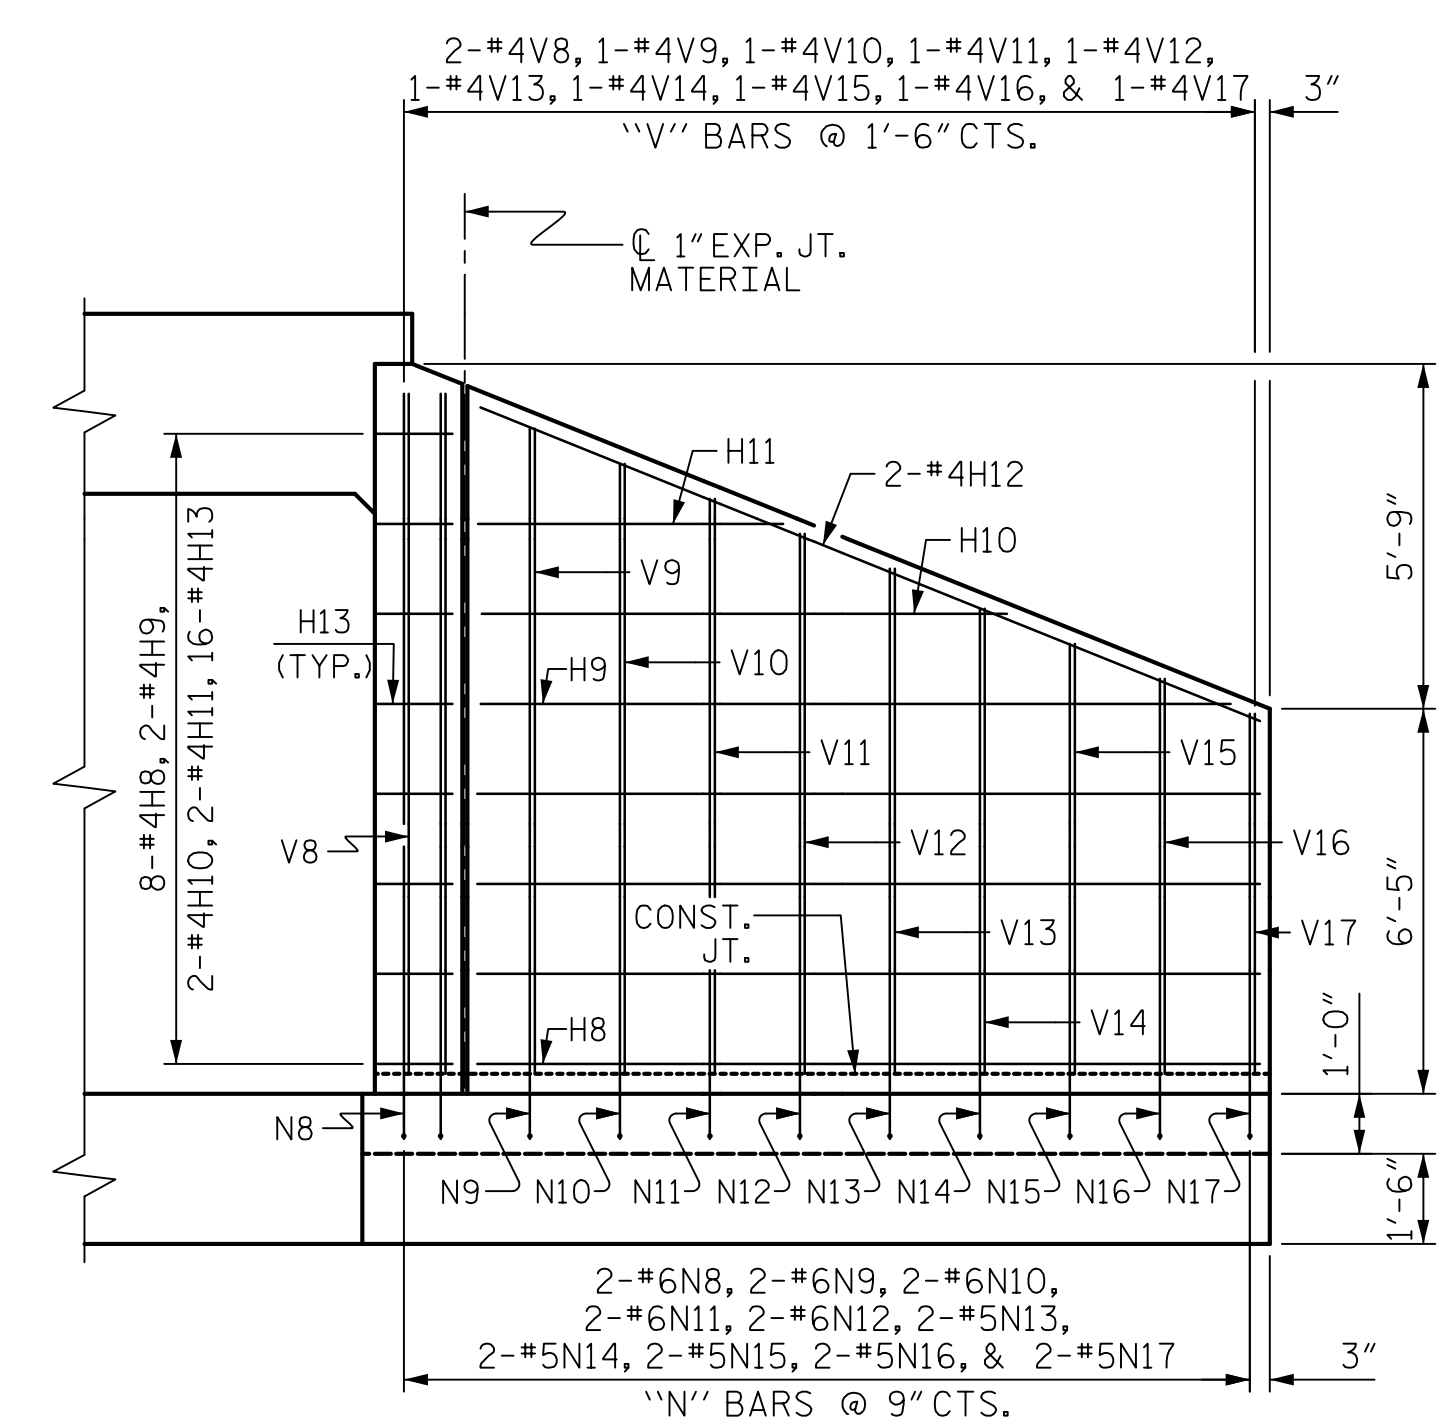

ELEVATION W4

Mead & Hunt
 111 E. Hargett Street
 Suite 300
 Raleigh, NC 27601
 919-714-8670
 meadhunt.com
 NC License No. F-1235

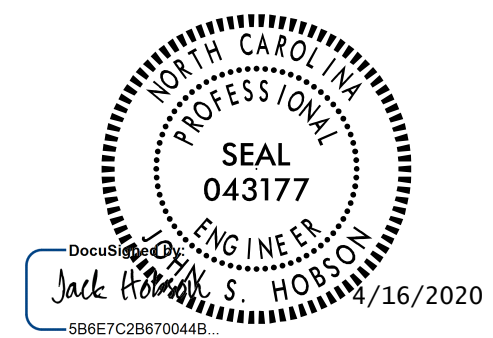


PROJECT NO. R-4707
GUILFORD COUNTY
 STATION: 46+07.79 -Y-
 SHEET 8 OF 9

STATE OF NORTH CAROLINA
 DEPARTMENT OF TRANSPORTATION
 RALEIGH
**LEFT SIDE WINGS
 FOR
 CONCRETE BOX CULVERT**
 H = 10'-0" SLOPE = 2:1

DRAWN BY : J.S. HOBSON DATE : 03/12/19
 CHECKED BY : J.A. LEE DATE : 04/08/19
 DESIGN ENGINEER OF RECORD : J.S. HOBSON DATE : 04/11/19

DOCUMENT NOT CONSIDERED
 FINAL UNLESS ALL
 SIGNATURES COMPLETED


REVISIONS						SHEET NO.
NO.	BY:	DATE:	NO.	BY:	DATE:	C2-08
1			3			TOTAL SHEETS
2			4			9

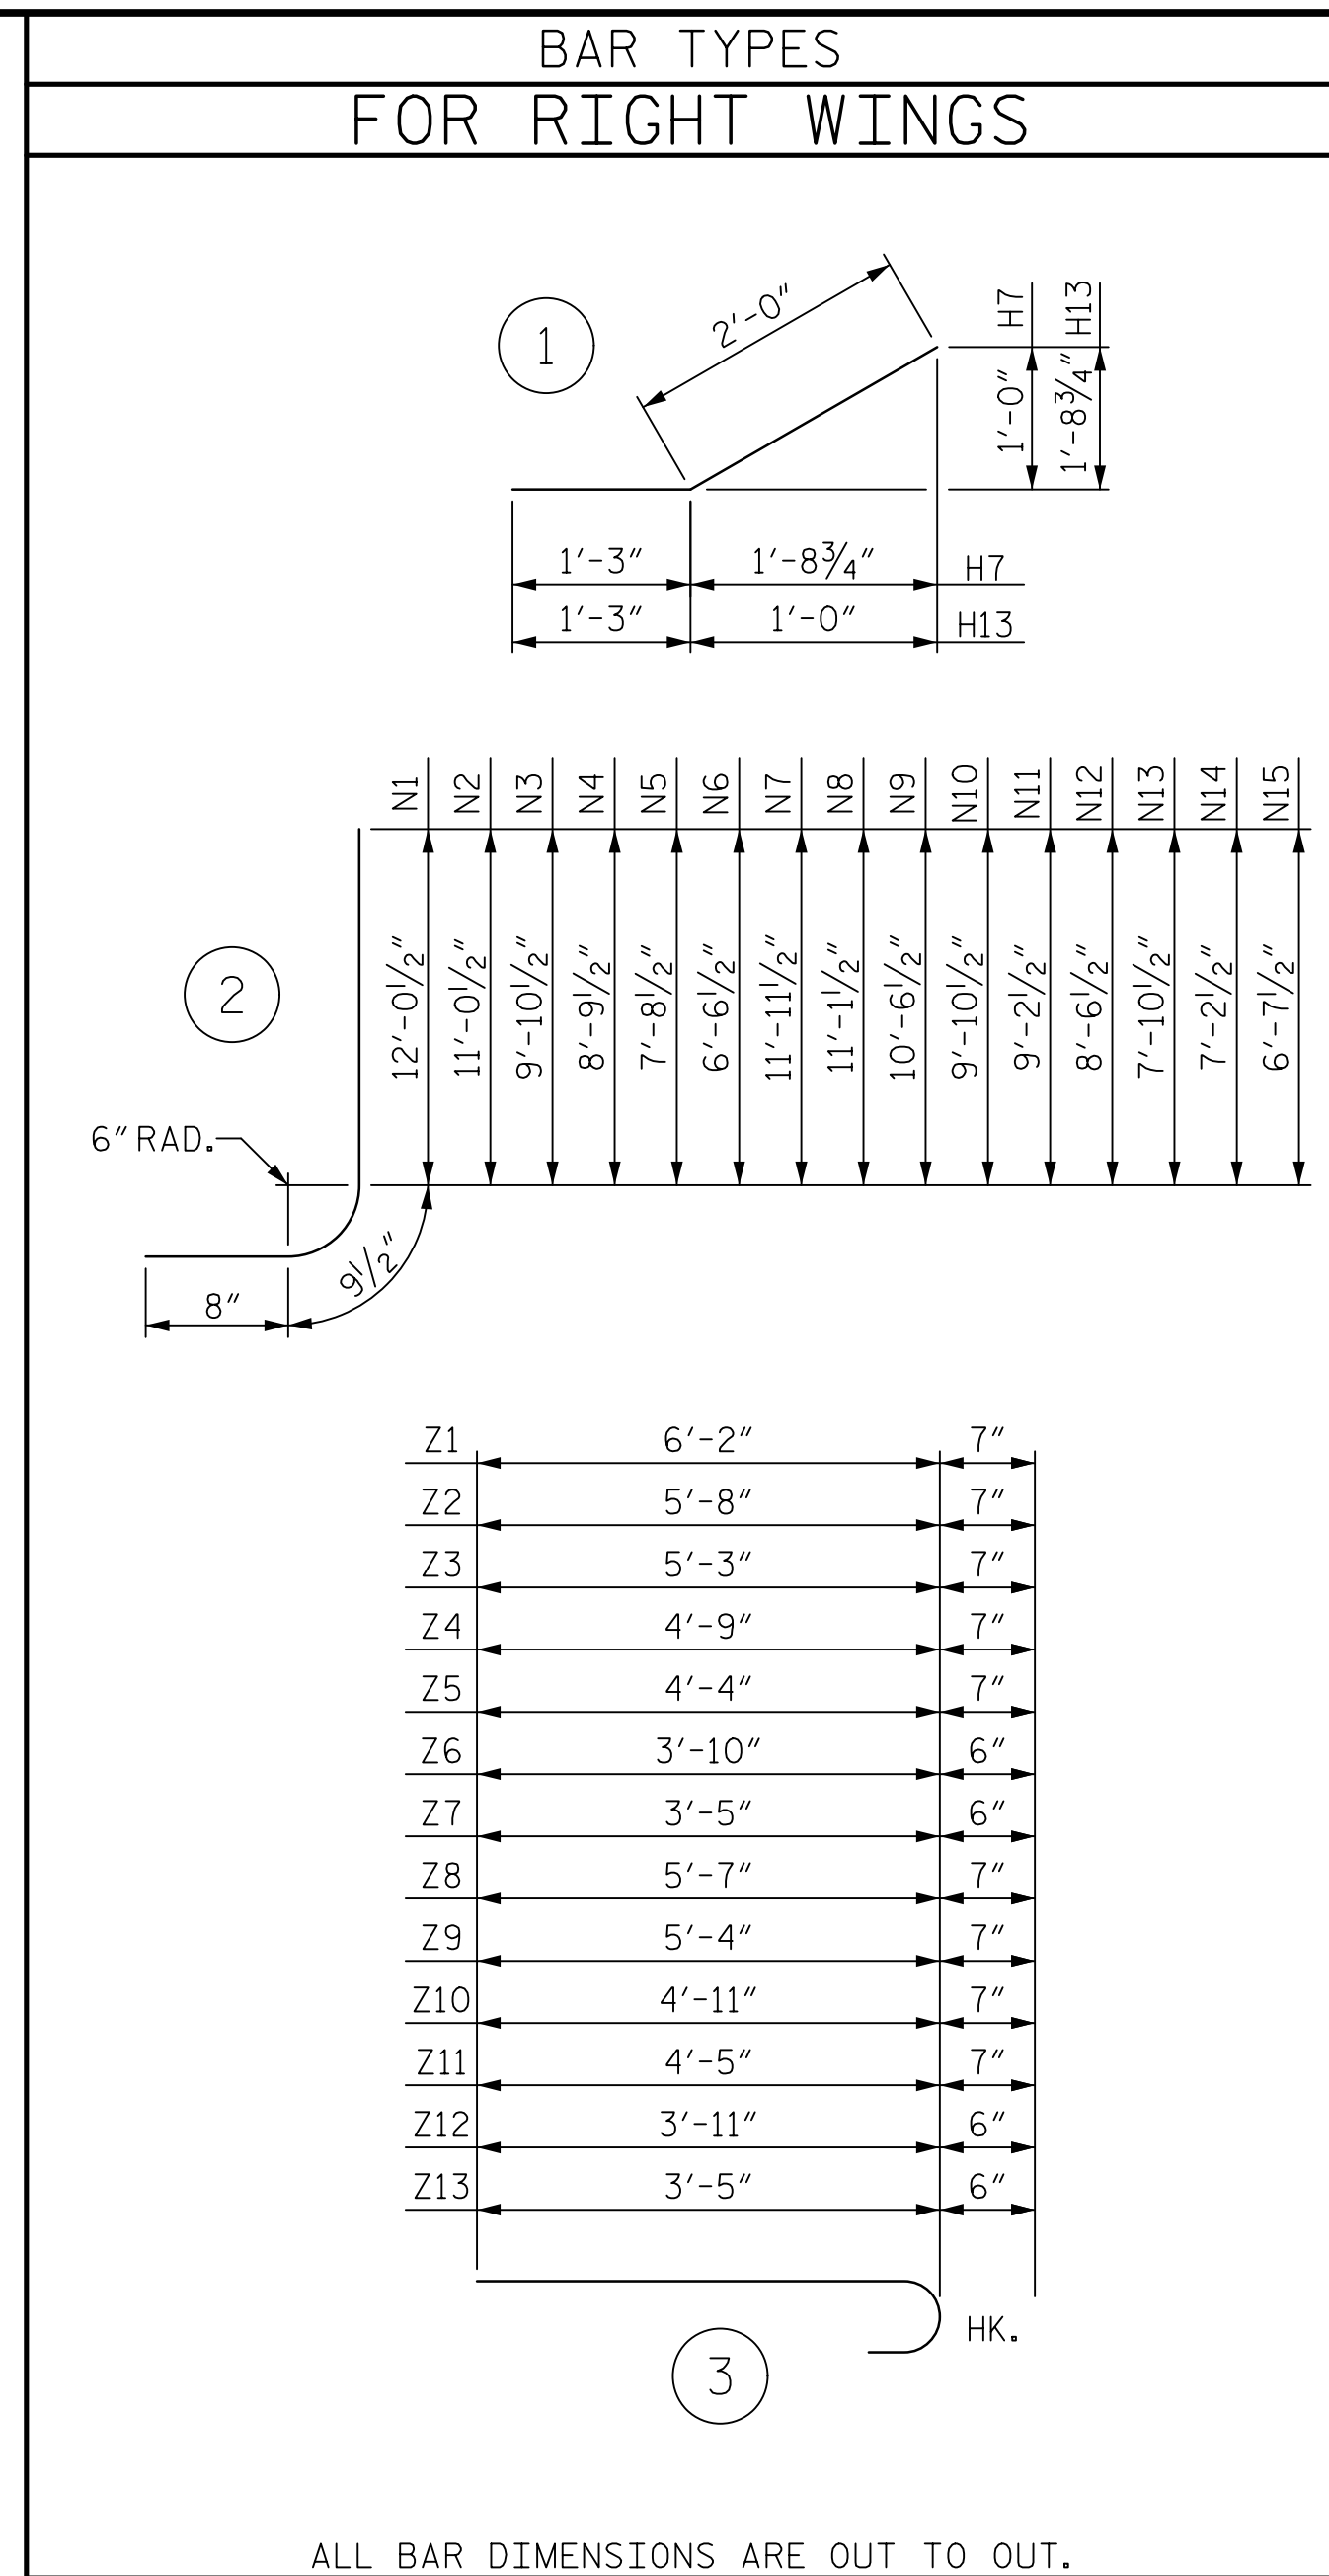

ALL BAR DIMENSIONS ARE OUT TO OUT.

BILL OF MATERIAL FOR RIGHT WINGS					
BAR	NO.	SIZE	TYPE	LENGTH	WEIGHT
H1	8	#4	STR	22'-4"	119
H2	2	#4	STR	21'-6"	29
H3	2	#4	STR	15'-5"	21
H4	2	#4	STR	9'-4"	12
H5	2	#4	STR	3'-3"	4
H6	2	#4	STR	23'-0"	31
H7	16	#4	1	3'-3"	35
H8	8	#4	STR	11'-10"	63
H9	2	#4	STR	11'-5"	15
H10	2	#4	STR	7'-11"	11
H11	2	#4	STR	4'-6"	6
H12	2	#4	STR	12'-11"	17
H13	16	#4	1	3'-3"	35
N1	3	#6	2	13'-6"	61
N2	6	#6	2	12'-6"	113
N3	6	#6	2	11'-4"	102
N4	6	#5	2	10'-3"	64
N5	6	#5	2	9'-2"	57
N6	6	#5	2	8'-0"	50
N7	2	#6	2	13'-5"	40
N8	2	#6	2	12'-7"	38
N9	2	#6	2	12'-0"	36
N10	2	#6	2	11'-4"	34
N11	2	#5	2	10'-8"	22
N12	2	#5	2	10'-0"	21
N13	2	#5	2	9'-4"	19
N14	2	#5	2	8'-8"	18
N15	2	#5	2	8'-1"	17
S1	6	#6	STR	6'-0"	54
T1	3	#5	STR	23'-9"	74
T2	3	#5	STR	13'-3"	41
V1	3	#4	STR	11'-5"	23
V2	3	#4	STR	10'-5"	21
V3	3	#4	STR	9'-3"	19
V4	3	#4	STR	8'-2"	16
V5	3	#4	STR	7'-1"	14
V6	3	#4	STR	5'-11"	12
V7	2	#4	STR	11'-4"	15
V8	1	#4	STR	10'-6"	7
V9	1	#4	STR	9'-11"	7
V10	1	#4	STR	9'-3"	6
V11	1	#4	STR	8'-7"	6
V12	1	#4	STR	7'-11"	5
V13	1	#4	STR	7'-3"	5
V14	1	#4	STR	6'-7"	4
V15	1	#4	STR	6'-0"	4
Z1	3	#5	3	6'-9"	21
Z2	5	#5	3	6'-3"	33
Z3	5	#5	3	5'-10"	30
Z4	5	#5	3	5'-4"	28
Z5	5	#5	3	4'-11"	26
Z6	5	#4	3	4'-4"	14
Z7	5	#4	3	3'-11"	13
Z8	3	#5	3	6'-2"	19
Z9	4	#5	3	5'-11"	25
Z10	4	#5	3	5'-6"	23
Z11	4	#5	3	5'-0"	21
Z12	4	#4	3	4'-5"	12
Z13	4	#4	3	3'-11"	10
REINFORCING STEEL FOR 2 RIGHT WINGS				1,698	LBS
CLASS A CONCRETE					
2 WINGS				20.1	CY
1 HEADWALL				1.9	CY
1 END CURTAIN WALL				2.3	CY
TOTAL				24.3	CY

BILL OF MATERIAL FOR LEFT WINGS					
BAR	NO.	SIZE	TYPE	LENGTH	WEIGHT
E1	16	#5	STR	2'-8"	45
H1	8	#4	STR	18'-4"	98
H2	2	#4	STR	17'-8"	24
H3	2	#4	STR	12'-7"	17
H4	2	#4	STR	7'-6"	10
H5	2	#4	STR	2'-5"	3
H6	2	#4	STR	19'-1"	25
H7	16	#4	1	3'-3"	35
H8	8	#4	STR	13'-0"	69
H9	2	#4	STR	12'-6"	17
H10	2	#4	STR	8'-9"	12
H11	2	#4	STR	5'-1"	7
H12	2	#4	STR	14'-0"	19
H13	16	#4	1	3'-3"	35
N1	3	#6	2	13'-4"	60
N2	4	#6	2	12'-6"	75
N3	4	#6	2	11'-7"	70
N4	4	#5	2	10'-8"	45
N5	4	#5	2	9'-10"	41
N6	4	#5	2	8'-11"	37
N7	4	#5	2	8'-0"	33
N8	2	#6	2	13'-5"	40
N9	2	#6	2	12'-10"	39
N10	2	#6	2	12'-3"	37
N11	2	#6	2	11'-8"	35
N12	2	#6	2	11'-1"	33
N13	2	#5	2	10'-6"	22
N14	2	#5	2	9'-10"	21
N15	2	#5	2	9'-3"	19
N16	2	#5	2	8'-8"	18
N17	2	#5	2	8'-1"	17
S1	6	#6	STR	6'-0"	54
T1	3	#5	STR	19'-6"	61
T2	3	#5	STR	14'-5"	45
V1	3	#4	STR	11'-3"	23
V2	2	#4	STR	10'-5"	14
V3	2	#4	STR	9'-6"	13
V4	2	#4	STR	8'-7"	11
V5	2	#4	STR	7'-9"	10
V6	2	#4	STR	6'-10"	9
V7	2	#4	STR	5'-11"	8
V8	2	#4	STR	11'-4"	15
V9	1	#4	STR	10'-9"	7
V10	1	#4	STR	10'-2"	7
V11	1	#4	STR	9'-7"	6
V12	1	#4	STR	9'-0"	6
V13	1	#4	STR	8'-5"	6
V14	1	#4	STR	9'-9"	7
V15	1	#4	STR	7'-2"	5
V16	1	#4	STR	6'-7"	4
V17	1	#4	STR	6'-0"	4
Z1	2	#5	3	6'-9"	14
Z2	5	#5	3	6'-2"	32
Z3	5	#5	3	5'-8"	30
Z4	5	#5	3	5'-1"	27
Z5	5	#4	3	4'-6"	15
Z6	5	#4	3	3'-11"	13
Z7	3	#5	3	6'-7"	21
Z8	2	#5	3	6'-3"	13
Z9	3	#5	3	5'-10"	18
Z10	3	#5	3	5'-4"	17
Z11	3	#4	3	4'-10"	10
Z12	3	#4	3	4'-5"	9
Z13	3	#4	3	3'-11"	8
REINFORCING STEEL FOR 2 LEFT WINGS				1,600	LBS
CLASS A CONCRETE					
2 WINGS				18.6	CY
1 HEADWALL				1.7	CY
1 END CURTAIN WALL				2.0	CY
TOTAL				22.3	CY

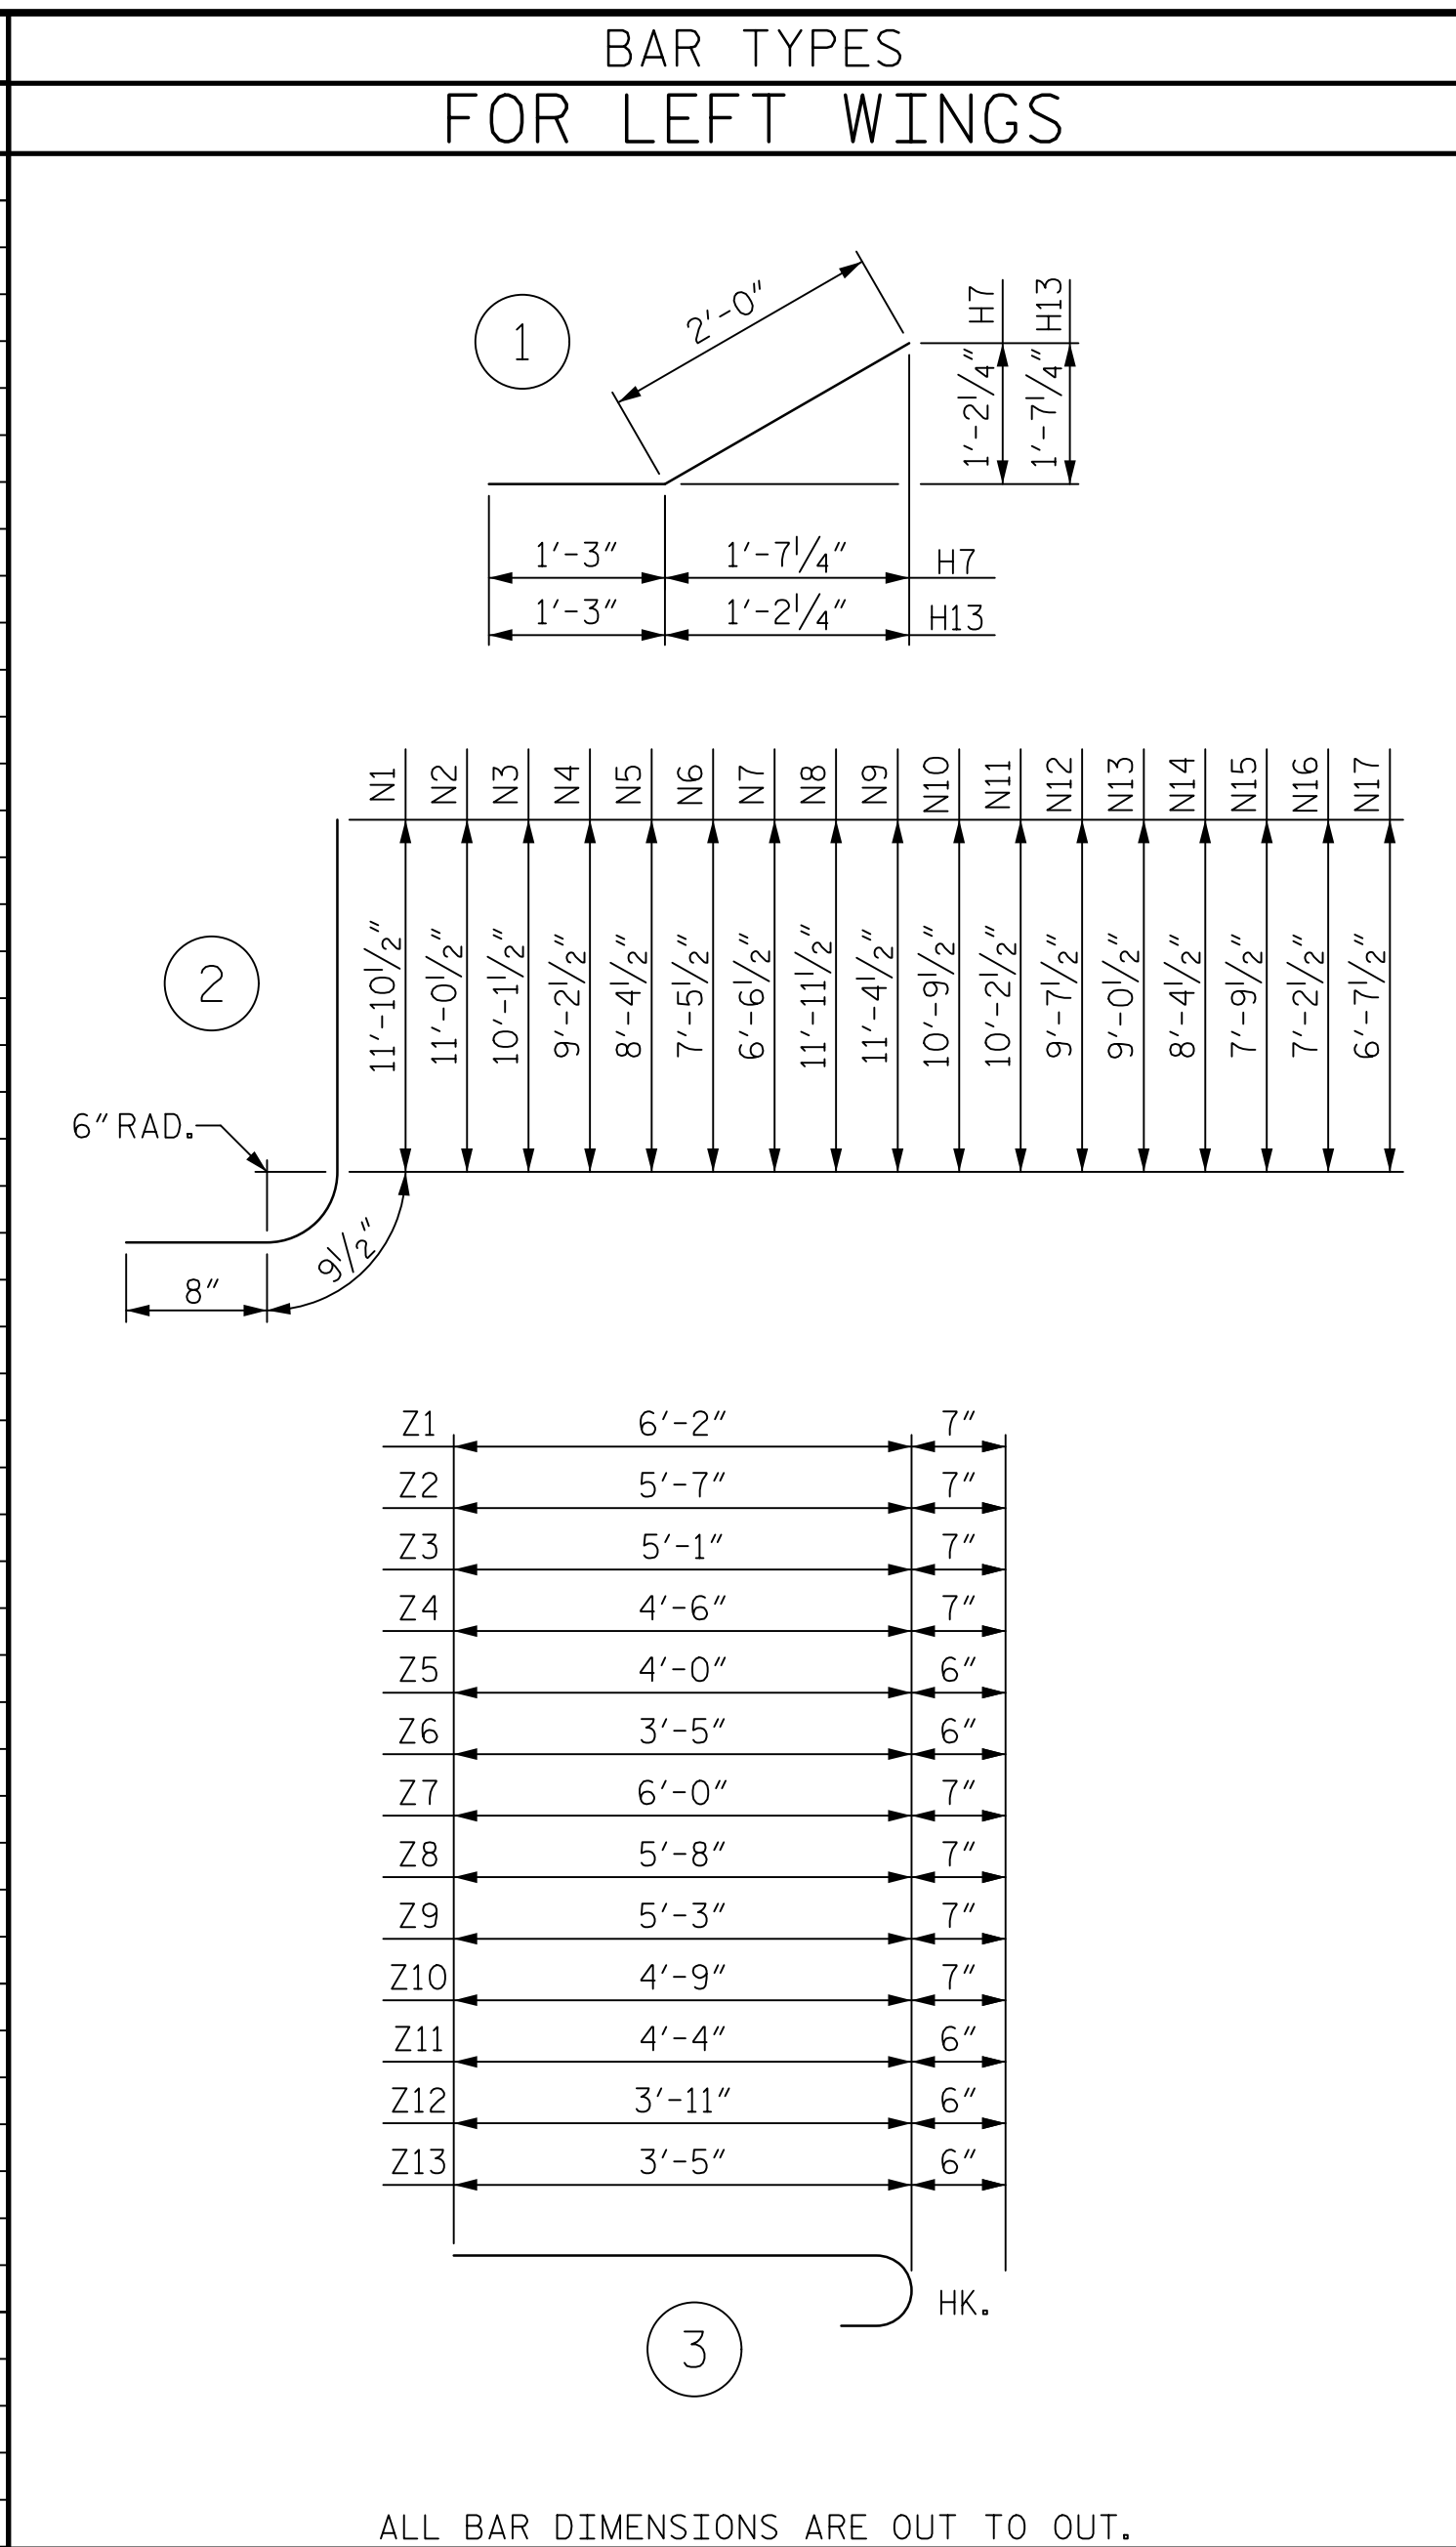

ALL BAR DIMENSIONS ARE OUT TO OUT.

DRAWN BY : J.S. HOBSON DATE : 03/12/19
 CHECKED BY : J.A. LEE DATE : 04/09/19
 DESIGN ENGINEER OF RECORD : J.S. HOBSON DATE : 04/11/19

Mead & Hunt
 111 E. Hargett Street
 Suite 300
 Raleigh, NC 27601
 919-714-8670
 meadhunt.com
 NC License No. F-1235

SEAL 043177
 Jack Hobson, S. HOBSON
 4/16/2020

DOCUMENT NOT CONSIDERED FINAL UNLESS ALL SIGNATURES COMPLETED

PROJECT NO. R-4707
 GUILFORD COUNTY
 STATION: 46+07.79 -Y-
 SHEET 9 OF 9

STATE OF NORTH CAROLINA DEPARTMENT OF TRANSPORTATION RALEIGH					
WINGWALL BILL OF MATERIAL FOR CONCRETE BOX CULVERT H = 10'-0" SLOPE = 2:1					
REVISIONS					
NO.	BY:	DATE:	NO.	BY:	DATE:
1			3		
2			4		
SHEET NO. C2-09					TOTAL SHEETS 9

STANDARD NOTES

DESIGN DATA:

SPECIFICATIONS	-----	A.A.S.H.T.O. (CURRENT)
LIVE LOAD	-----	SEE PLANS
IMPACT ALLOWANCE	-----	SEE A.A.S.H.T.O.
STRESS IN EXTREME FIBER OF STRUCTURAL STEEL - AASHTO M270 GRADE 36	--	20,000 LBS. PER SQ. IN.
	--	27,000 LBS. PER SQ. IN.
	--	27,000 LBS. PER SQ. IN.
REINFORCING STEEL IN TENSION - GRADE 60	----	24,000 LBS. PER SQ. IN.
CONCRETE IN COMPRESSION	-----	1,200 LBS. PER SQ. IN.
CONCRETE IN SHEAR	-----	SEE A.A.S.H.T.O.
STRUCTURAL TIMBER - TREATED OR UNTREATED EXTREME FIBER STRESS	----	1,800 LBS. PER SQ. IN.
COMPRESSION PERPENDICULAR TO GRAIN OF TIMBER	-----	375 LBS. PER SQ. IN.
EQUIVALENT FLUID PRESSURE OF EARTH	-----	30 LBS. PER CU. FT. (MINIMUM)

MATERIAL AND WORKMANSHIP:

EXCEPT AS MAY OTHERWISE BE SPECIFIED ON PLANS OR IN THE SPECIAL PROVISIONS, ALL MATERIAL AND WORKMANSHIP SHALL BE IN ACCORDANCE WITH THE 2018 "STANDARD SPECIFICATIONS FOR ROADS AND STRUCTURES" OF THE N.C. DEPARTMENT OF TRANSPORTATION.

STEEL SHEET PILING FOR PERMANENT OR TEMPORARY APPLICATIONS SHALL BE HOT ROLLED.

CONCRETE:

UNLESS OTHERWISE REQUIRED ON PLANS, CLASS A CONCRETE SHALL BE USED FOR ALL PORTIONS OF ALL STRUCTURES WITH THE EXCEPTION THAT: CLASS AA CONCRETE SHALL BE USED IN BRIDGE SUPERSTRUCTURES, ABUTMENT BACKWALLS, AND APPROACH SLABS; AND CLASS B CONCRETE SHALL BE USED FOR SLOPE PROTECTION AND RIP RAP.

CONCRETE CHAMFERS:

UNLESS OTHERWISE NOTED ON THE PLANS, ALL EXPOSED CORNERS ON STRUCTURES SHALL BE CHAMFERED $\frac{3}{4}$ " WITH THE FOLLOWING EXCEPTIONS: TOP CORNERS OF CURBS MAY BE ROUNDED TO $1\frac{1}{2}$ " RADIUS WHICH IS BUILT INTO CURB FORMS; CORNERS OF TRANSVERSE FLOOR EXPANSION JOINTS SHALL BE ROUNDED WITH A $\frac{1}{4}$ " FINISHING TOOL UNLESS OTHERWISE REQUIRED ON PLANS; AND CORNERS OF EXPANSION JOINTS IN THE ROADWAY FACES AND TOPS OF CURBS AND SIDEWALKS SHALL BE ROUNDED TO A $\frac{1}{4}$ " RADIUS WITH A FINISHING STONE OR TOOL UNLESS OTHERWISE REQUIRED ON PLANS.

DOWELS:

DOWELS WHEN INDICATED ON PLANS AS FOR CULVERT EXTENSIONS, SHALL BE EMBEDDED AT LEAST 12" INTO THE OLD CONCRETE AND GROUTED INTO PLACE WITH 1:2 CEMENT MORTAR.

ALLOWANCE FOR DEAD LOAD DEFLECTION, SETTLEMENT, ETC. IN CASTING SUPERSTRUCTURES:

BRIDGES SHALL BE BUILT ON THE GRADE OR VERTICAL CURVE SHOWN ON PLANS. SLABS, CURBS AND PARAPETS SHALL CONFORM TO THE GRADE OR CURVE.

ALL DIMENSIONS WHICH ARE GIVEN IN SECTION AND ARE AFFECTED BY DEAD LOAD DEFLECTIONS ARE DIMENSIONS AT CENTER LINE OF BEARING UNLESS OTHERWISE NOTED ON PLANS. IN SETTING FORMS FOR STEEL BEAM BRIDGES AND PRESTRESSED CONCRETE GIRDER BRIDGES, ADJUSTMENTS SHALL BE MADE DUE TO THE DEAD LOAD DEFLECTIONS FOR THE ELEVATIONS SHOWN. WHERE BLOCKS ARE SHOWN OVER BEAMS FOR BUILDING UP TO THE SLAB, THE VERTICAL DIMENSIONS OF THE BLOCKS SHALL BE ADJUSTED BETWEEN BEARINGS TO COMPENSATE FOR DEAD LOAD DEFLECTIONS, VERTICAL CURVE ORDINATE, AND ACTUAL BEAM CAMBER. WHERE BOTTOM OF SLAB IS IN LINE WITH BOTTOM OF TOP FLANGES, DEPTH OF SLAB BETWEEN BEARINGS SHALL BE ADJUSTED TO COMPENSATE FOR DEAD LOAD DEFLECTION, VERTICAL CURVE ORDINATE, AND ACTUAL BEAM CAMBER.

IN SETTING FALSEWORK AND FORMS FOR REINFORCED CONCRETE SPANS, AN ALLOWANCE SHALL BE MADE FOR DEAD LOAD DEFLECTIONS, SETTLEMENT OF FALSEWORK, AND PERMANENT CAMBER WHICH SHALL BE PROVIDED FOR IN ADDITION TO THE ELEVATIONS SHOWN. AFTER REMOVAL OF THE FALSEWORK, THE FINISHED STRUCTURES SHALL CONFORM TO THE PROFILE AND ELEVATIONS SHOWN ON THE PLANS AND CONSTRUCTION ELEVATIONS FURNISHED BY THE ENGINEER.

DETAILED DRAWINGS FOR FALSEWORK OR FORMS FOR BRIDGE SUPERSTRUCTURE AND ANY STRUCTURE OR PARTS OF A STRUCTURE AS NOTED ON THE PLANS SHALL BE SUBMITTED TO THE ENGINEER FOR APPROVAL BEFORE CONSTRUCTION OF THE FALSEWORK OR FORMS IS STARTED.

REINFORCING STEEL:

ALL REINFORCING STEEL SHALL BE DEFORMED. DIMENSIONS RELATIVE TO PLACEMENT OF REINFORCING ARE TO CENTERS OF BARS UNLESS OTHERWISE INDICATED IN THE PLANS. DIMENSIONS ON BAR DETAILS ARE TO CENTERS OF BARS OR ARE OUT TO OUT AS INDICATED ON PLANS.

WIRE BAR SUPPORTS SHALL BE PROVIDED FOR REINFORCING STEEL WHERE INDICATED ON THE PLANS. WHEN BAR SUPPORT PIECES ARE PLACED IN CONTINUOUS LINES, THEY SHALL BE SO PLACED THAT THE ENDS OF THE SUPPORTING WIRES SHALL BE LAPPED TO LOCK LEGS ON ADJOINING PIECES.

STRUCTURAL STEEL:

AT THE CONTRACTOR'S OPTION, HE MAY SUBSTITUTE $\frac{7}{8}$ " \emptyset SHEAR STUDS FOR THE $\frac{3}{4}$ " \emptyset STUDS SPECIFIED ON THE PLANS. THIS SUBSTITUTION SHALL BE MADE AT THE RATE OF 3 - $\frac{7}{8}$ " \emptyset STUDS FOR 4 - $\frac{3}{4}$ " \emptyset STUDS, AND STUD SPACING CHANGES SHALL BE MADE AS NECESSARY TO PROVIDE THE SAME EQUIVALENT NUMBER OF $\frac{7}{8}$ " \emptyset STUDS ALONG THE BEAM AS SHOWN FOR $\frac{3}{4}$ " \emptyset STUDS BASED ON THE RATIO OF 3 - $\frac{7}{8}$ " \emptyset STUDS FOR 4 - $\frac{3}{4}$ " \emptyset STUDS. STUDS OF THE LENGTH SPECIFIED ON THE PLANS MUST BE PROVIDED. THE MAXIMUM SPACING SHALL BE 2'-0".

EXCEPT AT THE INTERIOR SUPPORTS OF CONTINUOUS BEAMS WHERE THE COVER PLATE IS IN CONTACT WITH BEARING PLATE, THE CONTRACTOR MAY, AT HIS OPTION, SUBSTITUTE FOR THE COVER PLATES DESIGNATED ON THE PLANS COVER PLATES OF THE EQUIVALENT AREA PROVIDED THESE PLATES ARE AT LEAST $\frac{3}{16}$ " IN THICKNESS AND DO NOT EXCEED A WIDTH EQUAL TO THE FLANGE WIDTH LESS 2" OR A THICKNESS EQUAL TO 2 TIMES THE FLANGE THICKNESS. THE SIZE OF FILLET WELDS SHALL CONFORM TO THE REQUIREMENTS OF THE CURRENT ANSI/AASHTO/AWS "BRIDGE WELDING CODE". ELECTROSLAG WELDING WILL NOT BE PERMITTED.

WITH THE SOLE EXCEPTION OF EDGES AT SURFACES WHICH BEAR ON OTHER SURFACES, ALL SHARP EDGES AND ENDS OF SHAPES AND PLATES SHALL BE SLIGHTLY ROUNDED BY SUITABLE MEANS TO A RADIUS OF APPROXIMATELY $\frac{1}{16}$ " INCH OR EQUIVALENT FLAT SURFACE AT A SUITABLE ANGLE PRIOR TO PAINTING, GALVANIZING, OR METALLIZING.

HANDRAILS AND POSTS:

METAL STANDARDS AND FACES OF THE CONCRETE END POSTS FOR THE METAL RAIL SHALL BE SET NORMAL TO THE GRADE OF THE CURB, UNLESS OTHERWISE SHOWN ON PLANS. THE METAL RAIL AND TOPS OF CONCRETE POSTS USED WITH THE ALUMINUM RAIL SHALL BE BUILT PARALLEL TO THE GRADE OF THE CURB.

METAL HANDRAILS SHALL BE IN ACCORDANCE WITH THE PLANS. RAILS SHALL BE AS MANUFACTURED FOR BRIDGE RAILING. CASTINGS SHALL BE OF A UNIFORM APPEARANCE. FINS AND OTHER DEFORMATIONS RESULTING FROM CASTING OR OTHERWISE SHALL BE REMOVED IN A MANNER SO THAT A UNIFORM COLORING OF THE COMPLETED CASTING SHALL BE OBTAINED. CASTINGS WITH DISCOLORATIONS OR OF NON-UNIFORM COLORING WILL NOT BE ACCEPTED. CERTIFIED MILL REPORTS ARE REQUIRED FOR METAL RAILS AND POSTS.

SPECIAL NOTES:

GENERALLY, IN CASE OF DISCREPANCY, THIS STANDARD SHEET OF NOTES SHALL GOVERN OVER THE SPECIFICATIONS, BUT THE REMAINDER OF THE PLANS SHALL GOVERN OVER NOTES HEREON, AND SPECIAL PROVISIONS SHALL GOVERN OVER ALL. SEE SPECIFICATIONS ARTICLE 105-4.

ENGLISH

JANUARY, 1990

STD. NO. SN