

I hereby certify that this structure was built according to plans except as noted herein

W. R. Harding
RESIDENT ENGINEER

Bridge # 96

Built according to plans

PROJECT NO. 6.801771

CARTERET COUNTY


STATION: 31+76.46-1

STATE OF NORTH CAROLINA STATE HIGHWAY COMMISSION RALEIGH					
GENERAL DRAWINGS FOR BRIDGE TO HARKERS ISLAND OVER THE STRAITS					
SEPTEMBER 1969					
REVISIONS					
NO.	BY	DATE	NO.	BY	DATE
1	JCP	3-20-70	2		
2			3		

Rev. No. 1 - Revised to show extensions of Bulkheads No. 1 & No. 2 by JCP 3/20/70

Note: For details of bulkheads, see Bulkhead Sheet


DESIGNED BY: W. K. BARKER, JR. DATE: SEPT. 1969
CHECKED BY: E. G. ALWOOD, JR. DATE: SEPT. 69

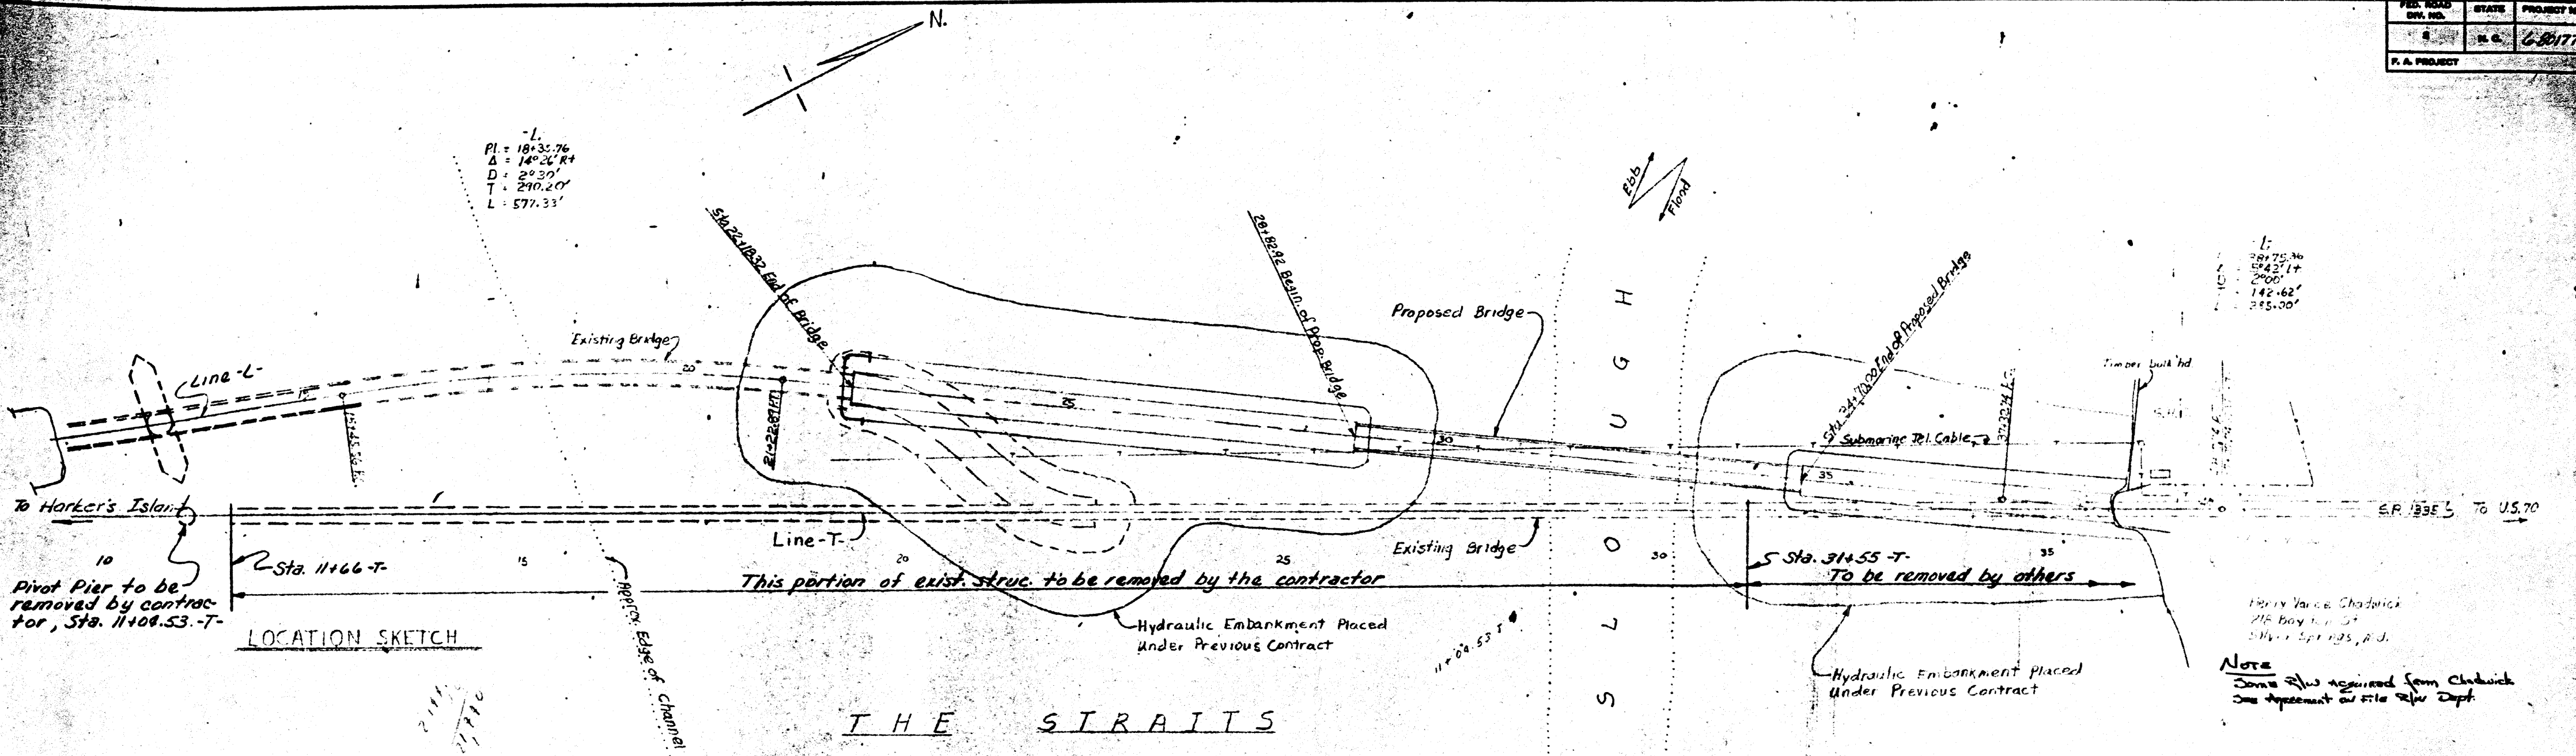

B.M. U-163: Disk on steel rod 31' Lt. Sta. 40+32-L, El. = 6.52

TOTAL BILL OF MATERIALS*

Item	Metal Railing Lin. Ft.	Class "A" Concrete Cu. Yds.	24" Prest. Concrete Slabs No. Lin. Ft.	17" Prest. Conc. Piles No. Lin. Ft.	20" Prest. Conc. Piles No. Lin. Ft.	24" Prest. Conc. Piles No. Lin. Ft.	Method of Damp Proofing	Asphalt Surf. Course Type 2	Concrete Plant Mix	20" Prest. Conc. Test Piles No.	Removal of Exist. Structure	Removal of Exist. Bridge Deck	Epoxy Resin Sealant for Bridge Deck
Superstructure	1166.6	1430.6	1430.6	3080	1920	1920	Asphalt	Asphalt	Asphalt	2	1920	1920	1920
End Bent #1	9.8	1732.0	1732.0	4	192.0	192.0	Asphalt	Asphalt	Asphalt	1	192.0	192.0	192.0
Bent #1	2.7	2,144.0	2,144.0	4	192.0	192.0	Asphalt	Asphalt	Asphalt	1	192.0	192.0	192.0
Bent #2	2.7	2,144.0	2,144.0	4	192.0	192.0	Asphalt	Asphalt	Asphalt	1	192.0	192.0	192.0
Bent #3	2.7	2,144.0	2,144.0	4	192.0	192.0	Asphalt	Asphalt	Asphalt	1	192.0	192.0	192.0
Bent #4	2.7	2,144.0	2,144.0	4	192.0	192.0	Asphalt	Asphalt	Asphalt	1	192.0	192.0	192.0
Bent #5	2.7	2,144.0	2,144.0	4	192.0	192.0	Asphalt	Asphalt	Asphalt	1	192.0	192.0	192.0
Bent #6	2.7	2,144.0	2,144.0	4	192.0	192.0	Asphalt	Asphalt	Asphalt	1	192.0	192.0	192.0
Bent #7	2.7	2,144.0	2,144.0	4	192.0	192.0	Asphalt	Asphalt	Asphalt	1	192.0	192.0	192.0
Bent #8	2.7	2,144.0	2,144.0	4	192.0	192.0	Asphalt	Asphalt	Asphalt	1	192.0	192.0	192.0
Bent #9	2.7	2,144.0	2,144.0	4	192.0	192.0	Asphalt	Asphalt	Asphalt	1	192.0	192.0	192.0
Bent #10	2.7	2,144.0	2,144.0	4	192.0	192.0	Asphalt	Asphalt	Asphalt	1	192.0	192.0	192.0
Bent #11	2.7	2,144.0	2,144.0	4	192.0	192.0	Asphalt	Asphalt	Asphalt	1	192.0	192.0	192.0
Bent #12	2.7	2,144.0	2,144.0	4	192.0	192.0	Asphalt	Asphalt	Asphalt	1	192.0	192.0	192.0
End Bent #2	2.3	1232.0	1232.0	7	3080	3080	Asphalt	Asphalt	Asphalt	2	3080	3080	3080
Bulkhead #1	11.0	1965.0	1965.0	1	168	168	Asphalt	Asphalt	Asphalt	1	168	168	168
Bulkhead #2	11.0	1965.0	1965.0	1	168	168	Asphalt	Asphalt	Asphalt	1	168	168	168
Bulkhead #3	30.9	5086.0	5086.0	3	360	360	Asphalt	Asphalt	Asphalt	3	360	360	360
TOTAL	1166.6	1430.6	1430.6	3080	1920	1920	Asphalt	Asphalt	Asphalt	2	1920	1920	1920

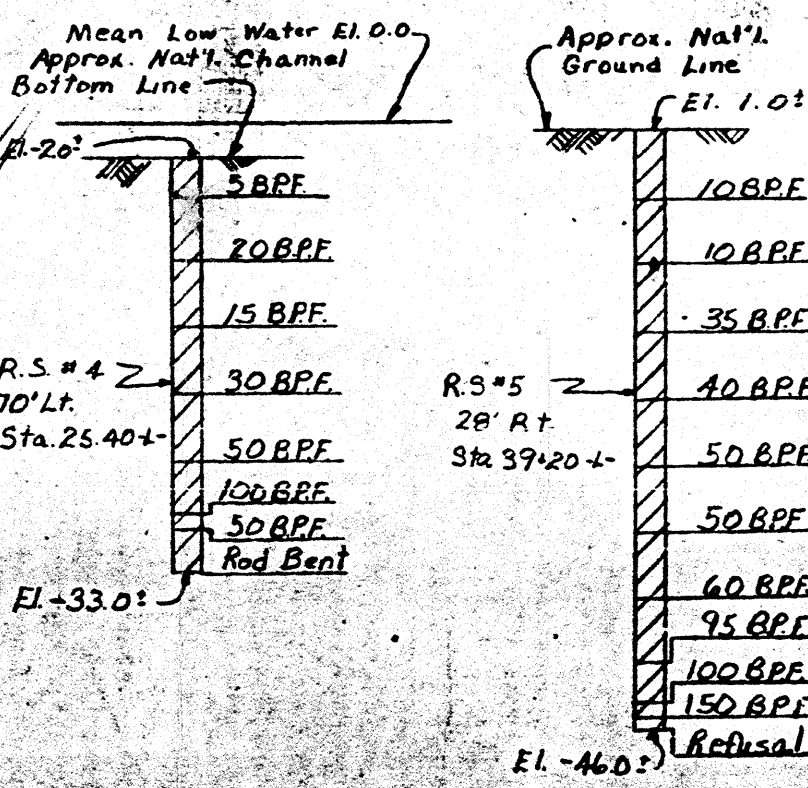

NOTES

Assumed Live Load = H.S. 15-44

For other design data and general notes, see sheet S-11.

Care shall be taken to prevent reinforcing steel from getting wet with salt water. If, despite precautions, reinforcing steel becomes wet with salt water, it shall be thoroughly washed with fresh water before concrete is placed on special provisions.

Traffic will be maintained by others over the existing structure during construction. See Special Provisions.

Planned work and hydraulic embankment to be done by others. The contractor shall be required to maintain water traffic in a manner satisfactory to both the Engineer and the U.S. Coast Guard and in accordance with the pilotage laws.

Order lengths for prestressed concrete sheet piles shall be as follows:

- Bulkhead No. 1 - 15'
- Bulkhead No. 2 - 18'

These sheet piles shall be driven to grade.

Order lengths for 12" prestressed concrete piles in bulkheads shall be as follows:

- Bulkhead No. 1 - 21'
- Bulkhead No. 2 - 24'

These piles shall be driven to grade.

The contractor will be required to drive 20" prestressed concrete test piles, not in place, at the following locations:

- Sta. 30+40 - 1 pile with a min. length of 60 ft.
- Sta. 33+10 - 1 pile with a min. length of 60 ft.

These piles to be driven and paid for as 20" Prestressed Concrete Test Piles. These test piles are to be pulled after they are driven.

Piles in the following bents to be driven to a minimum bearing capacity as follows:

- End Bents No. 1 and 2 - 26 tons each
- Bents No. 1-12 - 47 tons each

The lengths of piles shown in Bill of Material are approximate only. The actual length of all piles will be given after the test piles have been driven. See Special Provisions.

No rubbed surface finish will be required on any part of the structure except as specified in the Special Provisions.

* This bill does not include quantities shown for the extensions of Bulkhead #1 or #2 built originally under Proj. 5-16501. These quantities shown on sheet S-10B.

** One pile in each bent was driven as a test pile in permanent position.

* Paid for by E.W.D. 2-589

NOTES

Removal of Exist. Structure at Sta. 11+66-T - For removal of existing pivot pier at Sta. 11+04.53 T, see Specifications and Special Provisions.

Removal of Exist. Structure at Sta. 11+66-T - The existing structure between Sta. 11+66-T and Sta. 31+55-T, consisting of 117 timber spans approx. 17' long with timber floor and timber stringers on timber pile bents with 18" x 8" cl. rdy. shall be removed according to the Specifications and the material shall be salvaged. The limits of this removal shall begin with and include the rest bent at Sta. 11+66-T and end with and include the bent at Sta. 31+55-T. Removal shall not begin until traffic is placed on the proposed structure or as directed by the Engineer.





The remainder of the existing structure will be removed by others.

PROJECT NO. 6-801771
 CARTERET COUNTY
 STATION: 31+76.46-T

STATE OF NORTH CAROLINA
STATE HIGHWAY COMMISSION
 RALEIGH



GENERAL DRAWING
 FOR BRIDGE TO HARKER'S
 ISLAND OVER THE STRAITS

REVISIONS					
NO.	BY	DATE	NO.	BY	DATE
1	JEP	5-20-70	2		
2			3		

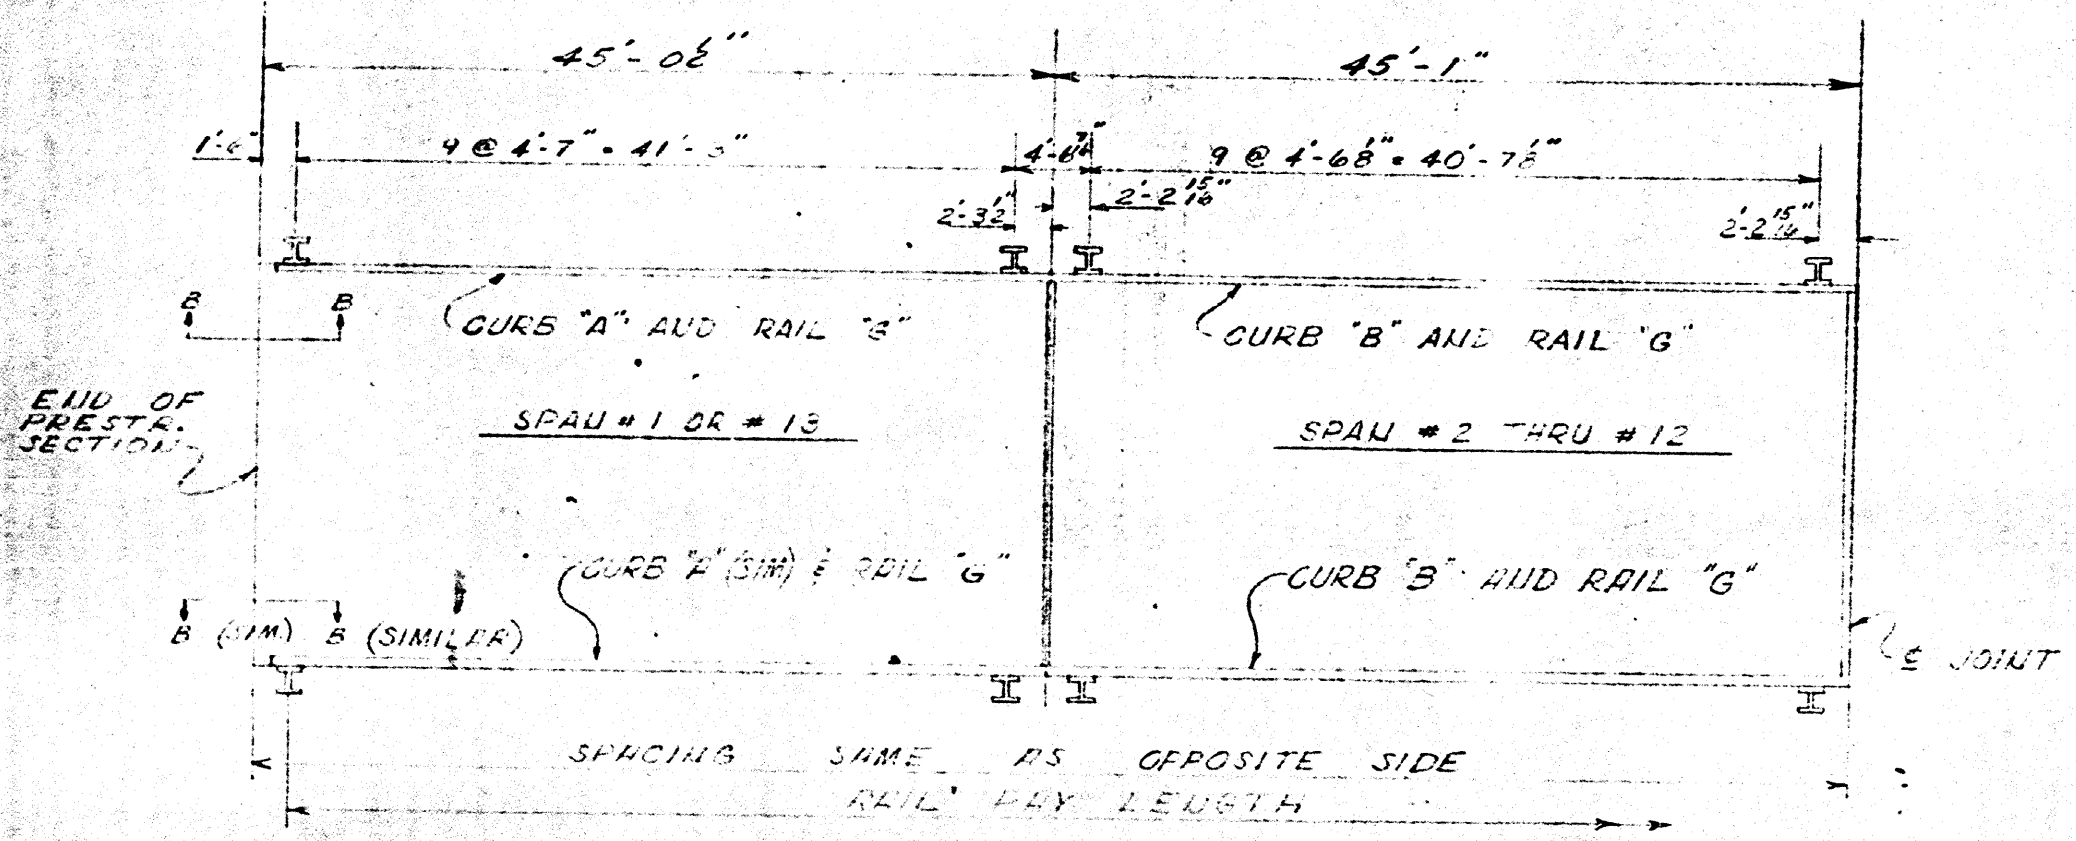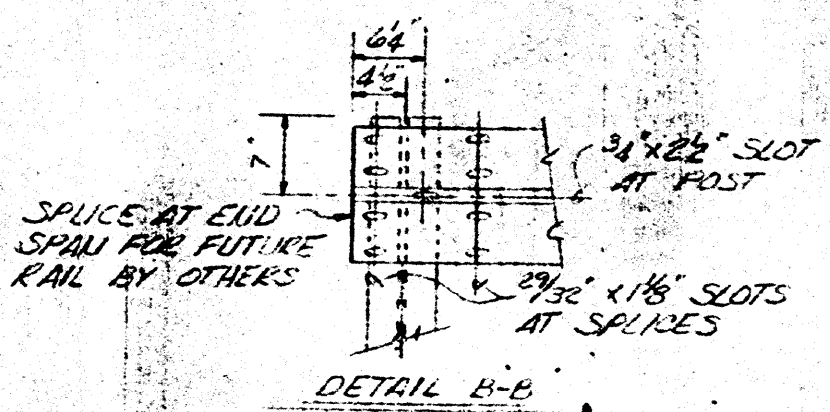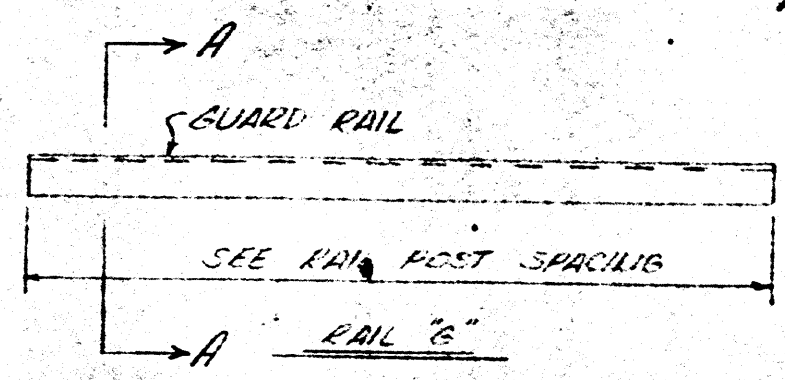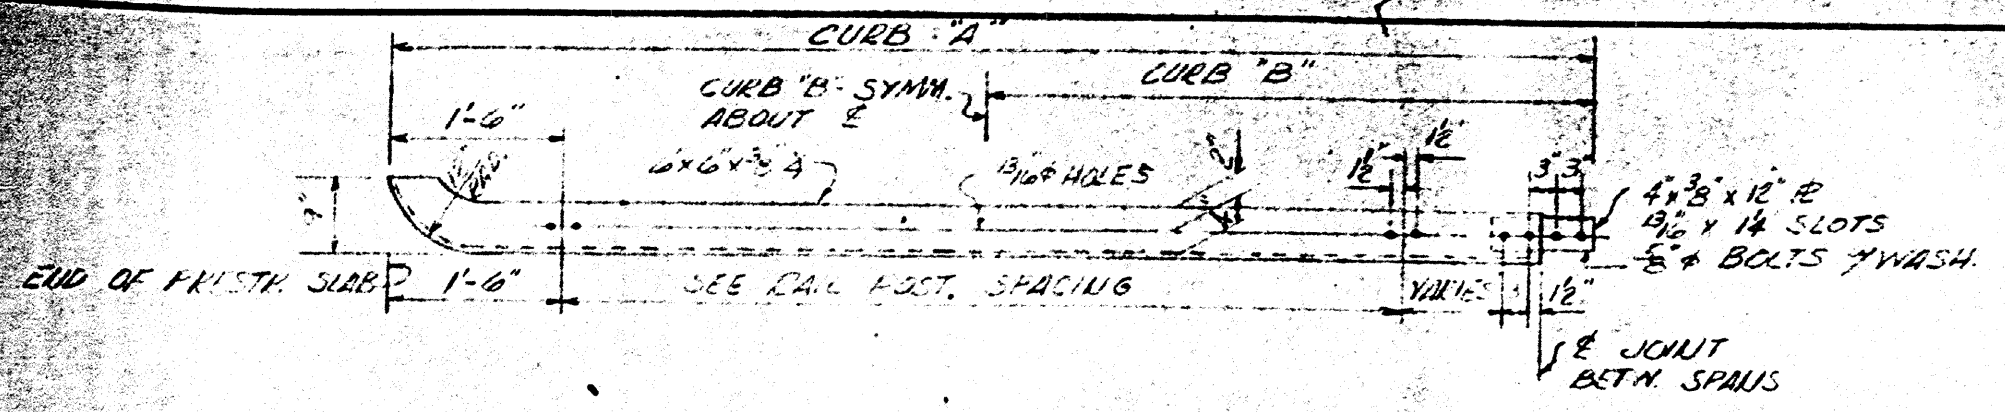

NOTE: RAIL RAY LENGTH WILL BEGIN AT E OF FIRST POST IN SPAN #1 AND WILL END AT E OF LAST POST IN SPAN #2.

NOTE: CURB RAIL SPLICES SHALL BE SET BY FABRICATOR EXCEPT FOR SPLICE AT END POSTS AS INDICATED IN DETAIL B-B.

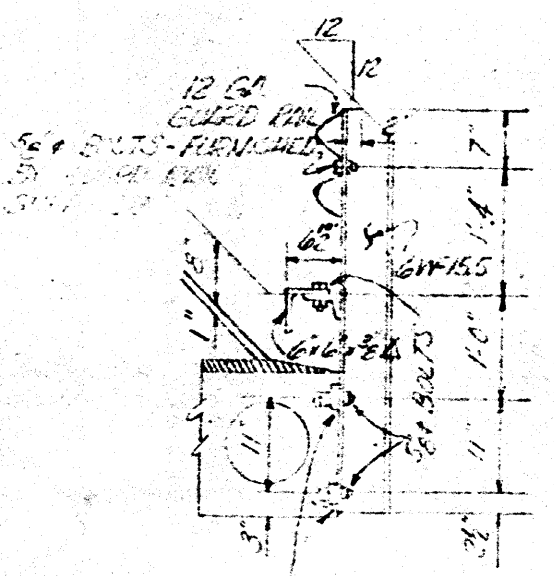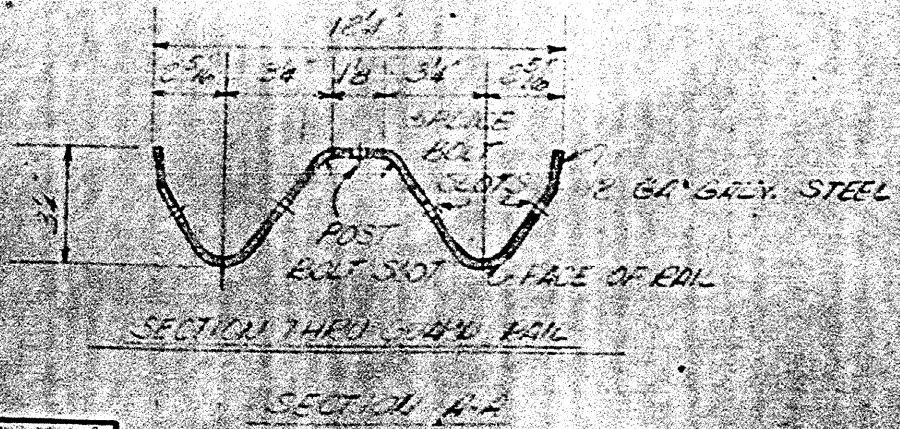


WASHERS TO BE FURNISHED AS NECESSARY TO SHIM POST FOR CORRECT ALIGNMENT OF RAIL.

CURB AND POST DETAIL

RAIL RAY LENGTH 1166.00 FT. BY COR'D SLAB FABRICATOR

Built according to plans See pay record Book #1 page 15

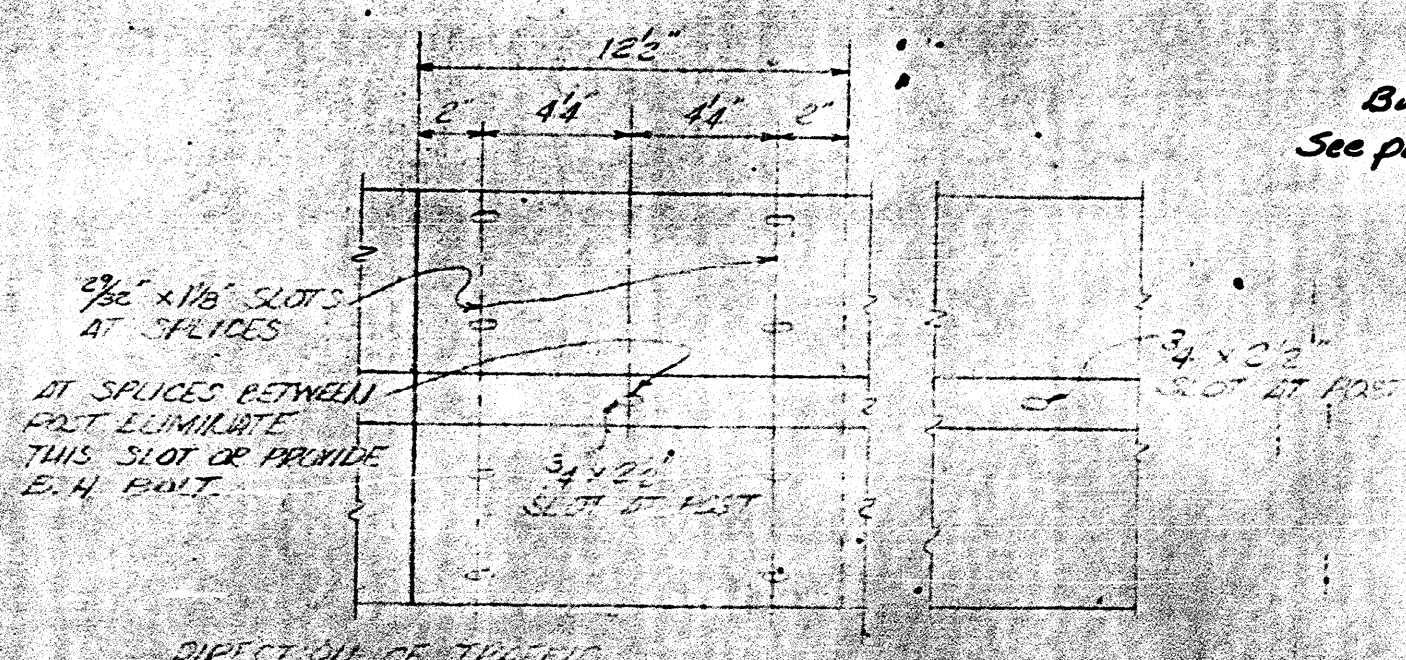

RAIL SPLICE AND POST CONNECTION

3/8" BOTTOM HD DUAL SHOULDER EXTS. HEX NUTS AT RAIL SLOTS THICKNESS OF HEX NUTS 3/8"

NOTES



- MINIMUM LENGTH OF GUARD RAIL AND CURB ANGLE = CURB POST SPACING.
- STRUCTURAL STEEL ITEMS SHALL BE OF A GRADE CONFORMING TO EITHER ASTM A7, A36, A375.
- STRUCTURAL STEEL SUPPLIER TO FURNISH RAIL POSTS AND CURB ANGLE WITH BOLTS.
- ALL RAIL PARTS TO BE GALVANIZED TO ASTM SPECIFICATIONS AS FOLLOWS:
- POSTS & CURB ANGLE A-15
- GUARD RAIL A-15
- WASHERS A-15
- ALL GALVANIZING TO BE DONE AFTER FABRICATION
- PAINT APPLICATION IS REQUIRED
- ALL BOLTS, NUTS, WASHERS, PLATES, AND CURB ANGLE ARE CONSIDERED AS PART OF THE RAIL FOR PAYMENT
- SUBJECTS WILL BE SUPPORTED

PROJECT No. 6.801771
 CARTERET COUNTY
 STATION: 31+76.46+1

STATE OF NORTH CAROLINA
 STATE HIGHWAY COMMISSION
 RALEIGH
 CURB AND RAIL DETAILS

REVISIONS					
NO.	BY	DATE	NO.	BY	DATE
1			2		
2			4		

DATE: SEPT. 63

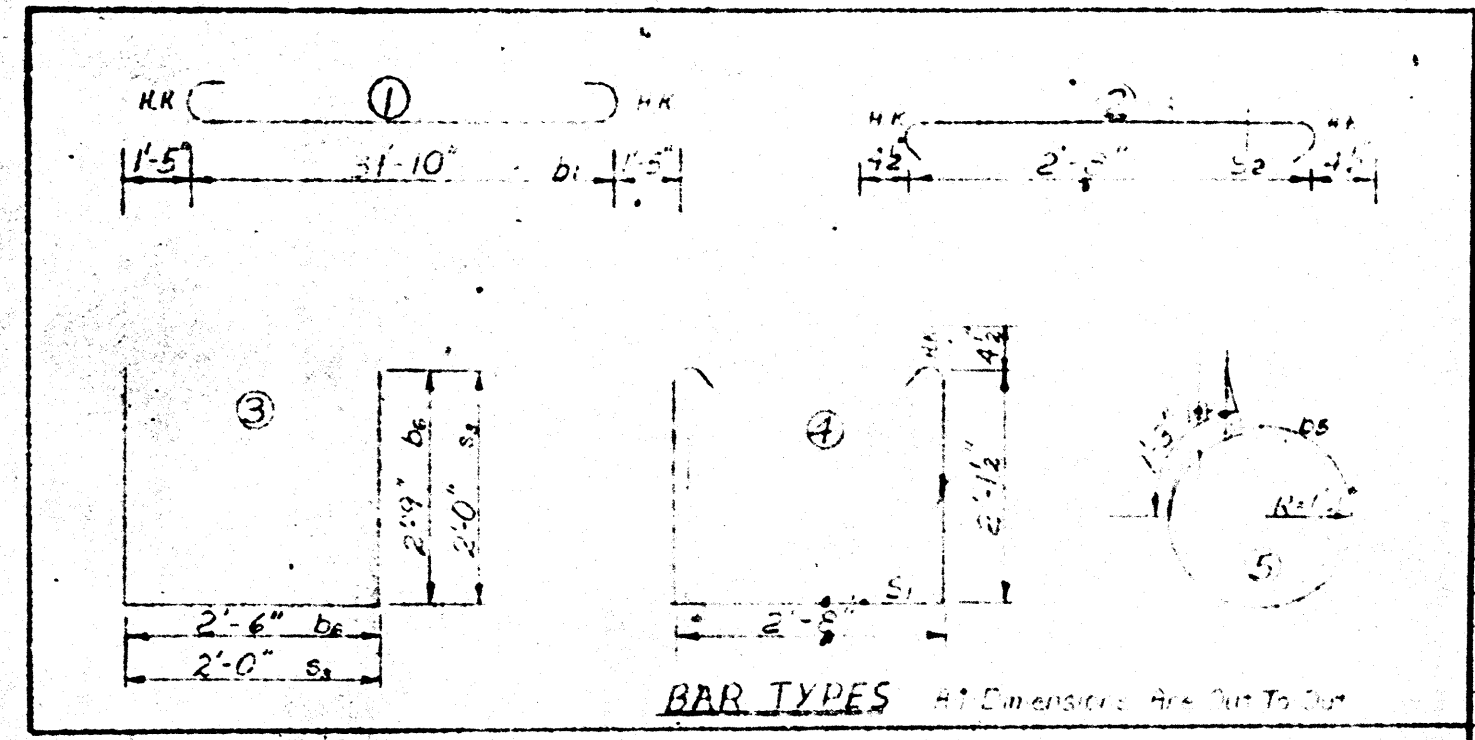
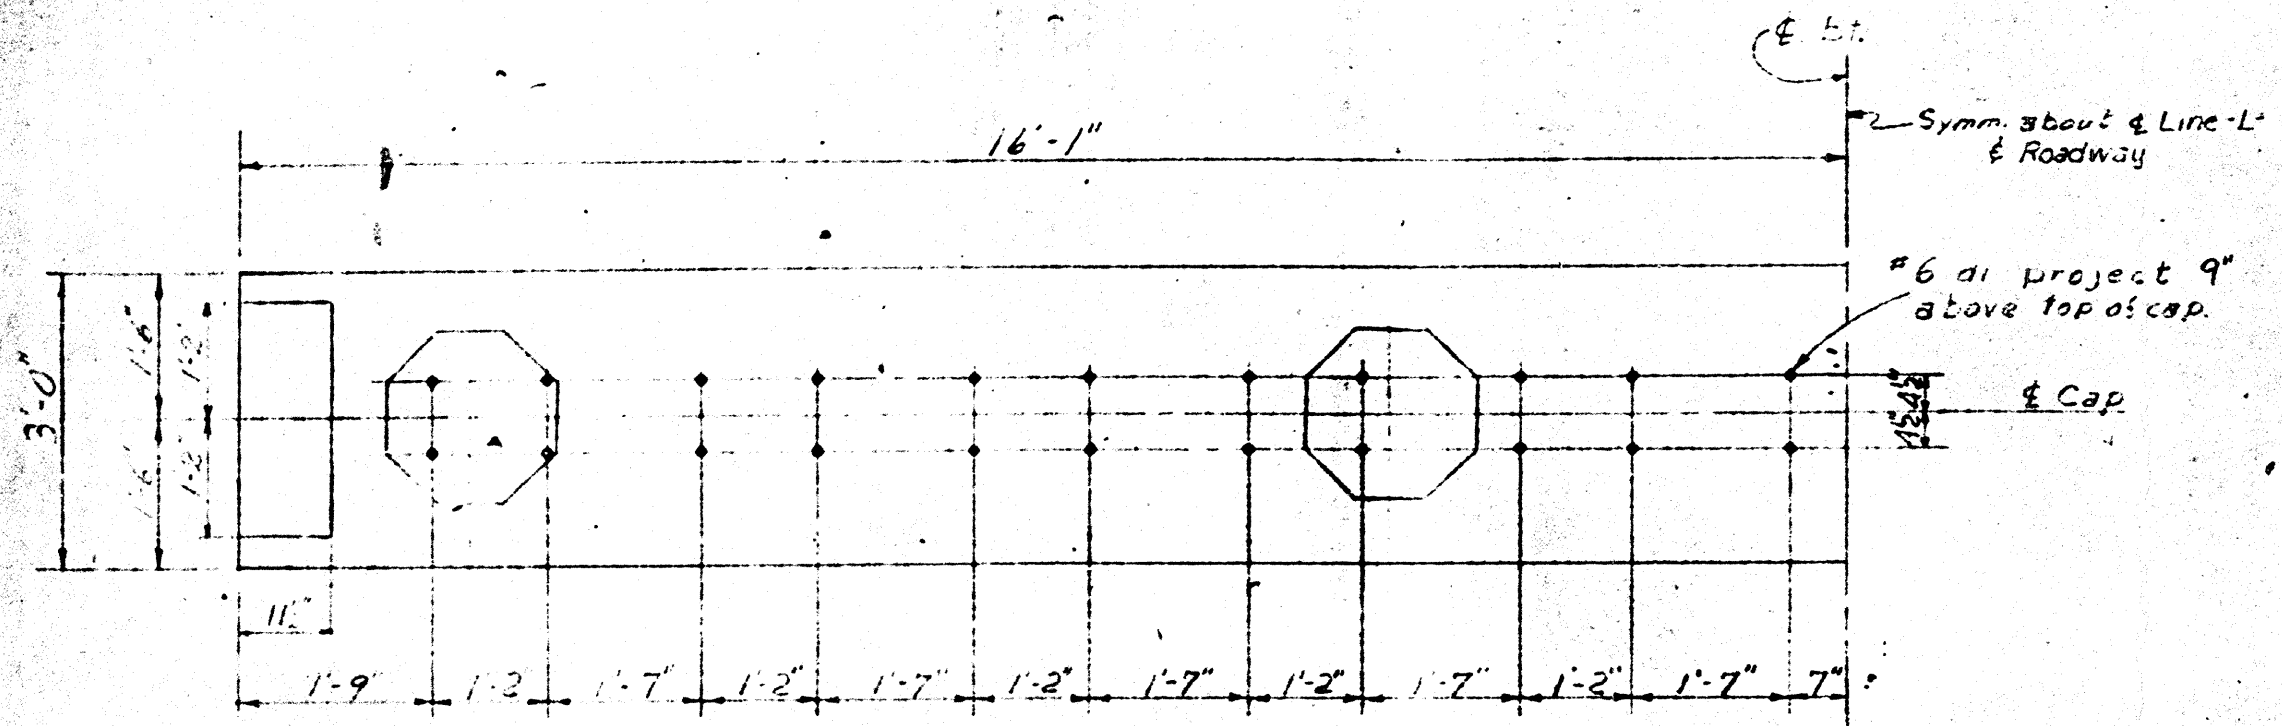


BILL OF MATERIAL

For Bent - Term. Required

BAR	NO.	SIZE	TYPE	LENGTH	WEIGHT
b1	6	#10	1	34'-8"	856
b2	4	#11	str	31'-8"	673
b3	12	#4	str	16'-7"	138
b4	20	#4	str	2'-8"	36
b5	8	#4	5	8'-7"	46
b6	2	#9	3	8'-0"	54
s1	26	#4	4	7'-2"	133
s2	26	#4	2	3'-5"	59
s3	4	#4	3	6'-0"	16
s4	44	#6	Str	7'-6"	99

NOTE: This Block to be poured after Superstructure Sals are in place.

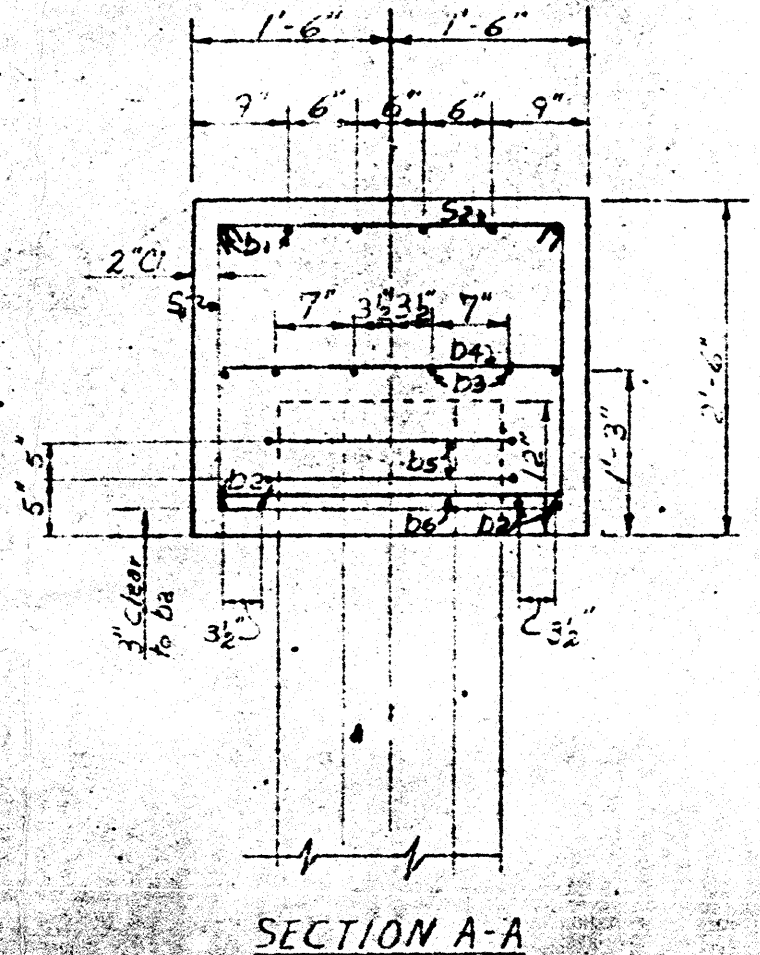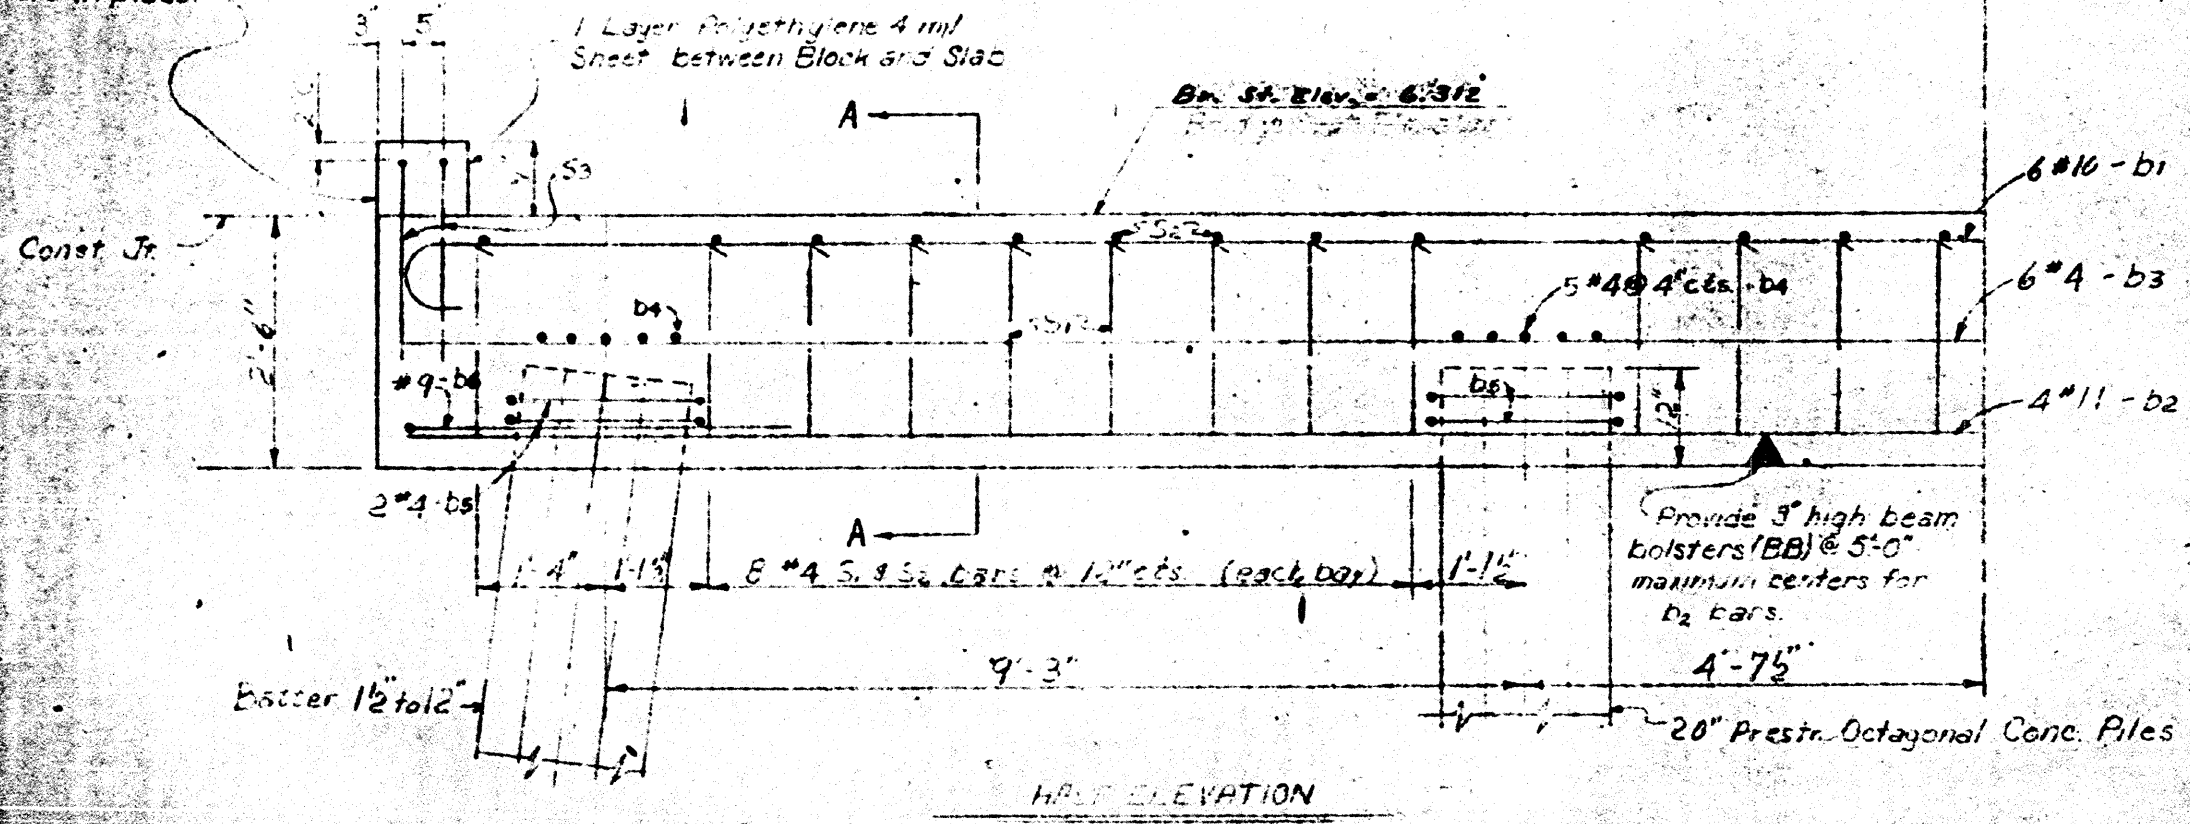

SECTION A-A

20" OCT. PRES. CONC. PILES		
BENT NO.	NO.	LIQ. FT.
1	4	220 192.0
2	4	220 192.0
3	4	220 192.0
5	4	220 192.0
6	4	220 192.0
7	4	220 192.0
8	4	220 192.0
10	4	220 192.0
11	4	220 192.0
12	4	220 192.0

* Note: Test piles driven in place. Prior agreement documented by letter dated 3-3-70 from Mr. L.C. Dillard

NOTES:

For Neoprene pads on bent caps, see Superstructures.
For Method D, dampproofing on piles, see Standard 20" prestressed Octagonal Concrete Pile Sheet

Built according to plans
See Pay Record Book No 2 pages 78, 9, 11-14, 16-18, 51

PROJECT No. 6-201771
CARTERET COUNTY
STATION: 131+76.46-65

STATE OF NORTH CAROLINA
STATE HIGHWAY COMMISSION
RALEIGH
SUBSTRUCTURE PILE BENTS 10
1, 2, 3, 5, 6, 7, 8, 10, 11, 12

REVISIONS

NO.	BY	DATE	NO.	BY	DATE
1					
2					







BILL OF MATERIAL
FOR ONE PILE - TWO REQUIRED

BAR	NO	SIZE	TYPE	LENGTH	WEIGHT
b1	6	#10	1	34.8	895
b2	4	#11	Str	31.8	673
b3	12	#4	Str	16.7	133
b4	10	#6	1	6.4	95
b5	2	#1	3	2.0	54
b6	20	#4	Str	2.3	36
b7	4	#4	2	5.7	23
S1	26	#4	5	7.9	133
S2	26	#4	4	3.5	59
S3	6	#6	6	16.4	147
b4	4	#4	3	6.0	16
d1	44	#4	Str	1.6	99

Reinforcing Steel (lbs) 2363
Loss & Waste (Cm. Wt.) * 10.6

Octagonal Prest. Conc. Pile
No. (Lbs.)
4 6 2800 2880
9 2 2800 2880

* Concrete displaced by Pile Heads has been deducted.

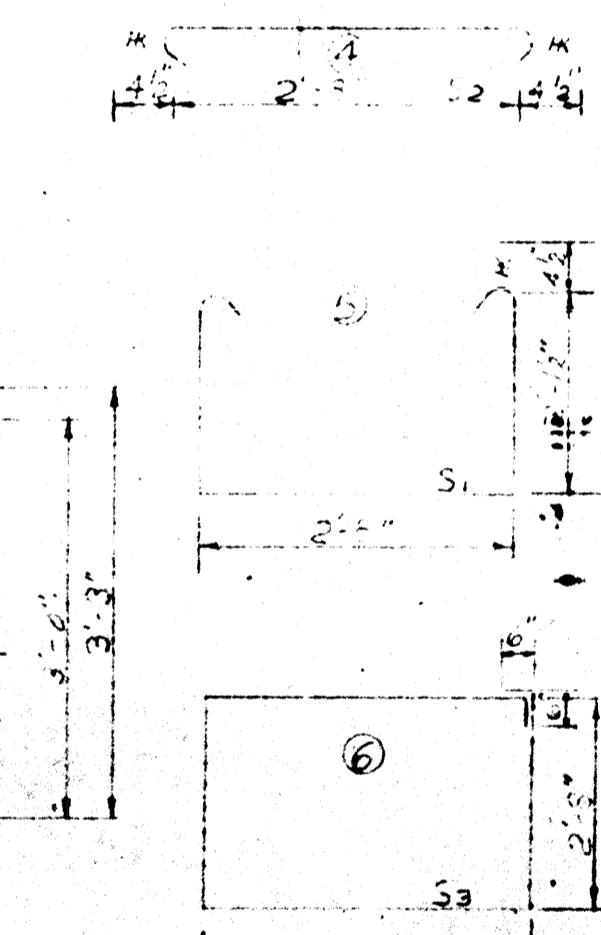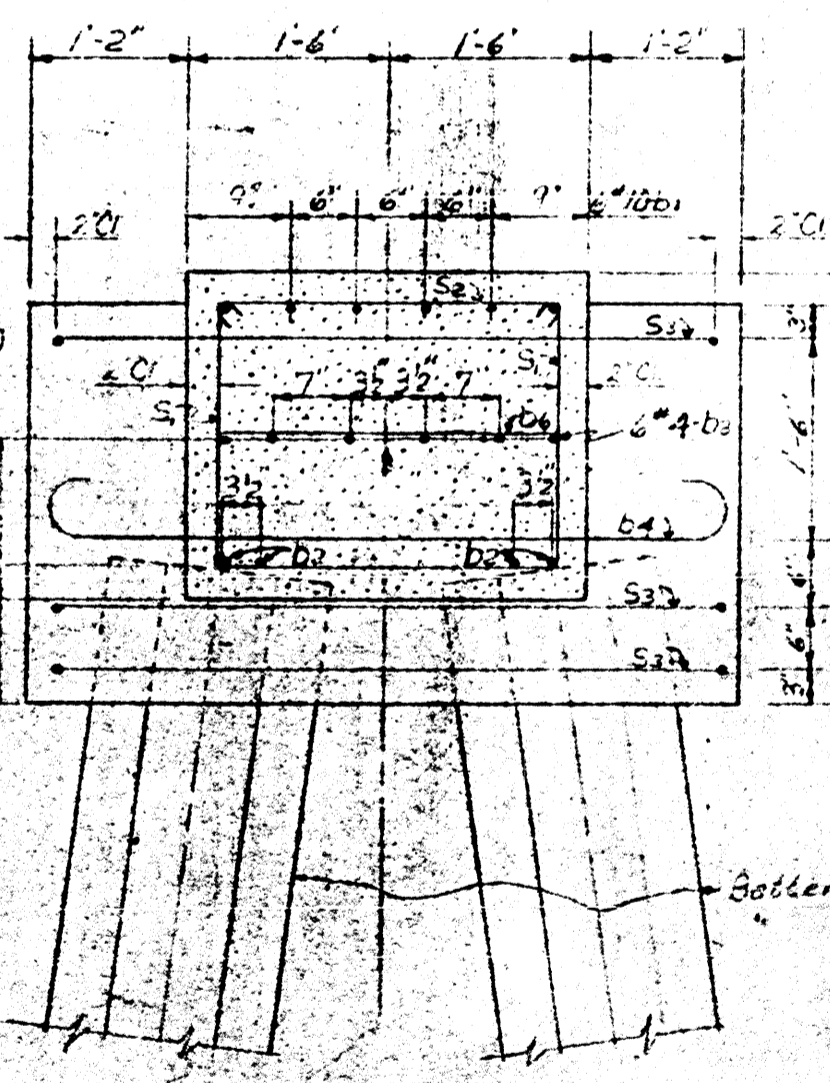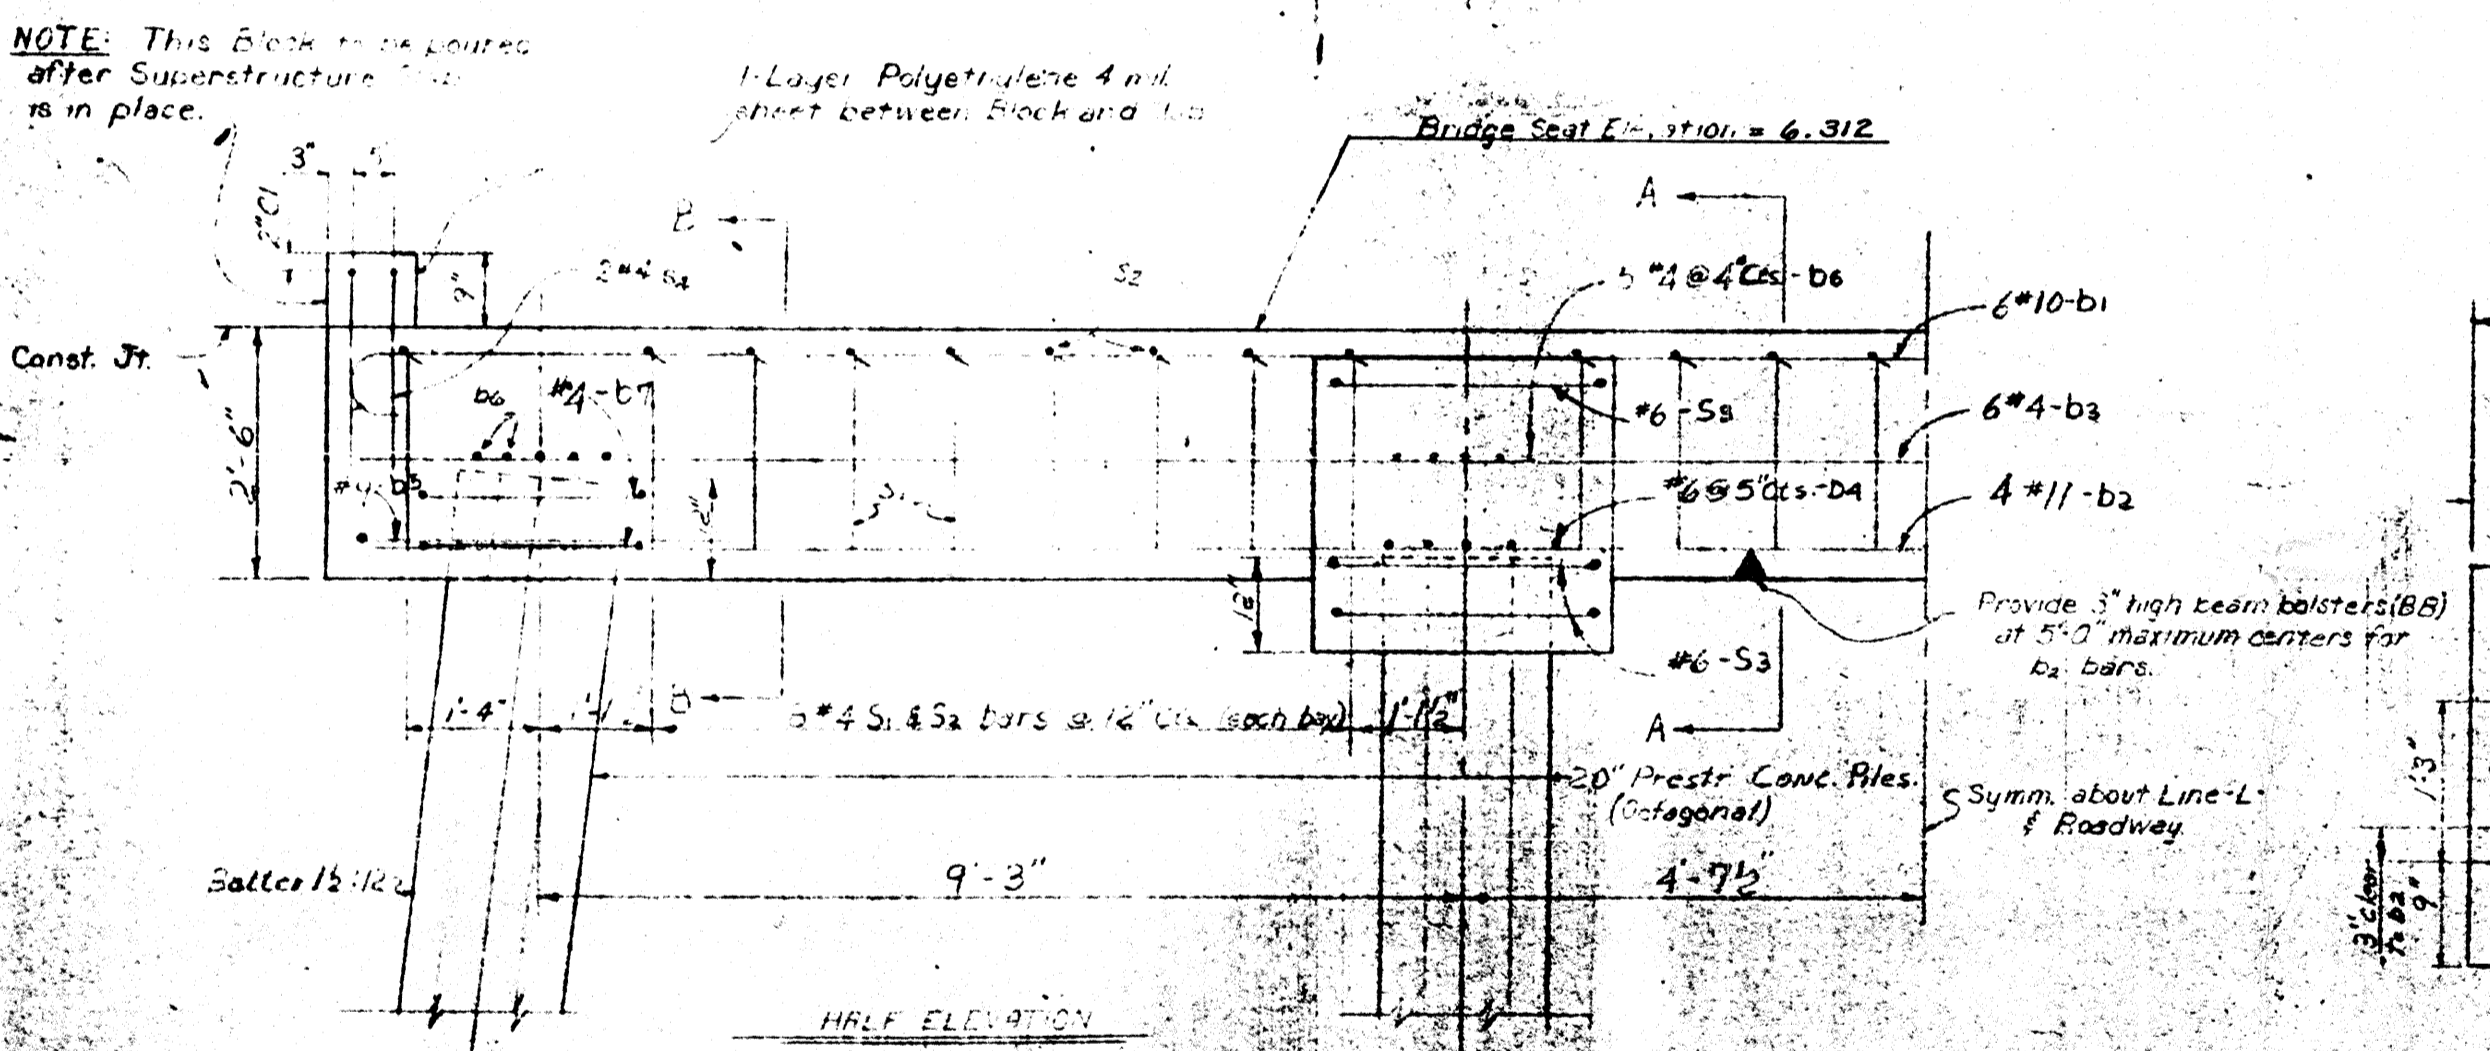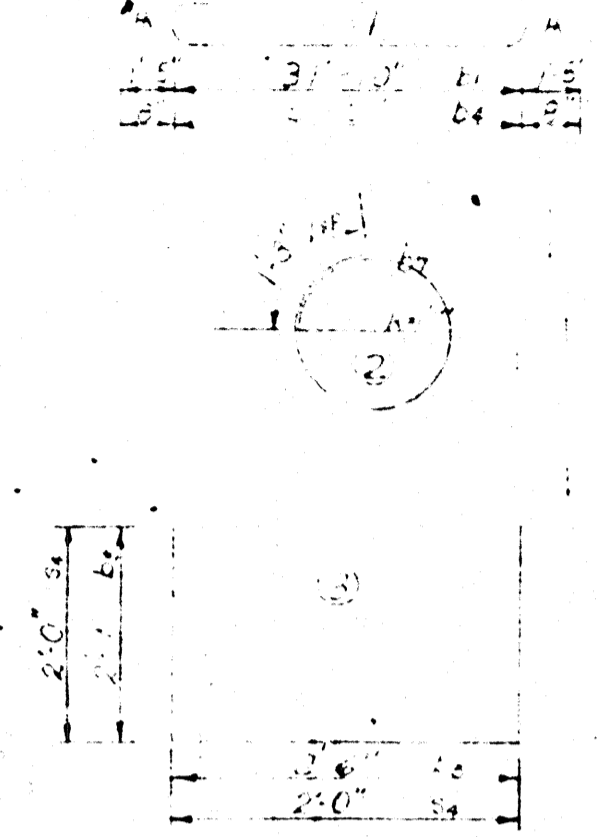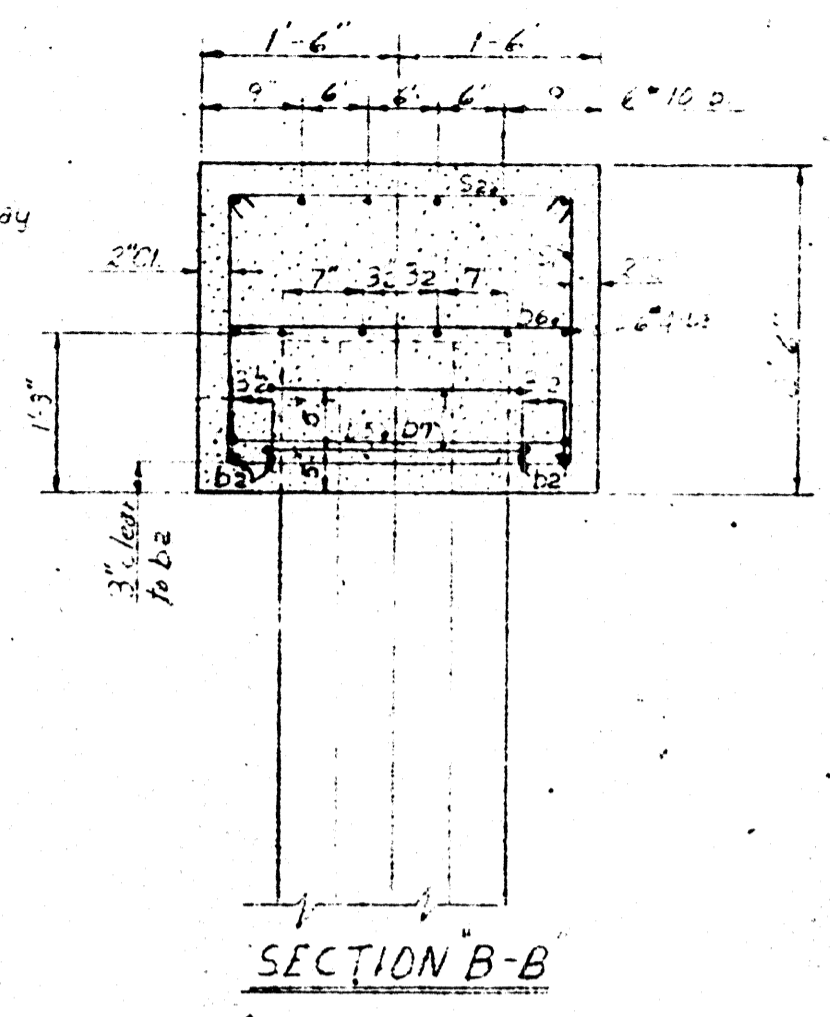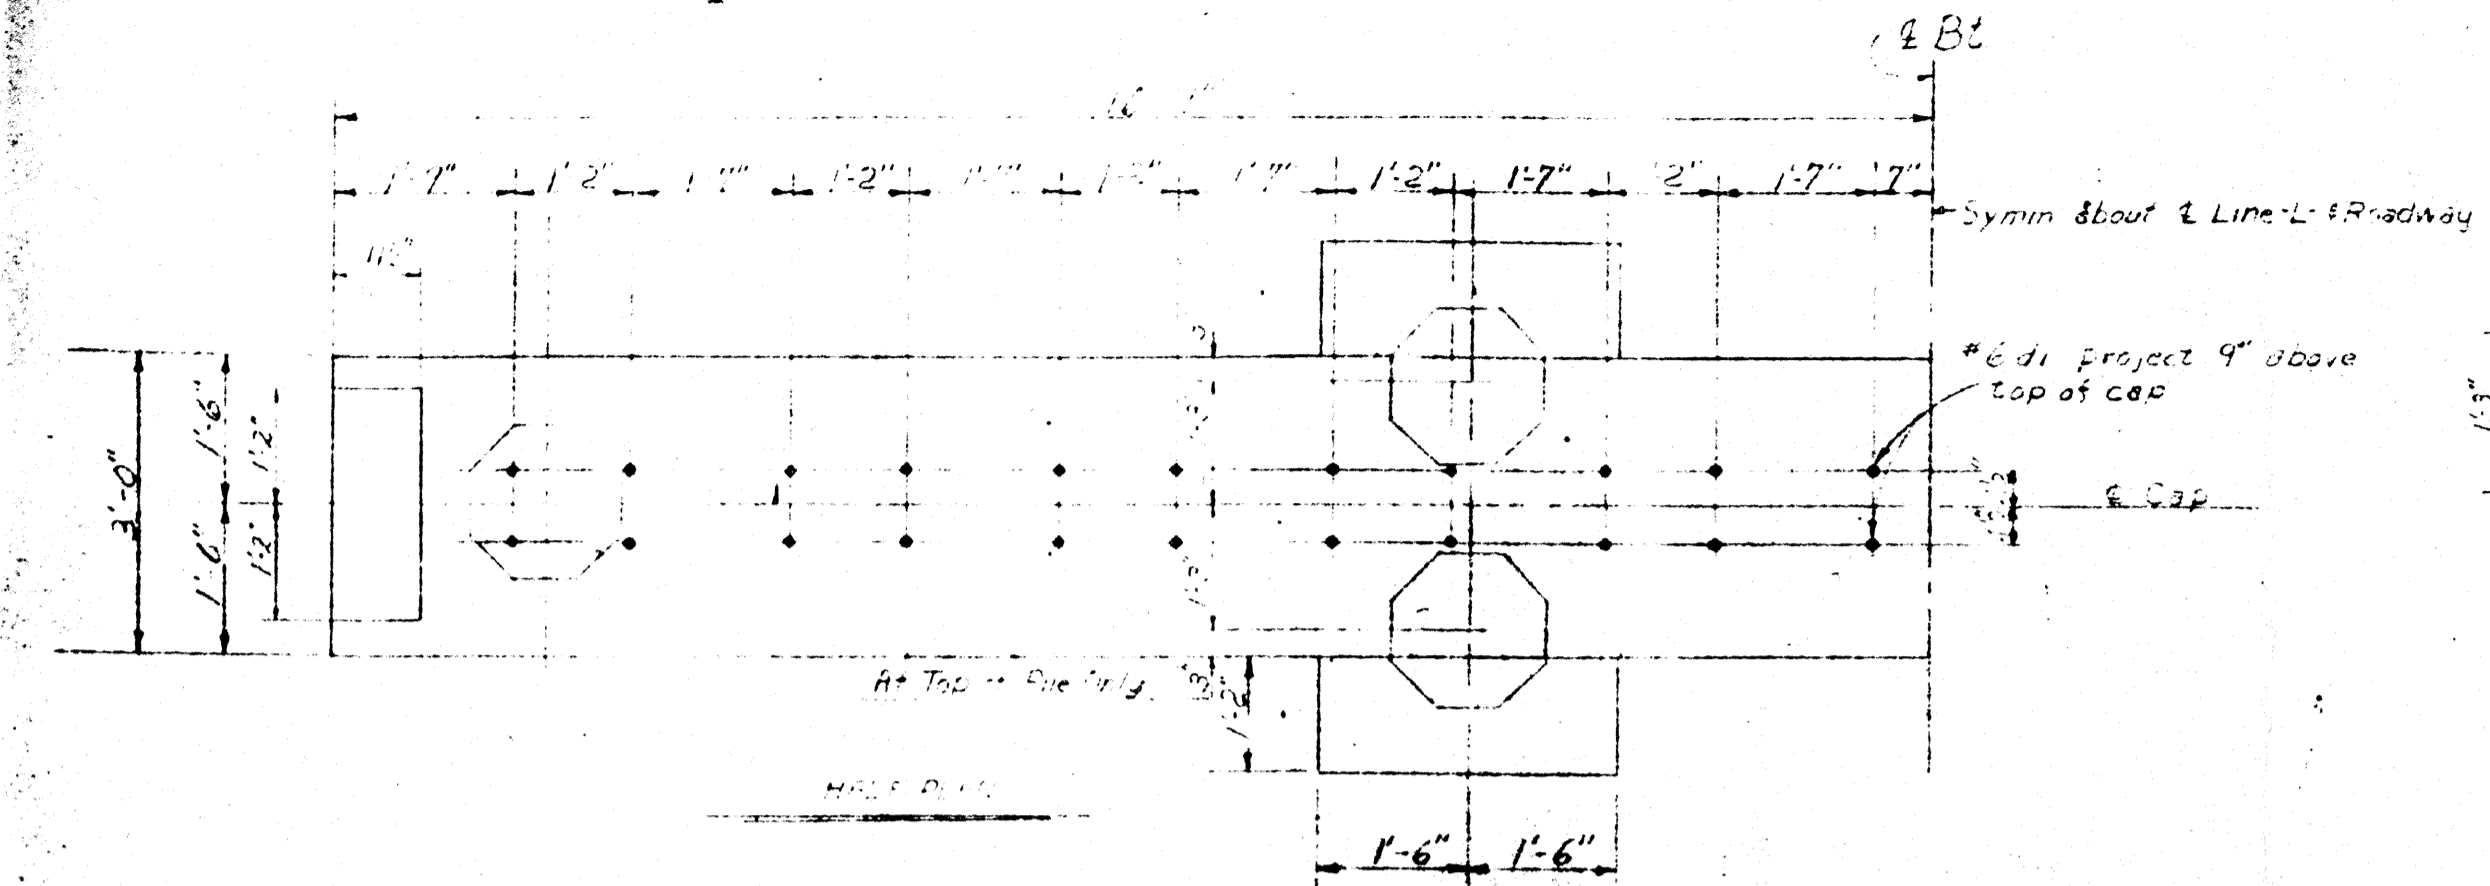

NOTE: This Block to be poured after Superstructure is in place.

1-Layer Polyethylene 4 mil sheet between Block and Cap

Bridge Seat Elevation = 6.312

Provide 3" high beam bolsters (BB) at 5'-0" maximum centers for b2 bars.

Symm. about Line-L & Roadway

NOTES:
For Neoprene pads on bent caps - see Superstructure
For Method "D" casting of piles - see standard 20" prestressed Octagonal Concrete Pile Sheet

Built according to plans
See Pay Record Book No 2 page 10, 15, 51

PROJECT No. 6.801771
CARTERET COUNTY
STATION: 31+76.46 -L-


STATE OF NORTH CAROLINA
STATE HIGHWAY COMMISSION
RALEIGH
SUBSTRUCTURE
FOR PILE NO. 4 & 9
October, 1968

REVISIONS					
NO.	BY	DATE	NO.	BY	DATE
1			2		
2			4		


E.G.A. SEPT 68
Koppel & Underburn 10-3-67
R.B. NEPPED, JR. DATE 2-8-68

NOTES


All prestress strands to be $\frac{3}{8}$ " Stress Relieved Cables. Each cable to be prestressed at 14,000 lbs. Concrete to be 4,000 psi per sq. inch. Prestressed concrete sheet piles shall be manufactured, placed and poured in accordance with the requirements for prestressed concrete piles in Section 207-A of the Specifications.

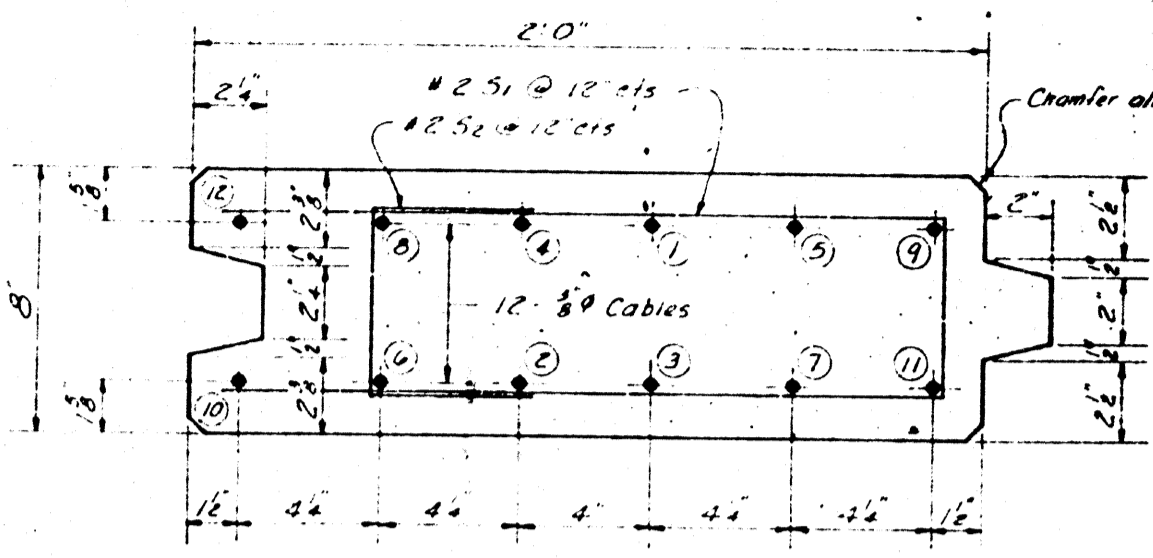

TYPE P1

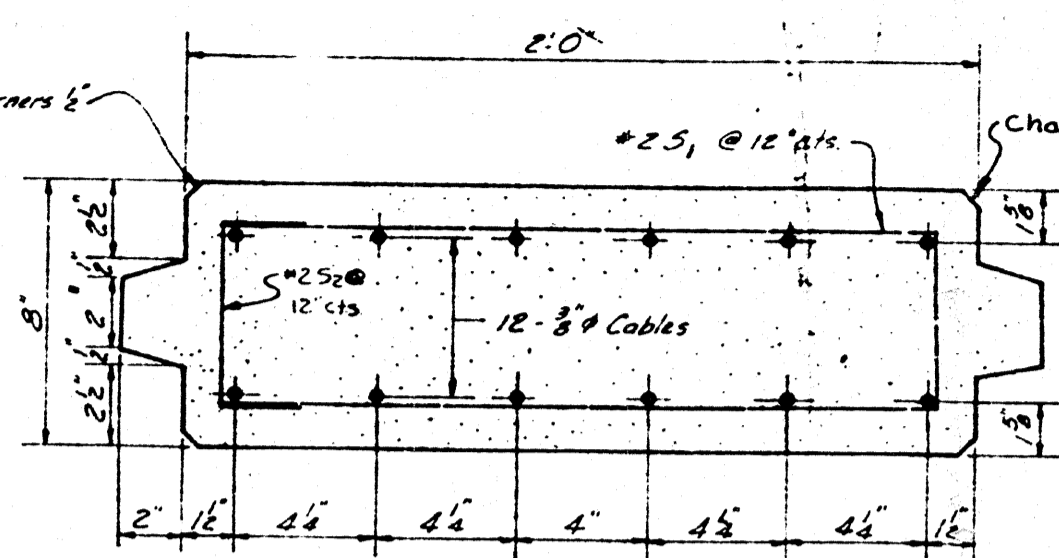


TYPE P2

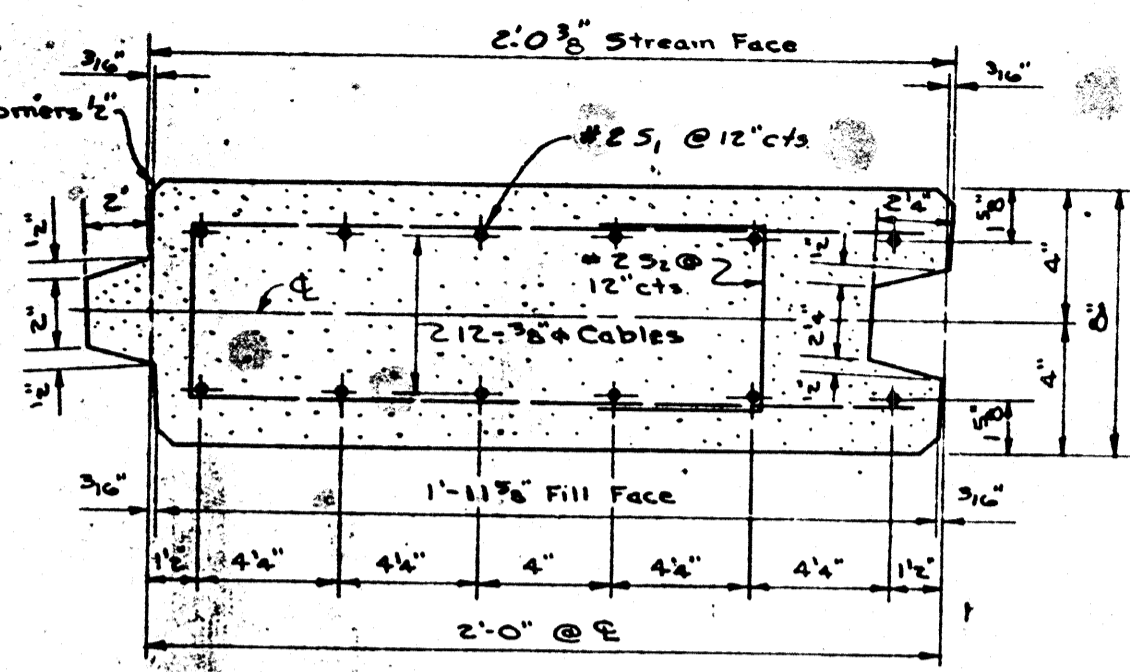

TYPE P3
(Type P4 opposite hand to P3)

○ Denotes criss of turning cables - Cables for all sheet piles P1 & P2 to be released by a similar pattern

This dimension is equal to sheet pile embedment in cap


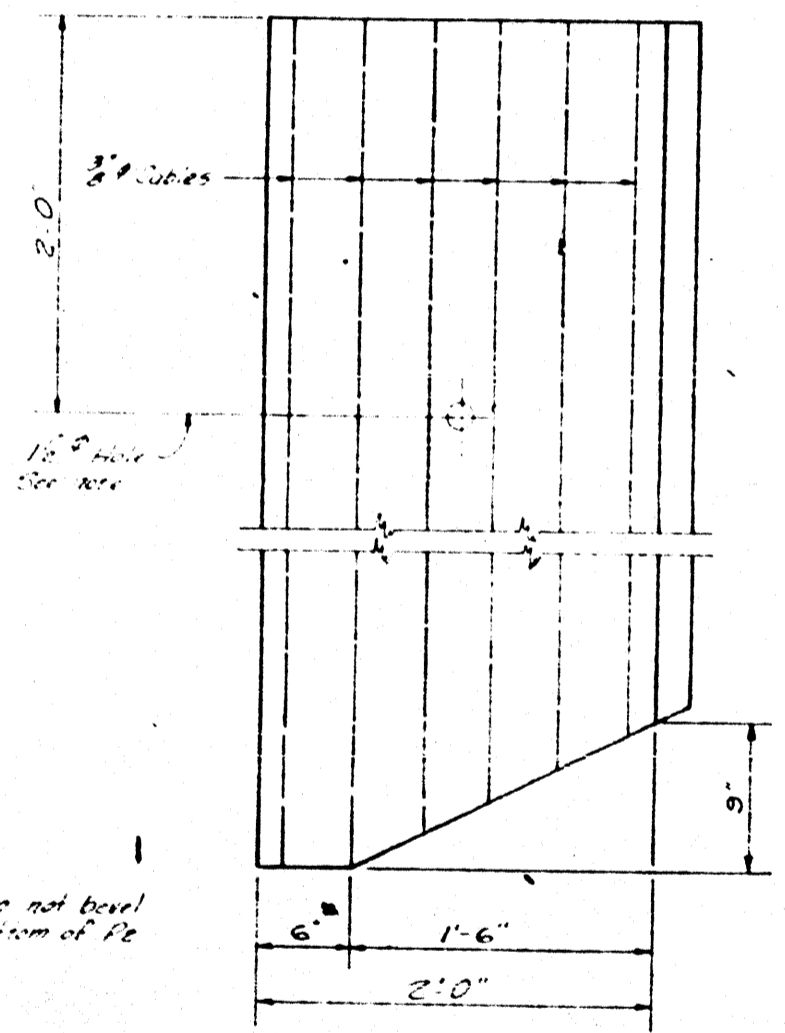


ELEVATION

REINFORCING STEEL FOR ONE SHEET PILE						
BAR	NO.	SIZE	TYPE	LENGTH	WEIGHT	
P1	S1	15	#2	1	4'-2"	10
P1	S2	15	#2	1	1'-6"	4
P2	S1	15	#2	1	4'-2"	10
P2	S2	15	#2	1	1'-6"	4
P3	S1	15	#2	1	4'-2"	10
P3	S2	15	#2	1	1'-6"	4
P4	S1	15	#2	1	4'-2"	10
P4	S2	15	#2	1	1'-6"	4

BAR TYPES
All dimensions are from out to out.

SUMMARY OF PRESTRESSED CONCRETE SHEET PILES					
MARK	NO.	SIZE	LENGTH	LIN. FEET	
BULKHEAD No. 1	P1	17	8'x24"	15'-0"	255'-0"
	P2	1	8'x24"	15'-0"	15'-0"
BULKHEAD No. 2	P2	17	8'x24"	15'-0"	255'-0"
	P2	17	8'x24"	15'-0"	255'-0"
	P2	17	8'x24"	18'-0"	306'-0"
	P2	1	8'x24"	18'-0"	18'-0"
TOTAL LINEAR FEET =				1716'-0"	

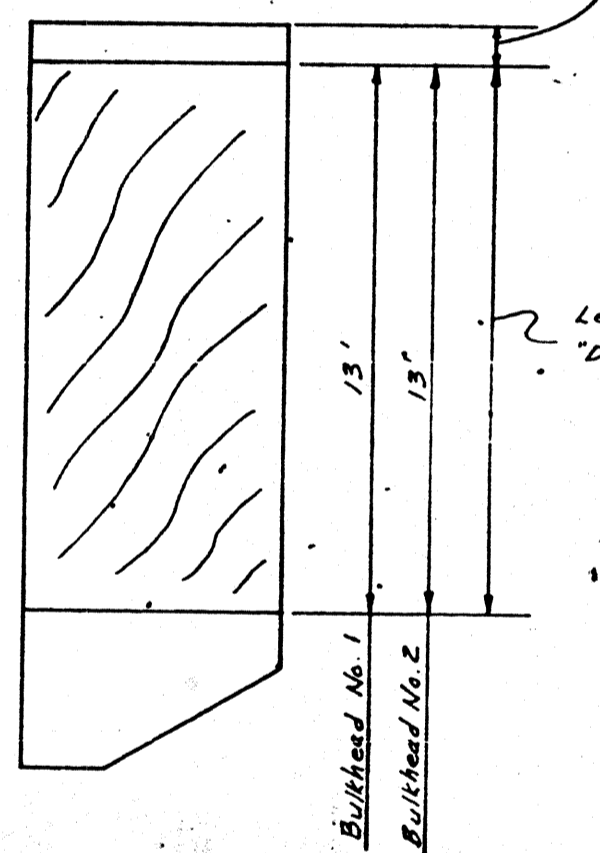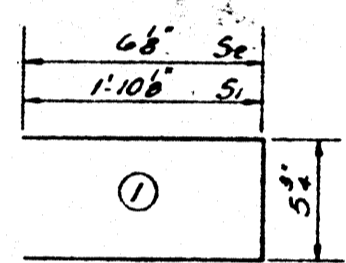

Length of Method "D" Dampproofing

3918.1064
800.5496
4218.6560

Built according to plans
See Pay Record Book No. 2 Page 52.

PRESTRESSED CONCRETE SHEET PILE AREA TO BE DAMPPROOFED

LOCATION	METHOD "D" DAMPPROOFING SQ. YDS.
BULKHEAD No. 1	435 3918.1064 S.F. 435.35 Sq. Yds.
BULKHEAD No. 2	435 3918.1064 S.F. 435.35 Sq. Yds.

PROJECT No. 6.801771
CARTERET COUNTY
STATION: 31+76.46-L

STATE OF NORTH CAROLINA
STATE HIGHWAY COMMISSION
RALEIGH
DETAILS OF 8" x 2'-0"
PRESTR. CONC. SHEET
PILES FOR BULKHEADS

FEBRUARY 1968

REVISIONS				
NO.	BY	DATE	NO.	BY
1	CBT	3-70	1	

Rev. No. 1 - This is a new sheet and represents a revision for Sheet Piles for extending Bulkhead no. 1 & no. 2. This sheet replaces sheet 510.

ASSEMBLED BY C.B. Taylor DATE 3-70
CHECKED BY R.E. Powell DATE 3-70
DRAWN BY S.L. SANTO-TOMAS DATE FEB 1968
ENGINEER BY R.E. Powell DATE FEB 1968

CHECKED BY R.E. Powell DATE 3/70

LOCATION OF SHEET PILES

DETAILS OF SHEET PILES

1 2 3 4 5