



NOTES

Assumed Live Load - H15-S12 (44)  
 For other design data and general note see sheet S-N.  
 Computed foundation load for Bent No. 1, 2 & 3 equals 2 1/2 tons per sq. ft.  
 No test piles are required. Order length shall be 27 ft. for End Bent No. 1 and 21 ft. for End Bent No. 2.  
 Piles for End Bents No. 1 & No. 2 to be driven to a minimum bearing capacity of 30 tons each.  
 Work is not to be started on this bridge until after roadway section has been excavated by the roadway contractor.  
 Unclassified structure excavation for Bents No. 1, 2 & 3 to be measured from surface of cut.  
 Shaded areas to be excavated by the structure contractor. See Special Provisions.  
 Traffic will be detoured over temporary run-around during construction of the proposed structure. See Special Provisions.

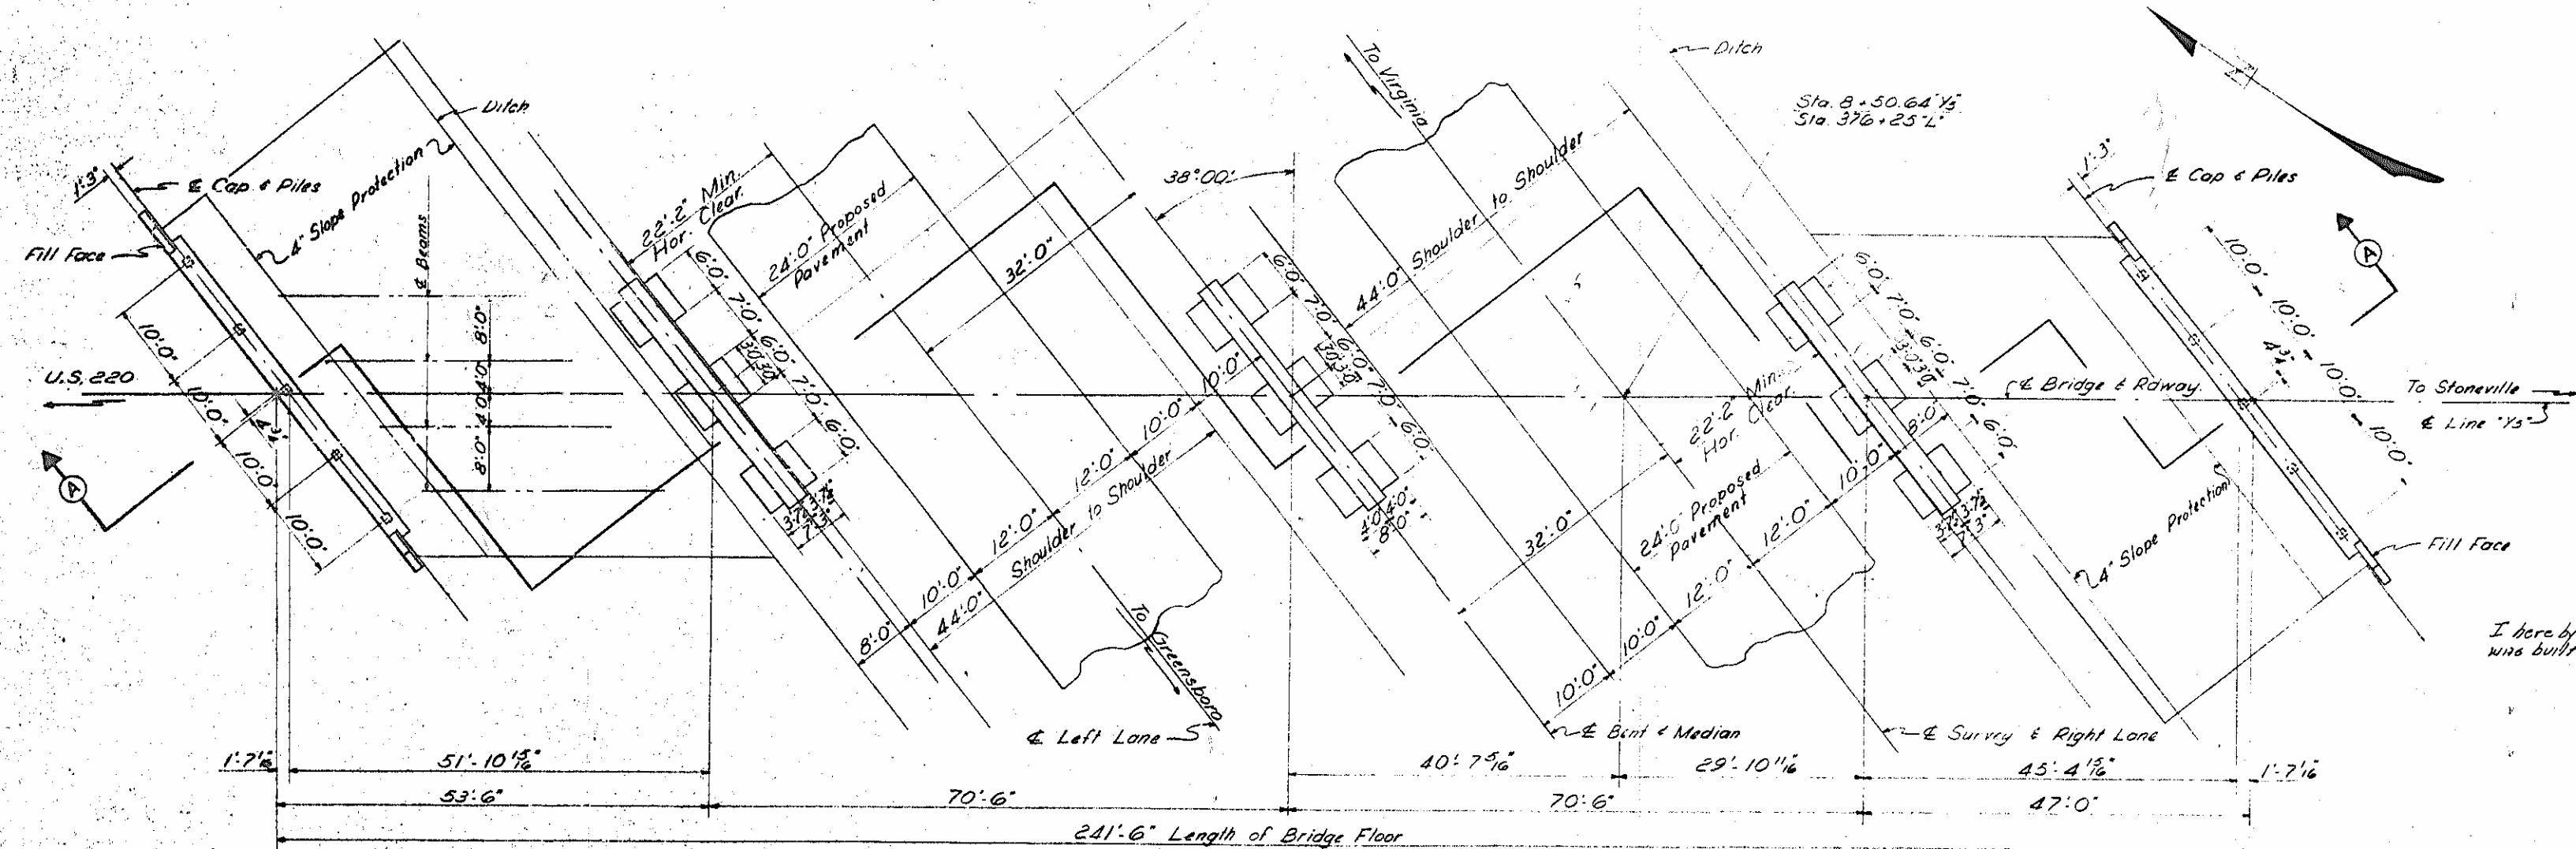

I hereby certify that this structure was built according to plans except noted  
 W.J. Brance  
 Resident Engineer

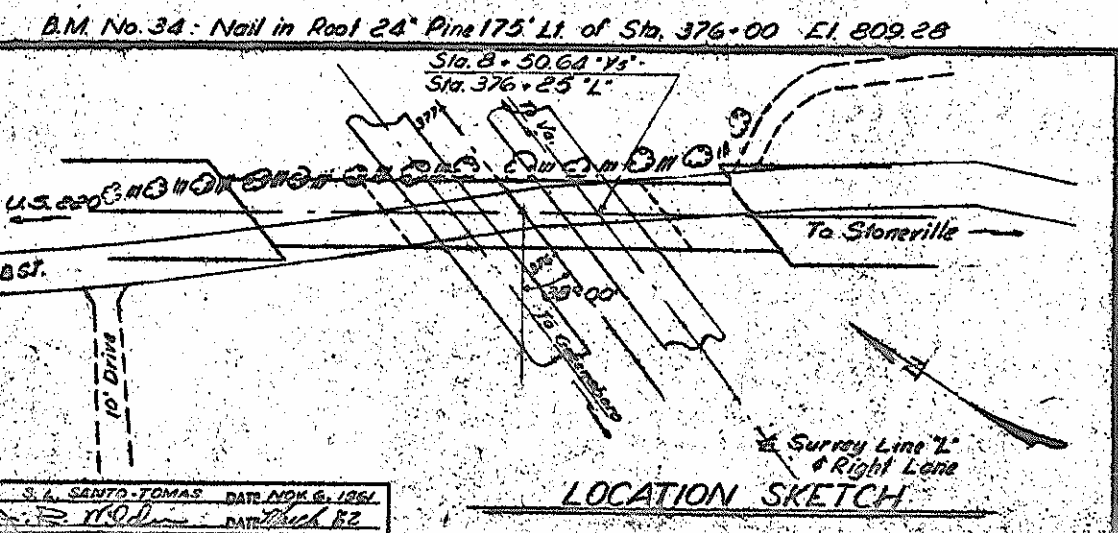








TOTAL BILL OF MATERIAL

|                | Class "A" Concrete Cu. Yds. | Reinforcing Steel Lbs. | 12" Prestr. Conc. Piles No. Lin. Ft. | Structural Steel Approx. Lbs. | Unclassified Struct. Excav. Cu. Yds. | One Bar Alum. Rail Lin. Ft. | 4" Concrete Slope Protec. Sq. Yds. | 4" Conc. Block Slope Protec. Sq. Yds. | 12" Prestr. Conc. Piles Cu. Yds. L.F. |
|----------------|-----------------------------|------------------------|--------------------------------------|-------------------------------|--------------------------------------|-----------------------------|------------------------------------|---------------------------------------|---------------------------------------|
| Superstructure |                             |                        |                                      |                               |                                      |                             |                                    |                                       |                                       |
| Span "A"       | 60.3                        | 11,905                 |                                      | 33,800                        |                                      | 101.83                      |                                    |                                       |                                       |
| Span "B"       | 66.9                        | 14,242                 |                                      | 52,200                        |                                      | 141.00                      |                                    |                                       |                                       |
| Span "C"       | 66.9                        | 14,242                 |                                      | 52,200                        |                                      | 141.00                      |                                    |                                       |                                       |
| Span "D"       | 53.7                        | 10,551                 |                                      | 23,700                        |                                      | 88.83                       |                                    |                                       |                                       |
| End Bent No. 1 | 14.1                        | 2,739                  | 5                                    | 133                           |                                      |                             | 340.00                             | 310                                   | 3.0                                   |
| Bent No. 1     | 33.1                        | 5,585                  |                                      |                               |                                      | 40.370                      |                                    |                                       |                                       |
| Bent No. 2     | 33.6                        | 6,066                  |                                      |                               |                                      | 45.518                      |                                    |                                       |                                       |
| Bent No. 3     | 31.7                        | 5,388                  |                                      |                               |                                      | 59.449                      |                                    |                                       |                                       |
| End Bent No. 2 | 14.0                        | 2,730                  | 5                                    | 125                           |                                      |                             | 340.00                             | 253                                   | 4.0                                   |
| Approach Curbs | 3.2                         | 76                     |                                      |                               |                                      |                             |                                    |                                       |                                       |
| TOTALS         | 377.5                       | 73,344                 | 10                                   | 168,900                       | 133.131                              | 472.66                      | 345.500                            | 563                                   | 7.0                                   |



PROJECT No. 815914  
 ROCKINGHAM COUNTY  
 STATION: 8+50.64 Ys  
 376+25 L.

STATE OF NORTH CAROLINA  
 STATE HIGHWAY COMMISSION  
 GENERAL DRAWING  
 FOR BRIDGE OVER RELOC.  
 U.S. 220 ON CO. RD. BETWEEN  
 U.S. 220 & STONEVILLE  
 NOVEMBER, 1961  
 APPROVED BY: [Signature]  
 DATE: [Date]

& 1 1/2 Exp. Jt. @ Bent #1  
 & 1 Exp. Jt. @ Bents #2 & 3

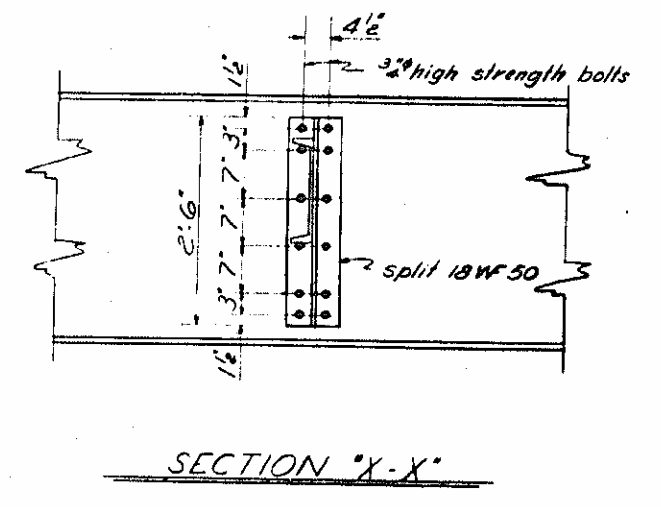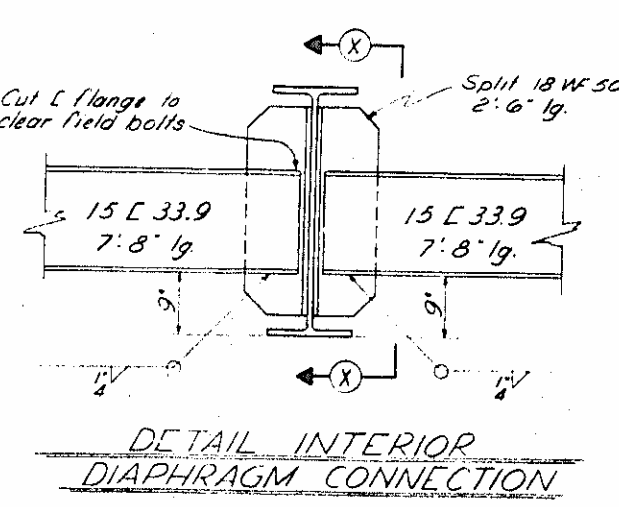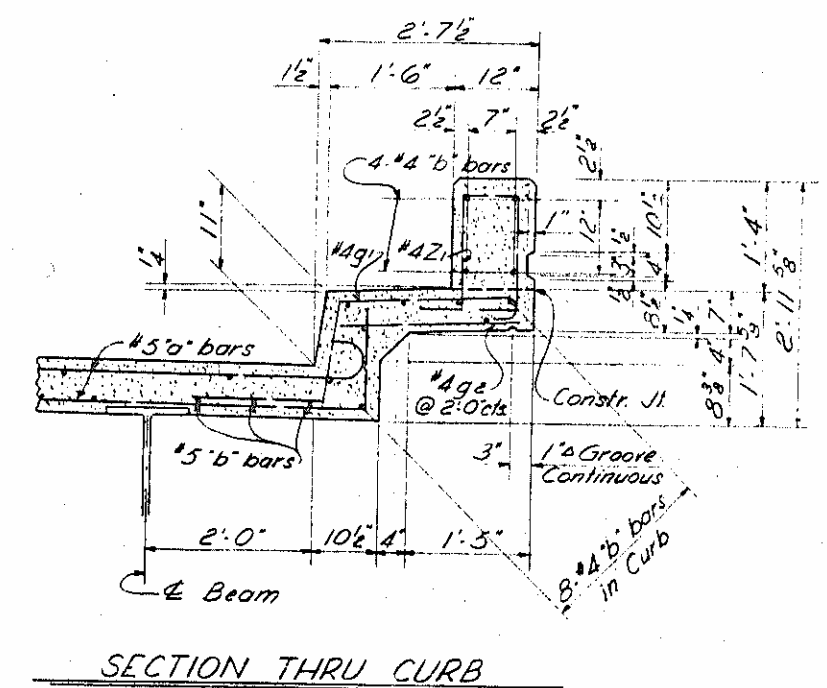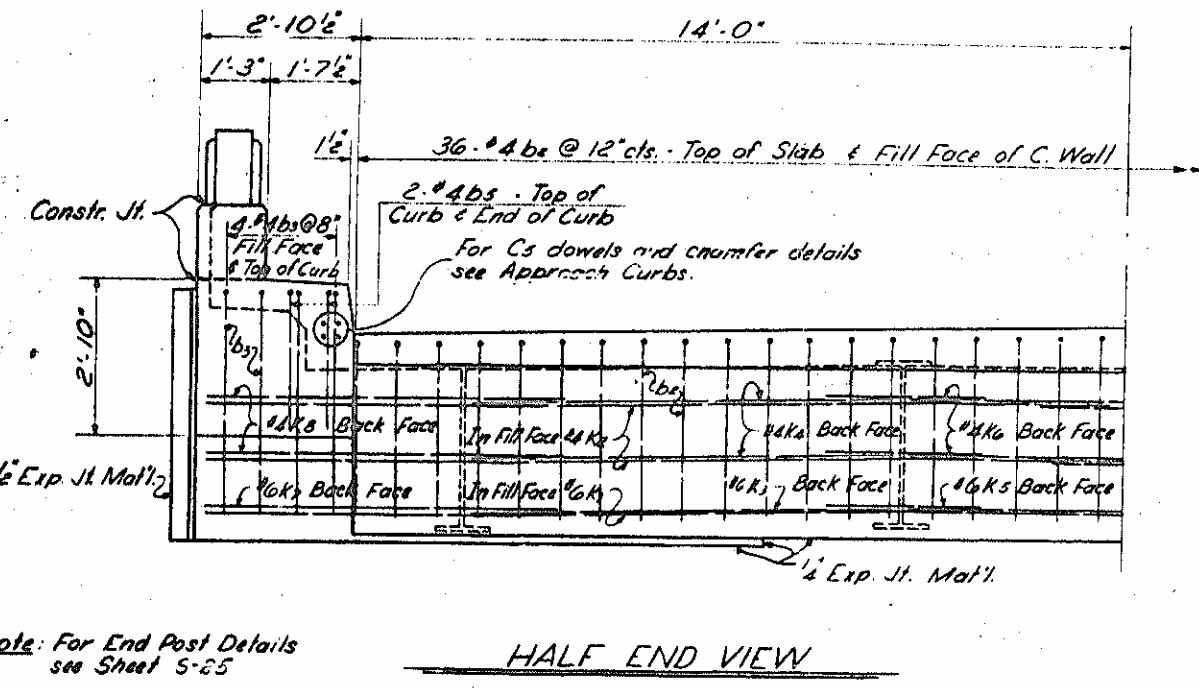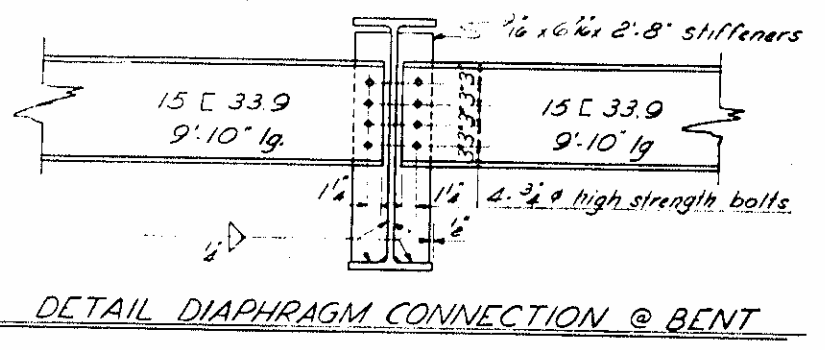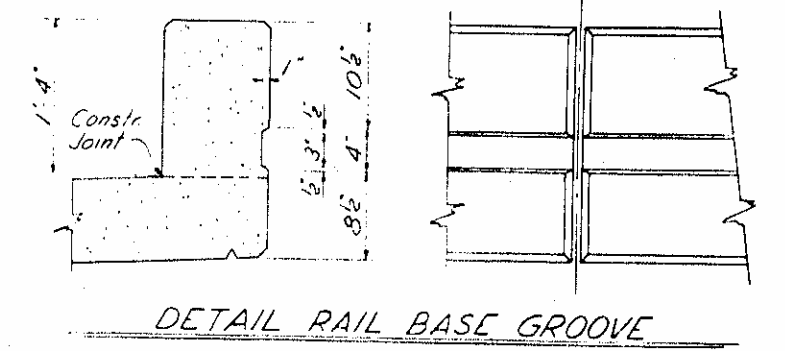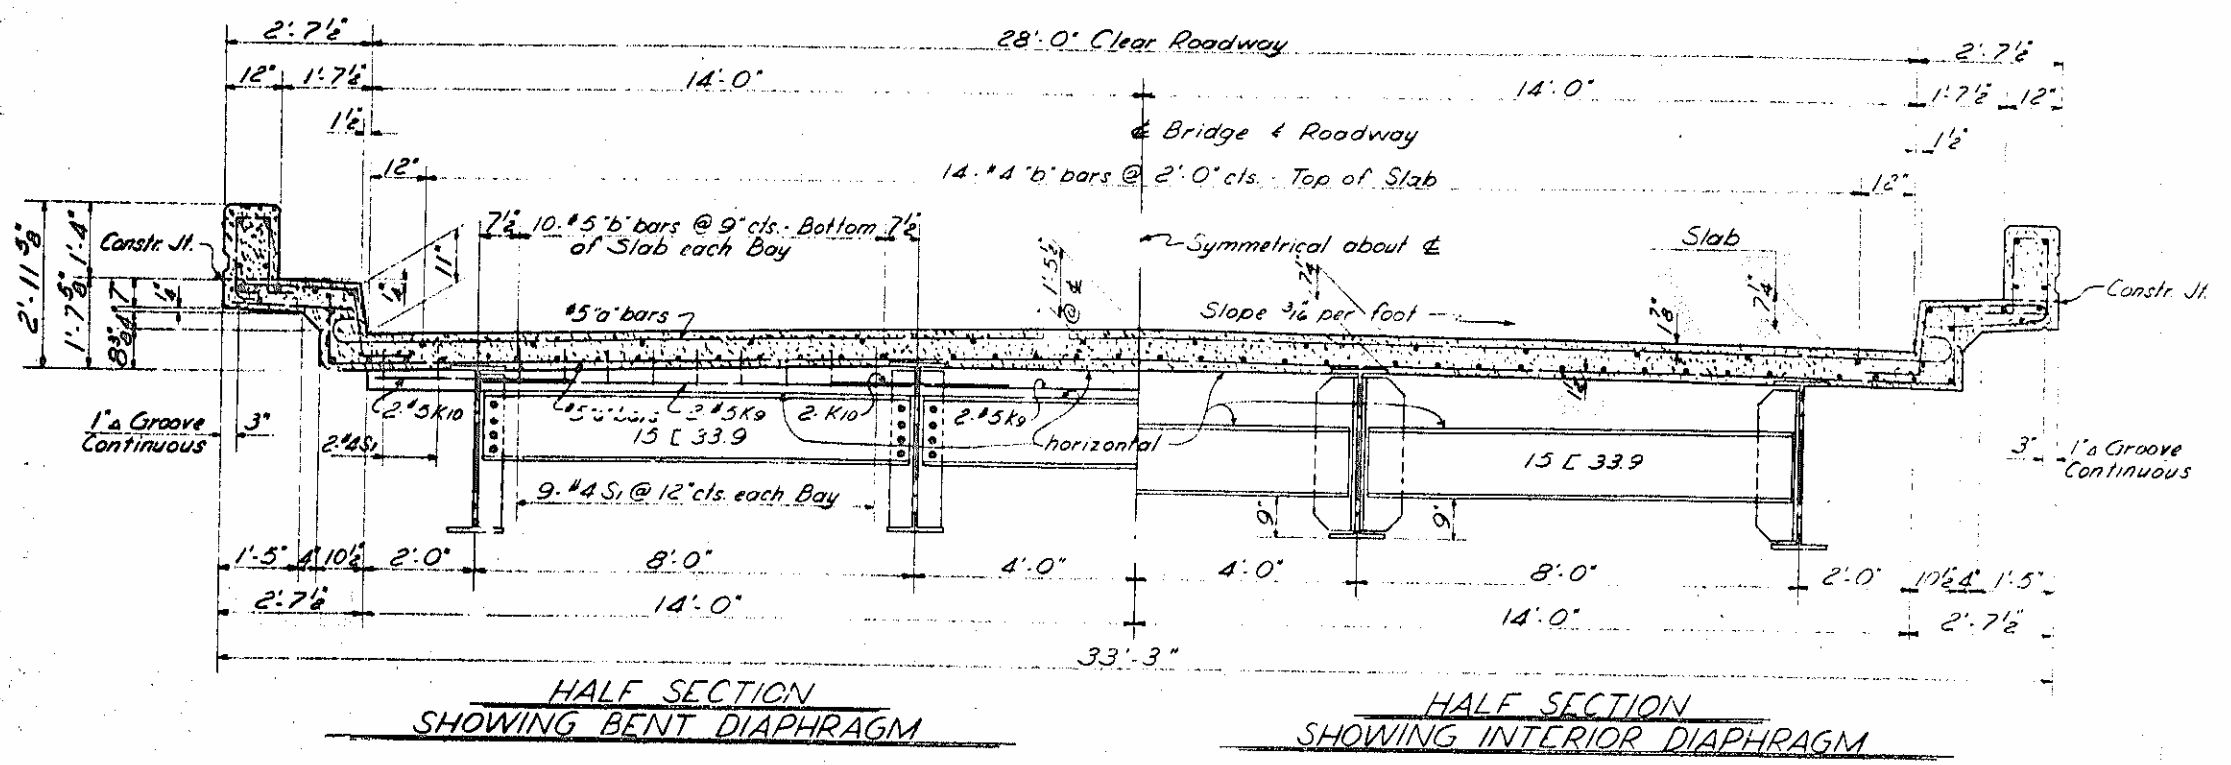


Note: For End Post Details see Sheet S-25

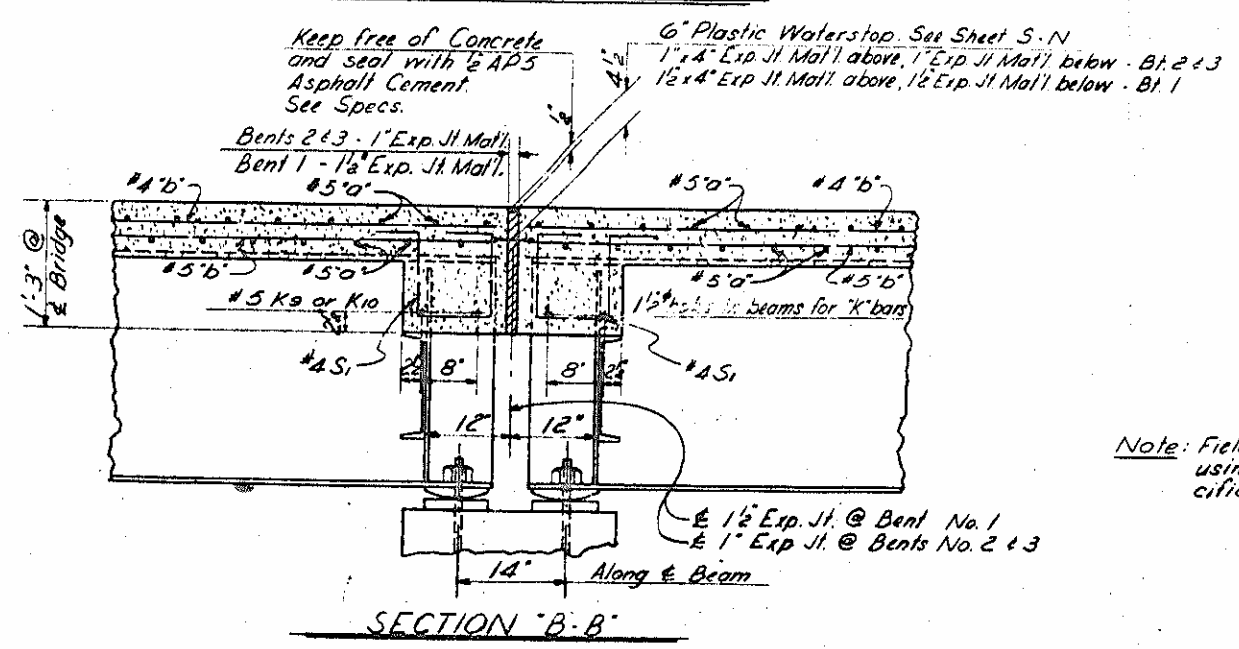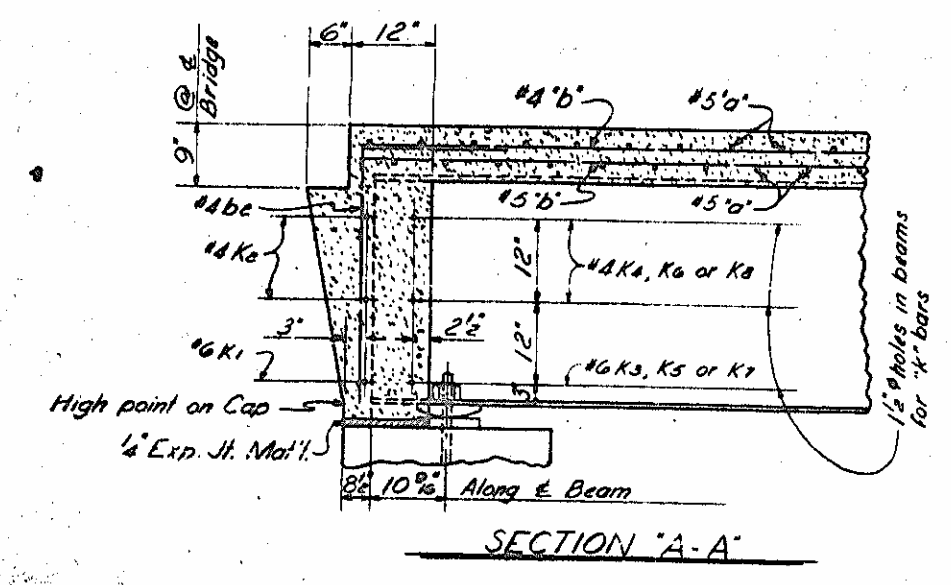

Note: Field connections of diaphragms to beams shall be bolted using 3/4" high strength bolts in accordance with the Specifications and Special Provisions

PROJECT No. 8-15914  
 ROCKINGHAM COUNTY  
 STATION: 8+50.64 "Ys"  
 376+25 "L"

STATE OF NORTH CAROLINA  
 STATE HIGHWAY COMMISSION  
 SUPERSTRUCTURE  
 SECTIONS & DETAILS  
 OCTOBER 1961

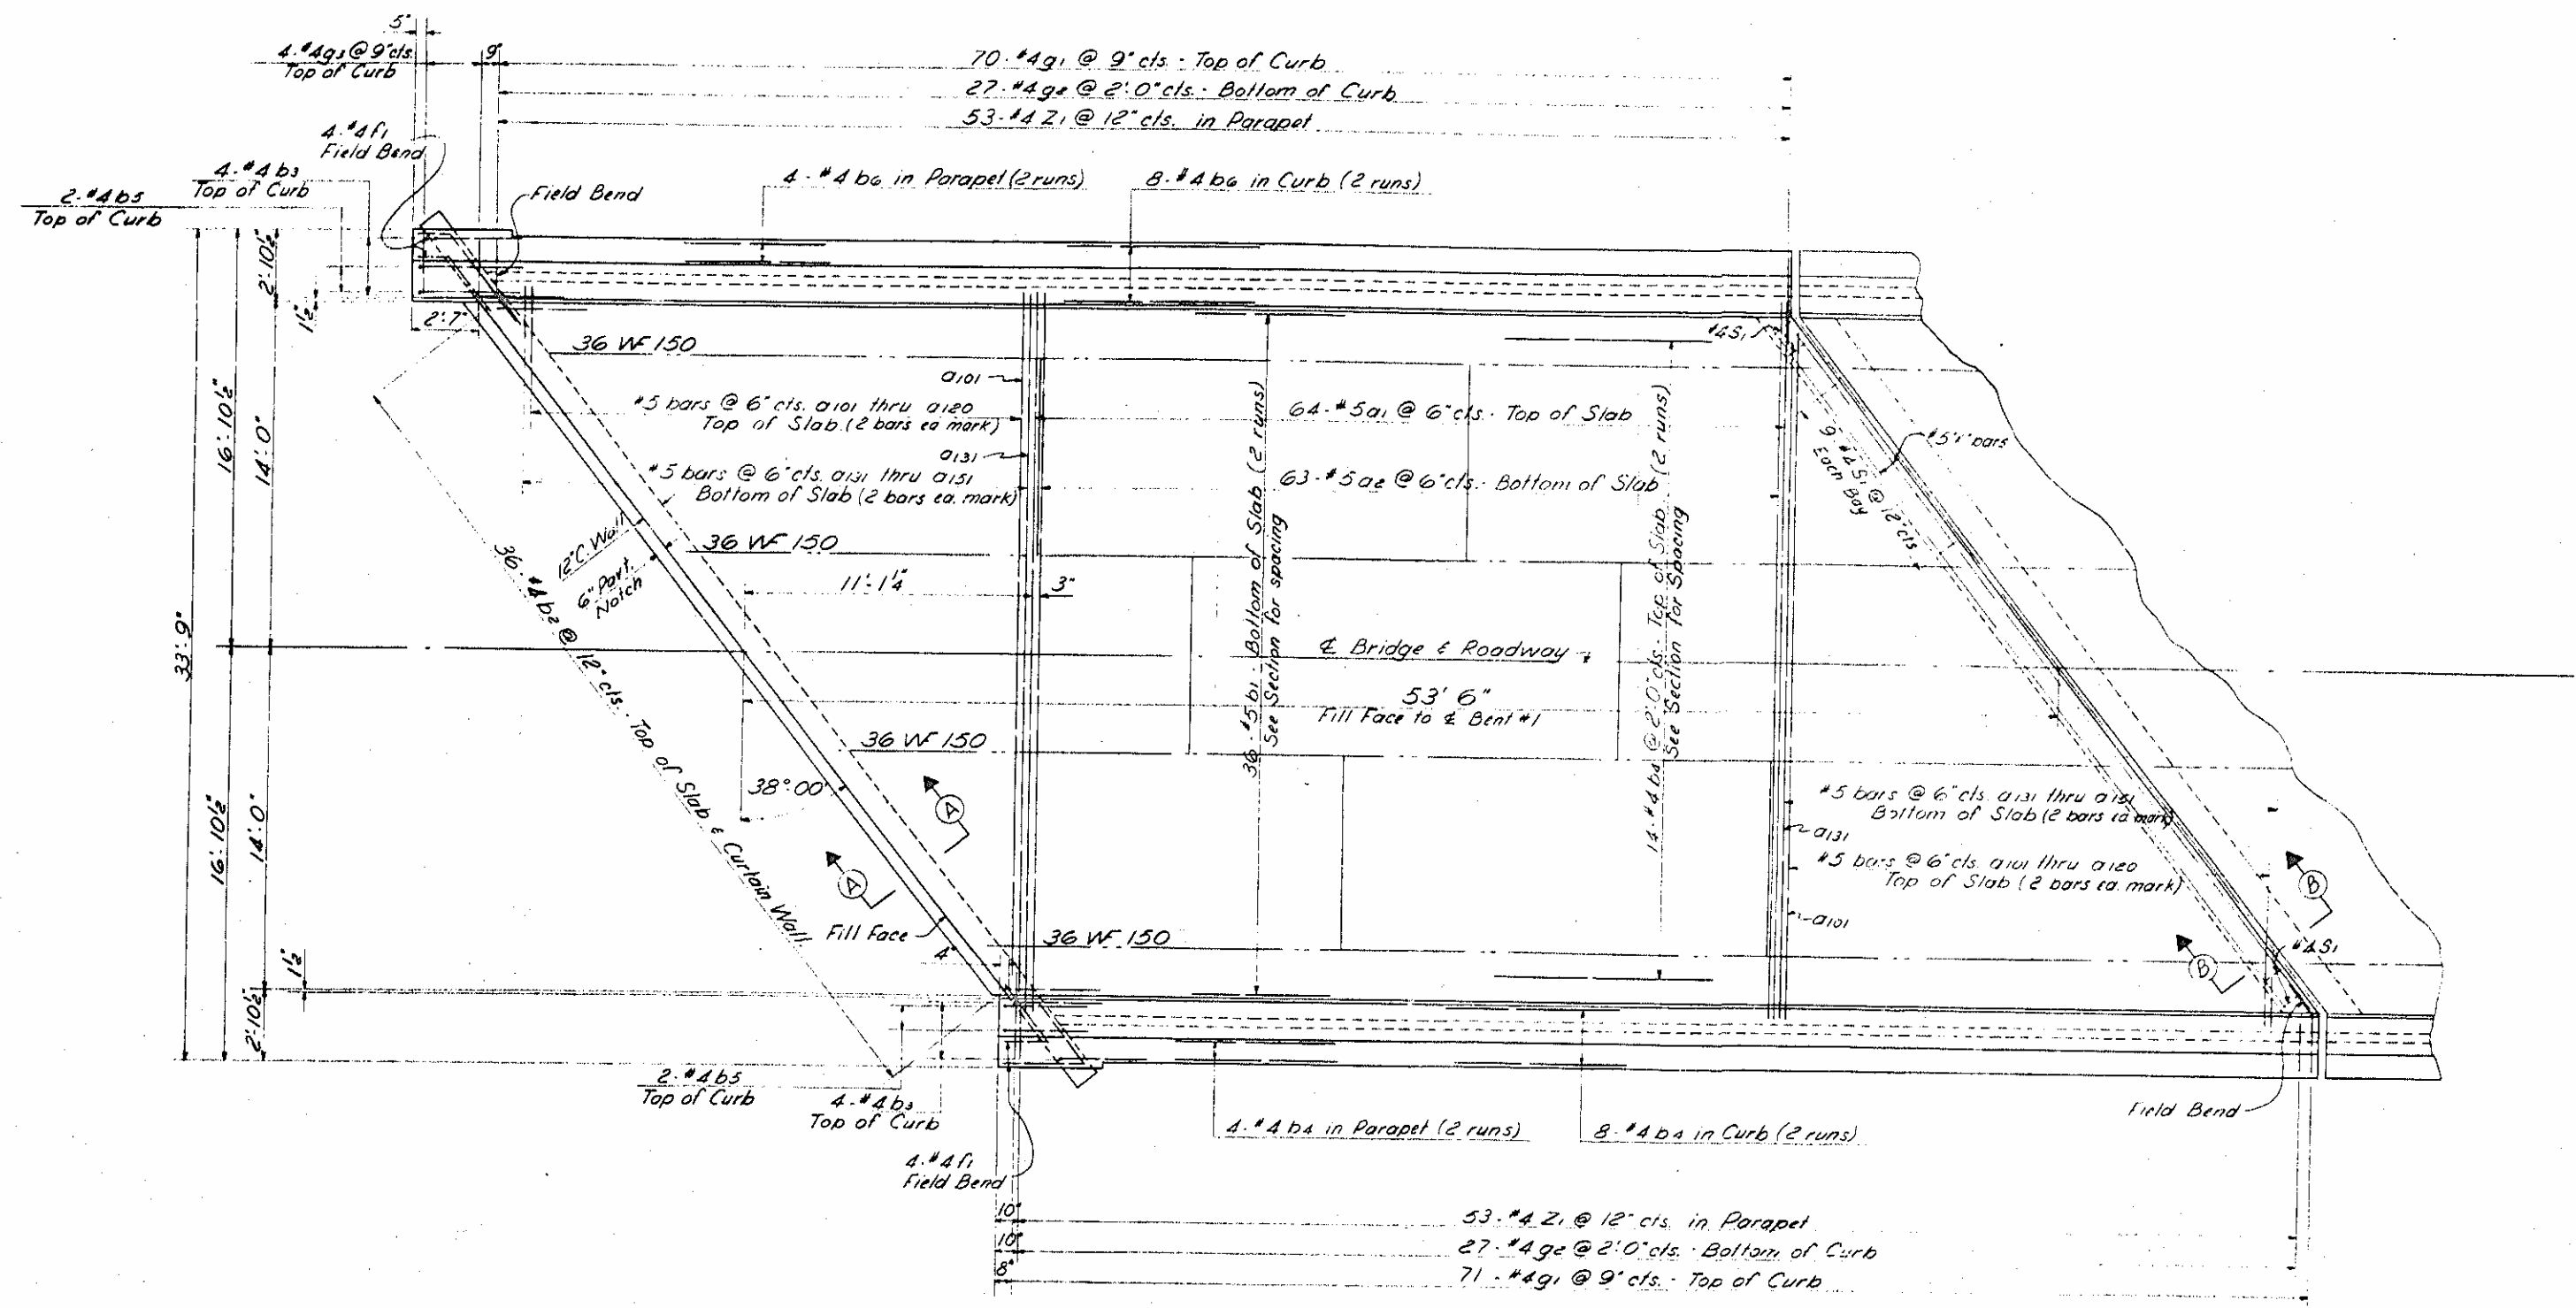


PLAN

PROJECT No. 8 1591A  
 ROCKINGHAM COUNTY  
 STATION: 8+50.64 'YS'  
 376+25 'L'

|           |      |    |
|-----------|------|----|
| REVISIONS | DATE | BY |
|           |      |    |
|           |      |    |
|           |      |    |
|           |      |    |

STATE OF NORTH CAROLINA  
 STATE HIGHWAY COMMISSION  
 SUPERSTRUCTURE  
 SPAN "A"  
 SEPTEMBER 1961

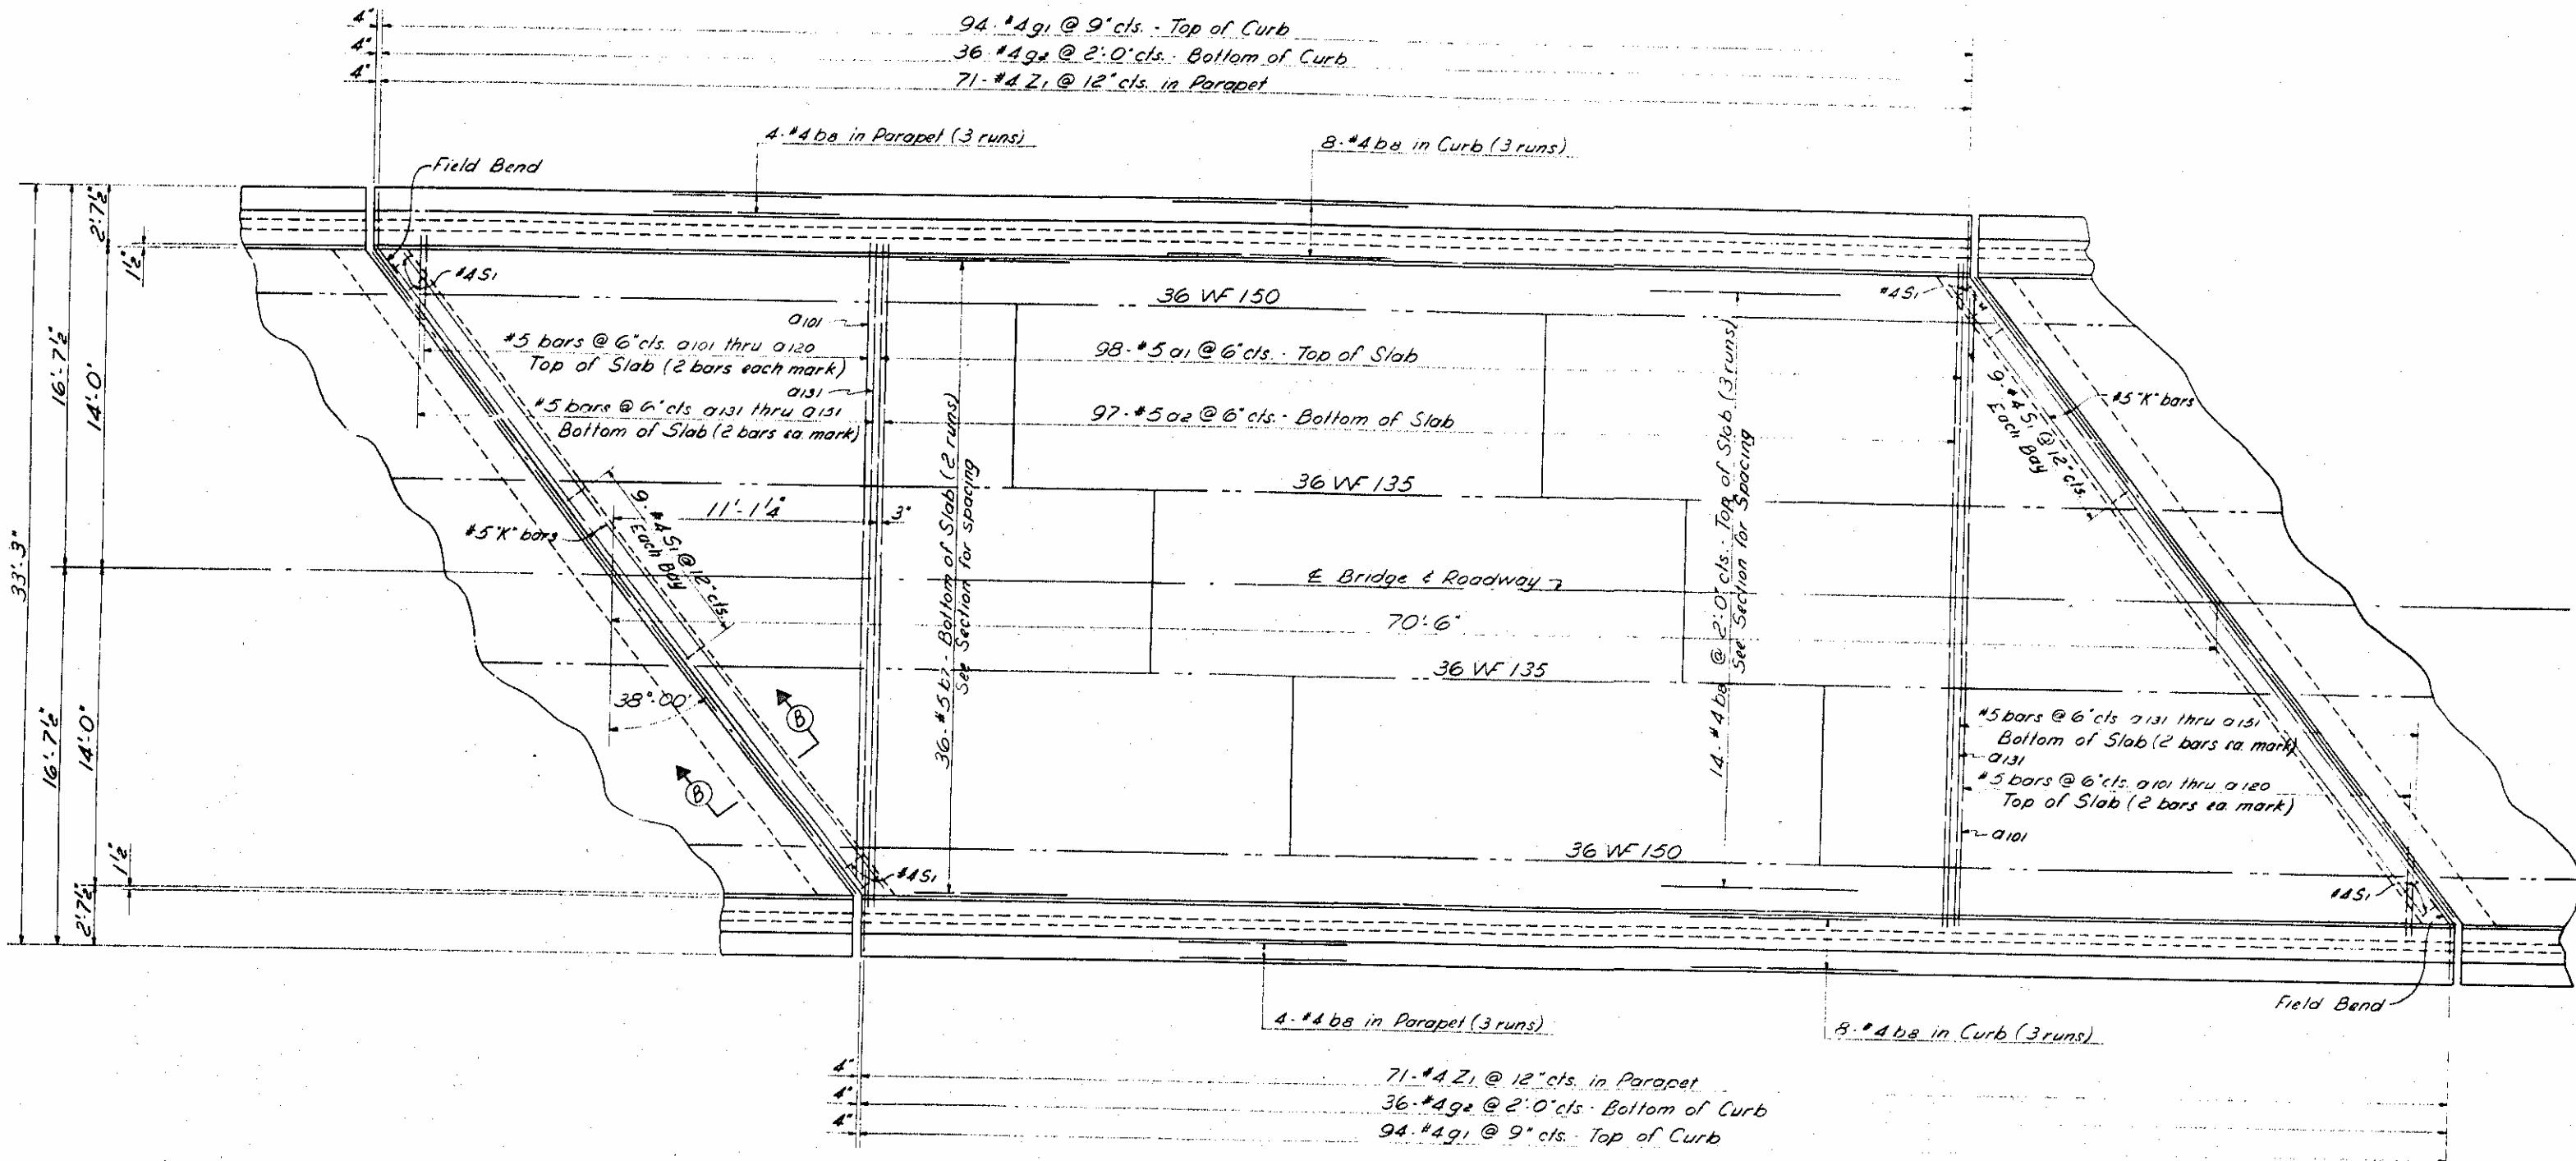


PLAN

PROJECT No. 8.15914  
 ROCKINGHAM COUNTY  
 STATION: 8+50.64 VS  
 376+25 L

|                          |  |
|--------------------------|--|
| STATE OF NORTH CAROLINA  |  |
| STATE HIGHWAY COMMISSION |  |
| SUPERSTRUCTURE           |  |
| SPAN "B" OR "C"          |  |
| SEPTEMBER 1961           |  |

DRAWN BY: S. L. SANTO-TOMAS DATE: SEP 28, 1961  
 CHECKED BY: R. E. NICHOLS DATE: 10 1962

5-21

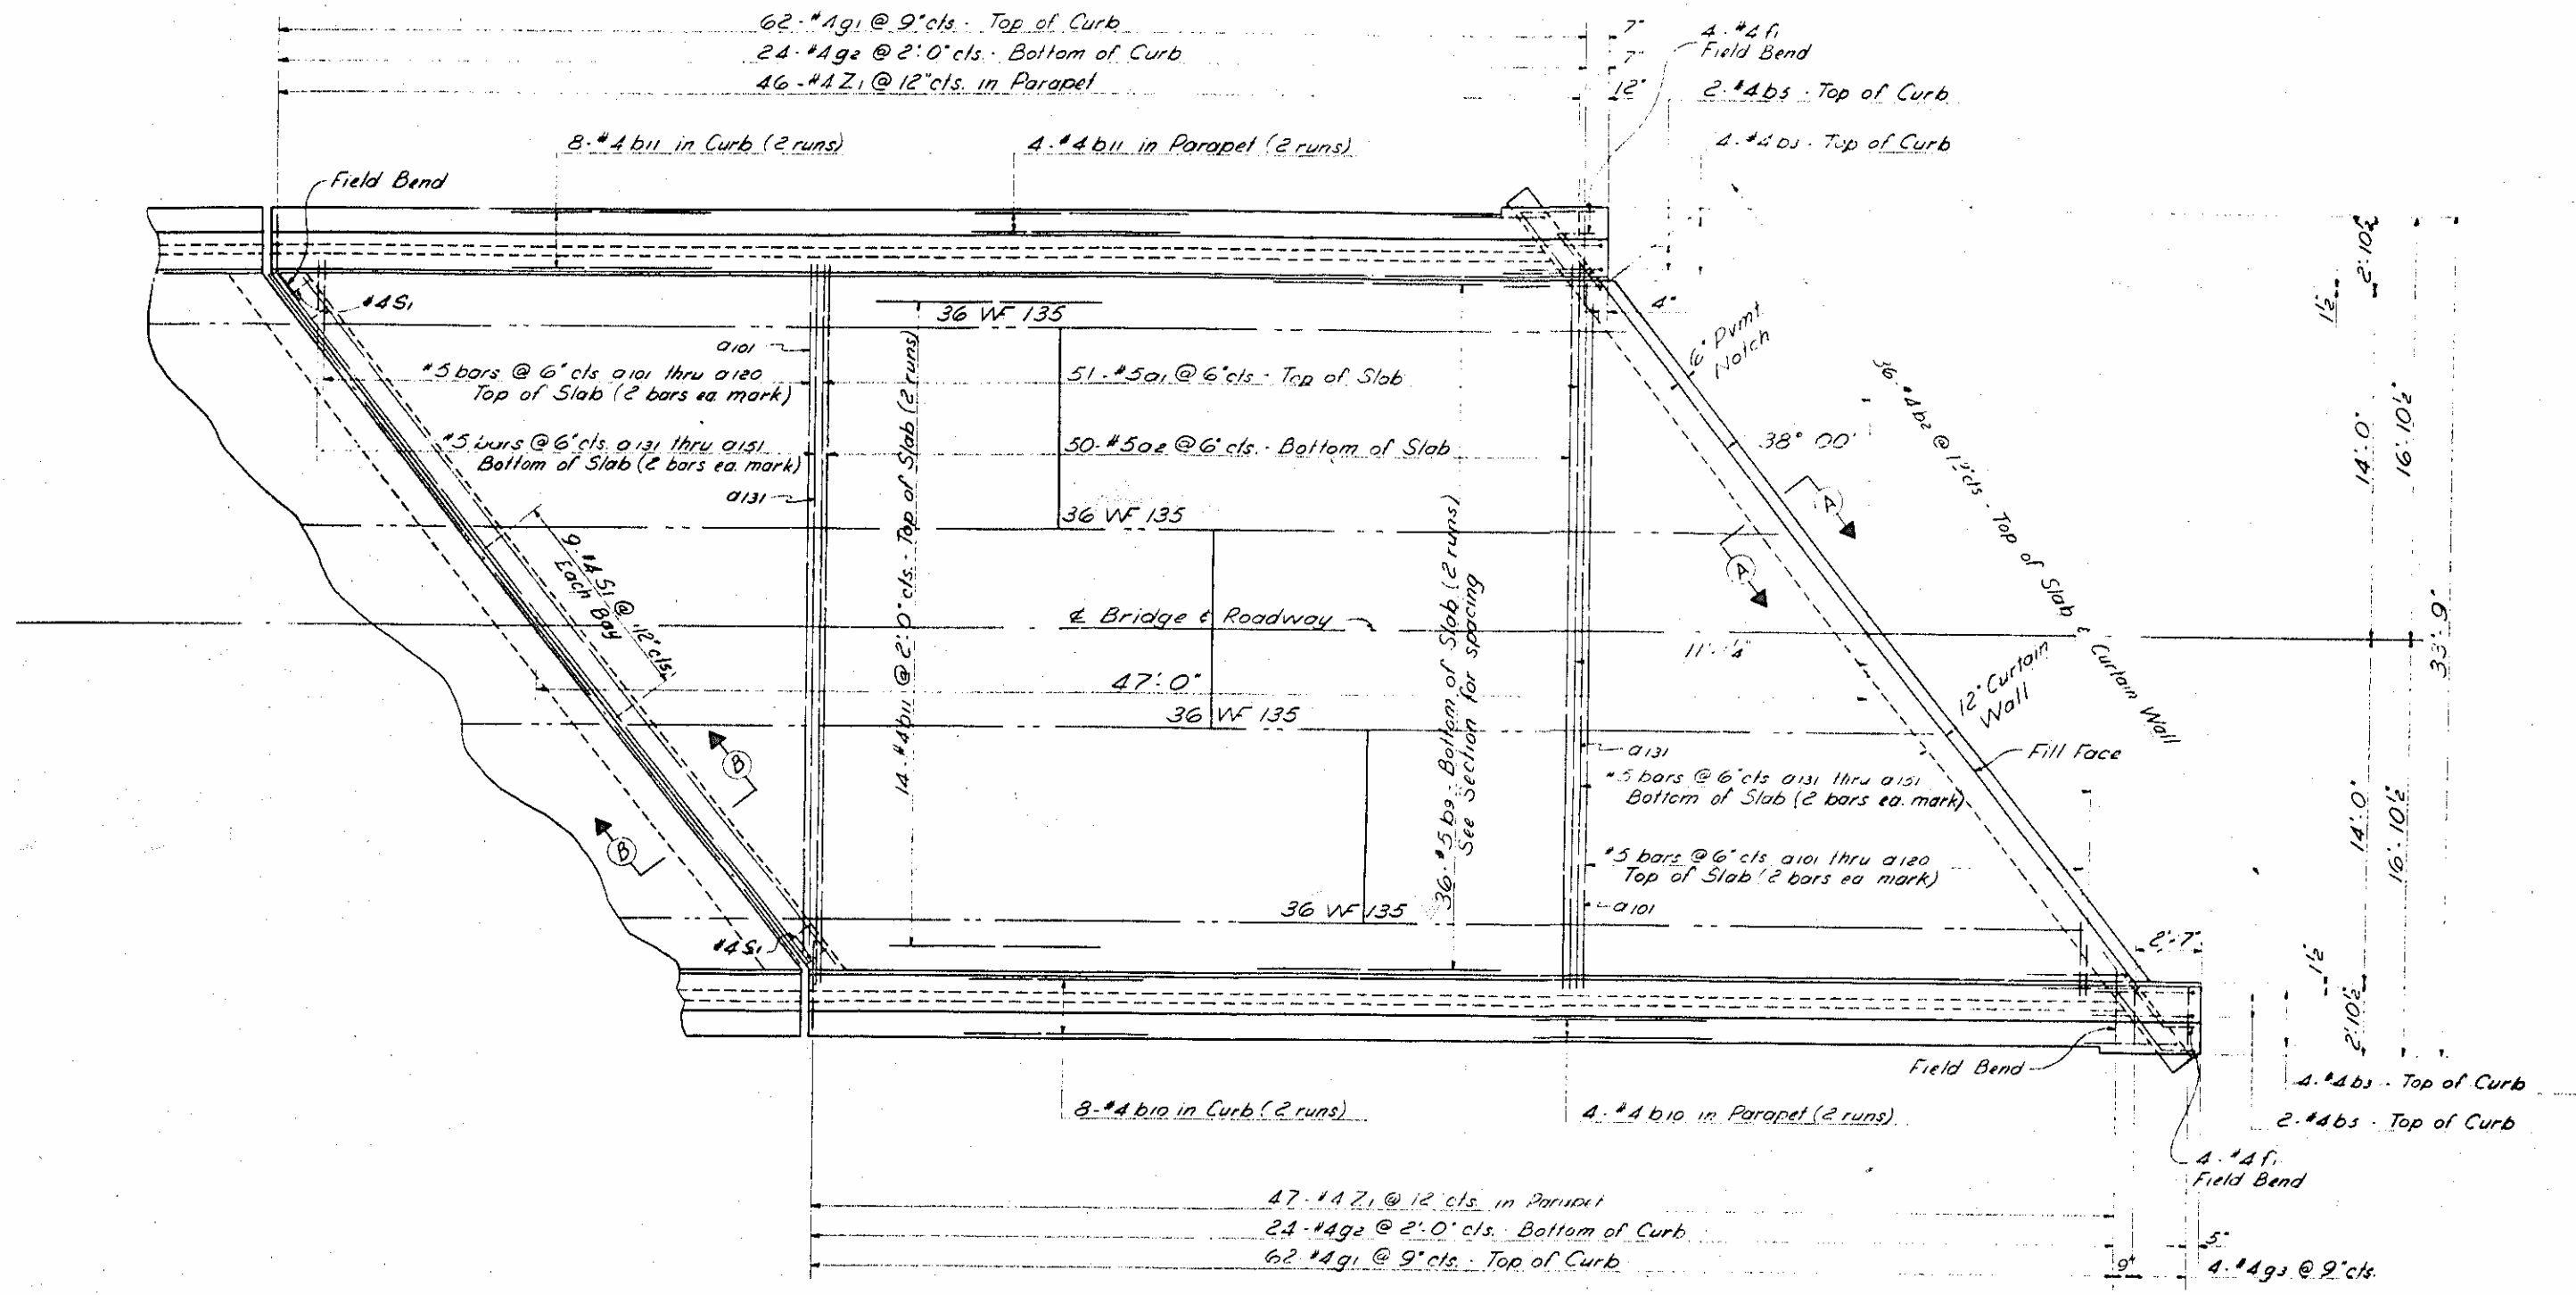

PLAN






PROJECT No. 815914  
 ROCKINGHAM COUNTY  
 STATION: 8+50.64 "L"  
 376+25 "L"

DRAWN BY S. A. SANTO-TOMAS DATE SEP 28 1961  
 CHECKED BY E. W. GIBSON DATE Feb 1962

|                          |      |
|--------------------------|------|
| STATE OF NORTH CAROLINA  |      |
| STATE HIGHWAY COMMISSION |      |
| RALEIGH                  |      |
| SUPERSTRUCTURE           |      |
| SPAN "D"                 |      |
| SEPTEMBER 1961           |      |
| REVISIONS                | DATE |
| BY                       | BY   |
| NO.                      | NO.  |
| DATE                     | DATE |
| BY                       | BY   |
| NO.                      | NO.  |
| DATE                     | DATE |
| BY                       | BY   |
| NO.                      | NO.  |
| DATE                     | DATE |

5-2  
 TOTAL SHEETS  
 48




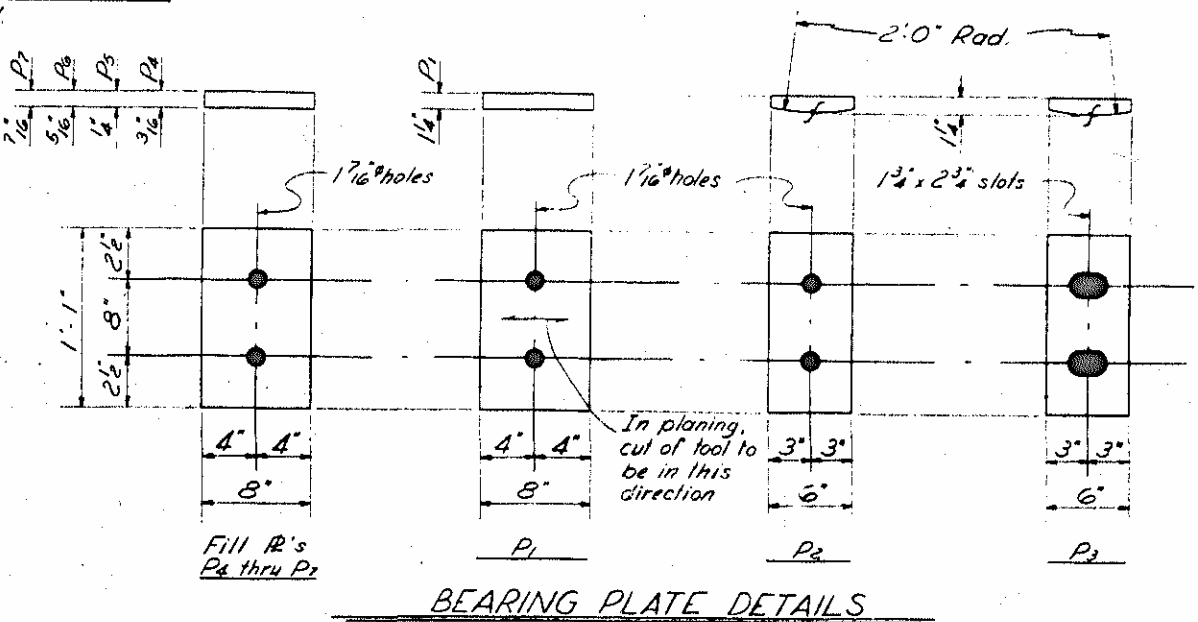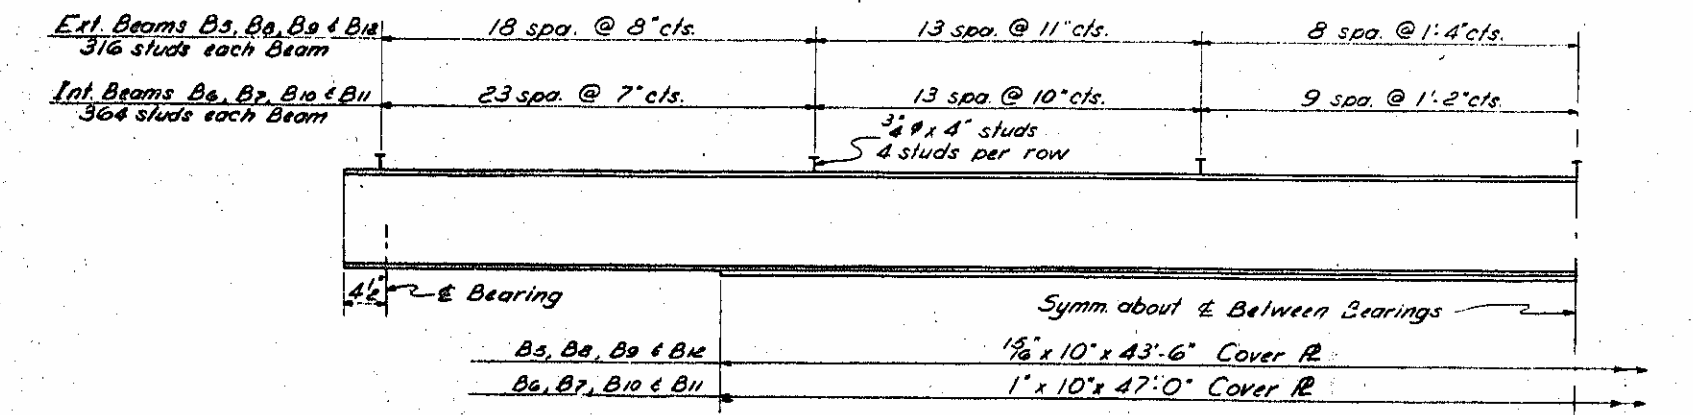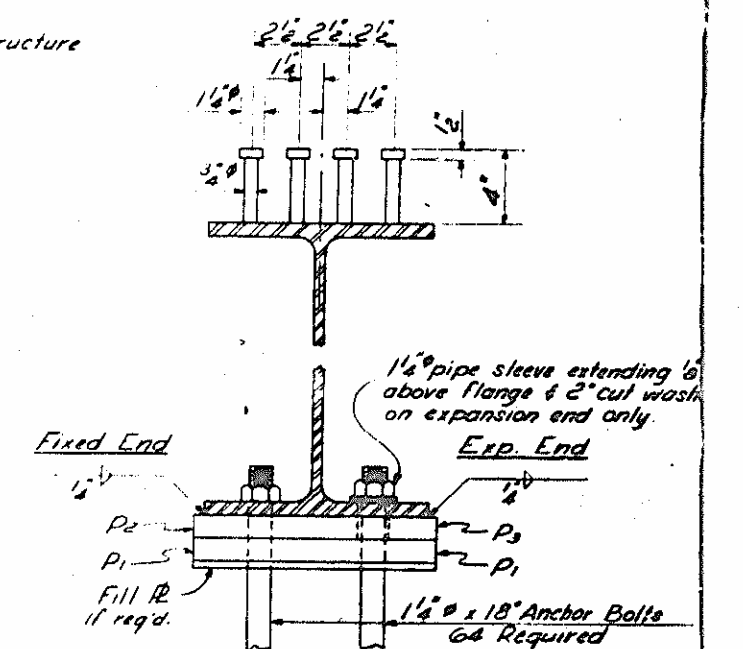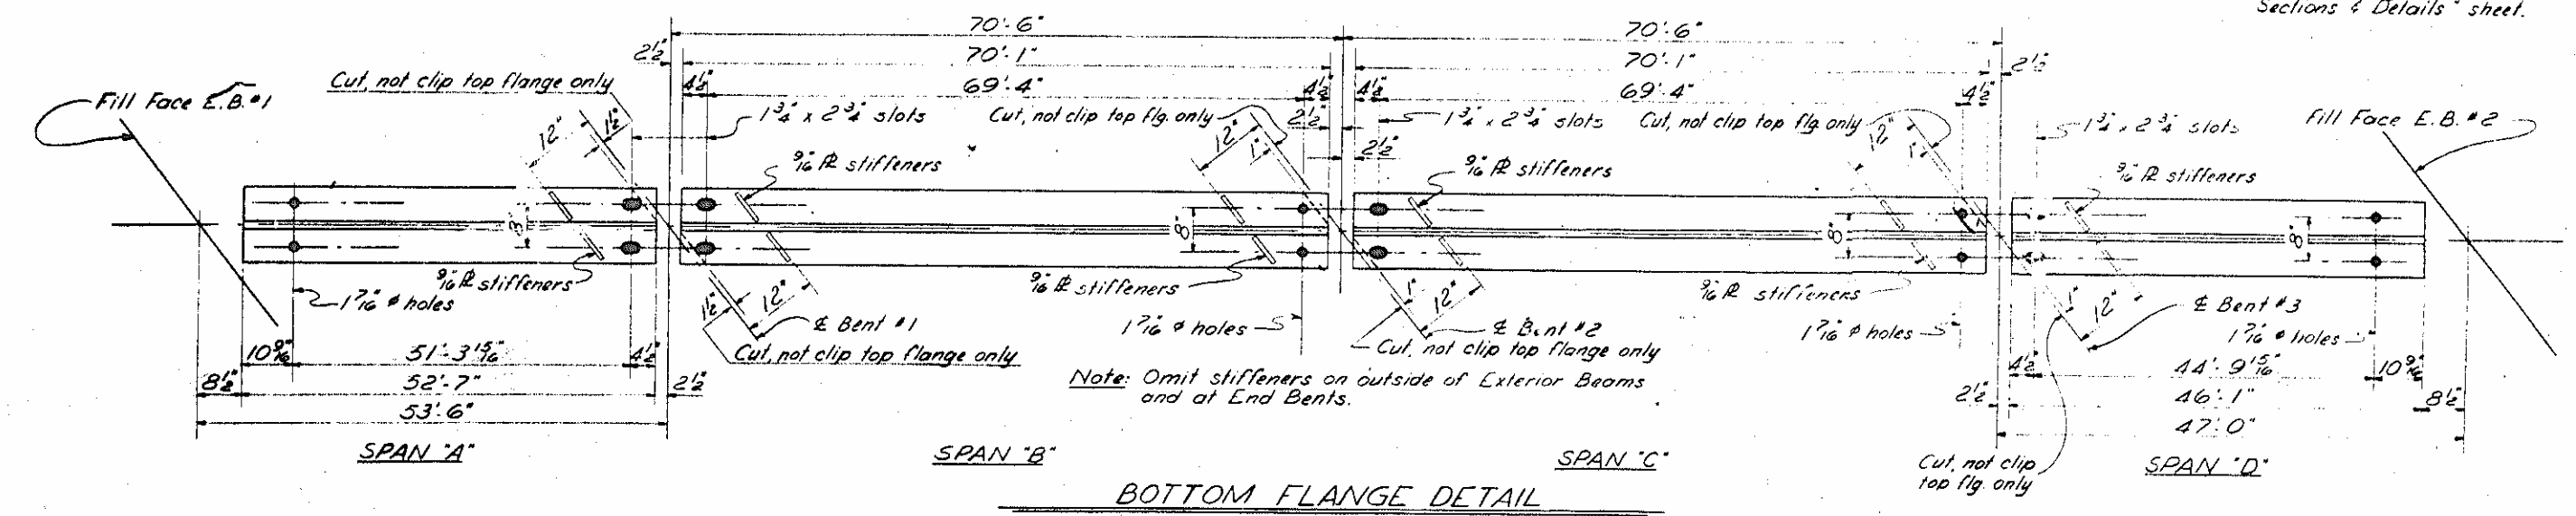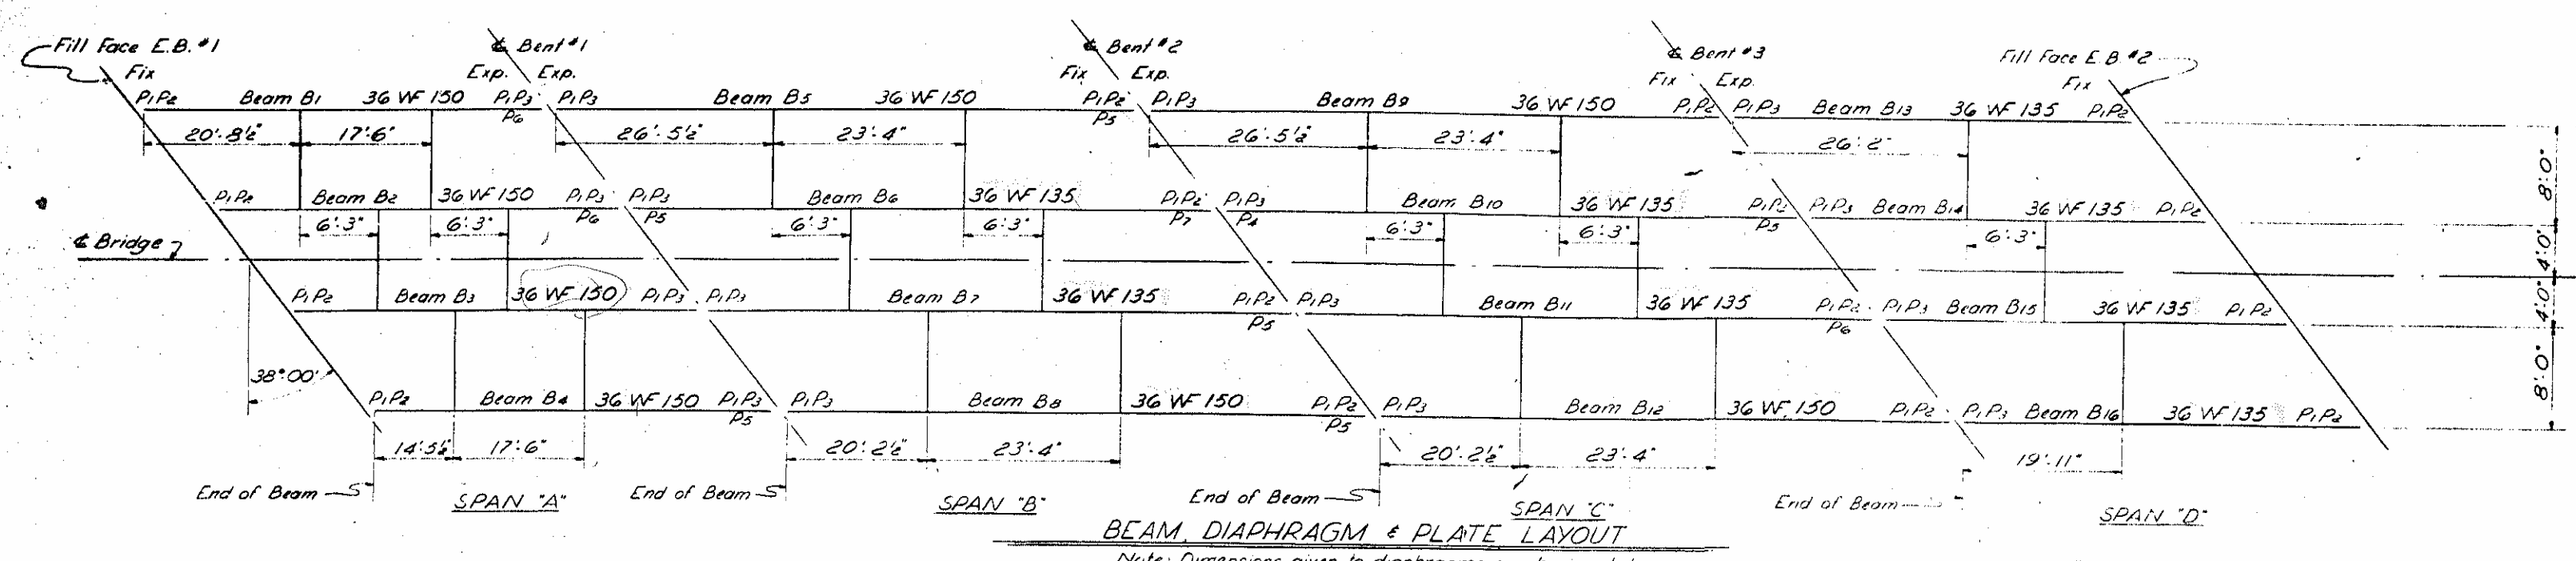

Note: All cover plates and studs spaced symmetrical about & between bearings. Shear studs and Cover R's not required for Beams B1, B2, B3, B4, B13, B14, B15 & B16.

| DEAD LOAD DEFLECTION AND BEAM CAMBER     | SPAN "A"     |              | SPAN "B" OR "C"                 |                           | SPAN "D"       |                |
|--|--------------|--------------|---------------------------------|---------------------------|----------------|----------------|
|  | B1 & B4 Ext. | B2 & B3 Int. | B5, B9, B10, B13, B14, B15 Ext. | B6, B7, B8, B11, B12 Int. | B12 & B16 Ext. | B14 & B15 Int. |
| Deflection due to weight of beam         | 1/16"        | 1/16"        | 1/16"                           | 1/16"                     | 1/16"          | 1/16"          |
| Deflection due to superimposed dead load | 1/8"         | 1/8"         | 1/8"                            | 1/8"                      | 1/8"           | 1/8"           |
| Total dead load deflection               | 3/16"        | 3/16"        | 3/16"                           | 3/16"                     | 3/16"          | 3/16"          |
| Camber                                   | 0"           | 0"           | 1/16"                           | 1/16"                     | 0"             | 0"             |

Note: No camber other than natural mill camber required for Spans A & D

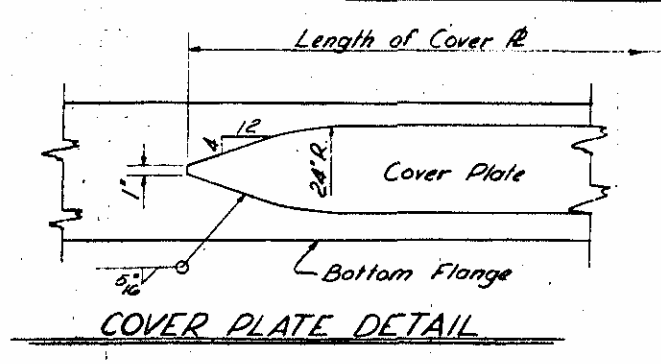


| REQ'D LIST OF BRG R'S |        |
|-----------------------|--------|
| P1 - 32               | P2 - 6 |
| P3 - 16               | P4 - 3 |
| P5 - 16               | P7 - 1 |
| P8 - 1                |        |

PROJECT No. 8.15914  
 ROCKINGHAM COUNTY  
 STATION: 8+50.64 to 376+25.1'

STATE OF NORTH CAROLINA  
 STATE HIGHWAY COMMISSION  
 SUPERSTRUCTURE  
 STRUCTURAL STEEL  
 DETAILS  
 OCTOBER 1961

5-23

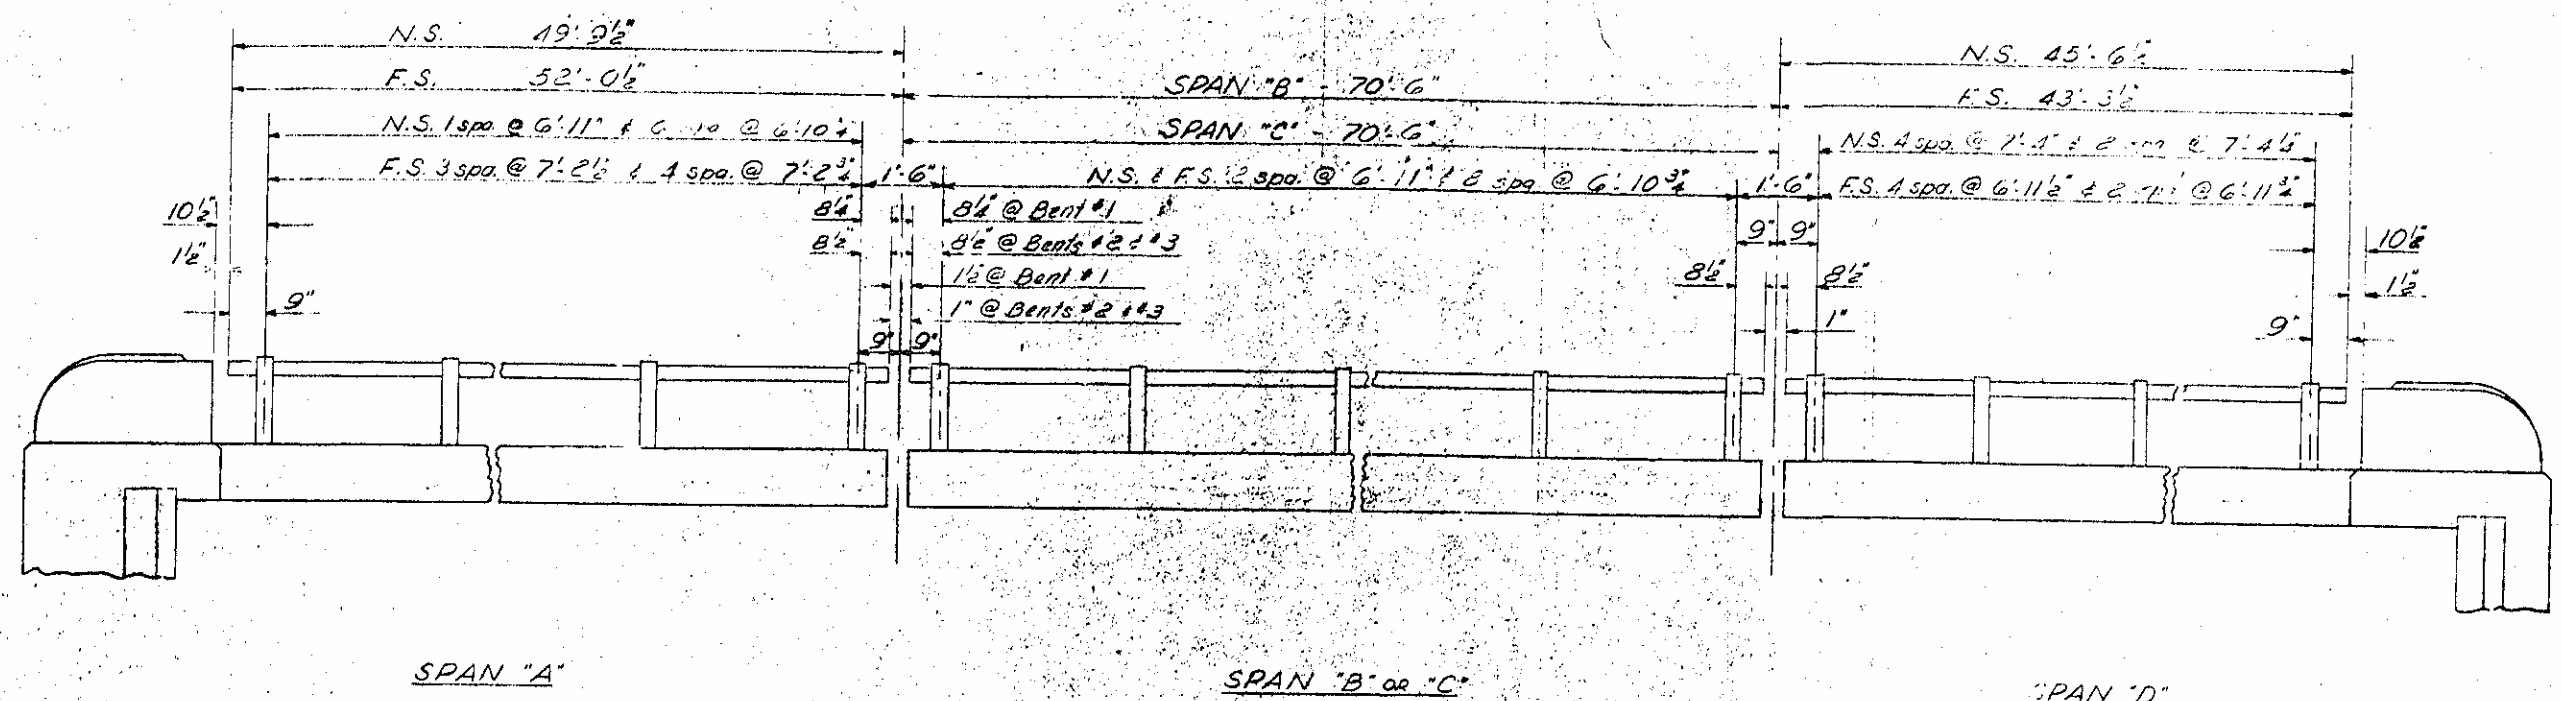

**NOTE**

Round Tubular Rail to be of size and wall thickness indicated.

Unless noted on the plans, maximum length of rail section to be two panels plus stick thru.

End of rail to clear face of concrete End Post by 1 1/2".

For double panel runs of rail, set screws shall be set tight at center post and snug at end to allow for expansion.

For single panel runs, set screw to be tight at one end and snug at other end.

Base of rail post or any other aluminum surface in contact with concrete, shall be thoroughly coated with an aluminum impregnated caulking compound of approved quality.

3/4" Anchor bolts - hex nuts and washers to be galvanized steel and painted aluminum after erection.

Cast posts to be as shown or an approved equal.

Certified Mill Reports are required for rails & posts. Shop inspection is not required.






Aluminum Rail Posts to be set normal to G grade.

Use aluminum alloys as follows:  
 Cast Rail Posts A 356-T6  
 Round Tubular Rail 6061-T6 or 6062-T6  
 Set Screws 2024-T4  
 Pipe Closure Plates 6061-T6 or 6062-T6

Method of measurement for Aluminum Rails:  
 Unless otherwise stated, the length of aluminum rails to be paid for shall be the continuous horizontal length measure from end to end of rail, excepting concrete posts, but without deductions for spaces between rail sections.

Concrete and reinforcing steel for End Post are included with Superstructure or End Bents.

Pay length = 472.64 L.F.






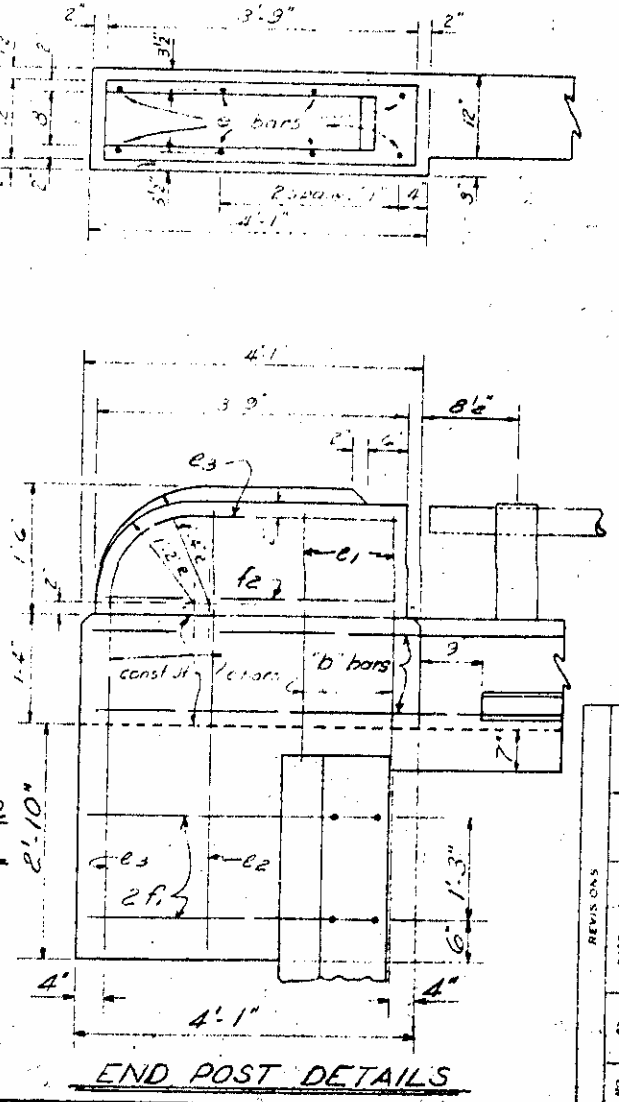
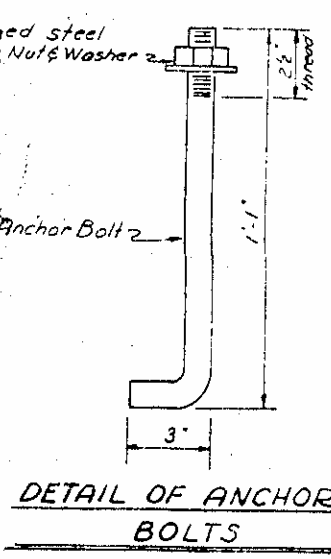
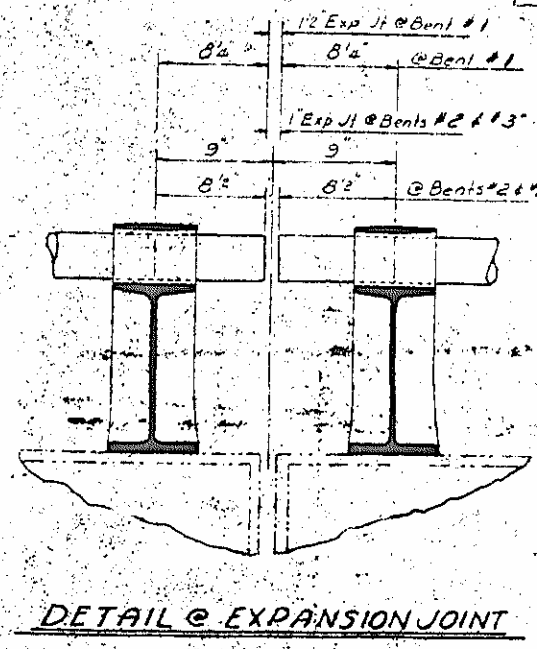
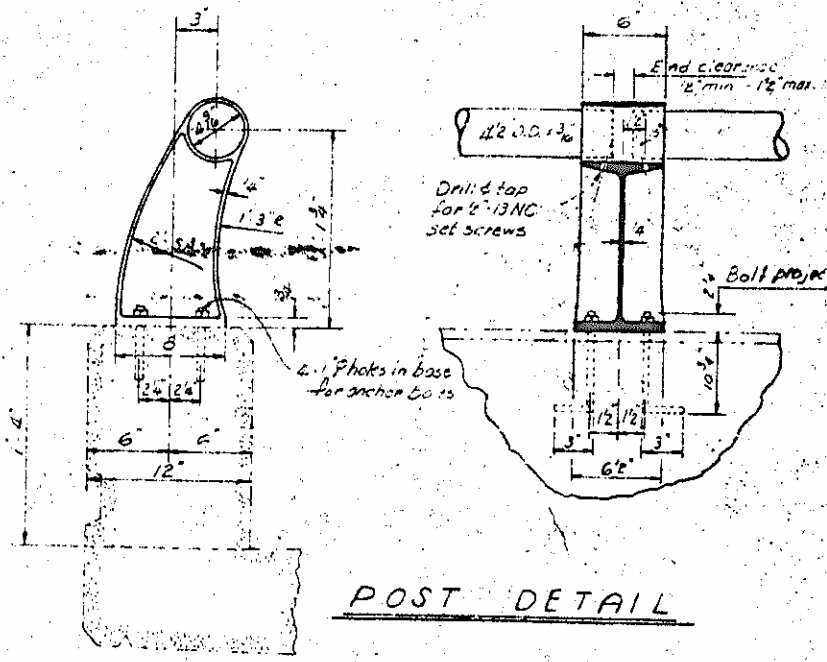
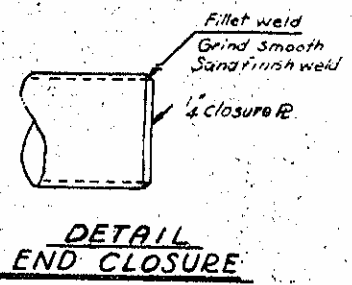


|             |      |
|-------------|------|
| DESIGNED BY | DATE |
| Checked by  | DATE |
| Checked by  | DATE |

**PROJECT NO. B. 1594**  
**ROCKINGHAM COUNTY**  
**STATION: 8+50.64 'X'**  
**376+25 'L'**

STATE OF NORTH CAROLINA  
 STATE HIGHWAY COMMISSION  
 RALEIGH  
**STANDARD**  
**1 BAR**  
**ALUMINUM RAIL**  
**AND END POSTS**  
**JULY 1961**

524

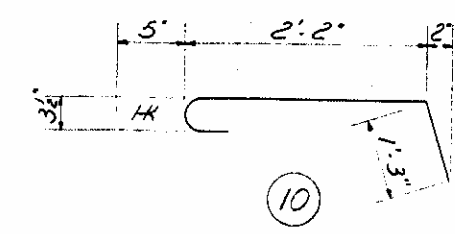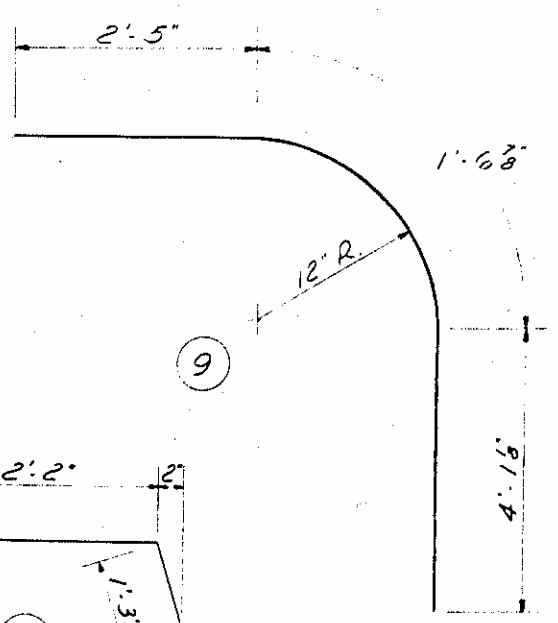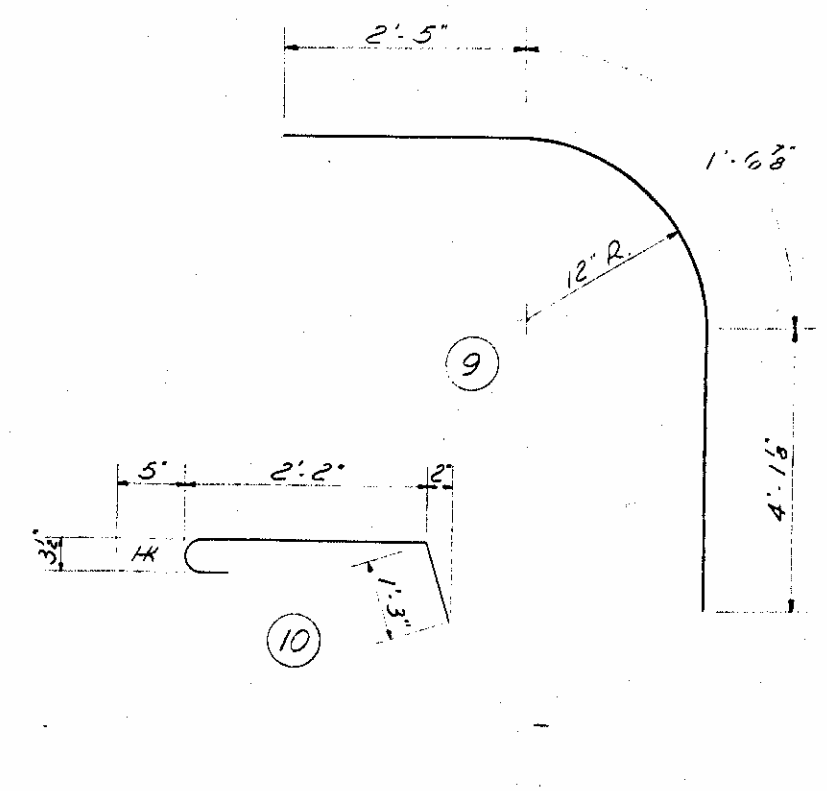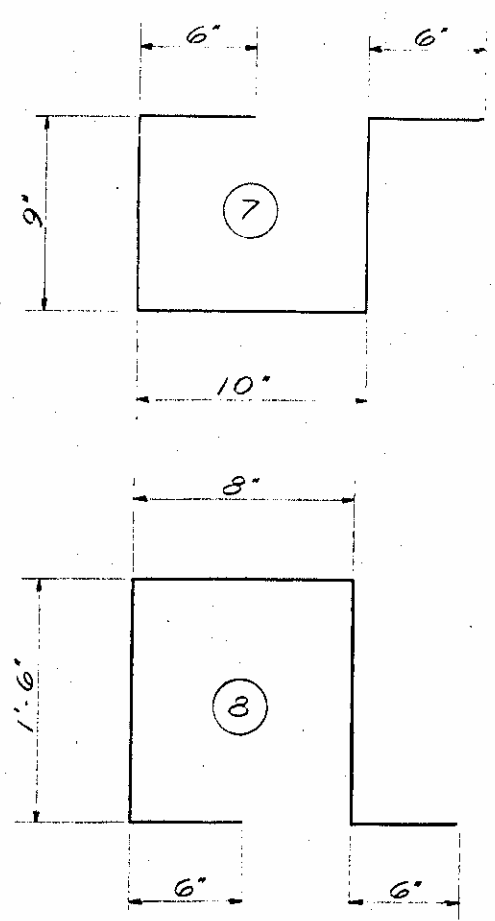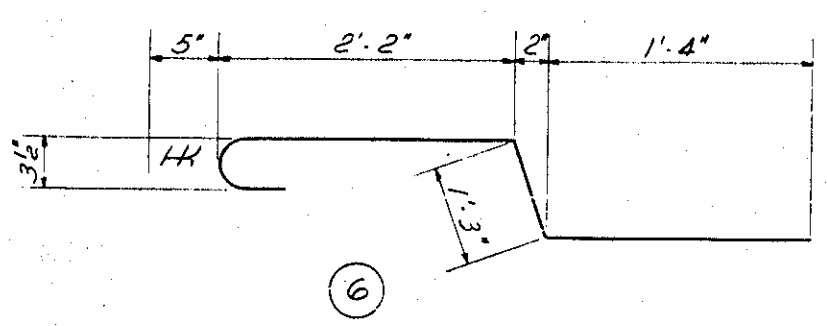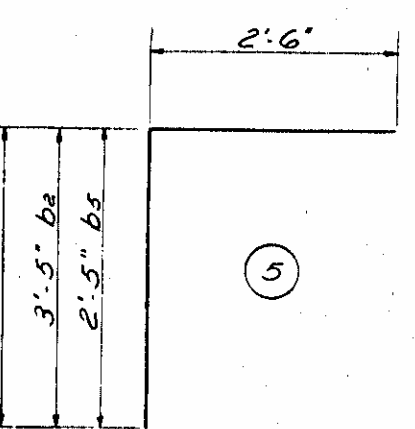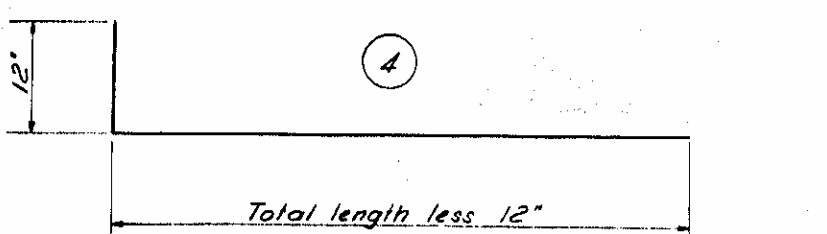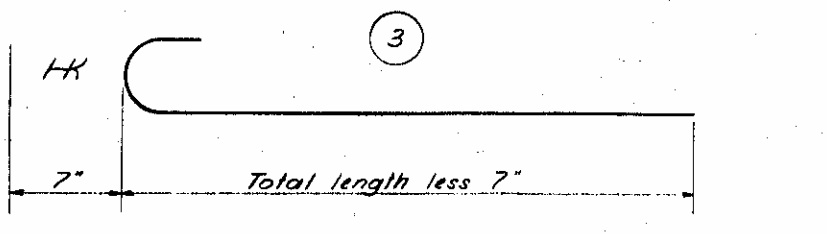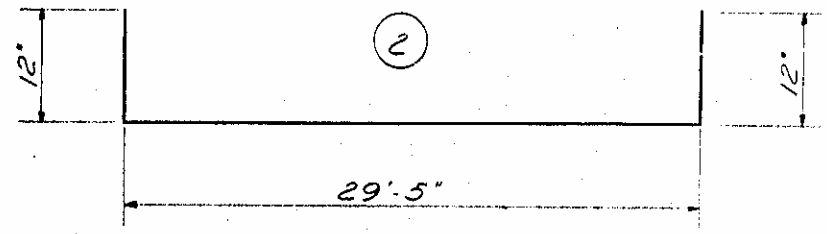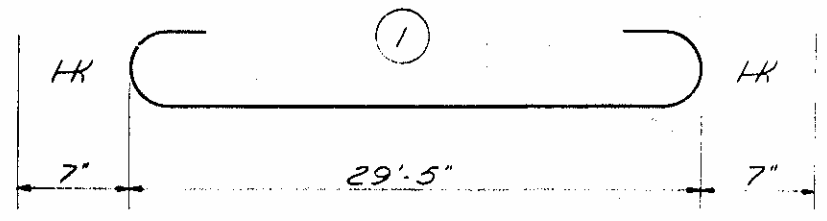

All bar dimensions are out to out.  
 BAR TYPES

| BILL OF MATERIAL |     |      |------------------|-----|------|------|--------|--------|-----|-----|------|-------|--------|---------------------|------|-----|------|-------|--------|--------|-----|-----|-------|------|--------|--------|------|----|-------|-----|-------|-------|
| SPAN 'A'         |     |      |      |        |        |     |     |      |       |        | ONE SPAN 'B' OR 'C' |      |     |      |       |        |        |     |     |       |      |        |        |      |    |       |     |       |       |
| BAR              | NO. | SIZE | TYPE | LENGTH | WEIGHT | BAR | NO. | SIZE | TYPE  | LENGTH | WEIGHT              | BAR  | NO. | SIZE | TYPE  | LENGTH | WEIGHT | BAR | NO. | SIZE  | TYPE | LENGTH | WEIGHT |      |    |       |     |       |       |
| a1               | 64  | #5   | 1    | 30.7   | 2,042  | b1  | 72  | #3   | Str   | 27.6   | 2,063               | a1   | 98  | #5   | 1     | 30.7   | 3,126  | b1  | 72  | #3    | Str  | 24.3   | 1,852  | a1   | 51 | #5    | 1   | 30.7  | 1,627 |
| a2               | 63  | #5   | 2    | 31.5   | 2,064  | b2  | 36  | #4   | 5     | 5.11   | 142                 | a2   | 97  | #5   | 2     | 31.5   | 3,178  | b2  | 114 | #4    | Str  | 24.3   | 1,847  | a2   | 50 | #5    | 2   | 31.5  | 1,638 |
| a101             | 4   | #3   | 3    | 27.11  | 116    | b3  | 8   | #5   | 6.10  | 37     | a101                | 4    | #3  | 3    | 27.11 | 116    | b3     | 8   | #5  | 6.10  | 37   | a101   | 4      | #3   | 3  | 27.11 | 116 |       |       |
| a102             |     |      |      | 26.8   | 111    | b4  | 52  | #4   | Str   | 27.3   | 947                 | a102 |     |      |       | 26.8   | 111    | b4  | 52  | #4    | Str  | 27.3   | 947    | a102 |    |       |     | 26.8  | 111   |
| a103             |     |      |      | 25.3   | 106    | b5  | 4   | #5   | 4.11  | 13     | a103                |      |     |      | 25.3  | 106    | b5     | 4   | #5  | 4.11  | 13   | a103   |        |      |    | 25.3  | 106 |       |       |
| a104             |     |      |      | 24.1   | 100    | b6  | 24  | #4   | Str   | 28.7   | 458                 | a104 |     |      |       | 24.1   | 100    | b6  | 24  | #4    | Str  | 28.7   | 458    | a104 |    |       |     | 24.1  | 100   |
| a105             |     |      |      | 22.10  | 95     |     |     |      |       |        |                     | a105 |     |      |       | 22.10  | 95     |     |     |       |      |        |        | a105 |    |       |     | 22.10 | 95    |
| a106             |     |      |      | 21.7   | 90     |     |     |      |       |        |                     | a106 |     |      |       | 21.7   | 90     |     |     |       |      |        |        | a106 |    |       |     | 21.7  | 90    |
| a107             |     |      |      | 20.3   | 84     | e1  | 8   | #4   | Str   | 2.11   | 16                  | a107 |     |      |       | 20.3   | 84     | e1  | 8   | #4    | Str  | 2.11   | 16     | a107 |    |       |     | 20.3  | 84    |
| a108             |     |      |      | 19.0   | 79     | e2  | 4   | #4   | Str   | 5.0    | 13                  | a108 |     |      |       | 19.0   | 79     | e2  | 4   | #4    | Str  | 5.0    | 13     | a108 |    |       |     | 19.0  | 79    |
| a109             |     |      |      | 17.9   | 74     | e3  | 4   | #4   | 9     | 8.1    | 22                  | a109 |     |      |       | 17.9   | 74     | e3  | 4   | #4    | 9    | 8.1    | 22     | a109 |    |       |     | 17.9  | 74    |
| a110             |     |      |      | 16.3   | 68     |     |     |      |       |        |                     | a110 |     |      |       | 16.3   | 68     |     |     |       |      |        |        | a110 |    |       |     | 16.3  | 68    |
| a111             |     |      |      | 15.2   | 63     | f1  | 8   | #4   | Str   | 4.2    | 22                  | a111 |     |      |       | 15.2   | 63     | f1  | 8   | #4    | Str  | 4.2    | 22     | a111 |    |       |     | 15.2  | 63    |
| a112             |     |      |      | 13.11  | 58     | f2  | 4   | #4   | Str   | 3.5    | 9                   | a112 |     |      |       | 13.11  | 58     | f2  | 4   | #4    | Str  | 3.5    | 9      | a112 |    |       |     | 13.11 | 58    |
| a113             |     |      |      | 12.7   | 52     |     |     |      |       |        |                     | a113 |     |      |       | 12.7   | 52     |     |     |       |      |        |        | a113 |    |       |     | 12.7  | 52    |
| a114             |     |      |      | 11.4   | 47     | g1  | 141 | #4   | 6     | 5.2    | 487                 | a114 |     |      |       | 11.4   | 47     | g1  | 141 | #4    | 6    | 5.2    | 487    | a114 |    |       |     | 11.4  | 47    |
| a115             |     |      |      | 10.0   | 42     | g2  | 54  | #4   | Str   | 2.3    | 81                  | a115 |     |      |       | 10.0   | 42     | g2  | 54  | #4    | Str  | 2.3    | 81     | a115 |    |       |     | 10.0  | 42    |
| a116             |     |      |      | 8.9    | 37     | g3  | 4   | #4   | 10    | 3.10   | 10                  | a116 |     |      |       | 8.9    | 37     | g3  | 4   | #4    | 10   | 3.10   | 10     | a116 |    |       |     | 8.9   | 37    |
| a117             |     |      |      | 7.6    | 31     | k1  | 1   | #6   | Str   | 17.5   | 64                  | a117 |     |      |       | 7.6    | 31     | k1  | 1   | #6    | Str  | 17.5   | 64     | a117 |    |       |     | 7.6   | 31    |
| a118             |     |      |      | 6.2    | 26     | k2  | 4   | #4   | 21.10 | 58     | a118                |      |     |      | 6.2   | 26     | k2     | 4   | #4  | 21.10 | 58   | a118   |        |      |    | 6.2   | 26  |       |       |
| a119             |     |      |      | 4.11   | 21     | k3  | 3   | #6   | 9.9   | 44     | a119                |      |     |      | 4.11  | 21     | k3     | 3   | #6  | 9.9   | 44   | a119   |        |      |    | 4.11  | 21  |       |       |
| a120             |     |      |      | 3.8    | 15     | k4  | 6   | #4   | 9.9   | 39     | a120                |      |     |      | 3.8   | 15     | k4     | 6   | #4  | 9.9   | 39   | a120   |        |      |    | 3.8   | 15  |       |       |
| a131             |     |      |      | 28.8   | 120    | k5  | 2   | #6   | 4.8   | 14     | a131                |      |     |      | 28.8  | 120    | k5     | 2   | #6  | 4.8   | 14   | a131   |        |      |    | 28.8  | 120 |       |       |
| a132             |     |      |      | 27.5   | 114    | k6  | 4   | #4   | 3.2   | 8      | a132                |      |     |      | 27.5  | 114    | k6     | 4   | #4  | 3.2   | 8    | a132   |        |      |    | 27.5  | 114 |       |       |
| a133             |     |      |      | 26.2   | 109    | k7  | 2   | #6   | 8.8   | 26     | a133                |      |     |      | 26.2  | 109    | k7     | 2   | #6  | 8.8   | 26   | a133   |        |      |    | 26.2  | 109 |       |       |
| a134             |     |      |      | 24.10  | 104    | k8  | 4   | #4   | 7.11  | 21     | a134                |      |     |      | 24.10 | 104    | k8     | 4   | #4  | 7.11  | 21   | a134   |        |      |    | 24.10 | 104 |       |       |
| a135             |     |      |      | 23.7   | 98     | k9  | 6   | #5   | 9.9   | 61     | a135                |      |     |      | 23.7  | 98     | k9     | 6   | #5  | 9.9   | 61   | a135   |        |      |    | 23.7  | 98  |       |       |
| a136             |     |      |      | 22.3   | 93     | k10 | 8   | #5   | Str   | 4.3    | 35                  | a136 |     |      |       | 22.3   | 93     | k10 | 8   | #5    | Str  | 4.3    | 35     | a136 |    |       |     | 22.3  | 93    |
| a137             |     |      |      | 21.0   | 88     |     |     |      |       |        |                     | a137 |     |      |       | 21.0   | 88     |     |     |       |      |        |        | a137 |    |       |     | 21.0  | 88    |
| a138             |     |      |      | 19.9   | 82     | s1  | 31  | #4   | 7     | 3.4    | 69                  | a138 |     |      |       | 19.9   | 82     | s1  | 31  | #4    | 7    | 3.4    | 69     | a138 |    |       |     | 19.9  | 82    |
| a139             |     |      |      | 18.5   | 77     |     |     |      |       |        |                     | a139 |     |      |       | 18.5   | 77     |     |     |       |      |        |        | a139 |    |       |     | 18.5  | 77    |
| a140             |     |      |      | 17.2   | 72     | z1  | 106 | #4   | 8     | 4.8    | 330                 | a140 |     |      |       | 17.2   | 72     | z1  | 106 | #4    | 8    | 4.8    | 330    | a140 |    |       |     | 17.2  | 72    |
| a141             |     |      |      | 15.11  | 66     |     |     |      |       |        |                     | a141 |     |      |       | 15.11  | 66     |     |     |       |      |        |        | a141 |    |       |     | 15.11 | 66    |
| a142             |     |      |      | 14.7   | 61     |     |     |      |       |        |                     | a142 |     |      |       | 14.7   | 61     |     |     |       |      |        |        | a142 |    |       |     | 14.7  | 61    |
| a143             |     |      |      | 13.4   | 56     |     |     |      |       |        |                     | a143 |     |      |       | 13.4   | 56     |     |     |       |      |        |        | a143 |    |       |     | 13.4  | 56    |
| a144             |     |      |      | 12.1   | 50     |     |     |      |       |        |                     | a144 |     |      |       | 12.1   | 50     |     |     |       |      |        |        | a144 |    |       |     | 12.1  | 50    |
| a145             |     |      |      | 10.9   | 45     |     |     |      |       |        |                     | a145 |     |      |       | 10.9   | 45     |     |     |       |      |        |        | a145 |    |       |     | 10.9  | 45    |
| a146             |     |      |      | 9.6    | 40     |     |     |      |       |        |                     | a146 |     |      |       | 9.6    | 40     |     |     |       |      |        |        | a146 |    |       |     | 9.6   | 40    |
| a147             |     |      |      | 8.3    | 34     |     |     |      |       |        |                     | a147 |     |      |       | 8.3    | 34     |     |     |       |      |        |        | a147 |    |       |     | 8.3   | 34    |
| a148             |     |      |      | 6.11   | 29     |     |     |      |       |        |                     | a148 |     |      |       | 6.11   | 29     |     |     |       |      |        |        | a148 |    |       |     | 6.11  | 29    |
| a149             |     |      |      | 5.8    | 24     |     |     |      |       |        |                     | a149 |     |      |       | 5.8    | 24     |     |     |       |      |        |        | a149 |    |       |     | 5.8   | 24    |
| a150             |     |      |      | 4.4    | 18     |     |     |      |       |        |                     | a150 |     |      |       | 4.4    | 18     |     |     |       |      |        |        | a150 |    |       |     | 4.4   | 18    |
| a151             |     |      |      | 3.1    | 13     |     |     |      |       |        |                     | a151 |     |      |       | 3.1    | 13     |     |     |       |      |        |        | a151 |    |       |     | 3.1   | 13    |

Reinforcing Steel Lbs. = 71,963  
 Class 'A' Concrete Cu. Yds. = 60.3  
 Structural Steel Approx Lbs. = 35,800  
 1 Bar Aluminum Rail Lin. Ft. = 101.83


Reinforcing Steel Lbs. = 14,243  
 Class 'A' Concrete Cu. Yds. = 66.9  
 Structural Steel Approx Lbs. = 52,200  
 1 Bar Aluminum Rail Lin. Ft. = 141.0

Reinforcing Steel Lbs. = 10.5  
 Class 'A' Concrete Cu. Yds. = 53.7  
 Structural Steel Approx Lbs. = 28.7  
 1 Bar Aluminum Rail Lin. Ft. = 38.8


PROJECT No. 8-15914  
 ROCKINGHAM COUNTY  
 STATION: 8-50.64 Yds  
 376-25 L

STATE OF NORTH CAROLINA  
 STATE HIGHWAY COMMISSION  
 SUPERSTRUCTURE  
 BAR TYPES &  
 BILL OF MATERIAL  
 OCTOBER 1961




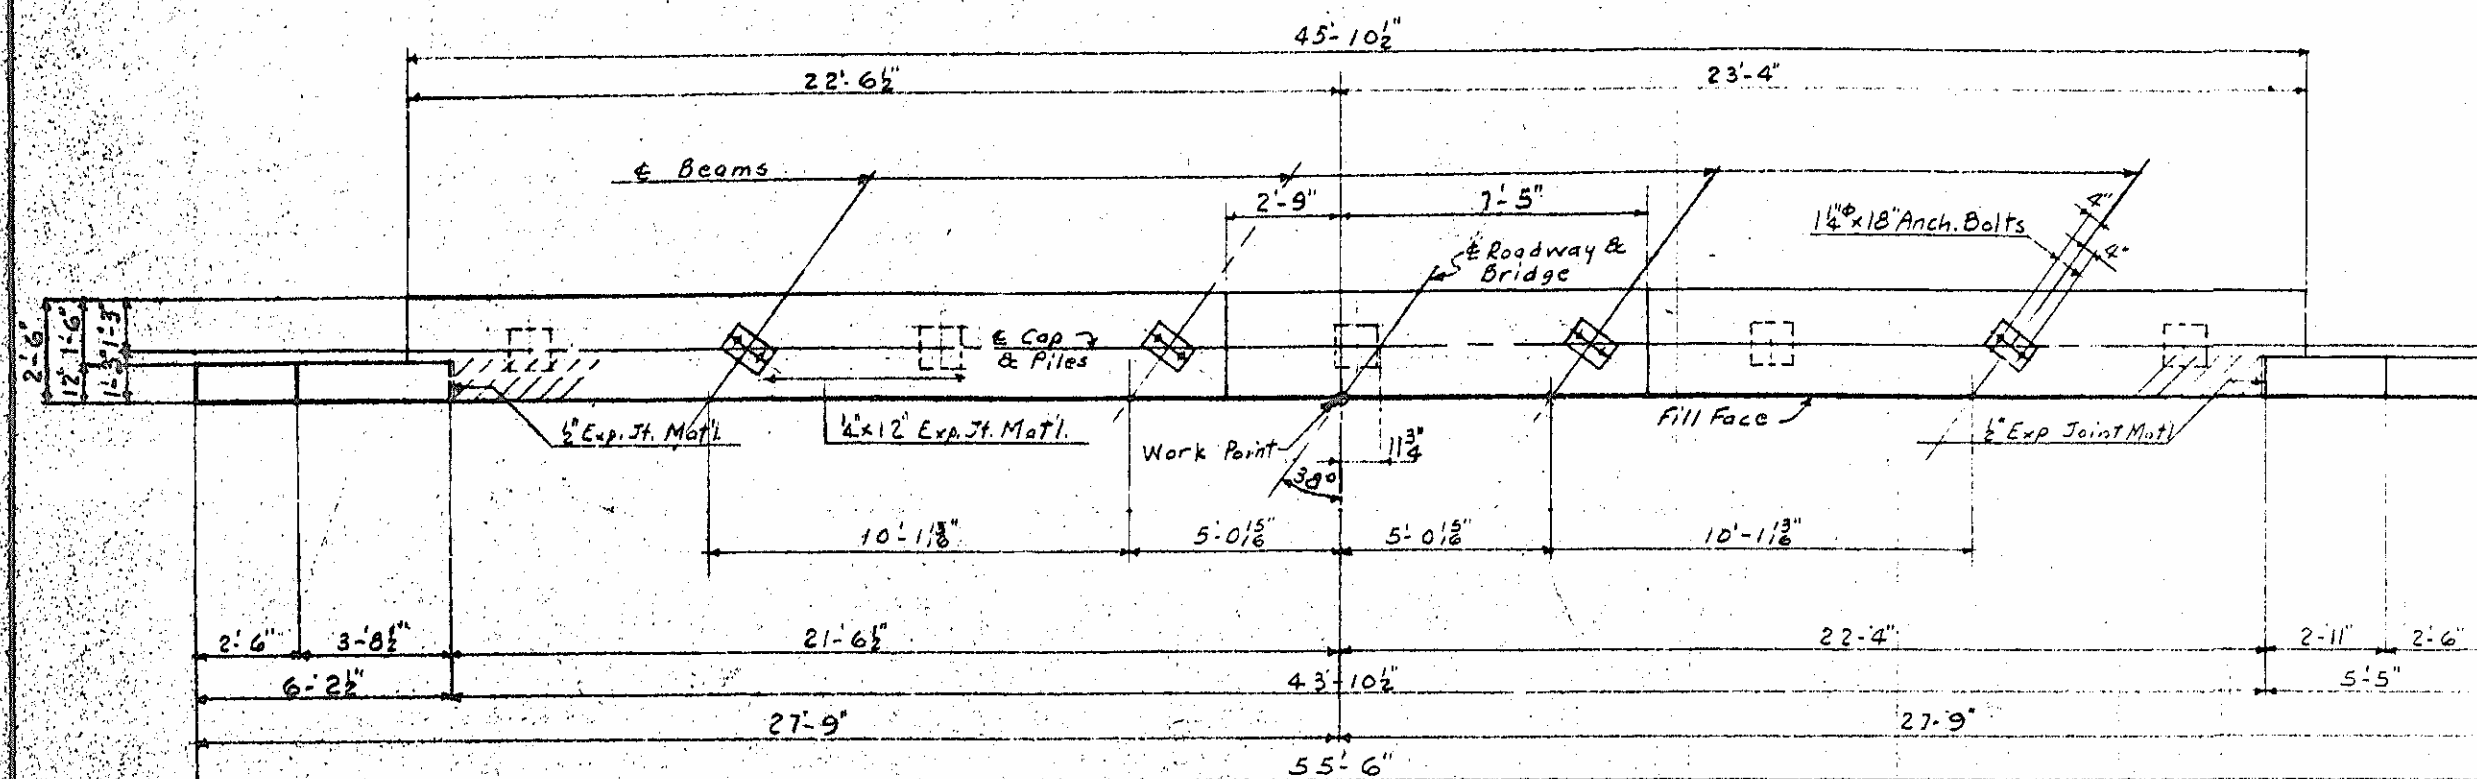


PLAN OF CAP

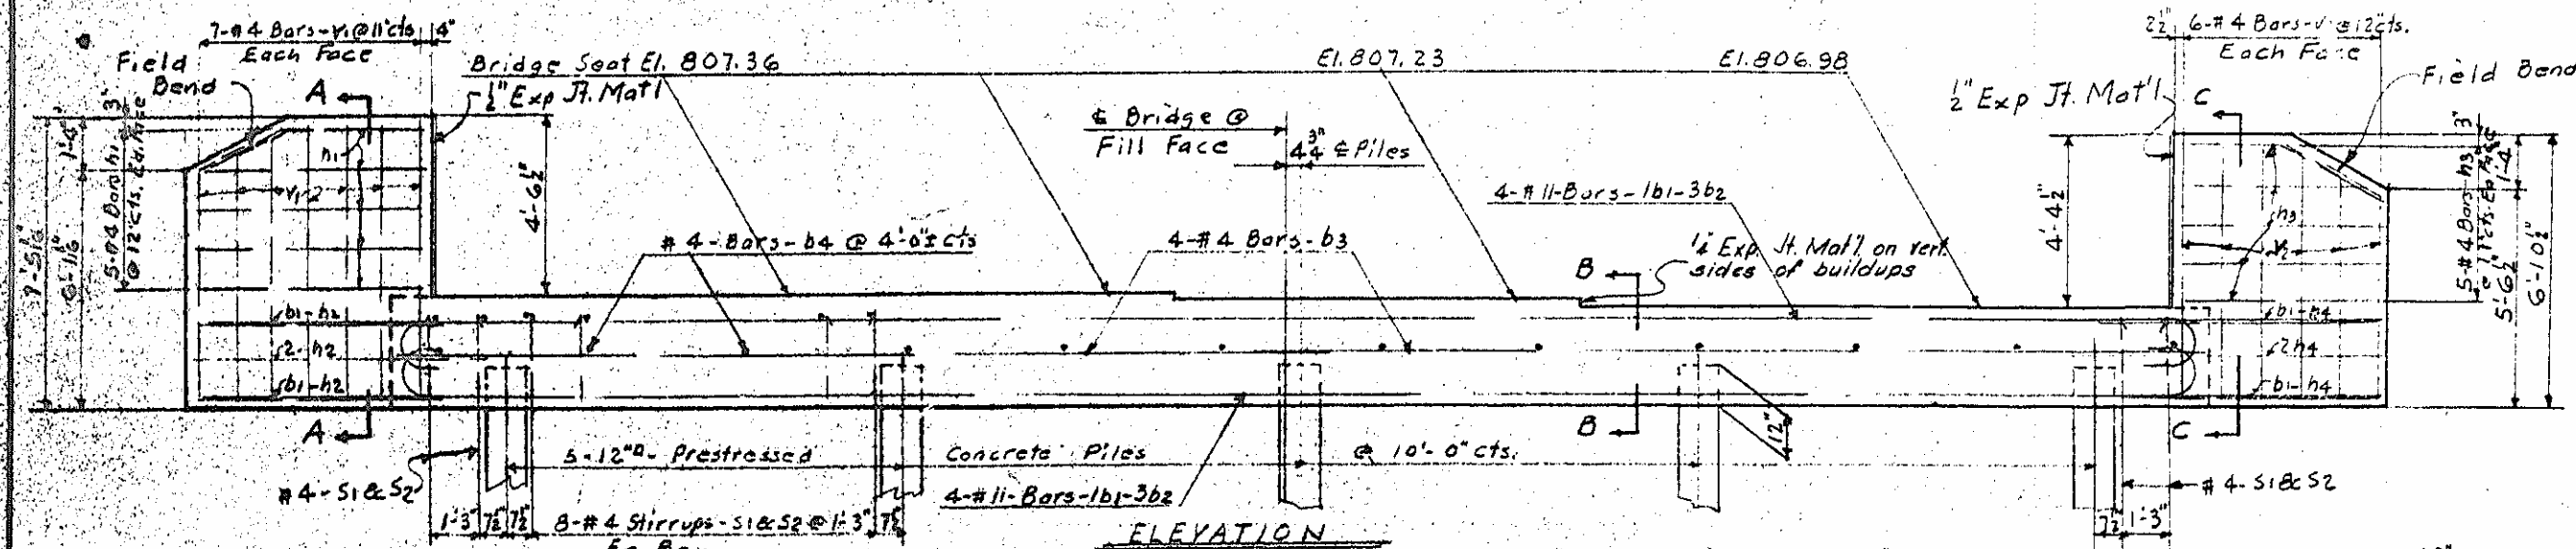


ELEVATION

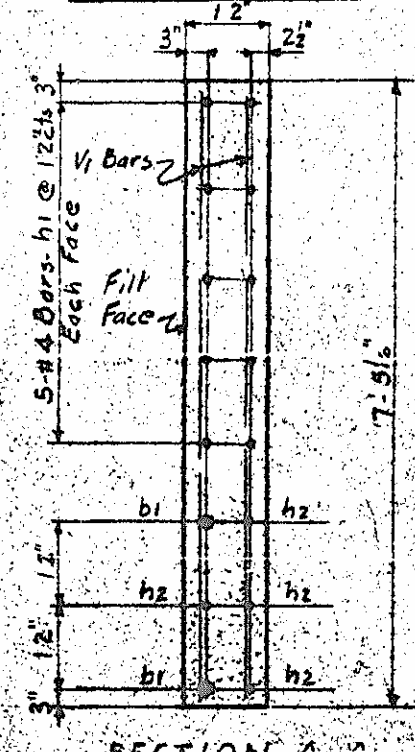

SECTION A-A

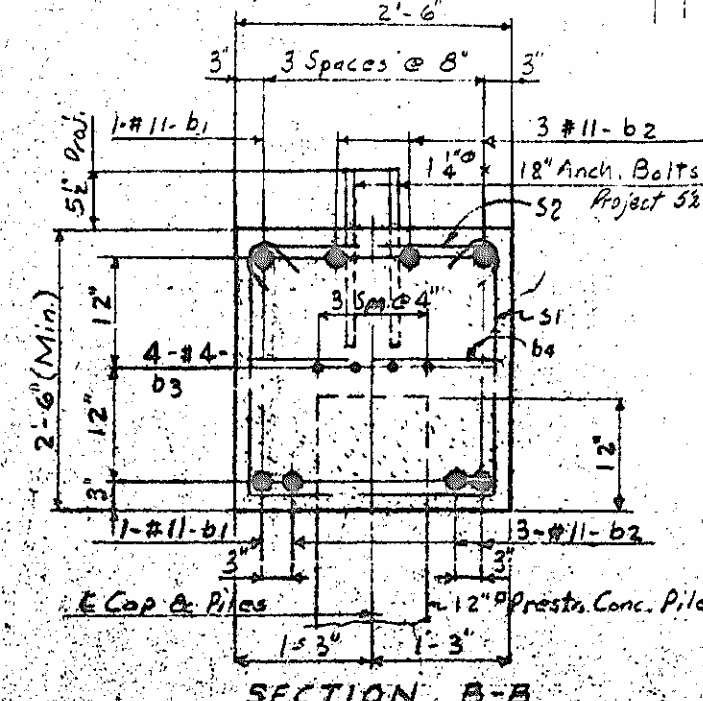

SECTION B-B

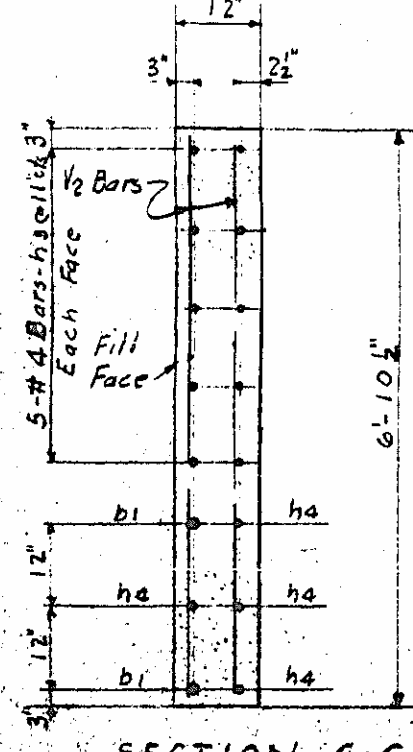


SECTION C-C

BILL OF MATERIAL

| BAR NO | SIZE  | TYPE | LENGTH | WEIGHT |
|--------|-------|------|--------|--------|
| b1     | 2 #11 | Str. | 65'-0" | 580    |
| b2     | 6 #11 | 1    | 65'-0" | 1540   |
| b3     | 8 #4  | Str. | 23'-0" | 125    |
| b4     | 12 #4 | Str. | 23'-0" | 17     |
| h1     | 10 #4 | Str. | 5'-10" | 89     |
| h2     | 4 #4  | Str. | 6'-5"  | 17     |
| h3     | 10 #4 | Str. | 5'-10" | 80     |
| h4     | 4 #4  | Str. | 5'-6"  | 15     |
|        |       |      |        |        |
| s1     | 3 #4  | 2    | 7'-5"  | 174    |
| s2     | 3 #4  | 3    | 2'-11" | 70     |
|        |       |      |        |        |
| v1     | 14 #4 | Str. | 7'-11" | 66     |
| v2     | 12 #4 | Str. | 6'-5"  | 52     |

Reinforcing Steel lbs. 2785  
Class "A" Conc. Cu. Yds. 14  
12" Prestressed Conc. Piles No. 5 - L.S. 13


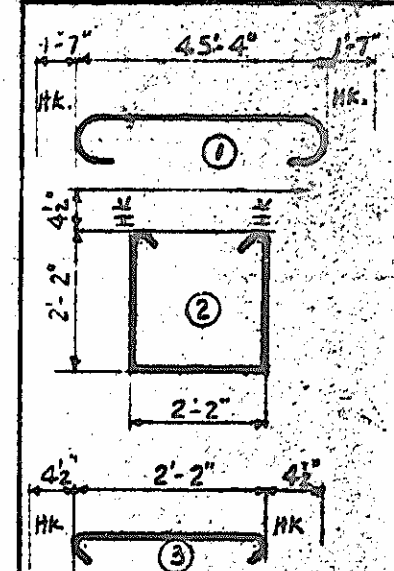


All dimensions are outside.  
BAR TYPES

PROJECT No. 815914  
ROCKINGHAM COUNTY  
STATION 376+25 LINE 1

STATE OF NORTH CAROLINA  
STATE HIGHWAY COMMISSION  
RALEIGH  
SUBSTRUCTURE  
END BENT NO. 1  
AUGUST-1961

| NO. | BY | DATE | NO. | BY | DATE |
|-----|----|------|-----|----|------|
| 1   |    |      | 2   |    |      |
| 2   |    |      | 3   |    |      |

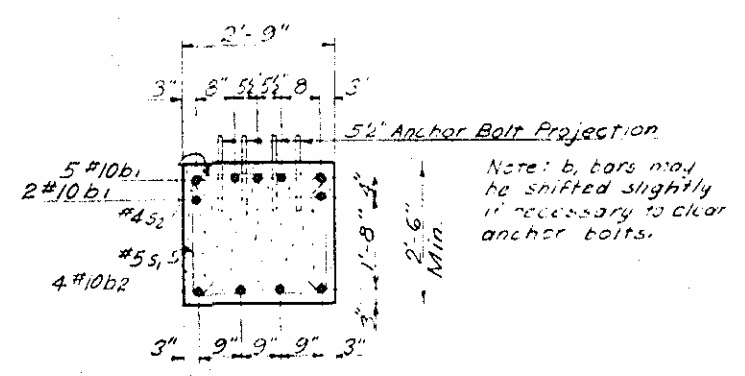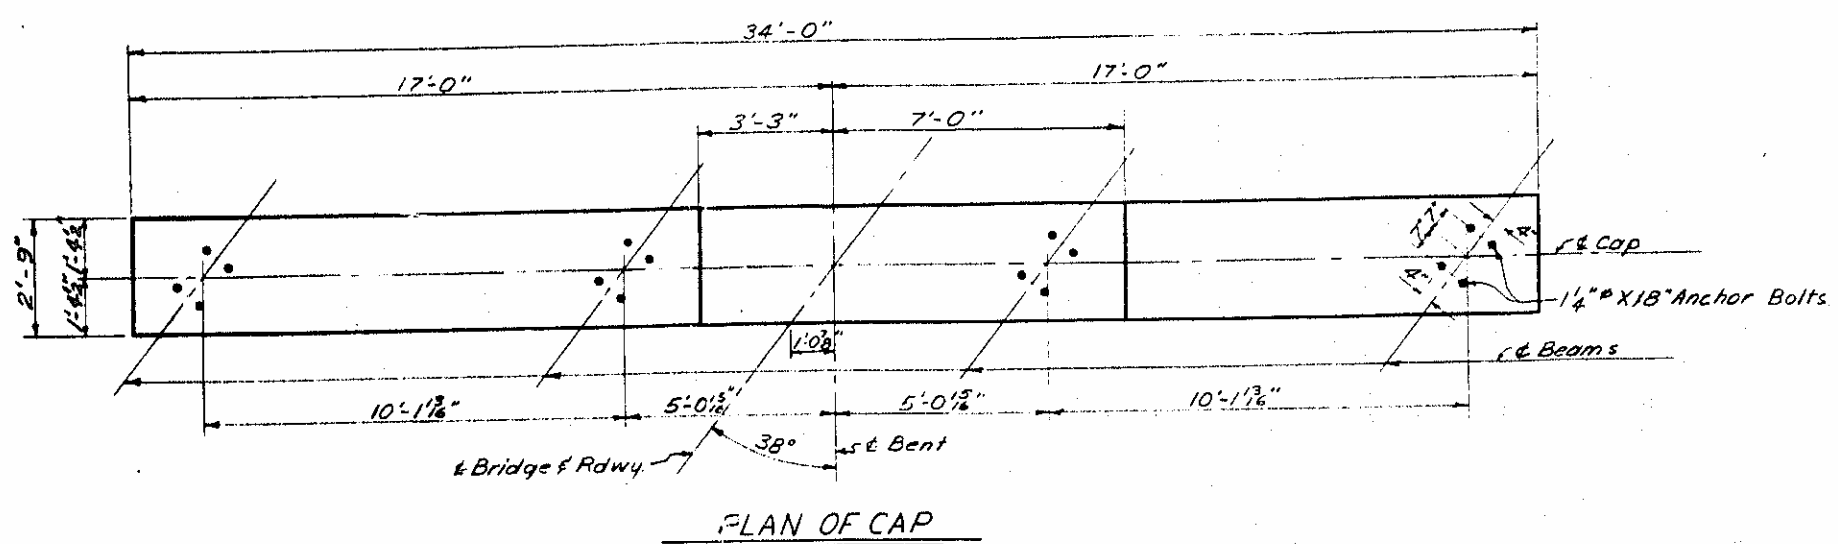

**BAR TYPES**  
All dimensions are out to out.





|       |        |    |
|-------|--------|----|
| HK    | (1)    | HK |
| 1'-5" | 33'-9" | b1 |
| 7"    | 5'-0"  | b3 |
| 6"    | 5'-5"  | t1 |
| 7"    | 6'-9"  | t2 |

|       |        |    |
|-------|--------|----|
| HK    | (2)    | HK |
| 1'-5" | 7'-8"  | m1 |
| 1'-5" | 19'-5" | v1 |
| 1'-5" | 17'-6" | v2 |

**BILL OF MATERIAL FOR ONE BENT-2 REQ'D.**

| BAR | NO. | SIZE | TYPE | LENGTH  | WEIGHT |
|-----|-----|------|------|---------|--------|
| b1  | 7   | #10  | 1    | 36'-6"  | 1095   |
| b2  | 4   | #10  | Str. | 33'-8"  | 579    |
| b3  | 18  | #5   | 1    | 6'-2"   | 116    |
| m1  | 24  | #10  | 2    | 9'-1"   | 936    |
| s1  | 40  | #5   | 3    | 7'-7"   | 316    |
| s2  | 16  | #4   | 4    | 3'-2"   | 34     |
| t1  | 30  | #4   | 1    | 6'-5"   | 129    |
| t2  | 27  | #5   | 1    | 7'-11"  | 229    |
| v1  | 24  | #10  | 2    | 20'-10" | 2151   |
| v2  | 24  | #10  | 2    | 18'-11" | 1954   |

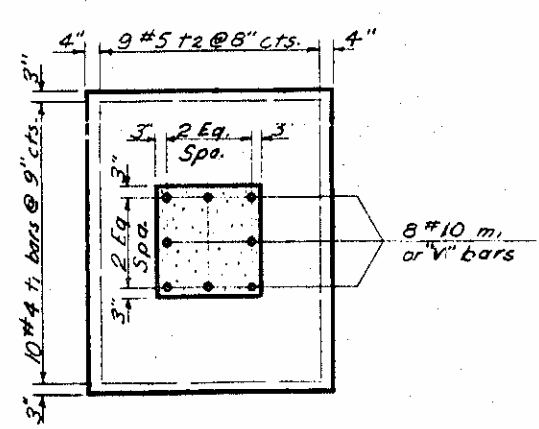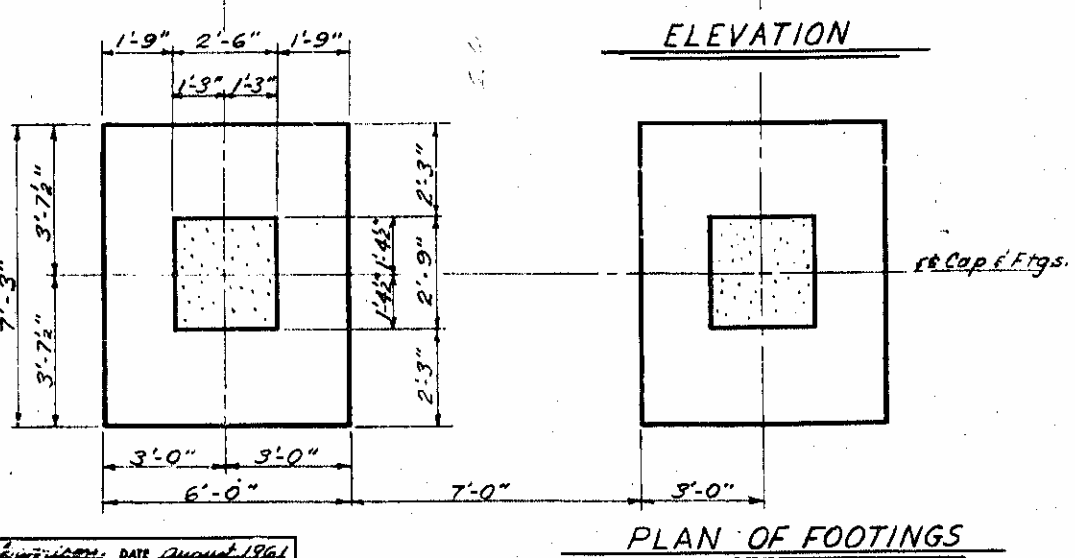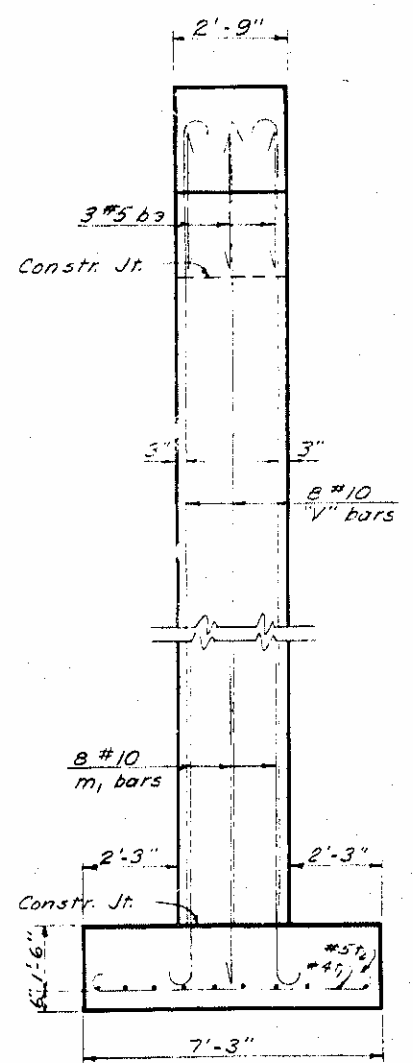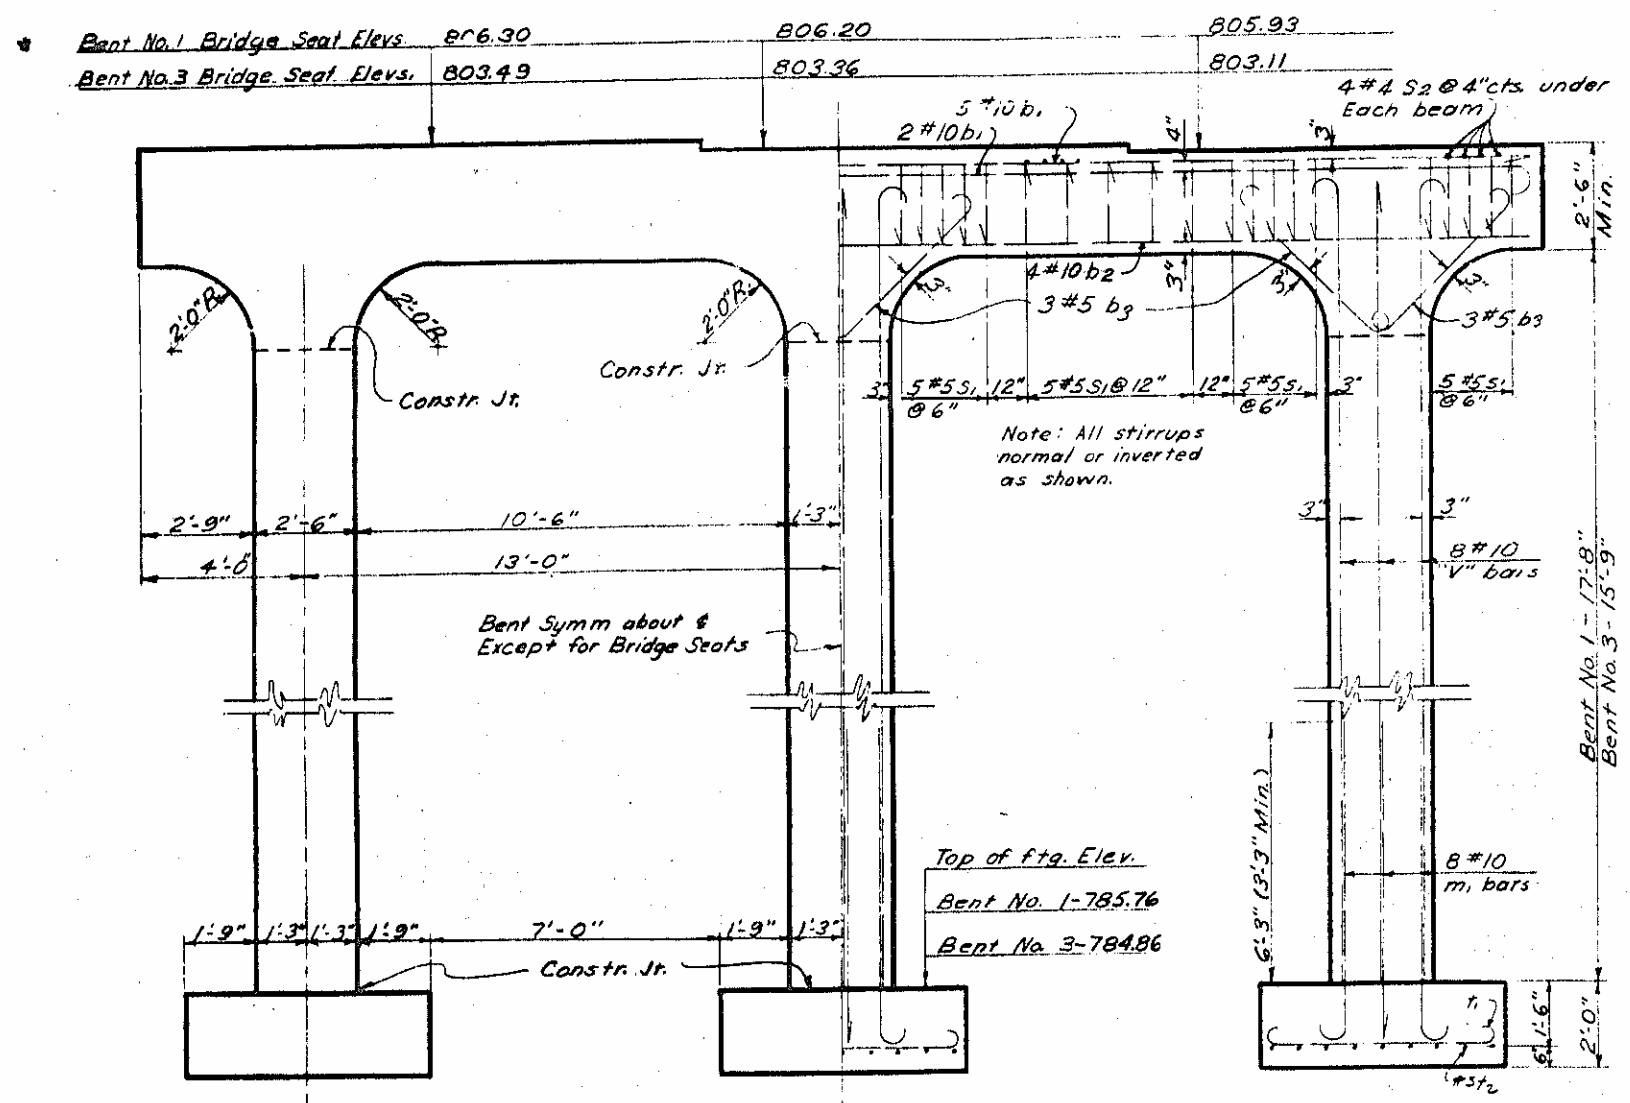

|            |                                  |
|------------|----------------------------------|
| Bent No. 1 | Reinforcing Steel-Lbs. 5585      |
|            | Class "A" Concrete-Cu. Yds. 33.1 |
| Bent No. 3 | Reinforcing Steel-Lbs. 5386      |
|            | Class "A" Concrete-Cu. Yds. 31.7 |

**PROJECT NO. 815914**  
**ROCKINGHAM COUNTY**  
**STATION: 376 + 25' L**



STATE OF NORTH CAROLINA  
STATE HIGHWAY COMMISSION

**SUBSTRUCTURE**  
**BENTS No 1 & 3**

AUGUST 1961

| REVISIONS |    |      |     |    |      |
|-----------|----|------|-----|----|------|
| NO.       | BY | DATE | NO. | BY | DATE |
| 1         |    |      | 1   |    |      |
| 2         |    |      | 2   |    |      |

DATE August 1961  
DATE 7-16-1961

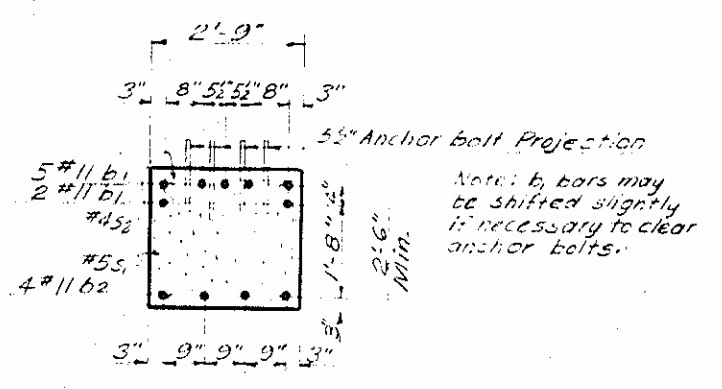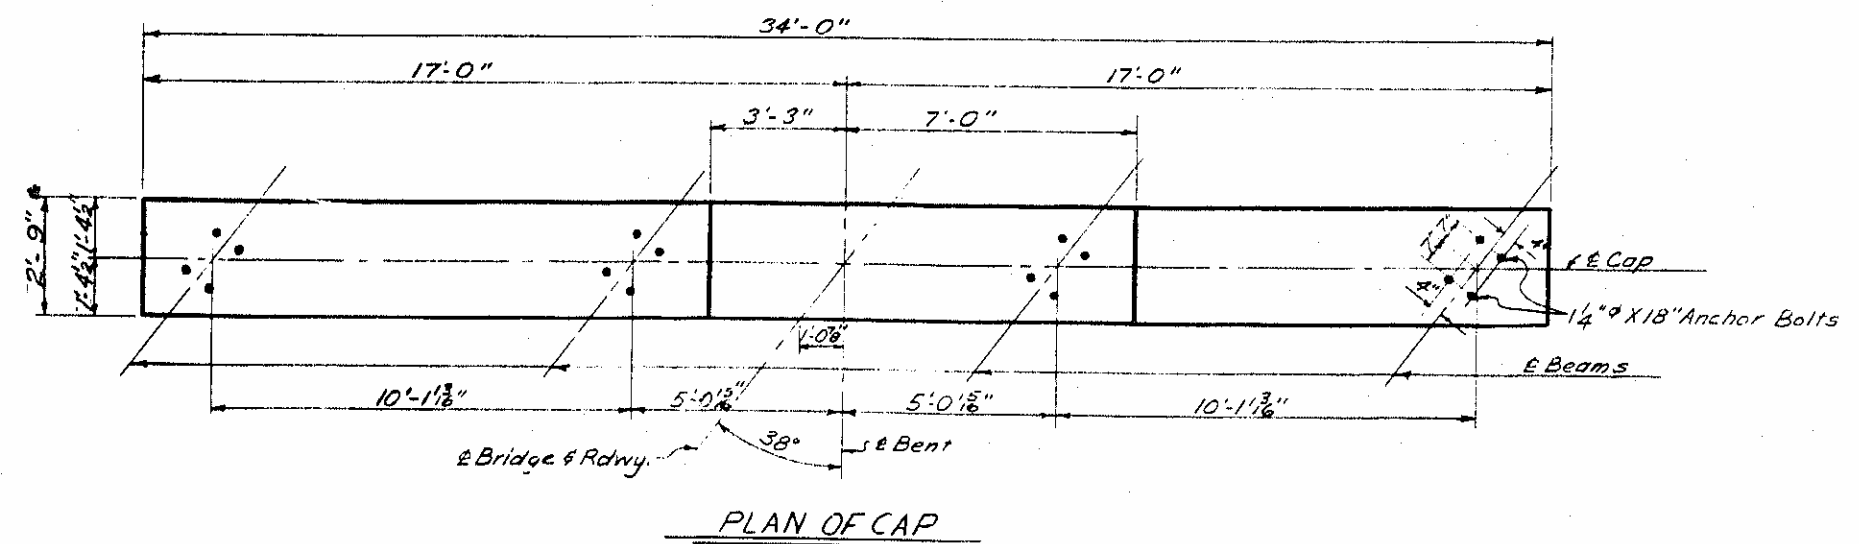

SECTION THRU CAP

**BAR TYPES**  
All dimensions are cut to out

|    |       |        |    |     |     |
|----|-------|--------|----|-----|-----|
| HK | 17"   | 33'-8" | b1 | 11K | 17" |
| 7" | 5'-0" | b3     | 7" |     |     |
| 6" | 5'-5" | t1     | 6" |     |     |
| 7" | 7'-6" | t2     | 7" |     |     |

②

|       |        |       |    |  |  |
|-------|--------|-------|----|--|--|
| HK    | 1'-5"  | 7'-8" | m1 |  |  |
| 1'-5" | 18'-0" | v1    |    |  |  |



③

|    |        |       |        |  |  |
|----|--------|-------|--------|--|--|
| HK | 4 1/2" | 2'-5" | 4 1/2" |  |  |
|----|--------|-------|--------|--|--|


**BILL OF MATERIAL FOR BENT No. 2**

| BAR NO. | SIZE | TYPE | LENGTH | QTY |
|---------|------|------|--------|-----|
| b1      | #11  | STR  | 33'-8" | 1   |
| b2      | #11  | STR  | 33'-8" | 4   |
| b3      | #5   | STR  | 6'-2"  | 18  |
| m1      | #10  | STR  | 9'-1"  | 24  |
| s1      | #5   | STR  | 7'-7"  | 46  |
| s2      | #4   | STR  | 3'-2"  | 16  |
| t1      | #4   | STR  | 6'-5"  | 33  |
| t2      | #5   | STR  | 8'-8"  | 36  |
| v1      | #10  | STR  | 20'-2" | 24  |

Reinforcing Steel-lbs. 608  
Class "A" Concrete-Cu Yds. 32

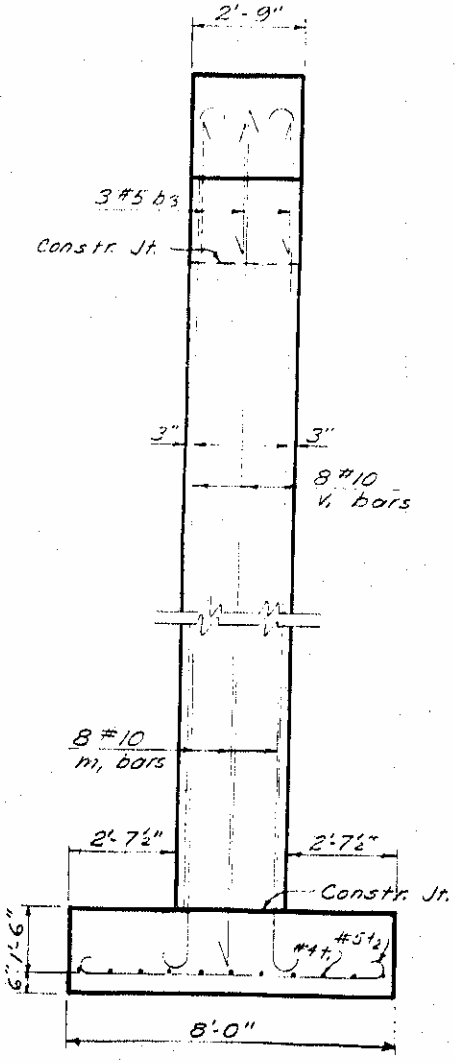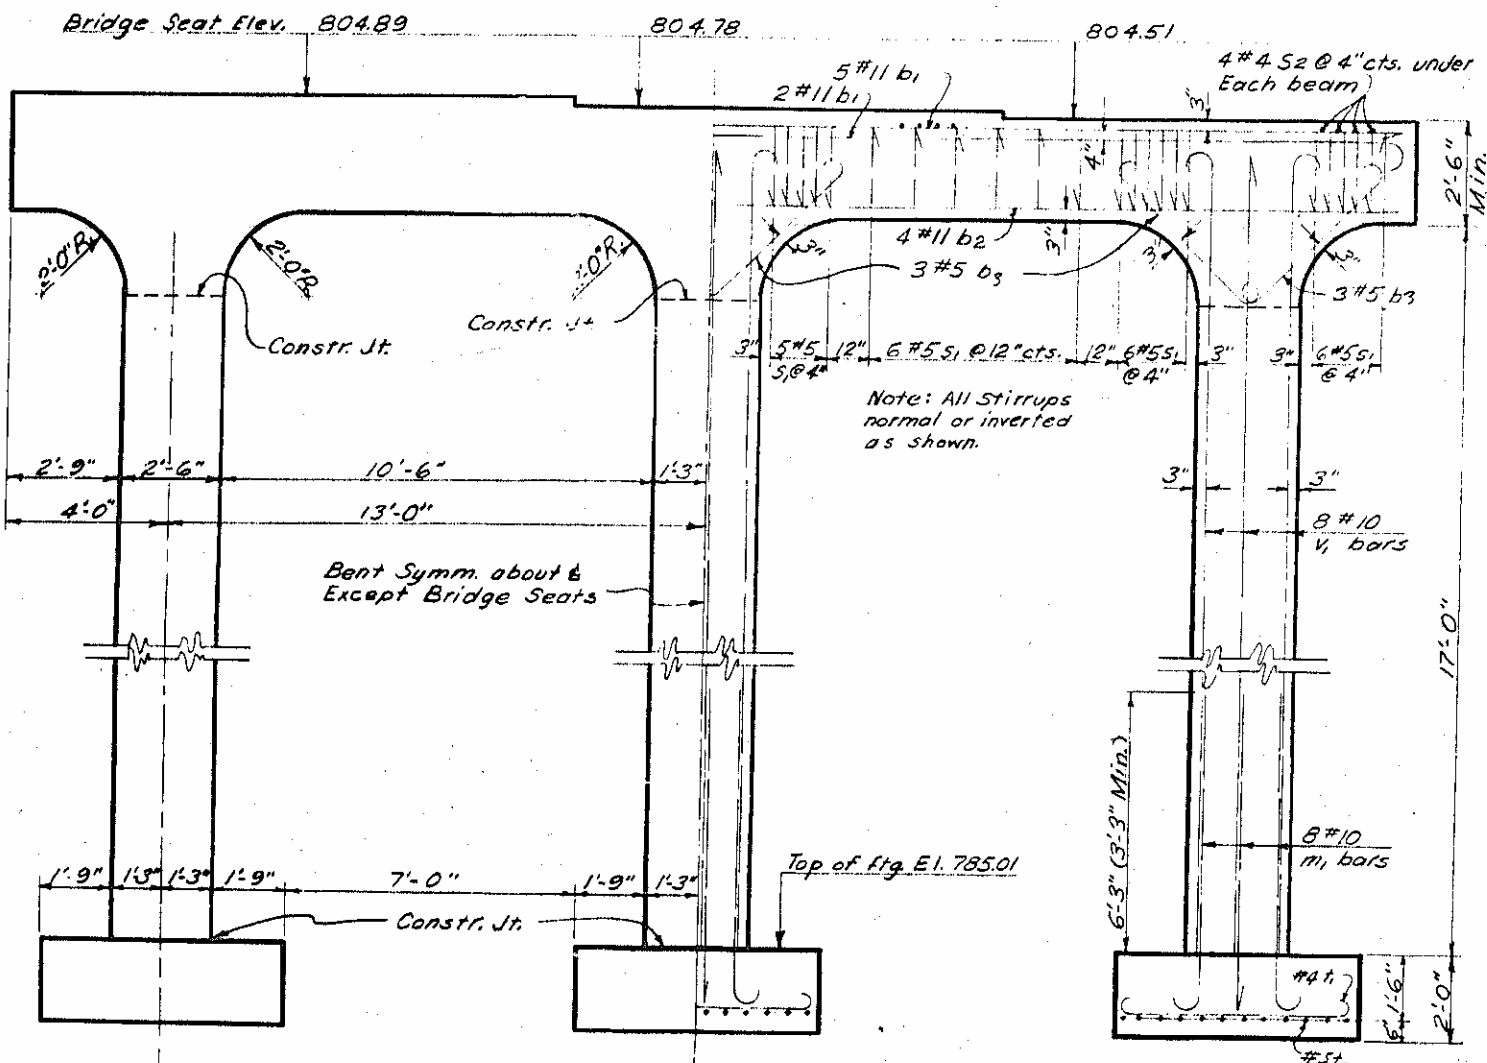

END ELEVATION

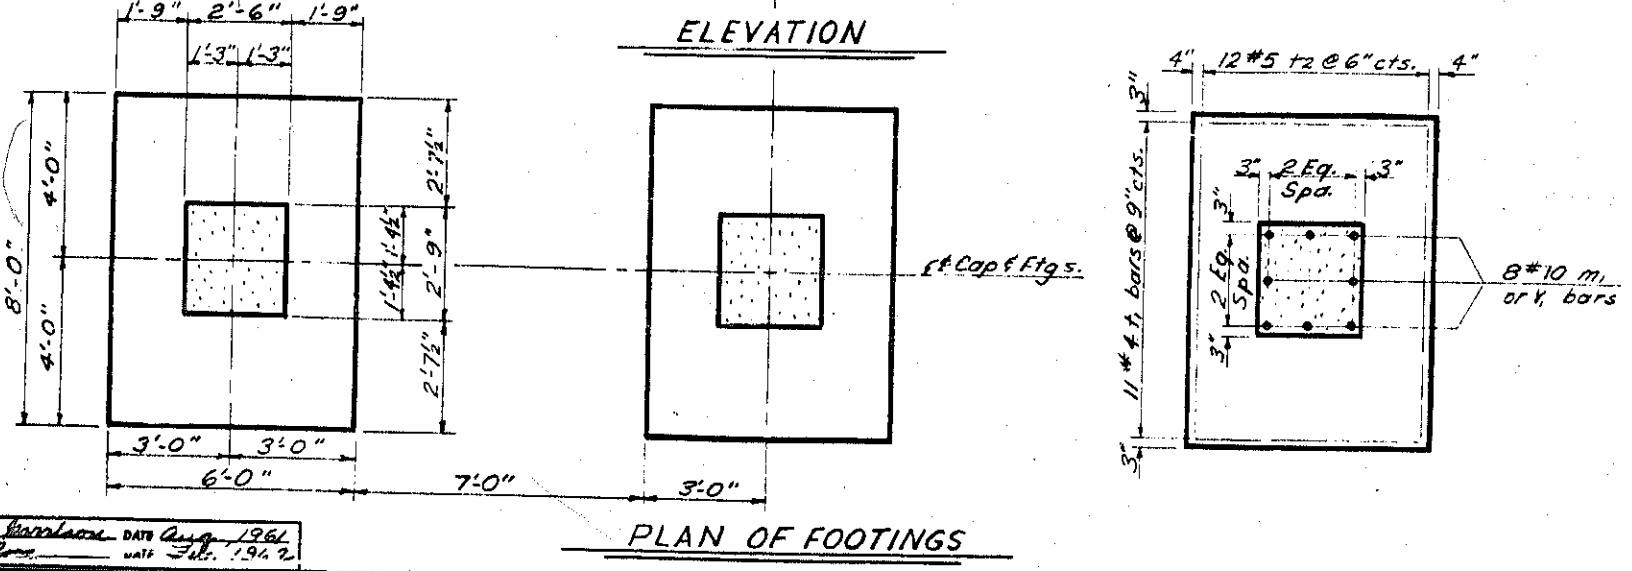


PLAN OF FOOTINGS

PROJECT NO. 815914  
ROCKINGHAM COUNTY  
STATION: 376+25 1/2


STATE OF NORTH CAROLINA  
STATE HIGHWAY COMMISSION  
BALDWIN  
SUBSTRUCTURE  
BENT No. 2

AUGUST 1961


| REVISIONS |    |      |        |
|-----------|----|------|--------|
| NO.       | BY | DATE | REASON |
| 1         |    |      |        |

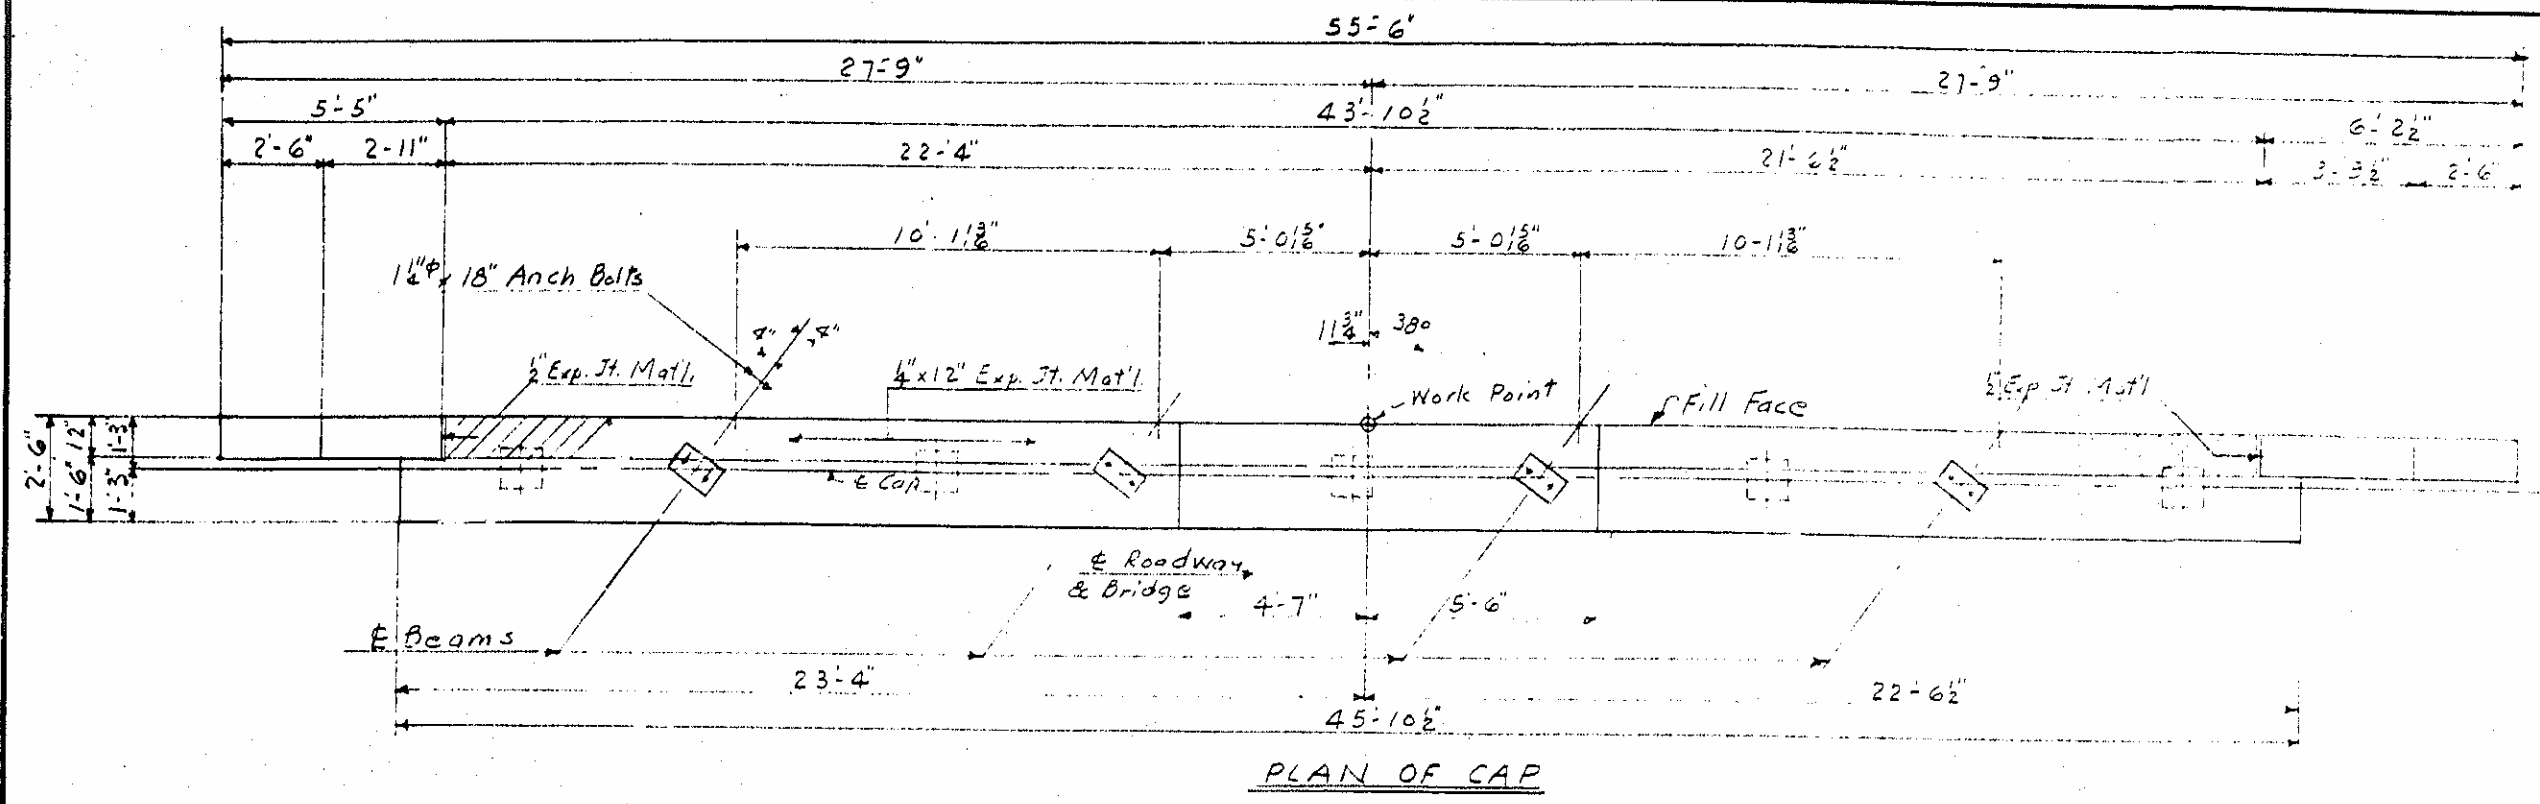


PLAN OF CAP

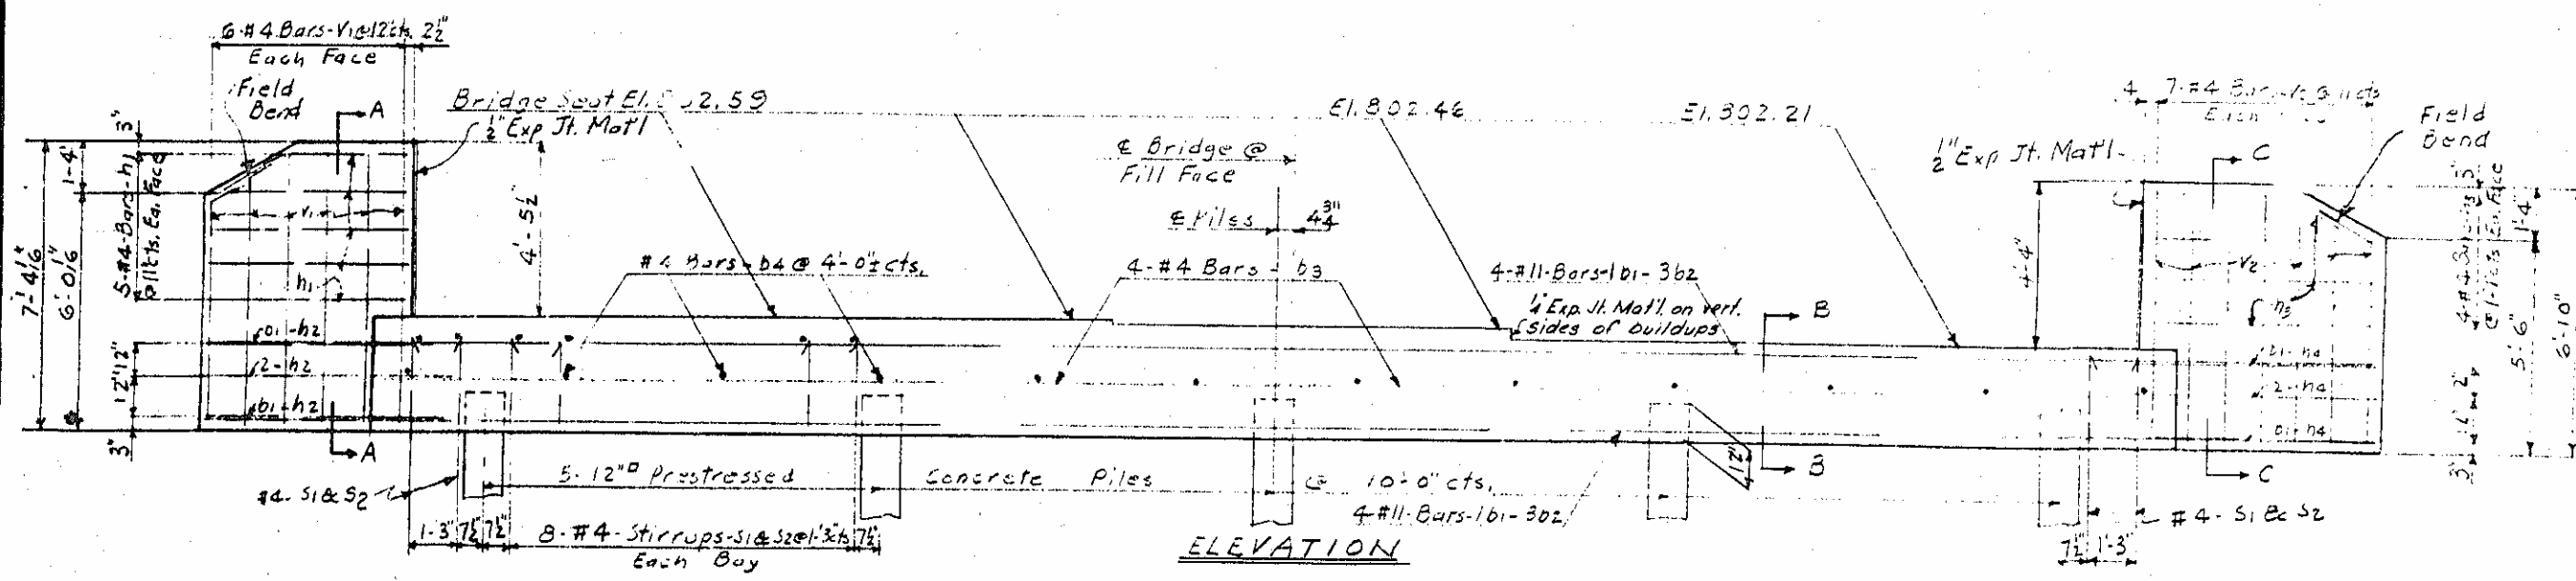


ELEVATION

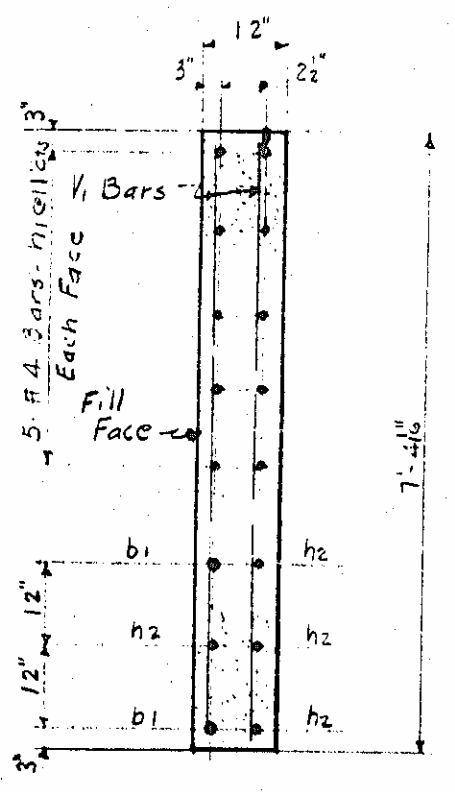

SECTION A-A

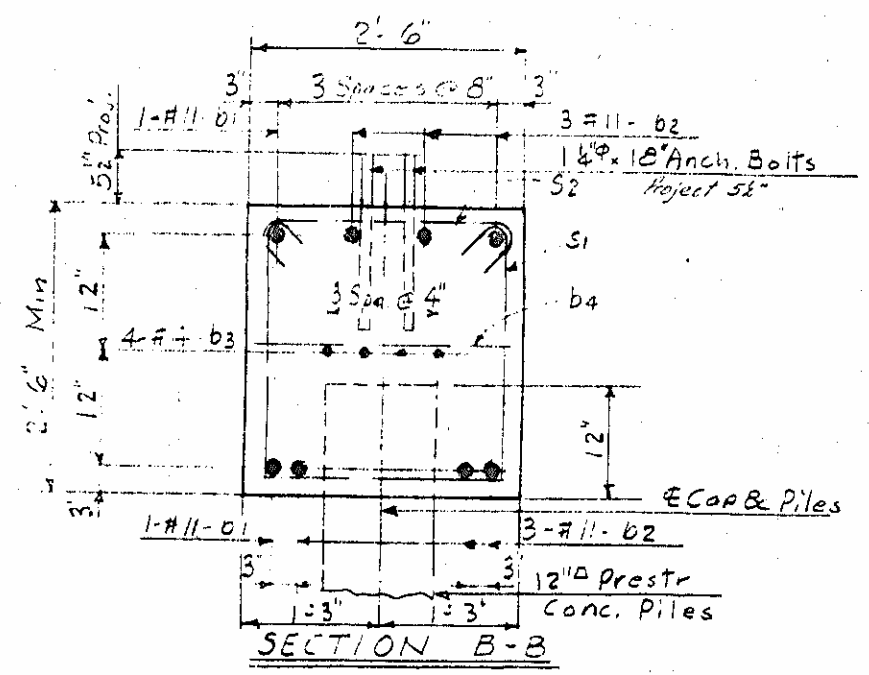


SECTION B-B

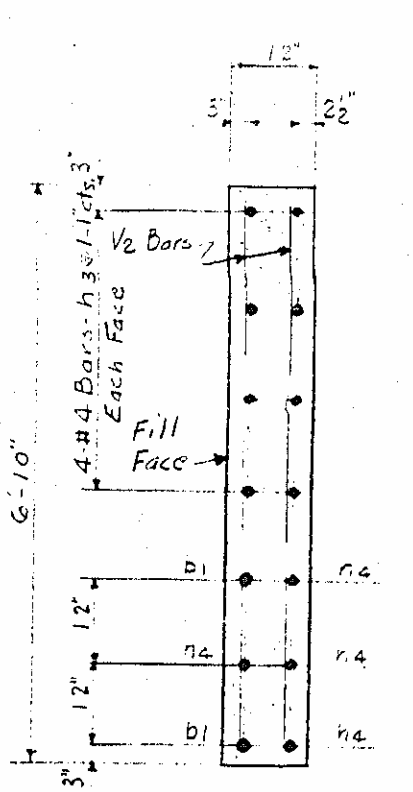

SECTION C-C

| BILL OF MATERIAL |       |      |        |        |
|------------------|-------|------|--------|--------|
| BAR NO.          | SIZE  | TYPE | LENGTH | WEIGHT |
| b1               | 2 #11 | Str. | 55'-6" | 58     |
| b2               | 6 #11 | Str. | 48'-6" | 154    |
| b3               | 8 #4  | Str. | 23'-4" | 12     |
| b4               | 12 #4 | Str. | 2'-2"  | 1      |
| h1               | 10 #4 | Str. | 5'-1"  | 34     |
| h2               | 4 #4  | Str. | 5'-6"  | 15     |
| h3               | 8 #4  | Str. | 5'-10" | 31     |
| h4               | 4 #4  | Str. | 6'-3"  | 17     |
| s1               | 36 #4 | 2    | 7'-3"  | 174    |
| s2               | 36 #4 | 3    | 2'-11" | 70     |
| v1               | 12 #4 | Str. | 7'-0"  | 56     |
| v2               | 14 #4 | Str. | 6'-6"  | 61     |

Reinforcing Steel - Lbs 2730  
 Class "A" Conc. Cu. Yds. 14.0  
 12" Precast Conc. Piles - No 5 LF 105

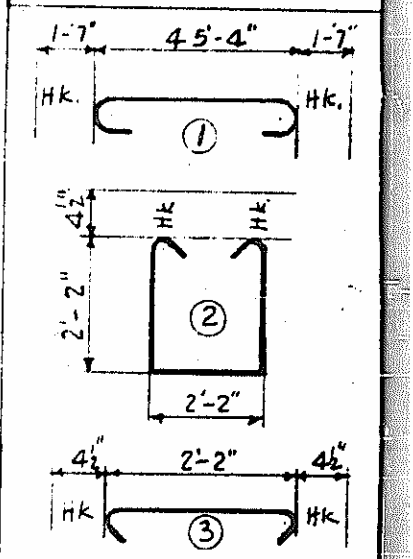


All dimensions are out to out.  
 BAR TYPES

PROJECT NO. 8.15914  
 ROCKINGHAM COUNTY  
 STATION: 376+25-LINE "L"

STATE OF NORTH CAROLINA  
 STATE HIGHWAY COMMISSION  
 RALEIGH  
 SUBSTRUCTURE  
 END BENT NO. 2.  
 AUGUST 1961

| REVISIONS |    |      |     |    |      | SHEET |  |
|-----------|----|------|-----|----|------|-------|--|
| NO.       | BY | DATE | NO. | BY | DATE | 5-29  |  |
| 1         |    |      | 3   |    |      | TOTAL |  |



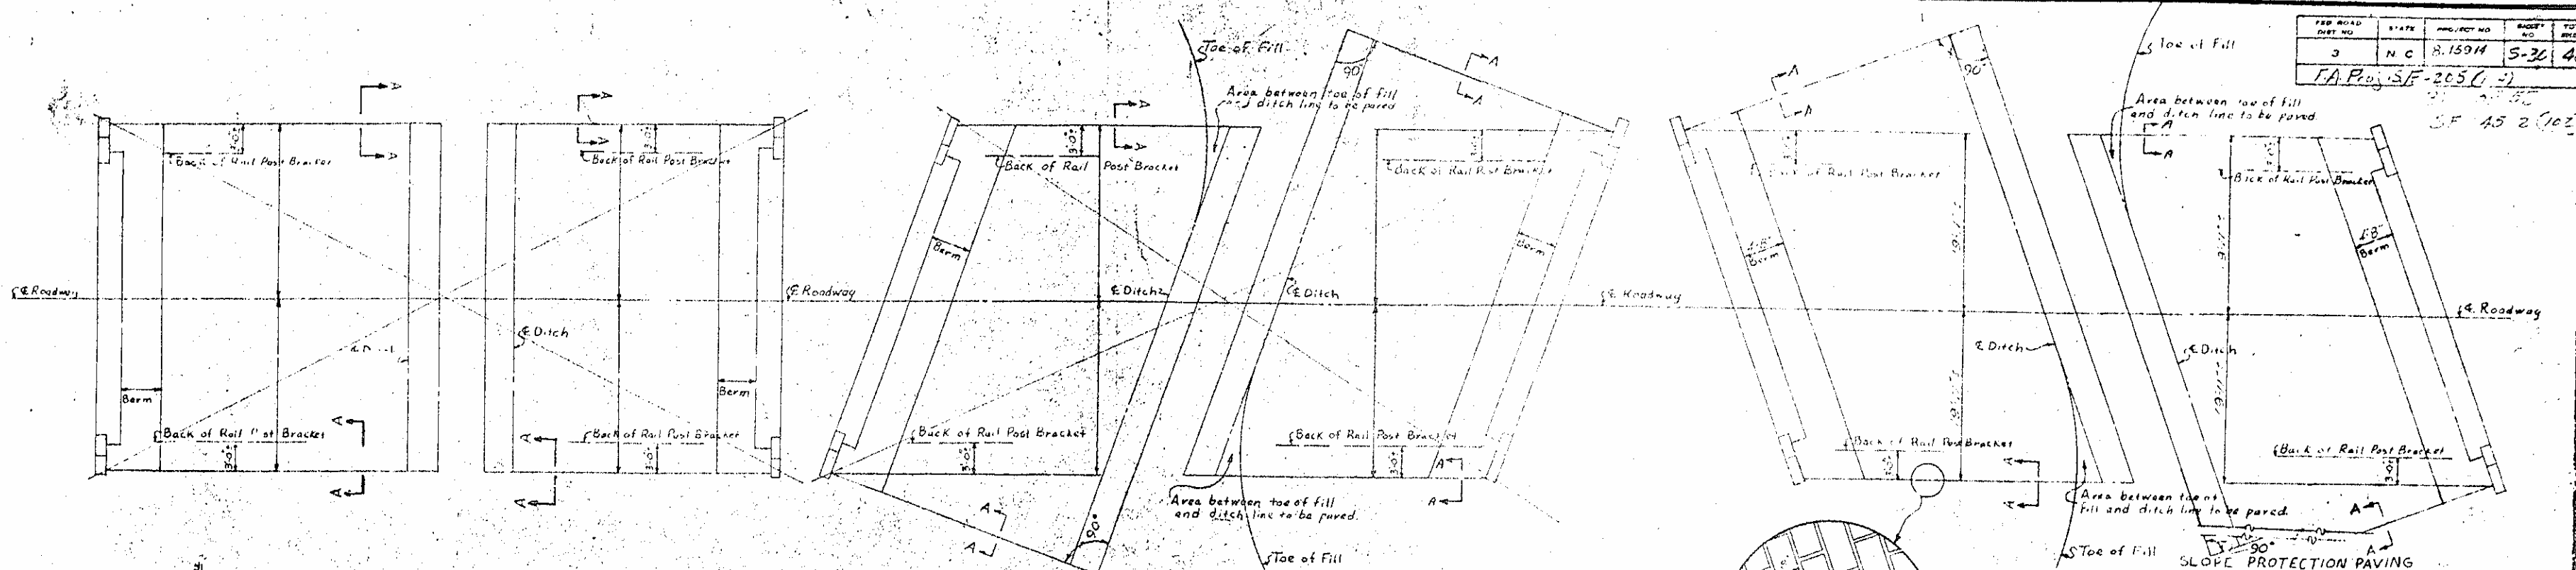


**PLAN**


**NOTE "A"**

If shoulder sand drains are to be constructed under the roadway grading contract, the concrete slope protection shall be constructed in accordance with Detail 1 after the drains have been constructed. If shoulder sand drains are to be constructed under the roadway paving contract, the concrete slope protection shall be constructed in accordance with Detail 2. The area of slope protection shown has been computed on basis of Detail 1, but the Contractor when fill catches in ditch will be paid for the area actually constructed as determined by field measurement.


**SECTION A-A**

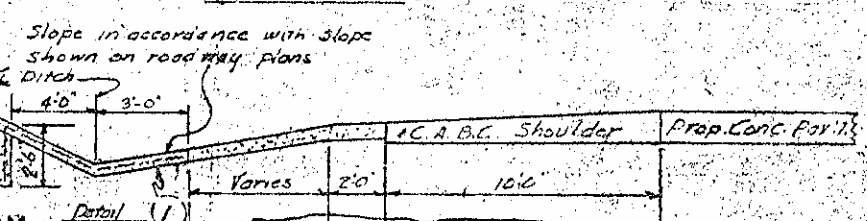


**SECTION ALONG ROADWAY WHEN DITCH IS NOT PROVIDED**

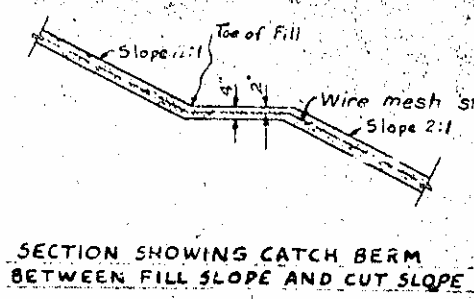


**SECTION SHOWING SLOPE WHEN TOE OF FILL IS BACK OF DITCH LINE**

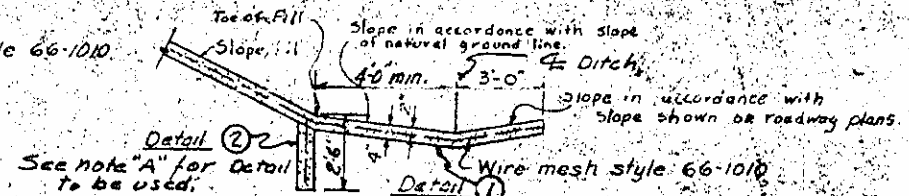


**SECTION ALONG ROADWAY WHEN FILL CATCHES IN DITCH**

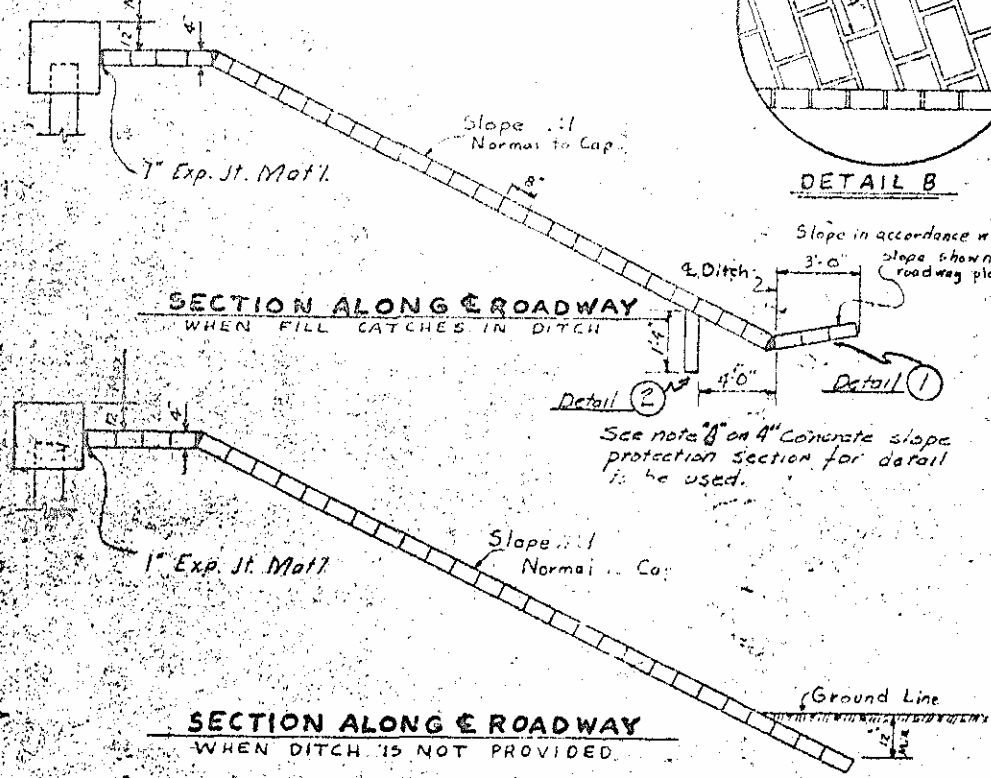



**SECTION ALONG ROADWAY WHEN DITCH IS NOT PROVIDED**

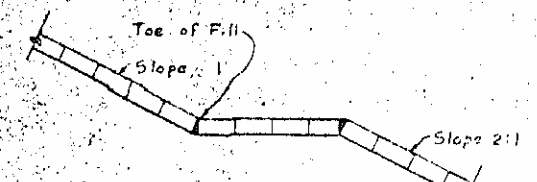

**SECTION SHOWING CATCH BERM BETWEEN FILL SLOPE AND CUT SLOPE**

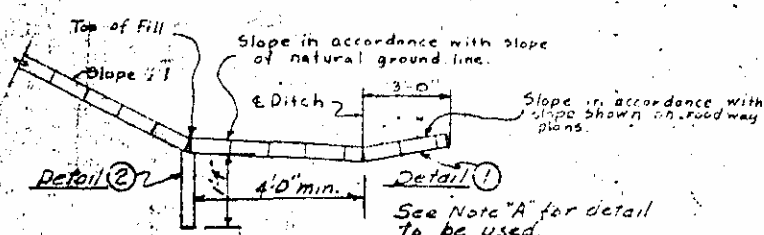

**SECTION SHOWING SLOPE WHEN TOE OF FILL IS BACK OF DITCH LINE**

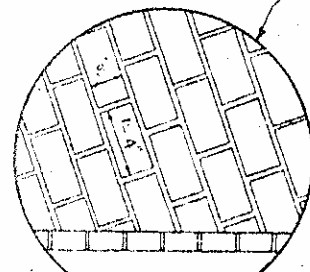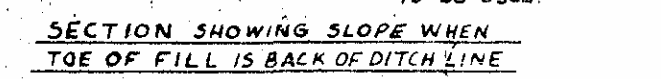

**DETAIL B**

A 4" concrete slope protection paving shall be placed under the ends of the bridge. Limits of the protection shall be as shown in the details. Bids will be accepted on either Alternate "A" or "B" as described below. Immediately before placing the paving, the slope shall be properly shaped and firmly compacted so that it conforms to the lines and grades shown. The finished surface shall be reasonably smooth and uniform and shall not vary from lines, grades and sections shown by more than 1/8" along a 10' straight edge.

**ALTERNATE "A"**  
Alternate "A" shall consist of 4" paved in place concrete paving as shown in details on this sheet. Concrete shall be Class B using Standard size Number 3 coarse aggregate. The concrete surface shall be floated with a wooden float and finished.

The quantity to be paid for under this item shall be the number of square yards of slope protection measured in place complete and accepted, including the area of the toe walls below 4" thickness of protection (for example 8" pay area for toe wall 1'-0" deep).

The quantity measured as provided for above, shall be paid for at the contract unit price per square yard for 4" concrete slope protection, complete in place, which price and payment shall be full compensation for all excavation, backfilling, preparation of slopes, and all materials, labor, equipment, tools and incidentals necessary to complete the work.

**ALTERNATE "B"**  
Alternate "B" shall consist of solid concrete blocks 4"x8"x16" laid in horizontal courses such that those in successive courses will break joints with units in the preceding one. Blocks are to be laid with their long axis parallel to the and joint cap with grouted joints preferably 3/4" but not less than 1/2" nor more than 1 1/4" between successive courses and ends of blocks. Joints shall be grouted by pouring a mixture of one part portland cement to three parts sand mixed with sufficient water to enable mixture to be poured through a spout.

The concrete blocks shall be cast to accurate dimensions, shall have uniform surface color and texture, and shall be manufactured of materials to produce a compressive strength of not less than 3000 p.s.i. at age of 28 days. No broken blocks shall be used except in constructing a straight line along each side of the paving down the slope. Care shall be taken to break the blocks so as to give a uniform workmanlike joint and surface.

Method of measurement and basis of payment shall be as prescribed above under Alternate A except that the item shall be 4" Concrete Block Slope Protection instead of 4" Concrete Slope Protection.

**POURING DETAIL**

Pour a 4" strip first. Strip widths may vary in curved portion.

PROJECT NO. 8-15914  
ROCKINGHAM COUNTY  
STATION: 376+25.2

**SECTION A-A**

| BRIDGE # | Wire Mesh 60" Wide Approx. L.F. | 4" Concrete Slope Protection or 4" Concrete Block Slope Protection |        |
|----------|---------------------------------|--|--------|
|          |                                 | E.B.#1   | E.B.#2 |
| 376+25.2 | 121                             | 3.0  | 2.55   |

STATE OF NORTH CAROLINA  
STATE HIGHWAY COMMISSION

STANDARD  
SLOPE PROTECTION PAVING  
DETAILS

SEPTEMBER, 1958

|             |      |
|-------------|------|
| DESIGNED BY | DATE |
| DRAWN BY    | DATE |
| CHECKED BY  | DATE |
| APPROVED BY | DATE |

Revision No. 1 - to add Section A-B by B.C.A. 11/24/58

Rev 5 - To show detail 1 B 2 and Note "A" J.N.P. 12/25/58  
Rev 4 - To add wire mesh to Alternate "A" W.J.R. 27 Jan 60  
Rev 3 - To eliminate toe wall along front edge C.A.K. 4-1-60  
Rev 2 - To show plan of Bent Column A.B. 3-8-60 U.L.

DETAILS FOR ALTERNATE "B"  
Rev #6 - To remove Section B-B and change Plan for Standard Bridges by J.N.B. 11/25/58