
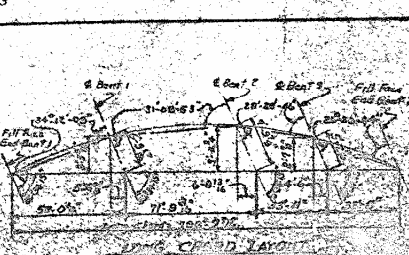
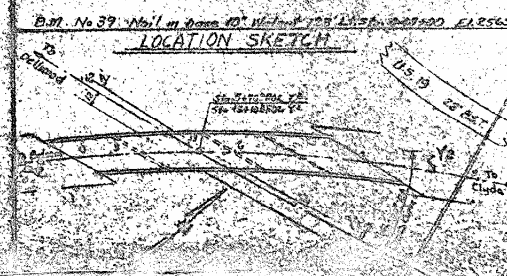
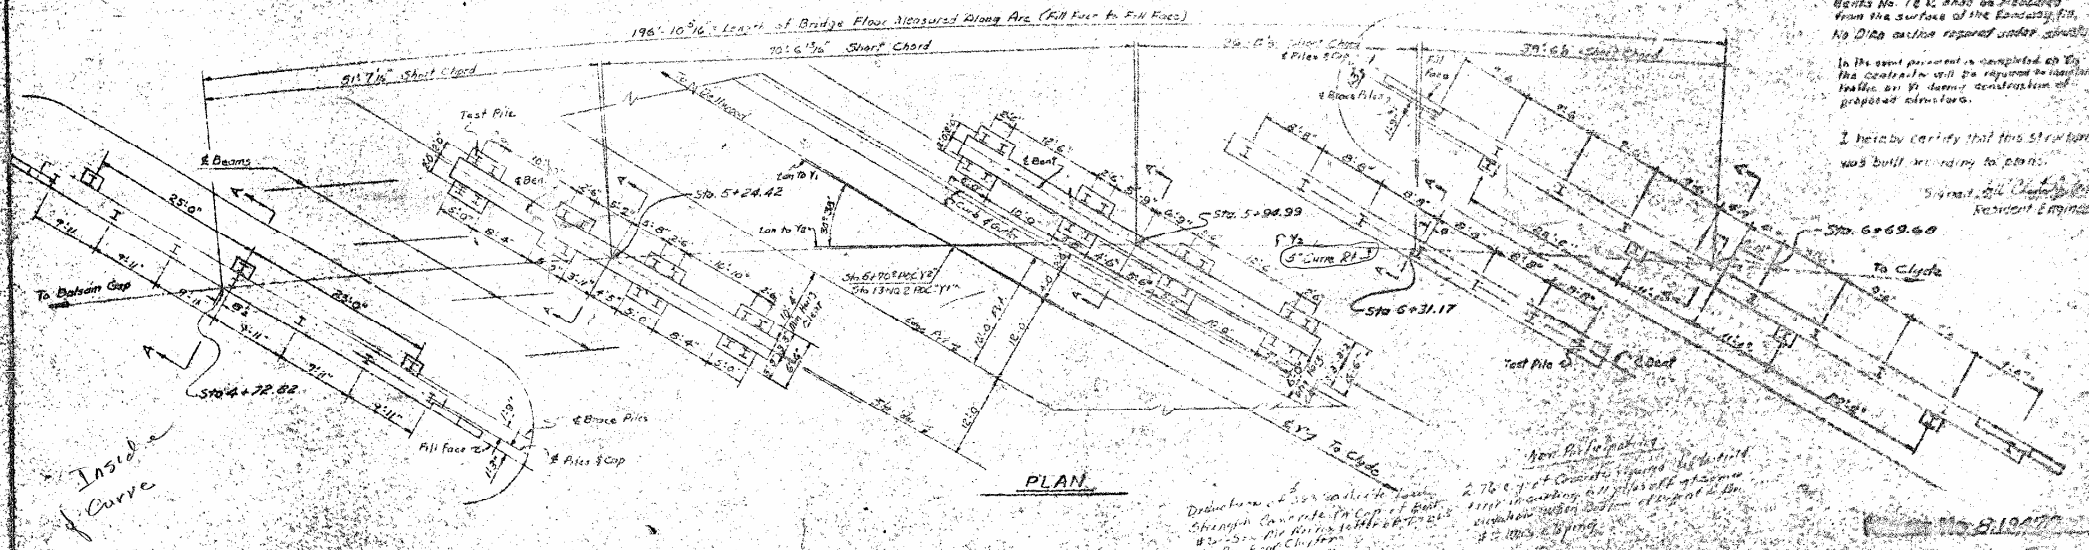


NOTES

Approved by Local H.Q. 5-16-65
 For other design data and General Notes see sheet 5-16.
 The Contractor will be required to drive one 1/2" H.S. Steel Test Pile 4' long in place for Bent No. 1 and one 1/2" H.S. Steel Test Pile 4' long in place for Bent No. 2. The Test Piles shall be paid for on a linear ft. of 10M² per pile. The other length for the 1/2" H.S. Steel Piles will be given after the Test Piles have been driven.
 Piles for End Bent No. 1 and for Bents No. 2, 3, 4 shall be driven to a minimum bearing capacity of 25 tons axial. Piles for End Bent No. 2 shall be driven to a minimum bearing capacity of 20 tons axial.
 Piles for End Bent No. 1 and No. 2, and Bents No. 2, 3, 4 to be driven through the roadway fill. Work is not to be started on this project until after roadway section has been completed by the Roadway Contractor. Unobstructed clearance for Bents No. 1 & 2 shall be measured from the surface of the roadway fill. No D/Ps shall be required under structure.
 In the event permanent is completed by the contractor will be required to install traffic as it forms construction of proposed structure.
 I hereby certify that this structure was built according to plans.
 Signed: *[Signature]*
 Resident Engineer



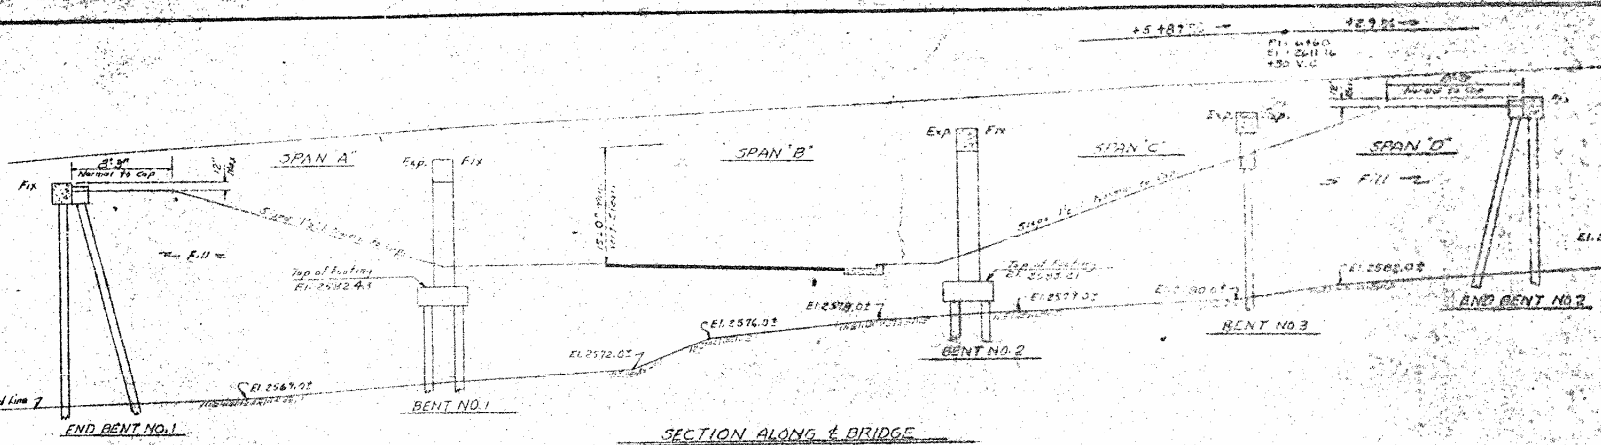


Bar #1 - To add stations for bents - E. P. H.




TOTAL BILL OF MATERIAL

Span	Class of Material	Quantity	Unit	Value
Span A	Structural Steel	30,000	Lbs.	90,000
	Welding Steel	18,000	Lbs.	54,000
Span B	Structural Steel	64,000	Lbs.	192,000
	Welding Steel	38,000	Lbs.	114,000
Span C	Structural Steel	24,000	Lbs.	72,000
	Welding Steel	14,000	Lbs.	42,000
Span D	Structural Steel	21,000	Lbs.	63,000
	Welding Steel	12,000	Lbs.	36,000
Total				588,000

196-10
 56-10

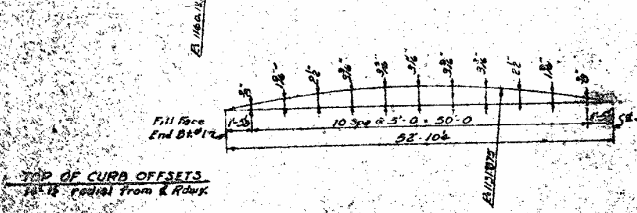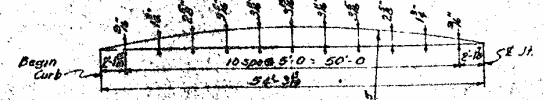
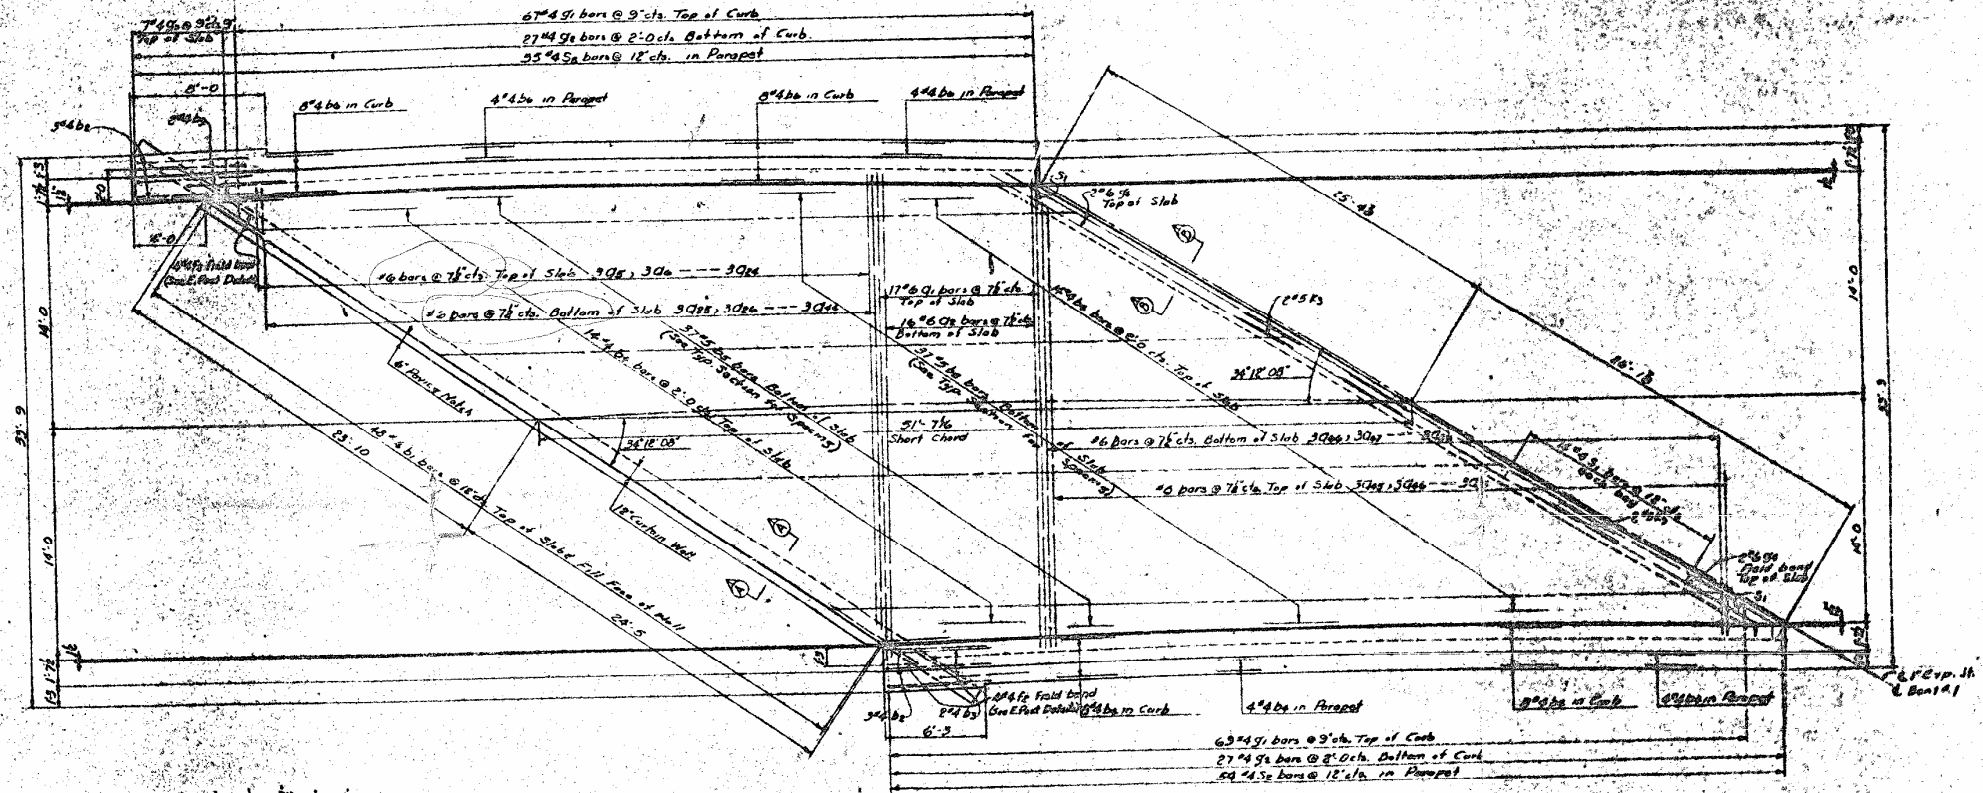


018470
MAY 1951

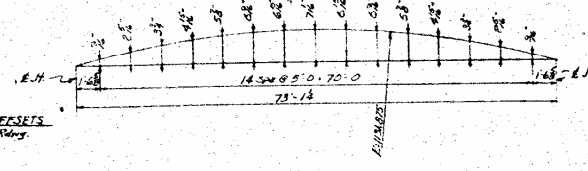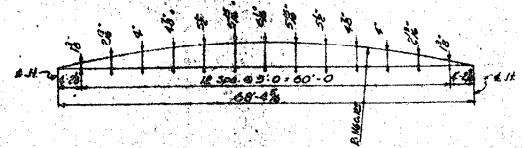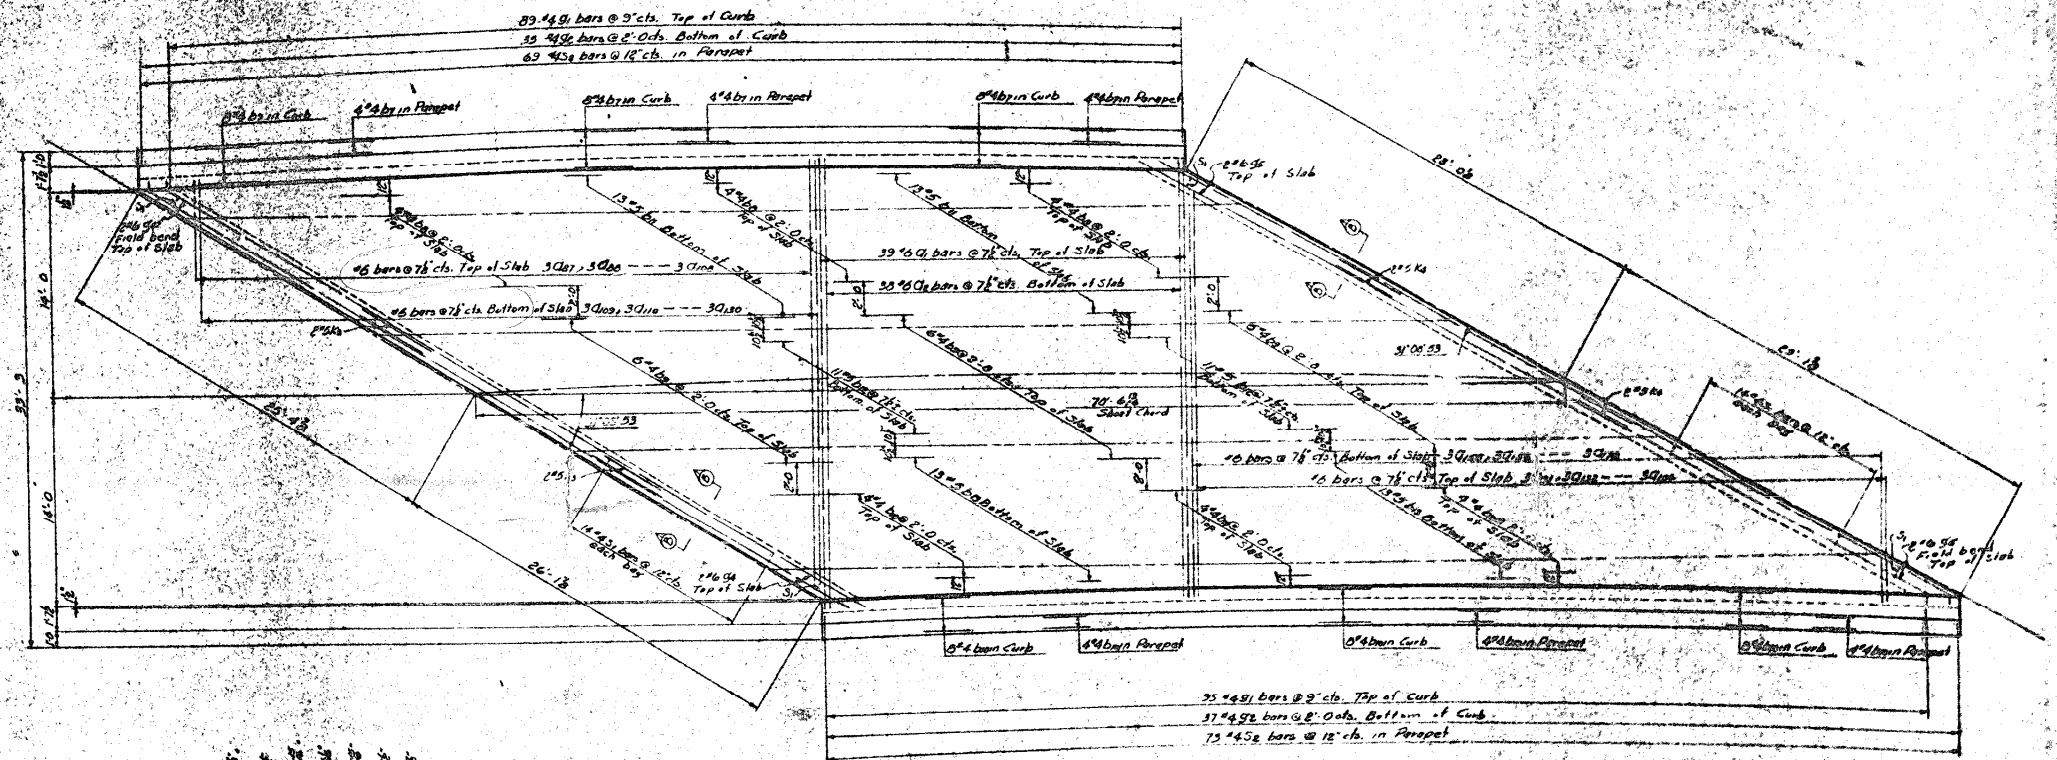


012470
 HAYWOOD
 20723
 SUPERSTRUCTURE
 SPAN B
 September 1952

15-572
 P. 1-20

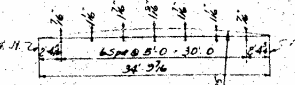
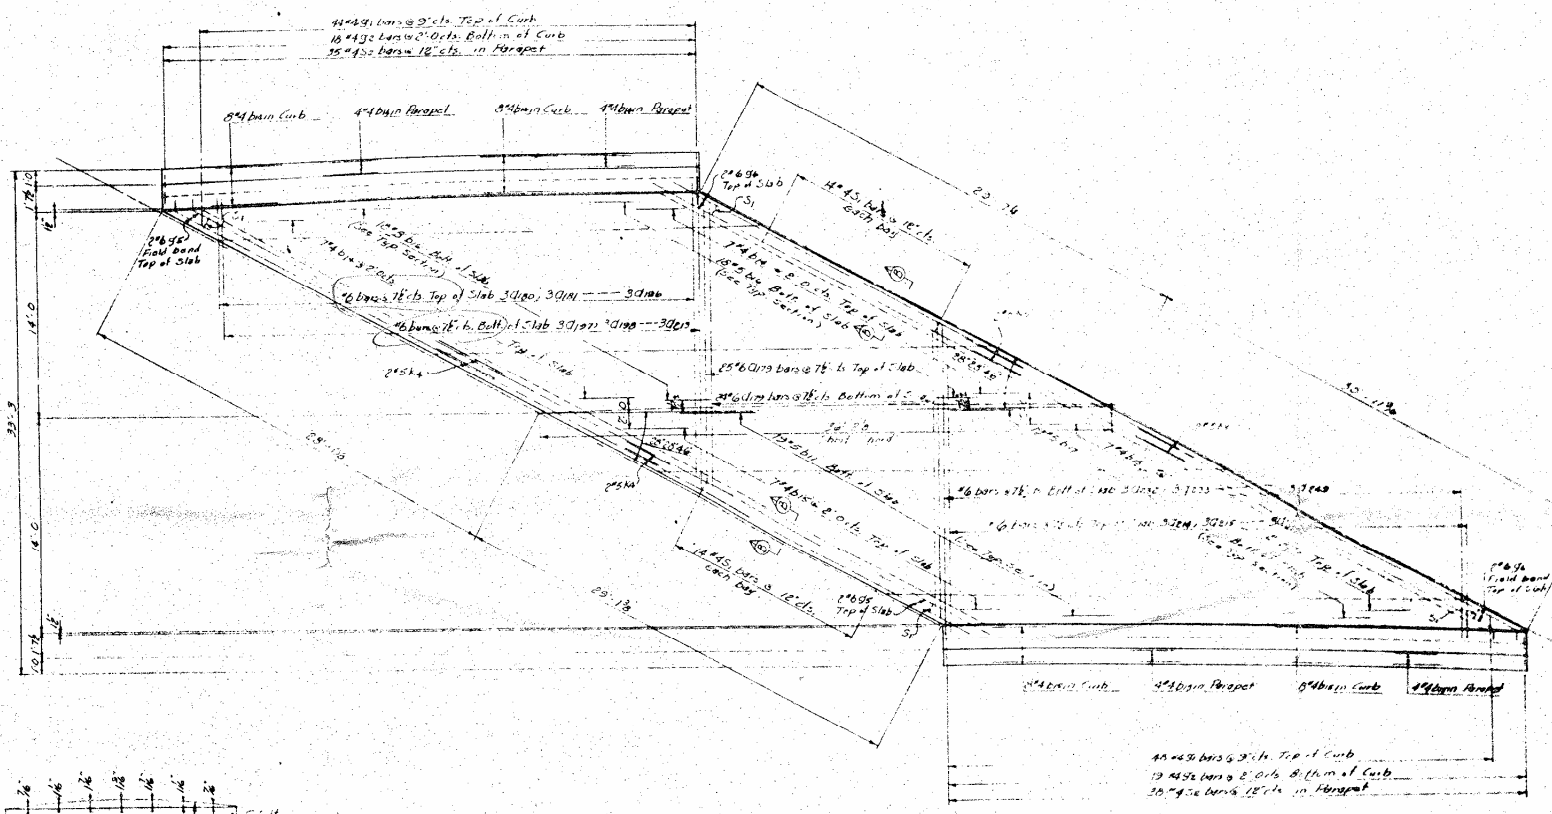


TOP OF CURB OFFSETS
 1/8" radial from Rany

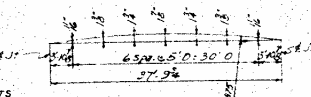


PROJECT NO. 61747D
 HAYWOOD COUNTY
 SEPTEMBER 21, 1968


STRUCTURE
 SUPERSTRUCTURE
 SPAN C
 September 1968

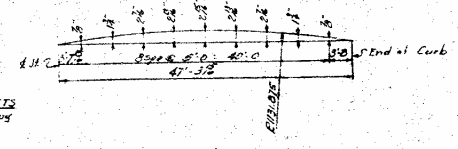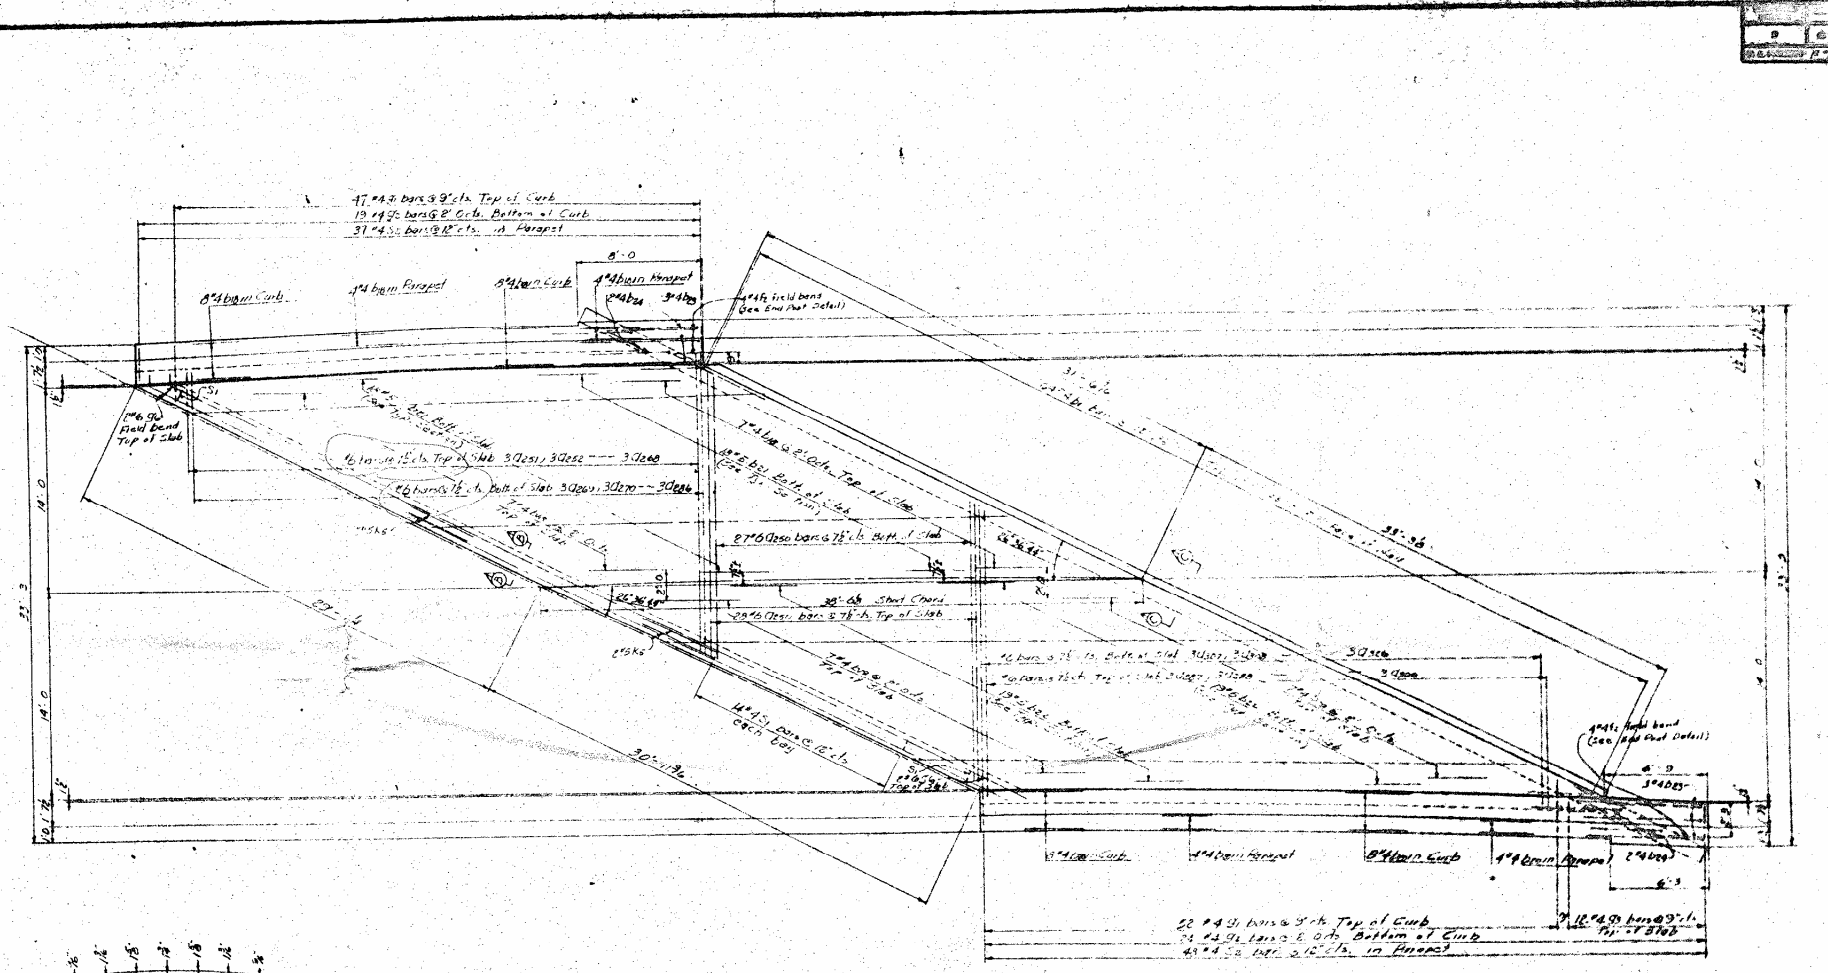


0.12472
MAYWOOD
9-10-07B
SUPERSTRUCTURE
SPAN D

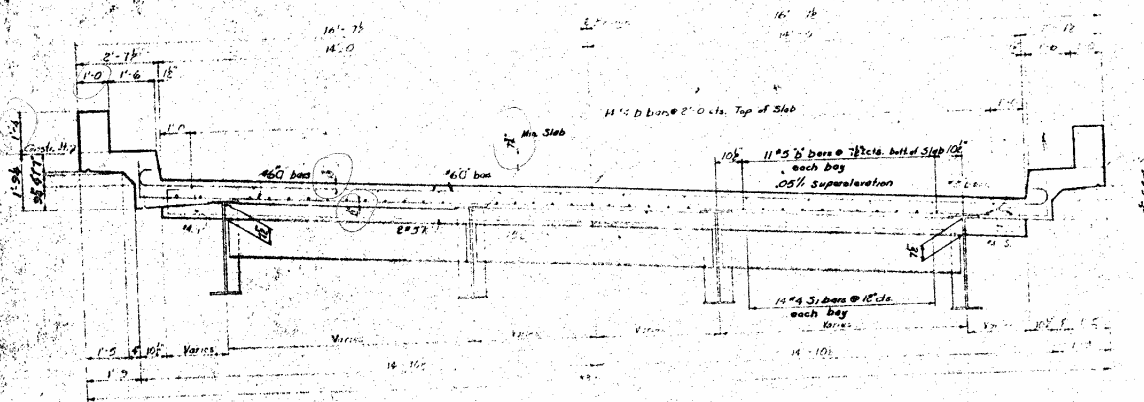


ELEVATION

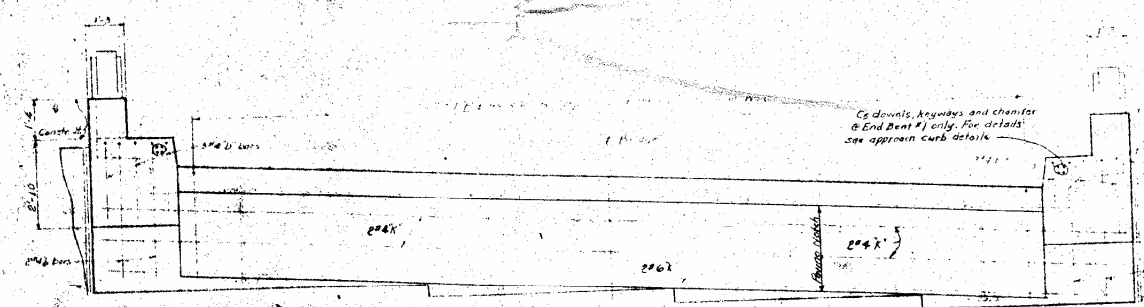

ELEVATION

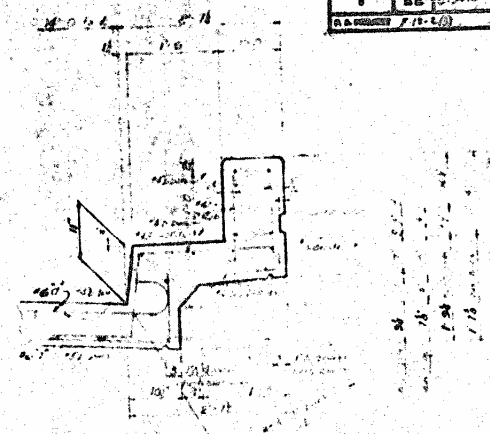

SECTION INHW CURB

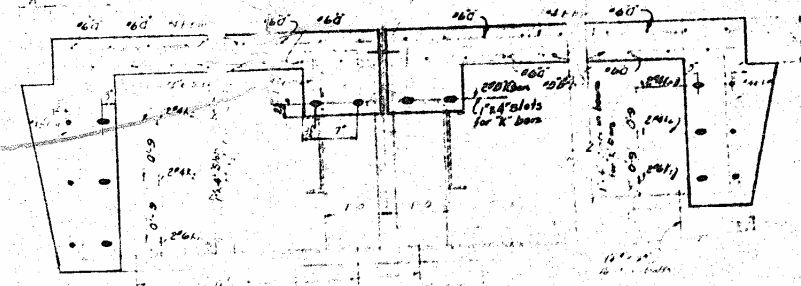


SECTION A-A

SECTION B-B


DATE	BY	CHKD
SHEET 7 OF 10		

PROJECT No. 115470
 HAYWOOD COUNTY
 STATION 5110.07E

STATE OF NORTH CAROLINA
STATE HIGHWAY COMMISSION
 DIVISION OF HIGHWAYS
 SUPERVISOR OF BRIDGE DEPARTMENT
 APR. 1962

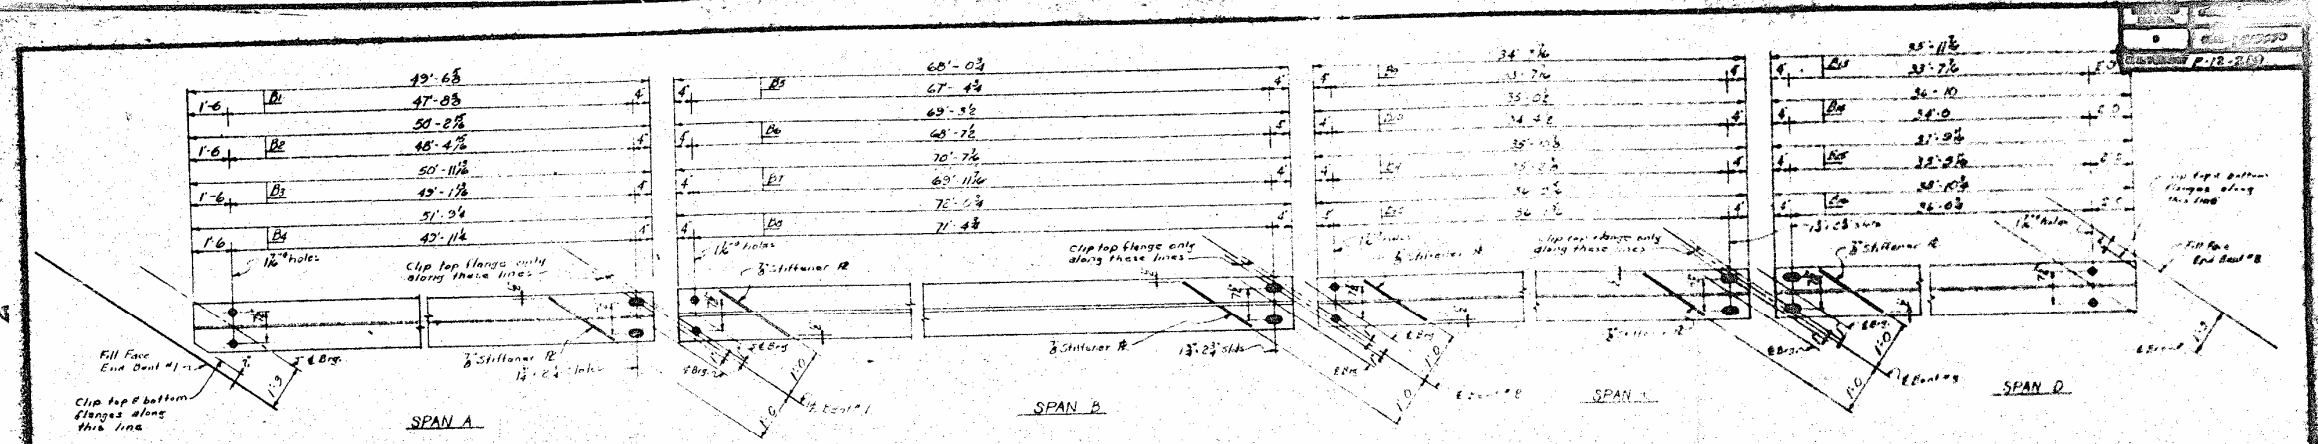


DETAIL OF BOTTOM BEAM FLANGE
 Note: Dimensions shown are horizontal

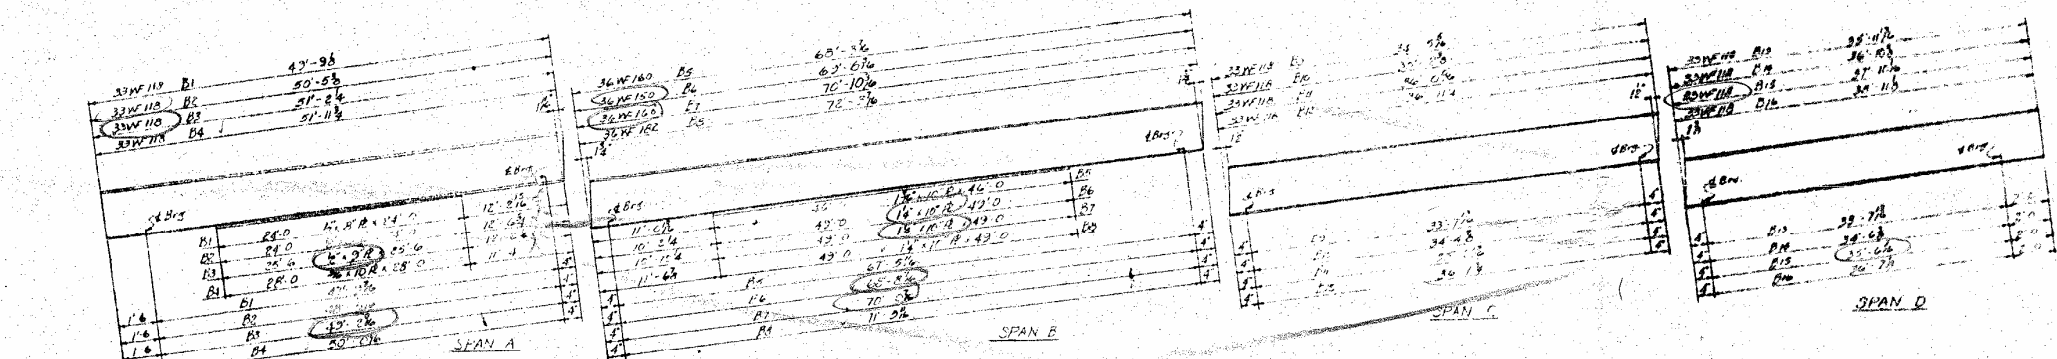

Span	Line	Dimension
SPAN A	1-6	47'-6 1/2
	1-6	47'-0 3/4
	1-6	50'-2 1/8
	1-6	48'-4 1/8
SPAN B	1-6	60'-0 3/4
	1-6	67'-4 1/8
	1-6	69'-5 1/8
	1-6	68'-7 1/8
SPAN C	1-6	34'-7 1/8
	1-6	31'-2 1/8
	1-6	35'-0 1/8
	1-6	34'-4 1/8
SPAN D	1-6	45'-1 1/8
	1-6	43'-7 1/8
	1-6	44'-10
	1-6	43'-9 1/8

STUD SPACING


Span	Line	Dimension
SPAN A	1-6	47'-6 1/2
	1-6	47'-0 3/4
	1-6	50'-2 1/8
	1-6	48'-4 1/8
SPAN B	1-6	60'-0 3/4
	1-6	67'-4 1/8
	1-6	69'-5 1/8
	1-6	68'-7 1/8
SPAN C	1-6	34'-7 1/8
	1-6	31'-2 1/8
	1-6	35'-0 1/8
	1-6	34'-4 1/8
SPAN D	1-6	45'-1 1/8
	1-6	43'-7 1/8
	1-6	44'-10
	1-6	43'-9 1/8

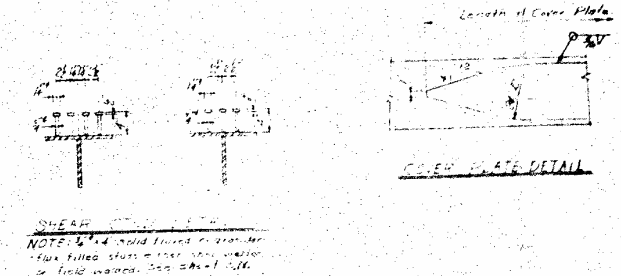

Project No. A-17410
HAYWOOD COUNTY
Station 5+70.0 72


STATE ENGINEER
STRUCTURAL STEEL
 September 1962

NO.	REV.	DATE
1	AS	1/15/22
DRAWN BY P. H. (2)		

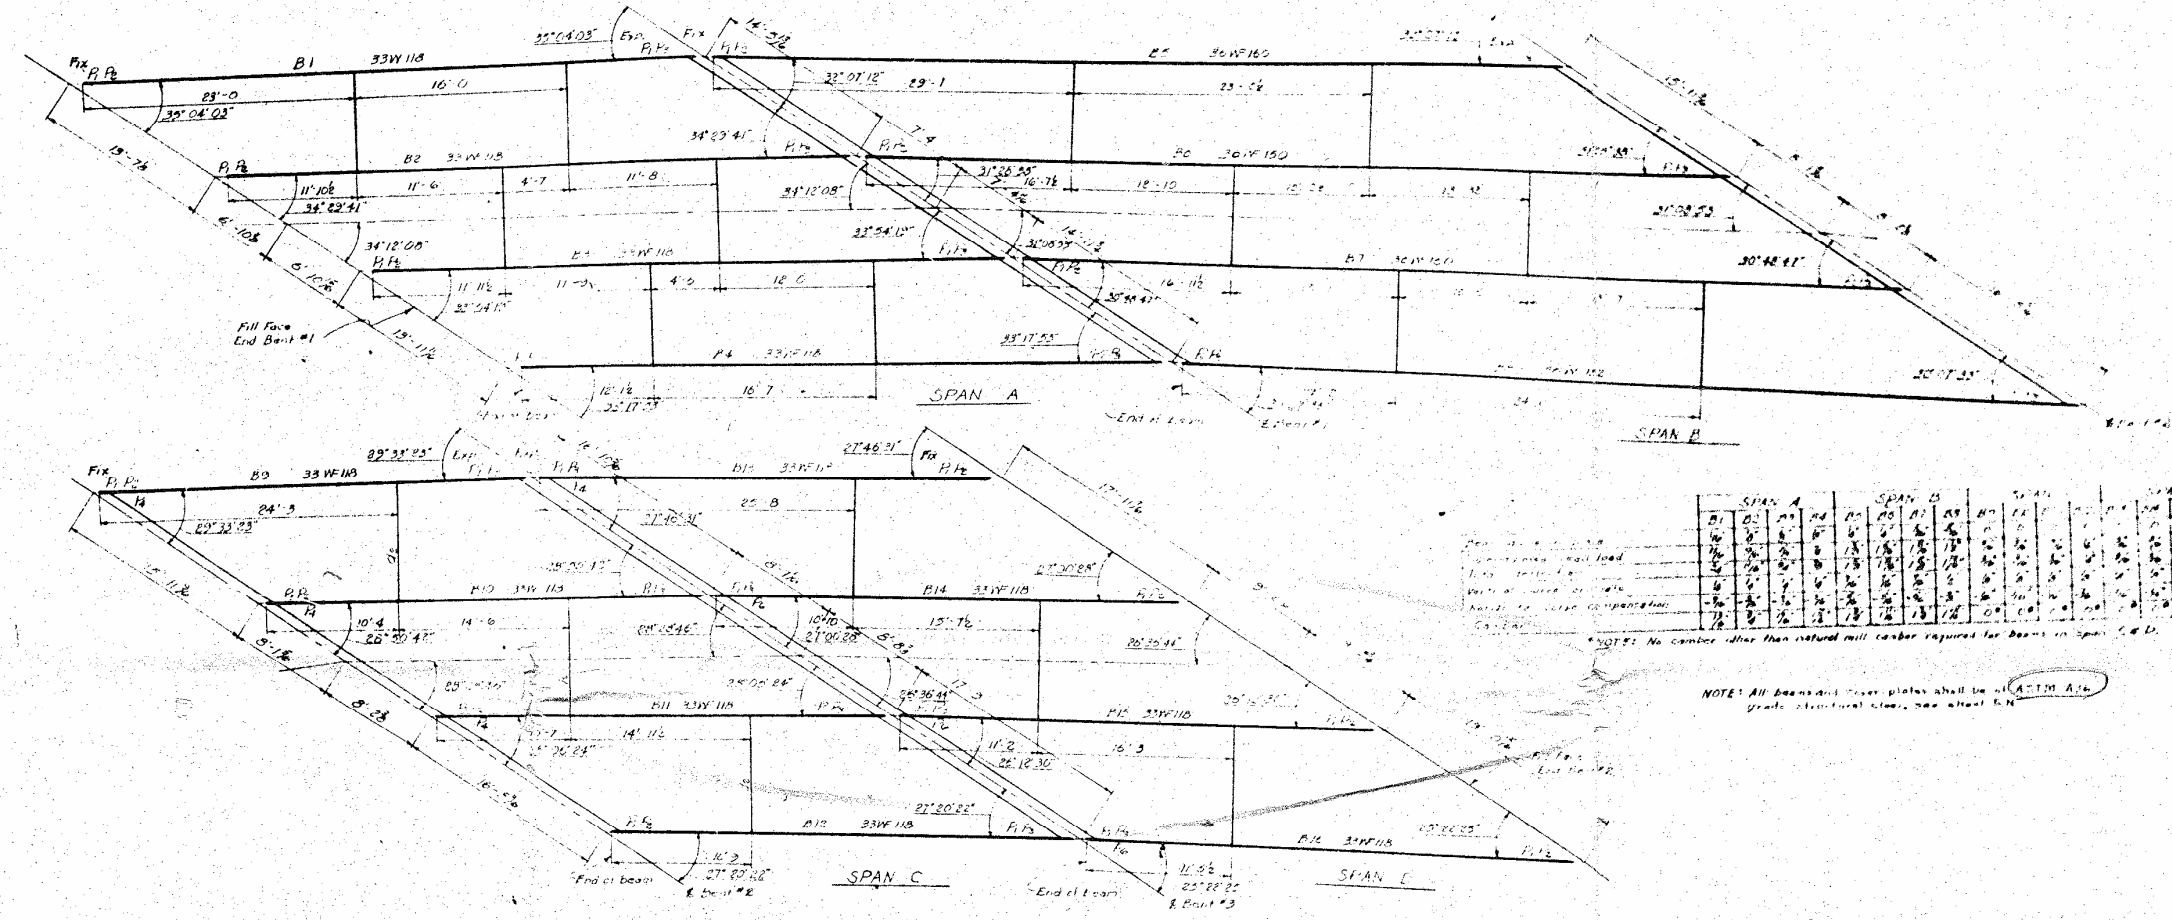


SPAN A		SPAN B		SPAN C		SPAN D	
Beam No.	Length	Beam No.	Length	Beam No.	Length	Beam No.	Length
B1	16.0	B1	11.6	B1	11.6	B1	11.6
B2	11.6	B2	11.6	B2	11.6	B2	11.6
B3	11.6	B3	11.6	B3	11.6	B3	11.6
B4	11.6	B4	11.6	B4	11.6	B4	11.6
B5	11.6	B5	11.6	B5	11.6	B5	11.6
B6	11.6	B6	11.6	B6	11.6	B6	11.6
B7	11.6	B7	11.6	B7	11.6	B7	11.6
B8	11.6	B8	11.6	B8	11.6	B8	11.6
B9	11.6	B9	11.6	B9	11.6	B9	11.6
B10	11.6	B10	11.6	B10	11.6	B10	11.6
B11	11.6	B11	11.6	B11	11.6	B11	11.6
B12	11.6	B12	11.6	B12	11.6	B12	11.6
B13	11.6	B13	11.6	B13	11.6	B13	11.6
B14	11.6	B14	11.6	B14	11.6	B14	11.6
B15	11.6	B15	11.6	B15	11.6	B15	11.6
B16	11.6	B16	11.6	B16	11.6	B16	11.6


NOTE: All beams and cover plates shall be of ASTM A36 grade structural steel, per actual S.N.

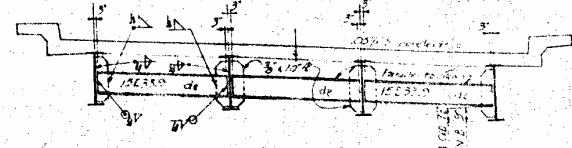

TYPICAL SECTION SHOWING INTERIOR DIAPHRAGM
 NOTE: In lieu of the welding procedure for shop and field welds indicated for the intermediate diaphragm connections, the Contractor may, at his option, shop weld the connector plates to the beam webs and field weld the channels to the connector plates. Special care in handling the beams must be observed if connector plates are shop welded to the beam webs.

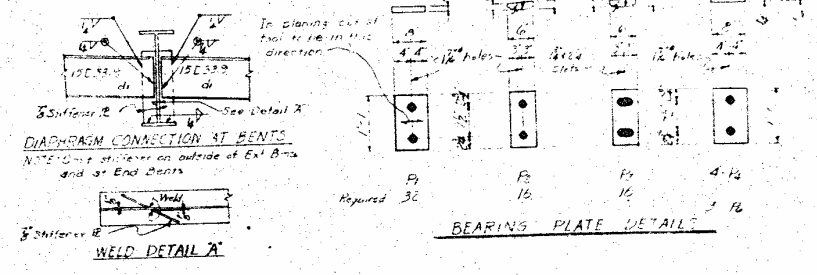

NOTE: Stiffeners to be placed parallel to end of beams.

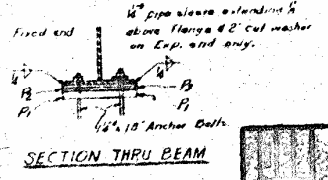

SECTION THRU BEAM

Project No. 613410
 HAYWOOD County
 Station 517020

STATE OF NORTH CAROLINA
 STATE ENGINEER
STRUCTURAL STEEL
 September, 1922