


REVISIONS		
NO.	DESCRIPTION	DATE
1	Added EXT. #18, #19, #44 & #45	10-01-85

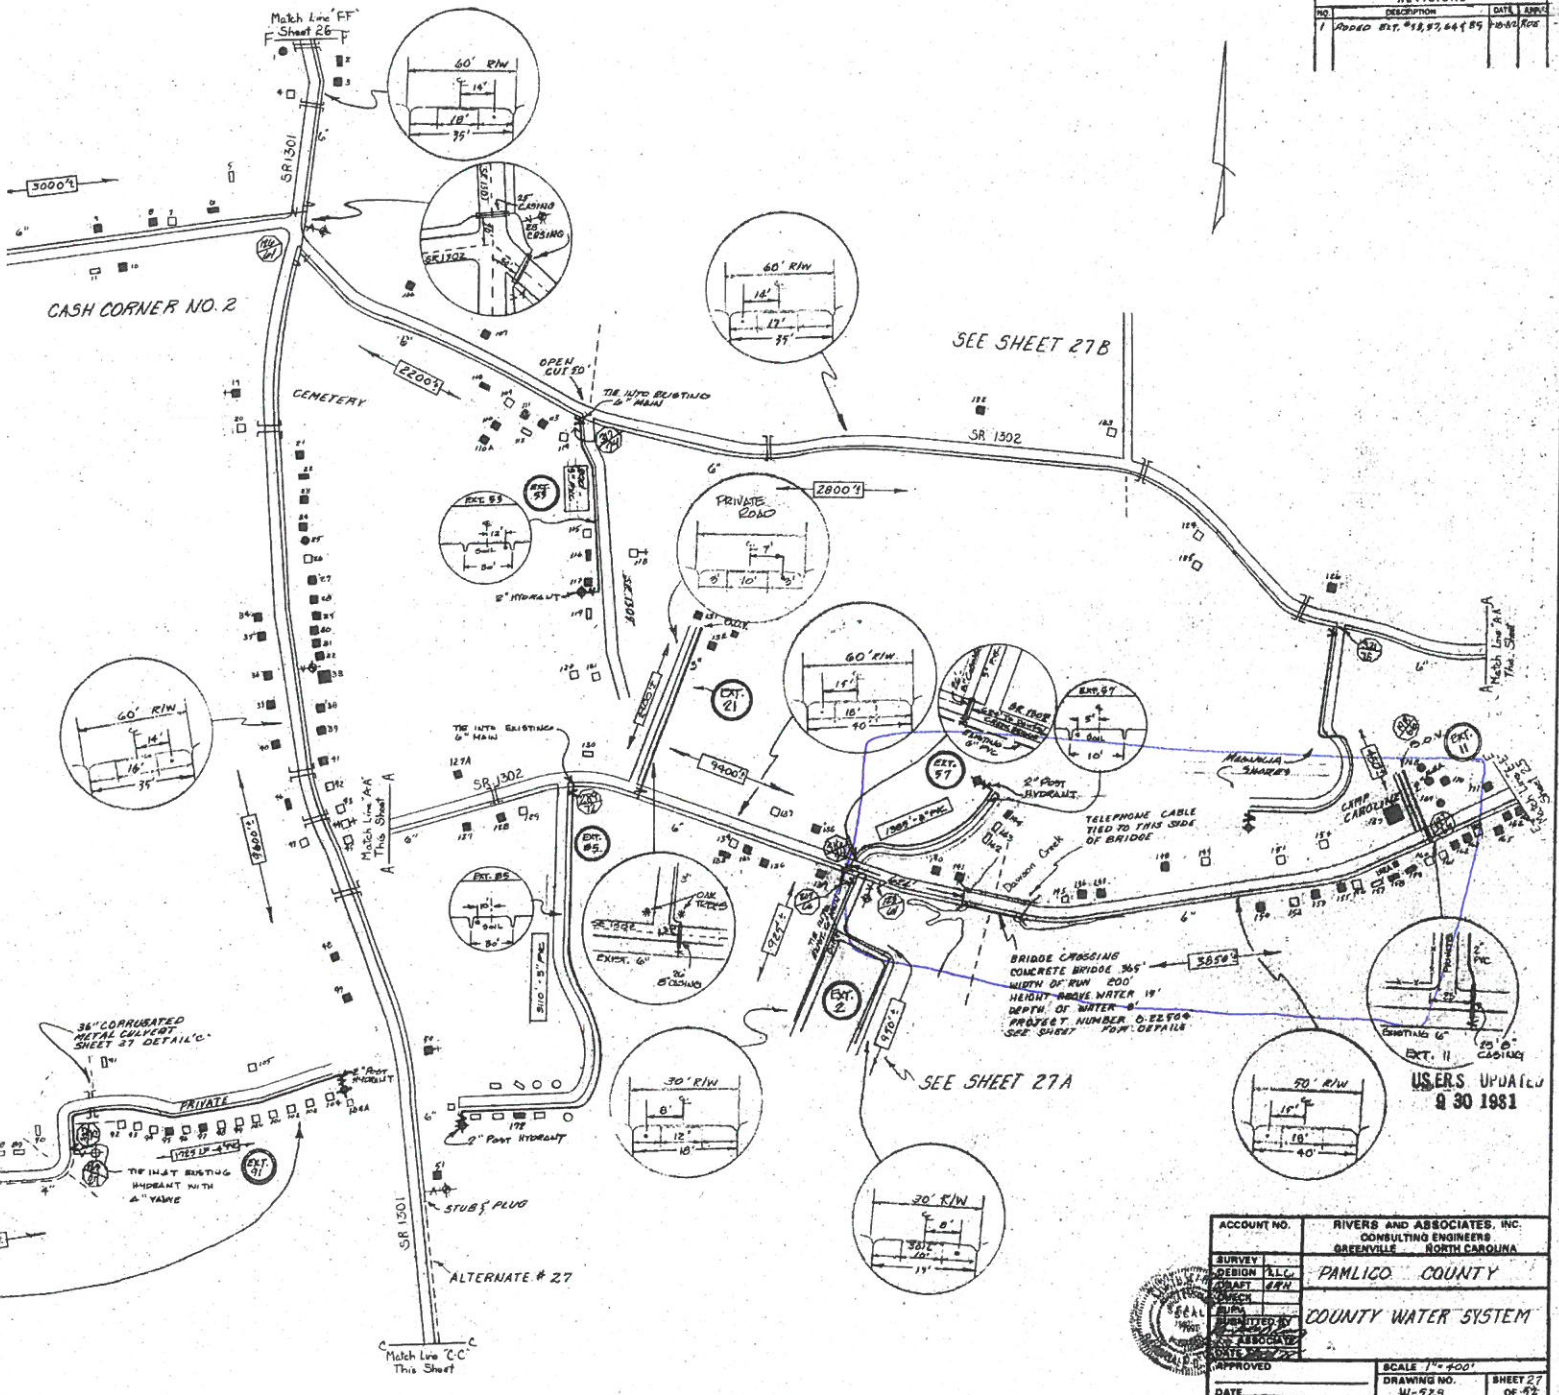

USERS UPDATED
9 30 1981

ACCOUNT NO.	RIVERS AND ASSOCIATES, INC.
SURVEY	CONSULTING ENGINEERS
DESIGN P.L.C.	GREENVILLE NORTH CAROLINA
DRAWN BY	PAMLICO COUNTY
CHECKED BY	COUNTY WATER SYSTEM
APPROVED	
DATE	
SCALE 1" = 400'	
DRAWING NO. W-729	
SHEET 27	OF 32