
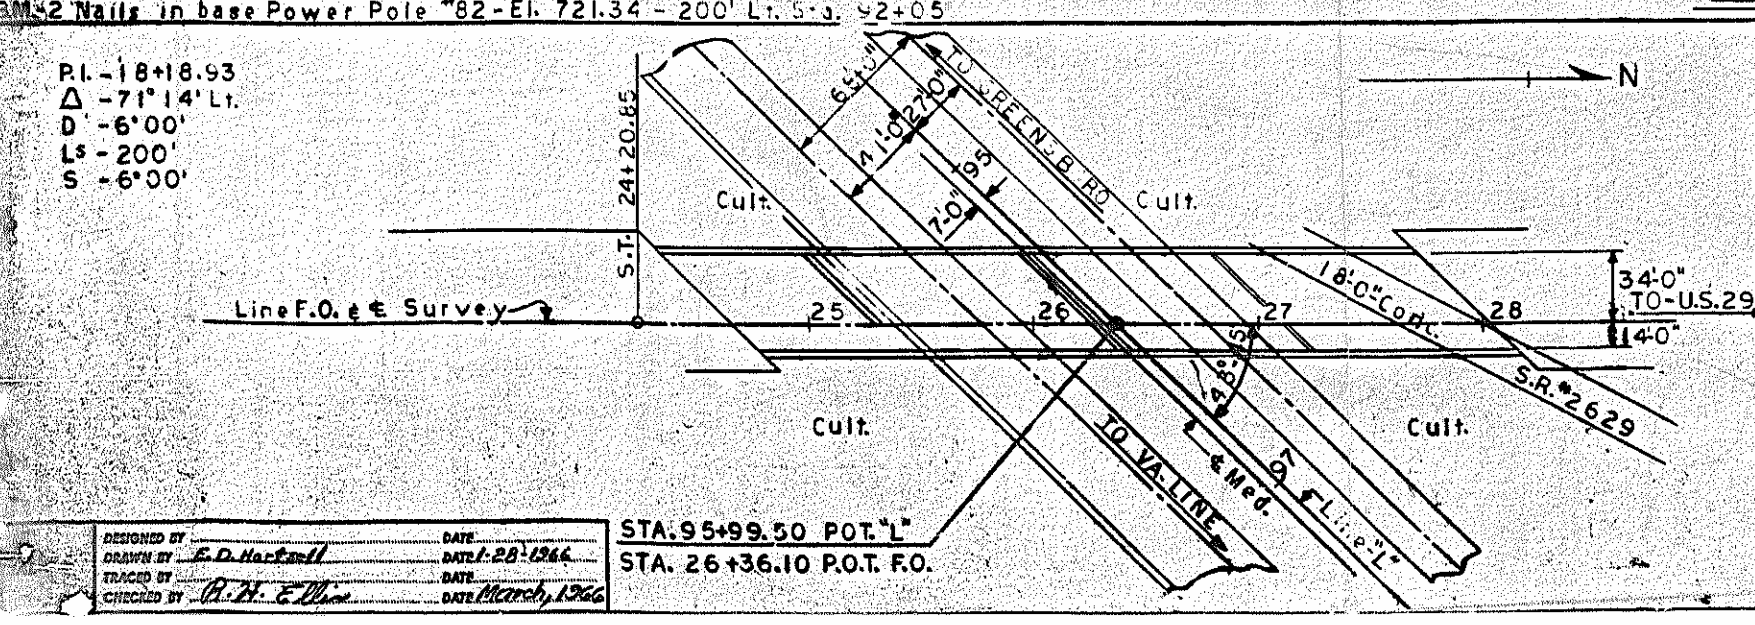


NOTES

Assumed Live Load - H20-S16 (44) or Alternate Load.
 The Contractor shall be responsible for determining the length of piles required. See Special Provisions.
 Piles for End Bents 1 & 2 and Bents 1, 2 & 3 to be driven to a minimum bearing capacity of 30 tons each.
 Work is not to be started on this bridge until roadway section has been excavated by roadway contractor.
 Unclass. Structure Excav. for Bents 1, 2 & 3 to be measured from surface of roadway cut.
 For other design data, General Note See Sheet S-N

I hereby Certify that this structure was built according to plans, except as noted herein
 E.E. DeWalt
 Resident Engineer

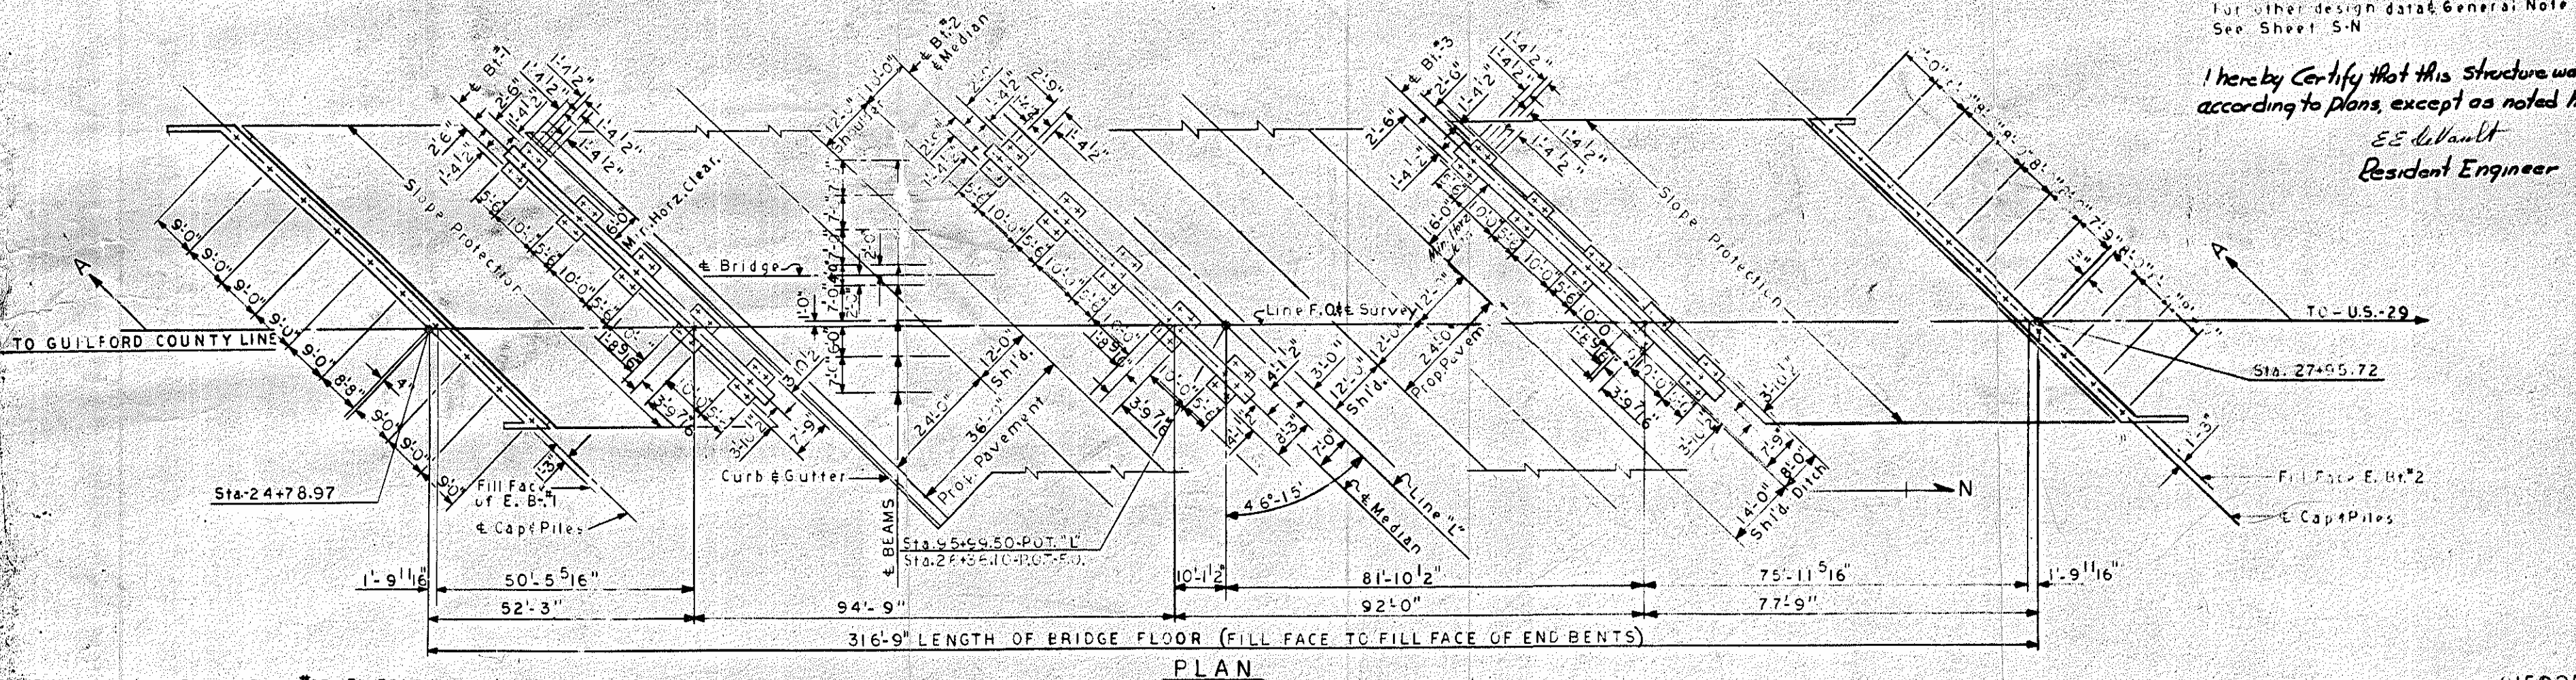

TOTAL BILL OF MATERIAL

CLASS	REINFORCING STEEL		STRUCT. STEEL	12" PRESTR. CONC. PILES	W-PAK METAL CLIP PILES	4" CONC. PROTECTION	UNCLASS. STRUCTURE EXCAV.
	Cu. Yds.	Lbs.					
SUPERSTRUCTURE	451.9	113,105	616,500				
END BENT #1	25.1	5,302		10	340	399.0'	400
BENT #1	69.5	11,177		23	526	586.0'	55
BENT #2	76.9	11,874		32	430	356.11'	125
BENT #3	76.5	13,428		23	523	362.5'	125
END BENT #2	25.0	5,178		11	396	399.17'	400
TOTAL	724.9	160,644	616,500	107	2,436	1,953.5'	1,300

PROJECT No. 81592504
ROCKINGHAM COUNTY
STATION: 95+99.50-P.O.T.-L. / 26+36.10-P.O.T.-F.O.

STATE OF NORTH CAROLINA
STATE HIGHWAY COMMISSION

GENERAL DRAWING FOR BRIDGE OVER FELLOSION - U.S. 29 BETWEEN GREENSBORO AND REIDSVILLE

JANUARY, 1966

REVISIONS

NO.	BY	DATE	NO.	BY	DATE
1			1		
2			2		
3			3		

NO. S-2
 130

DESIGNED BY: F.D. Marshall
 DRAWN BY: F.D. Marshall
 CHECKED BY: A.H. E. Price


DATE: 2-28-1966
 DATE: 2-28-1966
 DATE: March, 1966

NOTES:
 ALL BEAMS AND COVER PLATES SHALL BE OF A.S. GRADE STRUCTURAL STEEL. SEE SHEET 3-N.
 END STIFFENERS TO BE PARALLEL TO ENDS OF BEAM. NO STIFFENERS ARE REQUIRED AT END BENTS OR OF EXTERIOR BEAMS.
 FIELD CONNECTIONS OF DIAPHRAGMS TO BEAMS SHALL USE 3/8" N.S. BOLTS IN ACCORDANCE WITH THE SA
 AT THE CONTRACTOR'S OPTION FILL PLATES, WHEN COMBINED WITH MASONRY PLATES.
 AT THE CONTRACTOR'S OPTION HE MAY SUBSTITUTE FOR PLATES DESIGNATED ON THE PLANS COVER PLATES OF AREA PROVIDED THESE PLATES ARE AT LEAST 5/8" IN DO NOT EXCEED A WIDTH EQUAL TO THE FLANGE WIDTH A THICKNESS EQUAL TO 1/2 TIMES FLANGE THICKNESS OF THE WELD FOR ATTACHING THESE COVER PLATES ACCORDANCE WITH THE A.S. SPECIFICATIONS.
 SEE SUPERSTRUCTURE DETAILS FOR LOCATION OF WELD STEEL.
 FOR BEAM CAMBER, SEE "DEAD LOAD DEFLECTION AND TABLE.

Span-A Beams 1,2,3,4,5,6,7,8	73 rows - 4 - 3/4" x 4" studs each row - 292 studs each beam. 8 spa @ 6" = 4'-0" 9 spa @ 7" = 5'-3" 9 spa @ 8" = 6'-0" 6 spa @ 10" = 5'-0" 4 spa @ 12" = 4'-0"
Span-B Beams - 2,3,6,7	101 rows - 5 - 3/4" x 4" studs each row - 505 studs each beam. 18 spa @ 8" = 12'-0" 10 spa @ 10" = 8'-4" 10 spa @ 12" = 10'-0" 6 spa @ 11" = 3'-7-6" 6 spa @ 11" = 6'-9-0"
Span-B Beams - 1,4,5,8	77 rows - 5 - 3/4" x 4" studs each row - 385 studs each beam. 8 spa @ 11" = 7'-4" 9 spa @ 11" = 9'-9" 7 spa @ 11" = 8'-9" 14 spa @ 11" = 21'-0"
Span-C Beams - 2,3,6,7	95 rows - 5 - 3/4" x 4" studs each row - 475 studs each beam. 2 spa @ 9" = 18'-0" 11 spa @ 12" = 11'-0" 6 spa @ 11" = 7'-6" 6 spa @ 11" = 6'-9-0"
Span-C Beams - 1,4,5,8	77 rows - 5 - 3/4" x 4" studs each row - 385 studs each beam. 12 spa @ 11" = 11'-0" 6 spa @ 11" = 6'-6" 8 spa @ 11" = 10'-0" 12 spa @ 11" = 18'-0"
Span-D Beams - 1,2,3,4,5,6,7,8	107 rows - 4 - 3/4" x 4" studs each row - 428 studs each beam. 16 spa @ 6" = 8'-0" 12 spa @ 7" = 7'-0" 18 spa @ 9" = 6'-0" 18 spa @ 10" = 6'-8" 5 spa @ 12" = 5'-0" 4 spa @ 11" = 5'-0"

Bearing Span-B Beams - 1,8	Cover - R - 15" x 14" x 60'-6"
Span-B Beams - 2,3,7	Cover - R - 15" x 14" x 61'-7"
Span-B Beams - 4,5	Cover - R - 12" x 11" x 60'-0"
Span-C Beams - 1,8	Cover - R - 14" x 14" x 59'-0"
Span-C Beams - 2,3,6,7	Cover - R - 12" x 11" x 58'-0"
Span-C Beams - 4,5	Cover - R - 11" x 15 1/2" x 56'-6"
Span-D Beams - 1,8	Cover - R - 10" x 15 1/2" x 53'-0"
Span-D Beams - 2,3,6,7	Cover - R - 10" x 13 1/2" x 53'-0"
Span-D Beams - 4,5	Cover - R - 10" x 18" x 56'-0"

BEAM ELEVATION AND STUD SPACING

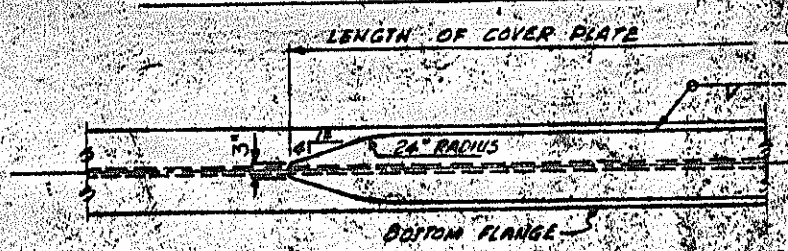

COVER PLATE WELD DETAIL


NOTE: COVER PLATE LENGTHS ARE SYMMETRICAL ABOUT E BETWEEN CENTER TO CENTER OF BEARINGS AND FOR BOTTOM FLANGE ONLY.

FILL PLATES REQUIRED	
1 - 8" x 3 1/2" x 1'-1"	
1 - 8" x 3 1/2" x 1'-5 1/2"	
1 - 8" x 1 1/2" x 1'-5 1/2"	
2 - 8" x 3 1/2" x 1'-1"	
4 - 8" x 5 1/2" x 1'-1"	
1 - 8" x 3 1/2" x 1'-1"	
2 - 8" x 7 1/2" x 1'-1"	
1 - 8" x 15 1/2" x 1'-1"	
5 - 8" x 1" x 1'-1"	


BEARING PLATES REQUIRED	
32 - P1 - 8" x 14" x 1'-1"	
16 - P2 - 6" x 14" x 1'-1"	
16 - P3 - 6" x 14" x 1'-1"	
32 - P4 - 8" x 12" x 1'-5 1/2"	
16 - P5 - 8" x 2" x 1'-5 1/2"	
16 - P6 - 8" x 2" x 1'-5 1/2"	

MASONRY PLATES AND FILL PLATES MAY BE COMBINED.


IN PLACING, CUT OF TOOL TO BE IN THIS DIRECTION. No planing required for fill plates.

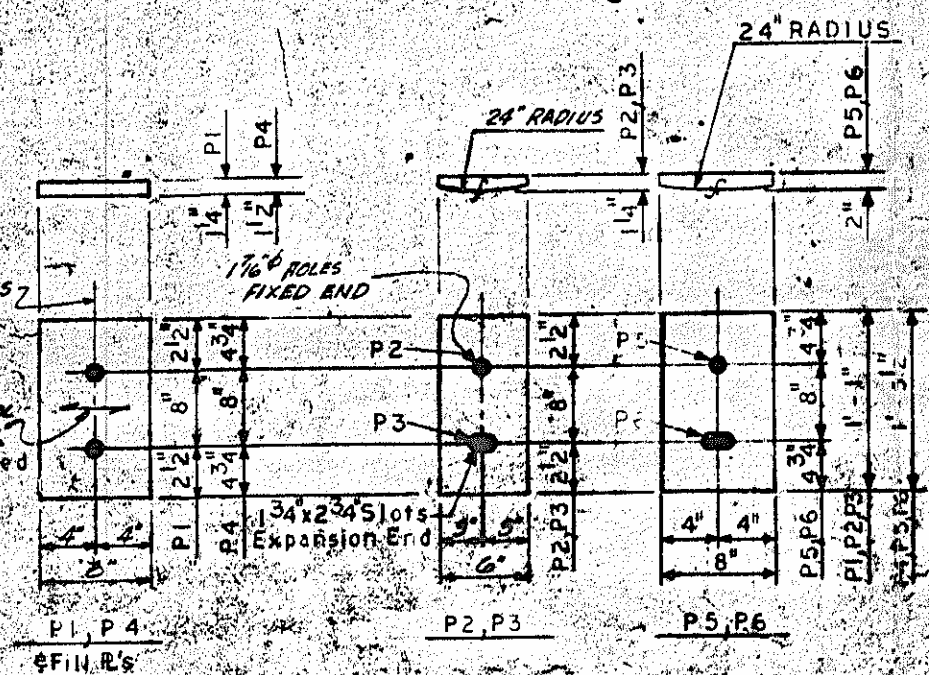

BEARING PLATE DETAILS

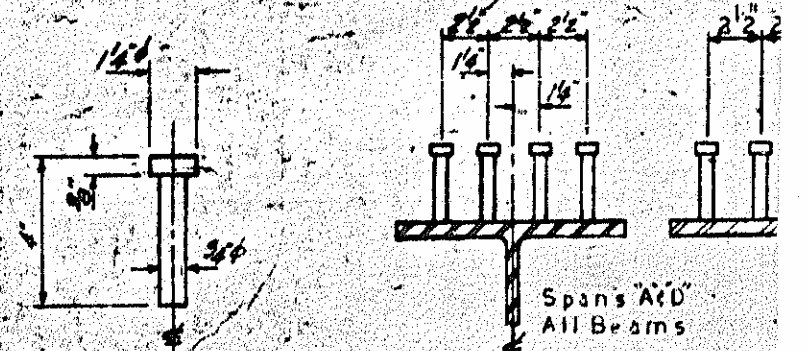

STUD DETAILS

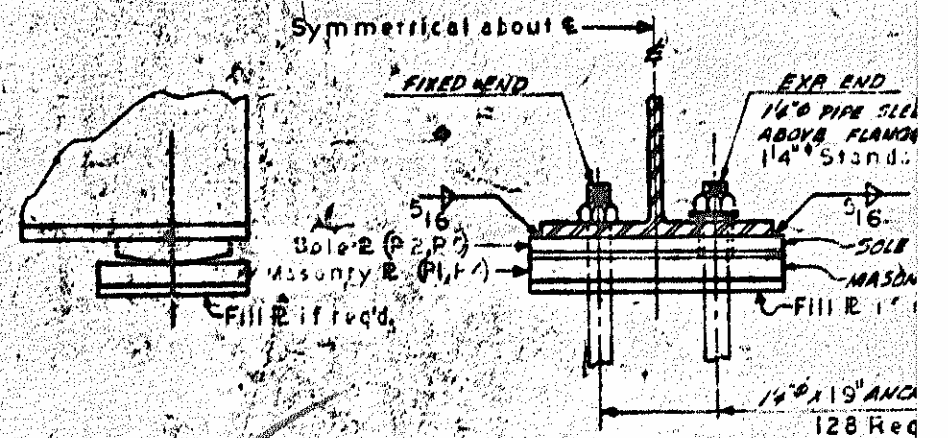

DETAIL AT BEARINGS

* No camber other than natural mill camber required.

DEAD LOAD DEFLECTION AND BEAM CAMBER				
SPAN	Beam	Deflection		Beam Camber
		Due To Weight of Beam	Due To Superimposed Dead Load	
SPAN-A	Exterior Bms. 1,8	1 1/8"	5 1/8"	3 1/8"
	Interior Bms. 2,3,6,7	1 1/8"	12"	3 1/8"
	Interior Bms. 4,5	1 1/8"	3 1/8"	3 1/8"
SPAN-B	Exterior Bms. 1,8	7 1/8"	2 1/8"	3 1/8"
	Interior Bms. 2,3,6,7	7 1/8"	2 1/8"	3 1/8"
	Interior Bms. 4,5	7 1/8"	11 1/8"	2 1/8"
SPAN-C	Exterior Bms. 1,8	3 1/8"	2 1/8"	3 1/8"
	Interior Bms. 2,3,6,7	13 1/8"	2 1/8"	2 1/8"
	Interior Bms. 4,5	13 1/8"	1 7/8"	2 1/8"
SPAN-D	Exterior Bms. 1,8	3 1/8"	1 3/4"	2 1/8"
	Interior Bms. 2,3,6,7	7 1/8"	1 1/8"	1 7/8"
	Interior Bms. 4,5	7 1/8"	1 3/4"	1 3/4"

PROJECT NO. ROCKINGHAM


STATION: 95.5
 Sheet 2 of 2

STATE OF NORTH CAROLINA
 STATE HIGHWAY

STRUCTURAL

REVISIONS			
NO.	BY	DATE	REASON
1			
2			

DESIGNED BY: F.D. Hartwell DATE: 12-15-65
 DRAWN BY: DATE:
 CHECKED BY: O.P. H. DATE: Jan, 1966

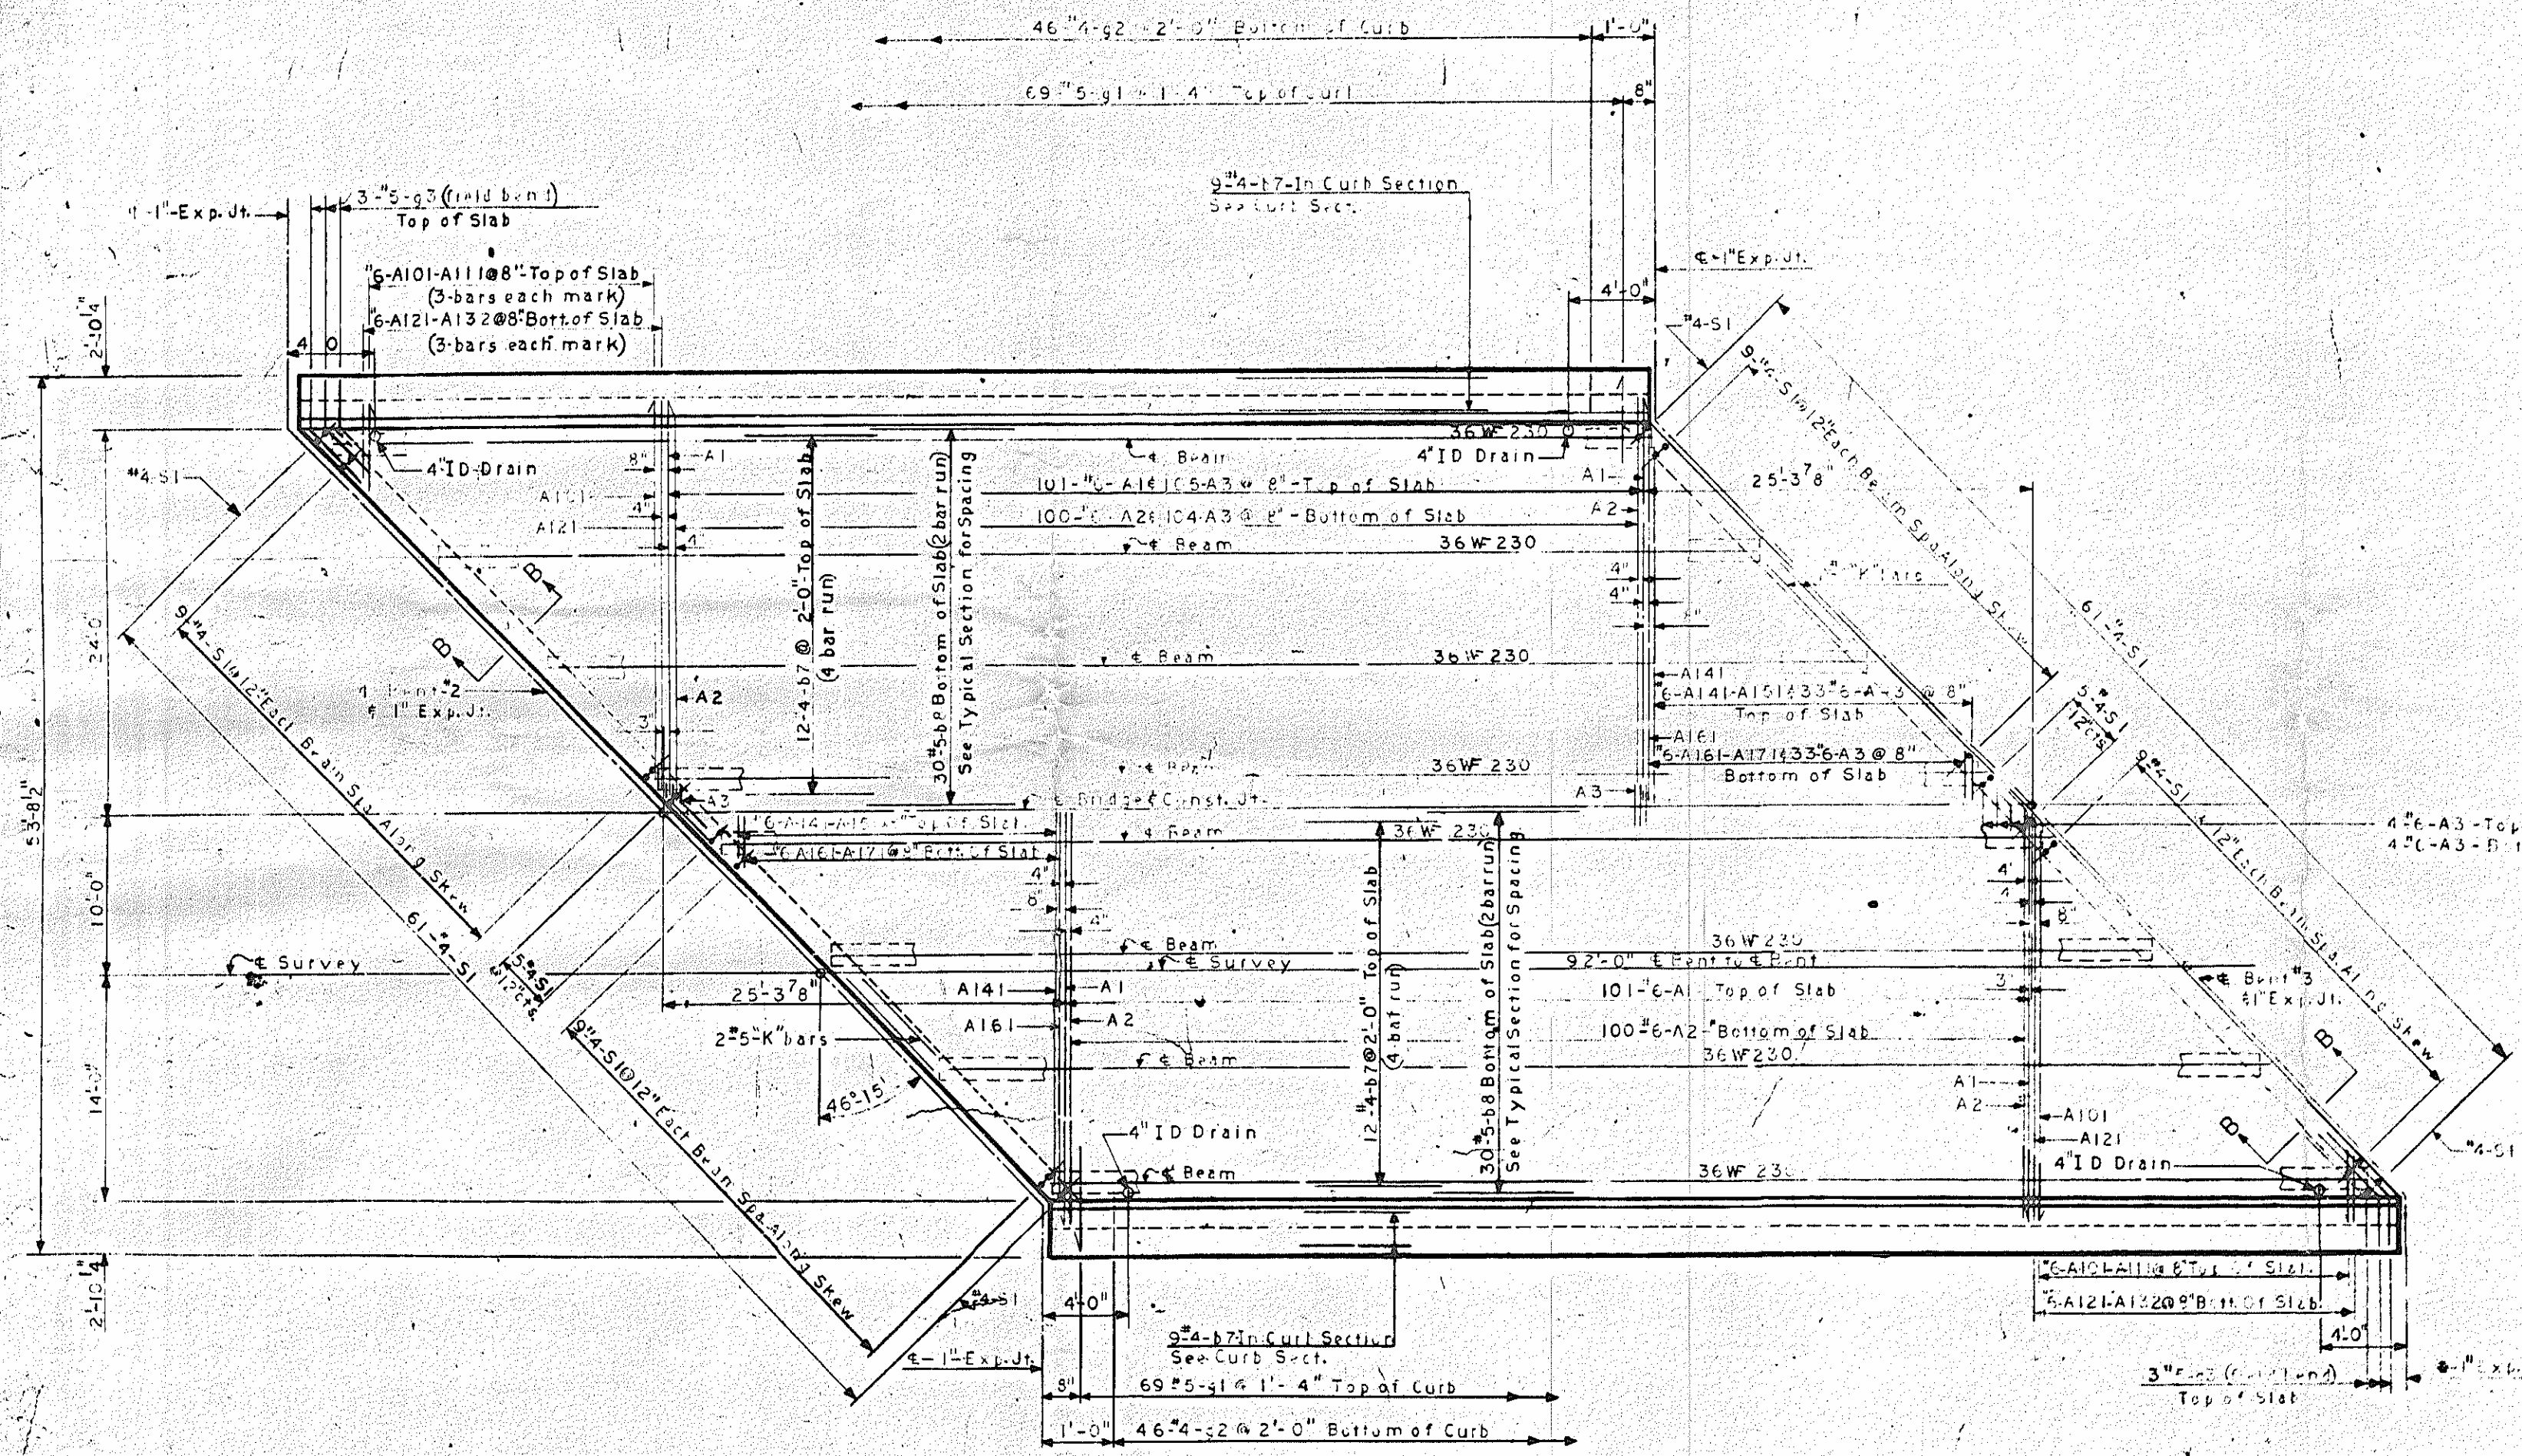

PLAN-SPAN "C"


PROJECT No. 1592504
 ROCKINGHAM COUNTY
 STATION: 95+44.5 L.

STATE OF NORTH CAROLINA
 STATE HIGHWAY COMMISSION

SUPERSTRUCTURE
 SPAN "C"

REVISIONS			
NO.	BY	DATE	REVISIONS
1			

S-8

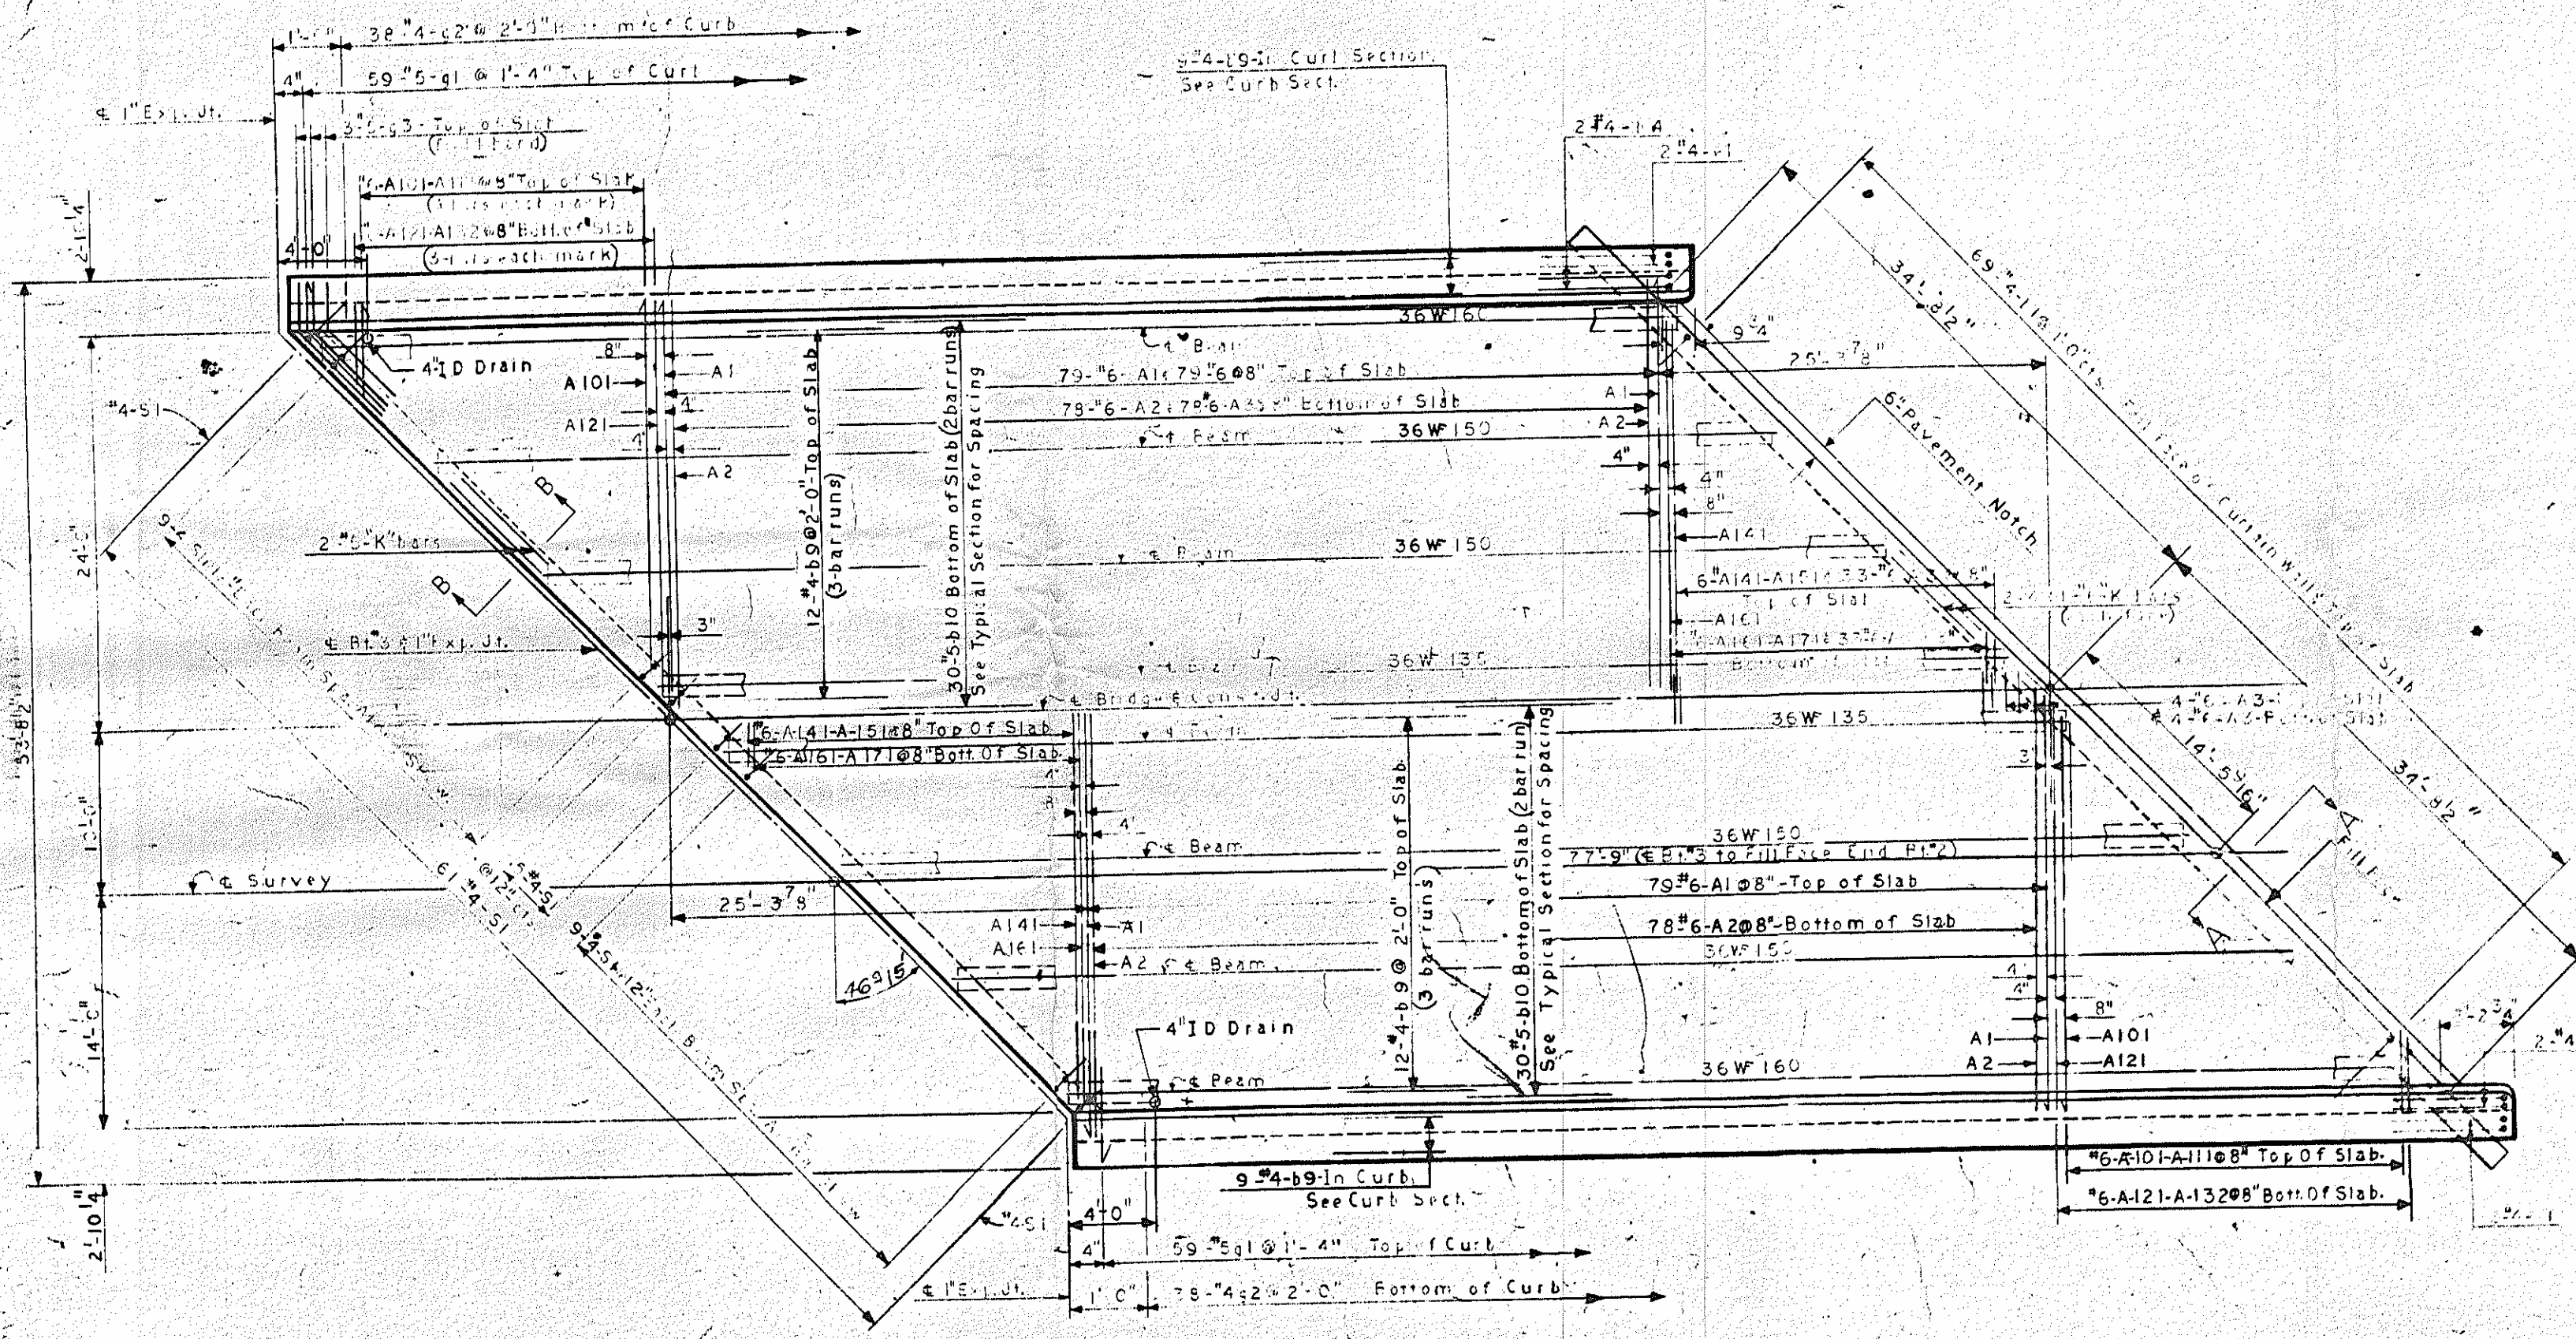

PLAN-SPAN-D

PROJECT NO. 159250A
 ROCKINGHAM COUNTY
 STATION: 95+55.5


STATE OF NORTH CAROLINA
 STATE HIGHWAY COMMISSION

SUPERSTRUCTURE
 SPAN-D

REVISIONS		DATE	BY	DATE	BY
NO.	BY	DATE	BY	DATE	BY
1					
2					

DATE OUT IS 1965
 DATE Feb, 1966


6-9
 730

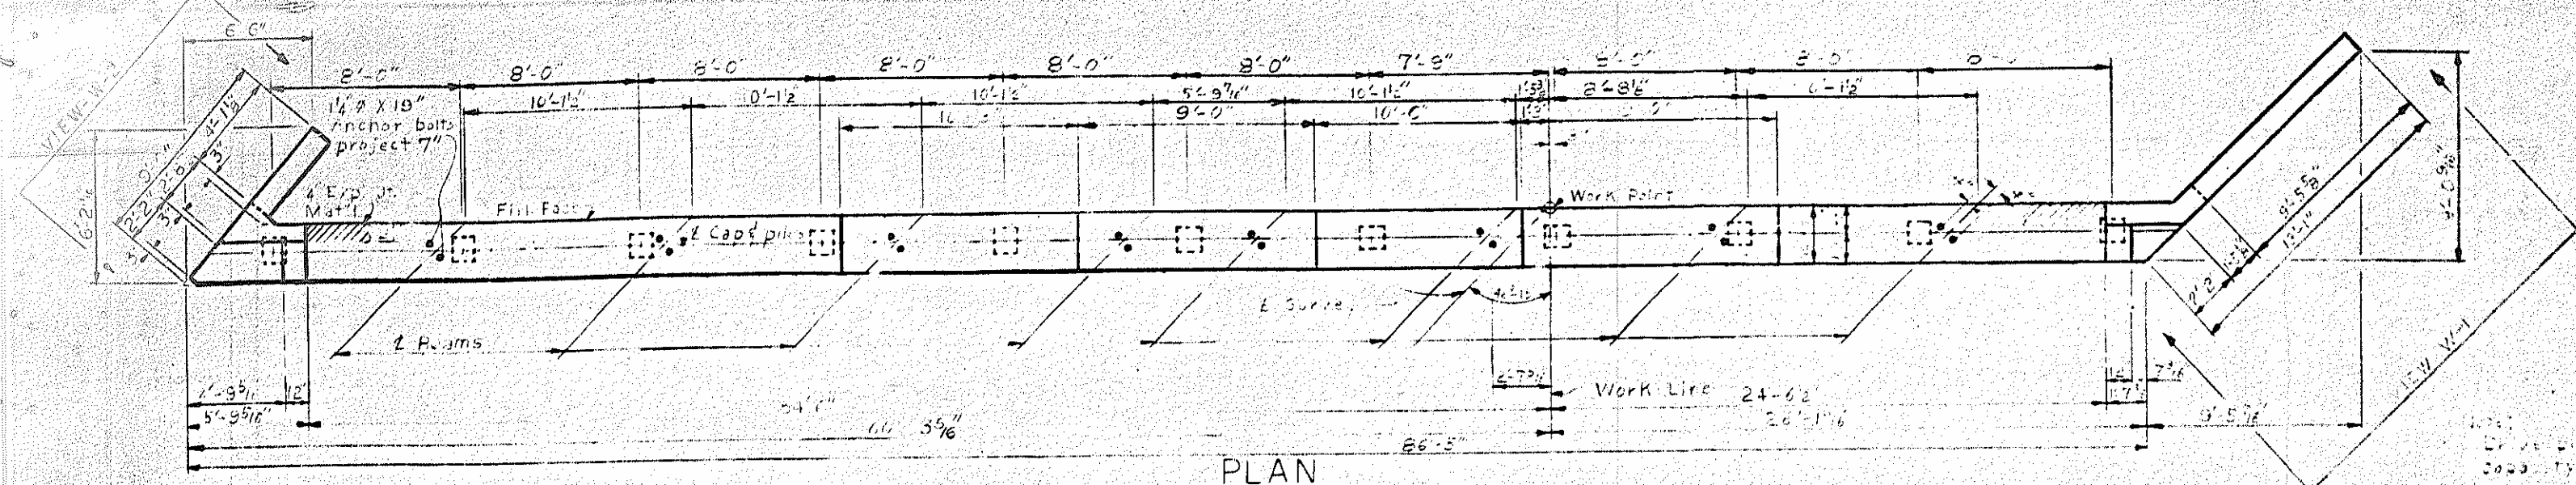


PLAN

Drive piles to Min. bearing capacity of 30 tons each.
Concrete displaced by pile heads has been deducted.
Reinforcing steel may be shifted as necessary to clear anchor bolts.


BILL OF MATERIALS			
END BENT			
BAR NO.	NO.	SIZE	FT.
B1	4	#18	
B2	4	#11	
B3	4	#11	
B4	4	#11	
B5	10	#4	
B6	1	#4	
B7	2	#4	
B8	2	#4	
B9	4	#4	
B10	15	#4	

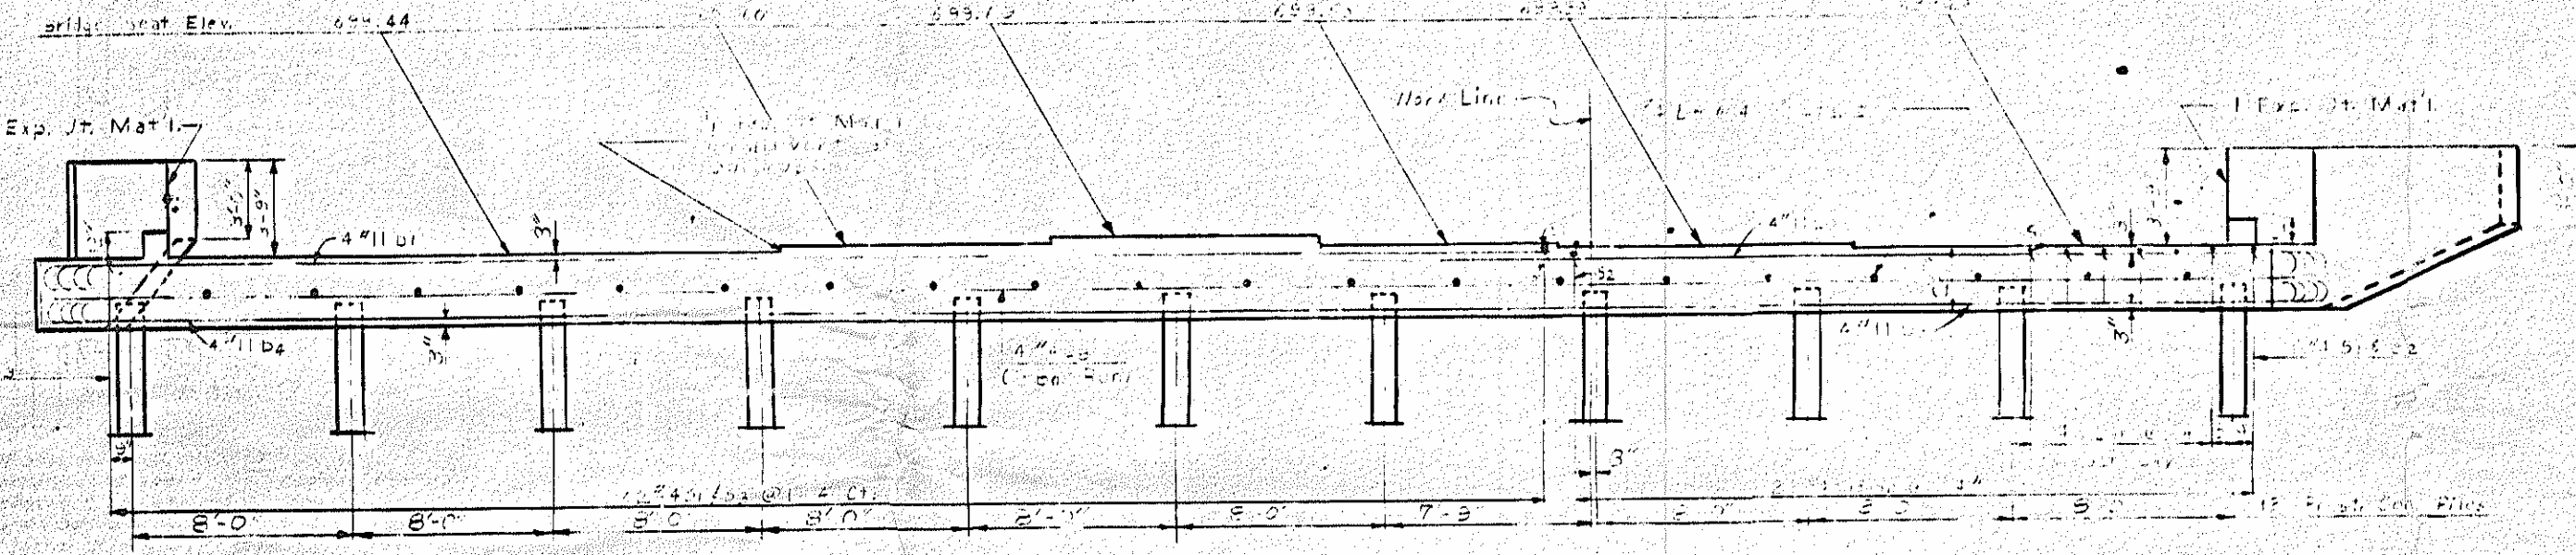


ELEVATION

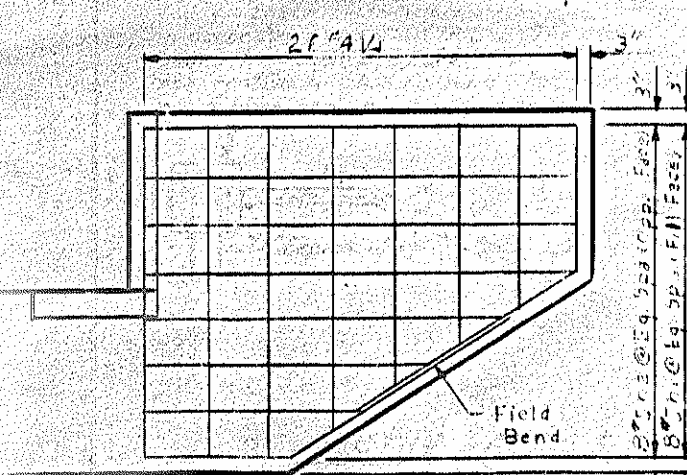


VIEW-W-1

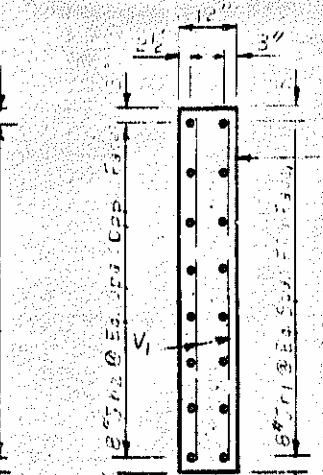


SECTION THRU WING-W-1

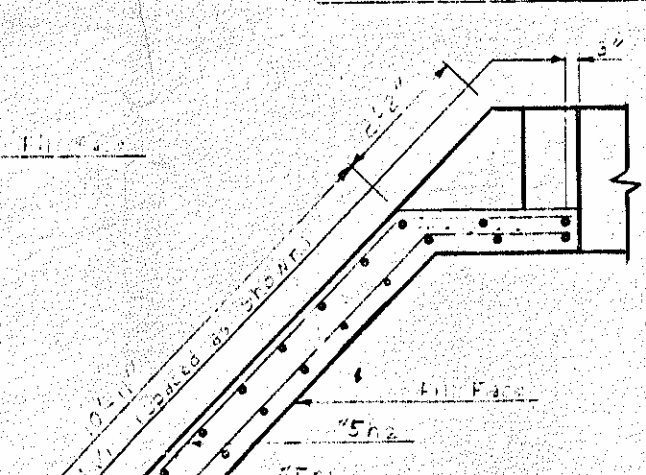


PLAN OF WING W-1 SHOWING REINFORCING

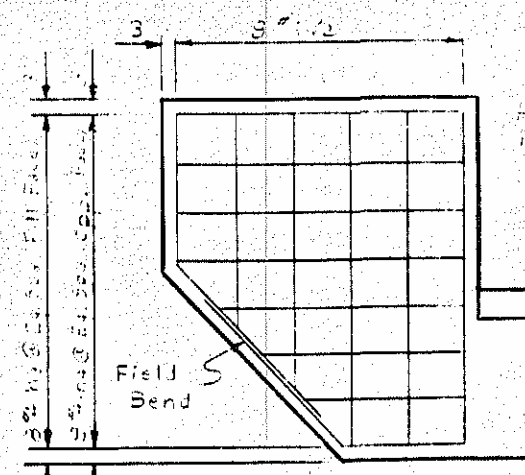

VIEW-W-2

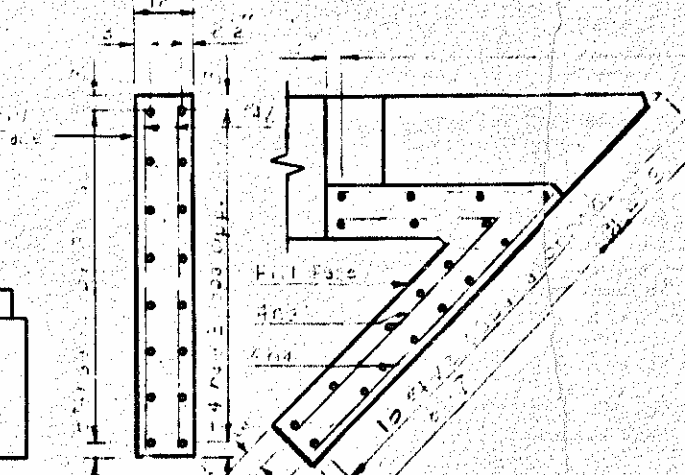

SECTION THRU WING-W-2 SHOWING REINFORCING



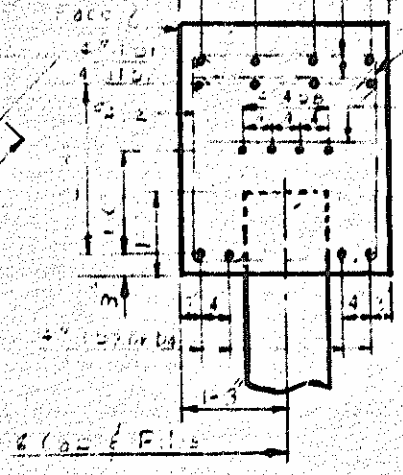


SECTION THRU CAP

BAR TYPES

ALL BAR DIMENSIONS ARE CUT TO CUT


b1	5'-6"	1'-7"
b2	3'-0"	1'-7"
b3	4'-0"	1'-7"
b4	4'-0"	1'-7"

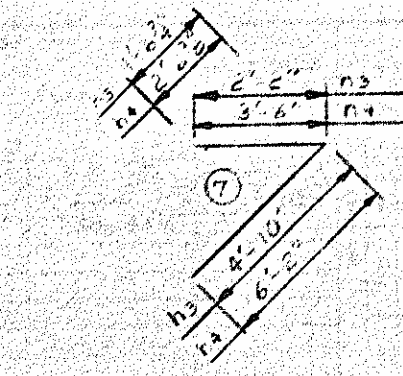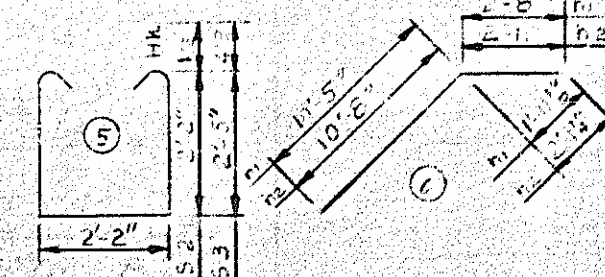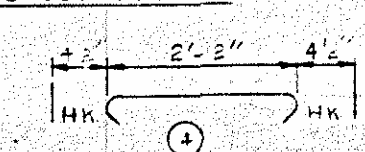


PROJECT NO. 95
ROCKINGHAM
STATION: 95+9

STATE OF NORTH CAROLINA
STATE HIGHWAY DEPARTMENT
SUBSTRUCTURE
END BENT NO. 95


REVISIONS					
NO.	BY	DATE	NO.	BY	
1			1		
2			2		

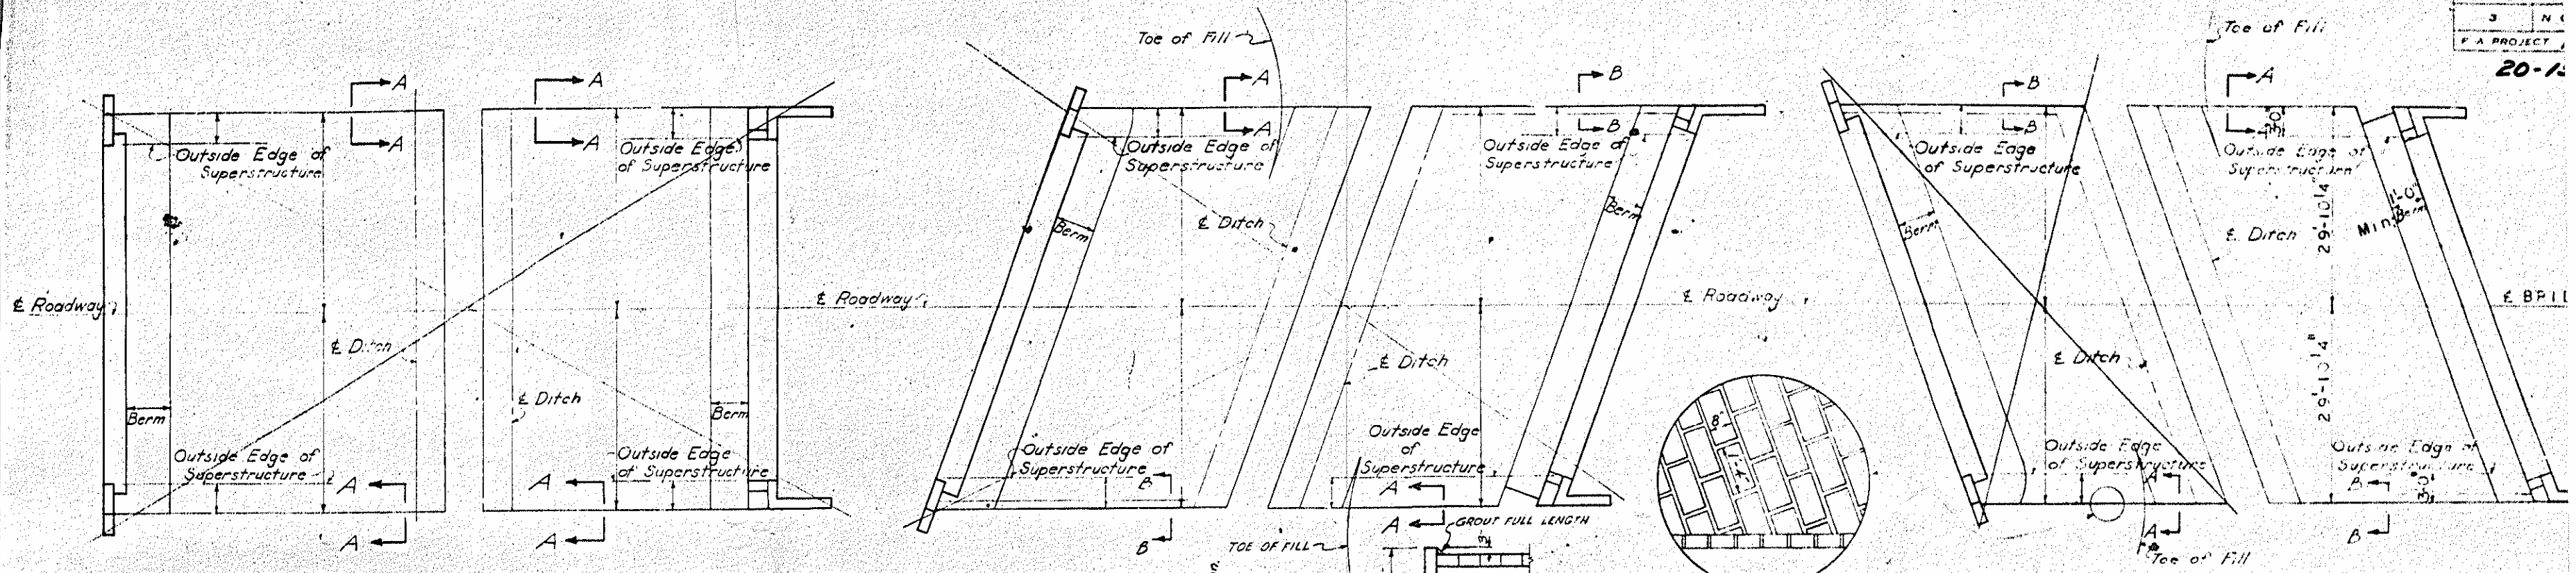


PLAN

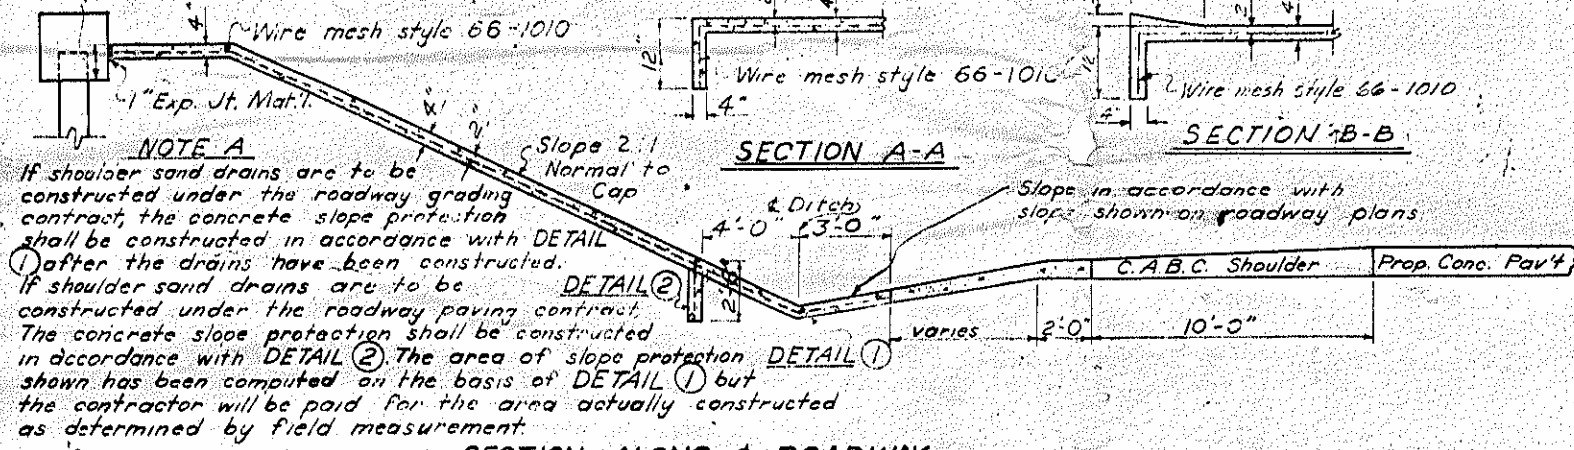


NOTE A
If shoulder sand drains are to be constructed under the roadway grading contract, the concrete slope protection shall be constructed in accordance with DETAIL ① after the drains have been constructed. If shoulder sand drains are to be constructed under the roadway paving contract, the concrete slope protection shall be constructed in accordance with DETAIL ②. The area of slope protection shown has been computed on the basis of DETAIL ① but the contractor will be paid for the area actually constructed as determined by field measurement.

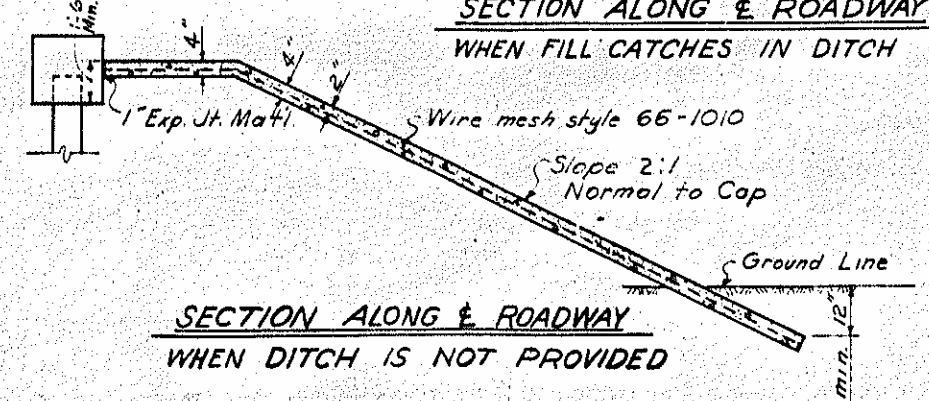

SECTION ALONG & ROADWAY WHEN DITCH IS NOT PROVIDED

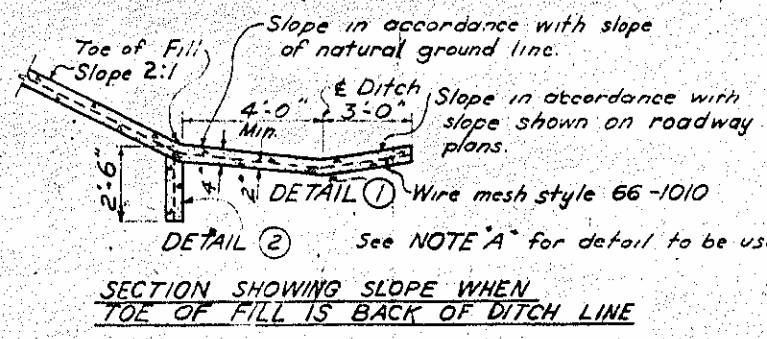


SECTION SHOWING SLOPE WHEN TOE OF FILL IS BACK OF DITCH LINE

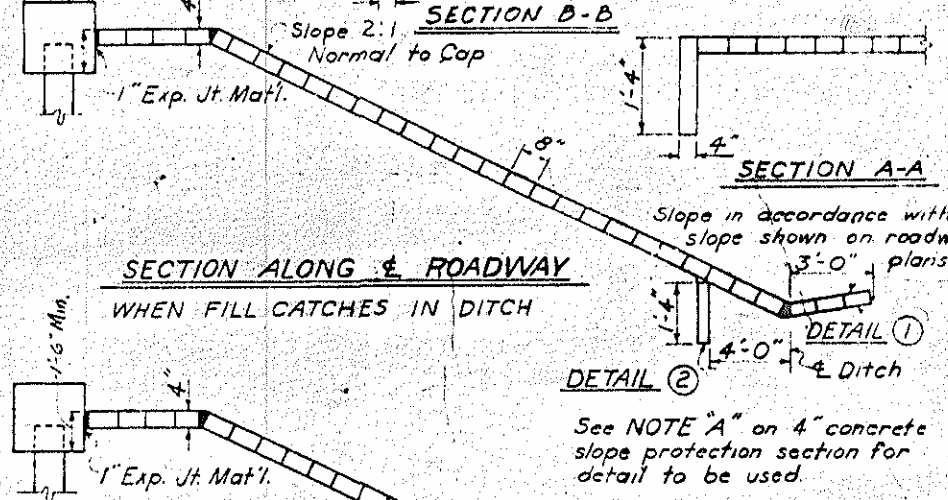


SECTION ALONG & ROADWAY WHEN FILL CATCHES IN DITCH


SECTION ALONG & ROADWAY WHEN DITCH IS NOT PROVIDED

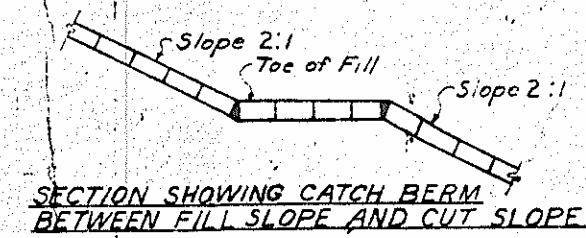

SECTION SHOWING CATCH BERM BETWEEN FILL SLOPE AND CUT SLOPE

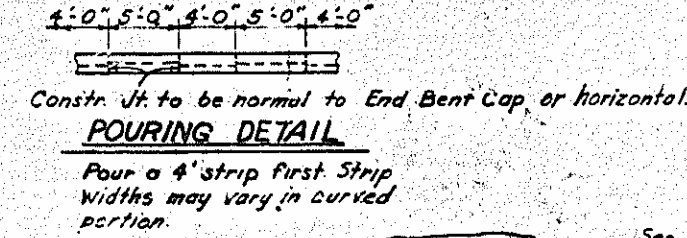

POURING DETAIL

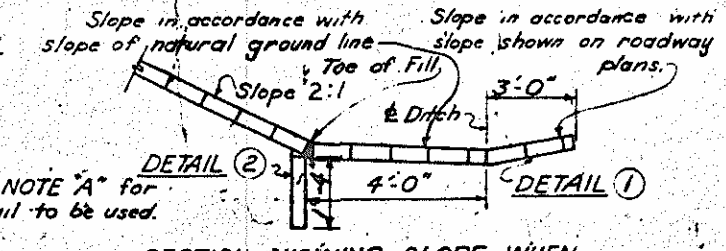

SECTION SHOWING SLOPE WHEN TOE OF FILL IS BACK OF DITCH LINE

NOTES:
A 4" concrete slope paving shall be placed under the ends of the bridge. The contractor, at his option, may use either type, Alternate "A" or "B", as described below. Immediately before placing the paving, the slope shall be properly shaped and firmly compacted so that it conforms to the lines and shown. The finished surface shall be reasonably smooth and uniform and shall not vary in lines, grades, and sections shown by more than 1/8" along a 10' straight edge.

ALTERNATE "A"
Alternate "A" shall consist of 4" poured in place concrete paving as shown in details on this sheet. The concrete shall be floated with a wooden float and finished. The quantity to be paid for under this item shall be the number of square yards of slope measured in place complete and accepted, including the area of the toe walls below 4" of protection. (For example 8" pay area for toe wall 1'-0" deep.) The quantity measured as provided for above, shall be paid for at the contract unit price per yard for mesh excavation, backfilling, preparation of slopes, and all materials, labor, equipment and incidentals necessary to complete the work.

ALTERNATE "B"
Alternate "B" shall consist of solid concrete blocks 4"x8"x16" laid in horizontal courses such that in successive courses will break joints with units in the preceding one. Blocks are to be with their long axis parallel to the end bent cap with grouted joints preferably 1/2" but not less than 1/4" wide between successive courses and ends of blocks. Joints shall be by pouring a mixture of one part Portland cement to three parts sand mixed with sufficient water to enable the mixture to be poured through a spout. The concrete blocks shall be cast to accurate dimensions, shall have uniform surface color, and shall be manufactured of materials to produce a compressive strength of not less than 2,000 p.s.i. at age of 28 days. No broken blocks shall be used except in constructing a strip along each side of the paving down the slope. Care shall be taken to break the blocks at a uniform workmanlike joint and surface. Method of measurement and basis of payment shall be as prescribed above under Alternate "A".

ALTERNATE "A" wire mesh reinforcing to be style 66-1010 60" wide. Adjacent wire mesh to lap at least 6". Slope Protection to be poured in alternate 4" x 5" strips as shown in Pouring Detail. The cost of wire mesh to be included in the contract unit price bid per yard for 4" concrete slope protection. The same type of slope protection shall be used under both ends of any one bridge.

PROJECT NO. 81592
ROCKINGHAM, N.C.
STATION: 95+93.5

SHEET 1 of 2

ASSEMBLED BY F.D. Hartsell DATE Dec. 1965
CHECKED BY R.H. ELL DATE March 1, 1966
DRAWN BY W.J. Baldwin DATE Mar 9, 66
CHECKED BY G.T. PHILLIPS DATE MAR 10, 66

DETAILS FOR ALTERNATE "A"

PLAN WHERE CONC. OR CONC. BLOCK SLOPE PROTECT. MUST BE PLACED AROUND A BENT COLUMN

DETAILS FOR ALTERNATE "B"

REV. NO. 3. TO TAKE OUT DIMENSIONS FROM OUTSIDE EDGE OF SUPERSTRUCTURE TO OUTSIDE SLOPE PROTECTION. ✓ KHW
REV. NO. 1. TO SHOW BERM 1'-6" ABOVE BOTTOM OF CAP. ✓ KHW

REVISION	DATE	BY	DESCRIPTION
1	12-1-65	F.D.H.	4" Conc. Slope Protection or 4" Conc. Block Slope Protect.
2	3-1-66	R.H.E.	Wire Mesh 60" Wide
3	3-9-66	W.J.B.	Approx. L.F. 1:40
4	3-10-66	G.T.P.	

STATE OF NORTH CAROLINA
STATE HIGHWAY COMMISSION
RALEIGH
STANDARD SLOPE PROTECTION PAVING DETAILS
March 1966