
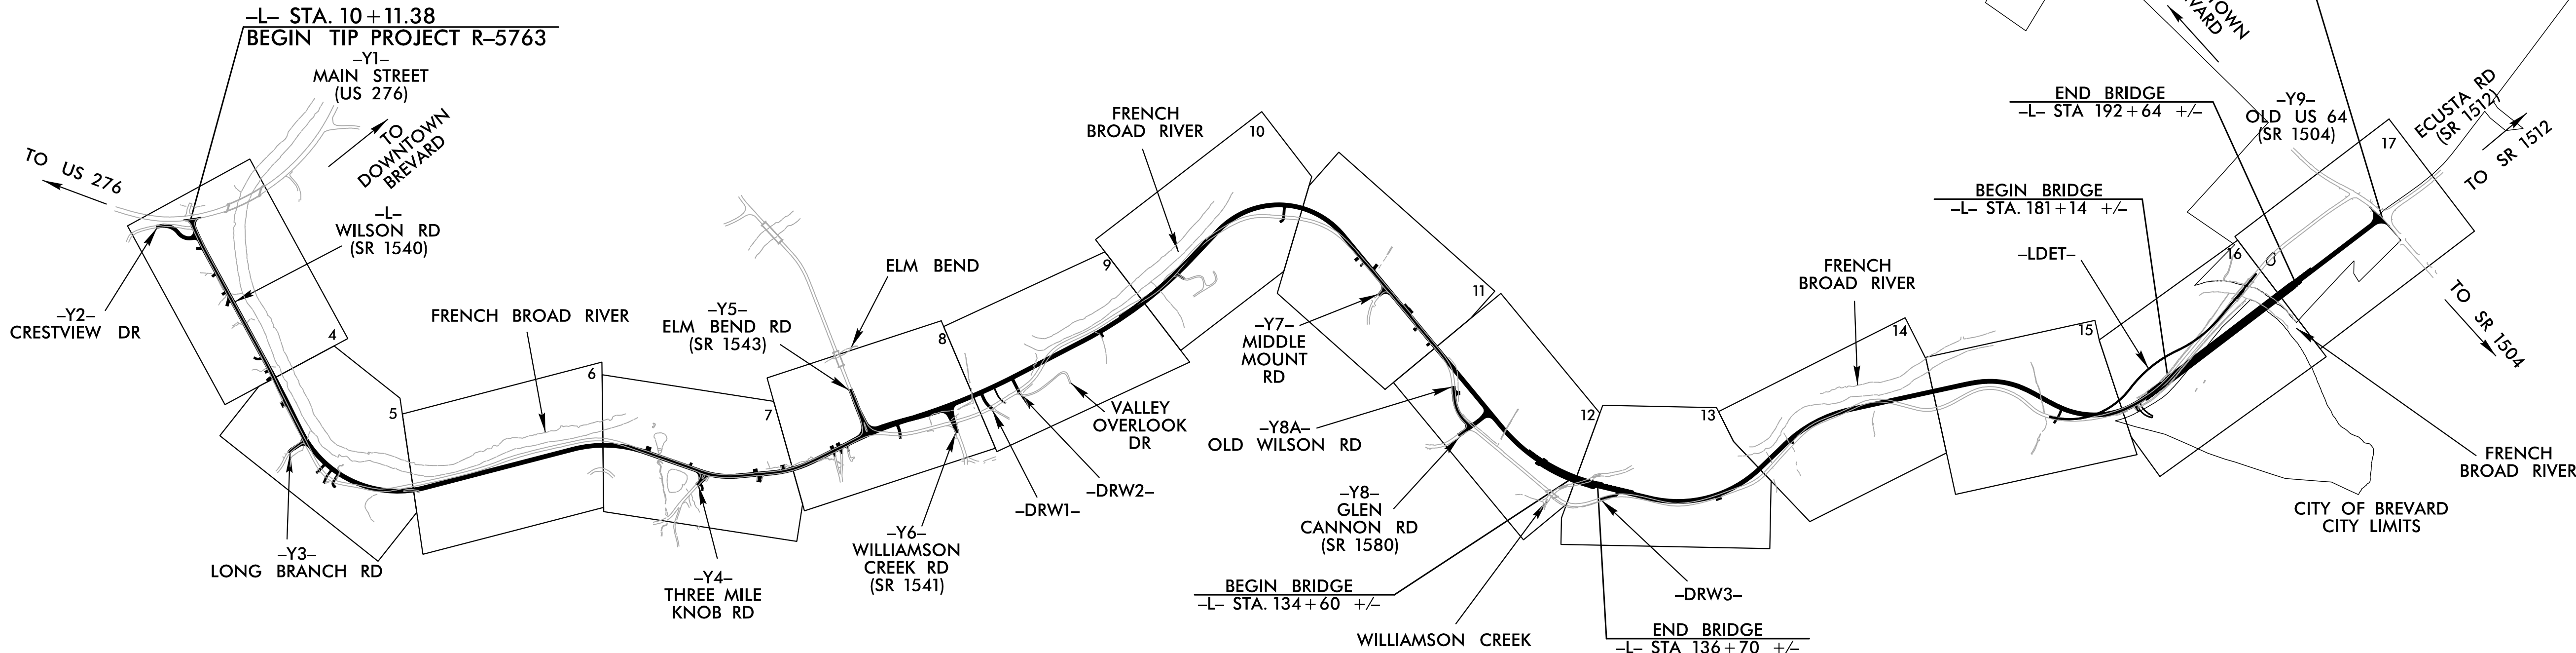



TIP PROJECT: R-5763

CONTRACT:

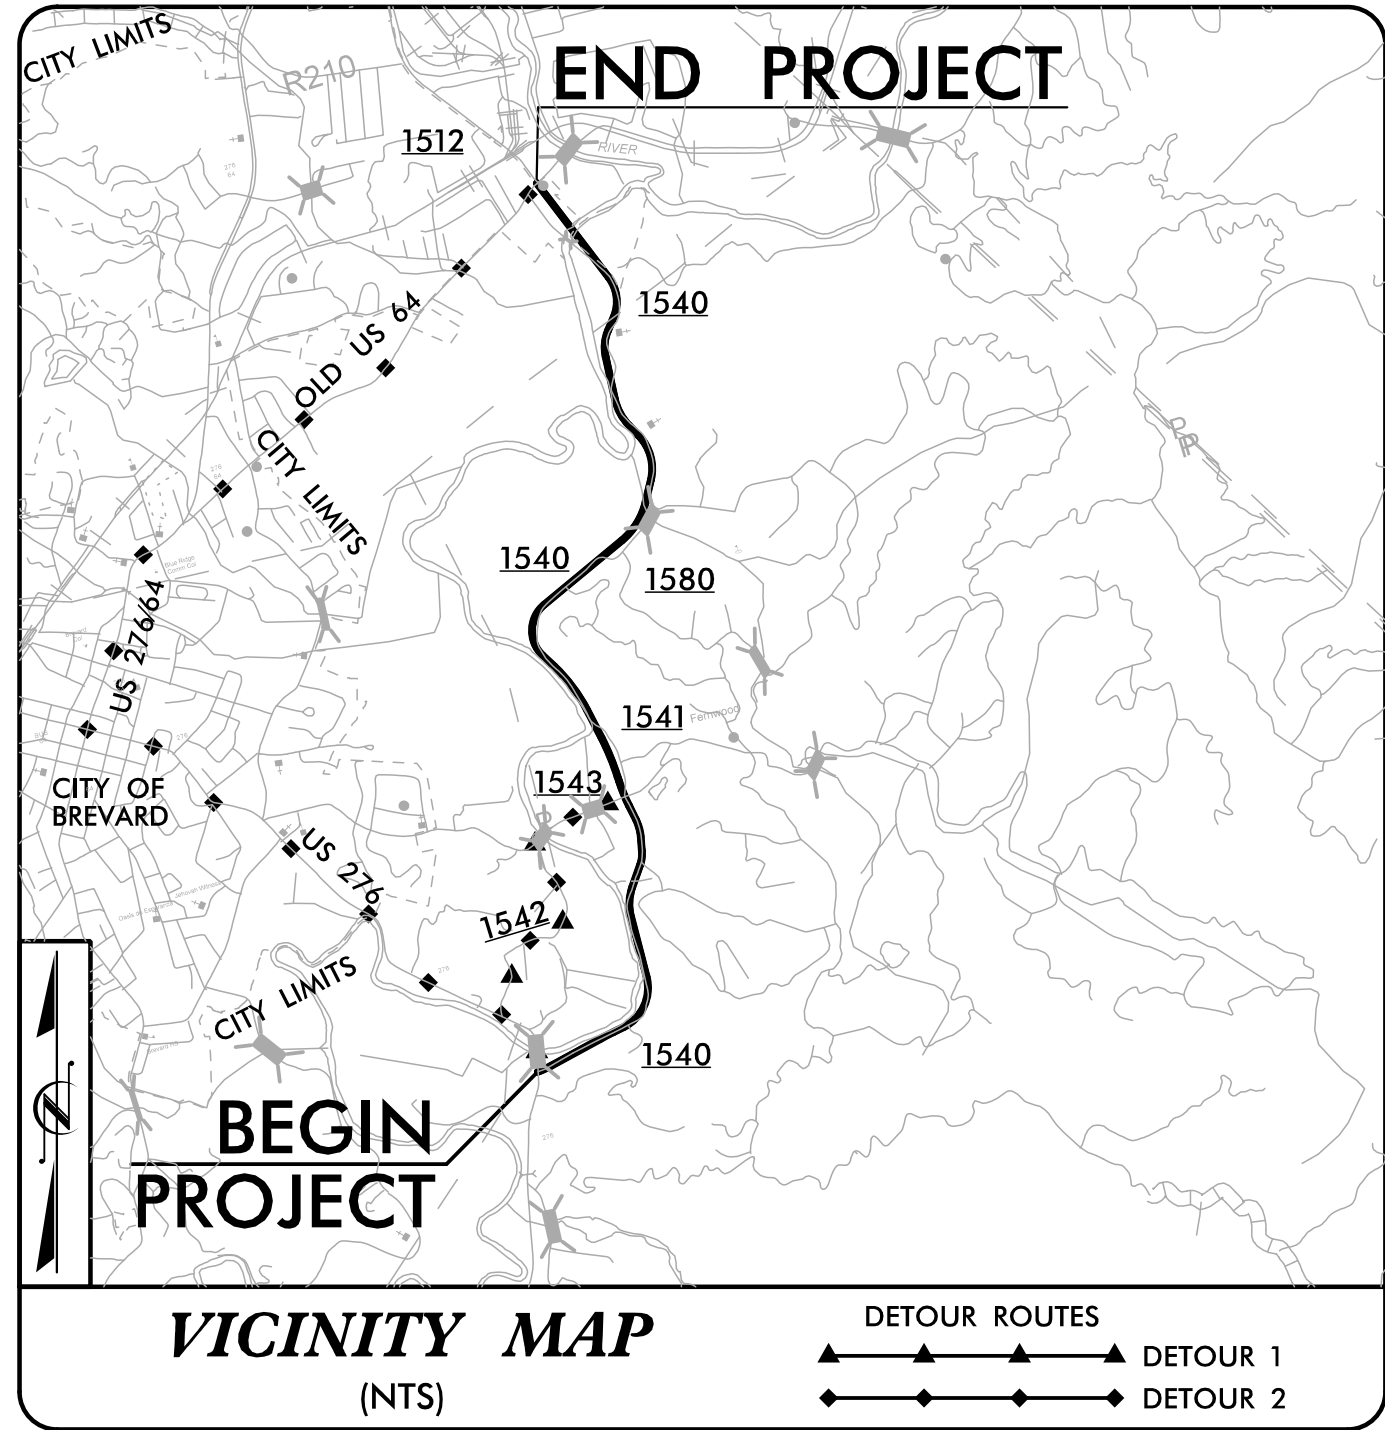

- NOTES:
1. CLEARING ON THIS PROJECT SHALL BE PERFORMED TO THE LIMITS ESTABLISHED BY METHOD ____.
 2. THIS PROJECT IS PARTIALLY WITHIN THE MUNICIPAL BOUNDARIES OF THE CITY OF BREVARD.

GRAPHIC SCALES

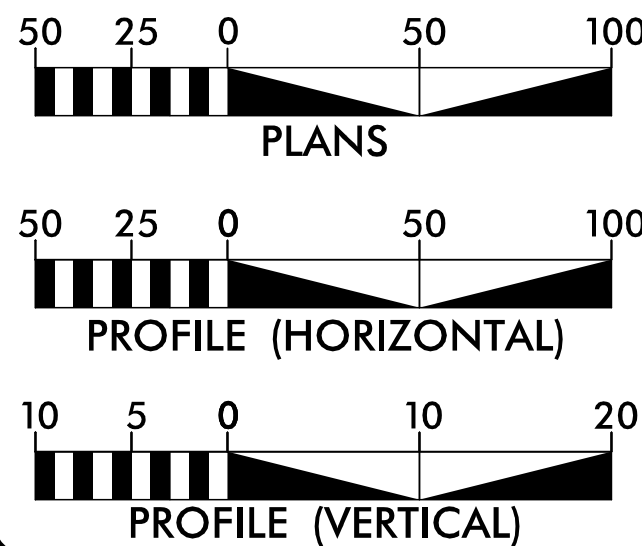

DESIGN DATA

ADT 2022 = 4290
ADT 2042 = 5420
K = 9 %
D = 60 %
T = 6 % *
V = 45 MPH
* TTST = 1% DUAL 5%
FUNC CLASS =
MAJOR COLLECTOR
SUBREGIONAL TIER

PROJECT LENGTH

LENGTH OF ROADWAY T.I.P. PROJECT R-5763 = 3.347 MILES
LENGTH OF STRUCTURES T.I.P. PROJECT R-5763 = 0.258 MILES
TOTAL LENGTH OF T.I.P. PROJECT R-5763 = 3.605 MILES

LENGTH BASED ON -L- CENTERLINE

STATE OF NORTH CAROLINA
DIVISION OF HIGHWAYS

TRANSYLVANIA COUNTY

LOCATION: SR 1540 (WILSON ROAD) FROM SR 1504 (OLD US 64) TO US 276

TYPE OF WORK: GRADING, DRAINAGE, PAVING, STRUCTURES, AND RETAINING WALLS

REDLINE DRAINAGE PLANS
AUGUST 18, 2020

STATE	STATE PROJECT REFERENCE NO.	SHEET NO.	TOTAL SHEETS
N.C.	R-5763	1	
STATE PROJ. NO.	F.A. PROJ. NO.	DESCRIPTION	
44638.1.1		P.E.	

NAD 83/NA 2011

INCOMPLETE PLANS
DO NOT USE FOR R/W ACQUISITION
DOCUMENT NOT CONSIDERED FINAL
UNLESS ALL SIGNATURES COMPLETED

PREPARED IN THE OFFICE OF:

HNTB

HNTB NORTH CAROLINA, P.C.
343 E. Six Forks Road, Suite 200
Raleigh, North Carolina 27609
NC License No: C-1554
FOR NCDOT DIVISION 14

2018 STANDARD SPECIFICATIONS

RIGHT OF WAY DATE:
JULY 10, 2020

LETTING DATE:
SEPTEMBER 20, 2022

ROY H. TELLIER, PE
PROJECT ENGINEER

ANDREW B. HALL, PE
PROJECT DESIGN ENGINEER


ADAM DOCKERY
NCDOT CONTACT

HYDRAULICS ENGINEER

SIGNATURE: _____ P.E.

ROADWAY DESIGN ENGINEER

SIGNATURE: _____ P.E.

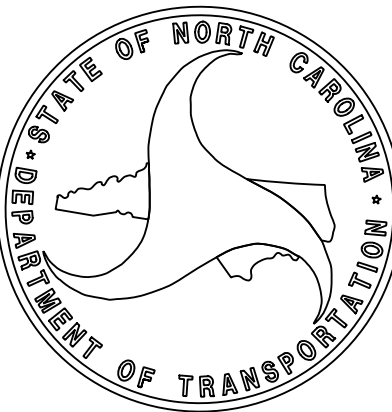


6/2/99

PRELIMINARY PAVEMENT DESIGN


C1	PROP. APPROX. 1.5" ACSC, TYPE S9.5C.
C2	PROP. APPROX. 3" ACSC, TYPE S9.5C.
C3	PROP. APPROX. VAR. ACSC, TYPE S9.5C.
D1	PROP. APPROX. 2½" ACIC, TYPE I19.0C.
D2	PROP. APPROX. VAR. ACIC, TYPE I19.0C.
E1	PROP. APPROX. 4" ACBC, TYPE B25.0C.
E2	PROP. APPROX. VAR. ACBC, TYPE B25.0C.
J1	PROP. 6" ABC.
J2	PROP. 8" ABC.
R1	EXPRESSWAY GUTTER.
T	EARTH MATERIAL.
U	EXISTING PAVEMENT.
V1	RETAINING WALL.
W	VARIABLE DEPTH ASPHALT PAVEMENT.

NOTE: PAVEMENT EDGE SLOPES ARE 1:1 UNLESS SHOWN OTHERWISE.

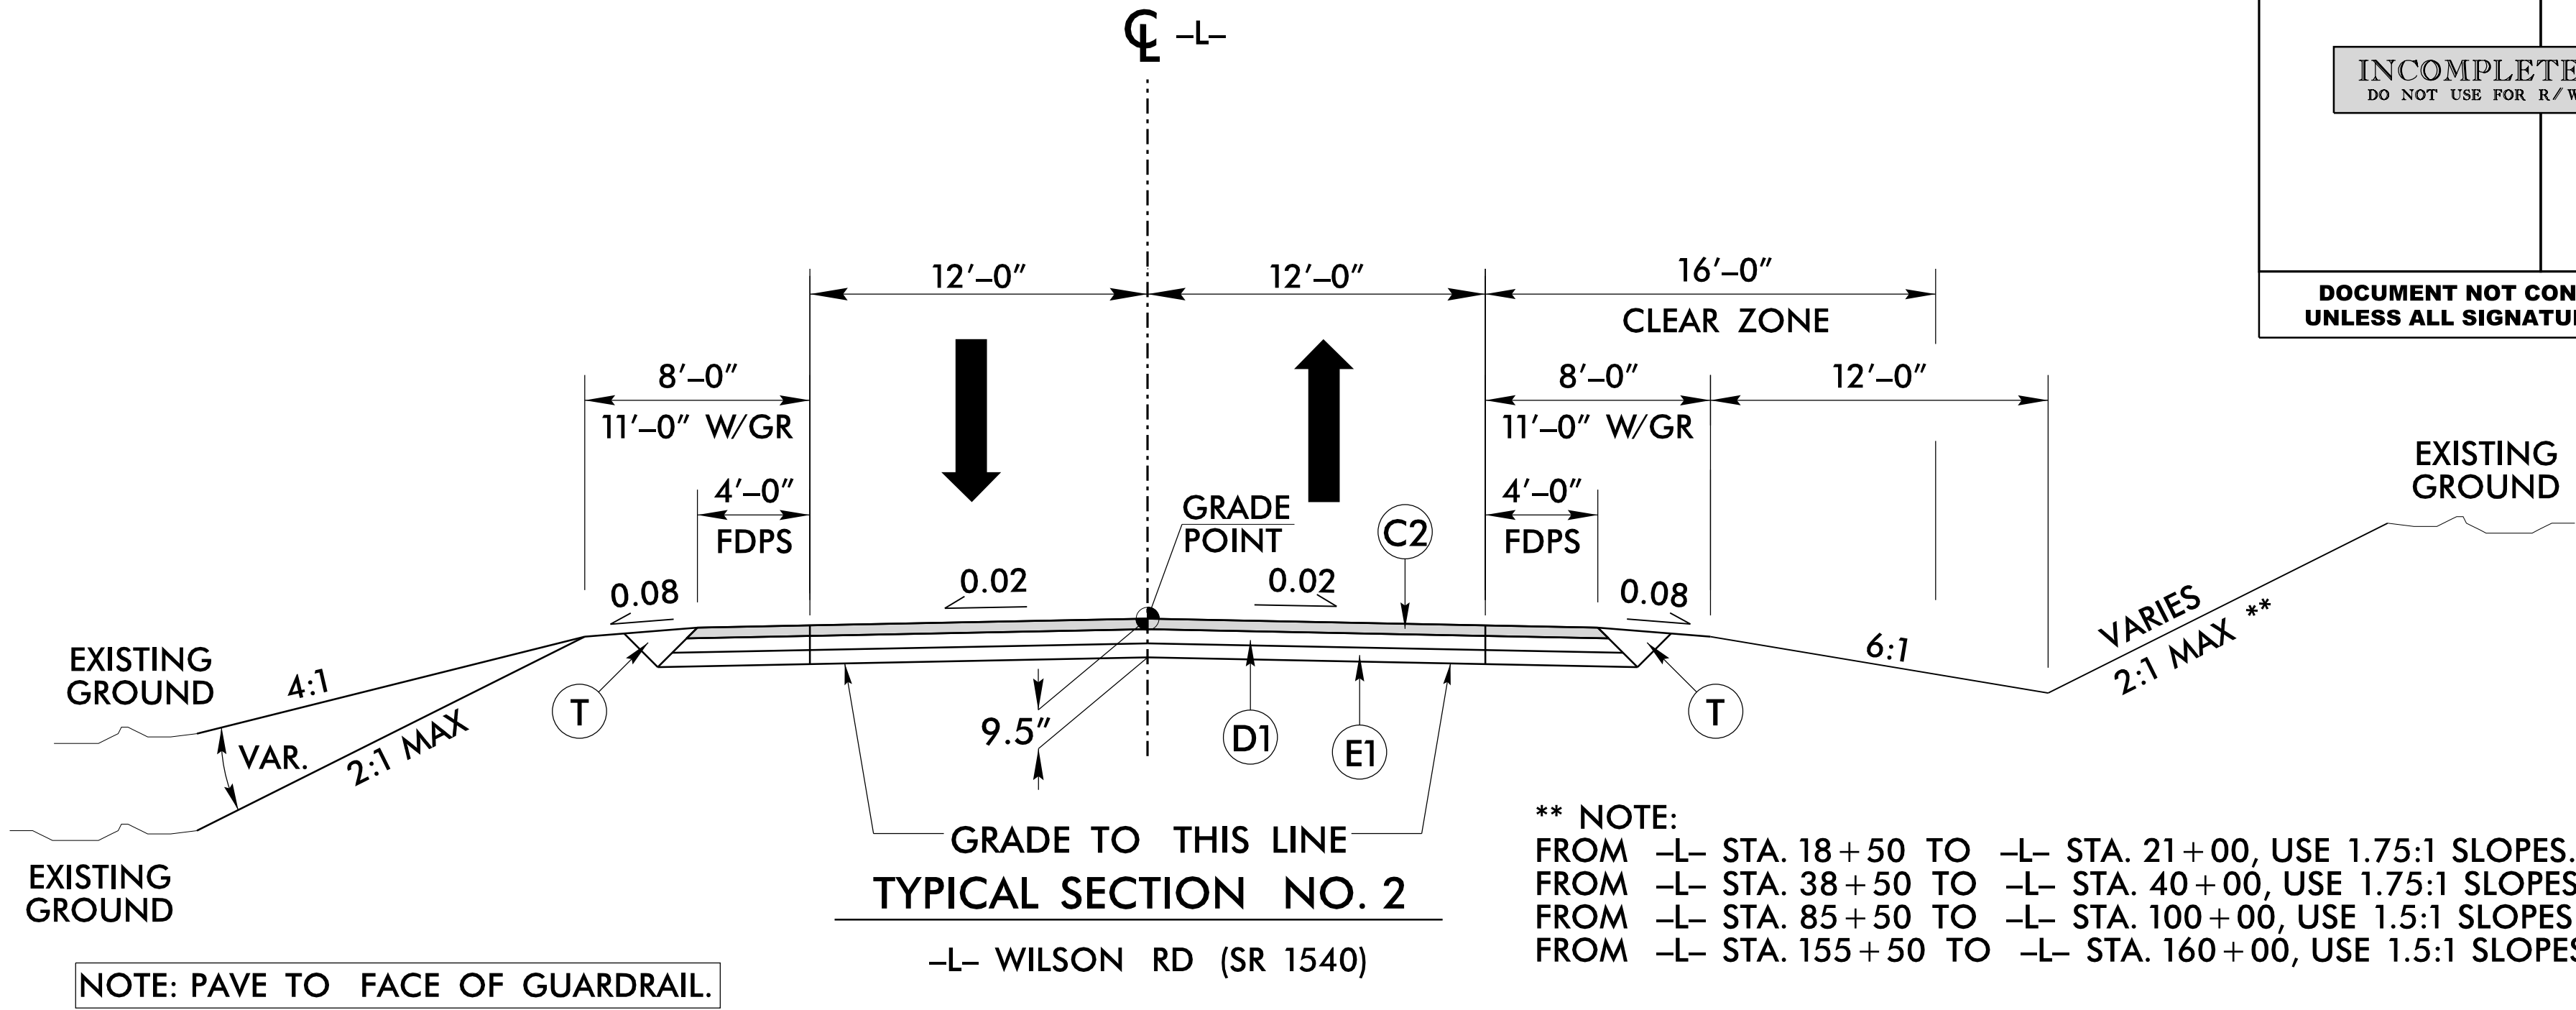

PROJECT REFERENCE NO.	SHEET NO.
R-5763	2A-2
ROADWAY DESIGN ENGINEER	PAVEMENT DESIGN ENGINEER
INCOMPLETE PLANS DO NOT USE FOR R/W ACQUISITION	
DOCUMENT NOT CONSIDERED FINAL UNLESS ALL SIGNATURES COMPLETED	


DETAIL 2A

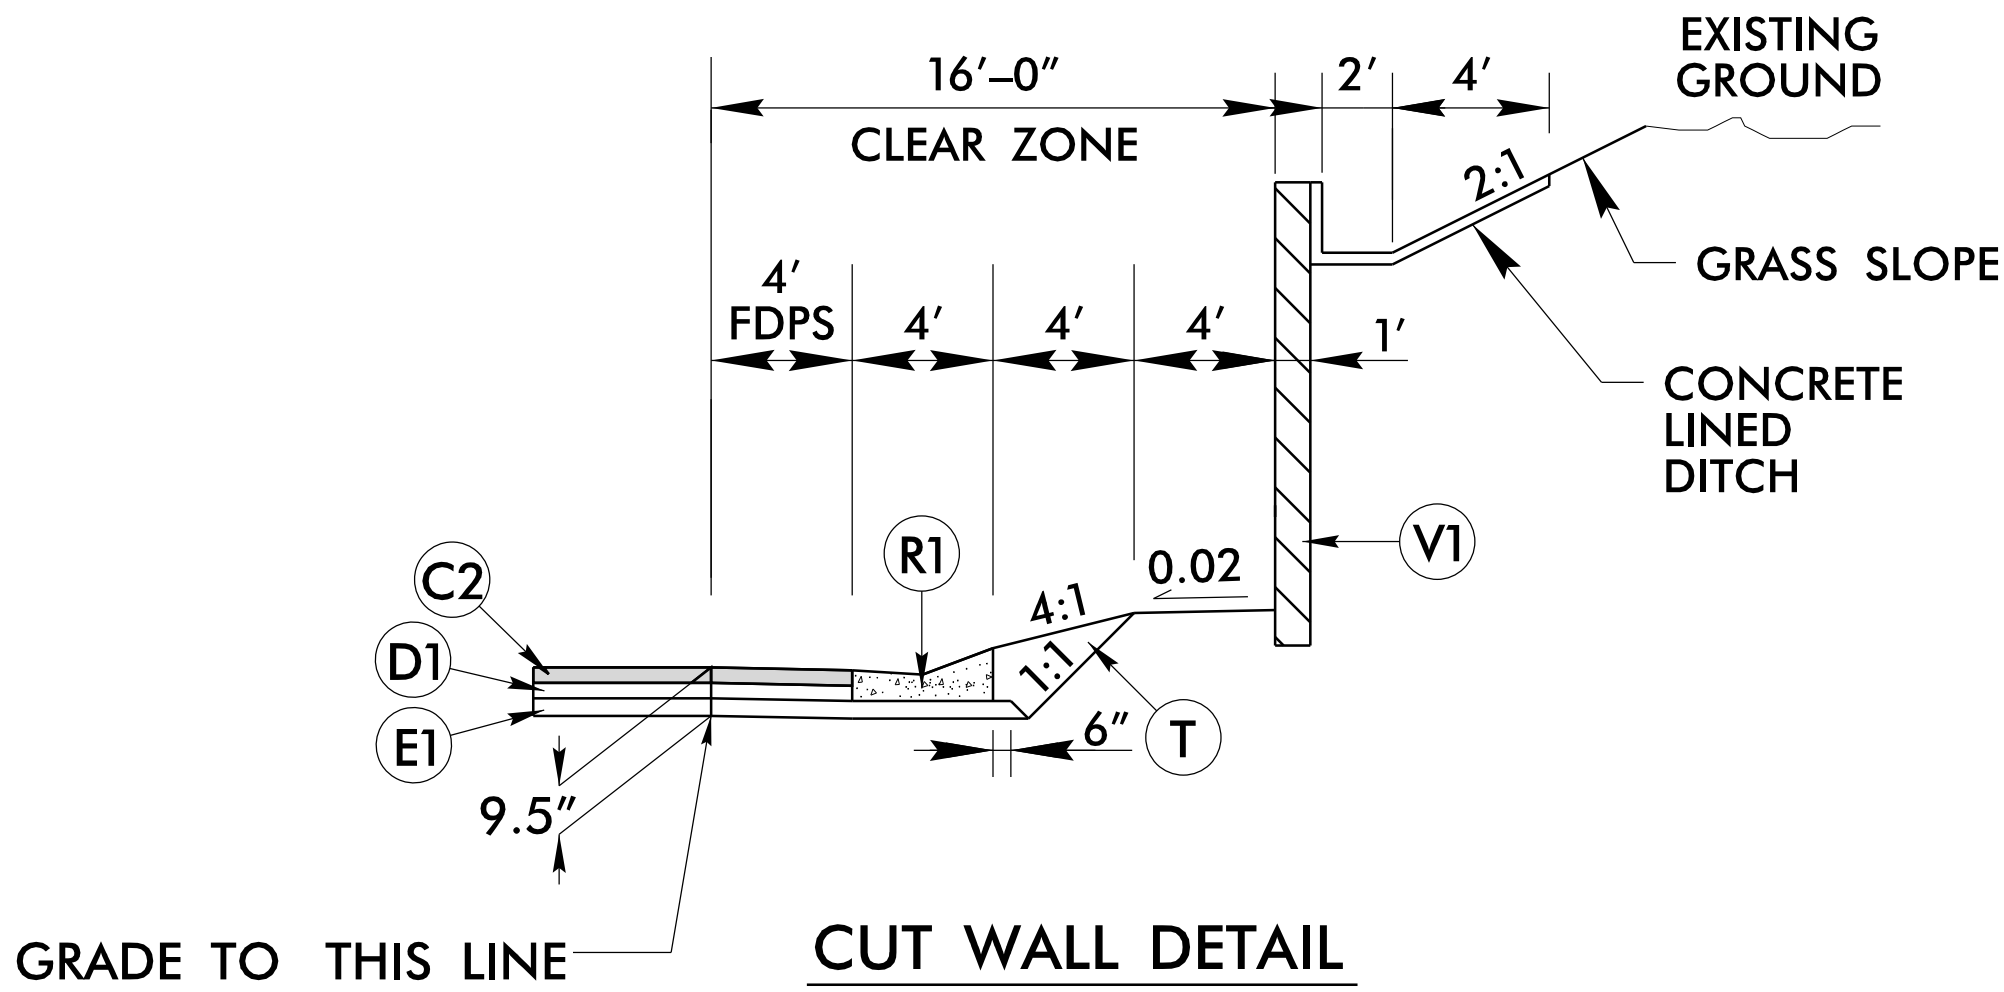

USE CUT WALL DETAIL IN CONJUNCTION WITH
TYPICAL SECTIONS NO. 1 & 2

-L- STA. 49+50.00 TO STA. 53+00.00 RT

DETAIL 2B

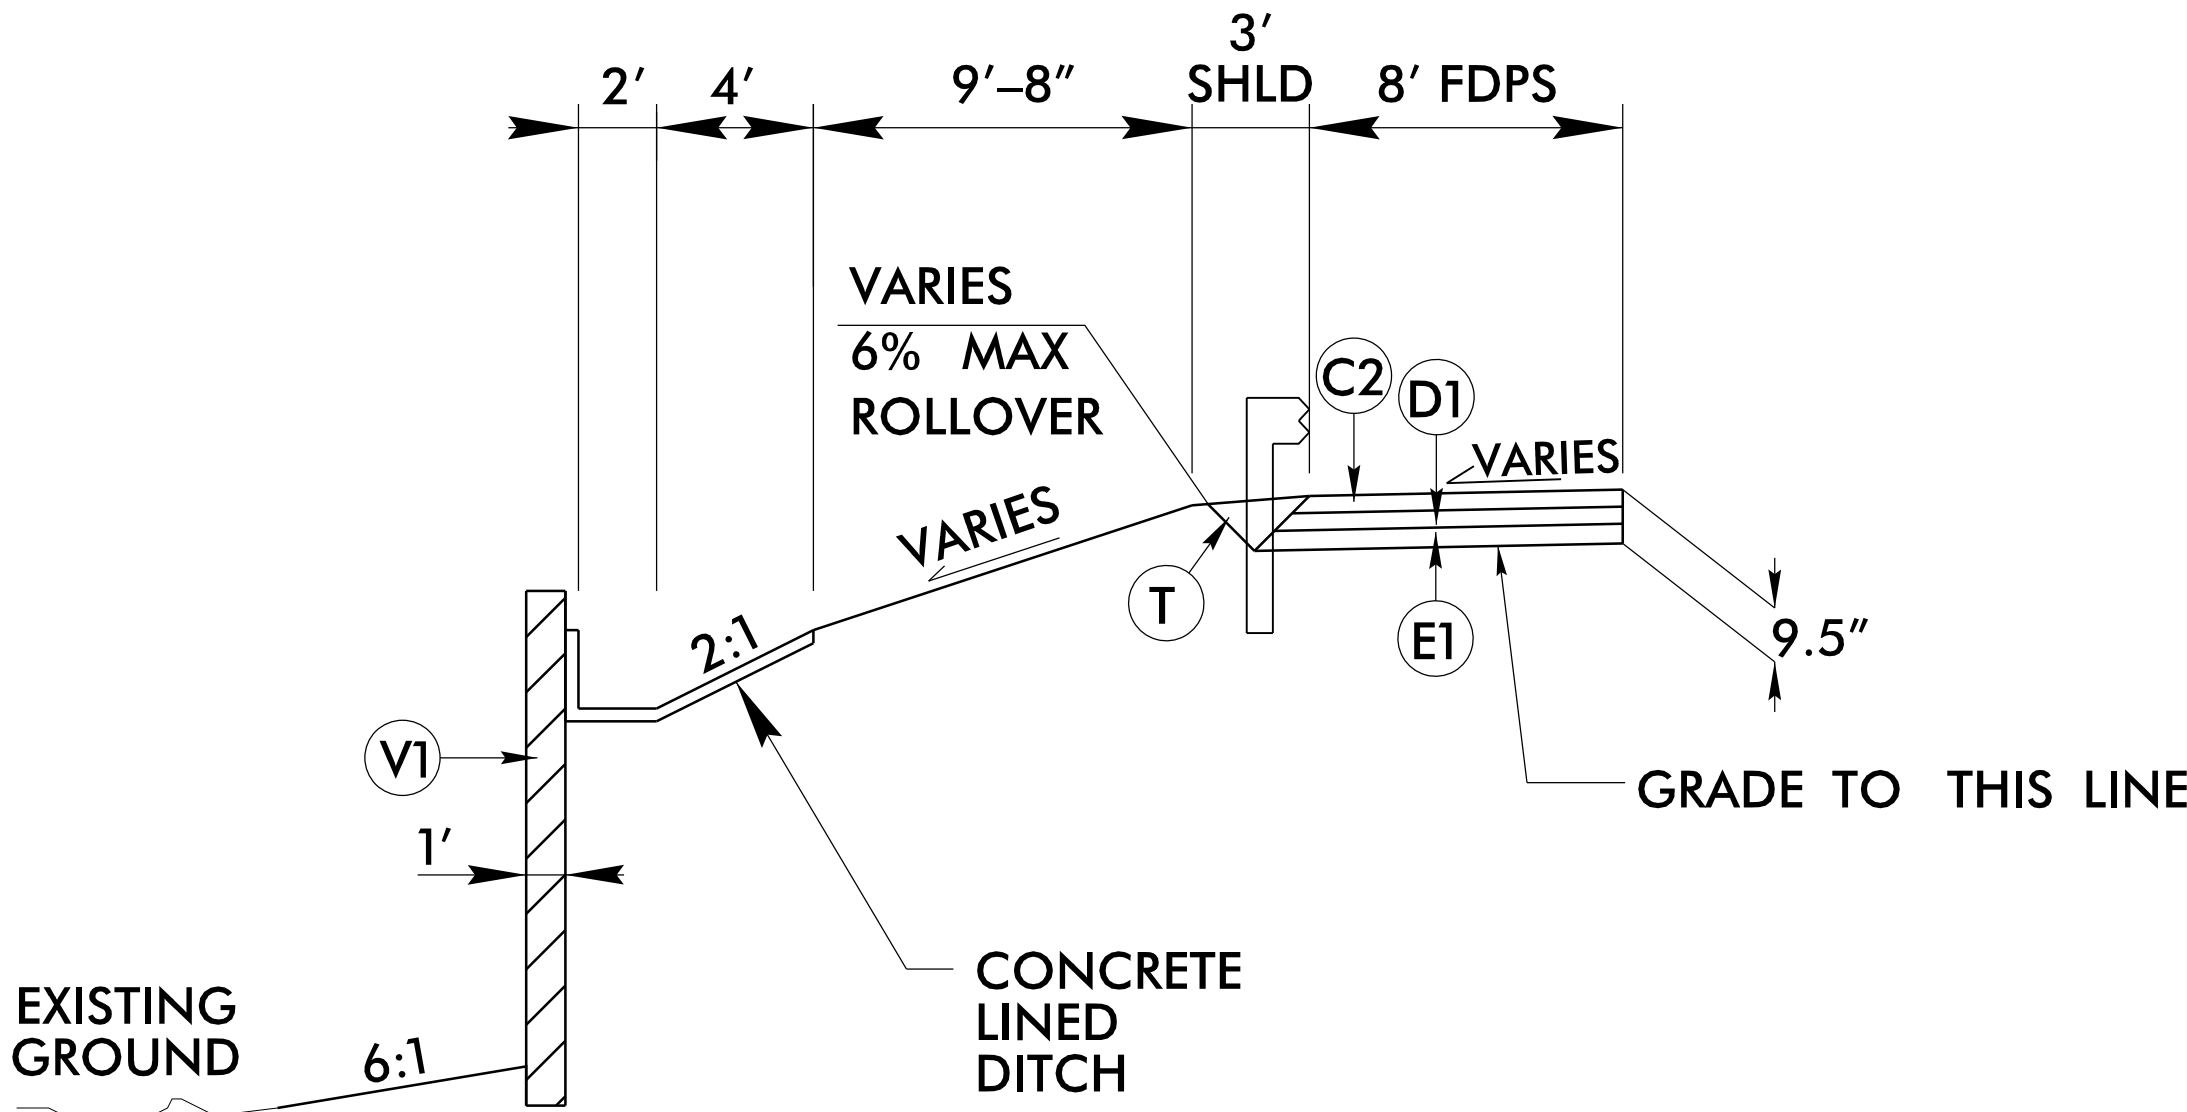

USE FILL WALL DETAIL IN CONJUNCTION WITH
TYPICAL SECTION NO. 1

-L- STA. 84+00.00 TO STA. 91+00.00 LT

18-AUG-2020 14:45
\\prodw051\p-oj\B6763_RDY_TYP.dgn
INTB


6/2/99

PRELIMINARY PAVEMENT DESIGN

C1	PROP. APPROX. 1.5" ACSC, TYPE S9.5C.
C2	PROP. APPROX. 3" ACSC, TYPE S9.5C.
C3	PROP. APPROX. VAR. ACSC, TYPE S9.5C.
D1	PROP. APPROX. 2½" ACIC, TYPE I19.0C.
D2	PROP. APPROX. VAR. ACIC, TYPE I19.0C.
E1	PROP. APPROX. 4" ACBC, TYPE B25.0C.
E2	PROP. APPROX. VAR. ACBC, TYPE B25.0C.
J1	PROP. 6" ABC.
J2	PROP. 8" ABC.
R1	EXPRESSWAY GUTTER.
T	EARTH MATERIAL.
U	EXISTING PAVEMENT.
V1	RETAINING WALL.
W	VARIABLE DEPTH ASPHALT PAVEMENT.


NOTE: PAVEMENT EDGE SLOPES ARE 1:1 UNLESS SHOWN OTHERWISE.

PROJECT REFERENCE NO.	SHEET NO.
R-5763	2A-3
ROADWAY DESIGN ENGINEER	PAVEMENT DESIGN ENGINEER
INCOMPLETE PLANS DO NOT USE FOR R/W ACQUISITION	
DOCUMENT NOT CONSIDERED FINAL UNLESS ALL SIGNATURES COMPLETED	

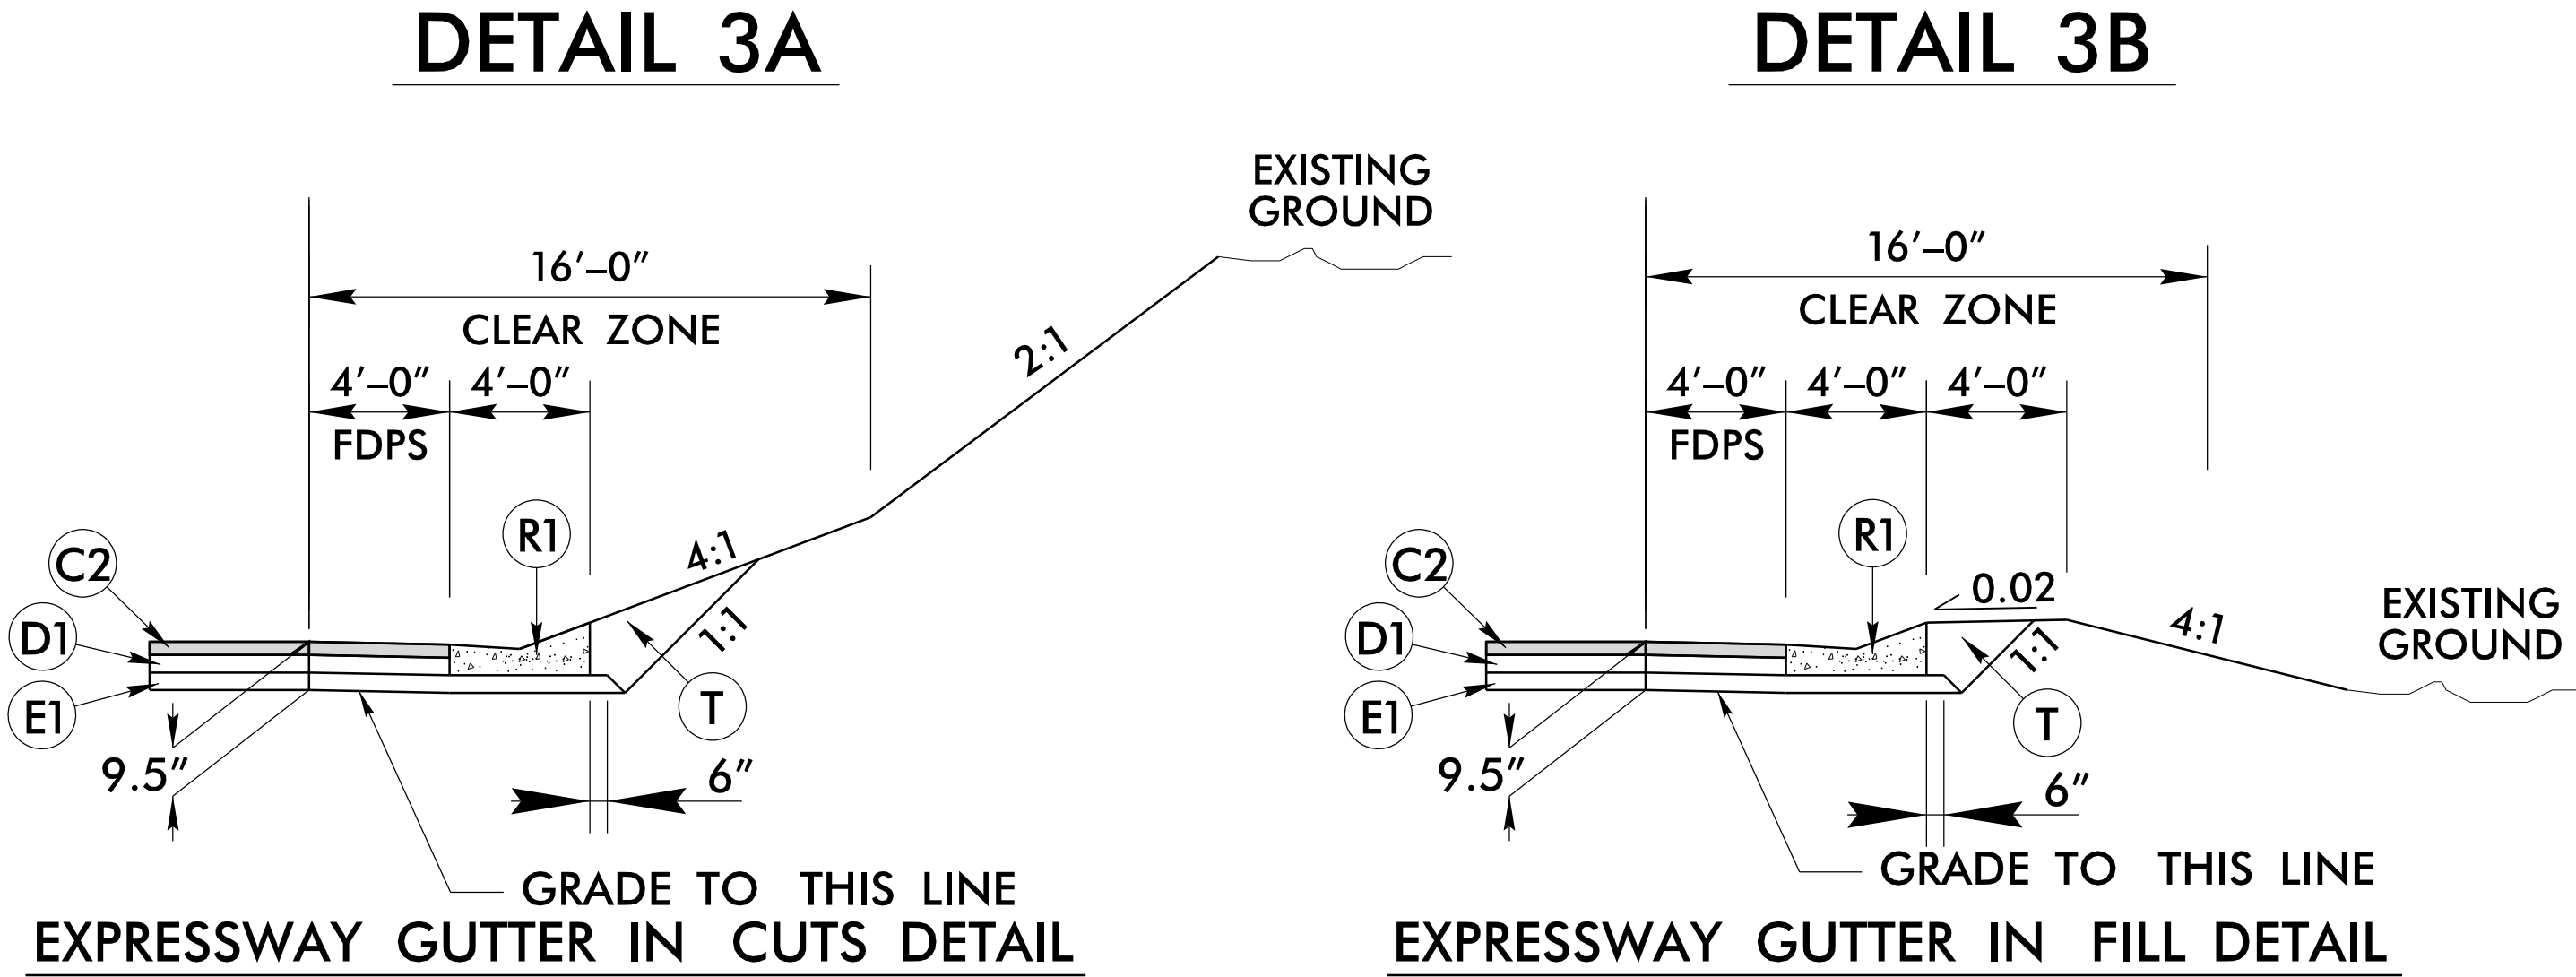

USE DETAILS 3A AND 3B IN CONJUNCTION
WITH TYPICAL SECTIONS NO. 1 & 2

- L- STA. 44+50.00 RT TO STA. 47+00.00 RT
- L- STA. 49+40.00 RT TO STA. 57+70.00 RT
- L- STA. 59+30.00 RT TO STA. 66+80.00 RT
- L- STA. 69+35.00 RT TO STA. 72+00.00 RT

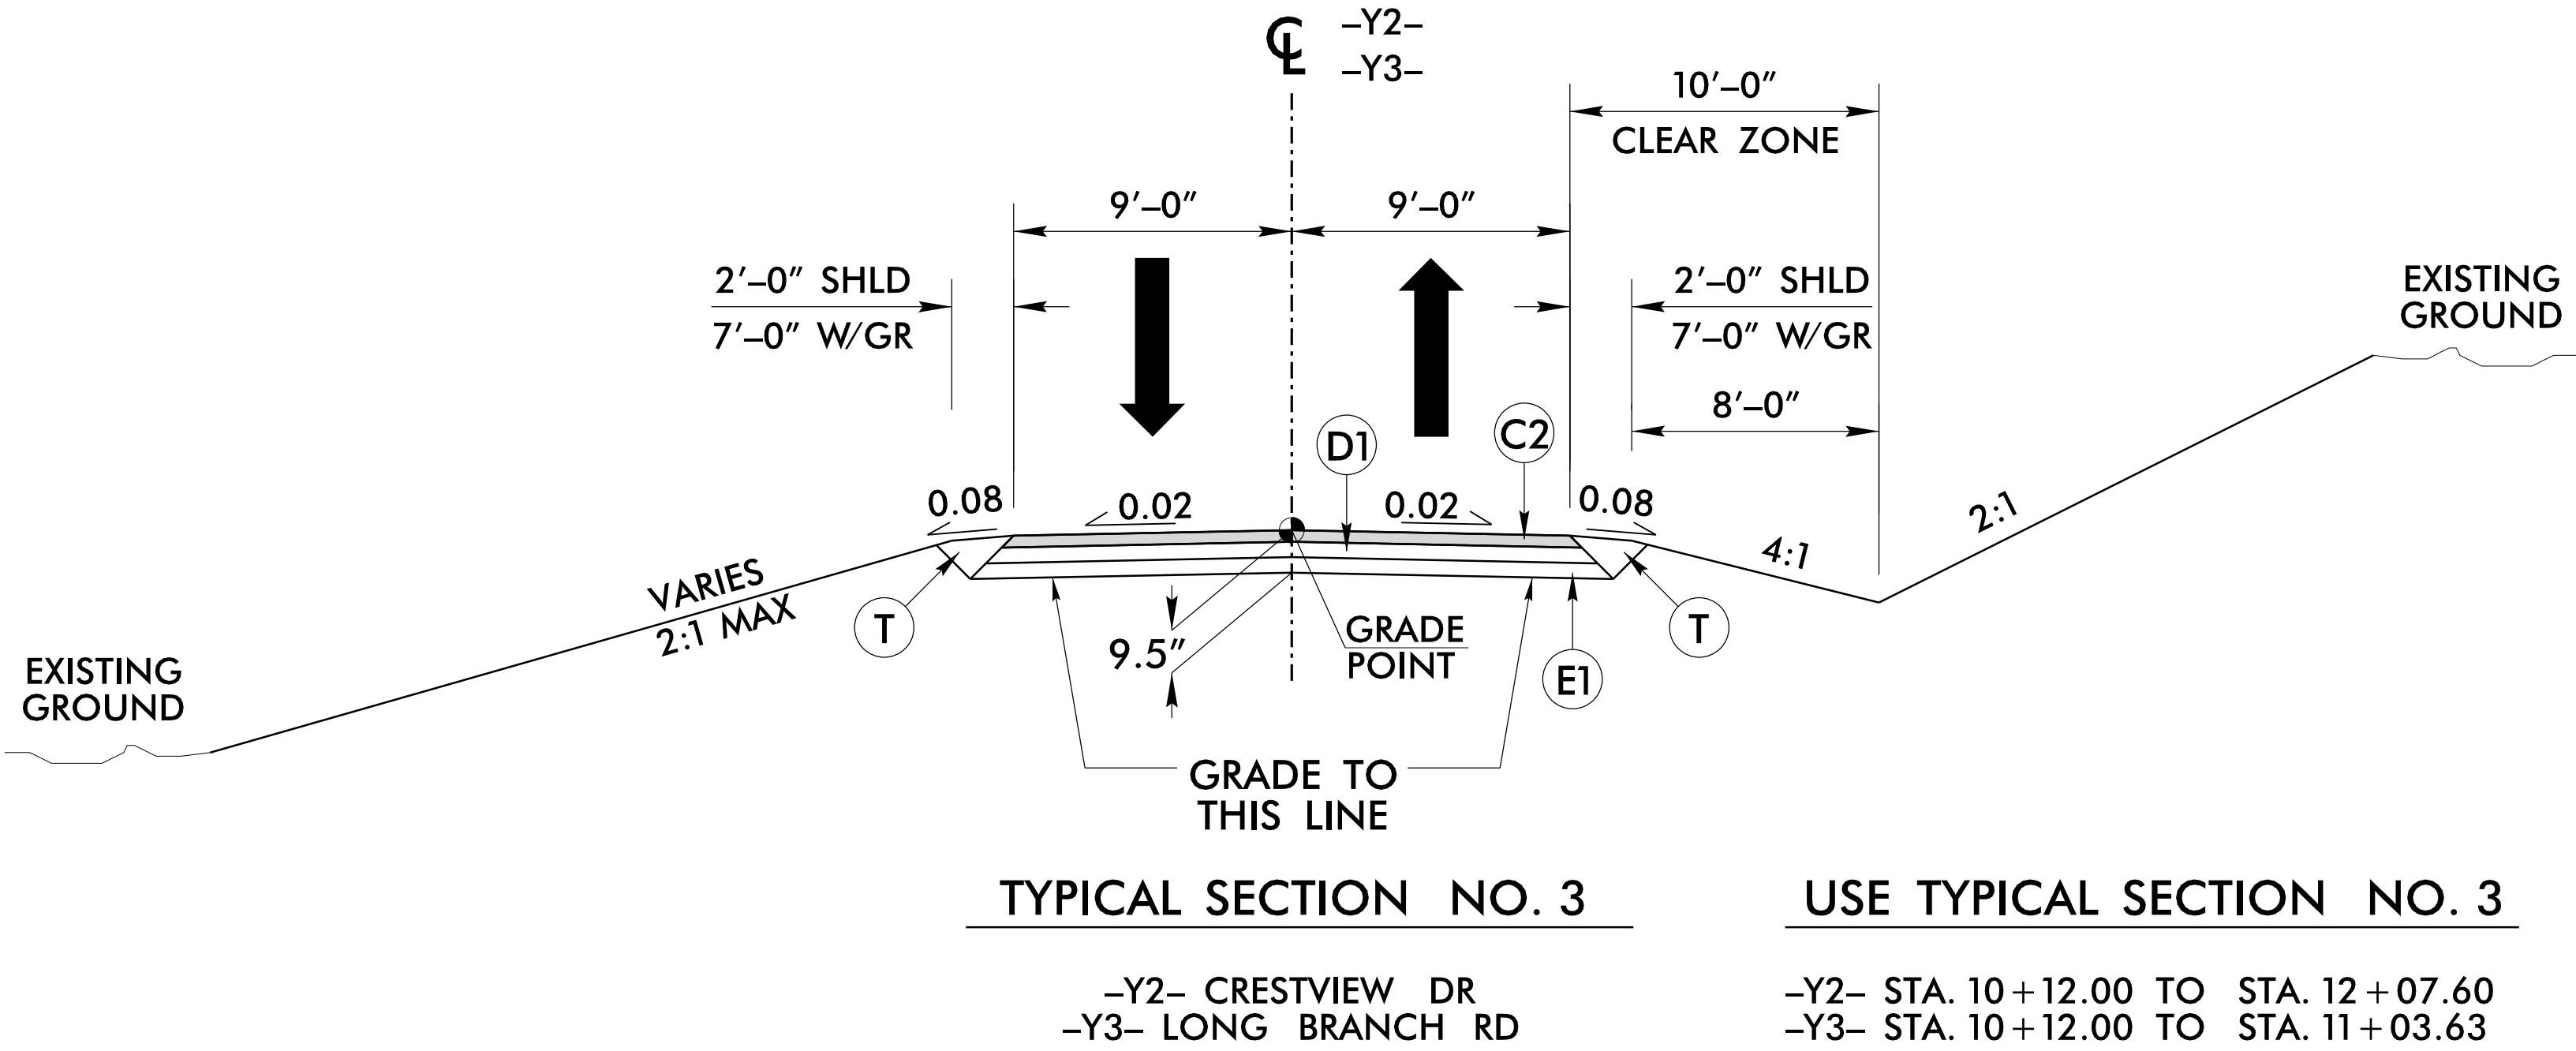

PROJECT REFERENCE NO.		SHEET NO.	
R-5763		2A-4	
ROADWAY DESIGN ENGINEER		PAVEMENT DESIGN ENGINEER	
INCOMPLETE PLANS DO NOT USE FOR R/W ACQUISITION			
DOCUMENT NOT CONSIDERED FINAL UNLESS ALL SIGNATURES COMPLETED			

NOTE: PAVEMENT EDGE SLOPES ARE 1:1 UNLESS SHOWN OTHERWISE.



-Y2- CRESTVIEW DR
-Y3- LONG BRANCH RD
-Y4- THREE MILE KNOB RD
-Y7- MIDDLE MOUNT RD

USE TYPICAL SECTION NO. 4

-Y2- STA. 12+07.60 TO STA. 13+25.00
 -Y3- STA. 11+03.63 TO STA. 11+50.00
 -Y4- STA. 10+12.00 TO STA. 11+00.00
 -Y7- STA. 10+12.11 TO STA. 10+75.00



-Y6- SR 1541 (WILLIAMSON CREEK RD)

USE TYPICAL SECTION NO. 5

-Y6- STA. 10+24.00 TO STA. 11+12.33


6/2/99

PRELIMINARY PAVEMENT DESIGN

C1	PROP. APPROX. 1.5" ACSC, TYPE S9.5C.
C2	PROP. APPROX. 3" ACSC, TYPE S9.5C.
C3	PROP. APPROX. VAR. ACSC, TYPE S9.5C.
D1	PROP. APPROX. 2½" ACIC, TYPE I19.0C.
D2	PROP. APPROX. VAR. ACIC, TYPE I19.0C.
E1	PROP. APPROX. 4" ACBC, TYPE B25.0C.
E2	PROP. APPROX. VAR. ACBC, TYPE B25.0C.
J1	PROP. 6" ABC.
J2	PROP. 8" ABC.
R1	EXPRESSWAY GUTTER.
T	EARTH MATERIAL.
U	EXISTING PAVEMENT.
V1	RETAINING WALL.
W	VARIABLE DEPTH ASPHALT PAVEMENT.

NOTE: PAVEMENT EDGE SLOPES ARE 1:1 UNLESS SHOWN OTHERWISE.

PROJECT REFERENCE NO.	SHEET NO.
R-5763	2A-5
ROADWAY DESIGN ENGINEER	PAVEMENT DESIGN ENGINEER
INCOMPLETE PLANS DO NOT USE FOR R/W ACQUISITION	
DOCUMENT NOT CONSIDERED FINAL UNLESS ALL SIGNATURES COMPLETED	

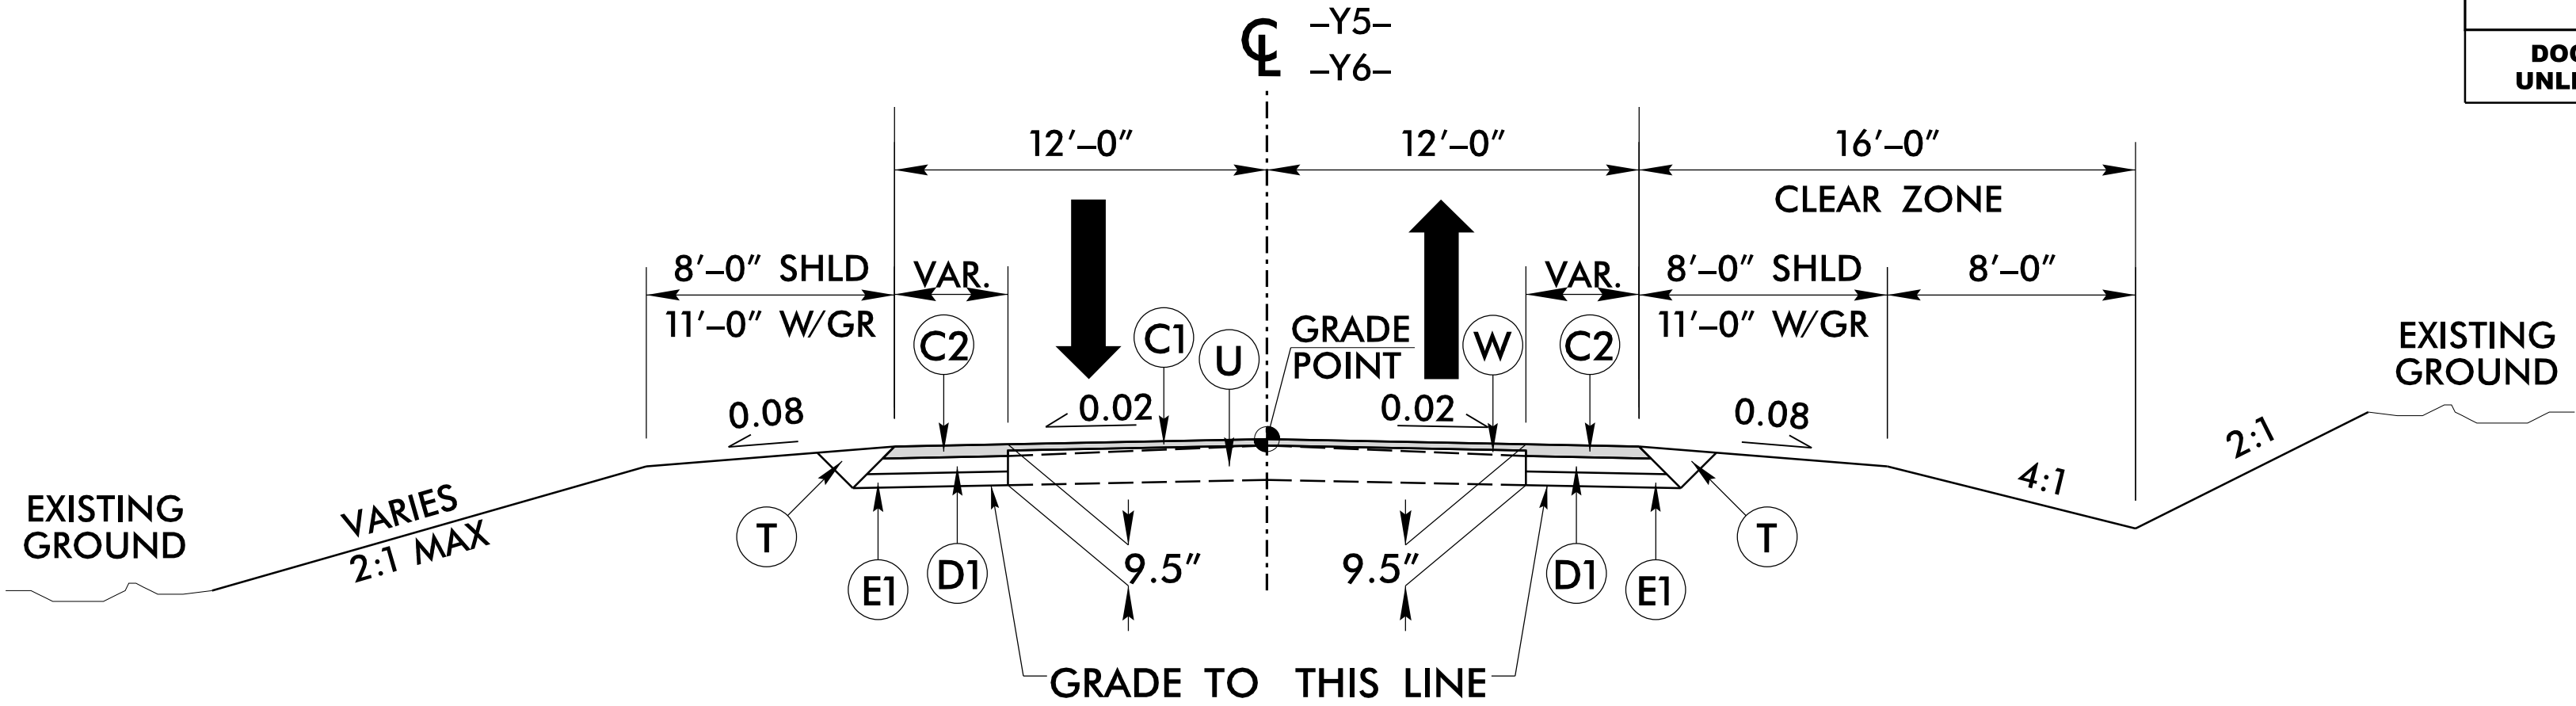


TYPICAL SECTION NO. 6

USE TYPICAL SECTION NO. 6

-Y5- SR 1543 (ELM BEND RD)
-Y6- SR 1541 (WILLIAMSON CREEK RD)

-Y5- STA. 18+50.00 TO STA. 21+69.60
-Y6- STA. 11+12.33 TO STA. 12+00.00

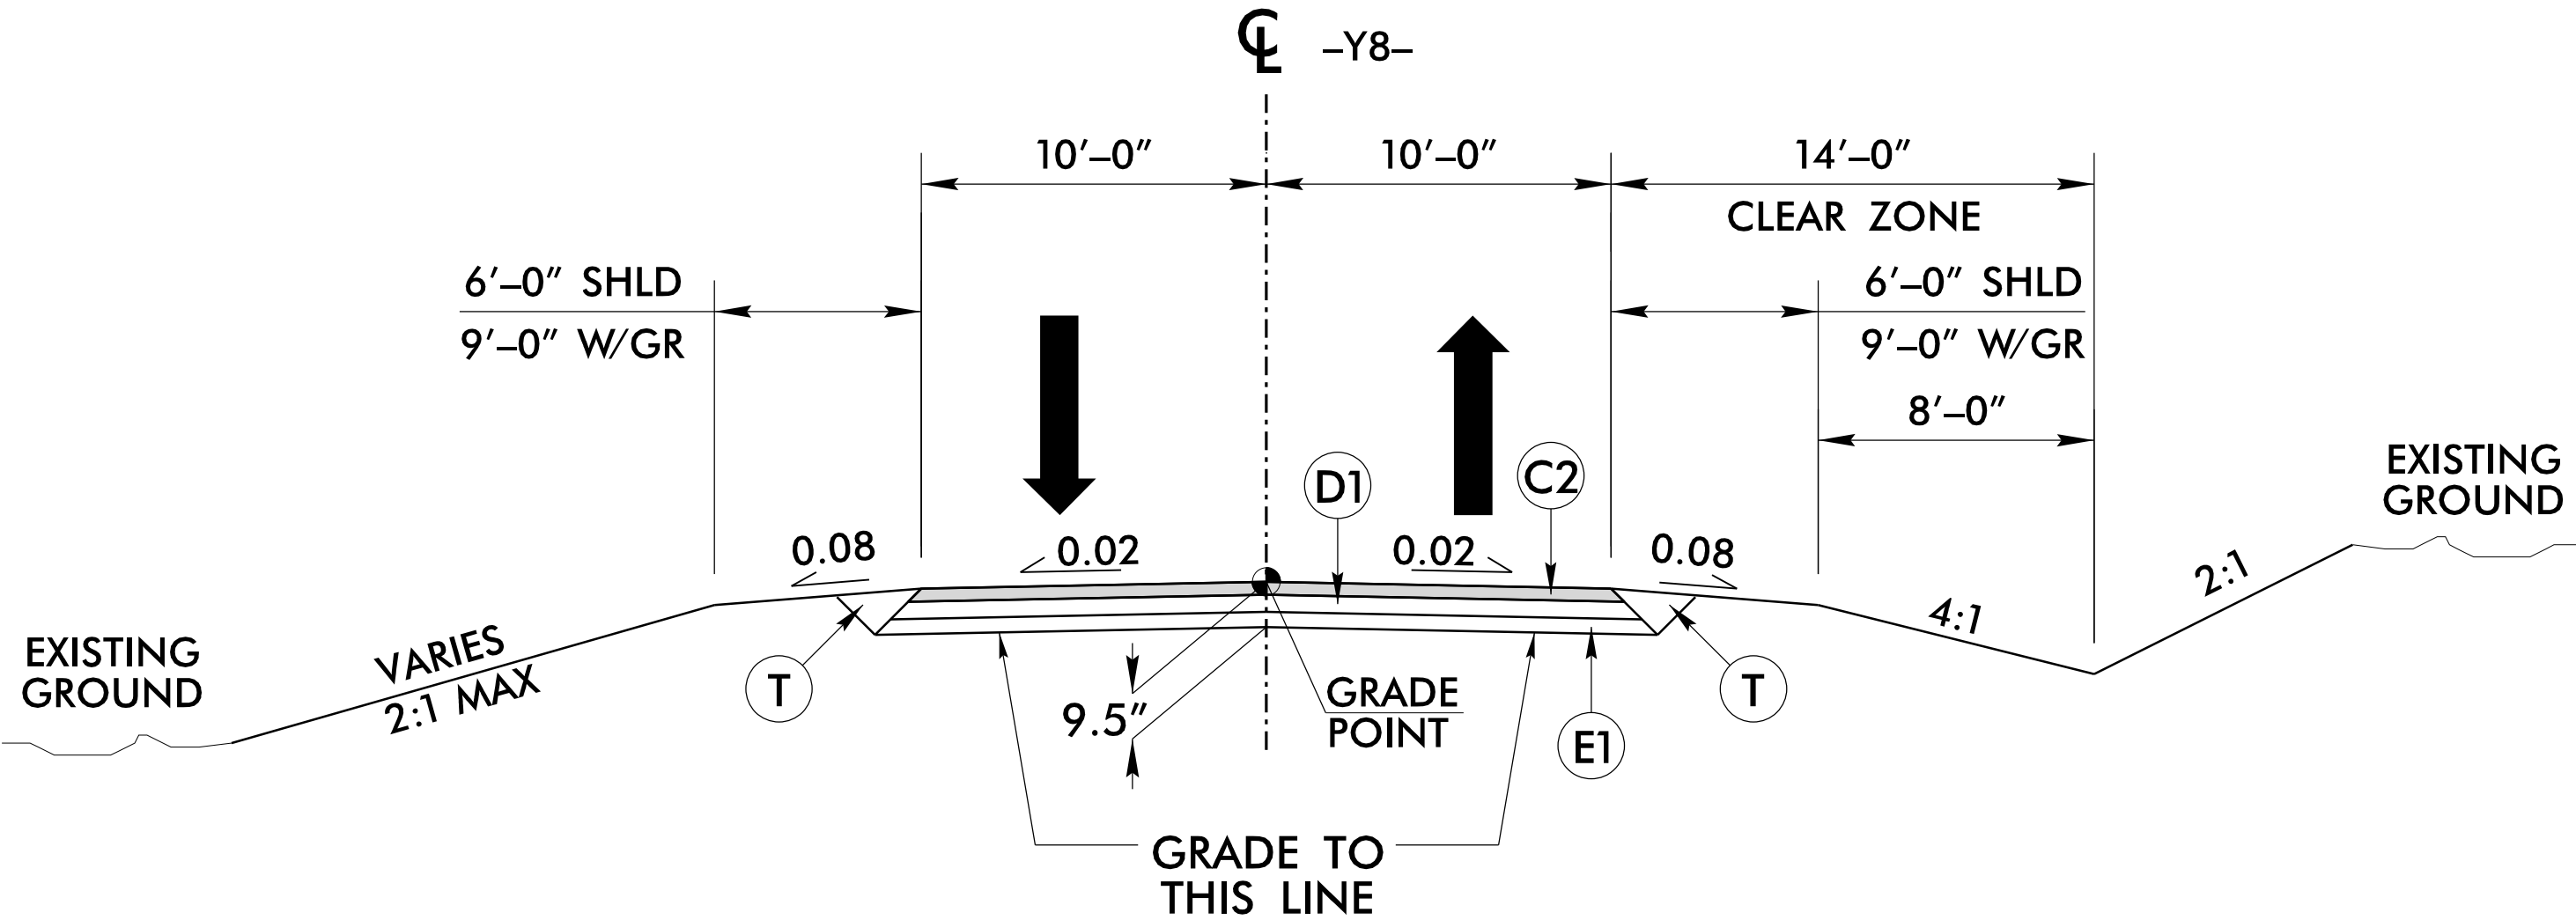

TYPICAL SECTION NO. 7

USE TYPICAL SECTION NO. 7

-Y8- SR 1580 (GLEN CANNON DR)

-Y8- STA. 10+12.00 TO STA. 11+56.37


6/2/99

PRELIMINARY PAVEMENT DESIGN

C1	PROP. APPROX. 1.5" ACSC, TYPE S9.5C.
C2	PROP. APPROX. 3" ACSC, TYPE S9.5C.
C3	PROP. APPROX. VAR. ACSC, TYPE S9.5C.
D1	PROP. APPROX. 2½" ACIC, TYPE I19.0C.
D2	PROP. APPROX. VAR. ACIC, TYPE I19.0C.
E1	PROP. APPROX. 4" ACBC, TYPE B25.0C.
E2	PROP. APPROX. VAR. ACBC, TYPE B25.0C.
J1	PROP. 6" ABC.
J2	PROP. 8" ABC.
R1	EXPRESSWAY GUTTER.
T	EARTH MATERIAL.
U	EXISTING PAVEMENT.
V1	RETAINING WALL.
W	VARIABLE DEPTH ASPHALT PAVEMENT.

NOTE: PAVEMENT EDGE SLOPES ARE 1:1 UNLESS SHOWN OTHERWISE.

PROJECT REFERENCE NO.	SHEET NO.
R-5763	2A-6
ROADWAY DESIGN ENGINEER	PAVEMENT DESIGN ENGINEER
INCOMPLETE PLANS DO NOT USE FOR R/W ACQUISITION	
DOCUMENT NOT CONSIDERED FINAL UNLESS ALL SIGNATURES COMPLETED	

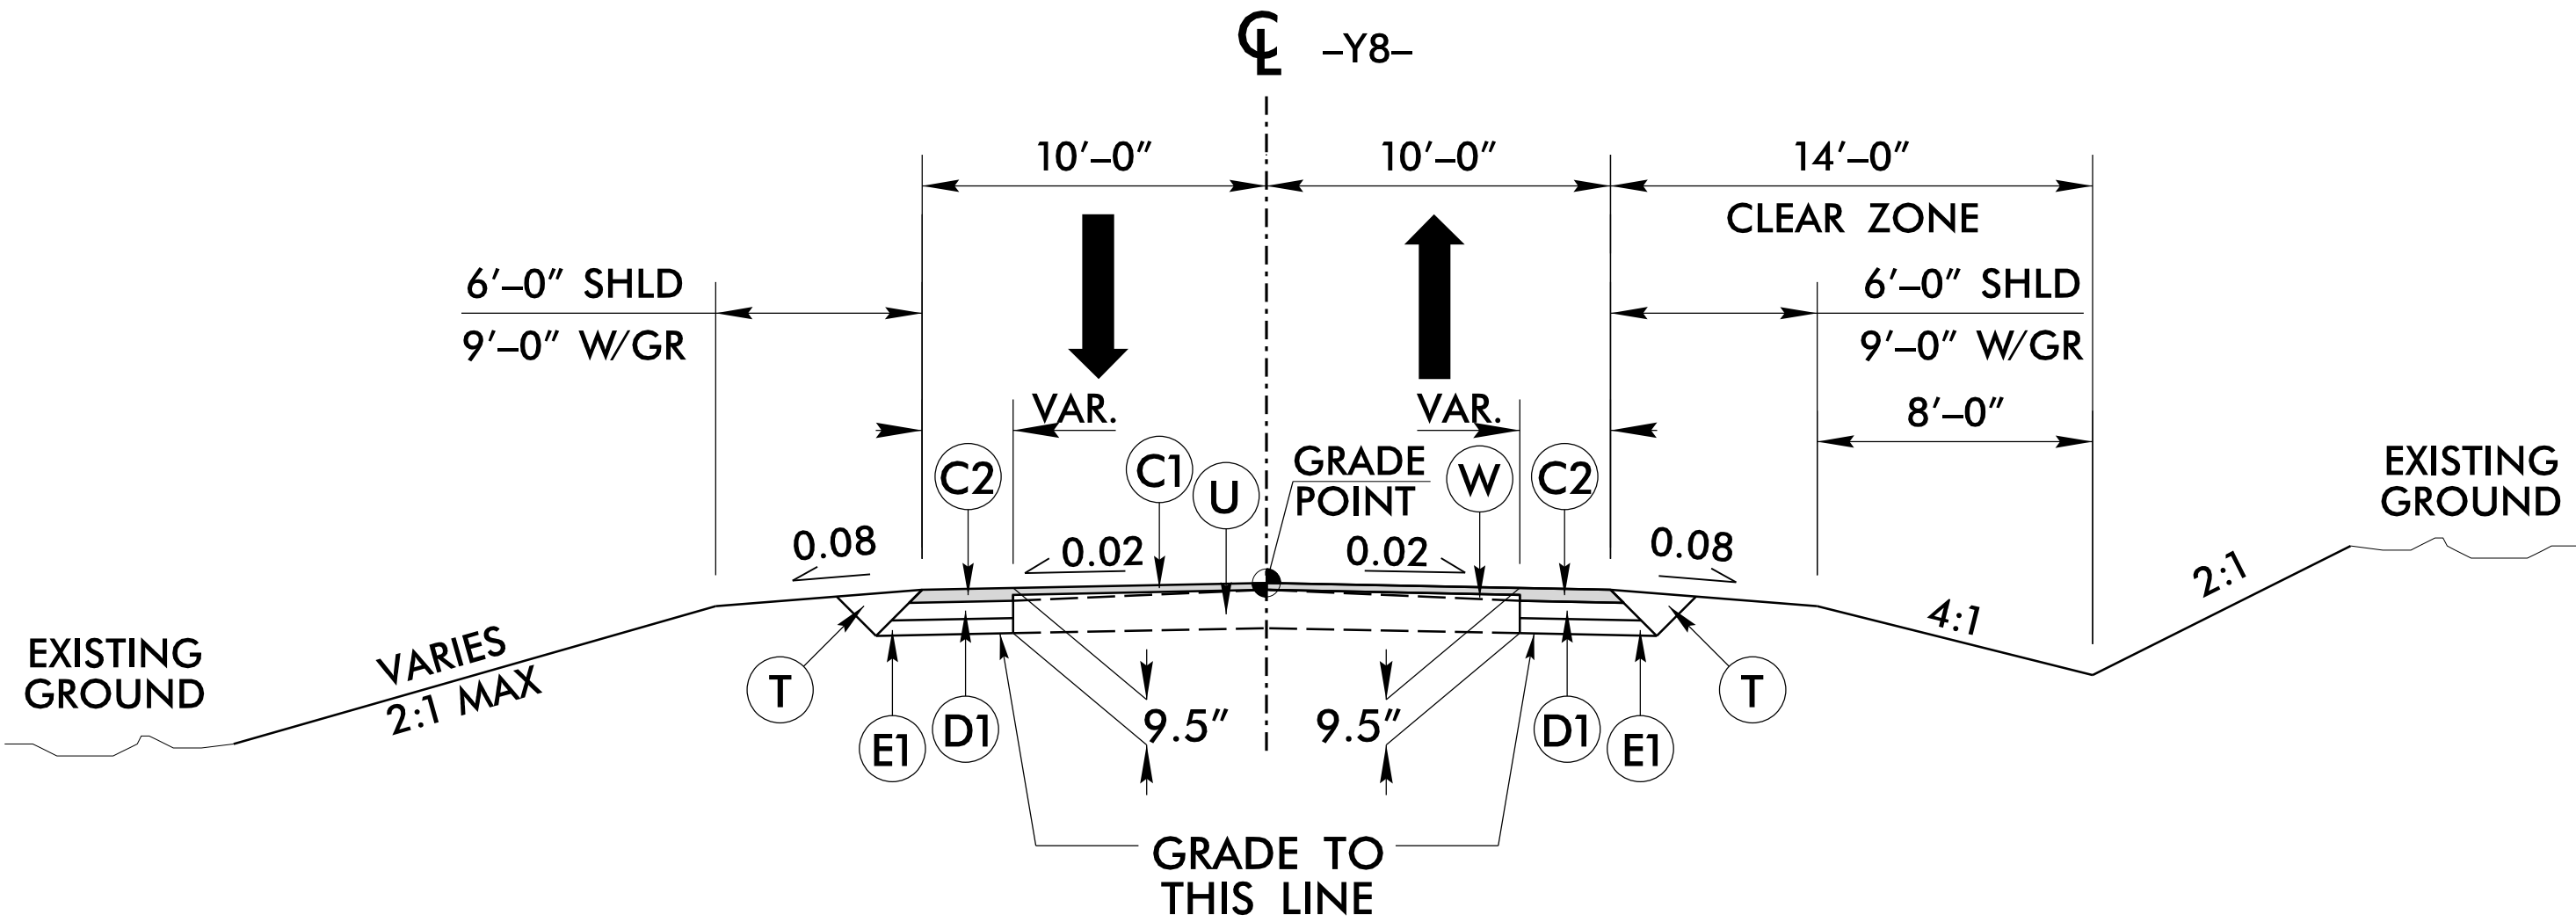


TYPICAL SECTION NO. 8

-Y8- SR 1580 (GLEN CANNON DR)

USE TYPICAL SECTION NO. 8

-Y8- STA. 11+56.37 TO STA. 12+75.00

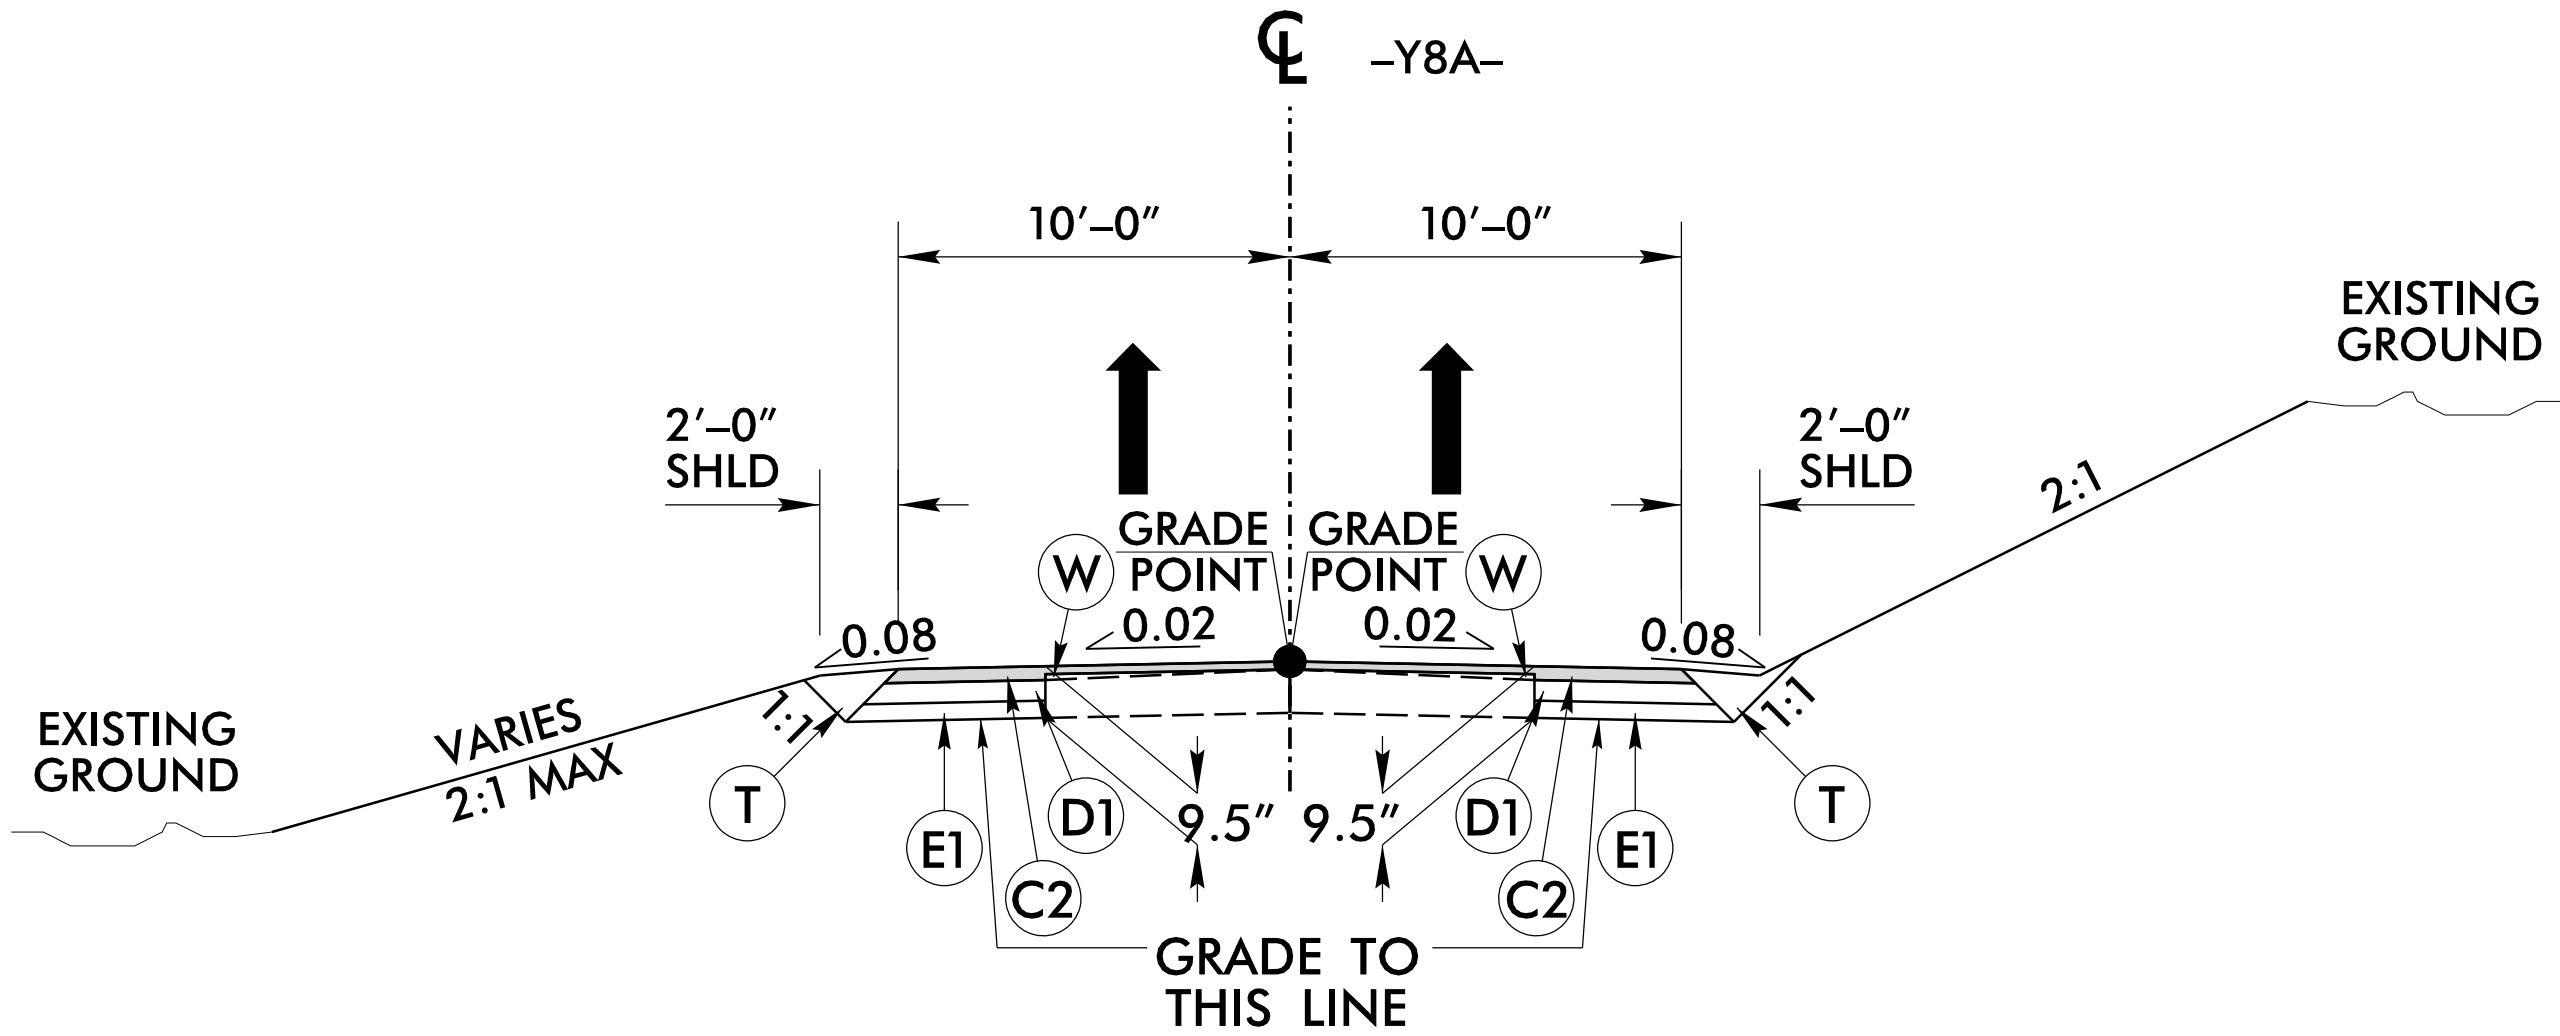


TYPICAL SECTION NO. 9

-Y8A-

USE TYPICAL SECTION NO. 9

-Y8A- STA. 10+10.35 TO STA. 13+25.00

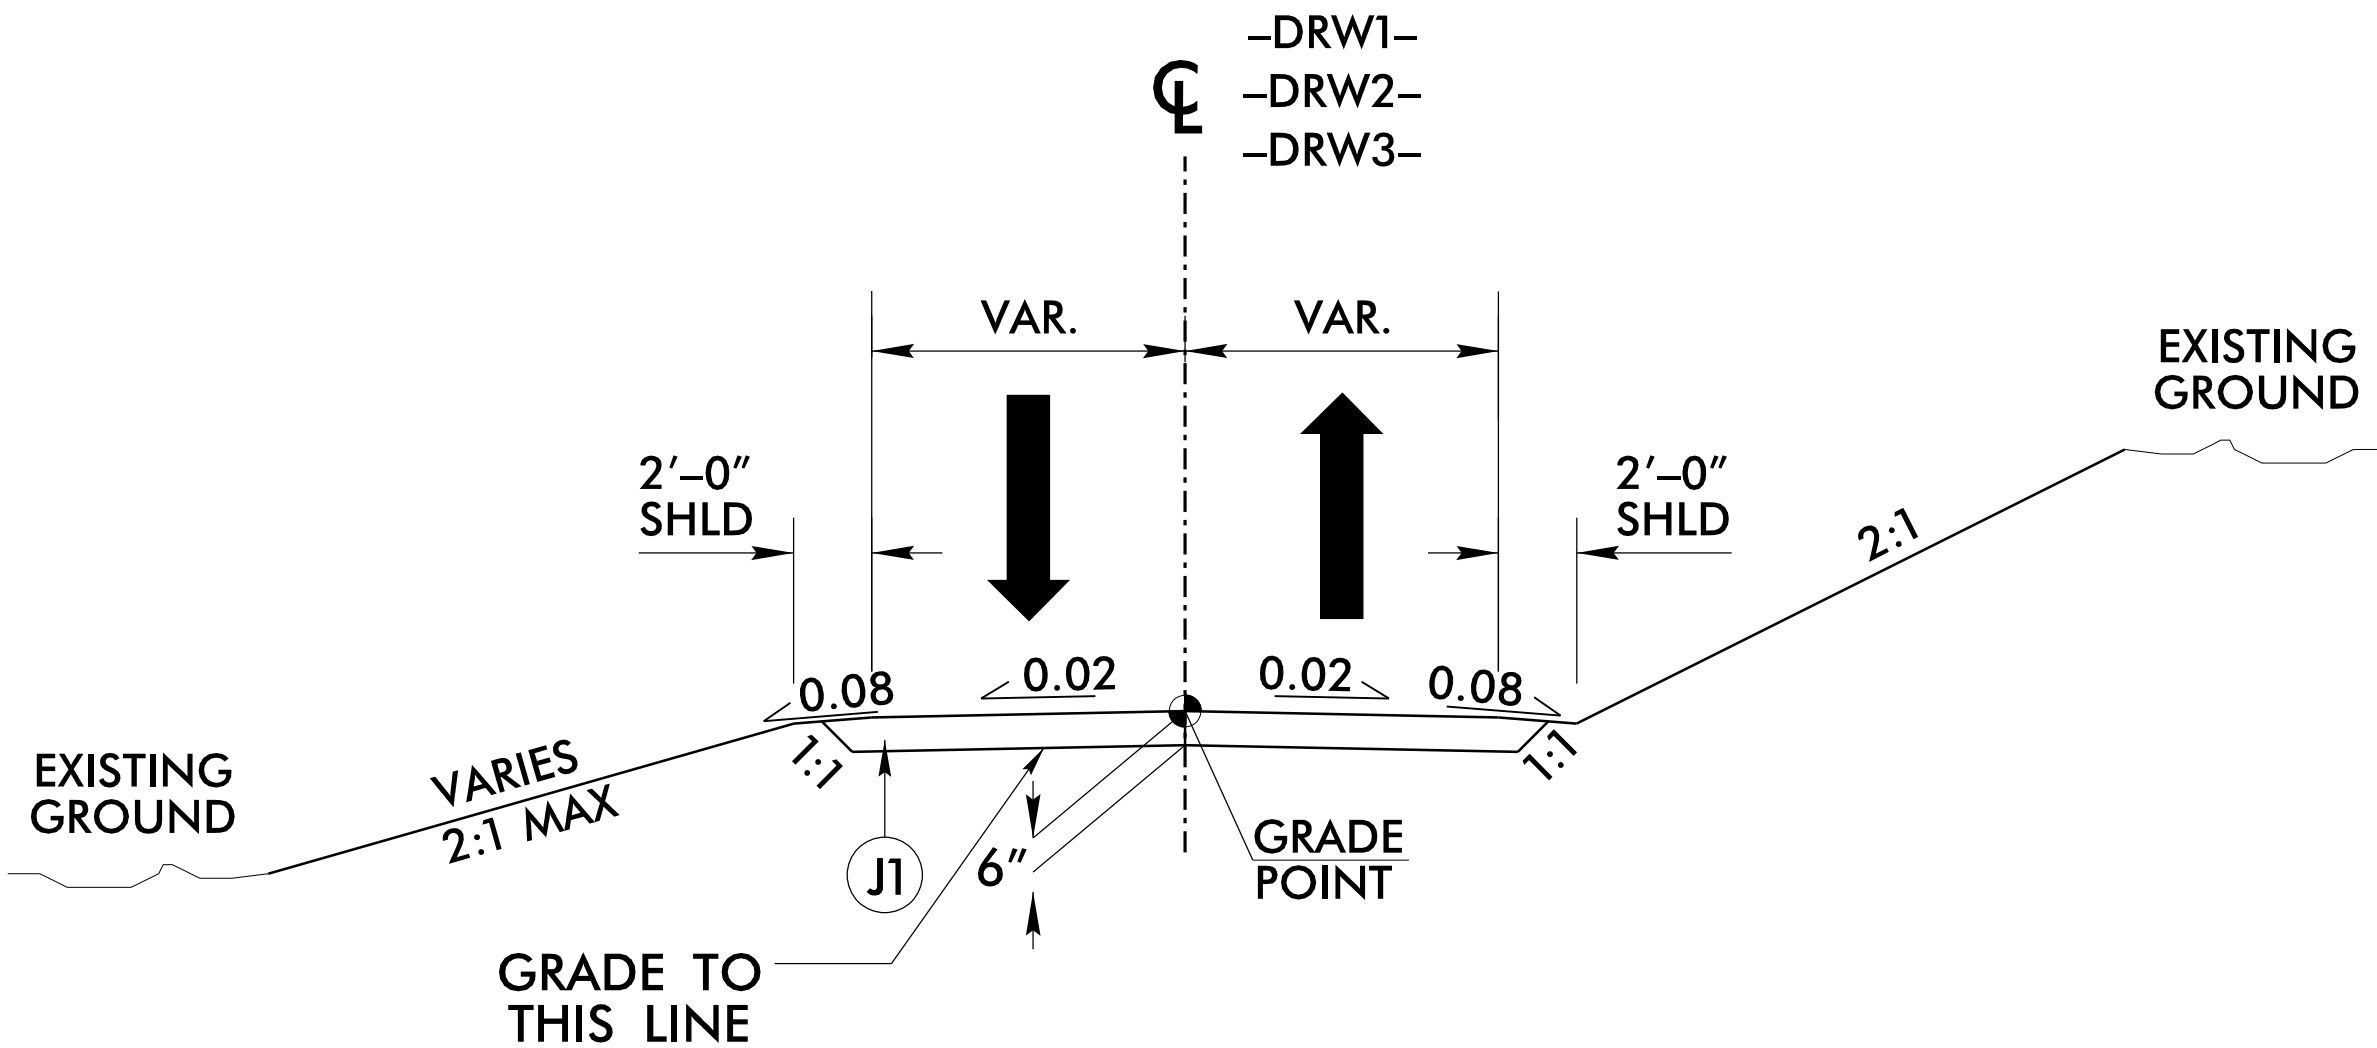

TYPICAL SECTION NO. 10

-DRW1-
-DRW2-
-DRW3-

USE TYPICAL SECTION NO. 10

-DRW1- STA. 10+12.00 TO STA. 11+50.00
-DRW2- STA. 10+12.00 TO STA. 11+50.00
-DRW3- STA. 10+12.00 TO STA. 11+50.00


6/2/99

PRELIMINARY PAVEMENT DESIGN

C1	PROP. APPROX. 1.5" ACSC, TYPE S9.5C.
C2	PROP. APPROX. 3" ACSC, TYPE S9.5C.
C3	PROP. APPROX. VAR. ACSC, TYPE S9.5C.
D1	PROP. APPROX. 2½" ACIC, TYPE I19.0C.
D2	PROP. APPROX. VAR. ACIC, TYPE I19.0C.
E1	PROP. APPROX. 4" ACBC, TYPE B25.0C.
E2	PROP. APPROX. VAR. ACBC, TYPE B25.0C.
J1	PROP. 6" ABC.
J2	PROP. 8" ABC.
R1	EXPRESSWAY GUTTER.
T	EARTH MATERIAL.
U	EXISTING PAVEMENT.
V1	RETAINING WALL.
W	VARIABLE DEPTH ASPHALT PAVEMENT.

NOTE: PAVEMENT EDGE SLOPES ARE 1:1 UNLESS SHOWN OTHERWISE.


PROJECT REFERENCE NO.	SHEET NO.
R-5763	2A-7
ROADWAY DESIGN ENGINEER	PAVEMENT DESIGN ENGINEER
INCOMPLETE PLANS DO NOT USE FOR R/W ACQUISITION	
DOCUMENT NOT CONSIDERED FINAL UNLESS ALL SIGNATURES COMPLETED	

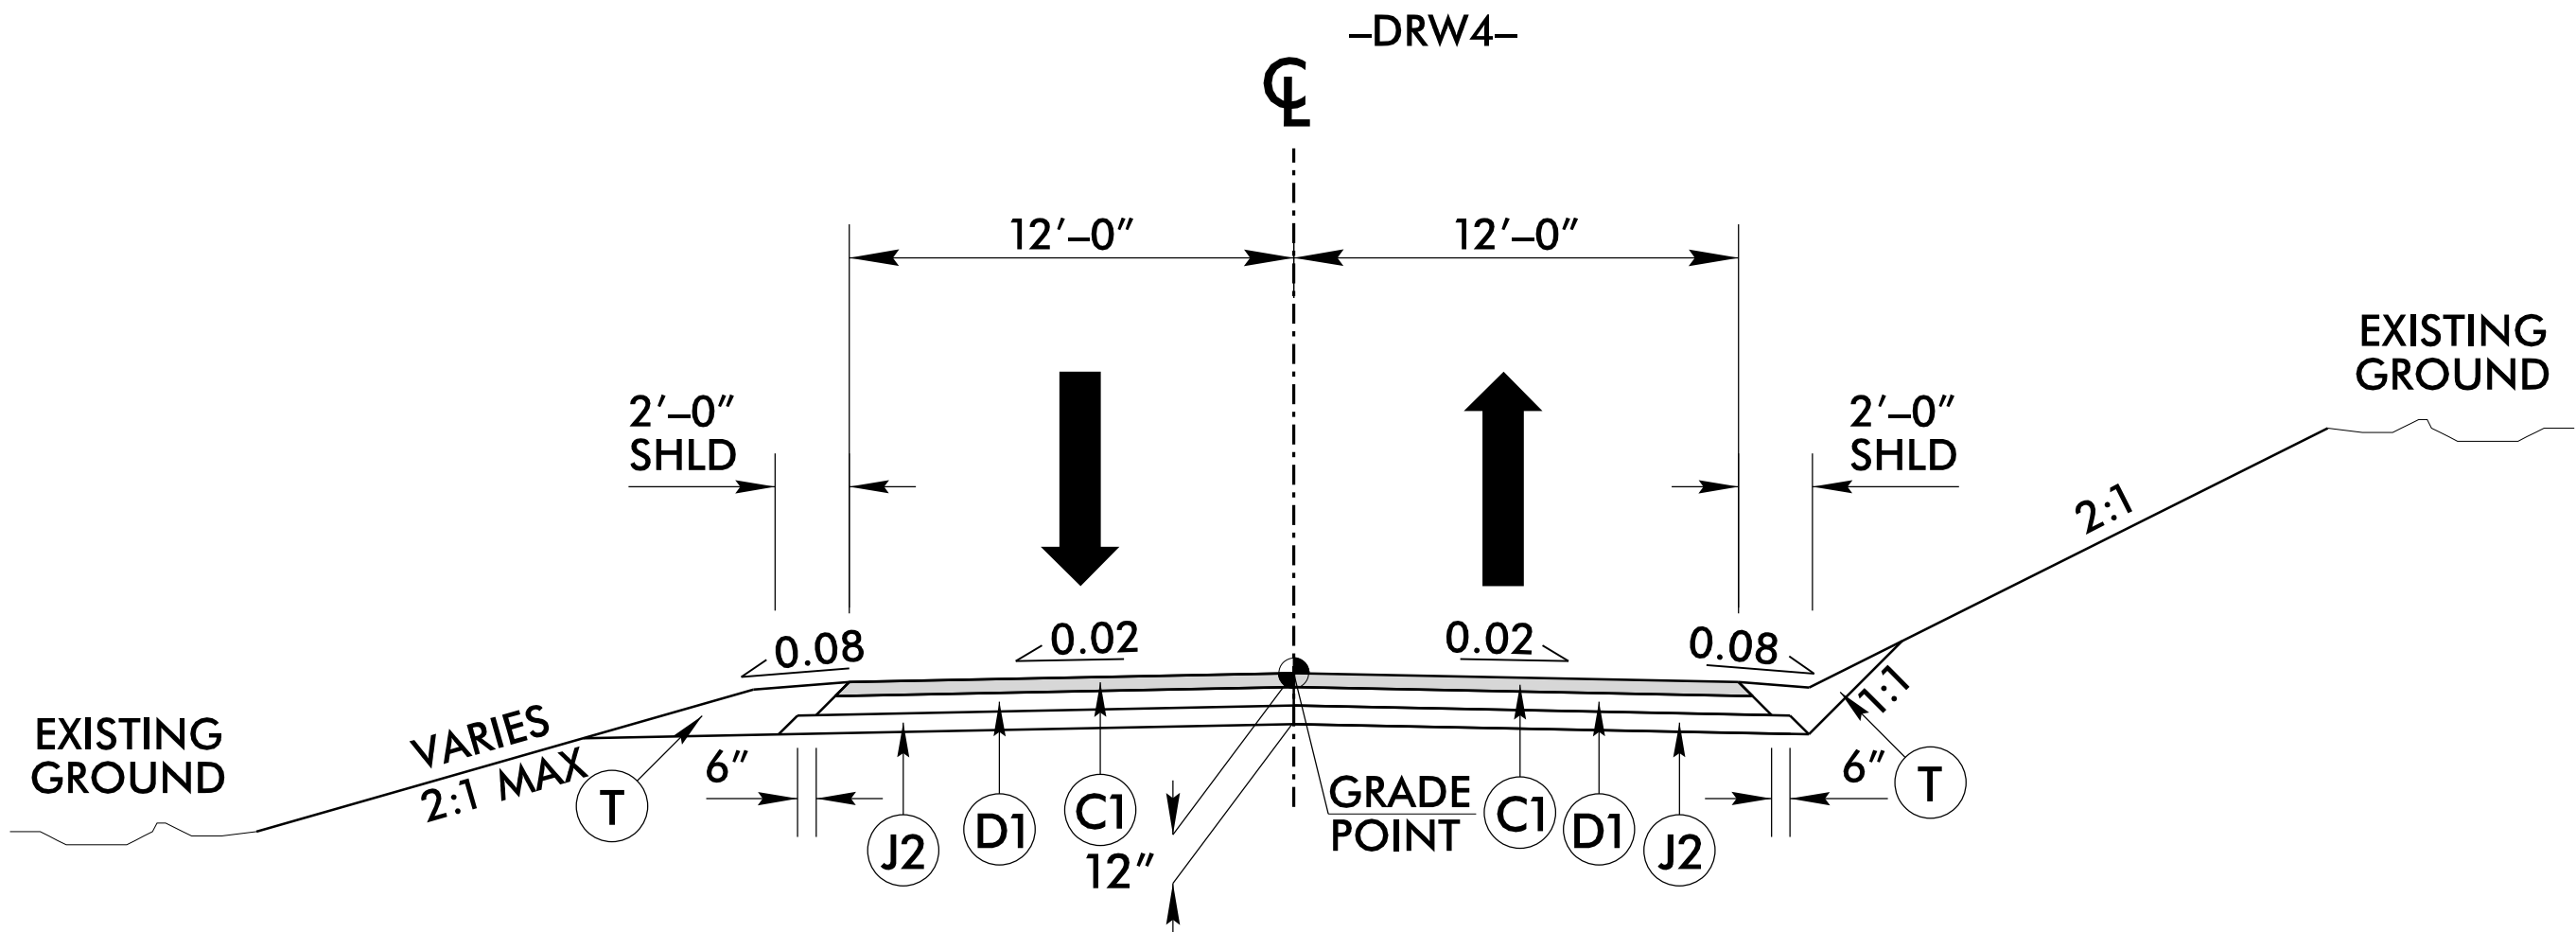

TYPICAL SECTION NO. 11

USE TYPICAL SECTION NO. 11

-DRW4- STA. 10+00.00 TO STA. 11+50.00

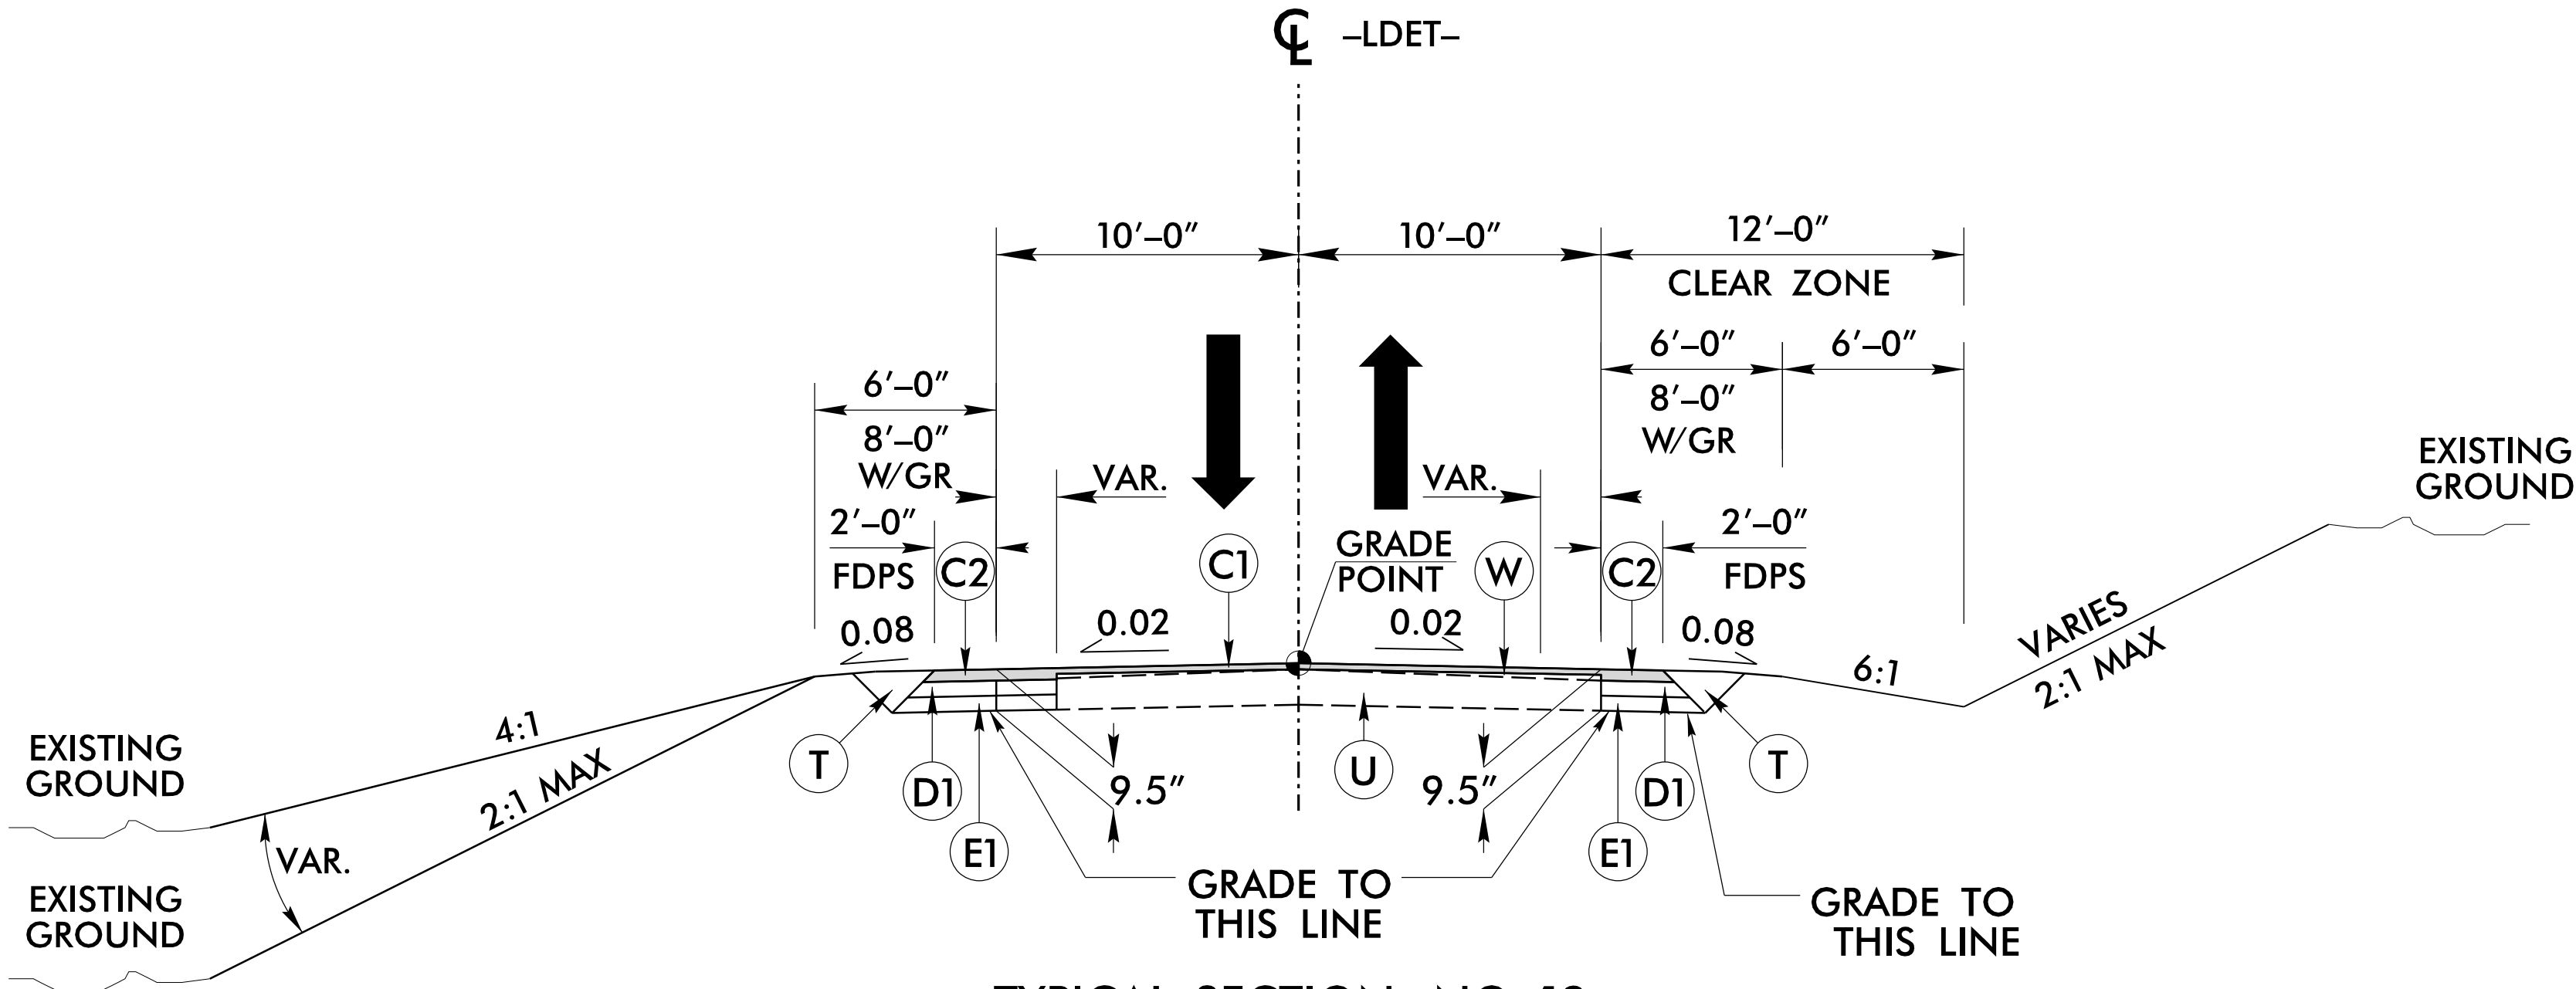

TYPICAL SECTION NO. 12

-LDET- ONSITE DETOUR

USE TYPICAL SECTION NO. 12

-LDET- STA. 10+00.00 TO STA. 13+06.59

-LDET- STA. 22+87.72 TO STA. 25+00.00

18-AUG-2020 14:45
\\prod\proj\18-01\186763_RDY_TYP.dgn
INTB

8/17/99

HNTB

HNTB NORTH CAROLINA, P.C.
343 E. Six Forks Road, Suite 200
Raleigh, North Carolina 27609
NC License No: C-1554

PROJECT REFERENCE NO.
R-5763

SHEET NO.
4

ROADWAY DESIGN ENGINEER

HYDRAULICS ENGINEER

INCOMPLETE PLANS
DO NOT USE FOR R/W ACQUISITION

DOCUMENT NOT CONSIDERED FINAL
UNLESS ALL SIGNATURES COMPLETED

LEGEND

--- DENOTES 100 YR FLOODWAY



--- DENOTES 100 YR FLOOD FRINGE

The plan view shows a road layout with stationing from 10+00 to 22+54.47. Key features include:
- Roadway alignment with stationing labels like -L- 10+23, -Y1- PCC Sta. 14+20.65, -L- STA. 10+11.38, -L- PC Sta. 10+36.63, -L- POT Sta. 10+00.00, -Y1- POC Sta. 13+42.65, -L- PT Sta. 12+79.47, -Y2- PC Sta. 10+20.15, -Y2- PRC Sta. 11+55.73, -Y2- PT Sta. 12+89.77, -Y2- POT Sta. 13+25.00, -Y2- PC Sta. 13+48.56, -Y2- PT Sta. 14+73.96, and -L- PC Sta. 22+54.47.
- Elevation points: ELEV. = 2128.42 (+) 2.0000 (-) 8.5210, ELEV. = 2144.77 (+) 0.5000 (-) 0.6500, and ELEV. = 2112.69.
- Engineering notes: "BEGIN TIP PROJECT R-5763", "BANK STABILIZATION EST. 7 TON CL I RIP RAP EST. 15 SYGF", "SCOUR HOLE 3' PERCH 8'X6'X4'", "REMOVE SYSTEM 20' BST", "CHANNEL CHANGE EST. 60 TON CL I RIP RAP SLOPE = 1.5% EST DDE = 188 CY SEE DETAIL CC1", "SPECIAL LATERAL V DITCH SEE DETAIL SLV1", "SPECIAL LATERAL V DITCH SEE DETAIL SLV2", "SPECIAL LATERAL V DITCH SEE DETAIL SLV3", "SPECIAL LATERAL V DITCH SEE DETAIL SLV4", "SPECIAL LATERAL V DITCH SEE DETAIL SLV5", "SPECIAL LATERAL V DITCH SEE DETAIL SLV6", "END CONSTRUCTION Y2- POT Sta. 13+25.00", "DA = 9.4 AC", "DA = 4.3 AC", "DA = 12.5 AC".
- Cross-sections: Several circular cross-sections showing channel widths and slopes, labeled "STABLE - VEGETATED" or "NON-STABLE - VEGETATED".
- Matchlines: "MATCHLINE -L- 23+00 SEE SHEET 5" on the right.

NOTE:
1. ALL DRIVEWAYS HAVE 10' RADII UNLESS OTHERWISE NOTED.

FOR -L- PROFILE, SEE SHEET 18
FOR -Y2- PROFILE, SEE SHEET 25
FOR INTERSECTION DETAIL, SEE SHEET 2B-1

PROJECT REFERENCE NO.	SHEET NO.
R-5763	5
RW SHEET NO.	
ROADWAY DESIGN ENGINEER	HYDRAULICS ENGINEER
INCOMPLETE PLANS DO NOT USE FOR R/W ACQUISITION	
DOCUMENT NOT CONSIDERED FINAL UNLESS ALL SIGNATURES COMPLETED	

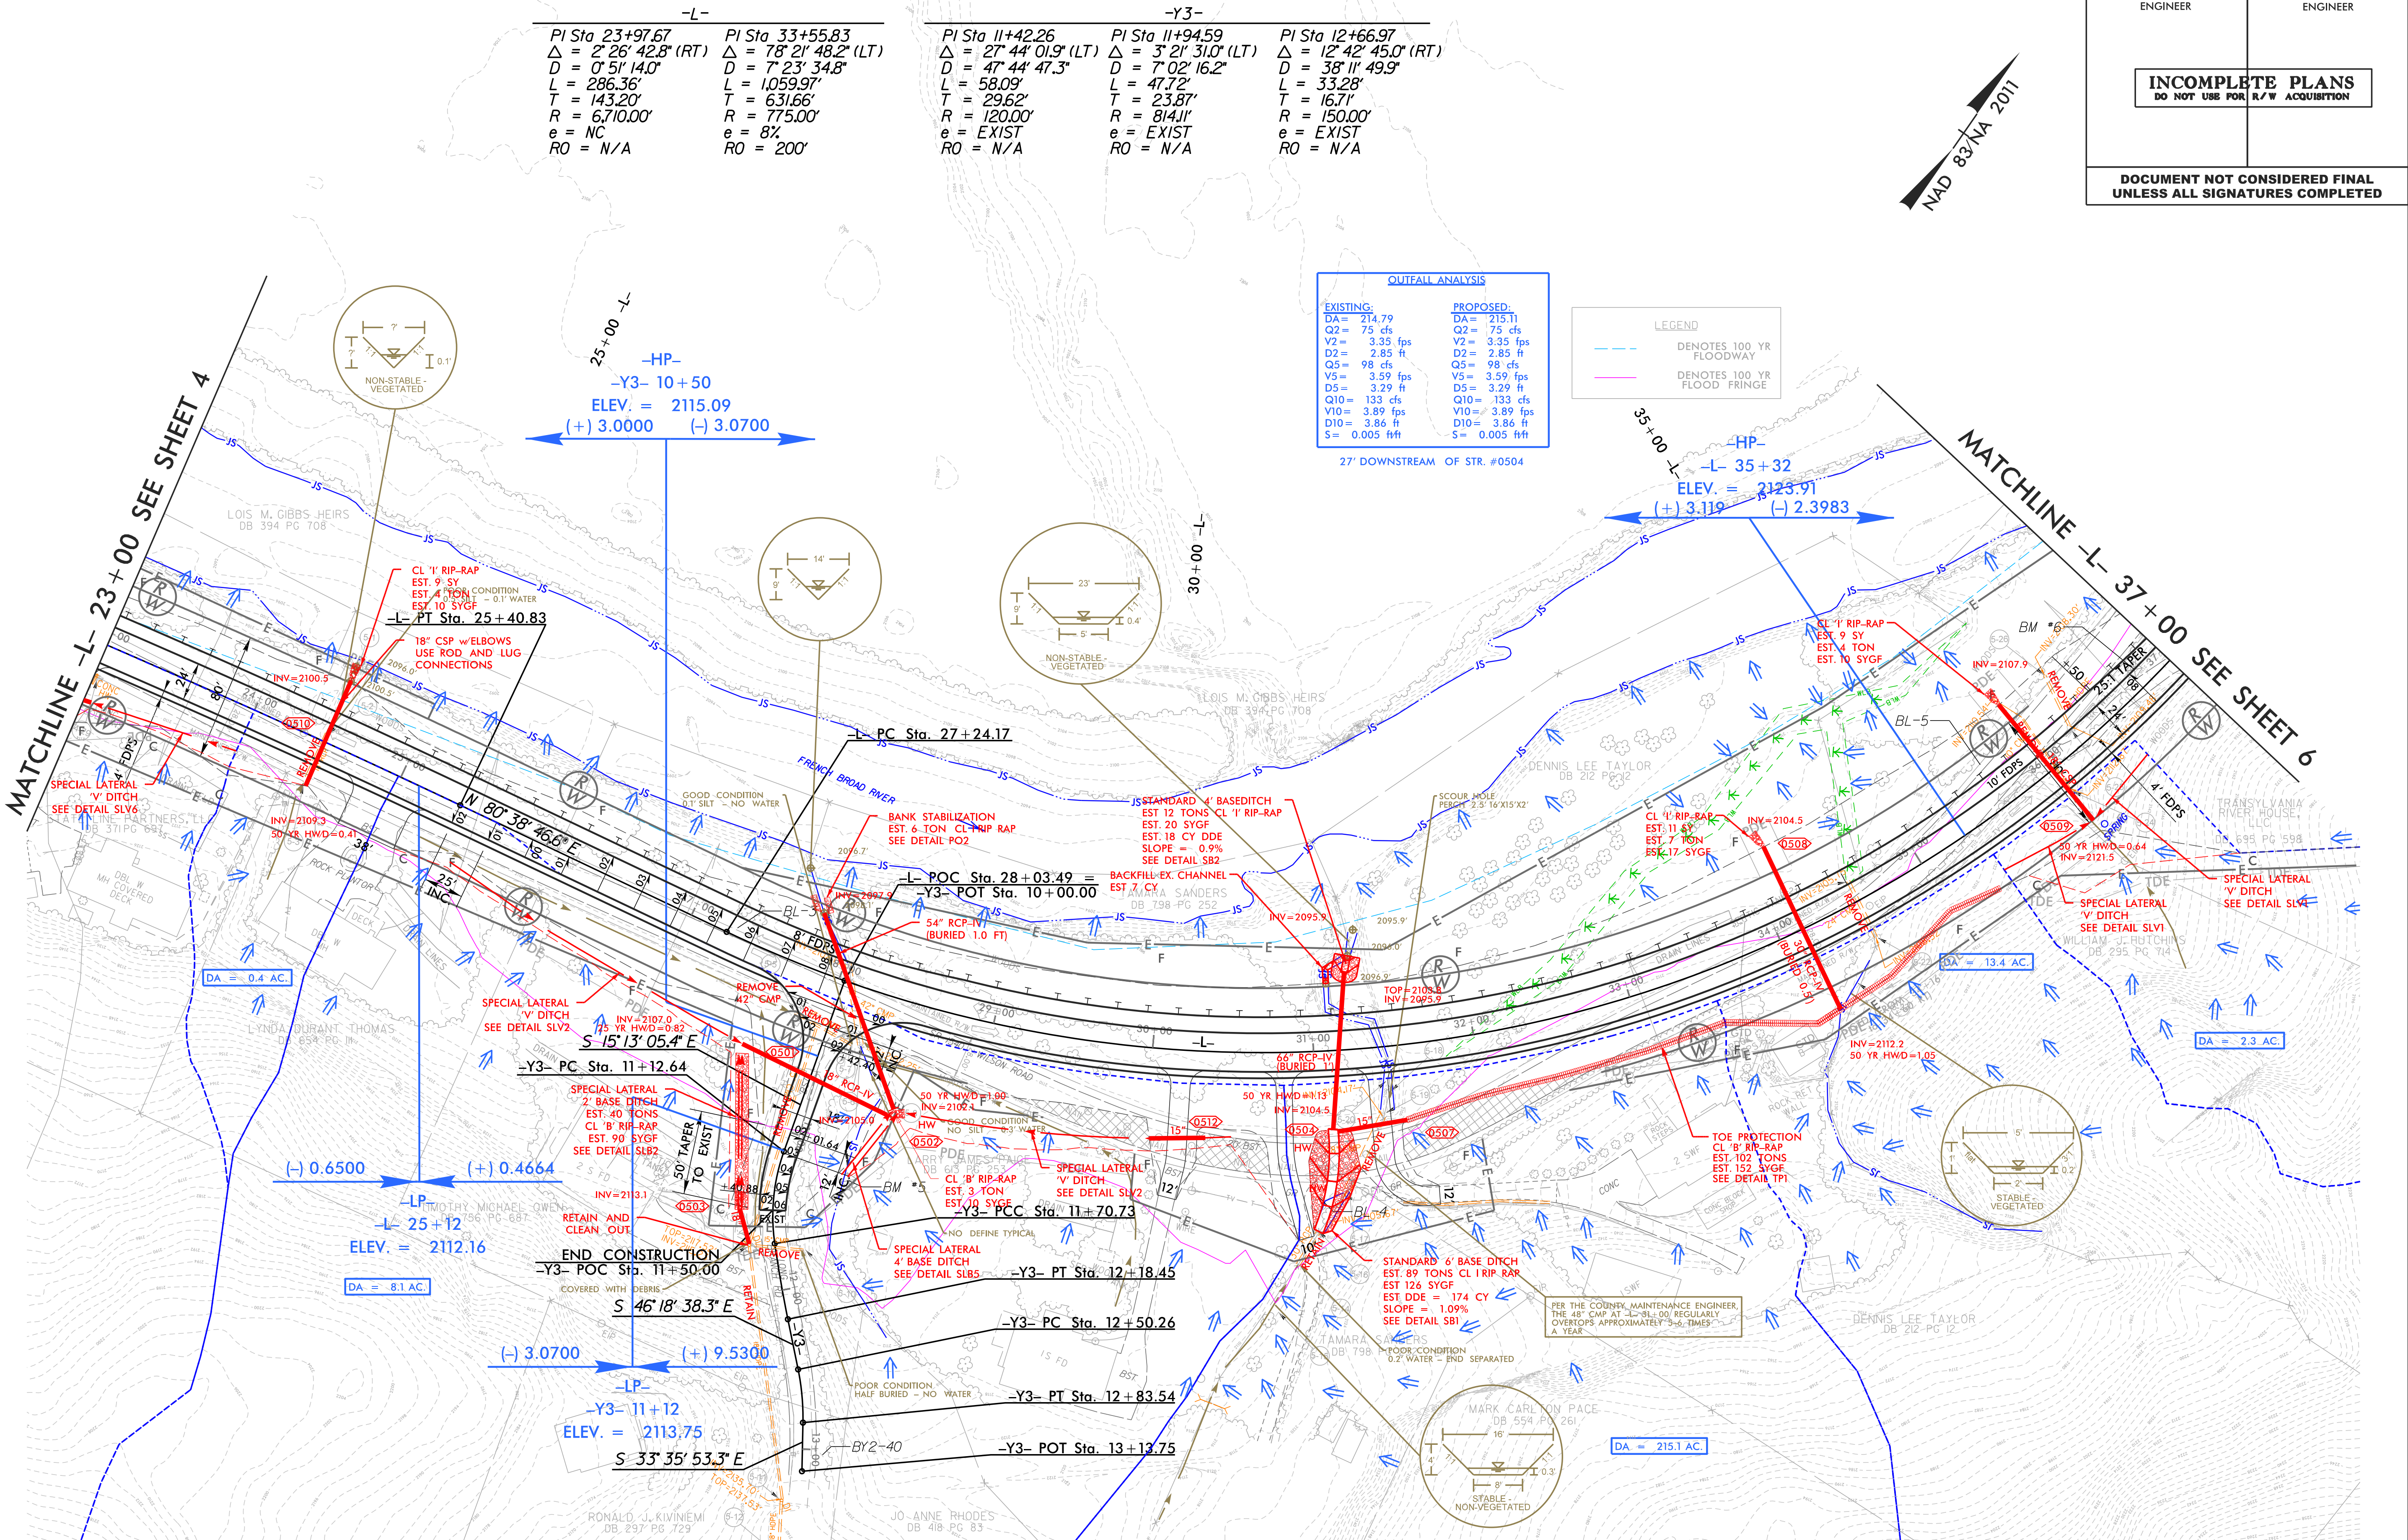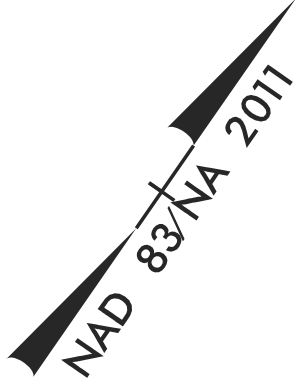

OUTFALL ANALYSIS	
EXISTING:	PROPOSED:
DA = 214.79	DA = 215.11
Q2 = 75 cfs	Q2 = 75 cfs
V2 = 3.35 fps	V2 = 3.35 fps
D2 = 2.85 ft	D2 = 2.85 ft
Q3 = 98 cfs	Q3 = 98 cfs
V3 = 3.59 fps	V3 = 3.59 fps
D3 = 3.29 ft	D3 = 3.29 ft
Q10 = 133 cfs	Q10 = 133 cfs
V10 = 3.89 fps	V10 = 3.89 fps
D10 = 3.86 ft	D10 = 3.86 ft
S = 0.005 ftf	S = 0.005 ftf

LEGEND	
	DENOTES 100 YR FLOODWAY
	DENOTES 100 YR FLOOD FRINGE

NOTE:
1. ALL DRIVEWAYS HAVE 10' RADII UNLESS OTHERWISE NOTED.


FOR -L- PROFILE, SEE SHEET 18
FOR -Y3- PROFILE, SEE SHEET 25
FOR INTERSECTION DETAIL, SEE SHEET 2B-2

8/17/99

HNTB

HNTB NORTH CAROLINA, P.C.
343 E. Six Forks Road, Suite 200
Raleigh, North Carolina 27609
NC License No: C-1554

PROJECT REFERENCE NO.		SHEET NO.
R-5763		7
RW SHEET NO.		
ROADWAY DESIGN ENGINEER		HYDRAULICS ENGINEER
INCOMPLETE PLANS DO NOT USE FOR R/W ACQUISITION		
DOCUMENT NOT CONSIDERED FINAL UNLESS ALL SIGNATURES COMPLETED		

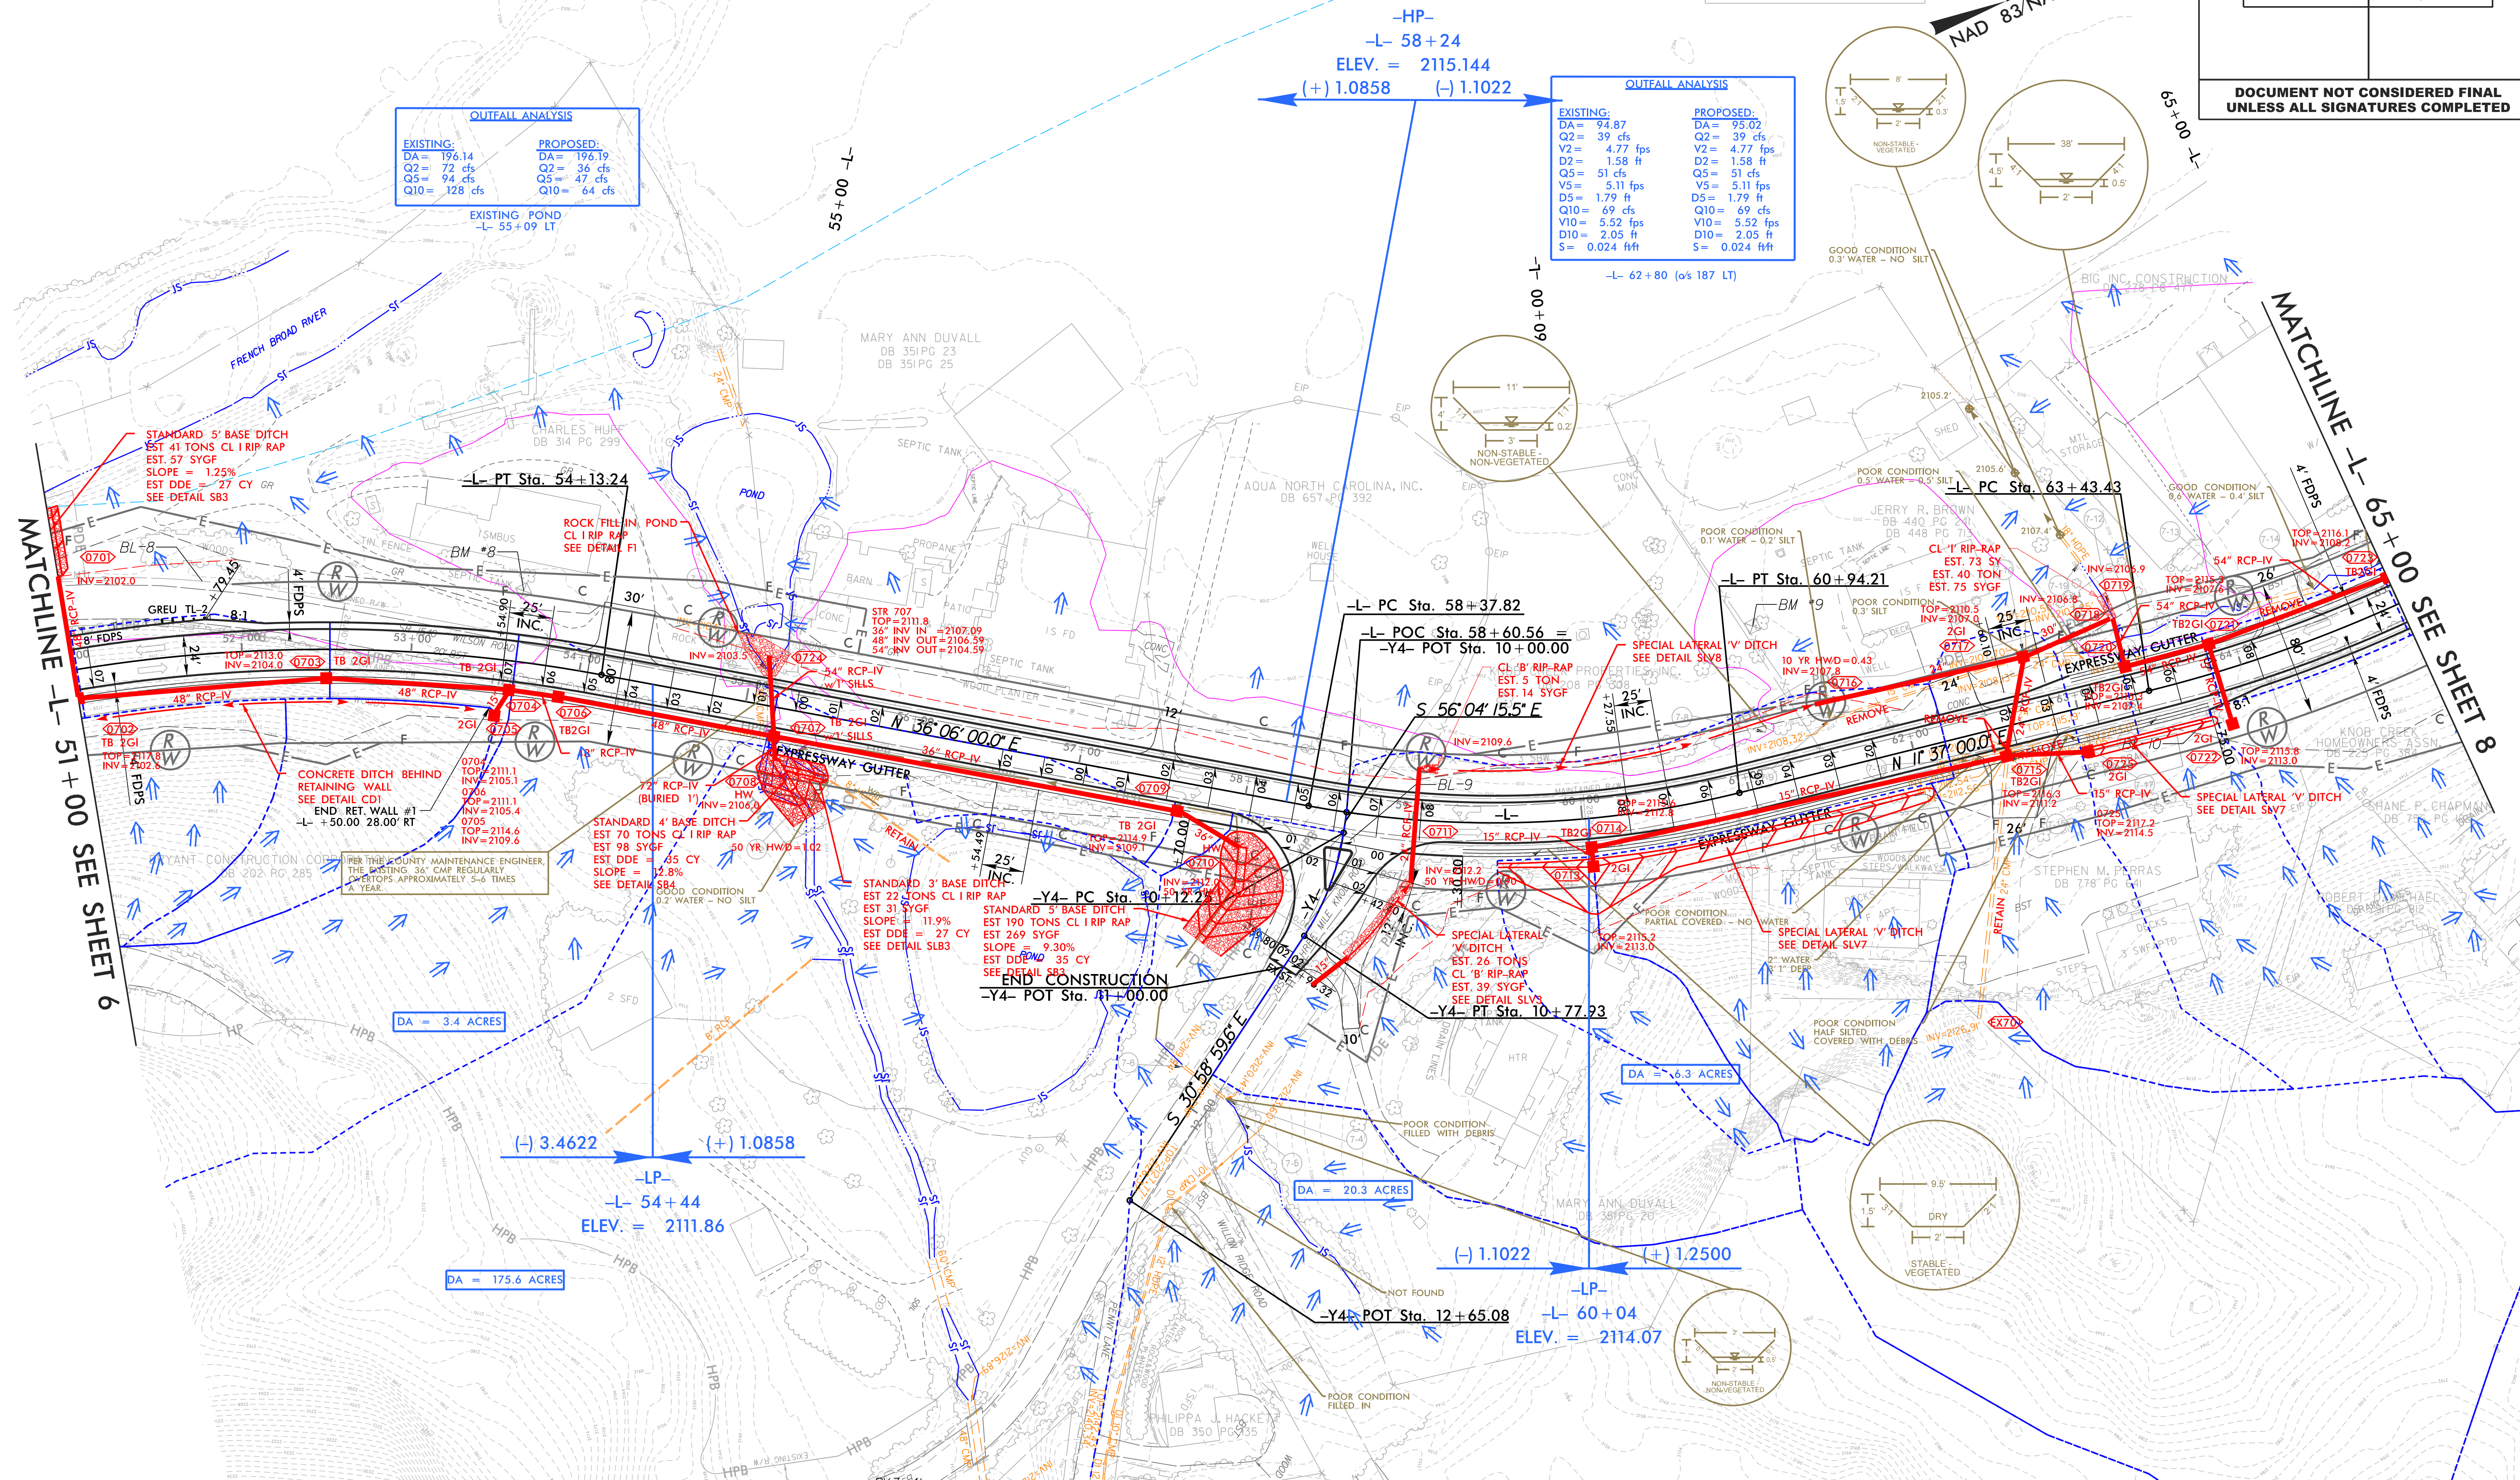

NOTE:
1. ALL DRIVEWAYS HAVE 10' RADII UNLESS OTHERWISE NOTED.

FOR -L- PROFILE, SEE SHEET 19
FOR -Y4- PROFILE, SEE SHEET 25
FOR INTERSECTION DETAIL, SEE SHEET 2B-2

8/17/99


HNTB

HNTB NORTH CAROLINA, P.C.
343 E. Six Forks Road, Suite 200
Raleigh, North Carolina 27609
NC License No: C-1554

PROJECT REFERENCE NO.		SHEET NO.
R-5763		8
RW SHEET NO.		
ROADWAY DESIGN ENGINEER	HYDRAULICS ENGINEER	
INCOMPLETE PLANS DO NOT USE FOR R/W ACQUISITION		
DOCUMENT NOT CONSIDERED FINAL UNLESS ALL SIGNATURES COMPLETED		

NAD 83/NA 2011

LEGEND	
	DENOTES 100 YR FLOODWAY
	DENOTES 100 YR FLOOD FRINGE

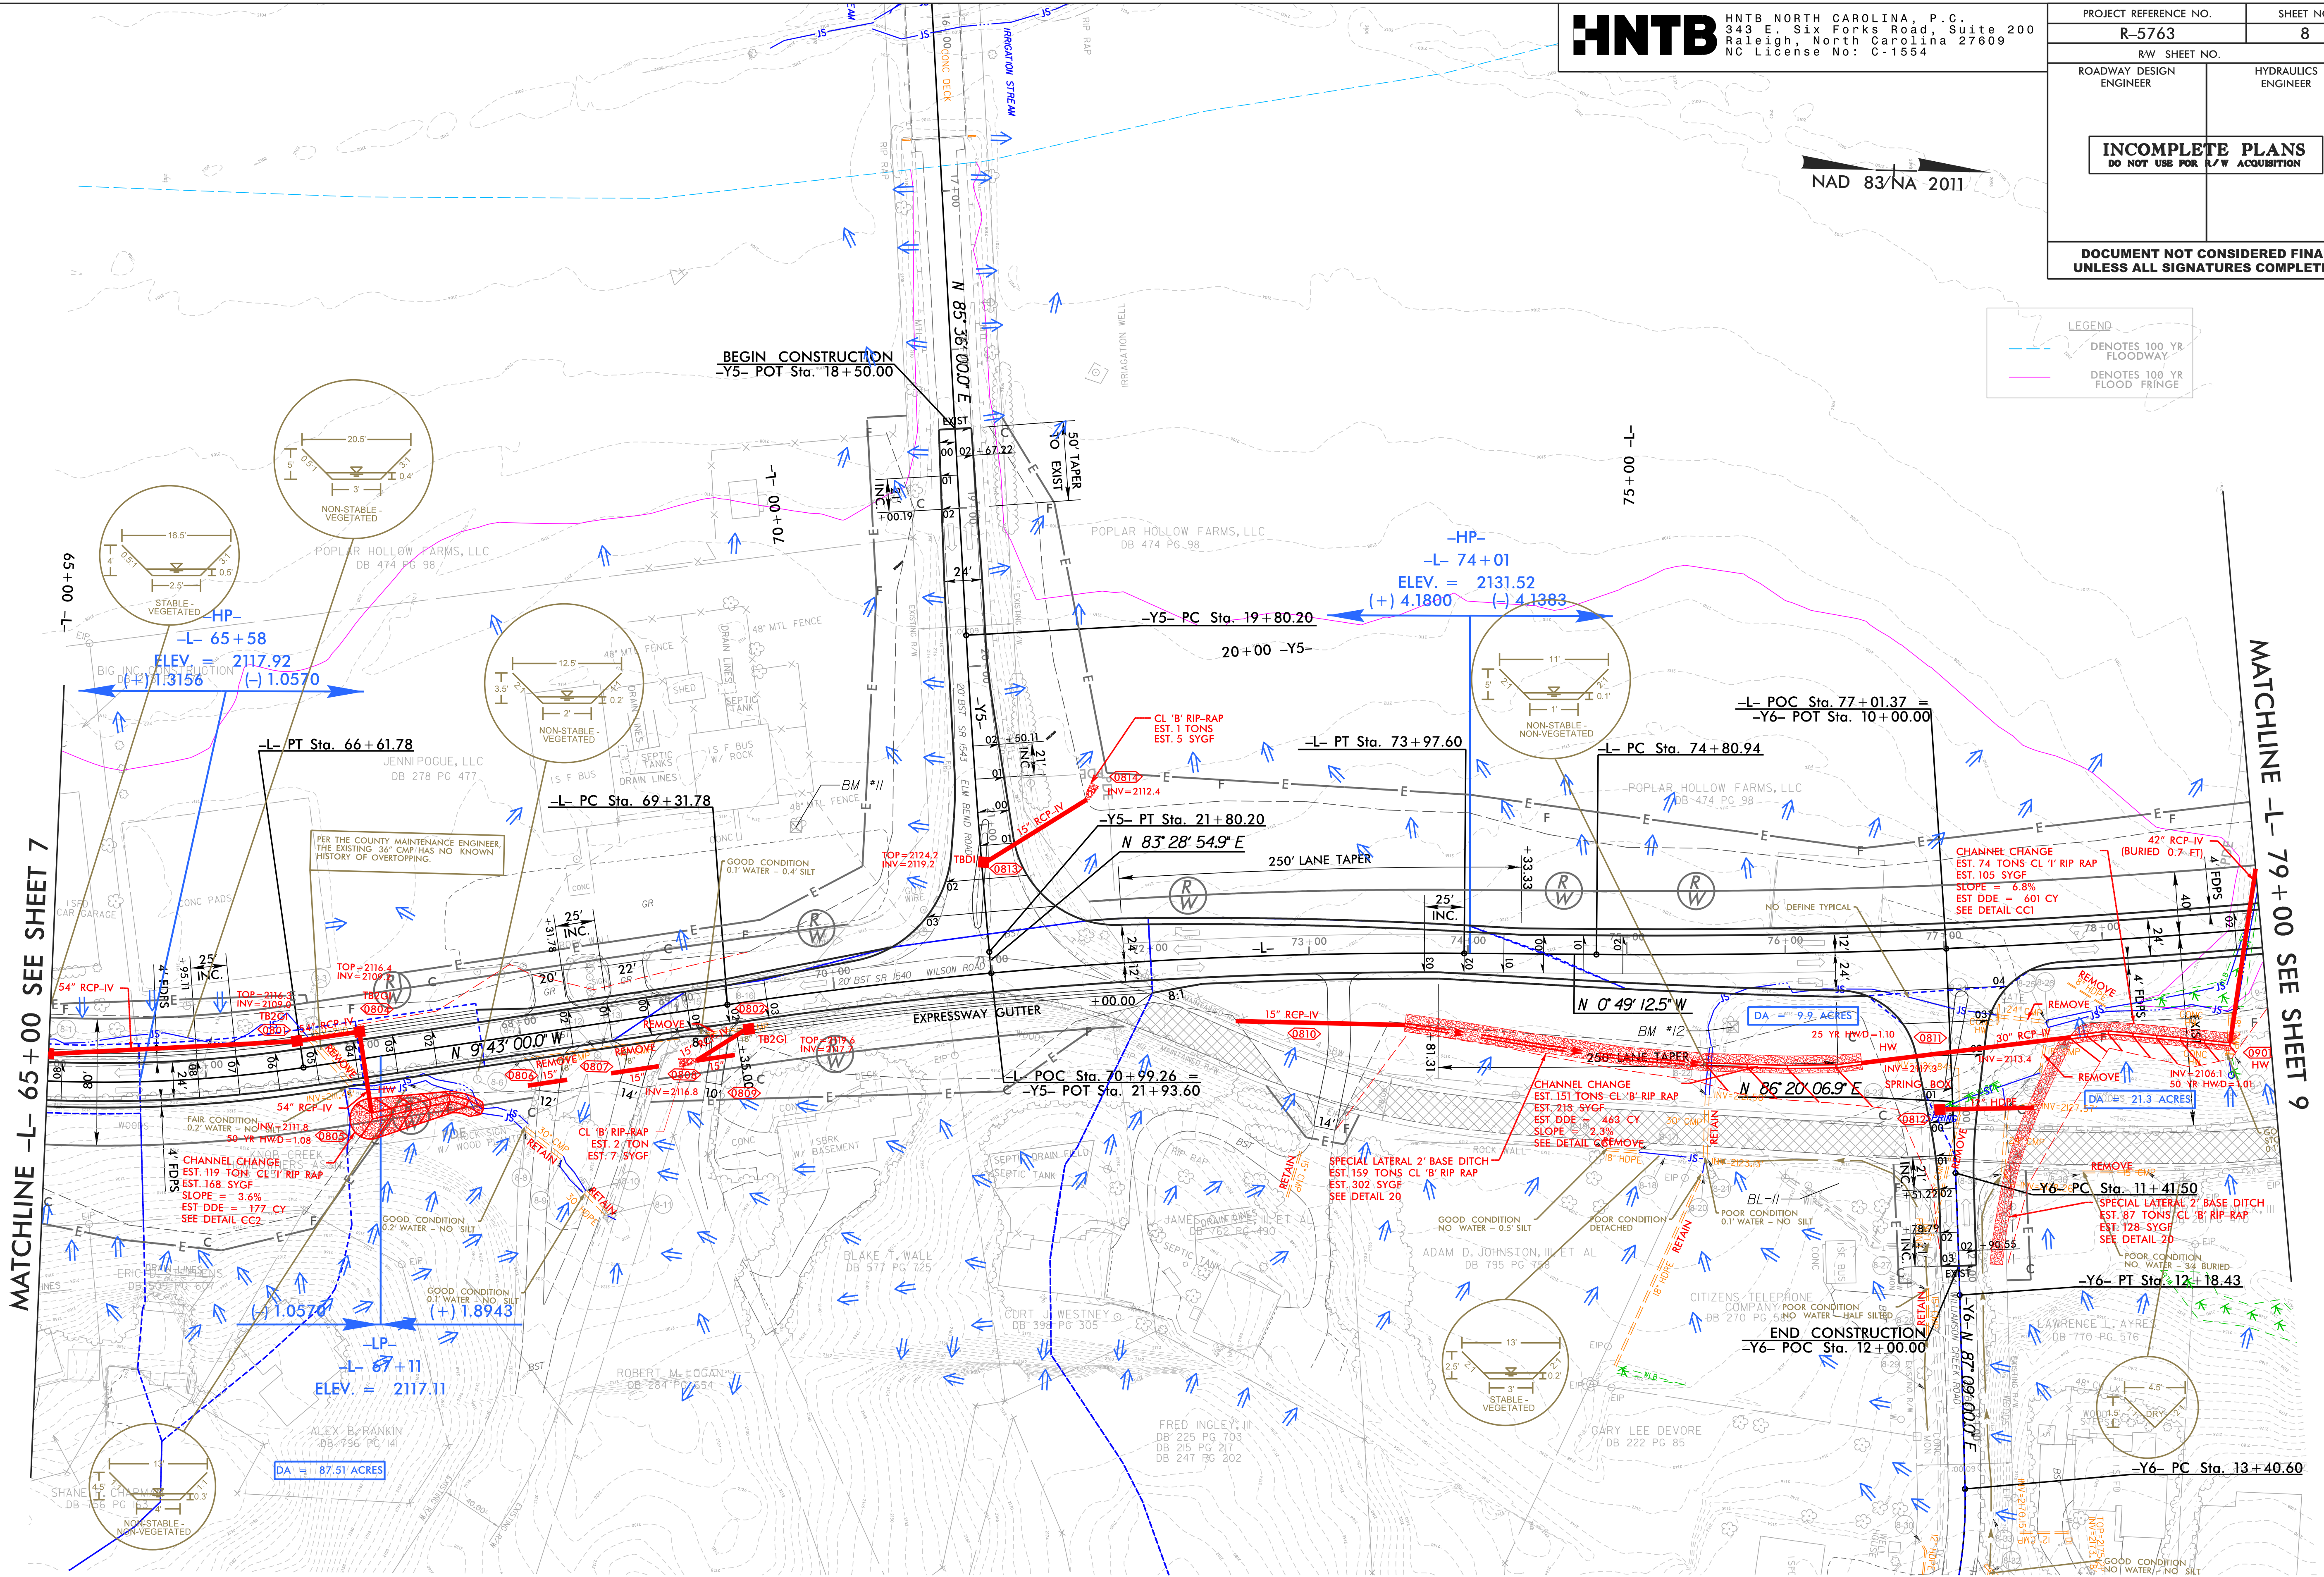

MATCHLINE -L- 65+00 SEE SHEET 7

MATCHLINE -L- 79+00 SEE SHEET 9

NOTE:
1. ALL DRIVEWAYS HAVE 10' RADII UNLESS OTHERWISE NOTED.

FOR -L- PROFILE, SEE SHEET 20
FOR -Y5- PROFILE, SEE SHEET 25
FOR -Y6- PROFILE, SEE SHEET 26
FOR INTERSECTION DETAILS, SEE SHEET 2B-3

8/17/99


HNTB

HNTB NORTH CAROLINA, P.C.
343 E. Six Forks Road, Suite 200
Raleigh, North Carolina 27609
NC License No: C-1554

PROJECT REFERENCE NO.		SHEET NO.
R-5763		9
RW SHEET NO.		
ROADWAY DESIGN ENGINEER	HYDRAULICS ENGINEER	
INCOMPLETE PLANS DO NOT USE FOR R/W ACQUISITION		
DOCUMENT NOT CONSIDERED FINAL UNLESS ALL SIGNATURES COMPLETED		

NAD 83/NA 2011

LEGEND	
	DENOTES 100 YR FLOODWAY
	DENOTES 100 YR FLOOD FRINGE

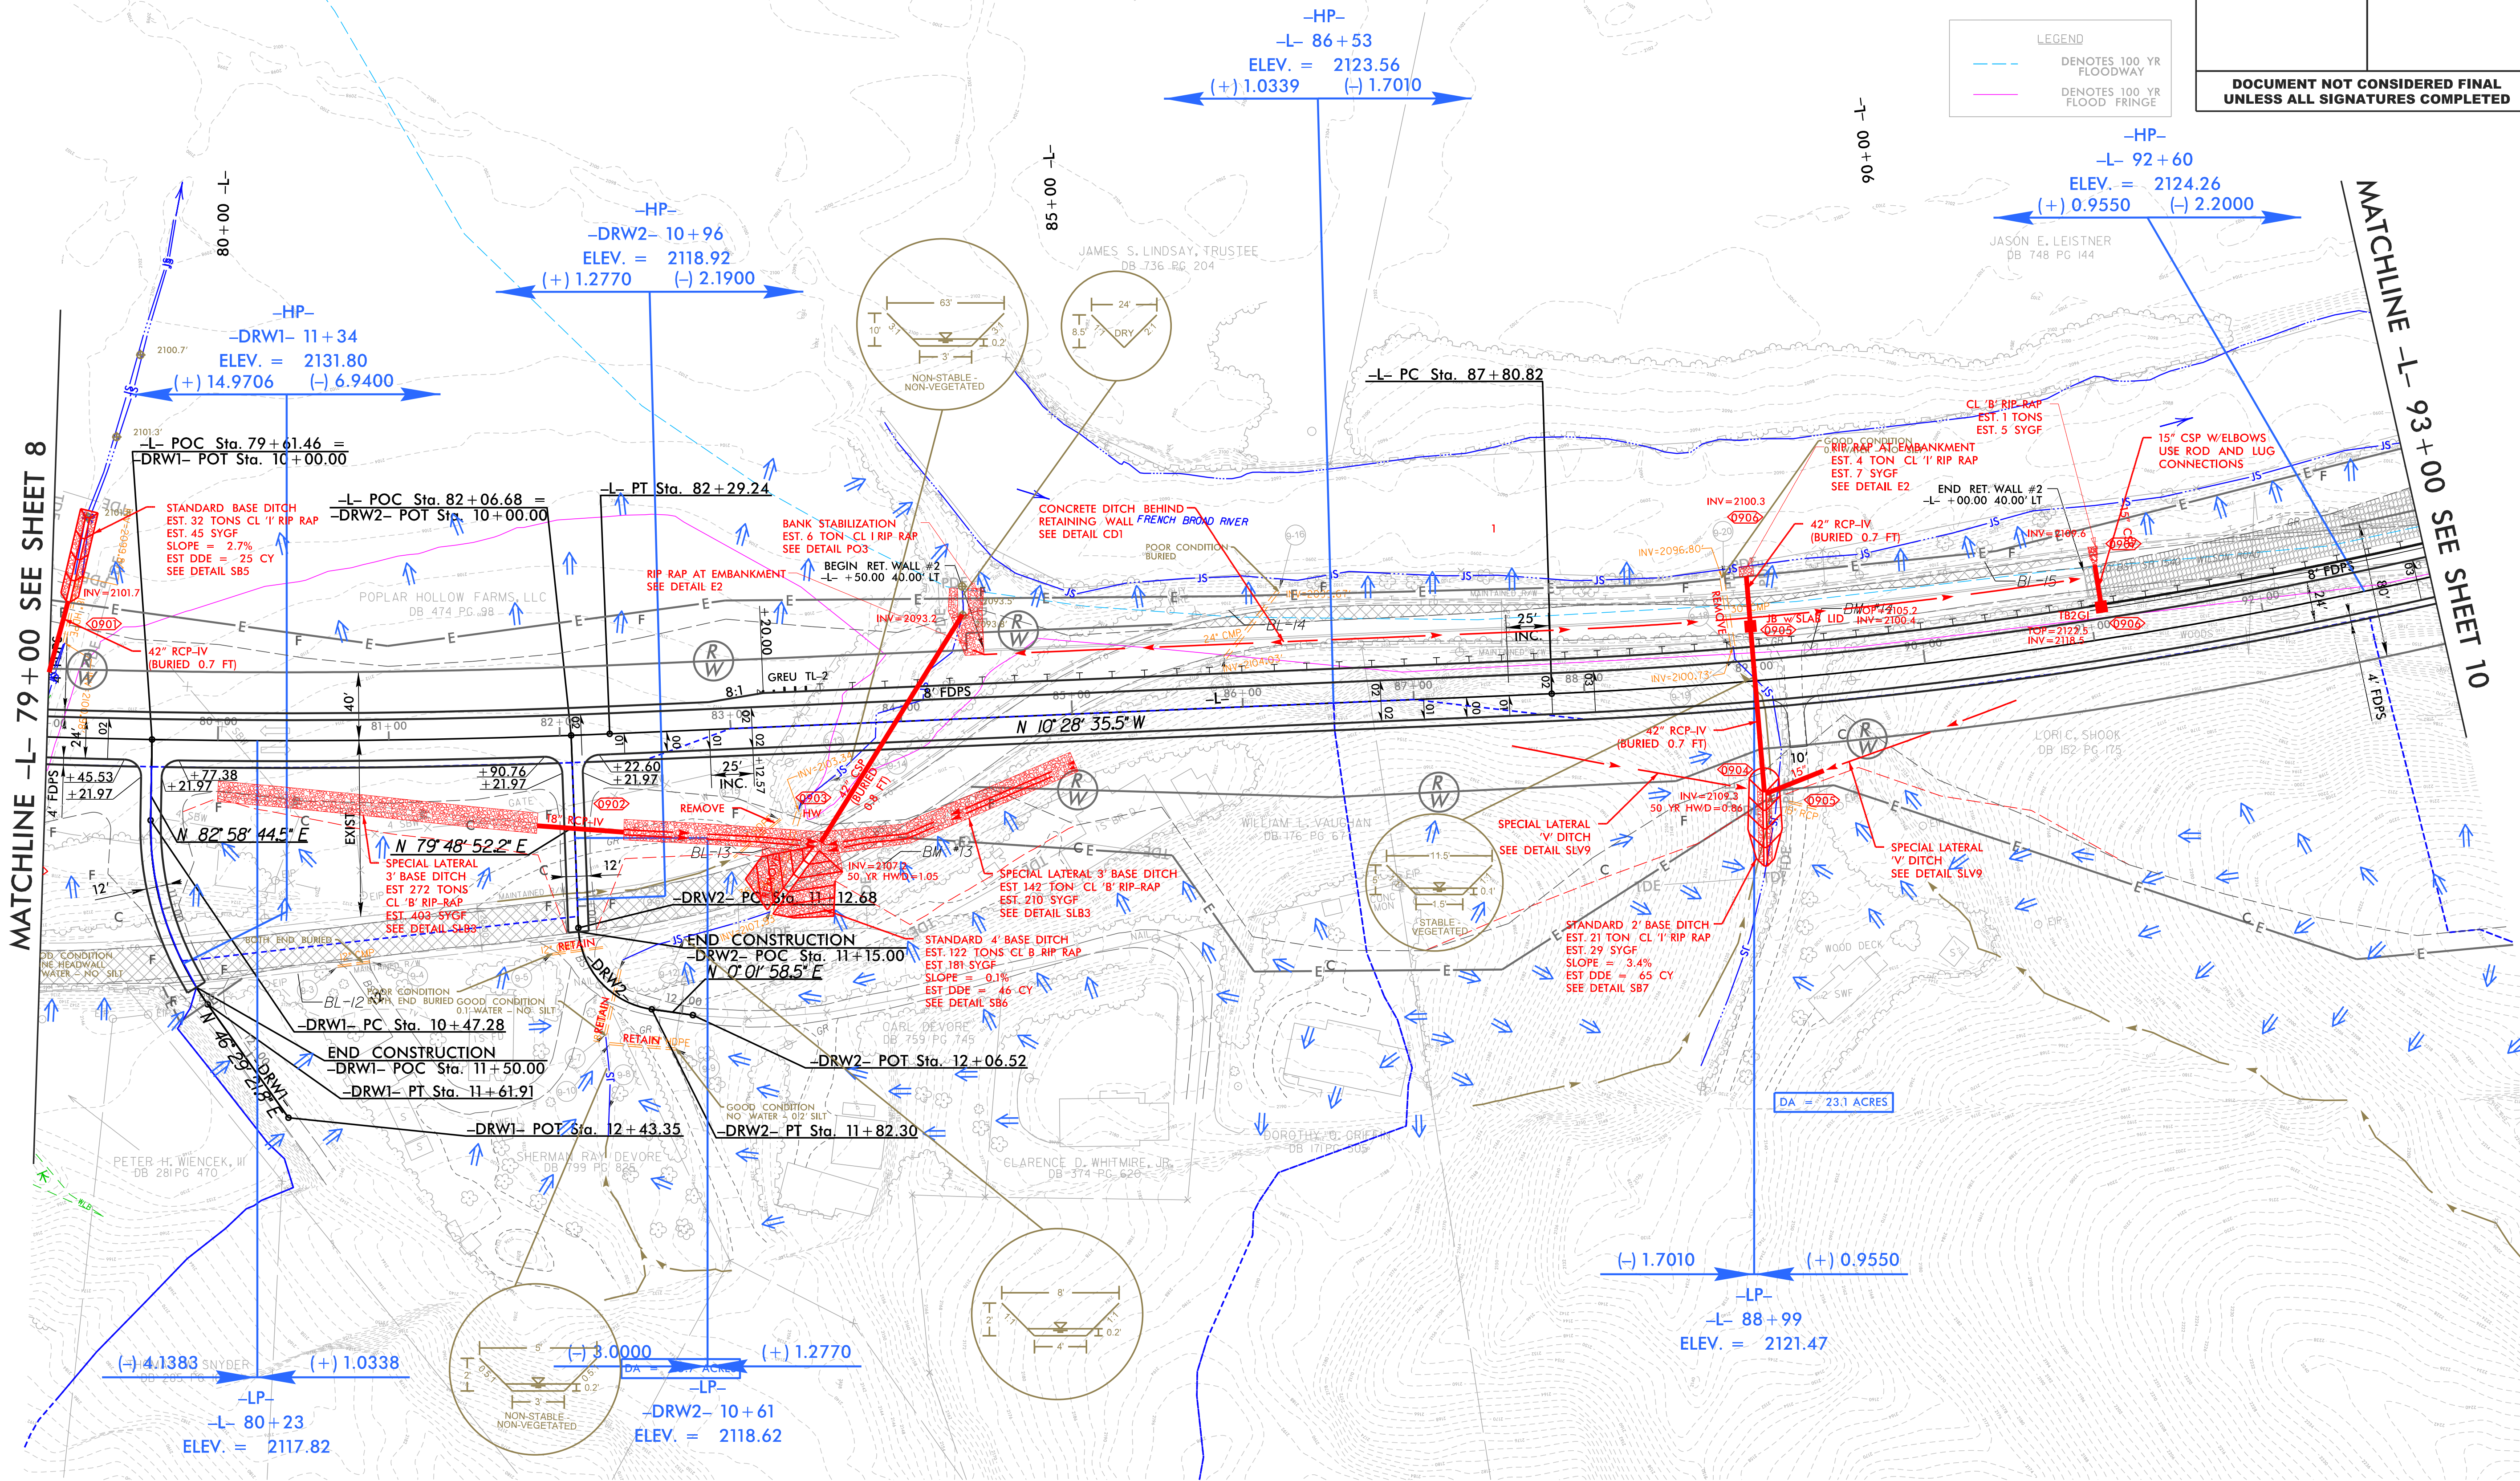

NOTE:
1. ALL DRIVEWAYS HAVE 10' RADII UNLESS OTHERWISE NOTED.

FOR -L- PROFILE, SEE SHEET 20
FOR -DRW1- PROFILE, SEE SHEET 27
FOR -DRW2- PROFILE, SEE SHEET 27

8/17/99


HNTB

HNTB NORTH CAROLINA, P.C.
343 E. Six Forks Road, Suite 200
Raleigh, North Carolina 27609
NC License No: C-1554

PROJECT REFERENCE NO.		SHEET NO.
R-5763		10
RW SHEET NO.		
ROADWAY DESIGN ENGINEER		HYDRAULICS ENGINEER
INCOMPLETE PLANS DO NOT USE FOR R/W ACQUISITION		
DOCUMENT NOT CONSIDERED FINAL UNLESS ALL SIGNATURES COMPLETED		

LEGEND	
	DENOTES 100 YR FLOODWAY
	DENOTES 100 YR FLOOD FRINGE

MATCHLINE -L- 93+00 SEE SHEET 9

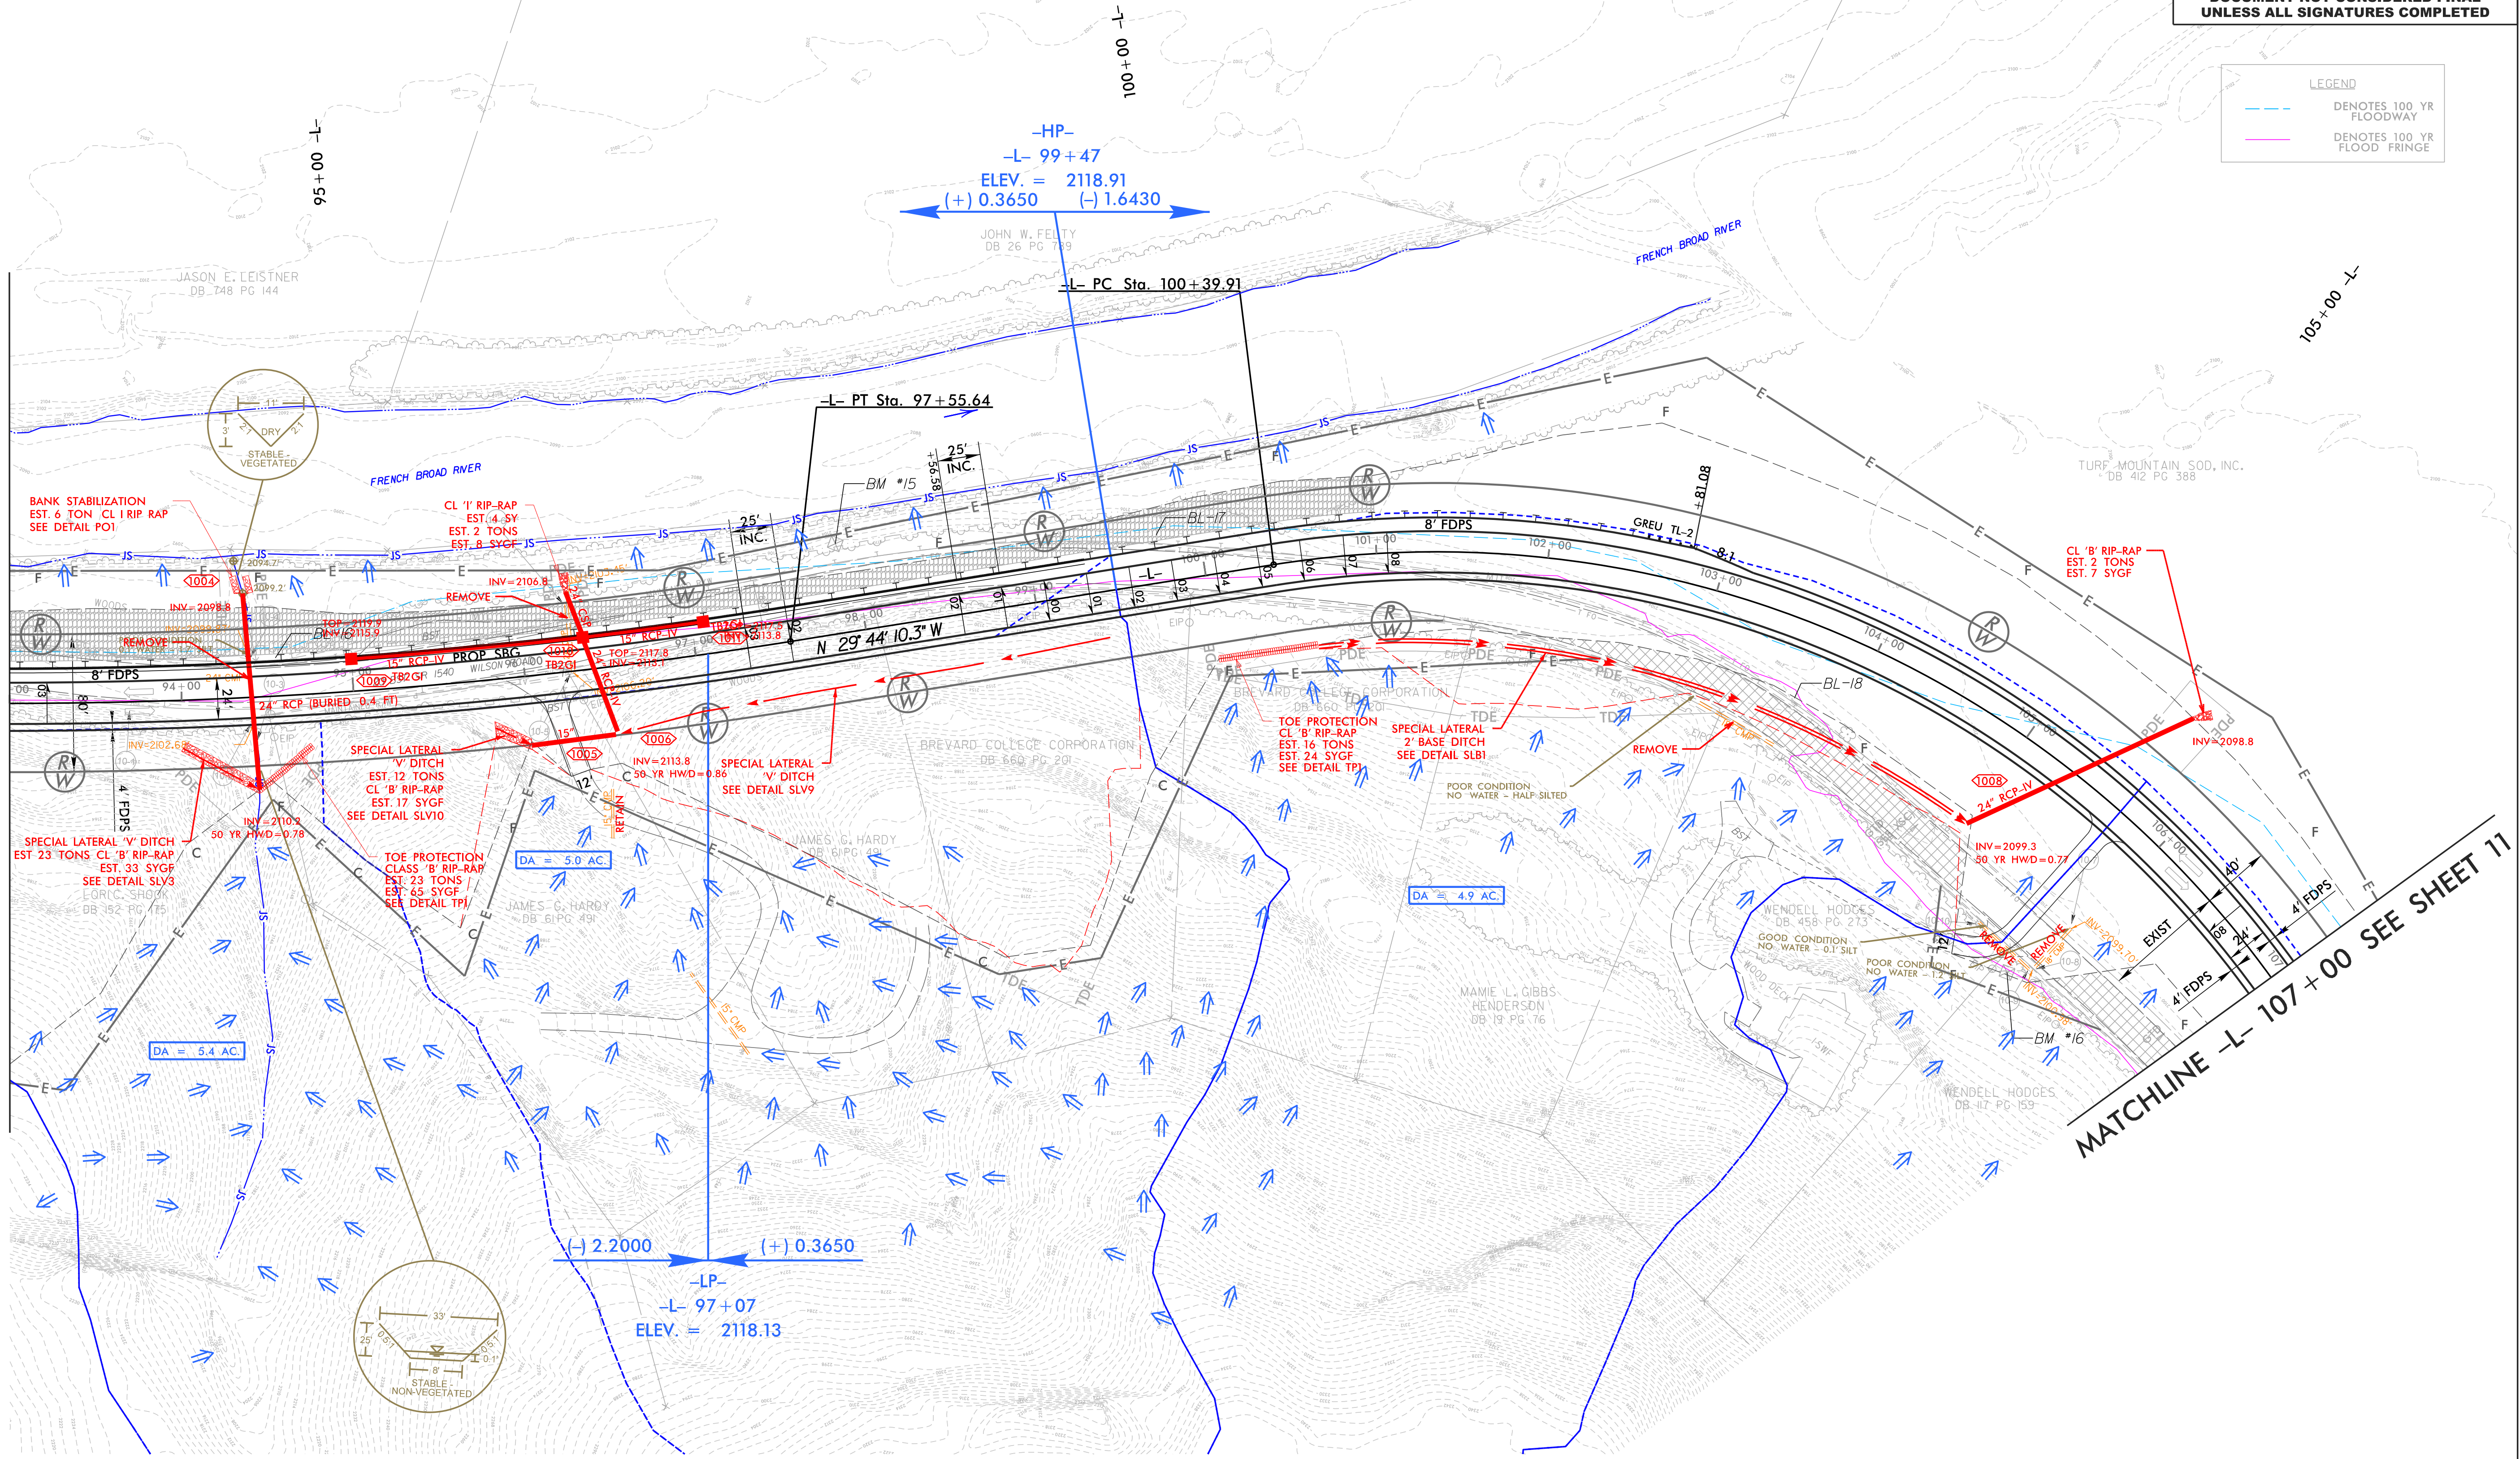

NOTE:
1. ALL DRIVEWAYS HAVE 10' RADII UNLESS OTHERWISE NOTED.

FOR -L- PROFILE, SEE SHEET 21

8/17/99


SYTIME DESIGN USER NAME

HNTB

HNTB NORTH CAROLINA, P.C.
343 E. Six Forks Road, Suite 200
Raleigh, North Carolina 27609
NC License No: C-1554

PROJECT REFERENCE NO.		SHEET NO.
R-5763		11
RW SHEET NO.		
ROADWAY DESIGN ENGINEER	HYDRAULICS ENGINEER	
INCOMPLETE PLANS DO NOT USE FOR R/W ACQUISITION		
DOCUMENT NOT CONSIDERED FINAL UNLESS ALL SIGNATURES COMPLETED		

NAD 83/NA 2011

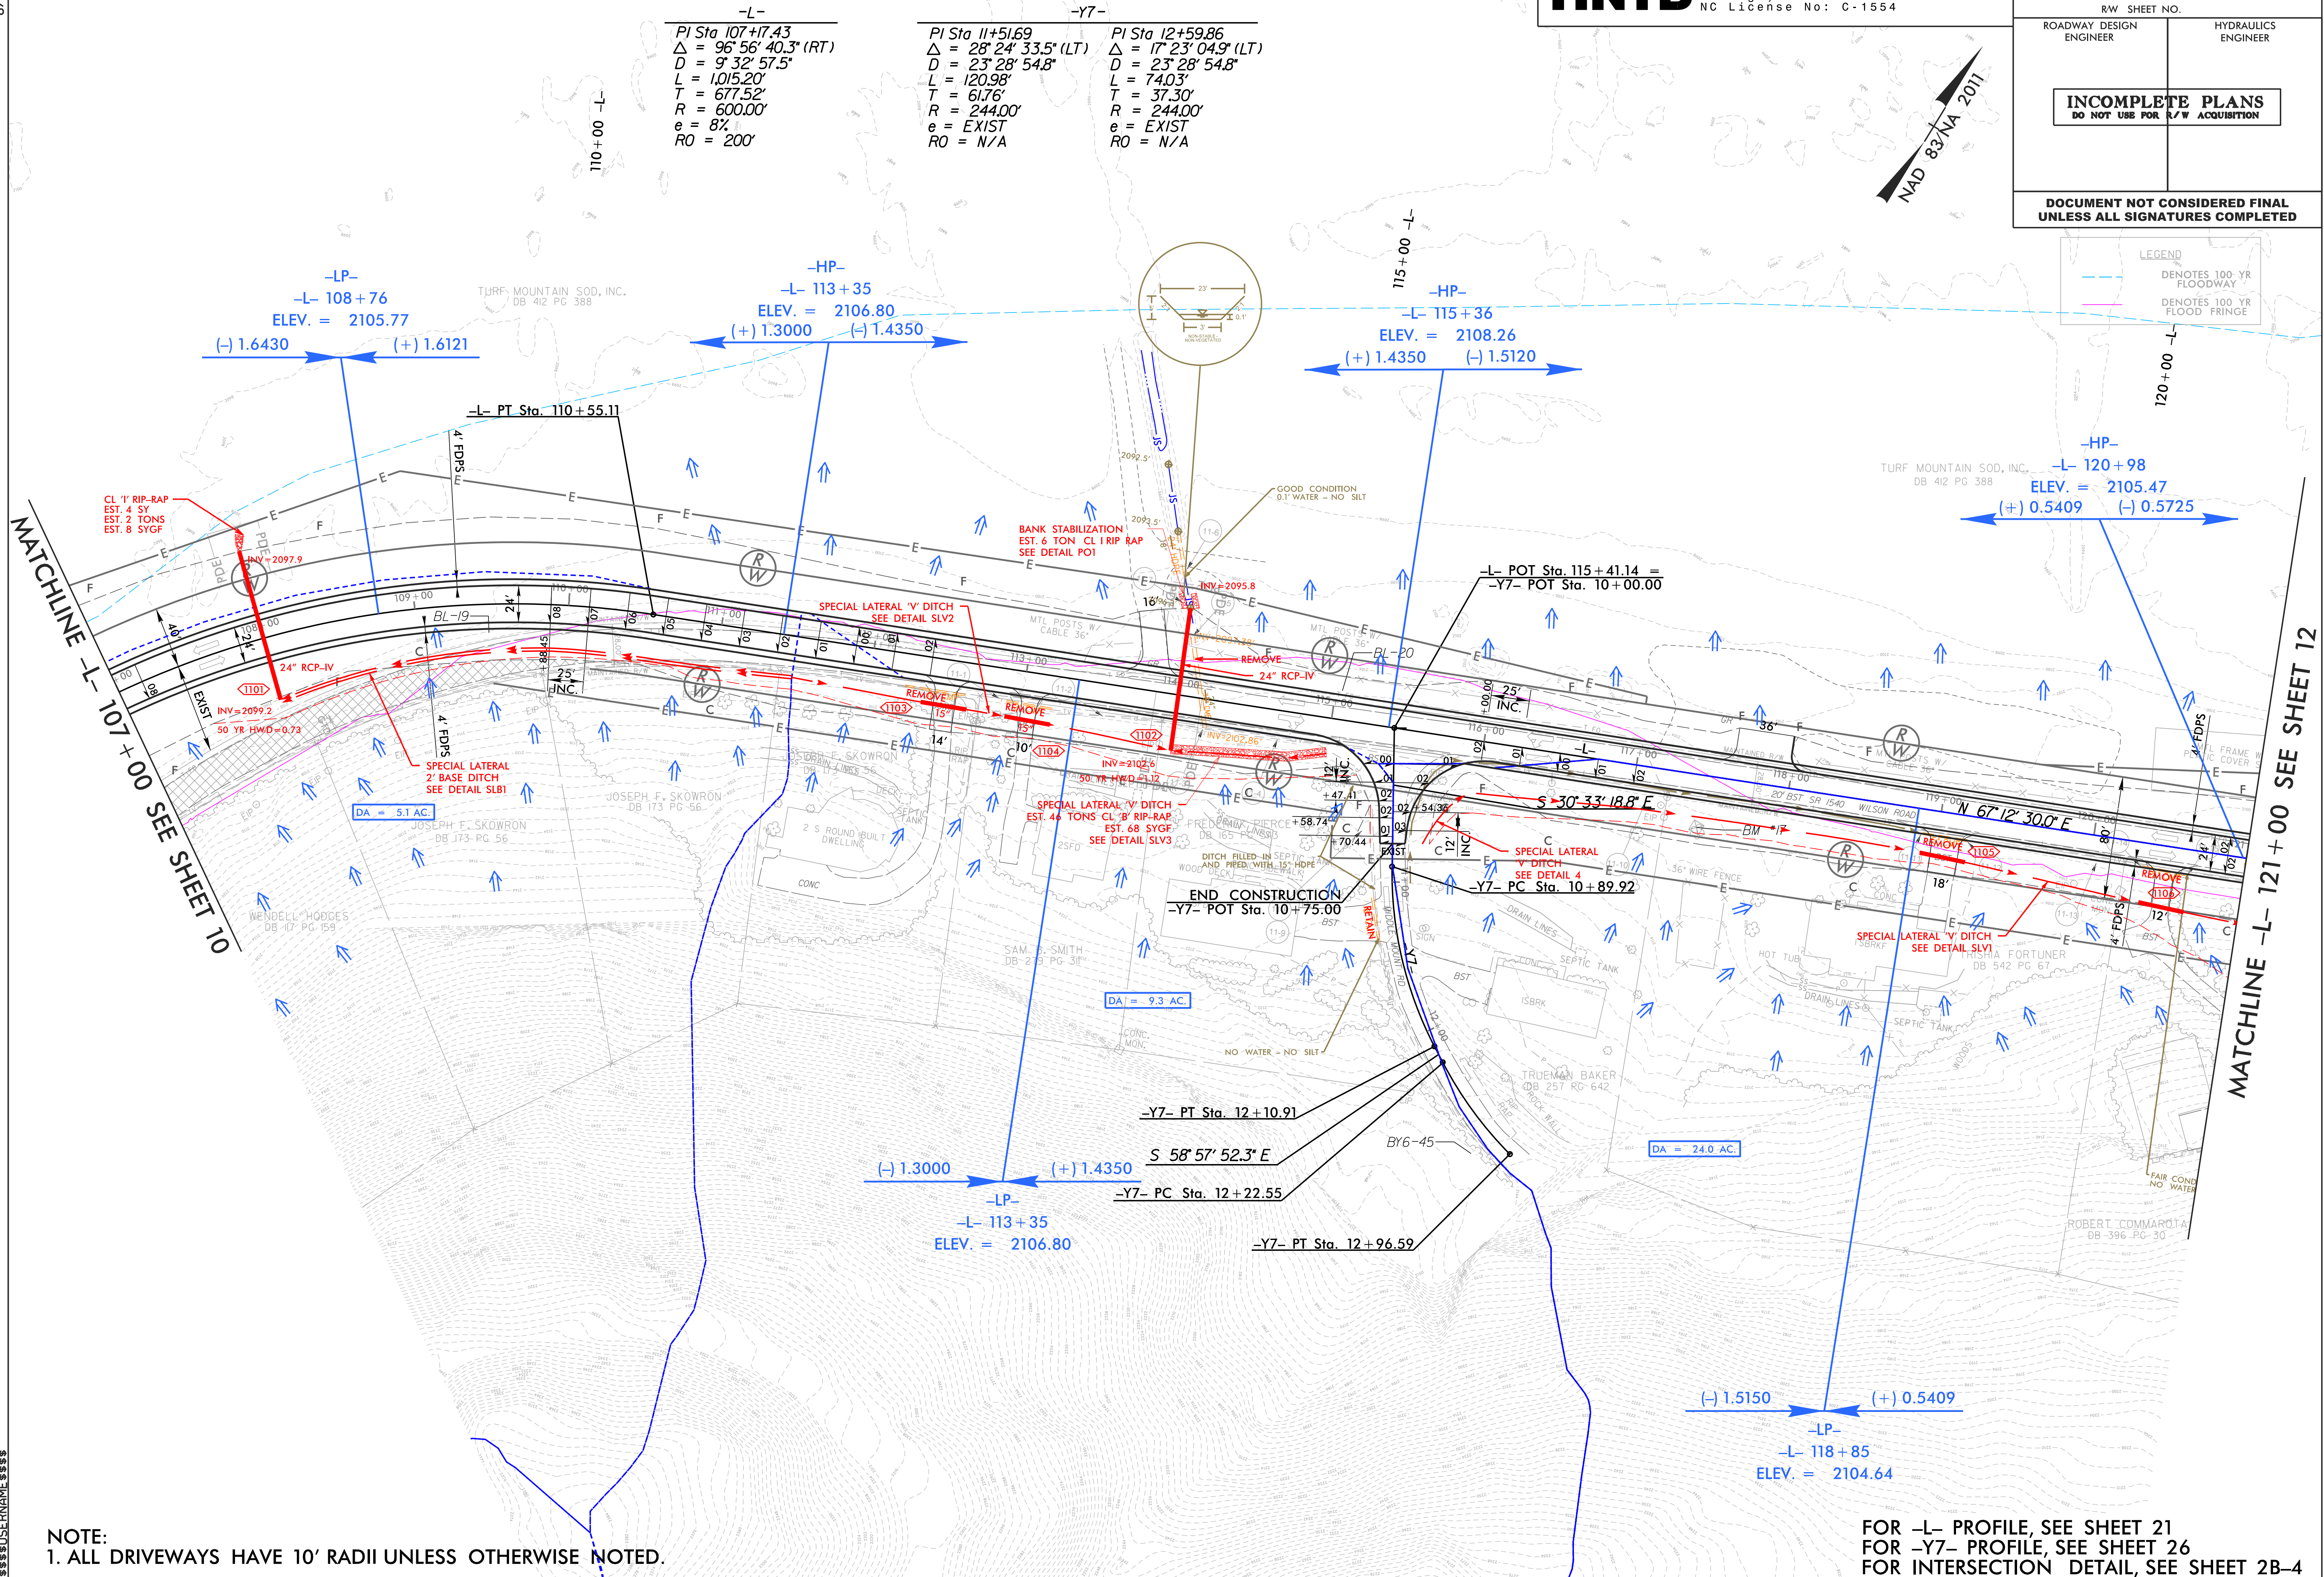

NOTE:
1. ALL DRIVEWAYS HAVE 10' RADII UNLESS OTHERWISE NOTED.

FOR -LP- PROFILE, SEE SHEET 21
FOR -Y7- PROFILE, SEE SHEET 26
FOR INTERSECTION DETAIL, SEE SHEET 2B-4


8/17/99

HNTB

HNTB NORTH CAROLINA, P.C.
343 E. Six Forks Road, Suite 200
Raleigh, North Carolina 27609
NC License No: C-1554

PROJECT REFERENCE NO.		SHEET NO.
R-5763		12
RW SHEET NO.		
ROADWAY DESIGN ENGINEER	HYDRAULICS ENGINEER	
INCOMPLETE PLANS DO NOT USE FOR R/W ACQUISITION		
DOCUMENT NOT CONSIDERED FINAL UNLESS ALL SIGNATURES COMPLETED		

MATCHLINE -L- 121+00 SEE SHEET 11

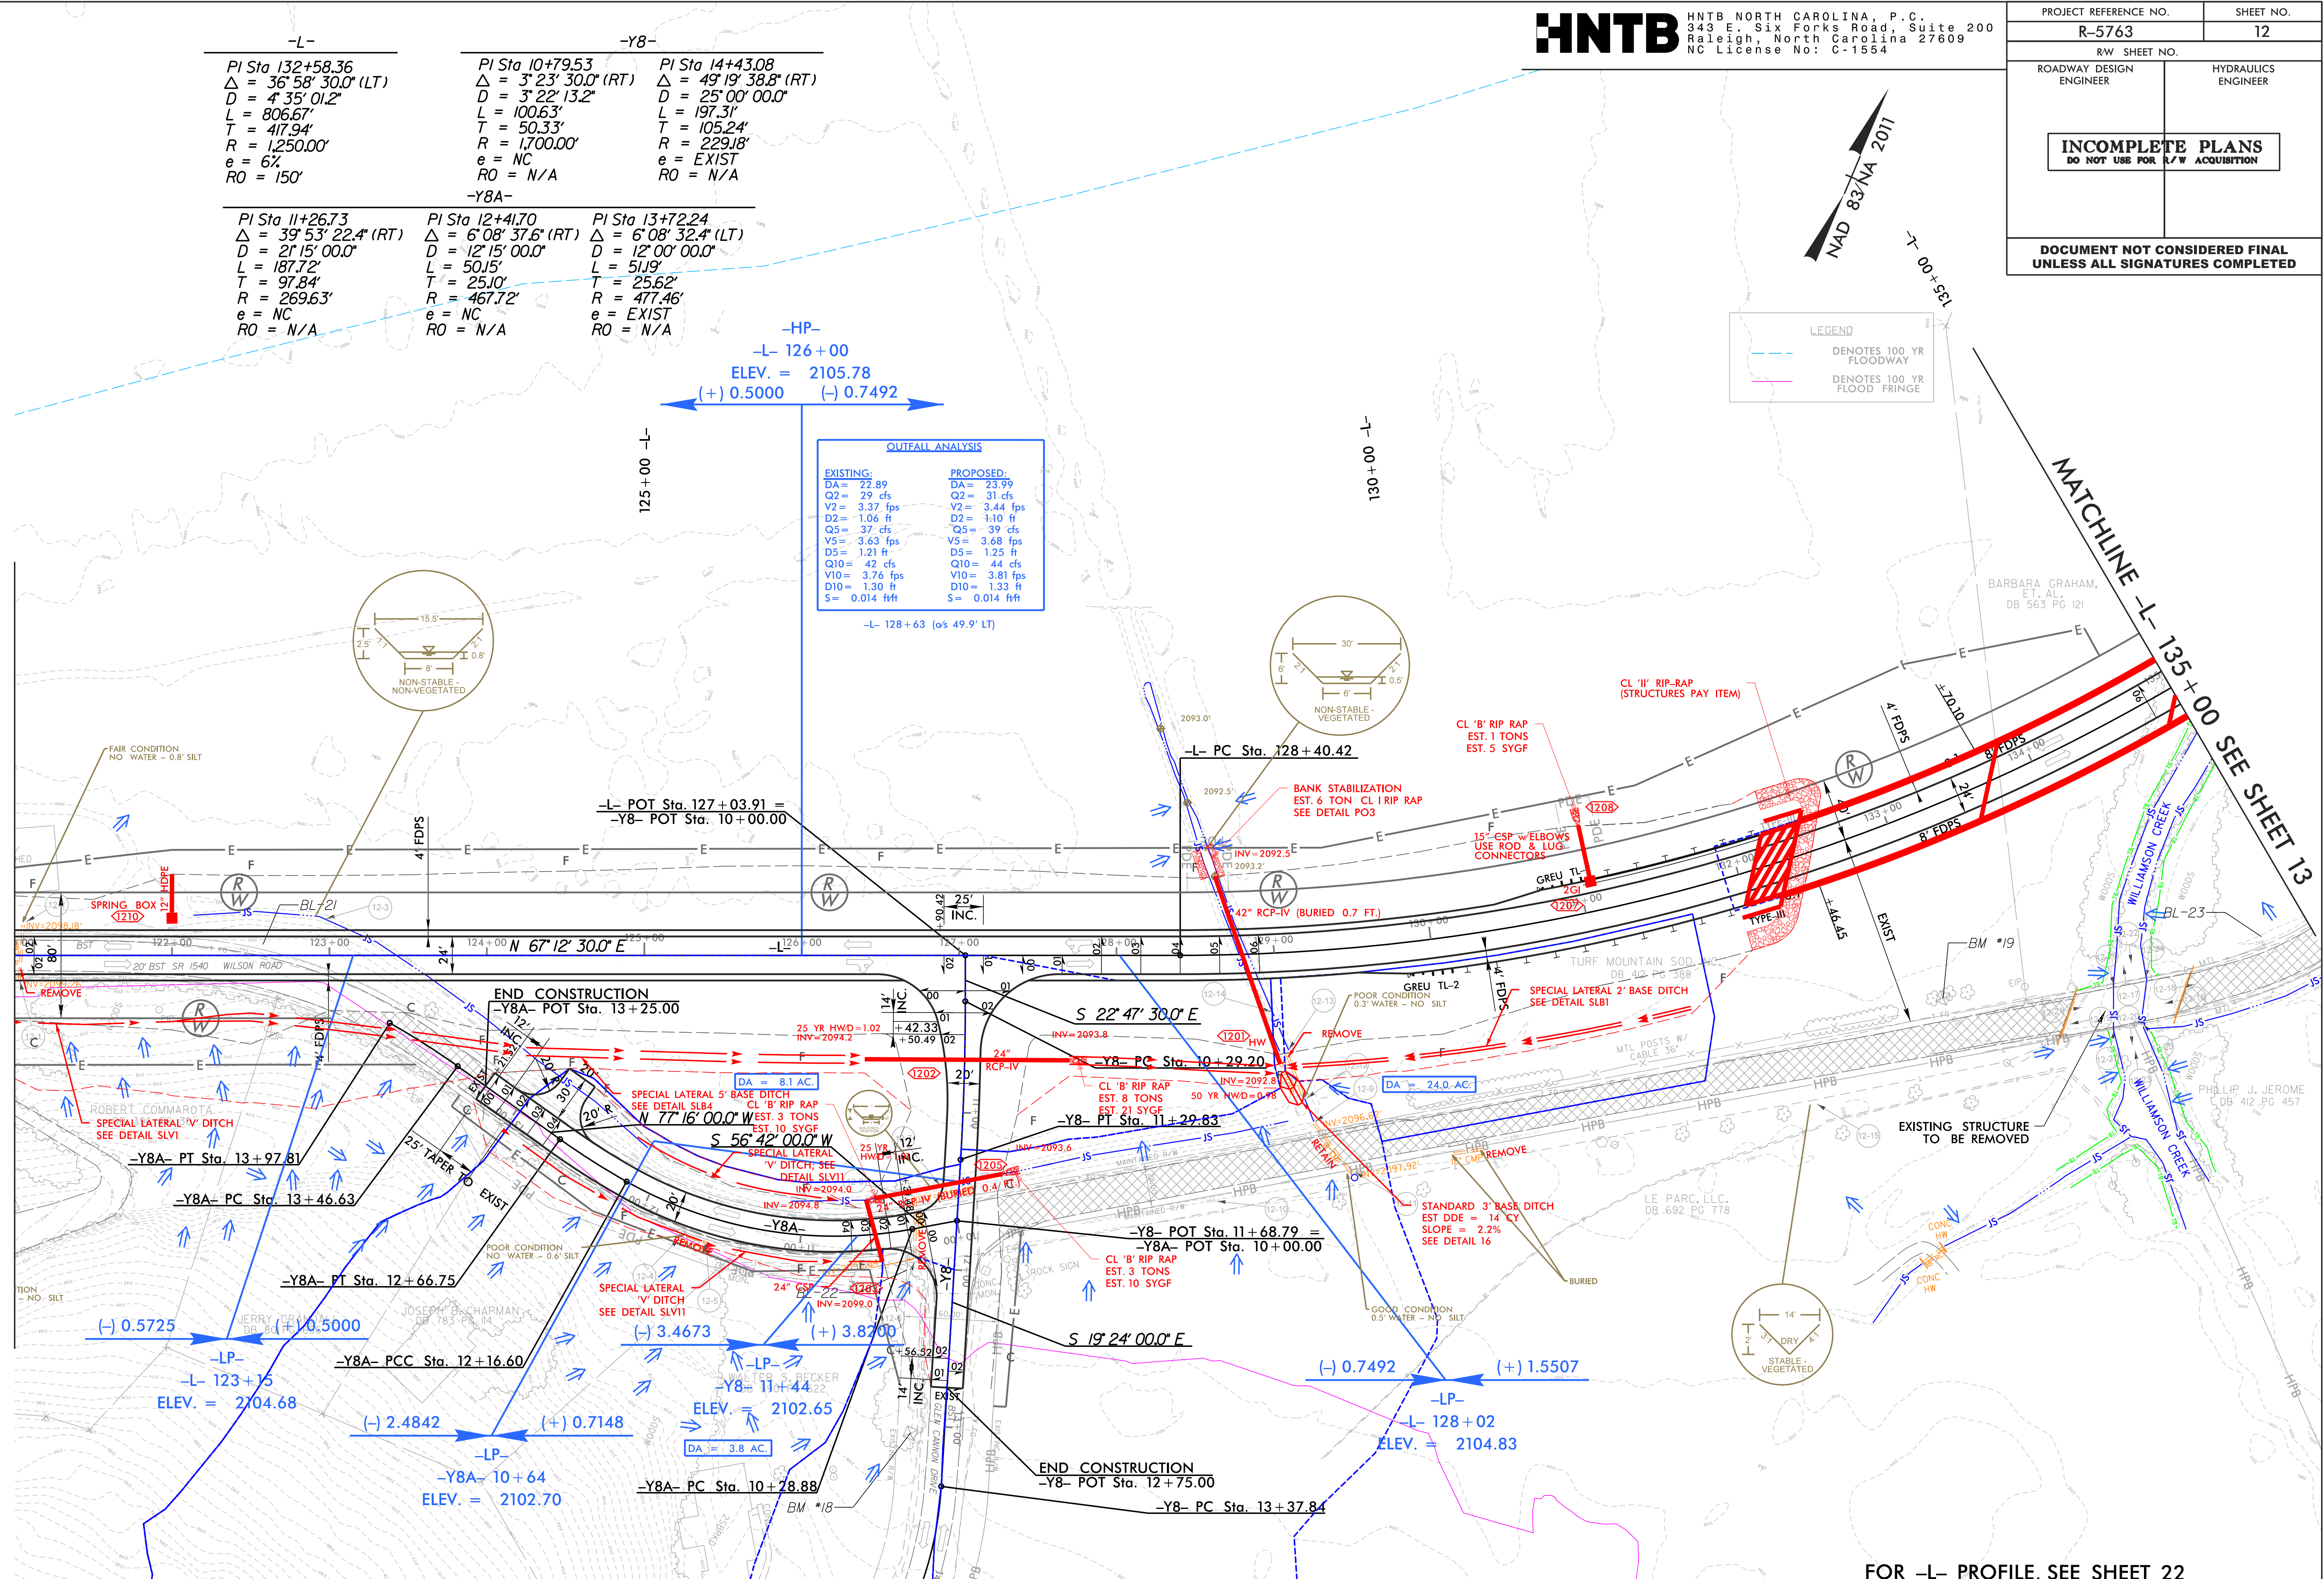

NOTE:
1. ALL DRIVEWAYS HAVE 10' RADII UNLESS OTHERWISE NOTED.


8/17/99

HNTB

HNTB NORTH CAROLINA, P.C.
343 E. Six Forks Road, Suite 200
Raleigh, North Carolina 27609
NC License No: C-1554

PROJECT REFERENCE NO.		SHEET NO.
R-5763		13
RW SHEET NO.		
ROADWAY DESIGN ENGINEER		HYDRAULICS ENGINEER
INCOMPLETE PLANS DO NOT USE FOR R/W ACQUISITION		
DOCUMENT NOT CONSIDERED FINAL UNLESS ALL SIGNATURES COMPLETED		

NAD 83/NA 2011

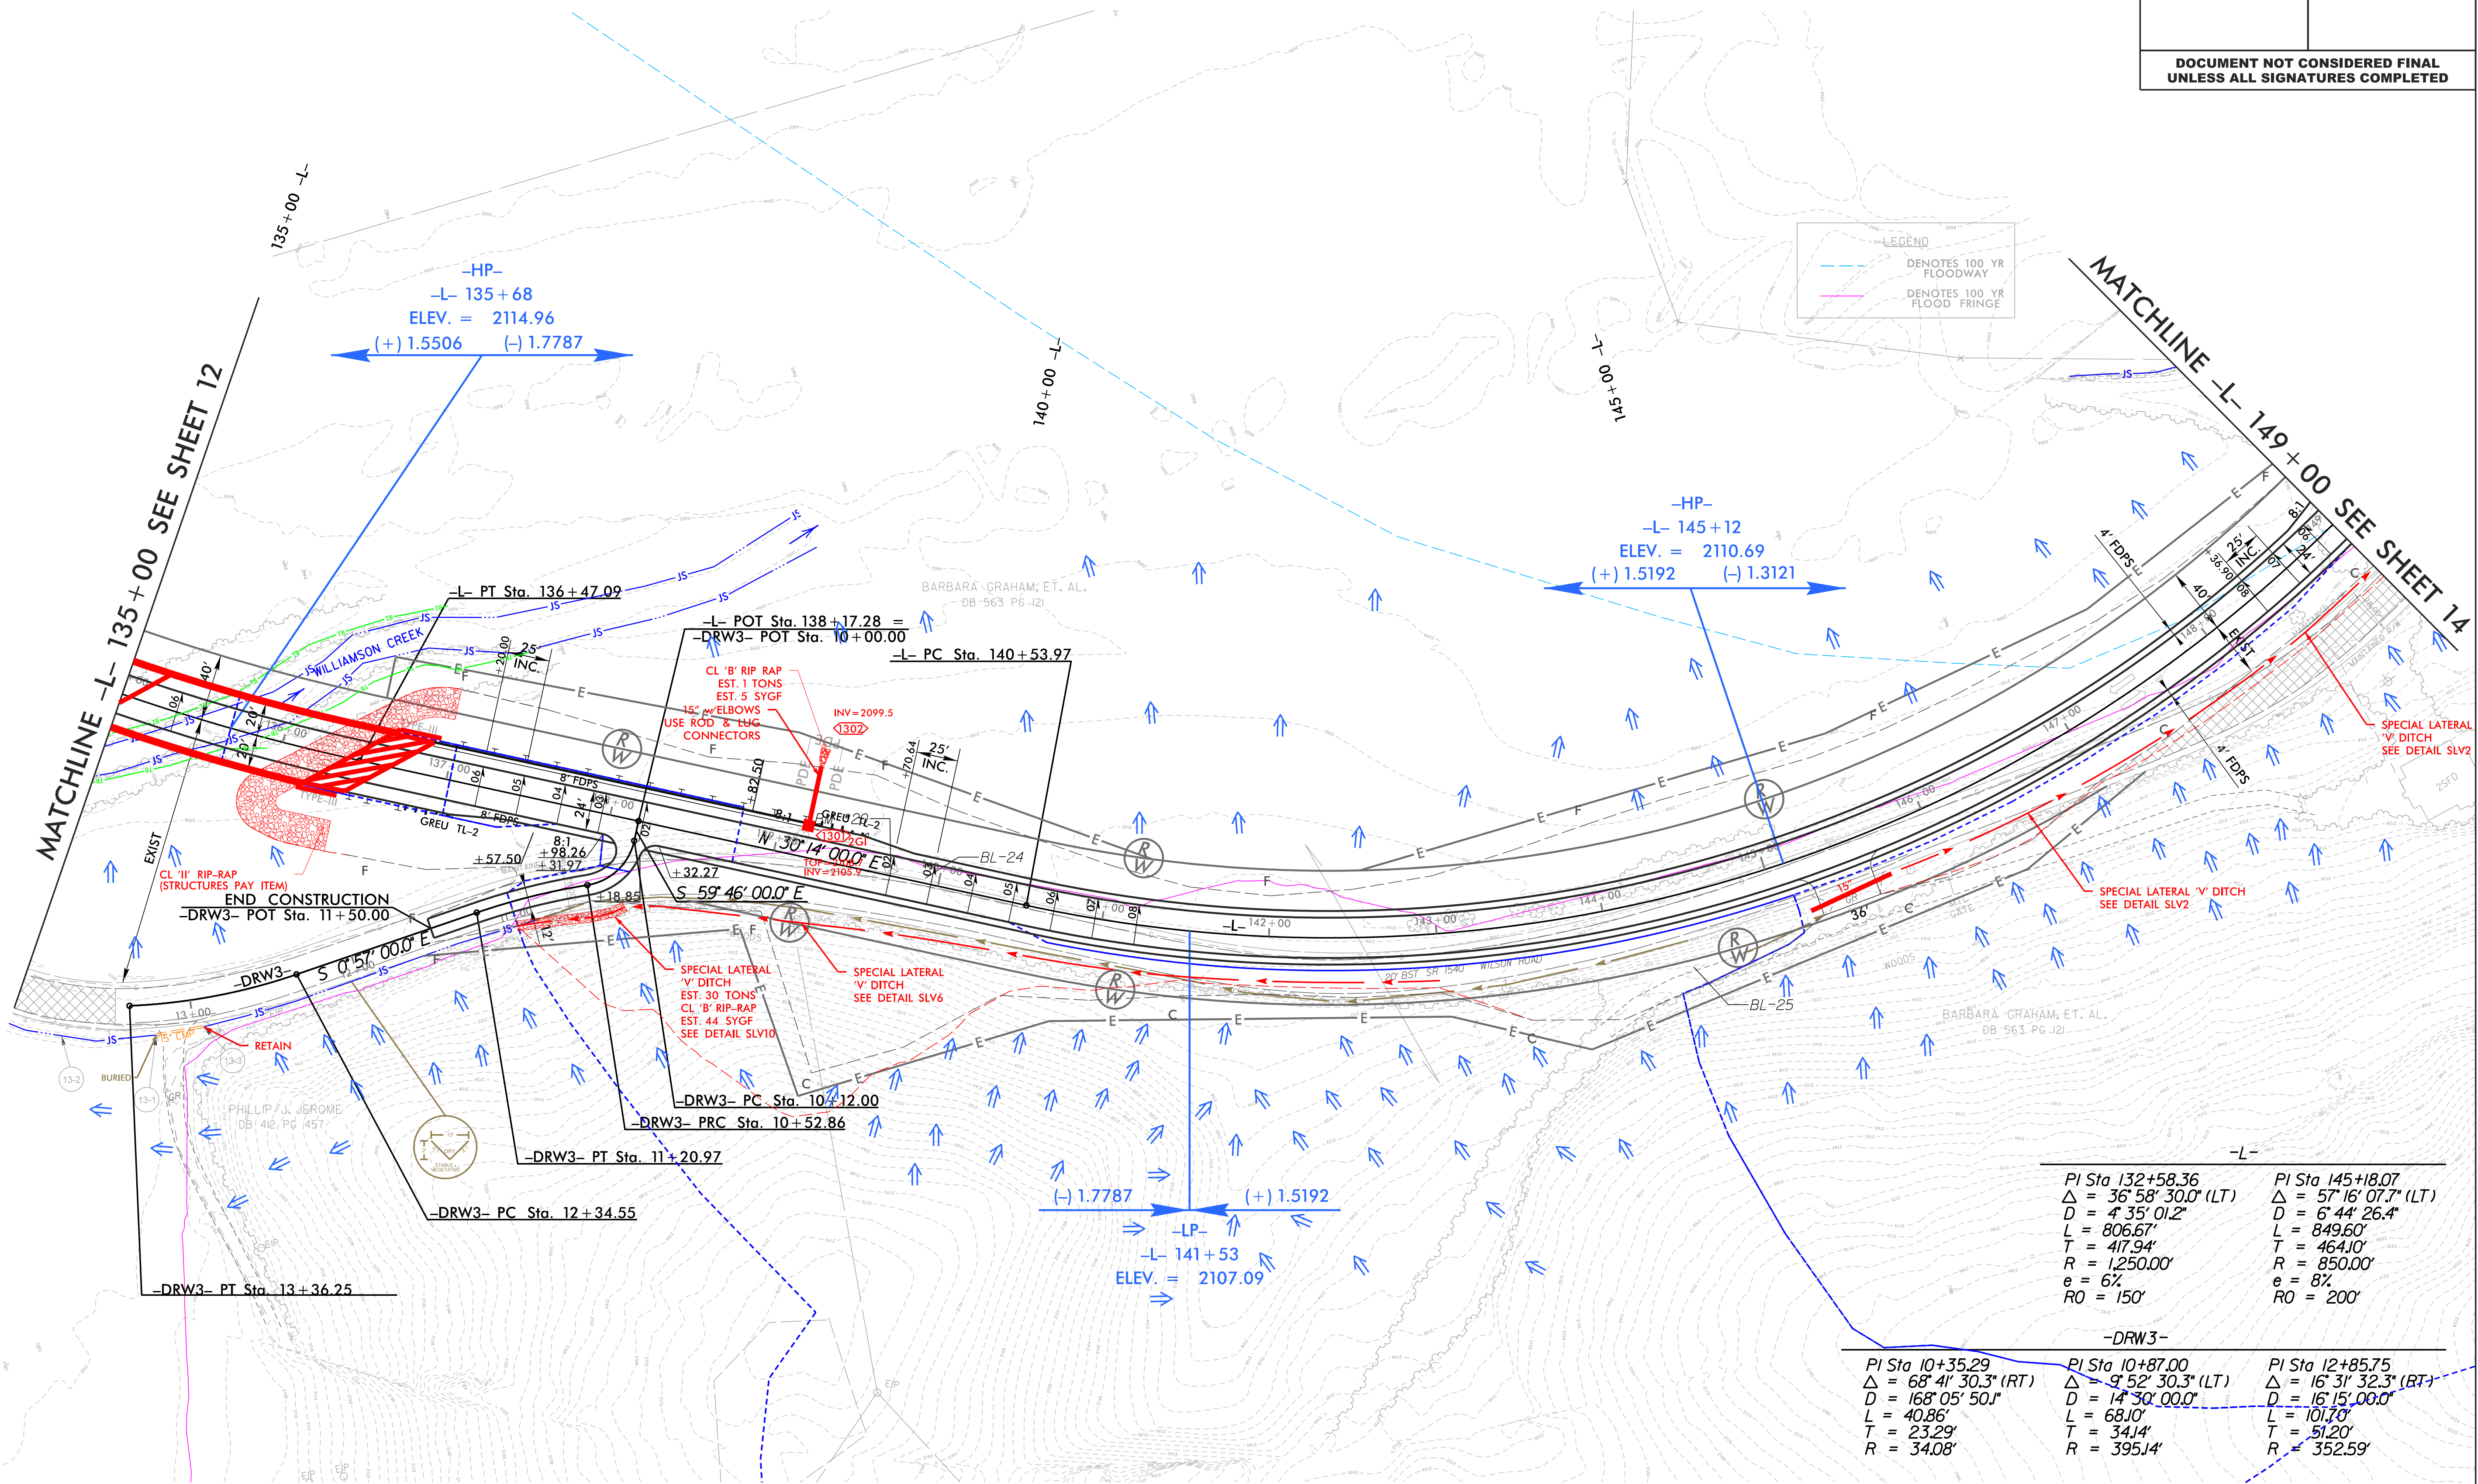

FOR -L- PROFILE, SEE SHEET 22
FOR -DRW3- PROFILE, SEE SHEET 27

8/17/99


HNTB

HNTB NORTH CAROLINA, P.C.
343 E. Six Forks Road, Suite 200
Raleigh, North Carolina 27609
NC License No: C-1554

PROJECT REFERENCE NO.		SHEET NO.
R-5763		14
RW SHEET NO.		
ROADWAY DESIGN ENGINEER	HYDRAULICS ENGINEER	
INCOMPLETE PLANS DO NOT USE FOR R/W ACQUISITION		
DOCUMENT NOT CONSIDERED FINAL UNLESS ALL SIGNATURES COMPLETED		

NAD 83/NA 2011

LEGEND	
	DENOTES 100 YR FLOODWAY
	DENOTES 100 YR FLOOD FRINGE

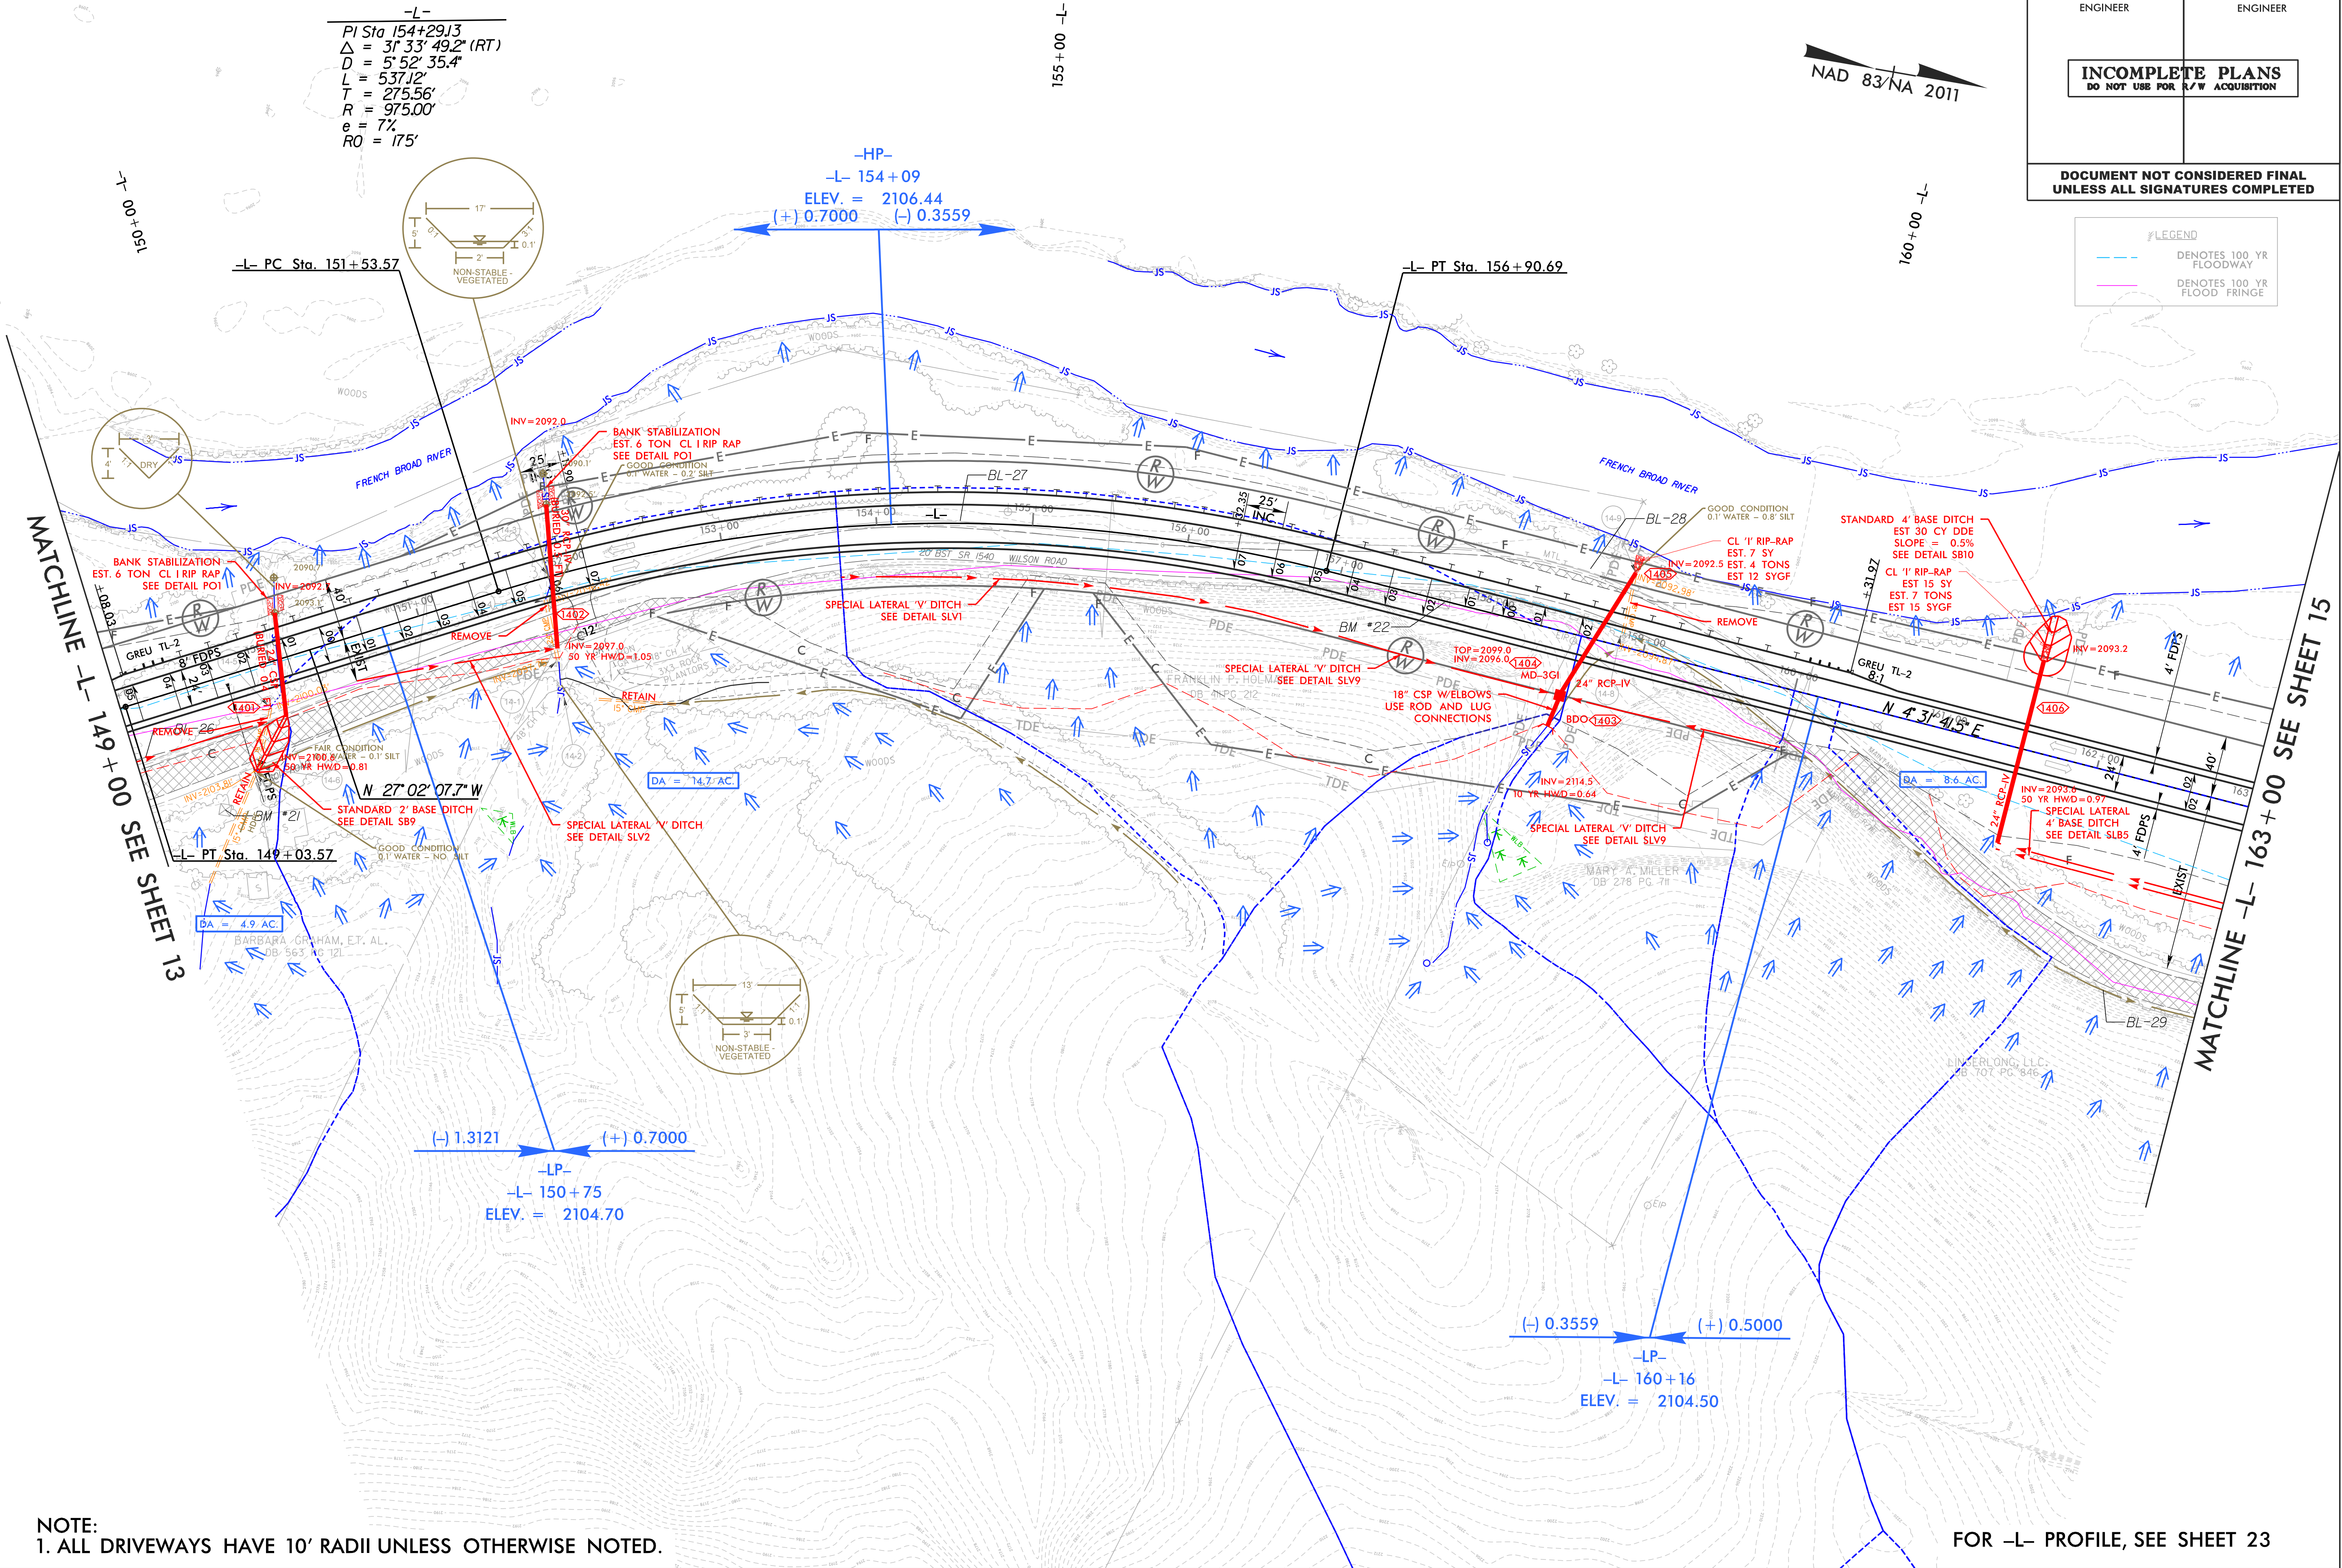


NOTE:
1. ALL DRIVEWAYS HAVE 10' RADII UNLESS OTHERWISE NOTED.

FOR -L- PROFILE, SEE SHEET 23

8/17/99

MATCHLINE -L- 163+00 SEE SHEET 14

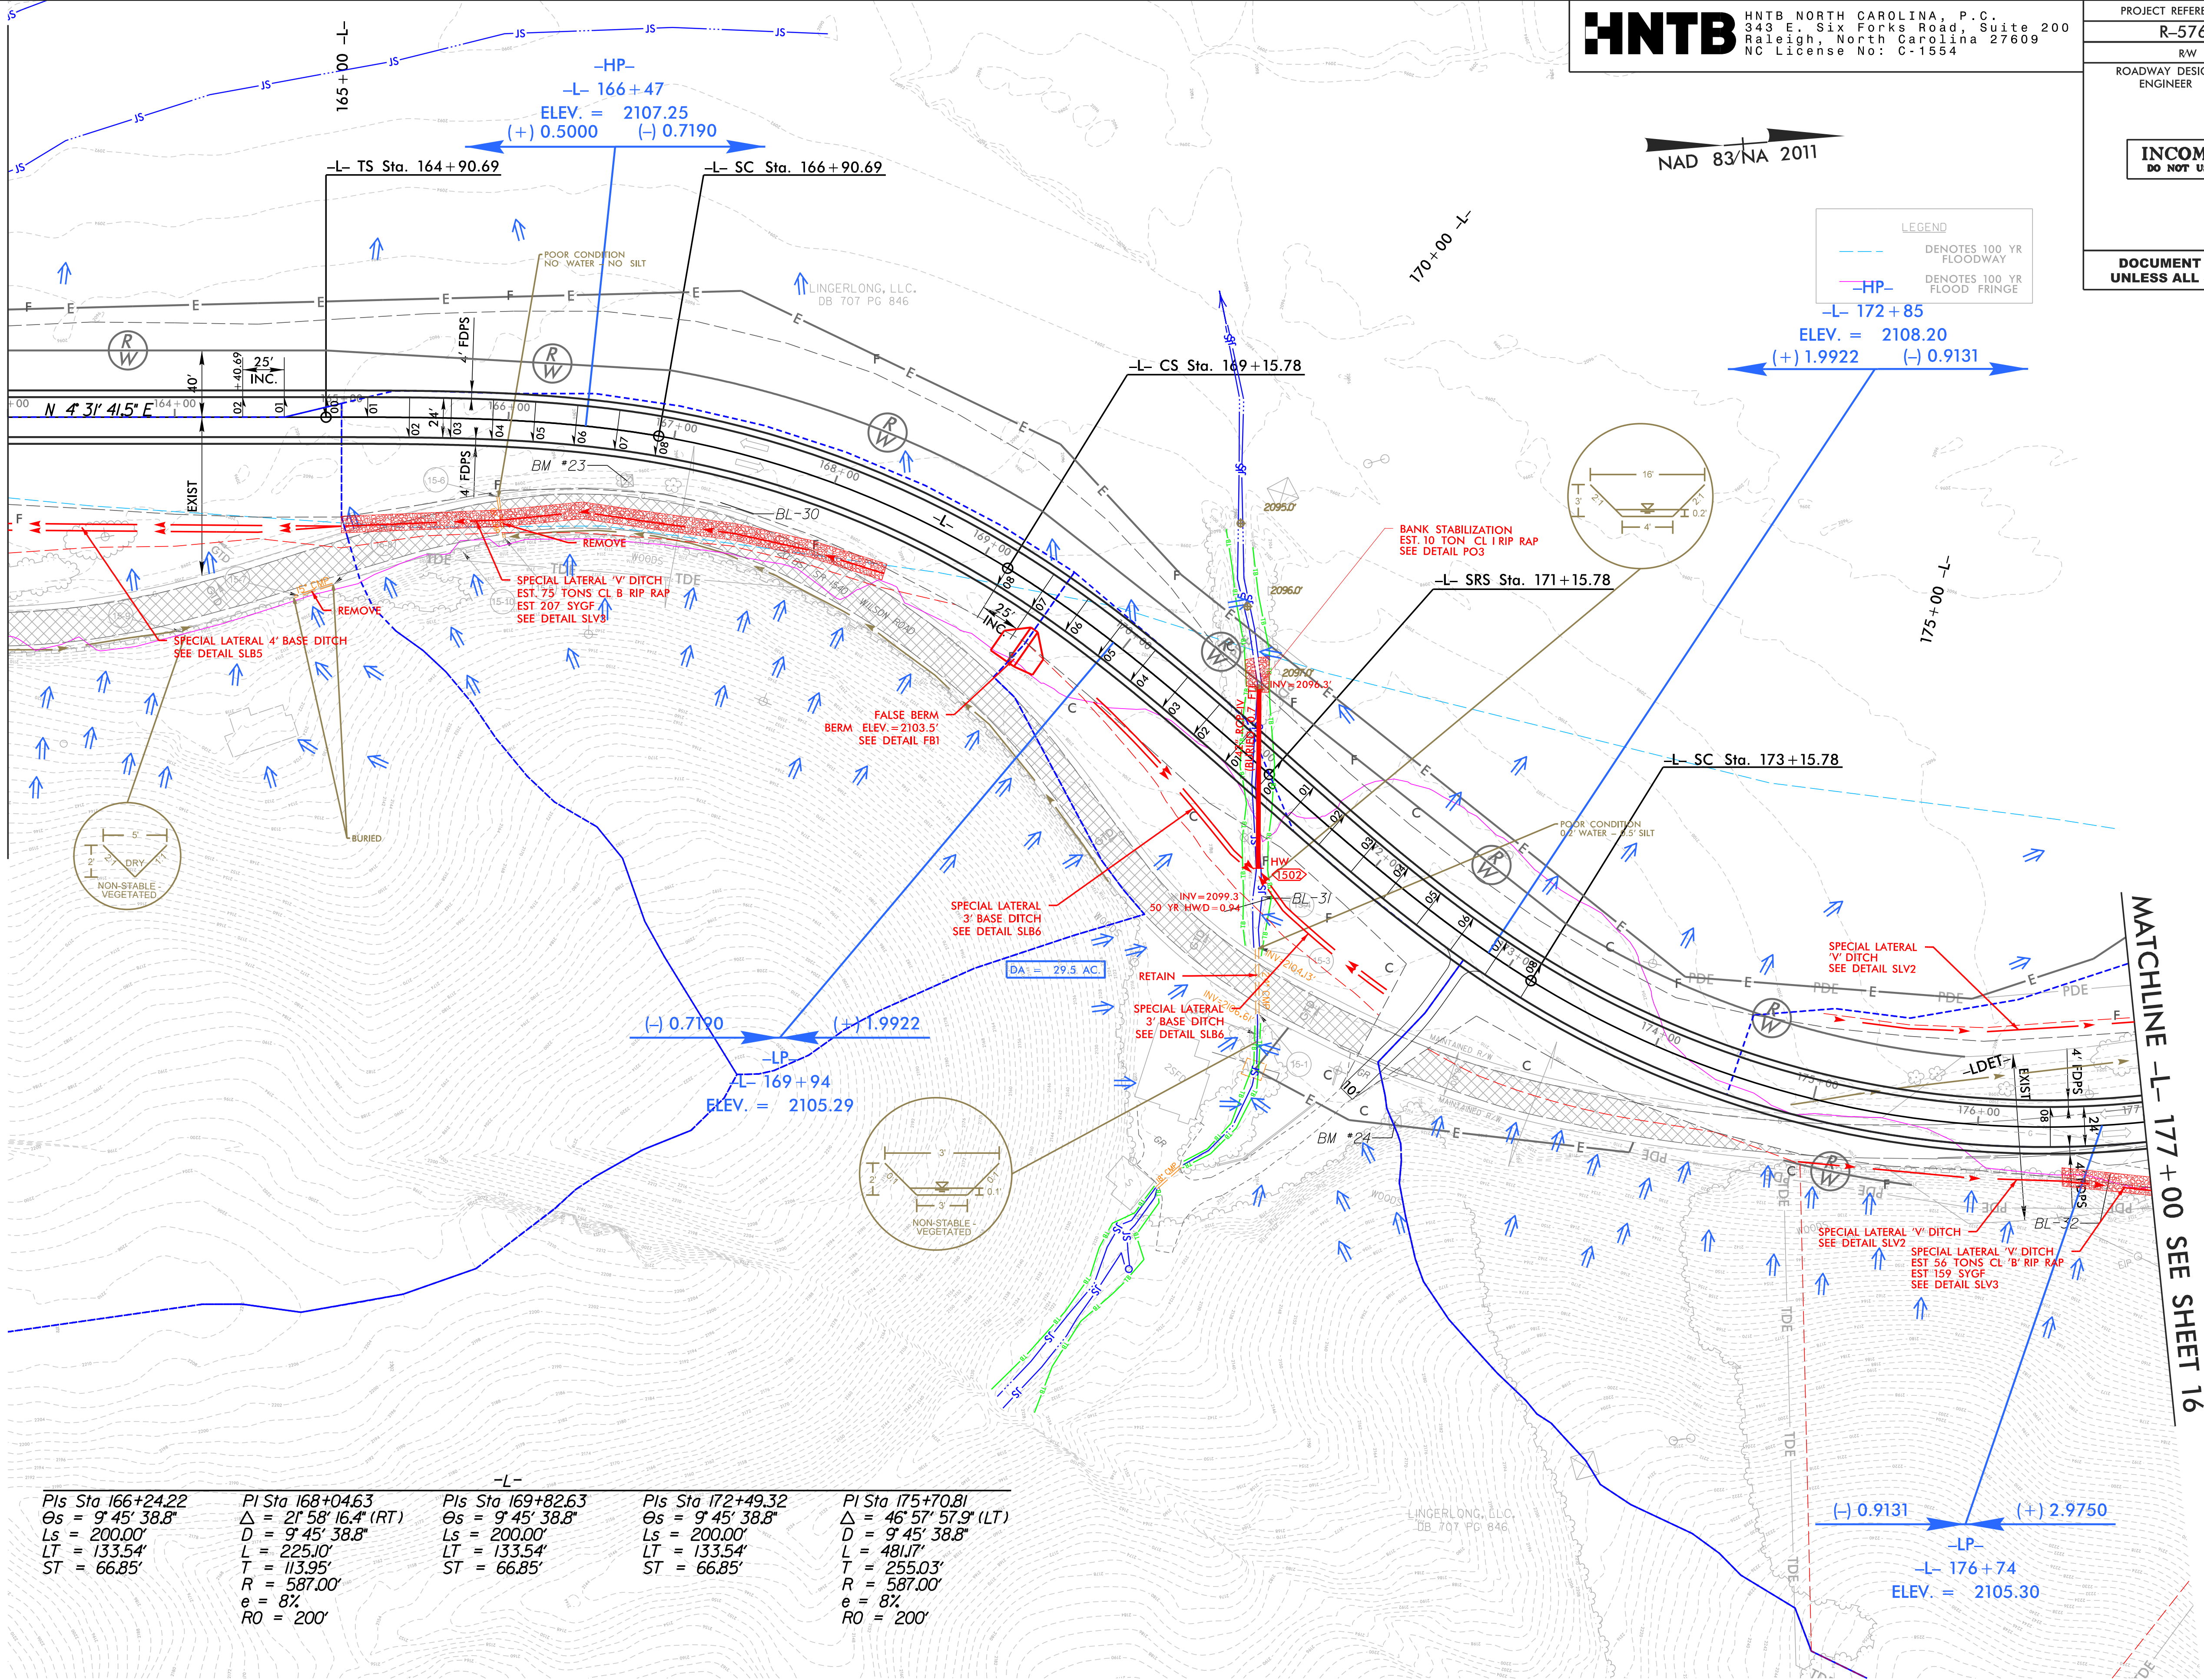

-L-				
PIs Sta 166+24.22	PI Sta 168+04.63	PIs Sta 169+82.63	PIs Sta 172+49.32	PI Sta 175+70.81
Os = 9' 45" 38.8"	Δ = 21' 58" 16.4" (RT)	Os = 9' 45" 38.8"	Os = 9' 45" 38.8"	Δ = 46' 57" 57.9" (LT)
Ls = 200.00'	D = 9' 45" 38.8"	Ls = 200.00'	Ls = 200.00'	D = 9' 45" 38.8"
LT = 133.54'	L = 225.10'	LT = 133.54'	LT = 133.54'	L = 481.17'
ST = 66.85'	T = 113.95'	ST = 66.85'	ST = 66.85'	T = 255.03'
	R = 587.00'			R = 587.00'
	e = 8%			e = 8%
	RO = 200'			RO = 200'

NOTE:
1. ALL DRIVEWAYS HAVE 10' RADII UNLESS OTHERWISE NOTED.

FOR -L- PROFILE, SEE SHEET 23
FOR -LDET- PLAN AND PROFILE SEE SHEETS 2B-5 & 2B-6

HNTB

HNTB NORTH CAROLINA, P.C.
343 E. Six Forks Road, Suite 200
Raleigh, North Carolina 27609
NC License No: C-1554


PROJECT REFERENCE NO.		SHEET NO.
R-5763		15
RW SHEET NO.		
ROADWAY DESIGN ENGINEER	HYDRAULICS ENGINEER	
INCOMPLETE PLANS DO NOT USE FOR R/W ACQUISITION		
DOCUMENT NOT CONSIDERED FINAL UNLESS ALL SIGNATURES COMPLETED		

8/17/99

HNTB

HNTB NORTH CAROLINA, P.C.
343 E. Six Forks Road, Suite 200
Raleigh, North Carolina 27609
NC License No: C-1554

PROJECT REFERENCE NO.		SHEET NO.
R-5763		16
RW SHEET NO.		
ROADWAY DESIGN ENGINEER	HYDRAULICS ENGINEER	
INCOMPLETE PLANS DO NOT USE FOR R/W ACQUISITION		
DOCUMENT NOT CONSIDERED FINAL UNLESS ALL SIGNATURES COMPLETED		

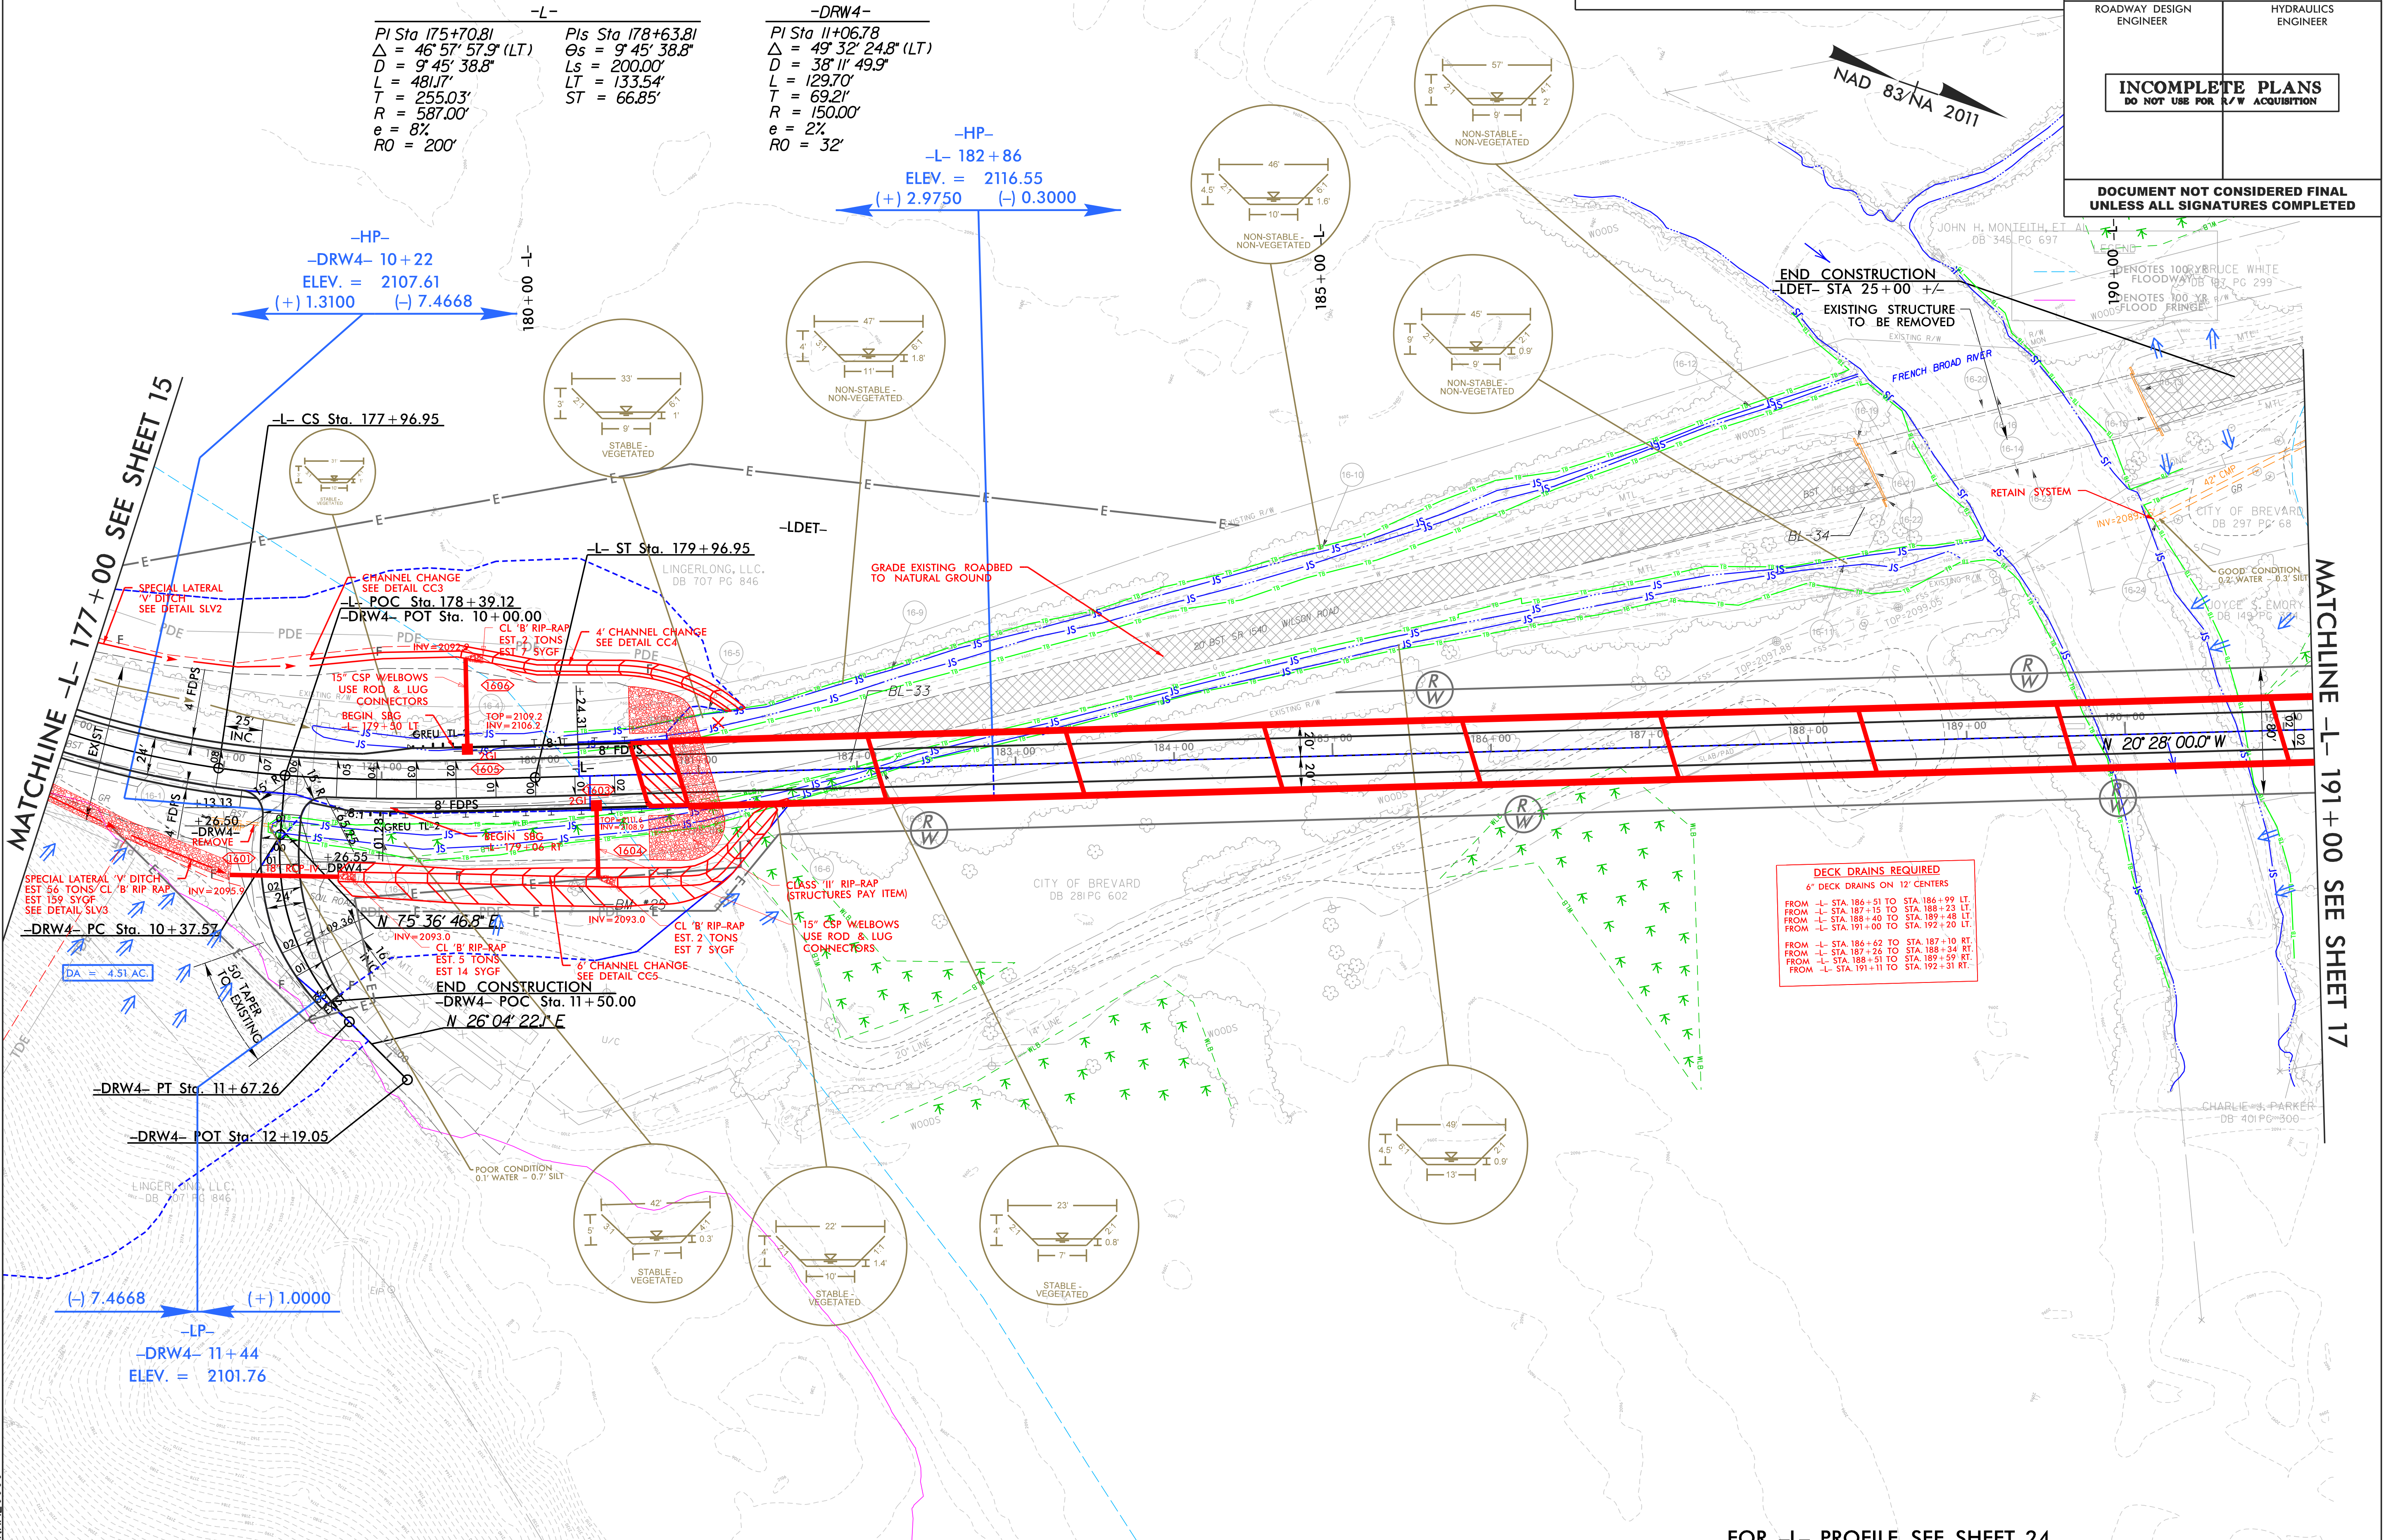

NOTE:
1. ALL DRIVEWAYS HAVE 10' RADII UNLESS OTHERWISE NOTED.

FOR -L- PROFILE, SEE SHEET 24
FOR -DRW4- PROFILE, SEE SHEET 27
FOR -L_DET- PLAN AND PROFILE, SEE SHEETS 2B-5 & 2B-6

8/17/99


SYSTEMS DESIGN USER NAME

HNTB

HNTB NORTH CAROLINA, P.C.
343 E. Six Forks Road, Suite 200
Raleigh, North Carolina 27609
NC License No: C-1554

PROJECT REFERENCE NO.		SHEET NO.
R-5763		17
RW SHEET NO.		
ROADWAY DESIGN ENGINEER	HYDRAULICS ENGINEER	
INCOMPLETE PLANS DO NOT USE FOR R/W ACQUISITION		
DOCUMENT NOT CONSIDERED FINAL UNLESS ALL SIGNATURES COMPLETED		

LEGEND	
	DENOTES 100 YR FLOODWAY
	DENOTES 100 YR FLOOD FRINGE

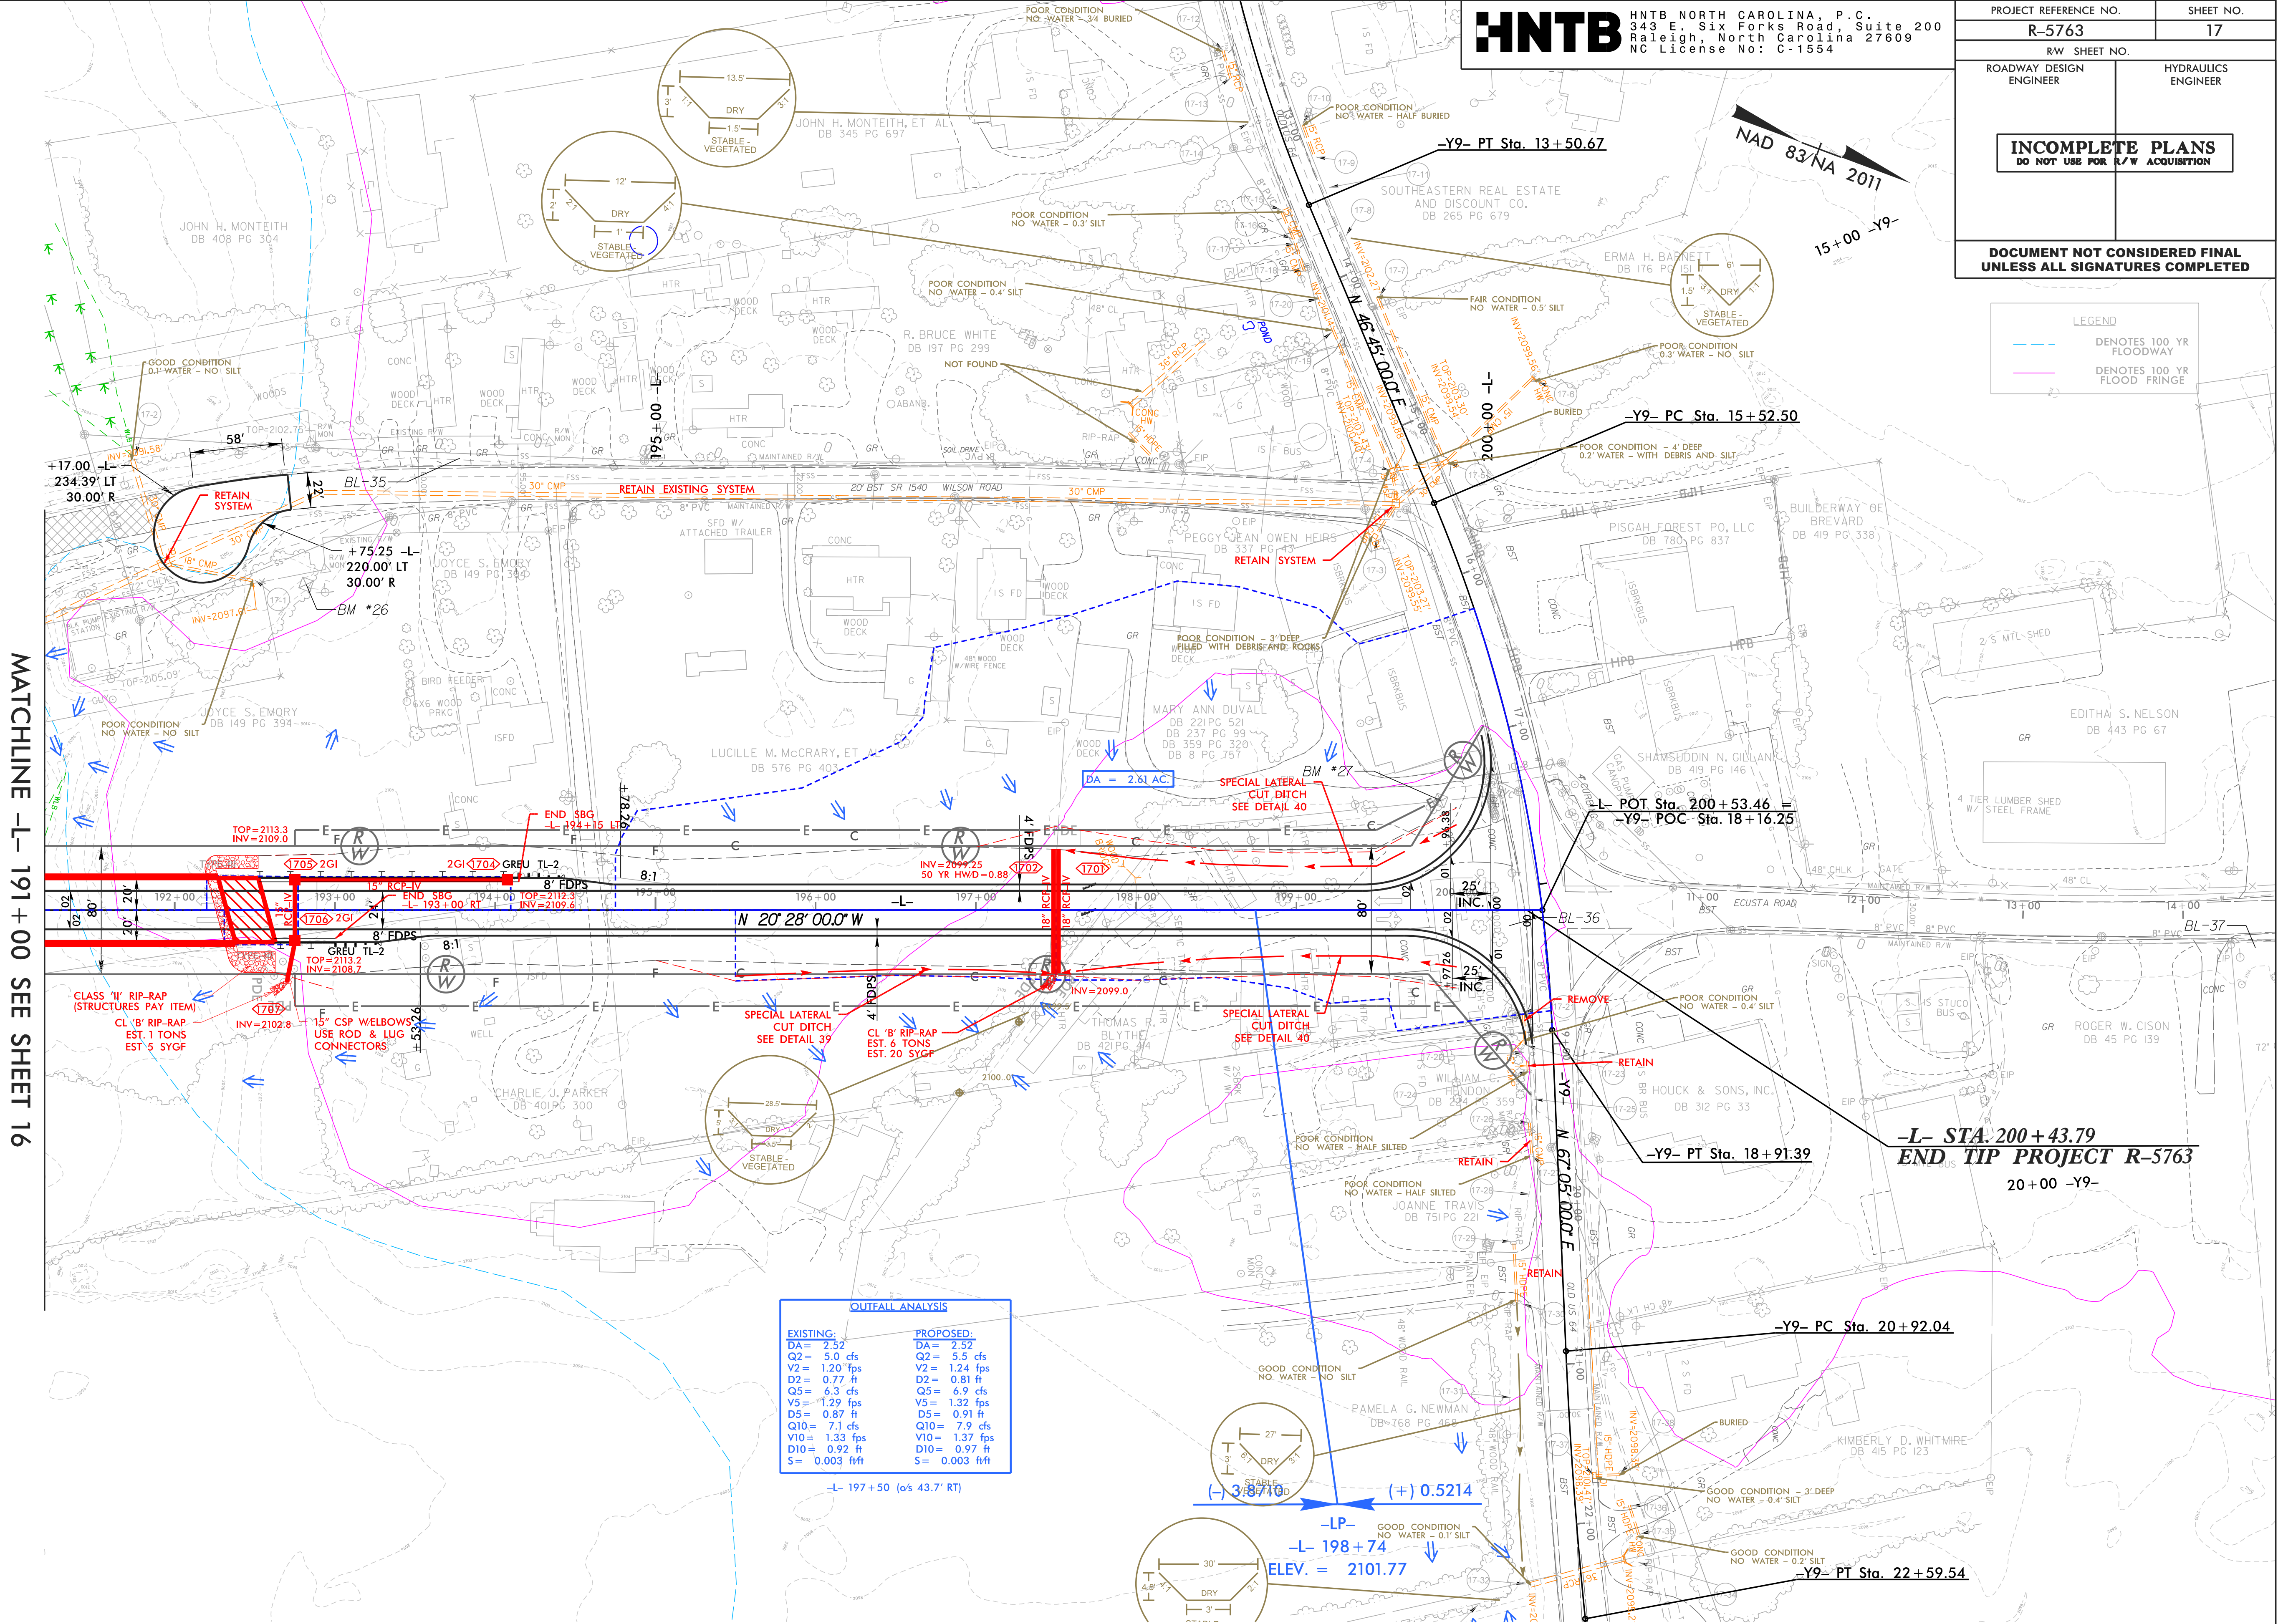

NOTE:
1. ALL DRIVEWAYS HAVE 10' RADII UNLESS OTHERWISE NOTED.

FOR -L- PROFILE, SEE SHEET 24


5/28/99




HNTB NORTH CAROLINA, P.C.
343 E. Sixth Street, Suite 200
Raleigh, North Carolina 27609
NC License No: C-1554

PROJECT REFERENCE NO.		SHEET NO.
R-5763		18
ROADWAY DESIGN ENGINEER	HYDRAULICS ENGINEER	
INCOMPLETE PLANS DO NOT USE FOR R/W ACQUISITION		


DOCUMENT NOT CONSIDERED FINAL
UNLESS ALL SIGNATURES COMPLETED

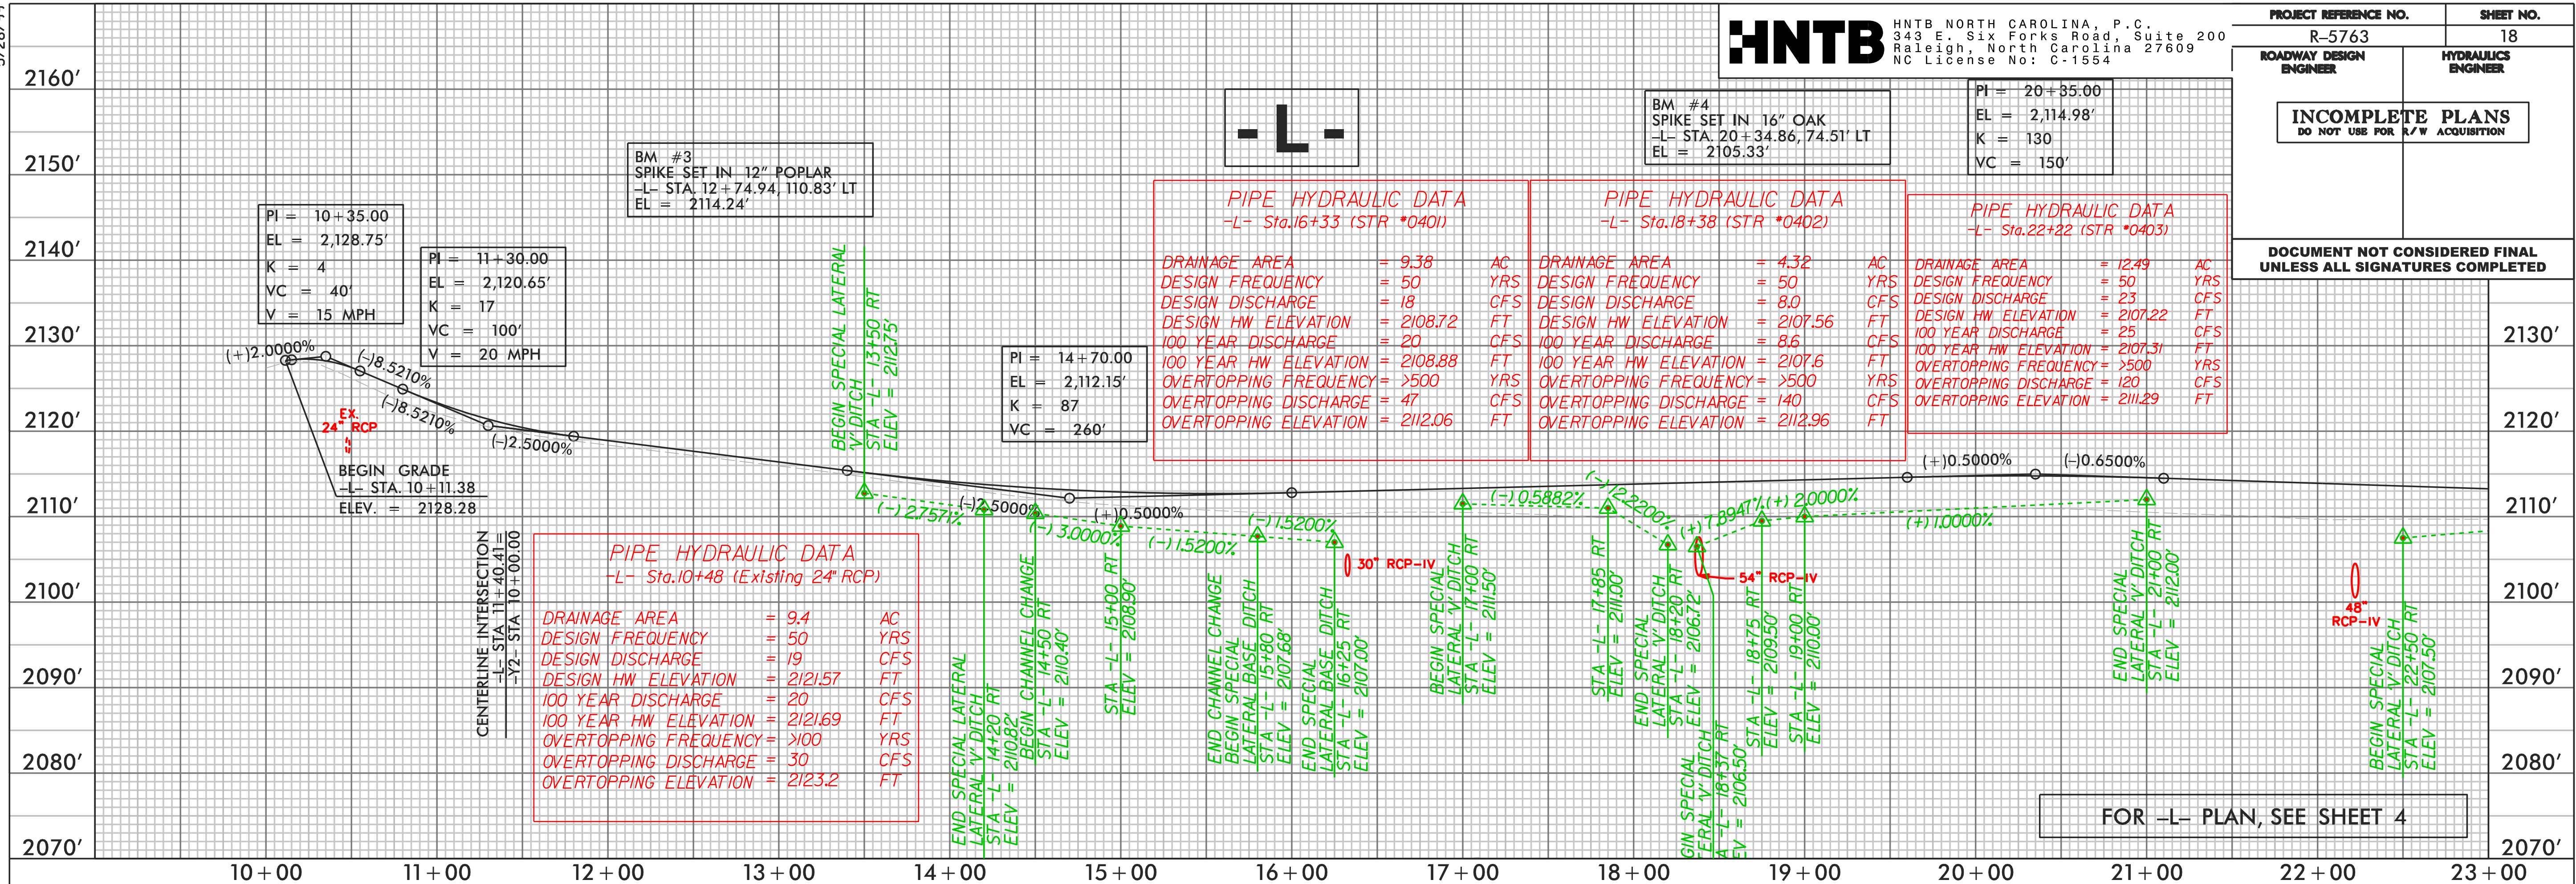

SYTIME\$\$\$\$
DESIGN\$\$\$\$
USERNAME\$\$\$\$

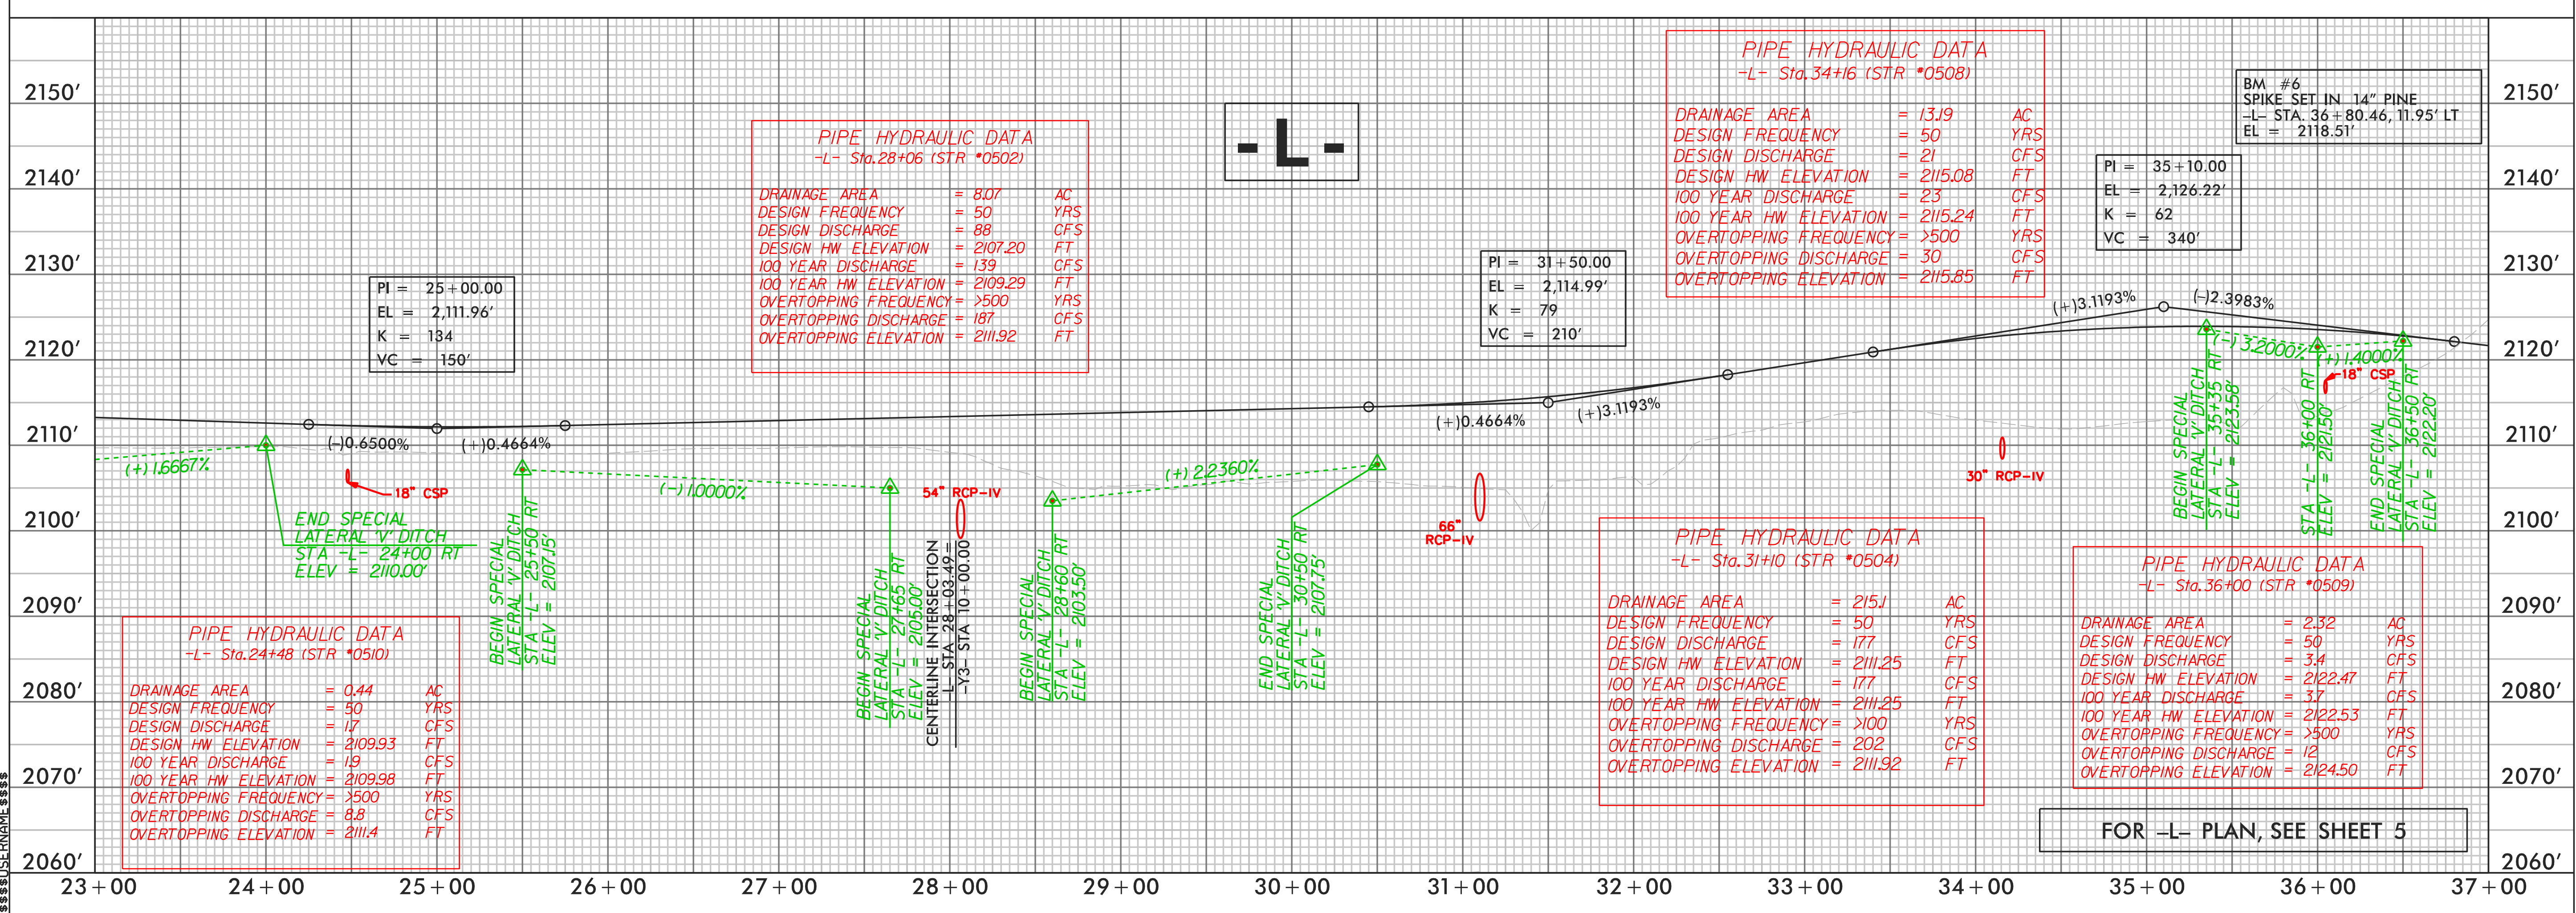


\$\$\$\$SERNAME\$\$\$\$
\$\$\$\$DGN\$\$\$\$

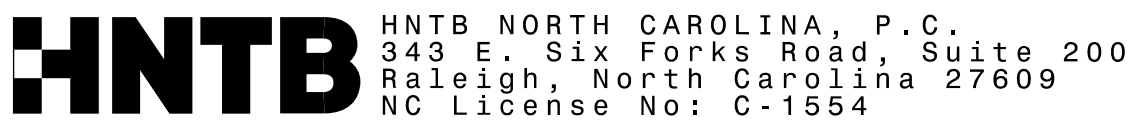


5/28/99

HNTB HNTB NORTH CAROLINA, P.C.
343 E. Six Forks Road, Suite 200
Raleigh, North Carolina 27609
NC License No: C-1554

PROJECT REFERENCE NO.		SHEET NO.	
R-5763		21	
ROADWAY DESIGN ENGINEER		HYDRAULICS ENGINEER	
INCOMPLETE PLANS DO NOT USE FOR R/W ACQUISITION			
DOCUMENT NOT CONSIDERED FINAL UNLESS ALL SIGNATURES COMPLETED			

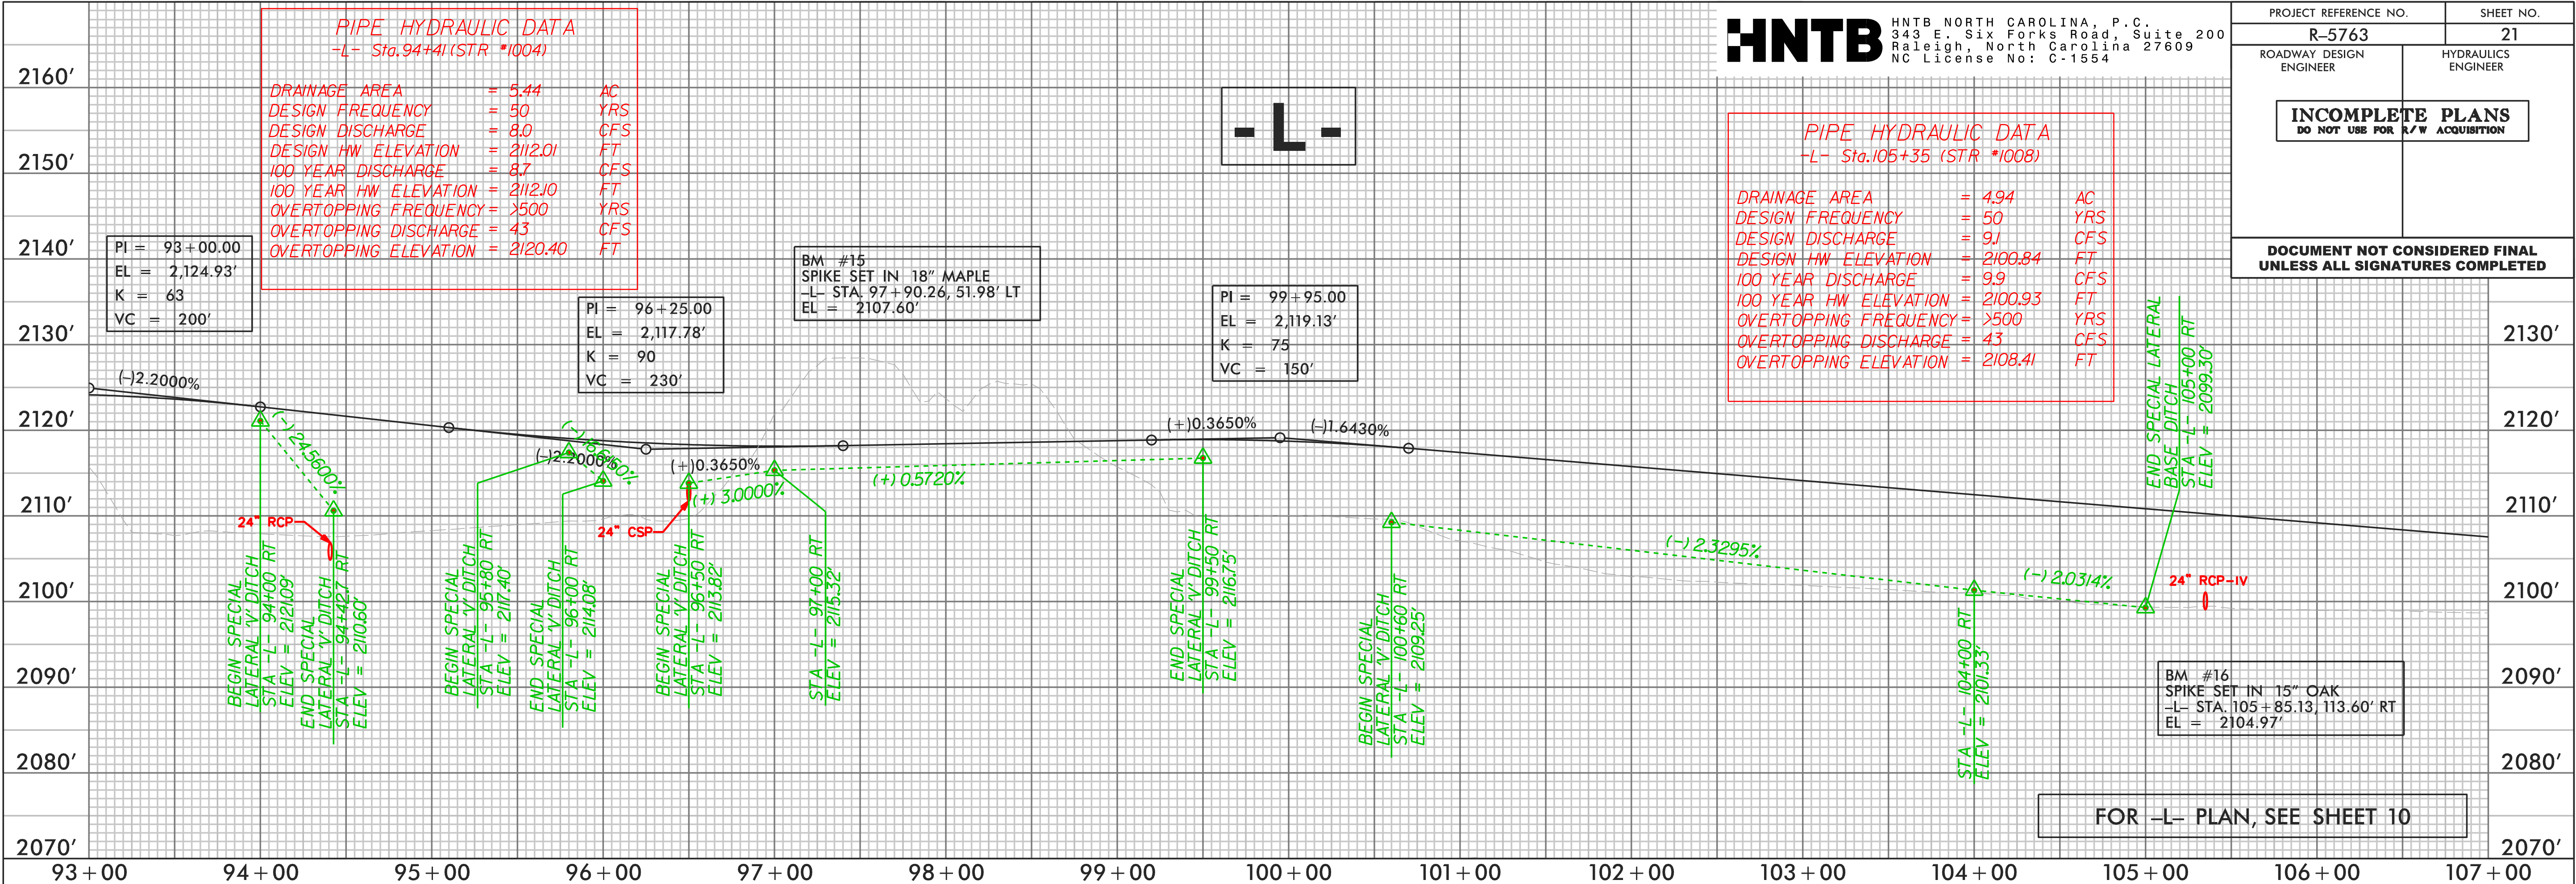


SYTIME\$\$\$\$
DESIGN\$\$\$\$
USERNAME\$\$\$\$

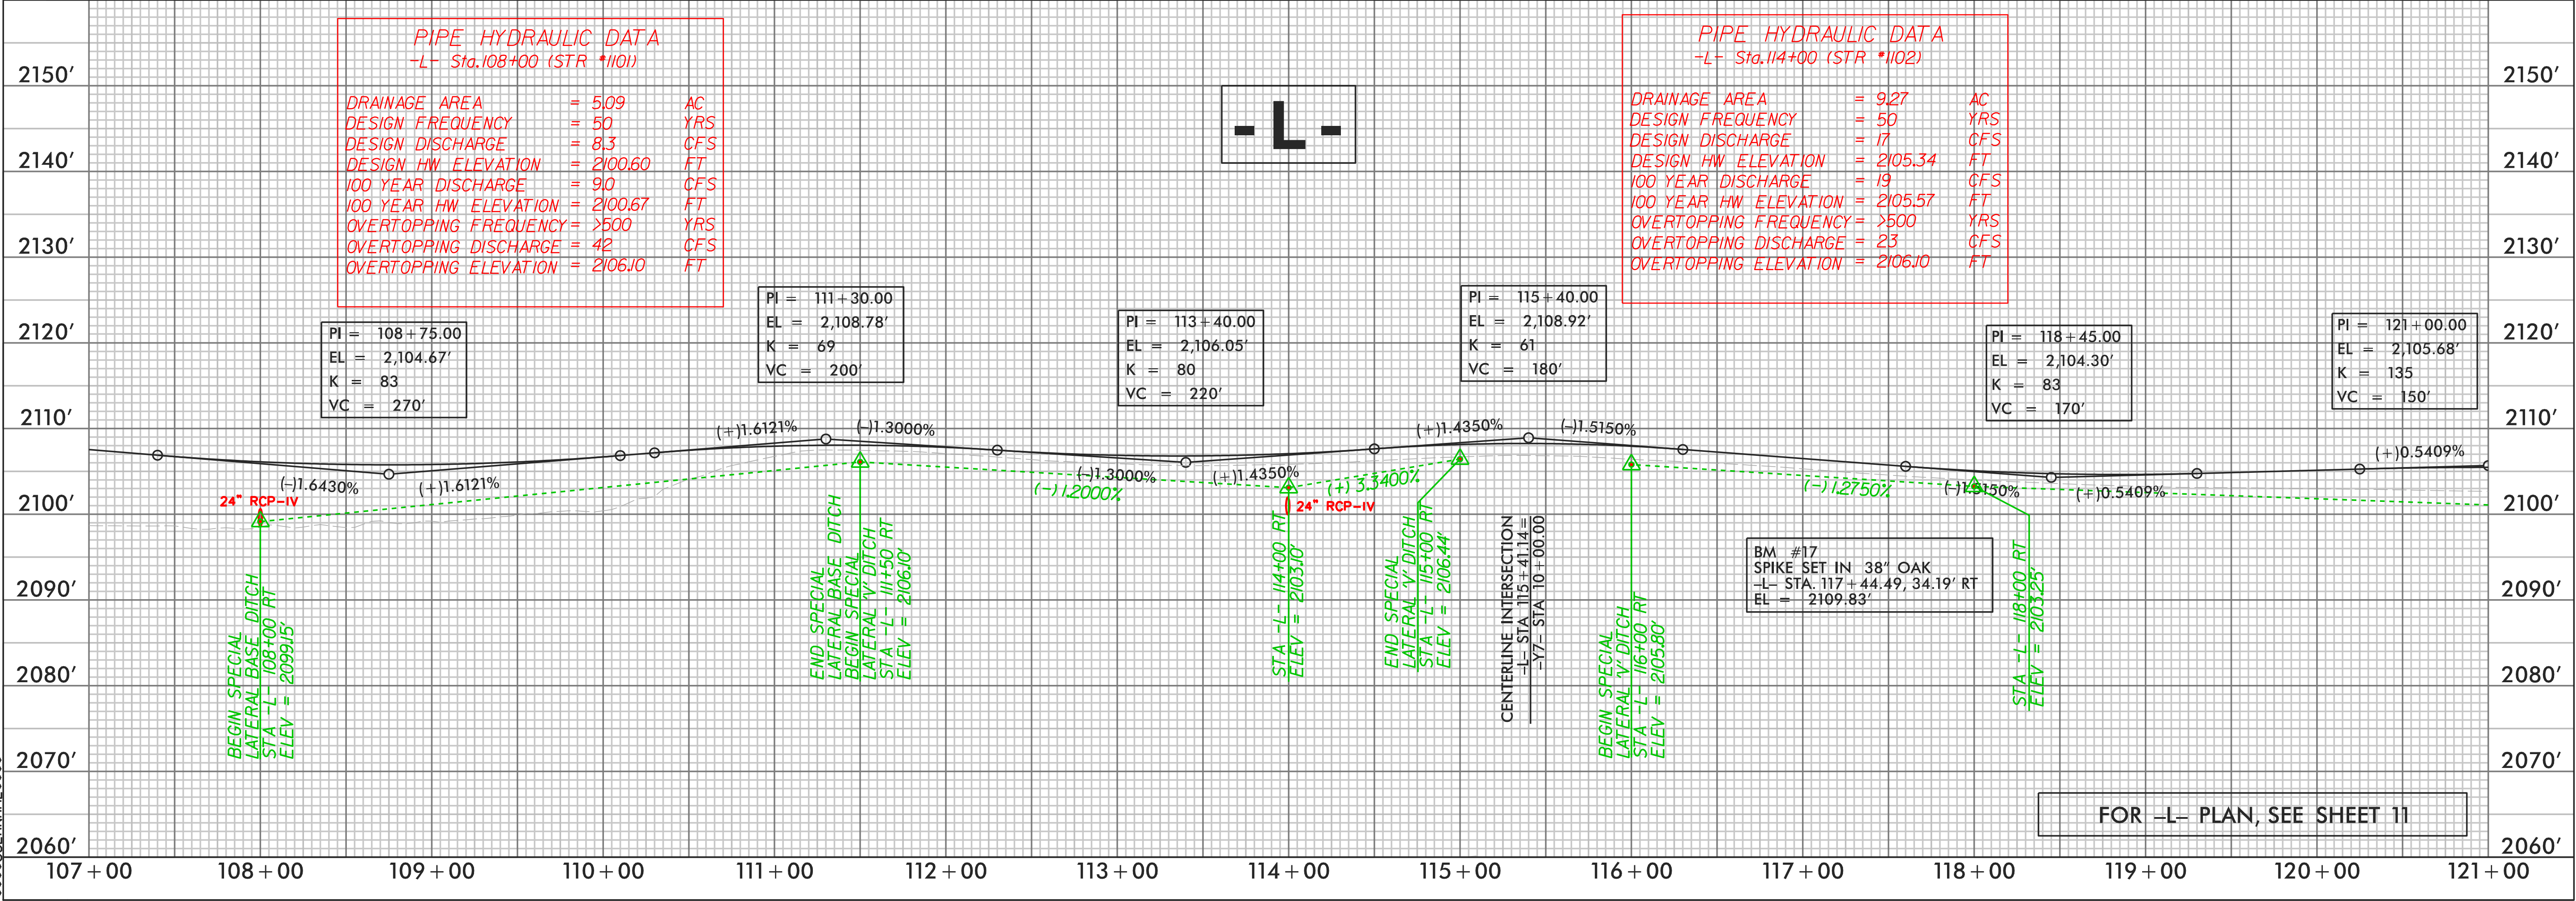

5/28/99

SYTIME\$\$\$\$
DESIGN\$\$\$\$
USERNAME\$\$\$\$

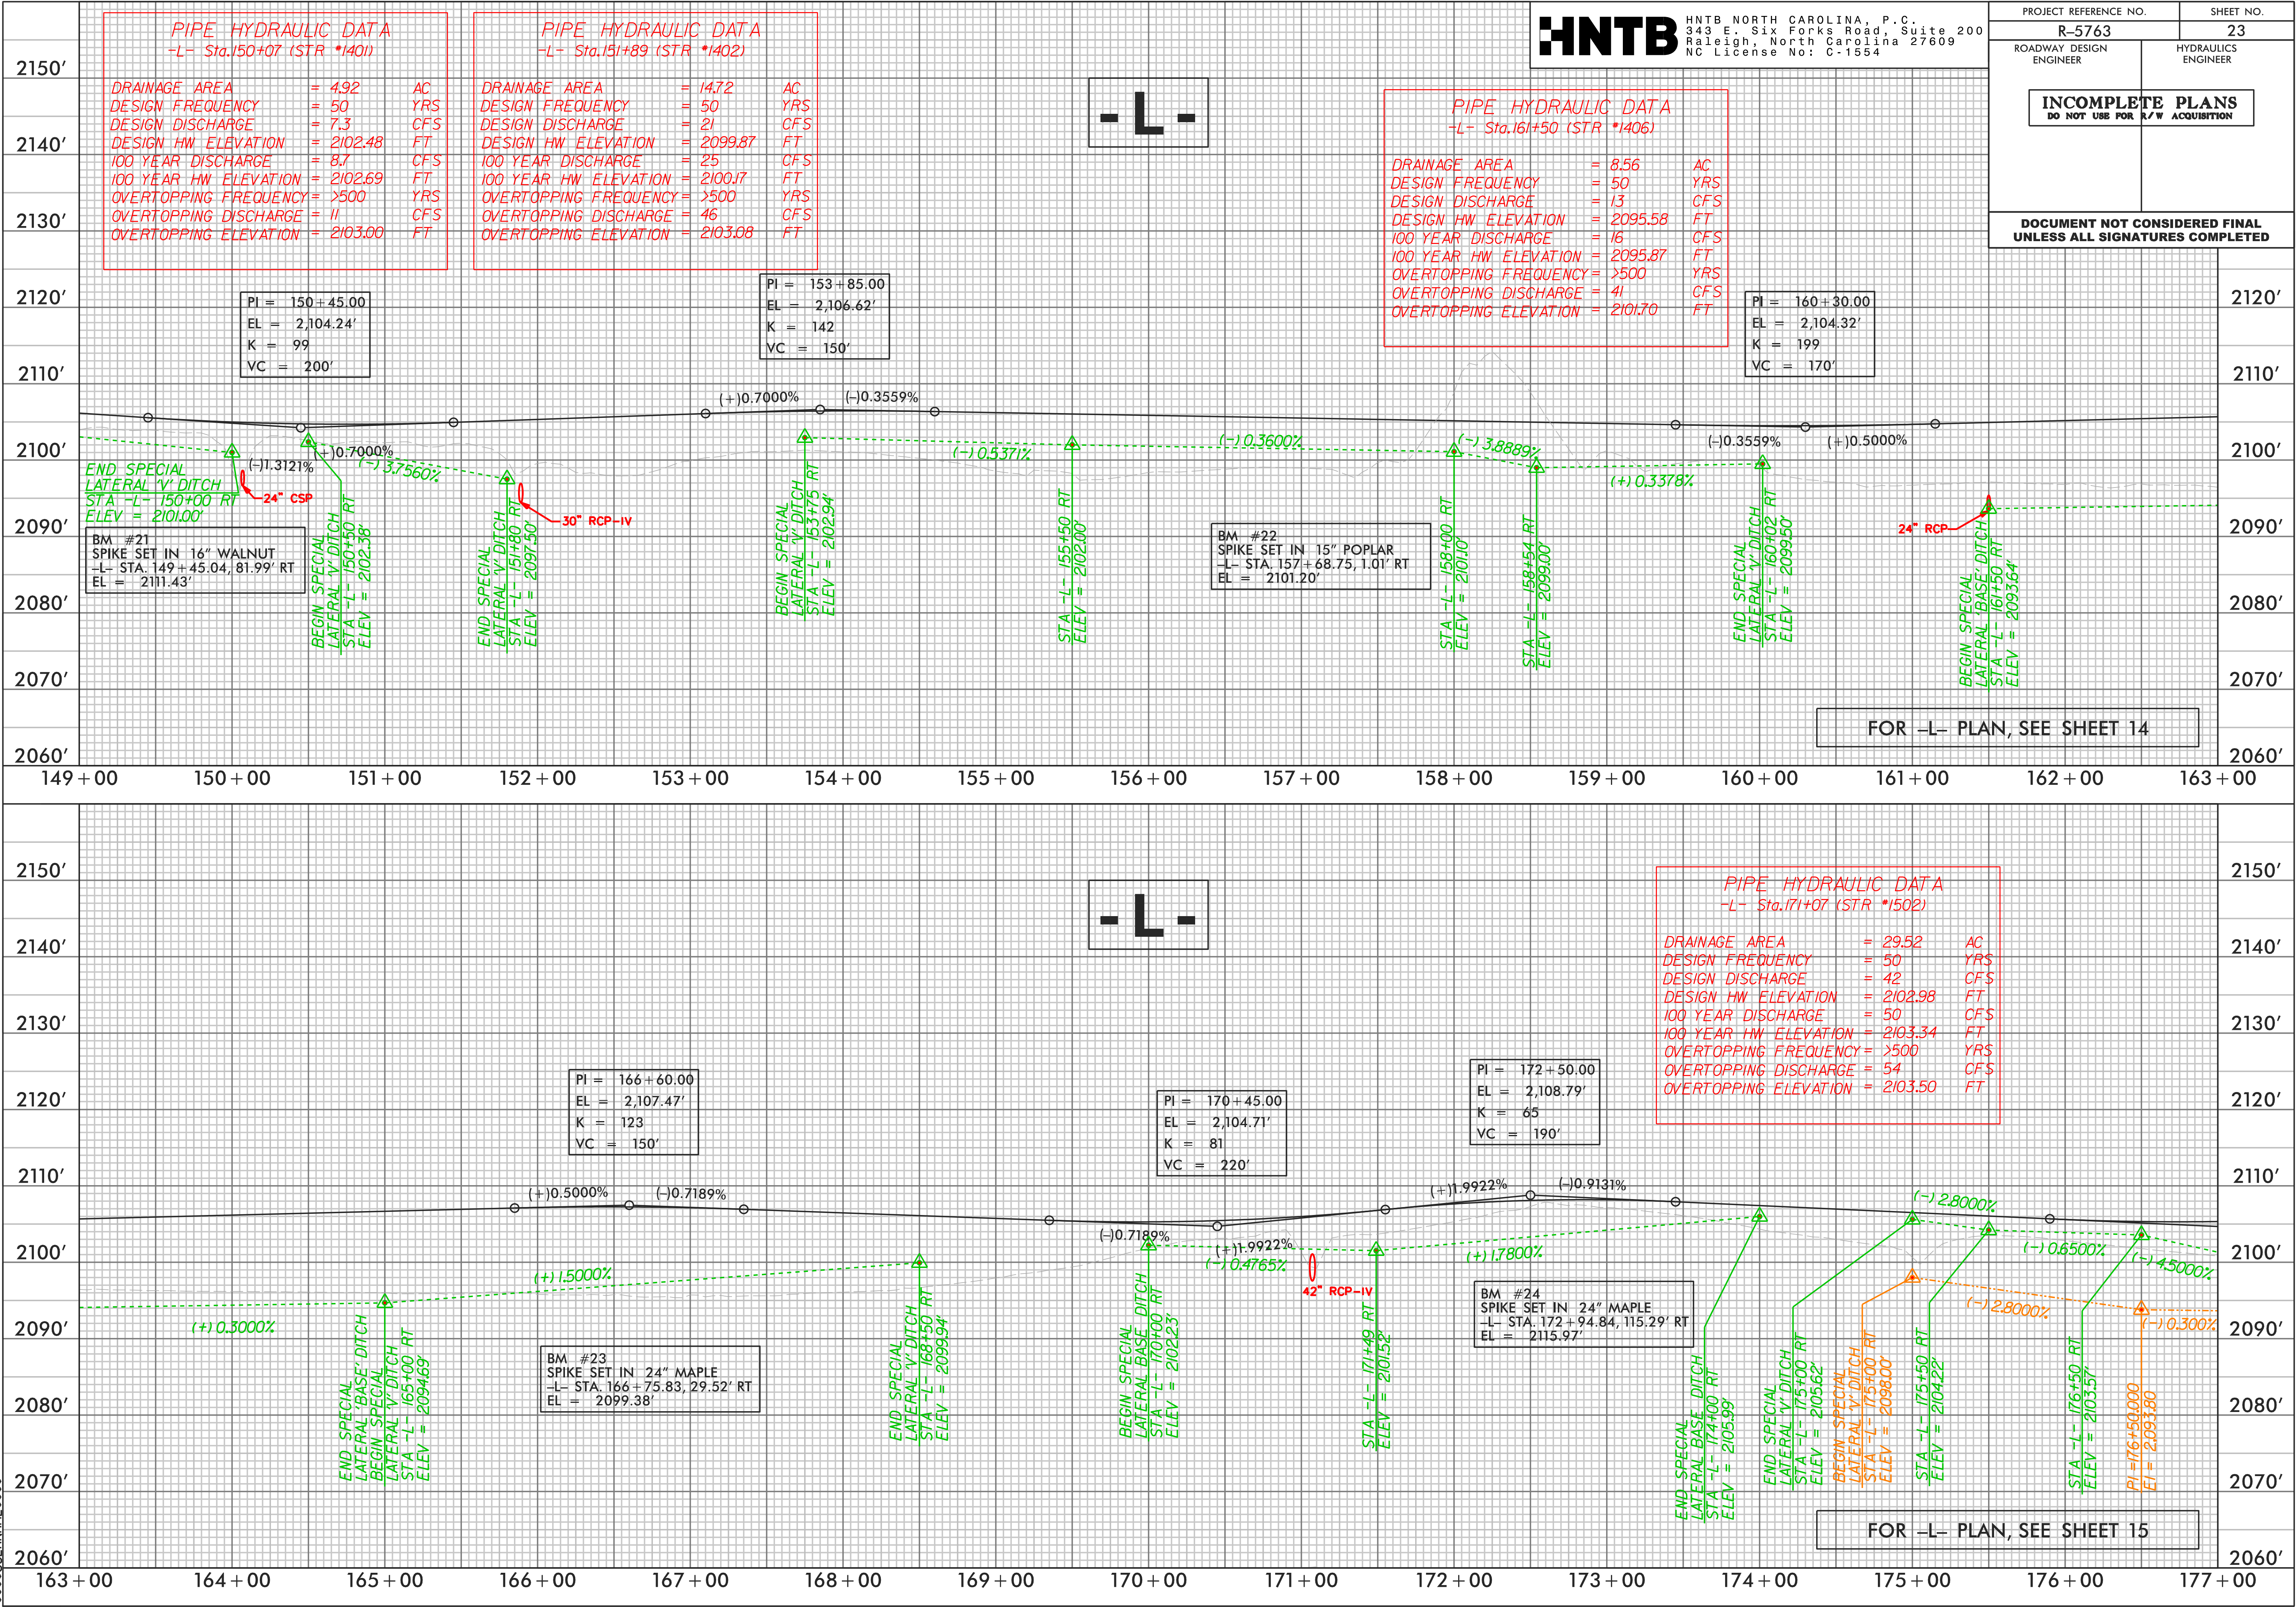

5/28/99

HNTB

HNTB NORTH CAROLINA, P.C.
343 E. Six Forks Road, Suite 200
Raleigh, North Carolina 27609
NC License No: C-1554

PROJECT REFERENCE NO.

R-5763

SHEET NO.

24

ROADWAY DESIGN
ENGINEER

HYDRAULICS
ENGINEER

INCOMPLETE PLANS
DO NOT USE FOR R/W ACQUISITION

DOCUMENT NOT CONSIDERED FINAL
UNLESS ALL SIGNATURES COMPLETED

BRIDGE HYDRAULIC DATA

DESIGN DISCHARGE	= 21400	CFS
DESIGN FREQUENCY	= 50	YRS
DESIGN HW ELEVATION	= 2102.6	FT
BASE DISCHARGE	= 25400	CFS
BASE FREQUENCY	= 100	YRS
BASE HW ELEVATION	= 2103.7	FT
OVERTOPPING DISCHARGE	>	CFS
OVERTOPPING FREQUENCY	>	YRS
OVERTOPPING ELEVATION	= 2101.75	FT
DATE OF SURVEY	=	
W.S. ELEVATION	=	FT
AT DATE OF SURVEY	=	

FOR -L- PLAN, SEE SHEET 16



SYSTEMS AND
CONSTRUCTION
SEQUENCE

PIPE HYDRAULIC DATA
-L- Sta. 197+78 (STR *1701 & *1702)


DRAINAGE AREA	= 2.61	AC
DESIGN FREQUENCY	= 50	YRS
DESIGN DISCHARGE	= 11	CFS
DESIGN HW ELEVATION	= 2100.58	FT
100 YEAR DISCHARGE	= 13	CFS
100 YEAR HW ELEVATION	= 2100.75	FT
OVERTOPPING FREQUENCY	= 100	YRS
OVERTOPPING DISCHARGE	= 16	CFS
OVERTOPPING ELEVATION	= 2101.14	FT

FOR -L- PLAN, SEE SHEET 17


5/28/99

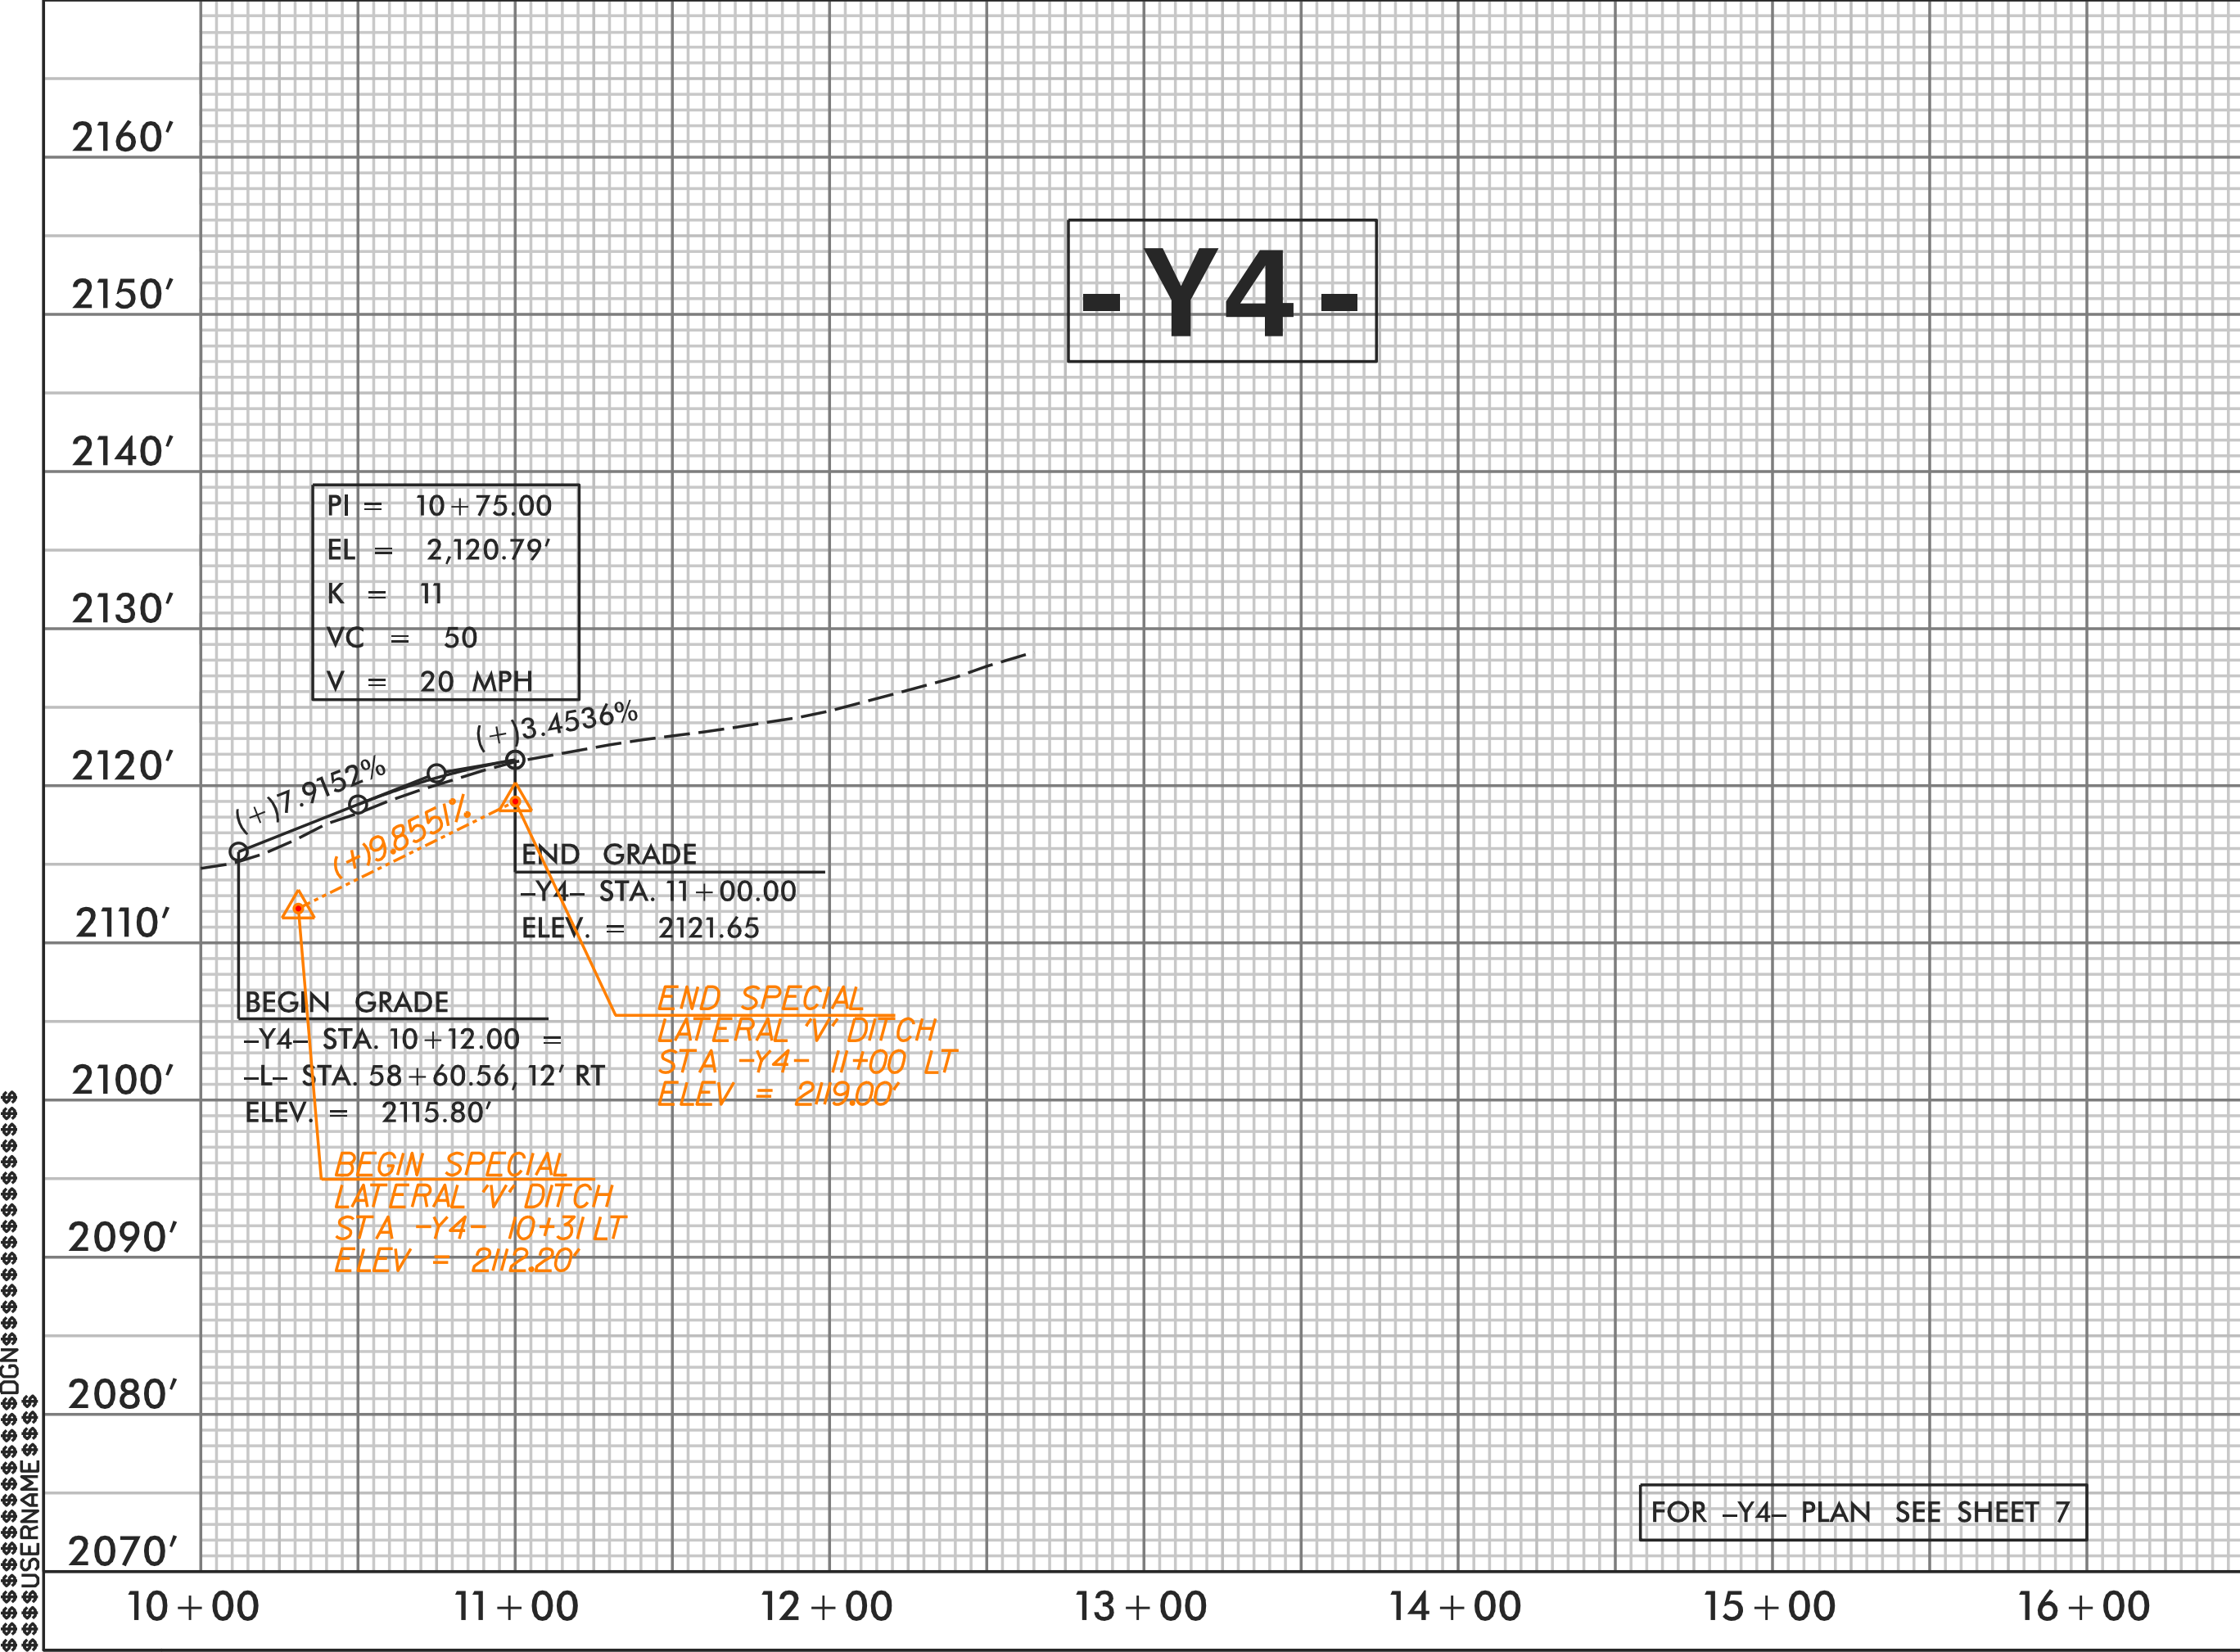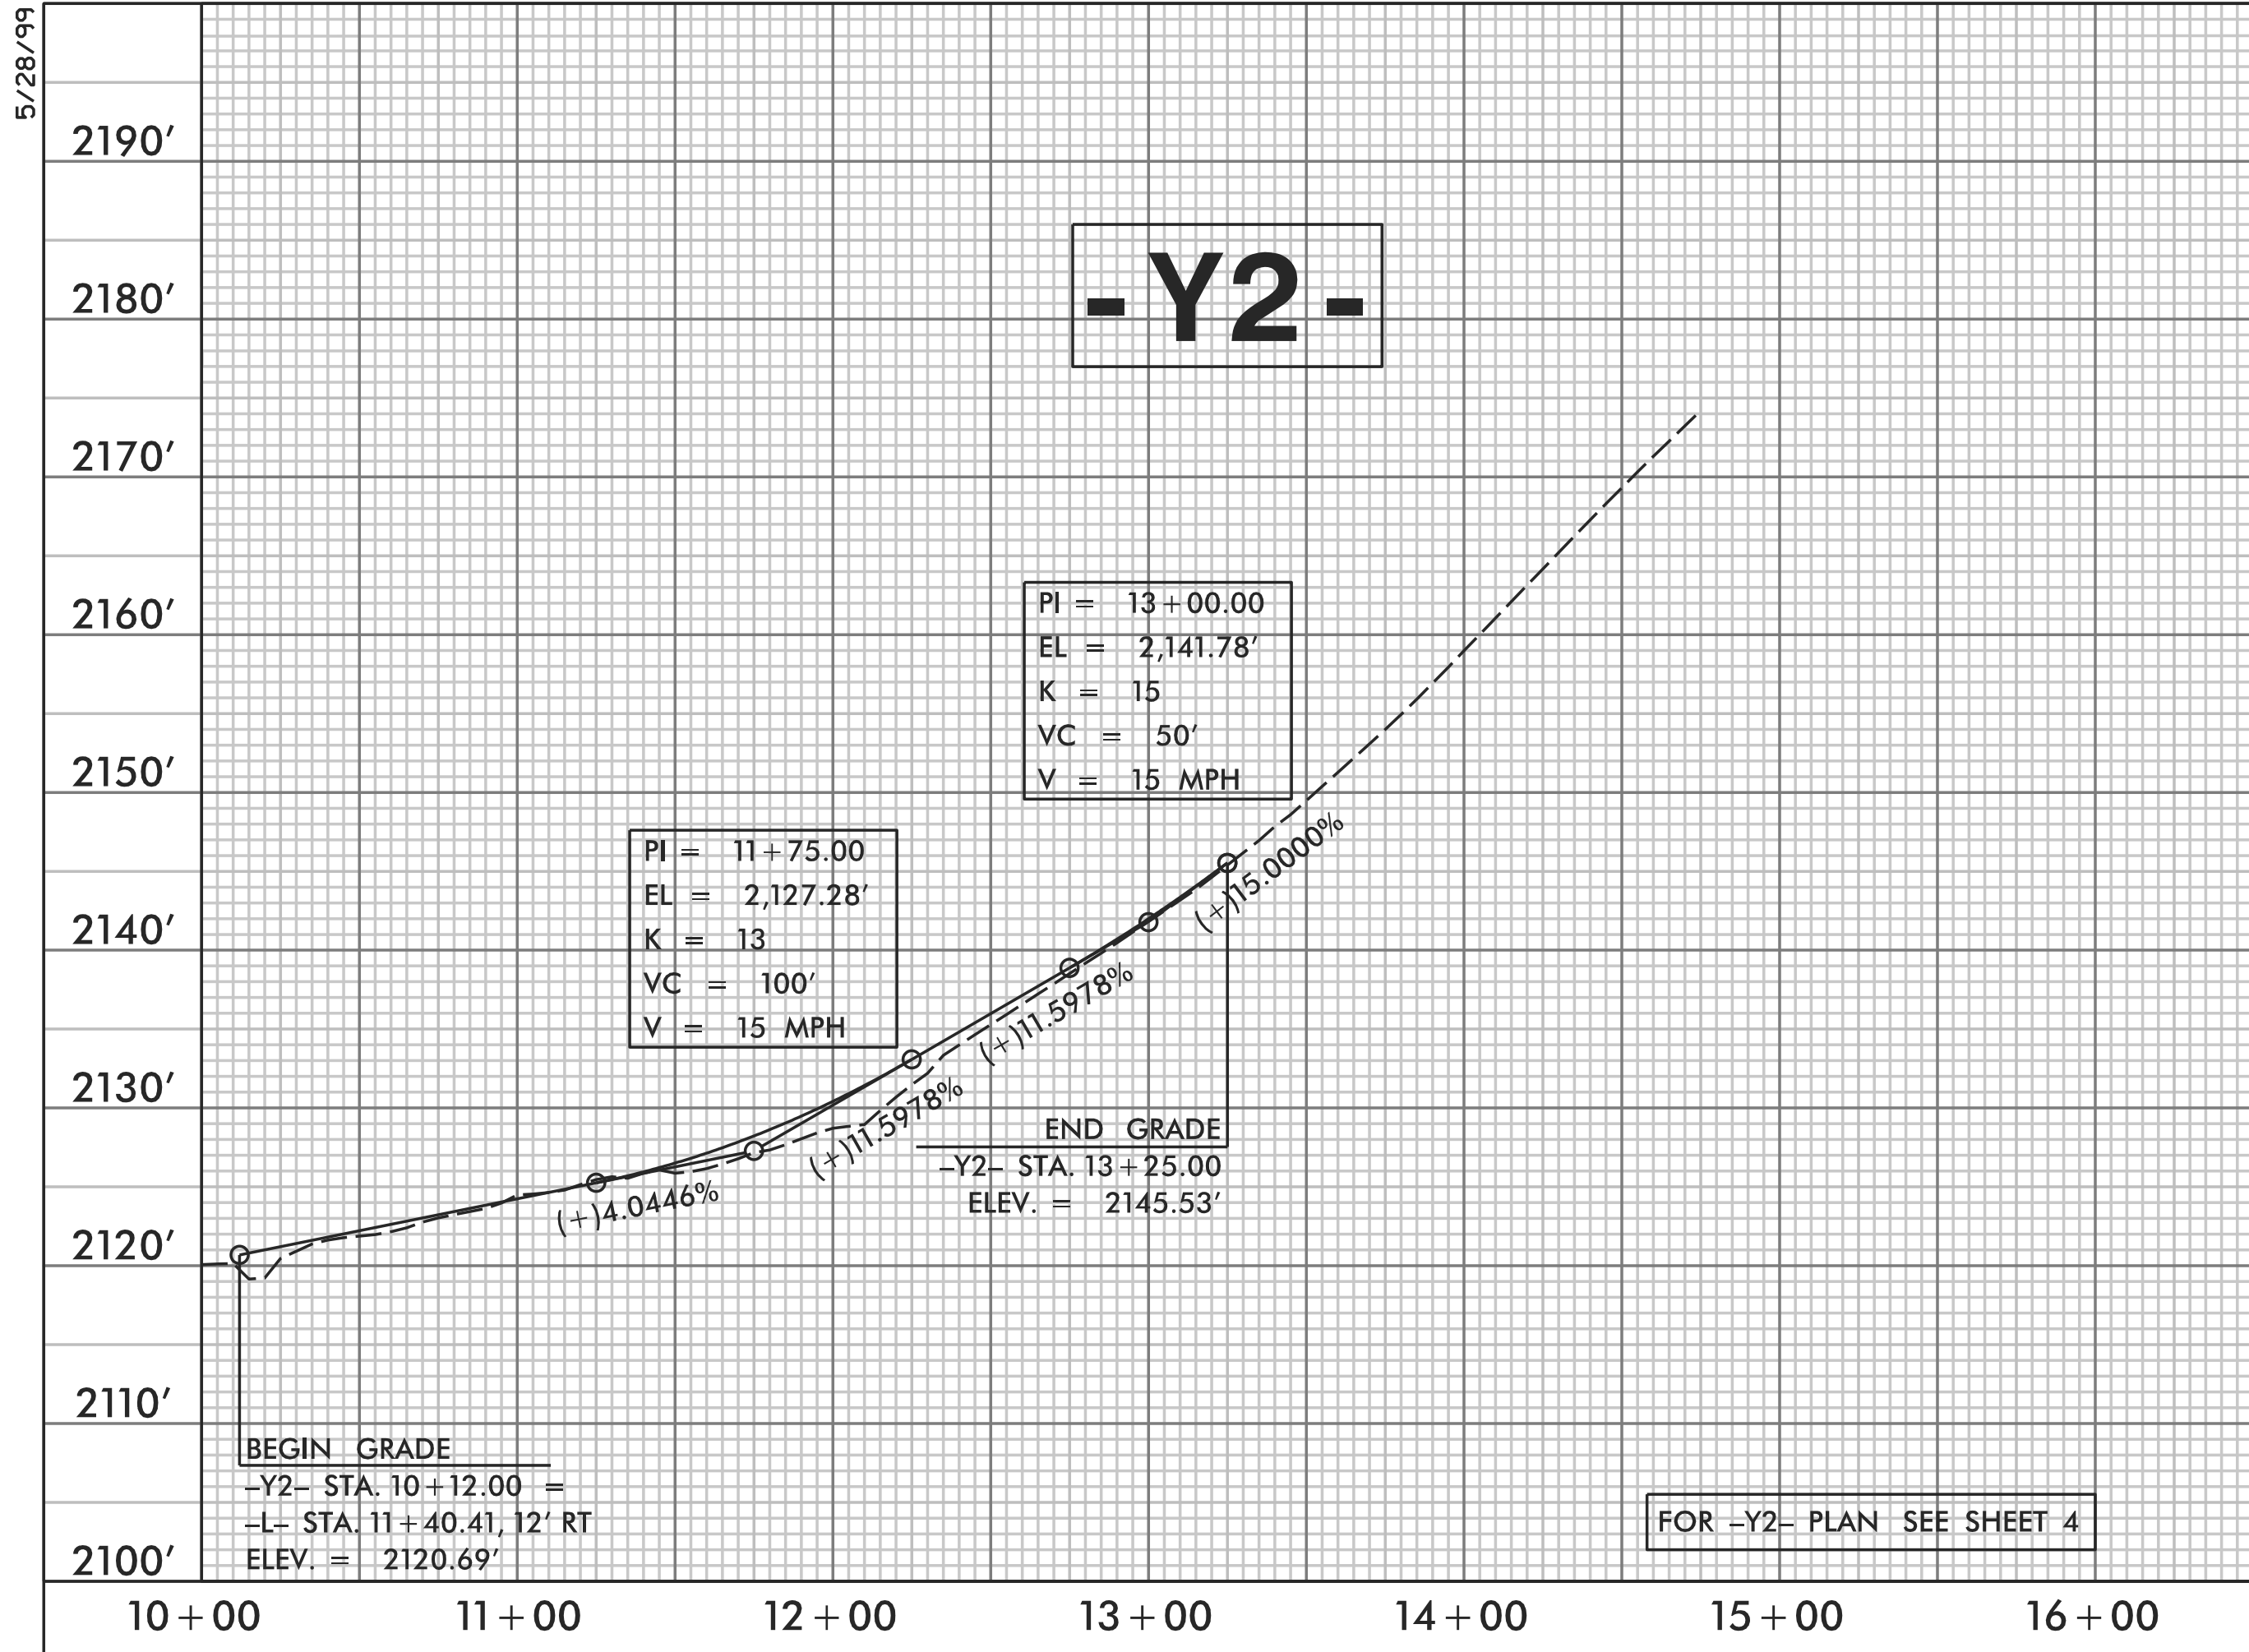

HNTB NORTH CAROLINA, P.C.
343 E. Six Forks Road, Suite 200
Raleigh, North Carolina 27609
NC License No: C-1554

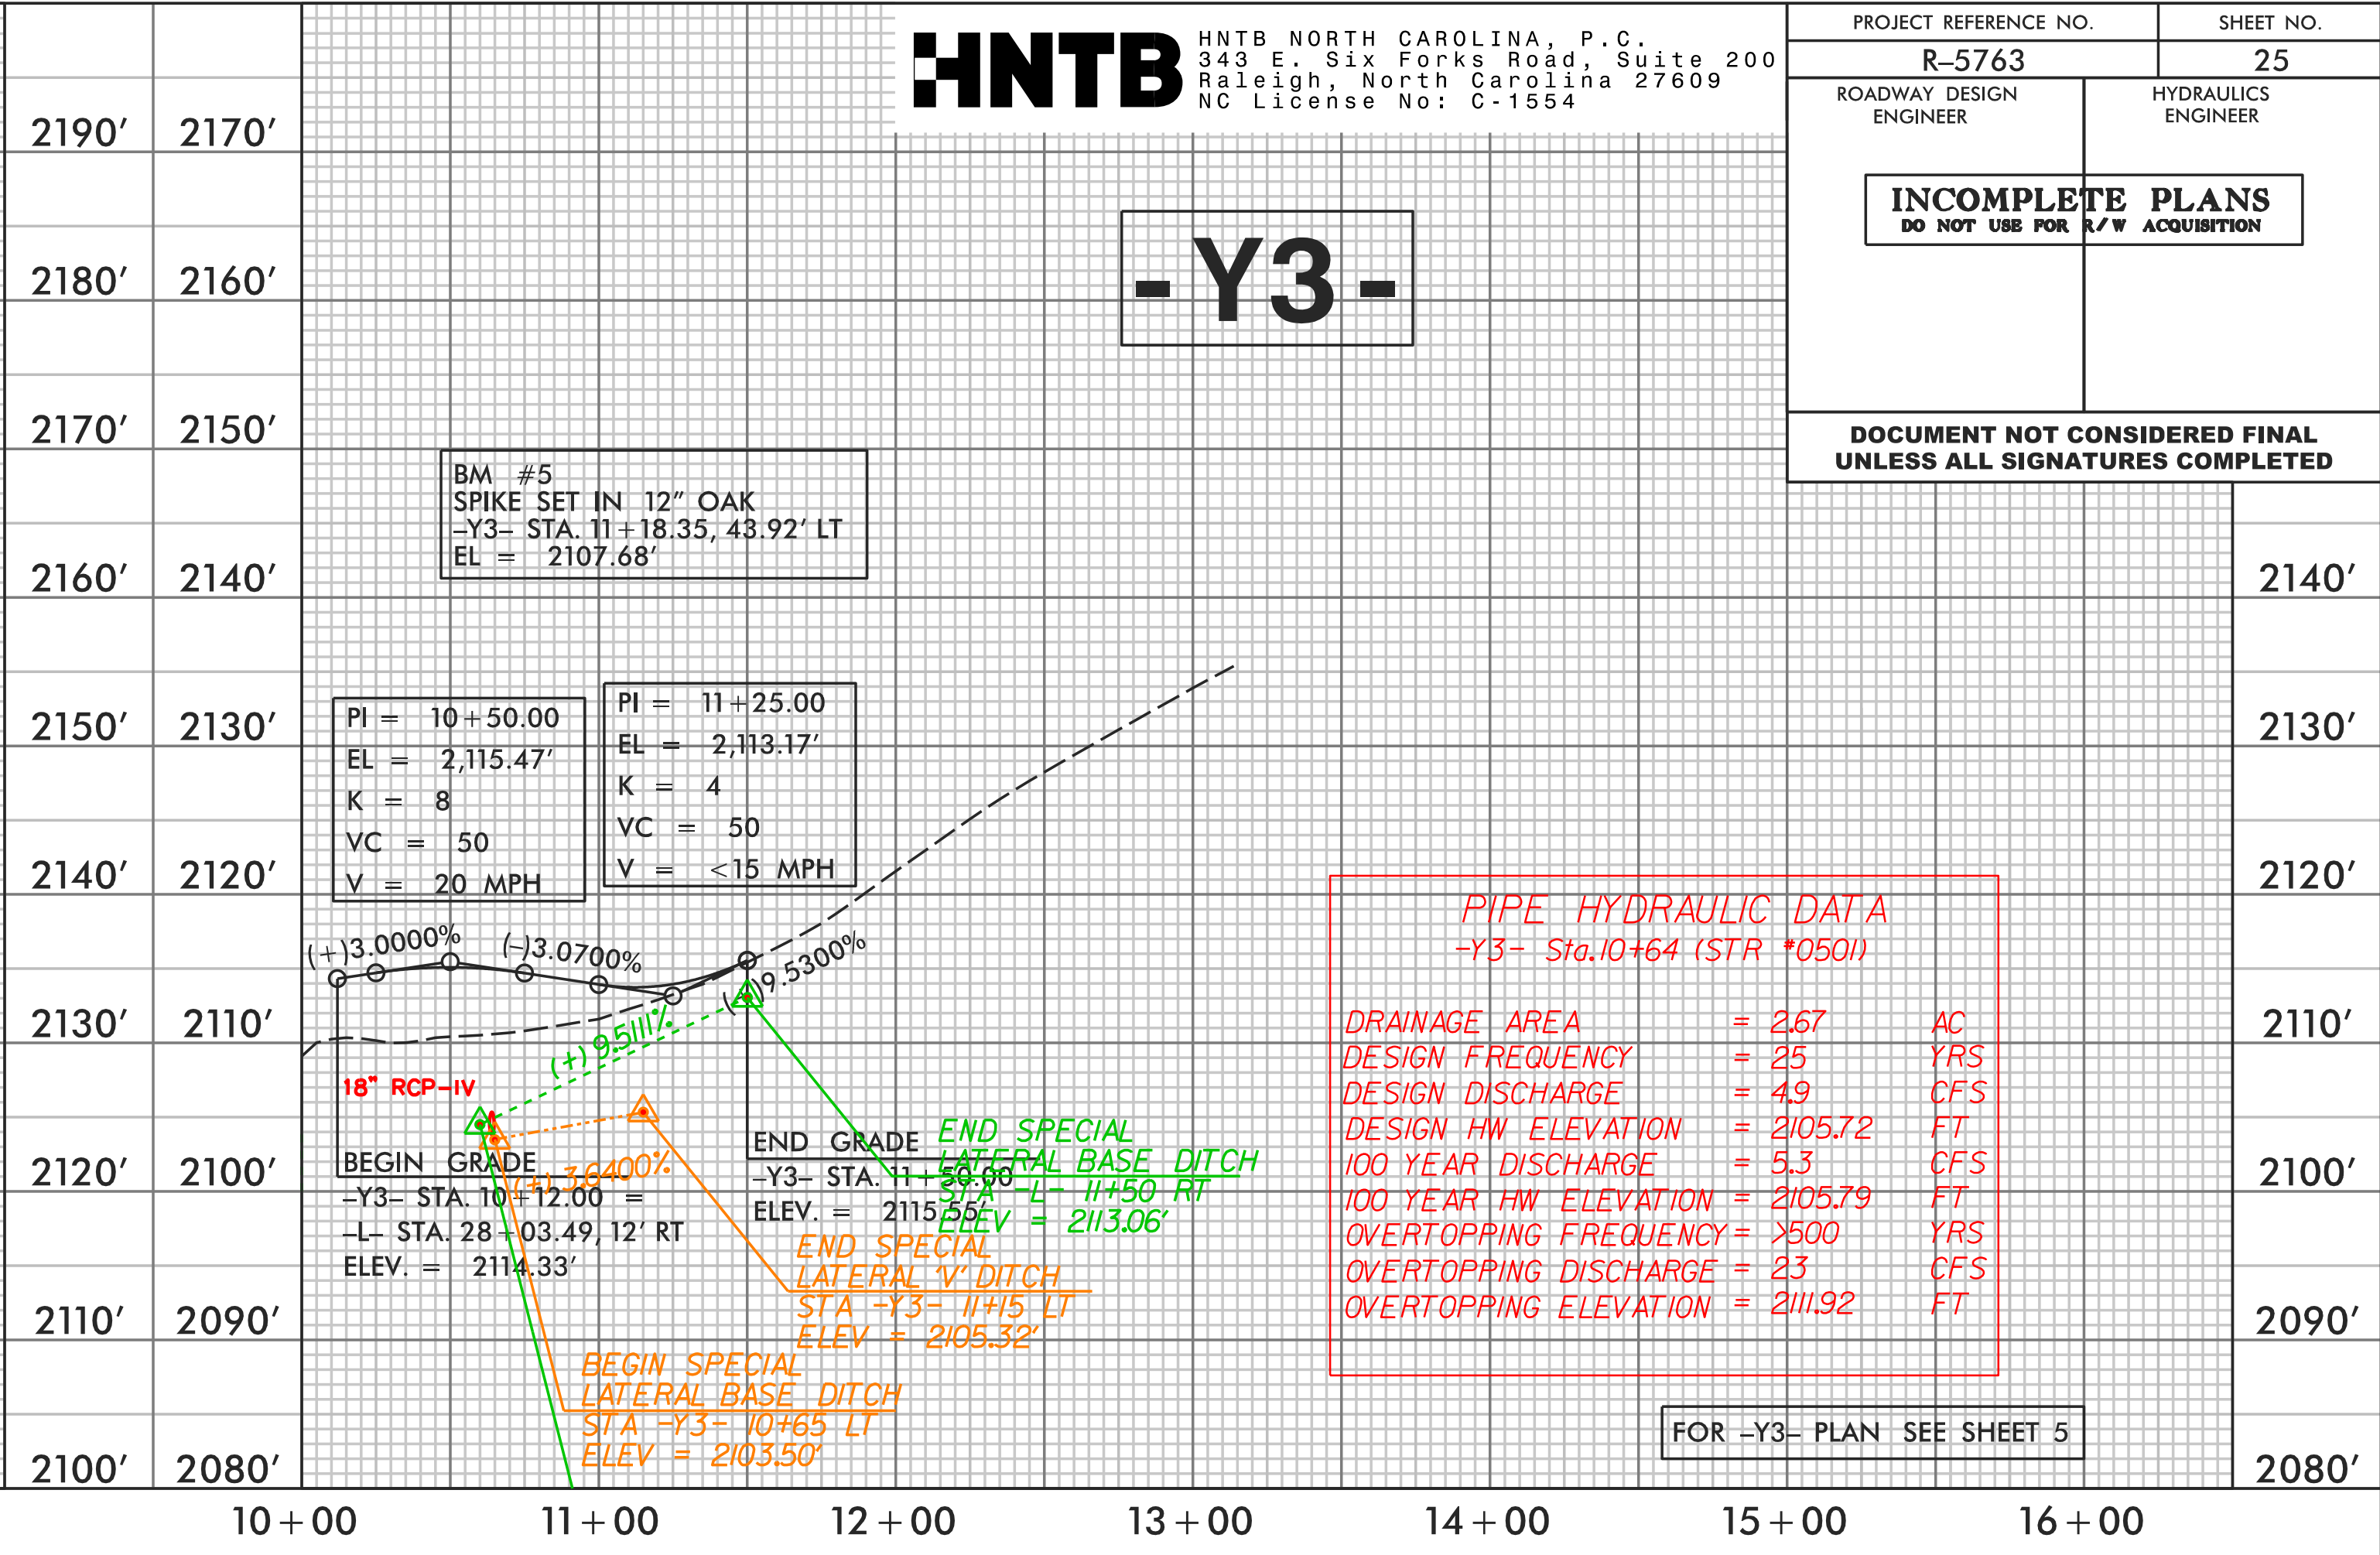


PIPE HYDRAULIC DATA -Y3- Sta.10+64 (STR #0501)		
DRAINAGE AREA	= 2.67	AC
DESIGN FREQUENCY	= 25	YRS
DESIGN DISCHARGE	= 4.9	CFS
DESIGN HW ELEVATION	= 2105.72	FT
100 YEAR DISCHARGE	= 5.3	CFS
100 YEAR HW ELEVATION	= 2105.79	FT
OVERTOPPING FREQUENCY	= >500	YRS
OVERTOPPING DISCHARGE	= 23	CFS
OVERTOPPING ELEVATION	= 2111.92	FT

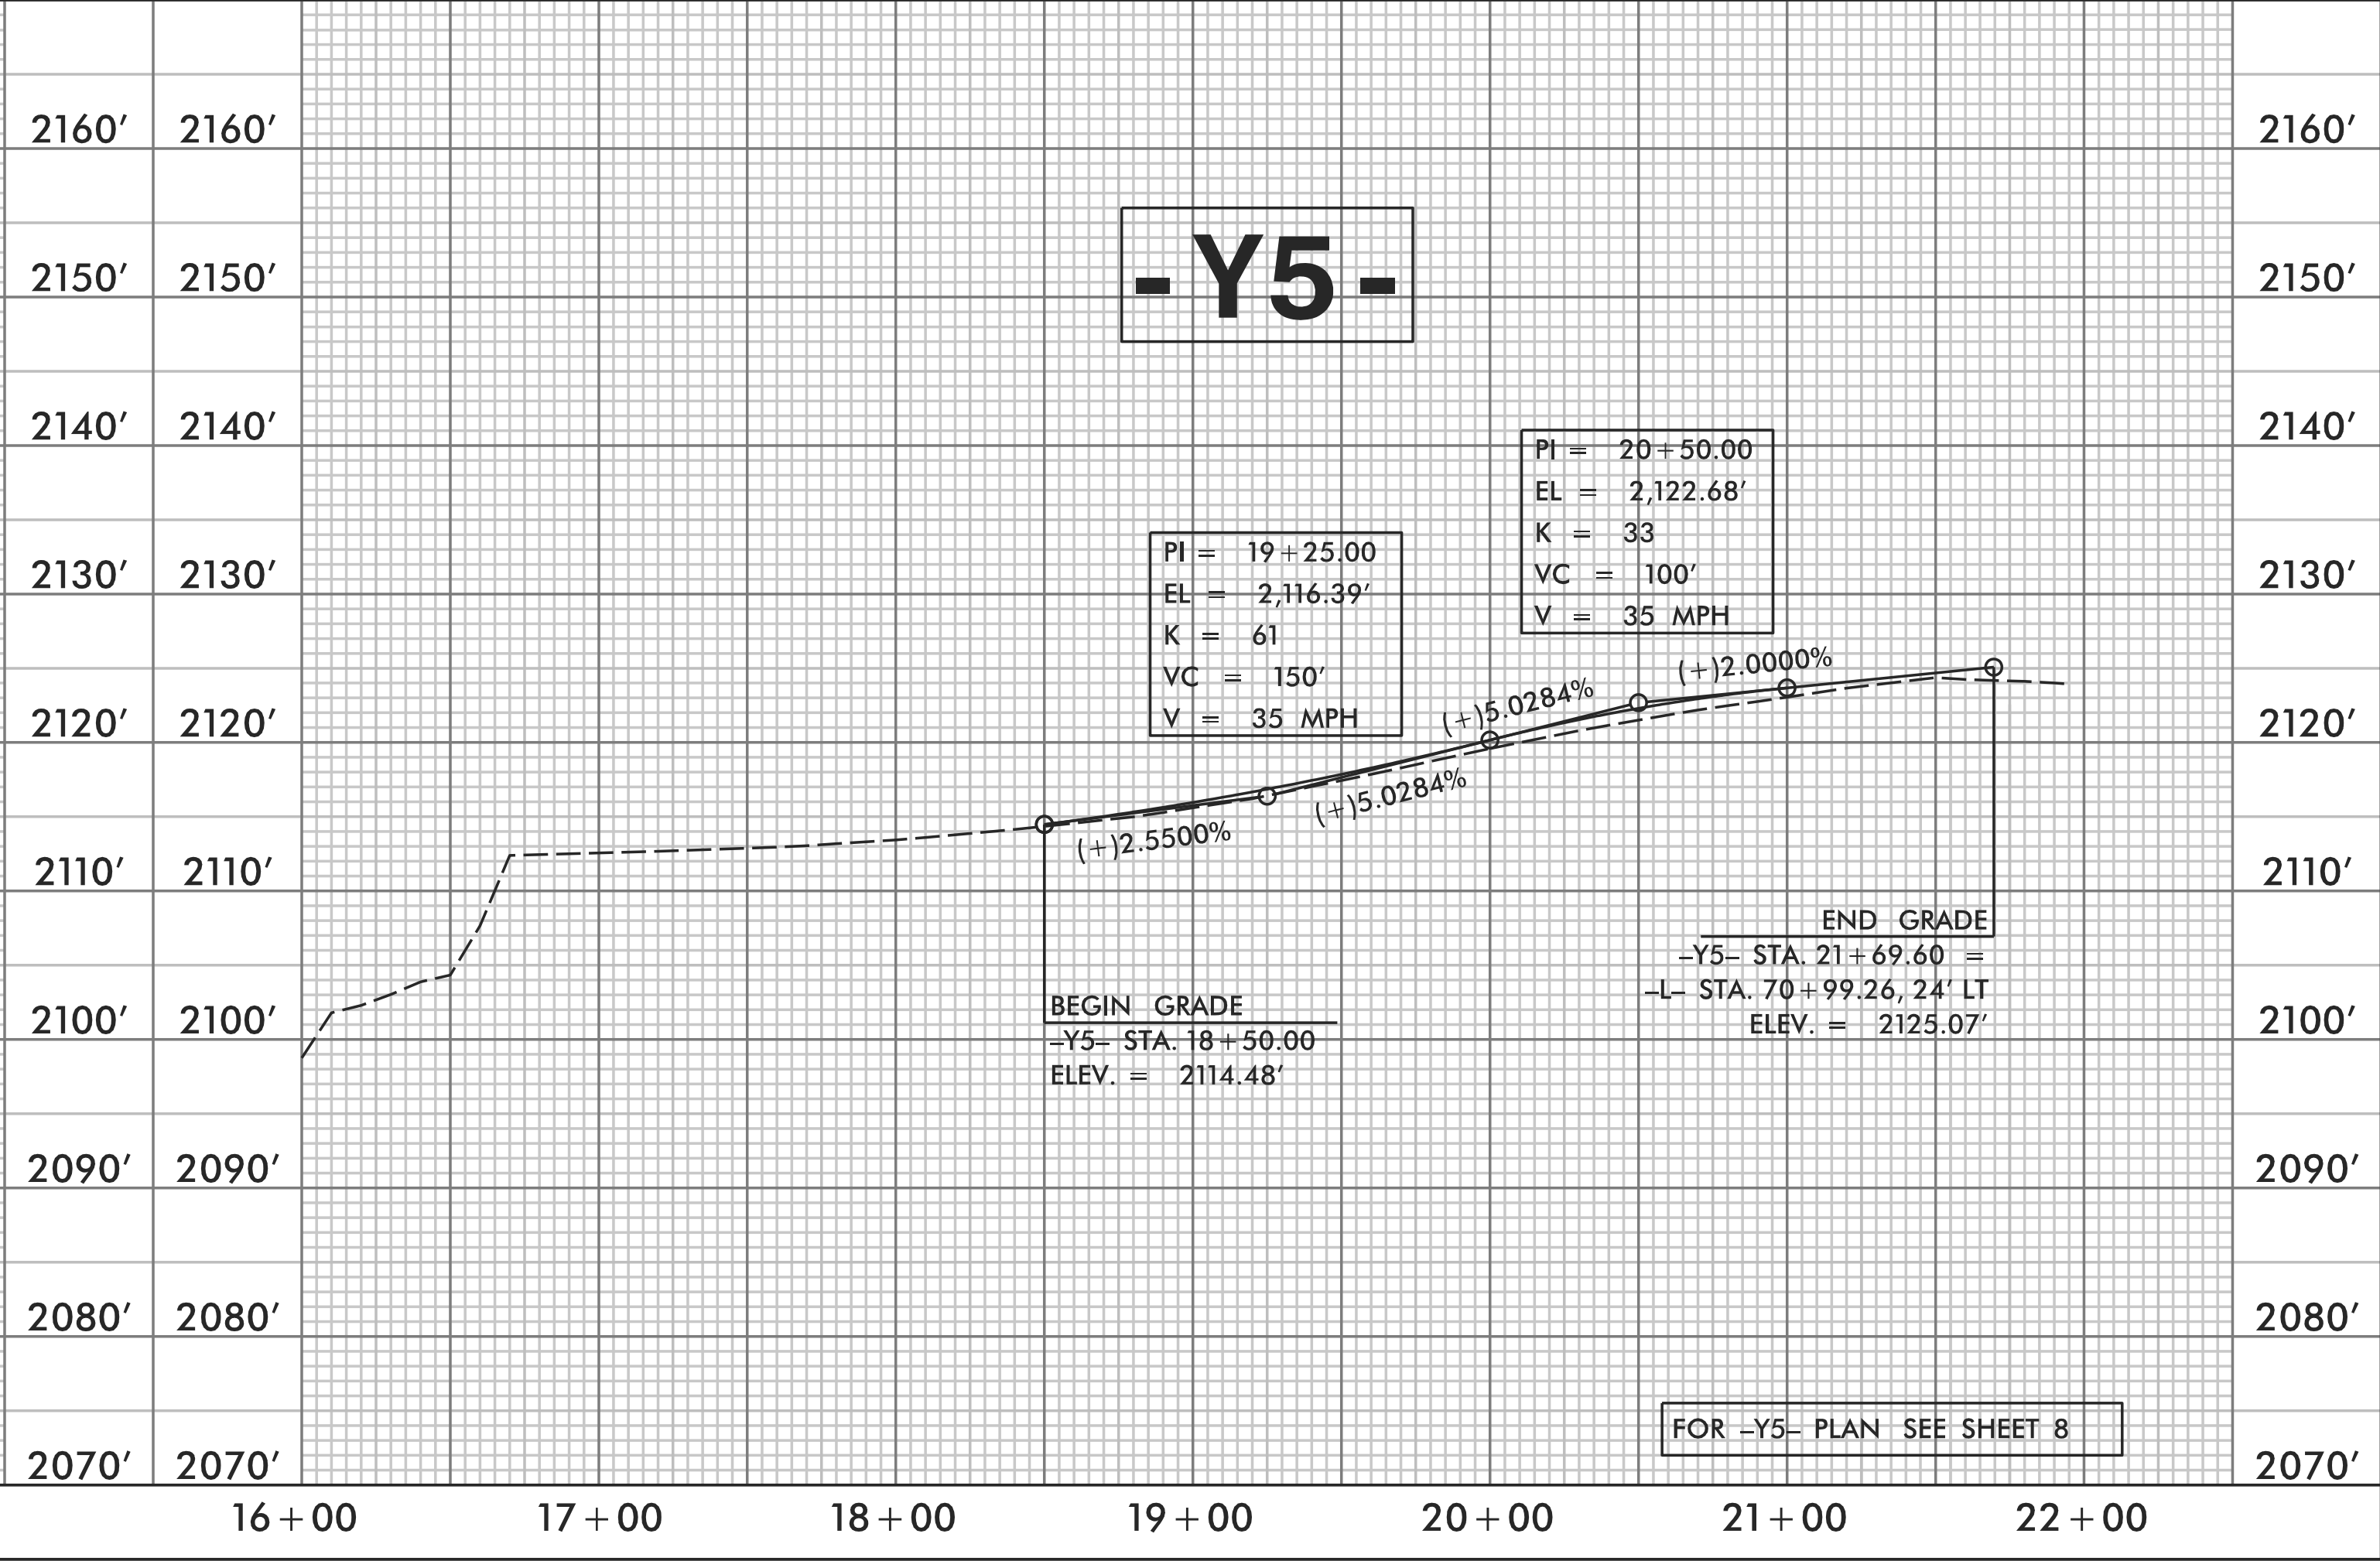

PROJECT REFERENCE NO.		SHEET NO.
R-5763		25
ROADWAY DESIGN ENGINEER	HYDRAULICS ENGINEER	
INCOMPLETE PLANS DO NOT USE FOR R/W ACQUISITION		
DOCUMENT NOT CONSIDERED FINAL UNLESS ALL SIGNATURES COMPLETED		

SYSTEMS SECTION
SERIALS

5/28/99

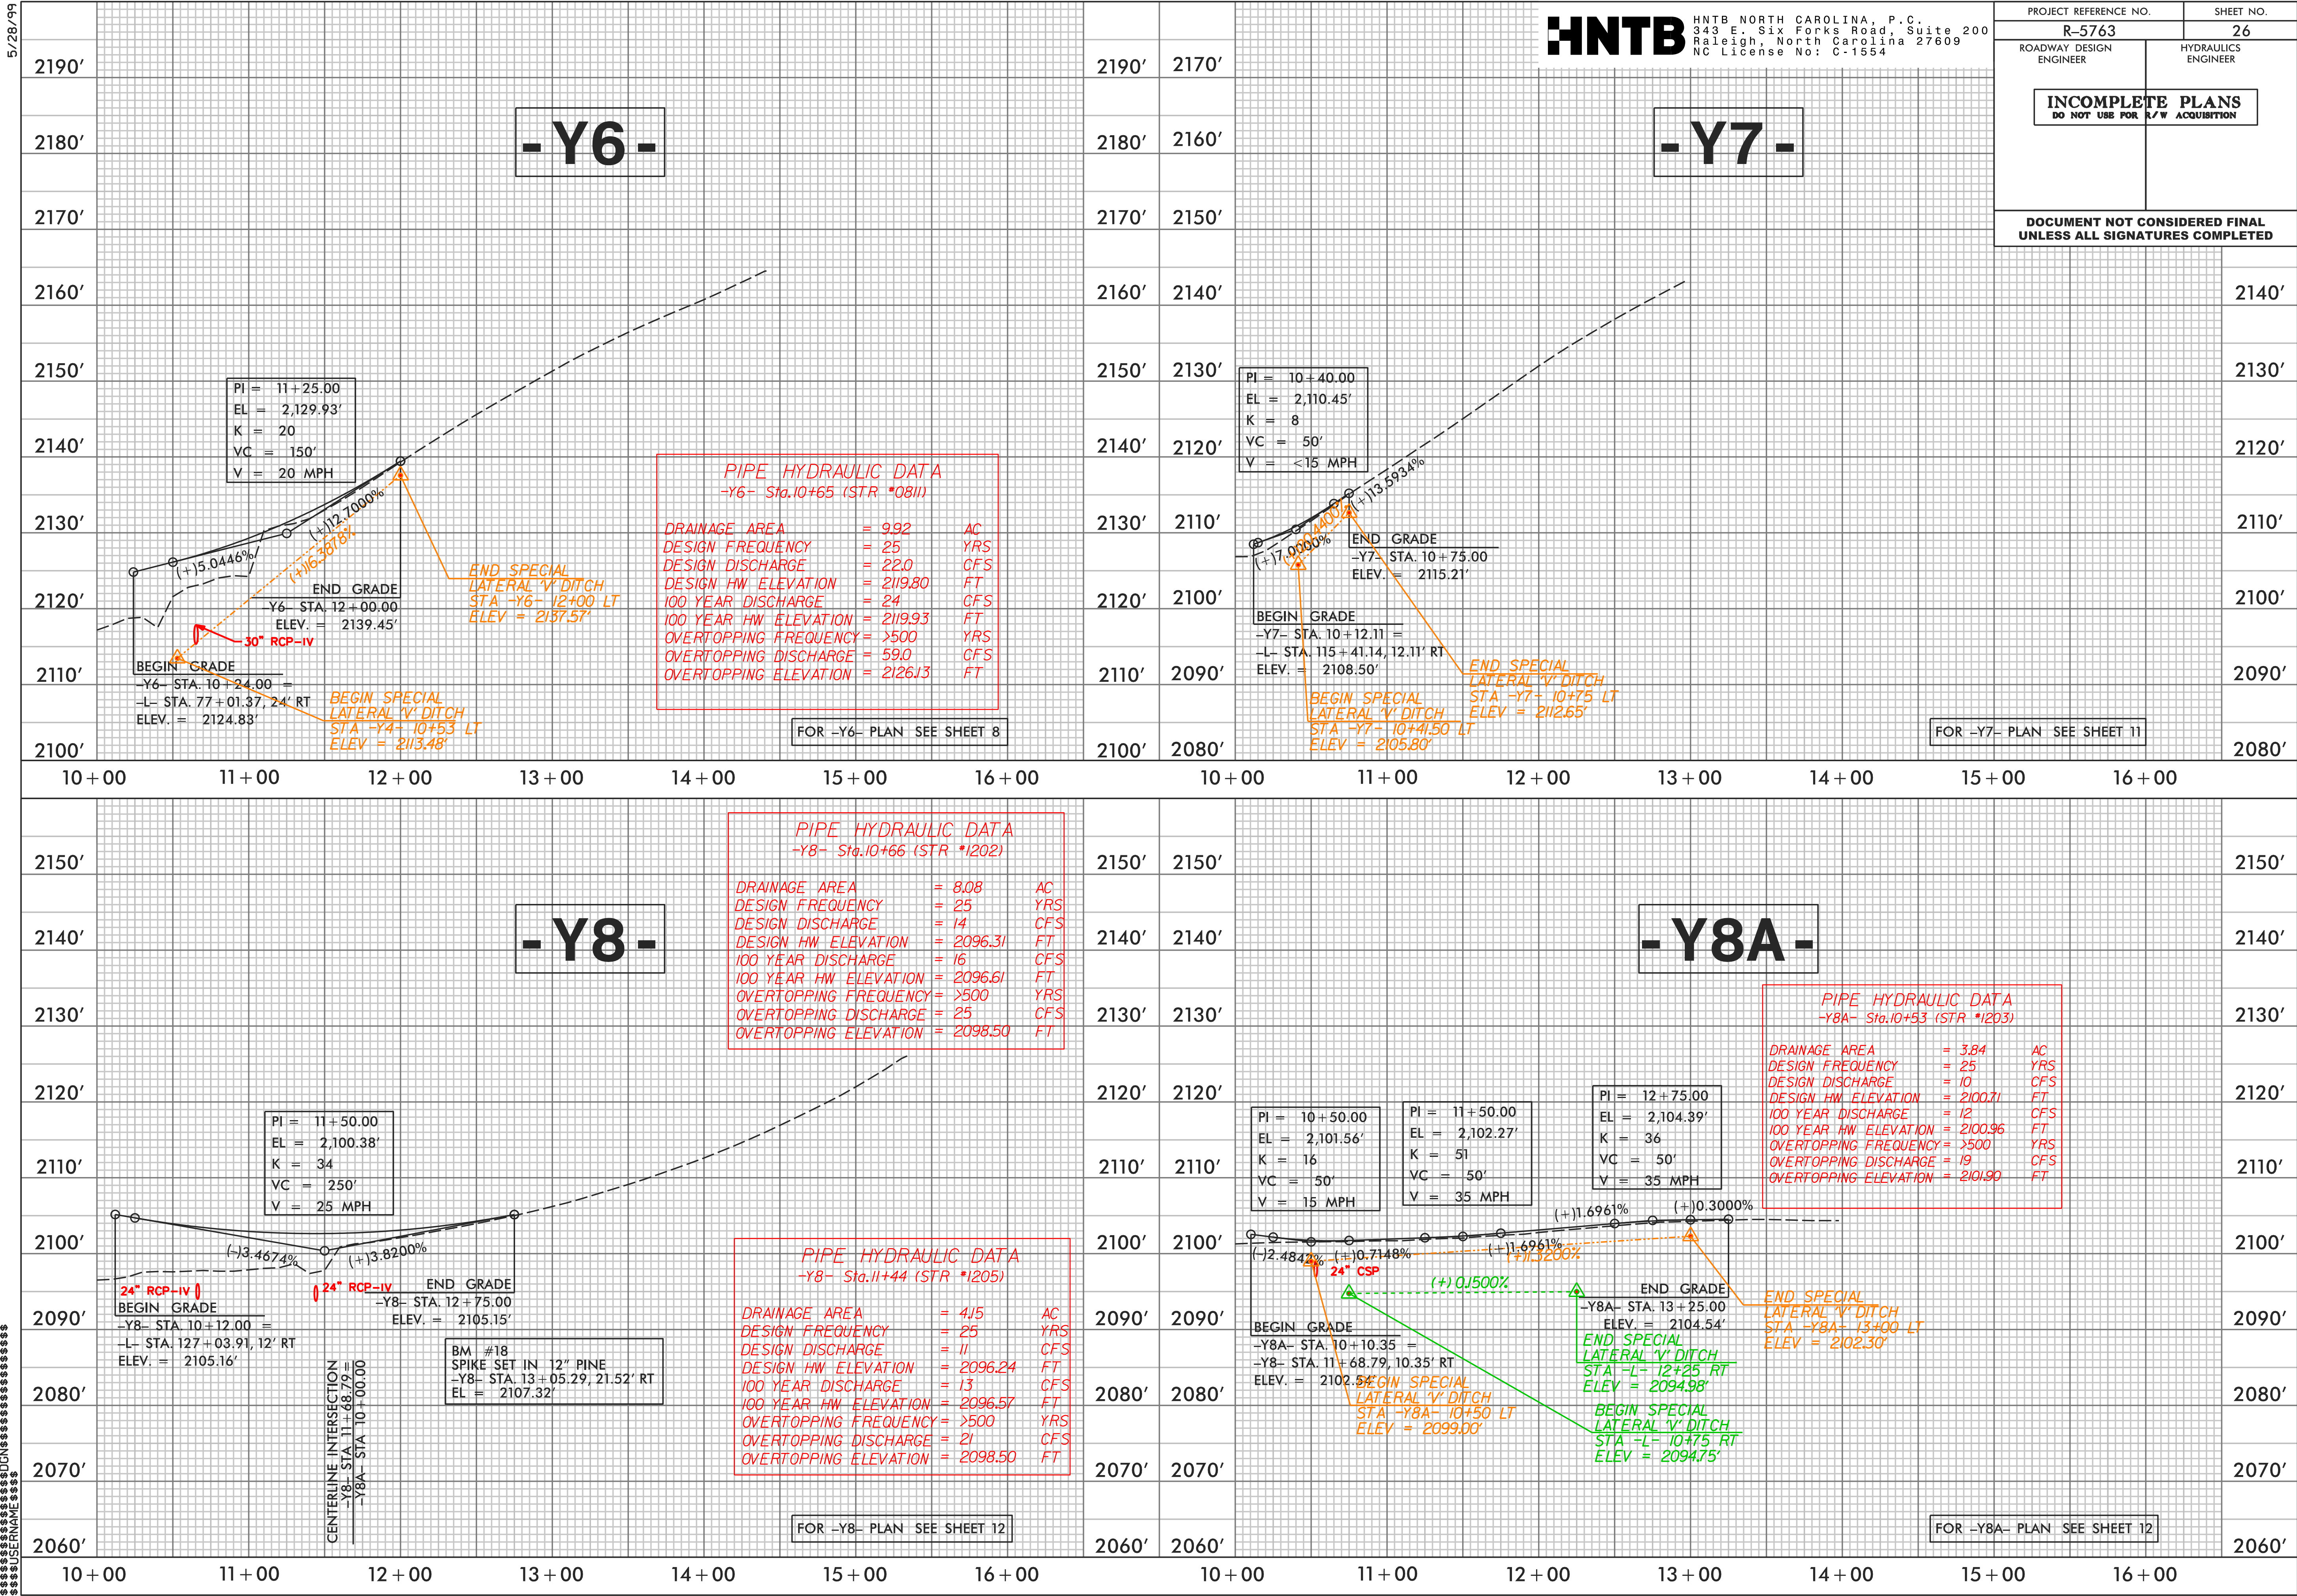

5/28/99

