



STATE OF NORTH CAROLINA  
DEPARTMENT OF TRANSPORTATION

MICHAEL F. EASLEY  
GOVERNOR

LYNDO TIPPETT  
SECRETARY

April 29, 2008

U. S. Army Corps of Engineers  
Asheville Regulatory Field Office  
151 Patton Avenue, Room 208  
Asheville, NC 28801

ATTENTION: Mr. David Baker  
NCDOT Coordinator

Dear Sir:

SUBJECT: Supplemental Information to the **Regional General Permit 31 and Section 401 Water Quality Certification** for the proposed widening of NC 146 (Long Shoals Road) from west of SR 2501 (Clayton Road) to east of I-26 in Buncombe County. NCDOT Division 13, Federal Aid Project No. STP-146(5), TIP No. R-2813B. Debit WBS Element 34505.1.1.

REFERENCE: USACE Section 404 Regional General Permit 31 No. SAW2007-3084-311 issued 11/19/2007.

NC Div. of Water Quality Section 401 Certification No. 20070124v.5 issued 10/22/2007.

Please see the enclosed permit drawing "Sheet 6A" for the revised "Site 5" for the above referenced project. Per our phone conversation on April 1, 2008, we briefly discussed the omission of this temporary impact permit drawing for the temporary work pad required to construct the bridge over the French Broad River on NC 146.

There are 5 phases (1, 2, 2A, 3, and 4) involved with the build-out of the causeways for construction of the bridge over the French Broad River. Phase "2A" (as found on Sheet 6A) was inadvertently left off of the original permit application. This sub-phase results in an increase in temporary fill by 0.04 acre (from 0.80 to 0.84 acre). Therefore the total amount of temporary fill in surface water for Site 5 should be 0.84 acre for a grand project total temporary fill in surface water of 0.84 acre. The linear feet of temporary impacts, noted in the 401 certification, remains accurate.

MAILING ADDRESS:  
NC DEPARTMENT OF TRANSPORTATION  
PROJECT DEVELOPMENT AND ENVIRONMENTAL ANALYSIS  
1548 MAIL SERVICE CENTER  
RALEIGH NC 27699-1548

TELEPHONE: 919-733-3141  
FAX: 919-733-9794


WEBSITE: [WWW.NCDOT.ORG](http://WWW.NCDOT.ORG)

LOCATION:  
PARKER LINCOLN BUILDING,  
2728 CAPITAL BLVD., SUITE 240  
RALEIGH NC 27604

From our conversation, NCDOT is not anticipating additional or modified written approvals, and is providing this information for your files. If approval becomes required, then by way of this letter, please provide written authorization for this modification.

Thank you for your assistance with this project. If you have any questions or need additional information, please contact Michael Turchy at [maturchy@dot.state.nc.us](mailto:maturchy@dot.state.nc.us) or (919) 715-1468.

Sincerely,

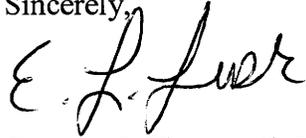

for


Gregory J. Thorpe, Ph.D., Environmental Management Director  
Project Development and Environmental Analysis Branch

cc:

W/attachment

Mr. Brian Wrenn, NCDWQ (2 Copies )  
Ms. Marella Buncick, USFWS  
Ms. Marla Chambers, NCWRC  
Mr. Nilesh Surti, PE, Alternative Delivery Unit

PROJECT REFERENCE NO.	SHEET NO.
R-28138	6A
R/W SHEET NO.	
ROADWAY DESIGN ENGINEER	HYDRAULICS ENGINEER

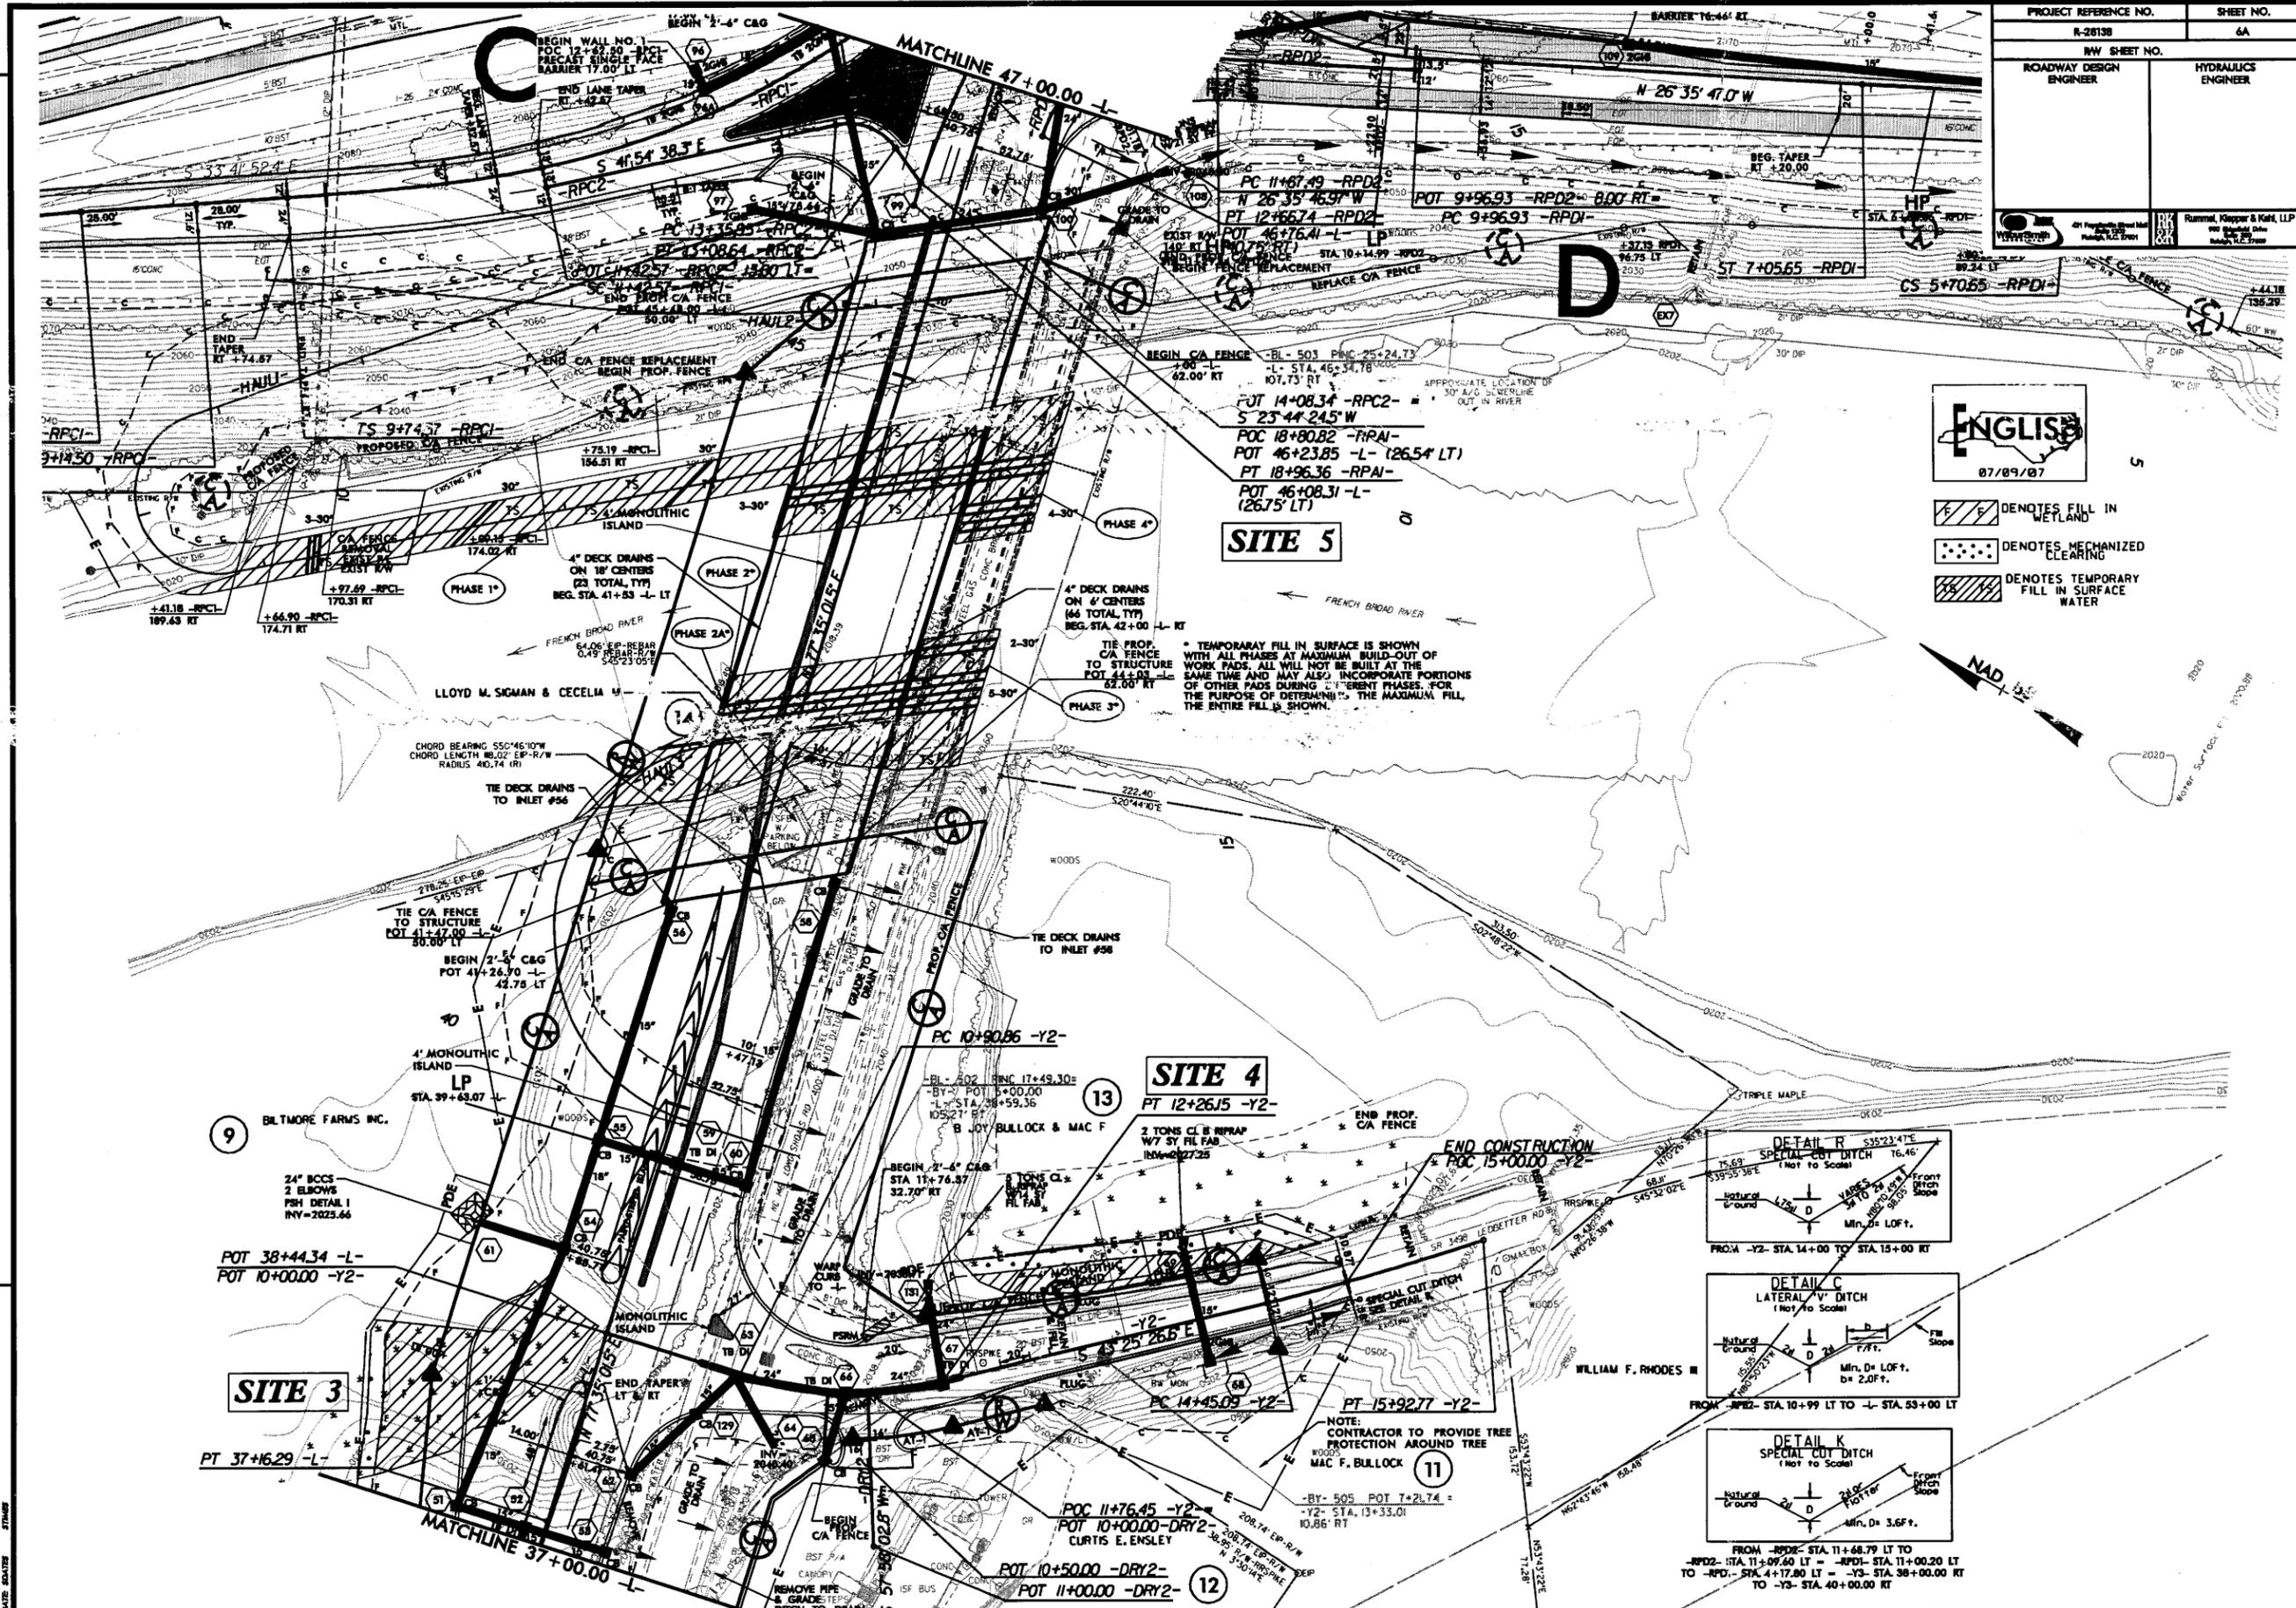


- DENOTES FILL IN WETLAND
- DENOTES MECHANIZED CLEARING
- DENOTES TEMPORARY FILL IN SURFACE WATER



**SITE 5**

**SITE 4**

**SITE 3**

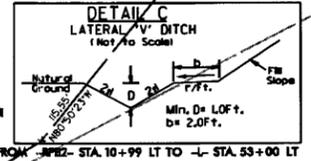

\* TEMPORARY FILL IN SURFACE IS SHOWN WITH ALL PHASES AT MAXIMUM BUILD-OUT OF WORK PADS. ALL WILL NOT BE BUILT AT THE SAME TIME AND MAY ALSO INCORPORATE PORTIONS OF OTHER PADS DURING THE EARLY PHASES. FOR THE PURPOSE OF DETERMINING THE MAXIMUM FILL, THE ENTIRE FILL IS SHOWN.

NOTE: CONTRACTOR TO PROVIDE TREE PROTECTION AROUND TREE

REVISIONS

DATE: 08/01/07