



STATE OF NORTH CAROLINA  
DEPARTMENT OF TRANSPORTATION

BEVERLY EAVES PERDUE  
GOVERNOR

EUGENE A. CONTI, JR.  
SECRETARY

November 9, 2011

Mr. Tom Steffens  
U.S. Army Corps of Engineers  
Regulatory Field Office  
Post Office Box 1000  
Washington, NC 27889-1000

Mr. Stephen Lane  
N.C. Dept. of Environment and Natural Resources  
Division of Coastal Management  
400 Commerce Avenue  
Morehead City, NC 28557

Dear Sirs:

**Subject: Application for Individual Section 404, Section 401 Water Quality Certification, Section 10 Permit, Isolated Waters Permit and CAMA Major Development Permit** for the proposed improvements to US 70 from existing four lanes at Radio Island to north of Olga Road (SR 1426), Carteret County, State Project No. 8.1162501, Federal Aid Project STPNHF-70(43), TIP R-3307. Debit \$475.00 from WBS 34528.1.1.

The North Carolina Department of Transportation (NCDOT), Division of Highways, in consultation with the Federal Highway Administration (FHWA), proposes to replace the existing drawbridge over Gallants Channel and related approaches, with a longer high-rise fixed bridge and improve US 70 to a multilane facility.

The purpose of this letter is to request approval for a Section 404 Individual Permit, a Section 401 Water Quality Certification, and a CAMA Major Development Permit. In addition to the cover letter ENG Form 4345, and CAMA MP Forms, this application package includes the following for R-3307: permit drawings, half size roadway plans, Turner Street Marsh Restoration Plan, and EEP Acceptance Letter.

## 1.0 Purpose and Need

The purpose for this project, as identified in the Final Environmental Assessment (EA), is to eliminate travel delays occurring at the drawbridge and to increase the traffic carrying capacity of US 70 through the town of Beaufort.

## 2.0 Project Description

The improvements involve replacement of the existing drawbridge over Gallants Channel and related approaches, with a longer high-rise fixed bridge and improve US 70 to a multilane facility. The proposed 3,395-foot bridge will carry a 4-lane divided roadway with 12-foot travel lanes, 8-foot bridge offsets, a 4-foot raised island, and a 1-foot offset on each side. In addition,

**MAILING ADDRESS:**  
NC DEPARTMENT OF TRANSPORTATION  
PROJECT DEVELOPMENT AND ENVIRONMENTAL ANALYSIS  
1598 MAIL SERVICE CENTER  
RALEIGH NC 27699-1598

TELEPHONE: 919-707-6100  
FAX: 919-212-5785

WEBSITE: [WWW.NCDOT.ORG](http://WWW.NCDOT.ORG)

**LOCATION:**  
1020 BIRCH RIDGE DRIVE  
RALEIGH NC 27610-4328

improvements to Turner Street include a 40-foot, three-lane curb and gutter section with two 12-foot travel lanes, and a 12-foot center turn lane. A 585-foot bridge with 8-foot offsets is proposed to replace the 61-foot box culvert on Turner Street. Total project length is 3.6 miles.

### **3.0 Summary of Impacts**

Waters of the U.S.: Proposed impacts to jurisdictional areas total 6.97 acres of permanent wetland impacts, 0.04 acre of temporary wetland impacts, 851 feet of permanent stream impacts, and 41 feet of temporary stream impacts.

### **4.0 Summary of Mitigation**

The proposed construction of R-3307 will impact 6.97 acres of jurisdictional wetlands that will require mitigation. The unavoidable impacts to the 0.5 acre of CAMA jurisdictional wetlands will be offset by on-site mitigation (see attached Turner Street Marsh Restoration Plan). The remaining unavoidable impacts to 1.78 acres of jurisdictional riparian wetlands, 4.51 acres of non-riparian wetlands, and 0.18 acre of isolated wetland will be offset by compensatory mitigation provided by the NC Ecosystem Enhancement Program (EEP). In addition, the unavoidable impacts to 843 linear feet of jurisdictional stream will also be offset by compensatory mitigation provided by the NC Ecosystem Enhancement Program (EEP).

### **5.0 Project Schedule**

Currently, R-3307 has a review date of May 29, 2012 and is scheduled to let July 17, 2012; it will be available for construction shortly thereafter. The let date, however, may advance as additional funds become available.

### **6.0 NEPA Document Status**

The FHWA and NCDOT completed the EA in October 2004 in compliance with the NEPA guidelines. The EA explains the purpose and need for the project, provides a description of the alternatives considered, and characterizes the social, economic, and environmental effects. The EA was approved and circulated to federal, state, and local agencies. Then following the EA, a Finding of No Significant Impact (FONSI) Statement was completed September 2006 and a FHWA Right-of-Way Consultation was completed June 2008. Copies of the project documents have been provided to regulatory review agencies involved in the approval process. Additional copies will be provided upon request.

#### **6.1 *Independent Utility***

R-3307 is in compliance with 23 CFR Part 771.111(f) which lists the FHWA characteristics of the independent utility of a project. The project meets the criteria for independent utility as discussed below:

- The project has logical termini and independent utility and is of sufficient length to address environmental matters on a broad scope;
- The project is usable and a reasonable expenditure of funds, even if no additional transportation improvements are made in the area; and
- The project does not restrict consideration of alternatives for other reasonably foreseeable transportation improvements.

## **7.0 Resource Status**

The project is located in the White Oak River Basin and lies within Hydrologic Unit 03020106 (Subbasin 03-05-03). This is within the Southern Outer Coastal Plain eco-region. The project crosses Gallants Channel and Town Creek.

### **7.1 *Wetland Delineations***

A wetland identification and preliminary assessment analysis for the study area was performed and summarized in the 2001 Natural Resources Technical Report (NRTR). The wetlands within the study area were delineated based on the 1987 U.S. Army Corps of Engineers (USACE) Wetland Delineation Manual and a preliminary design was prepared to avoid and minimize wetlands to the maximum extent possible. Wetland delineations were completed between February 1999 and November 1999. Subsequently, wetland delineations were updated in June 2007. This delineation was later field verified by Mr. William Wescott of the USACE, Wilmington District, and Mr. Stephen Lane with the N.C. Division of Coastal Management (NCDCM) on June 27, 2007.

### **7.2 *Stream Delineations***

Data collected for streams were derived from USGS topographic maps, the Carteret County Soil Survey (USDA, 1987), and site reconnaissance. The data included stream classification, which was presented in the NRTR. The USACE concurred on stream classifications on June 27, 2007, when Mr. William Wescott with the USACE visited the site.

## **7.3 *R-3307: Characterization of Jurisdictional Sites***

### **7.3.1 *Wetlands***

There are three wetland communities found within the project study area: Salt Marsh, Scrub Shrub, and Pine Flat. More detailed information about these wetlands can be found in the EA and the NRTR which includes figures showing the wetlands within the project area.

### **7.3.2 *Streams***

Best Usage Classifications for jurisdictional streams are provided in the EA. There are waters within the project vicinity classified as High Quality Waters (HQW), including the Newport River (Beaufort, Gallants, and Morehead Channels), Bogue Sound, Taylors Creek, Town Creek,

and Turner Creek. As such, NCDOT's Design Standards in Sensitive Watersheds will be implemented for this project.

Neither Water Supplies (WS-I: undeveloped watersheds or WS-II: predominately undeveloped watersheds), nor Outstanding Resource Waters (ORW) occur within 1.0 mile of the project study area. Gallants Channel and Town Creek are not designated as North Carolina Natural or Scenic Rivers, or as National Wild and Scenic Rivers. Additionally, these waters are not listed on the Final 2010 303(d) list of impaired waters due to sedimentation or turbidity for the White Oak River Basin, nor do they drain into any Section 303(d) waters within 1.0 mile of the project study area.

#### 7.4 Impacts to Jurisdictional Resources

Impacts to jurisdictional wetlands and surface waters for R-3307 are summarized below in Tables 1 & 2 respectively.

**Table 1. R-3307 Wetlands Impacts**

Permit Drawing Site Number (2011)	Map Label in FONSI (2001)	Type	Permanent Impacts (ac.)	Temporary Impacts* (ac.)	Mitigation Required**
1	A, D	Coastal	0.18	0.07	Yes
2	G, H	Riparian/Coastal	1.83	0	Yes
4	L	Isolated	0.18	0	Yes
5	O	Non-Riparian	4.51	0	Yes
6	J	Coastal	0.07	< 0.01	Yes
7	K	Coastal	0.20	0	Yes
<b>Total:</b>			<b>6.97</b>	<b>0.07</b>	<b>Yes</b>

\* There will be 0.04 acres of Temporary Fill in wetlands for erosion control measures

\*\*For permanent impacts

**Table 2. R-3307 Surface Water Impacts**

Permit Drawing Site Number	Waterbody	Permanent (ft)	Temporary (ft)	Permanent (ac.)	Temporary (ac.)	Mitigation Required***
1	Gallants Channel	0	0	0.03	0.06	No
2	UT to Gallants Channel	155*	9	0.02	0.01	Yes
3	UT to Town Creek	189**	22	0.04	0.01	Yes
4	UT to Gallants Channel	499	10	0.16	< 0.01	Yes
6	Town Creek	0	0	< 0.01	< 0.01	No
7	Town Creek	8	0	0	0	No
<b>Total:</b>		<b>851</b>	<b>41</b>	<b>0.25</b>	<b>0.09</b>	

\* Includes 16 linear feet of impacts from bank stabilization; mitigation required by the USACE exceeds the amount required by NCDWQ

\*\* Includes 24 linear feet of impacts from bank stabilization; mitigation required by the USACE exceeds the amount required by NCDWQ

\*\*\* For permanent impacts



**Permanent Impacts:** Proposed permanent impacts for R-3307 include fill, excavation, and mechanized clearing in wetlands. This includes impacts to 0.5 acre of CAMA jurisdictional coastal wetlands, 1.78 acres of riparian wetlands, 4.51 acres of non-riparian wetlands, and 0.18 acre of a NCDWQ jurisdictional isolated wetland. Proposed permanent impacts to surface waters are 851 linear feet (0.25 acre), which includes two pipes proposed to be extended and replaced at unnamed tributaries (UT) to Gallants Channel and a UT to Town Creek (sites 2 & 3), bridge construction over Gallants Channel and Town Creek, and the resulting fill and bank stabilization. Stream impacts were not addressed in the EA or FONSI, but were shown on the draft permit drawings provided at the 4C Permit Drawing Review meeting held October 20, 2010.

**Temporary Impacts:** There will be 41 linear feet of temporary impacts to surface water due to bridge construction and pipe installations. In addition, there will be 0.04 acre of temporary fill in CAMA wetlands for erosion control measures.

**Hand-Clearing:** There will be 0.20 acre of hand-clearing in jurisdictional wetlands due to project construction.

**Utility Impacts:** There will be < 0.01 acre of impacts due to fill associated with utilities. In addition, there will be 0.41 acre of hand-clearing due to utility relocations. As written approval is not required we will proceed with these activities under a Nationwide 12. A CAMA General Permit application has been submitted under separate cover.

## 8.0 Protected Species

The United States Fish and Wildlife Service (USFWS) list 13 federally protected species for Carteret County as of the March 21, 2011 listing (Table 3).

**Table 3. Federally Protected Species in Carteret County**

Scientific Name	Common Name	Federal Status	Habitat	Biological Conclusion
<i>Alligator mississippiensis</i>	American alligator	T(S/A)	Yes	N/A
<i>Chelonia mydas</i>	Green sea turtle	T	No	No Effect
<i>Lepidochelys kempii</i>	Kemp's ridley sea turtle	E	No	No Effect
<i>Eretmochelys imbricata</i>	Hawksbill sea turtle	E	No	No Effect
<i>Dermochelys coriacea</i>	Leatherback sea turtle	E	No	No Effect
<i>Caretta caretta</i>	Loggerhead sea turtle	T	No	No Effect
<i>Charadrius melodus</i>	Piping plover	T	No	No Effect
<i>Picoides borealis</i>	Red-cockaded woodpecker	E	No	No Effect
<i>Sterna dougallii dougallii</i>	Roseate tern	E	No	No Effect
<i>Acipenser brevirostrum</i>	Shortnose sturgeon	E	No	No Effect
<i>Trichechus manatus</i>	West Indian manatee	E	Yes	MANLAA
<i>Lysimachia asperulaefolia</i>	Rough-leaved loosestrife	E	No	No Effect
<i>Amaranthus pumilus</i>	Seabeach amaranth	T	No	No Effect

Key: E= Endangered, T= Threatened, T(S/A)= Threatened(Similarity of Appearance), MANLAA= May Affect, Not Likely to Adversely Affect

A Concurrence Request providing Biological Conclusions for each species was submitted to the USFWS in November 30, 2007. The USFWS responded with concurrence on December 26, 2007. A copy of the USFWS concurrence letter is included with this application.

A review of the North Carolina Natural Heritage Program (NCNHP) database, updated August 2011, indicated two occurrences of protected species within one mile of the project study area: West Indian manatee (last observed 2007) and seabeach amaranth (last observed 1991). As a result, the NCDOT will utilize *The Guidelines for Avoiding Impacts to the West Indian Manatee: Precautionary Measures for Construction Activities in North Carolina Waters* to the maximum extent practicable.

### **8.1 Bald and Golden Eagle Protection Act (BGPA)**

In the July 9, 2007 Federal Register (72:37346-37372), the bald eagle was declared recovered, and removed (de-listed) from the Federal List of Threatened and Endangered wildlife. This delisting took effect August 8, 2007. After delisting, the Bald and Golden Eagle Protection Act (Eagle Act) (16 U.S.C. 668-668d) became the primary law protecting bald eagles. A survey was conducted on November 21, 2007 found no nests within 660 feet of the project limits; however, nesting and foraging habitat was present.

### **8.2 Moratoria**

No moratoria have been recommended for R-3307.

## **9.0 Cultural Resources**

NCDOT coordinated with the NC Department of Cultural Resources to develop a Memorandum of Agreement (MOA) between NCDOT, FHWA, SHPO and the Town of Beaufort. The MOA addresses the concerns and incorporates the recommendations made by NC Department of Cultural Resources (see FONSI Appendix D).

No archaeological sites were found within the project's area of potential effects. Therefore, no additional archaeological investigation is recommended for this project. The SHPO concurred with these findings in a letter dated December 2, 1999, which can be found in the EA.

## **10.0 FEMA Compliance**

The project has been coordinated with appropriate state and local officials and the Federal Emergency Management Agency (FEMA) to assure compliance with FEMA, state, and local floodway regulations.

## **11.0 Mitigation Options**

The NCDOT is committed to incorporating all reasonable and practicable design features to avoid and minimize jurisdictional impacts, and to provide full compensatory mitigation of all remaining, unavoidable jurisdictional impacts. Avoidance measures were taken during the

planning and NEPA compliance stages; minimization measures were incorporated as part of the project design.

### ***11.1 Avoidance and Minimization***

All jurisdictional features were delineated, field verified and surveyed within the corridor for R-3307. Using these surveyed features, preliminary designs were adjusted to avoid and/or minimize impacts to jurisdictional areas. NCDOT employs many strategies to avoid and minimize impacts to jurisdictional areas in all of its designs. Many of these strategies have been incorporated into BMP documents that have been reviewed and approved by the resource agencies and which will be followed throughout construction. All wetland areas not affected by the project will be protected from unnecessary encroachment. Individual avoidance and minimization items are as follows:

- No staging of construction equipment or storage of construction supplies will be allowed in wetlands or near surface waters.
- The project was designed to avoid or minimize disturbance to aquatic life movements.
- NCDOT and its contractors will not excavate, fill, or perform land clearing activities within Waters of the U.S. or any areas under the jurisdiction of the USACE, except as authorized by the USACE. To ensure that all borrow and waste activities occur on high ground, except as authorized by permit, the NCDOT shall require its contractors to identify all areas to be used to borrow material, or to dispose of dredged, fill or waste material. Documentation of the location and characteristics of all borrow and disposal sites associated with the project will be available to the USACE on request.
- As part of the proposed design, part of the existing roadway along Turner Street and the metal pipe culverts at Town Creek shall be removed and replaced with a 585-foot long bridge.
- Preformed Scour Holes will be used where practicable.
- Storm water will be treated using grass swales and an infiltration basin.
- The use of 1.5:1 fill slopes between Sta. 28+00 to Sta. 29+50 and 3:1 fill slopes in jurisdictional areas when practicable elsewhere.
- NCDOT will implement Best Management Practices for Bridge Demolition and Removal.
- Sediment and erosion control measures shall adhere to the Design Standards in Sensitive Watersheds during construction of the project.
- Special Sediment Control Fence will be used where applicable.
- Deck drains for the proposed bridge carrying US 70 over Gallants Channel will be designed so that runoff is not discharged directly into Gallants Channel.
- NCDOT will implement the “Guidelines for Avoiding Impacts to the West Indian Manatee: Precautionary Measures for North Carolina Waters.”
- The use of hand clearing rather than mechanized clearing where possible.

### ***11.3 Compensation***

The NCDOT has avoided and minimized impacts to jurisdictional resources to the greatest extent possible as described above. The unavoidable impacts to CAMA jurisdictional wetlands will be offset by on-site mitigation resulting 1.56 acres of restoration from causeway removal on Turner

Street (see permit drawings and Turner Street Marsh Restoration Plan). The unavoidable impacts to jurisdictional riparian and non-riparian wetlands, the NCDWQ jurisdictional isolated wetland, and surface waters will be offset by compensatory mitigation provided by the EEP.

Of the 851 linear feet of stream impacts, 48 linear feet are impacts from bank stabilization. The NCDWQ requires that any bank stabilization impact be mitigated for a 1:1 ratio if the total permanent impact to the stream is over 150 linear feet. However, the 2:1 mitigation ratio will exceed the amount of 1:1 mitigation NCDWQ requires for this impact. Therefore, 2:1 mitigation will be calculated based on 803 linear feet of impacts. A copy of the revised EEP acceptance letter, dated October 27, 2011, is attached.

## **12.0 Indirect and Cumulative Effects**

The proposed project is expected to impart minimal indirect and cumulative effects. The project is only one of many factors affecting growth potential or potential for land use change in the Future Land Use Study Area (other factors include infrastructure, population growth and job growth, proximity to employment centers, etc.). This project is not the determining factor in how much, how fast, or how intense development is occurring or will occur in the study area. Taken in the context of other past, present and future actions, R-3307 should not incrementally result in substantial cumulative effects.

The Indirect Screening Report & Land Use Scenario Assessment, dated May 20, 2011, suggests that given the minimal indirect effects of R-3307, the contribution of the project to cumulative effects resulting from current and planned development patterns should be minimal. For these reasons, potential indirect and cumulative effects to downstream water quality should also be minimal. No additional ICE study is recommended.

## **13.0 Regulatory Approvals**

Section 404: Application is hereby made for a USACE Individual 404 Permit as required for the above-described activities. As previously mentioned, utility relocation activities are to proceed under the general conditions of the Nationwide 12.

Section 401: We are also requesting a Section 401 Water Quality Certification from the NCDWQ. We are providing five (5) copies of this application to the NCDWQ, for their approval. Utility relocation activities are to proceed under the conditions of General Certification # 3699.

Isolated Waters: Application is hereby made for a NCDWQ Isolated Waters Permit as required for the above-described activities.

Section 10: Application is hereby made for a USACE Section 10 Permit as required for the above-described activities.

CAMA: NCDOT requests that the proposed work be authorized under a Coastal Area Management Act Major Development Permit. The landowner receipts are provided with this

permit application. The return receipts will be forwarded once they have been received. A CAMA General Permit application has been submitted under separate cover for utility relocations. Authorization to debit the \$475 Permit Application Fee from WBS Element 34528.1.1 is hereby given.

USCG: Under separate cover, NCDOT submitted a request for a United States Coast Guard (USCG) permit for R-3307 on August 17, 2010.

A copy of this permit application and its distribution list will be posted on the NCDOT website at: <http://www.ncdot.org/doh/preconstruct/pe/neu/permit.html>

If you have any questions or need additional information, please contact Tyler Stanton at 919-707-6156 or [tstanton@ncdot.gov](mailto:tstanton@ncdot.gov).

Sincerely,



fw

Gregory J. Thorpe, Ph.D., Manager  
Project Development and Environmental Analysis

cc:

NCDOT Permit Application Standard Distribution List.

U.S. ARMY CORPS OF ENGINEERS  
APPLICATION FOR DEPARTMENT OF THE ARMY PERMIT  
(33 CFR 325)

OMB APPROVAL NO. 0710-0003  
EXPIRES: 31 AUGUST 2012

Public reporting for this collection of information is estimated to average 11 hours per response, including the time for reviewing instructions, searching existing data sources, gathering and maintaining the data needed, and completing and reviewing the collection of information. Send comments regarding this burden estimate or any other aspect of the collection of information, including suggestions for reducing this burden, to Department of Defense, Washington Headquarters, Executive Services and Communications Directorate, Information Management Division and to the Office of Management and Budget, Paperwork Reduction Project (0710-0003). Respondents should be aware that notwithstanding any other provision of law, no person shall be subject to any penalty for failing to comply with a collection of information if it does not display a currently valid OMB control number. Please DO NOT RETURN your form to either of those addresses. Completed applications must be submitted to the District Engineer having jurisdiction over the location of the proposed activity.

PRIVACY ACT STATEMENT

Authorities: Rivers and Harbors Act, Section 10, 33 USC 403; Clean Water Act, Section 404, 33 USC 1344; Marine Protection, Research, and Sanctuaries Act, Section 103, 33 USC 1413; Regulatory Programs of the Corps of Engineers; Final Rule 33 CFR 320-332. Principal Purpose: Information provided on this form will be used in evaluating the application for a permit. Routine Uses: This information may be shared with the Department of Justice and other federal, state, and local government agencies, and the public and may be made available as part of a public notice as required by Federal law. Submission of requested information is voluntary, however, if information is not provided the permit application cannot be evaluated nor can a permit be issued. One set of original drawings or good reproducible copies which show the location and character of the proposed activity must be attached to this application (see sample drawings and/or instructions) and be submitted to the District Engineer having jurisdiction over the location of the proposed activity. An application that is not completed in full will be returned.

(ITEMS 1 THRU 4 TO BE FILLED BY THE CORPS)

1. APPLICATION NO.	2. FIELD OFFICE CODE	3. DATE RECEIVED	4. DATE APPLICATION COMPLETE
--------------------	----------------------	------------------	------------------------------

(ITEMS BELOW TO BE FILLED BY APPLICANT)

5. APPLICANT'S NAME First -                      Middle -                      Last - Company - North Carolina Department of Transportation E-mail Address - tstanton@ncdot.gov	8. AUTHORIZED AGENT'S NAME AND TITLE (agent is not required) First -                      Middle -                      Last - Company - E-mail Address -
6. APPLICANT'S ADDRESS: Address- 1548 Mail Service Center City - Raleigh                      State - NC                      Zip - 27699                      Country - USA	9. AGENT'S ADDRESS: Address- City -                      State -                      Zip -                      Country -
7. APPLICANT'S PHONE NOS. w/AREA CODE a. Residence                      b. Business                      c. Fax 919.707.6000                      919.250.4224	10. AGENTS PHONE NOS. w/AREA CODE a. Residence                      b. Business                      c. Fax

STATEMENT OF AUTHORIZATION

11. I hereby authorize, \_\_\_\_\_ to act in my behalf as my agent in the processing of this application and to furnish, upon request, supplemental information in support of this permit application.

\_\_\_\_\_  
SIGNATURE OF APPLICANT

\_\_\_\_\_  
DATE

NAME, LOCATION, AND DESCRIPTION OF PROJECT OR ACTIVITY

12. PROJECT NAME OR TITLE (see instructions) R-3307	
13. NAME OF WATERBODY, IF KNOWN (if applicable) Gallants Channel	14. PROJECT STREET ADDRESS (if applicable) Address City -                      State-                      Zip-
15. LOCATION OF PROJECT Latitude: °N 34.725125                      Longitude: °W -76.667236	
16. OTHER LOCATION DESCRIPTIONS, IF KNOWN (see instructions) State Tax Parcel ID                      Municipality Section -                      Township -                      Range -	

17. DIRECTIONS TO THE SITE

Please see attached vicinity map and cover letter

18. Nature of Activity (Description of project, include all features)

Proposed replacement of the existing US 70 drawbridge over Gallants Channel and related approaches, with a longer high-rise fixed bridge and improve US 70 to a multilane facility. This involves proposed improvements to Turner Street, which include replacing the 61-foot box culvert with a 585-foot bridge.

19. Project Purpose (Describe the reason or purpose of the project, see instructions)

Eliminate travel delays occurring at the drawbridge and to increase the traffic carrying capacity of US 70 through the town of Beaufort.

USE BLOCKS 20-23 IF DREDGED AND/OR FILL MATERIAL IS TO BE DISCHARGED

20. Reason(s) for Discharge

Construction of roadway and bridge.

21. Type(s) of Material Being Discharged and the Amount of Each Type in Cubic Yards:

Type Amount in Cubic Yards	Type Amount in Cubic Yards	Type Amount in Cubic Yards
-------------------------------	-------------------------------	-------------------------------

Please see attached permit drawings

22. Surface Area in Acres of Wetlands or Other Waters Filled (see instructions)

Acres 6.97 acres (permanent) and 0.11 acre (temporary)  
or

Linear Feet 851 (permanent) and 41 (temporary)

23. Description of Avoidance, Minimization, and Compensation (see instructions)

See attached cover letter.

24. Is Any Portion of the Work Already Complete? ☐ Yes ☒ No IF YES, DESCRIBE THE COMPLETED WORK

25. Addresses of Adjoining Property Owners, Lessees, Etc., Whose Property Adjoins the Waterbody (if more than can be entered here, please attach a supplemental list).

a. Address- Please see sheet attached list in the permit drawing package.

City - State - Zip -

b. Address-

City - State - Zip -

c. Address-

City - State - Zip -

d. Address-

City - State - Zip -

e. Address-

City - State - Zip -

26. List of Other Certificates or Approvals/Denials received from other Federal, State, or Local Agencies for Work Described in This Application.

AGENCY	TYPE APPROVAL*	IDENTIFICATION NUMBER	DATE APPLIED	DATE APPROVED	DATE DENIED

\* Would include but is not restricted to zoning, building, and flood plain permits

27. Application is hereby made for permit or permits to authorize the work described in this application. I certify that this information in this application is complete and accurate. I further certify that I possess the authority to undertake the work described herein or am acting as the duly authorized agent of the applicant.

SIGNATURE OF APPLICANT

DATE

SIGNATURE OF AGENT

DATE


The Application must be signed by the person who desires to undertake the proposed activity (applicant) or it may be signed by a duly authorized agent if the statement in block 11 has been filled out and signed.

18 U.S.C. Section 1001 provides that: Whoever, in any manner within the jurisdiction of any department or agency of the United States knowingly and willfully falsifies, conceals, or covers up any trick, scheme, or disguises a material fact or makes any false, fictitious or fraudulent statements or representations or makes or uses any false writing or document knowing same to contain any false, fictitious or fraudulent statements or entry, shall be fined not more than \$10,000 or imprisoned not more than five years or both.



# APPLICATION for Major Development Permit

(last revised 12/27/06)

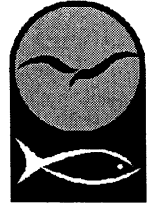

North Carolina DIVISION OF COASTAL MANAGEMENT

<b>1. Primary Applicant/ Landowner Information</b>			
Business Name North Carolina Department of Transportation		Project Name (if applicable) R-3307, Carteret County	
Applicant 1: First Name Gregory	MI	Last Name Thorpe	
Applicant 2: First Name	MI	Last Name	
<i>If additional applicants, please attach an additional page(s) with names listed.</i>			
Mailing Address 1598 Mail Service Center		PO Box	City Raleigh
			State NC
ZIP 27699 1598	Country USA	Phone No. 919 - 707 - 6000 ext.	FAX No. 919 - 250 - 4224
Street Address (if different from above) 1000 Birch Ridge Drive		City Raelgih	State NC
			ZIP 27610-
Email tstanton@ncdot.gov			

<b>2. Agent/Contractor Information</b>			
Business Name			
Agent/ Contractor 1: First Name	MI	Last Name	
Agent/ Contractor 2: First Name	MI	Last Name	
Mailing Address		PO Box	City
			State
ZIP		Phone No. 1 - - ext.	Phone No. 2 - - ext.
FAX No.		Contractor #	
Street Address (if different from above)		City	State
			ZIP -
Email			

&lt;Form continues on back&gt;

<b>3. Project Location</b>			
County (can be multiple) Carteret	Street Address US 70 from four lanes at Radio Island to near Olga Road (SR 1426)		State Rd. # US 70
Subdivision Name N/A	City Beaufort	State NC	Zip 28516 -
Phone No. - - ext.		Lot No.(s) (if many, attach additional page with list) , , , ,	
a. In which NC river basin is the project located? White Oak		b. Name of body of water nearest to proposed project Gallants Channel & Town Creek	
c. Is the water body identified in (b) above, natural or manmade? <input checked="" type="checkbox"/> Natural <input type="checkbox"/> Manmade <input type="checkbox"/> Unknown		d. Name the closest major water body to the proposed project site. Newport River	
e. Is proposed work within city limits or planning jurisdiction? <input checked="" type="checkbox"/> Yes <input type="checkbox"/> No		f. If applicable, list the planning jurisdiction or city limit the proposed work falls within. Beaufort	

<b>4. Site Description</b>	
a. Total length of shoreline on the tract (ft.) 800 ft. (approximately 400 ft. on each shore)	b. Size of entire tract (sq.ft.) Approximate Project Area = 3802000 sq. ft
c. Size of individual lot(s) N/A, (if many lot sizes, please attach additional page with a list)	d. Approximate elevation of tract above NHW (normal high water) or NWL (normal water level) 5.3' to 65' <input checked="" type="checkbox"/> NHW or <input type="checkbox"/> NWL
e. Vegetation on tract maintained/disturbed vegetation, salt marsh, loblolly pine forest	
f. Man-made features and uses now on tract roadway, sidewalks, buildings, bridges, and culverts	
g. Identify and describe the existing land uses <u>adjacent</u> to the proposed project site. commercial, residential, forested	
h. How does local government zone the tract? Port-Industrial, General Business, Commercial, Residential	i. Is the proposed project consistent with the applicable zoning? (Attach zoning compliance certificate, if applicable) <input checked="" type="checkbox"/> Yes <input type="checkbox"/> No <input type="checkbox"/> NA
j. Is the proposed activity part of an urban waterfront redevelopment proposal? <input type="checkbox"/> Yes <input checked="" type="checkbox"/> No	
k. Has a professional archaeological assessment been done for the tract? If yes, attach a copy. <input checked="" type="checkbox"/> Yes <input type="checkbox"/> No <input type="checkbox"/> NA  If yes, by whom? NCDOT Archaeology Group	
l. Is the proposed project located in a National Registered Historic District or does it involve a National Register listed or eligible property? <input checked="" type="checkbox"/> Yes <input type="checkbox"/> No <input type="checkbox"/> NA	

&lt;Form continues on next page&gt;

m. (i) Are there wetlands on the site?	<input checked="" type="checkbox"/> Yes <input type="checkbox"/> No
(ii) Are there coastal wetlands on the site?	<input checked="" type="checkbox"/> Yes <input type="checkbox"/> No
(iii) If yes to either (i) or (ii) above, has a delineation been conducted? (Attach documentation, if available)	<input checked="" type="checkbox"/> Yes <input type="checkbox"/> No
n. Describe existing wastewater treatment facilities. A sanitary sewer pumping station is located near the intersection of West Beaufort Rd and Turner St. This station will be relocated.	
o. Describe existing drinking water supply source. N/A	
p. Describe existing storm water management or treatment systems. N/A	

**5. Activities and Impacts**

a. Will the project be for commercial, public, or private use?	<input type="checkbox"/> Commercial <input checked="" type="checkbox"/> Public/Government <input type="checkbox"/> Private/Community
b. Give a brief description of purpose, use, and daily operations of the project when complete. Roadway and bridge for transportation use	
c. Describe the proposed construction methodology, types of construction equipment to be used during construction, the number of each type of equipment and where it is to be stored. Proposed construction utilizing temporary work bridges and potentially barges; however, no temporary causeway(s) will be used. Typical construction equipment includes crane, bulldozer, dump trucks, motor grader, etc.	
d. List all development activities you propose. Replace a movable span bridge with a high-rise fixed span bridge on new location and improve US 70 from four lanes at Radio Island to near Olga Road (SR 1426)	
e. Are the proposed activities maintenance of an existing project, new work, or both?	Both
f. What is the approximate total disturbed land area resulting from the proposed project?	64 <input type="checkbox"/> Sq.Ft or <input checked="" type="checkbox"/> Acres
g. Will the proposed project encroach on any public easement, public accessway or other area that the public has established use of?	<input checked="" type="checkbox"/> Yes <input type="checkbox"/> No <input type="checkbox"/> NA
h. Describe location and type of existing and proposed discharges to waters of the state. Existing Grayden Paul bridge has open steel deck that allows deck water to discharge directly to channel. New bridge will have closed drainage system. Treatment provided by infiltration basin for western end of bridge and by grass swale for eastern end of bridge. Existing causeway for Turner Street over Town Creek will be excavated and replaced with a bridge. Deck water will be routed to a grass swale for treatment.	
i. Will wastewater or stormwater be discharged into a wetland?	<input type="checkbox"/> Yes <input checked="" type="checkbox"/> No <input type="checkbox"/> NA
If yes, will this discharged water be of the same salinity as the receiving water?	<input type="checkbox"/> Yes <input type="checkbox"/> No <input type="checkbox"/> NA
j. Is there any mitigation proposed?	<input checked="" type="checkbox"/> Yes <input type="checkbox"/> No <input type="checkbox"/> NA
If yes, attach a mitigation proposal.	

&lt;Form continues on back&gt;

**6. Additional Information**

In addition to this completed application form, (MP-1) the following items below, if applicable, must be submitted in order for the application package to be complete. Items (a) – (f) are always applicable to any major development application. Please consult the application instruction booklet on how to properly prepare the required items below.

- a. A project narrative.
- b. An accurate, dated work plat (including plan view and cross-sectional drawings) drawn to scale. Please give the present status of the proposed project. Is any portion already complete? If previously authorized work, clearly indicate on maps, plats, drawings to distinguish between work completed and proposed.
- c. A site or location map that is sufficiently detailed to guide agency personnel unfamiliar with the area to the site.
- d. A copy of the deed (with state application only) or other instrument under which the applicant claims title to the affected properties.
- e. The appropriate application fee. Check or money order made payable to DENR.
- f. A list of the names and complete addresses of the adjacent waterfront (riparian) landowners and signed return receipts as proof that such owners have received a copy of the application and plats by certified mail. Such landowners must be advised that they have 30 days in which to submit comments on the proposed project to the Division of Coastal Management.
- |         |           |
|---------|-----------|
| Name    | Phone No. |
| Address |           |
| Name    | Phone No. |
| Address |           |
| Name    | Phone No. |
| Address |           |
- g. A list of previous state or federal permits issued for work on the project tract. Include permit numbers, permittee, and issuing dates.
- h. Signed consultant or agent authorization form, if applicable.
- i. Wetland delineation, if necessary.
- j. A signed AEC hazard notice for projects in oceanfront and inlet areas. *(Must be signed by property owner)*
- k. A statement of compliance with the N.C. Environmental Policy Act (N.C.G.S. 113A 1-10), if necessary. If the project involves expenditure of public funds or use of public lands, attach a statement documenting compliance with the North Carolina Environmental Policy Act.

**7. Certification and Permission to Enter on Land**

I understand that any permit issued in response to this application will allow only the development described in the application. The project will be subject to the conditions and restrictions contained in the permit.

I certify that I am authorized to grant, and do in fact grant permission to representatives of state and federal review agencies to enter on the aforementioned lands in connection with evaluating information related to this permit application and follow-up monitoring of the project.

I further certify that the information provided in this application is truthful to the best of my knowledge.

Date Nov 9, 2011

Print Name Gregory J. Thape, PhD

Signature E. J. Lusk for

Please indicate application attachments pertaining to your proposed project.

☒ DCM MP-2 Excavation and Fill Information

☒ DCM MP-5 Bridges and Culverts

☐ DCM MP-3 Upland Development

☐ DCM MP-4 Structures Information

**EXCAVATION and FILL****(Except for bridges and culverts)**

Attach this form to Joint Application for CAMA Major Permit, Form DCM MP-1. Be sure to complete all other sections of the Joint Application that relate to this proposed project. Please include all supplemental information.

Describe below the purpose of proposed excavation and/or fill activities. All values should be given in feet.

	Access Channel (NLW or NWL)	Canal	Boat Basin	Boat Ramp	Rock Groin	Rock Breakwater	Other (excluding shoreline stabilization)
Length							
Width							
Avg. Existing Depth					NA	NA	
Final Project Depth					NA	NA	

**1. EXCAVATION**☐ This section not applicable

- a. Amount of material to be excavated from below NHW or NWL in cubic yards.  
50

- b. Type of material to be excavated.  
soil

- c. (i) Does the area to be excavated include coastal wetlands/marsh (CW), submerged aquatic vegetation (SAV), shell bottom (SB), or other wetlands (WL)? If any boxes are checked, provide the number of square feet affected.

☐CW ☐SAV ☐SB ☐WL ☒None

- (ii) Describe the purpose of the excavation in these areas:

Bridge construction and to allow access for future maintenance and inspection

- d. High-ground excavation in cubic yards.  
675

**2. DISPOSAL OF EXCAVATED MATERIAL**☐ This section not applicable

- a. Location of disposal area.  
To be determined by the contractor

- b. Dimensions of disposal area.  
To be determined by the contractor

- c. (i) Do you claim title to disposal area?

☐Yes ☒No ☐NA

- (ii) If no, attach a letter granting permission from the owner.

- d. (i) Will a disposal area be available for future maintenance?

☐Yes ☐No ☐NA

- (ii) If yes, where?

To be determined by the contractor

- e. (i) Does the disposal area include any coastal wetlands/marsh (CW), submerged aquatic vegetation (SAV), shell bottom (SB), or other wetlands (WL)? If any boxes are checked, provide the number of square feet affected.

☐CW ☐SAV ☐SB ☐WL ☒None

- (ii) Describe the purpose of disposal in these areas:

- f. (i) Does the disposal include any area in the water?

☐Yes ☐No ☐NA

- (ii) If yes, how much water area is affected?

To be determined by the contractor

**3. SHORELINE STABILIZATION**☒ This section not applicable

(If development is a wood groin, use MP-4 – Structures)

- a. Type of shoreline stabilization:  
☐ Bulkhead ☐ Riprap ☐ Breakwater/Sill ☐ Other: \_\_\_\_\_
- b. Length: \_\_\_\_\_  
Width: \_\_\_\_\_
- c. Average distance waterward of NHW or NWL: \_\_\_\_\_
- d. Maximum distance waterward of NHW or NWL: \_\_\_\_\_
- e. Type of stabilization material: \_\_\_\_\_
- f. (i) Has there been shoreline erosion during preceding 12 months?  
☐ Yes ☒ No ☐ NA  
(ii) If yes, state amount of erosion and source of erosion amount information.  
\_\_\_\_\_
- g. Number of square feet of fill to be placed below water level.  
Bulkhead backfill \_\_\_\_\_ Riprap \_\_\_\_\_  
Breakwater/Sill \_\_\_\_\_ Other \_\_\_\_\_
- h. Type of fill material.  
\_\_\_\_\_
- i. Source of fill material.  
\_\_\_\_\_

**4. OTHER FILL ACTIVITIES**☐ This section not applicable

(Excluding Shoreline Stabilization)

- a. (i) Will fill material be brought to the site? ☒ Yes ☐ No ☐ NA  
If yes,  
(ii) Amount of material to be placed in the water \_\_\_\_\_  
(iii) Dimensions of fill area \_\_\_\_\_  
(iv) Purpose of fill  
Fill (not for bridge) will be brought to the site, but not placed in the water. Purpose will be to support the roadway.  
\_\_\_\_\_  
\_\_\_\_\_
- b. (i) Will fill material be placed in coastal wetlands/marsh (CW), submerged aquatic vegetation (SAV), shell bottom (SB), or other wetlands (WL)? If any boxes are checked, provide the number of square feet affected.  
☐ CW \_\_\_\_\_ ☐ SAV \_\_\_\_\_ ☐ SB \_\_\_\_\_  
☒ WL 173,460 ☐ None  
(ii) Describe the purpose of the fill in these areas:  
To support the roadway  
\_\_\_\_\_  
\_\_\_\_\_

**5. GENERAL**

- a. How will excavated or fill material be kept on site and erosion controlled?  
Use of standard NCDOT Best Management Practices and erosion control measures.  
\_\_\_\_\_  
\_\_\_\_\_
- b. What type of construction equipment will be used (e.g., dragline, backhoe, or hydraulic dredge)?  
Heavy highway construction equipment  
\_\_\_\_\_  
\_\_\_\_\_
- c. (i) Will navigational aids be required as a result of the project?  
☐ Yes ☒ No ☐ NA  
(ii) If yes, explain what type and how they will be implemented.  
\_\_\_\_\_  
\_\_\_\_\_
- d. (i) Will wetlands be crossed in transporting equipment to project site? ☒ Yes ☐ No ☐ NA  
(ii) If yes, explain steps that will be taken to avoid or minimize environmental impacts.  
Use of standard NCDOT Best Management Practices and erosion control measures.  
\_\_\_\_\_  
\_\_\_\_\_

Nov 9, 2011

Date

R-3307

Project Name

Gregory J. Thayer, PhD

Applicant Name

E. L. Lusk for

Applicant Signature

## Form DCM MP-5

**BRIDGES and CULVERTS**

Attach this form to Joint Application for CAMA Major Permit, Form DCM MP-1. Be sure to complete all other sections of the Joint Application that relate to this proposed project. Please include all supplemental information.

**1. BRIDGES**☐ This section not applicable

- a. Is the proposed bridge:  
☐ Commercial ☒ Public/Government ☐ Private/Community
- b. Water body to be crossed by bridge:  
 Gallants Channel
- c. Type of bridge (construction material):  
 Concrete
- d. Water depth at the proposed crossing at NLW or NWL:  
 37.7 feet
- e. (i) Will proposed bridge replace an existing bridge? ☒ Yes ☐ No  
 If yes,  
 (ii) Length of existing bridge: 673 feet  
 (iii) Width of existing bridge: 36.3 feet  
 (iv) Navigation clearance underneath existing bridge:  
unlimited when open  
 (v) Will all, or a part of, the existing bridge be removed?  
 (Explain) all
- f. (i) Will proposed bridge replace an existing culvert? ☐ Yes ☒ No  
 If yes,  
 (ii) Length of existing culvert: \_\_\_\_\_  
 (iii) Width of existing culvert: \_\_\_\_\_  
 (iv) Height of the top of the existing culvert above the NHW or  
 NWL: \_\_\_\_\_  
 (v) Will all, or a part of, the existing culvert be removed?  
 (Explain)
- g. Length of proposed bridge: 3,395 feet
- h. Width of proposed bridge: 80 feet
- i. Will the proposed bridge affect existing water flow? ☐ Yes ☒ No  
 If yes, explain:
- j. Will the proposed bridge affect navigation by reducing or  
 increasing the existing navigable opening? ☒ Yes ☐ No  
 If yes, explain: Increases the width of the opening, but  
 restricts the height to 65 feet from bridge low chord to  
 Mean High Water.
- k. Navigation clearance underneath proposed bridge: 65 feet from  
 low chord to Mean High Water
- l. Have you contacted the U.S. Coast Guard concerning their  
 approval? ☒ Yes ☐ No  
 If yes, explain: NCDOT submitted the application to USCG  
 on 6/17/2010
- m. Will the proposed bridge cross wetlands containing no navigable  
 waters? ☒ Yes ☐ No  
 If yes, explain: See plans
- n. Height of proposed bridge above wetlands: Varies from 4 feet  
 to 69 feet

**2. CULVERTS**☒ This section not applicable

- a. Number of culverts proposed: \_\_\_\_\_
- b. Water body in which the culvert is to be placed:



&lt; Form continues on back &gt;

c. Type of culvert (construction material):  
  
\_\_\_\_\_

d. (i) Will proposed culvert replace an existing bridge?

☐ Yes ☐ No

If yes,

(ii) Length of existing bridge: \_\_\_\_\_

(iii) Width of existing bridge: \_\_\_\_\_

(iv) Navigation clearance underneath existing bridge: \_\_\_\_\_

(v) Will all, or a part of, the existing bridge be removed?  
(Explain)  
\_\_\_\_\_  
\_\_\_\_\_  
\_\_\_\_\_

e. (i) Will proposed culvert replace an existing culvert?

☐ Yes ☐ No

If yes,

(ii) Length of existing culvert(s): \_\_\_\_\_

(iii) Width of existing culvert(s): \_\_\_\_\_

(iv) Height of the top of the existing culvert above the NHW or  
NWL: \_\_\_\_\_(v) Will all, or a part of, the existing culvert be removed?  
(Explain)  
\_\_\_\_\_  
\_\_\_\_\_  
\_\_\_\_\_

f. Length of proposed culvert: \_\_\_\_\_

g. Width of proposed culvert: \_\_\_\_\_

h. Height of the top of the proposed culvert above the NHW or NWL.  
\_\_\_\_\_i. Depth of culvert to be buried below existing bottom contour.  
\_\_\_\_\_j. Will the proposed culvert affect navigation by reducing or  
increasing the existing navigable opening? ☐ Yes ☐ NoIf yes, explain:  
\_\_\_\_\_  
\_\_\_\_\_  
\_\_\_\_\_

k. Will the proposed culvert affect existing water flow?

☐ Yes ☐ NoIf yes, explain:  
\_\_\_\_\_  
\_\_\_\_\_  
\_\_\_\_\_**3. EXCAVATION and FILL**☐ This section not applicablea. (i) Will the placement of the proposed bridge or culvert require any  
excavation below the NHW or NWL? ☒ Yes ☐ No

If yes,

(ii) Avg. length of area to be excavated: 100 ft(iii) Avg. width of area to be excavated: 50 ft(iv) Avg. depth of area to be excavated: 3.5 ft(v) Amount of material to be excavated in cubic yards: 880b. (i) Will the placement of the proposed bridge or culvert require any  
excavation within coastal wetlands/marsh (CW), submerged  
aquatic vegetation (SAV), shell bottom (SB), or other wetlands  
(WL)? If any boxes are checked, provide the number of square  
feet affected.☒ CW 7116 ☐ SAV \_\_\_\_\_ ☐ SB \_\_\_\_\_☐ WL \_\_\_\_\_ ☐ None

(ii) Describe the purpose of the excavation in these areas:

To provide clearance to construct and inspect the  
Gallants Channel Bridge.  
\_\_\_\_\_  
\_\_\_\_\_  
\_\_\_\_\_c. (i) Will the placement of the proposed bridge or culvert require any  
high-ground excavation? ☒ Yes ☐ No

If yes,

**SEE PERMIT DRAWINGS**(ii) Avg. length of area to be excavated: Varies with location(iii) Avg. width of area to be excavated: Varies with location(iv) Avg. depth of area to be excavated: Varies with location(v) Amount of material to be excavated in cubic yards: Varies

d. If the placement of the bridge or culvert involves any excavation, please complete the following:

(i) Location of the spoil disposal area: To be determined by the contractor

(ii) Dimensions of the spoil disposal area: Unknown

(iii) Do you claim title to the disposal area? ☐ Yes ☒ No (If no, attach a letter granting permission from the owner.)

(iv) Will the disposal area be available for future maintenance? ☐ Yes ☒ No

(v) Does the disposal area include any coastal wetlands/marsh (CW), submerged aquatic vegetation (SAVs), other wetlands (WL), or shell bottom (SB)?

☐ CW ☐ SAV ☐ WL ☐ SB ☒ None

If any boxes are checked, give dimensions if different from (ii) above.

(vi) Does the disposal area include any area below the NHW or NWL? ☐ Yes ☒ No

If yes, give dimensions if different from (ii) above.

e. (i) Will the placement of the proposed bridge or culvert result in any fill (other than excavated material described in Item d above) to be placed below NHW or NWL? ☒ Yes ☐ No

If yes,

(ii) Avg. length of area to be filled: Varies

(iii) Avg. width of area to be filled: Varies

(iv) Purpose of fill: To support the bridge (SEE PERMIT DRAWINGS)

f. (i) Will the placement of the proposed bridge or culvert result in any fill (other than excavated material described in Item d above) to be placed within coastal wetlands/marsh (CW), submerged aquatic vegetation (SAV), shell bottom (SB), or other wetlands (WL)? If any boxes are checked, provide the number of square feet affected.

☒ CW 1,226 sq.ft. ☐ SAV ☐ SB

☒ WL 26,246 sq.ft. ☐ None

(ii) Describe the purpose of the excavation in these areas:

Earth Fill: 106 sq. ft. at Begin Bridge, CW

Earth Fill: 26,224 sq. ft. at End Bridge, WL

Piles and Drilled Piers: 1,120 sq.ft. in CW 22 sq.ft. in WL

g. (i) Will the placement of the proposed bridge or culvert result in any fill (other than excavated material described in Item d above) to be placed on high-ground? ☒ Yes ☐ No

If yes,

(ii) Avg. length of area to be filled: Varies

(iii) Avg. width of area to be filled: Varies

(iv) Purpose of fill: To support the bridge (SEE PERMIT DRAWINGS)

#### 4. GENERAL

a. Will the proposed project require the relocation of any existing utility lines? ☒ Yes ☐ No

If yes, explain: A CAMA General Permit for utility relocations was applied for under separate cover.

b. Will the proposed project require the construction of any temporary detour structures? ☐ Yes ☒ No

If yes, explain:

If this portion of the proposed project has already received approval from local authorities, please attach a copy of the approval or certification.

&lt; Form continues on back &gt;

- c. Will the proposed project require any work channels?

☐ Yes ☒ No

If yes, complete Form DCM-MP-2.

- d. How will excavated or fill material be kept on site and erosion controlled?

Use of Standard NCDOT Best Management Practices and Erosion Control Measures

---

---

---

- e. What type of construction equipment will be used (for example, dragline, backhoe, or hydraulic dredge)?

Heavy highway construction equipment

---

---

---

- f. Will wetlands be crossed in transporting equipment to project site?

☒ Yes ☐ No

If yes, explain steps that will be taken to avoid or minimize environmental impacts.

Only wetlands to be crossed are those depicted in the Roadway plans and permits.

---

---

---

- g. Will the placement of the proposed bridge or culvert require any shoreline stabilization?

☒ Yes ☐ No

If yes, complete form MP-2, Section 3 for Shoreline Stabilization only.

Date

Nov 9, 2011

Project Name

R-3307

Applicant Name

Gregory J. Thompson, PhD

Applicant Signature

E. L. Lusk for

Form DCM MP-5

# BRIDGES and CULVERTS

Attach this form to Joint Application for CAMA Major Permit, Form DCM MP-1. Be sure to complete all other sections of the Joint Application that relate to this proposed project. Please include all supplemental information.

## 1. BRIDGES

☐ This section not applicable

- a. Is the proposed bridge:  
☐ Commercial ☒ Public/Government ☐ Private/Community
- b. Water body to be crossed by bridge:  
Town Creek
- c. Type of bridge (construction material):  
Concrete
- d. Water depth at the proposed crossing at NLW or NWL:  
5.2 feet
- e. (i) Will proposed bridge replace an existing bridge? ☐ Yes ☒ No  
If yes,  
(ii) Length of existing bridge: \_\_\_\_\_  
(iii) Width of existing bridge: \_\_\_\_\_  
(iv) Navigation clearance underneath existing bridge: \_\_\_\_\_  
(v) Will all, or a part of, the existing bridge be removed?  
(Explain)  
\_\_\_\_\_  
\_\_\_\_\_
- f. (i) Will proposed bridge replace an existing culvert? ☒ Yes ☐ No  
If yes,  
(ii) Length of existing culvert: 61 ft.  
(iii) Width of existing culvert: 4 @ 95" x 67" CMPA  
(iv) Height of the top of the existing culvert above the NHW or NWL: 0.8 ft.  
(v) Will all, or a part of, the existing culvert be removed?  
(Explain) All  
\_\_\_\_\_  
\_\_\_\_\_
- g. Length of proposed bridge: 585 ft
- h. Width of proposed bridge: 75 feet
- i. Will the proposed bridge affect existing water flow? ☒ Yes ☐ No  
If yes, explain: The causeway that currently carries Turner Street over Town Creek will be removed. Average flows will increase slightly per hydraulic report by Moffatt & Nichol. They found the following average increase in flows:  
Spring Tide: 0.9%  
Neap Tide: 2.0%  
Mid Tide: 1.6%  
\_\_\_\_\_  
\_\_\_\_\_
- j. Will the proposed bridge affect navigation by reducing or increasing the existing navigable opening? ☐ Yes ☒ No  
If yes, explain:  
\_\_\_\_\_  
\_\_\_\_\_
- k. Navigation clearance underneath proposed bridge: N/A
- l. Have you contacted the U.S. Coast Guard concerning their approval? ☐ Yes ☒ No  
If yes, explain:  
\_\_\_\_\_  
\_\_\_\_\_
- m. Will the proposed bridge cross wetlands containing no navigable waters? ☒ Yes ☐ No  
If yes, explain: See plans  
\_\_\_\_\_  
\_\_\_\_\_
- n. Height of proposed bridge above wetlands: Varies from 7.2 feet to 8.9 feet

## 2. CULVERTS

☒ This section not applicable

a. Number of culverts proposed: \_\_\_\_\_

b. Water body in which the culvert is to be placed:  
\_\_\_\_\_

&lt; Form continues on back &gt;

c. Type of culvert (construction material):  
\_\_\_\_\_

d. (i) Will proposed culvert replace an existing bridge?

☐ Yes ☐ No

If yes,

(ii) Length of existing bridge: \_\_\_\_\_

(iii) Width of existing bridge: \_\_\_\_\_

(iv) Navigation clearance underneath existing bridge: \_\_\_\_\_

(v) Will all, or a part of, the existing bridge be removed?  
(Explain)  
\_\_\_\_\_  
\_\_\_\_\_  
\_\_\_\_\_

e. (i) Will proposed culvert replace an existing culvert?

☐ Yes ☐ No

If yes,

(ii) Length of existing culvert(s): \_\_\_\_\_

(iii) Width of existing culvert(s): \_\_\_\_\_

(iv) Height of the top of the existing culvert above the NHW or  
NWL: \_\_\_\_\_(v) Will all, or a part of, the existing culvert be removed?  
(Explain)  
\_\_\_\_\_  
\_\_\_\_\_  
\_\_\_\_\_

f. Length of proposed culvert: \_\_\_\_\_

g. Width of proposed culvert: \_\_\_\_\_

h. Height of the top of the proposed culvert above the NHW or NWL.  
\_\_\_\_\_i. Depth of culvert to be buried below existing bottom contour.  
\_\_\_\_\_j. Will the proposed culvert affect navigation by reducing or  
increasing the existing navigable opening? ☐ Yes ☐ NoIf yes, explain:  
\_\_\_\_\_  
\_\_\_\_\_  
\_\_\_\_\_

k. Will the proposed culvert affect existing water flow?

☐ Yes ☐ NoIf yes, explain:  
\_\_\_\_\_  
\_\_\_\_\_  
\_\_\_\_\_**3. EXCAVATION and FILL**☐ This section not applicablea. (i) Will the placement of the proposed bridge or culvert require any  
excavation below the NHW or NWL? ☒ Yes ☐ No

If yes,

(ii) Avg. length of area to be excavated: 540 ft(iii) Avg. width of area to be excavated: 120 ft(iv) Avg. depth of area to be excavated: 1.4 ft(v) Amount of material to be excavated in cubic yards: 3360b. (i) Will the placement of the proposed bridge or culvert require any  
excavation within coastal wetlands/marsh (CW), submerged  
aquatic vegetation (SAV), shell bottom (SB), or other wetlands  
(WL)? If any boxes are checked, provide the number of square  
feet affected.☒ CW 67,760 ☐ SAV \_\_\_\_\_ ☐ SB \_\_\_\_\_☐ WL \_\_\_\_\_ ☐ None

(ii) Describe the purpose of the excavation in these areas:

The Turner Street causeway will be removed and  
excavated down to an elevation of -0.2 ft.  
\_\_\_\_\_  
\_\_\_\_\_  
\_\_\_\_\_

- c. (i) Will the placement of the proposed bridge or culvert require any high-ground excavation? ☒ Yes ☐ No

If yes,

(ii) Avg. length of area to be excavated: 540 ft.

(iii) Avg. width of area to be excavated: 120 ft.

(iv) Avg. depth of area to be excavated: 1.3 ft.

(v) Amount of material to be excavated in cubic yards: 3,100

- d. If the placement of the bridge or culvert involves any excavation, please complete the following:

(i) Location of the spoil disposal area: To be determined by the contractor

(ii) Dimensions of the spoil disposal area: Unknown

(iii) Do you claim title to the disposal area? ☐ Yes ☒ No (If no, attach a letter granting permission from the owner.)

(iv) Will the disposal area be available for future maintenance? ☐ Yes ☒ No

(v) Does the disposal area include any coastal wetlands/marsh (CW), submerged aquatic vegetation (SAVs), other wetlands (WL), or shell bottom (SB)?

☐ CW ☐ SAV ☐ WL ☐ SB ☒ None

If any boxes are checked, give dimensions if different from (ii) above.

(vi) Does the disposal area include any area below the NHW or NWL? ☐ Yes ☒ No

If yes, give dimensions if different from (ii) above.

- e. (i) Will the placement of the proposed bridge or culvert result in any fill (other than excavated material described in Item d above) to be placed below NHW or NWL? ☒ Yes ☐ No

If yes,

(ii) Avg. length of area to be filled: Varies

(iii) Avg. width of area to be filled: Varies

(iv) Purpose of fill: To support the bridge and roadway approach.

- f. (i) Will the placement of the proposed bridge or culvert result in any fill (other than excavated material described in Item d above) to be placed within coastal wetlands/marsh (CW), submerged aquatic vegetation (SAV), shell bottom (SB), or other wetlands (WL)? If any boxes are checked, provide the number of square feet affected.

☒ CW ☐ SAV ☐ SB

☒ WL ☐ None

- (ii) Describe the purpose of the excavation in these areas:

Earth Fill: 1,570 sq. ft. at Begin Bridge, CW

Earth Fill: 8,710 sq. ft. at End Bridge, CW

Piles:

178 sq.ft. in CW

- g. (i) Will the placement of the proposed bridge or culvert result in any fill (other than excavated material described in Item d above) to be placed on high-ground? ☒ Yes ☐ No

If yes,

(ii) Avg. length of area to be filled: Varies

(iii) Avg. width of area to be filled: Varies

(iv) Purpose of fill: To support the bridge and roadway approach

#### 4. GENERAL

- a. Will the proposed project require the relocation of any existing utility lines? ☒ Yes ☐ No

If yes, explain: Sewer line along Turner Street will require

- b. Will the proposed project require the construction of any temporary detour structures? ☐ Yes ☒ No

If yes, explain:

relocation.  
  
  
  

If this portion of the proposed project has already received approval from local authorities, please attach a copy of the approval or certification.

&lt; Form continues on back &gt;

- c. Will the proposed project require any work channels?

☐ Yes ☒ No

If yes, complete Form DCM-MP-2.

- d. How will excavated or fill material be kept on site and erosion controlled?

Use of Standard NCDOT Best Management Practices and Erosion Control Measures

- e. What type of construction equipment will be used (for example, dragline, backhoe, or hydraulic dredge)?

Heavy highway construction equipment

- f. Will wetlands be crossed in transporting equipment to project site?

☒ Yes ☐ No

If yes, explain steps that will be taken to avoid or minimize environmental impacts.

Only wetlands to be crossed are those depicted in the Roadway plans and permits.

- g. Will the placement of the proposed bridge or culvert require any shoreline stabilization?

☒ Yes ☐ No

If yes, complete form MP-2, Section 3 for Shoreline Stabilization only.

Date

Nov 9, 2011

Project Name

R-3307

Applicant Name

Gregory J. Thorne, PhD

Applicant Signature

E. J. Luck for



October 27, 2011

Mr. Gregory J. Thorpe, Ph.D.  
Manager, Project Development and Environmental Analysis Branch  
North Carolina Department of Transportation  
1548 Mail Service Center  
Raleigh, North Carolina 27699-1548

Dear Dr. Thorpe:

Subject: EEP Mitigation Acceptance Letter:

R-3307, US 70 from Existing 4 Lanes at Radio Island to US 70 North of Beaufort near  
SR 1429 (Olga Road), Carteret County

The purpose of this letter is to notify you that the Ecosystem Enhancement Program (EEP) will provide the compensatory stream and wetland mitigation for the subject project. Based on the information supplied by you on July 26 and October 27, 2011, the impacts are located in CU 03020106 of the White Oak River Basin in the Southern Outer Coastal Plain (SOCP) Eco-Region, and are as follows:

White Oak 03020106 SOCP	Stream			Wetlands			Buffer (Sq. Ft.)	
	Cold	Cool	Warm	Riparian	Non- Riparian	Coastal Marsh	Zone 1	Zone 2
Impacts (feet/acres)	0	0	803	1.78	4.69	0	0	0

**This mitigation acceptance letter replaces the mitigation acceptance letter issued on July 27, 2011.** EEP commits to implementing sufficient compensatory stream, riparian and non-riparian wetland mitigation credits to offset the impacts associated with this project in accordance with the N.C. Department of Environment and Natural Resources' Ecosystem Enhancement Program In-Lieu Fee Instrument dated July 28, 2010. If the above referenced impact amounts are revised, then this mitigation acceptance letter will no longer be valid and a new mitigation acceptance letter will be required from EEP.

If you have any questions or need additional information, please contact Ms. Beth Harmon at 919-715-1929.

Sincerely,

Michael Ellison  
EEP Deputy Director

cc: Mr. Tom Steffens, USACE – Washington Regulatory Field Office  
Mr. Brian Wrenn, Division of Water Quality, Wetlands/401 Unit  
File: R-3307

*Restoring... Enhancing... Protecting Our State*





**Turner Street Marsh Restoration Plan  
R-3307, Highway 70 Improvements  
Beaufort, Carteret County  
Federal Aid Project No. STPNHF-70(43)  
State Project No. 8.1162501  
WBS No. 34528.1.1**

**October 13, 2010**

The North Carolina Department of Transportation (NCDOT) will perform on-site mitigation for impacts associated with R-3307, Improvements to US 70 from existing four lanes at Radio Island to US 70 North of SR 1429 (Olga Road).

The mitigation site is located just north of the town of Beaufort along Turner Street adjacent to Town Creek. The mitigation is proposed to restore 1.4 acres of salt marsh by causeway removal along Turner Street. This mitigation will be used to offset the 1.1 acres of impacts to salt marsh, at a 1:1 ratio, associated with TIP R-3307. The residual 0.3 acres of restoration will be retained by the NCDOT as on-site assets for future projects in the area.

**Existing Conditions**

Turner Street is currently a two lane secondary road that crosses Town Creek approximately 300 feet south of West Beaufort Road. Town Creek flows to the west under Turner Street through four 60 ft. long, 95"x 67" corrugated aluminum pipes. To the south of the crossing, a salt marsh wetland dominated by smooth cordgrass (*Spartina alterniflora*) runs along the both sides of the causeway and extends outward along Town Creek.

The Environmental Assessment (EA) dated October 2004 and the Finding of No Significant Impact (FONSI) dated August, 2006, for TIP R-3307, provide further details concerning natural resource and roadway conditions.

**Proposed Conditions**

The mitigation site will consist of 1.4 acres of salt marsh restoration at the proposed Turner Street Bridge. The NCDOT will remove the existing culverts and approximately 560 ft. of causeway. The causeway and any higher knolls within the right-of-way will be graded to a target elevation of -0.2 ft msl. This elevation is slightly higher than the mean tide level and is within the range of elevations taken in the adjacent marsh. The restoration area will be planted on three foot centers with smooth cordgrass.

The Natural Environment Unit shall be contacted to provide construction oversight to ensure that the wetland mitigation area is constructed appropriately.

## **Monitoring**

Target elevations will be verified during construction to ensure the restoration area achieves the same hydrologic regime as the adjacent salt marsh wetland.

The quantitative marsh vegetation monitoring will be accomplished in accordance with the draft guidelines for “Site Monitoring Surveys for Emergent Marsh Mitigation”, established by the National Marine Fisheries Service, through the evaluation of randomly distributed 1 square meter plots located by GPS within the site.


The vegetation component of the wetland site will be deemed successful if the following criteria are met:

1. At year five, the average of all plots should have a scale value of 5 (>75% vegetative cover) consisting of wetland herbaceous species, not including any invasive species;
2. A minimum of 70% of the plots shall contain the target (planted) species.

NCDOT will perform the monitoring described above for 5 years or until the site is deemed successful. The site will be protected in perpetuity and placed on the Natural Environment Unit's Mitigation GeoDatabase.

STATE	STATE PROJECT REFERENCE NO.	SHEET NO.	TOTAL SHEETS
N.C.	R-3307	1	
STATE PROJ. NO.	F.A. PROJ. NO.	DESCRIPTION	
34528.1.1	STPNHF-70(43)	PE	
34528.2.2	STPNHF-70(105)	RW, UTIL.	

Permit Drawing  
Sheet 1 of 34

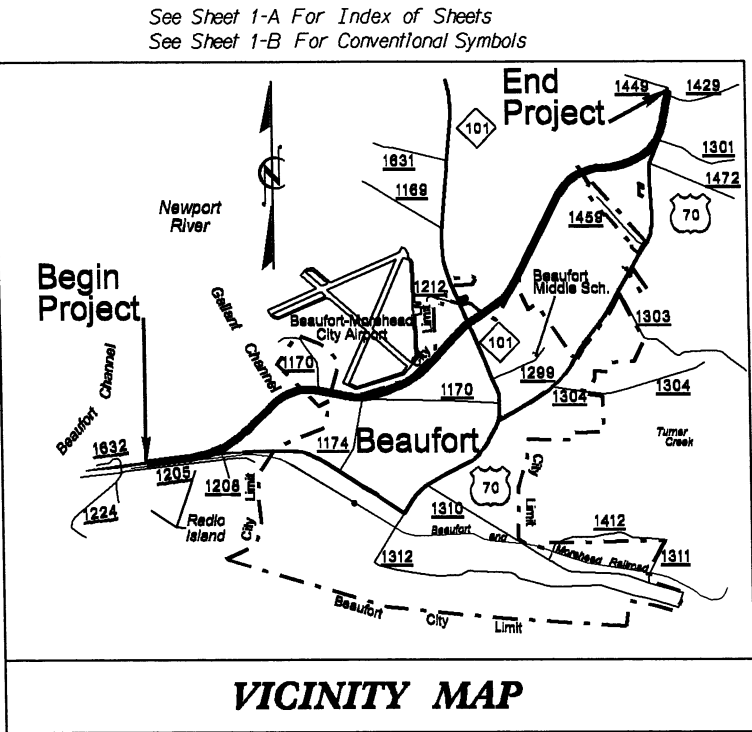

VICINITY MAP


STATE OF NORTH CAROLINA  
DIVISION OF HIGHWAYS  
**CARTERET COUNTY**

LOCATION: US 70 FROM EXISTING FOUR LANES AT RADIO  
ISLAND TO US 70 NORTH OF SR 1429  
(OLGA ROAD)

TYPE OF WORK: GRADING, PAVING, DRAINAGE, CURB & GUTTER  
SIGNALS, CULVERT AND STRUCTURES

**WETLAND & STREAM IMPACTS**


STA. 207+95.09 -L- END TIP PROJECT R-3307

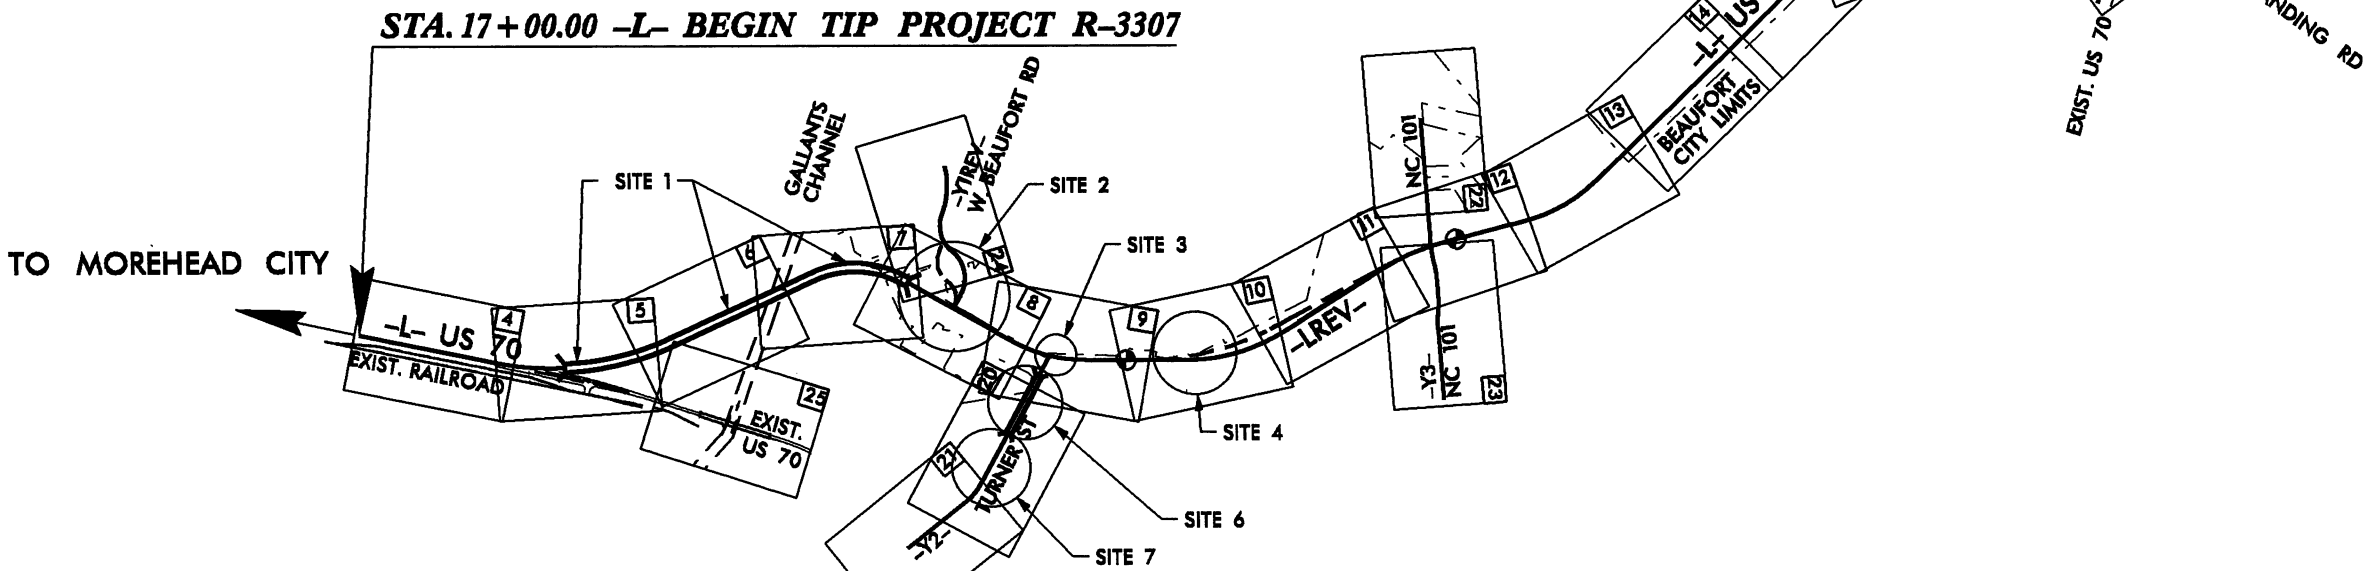

★ PROPOSED TRAFFIC SIGNAL  
CLEARING ON THIS PROJECT SHALL BE PERFORMED TO THE LIMITS ESTABLISHED BY METHOD III.  
A PORTION OF THIS PROJECT IS WITHIN THE MUNICIPAL BOUNDARIES OF THE CITY OF BEAUFORT.  
THIS IS A PARTIAL CONTROLLED-ACCESS PROJECT WITH ACCESS BEING LIMITED TO POINTS AS SHOWN ON THE PLANS.

PRELIMINARY PLANS  
DO NOT USE FOR CONSTRUCTION

CONTRACT:

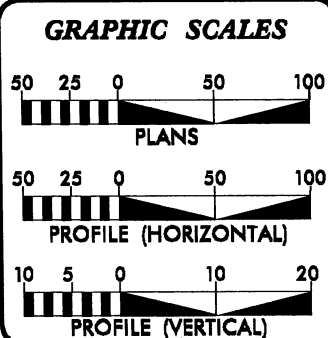

DESIGN DATA  
ADT 2011 = 27620  
ADT 2031 = 39389  
DHV = 11 %  
D = 60 %  
T = 5 % \*  
V (SHOULDER) = 60 MPH\*\*\*  
V (CURB & GUTTER) = 50 MPH  
\* (TTST 1 % + DUAL 4) %  
FUNC. CLASS = ARTERIAL  
STATEWIDE TIER

PROJECT LENGTH  
LENGTH OF ROADWAY PROJECT R-3307 = 2.980 MI  
LENGTH OF STRUCTURE PROJECT R-3307 = 0.643 MI  
TOTAL LENGTH OF F.A. PROJECT STPNHF-70(43) = 3.623 MI

Prepared In the Office of:  
**DIVISION OF HIGHWAYS**  
1000 Birch Ridge Dr., Raleigh NC, 27610  
2006 STANDARD SPECIFICATIONS  
RIGHT OF WAY DATE: JULY 18, 2008  
LETTING DATE: JULY 17, 2012  
BRENDA MOORE, PE  
PROJECT ENGINEER  
REKHA PATEL, PE  
PROJECT DESIGN ENGINEER

HYDRAULICS ENGINEER  
SIGNATURE: \_\_\_\_\_ P.E.  
ROADWAY DESIGN ENGINEER  
SIGNATURE: \_\_\_\_\_ P.E.

DIVISION OF HIGHWAYS  
STATE OF NORTH CAROLINA  
  
STATE HIGHWAY DESIGN ENGINEER  
P.E.




8/17/99

REVISIONS


DESIGNED BY: J. BLAHA  
CHECKED BY: J. BLAHA  
APPROVED BY: J. BLAHA  
DATE: 8/17/99

Permit Drawing  
Sheet 3 of 34

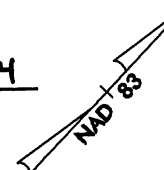

PROJECT REFERENCE NO. <i>R-3307</i>		SHEET NO. <i>6</i>	
RW SHEET NO.			
ROADWAY DESIGN ENGINEER		HYDRAULICS ENGINEER	
<div>PRELIMINARY PLANS</div> <div>DO NOT USE FOR CONSTRUCTION</div>			

FOR -L- PROFILE SEE SHEET 27

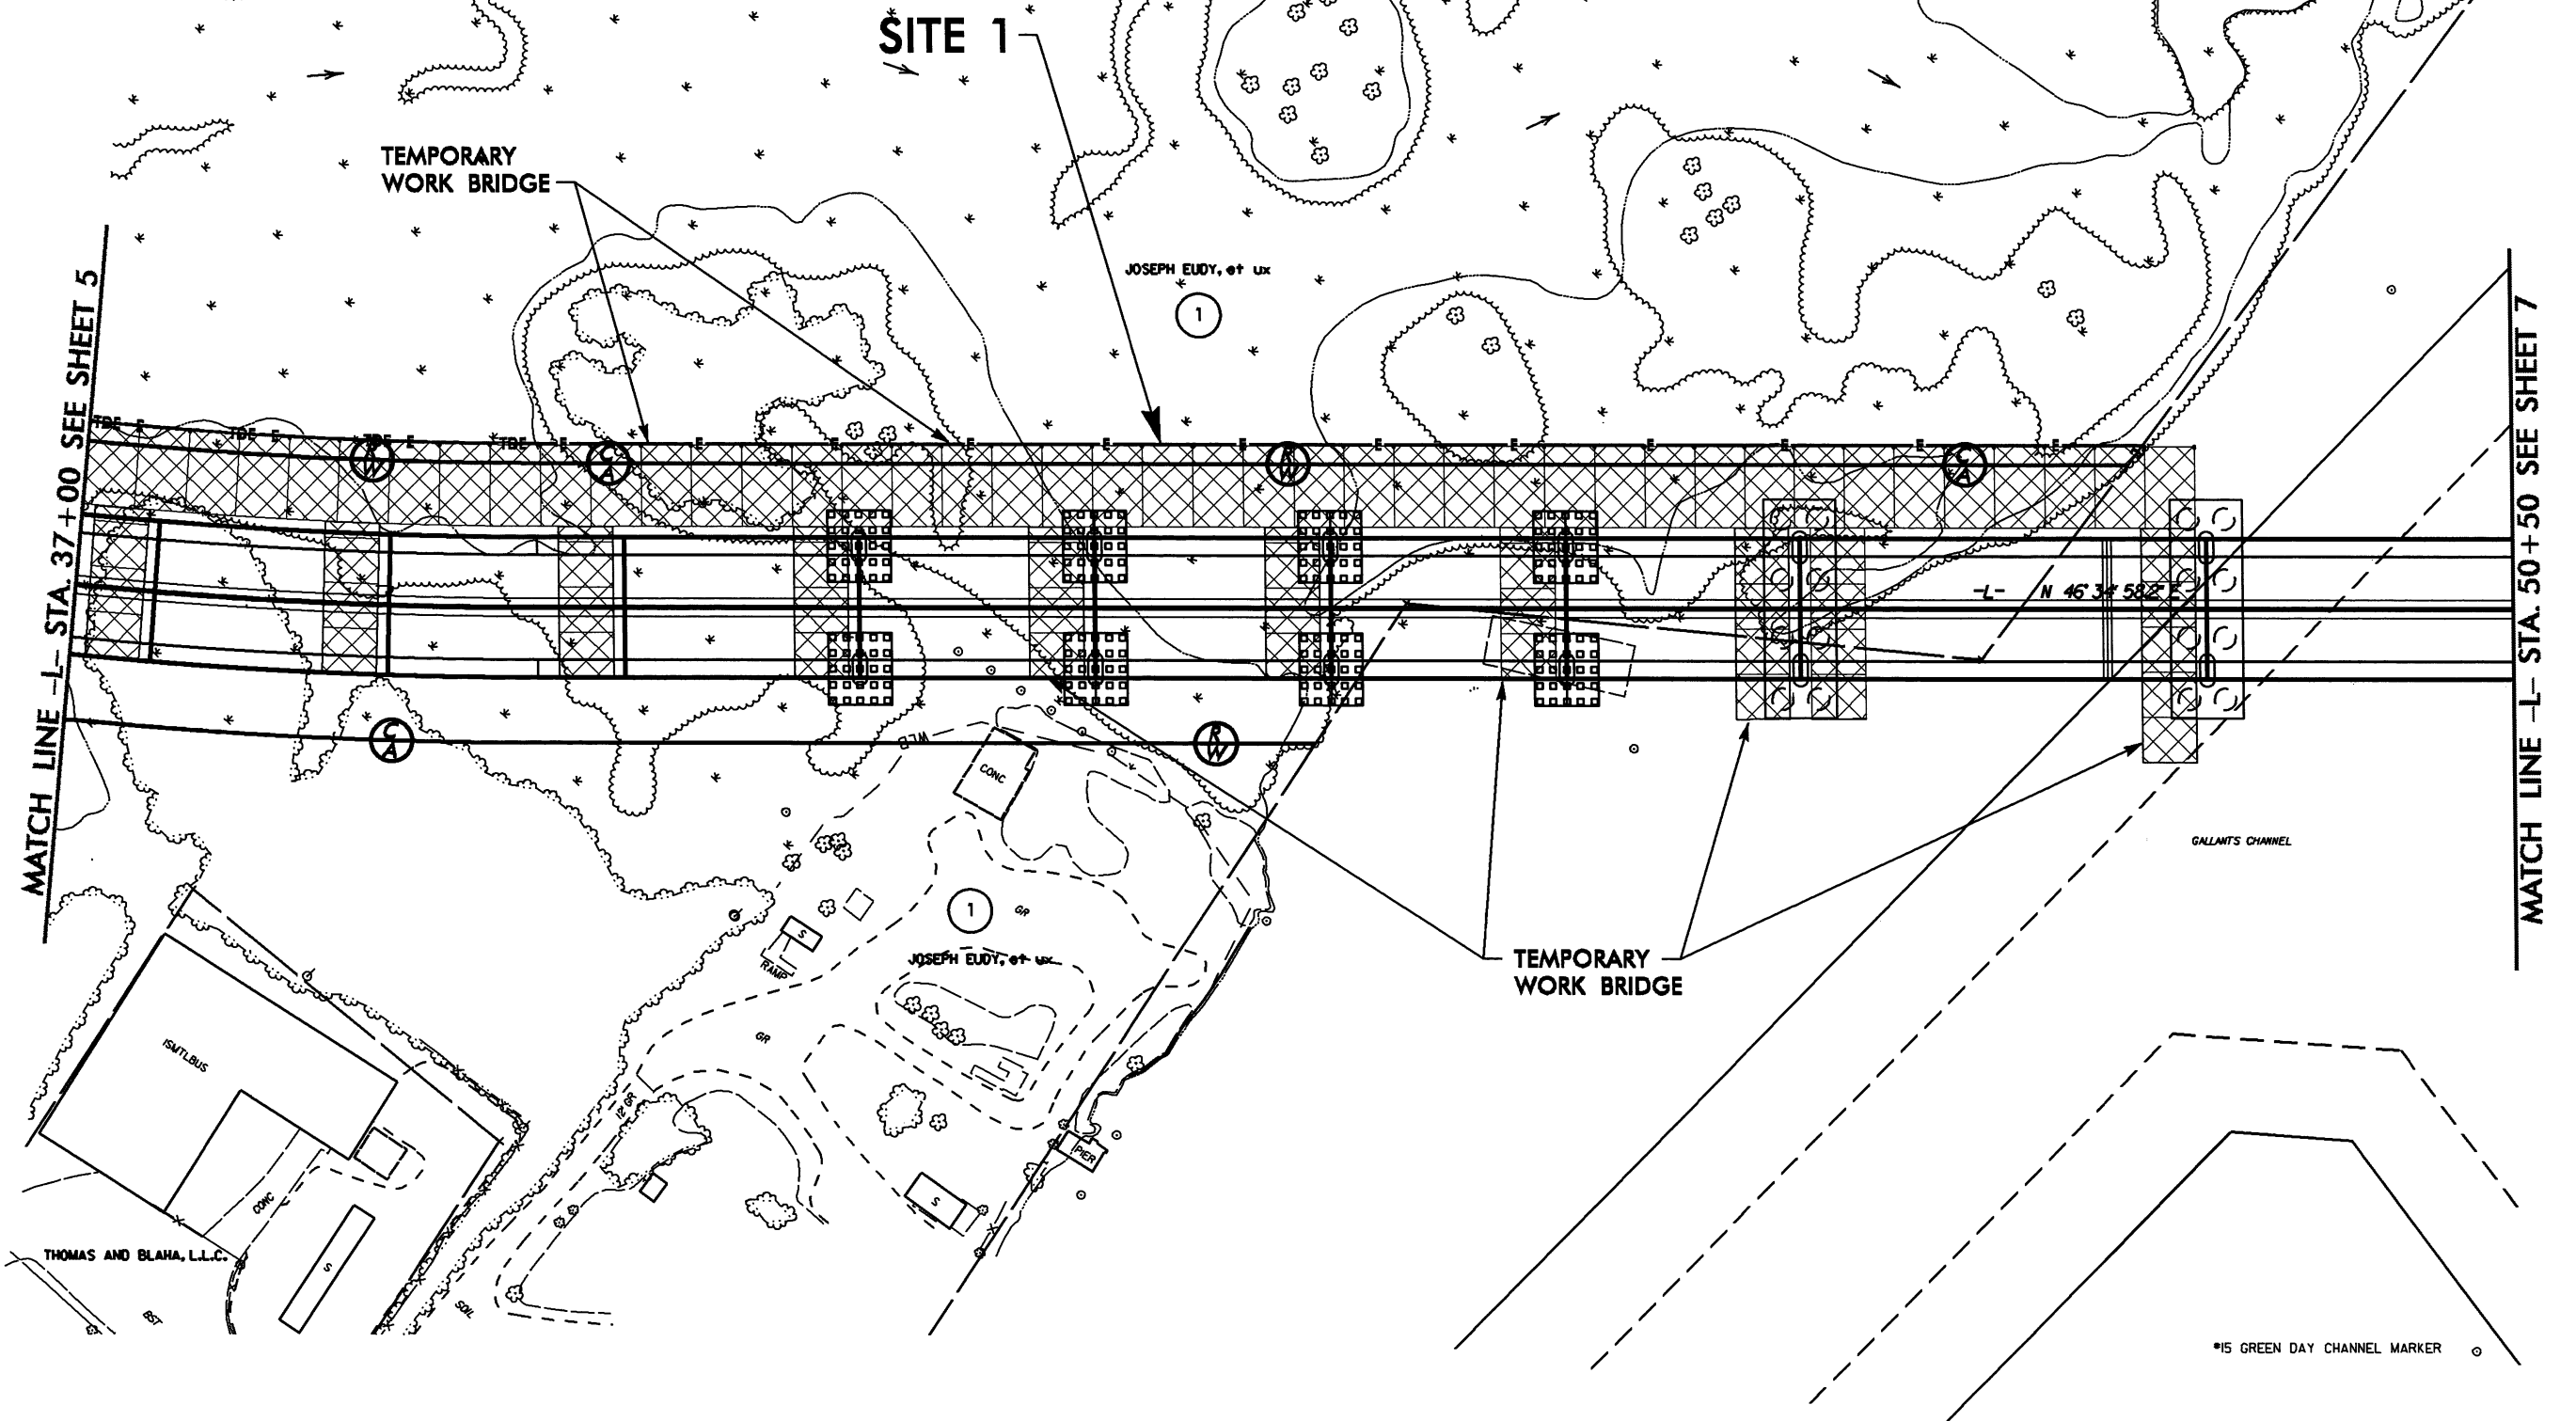


8/17/99

REVISIONS

R/W REV. 07/29/10 (KWW) REVISED EXIST. P/L TO NUMERICAL OFFSET.

SYTIME  
UNIVERSITY  
CERNAMIE

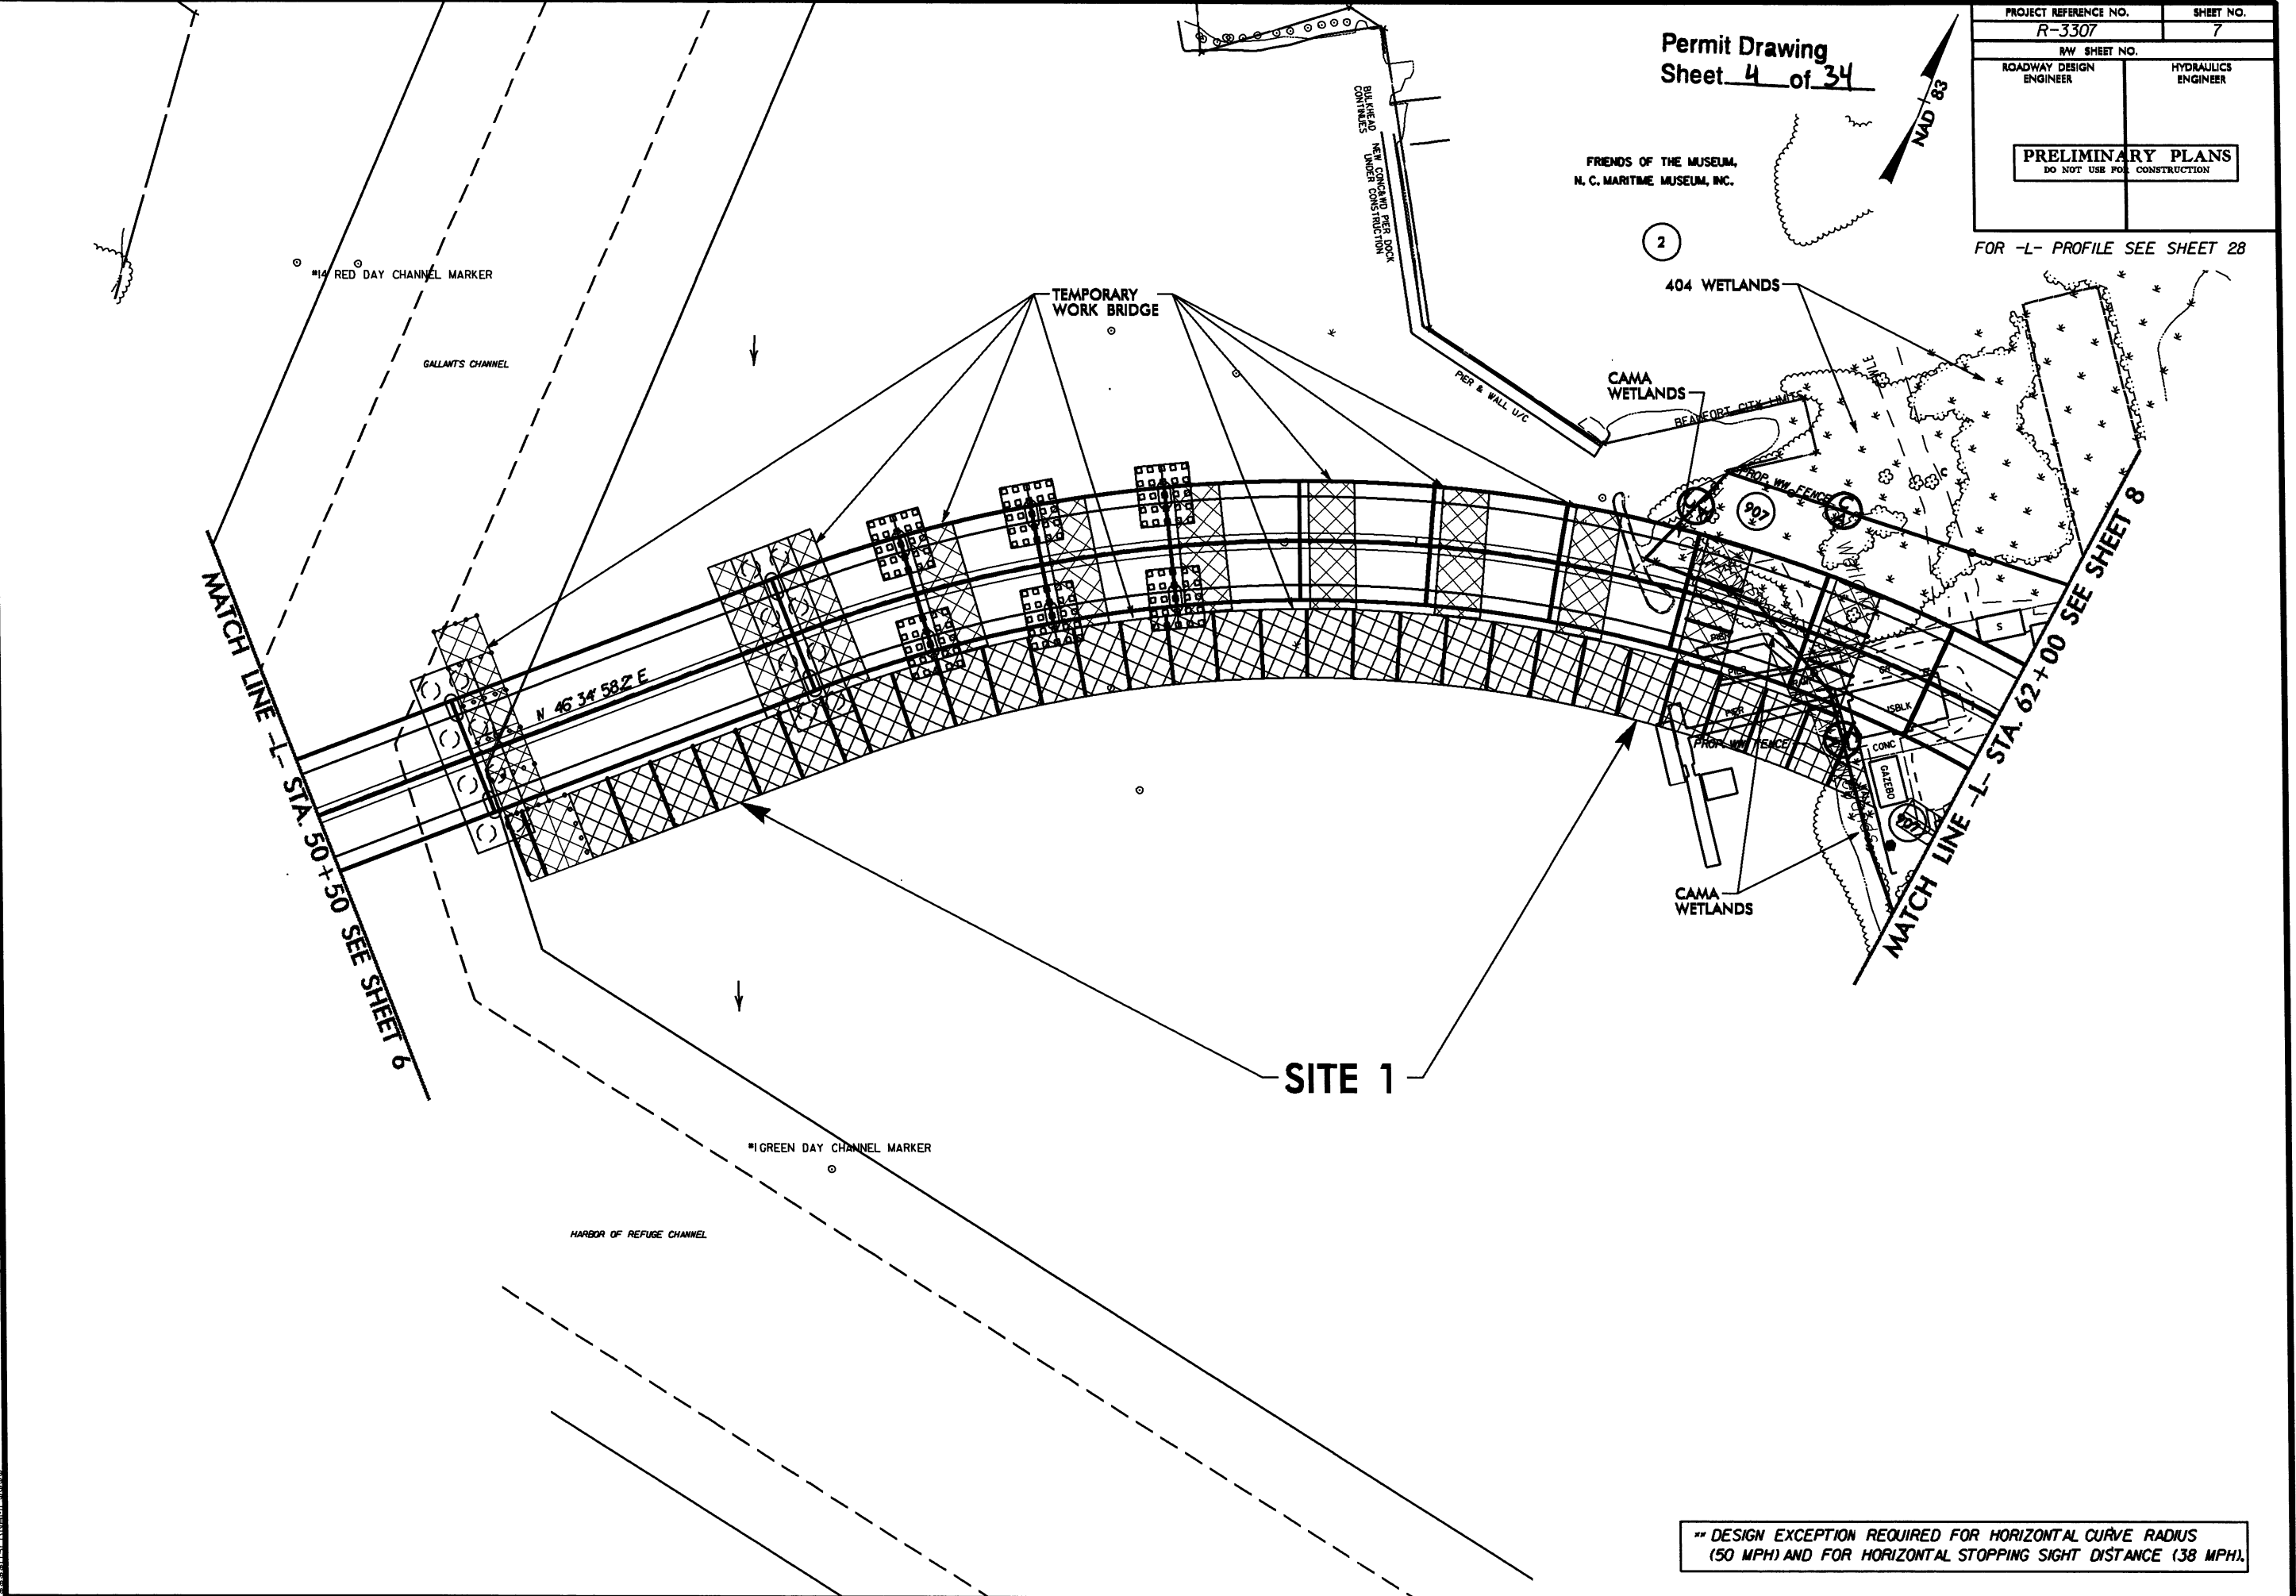

Permit Drawing  
Sheet 4 of 34

FRIENDS OF THE MUSEUM,  
N. C. MARITIME MUSEUM, INC.



PROJECT REFERENCE NO. <i>R-3307</i>		SHEET NO. <i>7</i>	
RW SHEET NO.			
ROADWAY DESIGN ENGINEER		HYDRAULICS ENGINEER	
<div>PRELIMINARY PLANS</div> <div>DO NOT USE FOR CONSTRUCTION</div>			

FOR -L- PROFILE SEE SHEET 28

\*\* DESIGN EXCEPTION REQUIRED FOR HORIZONTAL CURVE RADIUS  
(50 MPH) AND FOR HORIZONTAL STOPPING SIGHT DISTANCE (38 MPH).

## SITE 2

**SIAD**

**GRASS SWALE DATA**  
 DA= 4.13 gc  
 SLOPE = 0.3%  
 L = 84'  
 D2 = 5.7 cfs  
 V2 = 1.23 fps  
 D2 = 0.6'  
 Q10 = 8.3 cfs  
 V10 = 1.36 fps  
 D10 = 1.0'






-L- STA. 68+86 TO 77+50 LT

**GRASS SWALE DATA**

DA = 1.4 ac  
SLOPE = 0.33%  
L = 438'  
Q2 = 3.1cfs  
V2 = 1.2fps  
D2 = 1.2'  
Q10 = 6.2cfs  
V10 = 1.26fps  
D10 = 1.3'

-L STA. 68+79 TO 73+17 RT

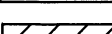-L- STA. 68+79 TO 73+17 RT

	DENOTES HAND CLEARING
	DENOTES MECHANIZED CLEARING
	DENOTES FILL IN WETLAND
	DENOTES TEMPORARY IMPACTS IN SURFACE WATER
	DENOTES IMPACTS IN SURFACE WATER

MATCH LINE -L- STA. 62+00 SEE SHEET /

MATCH LINE - I- STA. 74+00 SEE SHEET 9

REV	REV CT	REVISED	EXIST/PROP	R/W & P/I	TO NUMERICAL OFFSET.

8/17/99

SYSTEMS








8/17/99

REVISIONS

R/W REV. 07/29/10 (KMW) REVISED EXIST/PROP R/W TO NUMERICAL OFFSET.  
R/W REV. 04/18/11 (KMW) DELETED PDE, REVISED TDE, AND ADDED DUE ON PARCEL 910.


BEAUFORT-MOREHEAD CITY  
AIRPORT AUTHORITY

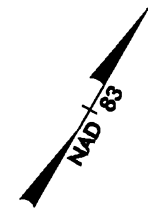

PROJECT REFERENCE NO.		SHEET NO.	
R-3307		10	
RW SHEET NO.			
ROADWAY DESIGN ENGINEER		HYDRAULICS ENGINEER	
<div>PRELIMINARY PLANS</div> <div>DO NOT USE FOR CONSTRUCTION</div>			

FOR -LREV- PROFILE SEE SHEET 30

Permit Drawing  
Sheet 7 of 34

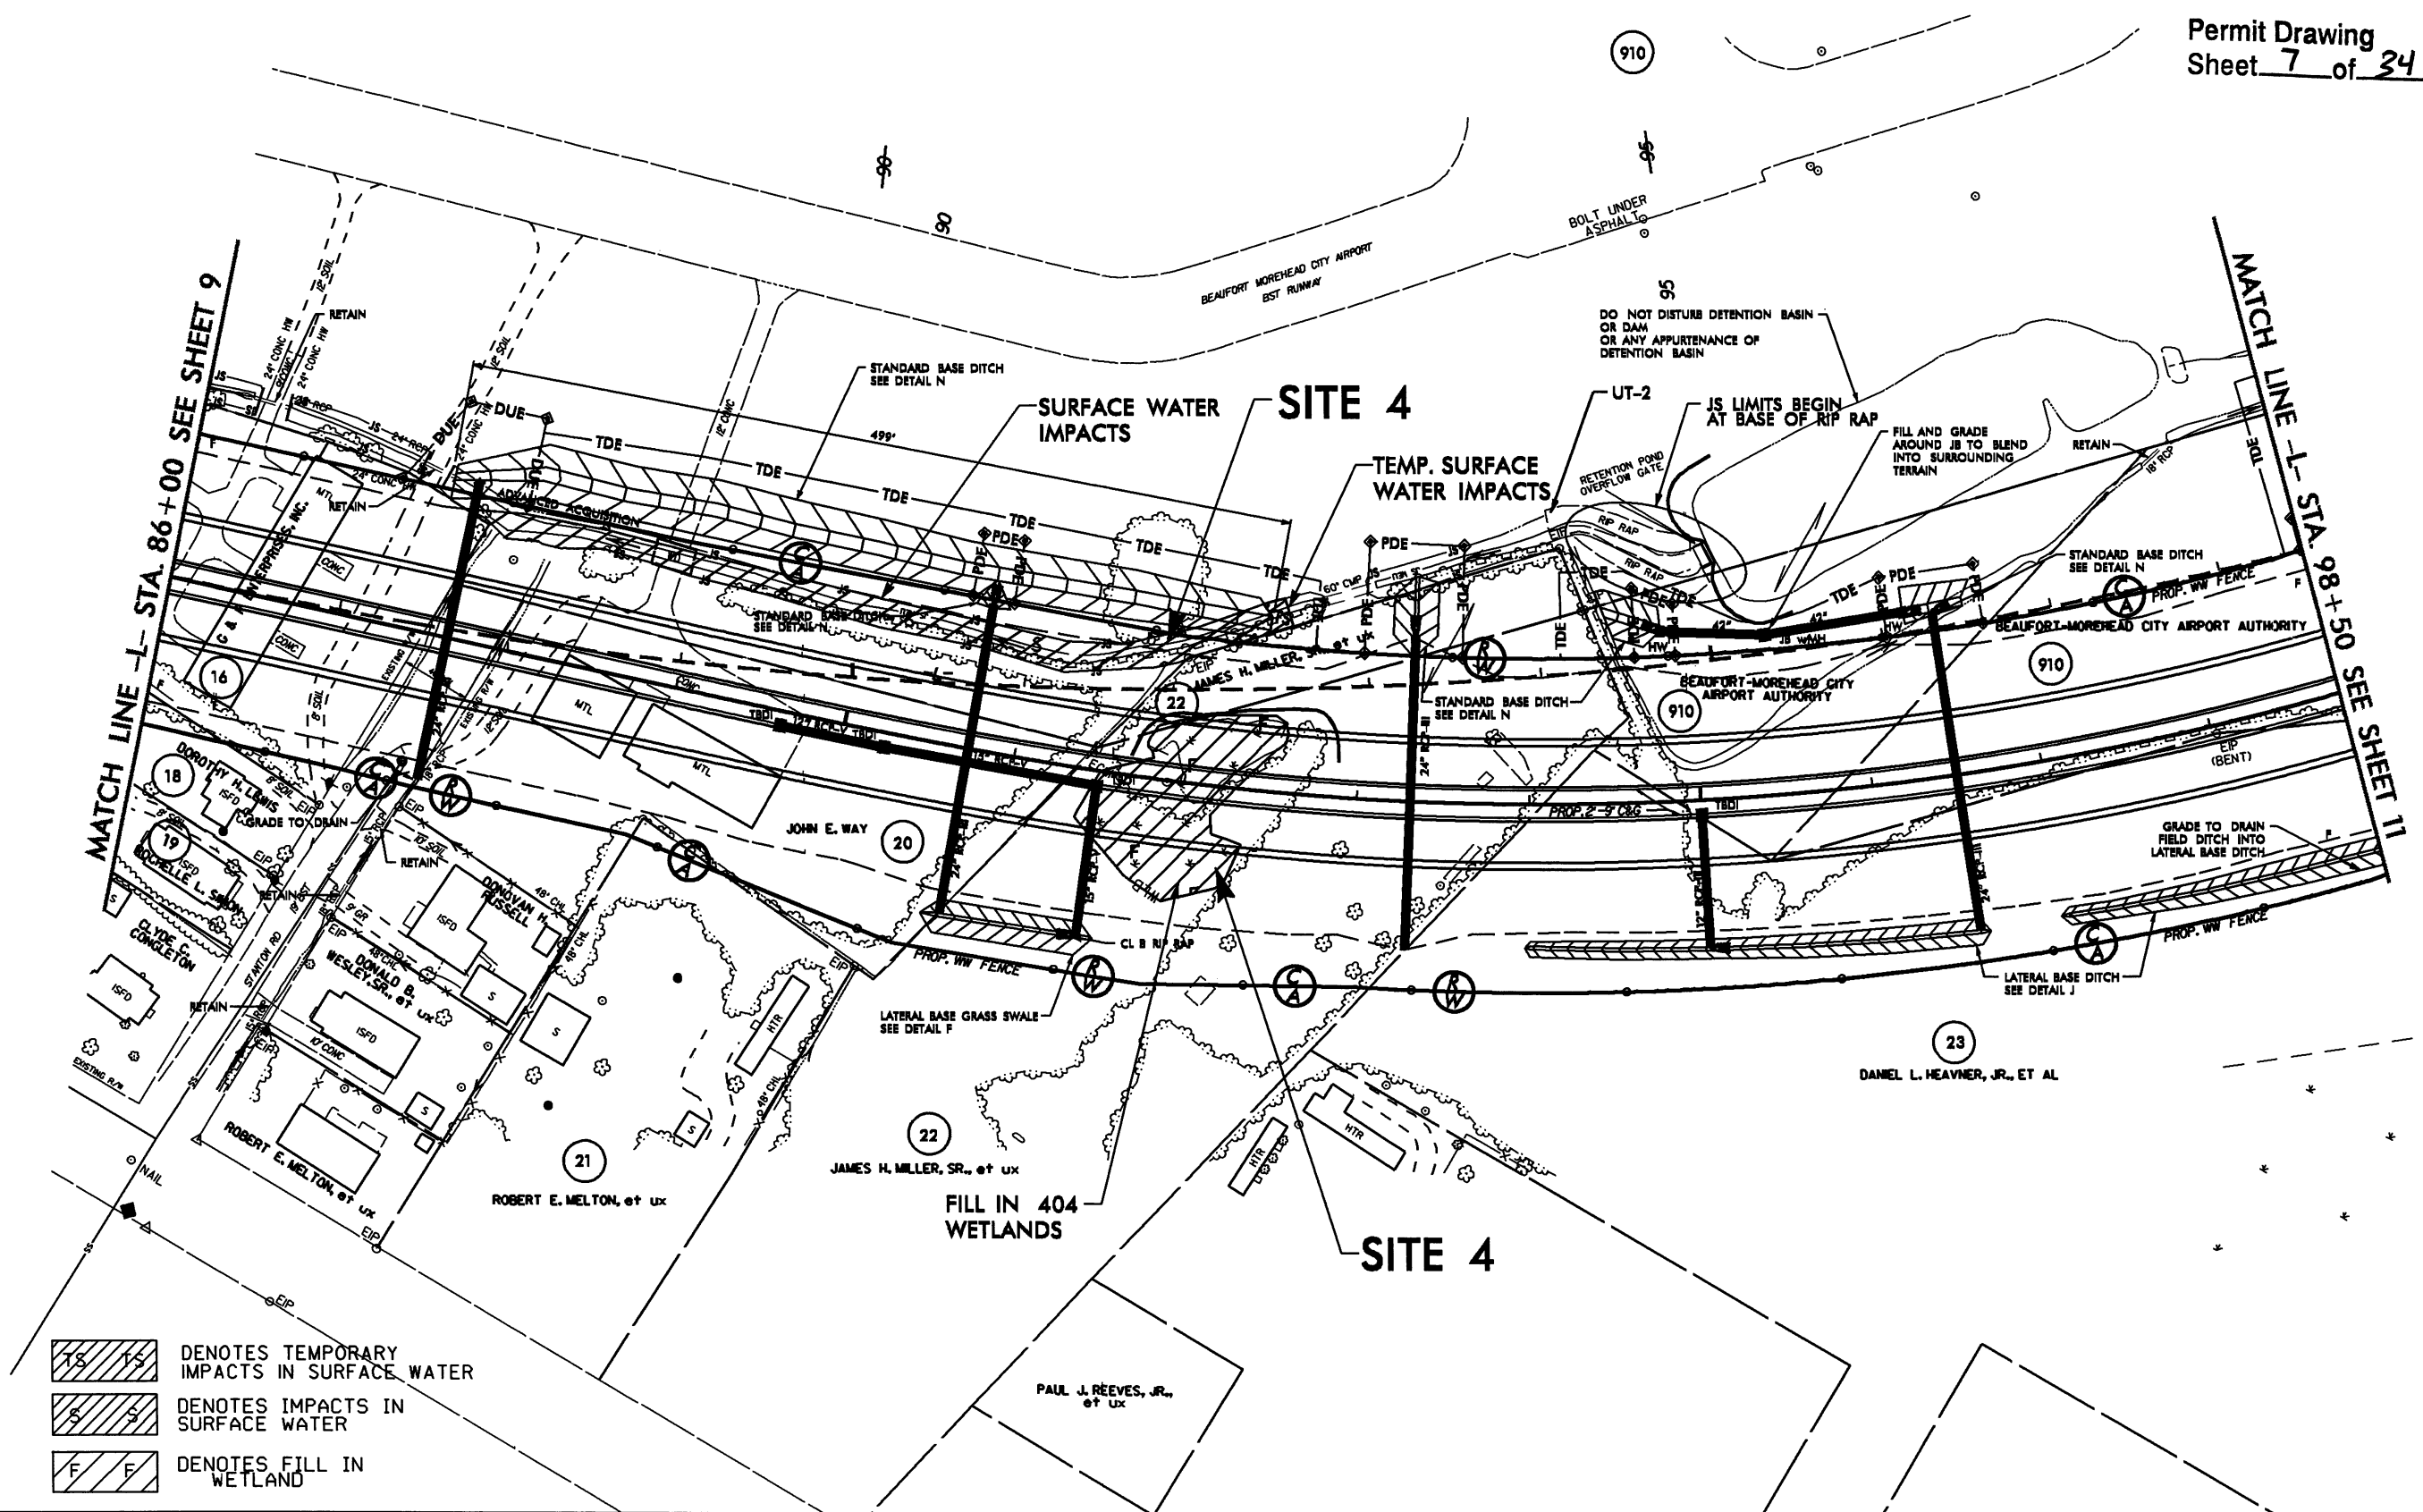



- DENOTES TEMPORARY IMPACTS IN SURFACE WATER
- DENOTES IMPACTS IN SURFACE WATER
- DENOTES FILL IN WETLAND

DANIEL L. HEAVNER, JR., ET AL

PROJECT REFERENCE NO.	SHEET NO.
R-3307	16
R/W SHEET NO.	
ROADWAY DESIGN ENGINEER	HYDRAULICS ENGINEER
PRELIMINARY PLANS DO NOT USE FOR CONSTRUCTION	

FOR -L- PROFILE SEE SHEET 33

Permit Drawing  
Sheet 8 of 34

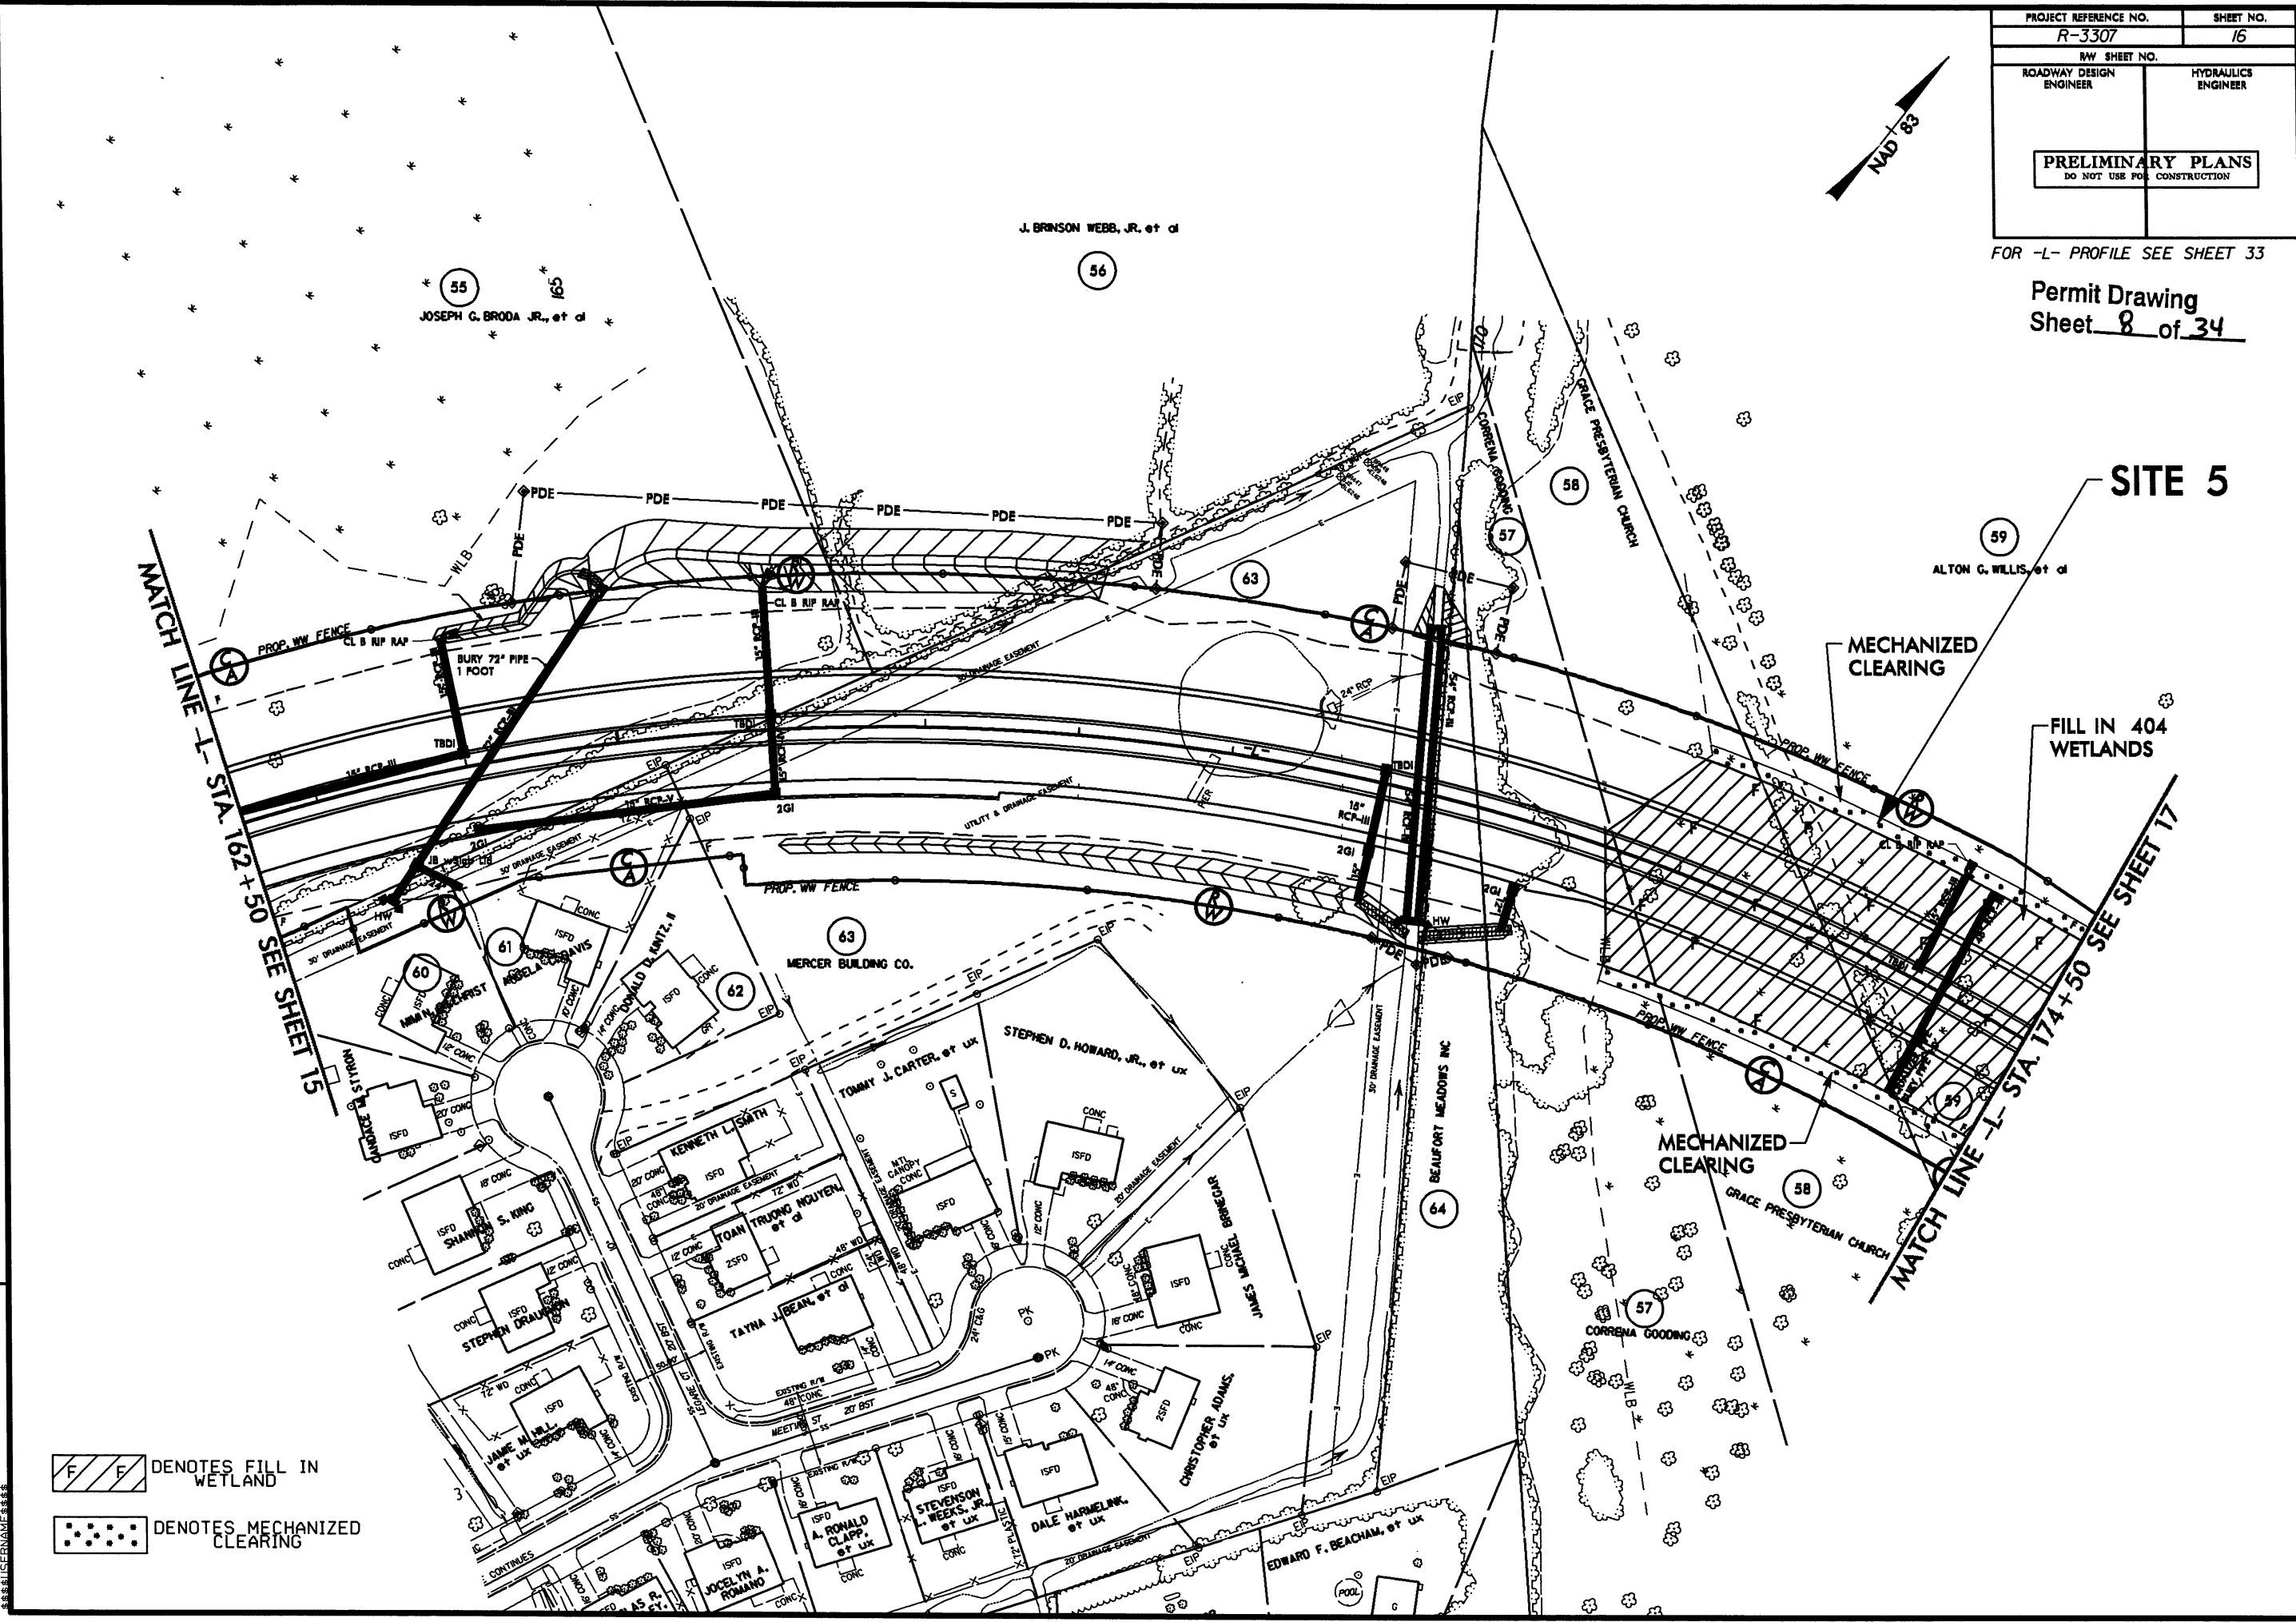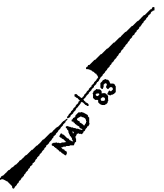

- DENOTES FILL IN WETLAND
- DENOTES MECHANIZED CLEARING

REVISIONS  
R/W REV. 07/29/10 (KMW) REVISED EXIST/PROP R/W TO NUMERICAL OFFSET.

8/17/99

8/17/99

REVISIONS


R/W REV. 07/29/10 (KMW): REVISED PROP R/W TO NUMERICAL OFFSET.

\*\*\*\*\*SYTIME\*\*\*\*\*  
\*\*\*\*\*DON\*\*\*\*\*  
\*\*\*\*\*US\*\*\*\*\*


PROJECT REFERENCE NO. R-3307		SHEET NO. 17	
RW SHEET NO.			
ROADWAY DESIGN ENGINEER		HYDRAULICS ENGINEER	
<b>PRELIMINARY PLANS</b> DO NOT USE FOR CONSTRUCTION			

FOR -L- PROFILE SEE SHEET 33

Permit Drawing  
Sheet 9 of 34

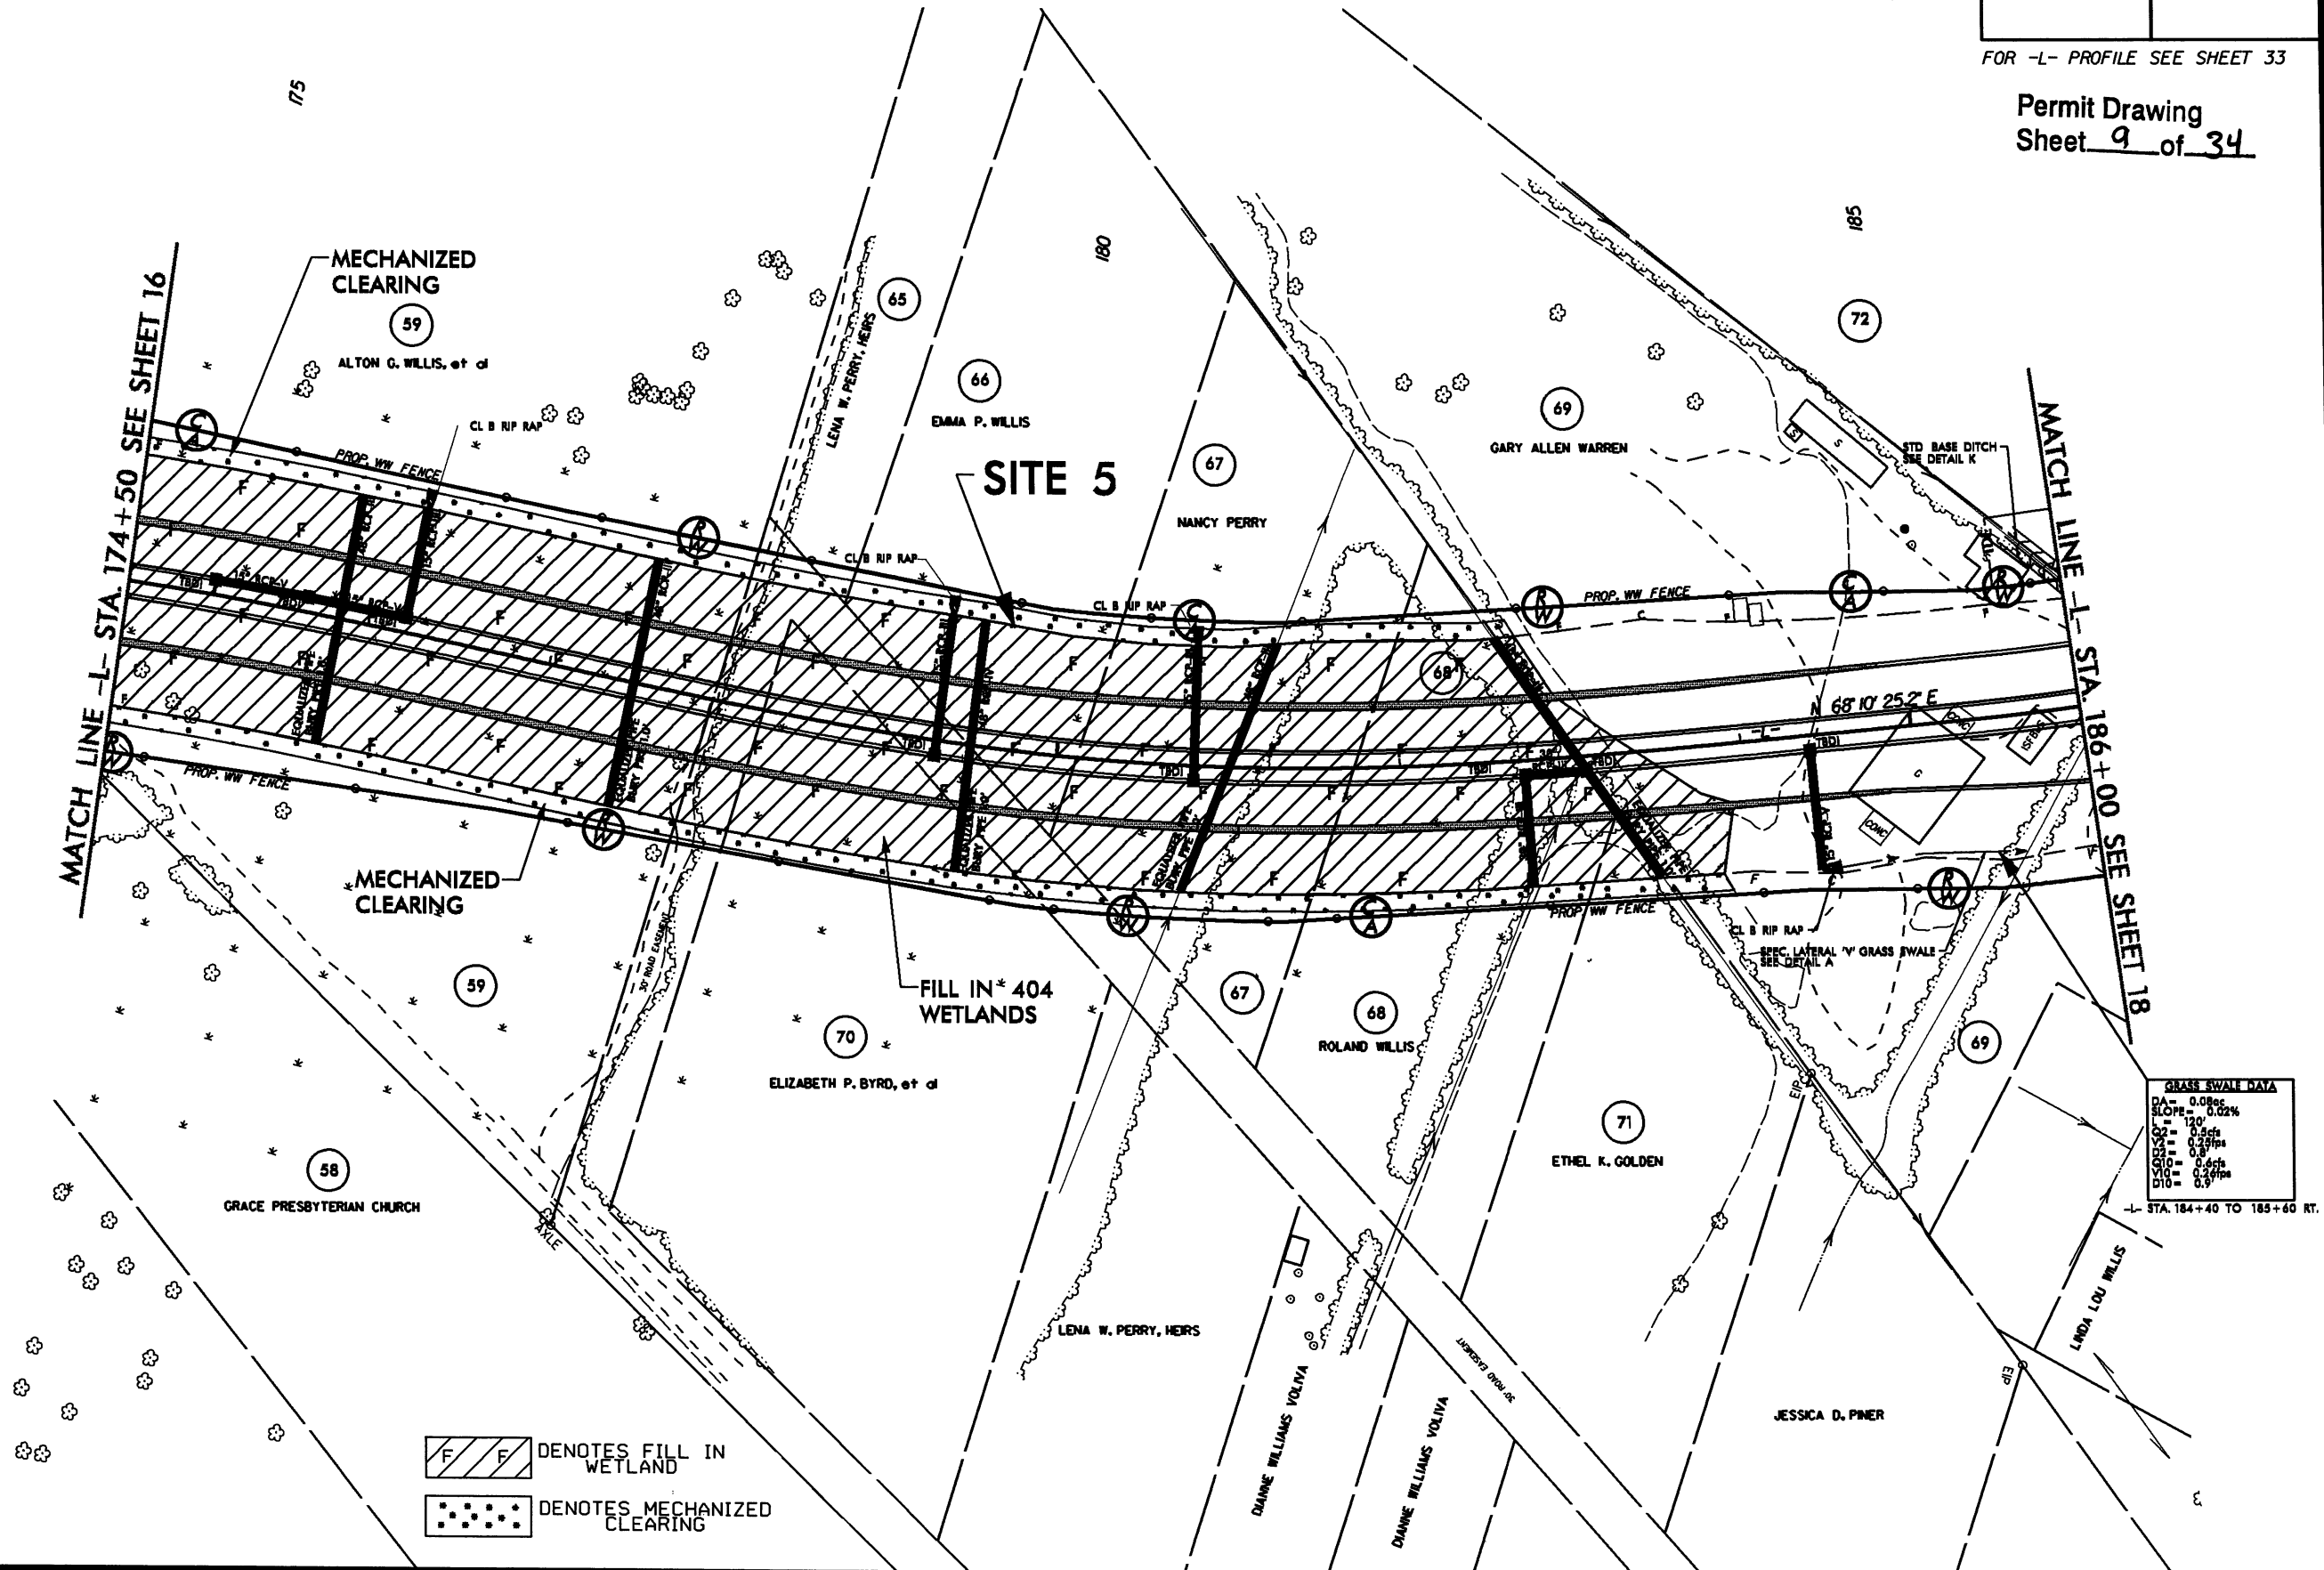


FOR -Y2- PROFILE SEE SHEETS 35 & 36

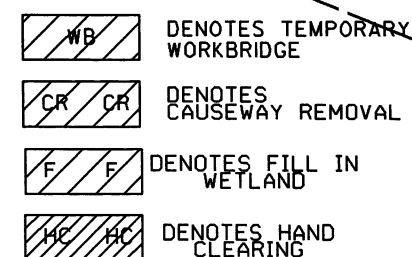Permit Drawing  
Sheet 10 of 34

R/W/ R/W REV. 07/29/10 (KNW):REVISED EXIST R/W TO NUMERICAL OFFSET.  
R/W/ R/W REV.04/18/11(KNW):DELETED PROP. R/W,ADDED PDE AND TCE ON PARCELS 106 & 107;ADDED PARCEL 120 AND ADDED TCE ON PARCEL 120.

## REVISIONS

FOR -L- PROFILE SEE SHEET 26  
Permit Drawing  
Sheet 11 of 34

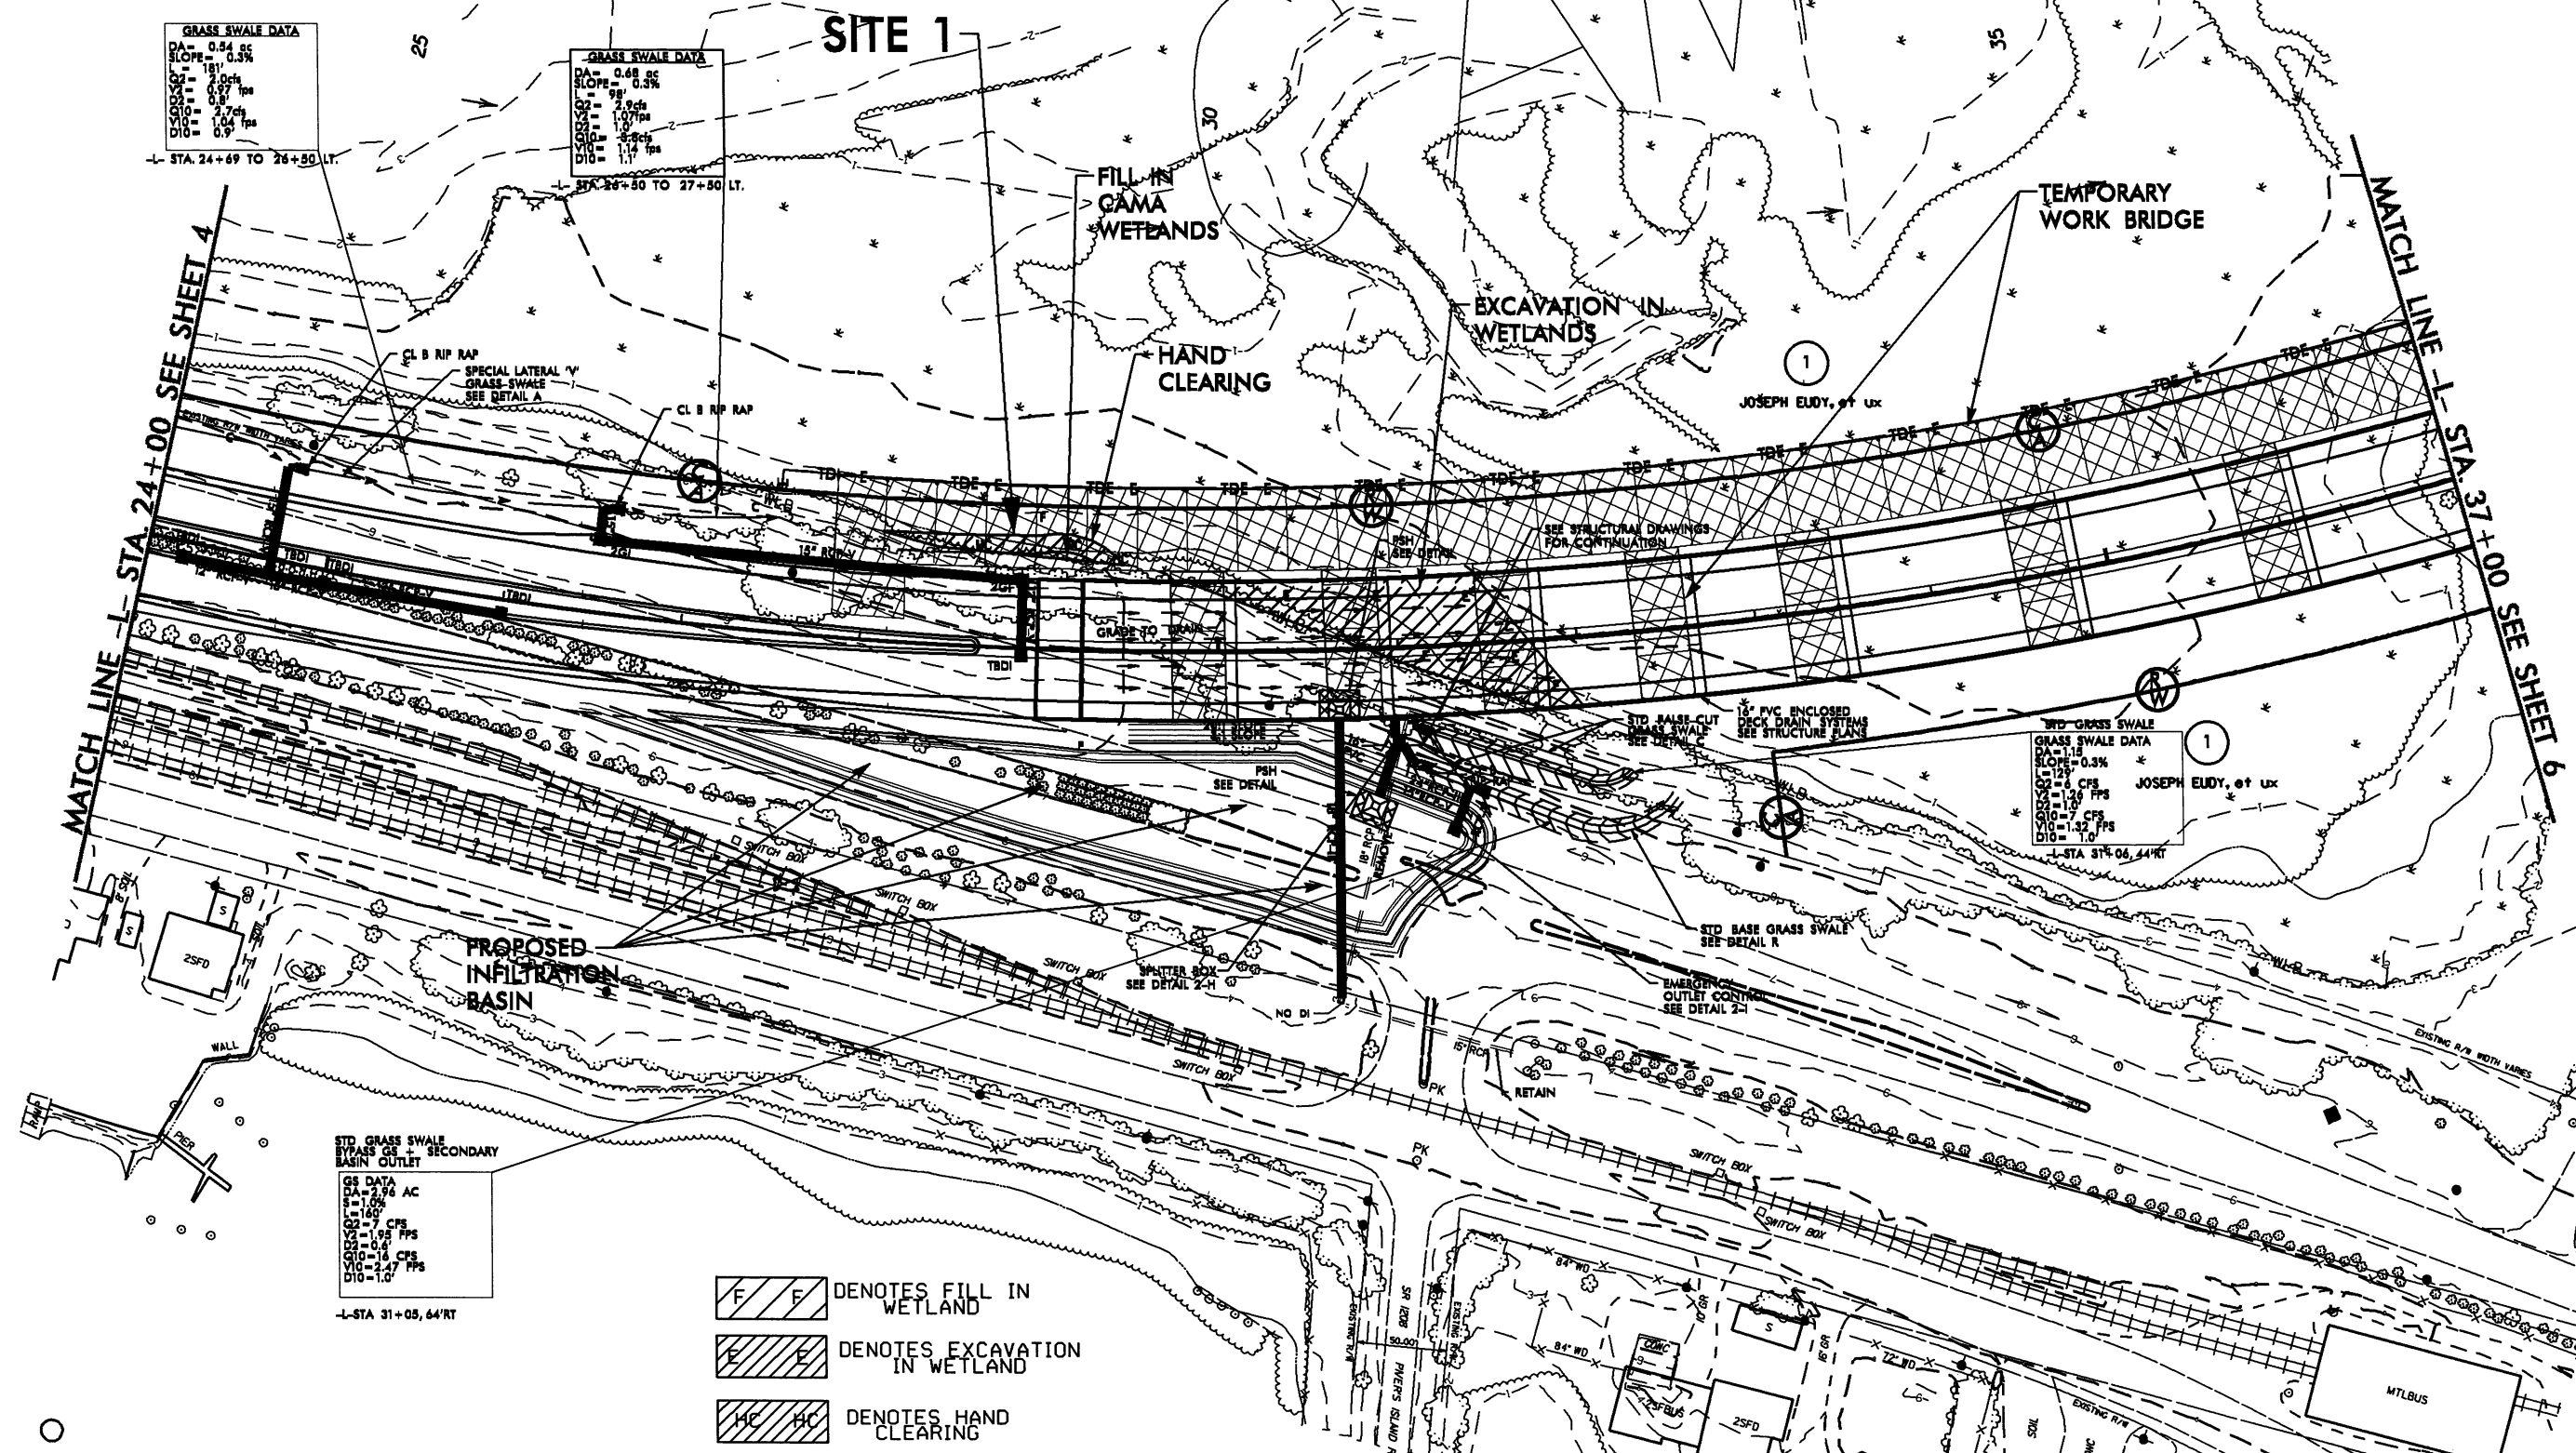






R/W REV. 07/29/10 (KNW): REVISED EXIST. P/L TO NUMERICAL OFFSET.

SYTIME DGN

PROJECT REFERENCE NO.	SHEET NO.
R-3307	7
RW SHEET NO.	
ROADWAY DESIGN ENGINEER	HYDRAULICS ENGINEER
<div style="border: 2px solid black; padding: 10px; text-align: center;"> <b>PRELIMINARY PLANS</b>          DO NOT USE FOR CONSTRUCTION       </div>	

FOR -L- PROFILE SEE SHEET 28

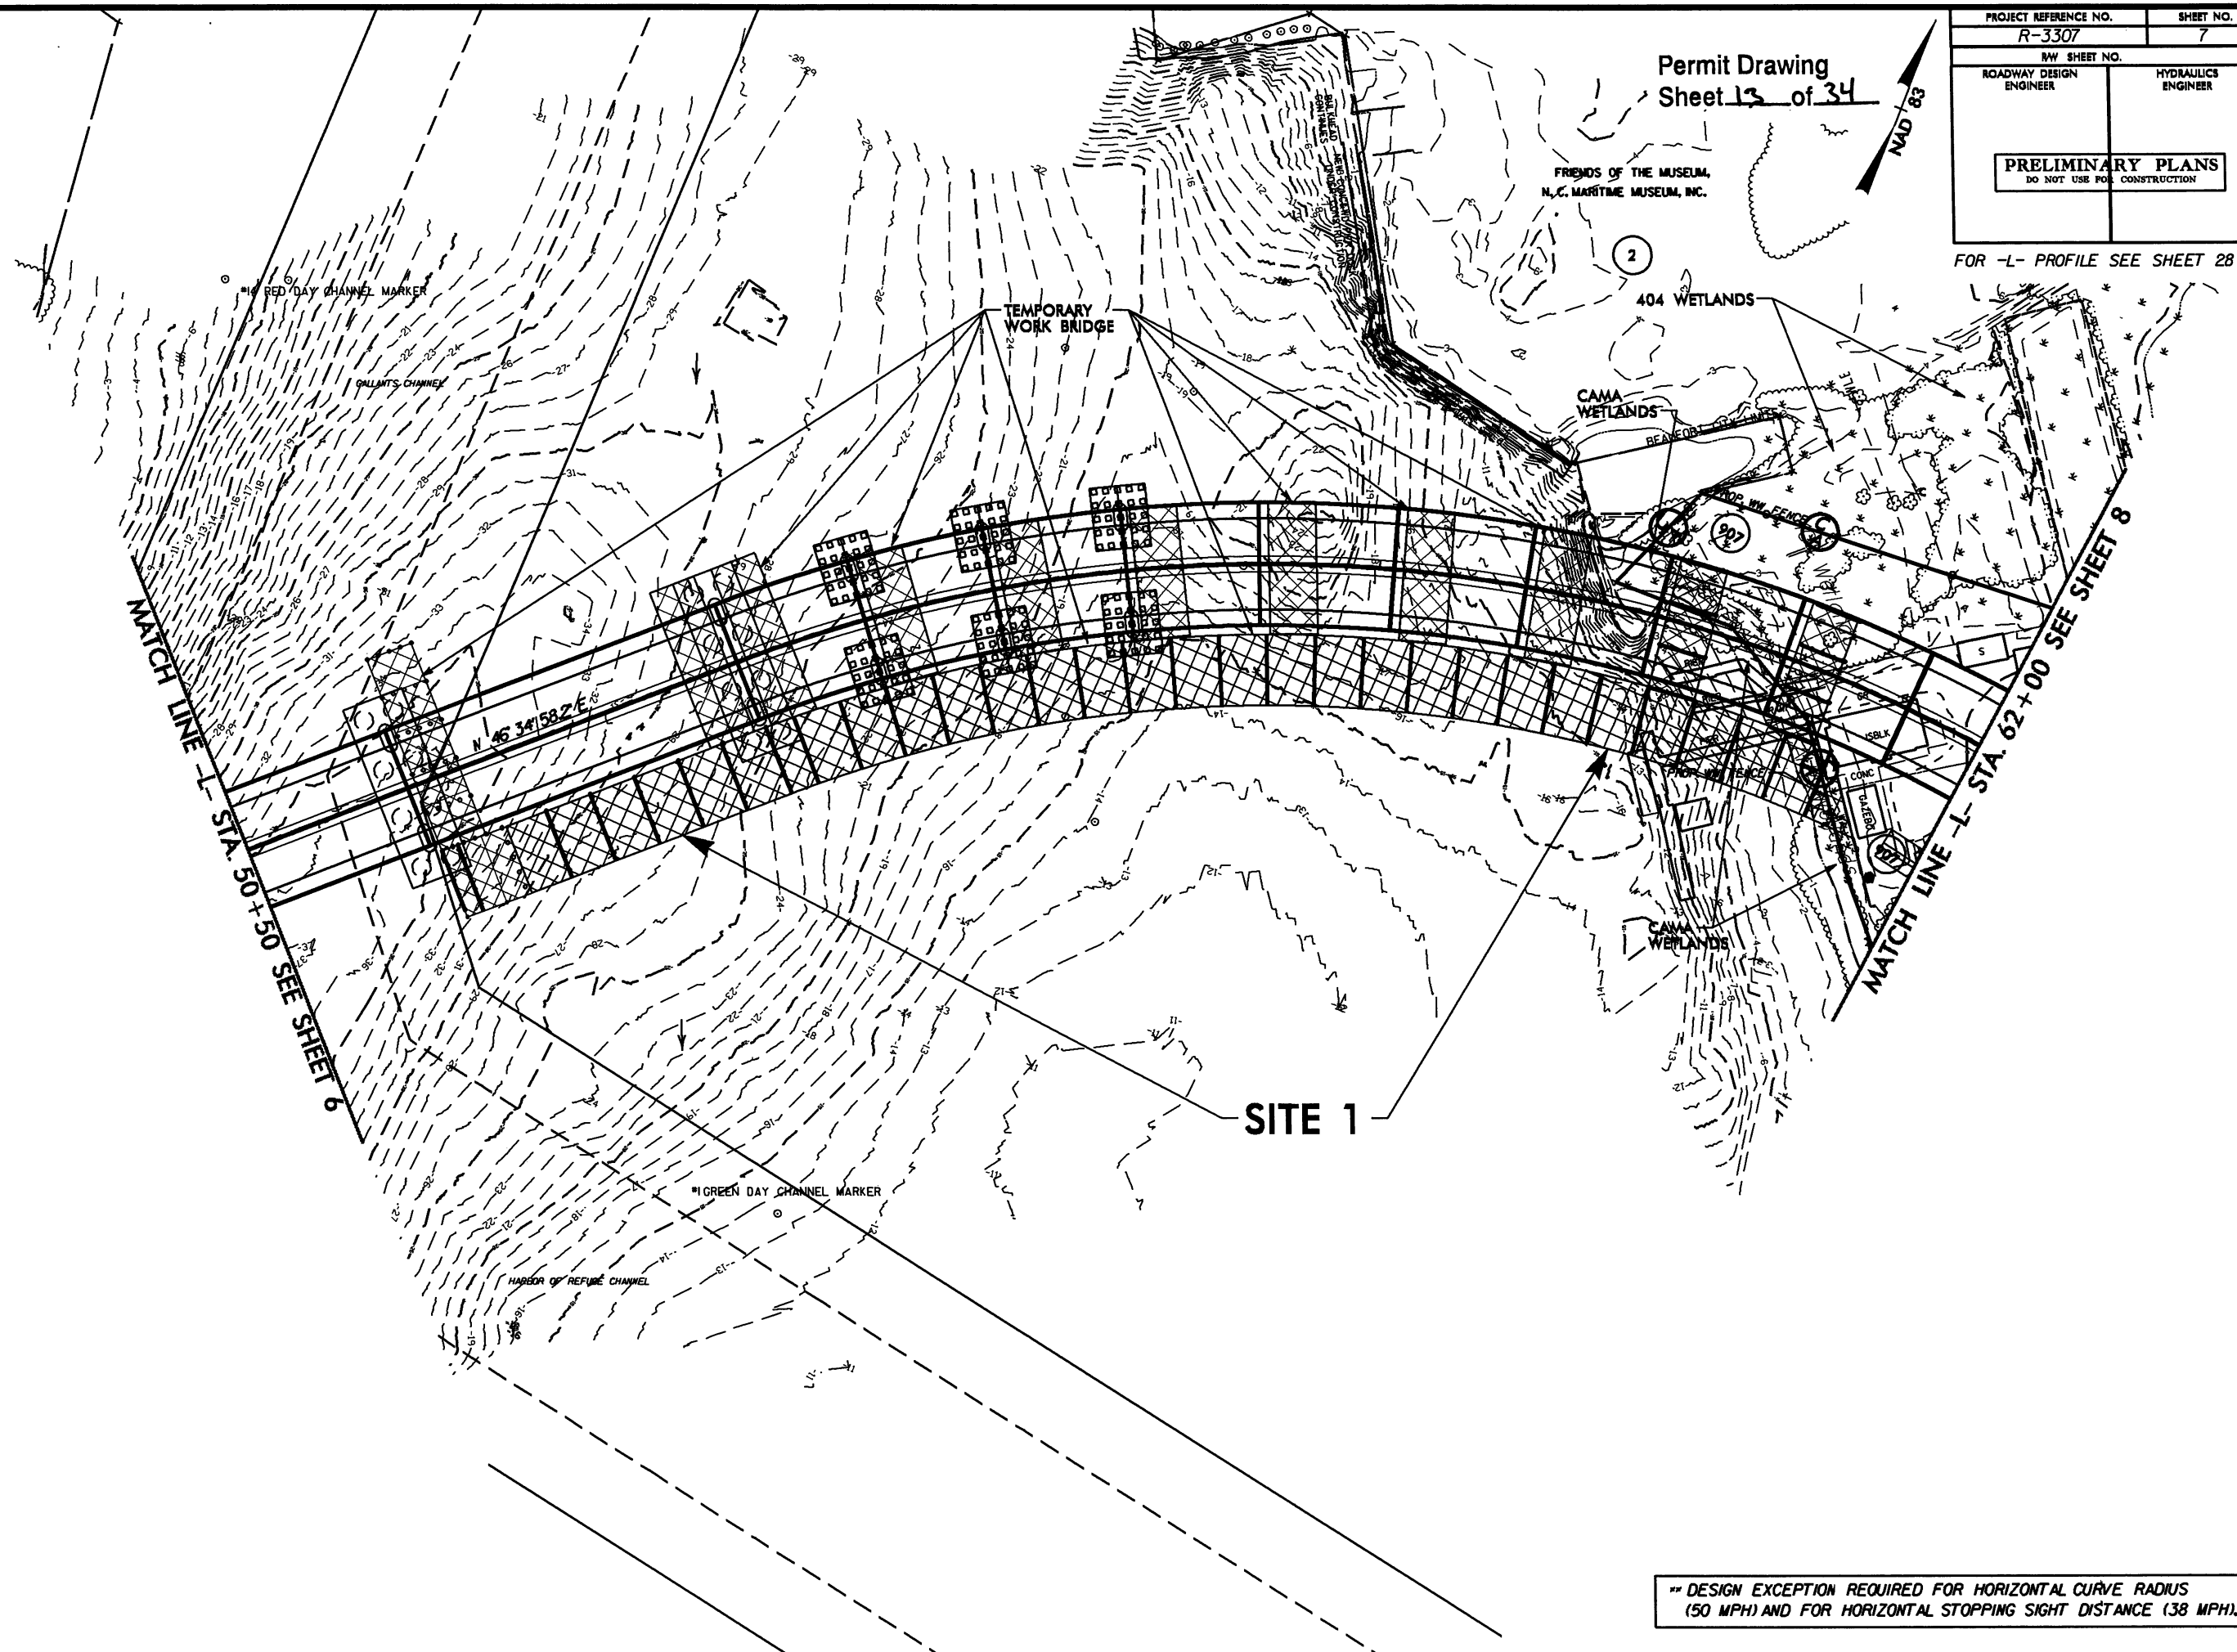

**\*\* DESIGN EXCEPTION REQUIRED FOR HORIZONTAL CURVE RADIUS (50 MPH) AND FOR HORIZONTAL STOPPING SIGHT DISTANCE (38 MPH).**

**NAD 83**

HC HC DENOTES HAND  
CLEARING

••••• DENOTES MECHANIZED  
CLEARING

F F DENOTES FILL IN  
WETLAND

TS TS DENOTES TEMPORARY  
IMPACTS IN SURFACE WATER

S S DENOTES IMPACTS IN  
SURFACE WATER

SYSTEMS

8/17/99



SYSTEM\$CNCN


**★ PROPOSED SIGNAL**

910  
BEAUFORT-MOREHEAD CITY  
AIRPORT AUTHORITY

Permit Drawing  
Sheet 15 of 34


PROJECT REFERENCE NO.	SHEET NO.
R-3307	9
RAW DESIGN NO.	
ROADWAY DESIGN ENGINEER	HYDRAULICS ENGINEER
<div style="border: 1px solid black; padding: 10px; text-align: center;"> <b>PRELIMINARY PLANS</b>              DO NOT USE FOR CONSTRUCTION         </div>	

FOR -L- PROFILE SEE SHEET 29  
FOR -LREV- PROFILE SEE SHEET 29  
FOR -Y2- PROFILE SEE SHEET 35  
FOR -Y5- PROFILE SEE SHEET 37

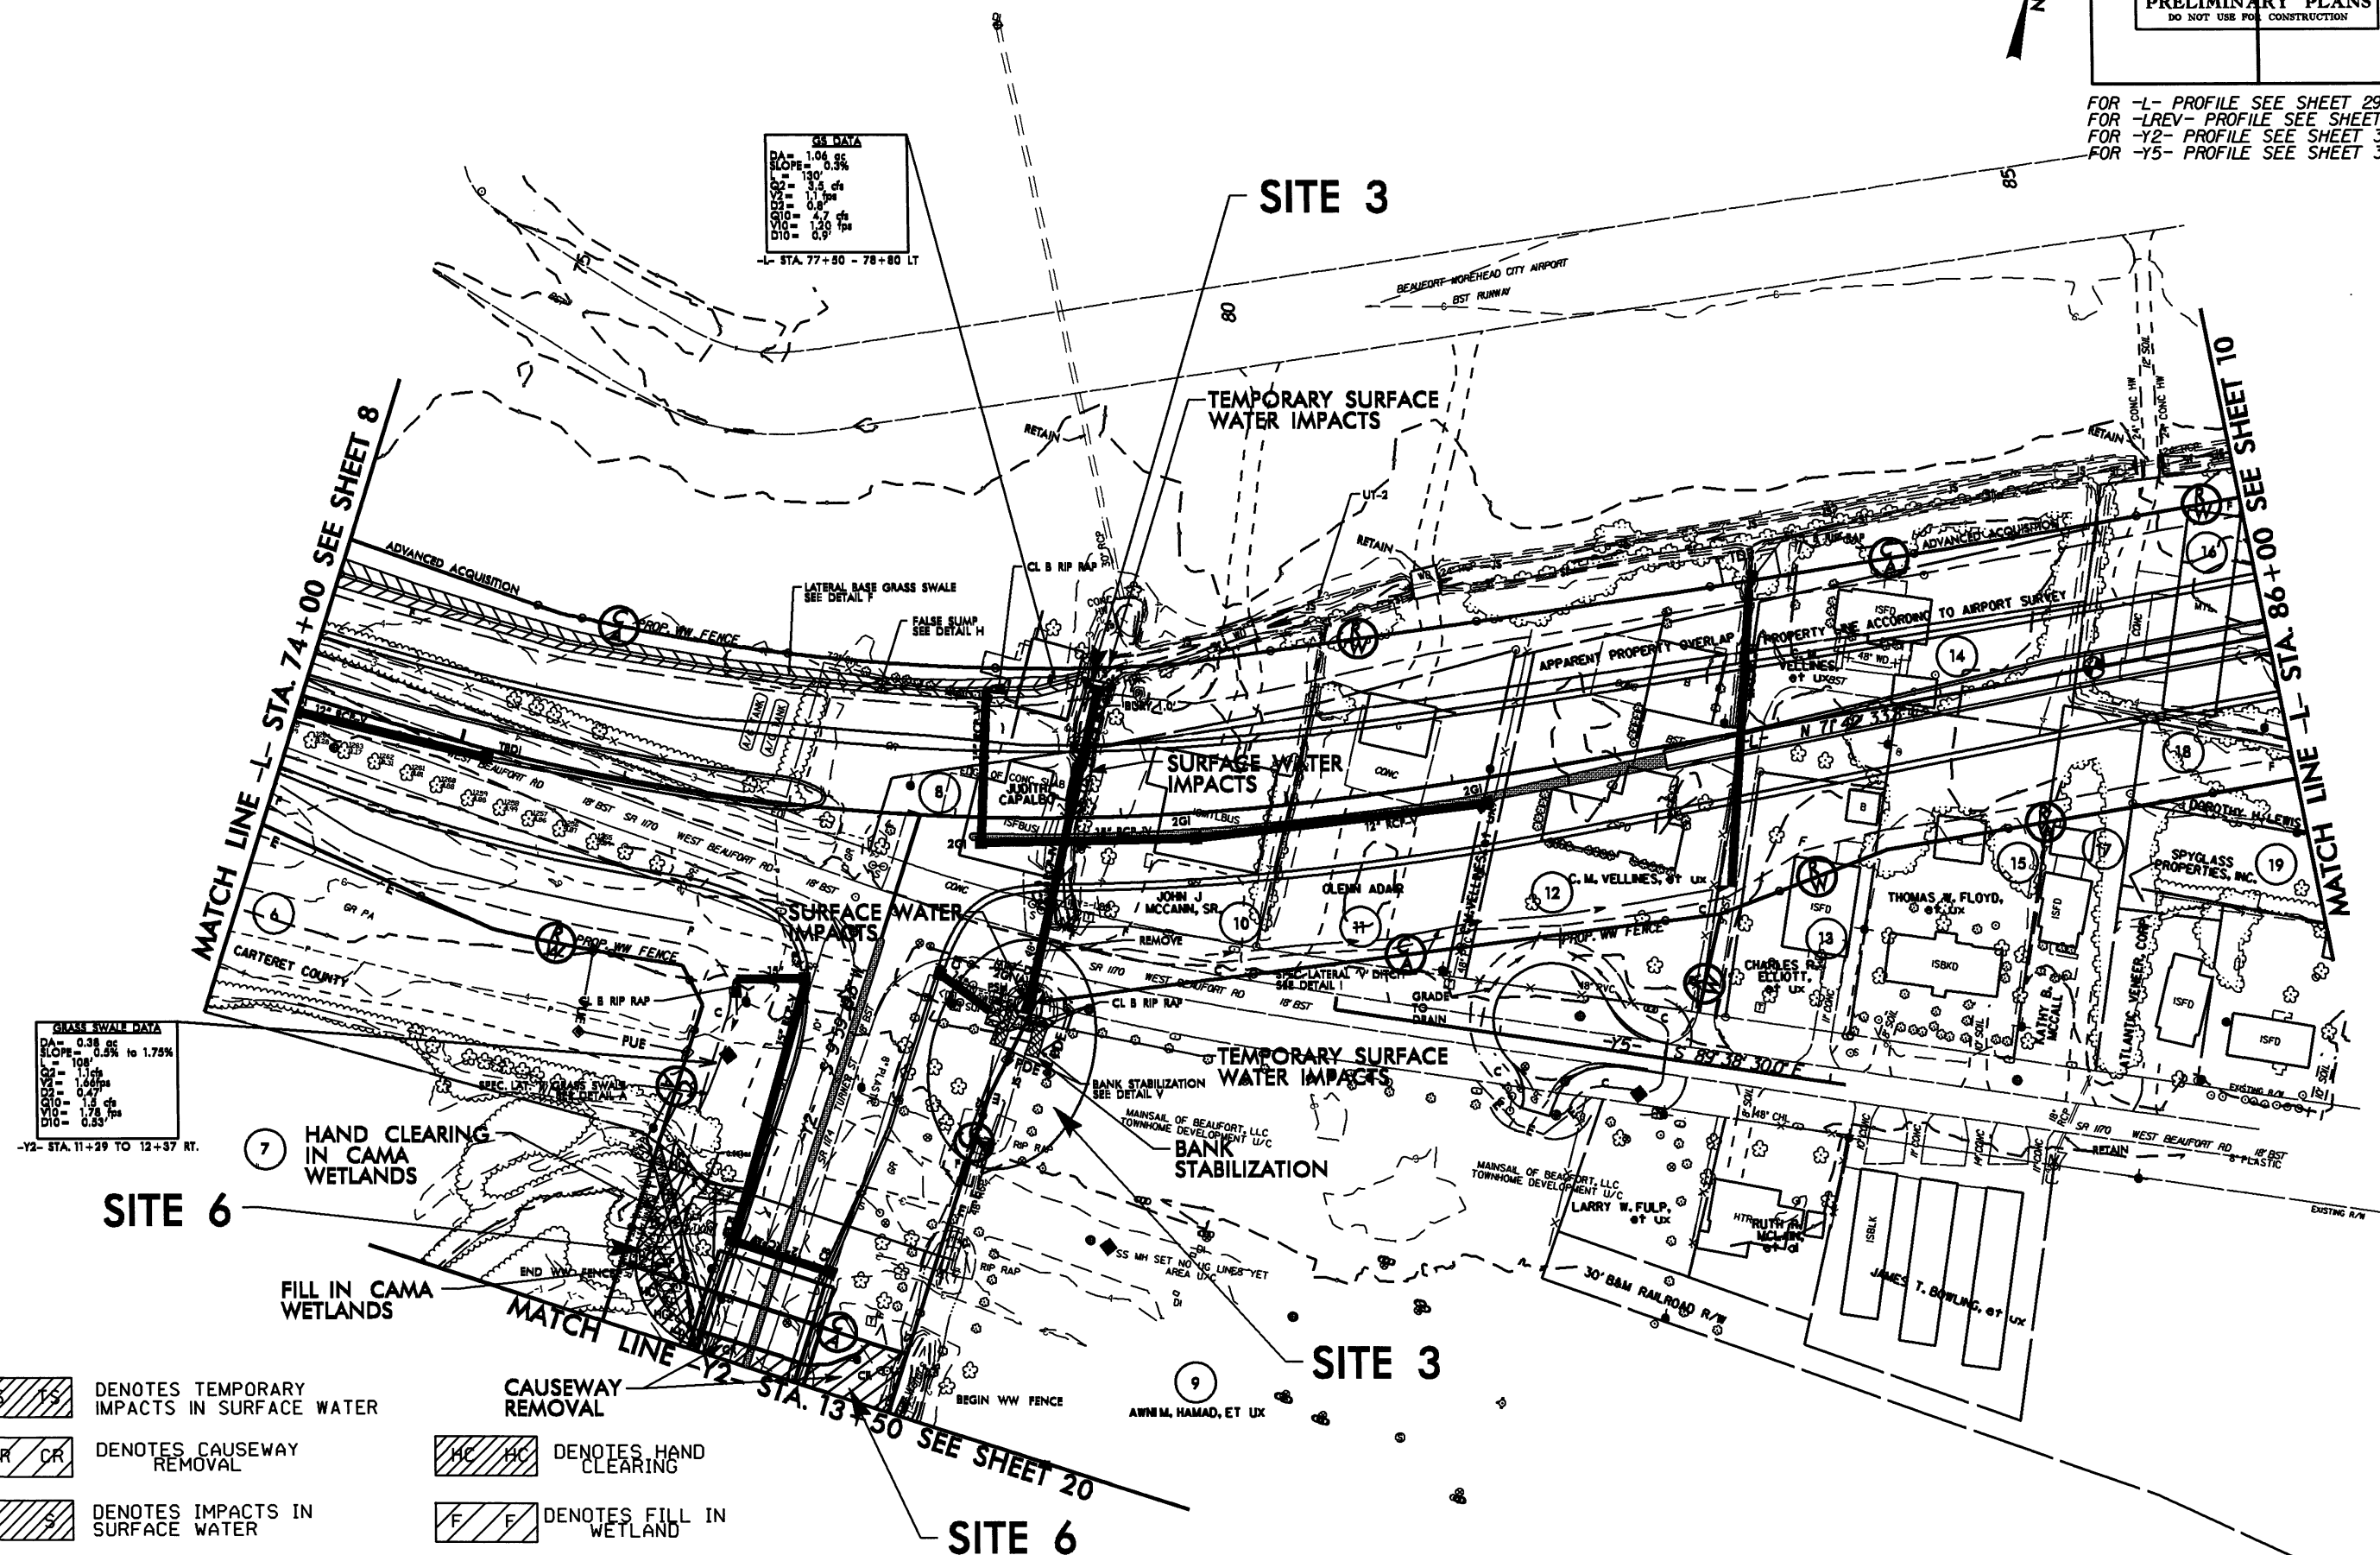

8/17/99

BEAUFORT-MOREHEAD CITY  
AIRPORT AUTHORITY

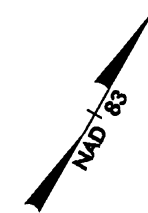


PROJECT REFERENCE NO. <i>R-3307</i>		SHEET NO. <i>10</i>	
RW SHEET NO.			
ROADWAY DESIGN ENGINEER		HYDRAULICS ENGINEER	
<div><b>PRELIMINARY PLANS</b> DO NOT USE FOR CONSTRUCTION</div>			

FOR -LREV- PROFILE SEE SHEET 30

Permit Drawing  
Sheet 10 of 34

REVISIONS

R/W REV. 07/29/10 (KMW) REVISED EXIST/PROP R/W TO NUMERICAL OFFSET.  
R/W REV. 04/18/11 (KMW) DELETED PDE, REVISED TDE, AND ADDED DUE ON PARCEL 910.


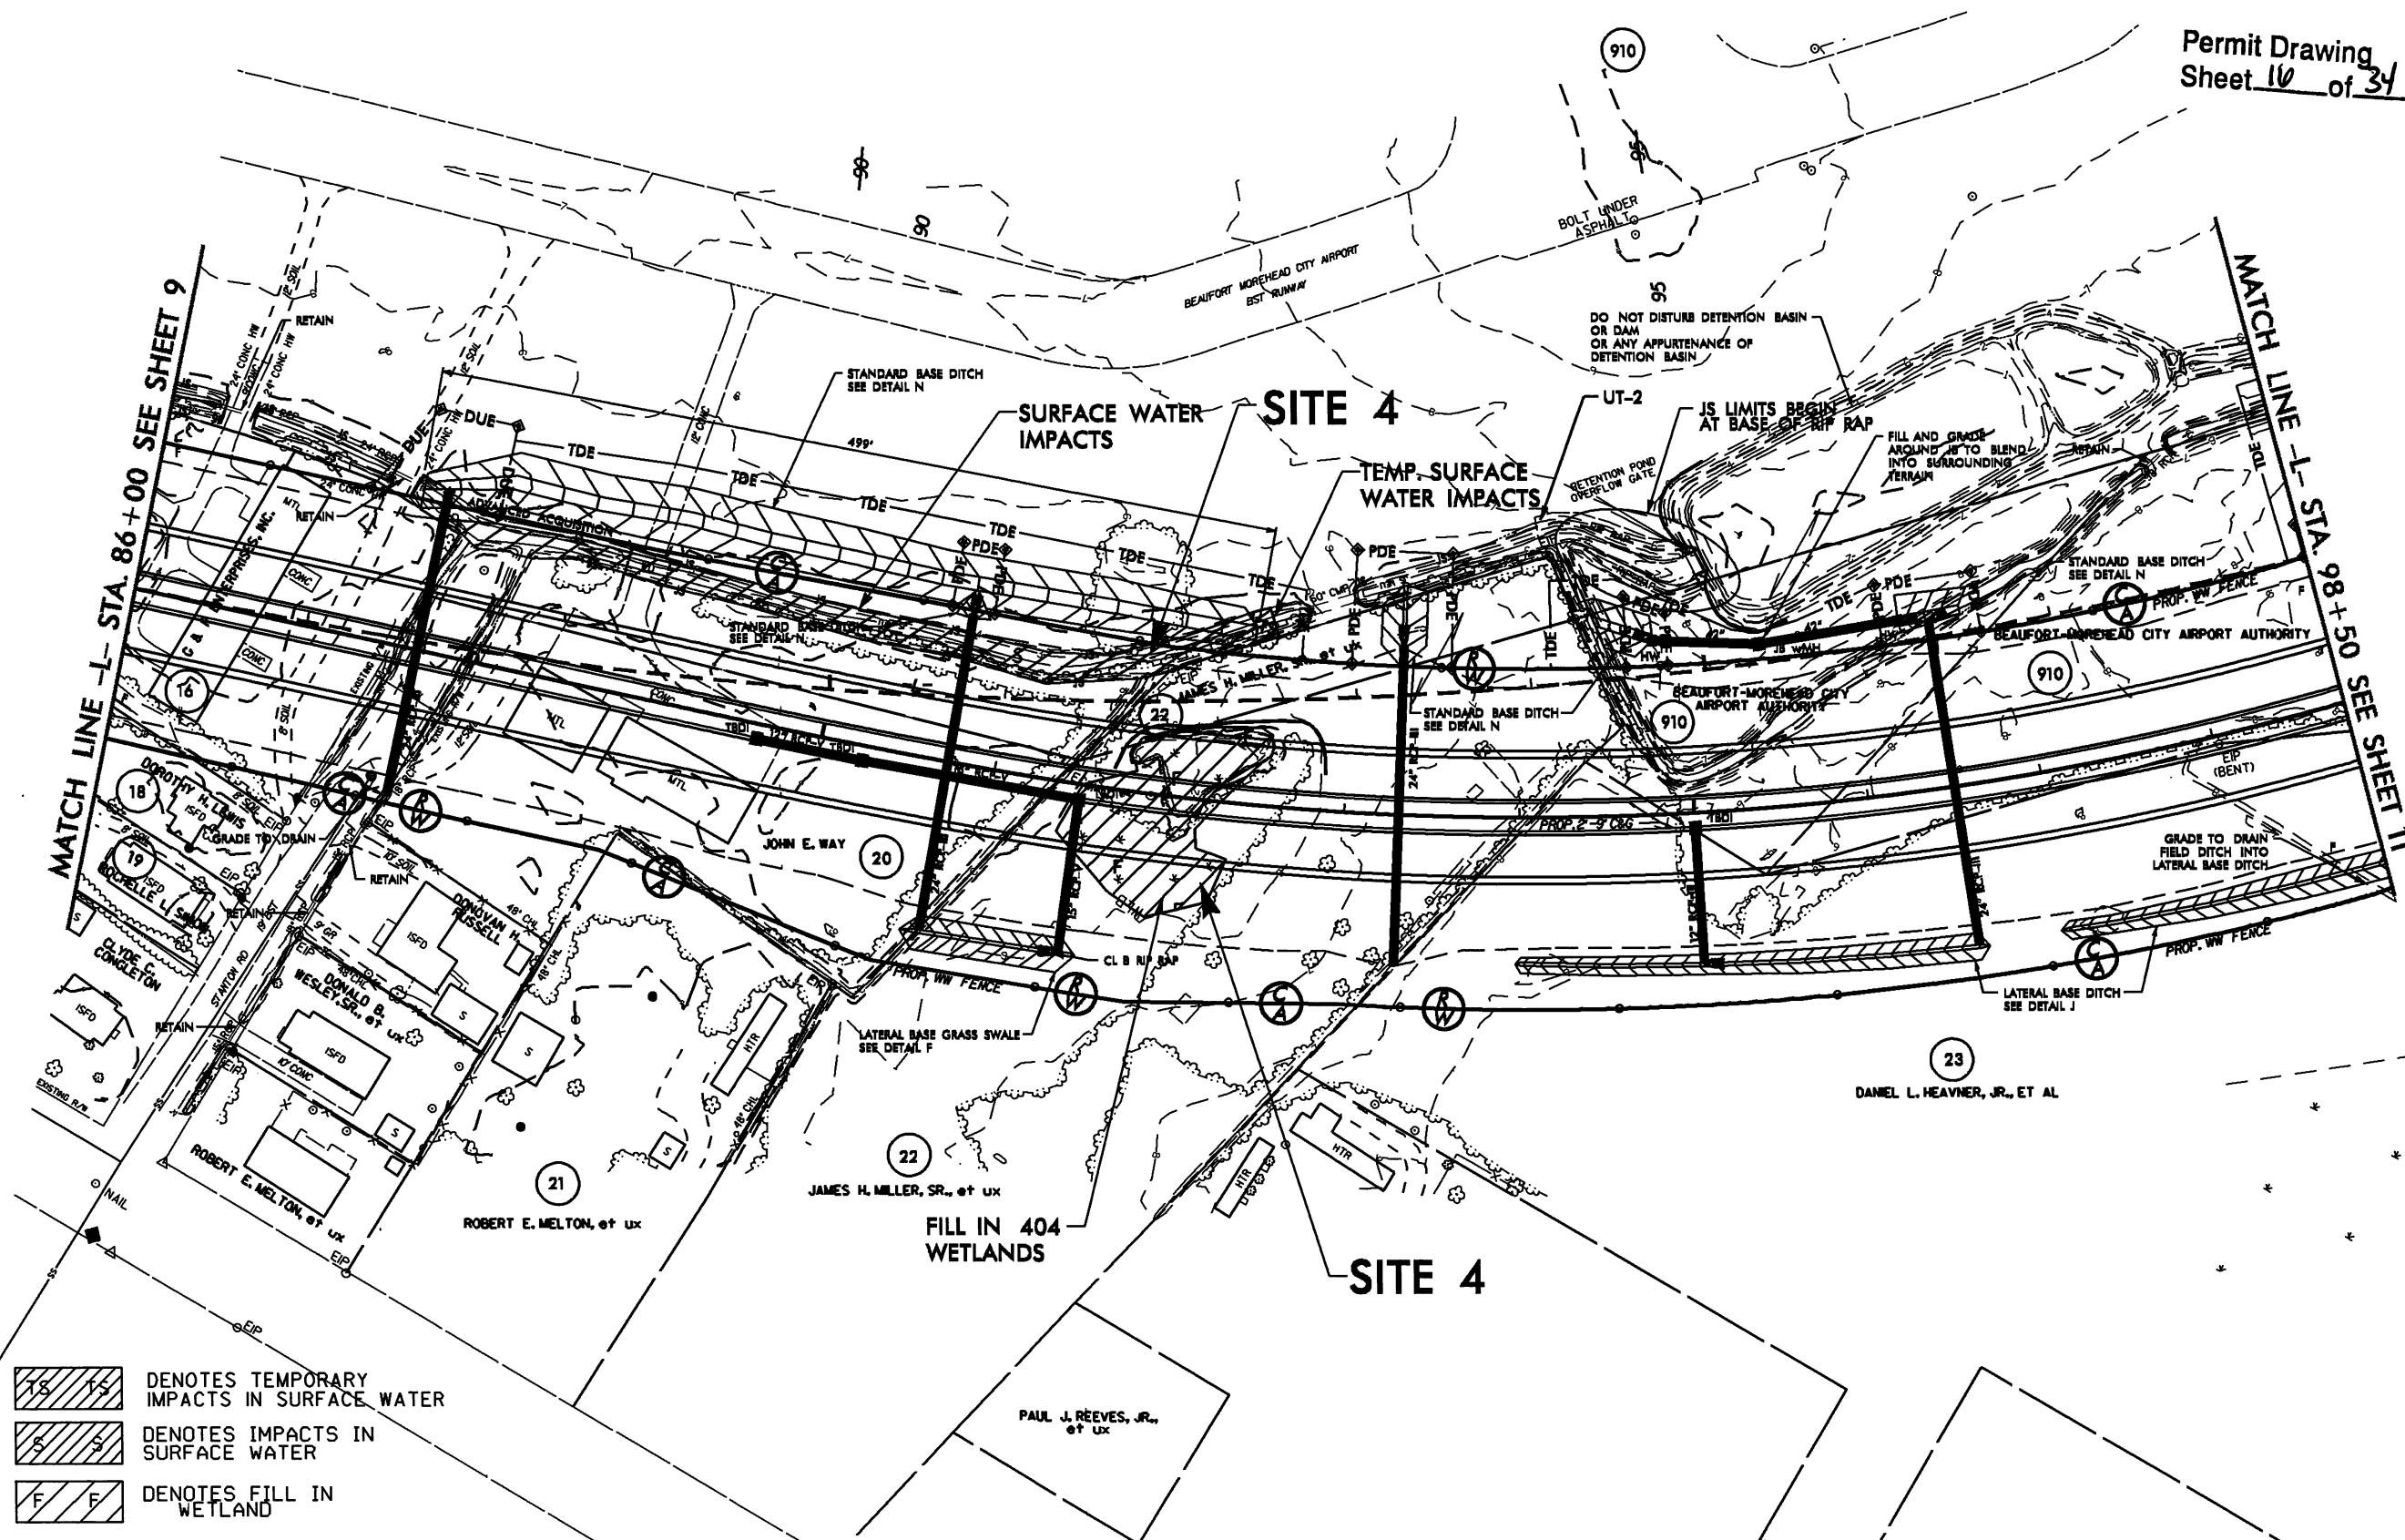



8/17/99

REVISIONS

R/W REV. 07/29/10 (KWA) REVISED EXIST/PROP R/W TO NUMERICAL OFFSET.

\*\*\*\*\*SYTIME\*\*\*\*\*  
\*\*\*\*\*DGN\*\*\*\*\*  
\*\*\*\*\*USERNAME\*\*\*\*\*

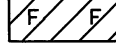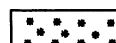
 DENOTES FILL IN WETLAND  
 DENOTES MECHANIZED CLEARING

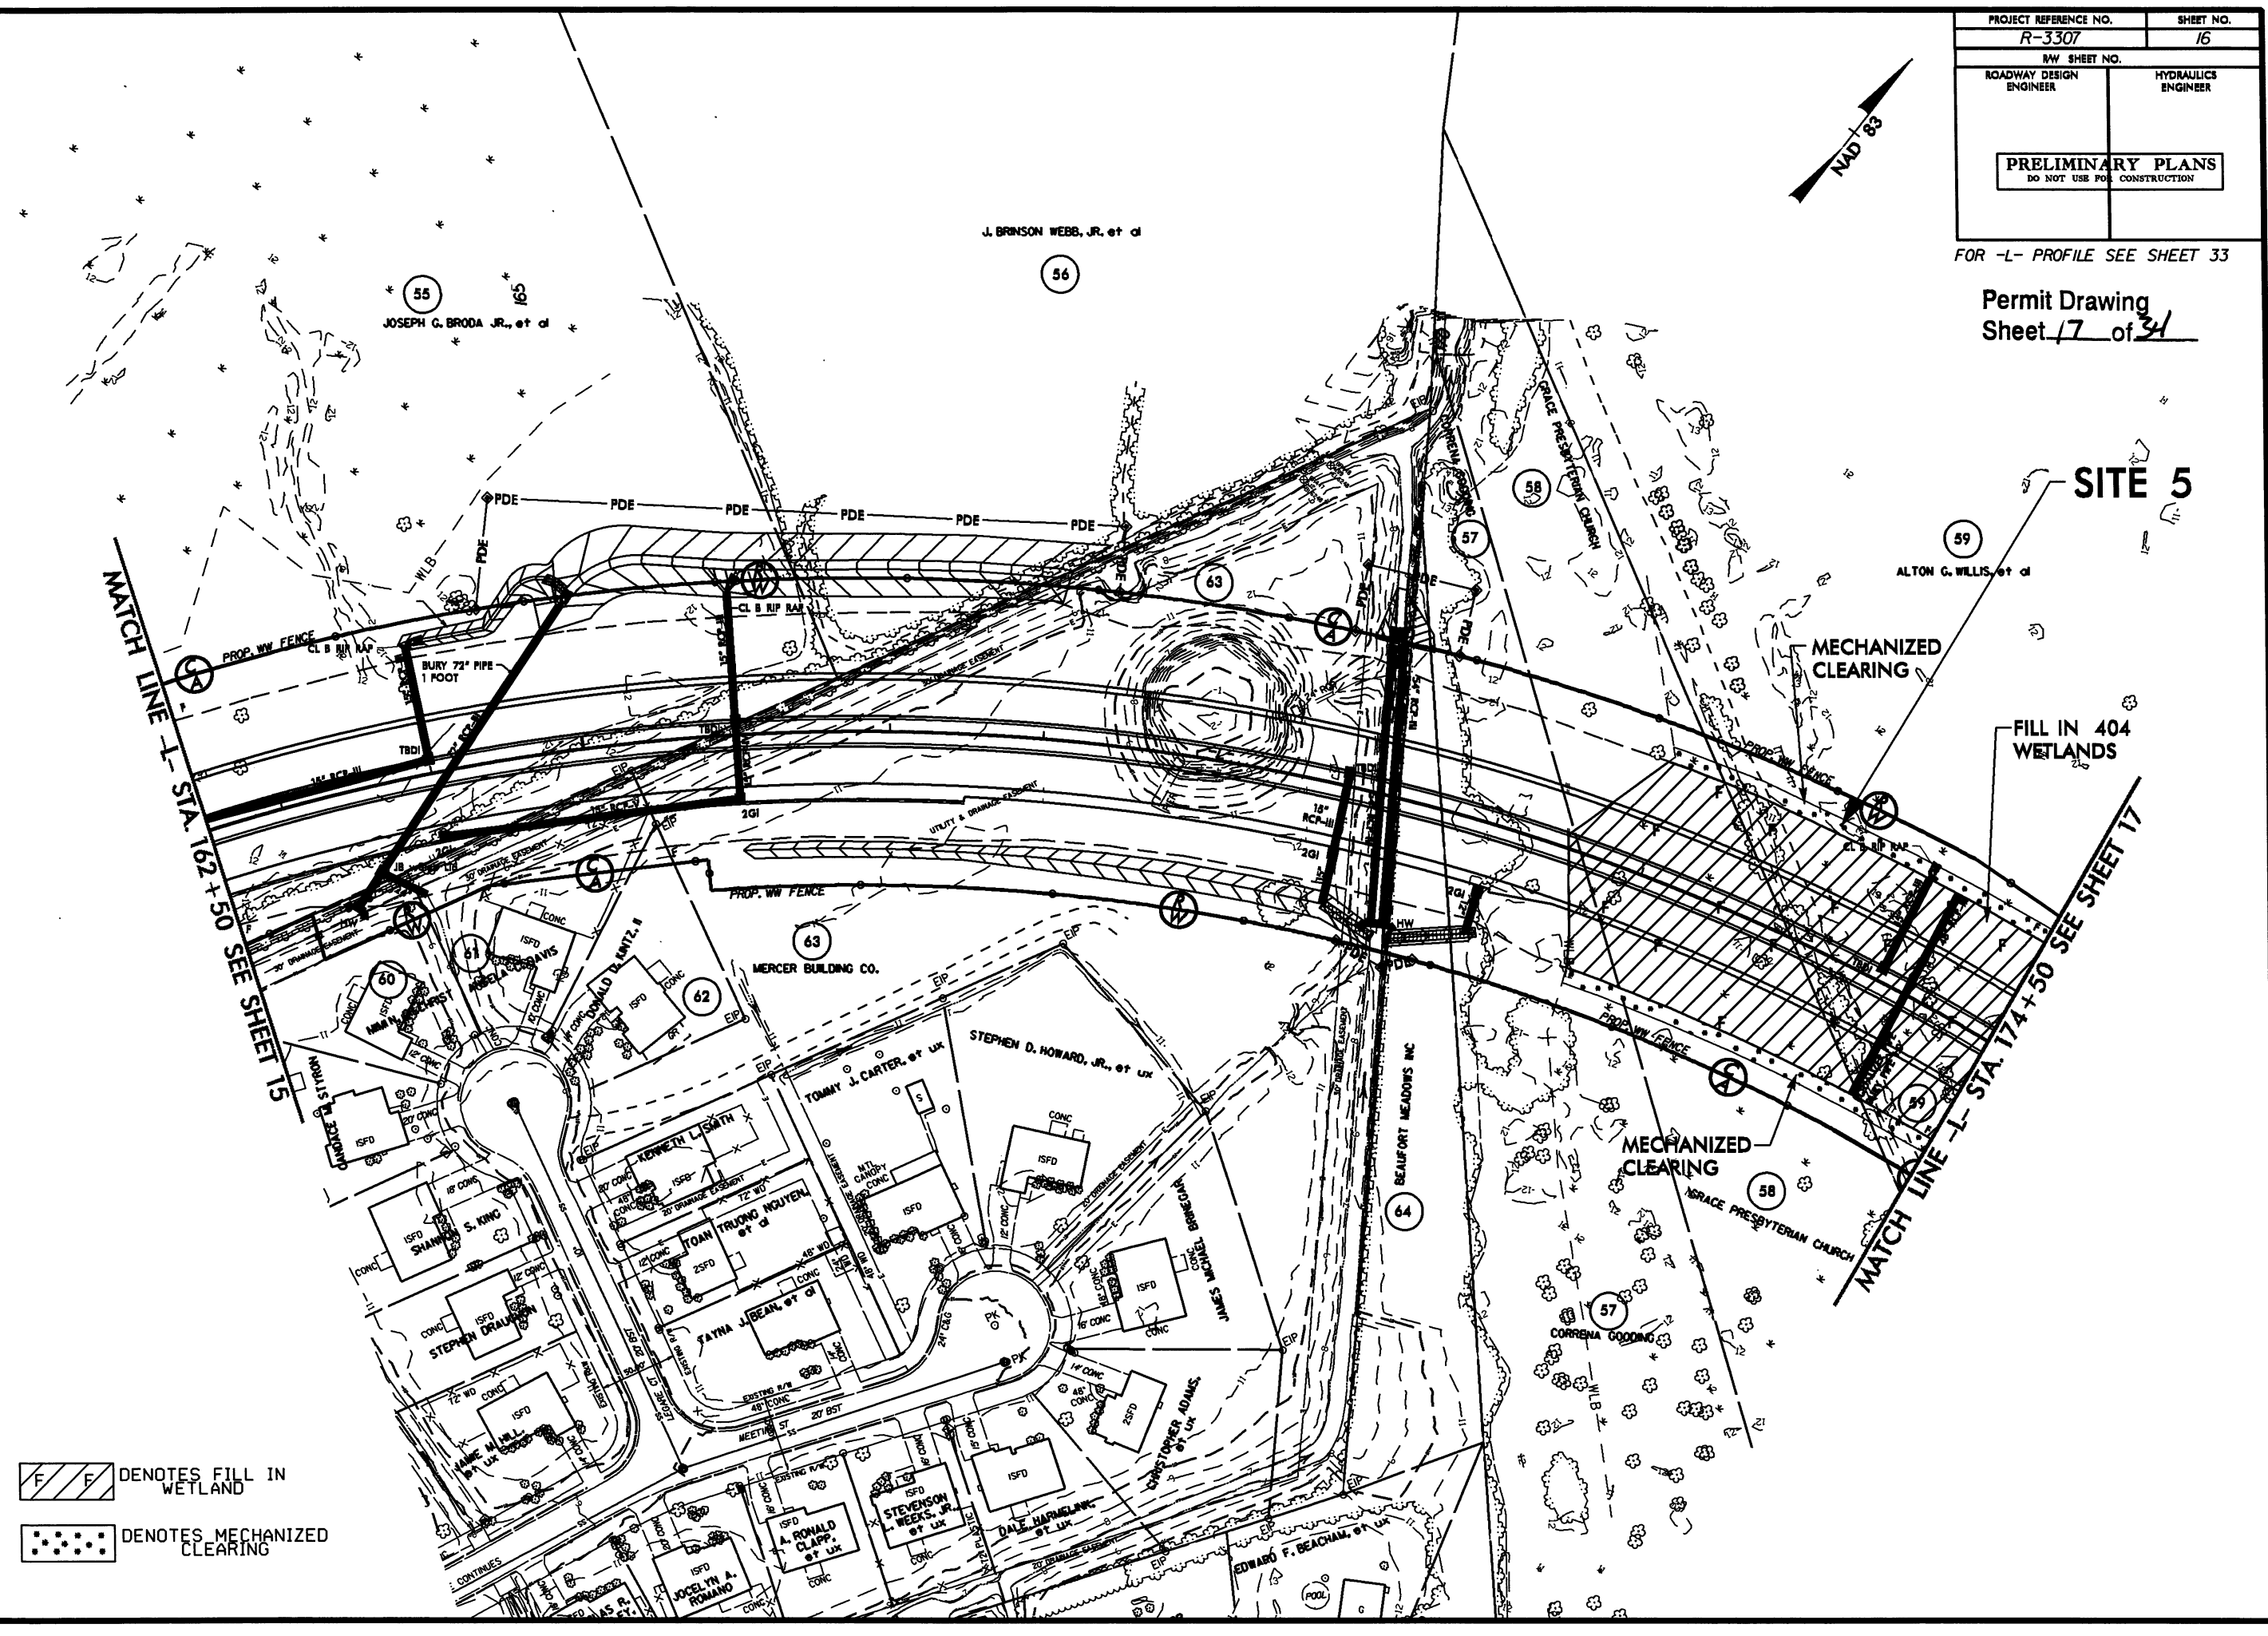

PROJECT REFERENCE NO. <i>R-3307</i>		SHEET NO. <i>16</i>	
RW SHEET NO.			
ROADWAY DESIGN ENGINEER		HYDRAULICS ENGINEER	
<div><b>PRELIMINARY PLANS</b> DO NOT USE FOR CONSTRUCTION</div>			

FOR -L- PROFILE SEE SHEET 33

Permit Drawing  
Sheet 7 of 31

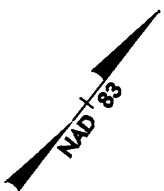

SITE 5

MECHANIZED  
CLEARING

FILL IN 404  
WETLANDS


MECHANIZED  
CLEARING

MATCH LINE -L- STA. 174+50 SEE SHEET 17


MATCH LINE -L- STA. 162+50 SEE SHEET 15

PROJECT REFERENCE NO.	SHEET NO.
R-3307	17
RW SHEET NO.	
ROADWAY DESIGN ENGINEER	HYDRAULICS ENGINEER
<div style="border: 2px solid black; padding: 10px; text-align: center;"> <b>PRELIMINARY PLANS</b>  DO NOT USE FOR CONSTRUCTION </div>	

FOR -L- PROFILE SEE SHEET 33

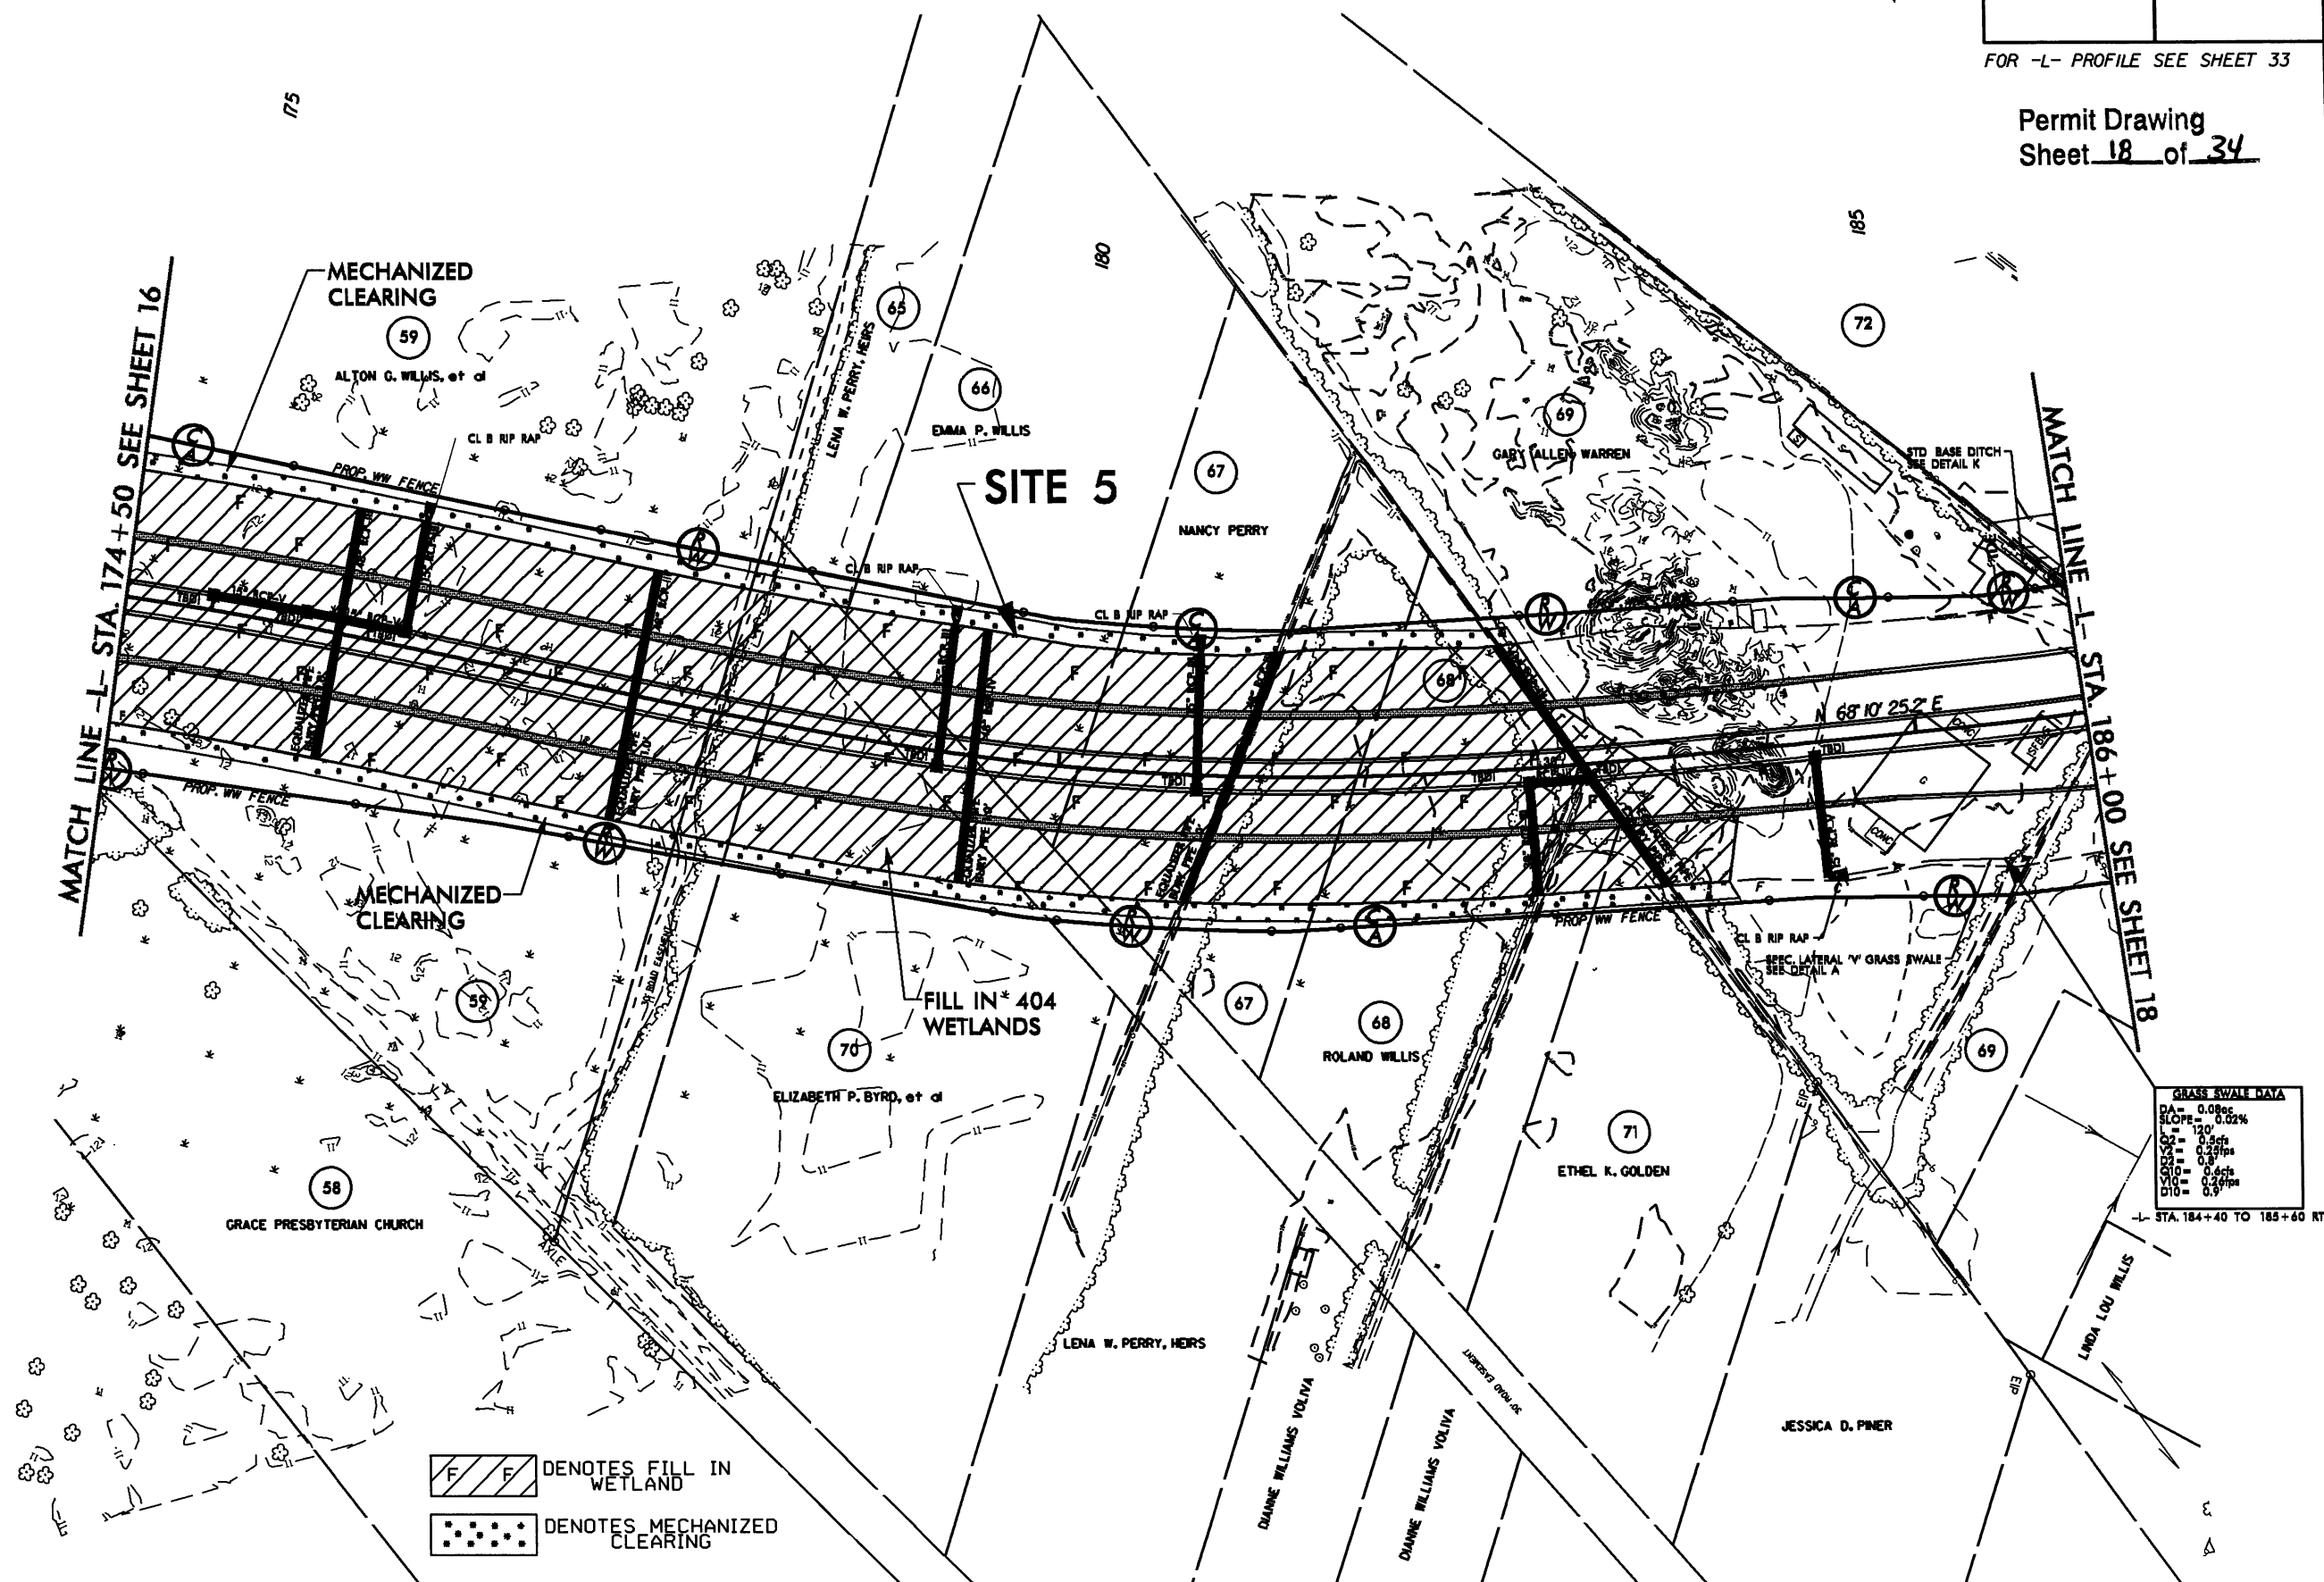Permit Drawing  
Sheet 18 of 34

PROJECT REFERENCE NO.	SHEET NO.
R-3307	20
RW SHEET NO.	
ROADWAY DESIGN ENGINEER	HYDRAULICS ENGINEER
<div style="border: 1px solid black; padding: 10px; text-align: center;"> <b>PRELIMINARY PLANS</b>              DO NOT USE FOR CONSTRUCTION         </div>	


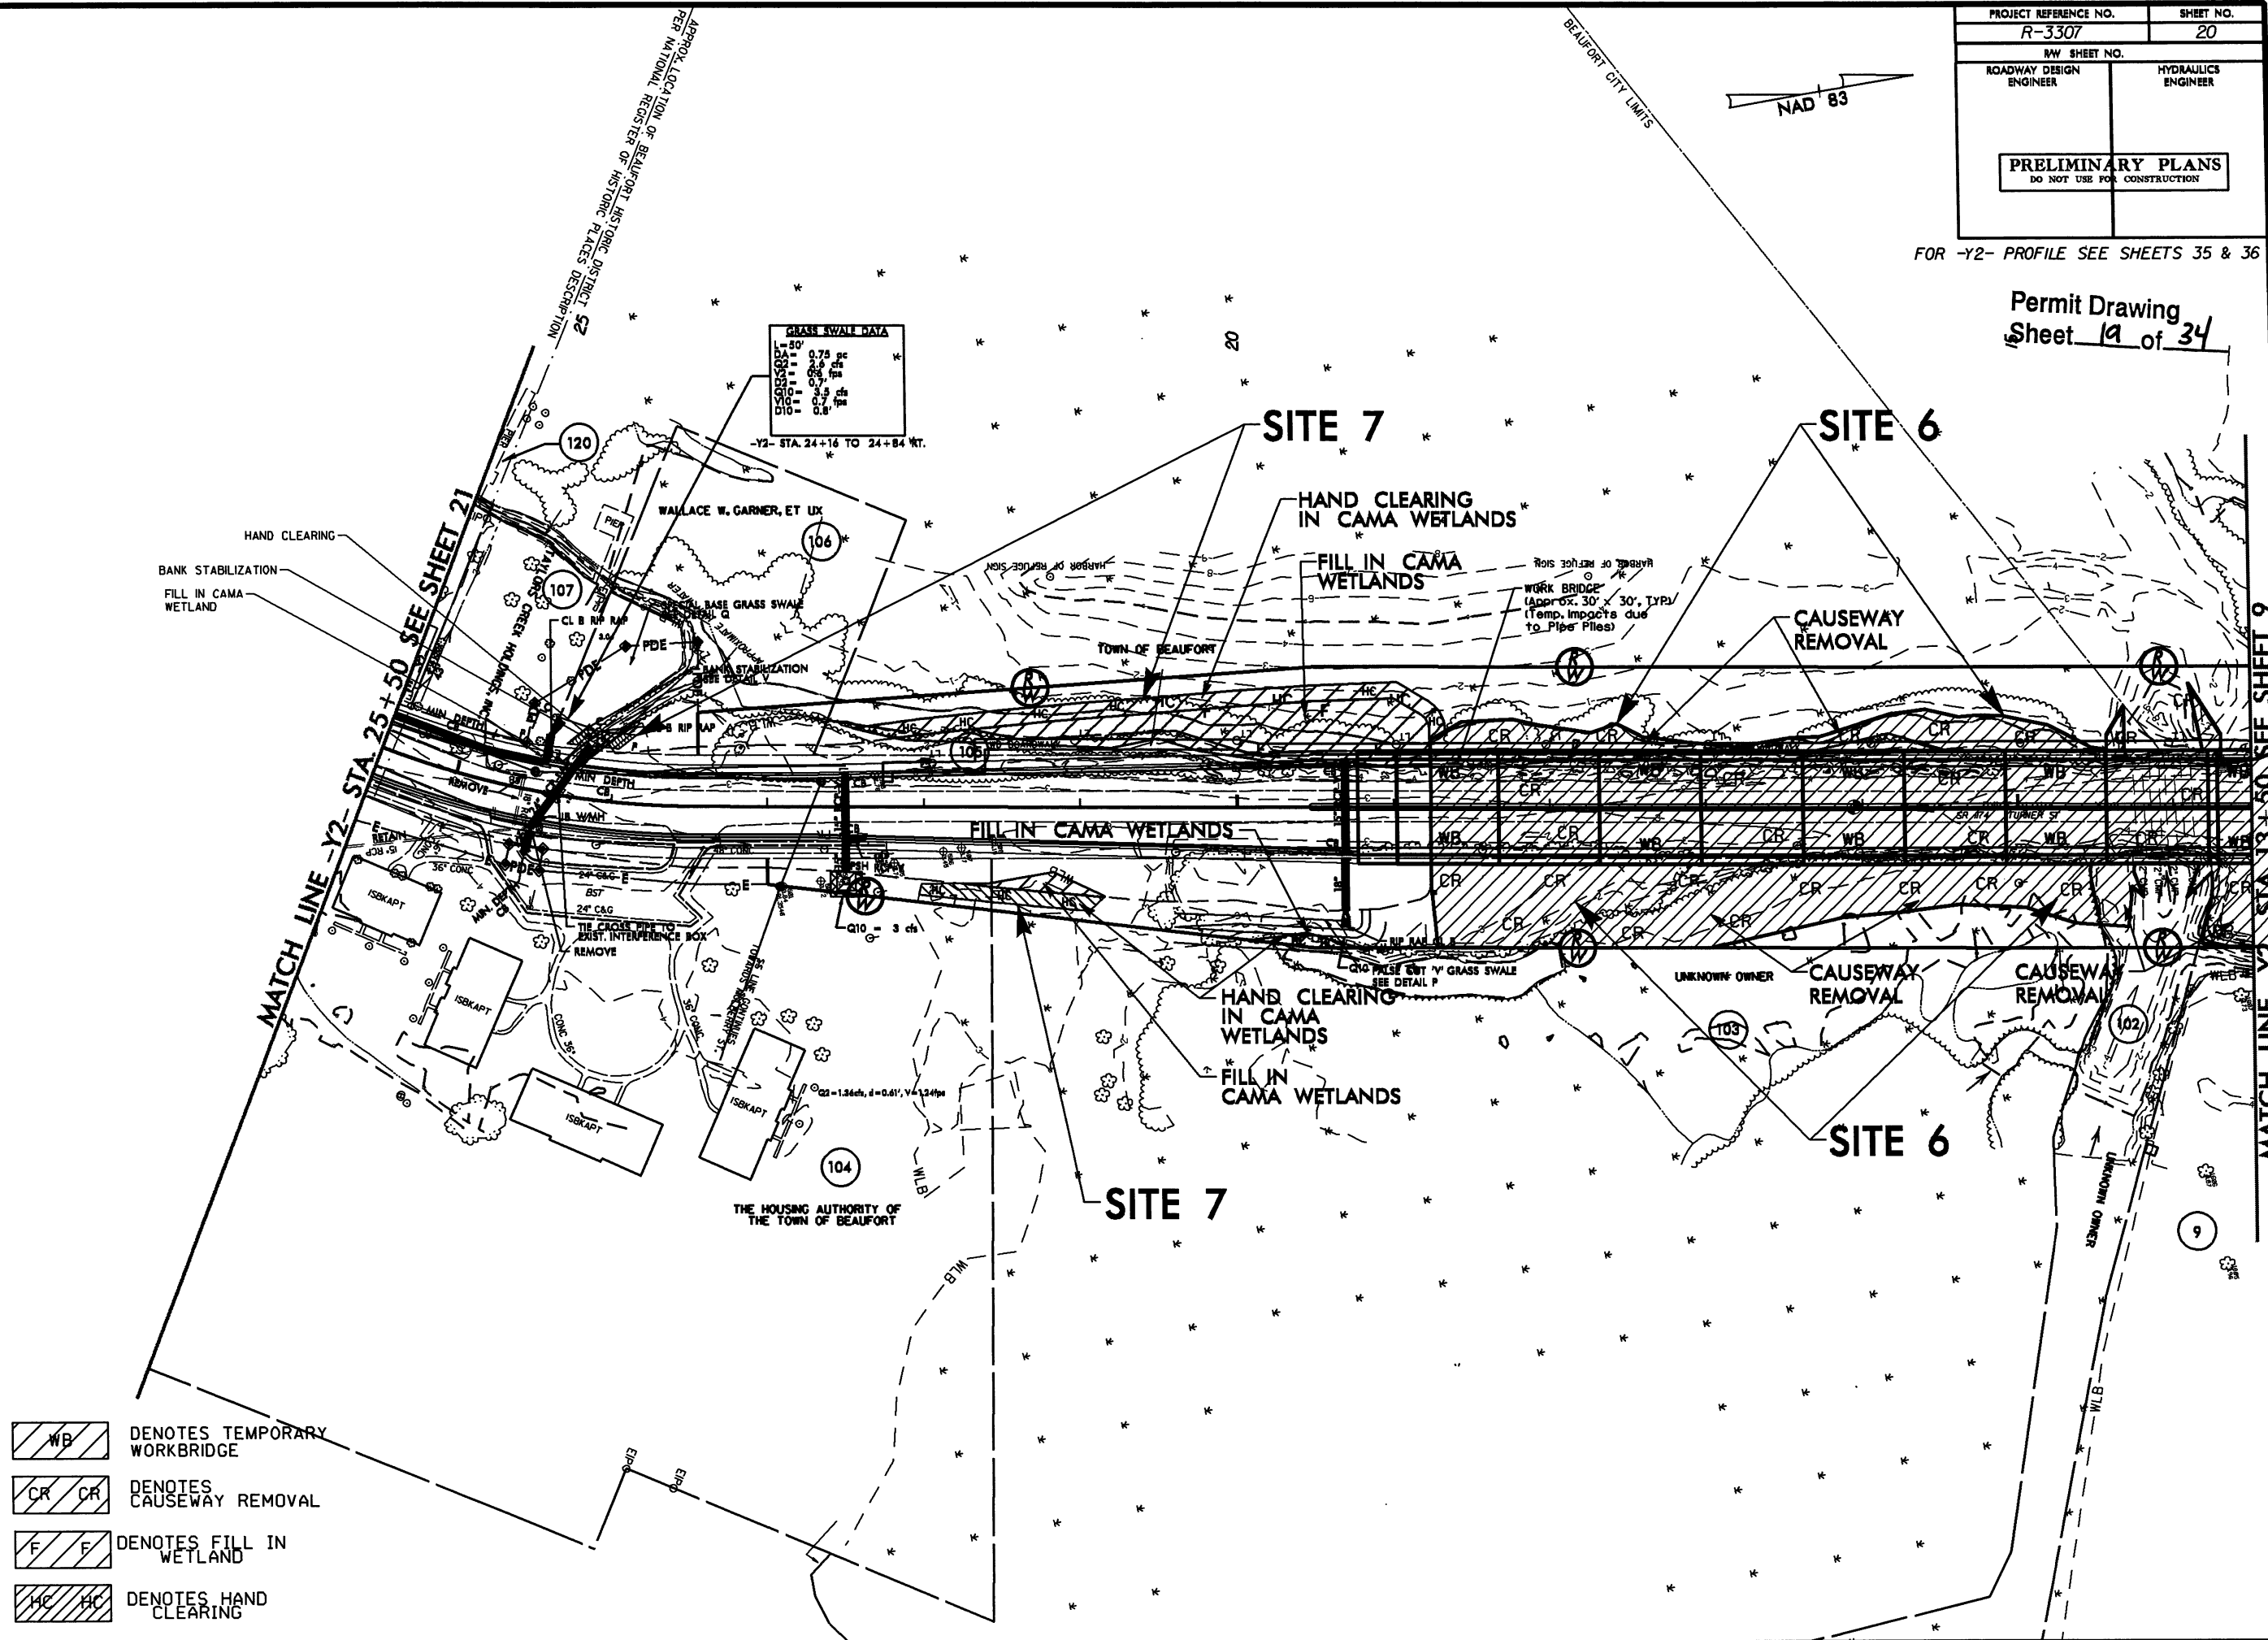
Permit Drawing  
Sheet 19 of 34



5/28/99

5/28/99

PROJECT REFERENCE NO. R-3307		SHEET NO. 26
ROADWAY DESIGN ENGINEER		HYDRAULICS ENGINEER
Permit Drawing Sheet 20 of 34 PRELIMINARY PLANS DO NOT USE FOR CONSTRUCTION		

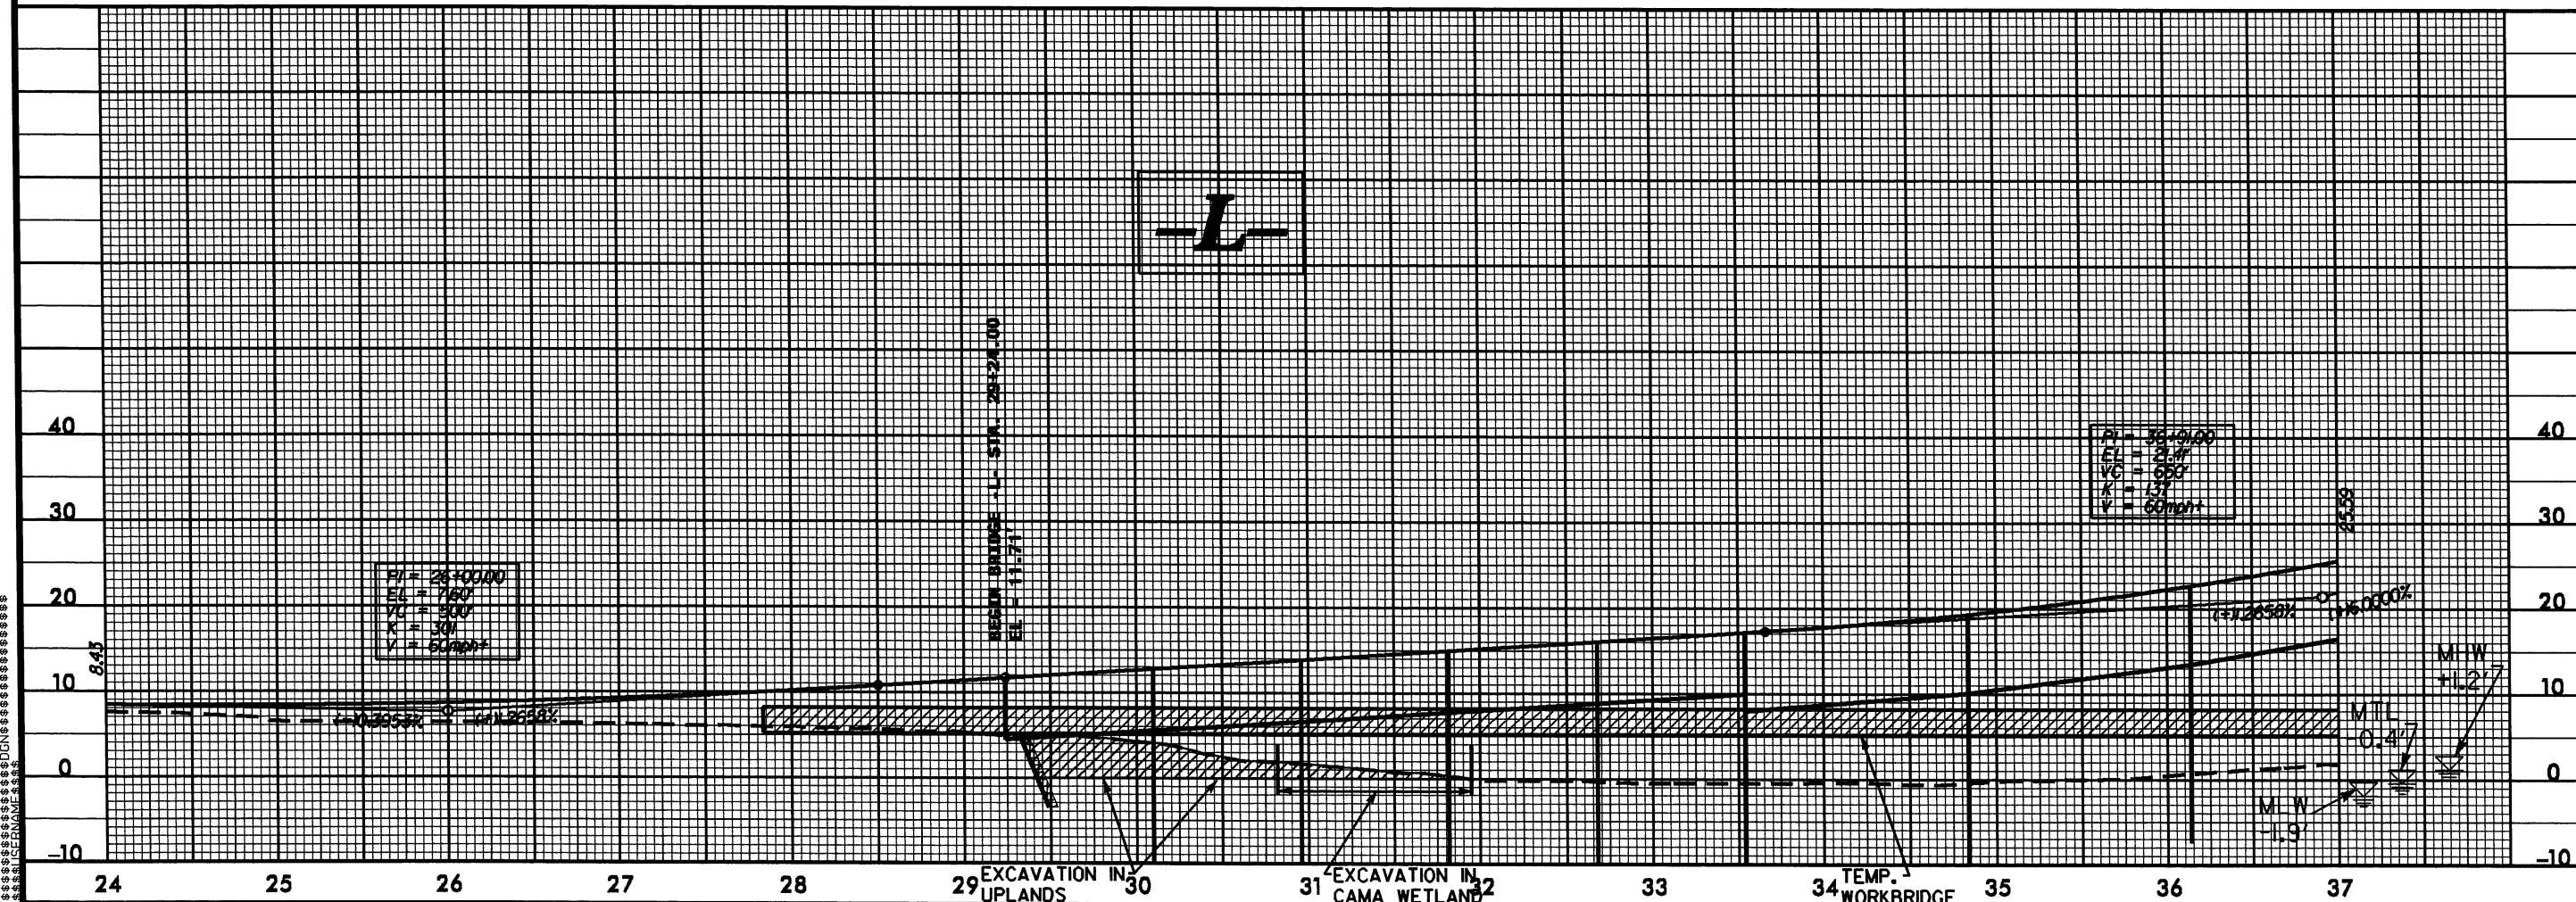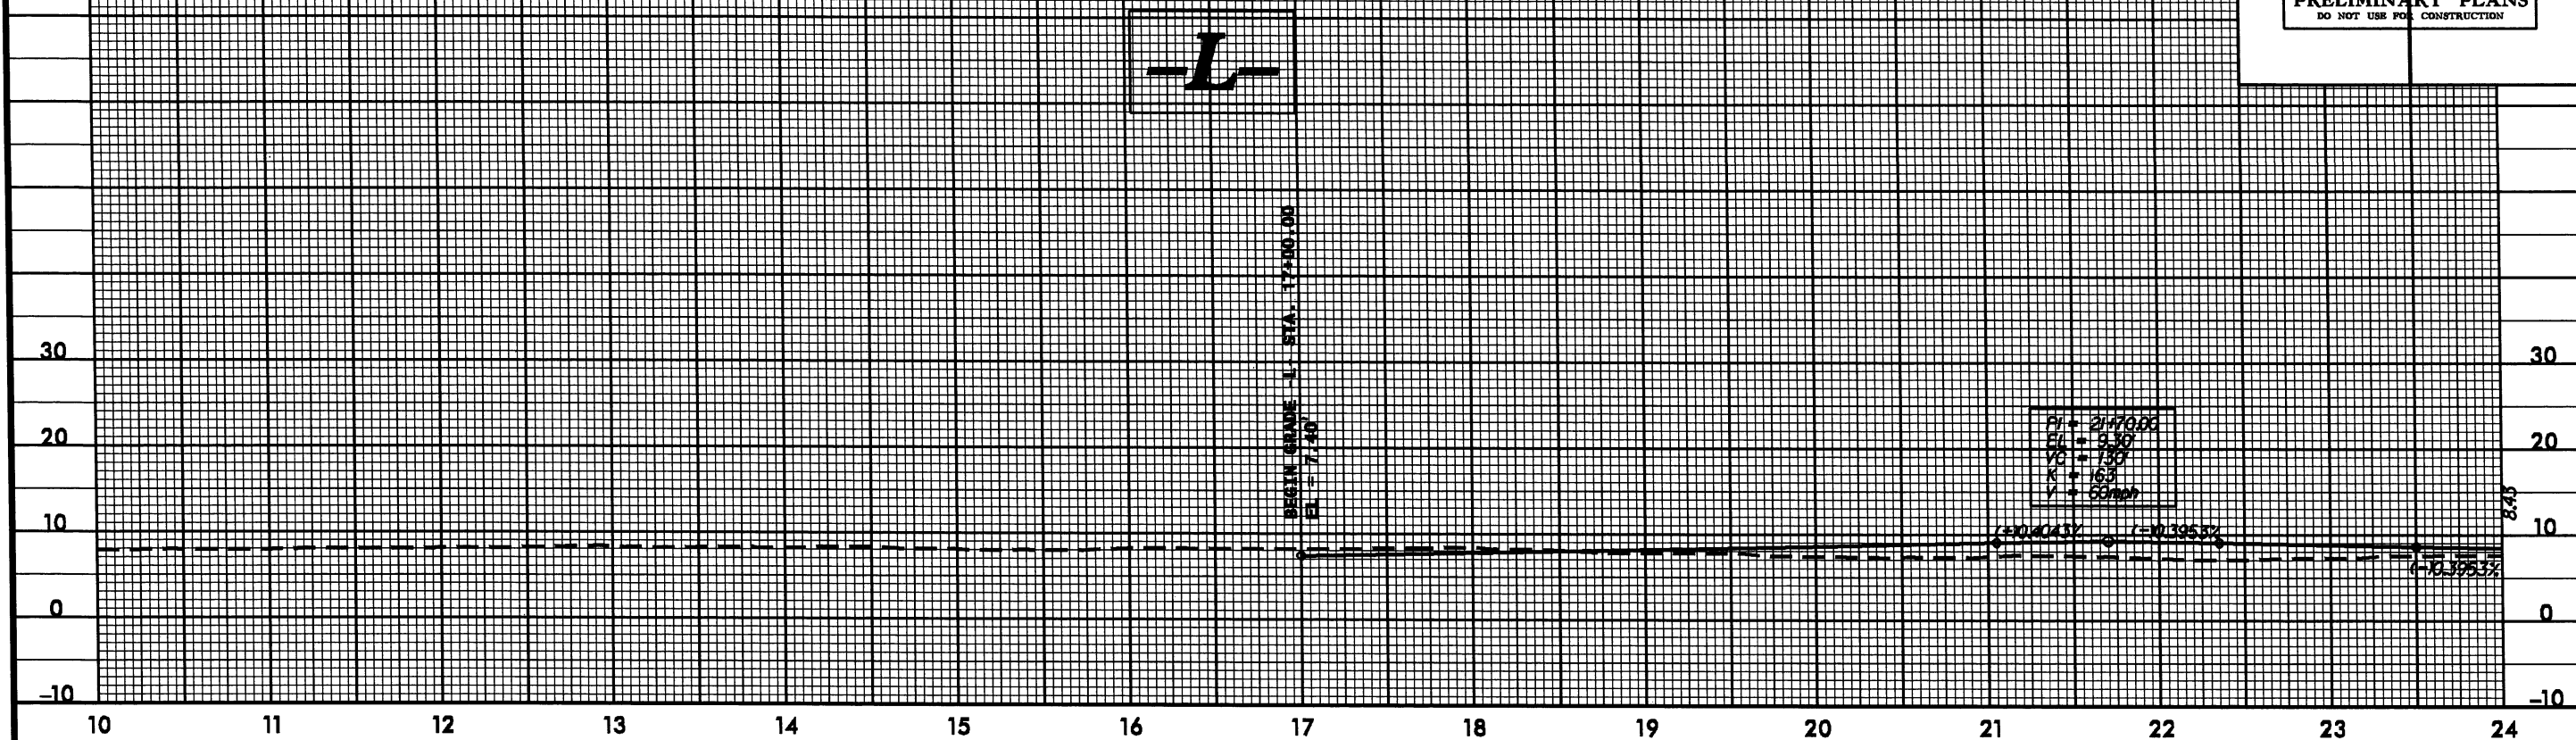

5/14/99

VERTICAL CURVE DATA  
STATION  
ELEVATION  
PC  
PT  
PVI  
VC  
ELEVATION  
PC  
PT  
PVI  
VC  
ELEVATION

DESIGN EXCEPTION IS REQUIRED  
FOR MAXIMUM GRADE.

PROJECT REFERENCE NO.  
R-3307

SHEET NO.  
27

ROADWAY DESIGN  
ENGINEER

HYDRAULICS  
ENGINEER


Permit Drawing  
Sheet 21 of 34

PRELIMINARY PLANS  
DO NOT USE FOR CONSTRUCTION

-L-

STA 48+21.50 -L-  
29 SPANS  
58861' - 54" PCG  
108130' - 78" BULB TEE  
10225' - 78" SPLICED BULB TEE  
10285' - 78" SPLICED BULB TEE  
10225' - 78" SPLICED BULB TEE  
11885' - 54" PCG  
0KEW = 50'

PI = 50+23.00  
ELEV = 101.3'  
VC = 1200'  
K = 125  
V = 55mph

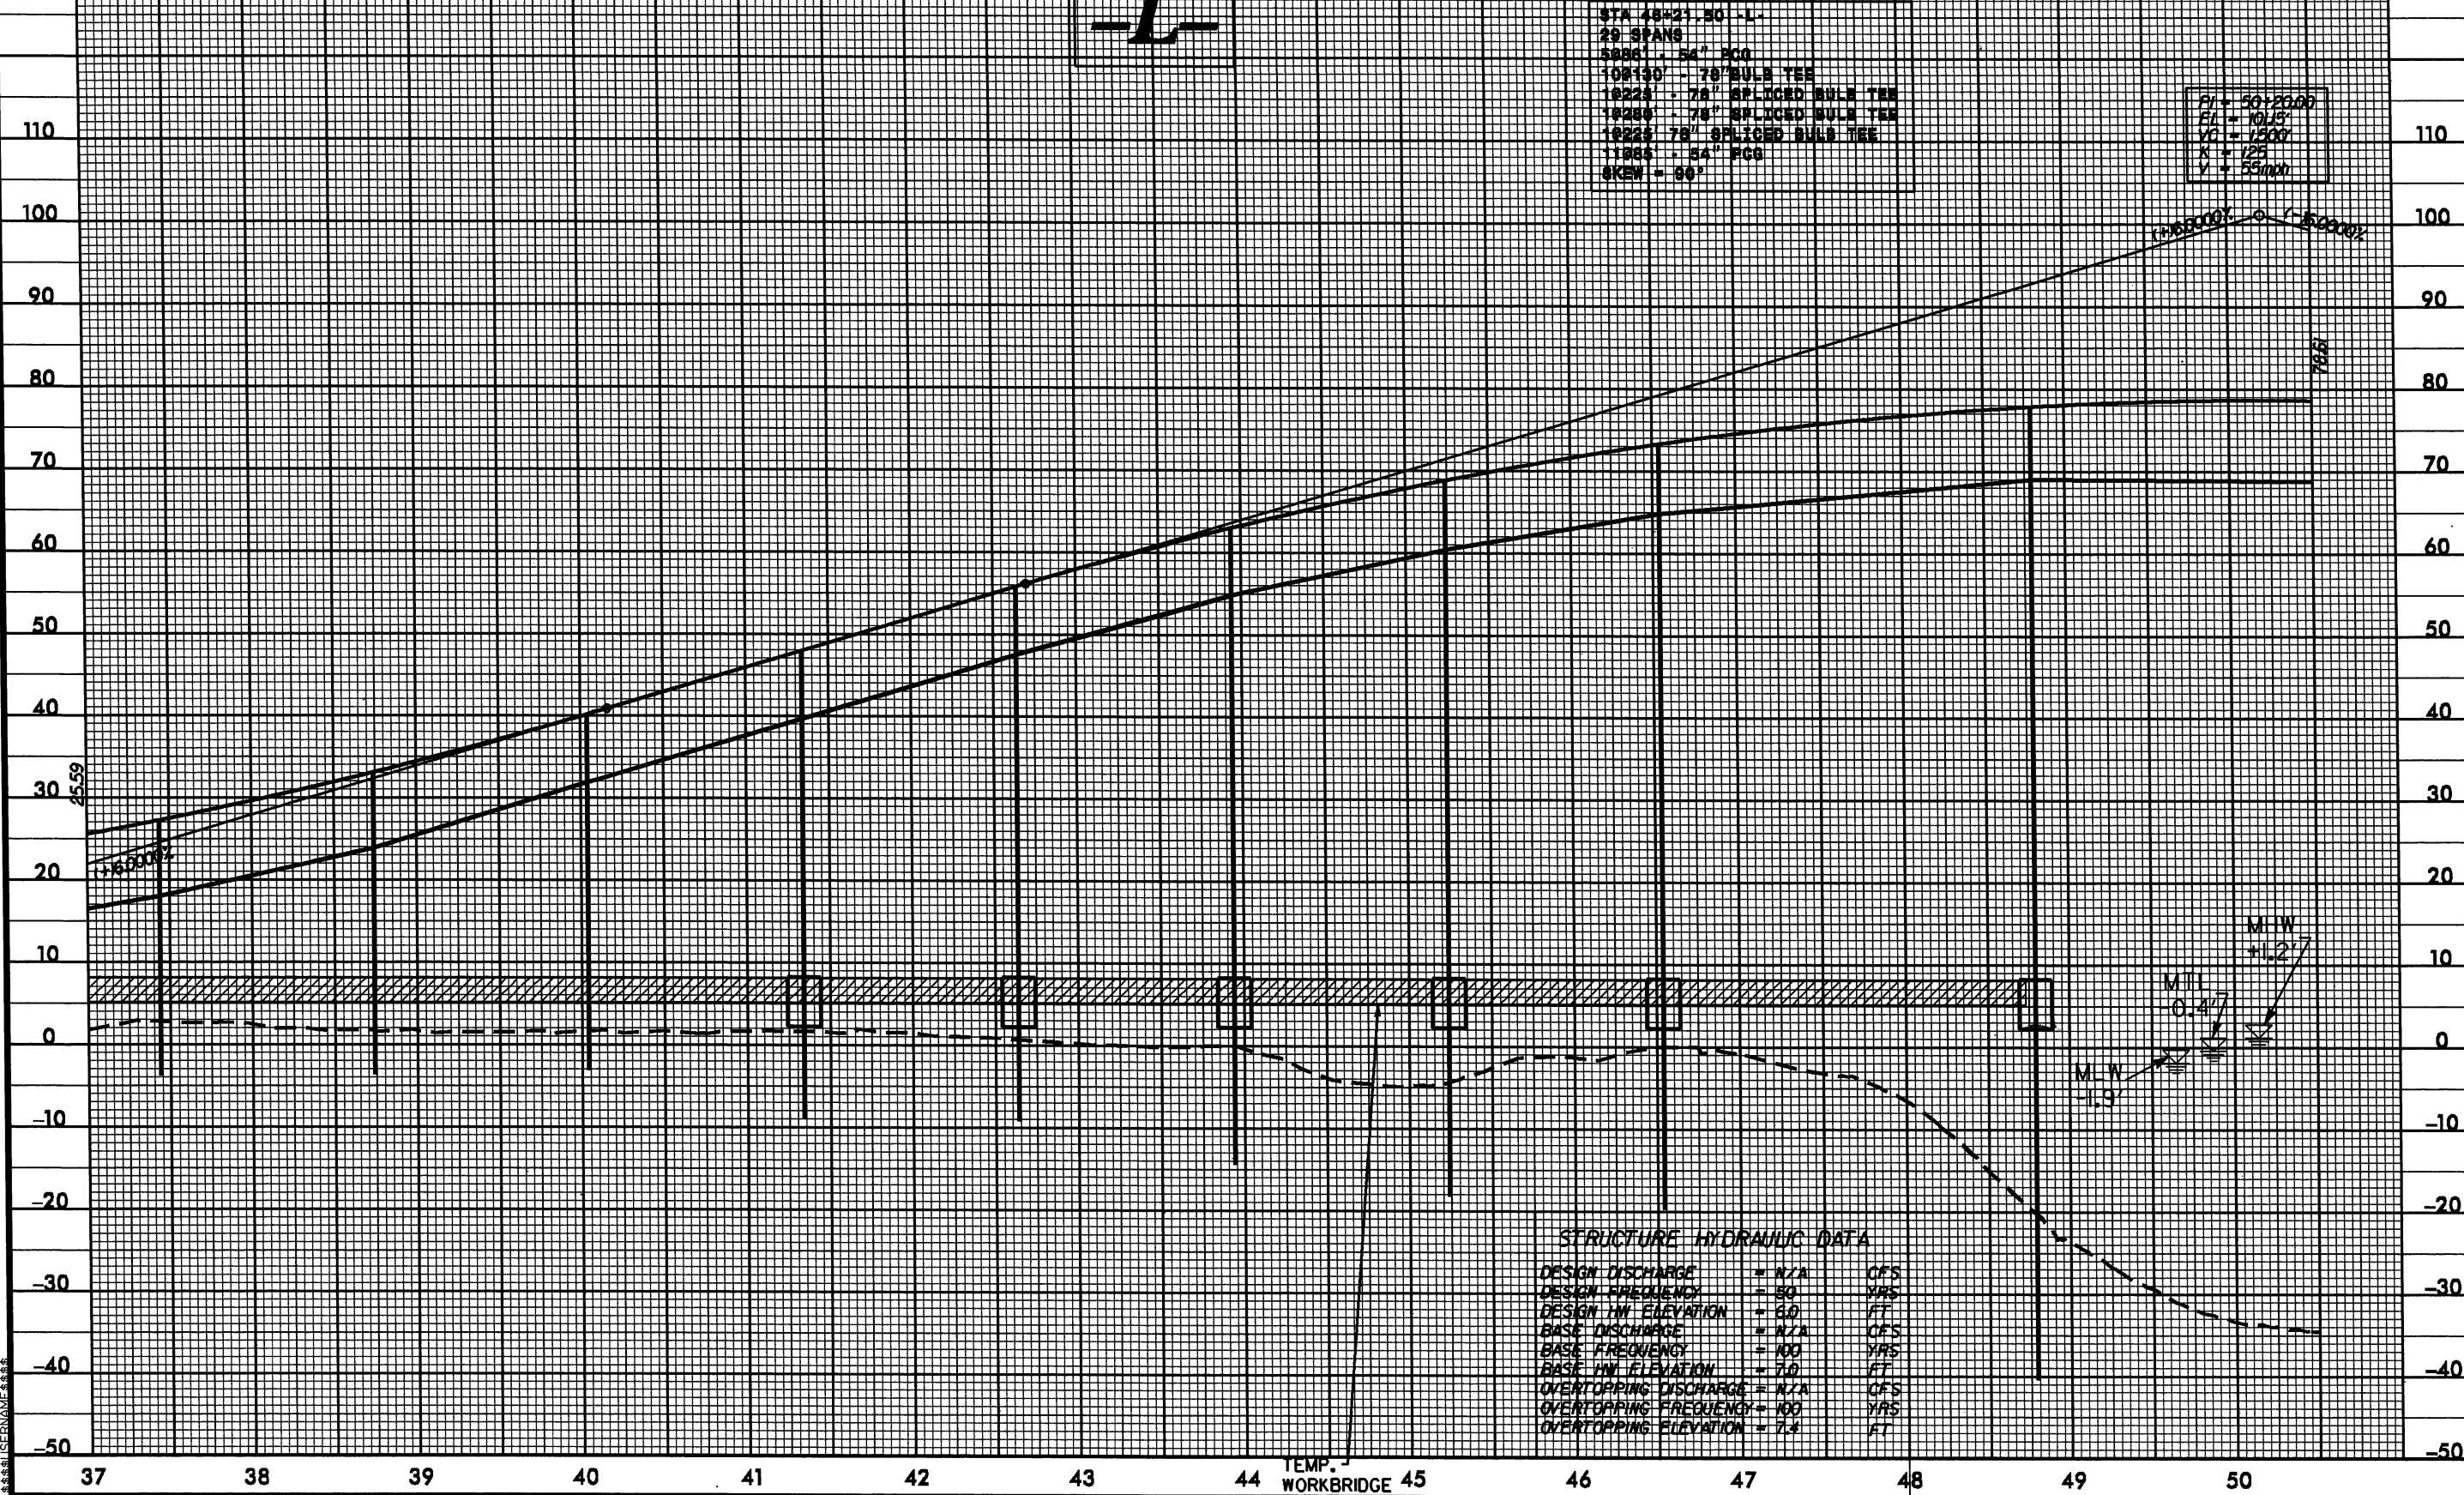

37 38 39 40 41 42 43 44 45 46 47 48 49 50


TEMP. WORKBRIDGE



SYSTEMS

PROJECT REFERENCE NO.		SHEET NO.	
R-3307		28	
ROADWAY DESIGN ENGINEER		HYDRAULICS ENGINEER	
<h1 style="text-align: center;">Permit Drawing</h1> <h2 style="text-align: center;">Sheet <u>22</u> of <u>34</u></h2>			
<div style="border: 1px solid black; padding: 5px; text-align: center;"> <b>PRELIMINARY PLANS</b>              DO NOT USE FOR CONSTRUCTION           </div>			

**-L-**

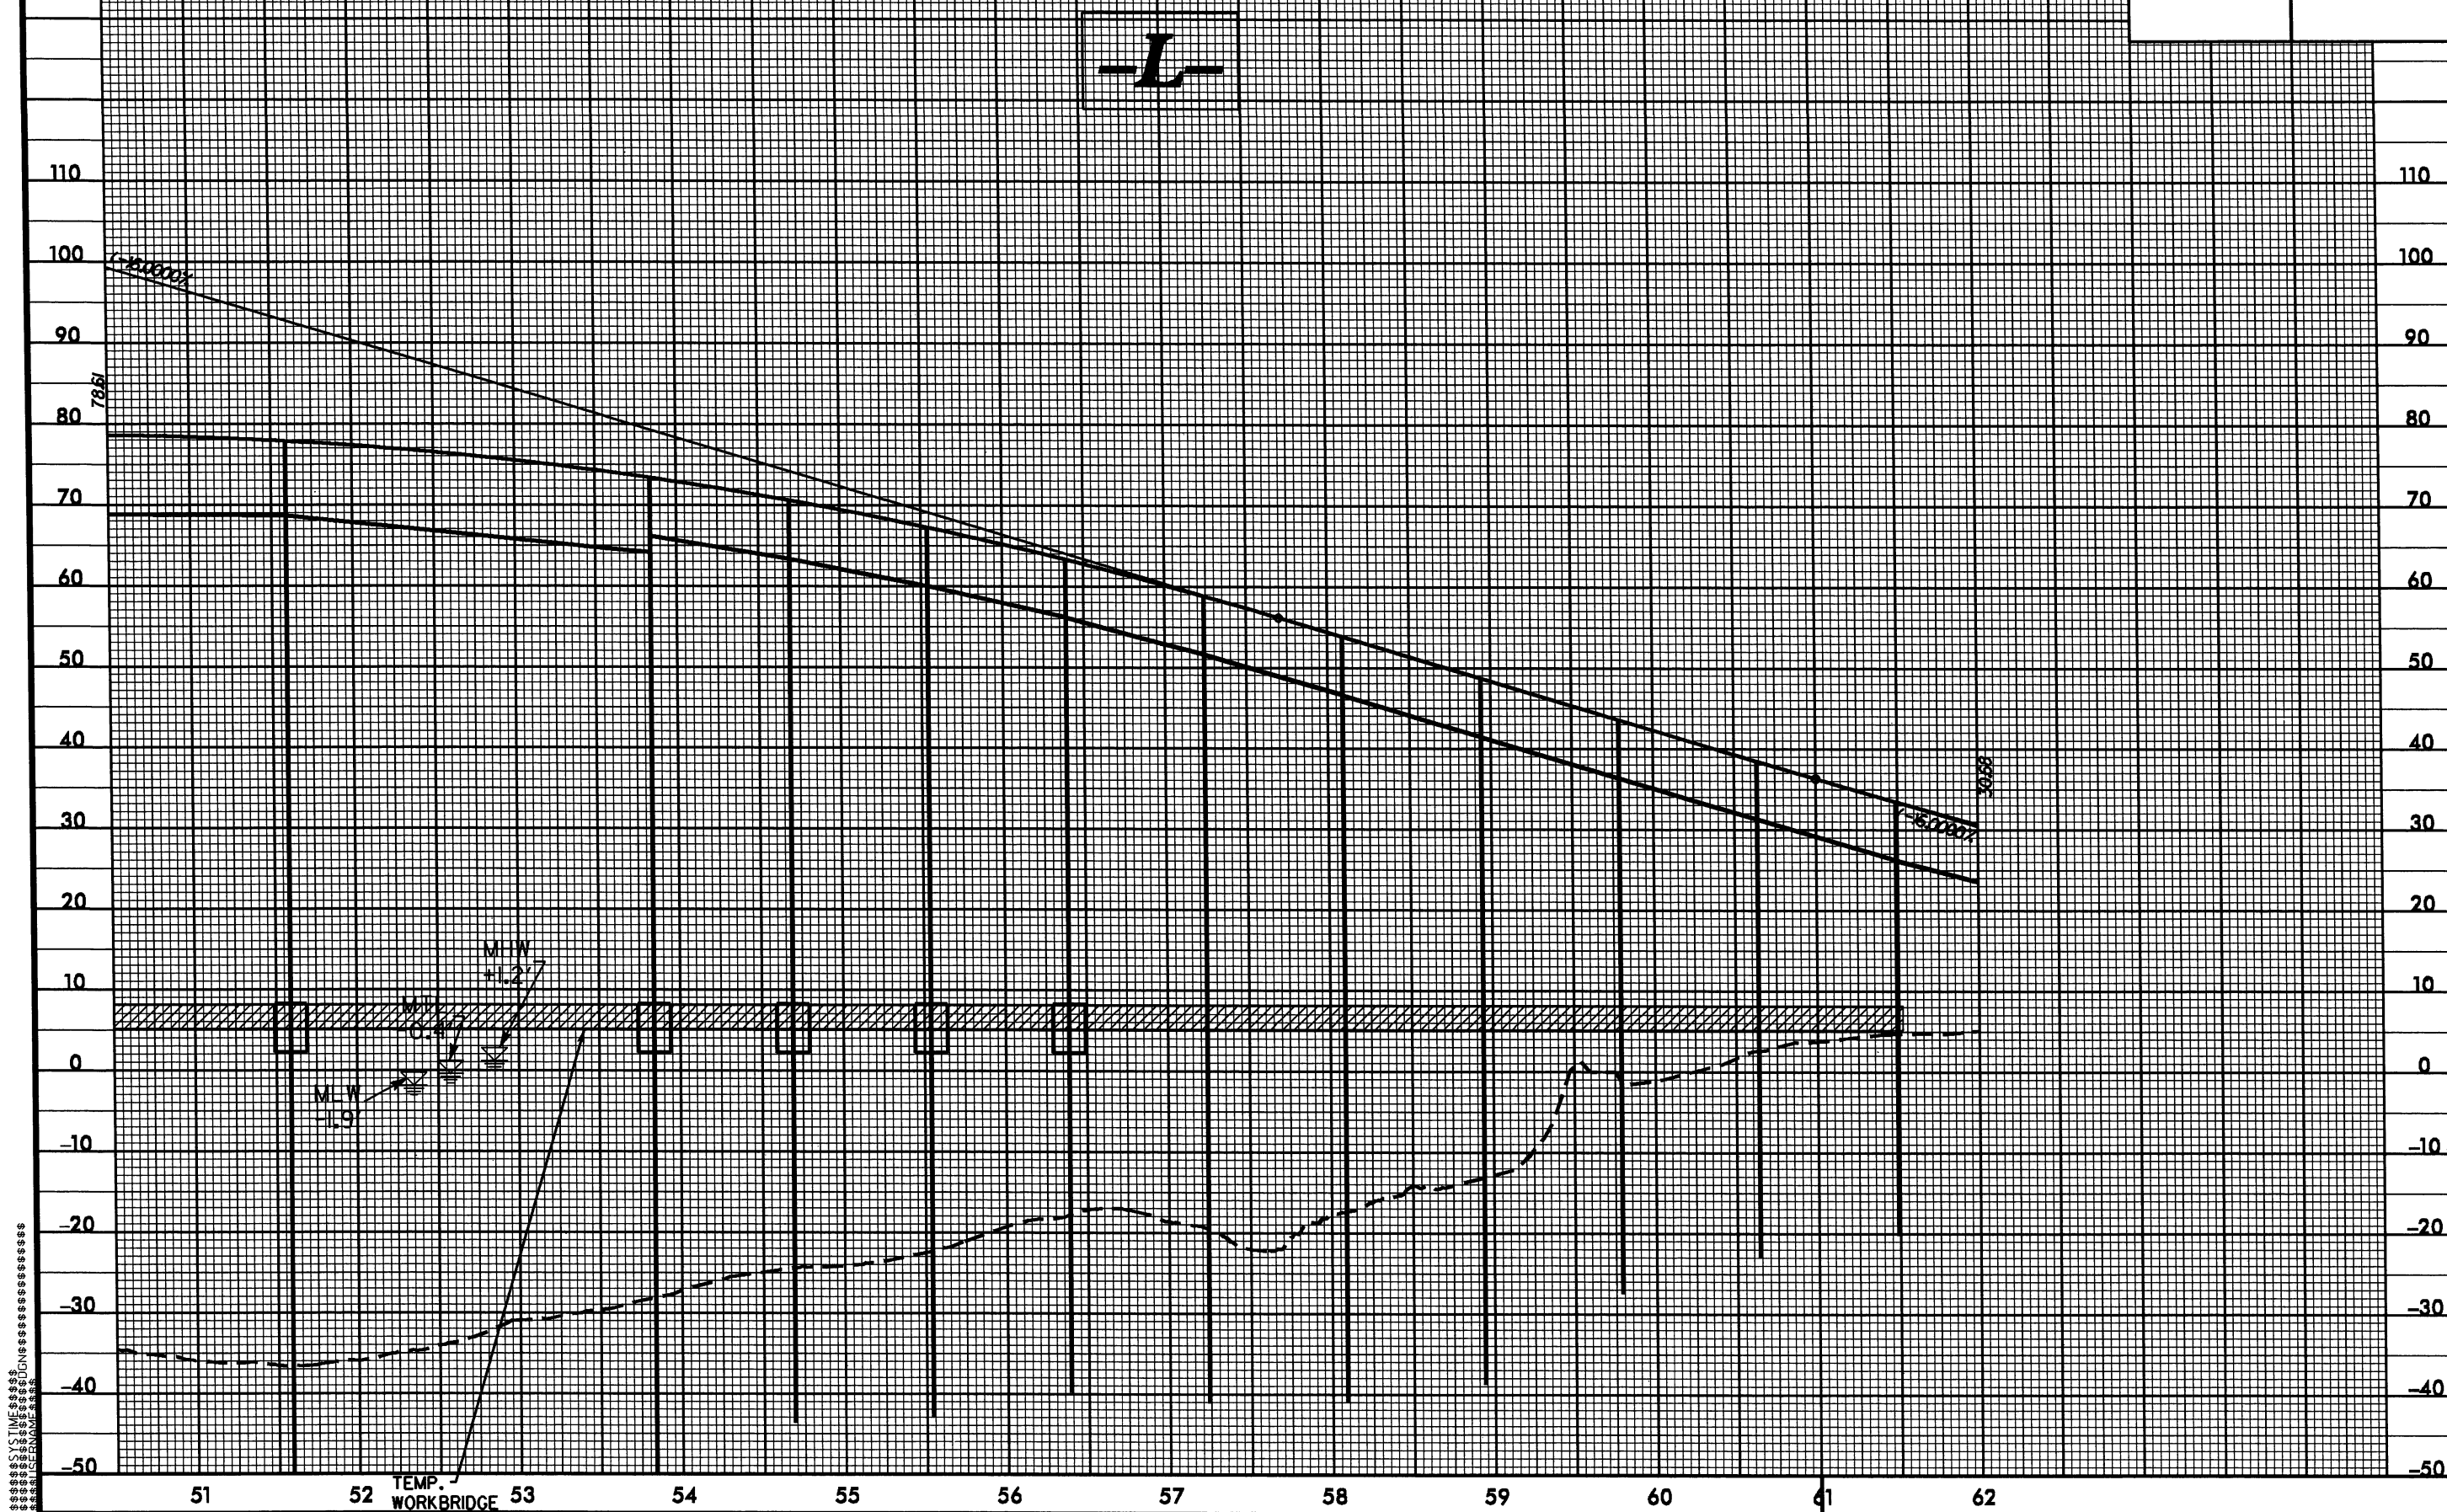





5/28/99

DESIGN EXCEPTION IS REQUIRED  
FOR MAXIMUM GRADE.

PROJECT REFERENCE NO. R-3307	SHEET NO. 29
ROADWAY DESIGN ENGINEER	HYDRAULICS ENGINEER
Permit Drawing Sheet 23 of 24	
PRELIMINARY PLANS DO NOT USE FOR CONSTRUCTION	

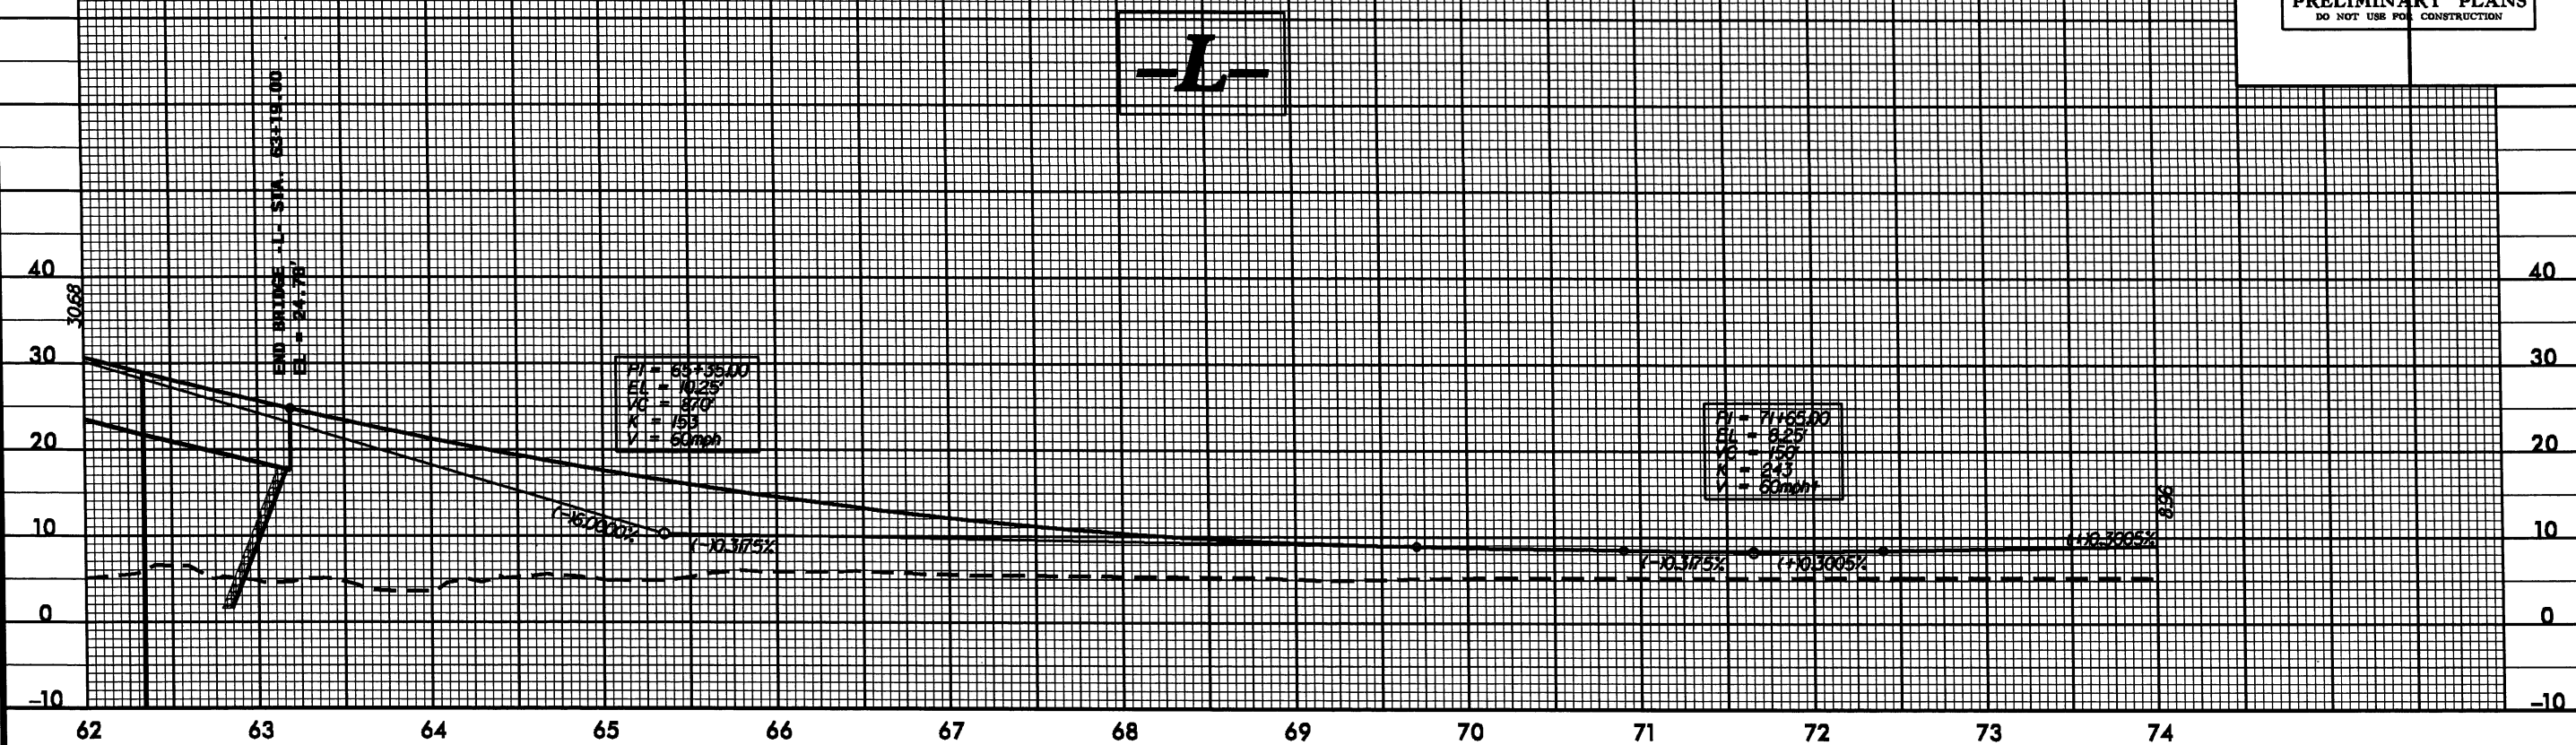


5/28/99

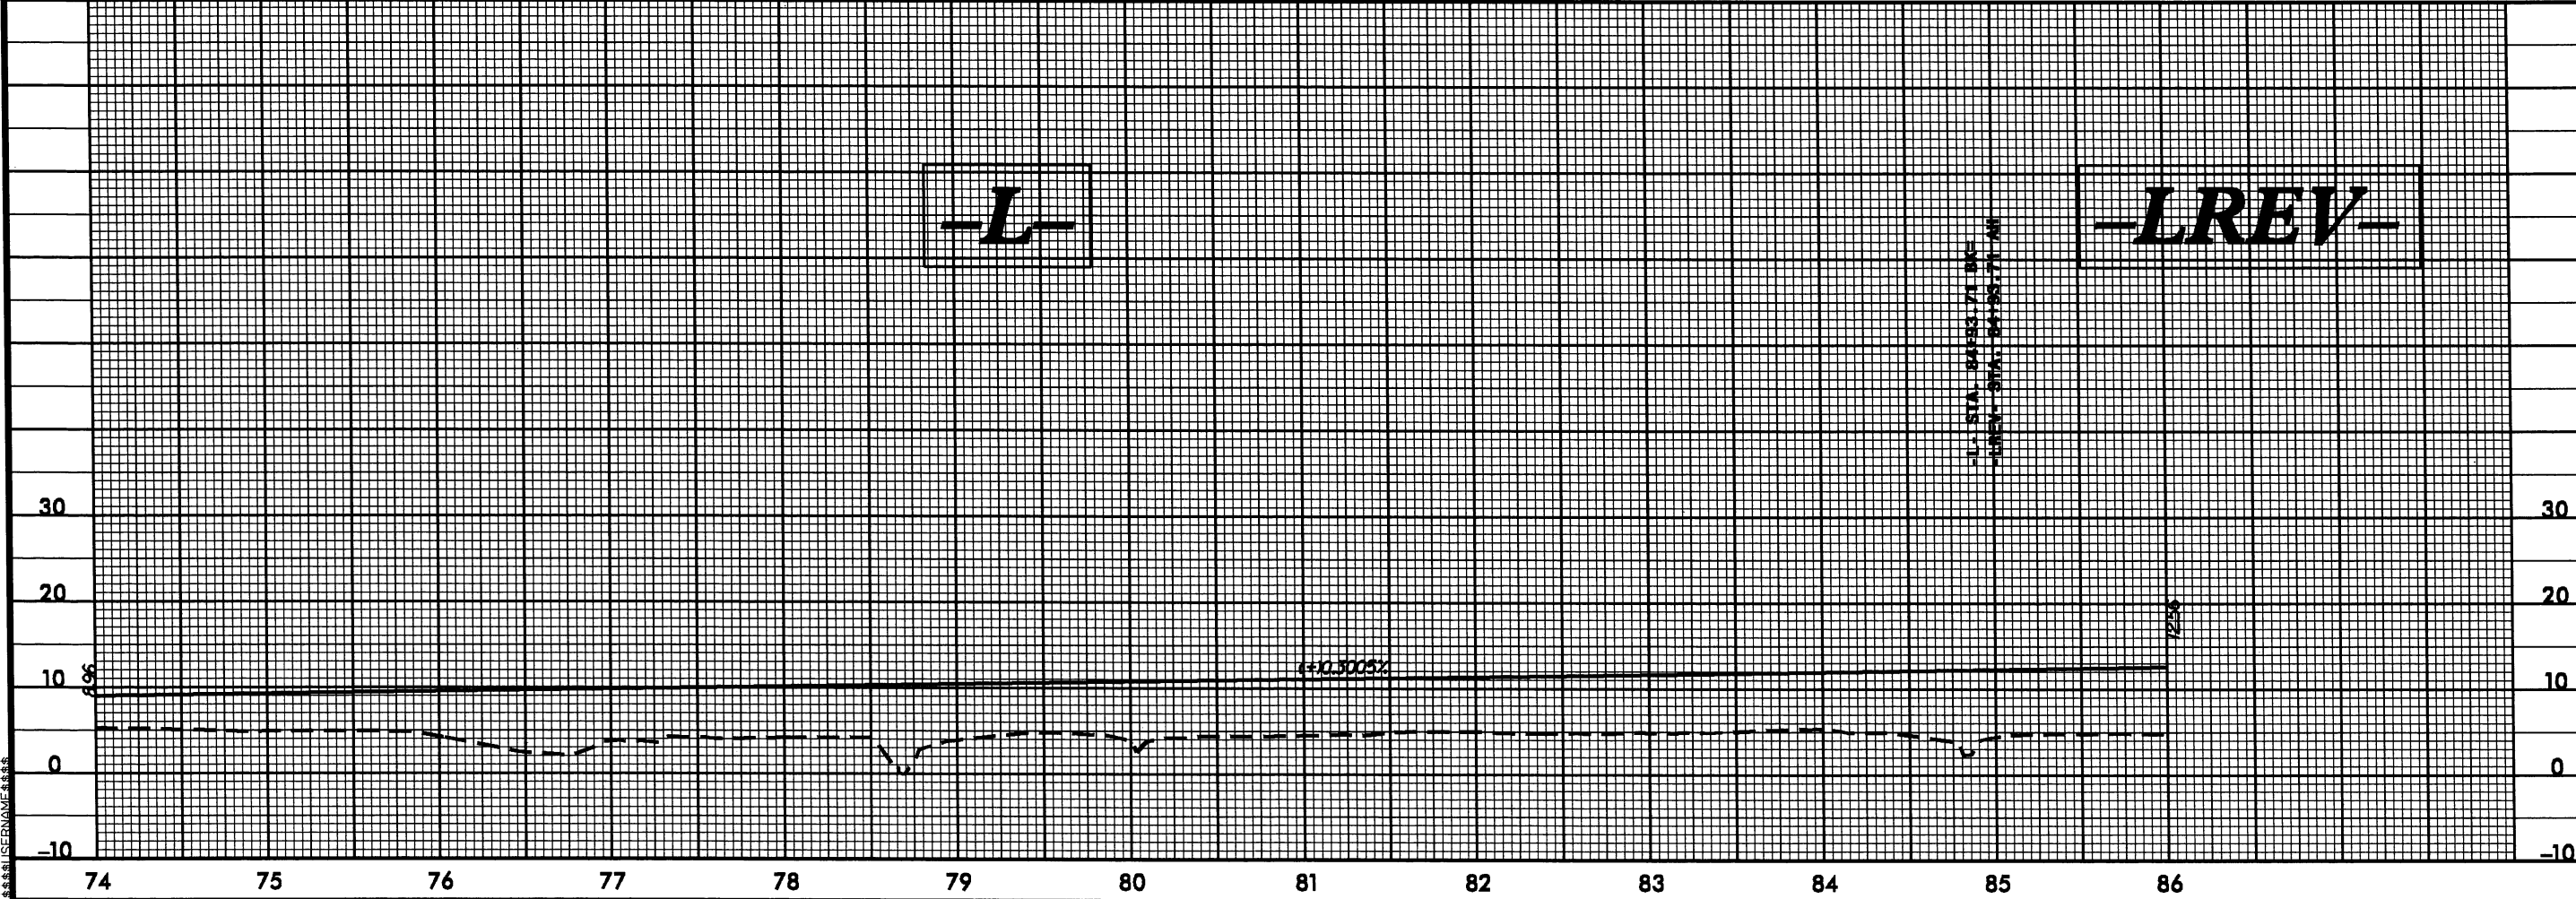

5/28/99

PROJECT REFERENCE NO.	SHEET NO.
R-3307	35
ROADWAY DESIGN	HYDRAULICS ENGINEER
Permit Drawing	
Sheet 24 of 34	
PRELIMINARY PLANS	
DO NOT USE FOR CONSTRUCTION	


**-YIREV-**

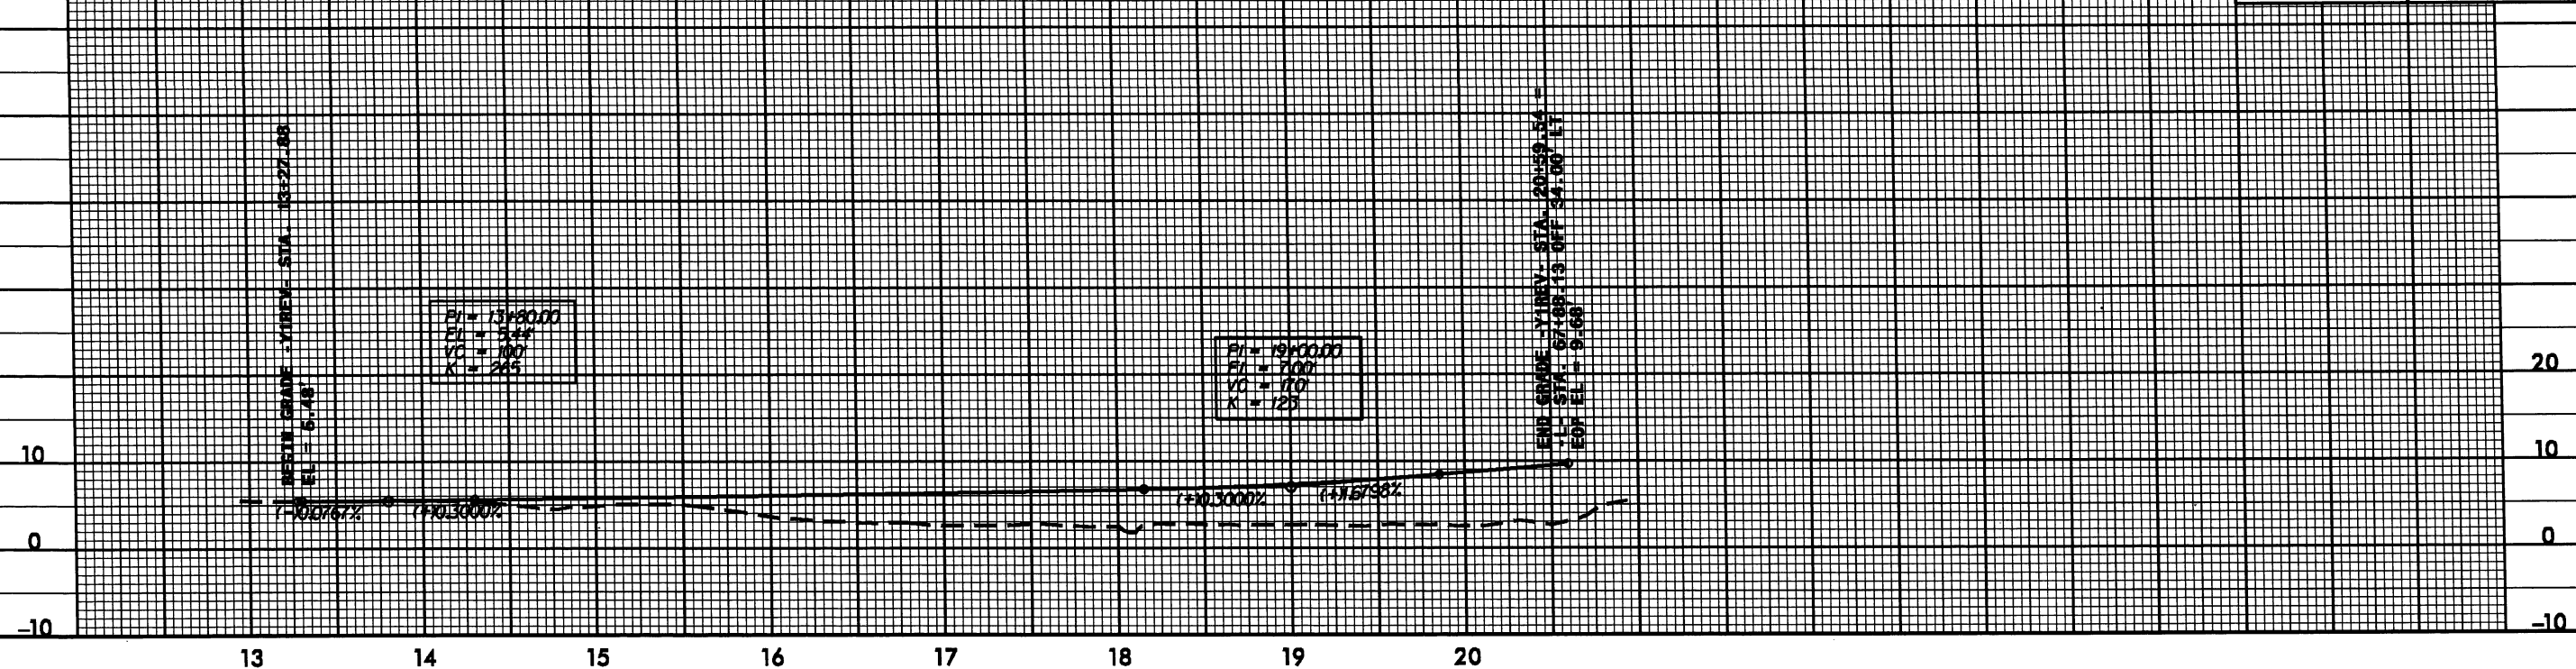


STRUCTURE HYDRAULIC DATA

DESIGN DISCHARGE	= N/A	CFS
DESIGN FREQUENCY	= 25	YRS
DESIGN HW ELEVATION	= 4.8	FT
BASE DISCHARGE	= N/A	CFS
BASE FREQUENCY	= 100	YRS
BASE HW ELEVATION	= 7.0	FT
OVERTOPPING DISCHARGE	= N/A	CFS
OVERTOPPING FREQUENCY	= 25	YRS
OVERTOPPING ELEVATION	= 4.8	FT

**-Y2-**

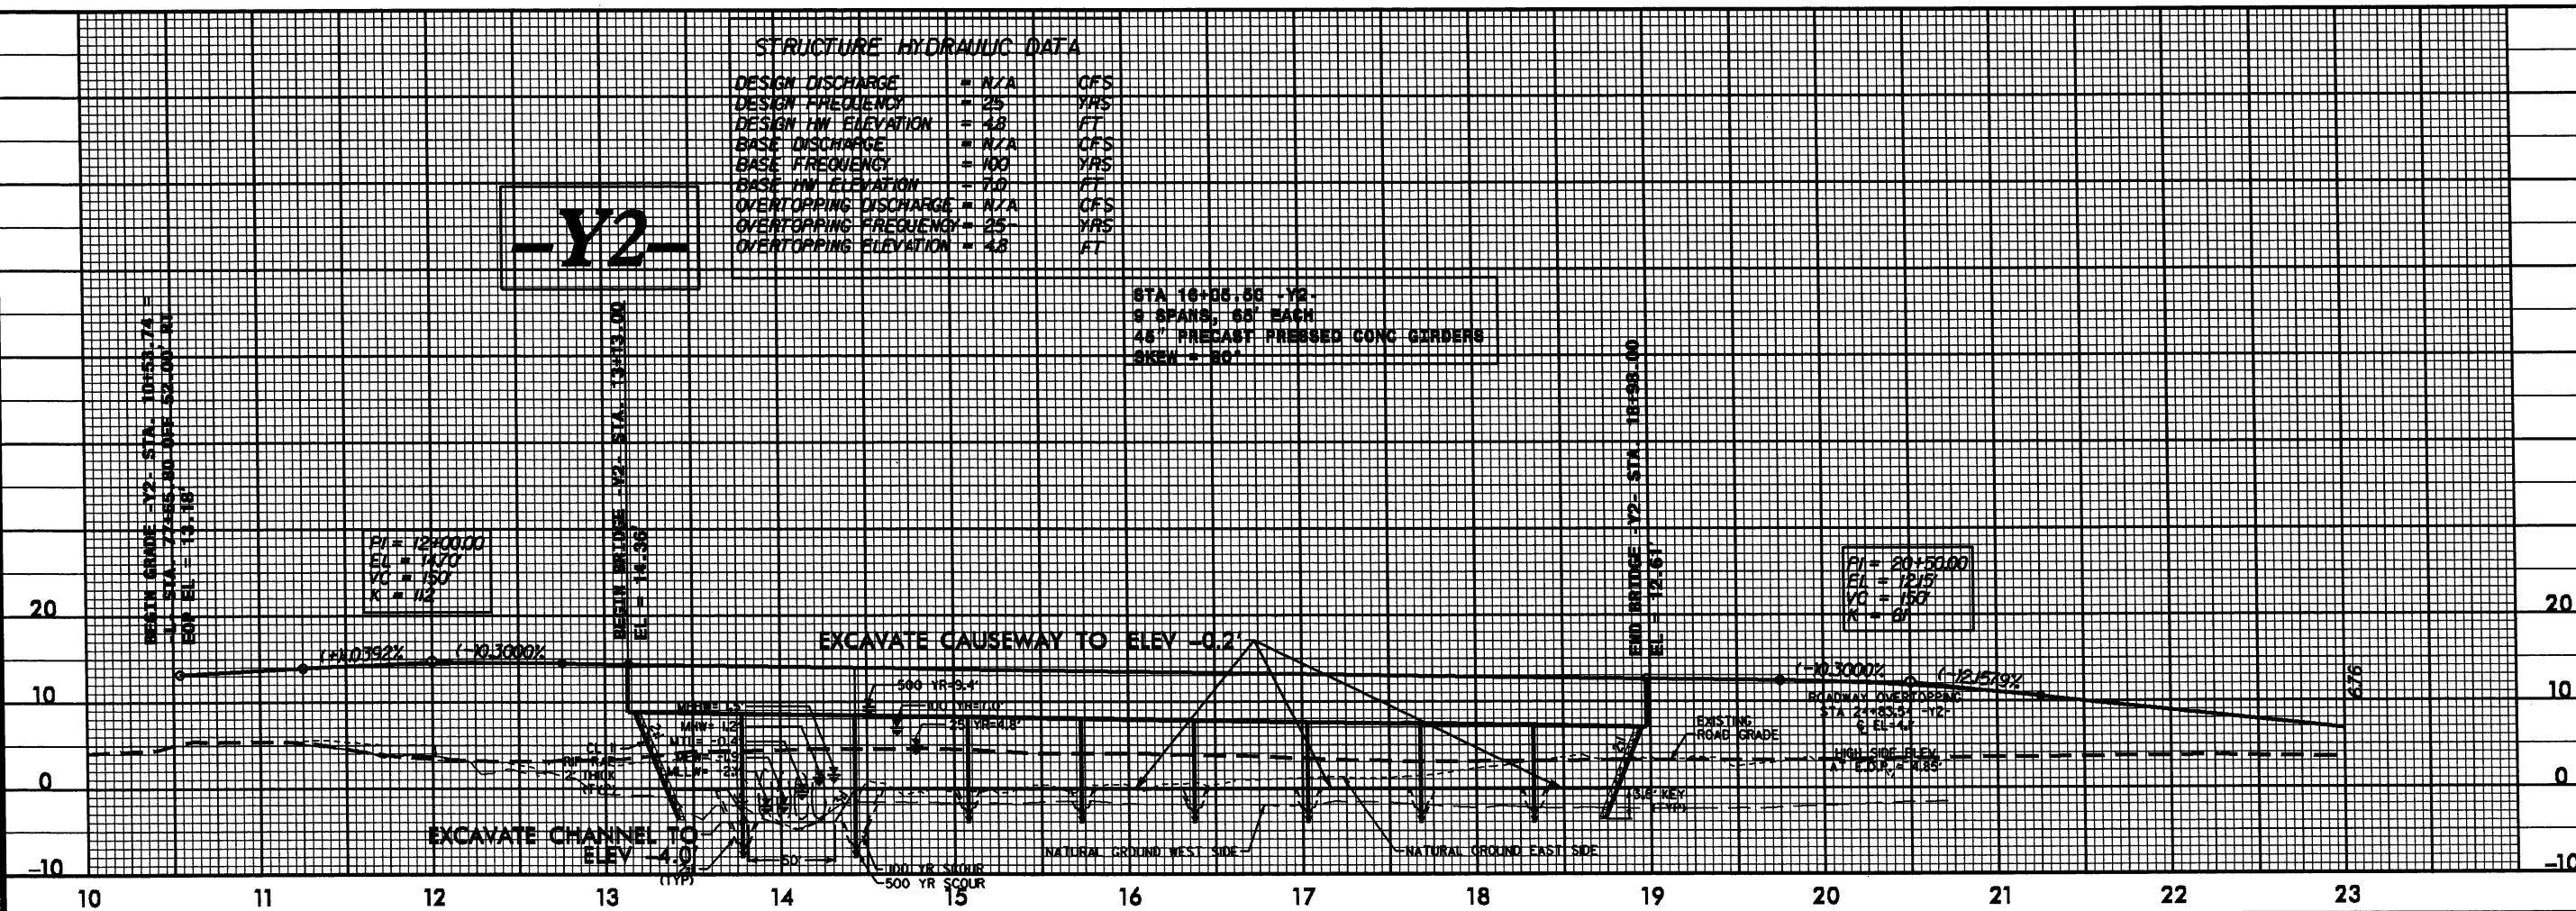



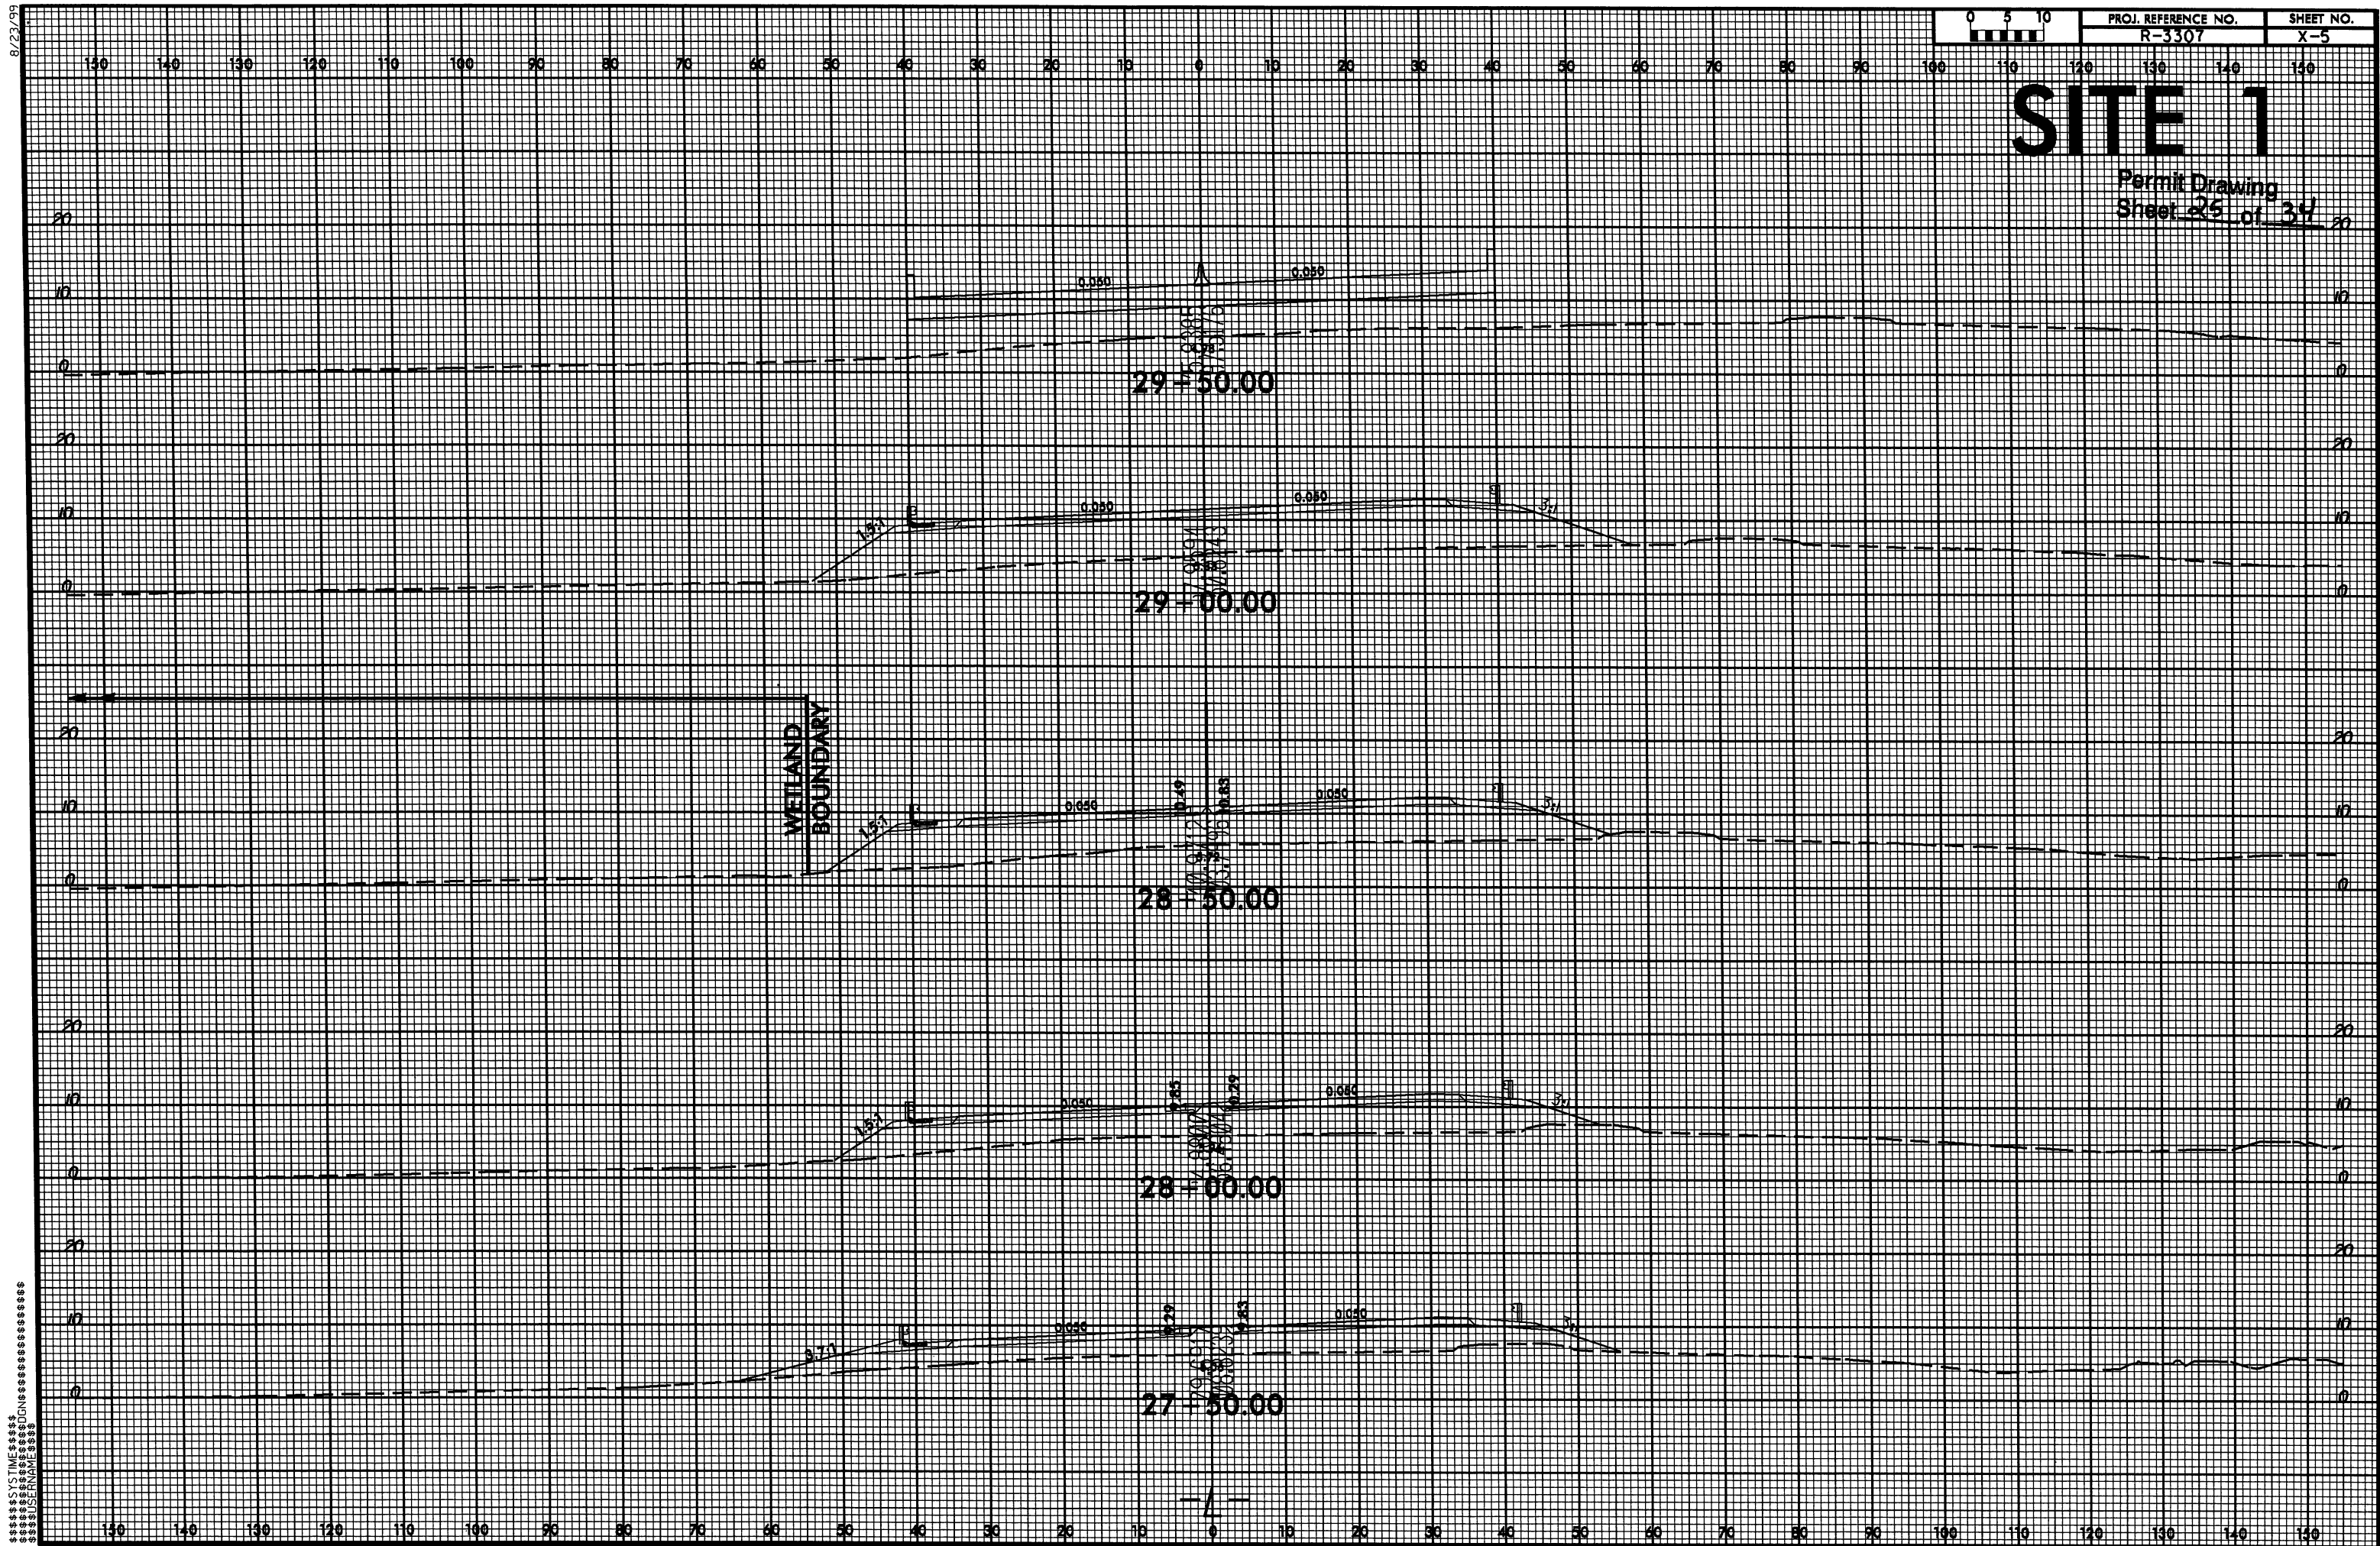




8/23/99

# SITE 2

Permit Drawing  
Sheet 24 of 34

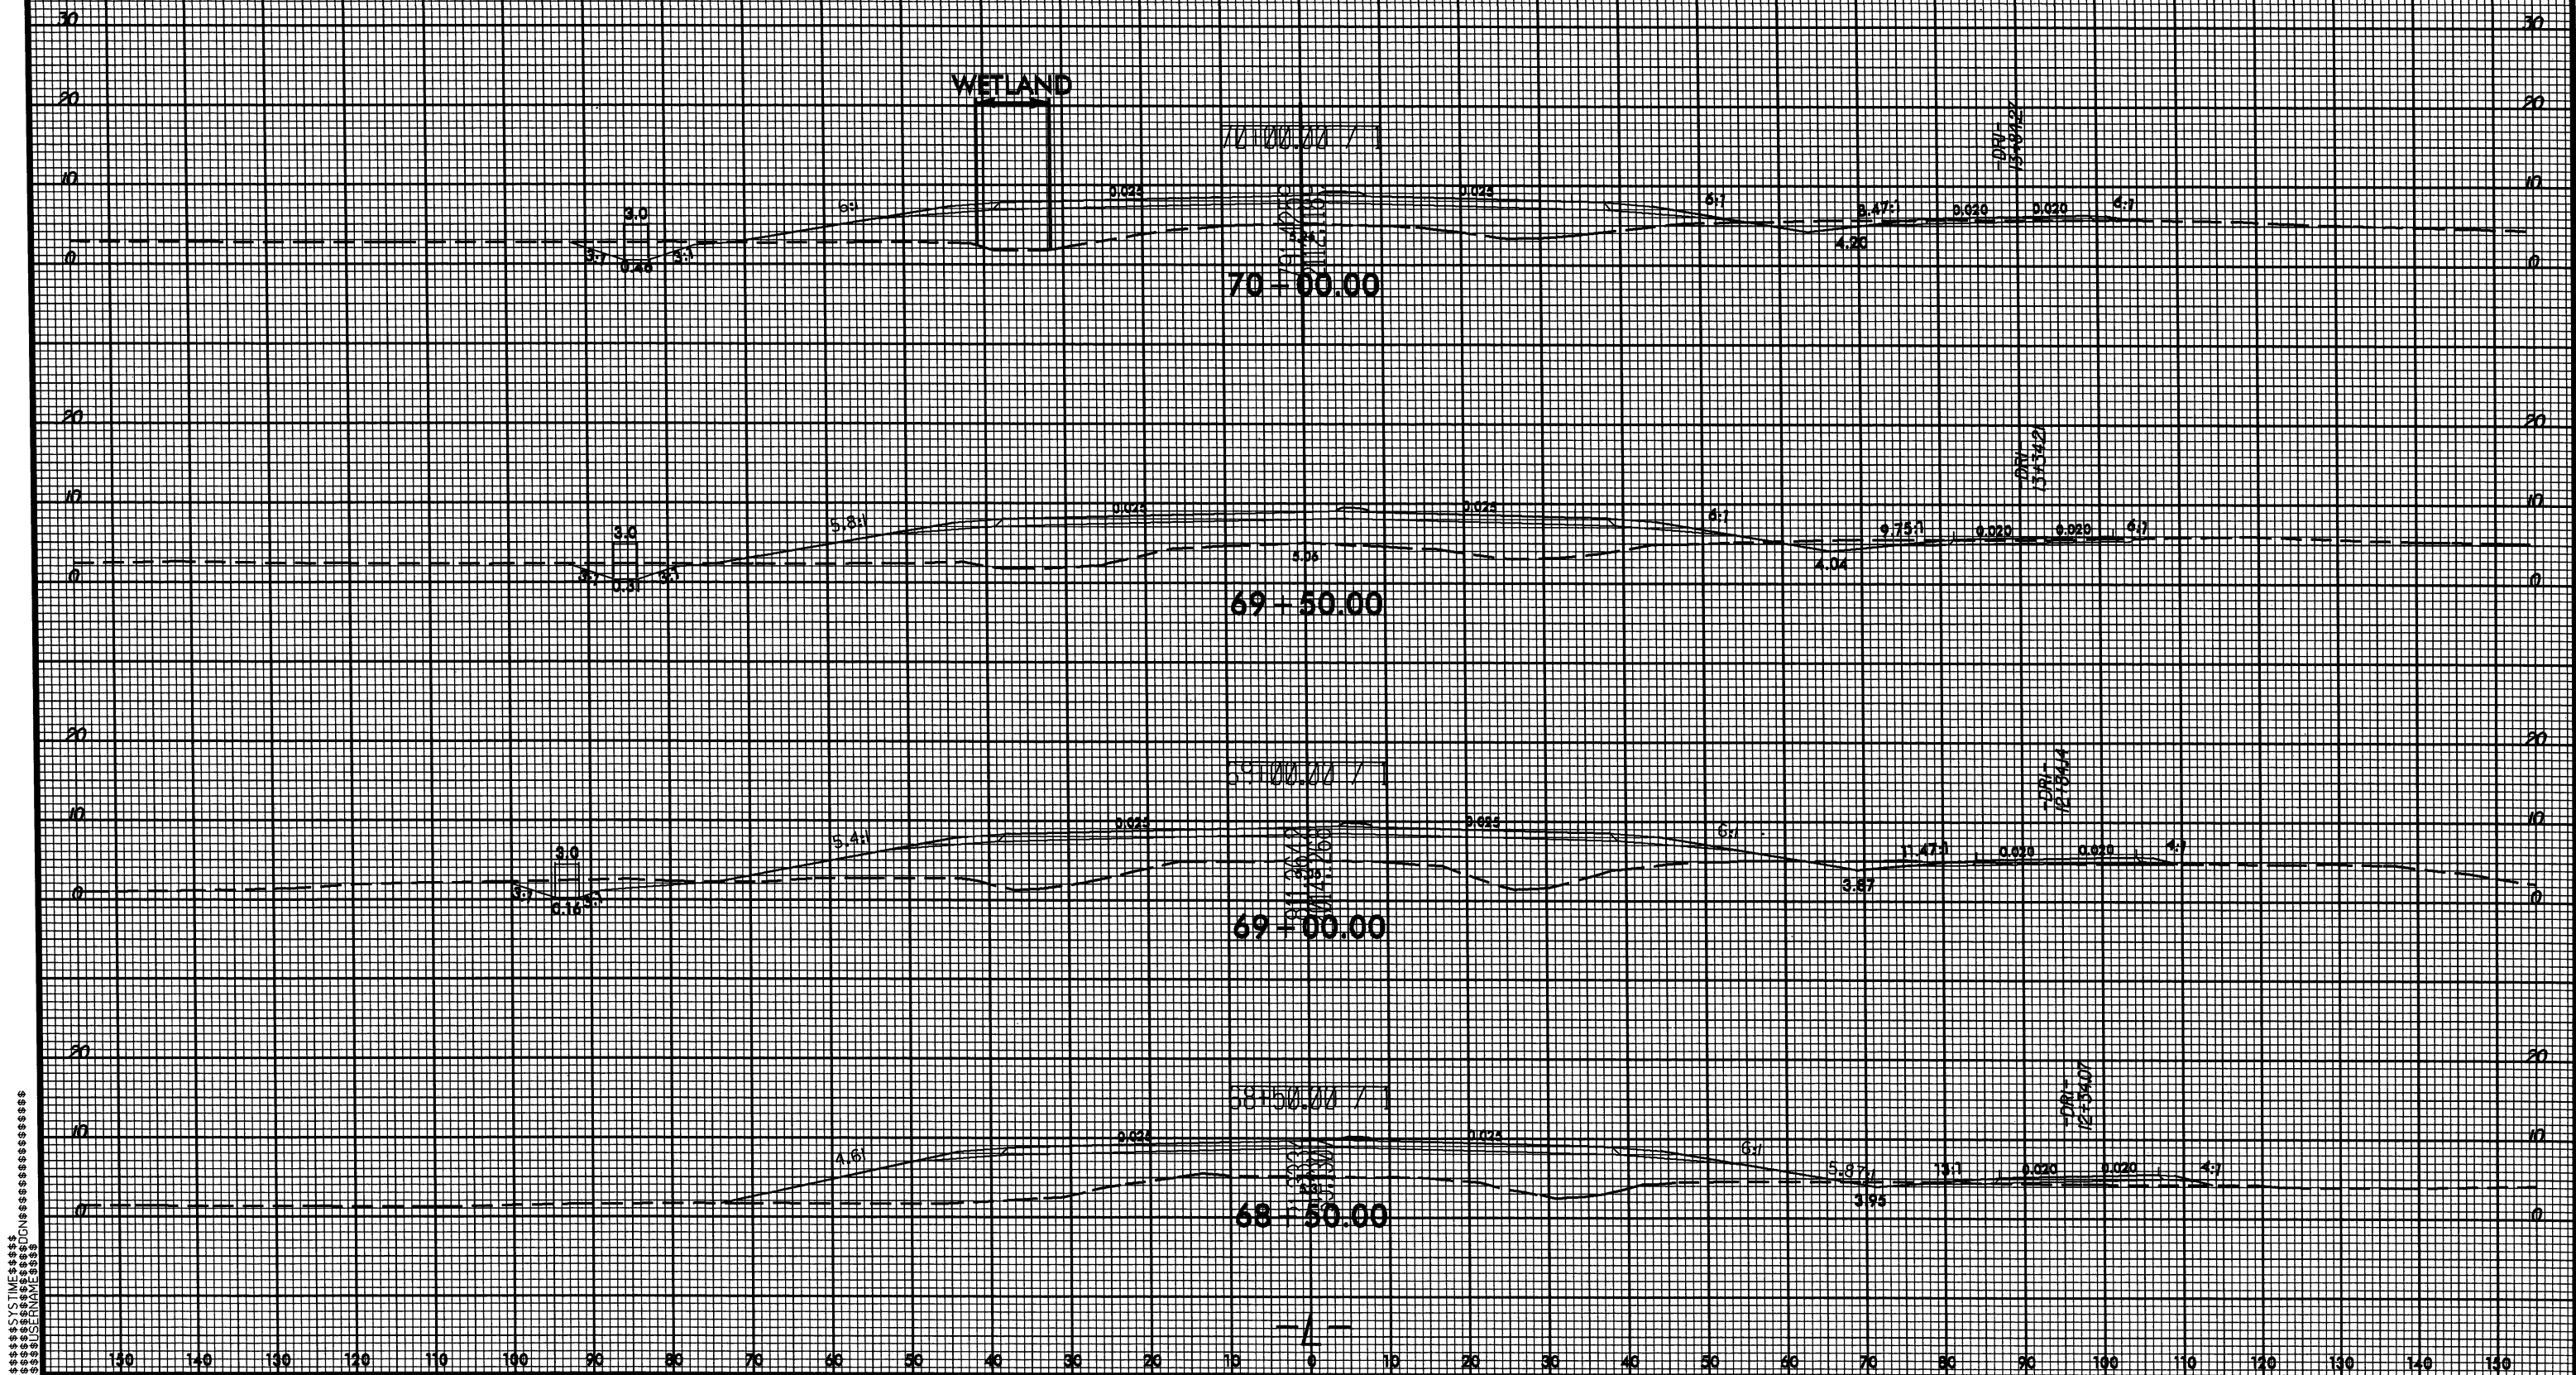





5/14/99

5/14/99


# SITE 3

PROJECT REFERENCE NO.		SHEET NO.	
R-3307			
ROADWAY DESIGN ENGINEER		HYDRAULICS ENGINEER	
INCOMPLETE PLANS DO NOT USE FOR R/W ACQUISITION		PRELIMINARY PLANS DO NOT USE FOR CONSTRUCTION	

Permit Drawing  
Sheet 28 of 34

15  
14  
13  
-1  
-2

15  
14  
13  
-1  
-2

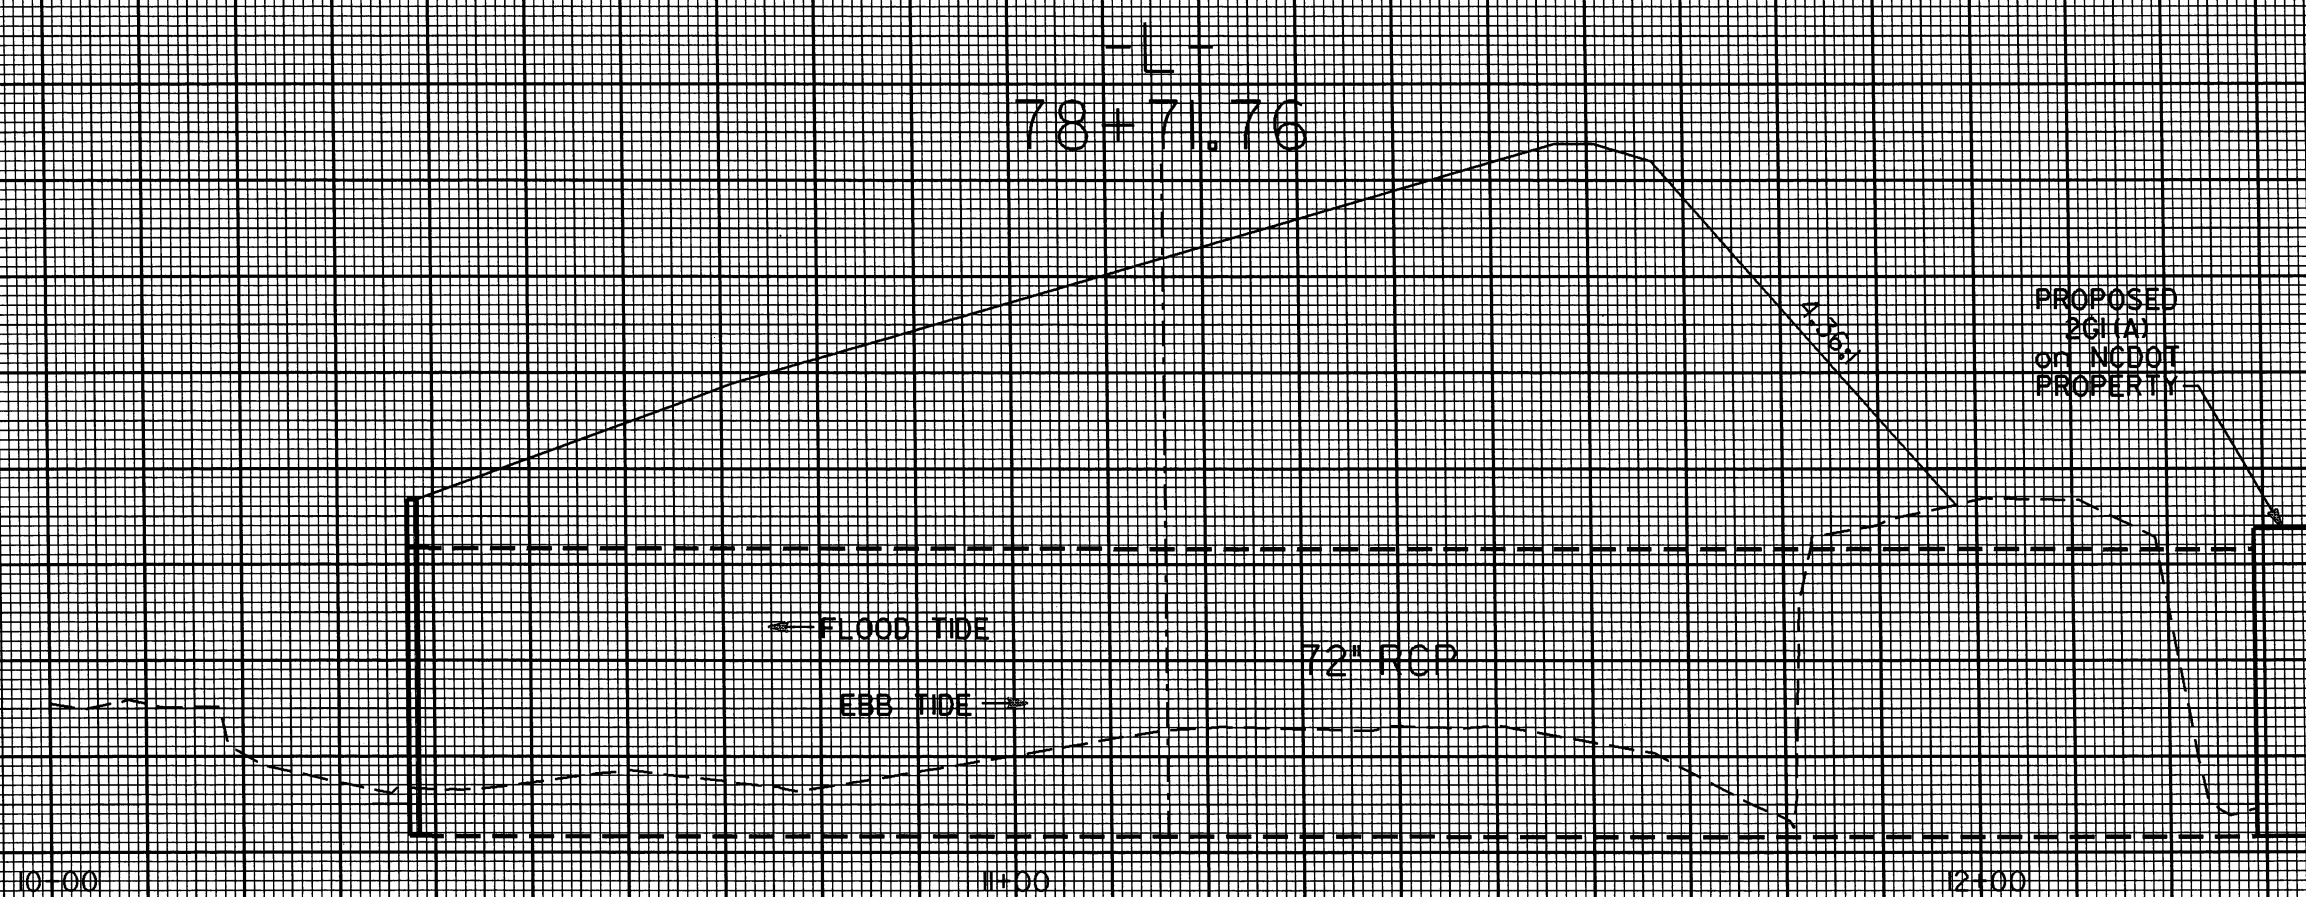


PROFILE  
FOR  
72' PIPE AT -L- STA 78+72 (+/-)




8/23/99

# SITE 4

Permit Drawing  
Sheet 21 of 31

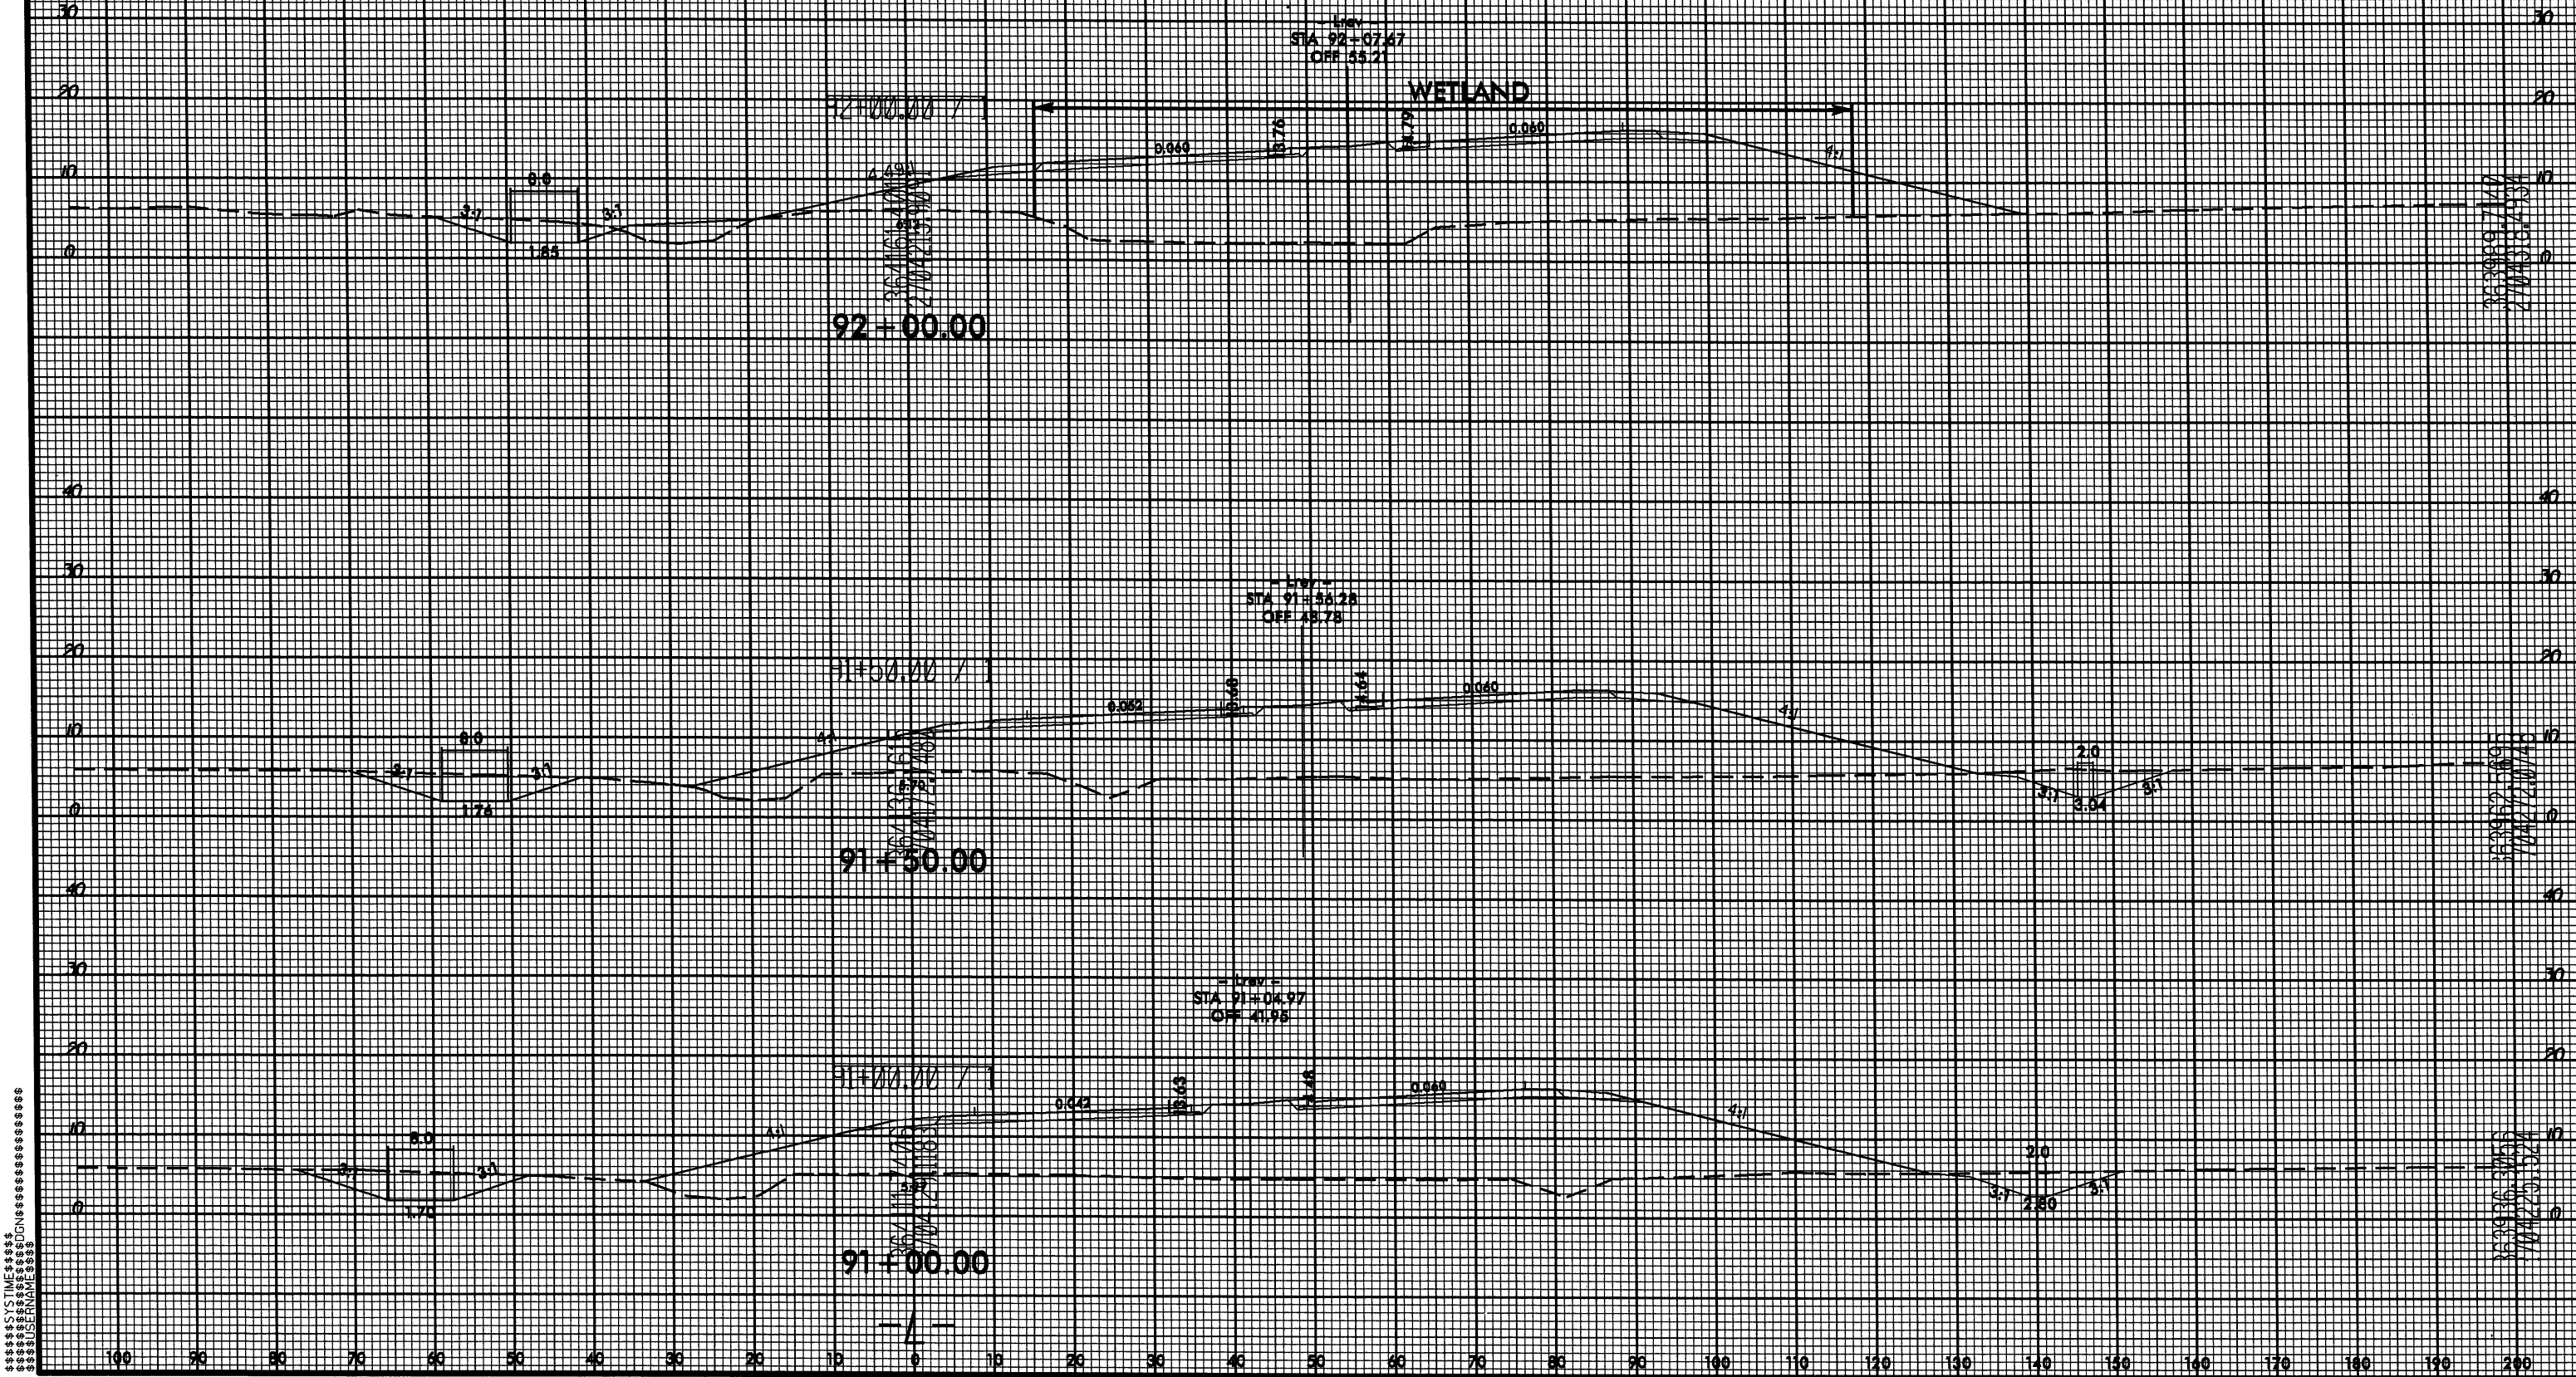



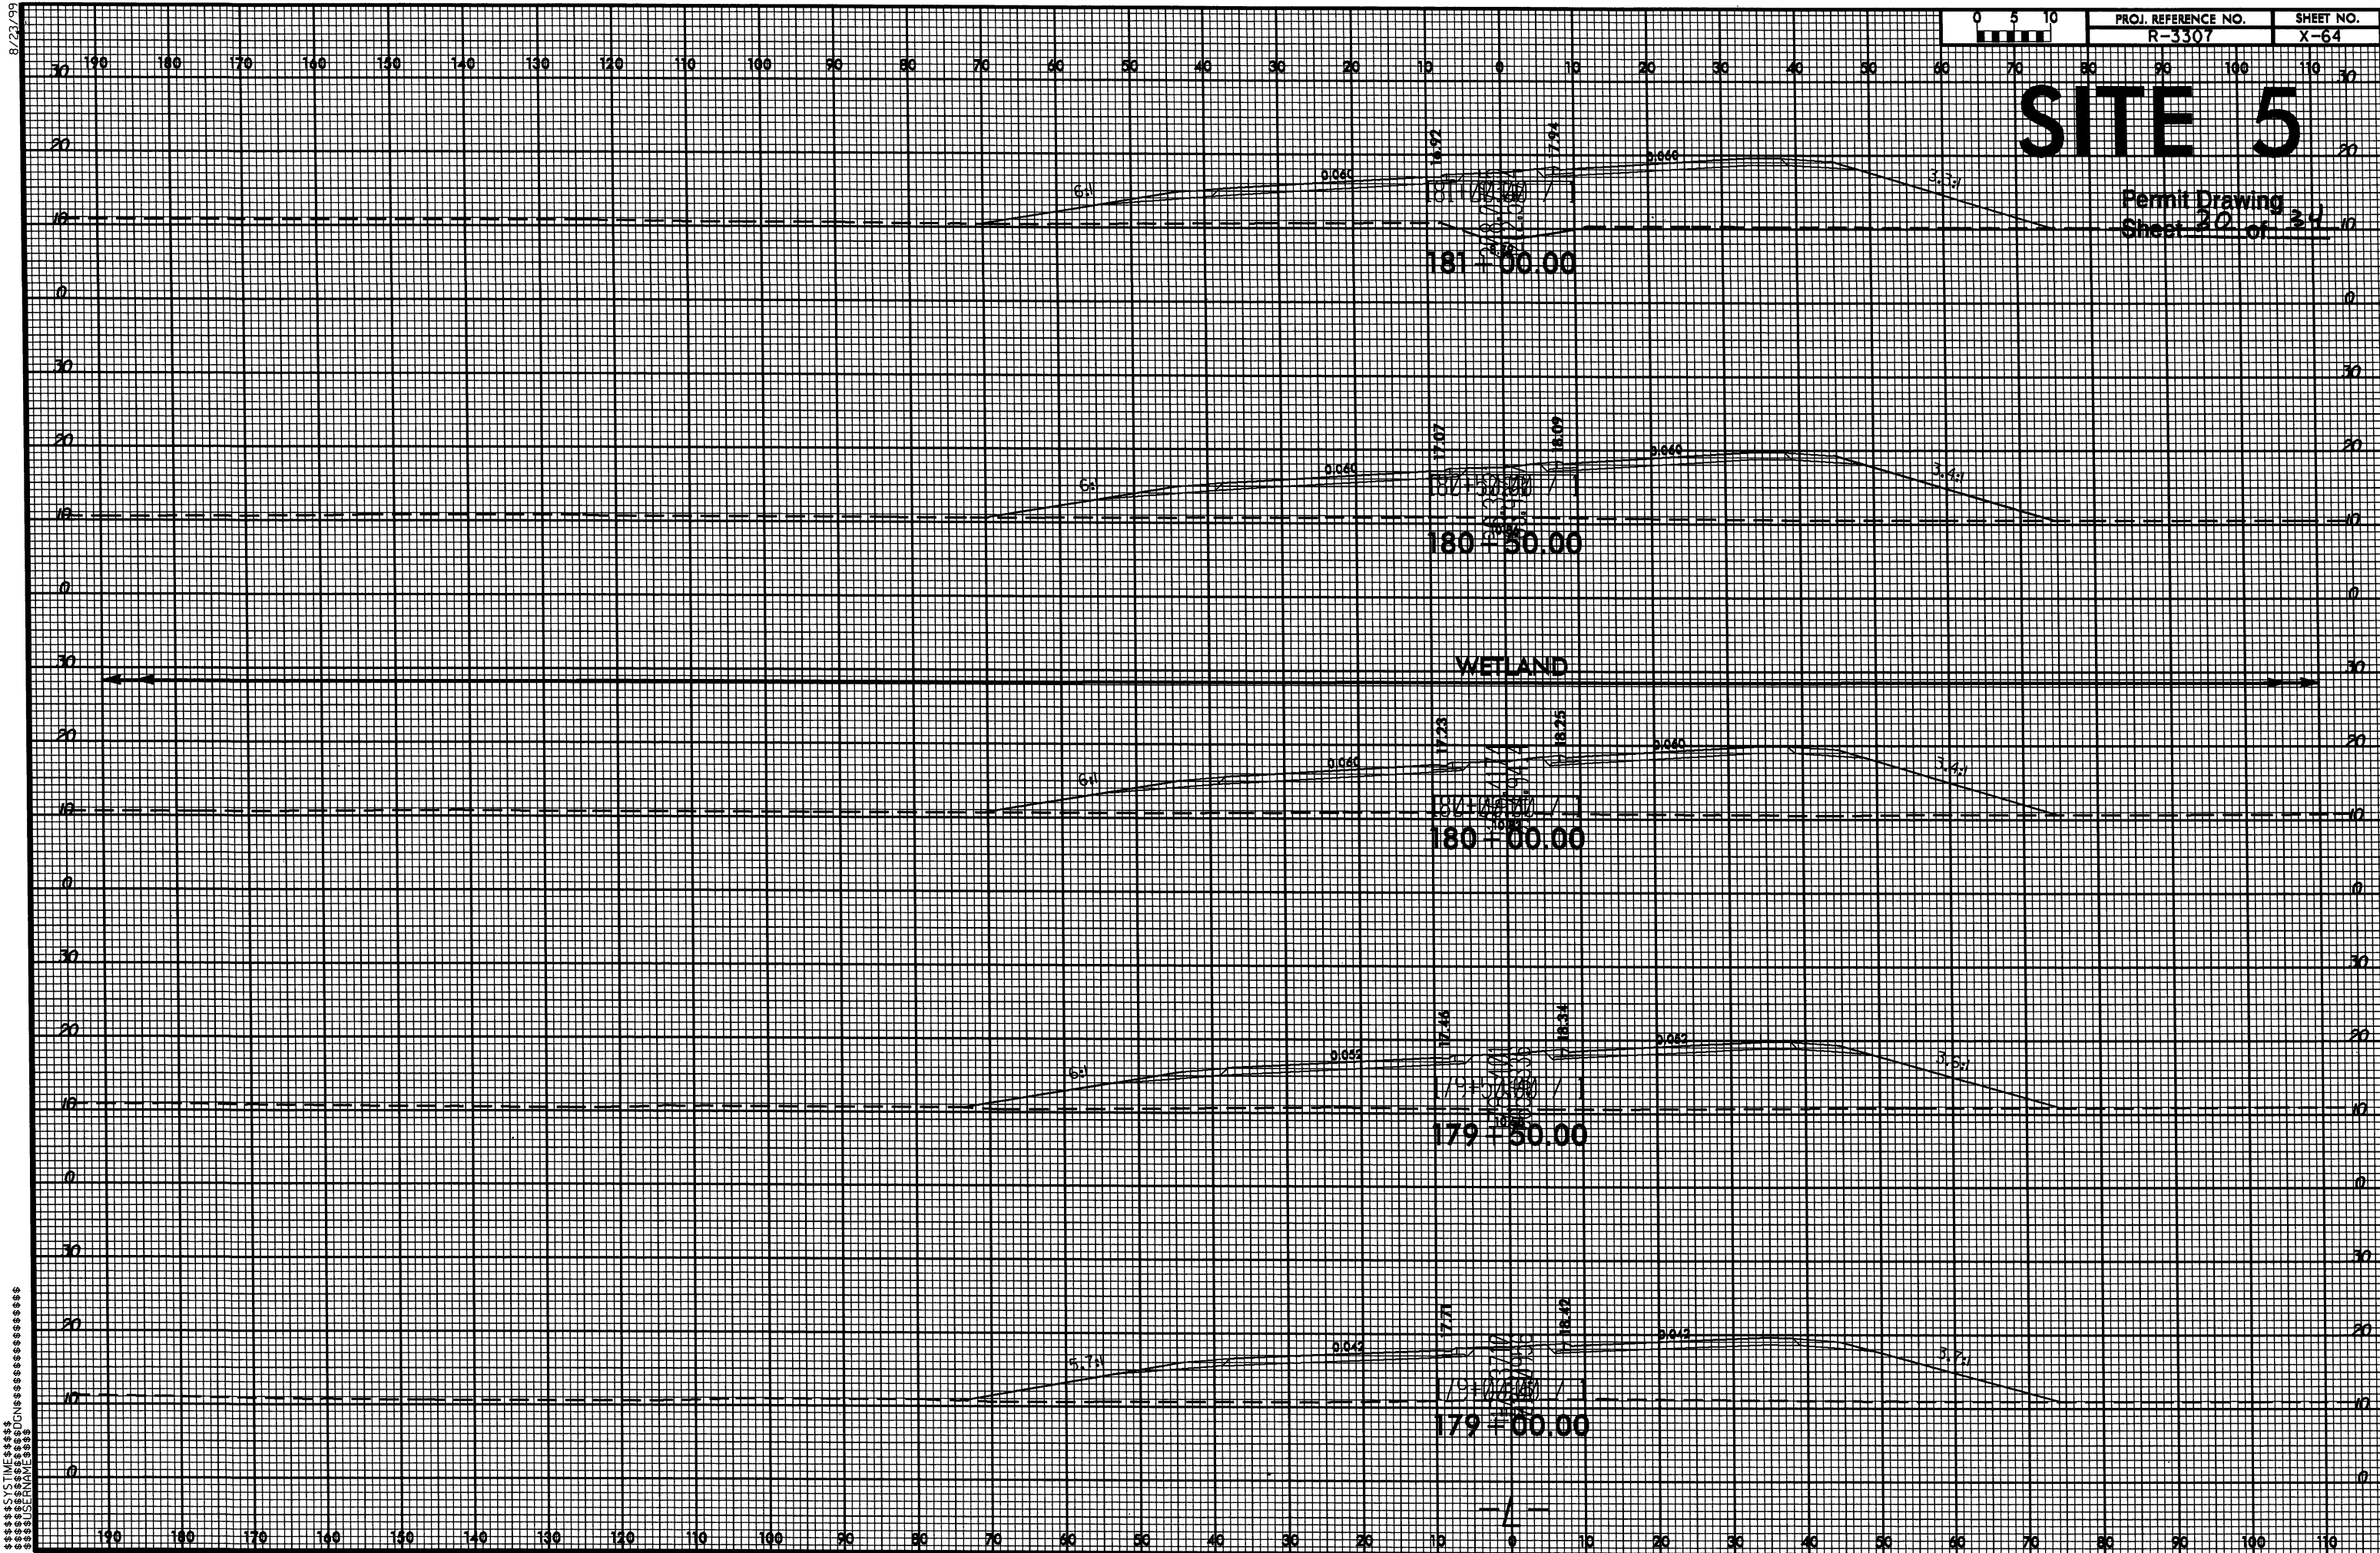




8/23/99


# SITE 6

Permit Drawing  
Sheet 31 of 34

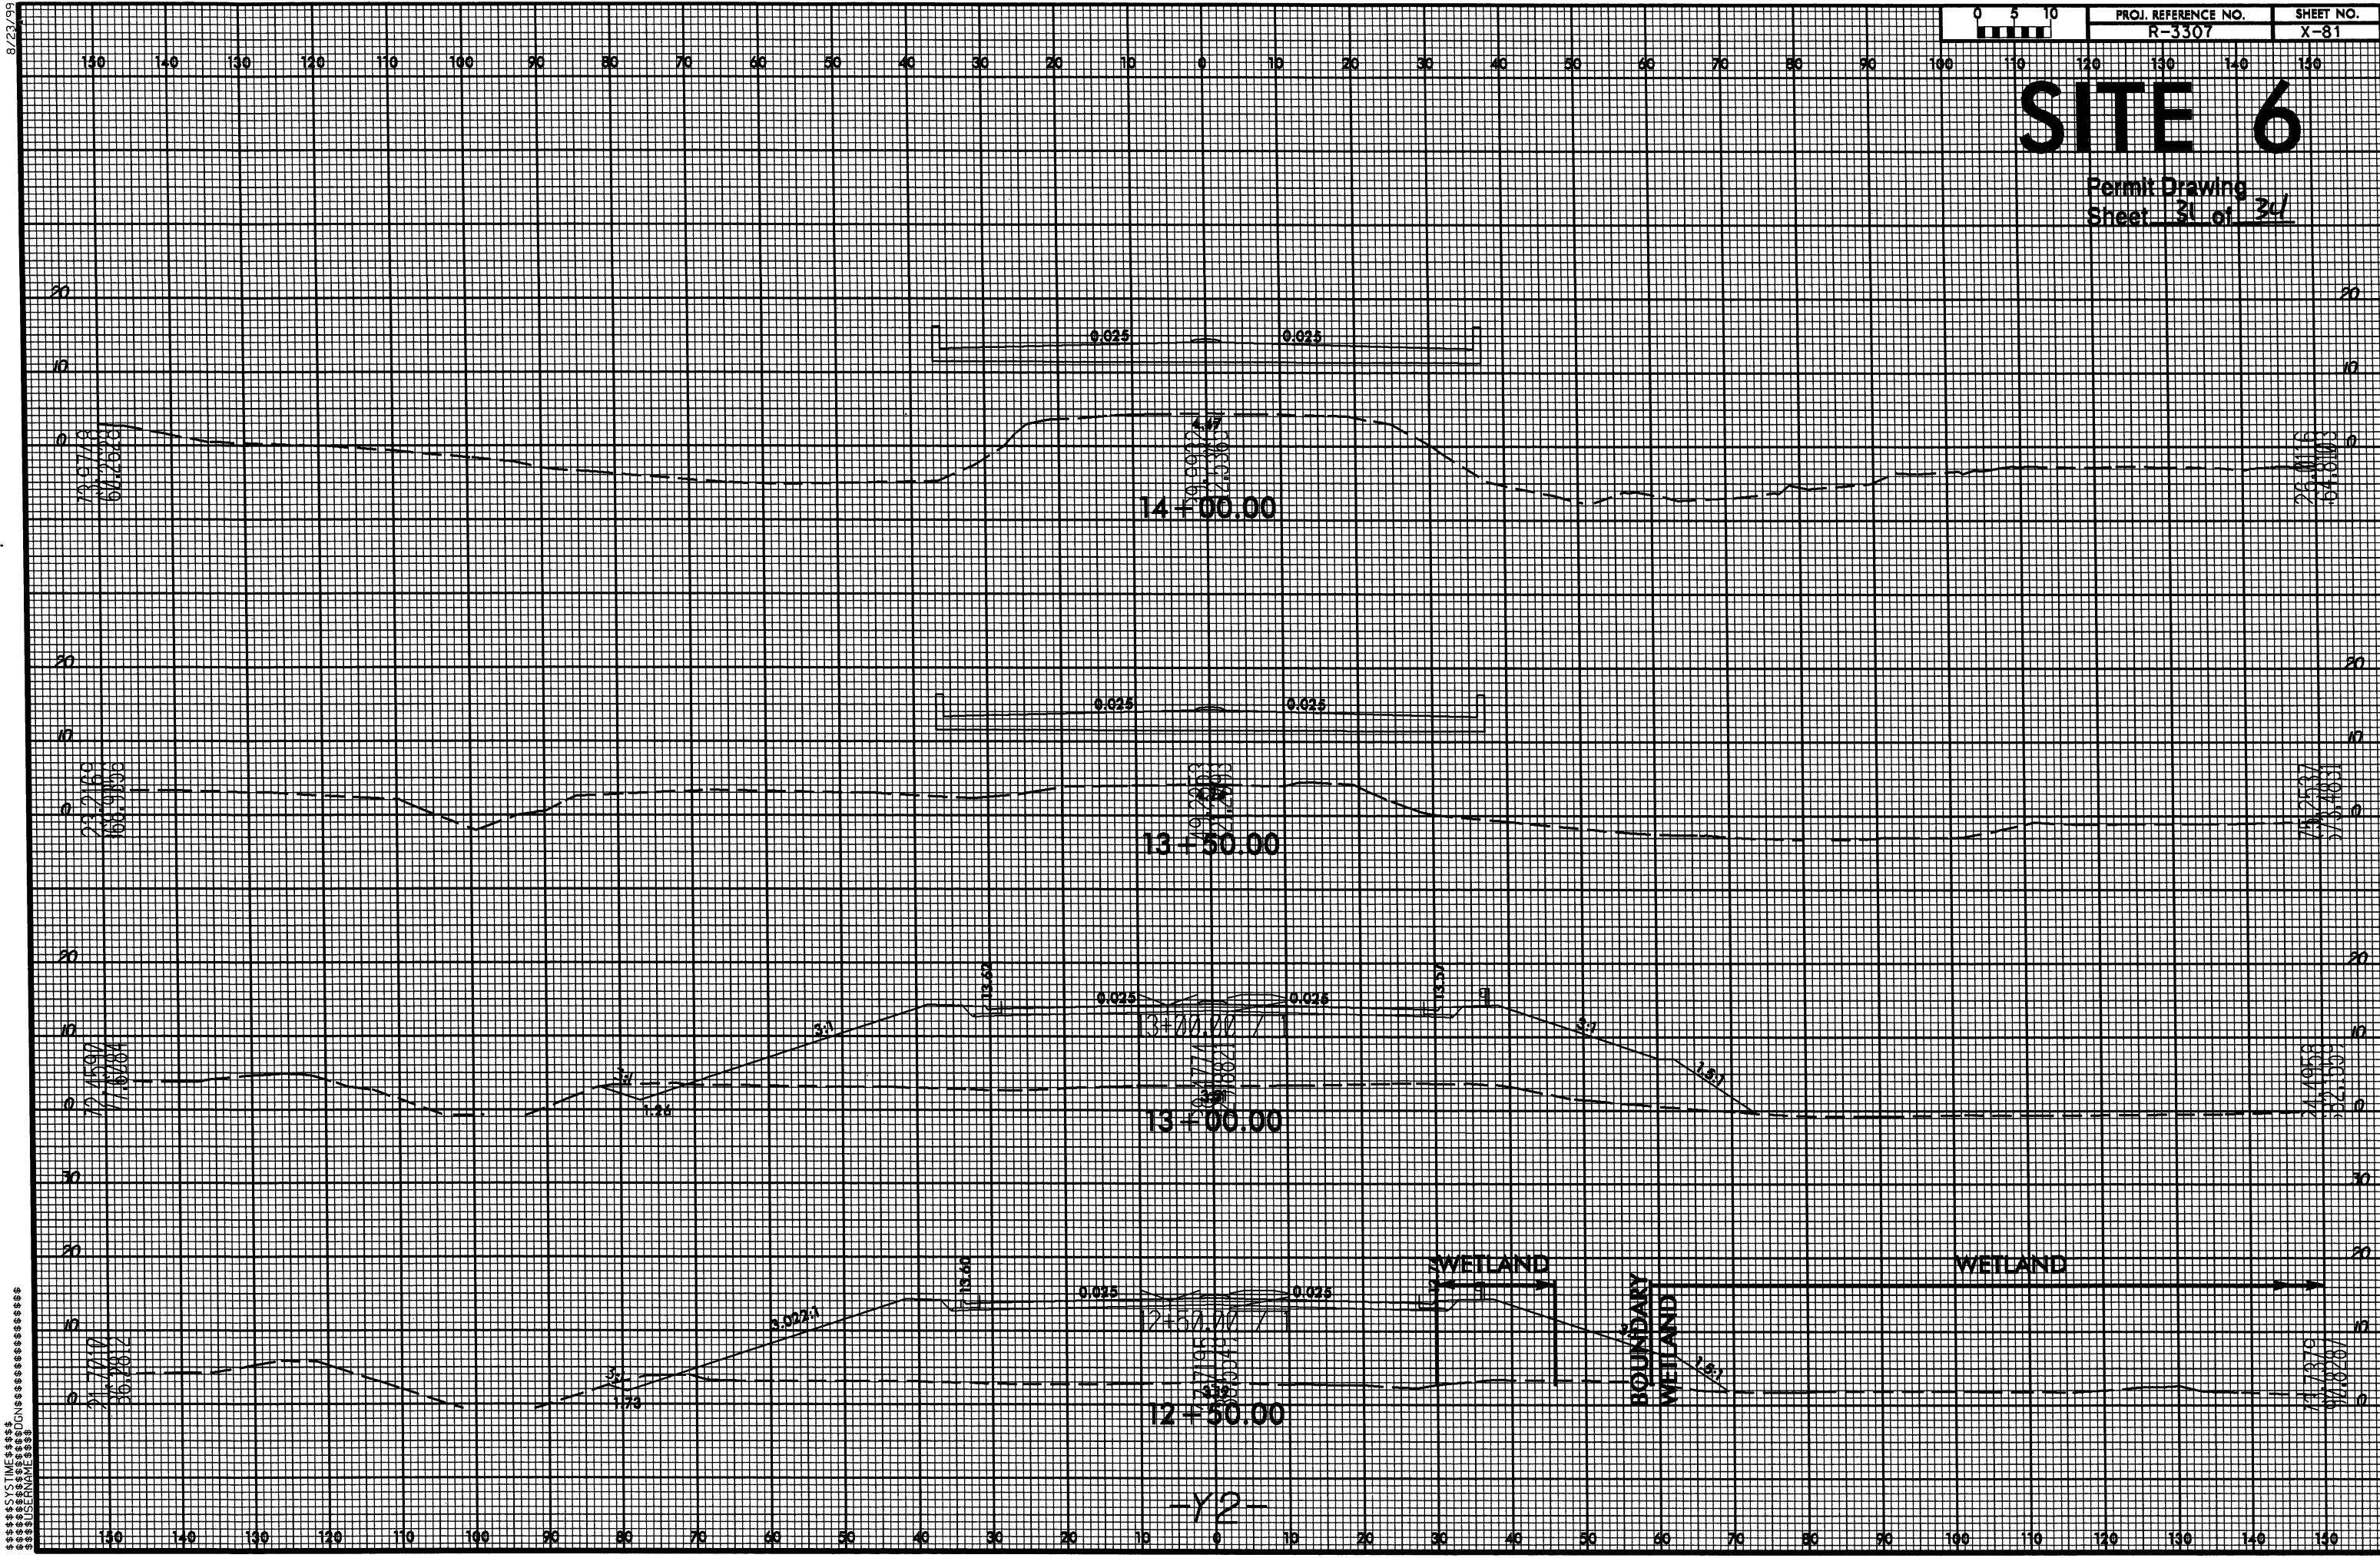

8/23/99

\$\$\$\$\$SYTIME\$\$\$\$\$  
\$\$\$\$\$DATE\$\$\$\$\$  
\$\$\$\$\$DRAWING\$\$\$\$\$  
\$\$\$\$\$USER\$\$\$\$\$

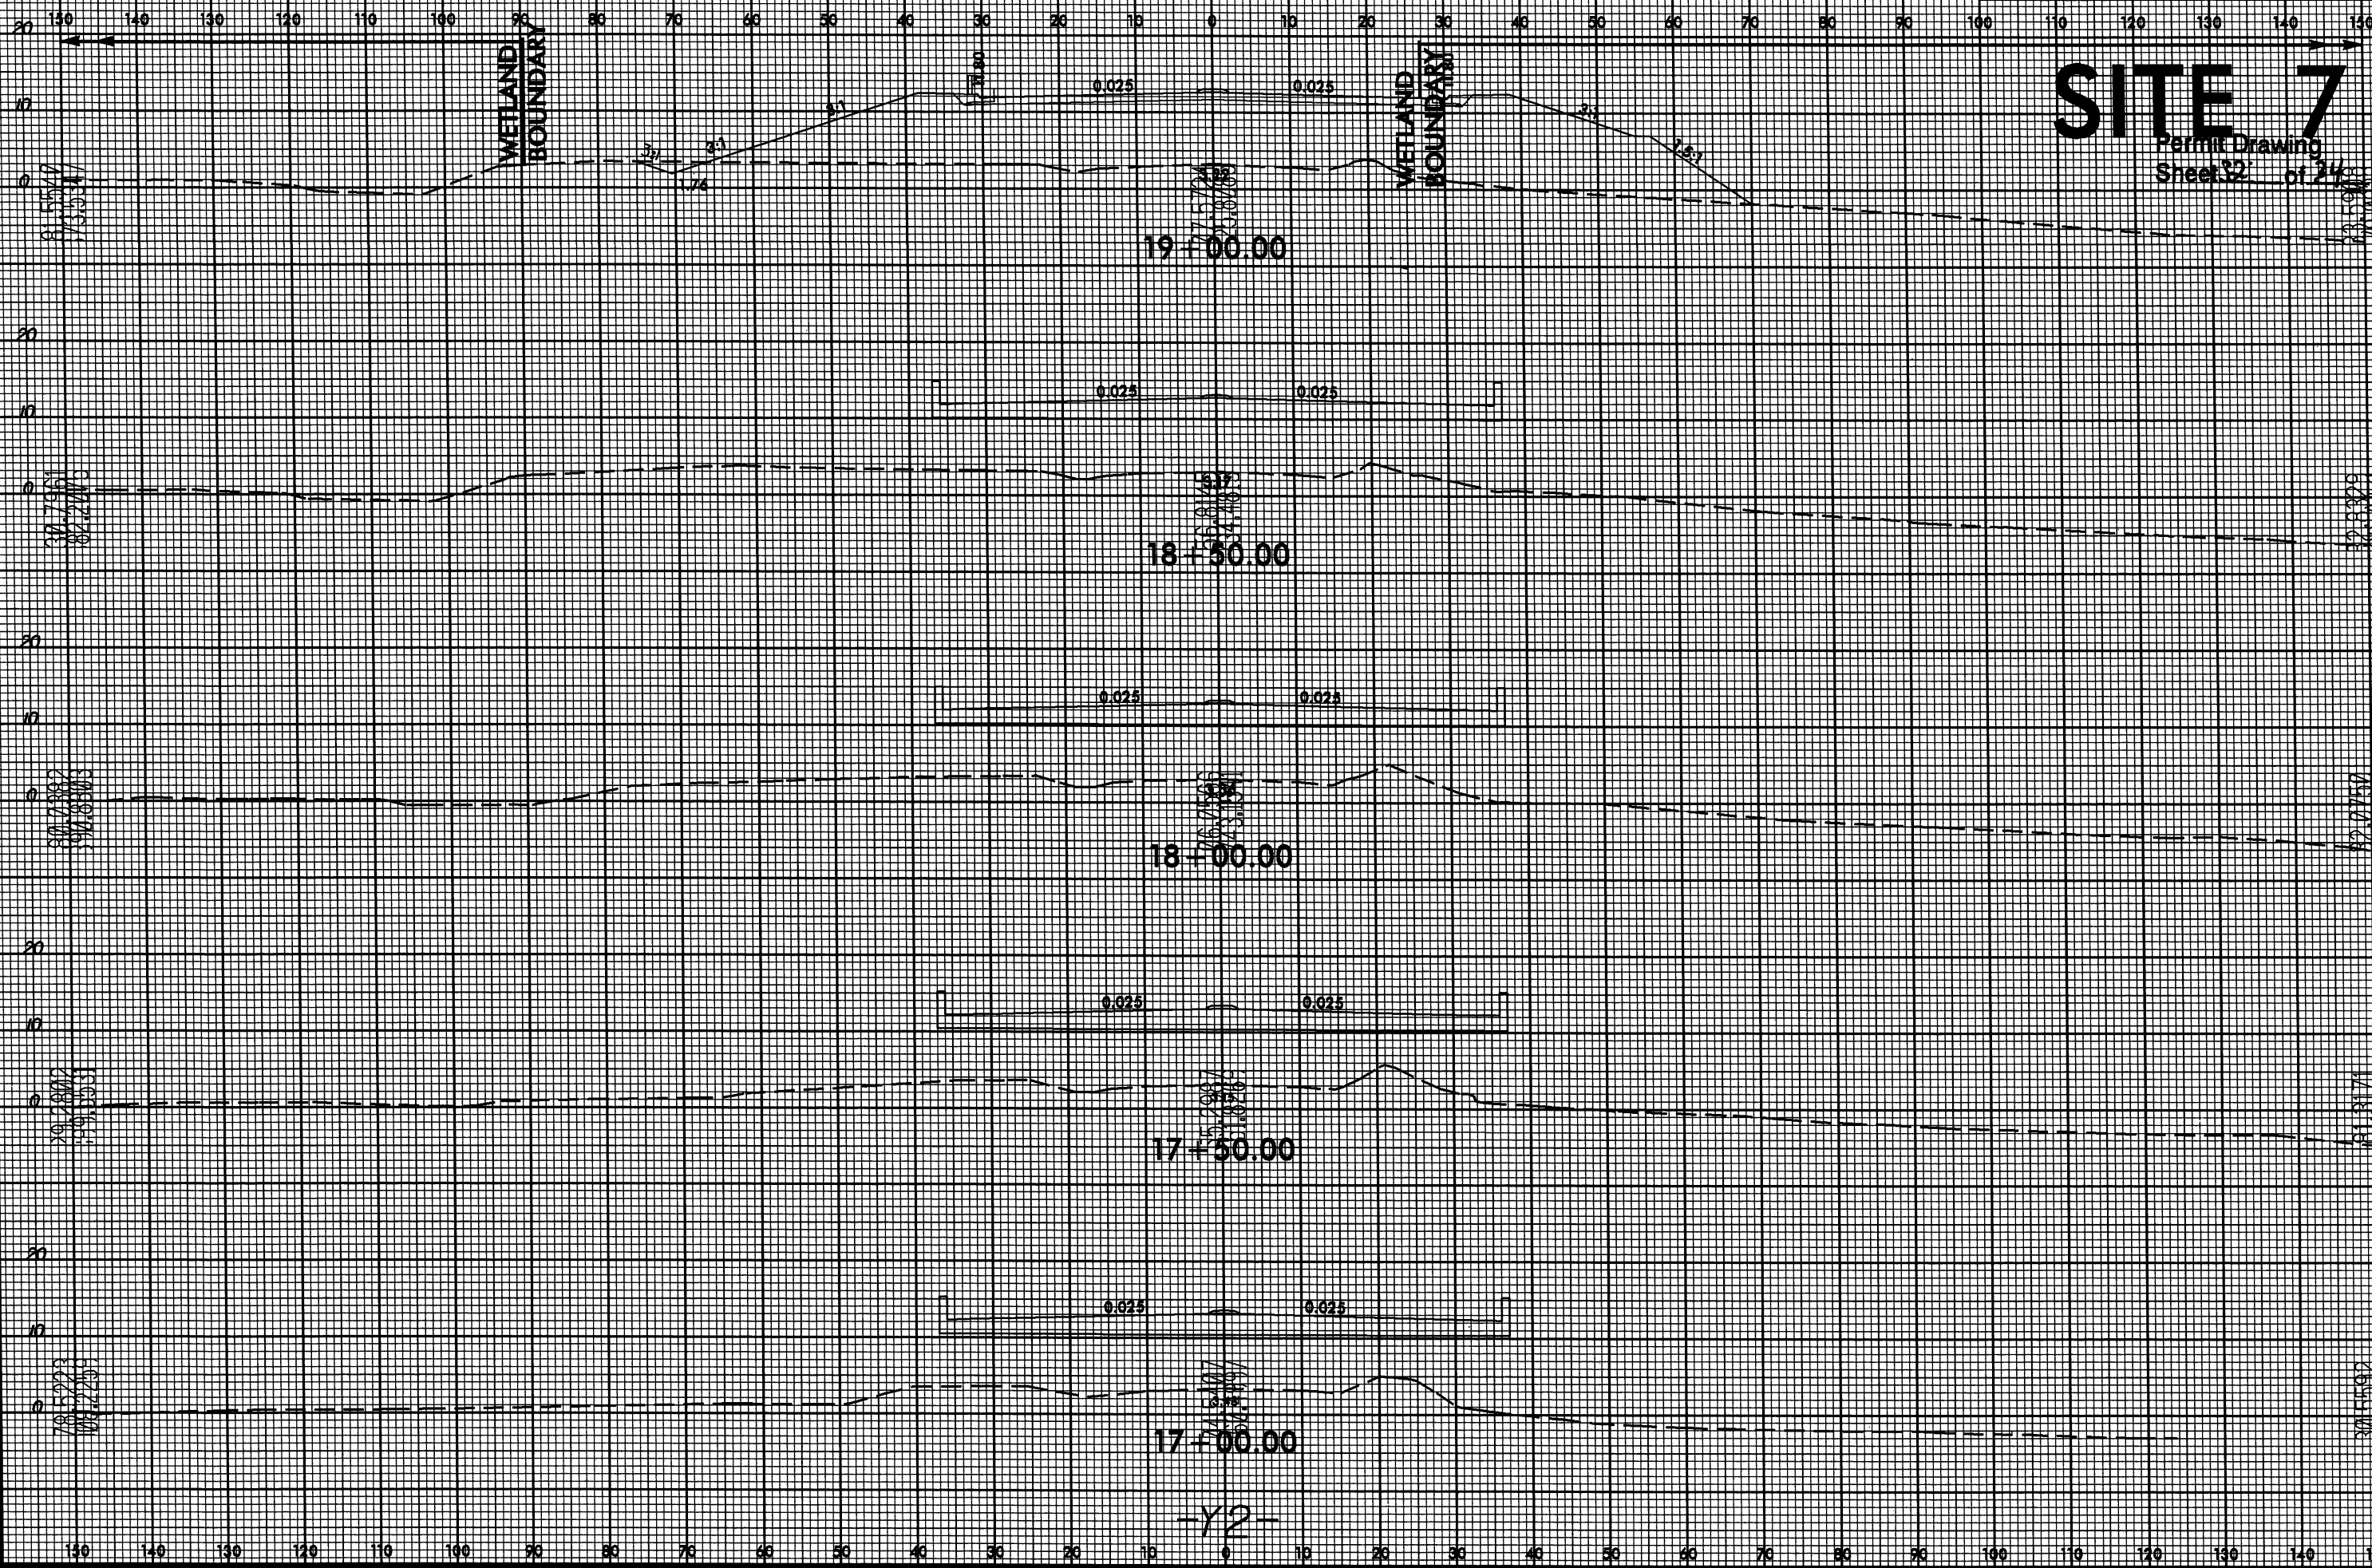

**SITE 7**  
Permit Drawing  
Sheet 32 of 24



PROJECT REFERENCE NO.		SHEET NO.	
R-3307			
RW SHEET NO.			
ROADWAY DESIGN ENGINEER		HYDRAULICS ENGINEER	
Permit Drawing Sheet 33		of 34	

[illegible]

WETLAND PERMIT IMPACT SUMMARY															
Site No.	Station (From/To)	Structure Size / Type	Wetland Restoration (ac)	WETLAND IMPACTS					SURFACE WATER IMPACTS						
				CAMA Permanent Fill In Wetlands (ac)	404 Permanent Fill In Wetlands (ac)	Temp. Fill In Wetlands (ac)	Excavation in Wetlands (ac)	Mechanized Clearing in Wetlands (ac)	Hand Clearing in Wetlands (ac)	Permanent SW impacts (ac)	Temp. SW impacts (ac)	Existing Channel Impacts Permanent (ft)	Existing Channel Impacts Temp. (ft)	Natural Stream Design (ft)	
1	-L- STA. 28+10 TO 29+47 LT -L- STA 28+99 TO 63+44	Roadway Fill Bridge		<0.01 0.02	<0.01	0.07	0.16			0.02	0.03	0.06			
2	-L- STA. 62+82 TO 72+30 & -Y1REV- STA. 15+74 TO 20+64	48" RCP & Roadway Fill Bank Stabilization		0.24	1.38			0.21	0.06	0.02	0.01	0.01	139	9	
3	-L- STA. 78+58 TO 79+06 & -Y2- STA. 10+78 TO 11+18 LT	72" RCP Roadway Fill Bank Stabilization								0.04	0.01	0.01	165	22	
4	-L- STA. 87+50 TO 92+56	Roadway Fill			*						0.16	<0.01	499	10	**
5	-L- STA. 171+47 TO 183+92	Roadway Fill			3.98			0.53							
6	-Y2- STA. 13+13 TO 18+77 *** -Y2- STA. 12+33 TO 13+48 RT	Bridge Roadway Fill	1.56	<0.01 0.04		<0.01		0.03		<0.01	<0.01				
7	-Y2- STA. 18+66 TO 24+34	Roadway Fill Bank Stabilization		0.20					0.12				8		
TOTALS:				1.56	5.36	0.07	0.16	0.77	0.20	0.25	0.09		851	41	0.00

\* 0.18 ACRES of ISOLATED WETLANDS

\*\* NEW BASE DITCH TO BE EXCAVATED PARALLEL TO EXISTING BASE DITCH. PROVIDES DRAINAGE FOR AIRPORT PROPERTY. MITIGATION NOT REQUIRED PER 4C MEETING ON 20 OCT 2010.

\*\*\* CAUSEWAY REMOVAL: SITE 6

BRIDGE IMPACTS: Impacts for permanent and temporary bents are included in table above. Break-out for impacts are as follows:

<b>Gallants Channel Bridge</b>
Perm. Fill in CAMA wetlands: 0.02 Ac
Perm. Fill in 404 wetlands: <0.01 Ac
Perm. Fill in Surface Waters: 0.03 Ac
Temp. Fill in wetlands: 0.07 Ac
Temp. Fill in Surface Waters: 0.06 Ac.

<b>Turner Street Bridge</b>
Perm. Fill in CAMA wetlands: <0.01 Ac
Perm. Fill in 404 wetlands: 0 Ac
Perm. Fill in Surface Waters: <0.01 Ac
Temp. Fill in wetlands: <0.01 Ac
Temp. Fill in Surface Waters: <0.01 Ac.

N.C.D.O.T.

DIVISION OF HIGHWAYS

CARTERET COUNTY

PROJECT: 34528.1.1 (R-3307)

US 70 FROM EXISTING FOUR LANES

AT RADIO ISLAND TO US 70 NORTH

OF SR 1429 (OLGA ROAD)

SHEET

(7/27/2011)

Permit Drawing  
Sheet 34 of 34

09/08/99

See Sheet 1-A For Index of Sheets  
See Sheet 1-B For Conventional Symbols


STATE OF NORTH CAROLINA  
DIVISION OF HIGHWAYS

**CARTERET COUNTY**

LOCATION: US 70 FROM EXISTING FOUR LANES AT RADIO  
ISLAND TO US 70 NORTH OF SR 1429  
(OLGA ROAD)


TYPE OF WORK: GRADING, PAVING, DRAINAGE, CURB & GUTTER  
SIGNALS, CULVERT AND STRUCTURES

STA. 207+95.09 -L- END TIP PROJECT R-3307

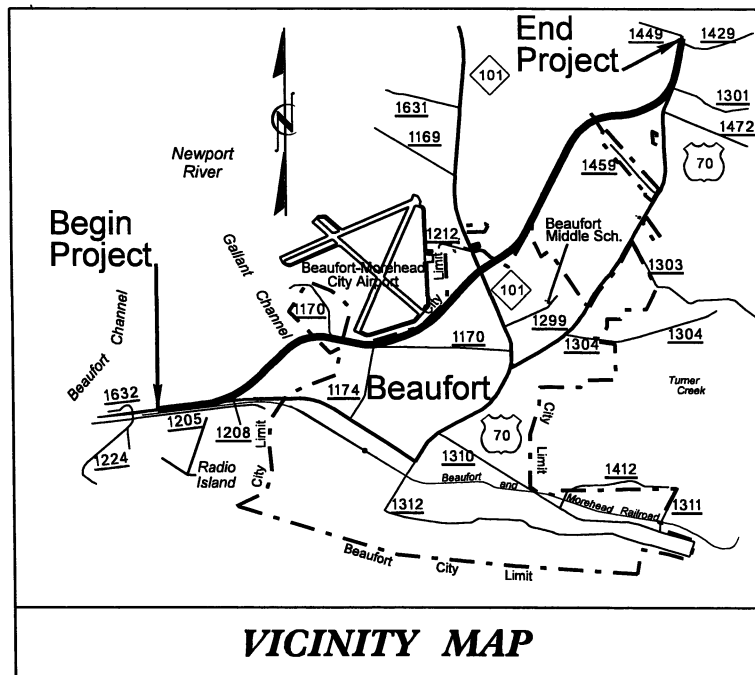

STATE	STATE PROJECT REFERENCE NO.	SHEET NO.	TOTAL SHEETS
N.C.	R-3307	1	
STATE PROJ. NO.	F.A. PROJ. NO.	DESCRIPTION	
34528.1.1	STPNHF-70(43)	PE	
34528.2.2	STPNHF-70(105)	R/W, UTIL.	

TIP PROJECT: R-3307

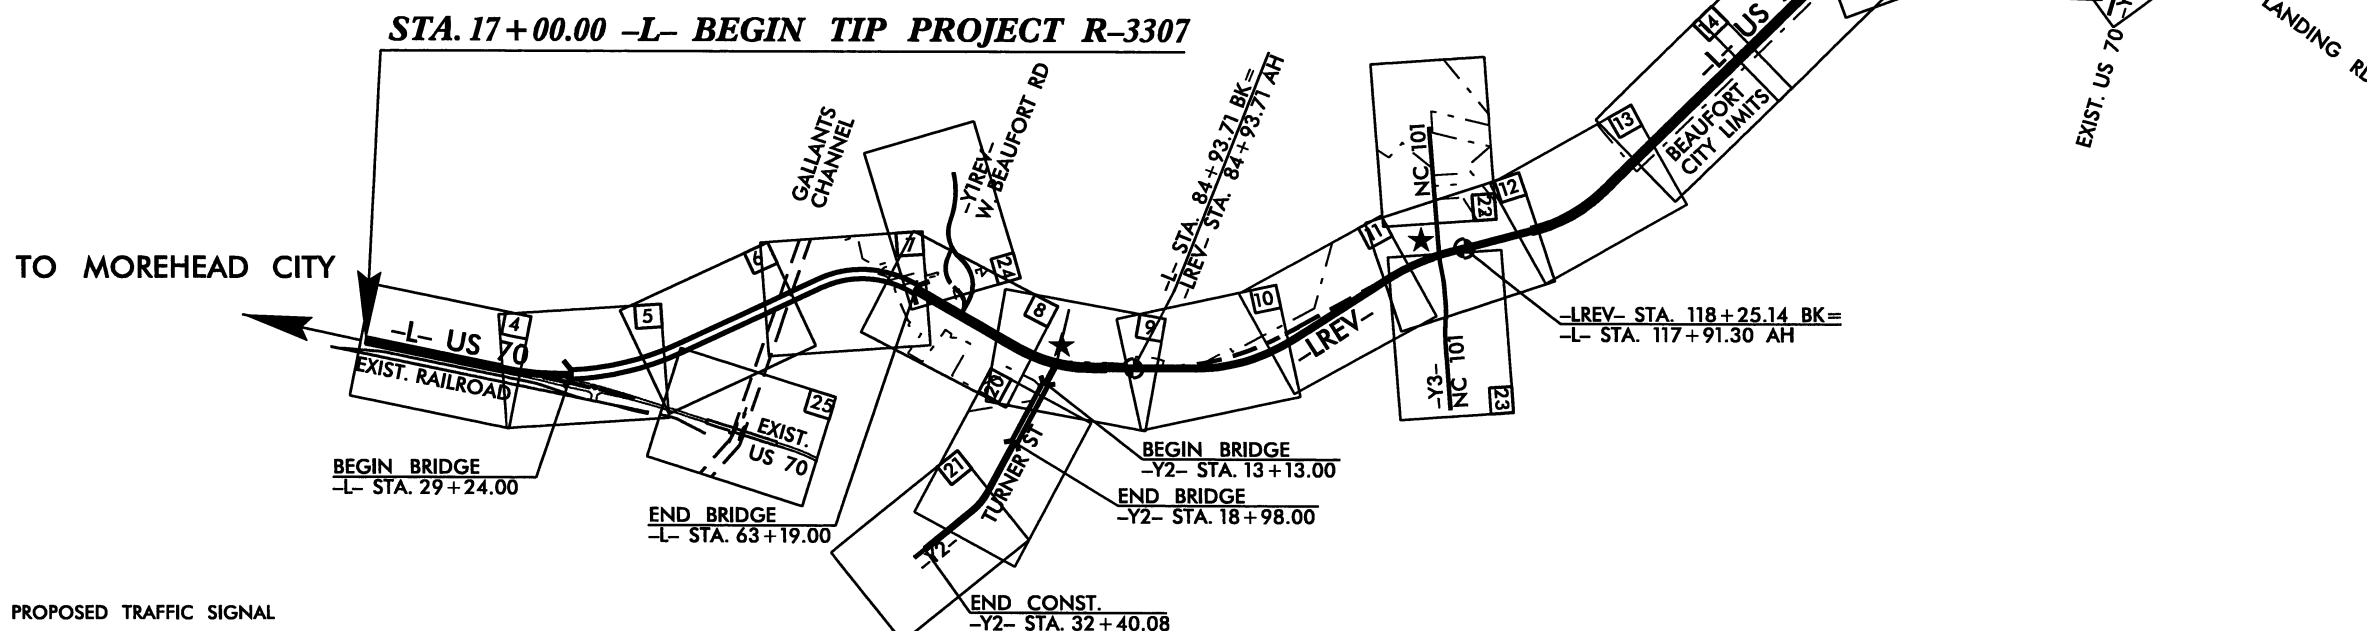


★ PROPOSED TRAFFIC SIGNAL

CLEARING ON THIS PROJECT SHALL BE PERFORMED TO THE LIMITS ESTABLISHED BY METHOD III.  
A PORTION OF THIS PROJECT IS WITHIN THE MUNICIPAL BOUNDARIES OF THE CITY OF BEAUFORT.  
THIS IS A PARTIAL CONTROLLED-ACCESS PROJECT WITH ACCESS BEING LIMITED TO POINTS AS SHOWN ON THE PLANS.

\*\* DESIGN EXCEPTION REQUIRED FOR HORIZONTAL CURVE RADIUS (50 MPH), HORIZONTAL STOPPING SIGHT DISTANCE (38 MPH), AND MAXIMUM VERTICAL GRADE (6%).

PRELIMINARY PLANS  
DO NOT USE FOR CONSTRUCTION

GRAPHIC SCALES

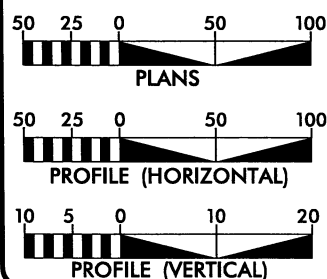

DESIGN DATA

ADT 2011 = 27620  
ADT 2031 = 39389  
DHV = 11 %  
D = 60 %  
T = 5 % \*  
V (SHOULDER) = 60 MPH\*\*  
V (CURB & GUTTER) = 50 MPH  
\* (TTST 1 % + DUAL 4) %  
FUNC. CLASS = ARTERIAL  
STATEWIDE TIER

PROJECT LENGTH

LENGTH OF ROADWAY PROJECT R-3307 = 2.973 MI  
LENGTH OF STRUCTURE PROJECT R-3307 = 0.643 MI  
TOTAL LENGTH OF F.A. PROJECT STPNHF-70(43) = 3.616 MI

Prepared In the Office of:  
**DIVISION OF HIGHWAYS**  
1000 Birch Ridge Dr., Raleigh NC, 27610

2006 STANDARD SPECIFICATIONS

RIGHT OF WAY DATE:  
JULY 18, 2008

LETTING DATE:  
JULY 17, 2012

BRENDA MOORE, PE  
PROJECT ENGINEER

KATRINA N. WASHINGTON, PE  
PROJECT DESIGN ENGINEER


HYDRAULICS ENGINEER

SIGNATURE: \_\_\_\_\_ P.E.

ROADWAY DESIGN  
ENGINEER

SIGNATURE: \_\_\_\_\_ P.E.

DIVISION OF HIGHWAYS  
STATE OF NORTH CAROLINA

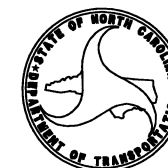

STATE HIGHWAY DESIGN ENGINEER P.E.

CONTRACT:

30-JUN-2011 14:33  
r:\roadway\proj\N-3307\_rdy\_tsh.dgn  
\$\$\$\$\$USERNAME\$\$\$\$\$

09/08/09

Note: Not to Scale

\*S.U.E. = Subsurface Utility Engineering

STATE OF NORTH CAROLINA

DIVISION OF HIGHWAYS

CONVENTIONAL PLAN SHEET SYMBOLS

BOUNDARIES AND PROPERTY:

State Line	-----
County Line	-----
Township Line	-----
City Line	-----
Reservation Line	-----
Property Line	-----
Existing Iron Pin	○ EP
Property Corner	---x---
Property Monument	□ ECV
Parcel/Sequence Number	①23
Existing Fence Line	-x-x-x-
Proposed Woven Wire Fence	○
Proposed Chain Link Fence	□
Proposed Barbed Wire Fence	◇
Existing Wetland Boundary	-W.B.-
Proposed Wetland Boundary	-W.B.-
Existing Endangered Animal Boundary	-EAB-
Existing Endangered Plant Boundary	-EPB-

BUILDINGS AND OTHER CULTURE:

Gas Pump Vent or U/G Tank Cap	○
Sign	○ S
Well	○ W
Small Mine	✕
Foundation	▭
Area Outline	▭
Cemetery	▭ †
Building	▭
School	▭
Church	▭
Dam	▭

HYDROLOGY:

Stream or Body of Water	~~~~~
Hydro, Pool or Reservoir	▭
Jurisdictional Stream	-JS-
Buffer Zone 1	-BZ 1-
Buffer Zone 2	-BZ 2-
Flow Arrow	→
Disappearing Stream	→
Spring	○
Wetland	W
Proposed Lateral, Tail, Head Ditch	→
False Sump	▽

RAILROADS:

Standard Gauge	=====
RR Signal Milepost	○
Switch	SWITCH
RR Abandoned	-----
RR Dismantled	-----

RIGHT OF WAY:

Baseline Control Point	◆
Existing Right of Way Marker	△
Existing Right of Way Line	-----
Proposed Right of Way Line	-----
Proposed Right of Way Line with Iron Pin and Cap Marker	-----
Proposed Right of Way Line with Concrete or Granite Marker	-----
Existing Control of Access	⊙
Proposed Control of Access	⊙
Existing Easement Line	-E-
Proposed Temporary Construction Easement	-E-
Proposed Temporary Drainage Easement	-TDE-
Proposed Permanent Drainage Easement	-PDE-
Proposed Permanent Drainage / Utility Easement	-DUE-
Proposed Permanent Utility Easement	-PUE-
Proposed Temporary Utility Easement	-TUE-
Proposed Permanent Easement with Iron Pin and Cap Marker	◆

ROADS AND RELATED FEATURES:

Existing Edge of Pavement	-----
Existing Curb	-----
Proposed Slope Stakes Cut	-C-
Proposed Slope Stakes Fill	-F-
Proposed Wheel Chair Ramp	WCR
Existing Metal Guardrail	=====
Proposed Guardrail	=====
Existing Cable Guiderail	=====
Proposed Cable Guiderail	=====
Equality Symbol	⊕
Pavement Removal	▨

VEGETATION:

Single Tree	⊕
Single Shrub	⊕
Hedge	~~~~~
Woods Line	~~~~~
Orchard	⊕ ⊕ ⊕ ⊕
Vineyard	Vineyard

EXISTING STRUCTURES:

MAJOR:	
Bridge, Tunnel or Box Culvert	CONC
Bridge Wing Wall, Head Wall and End Wall	CONC HW
MINOR:	
Head and End Wall	CONC HW
Pipe Culvert	-----
Footbridge	-----
Drainage Box: Catch Basin, DI or JB	CB
Paved Ditch Gutter	-----
Storm Sewer Manhole	⊙
Storm Sewer	-----

UTILITIES:

POWER:	
Existing Power Pole	●
Proposed Power Pole	○
Existing Joint Use Pole	●
Proposed Joint Use Pole	○
Power Manhole	⊙
Power Line Tower	⊗
Power Transformer	⊗
U/G Power Cable Hand Hole	⊕
H-Frame Pole	●
Recorded U/G Power Line	-----
Designated U/G Power Line (S.U.E.*)	-----

TELEPHONE:

Existing Telephone Pole	●
Proposed Telephone Pole	○
Telephone Manhole	⊙
Telephone Booth	⊕
Telephone Pedestal	⊕
Telephone Cell Tower	⊕
U/G Telephone Cable Hand Hole	⊕
Recorded U/G Telephone Cable	-----
Designated U/G Telephone Cable (S.U.E.*)	-----
Recorded U/G Telephone Conduit	-----
Designated U/G Telephone Conduit (S.U.E.*)	-----
Recorded U/G Fiber Optics Cable	-----
Designated U/G Fiber Optics Cable (S.U.E.*)	-----

WATER:

Water Manhole	⊙
Water Meter	○
Water Valve	⊗
Water Hydrant	⊕
Recorded U/G Water Line	-----
Designated U/G Water Line (S.U.E.*)	-----
Above Ground Water Line	A/G Water

TV:

TV Satellite Dish	⊕
TV Pedestal	⊕
TV Tower	⊕
U/G TV Cable Hand Hole	⊕
Recorded U/G TV Cable	-----
Designated U/G TV Cable (S.U.E.*)	-----
Recorded U/G Fiber Optic Cable	-----
Designated U/G Fiber Optic Cable (S.U.E.*)	-----

GAS:

Gas Valve	◇
Gas Meter	⊕
Recorded U/G Gas Line	-----
Designated U/G Gas Line (S.U.E.*)	-----
Above Ground Gas Line	A/G Gas


SANITARY SEWER:

Sanitary Sewer Manhole	⊙
Sanitary Sewer Cleanout	⊕
U/G Sanitary Sewer Line	SS
Above Ground Sanitary Sewer	A/G Sanitary Sewer
Recorded SS Forced Main Line	FSS
Designated SS Forced Main Line (S.U.E.*)	FSS

MISCELLANEOUS:

Utility Pole	●
Utility Pole with Base	⊕
Utility Located Object	○
Utility Traffic Signal Box	⊕
Utility Unknown U/G Line	UTIL
U/G Tank; Water, Gas, Oil	▭
AG Tank; Water, Gas, Oil	▭
U/G Test Hole (S.U.E.*)	⊕
Abandoned According to Utility Records	AATUR
End of Information	E.O.I.

6/2/99

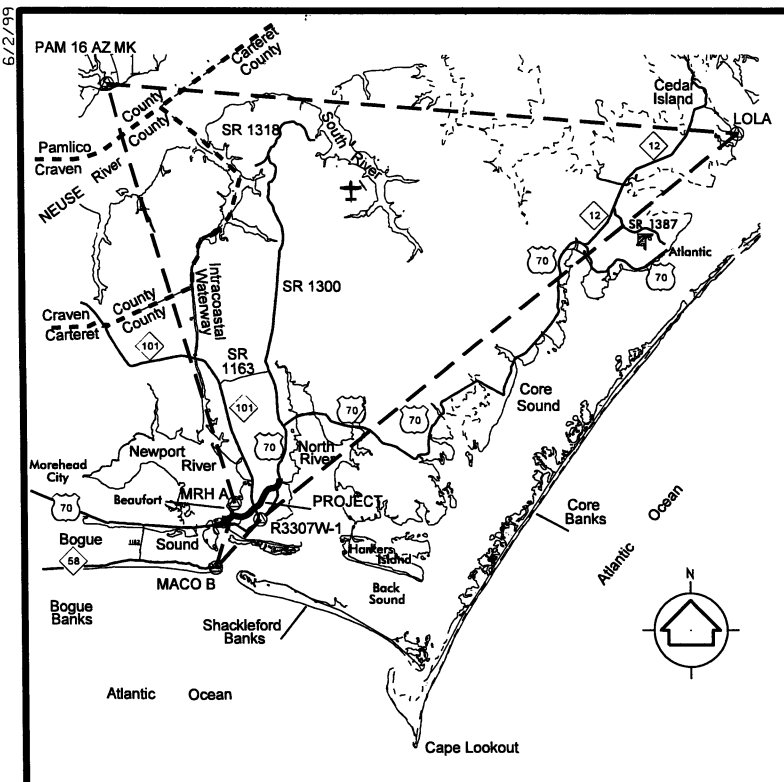

GPS CONTROL NETWORK VICINITY MAP

# SURVEY CONTROL SHEET R-3307

PROJECT REFERENCE NO.	SHEET NO.
R-3307	1-C
Location and Surveys	

## NOTES:

1. THE SITE CALIBRATION SHOWN IS BASED UPON A NETWORK TIED TO THE HARN (HIGH ACCURACY REFERENCE NETWORK) NAD 83/95 ADJUSTMENT. THIS CALIBRATION WILL ALLOW THE END USER TO WORK WITHIN THE SAME COORDINATE SYSTEM WHEN USING RTK (REAL TIME KINEMATIC) GPS AND A LOCAL BASE STATION. IF ANOTHER SYSTEM SUCH AS VRS (VIRTUAL REFERENCE STATION) IS USED, ADDITIONAL FIELD TIES MAY BE NEEDED TO REDUCE POSSIBLE ERRORS, OR BIASES.
2. THE CONTROL DATA FOR THIS PROJECT CAN BE FOUND ELECTRONICALLY BY SELECTING PROJECT CONTROL DATA AT:  
[HTTP://WWW.DOH.DOT.STATE.NC.US/PRECONSTRUCT/HIGHWAY/LOCATION/PROJECT/R3307](http://www.doh.dot.state.nc.us/preconstruct/highway/location/project/R3307)

THE FILES TO BE FOUND ARE AS FOLLOWS:

R3307\_LS\_GPSCALIB\_070501.HTML  
R3307\_LS\_WGS84\_070501.TXT  
R3307\_LS\_LOCAL\_070501.TXT  
R3307\_LS\_CONTROL\_070501.TXT



THE WGS84 AND LOCAL FILES ARE COMMA DELIMITED AND CAN BE USED TO REPRODUCE THE SITE CALIBRATION FOR THE END USER'S GPS EQUIPMENT. IF FURTHER INFORMATION IS NEEDED, PLEASE CONTACT THE LOCATION AND SURVEYS UNIT.

⊙ INDICATES GEODETIC CONTROL MONUMENTS USED OR SET FOR HORIZONTAL PROJECT CONTROL BY THE NCDOT LOCATION AND SURVEYS UNIT.

PROJECT CONTROL ESTABLISHED USING GLOBAL POSITIONING SYSTEM.

NETWORK ESTABLISHED FROM EXISTING HARN MONUMENTATION

SEE GPS CALIBRATION SHEET FOR HORIZONTAL AND VERTICAL COORDINATE VALUES.

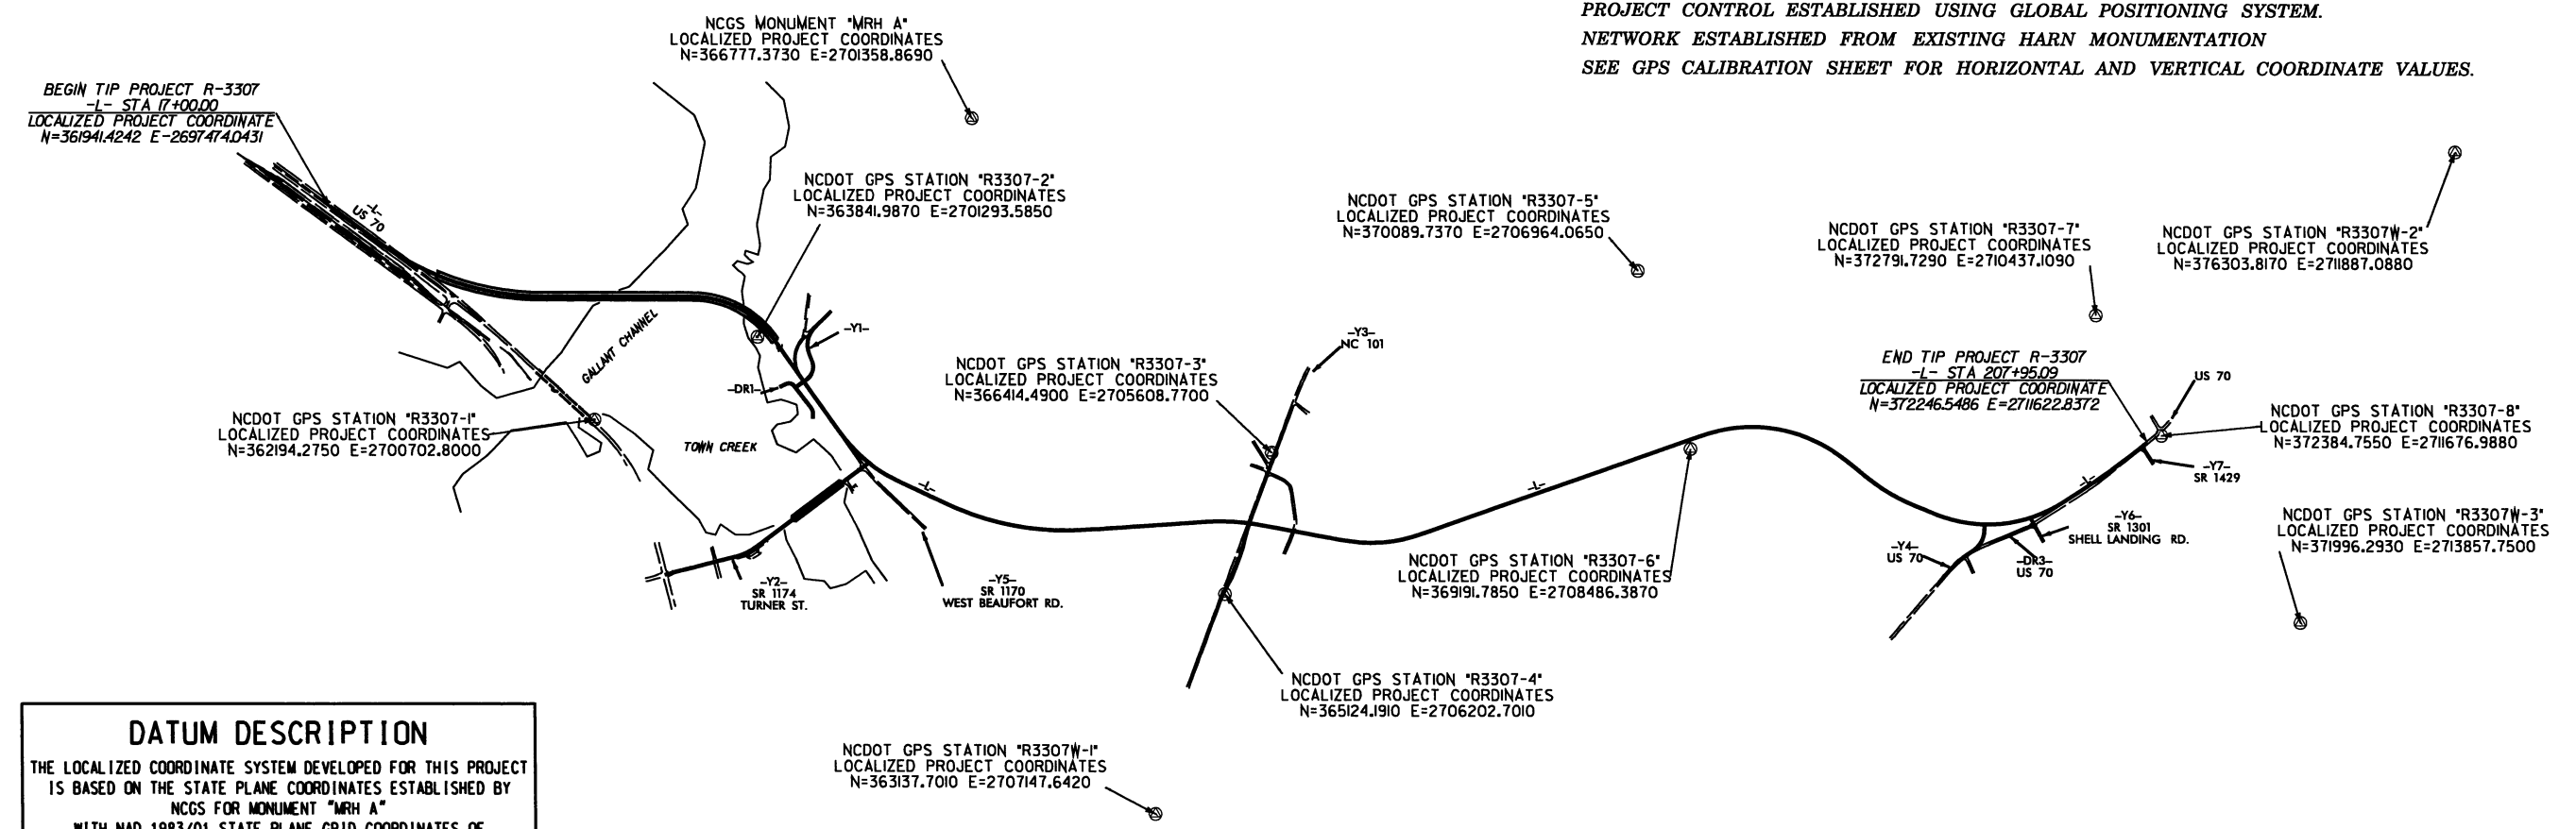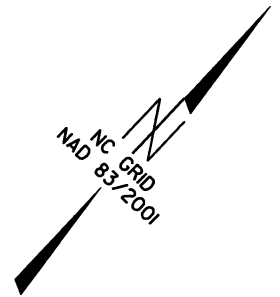

## DATUM DESCRIPTION

THE LOCALIZED COORDINATE SYSTEM DEVELOPED FOR THIS PROJECT IS BASED ON THE STATE PLANE COORDINATES ESTABLISHED BY NCGS FOR MONUMENT "MRH A" WITH NAD 1983/01 STATE PLANE GRID COORDINATES OF NORTHING: 366777.373(±) EASTING: 2701358.869(±) THE AVERAGE COMBINED GRID FACTOR USED ON THIS PROJECT (GROUND TO GRID) IS: 0.999918650 THE N.C. LAMBERT GRID BEARING AND LOCALIZED HORIZONTAL GROUND DISTANCE FROM "MRH A" TO -L- STATION 17+00.00 IS S 38°46'32.5" W 6203.086 (±) ALL LINEAR DIMENSIONS ARE LOCALIZED HORIZONTAL DISTANCES VERTICAL DATUM USED IS NAVD 88

NOTE: DRAWING NOT TO SCALE

30-JUN-2011 14:33  
P:\PROJECTS\2010\06\01\N-3307\_1.s.1c\_070502.dgn  
\*\*\*USER NAME\*\*\*





6/2/99  
30-JUN-2011 4:33  
F:\roadwork\proj\N-3307-1s-1e-070502.dgn  
\$\$\$\$\$USERNAME\$\$\$\$\$

SURVEY CONTROL SHEET R-3307

PROJECT REFERENCE NO.	SHEET NO.
R-3307	1-E
Location and Surveys	

BL	POINT	DESC.	NORTH	EAST	ELEVATION	L STATION	OFFSET
1		BL-1	361863.0495	2696484.3109	6.19	OUTSIDE PROJECT LIMITS	
2		BL-2	361954.0513	2697180.2423	5.86	14+09.91	48.25 LT
3		BL-3	362029.8265	2697862.2331	5.62	20+96.06	40.55 LT
4		BL-4	362116.3820	2698537.0110	5.78	27+78.88	2.07 RT
5		BL-5	362563.9416	2699358.9363	2.92	37+20.61	6.93 LT
6		BL-6	362855.5786	2699921.1478	5.64	43+30.36	157.12 RT
7		BL-7	363961.1444	2701425.2059	5.19	62+93.04	29.35 LT
8		BL-8	363794.7142	2702023.6539	4.01	69+12.66	14.42 RT
9		BL-9	363680.0011	2702484.3129	4.49	73+86.02	36.22 RT
10		BL-10	363880.9676	2703057.6900	5.00	79+95.65	155.87 LT
11		BL-11	364081.0845	2703843.5002	4.66	88+24.23	96.44 LT
12		BL-12	364343.1685	2704459.5603	7.42	95+04.63	13.66 LT
13		BL-13	364936.9035	2705081.3962	8.35	103+67.27	0.30 RT
14		BL-14	365398.2607	2705616.9559	8.18	110+69.80	80.11 RT
15		BL-15	365728.3975	2705946.3657	9.15	115+49.94	58.12 RT
16		BL-16	365889.0663	2705885.1770	9.39	115+92.32	108.42 LT
17		BL-17	366109.5957	2706227.8857	8.56	119+96.43	104.81 LT
R18	BL-18	RESET	366503.0255	2706948.7410	10.22	128+18.12	3.13 RT
19		BL-19	367124.7498	2707336.9038	10.21	135+52.45	9.40 RT
20		BL-20	367809.2900	2707689.3023	10.87	143+22.37	9.27 RT
21		BL-21	368706.4883	2708149.3226	11.45	153+30.63	7.46 RT
22		BL-22	369246.9494	2708415.4192	10.65	159+32.95	3.43 LT
23		BL-23	369720.4606	2708727.0379	11.57	165+00.12	9.78 LT
24		BL-24	370000.1768	2709143.2507	10.62	170+03.08	4.69 RT
25		BL-25	370135.9812	2709666.8429	10.86	175+48.92	6.08 RT
26		BL-26	370215.2906	2710253.1586	10.19	181+41.02	3.78 RT
27		BL-27	370287.3577	2710698.8314	9.30	185+78.90	93.48 RT
28		BL-28	370630.6459	2711033.3270	8.92	190+35.13	11.98 LT
29		BL-29	370855.0444	2711357.9833	9.06	194+02.93	99.98 RT
30		BL-30	371559.4948	2711499.4717	7.45	200+97.07	4.99 RT
31	GPS	R3307-8	372384.7550	2711676.9880	6.18	OUTSIDE PROJECT LIMITS	

BY3	POINT	DESC.	NORTH	EAST	ELEVATION	Y3 STATION	OFFSET
63		BY3-63	367216.7508	2705308.4840	11.23	OUTSIDE PROJECT LIMITS	
64	GPS	R3307-3	366414.4900	2705608.7700	6.60	14+76.52	31.10 RT
65		BL-16	365889.0663	2705885.1770	9.39	20+67.91	21.13 LT
66		BL-15	365728.3975	2705946.3657	9.15	22+40.68	11.81 LT
67	GPS	R3307-4	365124.1910	2706202.7010	9.76	28+97.52	17.66 LT
68		BY3-68	364606.3683	2706375.6393	9.31	34+43.49	17.69 RT
69		BY3-69	364226.6074	2706585.8557	8.34	OUTSIDE PROJECT LIMITS	

BY4	POINT	DESC.	NORTH	EAST	ELEVATION	Y4 STATION	OFFSET
70		BL-28	370630.6459	2711033.3270	8.92	OUTSIDE PROJECT LIMITS	
71		BY4-71	370423.0128	2711121.1922	9.69	12+13.07	1.93 RT
72		BY4-72	369819.6088	2711106.4846	9.02	OUTSIDE PROJECT LIMITS	
73		BY4-73	369184.8212	2711077.6404	8.96	OUTSIDE PROJECT LIMITS	

NOTE:  
THERE WERE NO SUPPLEMENTAL BENCHMARKS SET ON THIS PROJECT.  
THE BASELINES WERE LEVELED.

BY1	POINT	DESC.	NORTH	EAST	ELEVATION	Y1 STATION	OFFSET
52		BY1-52	364312.4317	2701615.5679	4.62	10+49.90	13.19 RT
53		BY1-53	363943.0203	2701666.0554	5.37	13+29.84	151.24 RT
54		BL-8	363794.7142	2702023.6539	4.01	OUTSIDE PROJECT LIMITS	

BY2	POINT	DESC.	NORTH	EAST	ELEVATION	Y2 STATION	OFFSET
55		BL-9	363680.0011	2702484.3129	4.49	10+82.68	389.16 RT
56		BY2-56	363617.6217	2702832.5641	4.97	10+83.71	35.37 RT
57		BY2-57	363227.6047	2702816.9222	3.93	14+70.53	16.88 LT
58		BY2-58	362655.2826	2702717.0256	2.97	20+51.50	17.77 LT
59		BY2-59	362299.9822	2702667.2422	3.08	24+06.38	34.09 LT
60		BY2-60	362023.5829	2702456.5858	3.85	27+45.23	18.90 RT
61		BY-50	361529.2312	2702217.2851	7.34	OUTSIDE PROJECT LIMITS	

DATUM DESCRIPTION

THE LOCALIZED COORDINATE SYSTEM DEVELOPED FOR THIS PROJECT IS BASED ON THE STATE PLANE COORDINATES ESTABLISHED BY NCGS FOR MONUMENT "MRH A" WITH NAD 1983/01 STATE PLANE GRID COORDINATES OF NORTHING: 366777.373(±) EASTING: 2701358.869(±) THE AVERAGE COMBINED GRID FACTOR USED ON THIS PROJECT (GROUND TO GRID) IS: 0.999918650 THE N.C. LAMBERT GRID BEARING AND LOCALIZED HORIZONTAL GROUND DISTANCE FROM "MRH A" TO -L- STATION 17+00.00 IS S 38°46'32.5" W 6203.086 (±) ALL LINEAR DIMENSIONS ARE LOCALIZED HORIZONTAL DISTANCES VERTICAL DATUM USED IS NAVD 88

NOTES:

1. THE SITE CALIBRATION SHOWN IS BASED UPON A NETWORK TIED TO THE HARN (HIGH ACCURACY REFERENCE NETWORK) NAD 83/95 ADJUSTMENT. THIS CALIBRATION WILL ALLOW THE END USER TO WORK WITHIN THE SAME COORDINATE SYSTEM WHEN USING RTK (REAL TIME KINEMATIC) GPS AND A LOCAL BASE STATION. IF ANOTHER SYSTEM SUCH AS VRS (VIRTUAL REFERENCE STATION) IS USED, ADDITIONAL FIELD TIES MAY BE NEEDED TO REDUCE POSSIBLE ERRORS, OR BIASES.

2. THE CONTROL DATA FOR THIS PROJECT CAN BE FOUND ELECTRONICALLY BY SELECTING PROJECT CONTROL DATA AT:  
[HTTP://WWW.DOH.DOT.STATE.NC.US/PRECONSTRUCT/HIGHWAY/LOCATION/PROJECT/R3307](http://www.doh.dot.state.nc.us/preconstruct/highway/location/project/r3307)

THE FILES TO BE FOUND ARE AS FOLLOWS:

R3307\_LS\_GPSCALIB\_070501.HTML

R3307\_LS\_WGS84\_070501.TXT

R3307\_LS\_LOCAL\_070501.TXT

R3307\_LS\_CONTROL\_070501.TXT

THE WGS84 AND LOCAL FILES ARE COMMA DELIMITED AND CAN BE USED TO REPRODUCE THE SITE CALIBRATION FOR THE END USER'S GPS EQUIPMENT. IF FURTHER INFORMATION IS NEEDED, PLEASE CONTACT THE LOCATION AND SURVEYS UNIT.

© INDICATES GEODETIC CONTROL MONUMENTS USED OR SET FOR HORIZONTAL PROJECT CONTROL BY THE NCDOT LOCATION AND SURVEYS UNIT.

PROJECT CONTROL ESTABLISHED USING GLOBAL POSITIONING SYSTEM.


NETWORK ESTABLISHED FROM EXISTING HARN MONUMENTATION

SEE GPS CALIBRATION SHEET FOR HORIZONTAL AND VERTICAL COORDINATE VALUES.

NOTE: DRAWING NOT TO SCALE


## (PRELIMINARY PAVEMENT DESIGN)

PROP. APPROX. 2.0" ASPHALT CONCRETE SURFACE COURSE, TYPE S9.5B, AT AN AVERAGE RATE OF 224 LBS. PER SQ. YD.
PROP. APPROX. 3.0" ASPHALT CONCRETE SURFACE COURSE, TYPE S9.5B, AT AN AVERAGE RATE OF 168 LBS. PER SQ. YD. IN EACH OF TWO LAYER
PROP. VAR. DEPTH ASPHALT CONCRETE SURFACE COURSE, TYPE S9.5B, AT AN AVERAGE RATE OF 112 LBS. PER SQ. YD. PER 1" DEPTH TO BE PLACED IN LAYERS NOT TO EXCEED 2.0" IN DEPTH.
PROP. APPROX. 2.5" ASPHALT CONCRETE INTERMEDIATE COURSE, TYPE I19.0B, AT AN AVERAGE RATE OF 285 LBS. PER SQ. YD.
PROP. APPROX. 4.0" ASPHALT CONCRETE INTERMEDIATE COURSE, TYPE I19.0B, AT AN AVERAGE RATE OF 456 LBS. PER SQ. YD.
PROP. VAR. DEPTH ASPHALT CONCRETE INTERMEDIATE COURSE, TYPE I19.0B, AT AN AVERAGE RATE OF 114 LBS. PER SQ. YD. PER 1" DEPTH TO BE PLACED IN LAYERS NOT LESS THAN 2.5" IN DEPTH OR GREATER THAN 4.0" IN DEPTH.
PROP. APPROX. 4.0" ASPHALT CONCRETE BASE COURSE, TYPE B25.0B, AT AN AVERAGE RATE OF 456 LBS. PER SQ. YD.
PROP. VAR. DEPTH ASPHALT CONCRETE BASE COURSE, TYPE B25.0B, AT AN AVERAGE RATE OF 114 LBS. PER SQ. YD. PER 1" DEPTH TO BE PLACED IN LAYERS NOT LESS THAN 3" IN DEPTH OR GREATER THAN 5.5" IN DEPTH.
PROP. 6.0" AGGREGATE BASE COURSE.
2'-6" CONCRETE CURB AND GUTTER.
2'-9" CONCRETE CURB AND GUTTER.
5" MONOLITHIC CONCRETE ISLAND (SURFACE MOUNTED).
SINGLE FACED CONCRETE BARRIER.
4" CONCRETE SIDEWALK.
EARTH MATERIAL.
EXISTING PAVEMENT.
VARIABLE DEPTH ASPHALT PAVEMENT (SEE STANDARD WEDGING DETAIL)

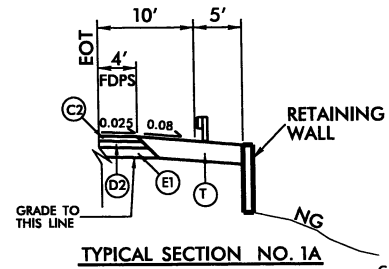


USE TYPICAL SECTION NO. 1A IN CONJUNCTION  
WITH TYPICAL SECTION NO. 1


-1- STA. 63+19.00 TO -1- STA. 66+50.00 RT.

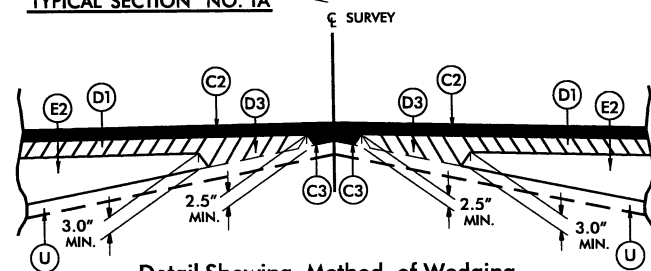


### Detail Showing Method of Wedging

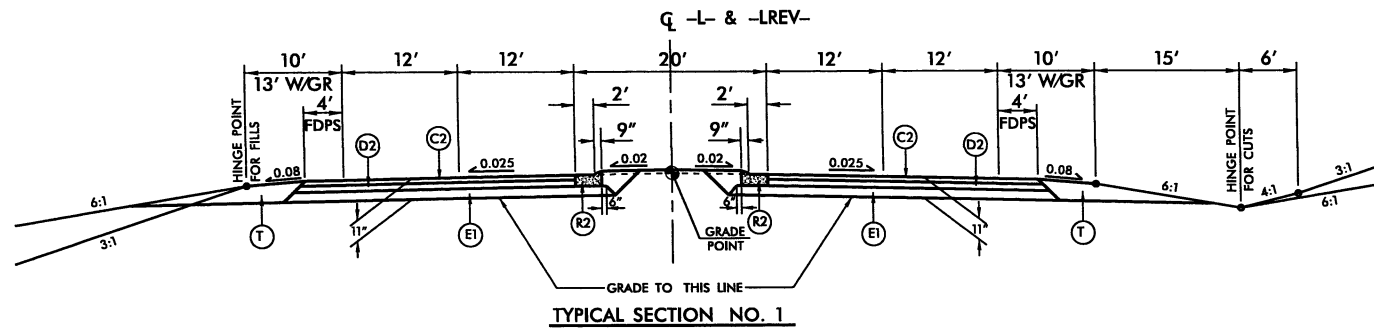


**TYPICAL SECTION NO. 1**

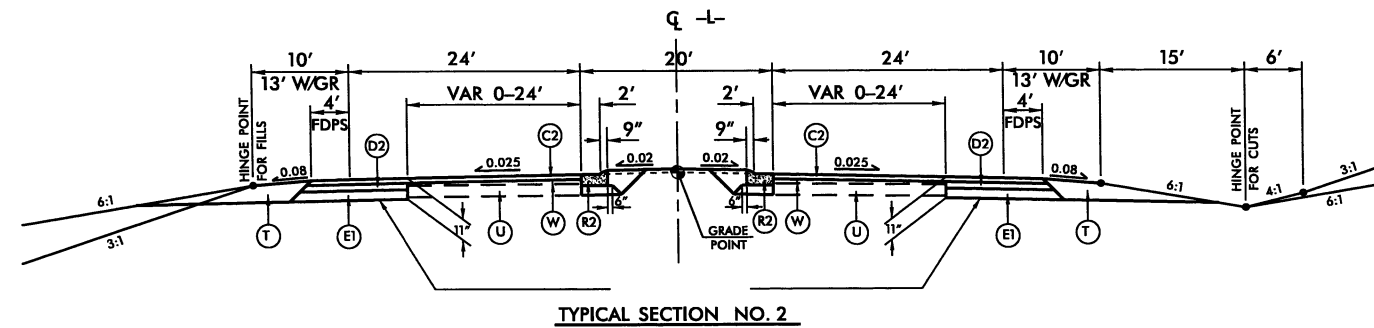

TYPICAL SECTION NO. 2

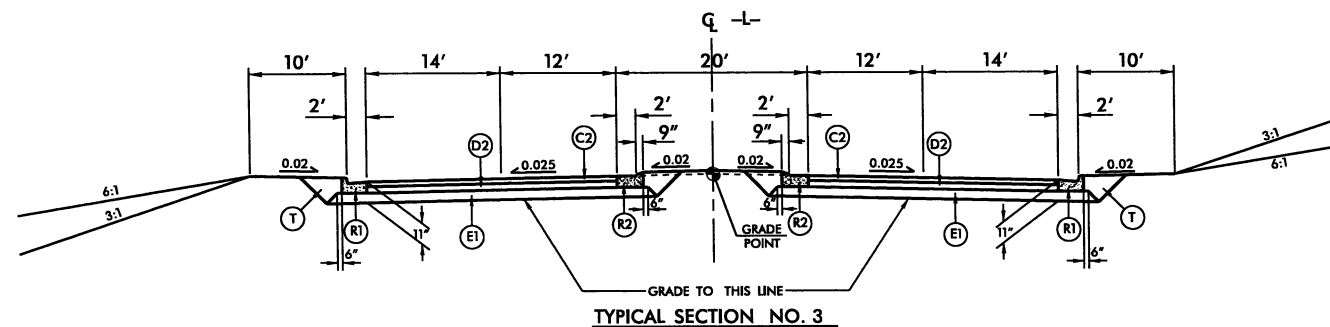

TYPICAL SECTION NO.

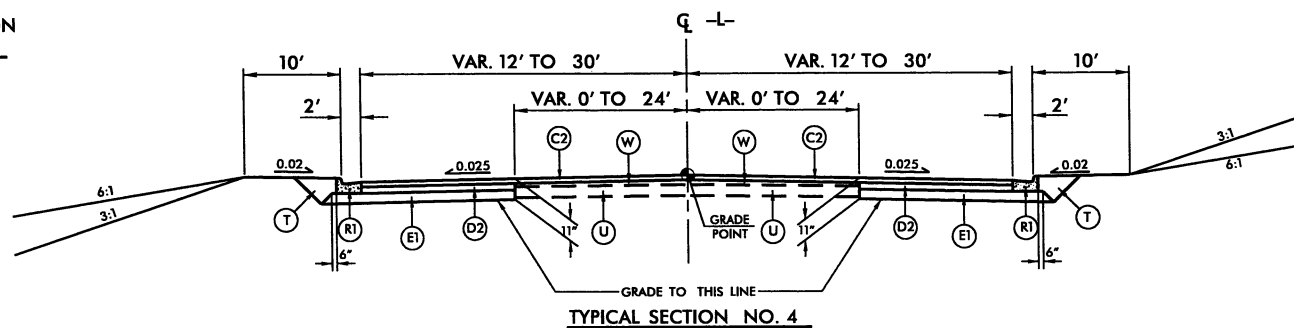

TYPICAL SECTION NO.

PROJECT REFERENCE NO.	SHEET NO.
R-3307	2
ROADWAY DESIGN ENGINEER	PAVEMENT DESIGN ENGINEER

**PRELIMINARY PLANS**

DO NOT USE FOR CONSTRUCTION

USE TYPICAL SECTION NO.

-L- STA. 19+50.00 TO -L- STA. 23+00.00 LT.  
 -L- STA. 25+50.00 TO -L- STA. 29+24.00  
 (BEGIN BRIDGE) LT.  
 -L- STA. 19+50.00 TO -L- STA. 29+24.00  
 (BEGIN BRIDGE) RT.  
 -L- STA. 63+19.00 (END BRIDGE) TO  
 -L- STA. 84+93.71  
 -LREV- STA. 84+93.71 TO -LREV- STA. 118+25.14  
 -L- STA. 117+91.30 TO -L- STA. 184+82.50

**USE TYPICAL SECTION NO. 2**

-L- STA. 17+00.00 TO -L- STA. 19+50.00  
-L- STA. 23+00.00 TO -L- STA. 25+50.00 LT.

**USE TYPICAL SECTION NO. 3**


-L- STA. 184+82.50 TO -L- STA. 202+00.00

USE TYPICAL SECTION NO. 4


-1- STA. 202+00.00 TO -1- STA. 207+00.00

TRANSITION TO EXISTING FROM -L- STA. 207+00.00  
TO -L- STA. 207+95.09


PROJECT REFERENCE NO.	SHEET NO.
R-3307	2-A
ROADWAY DESIGN ENGINEER	PAVEMENT DESIGN ENGINEER
PRELIMINARY PLANS DO NOT USE FOR CONSTRUCTION	

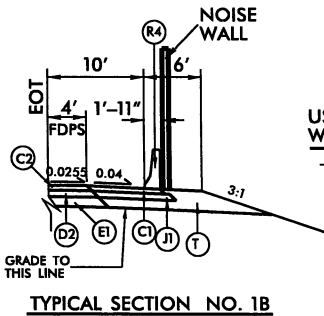


USE TYPICAL SECTION NO. 1B IN CONJUNCTION  
WITH TYPICAL SECTION NO. 1  
-L- STA. 147+00.00 TO -L- STA. 167+50.00 RT.

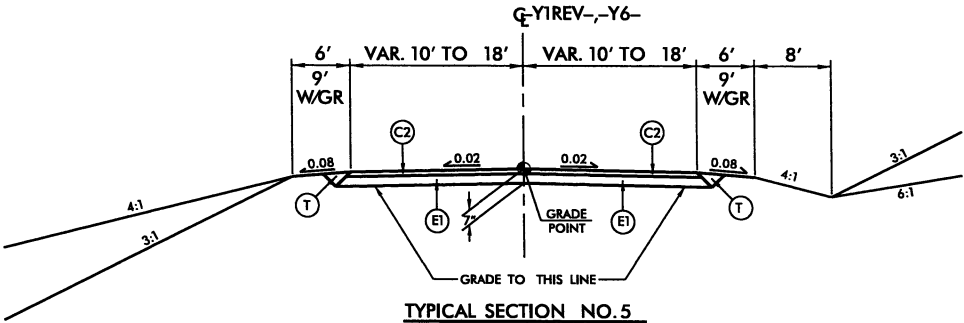


USE TYPICAL SECTION NO. 5  
-YIREV- STA. 14+50.00 TO -YIREV- STA. 20+59.54  
-Y6- STA. 10+36.59 TO -Y6- STA. 12+00.00

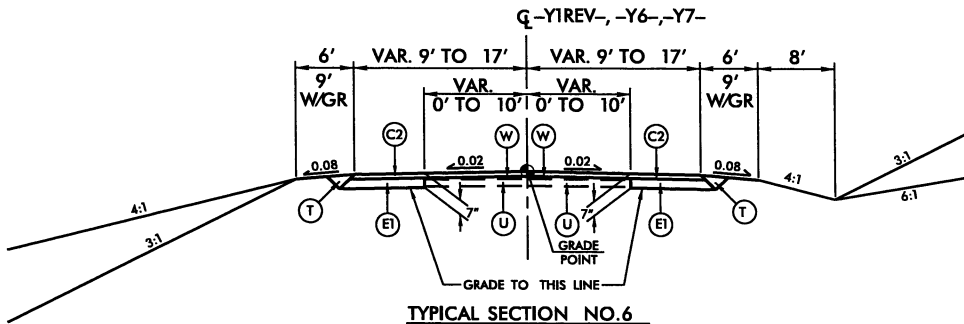

USE TYPICAL SECTION NO. 6  
-YIREV- STA. 13+27.88 TO -YIREV- STA. 14+50.00  
-Y6- STA. 12+00.00 TO -Y6- STA. 12+35.00  
-Y7- STA. 10+12.05 TO -Y7- STA. 11+60.29

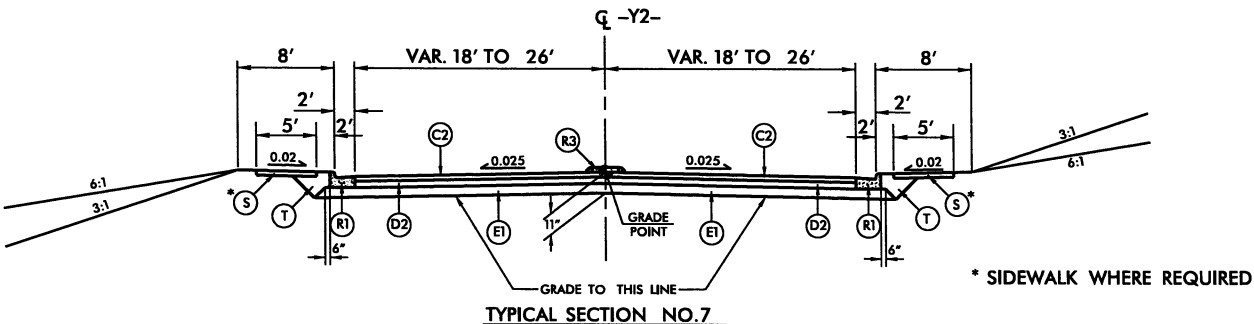


USE TYPICAL SECTION NO. 7  
-Y2- STA. 10+53.74 TO -Y2- STA. 13+13.00  
(BEGIN BRIDGE)  
-Y2- STA. 18+98.00 (END BRIDGE) TO  
-Y2- STA. 25+50.00

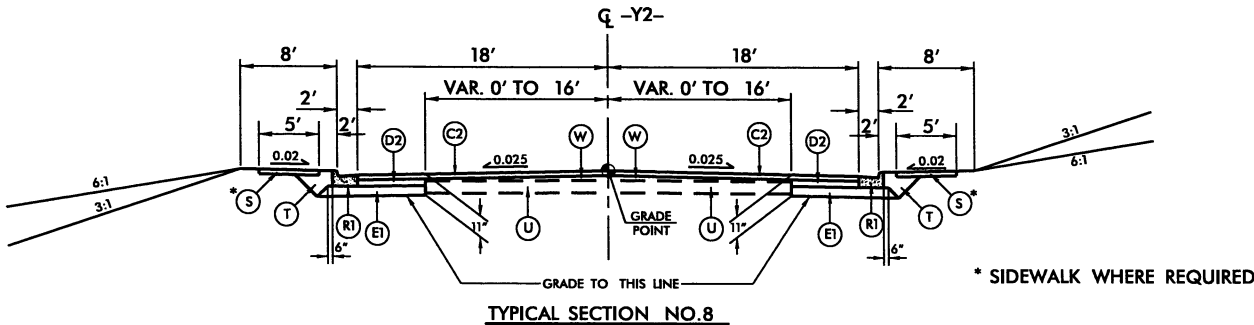

USE TYPICAL SECTION NO. 8  
-Y2- STA. 25+50.00 TO -Y2- STA. 32+40.08

PRELIM. PAVEMENT SCHEDULE


C1	2" S9.5B
C2	3" S9.5B
C3	VAR. S9.5B
D1	2.5" I19.0B
D2	4" I19.0B
D3	VAR. I19.0B
E1	4" B25.0B
E2	VAR. B25.0B
J1	6" ABC
R1	2'x6" C & G
R2	2'x9" C & G
R3	ISLAND
R4	CONCRETE BARRIER
S	4" SIDEWALK
T	EARTH MATERIAL
U	EXIST. PAVEMENT
W	WEDGING

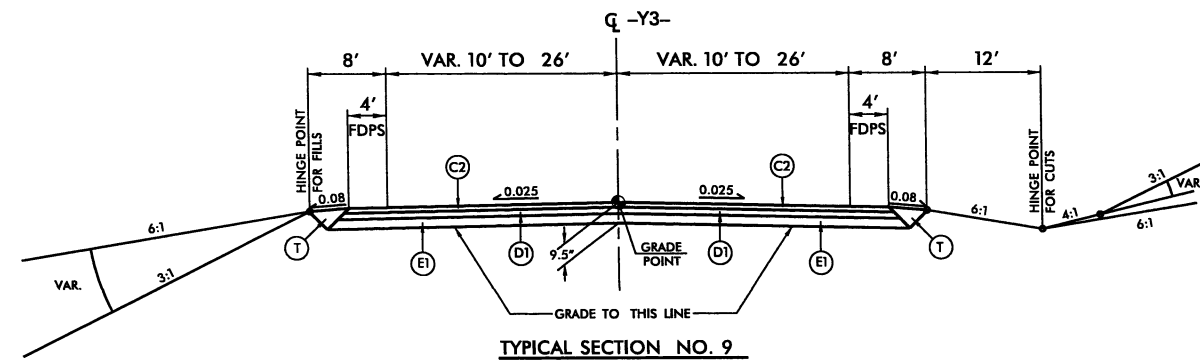

**USE TYPICAL SECTION NO. 9**

---


-Y3- STA. 15+50.00 TO -Y3- STA. 21+30.88  
-Y3- STA. 22+24.82 TO -Y3- STA. 23+50.00  
-Y3- STA. 24+50.00 TO -Y3- STA. 27+50.00

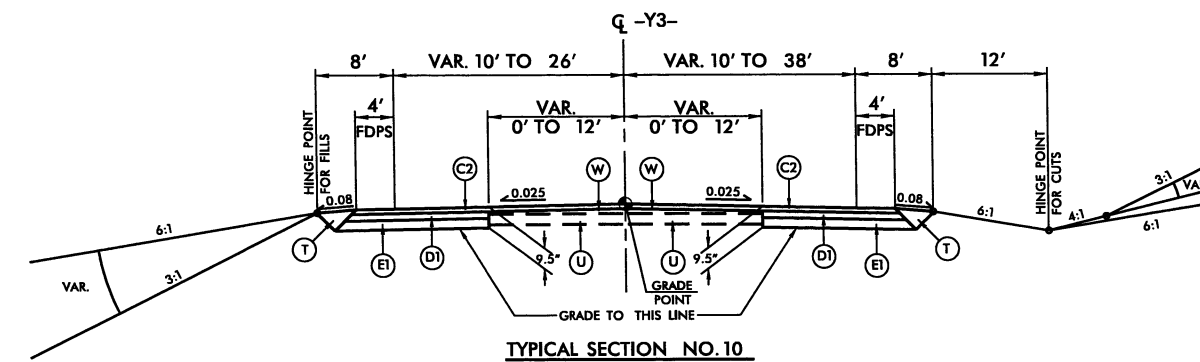


**USE TYPICAL SECTION NO. 10**

---

-Y3- STA. 10 + 66.00 TO -Y3- STA. 15 + 50.00  
-Y3- STA. 23 + 50.00 TO -Y3- STA. 24 + 50.00  
-Y3- STA. 27 + 50.00 TO -Y3- STA. 30 + 50.00

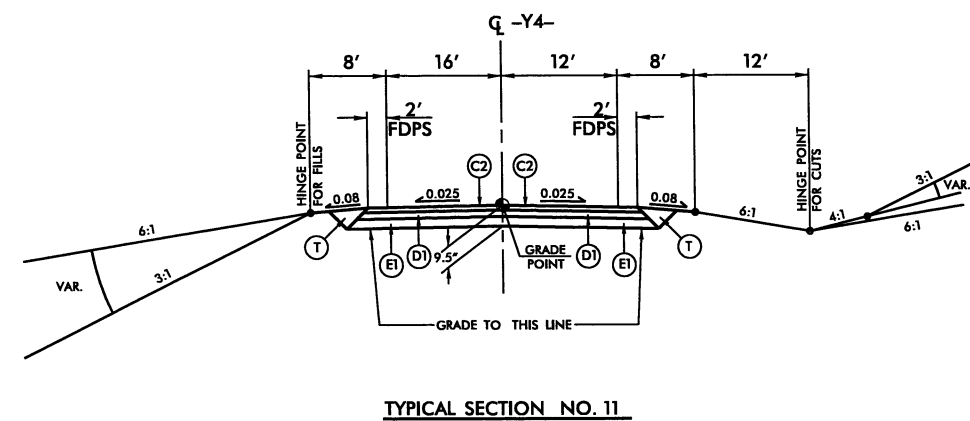


**USE TYPICAL SECTION NO. 11**  
**-Y4- STA. 10+48.00 TO -Y4- STA. 13+40.00**

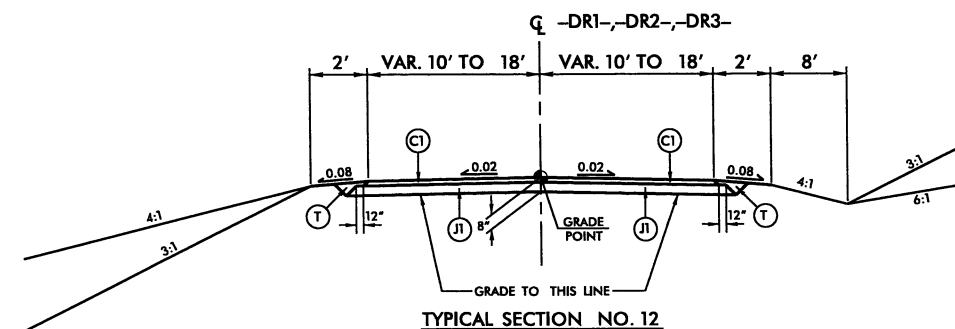












USE TYPICAL SECTION NO. 12	
-DR1- STA. 10+65.26 TO	-DR1- STA. 15+11.47
-DR2- STA. 10+46.00 TO	-DR2- STA. 10+89.89
-DR3- STA. 13+50.00 TO	-DR3- STA. 14+54.73

PRELIM. PAVEMENT SCHEDULE	
C1	2" S9.5B
C2	3" S9.5B
C3	VAR. S9.5B
D1	2.5" I19.0B
D2	4" I19.0B
D3	VAR. I19.0B
E1	4" B25.0B
E2	VAR. B25.0B
J1	6" ABC
R1	2'x6" C & G
R2	2'x9" C & G
R3	ISLAND
R4	CONCRETE BARRIER
S	4" SIDEWALK
T	EARTH MATERIAL
U	EXIST. PAVEMENT
W	WEDGING


## 8/17/99

 

## 3/17/99

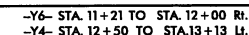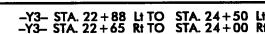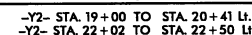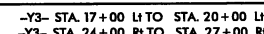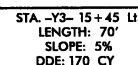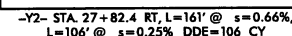     

MIN. D	B
2.0'	2.0'
1.7'	4.0'

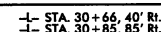

8/17/99

R/W REV. 07/29/10 (KWA) REVISED EXIST. R/W TO NUMERICAL OFFSET.

30-JUN-2011 14:52  
R:\Roadway\Projects\PSHV-3307\rdy-psv-s04.dgn  
\$\$\$\$\$USERNAME\$\$\$\$\$


REVISIONS

-L-  
PI Sta 31+49.36  
 $\Delta = 36^\circ 26' 02.2" (LT)$   
 $D = 210' 42.8"$   
 $L = 1672.40'$   
 $T = 865.56'$   
 $R = 2630.00'$   
 $SE = .05$



PROJECT REFERENCE NO. <b>R-3307</b>		SHEET NO. <b>4</b>
RW SHEET NO.		
ROADWAY DESIGN ENGINEER	HYDRAULICS ENGINEER	
<div><b>PRELIMINARY PLANS</b> DO NOT USE FOR CONSTRUCTION</div>		

FOR -L- PROFILE SEE SHEET 26

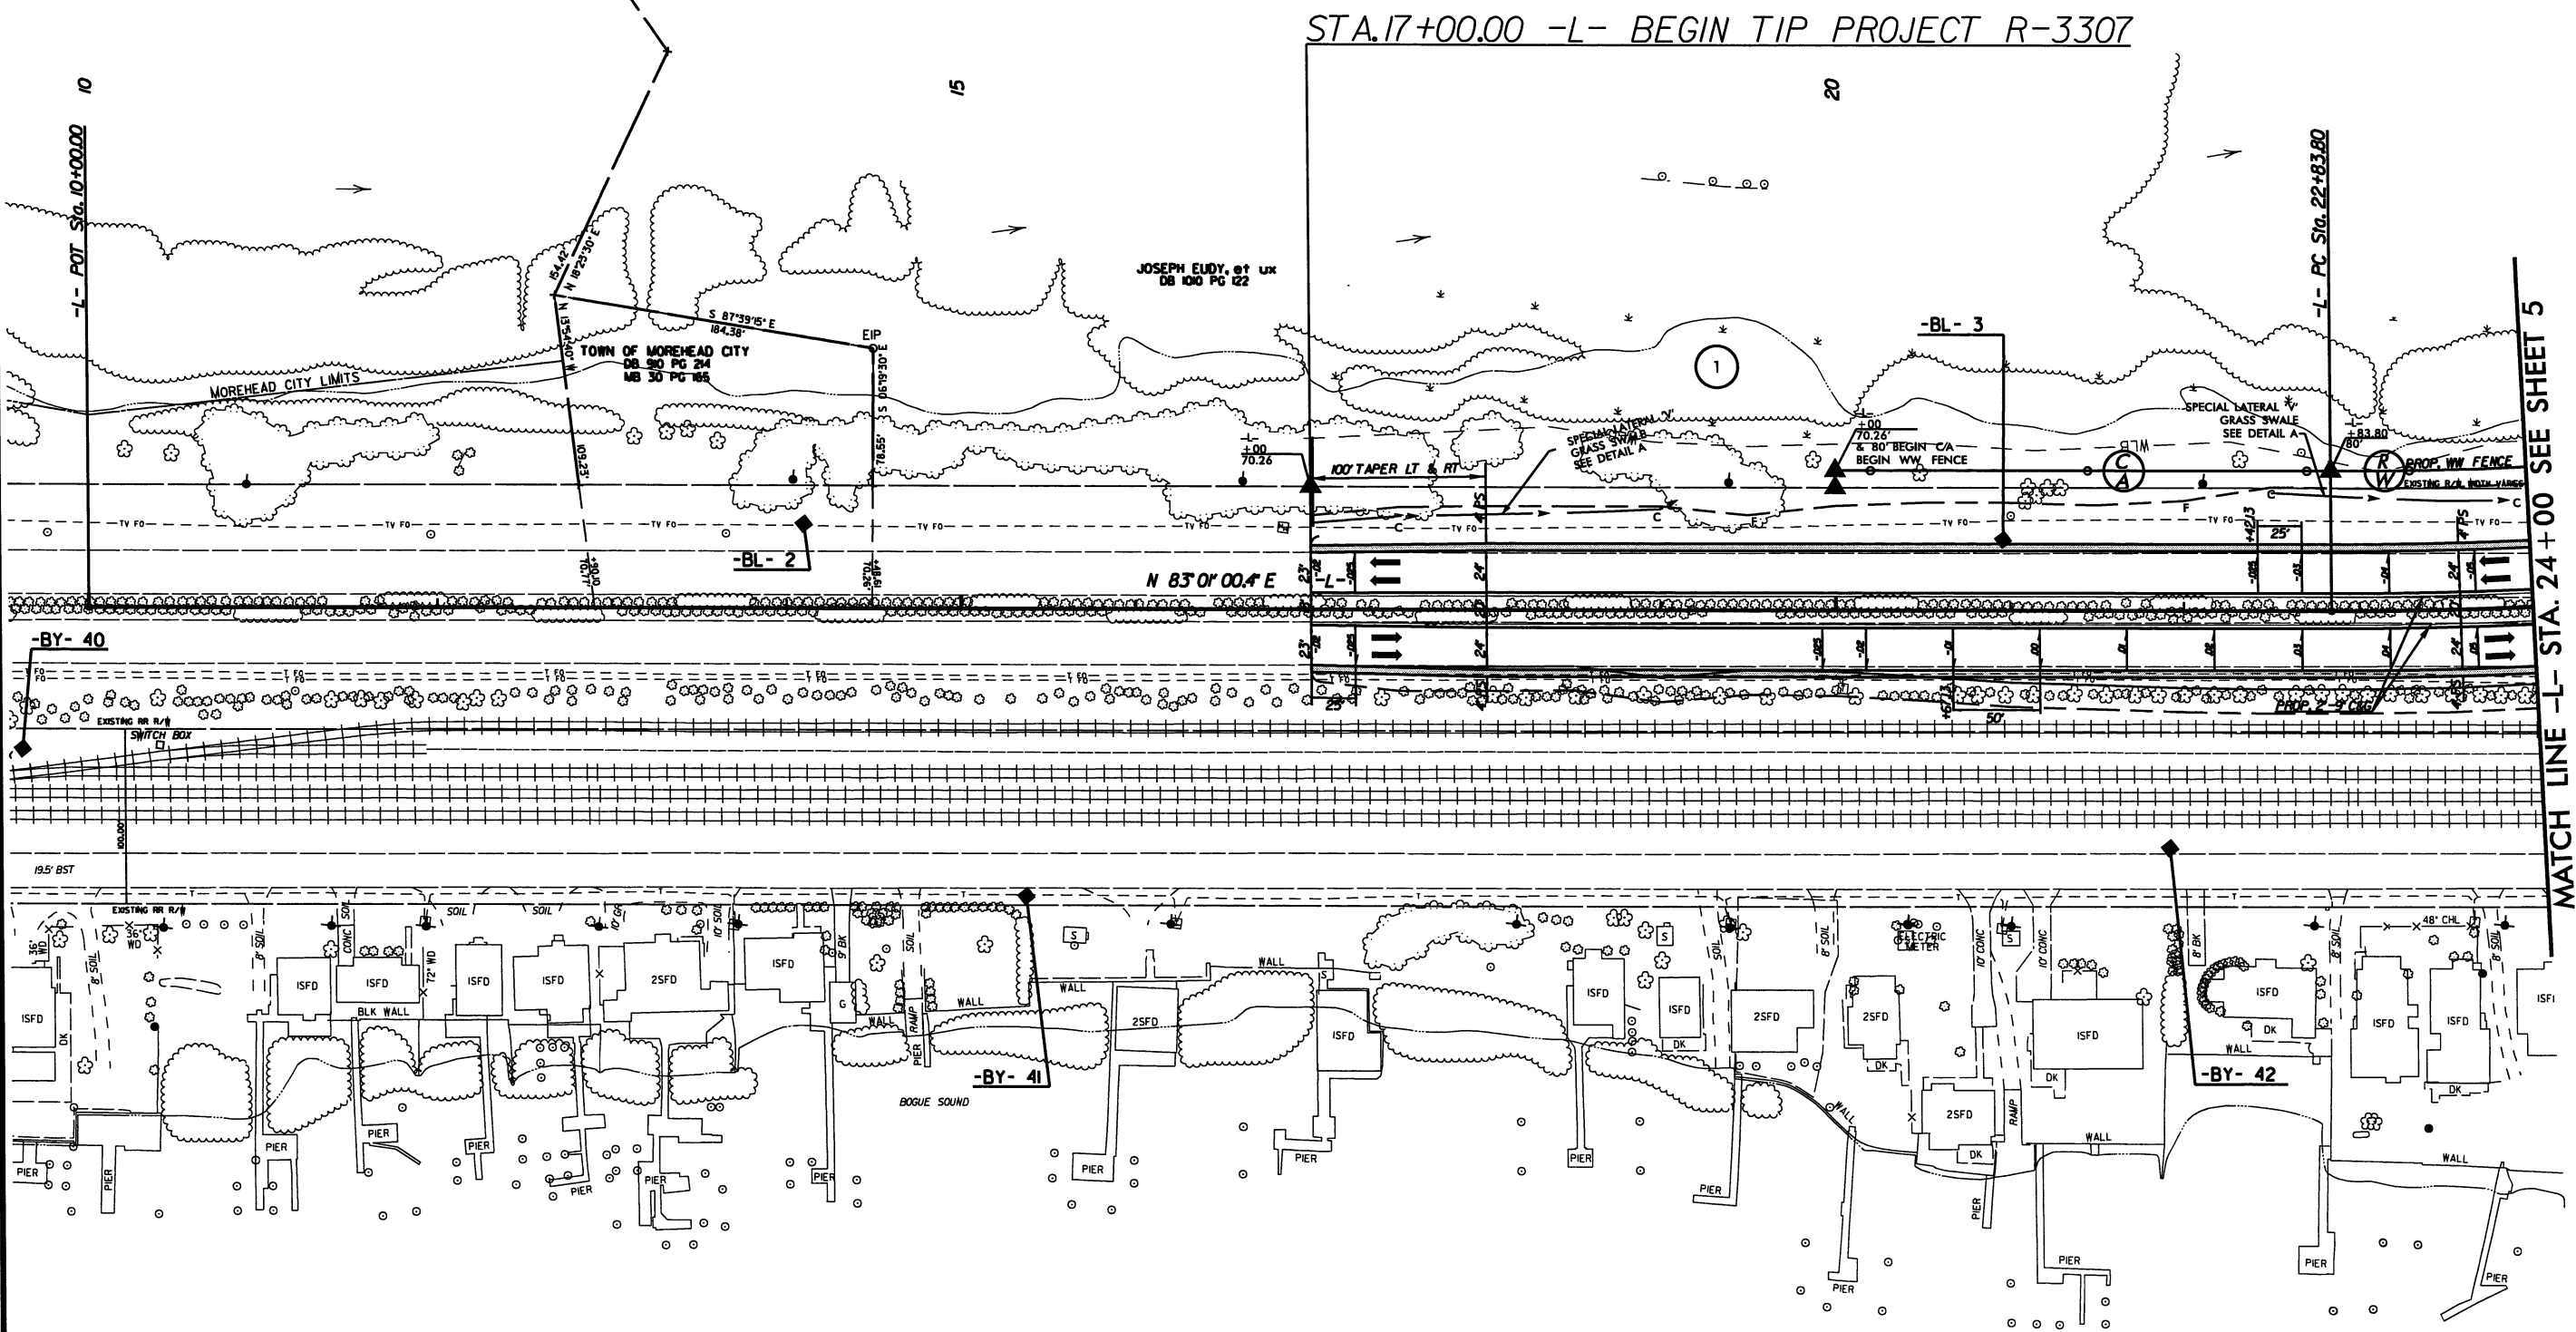




8/17/99


REVISIONS  
R/W REV. 07/29/10 (KMW) REVISED EXIST. R/W TO NUMERICAL OFFSET.  
R/W REV. 10/18/10 (RVP) ADDED PROPOSED TEMPORARY CONSTRUCTION EASEMENT ON PARCEL 1.

30-JUN-2011 14:52  
R:\Roadway\3307\PSHV\3307\_rdy\_psh.s05.dgn  
\*\*\*\*\*\$USER\$\*\*\*\*\*

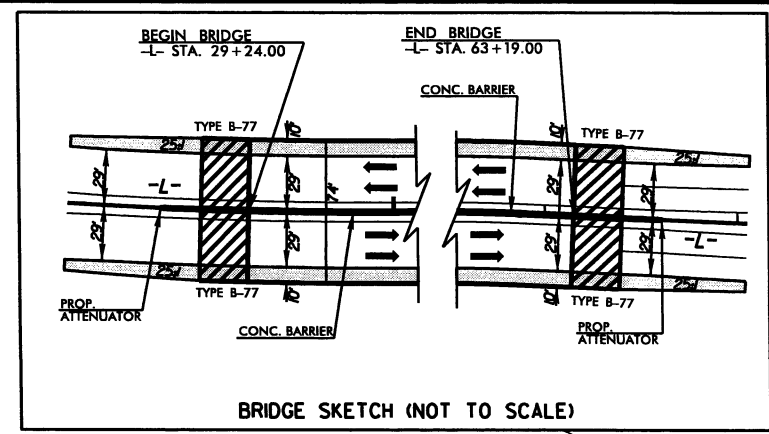

PROJECT REFERENCE NO.	SHEET NO.
R-3307	5
R/W SHEET NO.	
ROADWAY DESIGN ENGINEER	HYDRAULICS ENGINEER
PRELIMINARY PLANS DO NOT USE FOR CONSTRUCTION	

FOR -L- PROFILE SEE SHEET 26

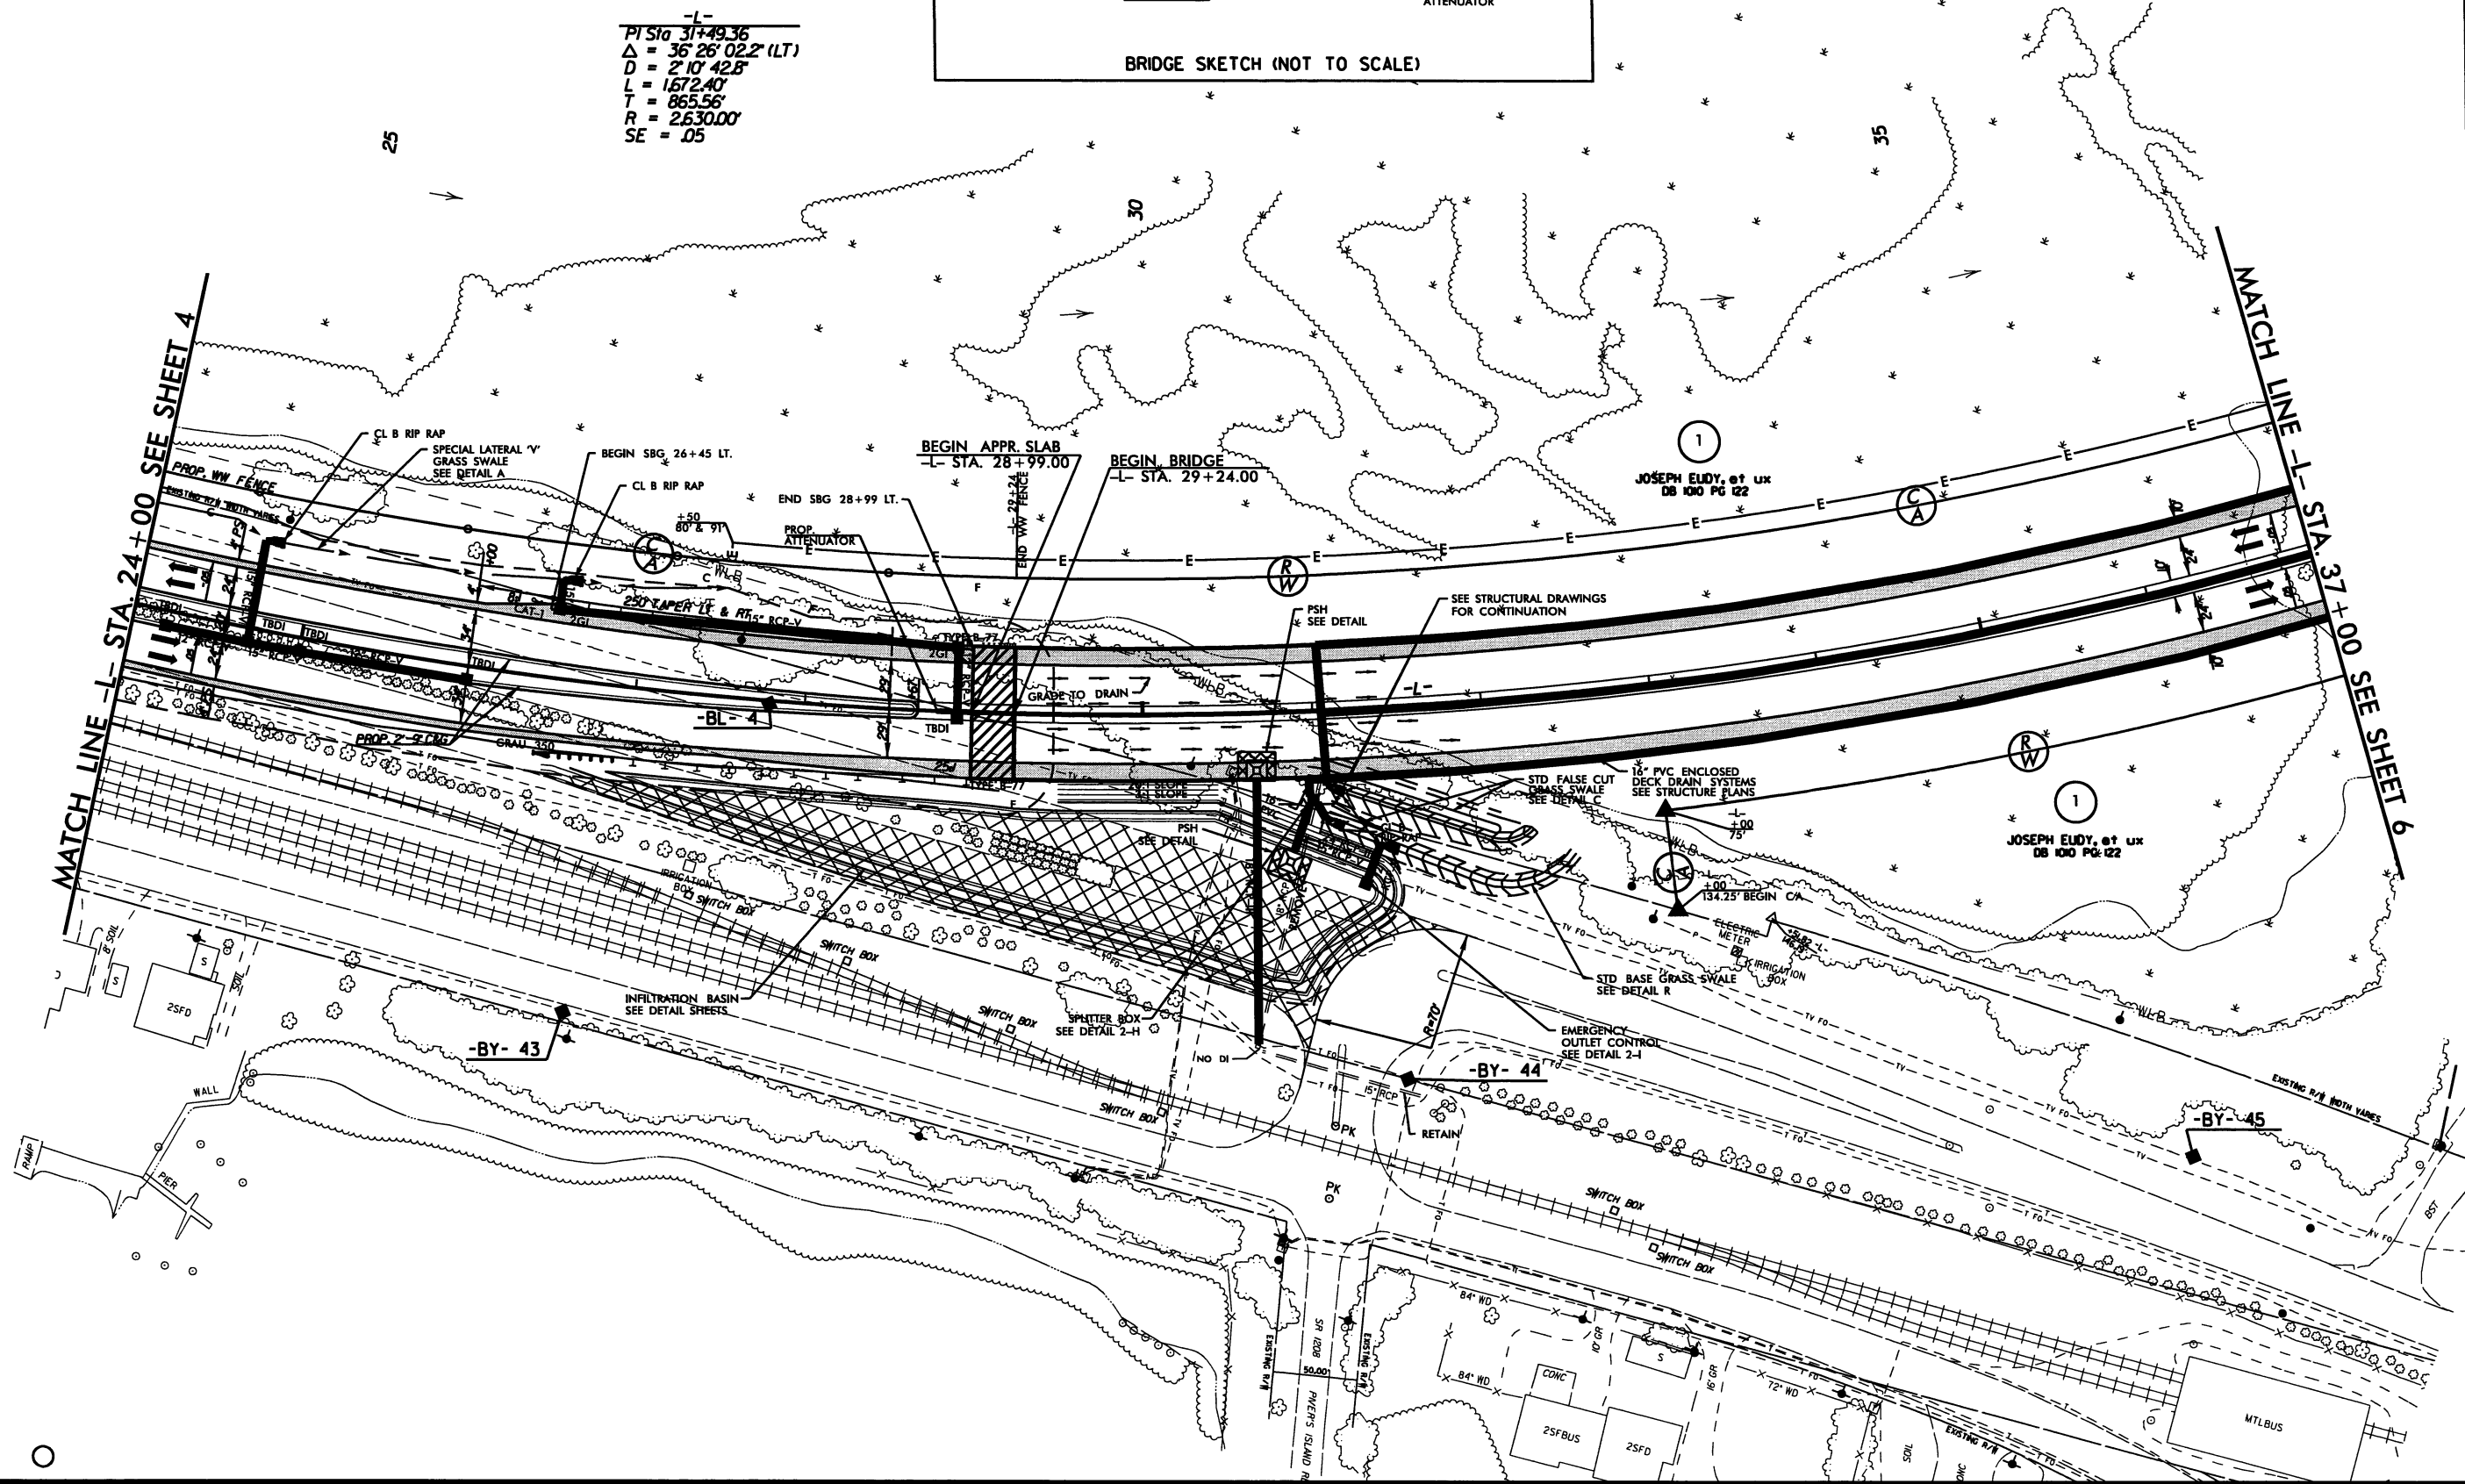

8/17/99


30-JUN-2011 14:52  
R:\Roadway\PSH\3307\_rdy.psh.s06.dgn  
\$\$\$\$\$SYTIME\$\$\$\$\$

REVISIONS  
R/W REV. 10/18/10 (R/W) ADDED PROPOSED TEMPORARY CONSTRUCTION EASEMENT ON PARCEL 1.

-L-  
P/Sig 31+49.36  
 $\Delta = 36^\circ 26' 02.2" (LT)$   
 $D = 2' 10" 42.8"$   
 $L = 1672.40'$   
 $T = 865.56'$   
 $R = 2630.00'$   
 $SE = .05$

PROJECT REFERENCE NO. <i>R-3307</i>		SHEET NO. <i>6</i>	
RW SHEET NO.			
ROADWAY DESIGN ENGINEER		HYDRAULICS ENGINEER	
<div>PRELIMINARY PLANS</div> <div>DO NOT USE FOR CONSTRUCTION</div>			

FOR -L- PROFILE SEE SHEET 27

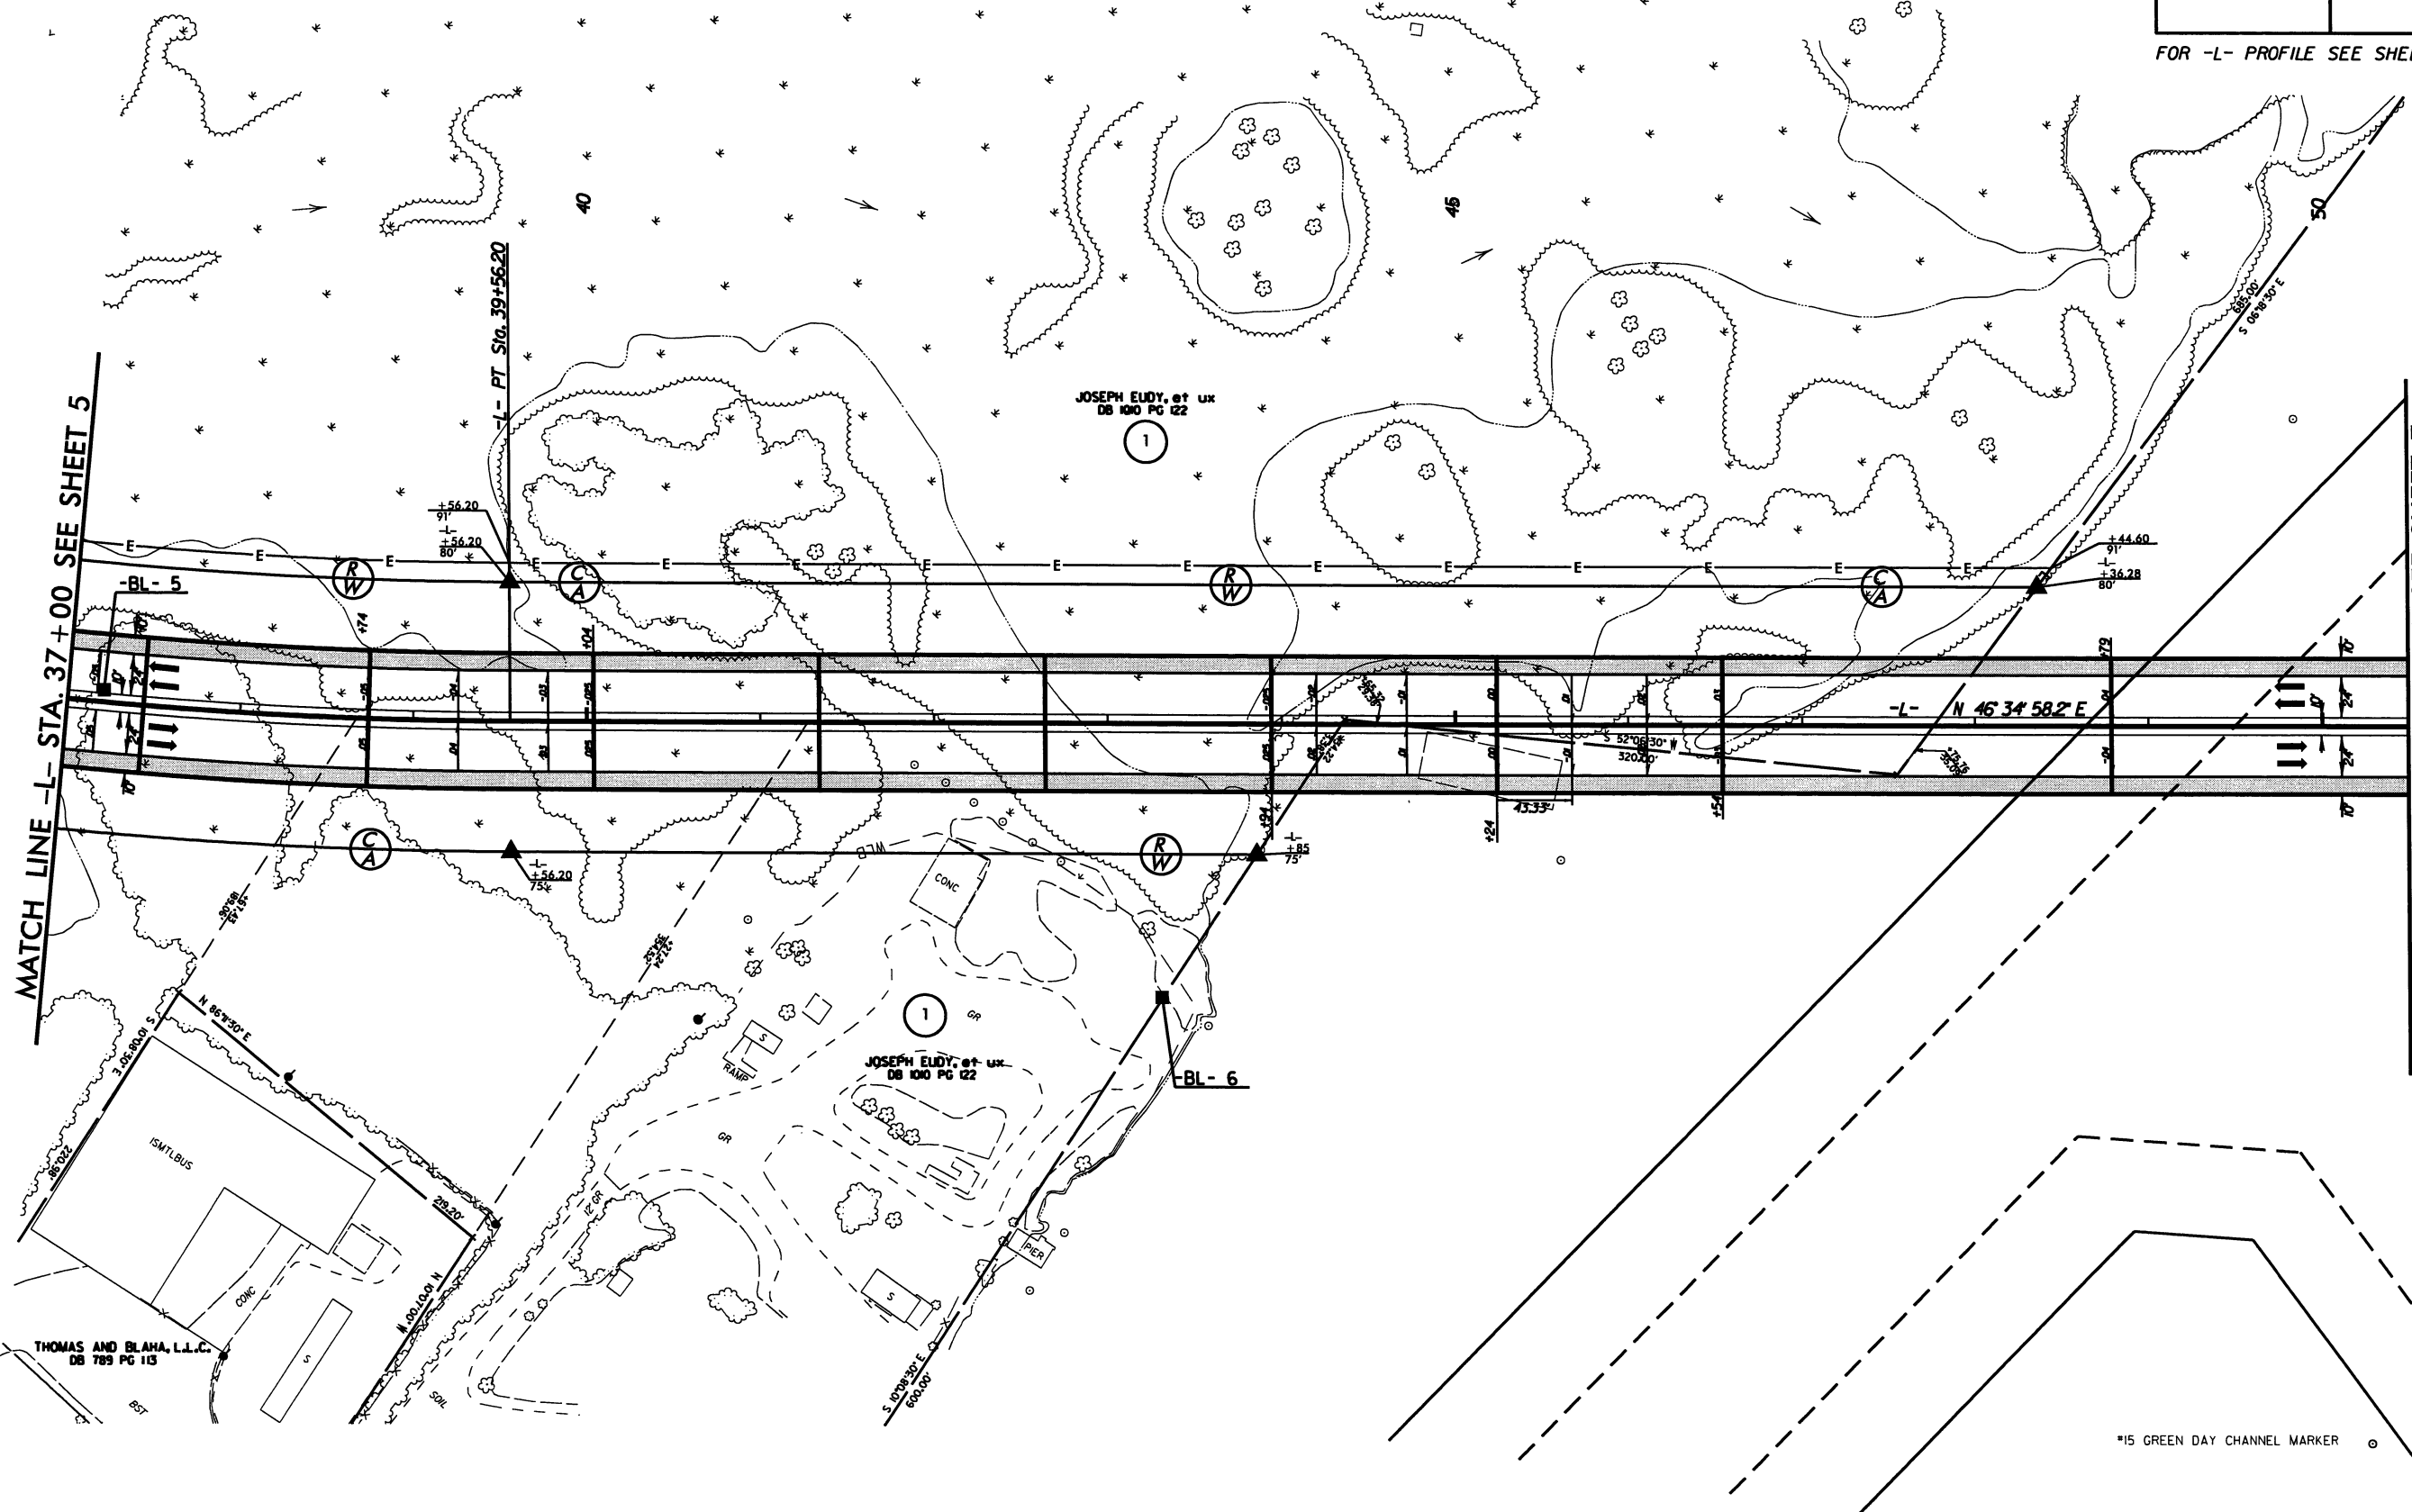

B.17/99


30-JUN-2011 4:52  
R:\Roadwork\PSH\3307\rdy.psh.s07.dgn  
USER:RDM

REVISIONS

R/W REV. 07/29/10 (KMW): REVISED EXIST. P/L TO NUMERICAL OFFSET.

PROJECT REFERENCE NO.	SHEET NO.
R-3307	7
RW SHEET NO.	
ROADWAY DESIGN ENGINEER	HYDRAULICS ENGINEER
PRELIMINARY PLANS DO NOT USE FOR CONSTRUCTION	


FOR -L- PROFILE SEE SHEET 28

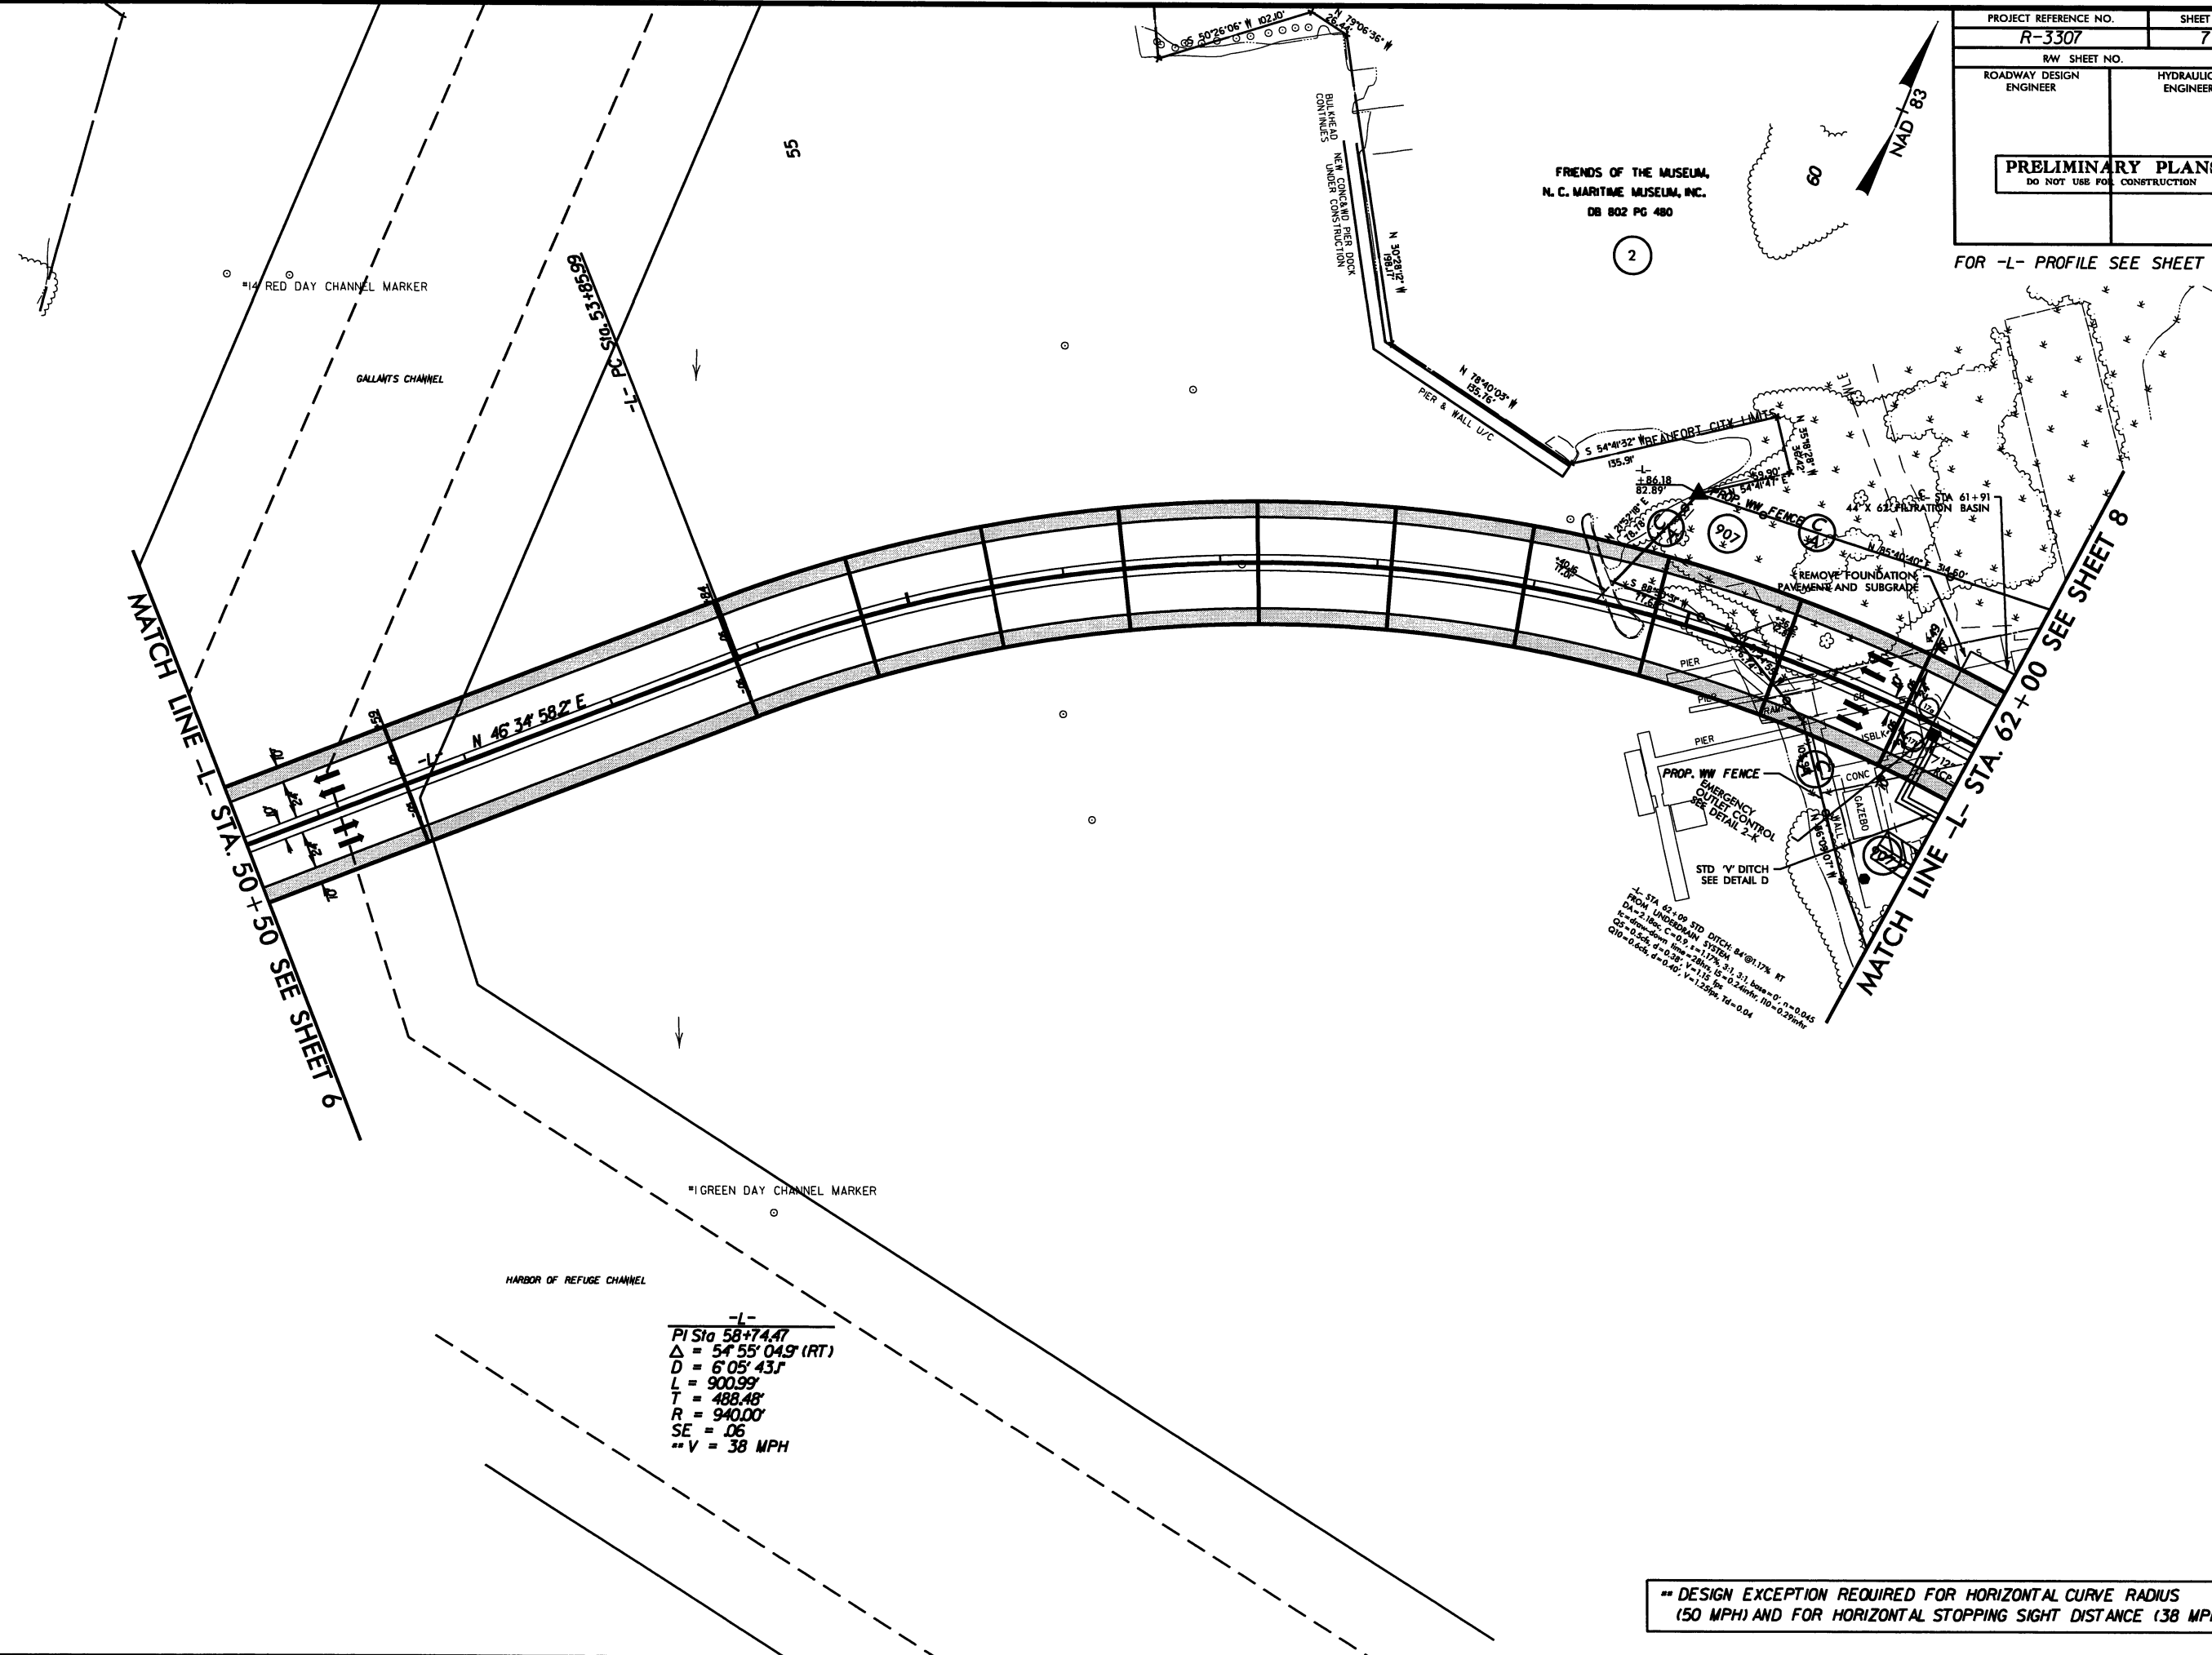

-L-  
PI Sta 58+74.47  
 $\Delta = 54^{\circ}55'04.9''$  (RT)  
 $D = 6^{\circ}05'43''$   
 $L = 900.99'$   
 $T = 488.48'$   
 $R = 940.00'$   
 $SE = .06$   
 $V = 38$  MPH

\*\* DESIGN EXCEPTION REQUIRED FOR HORIZONTAL CURVE RADIUS (50 MPH) AND FOR HORIZONTAL STOPPING SIGHT DISTANCE (38 MPH).

60-JUN-2011 14:52  
R:\Roadway\proj\PSH\3307\_rdy\_psh-s08.dgn  
\$\$\$\$\$USERNAME\$\$\$\$\$

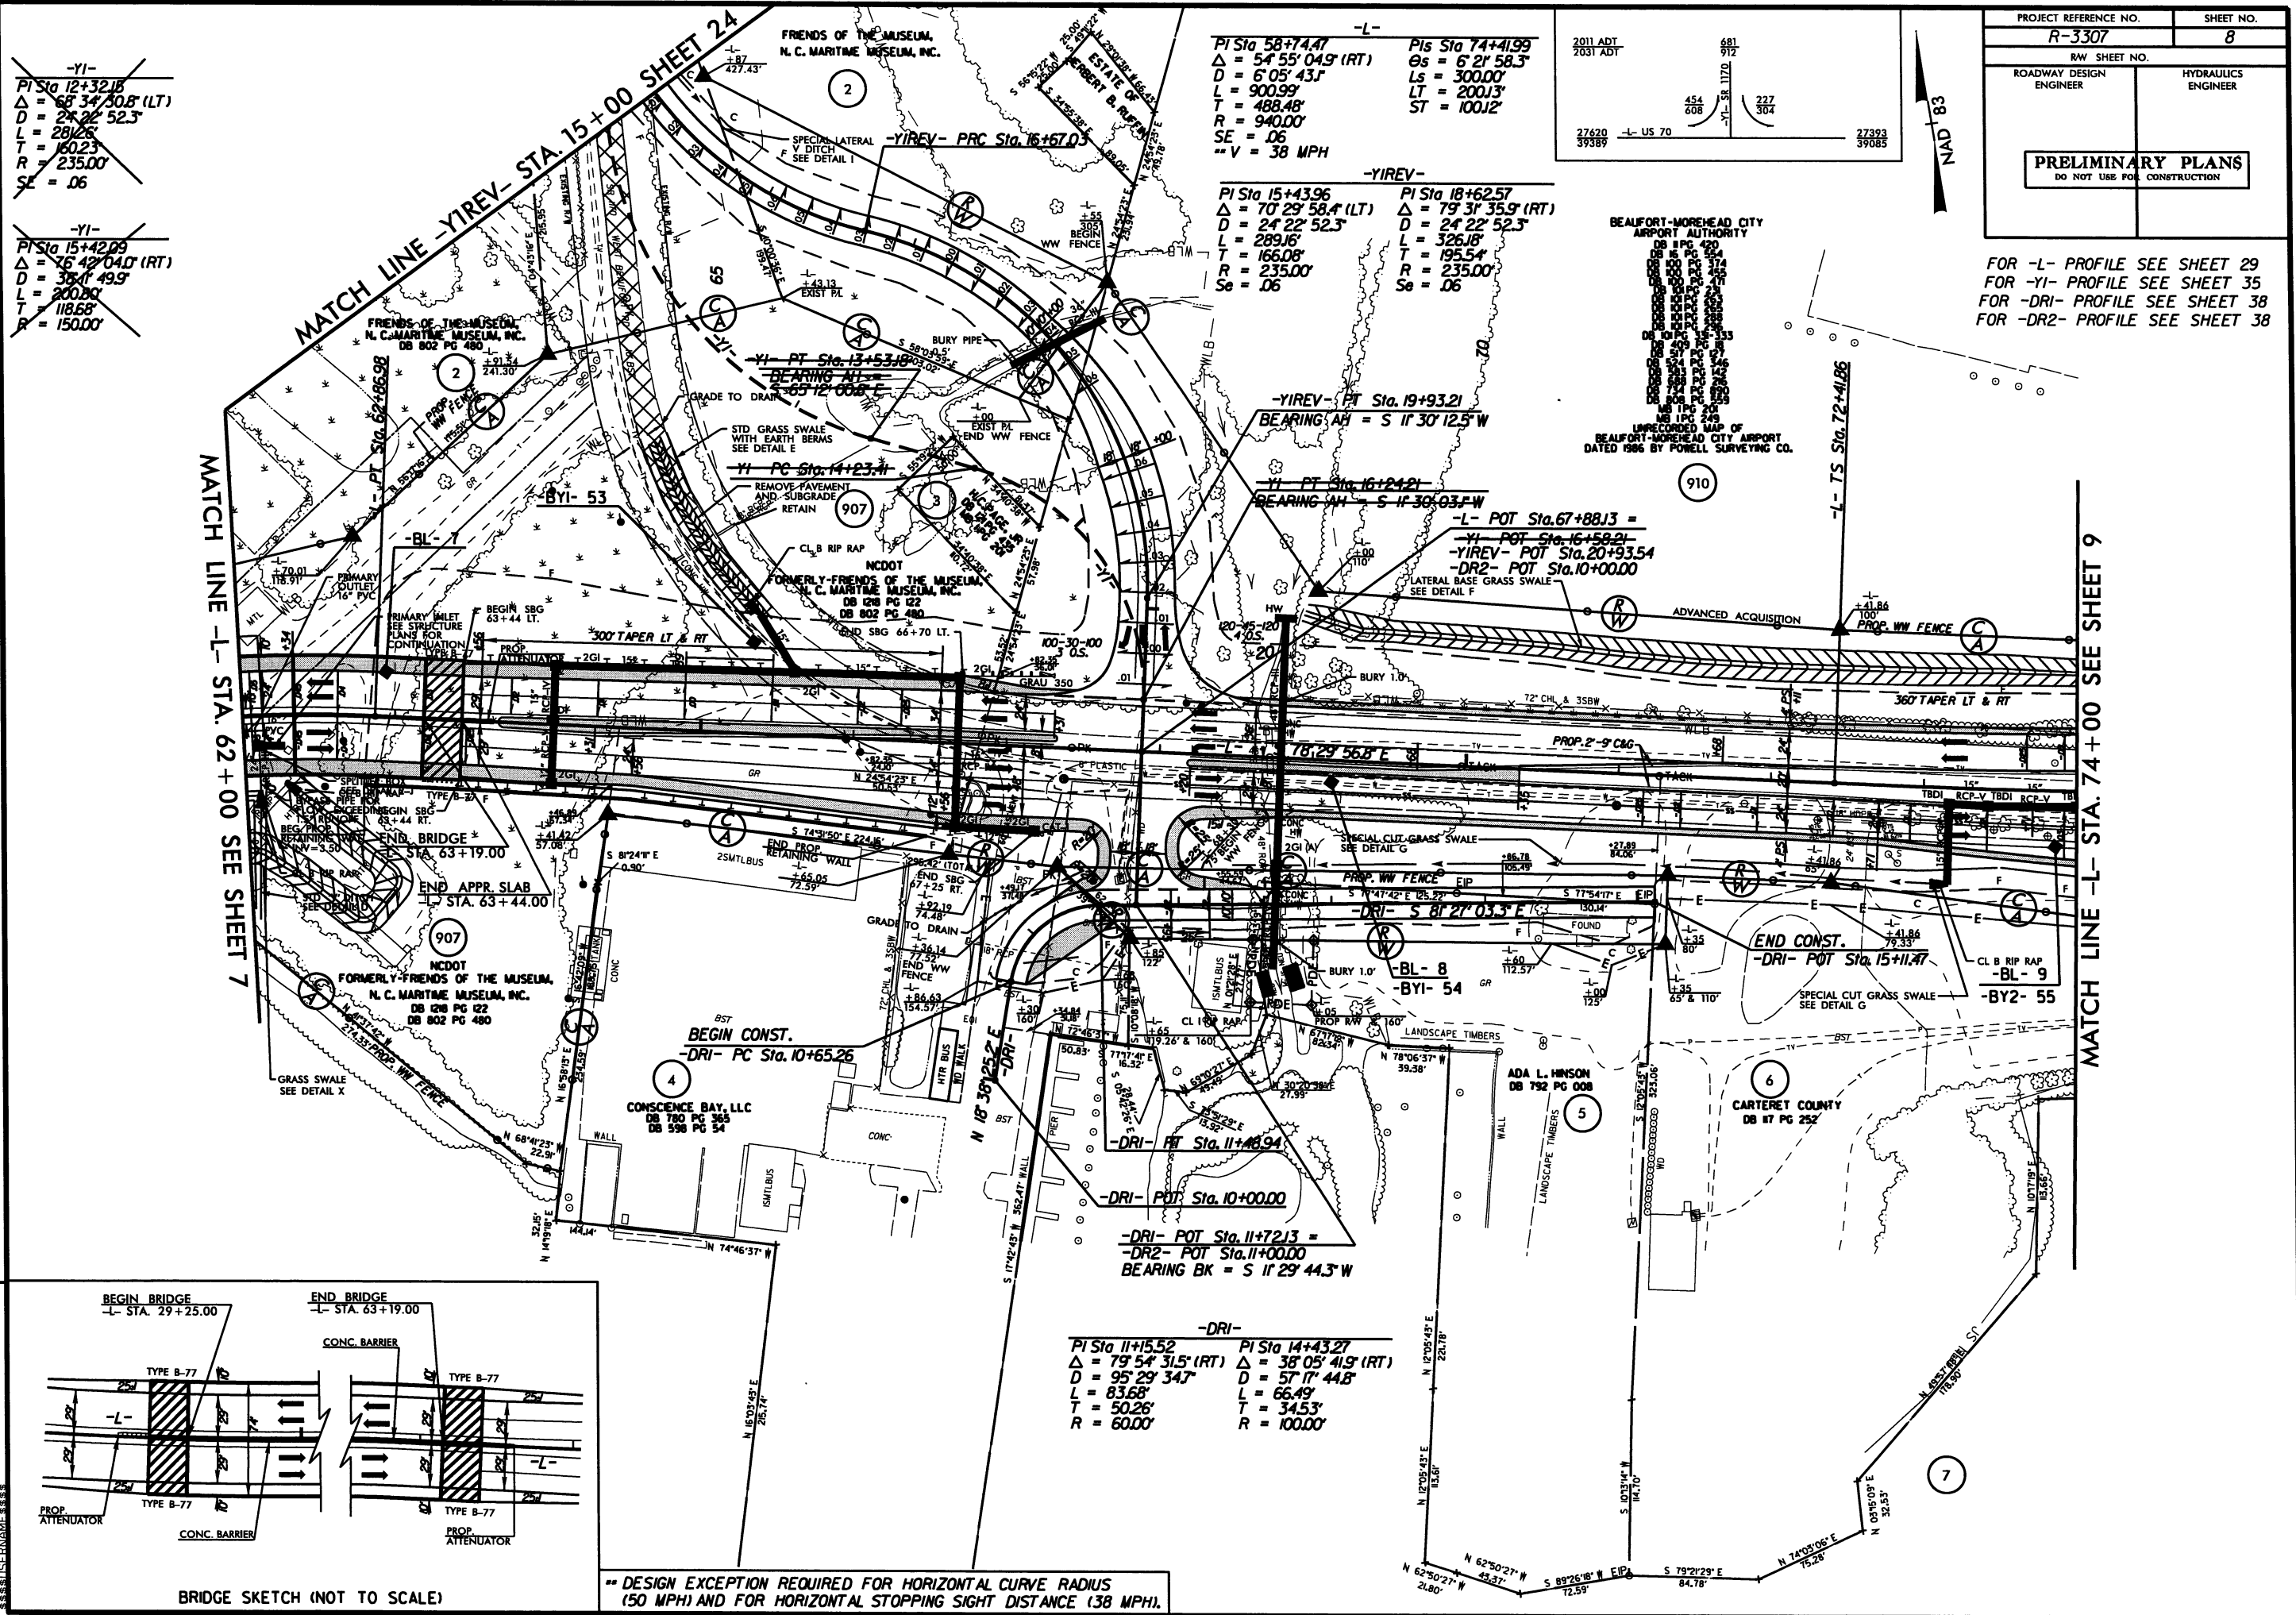


**BRIDGE SKETCH (NOT TO SCALE)**

**\*\* DESIGN EXCEPTION REQUIRED FOR HORIZONTAL CURVE RADIUS (50 MPH) AND FOR HORIZONTAL STOPPING SIGHT DISTANCE (38 MPH).**

30-JUN-2011 14:53  
R:\Roadway\Proj\PSH\1-3307\_rdy-ps-h-s09.dgn  
\$\$\$\$\$USERNAME\$\$\$\$\$

PROJECT REFERENCE NO.	SHEET NO.
<i>R-3307</i>	<i>9</i>
RW SHEET NO.	
ROADWAY DESIGN ENGINEER	HYDRAULICS ENGINEER
<div style="border: 2px solid black; padding: 10px; text-align: center;"> <b>PRELIMINARY PLANS</b>          DO NOT USE FOR CONSTRUCTION       </div>	

FOR -L- PROFILE SEE SHEET 29  
FOR -LREV- PROFILE SEE SHEET 29  
FOR -Y2- PROFILE SEE SHEET 35  
FOR -Y5- PROFILE SEE SHEET 37

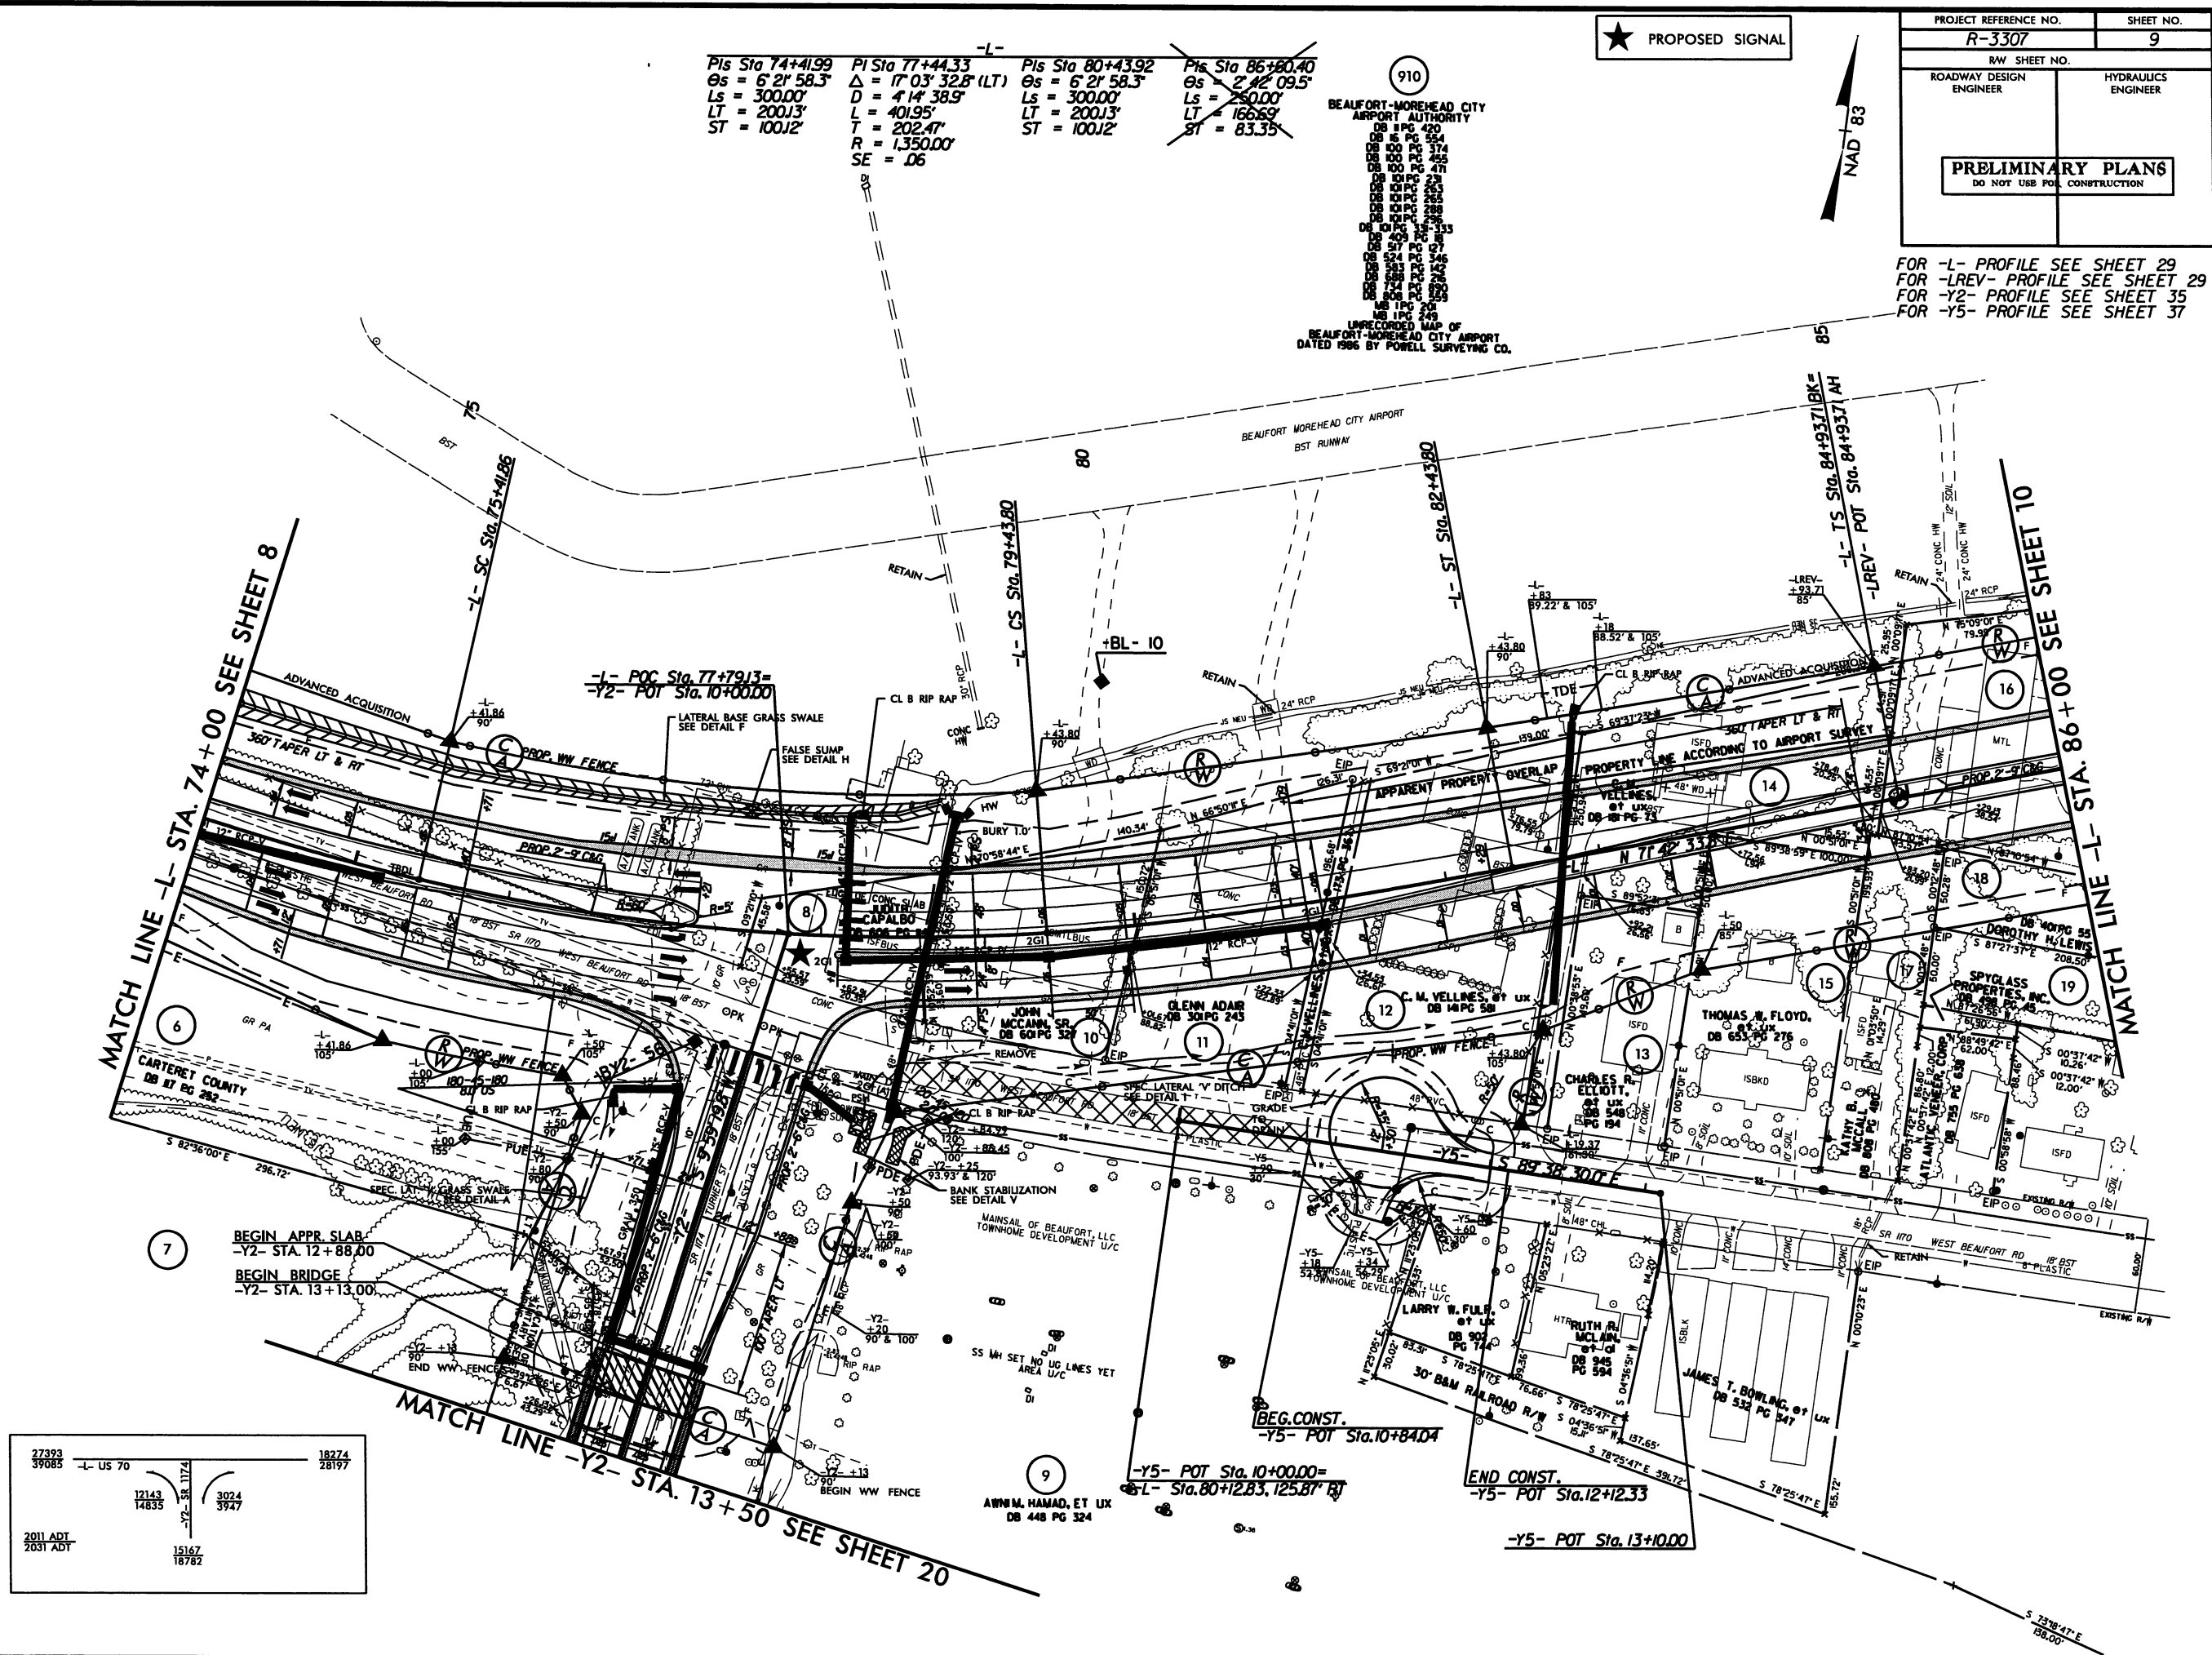

27393  
39085

US 70

12143  
14835

-172 -58 1174

3024  
3947

18274  
28197

15167  
18782

2011 ADT  
2031 ADT





8/17/99  
30-JUN-2011 14:53  
R:\Roadway\PSH\3307\PSH-3307.rdy.psh.all.dgn  
R/W REV. 07/29/10 (KMW) REVISED PROP R/W TO NUMERICAL OFFSET.


<b>-L-</b> Pis Sta 99+15.81 θs = 2° 42' 09.5" Ls = 250.00' LT = 165.69' ST = 83.35'	<b>-LREV-</b> Pis Sta 99+63.95 θs = 5° 03' 19.8" Ls = 300.00' LT = 200.08' ST = 100.07'	<b>-L-</b> Pis Sta 112+19.96 θs = 4° 38' 44.2" Ls = 300.00' LT = 200.07' ST = 100.06'	<b>-LREV-</b> Pis Sta 111+38.35 θs = 4° 38' 44.2" Ls = 300.00' LT = 200.07' ST = 100.06'
--	--	--	---

PROJECT REFERENCE NO. <b>R-3307</b>		SHEET NO. <b>II</b>
RW SHEET NO.		
ROADWAY DESIGN ENGINEER	HYDRAULICS ENGINEER	
<b>PRELIMINARY PLANS</b> DO NOT USE FOR CONSTRUCTION		

FOR -LREV- PROFILE SEE SHEET 30

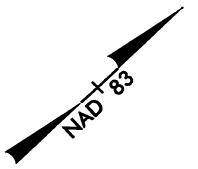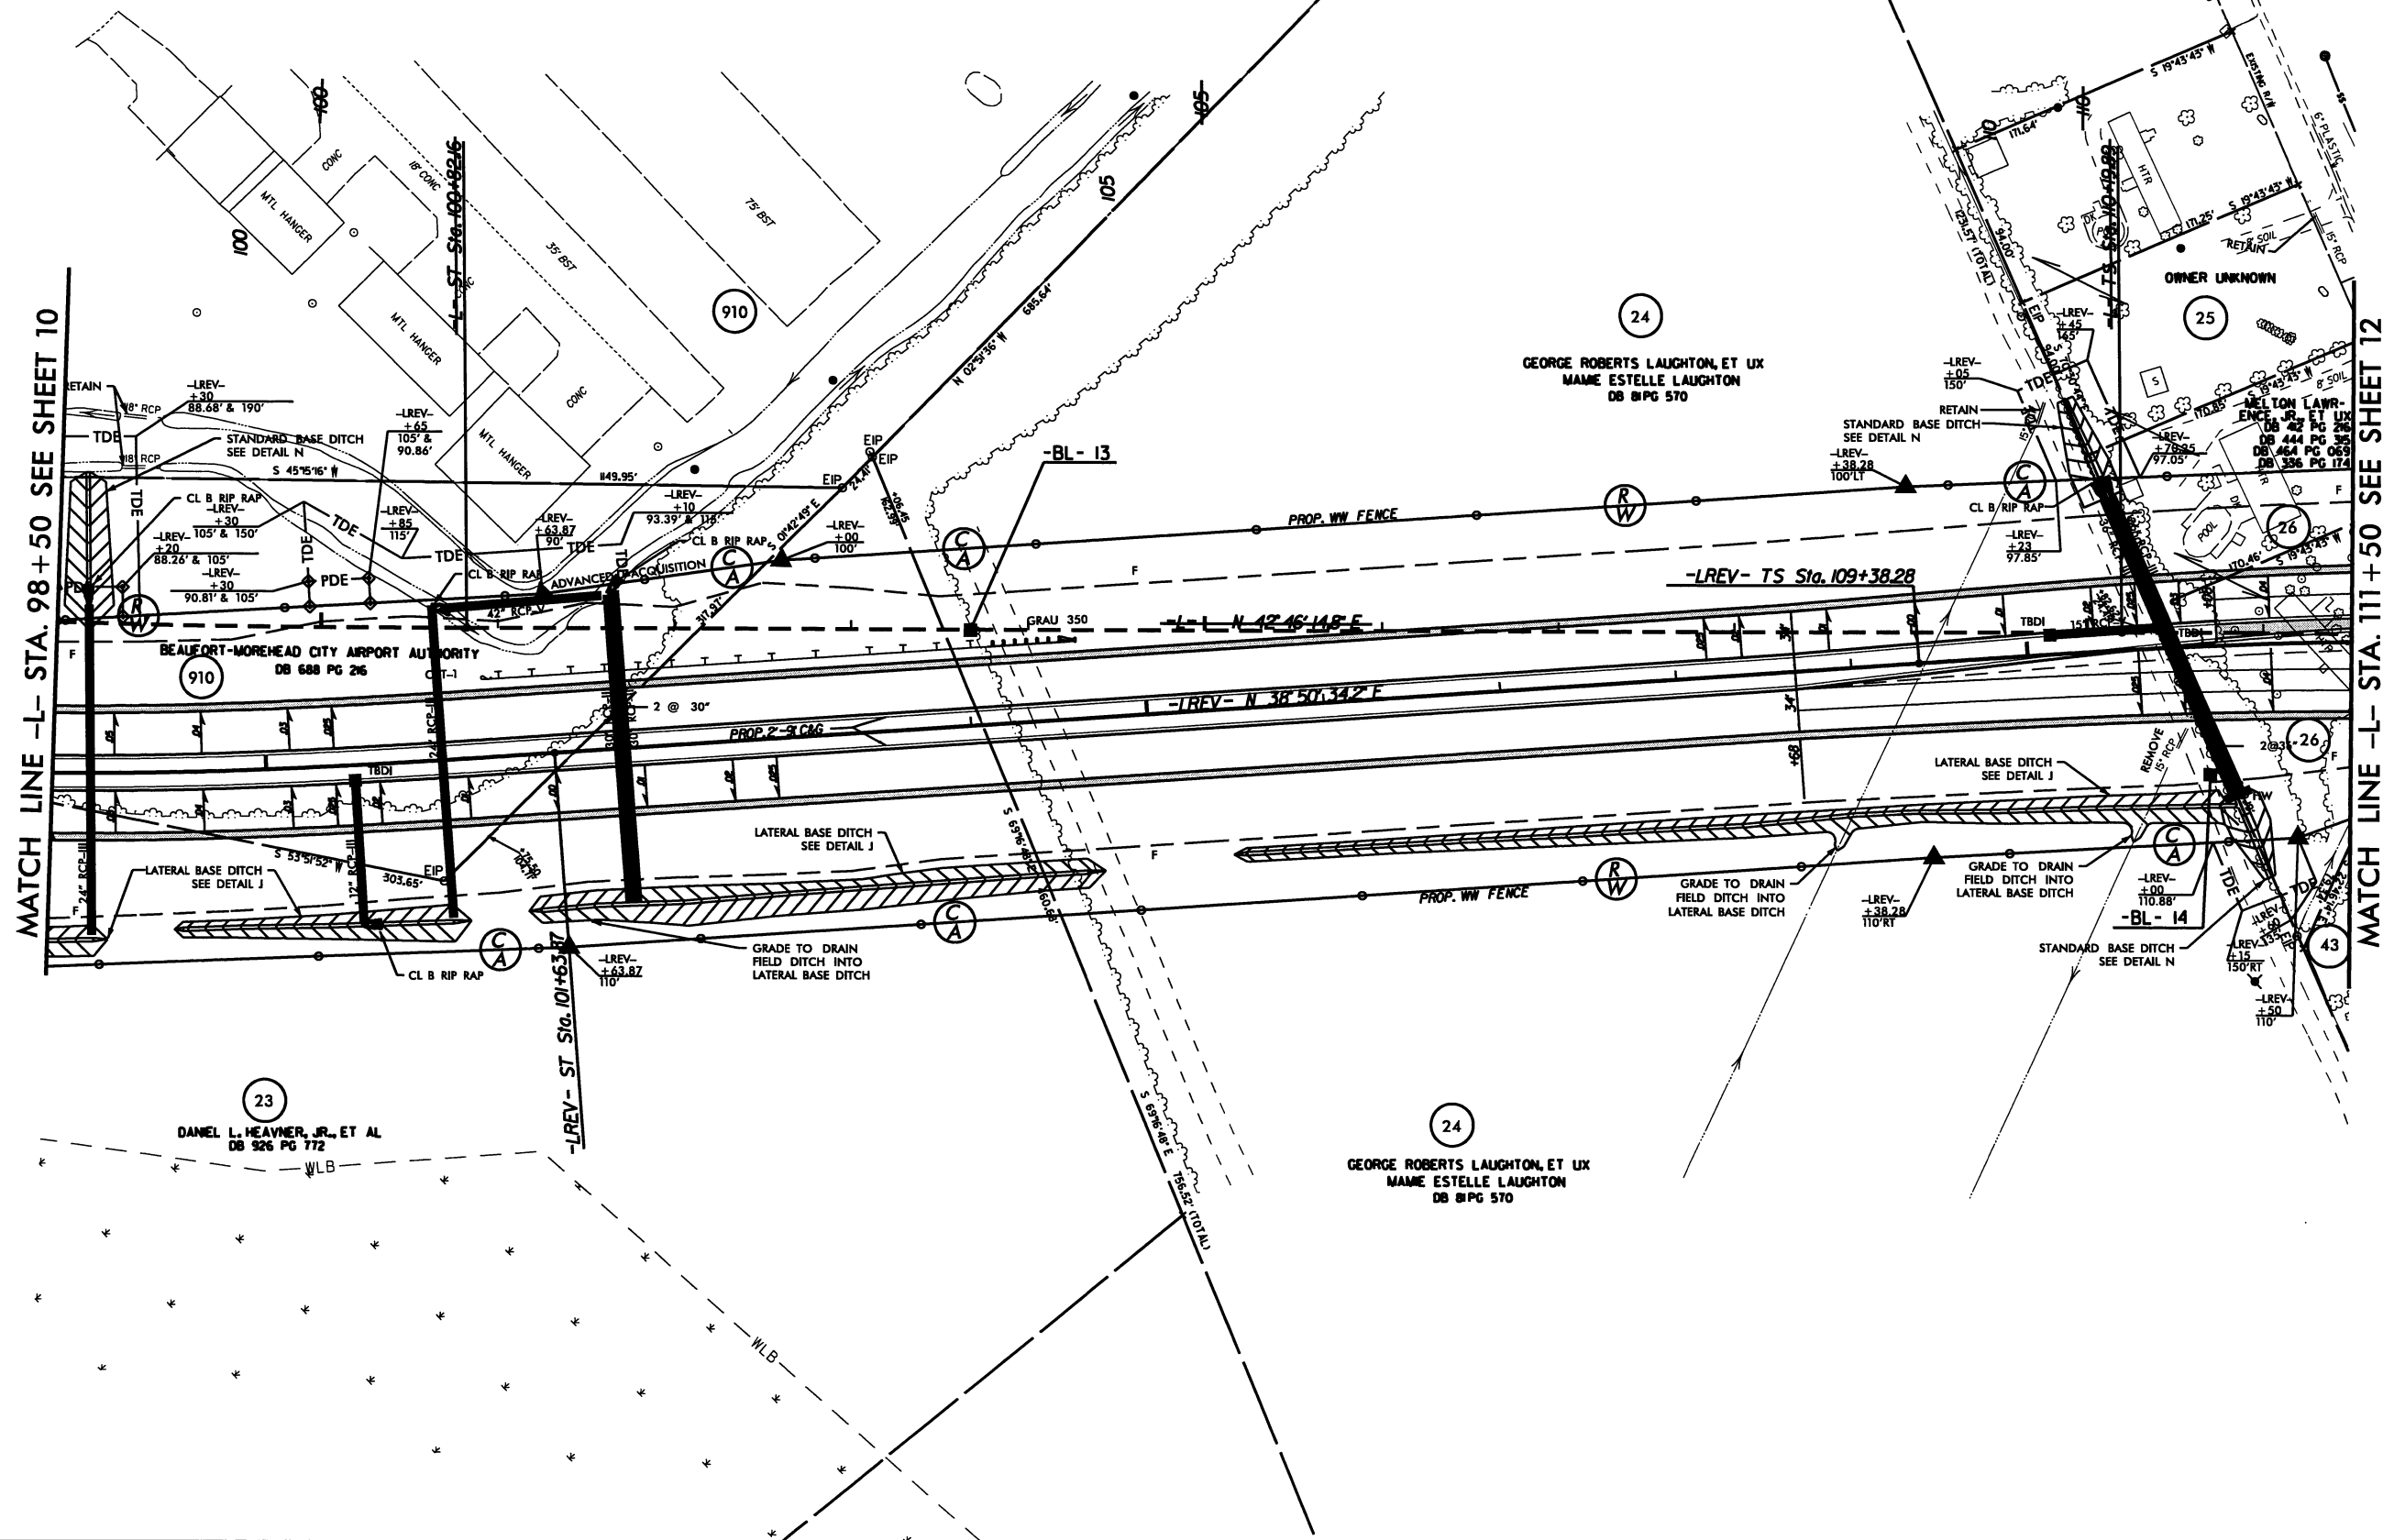

FOR -L- PROFILE SEE SHEET 31  
FOR -LREV- PROFILE SEE SHEET 31  
FOR -Y3- PROFILE SEE SHEETS 36 & 37

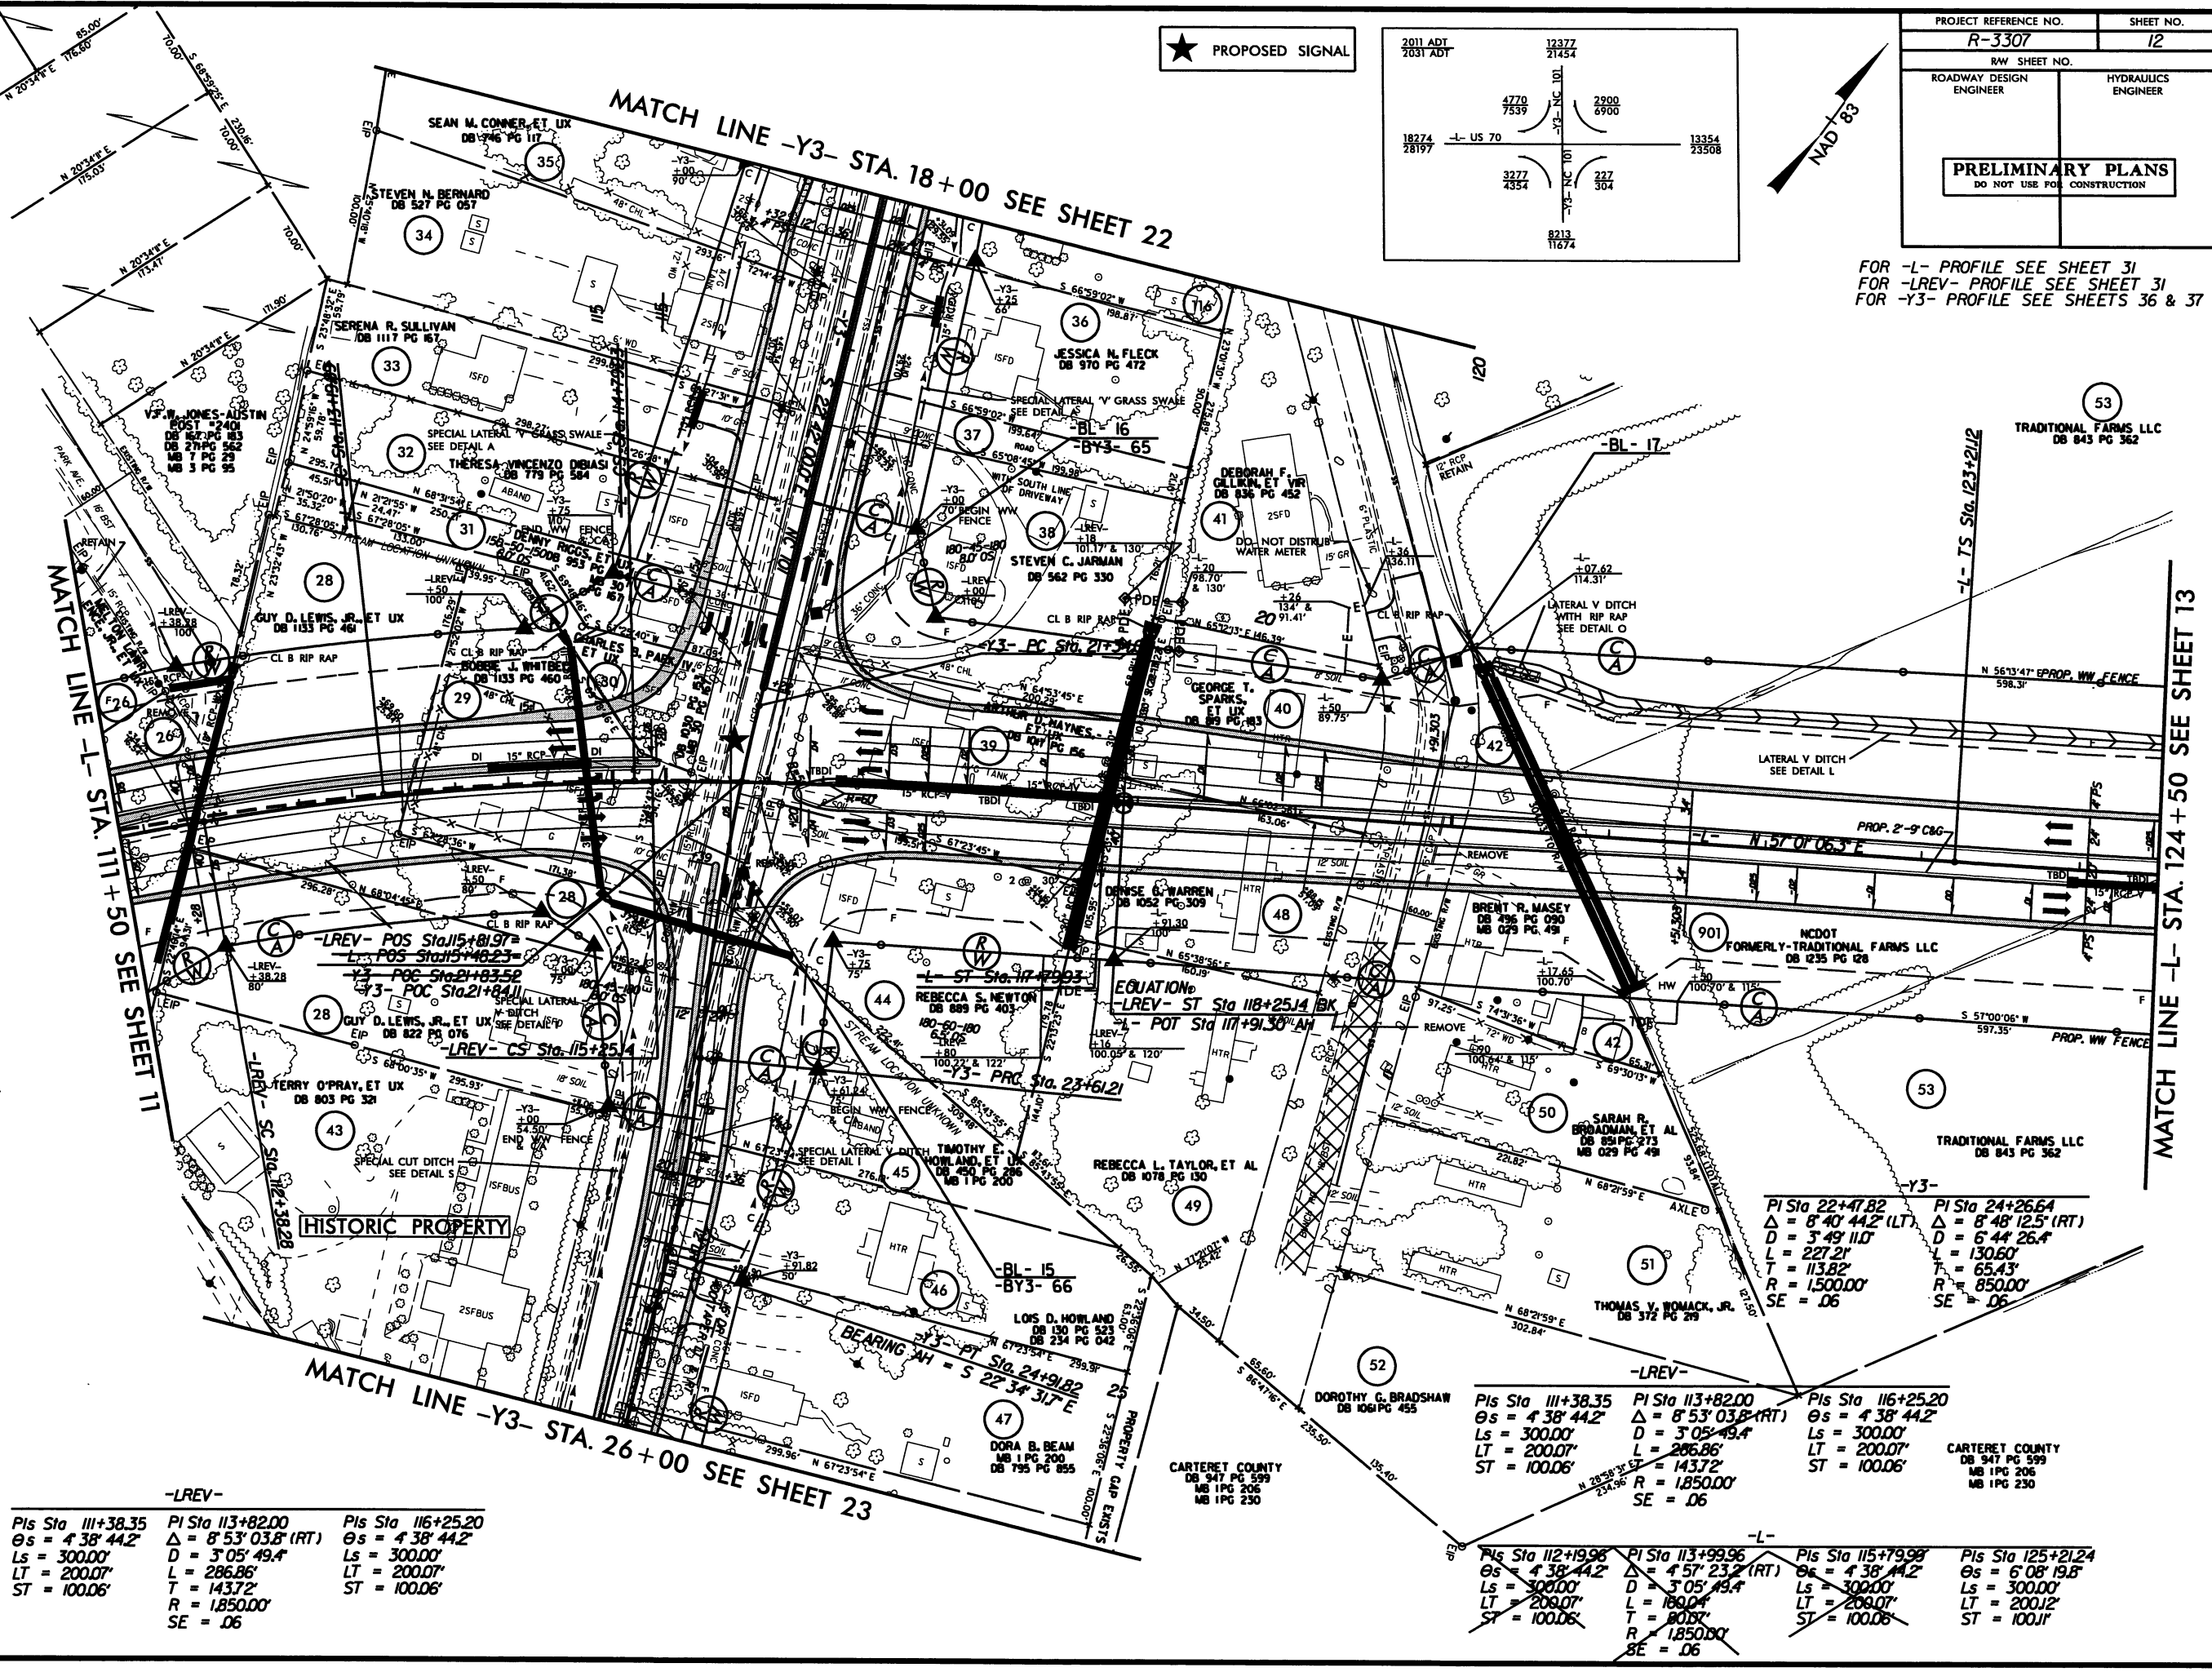

R/W REV. 07/29/10 (KNW): REVISED EXIST/PROP R/W TO NUMERICAL OFFSET.  
R/W REV. 08/01/11 (KNW): DELETED TDE ON PARCEL 53.

01-AUG-2011 09:48  
R:\Roadway\Proj\PSH\3307\_rdy-ps-h-s12.dgn  
\$\$\$\$USERNAME\$\$\$\$

<u>-LREV-</u>		
<i>Pls Sta 111+38.35</i>	<i>PI Sta 113+82.00</i>	<i>Pls Sta 116+25.20</i>
<i>Θs = 4° 38' 44.2"</i>	<i>Δ = 8° 53' 03.8" (RT)</i>	<i>Θs = 4° 38' 44.2"</i>
<i>Ls = 300.00'</i>	<i>D = 3° 05' 49.4"</i>	<i>Ls = 300.00'</i>
<i>LT = 200.07'</i>	<i>L = 286.86'</i>	<i>LT = 200.07'</i>
<i>ST = 100.06'</i>	<i>T = 143.72'</i>	<i>ST = 100.06'</i>
	<i>R = 1,850.00'</i>	
	<i>SE = .06</i>	

Pls Sta 111+38.35  
 $\theta_s = 4^\circ 38' 44.2''$   
 $L_s = 300.00'$   
 $LT = 200.07'$   
 $ST = 100.06'$

Pl Sta 113+82.00  
 $\Delta = 8^\circ 53' 03.8''$  (RT)  
 $D = 3^\circ 05' 49.4''$   
 $L = 266.86'$   
 $R = 1437.2'$   
 $SE = .06$

Pls Sta 116+25.20  
 $\theta_s = 4^\circ 38' 44.2''$   
 $L_s = 300.00'$   
 $LT = 200.07'$   
 $ST = 100.06'$

N  $28^\circ 58' 32''$  E  
 234.96'

-L-			
<del>Pis Sta 112+19.96</del>	<del>Pi Sta 113+99.96</del>	<del>Pis Sta 115+79.98</del>	<del>Pis Sta 125+21.24</del>
<del>Os = 4' 38" 44.2"</del>	<del>Δ = 4' 57" 23.2" (RT)</del>	<del>Os = 4' 38" 44.2"</del>	<del>Os = 6' 08" 19.8"</del>
<del>Ls = 300.00'</del>	<del>Δ = 3' 05" 19.4"</del>	<del>Ls = 300.00'</del>	<del>Ls = 300.00'</del>
<del>LT = 209.07'</del>	<del>L = 180.04'</del>	<del>LT = 209.07'</del>	<del>LT = 200.12'</del>
<del>ST = 100.06'</del>	<del>T = 80.87'</del>	<del>ST = 100.06'</del>	<del>ST = 100.11'</del>
	<del>R = 1,850.00'</del>		
	<del>SE = .06</del>		




8/17/99

-L-			-LREV-		
Pls Sta 86+60.40	Pls Sta 92+95.72	Pls Sta 99+15.51	Pls Sta 90+88.79	Pls Sta 95+30.80	Pls Sta 99+63.95
$\theta_s = 2' 42'' 09.5''$	$\Delta = 23' 32'' 00.0''$ (LT)	$\theta_s = 2' 42'' 09.5''$	$\theta_s = 5' 03'' 19.8''$	$\Delta = 22' 45'' 19.9''$ (LT)	$\theta_s = 5' 03'' 19.8''$
$L_s = 250.00'$	$D = 2' 09'' 43.6''$	$L_s = 250.00'$	$L_s = 300.00'$	$D = 3' 22'' 13.2''$	$L_s = 300.00'$
$LT = 166.69'$	$L = 1088.45'$	$LT = 166.69'$	$LT = 200.08'$	$L = 675.17'$	$LT = 200.08'$
$ST = 83.35'$	$T = 553.01'$	$ST = 83.35'$	$ST = 100.07'$	$T = 342.09'$	$ST = 100.07'$
	$R = 2650.00'$			$R = 1700.00'$	
	$SE = .05$			$SE = .06$	

BEAUFORT-MOREHEAD CITY  
AIRPORT AUTHORITY  
DB 16 PG 420  
DB 100 PG 374  
DB 100 PG 455  
DB 100 PG 471  
DB 100 PG 231  
DB 100 PG 263  
DB 100 PG 288  
DB 100 PG 296  
DB 100 PG 333  
DB 100 PG 346  
DB 100 PG 347  
DB 100 PG 348  
DB 100 PG 420

PROJECT REFERENCE NO. <i>R-3307</i>		SHEET NO. <i>10</i>	
RW SHEET NO.			
ROADWAY DESIGN ENGINEER		HYDRAULICS ENGINEER	
<div>PRELIMINARY PLANS</div> <div>DO NOT USE FOR CONSTRUCTION</div>			

FOR -LREV- PROFILE SEE SHEET 30

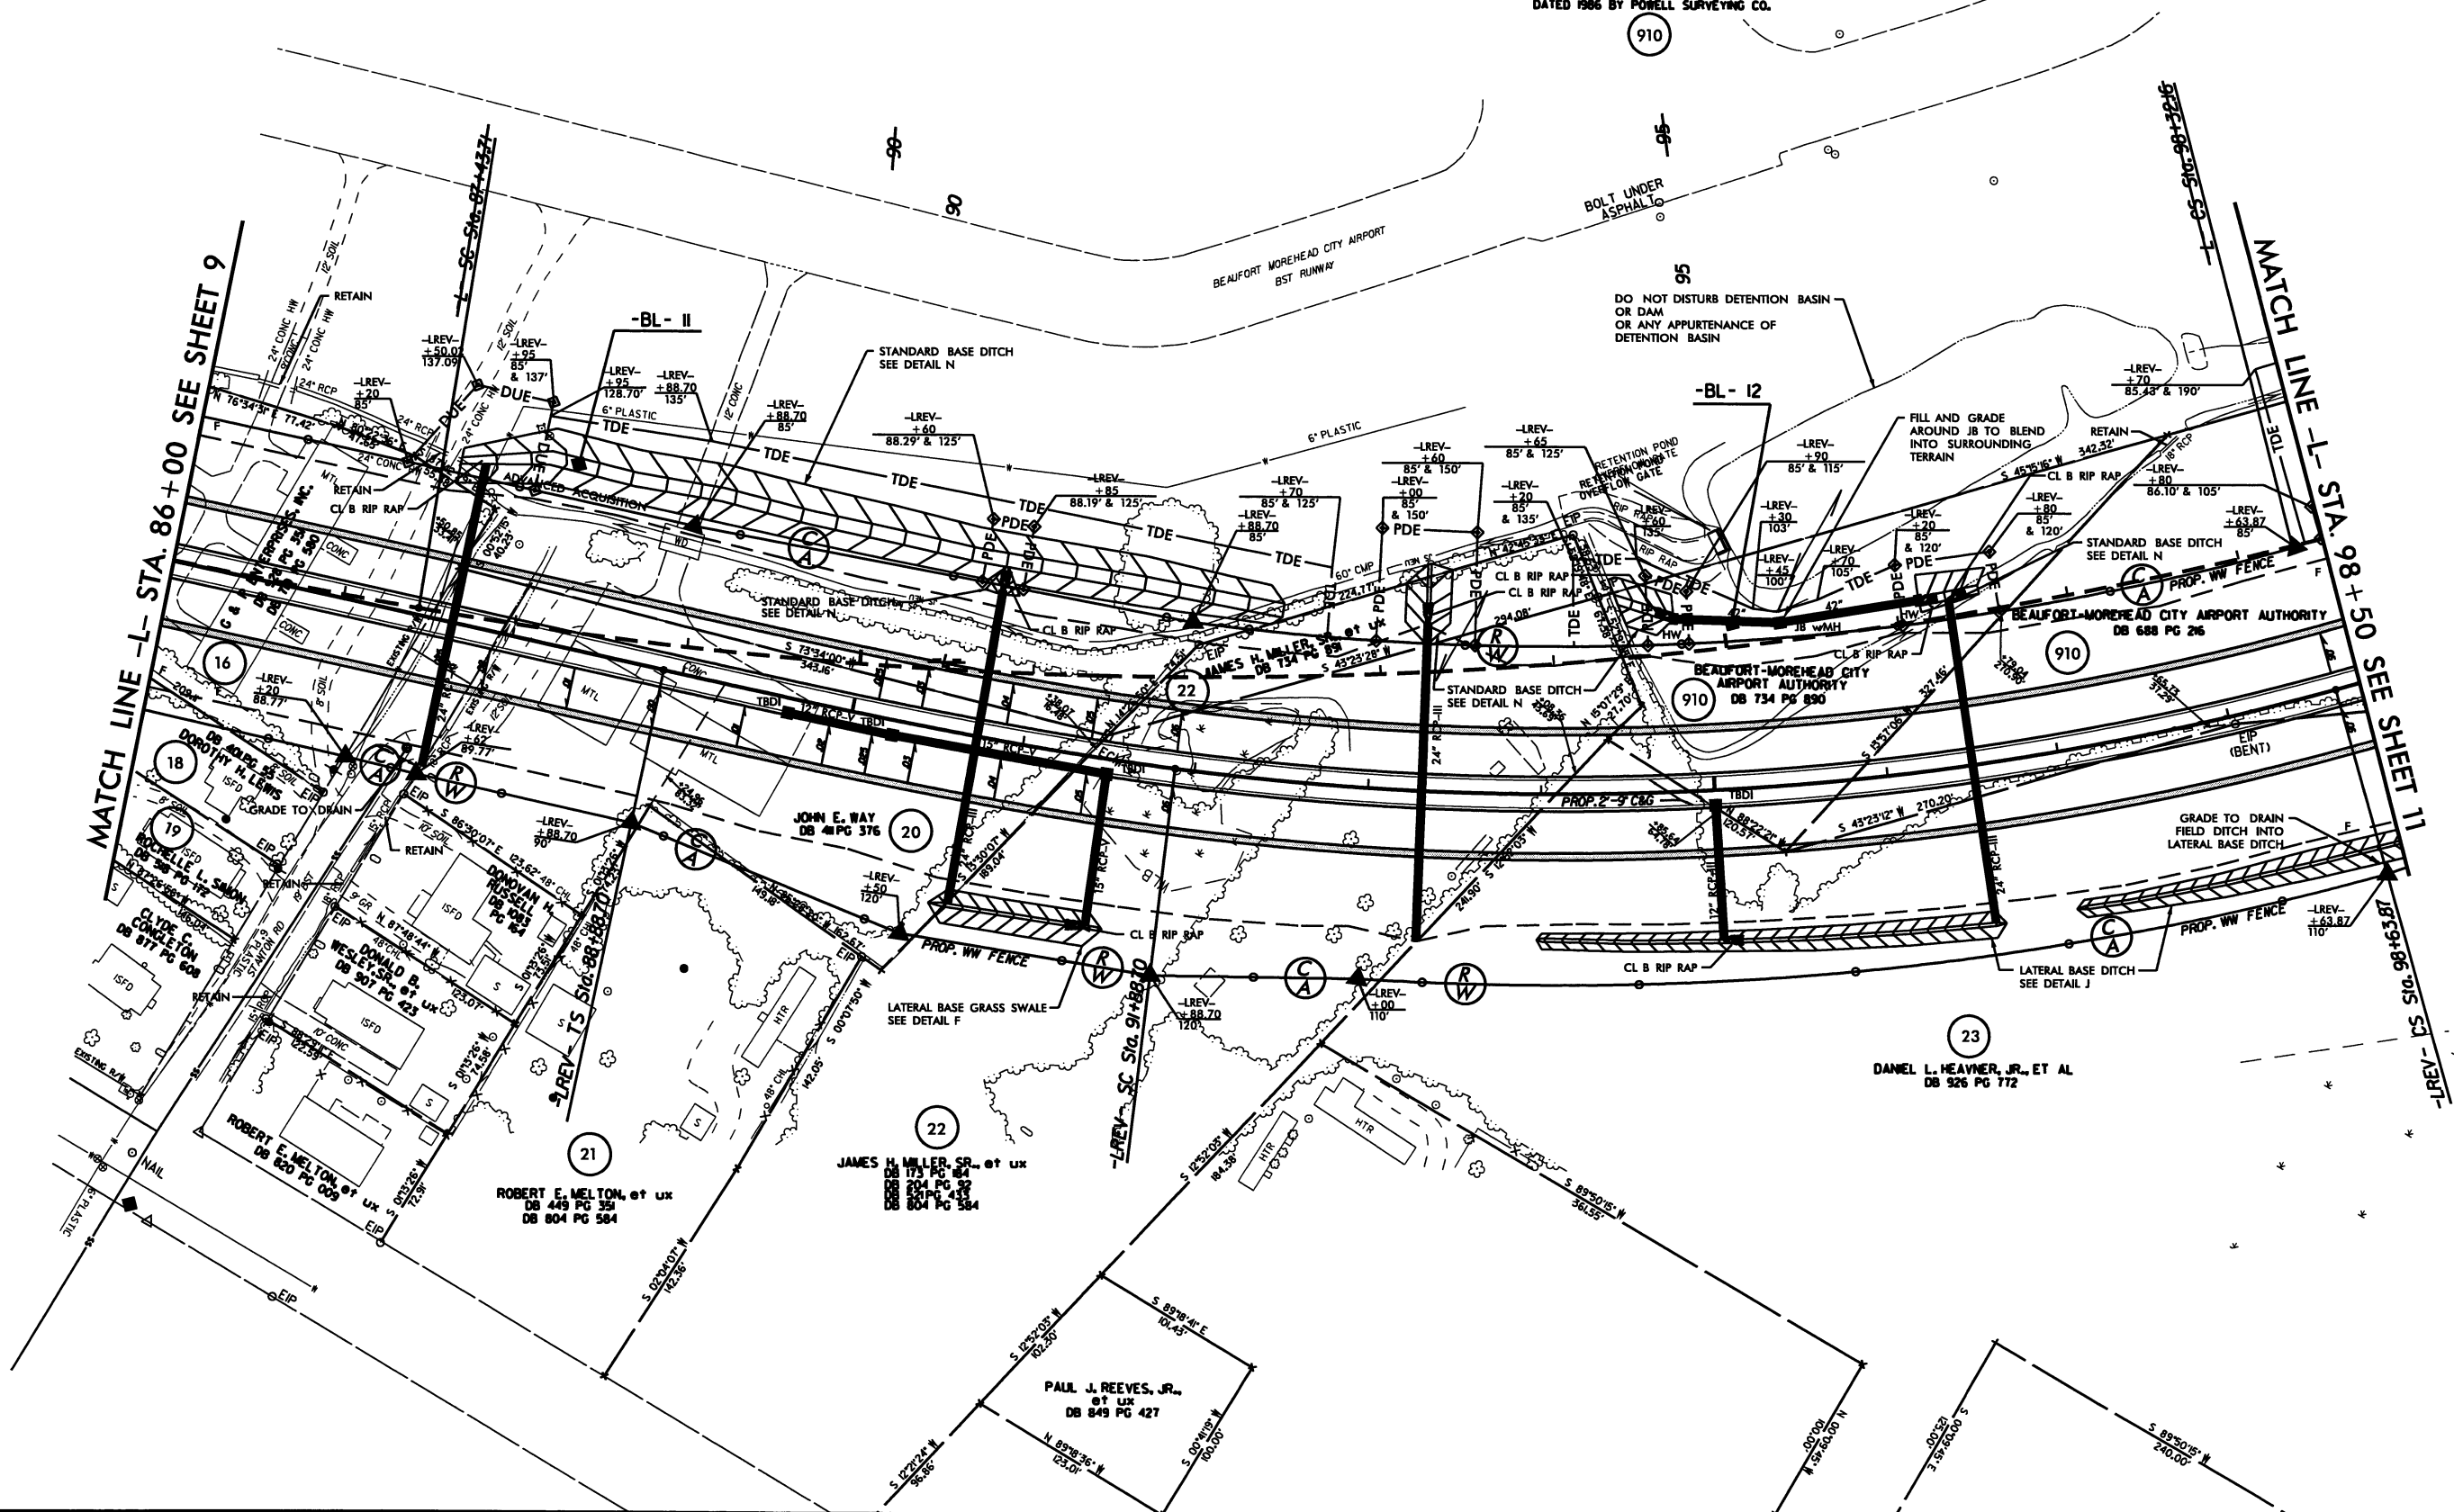

REVISIONS  
R/W REV. 07/29/10 (KMW) REVISED EXIST/PROP R/W TO NUMERICAL OFFSET.  
R/W REV. 04/18/11 (KMW) DELETED PDE, REVISED TDE, AND ADDED DUE ON PARCEL 910.

30-JUN-2011 14:53  
R:\Roadwork\3307\PSH\3307-rdy-psh.s10.dgn  
\$\$\$\$\$USERNAME\$\$\$\$\$


8/17/99

REVISIONS

Q:\AUG-2011\09\49  
R:\Roadway\04\1\01\PSHV-3307.rdy.psh.s13.dgn  
\$\$\$\$\$PRNAME\$\$\$\$\$

PROJECT REFERENCE NO.		SHEET NO.	
R-3307		13	
RW SHEET NO.			
ROADWAY DESIGN ENGINEER		HYDRAULICS ENGINEER	
<div>PRELIMINARY PLANS</div> <div>DO NOT USE FOR CONSTRUCTION</div>			


FOR -L- PROFILE SEE SHEET 31

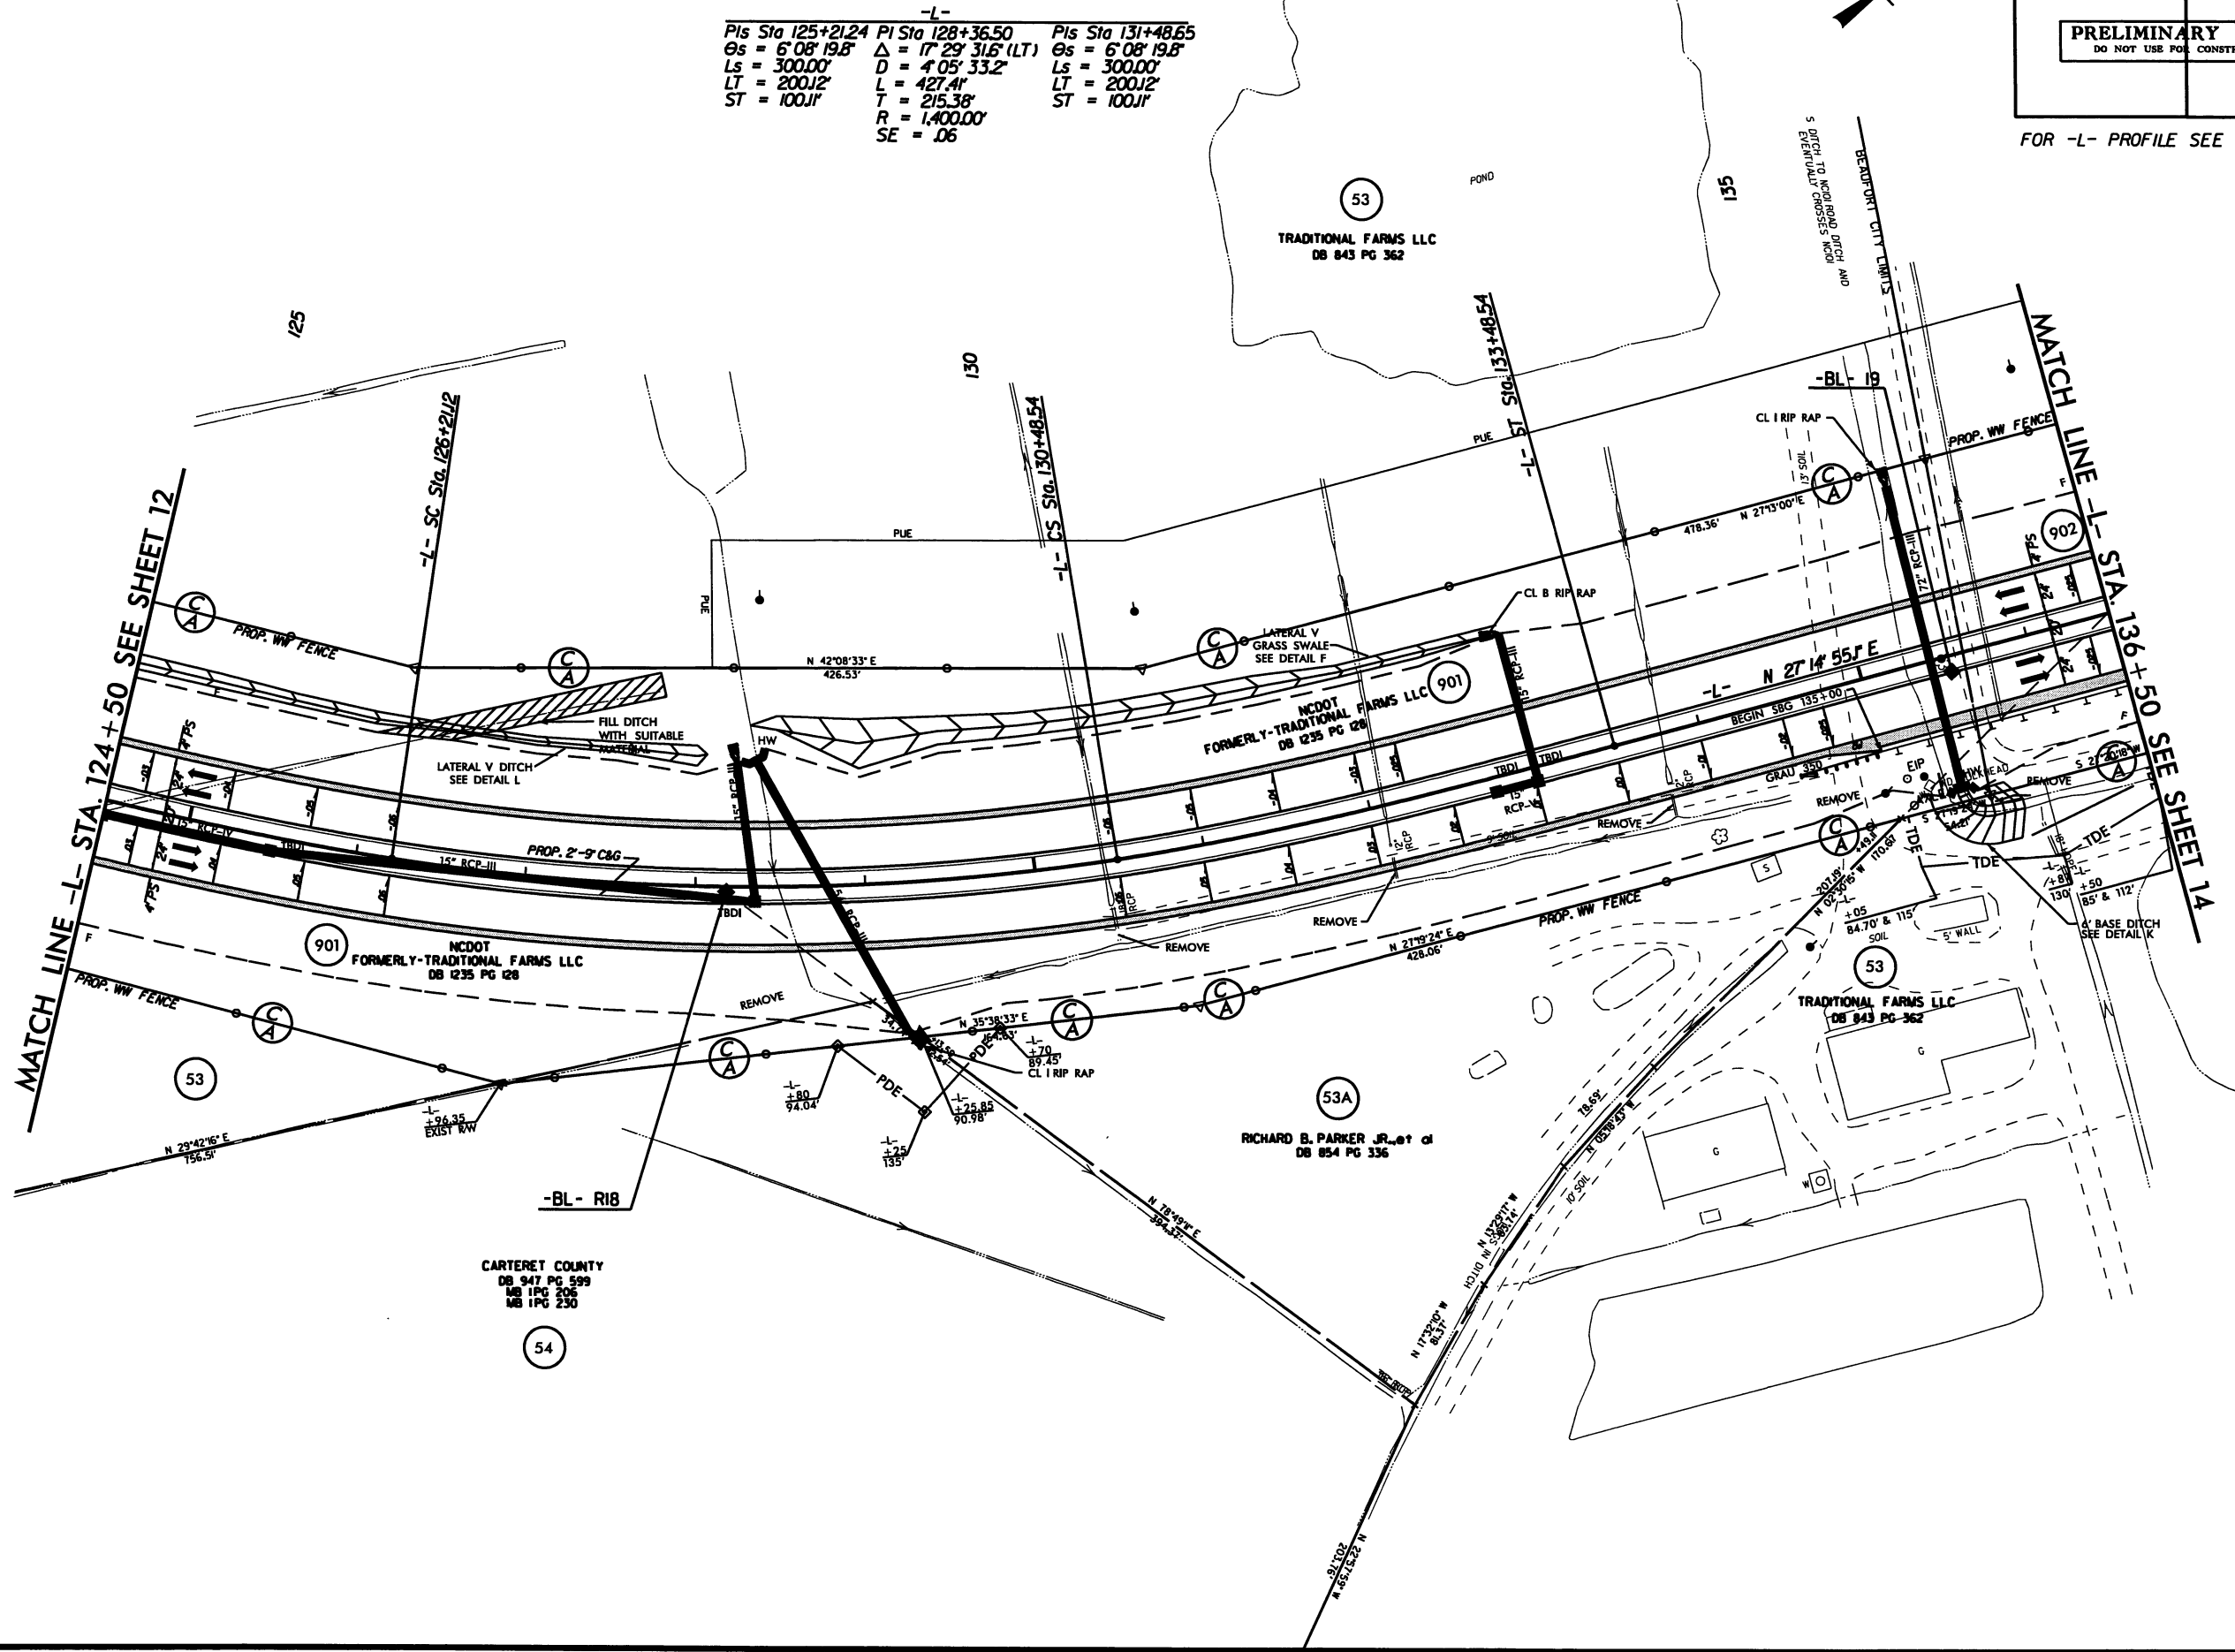

8/17/99  
30-JUN-2011 14:53  
R:\Roadway\Pro\PSHV-3307-rdj-psh-sl4.dgn  
\$\$\$\$\$

REVISIONS

MATCH LINE -L- STA. 136+50 SEE SHEET 13

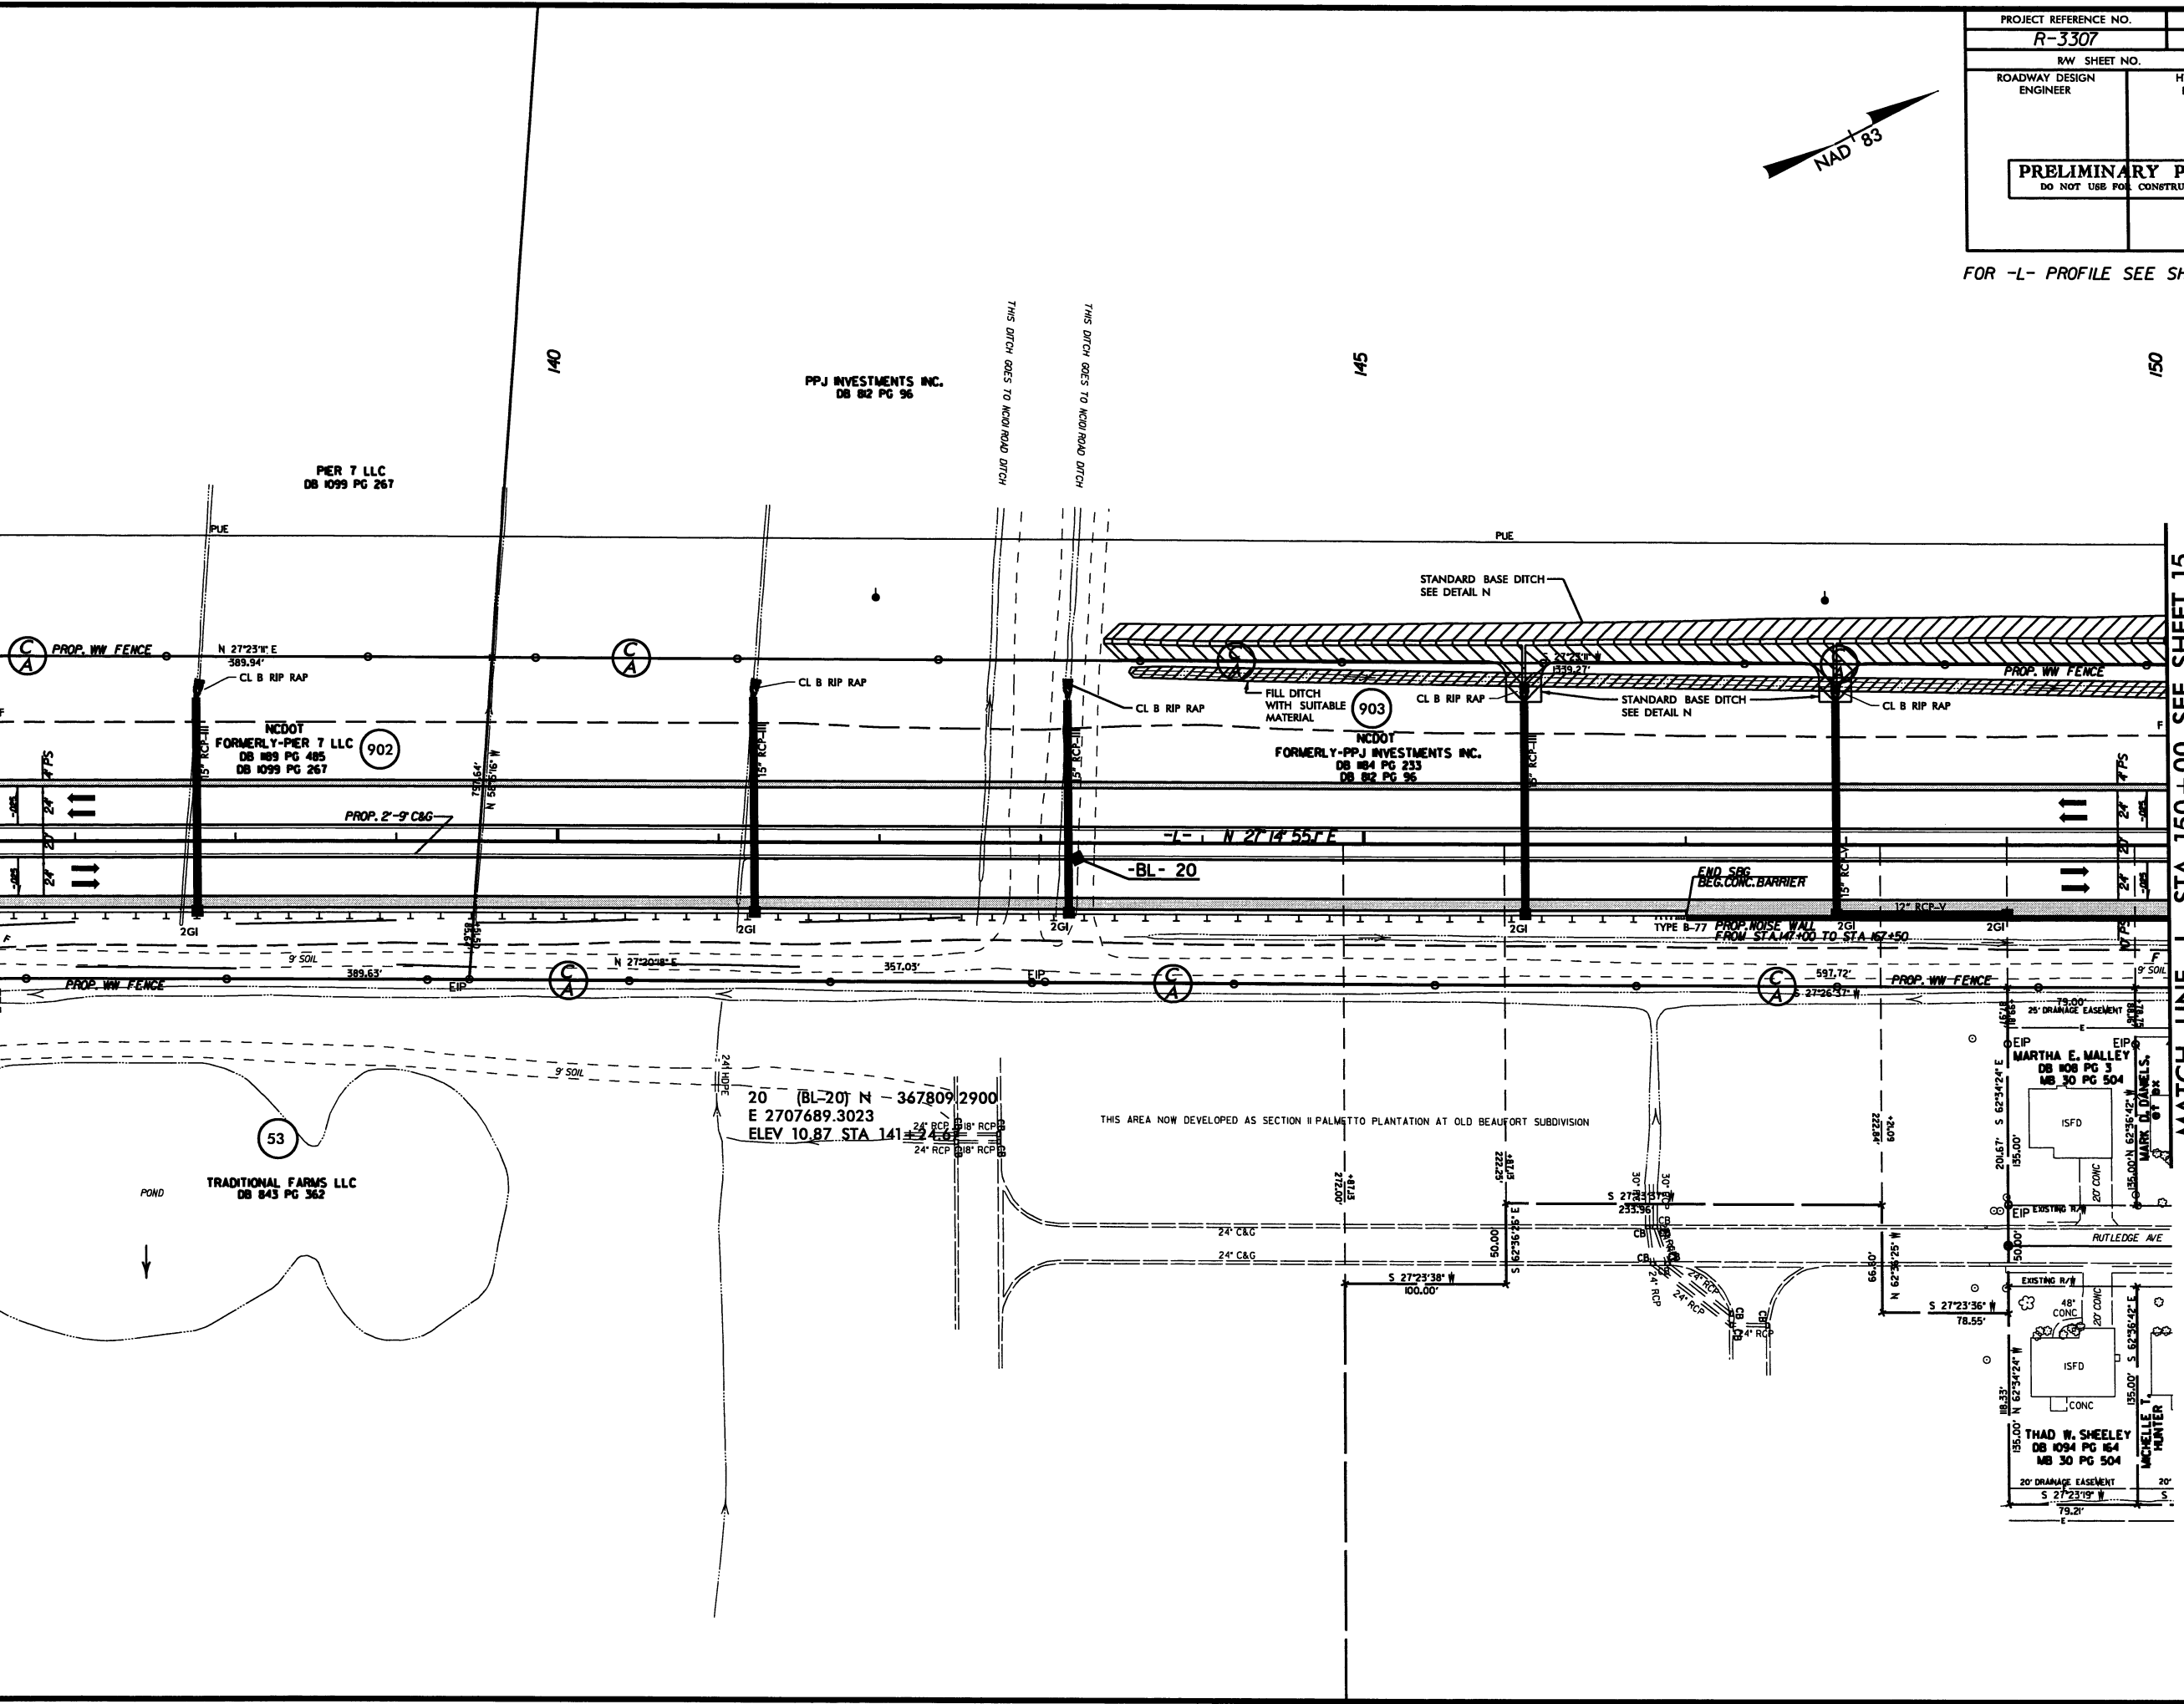

MATCH LINE -L- STA. 150+00 SEE SHEET 15

PROJECT REFERENCE NO. <b>R-3307</b>		SHEET NO. <b>14</b>	
RW SHEET NO.		HYDRAULICS ENGINEER	
ROADWAY DESIGN ENGINEER		HYDRAULICS ENGINEER	
<b>PRELIMINARY PLANS</b> DO NOT USE FOR CONSTRUCTION			

FOR -L- PROFILE SEE SHEET 32

8/17/99


30-JUN-2011 14:53  
R:\Roadway\3307\PSH\3307\_rdy\_psh\_al5.dgn  
SSS\SSS\SSS

REVISIONS  
R/W REV. 07/29/10 (KMW) REVISED EXIST R/W TO NUMERICAL OFFSET.

MATCH LINE -L- STA. 150+00 SEE SHEET 14


MATCH LINE -L- STA. 162+50 SEE SHEET 16

-L-  
Pis Sta 161+22.35 PI Sta 168+39.75 Pis Sta 174+88.19  
Es = 6'00'36.2" Δ = 46'42'44.3" (RT) Es = 6'00'36.2"  
Ls = 300.00' D = 4'00'24.1" Ls = 300.00'  
LT = 200.12' L = 1,65.86' LT = 200.12'  
ST = 100.10' T = 617.52' ST = 100.10'  
R = 1,430.00'  
SE = .06

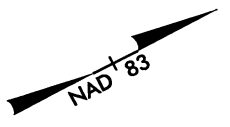

PROJECT REFERENCE NO. <b>R-3307</b>		SHEET NO. <b>15</b>	
RW SHEET NO.			
ROADWAY DESIGN ENGINEER		HYDRAULICS ENGINEER	
<b>PRELIMINARY PLANS</b> DO NOT USE FOR CONSTRUCTION			

FOR -L- PROFILE SEE SHEET 32

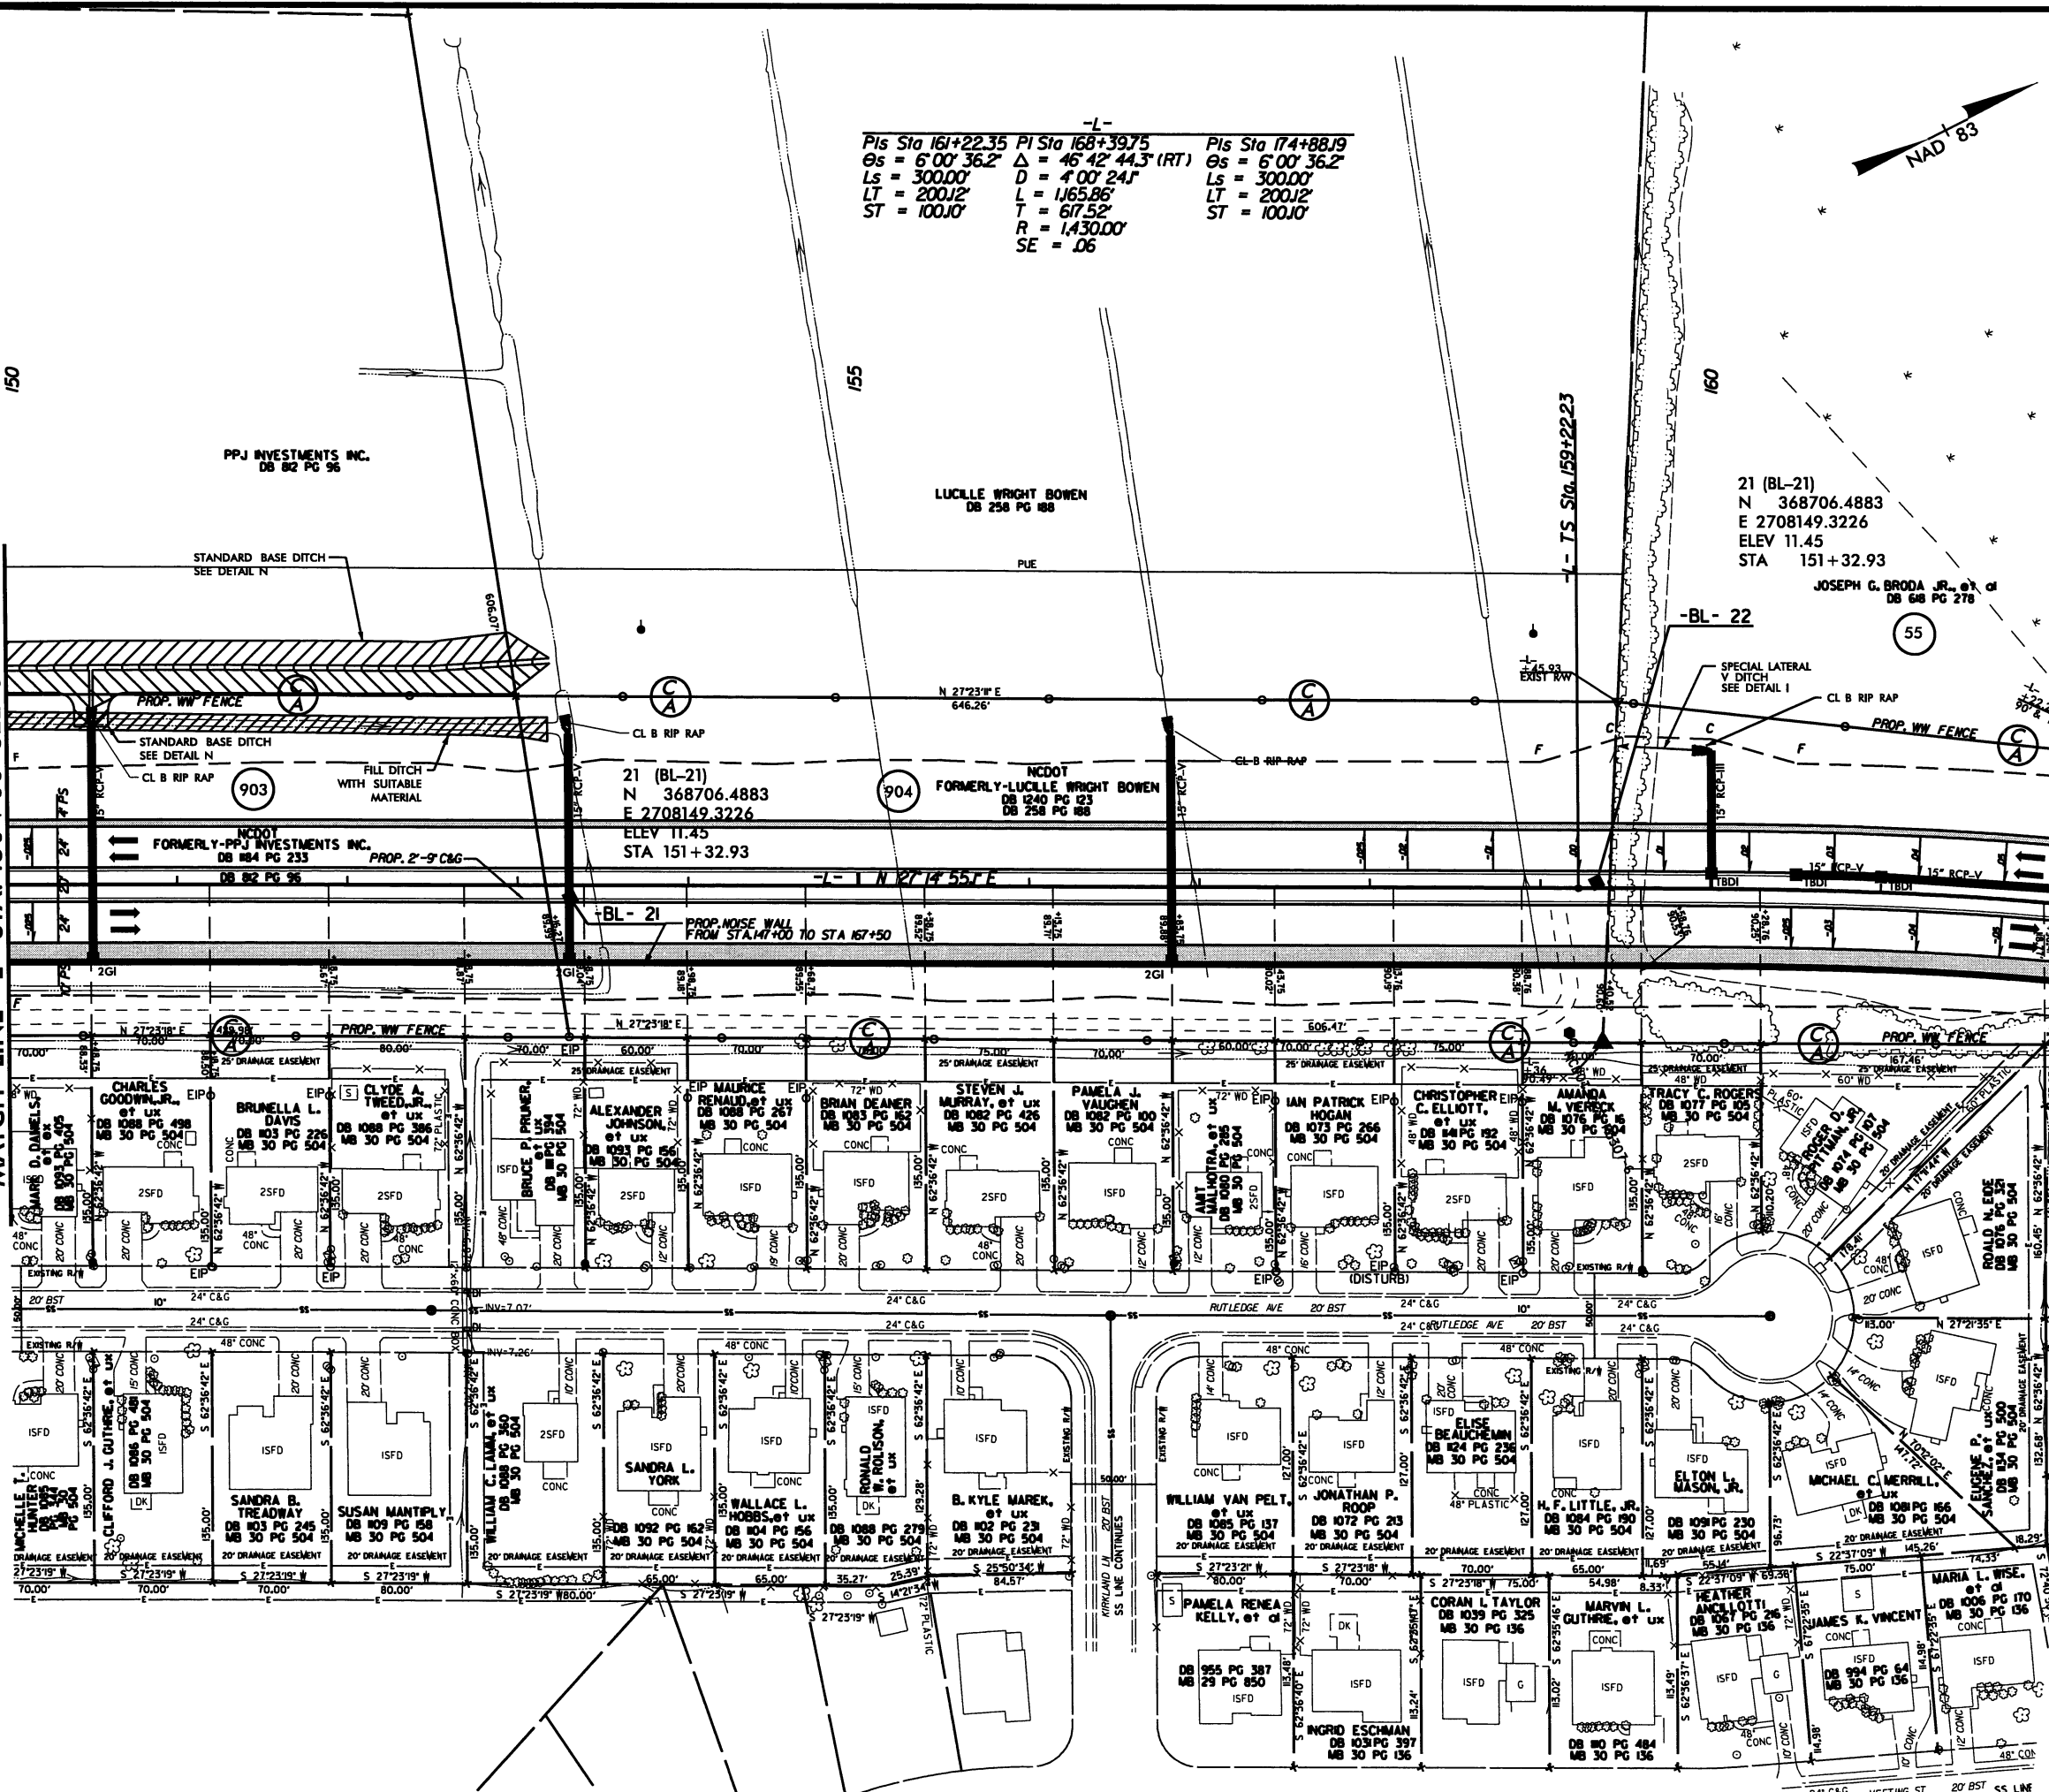

21 (BL-21)  
N 368706.4883  
E 2708149.3226  
ELEV 11.45  
STA 151+32.93

JOSEPH C. BRODA JR. et al  
DB 68 PG 278

LUCILLE WRIGHT BOWEN  
DB 258 PG 188

21 (BL-21)  
N 368706.4883  
E 2708149.3226  
ELEV 11.45  
STA 151+32.93

FORMERLY-LUCILLE WRIGHT BOWEN  
DB 1240 PG 123  
DB 258 PG 188

8/17/99

30-JUN-2011 14:53  
R:\Roadway\04\05\PSHYR-3307-rdy-psh-s16.dgn  
\*\*\*\*\*FRAME\*\*\*\*\*

REVISIONS  
R/W REV. 07/29/10 (KWW) REVISED EXIST/PROP R/W TO NUMERICAL OFFSET.

Pls Sta 161+22.35 PI Sta 168+39.75 Pls Sta 174+88.19  
Os = 6'00' 36.2" Δ = 46'42' 44.3" (RT) Os = 6'00' 36.2"  
Ls = 300.00' D = 4'00' 24.1" Ls = 300.00'  
LT = 200.12' L = 1,655.86' LT = 200.12'  
ST = 100.10' T = 617.52' ST = 100.10'  
R = 1,430.00'  
SE = 06

J. BRINSON WEBB, JR. et al  
DB 862 PG 697

24 (BL-24)  
N 370000.1768  
E 2709143.2507  
ELEV 10.62  
STA 168+03.67



23 (BL-28)  
N 369720.4606  
E 2708727.0379  
ELEV 11.57  
STA 163+02.20

JOSEPH G. BRODA JR. et al  
DB 68 PG 278

ALTON G. WILLIS, et al  
DB 473 PG 28


PROJECT REFERENCE NO.	SHEET NO.
R-3307	16
RW SHEET NO.	
ROADWAY DESIGN ENGINEER	HYDRAULICS ENGINEER
PRELIMINARY PLANS DO NOT USE FOR CONSTRUCTION	


FOR -L- PROFILE SEE SHEET 33

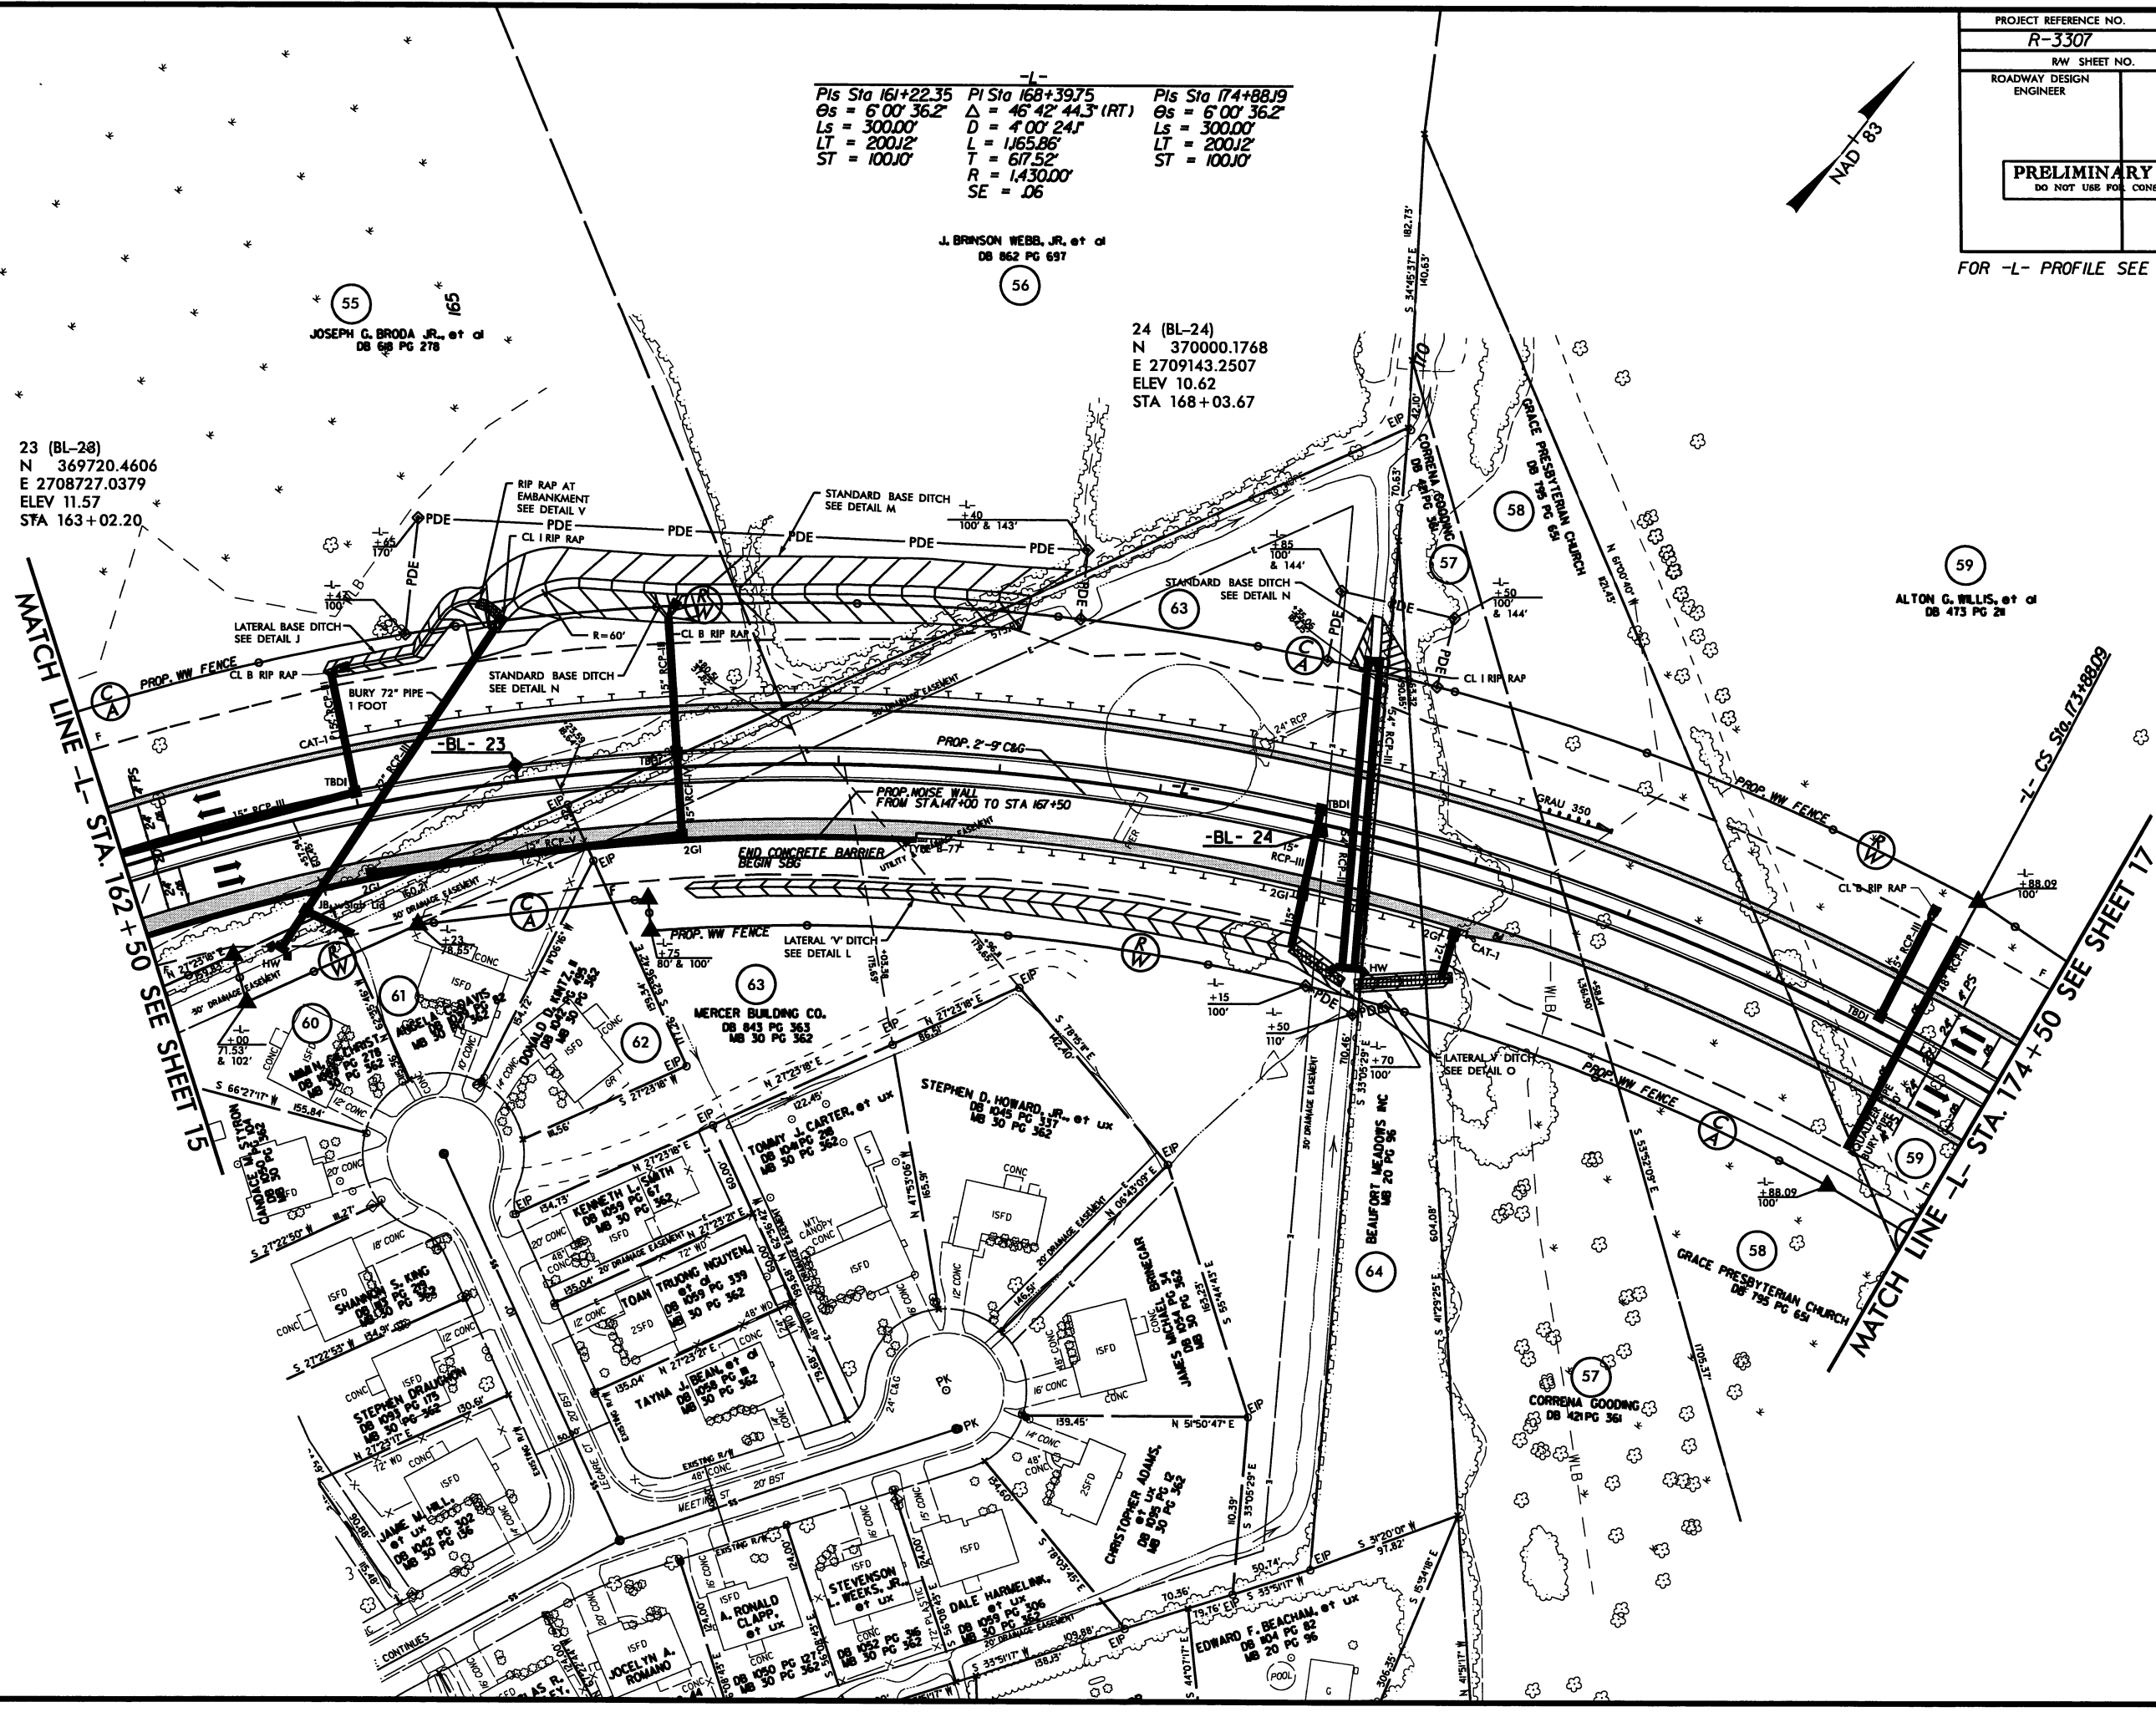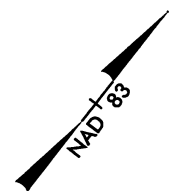




FOR -L- PROFILE SEE SHEET 33

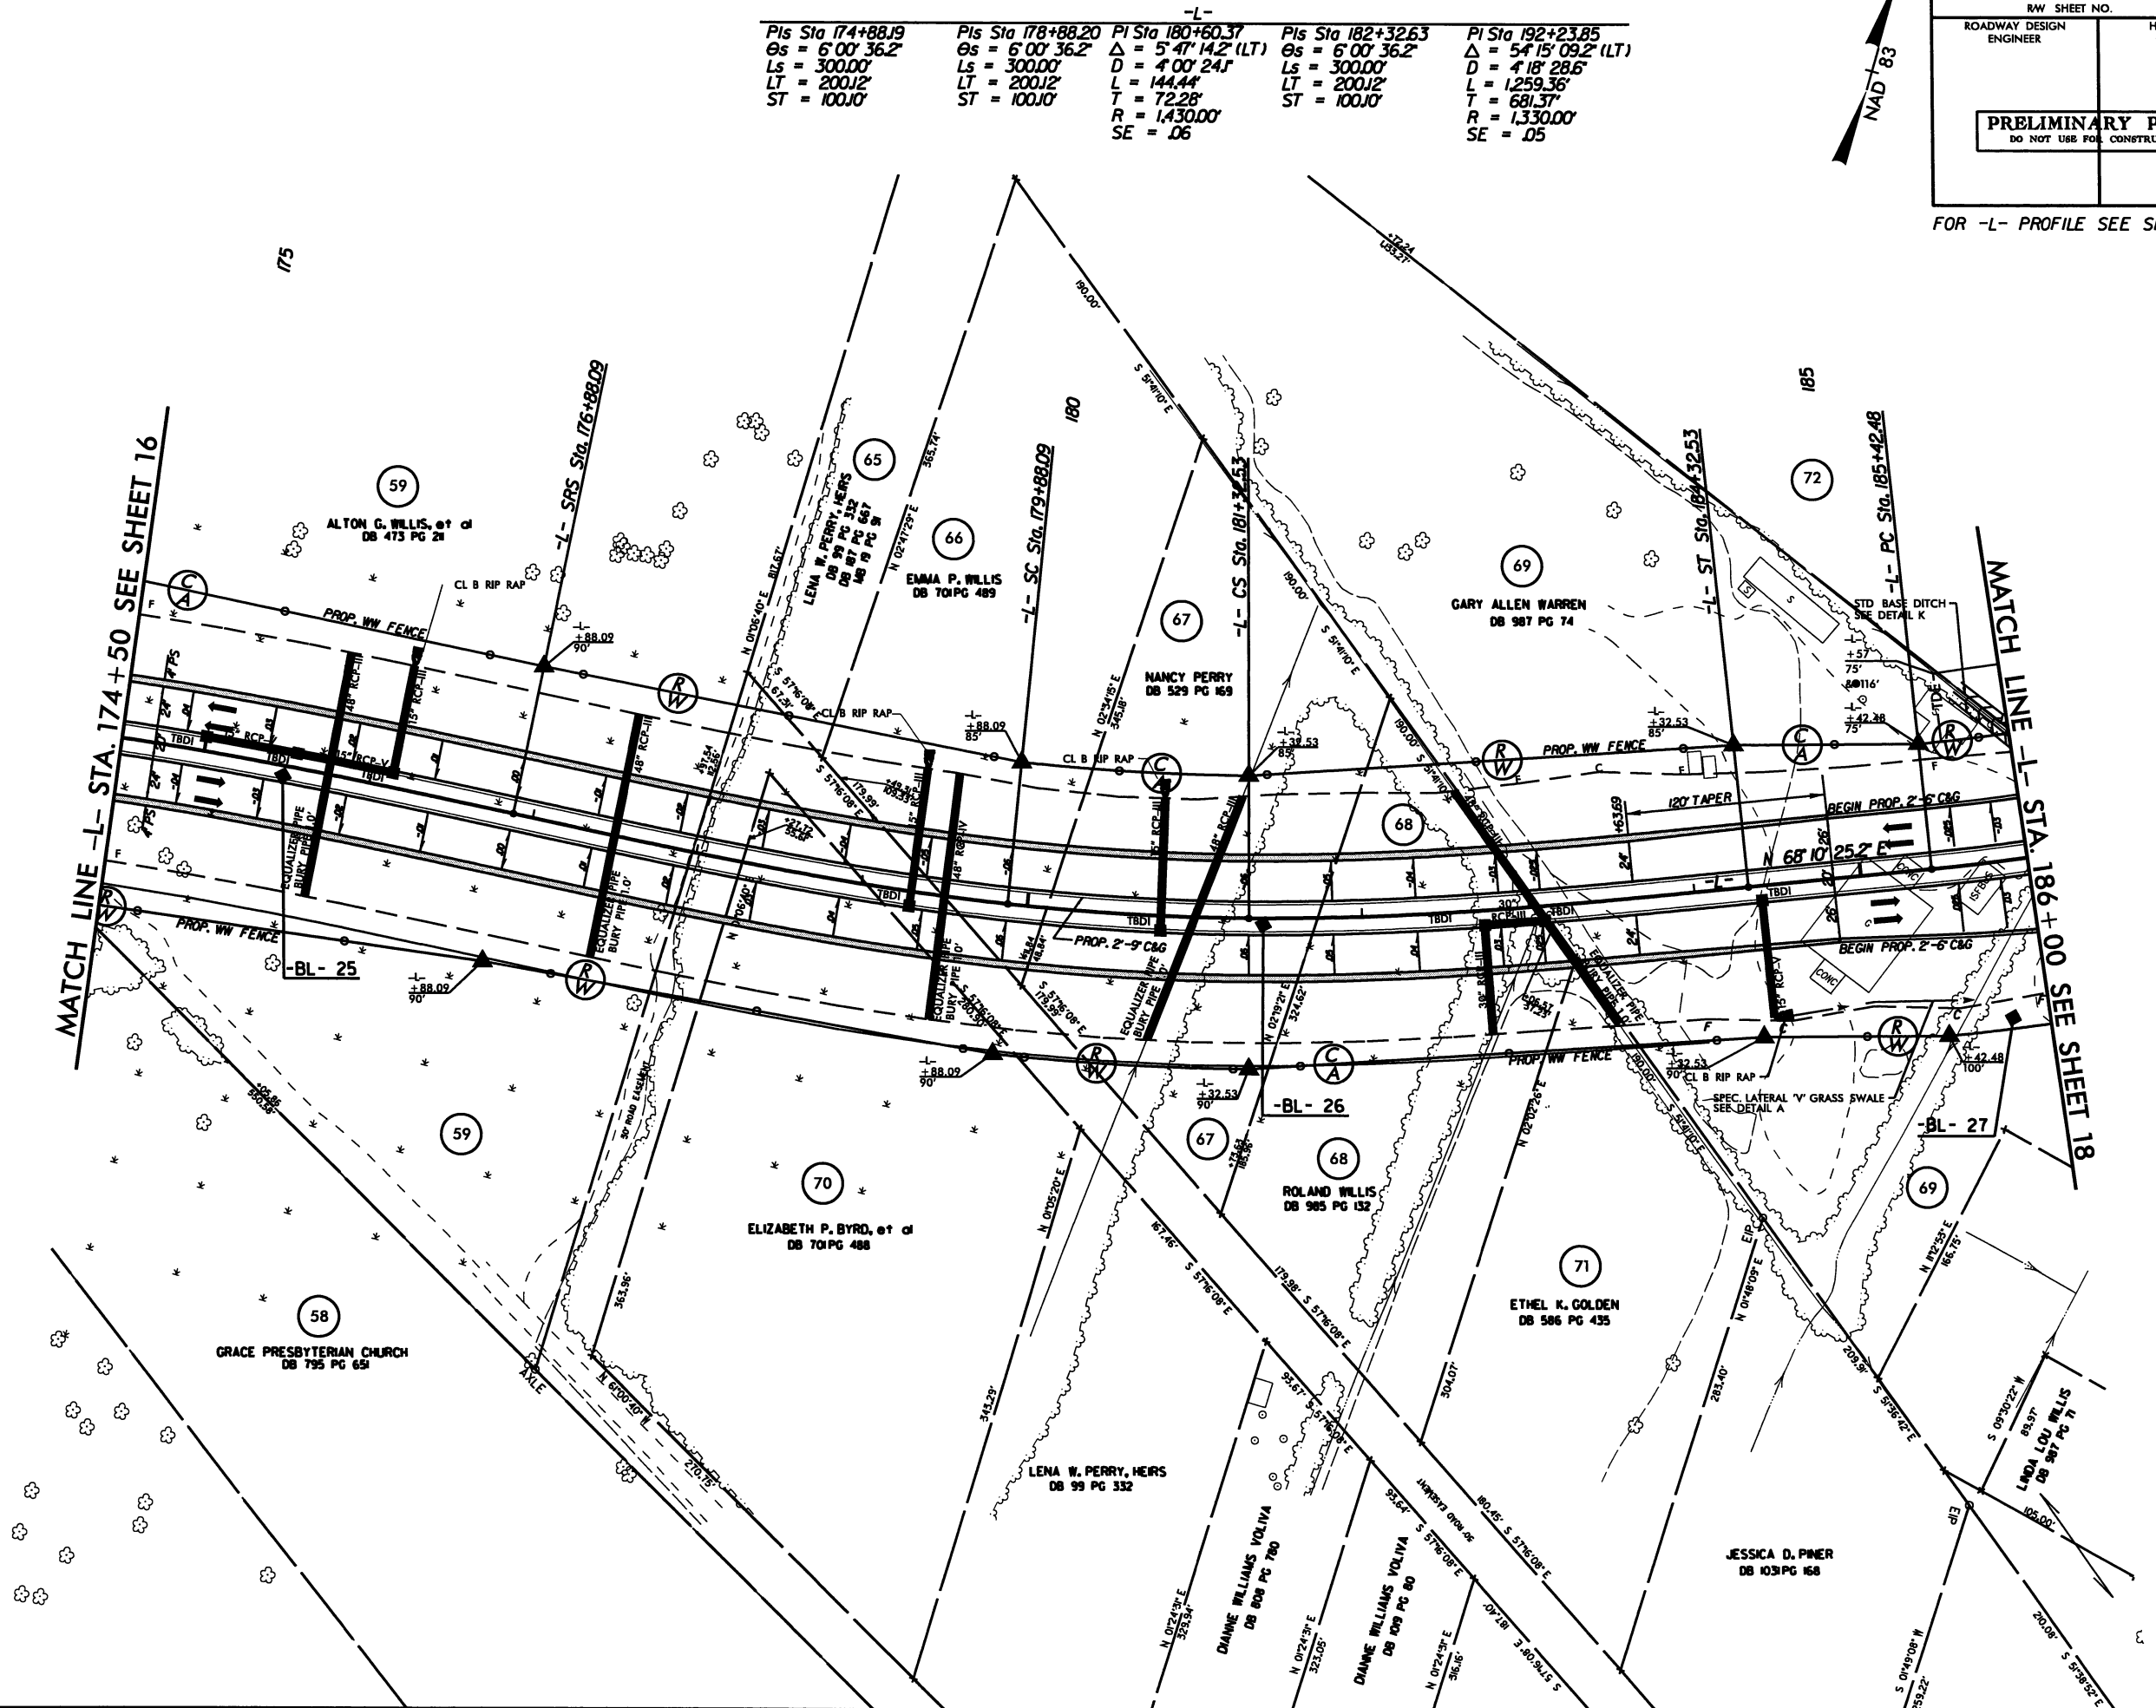

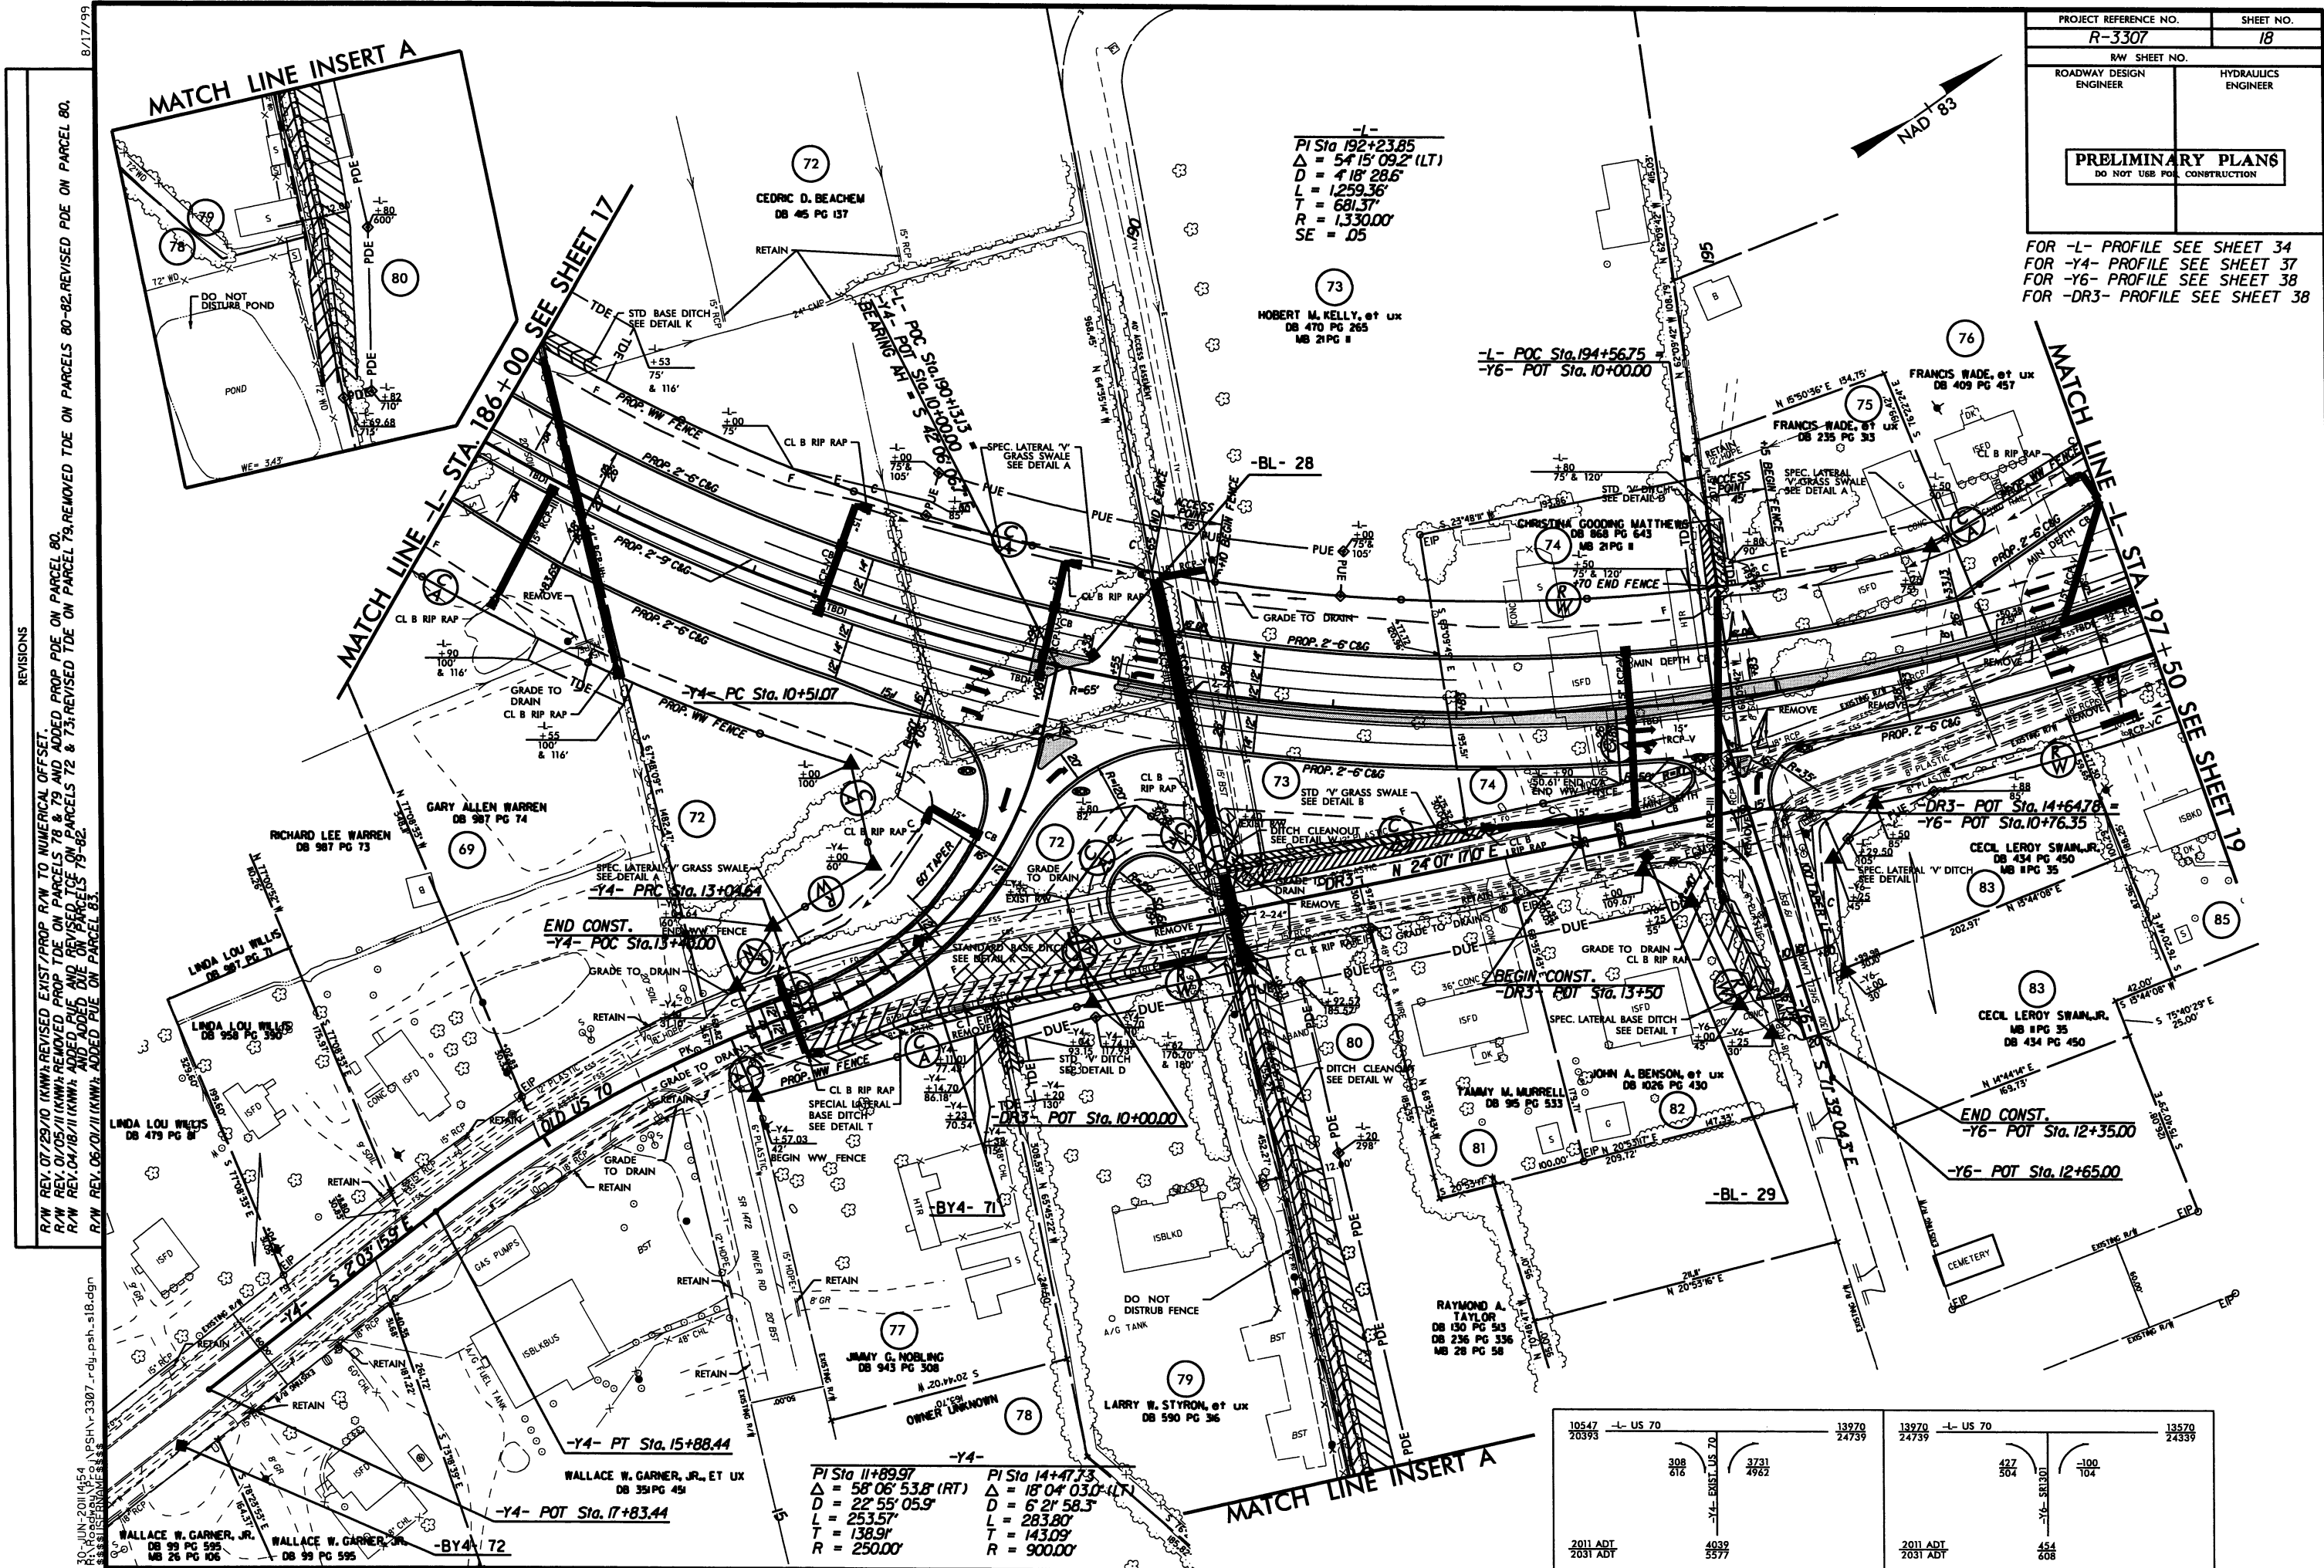

## REVISIONS

FOR -L- PROFILE SEE SHEET 34  
FOR -Y7- PROFILE SEE SHEET 38

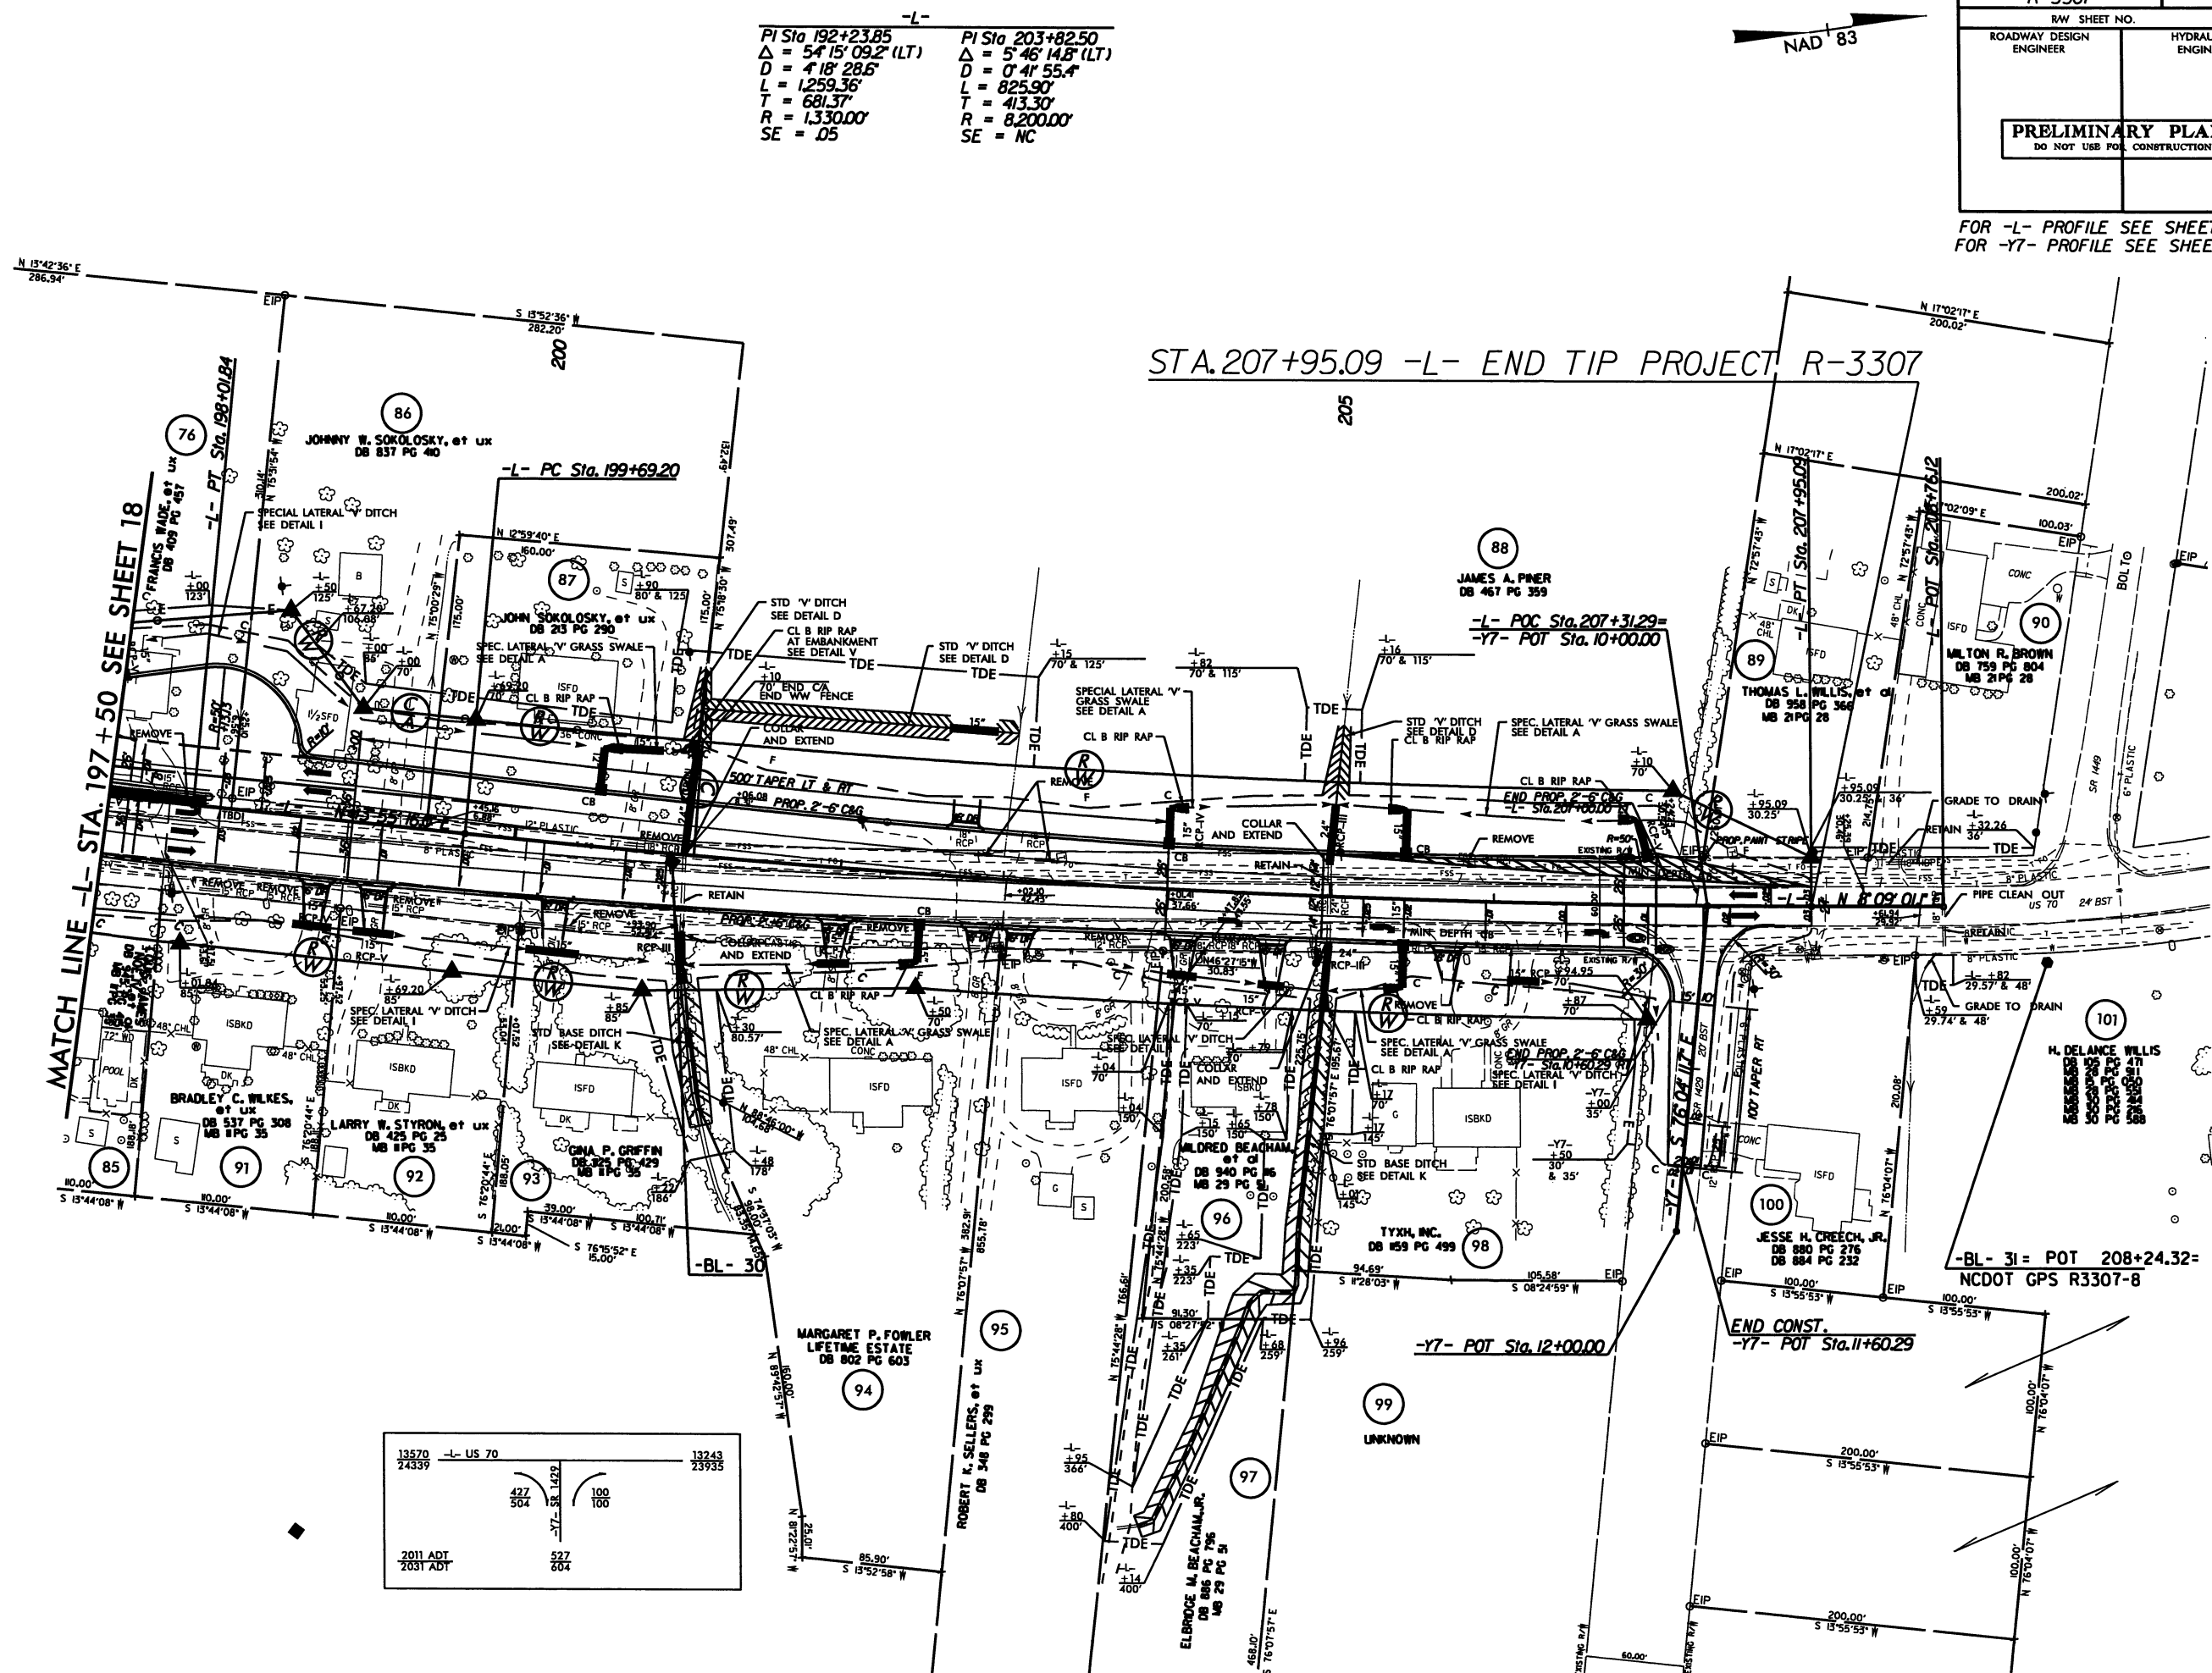

8/17/99



R/W REV. 07/23/10 (KIM) REVISED EXIST R/W TO NUMERICAL OFFSET.  
R/W REV. 04/18/11 (KIM) DELETED PROP. R/W ADDED PDE AND TCE ON PARCELS 106 & 107, ADDED PARCEL 120 AND ADDED TCE ON PARCEL 120.

30-JUN-2011 14:54  
R:\Roadway\2010\PSH\3307\_rdw\_psh.s20.dgn  
\$\$\$\$\$USERNAME\$\$\$\$\$

REVISIONS

PROJECT REFERENCE NO.		SHEET NO.
R-3307		20
RW SHEET NO.		
ROADWAY DESIGN ENGINEER	HYDRAULICS ENGINEER	
<div><div>PRELIMINARY PLANS</div><div>DO NOT USE FOR CONSTRUCTION</div></div>		

FOR -Y2- PROFILE SEE SHEETS 35 & 36

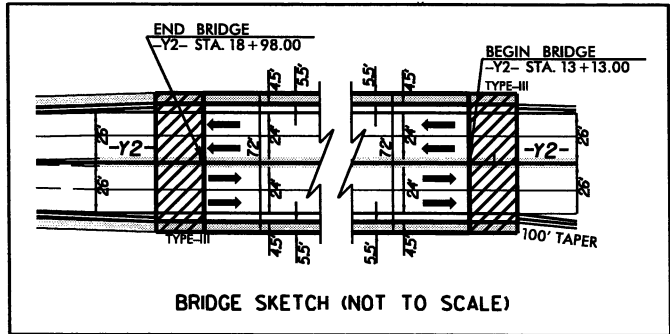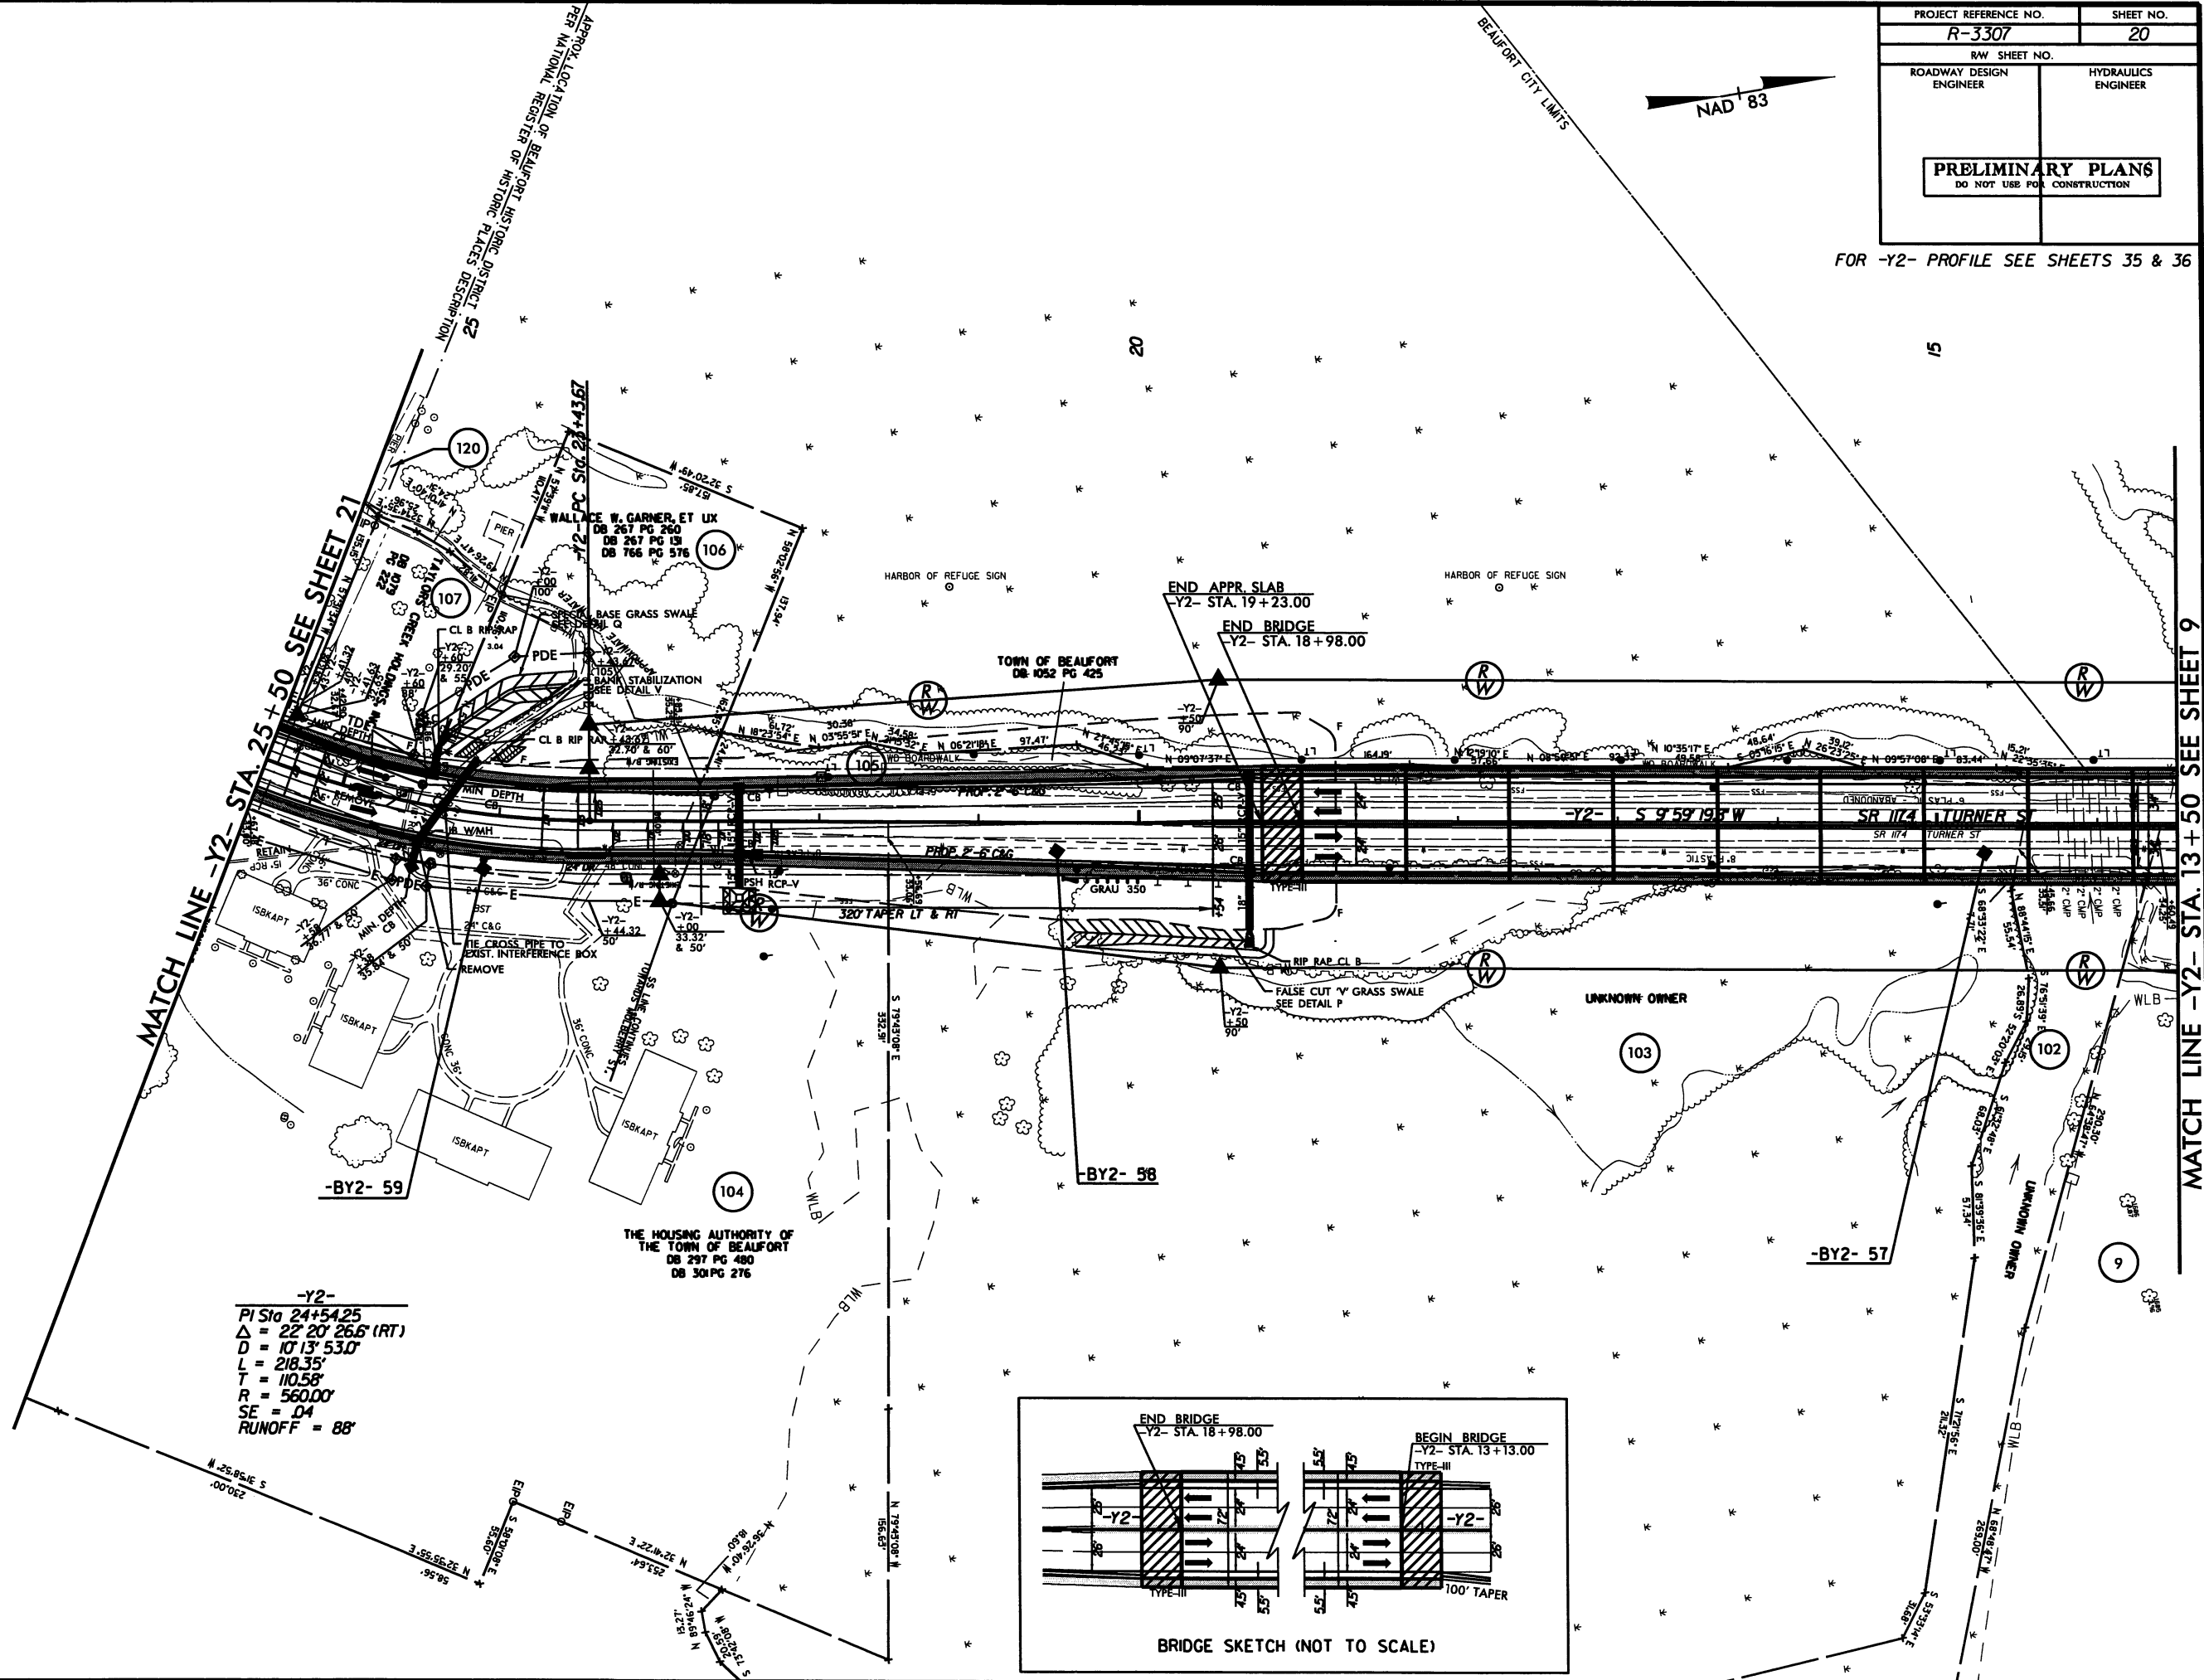

-Y2-  
PI Sta 24+54.25  
Δ = 22° 20' 26.6" (RT)  
D = 10° 13' 53.0"  
L = 218.35'  
T = 110.58'  
R = 560.00'  
SE = 04  
RUNOFF = 88'

MATCH LINE -Y2- STA 25+50 SEE SHEET 21


MATCH LINE -Y2- STA 13+50 SEE SHEET 9

8/17/99

30-JUN-2011 14:54  
R:\Roadway\3307\PSH\3307.rdy.psh.s21.dgn

REVISIONS

R/W REV. 07/29/10 (KMW): REVISED EXIST R/W TO NUMERICAL OFFSET.  
R/W REV. 04/18/11 (KMW): ADDED PARCEL 120 AND ADDED TCE ON PARCEL 120.

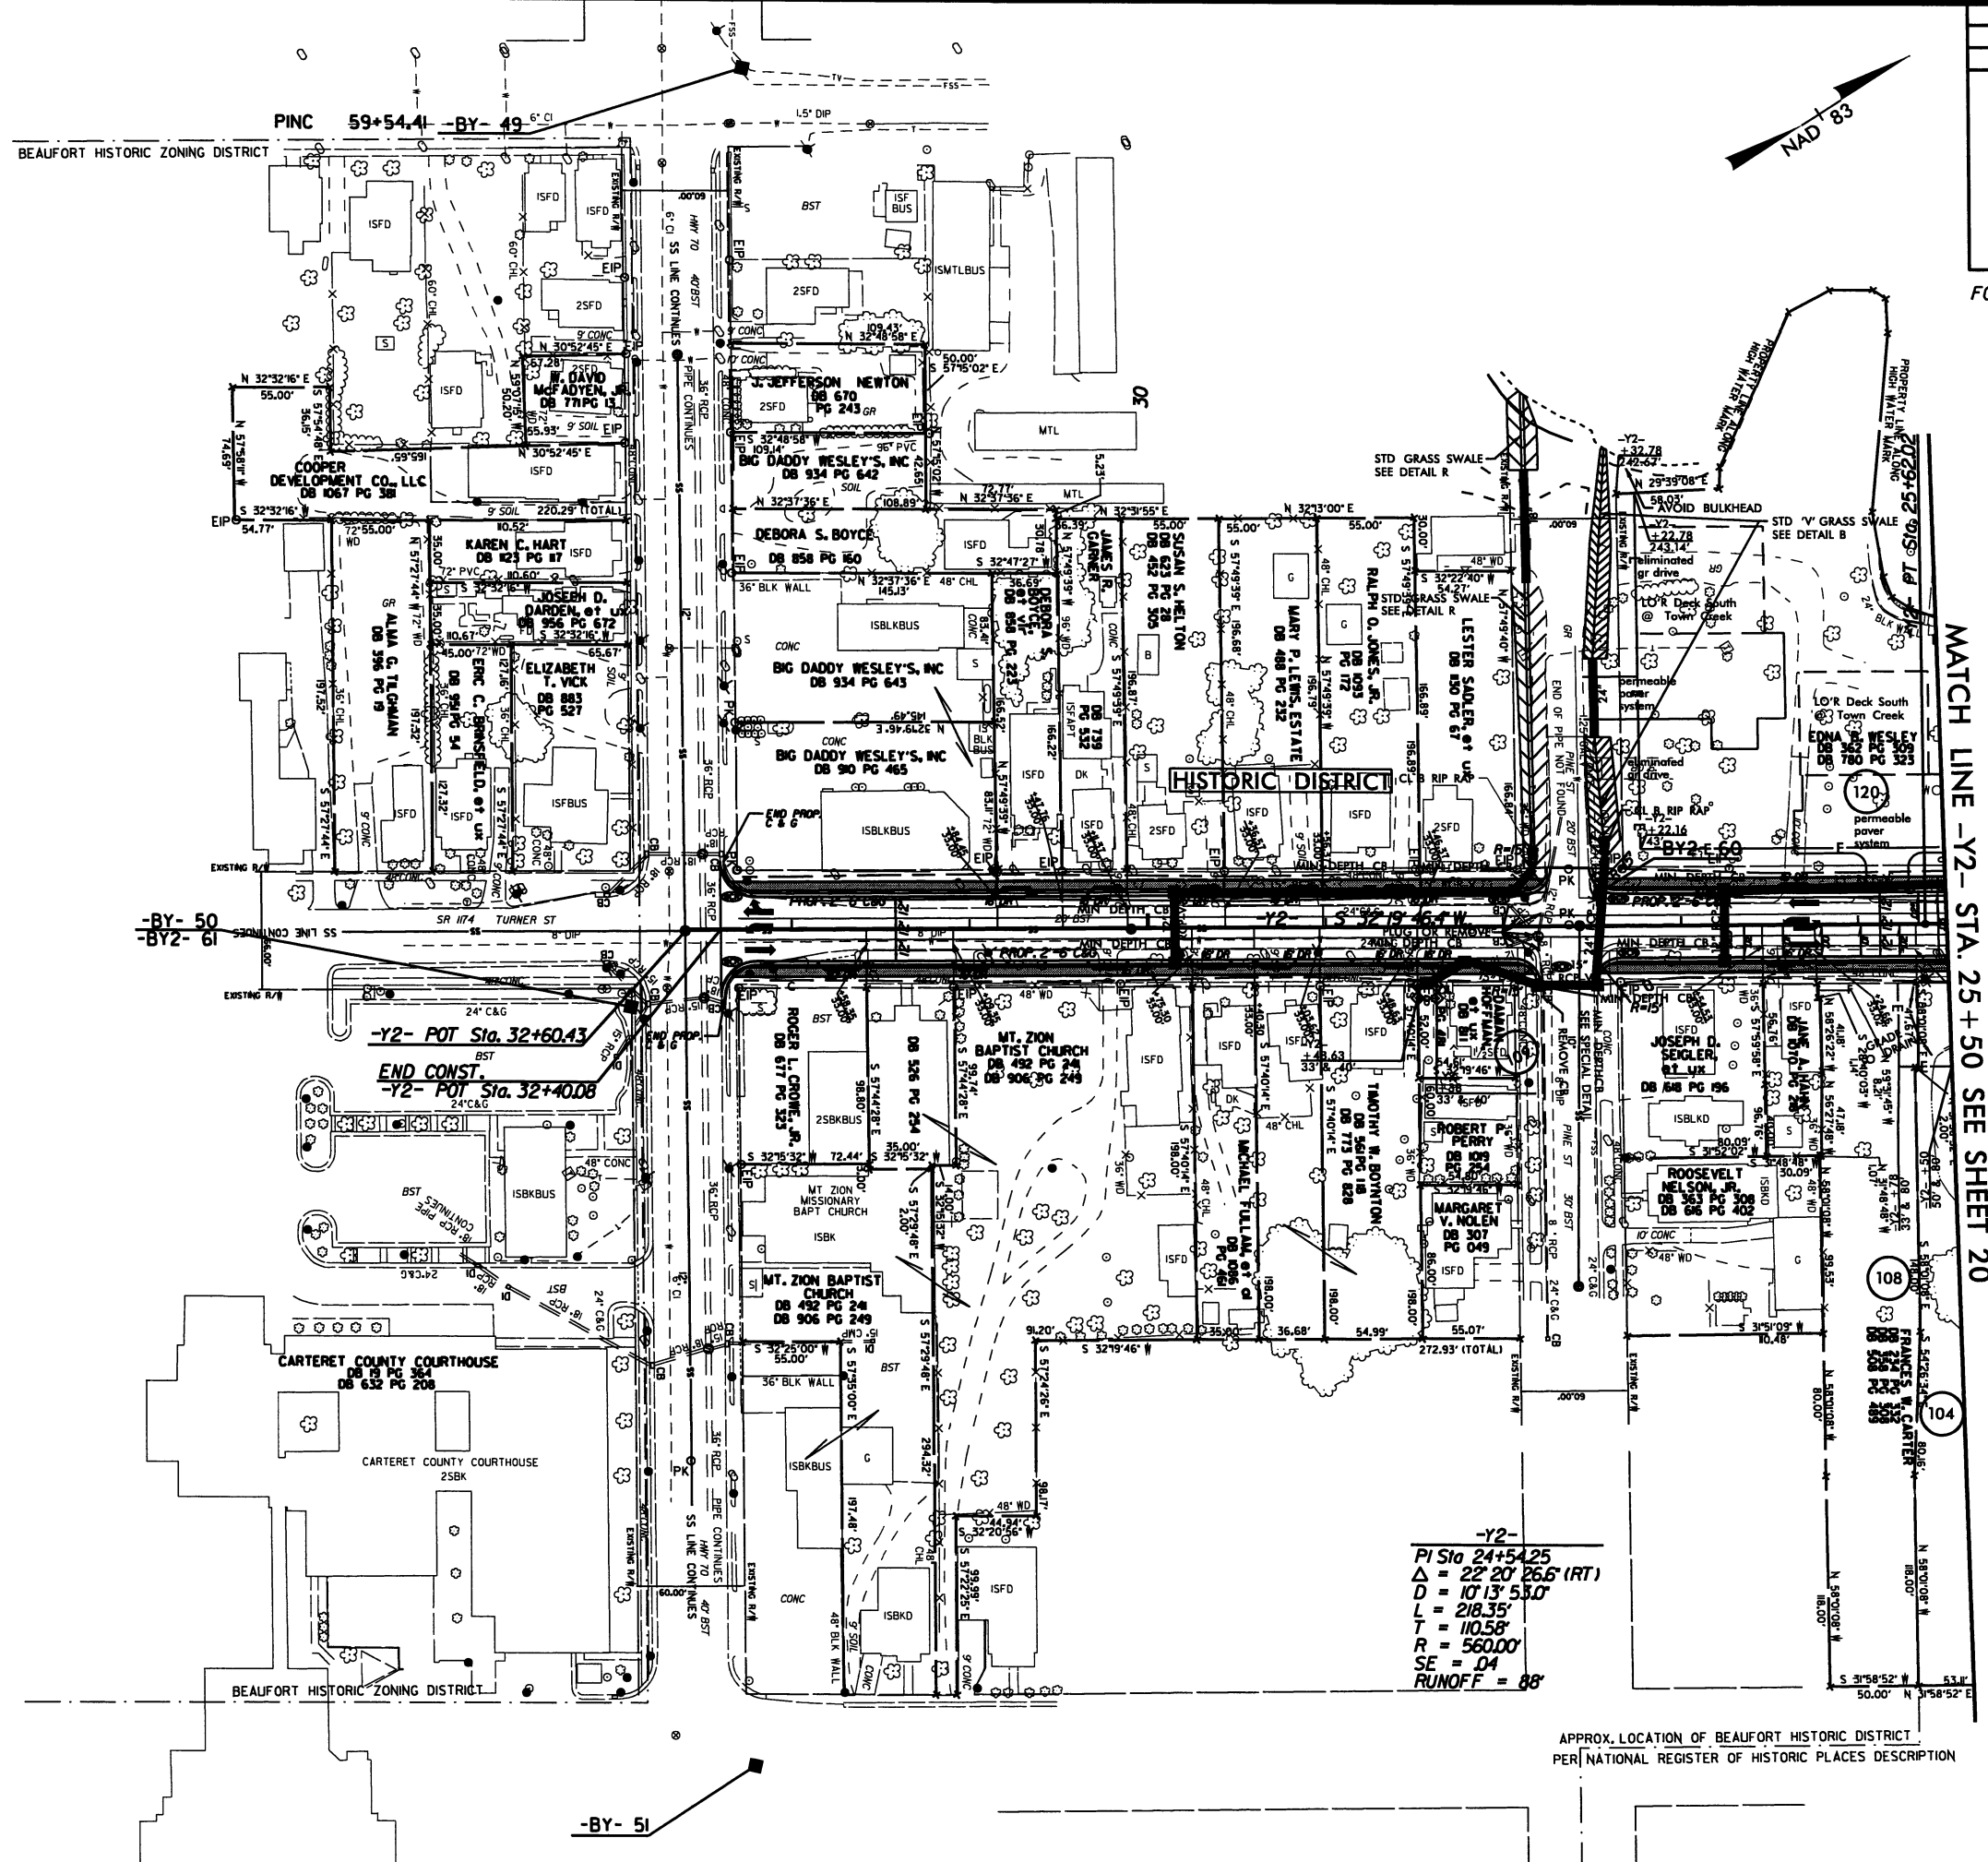

PROJECT REFERENCE NO.		SHEET NO.	
R-3307		21	
RW SHEET NO.			
ROADWAY DESIGN ENGINEER		HYDRAULICS ENGINEER	
<div>PRELIMINARY PLANS</div> <div>DO NOT USE FOR CONSTRUCTION</div>			

FOR -Y2- PROFILE SEE SHEET 36

APPROX. LOCATION OF BEAUFORT HISTORIC DISTRICT  
PER NATIONAL REGISTER OF HISTORIC PLACES DESCRIPTION



8/17/99

30-JUN-2011 14:54  
R:\PROJECTS\3307\3307.dgn  
R:\PROJECTS\3307\3307.dgn


REVISIONS

R/W REV. 07/29/10 (KMW) REVISED EXIST/PROP R/W TO NUMERICAL OFFSET.  
R/W REV. 04/18/11 (KMW) REPLACED PDE WITH DUE ON PARCELS 117 & 118.

PROJECT REFERENCE NO.		SHEET NO.	
R-3307		22	
RW SHEET NO.			
ROADWAY DESIGN ENGINEER		HYDRAULICS ENGINEER	
<div><b>PRELIMINARY PLANS</b> DO NOT USE FOR CONSTRUCTION</div>			

FOR -Y3- PROFILE SEE SHEET 36

FOR -Y3- PROFILE SEE SHEET 36

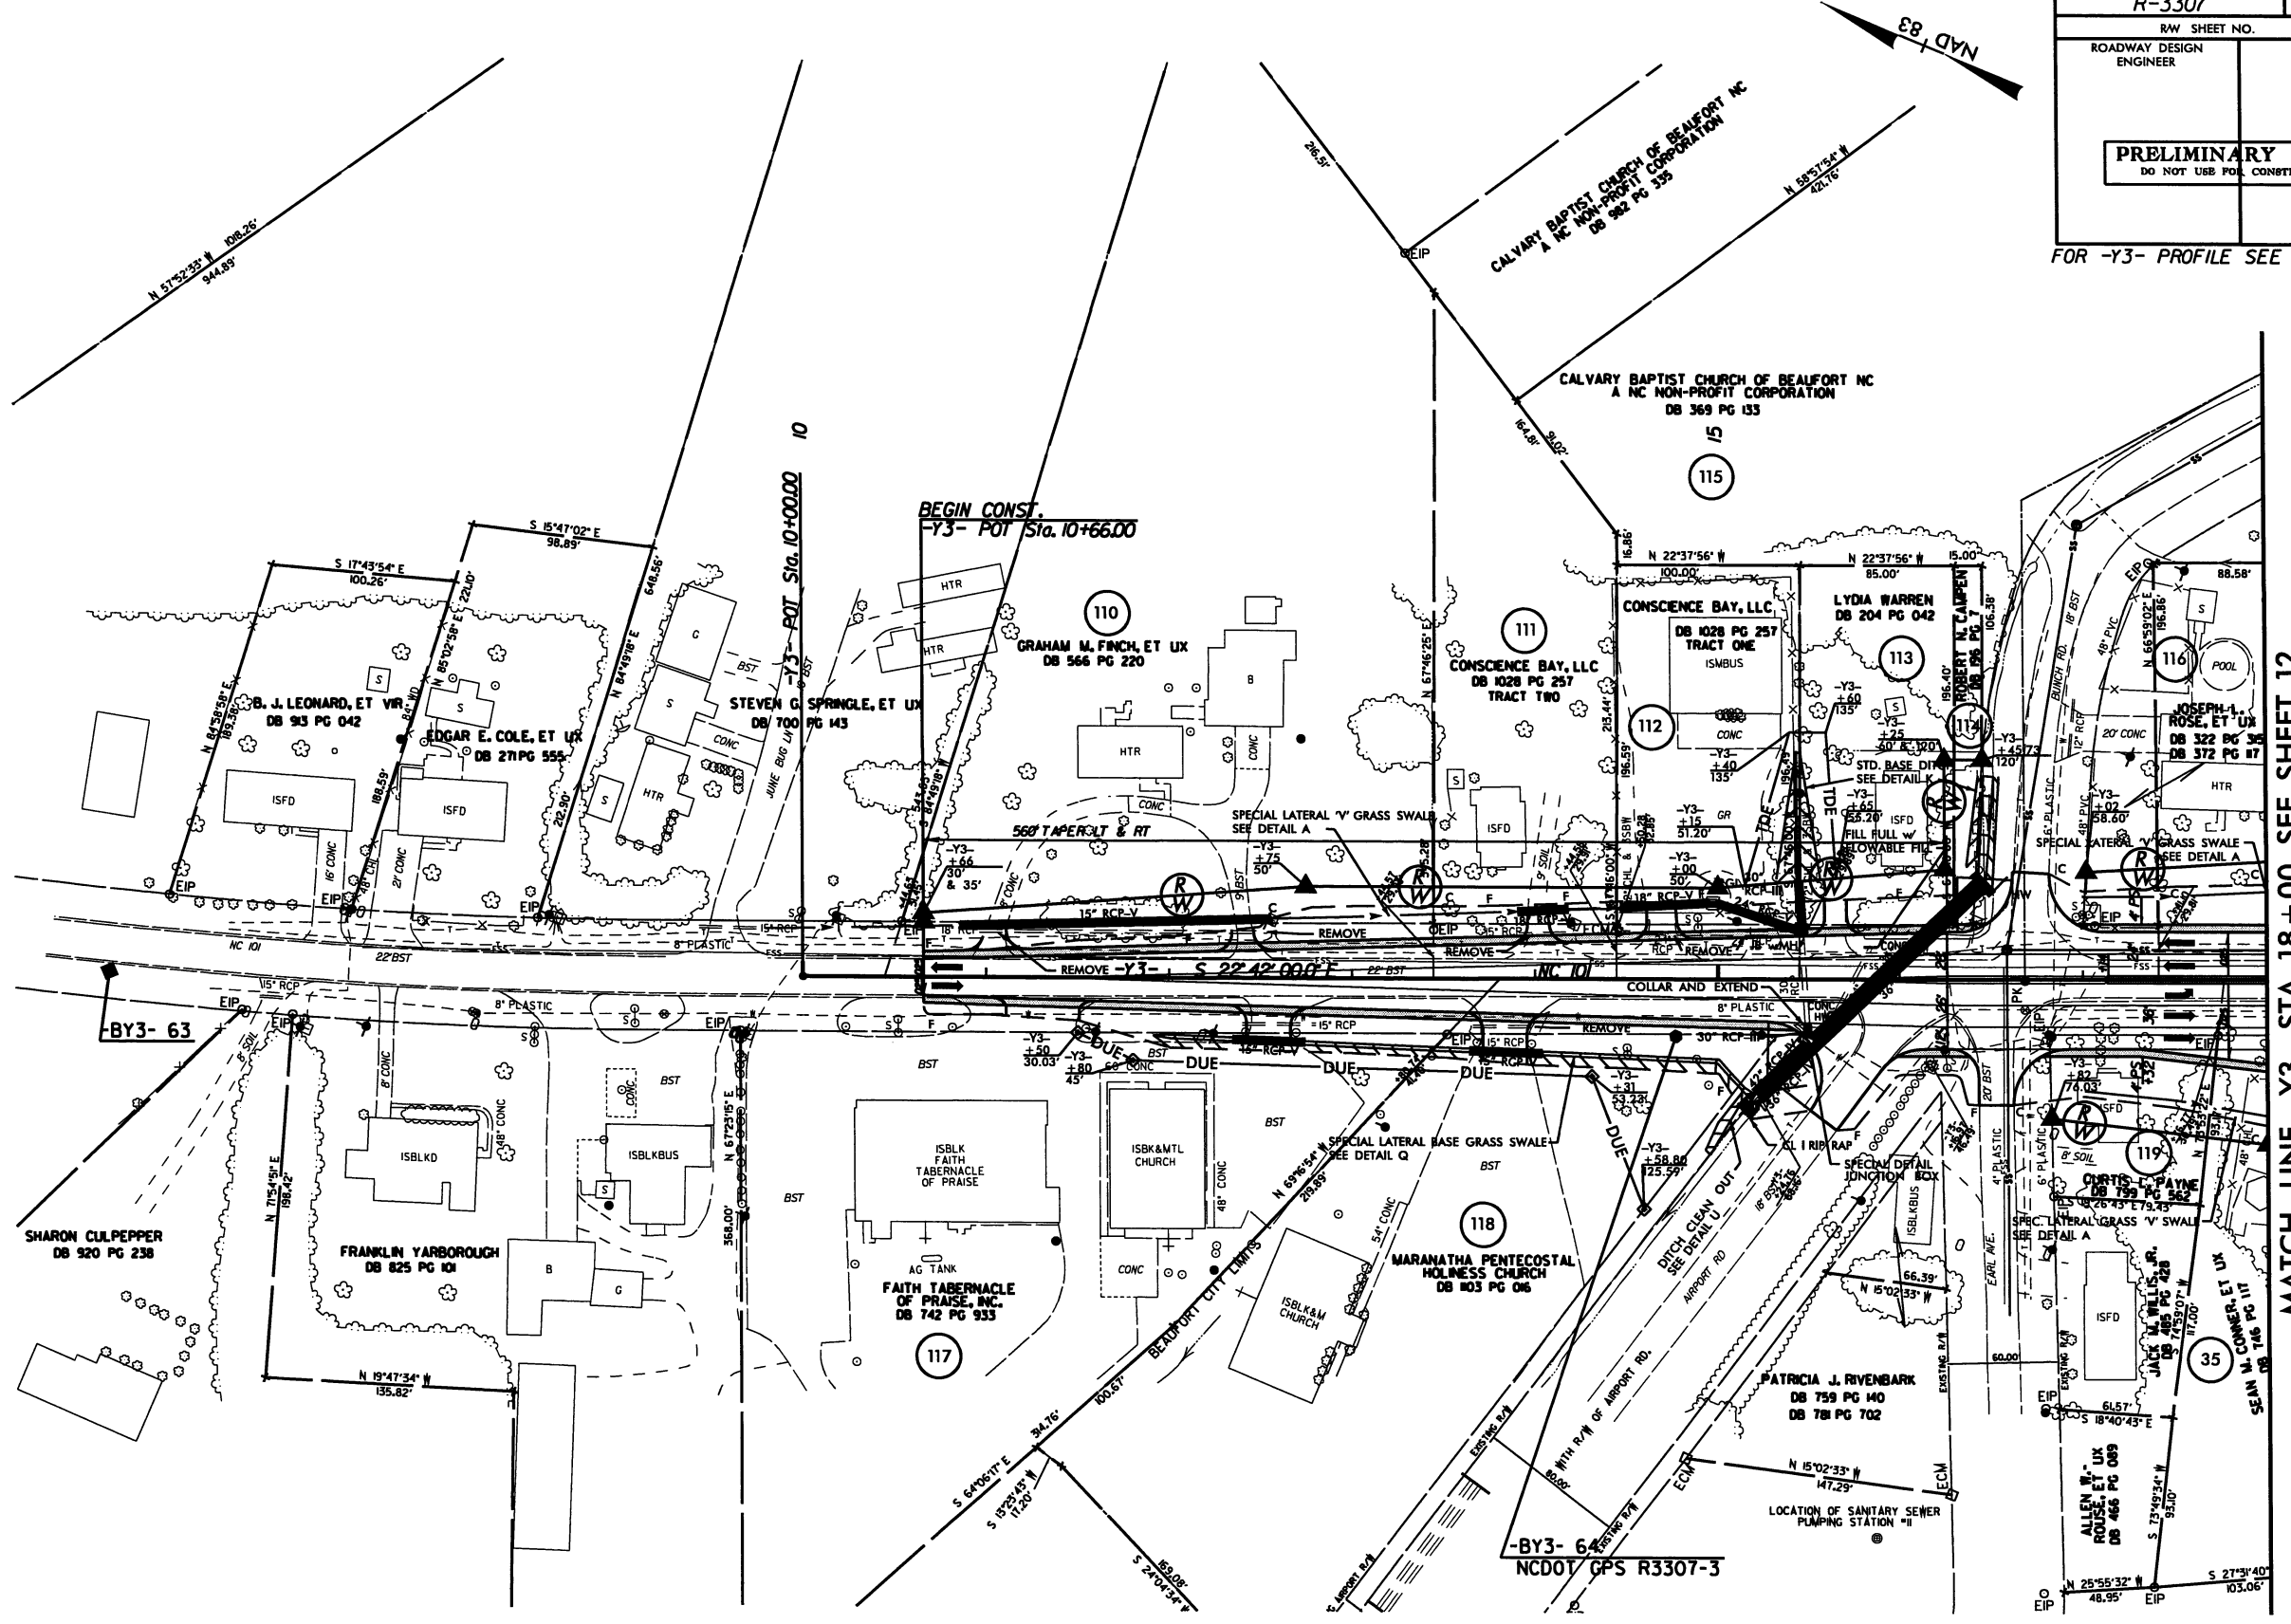

MATCH LINE -Y3- STA. 18+00 SEE SHEET 12


8/17/99

30-JUN-2011 14:54  
r:\roadwork\3307\psh\3307\_rdy.psh.s23.dgn  
\$\$\$\$\$USER\$END\$\$\$\$\$

REVISIONS

R/W REV. 07/29/10 (KMW) REVISED EXIST R/W TO NUMERICAL OFFSET.

MATCH LINE -Y3- STA. 26+00 SEE SHEET 12

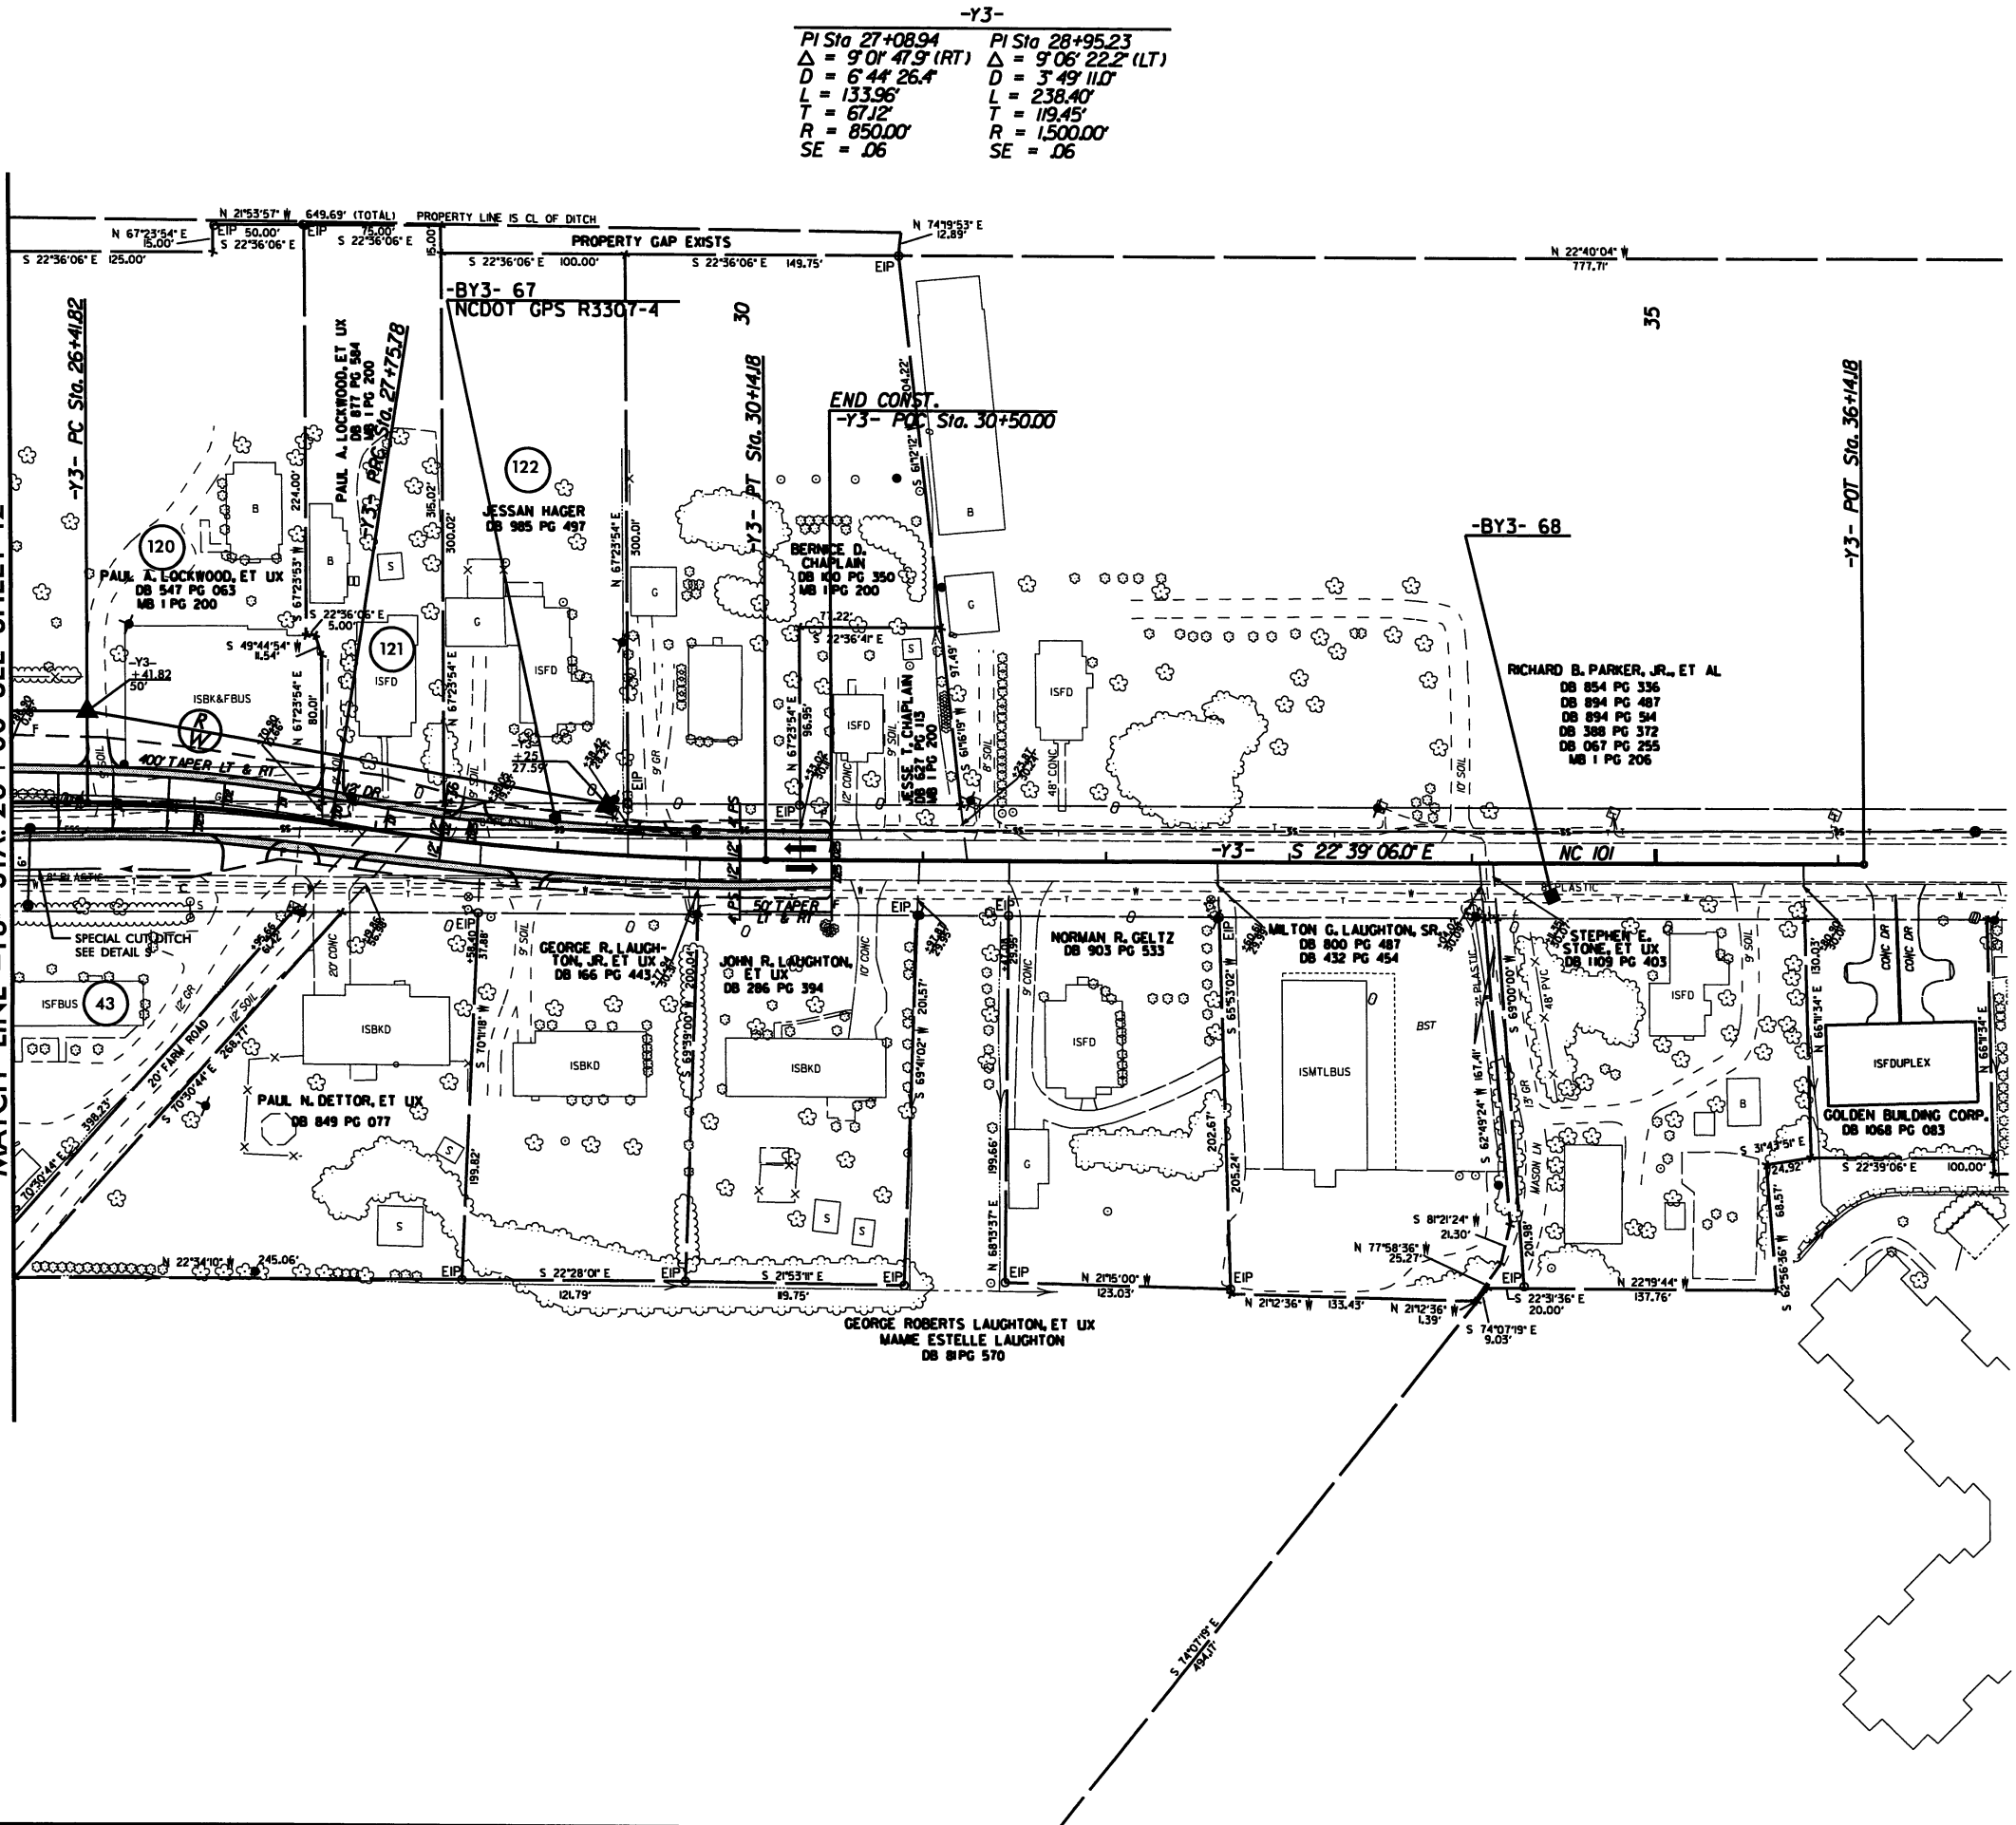


-Y3-  
PI Sta 27+08.94 PI Sta 28+95.23  
 $\Delta = 9^{\circ}01'47.9" (RT)$   $\Delta = 9^{\circ}06'22.2" (LT)$   
D = 6'44'26.4" D = 3'49'11.0"  
L = 133.96' L = 238.40'  
T = 67.12' T = 119.45'  
R = 850.00' R = 1500.00'  
SE = .06 SE = .06

PROJECT REFERENCE NO. <b>R-3307</b>		SHEET NO. <b>23</b>	
RW SHEET NO.		HYDRAULICS ENGINEER	
ROADWAY DESIGN ENGINEER		HYDRAULICS ENGINEER	
<b>PRELIMINARY PLANS</b> DO NOT USE FOR CONSTRUCTION			

FOR -Y3- PROFILE SEE SHEET 37

REVISIONS  
R/W REV. 07/29/10 (KMW) REVISED EXIST R/W TO NUMERICAL OFFSET.

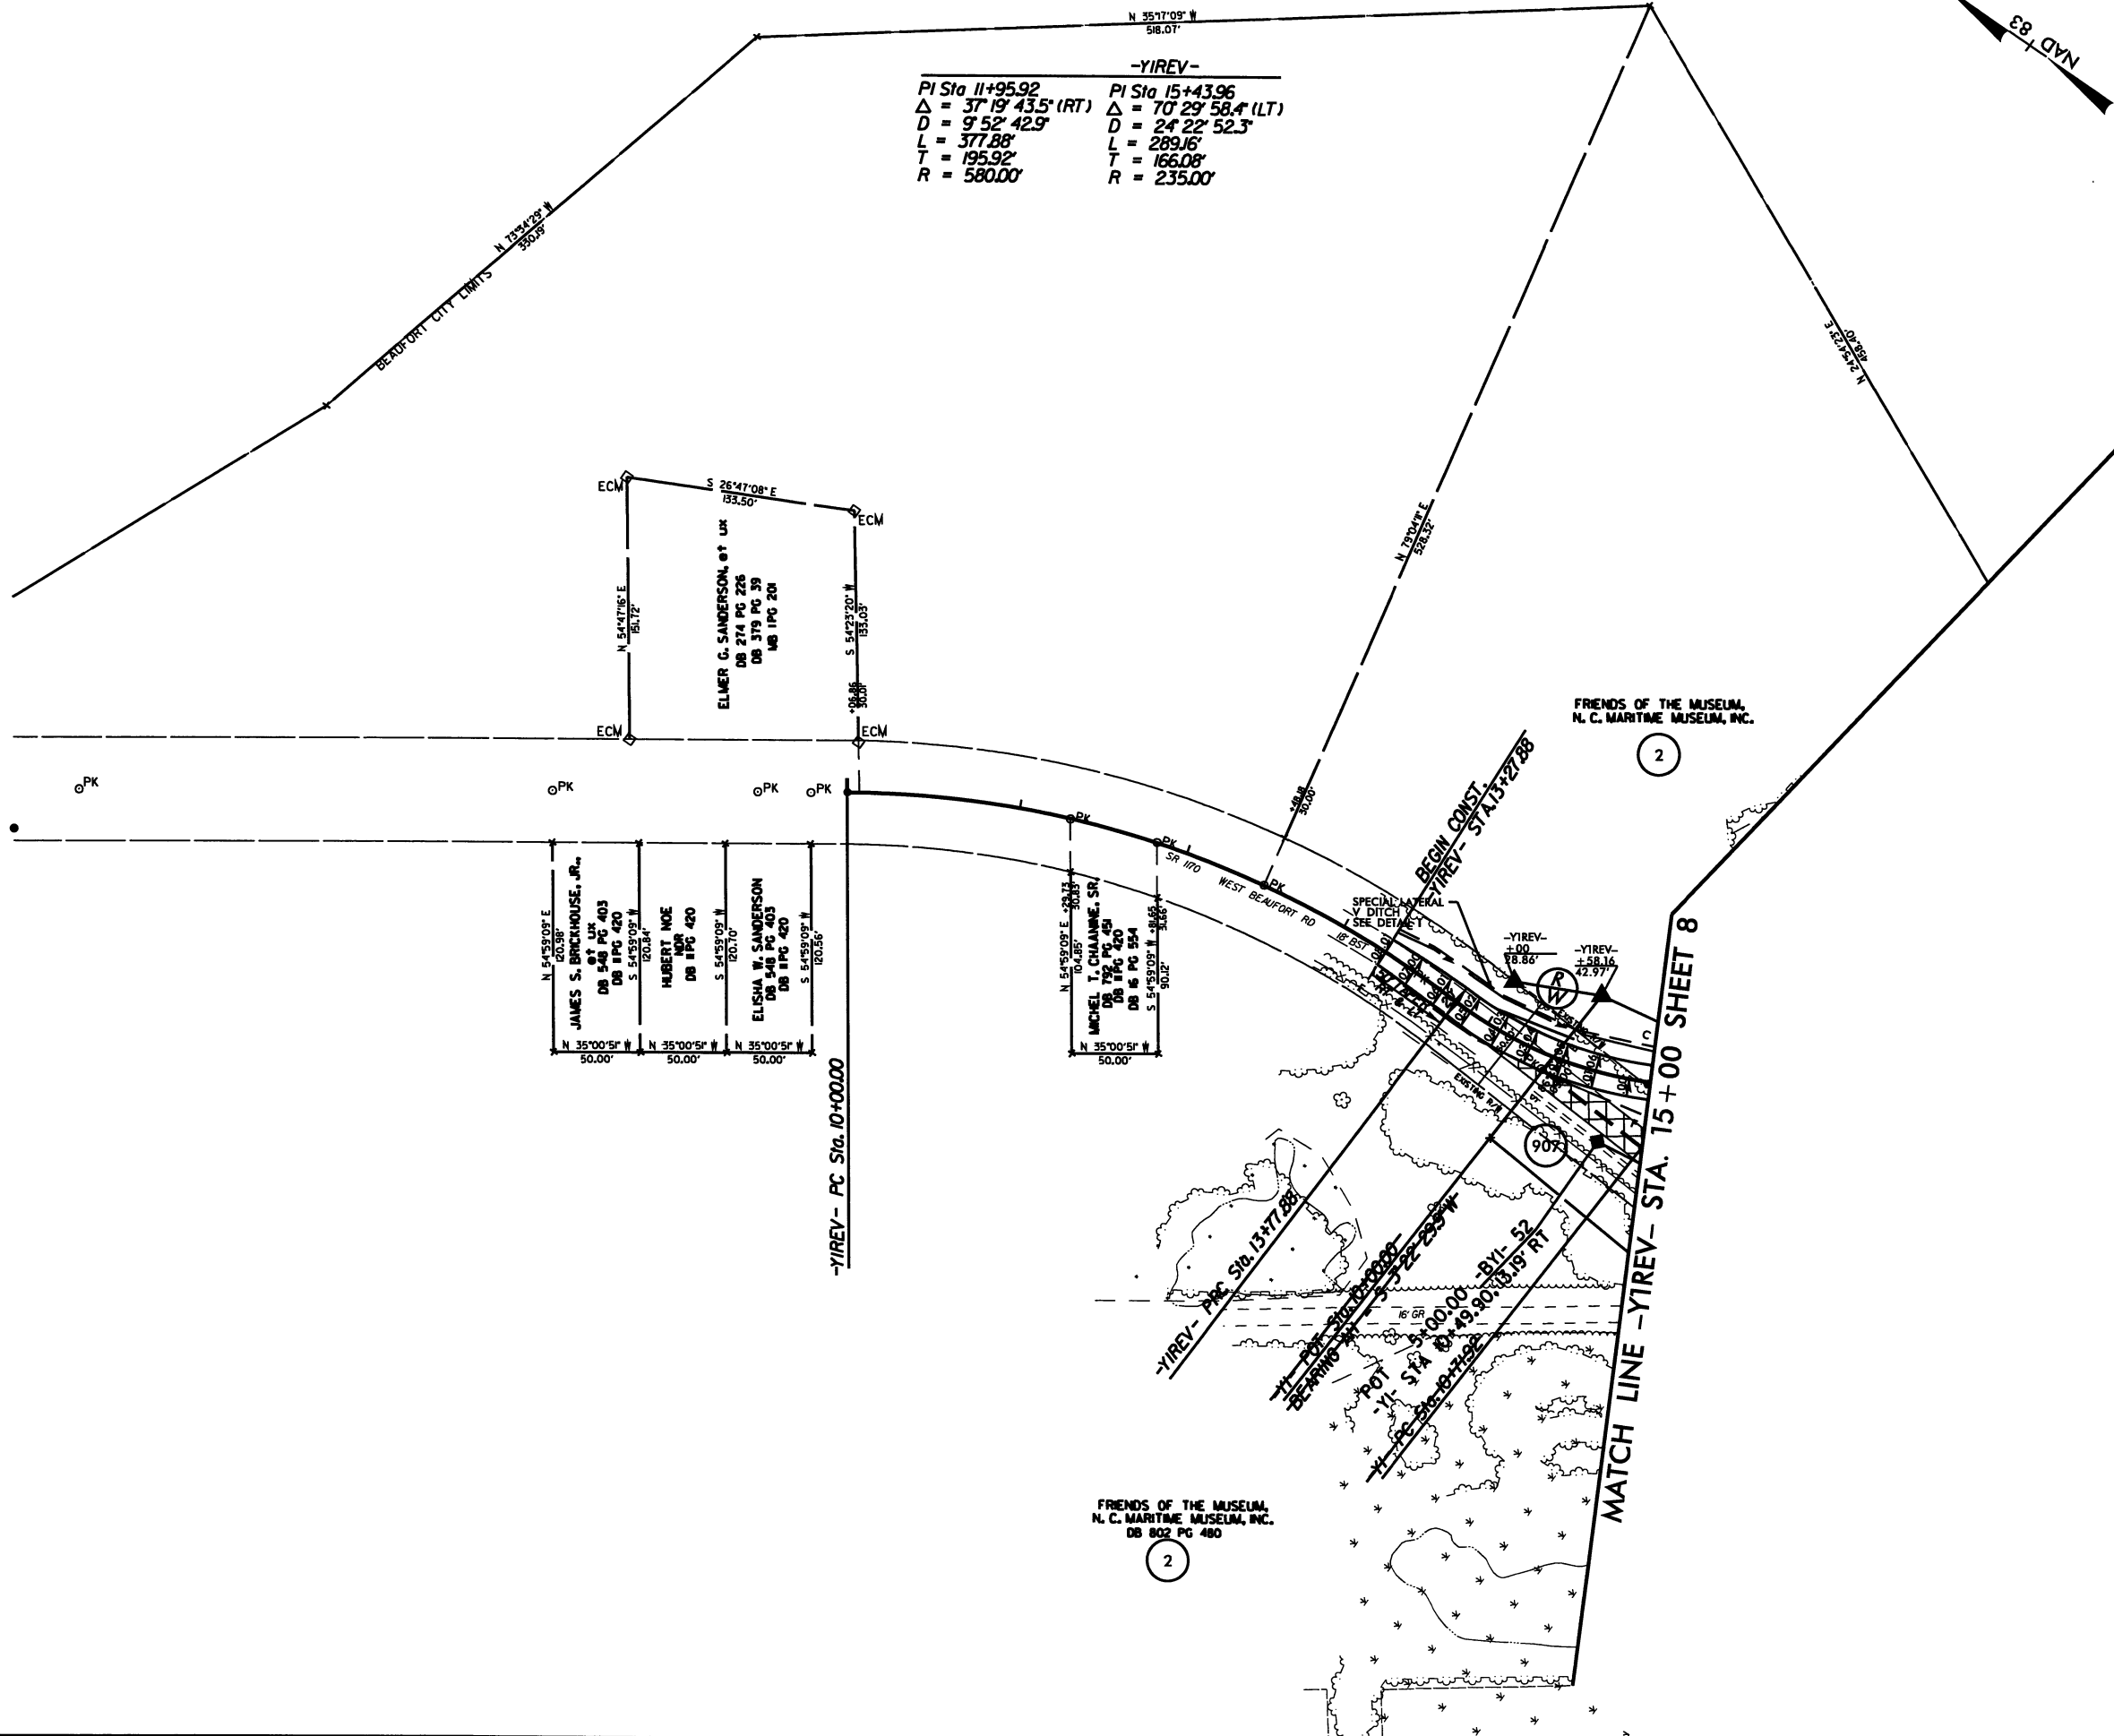

-YIREV-	
PI Sta 11+95.92	PI Sta 15+43.96
$\Delta = 37^{\circ} 19' 43.5''$ (RT)	$\Delta = 70^{\circ} 29' 58.4''$ (LT)
$D = 9^{\circ} 52' 42.9''$	$D = 24^{\circ} 22' 52.3''$
$L = 377.88'$	$L = 289.16'$
$T = 195.92'$	$T = 166.08'$
$R = 580.00'$	$R = 235.00'$

PROJECT REFERENCE NO.	SHEET NO.
R-3307	24
RW SHEET NO.	
ROADWAY DESIGN ENGINEER	HYDRAULICS ENGINEER
PRELIMINARY PLANS DO NOT USE FOR CONSTRUCTION	

FOR -YIREV- PROFILE SEE SHEET 35

8/17/99

30-JUN-2011 4:54  
R:\roadwork\3307\psh-r-3307\_rdy-ps-h-a25.dgn  
R:\roadwork\3307\psh-r-3307\_rdy-ps-h-a25.dgn

REVISIONS

# EXISTING BRIDGE LOCATION

NAD '83

PROJECT REFERENCE NO.		SHEET NO.
R-3307		25
RW SHEET NO.		
ROADWAY DESIGN ENGINEER		HYDRAULICS ENGINEER
<div><b>PRELIMINARY PLANS</b> DO NOT USE FOR CONSTRUCTION</div>		

