



STATE OF NORTH CAROLINA  
DEPARTMENT OF TRANSPORTATION

ROY COOPER  
GOVERNOR

JAMES H. TROGDON, III  
SECRETARY

June 14, 2019

U. S. Army Corps of Engineers  
Regulatory Field Office  
3331 Heritage Trade Drive, Suite 105  
Wake Forest, North Carolina 27587

ATTN: Mr. David Bailey  
NCDOT Coordinator

Subject: **NCDOT Response to Request for Additional Information Dated April 22, 2019, and subsequent Application Modification** for the Widening of US 70 from Mt. Hope Church Road to Sun Lake Road in Guilford County. NCDOT Division 7, TIP No. U-2581 BA, WBS 34840.1.4.

Dear Sir:

The North Carolina Department of Transportation (NCDOT) is in receipt of your request for additional information dated April 22, 2019. Item number 4, section "a" request profile/cross section views for stream impact Sites 1, 2, 3, and 6.

Pursuant to this request and subsequent conversations, the drawings were revised by way of:

**Site 1**

Detail 10 was added to display the cross section of the stabilization impact at the pipe outlet. The rip-rap will be "keyed-in" to stabilize the system, but not impede aquatic passage.

**Site 2**

Detail 11 was added to display the cross section of the stabilization impact at the pipe outlet.

**Site 3**

Detail 10 was added to display the cross section of the stabilization impact at the pipe outlet. The rip-rap will be "keyed-in" to stabilize the system, but not impede aquatic passage.

While re-reviewing Site 3, the engineer increased the size of the rip rap at this location. This increased the permanent impact from 11 to 13 feet, and decreased the temporary impact from 16 to 13 feet.

Please find included DMS Mitigation Acceptance for the 2 additional feet of impact (increasing project totals from 298 to 300 feet).

Table 2 from the January application has been revised below to reflect this change.

## **Site 6**

Detail 10 was added to display the cross section of the stabilization impact at the pipe outlet. The rip-rap will be “keyed-in” to stabilize the system, but not impede aquatic passage.

**Revised Table 2: Stream Impacts (values in linear feet)**

Permit Site	Stream Name/ NRTR ID	Status/ Class/ Index	Perm. Channel Impacts	Temp. Channel Impacts	ACOE Required Mitigation	DWR Required Mitigation	Impact Description
1	UT to Little Alamance Creek*	Perennial WS-IV NSW 16-19-3-(0.5)	10	19	10	--	The existing 24" reinforced concrete pipe will be upgraded to a 30". The impact is a result of the pipe and riprap pad installation.
2	UT to Little Alamance Creek SC	Perennial WS-IV NSW 16-19-3-(0.5)	6	10	6	--	A 24" base ditch will outlet adjacent to the stream. Due to the small size of this system, it would not be possible to use bank stabilization without impacting the channel bottom. As such, the impact was accounted for as loss of water.
3			<del>+13</del>	<del>+6 13</del>	<del>+13</del>	--	The 15" corrugated metal pipe will be replaced with a 30" reinforced concrete pipe.
5	UT to Little Alamance Creek SB	Perennial WS-IV NSW 16-19-3-(0.5)	251	33	251	--	The 46-foot long 10' x 6' culvert will be replaced with a 127-foot long, 10' x 8' culvert with sills.
6	UT to Little Alamance Creek **	Perennial WS-IV NSW 16-19-3-(0.5)	20	15	20	--	The existing 18" reinforced concrete pipe will be upgraded to a 24" reinforced concrete pipe. The impact is the result of raising the grade of the road as well as the larger pipe.
<b>Total Stream Impacts</b>			<b>298</b> <del>300</del>	<b>93</b> <del>90</del>	<b>298</b> <del>300</del>	<b>0</b>	
<b>Total Requested from DMS:</b>				<b>300</b>			

\* This system was outside of the original NRTR study limits. It was included due to the need to capture stormwater on the lane taper/transition.

\*\*This stream was outside of the original NRTR study limits. Raising of the grade of this intersecting road was not originally accounted for.

The buffer drawings have been revised to match the changes in the drawings. However, there are no changes to Buffer Impacts as a result of these revisions.

Thank you for your assistance with this project. Please do not hesitate to contact me for additional questions or concerns at [maturchy@ncdot.gov](mailto:maturchy@ncdot.gov) or (919) 707-6157.

Sincerely,

*Carla Dagnino*

*for* Philip S. Harris III, P.E., C.P.M.  
Environmental Analysis Unit Head

cc: Mr. John Fisher, Publix



NORTH CAROLINA  
*Environmental Quality*

ROY COOPER  
*Governor*

MICHAEL S. REGAN  
*Secretary*

TIM BAUMGARTNER  
*Director*

June 3, 2019

Mr. Philip S. Harris, P.E., CPM  
Environmental Analysis Unit  
North Carolina Department of Transportation  
1598 Mail Service Center  
Raleigh, North Carolina 27699-1598

Dear Mr. Harris:

Subject: DMS Mitigation Acceptance Letter:

**U-2581BA, US 70 (Burlington Road) from West of SR 3045 (Mount Hope Church Road) / SR 2819 (McCleansville Road) to just East of SR 3175 (Birch Creek Road), Guilford County**

The purpose of this letter is to notify you that the Division of Mitigation Services (DMS) will provide the stream, wetland and buffer mitigation for the subject project. Based on the information supplied by you on June 3, 2019, the impacts are located in CU 03030002 of the Cape Fear River basin in the Central Piedmont (CP) Eco-Region, and are as follows:

Stream and Wetlands	River Basin	CU Location	Eco-Region	Stream			Wetlands		
				Cold	Cool	Warm	Riparian	Non-Riparian	Coastal Marsh
Impacts	Cape Fear	03030002	CP	0	0	300.0	0.11	0	0

\*Some of the impacts may be proposed to be mitigated at a 1:1 mitigation ratio. See permit application for details.

All buffer mitigation requests and approvals are administrated through the Riparian Restoration Buffer Fund. The NCDOT will be responsible to ensure that appropriate compensation for the buffer mitigation will be provided in the agreed upon method of fund transfer. Upon receipt of the NCDWR's Buffer Authorization Certification, DMS will transfer funds from the NCDOT 2984 Fund into the Riparian Restoration Buffer Fund. Upon completion of transfer payment, NCDOT will have completed its riparian buffer mitigation responsibility for TIP Number U-2581BA. Subsequently, DMS will conduct a review of current NCDOT ILF Program mitigation projects in the river basin to determine if available buffer mitigation credits exist. If there are buffer mitigation credits available, then the Riparian Restoration Buffer Fund will purchase the appropriate amount of buffer mitigation credits from NCDOT ILF Program.




Mr. Harris  
June 3, 2019  
Page Two  
NCDOT TIP U-2581BA

Buffer	River Basin	CU	Eco-Region	Buffer Impacts		
				Zone 1	Zone 2	TOTAL
Impacts	Cape Fear	03030002 – Jordan – Haw	CP	11,763.0	4,355.0	16,118.0

**This mitigation acceptance letter replaces the mitigation acceptance letter issued on February 15, 2019.** The impacts and associated mitigation needs were not projected by the NCDOT in the 2019 impact data. DMS will commit to implement sufficient compensatory stream and wetland mitigation credits to offset the impacts associated with this project as determined by the regulatory agencies using the delivery timeline listed in Section F.3.c.iii of the In-Lieu Fee Instrument dated July 28, 2010. If the above referenced impact amounts increase, then this mitigation acceptance letter will no longer be valid and a new mitigation acceptance letter will be required from DMS.

If you have any questions or need additional information, please contact Ms. Beth Harmon at 919-707-8420.

Sincerely,

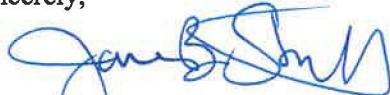


James B. Stanfill  
DMS Asset Management Supervisor

Cc: Mr. Monte Matthews, USACE – Raleigh Regulatory Field Office  
Ms. Amy Chapman, NC Division of Water Resources  
File: U-2581BA Revised





**-L- CURVE DATA**  
 PI Sta. 17+66.41  
 $\Delta = 12^\circ 58' 11''$  (LT)  
 $D = 1' 13' 08.6''$   
 $L = 1,063.9'$   
 $T = 534.24'$   
 $R = 4,700.00'$   
 $SE = 0.025$   
 $RO = 105'$   
 $INC = 42'$

**-Y2- CURVE DATA**  
 PI Sta. 13+49.93  
 $\Delta = 14^\circ 39' 42.3''$  (LT)  
 $D = 2' 06' 23.3''$   
 $L = 696.04'$   
 $T = 349.53'$   
 $R = 2,720.00'$   
 $SE = 0.04$   
 $RO = 144'$

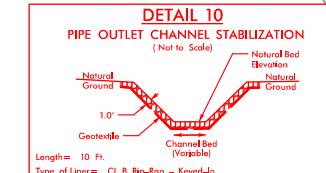

BEGIN CONSTRUCTION  
 -Y1- POT Sta. 13+45.00

US 70 (BURLINGTON RD.)  
 AT MT HOPE CHURCH RD.

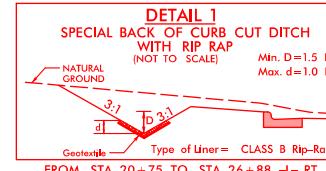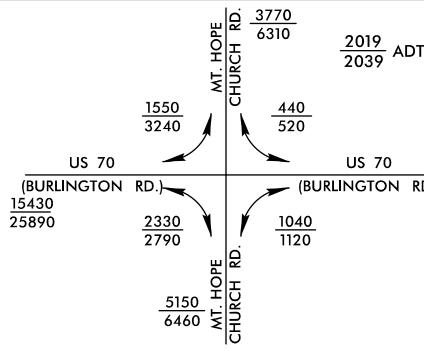

THOMAS EDWARD PAYNE  
 DB 3829 PG 416  
 PB 98 PG 89

ONE WAY BAPTIST CHURCH DB 4354 PG 1434 PB 113 PG 25

PROJECT REFERENCE NO.	SHEET NO.
U-2581BA	4
R/W SHEET NO.	
ROADWAY DESIGN ENGINEER	HYDRAULICS ENGINEER

**INCOMPLETE PLANS**  
 DO NOT USE FOR R/W ACQUISITION

**DOCUMENT NOT CONSIDERED FINAL**  
 UNLESS ALL SIGNATURES COMPLETED

Prepared by  
**vhb**  
 VHB Engineering NC, P.C. (C-2705)  
 940 Mill Campus Drive, Suite 500  
 Raleigh, NC 27605

**PERMIT DRAWING SHEET 2 OF 14**

Revised 5/30/2019

REVISIONS

**BEGIN TIP PROJECT U-2581BA**

**-L- PC STA. 12 + 32.17**


BEGIN MILL/RESURFACE  
 BEGIN WIDENING (LT SIDE ONLY)

BEGIN CONSTRUCTION

-L- POT Sta. 11+85.00

PIPE OUTLET CHANNEL STABILIZATION CLASS B RIP RAP SEE DETAIL 10

GEOTEXTILE SEE DETAIL 10

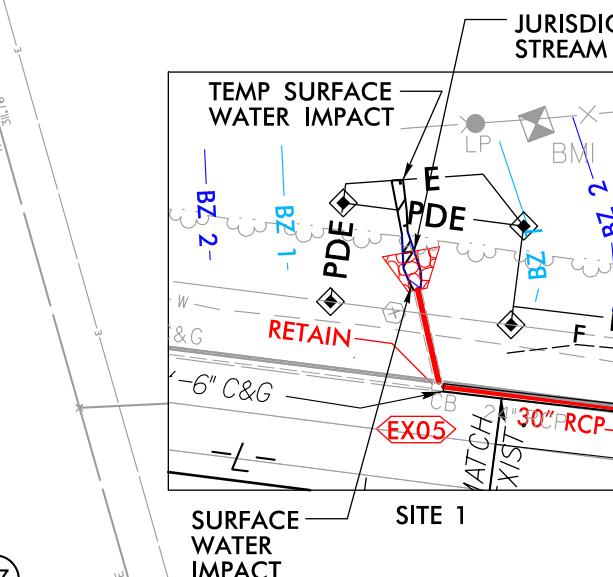

SITE 1  
 SURFACE WATER IMPACT


-L- POC Sta. 18+37.75=

-Y1- POT Sta. 20+24.64



-Y2- PC Sta. 10+00.00

MCLEANSVILLE LIONS CLUB DB 2650 PG 529 PB 98 PG 89

1

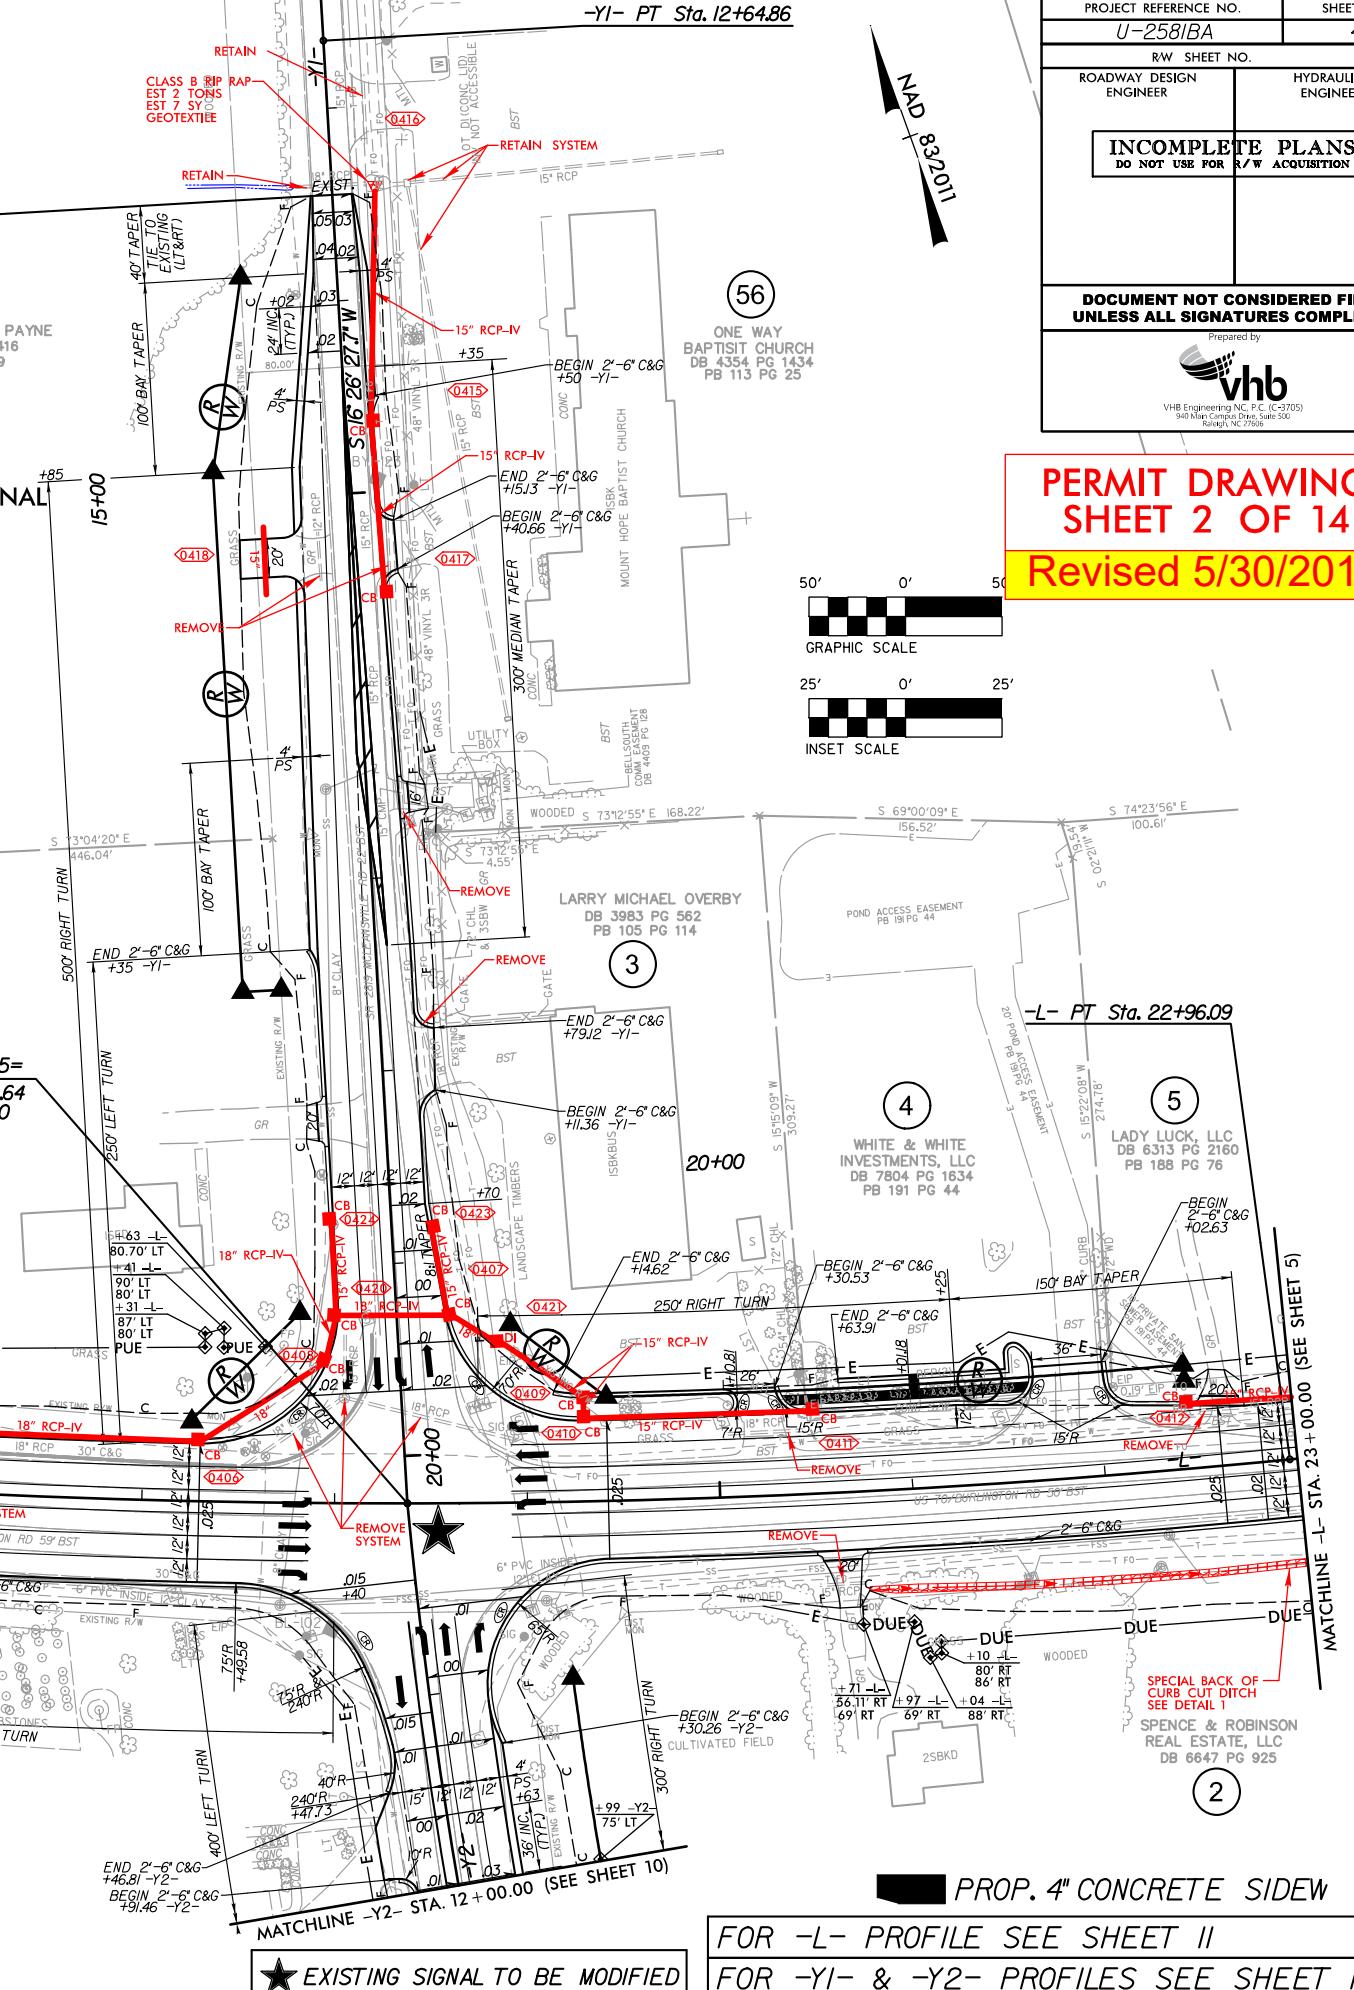

50' 0'  
GRAPHIC SCALE  
25' 0'  
INSET SCALE

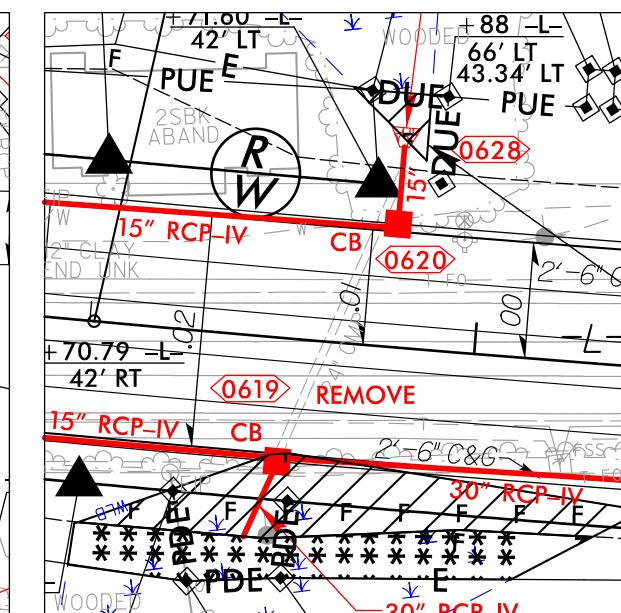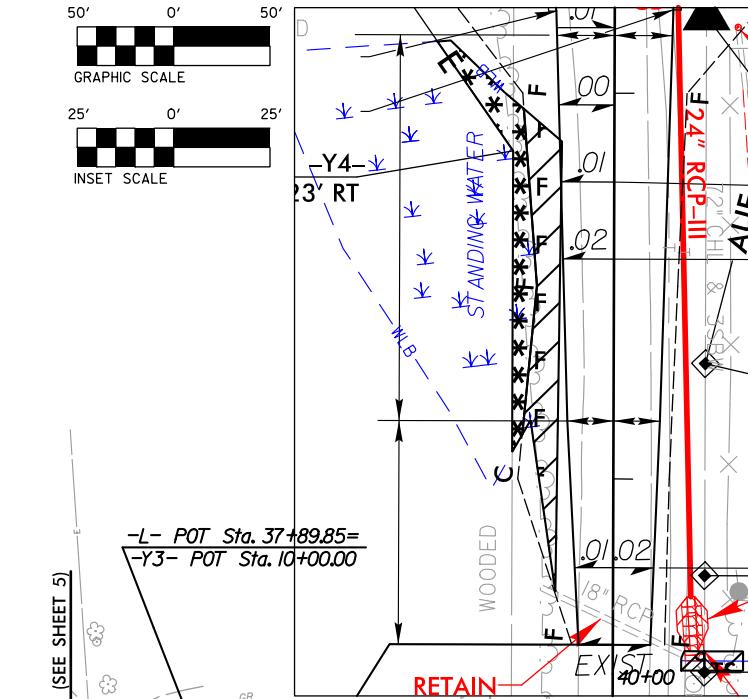

## PERMIT DRAWING SHEET 4 OF 14

Revised 5/30/2019

PROJECT REFERENCE NO.  
U-2581BA  
SHEET NO.  
6  
R/W SHEET NO.  
ROADWAY DESIGN  
ENGINEER  
HYDRAULICS  
ENGINEER

PLANS  
ACQUISITION

DOCUMENT NOT CONSIDERED FINAL  
UNLESS ALL SIGNATURES COMPLETED


vhb  
VHB Engineering NC, P.C. (C-2705)  
940 Mill Campus Drive, Suite 500  
Raleigh, NC 27605

TRIAD WORSHIP CENTER  
CHURCH OF GOD  
DB 7215 PG 1959  
PB 139 PG 91

SEE SHEET 5  
SEE SHEET 7

REVISIONS

25f29\_AW\_Permits\_Environmental\Drawings\Permit Drawings\PSHU-2581BA\_Hyd.prm-wet.ps06.dgn

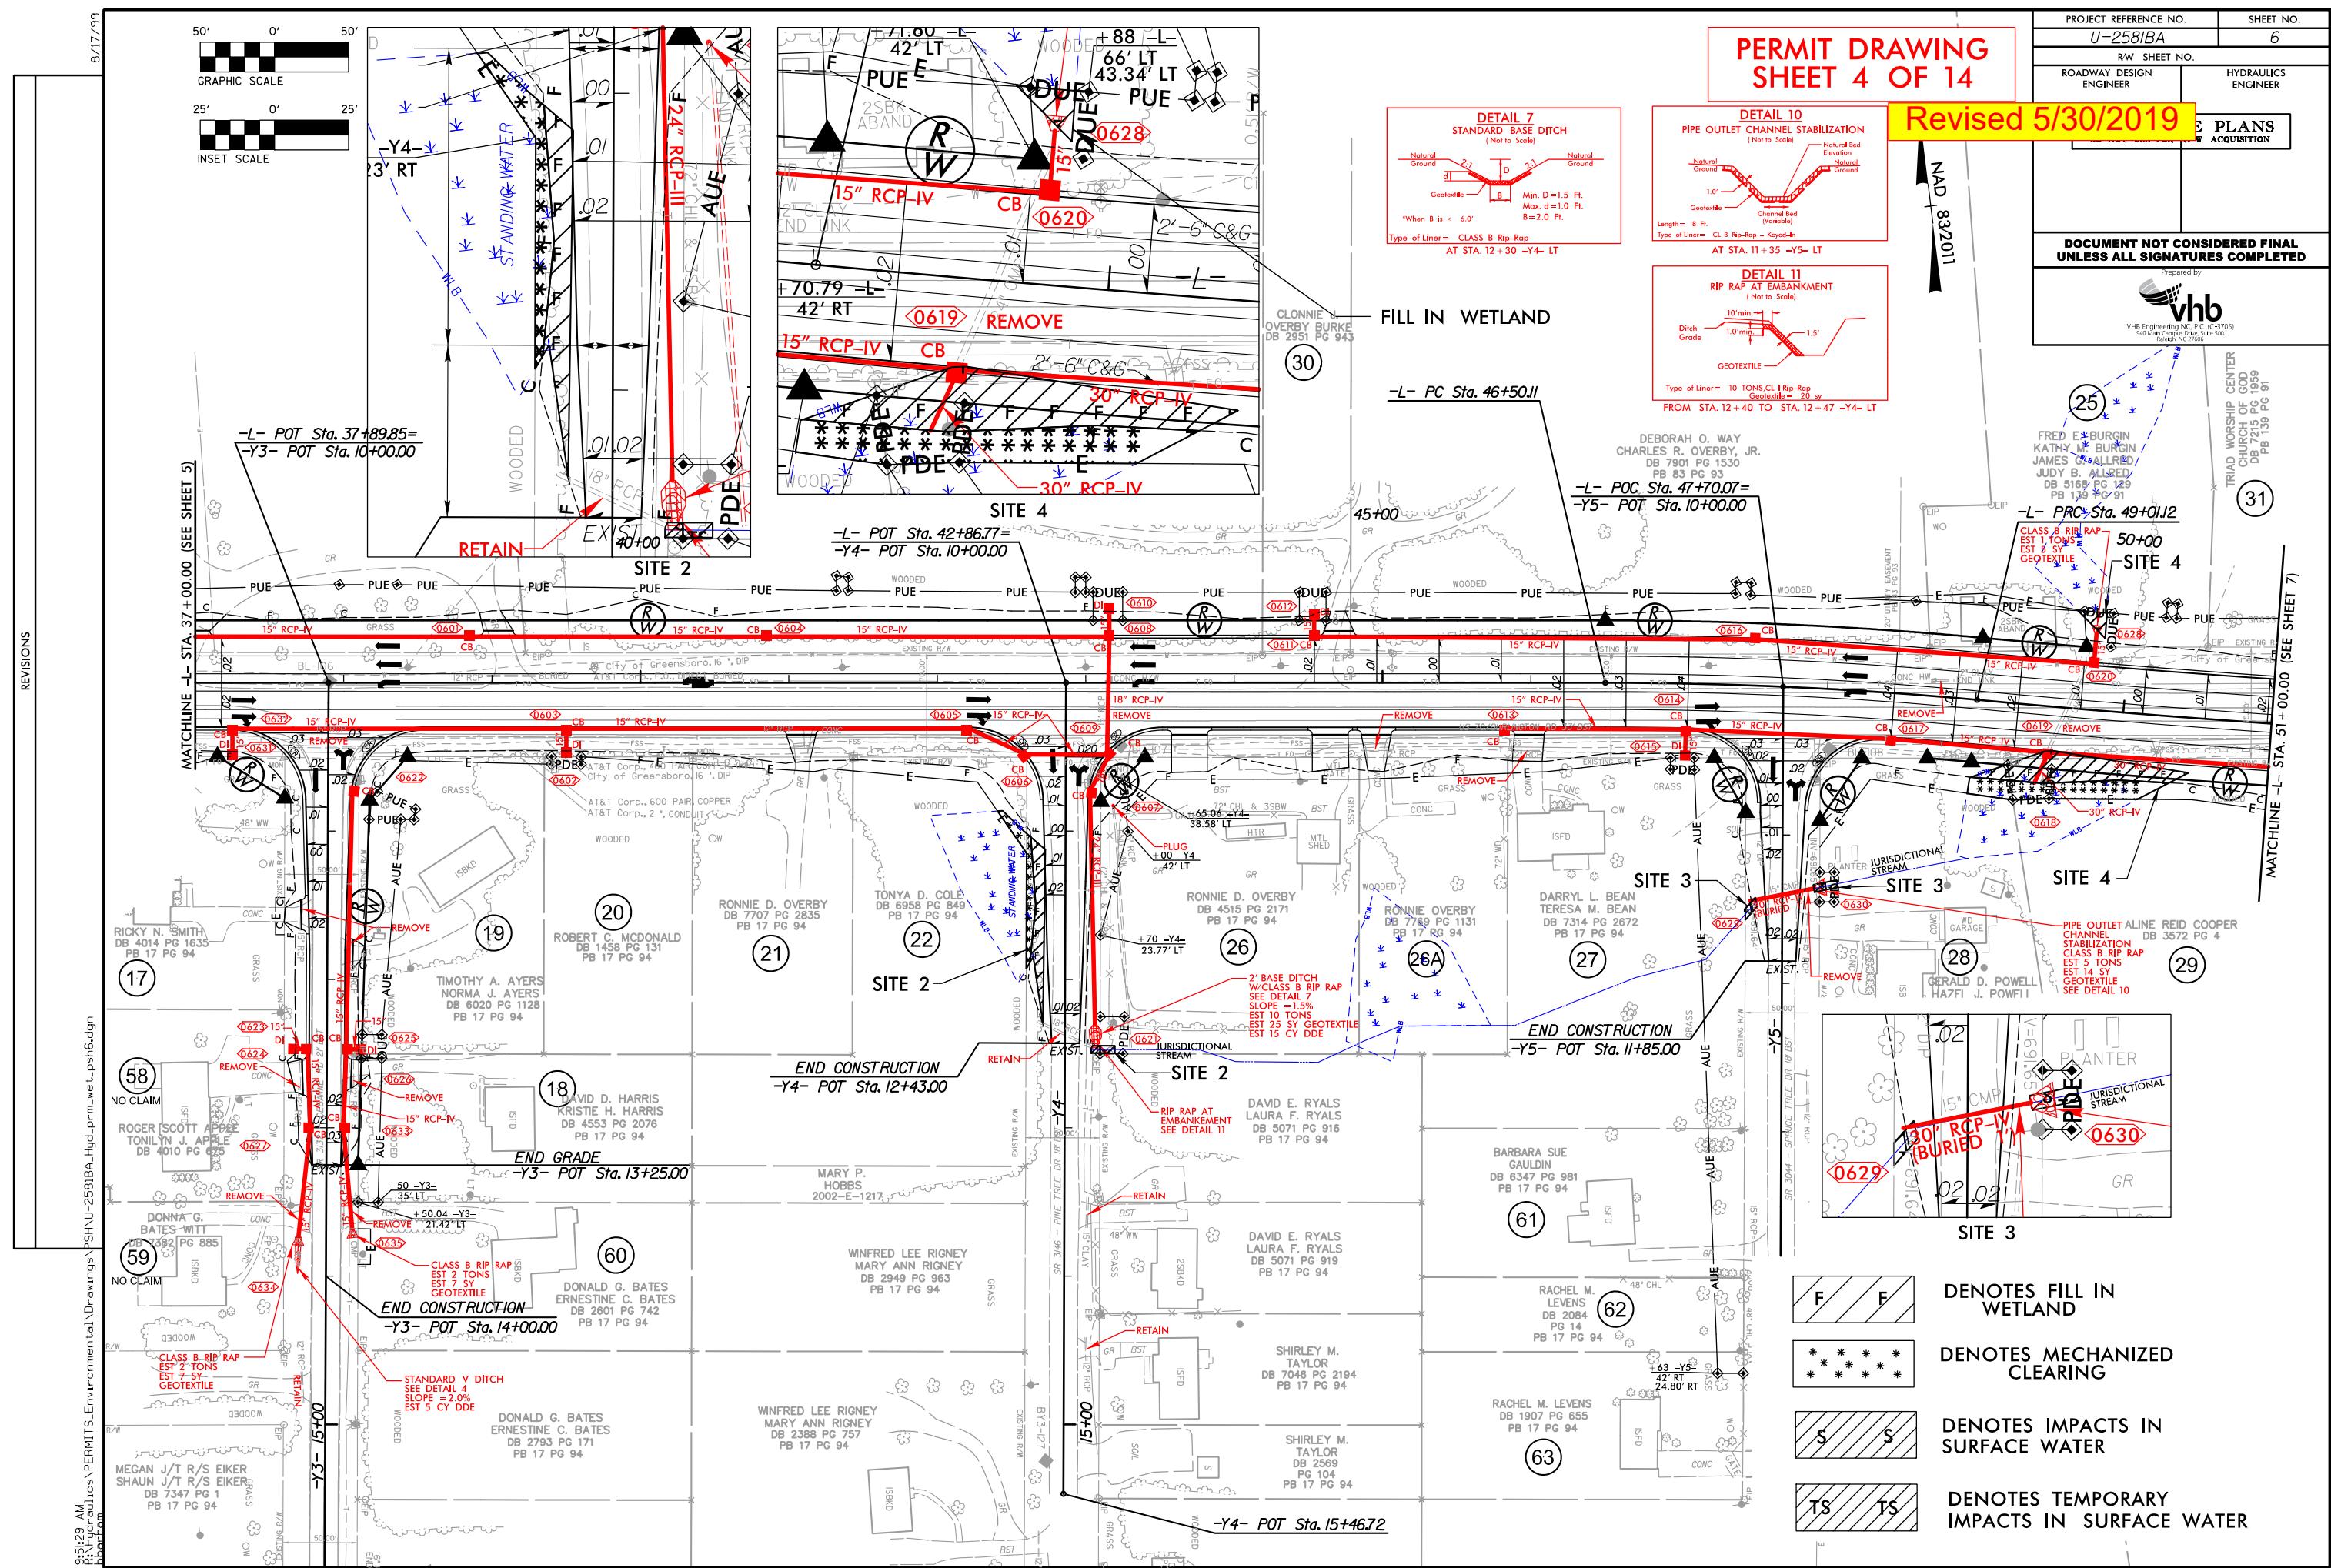



### WETLAND AND SURACE WATER IMPACTS SUMMARY

Site No.	Station (From/To)	Structure Size / Type	WETLAND IMPACTS					SURFACE WATER IMPACTS				
			Permanent Fill In Wetlands (ac)	Temp. Fill In Wetlands (ac)	Excavation in Wetlands (ac)	Mechanized Clearing in Wetlands (ac)	Hand Clearing in Wetlands (ac)	Permanent SW impacts (ac)	Temp. SW impacts (ac)	Existing Channel Impacts Permanent (ft)	Existing Channel Impacts Temp. (ft)	Natural Stream Design (ft)
1	12+02/12+07 -L- LT	30" RCP						< 0.01	< 0.01	10	19	
2	10+86/12+50 -Y4- RT	Roadway Fill/24" Pipe	0.02			0.01		< 0.01	< 0.01	6	10	
3	11+30/11+50 -Y5-	30" RCP								13	13	
4	49+00/50+47 -L-	Roadway Fill	0.05			0.03						
5	54+92/55+93 -L-	1@10'x8' RCBC/Roadway Fill	< 0.01					0.05	< 0.01	251	33	
6	14+60/14+66 -Y6- LT	24" RCP						< 0.01	< 0.01	20	15	
TOTALS*:			0.07			0.04		0.05	< 0.01	300	90	0

\*Rounded totals are sum of actual impacts

NOTES:




Revised 5/30/2019

NC DEPARTMENT OF TRANSPORTATION  
 DIVISION OF HIGHWAYS  
 05/30/2019  
 GUILFORD COUNTY  
 U-2581BA

**-L- CURVE DATA**  
 PI Sta. 17+66.41  
 $\Delta = 12^\circ 58' 11''$  (LT)  
 $D = 1' 13'' 08.6''$   
 $L = 1,063.9'$   
 $T = 534.24'$   
 $R = 4,700.00'$   
 $SE = 0.025$   
 $RO = 105'$   
 $INC = 42'$

**-Y2- CURVE DATA**  
 PI Sta. 13+49.93  
 $\Delta = 14^\circ 39' 42.3''$  (LT)  
 $D = 2' 06'' 23.3''$   
 $L = 696.04'$   
 $T = 349.53'$   
 $R = 2,720.00'$   
 $SE = 0.04$   
 $RO = 144'$

**US 70 (BURLINGTON RD.)  
AT MT HOPE CHURCH RD.**

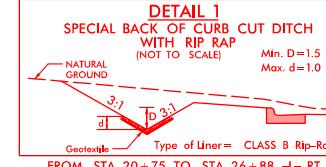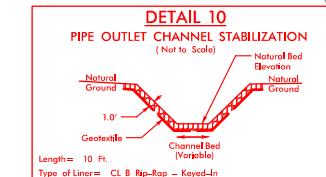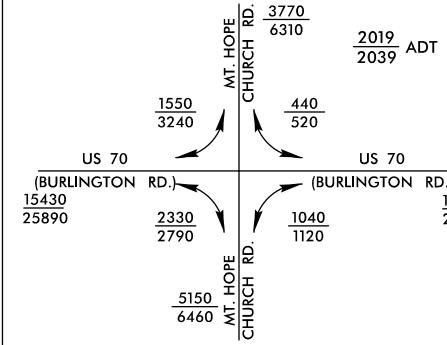

BEGIN CONSTRUCTION  
**-Y1- POT Sta. 13+45.00**

THOMAS EDWARD PAYNE  
 DB 3829 PG 416  
 PB 98 PG 89

(55)

**-Y1- PT Sta. 12+64.86**

PROJECT REFERENCE NO. U-2581BA SHEET NO. 4


R/W SHEET NO. ROADWAY DESIGN ENGINEER HYDRAULICS ENGINEER

INCOMPLETE PLANS DO NOT USE FOR R/W ACQUISITION

DOCUMENT NOT CONSIDERED FINAL UNLESS ALL SIGNATURES COMPLETED

vhb  
 VHB Engineering NC, P.C. (C-2705)  
 940 Mill Campus Drive, Suite 500  
 Raleigh, NC 27605

**BUFFER DRAWING  
SHEET 2 OF 7**  
 Revised 5/30/2019

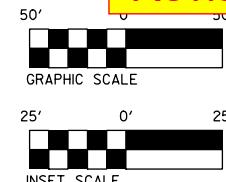

**BEGIN TIP PROJECT U-2581BA**


**-L- PC STA. 12 + 32.17**

BEGIN MILL/RESURFACE  
 BEGIN WIDENING (LT SIDE ONLY)

BEGIN CONSTRUCTION

**-L- POT Sta. 11+85.00**

PIPE OUTLET CHANNEL STABILIZATION CLASS B RIP RAP  
 EST 5 TONS  
 EST 7 SYNS  
 GEOTEXTILE SEE DETAIL 10

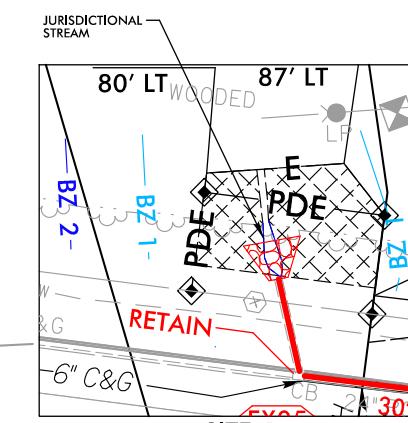

**-L- POC Sta. 18+37.75=**  
**-Y1- POT Sta. 20+24.64**  
**-Y2- PC Sta. 10+00.00**

MCLEANSVILLE LIONS CLUB  
 DB 2650 PG 529  
 PB 98 PG 89

(1)

**-Y1- PT Sta. 12+64.86**

PROJECT REFERENCE NO. U-2581BA SHEET NO. 4



R/W SHEET NO. ROADWAY DESIGN ENGINEER HYDRAULICS ENGINEER

INCOMPLETE PLANS DO NOT USE FOR R/W ACQUISITION

DOCUMENT NOT CONSIDERED FINAL UNLESS ALL SIGNATURES COMPLETED

vhb  
 VHB Engineering NC, P.C. (C-2705)  
 940 Mill Campus Drive, Suite 500  
 Raleigh, NC 27605

**BUFFER DRAWING  
SHEET 2 OF 7**  
 Revised 5/30/2019

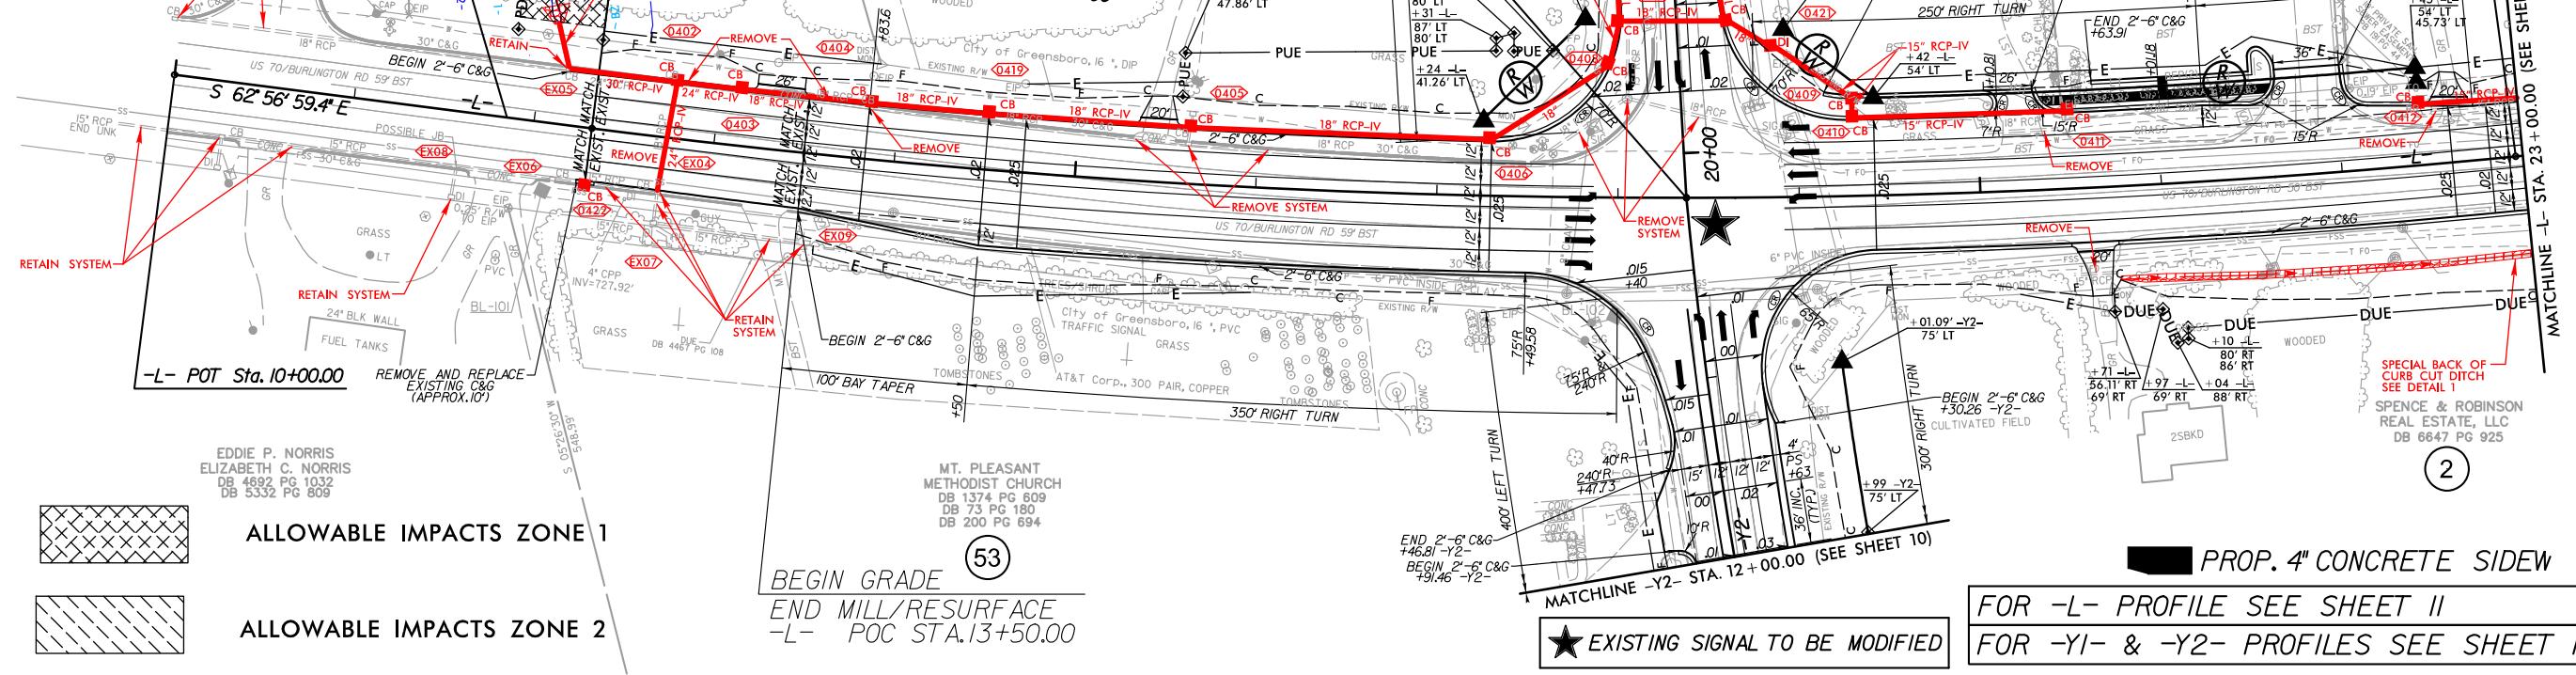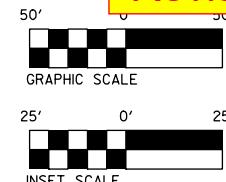

**BUFFER DRAWING  
SHEET 6 OF 7  
Revised 5/30/2019**

PROJECT REFERENCE NO.	SHEET NO.
U-2581BA	9
R/W SHEET NO.	
ROADWAY DESIGN ENGINEER	HYDRAULICS ENGINEER

**INCOMPLETE PLANS**  
**DO NOT USE FOR R/W ACQUISITION**

**DOCUMENT NOT CONSIDERED FINAL  
UNLESS ALL SIGNATURES COMPLETED**

Prepared by  
**vhb**  
VHB Engineering NC, P.C. (C-3705)  
940 Kiln Creek Drive, Suite 500  
Burlington, NC 27215

