



PAT McCrory
Governor

NICHOLAS J. TENNYSON
Secretary

September 22, 2016

North Carolina Division of Water Resources
Mooresville Regional Office
610 East Center Avenue, Suite 301
Mooresville, NC 28115

SUBJECT: Response to August 23, 2016 Review of NCDOT's application for Section 404 and 401 permits for the proposed improvements to NC 3 (Mooresville Road), from Kannapolis Parkway to Dale Earnhardt Boulevard/Loop Road (SR 1691), Cabarrus County, North Carolina. Tip No. U-3440.

Reference: NCDWR On-Hold letter, dated August 23, 2016
NCDOT 404 & 401 Application dated June 16, 2016

Dear Ms. Hood:

The North Carolina Department of Transportation (NCDOT) received the above referenced letter from the North Carolina Division of Water Resources (NCDWR), noting that the permit application was deficient in certain areas, pertinent to [15A NCAC 02H.056(b)(2)]. These items of deficiency are listed below, with NCDOT responses:

- NCDWR Comment: Existing stream profiles for all relocated and realigned streams are needed.
 - NCDOT Response: Ditch profiles have been included in the revised permit drawings for areas where streams will be realigned.
- NCDWR Comment: There is no detail for stream reconstruction at the end of the 10X9 culvert near Site MB.
 - NCDOT Response: Detail 6D has been added to the revised permit drawings to address this.
- NCDWR Comment: PSRM is listed as a liner in the bed of a relocated jurisdictional stream at Site S1. This is a permanent impact that was not agreed upon in previous merger meetings.
 - NCDOT Response: PSRM has been removed. Based on stream grade, Class B riprap armoring is needed and has been included in Detail 6A.



- NCDWR Comment: Clarify why there is a change in the culvert ~~site~~ [size] at Site MB from the merger notes to the plans submitted.
 - NCDOT Response: The approved Culvert Survey Report (CSR) shows a 10' X 9' culvert. During design, the culvert size was based on burying the culvert a foot and including baffles. As such, the hydraulic opening is still 10' X 8'.
- NCDWR Comment: Recommend Class 2 rip rap for Site IBC for bank stabilization and areas of rock/surface water interface.
 - NCDOT Response: The existing bank is only three feet above the stream bed. Class I riprap is sufficient for this purpose.
- NCDWR Comment: Detail for turning the jurisdictional stream at S2 into the new location.
 - NCDOT Response: The proposed stream line has been corrected to show it connecting to the proposed stream and the existing stream.
- NCDWR Comment: Detail for directing flow into the 42-inch bored pipe at Site S3.
 - NCDOT Response: Detail D is the detail used to direct flow into the pipe at the upstream end (Station 86+24 Rt.). This same detail has been added to the downstream end of the pipe (Station 89+05 Lt.) to convey water from the pipe back into the stream.
- NCDWR Comment: Recommend Class 2 rip rap for stabilization at the rock/surface water interface of Site S3.
 - NCDOT Response: Class I riprap is adequate for the 2:1 laid back slopes.
- NCDWR Comment: Please provide detail at Site S5 for turning flow from 15' CMP into stream.
 - NCDOT Response: A short riprap ditch (armored tail ditch) has been added at the outlet of the 15-inch CMP (see Detail 11F).
- NCDWR Comment: Recommend Class 2 riprap for bank stabilization at S5 due to a very steep grade.
 - NCDOT Response: Class I riprap is adequate for this crossing. The armored tail ditch (see comment above) will provide additional stability.

- NCDWR Comment: Recommend Class 2 riprap at Site S6 due to a very steep grade.
 ➤ **NCDOT Response**: Class II riprap will be used on the right side of the culvert.
- NCDWR Comment: Recommend bank stabilization for S7-1 discharge outlet to the stream.
 ➤ **NCDOT Response**: Bank stabilization added (see Detail 12H).
- NCDWR Comment: Site S7-2, recommend class 2 riprap for stabilization.
 ➤ **NCDOT Response**: Riprap has been revised to Class II for bank stabilization.
- NCDWR Comment: Site S7-3 depicts fill of a jurisdictional stream but no impacts are requested at this site. Please clarify.
 ➤ **NCDOT Response**: Per Bill Barrett's discussion with Donna Hood, this comment pertains to sites listed/not listed on the Stormwater Management Plan (SMP). The SMP has been revised to include all of the impact sites.

There will be no additional or changes in impacts with the above mentioned changes to the permit drawings. **A set of revised Permit Drawings are enclosed that replace the previously submitted permit drawing package.**

Thank you for your time and assistance with this project. Please contact Bill Barrett at either wabarrett@ncdot.gov or (919) 707-6103 if you have any questions or need additional information.

Sincerely,



for Philip Harris, P.E., C.P.M.
 Natural Environment Section Head

Enclosure: revised permit drawing package

cc: Crystal Amschler, USACE



North Carolina Department of Transportation

Highway Stormwater Program
STORMWATER MANAGEMENT PLAN
FOR LINEAR ROADWAY PROJECTS

(Version 1.2; Released September 2011)

Project/TIP No.: U-3440

County(ies): Cabarrus

Page 1 of 2

General Project Information

Project No.:	U-3440	Project Type:	Roadway Relocation	Date:	9/7/2016
NCDOT Contact:	Stephen Morgan, PE	Contractor / Designer:	John Shirley, PE / Stantec Consulting Inc.		
Address:	Design Support Group 1020 Birch Ridge Drive Raleigh, NC 27610	Address:	801 Jones Franklin Road Suite 300 Raleigh NC 27606		
	Phone:		919-707-6739	Phone:	919-851-1919
	Email:		smorgan@ncdot.gov	Email:	john.shirley@stantec.com
City/Town:	Kannapolis	County(ies):	Cabarrus		
River Basin(s):	Yadkin-Pee Dee	CAMA County?	No		
Primary Receiving Water:	Irish Buffalo Creek	NCDWQ Stream Index No.:	13-17-9-(2)		
NCDWQ Surface Water Classification for Primary Receiving Water	Primary:	Class C			
	Supplemental:	None			
Other Stream Classification:					
303(d) Impairments:	None				
Buffer Rules in Effect	N/A				

Project Description

Project Length (lin. Miles or feet):	2.646 miles	Surrounding Land Use:	urban	
	Proposed Project		Existing Site	
Project Built-Upon Area (ac.)	31.25 ac.		20.00 ac.	
Typical Cross Section Description:	Typical cross section varies however along the -L- line there is double 11' travel lanes on left and right of the project with 5' bike lanes on both sides of the road.			
Average Daily Traffic (veh/hr/day):	Design/Future: 16800/23900	Existing:	16800/2015	

General Project Narrative: The NCDOT proposed to improve NC 3 (Mooresville Road) from the Kannapolis Parkway to Dale Earnhardt Boulevard/ Loop Road (SR 1691). The proposed improvements will widen Mooresville Road to a four lane divided facility. The typical section will consist of two 11 foot travel lanes and a 5 foot bicycle lane in each direction, with a 23.5 foot wide grass median. Sidewalks are proposed on both sides of the proposed facility for the entire length of the project. The project is approximately 2.6 miles in length.

References



North Carolina Department of Transportation

Highway Stormwater Program
STORMWATER MANAGEMENT PLAN
FOR LINEAR ROADWAY PROJECTS

(Version 1.2; Released September 2011)

Project/TIP No.: U-3440

County(ies): Cabarrus

Page 2 of 2

Project Environmental Summary

Surface Water Impacts

Sheet No.	Station (From / To)	Feature Impacted	Water / Wetland / Buffer Type	Receiving Surface Water Name	NRTR Map ID	NCDWQ Stream Index	NCDWQ Surface Water Classification	303(d) Impairments	Type of Impact	Existing SCM	Proposed SCM
6	L37+00 LT	Stream	Perennial	Miller Branch	S1	N/A	C	None	Fill	N/A	
	L40+15 LT										
6	L40+61 RT	Stream	Perennial	Miller Branch	MB	N/A	C	None	Culvert	N/A	
8	L68+25	Stream	Perennial	Irish Buffalo Creek	IBC	13-17-9-(2)	C	None	Fill	N/A	
8	L70+31	Wetland	Wetland	Tributary to Irish Buffalo Creek	WA	N/A	C	None	Fill	N/A	
8	L73+02	Stream	Perennial	Tributary to Irish Buffalo Creek	S2	N/A	C	None	Fill	N/A	
9	86+12	Stream	Perennial	Tributary to Irish Buffalo Creek	S3	N/A	C	None	Culvert	N/A	
10	97+30	Stream	Perennial	Tributary to Irish Buffalo Creek	S4	N/A	C	None	Culvert	N/A	
11	L109+75	Stream	Perennial	Tributary to Irish Buffalo Creek	S5	N/A	C	None	Culvert	N/A	
12	L117+50	Stream	Perennial	Irish Buffalo Creek Tributary 3	S6	N/A	C	None	Fill	N/A	
12	Y15 12+25	Stream	Perennial	Tributary to Irish Buffalo Creek Tributary 3	S7-1	N/A	C	None	Culvert	N/A	
12	L126+30	Stream	Perennial	Tributary to Irish Buffalo Creek Tributary 3	S7-2	N/A	C	None	Stabilization	N/A	
12	L134+38	Stream	Perennial	Tributary to Irish Buffalo Creek Tributary 3	S7-3	N/A	C	None	Fill	N/A	

* List all stream and surface water impact locations regardless of jurisdiction or size.

Equalizer Pipes to be noted as a minimization of impacts.

All proposed SCMs listed must also be listed under Swales, Preformed Sour Holes and other Energy Dissipators, or Other Stormwater Control Measures.

Description of Minimization of Impacts or Mitigation

See Attachment


References

Description of Minimization of Impacts or Mitigation

Site S1: Includes channel relocation rather than piping. Site MB: Pipe outfall located 80' from stream channel in riprap lined ditch. Box culvert includes baffles with low flow channel and sills to retain native bed material. Site IBC: Pipe outfalls located 200'-300' from channel. Bridge bents located on top of banks to prevent permanent surface water impacts. Site S2: Includes stream channel relocation rather than piping. Site S3: Includes riprap on banks only at pipe inlet and outlet to minimize permanent surface water impacts. Site S4: Includes riprap on banks only at pipe outlet to minimize permanent surface water impacts. Pipe buried 1' below channel bed. Site S5: Includes riprap on banks only at pipe inlet and outlet to minimize permanent surface water impacts. Site S6: Box culvert includes baffles with low flow channel and sills to retain native bed material. Pipe outfall located 140' from channel. Site S7-1: Pipe outfall located 40' from channel. Site S7-2: Includes riprap on banks only at pipe inlet and outlet to minimize permanent surface water impacts. Site S7-3: Includes riprap on banks only at pipe outlet to minimize permanent surface water impacts.

TIP PROJECT: U-3440

CONTRACT:

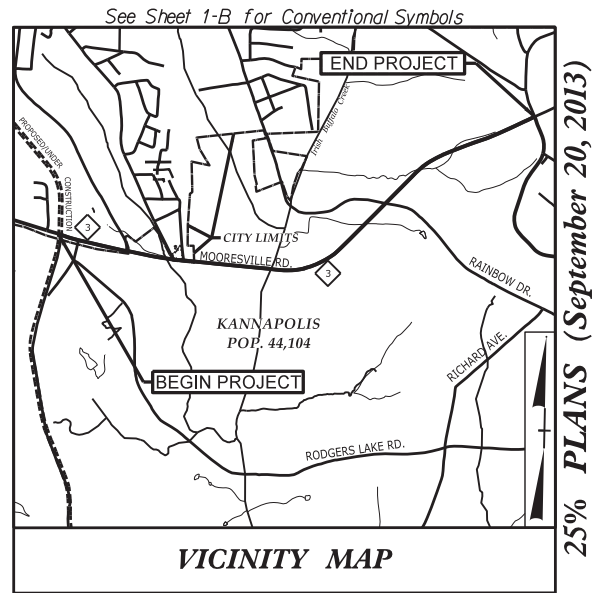


STATE OF NORTH CAROLINA
DIVISION OF HIGHWAYS

CABARRUS COUNTY

LOCATION: NC 3, PROPOSED WEST SIDE BYPASS TO
SR 1691 (LOOP ROAD) IN KANNAPOLIS
TYPE OF WORK: GRADING, DRAINAGE, PAVING, STRUCTURES, AND SIGNALS

WETLAND AND SURFACE WATER IMPACTS PERMIT

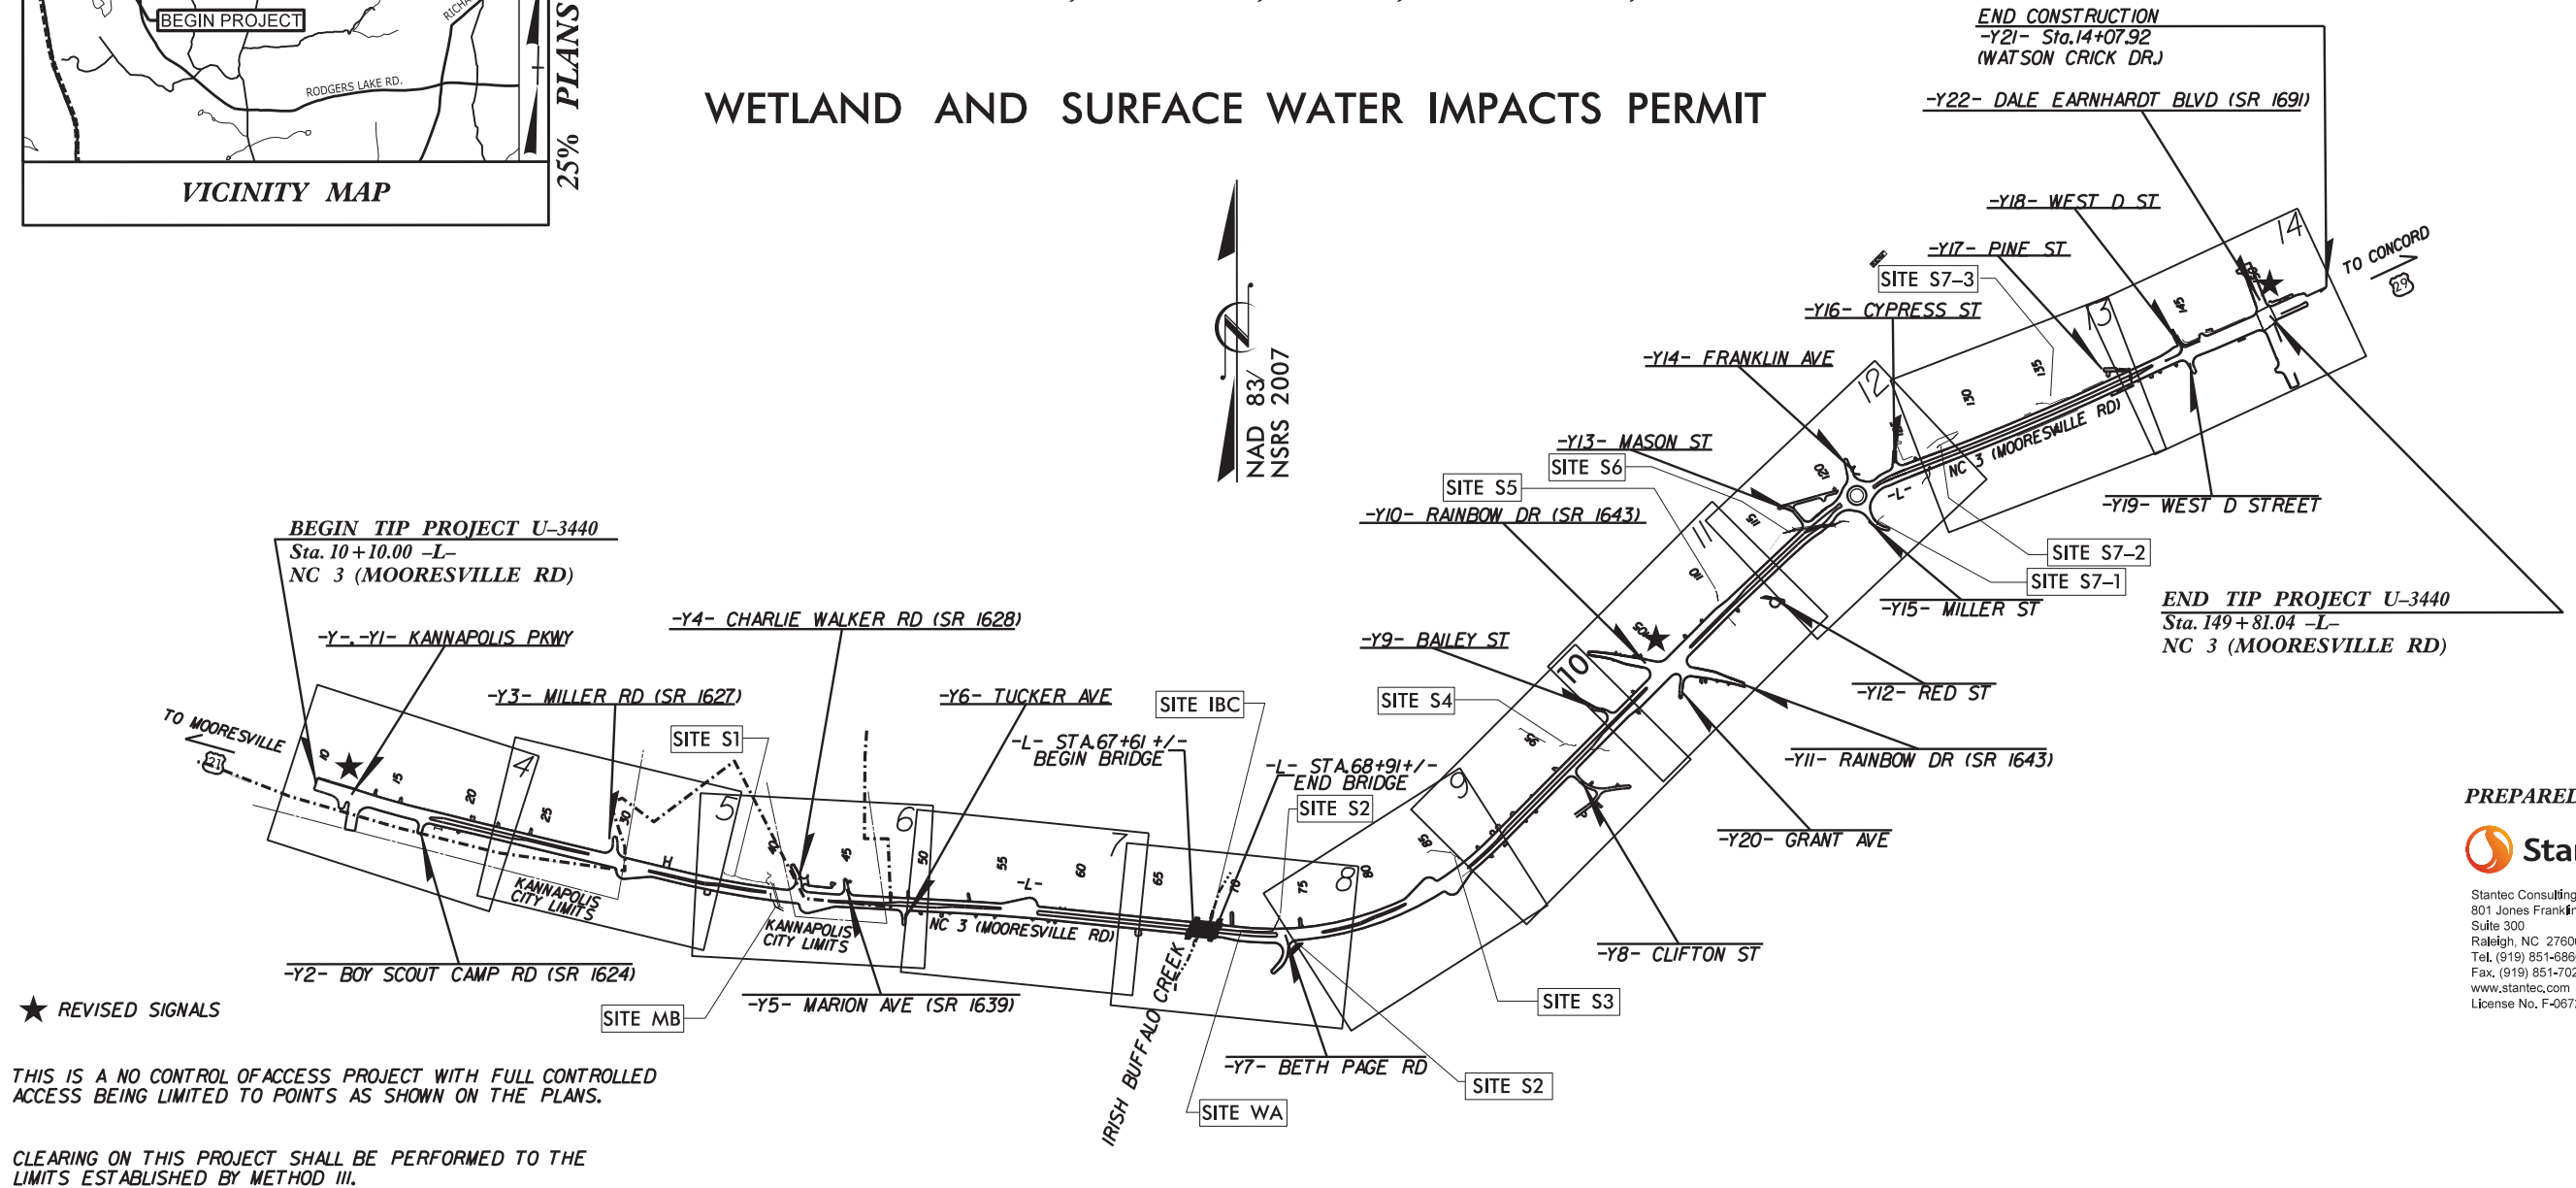

PERMIT DRAWING
SHEET 1 OF 23


STATE	STATE PROJECT REFERENCE NO.	SHEET NO.	TOTAL SHEETS
N.C.	U-3440	1	
STATE PROJ. NO.	P.A. PROJ. NO.	DESCRIPTION	
39010.1.1	STP-0003(6)	PE	

PREPARED BY:



Stantec Consulting Services Inc.
801 Jones Franklin Road
Suite 300
Raleigh, NC 27606
Tel. (919) 851-6866
Fax. (919) 851-7024
www.stantec.com
License No. F-0672

GRAPHIC SCALES

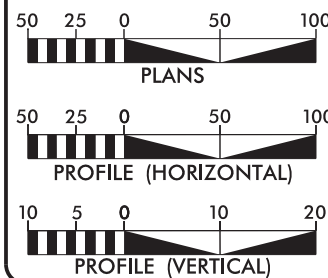

DESIGN DATA

ADT 2015 = 16,800
ADT 2035 = 23,900
DHV = 12 %
D = 60 %
T = 9 % *
V = 50 MPH
HIST. AREA V = 40 MPH
*(TTST 7% + DUALS 2%)
FUNC CLASS = MINOR ARTERIAL
REGIONAL TIER

PROJECT LENGTH

LENGTH ROADWAY TIP PROJECT U-3440 = 2.621 MILES
LENGTH STRUCTURE TIP PROJECT U-3440 = 0.025 MILE
TOTAL LENGTH TIP PROJECT U-3440 = 2.646 MILES

Prepared for the Office of:
DIVISION OF HIGHWAYS
1000 Birch Ridge Dr., Raleigh NC, 27610

2012 STANDARD SPECIFICATIONS
RIGHT OF WAY DATE: MAY 29, 2015
LETTING DATE: OCTOBER 18, 2016

MICHAEL LINDGREN, P.E.
PROJECT ENGINEER
MICHAEL LITTLEFIELD, P.E.
PROJECT DESIGN ENGINEER


NCDOT CONTACT: BRENDA MOORE, PE
ROADWAY DESIGN ENGINEERING
COORDINATION SECTION ENGINEER

HYDRAULICS ENGINEER

SIGNATURE: P.E.

ROADWAY DESIGN
ENGINEER

SIGNATURE: P.E.

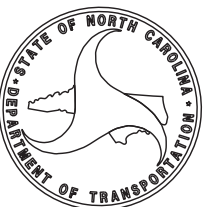

-Y4-
2015 ADT (CHARLIE WALKER ROAD)
2035 ADT

$\frac{1500}{1100}$	$\frac{3600}{2900}$	$\frac{2100}{1800}$
14200		14800
(NC 3) 22900		23600

NAD 83/NSRS 2007

SITE S1

4A
WEST OAKS

SITE ME

$$\begin{array}{r}
 \text{---}L\text{---} \quad \frac{14900}{(NC \ 3) \ 23800} \qquad \qquad \qquad \frac{15100}{23900} \\
 \qquad \qquad \qquad \frac{100}{100} \qquad \qquad \qquad \frac{200}{200} \\
 \qquad \qquad \qquad \frac{200}{300} \\
 \qquad \qquad \qquad -Y6- \\
 \qquad \qquad \qquad (TUCKER \ AVE.)
 \end{array}$$

DETAIL 6A
LATERAL BASE DITCH
 (Not to Scale)

Natural Ground

2:1

d

D

2:1

1' Ft.

B

Min. D = 1.5 Ft.
 Max. d = 1.5 Ft.
 B = 3.0 Ft.
 B = 5.0 Ft.

*When B is < 6.0'

Type of Liner = CL. B Rip-Rap

FROM -L STA. 37+00 TO STA. 40+15 LT

DETAIL 6B

LATERAL BASE DITCH
(Not to Scale)

*When $B < 6.0'$ *

Type of Liner = CL 1 Rip-Rap

Max. D = 1.5 Ft.
Min. d = 1.5 Ft.
B = 3.0 Ft.
b = 5.0 Ft.

FROM -L STA. 40+35 TO 41+31 LT
FROM -L STA. 40+30 TO 41+05 RT

DETAIL 6C
BERM 'V' DITCH
(Not to Scale)

Natural Ground

2:1

D

2:1

b

RDWY

2:1

Min. D=1.0 Ft.
b=5.0 Ft.

DETAIL 6D
SPECIAL CUT BASE DITCH
(Not to Scale)

Natural Ground

2:1

Geotextile

D

B

1:1

Natural Ground

Min. D = 1.5 Ft.
Max. d = 1.5 Ft.
B = 6.0 Ft.


Type of Liner = CL. 1 Rip-Rap

FROM -L- STA. 40+88 TO STA. 41+09 RT


 DENOTES TEMPORARY IMPACTS IN SURFACE WATER
 DENOTES IMPACTS IN SURFACE WATER

15.25

NOTE: SEE SHEET 15 THRU 16 FOR -L- PROFILE
SEE SHEET 21 FOR -Y4-, -Y5-, & -Y6- PROFILE
SEE SHEET 2-G FOR -Y4- INTERSECTION DETAIL

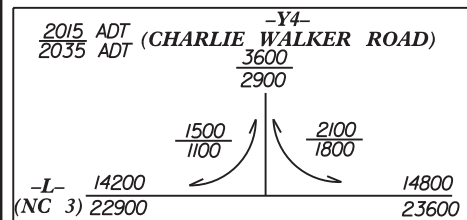


NAD 83/NSRS 2007










PROJECT REFERENCE NO.	SHEET NO.
<i>U-3440</i>	<i>6</i>
RW SHEET NO.	
ROADWAY DESIGN ENGINEER	HYDRAULICS ENGINEER








PERMIT DRAWING
SHEET 3 OF 23

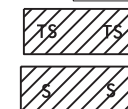

DENOTES TEMPORARY
 IMPACTS IN SURFACE WATER
 DENOTES IMPACTS IN
 SURFACE WATER

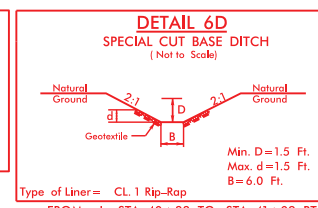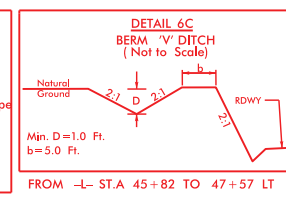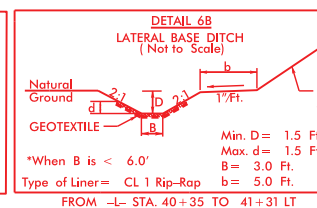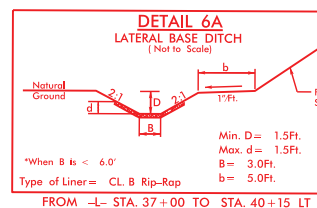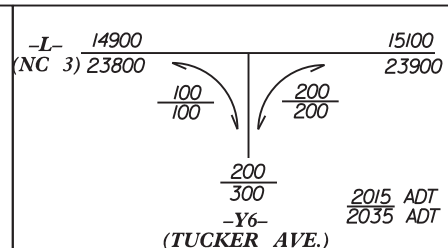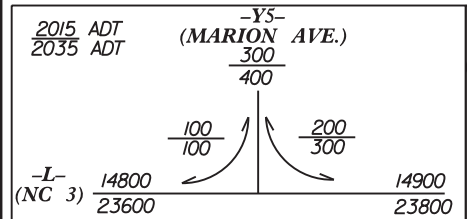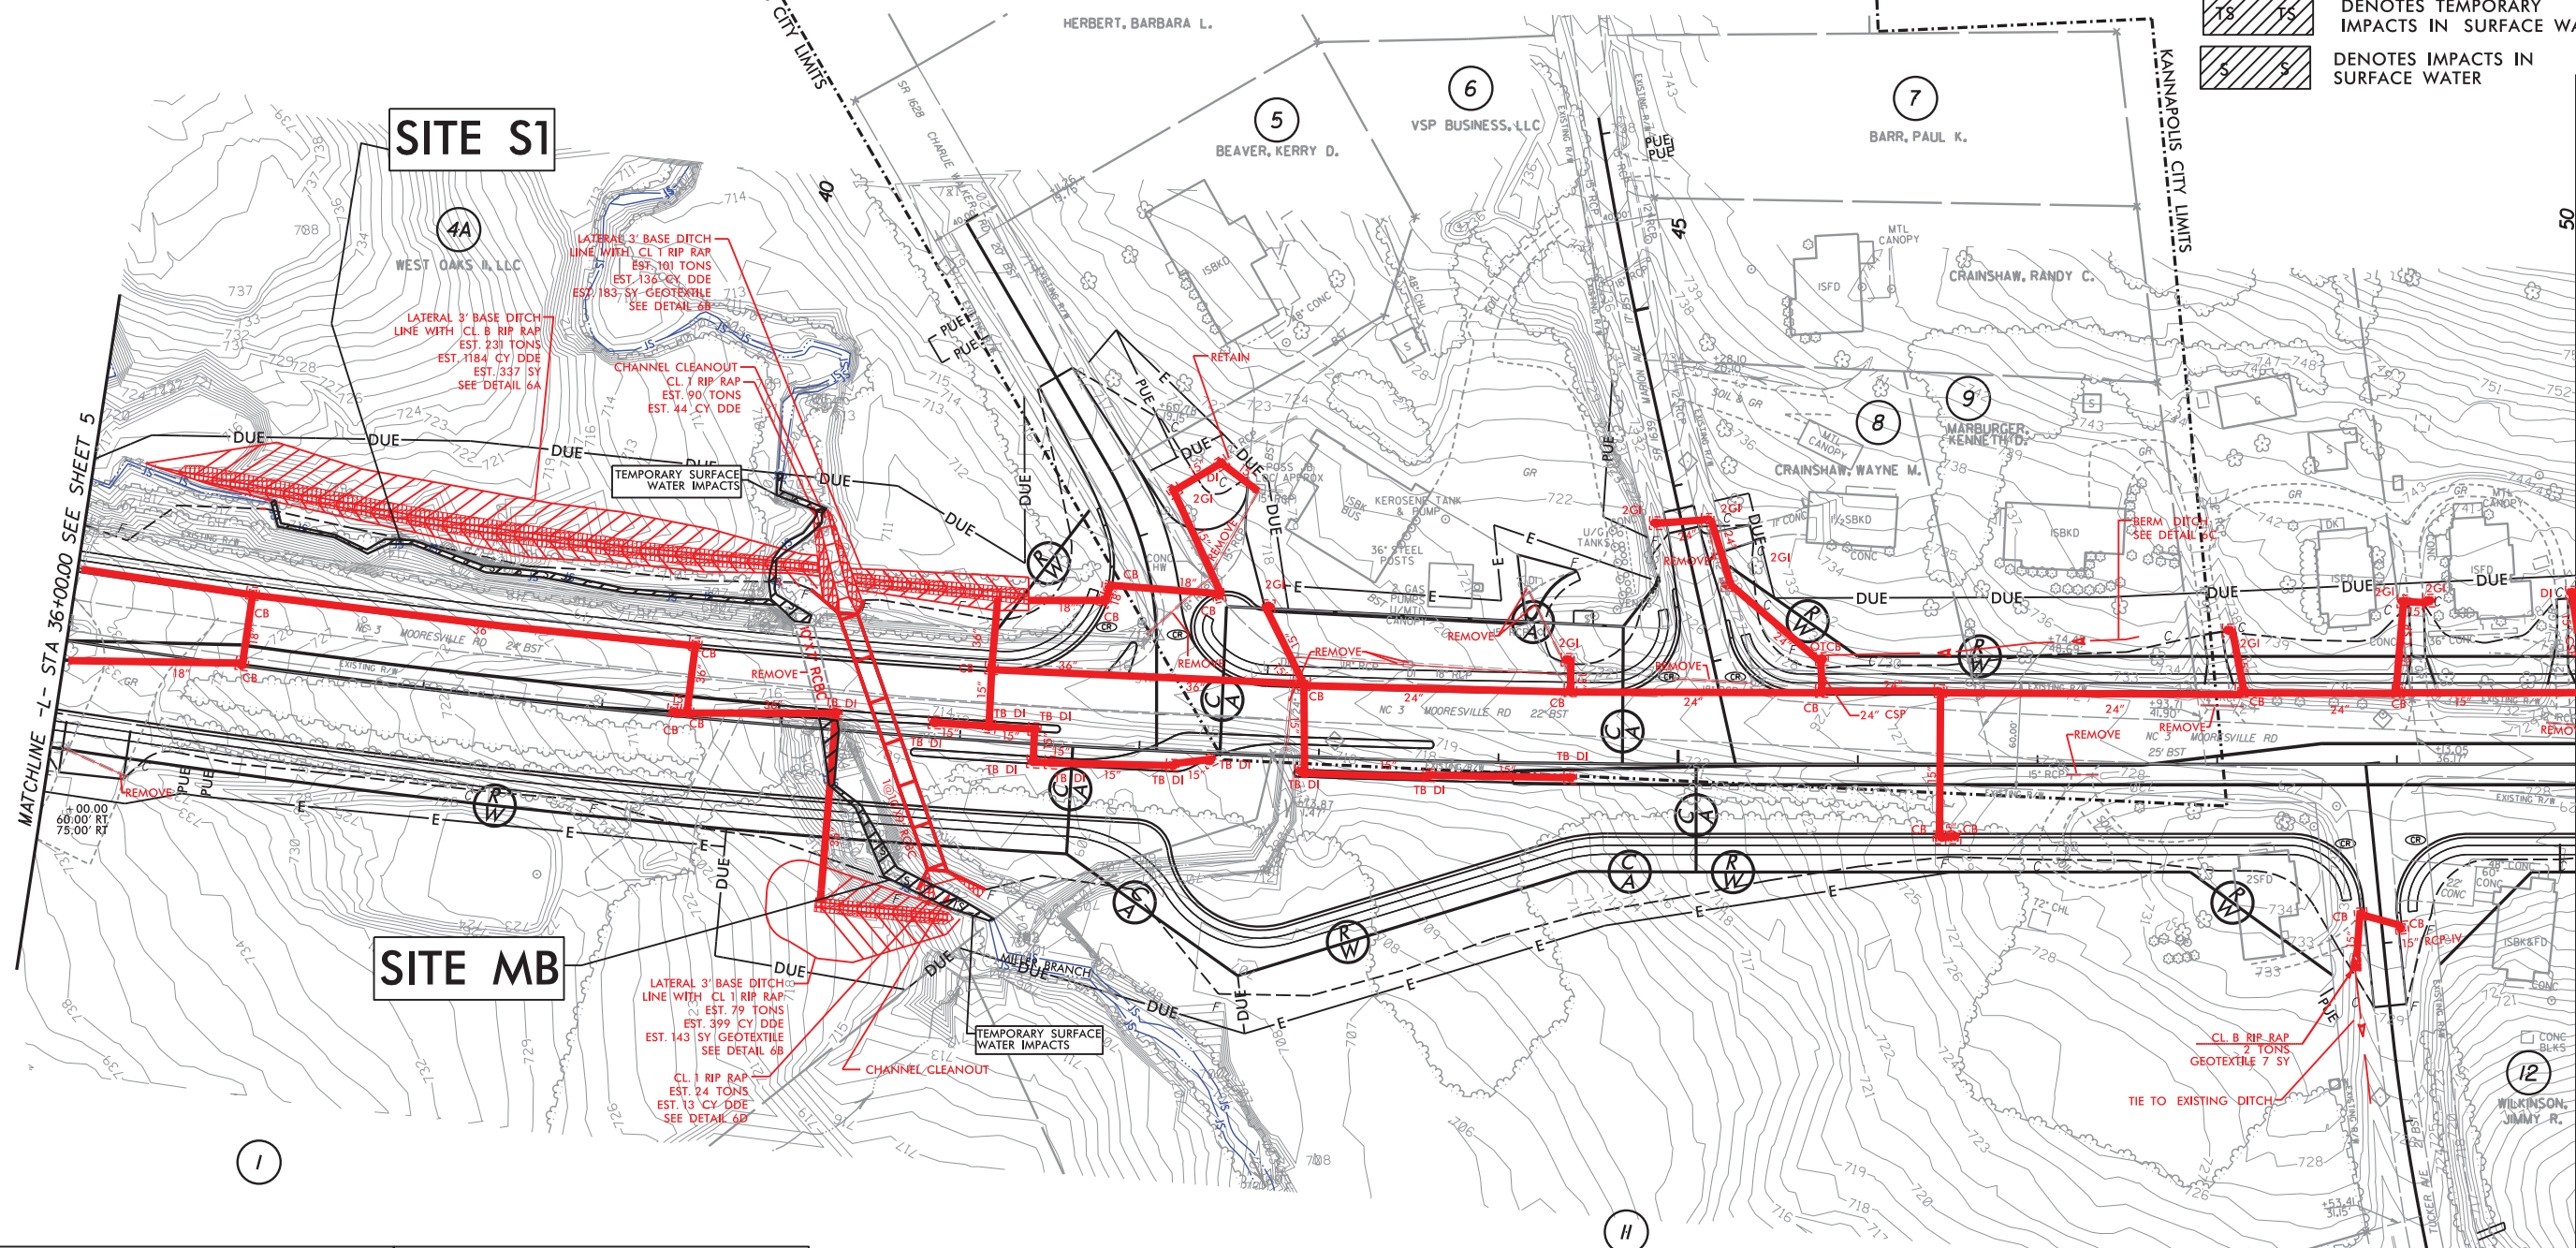

8/17/99

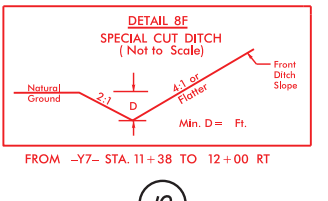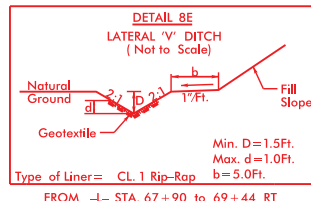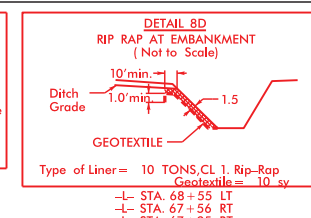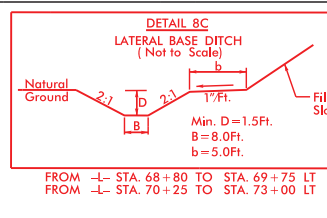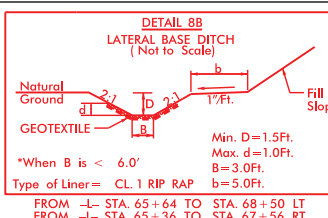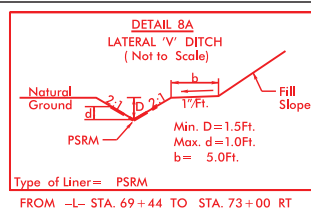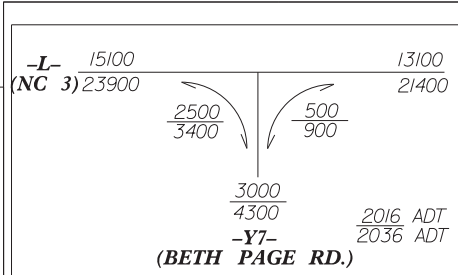

PERMIT DRAWING SHEET 5 OF 23

- DENOTES FILL IN WETLAND
- DENOTES IMPACTS IN SURFACE WATER
- DENOTES TEMPORARY IMPACTS IN SURFACE WATER





PROJECT REFERENCE NO.	SHEET NO.
U-3440	8
RW SHEET NO.	
ROADWAY DESIGN ENGINEER	HYDRAULICS ENGINEER
DOCUMENT NOT CONSIDERED FINAL UNLESS ALL SIGNATURES COMPLETED	

NAD 83/NSRS 2007

Stantec

Stantec Consulting Services Inc.
801 Jones Franklin Road
Suite 300
Raleigh, NC 27606
Tel. (919) 851-6866
Fax. (919) 851-7024
www.stantec.com
License No. F-0672

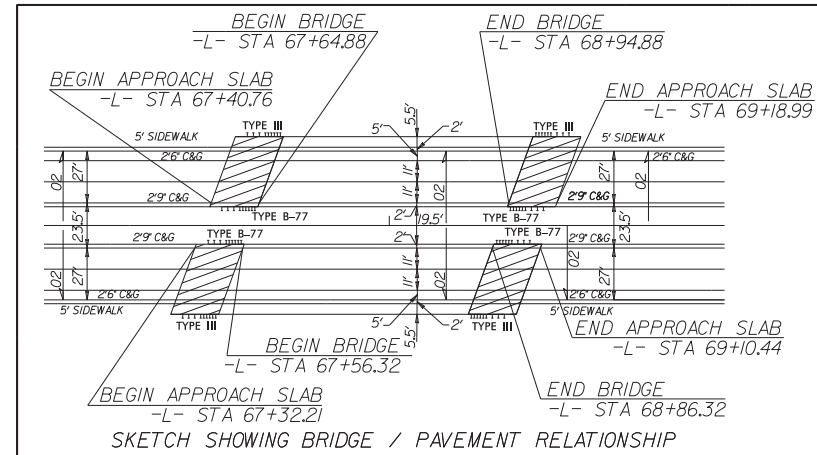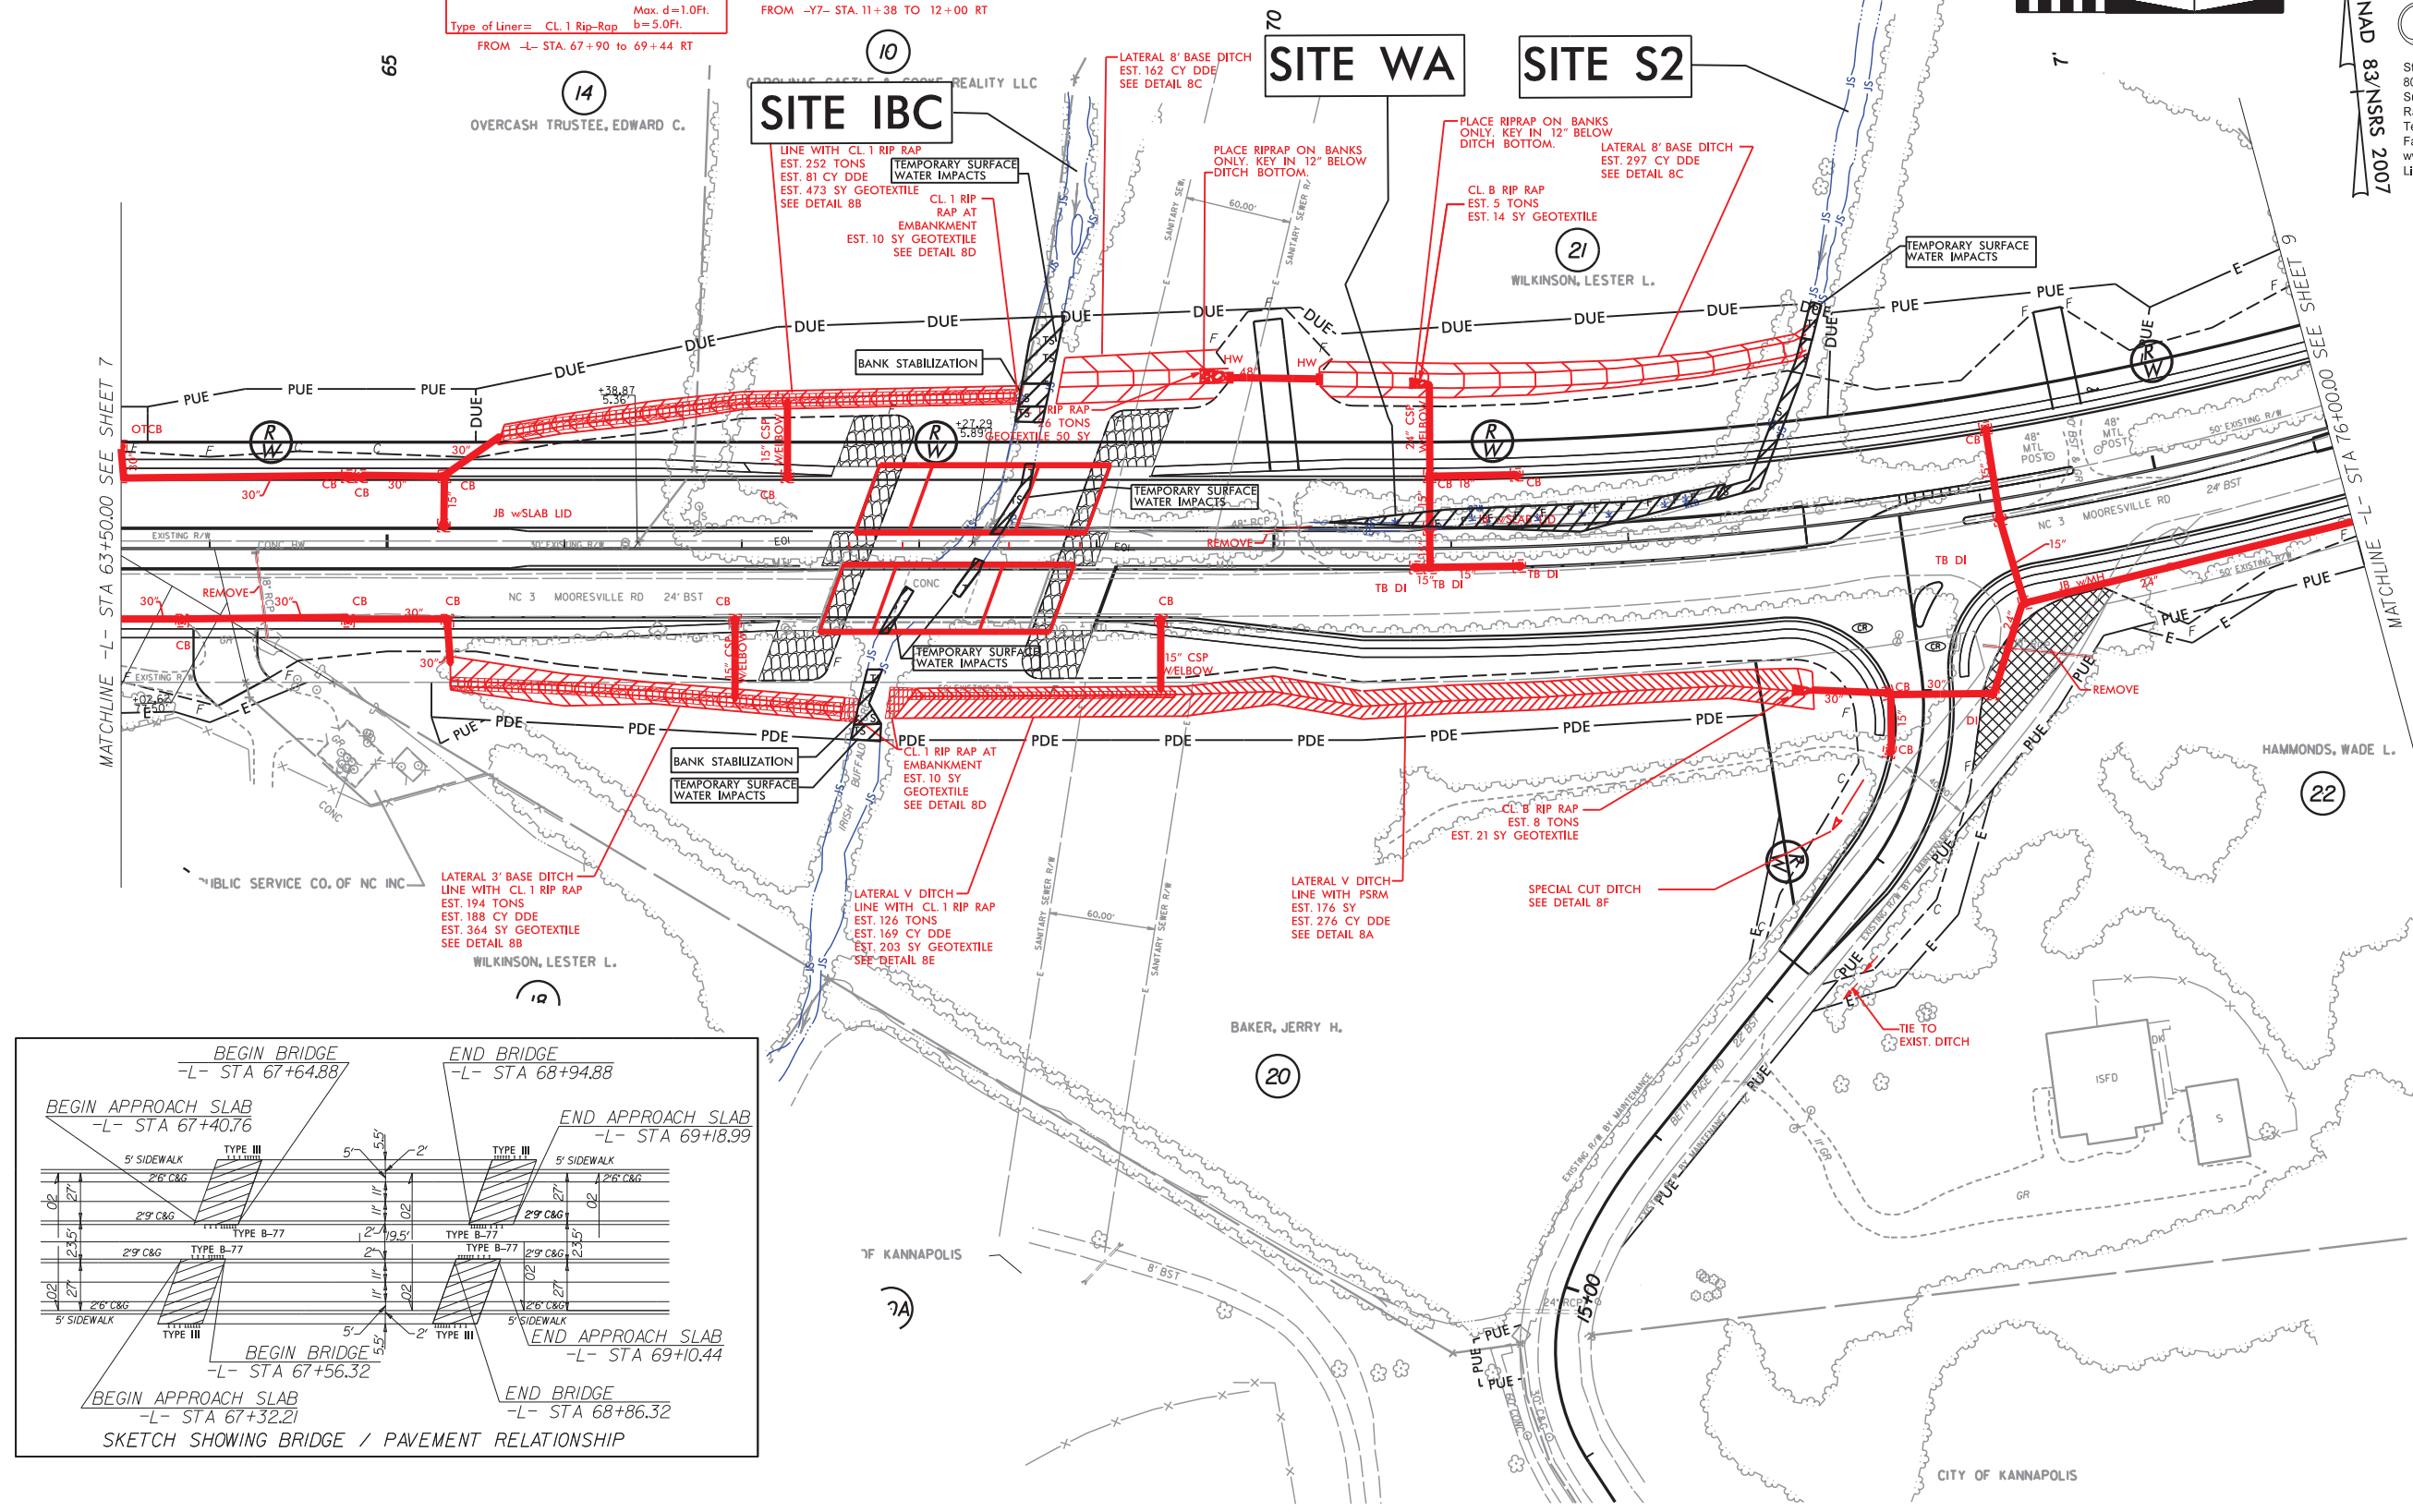

$$\begin{array}{r} \text{--}L\text{--} \quad 15100 \\ (\text{NC } 3) \quad 23900 \end{array}$$

$$\begin{array}{r} 2500 \\ \hline 3400 \end{array}$$





$$\begin{array}{r} 500 \\ \hline 900 \end{array}$$

$$\begin{array}{r} 13100 \\ 21400 \end{array}$$

$$\begin{array}{r} 3000 \\ \hline 4300 \end{array}$$

$$\begin{array}{r} 2016 \text{ ADT} \\ 2036 \text{ ADT} \end{array}$$

$$\begin{array}{r} \text{--}Y7\text{--} \\ \text{(BETH PAGE RD.)} \end{array}$$

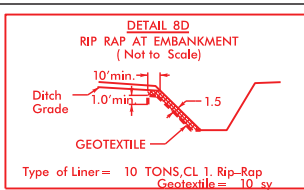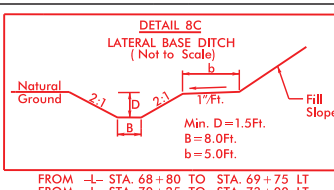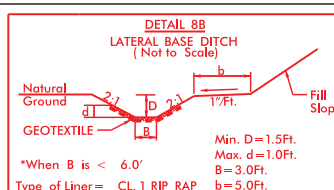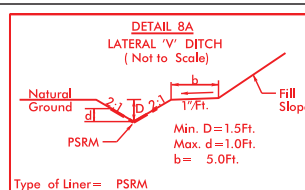

 DENOTES FILL IN WETLAND

 DENOTES IMPACTS IN SURFACE WATER

 DENOTES TEMPORARY IMPACTS IN SURFACE WATER


PROJECT REFERENCE NO.	SHEET NO.
<i>U-3440</i>	<i>8</i>
RW SHEET NO.	
ROADWAY DESIGN ENGINEER	HYDRAULICS ENGINEER
DOCUMENT NOT CONSIDERED FINAL UNLESS ALL SIGNATURES COMPLETED	





NAD
83/NSRS 2000

 **Stantec**

Stantec Consulting Services Inc.
801 Jones Franklin Road
Suite 300
Raleigh, NC 27606
Tel. (919) 851-6866
Fax. (919) 851-7024
www.stantec.com
License No. F-0672

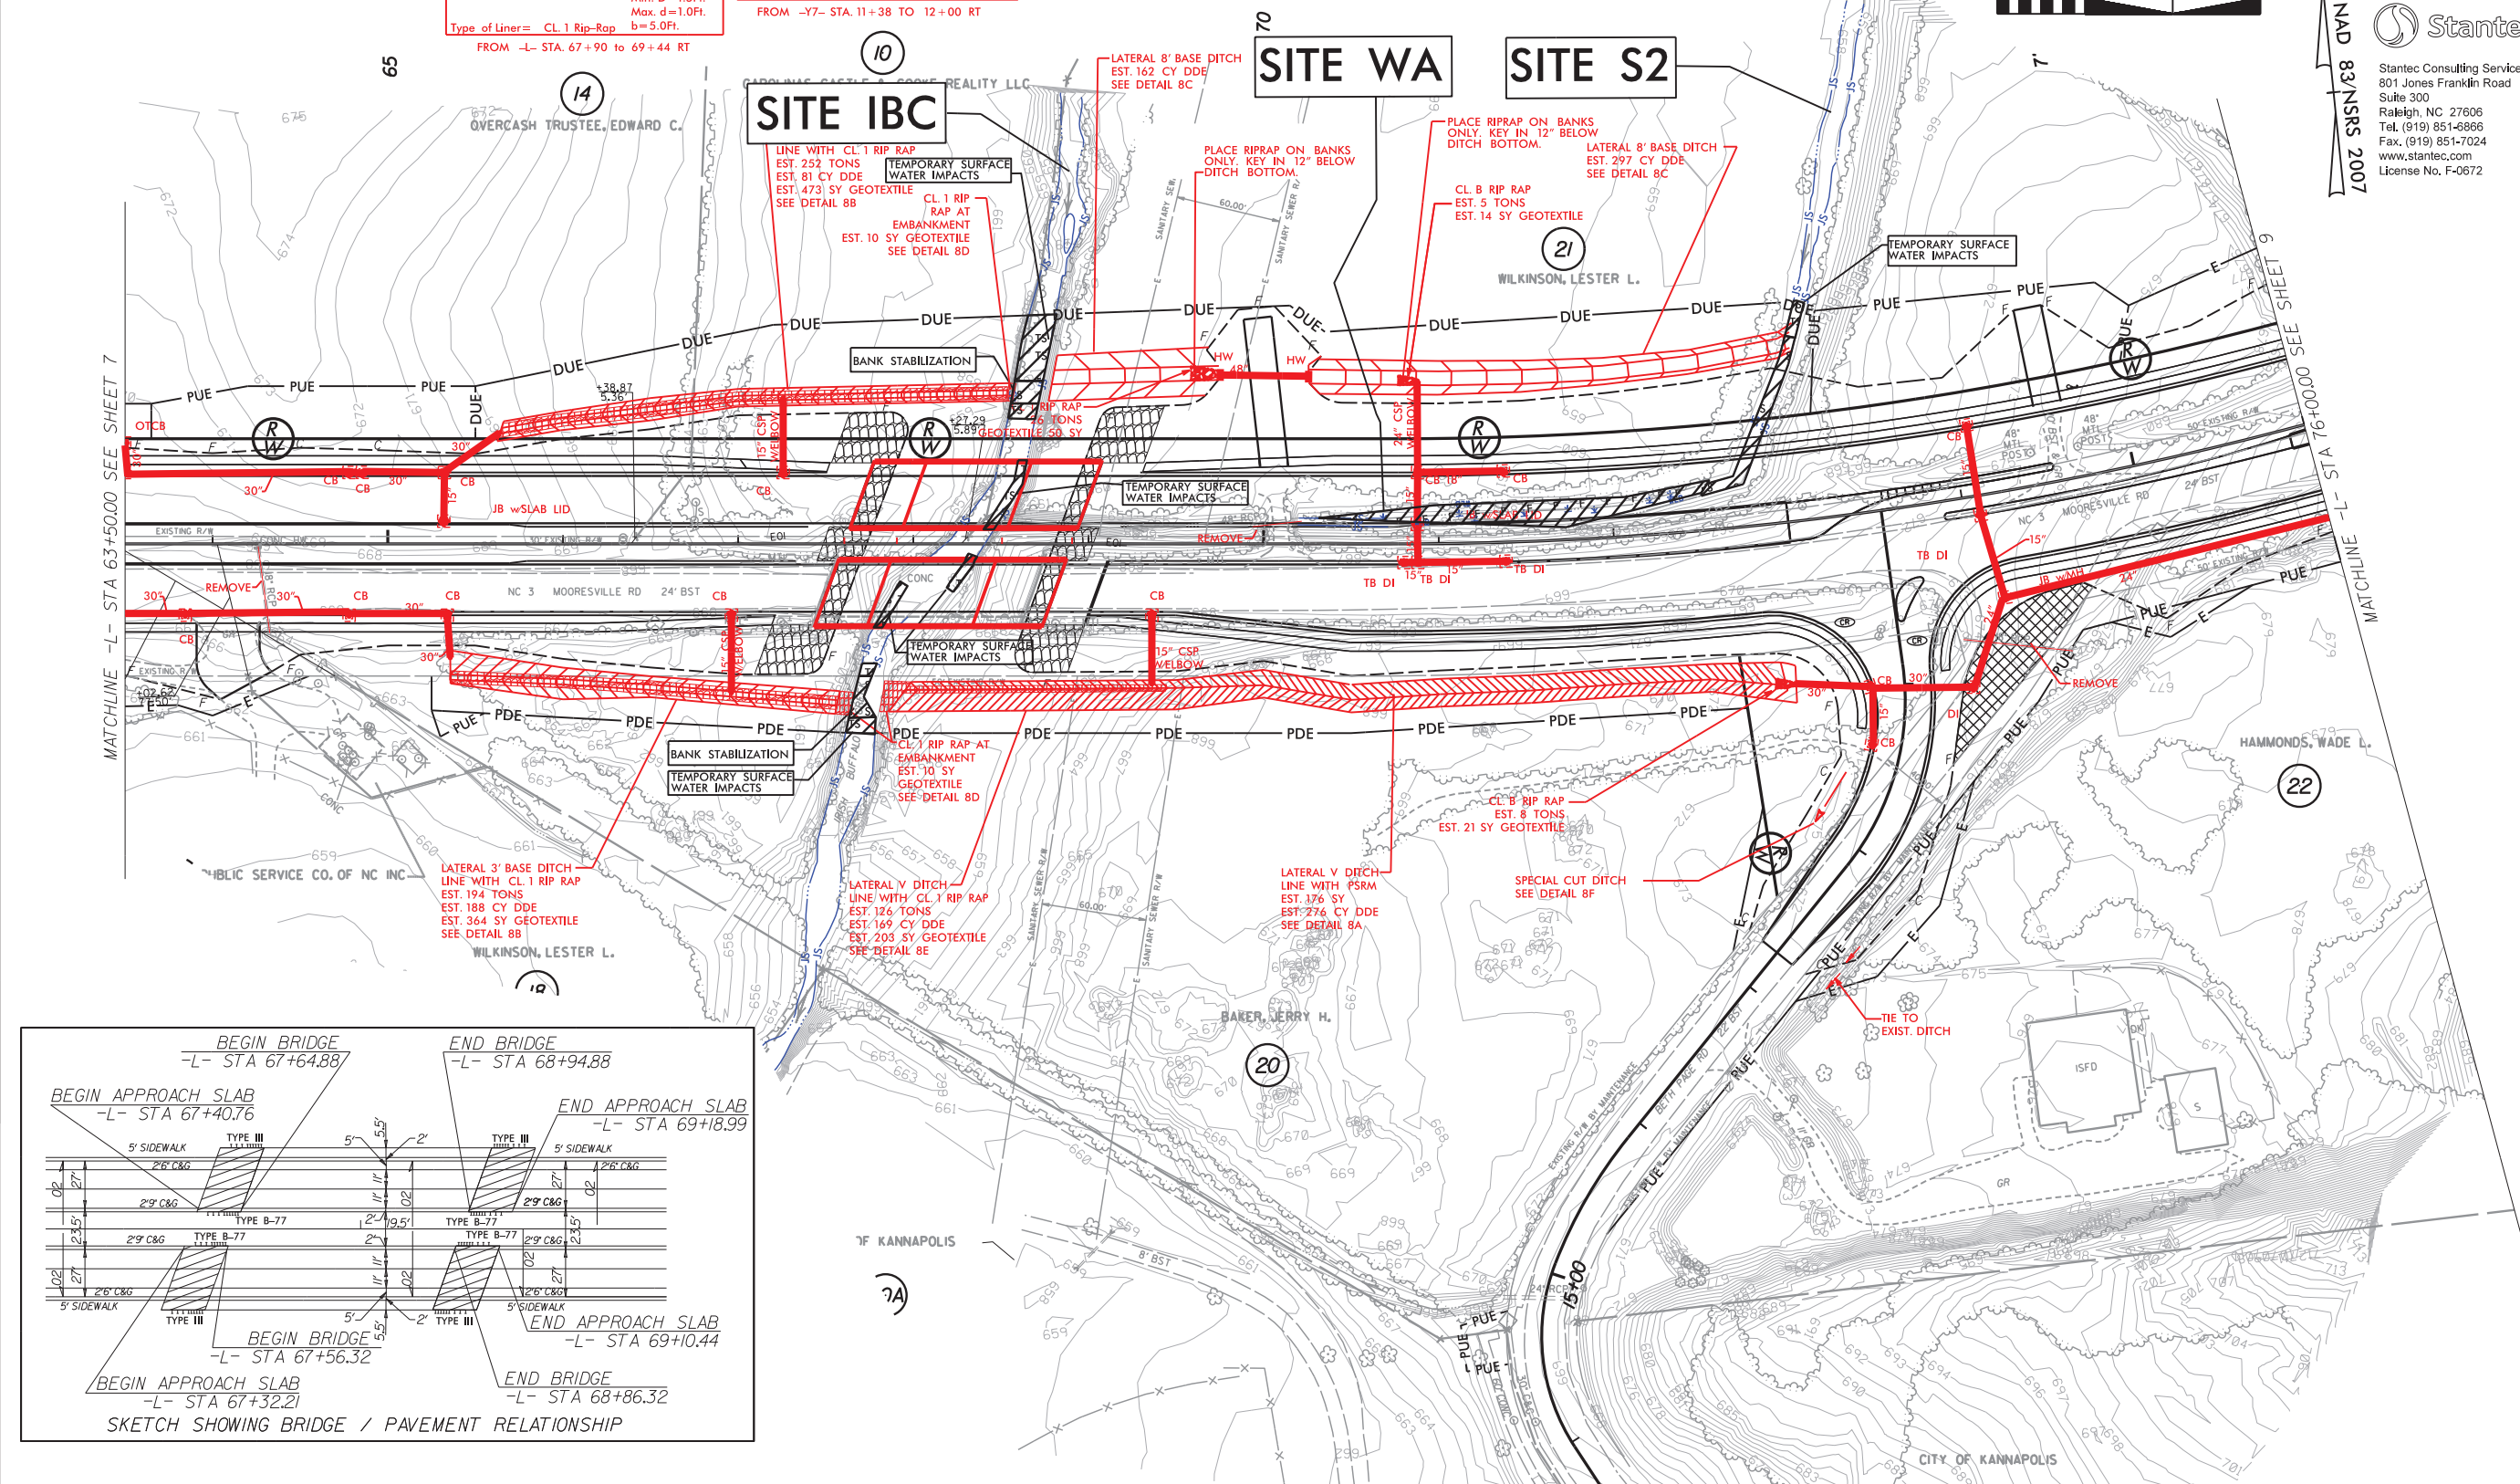


PERMIT DRAWING
SHEET 7 OF 23

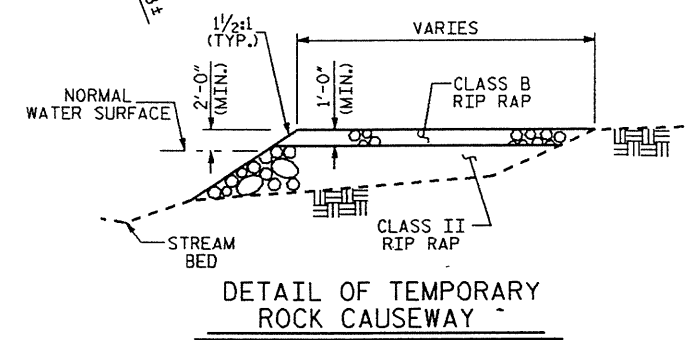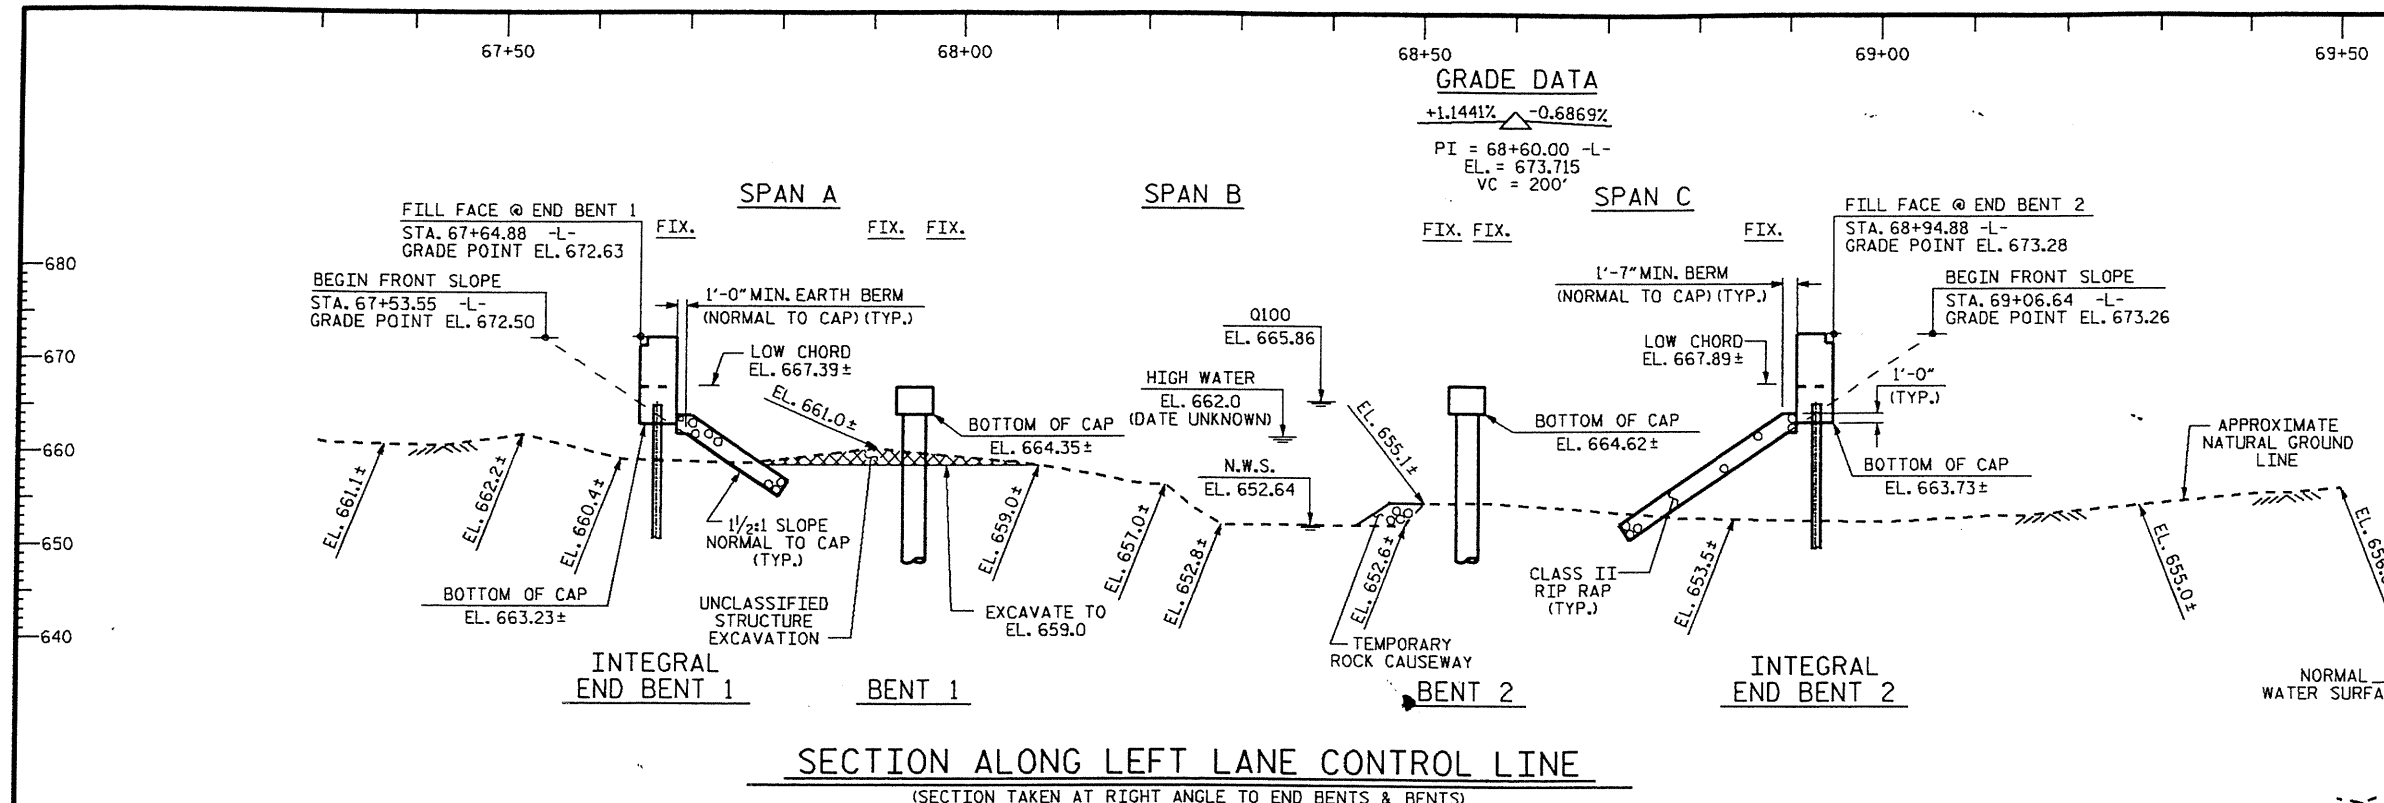

TEMPORARY
ROCK
CAUSEWAY

I HEREBY CERTIFY THESE PLANS
ARE THE AS-BUILT PLANS

PRELIMINARY PLANS
DO NOT USE FOR CONSTRUCTION

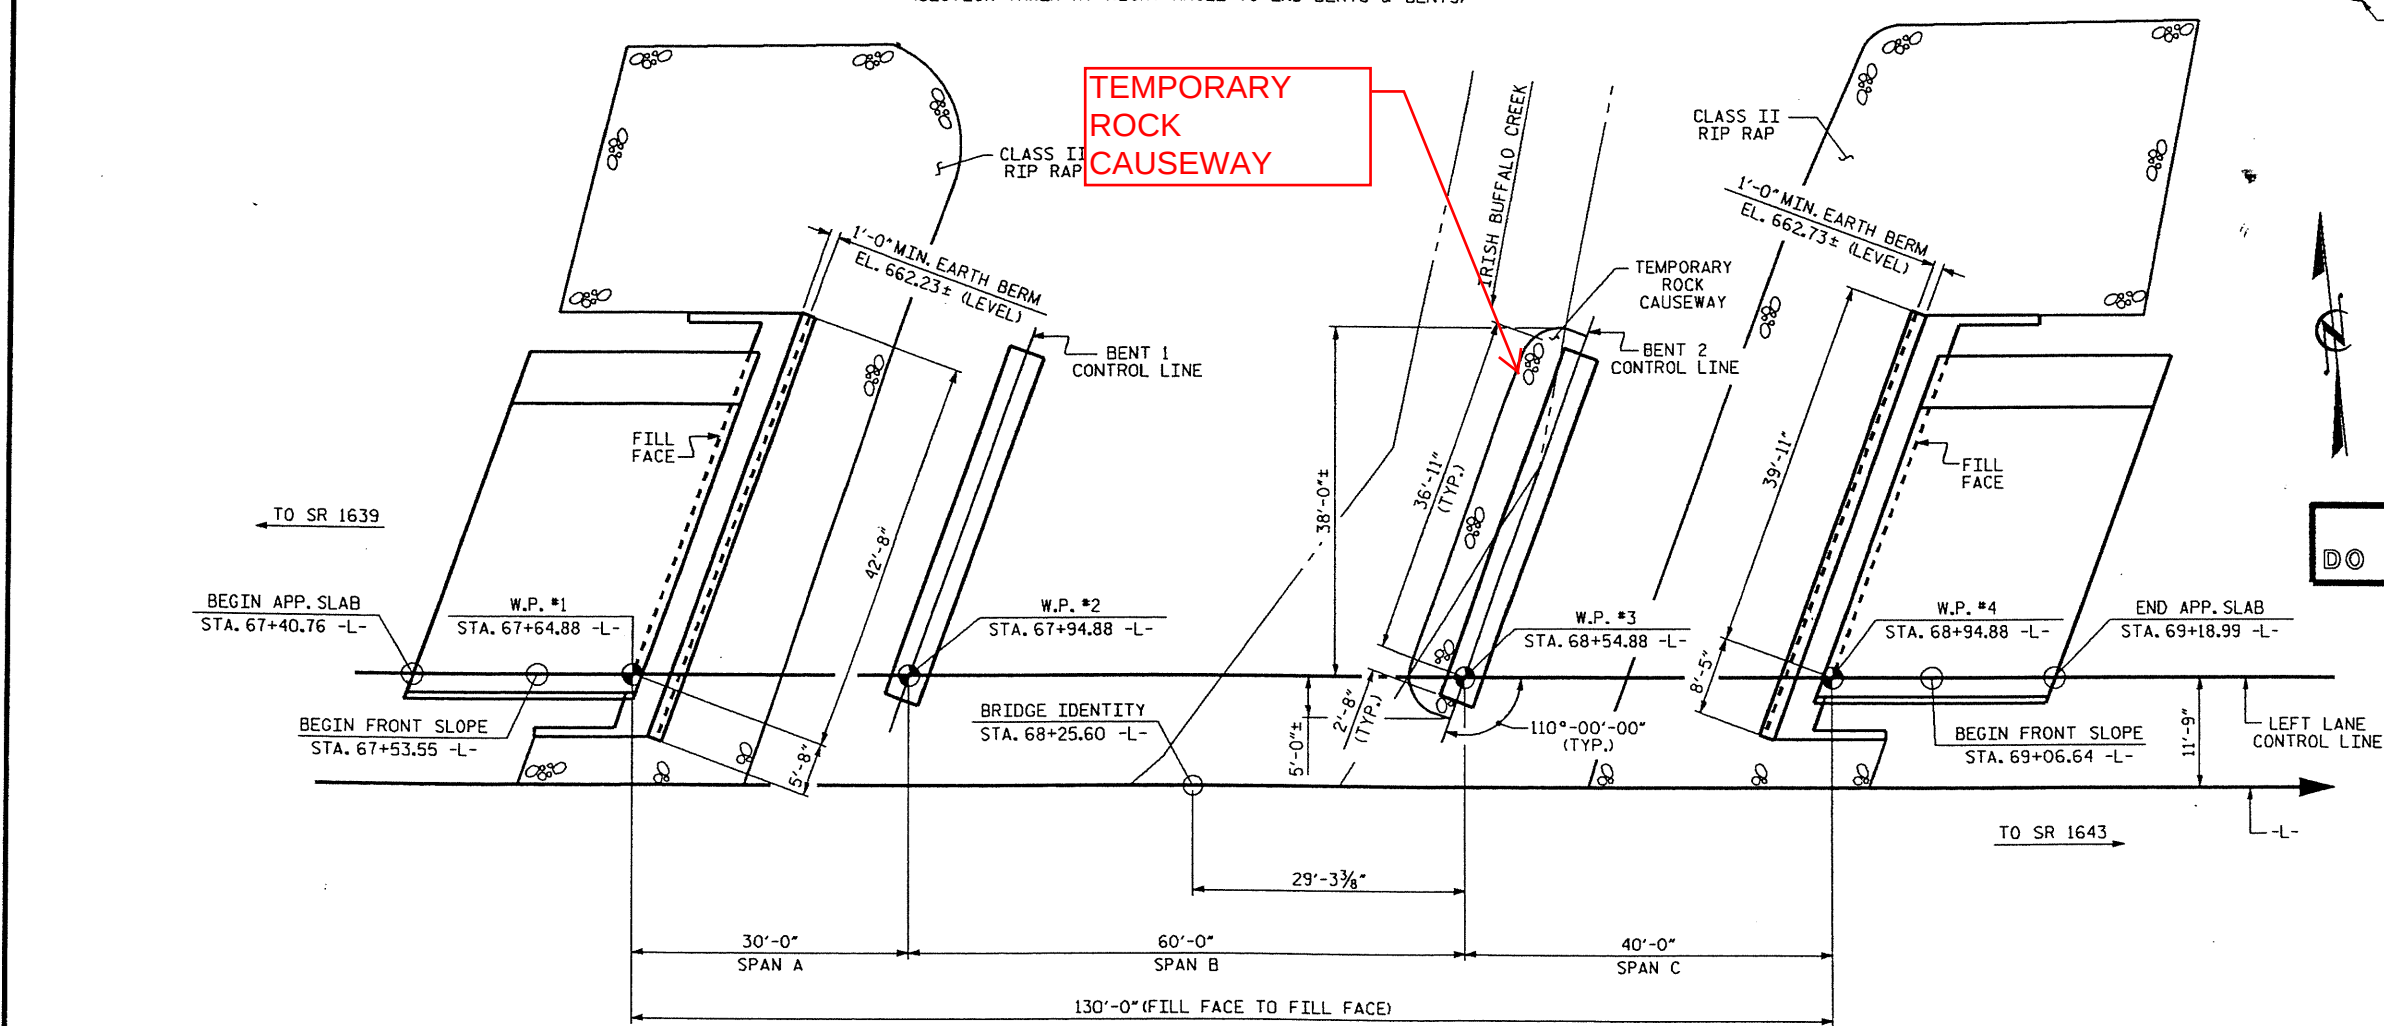

PLAN

(PILES & COLUMNS NOT SHOWN FOR CLARITY)

PROJECT NO. U-3440
CABARRUS COUNTY
STATION: 68+25.60 -L-

SHEET 1 OF 2 BRIDGE No. 402

STATE OF NORTH CAROLINA
DEPARTMENT OF TRANSPORTATION
RALEIGH
PRELIMINARY
GENERAL DRAWING
FOR BRIDGE OVER IRISH
BUFFALO CREEK ON NC 3
BETWEEN SR 1639 AND SR 1643
(LEFT LANE)

REVISIONS						SHEET NO.
NO.	BY	DATE	NO.	BY	DATE	
1			3			TOTAL SHEETS
2			4			

STR. #1

DRAWN BY: T. H. CARROLL DATE: 6/3/14
CHECKED BY: R. P. PATEL DATE: 6/9/14
DESIGN ENGINEER OF RECORD: T. H. CARROLL DATE: 6/19/14

29-OCT-2015 12:24
R:\Structures\Plans\Str02\U3440_SD_P02.dgn


67+00 67+50 68+00 68+50 69+00

GRADE DATA

+1.1441% -0.6869%


PI = 68+60.00 -L-
EL. = 673.715
VC = 200'

PERMIT DRAWING
SHEET 8 OF 23

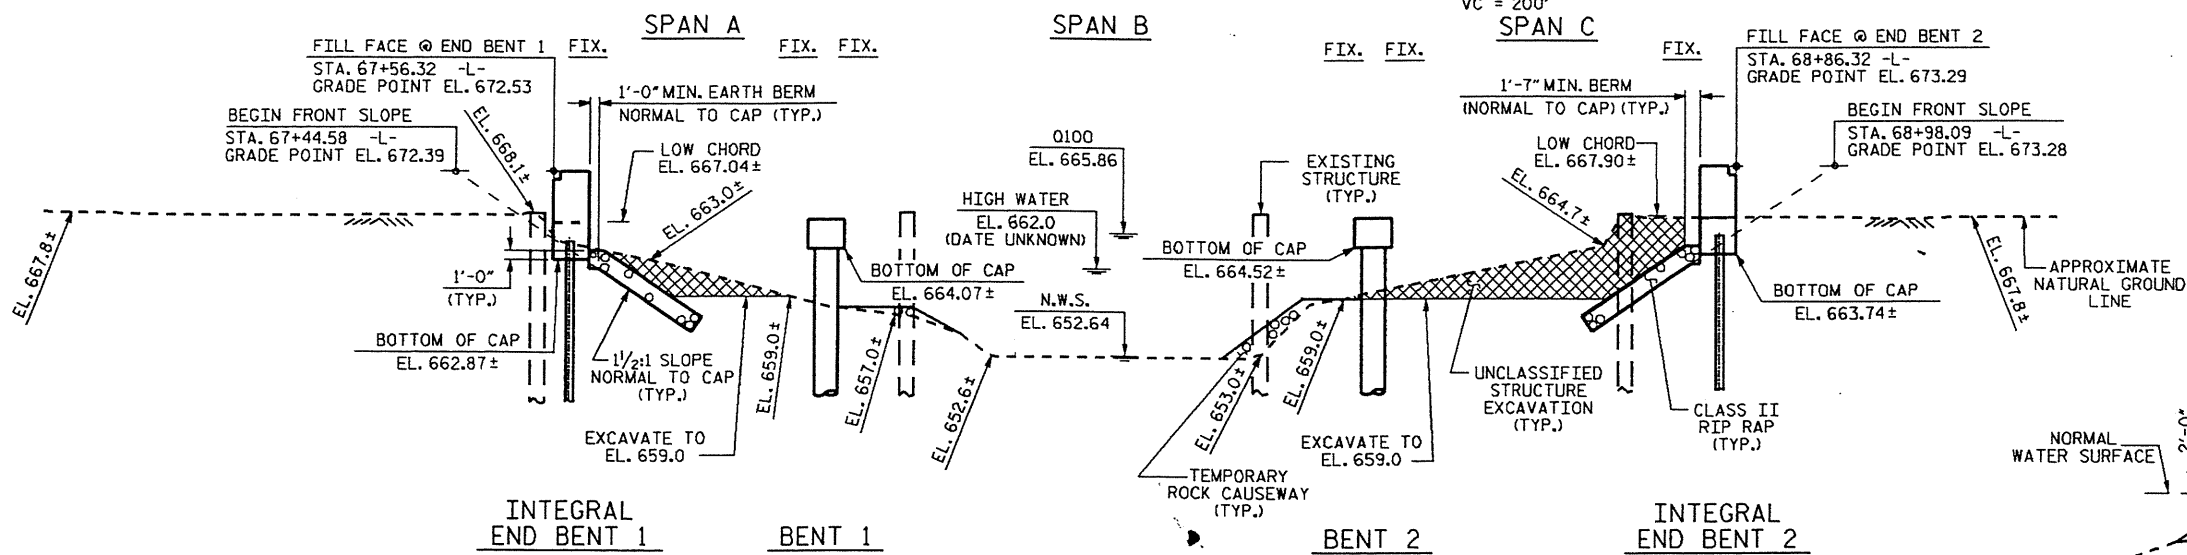

SECTION ALONG RIGHT LANE CONTROL LINE

(SECTION TAKEN AT RIGHT ANGLE TO END BENTS & BENTS)

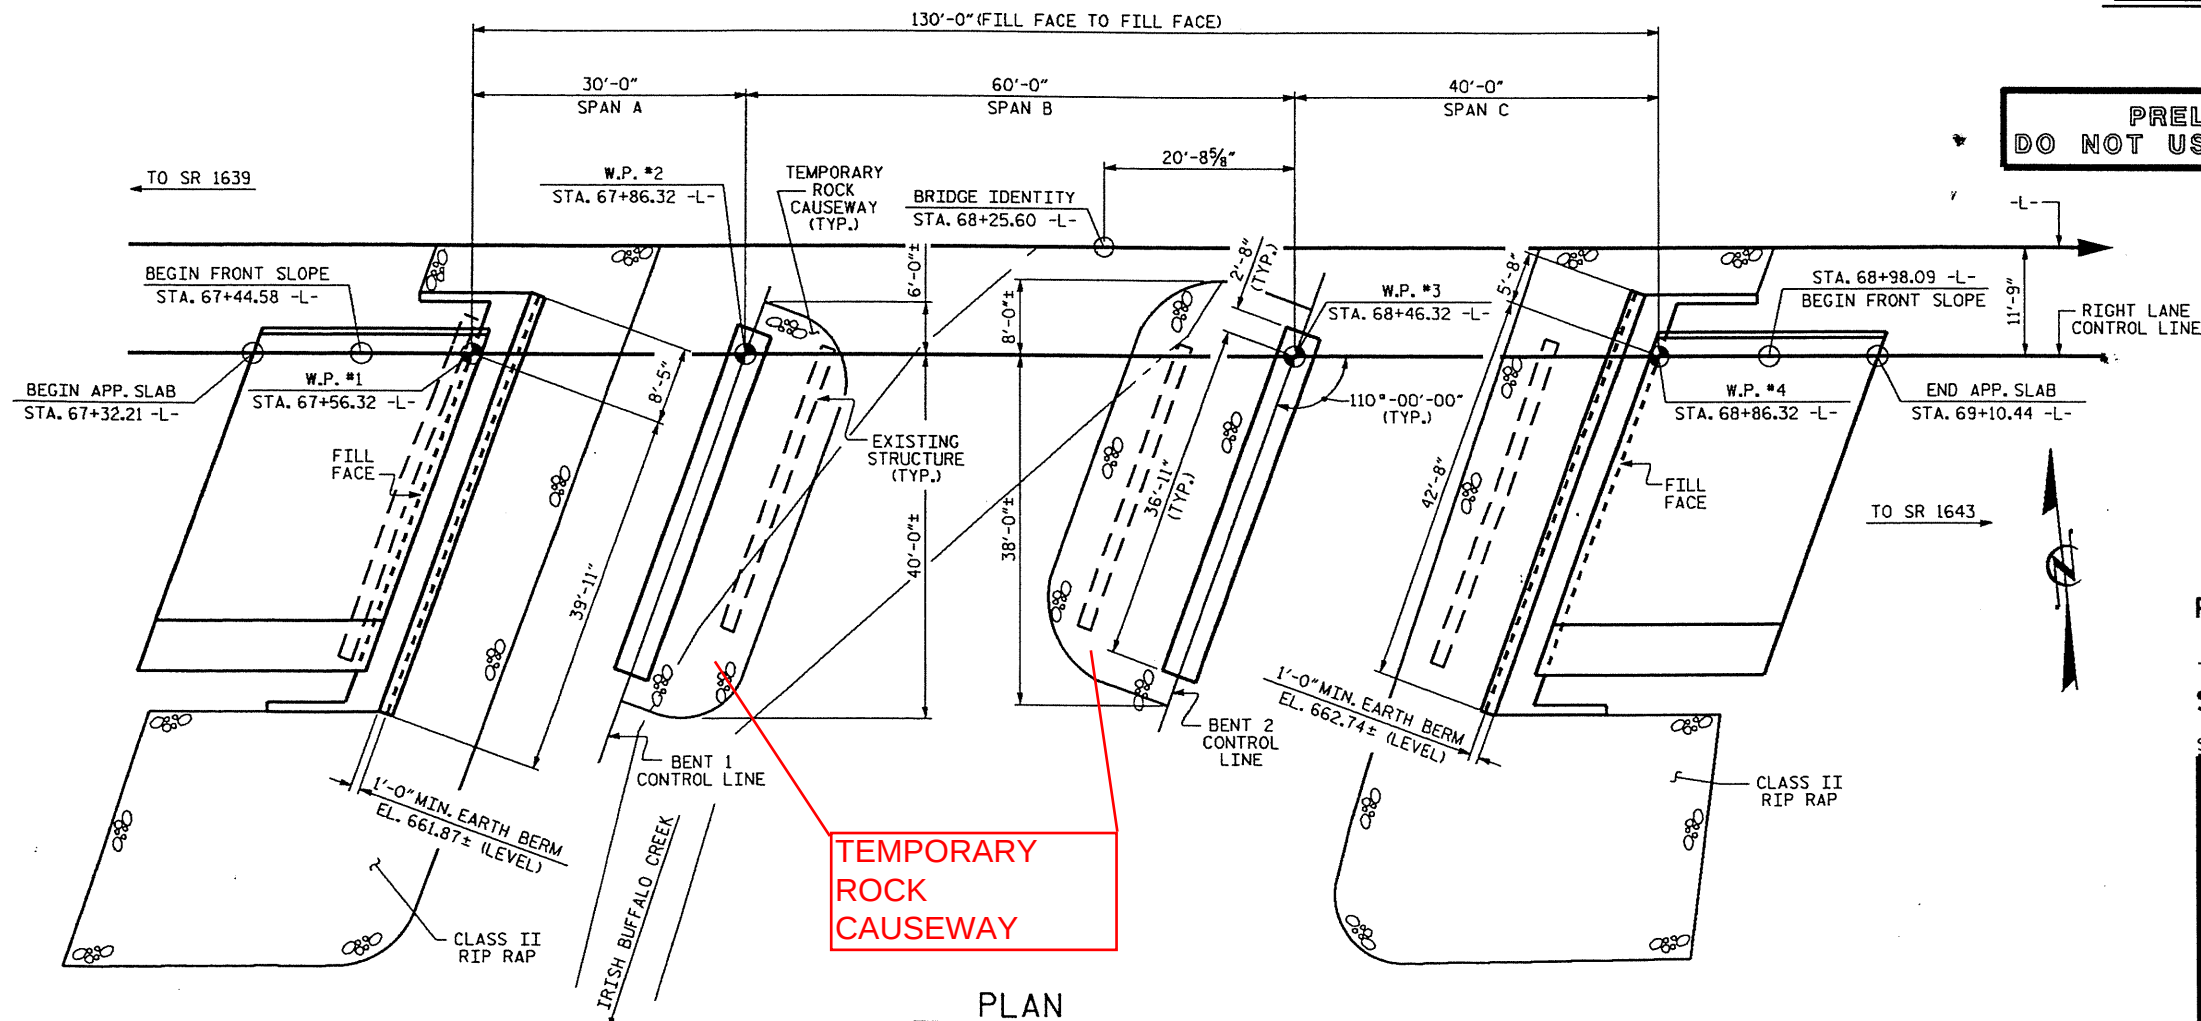

PLAN

(PILES & COLUMNS NOT SHOWN FOR CLARITY)

PRELIMINARY PLANS
DO NOT USE FOR CONSTRUCTION

I HEREBY CERTIFY THESE PLANS
ARE THE AS-BUILT PLANS



PROJECT NO. U-3440
CABARRUS COUNTY
STATION: 68+25.60 -L-

SHEET 1 OF 2 REPLACES BRIDGE No. 36

STATE OF NORTH CAROLINA
DEPARTMENT OF TRANSPORTATION
HALEIGH
PRELIMINARY
GENERAL DRAWING
FOR BRIDGE OVER IRISH
BUFFALO CREEK ON NC 3
BETWEEN SR 1639 AND SR 1643
(RIGHT LANE)


REVISIONS						SHEET NO.
NO.	BY	DATE	NO.	BY	DATE	
1			3			TOTAL SHEETS
2			4			

DRAWN BY: T. H. CARROLL DATE: 6/3/14
CHECKED BY: R. P. PATEL DATE: 6/9/14
DESIGN ENGINEER OF RECORD: T. H. CARROLL DATE: 6/19/14

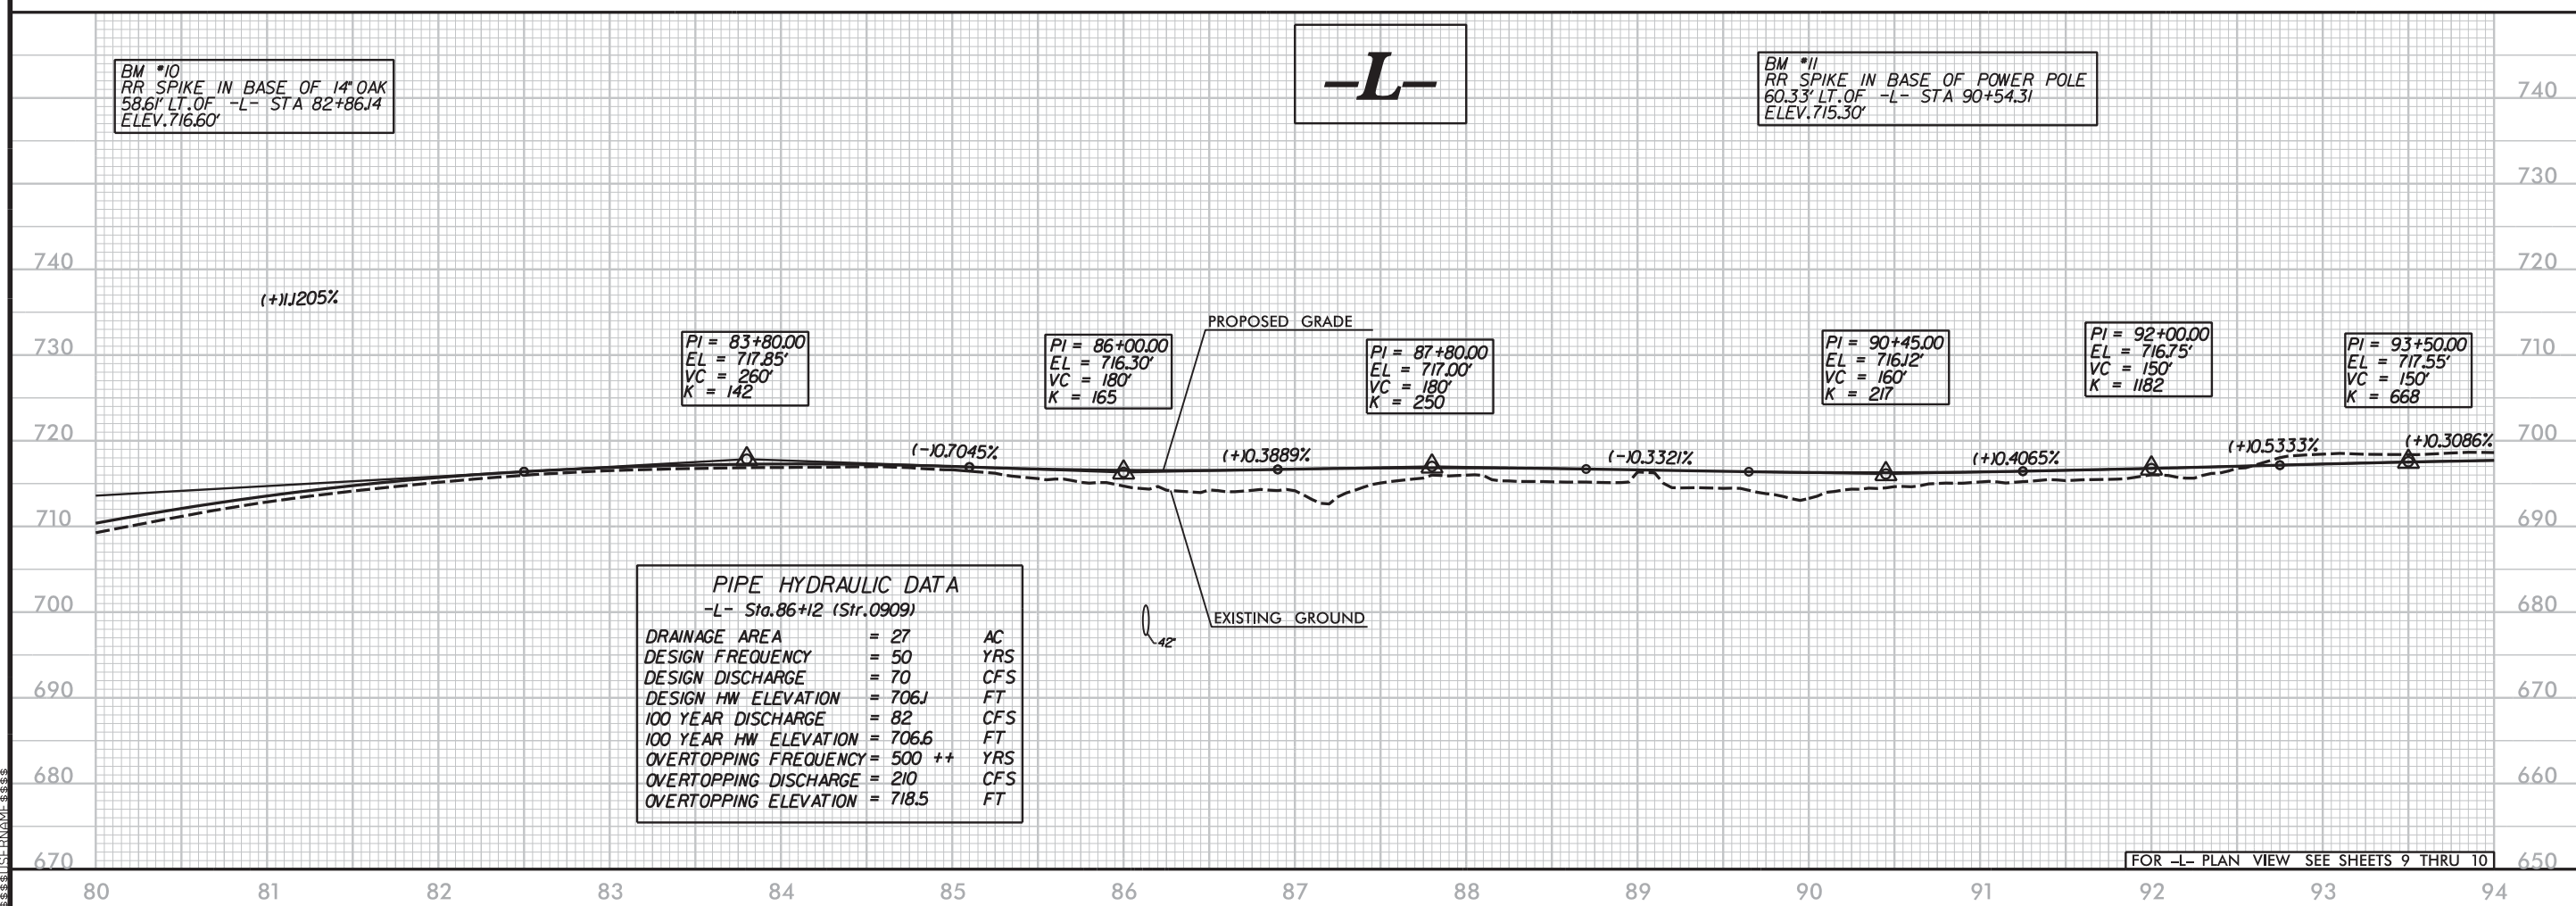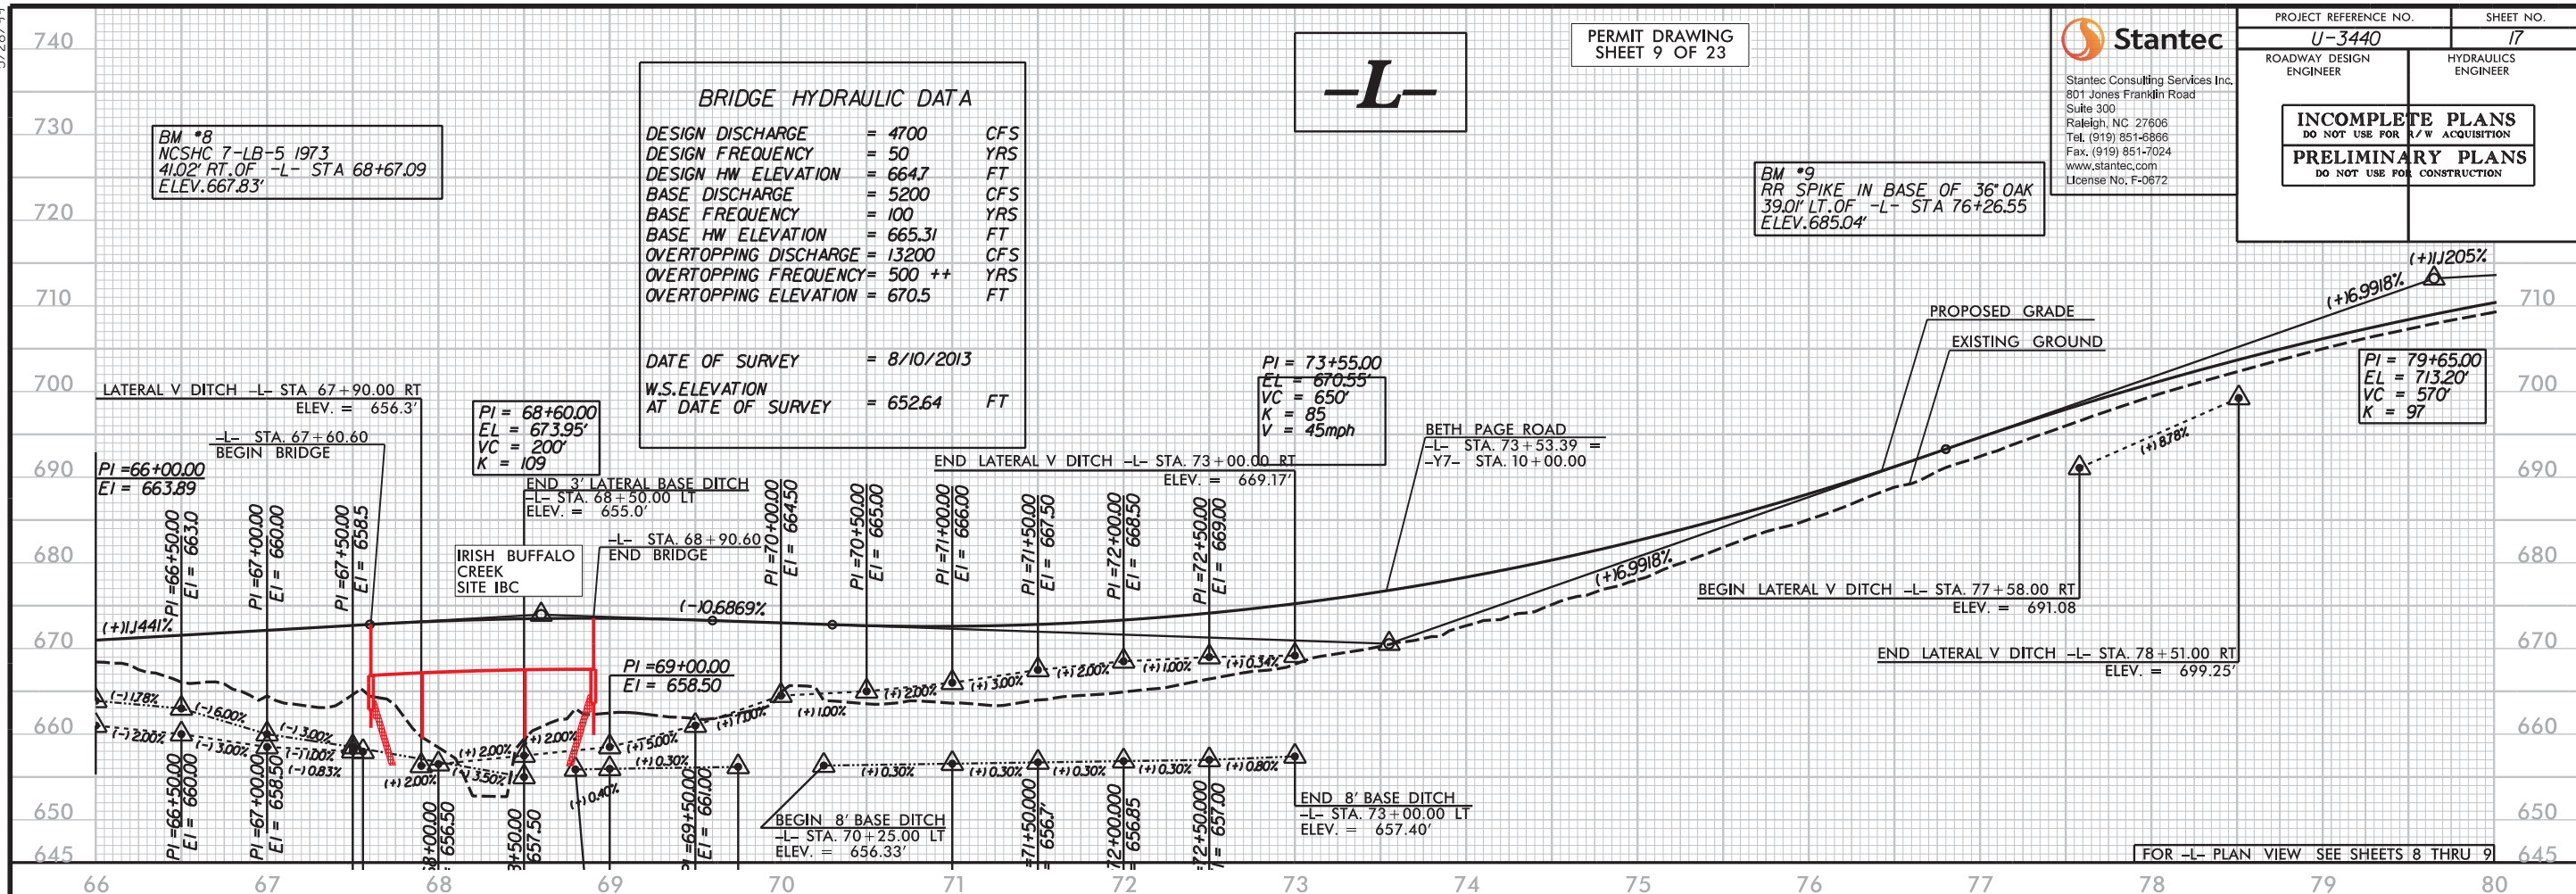

8/23/99

PERMIT DRAWING
SHEET 10 OF 23

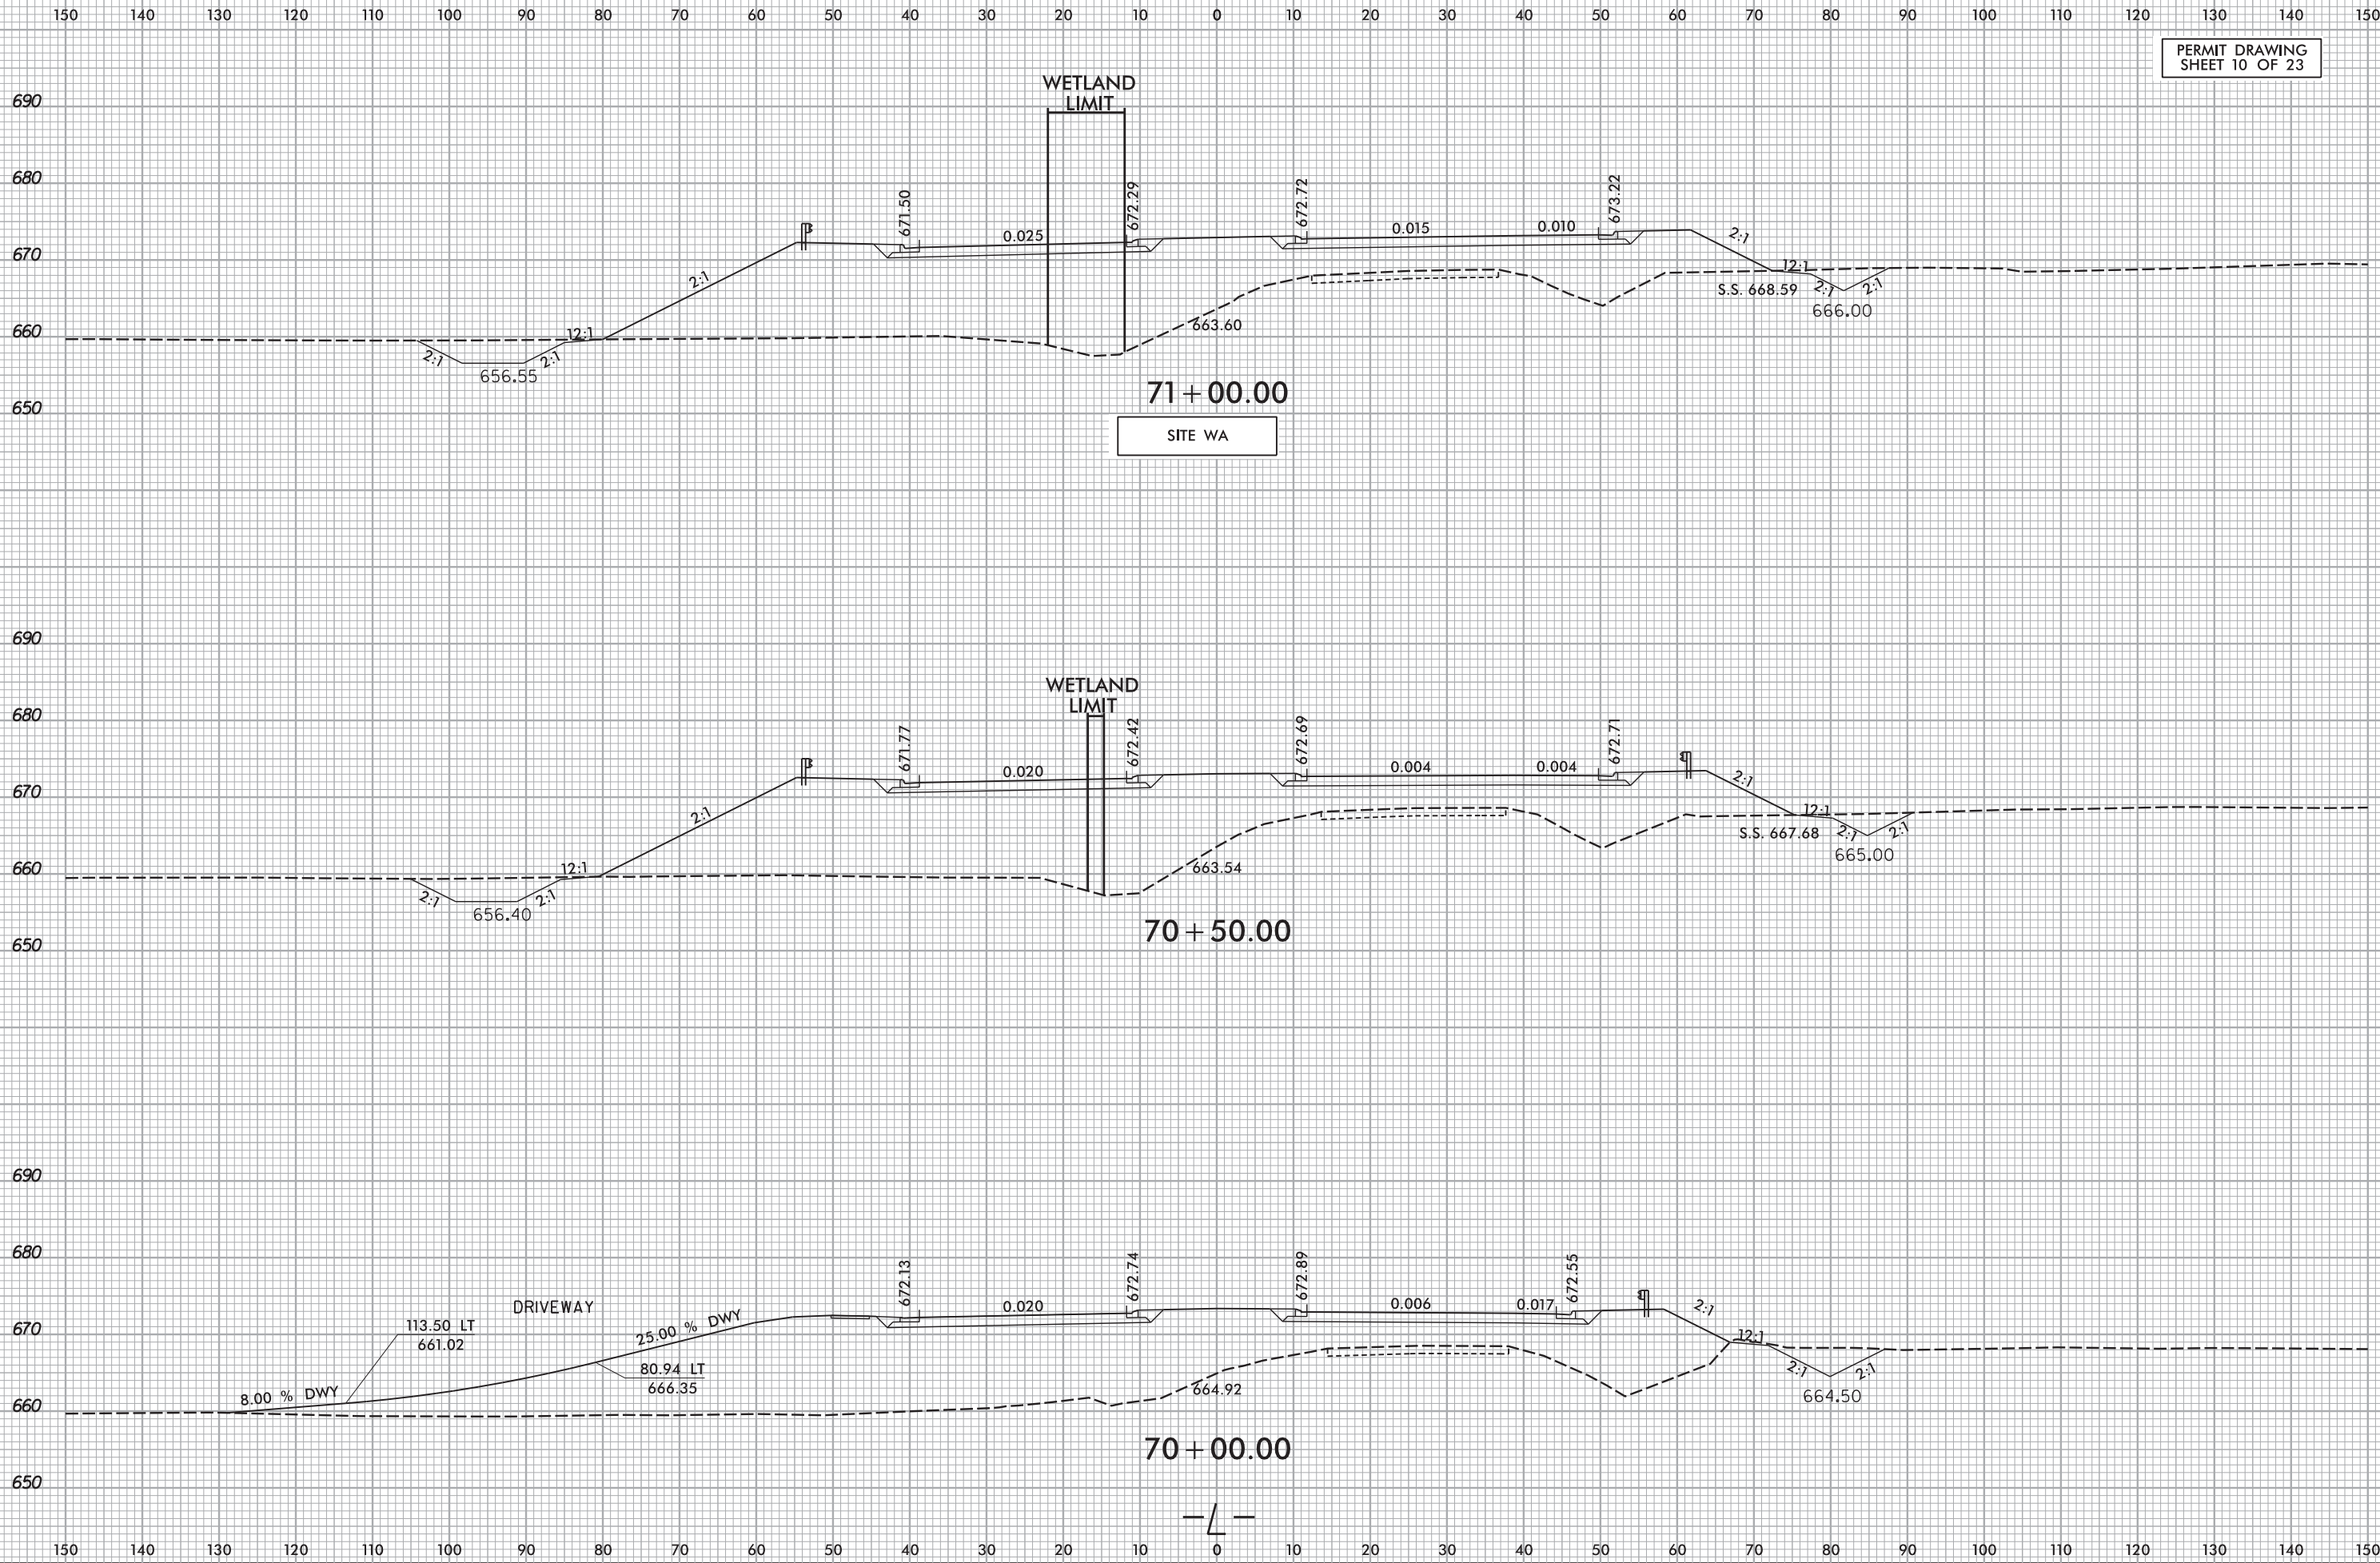









8/23/99

20150407
STANTEC
U3440 Permit Drawings 20150407.pdf

0 5 10	PROJ. REFERENCE NO.	SHEET NO.
	U-3440	X-43

PERMIT DRAWING
SHEET 11 OF 23

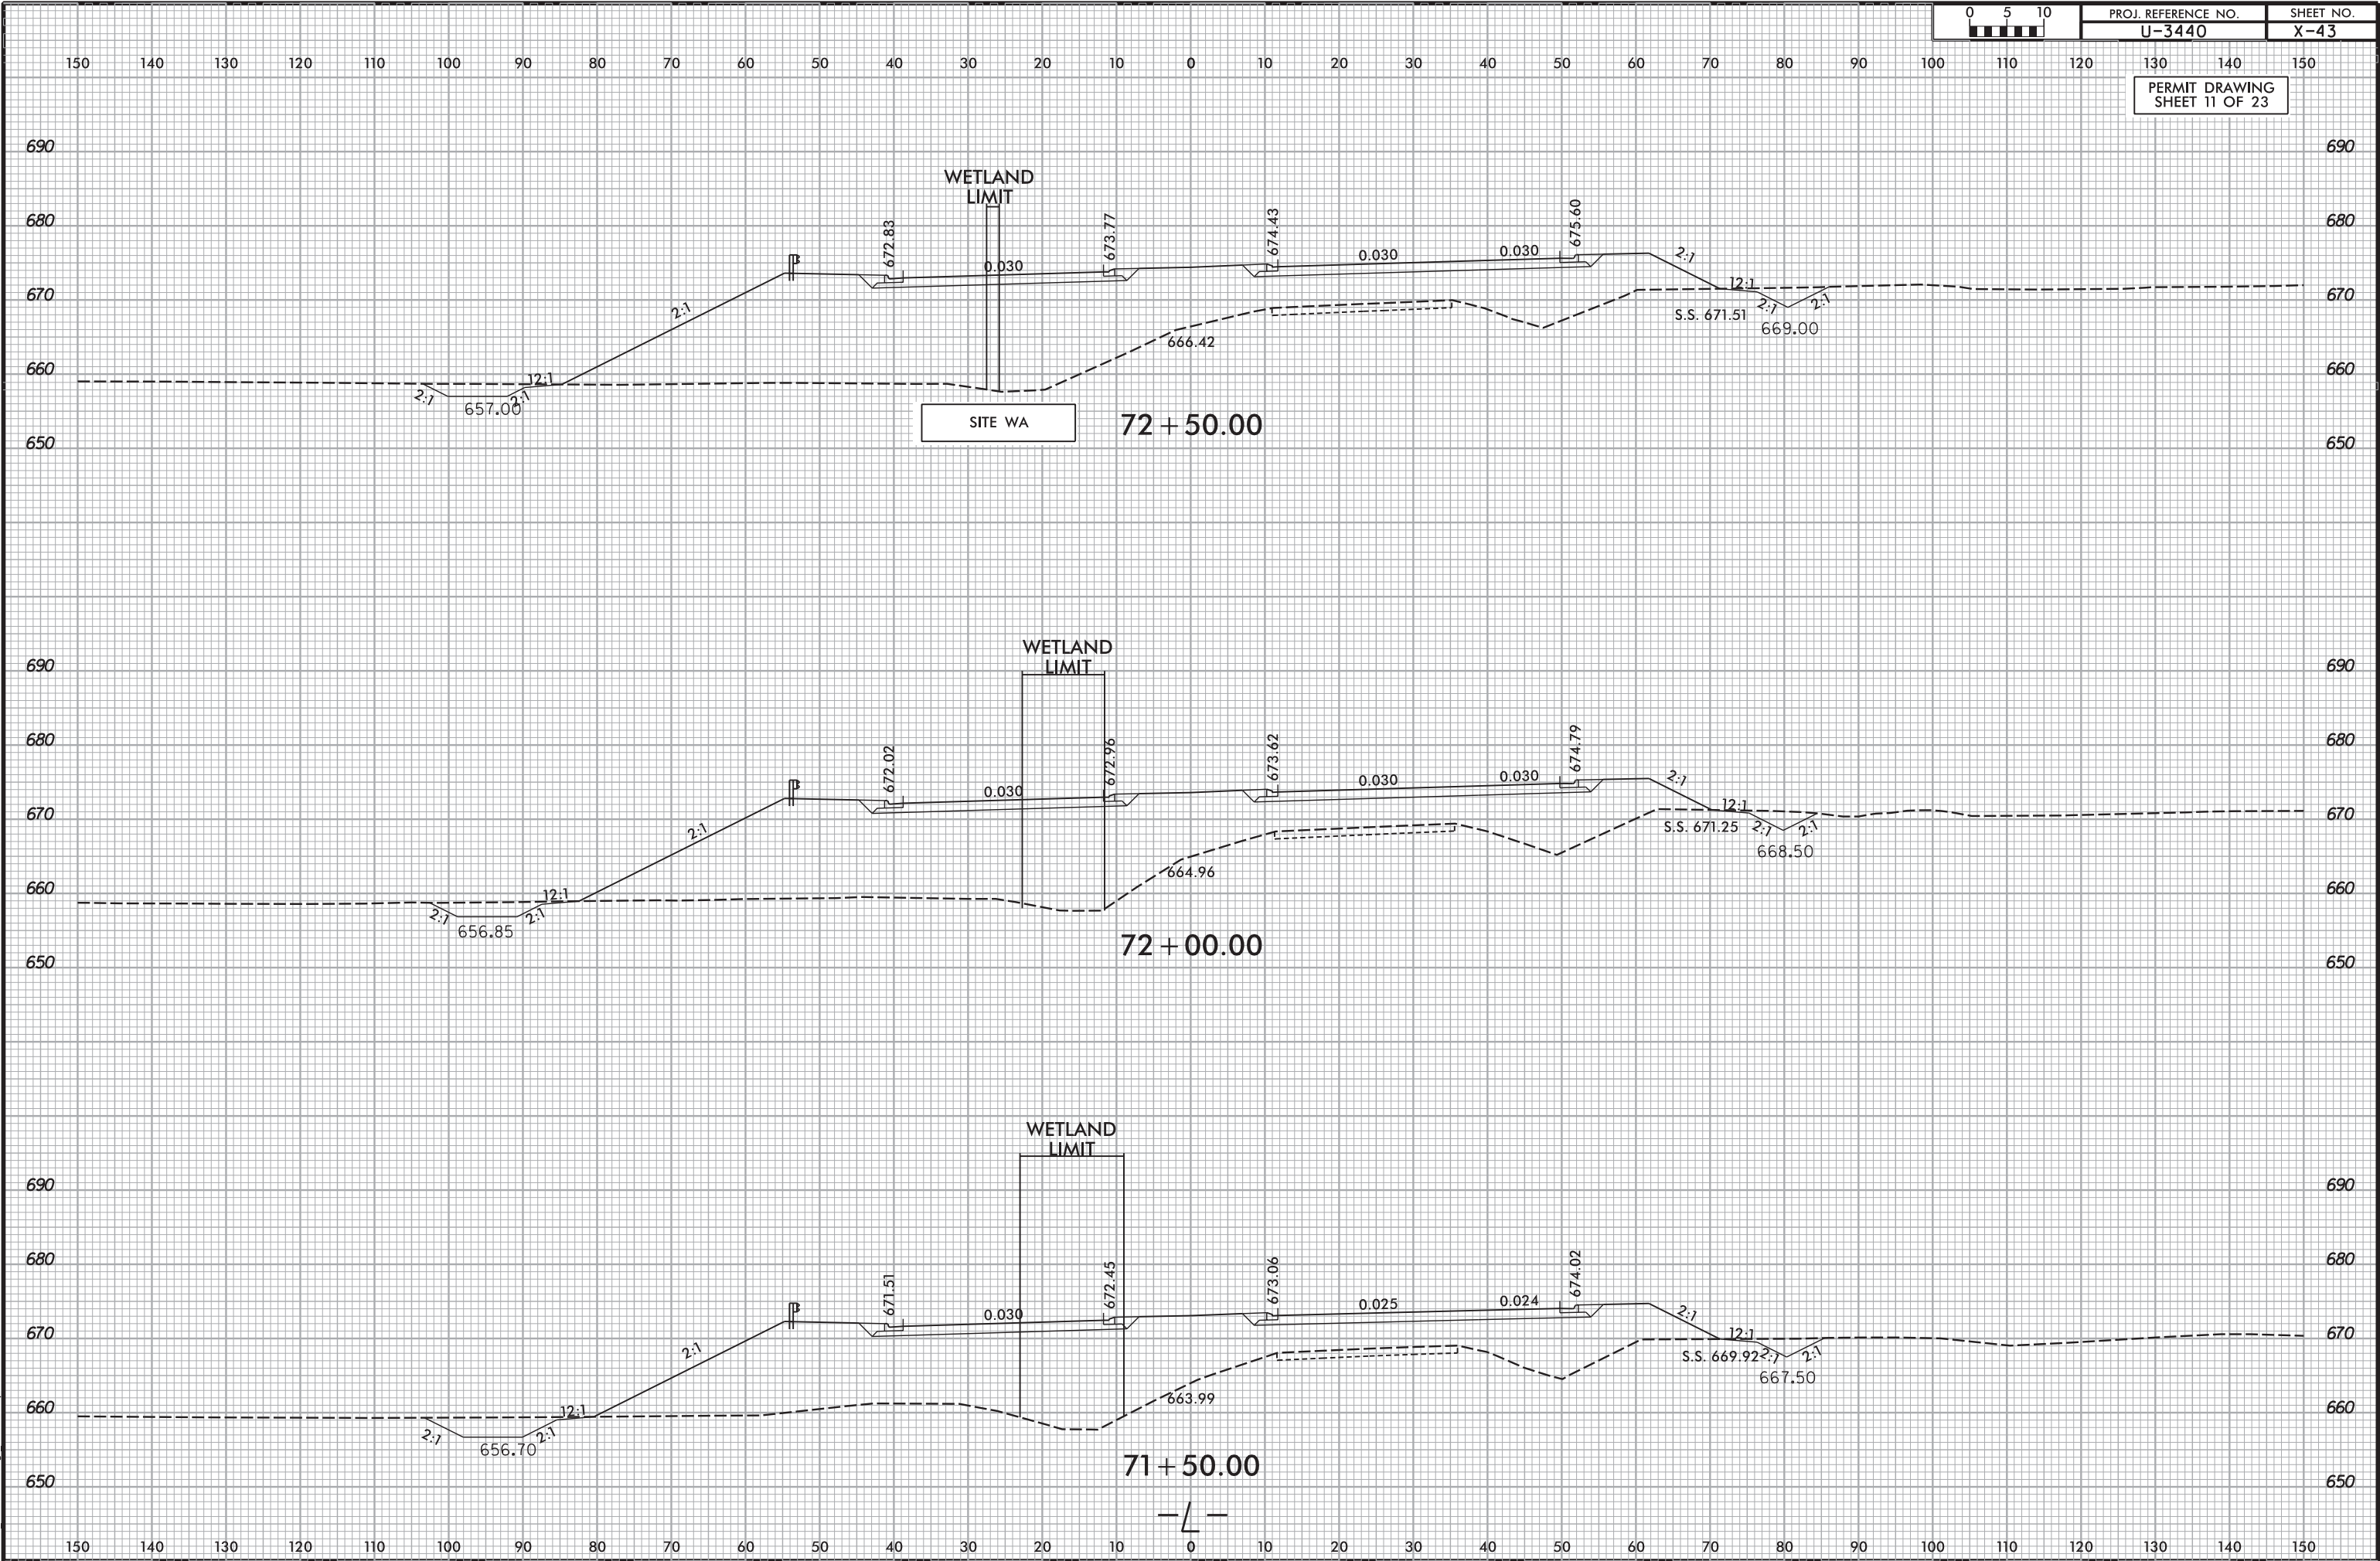

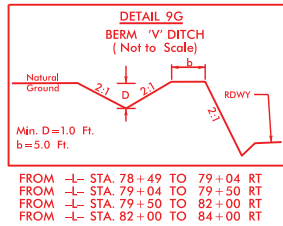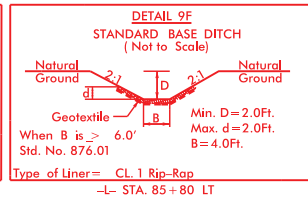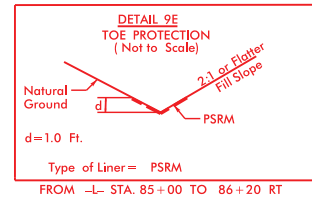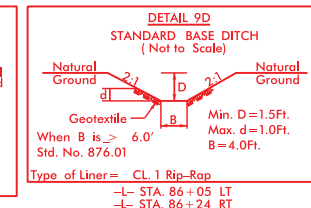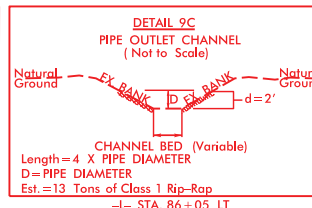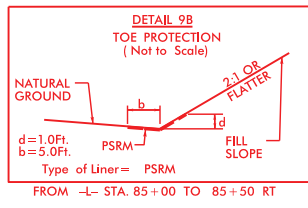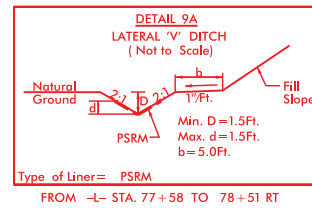PERMIT DRAWING
SHEET 12 OF 23DENOTES TEMPORARY
IMPACTS IN SURFACE WATERDENOTES IMPACTS IN
SURFACE WATER


-L-
PI Sta 80+28.76
 $\Delta = 50' 54' 39.2''$ (LT)
 $D = 2' 51' 53.2''$
 $L = 1,777.13'$
 $T = 952.04'$
 $R = 2,000.00'$
 $RO = 144'$
 $e = .03$



PROJECT REFERENCE NO.		SHEET NO.
RW SHEET NO.		
ROADWAY DESIGN ENGINEER	HYDRAULICS ENGINEER	



Stantec Consulting Services Inc.
801 Jones Franklin Road
Suite 300
Raleigh, NC 27606
Tel. (919) 851-6866
Fax. (919) 851-7024
www.stantec.com
License No. F-0672

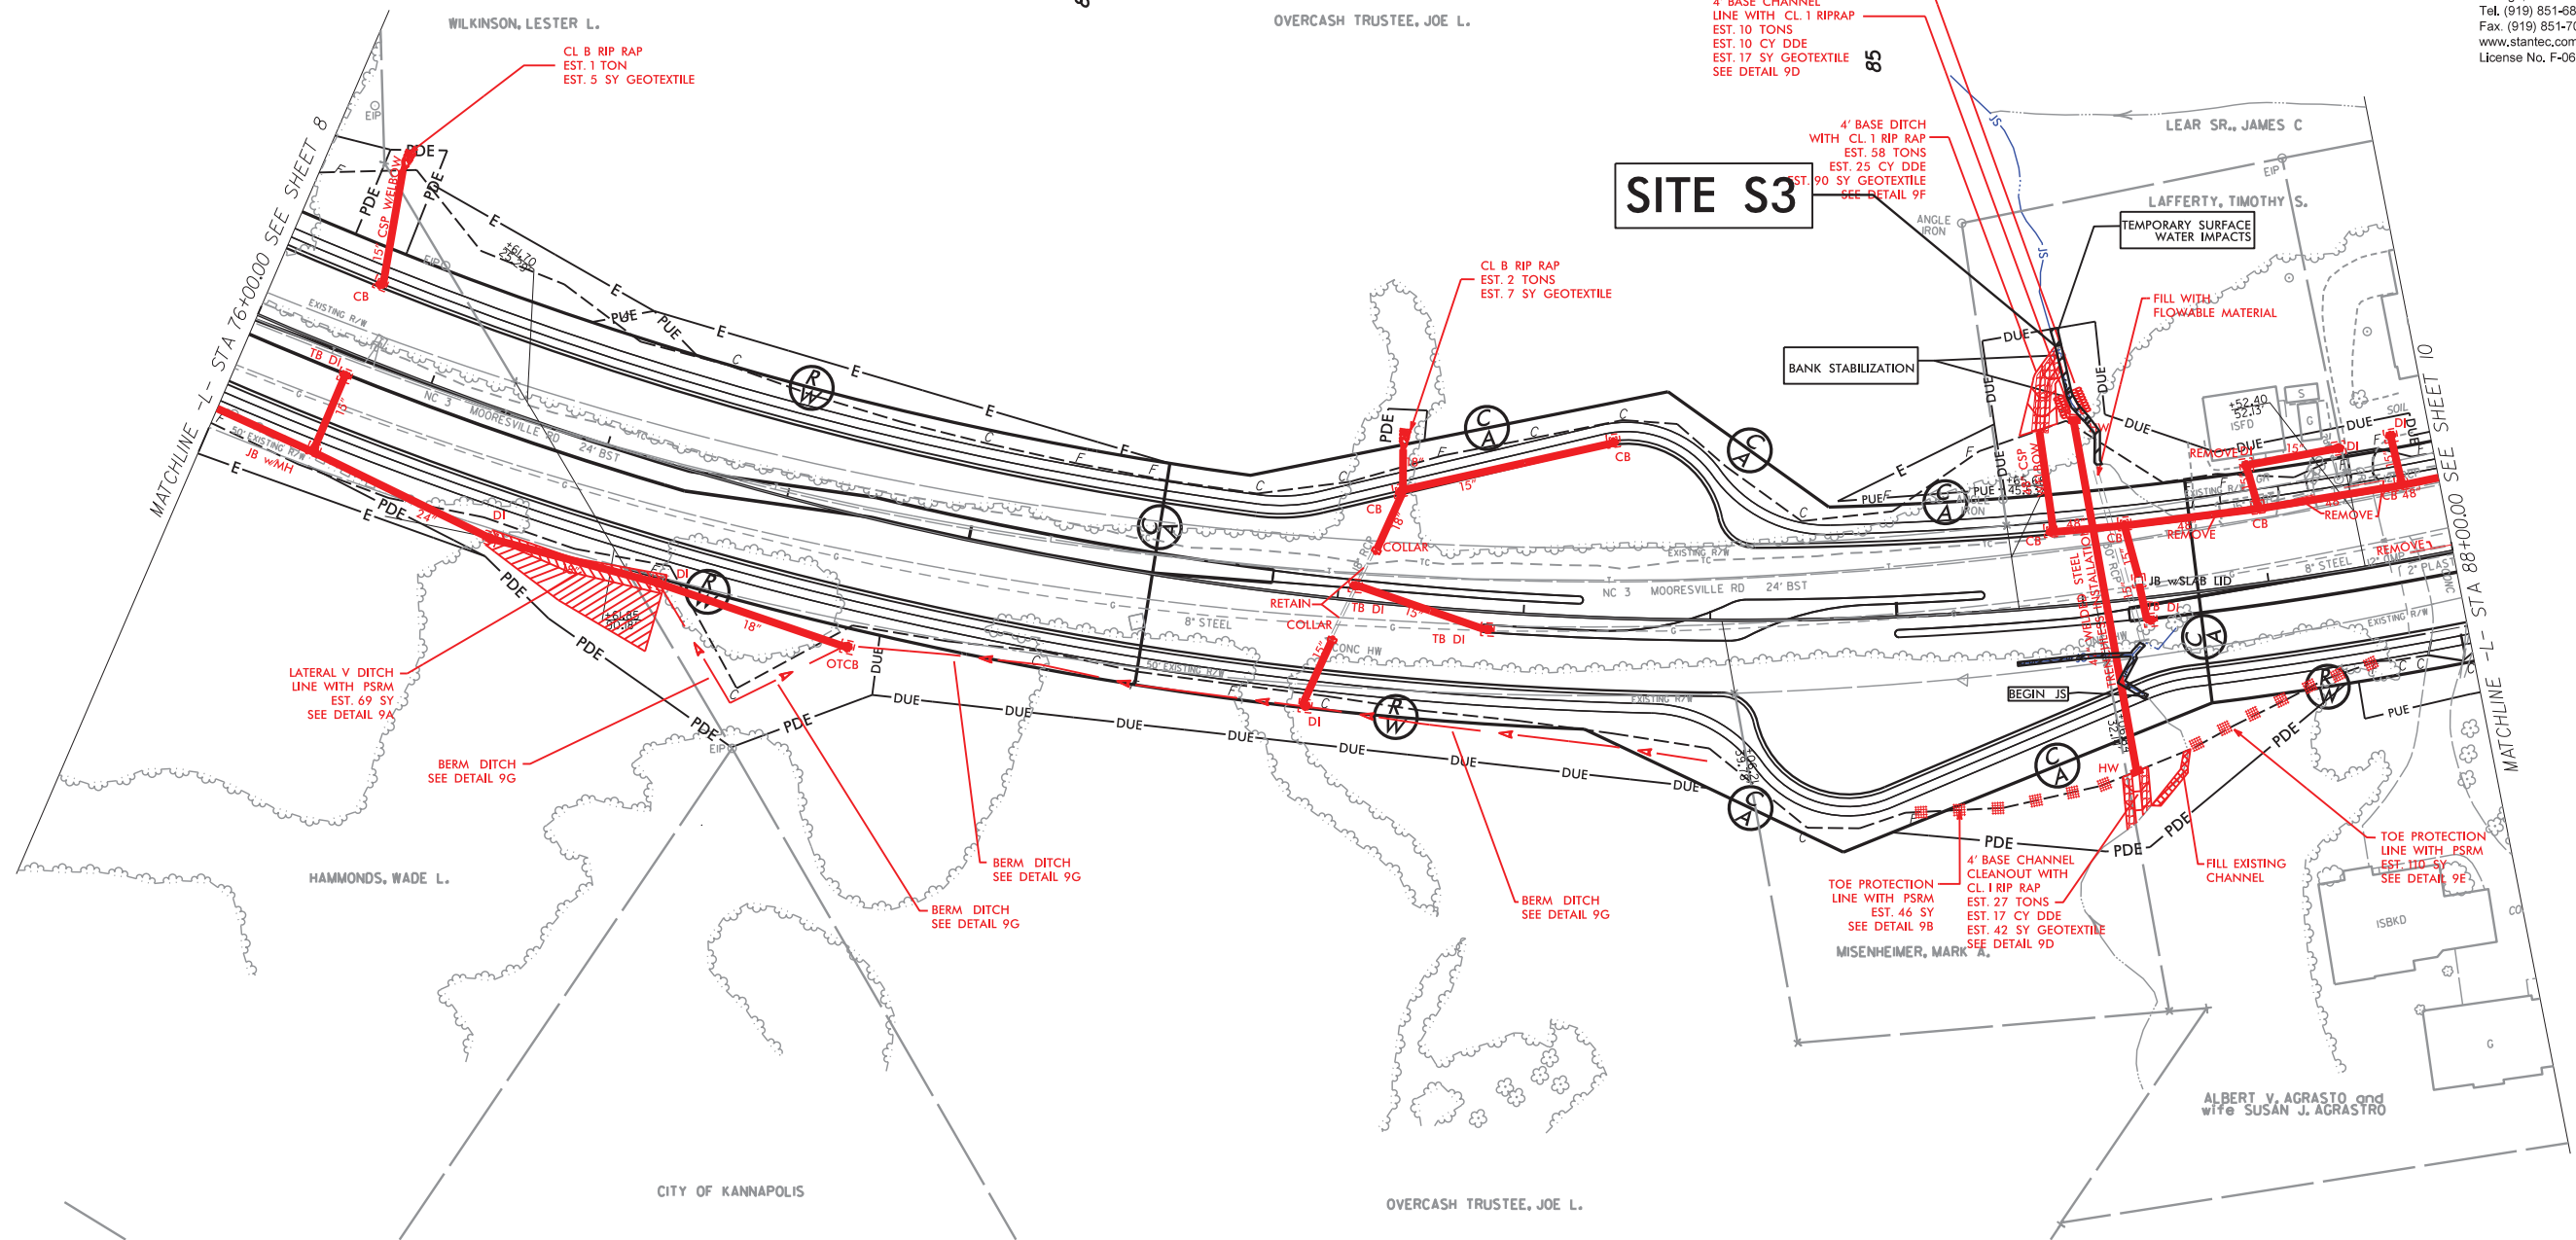

REVISIONS





PERMIT DRAWING SHEET 13 OF 23







DENOTES TEMPORARY
IMPACTS IN SURFACE WATER



DENOTES IMPACTS IN
SURFACE WATER

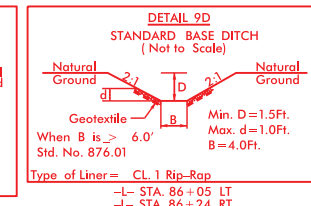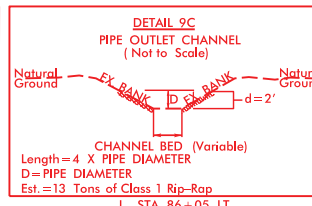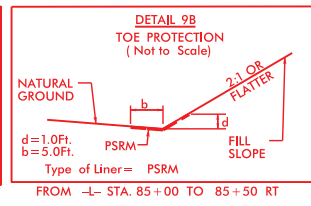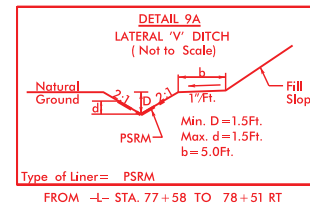

-L-
PI Sta 80+28.76
 $\Delta = 50' 54' 39.2''$ (LT)
 $D = 2' 51' 53.2''$
 $L = 1,777.13'$
 $T = 952.04'$
 $R = 2,000.00'$
 $RO = 144'$
 $e = .03$

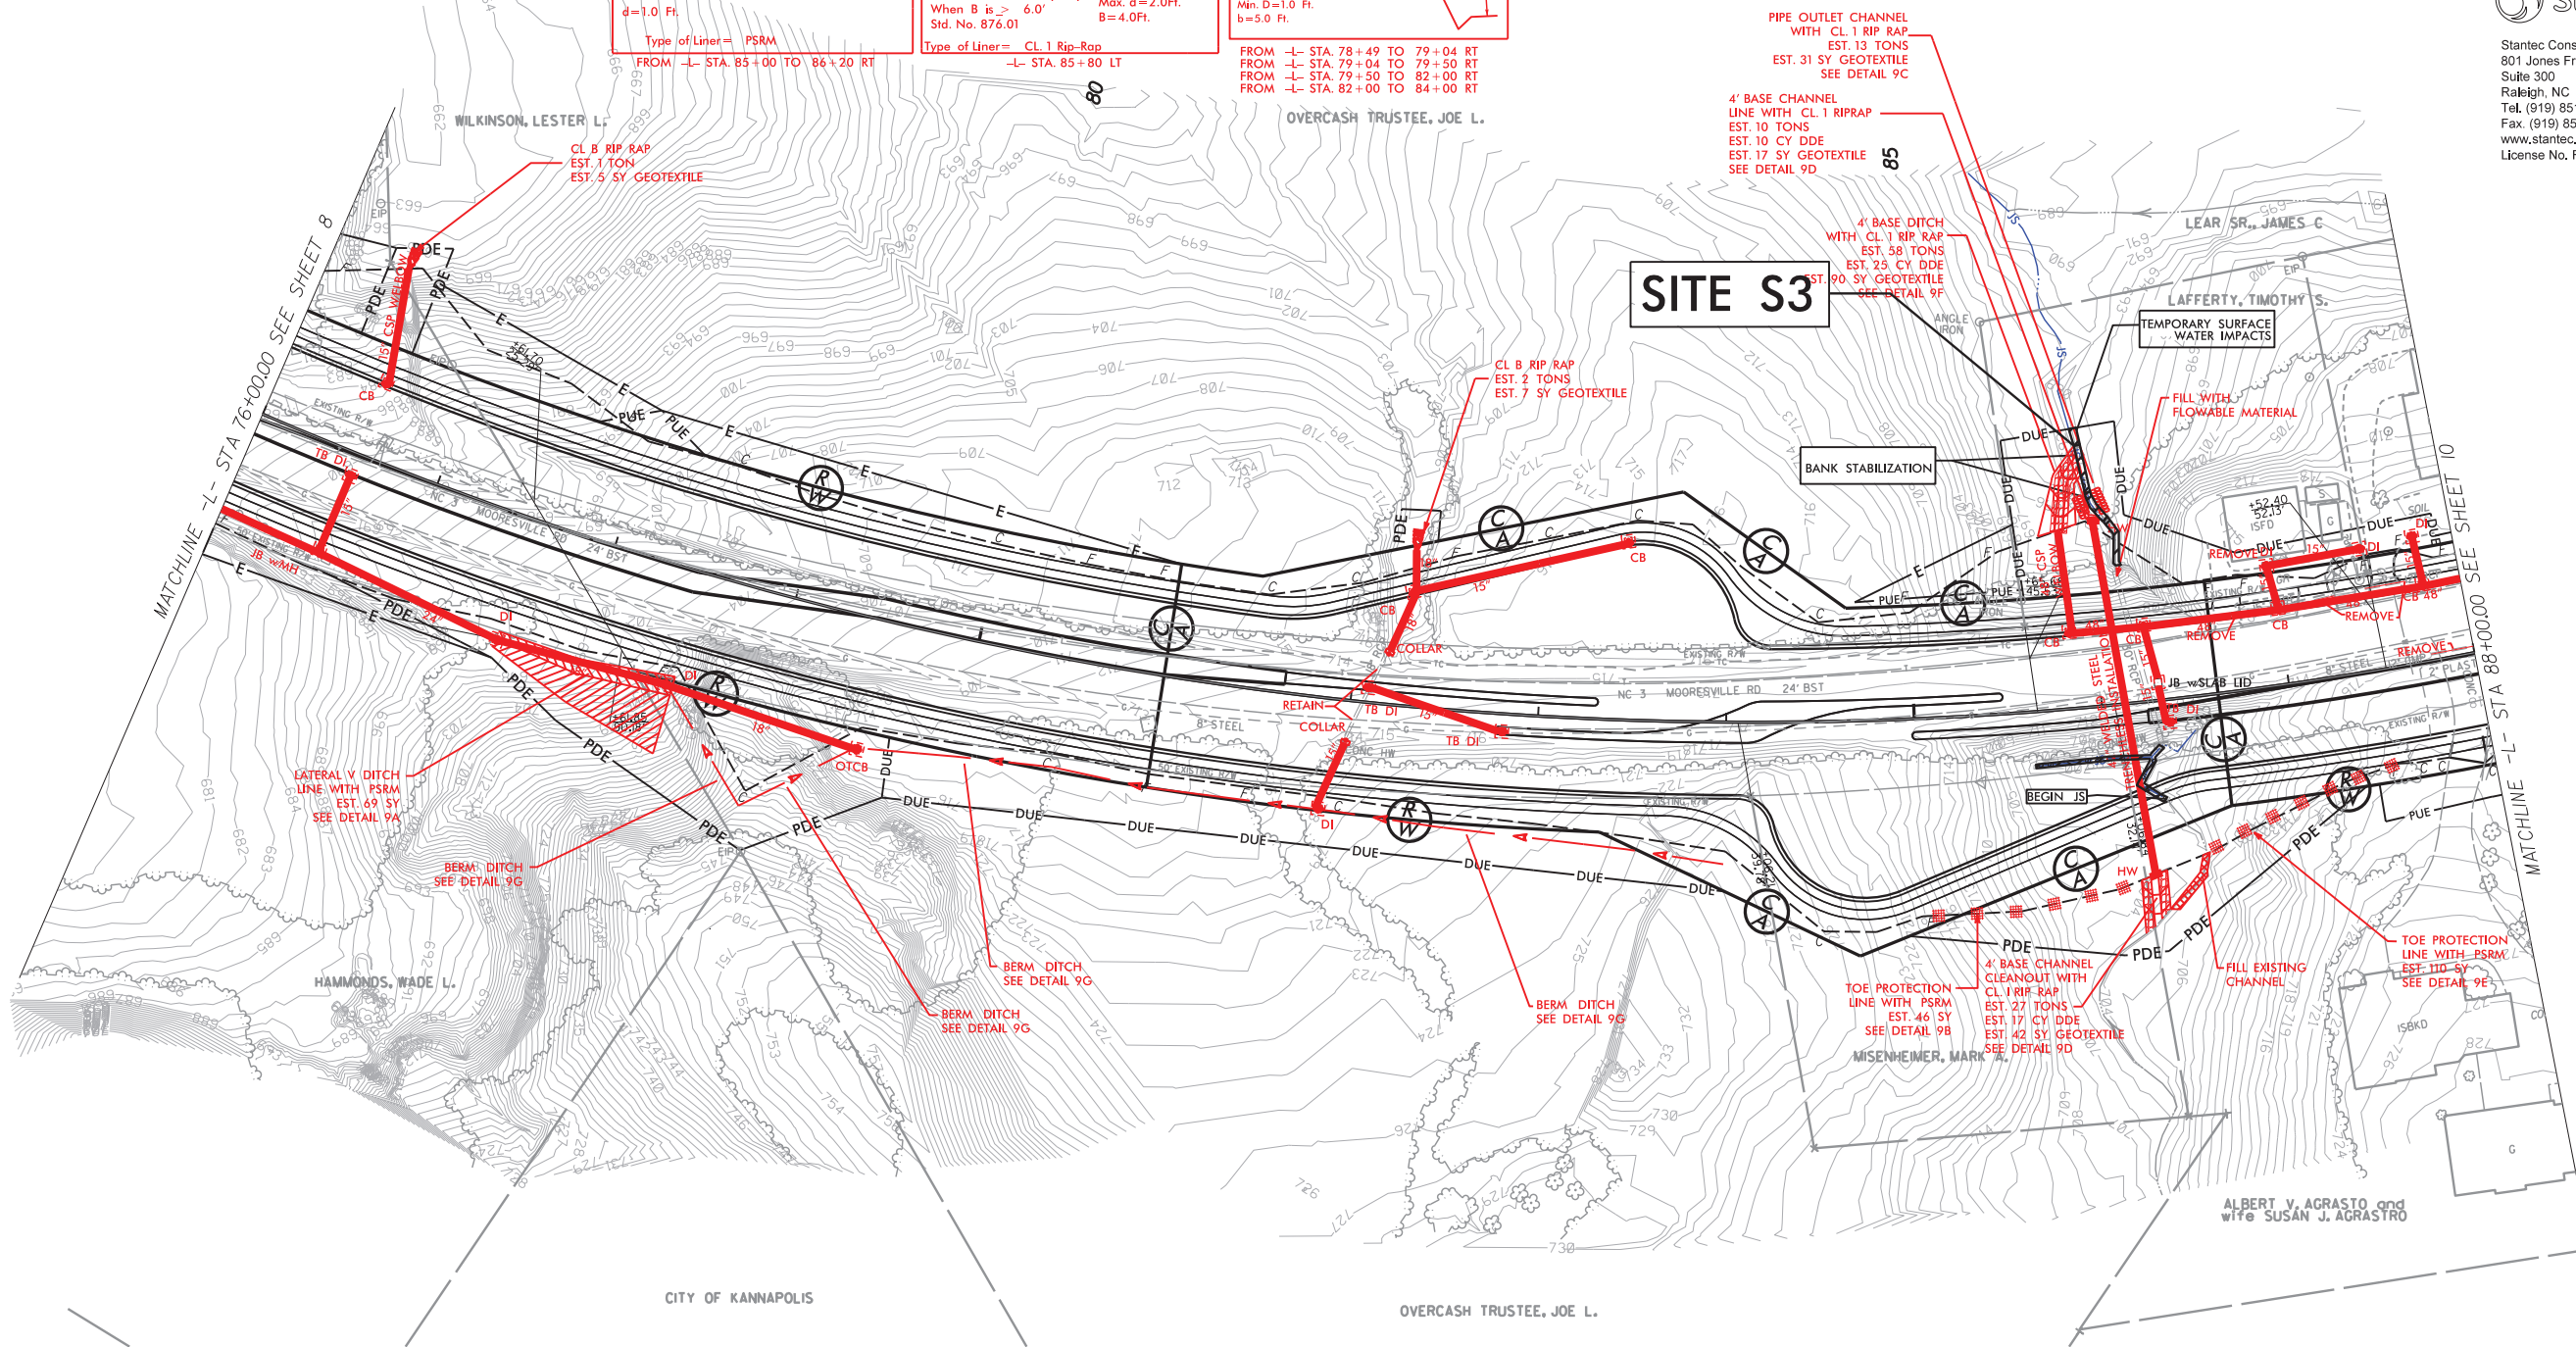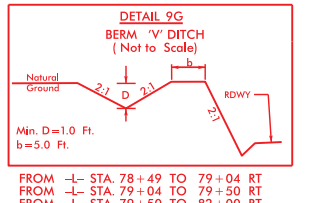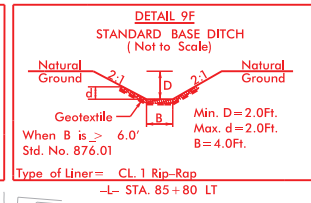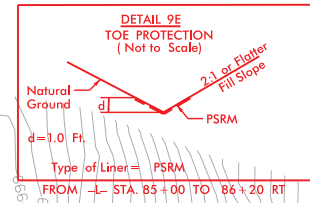

SITE S3

Stantec
Stantec Consulting Services Inc.
801 Jones Franklin Road
Suite 300
Raleigh, NC 27606
Tel. (919) 851-6866
Fax. (919) 851-7024
www.stantec.com
License No. F-0672

PROJECT REFERENCE NO.		SHEET NO.
RW SHEET NO.		
ROADWAY DESIGN ENGINEER	HYDRAULICS ENGINEER	

**DOCUMENT NOT CONSIDERED FINAL
UNLESS ALL SIGNATURES COMPLETED**

REVISIONS

 DENOTES IMPACTS IN SURFACE WATER

NOTE: DRIVEWAY RADII
ARE 5FT UNLESS
OTHERWISE NOTED

DETAIL 10E
BERM 'V' DITCH
(Not to Scale)

Natural Ground

2:1

2:1

D

b


2:1

RDWY

Min. D = 1.0 Ft.
b = 5.0 Ft.

FROM -L- STA. 92+35 TO 94+10 RT
FROM -L- STA. 94+10 TO 95+15 RT
FROM -L- STA. 96+00 TO 97+00 RT

23
OVERCASH TRUSTEE, JOE L.

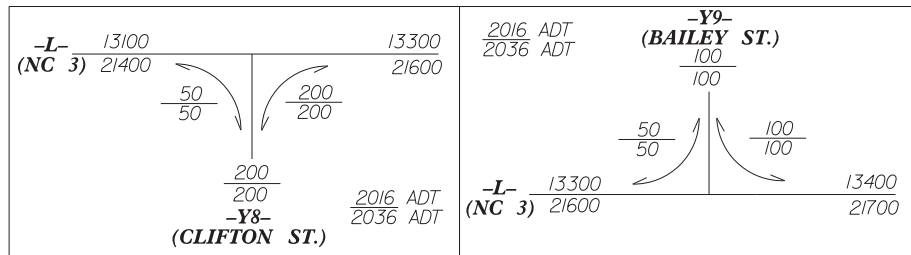

50 25 0 50 100



1S 1S

DENOTES TEMPORARY IMPACTS IN SURFACE WATER

S S

DENOTES IMPACTS IN SURFACE WATER

NOTE: DRIVEWAY RADII
ARE 5FT UNLESS
OTHERWISE NOTED

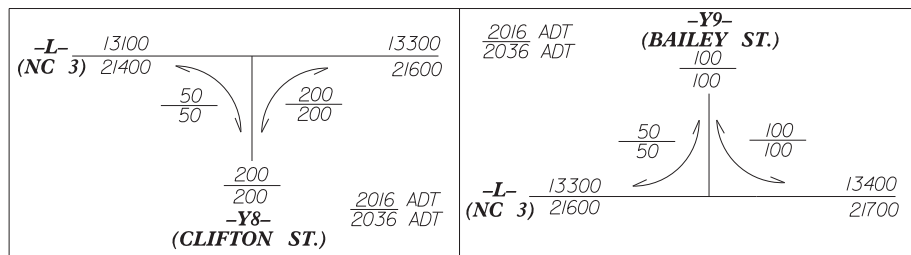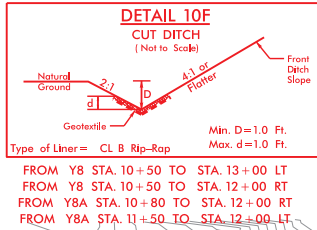

15 15
DENOTES TEMPORARY
IMPACTS IN SURFACE WATER

5 5
DENOTES IMPACTS IN
SURFACE WATER

PERMIT DRAWING SHEET 16 OF 23




PROJECT REFERENCE NO.	SHEET NO.
U-3440	11
RW SHEET NO.	
ROADWAY DESIGN ENGINEER	HYDRAULICS ENGINEER
DOCUMENT NOT CONSIDERED FINAL UNLESS ALL SIGNATURES COMPLETED	



Stantec Consulting Services Inc.
801 Jones Franklin Road
Suite 300
Raleigh, NC 27606
Tel. (919) 851-6866
Fax. (919) 851-7024
www.stantec.com
License No. F-0672

TIE TO EXISTING DITCHES LT & RT

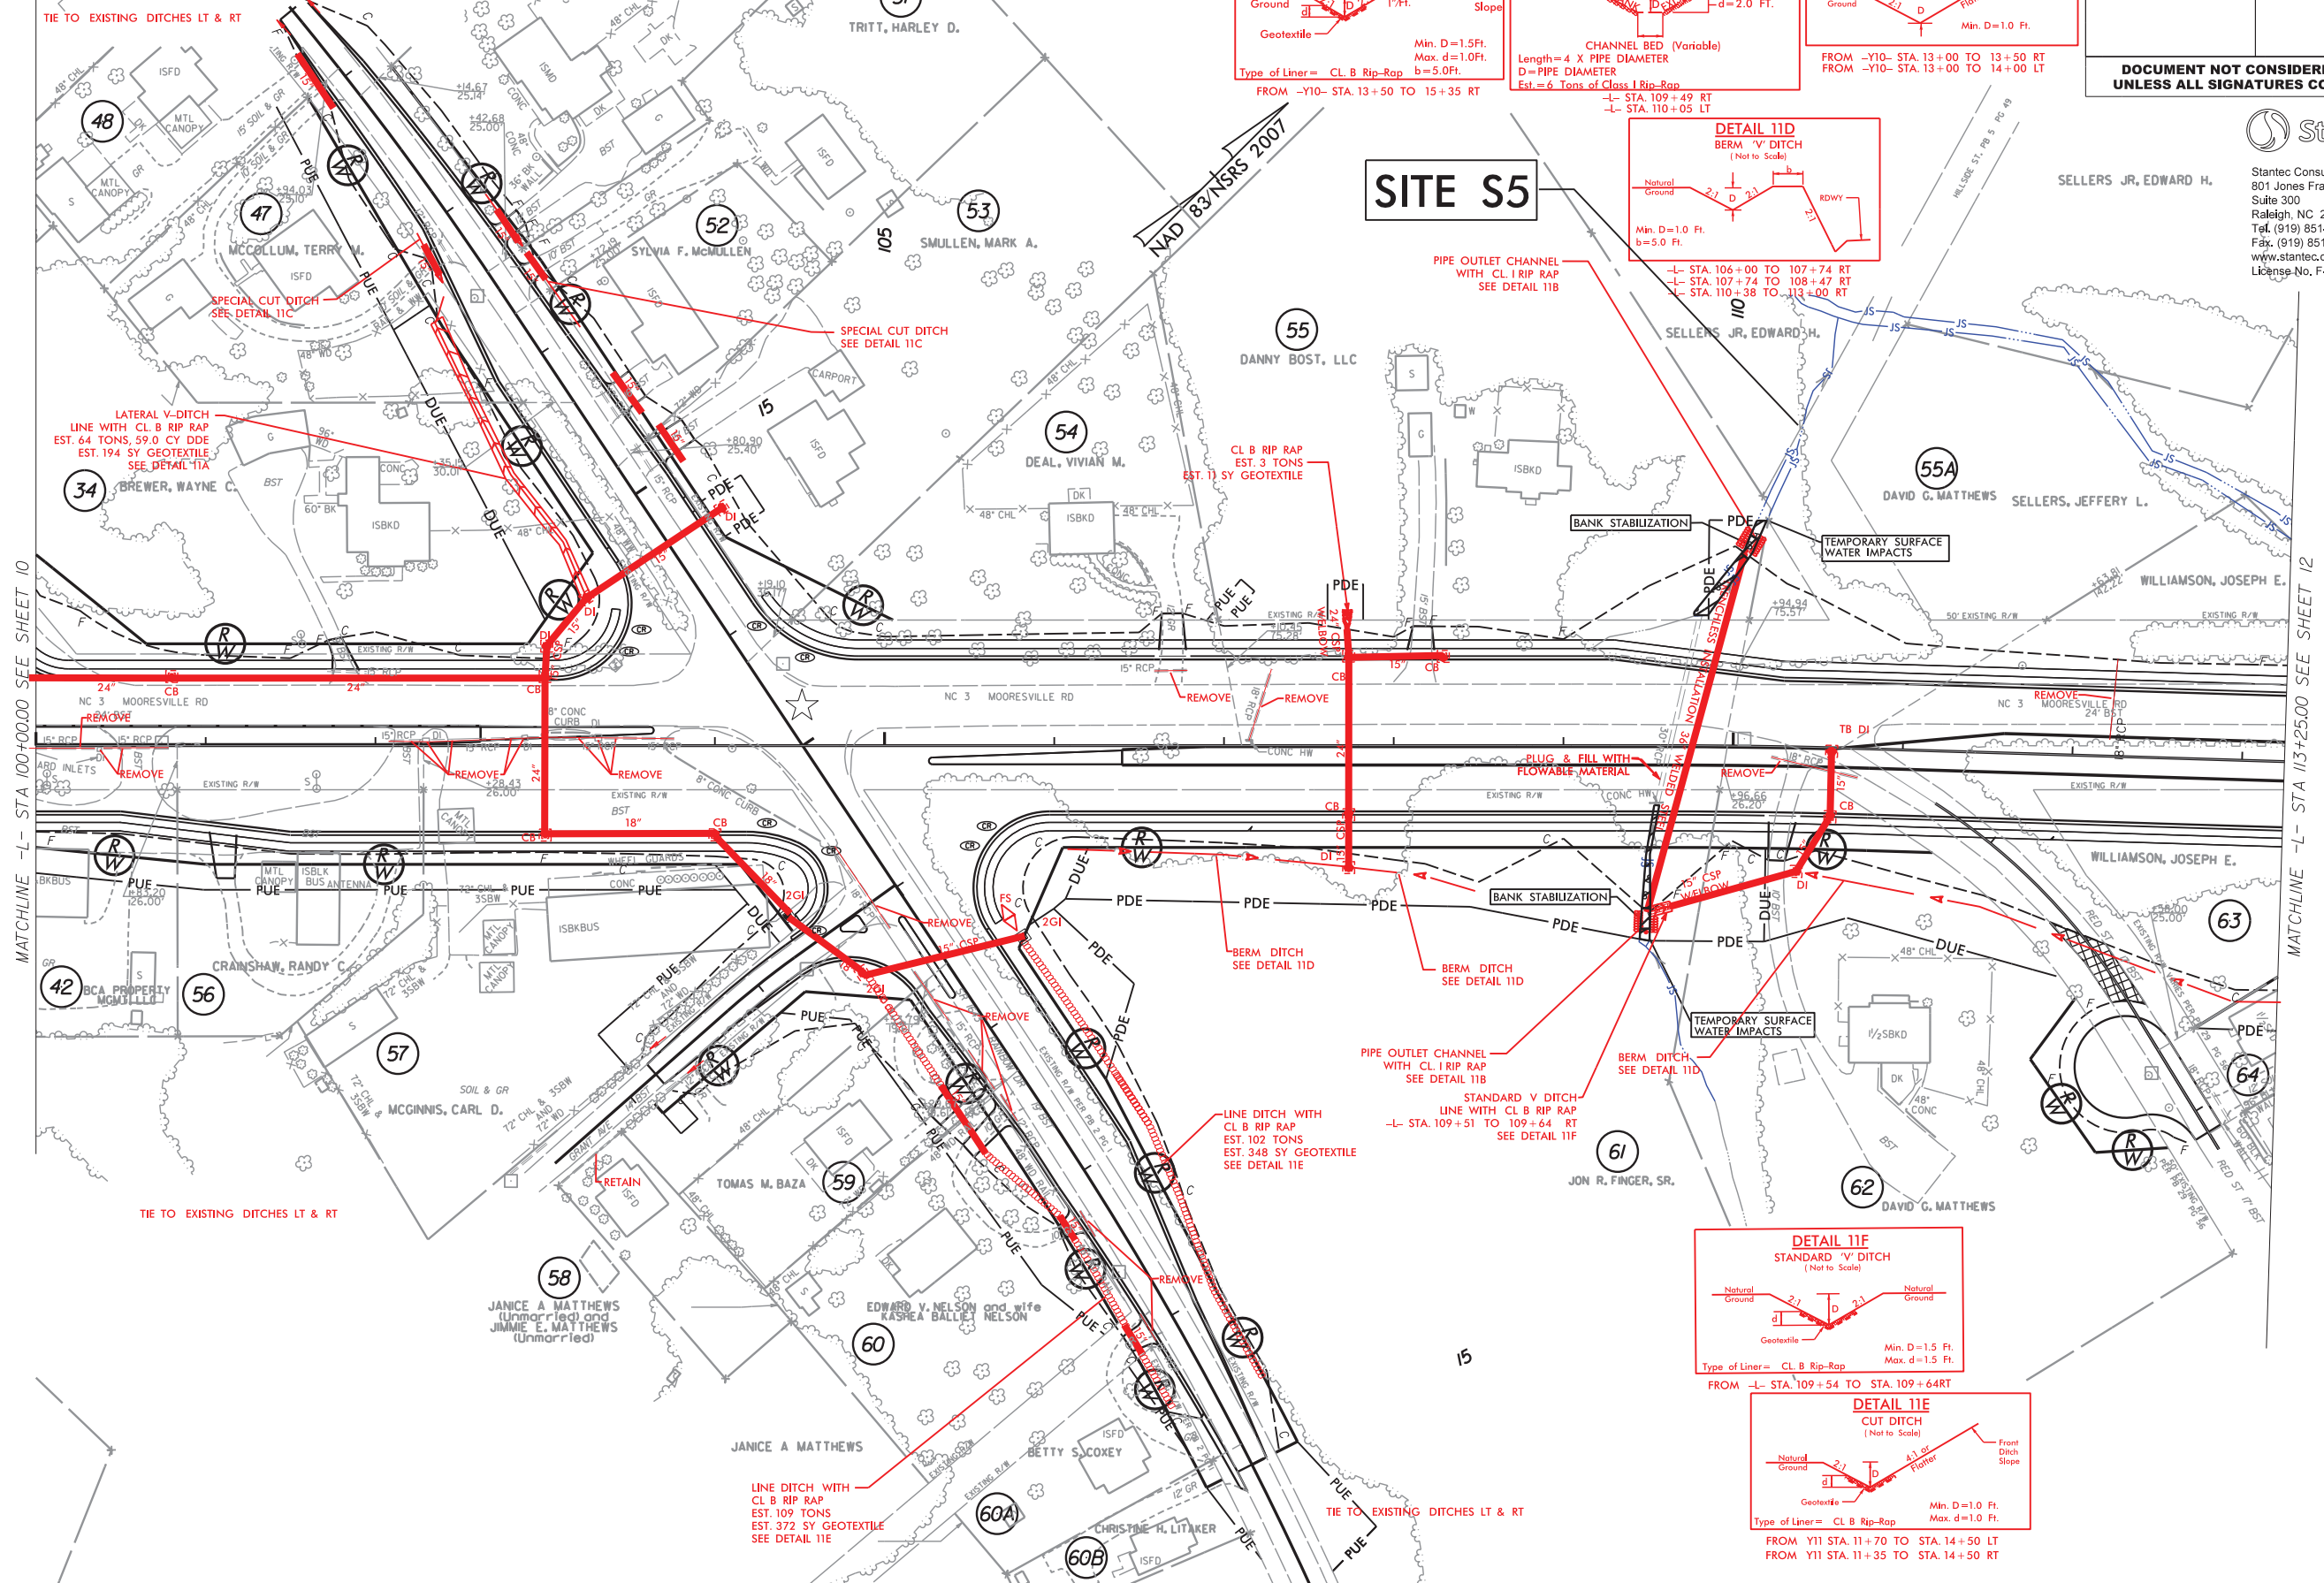

MATCHLINE -L- STA 100+00.00 SEE SHEET 10

MATCHLINE -L- STA 113+25.00 SEE SHEET 12

15 15
DENOTES TEMPORARY
IMPACTS IN SURFACE WATER

5 5
DENOTES IMPACTS IN
SURFACE WATER

PERMIT DRAWING SHEET 17 OF 23




PROJECT REFERENCE NO.		SHEET NO.	
U-3440		11	
RW SHEET NO.			
ROADWAY DESIGN ENGINEER		HYDRAULICS ENGINEER	




SELLERS JR, EDWARD H.

Stantec Consulting Services Inc.
801 Jones Franklin Road
Suite 300
Raleigh, NC 27606
Tel. (919) 851-6866
Fax. (919) 851-7024
www.stantec.com
License No. F-0672

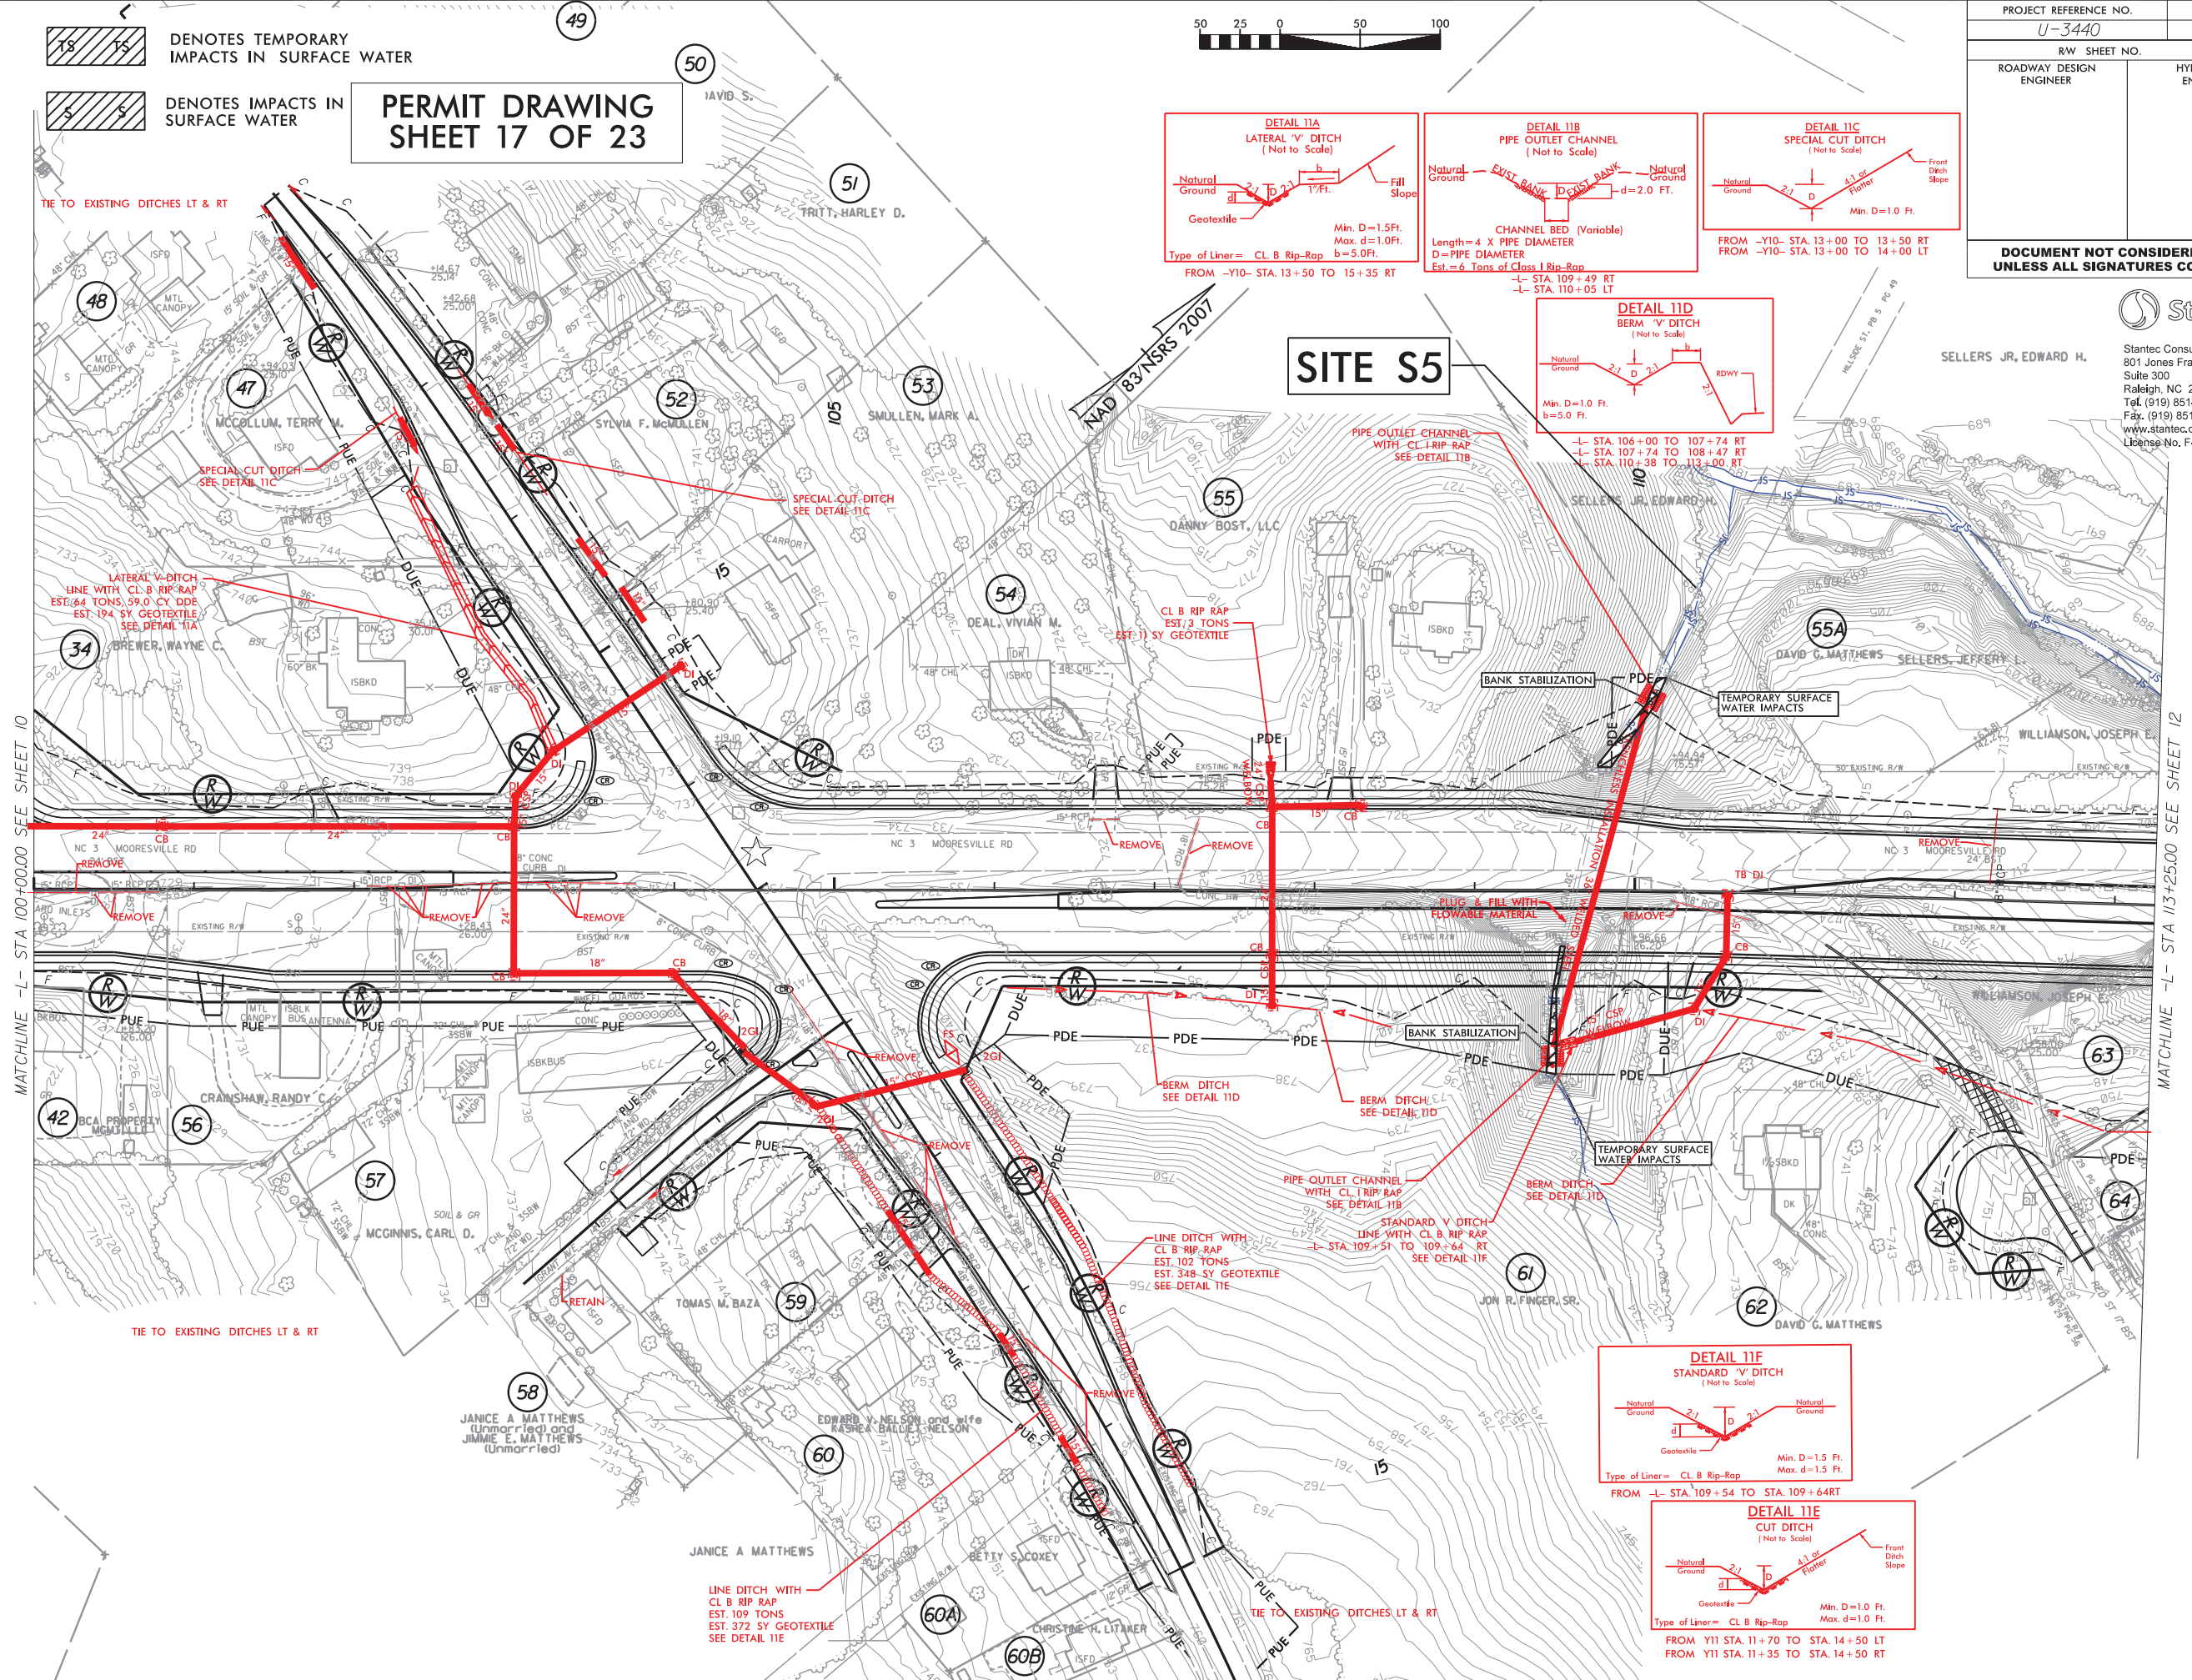

MATCHLINE -L- STA 100+00.00 SEE SHEET 10

MATCHLINE -L- STA 113+25.00 SEE SHEET 12

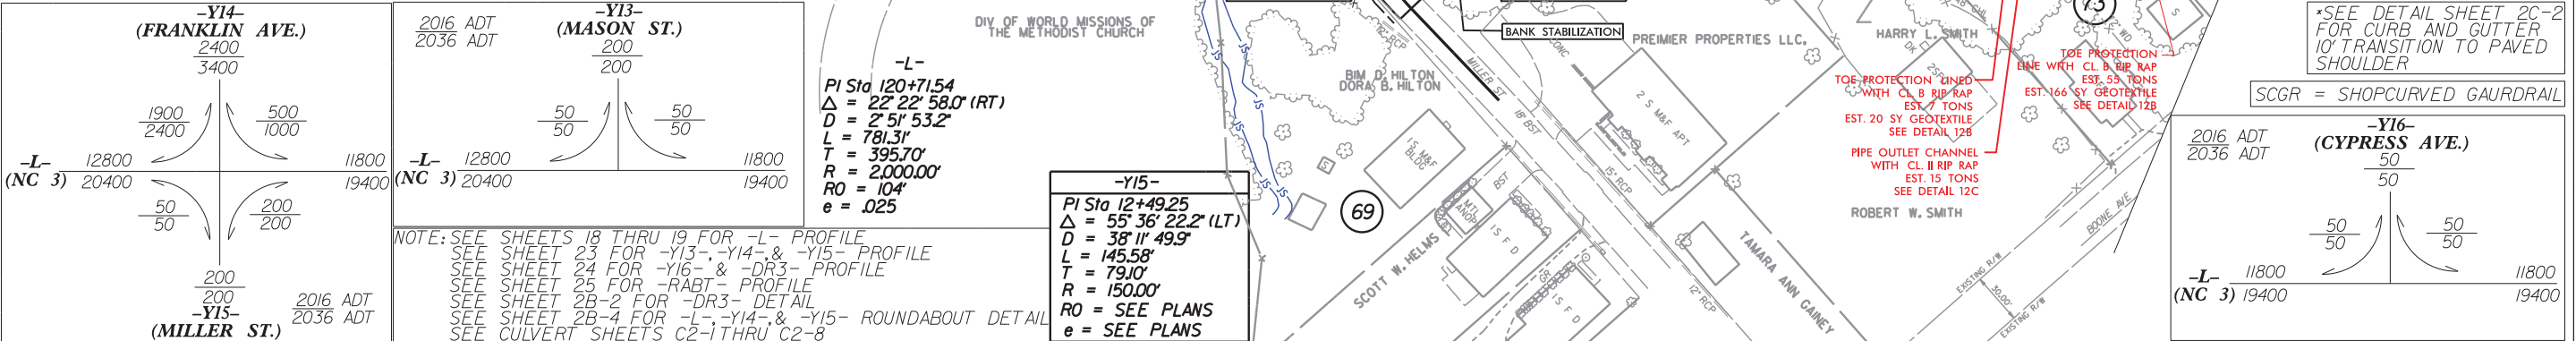



REVISIONS

20150407 STANTEC U3440_Permit Drawings_20150407.pdf	8/17/99
---	---------

PROJECT REFERENCE NO.	SHEET NO.
U-3440	12
RW SHEET NO.	
ROADWAY DESIGN ENGINEER	HYDRAULICS ENGINEER
DOCUMENT NOT CONSIDERED FINAL UNLESS ALL SIGNATURES COMPLETED	

PERMIT DRAWING
SHEET 19 OF 23

- 18 18 DENOTES TEMPORARY IMPACTS IN SURFACE WATER
- 5 5 DENOTES IMPACTS IN SURFACE WATER

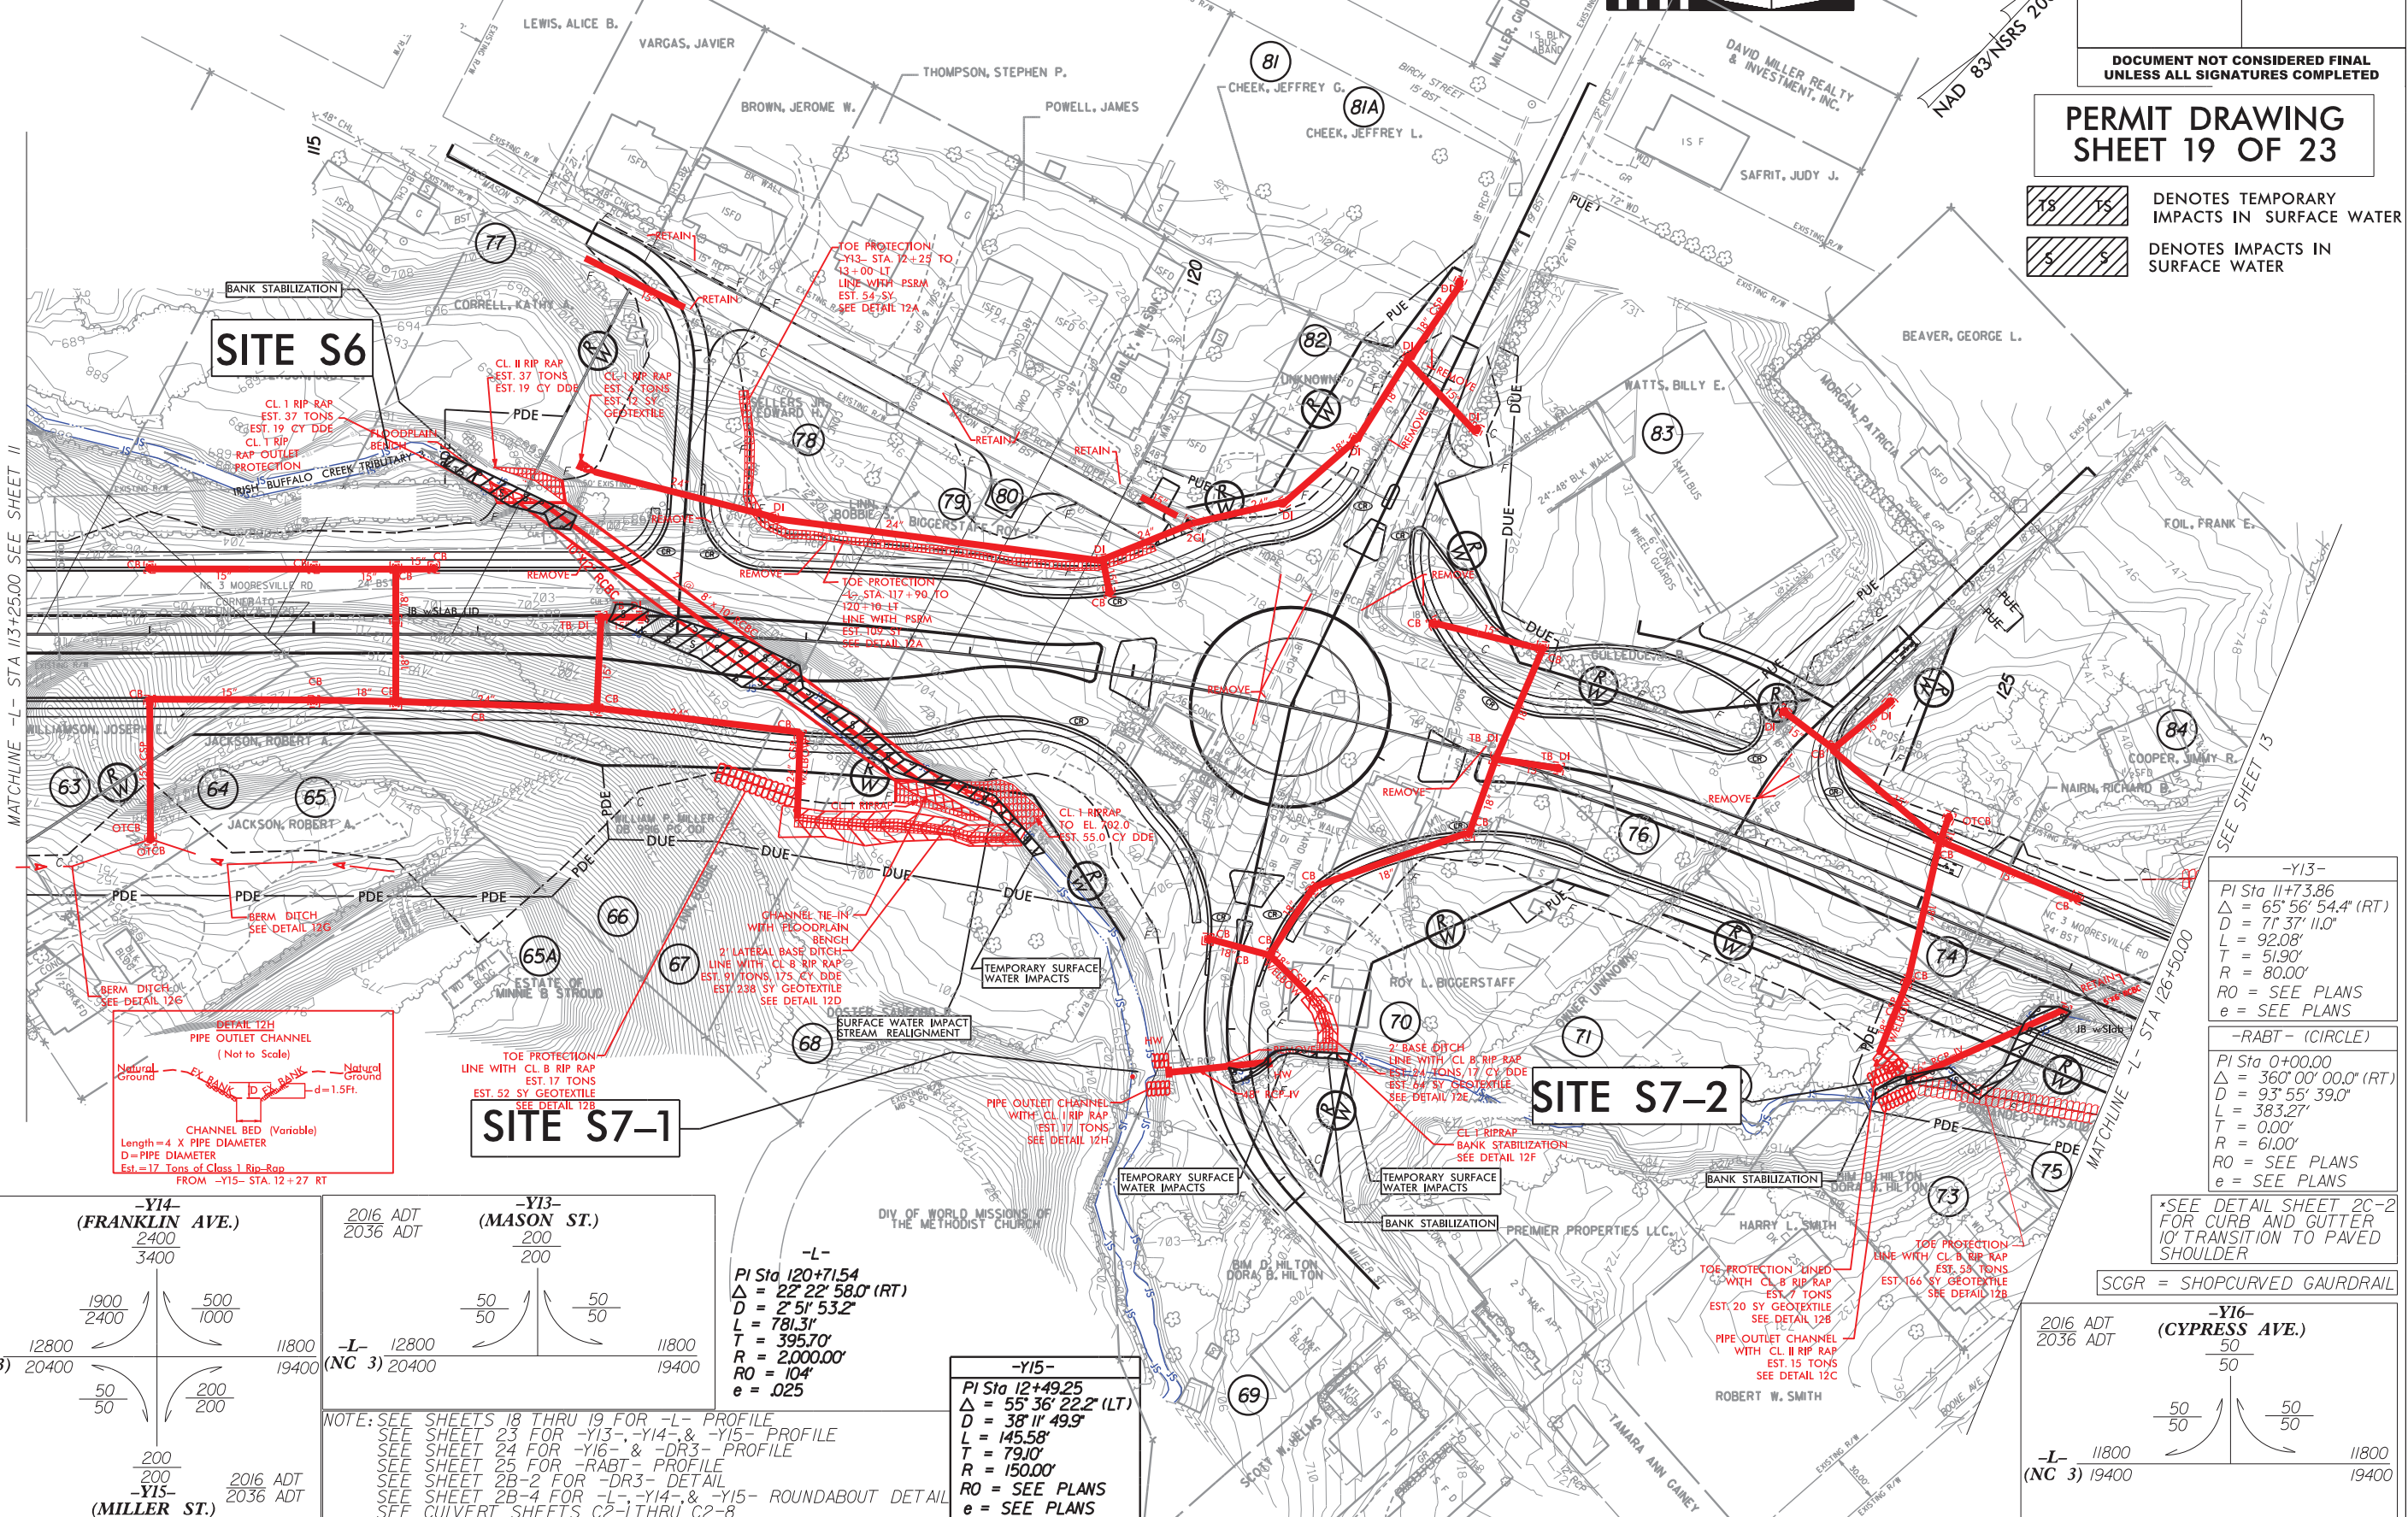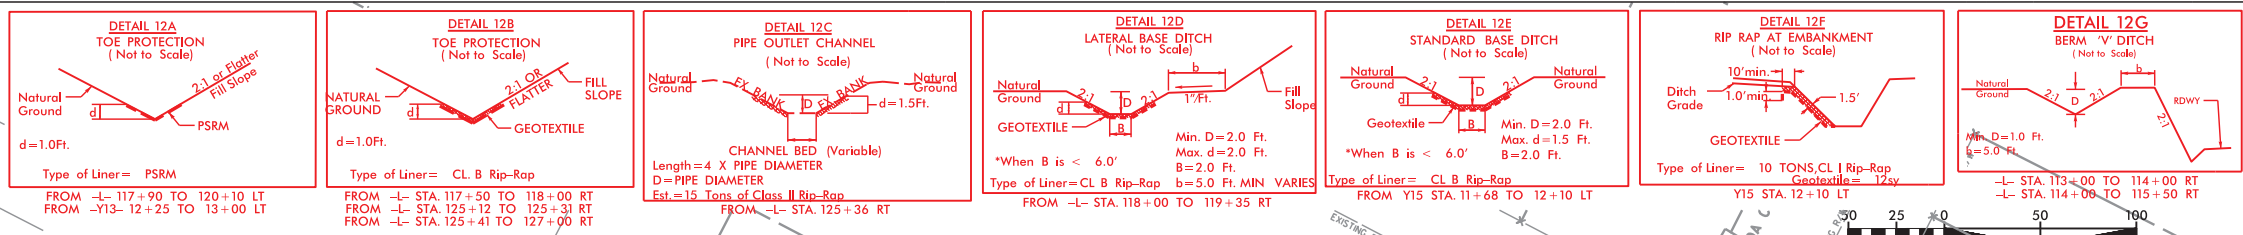


-Y13-
PI Sta 11+73.86
 $\Delta = 65^\circ 56' 54.4''$ (RT)
D = 71' 37' 11.0"
L = 92.08'
T = 51.90'
R = 80.00'
RO = SEE PLANS
e = SEE PLANS

-RABT- (CIRCLE)
PI Sta 0+00.00
 $\Delta = 360^\circ 00' 00.0''$ (RT)
D = 93' 55' 39.0"
L = 383.27'
T = 0.00'
R = 61.00'
RO = SEE PLANS
e = SEE PLANS

*SEE DETAIL SHEET 20-2
FOR CURB AND GUTTER
10' TRANSITION TO PAVED
SHOULDER

SCGR = SHOPCURVED GAUDDRAIL

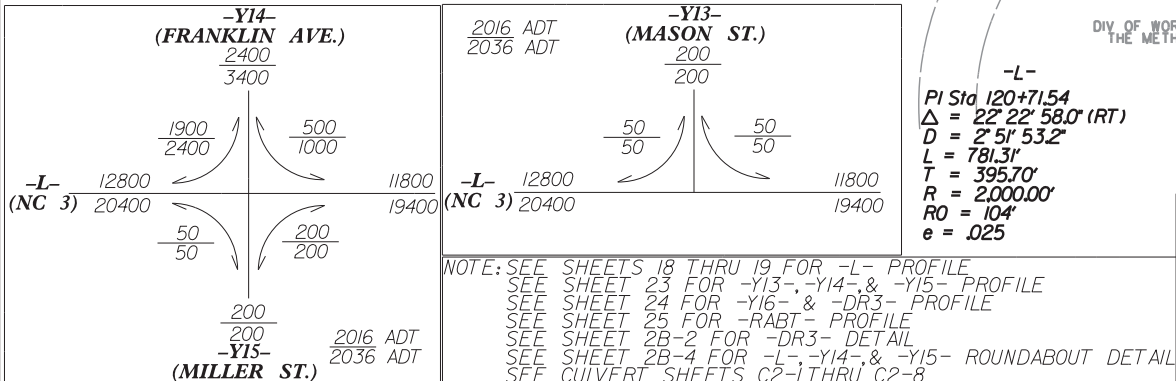

-Y15-
PI Sta 12+49.25
 $\Delta = 55^\circ 36' 22.2''$ (LT)
D = 38' 11' 49.9"
L = 145.58'
T = 79.10'
R = 150.00'
RO = SEE PLANS
e = SEE PLANS

PERMIT DRAWING
SHEET 20 OF 23

CENTERLINE STA. -L- 117+50
2 @ 8' x 10' RCBC
GRADE POINT 708.8'
SKEW = 34.4 DEGREES

3.62:1.0
2:1 NORMAL

3.62:1.0
2:1 NORMAL

PROP 100 YR = 700.75'

PROP 50 YR = 700.1'

NWSEL = 693.4'
(8/10/2013)

BOTTOM OF CULVERT
BURY 1'

2 @ 8' x 10' RCBC
CL EL. = 688.2
SLOPE = 2.4%

NCDOT
PERFORMANCE TABLE


	FREQUENCY				
	10yr.	25yr.	50yr.	100yr.	500yr.
NATURAL	697.8	698.9	699.6	699.87	700.4
EXISTING	697.8	699.2	699.6	700.28	702.2
PROPOSED	697.6	699.4	700.1	700.75	702.2

@SECTION 3757; CE 3770
204 FT. US FROM CL OF REVISED CULVERT


FEMA
PERFORMANCE TABLE

	100yr.
DUPLICATE EFFECTIVE	N/A
CORRECTED EFFECTIVE	700.0
REVISED	700.0

@SECTION 3757; CE 3770
204 FT. US FROM CL OF REV. C

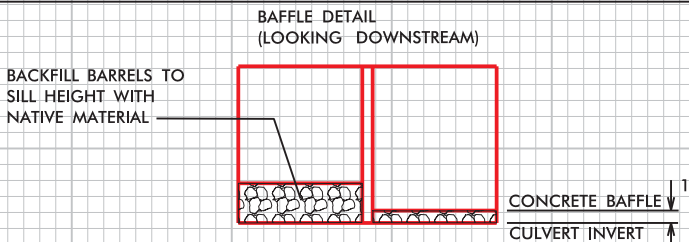

NATIVE MATERIAL CONSISTS OF MATERIAL THAT IS EXCAVATED FROM THE STREAM BED AT THE PROJECT SITE DURING CULVERT CONSTRUCTION. NATIVE MATERIAL IS SUBJECT TO APPROVAL BY THE ENGINEER AND MAY BE SUBJECT TO PERMIT CONDITIONS.

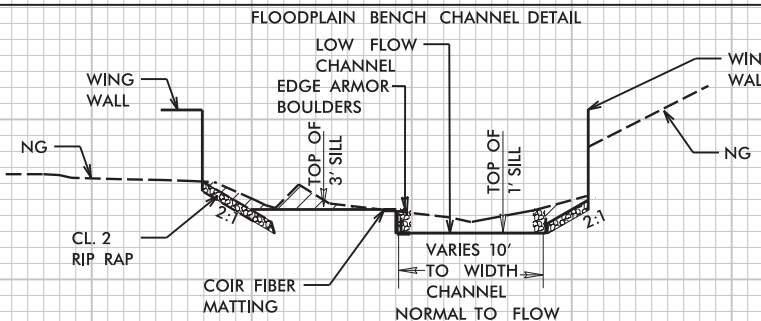

INLET/OUTLET SILL AND
CHANNEL CLEANOUT (LOOKING DOWNSTREAM)
(NOT TO SCALE)



NOTES:

1. THE EDGE OF THE LOW FLOW CHANNEL SHALL BE ARMORED WITH BOULDERS. THE DEPTH OF ARMOR PROTECTION SHOULD EXTEND 1.5' BELOW THE STREAM BED LINED WITH COIR FIBER MATTING.
2. EDGE ARMOR CAN BE NATURAL STREAM BOULDERS OR EXTRACTED FROM CLASS 1 RIP RAP OR SHOT ROCK MATERIAL AND CAN BE CUBICAL OR RECTANGULAR IN NATURE.
3. ACCEPTABLE BOULDERS FOR THE EDGE ARMOR SHALL HAVE THE FOLLOWING MINIMUM DIMENSIONS; 3'X2'X1'. UNSUITABLE EDGE ARMOR MATERIAL THAT REMAINS FROM CLASS 1 RIP RAP OR SHOT ROCK STORES, MAY BE USED IN BACK FILL OF THE OVER BANK AREA OR DISCARDED.

2 @ 8' x 10' RCBC

NC GRID
83/NSRS 2007

PERMIT DRAWING SHEET 21 OF 23

 DENOTES TEMPORARY IMPACTS IN SURFACE WATER







 DENOTES IMPACTS IN SURFACE WATER

-L-
PI Sta 133+14.77
 $\Delta = 3' 55' 58.4''$ (LT)
 $D = 0' 21' 29.2''$
 $L = 1,098.27'$
 $T = 549.35'$
 $R = 16,000.00'$
 $e = NC (0.02)$



Stantec Consulting Services Inc.
801 Jones Franklin Road
Suite 300
Raleigh, NC 27606
Tel. (919) 851-6866
Fax. (919) 851-7024
www.stantec.com
License No. F-0672

PROJECT REFERENCE NO.	SHEET NO.
U-3440	13
RW SHEET NO.	
ROADWAY DESIGN ENGINEER	HYDRAULICS ENGINEER
DOCUMENT NOT CONSIDERED FINAL UNLESS ALL SIGNATURES COMPLETED	

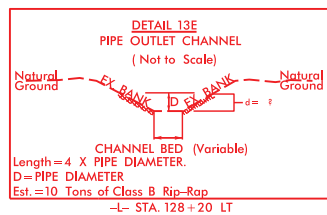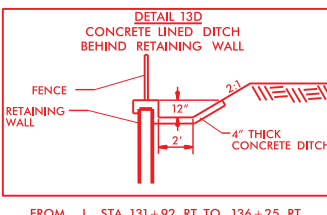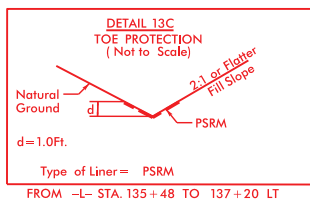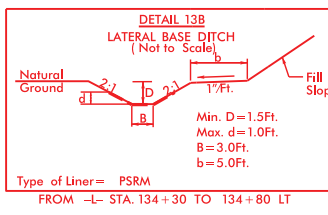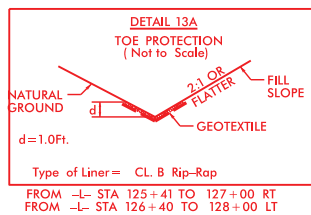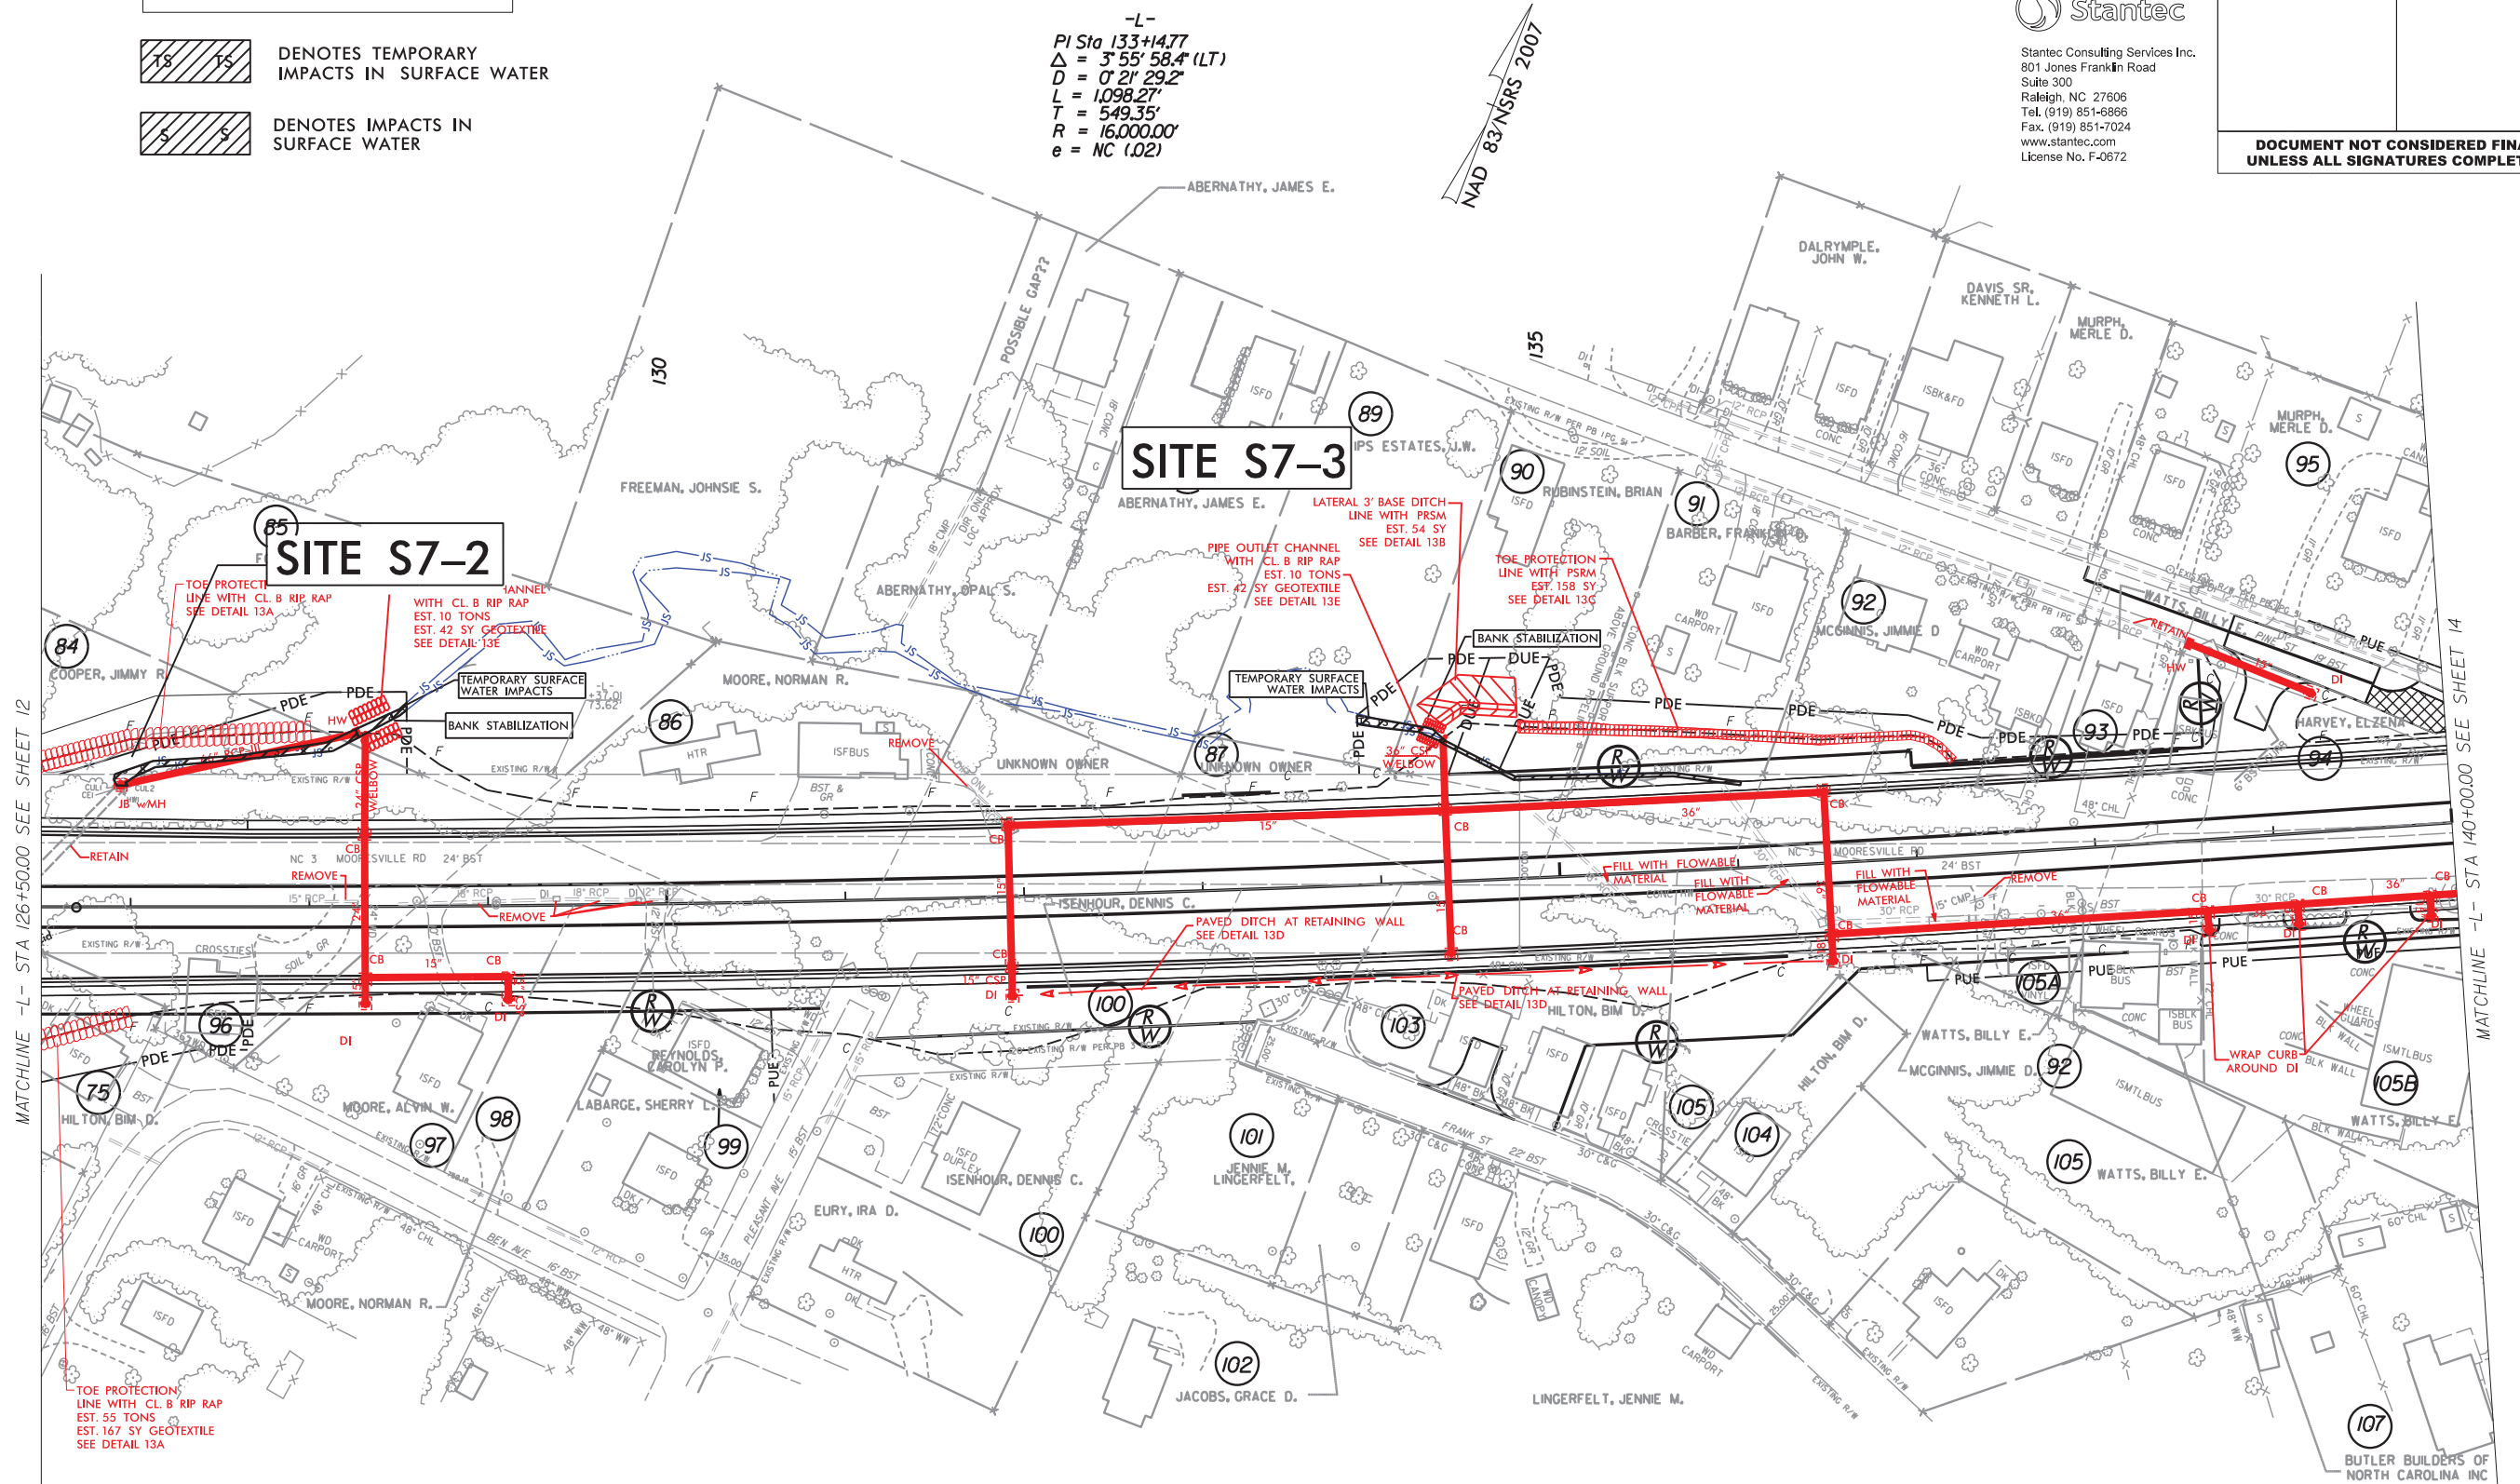

REVISIONS

PERMIT DRAWING SHEET 22 OF 23

 DENOTES TEMPORARY IMPACTS IN SURFACE WATER

 DENOTES IMPACTS IN SURFACE WATER

50 25 0 50 100









Stantec Consulting Services Inc.
801 Jones Franklin Road
Suite 300
Raleigh, NC 27606
Tel. (919) 851-6866
Fax. (919) 851-7024
www.stantec.com
License No. F-0672

PROJECT REFERENCE NO.	SHEET NO.
U-3440	13
RW SHEET NO.	
ROADWAY DESIGN ENGINEER	HYDRAULICS ENGINEER
DOCUMENT NOT CONSIDERED FINAL UNLESS ALL SIGNATURES COMPLETED	

-L-
PI Sta 133+14.77
 $\Delta = 3^{\circ} 55' 58.4" (LT)$
 $D = 0^{\circ} 21' 29.2"$
 $L = 1,098.27'$
 $T = 549.35'$
 $R = 16,000.00'$
 $e = NC (0.02)$

NAD 83 NRS 2007

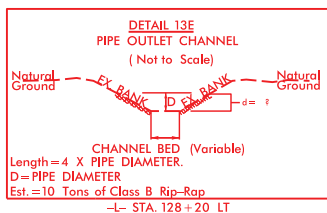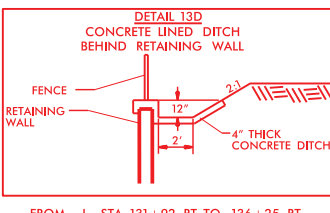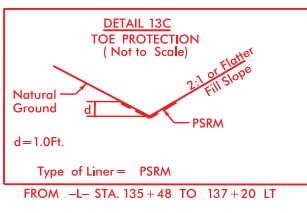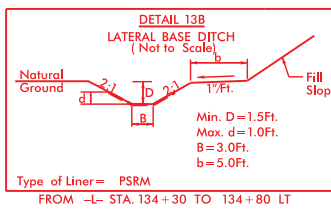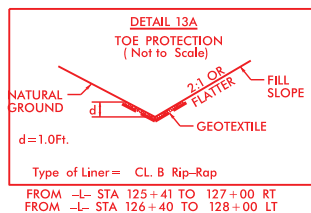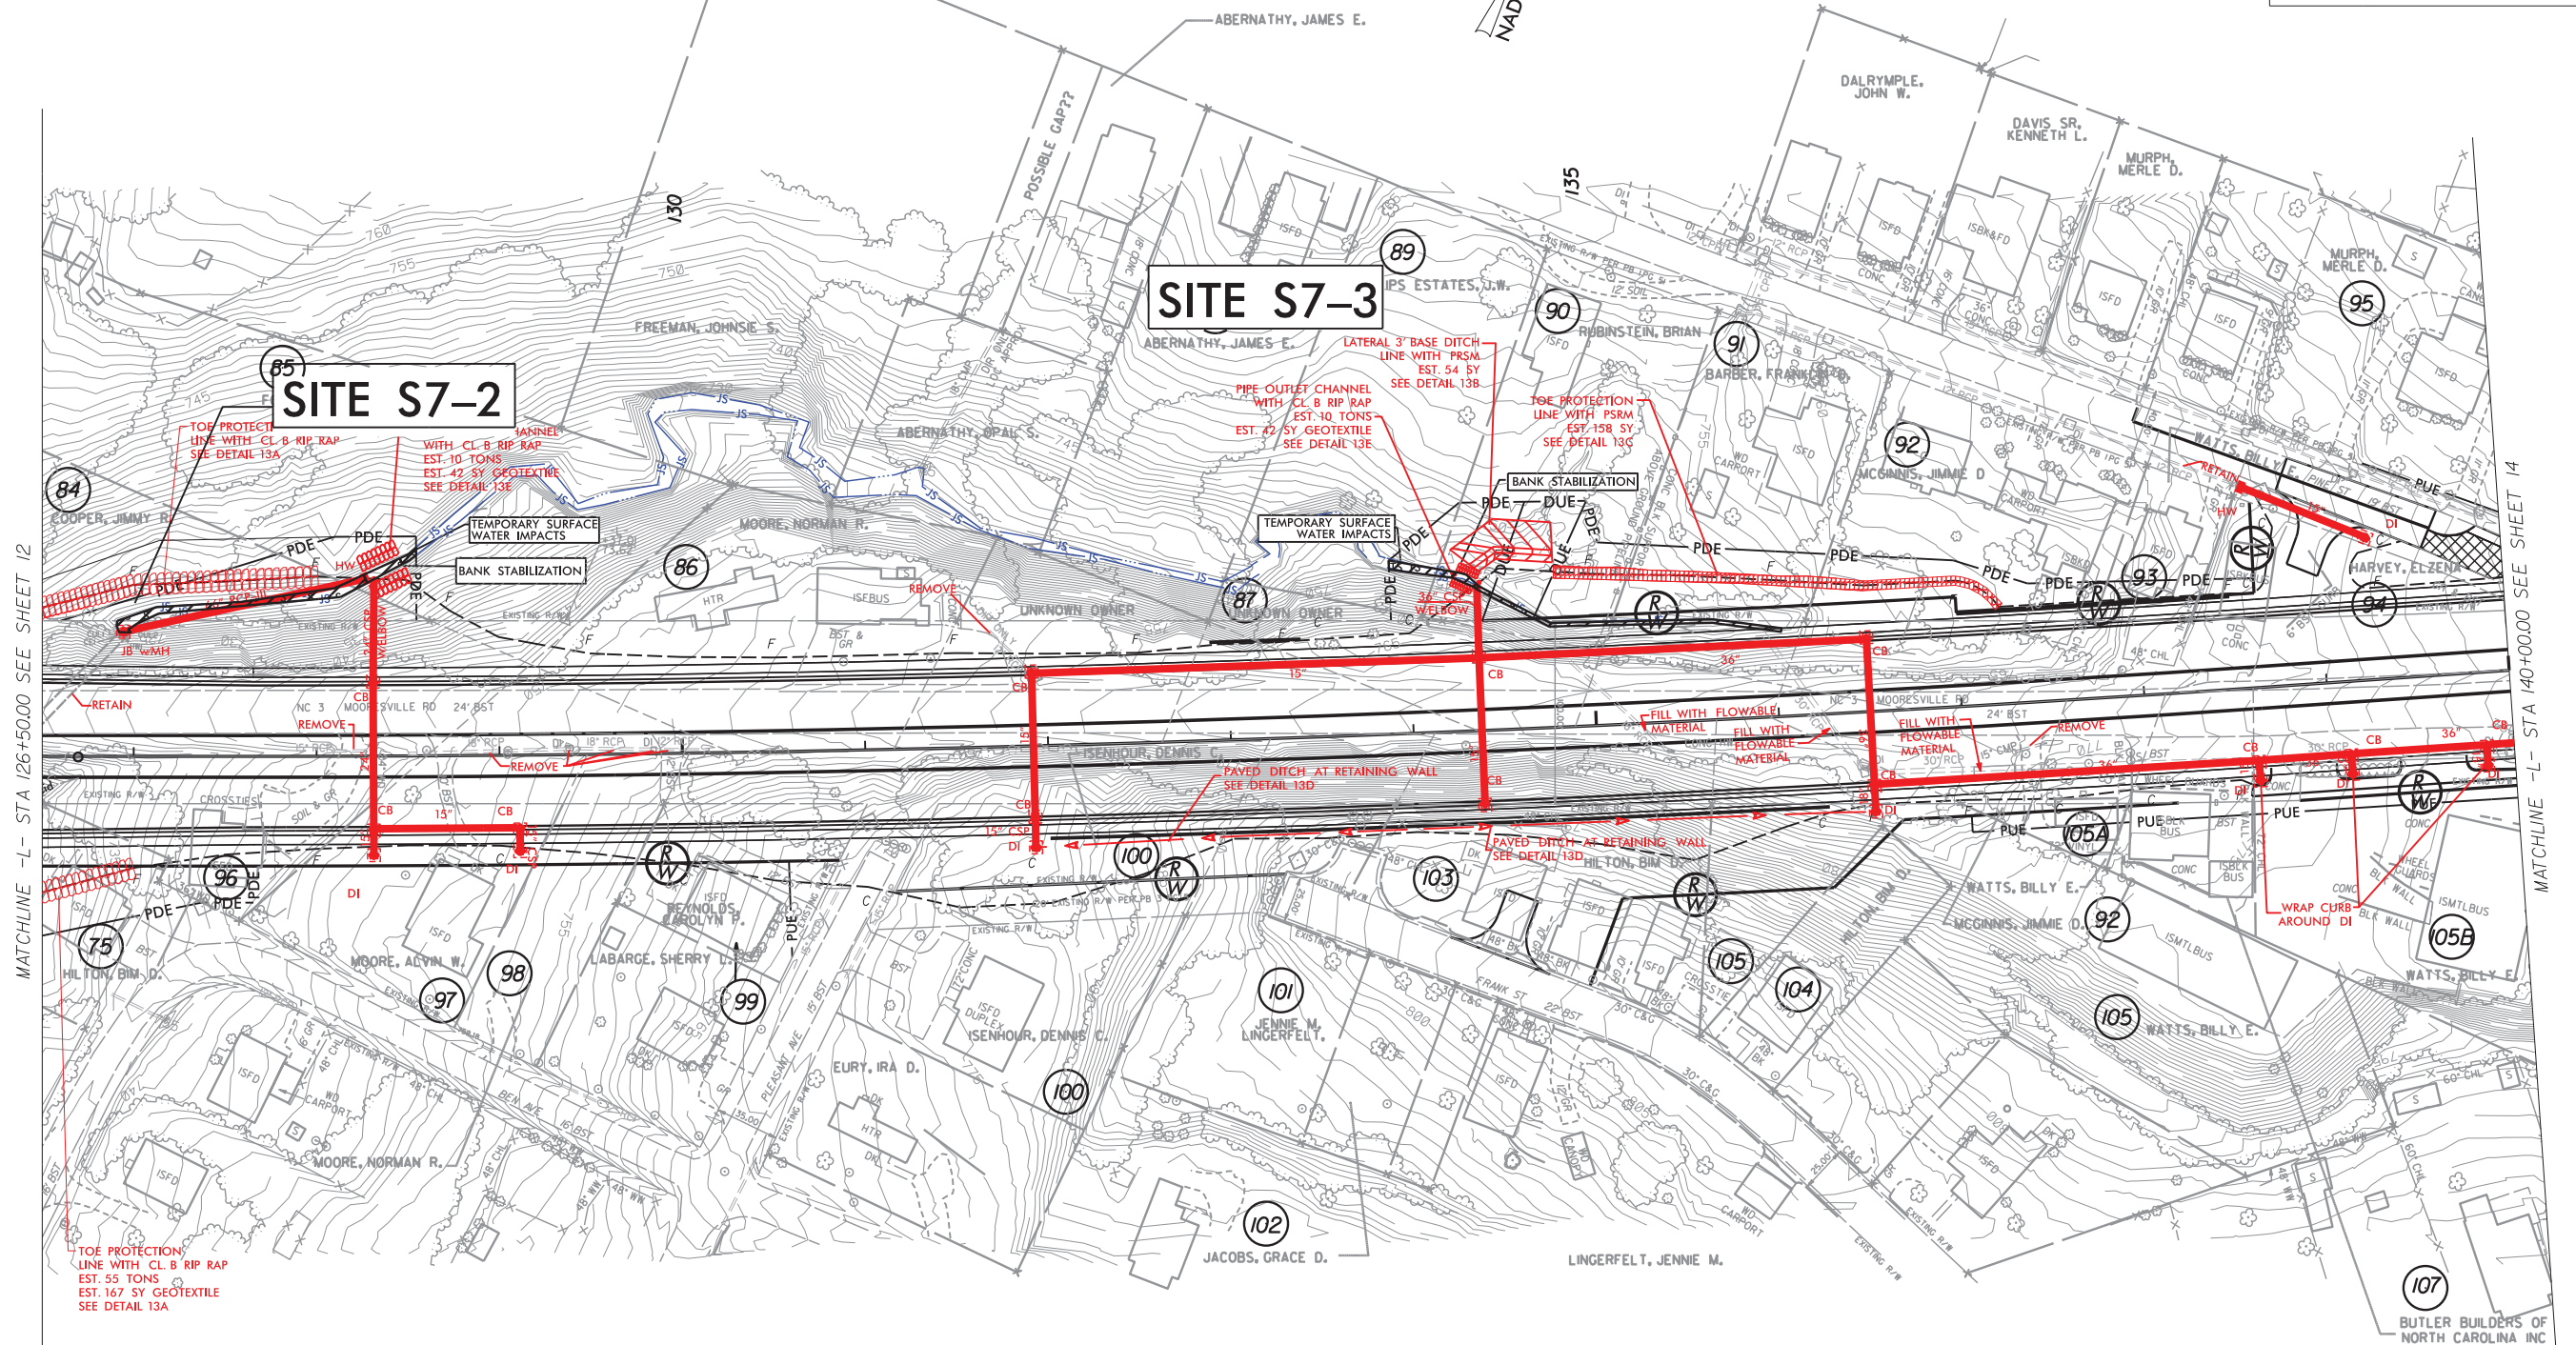

REVISIONS

WETLAND PERMIT IMPACT SUMMARY													
			WETLAND IMPACTS						SURFACE WATER IMPACTS				
Site No.	Station (From/To)	Structure Size / Type	Permanent Fill in Wetlands (ac)	Temp. Fill In Wetlands (ac)	Excavation in Wetlands (ac)	Temp Excavation in Wetlands (ac)	Mechanized Clearing in Wetlands (ac)	Hand Clearing in Wetlands (ac)	Permanent SW impacts (ac)	Temp. SW impacts (ac)	Existing Channel Impacts Permanent (ft)	Existing Channel Impacts Temp. (ft)	Natural Stream Design (ft)
S1	L 37+00 TO 40+15 LT	ROAD FILL							0.02		300		
MB	L 40+61	10' X 9' RCBC							0.03	< 0.01	214	51	
IBC	L 68+25	BRIDGE								0.01		96	
IBC	L 68+55 LT	BANK STABILIZATION							< 0.01	0.02	13	47	
IBC	L 67+61 RT	BANK STABILIZATION							< 0.01	< 0.01	24	16	
WA	L 70+30 TO 72+56 LT	ROAD FILL	0.05										
S2	L72+70 TO 73+16 LT	ROAD FILL							0.02	< 0.01	109	22	
S3	L 86+12	42" WELDED STEEL							< 0.01		126	0	
S3	L 86+12 LT	BANK STABILIZATION							< 0.01	< 0.01	54	9	
S4	L 97+30	66" WELDED STEEL							0.01		181		
S4	L 96+43 LT	BANK STABILIZATION							< 0.01	< 0.01	47	18	
S4	L 97+92 RT	BANK STABILIZATION							< 0.01	< 0.01	12	9	
S5	L 109+75	36" WELDED STEEL							0.01		105		
S5	L 110+07 LT	BANK STABILIZATION							< 0.01	< 0.01	12	12	
S5	L 109+46 RT	BANK STABILIZATION							< 0.01	< 0.01	12	6	
S6	L 117+50	2-8' X 10' RCBC							0.08		246		
S6	L115+79 LT	BANK STABILIZATION							< 0.01	< 0.01	15	17	
S6	L119+23 RT	STREAM REALIGNMENT							0.01	< 0.01	72	10	
S7-1	Y15 12+25	48" RCP							< 0.01	< 0.01	24	31	
S7-1	Y15 12+25	BANK STABILIZATION							< 0.01	< 0.01	12	8	
S7-2	L 126+30	66" RCP							0.03		265		
S7-2	L 125+15 RT	BANK STABILIZATION							< 0.01		20		
S7-2	L 128+55 LT	BANK STABILIZATION							< 0.01	< 0.01	22	10	
S7-3	L 134+38	ROAD FILL							< 0.01		170		
S7-3	L 134+38	BANK STABILIZATION							< 0.01	< 0.01	12	36	
TOTALS*:			0.05						0.25	0.06	2067	399	

*Rounded totals are sum of actual impacts

NOTES:

NC DEPARTMENT OF TRANSPORTATION
DIVISION OF HIGHWAYS
U-344005/13/2016
CABARRUS COUNTY
WBS - 39010.1.1 (U-3440)

SHEET23 OF 23