



STATE OF NORTH CAROLINA  
DEPARTMENT OF TRANSPORTATION

ROY COOPER  
GOVERNOR

JAMES H. TROGDON, III  
SECRETARY

February 21, 2019

US Army Corps of Engineers  
2407 West 5<sup>th</sup> Street  
Washington, North Carolina 27889-1000

Attention: Mr. Kyle Barnes  
NCDOT Coordinator

Dear Sir:

**Subject: Application for Section 404 Individual Permit and Section 401 Water Quality Certification** for US 158 improvements from I-95/NC 46 in Roanoke Rapids to SR 1312 (St. John Church Road) in Northampton County. TIP R-2582A. Debit \$570 from WBS 34472.1.4.

The North Carolina Department of Transportation (NCDOT) proposes to widen US 158 in Northampton County. The Preferred Alternative originates at an interchange with existing I-95/NC 46 in Roanoke Rapids and extends 8.2 miles to terminate at SR 1312 (St. Johns Church Road).

The purpose of this letter is to request approval for a Section 404 Individual Permit and Section 401 Water Quality Certification. In addition to this cover letter, this application package includes the following for R-1015: ENG Form 4345, stormwater management plan, permit drawings, utility drawings, roadway plans, DMS Acceptance Letter, and 4B/4C merger meeting minutes.

### Purpose and Need

The purpose of the project as stated in the State Record of Decision (ROD) is to “improve the traffic flow and Level of Service (LOS) on this section of US 158; thereby improving safety; and to improve access to existing and future industry in this region” (ROD, p. 1).

### Project Description

The overall US 158 improvement project (TIP’s R-2582 & R-2584) is proposed to be a four-lane median-divided freeway, along with associated bridges, interchange ramps, and service roads, designed using NCDOT design standards and design guidelines developed by the American Association of State Highway and Transportation Officials (AASHTO) for freeway facilities. The widening will convert the highway from its current configuration as a two-lane facility to a four-lane, median-divided facility. The proposed facility will have 12-foot lanes, paved shoulders, and a 46-foot grass median. Widened portions, on existing alignment, will have partial control of access, while new location segments will have full control of access. The design speed for the road is 70 mph, which will accommodate posted speed limits of 65 mph.

The location of the R-2582A segment is depicted in Figure 1 of the ROD. The improvement occurs primarily along the existing alignment of US 158, except for a bypass south of Garysburg which is partly

on new location. This segment will have independent utility, achieving part of the overall purpose and need for R-2582 by improving conditions along US 158 east of I-95 through Gariesburg. Additionally, R-2582B is currently unfunded. As such, the Department is only requesting approval to construct the R-2582A segment.

### **Project Schedule**

Currently, R-2582A is scheduled to let July 16, 2019.

### **Summary of Impacts**

Proposed permanent impacts to jurisdictional areas total 12.19 acres of permanent wetland impacts, 2,426 linear feet of permanent stream impacts, and 0.43 acres of permanent surface water impacts. The wetland impacts include 4.63 acres of non-riparian wetlands and 7.56 acres of riparian wetlands that will require mitigation.

### **Utility impacts**

There will be <0.01 acre of permanent fill and <0.01 acre of temporary fill in wetlands as a result of utility relocations. There will also be 0.22 acre of hand clearing in wetlands due to utilities. Please see the attached utility drawings for more detailed information.

### **Summary of Mitigation**

Mitigation for wetland and stream impacts will be provided by the North Carolina Department of Environmental Quality (NCDEQ)-Division of Mitigation Services (DMS).

### **NEPA Document Status**

The Final State Environmental Impact Statement (FEIS) and the ROD were approved in March 2011 and September 2013 respectively for R-2582 & R-2584. These documents are available at <https://xfer.services.ncdot.gov/pdea/EnvironmentalDocs/Documents/>.

### **INDEPENDENT UTILITY**

The R-2582A segment is the only part of R-2582 currently funded for construction. This project exhibits the following characteristics of independent utility of a project:

- 1) The project connects logical termini and is of sufficient length to address environmental matters on a broad scope;
- 2) The project is usable and a reasonable expenditure, even if no additional transportation improvements are made in the area;
- 3) The project does not restrict consideration of alternatives for other reasonably foreseeable transportation improvements.

### **Resource Status**

The R-2582A project is located entirely in the Roanoke River Basin (Hydrologic Unit 03010107). The project crosses numerous streams, unnamed tributaries, surface waters, and wetlands. Drainages within the R-2582A section are part of the Arthurs Creek and Trouble Field Creek watersheds, which drain southwards to their confluence with the Roanoke River. There are no Outstanding Resource Waters (ORW), High

Quality Waters (HQW), WS-I waters, or WS-II waters within 3 miles upstream or downstream of the project study corridors or within the project study area. No stream that flows through the project study corridors is designated as National Wild and Scenic River or a State Natural and Scenic River.

Wetland and stream delineations were primarily performed from September 2005 through May 2006 to prepare the Natural Resources Technical Report finalized in December 2006. The USACE and NCDWR field verified wetlands and streams in May, 2006.

An Addendum was prepared to the NRTR in 2011 to cover two additional areas where alignments were shifted. These areas are east of the limits of R-2582A; the impacts for the current project are described in the 2006 NRTR.

Field work was conducted in September 2018 to document any changes needed in the wetland and stream limits along R-2582A. Streams and wetlands were assessed by comparing aerial imagery from 2013 to the most recent. Following the desktop aerial evaluation, a field assessment of streams and wetlands occurred by spot-checking features to determine feature changes (if needed). GNSS/GPS data was collected at each area of change.

### **Impacts to Jurisdictional Resources**

Impacts to jurisdictional wetlands and surface waters for R-2582A are summarized in Tables 1 and 2 respectively.

**Table 1. R-2582A Wetland Impacts**

Permit Drawing Site Number	2006 NRTR Label	Type	Permanent Impacts (ac.)	Temporary Impacts (ac.)	Mitigation Required*
1	WA01	Riparian	0.38	0	Yes
2	WA03	Non-riparian	0.004	0	Yes
2	WA04 & WA06	Riparian	0.07	0	Yes
3	WA08 & WA09	Non-riparian	0.21	0	No <sup>1</sup>
4	WA07	Riparian	2.38	0	Yes
5	WB01, WB02 & WB03	Non-riparian	3.58	0	Yes
6	WB04	Riparian	3.10	0	Yes
7	WB06	Riparian	1.35	0	Yes
8	WB08 & WB09	Riparian	0.28	0	Yes
9	WB11	Non-riparian	0.83	0	Yes
10	WB12	Non-riparian	0.0005	0	Yes
11	WB13	Non-riparian	0.01	0	Yes
<b>Total:</b>			<b>12.19<sup>2</sup></b>	<b>0</b>	

Note: <sup>1</sup> WA08 and WA 09 are isolated wetlands, old gravel pits (2006 NRTR p. 45)

<sup>2</sup> Riparian 7.56, Non-riparian 4.63

**Table 2. R-2582A Surface Water Impacts**

Permit Drawing Site Number	2006 NRTR Label	Stream Name	Type	Perm. (lf)	Temp. (lf)	Perm. (ac.)	Temp. (ac.)	Mitigation Required
1	SA01	UT to Arthurs Creek	I	101	10	0.01	0.002	No
2	SA02	Arthurs Creek	P	226	35	0.14	0.01	Yes
4	SA04	UT to Arthurs Creek	P	252	21	0.01	0.001	Yes
6	SB01	UT to Trouble Field Creek	I	826	9	0.09	0.001	No
7	SB03	UT to Trouble Field Creek	I	480	63	0.04	0.007	No
8	SB05	Trouble Field Creek	P	332	29	0.11	0.005	Yes
12	SB02	UT to Arthurs Creek	I	209	20	0.02	0.002	No
		Total:		2,426	187	0.43	0.03*	

### Federally Protected Species

Table 5 lists the three federally protected species for Northampton County as of June 17, 2018. The red-cockaded woodpecker and bald eagle were discussed in the 2006 NRTR, although the bald eagle has been delisted from the Endangered Species Act since then. The bald eagle is protected by the Bald and Golden Eagle Protection Act, and is not subject to Section 7 consultation. The Atlantic sturgeon was listed as an Endangered Species effective July, 2014.

Scientific Name	Common Name	Federal Status	Habitat Present	Biological Conclusion
<i>Acipenser oxyrinchus oxyrinchus</i>	Atlantic sturgeon	E	No	No Effect
<i>Haliaeetus leucocephalus</i>	Bald eagle	NA	Yes	NA
<i>Picoides borealis</i>	Red-cockaded woodpecker	E	Yes	No Effect

### Biological Conclusions for ESA Listed Species:

Atlantic sturgeon

Suitable spawning habitat for the Atlantic sturgeon consisting of flowing water and hard substrate does not exist in the study area. A review of NCNHP records updated January 2019, does not indicate a known Atlantic sturgeon occurrence within 1.0 mile of the study area.

Red-cockaded woodpecker

The 2006 NRTR left the biological conclusion for the red cockaded woodpecker unresolved, although it did identify areas of potential habitat. NCDOT retained a consultant to survey the R-2582 and R-2584 projects for the red-cockaded woodpecker, and the results of that survey are detailed in an October 2007 report. This effort reached the conclusion of No Effect due to the lack of suitable habitat and no evidence

of current RCW activity at any of the potentially suitable locations. In September 2018, a consultant reevaluated the potential impacts of R-2582A for potential effects on the red-cockaded woodpecker, including a survey for cavity trees in areas of suitable nesting habitat. The surveys reached the conclusion of No Effect.

#### Northern long-eared bat

The USFWS has developed a programmatic biological opinion (PBO) in conjunction with the Federal Highway Administration (FHWA), the US Army Corps of Engineers (USACE), and NCDOT for the northern long-eared bat (NLEB) in eastern North Carolina. The PBO covers the entire NCDOT program in Divisions 1-8, including all NCDOT projects and activities. The programmatic determination for NLEB for the NCDOT program is "May Affect, Likely to Adversely Affect." The PBO provides incidental take coverage for NLEB and will ensure compliance with Section 7 of the Endangered Species Act for five years for all NCDOT projects with a federal nexus in Divisions 1-8, which includes Northampton County where R-2582A is located.

#### Bald and Golden Eagle Protection Act (BGPA)

In the July 9, 2007 Federal Register (72:37346-37372), the bald eagle was declared recovered, and removed (de-listed) from the Federal List of Threatened and Endangered wildlife. This delisting took effect August 8, 2007. After delisting, the Bald and Golden Eagle Protection Act (Eagle Act) (16 U.S.C. 668-668d) became the primary law protecting bald eagles. Suitable habitat does exist in the project area. Surveys conducted during preparation of the 2006 NRTR concluded that the proposed project will have no impact on the bald eagle due to the absence of nest sites, communal roost sites, or foraging areas for this species. This conclusion was reevaluated in 2018 for R-2582A and remains No Effect.

An August 2018 review of the Natural Heritage database revealed that an eagle was observed April 27, 2014 near the Roanoke River, just over a mile southwest of the beginning of the project at the interchange between US 158 and I-95. Additional sightings of eagles have been made along the river at a greater distance from the project alignment in 2014 and 2016.

#### Moratoria

An in-stream construction moratorium, to limit the effects on fishery resources, such as the striped bass, has been requested from February 15 through June 30 (as per NMFS, USFWS, and NCWRC) on the three perennial streams impacted by the project (Sites 2, 4 and 8). These streams are perennial tributaries of the Roanoke River, which is listed as a primary nursery area by the NMFS. This commitment is specified on p. 95 of the FEIS. NCWRC plans to confirm this request is still valid.

#### Essential Fish Habitat

The project will not impact any Essential Fish Habitat (EFH) identified by the National Marine Fisheries Service (NMFS), and NMFS has not requested further consultation regarding EFH.

#### Archaeological Resources

Archaeological investigations were undertaken in 2011 along the initial 34.6-mile long study-corridor for the proposed improvements to US 158 in Northampton County from the I-95/NC 46 interchange to the Murfreesboro Bypass using a combination of widened existing facilities and the construction of some segments on new location. In 2015, design changes were incorporated into the R-2582A segment that necessitated additional investigations from a point roughly 1,350 feet west of the I-95/NC 46 interchange in Roanoke Rapids to a point 893 feet east of SR 1312, St. John Church Road. Within the A Segment of the proposed project, the archaeological

investigations in 2011 and 2015 identified twenty-one (21) archaeological resources (31NP161/161\*\*, 31NP277\*\*, 31NP278\*\*, 31NP279\*\*, 31NP280\*\*, 31NP280, 31NP281, 31NP282, 31NP283/283\*\*, 31NP284/284\*\*, 31NP285\*\*, 31NP286\*\*, 31NP287\*\*, 31NP358\*\*, 31NP359, 31NP360\*\*, 31NP361\*\*, 31NP362\*\*, 31NP363\*\*, 31NP364/364\*\*, 31NP365\*\*). None of these archaeological resources was considered eligible for the National Register of Historic Places (State Historic Preservation Office concurrence letters dated November 22, 2011 and December 14, 2015; ER 00-7745). It should be noted that two National Register of Historic Places-eligible archaeological sites, 31NP290/290\*\* and 31NP317, are currently located in the remaining segments of the R-2582 project area.

### **Historic Architectural Resources**

In the R-2582/R-2584 project area, 520 historic architectural resources have been recorded and evaluated, of which 36 proved to be listed on or eligible for the National Register of Historic Places. Subsequent development of the project design has avoided or minimized its impact on most of the resources of concern. Three of the 36 resources are located in the R-2582A project area. The Oak Grove Baptist Church (NP0431) is located just west of Permit Site 1, the Henry Stephenson House (NP0230) is not within or proximate to any permit site, and part of Longview (NP0233) is located at Permit Site 11.

Findings of “no adverse effect” established for the Oak Grove Baptist Church and for Longview are contingent upon the use of temporary barrier and erosion control fencing during construction and the eventual installation of post-and-board, control-of-access fencing on both properties, as well as the development and implementation of landscape plans for those parts of the properties directly impacted by the project. A Memorandum of Agreement details the mitigation plan crafted to resolve the “adverse effect” finding established for the Henry Stephenson House. The plan includes the same fencing and landscaping provisions stipulated for the church and Longview properties, and additionally requires full photodocumentation prior to construction. The commitments for historic architectural resources are stated in the 2013 State Record of Decision and 2014 Right of Way Consultation for the R-2582A project.

### **FEMA Compliance**

The project has been coordinated with appropriate state and local officials and the Federal Emergency Management Agency (FEMA) to assure compliance with FEMA, state, and local floodway regulations.

### **Avoidance, Minimization and Mitigation**

The NCDOT is committed to incorporating all reasonable and practicable design features to avoid and minimize jurisdictional impacts, and to provide full compensatory mitigation of all remaining, unavoidable jurisdictional impacts. Avoidance measures were taken during planning and NEPA compliance stages; minimization measures were incorporated as part of the project design. These measures are discussed in Chapter 4 and Appendix F of the State FEIS, and p. 8 of the ROD.

The NCDOT has avoided and minimized impacts to jurisdictional resources to the greatest extent possible. The proposed construction of R-2582A will result in unavoidable impacts to 12.19 acres of permanent wetland impacts, 2,426 linear feet of permanent stream impacts, and 0.43 acres of permanent surface water impacts. The wetland impacts include 4.63 acres of non-riparian wetlands and 7.56 acres of riparian wetlands that will require mitigation. The stream impacts include 810 feet of perennial stream that will require mitigation.

The FEIS identified several potential onsite mitigation sites (FEIS, pp. 104-106). However, there is no onsite mitigation potential for the R-2582A section. The potential mitigation sites noted in the FEIS are along R-2582B which is unfunded for construction. Consequently, the wetland and stream mitigation will

be provided by the North Carolina Department of Environmental Quality (NCDEQ)-Division of Mitigation Services (DMS). The wetland and stream impacts are in the 8-digit hydrologic unit 03010107 of the Roanoke River Basin.

### **Indirect and Cumulative Effects**

Potential indirect and cumulative effects (ICE) attributable to this project were analyzed in a Qualitative Indirect and Cumulative Effects Assessment dated August 25, 2008. The results were summarized in Chapter 4.2 of the FEIS. Generally, effects to human and natural resources were found to be minimal.

### **Regulatory Approvals**

Section 404: Application is hereby made for a USACE Individual 404 Permit as required for the above-described activities.

Section 401: We are requesting a Section 401 Water Quality Certification from NCDWR. We are providing this application to NCDEQ, for their approval. Authorization to debit the \$570 Permit Application Fee from WBS Element 34472.1.4 is hereby given.

A copy of this permit application and its distribution list will be posted on the NCDOT website at:  
<https://xfer.services.ncdot.gov/pdea/PermApps/>

Thank you for your assistance with this project. If you have any questions or need additional information, please contact Gordon Cashin at [gcashin@ncdot.gov](mailto:gcashin@ncdot.gov) or (919) 707-6107.

Sincerely,

*Philip S. Harris III*  
for Philip S. Harris III, P.E., C.P.M.  
Environmental Analysis Unit Head

cc:

NCDOT Permit Application Standard Distribution List

**U.S. ARMY CORPS OF ENGINEERS  
APPLICATION FOR DEPARTMENT OF THE ARMY PERMIT  
(33 CFR 325)**

OMB APPROVAL NO. 0710-0003  
EXPIRES: 31 AUGUST 2012

Public reporting for this collection of information is estimated to average 11 hours per response, including the time for reviewing instructions, searching existing data sources, gathering and maintaining the data needed, and completing and reviewing the collection of information. Send comments regarding this burden estimate or any other aspect of the collection of information, including suggestions for reducing this burden, to Department of Defense, Washington Headquarters, Executive Services and Communications Directorate, Information Management Division and to the Office of Management and Budget, Paperwork Reduction Project (0710-0003). Respondents should be aware that notwithstanding any other provision of law, no person shall be subject to any penalty for failing to comply with a collection of information if it does not display a currently valid OMB control number. Please DO NOT RETURN your form to either of those addresses. Completed applications must be submitted to the District Engineer having jurisdiction over the location of the proposed activity.

**PRIVACY ACT STATEMENT**

Authorities: Rivers and Harbors Act, Section 10, 33 USC 403; Clean Water Act, Section 404, 33 USC 1344; Marine Protection, Research, and Sanctuaries Act, Section 103, 33 USC 1413; Regulatory Programs of the Corps of Engineers; Final Rule 33 CFR 320-332. Principal Purpose: Information provided on this form will be used in evaluating the application for a permit. Routine Uses: This information may be shared with the Department of Justice and other federal, state, and local government agencies, and the public and may be made available as part of a public notice as required by Federal law. Submission of requested information is voluntary, however, if information is not provided the permit application cannot be evaluated nor can a permit be issued. One set of original drawings or good reproducible copies which show the location and character of the proposed activity must be attached to this application (see sample drawings and/or instructions) and be submitted to the District Engineer having jurisdiction over the location of the proposed activity. An application that is not completed in full will be returned.

**(ITEMS 1 THRU 4 TO BE FILLED BY THE CORPS)**

1. APPLICATION NO.	2. FIELD OFFICE CODE	3. DATE RECEIVED	4. DATE APPLICATION COMPLETE
--------------------	----------------------	------------------	------------------------------

**(ITEMS BELOW TO BE FILLED BY APPLICANT)**

5. APPLICANT'S NAME  First - Philip                    Middle - S.                    Last - Harris  Company - NCDOT-EAU  E-mail Address -	8. AUTHORIZED AGENT'S NAME AND TITLE (agent is not required)  First -                            Middle -                            Last -  Company -  E-mail Address -
6. APPLICANT'S ADDRESS:  Address-  City -                            State -                            Zip -                            Country -	9. AGENT'S ADDRESS:  Address-  City -                            State -                            Zip -                            Country -
7. APPLICANT'S PHONE NOS. w/AREA CODE  a. Residence                    b. Business                    c. Fax 919-707-6123	10. AGENTS PHONE NOS. w/AREA CODE  a. Residence                    b. Business                    c. Fax

**STATEMENT OF AUTHORIZATION**

11. I hereby authorize, \_\_\_\_\_ to act in my behalf as my agent in the processing of this application and to furnish, upon request, supplemental information in support of this permit application.

\_\_\_\_\_  
SIGNATURE OF APPLICANT

\_\_\_\_\_  
DATE

**NAME, LOCATION, AND DESCRIPTION OF PROJECT OR ACTIVITY**

12. PROJECT NAME OR TITLE (see instructions)  R-2582A US 158 from I-95/NC 46 in Roanoke Rapids to SR 1312 (St. John Church Rd)	
13. NAME OF WATERBODY, IF KNOWN (if applicable)  Arthurs Creek, Trouble Field Creek, and UTs to both	14. PROJECT STREET ADDRESS (if applicable)  Address
15. LOCATION OF PROJECT  Latitude: °N 36.468618                    Longitude: °W -77.611234	City -    State-                                    Zip-
16. OTHER LOCATION DESCRIPTIONS, IF KNOWN (see instructions)  State Tax Parcel ID                            Municipality  Section -    Township -                                    Range -	

**17. DIRECTIONS TO THE SITE**

Please see attached vicinity map.

**18. Nature of Activity (Description of project, include all features)**

Widening of 8.2 miles of US 158 from I-95/NC 46 Interchange to SR 1312 (St. John Church Rd) in Northampton County. The proposed action involves a combination of widening, new location segments and other improvements to existing US 158. The R-2582A project includes a southern bypass of Garysburg.

**19. Project Purpose (Describe the reason or purpose of the project, see instructions)**

The purpose of the project is to improve the traffic flow and Level of Service (LOS) on this section of US 158; thereby improving safety; and to improve access to existing and future industry in this region.

**USE BLOCKS 20-23 IF DREDGED AND/OR FILL MATERIAL IS TO BE DISCHARGED**

**20. Reason(s) for Discharge**

Wetlands and streams will be impacted by construction activities, i.e., widening of road, new locations, and installation of drainage structures.

**21. Type(s) of Material Being Discharged and the Amount of Each Type in Cubic Yards:**

Type Amount in Cubic Yards	Type Amount in Cubic Yards	Type Amount in Cubic Yards
-------------------------------	-------------------------------	-------------------------------

See attached cover letter.

**22. Surface Area in Acres of Wetlands or Other Waters Filled (see instructions)**

Acres See attached cover letter.  
or

Linear Feet See attached cover letter.

**23. Description of Avoidance, Minimization, and Compensation (see instructions)**

See attached cover letter.

24. Is Any Portion of the Work Already Complete?  Yes  No IF YES, DESCRIBE THE COMPLETED WORK

25. Addresses of Adjoining Property Owners, Lessees, Etc., Whose Property Adjoins the Waterbody (if more than can be entered here, please attach a supplemental list).

a. Address- See attached list.

City - \_\_\_\_\_ State - \_\_\_\_\_ Zip \_\_\_\_\_

b. Address-

City - \_\_\_\_\_ State - \_\_\_\_\_ Zip \_\_\_\_\_

c. Address-

**City -** \_\_\_\_\_ **State -** \_\_\_\_\_ **Zip** \_\_\_\_\_

d. Address-

City - \_\_\_\_\_ State - \_\_\_\_\_ Zip \_\_\_\_\_

e. Address-

**City -** \_\_\_\_\_ **State -** \_\_\_\_\_ **Zip -** \_\_\_\_\_

26. List of Other Certificates or Approvals/Denials received from other Federal, State, or Local Agencies for Work Described in This Application.

AGENCY	TYPE APPROVAL*	IDENTIFICATION NUMBER	DATE APPLIED	DATE APPROVED	DATE DENIED

\* Would include but is not restricted to zoning, building, and flood plain permits

27. Application is hereby made for permit or permits to authorize the work described in this application. I certify that this information in this application is complete and accurate. I further certify that I possess the authority to undertake the work described herein or am acting as the duly authorized agent of the applicant.

Carla D'Orsi  
SIGNATURE OF APPLICANT  
for Philip S. Harris, PE

2/21/19  
DATE

SIGNATURE OF AGENT

DATE

The Application must be signed by the person who desires to undertake the proposed activity (applicant) or it may be signed by a duly authorized agent if the statement in block 11 has been filled out and signed.

18 U.S.C. Section 1001 provides that: Whoever, in any manner within the jurisdiction of any department or agency of the United States knowingly and willfully falsifies, conceals, or covers up any trick, scheme, or disguise a material fact or makes any false, fictitious or fraudulent statements or representations or makes or uses any false writing or document knowing same to contain any false, fictitious or fraudulent statements or entry, shall be fined not more than \$10,000 or imprisoned not more than five years or both.

## **Minutes from the Interagency 4B Hydraulic Design Review Meeting**

**State Project 34472.1.4 (R-2582A) in Northampton County**

**F.A. Project: NHF-158(7)**

**Meeting Date: September 19, 2013**

**Minutes Date: Final - October 30, 2013**

### **Team Members:**

Tracey Wheeler, USACE (Present)

Gary Jordan, USFWS (Present)

Travis Wilson, NCWRC (Present)

Ron Lucas, FHWA (Absent)

Chris Militscher, EPA (Absent)

David Wainwright, NCDWR (Present)

Bill Stephens, URS (Present)

Dennis Hoyle, URS (Present)

Claudia Lee, URS (Present)

### **Support Staff/Other Attendees:**

Chris Rivenbark, NCDOT-PDEA NES (Present)

John Merritt, NCDOT-NEU (Present)

Paul Atkinson, NCDOT Hydraulics (Present)

Omar Azizi, NCDOT – SMU (Present)

Scott Emory, NCDOT Div. 1 (Present)

Jerry Jennings, NCDOT Div. 1 (Absent)

Jason Moore, NCDOT Roadway (Absent)

Bryan Key, NCDOT Roadway (Present)

Robert O'Dell, NCDOT Roadway (Present)

David Harris, NCDOT Roadside (Absent)

Charles Cox, NCDOT-PDEA (Absent)

Corey Bousquet, NCDOT Utilities (Absent)

Sonia Carrillo, NCDWR (Present)

### **Project Description:**

R-2582A is located in Northampton County and consists of improving US 158 to a 4 lane facility with a typical 46' median from NC 46 just west of I-95 in Roanoke Rapids to just east of SR 1312 (St. Johns Church Road). The project is approximately 8.4 miles long with approximately 5.4 miles widening along the existing roadway and approximately 3.0 miles on new location.

### **Minutes:**

The “4B” Meeting for R-2582A was held on September 19, 2013 from 2:45 PM to 4:15 PM in the NCDOT Structure Design Conference Room C, at the Century Center Complex in Raleigh, NC.

Introductions were made by all in attendance.

Bill Stephens provided a brief description of the project and proceeded through the 4B Hydraulic Redline Plans dated September 2013.

### **General:**

- It was noted that the current jurisdictional delineations have expired due to their age and that re-verification is currently underway by NCDOT.
- Cross pipes in jurisdictional streams up to 48" will be buried below the stream bed elevations 20% of their diameter. Pipes over 48" will be buried 1' below the stream bed.
- URS noted that the proposed drainage design currently shown on the 4B plans is preliminary and subject to change as the design progresses.

### **Sheet 5:**

- Impacts include project fill in wetlands and a jurisdictional stream.
- Existing stream water source was questioned on the JS (jurisdictional stream) on this sheet. URS indicated that the stream currently receives flow from the north side of the existing roadway as well

as the south side of the roadway. Flow from the south side of the roadway (inlet end of the existing cross pipe) is from existing roadway ditches. Existing flow patterns will be maintained in the proposed design.

- It was questioned if only the channel on the north side of the project was considered jurisdictional. Currently the JS designation received from NCDOT shows the channel on the north side of the roadway beginning at the outlet end of the existing cross pipe as a JS.

#### **Sheet 7:**

- Wetlands present on the south side of the project. No impacts anticipated. No comments.

#### **Sheet 8:**

- Project impacts include fill in wetlands and a jurisdictional stream (Arthur's Creek). An existing box culvert is proposed to be extended.
- It was questioned if sills could be added to the culvert to reduce the flow width. This culvert is being extended and the existing culvert has no sills. Adding sills to this culvert would reduce the flow area that is currently being provided and would cause increases in flood elevations upstream.
- It was questioned if the check dam in the lateral ditch at the inlet end of the culvert will have stone placed in the stream. URS indicated that bank stabilization will be called for here to protect the stream bank at the ditch to stream transition and rip rap will be placed down to the stream bed.

#### **Sheet 9:**

- Currently no jurisdictional features located on this sheet.
- The inlet location of the proposed pipe at structure no. 0905 was questioned. URS has not completed field work or drainage design at this location to determine the correct inlet location.

#### **Sheet 12:**

- Project impacts include fill in wetlands and a jurisdictional stream.
- It was noted that the stream and wetlands on this sheet likely extend further north across the proposed project area than what is currently shown. NCDOT NES indicated that this area would be studied during the re-verification of wetlands
- It was questioned if the proposed cross pipe at -L-Sta. 142+30+- would drain the wetlands on the south side of the project. Since the existing stream currently extends across to the north side of the project and the proposed pipe will be located in the stream, the wetlands would not be drained by the proposed cross pipe.

#### **Sheet 13:**

- Project impacts include fill in a jurisdictional stream.
- The drainage features and structures on the right side of the project and -Y5B- were discussed. URS indicated that this area appeared to be an existing storm water treatment device and that the outlet pipe was failing and collapsing into the existing outlet ditch. URS has contacted the property owner and the County concerning this device and its purpose and neither had any history or information. A representative from the NCDWR will check to see if they have any information on the structure.

**Sheet 16:**

- Project impacts include fill in wetlands and a jurisdictional stream.
- It was questioned if the wetland area to the east side of -Y9- would be considered a total take. USACE indicated that if there was no connectivity between wetlands across the project and there was 0.25 acres or less of undisturbed wetlands left within the project area, the total wetland area may be considered a total take. This determination will be made after the re-verification of wetlands.
- It was questioned whether the wetland area continues further east of -Y9RPA- than what is currently shown. This area should be checked during re-verification of wetlands.
- URS indicated that the stream that flows from west to east through the interchange area would be piped and relocated through the project area. In the current preliminary design, the stream is proposed to be carried around the south side of Loop A through the wetlands by way of a proposed channel or ditch.

**Sheet 17:**

- Small area of wetlands located on the south side of the project. No impacts anticipated. No comments.

**Sheet 19:**

- Project impacts include fill in wetlands and a jurisdictional stream.
- URS indicated that there were 2 separate channels on the north side of the project at the inlet end of the proposed cross pipe and that the one on the left (west) appeared to be the main flow channel even though it was smaller than the other channel. URS intends to shift the pipe inlet into the main channel.
- URS recommends that the fill slopes in this area be revised from 4:1 to 3:1 to reduce impacts to the wetlands.
- URS indicated that the defined stream channel on the south side of the project does appear to end in the wetland area as shown on the plans.

**Sheet 21:**

- Wetlands located on the north side of the existing roadway. No impacts anticipated. No comments.

**Sheet 22:**

- Project impacts include fill in wetlands and a jurisdictional stream (Trouble Field Creek). The existing box culvert is proposed to be removed and replaced with a new box culvert.
- It was asked if URS could transition the stream less abruptly at the tie between the relocated channel and the existing channel on the outlet end of the proposed culvert. URS will adjust the design to show a less abrupt transition.
- Low flow sills were recommended for this culvert to mimic the natural channel width.
- URS indicated that the design of the box culvert will include burying the culvert 1' below the stream bed.

**Sheet 25:**

- Small area of wetlands located on the north side of the existing roadway. Currently no impacts anticipated. No comments.

**Sheet 29:**

- Project impacts include fill in wetlands.
- It was asked if the toe protection shown on the south side of the project was impacting the wetlands and if so could it be removed. This is a location where there is a proposed lateral ditch ending at the wetland boundary and the general slope of the natural ground is toward the proposed fill slope. Typically a lateral ditch along the fill slope would be continued to protect the fill slope from erosion. However since this is a wetland area, toe protection is being recommended instead of a lateral ditch to reduce impacts to the wetlands.

**Sheet 31:**

- Area of wetlands located on the north side of the project. No anticipated impacts. No comments.

**Sheet 32:**

- Two areas of wetlands located on the north side of the project. No anticipated impacts. No comments.

**Sheet 34:**

- Project impacts include fill in wetlands and a jurisdictional stream. This sheet is the end of R-2582A and the beginning of R-2582B. The fill in wetlands and stream occurs on the R-2582B section of the project. The existing box culvert shown on this sheet occurs on the R-2582B section.
- The description of the pond located on the north side of the project and whether it would be impacted by the project was questioned. URS indicated that it appeared to be an old farm pond and that impacts would be evaluated as the project hydraulic design progresses.

No further comments.

**Meeting adjourned.**

## **Minutes from the Interagency 4C Permit Drawings Review Meeting**

**State Project 34472.1.4 (R-2582A) in Northhampton County**

**F.A. Project: NHF-158(7)**

**Meeting Date: February 14, 2018**

**Minutes Date: Final - March 22, 2018**

### **Team Members:**

Kyle Barnes, USACE (Present)

Gary Jordan, USFWS (Absent)

Travis Wilson, NCWRC (Absent)

Ron Lucas, FHWA (Absent)

Chris Militscher, USEPA (Absent)

Garcy Ward, NCDWR (Present)

### **Support Staff/Other Attendees:**

Paul Atkinson, NCDOT Hydraulics (Present)

Meme Buscemi, AECOM (Present)

Bill Stephens, AECOM (Present)

Gordon Cashin, NCDOT Env. Analyis (Present)

Kevin Fischer, NCDOT Structures (Absent)

Clay Willis, NCDOT Div. 1 (Absent)

Pablo Hernandez, NCDOT Div. 1 (Absent)

Gary Lovering, NCDOT PMU (Present)

Robert Gallo, NCDOT Roadway (Present)

Brian Yamamoto, NCDOT PDEA (Absent)

Mark Staley, NCDOT Roadside (Phone)

Ashley Cox, NCDOT Utilities (Present)

Dayton Martin, NCDOT Utilities (Present)

Rekha Patel, Summit (Present)

Dan Duffield, Summit (Present)

### **Project Description:**

R-2582A is located in Northhampton County and consists of improving US 158 to a 4 lane facility with a typical 46' median from NC 46 just west of I-95 in Roanoke Rapids to just east of SR 1312 (St. Johns Church Road). The project is approximately 8.4 miles long with approximately 5.4 miles widening along the existing roadway and approximately 3.0 miles on new location.

### **Minutes:**

The “4C” Meeting for R-2582A was held on February 14, 2018 from 3:00 PM to 4:00 PM in the NCDOT Structure Design Conference Room C, at the Century Center Complex in Raleigh, NC.

Introductions were made by all in attendance.

Bill Stephens provided a brief description of the project and proceeded through the 4C Permit Drawings dated February 2018.

### **General:**

- It was asked if the project jurisdictional delineations were current. NCDOT to verify.

### **Site 1:**

- NCDWR asked if the proposed drainage ditch from -L- Sta. 37+00 LT to 38+50 LT could be removed. According to drainage calculations, that proposed ditch is required due to the amount of discharge it will carry, therefore the ditch must remain.

### **Site 2:**

- NCDWR asked if the proposed culvert extension would be buried. Because the existing culvert is not

buried, the proposed culvert extension will not be buried either. Proposed culvert extension outlet elevation sits at the stream bed elevation, not considering the existing scour hole.

- NCDWR inquired about the outlet of the proposed ditch at -L- Sta. 87+34 RT. The proposed ditch outlets to natural ground and flows to the existing stream.

#### **Site 3:**

- Corps asked if the roadway fill slope could be changed from 4:1 to 3:1. Gary Lovering stated that it would be preferred not to change the roadway fill slope for safety reasons. If the fill slope were to be changed to 3:1, guardrail would have to be installed back around the bulb, creating a hard angle in the guardrail that would present a safety hazard. Also, adding in the guardrail would add 3 feet of width to the roadway, which would lessen reductions of wetland impact with a 3:1 fill slope.
- Corps reminded the group that there was a 4B commitment to reduce the fill slope to 3:1 in wetlands wherever possible.
- Garcy Ward asked if the proposed roadway ditch at site three outlet to natural ground. Yes, it does.

#### **Site 4:**

- Most recent wetland boundaries to be referenced into permit drawings.

#### **Site 5:**

- Kyle Barnes asked if it was the height of the fill is what required the taking of the entire wetland. Paul Atkinson stated that it was unsure if the entire wetland was being taken. The most recent wetland file would need to be referenced. Upon investigation, the wetland file dated 03/21/2014 does not appear to delineate the entire wetland on the west side of the site.
- KB asked if a bridge was discussed as an option for this area. Gordon Cashin said he would look back through project records to see if he could find out.
- Garcy Ward stated that he would like to know if the wetlands were considered high quality. Gordon Cashin said he would look into it.

#### **Site 6:**

- Most recent wetland boundaries to be referenced into permit drawings.
- Kyle Barnes requested to know the area of the remaining wetland within the loop. If it no longer has a water source feeding it and is less than a quarter acre, could be considered a complete take. Area of remaining wetland is 0.46 acres.
- Garcy Ward asked if rip rap on the stream bed would be warranted due to erosion or scour was a concern at the pipes outlet on the northeast side of the site. The design velocities are low for this pipe outlet and. rip rap on the stream bottom is not believed to be necessary with these velocities.
- Garcy Ward asked if the roadway fill slopes could be changed from 4:1 to 3:1. Gary Lovering stated that they could not place guardrail on such tight loops.

#### **Site 7:**

- Kyle Barnes – Aerial images indicate a solar farm has been constructed between sites 6 and 7. Also believes there is a wetland delineation missing. Gordon Cashin to look into the missing wetland. Based on aerial photography, the solar farm located at about -L- Sta. 215+00 RT, does not appear to be in conflict with the proposed project.
- Garcy Ward asked how the pipe alignment was chosen. Bill Stephens stated that the pipes were aligned with the main channel as determined during field investigations.

- Garcy Ward asked if the rip rap pad was necessary. Bill Stephens stated that it was to minimize erosion or scour because the pipe outlets to a marsh area and not a defined channel.
- Kyle Barnes asked if mechanized clearing is considered a permanent impact. Yes it is.

**Site 8:**

- Garcy Ward asked why the existing channel segment was being abandoned. Bill Stephens stated that it was because the segment was under the proposed fill slope.

**General:**

- It should be noted that impact values may change after some re-evaluation.
- Updated permit drawings will be posted 2/15/2018
- If missing wetland found, area needs to be evaluated and included with permit drawings.
- Ashley Cox requested the impact delineation dgn file.

No further comments.

**Meeting adjourned.**



NORTH CAROLINA  
Environmental Quality

ROY COOPER  
*Governor*

MICHAEL S. REGAN  
*Secretary*

TIM BAUMGARTNER  
*Director*

February 20, 2019

Mr. Philip S. Harris, III, P.E.  
Environmental Analysis Unit  
North Carolina Department of Transportation  
1598 Mail Service Center  
Raleigh, North Carolina 27699-1598

Dear Mr. Harris:

Subject: Mitigation Acceptance Letter:

R-2582A, US 158 / NC 46 from I-95 / NC 46 in Roanoke Rapids to SR 1312 (St. John Church Road), Northampton County

The purpose of this letter is to notify you that the Division of Mitigation Services (DMS) will provide the compensatory stream and wetland mitigation for the subject project. Based on the information supplied by you on February 20, 2019, the impacts are located in CU 03010107 of the Roanoke River basin in the Northern Inner Coastal Plain (NICP) Eco-Region, and are as follows:

Roanoke 03010107 NICP	Stream			Wetlands			Buffer (Sq. Ft.)	
	Cold	Cool	Warm	Riparian	Non-Riparian	Coastal Marsh	Zone 1	Zone 2
Impacts (feet/acres)	0	0	810.0	7.56	4.63	0	0	0

\*Some of the stream and/or wetland impacts may be proposed to be mitigated at a 1:1 mitigation ratio. See permit application for details.

DMS commits to implementing sufficient compensatory stream and wetland mitigation credits to offset the impacts associated with this project as determined by the regulatory agencies in accordance with the In-Lieu Fee Instrument dated July 28, 2010. If the above referenced impact amounts are revised, then this mitigation acceptance letter will no longer be valid and a new mitigation acceptance letter will be required from DMS.

If you have any questions or need additional information, please contact Beth Harmon at 919-707-8420.

Sincerely,

James B. Stanfill  
DMS Asset Management Supervisor

cc: Mr. Monte Matthews, USACE – Raleigh Regulatory Field Office  
Ms. Amy Chapman, NCDWR  
File: R-2582A





(Version 2.07; Released October 2016)

North Carolina Department of Transportation  
Highway Stormwater Program  
STORMWATER MANAGEMENT PLAN  
FOR NCDOT PROJECTS



Page 1 of 2

WBS Element:	34472.1.4	TIP No.:	R-2582A	County(ies):	Northampton	
<b>General Project Information</b>						
WBS Element:	34472.1.4	TIP Number:	R-2582A	Project Type:	Roadway Widening	Date:
NCDOT Contact:	Paul Atkinson		Contractor / Designer:	AECOM/William Stephens		
	Address:	1000 Birch Ridge Drive  Raleigh, NC 27610		Address:	701 Corporate Center Drive Suite 475 Raleigh, NC 27607	
	Phone:	919-707-6707		Phone:	919-854-6200	
	Email:	<a href="mailto:patkinson@ncdot.gov">patkinson@ncdot.gov</a>		Email:	<a href="mailto:wiliam.stephens@aecom.com">wiliam.stephens@aecom.com</a>	
City/Town:	Garysburg		County(ies):	Northampton		
River Basin(s):	Roanoke		CAMA County?	No		
Wetlands within Project Limits?	Yes					
<b>Project Description</b>						
Project Length (lin. miles or feet):	8.22 Miles	Surrounding Land Use:	Residential, Agricultural, Light Commercial			
	Proposed Project			Existing Site		
Project Built-Upon Area (ac.)	77.3 ac.		25.4 ac.			
Typical Cross Section Description:	4-lane, ditch median divided. Primary shoulder section with areas of shoulder berm gutter. Ditches and storm sewer. 12-foot lanes.			2-lane shoulder section with roadside ditches and 12-foot lanes. Limited storm sewer.		
Annual Avg Daily Traffic (veh/hr/day):	Design/Future: 8000	Year: 2035	Existing: 6100	Year: 2016		
General Project Narrative: (Description of Minimization of Water Quality Impacts)	R-2582A involves the widening of US 158 from a two lane shoulder section roadway to a four lane shoulder section roadway with a ditch divided median. The Arthur's Creek culvert and the Trouble Field Creek culvert are the major structures on the project to be either extended or replaced. The existing Arthurs Creek culvert is proposed to be extended on both ends and the Trouble Field Creek culvert is proposed to be replaced. Stormwater management is accomplished in grass ditches where possible. Lined ditches and storm sewer are also used on the project where needed. Riprap pads are used at pipe outlets and along stream banks to prevent erosion and reduce discharge velocity in most cases to non erosive levels. Velocities for all ditches are designed to be non-erosive for the Q10 storm. Pipe culverts up to 48" in diameter located in jurisdictional streams are proposed to be buried 20% of the pipes diameter. Pipe culverts 48" and larger and the box culvert at Trouble Field Creek are proposed to be buried 1'.					
<b>Waterbody Information</b>						
Surface Water Body (1):	Arthur's Creek		NCDWR Stream Index No.:	23-28		
NCDWR Surface Water Classification for Water Body	Primary Classification:	Class C				
	Supplemental Classification:	None				
Other Stream Classification:	None					
Impairments:	None					
Aquatic T&E Species?	No	Comments:				
NRTR Stream ID:	Arthur's Creek			Buffer Rules in Effect:	N/A	
Project Includes Bridge Spanning Water Body?	No	Deck Drains Discharge Over Buffer?	N/A	Dissipator Pads Provided in Buffer?	N/A	
Deck Drains Discharge Over Water Body?	No	(If yes, provide justification in the General Project Narrative)		(If yes, describe in the General Project Narrative; if no, justify in the General Project Narrative)		
(If yes, provide justification in the General Project Narrative)						



(Version 2.07; Released October 2016)

North Carolina Department of Transportation  
Highway Stormwater Program  
STORMWATER MANAGEMENT PLAN  
FOR NCDOT PROJECTS




Page 2 of 2

WBS Element:	34472.1.4	TIP No.:	R-2582A	County(ies):	Northampton		
Additional Waterbody Information							
Surface Water Body (2):	Trouble Field Creek		NCDWR Stream Index No.:	23-29.2			
NCDWR Surface Water Classification for Water Body		Primary Classification:	Class C				
		Supplemental Classification:	None				
Other Stream Classification:	None						
Impairments:	None						
Aquatic T&E Species?	No	Comments:					
NRTR Stream ID:	Trouble Field Creek			Buffer Rules in Effect:	N/A		
Project Includes Bridge Spanning Water Body?		Deck Drains Discharge Over Buffer?	N/A	Dissipator Pads Provided in Buffer?	N/A		
Deck Drains Discharge Over Water Body?	No	(If yes, provide justification in the General Project Narrative)		(If yes, describe in the General Project Narrative; if no, justify in the General Project Narrative)			
(If yes, provide justification in the General Project Narrative)							

# CONTRACT:

TIP PROJECT: R-2582A

R:\Hydraulics\PERMITS\_Environmental\Drawings\01\_R2582A\_Rdy-tsh.dgn  
mwm\_hussemi

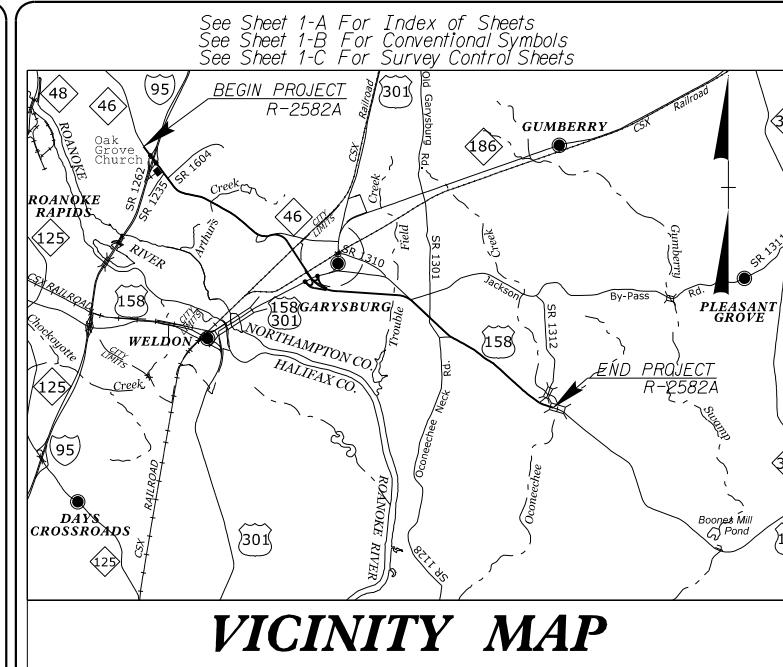

STATE OF NORTH CAROLINA  
DIVISION OF HIGHWAYS


# **NORTHAMPTON COUNTY**

**LOCATION: US 158 FROM I-95/NC 46 IN ROANOKE RAPIDS  
TO SR 1312 (ST. JOHN CHURCH RD)**

**TYPE OF WORK: GRADING, DRAINAGE, PAVING, RESURFACING,  
GUARDRAIL, SIGNALS AND STRUCTURES.**

## **WETLAND AND SURFACE WATER IMPACTS PERMIT**

FEBRUARY 2019

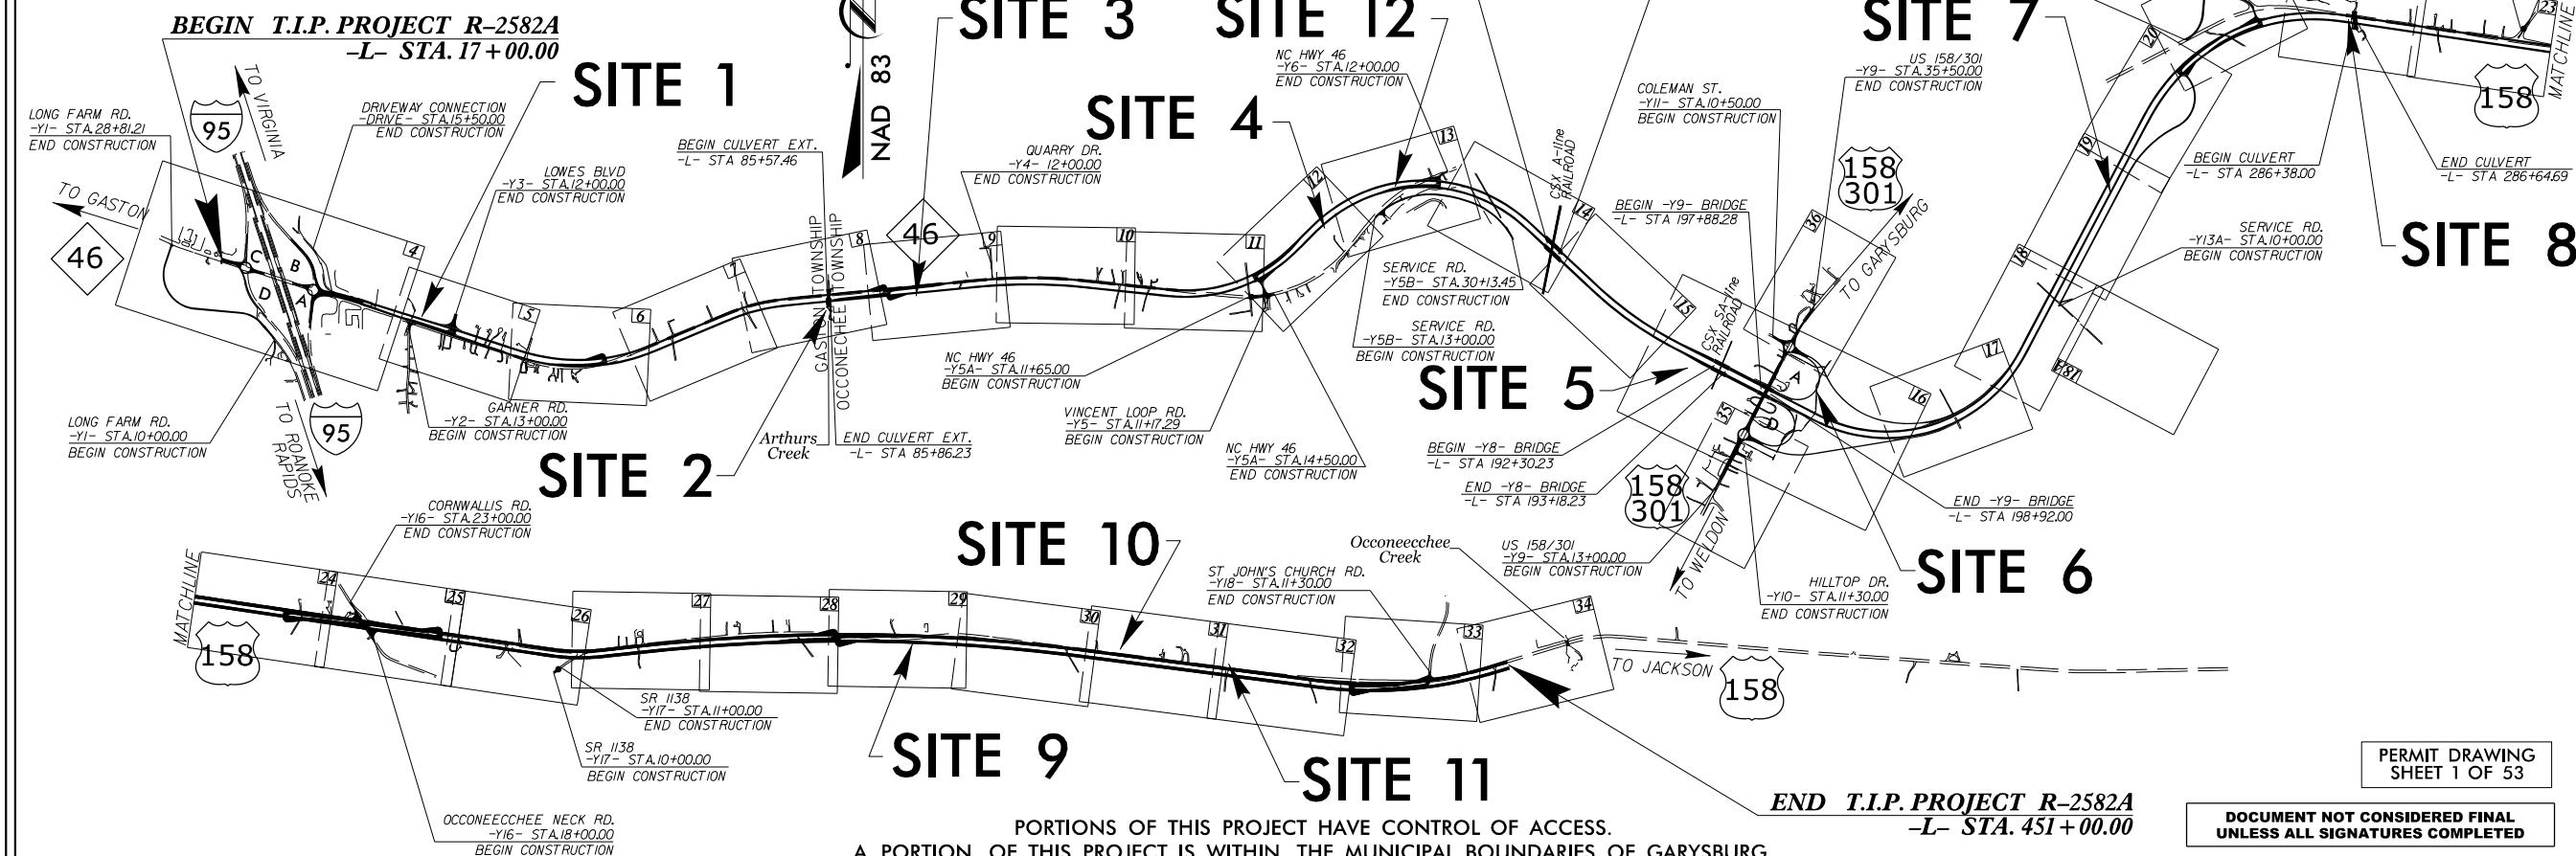

PORTIONS OF THIS PROJECT HAVE CONTROL OF ACCESS.  
A PORTION OF THIS PROJECT IS WITHIN THE MUNICIPAL BOUNDARIES OF GARYSBURG.  
CLEARING ON THIS PROJECT SHALL BE PERFORMED TO THE LIMITS ESTABLISHED BY METHOD III.

The figure displays three graphic scales, each consisting of a horizontal line with numerical markings (50, 25, 0, 50, 100) and a corresponding shaded triangular area representing a range of values.

- PLANS:** The scale shows a triangular area starting at 50 on the left, decreasing to 0 at the center, and increasing to 100 on the right.
- PROFILE (HORIZONTAL):** The scale shows a triangular area starting at 50 on the left, decreasing to 0 at the center, and increasing to 100 on the right.
- PROFILE (VERTICAL):** The scale shows a triangular area starting at 10 on the left, decreasing to 0 at the center, and increasing to 20 on the right.


**DESIGN DATA**

ADT 2017 =	6200
ADT 2037 =	8200
DHV =	11 %
D =	60 %
T =	21 % *
V =	70 MPH
* TTST =	14 DUAL =
FUNC CLASS =	
EXPRESSWAY / FREEWAY	
STATEWIDE TIER	

### **PROJECT LENGTH**


<p><i>Prepared in the Office of:</i></p> <p><b>DIVISION OF HIGHWAYS</b></p> <p><i>1000 Birch Ridge Dr., Raleigh NC, 27610</i></p> <p><b>2012 STANDARD SPECIFICATIONS</b></p> <hr/> <p><b>RIGHT OF WAY DATE:</b> <u>June 30, 2017</u></p> <hr/> <p><b>LETTING DATE:</b> <u>December 18, 2019</u></p>	<p><b>GARY R. LOVERING, PE</b></p> <hr/> <p><i>PROJECT ENGINEER</i></p> <hr/> <p><b>BRYAN C. KEY, PE</b></p> <hr/> <p><i>PROJECT DESIGN ENGINEER</i></p>
---	--

<b>HYDRAULICS ENGINEER</b> <hr/> <b>R.O.A.D.W.A.Y. D.E.S.I.G.N. E.N.G.I.N.E.E.R.</b>	<u>P.E.</u> <hr/> <u>P.E.</u>
<b>SIGNATURE:</b> _____	
<b>SIGNATURE:</b> _____	

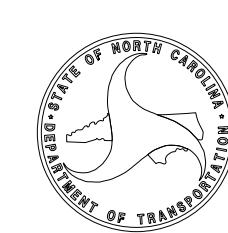


PERMIT DRAWING  
SHEET 1 OF 53

**DOCUMENT NOT CONSIDERED FINAL  
UNLESS ALL SIGNATURES COMPLETED**

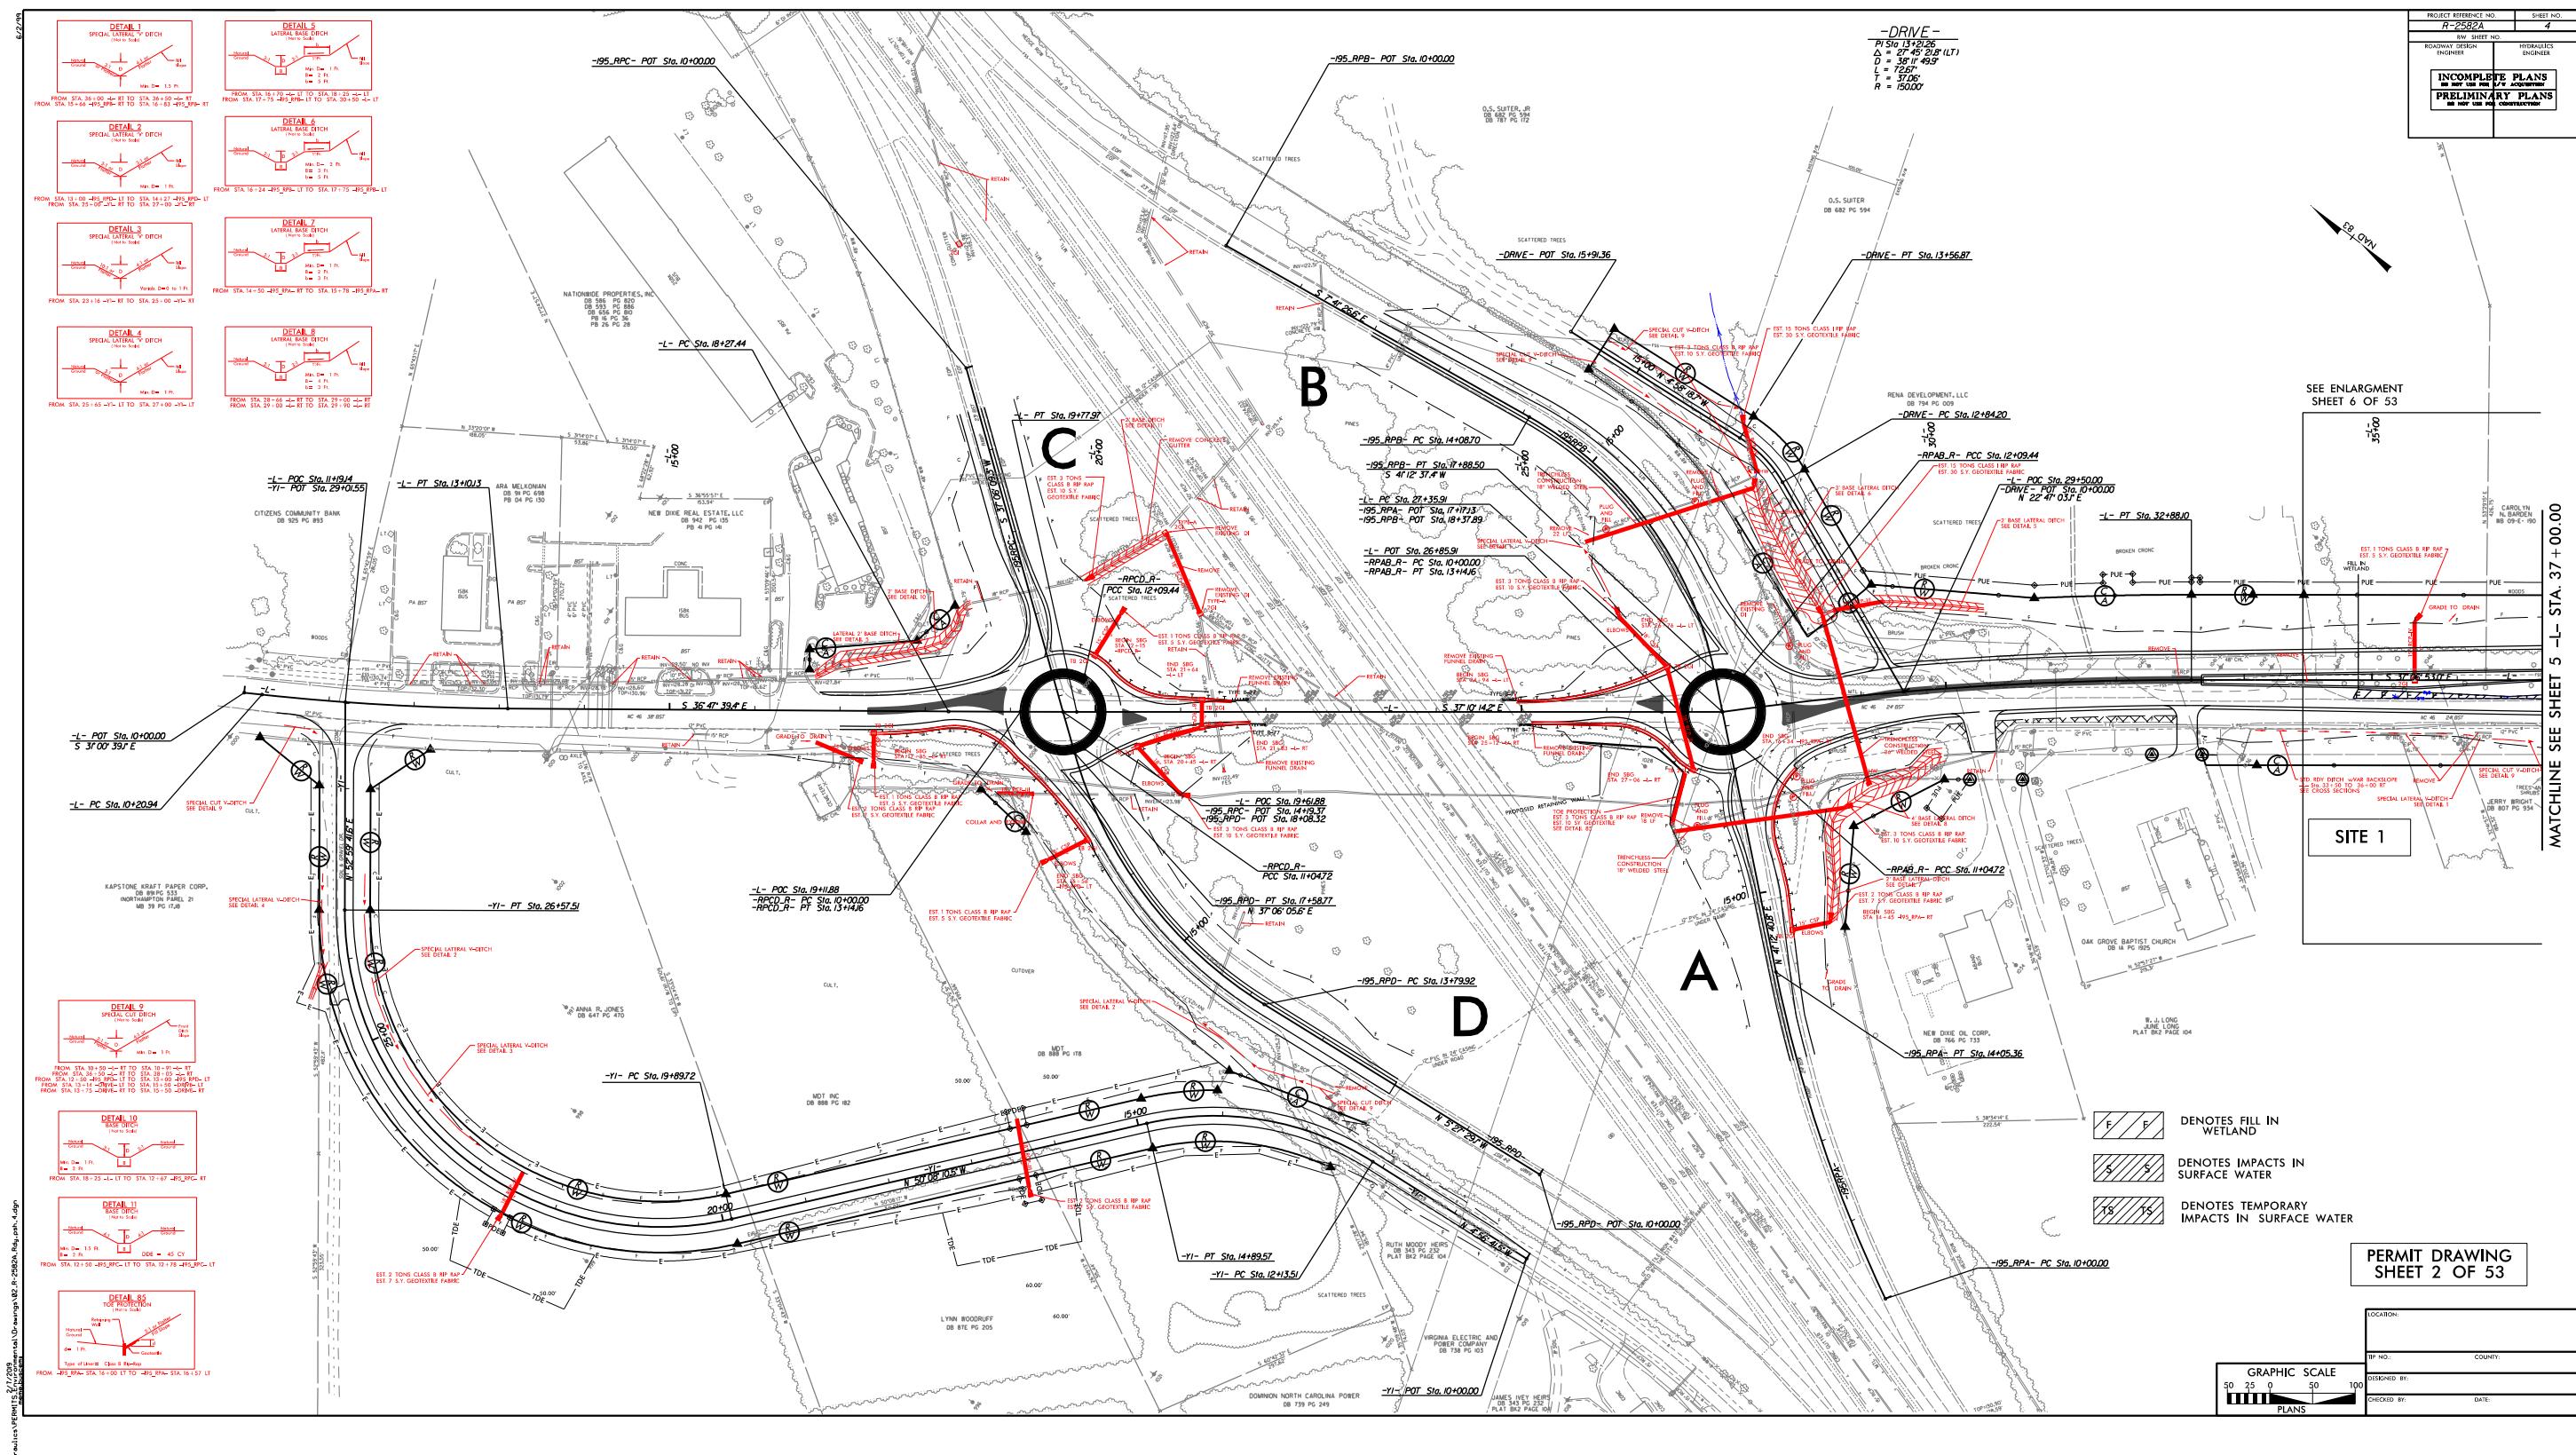

R:\Hydraulics\PERMIS\_Environmental\Drawings\03\_R-2582A\_Rdy-psh\_b.dgn  
memebuscm

MATCHLINE SEE SHEET 4 -L- STA. 37 + 00.00

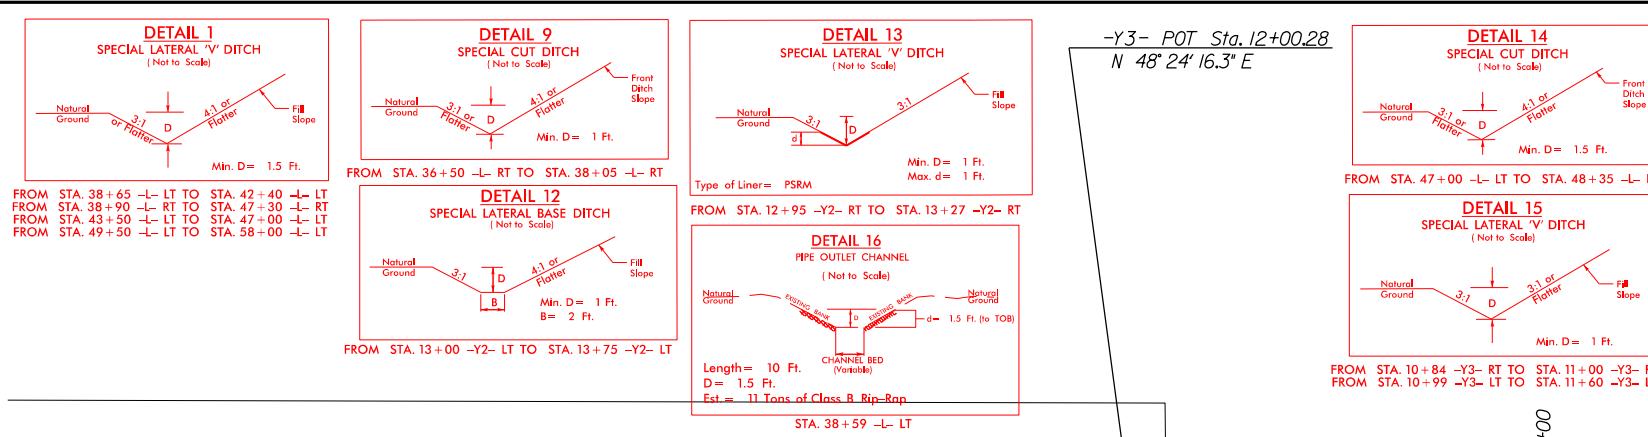

45+00

28

1

**DB  
SPECIAL**

AIL 14  
CUT DIT

1

1

14

R-25

32A


1

5


3

WATSON


**PERMIT DRAWING  
SHEET 3 OF 53**

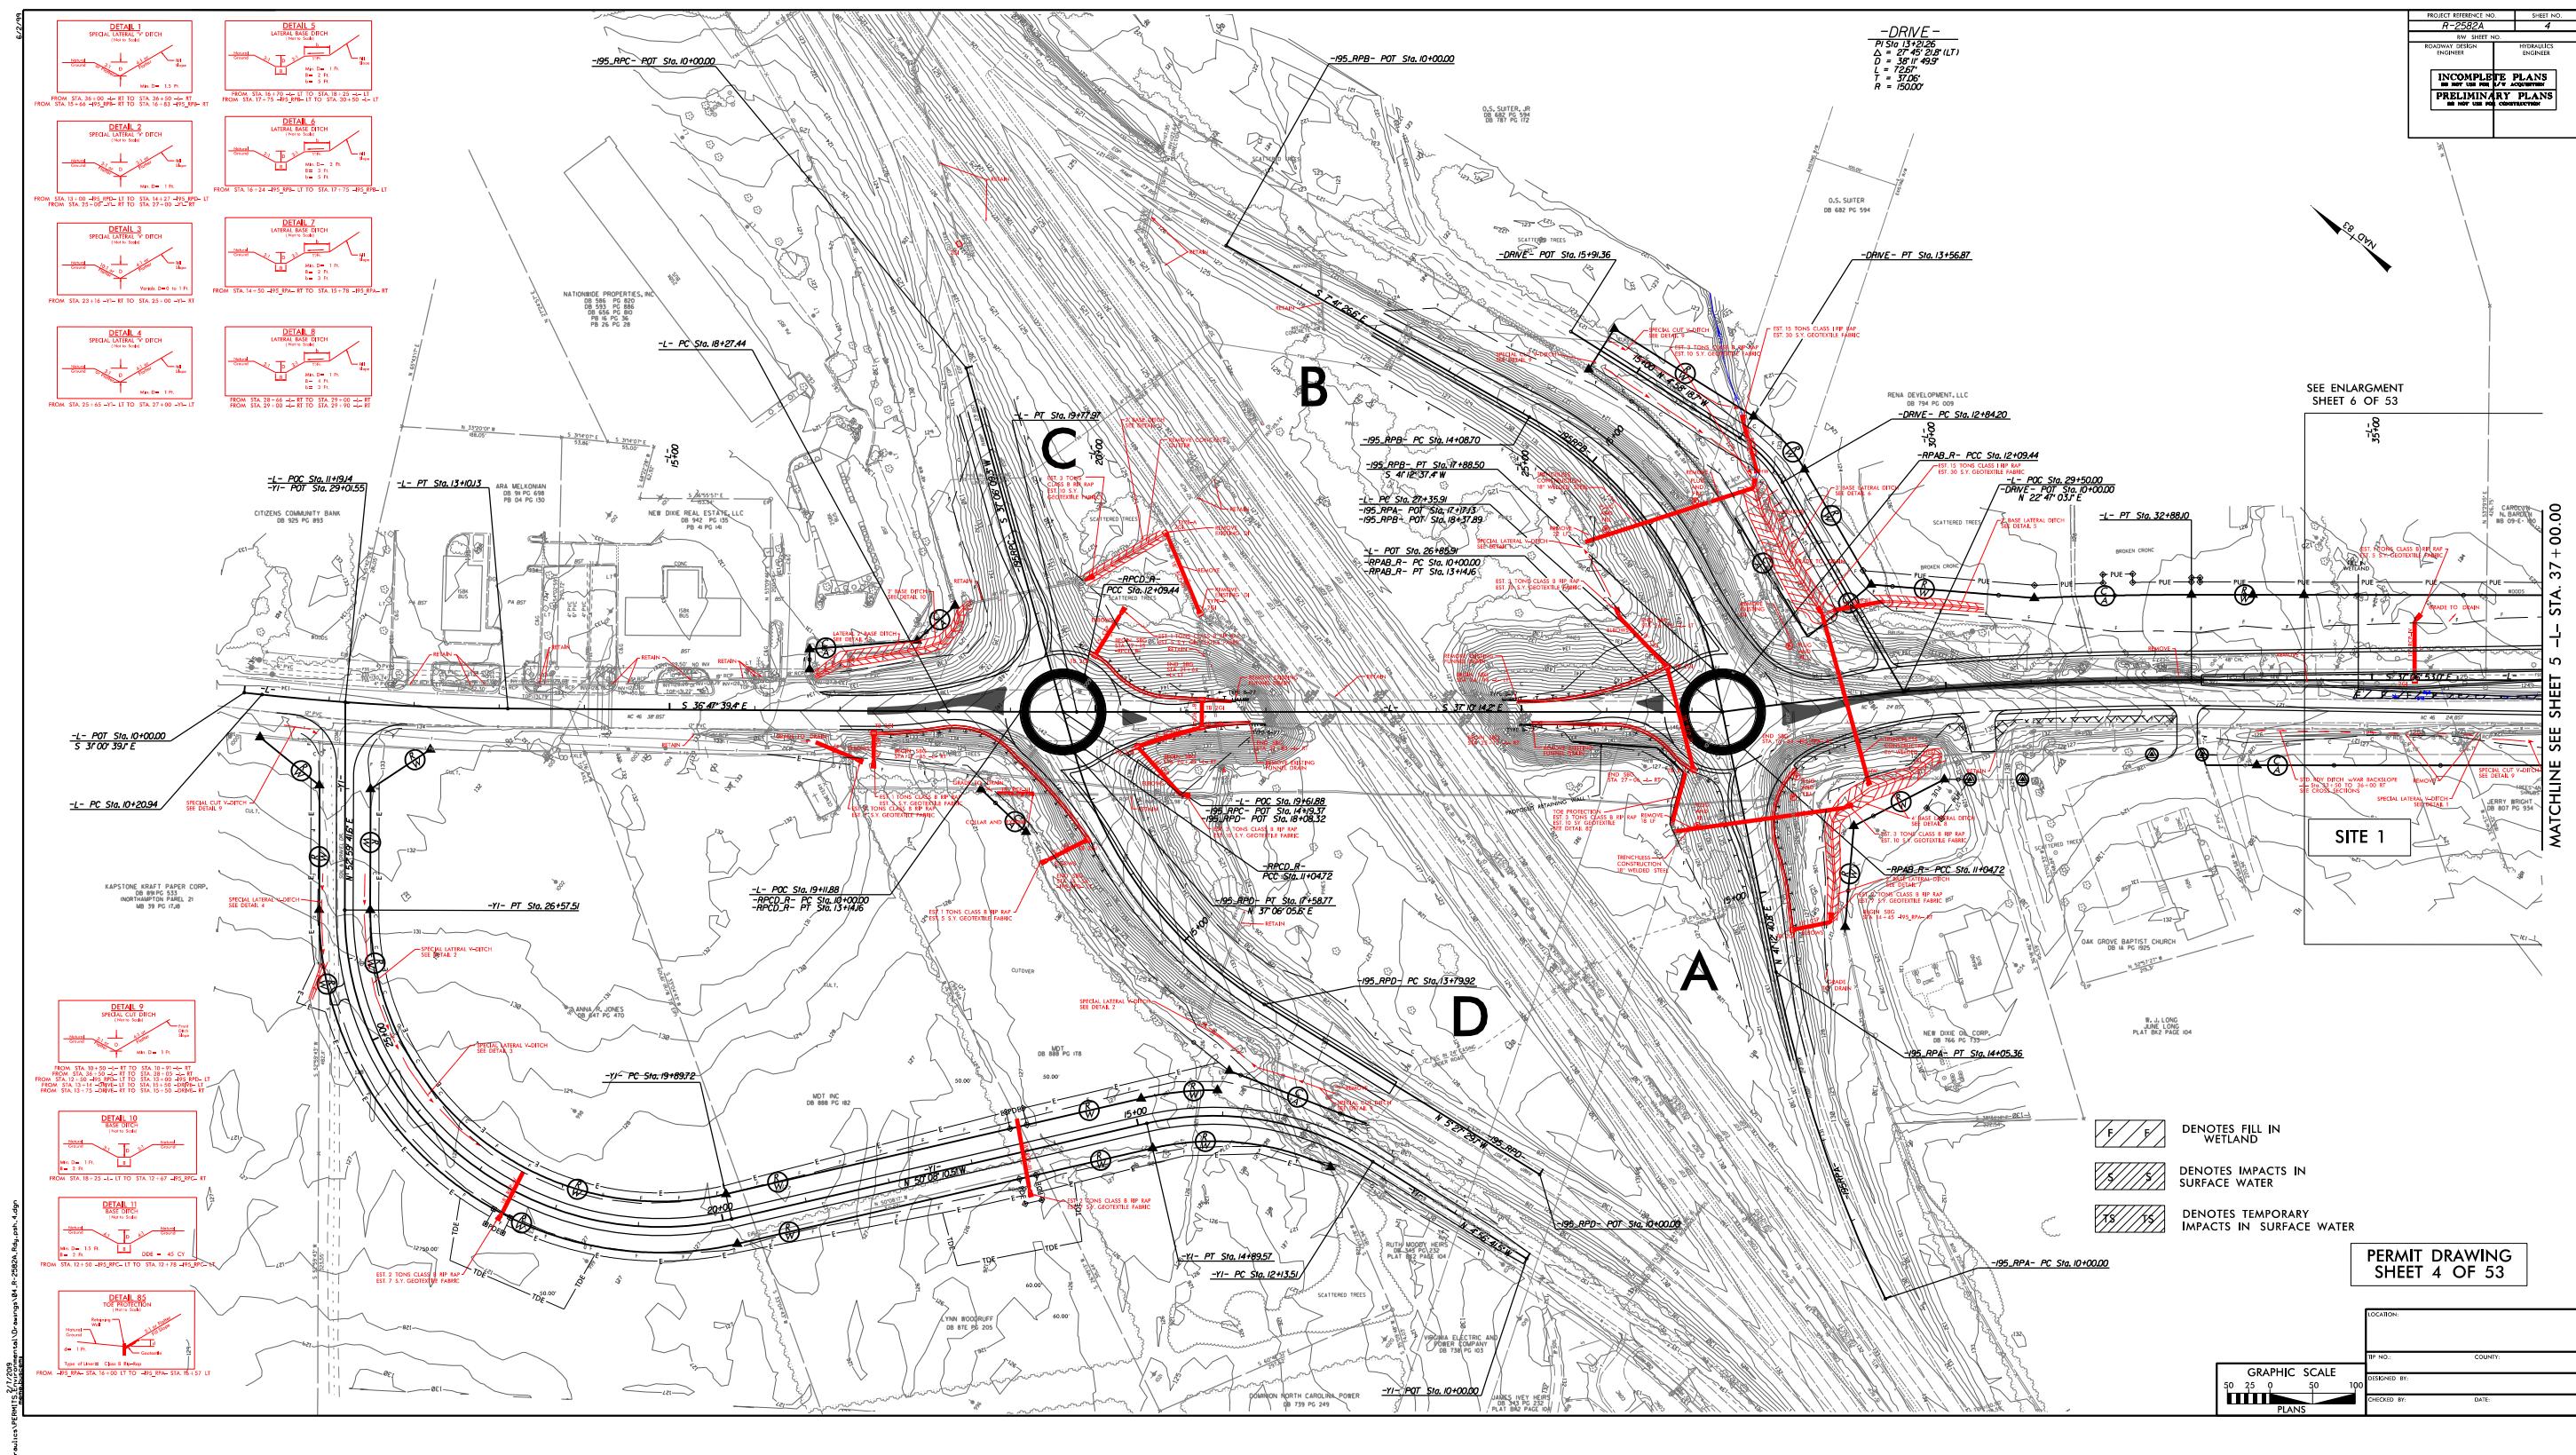









## MATCHLINE SEE SHEET 4 -L- STA. 37+00.00

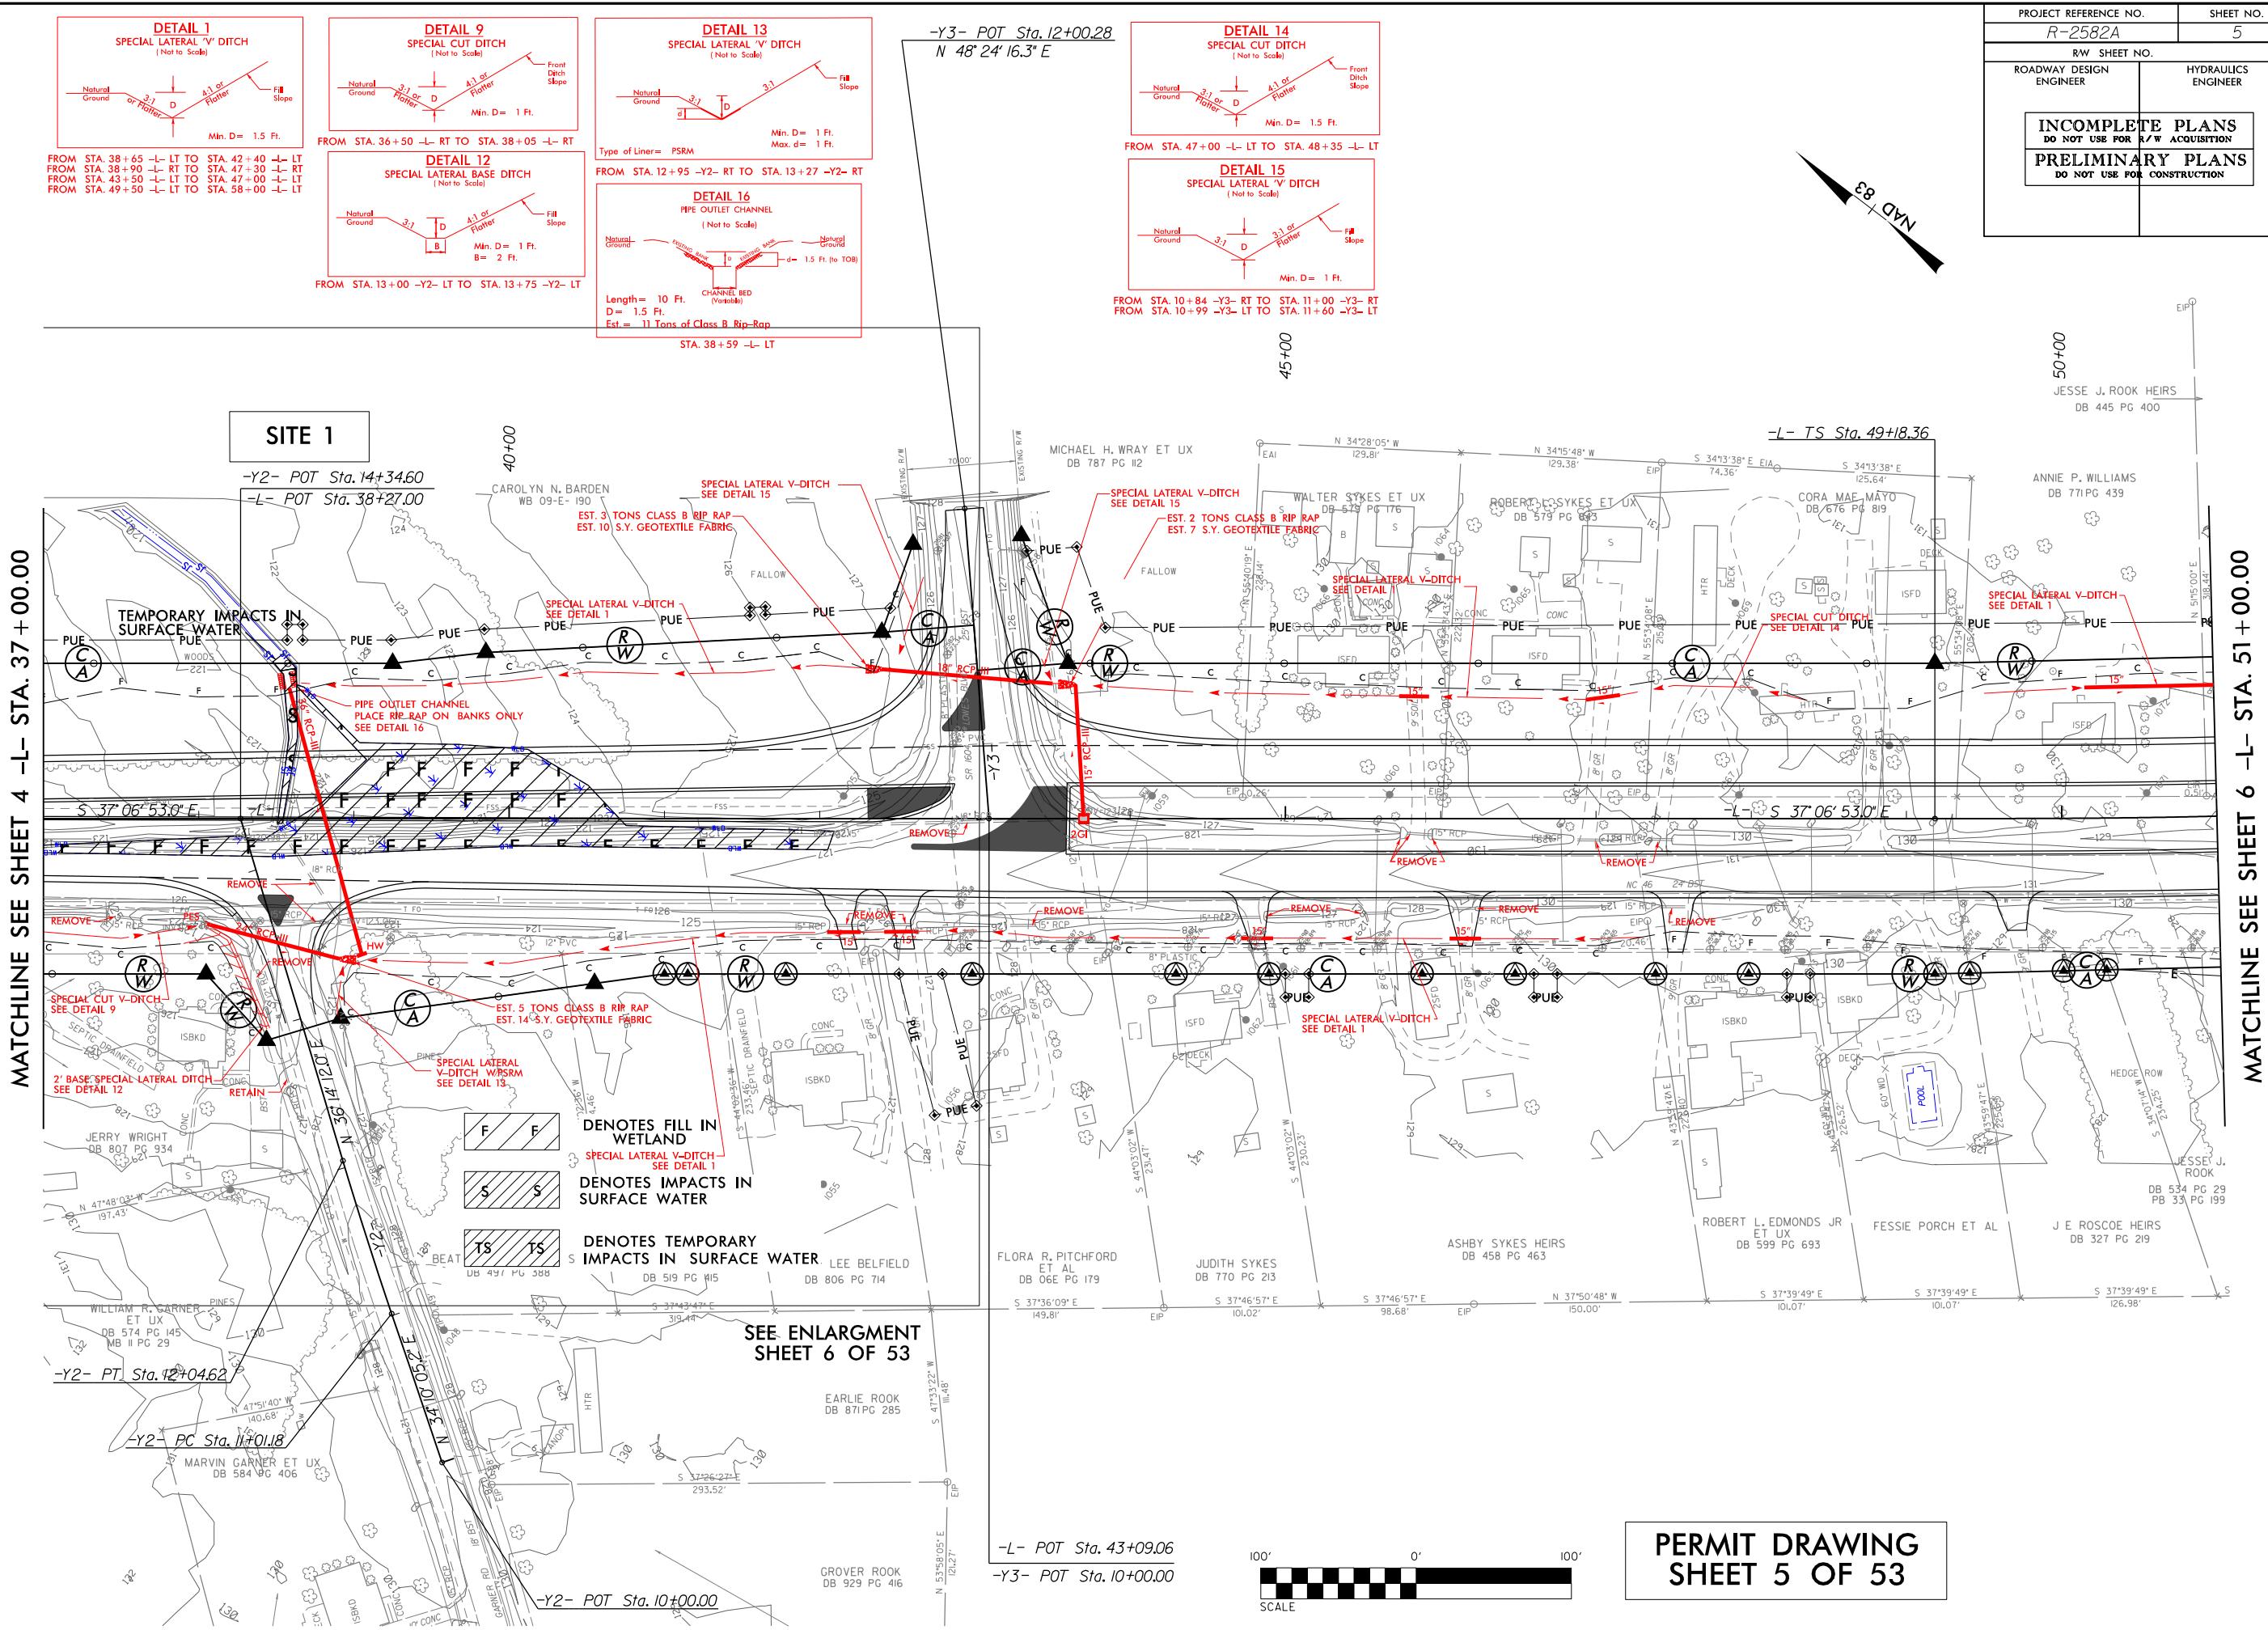



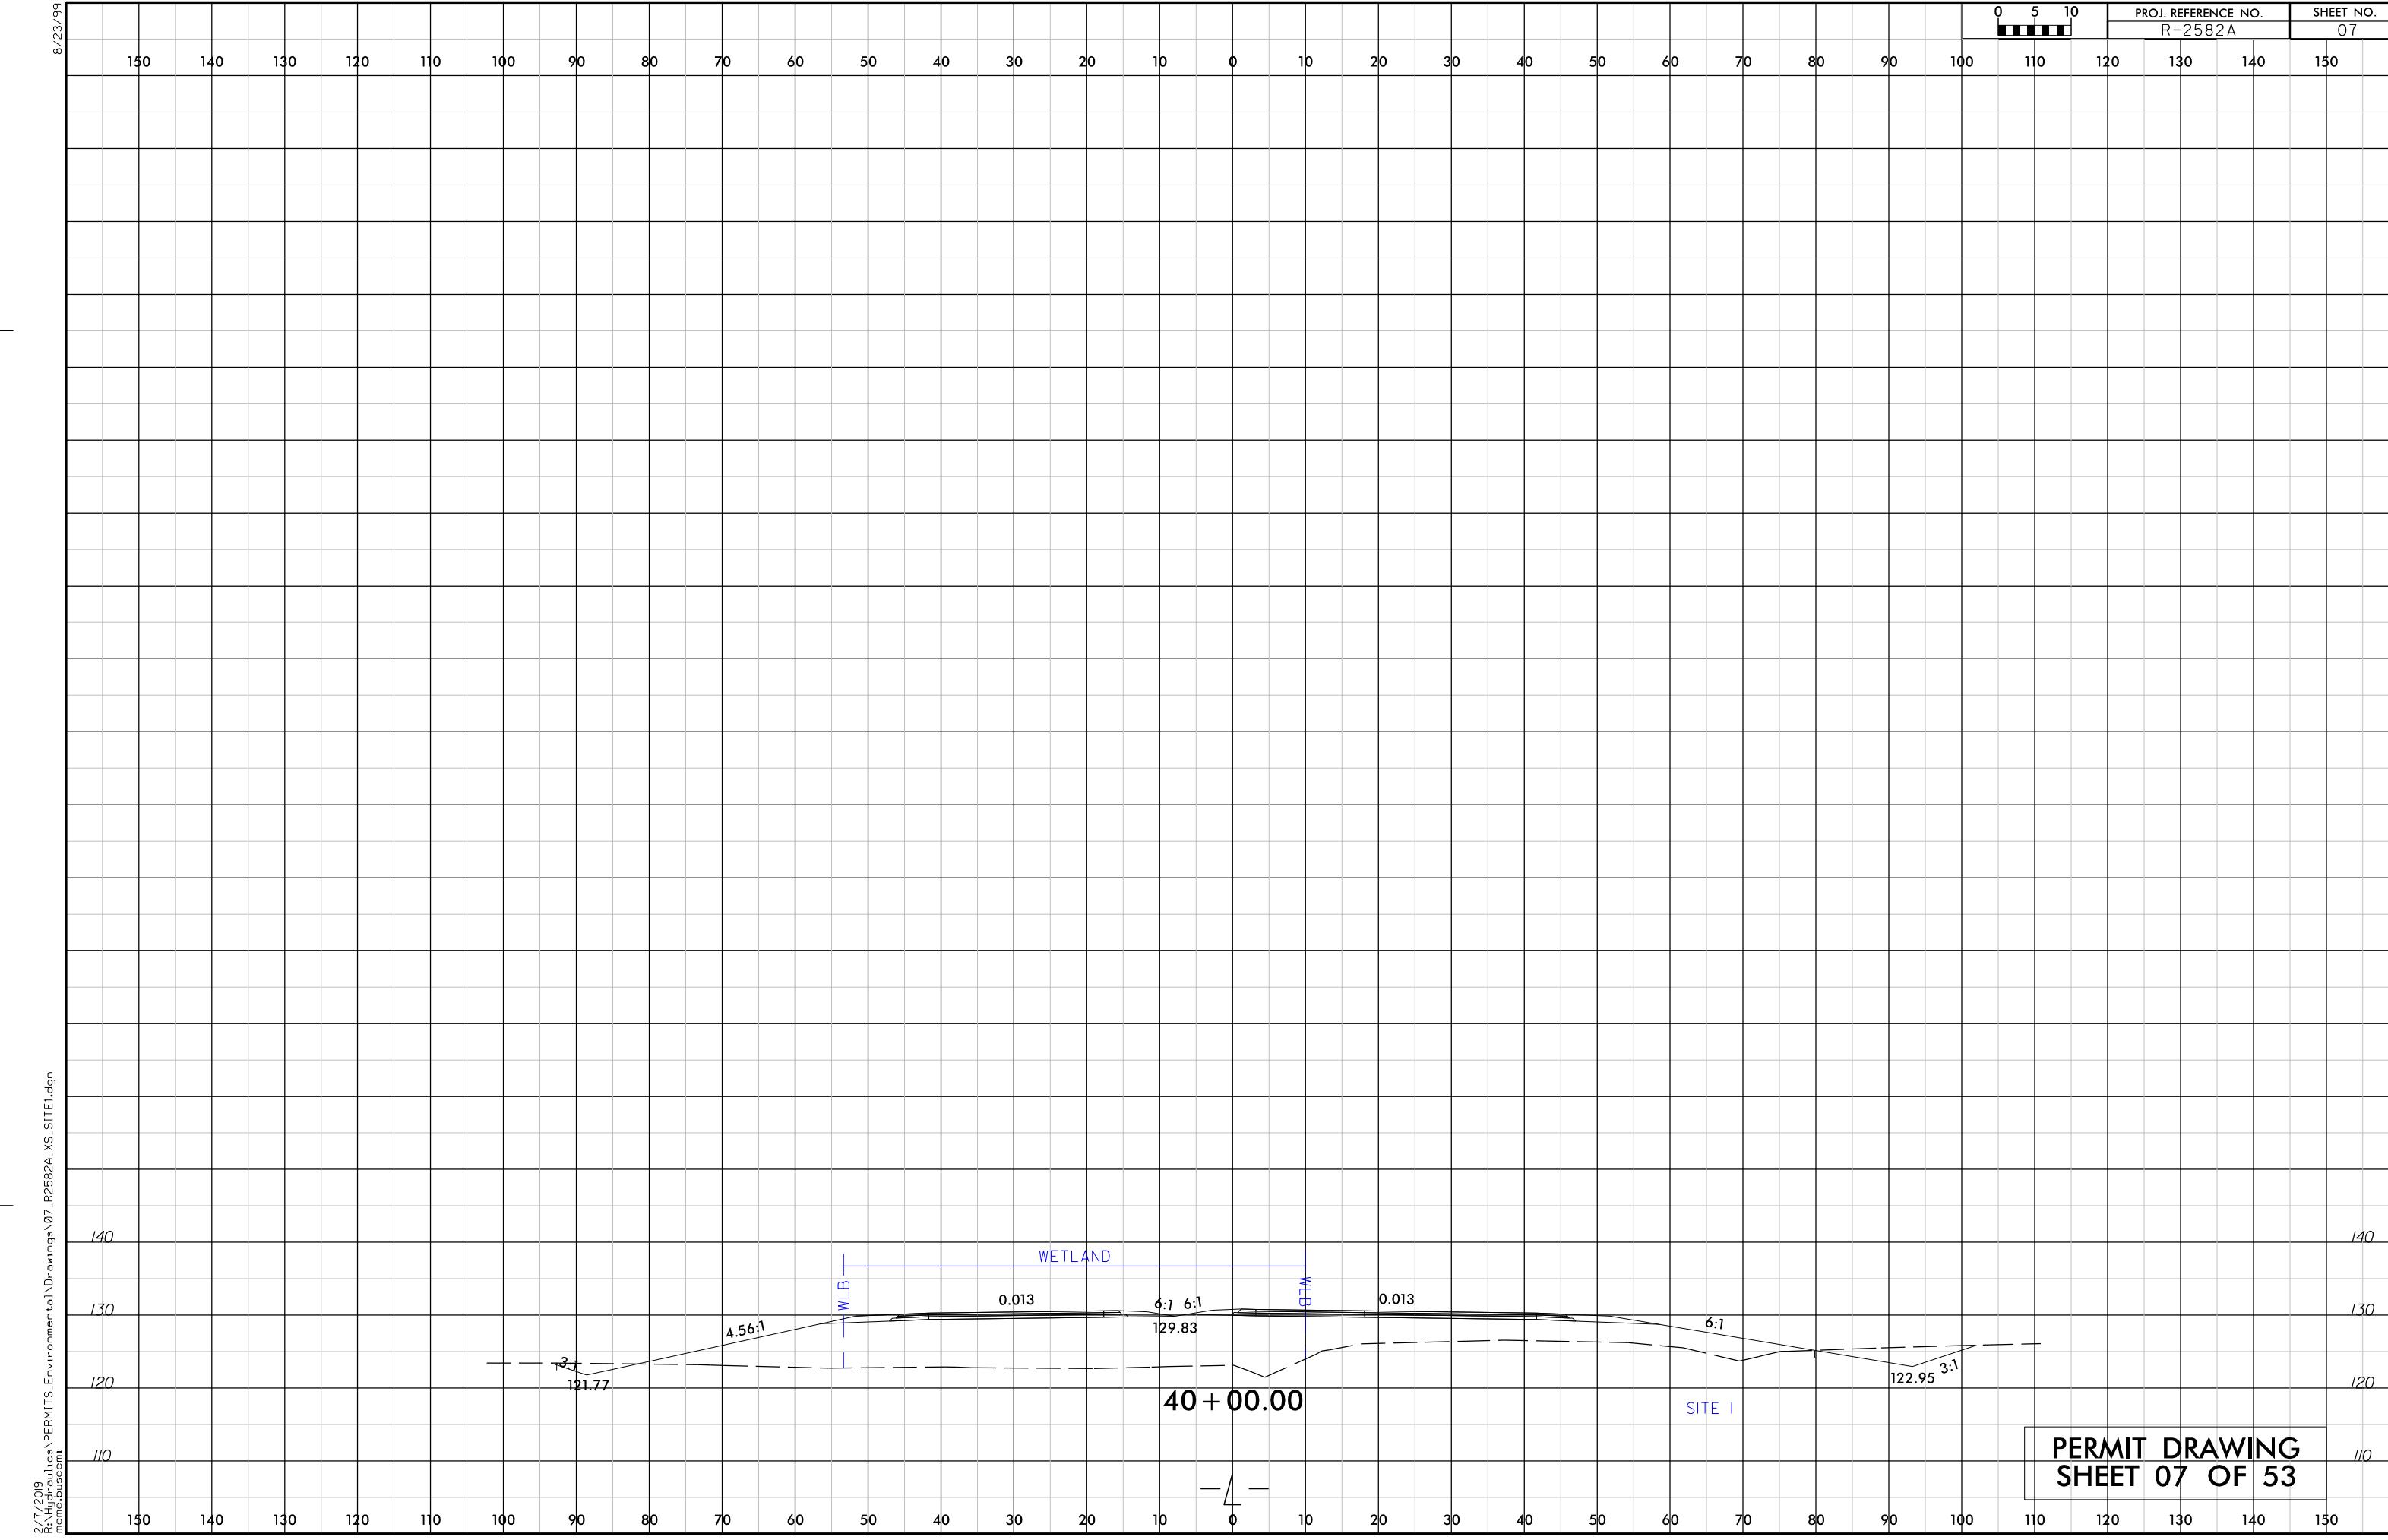

8/17/99

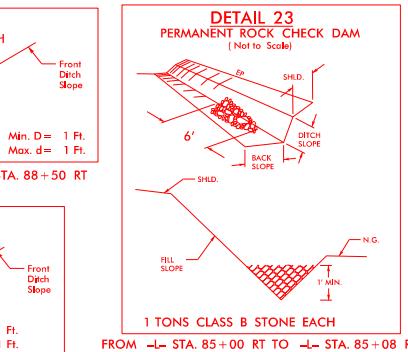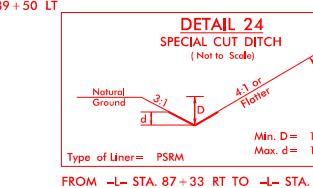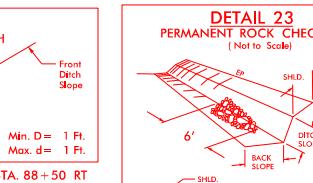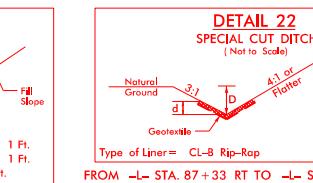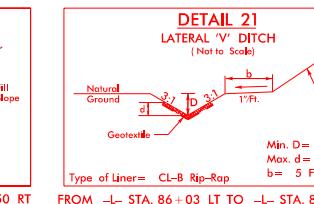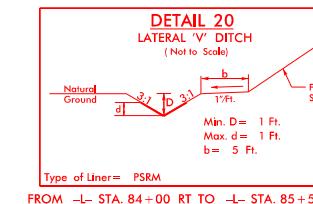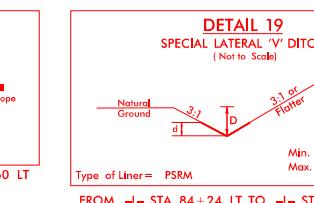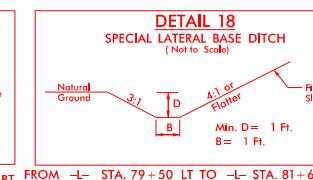

-L-

Pls Sta 75+24.24 Pls Sta 77+00.56 Pls Sta 80+36.38  
 $\theta_s = 4^{\circ}12' 00.3'' (RT)$   $\theta_s = 4^{\circ}12' 46.5''$   
 $L_s = 300.00'$   $D = 2^{\circ}48' 31.0''$   $L_s = 300.00'$   
 $LT = 200.06'$   $L = 312.4'$   $LT = 200.06'$   
 $ST = 100.05'$   $T = 156.37'$   $ST = 100.05'$   
 $R = 2,040.00'$   $SE = .06$   
 $V_d = 70$



PROJECT REFERENCE NO.	SHEET NO.
R-2582A	8
RW SHEET NO.	
ROADWAY DESIGN ENGINEER	HYDRAULICS ENGINEER
INCOMPLETE PLANS DO NOT USE FOR R/W ACQUISITION	
PRELIMINARY PLANS DO NOT USE FOR CONSTRUCTION	

ANNIE TUDOR  
DB 02E PG 164

80+00

80+00

85+00


85+00


SITE 2

NEDA SOBHANI  
DB 967 PG 334

80+00

MATCHLINE SEE SHEET 9 -L STA. 90+50.00

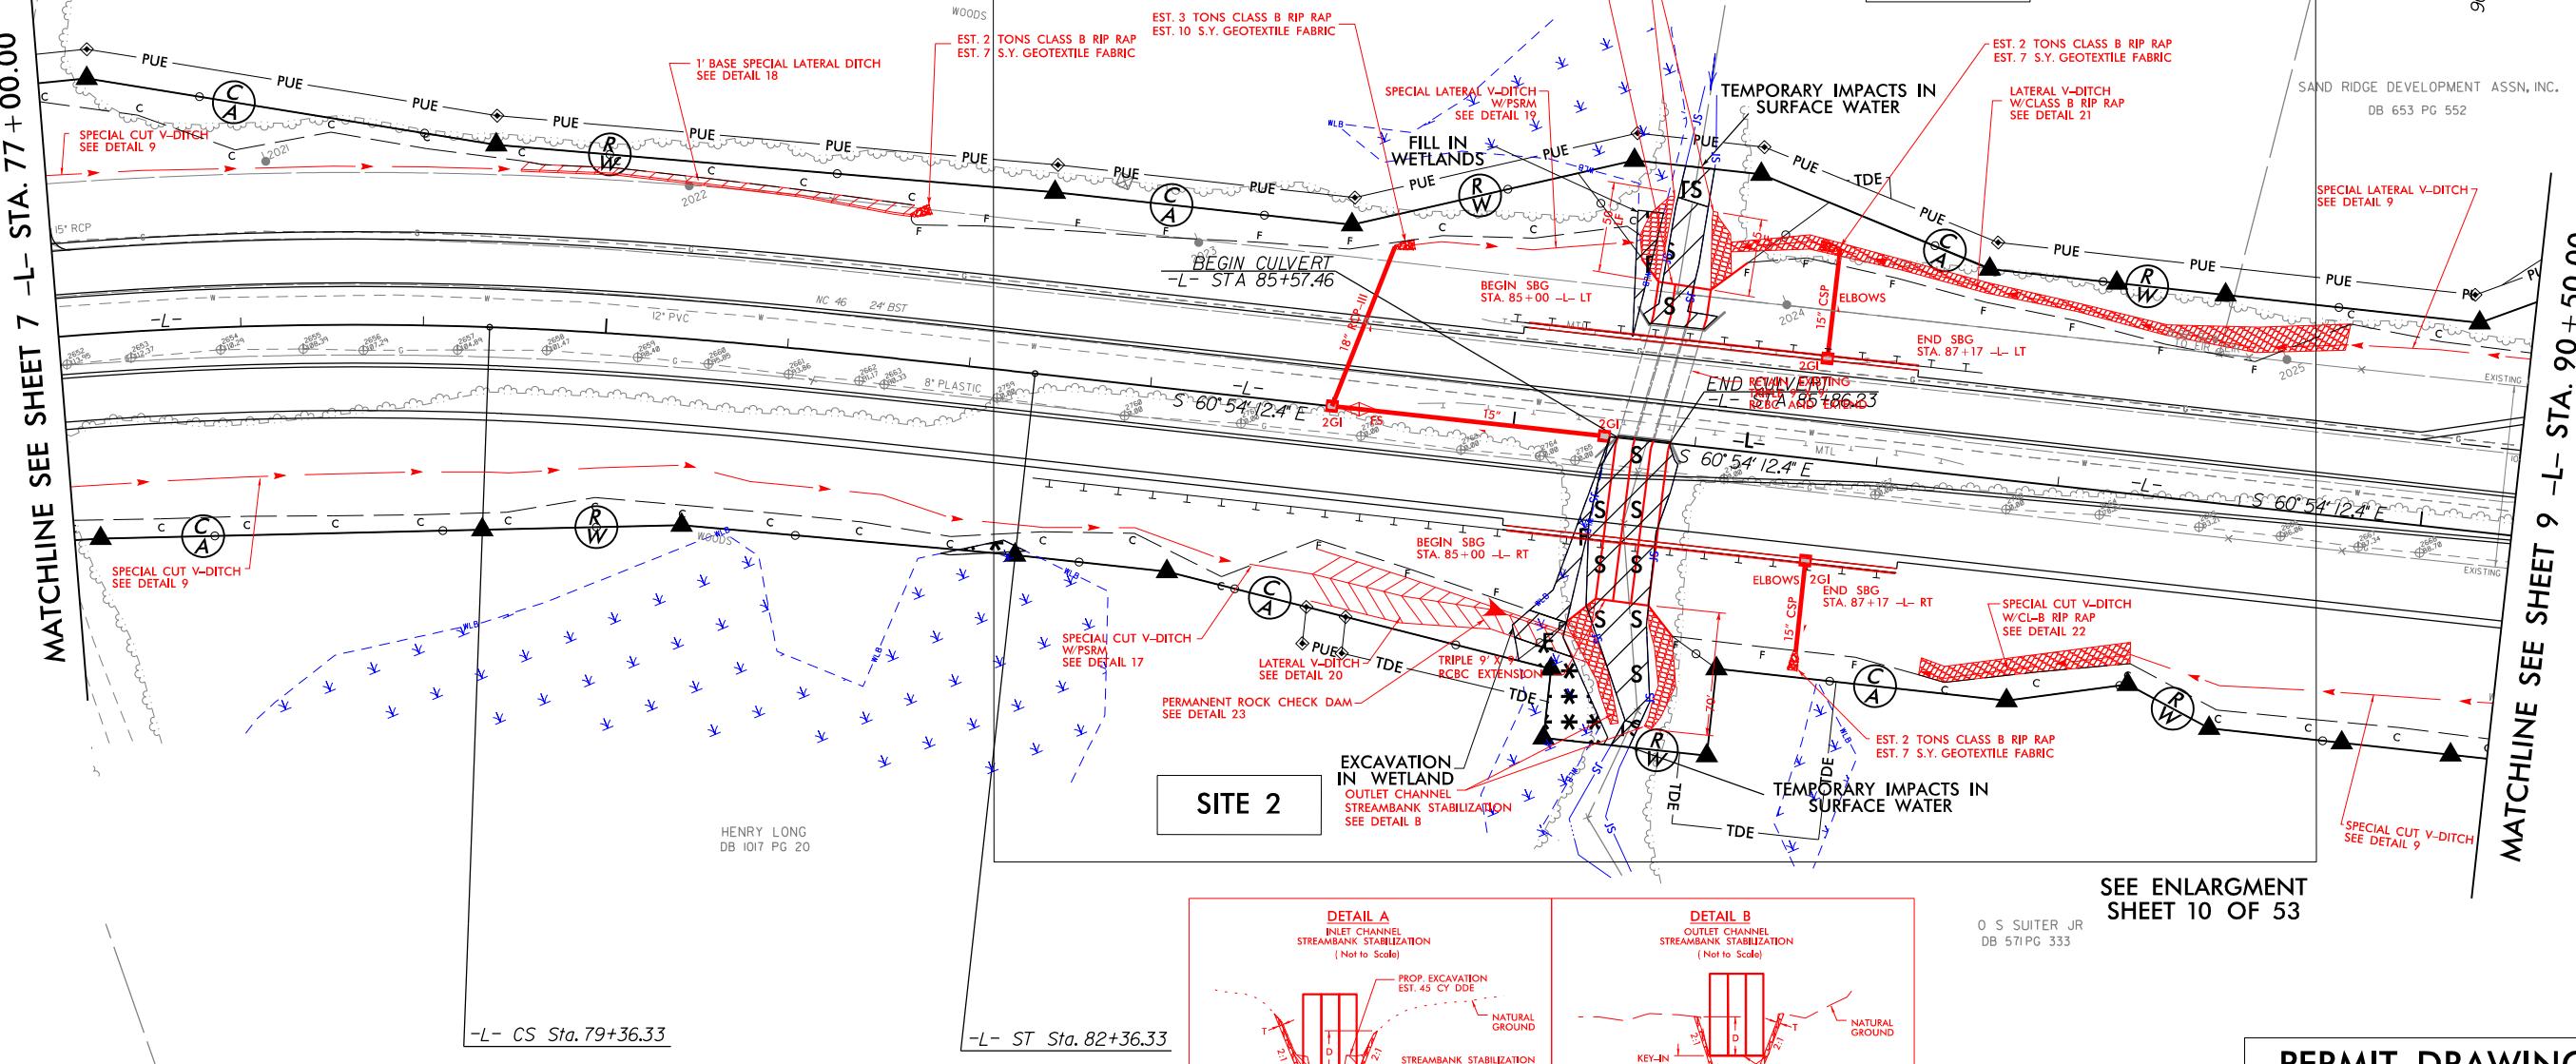

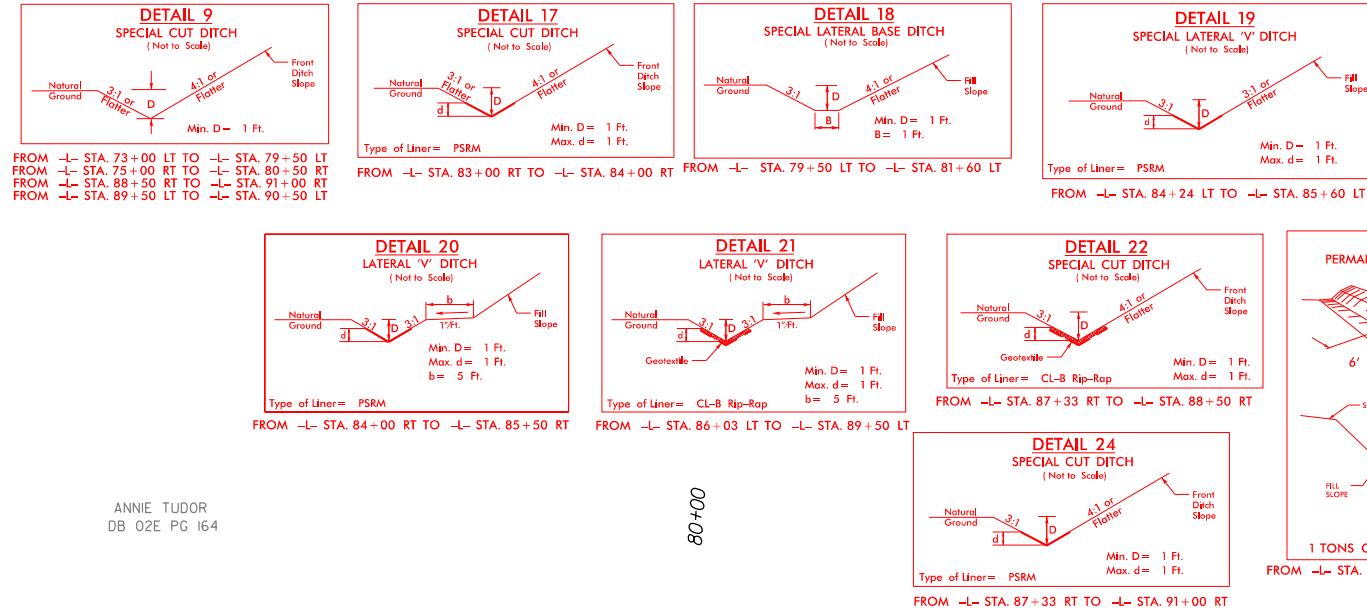

**DETAIL 9 SPECIAL CUT DITCH (Not to Scale)**  
Natural Ground  
Front Ditch Slope  
Min. D = 1 Ft.  
Type of Liner = PSRM

**DETAIL 17 SPECIAL CUT DITCH (Not to Scale)**  
Natural Ground  
Front Ditch Slope  
Min. D = 1 Ft.  
Max. d = 1 Ft.  
Type of Liner = PSRM

**DETAIL 18 SPECIAL LATERAL BASE DITCH (Not to Scale)**  
Natural Ground  
Front Ditch Slope  
Min. D = 1 Ft.  
Max. d = 1 Ft.  
B = 1 Ft.  
Type of Liner = PSRM

**DETAIL 19 SPECIAL LATERAL 'V' DITCH (Not to Scale)**  
Natural Ground  
Front Ditch Slope  
Min. D = 1 Ft.  
Max. d = 1 Ft.  
Type of Liner = PSRM


**DETAIL 20 LATERAL 'V' DITCH (Not to Scale)**  
Natural Ground  
Front Ditch Slope  
Min. D = 1 Ft.  
Max. d = 1 Ft.  
b = 5 Ft.  
Type of Liner = PSRM

**DETAIL 21 LATERAL 'V' DITCH (Not to Scale)**  
Natural Ground  
Front Ditch Slope  
Min. D = 1 Ft.  
Max. d = 1 Ft.  
b = 5 Ft.  
Type of Liner = CL-B Rip-Rap

**DETAIL 22 SPECIAL CUT DITCH (Not to Scale)**  
Natural Ground  
Front Ditch Slope  
Min. D = 1 Ft.  
Max. d = 1 Ft.  
Type of Liner = CL-B Rip-Rap

**DETAIL 23 PERMANENT ROCK CHECK DAM (Not to Scale)**  
Natural Ground  
Front Ditch Slope  
Min. D = 1 Ft.  
Max. d = 1 Ft.  
Type of Liner = CL-B Rip-Rap

-L-  
Pls Sta 75+24.24 PI Sta 77+00.56 Pls Sta 80+36.38  
θs = 4°12' 46.5" Δ = 8°46' 00.3" (RT) θs = 4°12' 46.5"  
Ls = 300.00' D = 2'48" 31.0" Ls = 300.00'  
LT = 200.06' L = 312.4' LT = 200.06'  
ST = 100.05' T = 156.37' ST = 100.05'  
R = 2,040.00' SE = .06  
Vd = 70

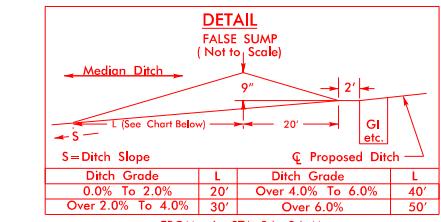


DENOTES FILL IN WETLAND



DENOTES IMPACTS IN SURFACE WATER




DENOTES MECHANIZED CLEARING

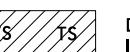


DENOTES TEMPORARY IMPACTS IN SURFACE WATER

### MATCHLINE SEE SHEET 7 -L STA. 77 +00.00


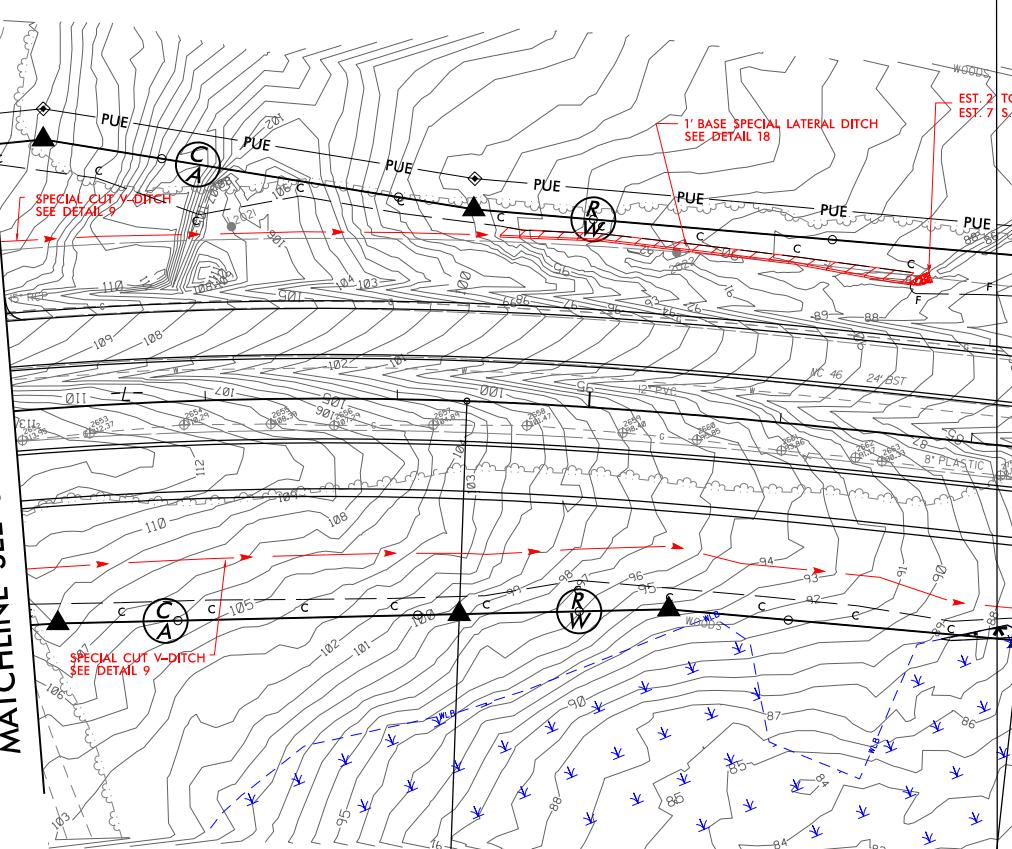


HENRY LONG  
DB 1017 PG 20

-L CS Sta. 79+36.33  
0' 100' 100'  
SCALE

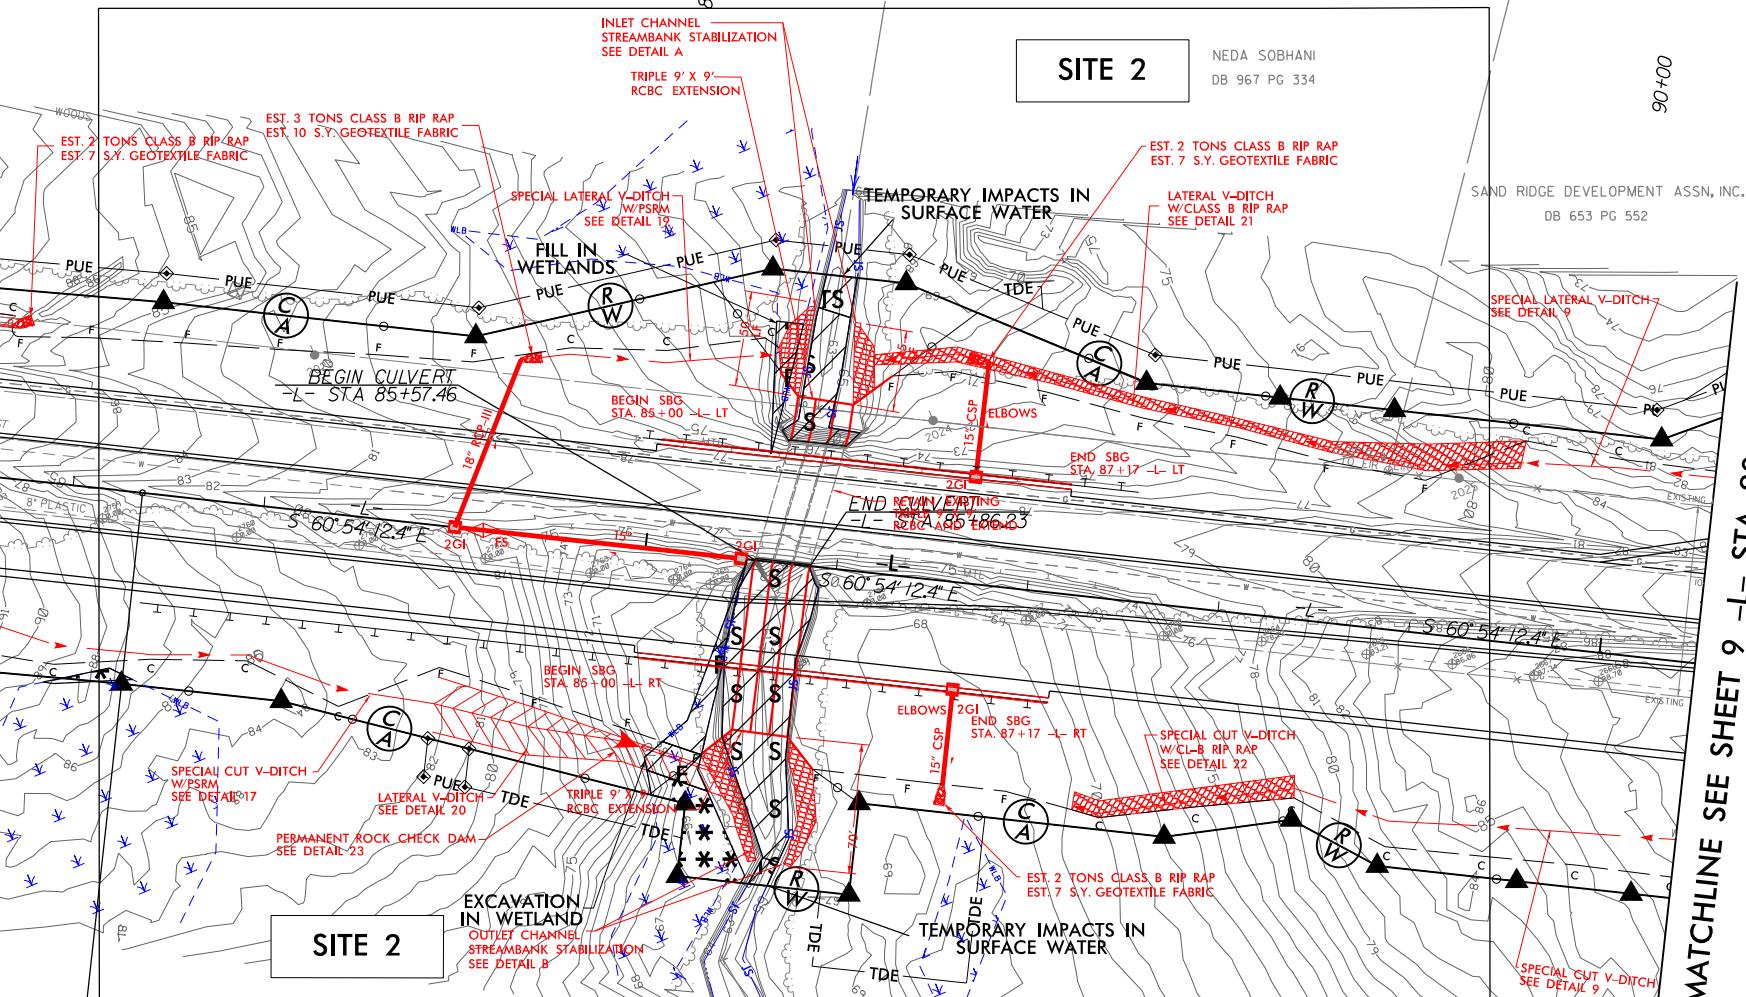

-L ST Sta. 82+36.33

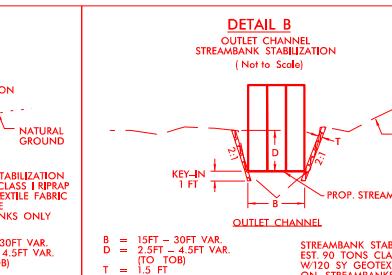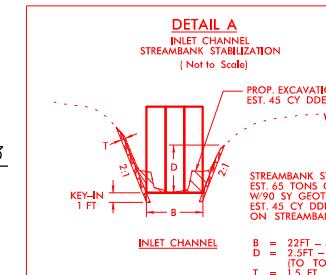


**PERMIT DRAWING SHEET 9 OF 53**


PROJECT REFERENCE NO.	SHEET NO.	
R-2582A	8	
RW SHEET NO.		
ROADWAY DESIGN ENGINEER	HYDRAULICS ENGINEER	
<b>INCOMPLETE PLANS</b> DO NOT USE FOR R/W ACQUISITION		
<b>PRELIMINARY PLANS</b> DO NOT USE FOR CONSTRUCTION		




# SITE 2 – PROFILE VIEW ALONG STRUCTURE

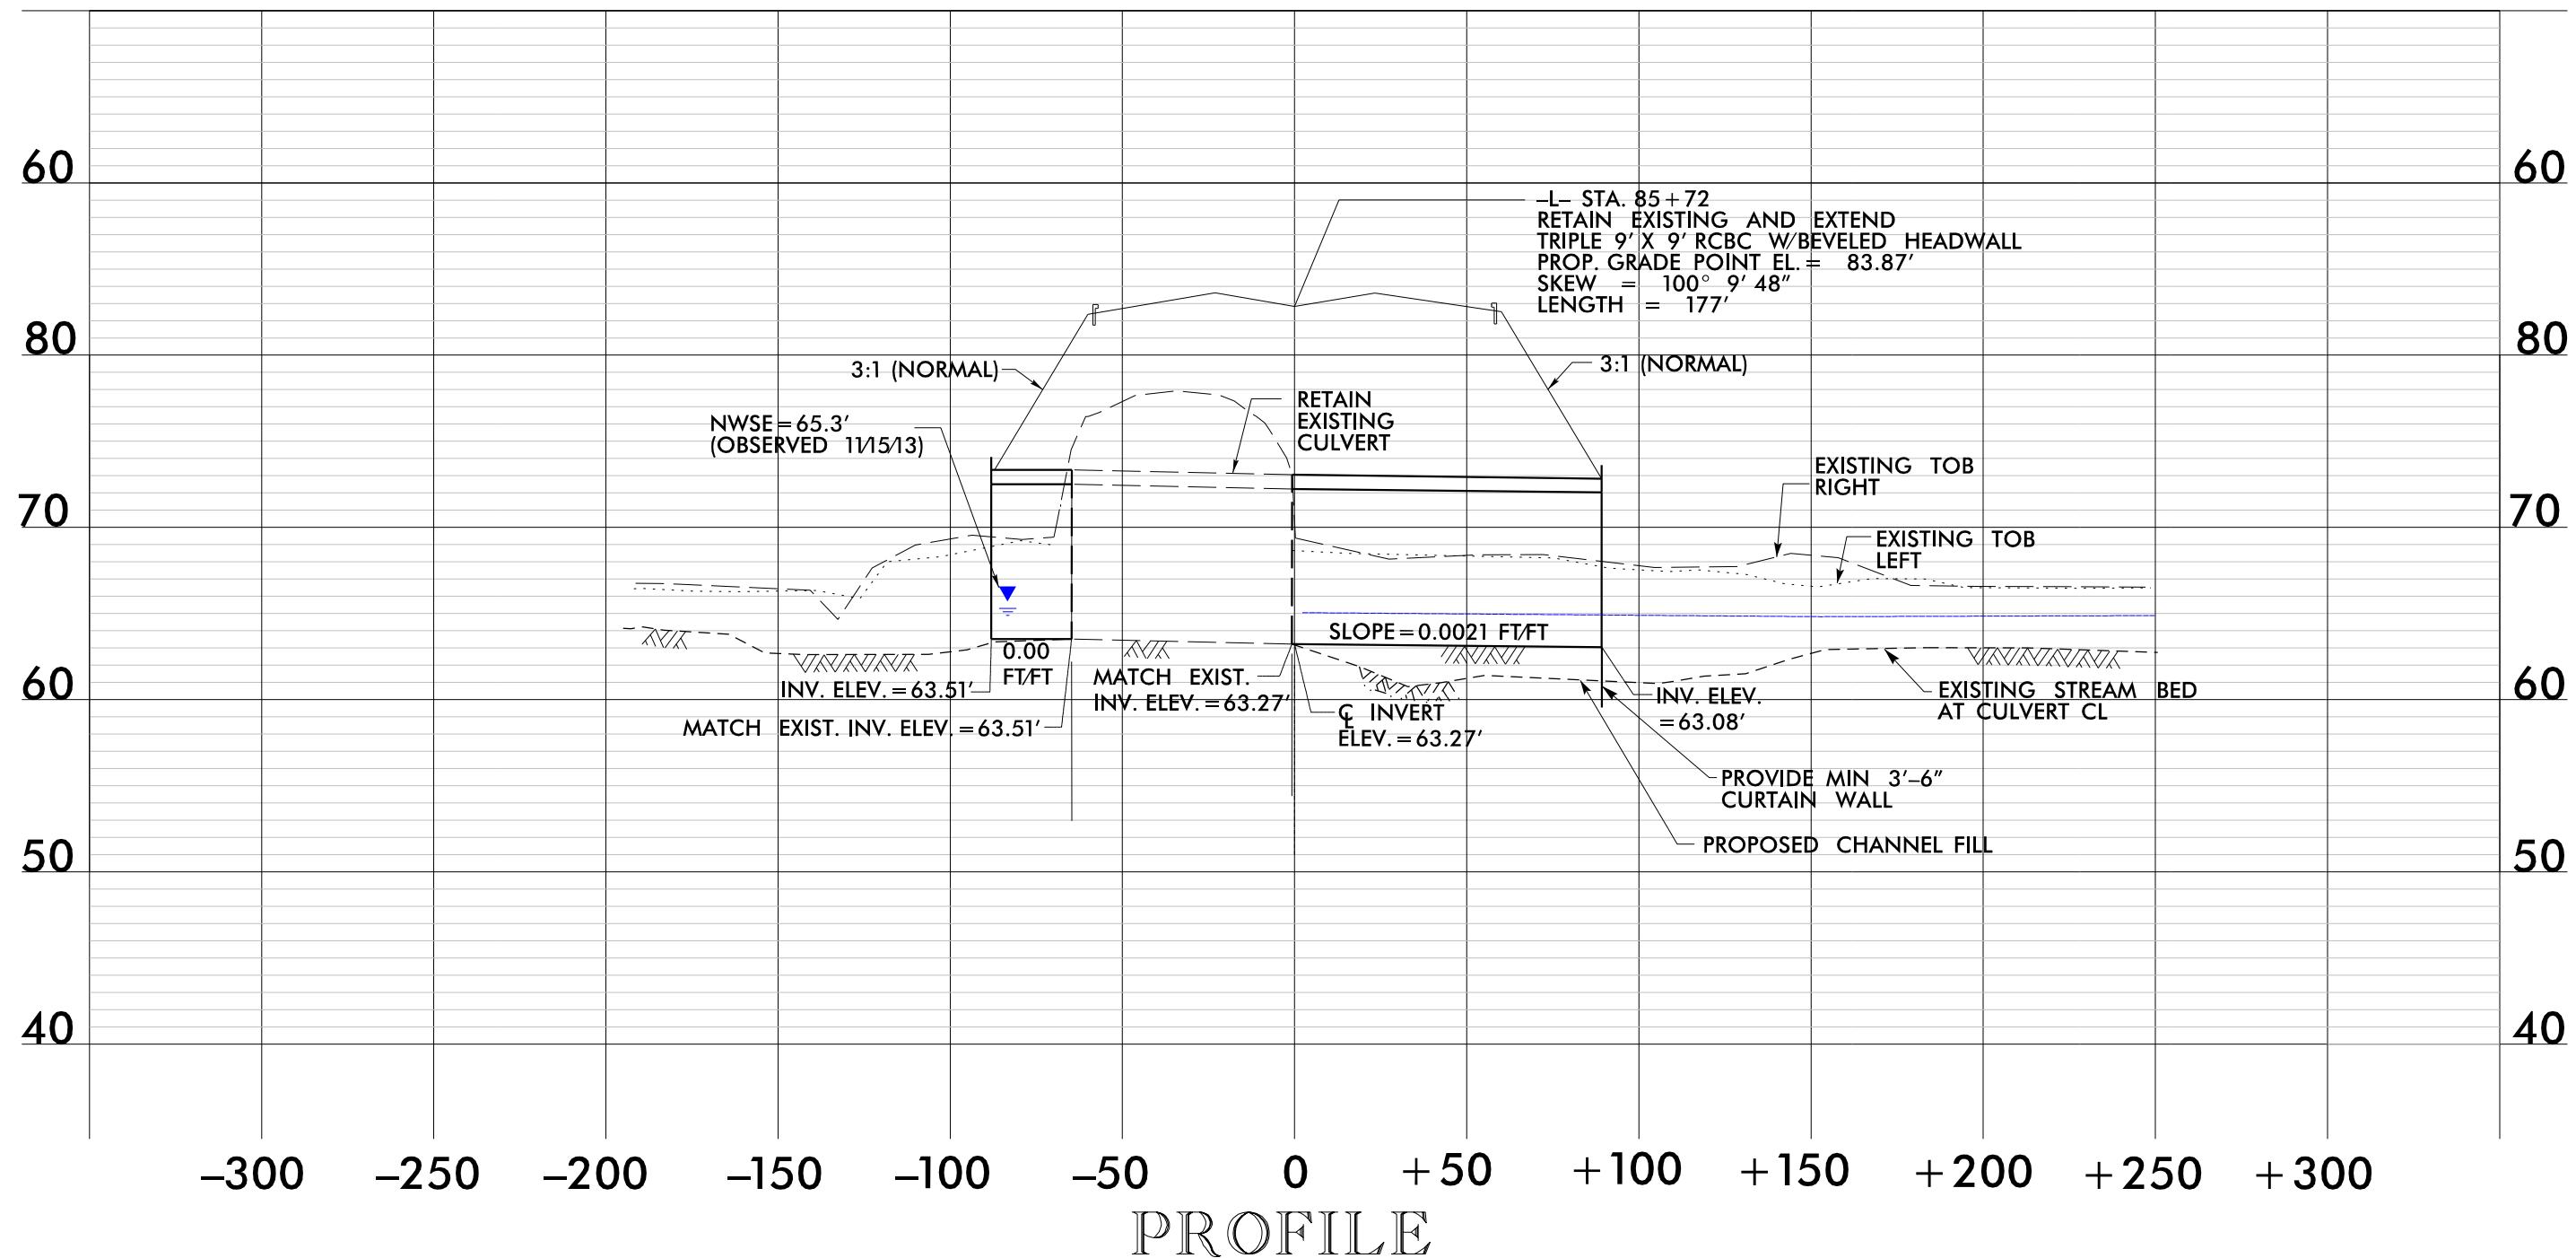

**NC DOT**  
 DIVISION OF HIGHWAYS  
 NORTHAMPTON COUNTY  
 PROJECT: 34472.1.4 (R-2582A)  
 US 158 FROM I-95 / NC  
 TO SR 1312 (ST. JOHN CHURCH RD)  
 PERMIT DRAWING SITE 2  
 SHEET 11 OF 53

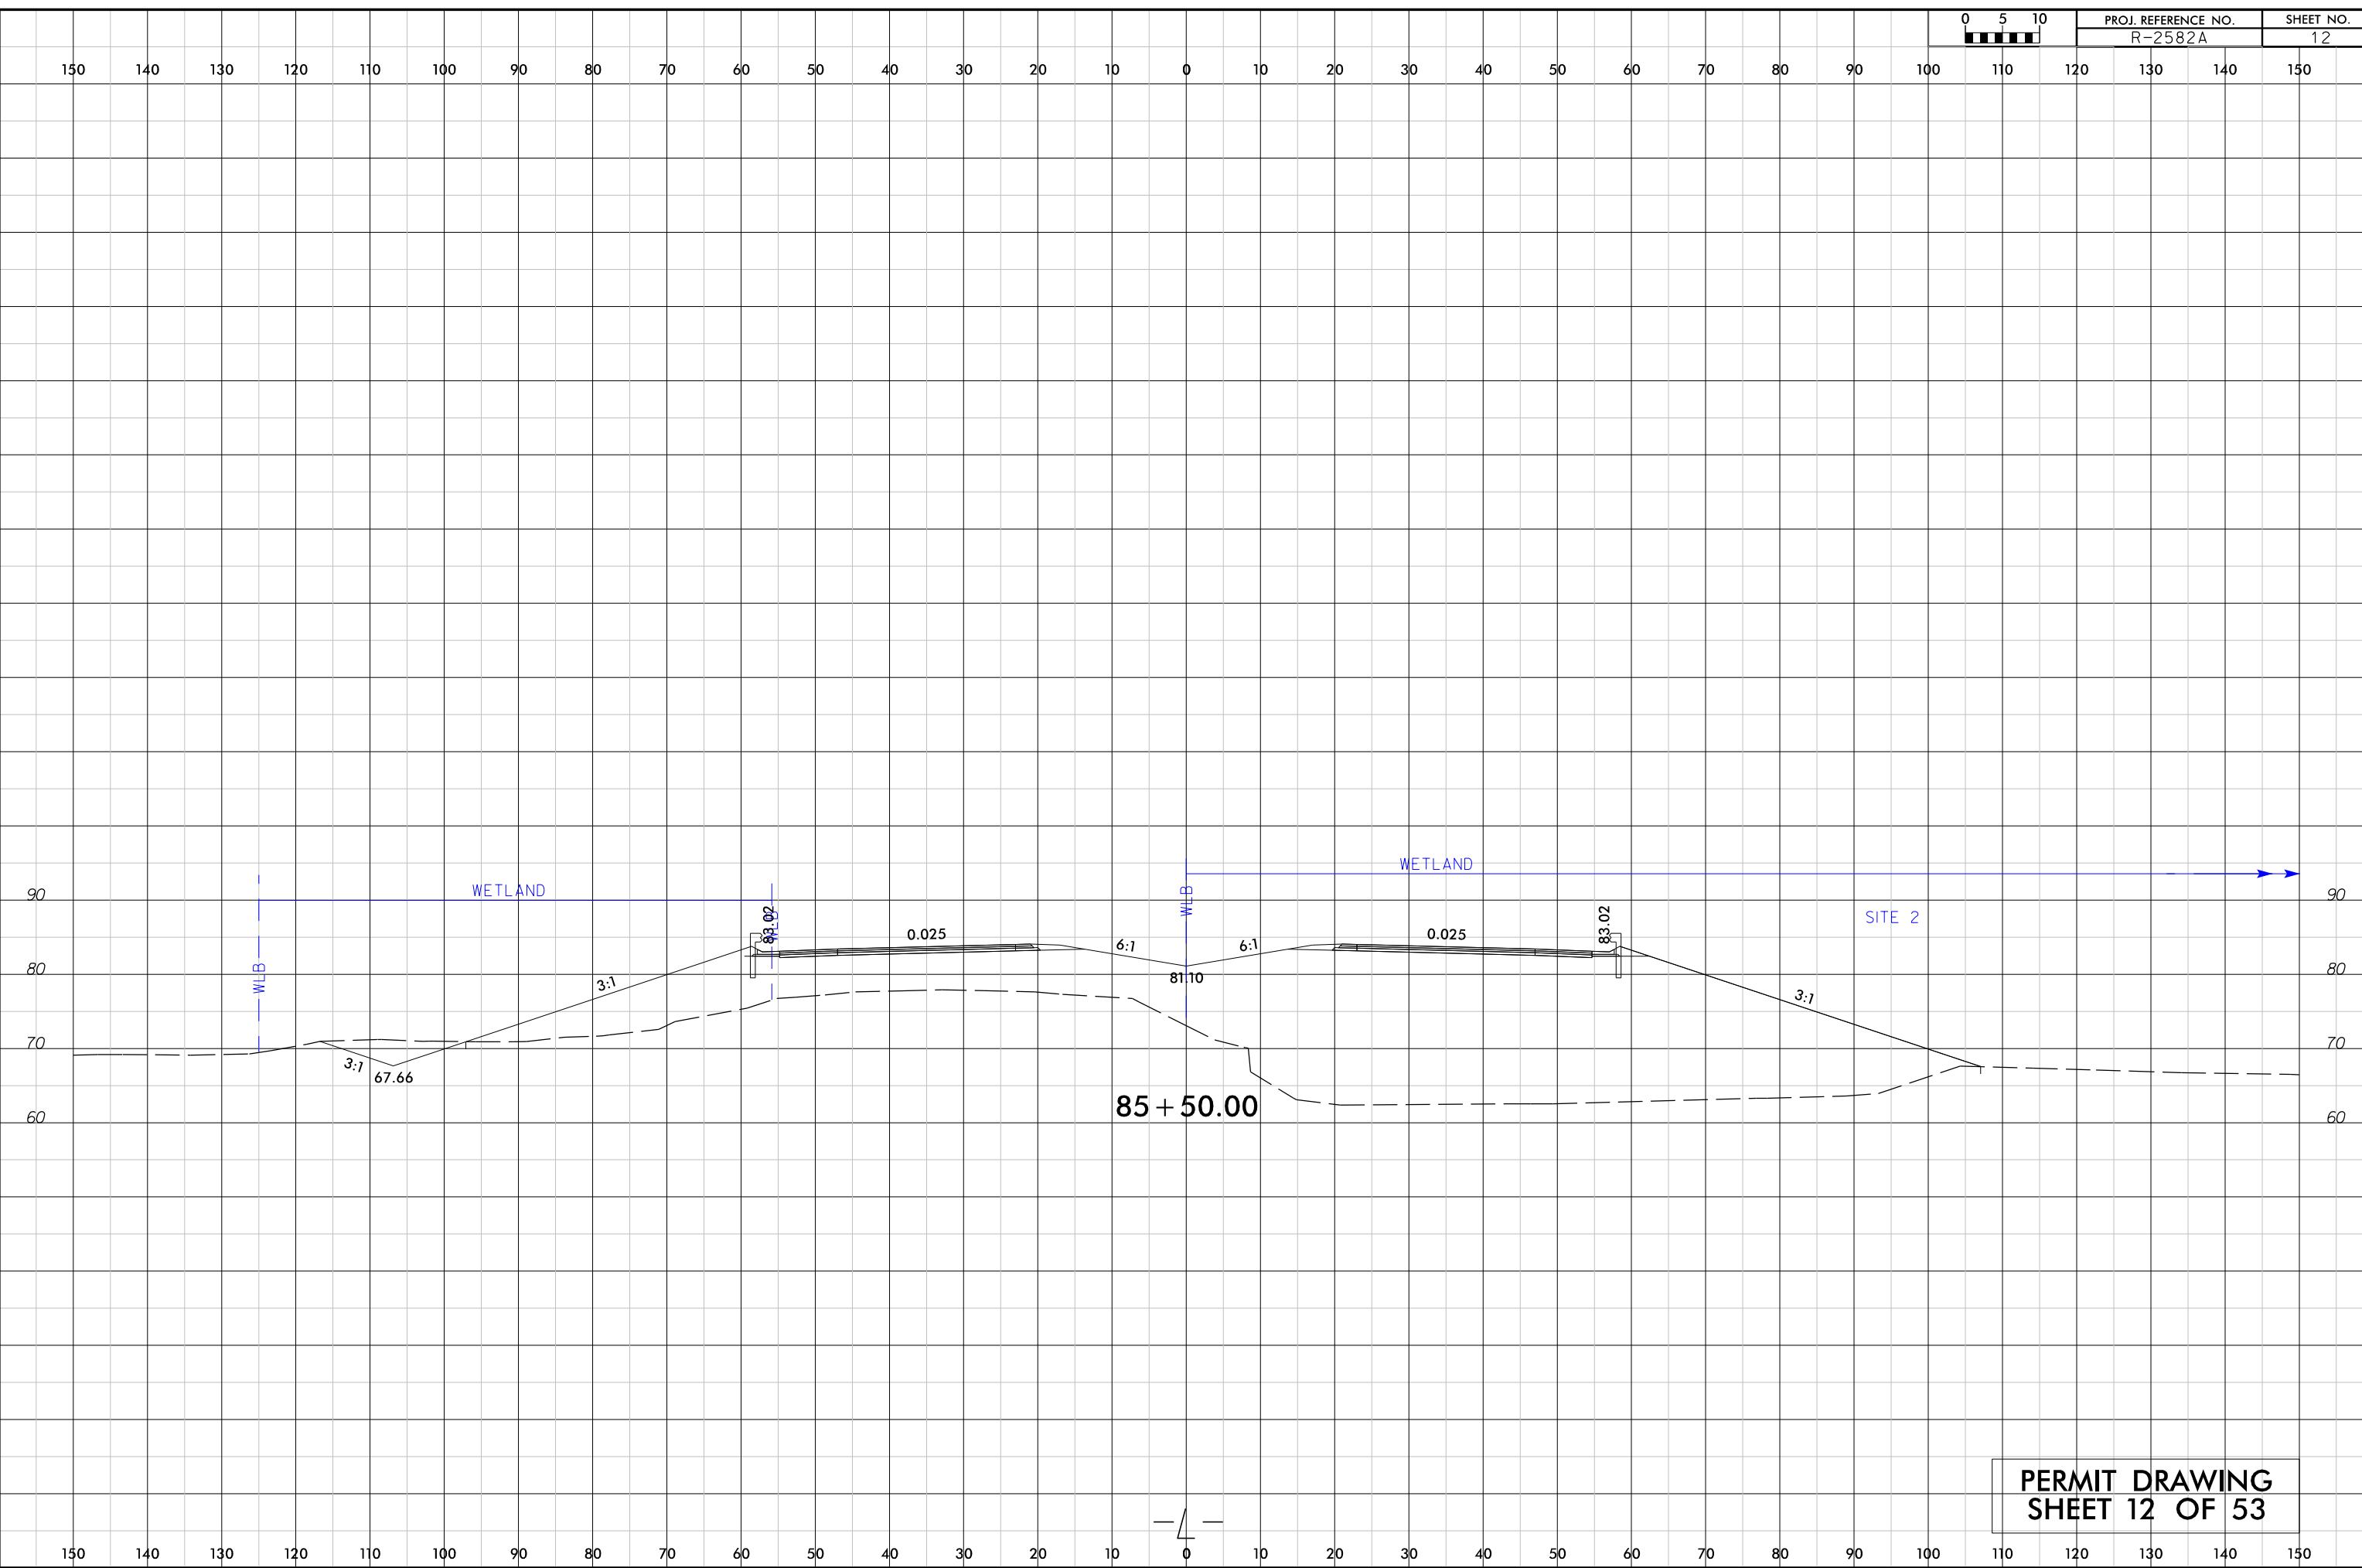

## MATCHLINE SEE SHEET 8 -L- STA. 90 + 50.00

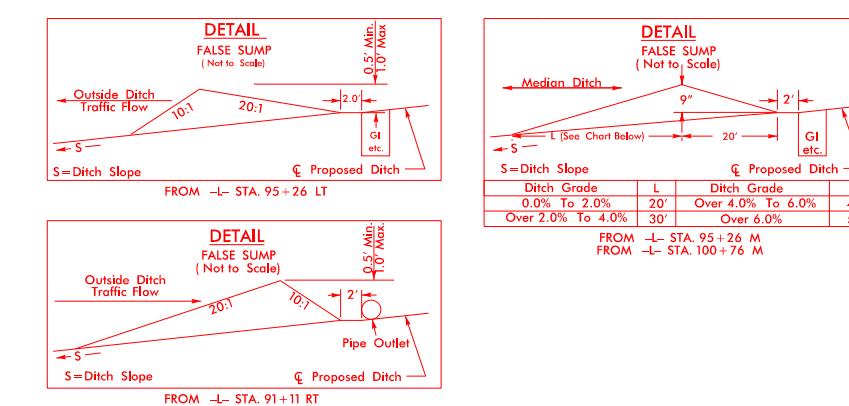

**DETAIL**  
FALSE SUMP  
(Not to Scale)

Outside Ditch Traffic Flow  
FROM -L- STA. 95+26 LT

S=Ditch Slope  
Proposed Ditch

0.5' Min.  
10' Max.

**DETAIL**  
FALSE SUMP  
(Not to Scale)

Median Ditch  
S=Ditch Slope  
Proposed Ditch

Ditch Grade L Ditch Grade L  
0.0% To 2.0% 20' Over 4.0% To 6.0% 40'  
Over 2.0% To 4.0% 30' Over 6.0% 50'

FROM -L- STA. 95+26 M  
FROM -L- STA. 100+76 M


**DETAIL**  
FALSE SUMP  
(Not to Scale)

Outside Ditch Traffic Flow  
FROM -L- STA. 91+11 RT

S=Ditch Slope  
Proposed Ditch

0.5' Min.  
10' Max.

Pipe Outlet

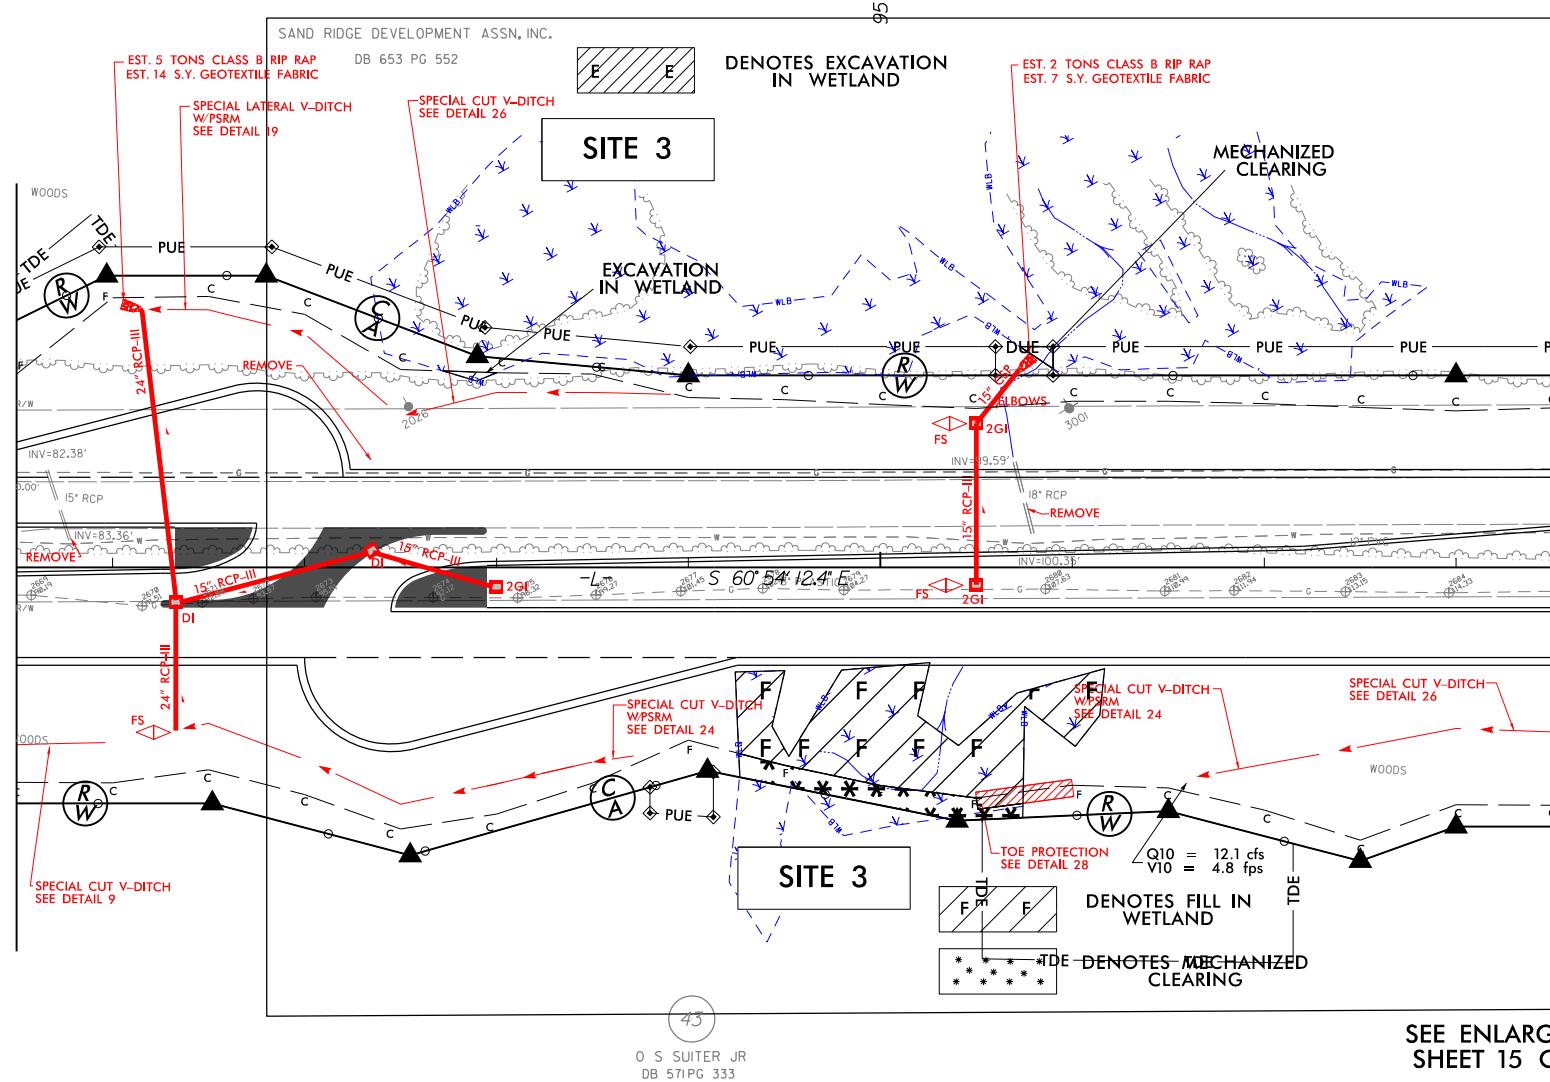

**DETAIL 4**  
SPECIAL LATENT 'V' DITCH  
(Not to Scale)

Natural Ground  
Min. D = 1 Ft.  
Max. d = 1 Ft.

FROM -Y4- STA. 11+50 RT TO -L- STA. 106+50 LT

**DETAIL 19**  
SPECIAL LATENT 'V' DITCH  
(Not to Scale)

Natural Ground  
Min. D = 1 Ft.  
Max. d = 1 Ft.

Type of Liner = PSRM

FROM -L- STA. 91+15 LT TO -L- STA. 92+50 LT

**DETAIL 26**  
SPECIAL CUT DITCH  
(Not to Scale)

Natural Ground  
Min. D = 1 Ft.  
Max. d = 1 Ft.

FROM -L- STA. 92+50 LT TO -L- STA. 94+00 LT  
FROM -L- STA. 98+00 RT TO -L- STA. 114+00 RT

**DETAIL 24**  
SPECIAL CUT DITCH  
(Not to Scale)

Natural Ground  
Min. D = 1 Ft.  
Max. d = 1 Ft.

Type of Liner = PSRM

FROM -L- STA. 91+33 RT TO -L- STA. 94+00 RT  
FROM -L- STA. 96+00 RT TO -L- STA. 98+00 RT

**DETAIL 25**  
SPECIAL LATENT 'V' DITCH  
(Not to Scale)

Natural Ground  
Min. D = 1 Ft.

FROM -L- STA. 101+00 LT TO -Y4- STA. 11+50 LT  
FROM -Y4- STA. 11+50 RT TO -L- STA. 106+50 LT

**DETAIL 27**  
BASE TAIL DITCH  
(Not to Scale)

Natural Ground  
Min. D = 1 Ft.  
Max. d = 1 Ft.  
When B < 6.0' B = 2 Ft.

Type of Liner = CL-I Rip-Rap  
DDE = 400 CY


FROM -L- STA. 100+88 LT TO -L- STA. 101+00 RT

**PERMIT DRAWING  
SHEET 13 OF 53**


-L- TS Sta. 101+02.50

-L- SC Sta. 103+02.50





-Y4- POT Sta. 10+00.00  
-L- POC Sta. 103+64.46

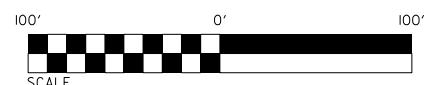

PROJECT REFERENCE NO.		SHEET NO.
R-2582A		9
RW SHEET NO.		
ROADWAY DESIGN ENGINEER	HYDRAULICS ENGINEER	
<b>INCOMPLETE PLANS DO NOT USE FOR R/W ACQUISITION</b>	<b>PRELIMINARY PLANS DO NOT USE FOR CONSTRUCTION</b>	

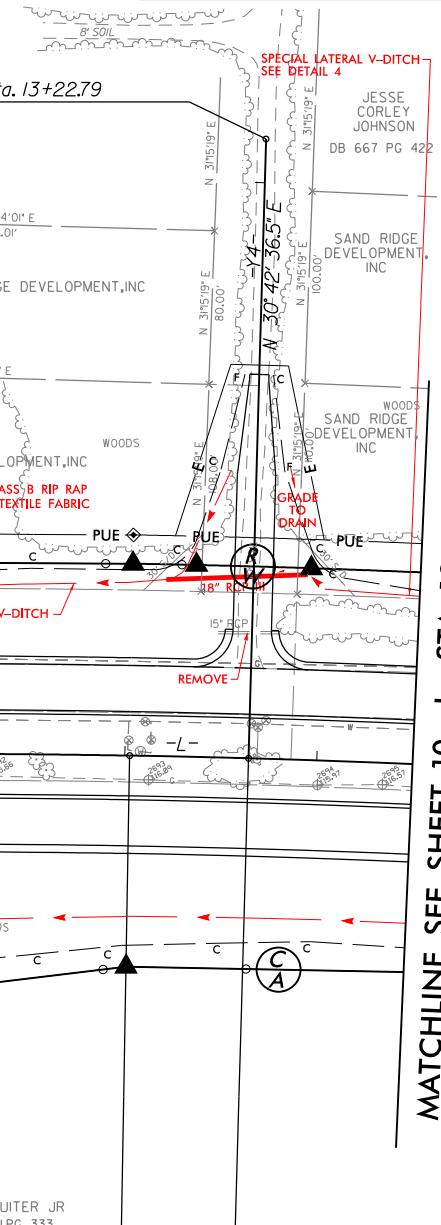


O S SUITER JR  
DB 571PG 333

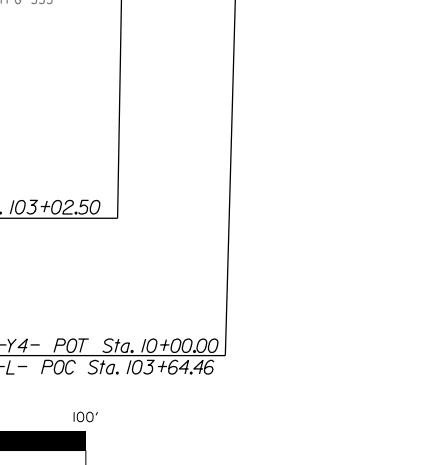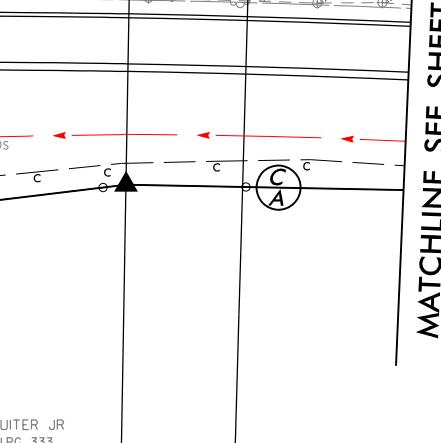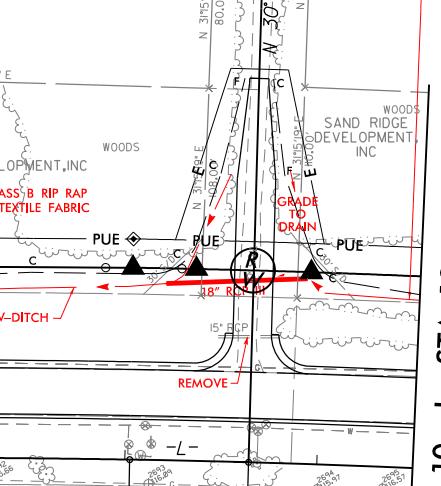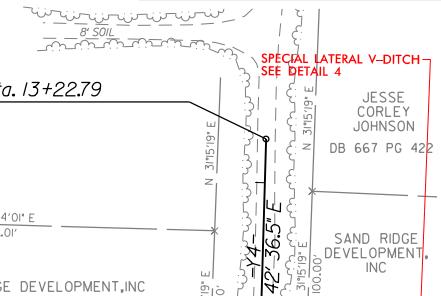


R:\Hydraulics\PERMIS\_Environmental\Drawings\4\_R-2582A\_Rdy-psh\_y.dgn  
memes,buscam

MATCHLINE SEE SHEET 8 -L- STA. 90 + 50.00

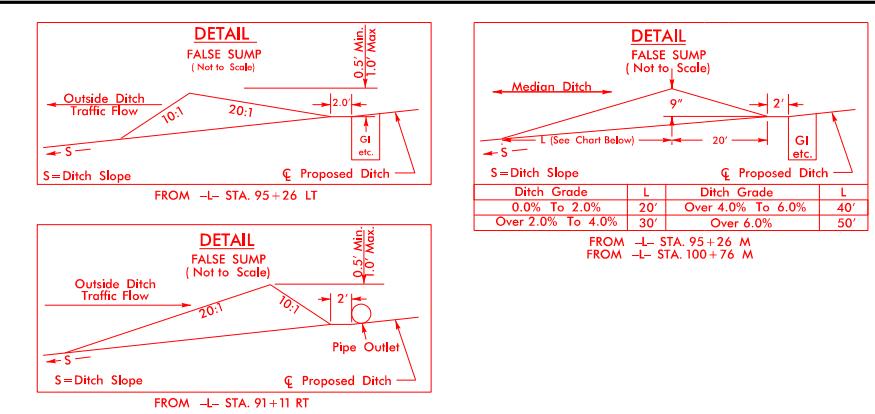

<i>Pls Sta</i> 102+35.83	<i>Pls Sta</i> 107+85.54	<i>Pls Sta</i> 113+33.00
$\Theta_S = 0^\circ 59' 47.2''$	$\Delta = 9^\circ 36' 14.6'' \text{ (RT)}$	$\Theta_S = 0^\circ 59' 47.2''$
$L_S = 200.00'$	$D = 0^\circ 59' 47.2''$	$L_S = 200.00'$
$L_T = 133.34'$	$L = 963.83'$	$L_T = 133.34'$
$ST = 66.67'$	$T = 483.05'$	$ST = 66.67'$
	$R = 5,750.00'$	
	$SE = NC$	
	$V_d = 70+$	

PROJECT REFERENCE NO.		SHEET NO.
<i>R-2582A</i>		<i>9</i>
RAW SHEET NO.		
ROADWAY DESIGN ENGINEER	HYDRAULICS ENGINEER	
<div style="border: 1px solid black; padding: 10px; text-align: center;"> <b>INCOMPLETE PLANS</b>            DO NOT USE FOR R/W ACQUISITION         </div>		
<div style="border: 1px solid black; padding: 10px; text-align: center;"> <b>PRELIMINARY PLANS</b>            DO NOT USE FOR CONSTRUCTION         </div>		

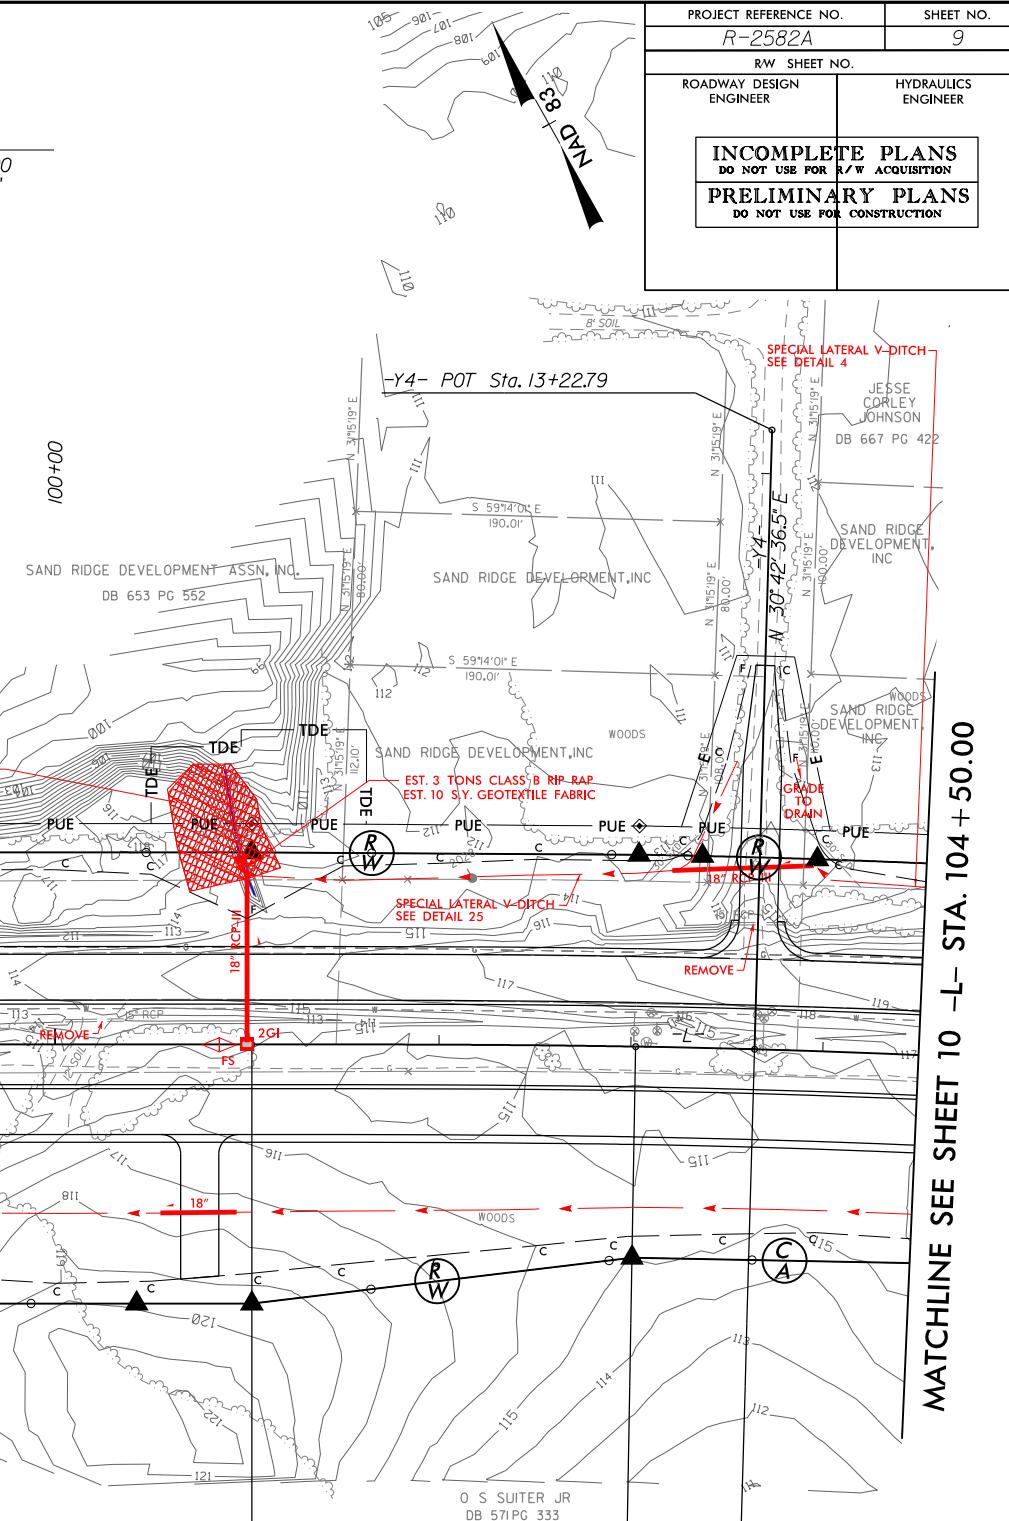

SEE ENLARGEMENT  
SHEET 15 OF 53

-L- TS Sta. 101+02.50

-/- SC Sta 103+02.50

- POT Sta. 10+00.00  
POC Sta. 103+64.46

**DETAIL 4**  
**SPECIAL LATERAL "V" DITCH**  
*(Not to Scale)*

Natural  
Ground

3.7

D

Fill  
Slope

4.1 or  
Flatter

Min. D = 1 Ft.

**DETAIL 19**

**SPECIAL LATERAL 'V' DITCH**  
(Not to Scale)

Type of Liner = PSRM

Min. D = 1 Ft.  
Max. d = 1 Ft.

**DETAIL 24**  
**SPECIAL CUT DITCH**  
(Not to Scale)

The diagram illustrates a 'Special Cut Ditch' with the following features:

- Natural Ground:** The original surface level.
- Front Ditch Slope:** The angle of the cut face.
- Min. D. = 1 Ft.:** Minimum depth of the ditch.
- Max. d. = 1 Ft.:** Maximum depth of the ditch.
- d:** Depth of the ditch.
- l:** Length of the ditch.
- Angle:** The angle between the front ditch slope and the horizontal.
- Plumb:** A vertical line indicating the vertical axis of the ditch.

FROM -L- STA. 91+15 LT TO -L- STA. 92+50 LT

**DETAIL 28**  
TOE PROTECTION  
(Not to Scale)

NATURAL GROUND

b

3:1 OR FLATTER

d

FILL SLOPE

Type of Liner = PSRM

PERMIT DRAWING  
SHEET 14 OF 53



RIP RAP  
Ξ FABRIC

ERAL V-DITCH

19

19

SPECIAL CUT V-DIT  
SEE DETAIL 26



**DENOTES EXCAVATION  
IN WETLAND**


## SITE


EST. 2 TONS CLASS B RIP RAP  
EST. 7 S.Y. GEOTEXTILE FABRIC


PROJECT REFERENCE NO.		SHEET NO.								
<i>R-2582A</i>		<i>9</i>								
RW SHEET NO.										
ROADWAY DESIGN ENGINEER	HYDRAULICS ENGINEER									
<table border="1"> <tr> <td colspan="2"><b>INCOMPLETE PLANS</b></td> </tr> <tr> <td colspan="2">DO NOT USE FOR R/W ACQUISITION</td> </tr> <tr> <td colspan="2"><b>PRELIMINARY PLANS</b></td> </tr> <tr> <td colspan="2">DO NOT USE FOR CONSTRUCTION</td> </tr> </table>			<b>INCOMPLETE PLANS</b>		DO NOT USE FOR R/W ACQUISITION		<b>PRELIMINARY PLANS</b>		DO NOT USE FOR CONSTRUCTION	
<b>INCOMPLETE PLANS</b>										
DO NOT USE FOR R/W ACQUISITION										
<b>PRELIMINARY PLANS</b>										
DO NOT USE FOR CONSTRUCTION										


The site plan shows a wetland area with diagonal hatching labeled 'F' for fill. A dashed line labeled 'PUE' indicates a proposed utility easement. A circle labeled 'C A' is positioned near the wetland. The plan includes several 'F' symbols and asterisks (\*) indicating mechanized clearing. A 'SPECIAL CUT V-DITCH W/PSRM SEE DETAIL 24' is shown at the top left. A 'SPECIAL CUT V-DITCH W/PSRM SEE DETAIL 24' is also shown on the right side. A 'TOE PROTECTION SEE DETAIL 28' is indicated with a red shaded area. A circle labeled 'R W' is located on the right. A box labeled 'SITE 3' is centered below the main area. A legend at the bottom left defines symbols: a box with diagonal hatching for 'DENOTES FILL IN WETLAND' and a box with asterisks for 'DENOTES MECHANIZED CLEARING'. To the right, a scale bar shows 50', 0', and 50' with a checkerboard pattern. A box labeled 'PERMIT DRAWING SHEET 15 OF 53' is at the bottom right.




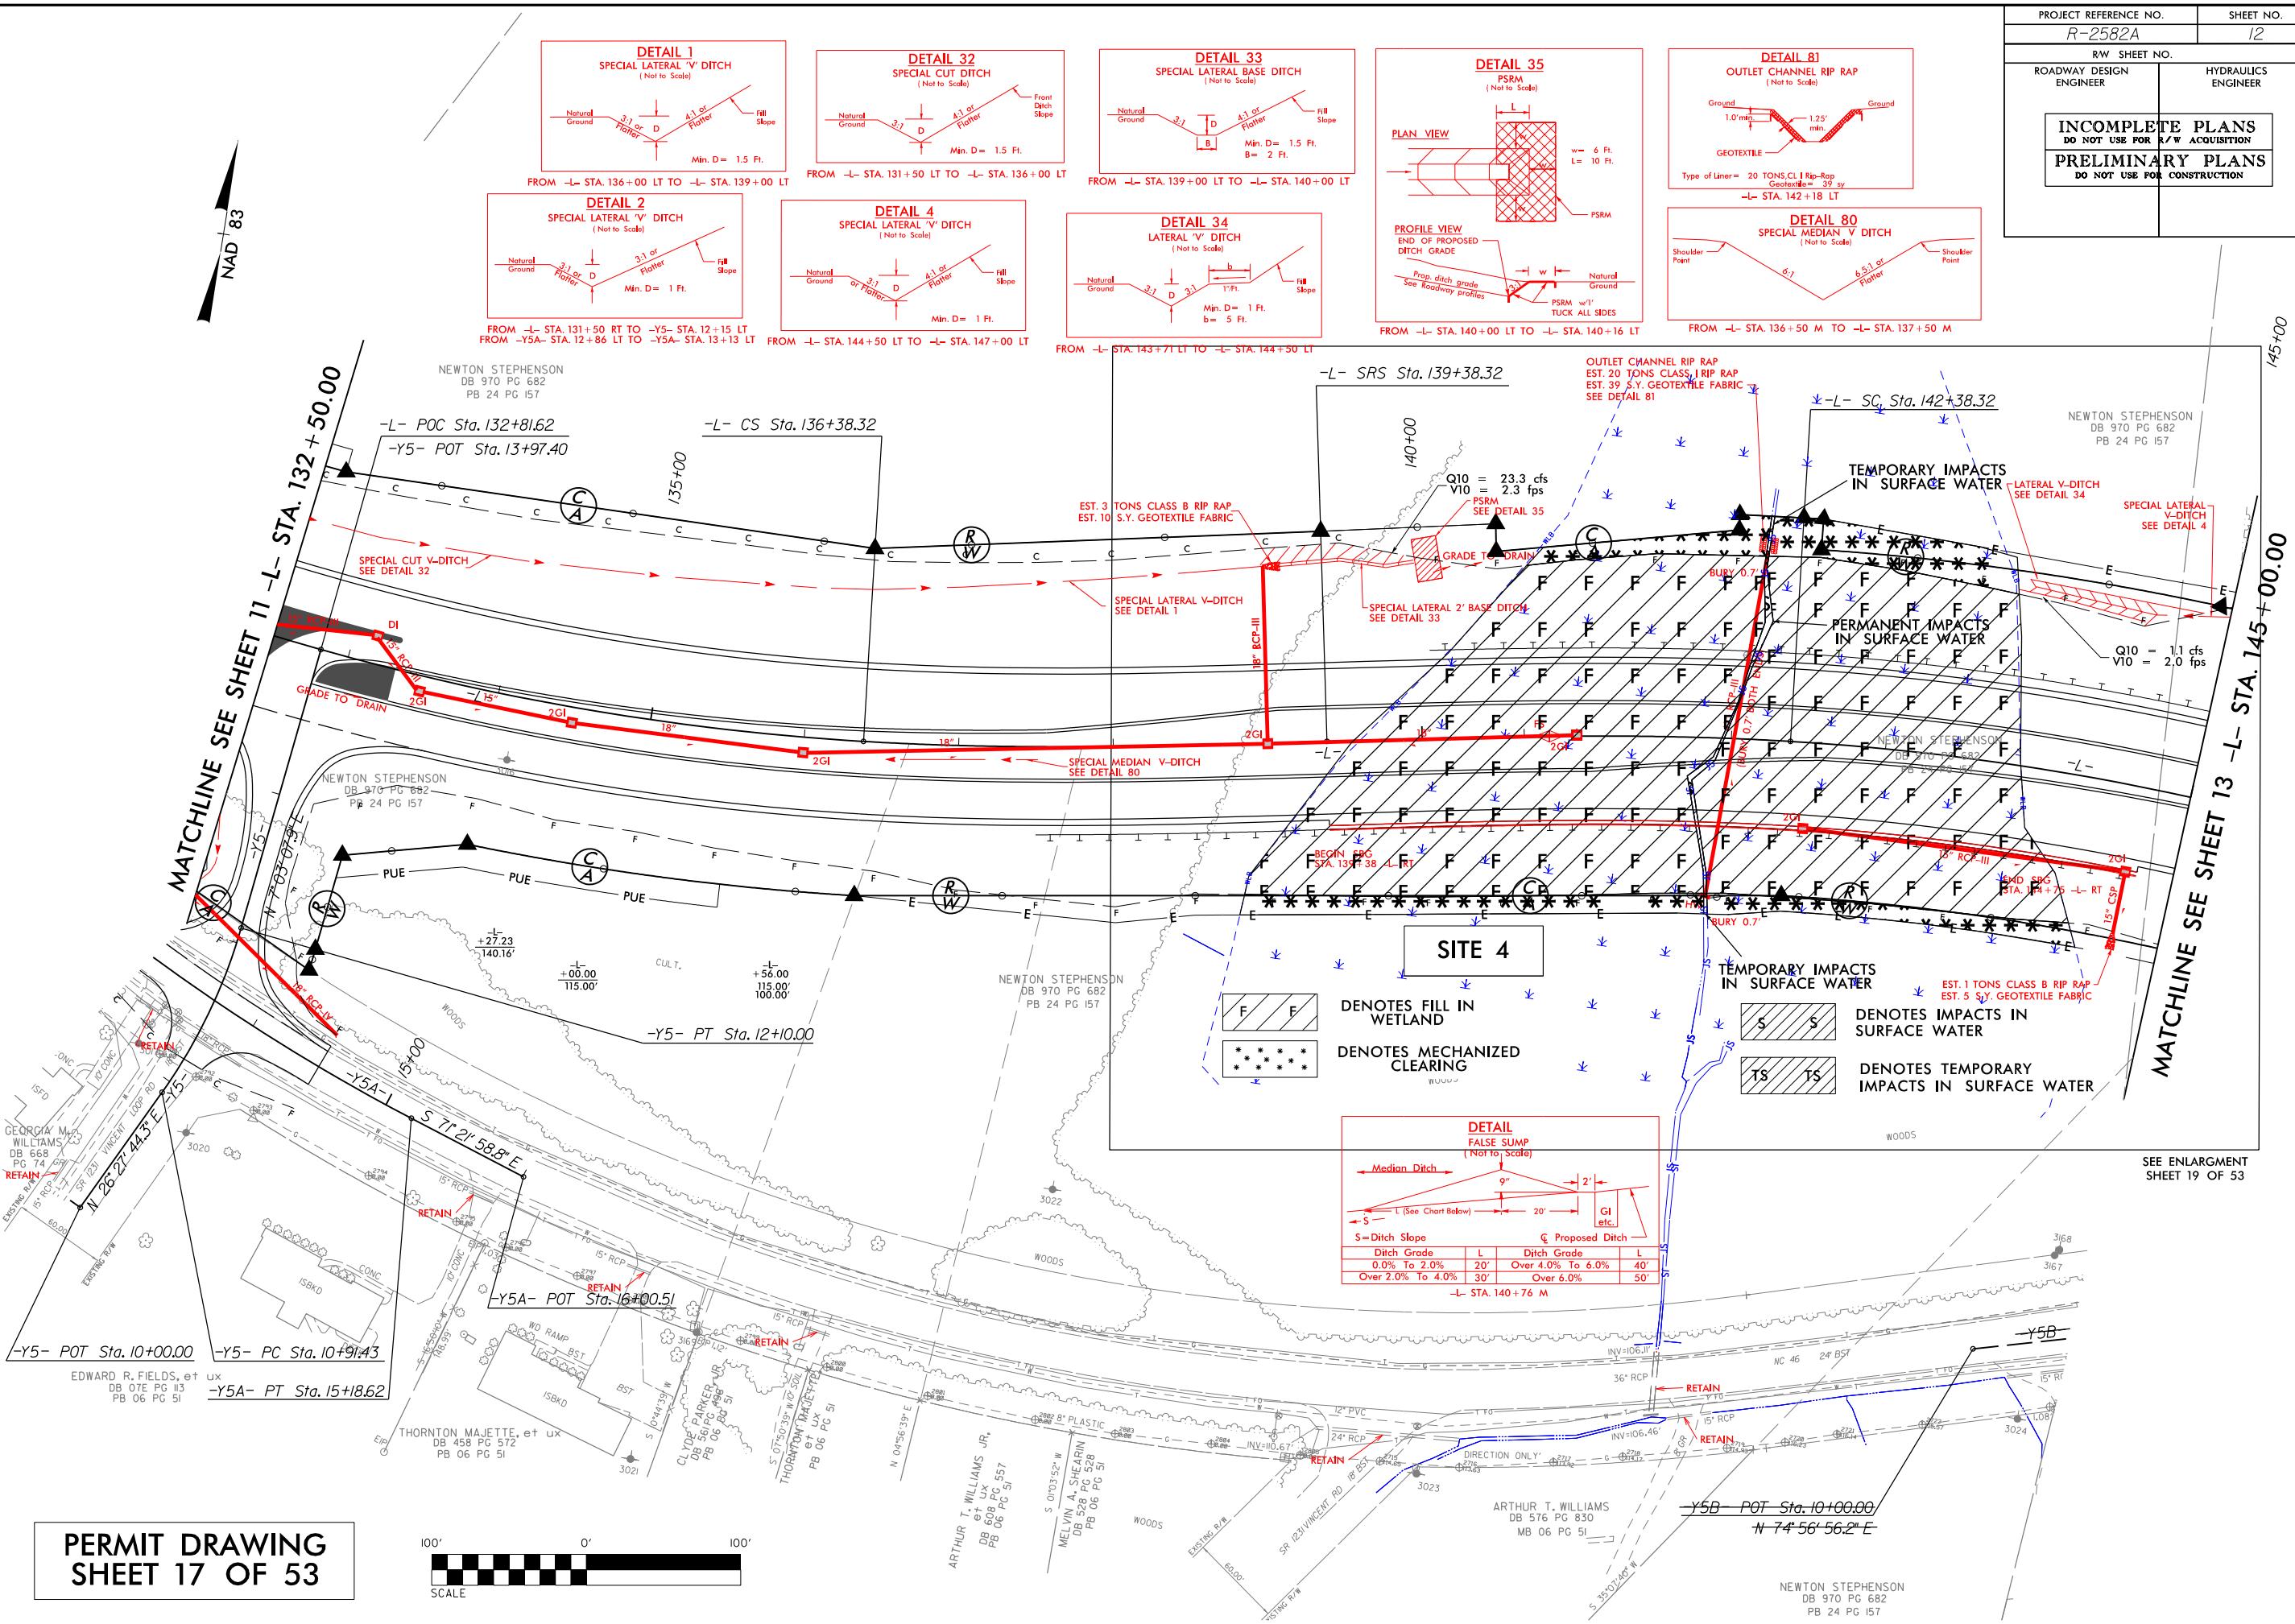


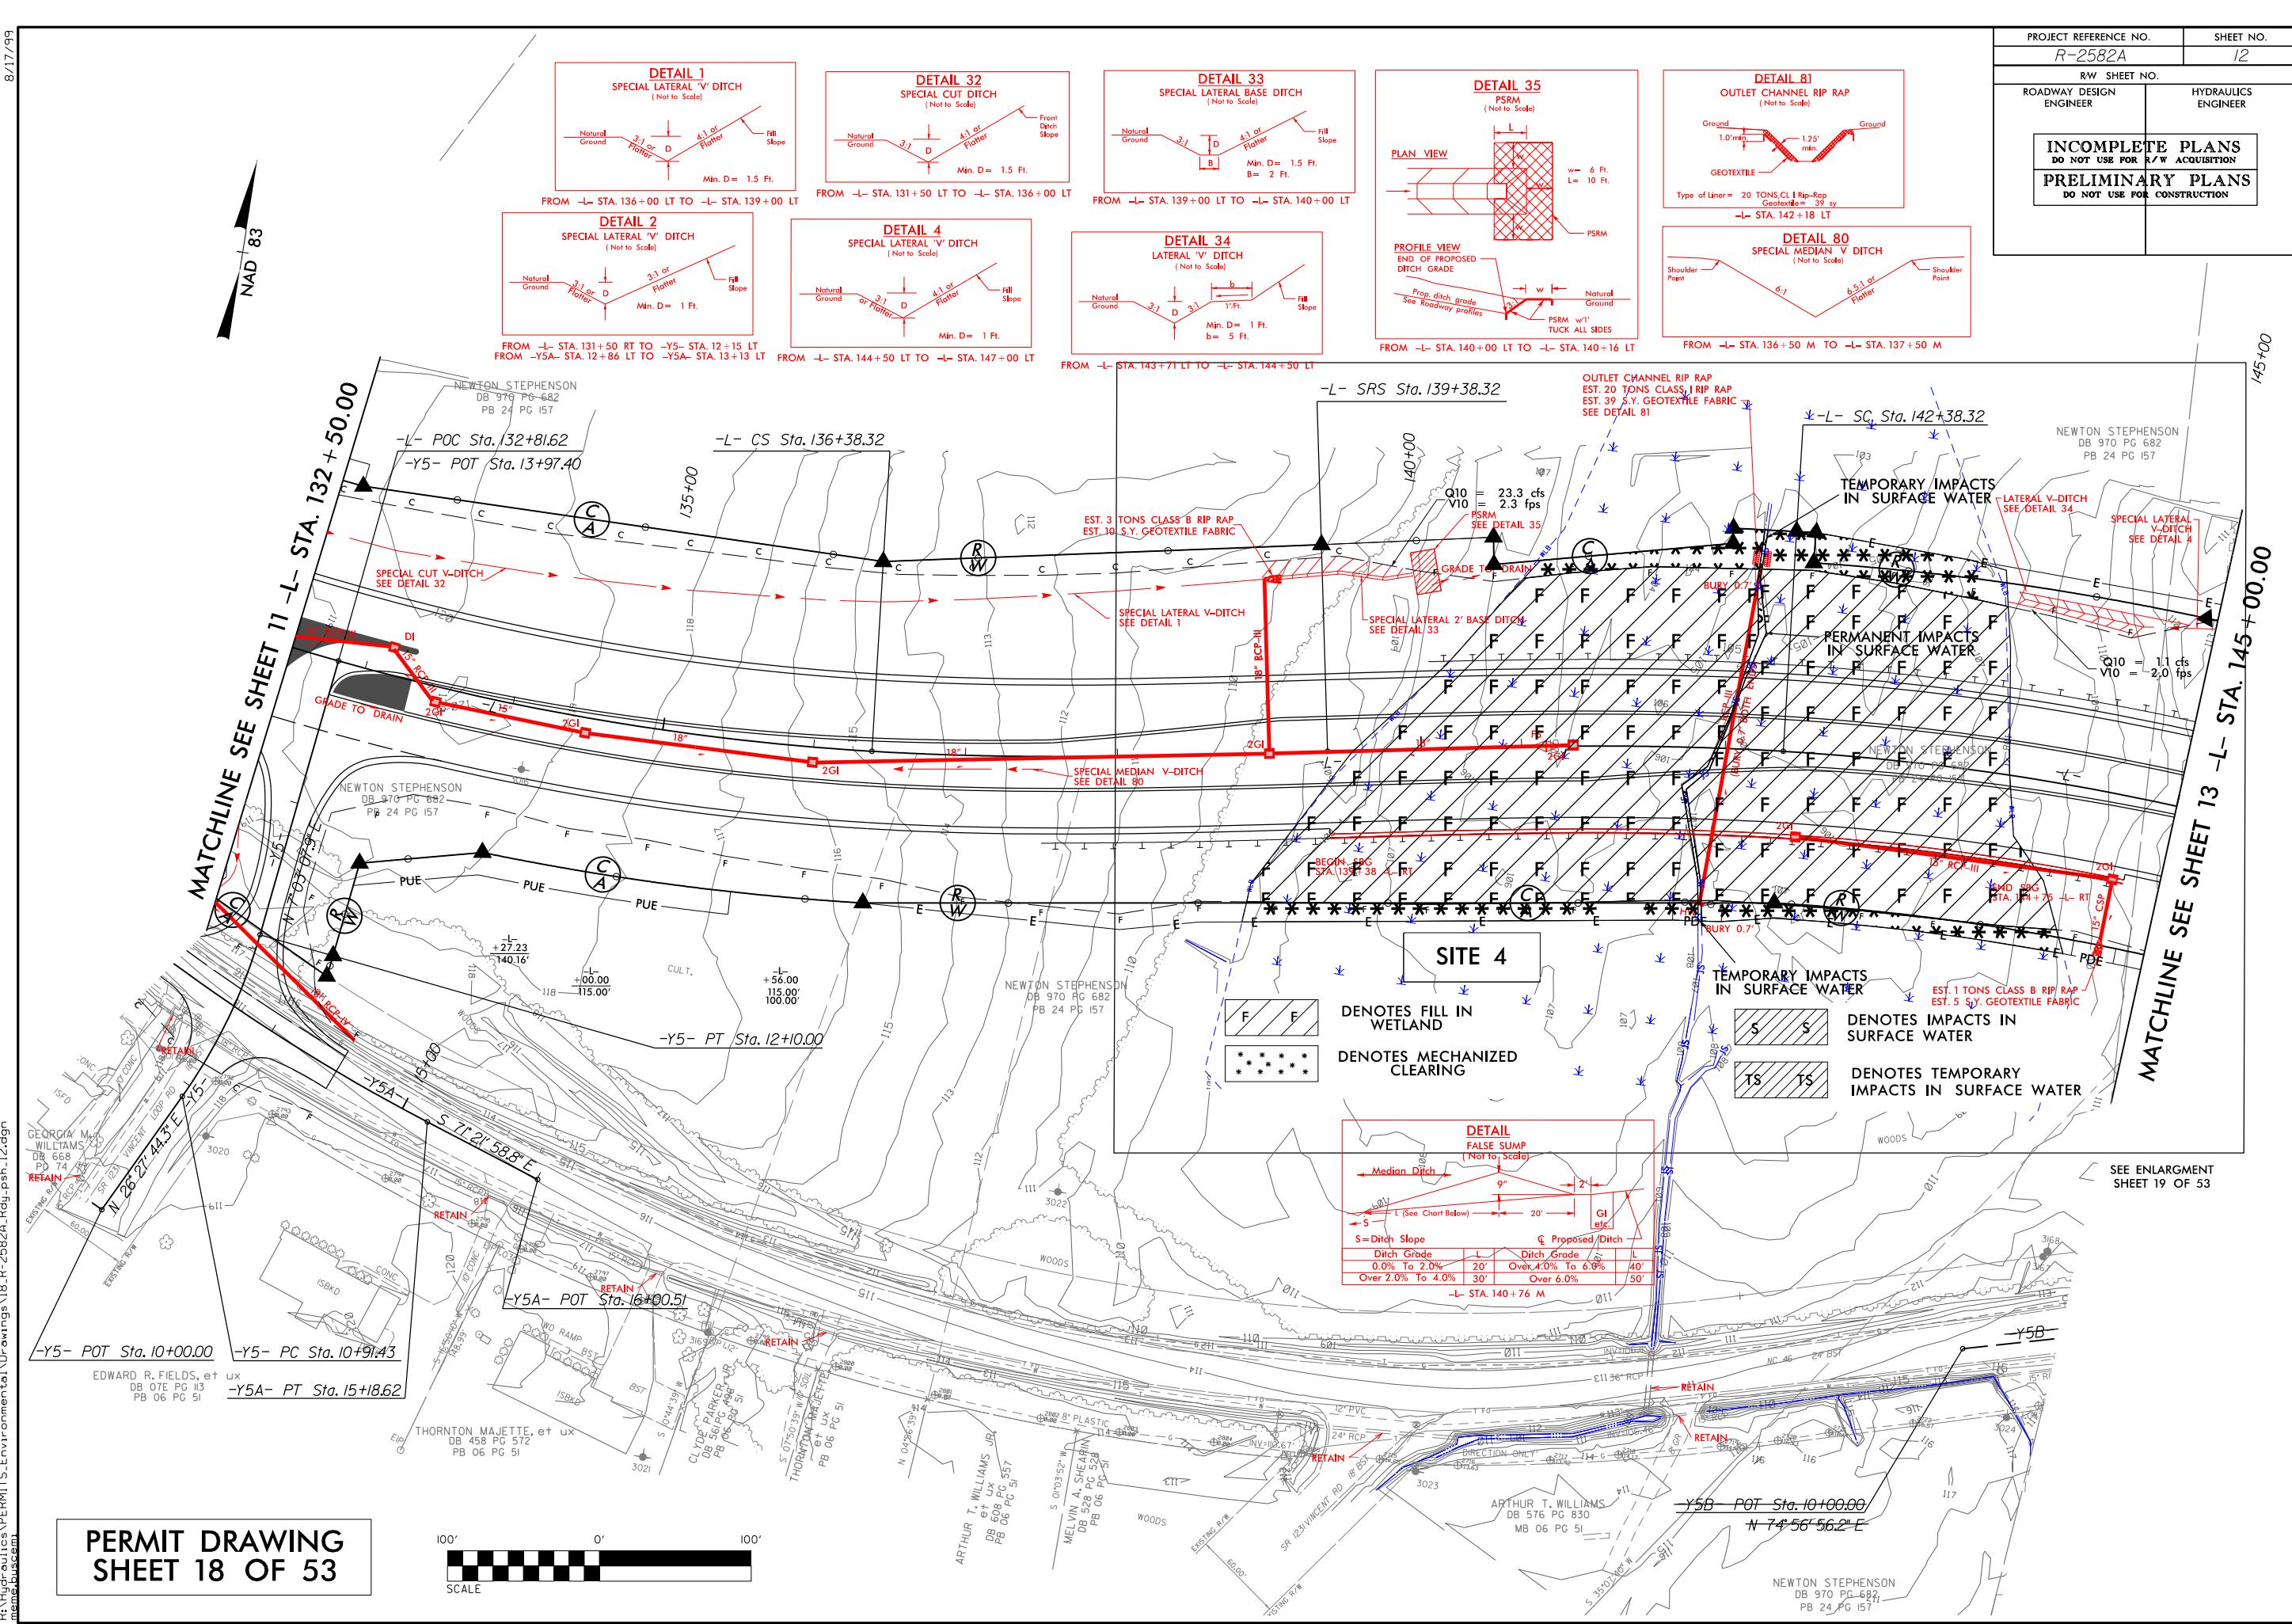


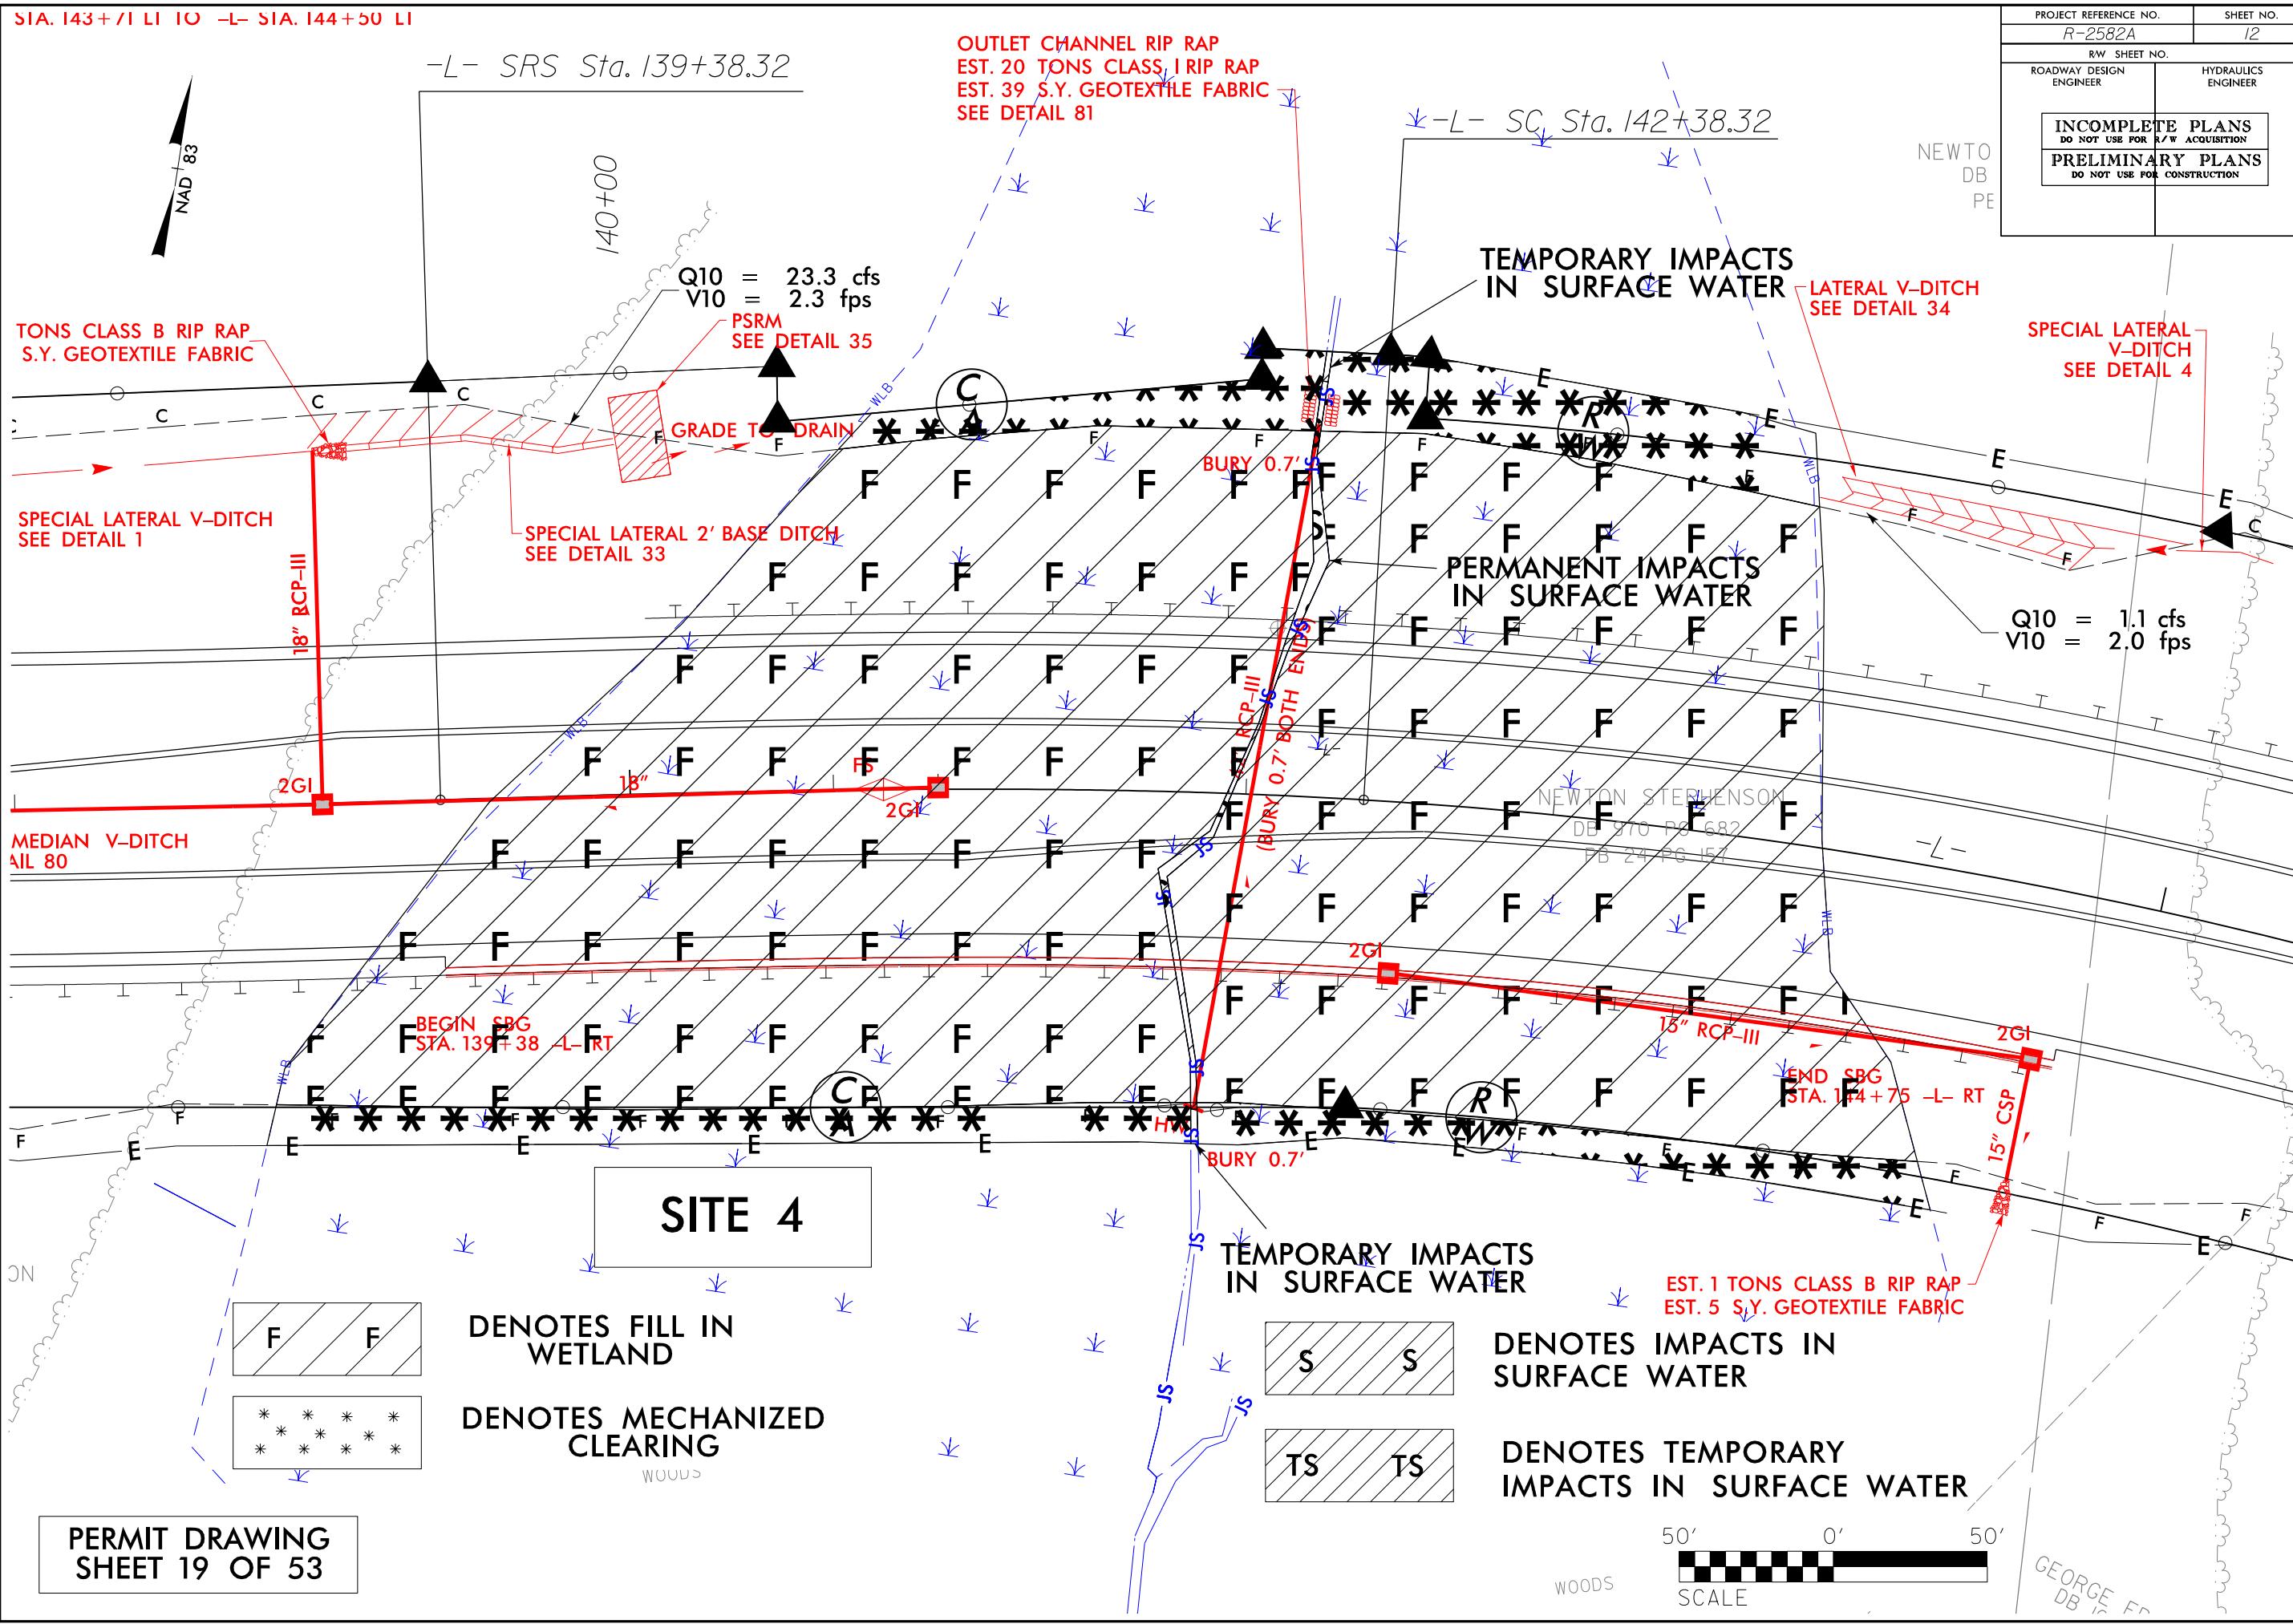


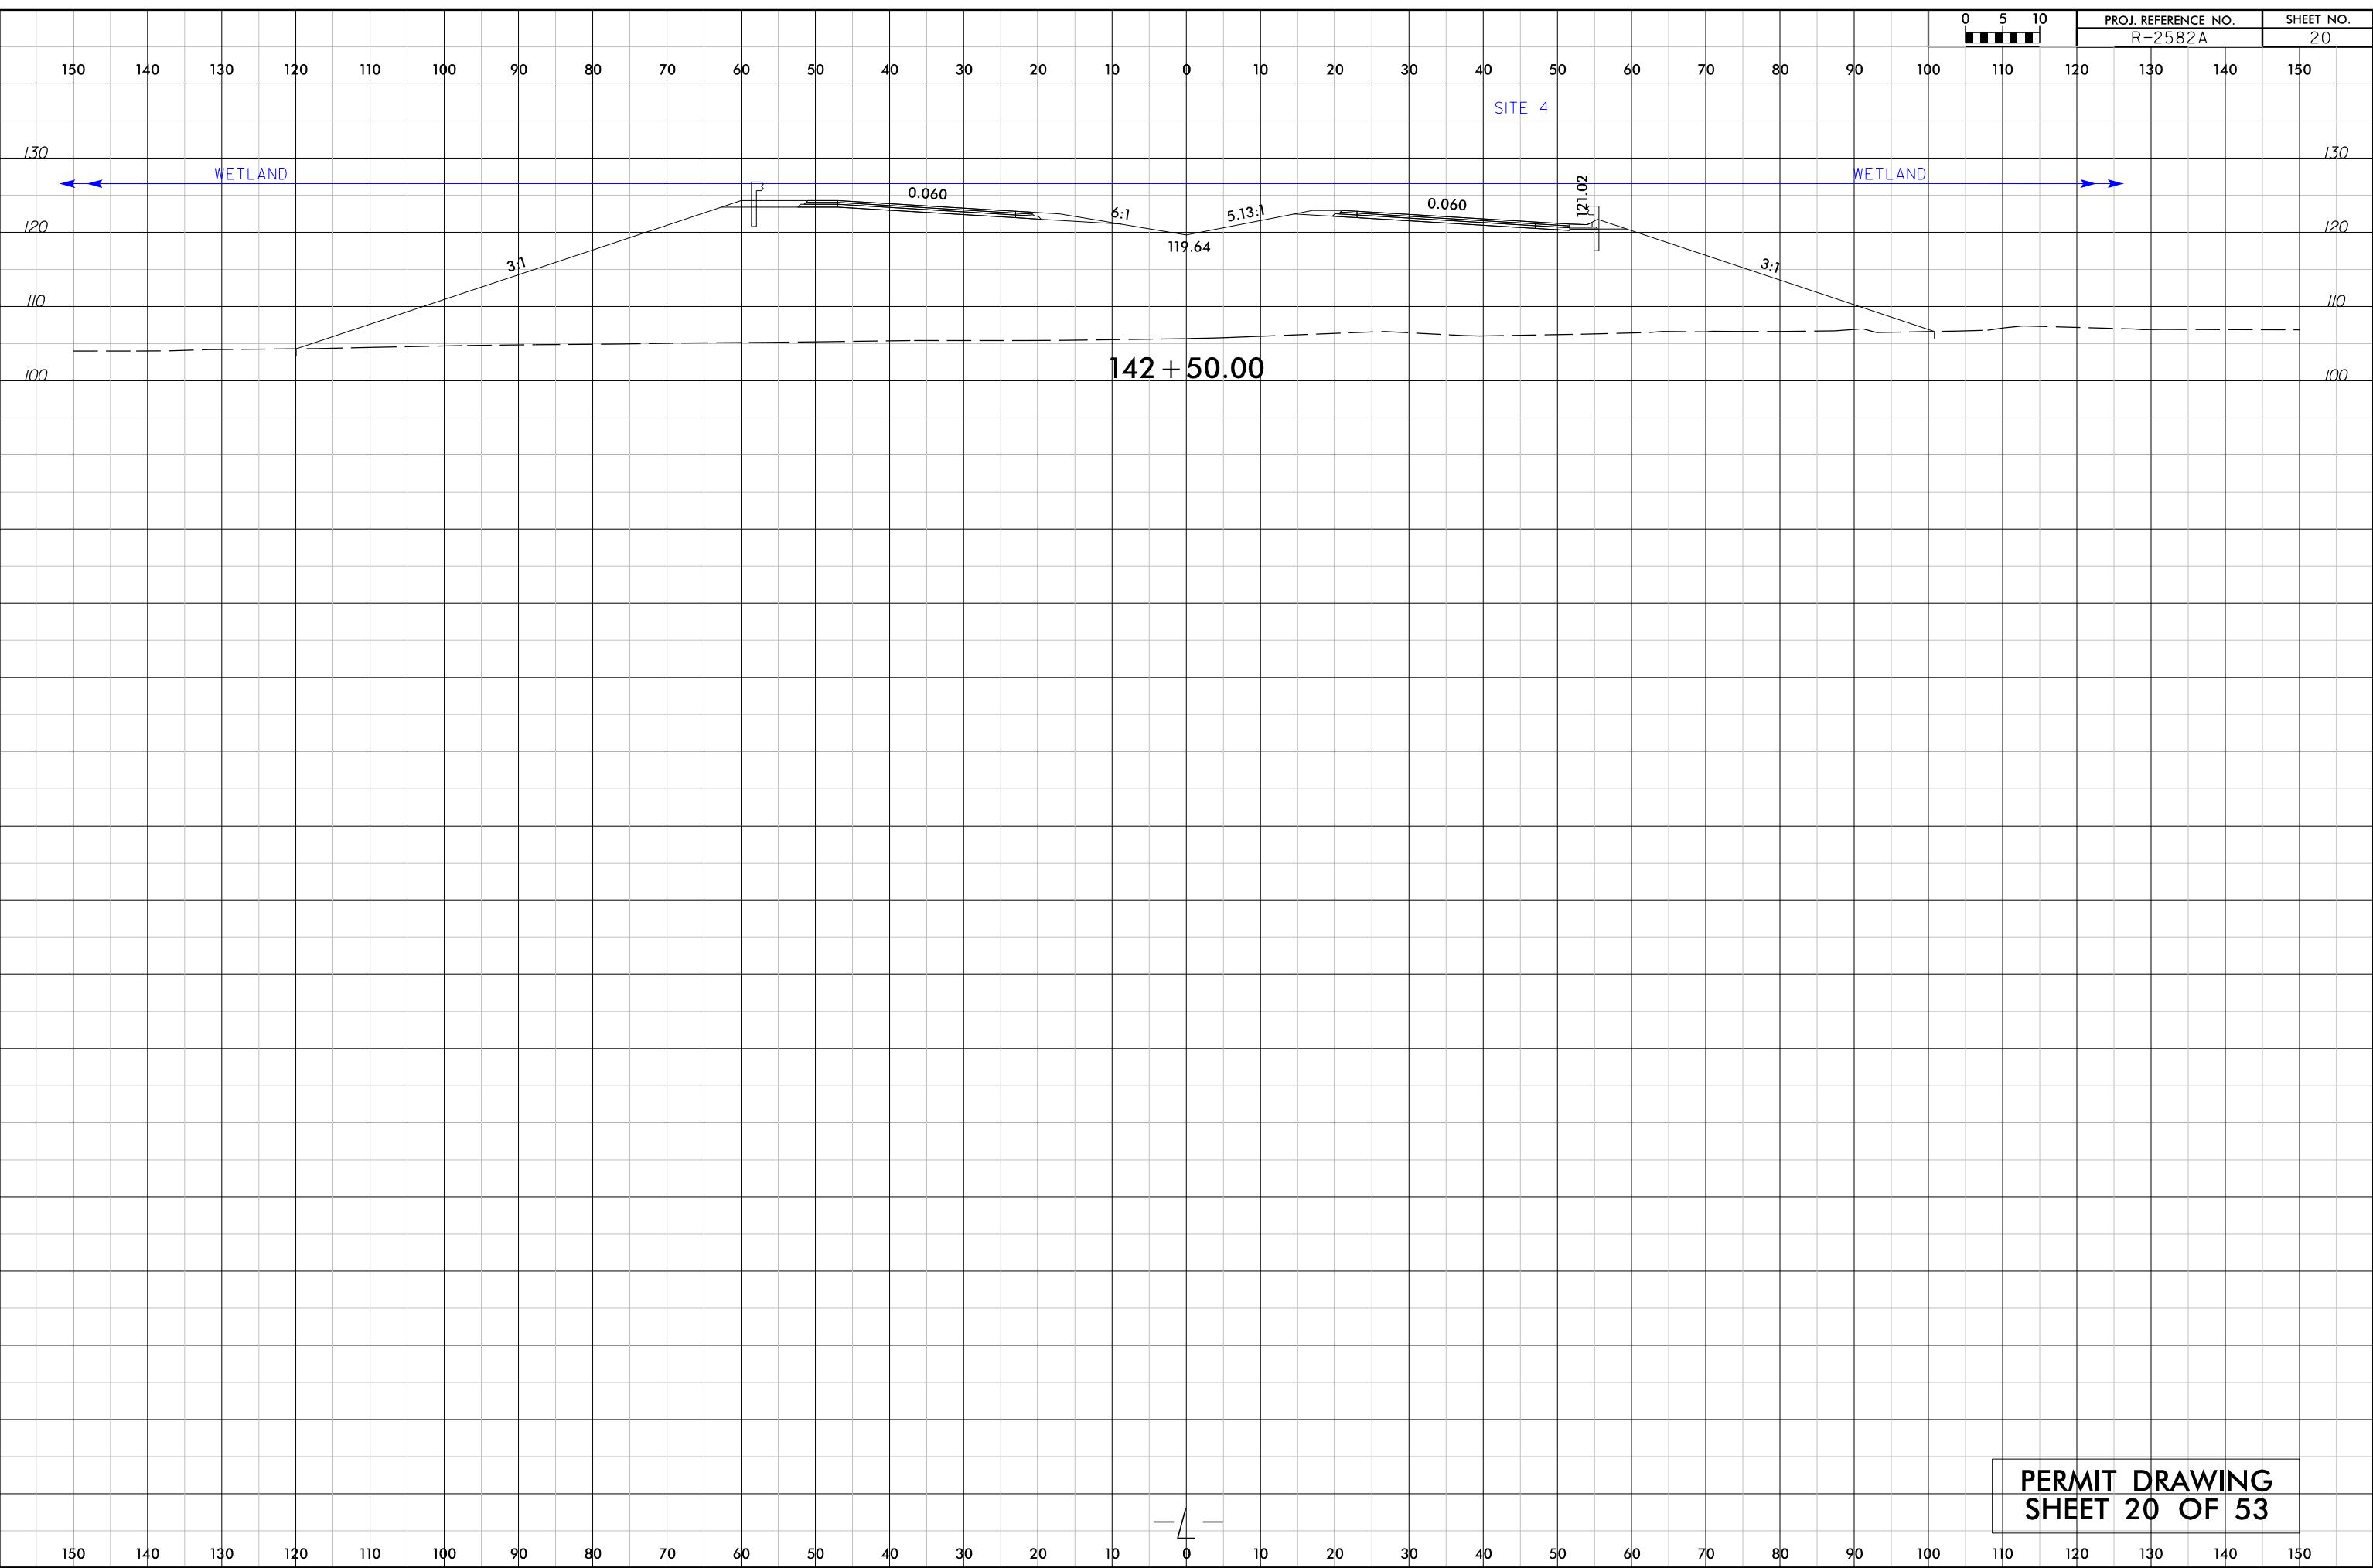


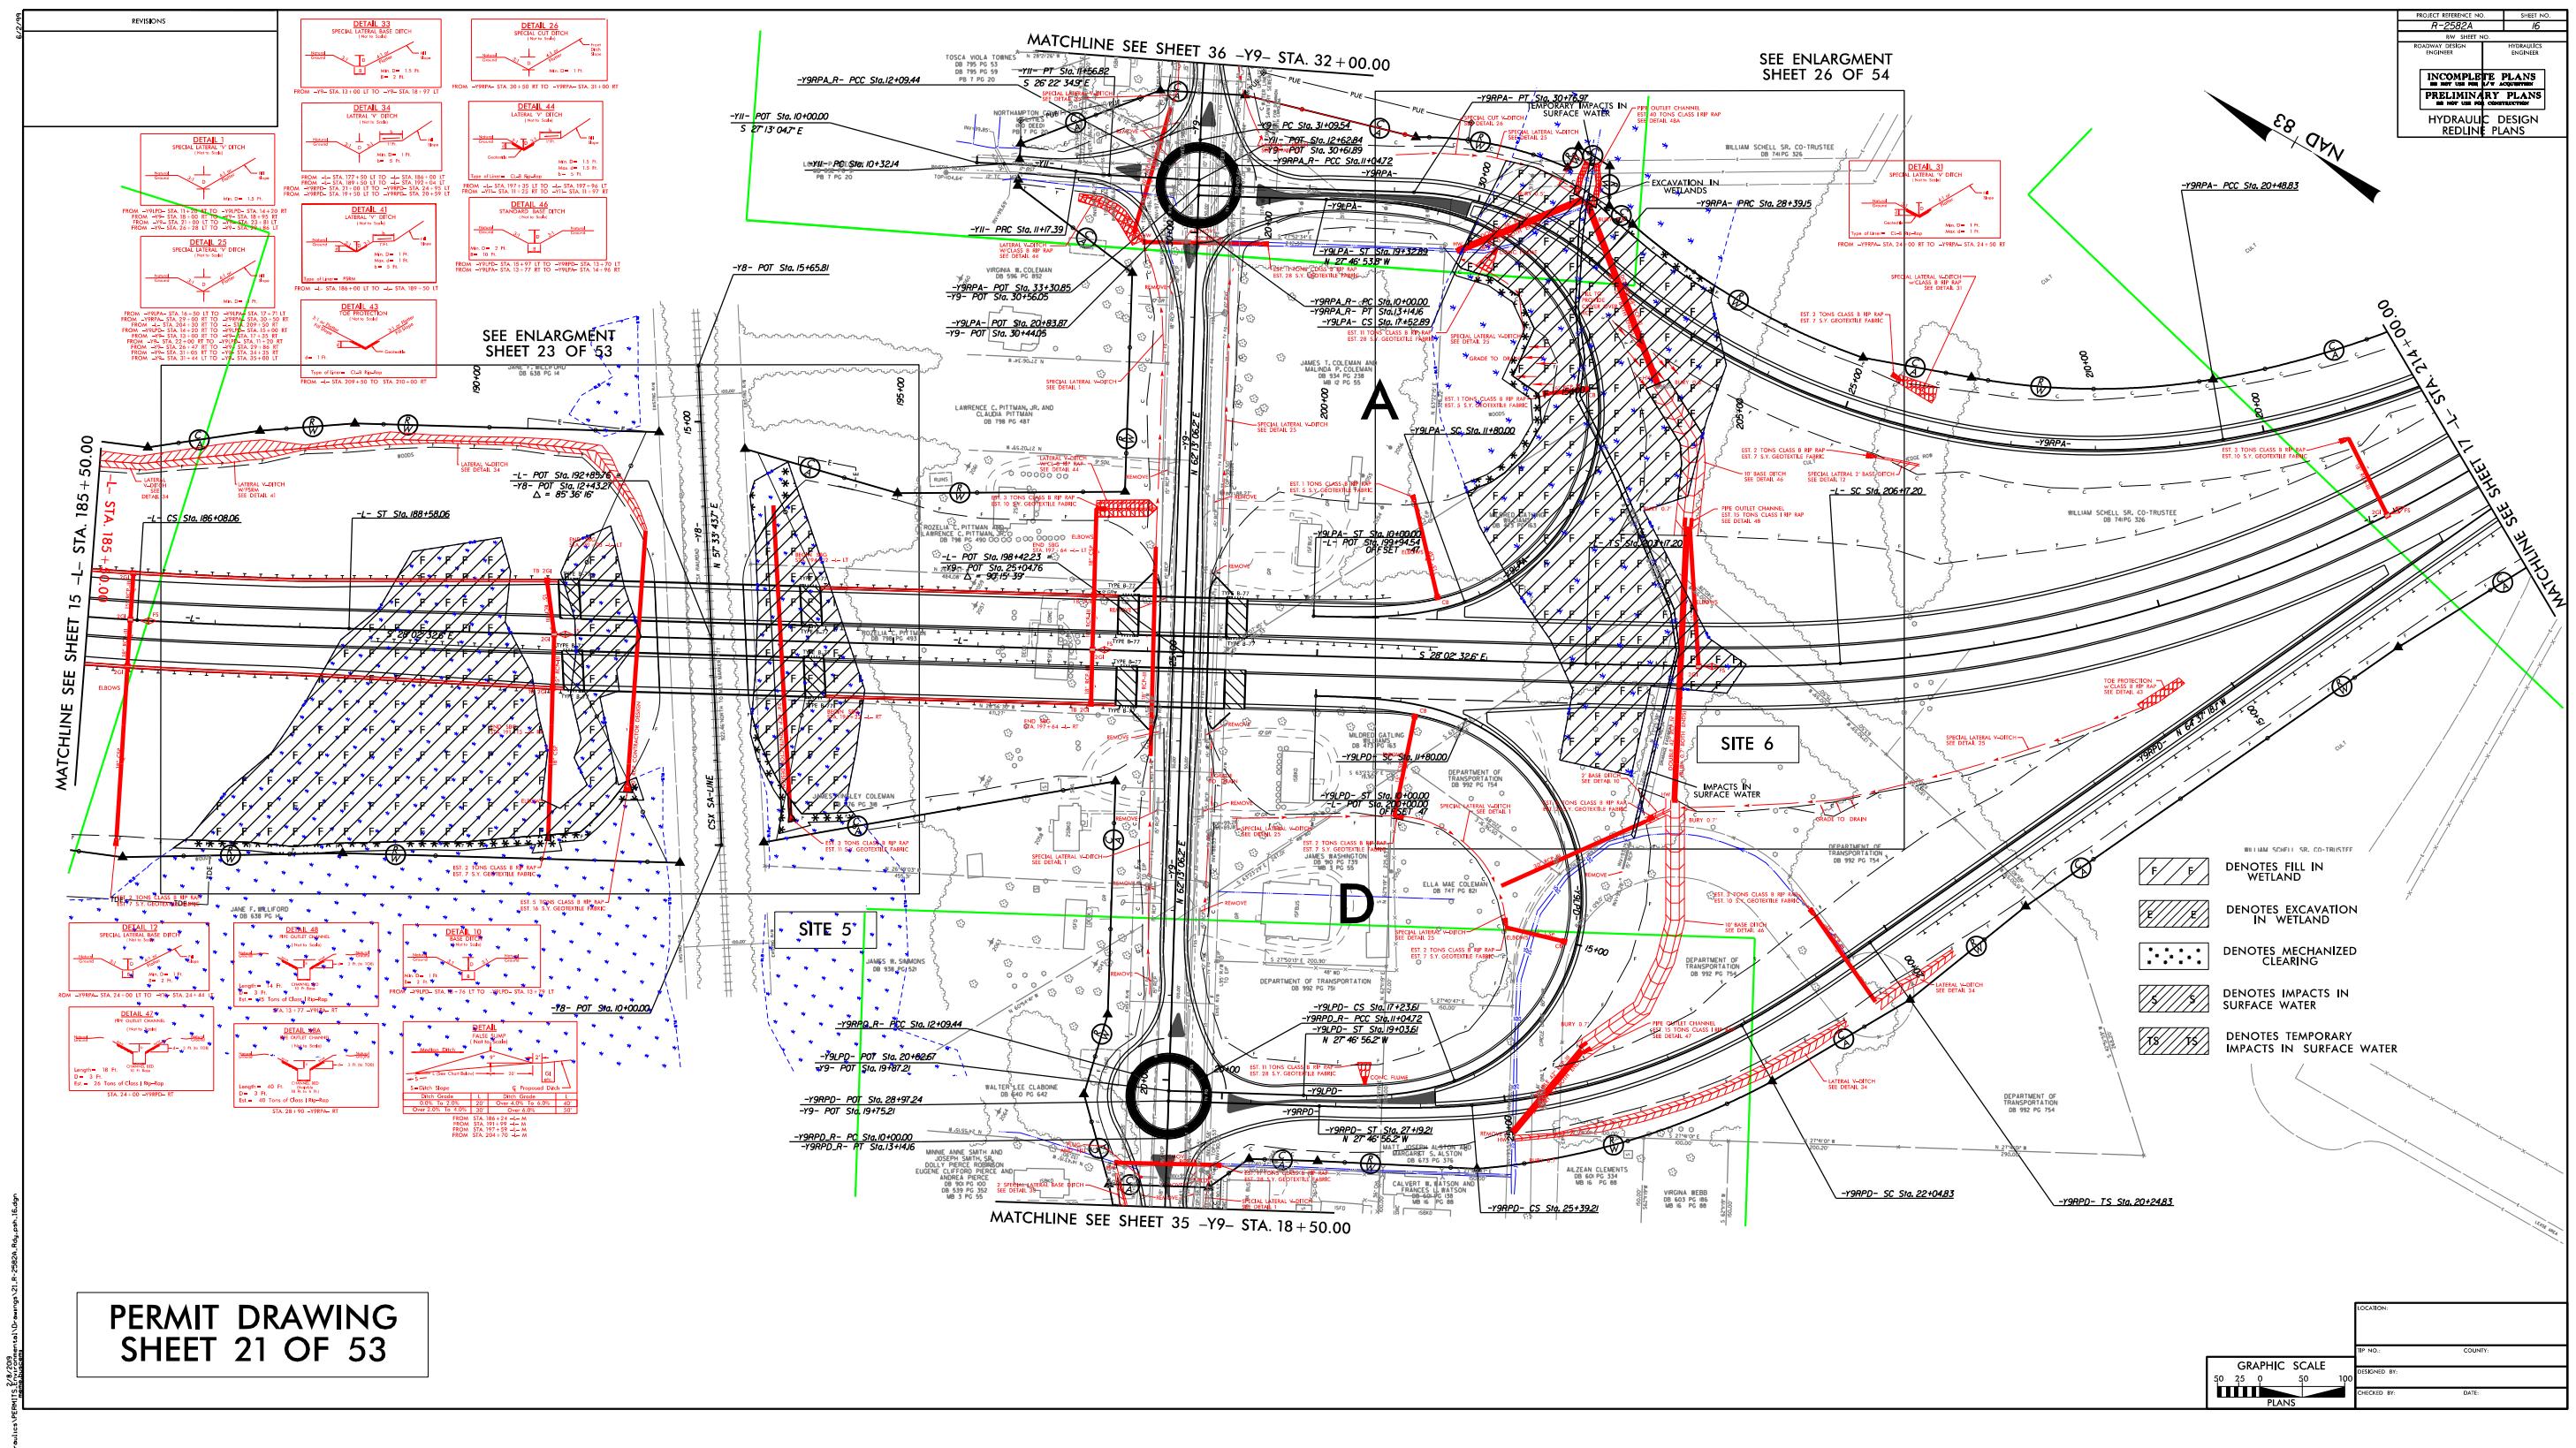

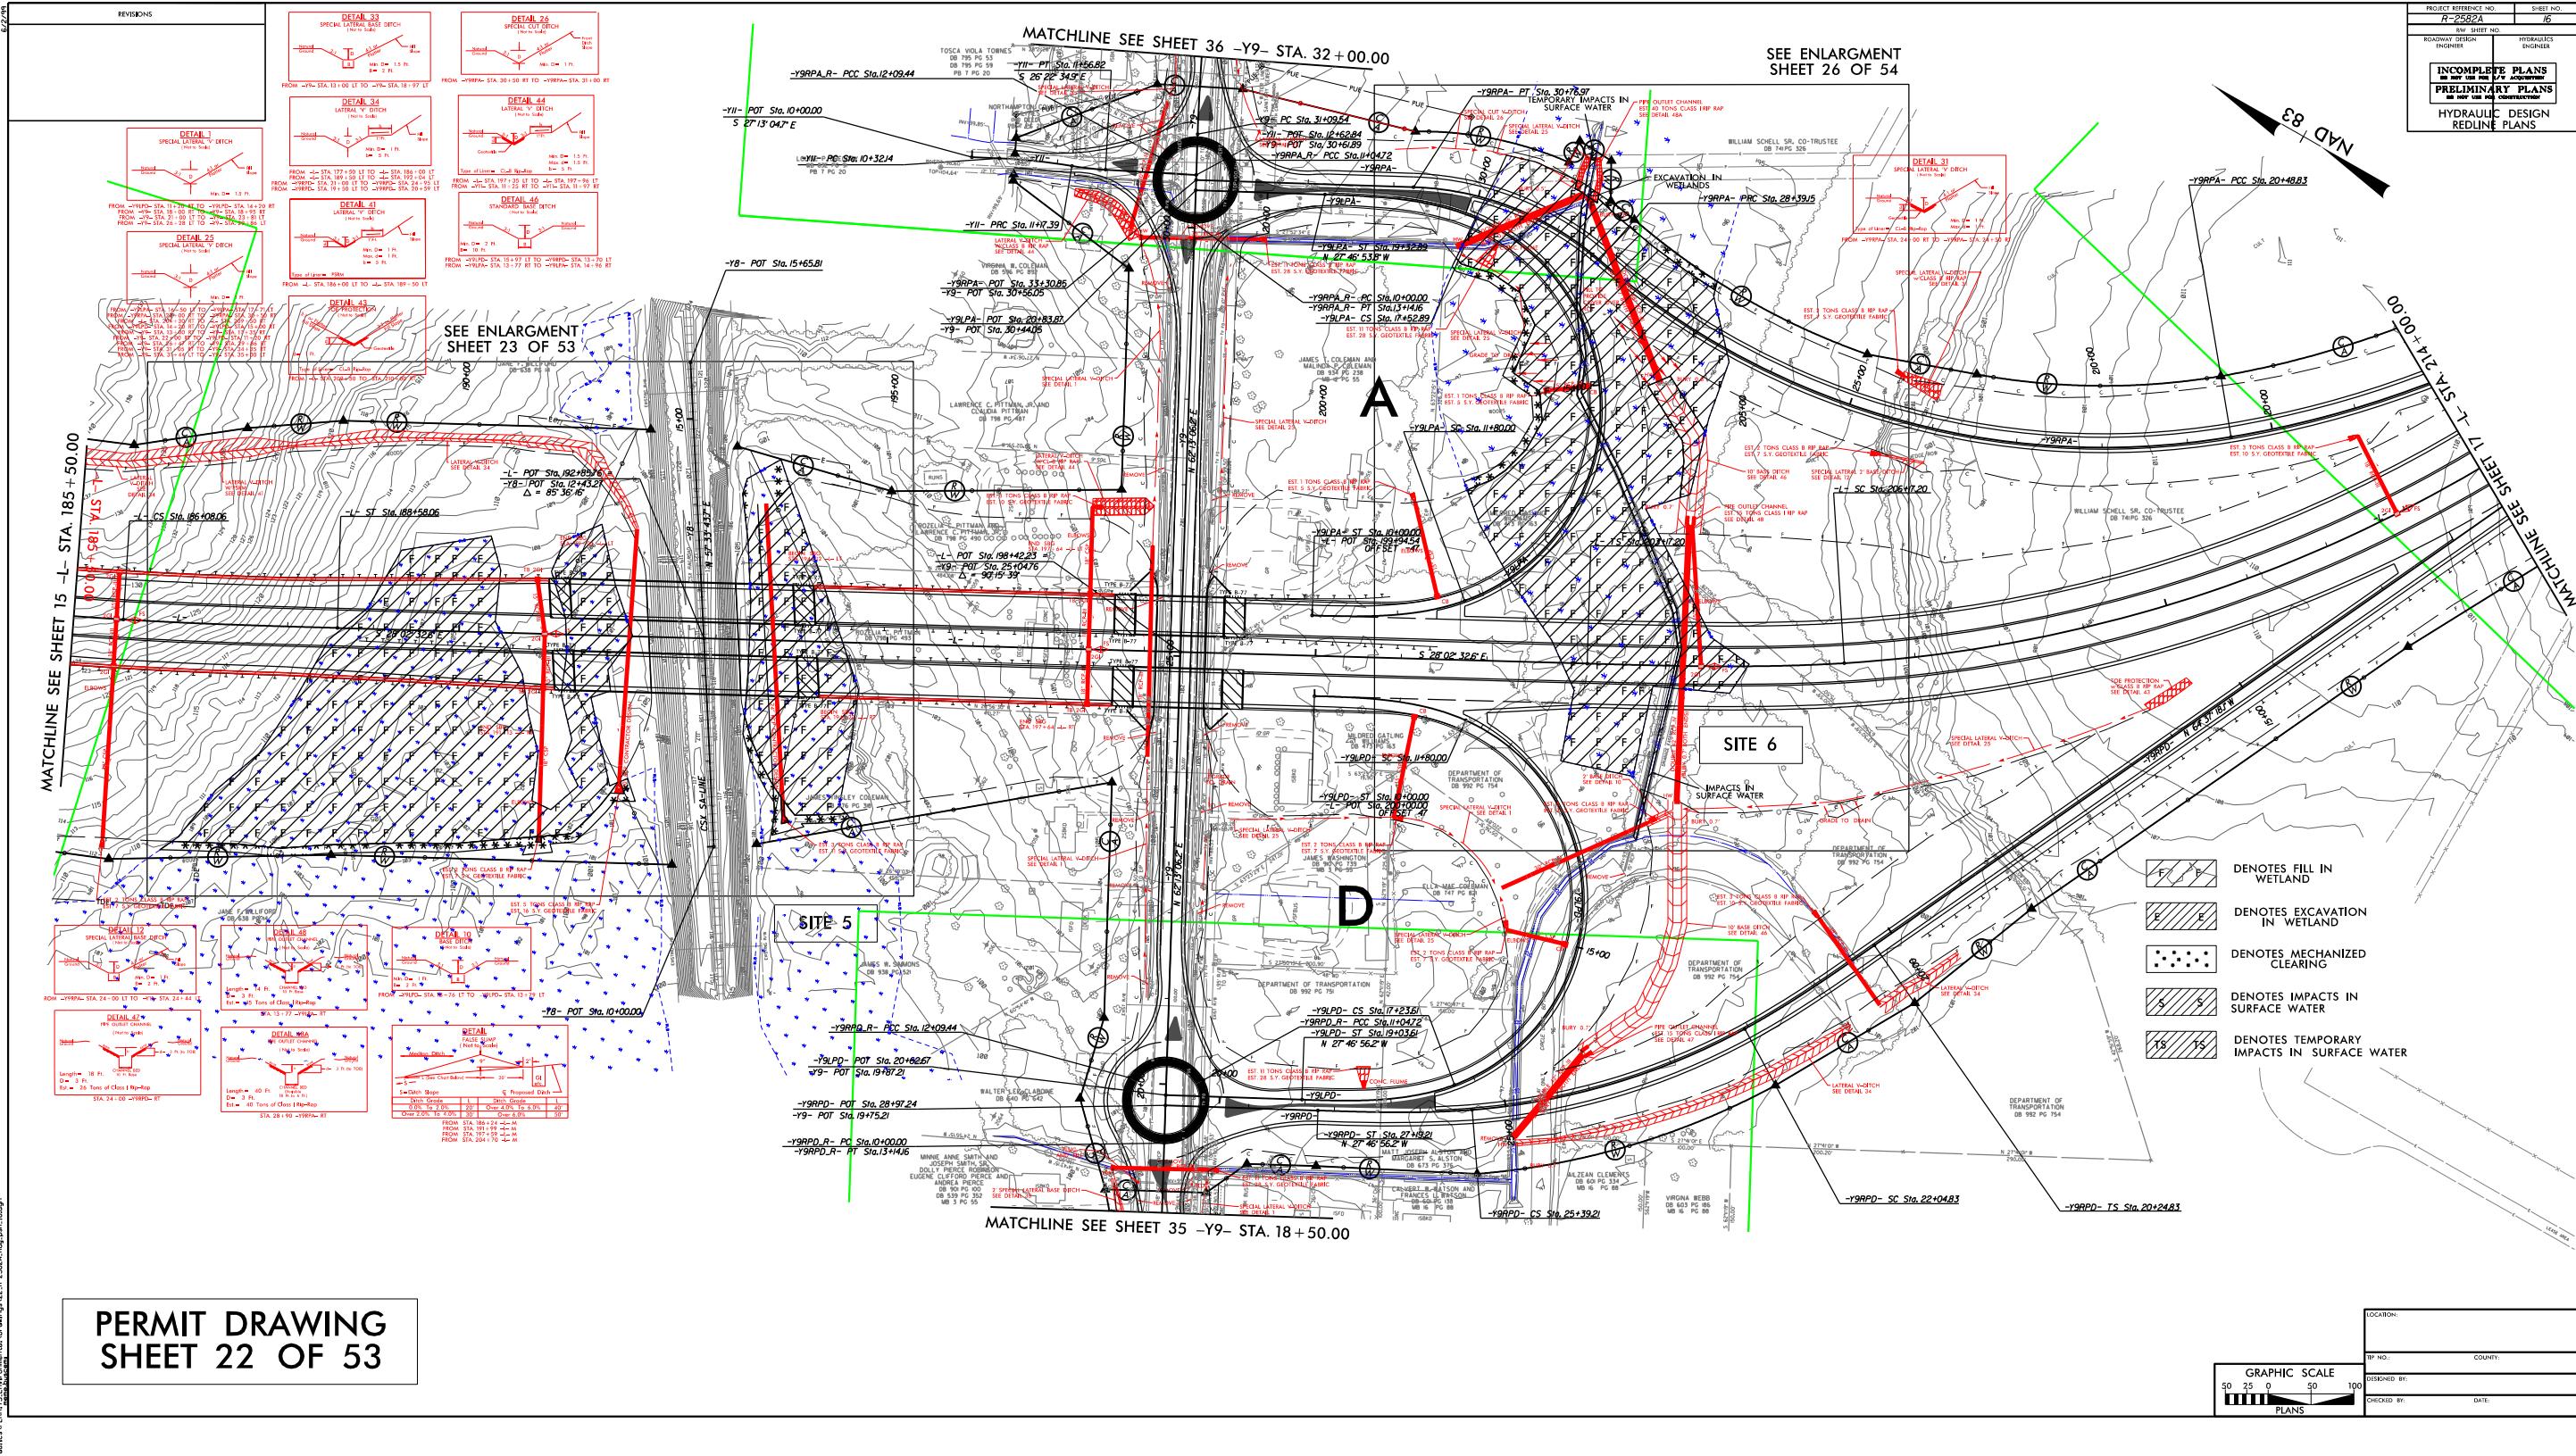

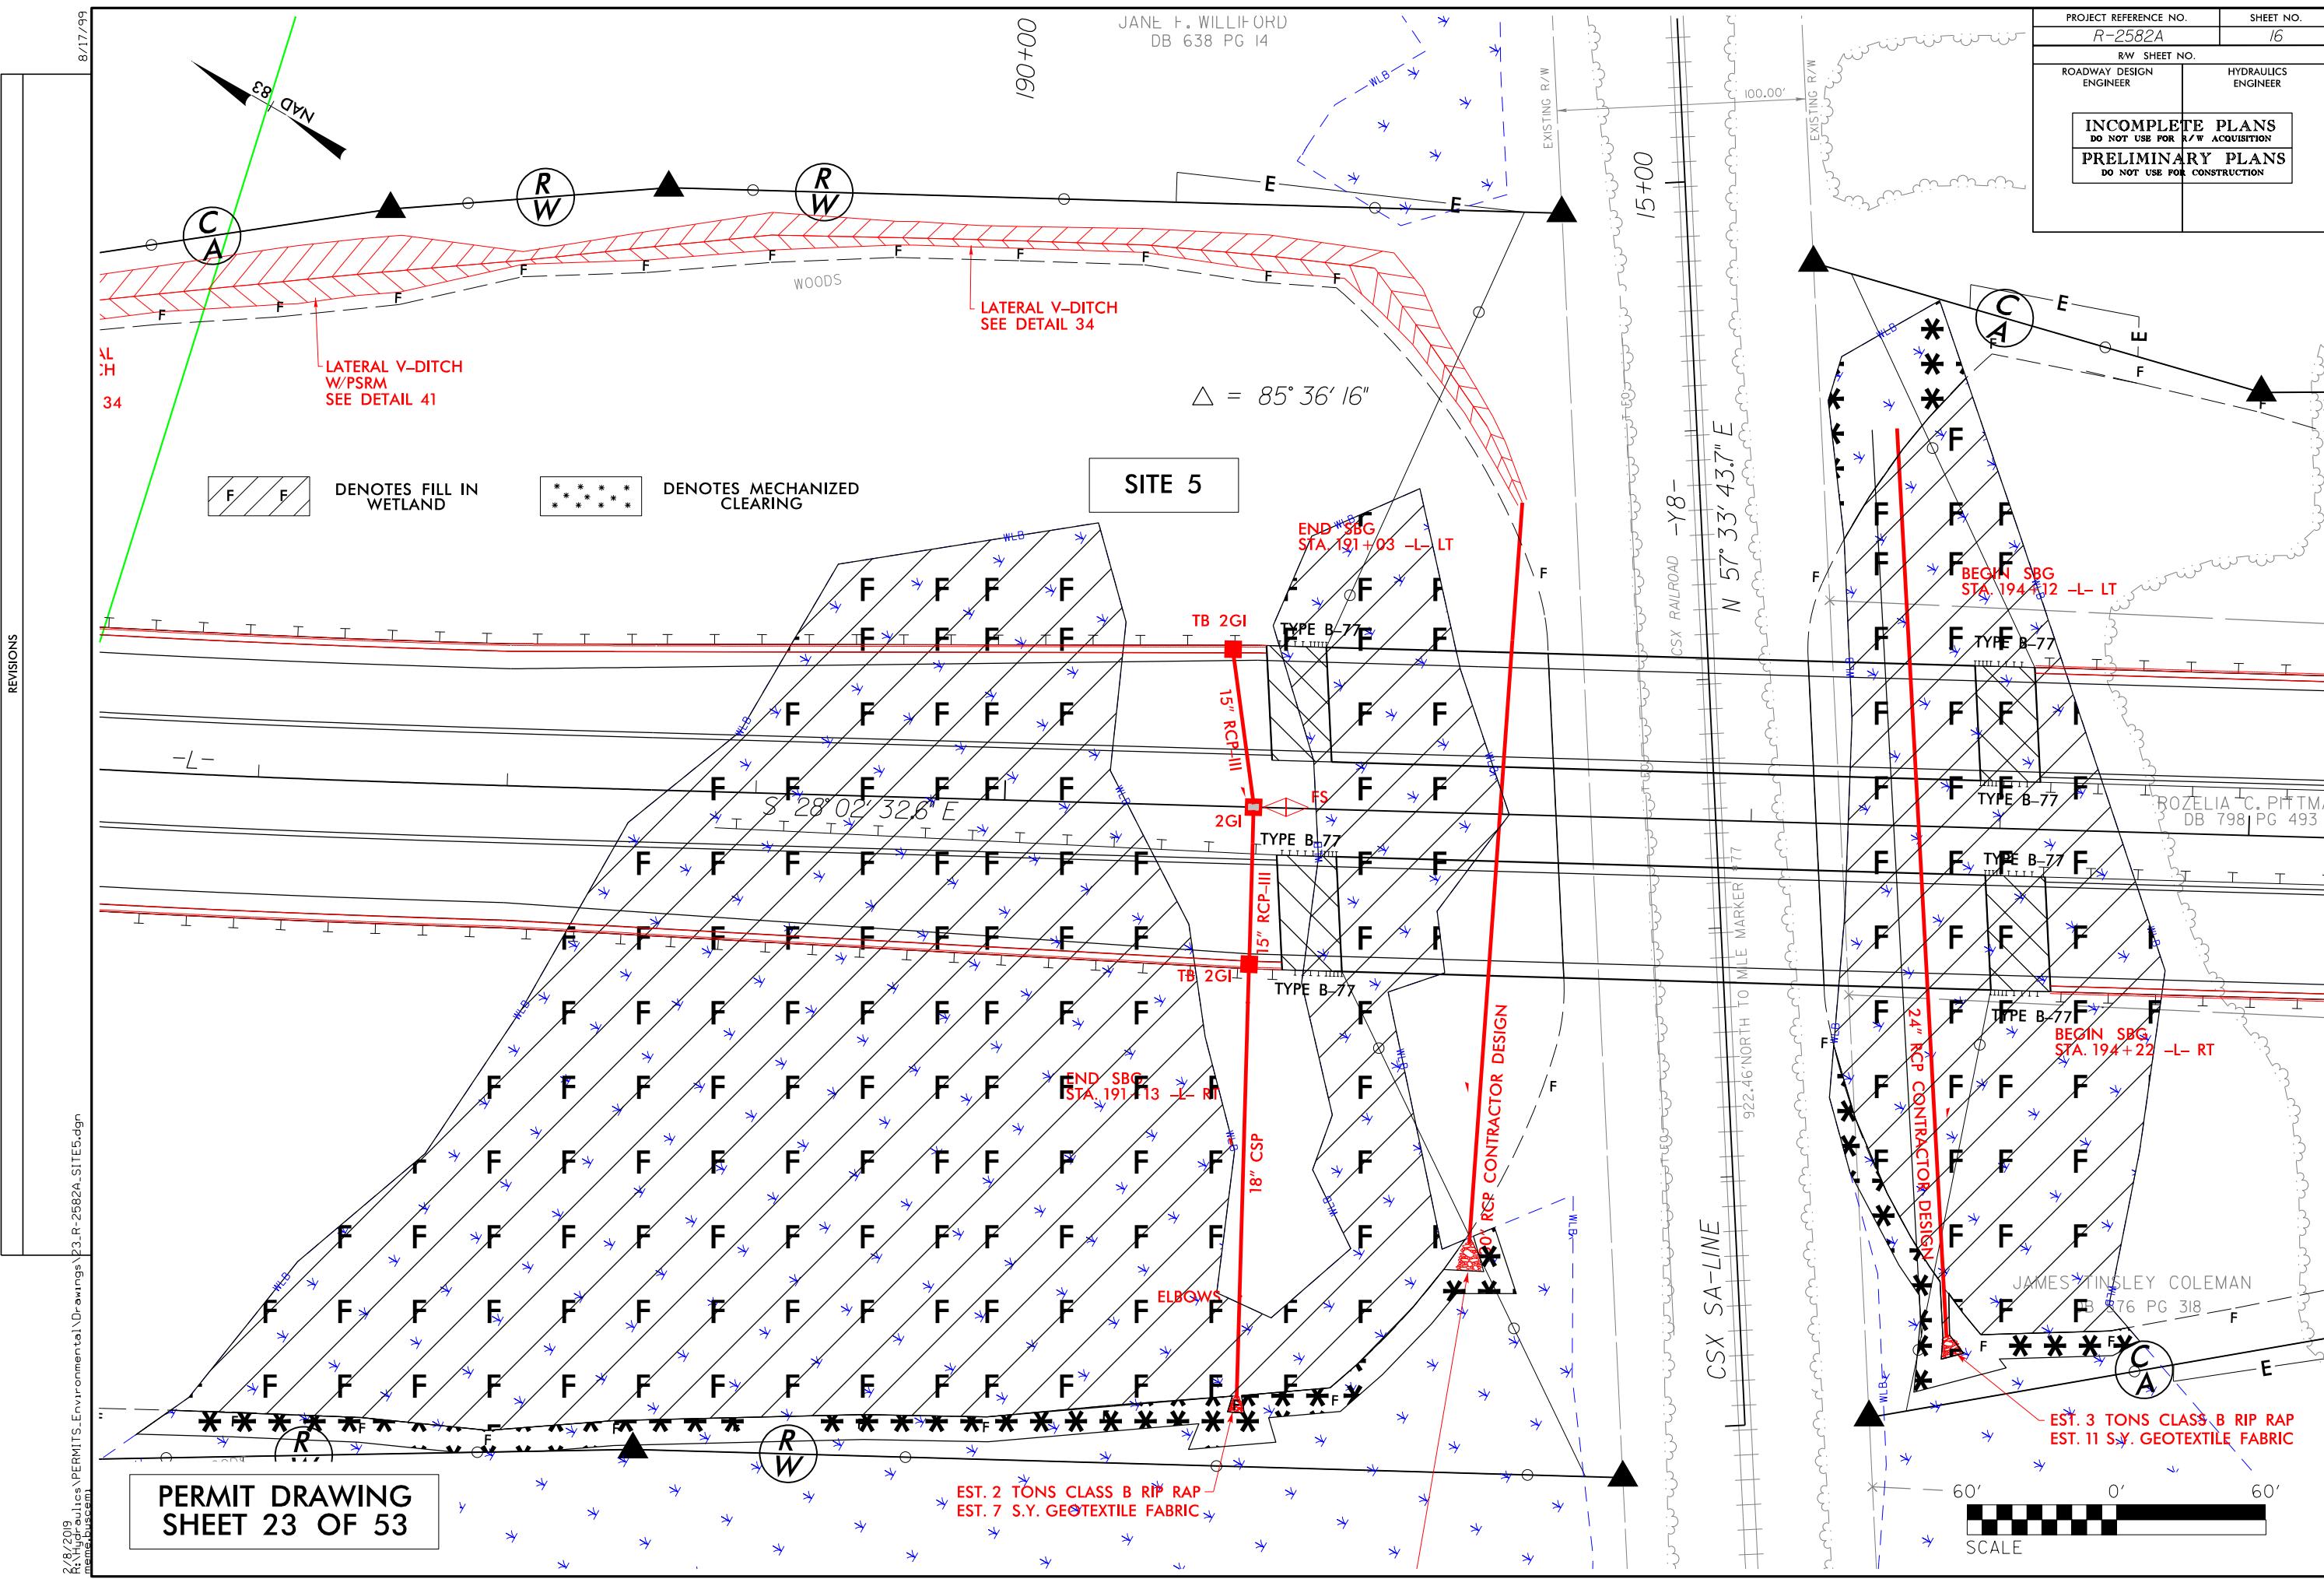

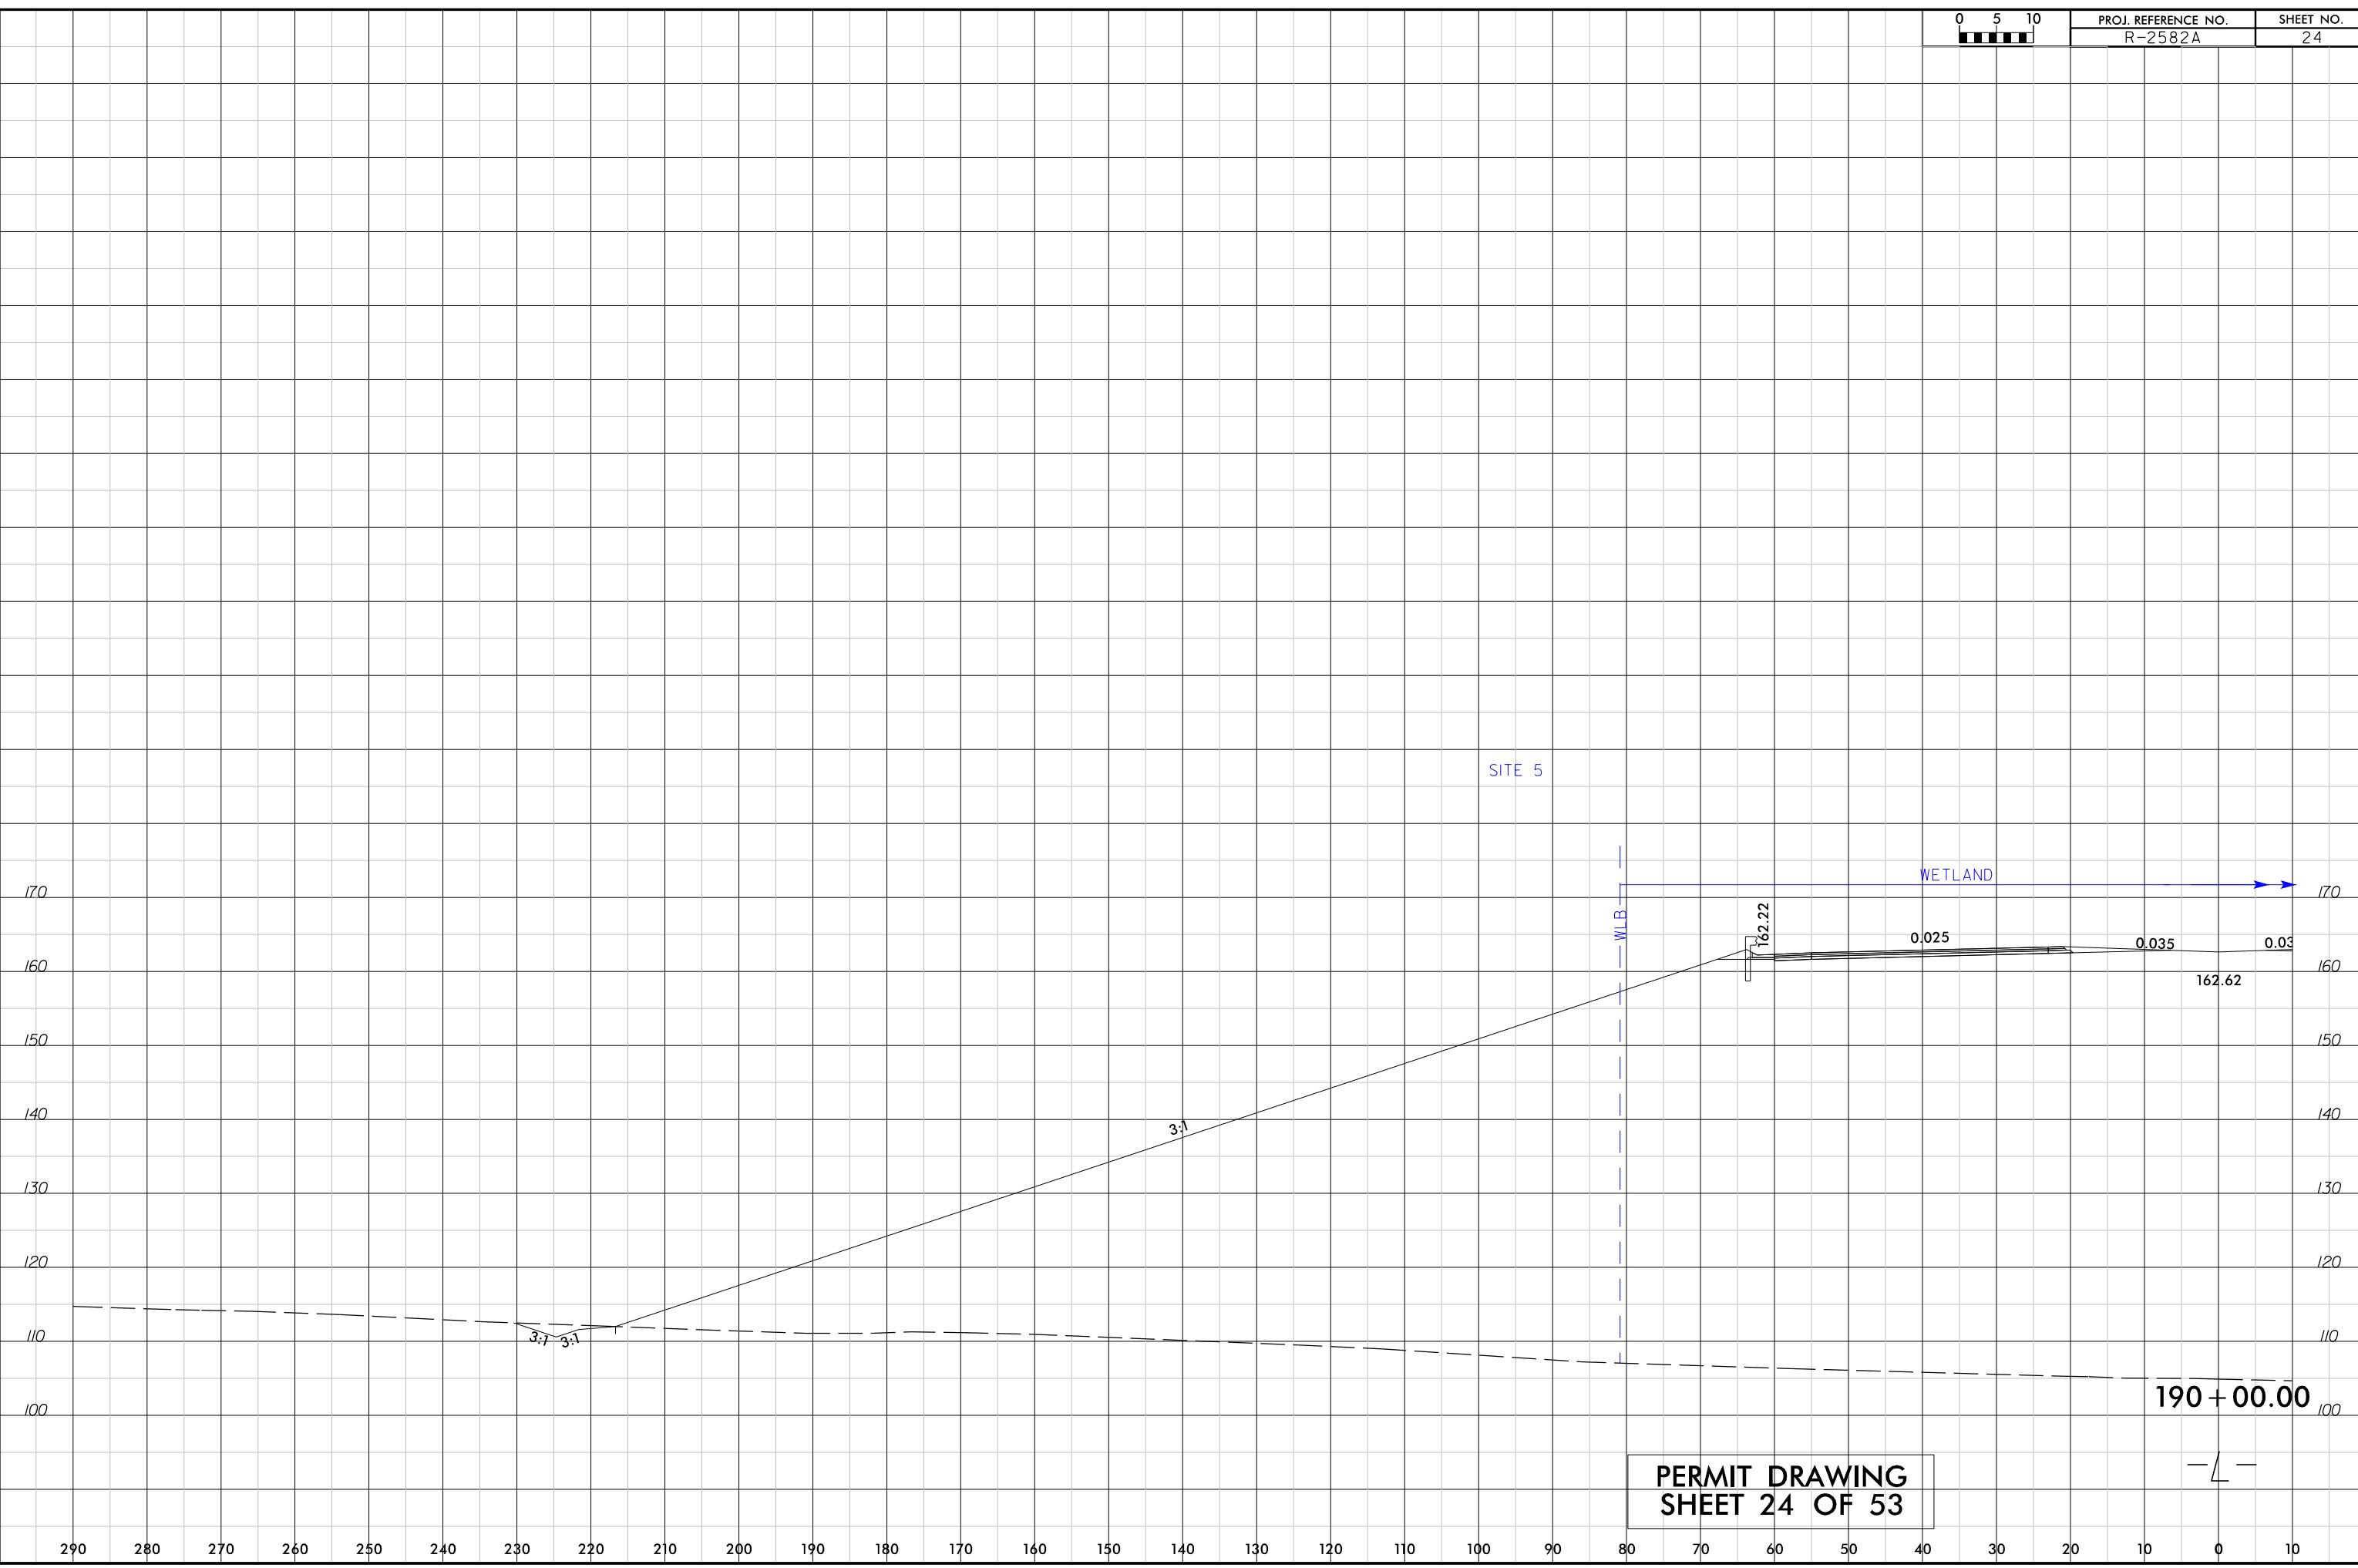

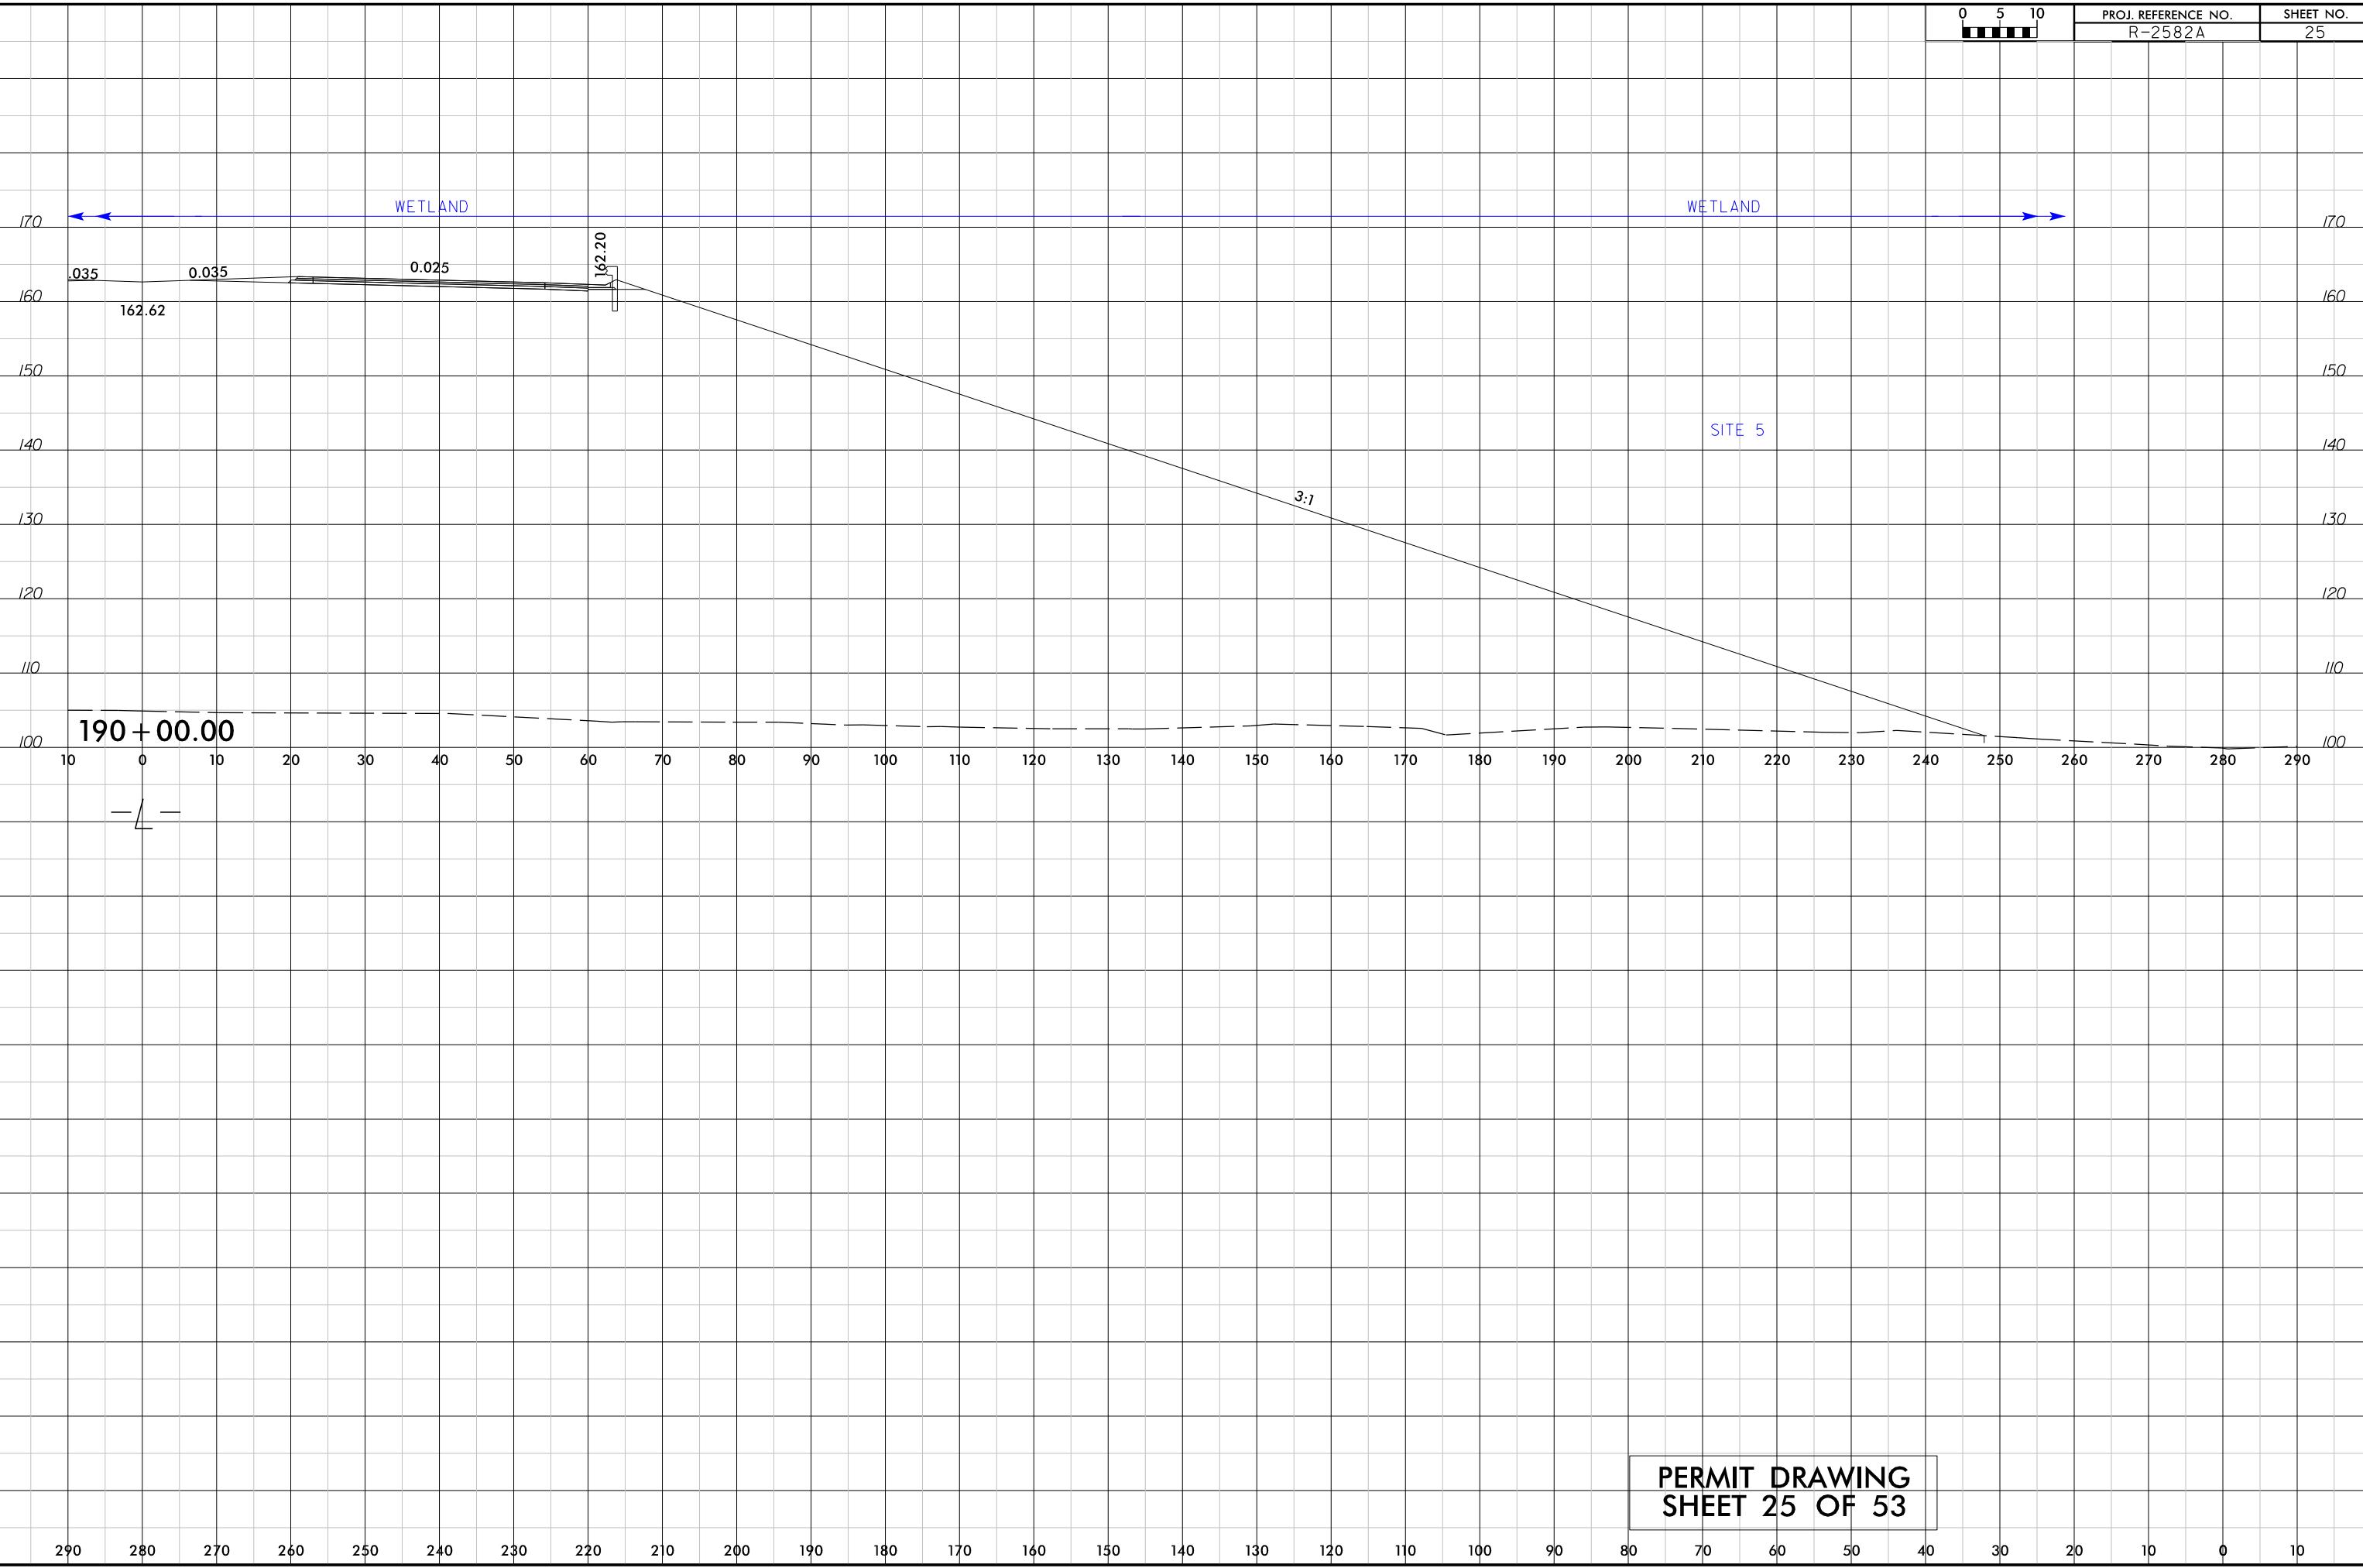



WETLAND


SITE 6


WETLAND

0.025

5.829:1  
6:1  
119.45

203 + 50.00

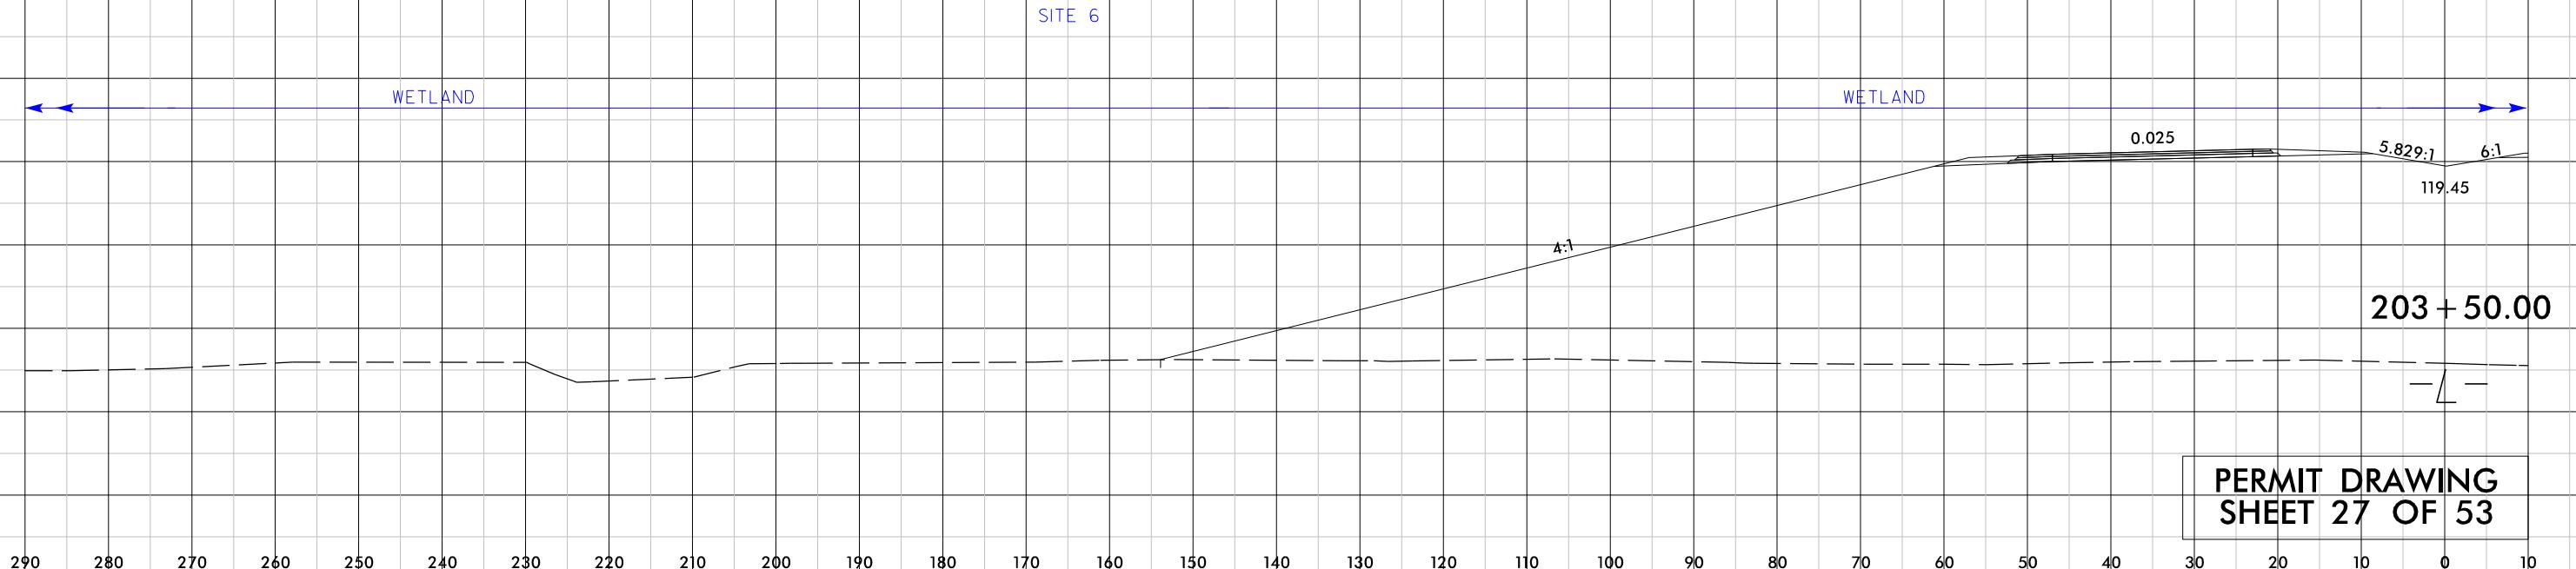
PERMIT DRAWING  
SHEET 27 OF 53

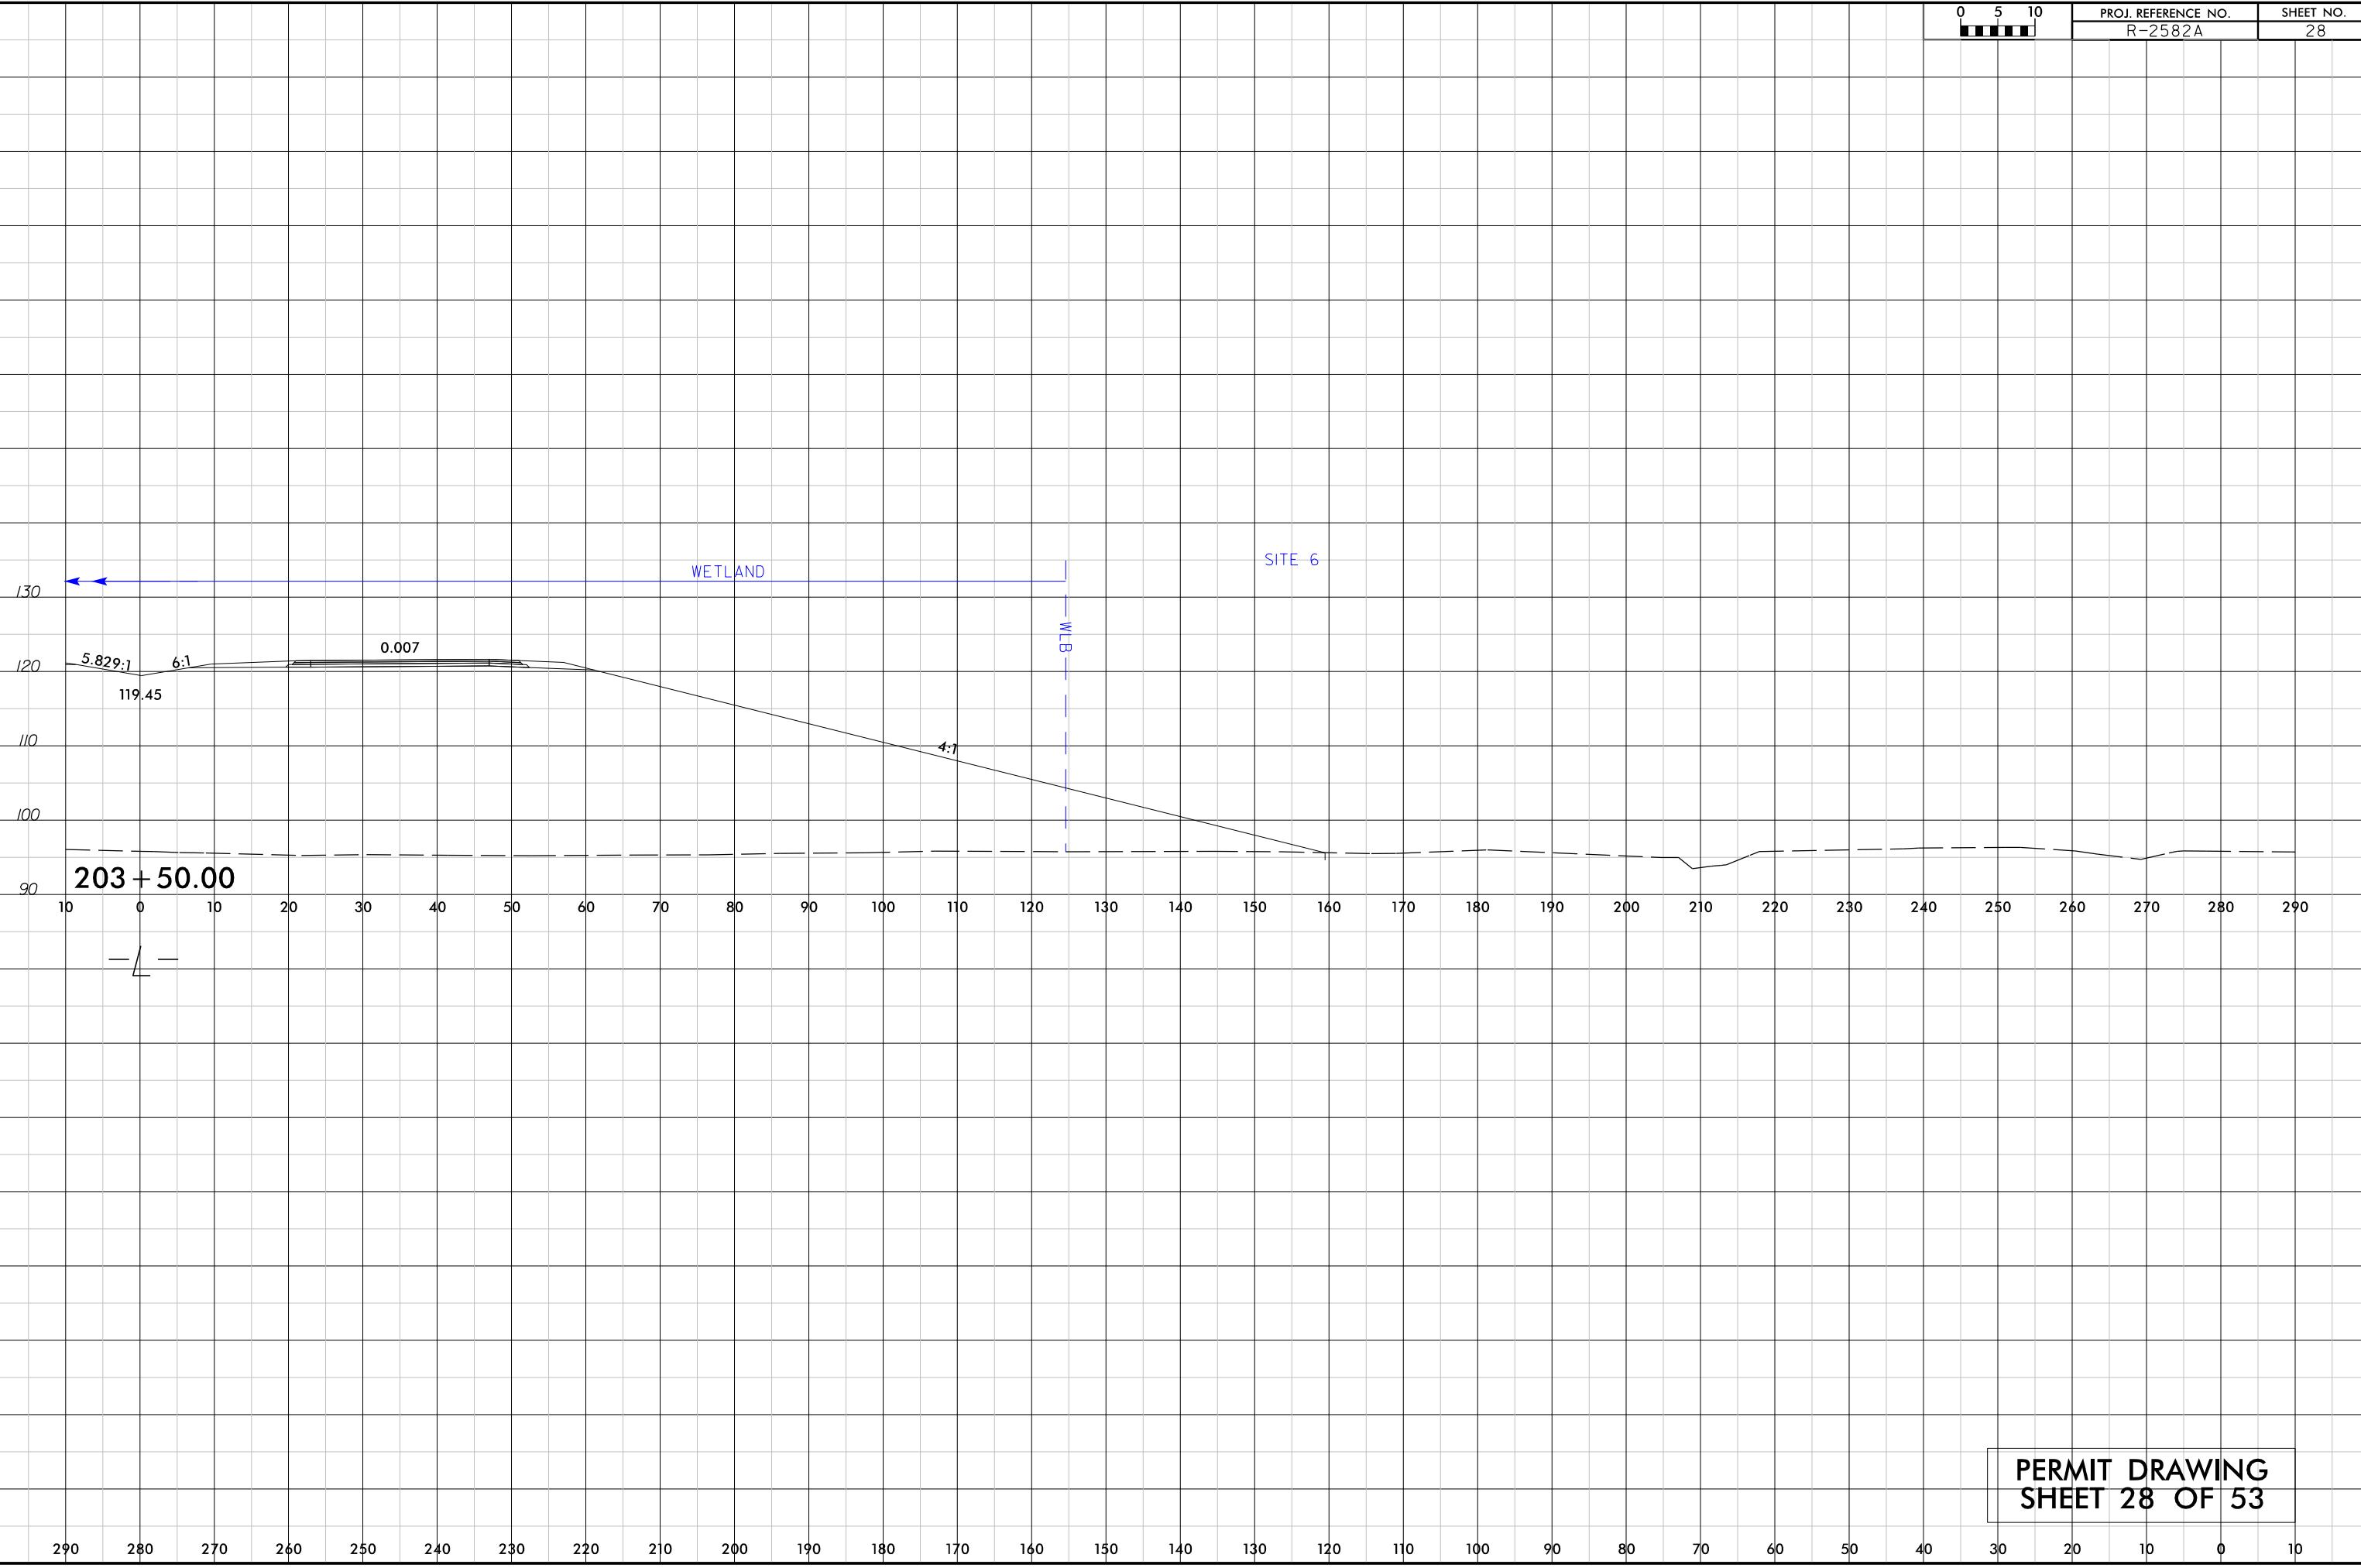


PERMIT DRAWING  
SHEET 28 OF 53

8/17/99


MATCHLINE SEE SHEET 18 -L- STA. 240 + 50.00

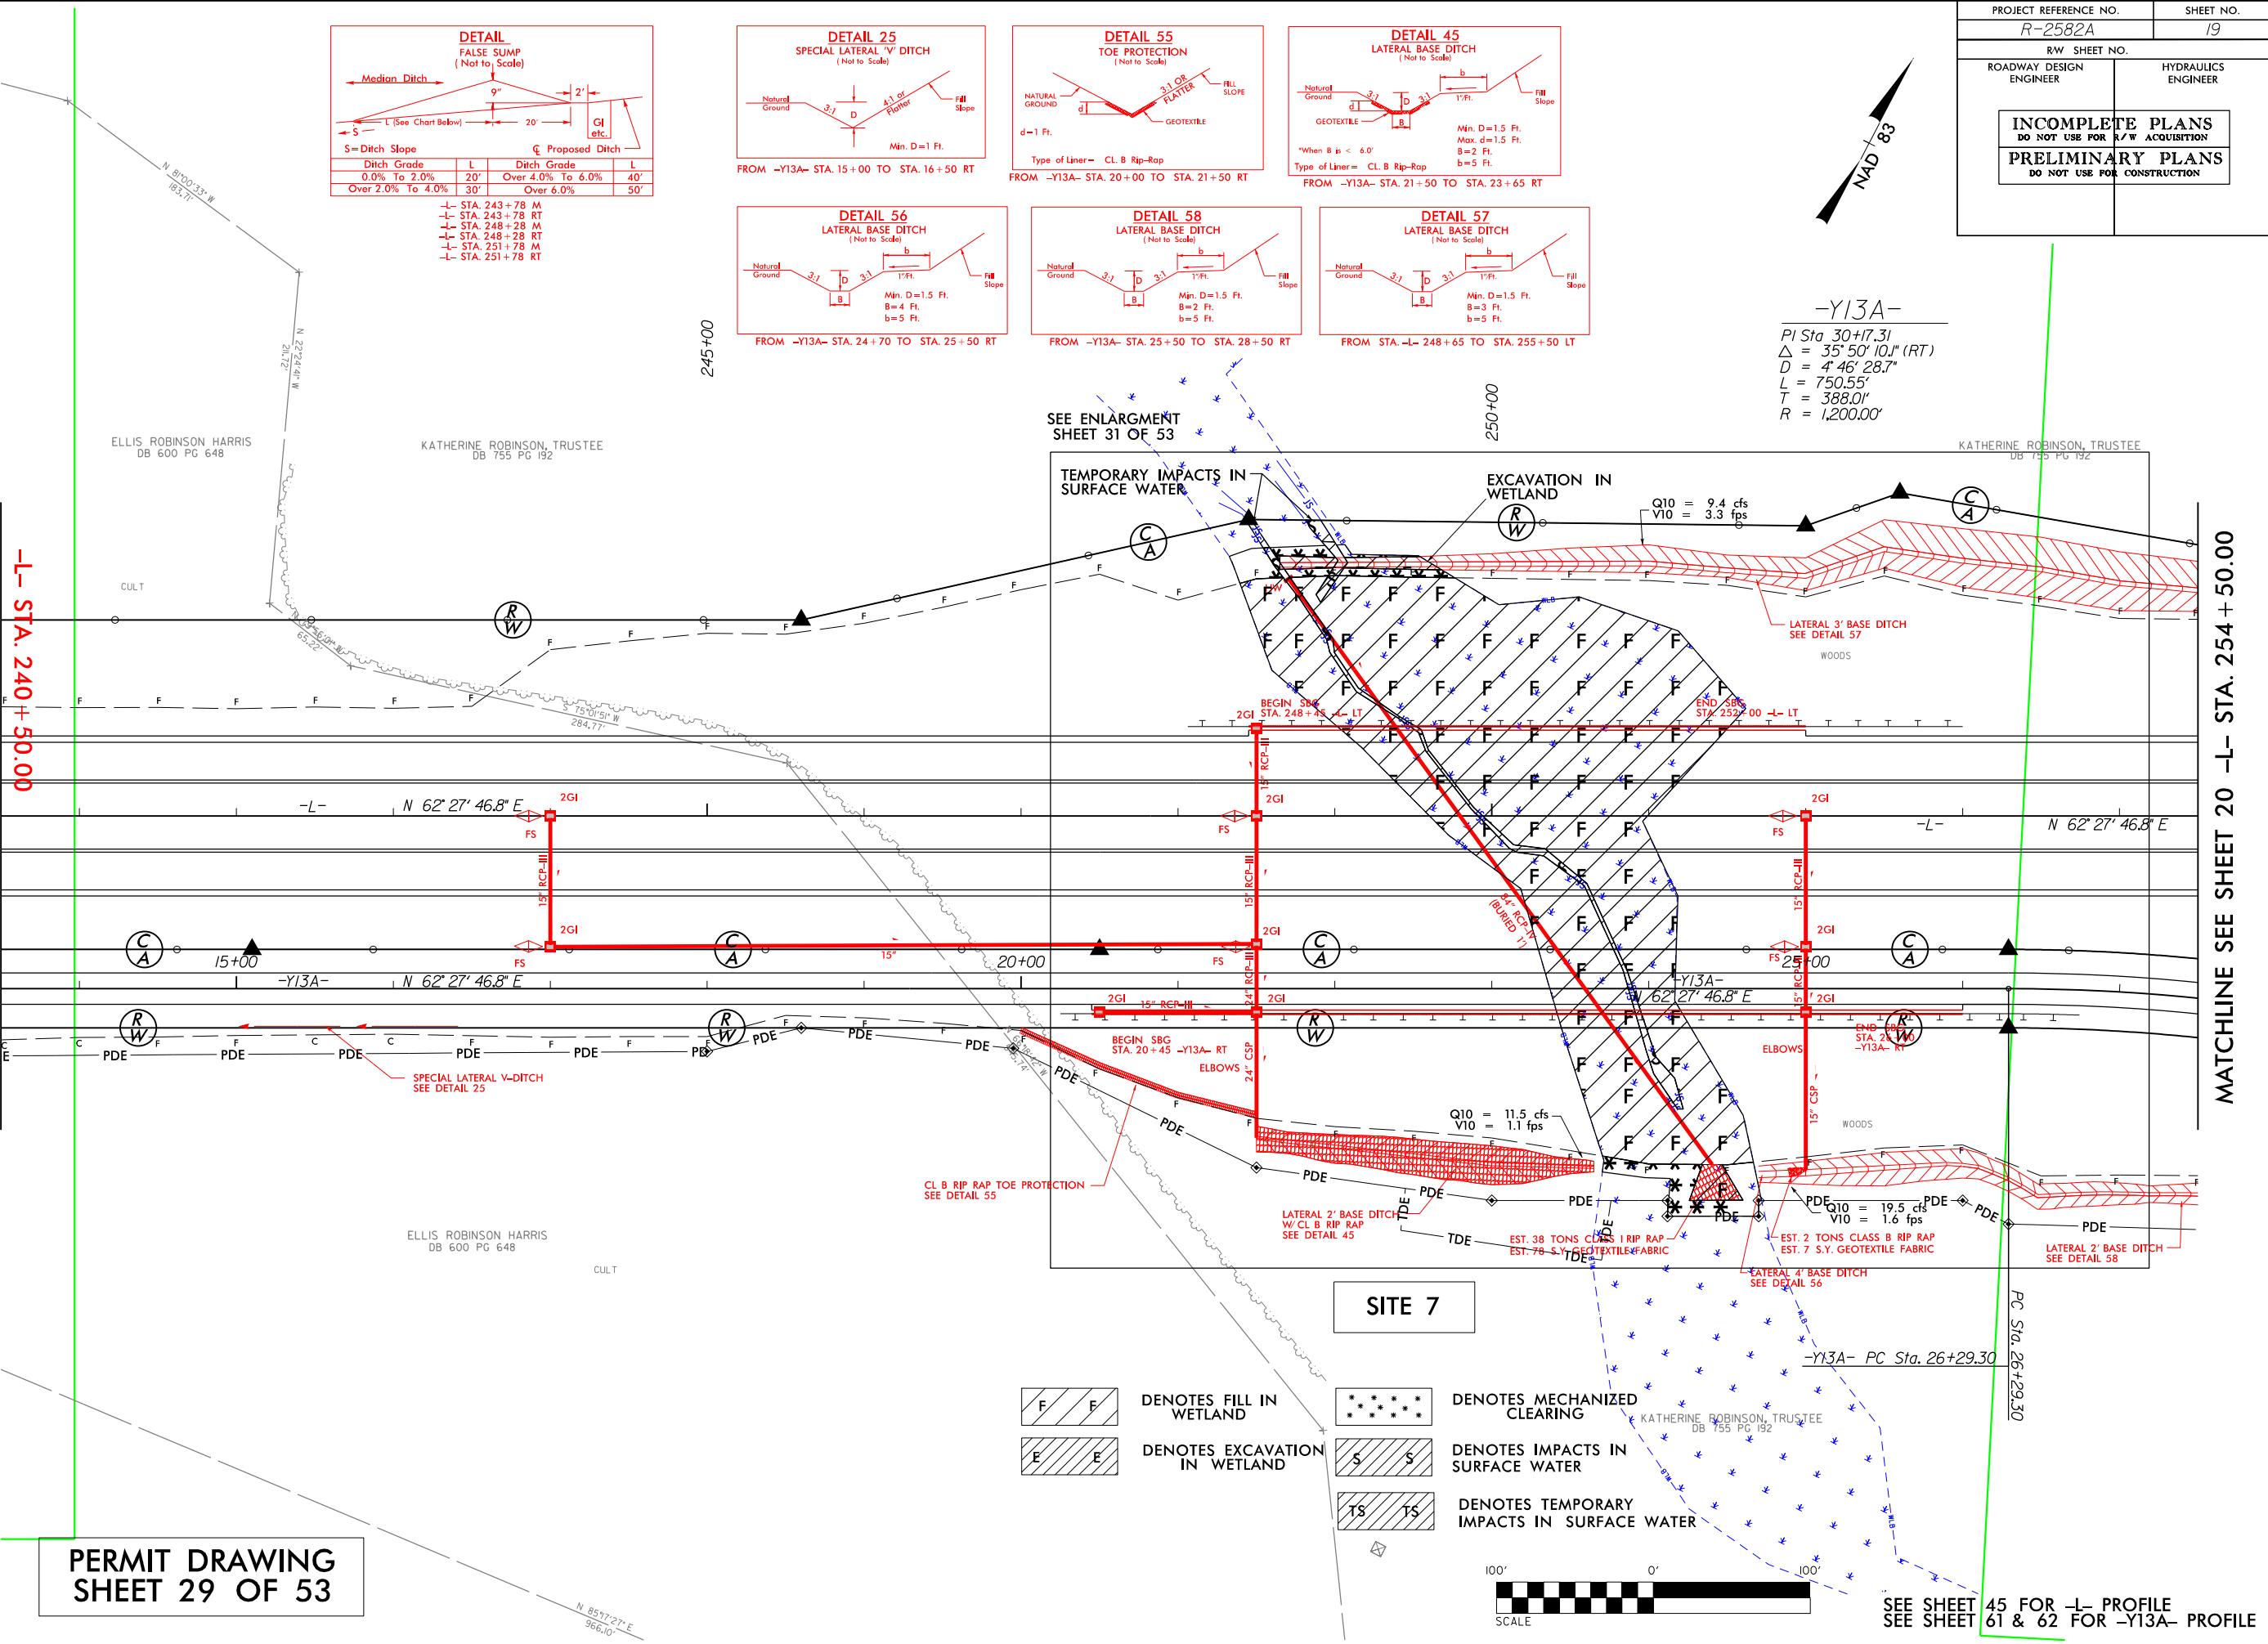



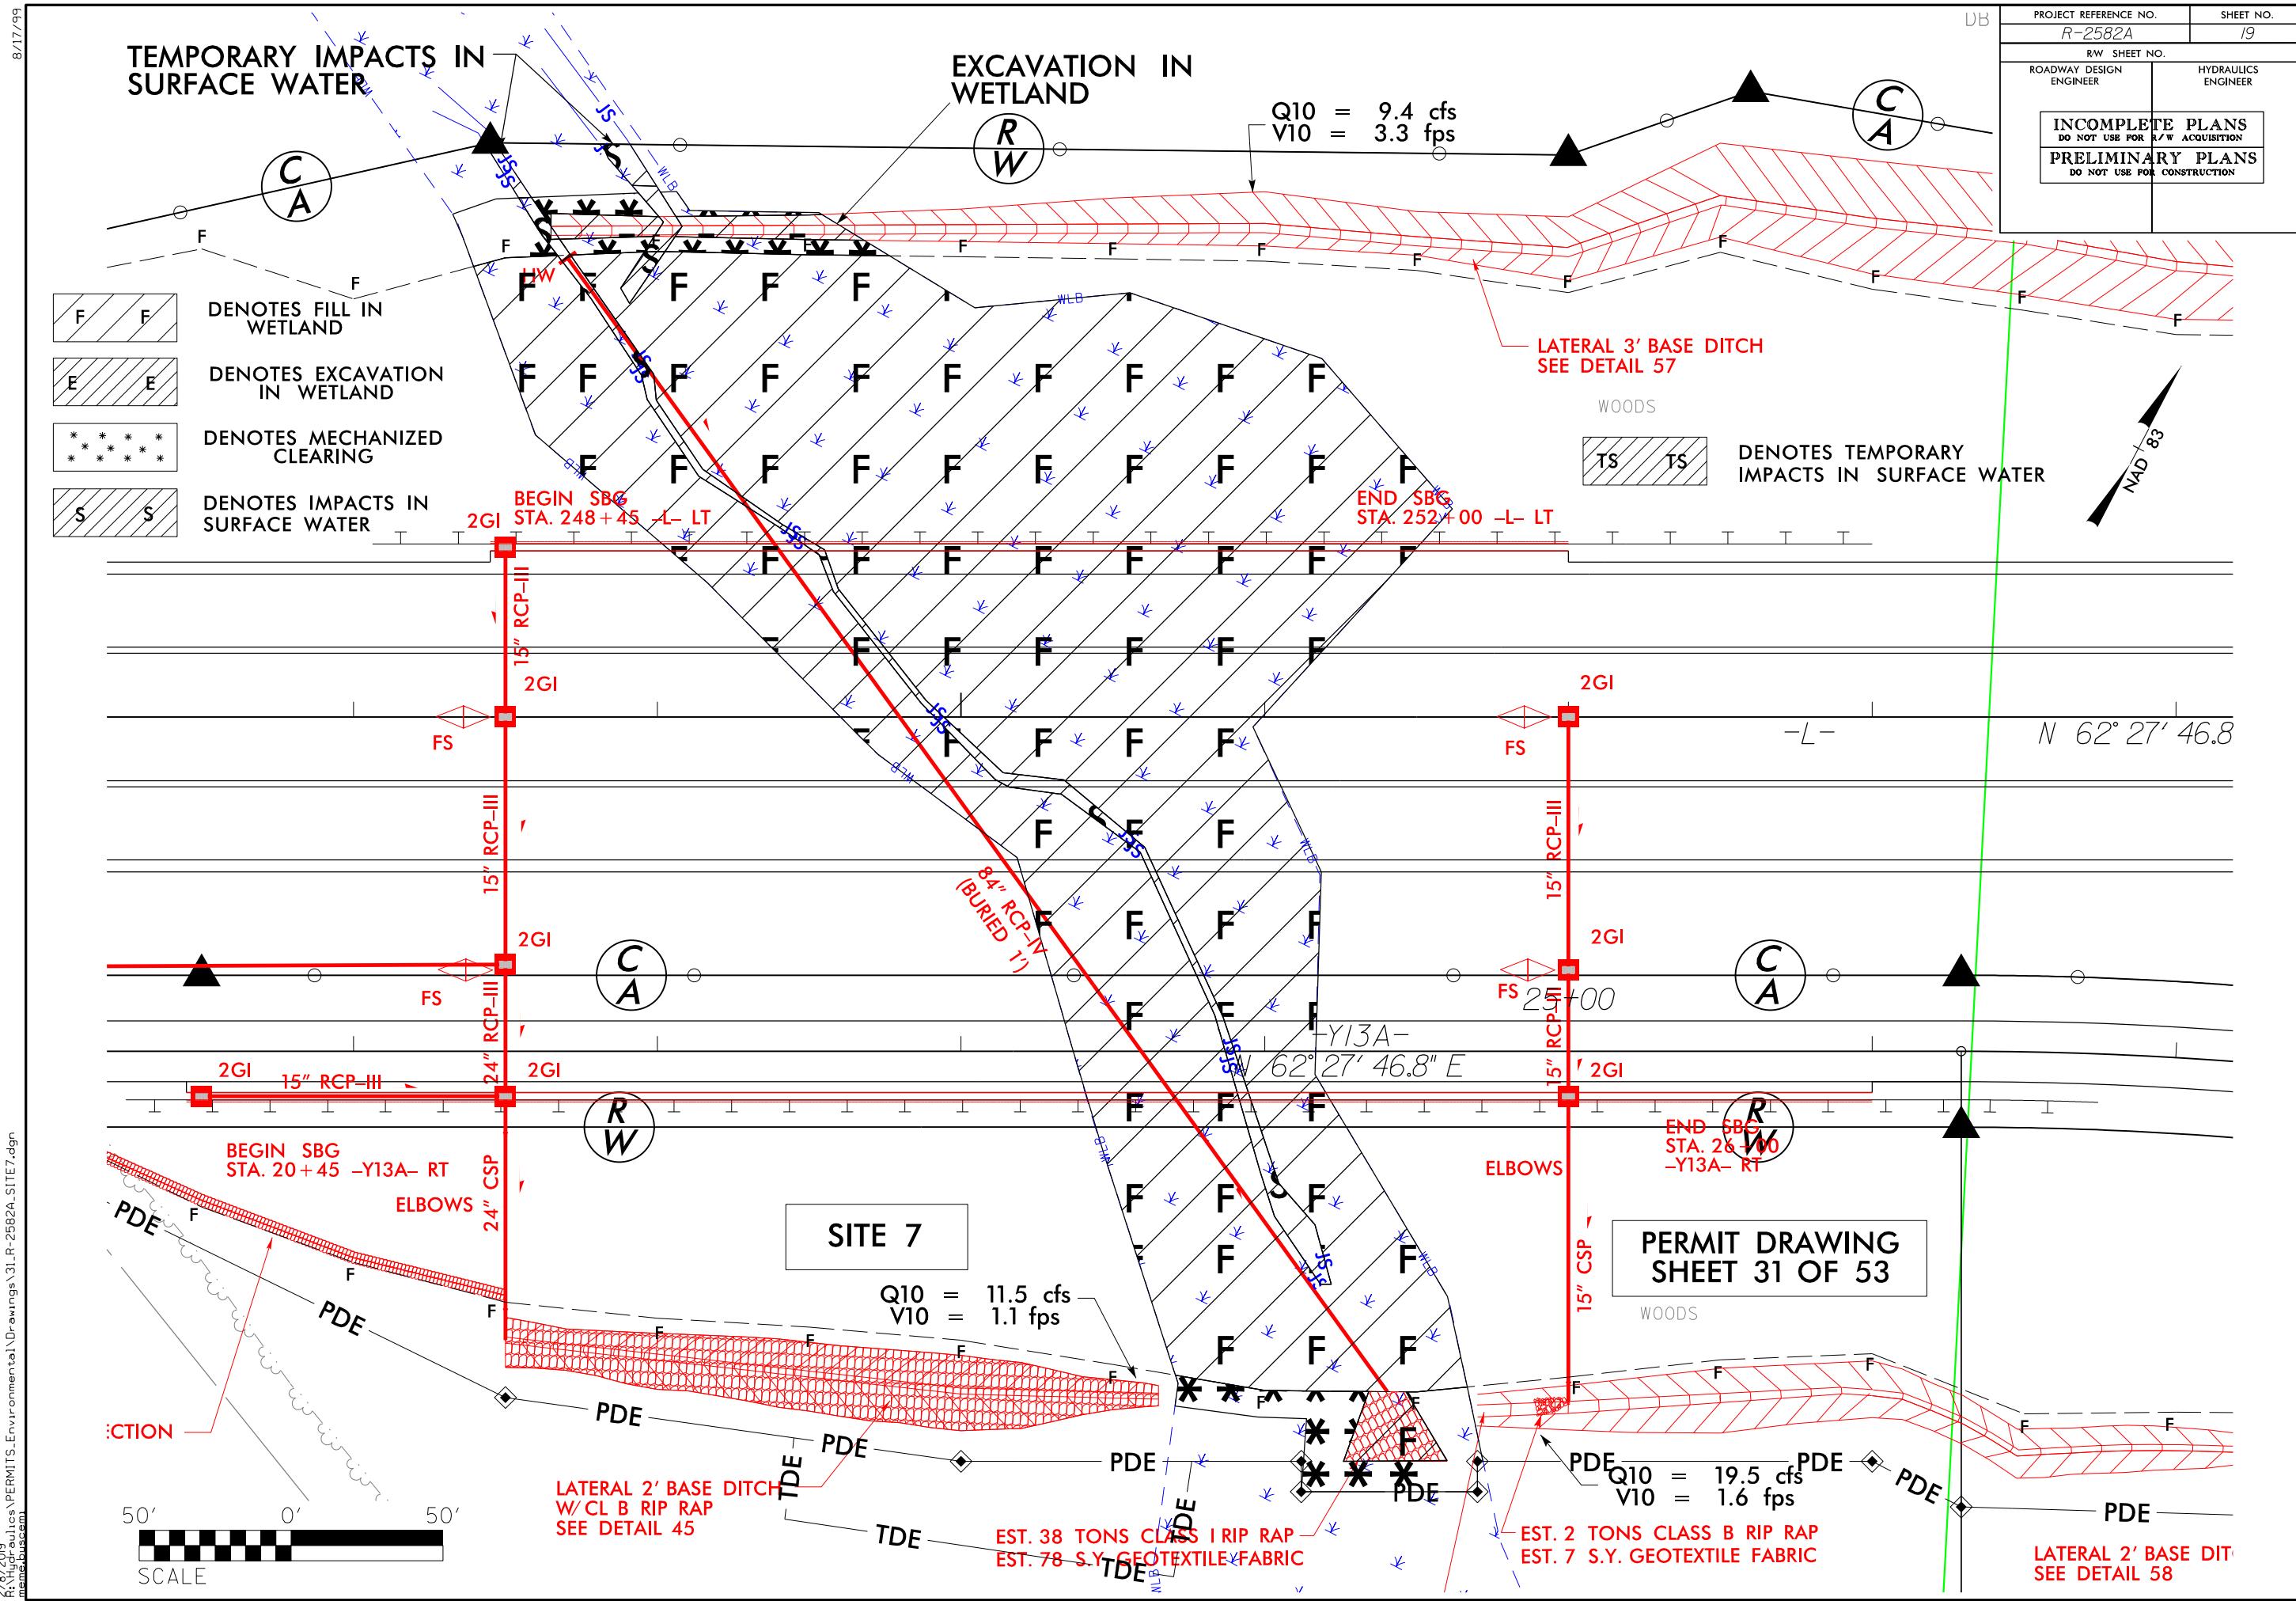


# SITE 7 – PROFILE VIEW ALONG STRUCTURE

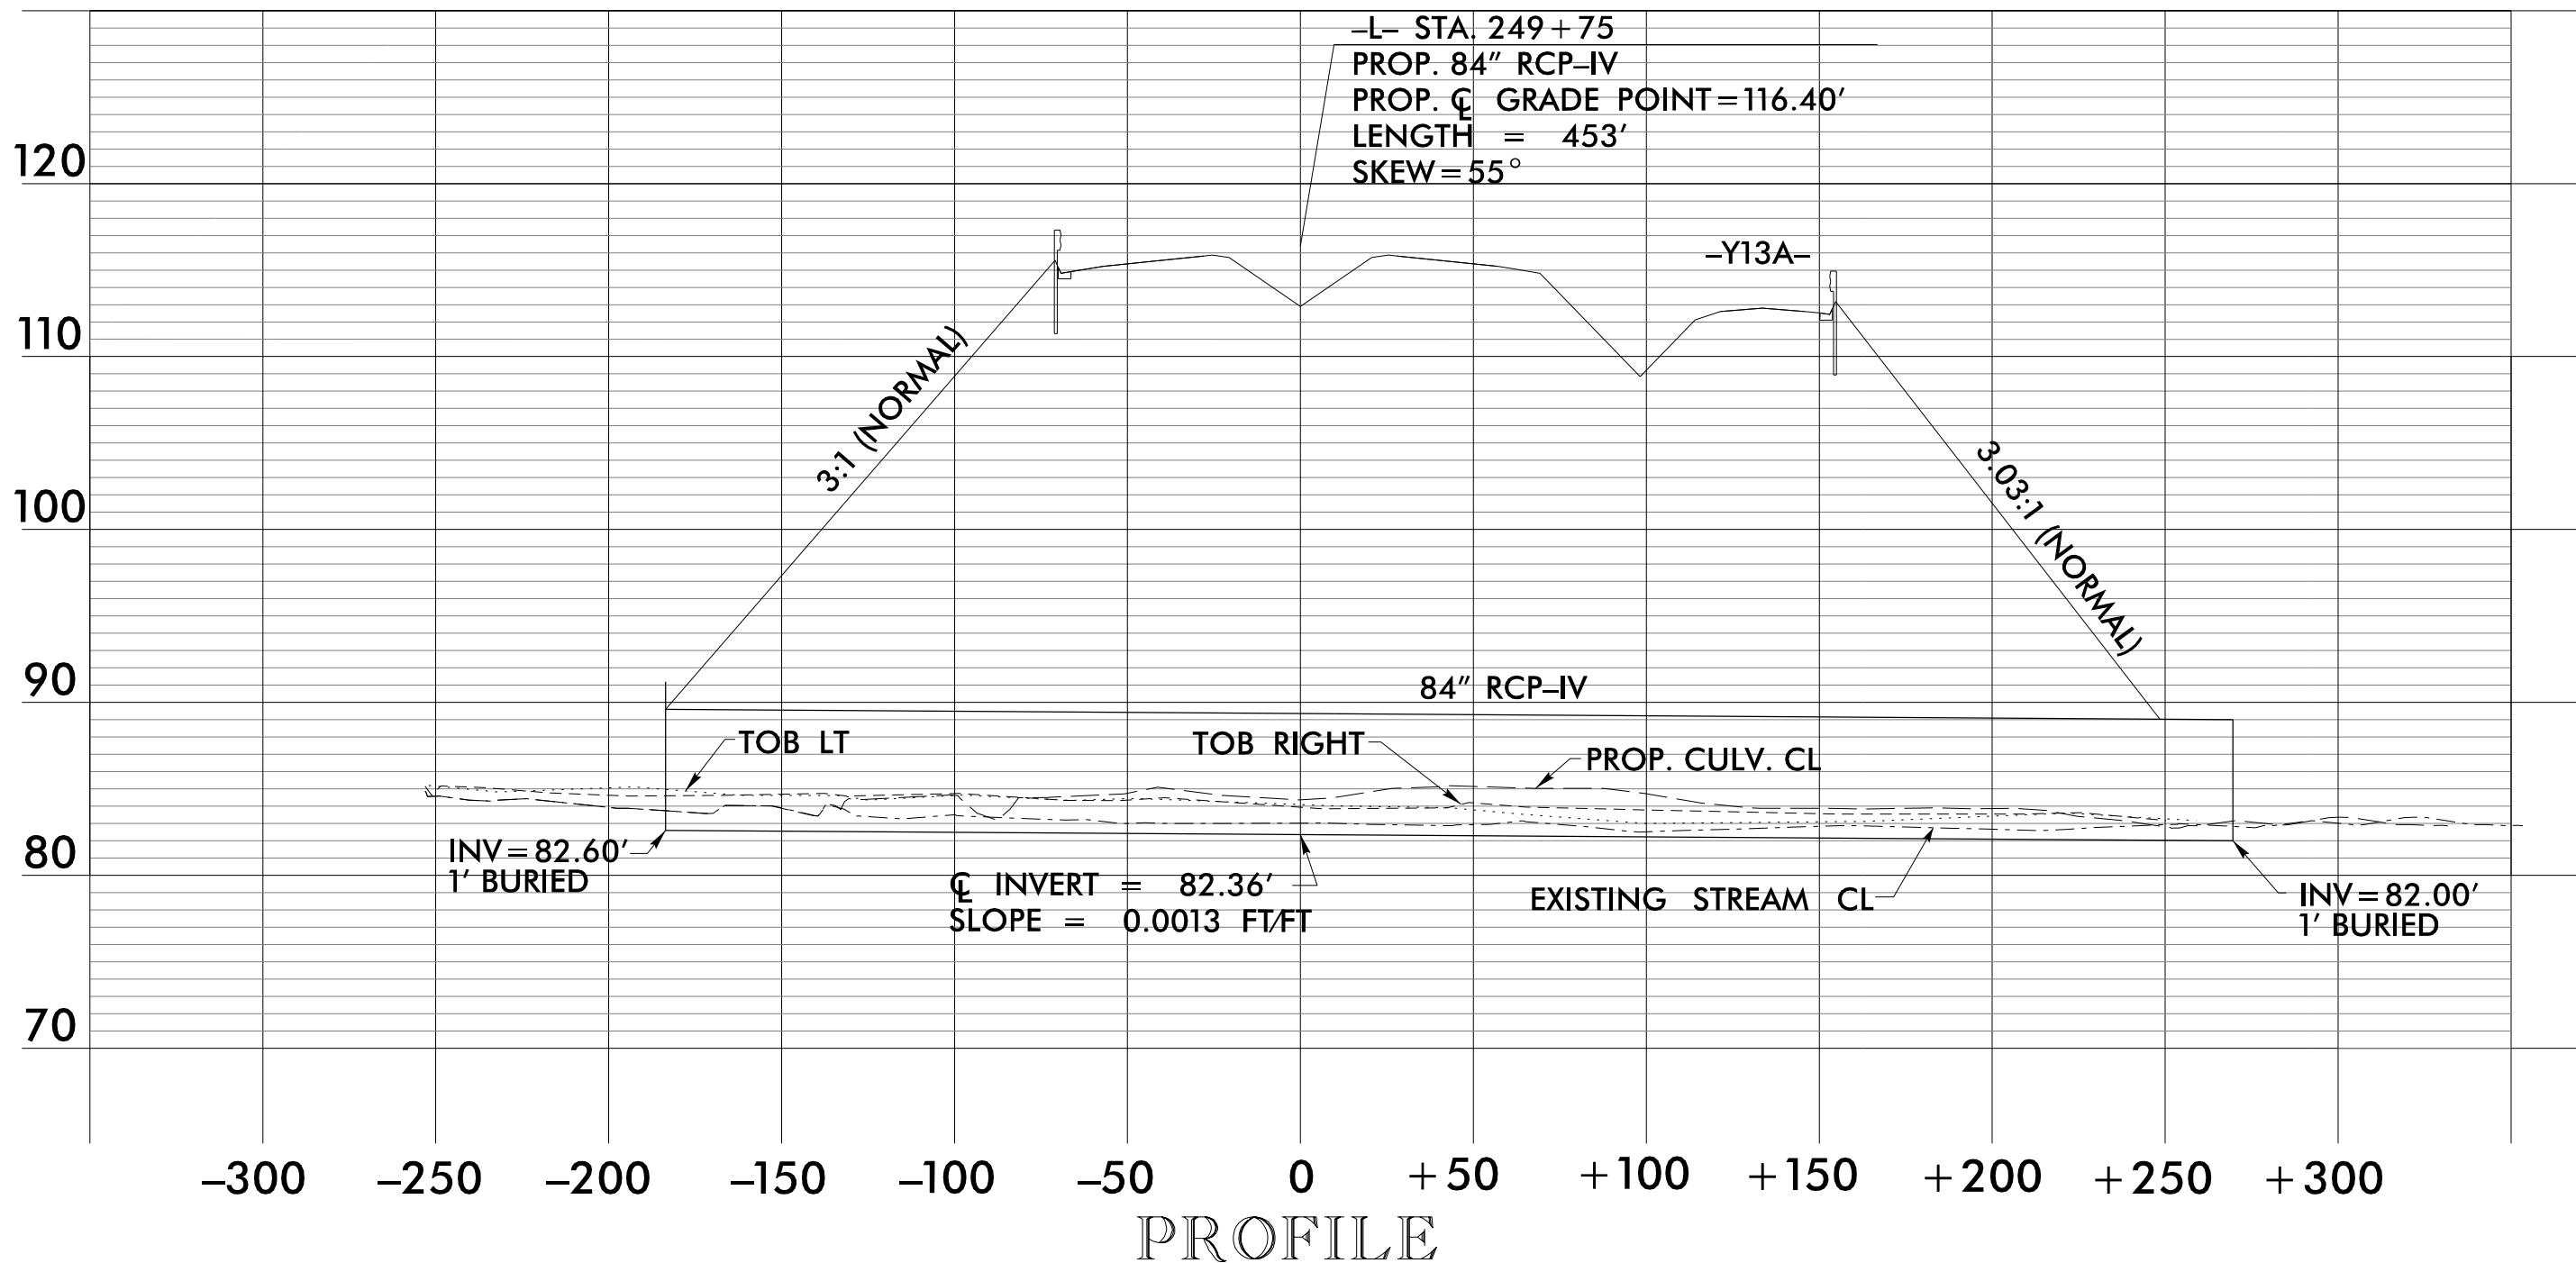


NC DOT  
DIVISION OF HIGHWAYS  
NORTHAMPTON COUNTY  
PROJECT: 34472.1.4 (R-2582A)  
US 158 FROM I-95 / NC  
TO SR 1312 (ST. JOHN CHURCH RD)  
PERMIT DRAWING SITE 7  
SHEET 32 OF 53


8/23/99


0 5 10

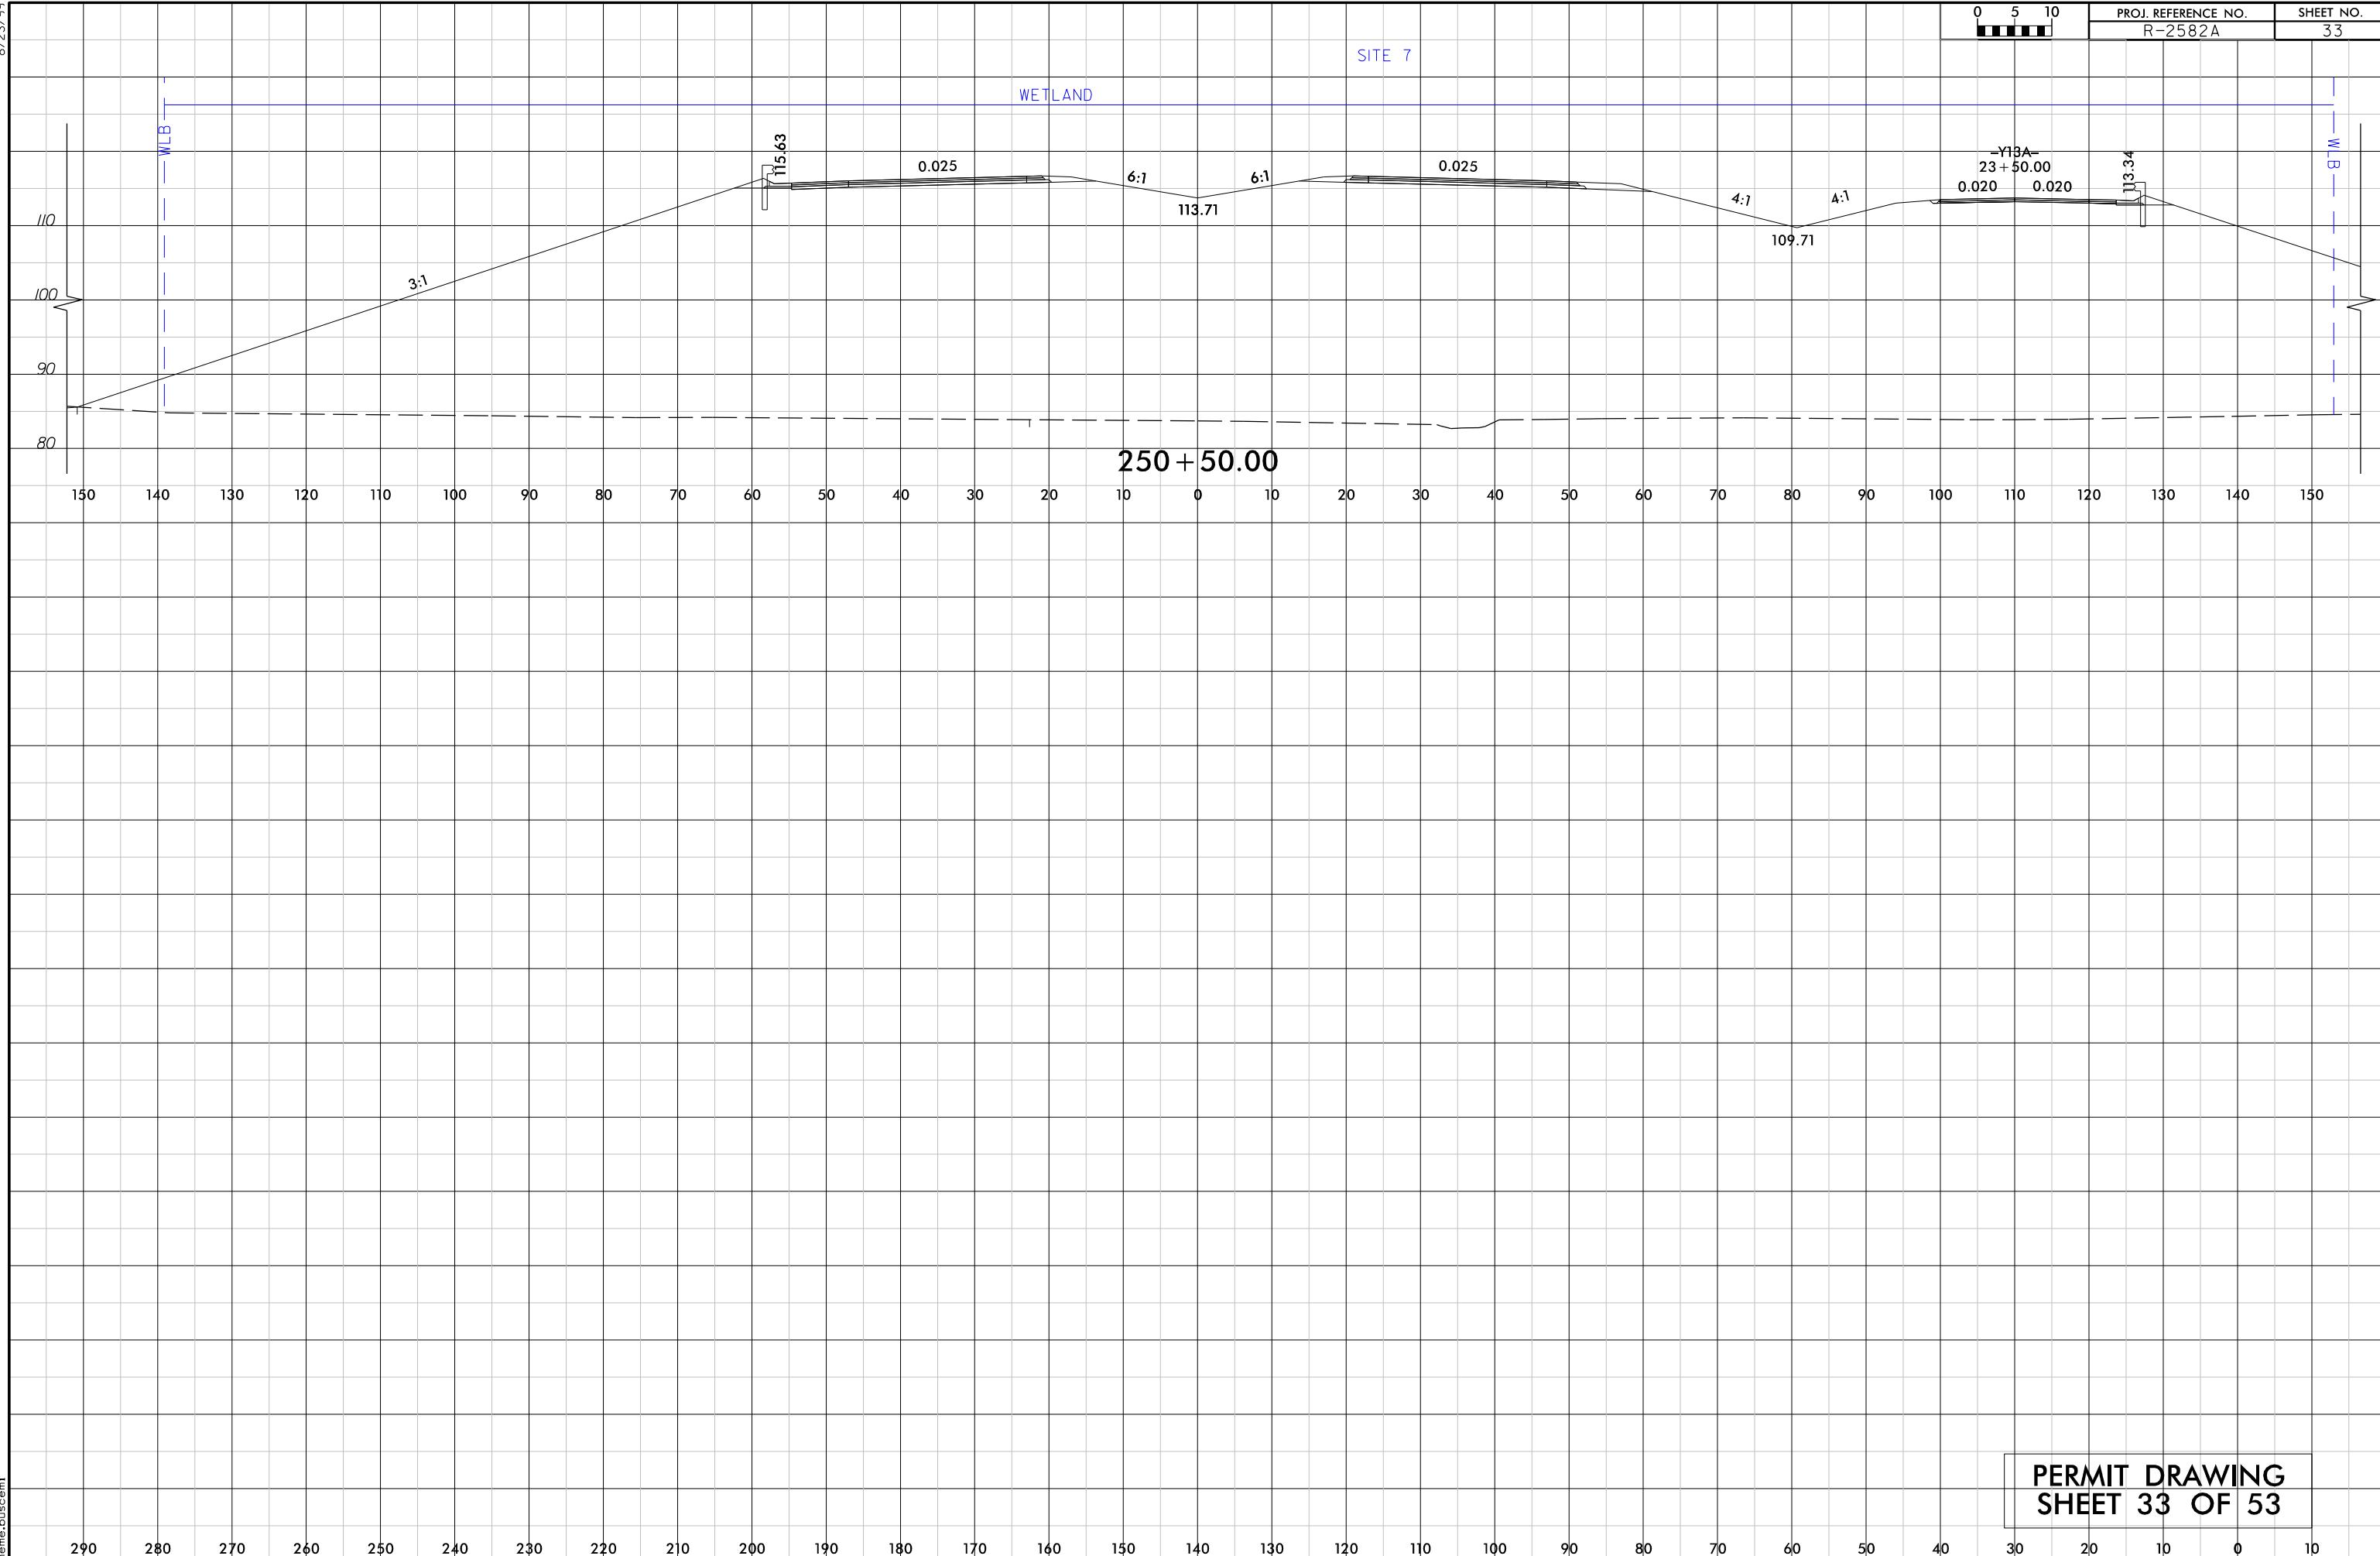PROJ. REFERENCE NO.  
R-2582ASHEET NO.  
33


8/17/99  
8/17/99

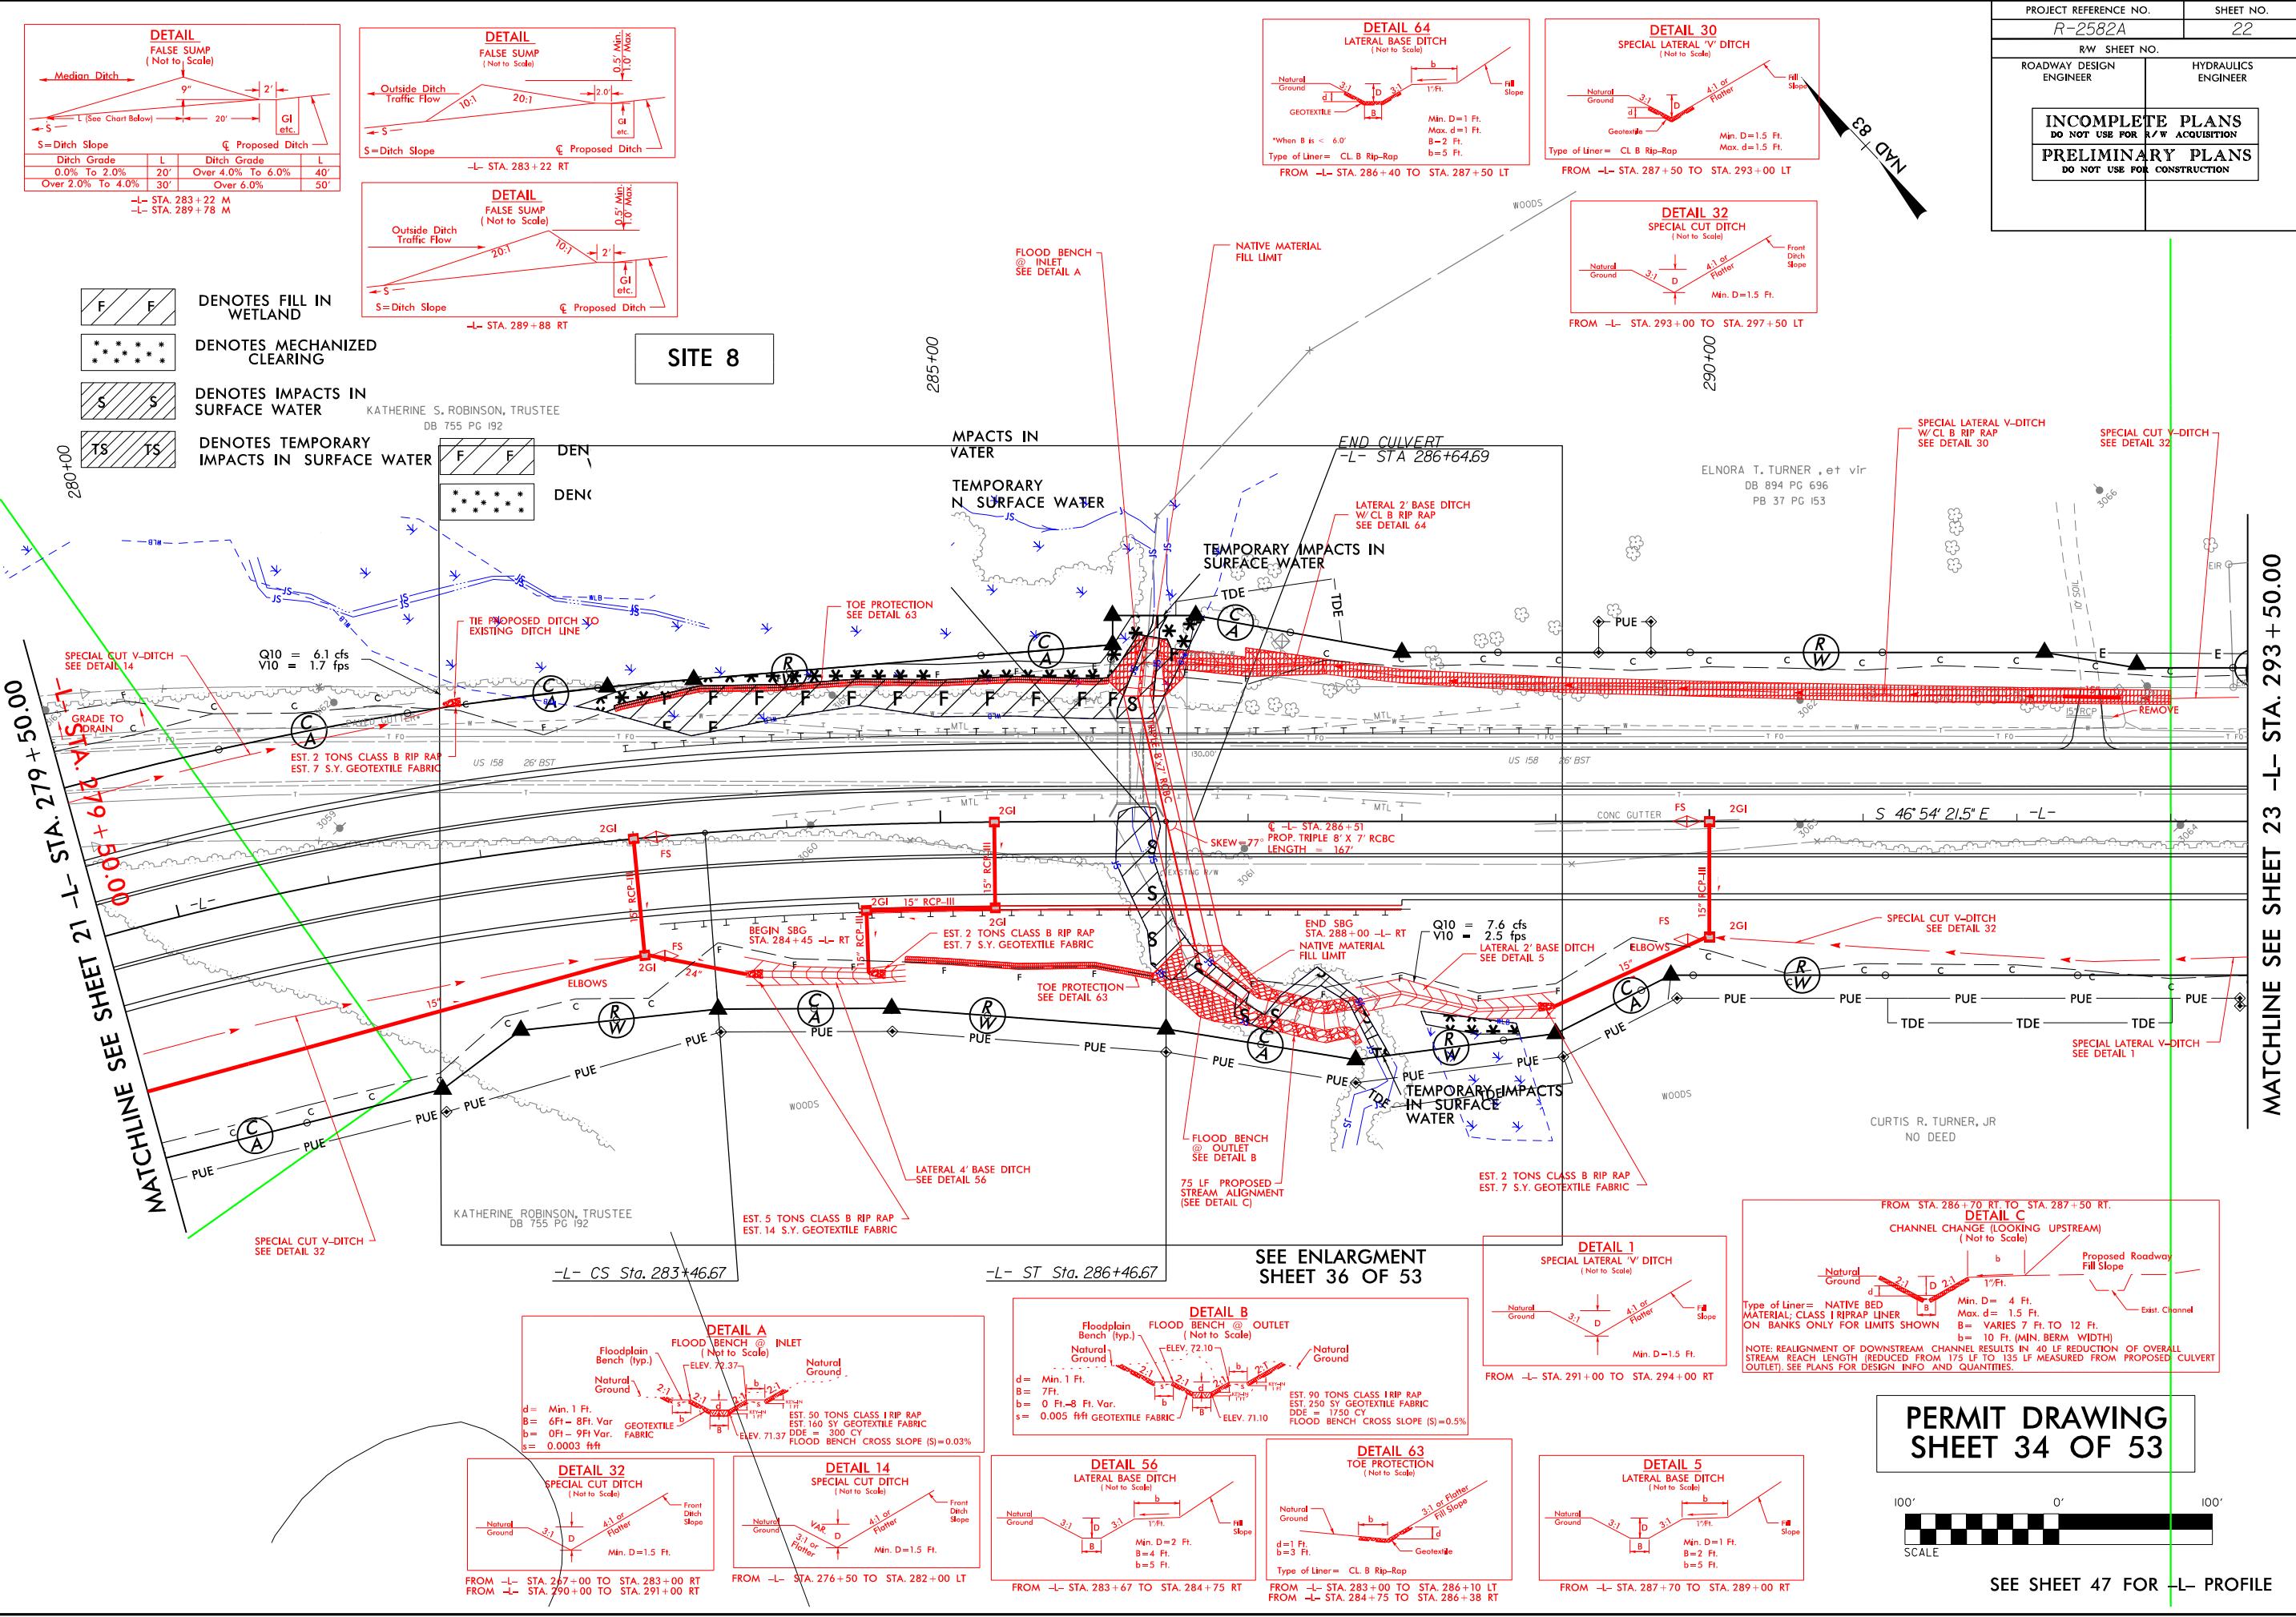

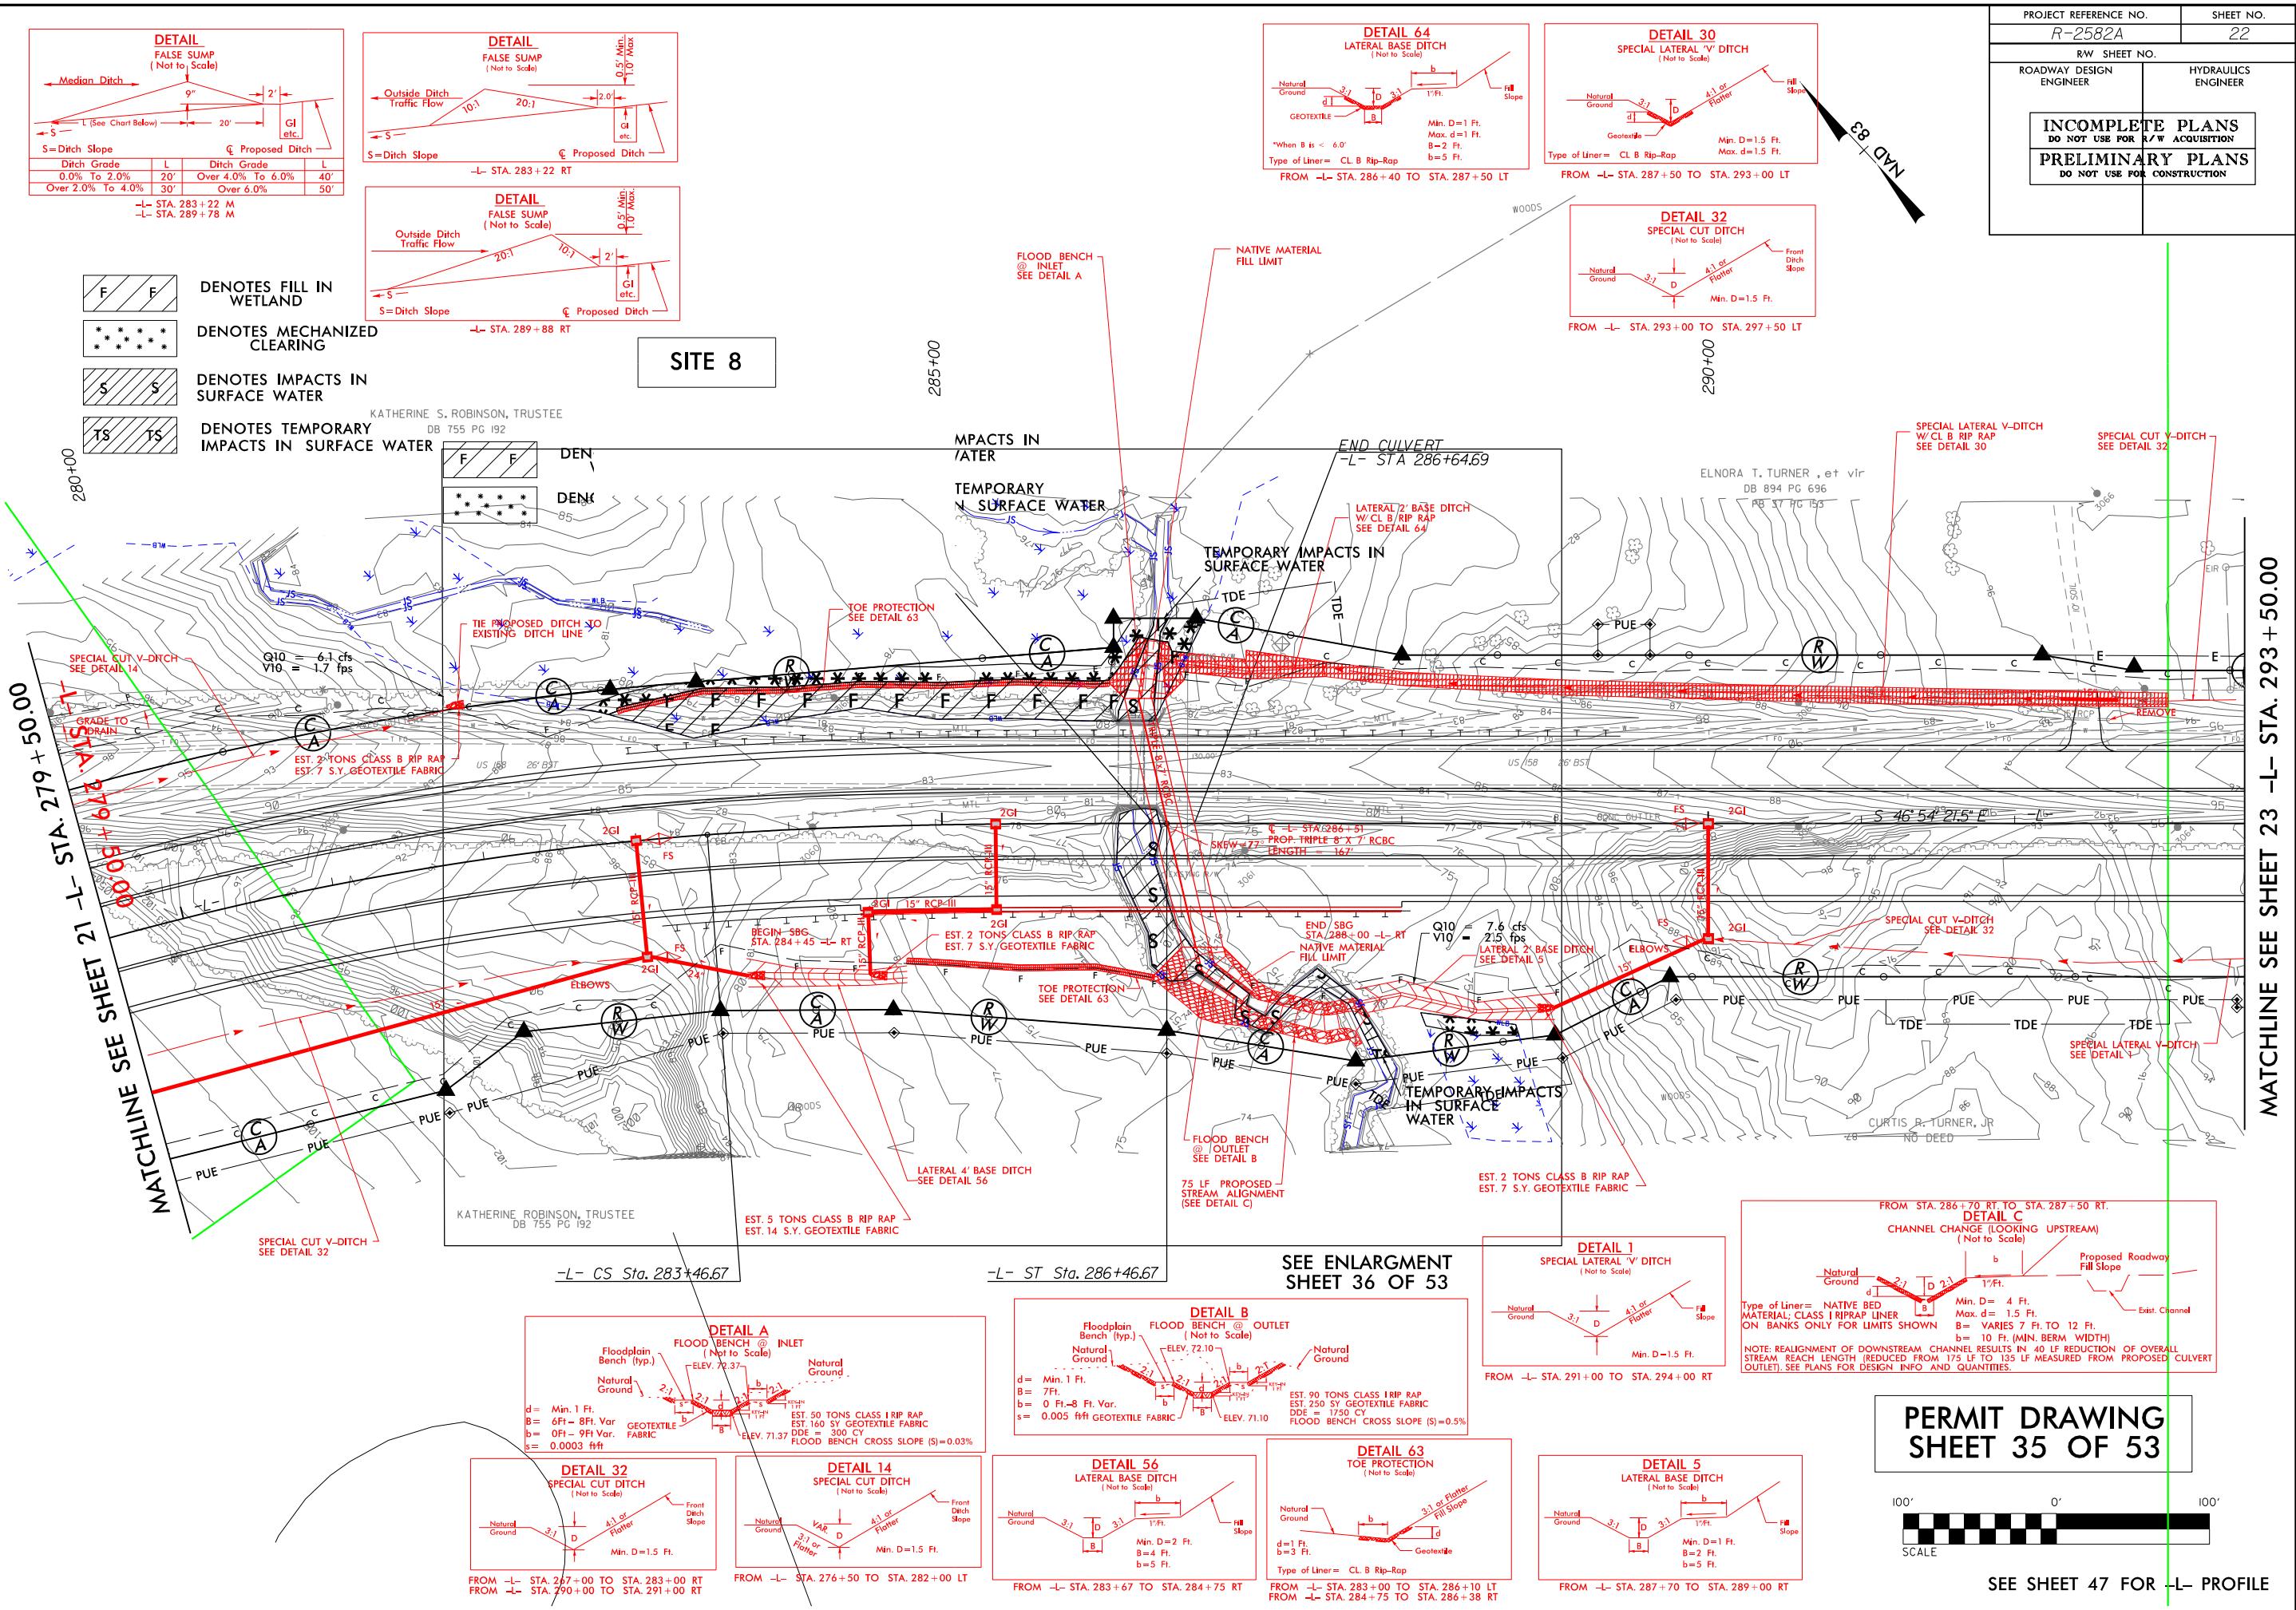


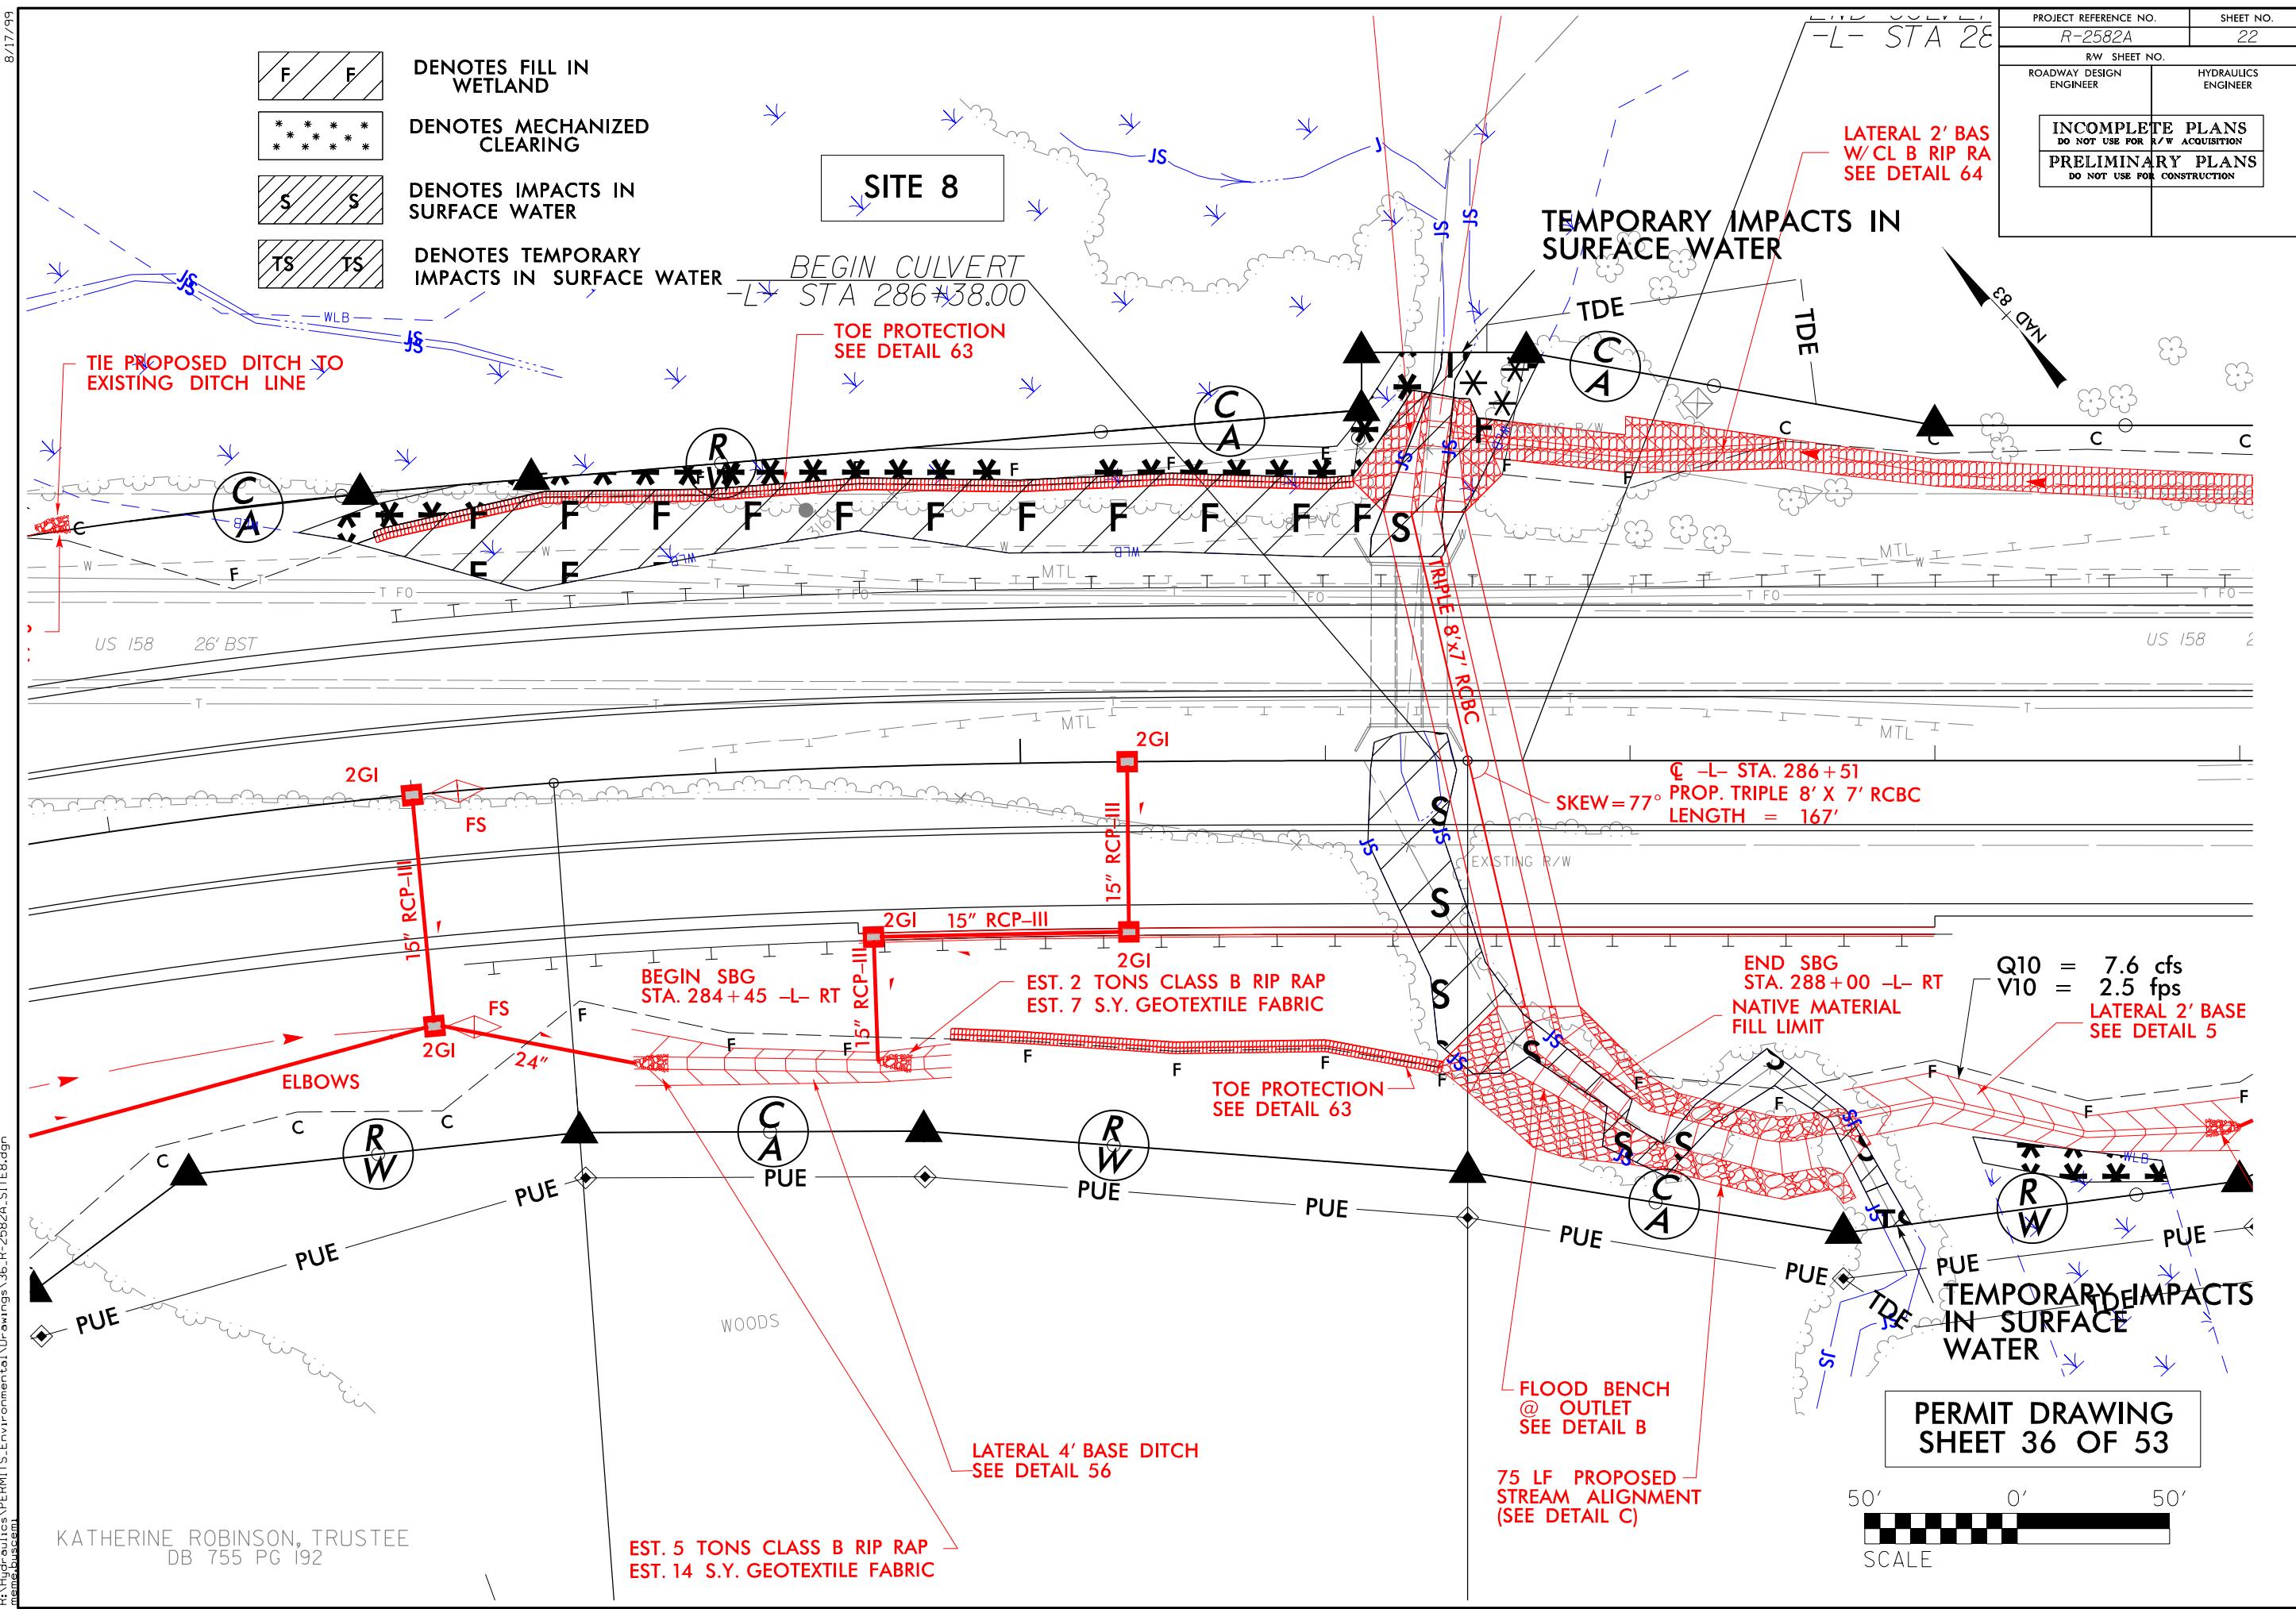

# SITE 8 – PROFILE VIEW ALONG STRUCTURE

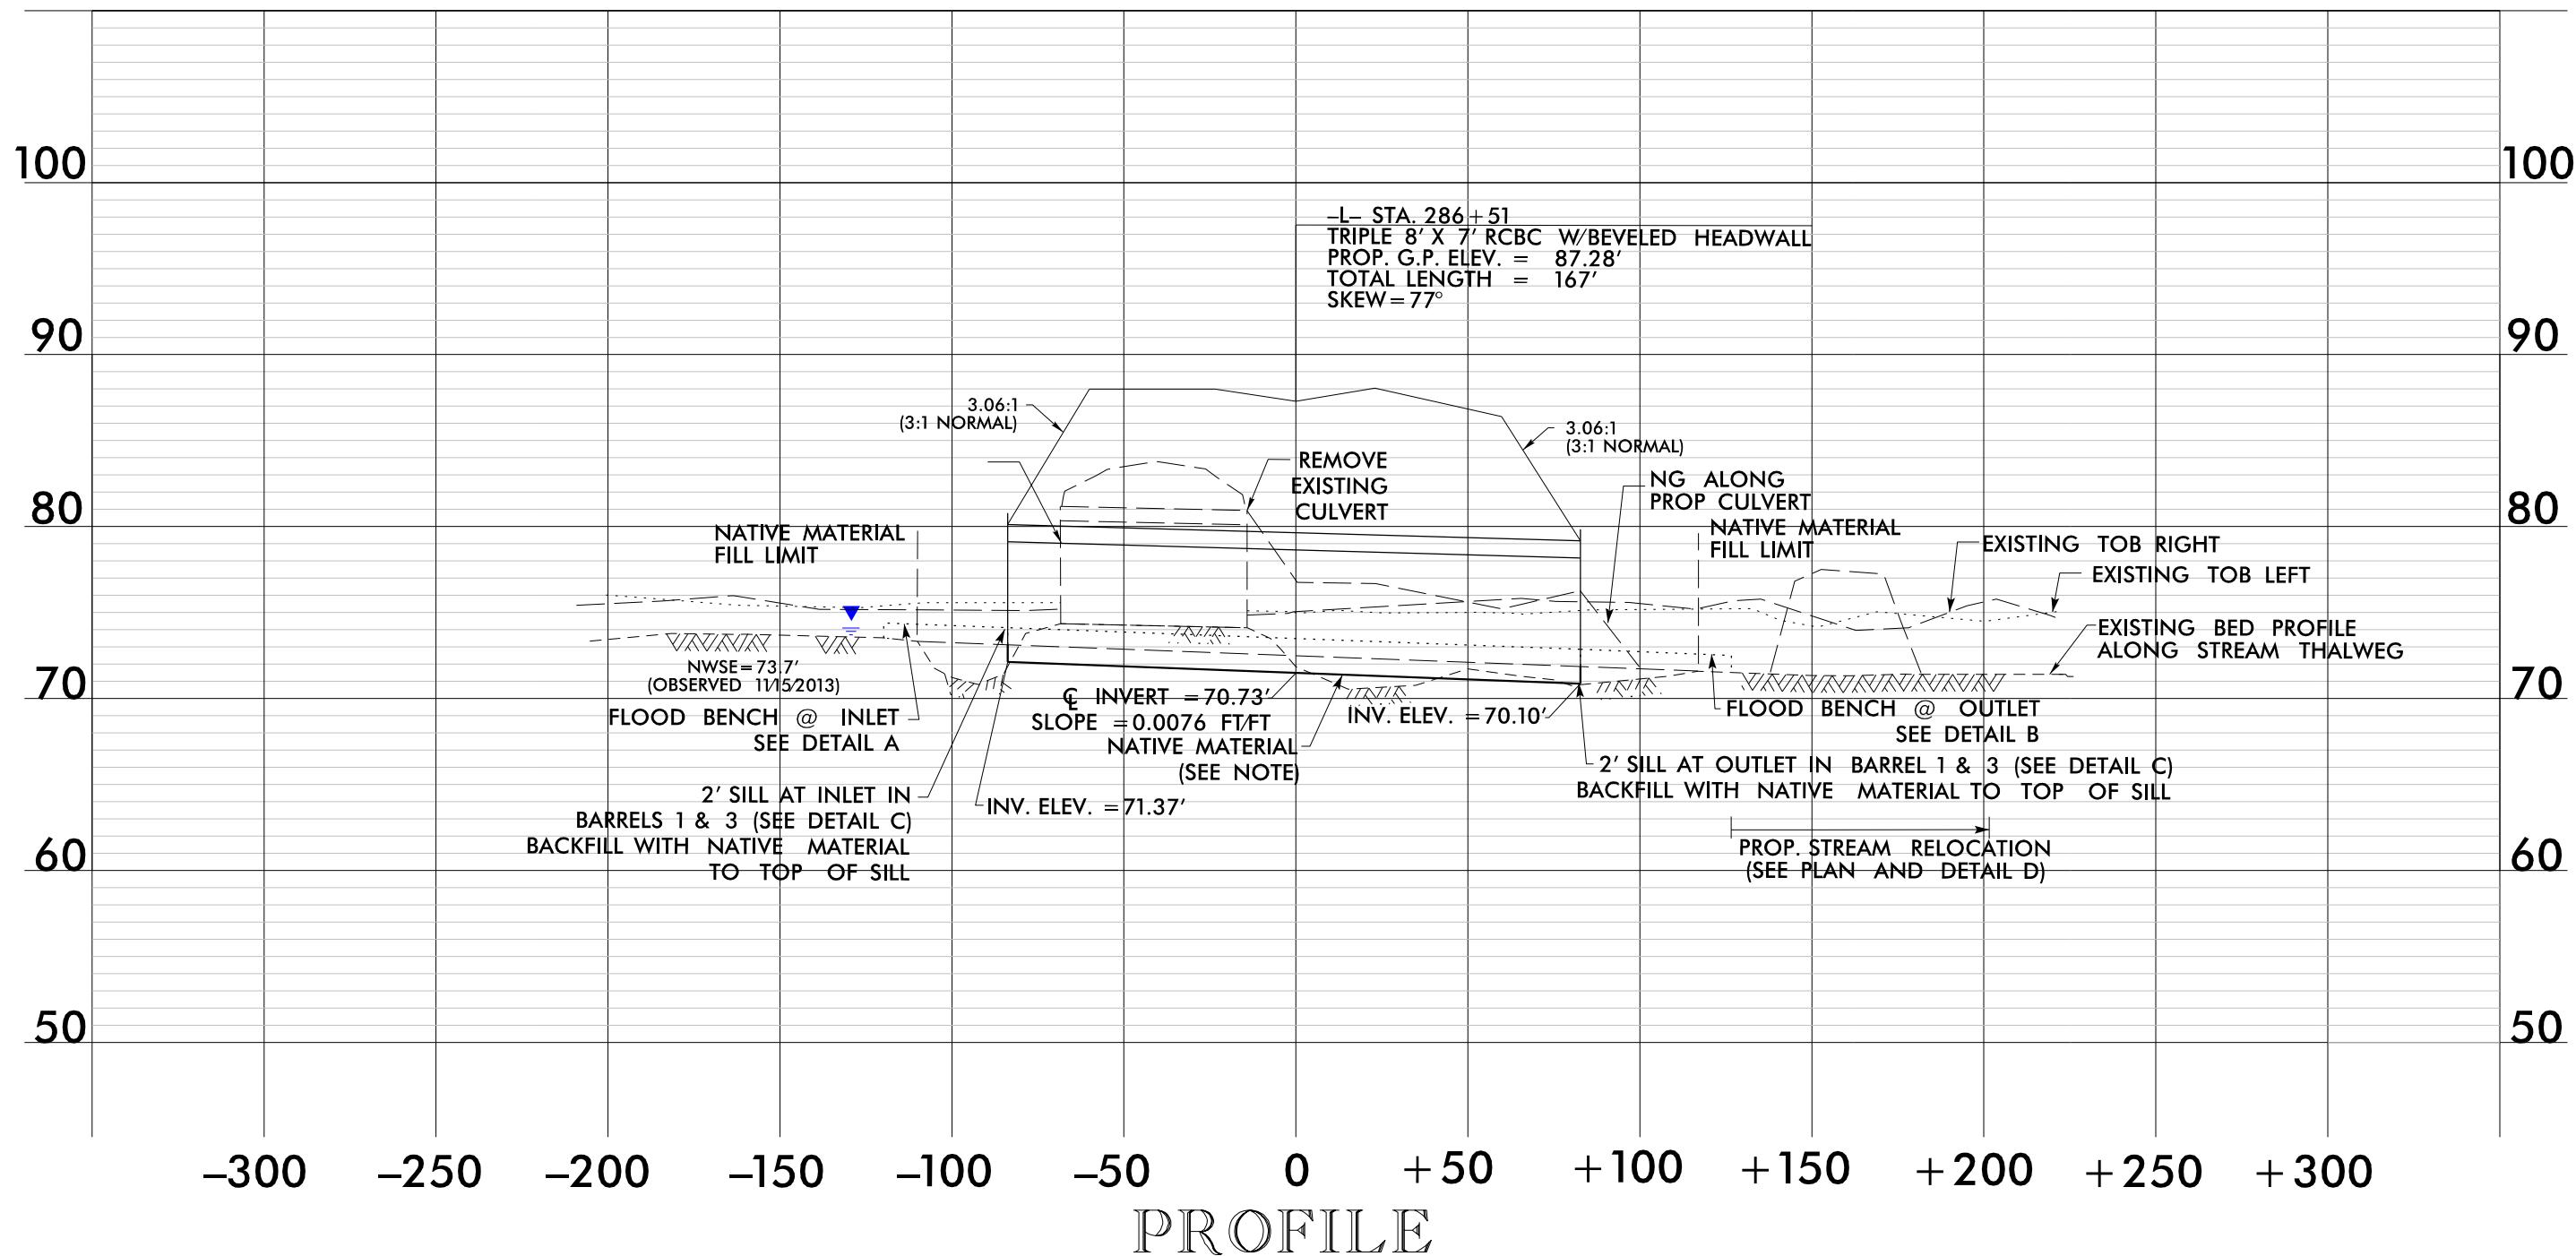

NC DOT  
DIVISION OF HIGHWAYS  
NORTHAMPTON COUNTY  
PROJECT: 34472.1.4 (R-2582A)  
US 158 FROM I-95 / NC  
TO SR 1312 (ST. JOHN CHURCH RD)  
PERMIT DRAWING SITE 8  
SHEET 37 OF 53

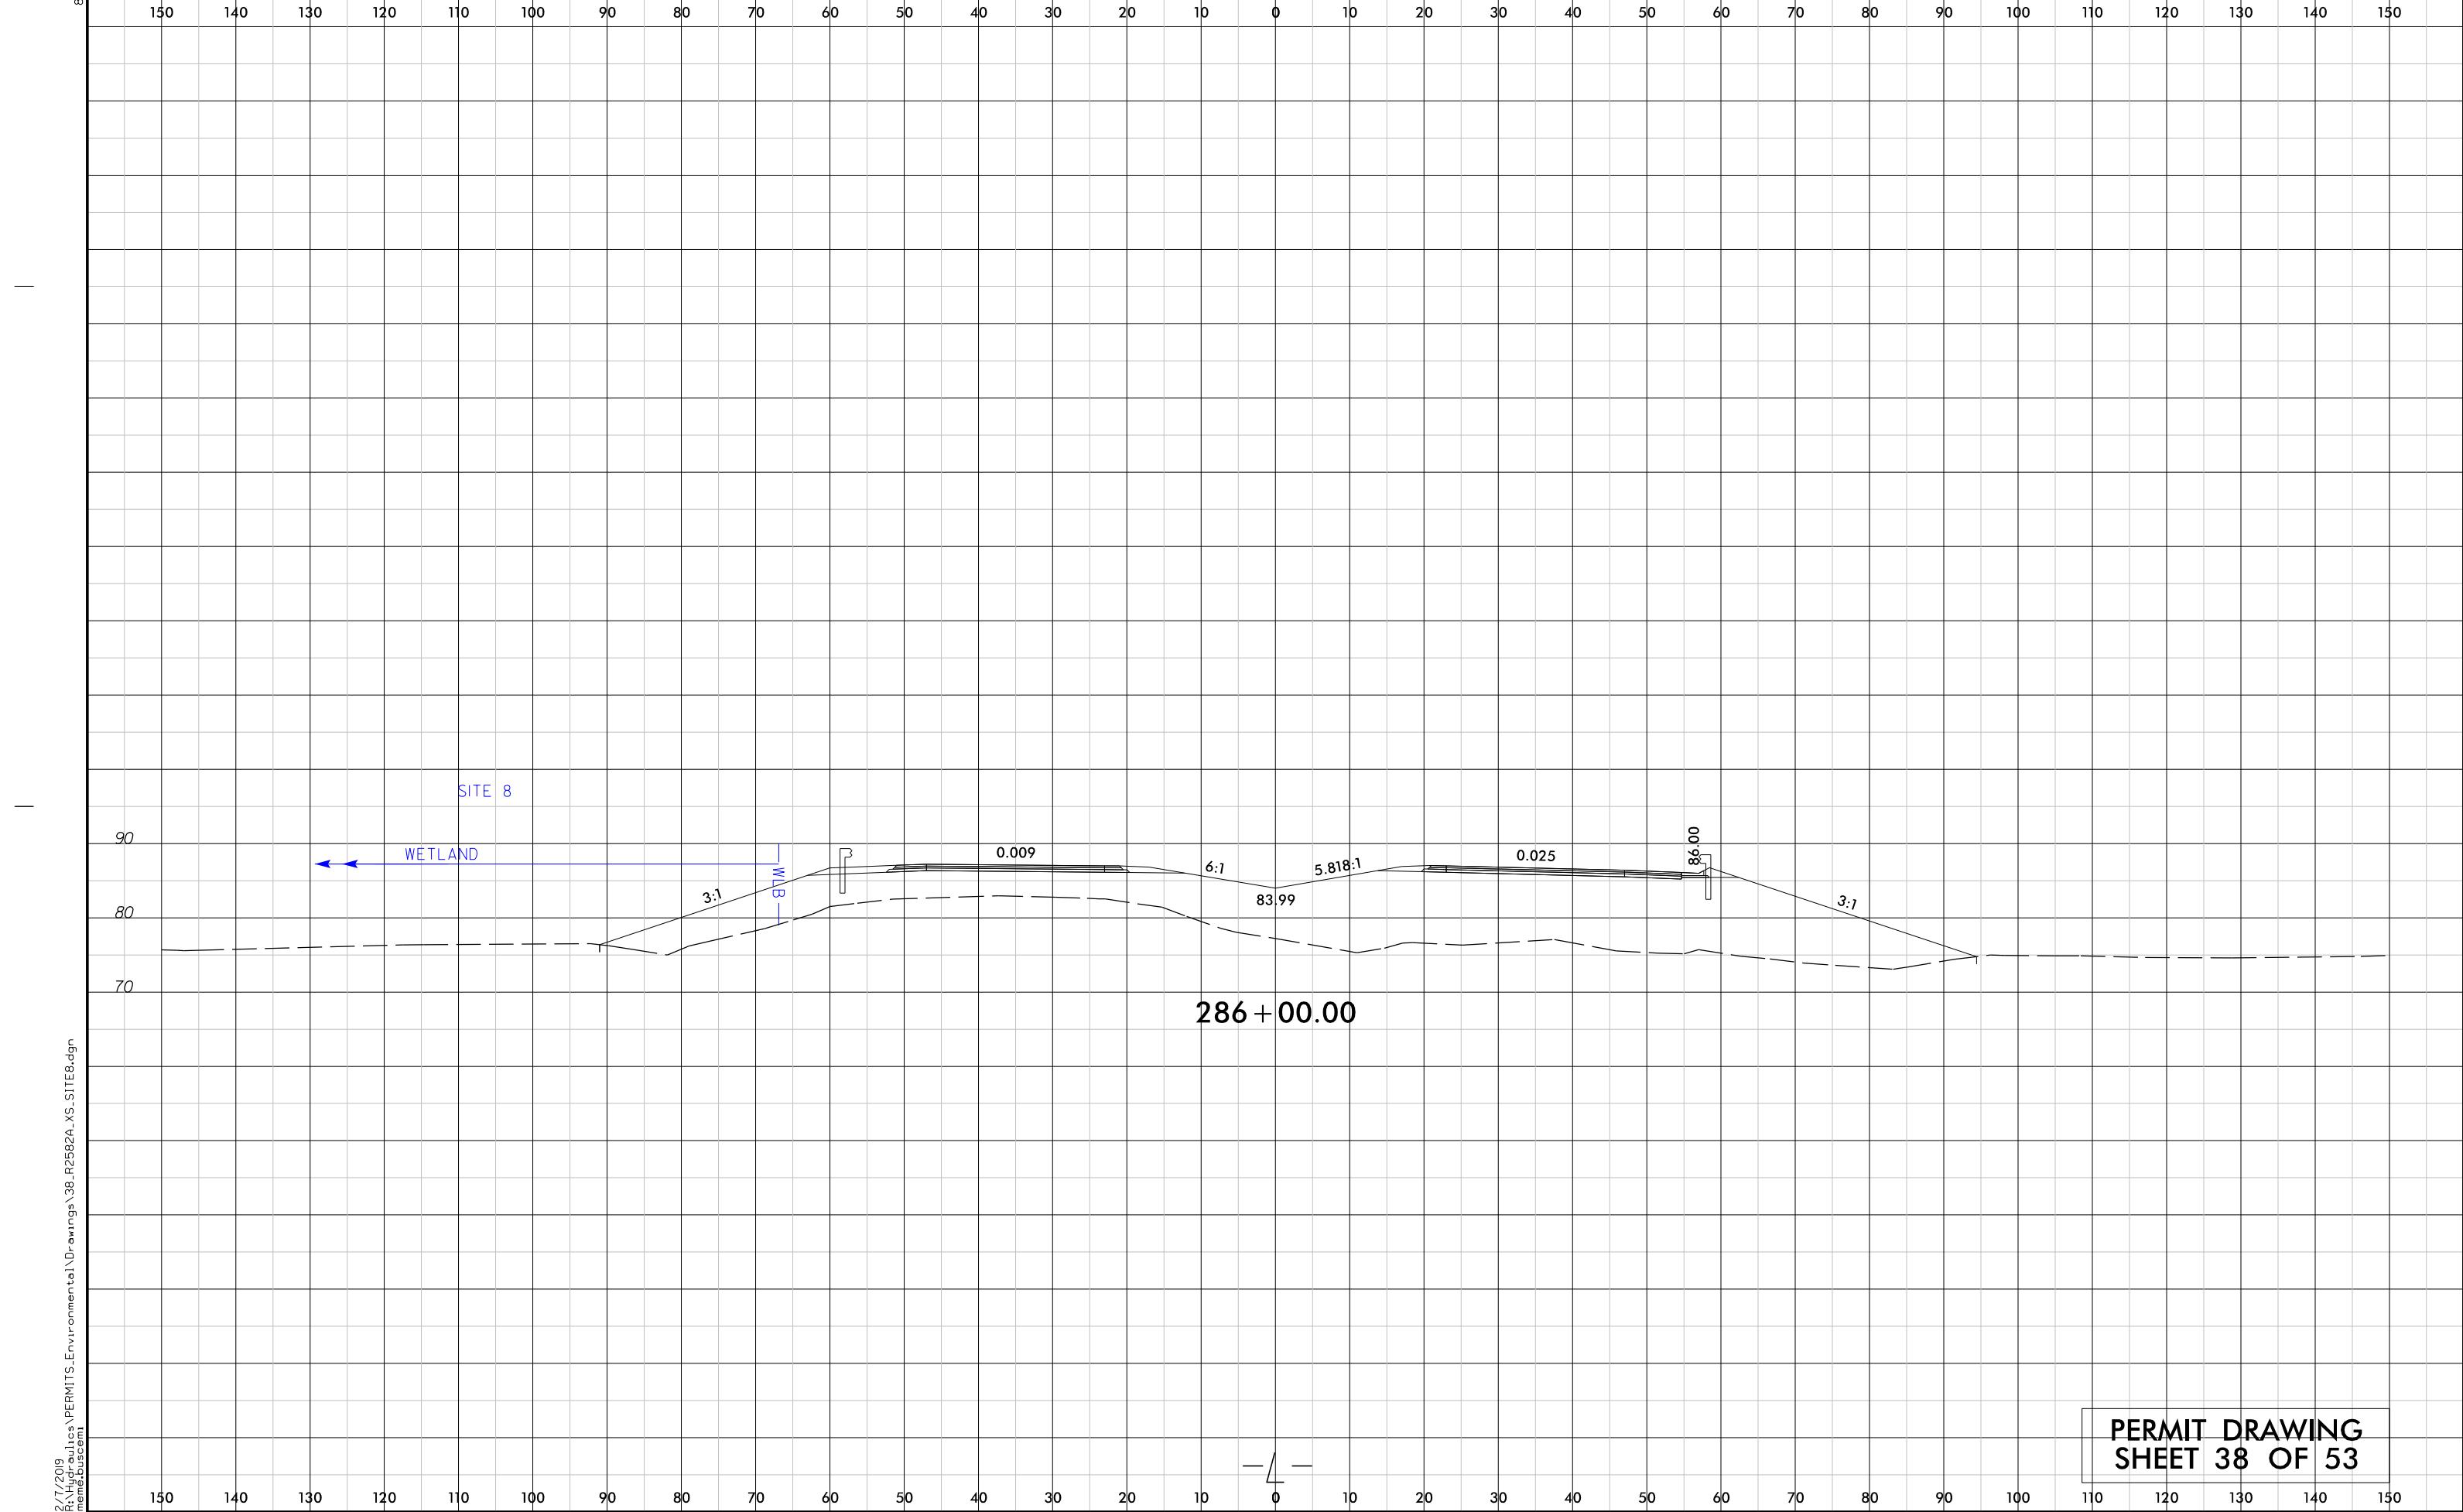

MATCHLINE SEE SHEET 28 -L- STA. 377 +00.00

MILDRED S. EDWARDS, e  
WB 09E PG 135

ELISE BROWN SMITH  
DB 542 PG 12

MILDRED S. EDWARDS, et al  
WB 09E PG 135

三


MATCHLINE SEE SHEET 30 - STA. 391+00.00

TAYLOR FARM PROPERTIES  
DB 955 PG 272

TAYLOR FARM PROPERTY  
DB 955 PG 272

SEE ENLARGEMENT  
SHEET 41 OF 53

**PERMIT DRAWING  
SHEET 39 OF 53**

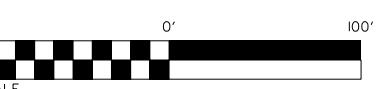

JLB, LLC  
7 PG 834

**DETAIL 33**

SPECIAL LATERAL BASE DITCH  
(Not to Scale)

Natural Ground

Fill Slope

A1 or Plater

D

B

Min. D = 1.5 Ft.

B = 2 Ft.

FROM I STA 274+20 BT I STA 280+00.5

**DETAIL 50**  
**SPECIAL LATERAL BASE DITCH**  
*(Not to Scale)*

Natural Ground

Ditch

Fill Slope

4 ft of  
Ditch

3 ft

B-B

Mrn. D = 1 Ft.  
B = 3 ft

FROM I STA 272 + 10 LT TO I STA 282 + 00

**DETAILED 69**

**SPECIAL CUT BASE DITCH**  
(Not to Scale)

FROM —L STA. 380+50 RT TO —L STA. 381+70 R

Natural Ground      3/7      D      A1/ or  
Plated      Front Ditch Slope

B      Min. D. = 1.5 Ft.  
B = 2 Ft.

**DETAIL 70**  
SPECIAL LATERAL BASE DITCH  
(Not to Scale)

Natural Ground      Fill Slope

D

B

3 ft

4:1 or  
Flatter

Min. D = 1.5 Ft.  
B = 3 Ft.

FROM -L- STA. 382 +00 LT TO -L- STA. 391 +30

**DETAIL**  
**FALSE SUMP**  
( Not to Scale)

Median Ditch

9"

2'

20'

L (See Chart Below)

S

GI  
etc.







**S=Ditch Slope**

Ditch Grade	L	Ditch Grade
0.0% To 2.0%	Over 4.0%	To 6.0%
Over 2.0% To 4.0%	30'	Over 6.0%


**Proposed Ditch**

PROJECT REFERENCE NO.	SHEET NO.
R-2582A	29
R/W SHEET NO.	
ROADWAY DESIGN ENGINEER	HYDRAULICS ENGINEER
INCOMPLETE PLANS DO NOT USE FOR R/W ACQUISITION	PRELIMINARY PLANS DO NOT USE FOR CONSTRUCTION


## MATCHLINE SEE SHEET 28 -L- STA. 377 + 00.00

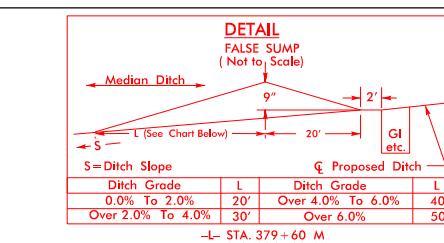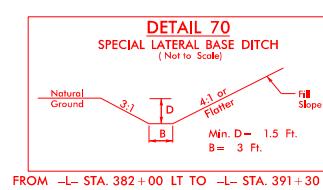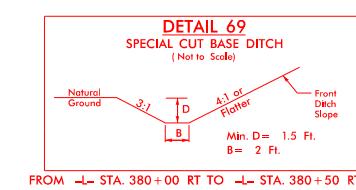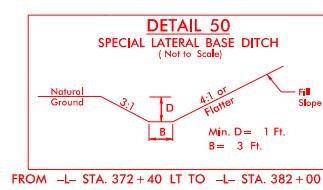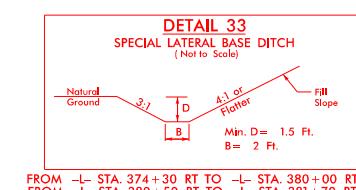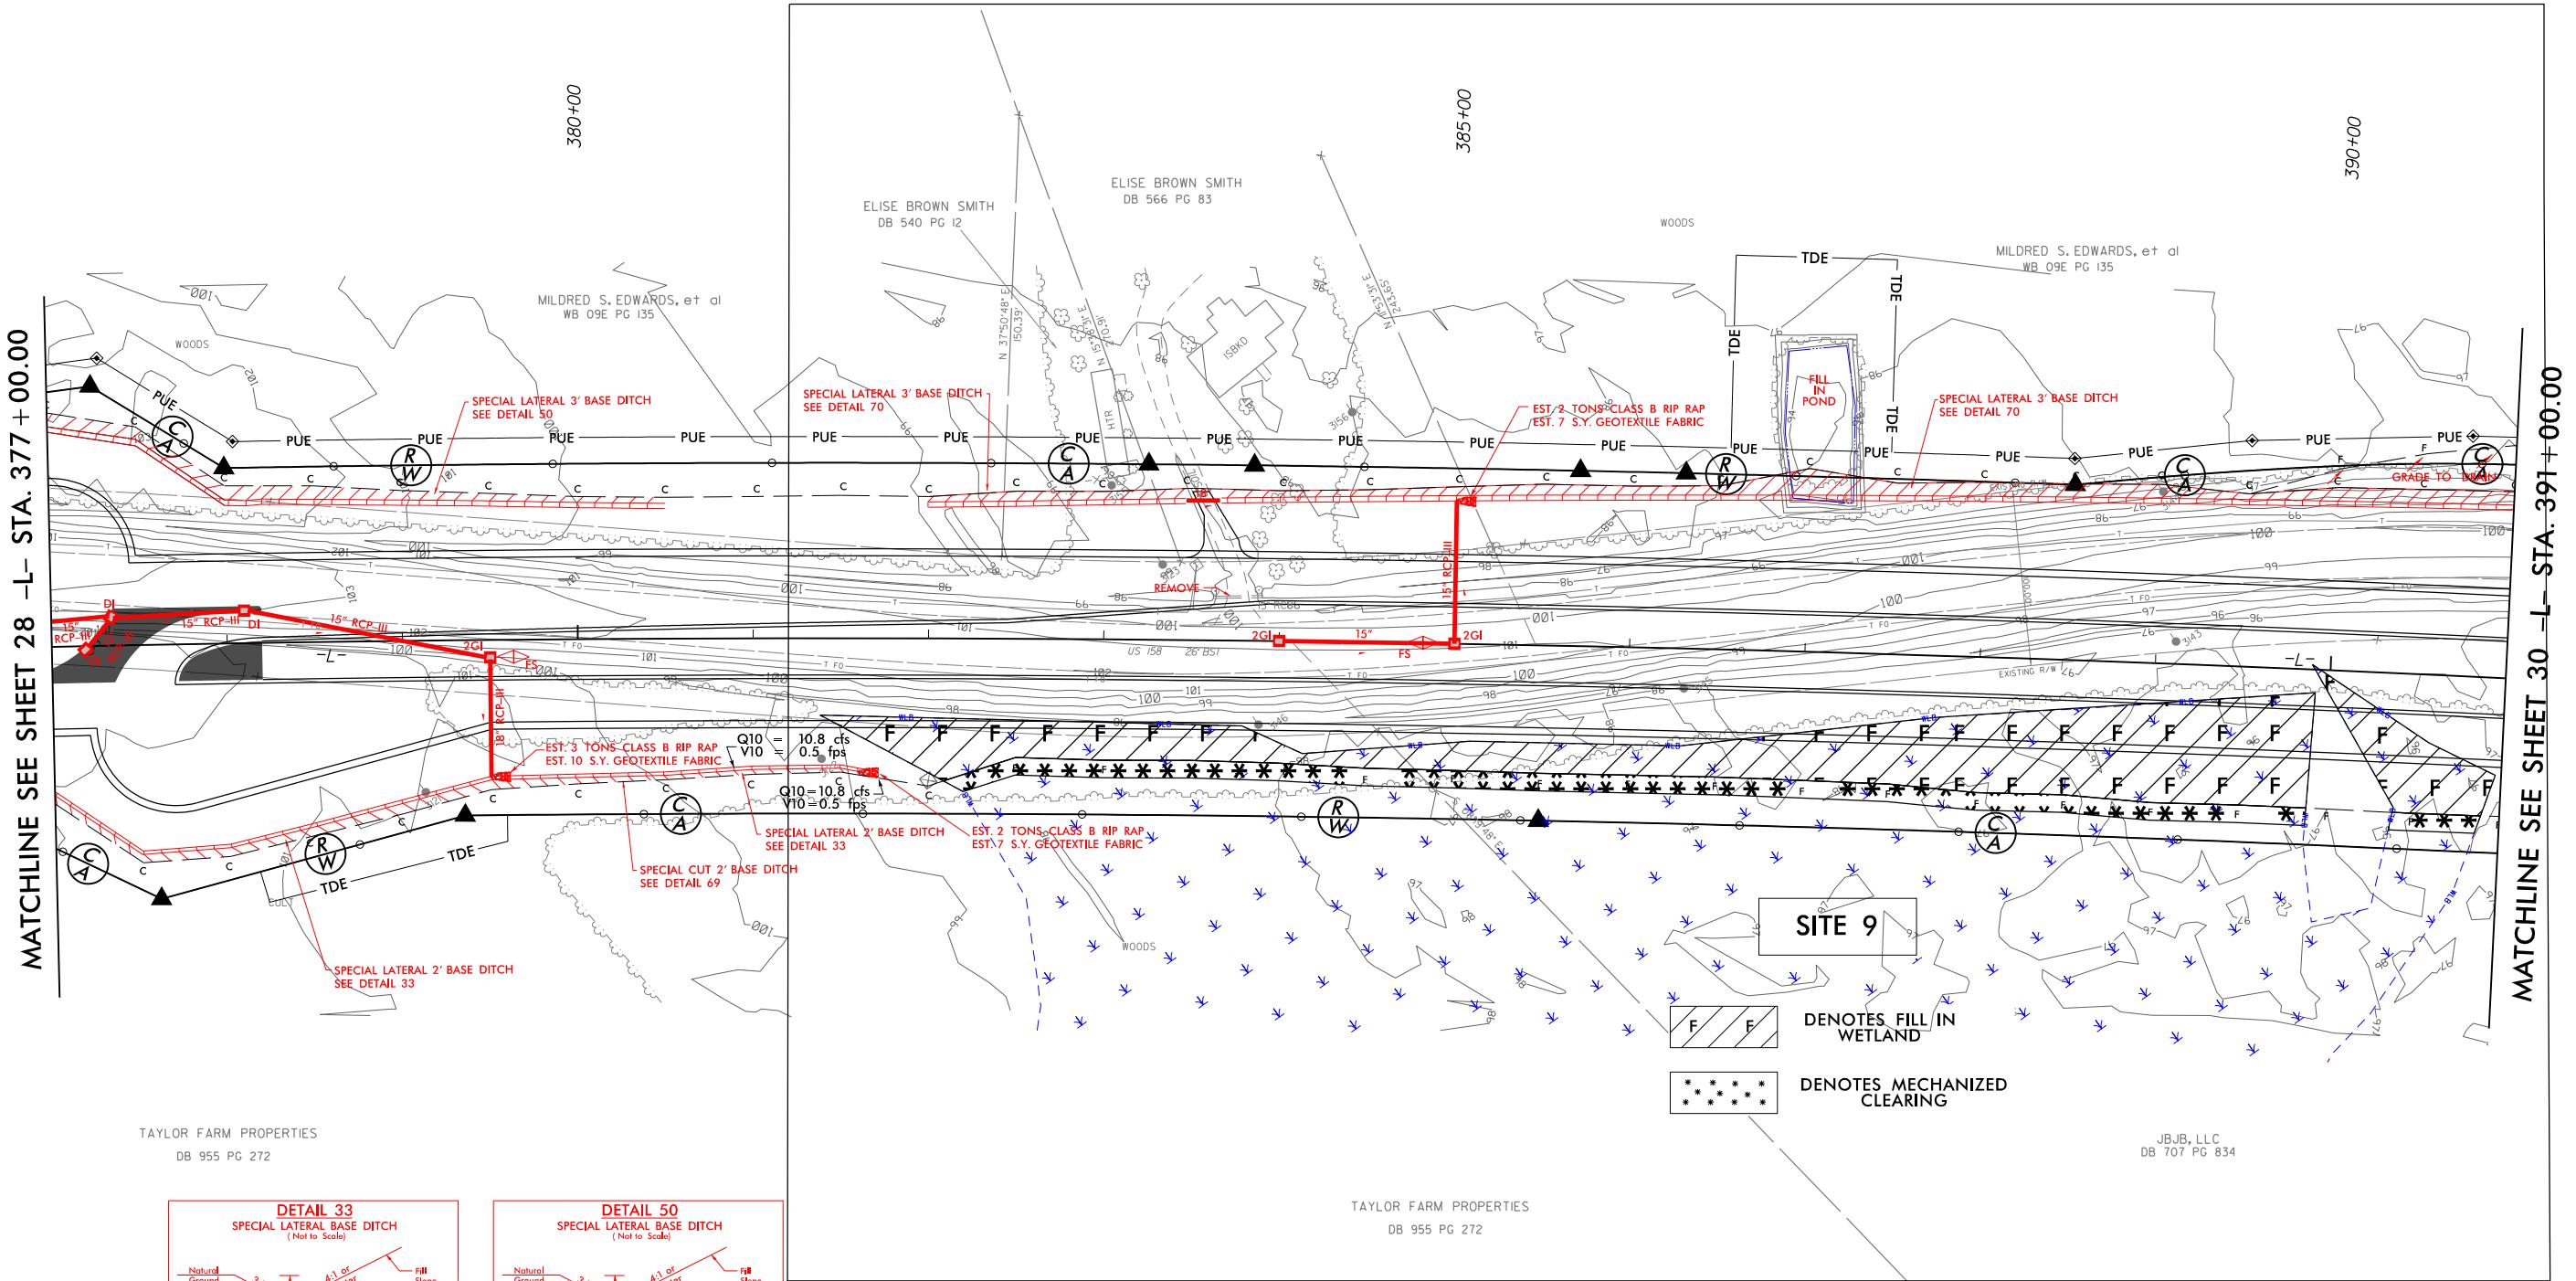


**PERMIT DRAWING  
SHEET 40 OF 53**

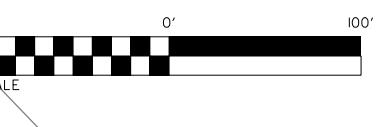

PROJECT REFERENCE NO.	SHEET NO.
R-2582A	29
RW SHEET NO.	
ROADWAY DESIGN ENGINEER	HYDRAULICS ENGINEER
INCOMPLETE PLANS DO NOT USE FOR R/W ACQUISITION	PRELIMINARY PLANS DO NOT USE FOR CONSTRUCTION

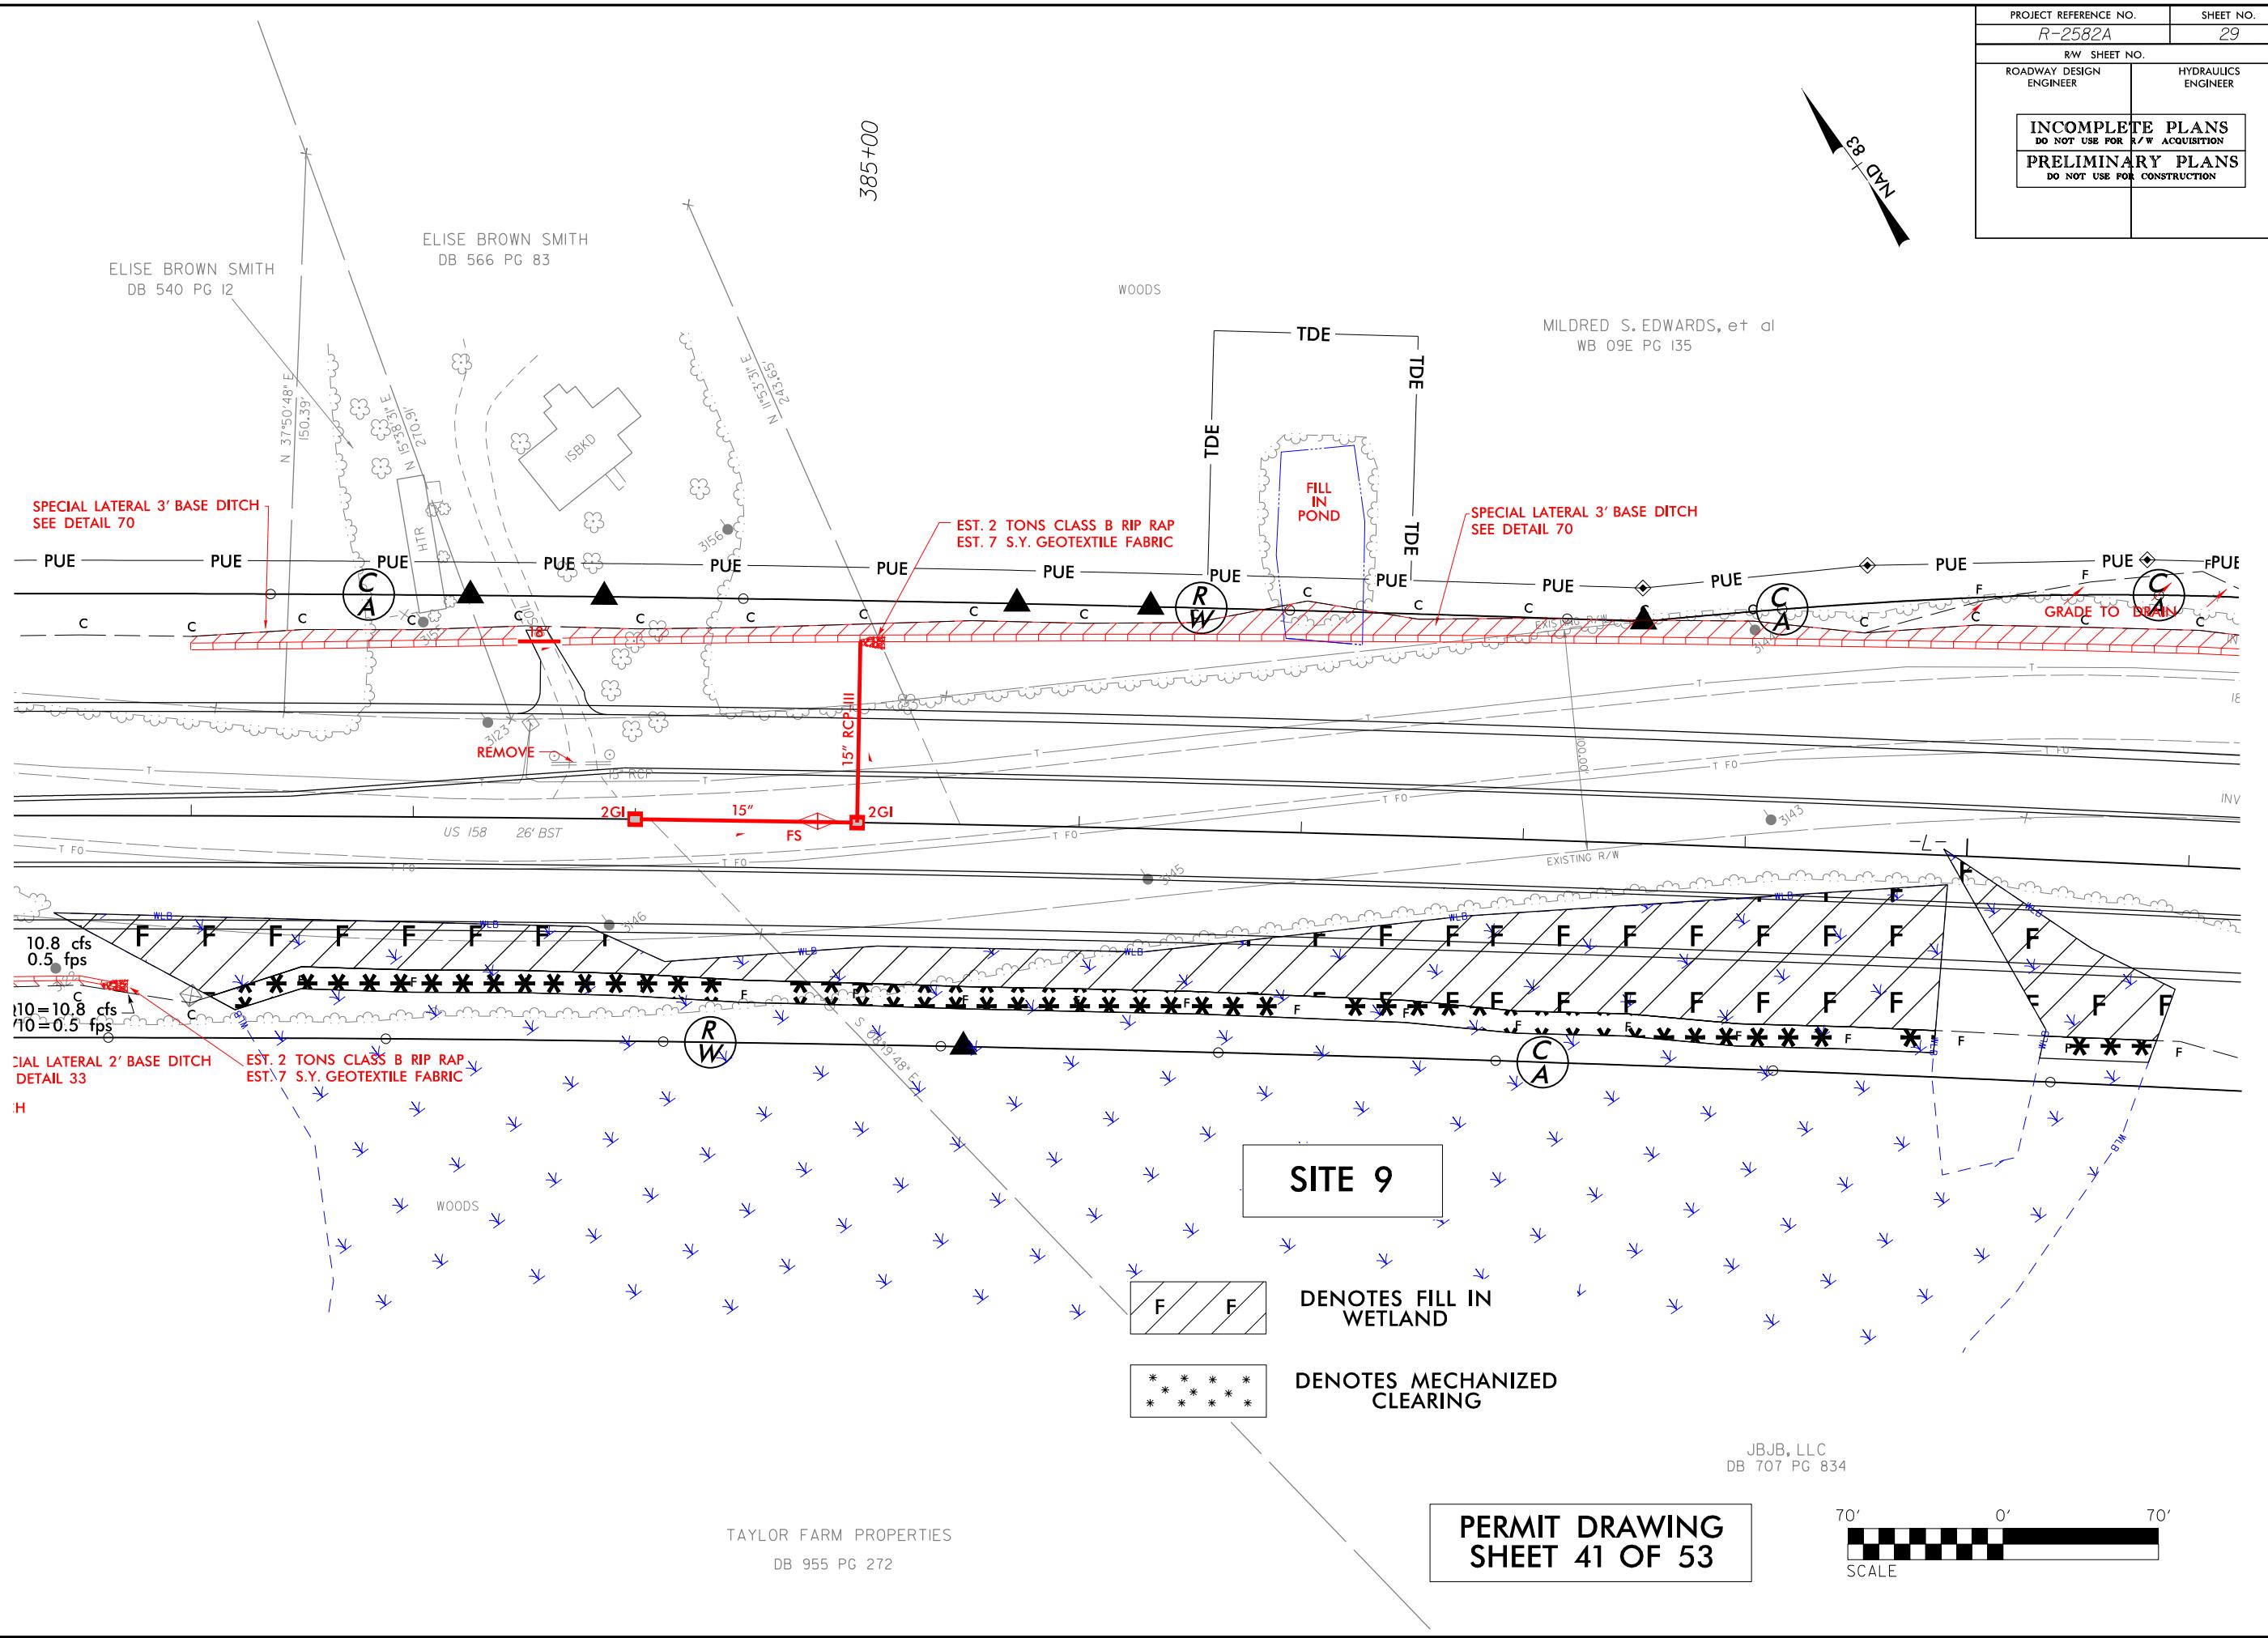

150	140	130	120	110	100	90	80	70	60	50	40	30	20	10	0	10	20	30	40	50	60	70	80	90	100	110	120	130	140	150
-----	-----	-----	-----	-----	-----	----	----	----	----	----	----	----	----	----	---	----	----	----	----	----	----	----	----	----	-----	-----	-----	-----	-----	-----











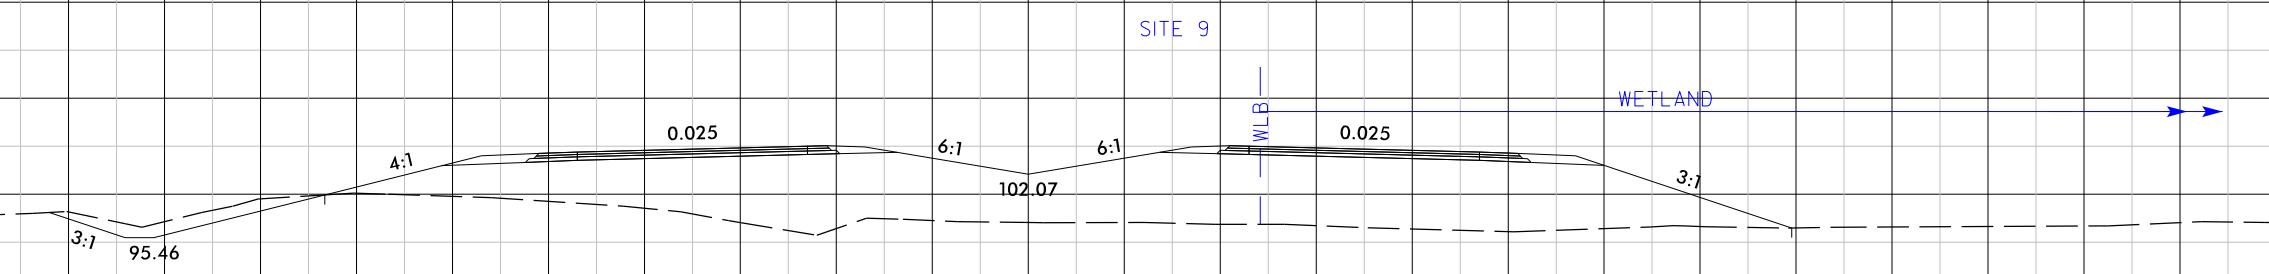


PERMIT DRAWING  
SHEET 42 OF 53

150	140	130	120	110	100	90	80	70	60	50	40	30	20	10	0	10	20	30	40	50	60	70	80	90	100	110	120	130	140	150
-----	-----	-----	-----	-----	-----	----	----	----	----	----	----	----	----	----	---	----	----	----	----	----	----	----	----	----	-----	-----	-----	-----	-----	-----

## MATCHLINE SEE SHEET 30 -L- STA. 405 + 00.00

405+00

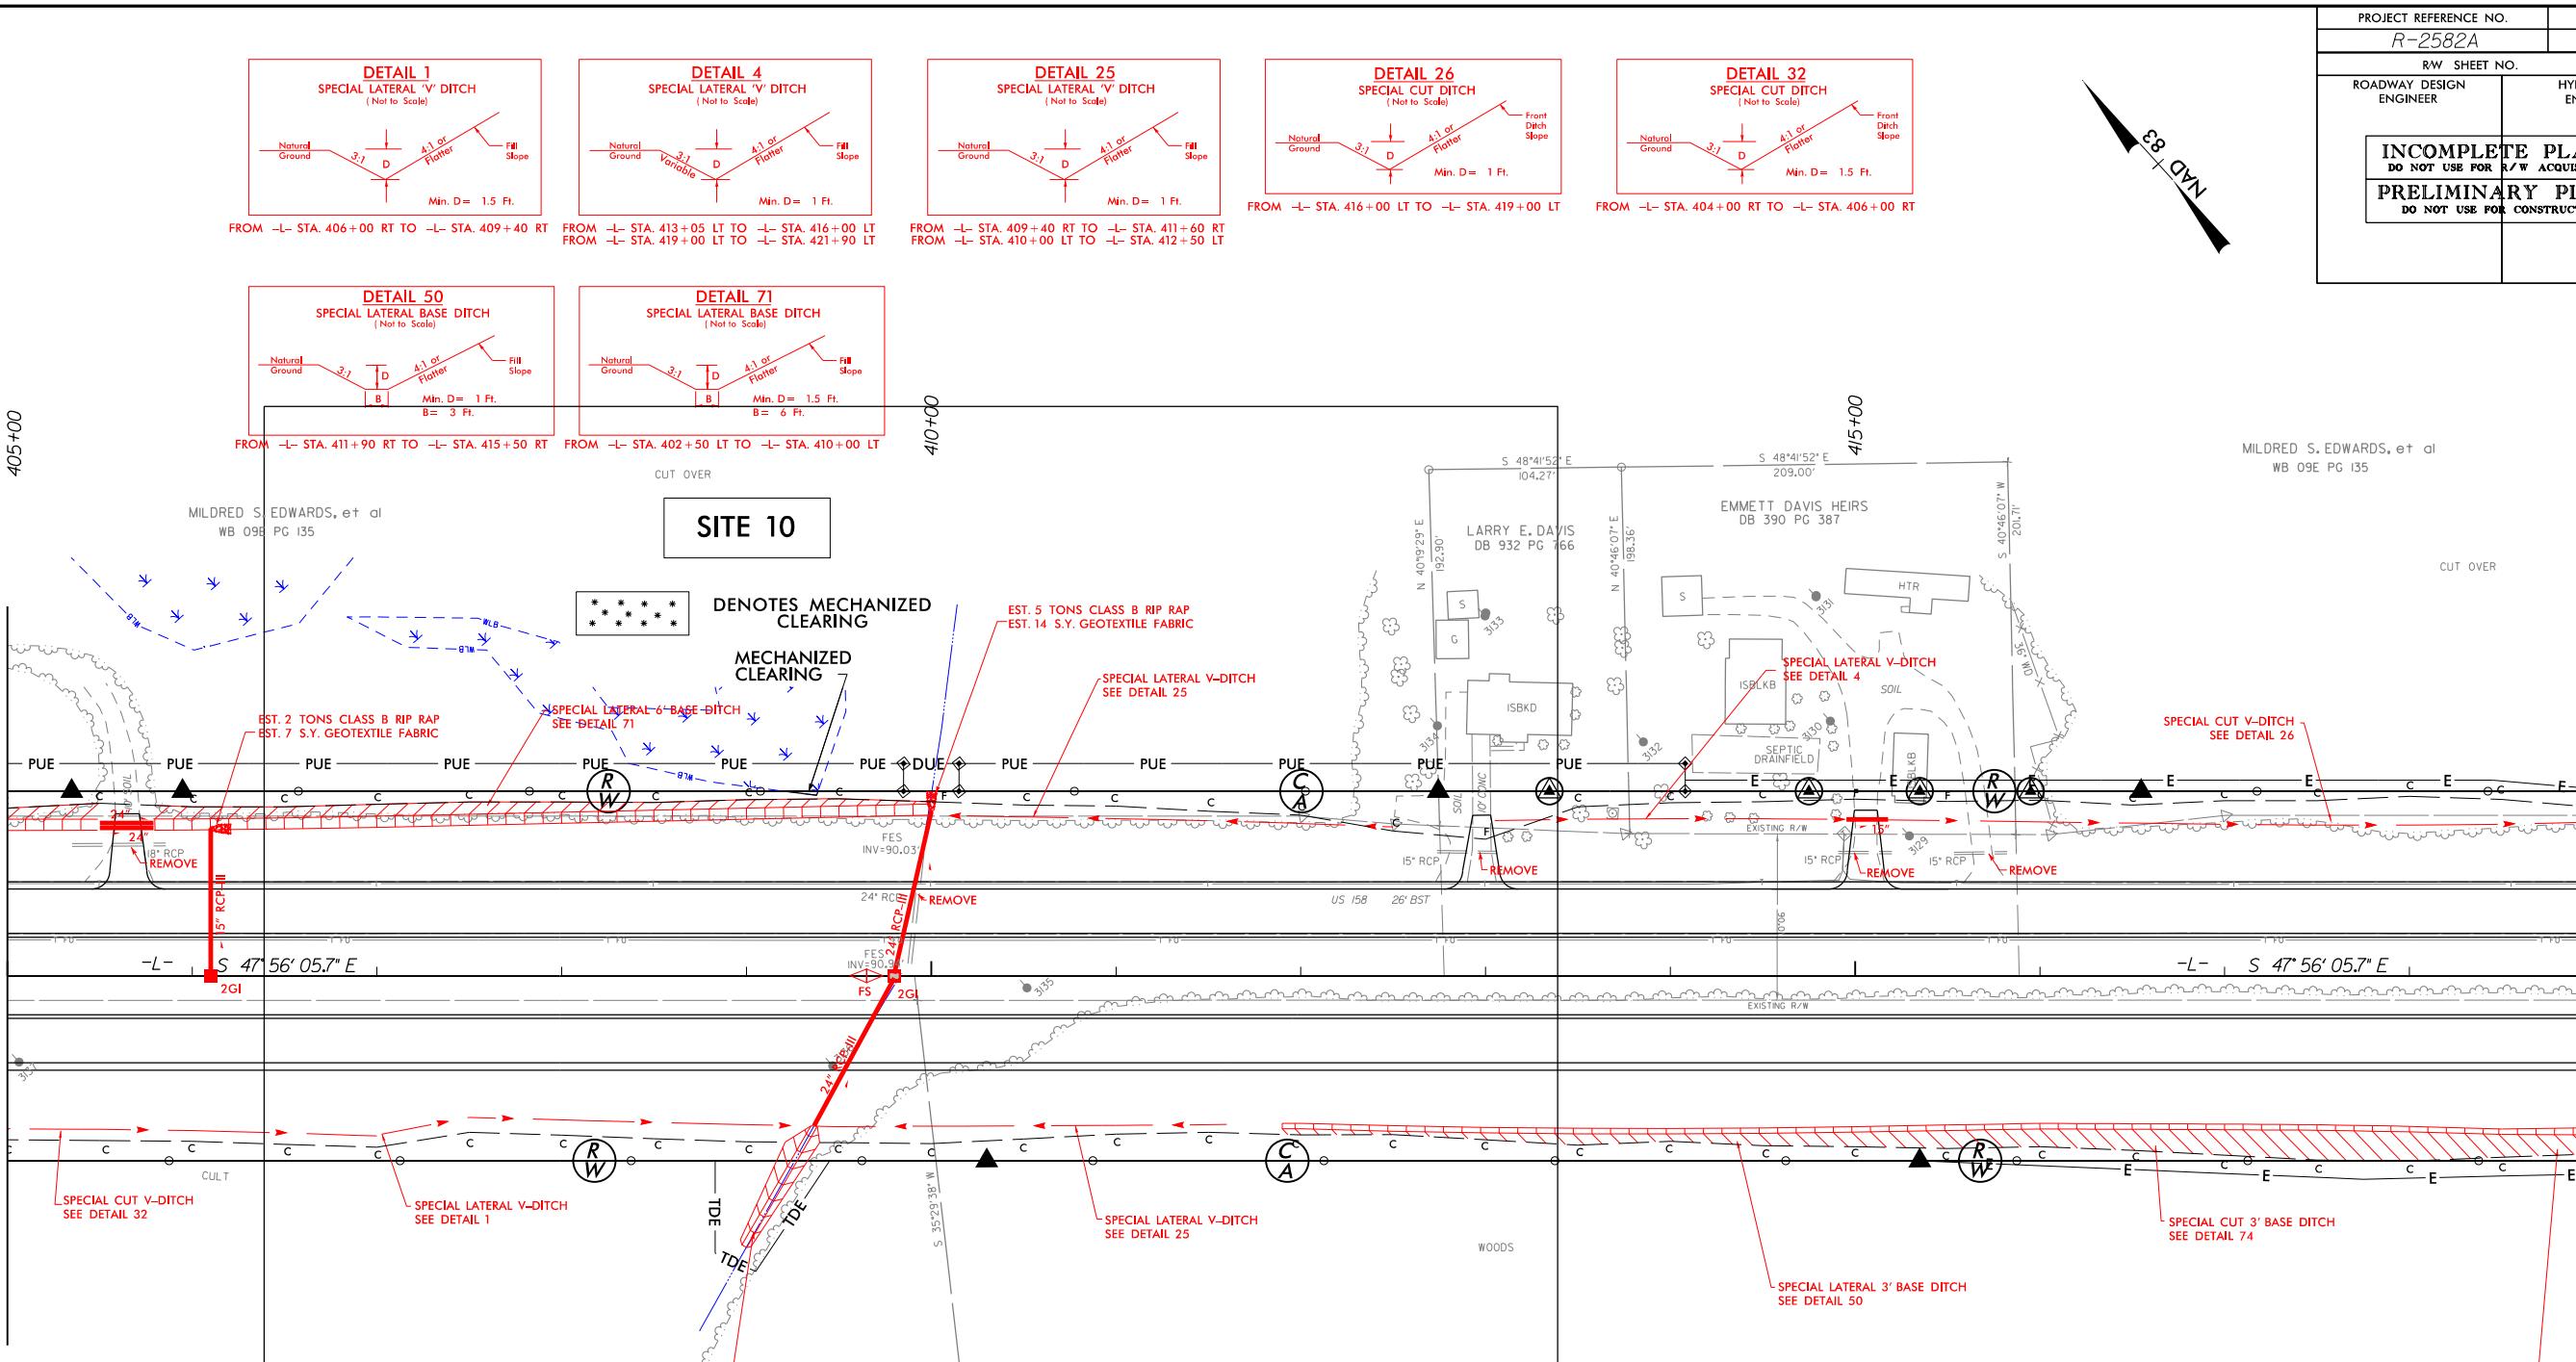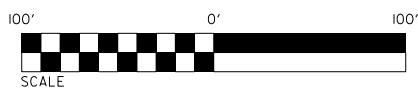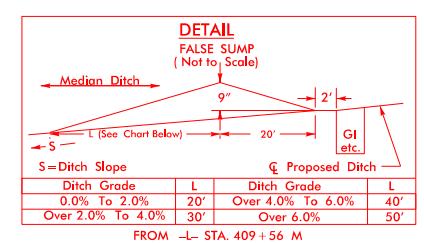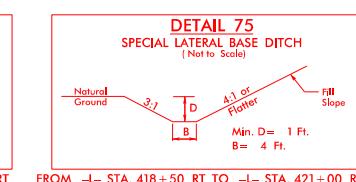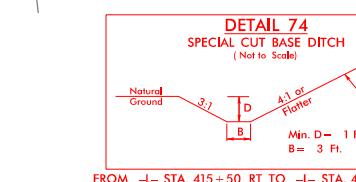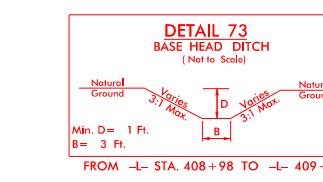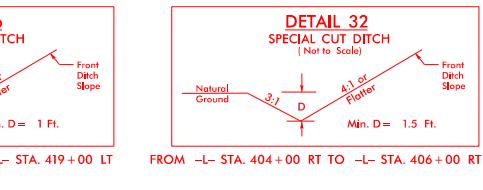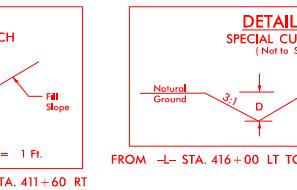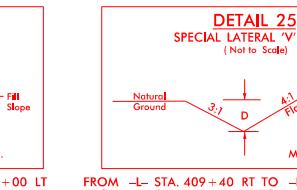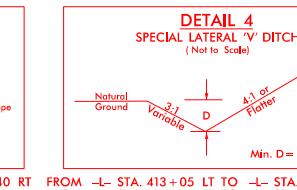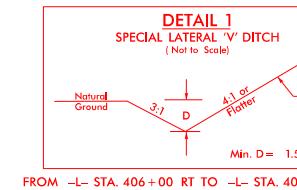SEE ENLARGEMENT  
SHEET 45 OF 53PERMIT DRAWING  
SHEET 43 OF 53MILDRED S. EDWARDS, et al  
WB 09E PG 135

CUT OVER


## MATCHLINE SEE SHEET 32 -L- STA. 419 + 00.00

PROJECT REFERENCE NO. R-2582A	HEET NO. 31
RW SHEET NO.	
ROADWAY DESIGN ENGINEER	HYDRAULICS ENGINEER

**INCOMPLETE PLANS**  
DO NOT USE FOR R/W ACQUISITION  
**PRELIMINARY PLANS**  
DO NOT USE FOR CONSTRUCTION

MATCHLINE SEE SHEET 30 -L- STA. 405 +00.00

PERMIT DRAWING  
SHEET 44 OF 53

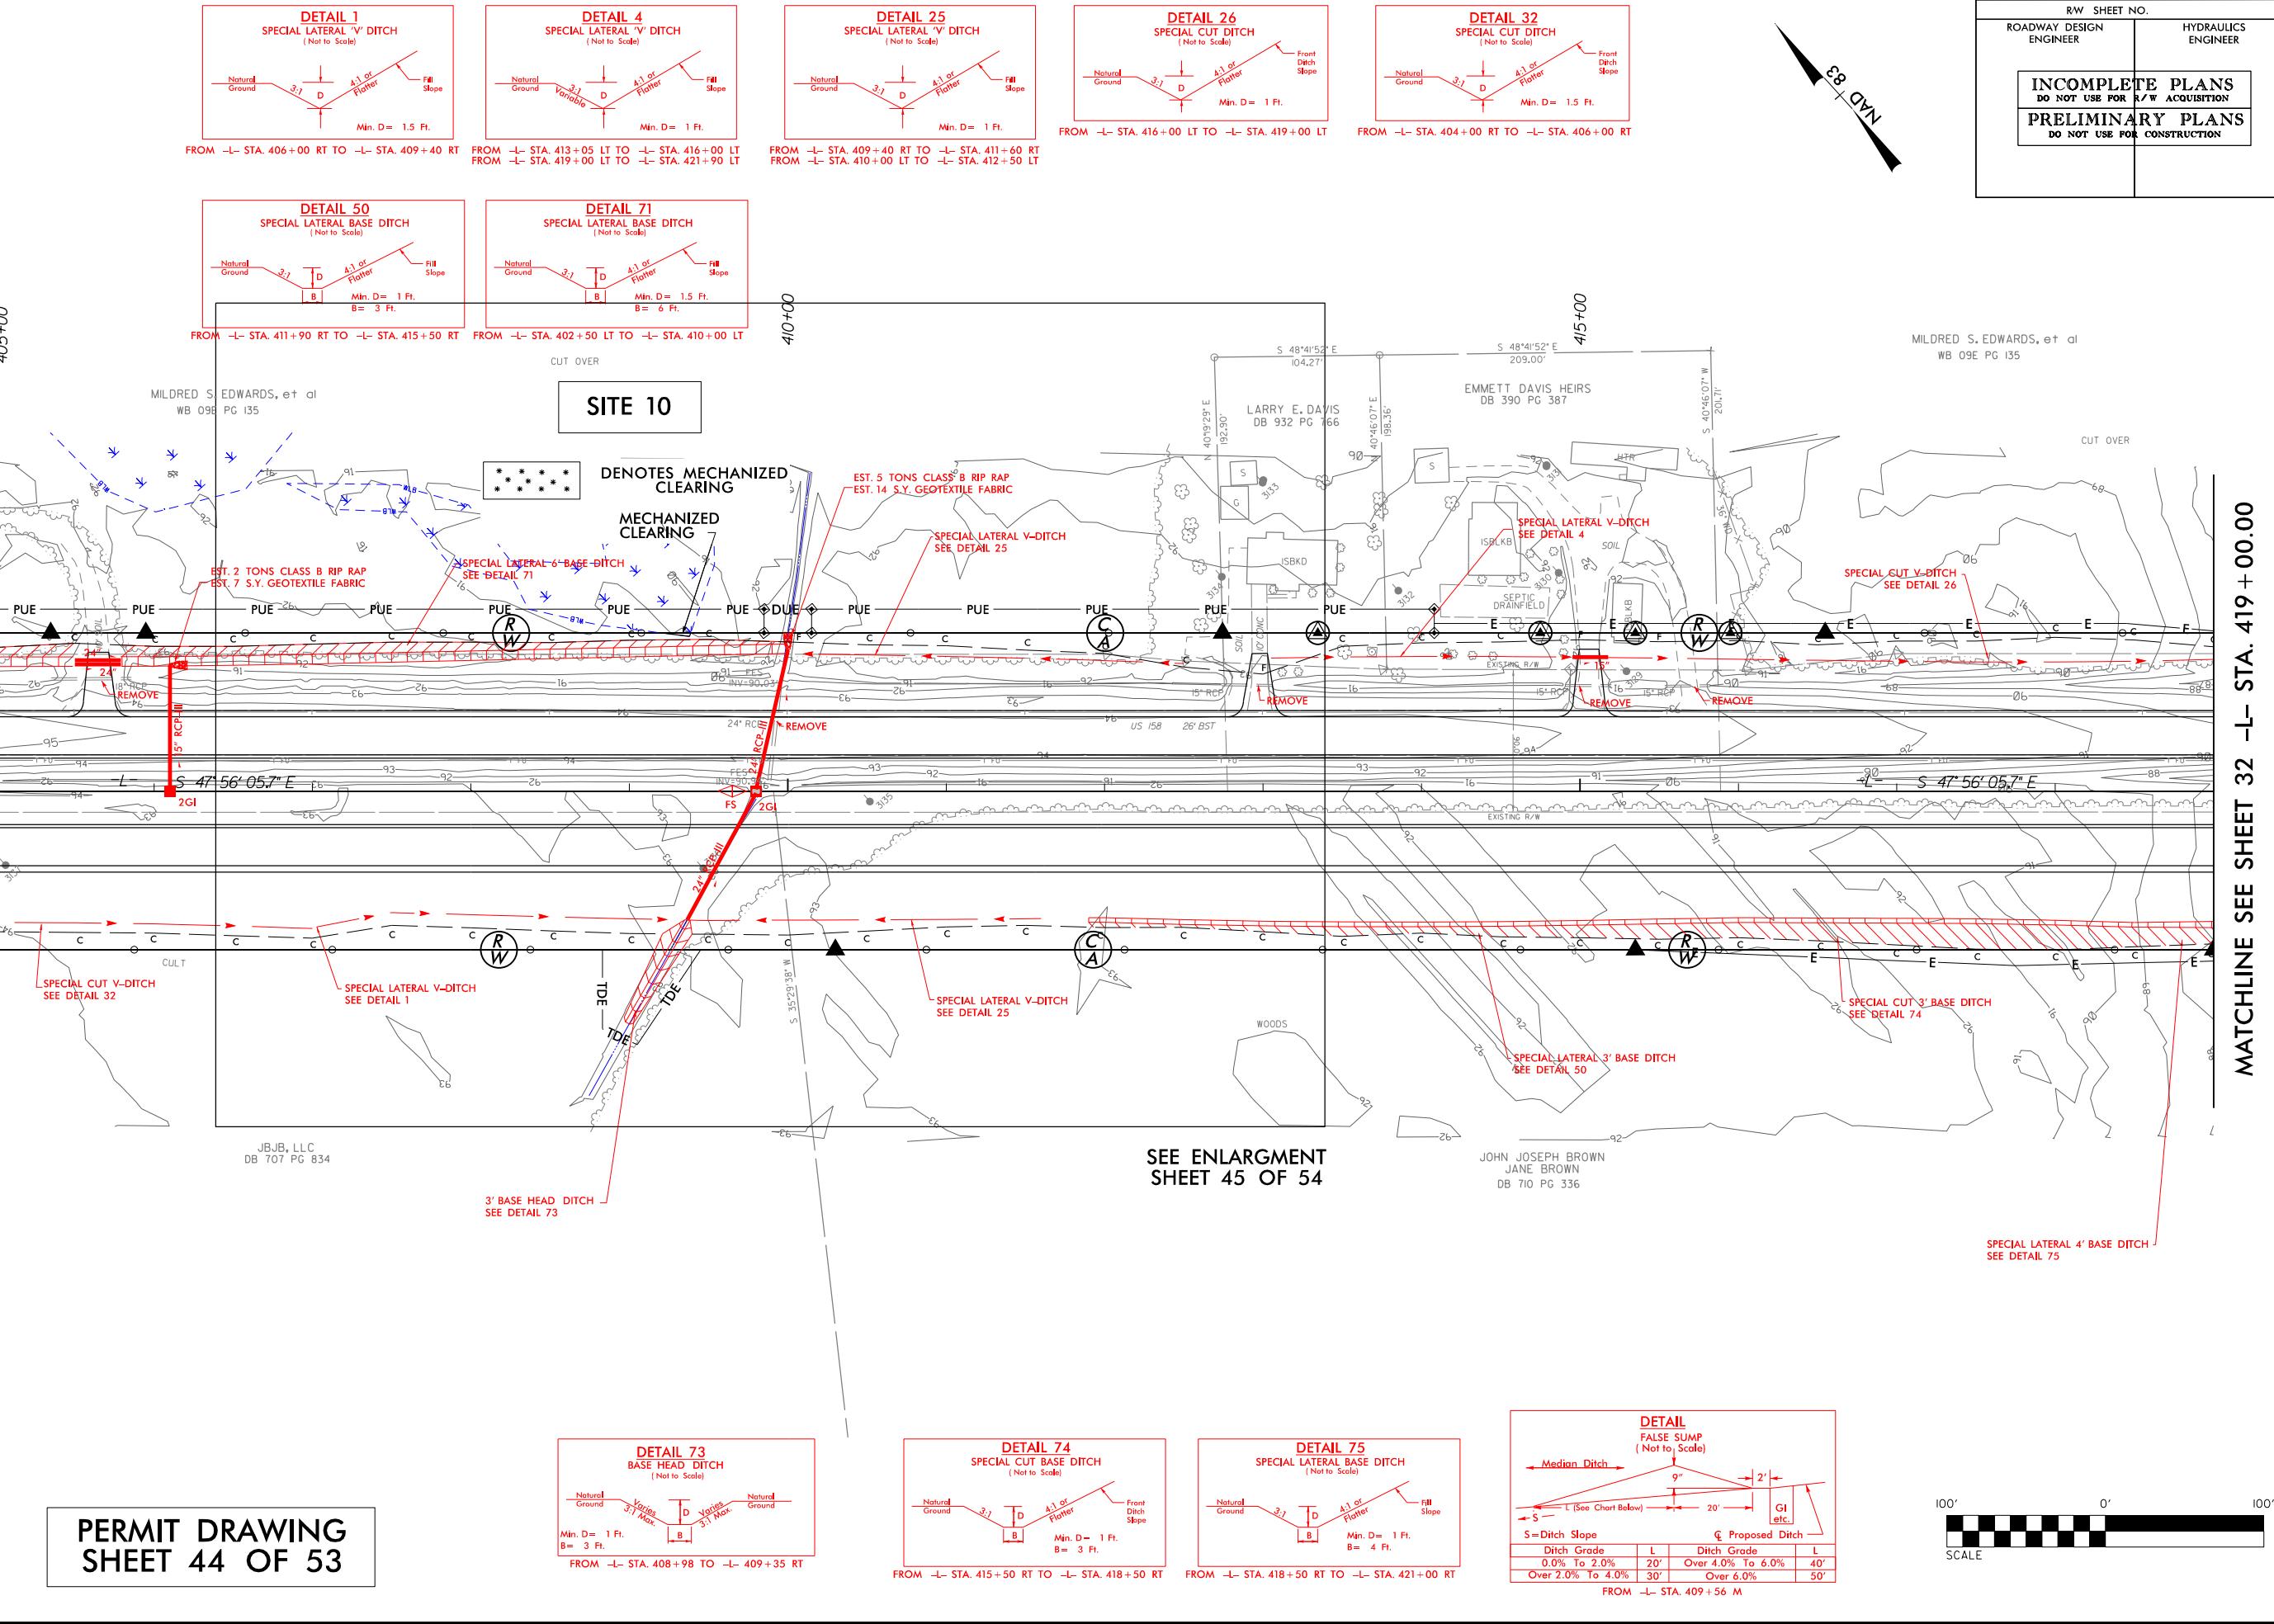

MATCHLINE SEE SHEET 32 -L- STA. 419 + 00.00

EDWARDS, et al  
PG I35

SITE 1

4/0+0

NAD<sup>+</sup> 83

PROJECT REFERENCE NO.		SHEET NO.
<i>R-2582A</i>		<i>31</i>
R/W SHEET NO.		
Roadway Design Engineer	Hydraulics Engineer	
<b>INCOMPLETE PLANS</b> DO NOT USE FOR R/W ACQUISITION		
<b>PRELIMINARY PLANS</b> DO NOT USE FOR CONSTRUCTION		

**ST. 2 TONS CLASS B RIP RAP  
ST. 7 S.Y. GEOTEXTILE FABRIC**

A rectangular box containing ten black asterisks arranged in a scattered pattern.

\* \*  
DENOTES MECHANIZED  
CLEARING

# MECHANIZED CLEARING

EST. 5 TONS CLASS B RIP RAP  
EST. 14 S.Y. GEOTEXTILE FABRIC

SPECIAL LATERAL V-DITCH  
SEE DETAIL 25

**ST. 2 TONS CLASS B RIP RAP  
ST. 7 S.Y. GEOTEXTILE FABRIC**

~~SPECIAL LATERAL 6 BASE DIT  
SEE DETAIL 71~~

56° 05.7" E

F  
INV=S

US 158 26' BS

24" RCF REMC

SPECIAL LATERAL V-DITC  
SFF DETAIL 1








SPECIAL LATERAL V-DITCH  
SEE DETAIL 25

PERMIT DRAWING  
SHEET 45 OF 53


A scale bar and a north arrow are positioned at the bottom center of the map. The scale bar consists of a horizontal line with black and white squares on the left and a solid black bar on the right, labeled '50' at each end. Below it, the word 'SCALE' is written. Above the scale bar is a north arrow pointing upwards, consisting of a circle divided into four quadrants by a crosshair.

PROJECT REFERENCE NO.	SHEET NO.
R-2582A	32
RW SHEET NO.	
ROADWAY DESIGN ENGINEER	HYDRAULICS ENGINEER
INCOMPLETE PLANS DO NOT USE FOR R/W ACQUISITION	
PRELIMINARY PLANS DO NOT USE FOR CONSTRUCTION	

## MATCHLINE SEE SHEET 31 -L- STA. 419+00.00

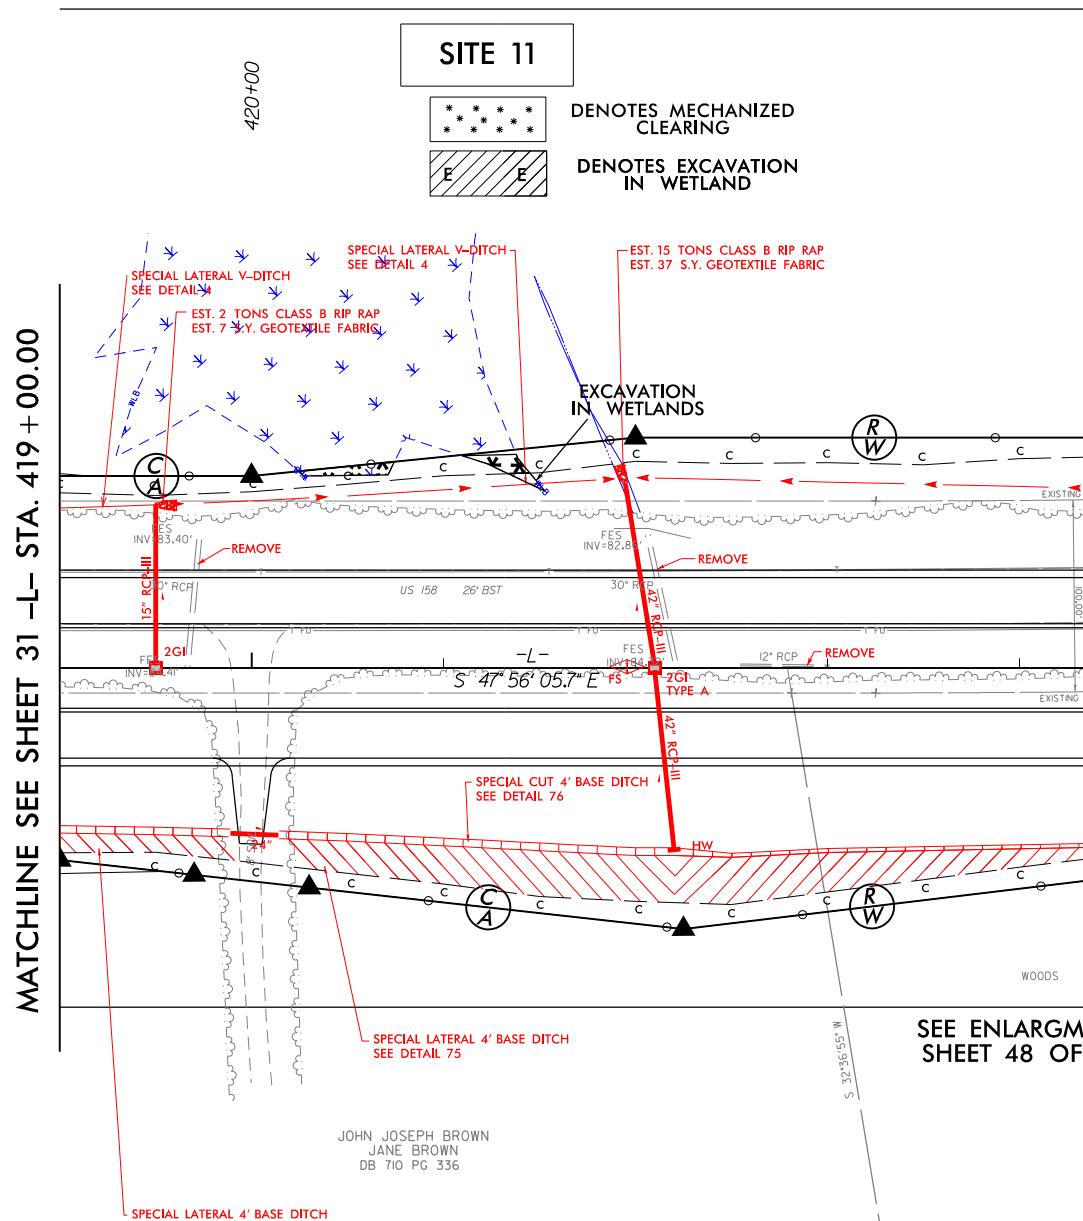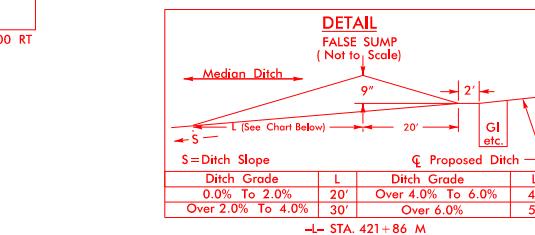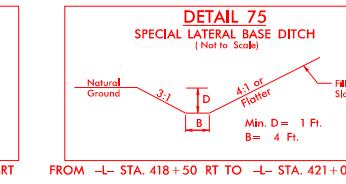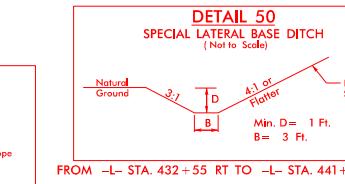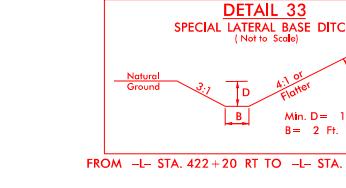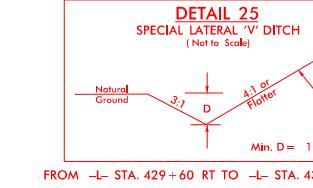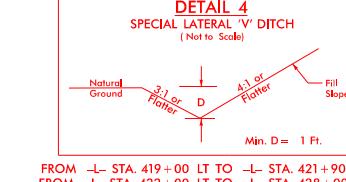W&M ASSOCIATES  
DB 908 PG 765W&M ASSOCIATES  
DB 908 PG 765

-L- STA. 421+86 M

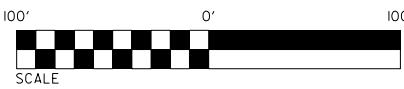PERMIT DRAWING  
SHEET 46 OF 53

-L- TS Sta. 429+06.35

CUT OVER

MILDRED S. EDWARDS, et al  
WB 09E PG 135











-L- SC Sta. 431+06.35

STANDARD 3' BASE TAIL DITCH  
EST. 11 TONS CLASS B RIP RAP  
EST. 40 S.Y. GEOTEXTILE FABRIC  
SEE DETAIL 77

MATCHLINE SEE SHEET 33 -L- STA. 433+00.00


PROJECT REFERENCE NO.	SHEET NO.
R-2582A	32
RW SHEET NO.	
ROADWAY DESIGN ENGINEER	HYDRAULICS ENGINEER
INCOMPLETE PLANS DO NOT USE FOR R/W ACQUISITION	
PRELIMINARY PLANS DO NOT USE FOR CONSTRUCTION	

## MATCHLINE SEE SHEET 31 -L- STA. 419 + 00.00

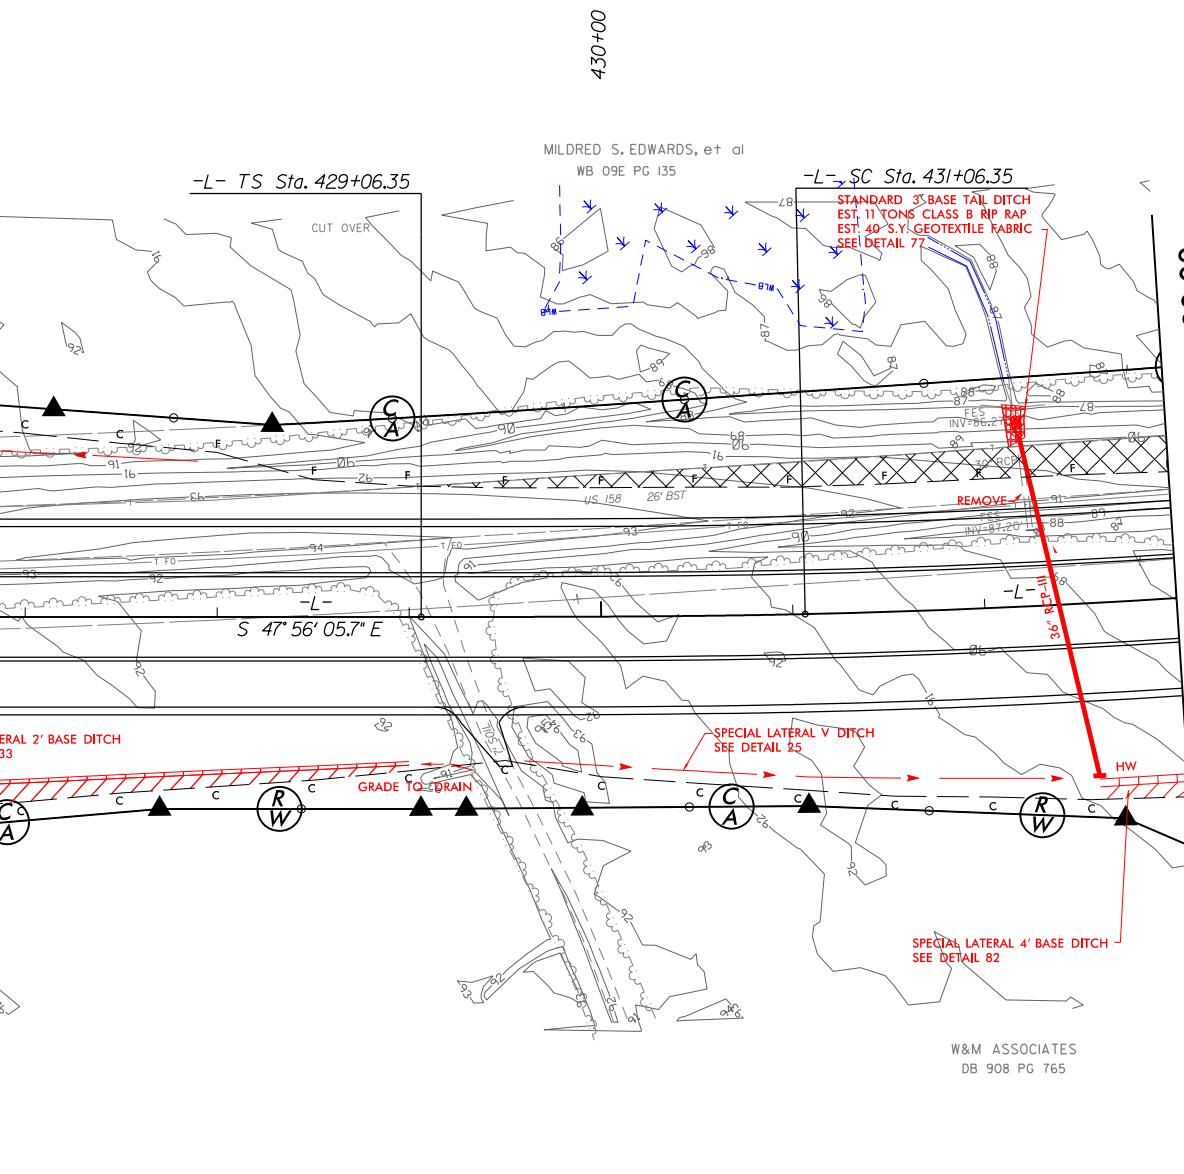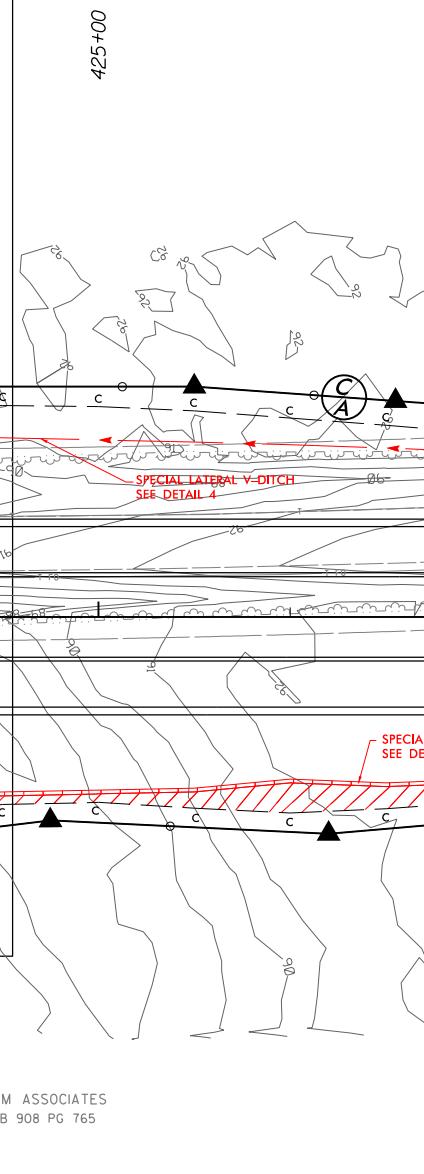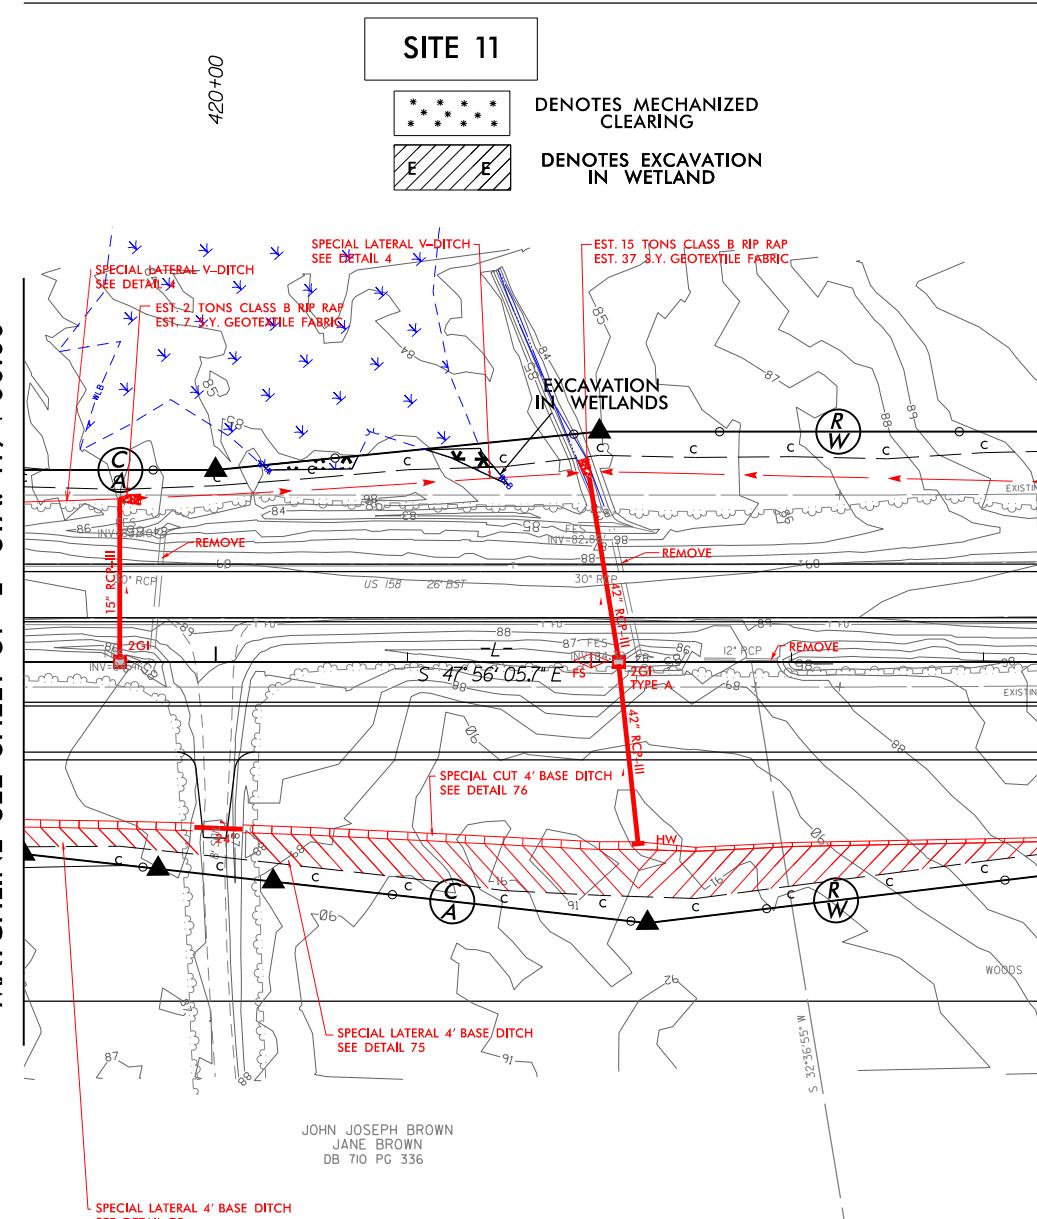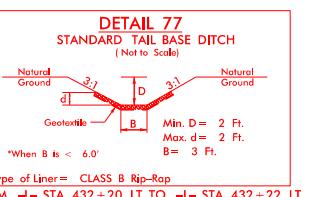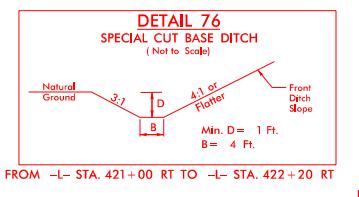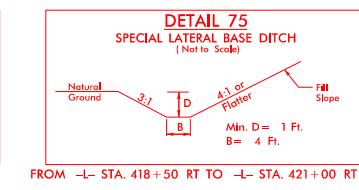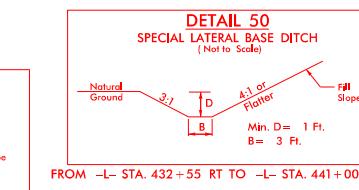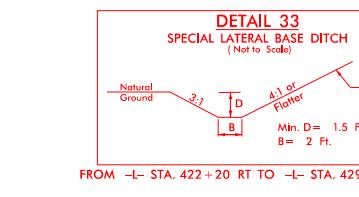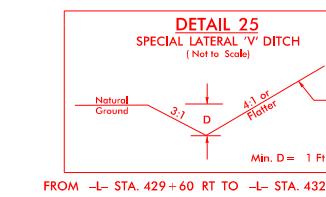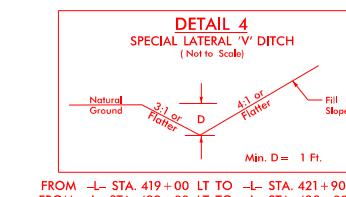SEE ENLARGEMENT  
SHEET 48 OF 53PERMIT DRAWING  
SHEET 47 OF 53

DETAIL 76 FALSE SUMP (Not to Scale)			
Median Ditch		G.I. Ditch	
S=Ditch Slope	9"	2'	
L (See Chart Below)	20'	20'	
Ditch Grade	L	Ditch Grade	L
0.0% To 2.0%	20'	Over 4.0% To 6.0%	40'
Over 2.0% To 4.0%	30'	Over 6.0%	50'


-L- STA. 421 + 86 M

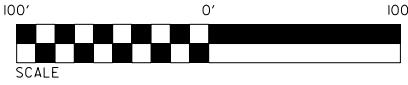


RDS, et al  
35


## SITE 11


420+00

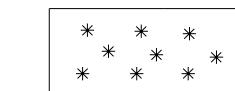
DENOTES MECHANIZED  
CLEARINGDENOTES EXCAVATION  
IN WETLAND


PROJECT REFERENCE NO.		SHEET NO.
R-2582A		32
RW SHEET NO.		
ROADWAY DESIGN ENGINEER	HYDRAULICS ENGINEER	
INCOMPLETE PLANS DO NOT USE FOR R/W ACQUISITION	PRELIMINARY PLANS DO NOT USE FOR CONSTRUCTION	

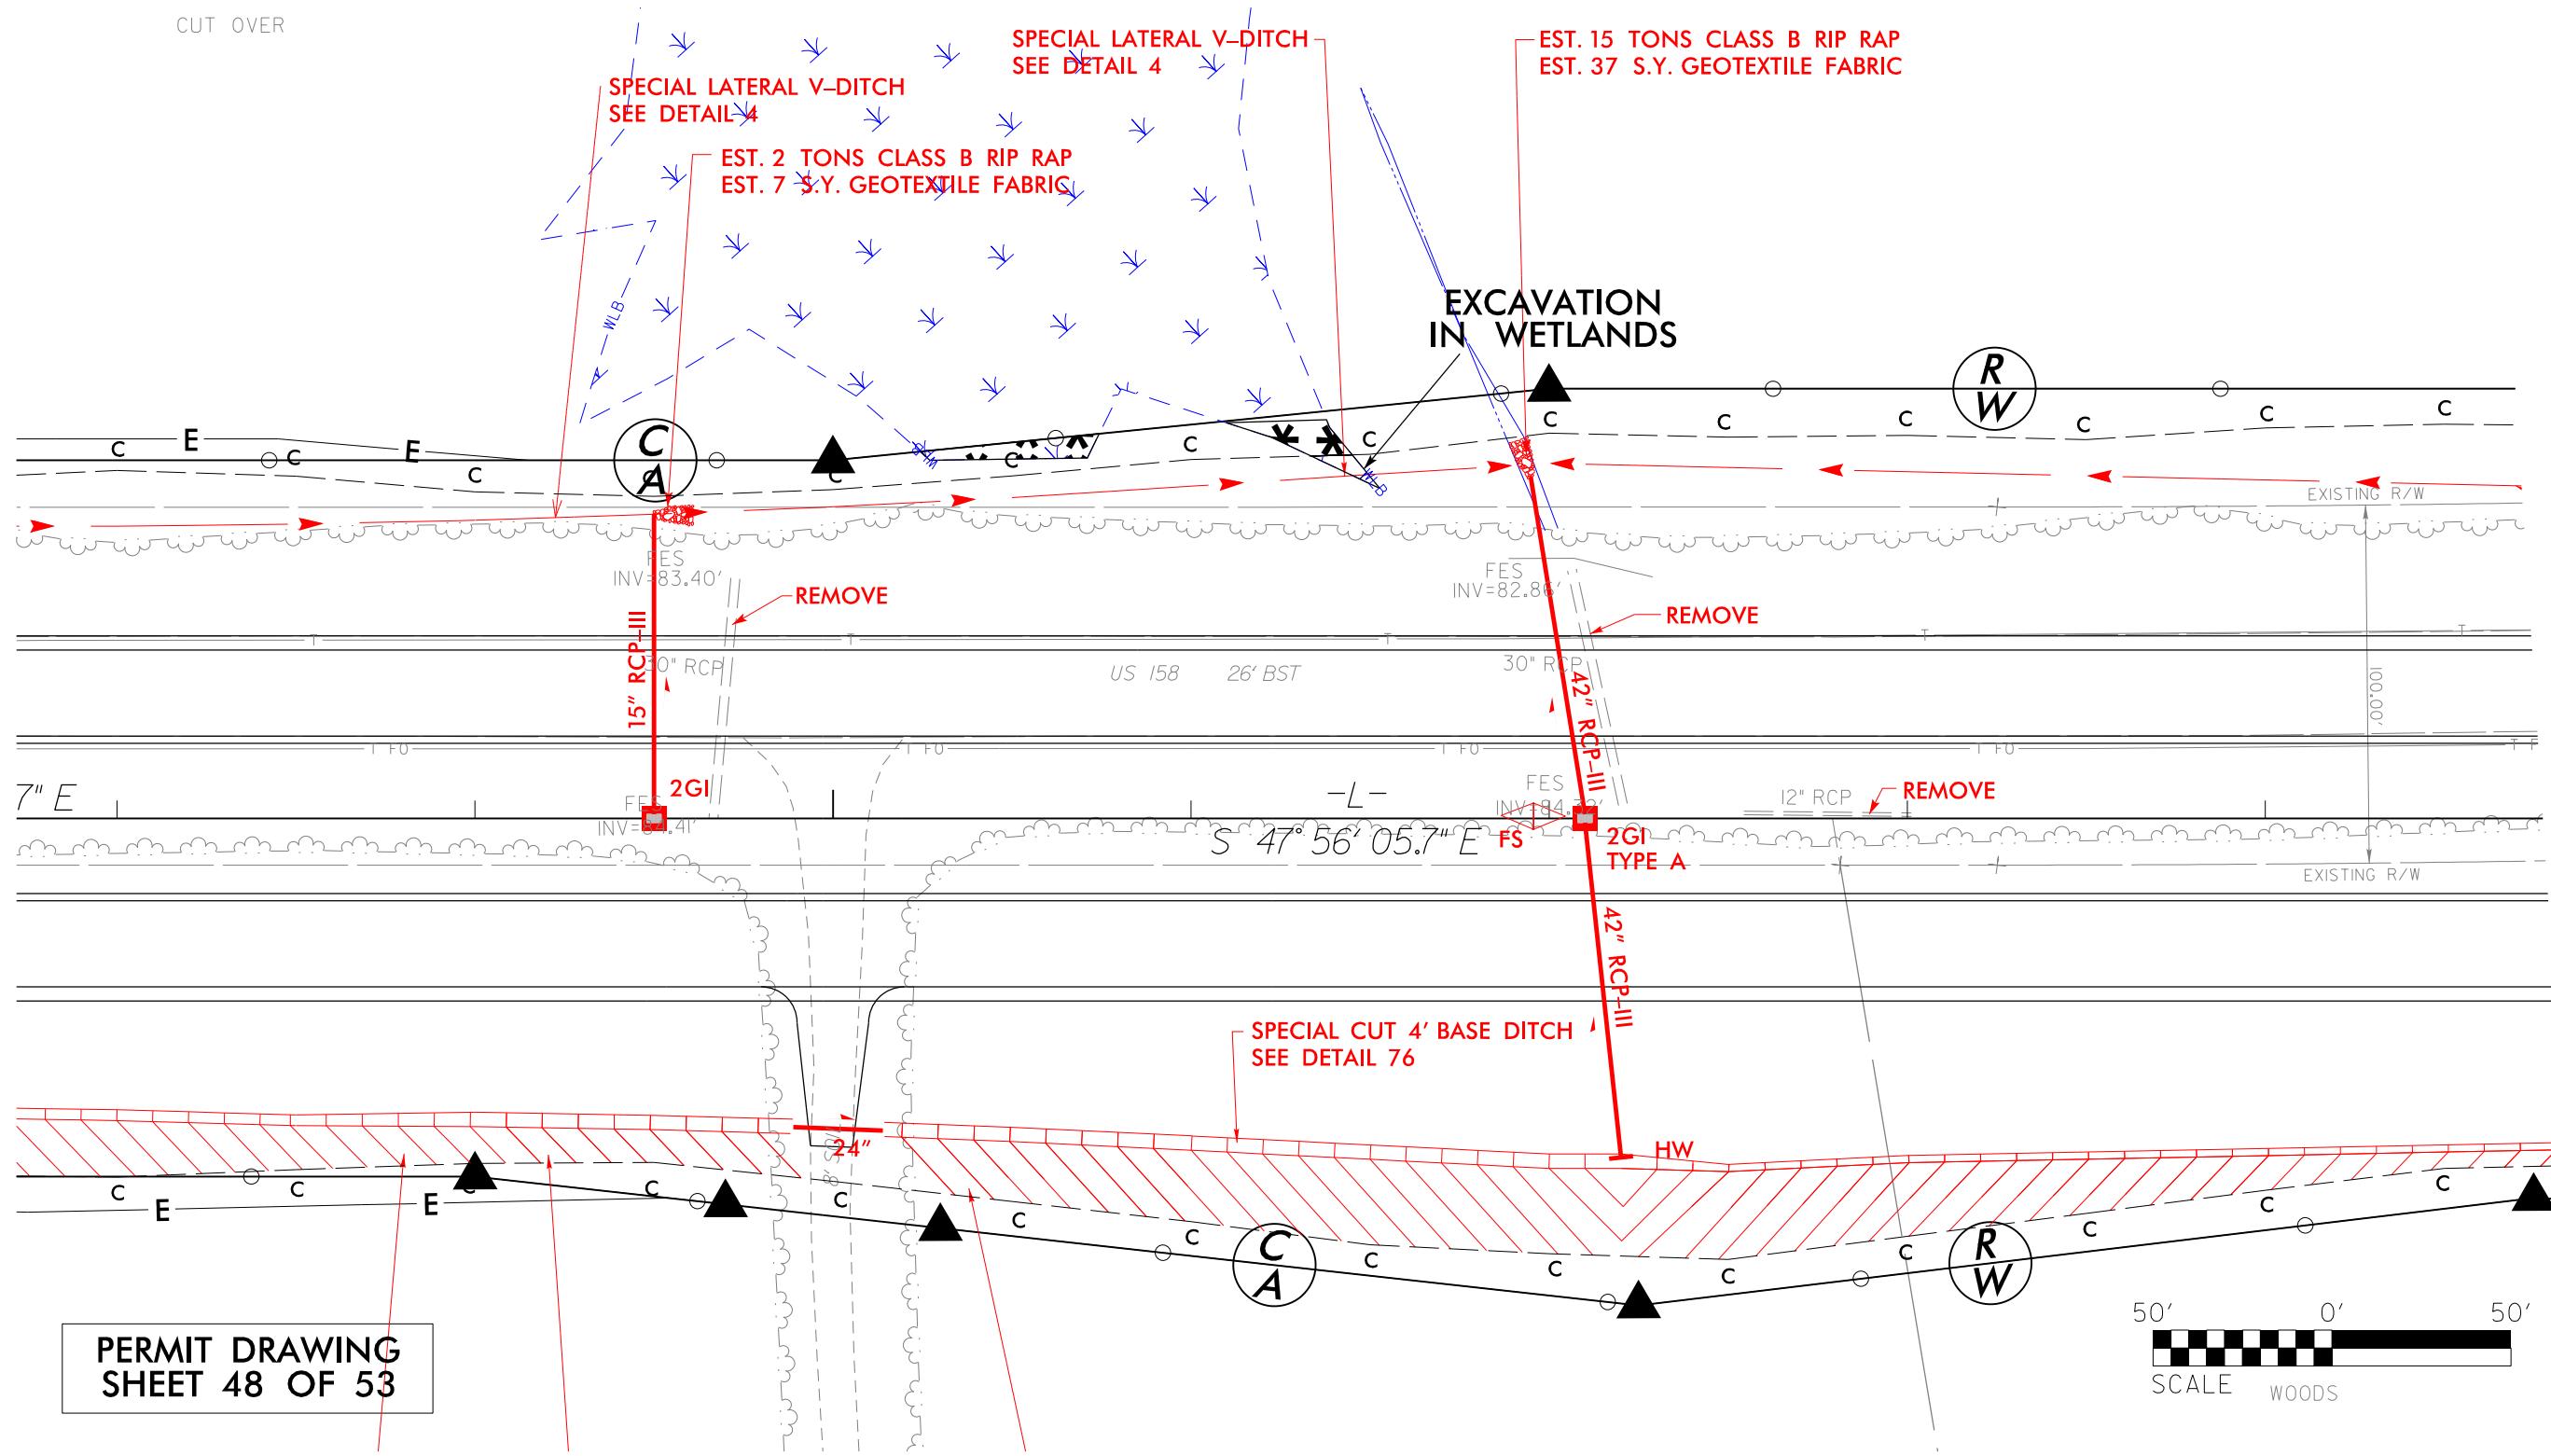

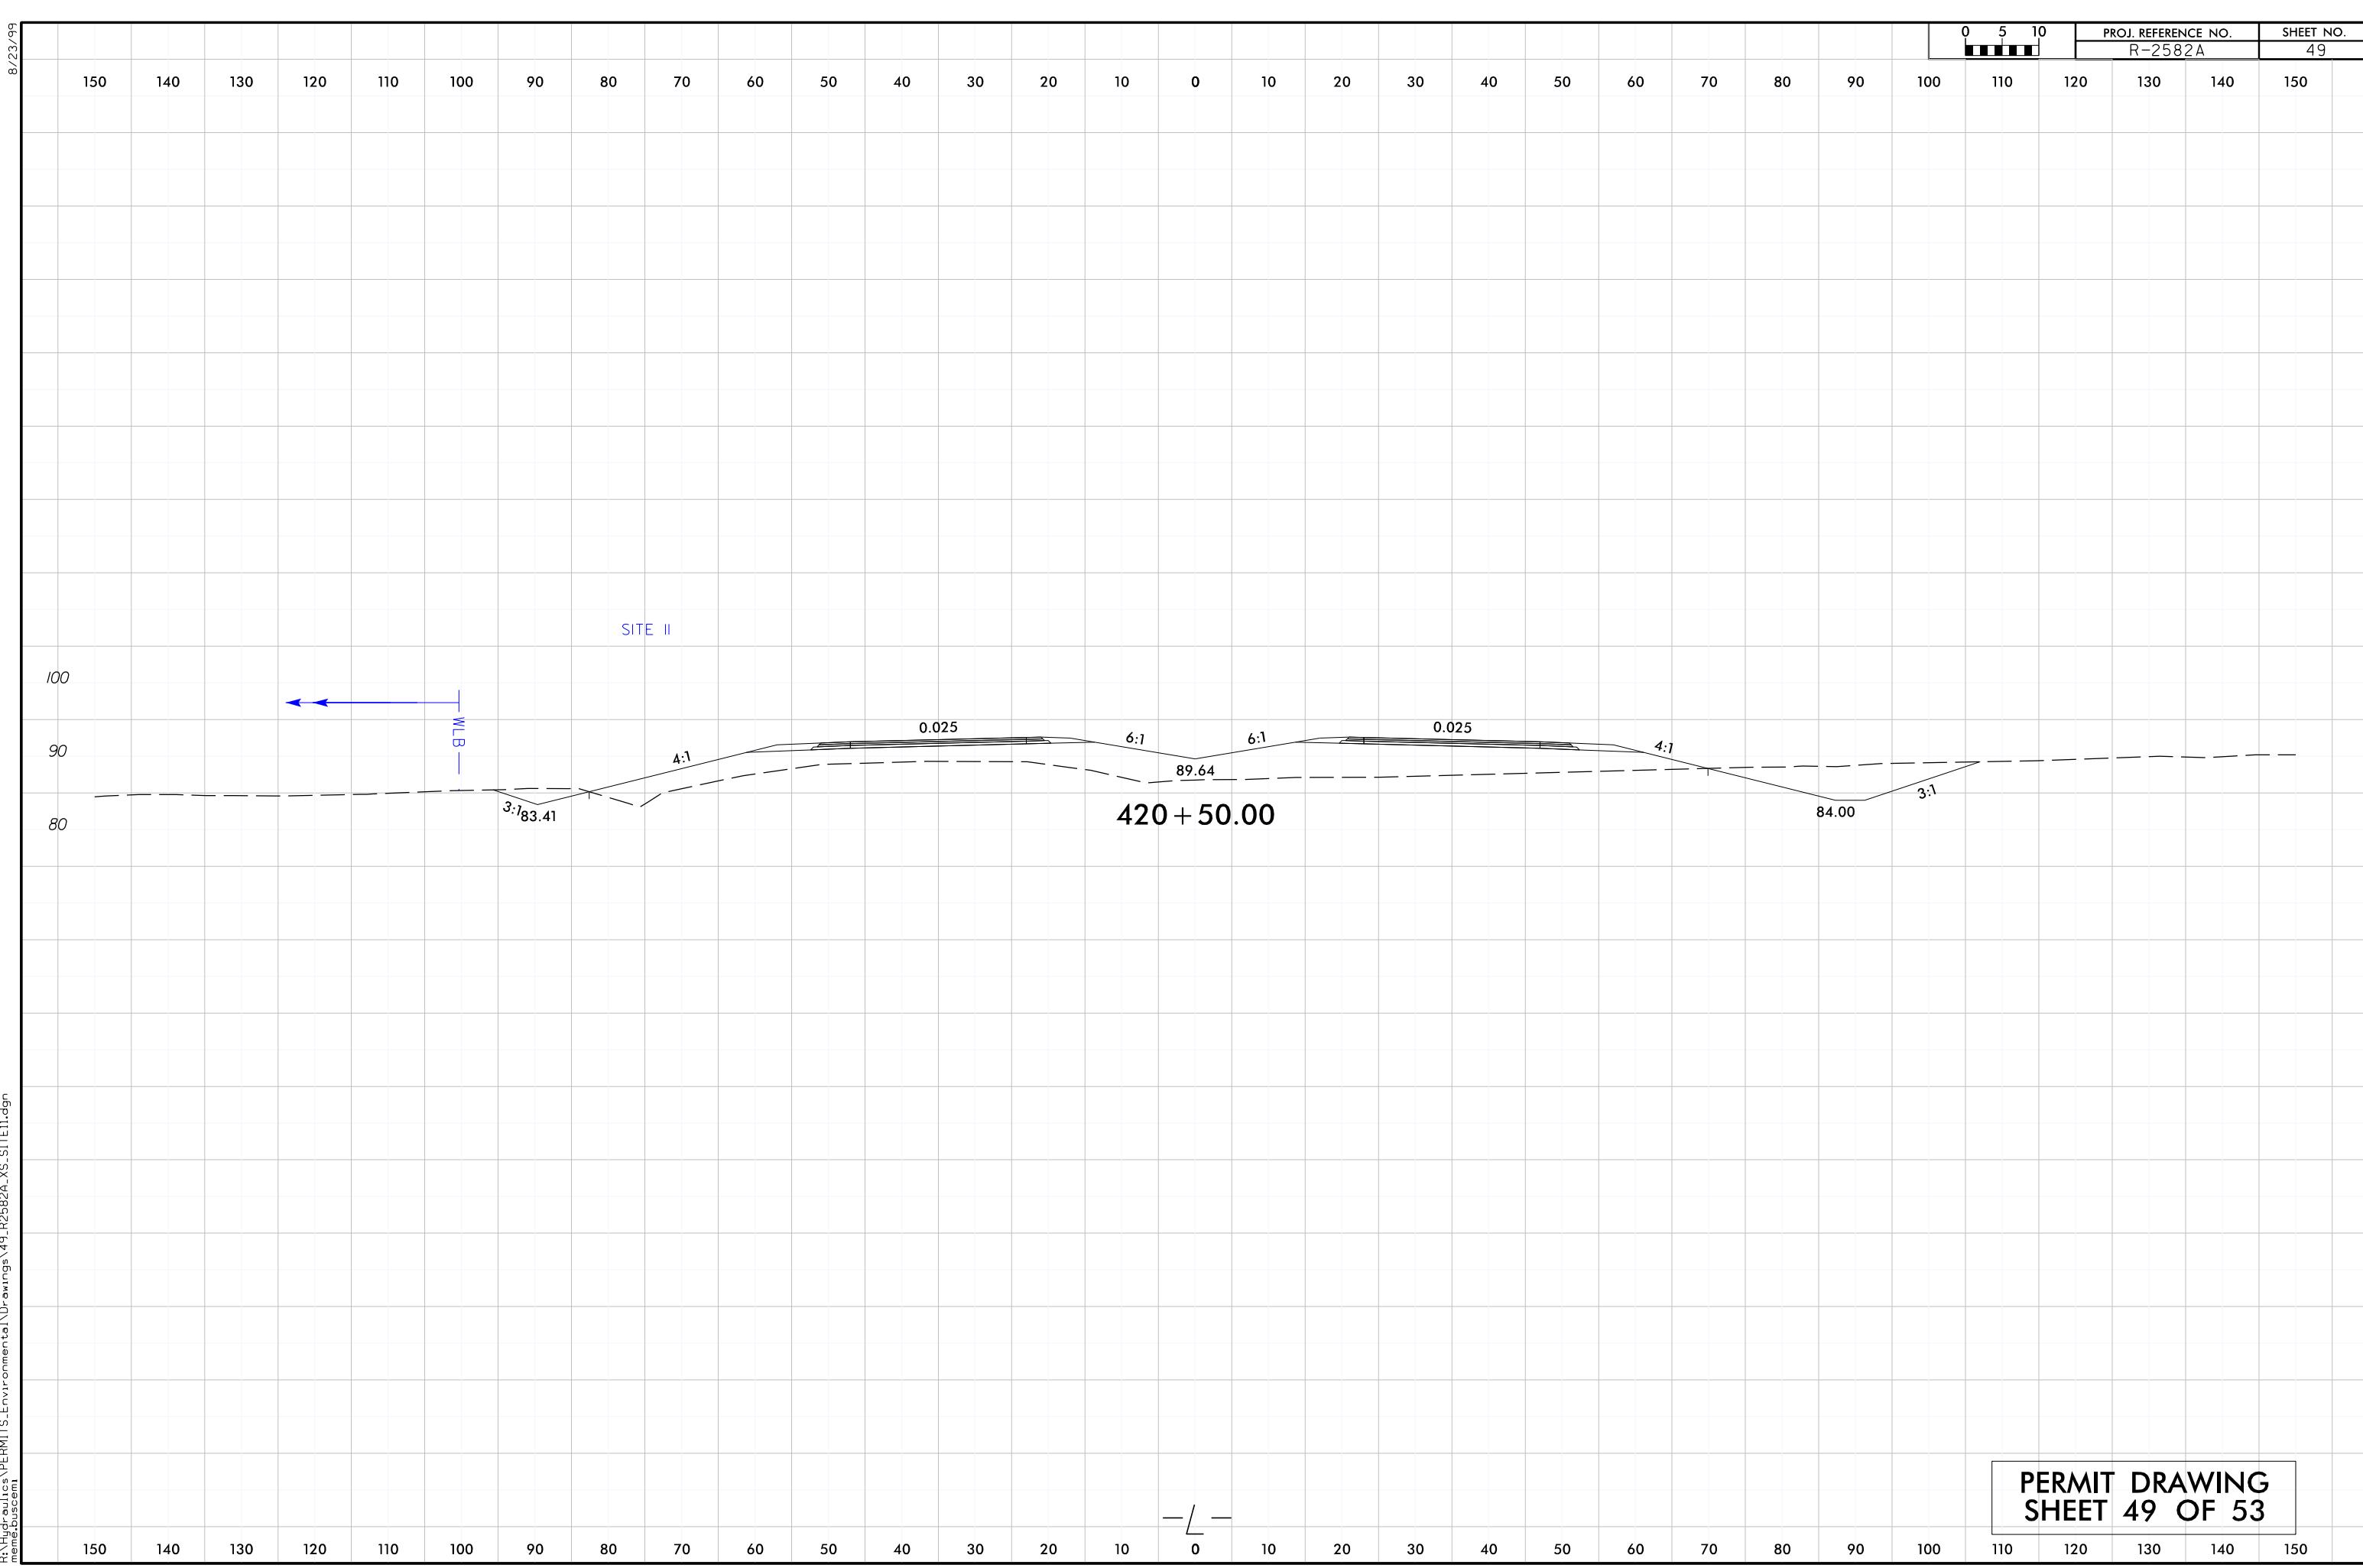

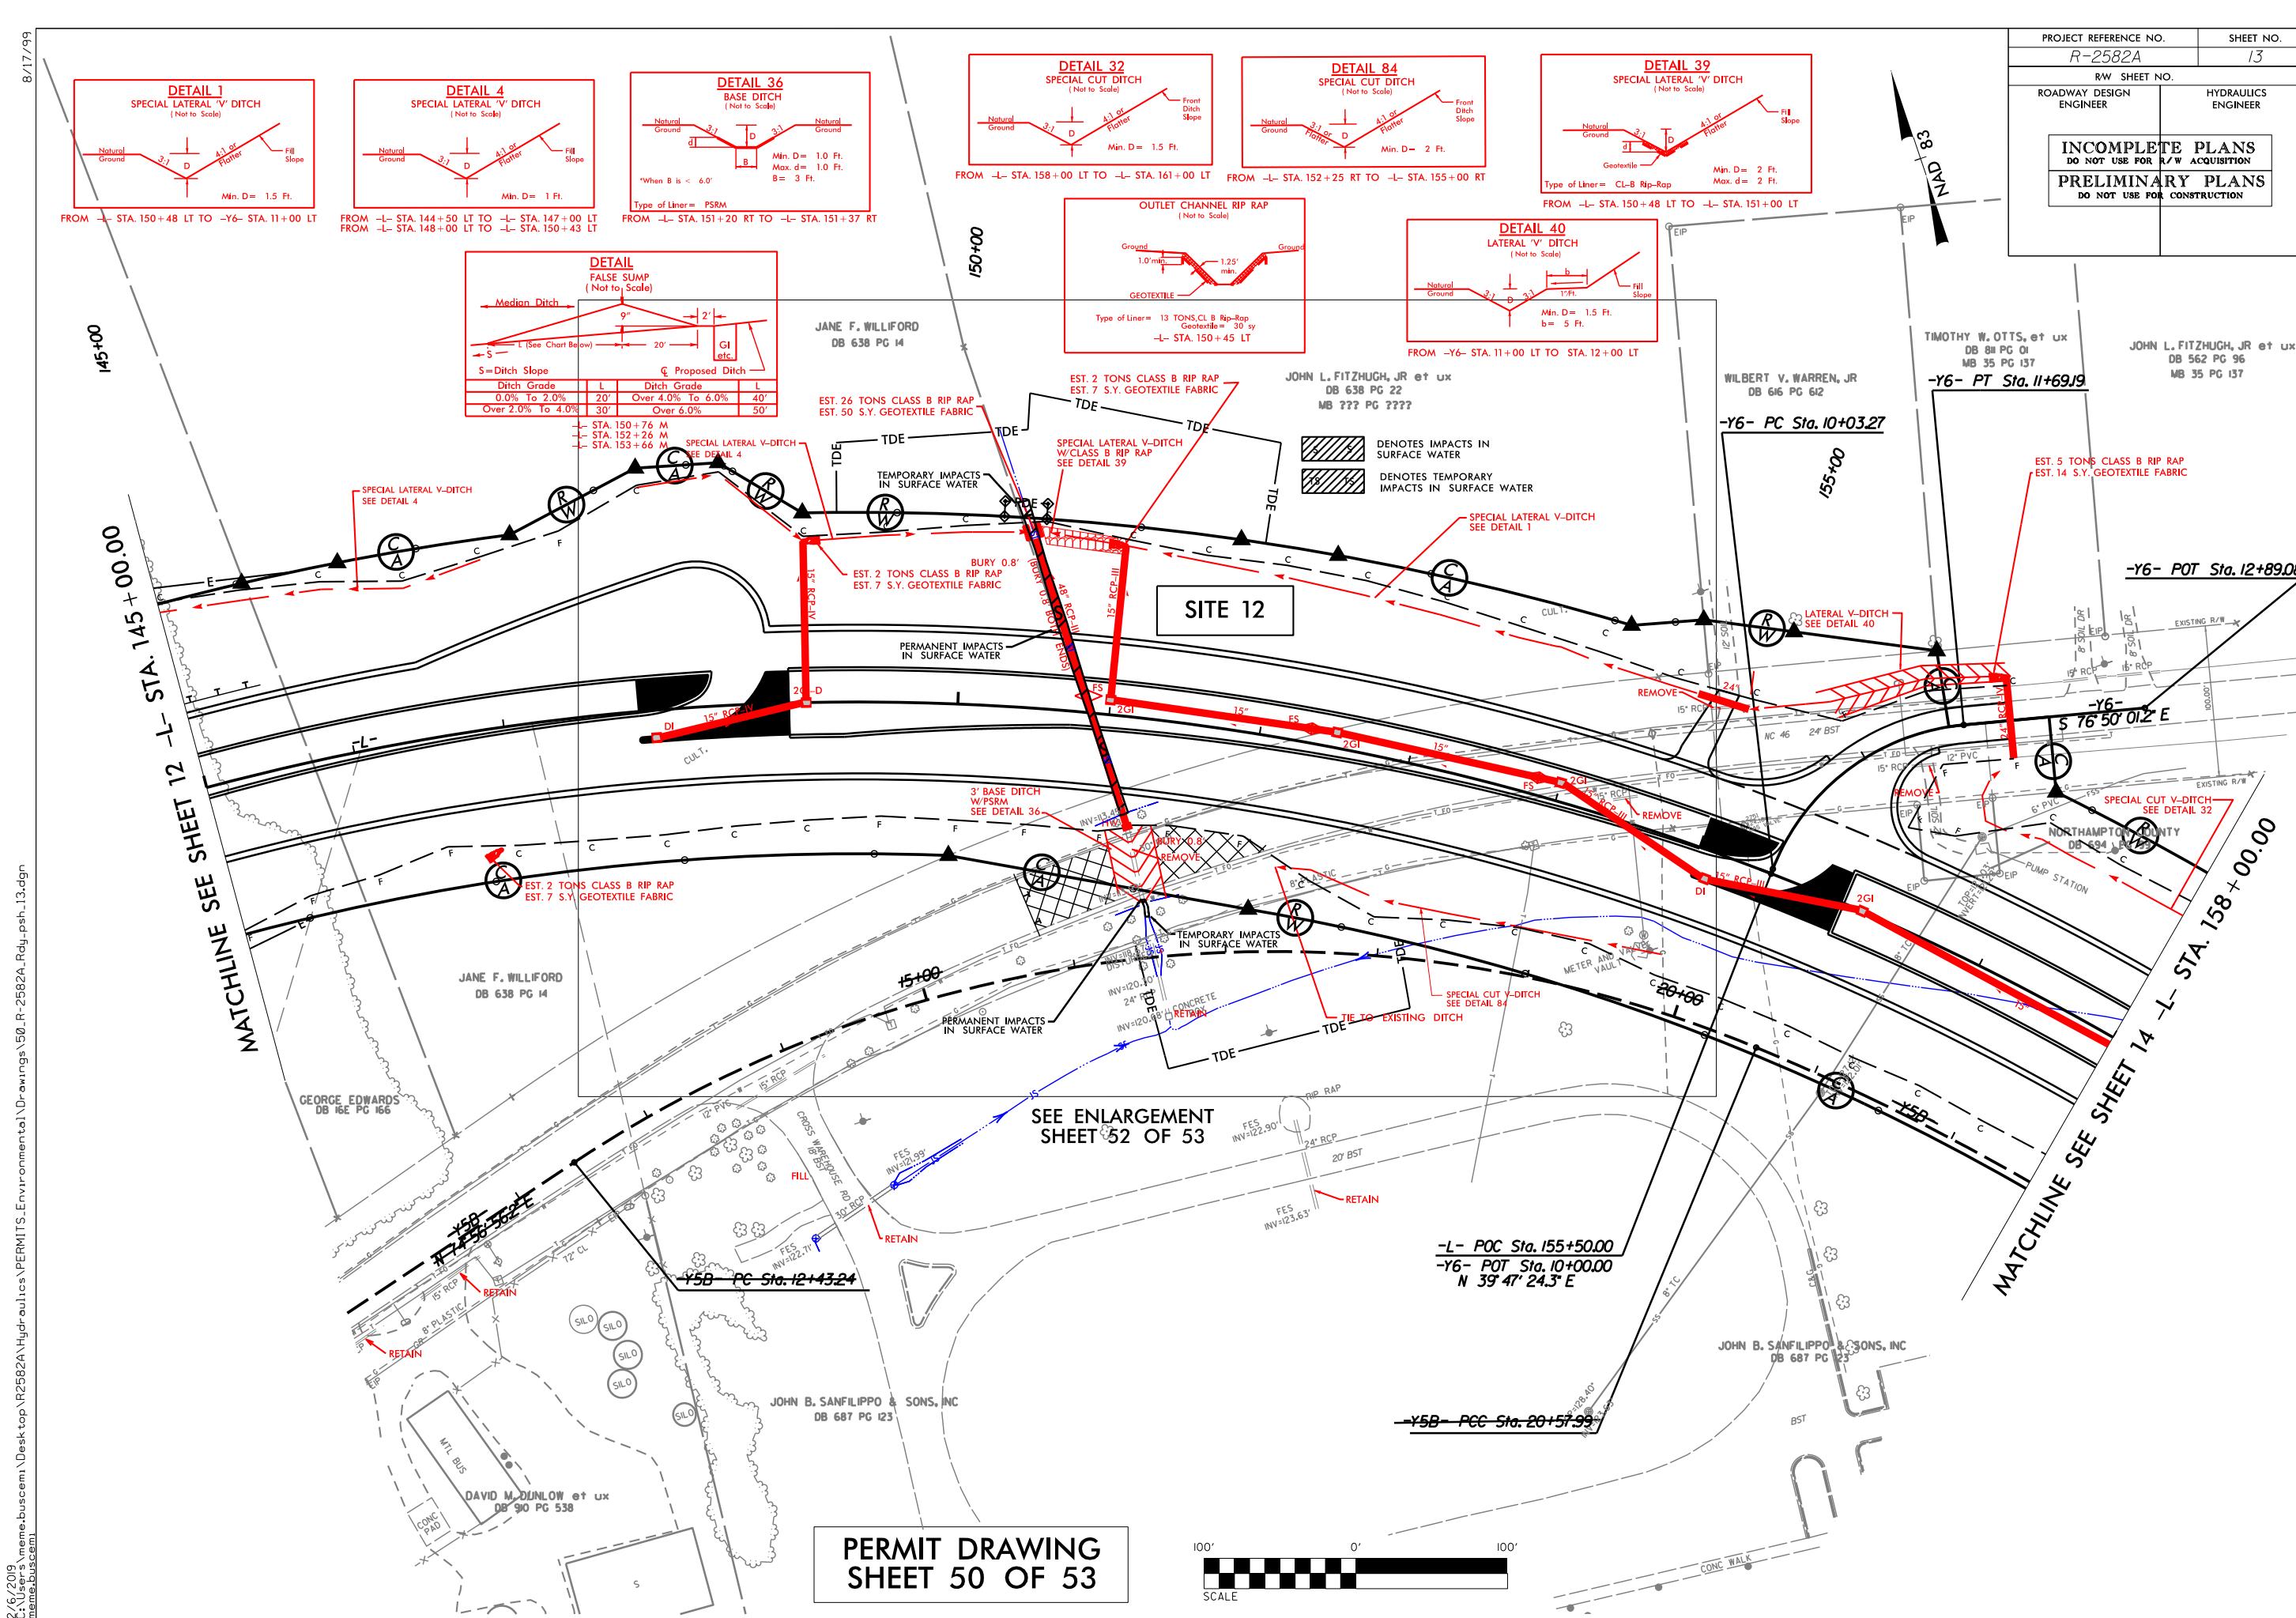

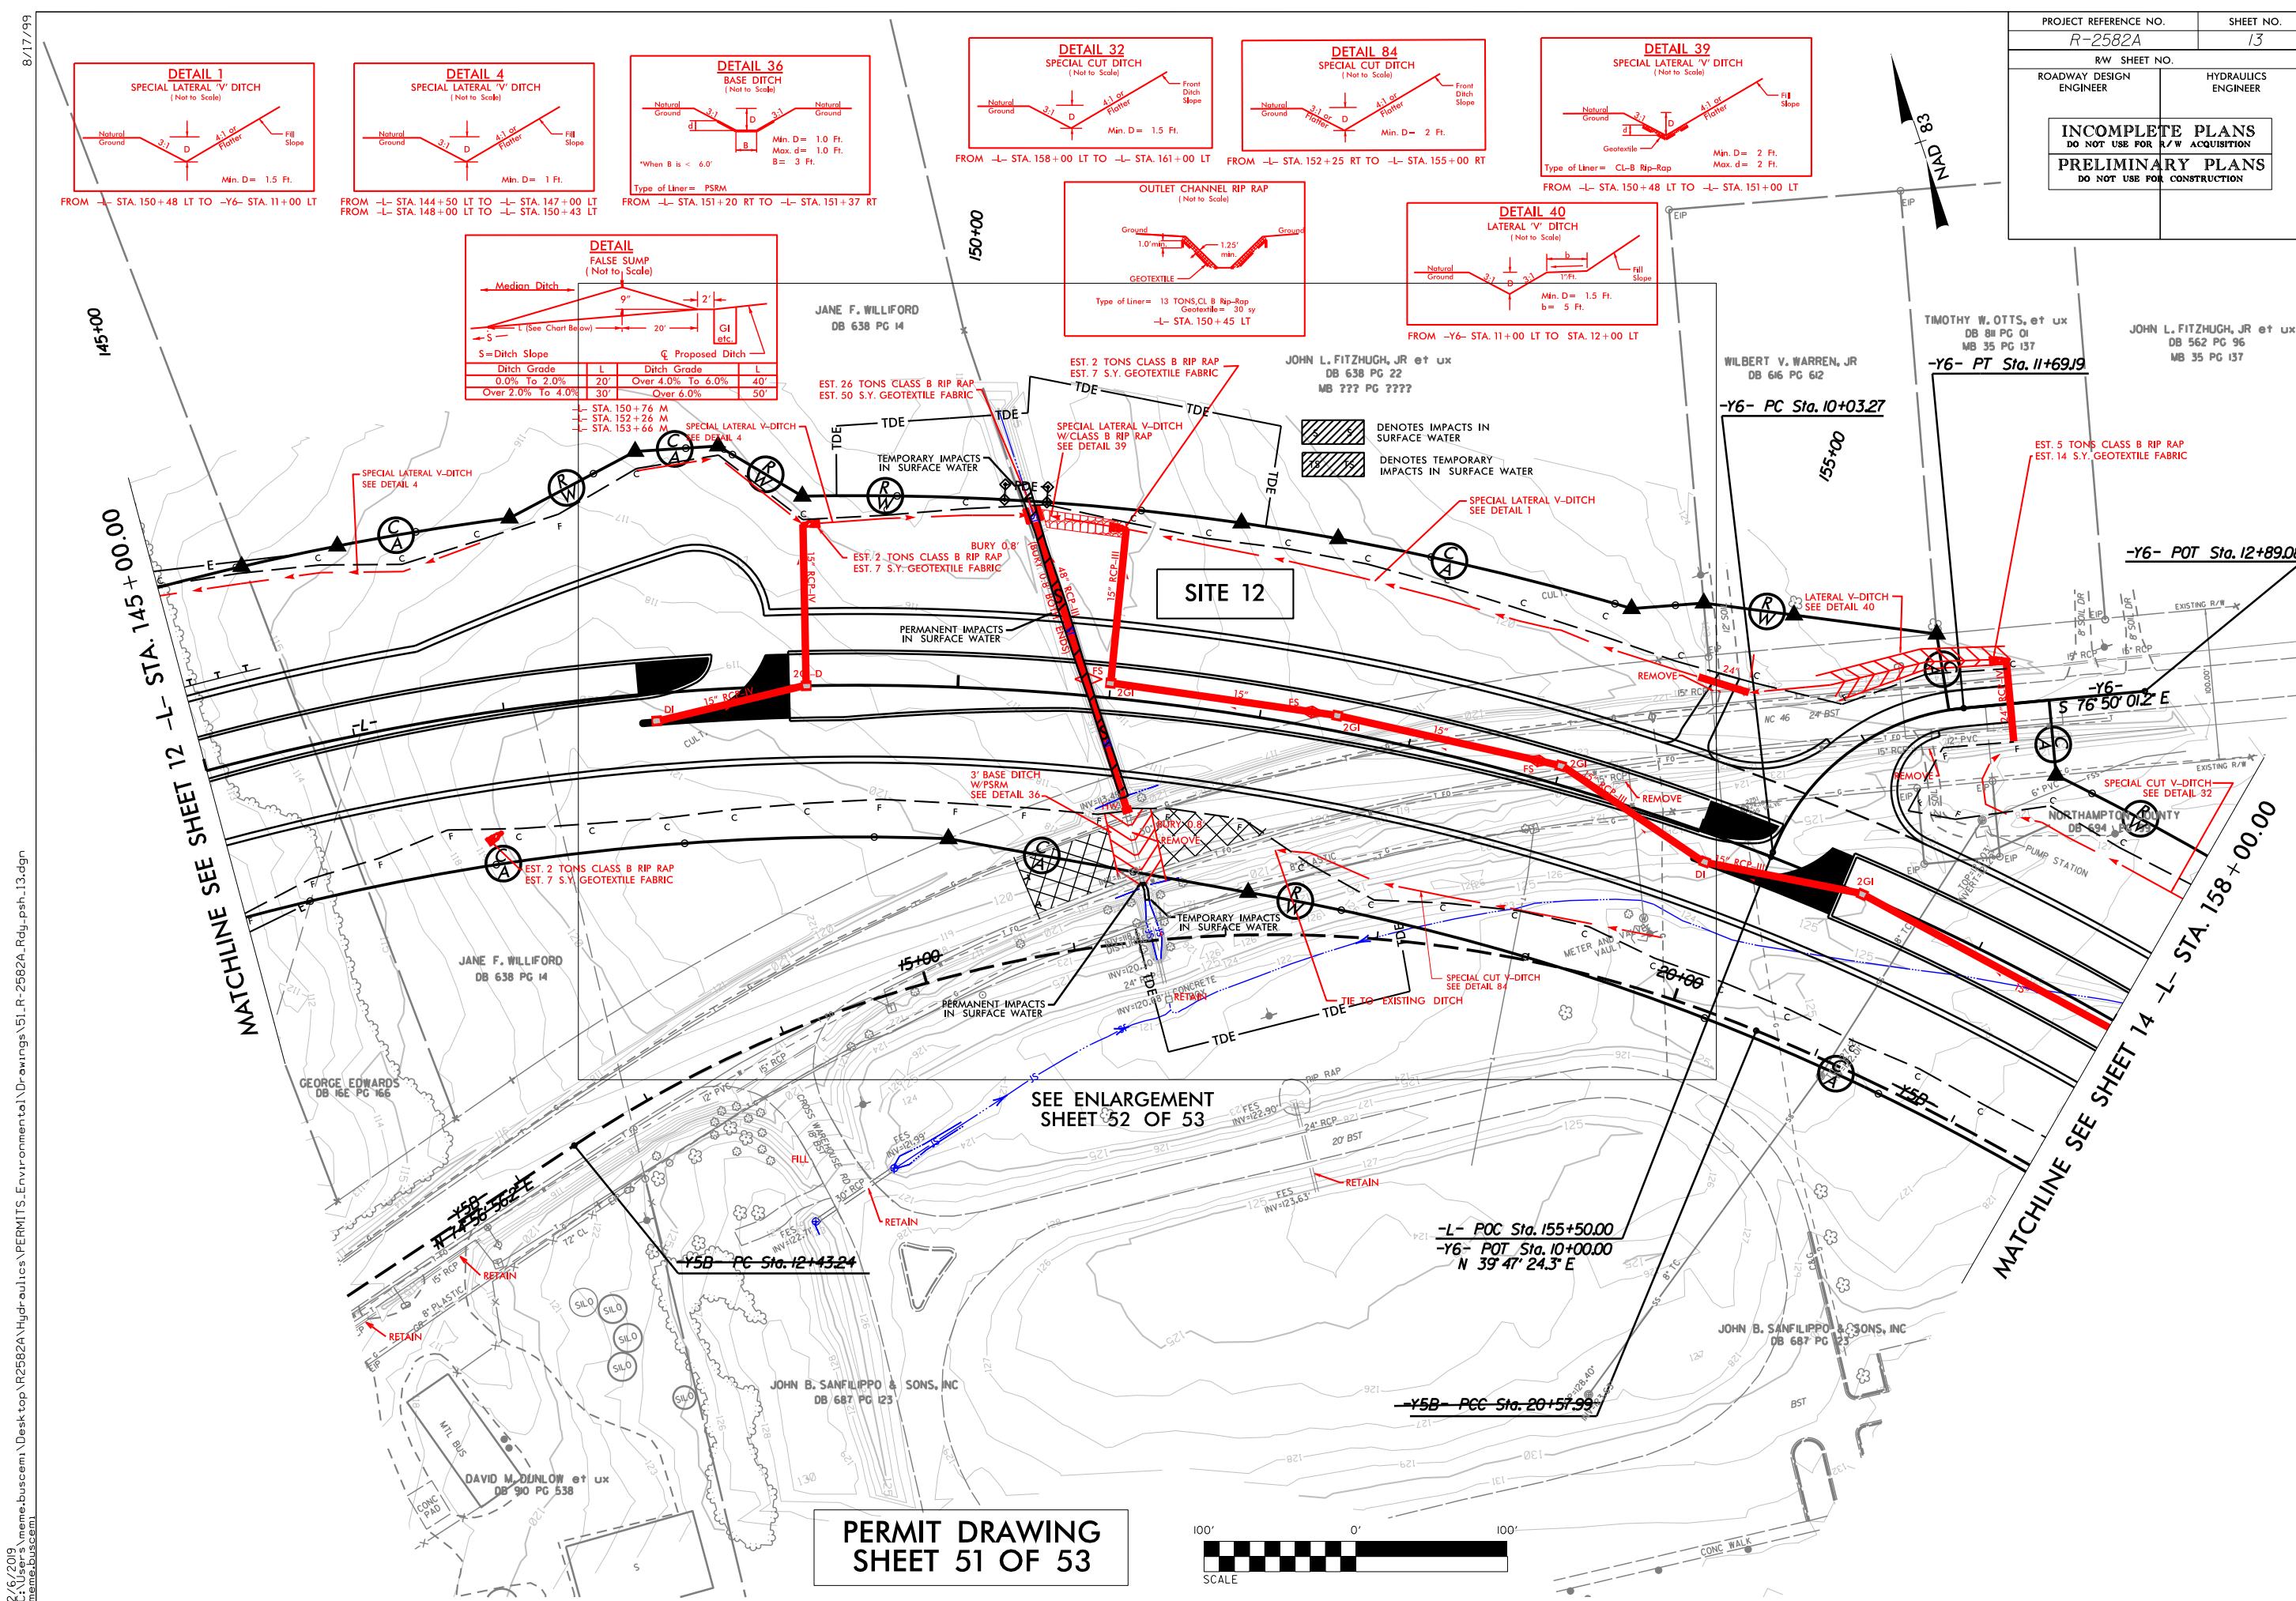

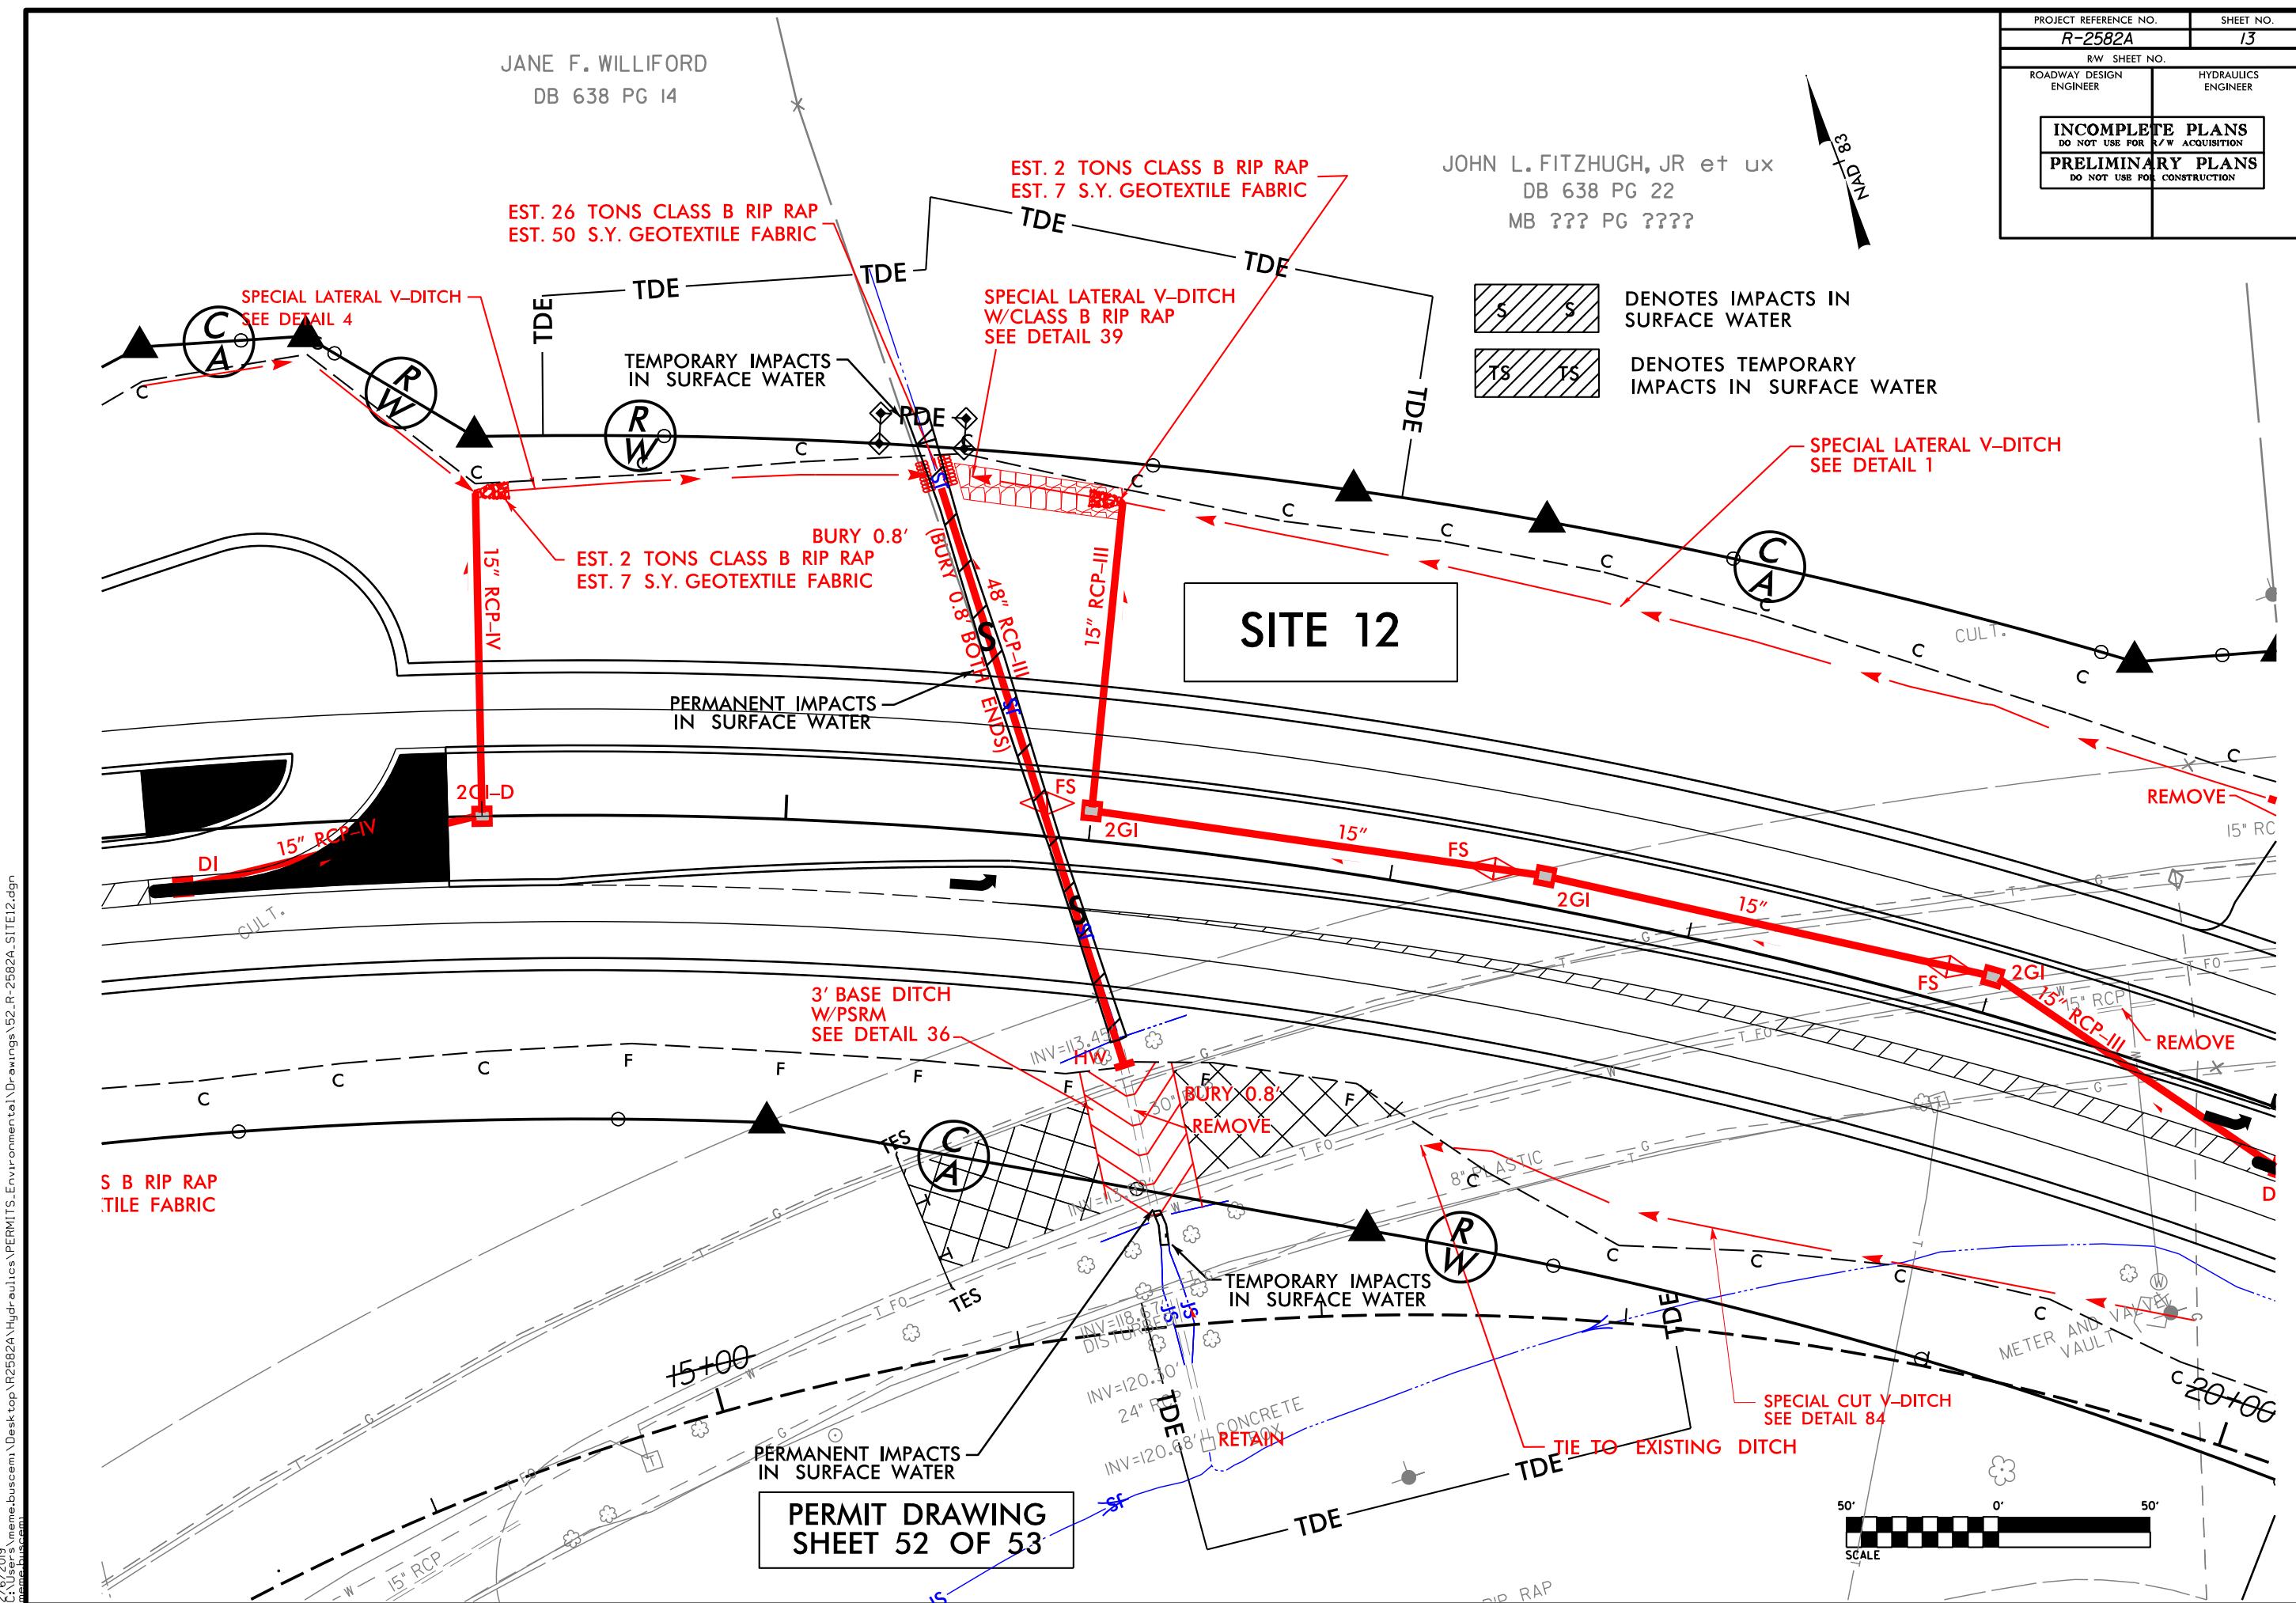

## **WETLAND AND SURFACE WATER IMPACTS SUMMARY**

\*Rounded totals are sum of actual impacts

## NOTES:


Site 6 includes 0.465 acres of fill impact due to the total take of wetland within the proposed roadway loop.

NC DEPARTMENT OF TRANSPORTATION  
DIVISION OF HIGHWAYS  
REVISED 03/13/2019  
NORTHAMPTON COUNTY

SHEET 53 OF 53

**CONTRACT: C204210****TIP PROJECT: R-2582A**

2/9/2019

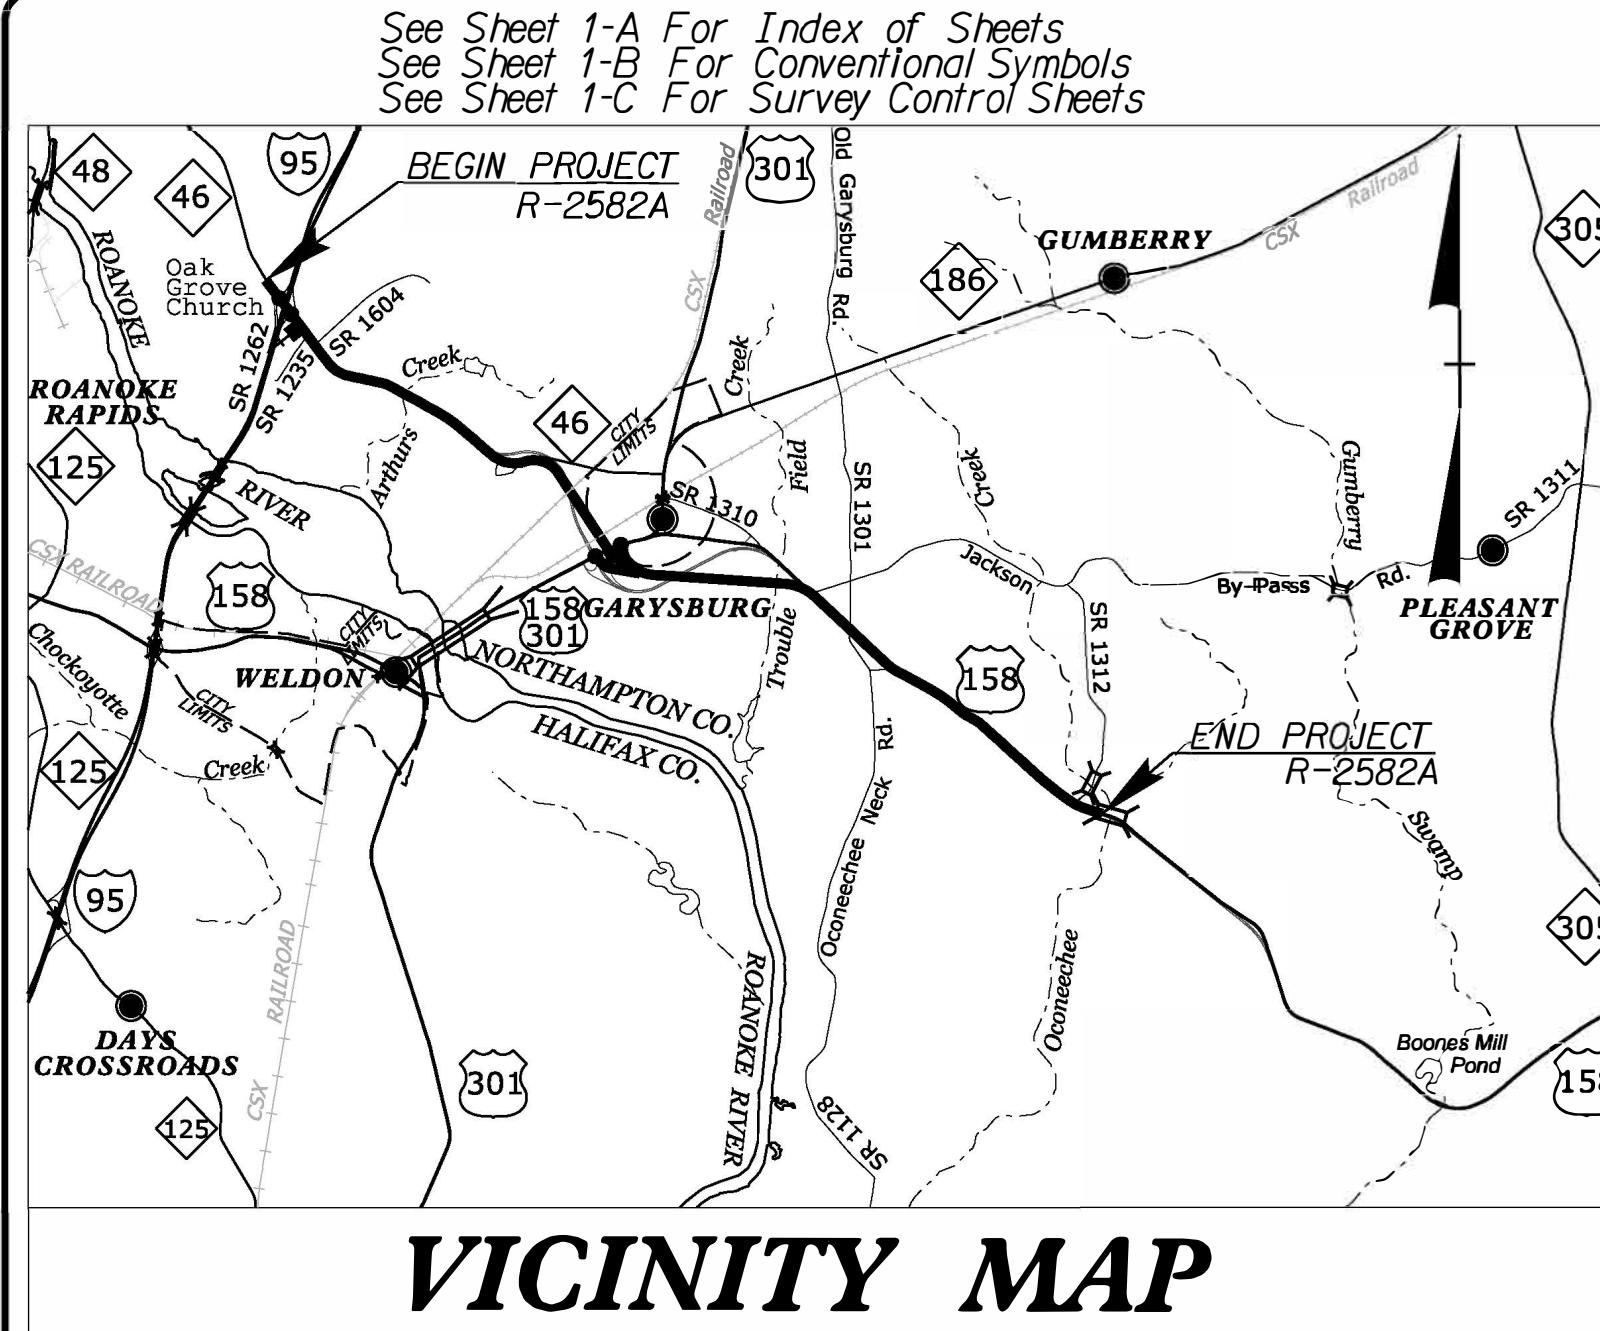


# STATE OF NORTH CAROLINA DIVISION OF HIGHWAYS

## NORTHAMPTON COUNTY

### NEU UTILITY RELOCATION PERMIT PLANS


**LOCATION: US 158 FROM I-95/NC 46 IN ROANOKE RAPIDS  
TO SR 1312 (ST. JOHN CHURCH RD)**

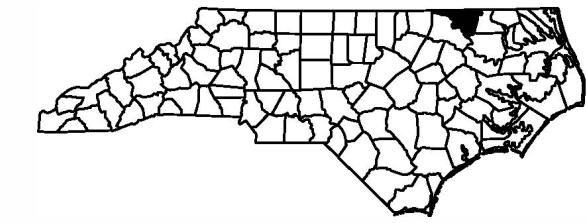


STATE	STATE PROJECT REFERENCE NO.	SHEET NO.	TOTAL SHEETS
N.C.	R-2582A	NE-1	
STATE PROJ. NO.	P.A. PROJ. NO.	DESCRIPTION	
34472.1.4		PE	
34472.2.4		RW, UTIL.	
34472.3.2		CONSTRUCTION	

#### VICINITY MAP

**BEGIN T.I.P. R-2582A -L- STA.17+00.00**

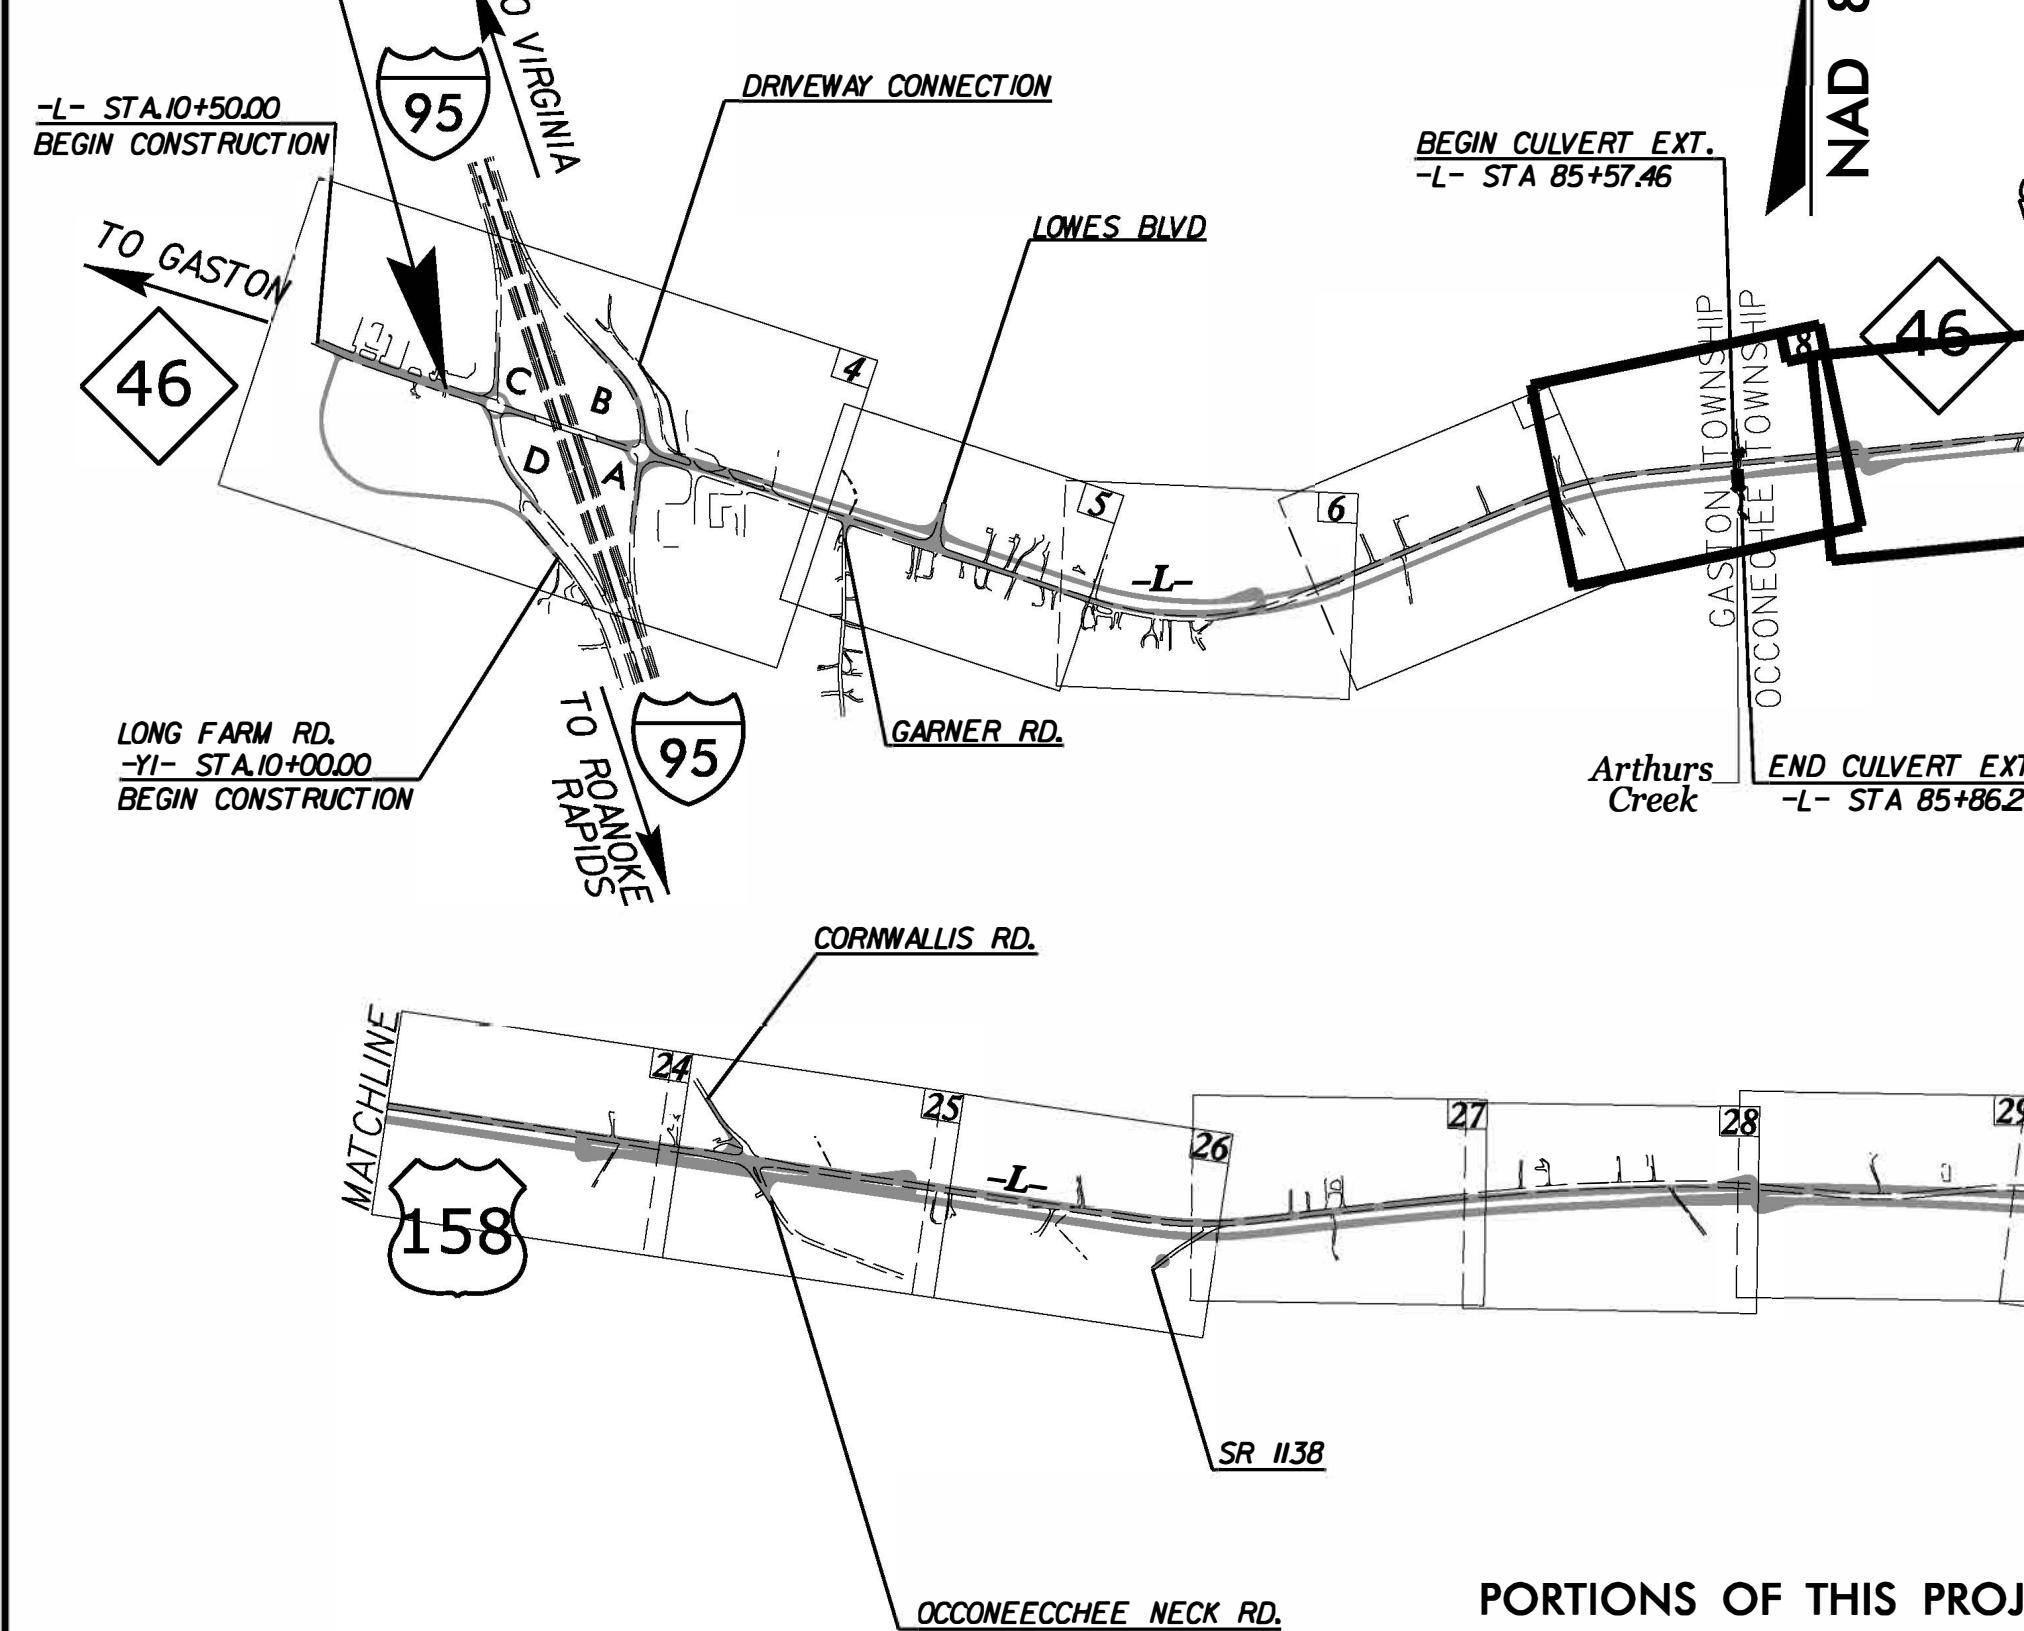

NAD 83

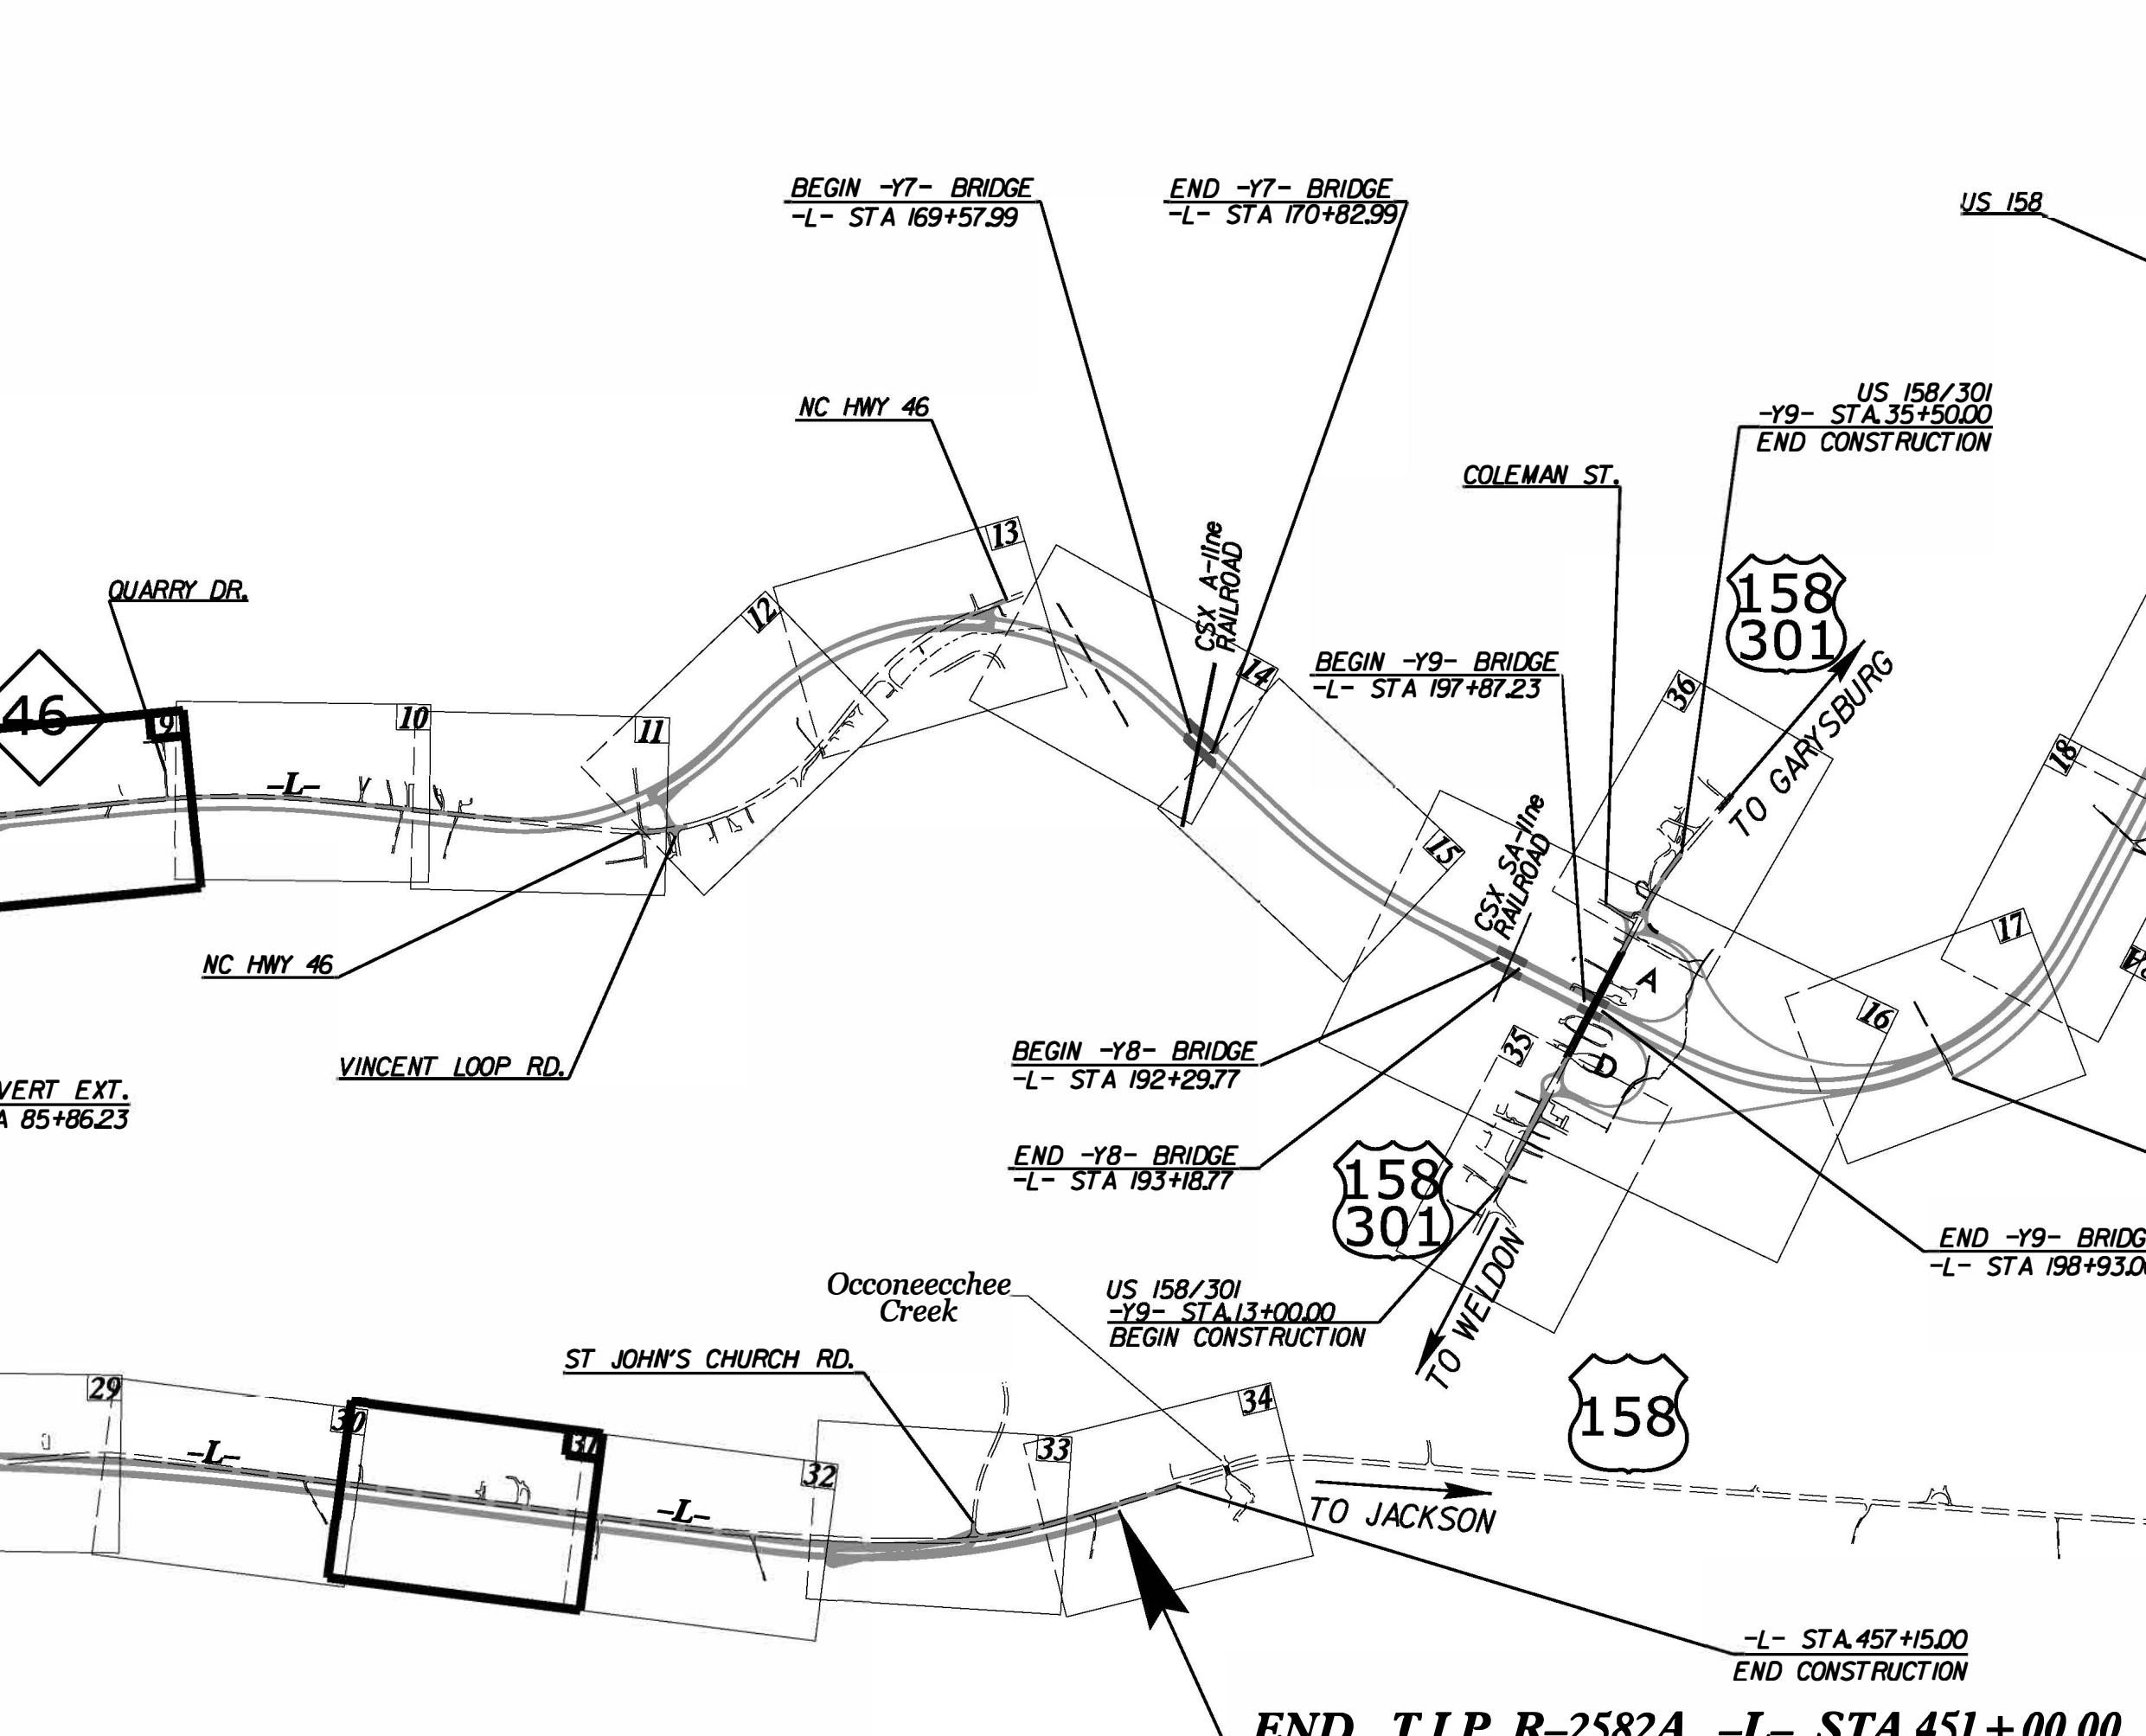


**END T.I.P. R-2582A -L- STA.451+00.00**

PORTIONS OF THIS PROJECT HAVE PARTIAL AND/OR FULL CONTROL OF ACCESS.  
A PORTION OF THIS PROJECT IS WITHIN THE MUNICIPAL BOUNDARIES OF GARYSBURG.  
CLEARING ON THIS PROJECT SHALL BE PERFORMED TO THE LIMITS ESTABLISHED BY METHOD III.

DOCUMENT NOT CONSIDERED FINAL  
UNLESS ALL SIGNATURES COMPLETED

#### GRAPHIC SCALES

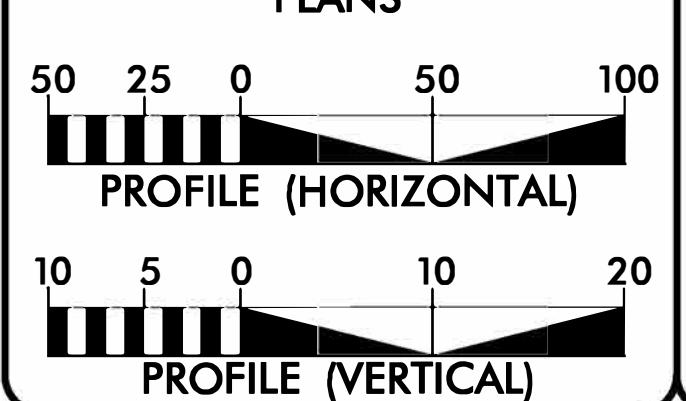

#### DESIGN DATA

ADT 2019 = 6400  
ADT 2039 = 8418  
K = 11 %  
D = 60 %  
T = 21 % \*  
V = 70 MPH  
\* TTST = 14 DUAL=7  
FUNC CLASS = EXPRESSWAY STATEWIDE TIER

#### PROJECT LENGTH

LENGTH ROADWAY T.I.P. PROJECT R-2582A = 8.149 MILES  
LENGTH STRUCTURE T.I.P. PROJECT R-2582A = 0.071 MILES  
TOTAL LENGTH OF T.I.P. PROJECT R-2582A = 8.220 MILES

GARY LOVERING, PE  
NCDOT CONTACT




2018 STANDARD SPECIFICATIONS

RIGHT OF WAY DATE:  
June 30, 2017

LETTING DATE:  
April 16, 2019

#### HYDRAULICS ENGINEER

TRACY N. PARROTT, PE  
PROJECT ENGINEER  
REKHA V. PATEL, PE  
PROJECT DESIGN ENGINEER

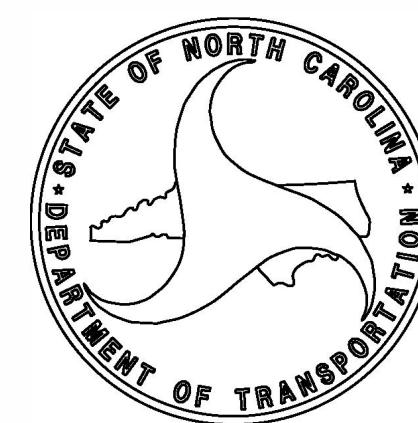

PROJECT REFERENCE NO.	SHEET NO.
R-2582A	NE-02
RW SHEET NO.	
ROADWAY DESIGN ENGINEER	HYDRAULICS ENGINEER

DOCUMENT NOT CONSIDERED FINAL  
UNLESS ALL SIGNATURES COMPLETED

Prepared in the  
Office of:  
**SUMMIT**  
DESIGN AND ENGINEERING SERVICES

NC FIRM LICENSE No P-0339  
500 South Main Street, Suite 100  
Hillsborough, NC 27278  
(919) 732-3883  
(919) 732-6676 FAX

31

ANNIE TUDOR  
DB 02E PG 164DENOTES HAND  
CLEARING

80+00

**Utility Site 2**

Added 6/24/19

A=0.010 AC


MATCHLINE SEE SHEET 7 -L- STA. 77 +00.00

HENRY LONG  
DB 1017 PG 20


-L- CS Sta. 79+36.33

STA. 85+30 - L - LT 453 SQUARE FEET TO BE  
HAND CLEARED FOR POWER

WOODS

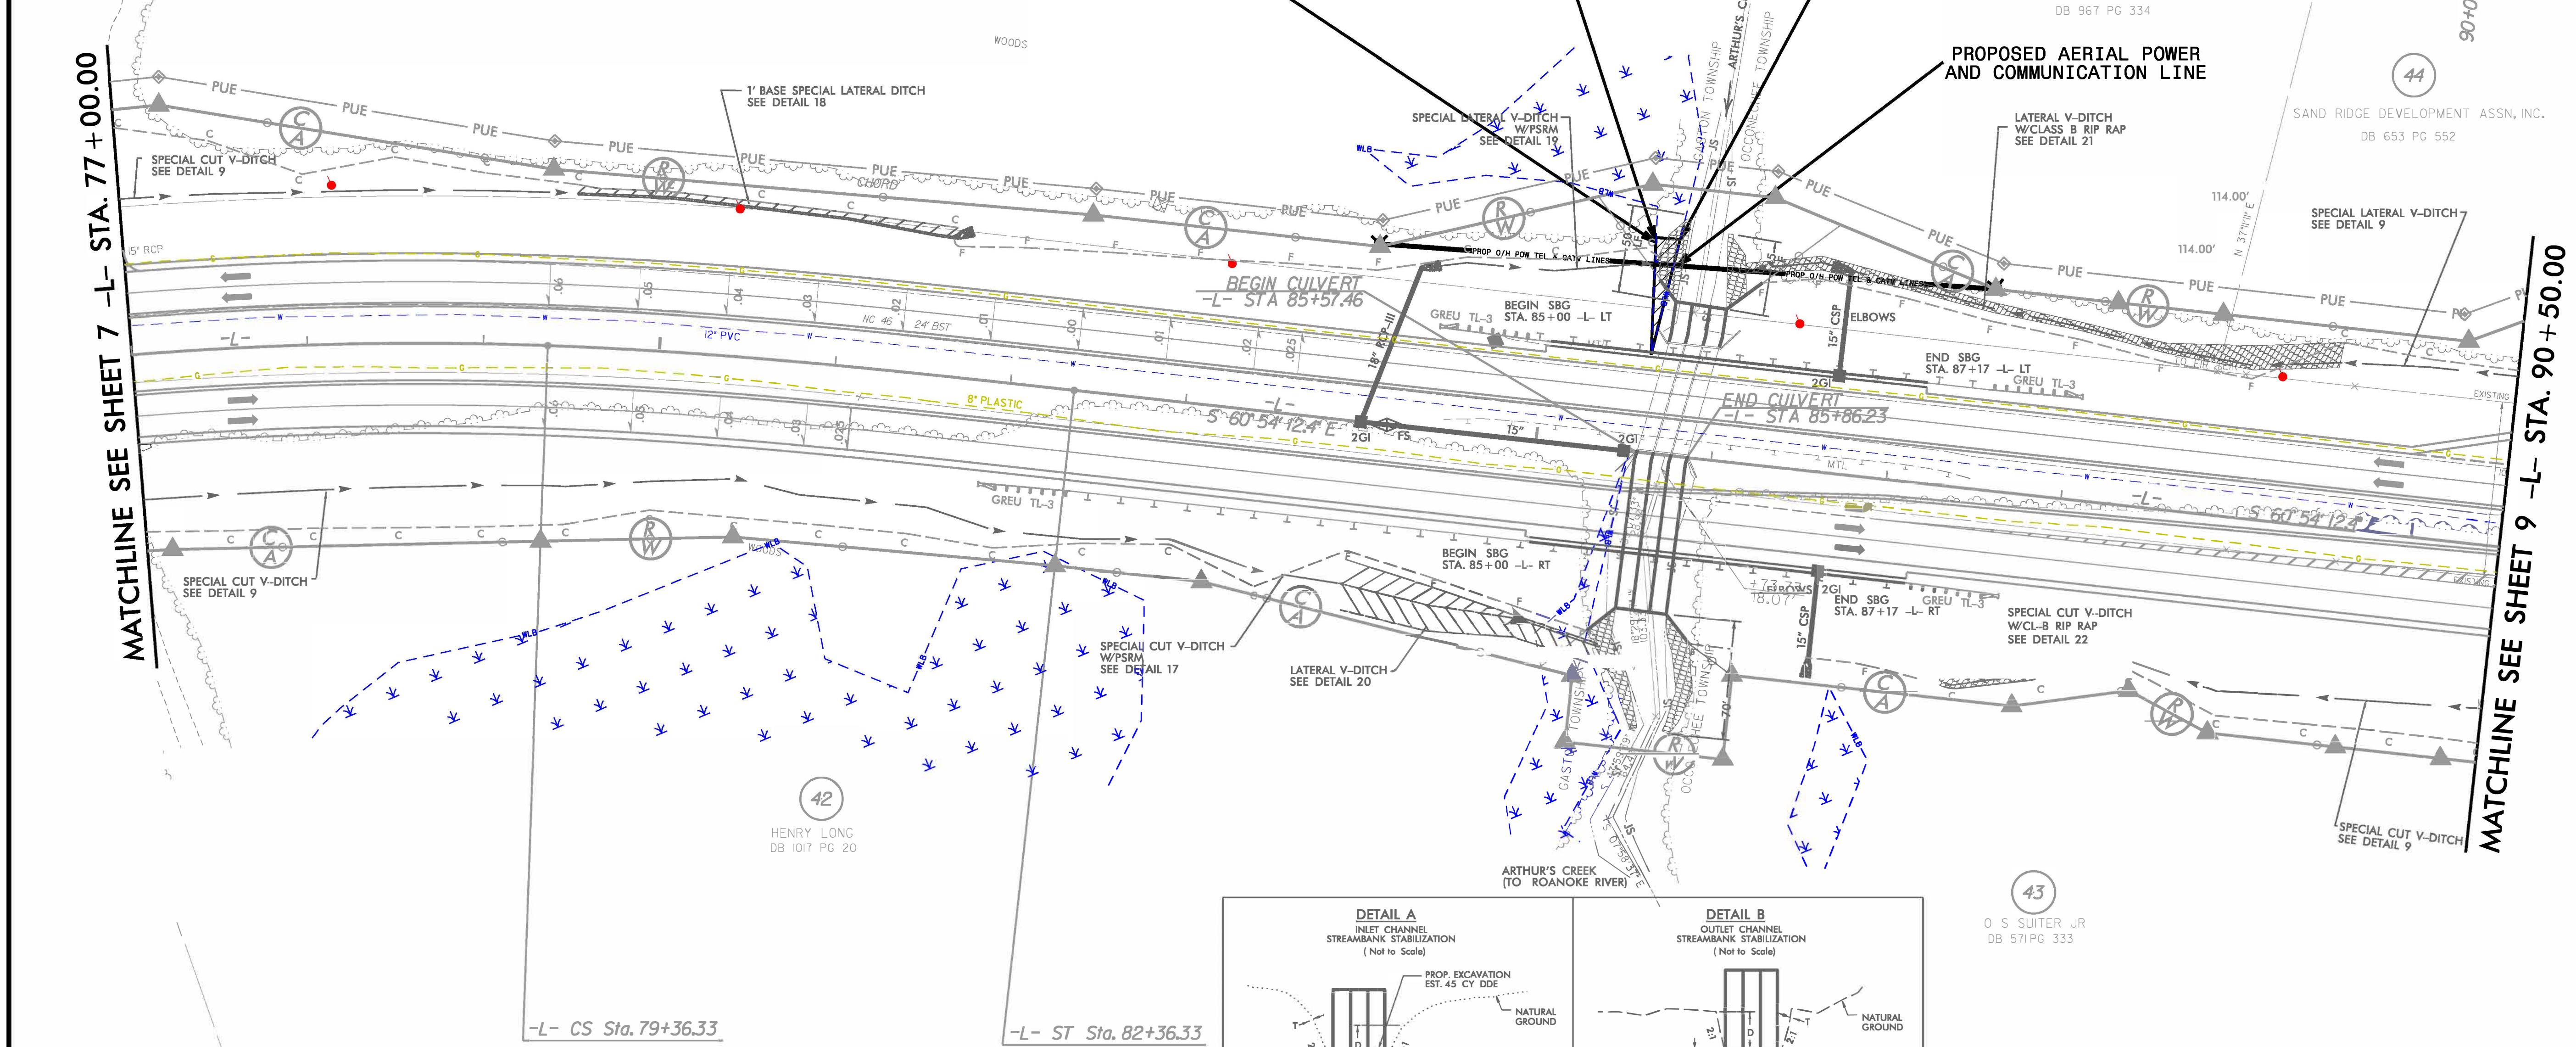
1' BASE SPECIAL LATURAL DITCH  
SEE DETAIL 18

-L- ST Sta. 82+36.33

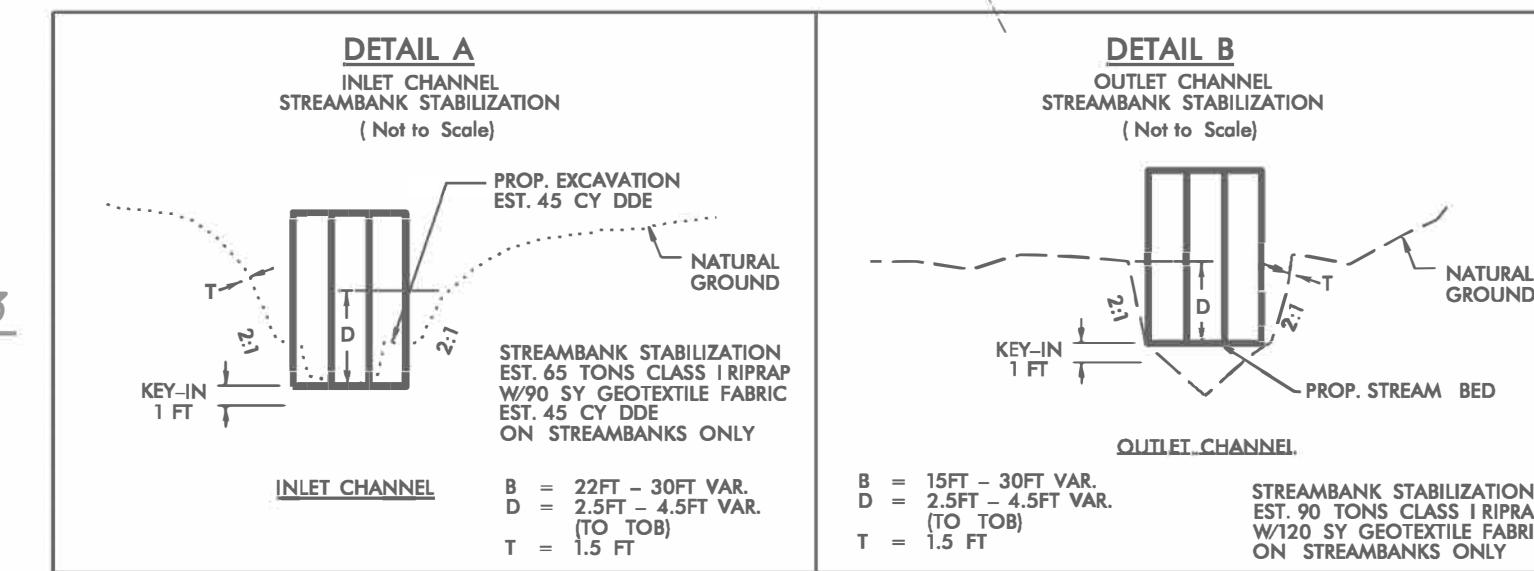O S SUITER JR  
DB 571PG 333

SEE SHEET 39 FOR -L- PROFILE

DENOTES HAND  
CLEARING

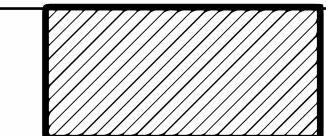


## Utility Site 3

A=0.150 AC

NWD 183


PERMANENT FILL 1 POWER POLE = .0001

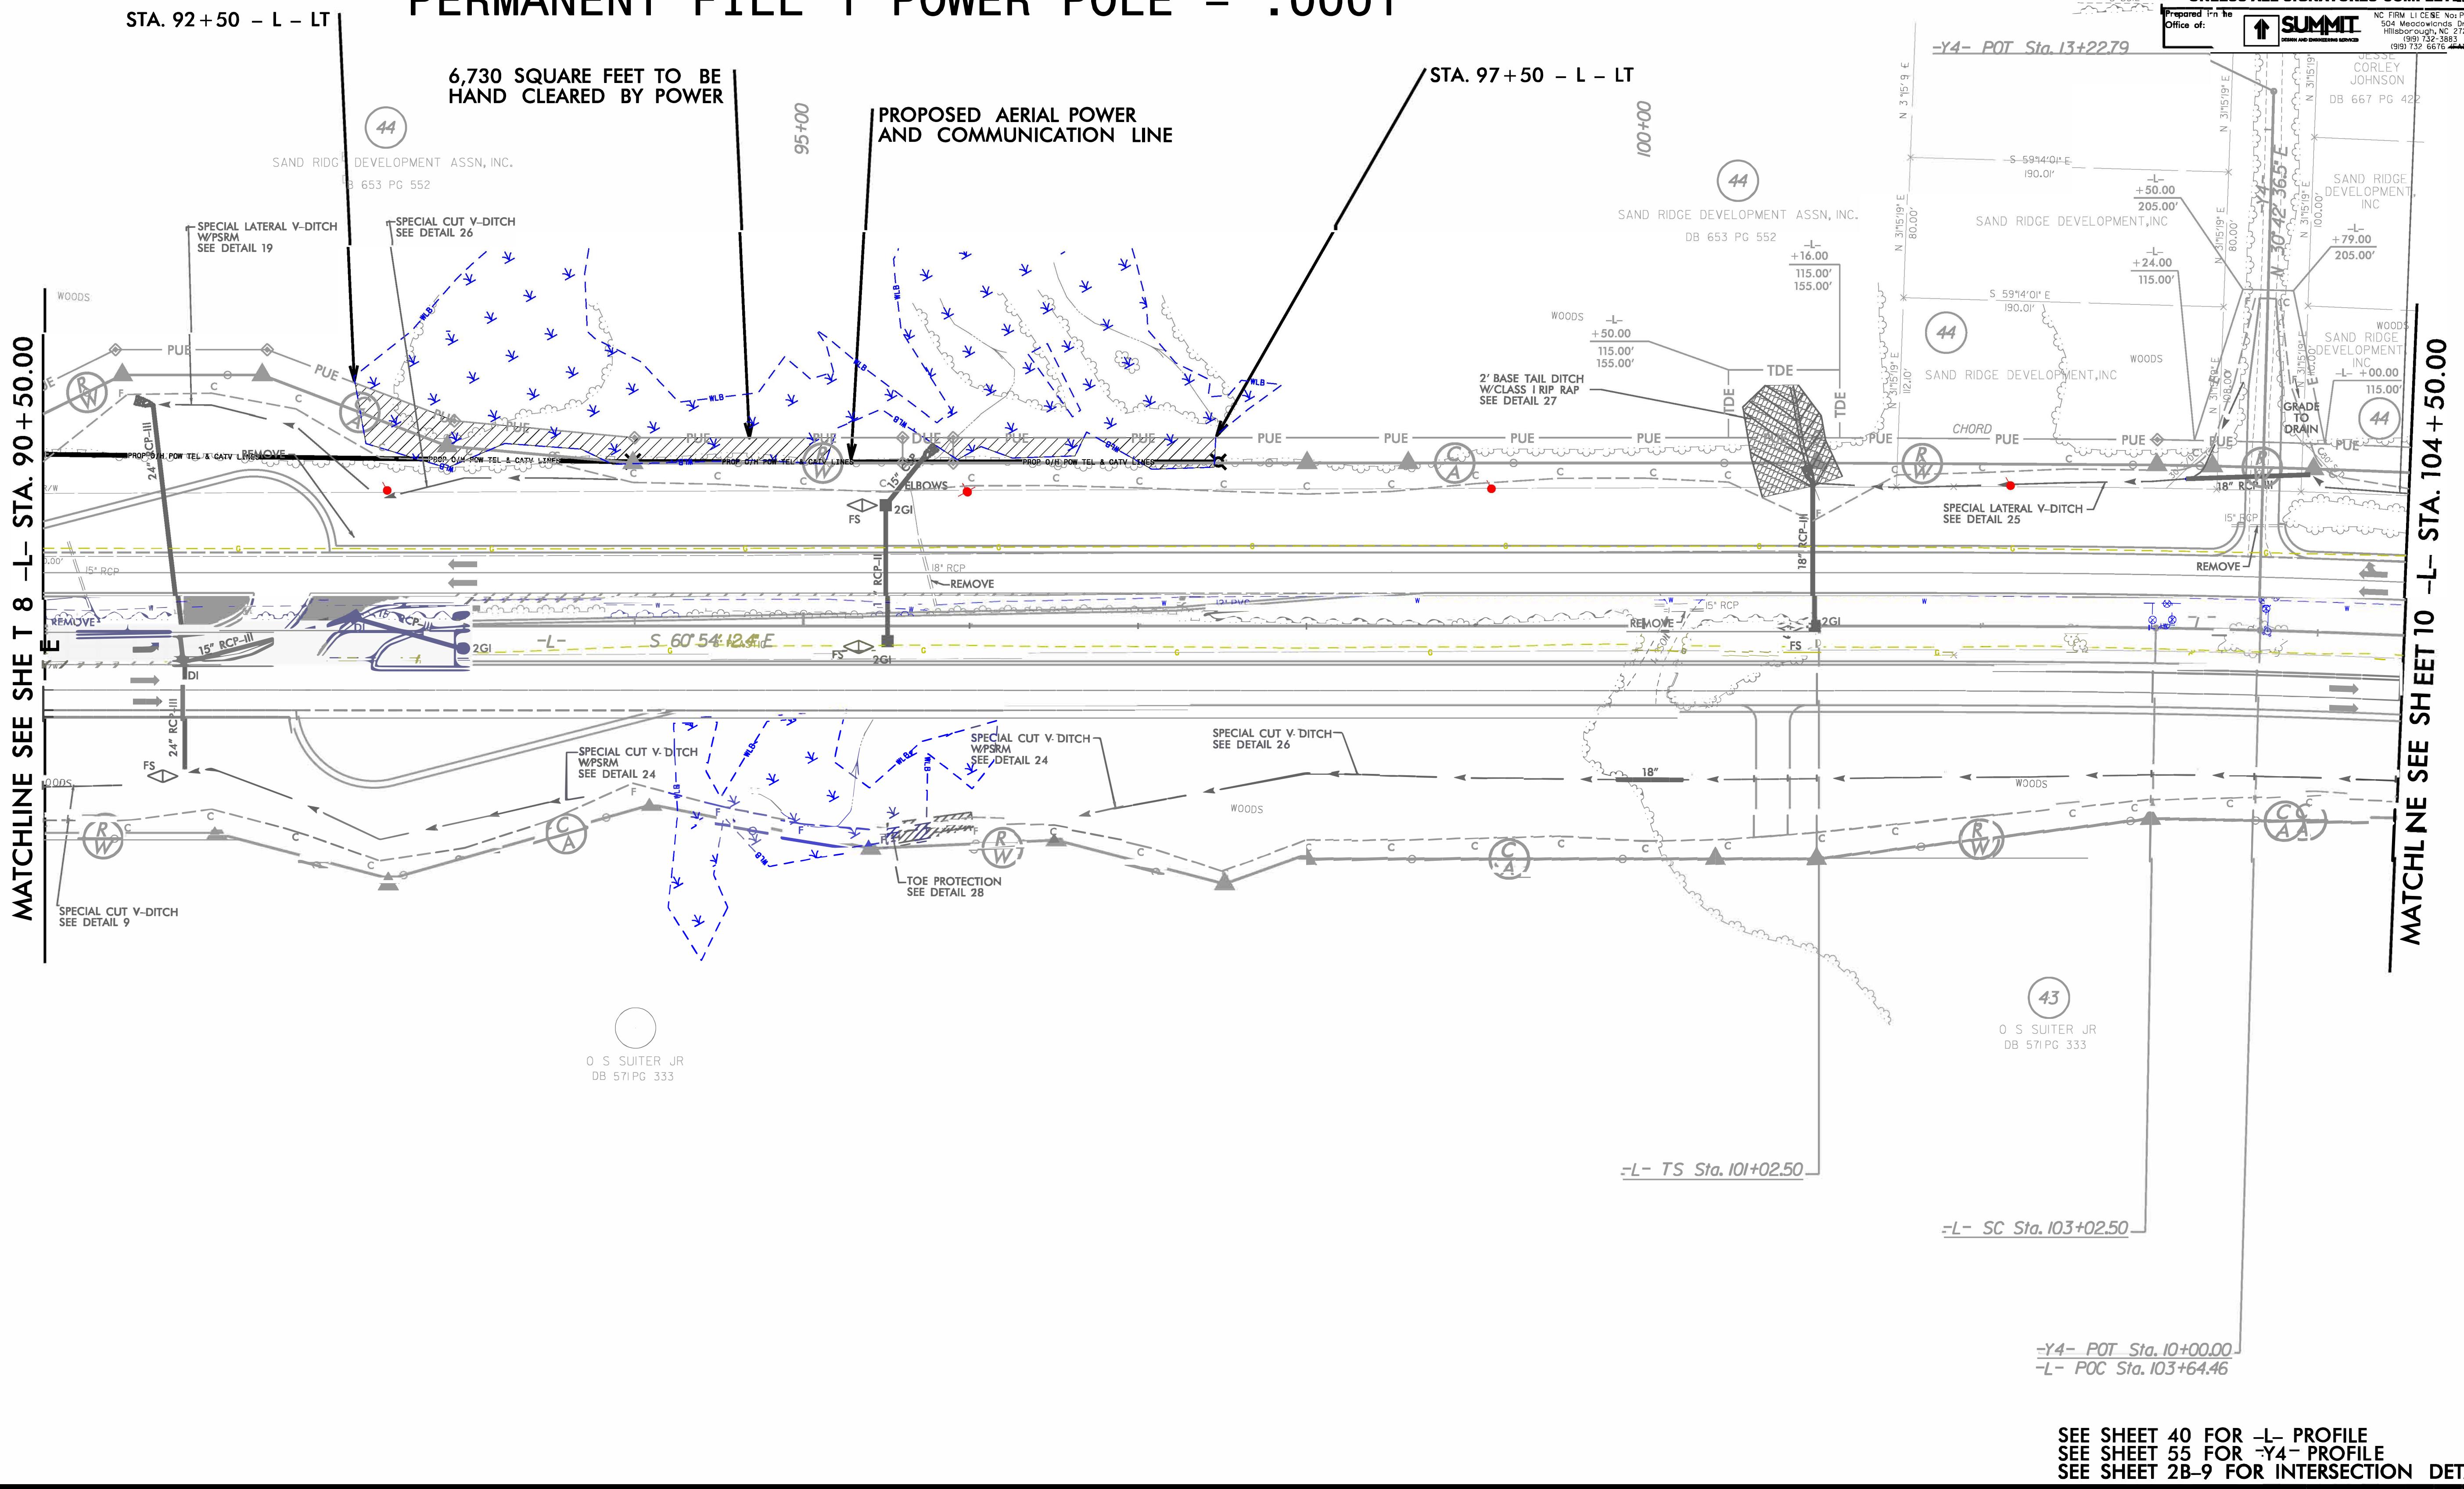

PROJECT REFERENCE NO.	SHEET NO.
R-2582A	NE-04
RW SHEET NO.	
ROADWAY DESIGN ENGINEER	HYDRAULICS ENGINEER
<b>DOCUMENT NOT CONSIDERED FINAL UNLESS ALL SIGNATURES COMPLETED</b>	

Prepared in the  
Office of: **SUMMIT**  
DESIGN AND ENGINEERING SERVICES

NC FIRM LICENSE No P-0339  
500 South University Drive  
Hillsborough, NC 27278  
(919) 732-3863  
(919) 732-6876 FAX

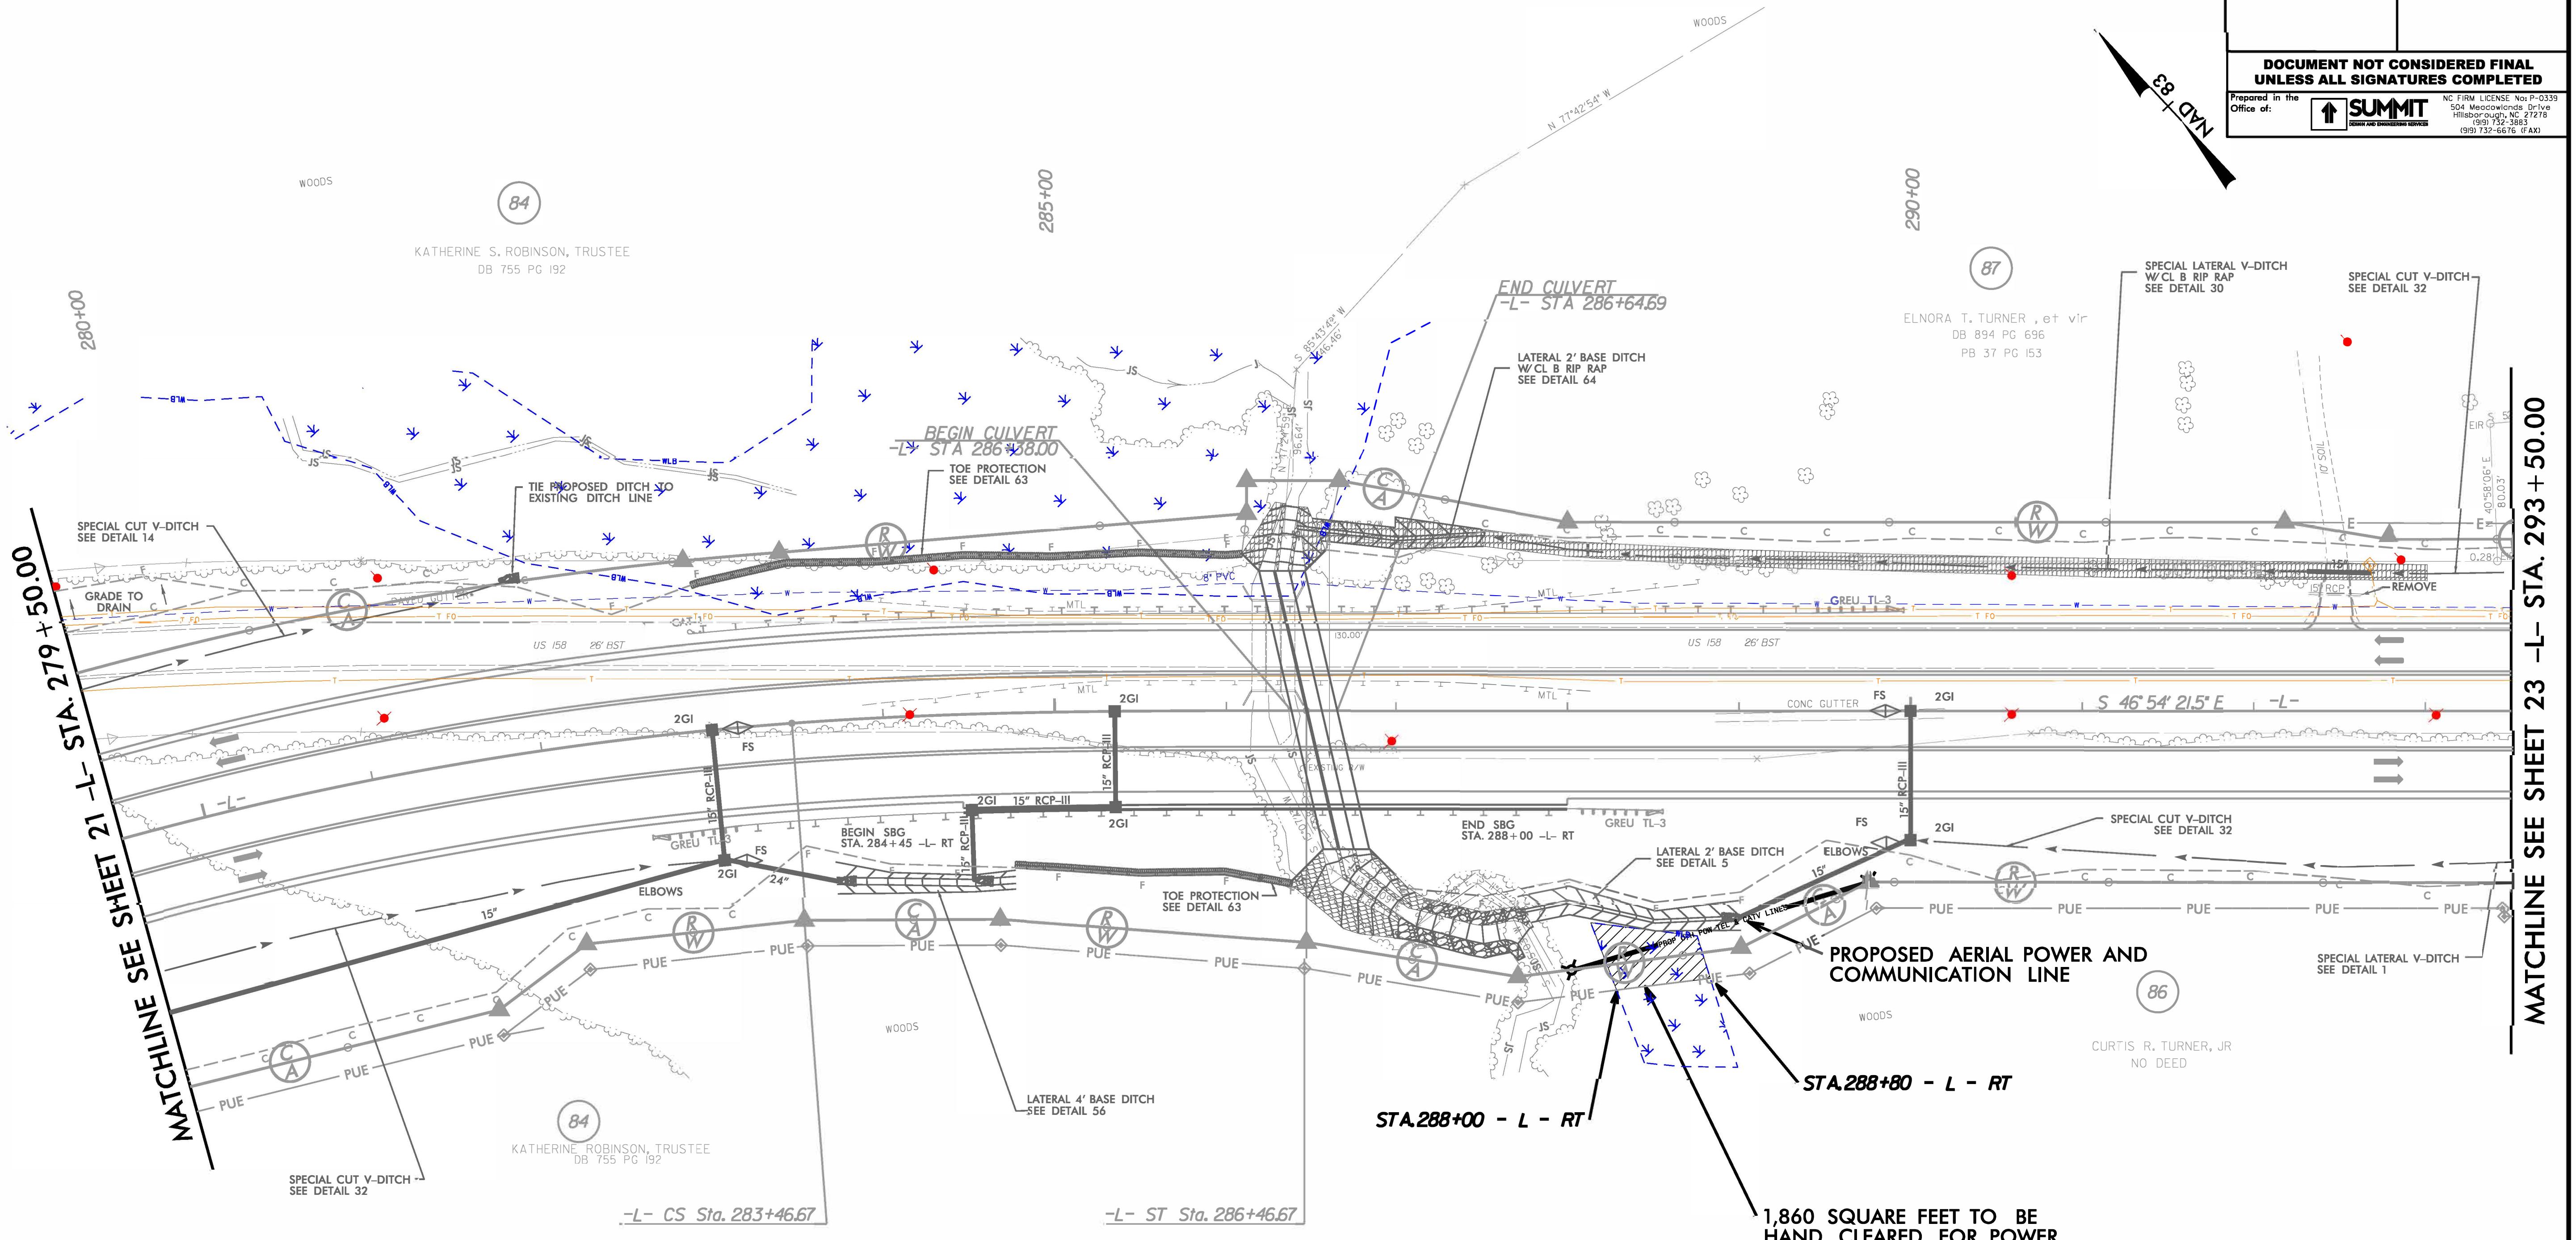

**Utility Site 8**

Added 6/24/19

A=0.040 AC

SEE SHEET 47 FOR -L- PROFILE

# DENOTES HAND CLEARING

# Utility Site 1

**Added 6/24/1**

A=0.020 AC

The logo consists of a black diagonal arrow pointing from the top-left towards the bottom-right. Inside the arrow, the text "NAD+" is written vertically along the left side, and the number "83" is positioned near the center.

PROJECT REFERENCE NO.		SHEET NO.
<b>R-2582A</b>		<b>NE-05</b>
<b>RW SHEET NO.</b>		
<b>ROADWAY DESIGN ENGINEER</b>		<b>HYDRAULICS ENGINEER</b>
<p><b>DOCUMENT NOT CONSIDERED FINAL UNLESS ALL SIGNATURES COMPLETED</b></p> <p>ared in the te of:</p>  <b>SUMMIT</b> <small>DESIGN AND ENGINEERING SERVICES</small>		
<small>NC FIRM LICENSE No: P-0339</small> <small>504 Meadowlands Drive</small> <small>Hillsborough, NC 27278</small> <small>(919) 732-3883</small> <small>www.summitdesign.com</small>		

MILDRED S. EDWARDS, et al  
WB 09E PG 135

WETLAND AND SURACE WATER IMPACTS SUMMARY												
Site No.	Station (From/To)	Structure Size / Type	WETLAND IMPACTS					SURFACE WATER IMPACTS				
			Permanent Fill In Wetlands (ac)	Temp. Fill In Wetlands (ac)	Excavation in Wetlands (ac)	Mechanized Clearing in Wetlands (ac)	Hand Clearing in Wetlands (ac)	Permanent SW impacts (ac)	Temp. SW impacts (ac)	Existing Channel Impacts Permanent (ft)	Existing Channel Impacts Temp. (ft)	Natural Stream Design (ft)
2	85+30 TO 85+50 -L-	POWER LINE&POWER POLE					0.01					
3	92+50 TO 97+50 -L-	POWER LINE & POWER POLE	< 0.01	< 0.01			0.15					
8	288+00 TO 288+80 -L-	POWER LINE&POWER POLE					0.04					
10	408+50 TO 409+50 -L-	POWER LINE&POWER POLE					0.02					
TOTALS*:			< 0.01	< 0.01			0.22		0	0	0	

\*Rounded totals are sum of actual impacts

NOTES:

Revised 2016 09 09

NC DEPARTMENT OF TRANSPORTATION  
DIVISION OF HIGHWAYS  
6/24/2019  
NORTHAMPTON  
R-2582a  
34472.2.4  
SHEET 0 OF 0