



PAT McCRORY
Governor

NICHOLAS J. TENNYSON
Secretary

May 4, 2016

U. S. Army Corps of Engineers
Regulatory Field Office
3331 Heritage Trade Drive, Suite 105
Wake Forest, NC 27587

ATTN: Mr. Eric Alsmeyer
NCDOT Division 5 Coordinator

SUBJECT: **Request for Modification of the Section 404 Individual Permit, Section 401 Water Quality Certification, Isolated Waters State General Permit, and Neuse River Riparian Buffer Certification** for the proposed East End Connector from NC 147 (Durham Freeway/Buck Dean Expressway) to north of NC 98 (Holloway Street) in Durham, Durham County, North Carolina, Division 5. Federal Aid Project No. NHF-76-1(2), TIP No. U-0071.

Debit \$570.00 from WBS Element No. 34745.1.1

REFERENCE: 1) USACE Individual Permit, Action ID No. SAW-2011-00796, dated March 24, 2014.
2) USACE Individual Permit Modification, Action ID No. SAW-2011-00796, dated May 7, 2015.
3) USACE Individual Permit Modification, Action ID No. SAW-2011-00796, dated December 7, 2015.
4) NCDWR Section 401 Water Quality Certification, Neuse River Buffer Authorization, and Isolated Wetlands Permit, NCDWR Project No. 20131282, Certification No. 3980, dated January 28, 2014.
5) Modification to the NCDWR Section 401 Water Quality Certification, Neuse River Buffer Authorization, and Isolated Wetlands Permit, NCDWR Project No. 20131282 ver. 2, Certification No. 3980, dated April 15, 2015.
6) Modification to the NCDWR Section 401 Water Quality Certification, Neuse River Buffer Authorization, and Isolated Wetlands Permit, NCDWR Project No. 20131282 ver. 3, Certification No. 3980, dated October 26, 2015.

Dear Sir:

The purpose of this letter is to request a modification to the United States Army Corps of Engineers (USACE) Section 404 Individual Permit and North Carolina Division of Water Resources (NCDWR) Section 401 Water Quality Certification, Isolated Waters State General Permit, and Neuse River Riparian Buffer Certification for the above-referenced project.



In addition to this cover letter, please find enclosed revised Wetland Permit Drawing Sheet Nos. 30, 53, 55, 60, 90, and 91 of 91; revised Buffer Permit Drawing Sheet Nos. 6, 16, and 18 of 18; new ABF Freight Wetland Permit Drawing Sheet Nos. 1 and 2 of 2 for new Site No. 33, which is associated with the loss of property remediation between the N.C. Department of Transportation (NCDOT) and ABF Freight Corporation; a letter and accompanying map addressed to Mr. Dennis Jernigan, PE, Division 5 Construction Engineer, from Horvath Associates (representing ABF Freight) explaining the proposed loss of property remediation and how it will result in unavoidable wetland impacts at the above-mentioned Site 33; and the revised Mitigation Acceptance Letter from the N.C. Division of Mitigation Services (DMS).

IMPACTS TO WATERS OF THE UNITED STATES

Surface Waters

All revisions occur within the Neuse River Basin (HUC 03020201). Stream impact revisions occur at Sites 4, 12, 17, and 17A. Descriptions of the changes at each site are below. Please also see Table 1, which has been revised to reflect these modifications. Revised Sites, sub-totals, and totals are in bold.

Permit Site 4 (Permit Drawing 30 of 91) at 36+20 -SR2- Lt

- The contractor has installed the 48-inch pipe structure and rip rap bank stabilization following the most recently approved permit drawing at this site. Recent rain events have resulted in significant scour and failure of streambanks immediately upstream of the rip rap that has been installed by the contractor. The Department proposes to install additional Class II rip rap on the stream banks that would allow for the permanent stabilization within the project limits.
- This design change will result in an increase in temporary stream impacts of 5 linear feet and an increase in permanent bank stabilization impacts of 105 linear feet.

Permit Site 12 (Permit Drawing 53 of 91 and 55 of 91) at 25+50 -Y2- Rt

- Installation of the complete hydraulic system will result in an increase in runoff velocity during heavy rain events at this location. The Department has evaluated the existing stream channel and determined that the channel should be lined with a rip rap-lined 3 foot-base ditch to provide long-term stability.
- This design change will result in a decrease in temporary stream impacts of 60 linear feet, an increase of permanent stream loss impacts of 84 linear feet, and a decrease in permanent bank stabilization impacts of 24 linear feet.

Permit Site 17 (Permit Drawing 60 of 91) at 133+15 -L- Lt and Permit Site 17A (Permit Drawing 60 of 91) at 133+26 -L- Lt

- The contractor is currently installing the culvert at this location. The Department evaluated the existing stream channel at the culvert outlet and determined that the previously-permitted permanent rip rap bank stabilization at Permit Site 17 and previously-permitted temporary stream impacts at Permit Site 17A will not provide appropriate long-term stability. Additional Class II rip rap bank stabilization is proposed at the culvert outlet.
- At Permit Site 17, this design change will result in an increase in temporary stream impacts of 5 linear feet and an increase in permanent bank stabilization impacts of 55 linear feet.
- At Permit Site 17A, this design change will result in a decrease in temporary stream impacts of 19 linear feet and an increase in permanent bank stabilization impacts of 25 linear feet.

Table 1. Revised Surface Water Impacts within the Neuse River Basin (HUC 03020201)

Permit Site No.	Stream Name	Stream ID ¹	Intermittent/ Perennial	Impact Type	Impacts (lin. ft.)	Impacts Requiring USACE mitigation (lin. ft.)	USACE Mitigation Ratio	Impacts Requiring 1:1 DWR mitigation (lin. ft.)
1	UT of Goose Creek	S-B	Intermittent	Perm. Fill	412	0 ²		0 ³
2	UT of Goose Creek	S-A	Intermittent	Temp. Fill	14	0		0
				Perm. Fill	673	0 ²		0 ³
				Bank Stabil.	20	0 ⁵		0 ³
3	UT of Goose Creek	S-35	Intermittent	Perm. Fill	410	0 ²		0 ³
4	UT of Little Lick Creek	S-26	Intermittent (Isolated)	Temp. Fill	20	0		0
				Perm. Fill	349	0 ⁴		0 ³
				Bank Stabil.	175	0 ⁴		0 ³
6	UT of Little Lick Creek	S-25	Intermittent	Bank Stabil.	25	0 ²		0 ³
7	UT of Little Lick Creek	S-18	Perennial	Temp. Fill	104	0		0
				Perm. Fill	665	665	2:1	665
				Bank Stabil.	305	0 ⁵		305
8	UT of Little Lick Creek	S-19	Intermittent	Perm. Fill	443	0 ²		0 ³
9	UT of Little Lick Creek	S-24	Intermittent	Perm. Fill	29	0 ²		0 ³
				Bank Stabil.	43	0 ⁵		0 ³
12	UT of Little Lick Creek	S-16	Intermittent	Temp. Fill	72	0		0
				Perm. Fill	789	0 ²		0 ³
				Bank Stabil.	18	0 ⁵		0 ³

Table 1. Revised Surface Water Impacts within the Neuse River Basin (HUC 03020201) (Continued)

Permit Site No.	Stream Name	Stream ID ¹	Intermittent/ Perennial	Impact Type	Impacts (lin. ft.)	Impacts Requiring USACE mitigation (lin. ft.)	USACE Mitigation Ratio	Impacts Requiring 1:1 DWR mitigation (lin. ft.)
17	UT of Little Lick Creek	S-6	Perennial	Temp. Fill	33	0		0
				Perm. Fill	479	479	2:1	479
				Bank Stabil.	140	0 ⁵		140
17A	UT of Little Lick Creek	S-12	Intermittent	Temp. Fill	37	0		0
				Bank Stabil.	25	0 ⁵		0 ³
17B	UT of Little Lick Creek	S-14	Intermittent	Temp. Fill	7	0		0
23	UT of Little Lick Creek	S-6	Perennial	Temp. Fill	65	0		0
				Perm. Fill	270	270	2:1	270
				Bank Stabil.	140	0 ⁵		140
24	UT of Little Lick Creek	S-7	Intermittent	Temp. Fill	23	0		0
				Perm. Fill	104	0 ²		0 ³
25	UT of Little Lick Creek	S-2	Intermittent	Temp. Fill	10	0		0
				Perm. Fill	168	0 ²		0 ³
				Bank Stabil.	35	0 ⁵		0 ³
26	UT of Little Lick Creek	S-2	Intermittent	Temp. Fill	23	0		0
				Perm. Fill	50	0 ²		0 ³
				Bank Stabil.	50	0 ⁵		0 ³

Table 1. Revised Surface Water Impacts within the Neuse River Basin (HUC 03020201) (Continued)

Permit Site No.	Stream Name	Stream ID ¹	Intermittent/ Perennial	Impact Type	Impacts (lin. ft.)	Impacts Requiring USACE mitigation (lin. ft.)	USACE Mitigation Ratio	Impacts Requiring 1:1 DWR mitigation (lin. ft.)
27	UT of Little Lick Creek	S-6	Perennial	Bank Stabil.	10	0 ⁵		10 ⁶
U-1	UT of Little Lick Creek	S-25	Intermittent	Utility/ Bank Stabil.	20	0 ⁵		0 ³
Temporary Fill Impacts (Non-isolated)					388	0		0
Temporary Fill Impacts (Isolated)					20	0		0
Permanent Fill Impacts (Non-isolated)					4,492	1,414		1,414
Permanent Fill Impacts (Isolated)					349	0 ⁴		0
Bank Stabilization Impacts (Non-isolated)					831	0		595
Bank Stabilization Impacts (Isolated)					175	0 ⁴		0
TOTAL TEMPORARY IMPACTS					408	0		0
TOTAL PERMANENT IMPACTS					5,847	1,414		2,009

¹Stream IDs are from the JD re-verification packet, dated April 7, 2011.

²Per USACE, no compensatory mitigation is required for permanent impacts (including bank stabilization) to USACE-regulated intermittent streams associated with this project.

³Per the NCDWQ Public Memorandum dated August 14, 2009, any NCDOT project within the Merger 01 process that has reached CP 4A prior to the effective date of October 16, 2009 is not subject to the NCDWR Intermittent Stream Mitigation Policy. This project reached CP 4A on December 13, 2007 and is not subject to this policy. Therefore, no compensatory mitigation for permanent impacts along intermittent streams is required by NCDWR for this project.

⁴Isolated streams are not regulated by USACE.

⁵Per USACE, bank stabilization impacts do not require compensatory mitigation.

⁶Although this Site does not individually exceed the 150 linear foot threshold set by NCDWR for requiring compensatory mitigation, when combined with other Sites along the same stream, the cumulative impact to the stream exceeds that threshold.

Wetlands

A new wetland impact site has been added to the project. Per USACE request, proposed impacts to this site are included with this modification request. This new site, Site No. 33, occurs within the Neuse River Basin (HUC 03020201). A description of this addition is below. Please also see Table 2, which has been revised to reflect this addition. Revised Sites, sub-totals, and totals are in bold.

Permit Site 33

- ABF Freight Corporation, Horvath Associates (representing ABF Freight), and NCDOT have been working on a plan to remediate the loss of property resulting from TIP Project No. U-0071 on the ABF Freight parcel located at 208 Muldee Street in Durham, North Carolina. The remediation plan consists of replacing the lost truck terminal parking spaces and necessary truck turning movement area (which were lost due to NCDOT ROW encroachment) on an adjacent property. This property will remain outside of the limits of the NCDOT ROW upon completion of U-0071. Within the proposed limits of disturbance for the proposed work, there is a small portion of a jurisdictional

wetland (Wetland WA) that needs to be impacted in order for the replacement parking areas to reasonably function for the intended uses. Additionally, for proper truck movements to occur and for the replacement area to be used as needed by the ABF Freight Corporation, the disturbance of this wetland area is unavoidable. A large portion of this wetland will remain undisturbed and this request is only for disturbance of the area necessary for the site to function properly.

- This design addition will result in 0.09 ac. of permanent fill at Site No. 33.

Table 2. Revised Wetland Impacts within the Neuse River Basin (HUC 03020201)

Permit Site No.	Wetland ID	Wetland Type	Impact Type	Permanent Impacts (ac.)	Impacts Requiring USACE mitigation (ac.) ¹	Temporary Impacts (ac.)
2	W-B	Riparian	Fill	0.08	0.08	0
3	W-30	Riparian	Fill	0.06	0.06	0
4	W-29	Riparian (Isolated)	Fill	0.05	0 ²	0
5	W-39	Riparian (Isolated)	Fill	0.06	0 ²	0
8	W-28	Riparian	Fill	0.04	0.04	0
10	W-25	Riparian	Fill	0.01	0.01	0.01
11	W-24	Riparian	Mechanized Clearing	<0.01	<0.01	0
14	W-10A	Riparian (Isolated)	Fill	0.08	0 ²	0
15	W-PX	Non-Riparian (Isolated)	Fill	0.03	0 ²	0
16	W-11	Non-Riparian (Isolated)	Fill	0.05	0 ²	0
33	WA⁴	Riparian	Fill	0.09	0.09	0
Riparian, Non-Isolated Impacts				0.28	0.28	0.01
Riparian, Isolated Impacts				0.19	0 ²	0
Non-Riparian, Isolated Impacts				0.08	0 ²	0
TOTAL IMPACTS				0.55³	0.28³	0.01

¹ Mitigation ratio for all applicable wetland sites is 2:1.

² Isolated wetlands are not regulated by the USACE. Additionally, NCDOT does not anticipate compensatory mitigation being required by NCDWR for isolated wetlands because total wetland impacts for the project do not exceed 1.0 acre.

³ Rounded total is based on the sum of the actual impacts.

⁴ This wetland is associated with the ABF Freight property.

Riparian Buffers

All revisions occur within the Neuse River Basin (HUC 03020201). Riparian buffer impact revisions occur at Sites 4 and 17. Descriptions of the changes at each site are below. Please also see Table 3, which has been revised to reflect these modifications. Revisions are in bold.

Permit Site 4 (Permit Drawing 6 of 18) at 36+20 -SR2- Lt

- The contractor has installed the 48 inch pipe structure and rip rap bank stabilization following the most recently approved permit drawing at this site. Recent rain events have resulted in significant scour and failure of streambanks immediately upstream of the rip rap that has been installed by the contractor. The Department proposes to install additional Class II rip rap on the stream banks that would allow for the permanent stabilization within the project limits.
- This design change will result in an increase in mitigable Road Crossing, Riparian Buffer Zone 1 impacts of 633 square feet.

Permit Site 17 (Permit Drawing 16 of 18) at 133+50 -L- Lt

- The contractor is currently installing the culvert this location. The Department evaluated the existing stream channel at the culvert outlet and determined that the previously-permitted permanent rip rap bank stabilization at Permit Site 17 and previously-permitted temporary stream impacts at Permit Site 17A will not provide appropriate long-term stability. Additional Class II rip rap bank stabilization is proposed at the culvert outlet.
- This design change will result in an increase in mitigable Road Crossing, Riparian Buffer Zone 1 impacts of 3,845 square feet and an increase in mitigable Road Crossing, Riparian Buffer Zone 2 impacts of 671 square feet.

Table 3. Revised Riparian Buffer Impacts within the Neuse River Basin (HUC 03020201)

Impact Type¹	Zone 1 Impacts (sq. ft.)	Zone 2 Impacts (sq. ft.)	Buffer Impact Total (sq. ft.)
Allowable Stormwater Management Impacts	5,584	3,789	9,373
Allowable Utility Impacts	2,599	1,960	4,559
Allowable Road Crossing Impacts	20,076	12,601	32,677
Mitigable Utility Impacts	329	0	329
Mitigable Parallel Impacts	5,317	7,867	13,184
Mitigable Road Crossing Impacts	355,113	236,440	591,553
Total Allowable Impacts	28,259	18,350	46,609
Total Mitigable Impacts	360,759	244,307	605,066
Wetlands in Buffer Within Mitigable Impacts	6,999	2,335	9,334
Total Mitigable Impacts, Minus Wetlands In Buffer	353,760	241,972	595,732
TOTAL IMPACTS	389,018	262,657	651,675
TOTAL WETLANDS IN BUFFER	6,999	2,335	9,334
TOTAL IMPACTS, MINUS WETLANDS IN BUFFER	382,019	260,322	642,341

¹ See Buffer Impact Summary Sheet in the attached revised buffer drawings for site-by-site impacts.

Compensatory Mitigation

Compensatory mitigation requirements for permanent stream, wetland, and riparian buffer impacts associated with U-0071 within the Neuse River Basin (HUC 03020201) are summarized below in Table 4. Revised sub-totals and totals are in bold. Mitigation for the revised totals will be provided by DMS. Please see the attached DMS Mitigation Acceptance Letter.

Stream Impacts

A total of 5,847 linear feet of permanent warm water stream impacts will occur within the Neuse Basin. This is an increase of 245 linear feet compared to the 5,602 linear feet that was reported in the 2nd permit modification application.

A total of 1,414 linear feet of permanent warm water stream impacts will require compensatory mitigation per USACE at a 2:1 ratio. This is unchanged since the 2nd permit modification. The amount of permanent stream impacts requiring compensatory mitigation per NCDWR increased since the 2nd permit modification application from 1,954 linear feet to 2,009 linear feet; these impacts will be mitigated for at a 1:1 ratio.

Wetland Impacts

A total of 0.55 acres of permanent wetland impacts will occur within the Neuse Basin. Of that 0.55 acres, 0.27 acres are isolated and do not require mitigation. The remaining 0.28 acres will require compensatory mitigation per USACE at a 2:1 ratio. This is an increase of 0.09 acres due to the inclusion of Site 33. This is the 1st modification to wetland impacts since the original permit.

Riparian Buffer Impacts

A total of 353,760 square feet of mitigable Zone 1 Riparian Buffer impacts and 241,972 square feet of mitigable Zone 2 Riparian Buffer impacts will occur within the Neuse Basin. This is an increase of 4,478 square feet of mitigable Zone 1 buffer impacts and 671 square feet of mitigable Zone 2 buffer impacts when compared to previously-permitted amounts (most recently modified by the 1st permit modification). Zone 1 impacts will be mitigated for at a 3:1 ratio, while Zone 2 impacts will be mitigated for at a 1.5:1 ratio.

Table 4. Revised Neuse River Basin Compensatory Mitigation Summary

	Stream Impacts (lin. ft.)	Riparian Wetland Impacts (ac.)	Mitigable Zone 1 Buffer Impacts (sq. ft.)	Mitigable Zone 2 Buffer Impacts (sq. ft.)
Impacts Requiring Mitigation	1,414	0.28	353,760	241,972
Mitigation Ratio	2:1	2:1	3:1	1.5:1
Total DMS Mitigation Required	2,828	0.56	1,061,280	362,958

A copy of this permit modification application and its distribution list will be posted on the NCDOT website at <https://connect.ncdot.gov/resources/Environmental/Pages/default.aspx>, under *Quick Links > Permit Applications*. Thank you for your time and assistance with this project. Please contact James Mason at either jsmason@ncdot.gov or (919) 707-6136 if you have any questions or need additional information.

Sincerely,

A handwritten signature in black ink, appearing to read "Philip S. Harris, III". The signature is stylized and written in a cursive-like font.

Philip S. Harris, III, P.E., Manager
Natural Environment Section

cc: NCDOT Permit Application Standard Distribution List



HORVATH
ASSOCIATES

Civil Engineers
Planners
Landscape Architects

Dennis Jernigan
North Carolina Department of Transportation
NCDOT Division 5 District 2
815 Stadium Drive
Durham, NC 27704
Re: ABF Freight / U-0071 Terminal Wetlands Disturbance

Mr. Jernigan,

As you are aware the ABF Freight Corporation, Horvath Associates, and NCDOT have been working on a plan to remediate the loss of property due to the U-0071 project on the ABF Freight Parcel located at 208 Muldee Street in Durham, North Carolina. The plan consists of replacing the lost truck terminal parking spaces and necessary truck turning movement area on an adjacent property which will remain outside of the limits of the right of way upon completion of project U-0071. Inside the proposed limits of disturbance for this replacement parking and movement area there is a small portion of an isolated wetland (approximately 4,000 SF \pm) that needs to be disturbed in order for the replacement parking areas to reasonably function for the intended uses. Provided with this letter is a truck turnaround exhibit which clearly shows that for proper truck movements to occur and for the replacement area to be used as needed by the ABF Freight Corporation, the disturbance of this wetland area is unavoidable. It should be noted that a large portion of this wetland will remain undisturbed and that this request is only for disturbance of the area necessary for the site to function properly.

Sincerely,

Neil Allen
Horvath Associates, PA



HORVATH
ASSOCIATES

14 CONSULTANT PLACE, SUITE 201
DURHAM, NORTH CAROLINA 27707
P 919.490.4990 F 919.490.8953


P.O. BOX 970
HARRISON, TENNESSEE 37341
P 423.266.4990

www.horvathassociates.com

ABF FREIGHT
208 MULDEE STREET
DURHAM, NC 27703

TRUCK
TURNAROUND
EXHIBIT

NORTH CAROLINA BOARD OF
EXAMINERS FOR ENGINEERS AND
SURVEYORS LICENSE NO.: C-0676

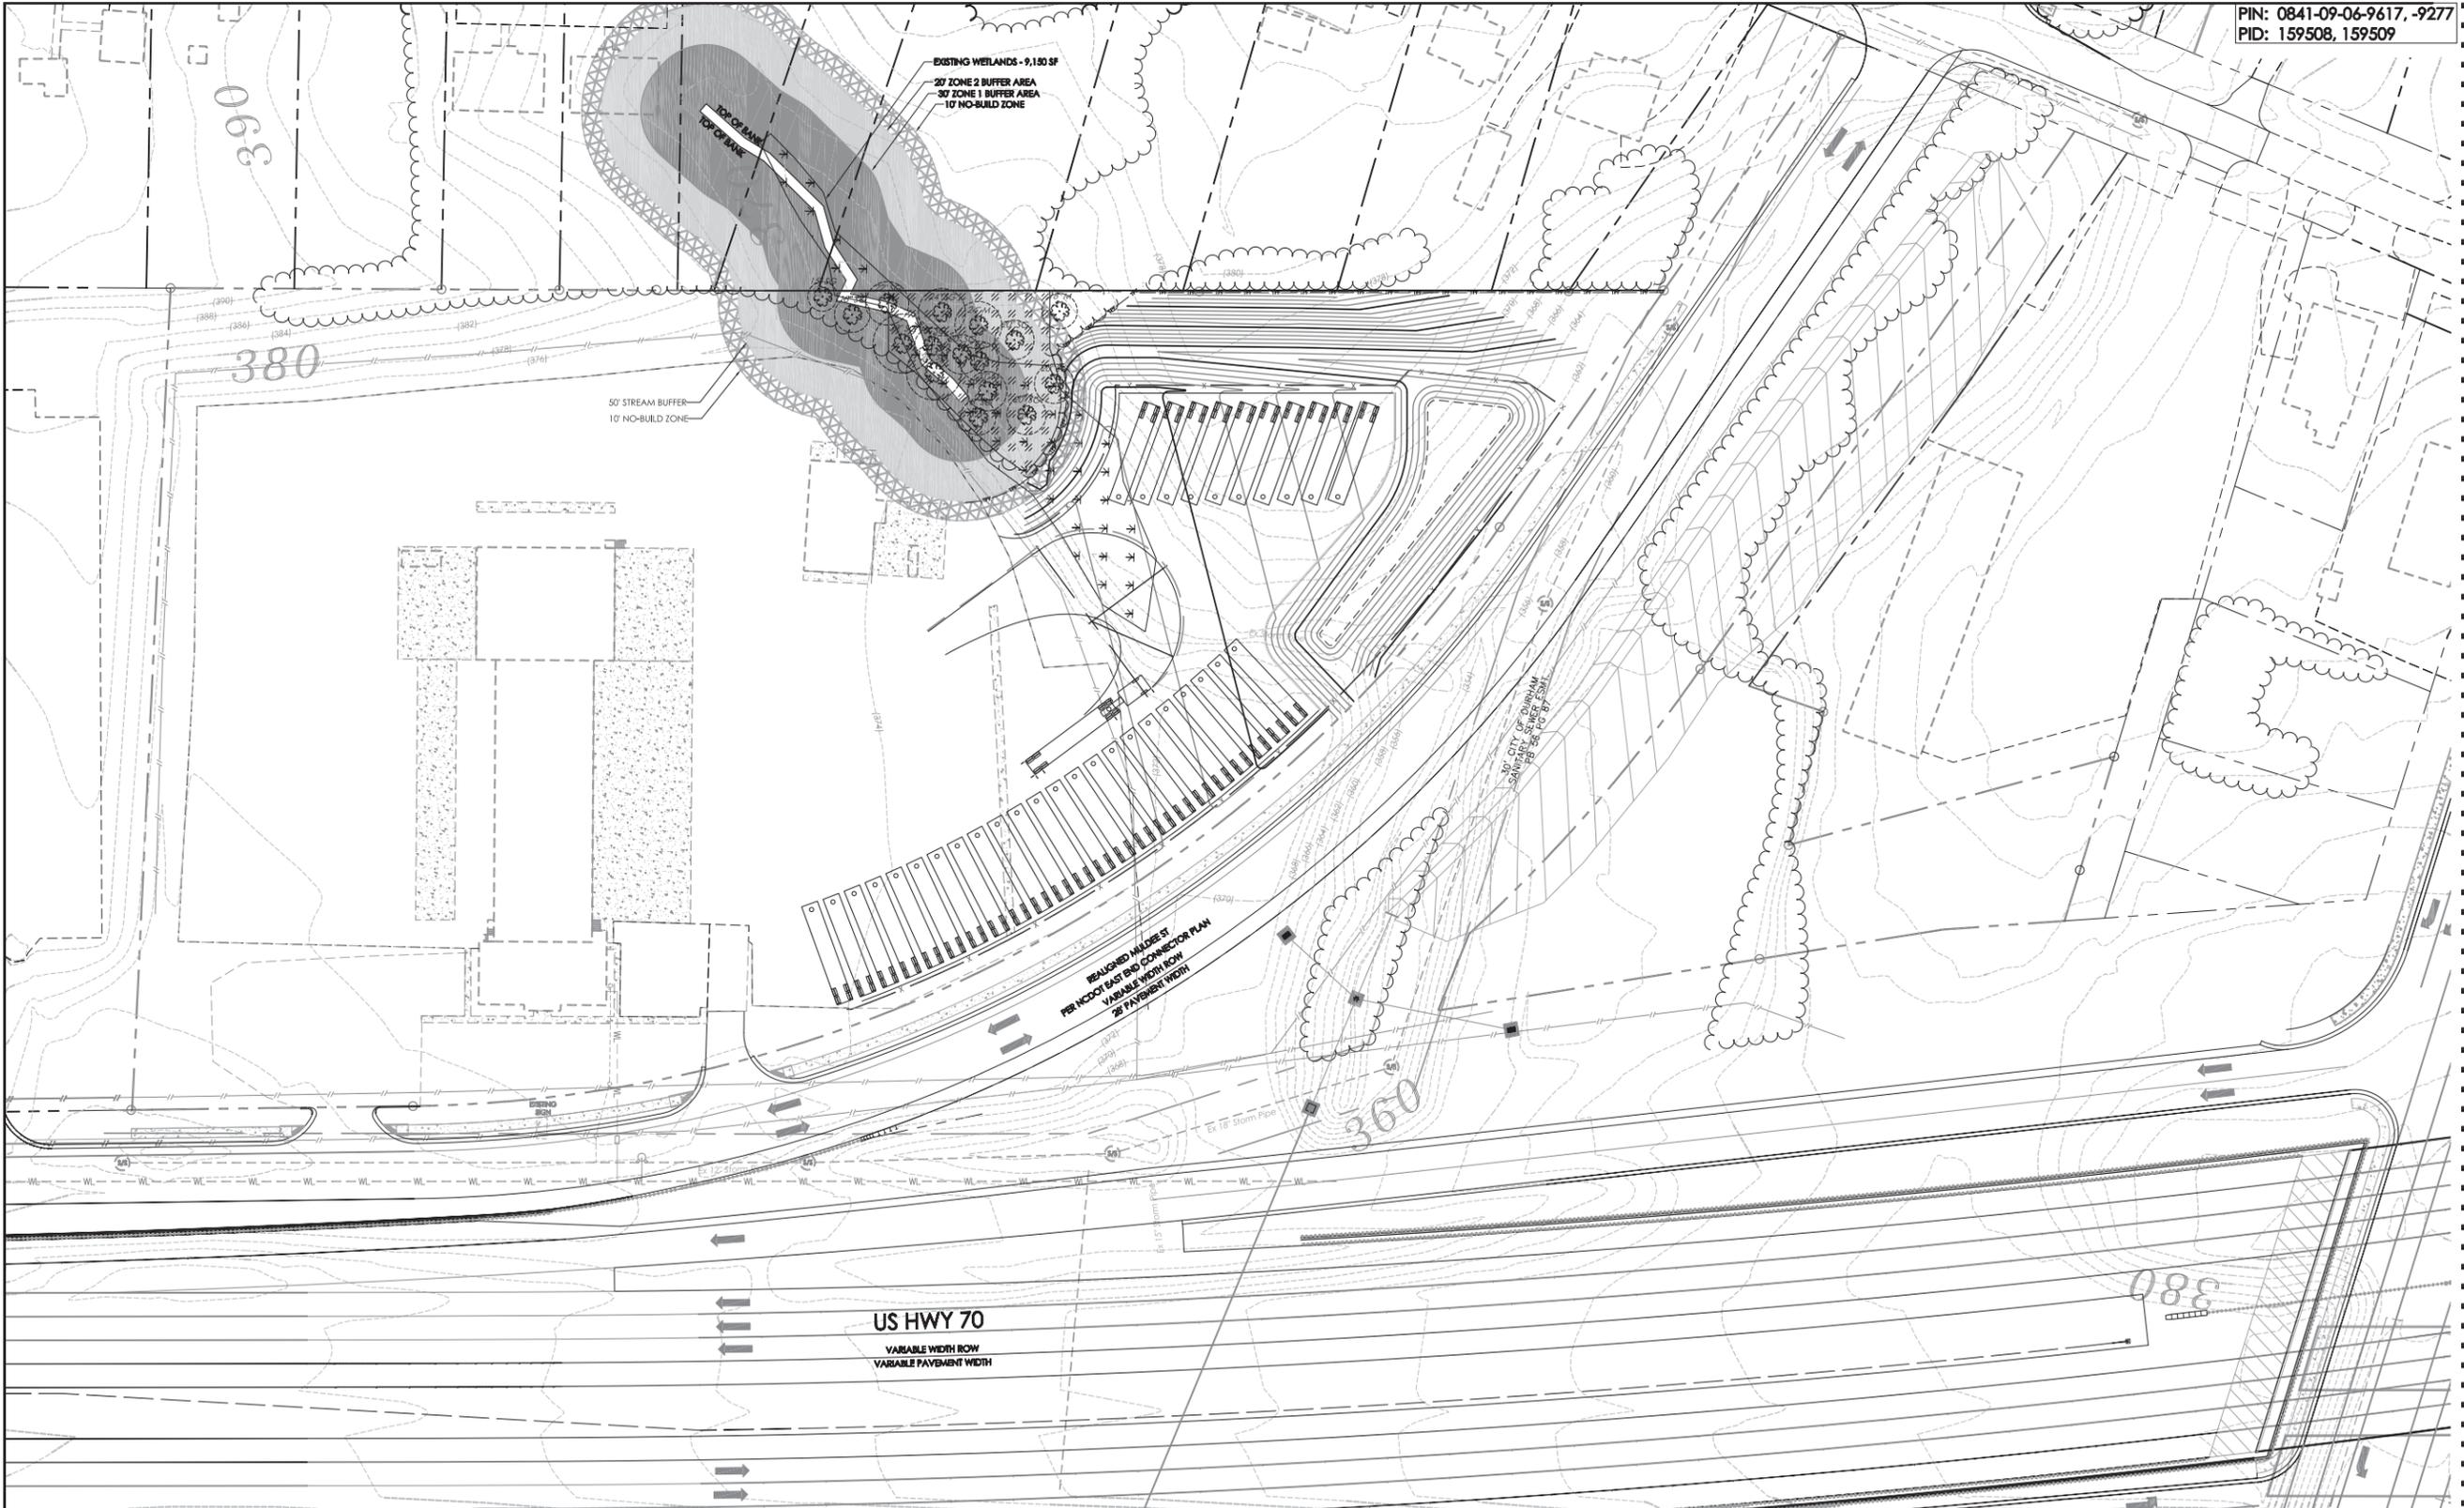

1 TRUCK TURNAROUND EXHIBIT
X-1 SCALE: 1"=40'



DRAWN BY: NDA
CHECKED BY: KG
DATE: APRIL 15, 2016
SCALE: AS NOTED
PROJECT NO.: 1319
SHEET NO.:

X-1
CONSTRUCTION DRAWINGS



May 3, 2016

Mr. Philip S. Harris, P.E., PLS
Project Development & Environmental Analysis Unit
North Carolina Department of Transportation
1598 Mail Service Center
Raleigh, North Carolina 27699-1598

Dear Mr. Harris:

Subject: Mitigation Acceptance Letter:

U-0071, East End Connector from NC 147 (Buck Dean Fwy) to North of NC 98, Durham County

References: USACE 404 Individual Permit issued March 24, 2014 (USACE Action ID 2011-00796) and 404 Individual Permit Modification issued May 7, 2015

NCDWR 401 Water Quality Certification issued January 28, 2014 (NCDWR Project ID 2013-1282) and 401 Water Quality Certification modification issued April 15, 2015

The purpose of this letter is to notify you that the Division of Mitigation Services (DMS) will provide the additional stream, riparian wetland and buffer mitigation for the subject project. Based on the information supplied by you on May 3, 2016, the additional impacts are located in CU 03020201 of the Neuse River Basin in the Central Piedmont (CP) Eco-Region, and are as follows:

Table 1 – Additional Impacts (feet / acres)

Neuse 03020201 CP	Stream			Wetlands			Buffer (Sq. Ft.)	
	Cold	Cool	Warm	Riparian	Non-Riparian	Coastal Marsh	Zone 1 (3:1)	Zone 2 (1.5:1)
Impacts (feet/acres)	0	0	58.0	0.09	0	0	4,478.0	671.0

All buffer mitigation requests and approvals are administrated through the Riparian Restoration Buffer Fund. The NCDOT will be responsible to ensure that appropriate compensation for the buffer mitigation will be provided in the agreed upon method of fund transfer. Upon receipt of the NCDWR's Buffer Authorization Certification, DMS will transfer funds from the NCDOT 2984 Fund into the Riparian Restoration Buffer Fund. Upon completion of transfer payment, NCDOT will have completed its addition riparian buffer mitigation responsibility for TIP Number U-0071. These additional impacts and associated mitigation needs were not projected by the NCDOT in the 2016 impact data. DMS is currently providing stream and riparian wetland mitigation for the impacts associated with this project located in cataloging unit 03030002 of the Cape Fear River basin and cataloging unit 03020201 of the Neuse River basin as required by the 404 and 401 permits that were issued in 2014 and 2015, as shown in the below table (in mitigation credits):

Mr. Harris
 TIP U-0071 Additional
 May 3, 2016
 Page Two

Table 2 – Current Permitted Impacts and Mitigation Requirements (based on 2014 permits) and Revised Anticipated Impacts (based on mitigation request)

Neuse 03020201

Impact Type	Total Permitted Impacts (feet / acre)	Mitigation Provided by DMS per Issued Permits (Credits)	Additional Impact (for approval)	Revised Total Impacts*
Stream	1,951.0	2,975.0	58.0	2,009.0
Riparian Wetland	0.19	0.38	0.09	0.28
Buffer – Zone 1	349,282.0 sq ft	1,047,846.0 sq ft	4,478.0 sq ft	353,760.0 sq ft
Buffer – Zone 2	241,301.0 sq ft	361,952.0 sq ft	671.0 sq ft	241,972.0 sq ft

Cape Fear 03030002

Impact Type	Total Permitted Impacts (feet / acre)	Mitigation Provided by DMS per Issued Permits (Credits)	Additional Impact (for approval)	Revised Total Impacts*
Stream	440.0	880.0	0	440.0

*Some of the stream and wetland impacts may be proposed to be mitigated at a 1:1 mitigation ratio. See permit application for details. DMS will provide the amount of mitigation as determined by the regulatory agencies.

DMS has previously made debits for the stream and riparian wetland mitigation requirements to mitigation sites available in the cataloging units based on the amounts required in the 404 and 401 permits issued in 2014 and 2015. NCDOT has made payment for all riparian buffer mitigation as required by DWR. Upon issuance of the permit modifications for the project, DMS will make appropriate adjustments to the existing mitigation debits.

If you have any questions or need additional information, please contact Ms. Beth Harmon at 919-707-8420.

Sincerely,



James B. Stanfill
 DMS Asset Management Supervisor

Cc: Mr. Eric Alsmeyer, USACE – Raleigh Regulatory Field Office
 Ms. Amy Chapman, NC Division of Water Resources
 File: U-0071 Additional 2

PROJECT REFERENCE NO. U-0071	SHEET NO. 10-B
RW SHEET NO. ROADWAY DESIGN ENGINEER	HYDRAULICS ENGINEER
INCOMPLETE PLANS DO NOT USE FOR R/W ACQUISITION PRELIMINARY PLANS DO NOT USE FOR CONSTRUCTION	

PERMIT DRAWING
SHEET 55 OF 91
 Revised April 2016

N.C.D.O.T.

(FORMERLY ALVIS M. BAUCOM)

WOODS
SITE 13

SITE 12

Site continued on
Sheet 10-A

SPECIAL LATERAL V DITCH
 SEE DETAIL SLIR
 EST 97 TONS CL. I
 EST 300 SY GFD

 CLASS 'I' RIP RAP
 EST. 7 TONS
 15 SY GFD

REMOVE

TDI WANGLE
 VANE GRATE

DRAIN POND

PROACH SLAB
 OC STA. 33+86.10
 IN SBG
 - STA. 33+72.21
 BRIDGE
 POC STA. 33+62.43

MED. GR ANCHOR

RETAINING WALL

TYPE B-77

TYPE B-77


TYPE B-77

15" RCP-III


15" RCP-III

2GI

Sta. 32+13.85
 Sta. 32+45.55

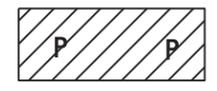

DENOTES IMPACTS IN SURFACE WATER (POND)

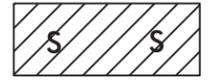

DENOTES IMPACTS IN SURFACE WATER



DENOTES TEMPORARY IMPACTS IN SURFACE WATER

REVISIONS


8/17/99

SYSTEMS DESIGN
 DESIGN
 DESIGN

PERMIT DRAWING
SHEET 60 OF 91

Revised April 2016

REVISIONS
 7/02 RIP, PARCELS NOS. 37 & 40 COMBINED INTO PARCEL NO. 379, PARCEL NO. 85 REVISED TO "S", PARCEL NO. 90 REVISED TO "H",
 8/17/99 R/W REVISION / 7/02 RIP, PARCELS NOS. 37 & 40 COMBINED INTO PARCEL NO. 379, PARCEL NO. 85 REVISED TO "S", PARCEL NO. 90 REVISED TO "H",
 PARCEL NO. 384 REVISED TO "R".

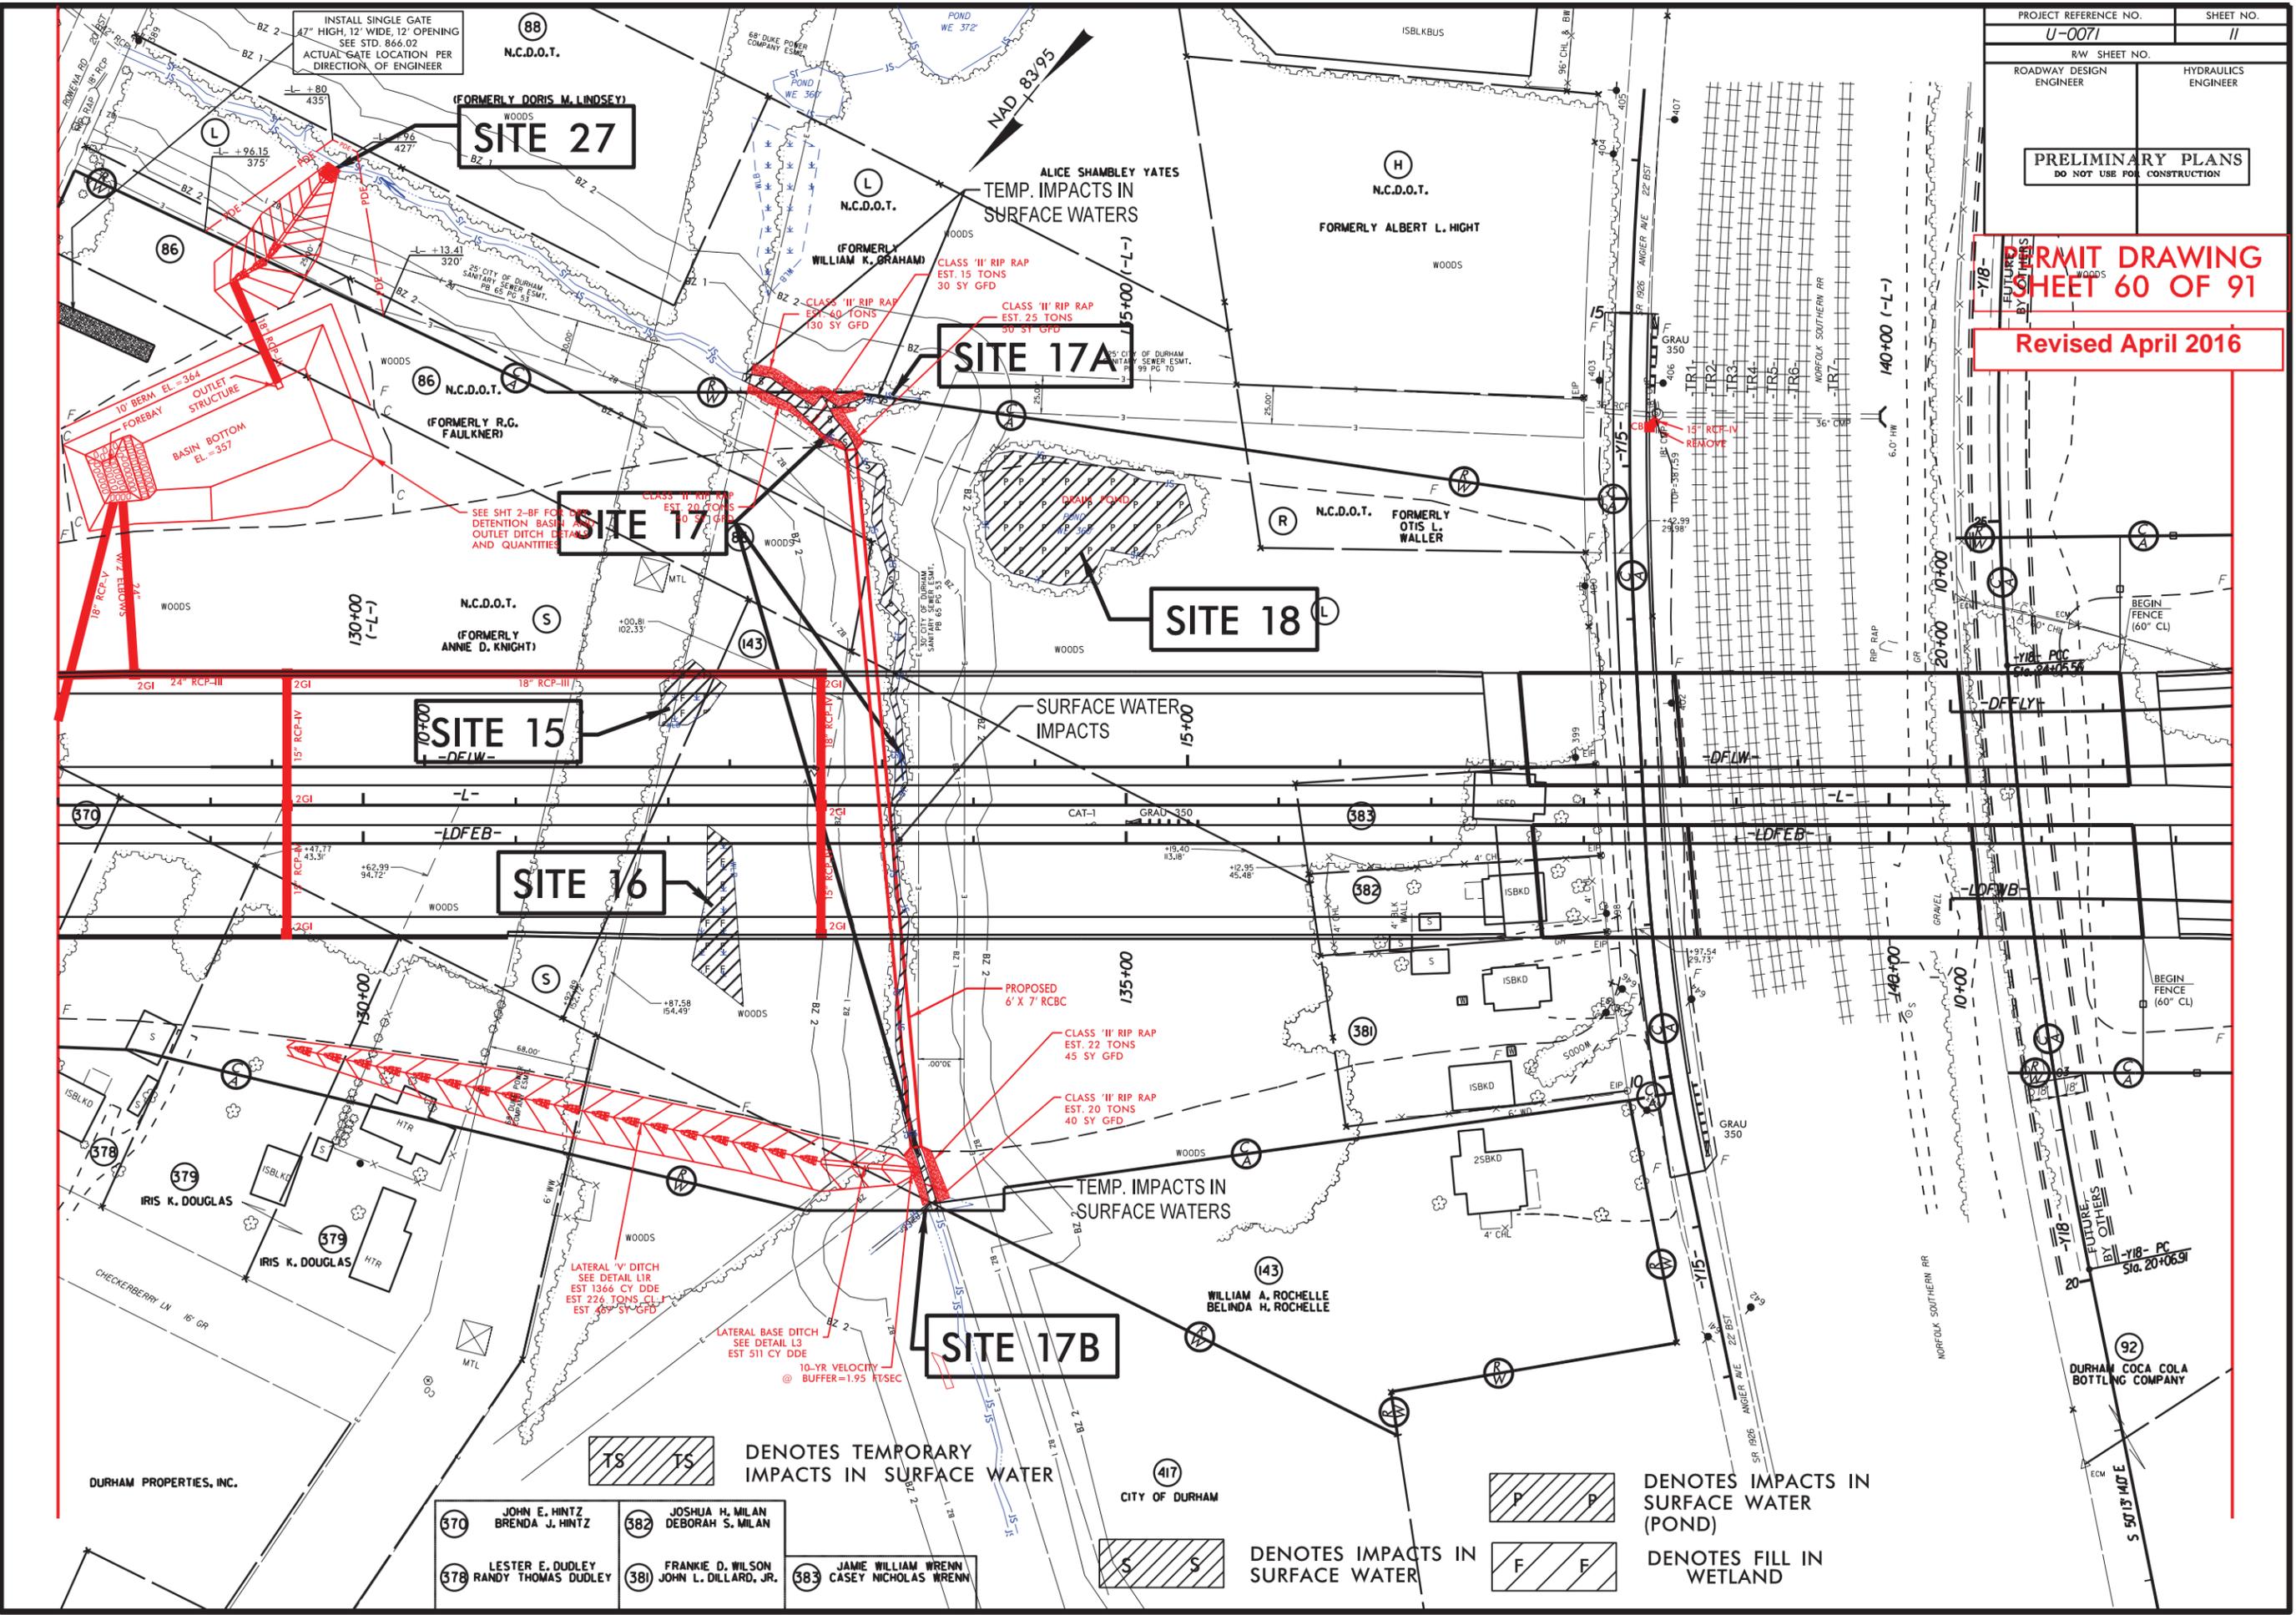

- | | |
|---|---|
| 370 JOHN E. HINTZ
BRENDA J. HINTZ | 382 JOSHUA H. MILAN
DEBORAH S. MILAN |
| 378 LESTER E. DUDLEY
RANDY THOMAS DUDLEY | 381 FRANKIE D. WILSON
JOHN L. DILLARD, JR. |
| 383 JAMIE WILLIAM WRENN
CASEY NICHOLAS WRENN | |

WETLAND PERMIT IMPACT SUMMARY												
Site No.	Station (From/To)	Structure Size / Type	WETLAND IMPACTS					SURFACE WATER IMPACTS				
			Permanent Fill In Wetlands (ac)	Temp. Fill In Wetlands (ac)	Excavation in Wetlands (ac)	Mechanized Clearing in Wetlands (ac)	Hand Clearing in Wetlands (ac)	Permanent SW impacts (ac)	Temp. SW impacts (ac)	Existing Channel Impacts Permanent (ft)	Existing Channel Impacts Temp. (ft)	Natural Stream Design (ft)
1	L 32+58 to 36+64	FILL						0.04		412		
2	L 37+75 - SR1 34+84 Y17 11+14	66" RCP-IV, 48"RCP-III, 24"RCP-III	0.08					0.07	<0.01	673	14	
		BANK STABILIZATION								20		
3	L 44+53	30" RCP-III	0.06					0.06		410		
* 4	SR2 36+89 Y7 17+24	48" RCP-III, 60" RCP-III	0.05					0.03	<0.01	349	20	
		BANK STABILIZATION								175		
* 5(T)	Y7LPA 13+98	60" RCP-III	0.06									
6	Y7RPA 21+78	BANK STABILIZATION						<0.01		25		
7	Y7RPA 20+75 to Y6 15+90	8'x9' RCBC						0.17	0.01	665	104	
		BANK STABILIZATION								305		
8	Y4 19+63 to 22+30 and Y4 23+04 to 25+59	30" RCP-III, FILL	0.04					0.07		443		
9	Y5 23+20 RT.	30" RCP-III						0.03	<0.01	29	0	
		BANK STABILIZATION								43		
10	Y5 26+62 RT.	FILL	0.01	0.01								
11	Y6 11+15 off 104 RT.	18" RCP-III					<0.01					
12	Y2 26+53 to 27+90 LT.	48" RCP-III & RECHANNELIZATION						0.12	0.02	789	72	
		BANK STABILIZATION								18		
13(T)	Y4 35+48	36" RCP-IV						0.78				
* 14(T)	L 122+93	30" RCP-V	0.08									
* 15(T)	L 132+13	FILL	0.03									
* 16(T)	L 132+33 RT.	FILL	0.05									
17	L 133+41	6'x7' RCBC						0.06	<0.01	479	33	
		BANK STABILIZATION								140		
17A	L 133+26 264' LT	BANK STABILIZATION						<0.01	<0.01	25	37	
TOTALS:			0.46	0.01			<0.01	1.43	0.03	5000	280	

*Rounded totals are sum of actual impacts

NOTES:

* indicates isolated wetland

(T) Indicates Total Take

NC DEPARTMENT OF TRANSPORTATION
DIVISION OF HIGHWAYS

DURHAM COUNTY
WBS - 34745.1.1 (U-0071)

WETLAND PERMIT IMPACT SUMMARY												
Site No.	Station (From/To)	Structure Size / Type	WETLAND IMPACTS					SURFACE WATER IMPACTS				
			Permanent Fill In Wetlands (ac)	Temp. Fill In Wetlands (ac)	Excavation in Wetlands (ac)	Mechanized Clearing in Wetlands (ac)	Hand Clearing in Wetlands (ac)	Permanent SW impacts (ac)	Temp. SW impacts (ac)	Existing Channel Impacts Permanent (ft)	Existing Channel Impacts Temp. (ft)	Natural Stream Design (ft)
17B	L 133+69 263' RT	FILL							<0.01			7
18(T)	L 134+53 LT.	FILL						0.19				
19	not jurisdictional	0										
20	DFLW 27+34 to 38+06	42" RCP-III						0.02	<0.01	218	17	
21	DFLW 39+19	FILL						0.01		28		
22	DFLW 41+62	FILL						0.01		23		
23	Y3 34+45	8'x10' CULVERT						0.09	0.01	270	65	
		BANK STABILIZATION								140		
24	Y3 40+16.69 RT	30" RCP-III						0.04	0.01	104	23	
25	Y9 28+10 LT to 26+85 RT	66" RCP-III						0.01	<0.01	168	10	
		BANK STABILIZATION								35		
26	Y3 57+75 LT to RT	60" RCP-III						0.01	<0.01	50	23	
		BANK STABILIZATION								50		
27	L 129+77 414LT.	BANK STABILIZATION								10		
28	DFLW 52+08 LT & RT	36" RCP						0.02	0.01	121	20	
29	DFLW 72+35 LT	FILL						< 0.01		40		
30	DFLW 73+72 LT	FILL						< 0.01		10		
31	DFLW 78+76 LT& 81+14 RT	BANK STABILIZATION								61		
		Construction Activity							<0.01		22	
32	DFLW 78+79 LT	Construction Activity							<0.01		9	
TOTALS (page 2 of 2):			0.00	0.00		0.00		0.4	0.03	1328	196	
TOTALS (page 1 of 2):			0.46	0.01		<0.01		1.43	0.02	5000	280	
TOTALS:			0.46	0.01		<.0.01		1.83	0.06	6328	476	

*Rounded totals are sum of actual impacts

NOTES:

* indicates isolated wetland

(T) Indicates Total Take


NC DEPARTMENT OF TRANSPORTATION
DIVISION OF HIGHWAYS

DURHAM COUNTY
WBS - 34745.1.1 (U-0071)

PROJECT REFERENCE NO.	U-0071	SHEET NO.	6
R/W SHEET NO.		HYDRAULICS ENGINEER	

ABF Freight
Permit Drawing
Sheet 1 of 2
Added April 2016

 DENOTES IMPACTS IN SURFACE WATER
 DENOTES FILL IN WETLAND

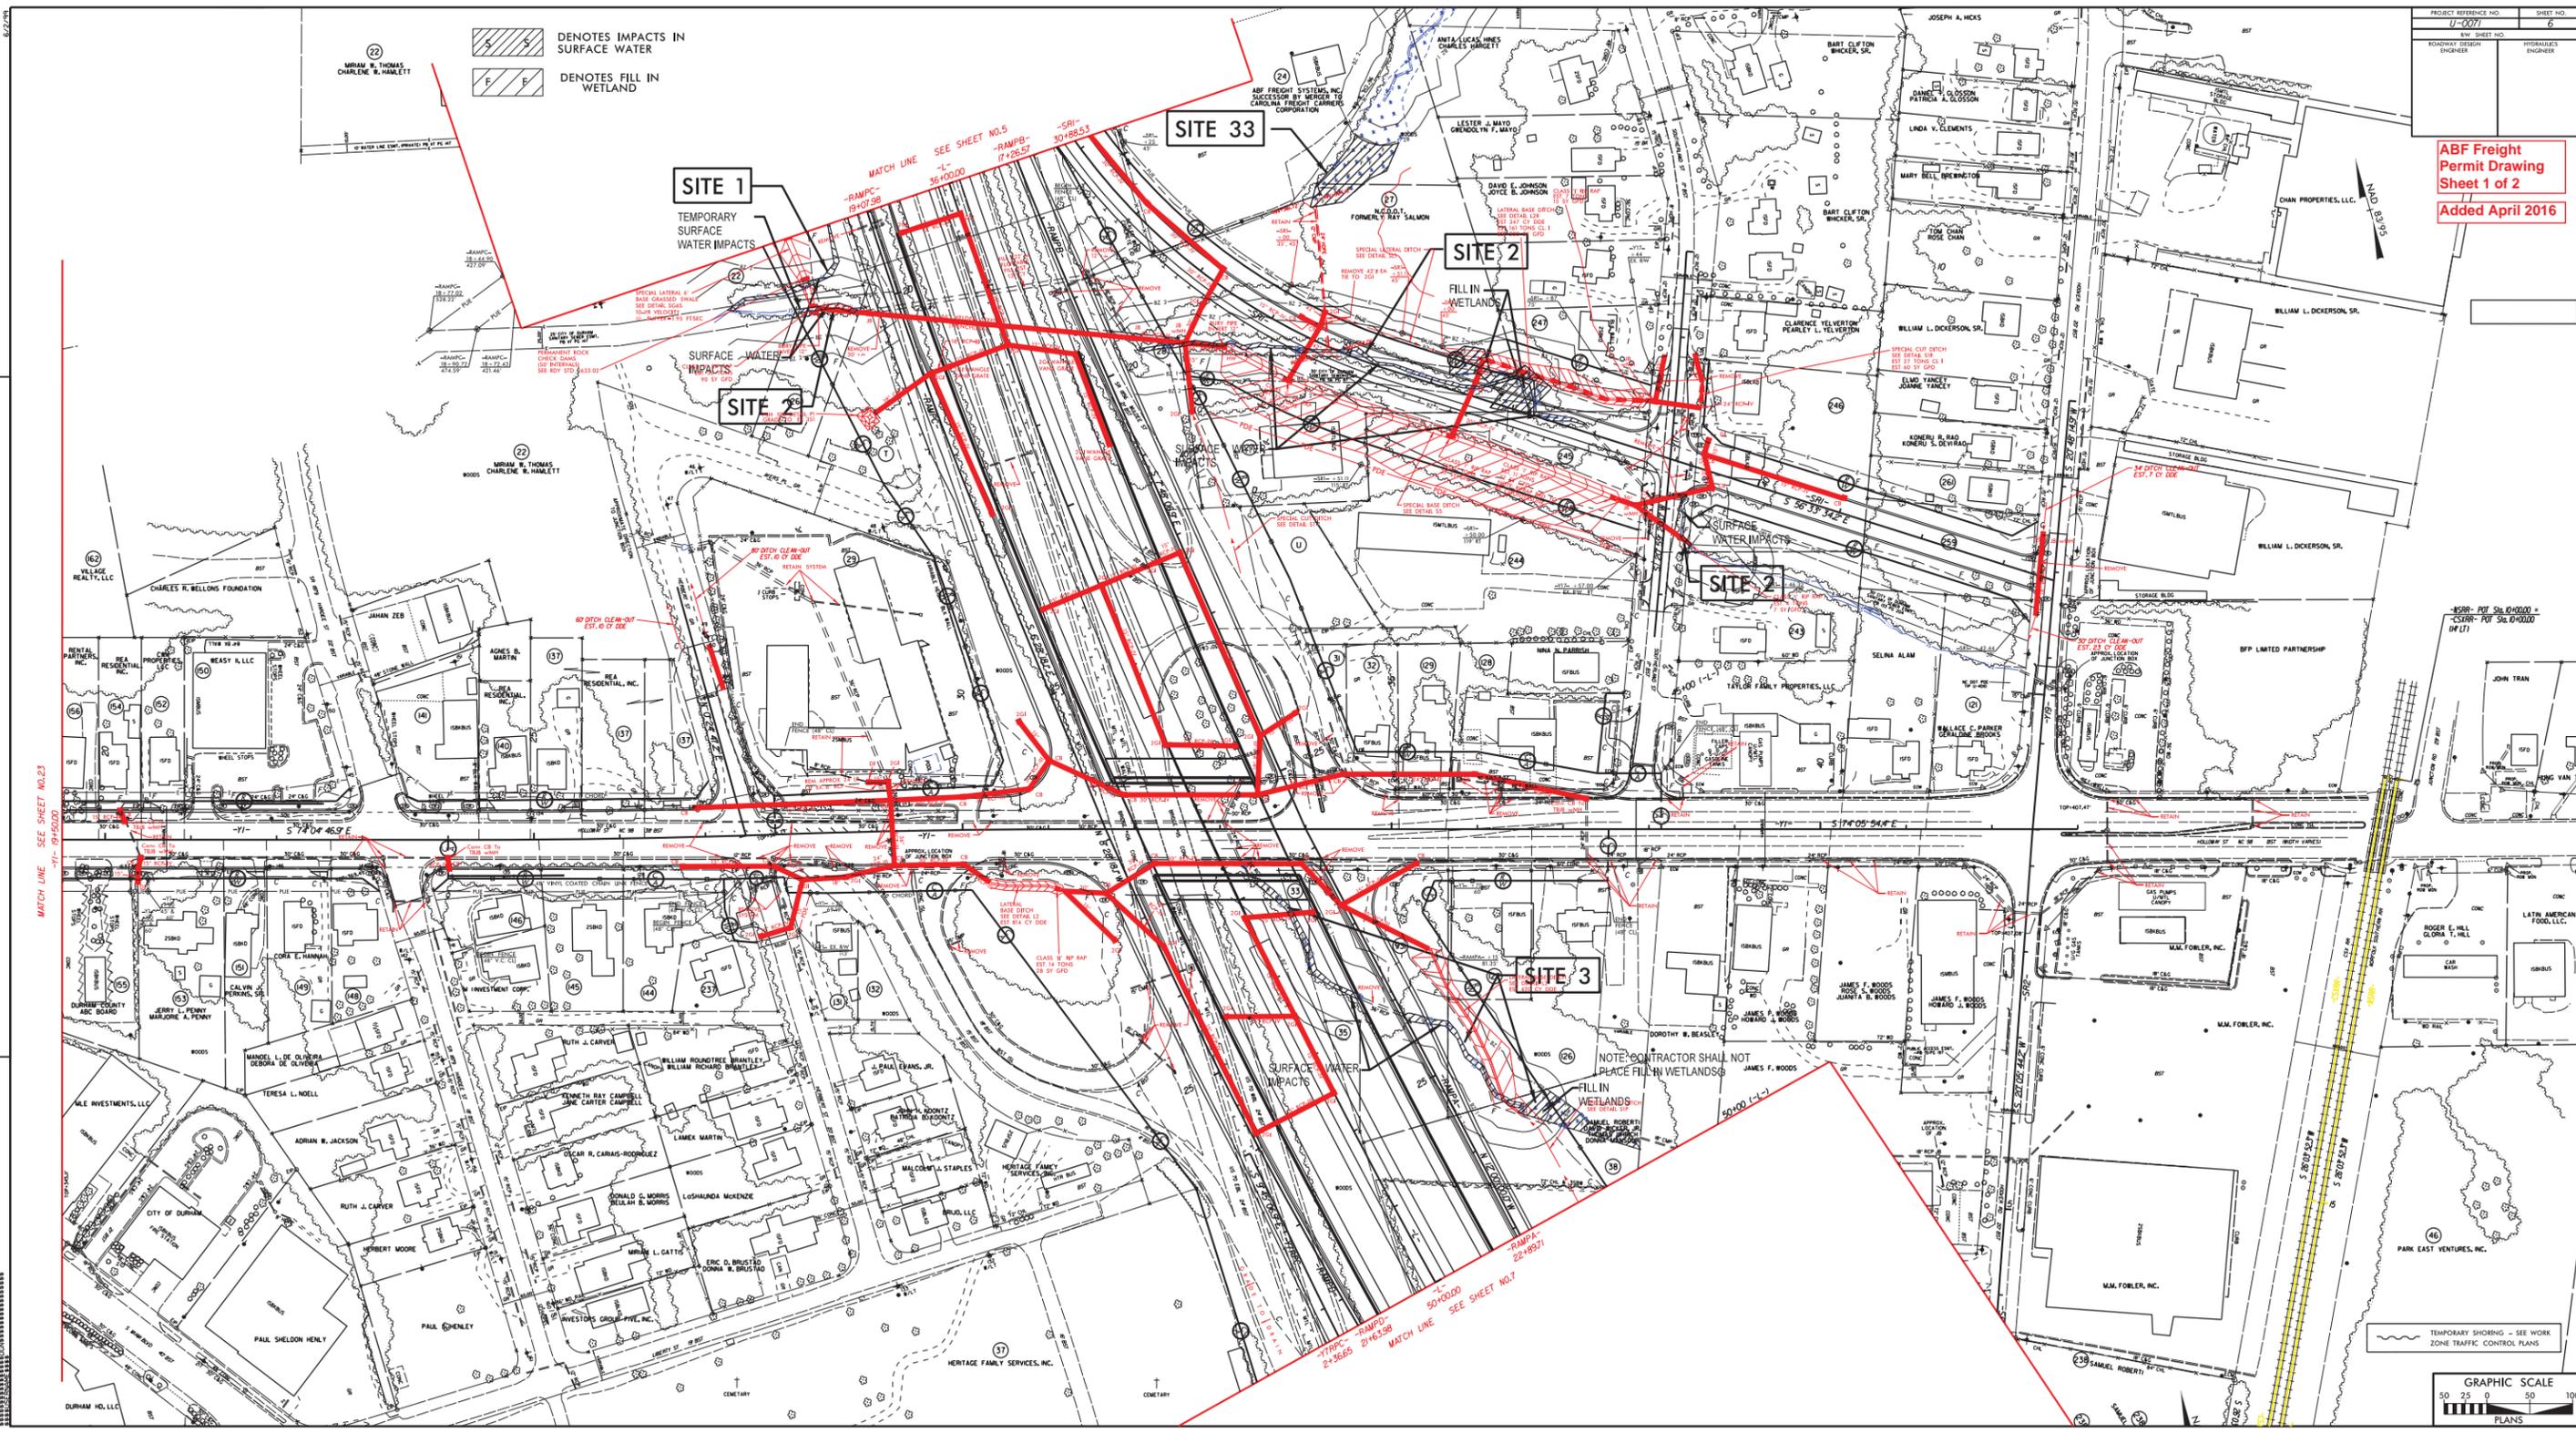

MATCH LINE - SEE SHEET NO. 5
 MATCH LINE - SEE SHEET NO. 6
 MATCH LINE - SEE SHEET NO. 7

GRAPHIC SCALE
 0 25 50 100
 FEET
 PLANS
 TEMPORARY SHORING - SEE WORK ZONE TRAFFIC CONTROL PLANS

