

PROJECT COMMITMENTS

**T.I.P. Project No. U-2579 D,E,F
Winston-Salem Northern Beltway
Forsyth County
Federal-Aid Project No. NHF-0918 (93)
WBS No. 34839.2.10**

All commitments developed during the project development and design phase have been incorporated into the design. Current status, changes, or additions to the project commitments as shown in the environmental document for the project are printed in *italic black font*; for the purpose of this consultation, all commitments, which are not pertinent to U-2579 Section DEF have been grayed out.

PDEA, Roadway Design, Division 9:

1. Archaeological site 31FY570**, a historic cemetery, will require avoidance or compliance with North Carolina General Statute, Chapter 70.

This commitment will be fulfilled at final design and during construction

2. Temporary construction easements may be needed on the historic Clayton Family Farm property. It has been determined that these temporary easements do not constitute a use under Section 4(f). No permanent right of way will be acquired from the Clayton Family Farm property. All work will be contained in temporary easements, and the encroachment on the property will be minimal. The duration of the temporary encroachment on the Clayton Family Farm property will be shorter than the timeframe for the construction of the project. The land temporarily occupied from the Clayton Family Farm will be fully restored, that is, the Clayton Family Farm property will be returned to a condition that is at least as good as that which existed prior to the project.

Based on the preliminary plans, temporary easement is required. This commitment will be fulfilled during right of way acquisition and construction.

3. Eligibility of Site 31FY64 is unknown because archaeologists were denied access to the property. If the site falls within the Preferred Alternative after final design, an assessment would be conducted prior to construction after it is acquired by NCDOT. Currently, the site is adjacent to non-preferred Detailed Study Alternative segment E3.

This commitment will be fulfilled during right of way acquisition.

4. A design noise study will be prepared for the selected alternative. The date of public knowledge for noise abatement purposes is the date the Record of Decision (ROD) is signed. Projects let for construction on or after July 13, 2011 shall be reviewed under NCDOT 2011 noise analysis criteria; however, the original date of public knowledge shall remain unchanged.

Action: *The ROD was signed in February 2008. Design Noise Reports based upon preliminary design were completed for U-2579 AB, B &C in 2009. A Revised Design Noise Report based upon final design was completed for U-2579B and approved by FHWA in 2014. A Revised Design Noise Report based upon final design will be completed for U-2579C in 2015. Revised Design Noise Reports based upon final design of U-2579AA and AB will be completed prior to Project Letting scheduled for October 2021. All Design Noise Reports are subject to approval by NCDOT and FHWA. The original Date of Public Knowledge of February 15, 2008 will remain unchanged for all sections of U-2579. A revised DNR will be prepared in 2015 for U-2579C under the NCDOT 2011 noise abatement criteria.*

Update 3/28/2017 regarding U-2579C – A DNR for U-2579C was completed in July 2016 under the 2011 NCDOT Traffic Noise Abatement Policy. An Addendum to the DNR will be prepared in 2017 to reflect additional changes that have occurred during the final design process.

The design noise study for the Project R-2247 portion of the Beltway will include an evaluation of Ronald Reagan High School.

- *6. The NCDOT will develop Data Recovery Plans (DRP) for Sites 31FY888, 31FY893**, 31FY901, 31FY902**, 31FY903, 31FY910**, 31FY911 **, 31FY912**, 31FY921, 31FY925**, 31FY944, 31FY1053/I053**, all of which will be affected by the subject project, in consultation with the North Carolina SHPO.

Data Recovery Plan will be developed and implemented after design is completed and Right-of-Way is acquired.

- *7. The NCDOT will ensure that each DRP is implemented after Right-of-Way is acquired or once Right-of-Entry is secured from the property owners and prior to construction activities within the site location as shown in the DRP.

Data Recovery Plan will be developed and implemented after design is completed and Right-of-Way is acquired.

- *8. As they are developed, each individual DRP will be forwarded for review by the SHPO.

This commitment will be fulfilled after the completion of the DRP.

- *9. Upon completion of each Data Recovery effort, the NCDOT will prepare and forward a Management Summary to the SHPO detailing the results of the Data Recovery field investigations. The Management Summary will contain sufficient information to demonstrate that the field investigation portion of the DRP has been implemented.

This commitment will be fulfilled after the completion of each data recovery effort.

- *10. Upon receipt of the Management Summary, the SHPO will respond within ten (10) days to the recommendations contained within the document.

This commitment will take place after the completion of the DRP.

- *11. Upon acceptance of the recommendations contained in the Management Summary, the SHPO will issue the NCDOT documentation that the Data Recovery field investigations have been completed.

This commitment will be fulfilled after the completion of the DRP.

- *12. The analysis and report preparation, detailing Sites 31FY888, 31FY893**, 31FY901, 31FY902**, 31FY903, 31FY910**, 31FY911 **, 31FY912**, 31FY921, 31FY925**, 31FY944, 31FY1053/I053** will be completed by the NCDOT, or their consultants, within twenty-four (24) months after completion of each site's fieldwork schedule.

This commitment will be fulfilled after the completion of the DRP.

Roadway Design, Division 9, Right of Way Branch:

- *1. In the vicinity of Alexander Hege House, NCDOT in consultation with SHPO will determine the extent of control-of-access fencing, as well as its type, material, and finish. NCDOT will purchase and then install the control-of-access fencing within the NCDOT right-of-way. NCDOT will maintain the control-of-access fencing.

Roadway Design, Utility Unit, Division 9, Right of Way Branch, GeoEnvironmental:

1. NCDOT will continue to work with residents of affected communities to develop mitigation strategies for community impacts. The following options will be considered during final design to minimize impacts to communities/subdivisions: construction of noise abatement barriers landscaping or vegetative screens based on NCDOT policies and guidelines. These types of options already have been incorporated into the Project R-2247, Project U-2579, and Project U-2579A preliminary engineering designs where practicable, but will be further considered

during final design.

Action: The final designs are completed; the above commitments have been addressed.

2. During final design for Projects R-2247, U-2579, and U-2579A, all utility providers and railroad operators would be coordinated with to ensure that the proposed design and construction of the project would not substantially disrupt service.

This is a standard commitment.

3. The development of this project will be further coordinated with the City of Winston Salem and Forsyth County Parks and Recreation Departments to minimize any conflicts with future parks and greenways planning. Provisions will be considered to maintain the future viability of any impacted proposed greenways.

Action: Roadway Design coordinated with the city of Winston Salem and avoided any impacts to greenways.

4. NCDOT will coordinate with the NC DENR Division of Waste Management regarding the Reynolds Auto Junkyard and other solid waste sites along the selected alternatives for Projects R-2247, U-2579, and U-2579A. Impacted sites will be remediated as required.

Action: The GeoEnvironmental Section of the Geotechnical Engineering Unit will coordinate with the Right of Way Branch to provide acquisition recommendations for potentially contaminated parcels. This coordination will occur prior to the parcel being acquired. Prior to construction the GeoEnvironmental Section will also coordinate with the NC DENR Division of Waste Management to address contaminated soil and ground water that may be encountered during construction.

5. NCDOT will consider wildlife crossings where appropriate in the vicinity of stream crossings, which will allow animals to cross under the Beltway.

Action: No special wildlife crossings are proposed. Opportunities for wildlife to cross exist along streams under bridges and through culverts. Also, small wildlife can use floodplain drains which are provided in the B and C projects.

6. NCDOT will coordinate with the Town of Kernersville regarding the compatibility of the Beltway design with the proposed Big Mill Farm Road interchange at US 421. This coordination will take place once all relevant design information has been obtained regarding the design of the Big Mill Farm Road interchange.

Action: Roadway Design coordinated and will continue to coordinate until project completion.

7. NCDOT intends to maintain a connection from Northampton Road to Old Walkertown Road. The final design will be developed based on design constraints and cost considerations.

Action: Current connection will be maintained.

- *8. *NCDOT will align the Alexander Hege House driveway opposite the new intersection ramp, so property access will be under full traffic control. This will allow NCDOT and the property owner full movement for equipment and trucks.*

Hydraulics Unit:

1. All bridges and culverts located in designated FEMA flood zones will be designed such that an increase in flood elevation would not exceed the lesser of 0.5 foot for the 100-year flood event or the elevation needed to protect structures.

Action: This commitment has been fulfilled.

2. The Hydraulics Unit will coordinate with the NC Floodplain Mapping Program (FMP), to determine status of project with regard to applicability of NCDOT'S Memorandum of Agreement, or approval of a Conditional Letter of Map Revision (CLOMR) and subsequent final Letter of Map Revision (LOMR).

The Hydraulics Unit will continue coordinate with the NC Floodplain Mapping Program (FMP) until project completion.

3. NCDOT will avoid installing bridge bents in creeks to the maximum extent practicable.

Action: This commitment has been fulfilled and no bridge bents are located in creeks.

Roadside Environmental, Division 9:

1. During design and construction, efforts will be made to minimize the impact to existing vegetative buffers and natural areas. NCDOT will prepare a post construction landscape design/corridor plan to mitigate construction impacts and integrate enhancements, while remaining sensitive to the environment and to the safety of the traveling public.

This is standard commitment; post construction plans will be prepared.

2. NCDOT will incorporate sediment and erosion control measures according to the Design Standards in Sensitive Watersheds for all construction in high quality water (HQW) zones in compliance with 15a NCAC 04B.0124.

Action: There are no qualifying factors present at this section.

*3 NCDOT will provide tree protection measures along the National Register boundary lines adjoining project construction areas. NCDOT will exercise best management practices to minimize, as practicable, tree trimming and disturbance of existing plantings along the National Register boundary.

Action: NCDOT will implement this commitment as described in the concurrence form with SHPO. Properties listed are Alexander Hege House, Samuel Stauber House & Barn John Henry Kapp Farm, Clayton Family Farm Seaver's Gas Station, Hammock Family Farm And John & Charles Fries Day Farm.

Roadway, Hydraulics:

Generally, 2:1 slopes will be used where possible to minimize culvert length, and NCDOT will shorten culvert lengths where possible and daylight systems between culverts where possible in interchange areas.

Action: The current plans show side slopes near streams and wetlands are mostly 2:1 to minimize impact.

Right of Way Branch:

1. NCDOT will work with the property owner of Walker Mobile Home Park off of Bethania-Tobaccoville Road to determine the feasibility of relocating the homes to another area of the parcel.

This commitment will take place after design is complete and during Right of Way acquisition.

2. NCDOT will contact the pastor of Mount Pleasant Holiness Church prior to the public hearing and will, if desired, meet with the pastor and members of the church to discuss the impact of Project U-2579 on the church, NCDOT relocation policies, and potential mitigation.

Action: Since the 2004 SFEIS/SDEIS, NCDOT and consultant staff met with the Pastor and members of Mount Pleasant Holiness Church during the 2005 Public hearings. The church representatives declined to attend an Additional meeting regarding this project or impacts of the Northern Beltway on the church.

3. NCDOT will contact minority residents of North Oaks subdivision prior to the public hearing and will, if desired, meet with them to discuss the impacts of Project U-2579 on the community, NCDOT relocation policies, and potential mitigation.

Action: NCDOT and consultant staff met with North Oaks community on

November 15, 2004.

Division 9, Construction Unit:

A pre-construction survey will be done in areas of possible concern regarding structural damage to assess a pre-construction condition.

This commitment will be done prior to initiation of construction.

Division 9:

1. During construction for Project U-2579AB, NCDOT will coordinate with the Forsyth County School Board to ensure the safety of those students bicycling and/or walking to Sedge Garden Elementary School. If a portion of school property is needed for a temporary construction easement, that area will be fenced to keep school children out of the construction site. The school property will be restored following construction.

This commitment will be implemented during construction.

2. NCDOT will coordinate with local media during the construction of the project to alert the public of traffic restrictions and construction related activities.

This commitment will be implemented during construction

3. NCDOT shall not approve any new driveway permits along the property of the historic John Henry Kapp Farm within the right of way for the Preferred Alternative. This condition shall be filed in the NCDOT Division office responsible for driveway permits.

This commitment will be implemented as described in the concurrence form with SHPO, during construction of the project.

4. This project involves construction activities on or adjacent to FEMA-regulated stream(s). Therefore, the Division shall submit sealed as-built construction plans to the Hydraulics Unit upon completion of project construction, certifying that the drainage structure(s) and roadway embankment that are located within the 100-year floodplain were built as shown in the construction plans, both horizontally and vertically.

This commitment will be fulfilled after the completion of the project.

PDEA-NES:

The biological conclusion for the Northern long-eared bat is Unresolved. Construction authorization will not be requested until ESA compliance is satisfied for the northern long-eared bat.

NCDOT has determined that the proposed action does not require separate consultation on the grounds that the proposed action is consistent with the final Section 4(d) rule, codified at 50 C.F.R. § 17.40(o) and effective February 16, 2016. NCDOT may presume its determination is informed by best available information and consider Section 7 responsibilities fulfilled for NLEB.

COMMITMENTS FROM PERMITTING

Design Build Team:

401 WQC Project Specific Condition No. 3: The pond drainage plan for Site 14A provided to NCDOT by the design build team shall be forwarded to NCDWR for review prior to dewatering. [15A NCAC 02H.0506(b)(2)]

401 WQC Project Specific Condition No. 4: Design and placement of culverts and other structures including temporary erosion control measures shall not be conducted in a manner that may result in dis-equilibrium of wetlands or stream beds or banks, adjacent to or upstream and downstream of the above structures. The applicant is required to provide evidence that equilibrium is being maintained if requested in writing by NCDWR. Table 5 below summarizes approved culvert burial practices as described in the permit modification application. [15A NCAC 02H.0506(b)(2)]

Table 5. Pipe invert burial depths for U-2579 D, E & F*.

Site	Location	Burial Depth (feet)
19	279+30-L-	1.0
27	356+07-L-	1.0

*All other pipe locations as described in the permit modification application do not require burial.



DEPARTMENT OF THE ARMY
WILMINGTON DISTRICT, CORPS OF ENGINEERS
69 DARLINGTON AVENUE
WILMINGTON, NORTH CAROLINA 28403-1343

March 04, 2019

Regulatory Division/1200A

Action ID: SAW-2017-02112, NC DOT U-2579, D, E, & F, (to include U 2579 C, Phase 2, Sites 1-2), Winston-Salem Northern Beltway, from US 52 to US 311 (New Walkertown Road), Individual Permit issued January 22, 2018

Mr. Philip S. Harris III, P.E., C.P.M.
Natural Environment Section Head
North Carolina Department of Transportation
Division of Highways
1598 Mail Service Center
Raleigh, North Carolina 27699-1598

Dear Mr. Harris:

Reference the Department of the Army (DA) permit issued on January 22, 2018, to the North Carolina Department of Transportation, (NC DOT) for impacts associated with the new location project identified as U-2579 C, Phase 2 and U 2579 D, E, & F. The project is a 6.95 miles, six-lane, divided facility, extending east from US 52 to US 311, near Winston Salem, Forsyth County, North Carolina. Coordinates (in decimal degrees) for the site are 36.1788° N, -80.2166° W. The project area contains unnamed tributaries to Mill Creek, Mill Creek, Trick-Um Creek, unnamed tributaries to Trick-Um Creek, an unnamed tributary to Ogburn Branch, Buffalo Creek, Rough Fork, unnamed tributaries to Rough Fork, unnamed tributaries to Frazier Creek, and sixteen (16) wetland areas in the Yadkin & Roanoke River Basins (8-Digit Cataloging Units 03040101 and 03010103, respectively). Also reference the North Carolina Department of Environmental Quality Water Quality Certification # 004131, dated December 21, 2017.

Impacts authorized by the January 2018 phased standard permit included preliminary designs for U 2579 D, E & F. On January 9, 2019, the U.S. Army Corps of Engineers (Corps) received a request from NC DOT to modify the phased standard permit, SAW No. 2017-02112, to include the final design impacts for the U 2579 D, E and F segments, and to include two previous permitted sites from U 2579 C, Phase 2, within this permit modification. These sites were previously referred to as Sites 1 & 2, and they were originally permitted under SAW No. 2017-02112. These sites are now Sites 28 & 29 (for Site 1) and Site 30 (for Site 2) and have been modified (See enclosed Permit Modification Impact Sheets 80-89 of 97, dated December 18, 2018).

These modifications to the above phased standard permit are for the following impacts: 1) the permanent placement of fill material into 13,578 linear feet of jurisdictional stream channel (13,090 linear feet of permanent loss and 488 linear feet of bank stabilization/pipeline removal), 608 linear feet of temporary stream impacts associated with U 2579 D, E, & F, and U 2579 C Phase 2 (Sites 1-2 or Sites 28 – 30). Permanent impacts to wetlands total 1.66 acres of fill, excavation and mechanized clearing. There are no temporary wetland impacts for the above requested modification. These final design modifications have resulted in less impacts to waters of the U.S. than originally permitted on January 22, 2018. (This modification is for 830 linear feet of permanent stream channel less than permitted and 0.22 acres of permanent wetland impact less than permitted for U 2579 DEF; and is for 231 linear feet of permanent stream channel less than permitted for U 2579 C Phase 2, Sites 1-2). In a letter dated February 5, 2018, the North Carolina Division of Mitigation Services, accepted responsibility for the compensatory mitigation for U 2579 C, Phase 2. Those mitigated impacts (streams and wetlands) will be subtracted from what is owed for U 2579D, E & F.

The Corps has completed the evaluation of your request and has determined that it is appropriate and reasonable, and no public notice is required for this modification. This decision had been transmitted to you in a letter dated February 27, 2019, however inaccurate impact amounts were reflected in the letter. Please allow this corrected correspondence to supersede the February 27th letter. As such, the permit is modified as requested and shown in the enclosed “U-2579DEF: PERMIT MODIFICATION PACKAGE,” Sheets 1-97, dated December 18, 2018.

For your information, the following special conditions from the original authorization have been updated to include the new compensatory mitigation requirements and the new modified plan set (it is understood that condition 25 below has been completed):

1. Construction Plans: All work authorized by this permit must be performed in strict compliance with the attached plans, entitled: “U-2579DEF: PERMIT MODIFICATION PACKAGE,” Sheets 1-97, dated December 18, 2018. Any modification to these plans must be approved by the US Army Corps of Engineers (Corps) prior to implementation.
25. In order to compensate for impacts associated with this permit, mitigation shall be provided in accordance with the provisions outlined on the most recent version of the attached Compensatory Mitigation Responsibility Transfer Form. The requirements of this form, including any special conditions listed on this form, are hereby incorporated as special conditions of this permit authorization.

This correspondence contains a proffered modified permit for the above described project. If you object to this decision, you may request an administrative appeal under Corps regulations at 33 CFR part 331. Enclosed you will find a Notification of Appeal Process (NAP) fact sheet and request for appeal (RFA) form. If you request to appeal this decision you must submit a completed RFA form to the following address:

District Engineer, Wilmington Regulatory Division
Attn: Nicholle Braspenickx
69 Darlington Avenue
Wilmington, North Carolina 28403

In order for an RFA to be accepted by the Corps, the Corps must determine that it is complete, that it meets the criteria for appeal under 33 CFR part 331.5, and that it has been received by the Division Office within 60 days of the date of the NAP. Should you decide to submit an RFA form, it must be received at the above address by April 3, 2019.

It is not necessary to submit an RFA form to the Division Office if you do not object to the decision in contained in this correspondence.

All other conditions of the permit, including the permit expiration date of December 31, 2028, remain in effect as written. Should you have questions, contact Ms. Nicholle Braspenickx, Charlotte Regulatory Field Office, via email at Nicholle.M.Braspenickx@usace.army.mil or by telephone at (704) 510-0162.

FOR THE COMMANDER

Sincerely,



Robert J. Clark
Colonel, U.S. Army
District Commander

Enclosures:

1. Permit Impact Sheets 1-97, dated December 18, 2018
2. Compensatory Mitigation Responsibility Transfer Form
3. Notification of Administrative Appeal Options Process
4. Request for Appeal Form

Copies Furnished w/o enclosures:

Mr. Dave Wanucha
Transportation Permitting Unit
Division of Water Resources
North Carolina Department of
Environment and Natural Resources
450 West Hanes Mill Rd., suite 300
Winston-Salem, North Carolina 27105

Ms. Amy Euliss
Division Environmental Officer, Division 9
North Carolina Department of Transportation
375 Silas Creek Parkway
Winston-Salem, North Carolina 27127

Ms. Clair Ellwanger
U.S. Fish and Wildlife Services
Asheville Ecological Service Field Office
160 Zillicoa Street
Asheville, North Carolina 28801

Mr. Todd Bowers
Oceans, Wetlands and Streams Protection Branch
Wetlands and Streams Regulatory Section
U.S. Environmental Protection Agency-Region 4
Sam Nunn Atlanta Federal Center
61 Forsyth Street, SW
Atlanta, Georgia 30303-8931

Ms. Marla Chambers
Division of Inland Fisheries
North Carolina Wildlife Resources Commission
7121 Mail Service Center
Raleigh, North Carolina 27699-1721

USACE Wilmington District
Compensatory Mitigation Responsibility Transfer Form, Page 2

Compensatory Mitigation Responsibility Transfer Form

Permittee: North Carolina Department of Transportation
Project Name: U 2579D, E, F Winston-Salem Northern Beltway

Action ID: SAW No. 2017-02112
County: Forsyth

Instructions to Permittee: The Permittee must provide a copy of this form to the Mitigation Sponsor, either an approved Mitigation Bank or the North Carolina Division of Mitigation Services (NCDMS), who will then sign the form to verify the transfer of the mitigation responsibility. Once the Sponsor has signed this form, it is the Permittee's responsibility to ensure that to the U.S. Army Corps of Engineers (USACE) Project Manager identified on page two is in receipt of a signed copy of this form before conducting authorized impacts, unless otherwise specified below. If more than one mitigation Sponsor will be used to provide the mitigation associated with the permit, or if the impacts and/or the mitigation will occur in more than one 8-digit Hydrologic Unit Code (HUC), multiple forms will be attached to the permit, and the separate forms for each Sponsor and/or HUC must be provided to the appropriate mitigation Sponsors.

Instructions to Sponsor: The Sponsor must verify that the mitigation requirements (credits) shown below are available at the identified site. By signing below, the Sponsor is accepting full responsibility for the identified mitigation, regardless of whether or not they have received payment from the Permittee. Once the form is signed, the Sponsor must update the bank ledger and provide a copy of the signed form and the updated bank ledger to the Permittee, the USACE Project Manager, and the Wilmington District Mitigation Office (see contact information on page 2). The Sponsor must also comply with all reporting requirements established in their authorizing instrument.

Permitted Impacts and Compensatory Mitigation Requirements

Permitted Impacts Requiring Mitigation*:

8-digit HUC and Basin: 03040101, Yadkin River Basin

Stream Impacts (linear feet)			Wetland Impacts (acres)			
Warm	Cool	Cold	Riparian Riverine	Riparian Non-Riverine	Non-Riparian	Coastal
4302 l.f.				0.04 acres		

*If more than one mitigation sponsor will be used for the permit, only include impacts to be mitigated by this sponsor.

Compensatory Mitigation Requirements:

8-digit HUC and Basin: 03040101, Yadkin River Basin

Stream Mitigation (credits)			Wetland Mitigation (credits)			
Warm	Cool	Cold	Riparian Riverine	Riparian Non-Riverine	Non-Riparian	Coastal
6607 l.f.				0.08 acres		

Permitted Impacts Requiring Mitigation*:

8-digit HUC and Basin: 03010103, Roanoke River Basin

Stream Impacts (linear feet)			Wetland Impacts (acres)			
Warm	Cool	Cold	Riparian Riverine	Riparian Non-Riverine	Non-Riparian	Coastal
7319 l.f.				1.05 acres		

*If more than one mitigation sponsor will be used for the permit, only include impacts to be mitigated by this sponsor.

Compensatory Mitigation Requirements:

8-digit HUC and Basin: 03010103, Roanoke River Basin

Stream Mitigation (credits)			Wetland Mitigation (credits)			
Warm	Cool	Cold	Riparian Riverine	Riparian Non-Riverine	Non-Riparian	Coastal
12492 l.f.				2.10 acres		

U.S. ARMY CORPS OF ENGINEERS
Wilmington District

Mitigation Site Debited: NCDMS

(List the name of the bank to be debited. For umbrella banks, also list the specific site. For NCDMS, list NCDMS. If the NCDMS acceptance letter identifies a specific site, also list the specific site to be debited).

Permittee: North Carolina Department of Transportation

Action ID: SAW No. 2017-02112

Project Name: U 2579D, E, F Winston-Salem Northern Beltway

County: Forsyth

Section to be completed by the Mitigation Sponsor

Statement of Mitigation Liability Acceptance: I, the undersigned, verify that I am authorized to approve mitigation transactions for the Mitigation Sponsor shown below, and I certify that the Sponsor agrees to accept full responsibility for providing the mitigation identified in this document (see the table above), associated with the USACE Permittee and Action ID number shown. I also verify that released credits (and/or advance credits for NCDMS), as approved by the USACE, are currently available at the mitigation site identified above. Further, I understand that if the Sponsor fails to provide the required compensatory mitigation, the USACE Wilmington District Engineer may pursue measures against the Sponsor to ensure compliance associated with the mitigation requirements.

Mitigation Sponsor Name: NCDEQ DMS

Name of Sponsor's Authorized Representative: Beth Thivron

Signature of Sponsor's Authorized Representative: Beth Thivron

Date of Signature: 02/28/2019

Conditions for Transfer of Compensatory Mitigation Credit:

- Once this document has been signed by the Mitigation Sponsor and the USACE is in receipt of the signed form, the Permittee is no longer responsible for providing the mitigation identified in this form, though the Permittee remains responsible for any other mitigation requirements stated in the permit conditions.
- Construction within jurisdictional areas authorized by the permit identified on page one of this form can begin only after the USACE is in receipt of a copy of this document signed by the Sponsor, confirming that the Sponsor has accepted responsibility for providing the mitigation requirements listed herein. For authorized impacts conducted by the North Carolina Department of Transportation (NCDOT), construction within jurisdictional areas may proceed upon permit issuance; however, a copy of this form signed by the Sponsor must be provided to the USACE within 30 days of permit issuance. NCDOT remains fully responsible for the mitigation until the USACE has received this form, confirming that the Sponsor has accepted responsibility for providing the mitigation requirements listed herein.
- Signed copies of this document must be retained by the Permittee, Mitigation Sponsor, and in the USACE administrative records for both the permit and the Bank/ILF Instrument. It is the Permittee's responsibility to ensure that the USACE Project Manager (address below) is provided with a signed copy of this form.
- If changes are proposed to the type, amount, or location of mitigation after this form has been signed and returned to the USACE, the Sponsor must obtain case-by-case approval from the USACE Project Manager and/or North Carolina Interagency Review Team (NCIRT). If approved, higher mitigation ratios may be applied, as per current District guidance and a new version of this form must be completed and included in the USACE administrative records for both the permit and the Bank/ILF Instrument.

Comments/Additional Conditions: This is for U 2579 D, E & F Winston-Salem Northern Beltway only.

This form is not valid unless signed below by the USACE Project Manager and by the Mitigation Sponsor on Page 1. *Once signed, the Sponsor should provide copies of this form along with an updated bank ledger to: 1) the Permittee, 2) the USACE Project Manager at the address below, and 3) the Wilmington District Mitigation Office, Attn: Todd Tugwell, 3331 Heritage*

U.S. ARMY CORPS OF ENGINEERS

Wilmington District

Trade Drive, Suite 105, Wake Forest, NC 27587 (email: todd.tugwell@usace.army.mil). Questions regarding this form or any of the permit conditions may be directed to the USACE Project Manager below.

USACE Project Manager: Nicholle Braspenickx

USACE Field Office: US Army Corps of Engineers
c/o Asheville Regulatory Office
151 Patton Avenue, Room 208
Asheville, NC 28801-5006

Email: Nicholle.M.Braspennickx@usace.army.mil

BRASPENNICKX.NICHOLLE.M.122
9304590

Digitally signed by BRASPENNICKX.NICHOLLE.M.1229304590
DN: c=US, o=U.S. Government, ou=DoD, ou=PKI, ou=USA,
cn=BRASPENNICKX.NICHOLLE.M.1229304590
Date: 2019.02.27 11:55:54 -05'00'

February 27, 2019

Date of Signature

USACE Project Manager Signature

Current Wilmington District mitigation guidance, including information on mitigation ratios, functional assessments, and mitigation bank location and availability, and credit classifications (including stream temperature and wetland groupings) is available at <http://ribits.usace.army.mil>.

ROY COOPER
Governor

MICHAEL S. REGAN
Secretary

LINDA CULPEPPER
Director



February 7, 2019

Mr. Philip S. Harris, III, P.E., CPM
Natural Environment Section Head
Project Development and Environmental Analysis
North Carolina Department of Transportation
1598 Mail Service Center
Raleigh, North Carolina, 27699-1598

Subject: **Modification to 401 Water Quality Certification** Pursuant to Section 401 of the Federal Clean Water Act with ADDITIONAL CONDITIONS for Proposed Winston Salem Northern Beltway from I-40 to US 52 (TIP Nos. R-2247B Phase 2, CA, CB, CD, D, EA, EB, and EC); and from US 52 to US 311 north (U-2579C Phase 2, D, E, and F); and, from I-40 Business to US 311 South (U-2579AA, and AB) in Forsyth County. Federal Aid Project No. NHP-0074(213); WBS 34839.3GV7. NCDWR Project No. 19980260 v3.

Dear Mr. Harris:

Attached hereto is a copy of Certification No. WQC004131 for TIP U-2579 Sections D, E and F with revisions to Section C-Phase 2 issued to The North Carolina Department of Transportation (NCDOT) dated February 7, 2019.

The original Certification was dated October 12, 1998. A new application was received on October 2, 2017 for a phased project. The phased permit was issued on November 14, 2017, revised on November 27, 2017 and revised again on December 21, 2017.

If we can be of further assistance, do not hesitate to contact us.

Sincerely,

A handwritten signature in blue ink, appearing to read "Linda Culpepper" followed by initials "F.O."

Linda Culpepper, Director
Division of Water Resources

Attachments

Electronic copy only distribution:

Nicholle Braspennickx, US Army Corps of Engineers, Charlotte Field Office
Amy Euliss, Division 9 Environmental Officer
Carla Dagnino, NC Department of Transportation
Chris Miltitscher, US Environmental Protection Agency
Marella Buncick, US Fish and Wildlife Service
Marla Chambers, NC Wildlife Resources Commission
Beth Harmon, Division of Mitigation Services
File Copy



401 Water Quality Certification Pursuant to Section 401 of the Federal Clean Water Act with ADDITIONAL CONDITIONS

THIS CERTIFICATION is issued in conformity with the requirements of Section 401 Public Laws 92-500 and 95-217 of the United States and subject to the North Carolina Division of Water Resources (NCDWR) Regulations in 15 NCAC 2H .0500. This certification authorizes the NCDOT to impact an additional 1.66 acres of jurisdictional wetlands, 3.06 acres of open water (pond) and 14,186 linear feet (including permanent, temporary and bank stabilization impacts) of jurisdictional streams in Forsyth County. The project shall be constructed pursuant to the modification dated January 7, 2019. The authorized impacts are as described below:

Table 1. Stream Impacts in the Yadkin Pee Dee River Basin Section D of U-2579 D, E & F.

Site	Permanent Fill in Intermittent Stream (linear ft)	Temporary Fill in Intermittent Stream (linear ft)	Permanent Fill in Perennial Stream (linear ft)		Temporary Fill in Perennial Stream (linear ft)	Stream Impacts Requiring Mitigation (linear ft)
			Fill	Bank Stabilization		
15	520	15	0	0	0	0
16	152	0	361	0	20	361
17	0	0	928	0	23	928
18	161	11	0	0	0	0
19	0	0	341	0	26	341
20	0	0	35*	0	31	0
20A	0	0	0	16	21	0
20B	0	0	0	20	21	0
20C	0	0	0	0	165	0
21	0	0	133	10	10	0
22	0	0	97	0	7	0
23	0	0	348	26	21	348
24	120	10	0	0	0	0
25	294	10	0	0	0	0
26	0	0	519	24	20	519
27	0	0	328	72	20	328
32	0	0	0	172	19	0
34	0	0	0	24	11	0
Totals	1,247	46	3,090	364	415	2,825

* Pipe removal.

Table 2. Stream Impacts in the Yadkin Pee Dee and Roanoke River Basin Section E and F of U-2579 D, E & F and C-Phase 2.

Site	Permanent Fill in Intermittent Stream (linear ft)	Temporary Fill in Intermittent Stream (linear ft)	Permanent Fill in Perennial Stream (linear ft)		Temporary Fill in Perennial Stream (linear ft)	Stream Impacts Requiring Mitigation (linear ft)
			Fill	Bank Stabilization		
6	0	0	824	0	7	824
7	266	0	0	0	0	0
8	215	0	703	0	19	703
9	154	0	632	14	0	632
10	0	0	364	0	13	364
11	0	0	615	0	0	615
12	0	0	410	0	10	410
13	0	0	337	0	22	337
14	0	0	220	0	11	0
31	57	0	0	0	0	0
33	0	0	20	0	21	0
Totals	692	0	4,125	14	103	3,885
Section F						
1	0	0	1522	20	0	1,522
2	0	0	86	0	0	0
3	0	0	120	0	0	0
4	0	0	132	0	0	0
5	0	0	642	0	10	642
Totals	0	0	2,502	20	10	2,164
Section C-Phase 2						
29	0	0	906	40	10	906
30	0	0	563	15	24	563
Totals	0	0	1,469	55	34	1,469*

* Previously Site 1 in Section C-Phase 2, impacts of which were previously mitigated resulting in a surplus (refer to permit application).

Table 3. Wetland (Riverine) Impacts in the Yadkin Pee Dee and Roanoke River Basin U-2579 D, E & F and C-Phase 2.

Site	Fill (ac)	Excavation (ac)	Mechanized Clearing (ac)	Impacts Requiring Mitigation (ac)
Section D				
15A	0.04	0	0	0.04
Total	0.04	0	0	0.04
Section E				
6A	0.11	<0.01	0.01	0.12
8A	<0.01	0	0	0.01
8B	0.51	0	0	0.51
10A	0.03	0	<0.01	0.03
10B	<0.01	0	0	0.01
11A	0.08	0	0	0.08
12A	0.08	0	0	0.08
13A	0.0	0	<0.01	0.01
Total	0.82	0.01	0.02	0.85
Section F				
1A	0.06	0	0	0.06
1B	0.07	0	0	0.07
1C	0.02	0	0	0.02
1D	<0.01	0	0	0.01
2A	0.01	0	0	0.01
5A	0.02	0	0	0.02
5B	<0.01	<0.01	0	0.01
Total	0.19	<0.01	0	0.20
Section C-Phase 2				
28*	0.26	0	0	0.26
29A*	<0.01	0	0	0.01
29B*	0.26	0.03	0.01	0.30
Total	0.53	0.03	0.01	0.57

* Previously Site 1 in Section C-Phase 2, impacts of which were previously mitigated (refer to permit application).

Table 4. Open Water (Pond) Impacts in the Yadkin Pee Dee River Basin U-2579 D, E & F.

Site	Permanent Fill in Open Waters (ac)	Temporary Fill in Open Waters (ac)
14A	3.06	0

The modification application provides adequate assurance that the discharge of fill material into the waters of the Yadkin Pee Dee and Roanoke River Basin in conjunction with the proposed development will not result in a violation of applicable Water Quality Standards and discharge guidelines. Therefore, the State of North Carolina certifies that this activity will not violate the applicable portions of Sections 301, 302, 303, 306, 307 of PL 92-500 and PL 95-217 if conducted in accordance with the application and conditions hereinafter set forth.

This approval is only valid for the purpose and design that you submitted in your application for a modification dated January 7, 2019. All the authorized activities and conditions associated with the phased permit Water Quality Certification issued on November 14, 2017, revised on November 27, 2017 and revised again on December 21, 2017, still apply except where superseded by this certification.

Should your project change, you are required to notify NCDWR and submit a new application. If the property is sold, the new owner must be given a copy of this Certification and approval letter and is thereby responsible for complying with all the conditions. If any additional wetland impacts, or stream impacts, for this project (now or in the future) exceed one acre or 300 linear feet, respectively, additional compensatory mitigation may be required as described in 15A NCAC 2H .0506 (h) (6) and (7). For this approval to remain valid, you are required to comply with all the conditions listed below. In addition, you should obtain all other federal, state or local permits before proceeding with your project including (but not limited to) Sediment and Erosion control, Coastal Stormwater, Non-discharge and Water Supply watershed regulations. This Certification shall expire on the same day as the expiration date of the corresponding Corps of Engineers Permit.

Condition(s) of Certification:**Project Specific Conditions**

1. Compensatory mitigation for 10,343 linear feet of impact to streams and 1.66 acres of wetlands is required. We understand that you have chosen to perform compensatory mitigation for impacts to streams through the North Carolina Division of Mitigation Service (DMS) (formerly NCEEP), and that the DMS has agreed to implement the mitigation for the project. The DMS has indicated in a letter dated September 29, 2017 that they will assume responsibility for satisfying the federal Clean Water Act compensatory mitigation requirements for the above-referenced project, in accordance with the DMS Mitigation Banking Instrument signed July 28, 2010.

2. This approval is only valid for the purpose and design that you submitted in your application for a modification dated January 7, 2019. All the authorized activities and conditions associated with the phased permit Water Quality Certification issued on November 14, 2017, revised on November 27, 2017 and again on December 21, 2017, still apply except where superseded by this certification.

3. The pond drainage plan for Site 14A provided to NCDOT by the design build team shall be forwarded to NCDWR for review prior to dewatering. [15A NCAC 02H.0506(b)(2)]

4. Design and placement of culverts and other structures including temporary erosion control measures shall not be conducted in a manner that may result in dis-equilibrium of wetlands or streambeds or banks, adjacent to or upstream and downstream of the above structures. The applicant is required to provide evidence that equilibrium is being maintained if requested in writing by NCDWR. Table 5 below summarizes approved culvert burial practices as described in the permit modification application. [15A NCAC 02H.0506(b)(2)]

Table 5. Pipe invert burial depths for U-2579 D, E & F*.

Site	Location	Burial Depth (feet)
19	279+30 -L-	1.0
27	356+07 -L-	1.0

*All other pipe locations as described in the permit modification application do not require burial.

Violations of any condition herein set forth may result in revocation of this Certification and may result in criminal and/or civil penalties. This Certification shall become null and void unless the above conditions are made conditions of the Federal 404 and/or Coastal Area Management Act Permit. This Certification shall expire upon the expiration of the 404 or CAMA permit.

If you wish to contest any statement in the attached Certification you must file a petition for an administrative hearing. You may obtain the petition form from the office of Administrative hearings. You must file the petition with the office of Administrative Hearings within sixty (60) days of receipt of this notice. A petition is considered filed when it is received in the office of Administrative Hearings during normal office hours. The Office of Administrative Hearings accepts filings Monday through Friday between the hours of 8:00am and 5:00pm, except for official state holidays. The original and one (1) copy of the petition must be filed with the Office of Administrative Hearings.

The petition may be faxed-provided that the original and one copy of the document is received by the Office of Administrative Hearings within five (5) business days following the faxed transmission.

The mailing address for the Office of Administrative Hearings is:

Office of Administrative Hearings
6714 Mail Service Center
Raleigh, NC 27699-6714
Telephone: (919) 431-3000, Facsimile: (919) 431-3100

A copy of the petition must also be served on DEQ as follows:

Mr. Bill F. Lane, General Counsel
Department of Environmental Quality
1601 Mail Service Center

This the 7th day of February 2019

DIVISION OF WATER RESOURCES



Linda Culpepper, Director

WQC No. 004131

ROY COOPER
Governor

MICHAEL S. REGAN
Secretary

LINDA CULPEPPER
Director



NORTH CAROLINA
Environmental Quality

NCDWR Project No.: _____ **County:** _____

Applicant: _____

Project Name: _____

Date of Issuance of 401 Water Quality Certification: _____

Certificate of Completion

Upon completion of all work approved within the 401 Water Quality Certification or applicable Buffer Rules, and any subsequent modifications, the applicant is required to return this certificate to the 401 Transportation Permitting Unit, North Carolina Division of Water Resources, 1617 Mail Service Center, Raleigh, NC, 27699-1617. This form may be returned to NCDWR by the applicant, the applicant's authorized agent, or the project engineer. It is not necessary to send certificates from all of these.

Applicant's Certification

I, _____, hereby state that, to the best of my abilities, due care and diligence was used in the observation of the construction such that the construction was observed to be built within substantial compliance and intent of the 401 Water Quality Certification and Buffer Rules, the approved plans and specifications, and other supporting materials.

Signature: _____ Date: _____

Agent's Certification

I, _____, hereby state that, to the best of my abilities, due care and diligence was used in the observation of the construction such that the construction was observed to be built within substantial compliance and intent of the 401 Water Quality Certification and Buffer Rules, the approved plans and specifications, and other supporting materials.

Signature: _____ Date: _____

Engineer's Certification

Partial Final

I, _____, as a duly registered Professional Engineer in the State of North Carolina, having been authorized to observe (periodically, weekly, full time) the construction of the project for the Permittee hereby state that, to the best of my abilities, due care and diligence was used in the observation of the construction such that the construction was observed to be built within substantial compliance and intent of the 401 Water Quality Certification and Buffer Rules, the approved plans and specifications, and other supporting materials.

Signature _____ Registration No. _____

Date _____



North Carolina Department of Environmental Quality | Division of Water Resources
512 North Salisbury Street | 1617 Mail Service Center | Raleigh, North Carolina 27699-1617
919.707.9000



(Version 2.08; Released April 2018)

North Carolina Department of Transportation

Highway Stormwater Program
STORMWATER MANAGEMENT PLAN
FOR NCDOT PROJECTS

Page 1 of 17

WBS Element:	34839.3.GV7	TIP No.:	U-2579DEF	County(ies):	Forsyth		
General Project Information							
WBS Element:	34839.3.GV7	TIP Number:	U-2579DEF	Project Type:	New Location	Date:	10/16/2018
NCDOT Contact:	Craig J Lee, PE			Contractor / Designer:	Brian M Steffen, PE		
	Address:	1020 Birch Ridge Dr. Raleigh, NC 27610			Address:	555 Fayetteville St., Suite 900 Raleigh, NC 27601	
	Phone:	919-707-6708			Phone:	919-232-6609	
Email:	cjlee@ncdot.gov		Email:	brian.steffen@hdrinc.com			
City/Town:	Winston-Salem			County(ies):	Forsyth		
River Basin(s):	Yadkin-Pee Dee	Roanoke	CAMA County?	No			
Wetlands within Project Limits?	Yes						
Project Description							
Project Length (lin. miles or feet):	6.95 miles	Surrounding Land Use:	Residential (Single Family)				
	Proposed Project			Existing Site			
Project Built-Upon Area (ac.)	189.0 ac.			43.0 ac.			
Typical Cross Section Description:	6 lane divided freeway w/ an 18 foot grass median: (2) 12 foot outside paved shoulders, (3) 12 foot travel lanes, (2) 12 foot paved median shoulders - Total width of 146'			N/A - new alignment			
Annual Avg Daily Traffic (veh/hr/day):	Design/Future: 60,200	Year: 2040	Existing: 34,000	Year: 2016			
General Project Narrative: (Description of Minimization of Water Quality Impacts)	<p>Project Description: The proposed project (U-2579DEF) is part of the future I-74 Winston-Salem Northern Beltway from west of NC 66/SR 4000 to US 311 and will construct approximately 7 miles of 6-lane divided highway in new location. The project includes 3 major interchanges: University Parkway, Germantown Rd., and Baux Mountain Rd. There are 8 proposed single barrel culvert crossings on the project at Rough Fork, Trickum Creek, 5 Unnamed Tributaries to Mill Creek, an unnamed tributary to Frazier Creek, and one supplemented existing triple barrel culvert crossing at Mill Creek. The project includes one major bridge crossing over Mill Creek. Pipe culverts will be used to convey all other jurisdictional stream crossings through the project. Wetlands are also located throughout the length of the entire project.</p> <p>Impact Minimization Efforts: Guardrail with 2:1 slopes were utilized throughout the project to minimize surface water impacts to streams and wetlands. Ditches and pipes that outlet adjacent to wetlands have been designed to have non-erosive velocities to help protect the existing wetlands.</p> <p>Stormwater BMP Measures: Stormwater control measures such as dry detention and energy dissipator basins were proposed at specific locations along the project. The Design-Build Team has designed ditches to achieve grass swale credit</p>						
Waterbody Information							
Surface Water Body (1):	Rough Fork		NCDWR Stream Index No.:	22-25-5-2			
NCDWR Surface Water Classification for Water Body		Primary Classification:	Class C				
		Supplemental Classification:	None				
Other Stream Classification:	None						
Impairments:	None						
Aquatic T&E Species?	Comments:						
NRTR Stream ID:	ES-S1, ES-S2, ES-S3, ES-S67, ES-S65			Buffer Rules in Effect:	N/A		
Project Includes Bridge Spanning Water Body?	No	Deck Drains Discharge Over Buffer?	N/A	Dissipator Pads Provided in Buffer?	N/A		
Deck Drains Discharge Over Water Body?	N/A	(If yes, provide justification in the General Project Narrative)			(If yes, describe in the General Project Narrative; if no, justify in the General Project Narrative)		
(If yes, provide justification in the General Project Narrative)							



(Version 2.08; Released April 2018)

North Carolina Department of Transportation

Highway Stormwater Program
STORMWATER MANAGEMENT PLAN
FOR NCDOT PROJECTS

Page 2 of 17

WBS Element:	34839.3.GV7	TIP No.:	U-2579DEF	County(ies):	Forsyth
Additional Waterbody Information					
Surface Water Body (2):	Trick-um Creek		NCDWR Stream Index No.:	22-25-5-1	
NCDWR Surface Water Classification for Water Body		Primary Classification:	Class C		
		Supplemental Classification:	None		
Other Stream Classification:	None				
Impairments:	None				
Aquatic T&E Species?	Comments:				
NRTR Stream ID:	ES-S4, ES-S5, ES-S6		Buffer Rules in Effect:	N/A	
Project Includes Bridge Spanning Water Body?	No	Deck Drains Discharge Over Buffer?	N/A	Dissipator Pads Provided in Buffer?	N/A
Deck Drains Discharge Over Water Body?	N/A	(If yes, provide justification in the General Project Narrative)		(If yes, describe in the General Project Narrative; if no, justify in the General Project Narrative)	
Surface Water Body (3):	Ogburn Branch		NCDWR Stream Index No.:	12-94-7-2	
NCDWR Surface Water Classification for Water Body		Primary Classification:	Class C		
		Supplemental Classification:	None		
Other Stream Classification:	None				
Impairments:	None				
Aquatic T&E Species?	Comments:				
NRTR Stream ID:	ES-S59, ES-S60		Buffer Rules in Effect:	N/A	
Project Includes Bridge Spanning Water Body?	No	Deck Drains Discharge Over Buffer?	N/A	Dissipator Pads Provided in Buffer?	N/A
Deck Drains Discharge Over Water Body?	N/A	(If yes, provide justification in the General Project Narrative)		(If yes, describe in the General Project Narrative; if no, justify in the General Project Narrative)	
Surface Water Body (4):	Buffalo Creek		NCDWR Stream Index No.:	22-25-5	
NCDWR Surface Water Classification for Water Body		Primary Classification:	Class C		
		Supplemental Classification:	None		
Other Stream Classification:	None				
Impairments:	None				
Aquatic T&E Species?	Comments:				
NRTR Stream ID:	ES-S7, ES-8, ES-S9, ES-S62		Buffer Rules in Effect:	N/A	
Project Includes Bridge Spanning Water Body?	No	Deck Drains Discharge Over Buffer?	N/A	Dissipator Pads Provided in Buffer?	N/A
Deck Drains Discharge Over Water Body?	N/A	(If yes, provide justification in the General Project Narrative)		(If yes, describe in the General Project Narrative; if no, justify in the General Project Narrative)	
Surface Water Body (5):	Mill Creek		NCDWR Stream Index No.:	12-94-7	
NCDWR Surface Water Classification for Water Body		Primary Classification:	Class C		
		Supplemental Classification:	None		
Other Stream Classification:	None				
Impairments:	None				
Aquatic T&E Species?	Comments:				
NRTR Stream ID:	ES-S10, ES-S11, ES-S13, ES-S26, ES-S27, ES-S48, ES-S52, ES-S58		Buffer Rules in Effect:	N/A	
Project Includes Bridge Spanning Water Body?	No	Deck Drains Discharge Over Buffer?	N/A	Dissipator Pads Provided in Buffer?	N/A
Deck Drains Discharge Over Water Body?	N/A	(If yes, provide justification in the General Project Narrative)		(If yes, describe in the General Project Narrative; if no, justify in the General Project Narrative)	



(Version 2.08; Released April 2018)

North Carolina Department of Transportation

Highway Stormwater Program
STORMWATER MANAGEMENT PLAN
FOR NCDOT PROJECTS

Page 3 of 17

WBS Element:	34839.3.GV7	TIP No.:	U-2579DEF	County(ies):	Forsyth			
Additional Waterbody Information								
Surface Water Body (6):	Grassy Creek		NCDWR Stream Index No.:	12-94-7-3				
NCDWR Surface Water Classification for Water Body		Primary Classification:	Class C					
		Supplemental Classification:	None					
Other Stream Classification:	None							
Impairments:	None							
Aquatic T&E Species?	Comments:							
NRTR Stream ID:	N/A			Buffer Rules in Effect:	N/A			
Project Includes Bridge Spanning Water Body?	No	Deck Drains Discharge Over Buffer?	N/A	Dissipator Pads Provided in Buffer?	N/A			
Deck Drains Discharge Over Water Body?	N/A	(If yes, provide justification in the General Project Narrative)			(If yes, describe in the General Project Narrative; if no, justify in the General Project Narrative)			
(If yes, provide justification in the General Project Narrative)								
Surface Water Body (7):	Frazier Creek		NCDWR Stream Index No.:	Frazier Creek				
NCDWR Surface Water Classification for Water Body		Primary Classification:	Class C					
		Supplemental Classification:	None					
Other Stream Classification:	None							
Impairments:	None							
Aquatic T&E Species?	Comments:							
NRTR Stream ID:	N/A			Buffer Rules in Effect:	N/A			
Project Includes Bridge Spanning Water Body?	No	Deck Drains Discharge Over Buffer?	N/A	Dissipator Pads Provided in Buffer?	N/A			
Deck Drains Discharge Over Water Body?	N/A	(If yes, provide justification in the General Project Narrative)			(If yes, describe in the General Project Narrative; if no, justify in the General Project Narrative)			
(If yes, provide justification in the General Project Narrative)								



**North Carolina Department of Transportation
Highway Stormwater Program
STORMWATER MANAGEMENT PLAN
FOR NCDOT PROJECTS**



(Version 2.08; Released April 2018)

WBS Element: 34839.3.GV7 **TIP No.:** U-2579DEF

County(ies): Forsyth

Page 4 **of** 17

Swales

Sheet No.	Station & Coordinates (Road and Non Road Projects)	Surface Water Body	Base Width (ft)	Front Slope (H:1)	Back Slope (H:1)	Drainage Area (ac)	Recommended Treatm't Length (ft)	Actual Length (ft)	Longitudinal Slope (%)	Q2 (cfs)	V2 (fps)	Q10 (cfs)	V10 (fps)	Rock Checks Used	BMP Associated w/ Buffer Rules?
5	-Y1RPD- 19+75 RT 36.204277/-80.277437	(1)Rough Fork	0.0	6.0	4.0	0.3	34	63	2.00%	0.9	1.6	1.1	1.7	No	No
5	-Y1- 22+98 RT 36.207540/-80.281904	(1)Rough Fork	0.0	6.0	6.0	0.3	34	188	1.00%	0.9	1.4	1.1	1.4	No	No
5	-Y1- 28+00 RT 36.206175/-80.281384	(1)Rough Fork	0.0	2.0	2.0	0.5	48	55	2.00%	1.2	1.9	1.6	2.0	No	No
5	-Y1- 28+20 RT 36.206175/-80.281384	(1)Rough Fork	0.0	2.0	2.0	1.1	109	515	0.24%	2.8	1.0	3.6	1.1	No	No
5	-L- 59+34 M 36.204306/-80.281710	(1)Rough Fork	0.0	6.0	6.0	0.2	15	135	0.27%	0.4	0.6	0.5	0.7	No	No
5	-L- 59+34 LT 36.204587/-80.281767	(1)Rough Fork	0.0	6.0	4.0	0.5	49	135	0.27%	1.3	0.9	1.6	1.0	No	No
5	-L- 61+00 RT 36.204104/-80.281094	(1)Rough Fork	0.0	6.0	4.0	1.1	106	301	0.60%	2.7	1.5	3.5	1.6	No	No
5	-L- 61+00 LT 36.204659/-80.281204	(1)Rough Fork	0.0	6.0	4.0	0.5	52	166	0.87%	1.3	1.4	1.7	1.5	No	No
5	-L- 61+00 LT 36.204659/-80.281204	(1)Rough Fork	0.0	6.0	4.0	0.2	23	77	2.62%	0.6	1.7	0.8	1.9	No	No
5	-L- 65+55 M 36.204597/-80.279634	(1)Rough Fork	0.0	6.0	6.0	0.3	33	226	1.64%	0.9	1.5	1.1	1.6	No	No
5	-L- 69+50 M 36.204772/-80.278339	(1)Rough Fork	0.0	6.0	6.0	0.7	71	395	1.35%	1.8	1.7	2.3	1.8	No	No
5	-L- 70+27 M 36.204807/-80.278061	(1)Rough Fork	0.0	6.0	6.0	0.9	86	472	0.23%	2.2	0.9	2.8	1.0	No	No
5	-L- 70+27 M 36.204807/-80.278061	(1)Rough Fork	0.0	6.0	6.0	0.4	42	123	0.28%	1.1	0.8	1.4	0.9	No	No
6	-Y1RPD- 18+50 LT 36.2042745/-80.276989	(1)Rough Fork	0.0	6.0	4.0	0.6	59	190	0.63%	1.5	1.3	2.0	1.4	No	No
6	-Y1RPD- 18+50 RT 36.204449/-80.277097	(1)Rough Fork	0.0	6.0	4.0	0.3	34	190	0.63%	0.9	1.1	2.3	1.1	No	No
6	-Y1RPD- 18+50 RT 36.204449/-80.277097	(1)Rough Fork	0.0	6.0	4.0	0.2	19	200	1.04%	0.5	1.2	0.6	1.3	No	No
6	-L- 71+71 RT 36.204625/-80.277505	(1)Rough Fork	0.0	6.0	4.0	0.5	52	91	0.56%	1.3	1.2	1.7	1.3	No	No
6	-L- 72+50 RT 36.204640/-80.277273	(1)Rough Fork	0.0	6.0	4.0	0.5	52	170	0.22%	1.3	0.8	1.7	0.9	No	No
6	-L- 73+00 RT 36.204661/-80.277111	(1)Rough Fork	0.0	6.0	4.0	1.0	96	170	1.44%	2.5	2.0	3.2	2.1	No	No

Additional Comments



**North Carolina Department of Transportation
Highway Stormwater Program
STORMWATER MANAGEMENT PLAN
FOR NCDOT PROJECTS**



(Version 2.08; Released April 2018)

WBS Element: 34839.3.GV7 **TIP No.:** U-2579DEF

County(ies): Forsyth

Page 5 **of** 17

Swales

Sheet No.	Station & Coordinates (Road and Non Road Projects)	Surface Water Body	Base Width (ft)	Front Slope (H:1)	Back Slope (H:1)	Drainage Area (ac)	Recommended Treatm't Length (ft)	Actual Length (ft)	Longitudinal Slope (%)	Q2 (cfs)	V2 (fps)	Q10 (cfs)	V10 (fps)	Rock Checks Used	BMP Associated w/ Buffer Rules?
6	-L- 71+50 M 36.204861/-80.277624	(1)Rough Fork	0.0	6.0	4.0	0.4	42	100	0.67%	1.1	1.2	1.4	1.3	No	No
6	-L- 72+50 M 36.204894/-80.277309	(1)Rough Fork	0.0	6.0	4.0	0.7	67	350	1.45%	1.7	1.8	2.2	1.9	No	No
6	-L- 80+86 M 36.204839/-80.274480	(1)Rough Fork	0.0	6.0	4.0	0.4	44	214	1.54%	1.1	1.7	1.5	1.8	No	No
6	-L- 83+00 M 36.204724/-80.273772	(1)Rough Fork	0.0	6.0	4.0	0.4	38	150	1.54%	1.0	1.6	1.3	1.7	No	No
6	-L- 72+50 LT 36.205301/-80.277362	(1)Rough Fork	0.0	2.0	2.0	0.7	71	103	0.20%	1.8	1.1	2.3	1.1	No	No
7	-Y2- 26+00 RT 36.202694/-80.271675	(1)Rough Fork	0.0	4.0	2.0	0.3	31	367	1.15%	0.7	1.5	0.9	1.6	No	No
7	-L- 84+00 M 36.204662/-80.273442	(1)Rough Fork	0.0	7.0	4.0	0.6	64	336	1.47%	1.7	1.8	2.1	1.9	No	No
7	-L- 87+36 M 36.204382/-80.272357	(1)Rough Fork	0.0	7.0	4.0	0.3	27	139	1.51%	0.7	1.4	0.9	1.5	No	No
7	-L- 88+75 M 36.204234/-80.271923	(1)Rough Fork	0.0	6.0	6.0	0.7	67	488	1.35%	1.7	1.7	2.2	1.8	No	No
7	-L- 93+63 M 36.203698/-80.270407	(1)Rough Fork	0.0	6.0	6.0	0.3	31	297	1.19%	0.8	1.3	1.0	1.4	No	No
7	-L- 88+75 RT 36.203984/-80.272052	(1)Rough Fork	0.0	6.0	4.0	0.6	59	260	1.74%	1.5	1.9	2.0	2.0	No	No
7	-L- 93+63 RT 36.203464/-80.270542	(1)Rough Fork	0.0	6.0	4.0	0.5	51	88	0.95%	1.3	1.5	1.7	1.6	No	No
7	-L- 93+63 RT 36.203464/-80.270542	(1)Rough Fork	0.0	6.0	4.0	1.1	105	297	1.22%	2.7	1.9	3.5	2.0	No	No
7	-L- 87+36 LT 36.204610/-80.272250	(1)Rough Fork	0.0	6.0	4.0	0.9	88	506	0.47%	2.3	1.3	2.9	1.4	No	No
7	-L- 93+63 LT 36.203942/-80.270274	(1)Rough Fork	0.0	6.0	4.0	0.2	23	69	2.65%	0.6	1.8	0.8	1.9	No	No
7	-L- 93+63 LT 36.203942/-80.270274	(1)Rough Fork	0.0	6.0	4.0	0.8	76	297	1.25%	2.0	1.8	2.5	1.9	No	No
8	-L- 108+05 LT 36.202327/-80.265812	(2)Trick-um Creek	0.0	2.0	2.0	0.2	18	195	2.34%	0.4	1.5	0.5	1.6	No	No
8	-L- 96+60 LT 36.203594/-80.269364	(2)Trick-um Creek	0.0	6.0	6.0	1.0	95	368	0.70%	2.5	1.5	3.1	1.6	No	No
8	-L- 108+05 LT 36.202329/-80.265811	(2)Trick-um Creek	0.0	6.0	6.0	0.3	26	105	2.81%	0.7	1.8	0.9	1.9	No	No

Additional Comments



**North Carolina Department of Transportation
Highway Stormwater Program
STORMWATER MANAGEMENT PLAN
FOR NCDOT PROJECTS**



(Version 2.08; Released April 2018)

WBS Element: 34839.3.GV7 **TIP No.:** U-2579DEF

County(ies): Forsyth

Page 6 **of** 17

Swales

Sheet No.	Station & Coordinates (Road and Non Road Projects)	Surface Water Body	Base Width (ft)	Front Slope (H:1)	Back Slope (H:1)	Drainage Area (ac)	Recommended Treatm't Length (ft)	Actual Length (ft)	Longitudinal Slope (%)	Q2 (cfs)	V2 (fps)	Q10 (cfs)	V10 (fps)	Rock Checks Used	BMP Associated w/ Buffer Rules?
8	-L- 96+60 M 36.203369/-80.269487	(2)Trick-um Creek	0.0	6.0	6.0	0.4	39	368	1.24%	1.0	1.4	1.3	1.5	No	No
8	-L- 107+00 M 36.202216/-80.266262	(2)Trick-um Creek	0.0	6.0	6.0	0.7	72	672	1.62%	1.9	1.9	2.4	2.0	No	No
8	-L- 96+60 RT 36.203139/-80.269612	(2)Trick-um Creek	0.0	6.0	6.0	1.0	96	368	0.70%	2.5	1.5	3.2	1.6	No	No
9	-L- 122+00 M 36.200549/-80.261612	(2)Trick-um Creek	0.0	6.0	6.0	0.5	53	500	3.72%	1.4	1.9	1.8	2.1	No	No
10	-L- 125+50 M 36.200157/-80.260530	(2)Trick-um Creek	0.0	6.0	6.0	0.4	37	350	1.90%	1.0	1.7	1.2	1.8	No	No
10	-L- 127+22 M 36.199967/-80.259996	(2)Trick-um Creek	0.0	6.0	6.0	0.2	17	172	0.47%	0.4	0.8	0.6	0.9	No	No
10	-L- 127+22 M 36.199967/-80.259996	(2)Trick-um Creek	0.0	6.0	6.0	0.2	23	213	0.57%	0.6	0.9	0.8	1.0	No	No
11	-Y3- 26+87 RT 36.198691/-80.254395	(2)Trick-um Creek	0.0	6.0	6.0	0.2	22	57	0.28%	0.6	0.7	0.8	0.8	No	No
11	-Y3- 27+70 RT 36.198475/-80.254491	(2)Trick-um Creek	0.0	6.0	6.0	0.2	22	140	1.88%	0.6	1.5	0.8	1.6	No	No
11	-Y3- 26+70 LT 36.198676/-80.254062	(2)Trick-um Creek	0.0	6.0	6.0	0.5	51	110	0.71%	1.1	1.2	1.4	1.3	No	No
11	-Y3- 27+70 LT 36.198403/-80.254111	(2)Trick-um Creek	0.0	6.0	6.0	0.5	51	210	0.58%	1.1	1.1	1.4	1.2	No	No
11	-Y3- 31+40 LT 36.197400/-80.254323	(2)Trick-um Creek	0.0	2.0	2.0	0.2	15	30	3.87%	0.5	1.9	0.6	2.0	No	No
11	-L- 139+00 M 36.198657/-80.256345	(2)Trick-um Creek	0.0	6.0	6.0	0.3	32	300	1.00%	0.8	1.3	1.1	1.4	No	No
11	-L- 142+00 M 36.198323/-80.255415	(2)Trick-um Creek	0.0	6.0	6.0	0.2	21	450	1.00%	0.5	1.1	0.7	1.2	No	No
11	-L- 146+50 M 36.197823/-80.254021	(4)Buffalo Creek	0.0	6.0	6.0	0.5	47	375	1.01%	1.2	1.4	1.6	1.5	No	No
11	-L- 150+25 M 36.197407/-80.252859	(4)Buffalo Creek	0.0	6.0	6.0	0.4	40	235	0.90%	1.0	1.3	1.3	1.4	No	No
11	-L- 152+60 M 36.197145/-80.252130	(4)Buffalo Creek	0.0	6.0	6.0	0.3	25	379	0.35%	0.6	0.8	0.8	0.9	No	No
11	-L- 134+50 RT 36.198898/-80.257881	(2)Trick-um Creek	0.0	6.0	4.0	0.3	33	100	1.10%	0.9	1.4	1.2	1.5	No	No

Additional Comments



**North Carolina Department of Transportation
Highway Stormwater Program
STORMWATER MANAGEMENT PLAN
FOR NCDOT PROJECTS**



(Version 2.08; Released April 2018)

WBS Element: 34839.3.GV7 **TIP No.:** U-2579DEF

County(ies): Forsyth

Page 7 **of** 17

Swales

Sheet No.	Station & Coordinates (Road and Non Road Projects)	Surface Water Body	Base Width (ft)	Front Slope (H:1)	Back Slope (H:1)	Drainage Area (ac)	Recommended Treatm't Length (ft)	Actual Length (ft)	Longitudinal Slope (%)	Q2 (cfs)	V2 (fps)	Q10 (cfs)	V10 (fps)	Rock Checks Used	BMP Associated w/ Buffer Rules?
11	-L- 142+30 RT 36.198061/-80.255447	(2)Trick-um Creek	2.0	6.0	4.0	0.8	80	270	1.00%	2.1	1.6	2.6	1.7	No	No
11	-L- 142+70 RT 36.198012/-80.255326	(2)Trick-um Creek	0.0	6.0	4.0	0.8	80	230	0.80%	2.1	1.5	2.6	1.6	No	No
11	-L- 146+60 RT 36.197574/-80.254120	(4)Buffalo Creek	0.0	6.0	4.0	0.3	25	88	2.03%	0.6	1.6	0.8	1.7	No	No
11	-L- 146+60 RT 36.197574/-80.254120	(4)Buffalo Creek	0.0	6.0	4.0	1.4	143	340	1.05%	3.1	1.9	3.9	2.0	No	No
11	-L- 152+20 RT 36.196961/-80.252379	(4)Buffalo Creek	0.0	6.0	4.0	0.9	85	380	1.04%	2.2	1.7	2.8	1.8	No	No
11	-L- 140+80 LT 36.198751/-80.255698	(2)Trick-um Creek	0.0	6.0	4.0	0.1	13	60	1.00%	0.3	1.1	0.4	1.1	No	No
11	-L- 141+40 LT 36.198617/-80.255478	(2)Trick-um Creek	0.0	6.0	4.0	1.3	129	326	0.90%	3.0	1.8	3.9	1.9	No	No
11	-L- 146+20 LT 36.198098/-80.253982	(4)Buffalo Creek	0.0	6.0	4.0	0.4	37	80	2.40%	0.9	1.9	1.1	2.0	No	No
11	-L- 146+20 LT 36.198098/-80.253982	(4)Buffalo Creek	0.0	6.0	4.0	1.0	101	330	1.06%	2.4	1.8	3.1	1.9	No	No
11	-L- 152+60 LT 36.197148/-80.252129	(4)Buffalo Creek	0.0	6.0	4.0	0.9	86	390	0.37%	2.4	1.2	3.1	1.3	No	No
11	-Y3RPA- 19+50 RT 36.197900/-80.251290	(4)Buffalo Creek	0.0	6.0	4.0	0.7	71	420	0.81%	2.0	1.5	2.5	1.6	No	No
11	-Y3RPA- 19+50 LT 36.197763/-80.251503	(4)Buffalo Creek	0.0	6.0	4.0	1.0	102	407	1.51%	1.5	1.8	2.0	1.9	No	No
11	-Y3RPD- 16+55 RT 36.196697/-80.251825	(4)Buffalo Creek	0.0	6.0	4.0	0.1	12	98	0.38%	0.2	0.6	0.2	0.7	No	No
11	-Y3RPD- 17+50 LT 36.196505/-80.252170	(4)Buffalo Creek	0.0	6.0	4.0	2.3	230	530	0.26%	4.9	1.3	6.3	1.3	No	No
12	-L- 159+00 M 36.196434/-80.250147	(4)Buffalo Creek	0.0	4.0	4.0	0.3	28	261	0.76%	0.7	1.2	0.9	1.3	No	No
12	-L- 164+00 M 36.195864/-80.248605	(4)Buffalo Creek	0.0	6.0	6.0	0.9	87	500	0.74%	2.7	1.5	3.5	1.6	No	No
12	-L- 164+00 M 36.195864/-80.248605	(4)Buffalo Creek	0.0	6.0	4.0	0.7	70	350	0.27%	2.3	1.0	2.9	1.1	No	No
12	-L- 166+00 M 36.195605/-80.248007	(4)Buffalo Creek	0.0	7.0	4.0	0.7	70	150	0.52%	2.3	1.3	2.9	1.4	No	No
12	-L- 164+00 RT 36.195609/-80.248763	(4)Buffalo Creek	0.0	6.0	4.0	0.9	88	350	0.44%	2.3	1.3	3.0	1.3	No	No

Additional Comments



**North Carolina Department of Transportation
Highway Stormwater Program
STORMWATER MANAGEMENT PLAN
FOR NCDOT PROJECTS**



(Version 2.08; Released April 2018)

WBS Element: 34839.3.GV7 **TIP No.:** U-2579DEF

County(ies): Forsyth

Page 8 **of** 17

Swales

Sheet No.	Station & Coordinates (Road and Non Road Projects)	Surface Water Body	Base Width (ft)	Front Slope (H:1)	Back Slope (H:1)	Drainage Area (ac)	Recommended Treatm't Length (ft)	Actual Length (ft)	Longitudinal Slope (%)	Q2 (cfs)	V2 (fps)	Q10 (cfs)	V10 (fps)	Rock Checks Used	BMP Associated w/ Buffer Rules?
12	-L- 167+50 RT 36.194177/-80.247737	(4)Buffalo Creek	0.0	6.0	4.0	0.6	61	250	0.49%	1.6	1.2	2.0	1.3	No	No
13	-L- 167+50 M 36.195396/-80.247570	(4)Buffalo Creek	0.0	7.0	4.0	0.9	85	450	0.52%	2.7	1.4	3.5	1.5	No	No
13	-L- 172+00 M 36.194685/-80.246323	(4)Buffalo Creek	0.0	7.0	4.0	1.0	95	500	0.52%	3.1	1.4	3.9	1.5	No	No
13	-L- 177+00 M 36.193766/-80.245066	(4)Buffalo Creek	0.0	7.0	4.0	0.8	76	400	0.49%	2.5	1.3	3.1	1.4	No	No
13	-L- 177+00 RT 36.193591/-80.245287	(4)Buffalo Creek	0.0	6.0	4.0	0.8	80	400	0.52%	2.2	1.3	2.8	1.4	No	No
13	-L- 172+25 LT 36.194878/-80.246023	(4)Buffalo Creek	0.0	4.0	4.0	0.6	55	225	0.73%	1.1	1.3	1.4	1.4	No	No
13	-L- 174+50 LT 36.194487/-80.245403	(4)Buffalo Creek	0.0	4.0	4.0	0.6	61	250	1.85%	1.2	1.9	1.5	2.0	No	No
13	-L- 175+50 LT 36.194300/-80.245151	(4)Buffalo Creek	0.0	6.0	4.0	0.6	61	150	1.19%	1.2	1.5	1.5	1.6	No	No
13	-L- 177+00 LT 36.194004/-80.244764	(4)Buffalo Creek	0.0	6.0	4.0	1.0	97	400	1.50%	1.9	1.9	2.4	2.0	No	No
13	-Y4- 33+20 LT 36.194118/-80.244612	(4)Buffalo Creek	0.0	4.0	2.0	0.1	5	90	0.52%	0.1	0.6	0.1	0.7	No	No
13	-Y4- 33+20 LT 36.194118/-80.244612	(4)Buffalo Creek	0.0	4.0	2.0	0.2	24	410	2.71%	0.3	1.7	0.4	1.8	No	No
13	-Y4- 34+20 LT 36.193899/-80.244400	(4)Buffalo Creek	0.0	4.0	2.0	0.2	24	310	1.44%	0.3	1.3	0.4	1.4	No	No
14	-L- 181+00 M 36.192941/-80.244170	(4)Buffalo Creek	0.0	7.0	4.0	1.3	132	765	0.34%	4.3	1.3	5.5	1.4	No	No
14	-L- 195+00 M 36.189723/-80.241579	(5)Mill Creek	0.0	7.0	4.0	1.0	101	635	0.37%	3.3	1.3	4.2	1.3	No	No
14	-L- 181+00 RT 36.192788/-80.244409	(4)Buffalo Creek	0.0	6.0	4.0	1.9	191	770	0.53%	3.9	1.5	4.9	1.6	No	No
14	-L- 188+70 RT 36.191053/-80.242985	(5)Mill Creek	0.0	6.0	4.0	1.2	120	630	0.65%	2.3	1.5	3.0	1.5	No	No
14	-Y4- 37+33 RT 36.193155/-80.243838	(4)Buffalo Creek	0.0	6.0	4.0	1.0	98	637	1.66%	1.9	2.0	2.4	2.1	No	No
15	-L- 205+50 M 36.187613/-80.238168	(5)Mill Creek	0.0	7.0	4.0	0.4	43	130	0.98%	1.4	1.5	1.8	1.6	No	No
15	-L- 206+32 M 36.187441/-80.238904	(5)Mill Creek	0.0	6.0	4.0	0.4	43	212	0.60%	1.3	0.9	1.7	0.9	No	No

Additional Comments



**North Carolina Department of Transportation
Highway Stormwater Program
STORMWATER MANAGEMENT PLAN
FOR NCDOT PROJECTS**



(Version 2.08; Released April 2018)

WBS Element: 34839.3.GV7 **TIP No.:** U-2579DEF

County(ies): Forsyth

Page 9 of 17

Swales

Sheet No.	Station & Coordinates (Road and Non Road Projects)	Surface Water Body	Base Width (ft)	Front Slope (H:1)	Back Slope (H:1)	Drainage Area (ac)	Recommended Treatm't Length (ft)	Actual Length (ft)	Longitudinal Slope (%)	Q2 (cfs)	V2 (fps)	Q10 (cfs)	V10 (fps)	Rock Checks Used	BMP Associated w/ Buffer Rules?
15	-L- 204+20 RT 36.187654/-80.239711	(5)Mill Creek	0.0	6.0	4.0	0.5	49	320	2.04%	0.8	1.4	1.1	1.5	No	No
16	-L- 206+50 M 36.187441/-80.238903	(5)Mill Creek	0.0	6.0	4.0	0.7	68	360	0.50%	2.2	1.3	2.8	1.4	No	No
16	-L- 209+00 M 36.187033/-80.238223	(5)Mill Creek	0.0	7.0	4.0	0.7	68	110	1.31%	2.2	1.8	2.8	1.9	No	No
35	-Y1A- 18+72 RT 36.208636/-80.282386	(1)Rough Fork	0.0	4.0	2.0	0.1	10	72	0.35%	0.3	0.7	0.3	0.8	No	No
35	-Y1- 21+10 RT 36.208025/-80.282102	(1)Rough Fork	0.0	6.0	6.0	0.7	66	235	1.16%	1.7	1.6	2.2	1.7	No	No
35	-Y1- 18+58 LT 36.208790/-80.282026	(1)Rough Fork	0.0	6.0	6.0	0.3	34	252	1.23%	0.9	1.4	1.1	1.5	No	No
43	-Y3- 18+70 RT 36.200852/-80.253682	(2)Trick-um Creek	0.0	6.0	4.0	0.5	51	320	1.00%	1.4	1.5	1.8	1.6	No	No
4	-L- 48+50 M 36.203914/-80.2853011	(6)Grassy Creek	0.0	6.0	6.0	0.3	26	250	2.38%	0.7	1.7	0.9	1.8	No	No
4	-L- 51+00 M 36.2039061/-80.2845716	(6)Grassy Creek	0.0	6.0	6.0	0.7	74	700	1.36%	1.9	1.8	2.3	1.9	No	

Additional Comments



North Carolina Department of Transportation
Highway Stormwater Program
STORMWATER MANAGEMENT PLAN
FOR NCDOT PROJECTS



(Version 2.08; Released April 2018)

WBS Element: 34839.3.GV7 TIP No.: U-2579DEF

County(ies): Forsyth

Page 10 of 17

Swales															
Sheet No.	Station & Coordinates (Road and Non Road Projects)	Surface Water Body	Base Width (ft)	Front Slope (H:1)	Back Slope (H:1)	Drainage Area (ac)	Recommended Treatm't Length (ft)	Actual Length (ft)	Longitudinal Slope (%)	Q2 (cfs)	V2 (fps)	Q10 (cfs)	V10 (fps)	Rock Checks Used	BMP Associated w/ Buffer Rules?
18	-L- 236+50 M 36.184444/-80.229444	(5)Mill Creek	0.0	6.0	6.0	0.6	60	572	1.26%	2.3	1.5	3.0	1.7	No	No
18	-L- 242+22 M 36.184167/-80.227250	(5)Mill Creek	0.0	6.0	6.0	0.7	71	678	0.34%	2.7	1.0	3.5	1.1	No	No
18	-L- 236+50 RT 36.184444/-80.229444	(5)Mill Creek	0.0	6.0	6.0	1.5	146	550	1.25%	3.8	1.8	4.8	1.9	No	No
18	-L- 229+50 M 36.185000/-80.231667	(5)Mill Creek	0.0	6.0	6.0	0.6	60	700	1.67%	2.3	1.7	3.0	1.9	No	No
18	-L- 241+00 LT 36.184722/-80.227777	(5)Mill Creek	0.0	4.0	4.0	1.1	109	285	0.67%	3.1	1.5	4.0	1.6	No	No
18	-L- 244+50 LT 36.184722/-80.226944	(5)Mill Creek	0.0	6.0	4.0	1.4	144	475	0.53%	3.4	1.3	4.3	1.4	No	No
19	-L- 266+50 LT 36.182534/-80.219483	(5)Mill Creek	0.0	2.0	2.0	0.5	53	150	0.73%	1.1	1.4	1.4	1.5	No	No
19	-Y6RPB- 27+50 LT 36.184636/-80.224103	(5)Mill Creek	0.0	6.0	6.0	0.4	37	300	2.17%	0.7	1.3	0.9	1.4	No	No
19	-Y6RPB- 27+50 RT 36.184414/-80.224157	(5)Mill Creek	0.0	6.0	6.0	0.6	57	300	2.51%	1.5	1.7	1.9	1.8	No	No
19	-Y6RPA- 23+50 RT 36.183963/-80.221654	(5)Mill Creek	0.0	6.0	6.0	0.7	65	200	0.30%	1.3	0.8	1.6	0.9	No	No
19	-Y6RPA- 25+50 RT 36.184179/-80.222278	(5)Mill Creek	0.0	6.0	6.0	0.3	34	130	0.31%	0.8	0.7	1.0	0.7	No	No
19	-L- 248+90 RT 36.183435/-80.225501	(5)Mill Creek	0.0	6.0	4.0	1.2	121	240	0.97%	3.3	1.7	4.2	1.8	No	No
19	-L- 249+50 RT 36.183433/-80.22592	(5)Mill Creek	0.0	6.0	6.0	1.4	139	550	0.16%	3.9	0.9	5.0	0.9	No	No
19	-L- 249+00 M 36.183708/-80.225382	(5)Mill Creek	0.0	6.0	4.0	1.2	122	600	0.33%	4.7	1.2	6.0	1.3	No	No
19	-L- 250+50 LT 36.183850/-80.224812	(5)Mill Creek	0.0	6.0	4.0	1.0	99	450	0.58%	1.5	1.1	1.9	1.2	No	No
19	-L- 255+00 M 36.183260/-80.223425	(5)Mill Creek	0.0	6.0	4.0	0.6	57	300	0.37%	2.2	1.1	2.8	1.1	No	No
19	-L- 258+00 M 36.182982/-80.222471	(5)Mill Creek	0.0	6.0	4.0	0.5	53	300	1.40%	2.1	1.7	2.6	1.8	No	No
19	-L- 258+00 LT 36.183220/-80.222355	(5)Mill Creek	0.0	6.0	4.0	0.4	35	200	1.20%	0.6	1.1	0.7	1.1	No	No
19	-L- 267+00 RT 36.181559/-80.219966	(5)Mill Creek	0.0	6.0	4.0	0.9	85	250	1.45%	2.4	1.8	3.1	1.9	No	No

Additional Comments



**North Carolina Department of Transportation
Highway Stormwater Program
STORMWATER MANAGEMENT PLAN
FOR NCDOT PROJECTS**



(Version 2.08; Released April 2018)

WBS Element: 34839.3.GV7 TIP No.: U-2579DEF

County(ies): Forsyth

Page 11 of 17

Swales															
Sheet No.	Station & Coordinates (Road and Non Road Projects)	Surface Water Body	Base Width (ft)	Front Slope (H:1)	Back Slope (H:1)	Drainage Area (ac)	Recommended Treat'mt Length (ft)	Actual Length (ft)	Longitudinal Slope (%)	Q2 (cfs)	V2 (fps)	Q10 (cfs)	V10 (fps)	Rock Checks Used	BMP Associated w/ Buffer Rules?
19	-L- 266+50 M 36.181976/-80.219870	(5)Mill Creek	0.0	6.0	4.0	1.3	128	525	0.46%	4.9	1.4	6.3	1.5	No	NO
19	-L- 248+00 RT 36.183284/-80.225862	(5)Mill Creek	0.0	6.0	6.0	0.6	55	300	0.32%	1.3	0.8	1.6	0.9	No	NO
19	-Y6RPC- 18+50 RT 36.183034/-80.225436	(5)Mill Creek	0.0	6.0	6.0	0.5	52	400	2.46%	1.0	1.5	1.3	1.6	No	NO
19	-Y6RPC- 18+50 LT 36.183203/-80.225261	(5)Mill Creek	0.0	6.0	4.0	1.1	106	350	0.82%	1.9	1.4	2.4	1.5	No	NO
19	-Y6RPC- 25+00 LT 36.182281/-80.223470	(5)Mill Creek	0.0	6.0	4.0	0.6	63	50	0.72%	1.8	1.3	2.3	1.4	No	NO
20	-L- 280+80 RT 36.179370/-80.216304	(5)Mill Creek	6.0	2.0	2.0	3.4	341	30	1.67%	9.4	1.8	12.5	2.0	No	No
20	-L- 275+50 RT 36.180372/-80.217565	(5)Mill Creek	0.0	6.0	4.0	0.9	89	375	0.79%	2.6	1.5	3.3	1.6	No	No
20	-L- 274+25 LT 36.181017/-80.217485	(5)Mill Creek	0.0	6.0	4.0	0.4	38	250	0.72%	0.7	0.9	1.0	1.0	No	No
20	-L- 279+00 M 36.179981/-80.216438	(5)Mill Creek	0.0	7.0	4.0	0.8	76	400	0.65%	2.9	1.4	3.7	1.5	No	No
21	-L- 293+50 M 36.176998/-80.213202	(5)Mill Creek	0.0	6.0	4.0	1.1	114	590	2.47%	3.3	1.7	4.4	1.8	No	No
21	-L- 293+50 LT 36.177138/-80.212945	(5)Mill Creek	0.0	6.0	4.0	1.3	125	590	2.20%	1.7	1.4	2.3	1.5	No	No
22	-L- 304+00 RT 36.174373/-80.211695	(5)Mill Creek	2.0	2.0	2.0	2.1	212	50	19.38%	4.3	1.8	5.5	1.8	No	NO
22	-L- 307+00 M 36.173804/-80.210878	(5)Mill Creek	0.0	6.0	6.0	0.5	53	500	0.55%	2.1	1.2	2.6	1.2	No	NO
22	-L- 299+50 M 36.175592/-80.212136	(5)Mill Creek	0.0	4.0	6.0	0.8	82	750	0.98%	3.2	1.7	4.1	1.8	No	NO
22	-L- 307+00 RT 36.173679/-80.211145	(5)Mill Creek	0.0	4.0	6.0	1.3	128	500	0.55%	3.3	1.4	4.2	1.4	No	NO
22	-L- 299+50 RT 36.175592/-80.212137	(5)Mill Creek	0.0	4.0	6.0	1.2	124	400	1.28%	3.2	1.8	4.0	2.0	No	NO
22	-L- 307+00 LT 36.173926/-80.210609	(5)Mill Creek	0.0	4.0	6.0	1.1	108	500	0.55%	2.9	1.3	3.7	1.4	No	NO
22	-L- 305+50 LT 36.174290/-80.210853	(5)Mill Creek	0.0	4.0	6.0	0.3	31	150	0.63%	0.9	0.9	1.1	1.0	No	NO
22	-L- 299+50 LT 36.175717/-80.211869	(5)Mill Creek	0.0	4.0	6.0	0.3	31	350	0.97%	0.9	1.1	1.1	1.2	No	NO

Additional Comments

--



**North Carolina Department of Transportation
Highway Stormwater Program
STORMWATER MANAGEMENT PLAN
FOR NCDOT PROJECTS**



(Version 2.08; Released April 2018)

WBS Element: 34839.3.GV7 TIP No.: U-2579DEF

County(ies): Forsyth

Page 12 of 17

Swales															
Sheet No.	Station & Coordinates (Road and Non Road Projects)	Surface Water Body	Base Width (ft)	Front Slope (H:1)	Back Slope (H:1)	Drainage Area (ac)	Recommended Treatm't Length (ft)	Actual Length (ft)	Longitudinal Slope (%)	Q2 (cfs)	V2 (fps)	Q10 (cfs)	V10 (fps)	Rock Checks Used	BMP Associated w/ Buffer Rules?
23	-L- 316+35 LT 36.171763/-80.208897	(5)Mill Creek	2.0	2.0	2.0	1.2	115	165	12.99%	2.3	1.5	3.0	1.5	NO	NO
23	-L- 318+50 M 36.171058/-80.208945	(5)Mill Creek	0.0	6.0	6.0	0.7	68	650	0.55%	2.6	1.2	3.4	1.3	NO	NO
23	-L- 312+00 M 36.172611/-80.210037	(5)Mill Creek	0.0	6.0	6.0	0.7	69	650	0.55%	2.7	1.2	3.4	1.3	NO	NO
23	-L- 318+50 RT 36.170936/-80.209213	(5)Mill Creek	0.0	4.0	6.0	1.9	189	700	0.55%	4.7	1.5	6.0	1.6	NO	NO
23	-L- 312+00 RT 36.172488/-80.210305	(5)Mill Creek	0.0	4.0	6.0	1.3	130	350	0.51%	3.1	1.3	3.9	1.4	NO	NO
23	-L- 318+50 LT 36.171189/-80.208667	(5)Mill Creek	0.0	4.0	6.0	1.1	112	450	0.58%	2.9	1.3	3.7	1.4	NO	NO
23	-L- 312+00 LT 36.172734/-80.209770	(5)Mill Creek	0.0	4.0	6.0	0.7	67	300	0.51%	1.9	1.1	2.4	1.2	NO	NO
24	-L- 335+80 M 36.166937/-80.206028	(5)Mill Creek	0.0	4.0	11.0	0.4	39	170	2.75%	1.5	1.7	1.9	1.8	NO	NO
24	-L- 334+50 M 36.167242/-80.206259	(5)Mill Creek	0.0	4.0	32.0	0.3	30	130	2.75%	1.2	1.3	1.5	1.4	NO	NO
24	-L- 331+50 M 36.167960/-80.206762	(5)Mill Creek	0.0	4.0	6.0	0.5	46	300	2.10%	1.8	1.8	2.3	1.9	NO	NO
24	-L- 328+50 M 36.168676/-80.207268	(5)Mill Creek	0.0	4.0	6.0	0.3	32	300	0.62%	1.2	1.0	1.6	1.2	NO	NO
24	-L- 325+00 M 36.169509/-80.207855	(5)Mill Creek	0.0	6.0	6.0	0.4	37	350	0.55%	1.4	1.0	1.8	1.1	NO	NO
24	-L- 328+50 RT 36.168551/-80.207535	(5)Mill Creek	0.0	4.0	6.0	1.1	106	300	0.94%	2.4	1.5	3.0	1.6	NO	NO
24	-L- 325+50 RT 36.169267/-80.208039	(5)Mill Creek	0.0	4.0	6.0	0.8	78	300	0.55%	2.0	1.2	2.5	1.3	NO	NO
24	-L- 331+75 LT 36.168022/-80.206452	(5)Mill Creek	0.0	4.0	6.0	0.7	71	325	1.68%	2.0	1.7	2.5	1.9	NO	NO
24	-L- 328+50 LT 36.168797/-80.206999	(5)Mill Creek	0.0	4.0	6.0	0.9	89	325	0.66%	2.2	1.3	2.8	1.4	NO	NO
24	-L- 324+50 LT 36.169757/-80.207663	(5)Mill Creek	0.0	4.0	6.0	1.1	114	400	0.58%	2.8	1.3	3.6	1.4	NO	NO
25	-Y7- 22+00 LT 36.163920/-80.203053	(5)Mill Creek	0.0	2.0	2.0	0.5	48	100	1.54%	0.9	1.7	1.2	1.9	NO	NO
25	-Y7- 22+80 RT 36.163716/-80.203278	(5)Mill Creek	0.0	2.0	2.0	0.1	9	20	0.30%	0.3	0.6	0.4	0.8	NO	NO

Additional Comments

--



**North Carolina Department of Transportation
Highway Stormwater Program
STORMWATER MANAGEMENT PLAN
FOR NCDOT PROJECTS**



(Version 2.08; Released April 2018)

WBS Element: 34839.3.GV7 TIP No.: U-2579DEF

County(ies): Forsyth

Page 13 of 17

Swales															
Sheet No.	Station & Coordinates (Road and Non Road Projects)	Surface Water Body	Base Width (ft)	Front Slope (H:1)	Back Slope (H:1)	Drainage Area (ac)	Recommended Treatm't Length (ft)	Actual Length (ft)	Longitudinal Slope (%)	Q2 (cfs)	V2 (fps)	Q10 (cfs)	V10 (fps)	Rock Checks Used	BMP Associated w/ Buffer Rules?
25	-L- 347+50 RT 36.164258/-80.203626	(5)Mill Creek	0.0	2.0	2.0	0.3	27	131	0.30%	0.7	0.9	0.9	0.9	NO	NO
25	-L- 343+50 M 36.165308/-80.204377	(5)Mill Creek	0.0	4.0	9.0	0.8	83	450	0.99%	3.2	1.6	4.1	1.7	NO	NO
25	-L- 340+75 M 36.165843/-80.205019	(5)Mill Creek	0.0	4.0	12.0	0.5	52	275	1.99%	2.0	1.6	2.6	1.7	NO	NO
25	-L- 338+00 M 36.166437/-80.205612	(5)Mill Creek	0.0	4.0	11.0	0.5	54	275	2.52%	2.1	1.8	2.7	1.9	NO	NO
25	-L- 351+50 RT 36.163836/-80.202300	(5)Mill Creek	0.0	6.0	4.0	0.9	90	375	0.73%	1.5	1.2	1.9	1.3	NO	NO
25	-L- 343+50 RT 36.165107/-80.204561	(5)Mill Creek	0.0	6.0	4.0	0.8	75	400	0.87%	1.1	1.1	1.4	1.2	NO	NO
25	-L- 343+50 LT 36.165492/-80.204166	(5)Mill Creek	0.0	6.0	4.0	1.2	123	425	0.87%	3.3	1.6	4.2	1.7	NO	NO
26	-L- 360+50 M 36.163239/-80.199291	(5)Mill Creek	0.0	4.0	6.0	0.4	37	350	2.43%	1.4	1.8	1.8	1.9	NO	NO
26	-L- 357+50 M 36.163460/-80.200270	(5)Mill Creek	0.0	4.0	7.0	0.5	49	300	1.16%	1.9	1.4	2.4	1.6	NO	NO
26	-L- 356+31 M 36.163554/-80.200656	(5)Mill Creek	0.0	4.0	10.0	0.2	20	119	0.18%	0.8	0.5	1.0	0.6	NO	NO
26	-L- 352+00 M 36.163992/-80.202011	(5)Mill Creek	0.0	4.0	9.0	1.0	95	400	1.12%	3.7	1.7	4.7	1.8	NO	NO
26	-L- 355+13 M 36.163658/-80.201035	(5)Mill Creek	0.0	4.0	8.0	0.6	60	313	1.58%	2.3	1.6	3.0	1.9	NO	NO
26	-L- 356+31 M 36.163554/-80.200656	(5)Mill Creek	0.0	4.0	8.0	0.2	21	118	0.37%	0.8	0.7	1.0	0.8	NO	NO
26	-L- 352+00 LT 36.164214/-80.201871	(5)Mill Creek	0.0	4.0	6.0	0.9	94	50	1.62%	2.3	1.9	3.0	2.0	NO	NO
26	-L- 354+50 LT 36.163952/-80.201124	(5)Mill Creek	0.0	4.0	6.0	0.5	54	250	1.64%	1.5	1.5	1.9	1.6	NO	NO
26	-L- 352+00 RT 36.163770/-80.202149	(5)Mill Creek	0.0	6.0	4.0	0.9	90	50	1.54%	1.5	1.5	1.9	1.6	NO	NO
26	-L- 355+00 RT 36.163427/-80.201185	(5)Mill Creek	0.0	6.0	4.0	1.1	110	300	1.56%	1.8	1.6	2.4	1.8	NO	NO
26	-L- 360+50 RT 36.162997/-80.199373	(5)Mill Creek	0.0	6.0	4.0	0.7	71	250	2.08%	2.0	1.8	2.5	1.9	NO	NO
27	-L- 372+50 LT 36.162585/-80.195264	(6)Mill Creek	2.0	2.0	2.0	0.9	94	250	1.69%	1.4	1.7	1.8	1.8	NO	NO

Additional Comments

--



**North Carolina Department of Transportation
Highway Stormwater Program
STORMWATER MANAGEMENT PLAN
FOR NCDOT PROJECTS**



(Version 2.08; Released April 2018)

WBS Element: 34839.3.GV7 TIP No.: U-2579DEF

County(ies): Forsyth

Page 14 of 17

Swales															
Sheet No.	Station & Coordinates (Road and Non Road Projects)	Surface Water Body	Base Width (ft)	Front Slope (H:1)	Back Slope (H:1)	Drainage Area (ac)	Recommended Treatm't Length (ft)	Actual Length (ft)	Longitudinal Slope (%)	Q2 (cfs)	V2 (fps)	Q10 (cfs)	V10 (fps)	Rock Checks Used	BMP Associated w/ Buffer Rules?
27	-L- 370+50 LT 36.162858/-80.195888	(6)Mill Creek	2.0	2.0	2.0	0.9	94	50	0.86%	1.4	1.3	1.8	1.4	NO	NO
27	-L- 373+50 RT 36.161950/-80.195217	(6)Mill Creek	0.0	6.0	2.0	0.3	31	50	0.84%	0.7	1.0	0.9	1.1	NO	NO
27	-L- 363+00 RT 36.162816/-80.198556	(6)Mill Creek	0.0	4.0	6.0	0.7	71	100	2.21%	2.0	1.8	2.5	1.9	NO	NO
28	-Y8ADR1- 10+64 LT 36.161755/-80.194609	(6)Mill Creek	2.0	2.0	2.0	0.6	60	95	1.51%	0.9	1.4	1.2	1.5	NO	NO
28	-Y8ADR1- 10+64 LT 36.161511/-80.194693	(6)Mill Creek	0.0	2.0	2.0	0.0	2	50	9.24%	0.0	1.3	0.0	1.4	NO	NO
28	-L- 384+50 M 36.160530/-80.191988	(6)Mill Creek	0.0	5.0	6.0	0.4	42	400	1.94%	1.6	1.6	2.1	1.7	NO	NO
28	-Y8- 28+00 LT 36.161442/-80.191883	(6)Mill Creek	0.0	4.0	2.0	2.9	293	700	0.34%	6.6	1.9	8.4	2.0	NO	NO
29	-L- 396+50 LT 36.158762/-80.188513	(6)Mill Creek	2.0	2.0	2.0	2.0	202	200	7.04%	3.7	1.1	4.7	1.1	NO	NO
29	-Y9- 25+50 LT 36.160062/-80.188895	(6)Mill Creek	0.0	2.0	2.0	0.1	10	30	4.43%	0.2	1.6	0.2	1.7	NO	NO
29	-L- 388+50 M 36.159813/-80.190978	(6)Mill Creek	0.0	6.0	6.0	0.2	16	150	0.33%	0.6	0.6	0.8	0.7	NO	NO
30	-L- 408+00 LT 36.156716/-80.185568	(8)Frazier Creek	2.0	2.0	2.0	1.7	174	112	16.46%	3.1	0.7	4.0	0.7	NO	NO
30	-L- 409+00 LT 36.156597/-80.185257	(8)Frazier Creek	2.0	2.0	2.0	1.7	174	10	12.31%	3.1	0.6	4.0	0.6	NO	NO
30	-L- 409+49 LT 36.156546/-80.185102	(8)Frazier Creek	2.0	2.0	2.0	1.7	174	49	2.98%	3.1	1.9	4.0	2.0	NO	NO
30	-L- 409+00 M 36.156130/-80.185726	(8)Frazier Creek	0.0	6.0	6.0	0.5	53	500	1.19%	2.1	1.4	2.6	1.6	NO	NO
31	-L- 410+50 M 36.155983/-80.185501	(8)Frazier Creek	0.0	6.0	6.0	0.1	13	150	1.01%	0.5	0.9	0.7	1.0	NO	NO
31	-L- 411+58 RT 36.155129/-80.185583	(8)Frazier Creek	8.0	2.0	2.0	6.3	626	108	5.72%	24.2	3.5	31.0	3.8	Yes	No
52	-Y7- 23+00 LT 36.163647/-80.203085	(6)Mill Creek	0.0	2.0	2.0	0.5	48	100	1.53%	0.9	1.7	1.1	1.8	NO	NO
52	-Y7- 23+00 RT 36.163670/-80.203283	(6)Mill Creek	0.0	2.0	2.0	0.1	10	32	0.31%	0.3	0.7	0.4	0.8	NO	NO
56	-Y9- 27+00 LT 36.160199/-80.188409	(6)Mill Creek	0.0	2.0	2.0	0.1	10	150	4.43%	0.2	1.6	0.2	1.7	NO	NO

Additional Comments

--



North Carolina Department of Transportation
Highway Stormwater Program
STORMWATER MANAGEMENT PLAN
FOR NCDOT PROJECTS



(Version 2.08; Released April 2018)

WBS Element: 34839.3.GV7 **TIP No.:** U-2579DEF

County(ies): Forsyth

Page 15 of 17

Additional Comments



North Carolina Department of Transportation
Highway Stormwater Program
STORMWATER MANAGEMENT PLAN
FOR NCDOT PROJECTS



(Version 2.08; Released April 2018)

Page 16 of 17

WBS Element:

TIP No.: U-2579DEF

County(ies): Forsyth

Preformed Scour Holes and Energy Dissipators

Sheet No.	Station & Coordinates (Road and Non Road Projects)	Surface Water Body	Energy Dissipator Type	Riprap Type	Drainage Area (ac)	Conveyance Structure	Pipe/Structure Dimensions (in)	Q10 (cfs)	V10 (fps)	BMP Associated w/ Buffer Rules?
5	-Y1C- 14+57 RT 36.207284/-80.283053	(6)Grassy Creek	Riprap Energy Dissipator Basin	Class 'B'	3.6	Pipe	24	12.0	0.7	N/A
11	-Y3RPC- 25+65 LT 36.197365/-80.255748	(2)Trick-um Creek	Riprap Energy Dissipator Basin	Class II	13.4	Pipe	36	31.0	1.0	N/A
11	-Y3RPA- 21+52 RT 36.198533/-80.251352	(2)Trick-um Creek	Riprap Energy Dissipator Basin	Class II	13.2	Pipe	42	75.0	1.2	N/A
13	-Y4- 28+75 LT 36.1952386/-80.2454770	(4)Buffalo Creek	Riprap Energy Dissipator Basin	Class I	14.6	Pipe	30	42.0	1.0	N/A
14	-Y4- 44+56 LT 36.192132/-80.241853	(4)Buffalo Creek	Riprap Energy Dissipator Basin	Class 'B'	2.8	Pipe	24	8.0	0.7	N/A
22	-L- 303+73 LT 36.174722/-80.211111	(6)Mill Creek	Riprap Energy Dissipator Basin	Class 'B'	6.1	Culvert	36	13.2	1.2	N/A
28	-Y8- 29+84 LT 36.161111/-80.191389		Riprap Energy Dissipator Basin	Class II	23.2	Culvert	42	55.6	1.1	N/A
10	-L- 127+52 RT 36.1996038/-80.2600804	(2)Trick-um Creek	Riprap Energy Dissipator Basin	Class I	25.0	Pipe	42	75.0	1.2	N/A
31	-L- 410+36 RT 36.155406/-80.185855	(7)Frazier Creek	Riprap Energy Dissipator Basin	Class II	6.3	Pipe	30	30.8	1.2	N/A
<hr/>										
<hr/>										
Additional Comments

* Refer to the NCDOT Best Management Practices Toolbox (2014), NCDOT Standards, the Federal Highway Administration (FHWA) Hydraulic Engineering Circular No. 14 (HEC-14), Third Edition, Hydraulic Design of Energy Dissipators for Culverts and Channels (July 2006), as applicable, for design guidance and criteria.



(Version 2.08; Released April 2018)

North Carolina Department of Transportation
Highway Stormwater Program
STORMWATER MANAGEMENT PLAN
FOR NCDOT PROJECTS



WBS Element: 34839.3.GV7

TIP No.: U-2579DEF

County(ies): Forsyth

Page 17 of 17

Other Best Management Practices

Sheet No.	Station & Coordinates (Road and Non Road Projects)	Surface Water Body	BMP Type	Drainage Area (ac)	New Built-Upon Area (ac)	Volume Treated (ac-ft)	Precipitation Depth Treated over NBUA (in)	BMP Associated w/ Buffer Rules?
5	-Y1LPA- 15+00 LT 36.2054702/-80.2786901	(1)Rough Fork	Dry Detention Basin	21.1	4.4	0.43	1.23	No
5	-Y1LPD- 14+00 RT 36.203836/-80.279466	(1)Rough Fork	Dry Detention Basin	7.9	3.5	0.54	1.95	No
26	-L- 357+17 LT 36.163889/-80.200278	(5)Mill Creek	Dry Detention Basin	19.9	10.8	0.99	1.16	No


Additional Comments

CONTRACT: C204088

卷之三


四

TIP PROJECT: U-2579D,E&F

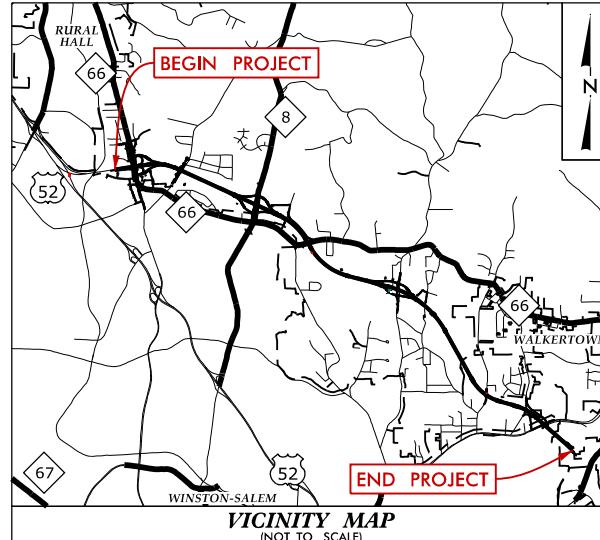



STATE OF NORTH CAROLINA
DIVISION OF HIGHWAYS

FORSYTH COUNTY

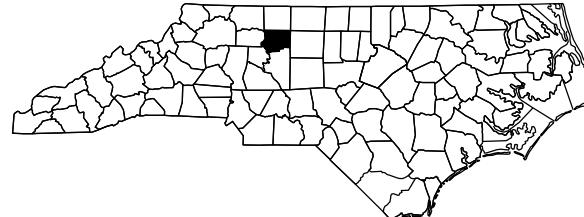

**LOCATION: WINSTON-SALEM – NORTHERN BELTWAY
FROM WEST OF NC 66 /SR 4000 (UNIVERSITY
PARKWAY) TO US 311 (NEW WALKERTON ROAD)**

**TYPE OF WORK: DESIGN-BUILD AS SPECIFIED IN THE SCOPE OF WORK
CONTAINED IN THE REQUEST FOR PROPOSALS**

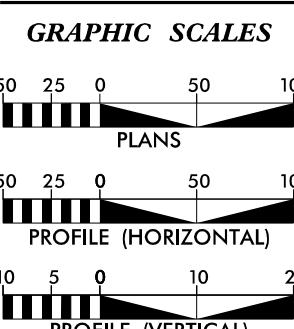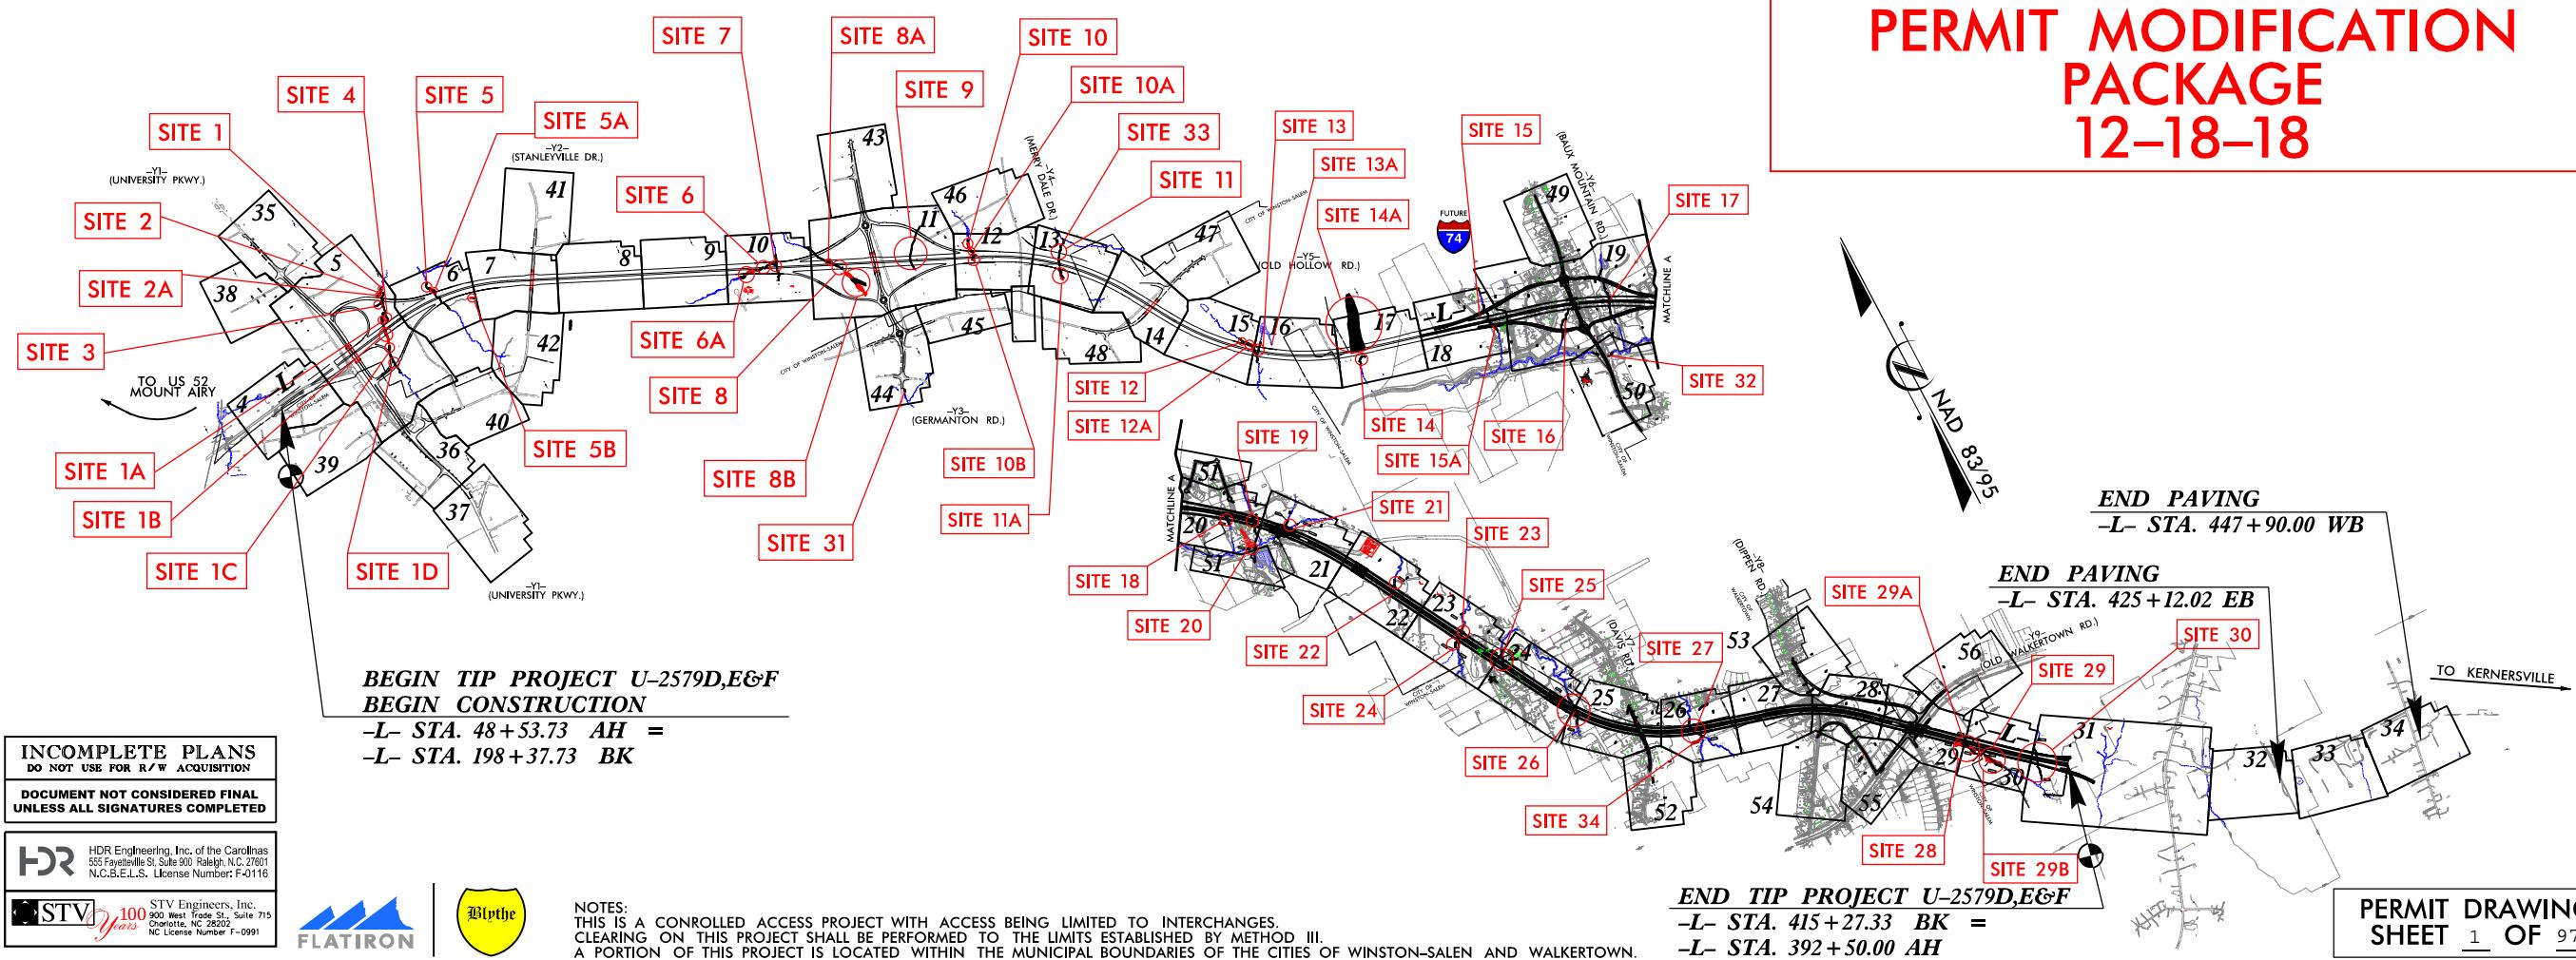

DESIGN DATA

ADT 2016 =	34,000
ADT 2040 =	60,200
K =	9 %
D =	55 %
T =	15 %
V =	70 MPH

* TTST = 10%DUAL =
 FUNC CLASS =
 INTERSTATE
 STATEWIDE TIER


PROJECT LENGTH


LENGTH ROADWAY TIP PROJECT U-2579DEF = 6.859 MILES
LENGTH STRUCTURES TIP PROJECT U-2579DEF = 0.087 MILES
TOTAL LENGTH TIP PROJECT U-2579DEF = 6.946 MILES


Prepared for the Office of:

DIVISION OF HIGHWAYS

The North Carolina State Seal is circular. The outer ring contains the text "THE GREAT SEAL OF THE STATE OF NORTH CAROLINA" at the top and "THE UNITED STATES OF AMERICA" at the bottom. Inside the seal is a map of North Carolina showing coastal areas and rivers. A central shield features a plow, a sheaf of wheat, and a cotton plant.

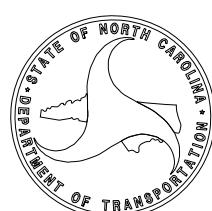

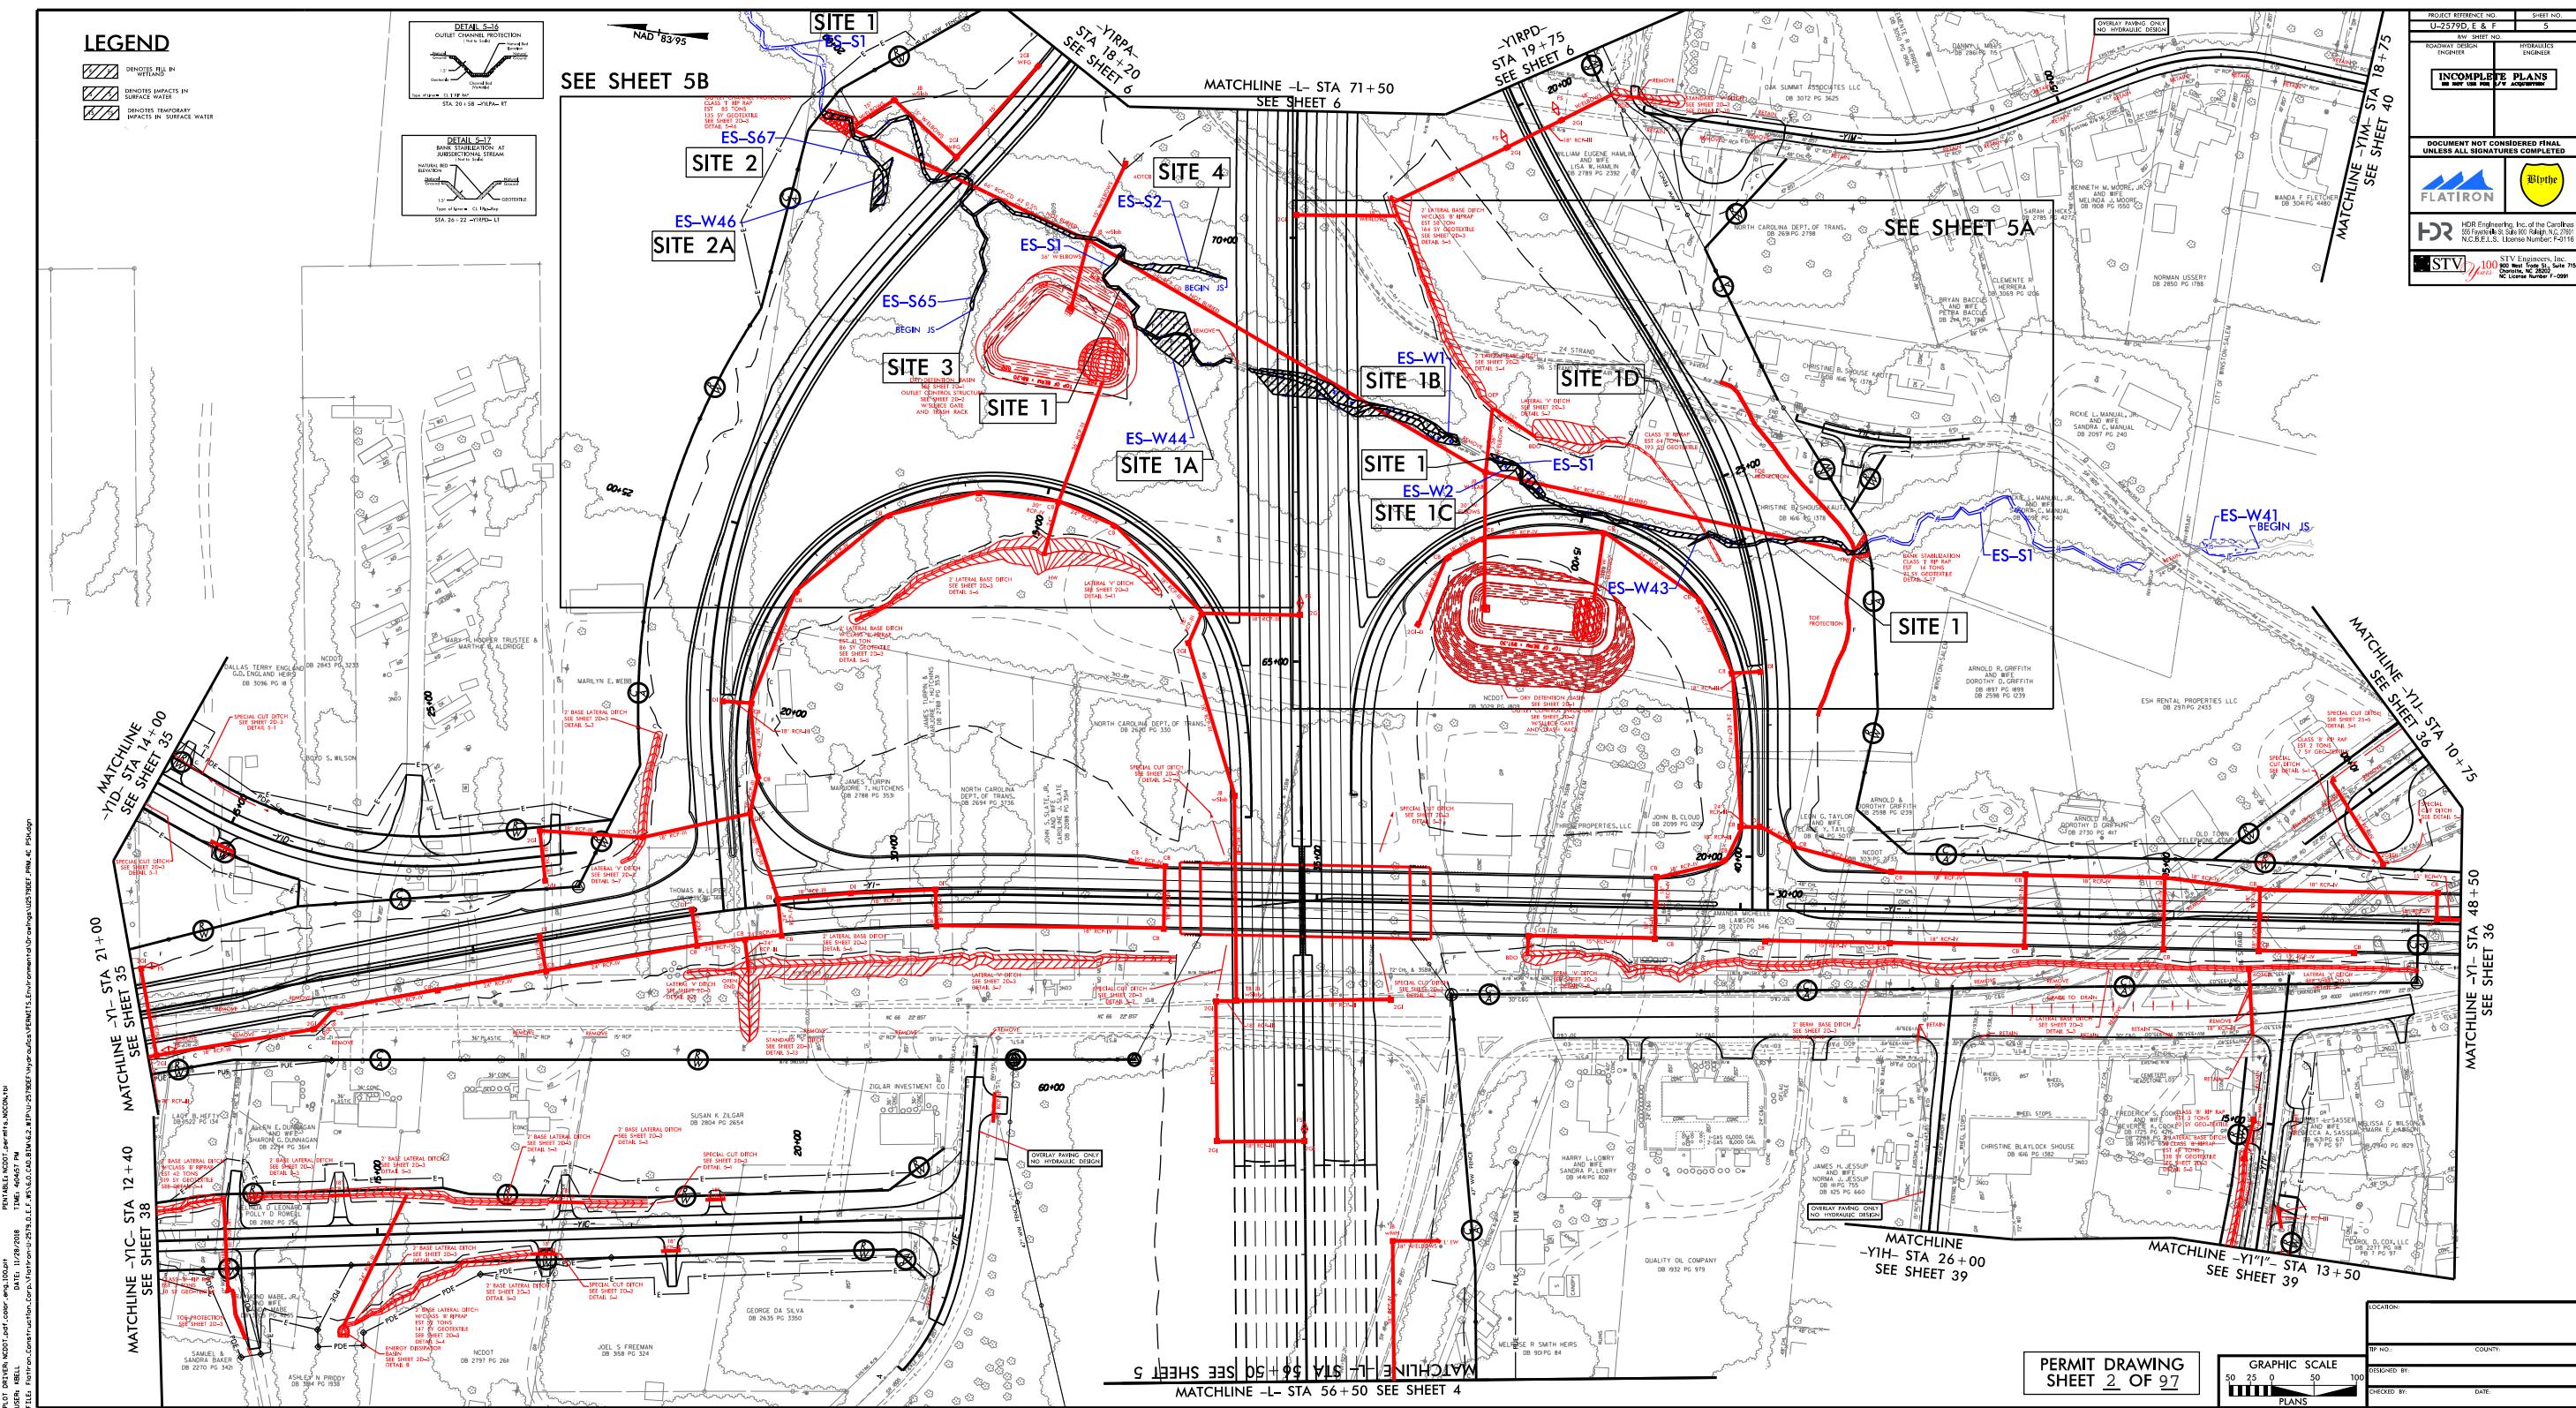

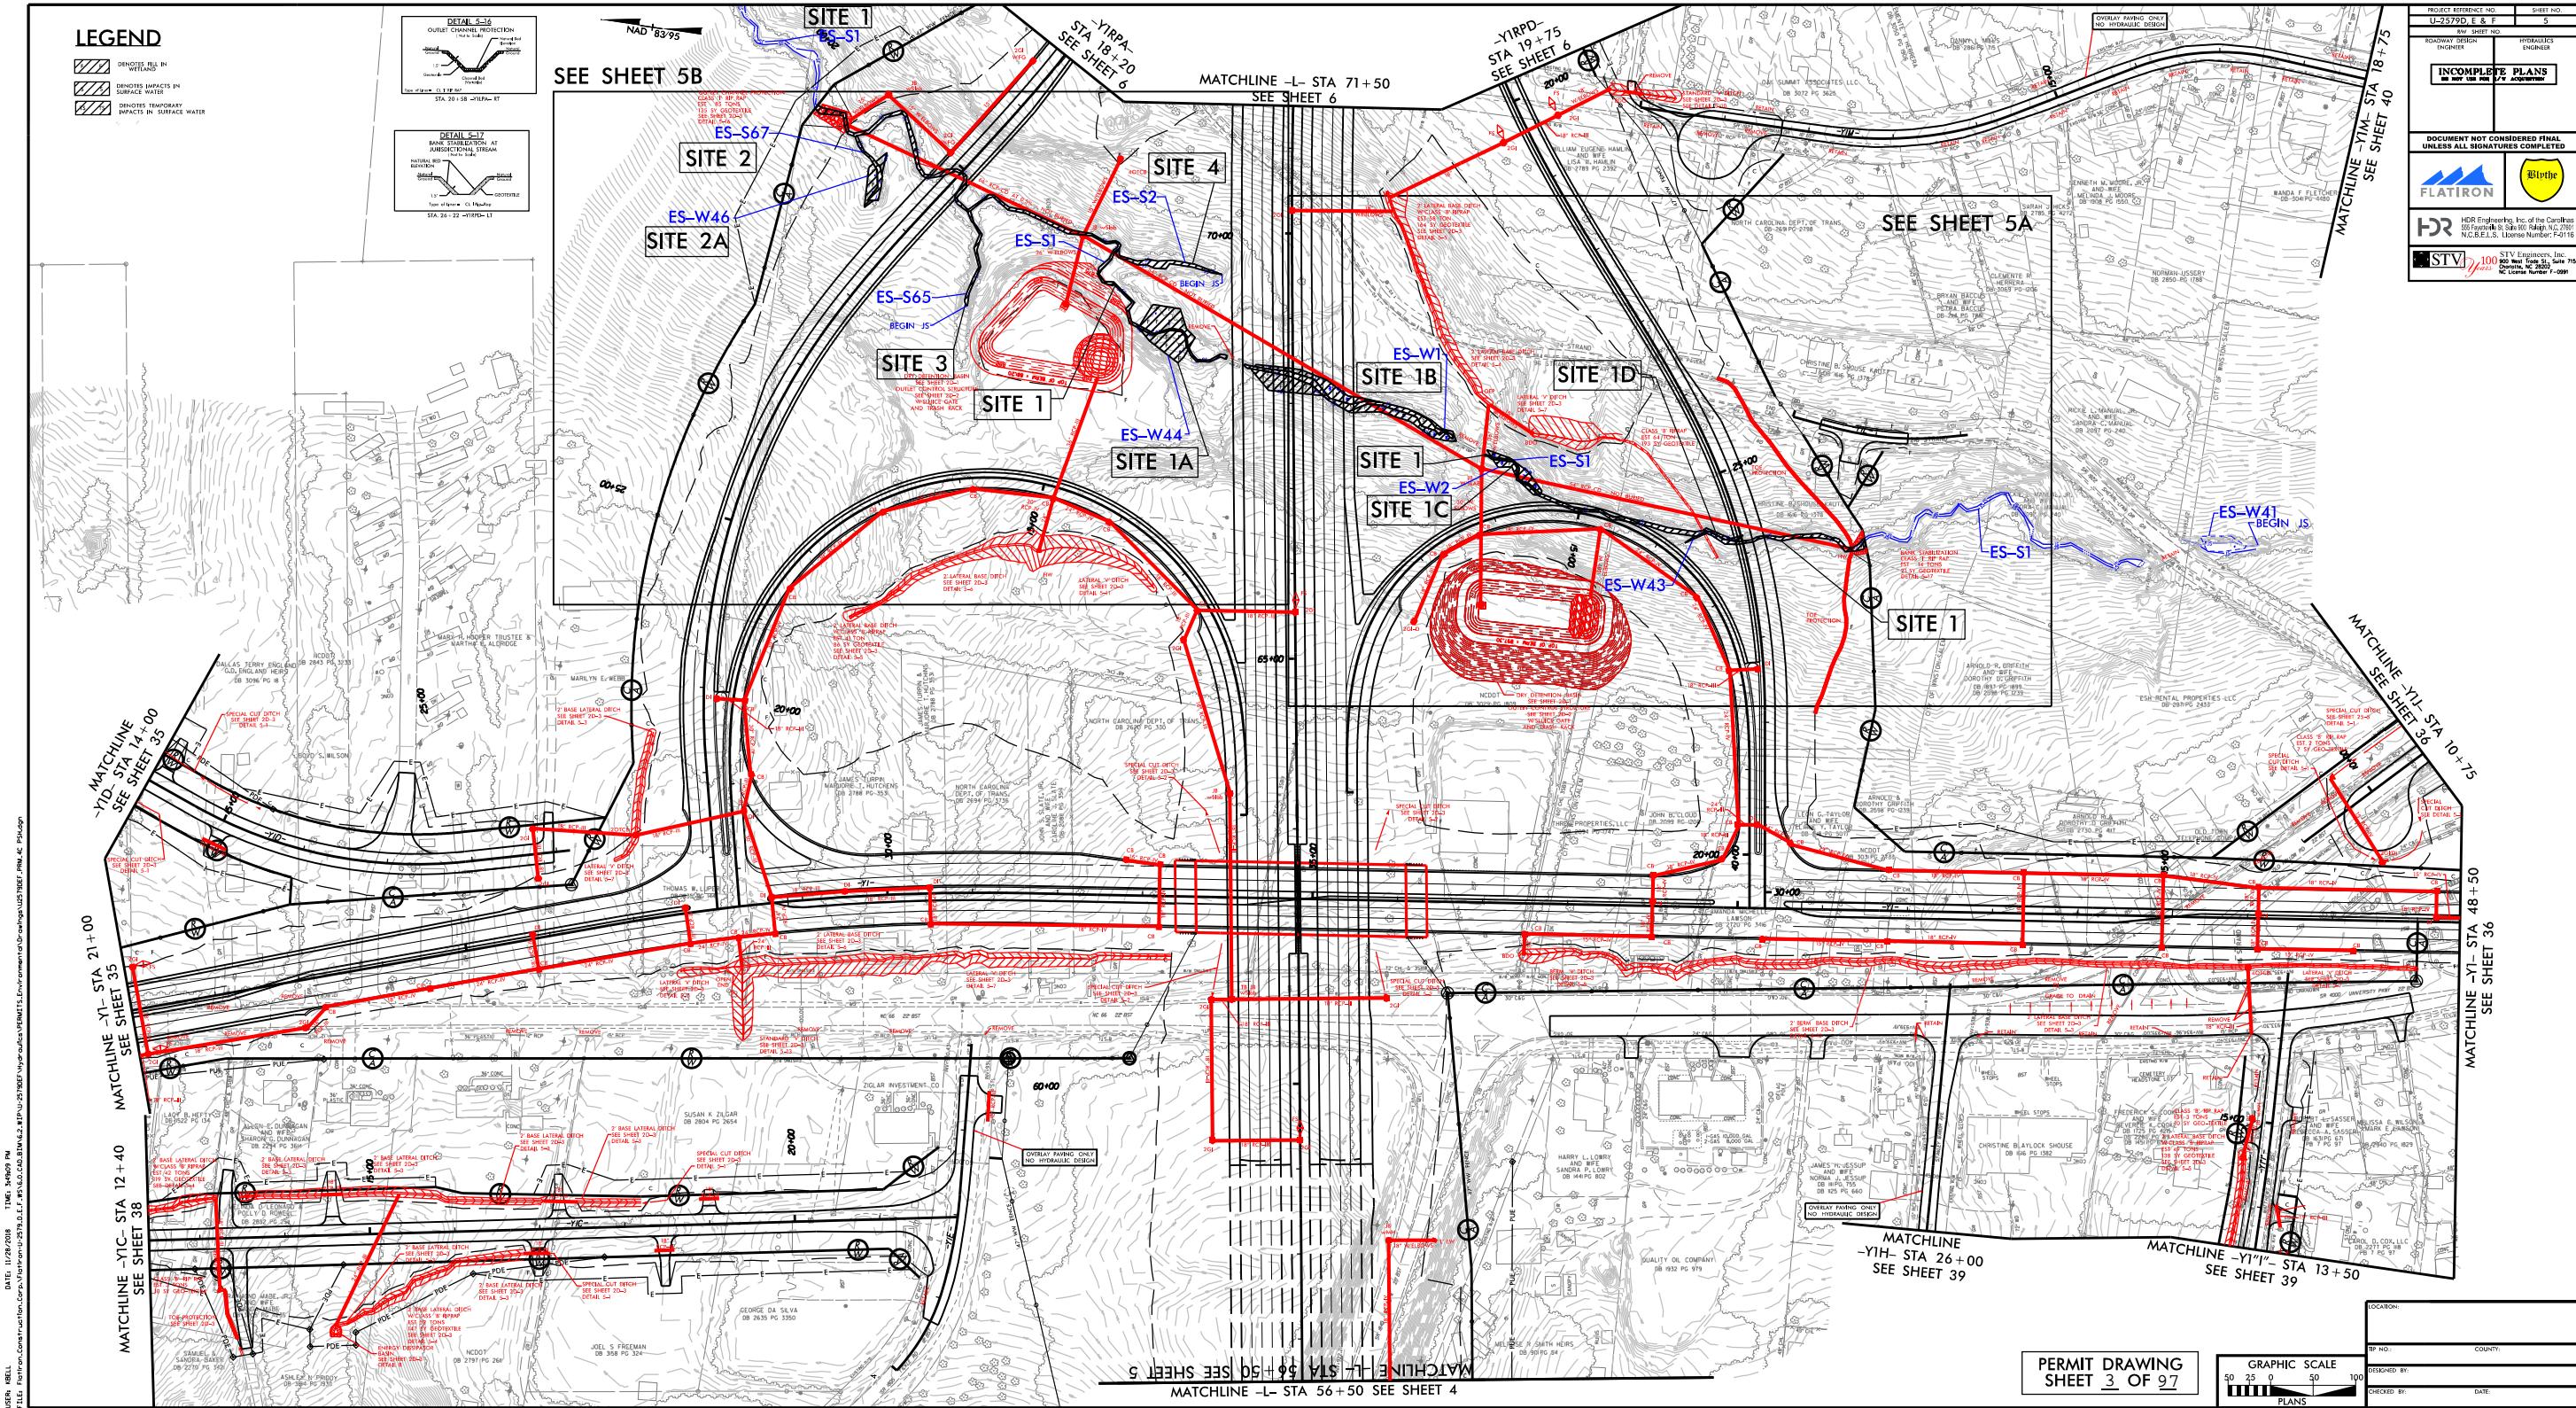

300 280 260 240 220 200 180 160 140 120 100 80 60 40 20 0 20 40 60 80 100 120 140 160 180 200 220 240 260 280 300

U-2579DEF
PERMIT SITE 1B

WETLANDS

WETLANDS

900 880 860 840 820 800 780 760 740 720 700 680 660 640 620 600 580 560 540 520 500 480 460 440 420 400 380 360 340 320 300

900 880 860 840 820 800 780 760 740 720 700 680 660 640 620 600 580 560 540 520 500 480 460 440 420 400 380 360 340 320 300

900 880 860 840 820 800 780 760 740 720 700 680 660 640 620 600 580 560 540 520 500 480 460 440 420 400 380 360 340 320 300

920 900 880 860 840 820 800 780 760 740 720 700 680 660 640 620 600 580 560 540 520 500 480 460 440 420 400 380 360 340 320 300


920 900 880 860 840 820 800 780 760 740 720 700 680 660 640 620 600 580 560 540 520 500 480 460 440 420 400 380 360 340 320 300

920 900 880 860 840 820 800 780 760 740 720 700 680 660 640 620 600 580 560 540 520 500 480 460 440 420 400 380 360 340 320 300

920 900 880 860 840 820 800 780 760 740 720 700 680 660 640 620 600 580 560 540 520 500 480 460 440 420 400 380 360 340 320 300


300 280 260 240 220 200 180 160 140 120 100 80 60 40 20 0 20 40 60 80 100 120 140 160 180 200 220 240 260 280 300

PERMIT DRAWING
SHEET 5 OF 97

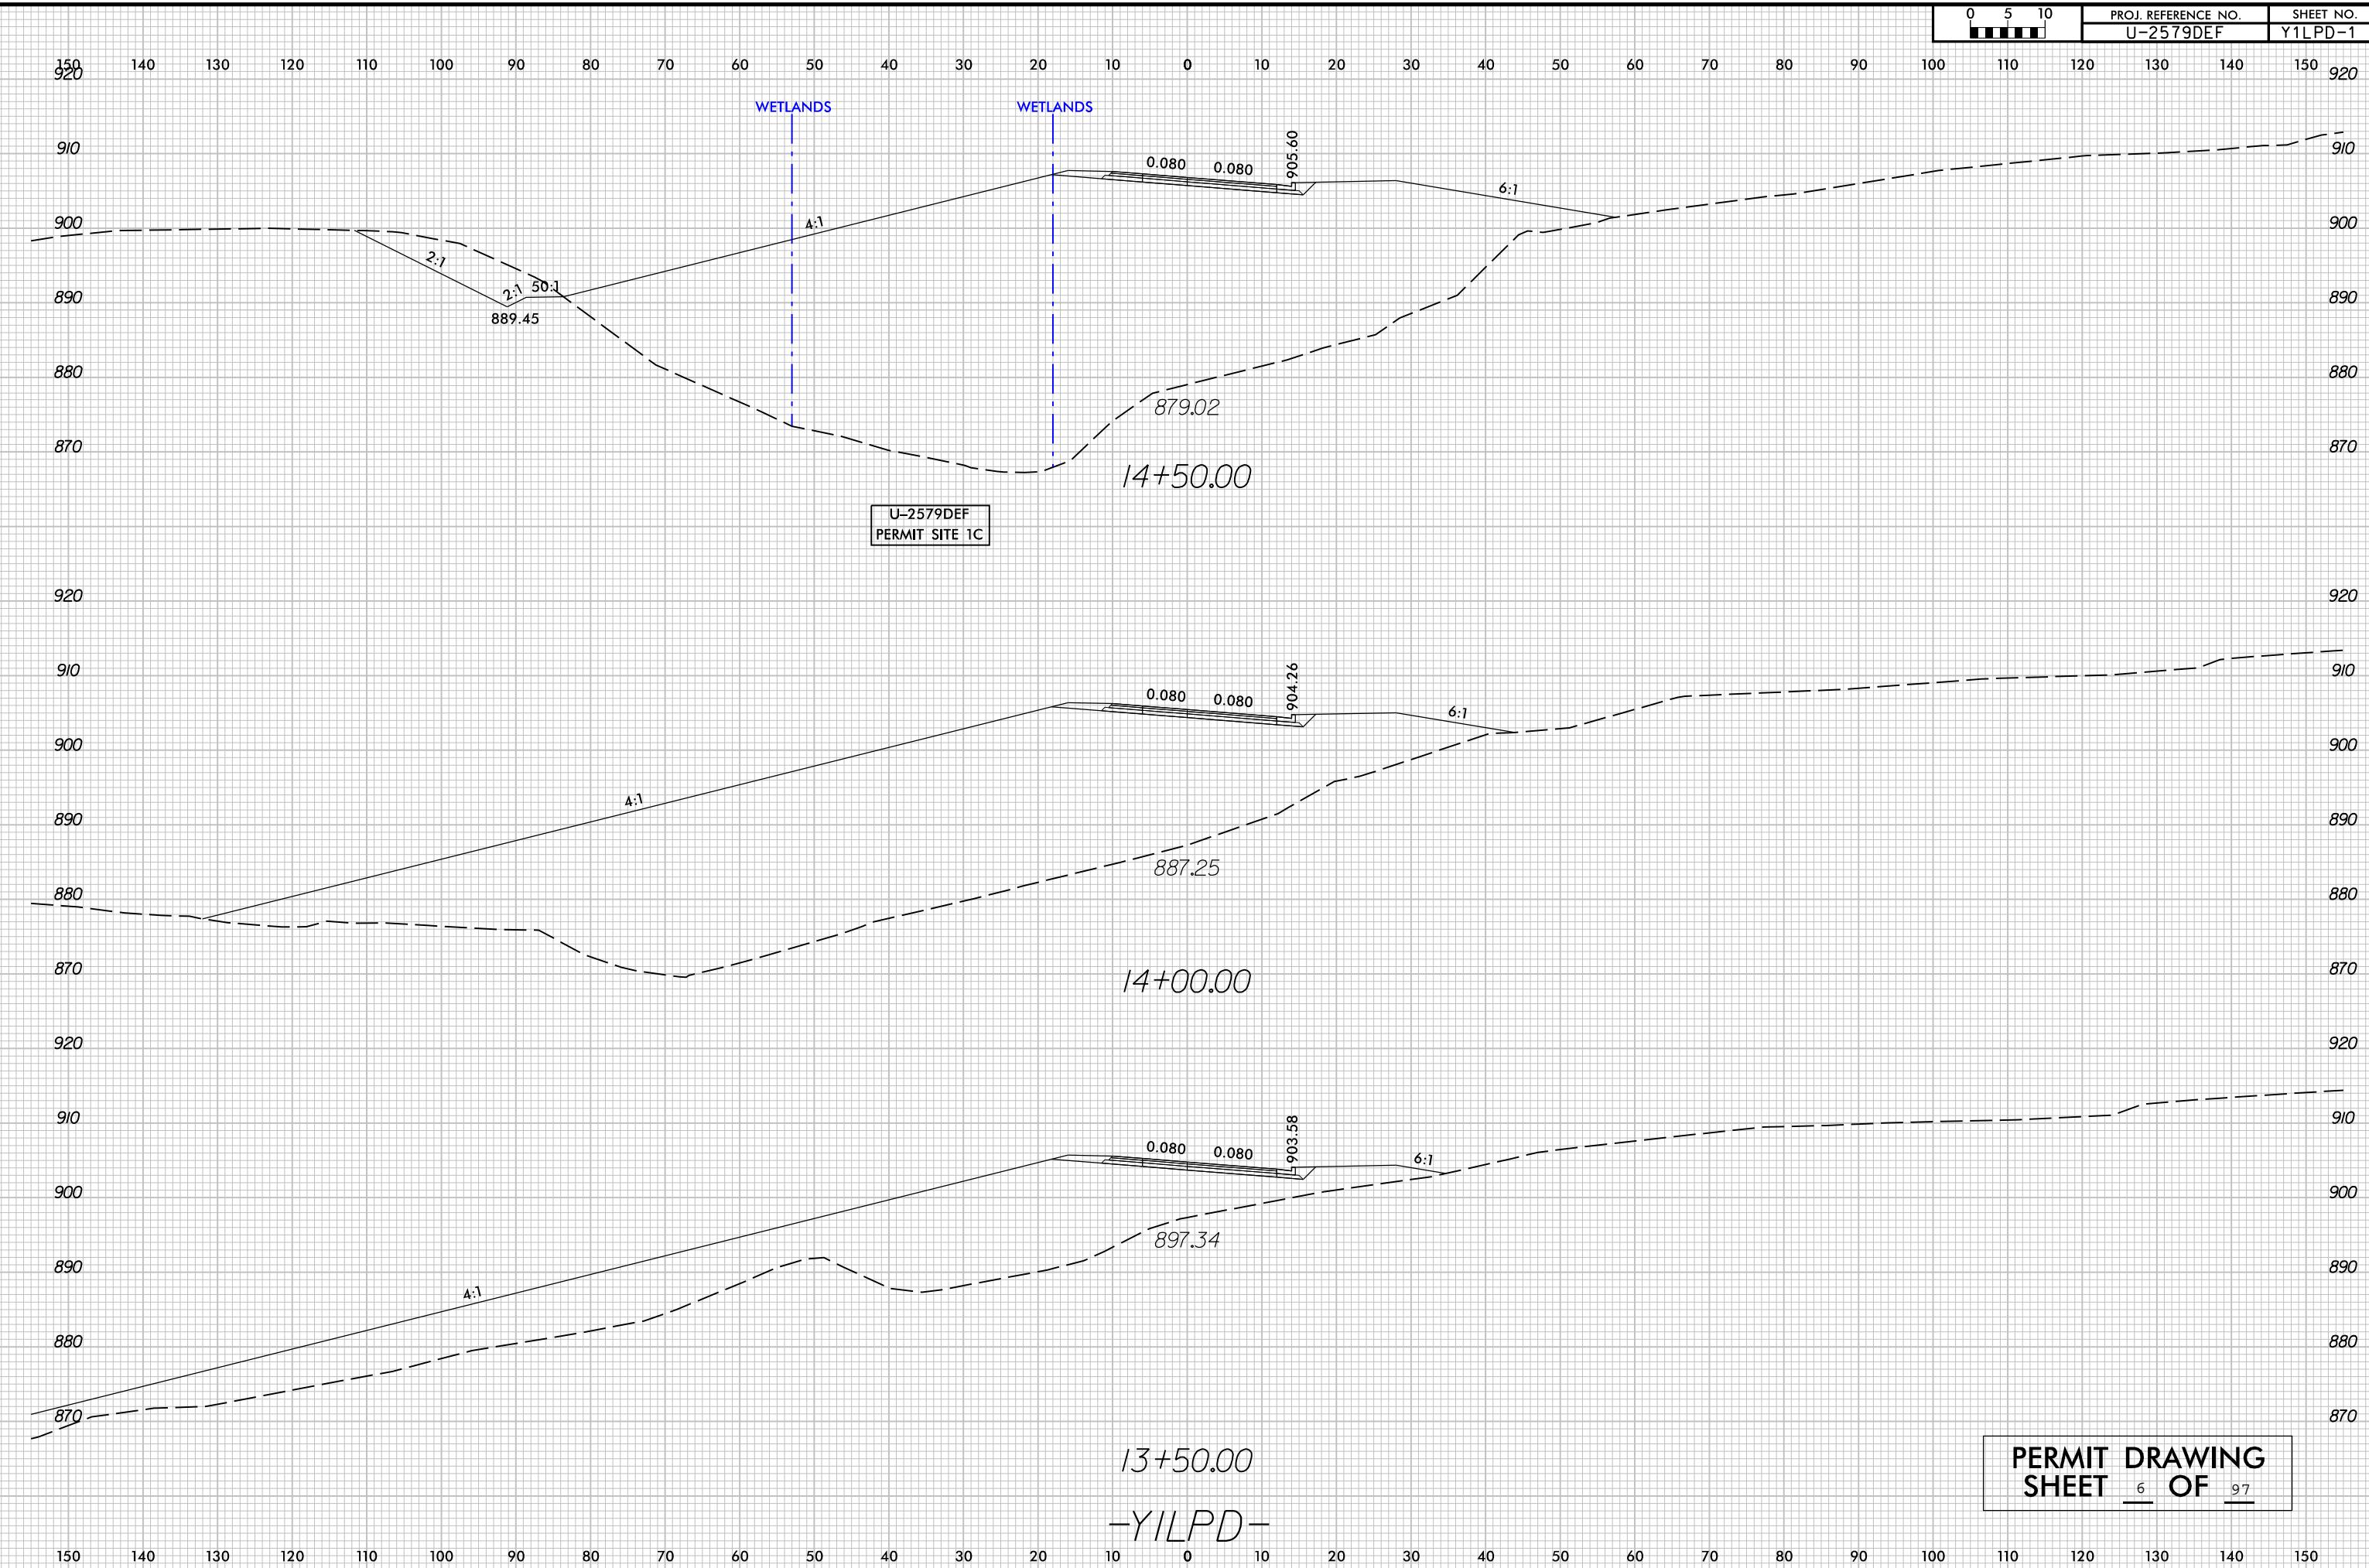

LEGEND

The legend consists of two parts. The top part shows a box with diagonal hatching and the letters 'F' in each half, labeled 'DENOTES FILL IN WETLAND'. The bottom part shows a box with diagonal hatching and the letters 'S' in each half, labeled 'DENOTES IMPACTS IN SURFACE WATER'.

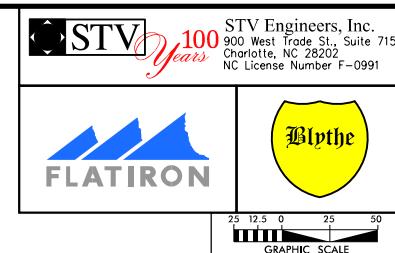


PROJECT REFERENCE NO.	SHEET NO.
U-2579D, E & F	5B


INCOMPLETE PLANS
DO NOT USE FOR R/W ACQUISITION


**DOCUMENT NOT CONSIDERED FINAL
UNLESS ALL SIGNATURES COMPLETED**


HDR HDR Engineering, Inc. of the Carolinas
555 Fayetteville St, Suite 900 Raleigh, NC 27601
N.C.B.E.L.S. License Number: F-0116

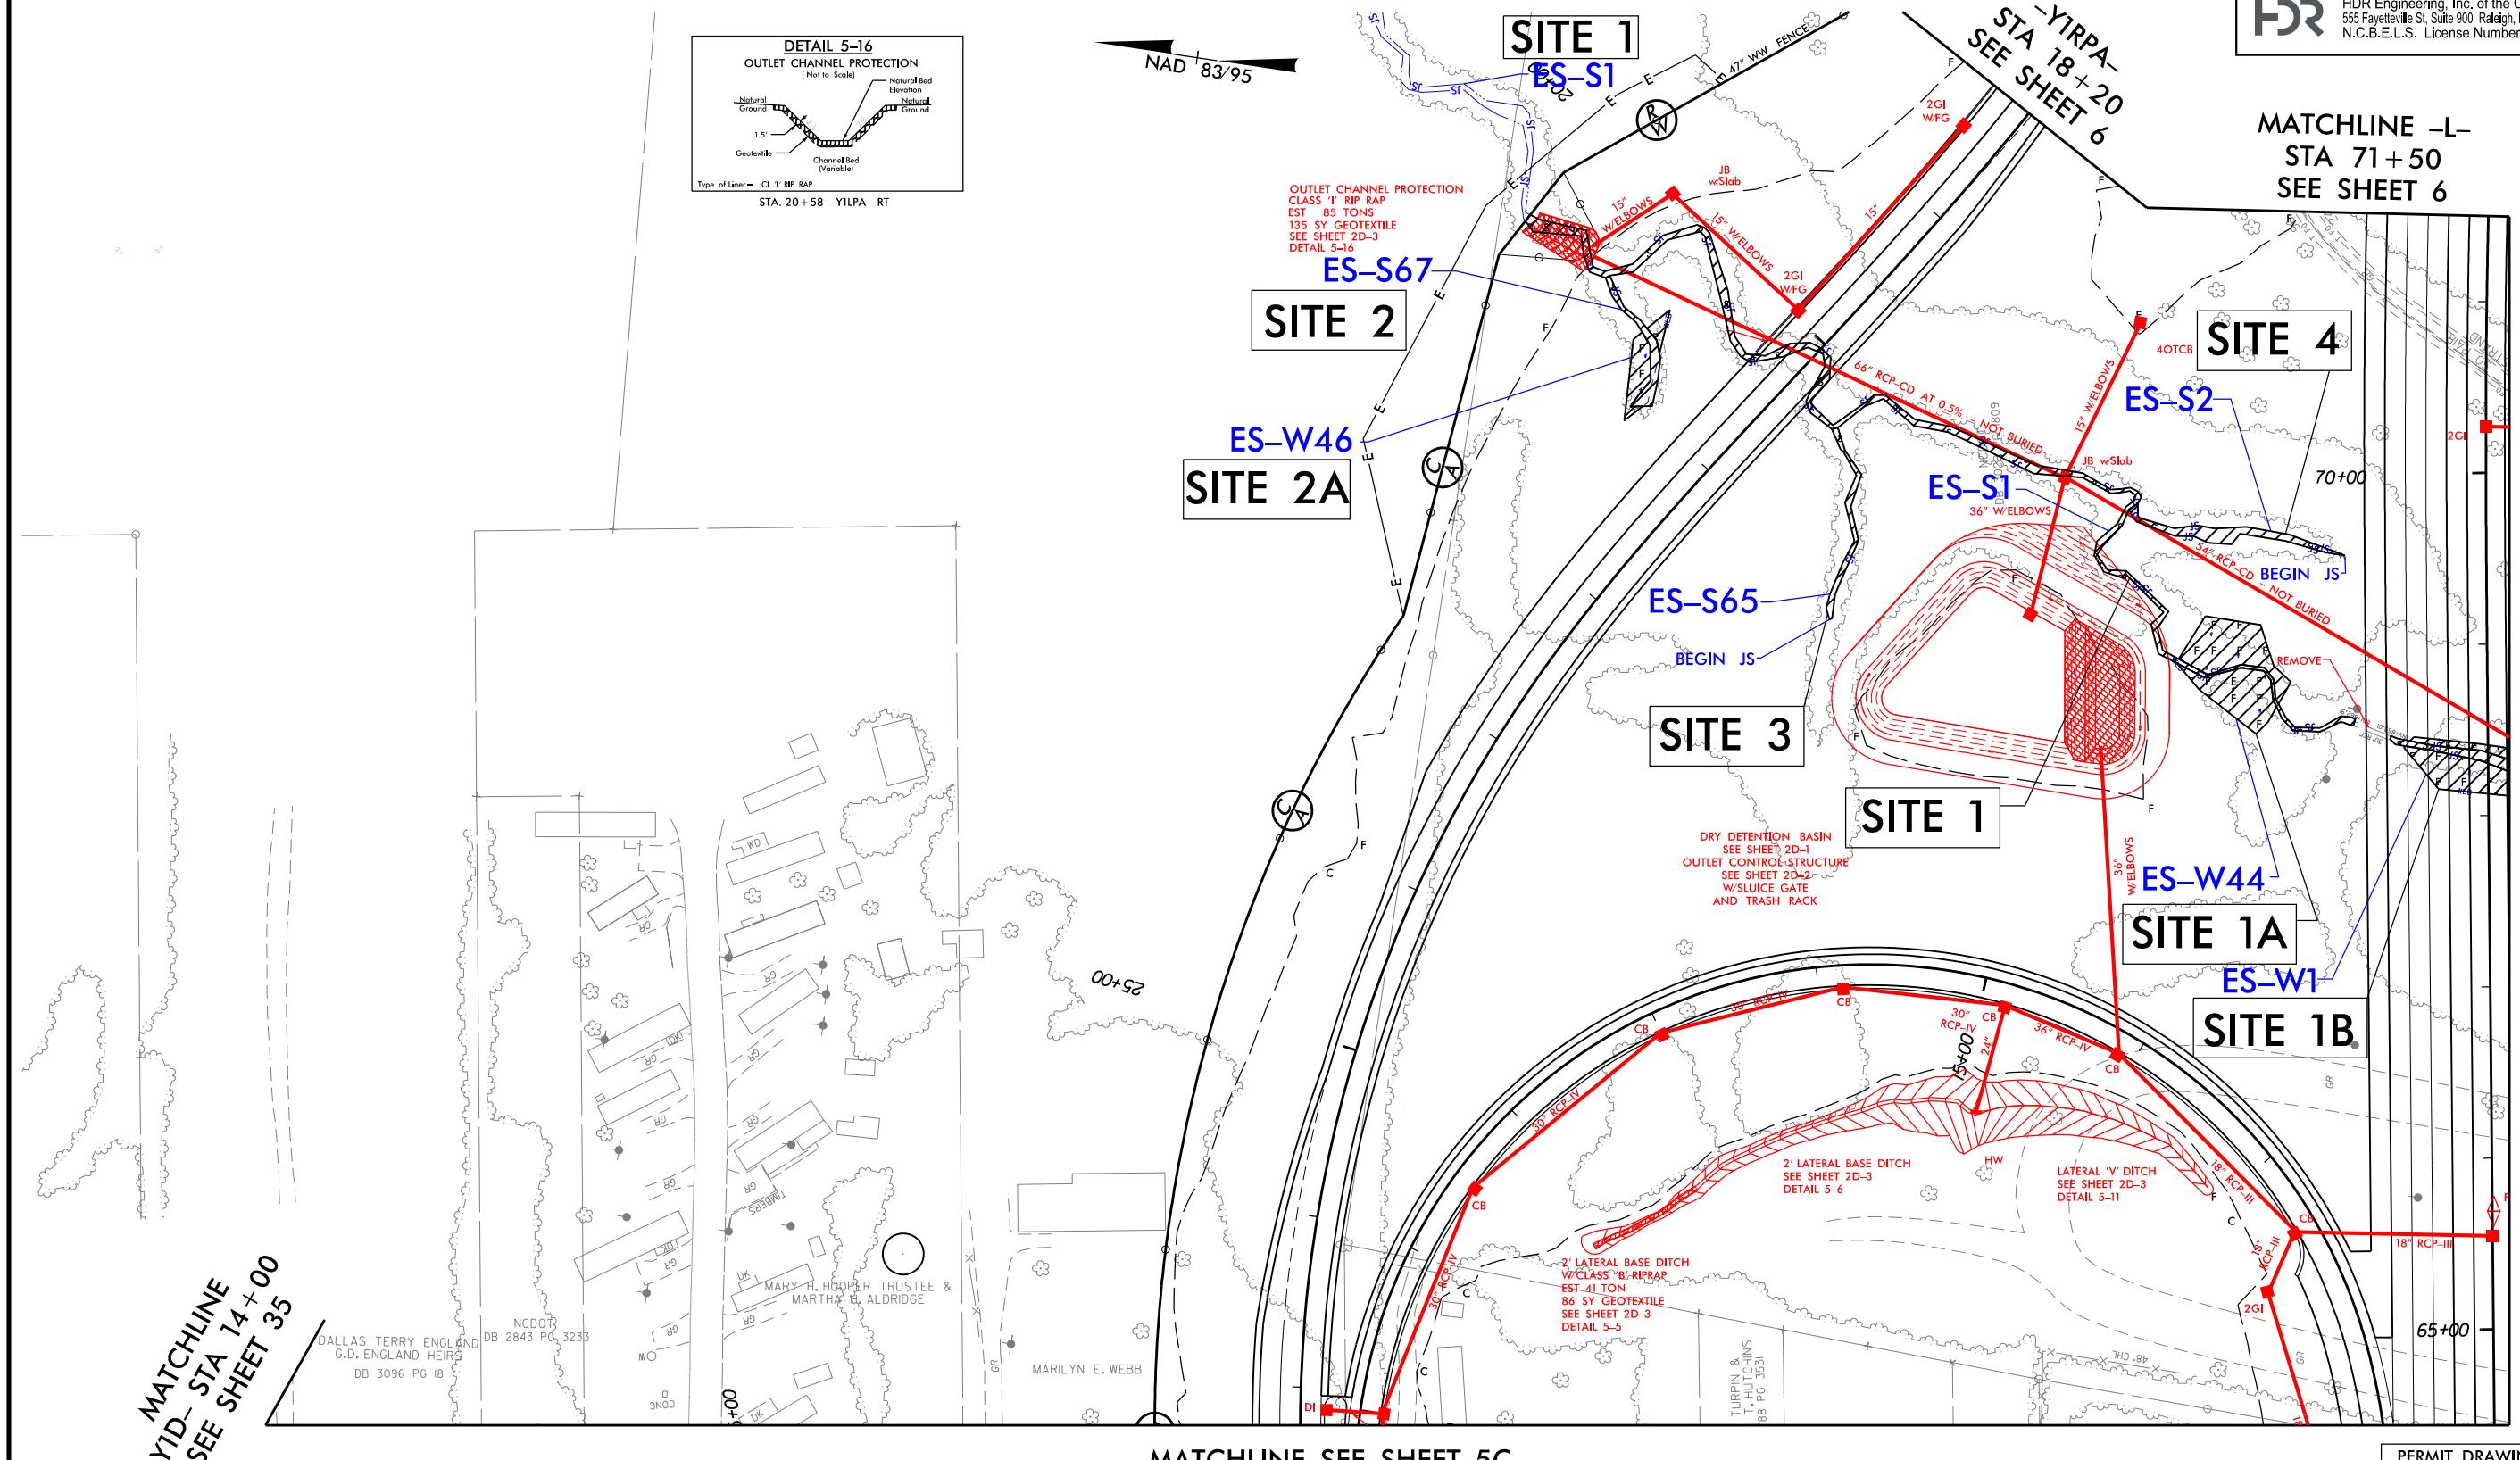



300	280	260	240	220	200	180	160	140	120	100	80	60	40	20	0	20	40	60	80	100	120	140	160	180	200	220	240	260	280	300
-----	-----	-----	-----	-----	-----	-----	-----	-----	-----	-----	----	----	----	----	---	----	----	----	----	-----	-----	-----	-----	-----	-----	-----	-----	-----	-----	-----

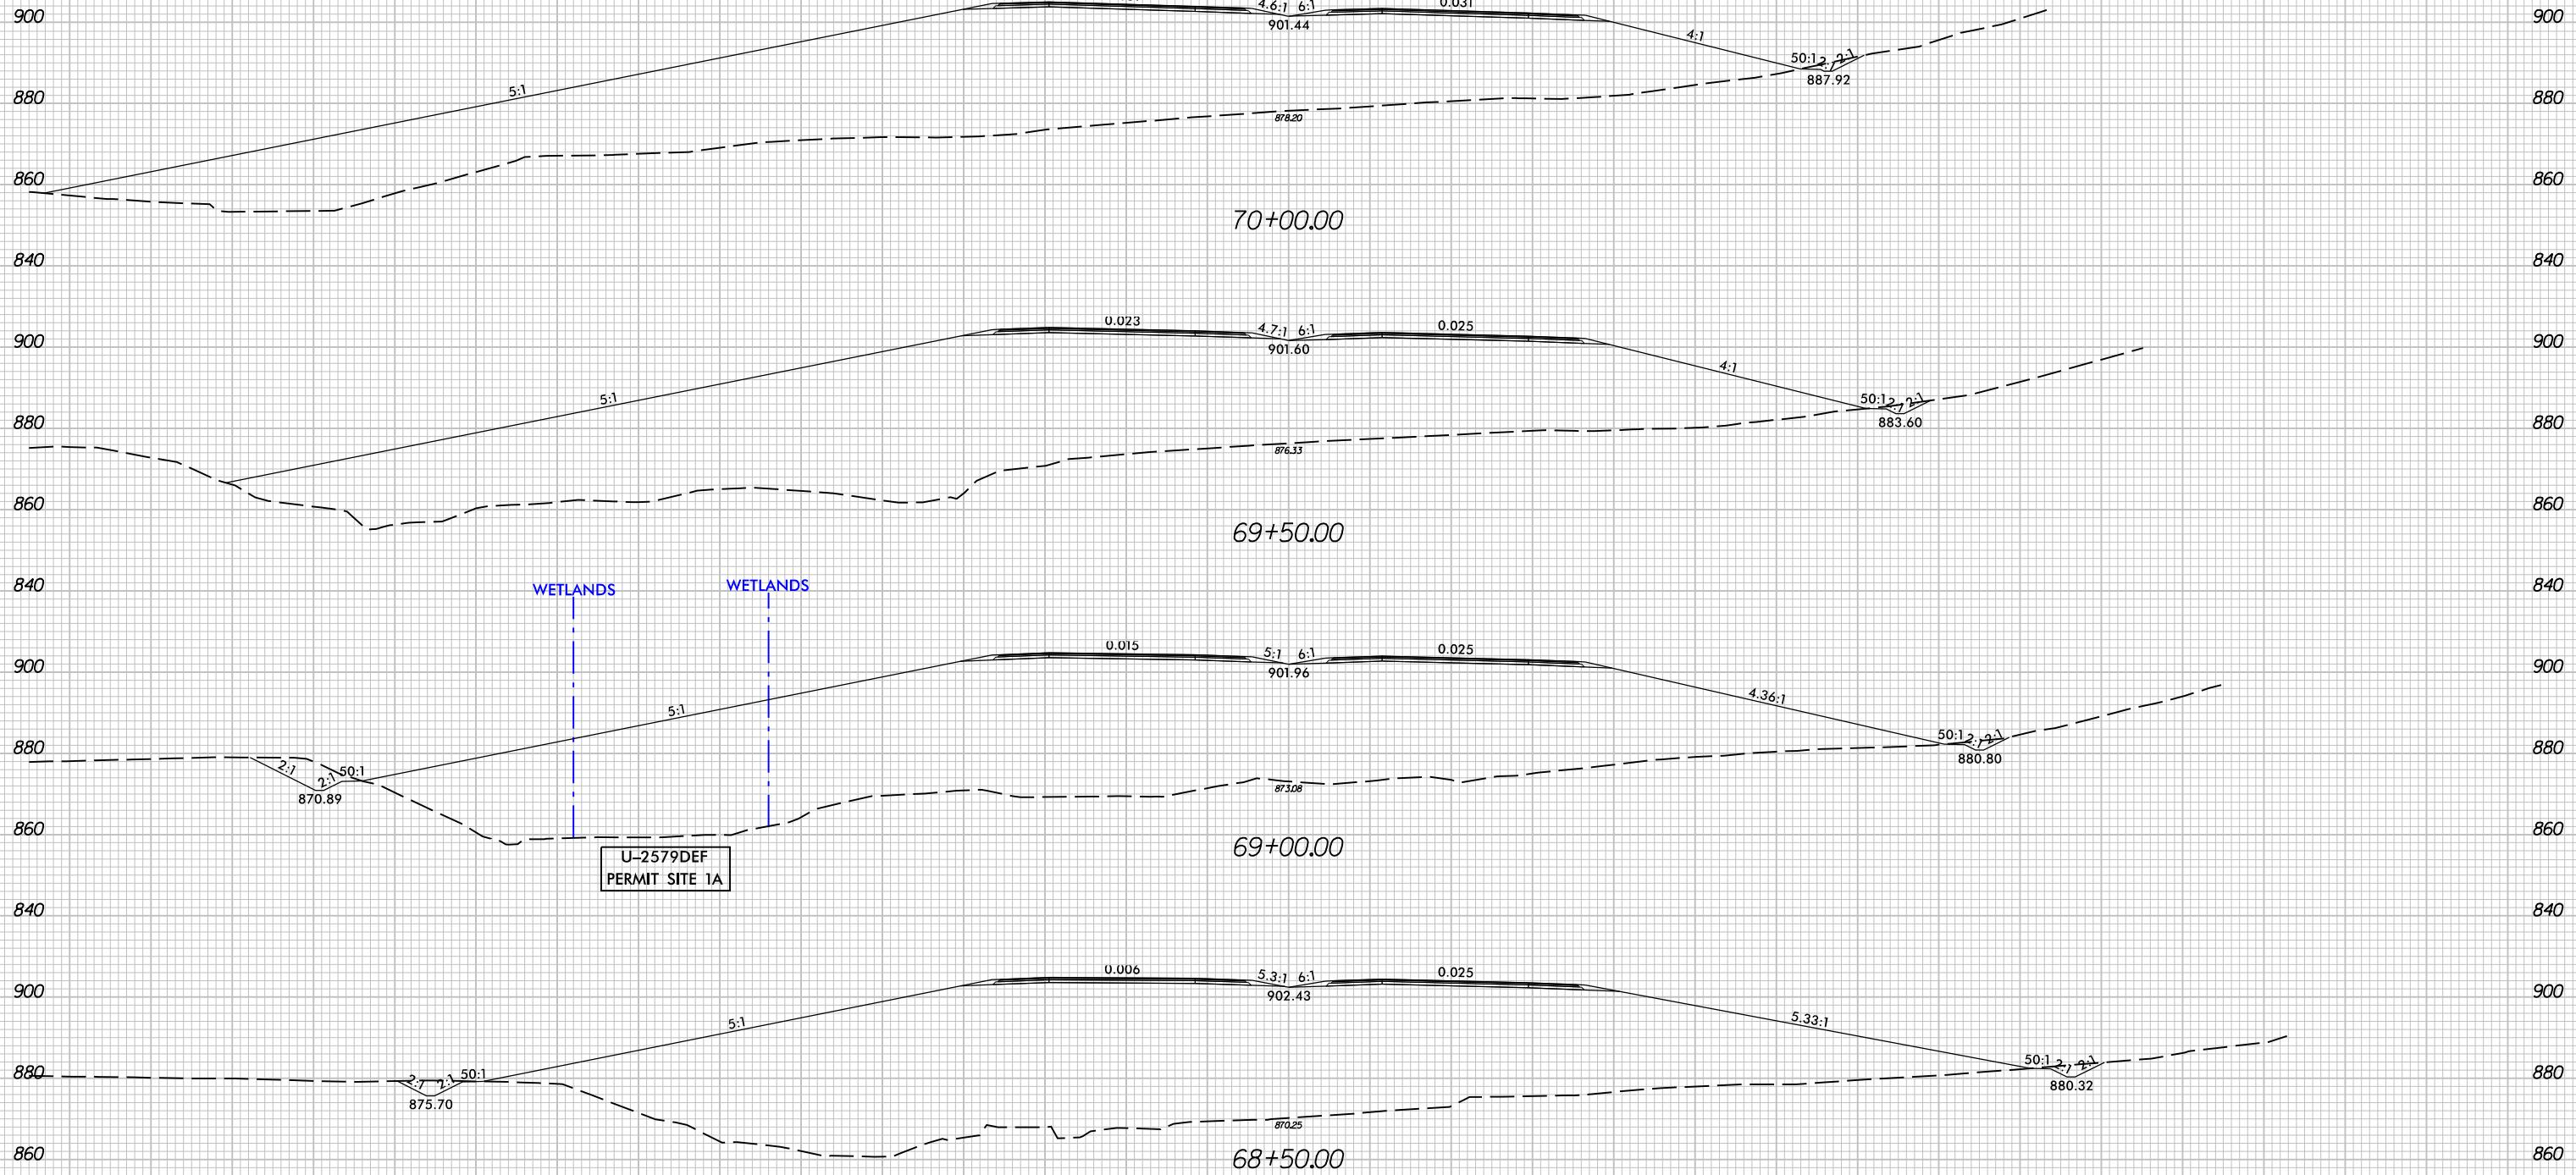

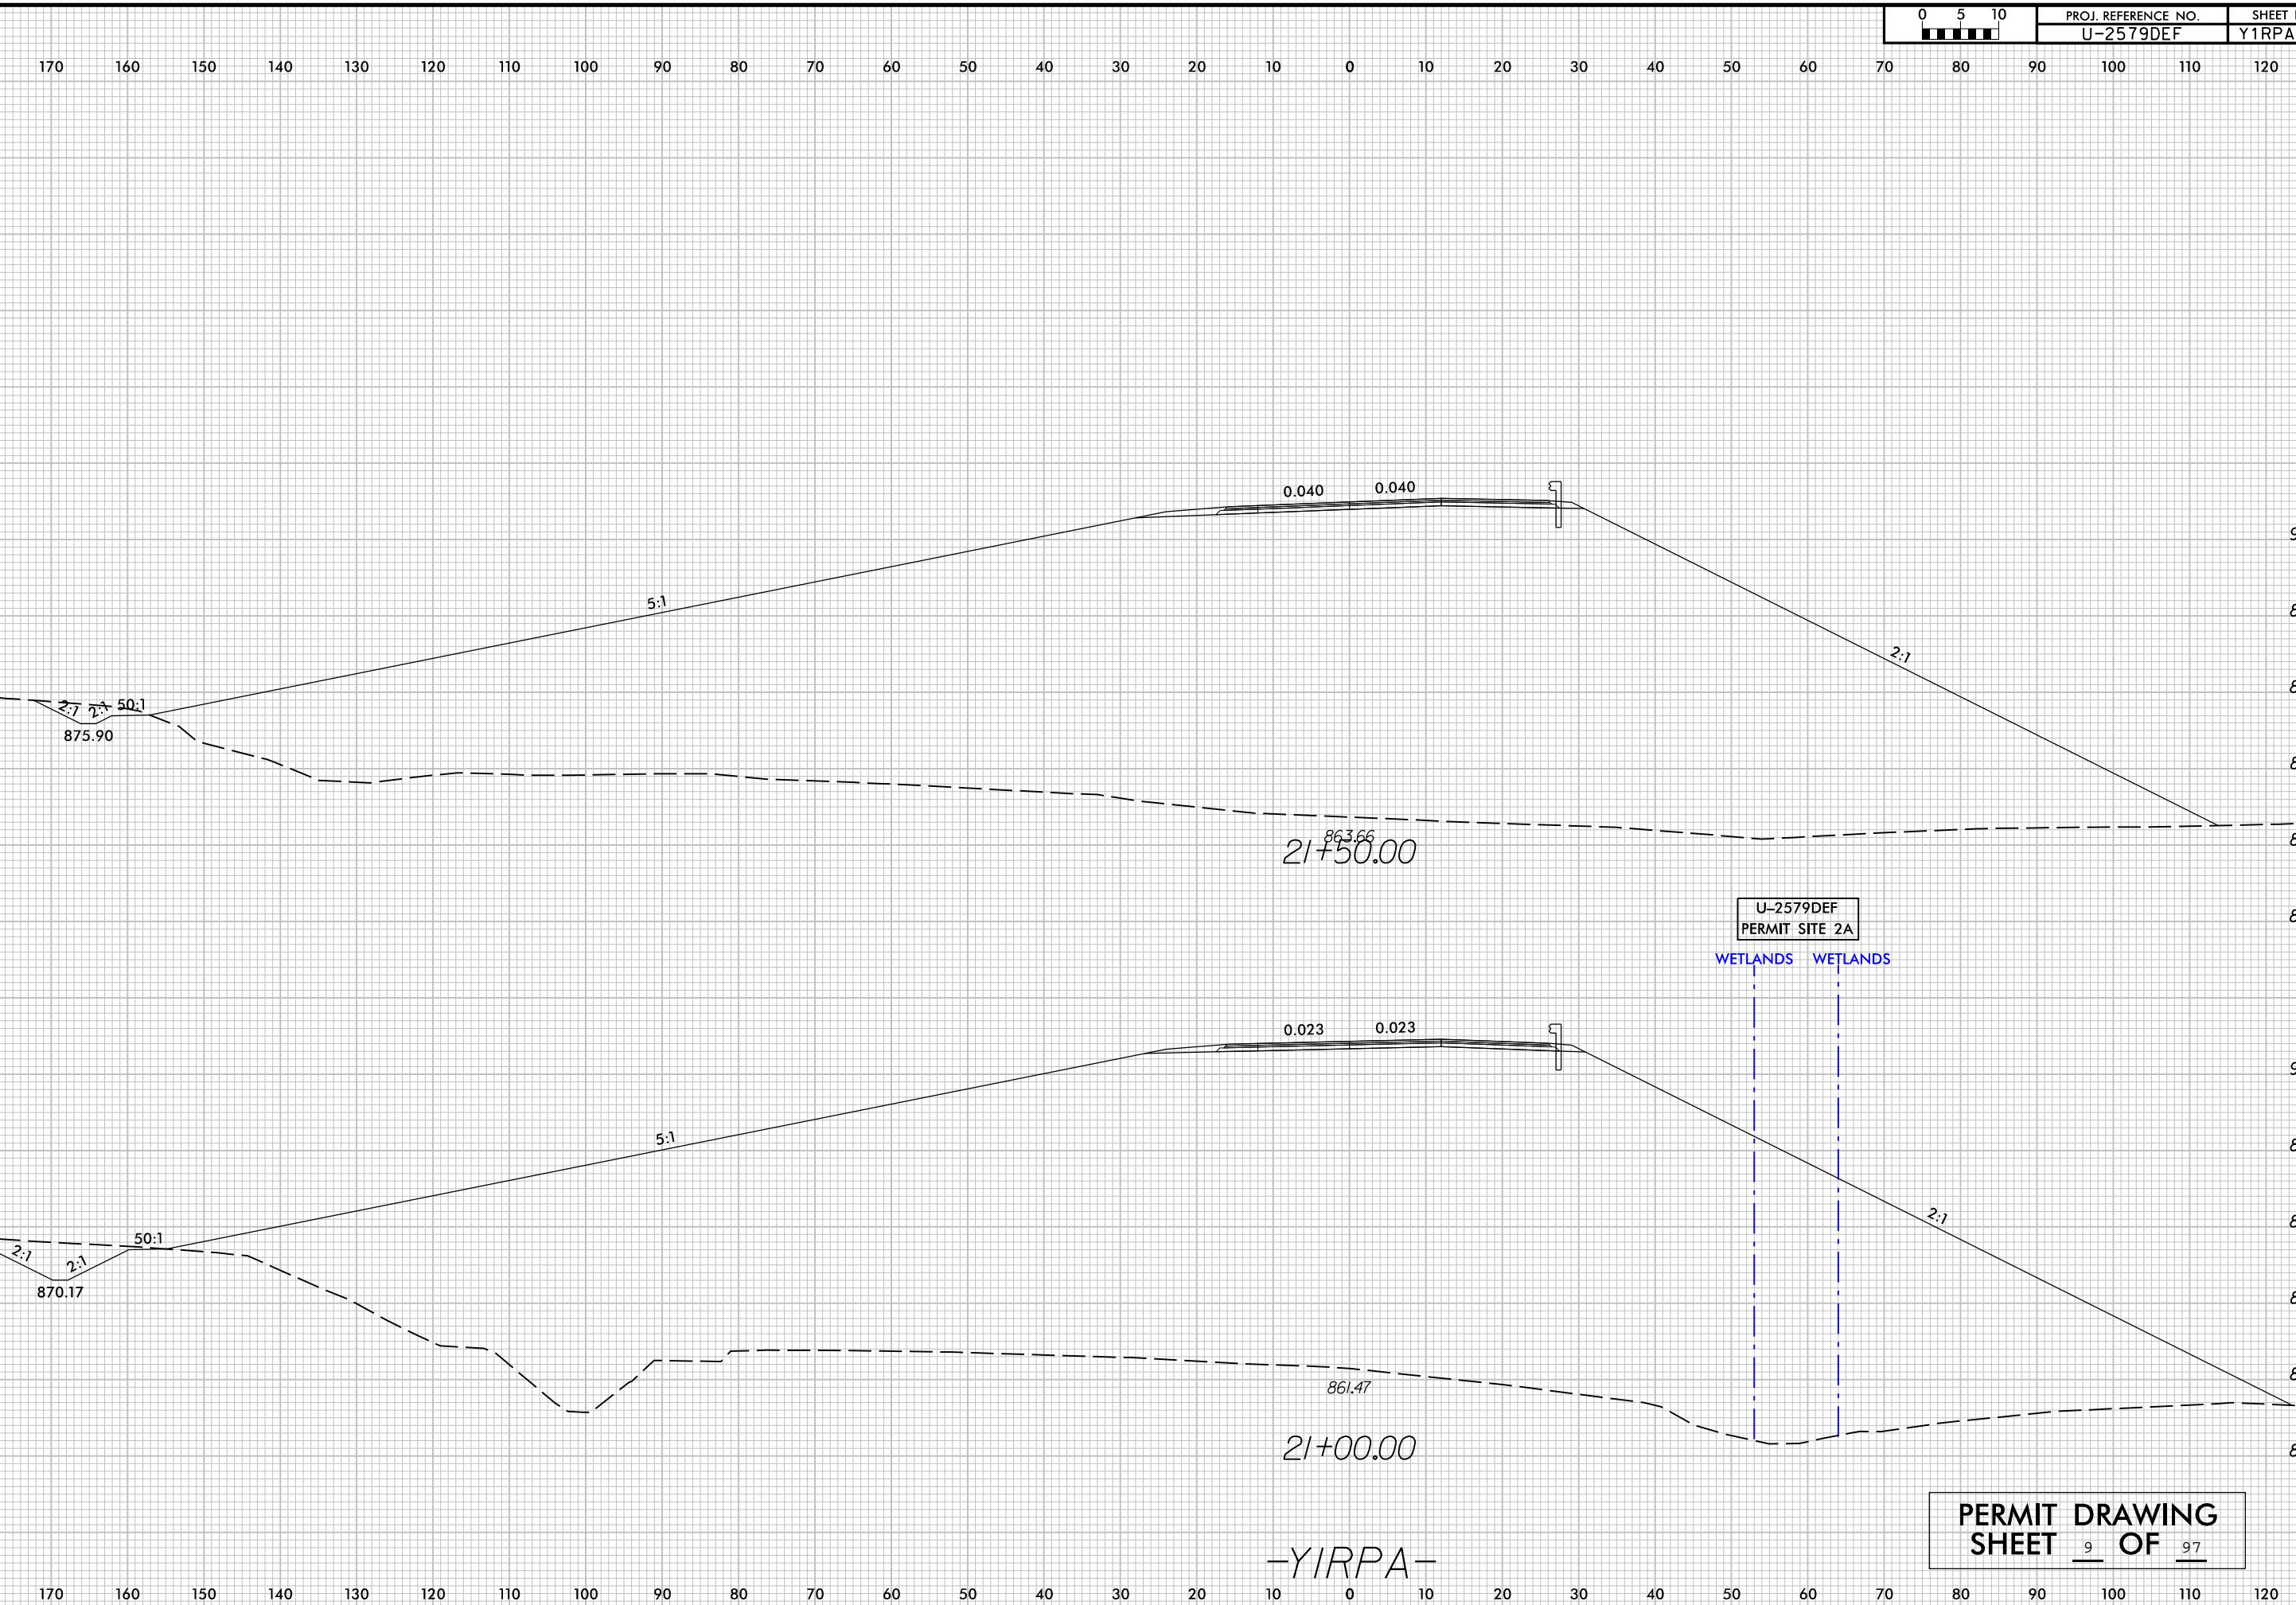

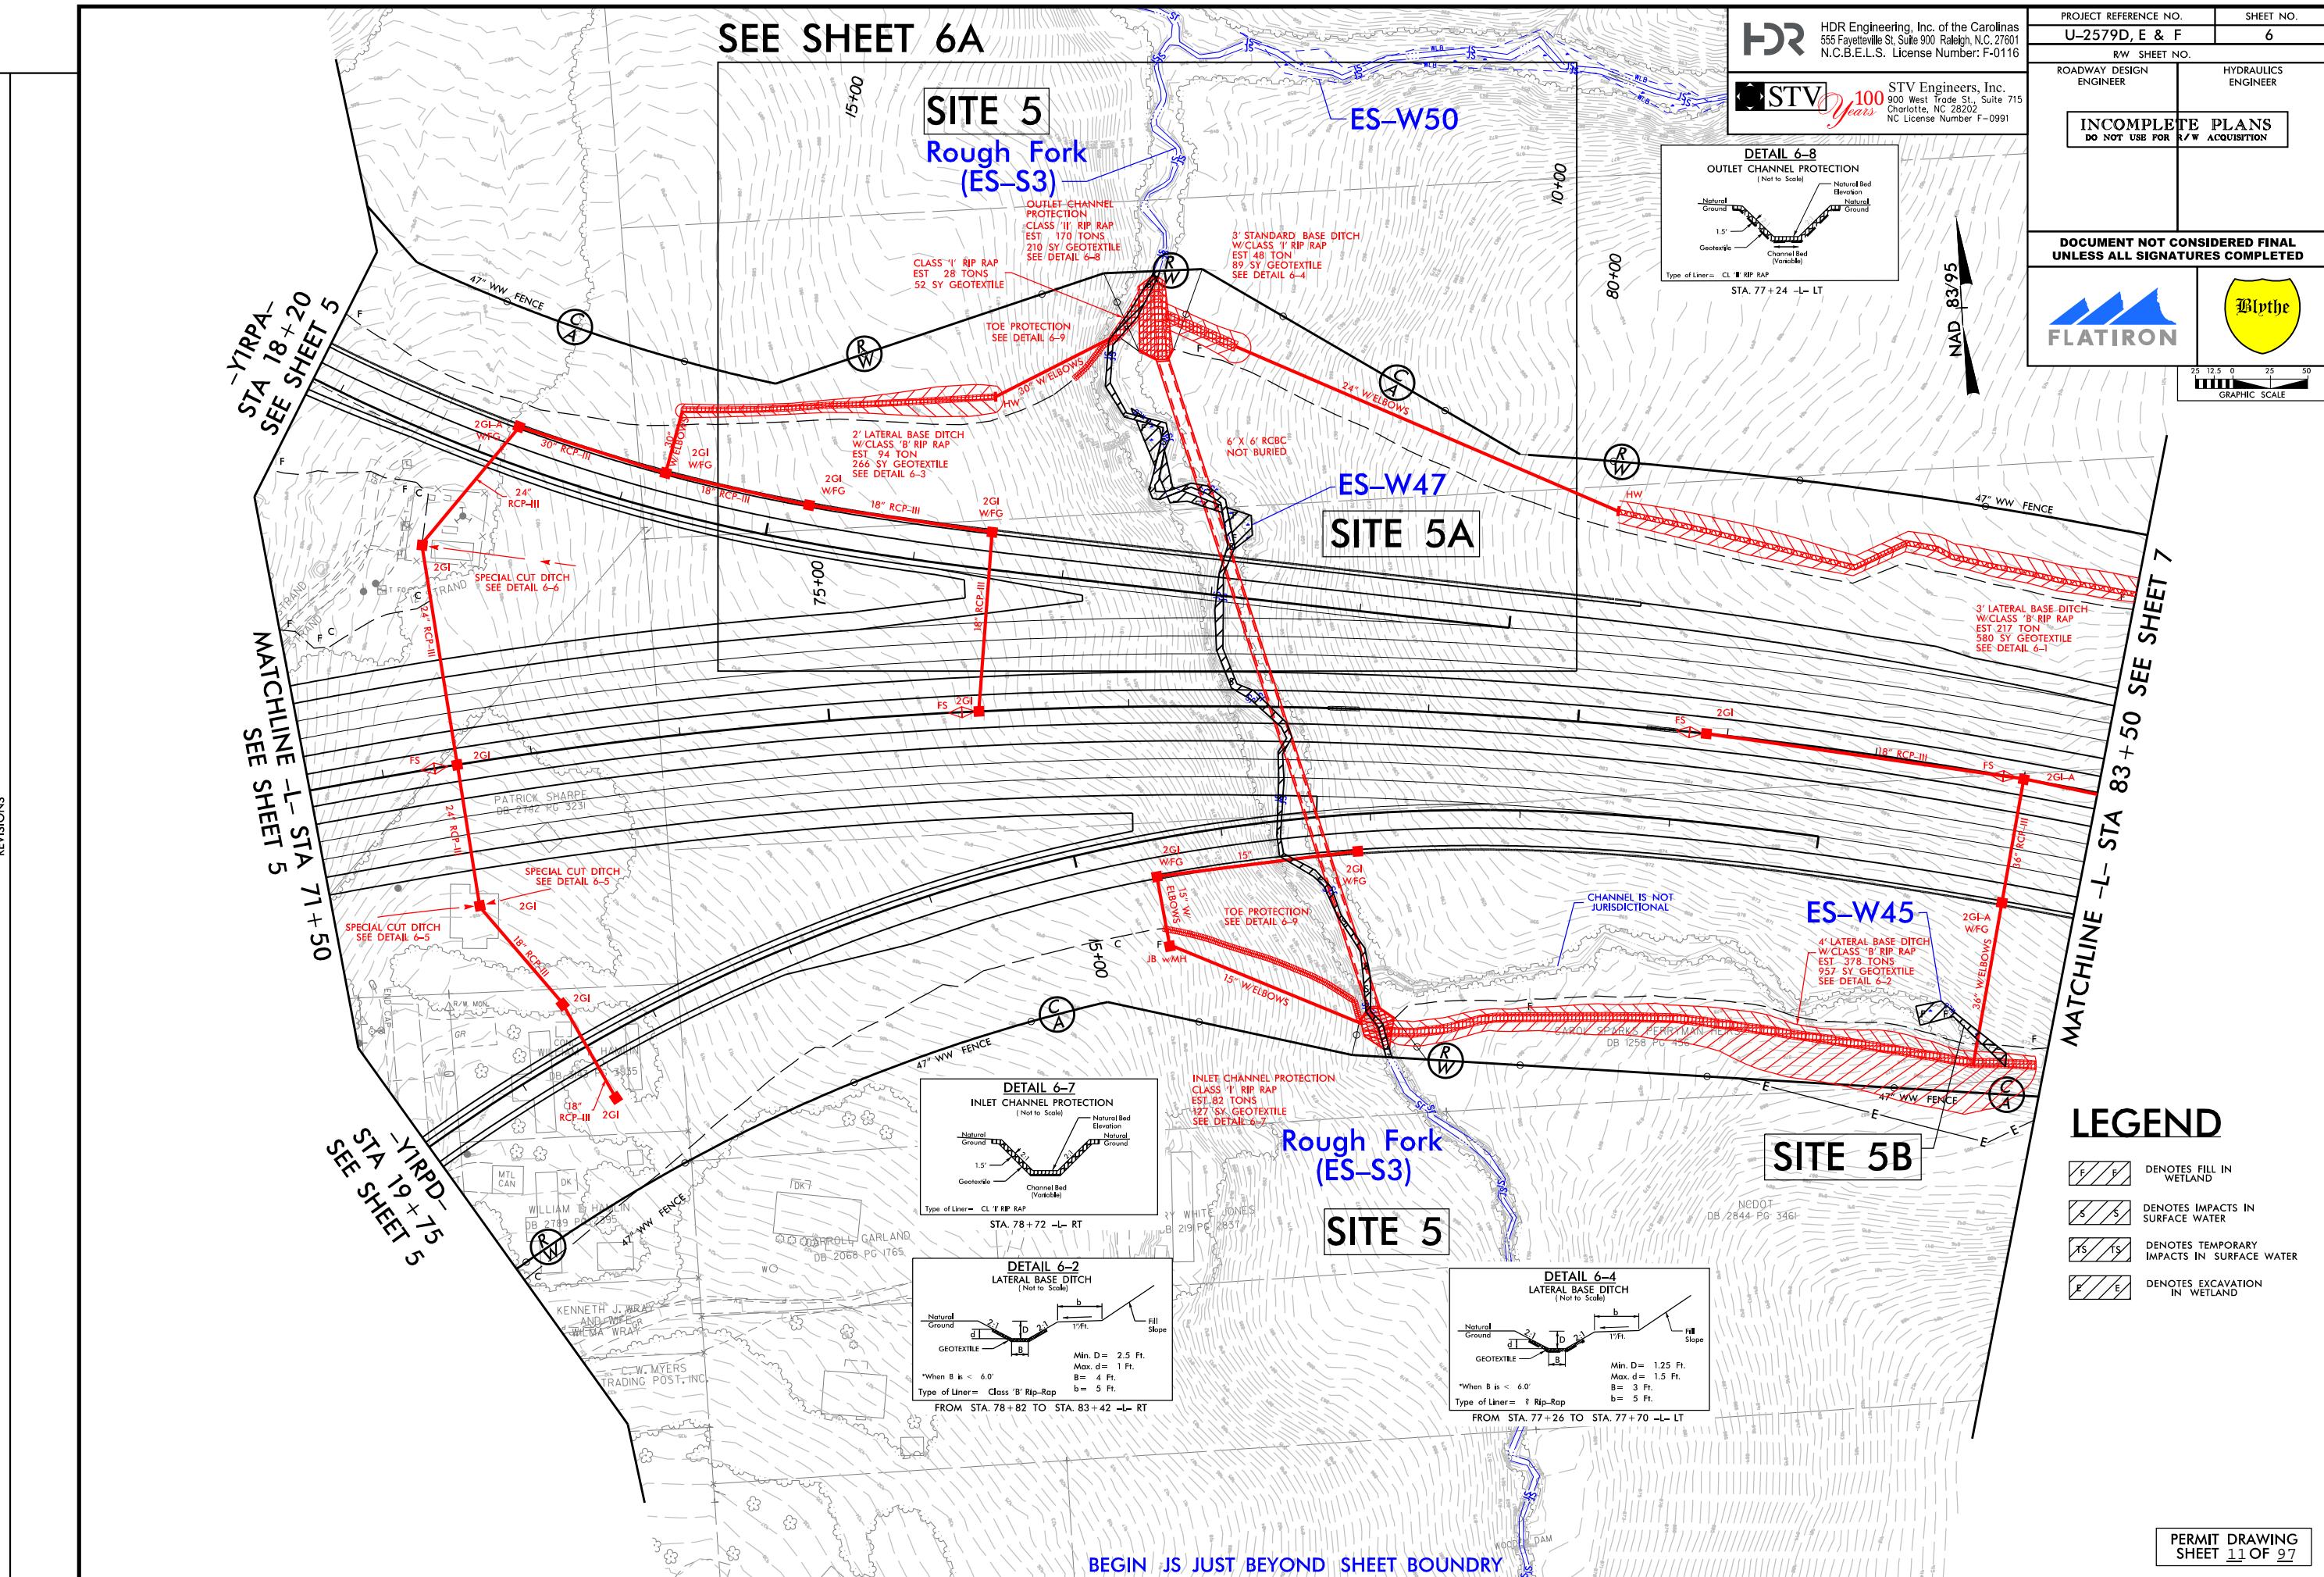

PROJECT REFERENCE NO.	SHEET NO.
U-2579D, E & F	6A
R/W SHEET NO.	
ROADWAY DESIGN ENGINEER	HYDRAULICS ENGINEER
INCOMPLETE PLANS DO NOT USE FOR R/W ACQUISITION	
DOCUMENT NOT CONSIDERED FINAL UNLESS ALL SIGNATURES COMPLETED	

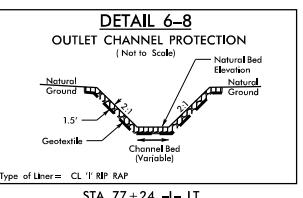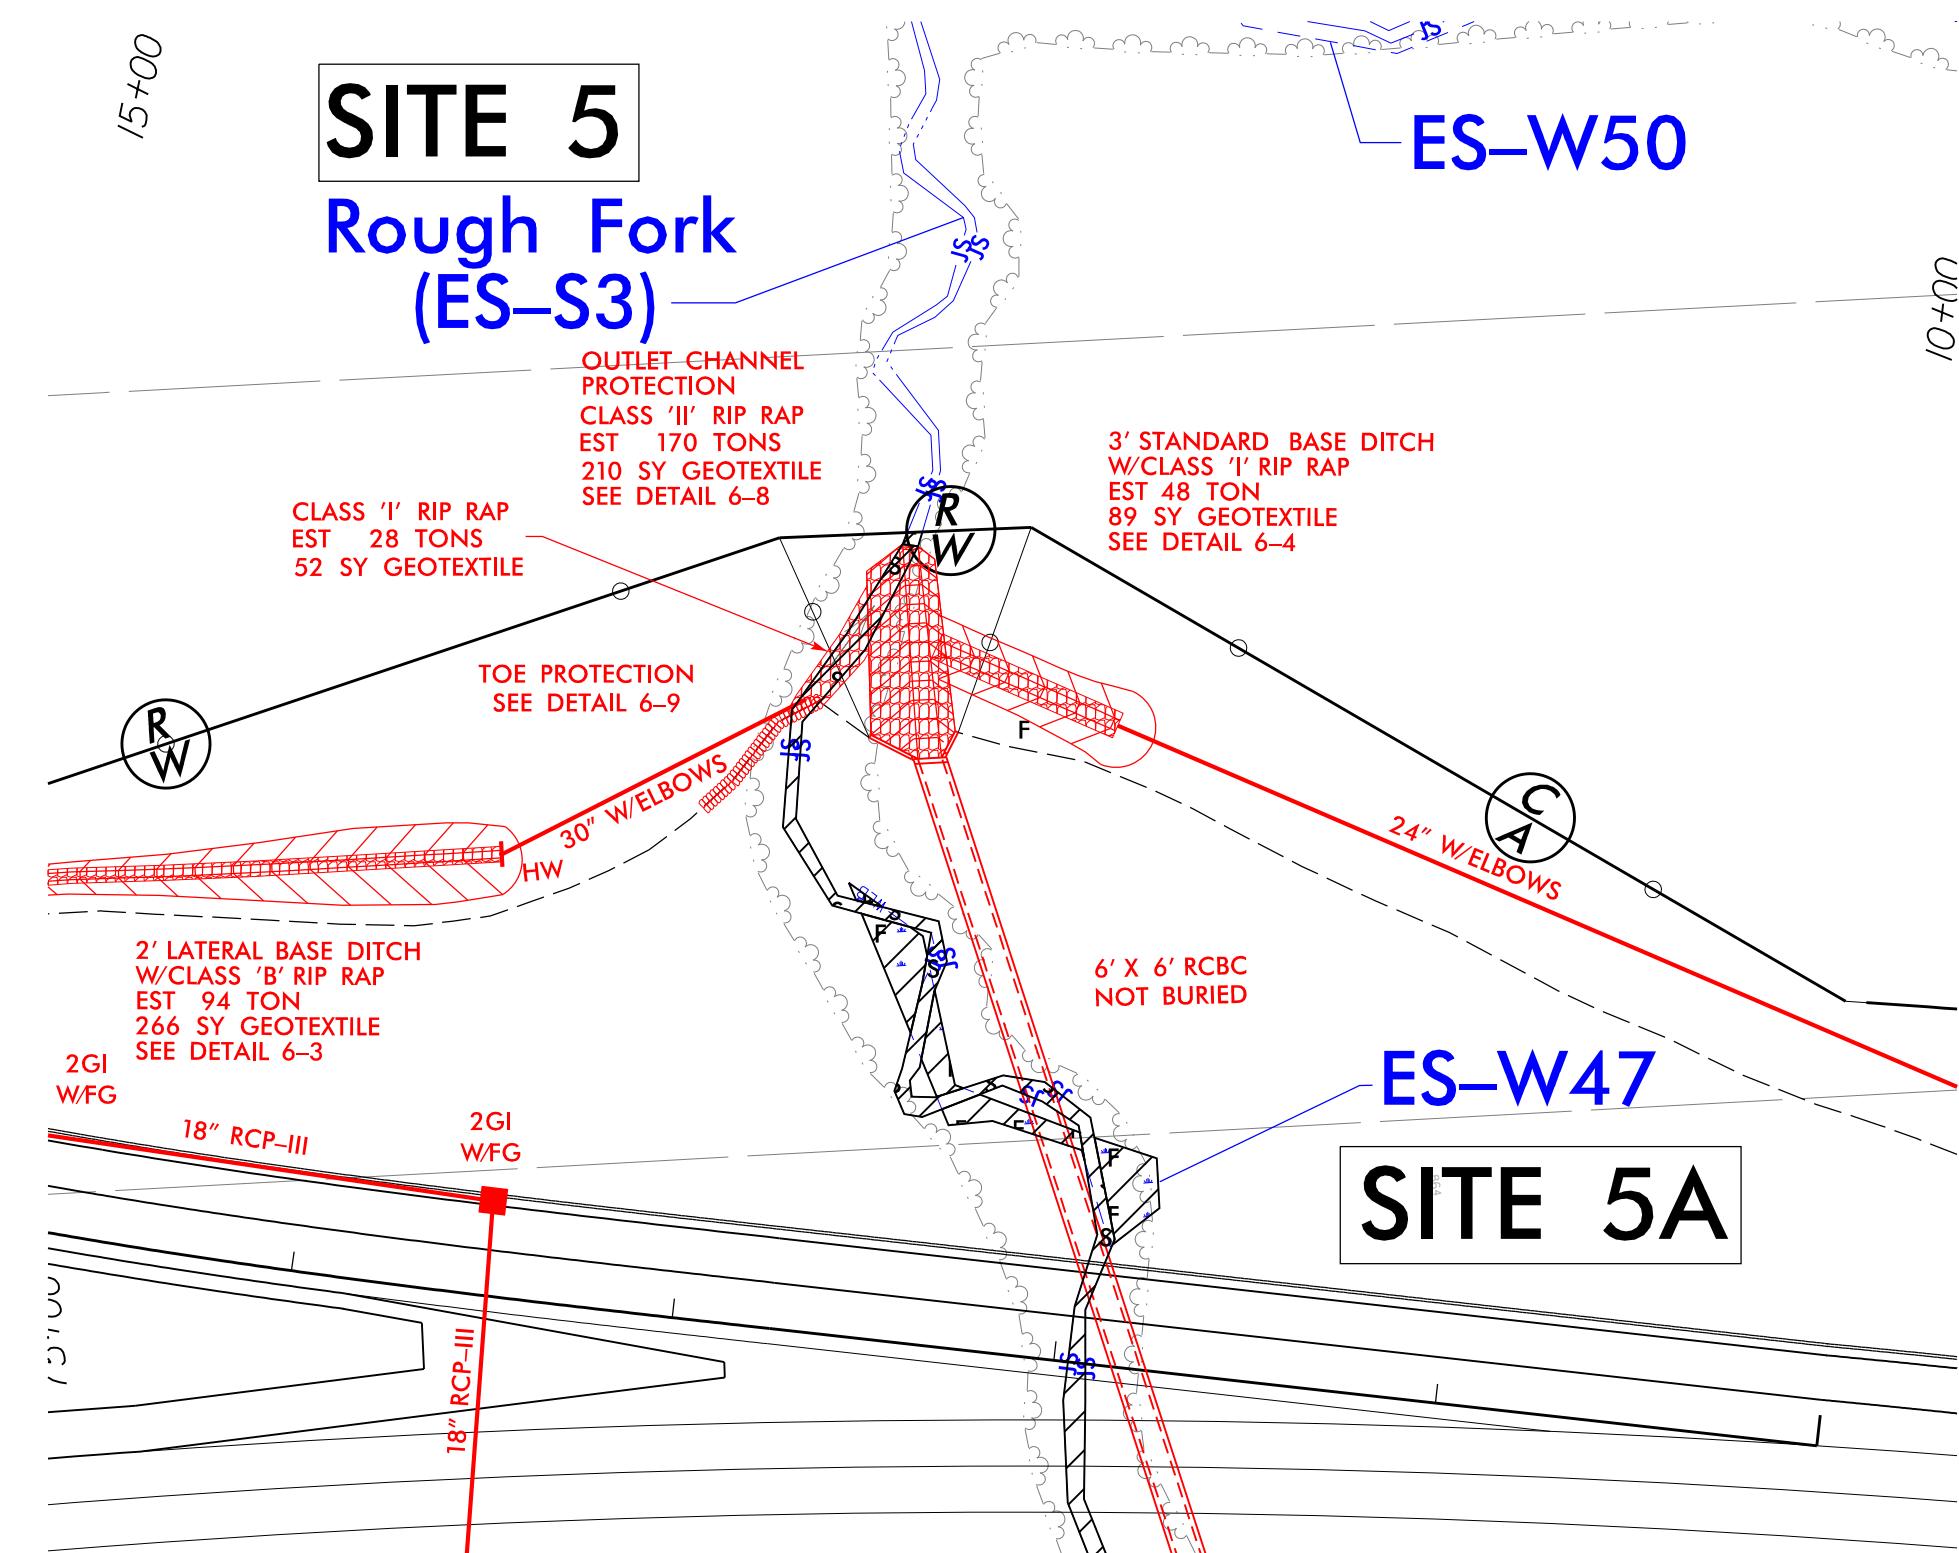


PROJECT REFERENCE NO.	SHEET NO.
U-2579D,E & F	
ROADWAY DESIGN ENGINEER	HYDRAULICS ENGINEER

DOCUMENT NOT CONSIDERED FINAL
UNLESS ALL SIGNATURES COMPLETED


SCALE:
1"=100' HORIZONTAL
1"=20' VERTICAL

300 250 200 150 100 50 0 50 100 150 200 250

SITE 5

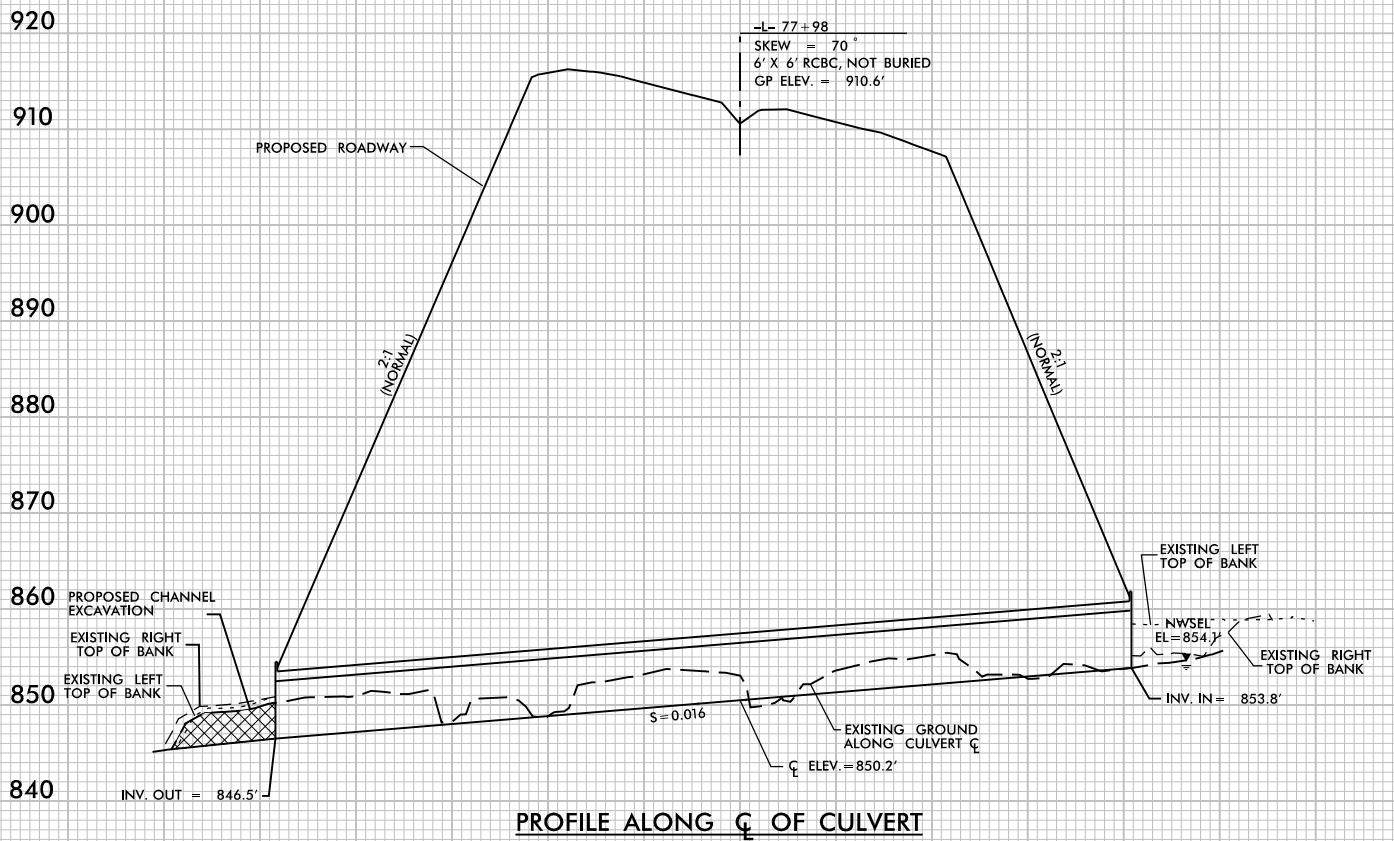


300 280 260 240 220 200 180 160 140 120 100 80 60 40 20 0 20 40 60 80 100 120 140 160 180 200 220 240 260 280 300

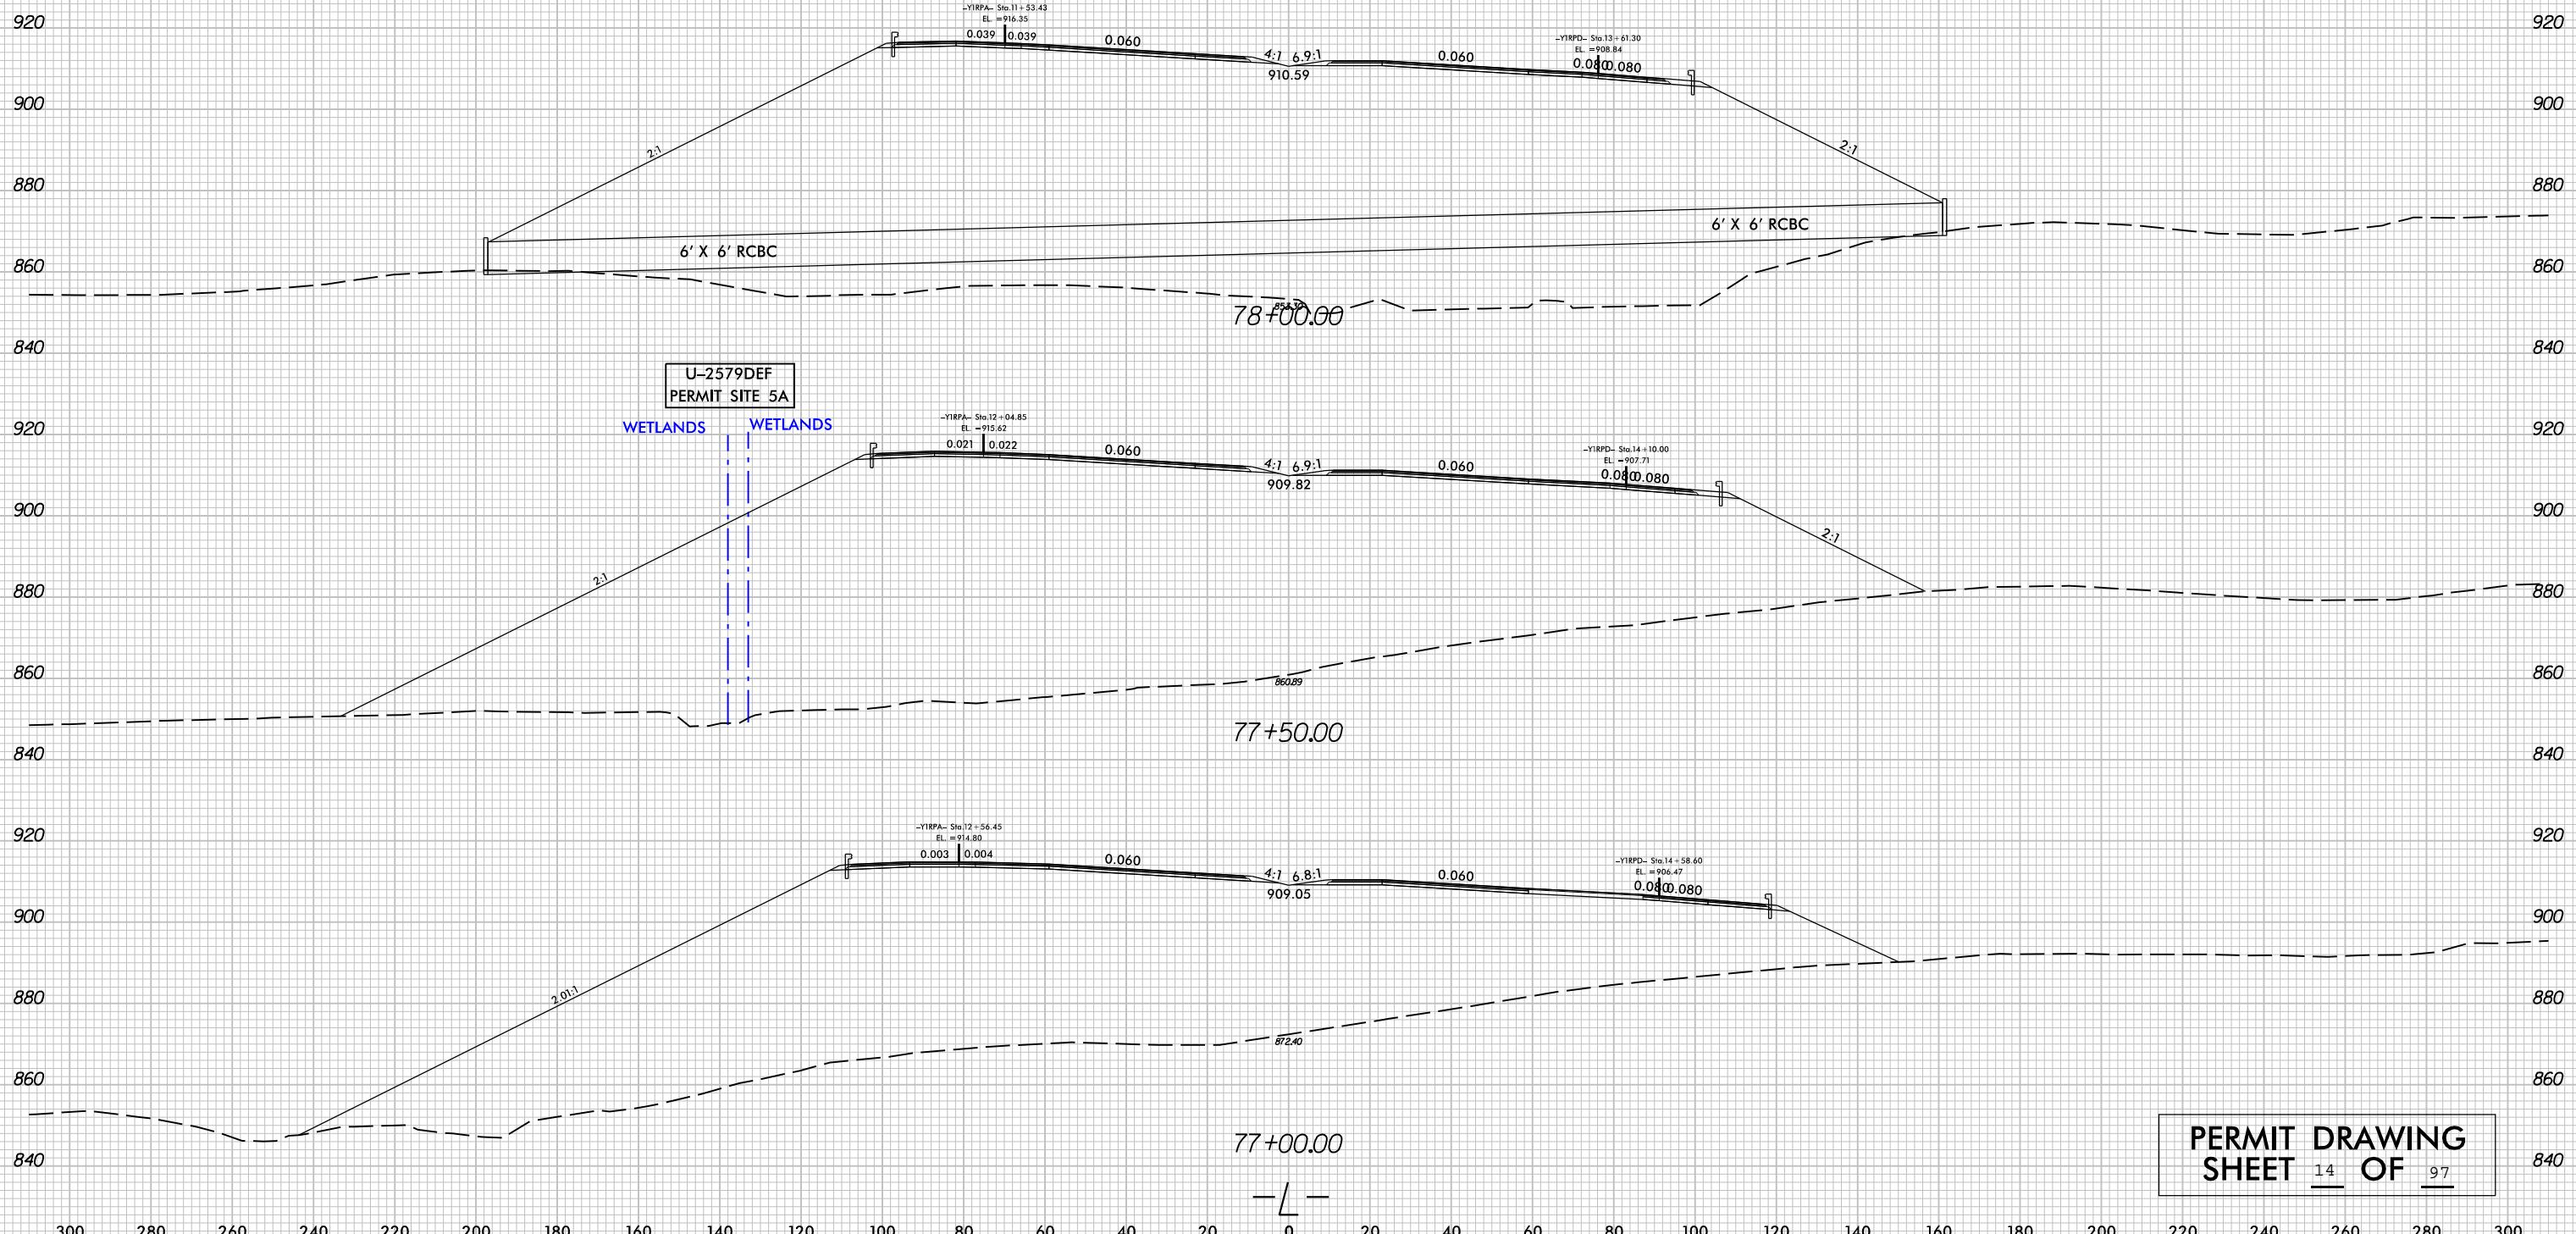

300 280 260 240 220 200 180 160 140 120 100 80 60 40 20 0 20 40 60 80 100 120 140 160 180 200 220 240 260 280 300

U-2579DEF
PERMIT SITE 5B


WETLANDS WETLANDS

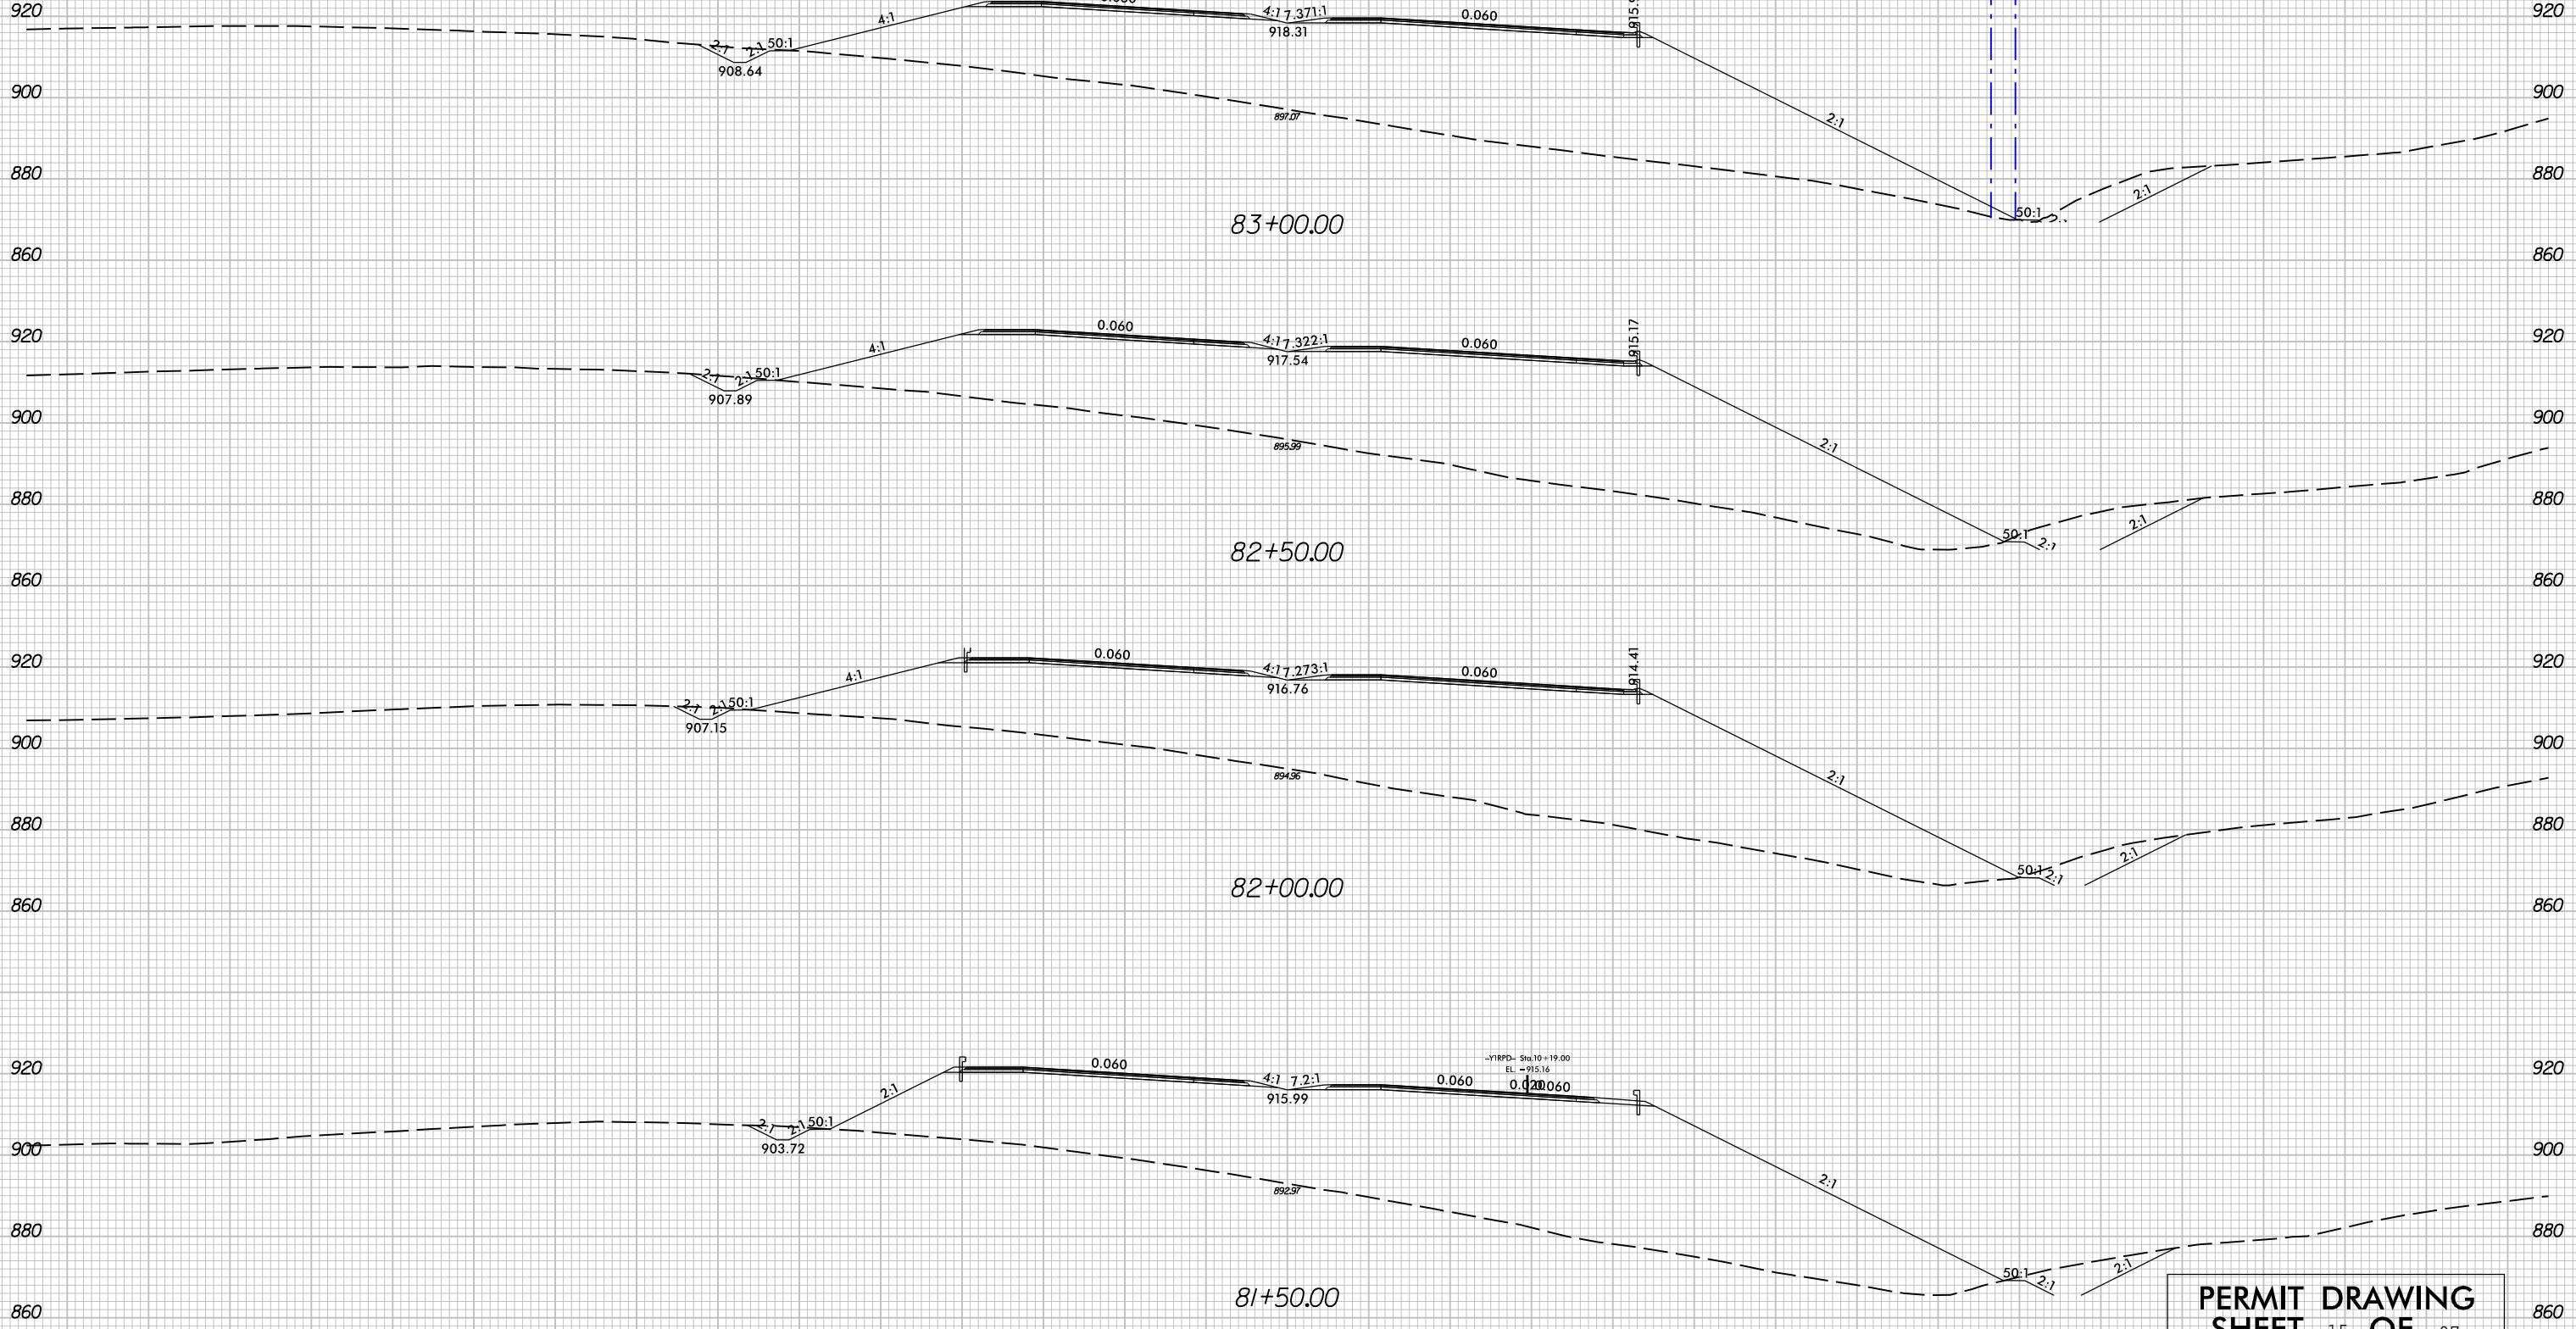

**PERMIT DRAWING
SHEET 15 OF 97**

PLOT DRIVER: NCDOT.pdf-color-100.pit
PINTERABLE: NCDOT-permits-NOCON.tbi
USER: CMYERS DATE: 10/17/2018 TIME: 6:02:28 PM
FILE: Flatiron_Construction_Corp.\Flatiron-U-2579_D.E.F._WS\6.O..CAD.BIN\6.2.WIPU-2579DEF\Hydraulics\PERMITS_Environment\Drawings\U2579DEF_PRM_4C.PSH.dgn

REVISIONS

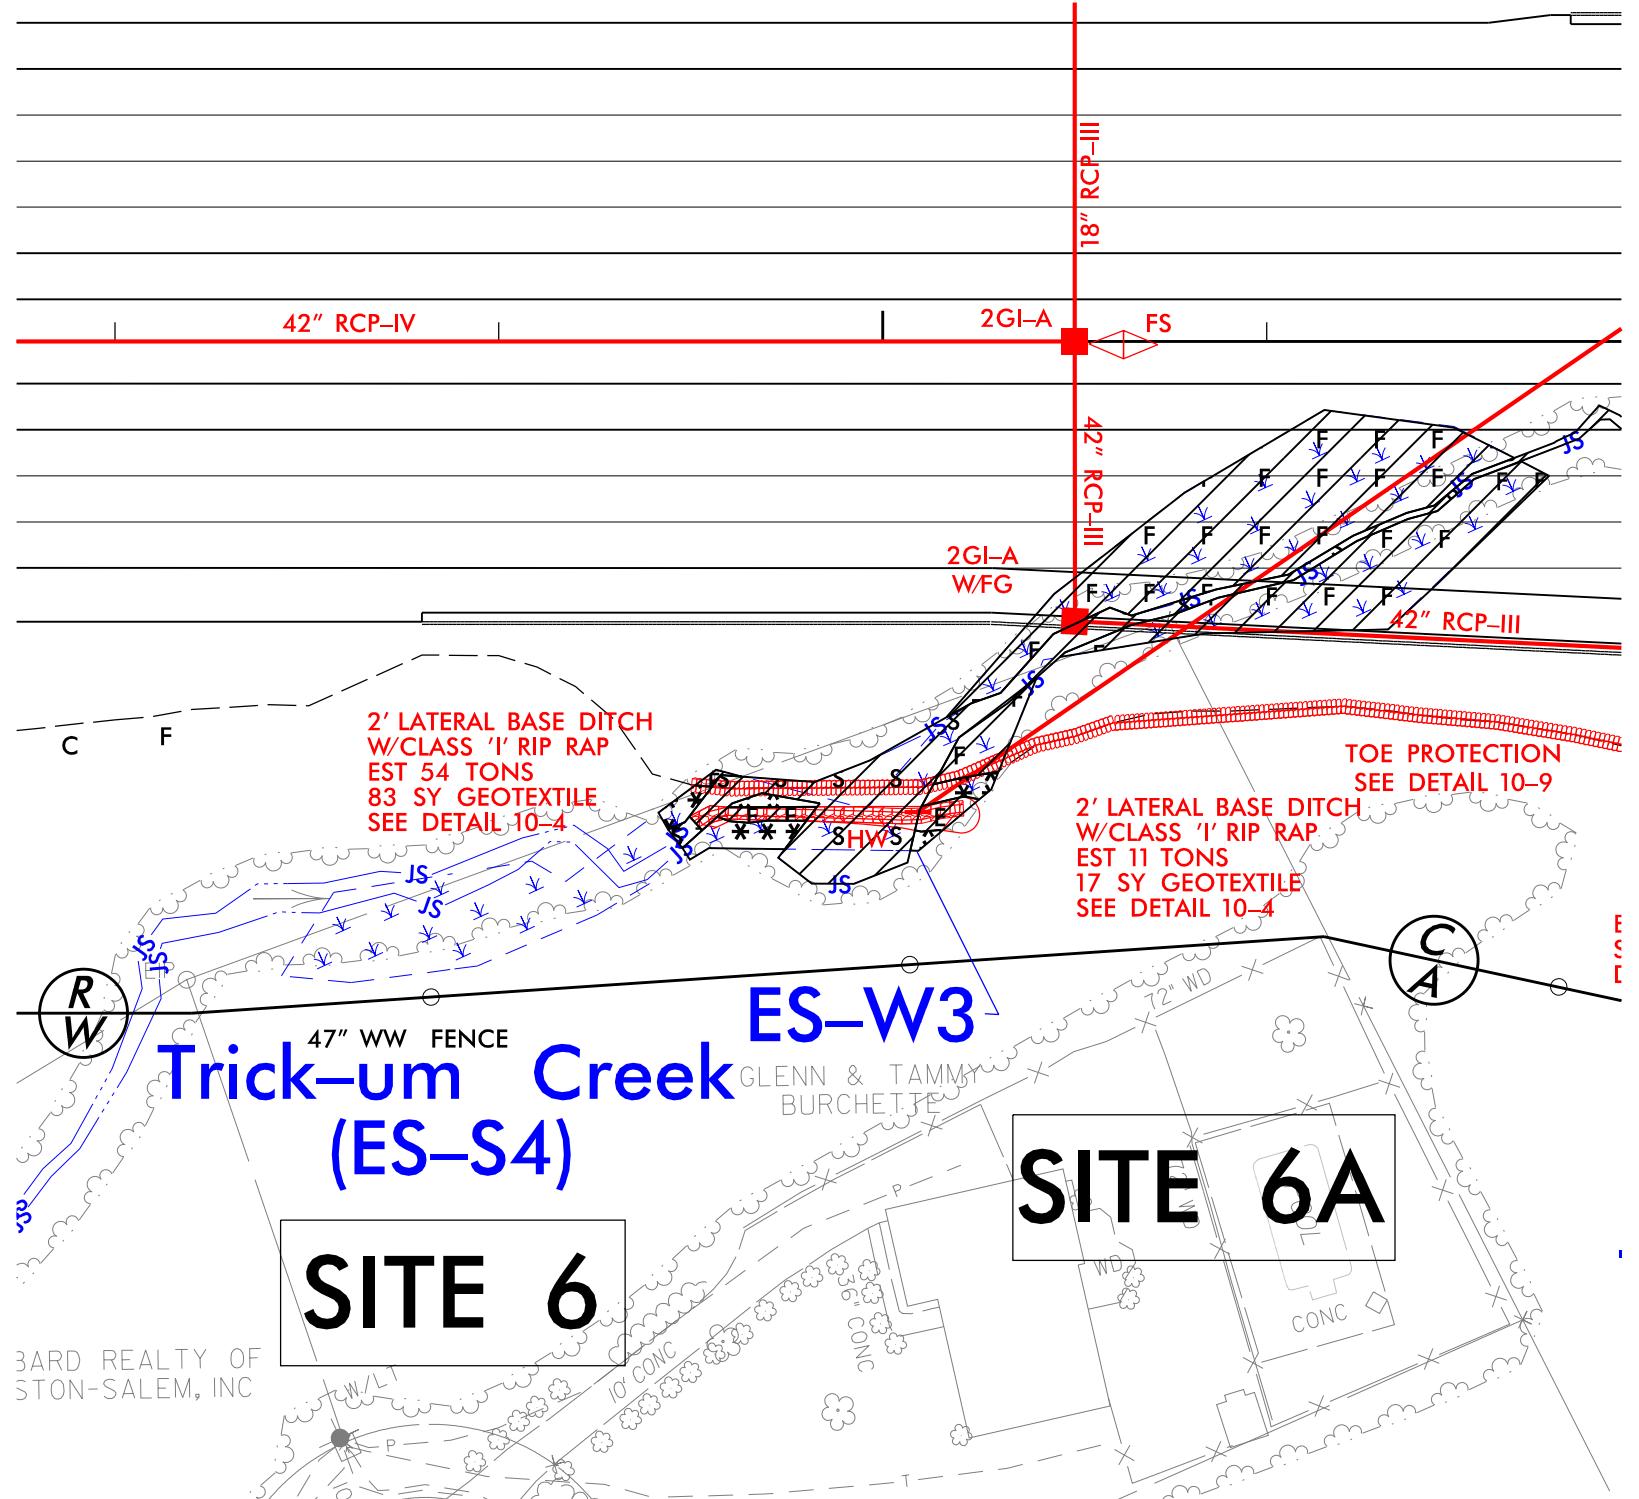

LEGEND



DENOTES MECHANIZED
CLEARING





DENOTES FILL IN
WFTI AND



DENOTES IMPACTS IN
SURFACE WATER




DENOTES EXCAVATION IN WETLAND

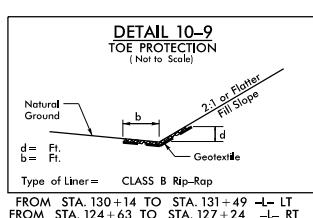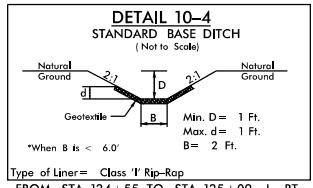



**PERMIT DRAWING
SHEET 18 OF 97**

300 280 260 240 220 200 180 160 140 120 100 80 60 40 20 0 20 40 60 80 100 120 140 160 180 200 220 240 260 280 300

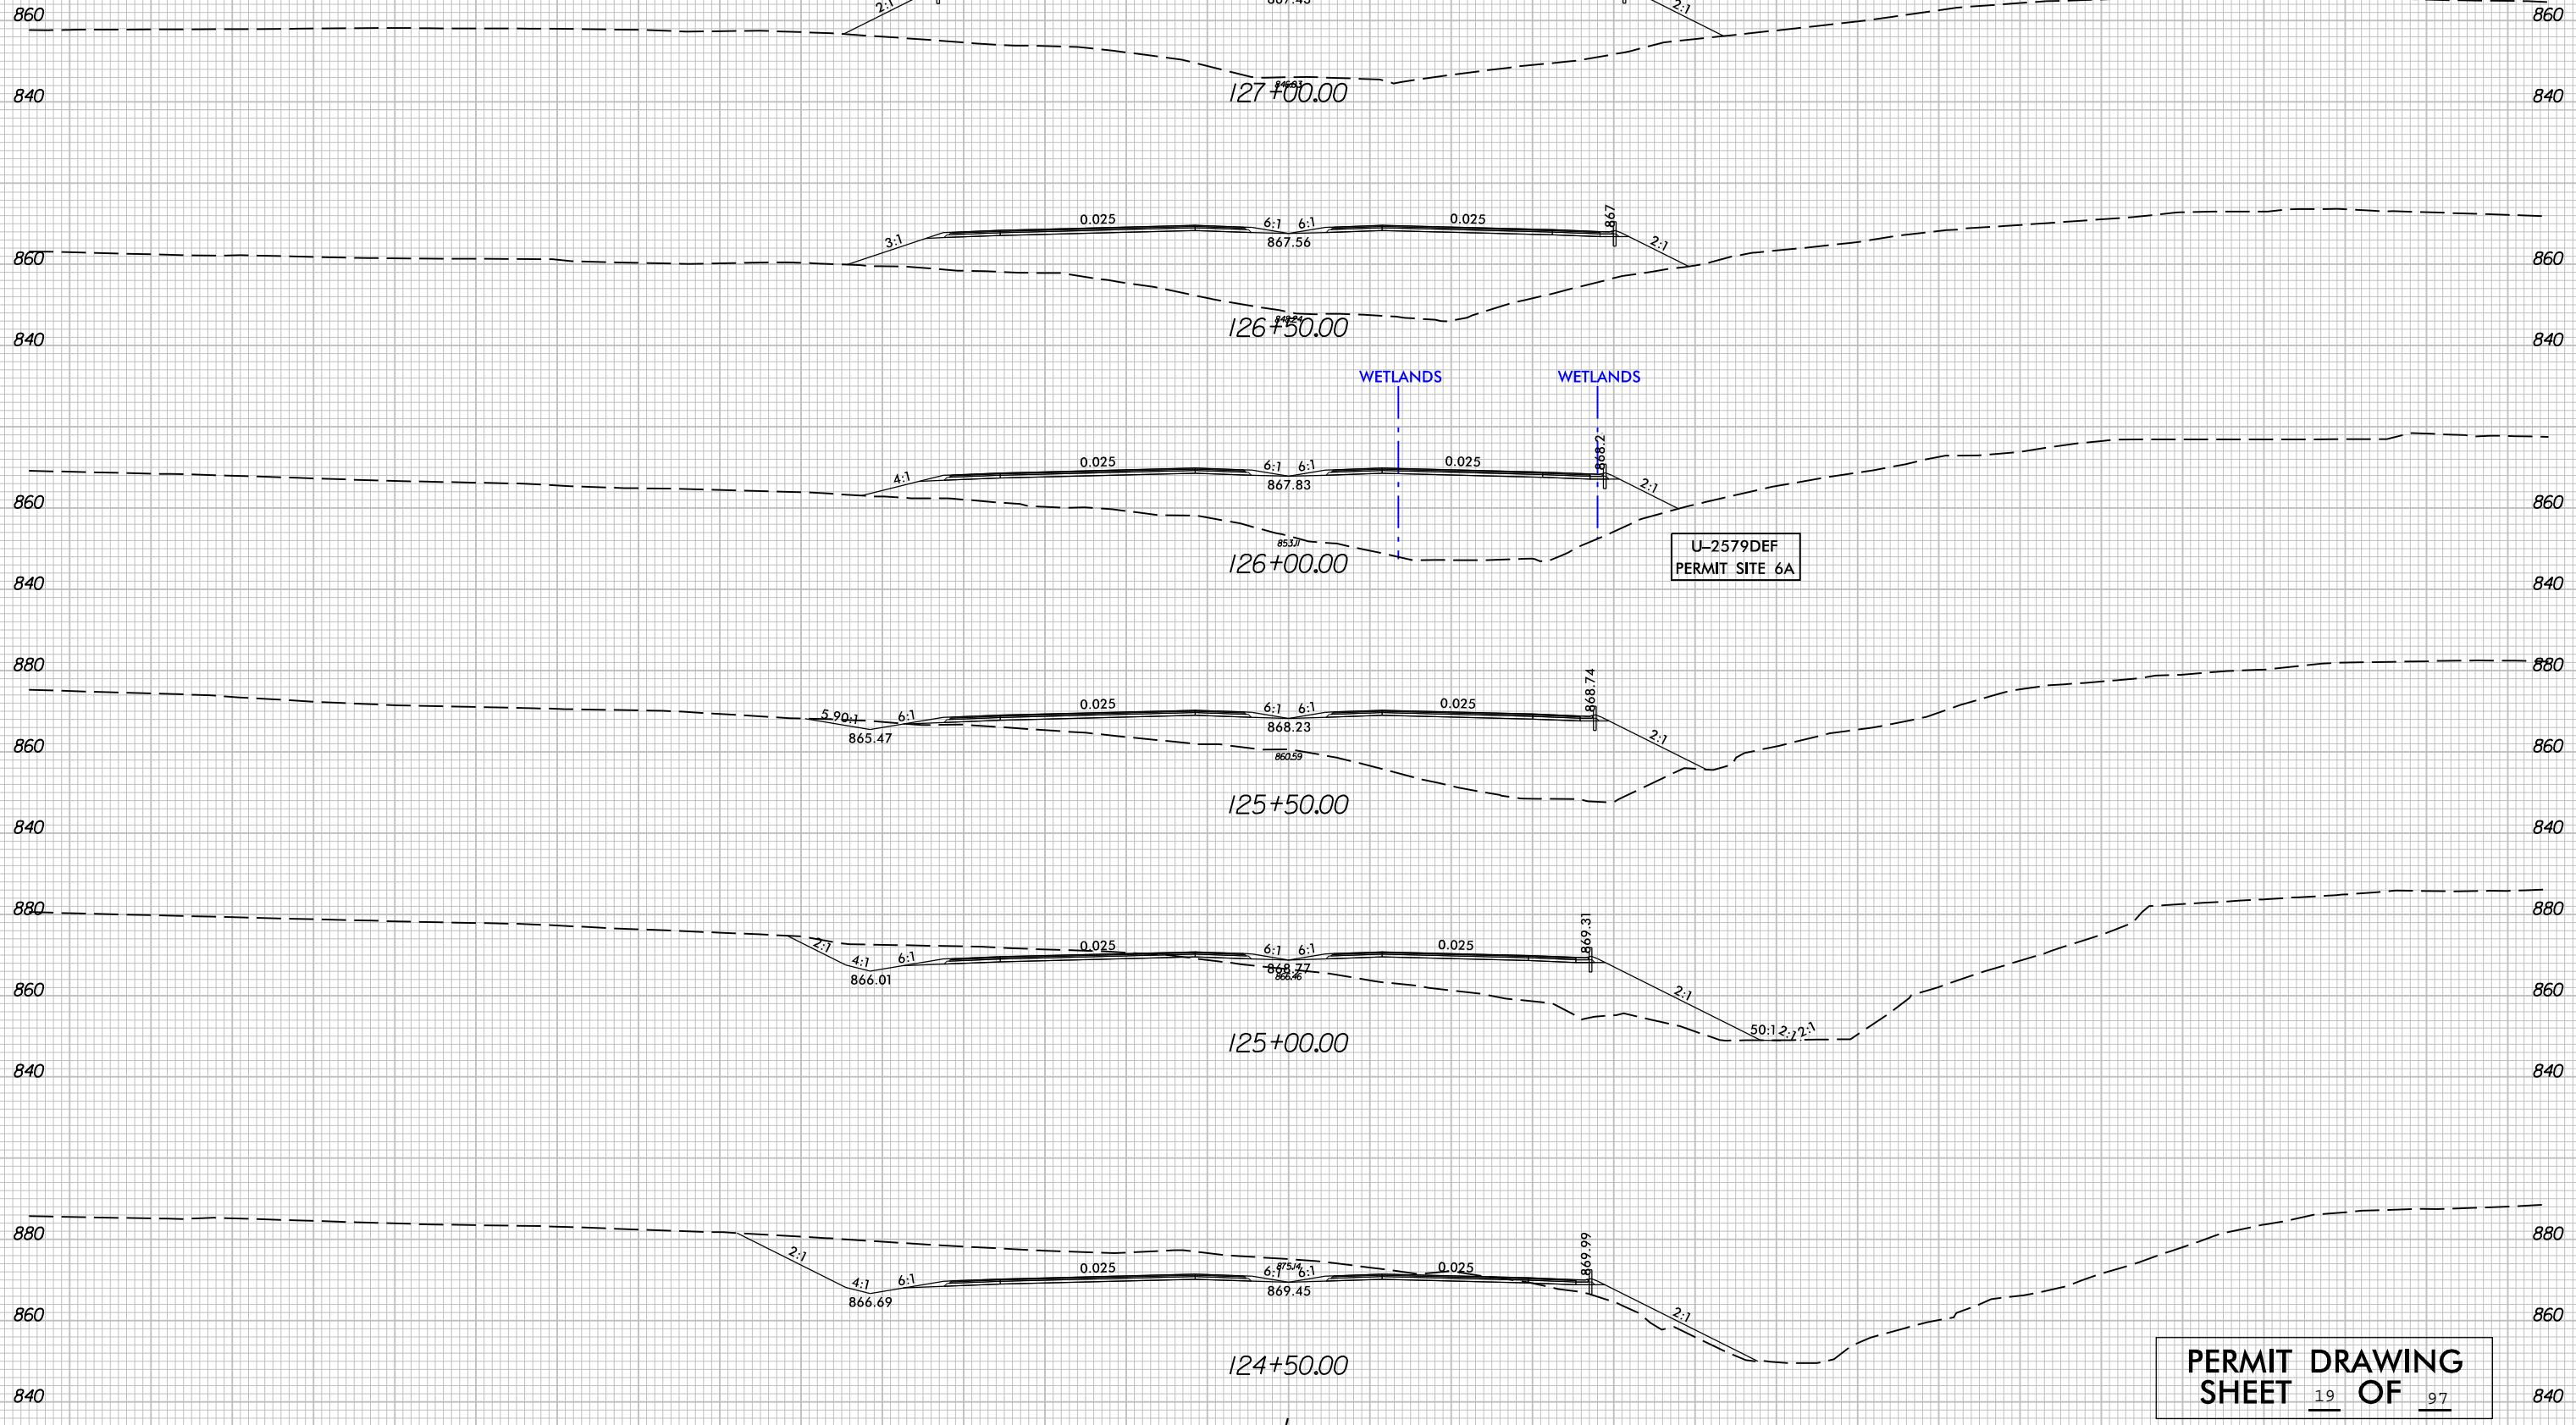


**DOCUMENT NOT CONSIDERED FINAL
UNLESS ALL SIGNATURES COMPLETED**

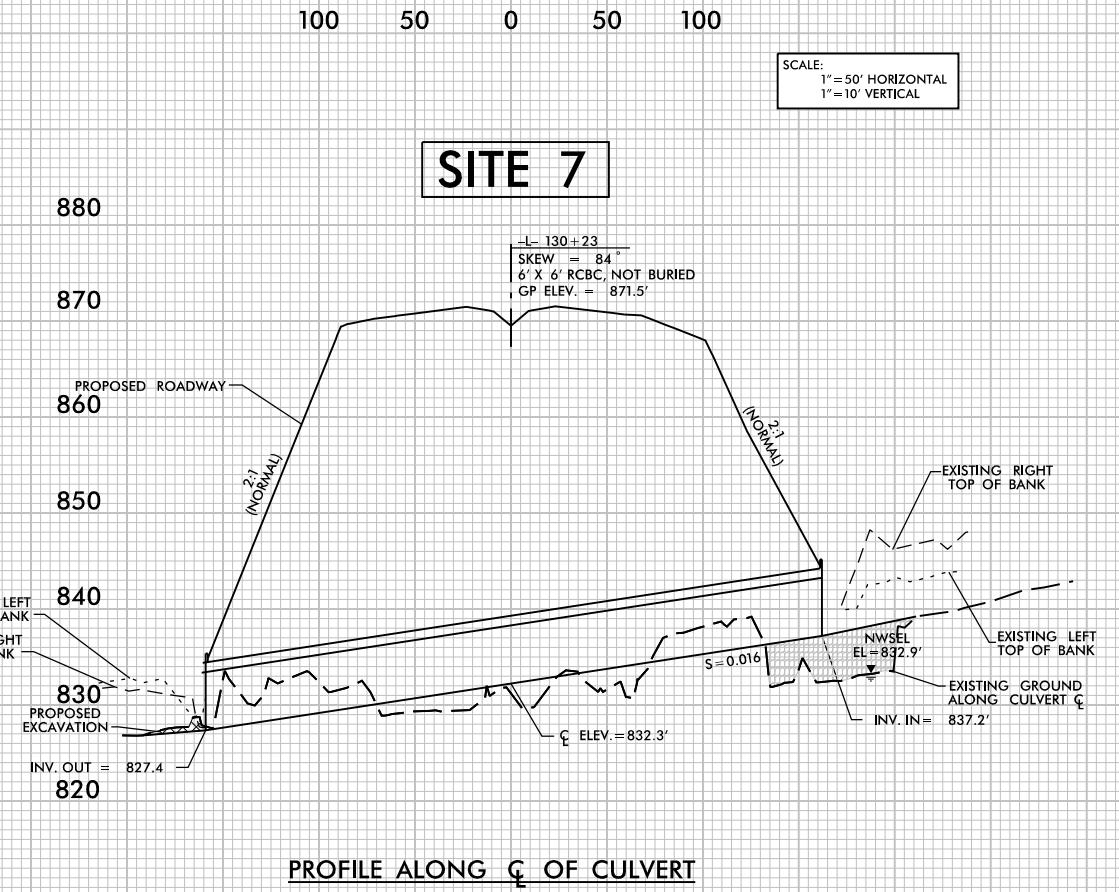

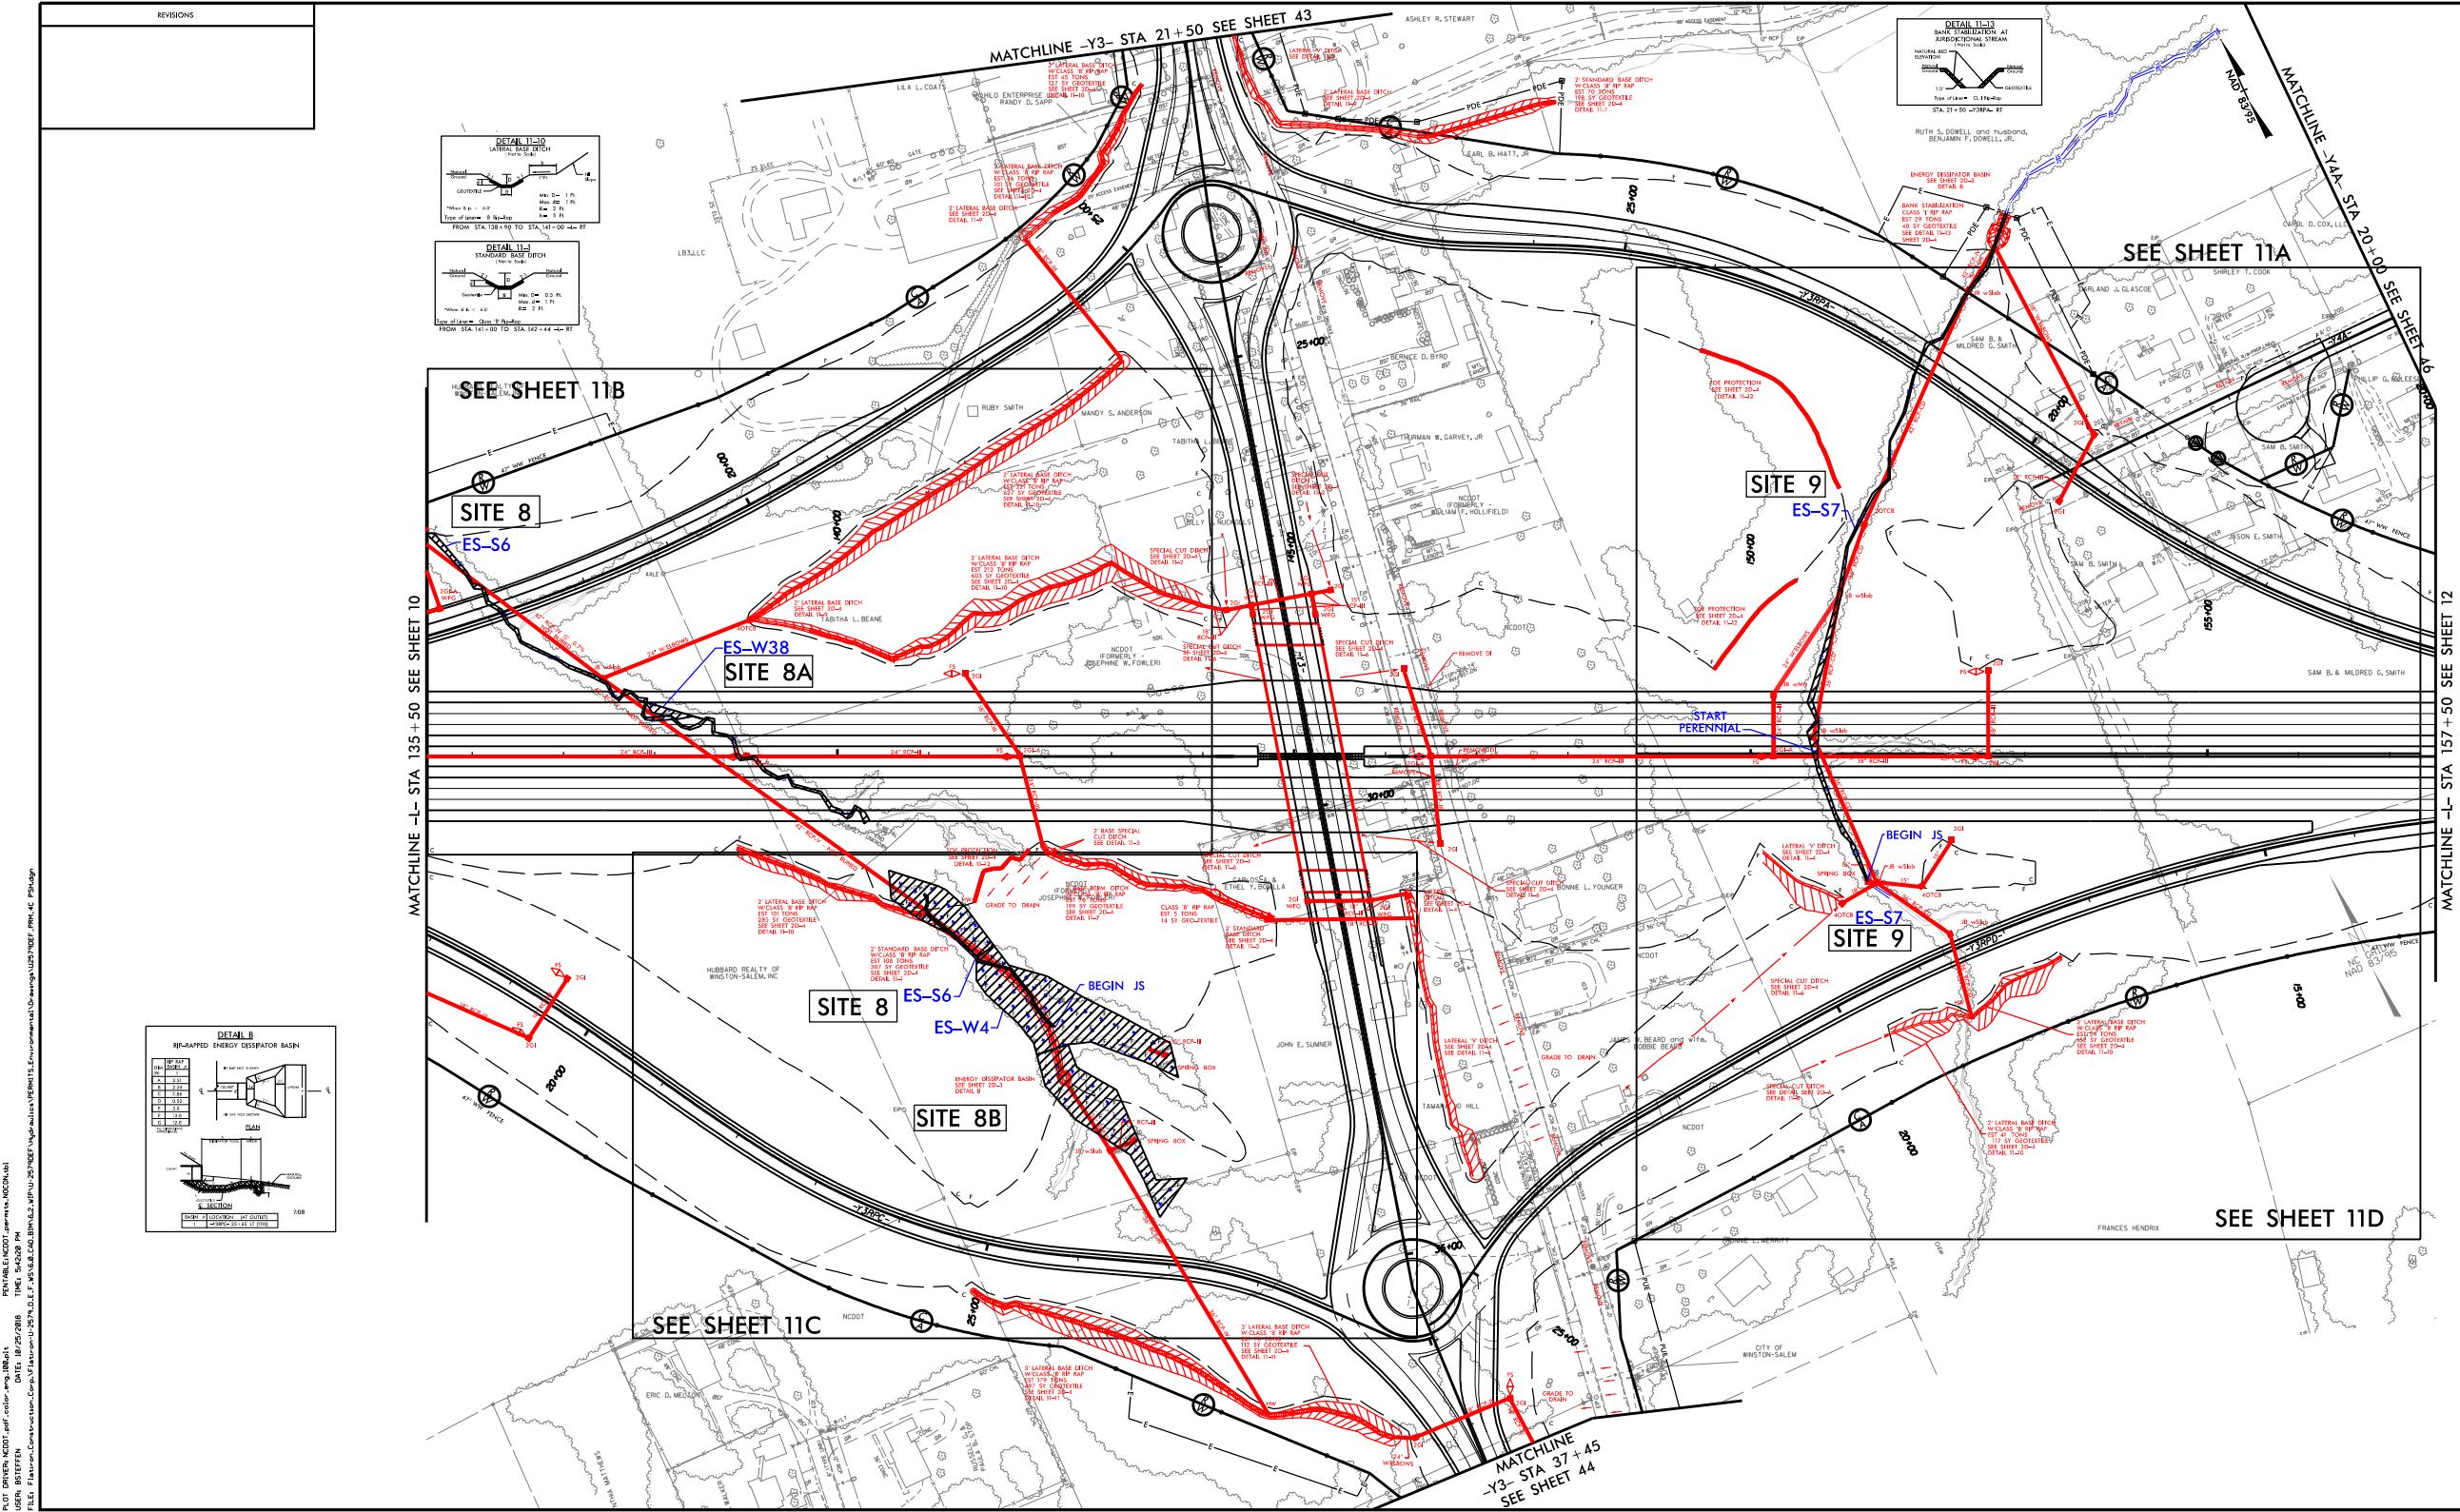


PIANTO F. NORDI SORRIDA. NORDI HA PIANTATO NORDI. NORDI HA COLORATO 100 GI

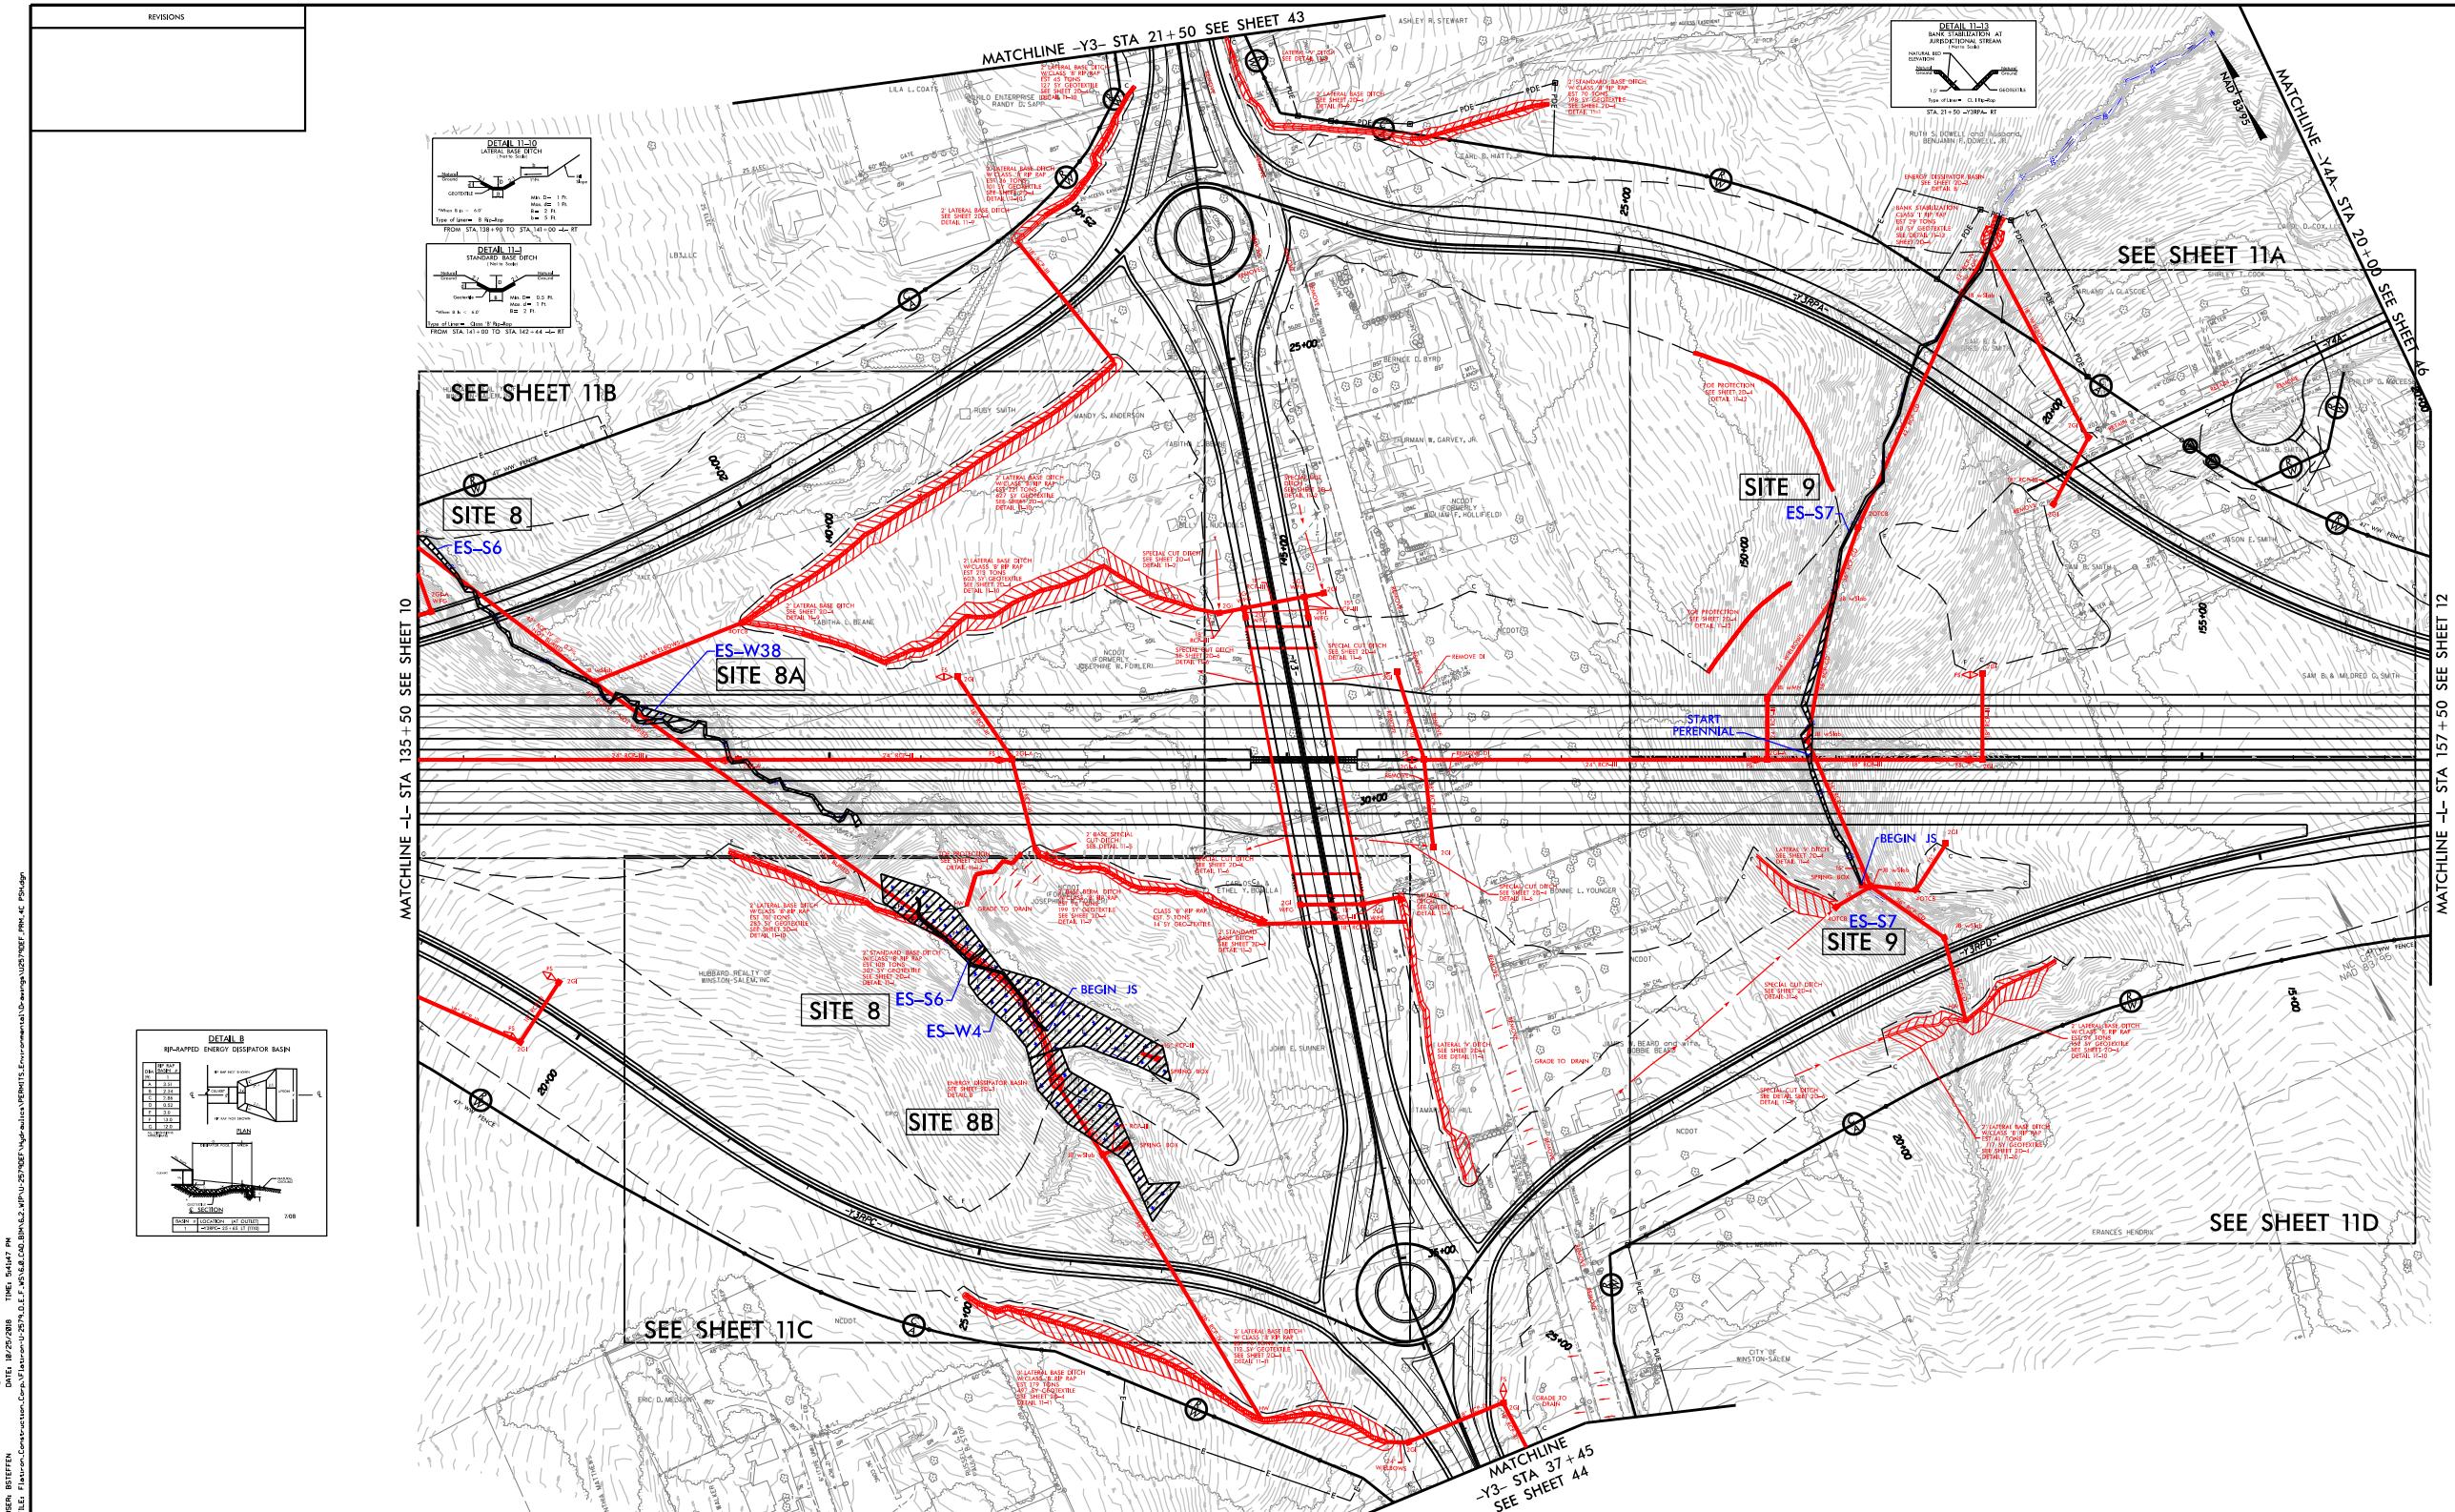


PENTAFIELD-PC-00195, CON.tbx
FILE: 541447 PH
DATE: 10/25/2018 TIME: 10:18,01
SUBJ: BIEFFEN, NEDOT.pdf .color -eng.100,01

LEGEND

- [F/F] DENOTES FILL IN WETLAND
- [S/S] DENOTES IMPACTS IN SURFACE WATER
- [TS/TS] DENOTES TEMPORARY IMPACTS IN SURFACE WATER

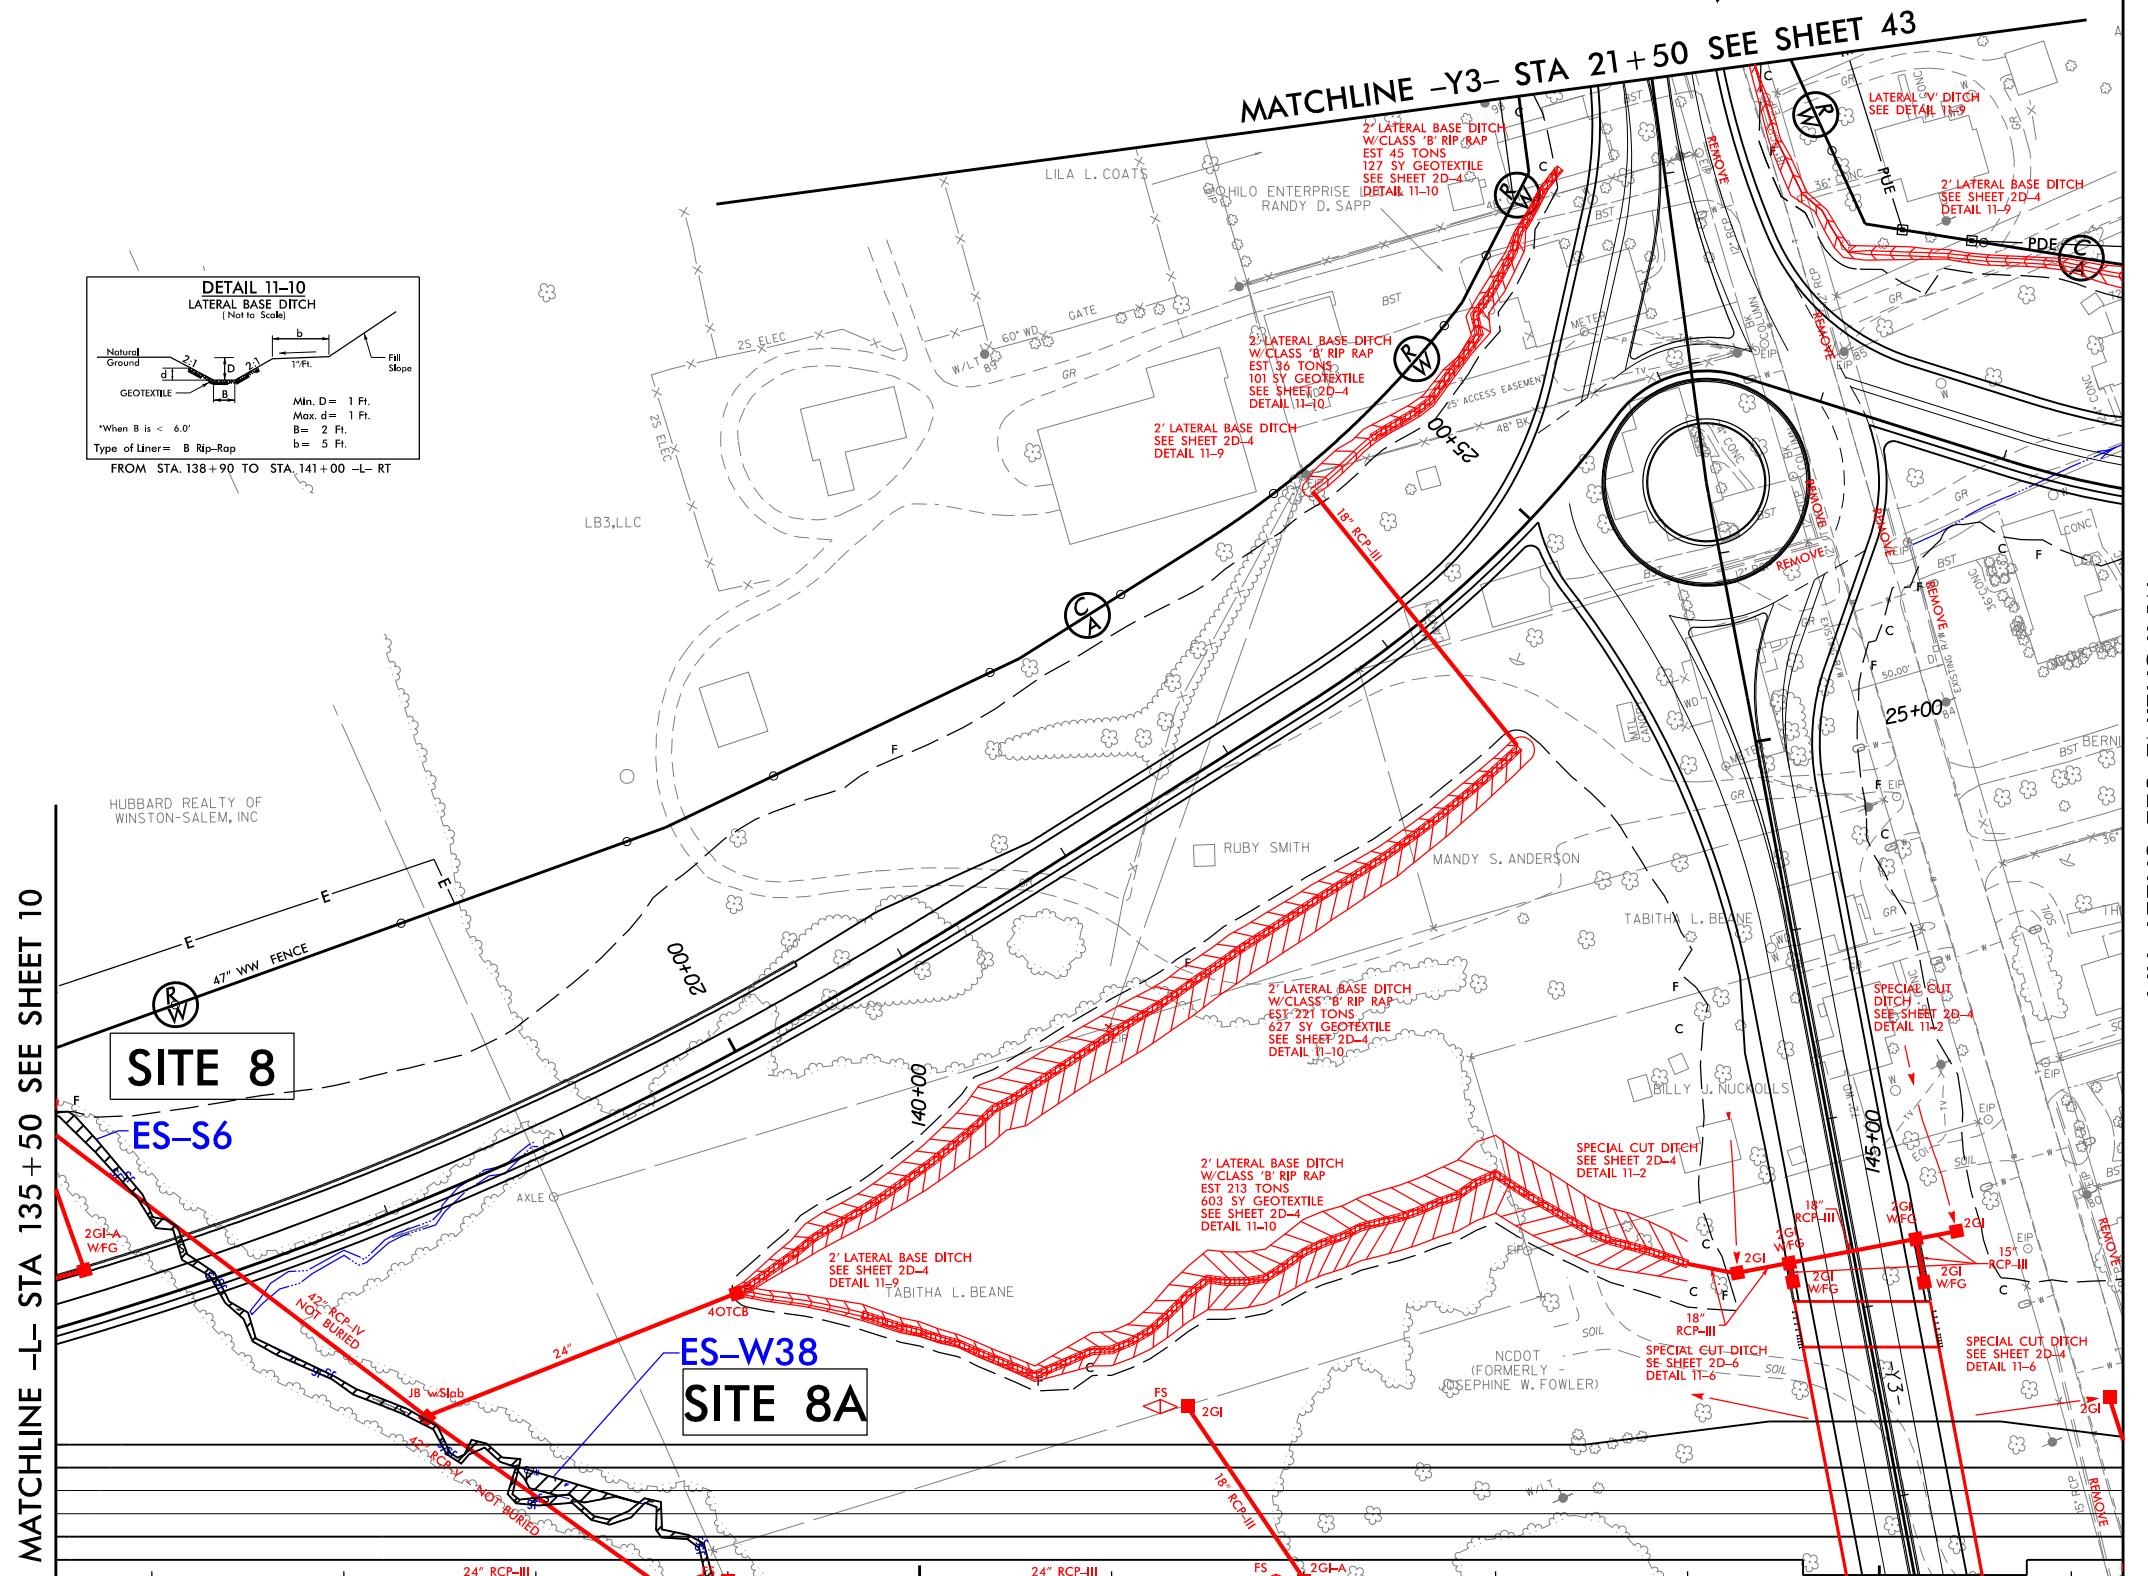MATCHLINE SEE SHEET 11A

300	280	260	240	220	200	180	160	140	120	100	80	60	40	20	0	20	40	60	80	100	120	140	160	180	200	220	240	260	280	300
-----	-----	-----	-----	-----	-----	-----	-----	-----	-----	-----	----	----	----	----	---	----	----	----	----	-----	-----	-----	-----	-----	-----	-----	-----	-----	-----	-----

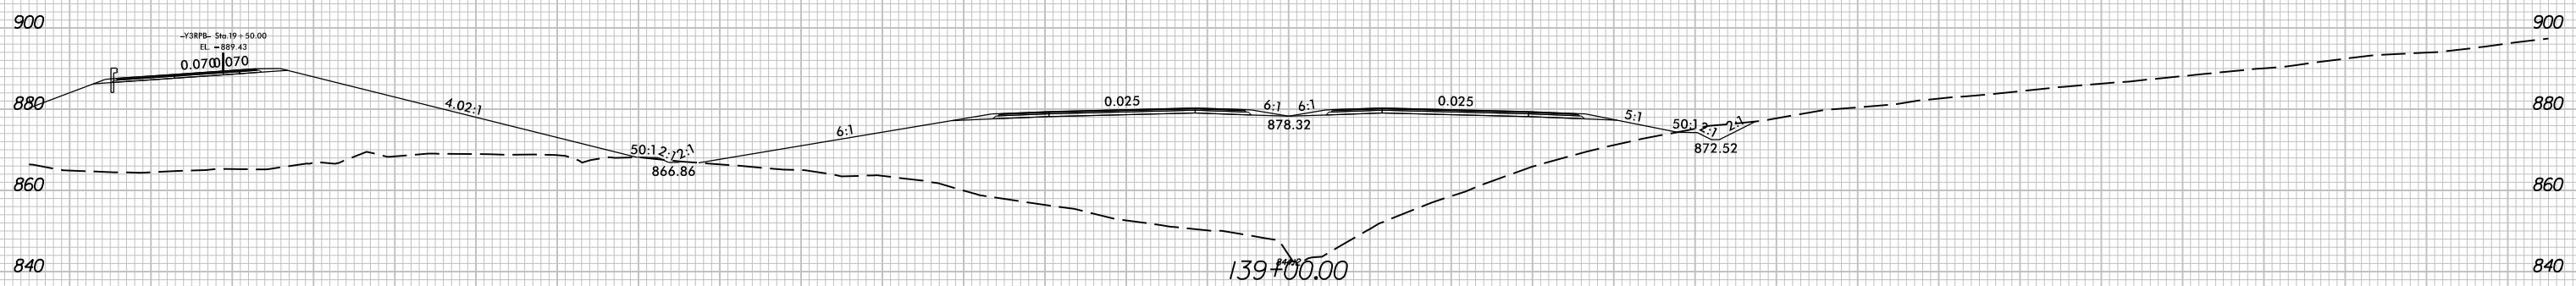

PENTABLE: NCDOOT-PFL.XSC.b1

TIME: 6:10:34 PM


DATE: 10/17/2018

PLOT DRIVER: NCDOOT-pdf-color-eng-100.pdf

USER: J_USERNAME_

DATE: 10/17/2018


FILE: U2579DEF.PRM_XPL.HDR.dgn

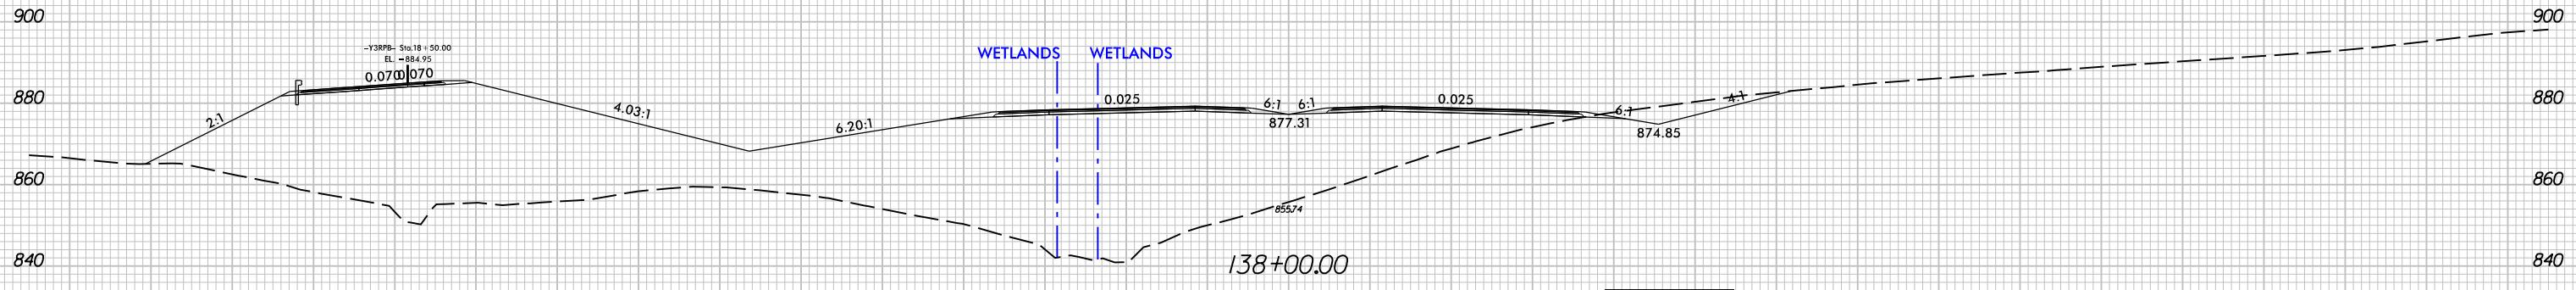

300	280	260	240	220	200	180	160	140	120	100	80	60	40	20	0	20	40	60	80	100	120	140	160	180	200	220	240	260	280	300
-----	-----	-----	-----	-----	-----	-----	-----	-----	-----	-----	----	----	----	----	---	----	----	----	----	-----	-----	-----	-----	-----	-----	-----	-----	-----	-----	-----

U-2579DEF
PERMIT SITE 8APERMIT DRAWING
SHEET 25 OF 97


300 280 260 240 220 200 180 160 140 120 100 80 60 40 20 0 20 40 60 80 100 120 140 160 180 200 220 240 260 280 300

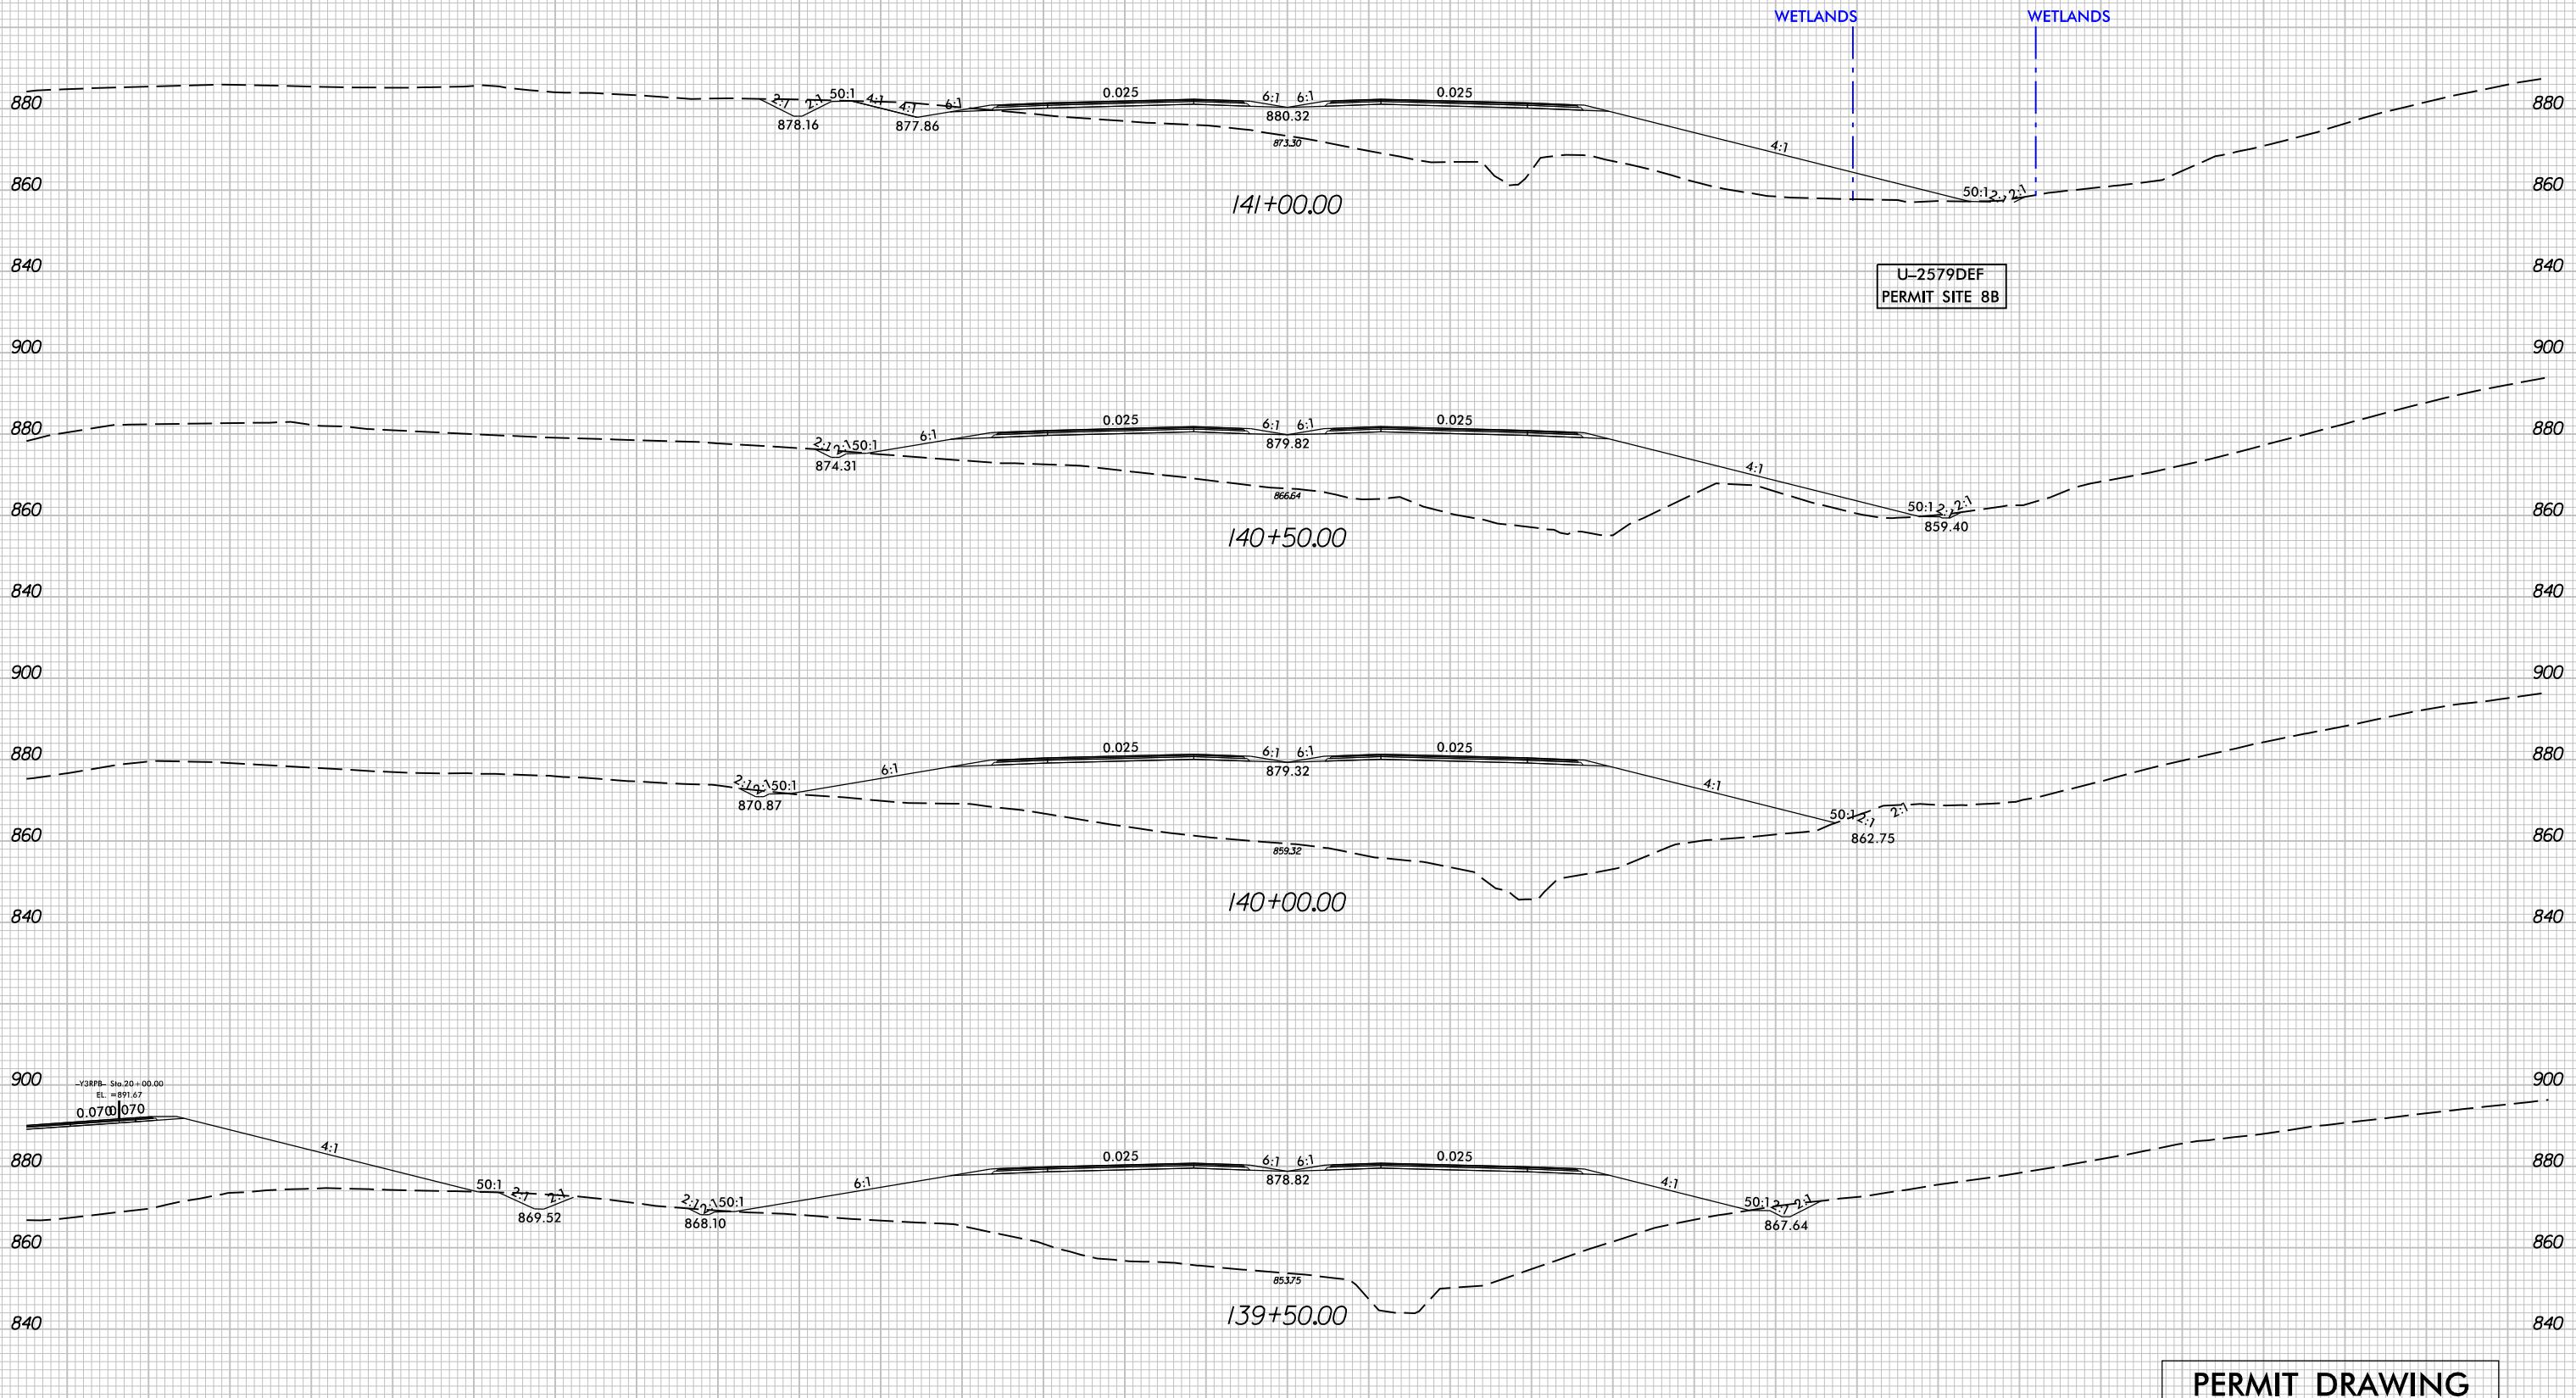

300 280 260 240 220 200 180 160 140 120 100 80 60 40 20 0 20 40 60 80 100 120 140 160 180 200 220 240 260 280 300

MATCHLINE SEE SHEET 11C

MATCHLINE SEE SHEET 11A

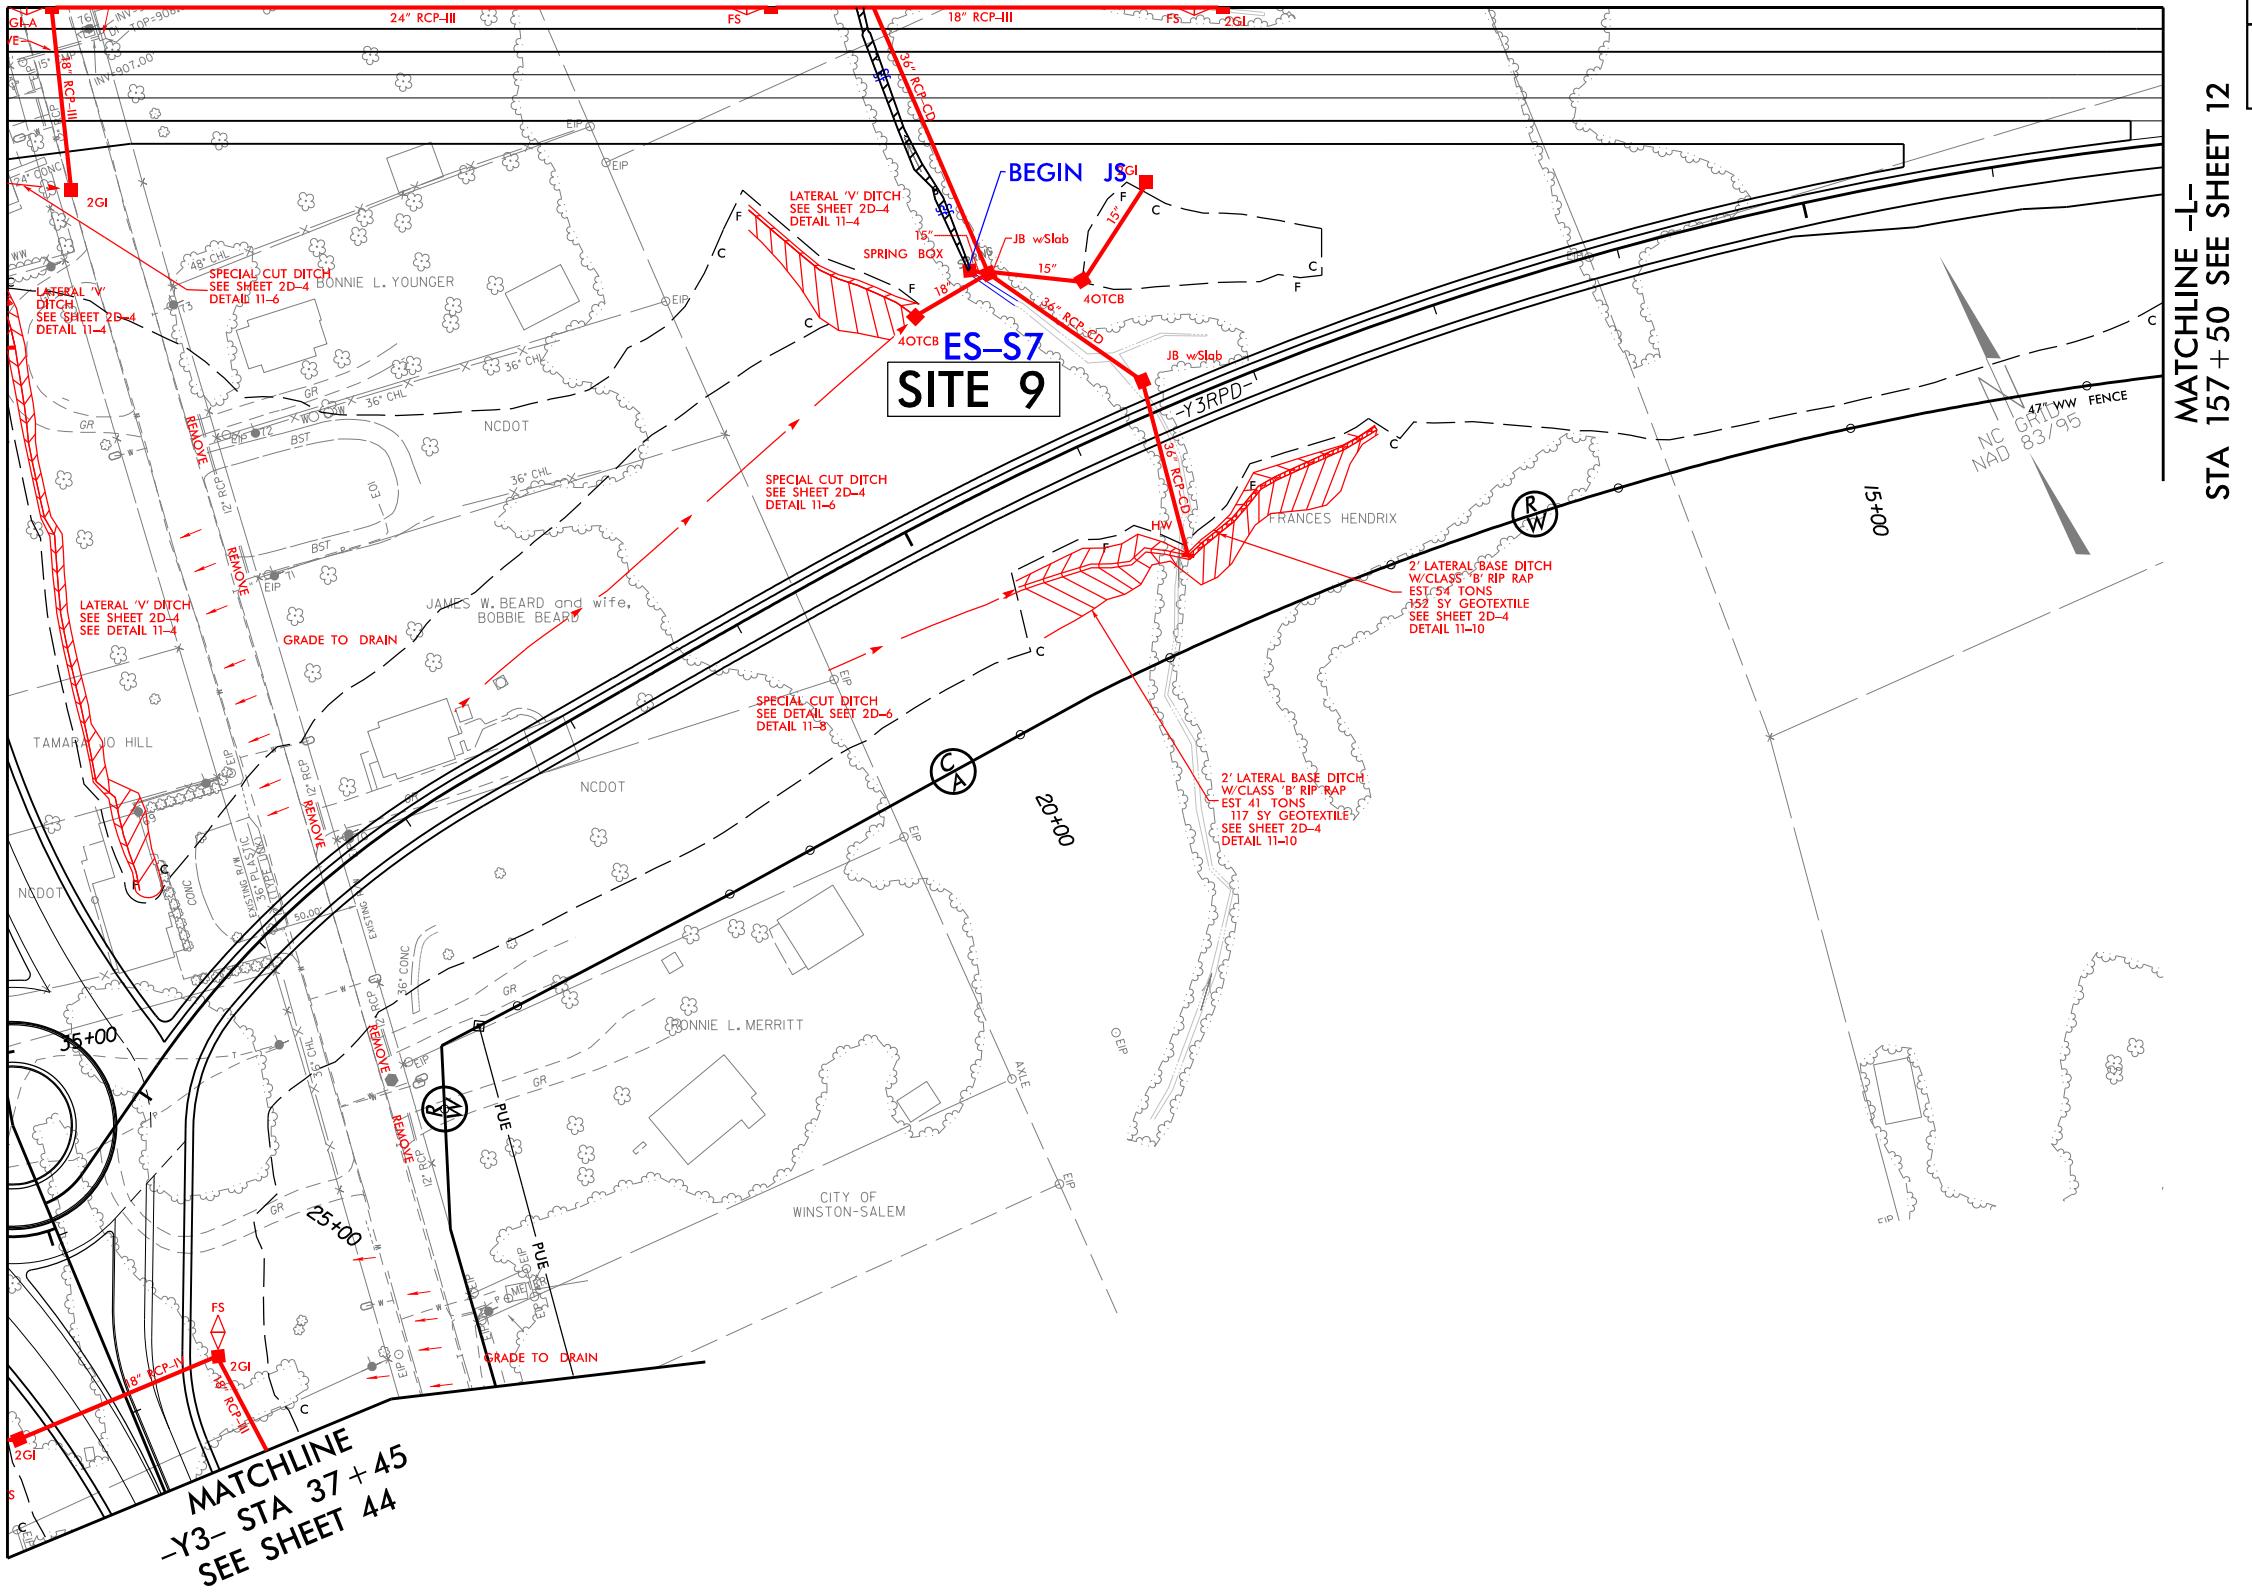

STA 157 + 50 SEE SHEET 12

LEGEND

 S DENOTES IMPACTS IN SURFACE WATER

PROJECT REFERENCE NO. U-2579D, E & F	SHEET NO. 12
RW SHEET NO.	
ROADWAY DESIGN ENGINEER	HYDRAULICS ENGINEER
INCOMPLETE PLANS DO NOT USE FOR R/W ACQUISITION	
DOCUMENT NOT CONSIDERED FINAL UNLESS ALL SIGNATURES COMPLETED	




HDR Engineering, Inc. of the Carolinas
555 Fayetteville St, Suite 900, Raleigh, NC 27601
N.C.B.E.L.S. License Number: F-0116


STV Engineers, Inc.
900 West Trade St., Suite 715
Charlotte, NC 28202
NC License Number F-0991



100 Years

PERMIT DRAWING
SHEET 29 OF 97

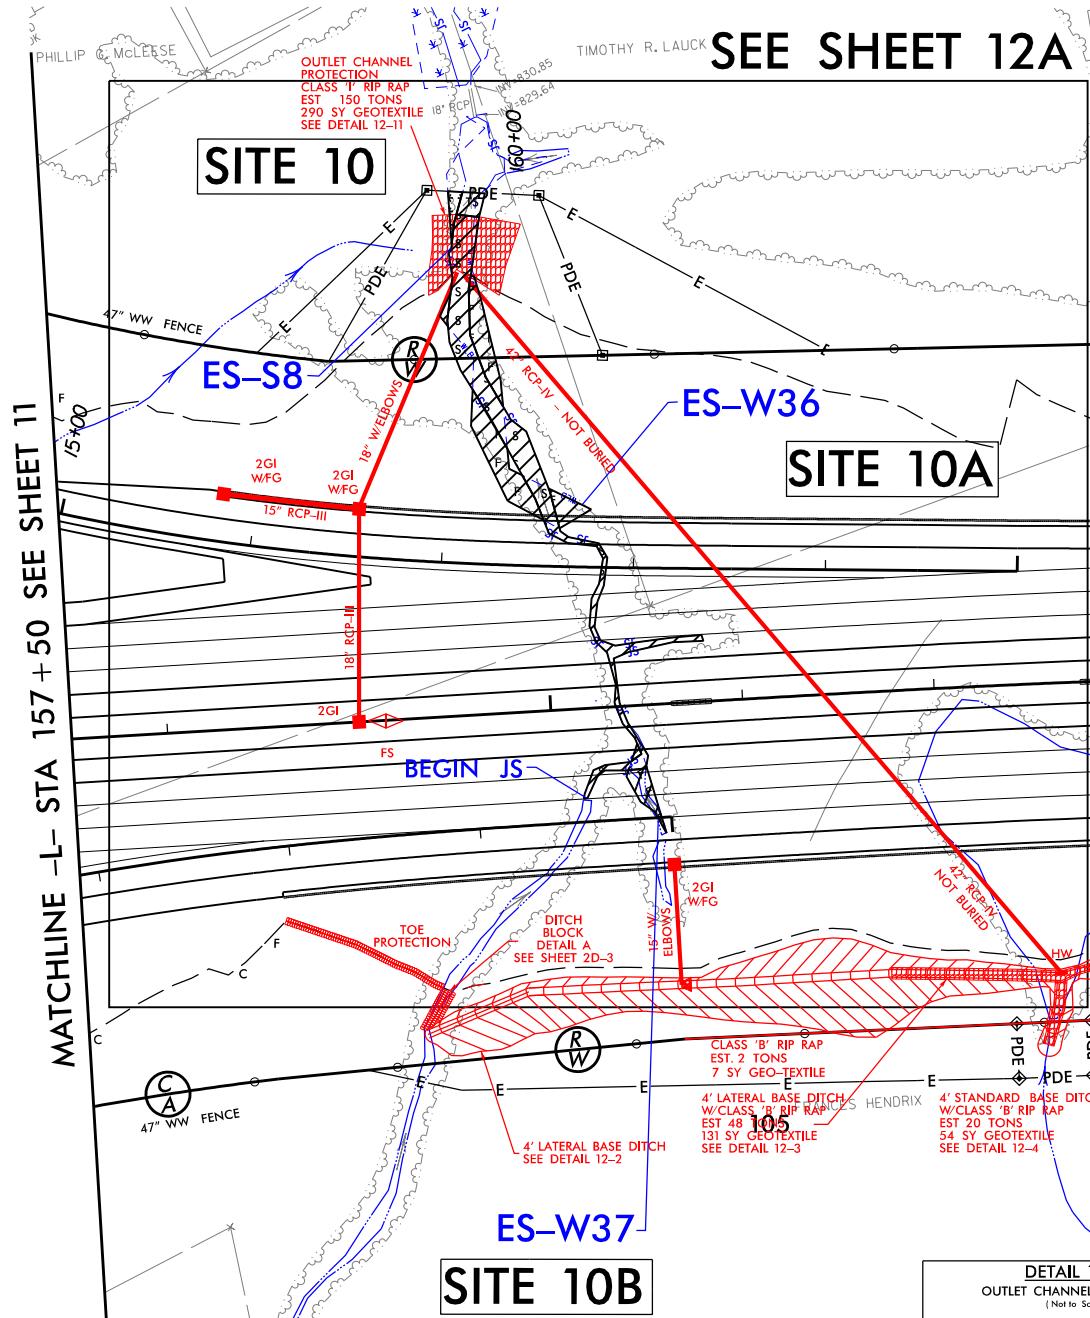

PROJECT REFERENCE NO. U-2579D, E & F	SHEET NO. 12
RW SHEET NO.	
ROADWAY DESIGN ENGINEER	HYDRAULICS ENGINEER
INCOMPLETE PLANS DO NOT USE FOR R/W ACQUISITION	
DOCUMENT NOT CONSIDERED FINAL UNLESS ALL SIGNATURES COMPLETED	
GRAPHIC SCALE	

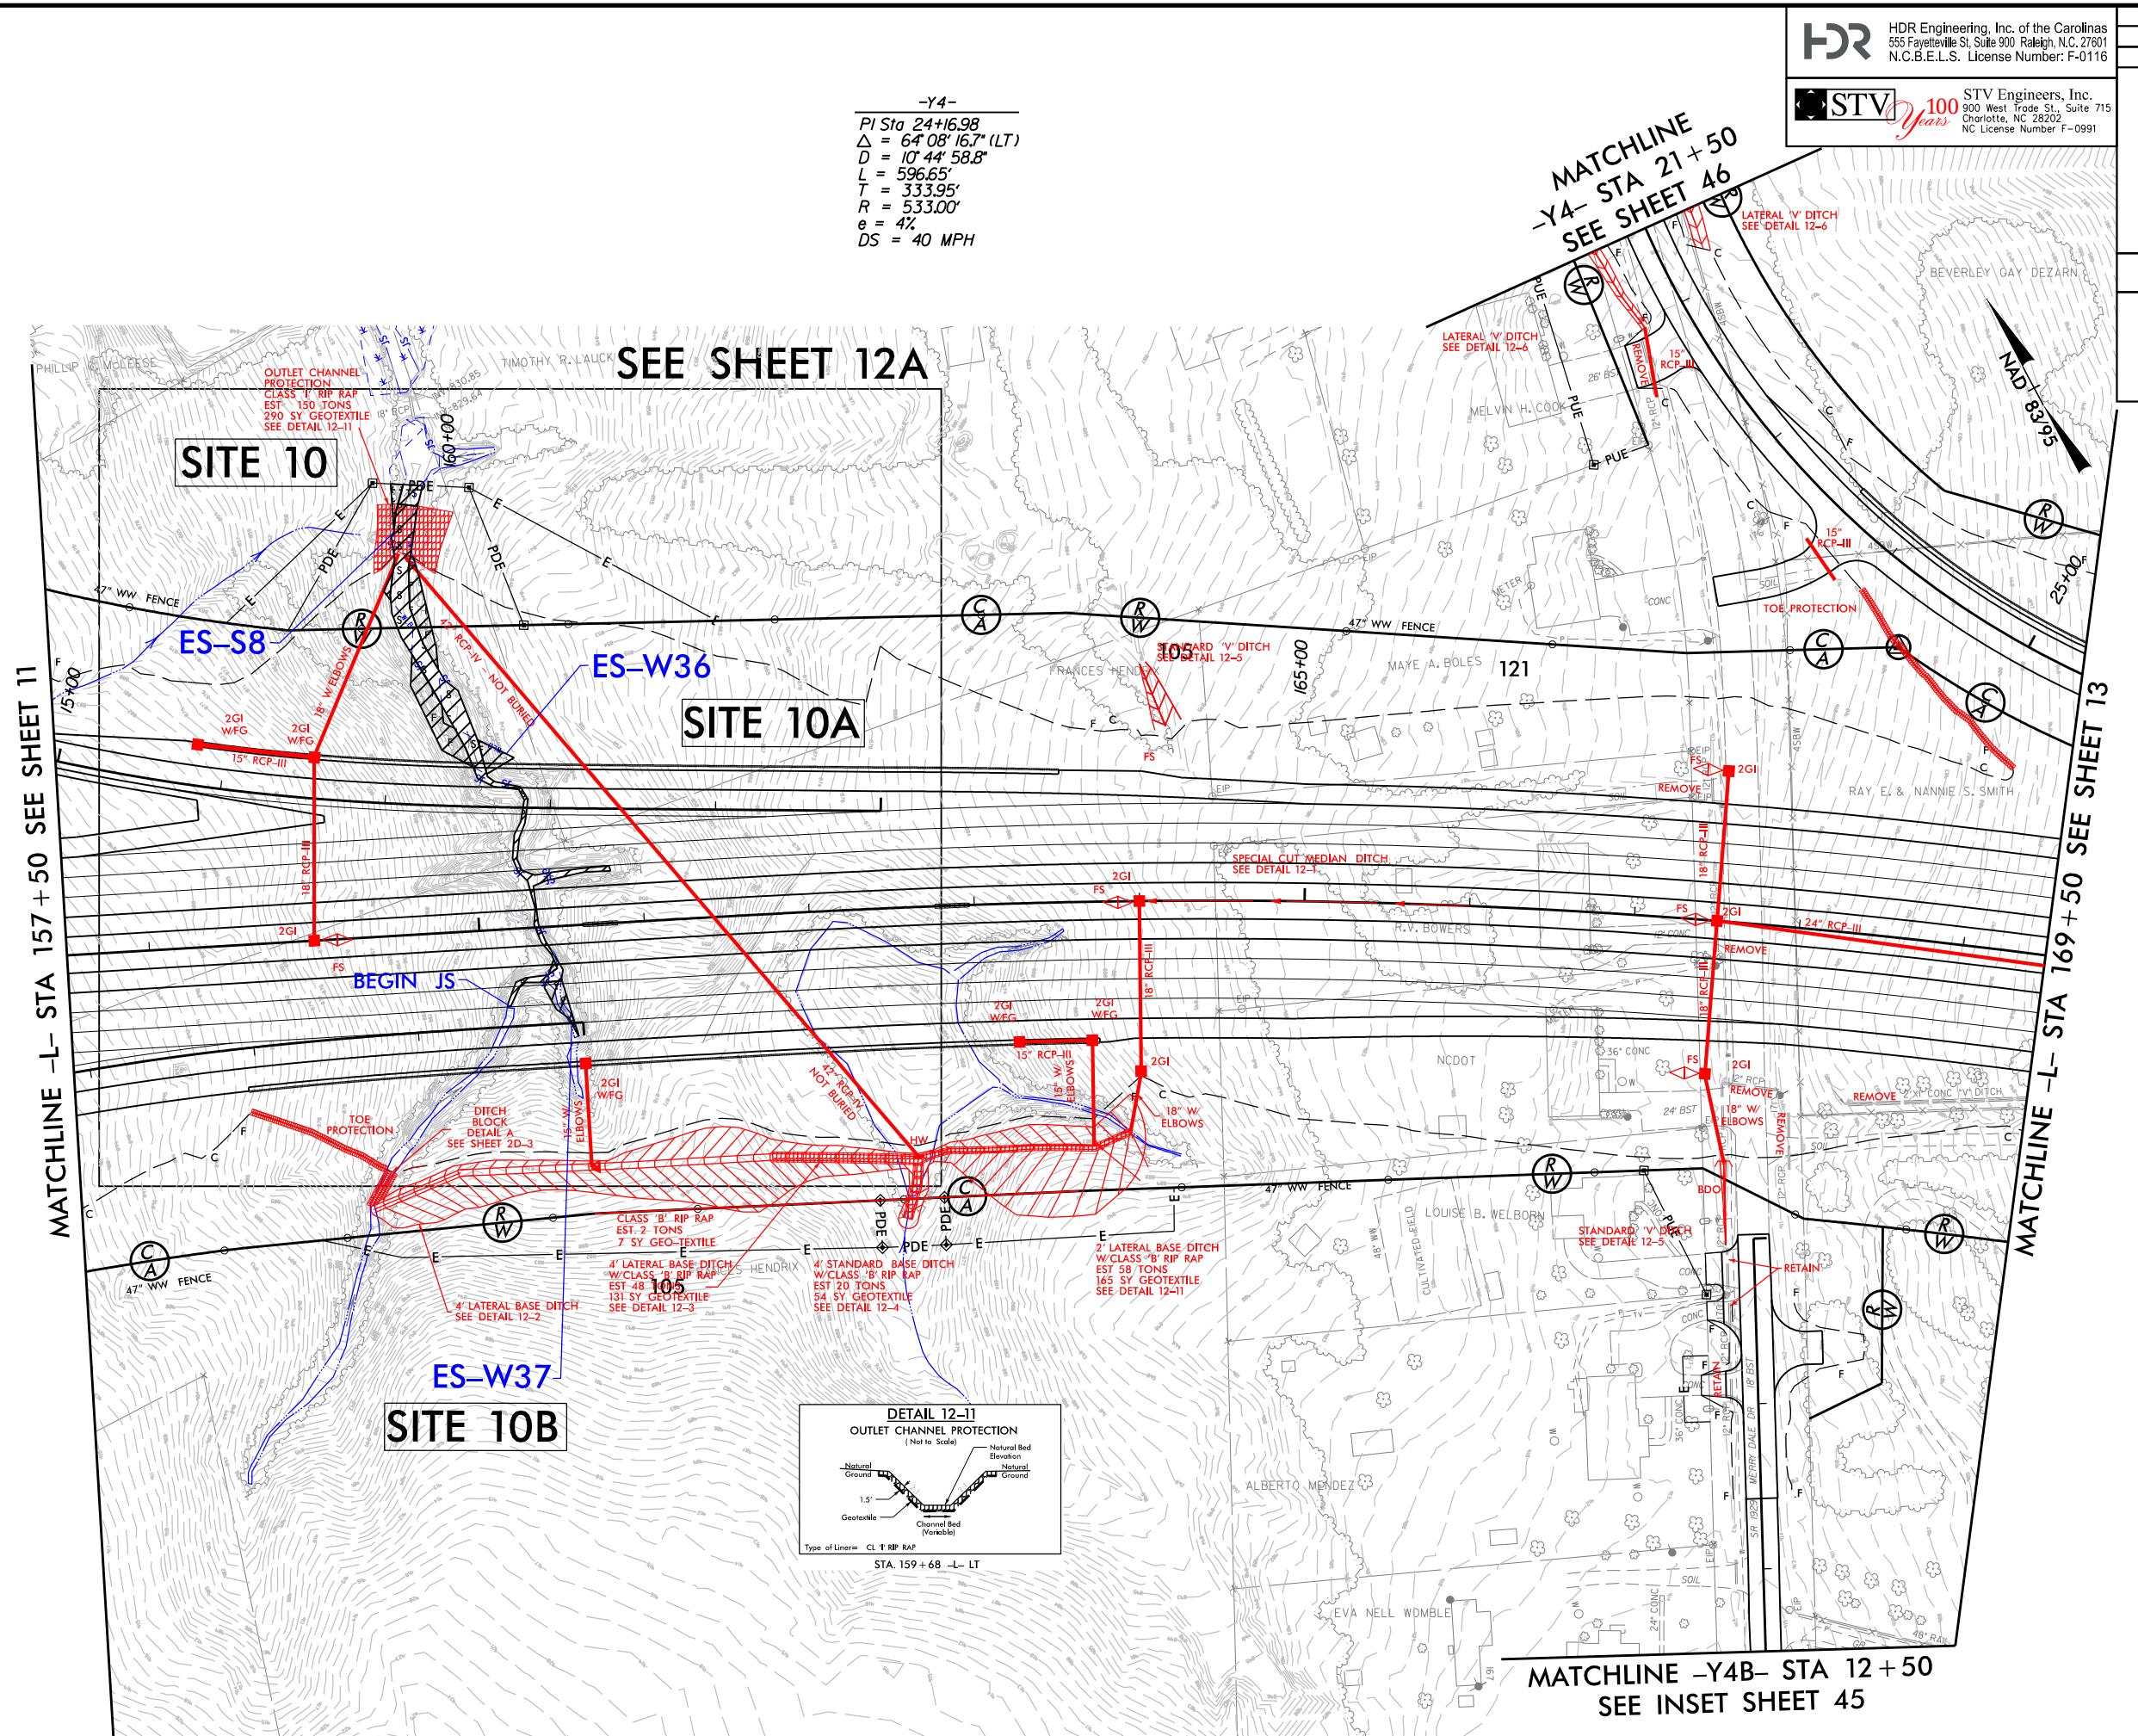

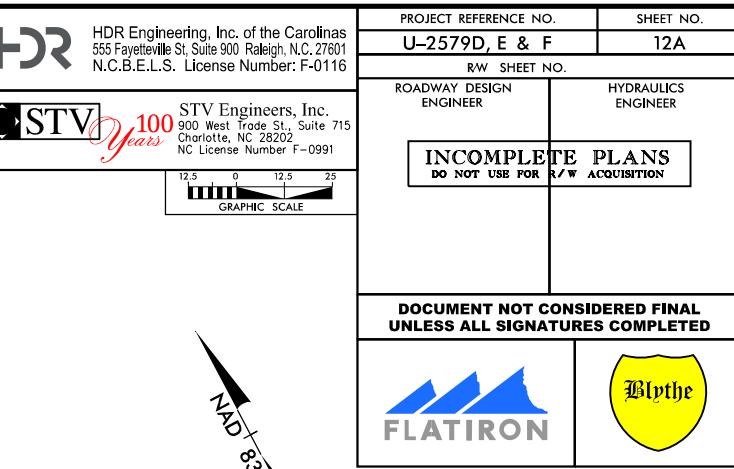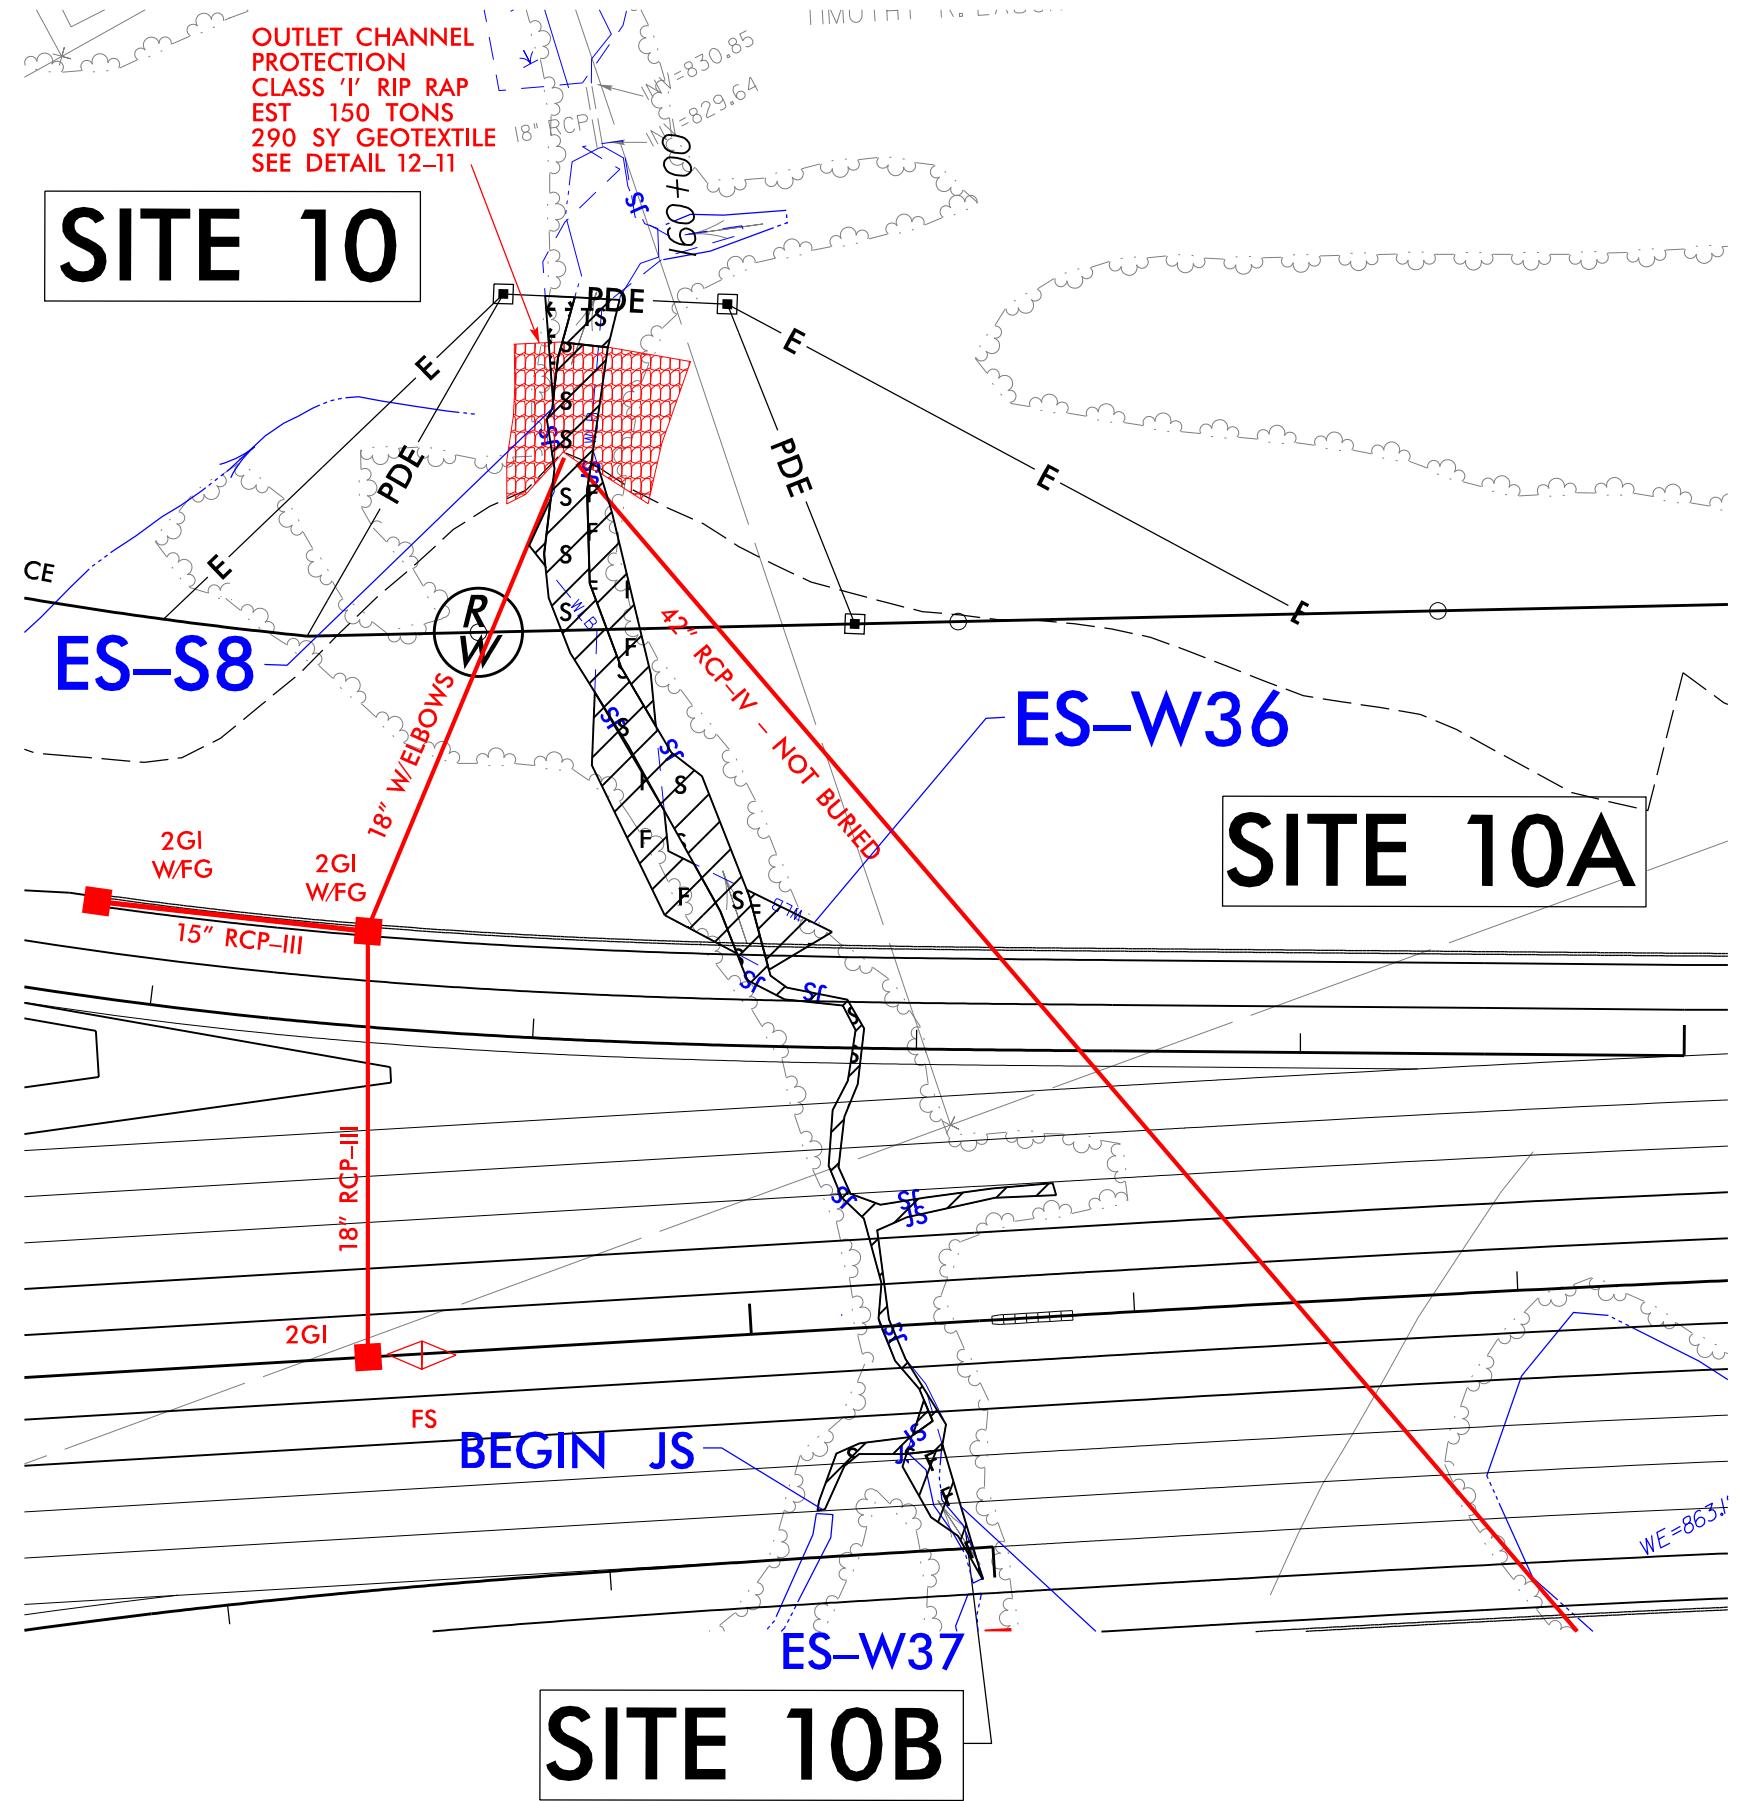

LEGEND

 DENOTES FILL IN WETLAND

 DENOTES IMPACTS IN SURFACE WATER

 DENOTES MECHANIZED CLEARING

 DENOTES TEMPORARY IMPACTS IN SURFACE WATER

**PERMIT DRAWING
SHEET 31 OF 97**

300 280 260 240 220 200 180 160 140 120 100 80 60 40 20 0 20 40 60 80 100 120 140 160 180 200 220 240 260 280 300

WETLANDS WETLANDS

-Y3RPA- Sta.12 + 47.48
EL = 894.08

0.030|036

0.010

6:1

6:1

0.025

0.025

892.21

-Y3RPD- Sta.10 + 59.57
EL = 893.31

0.025

0.025

892.21

900

880

860

840

820

920

U-2579DEF
PERMIT SITE 10A

160+00.00

900

880

860

840

820

920

-Y3RPA- Sta.12 + 97.72
EL = 893.54

0.050|055

0.002

6:1

6:1

0.025

0.038

892.36

-Y3RPD- Sta.11 + 09.58
EL = 893.44

0.038

0.025

892.36

900

880

860

840

820

920

159+50.00

-Y3RPA- Sta.13 + 48.11
EL = 892.90

0.070|073

0.007

6:1

6:1

0.025

0.056

892.51

-Y3RPD- Sta.11 + 59.59
EL = 893.50

0.056

0.025

892.51

900

880

860

840

920

159+00.00

-/-

PERMIT DRAWING
SHEET 32 OF 97

300 280 260 240 220 200 180 160 140 120 100 80 60 40 20 0 20 40 60 80 100 120 140 160 180 200 220 240 260 280 300

900 880 860 840 820 800 780 760 740 720 700 680 660 640 620 600 580 560 540 520 500 480 460 440 420 400 380 360 340 320 300

900 880 860 840 820 800 780 760 740 720 700 680 660 640 620 600 580 560 540 520 500 480 460 440 420 400 380 360 340 320 300

300 280 260 240 220 200 180 160 140 120 100 80 60 40 20 0 20 40 60 80 100 120 140 160 180 200 220 240 260 280 300

900 880 860 840 820 800 780 760 740 720 700 680 660 640 620 600 580 560 540 520 500 480 460 440 420 400 380 360 340 320 300

900 880 860 840 820 800 780 760 740 720 700 680 660 640 620 600 580 560 540 520 500 480 460 440 420 400 380 360 340 320 300

-Y3RPA Sta 10 + 46.46
EL = 895.26
0.037 0.043
6:1 5:1
891.53

868.02

162+00.00

-Y3RPA Sta 10 + 96.87
EL = 895.10
0.018 0.019
0.035
6:1 5.5:1
891.76

855.31

161+50.00

-Y3RPA Sta 11 - 47.16
EL = 894.87
0.000 0.000
0.027
6:1 5.9:1
891.91

853.42

161+00.00

-Y3RPA Sta 11 + 97.33
EL = 894.53
0.018 0.018
0.018
6:1 6:1
892.06

843.25


160+50.00


U-2579DEF
PERMIT SITE 10B

WETLANDS
WETLANDS

-Y3RPD Sta 10 + 09.57
EL = 893.16
0.025
0.025
50:1 2:1
866.22

PERMIT DRAWING
SHEET 33 OF 97

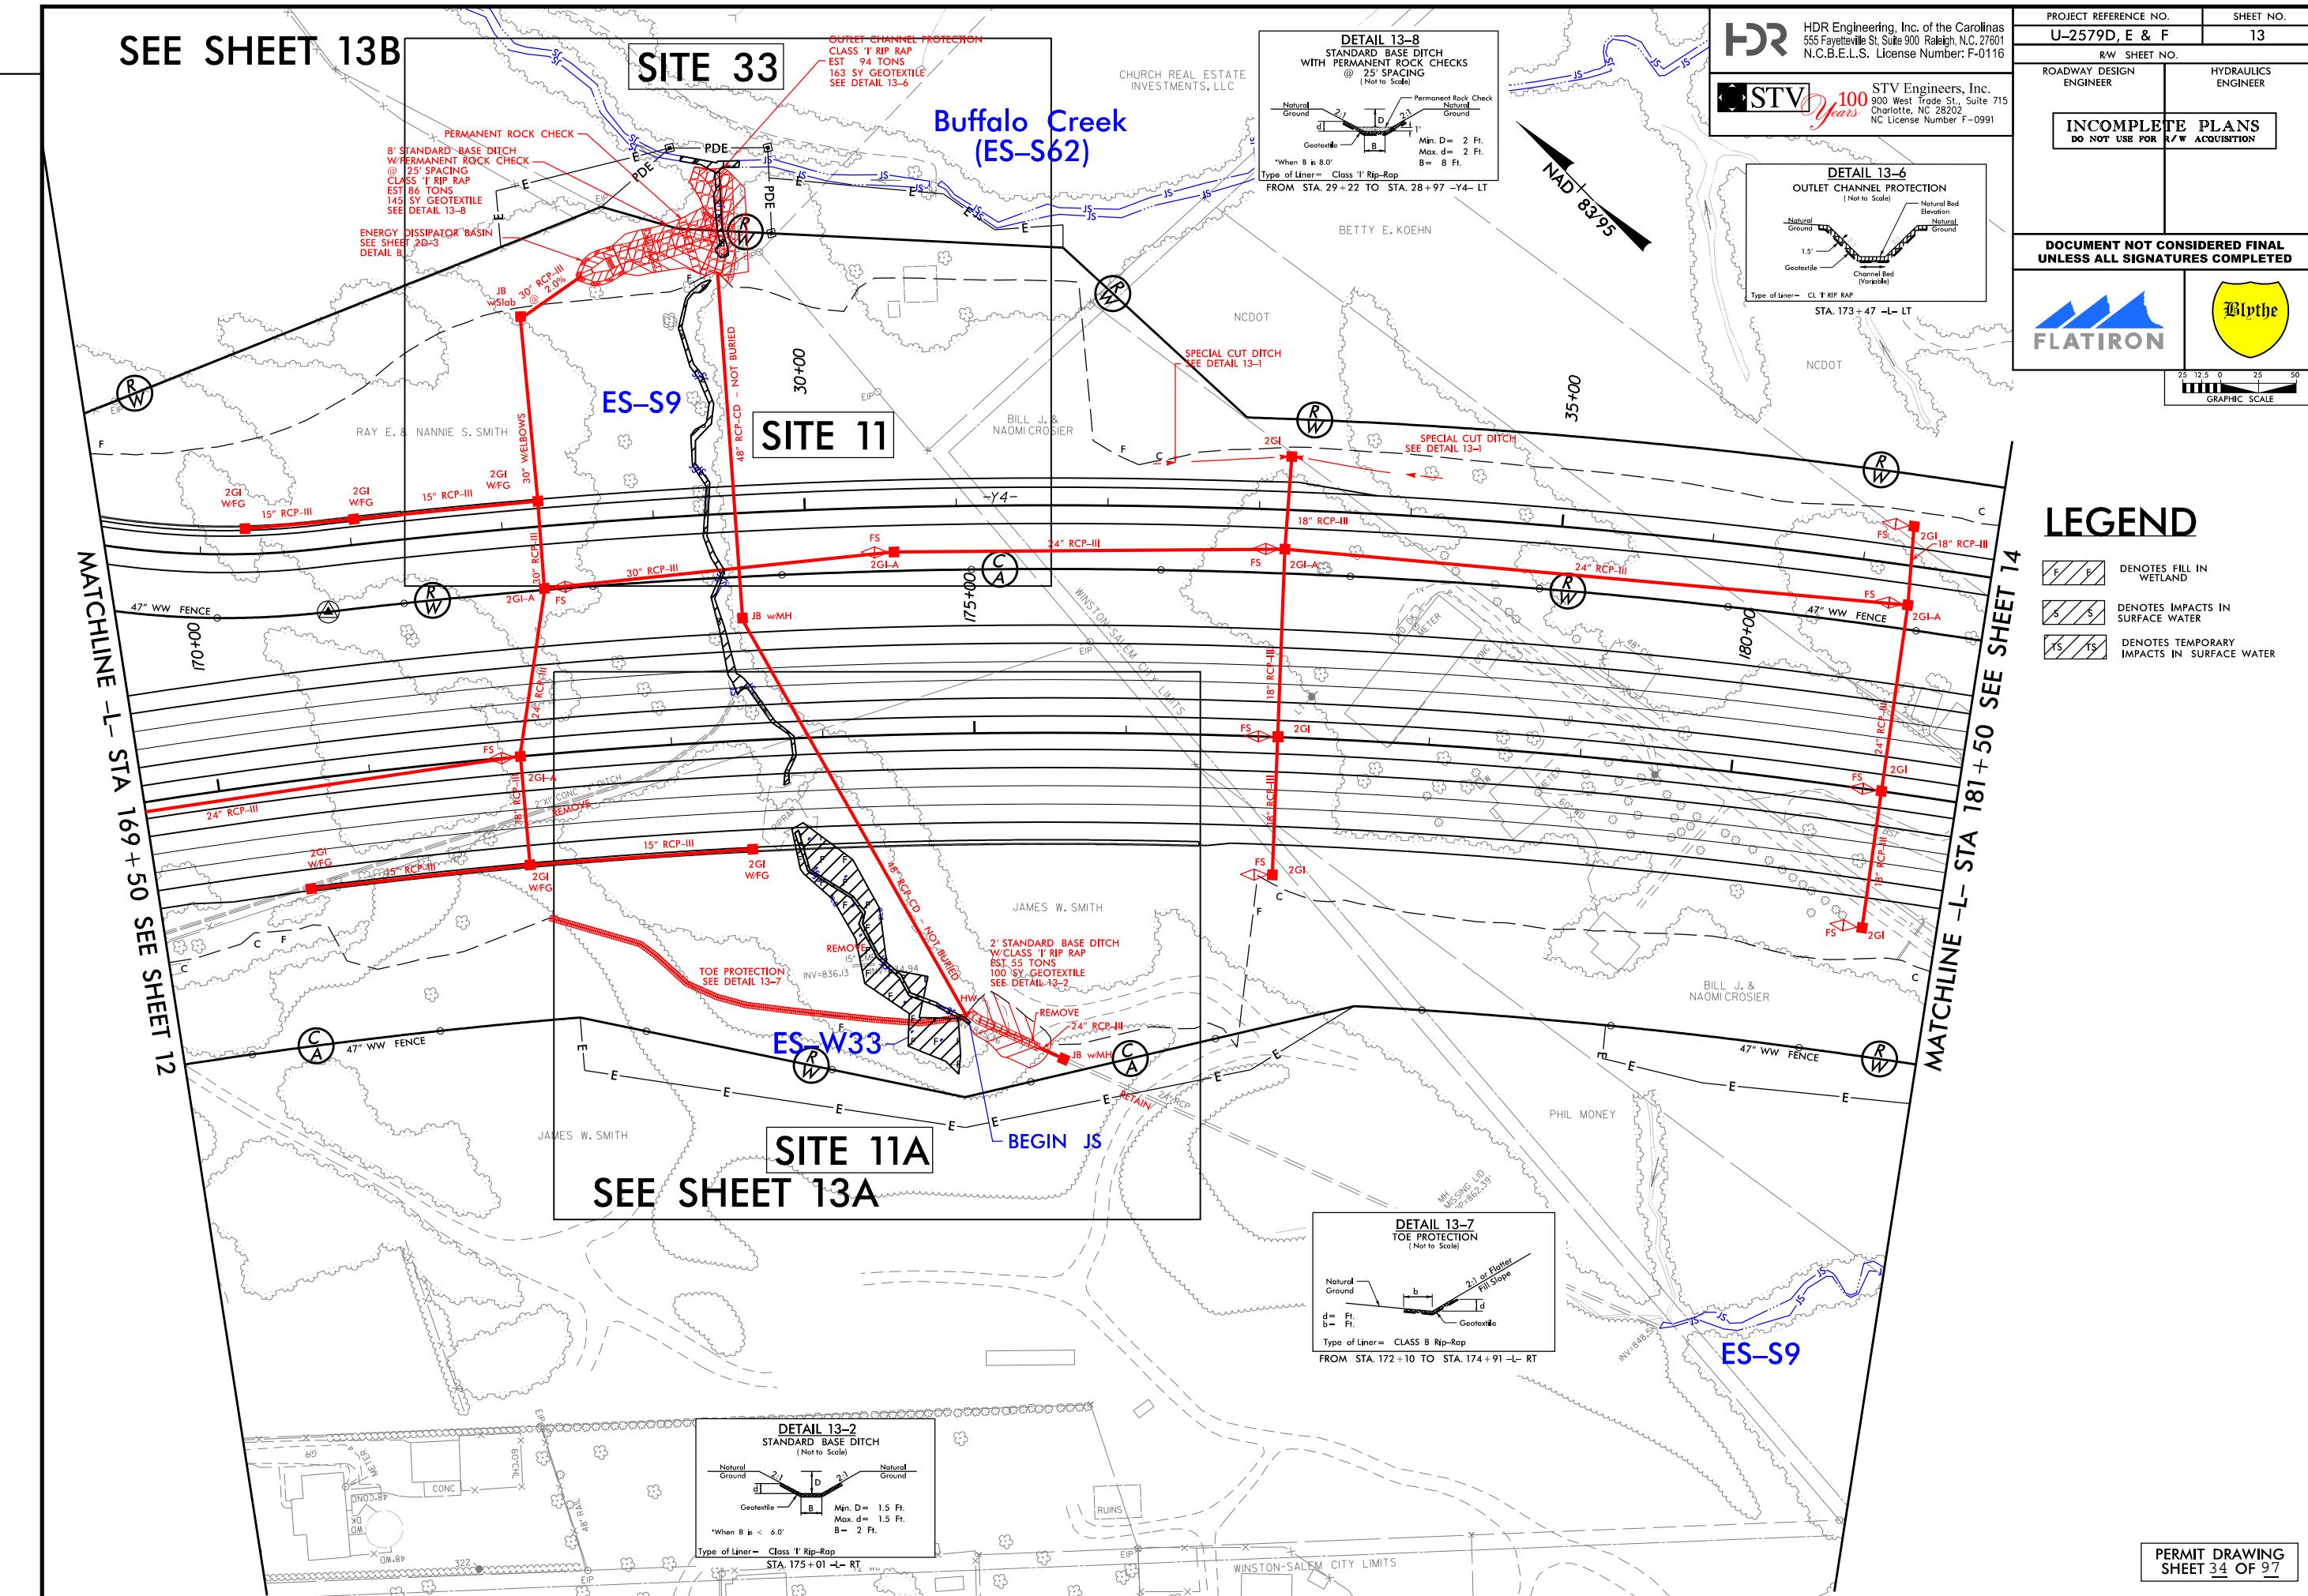

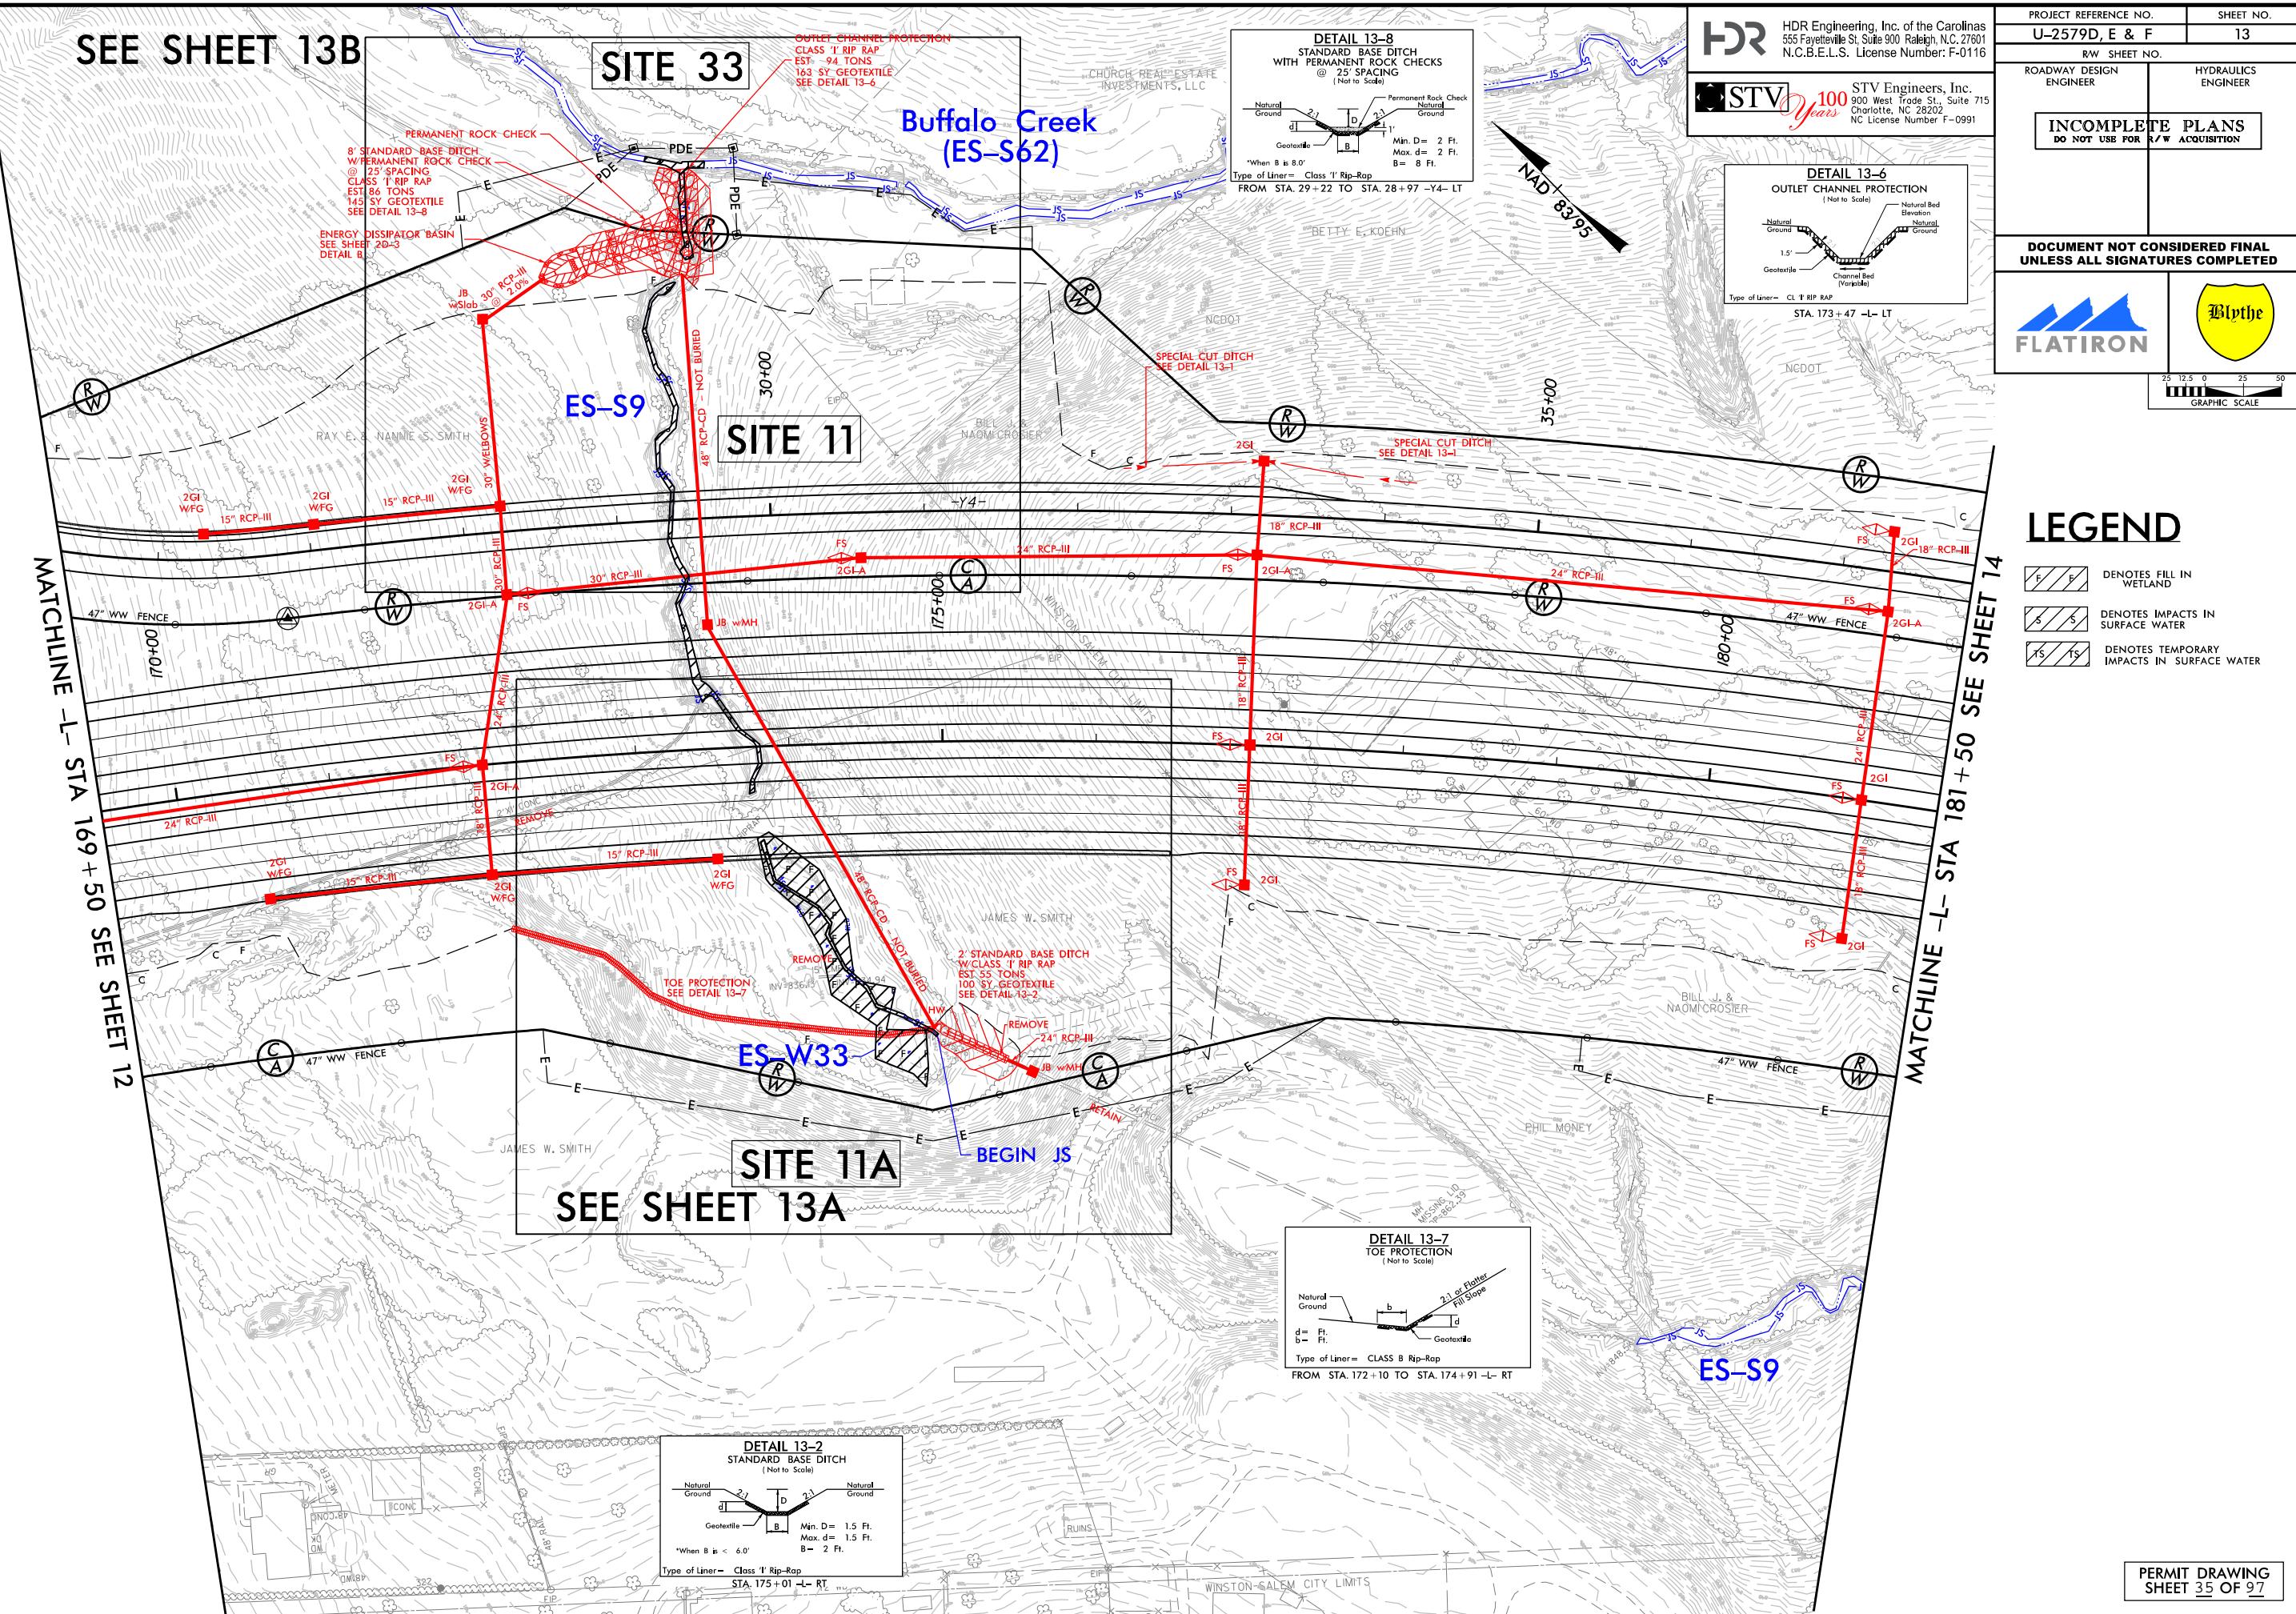

LOT DRIVER: NCDOT-pdf_color_eng_100.ptt
USER: KBELL
FILE: Flatiron_Construction-Corp.\Flatir

PENTABLE: NCDOT_permits_CON.tbl




REVISI観

1

PLOT DRIVER:

PROJECT REFERENCE NO. U-2579D, E & F	SHEET NO. 13A
R/W SHEET NO.	
ROADWAY DESIGN ENGINEER	HYDRAULICS ENGINEER
INCOMPLETE PLANS DO NOT USE FOR R/W ACQUISITION	
DOCUMENT NOT CONSIDERED FINAL UNLESS ALL SIGNATURES COMPLETED	
FLATIRON	Blythe


NAD 83 95

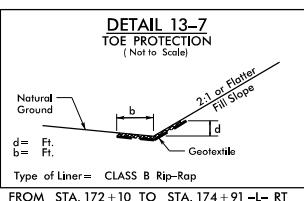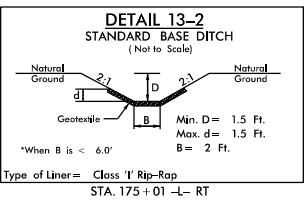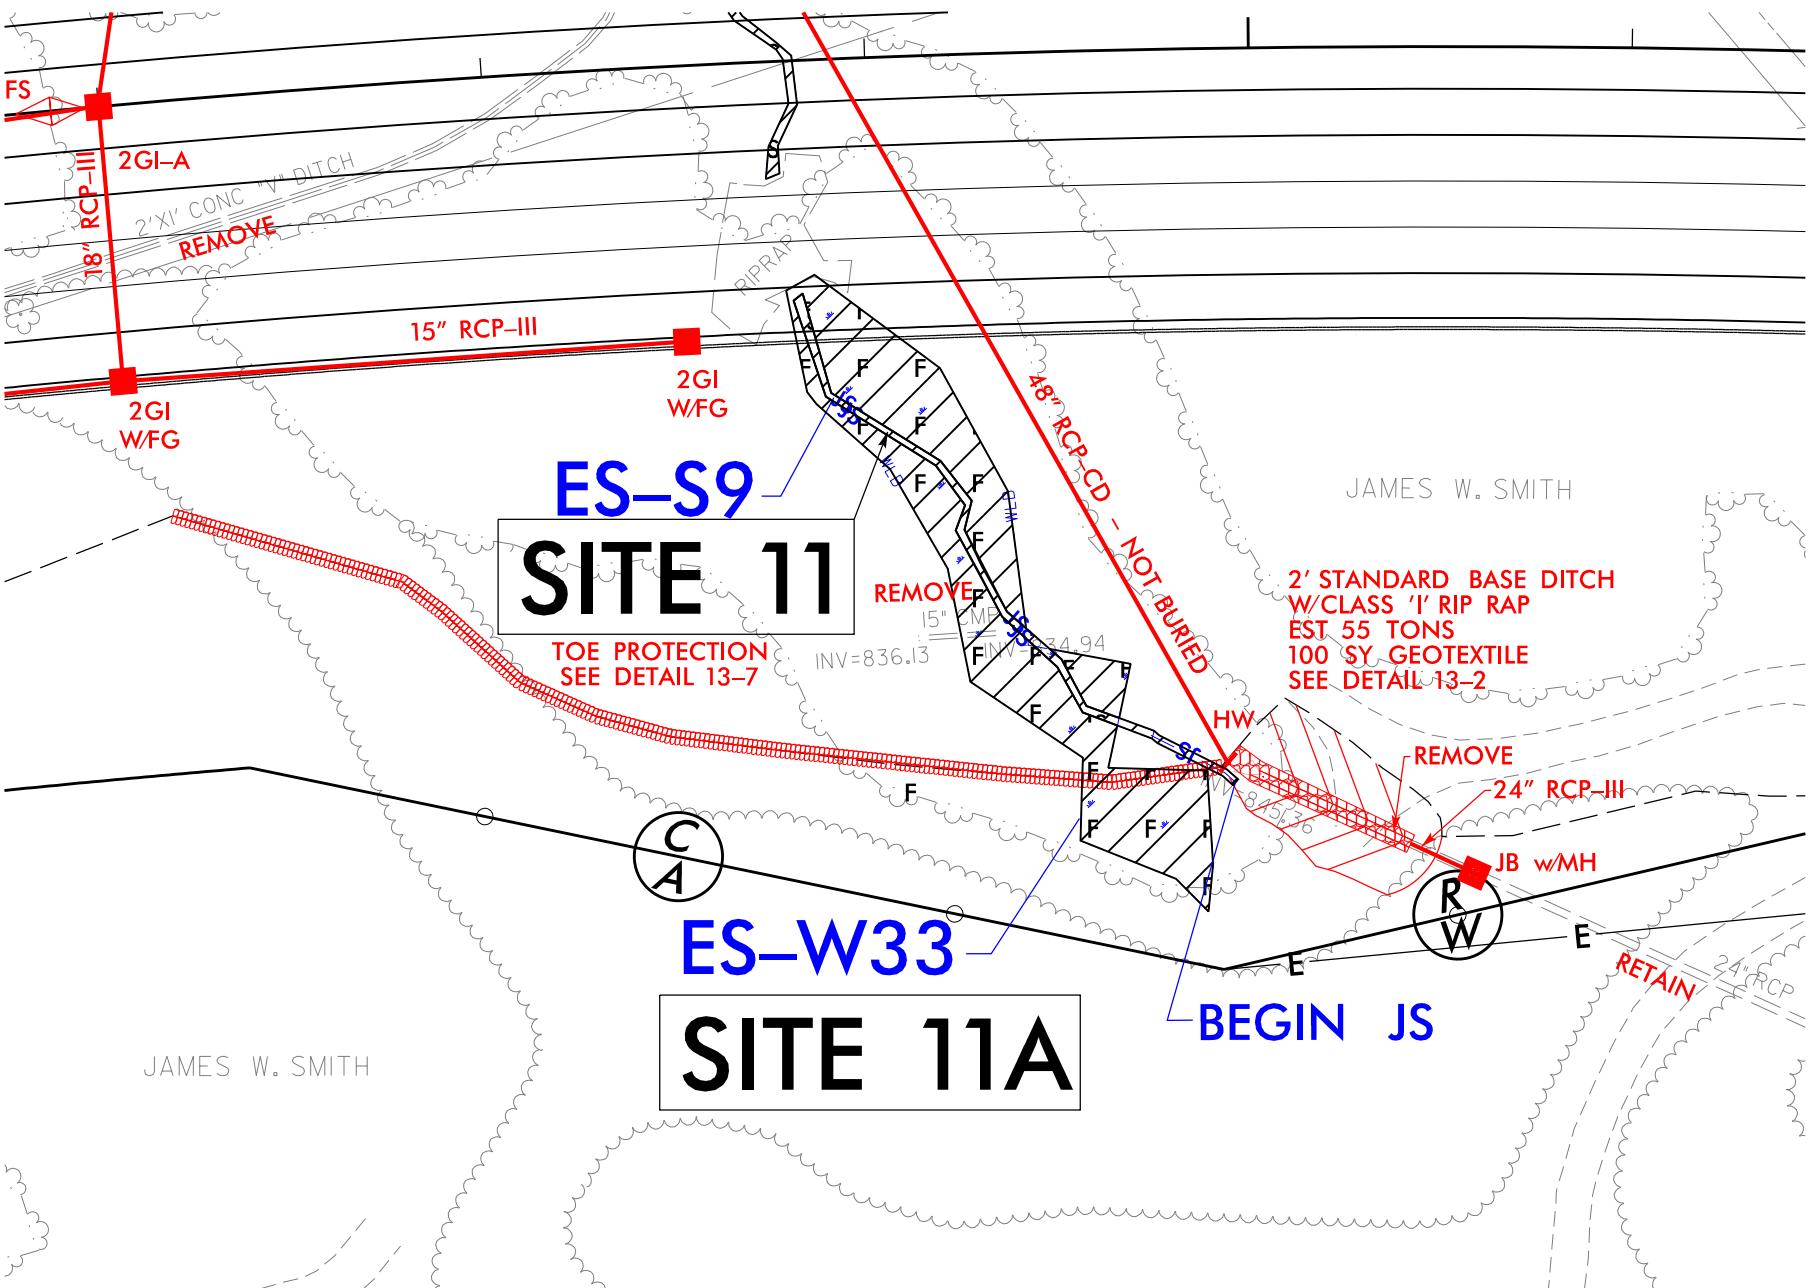



LEGEND

- F F** DENOTES FILL IN WETLAND
- TS TS** DENOTES TEMPORARY IMPACTS IN SURFACE WATER
- S S** DENOTES IMPACTS IN SURFACE WATER

PROJECT REFERENCE NO. U-2579D, E & F		SHEET NO. 13B
R/W SHEET NO.		
ROADWAY DESIGN ENGINEER	HYDRAULICS ENGINEER	
INCOMPLETE PLANS DO NOT USE FOR R/W ACQUISITION		
DOCUMENT NOT CONSIDERED FINAL UNLESS ALL SIGNATURES COMPLETED		
		

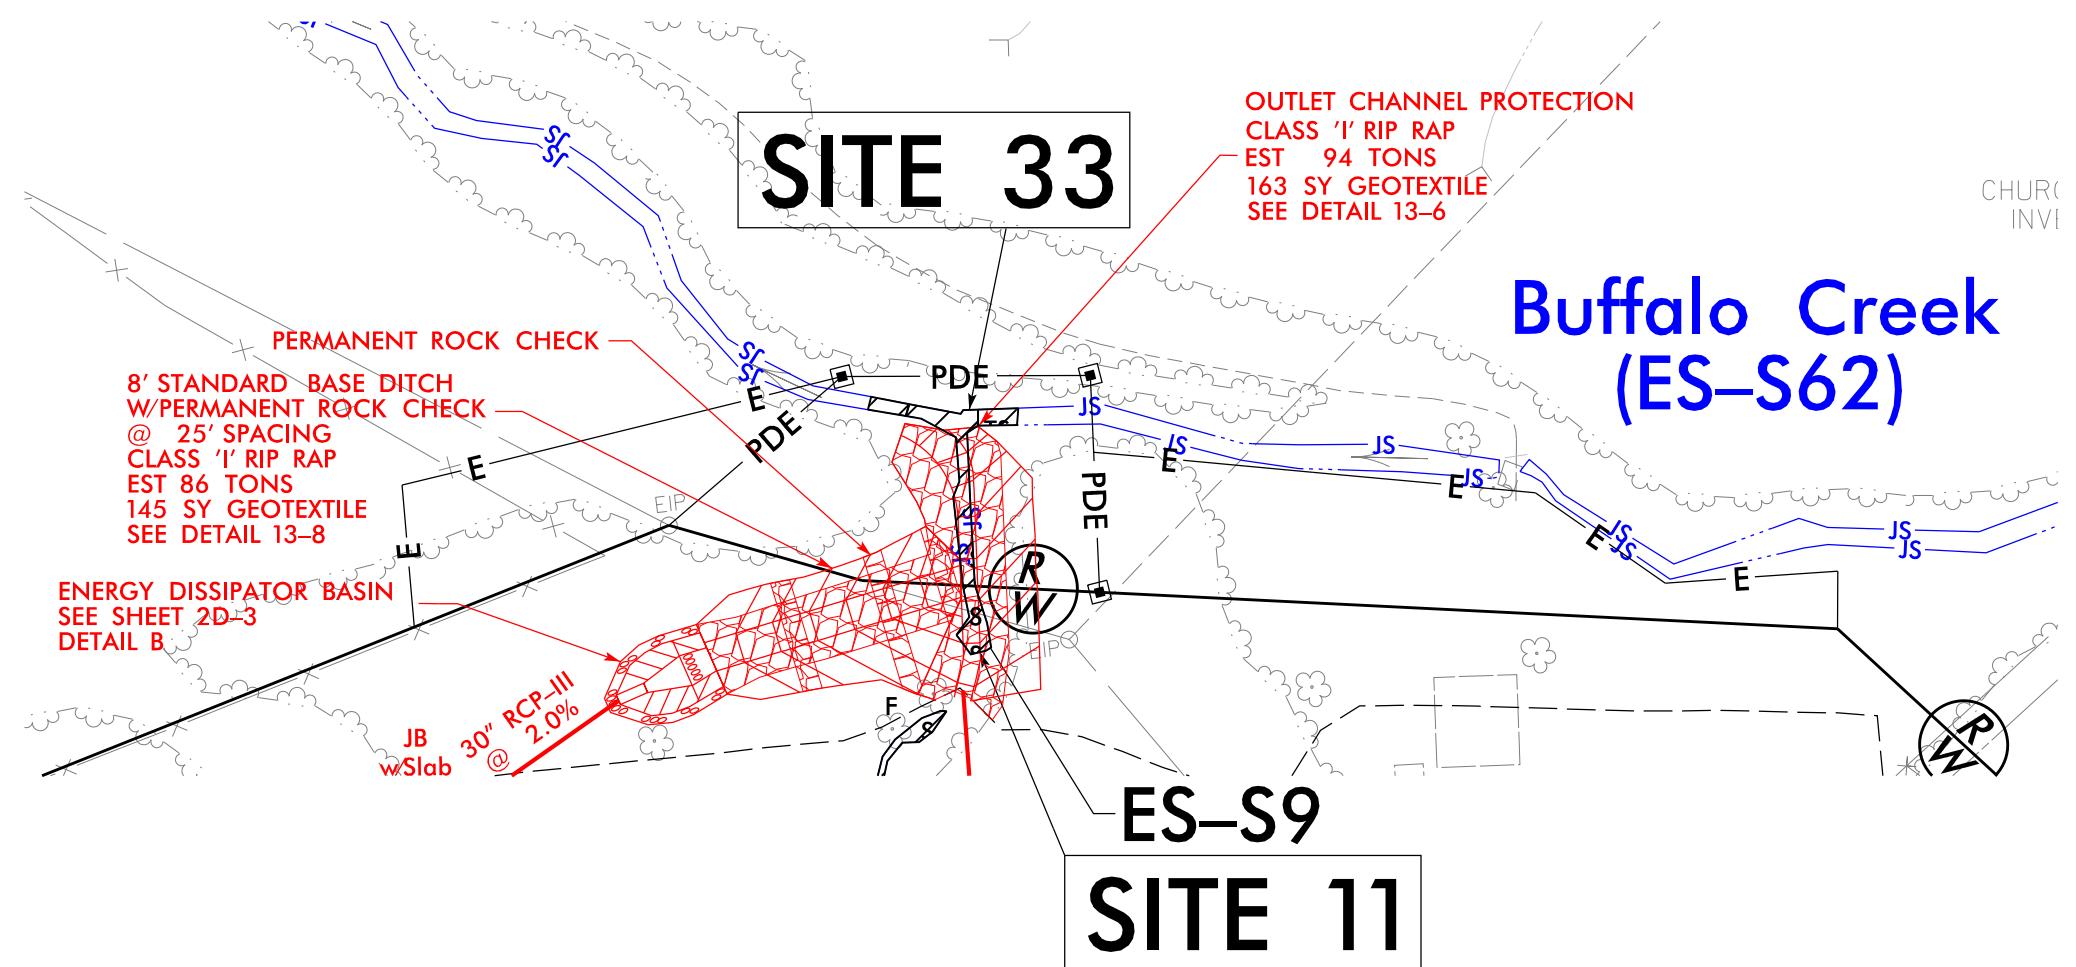


300 280 260 240 220 200 180 160 140 120 100 80 60 40 20 0 20 40 60 80 100 120 140 160 180 200 220 240 260 280 300

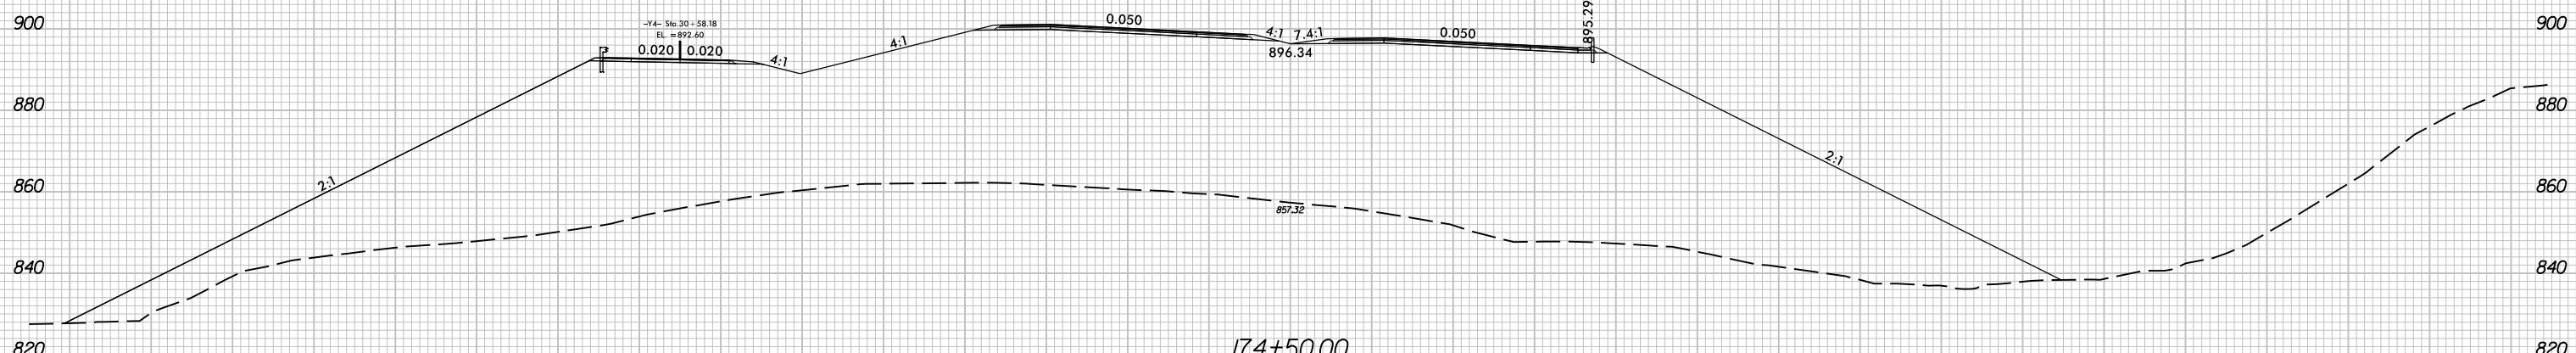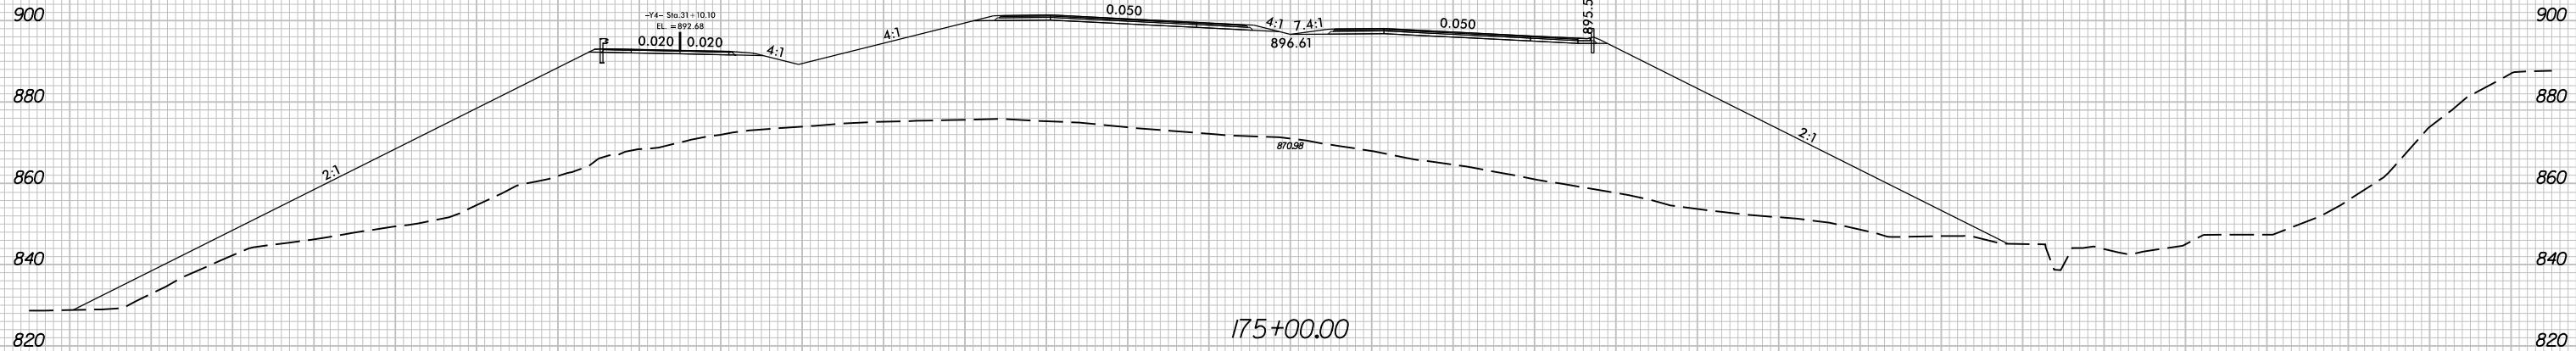


PENTABLE: NCDOT-PFL.XSC.rbl
TIME: 6:10:41 PM

PLOT DRIVER: NCDOT_PDF_COLOR_100.PDF
USER: J_USERNAME_DATE: 10/17/2018
FILE: U2579DEF_PRM_XPL.HDR.dgn

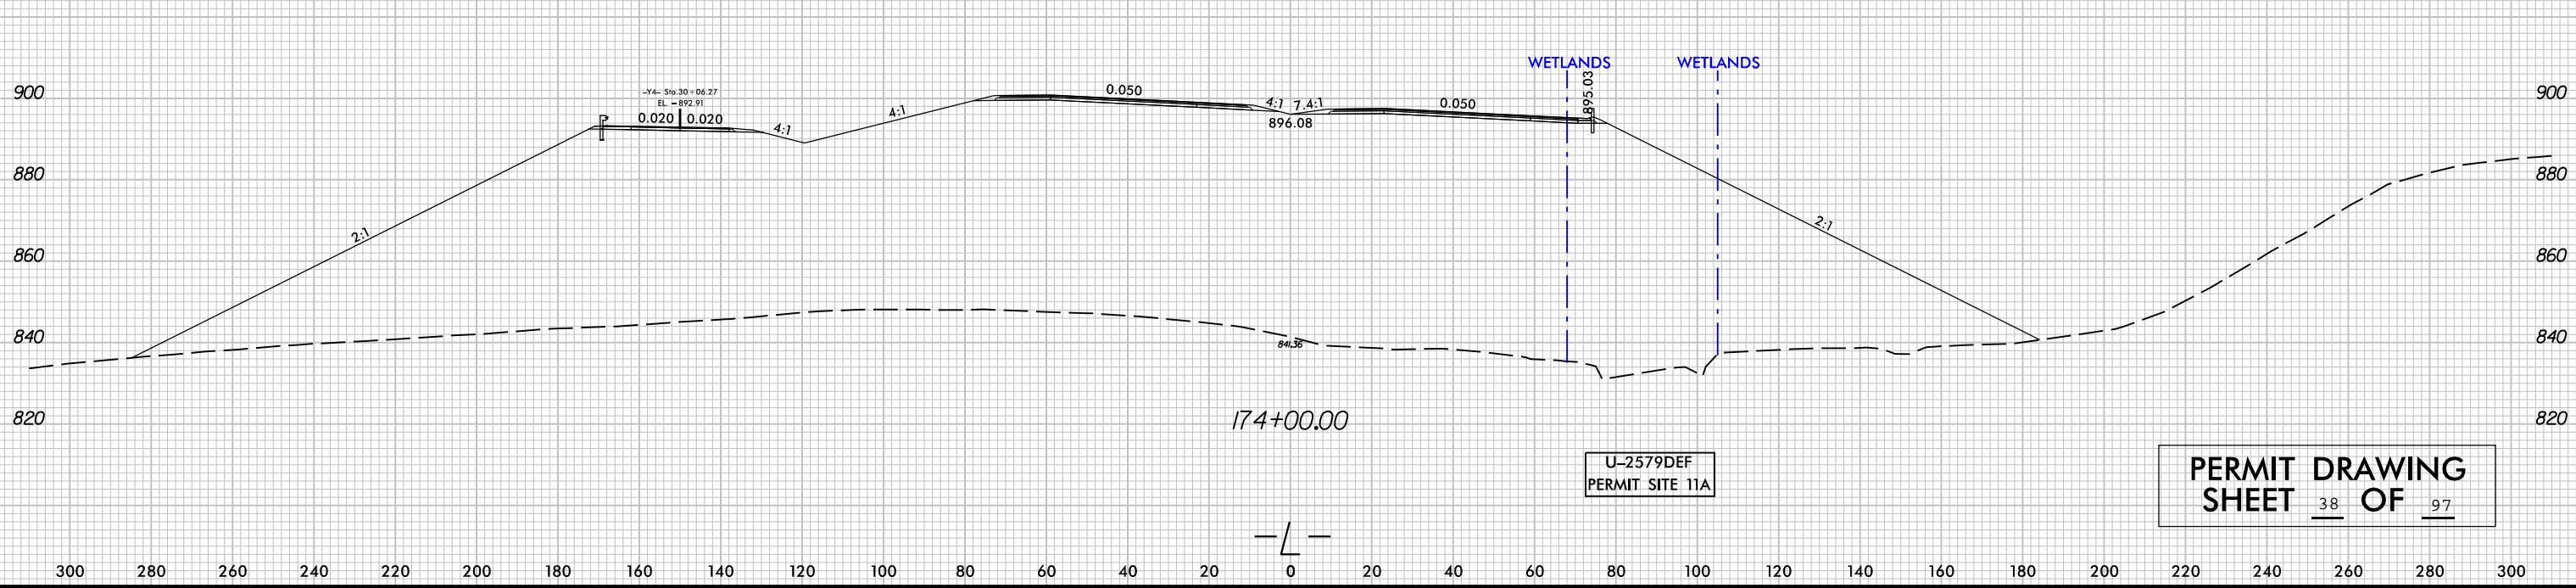


U-2579DEF
PERMIT SITE 11A


PERMIT DRAWING
SHEET 38 OF 97

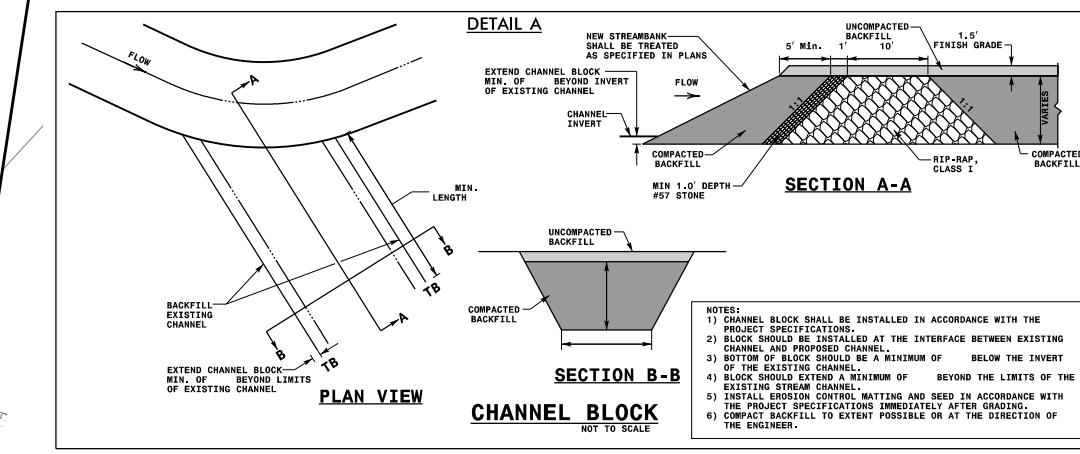


MATCHLINE -L- STA 194+50 SEE SHEET 14

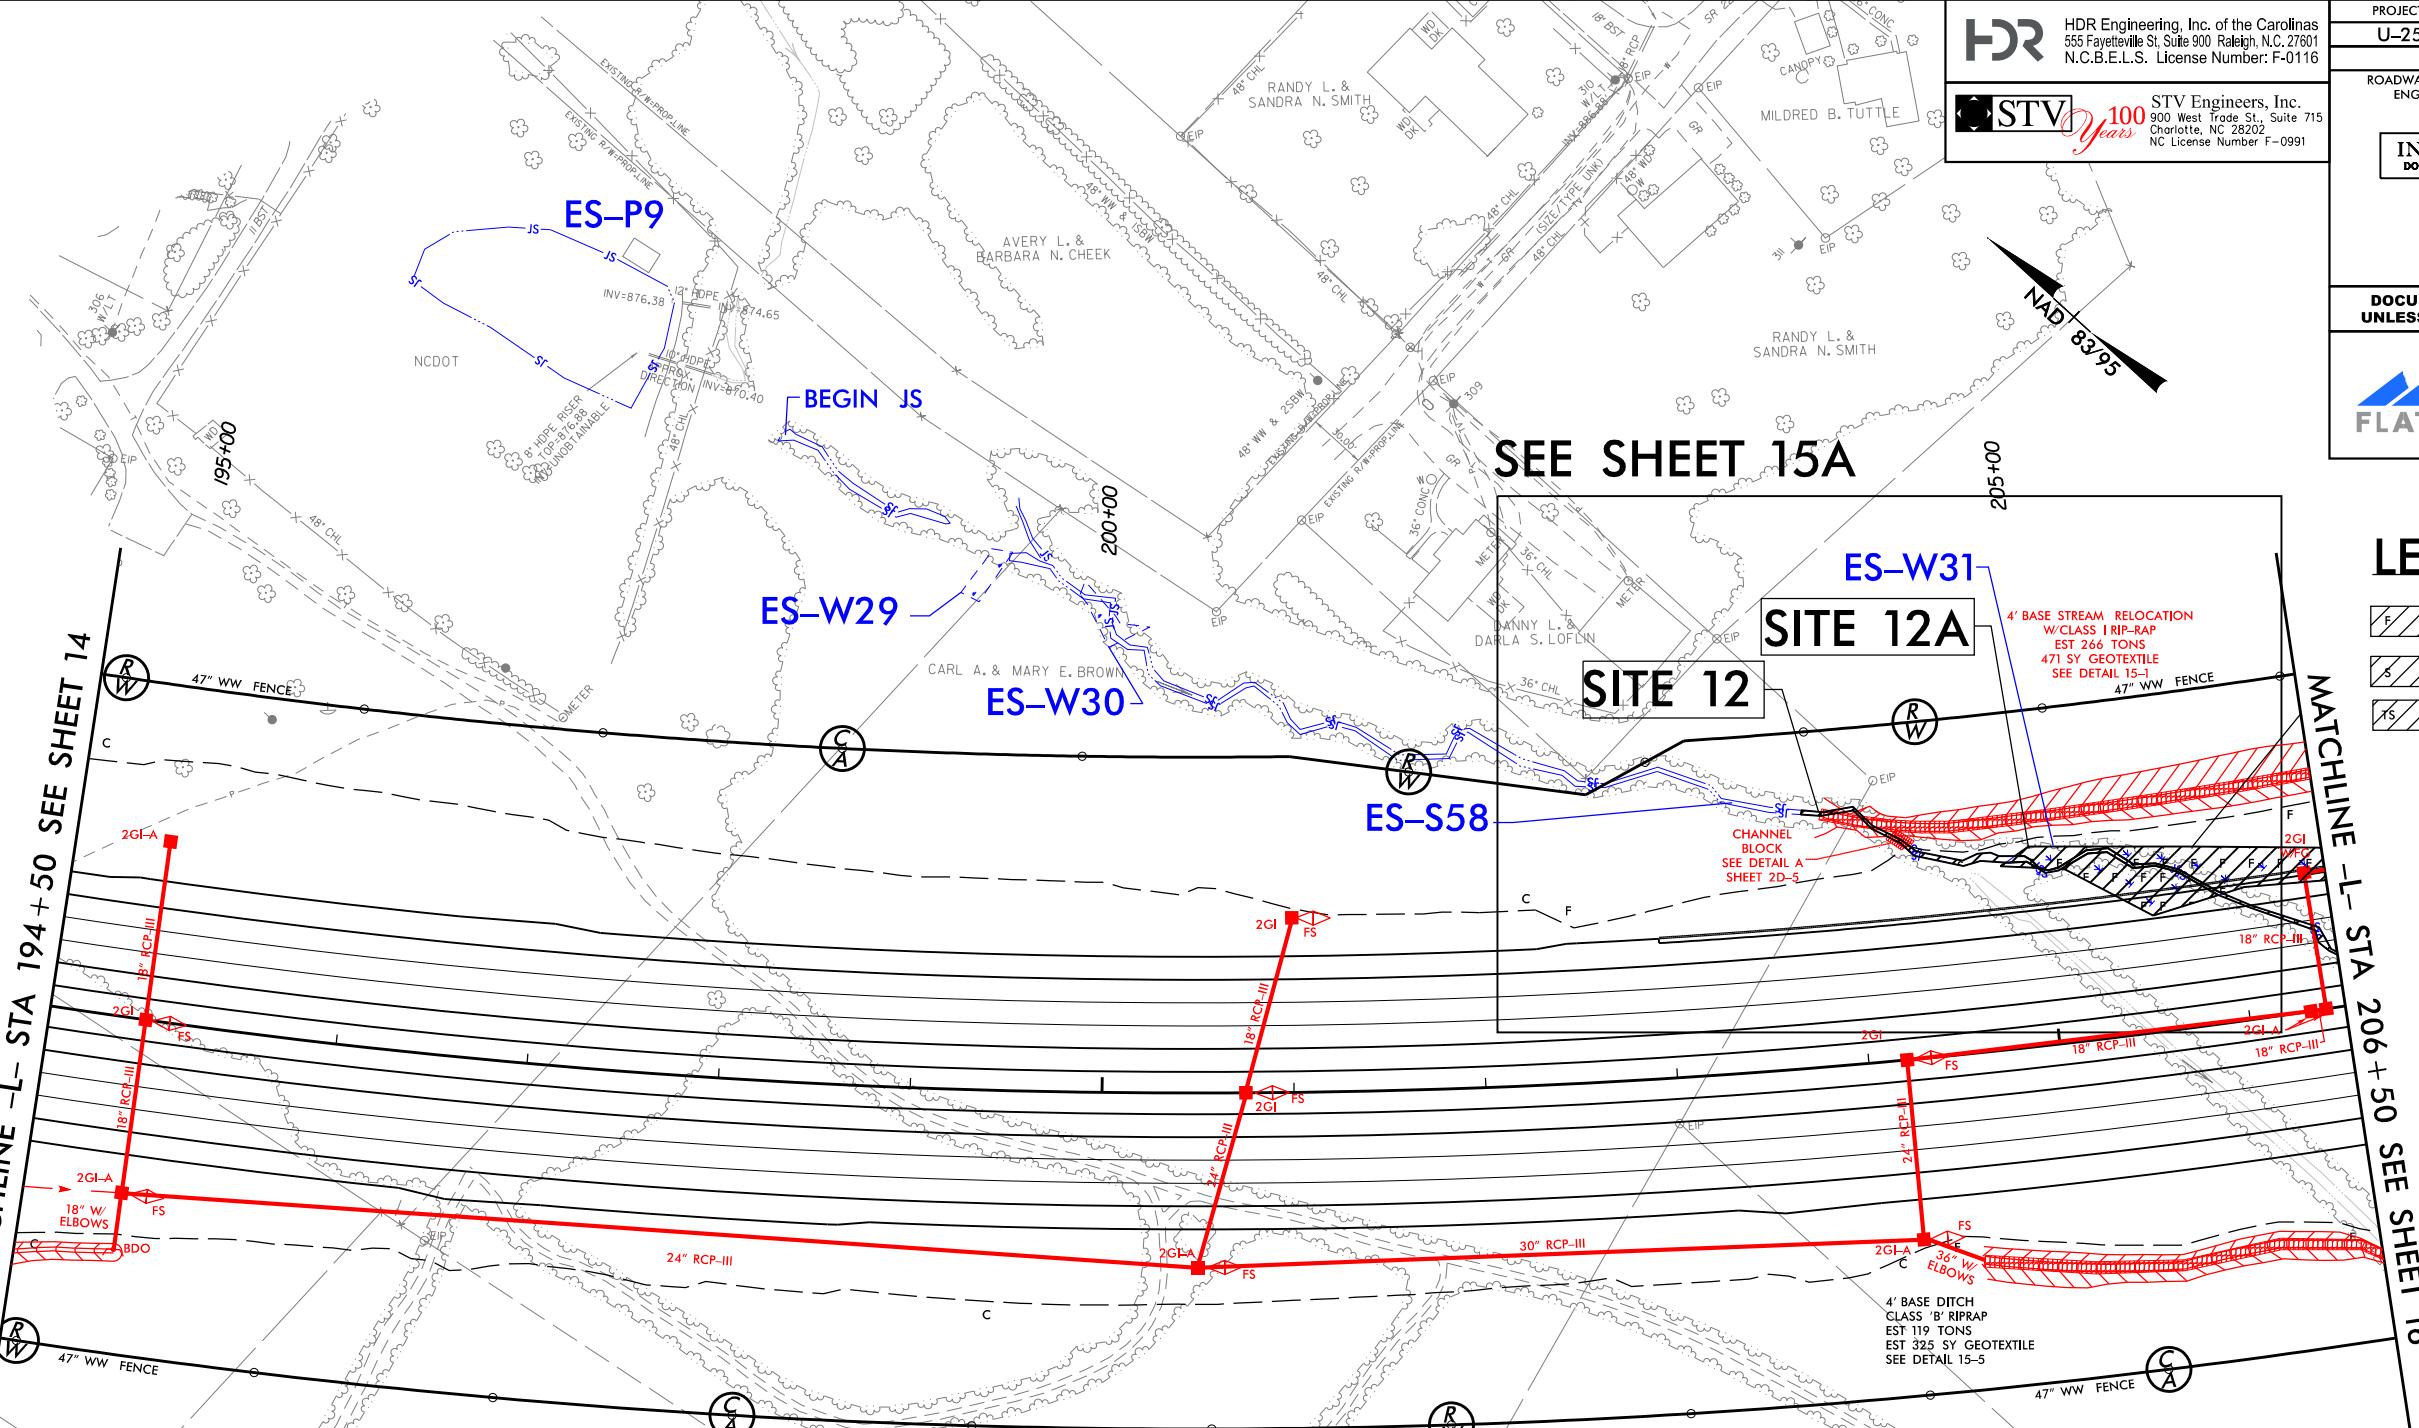

PROJECT REFERENCE NO. U-2579D, E & F	SHEET NO. 15
R/W SHEET NO.	
ROADWAY DESIGN ENGINEER	HYDRAULICS ENGINEER
INCOMPLETE PLANS DO NOT USE FOR R/W ACQUISITION	
DOCUMENT NOT CONSIDERED FINAL UNLESS ALL SIGNATURES COMPLETED	
FLATIRON	Blythe
GRAPHIC SCALE	

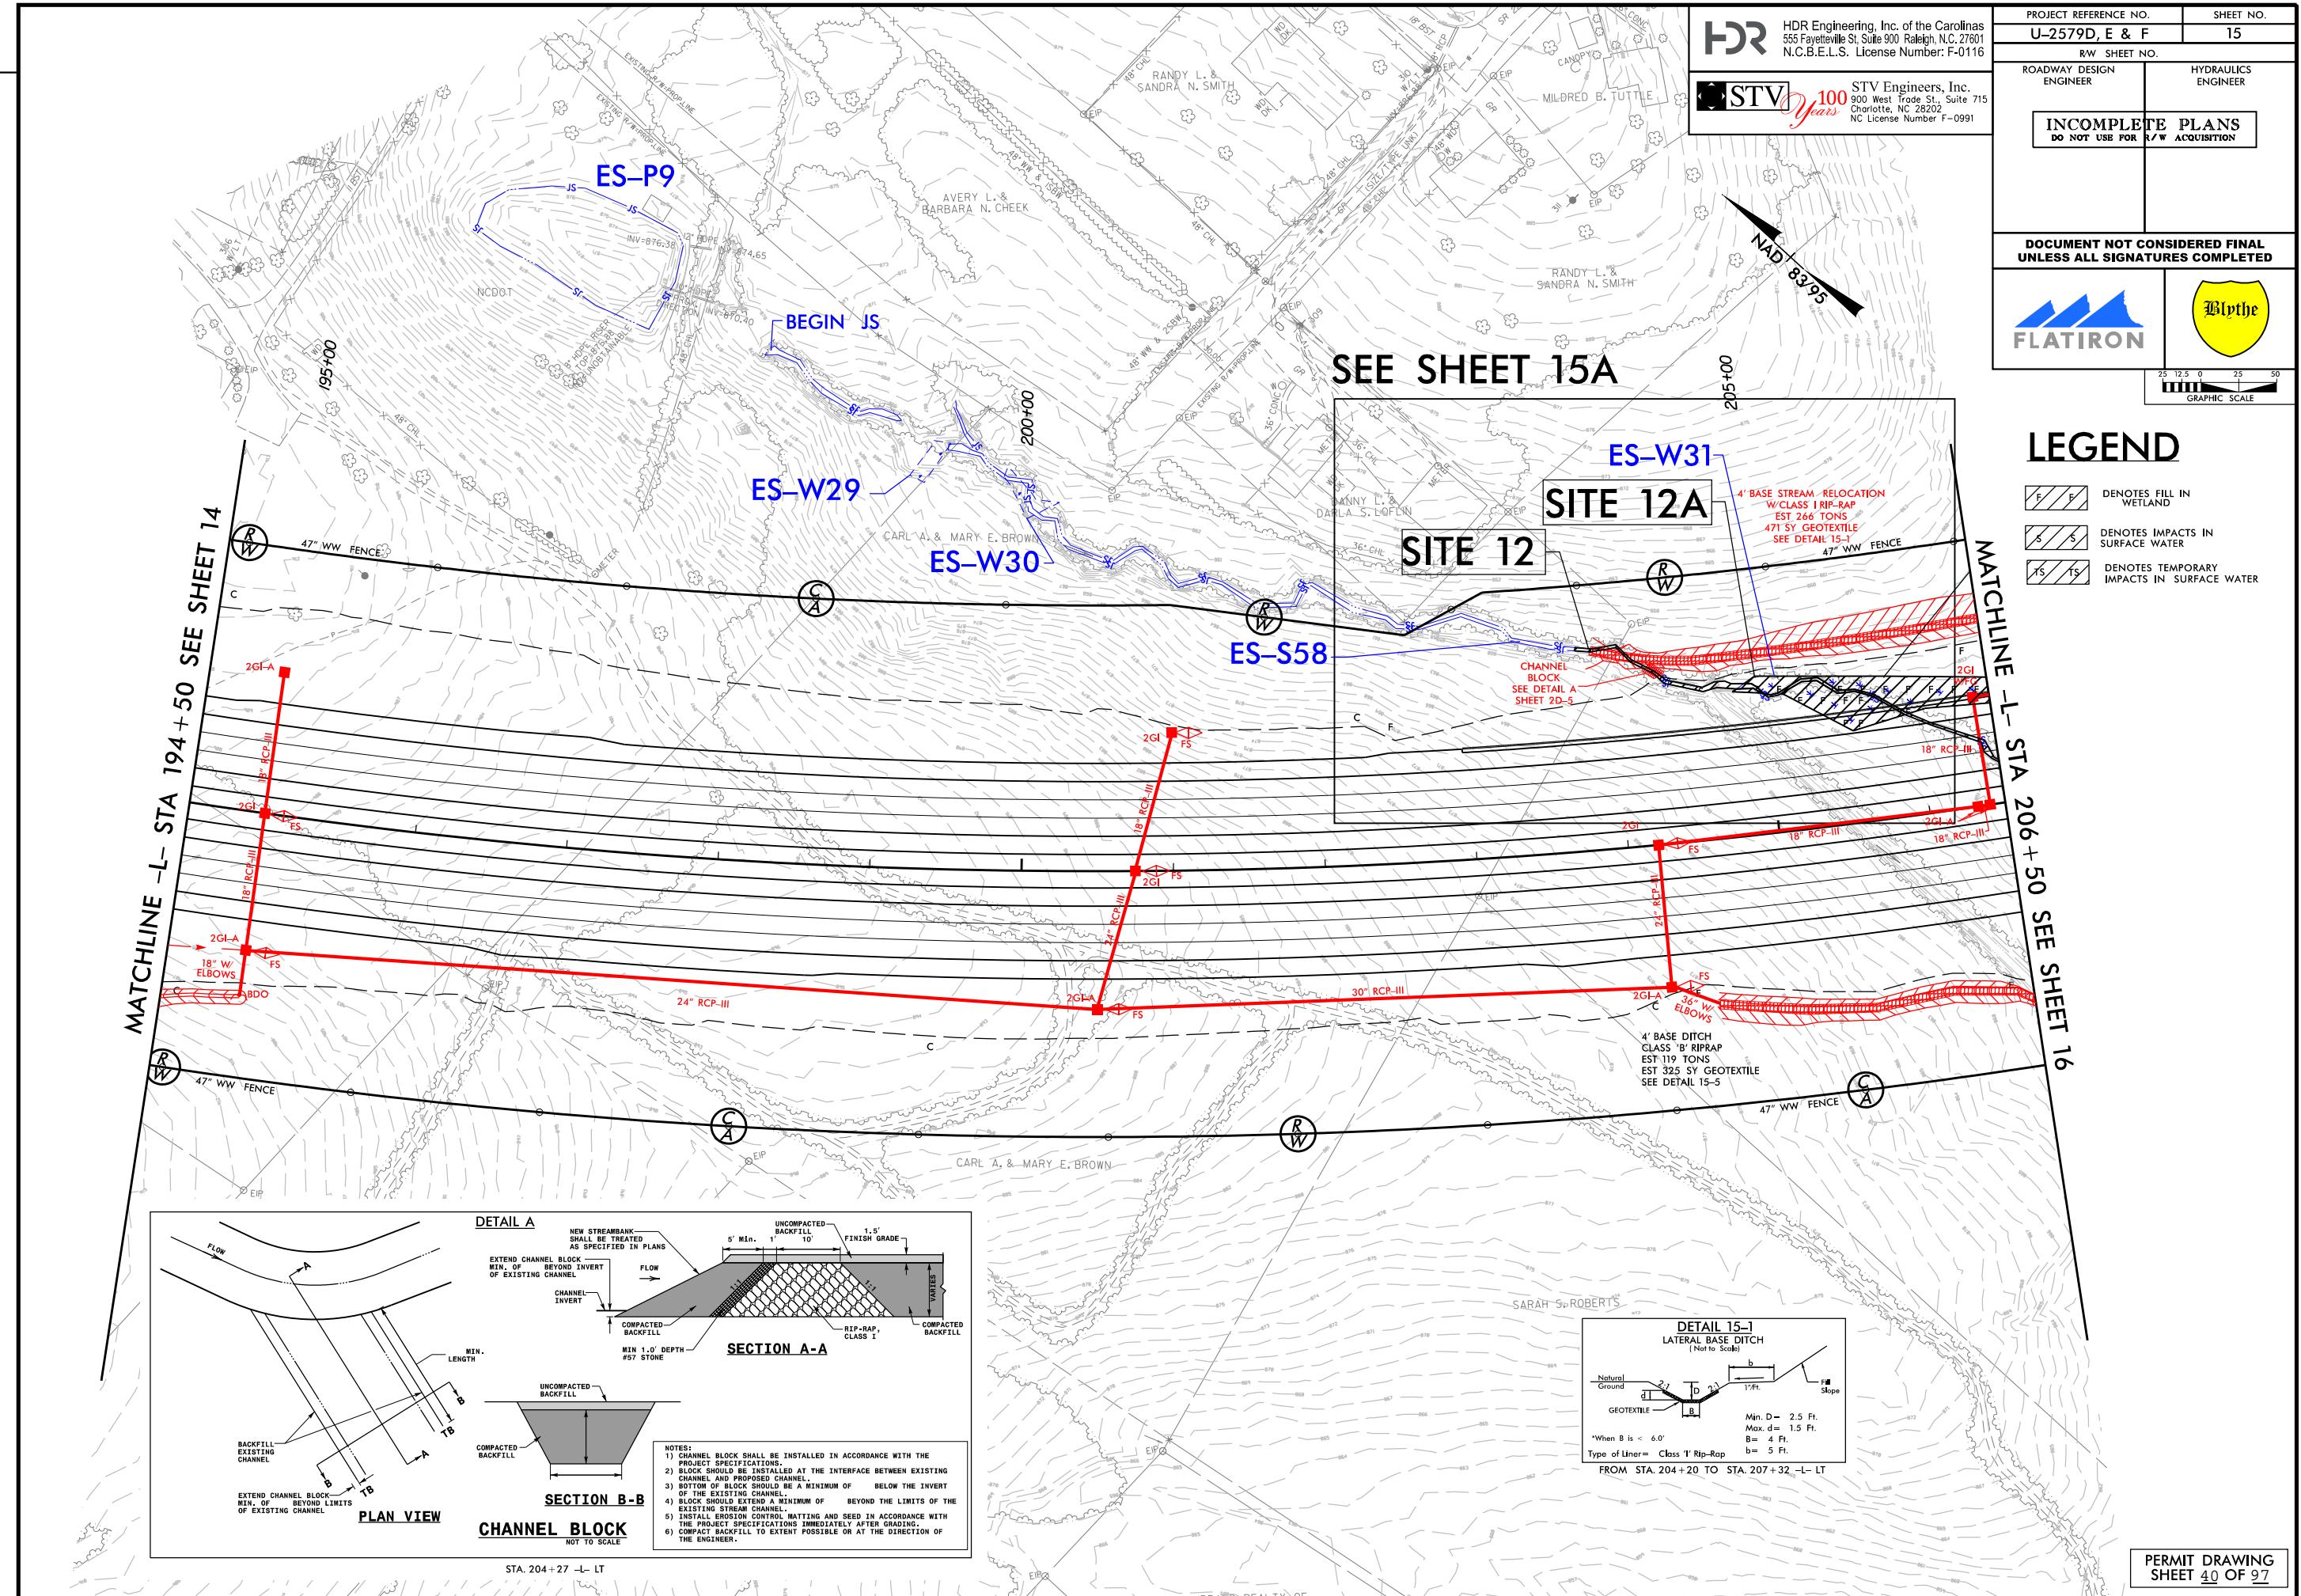

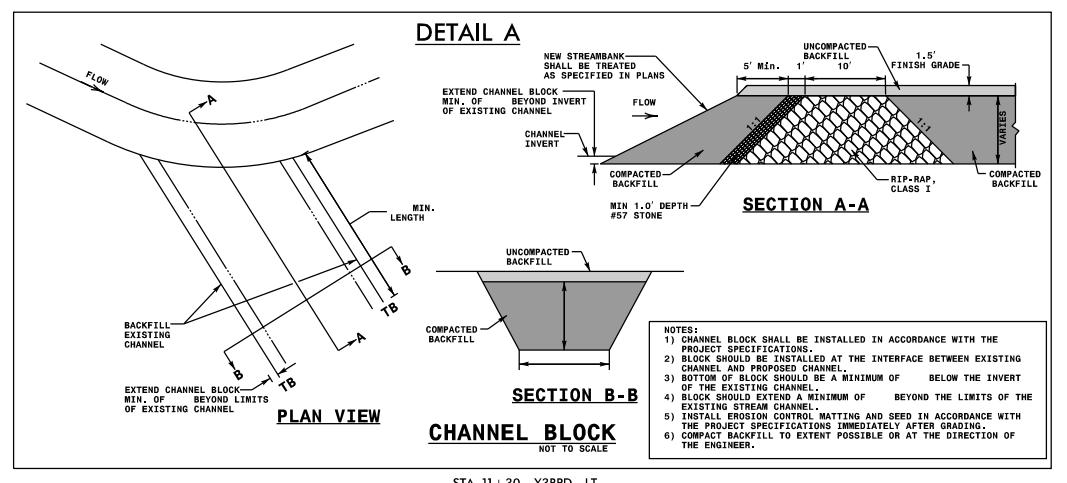

HDR HDR Engineering, Inc. of the Carolinas
555 Fayetteville St, Suite 900 Raleigh, NC 27601
N.C.B.E.L.S. License Number: F-0116

STV STV Engineers, Inc.
900 West Trade St., Suite 715 Charlotte, NC 28202
NC License Number F-0991


100 Years

PROJECT REFERENCE NO.	SHEET NO.
U-2579D, E & F	15A
R/W SHEET NO.	
ROADWAY DESIGN ENGINEER	HYDRAULICS ENGINEER
INCOMPLETE PLANS DO NOT USE FOR R/W ACQUISITION	
DOCUMENT NOT CONSIDERED FINAL UNLESS ALL SIGNATURES COMPLETED	



NAD 83 95


STA. 11+30 -Y3RPD- LT
STA. 204+27 -L- LT

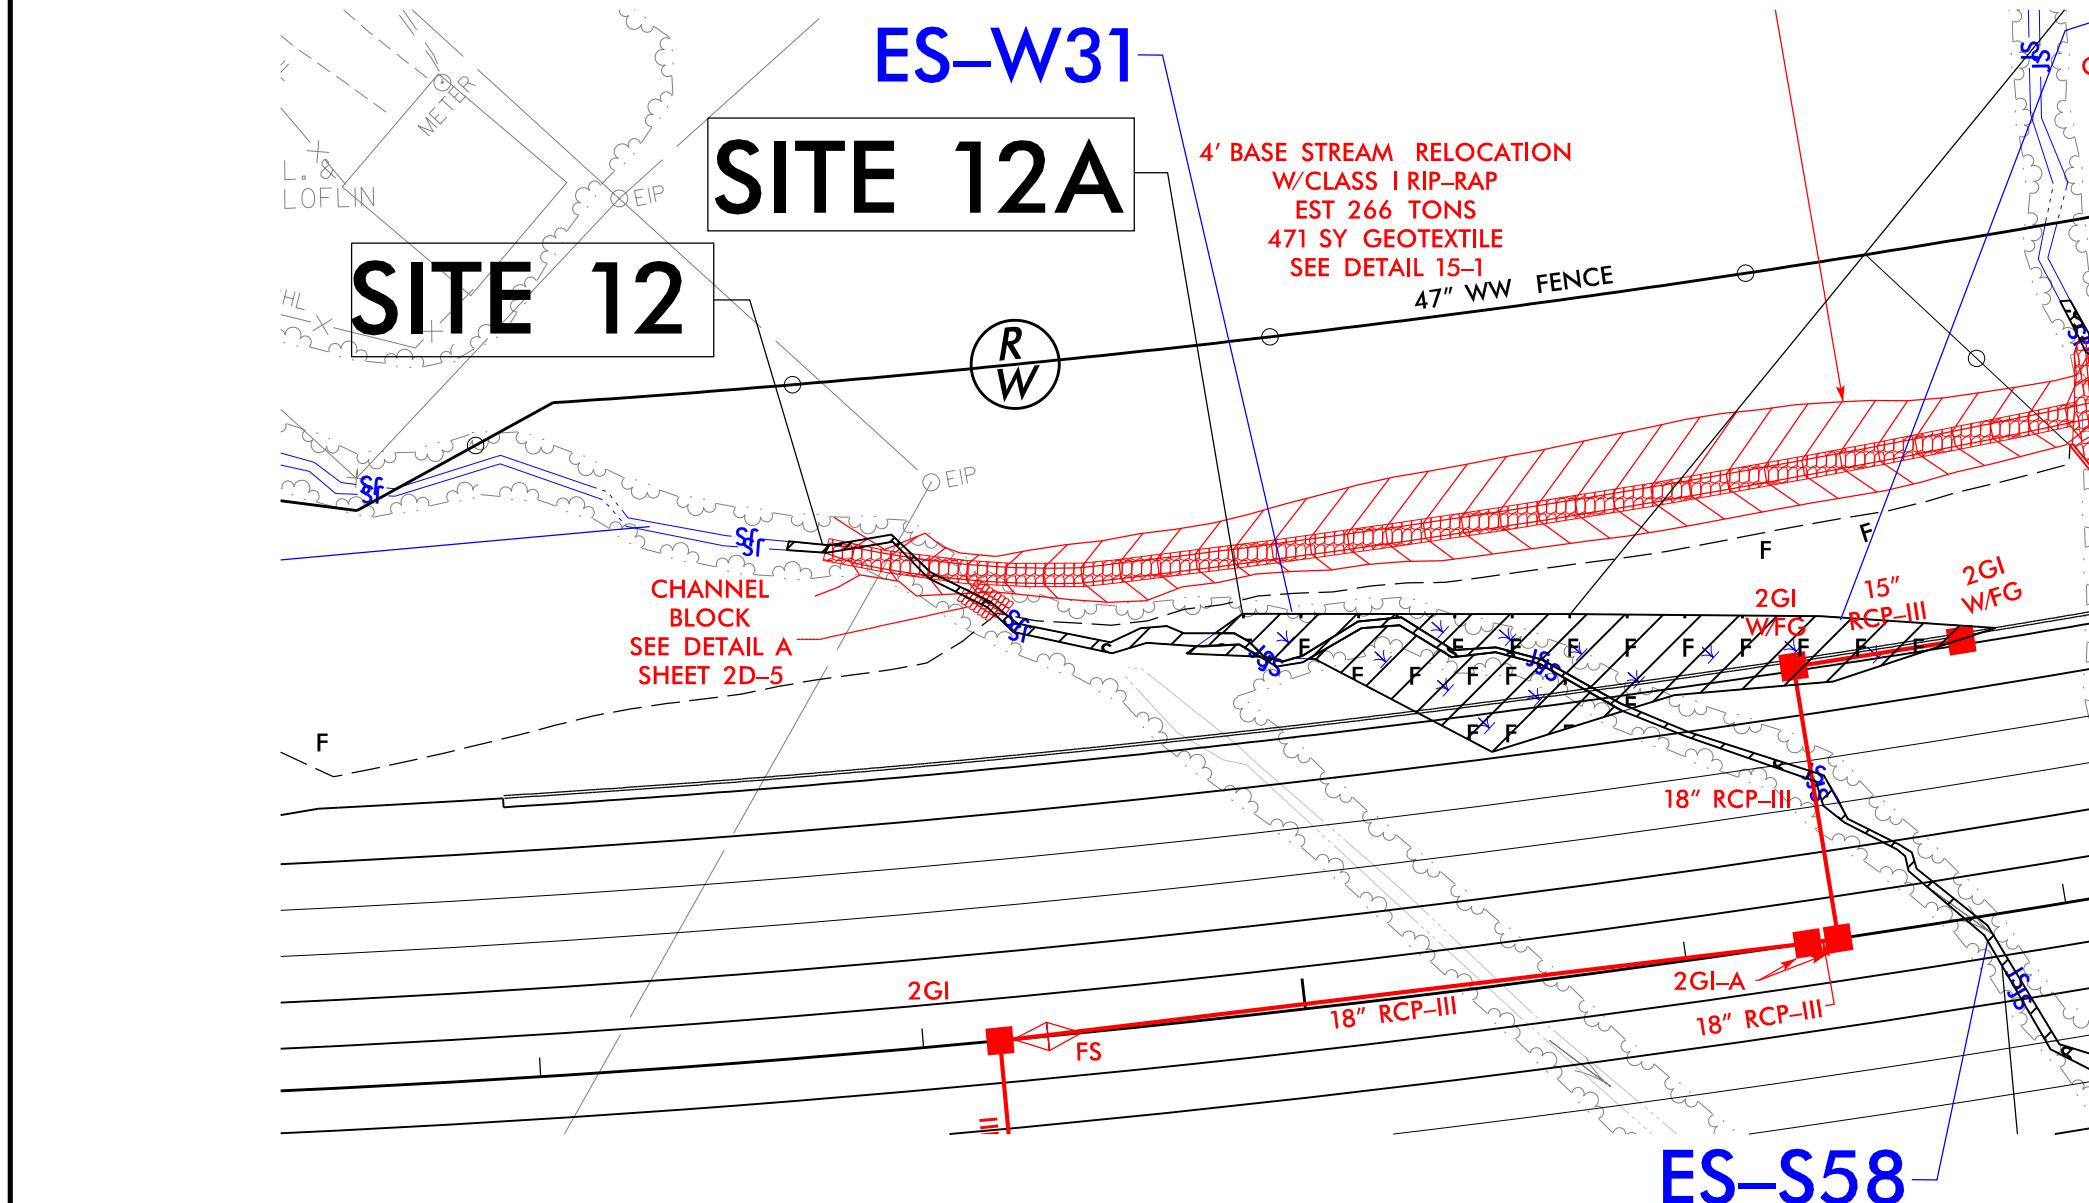

LEGEND

- DENOTES FILL IN WETLAND**
- DENOTES IMPACTS IN SURFACE WATER**
- DENOTES TEMPORARY IMPACTS IN SURFACE WATER**

300 280 260 240 220 200 180 160 140 120 100 80 60 40 20 0 20 40 60 80 100 120 140 160 180 200 220 240 260 280 300

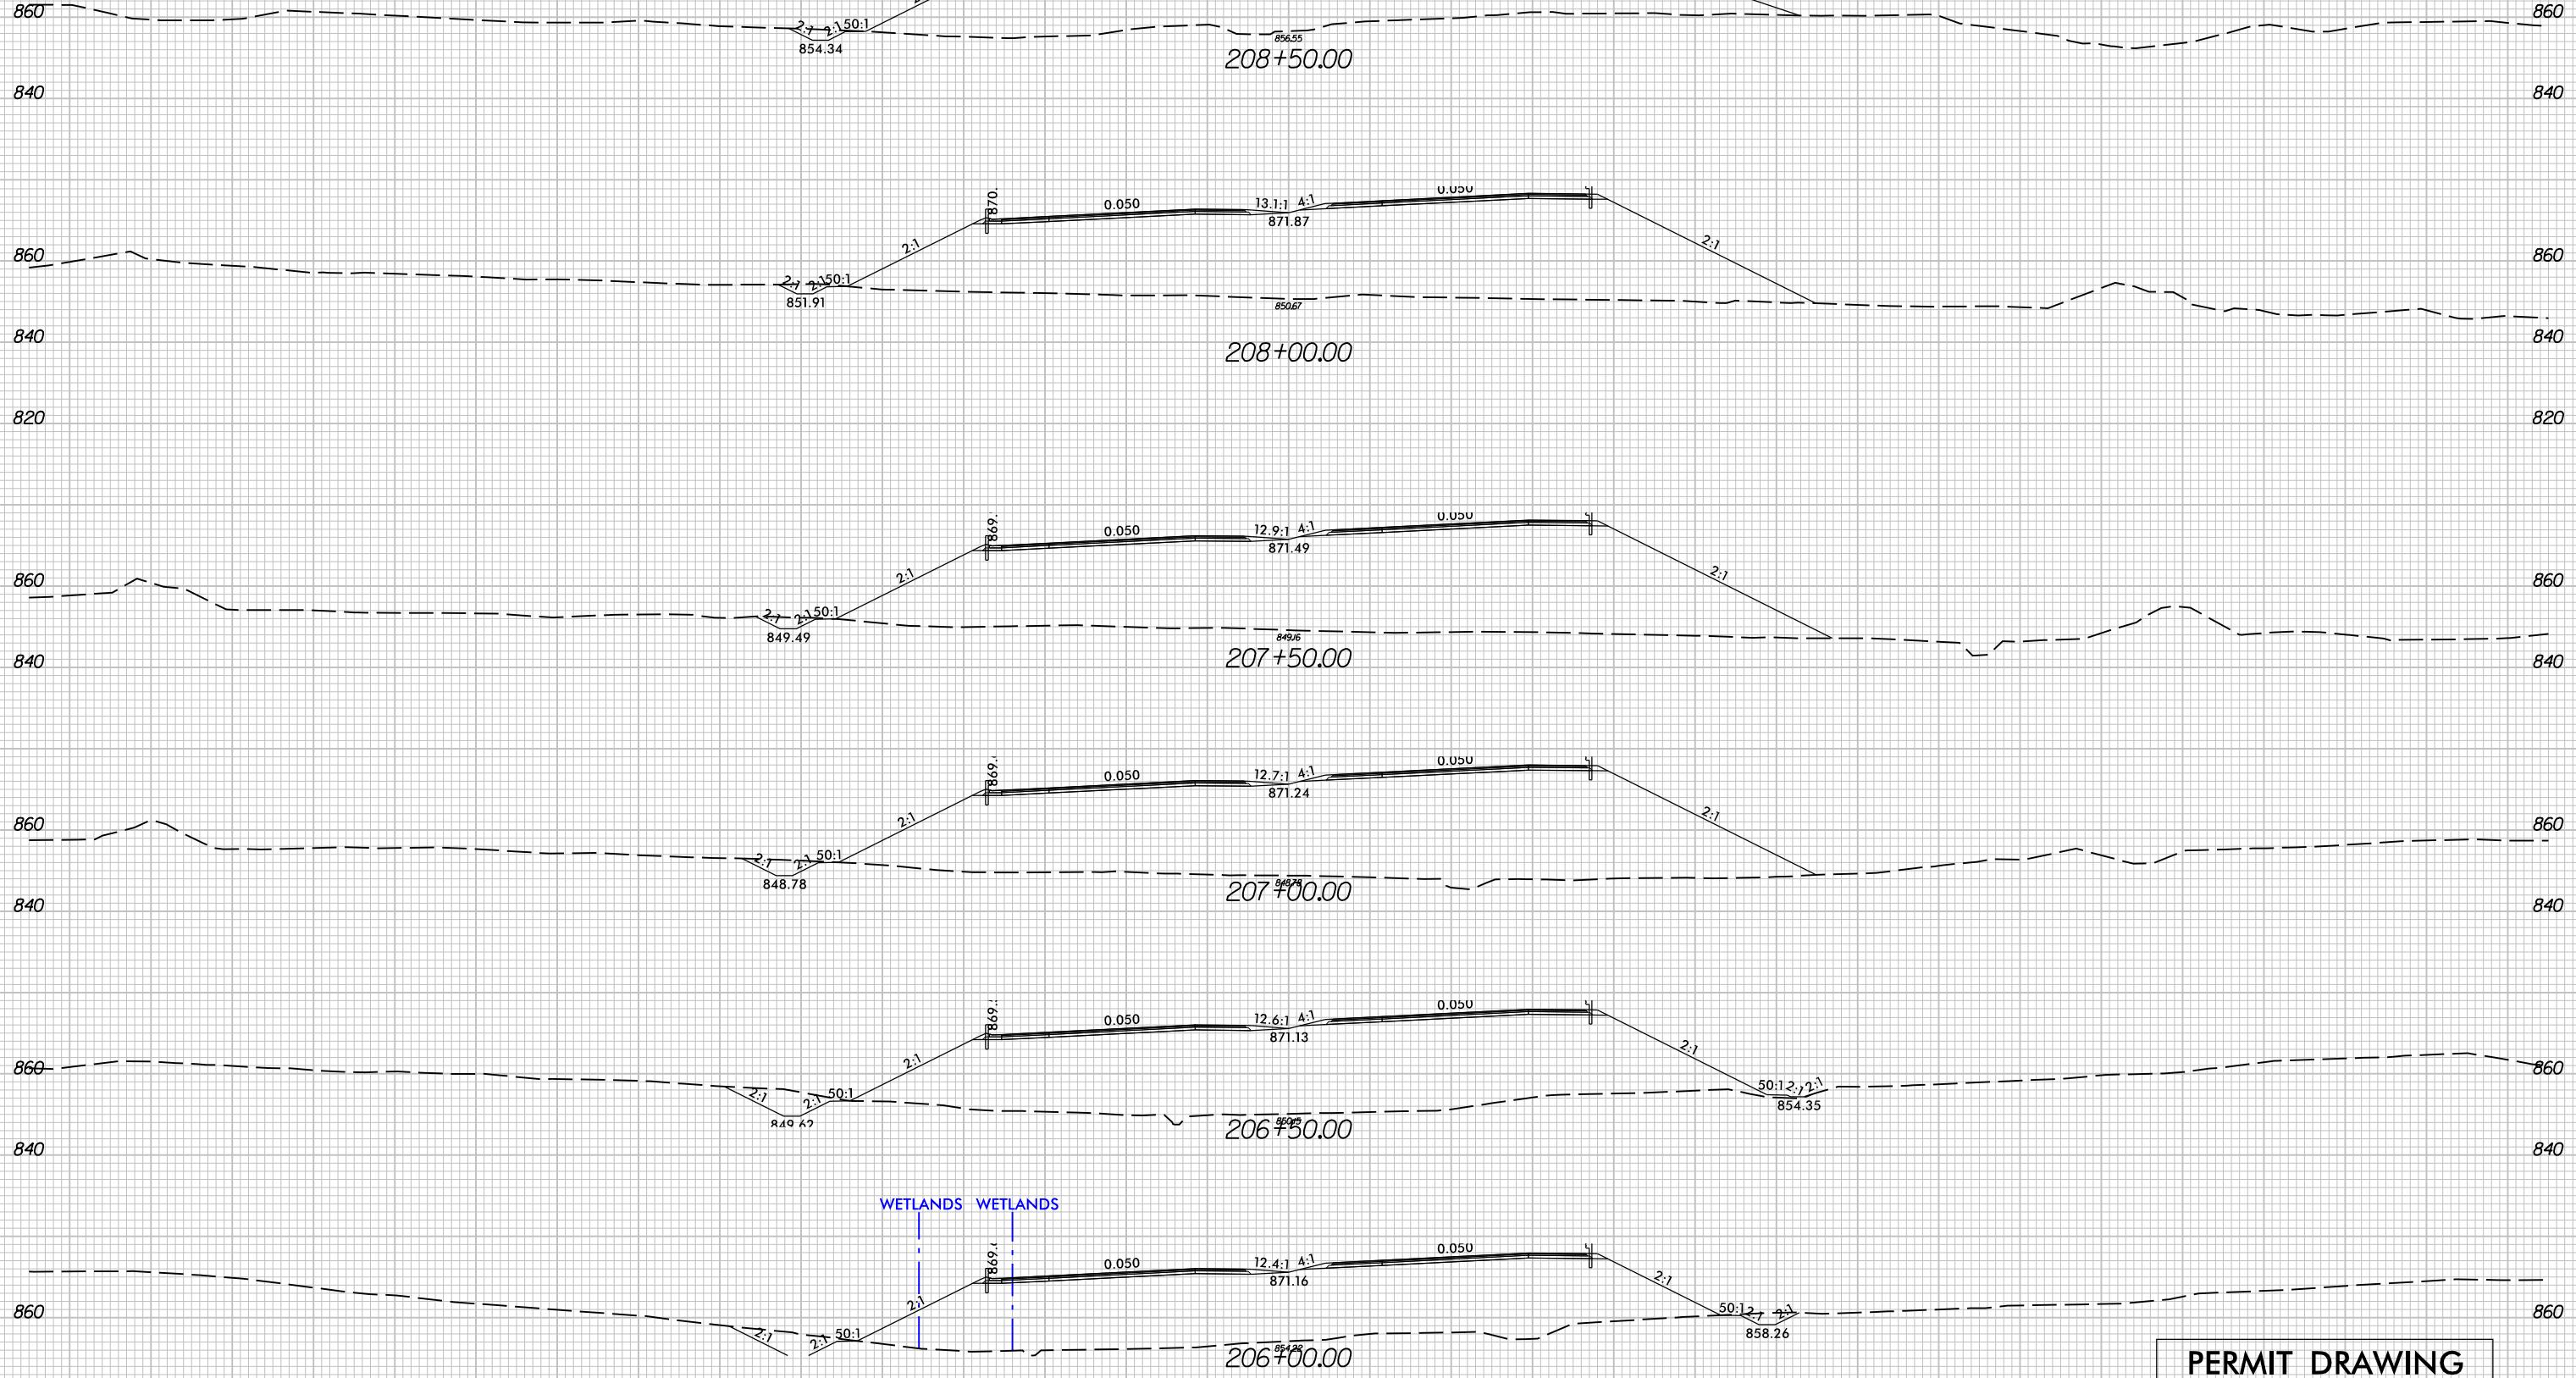


U-2579DEF
PERMIT SITE 12A


PERMIT DRAWING
SHEET 42 OF 97

LEGEND

- [F/F] DENOTES FILL IN WETLAND
- [S/S] DENOTES IMPACTS IN SURFACE WATER
- [TS/TS] DENOTES TEMPORARY IMPACTS IN SURFACE WATER

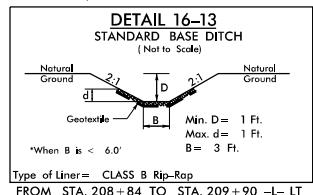

ARLYSS K. SMITH

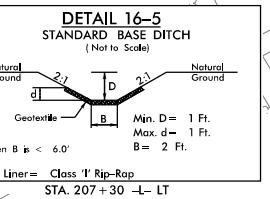

JOHNNIE F. RICHARDS



HDR Engineering, Inc. of the Carolinas
555 Fayetteville St, Suite 900, Raleigh, NC, 27601
N.C.B.E.L.S. License Number: F-0116

STV Engineers, Inc.
900 West Trade St., Suite 715
Charlotte, NC 28202
NC License Number F-0991

PROJECT REFERENCE NO. U-2579D, E & F SHEET NO. 16

RW SHEET NO. 100

ROADWAY DESIGN ENGINEER


HYDRAULICS ENGINEER


INCOMPLETE PLANS
DO NOT USE FOR R/W ACQUISITION

DOCUMENT NOT CONSIDERED FINAL
UNLESS ALL SIGNATURES COMPLETED



GRAPHIC SCALE
25 12.5 0 25 50

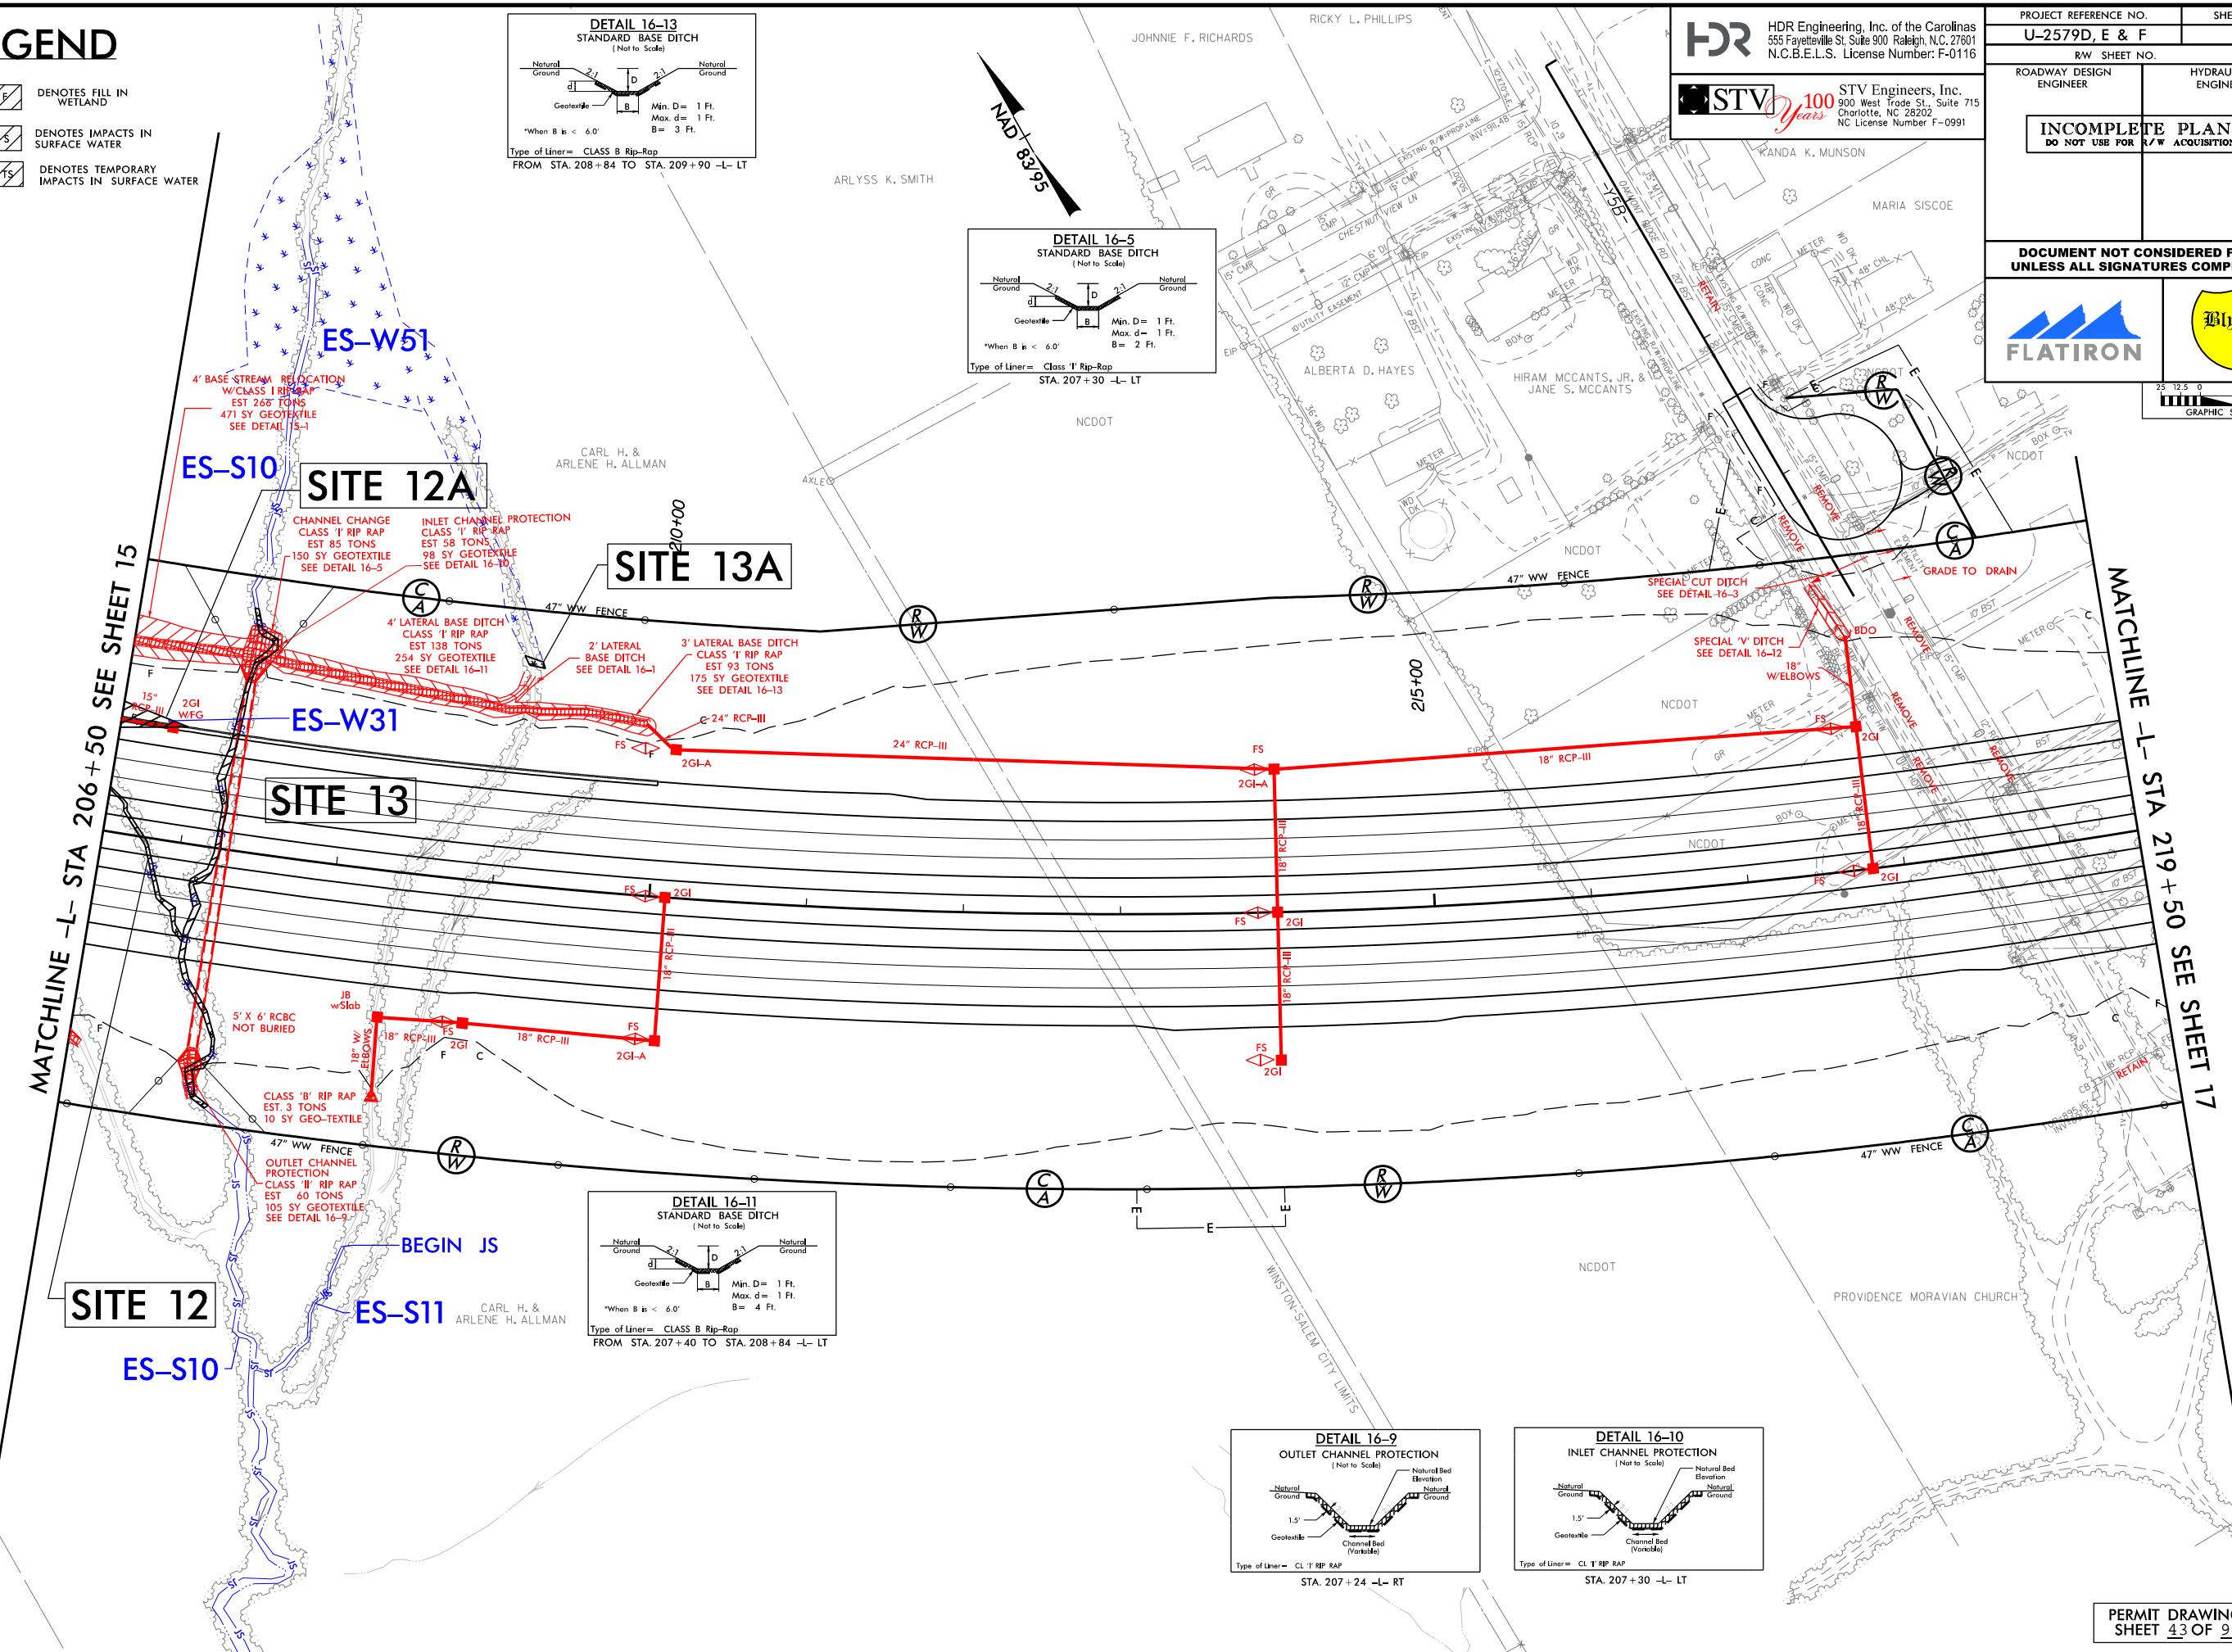

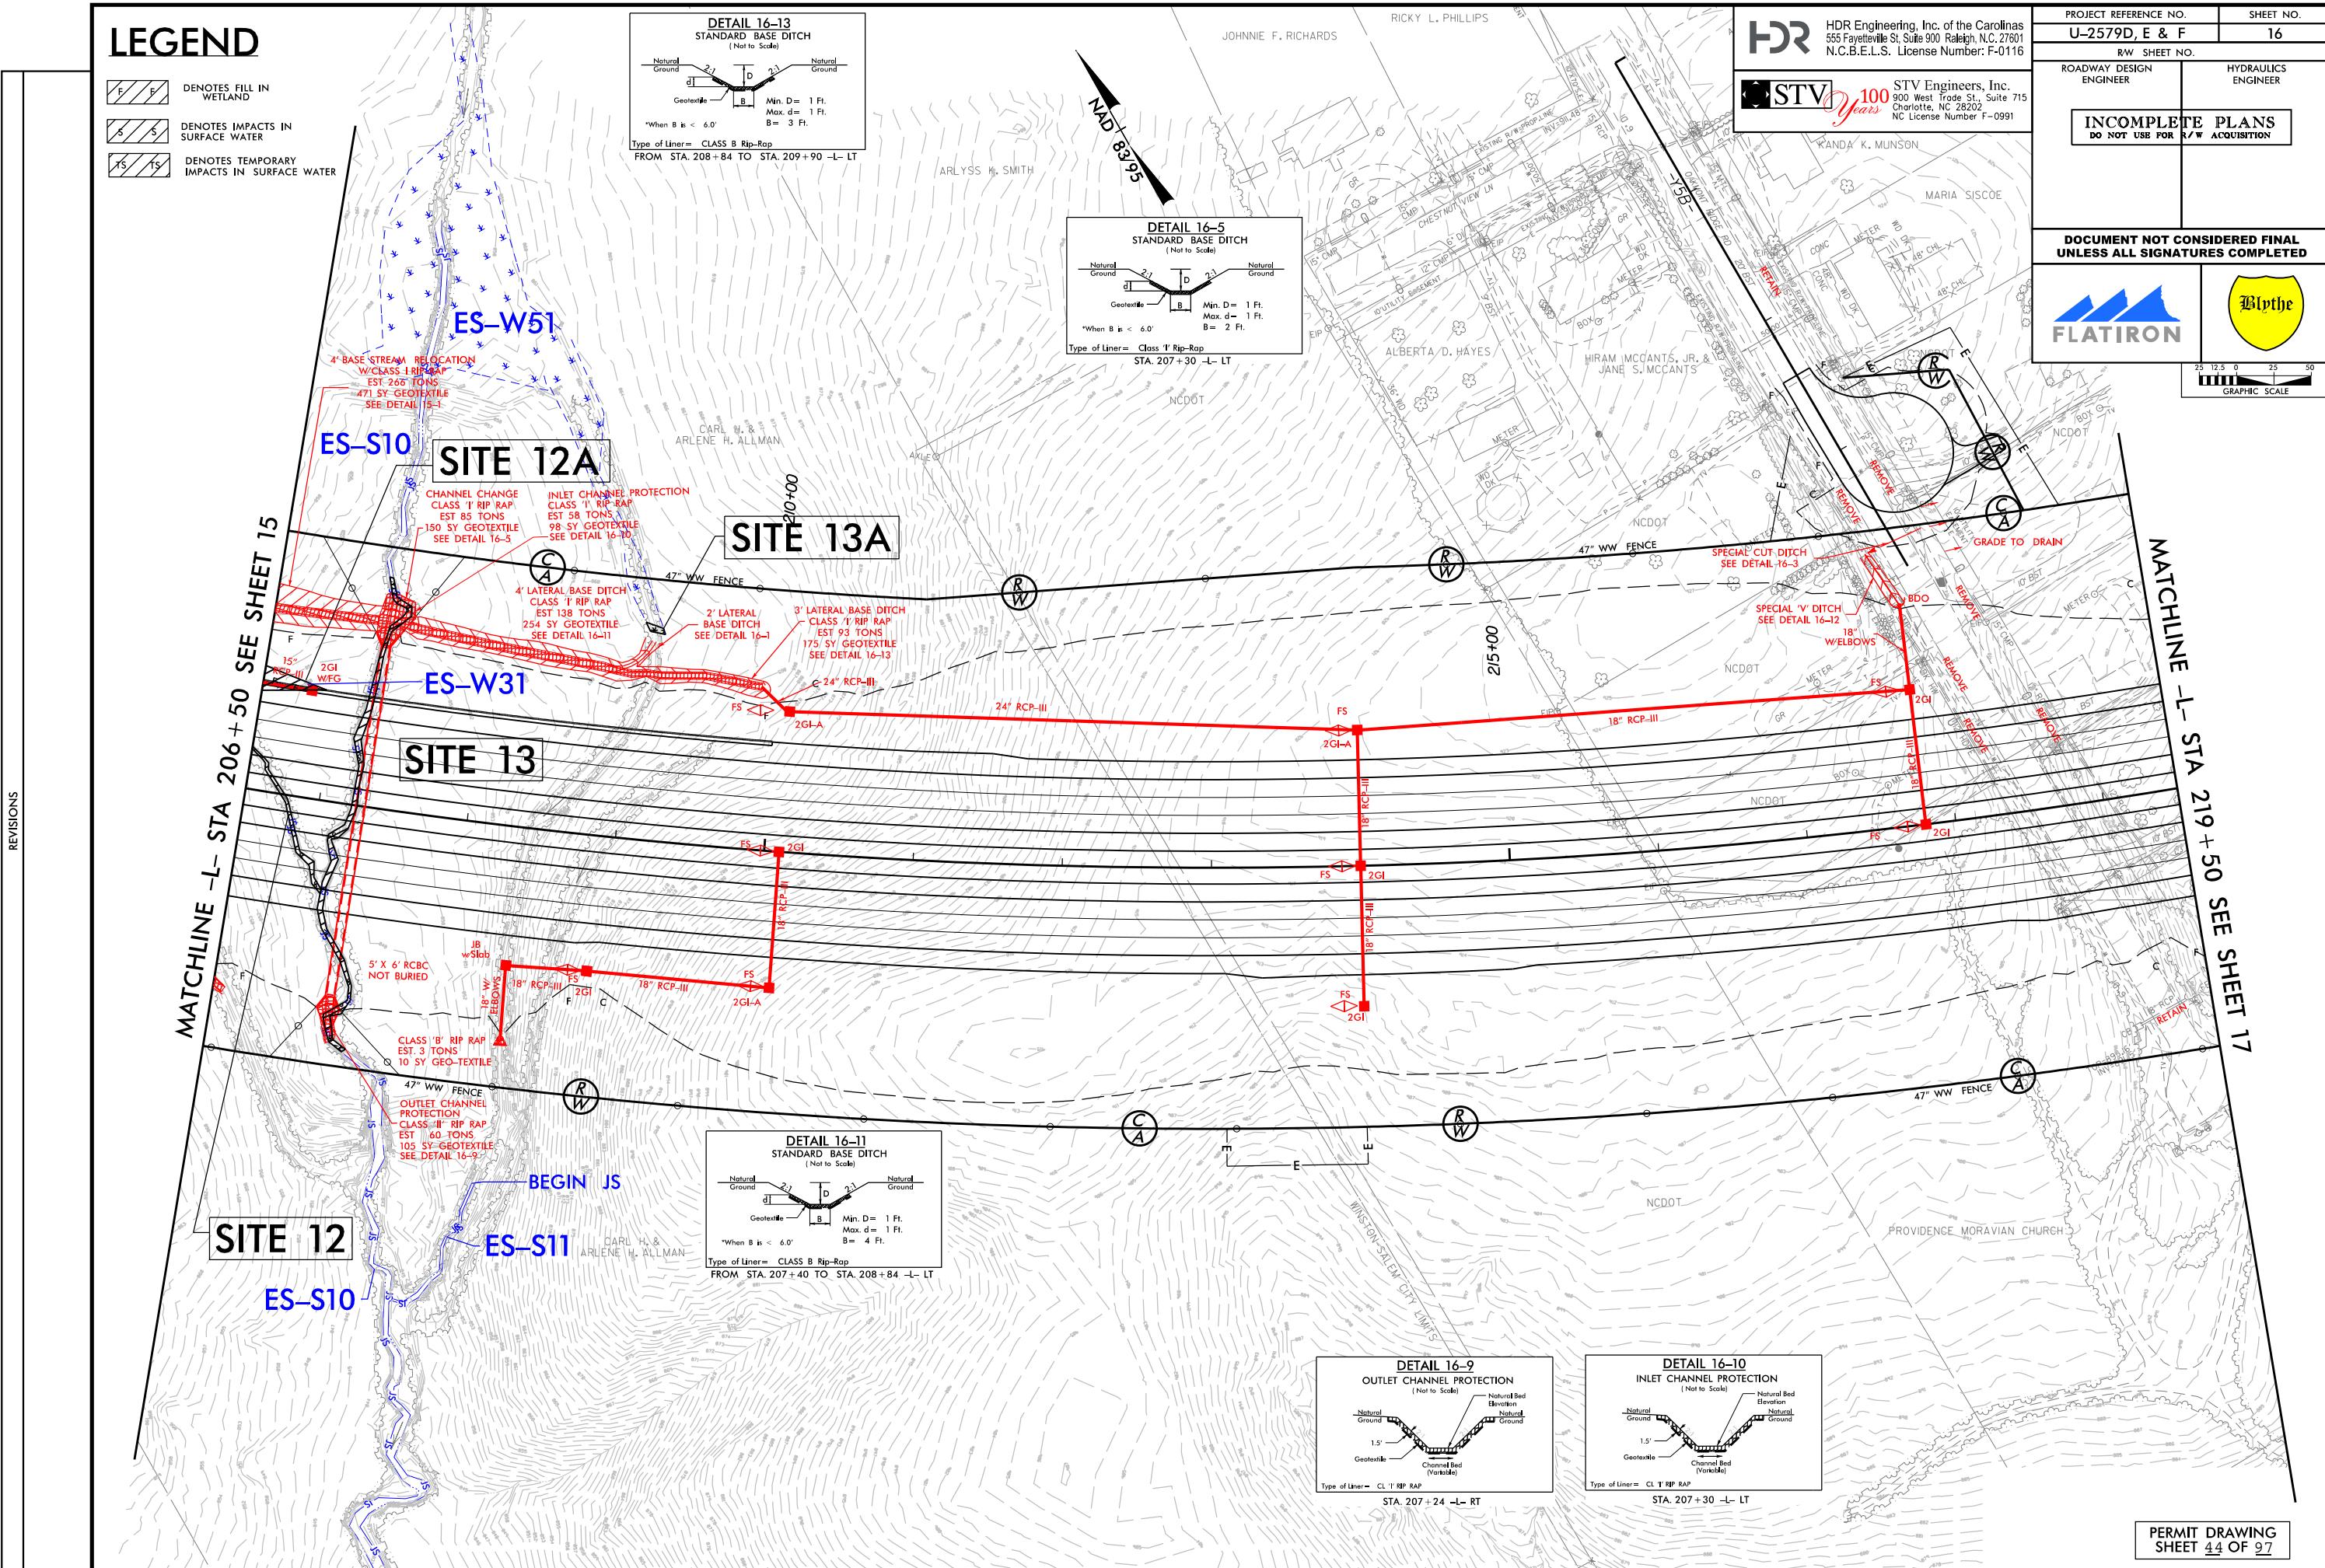


PROJECT REFERENCE NO.		SHEET NO.
U-2579D,E & F		
ROADWAY DESIGN ENGINEER	HYDRAULICS ENGINEER	
DOCUMENT NOT CONSIDERED FINAL UNLESS ALL SIGNATURES COMPLETED		

SCALE:
1' = 50' HORIZONTAL
1" = 10' VERTICAL

100 50 0 50 100

SITE 13

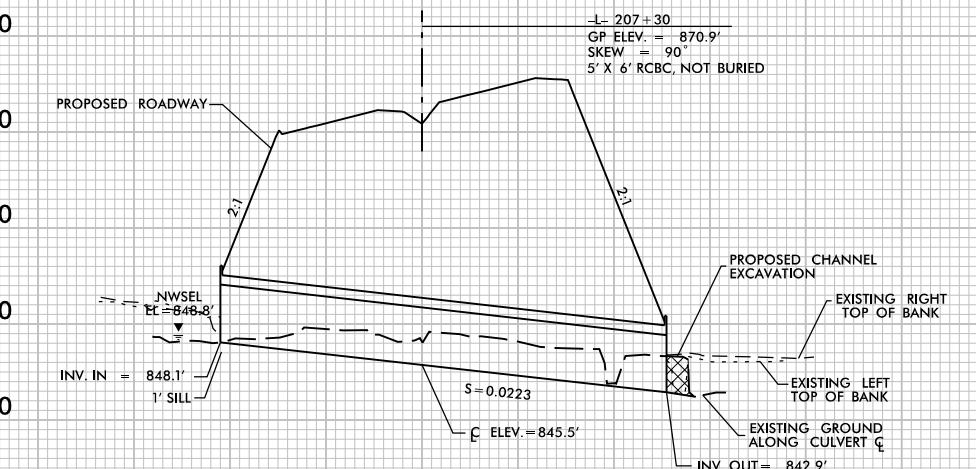

PROFILE ALONG C OF CULVERT


LEGEND

- [P/P] DENOTES IMPACTS IN SURFACE WATER (POND)
- [S/S] DENOTES IMPACTS IN SURFACE WATER
- [TS/TS] DENOTES TEMPORARY IMPACTS IN SURFACE WATER

MATCHLINE SEE SHEET 17A

NCDOT OWNED PROPERTY

DRAIN POND
THE LOCATION AND STABILIZATION OF CHANNEL MAY BE ADJUSTED BY THE ENGINEER IN THE FIELD.

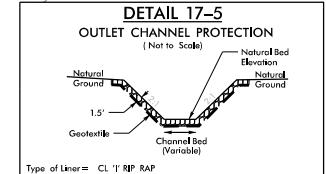

HDR Engineering, Inc. of the Carolinas
555 Fayetteville St, Suite 900, Raleigh, NC 27601
N.C.B.E.L.S. License Number: F-0116

STV Engineers, Inc.
900 West Trade St., Suite 715
Charlotte, NC 28202
NC License Number F-0991

PROJECT REFERENCE NO. U-2579D, E & F	SHEET NO. 17
RW SHEET NO.	
ROADWAY DESIGN ENGINEER	HYDRAULICS ENGINEER
INCOMPLETE PLANS DO NOT USE FOR R/W ACQUISITION	
DOCUMENT NOT CONSIDERED FINAL UNLESS ALL SIGNATURES COMPLETED	



GRAPHIC SCALE

MATCHLINE -L- STA 219+50 SEE SHEET 16

ES-P2
SITE 14A


TOE PROTECTION SEE DETAIL 17-7

BEGIN JS

OUTLET CHANNEL PROTECTION
CLASS 'I' RIP RAP
EST. 80 TONS
10 SY GEOTEXTILE
SEE DETAIL 17-5

ES-S13

SITE 14

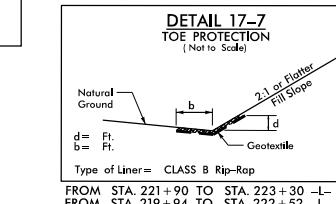

FROM STA. 221+90 TO STA. 223+30 -L- LT
FROM STA. 219+94 TO STA. 222+52 -L- RT


MATCHLINE -L- STA 232+50 SEE SHEET 18

PERMIT DRAWING
SHEET 46 OF 97


LEGEND

- [P/P] DENOTES IMPACTS IN SURFACE WATER (POND)
- [S/S] DENOTES IMPACTS IN SURFACE WATER
- [TS/TS] DENOTES TEMPORARY IMPACTS IN SURFACE WATER

MATCHLINE SEE SHEET 17A

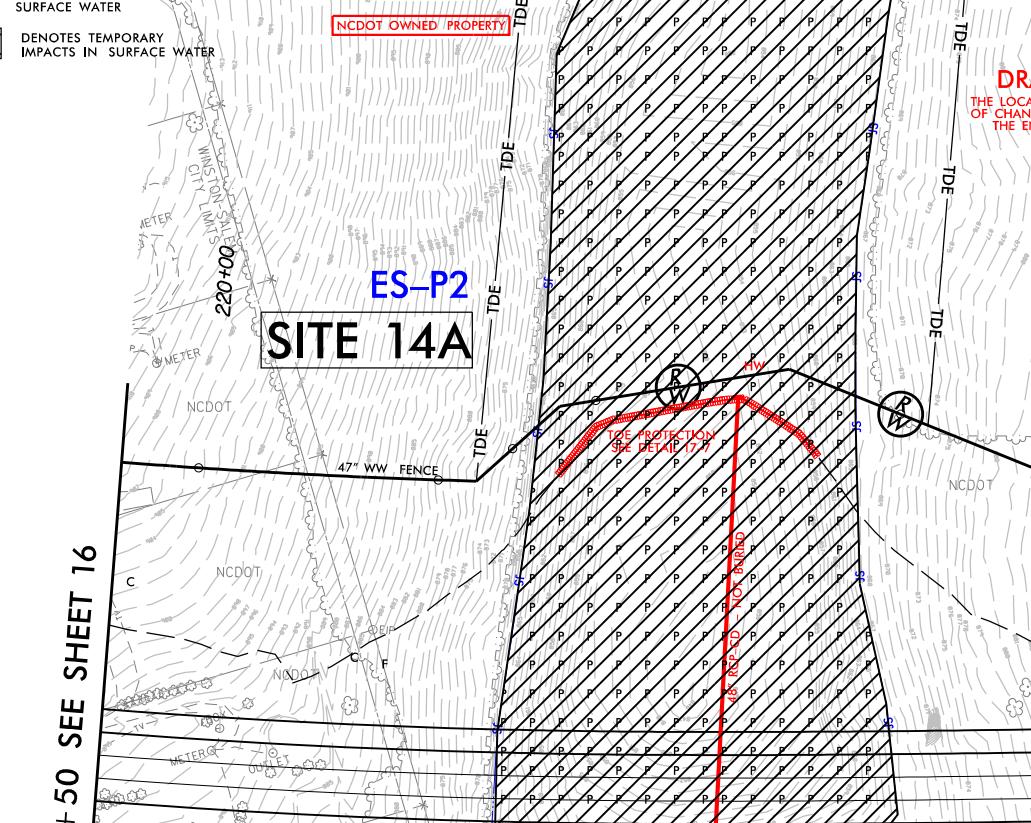

DRAIN POND
THE LOCATION AND STABILIZATION OF CHANNEL MAY BE ADJUSTED BY THE ENGINEER IN THE FIELD.

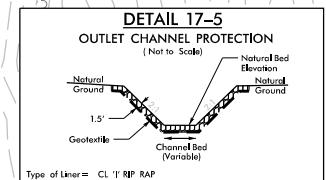

HDR Engineering, Inc. of the Carolinas
555 Fayetteville St, Suite 900, Raleigh, NC 27601
N.C.B.E.L.S. License Number: F-0116

STV Engineers, Inc.
900 West Trade St., Suite 715
Charlotte, NC 28202
NC License Number F-0991



PROJECT REFERENCE NO.	SHEET NO.
U-2579D, E & F	17
R/W SHEET NO.	
ROADWAY DESIGN ENGINEER	HYDRAULICS ENGINEER
INCOMPLETE PLANS DO NOT USE FOR R/W ACQUISITION	

DOCUMENT NOT CONSIDERED FINAL
UNLESS ALL SIGNATURES COMPLETED



GRAPHIC SCALE

MATCHLINE -L- STA 219+50 SEE SHEET 16

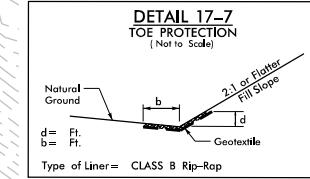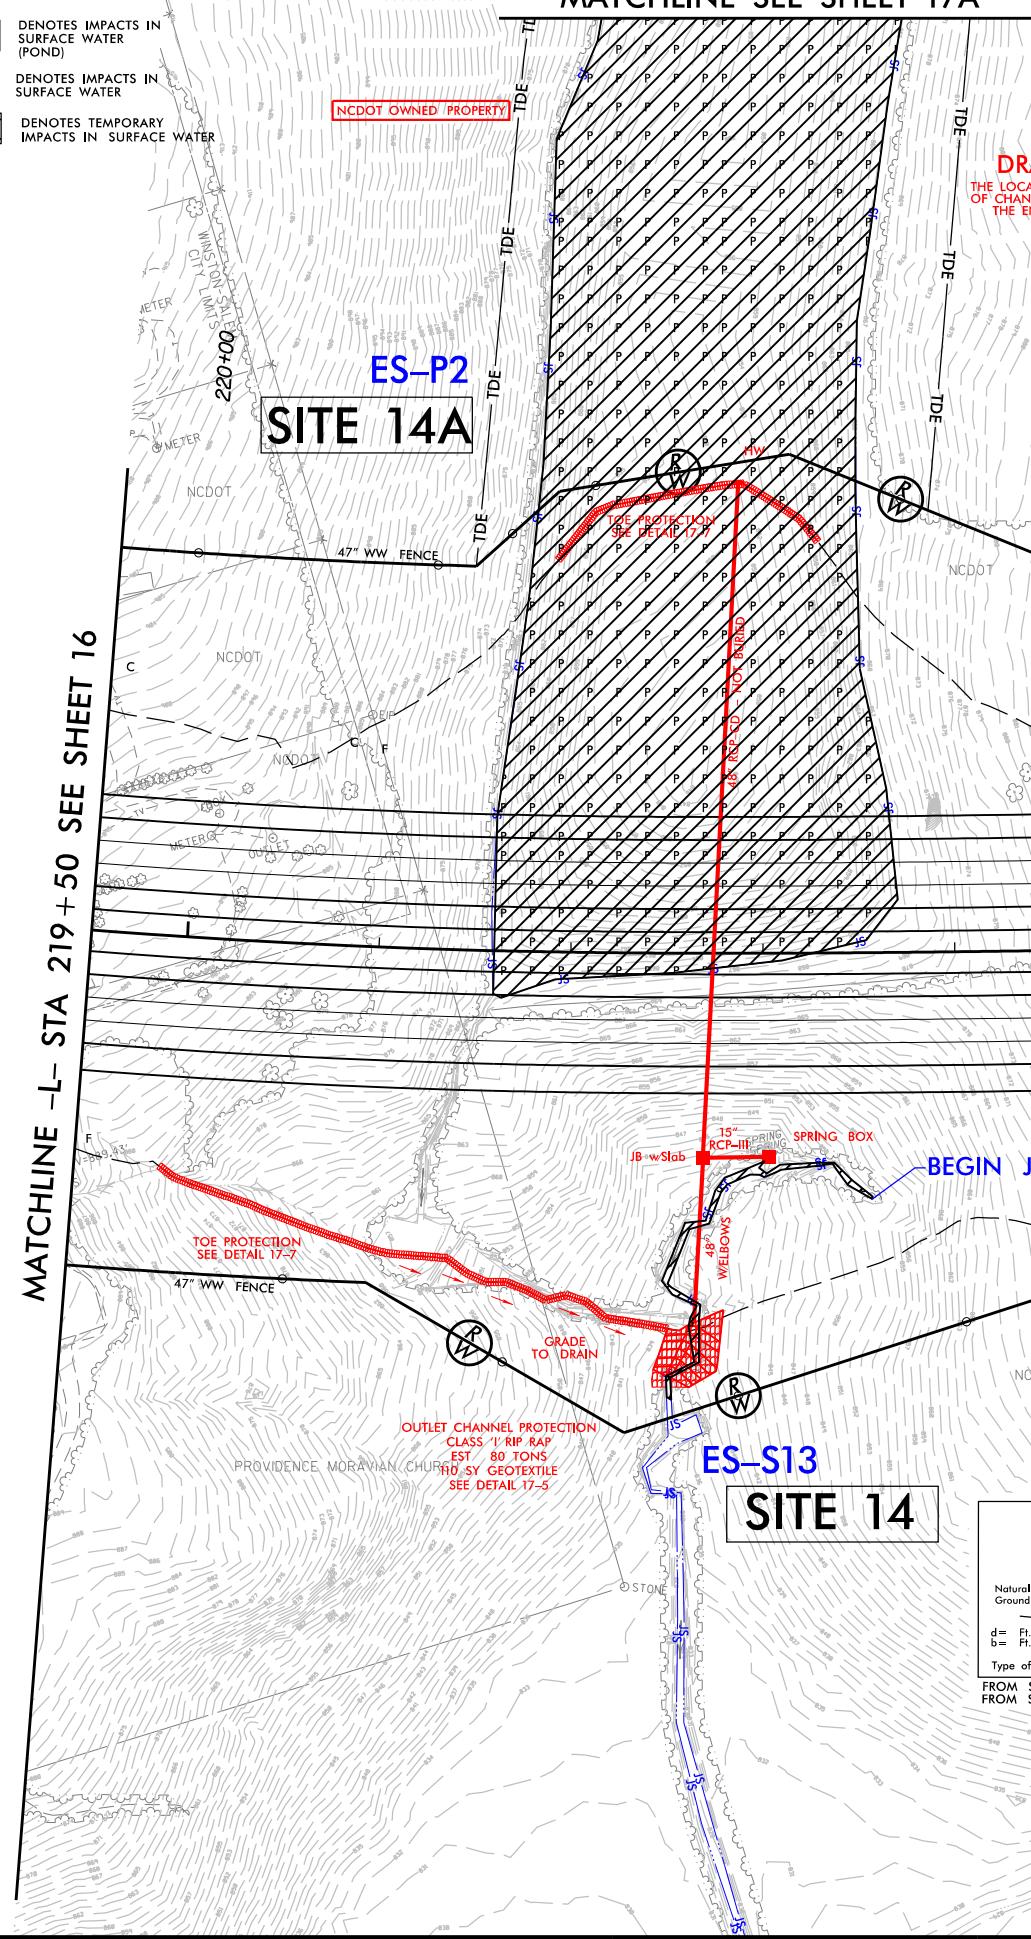


Type of Liner = CLASS 8 Rip-Rap


FROM STA. 221+90 TO STA. 223+30 -L- LT

FROM STA. 219+94 TO STA. 222+52 -L- RT


MATCHLINE -L- STA 232+50 SEE SHEET 18

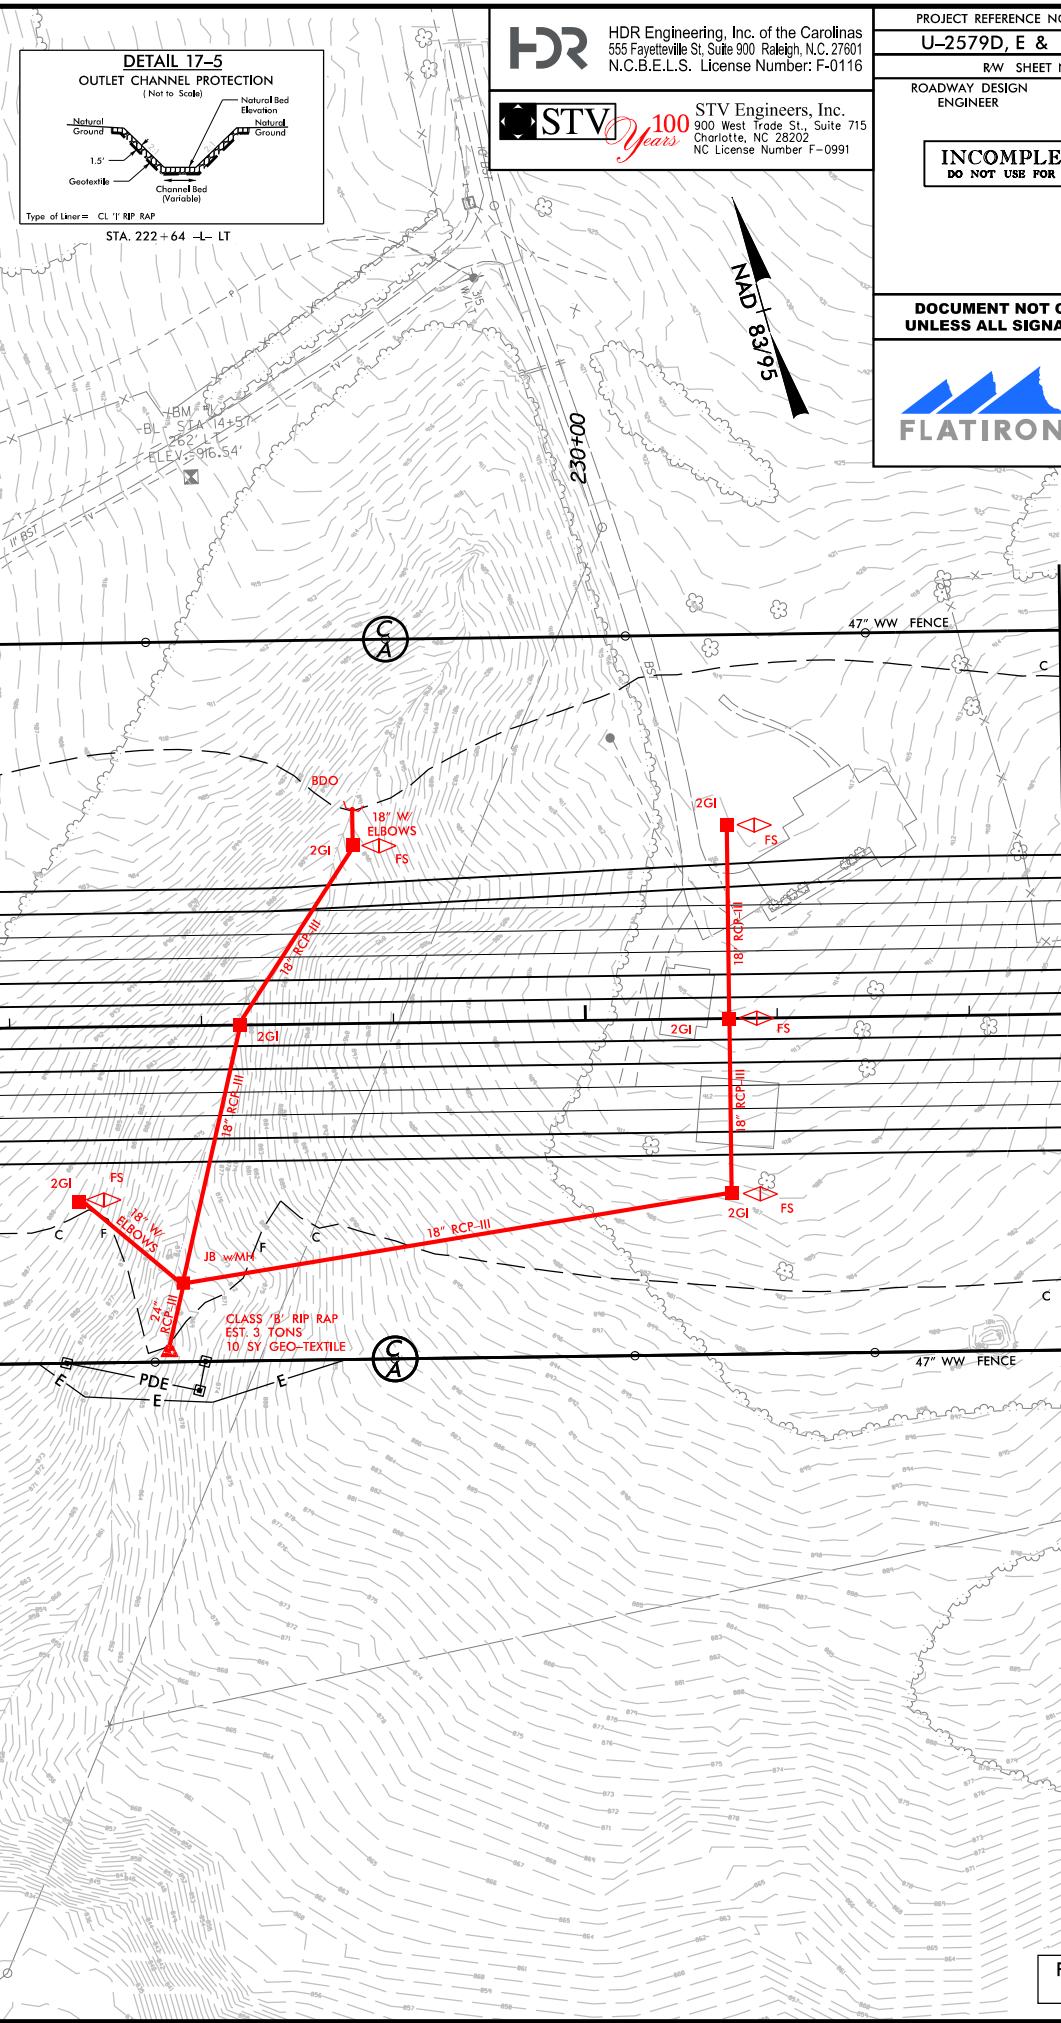

PERMIT DRAWING SHEET 47 OF 97

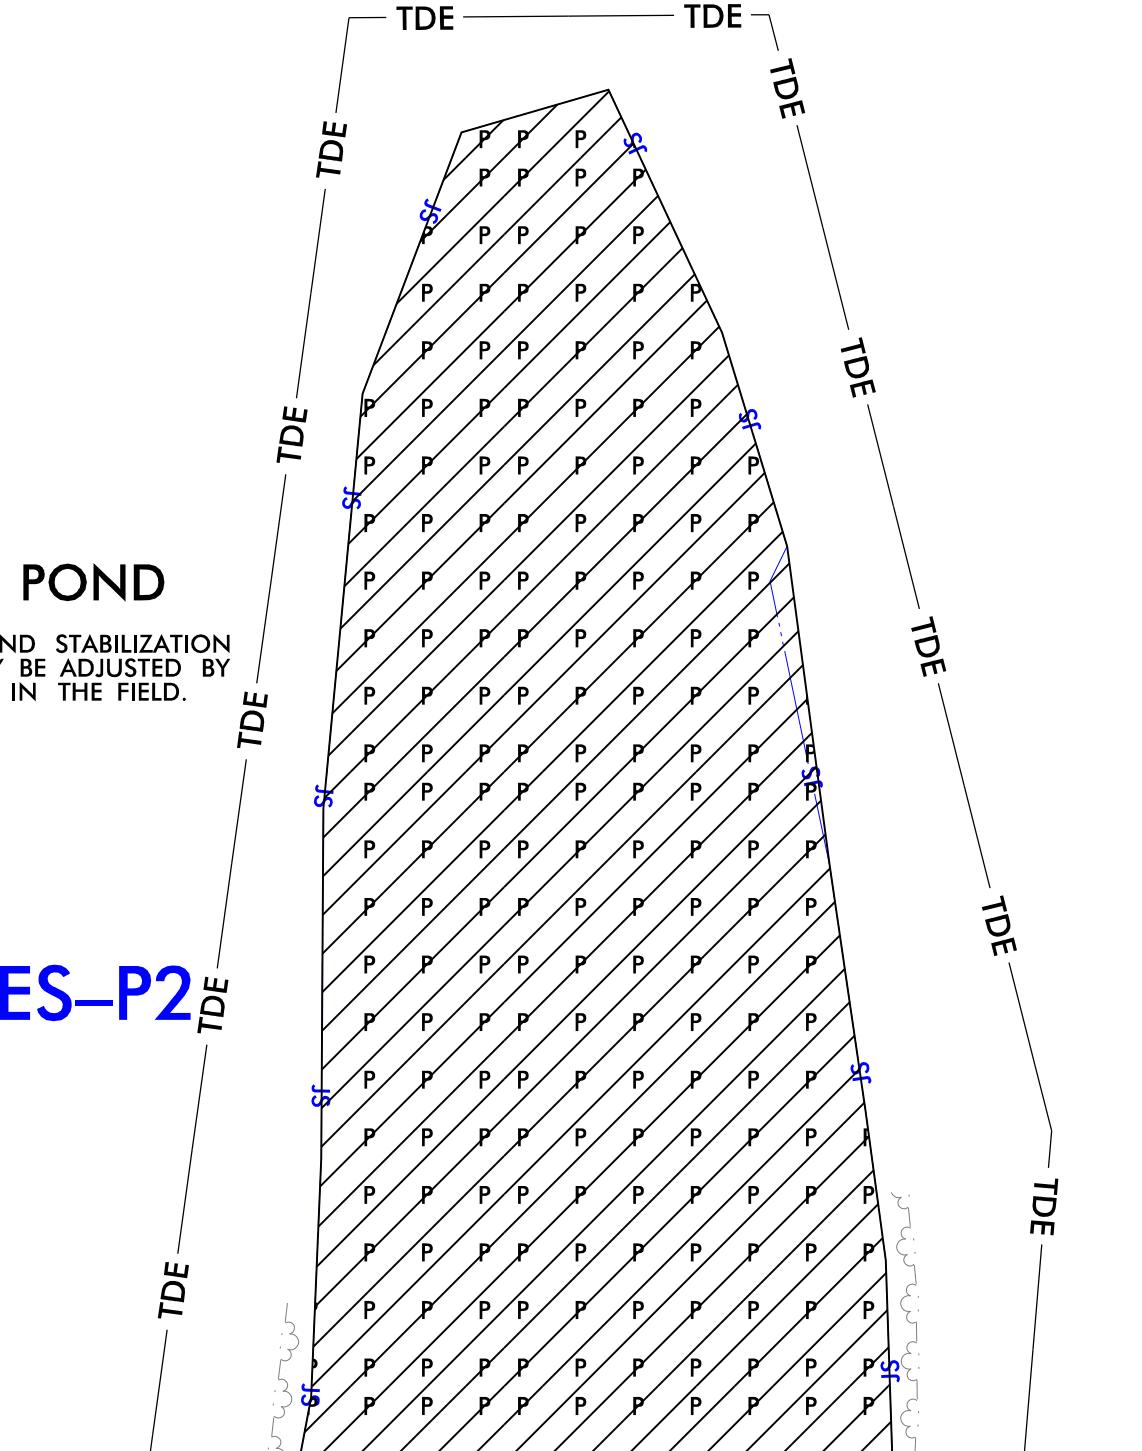

MATCHLINE SEE SHEET 17

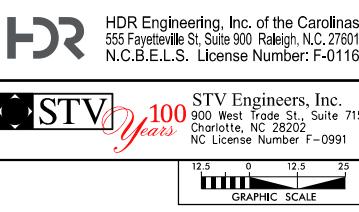

PROJECT REFERENCE NO.	SHEET NO.
U-2579D, E & F	17A
R/W SHEET NO.	
ROADWAY DESIGN ENGINEER	HYDRAULICS ENGINEER
INCOMPLETE PLANS DO NOT USE FOR R/W ACQUISITION	
DOCUMENT NOT CONSIDERED FINAL UNLESS ALL SIGNATURES COMPLETED	
FLATIRON	Blythe

NAD 83'95




DENOTES IMPACTS IN SURFACE WATER (POND)

LEGEND

DRAIN POND

THE LOCATION AND STABILIZATION OF CHANNEL MAY BE ADJUSTED BY THE ENGINEER IN THE FIELD.

ES-P2

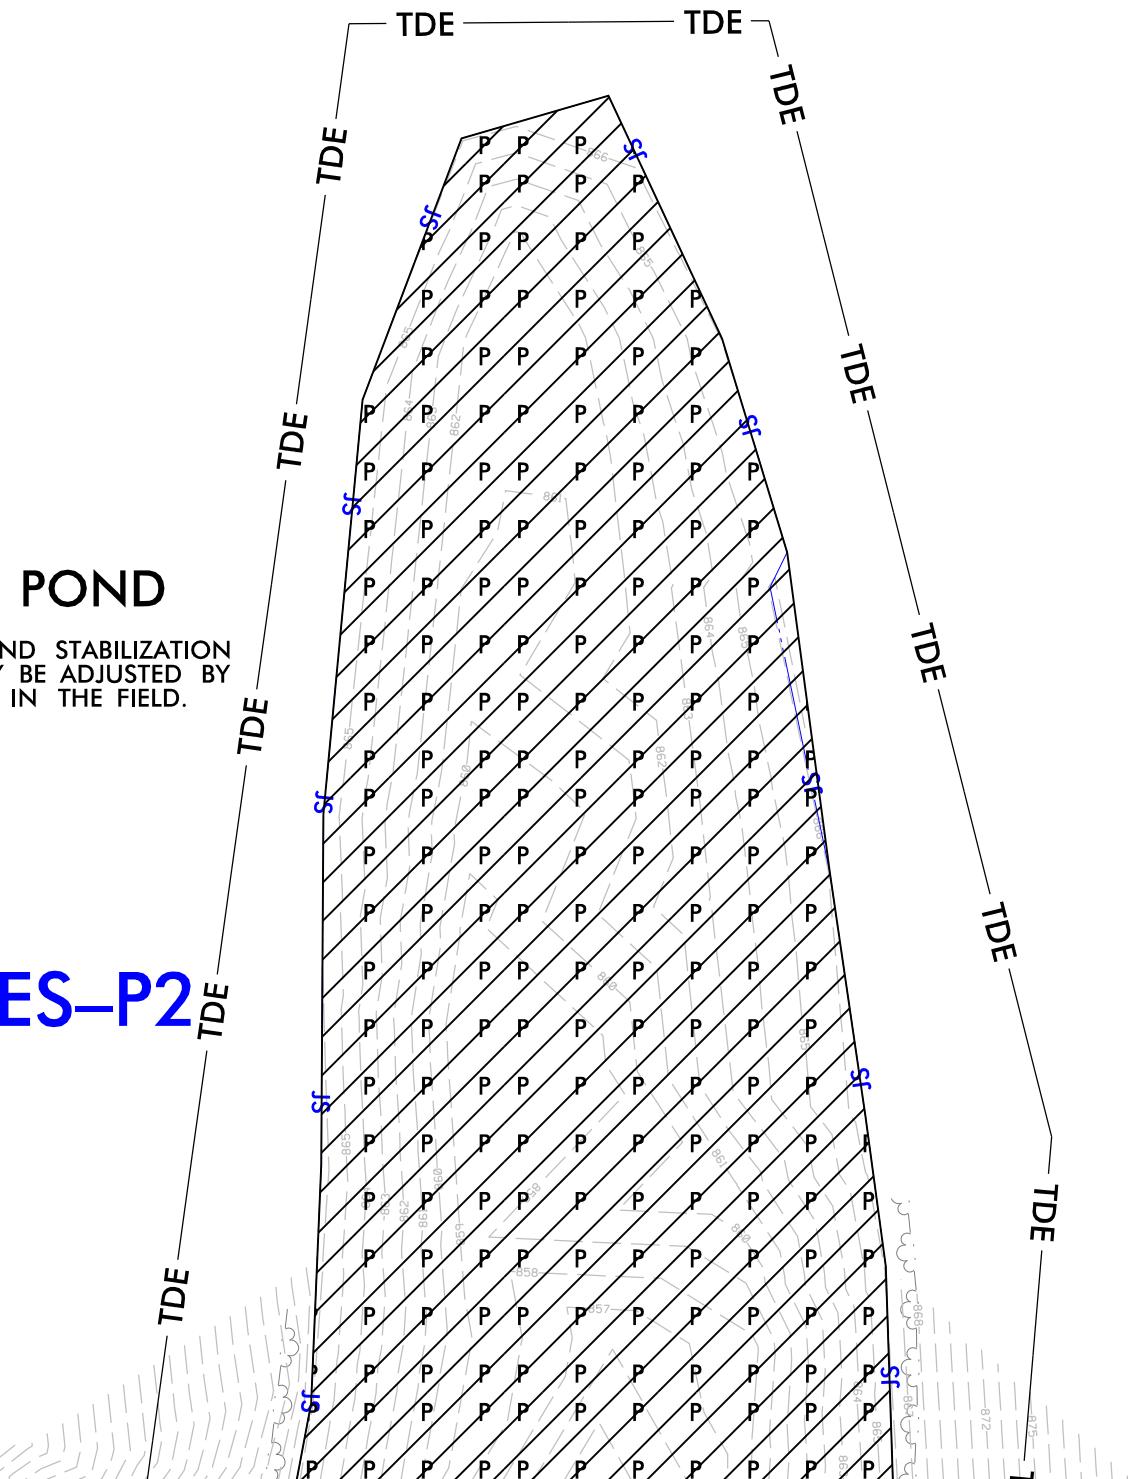


MATCHLINE SEE SHEET 17




ROADWAY DESIGN ENGINEER	HYDRAULICS ENGINEER
INCOMPLETE PLANS DO NOT USE FOR R/W ACQUISITION	
DOCUMENT NOT CONSIDERED FINAL UNLESS ALL SIGNATURES COMPLETED	




LEGEND

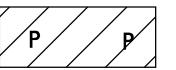

DENOTES IMPACTS IN SURFACE WATER (POND)

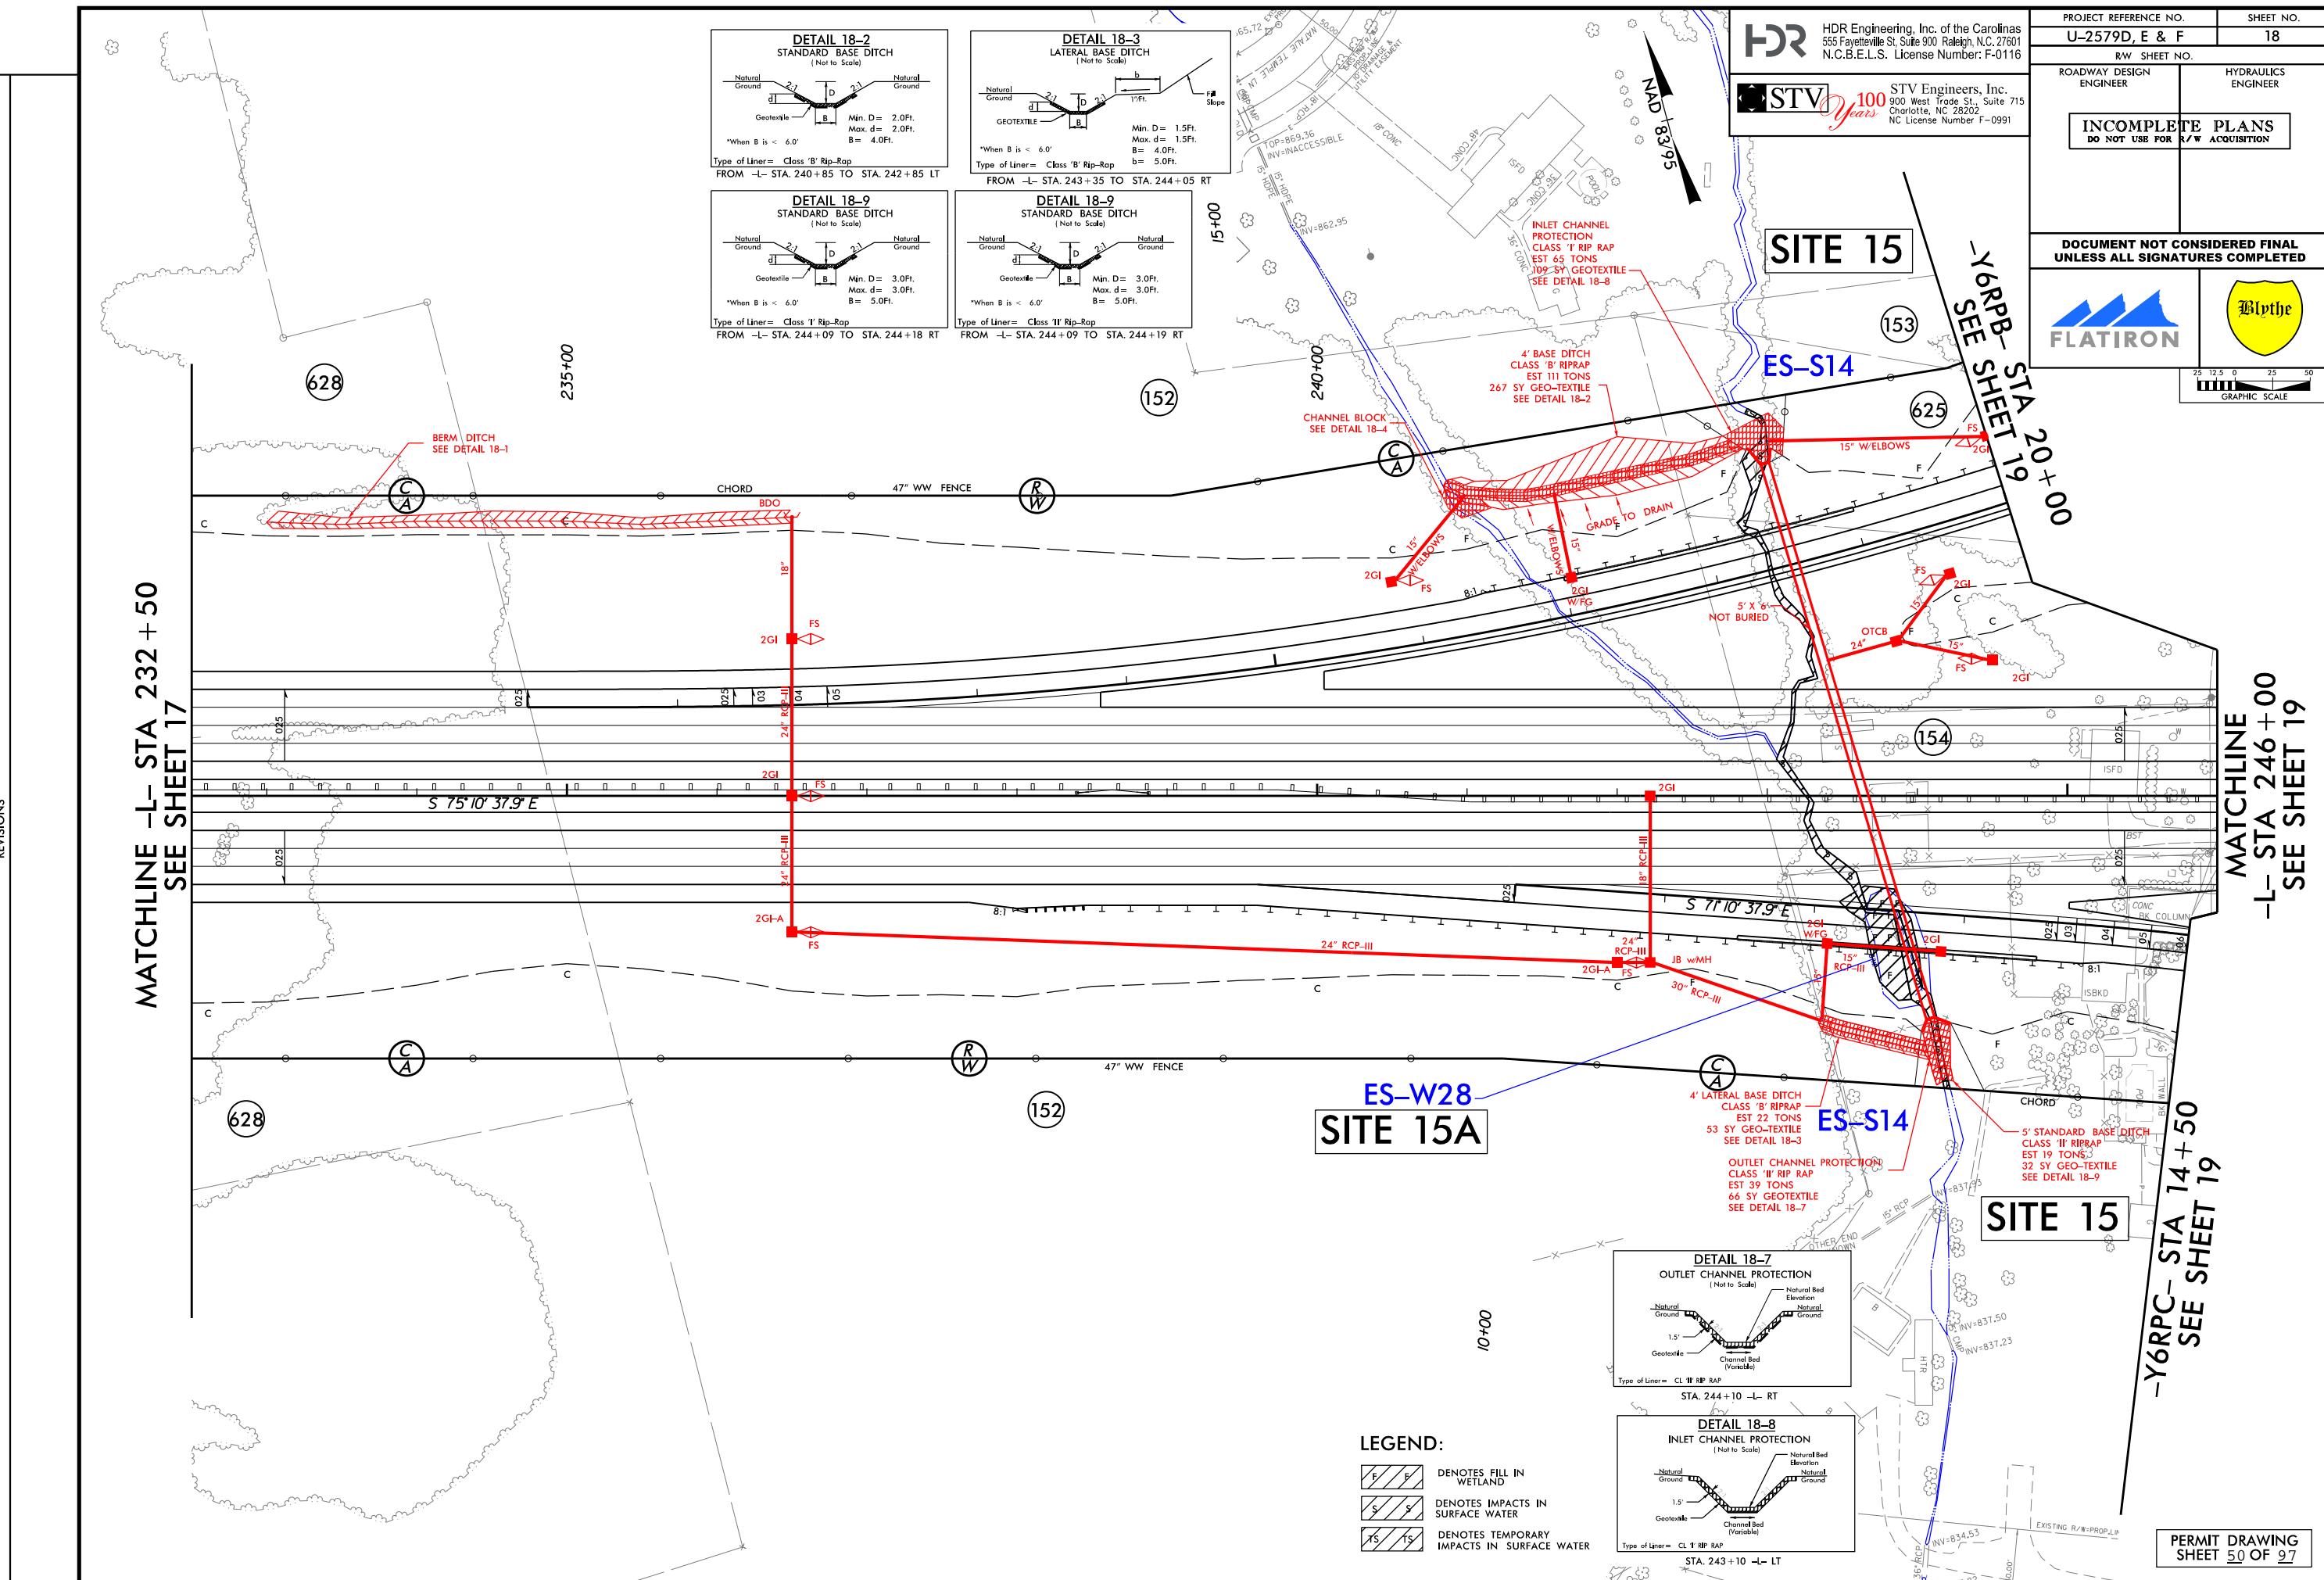

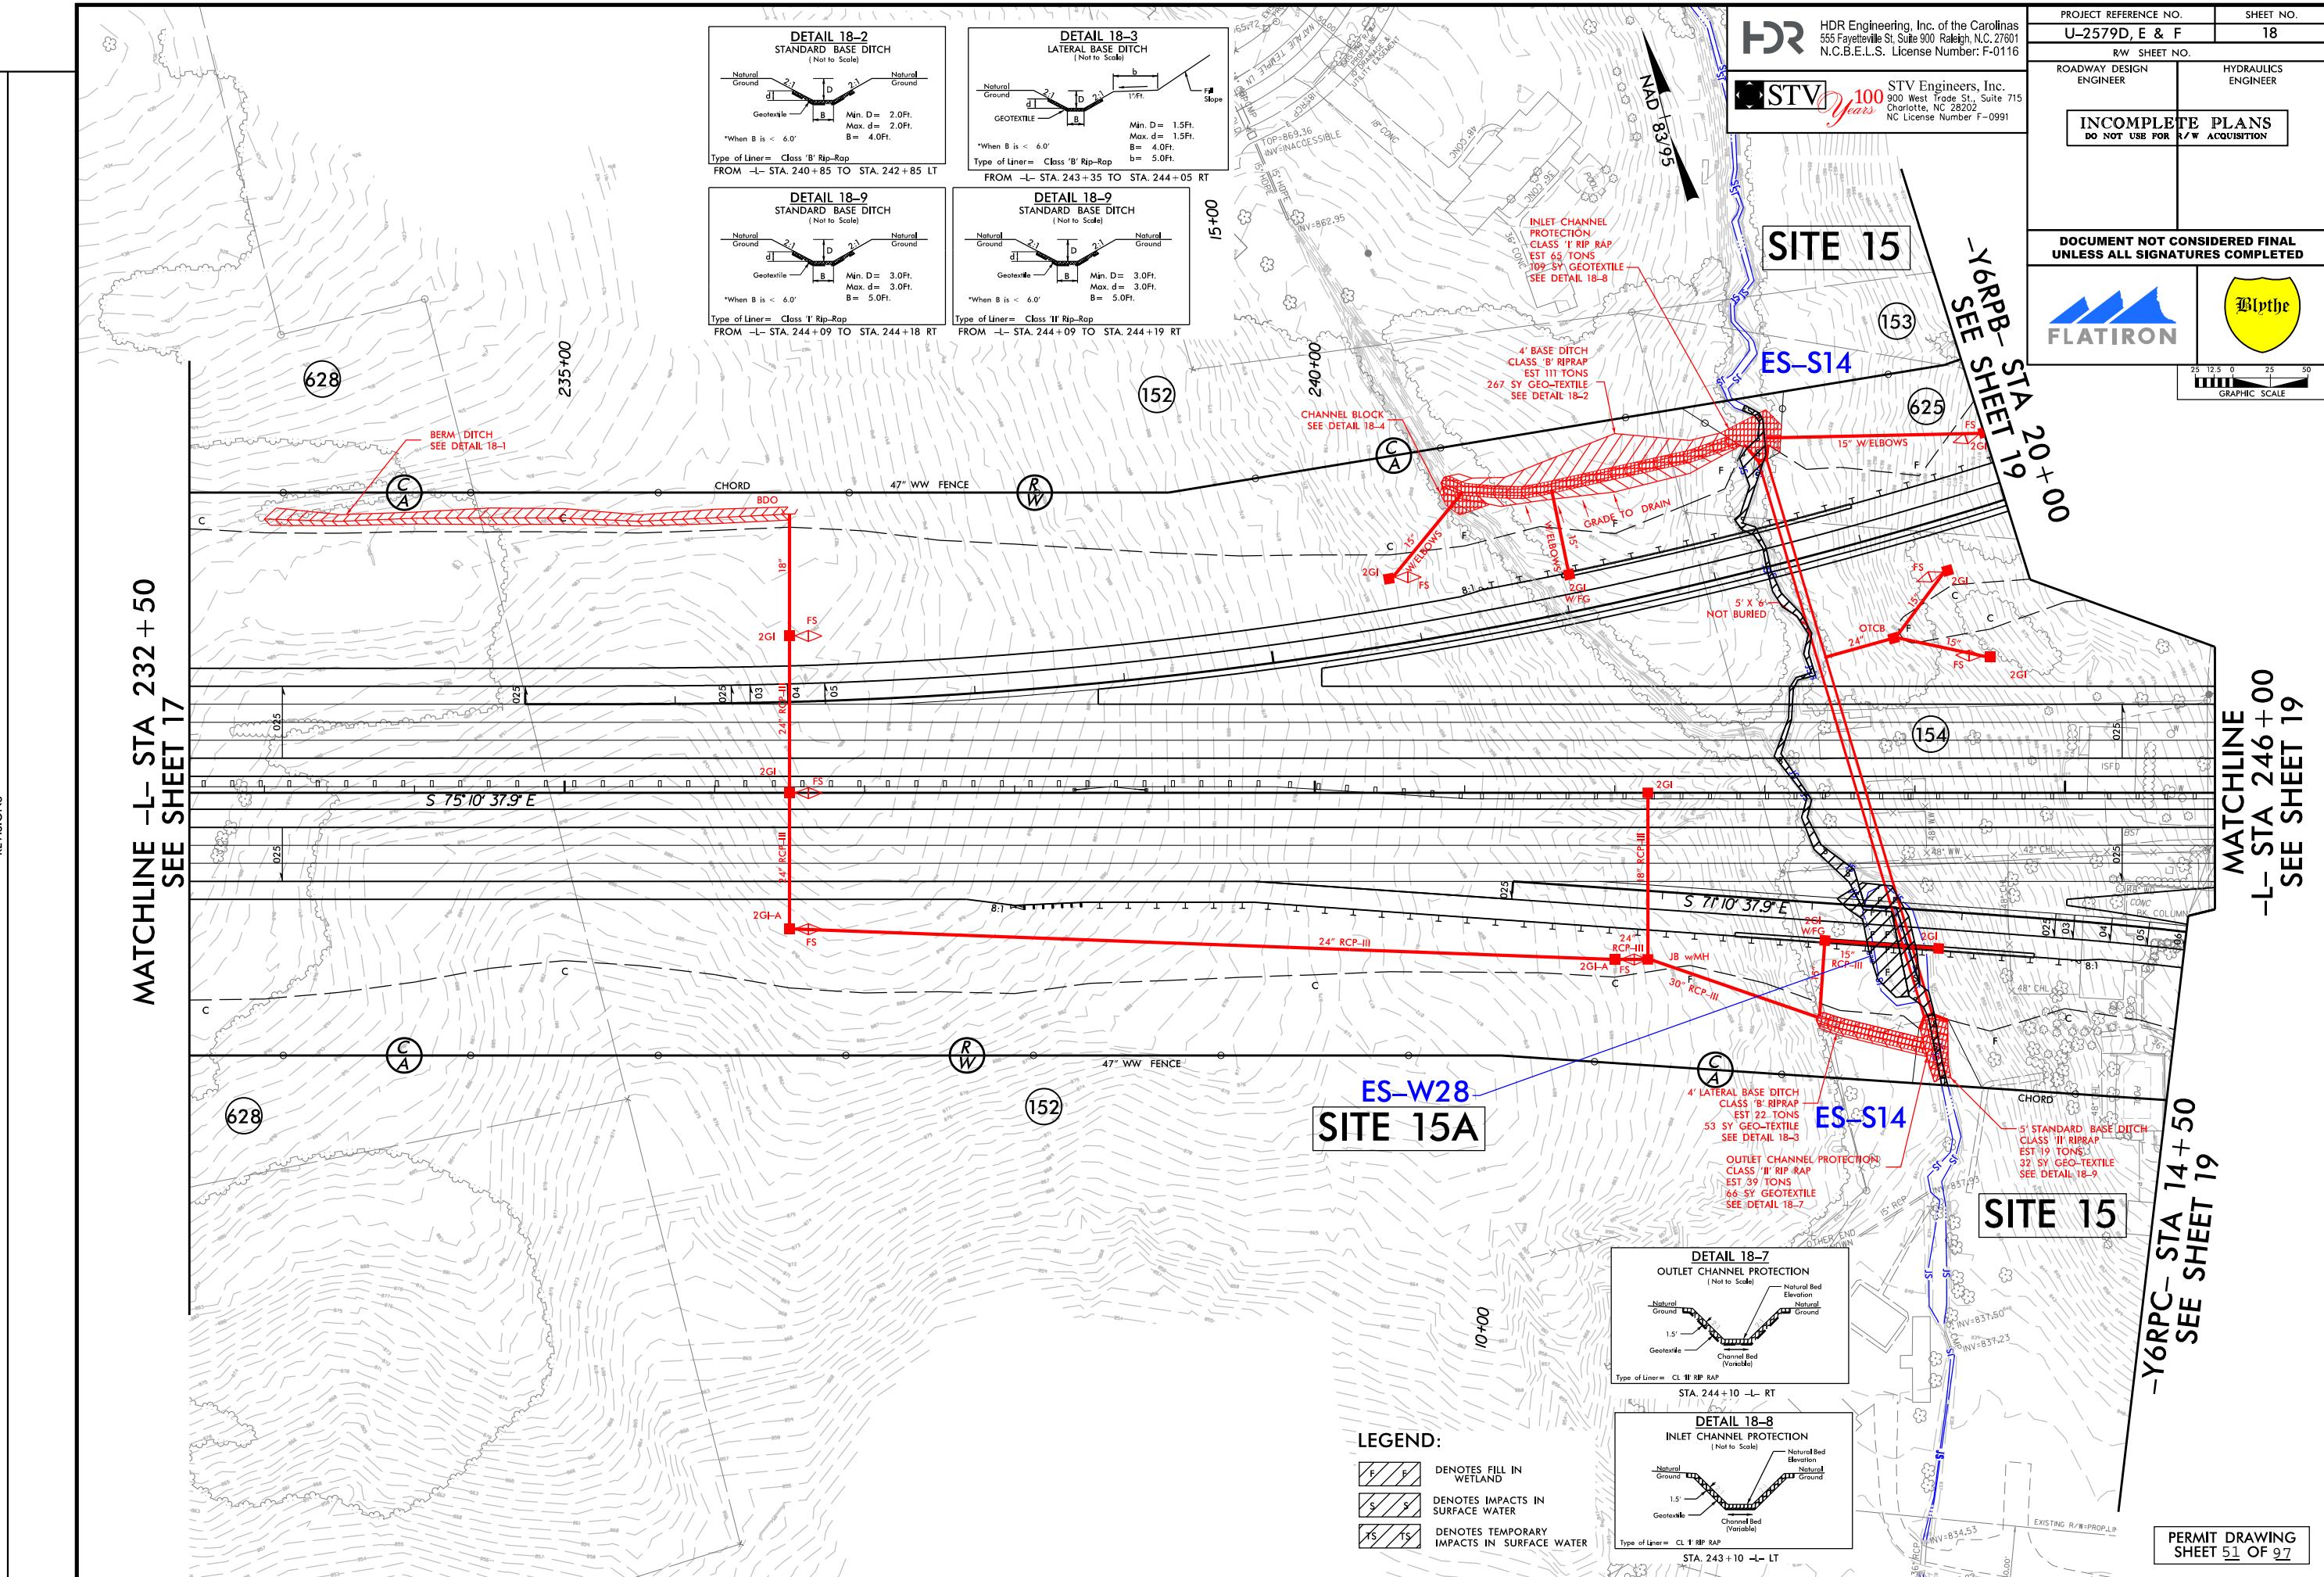



PROJECT REFERENCE NO.		SHEET NO.
U-2579D,E & F		
ROADWAY DESIGN ENGINEER	HYDRAULICS ENGINEER	
DOCUMENT NOT CONSIDERED FINAL UNLESS ALL SIGNATURES COMPLETED		


SCALE:
1" = 50' HORIZONTAL
1" = 10' VERTICAL


250 200 150 100 50 0 50 100 150 200

SITE 15

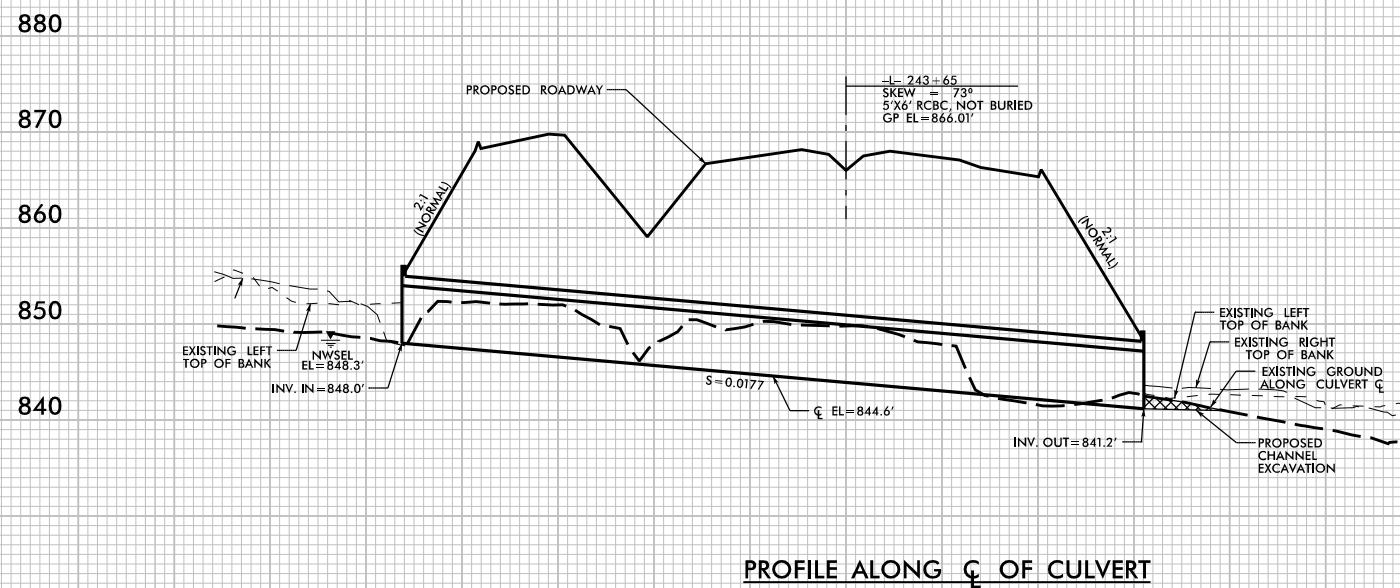


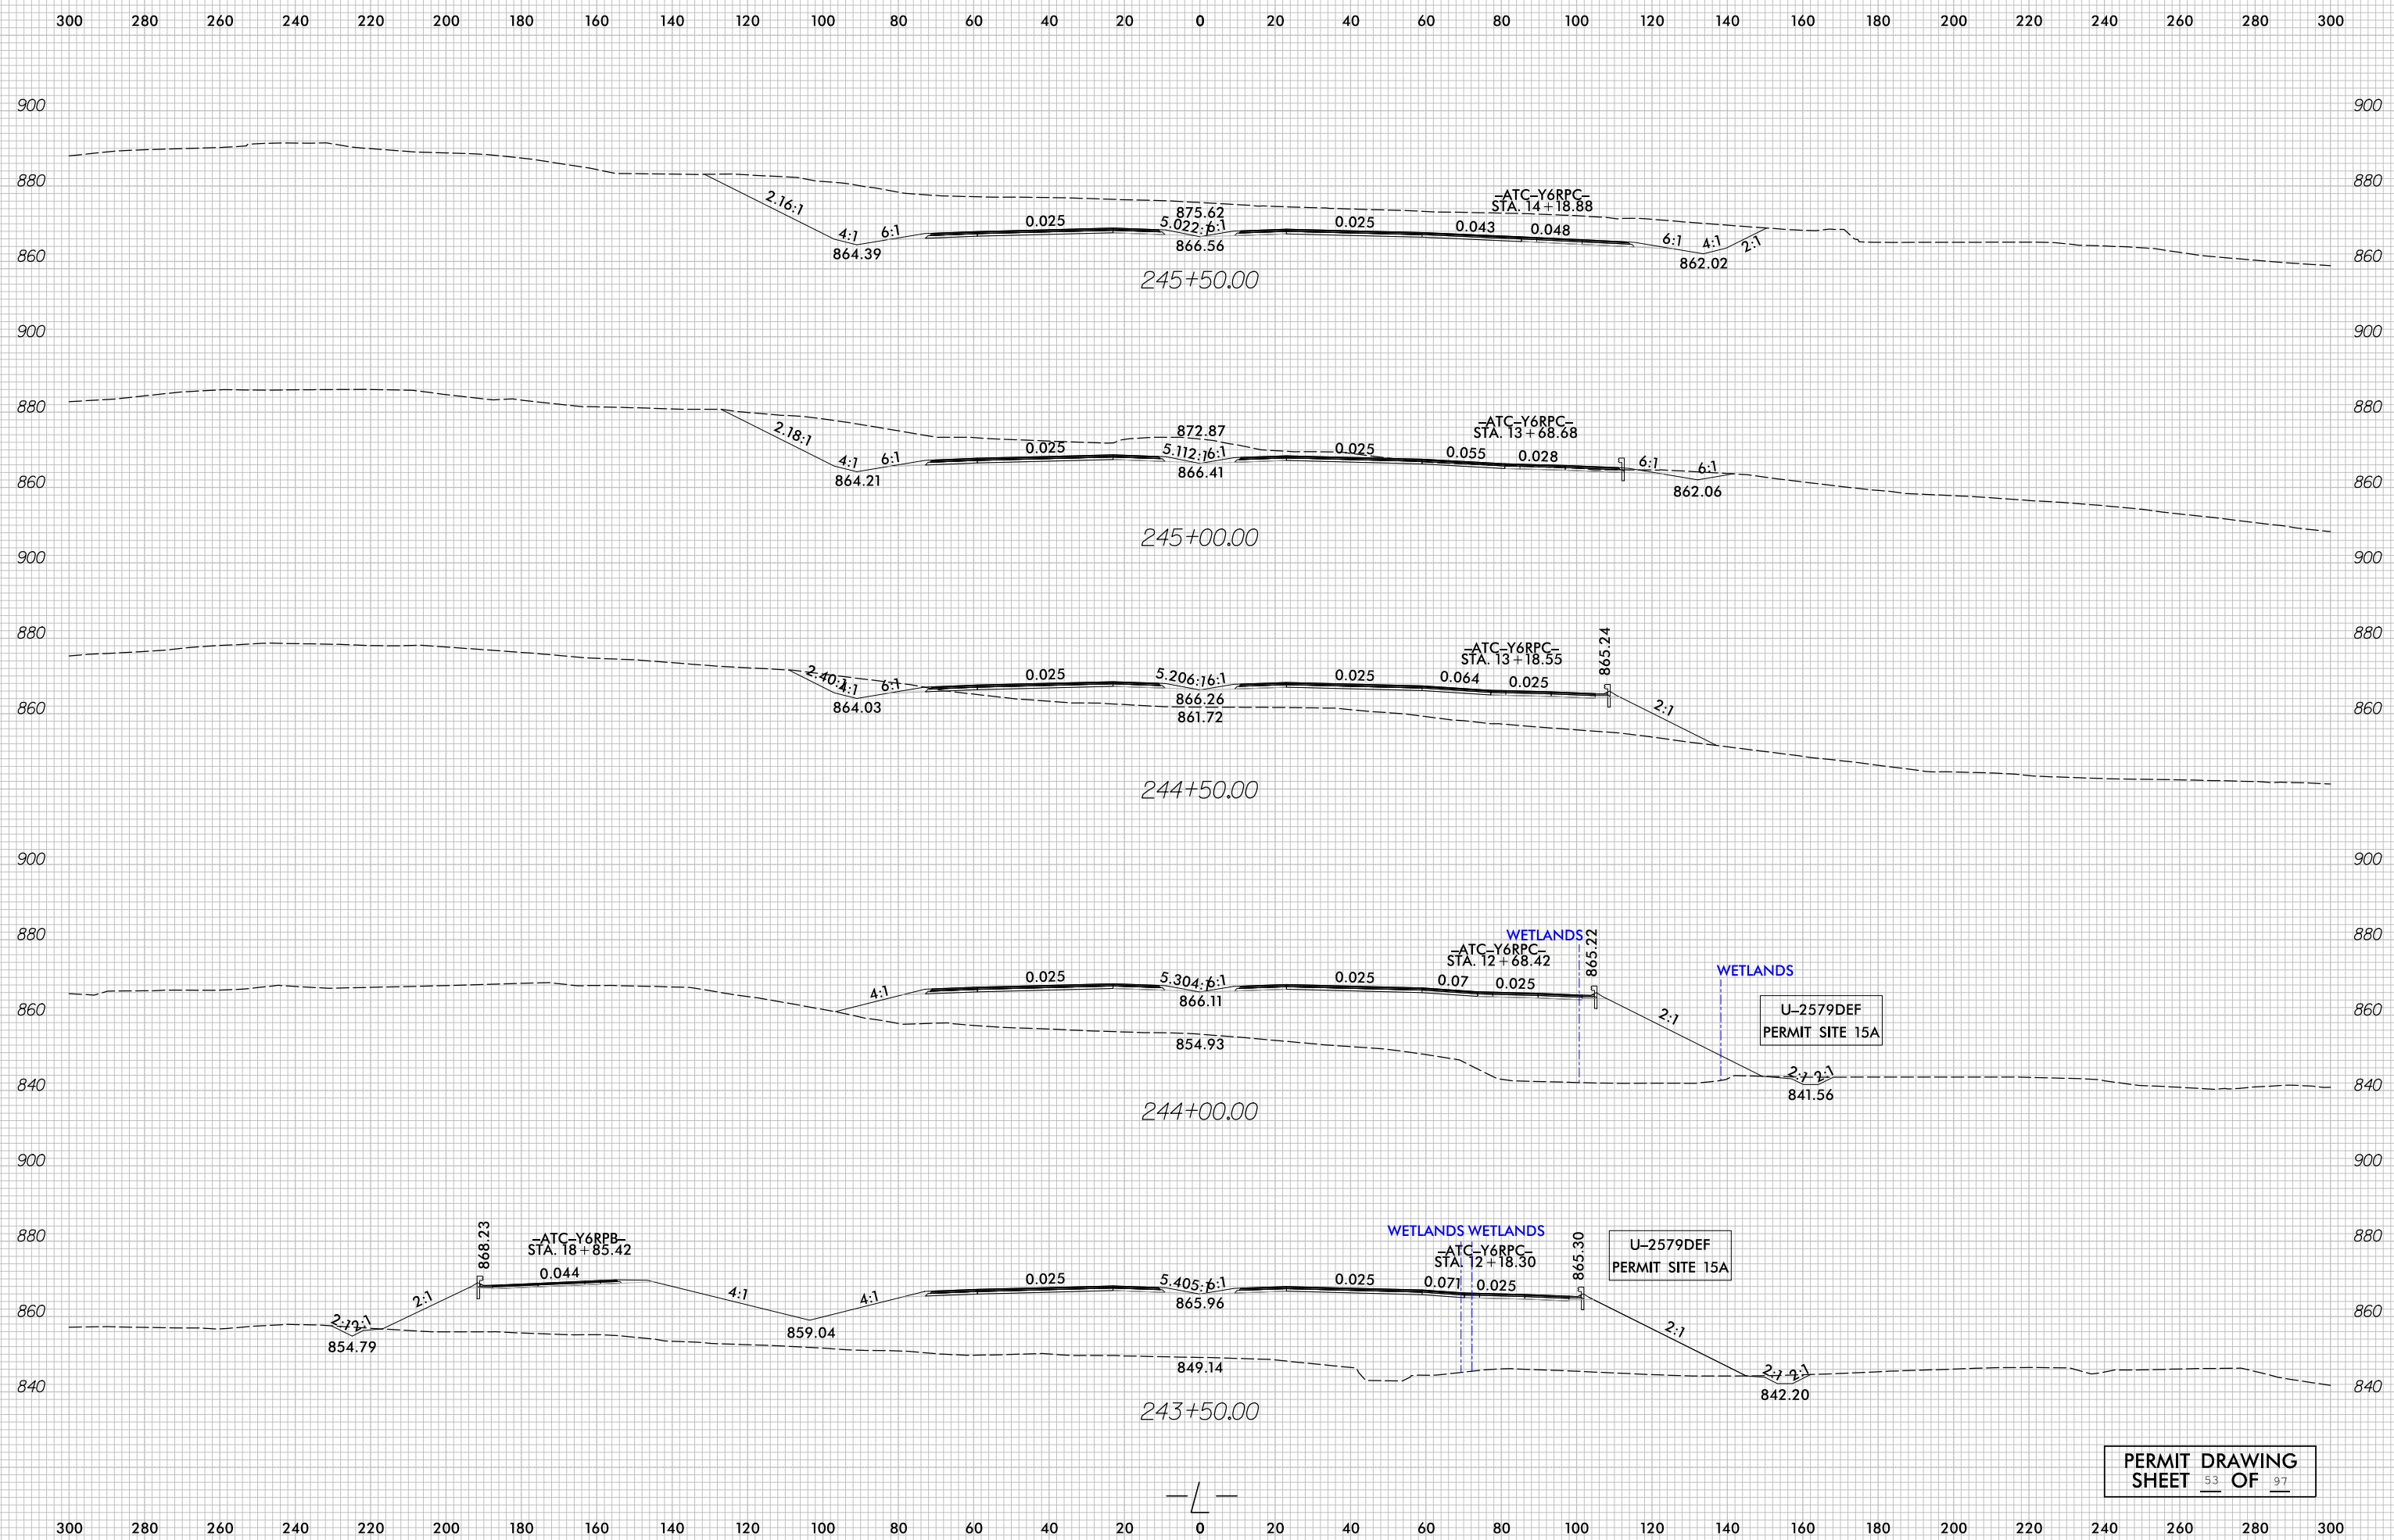

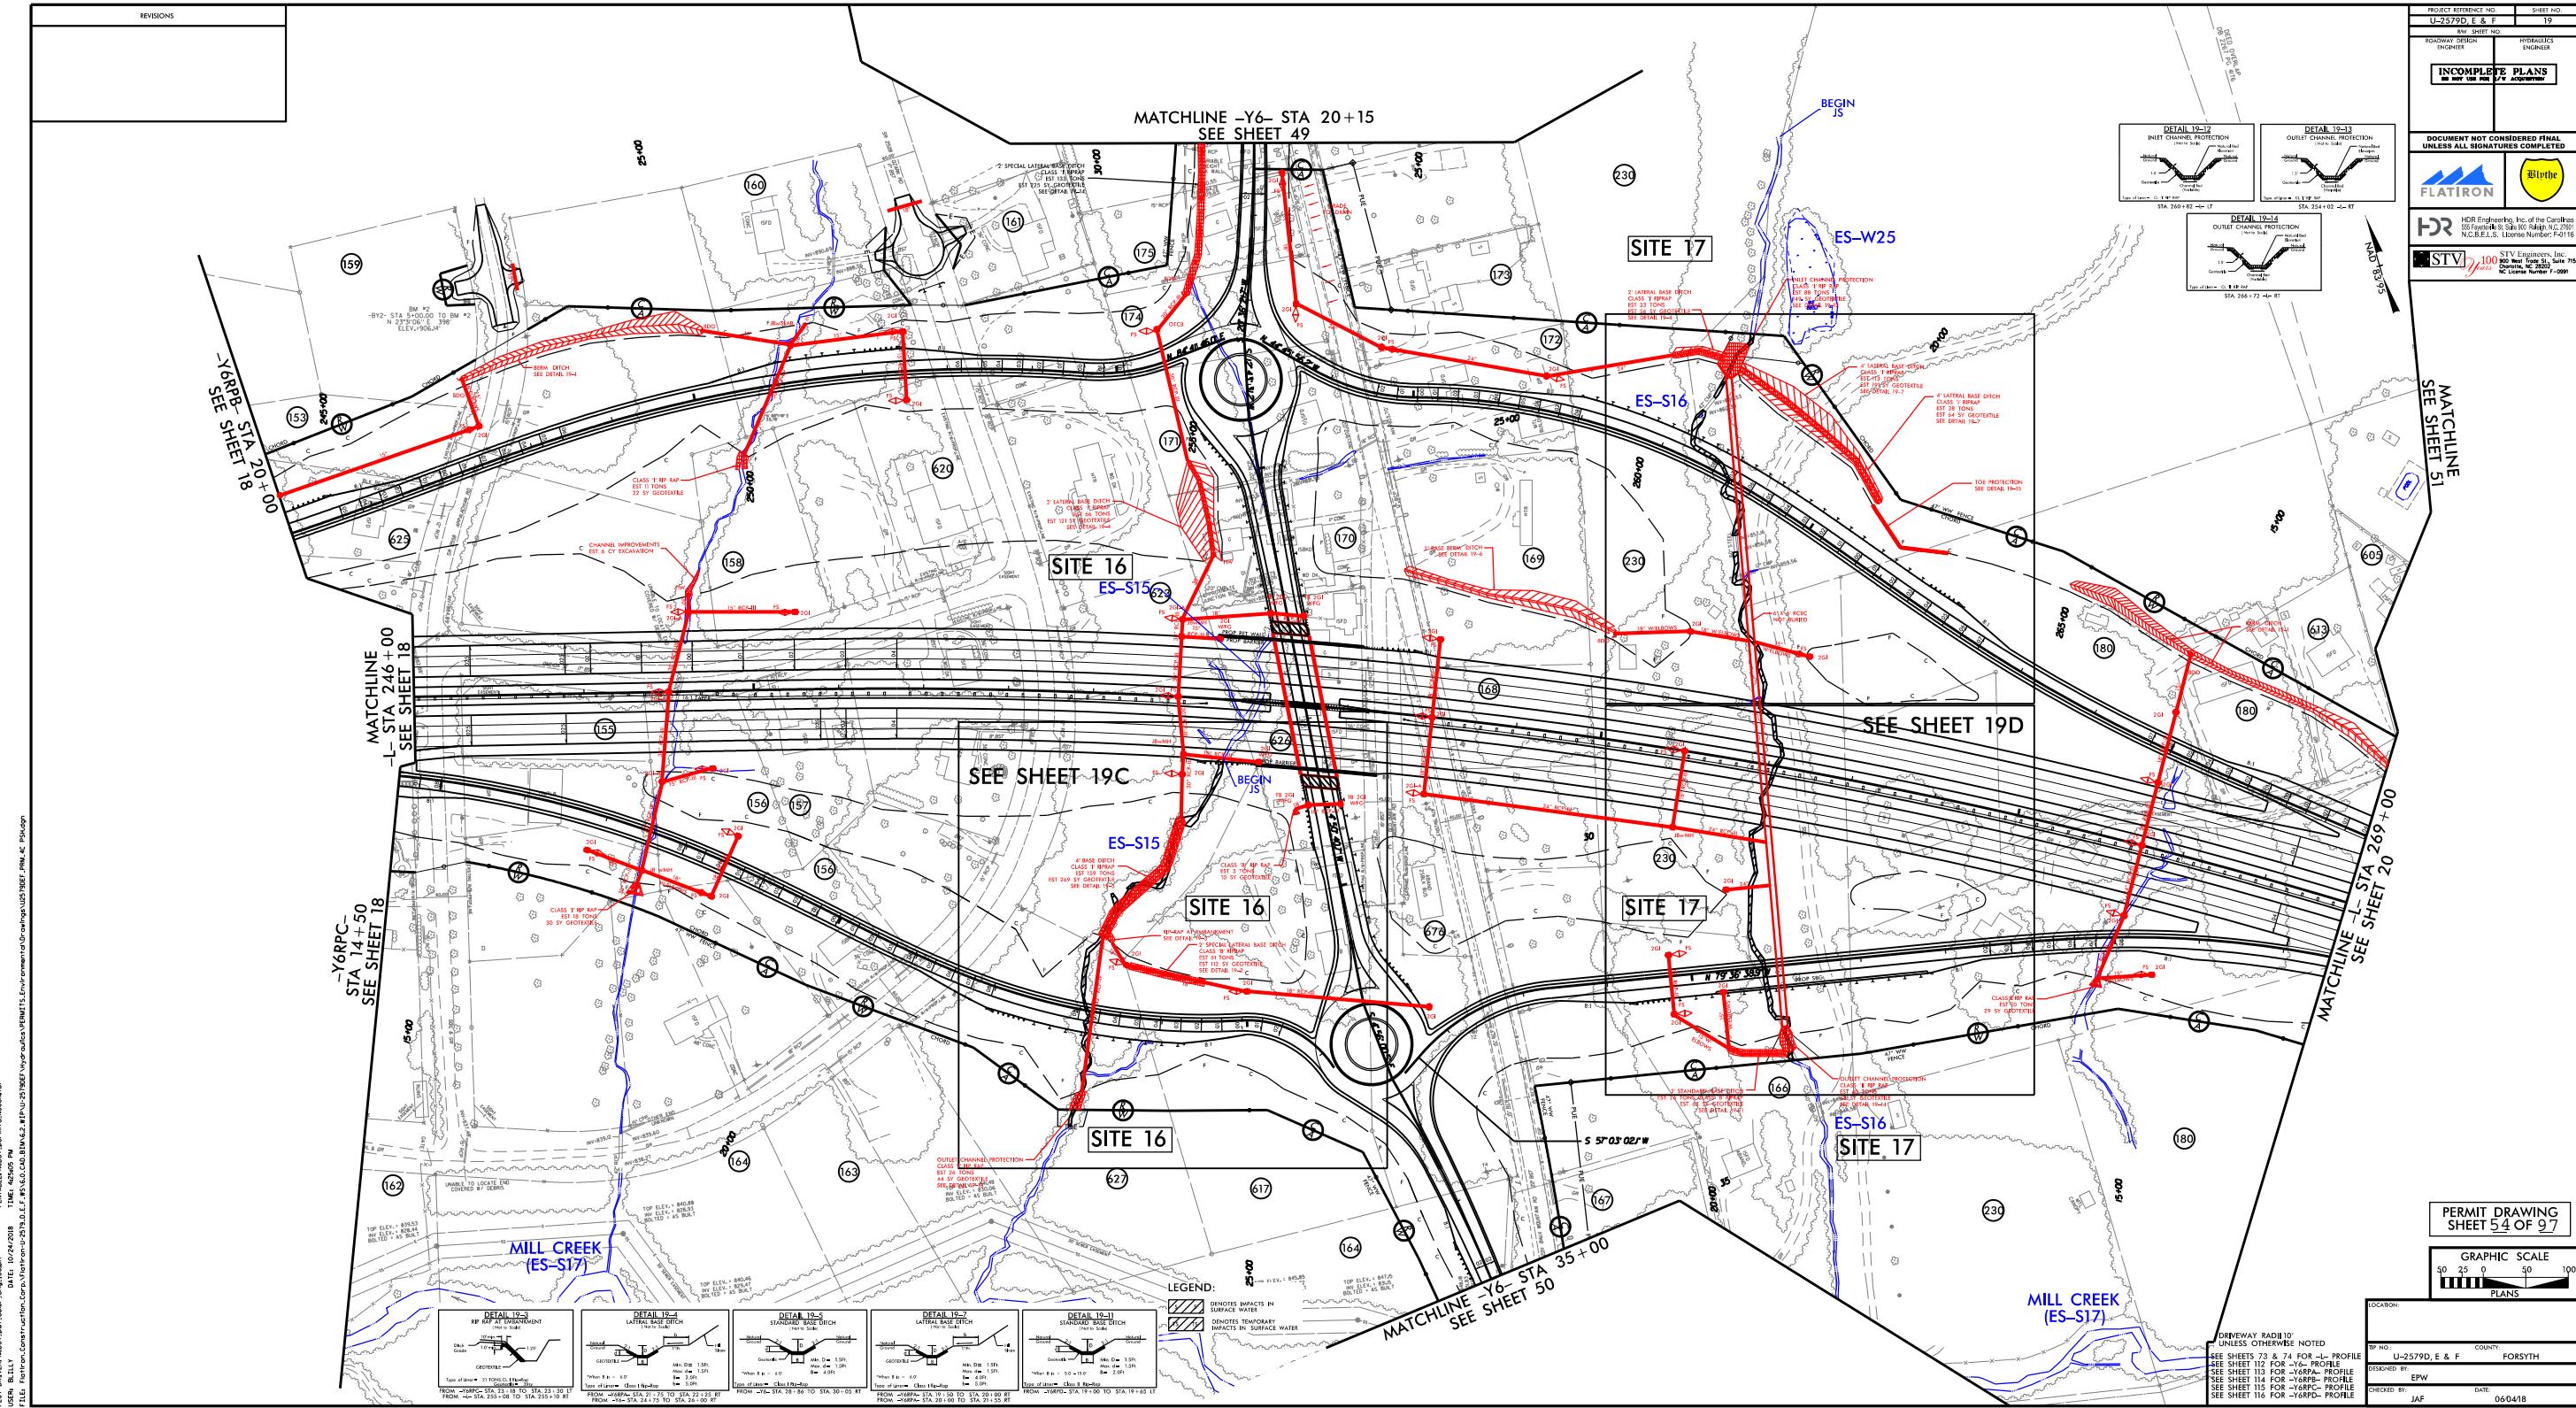

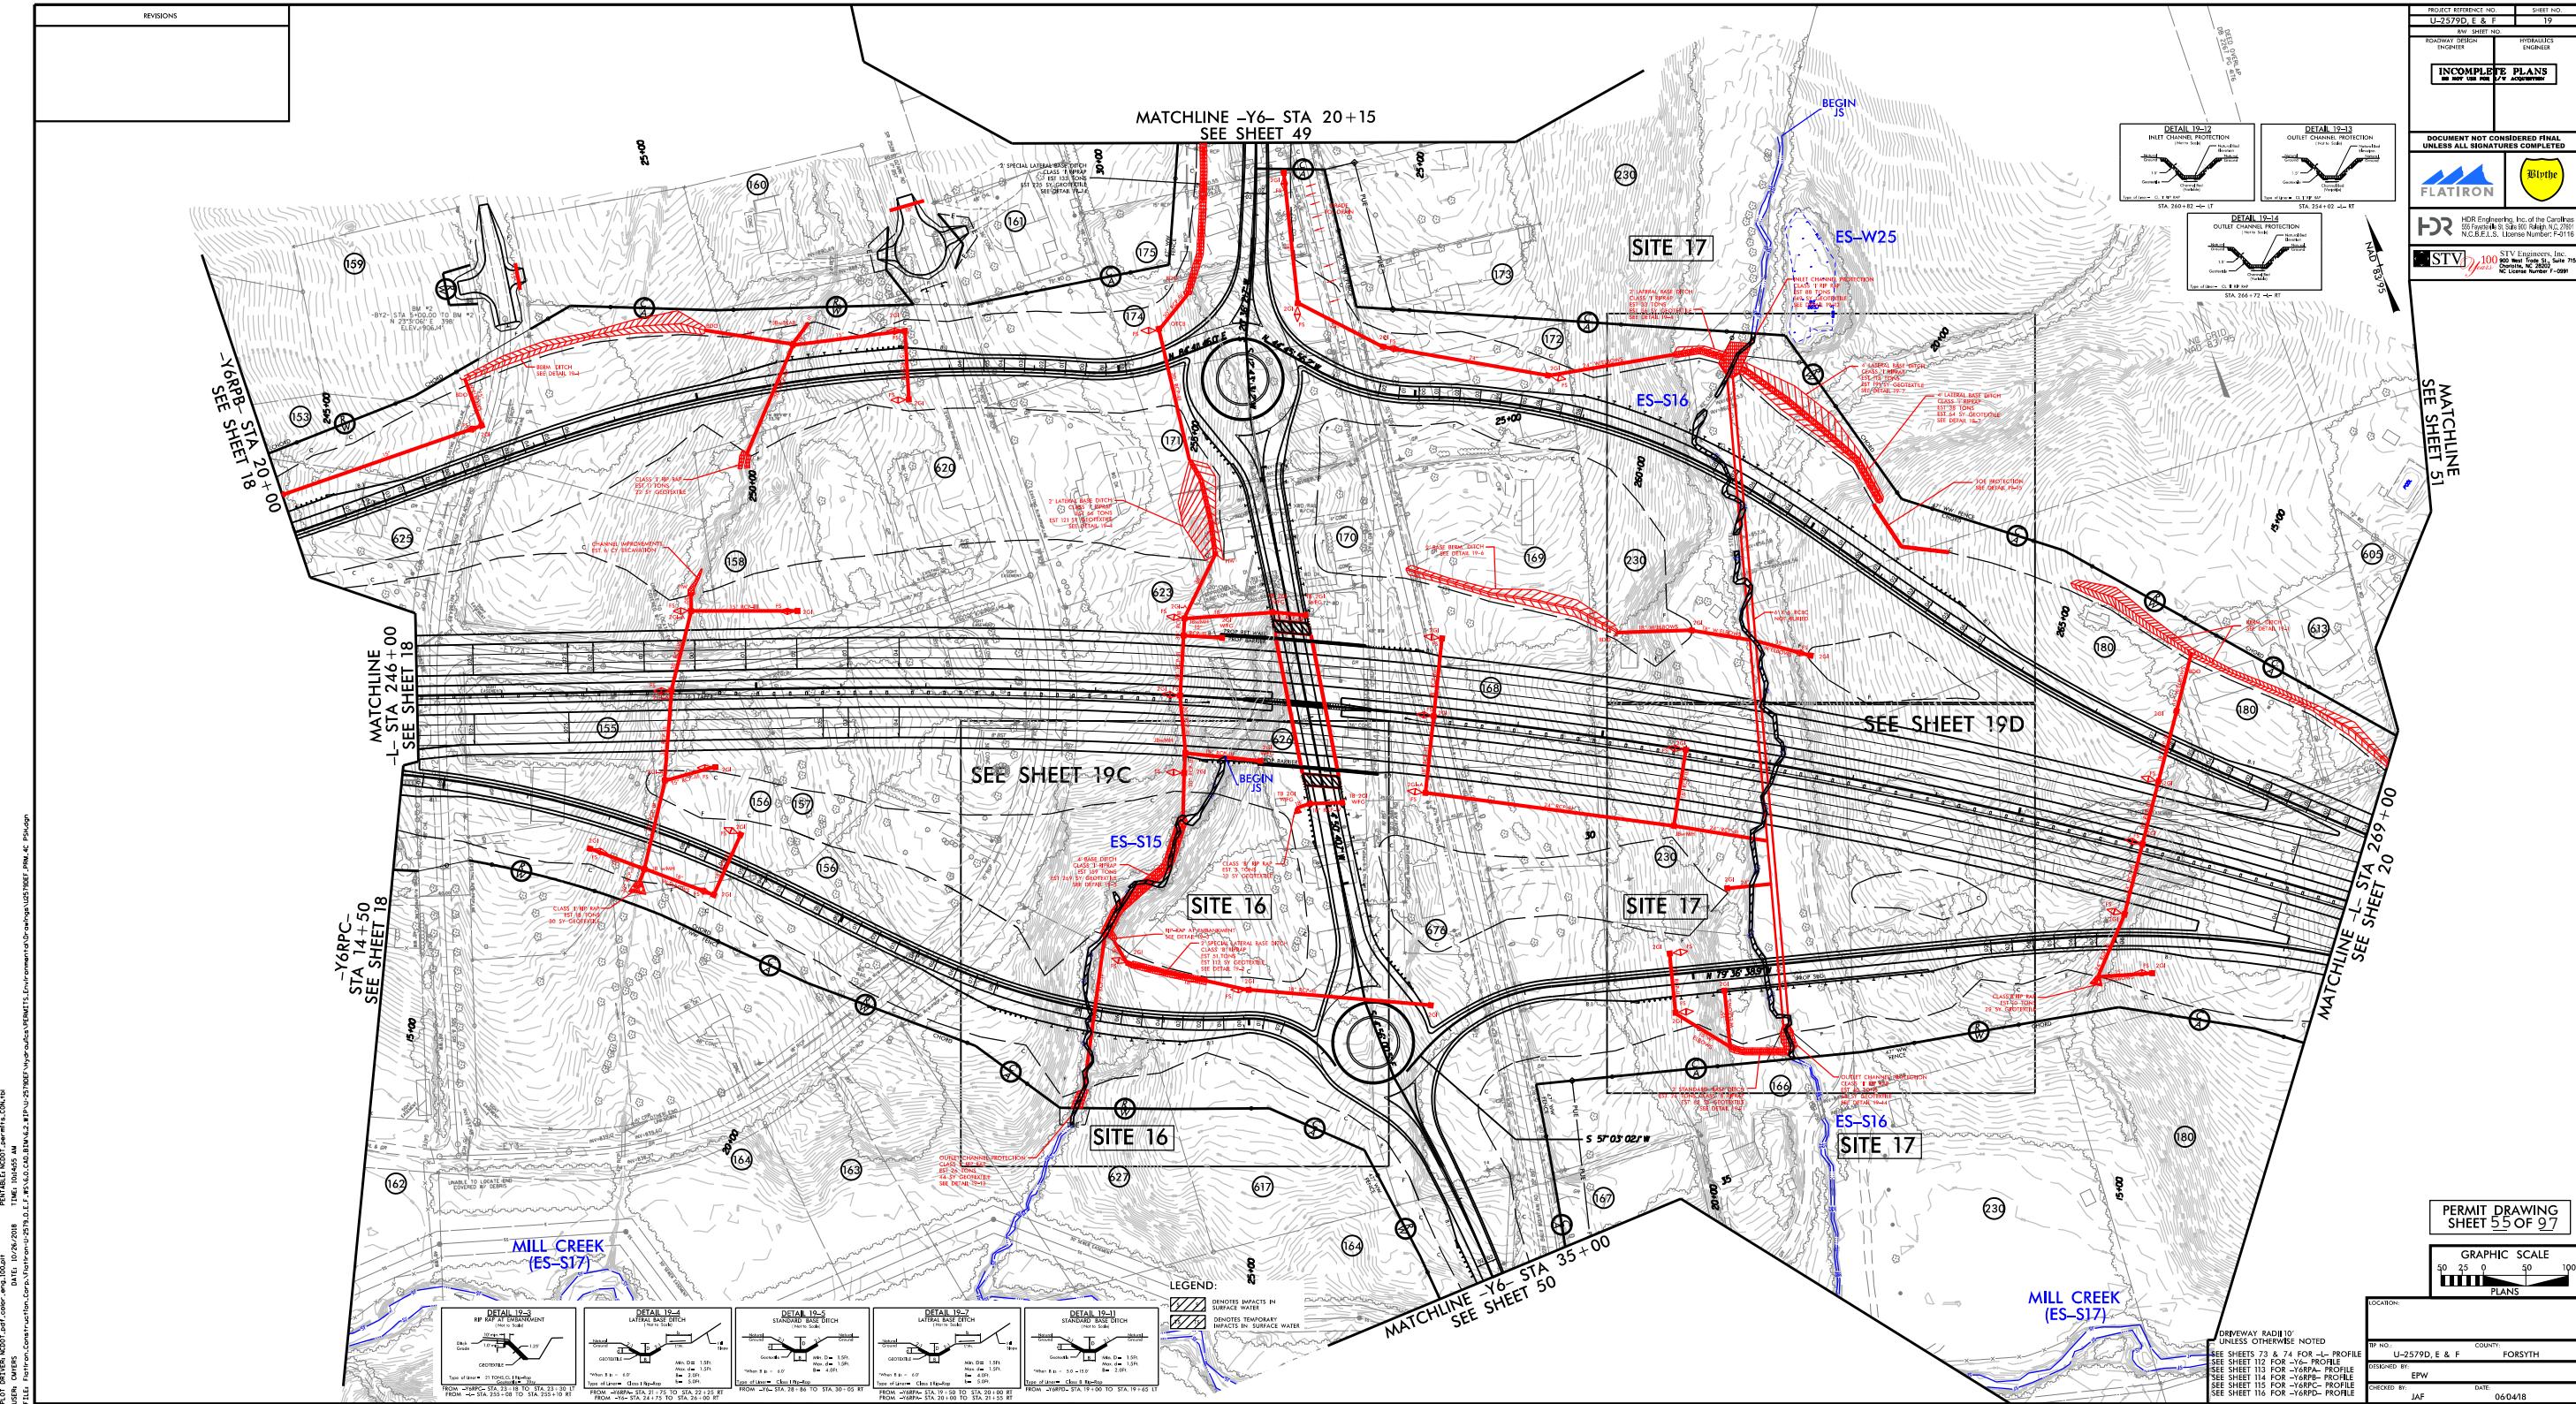

8/17/99

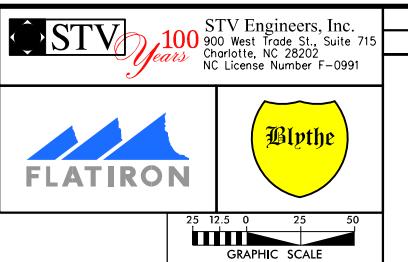


PROJECT REFERENCE NO. U-2759D, E & F SHEET NO. 19D
ROADWAY DESIGN ENGINEER

INCOMPLETE PLANS
DO NOT USE FOR R/W ACQUISITION

DOCUMENT NOT CONSIDERED FINAL
UNLESS ALL SIGNATURES COMPLETED


HDR Engineering, Inc. of the Carolinas
555 Fayetteville St. Suite 900 Raleigh, N.C. 27601
N.C.B.E.L.S. License Number: F-0916


MATCHLINE SEE SHEET 19A

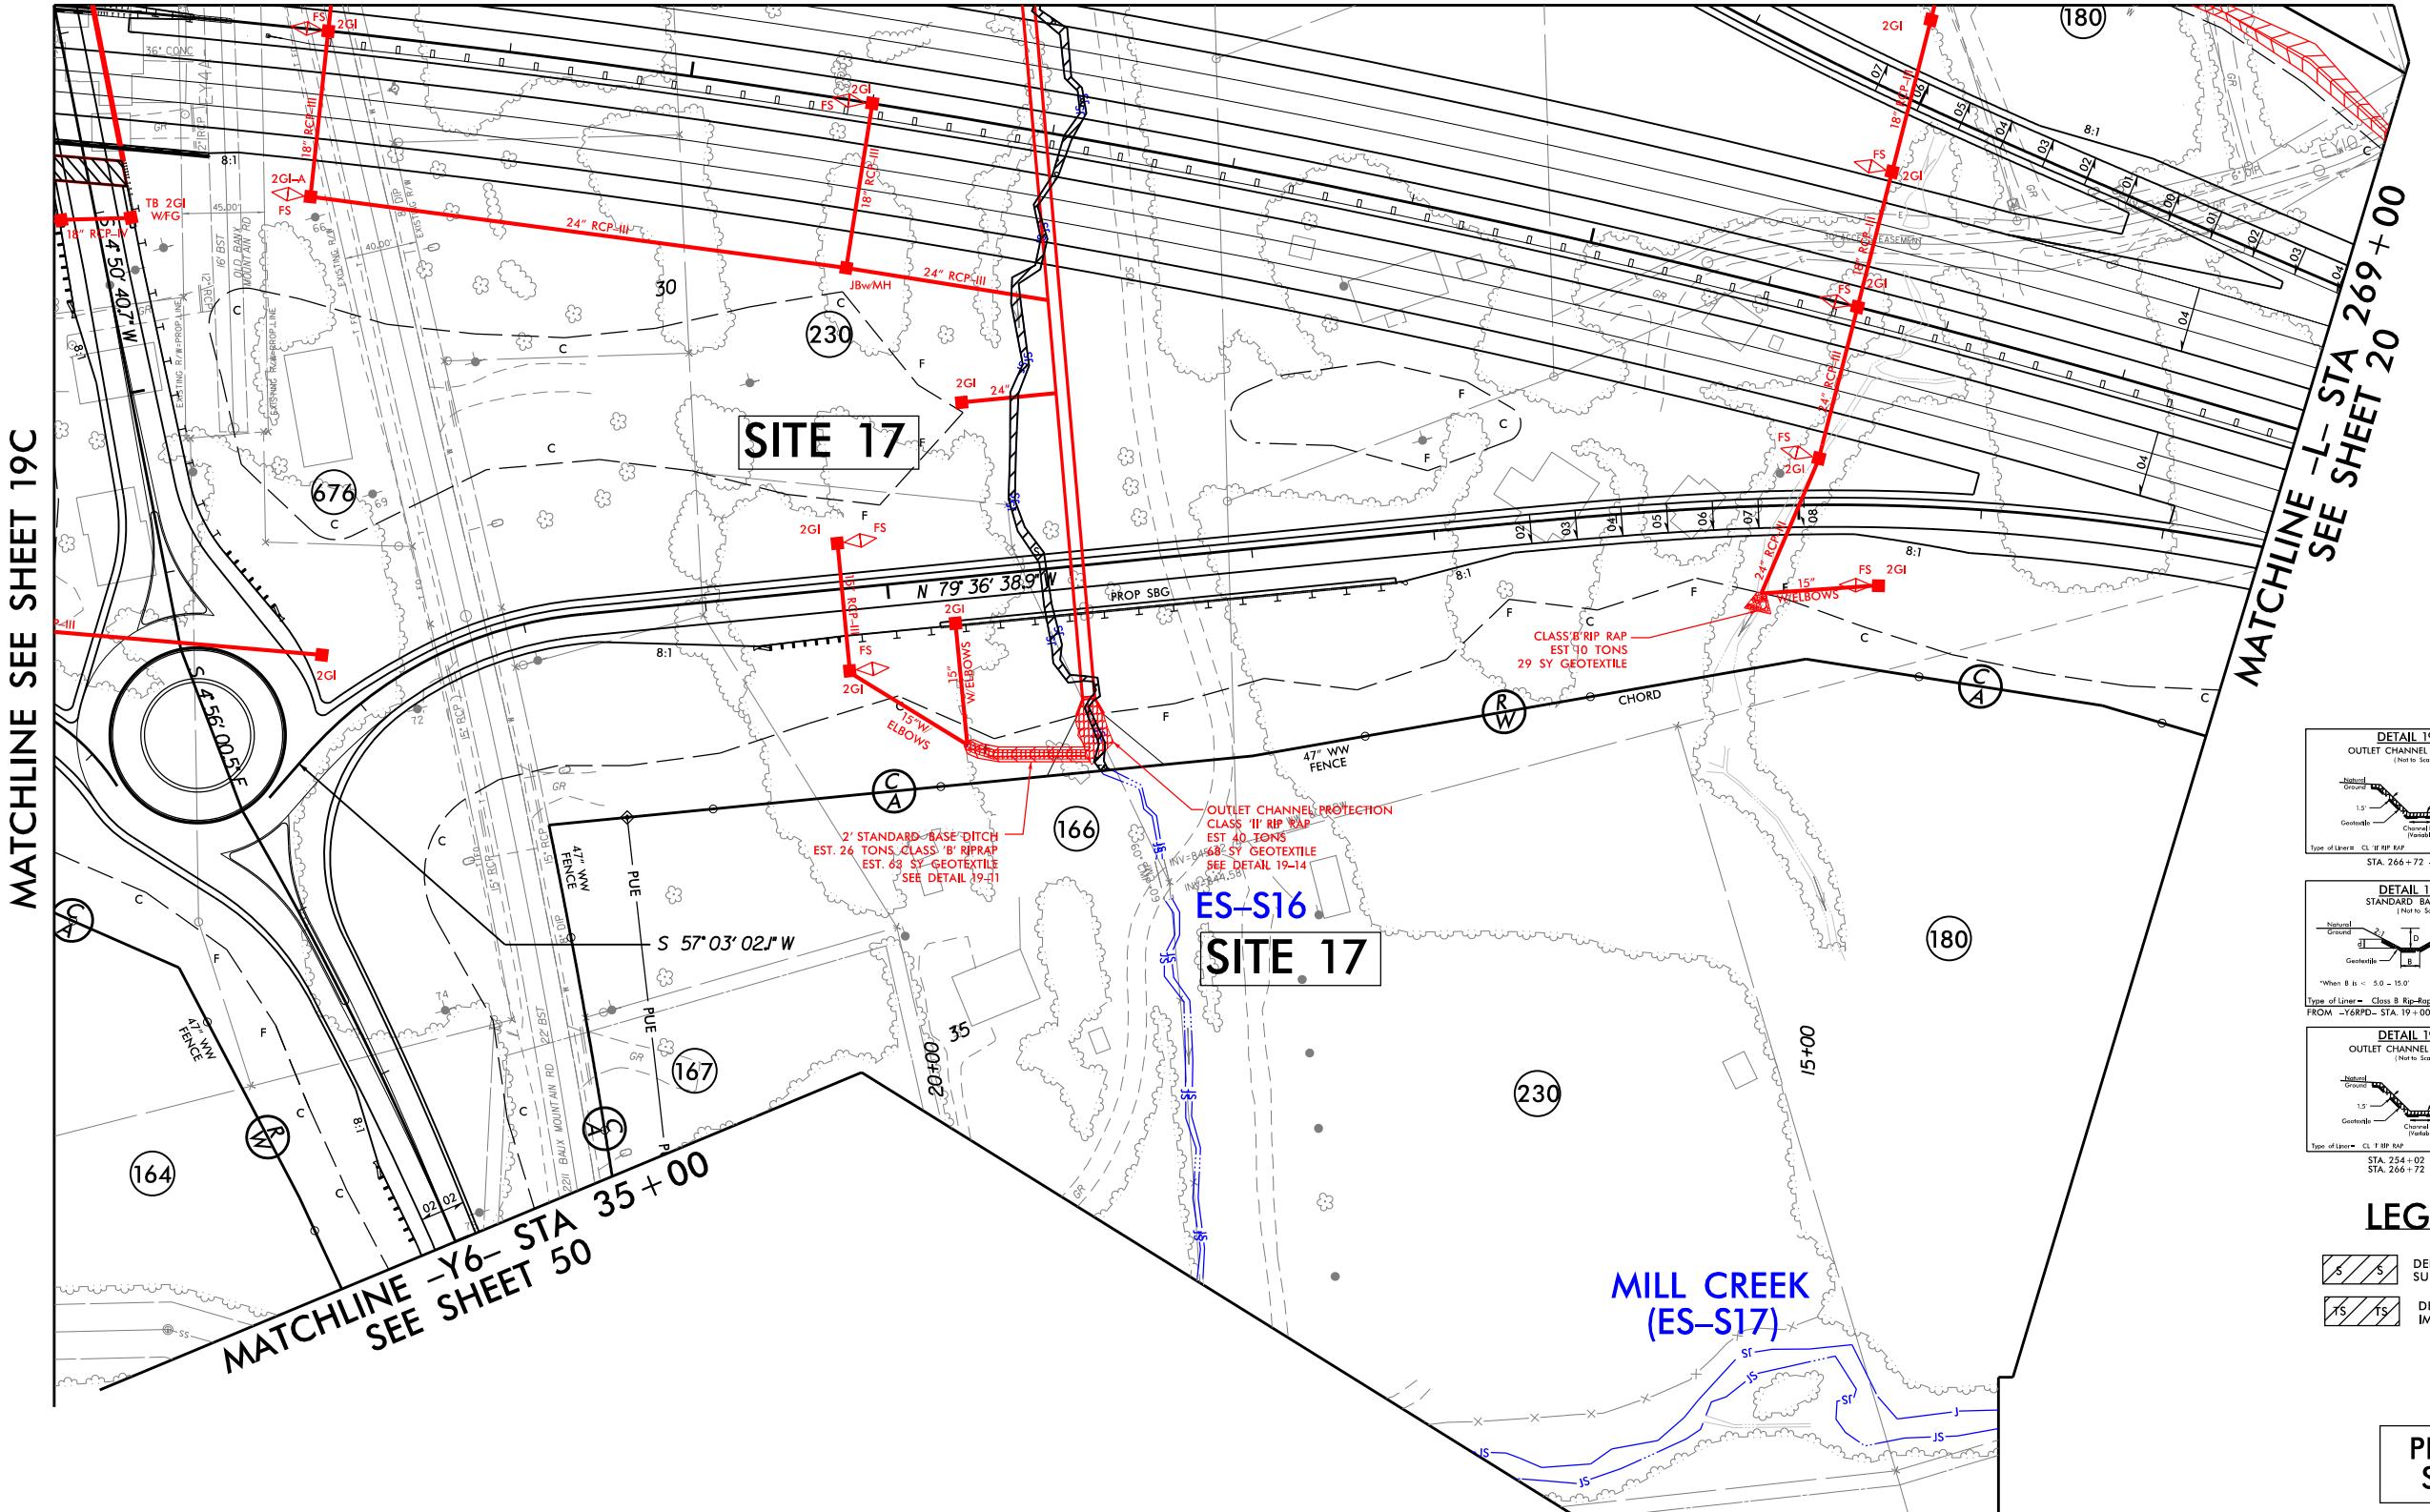



PROJECT REFERENCE NO.		SHEET NO.
U-2579D,E & F		
ROADWAY DESIGN ENGINEER	HYDRAULICS ENGINEER	
DOCUMENT NOT CONSIDERED FINAL UNLESS ALL SIGNATURES COMPLETED		

SCALE:
1" = 50' HORIZONTAL
1" = 10' VERTICAL

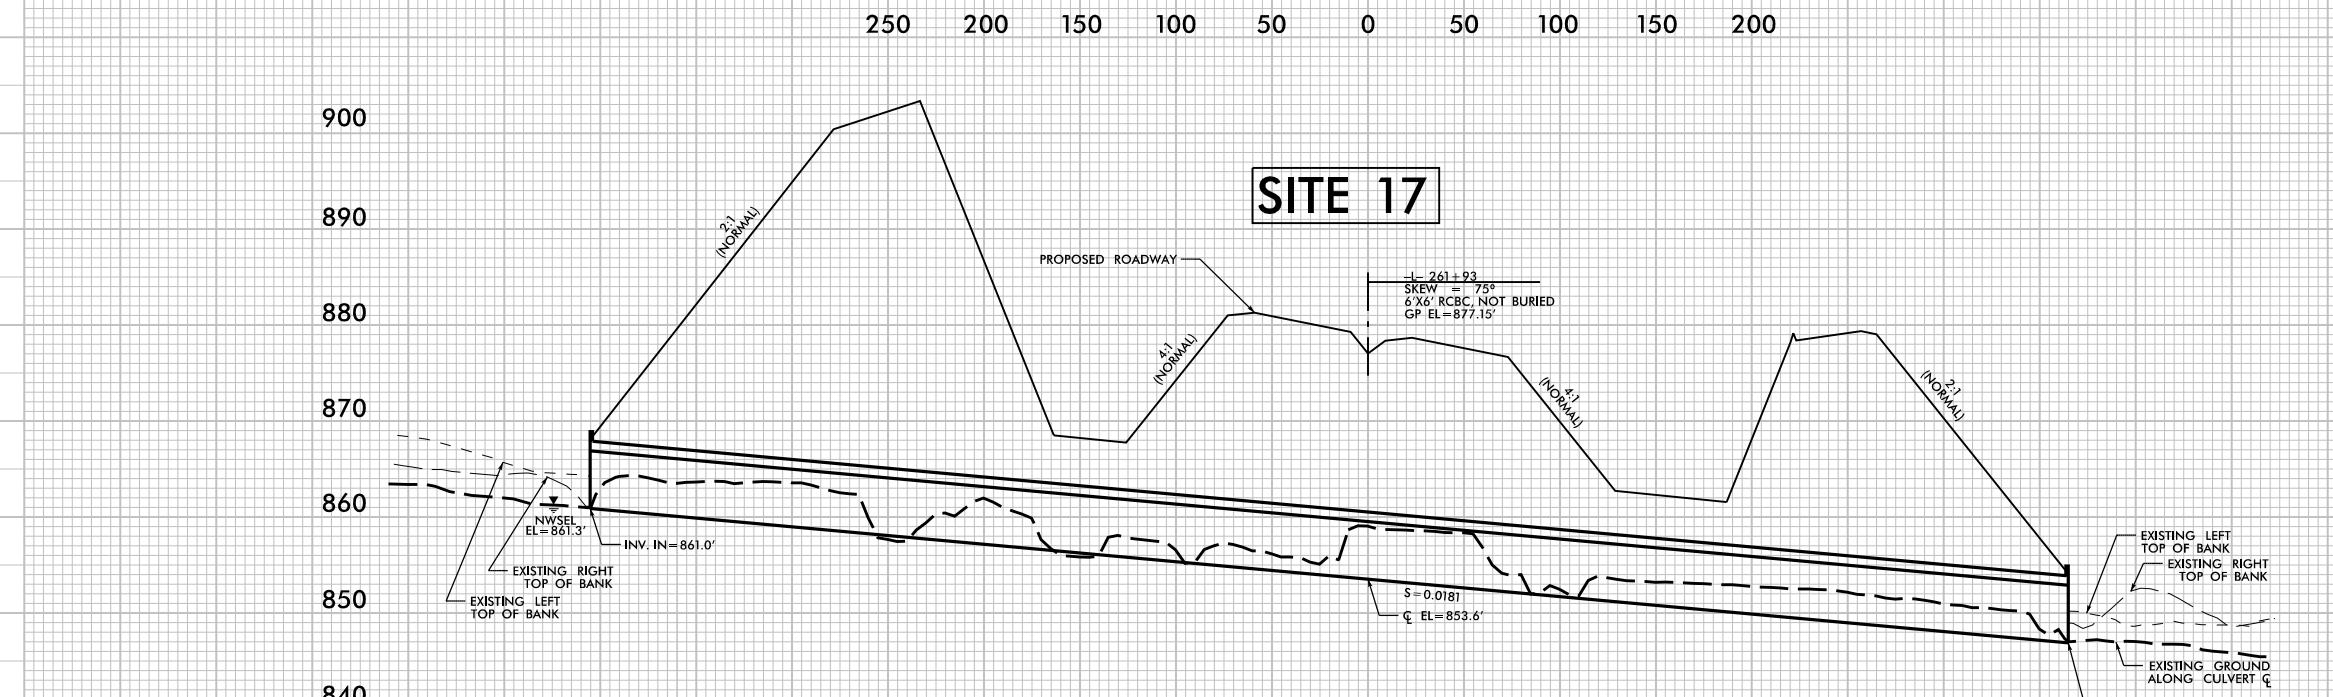

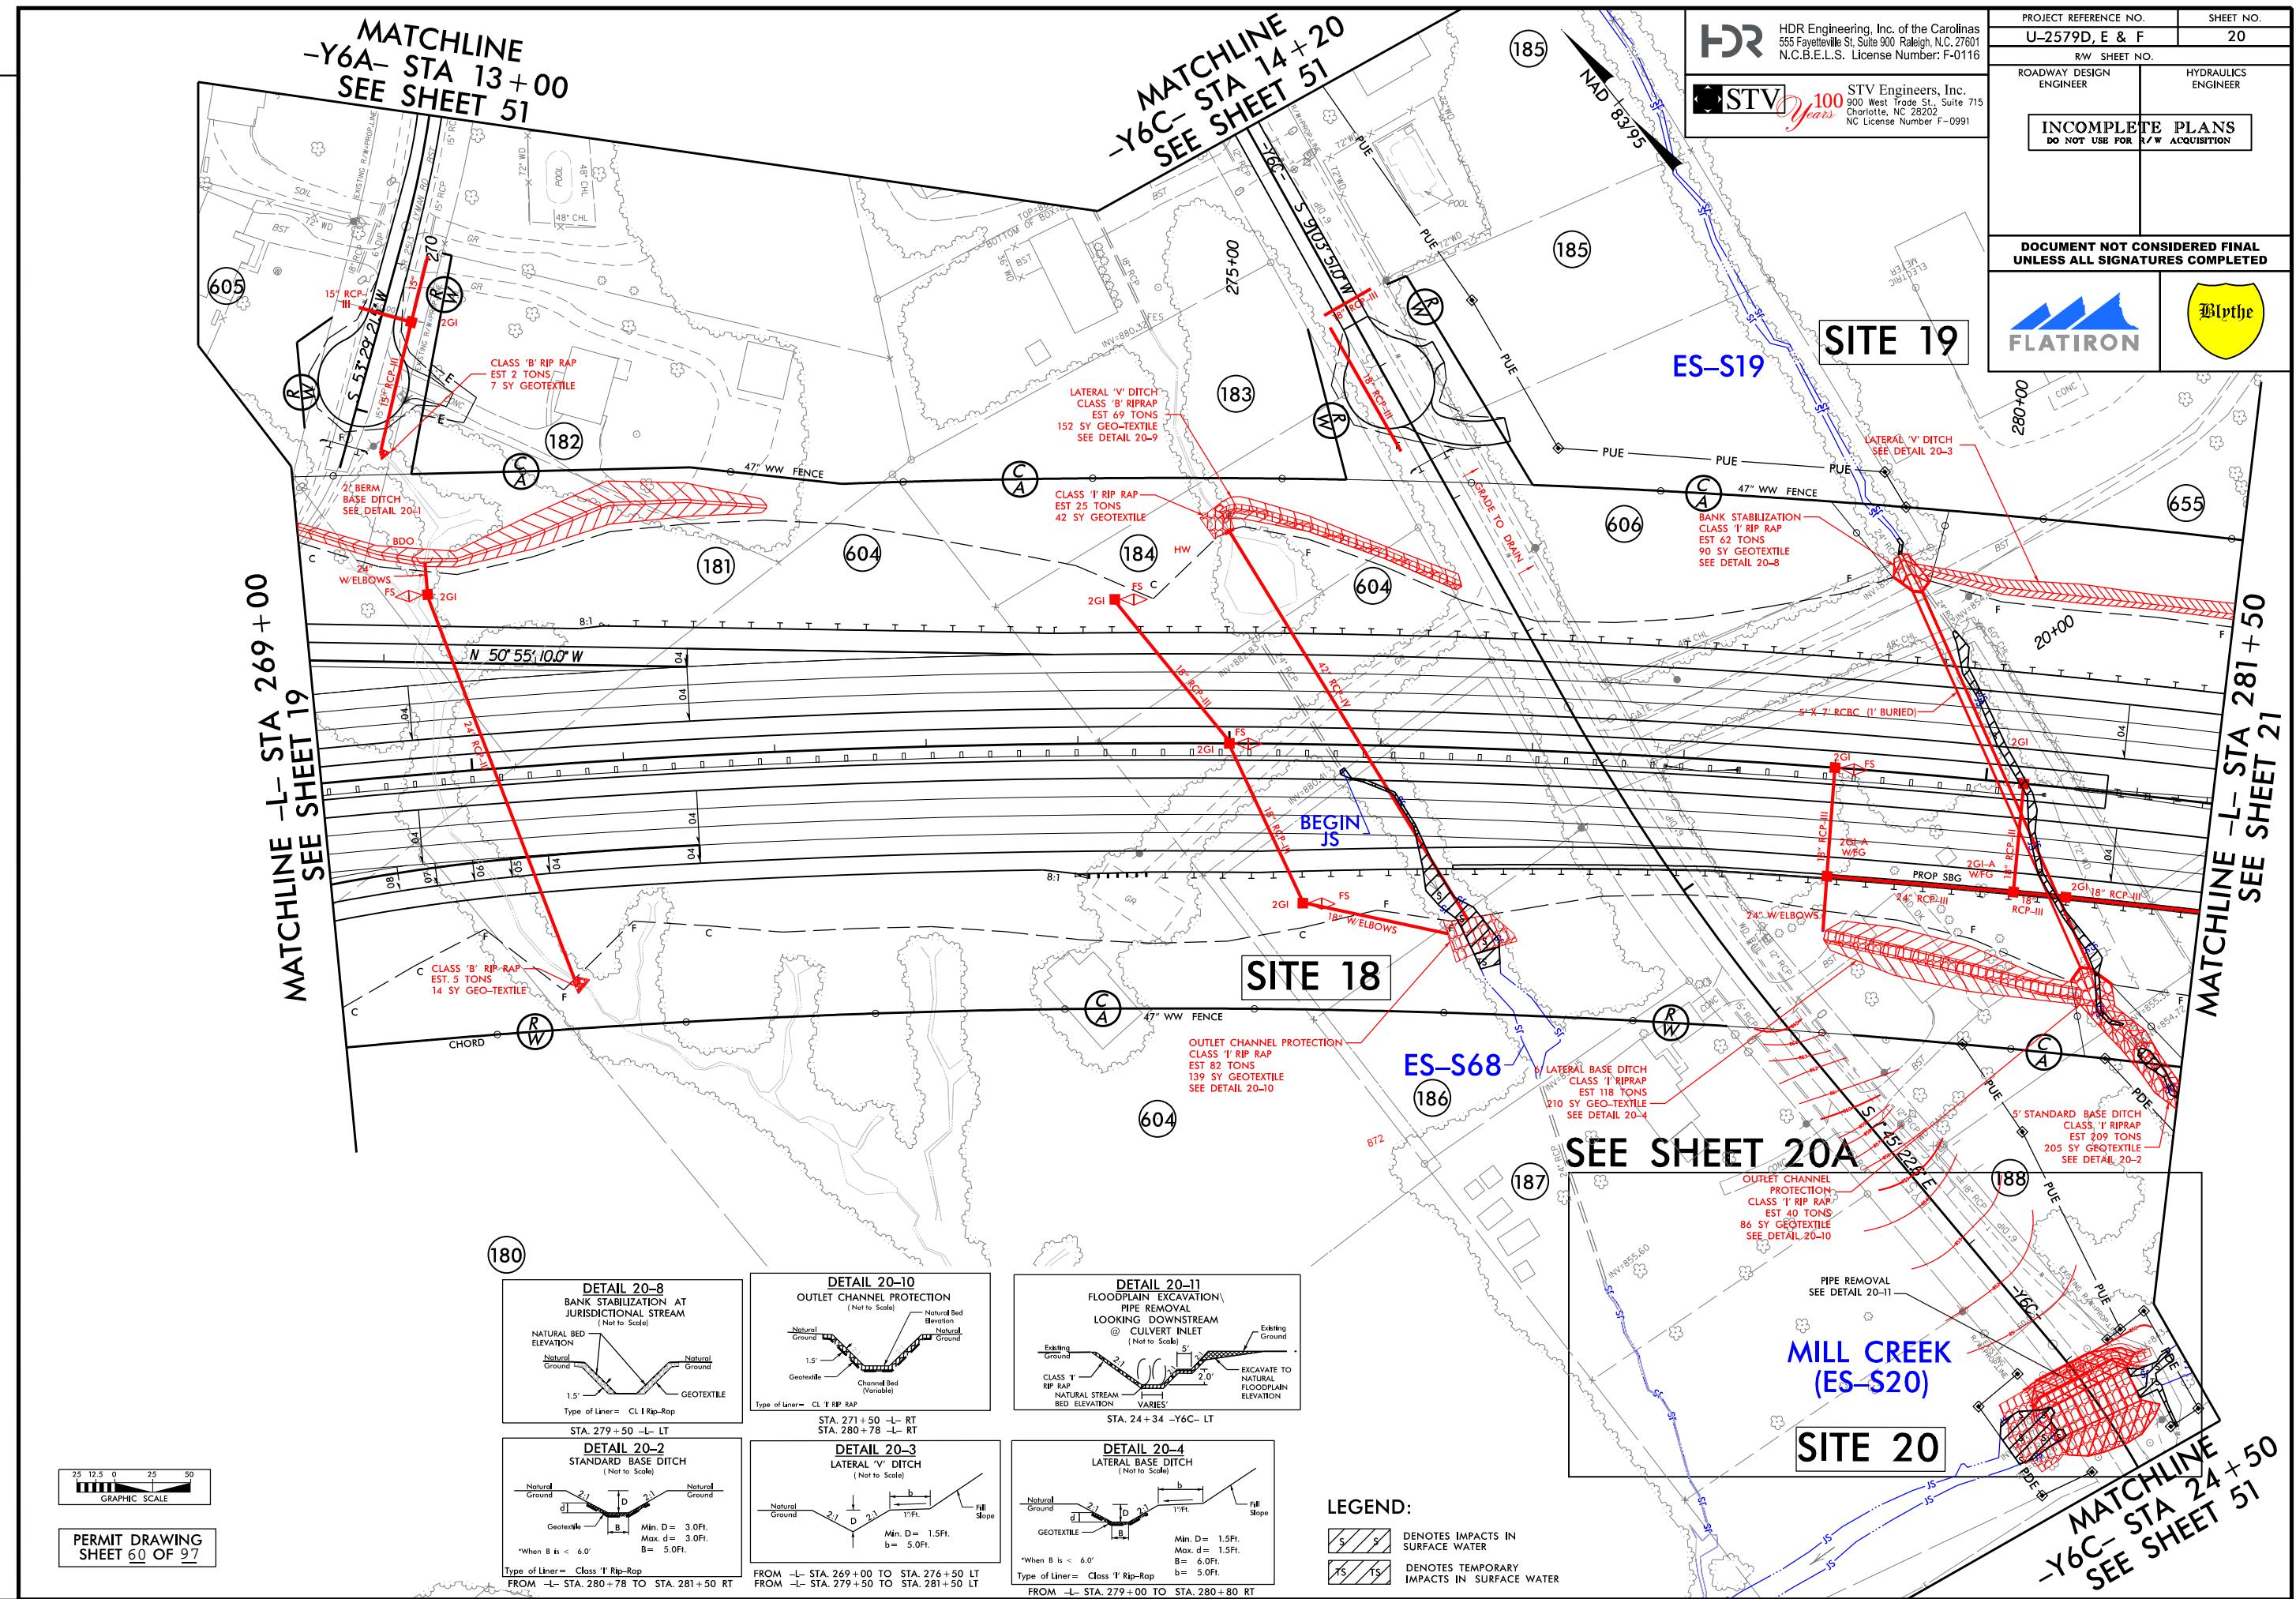

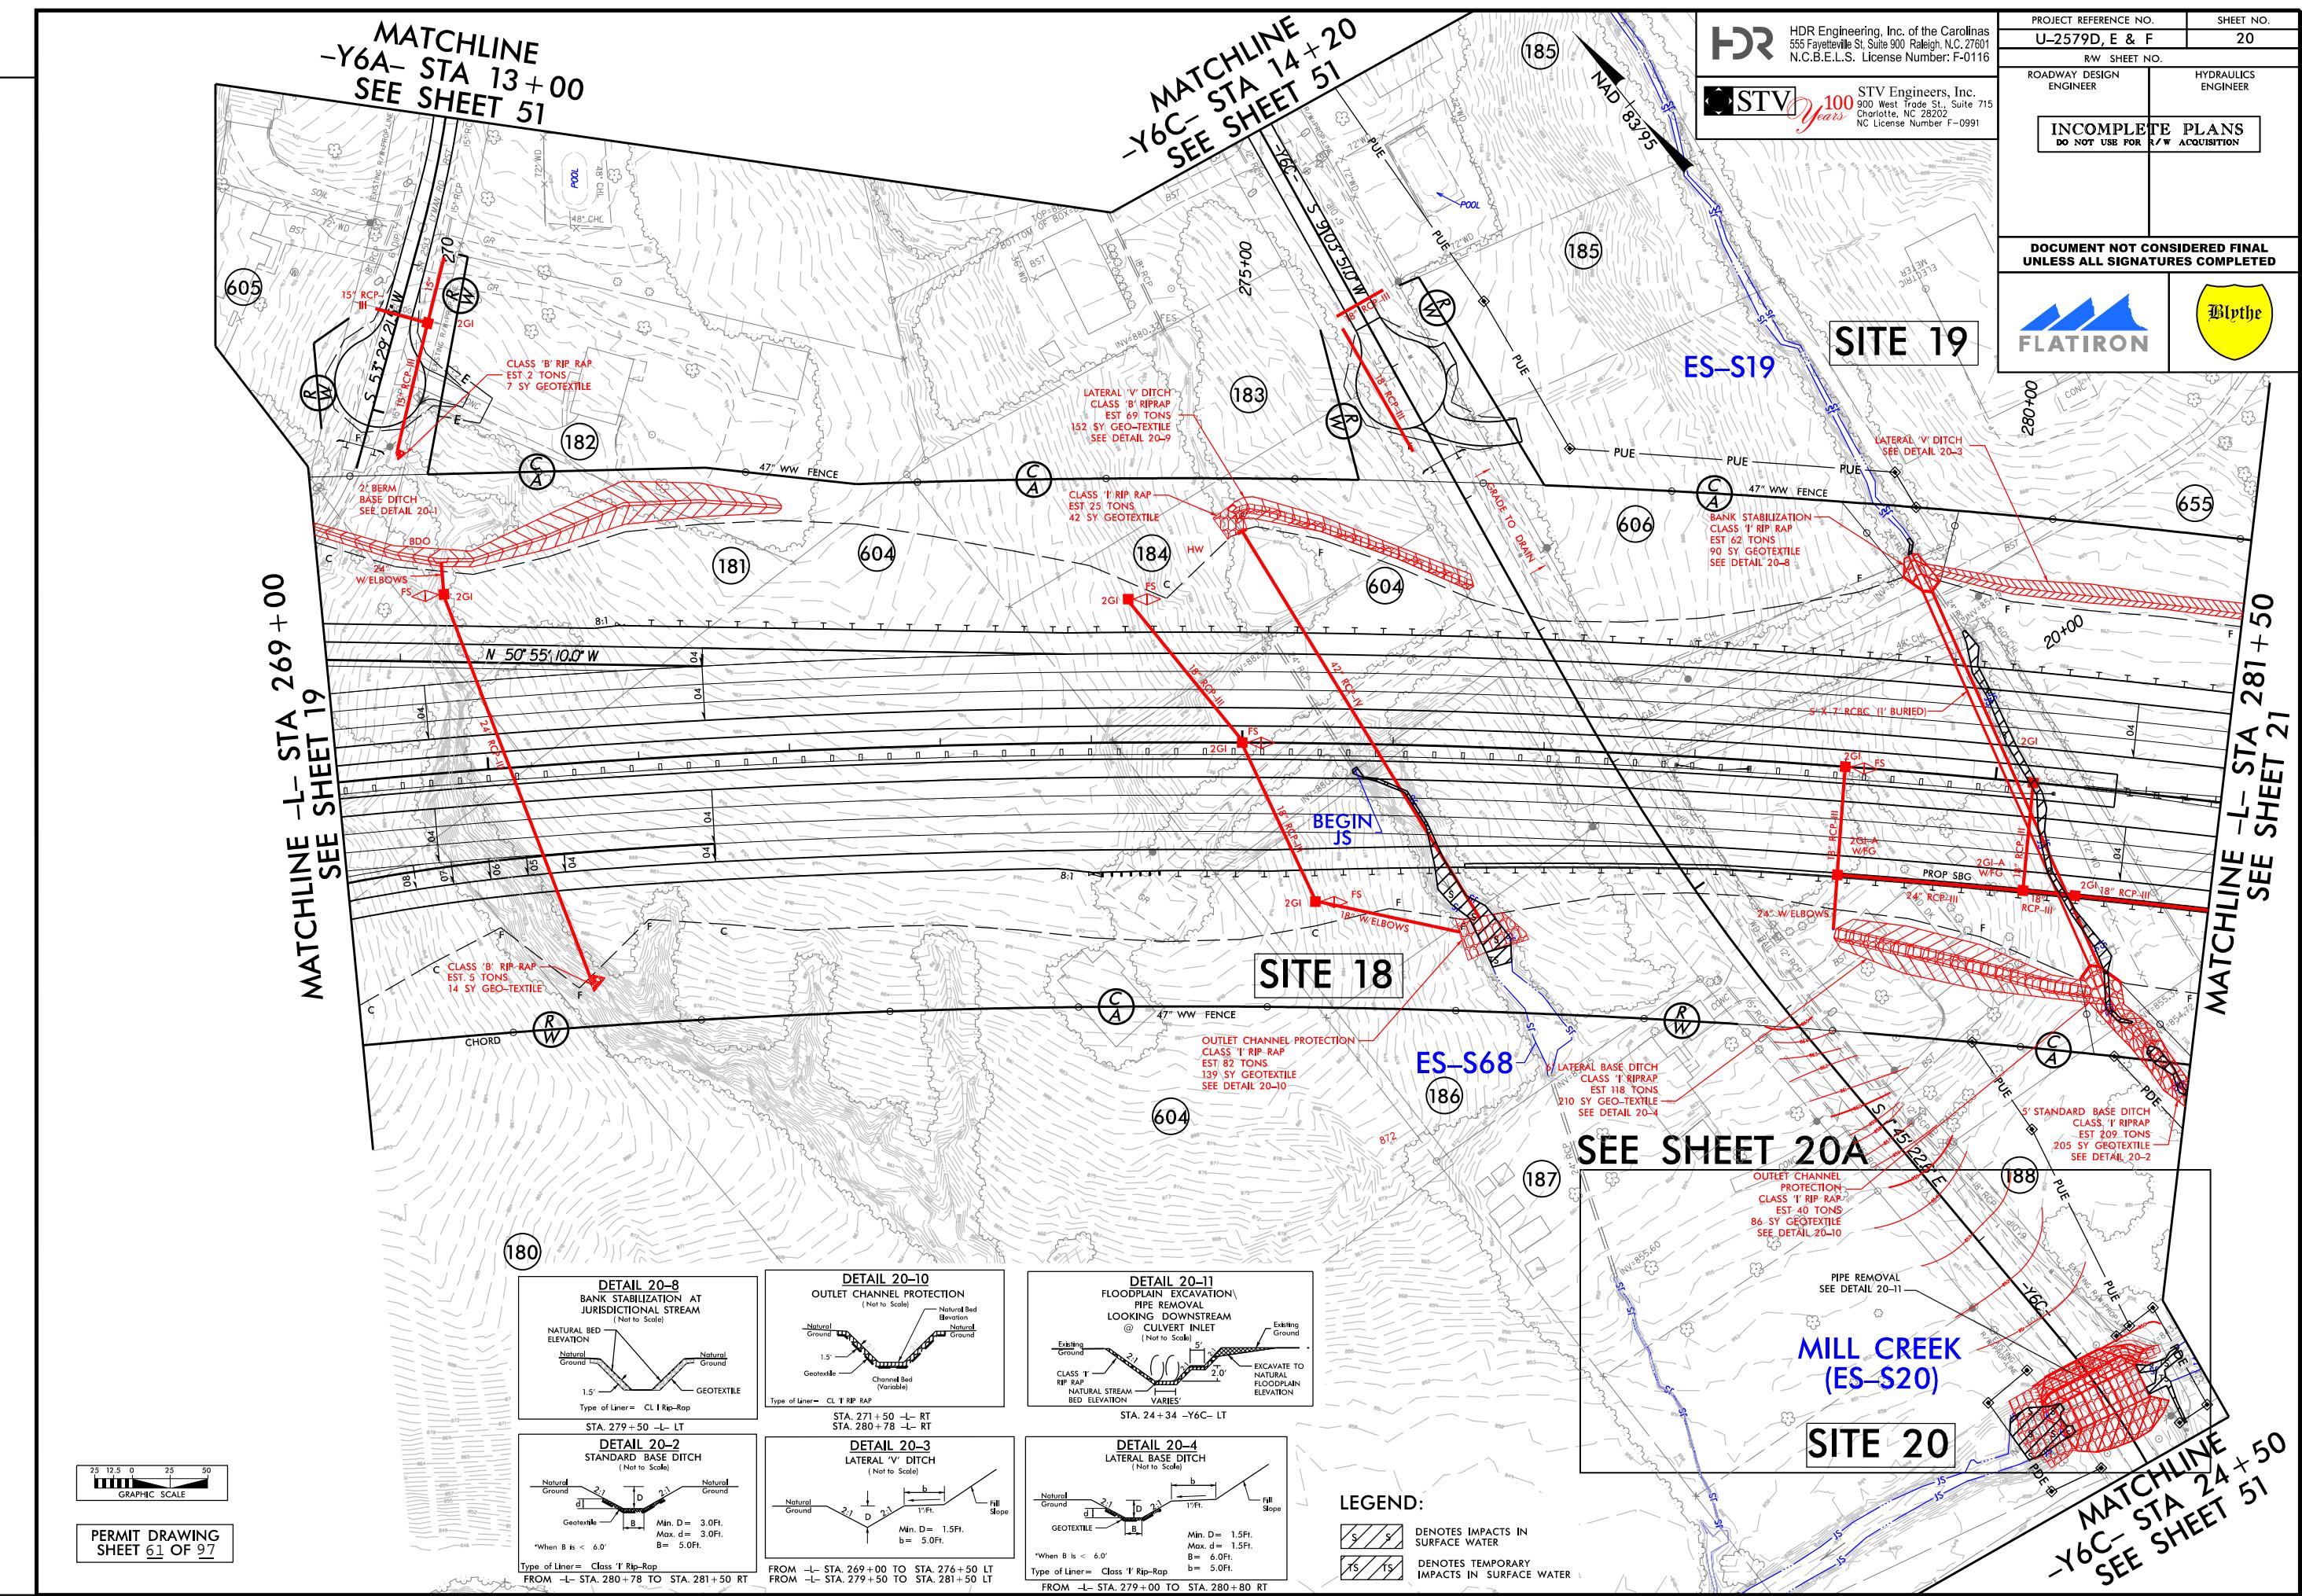

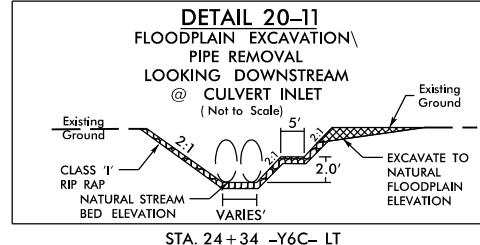

HDR HDR Engineering, Inc. of the Carolinas
555 Fayetteville St, Suite 900, Raleigh, NC 27601
N.C.B.E.L.S. License Number: F-0116

STV STV Engineers, Inc.
900 West Trade St., Suite 715
Charlotte, NC 28202
NC License Number F-0991

100 Years


PROJECT REFERENCE NO.	SHEET NO.
U-2579D, E & F	20A
R/W SHEET NO.	
ROADWAY DESIGN ENGINEER	HYDRAULICS ENGINEER
INCOMPLETE PLANS DO NOT USE FOR R/W ACQUISITION	
DOCUMENT NOT CONSIDERED FINAL UNLESS ALL SIGNATURES COMPLETED	




PLOT DRIVER: NCDOT_color_eng-100.ptt
PENTABLE: NCDOT_permits_NOCON.tbi
TIME: 2:13:08 PM
DATE: 12/17/2018
FILE: Flatiron_Construction_Corp\Flatiron_Construction_Corp\Permits\Environmental Drawings\U2579DEF_Permits_Environmental Drawings\U2579DEF_PRM_4C_PSH.dgn

REVISIONS

SEE DETAIL 20-11
MILL CREEK (ES-S20)
SITE 20

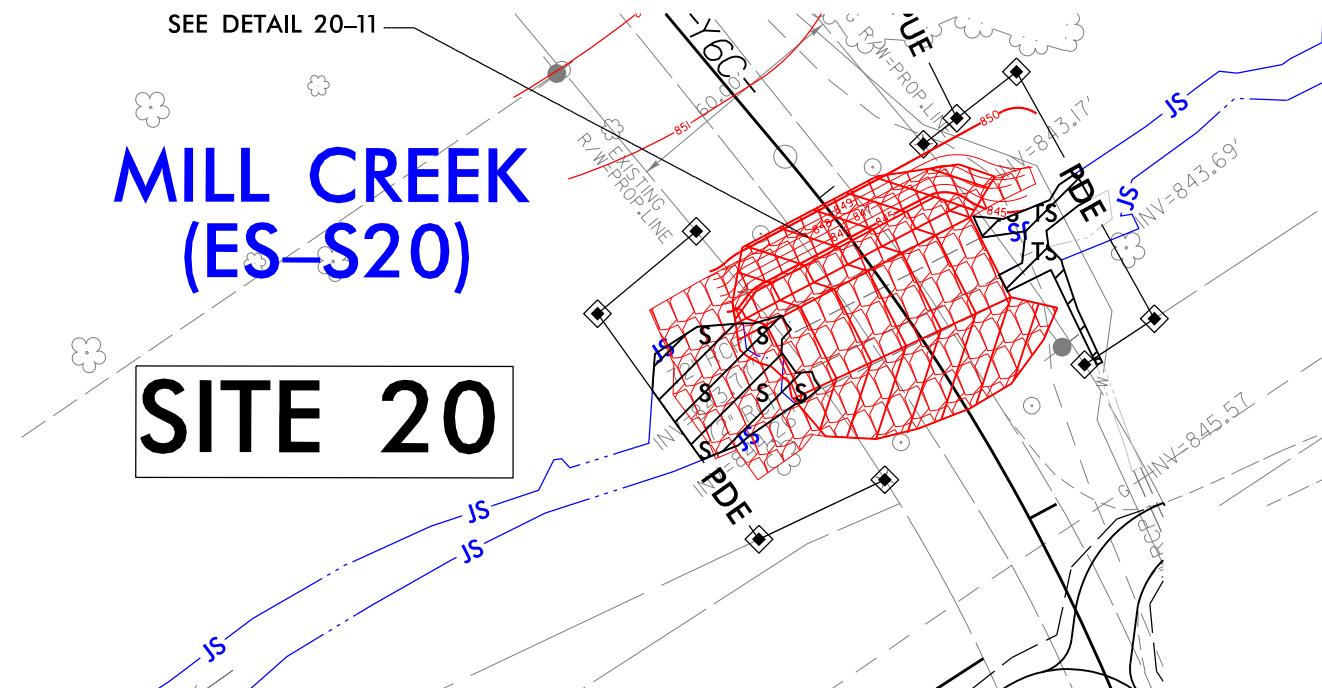

LEGEND

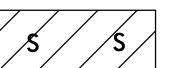

DENOTES IMPACTS IN SURFACE WATER





DENOTES TEMPORARY IMPACTS IN SURFACE WATER


PROJECT REFERENCE NO.		SHEET NO.
U-2579D,E & F		
ROADWAY DESIGN ENGINEER	HYDRAULICS ENGINEER	
DOCUMENT NOT CONSIDERED FINAL UNLESS ALL SIGNATURES COMPLETED		

SCALE:
1" = 50' HORIZONTAL
1" = 10' VERTICAL

SITE 19

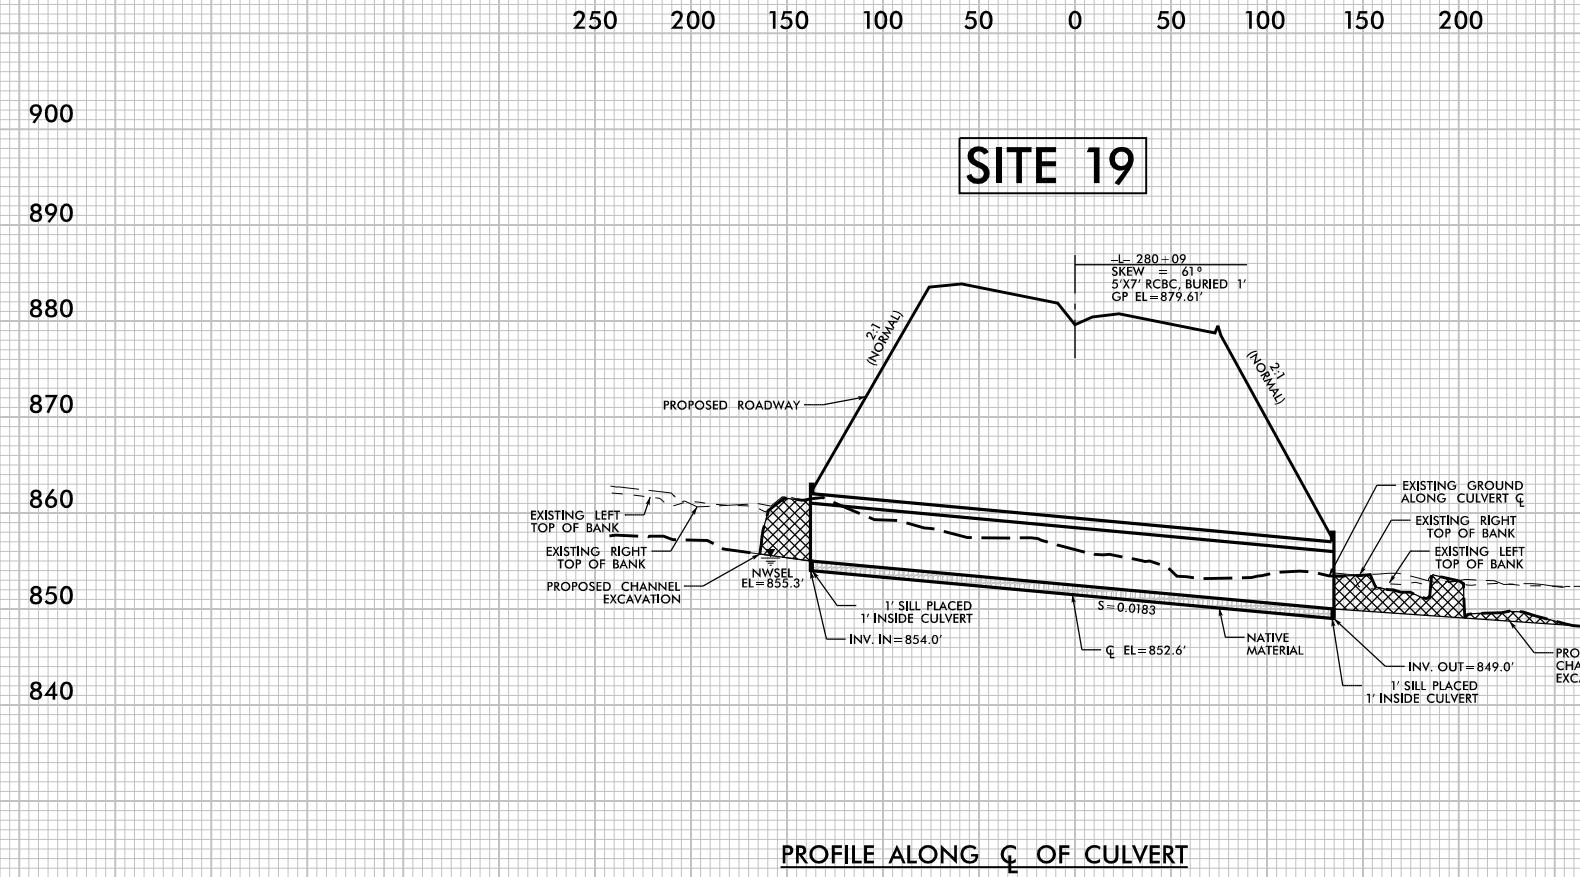

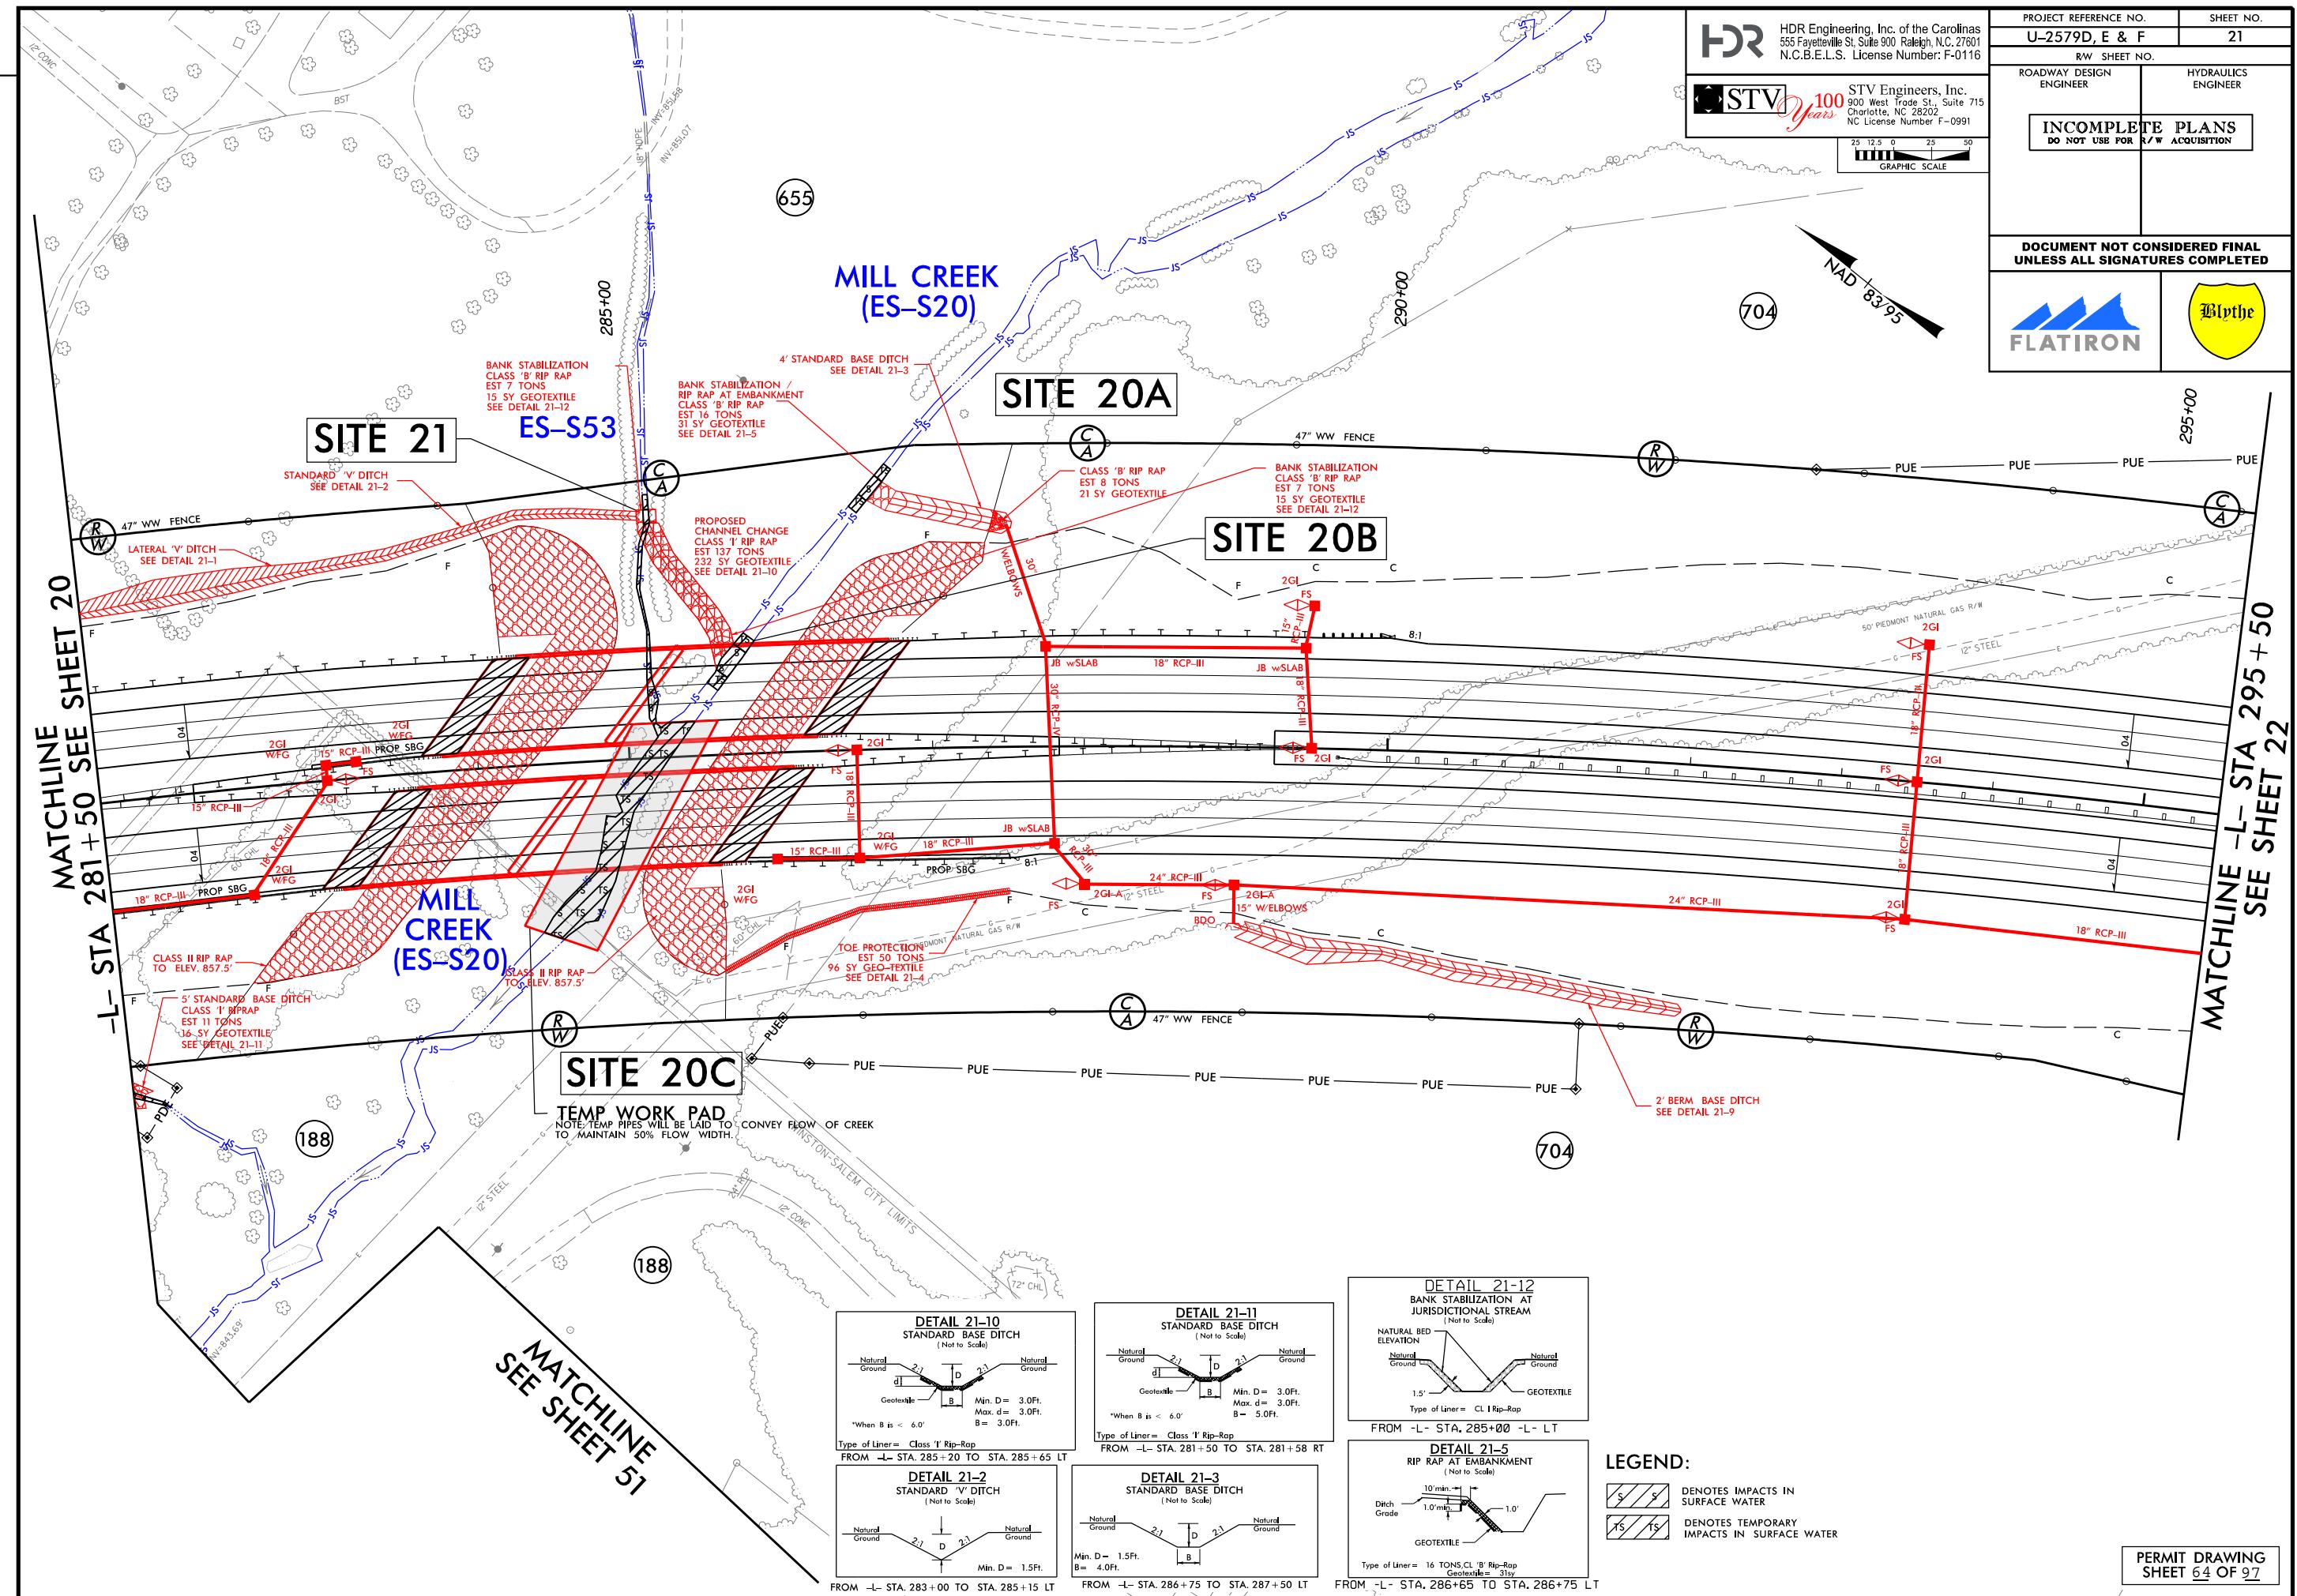


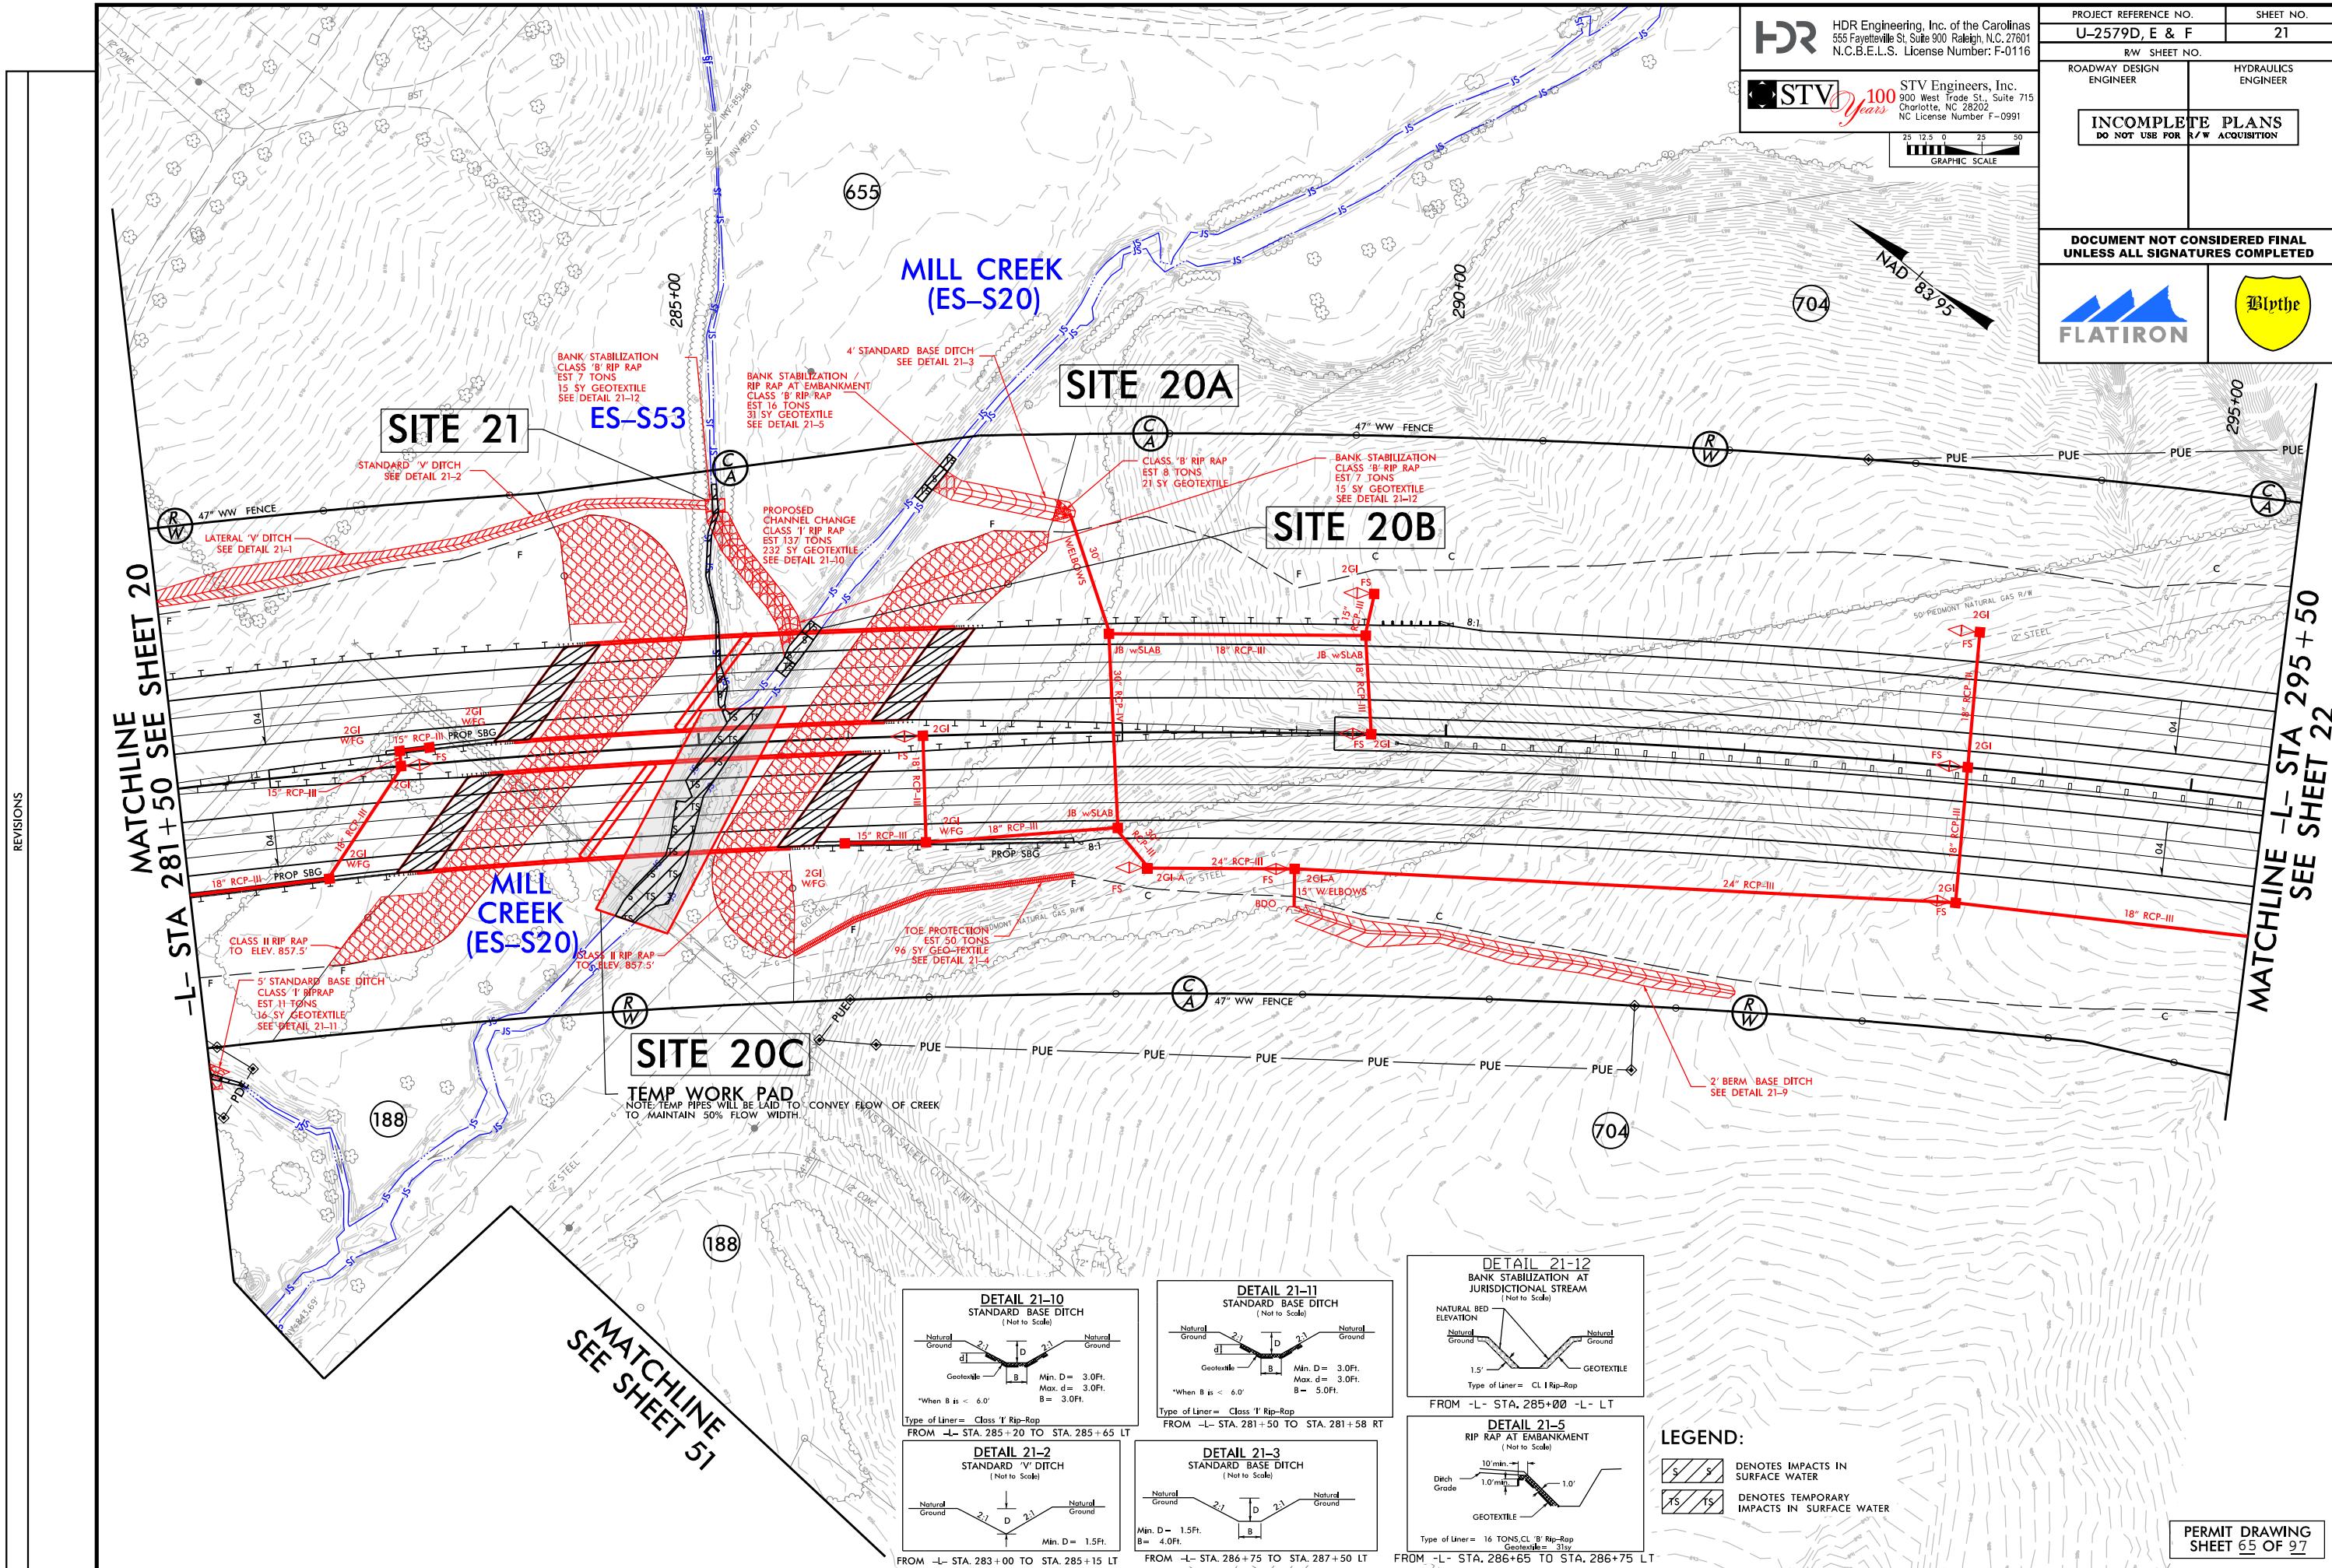

PROJECT REFERENCE NO.	SHEET NO.
U-2579D,E & F	
ROADWAY DESIGN ENGINEER	HYDRAULICS ENGINEER
DOCUMENT NOT CONSIDERED FINAL UNLESS ALL SIGNATURES COMPLETED	

SCALE:
1" = 50' HORIZONTAL
1" = 10' VERTICAL

SITE 20 & 21

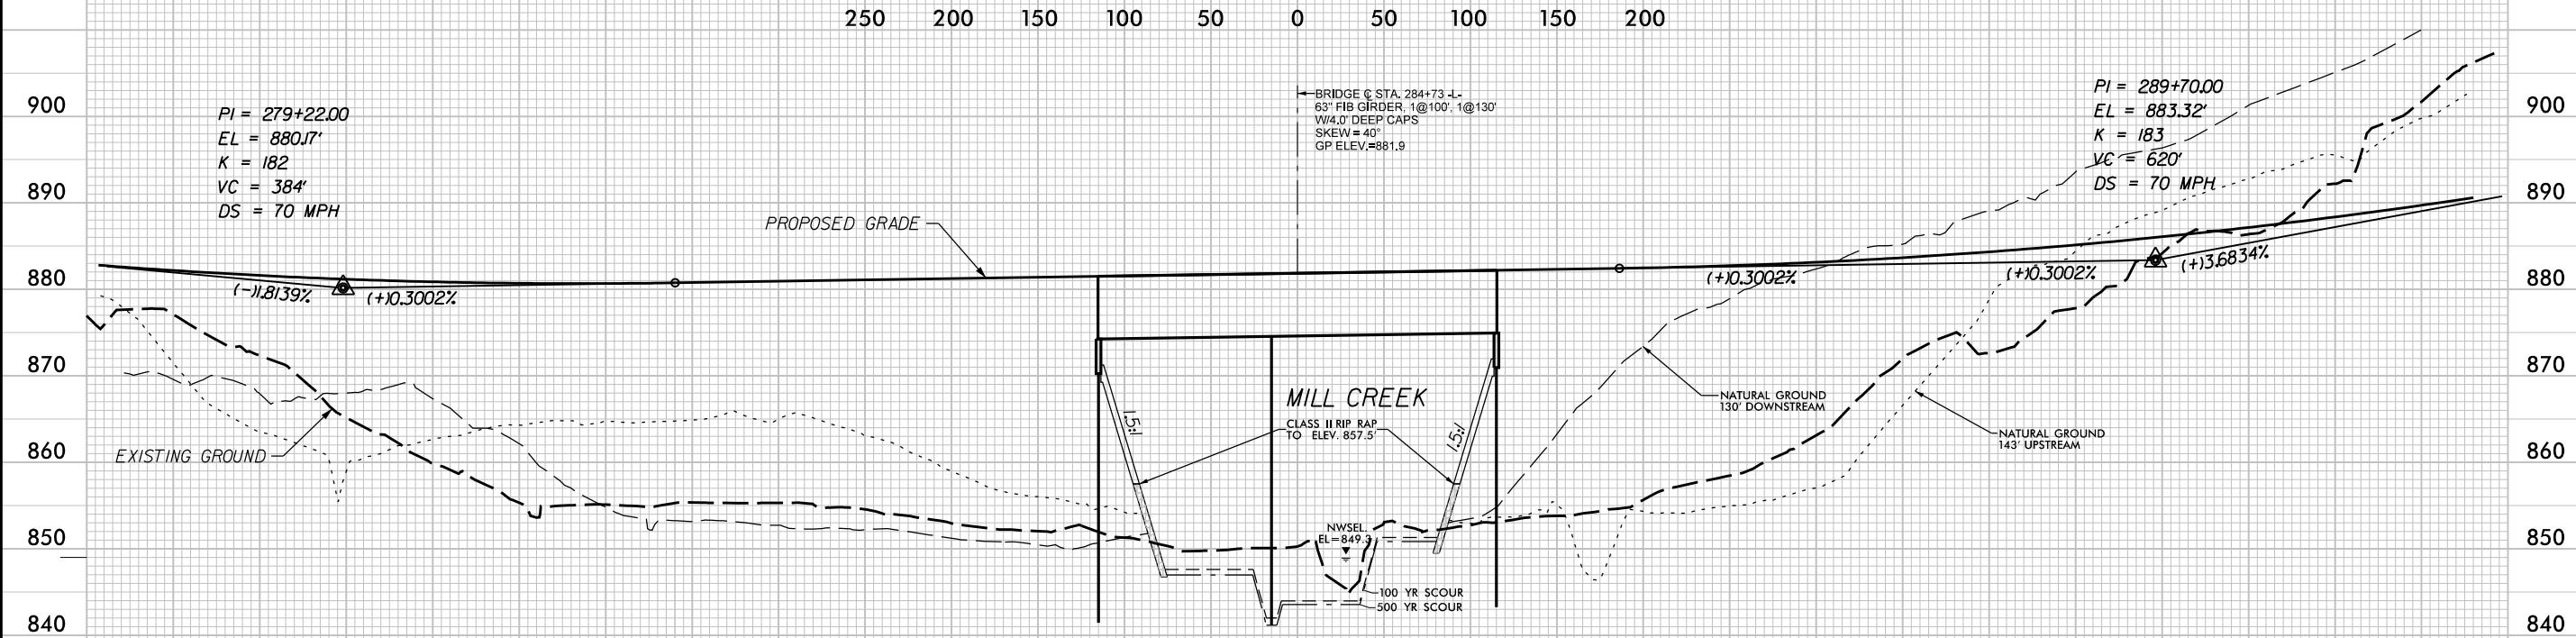


PROFILE - PROPOSED BRIDGE

MATCHLINE -L- STA 295 + 50
 SEE SHEET 21

LEGEND:

DENOTES IMPACTS IN SURFACE WATER
 DENOTES TEMPORARY IMPACTS IN SURFACE WATER

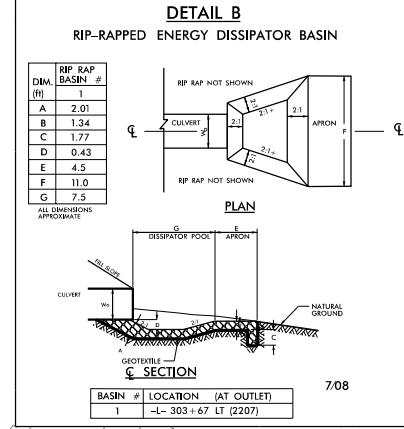

HDR Engineering, Inc. of the Carolinas
 555 Fayetteville St, Suite 900 Raleigh, NC 27601
 N.C.B.E.L.S. License Number: F-0116

STV Engineers, Inc.
 900 West Trade St., Suite 715 Charlotte, NC 28202
 NC License Number F-0991

PROJECT REFERENCE NO. U-2579D, E & F SHEET NO. 22
 RW SHEET NO.

ROADWAY DESIGN ENGINEER HYDRAULICS ENGINEER

INCOMPLETE PLANS
 DO NOT USE FOR R/W ACQUISITION

DOCUMENT NOT CONSIDERED FINAL
 UNLESS ALL SIGNATURES COMPLETED



300+00

704

305+00

SITE 22
ES-S52

47° WW FENCE

OUTLET CHANNEL PROTECTION
 CLASS 'I' RIP RAP
 EST 29 TONS
 49 SY GEOTEXTILE
 SEE DETAIL 22-7

ENERGY DISSIPATOR BASIN
 SEE DETAIL SHEET 2D-3
 DETAIL B

JBw/MH

24" RCP-III

15" w/ELBOWS


30" w/ELBOWS

JBw/MH

24" RCP-III

2GI-A

MATCHLINE -L- STA 295 + 50
SEE SHEET 21

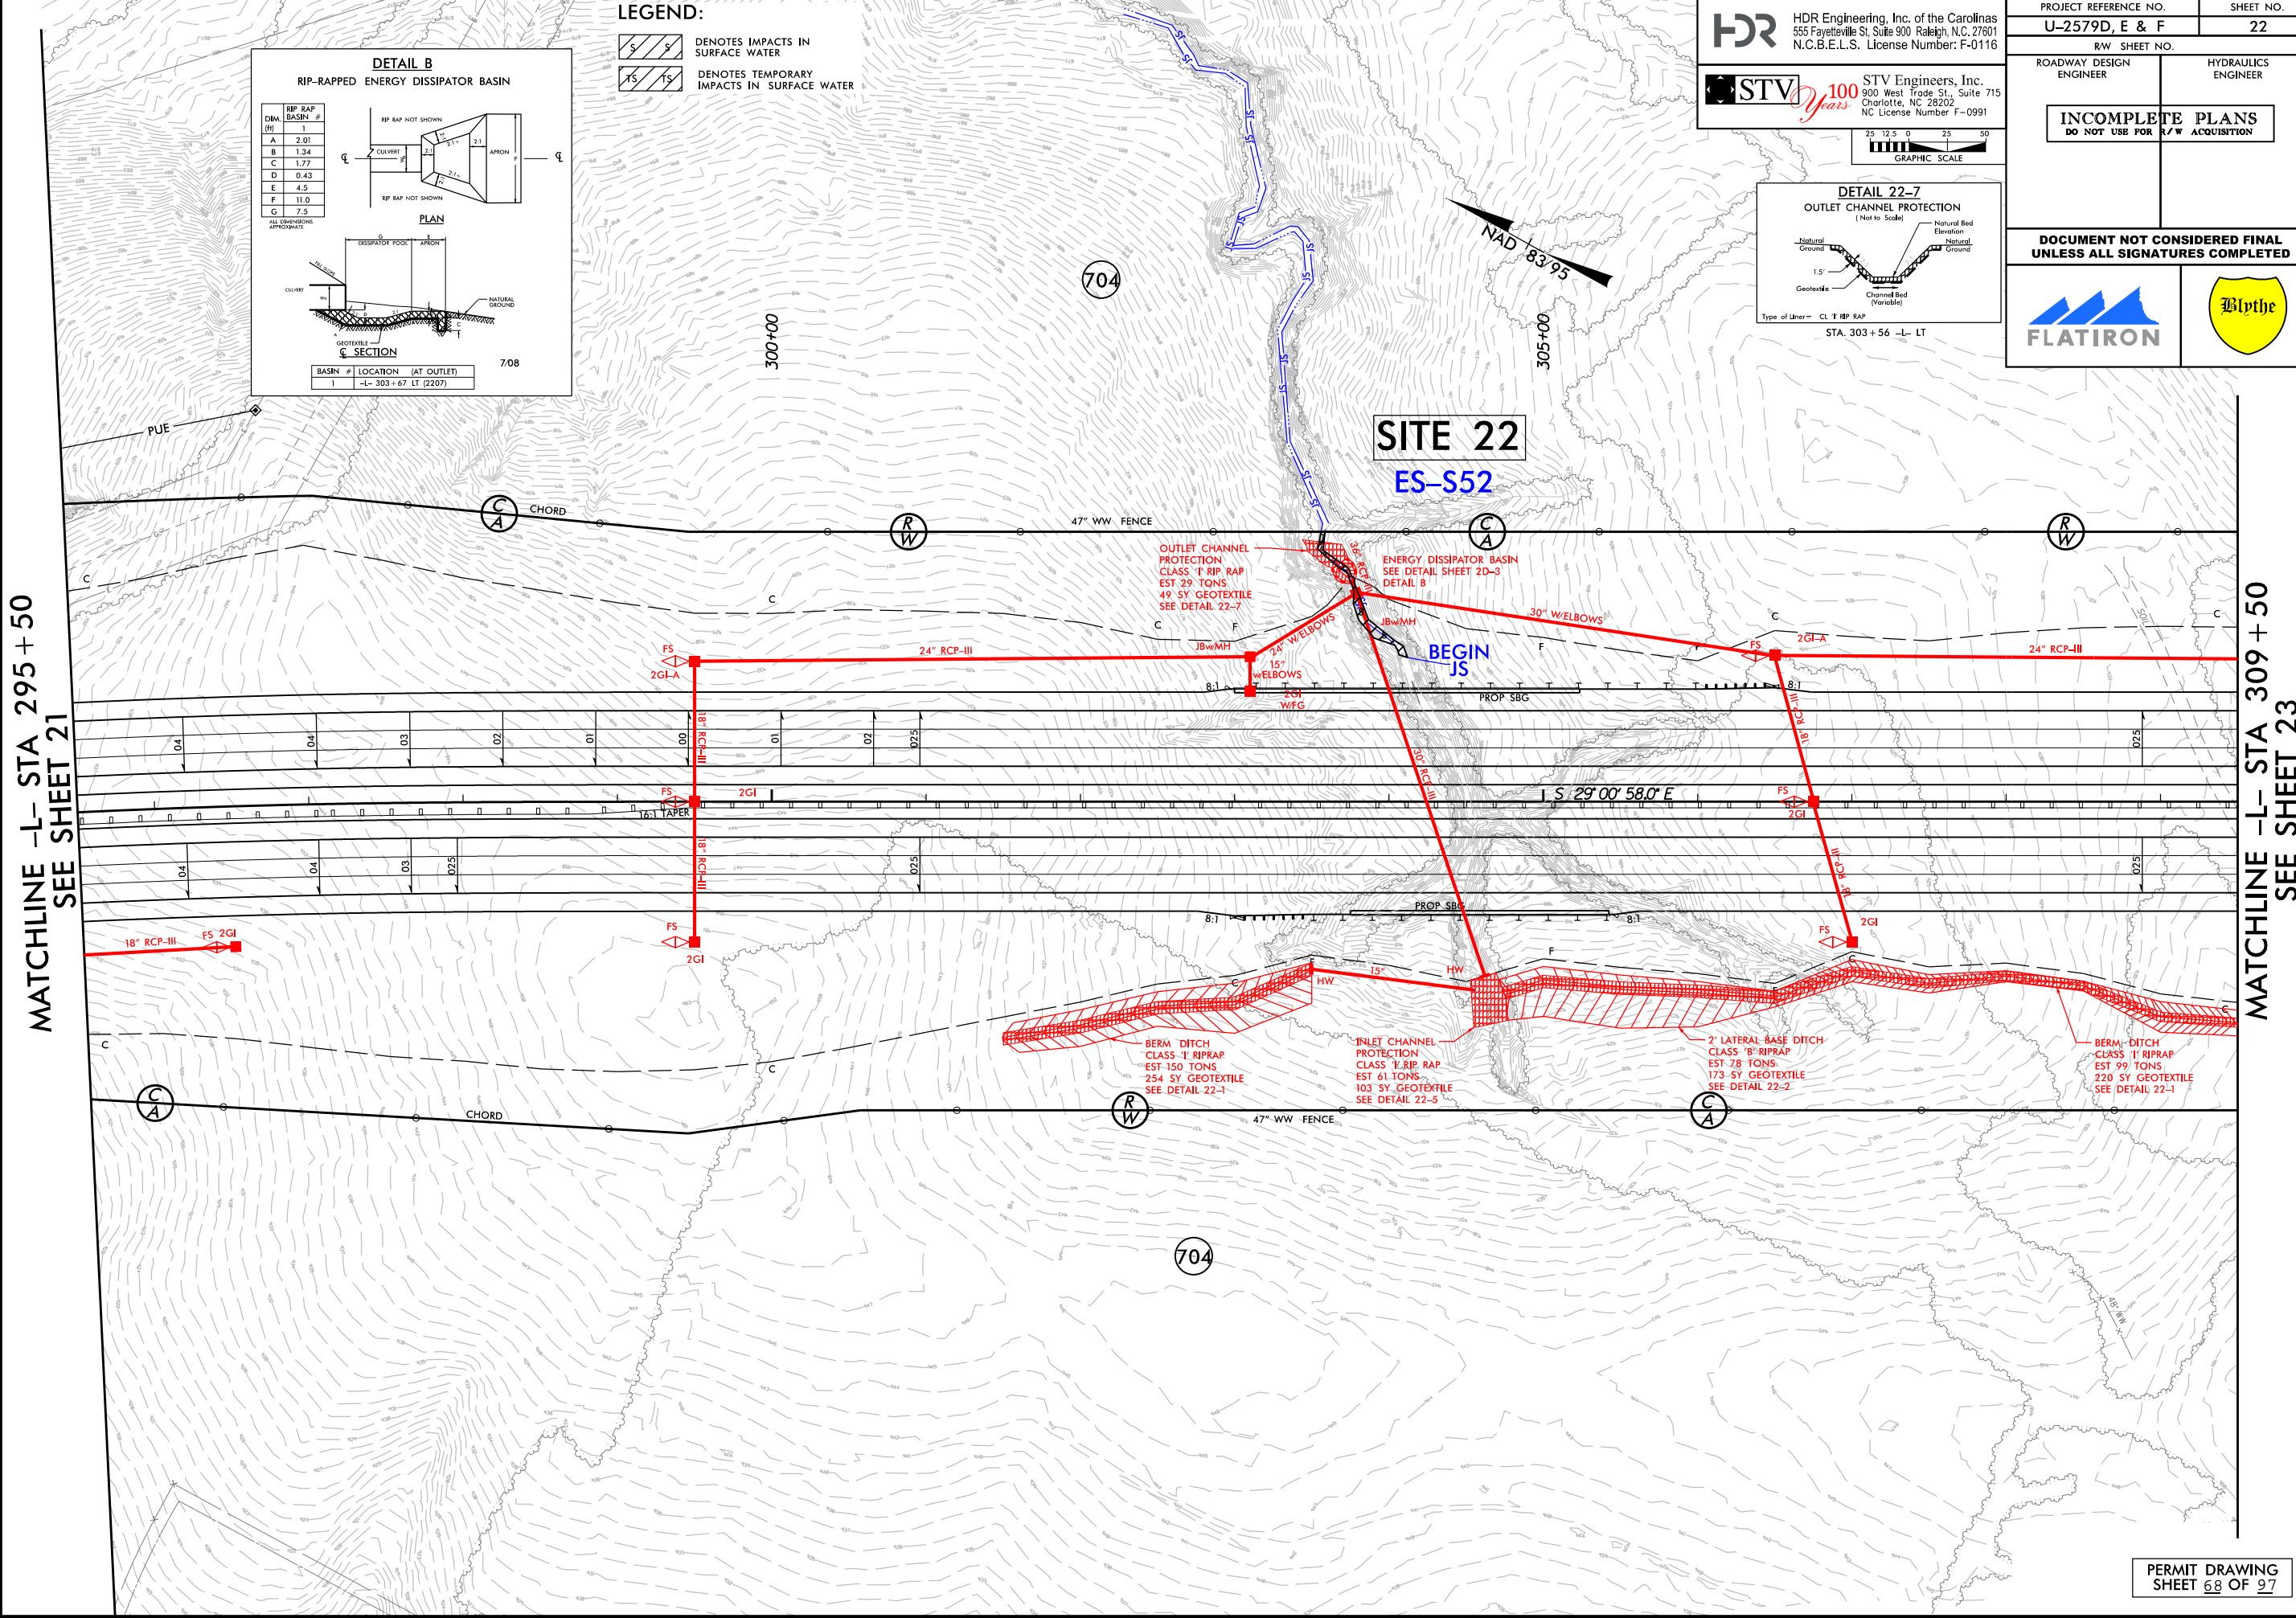

PROJECT REFERENCE NO. U-2579D, E & F	HEET NO. 22
RW SHEET NO.	
ROADWAY DESIGN ENGINEER	HYDRAULICS ENGINEER
INCOMPLETE PLANS DO NOT USE FOR R/W ACQUISITION	
DOCUMENT NOT CONSIDERED FINAL UNLESS ALL SIGNATURES COMPLETED	
FLATIRON	Blythe

MATCHLINE -L- STA 309 + 50
SEE SHEET 22

DETAIL 23-8

TOE PROTECTION
(Not to Scale)

NATURAL GROUND

d

FLATTER SLOPE

FILL SLOPE

2:1 OR
3:1 FLATTER SLOPES

GEOTEXTILE

$d = 1.0\text{Ft}$

Type of Liner = Class 'I' Rip-Rap

DETAIL 23-9
LATERAL 'V' DITCH
(Not to Scale)

Natural Ground

Geotextile

Min. D = 1.5Ft.
Max. d = 1.5Ft.
b = 5Ft.

Type of Liner = CL-B Rip-Rap

FROM -L- STA. 315 + 95 TO STA. 316 + 00 LT

DETAIL 23-1
PROPOSED CHANNEL CHANGE
(Not to Scale)

Natural Ground Natural Ground

Geotextile

B D

Min. D = 2.5 Ft.
Max. d = 1.5 Ft.
B = 2.0 Ft.

*When $B < 6.0'$

Type of Liner = CL I' Rip-Rap

FROM -L- STA. 316 +98 TO STA. 317 +30 RT

DETAIL 23-2
OUTLET CHANNEL PROTECTION
(Not to Scale)

Natural Ground Natural Bed Elevation Natural Ground

Geotextile

1.5'

Channel Bed (Variable)

Type of liner = CL II' RIP RAP

STA. 316 +32 -L- LT

DETAIL 23-3
OUTLET CHANNEL PROTECTION
(Not to Scale)

Natural Ground Natural Bed Elevation Natural Ground

Geotextile

1.5'

Channel Bed (Variable)

Type of liner = CL II' RIP RAP

STA. 316 +32 -L- LT

DETAIL 23-4
OUTLET CHANNEL PROTECTION
(Not to Scale)

Natural Ground Natural Bed Elevation Natural Ground

Geotextile

1.5'

Channel Bed (Variable)

Type of liner = CL II' RIP RAP

STA. 316 +32 -L- LT

DETAIL 23-5
OUTLET CHANNEL PROTECTION
(Not to Scale)

Natural Ground Natural Bed Elevation Natural Ground

Geotextile

1.5'

Channel Bed (Variable)

Type of Liner = CL I' Rip-Rap

STA. 323 +42 -L- LT

DETAIL 23-7
BANK STABILIZATION AT JURISDICTIONAL STREAM
(Not to Scale)

NATURAL BED ELEVATION

Natural Ground Natural Ground

GEOTEXTILE


1.5'

Type of liner = CL I' Rip-Rap

STA. 317 +28 -L- RT

LEGEND:

	DENOTES IMPACTS IN SURFACE WATER
	DENOTES TEMPORARY IMPACTS IN SURFACE WATER

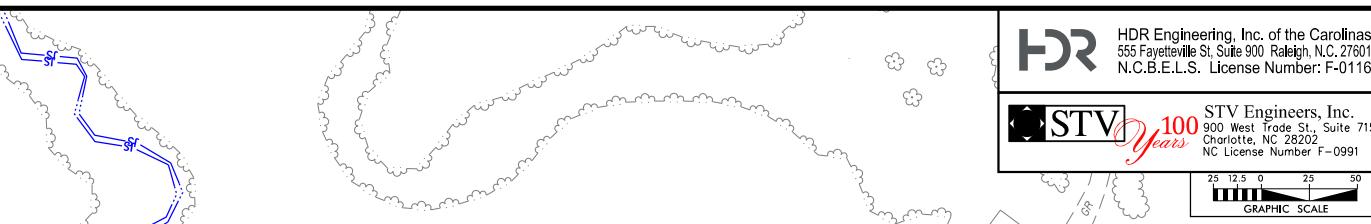


HDR HDR Engineering, Inc. of the Carolinas
555 Fayetteville St. Suite 900 Raleigh, N.C. 27601
N.C.B.E.L.S. License Number: F-0116

STV STV Engineers, Inc.
100 Years 900 West Trade St., Suite 715
Charlotte, NC 28202
NC License Number F-0991

25 12.5 0 25 50
GRAPHIC SCALE

PROJECT REFERENCE NO.		SHEET NO.
U-2579D, E & F		23
R/W SHEET NO.		
Roadway Design Engineer		Hydraulics Engineer
INCOMPLETE PLANS DO NOT USE FOR R/W ACQUISITION		
DOCUMENT NOT CONSIDERED FINAL UNLESS ALL SIGNATURES COMPLETED		
 FLATIRON		 Blythe

PERMIT DRAWING
SHEET 69 OF 97

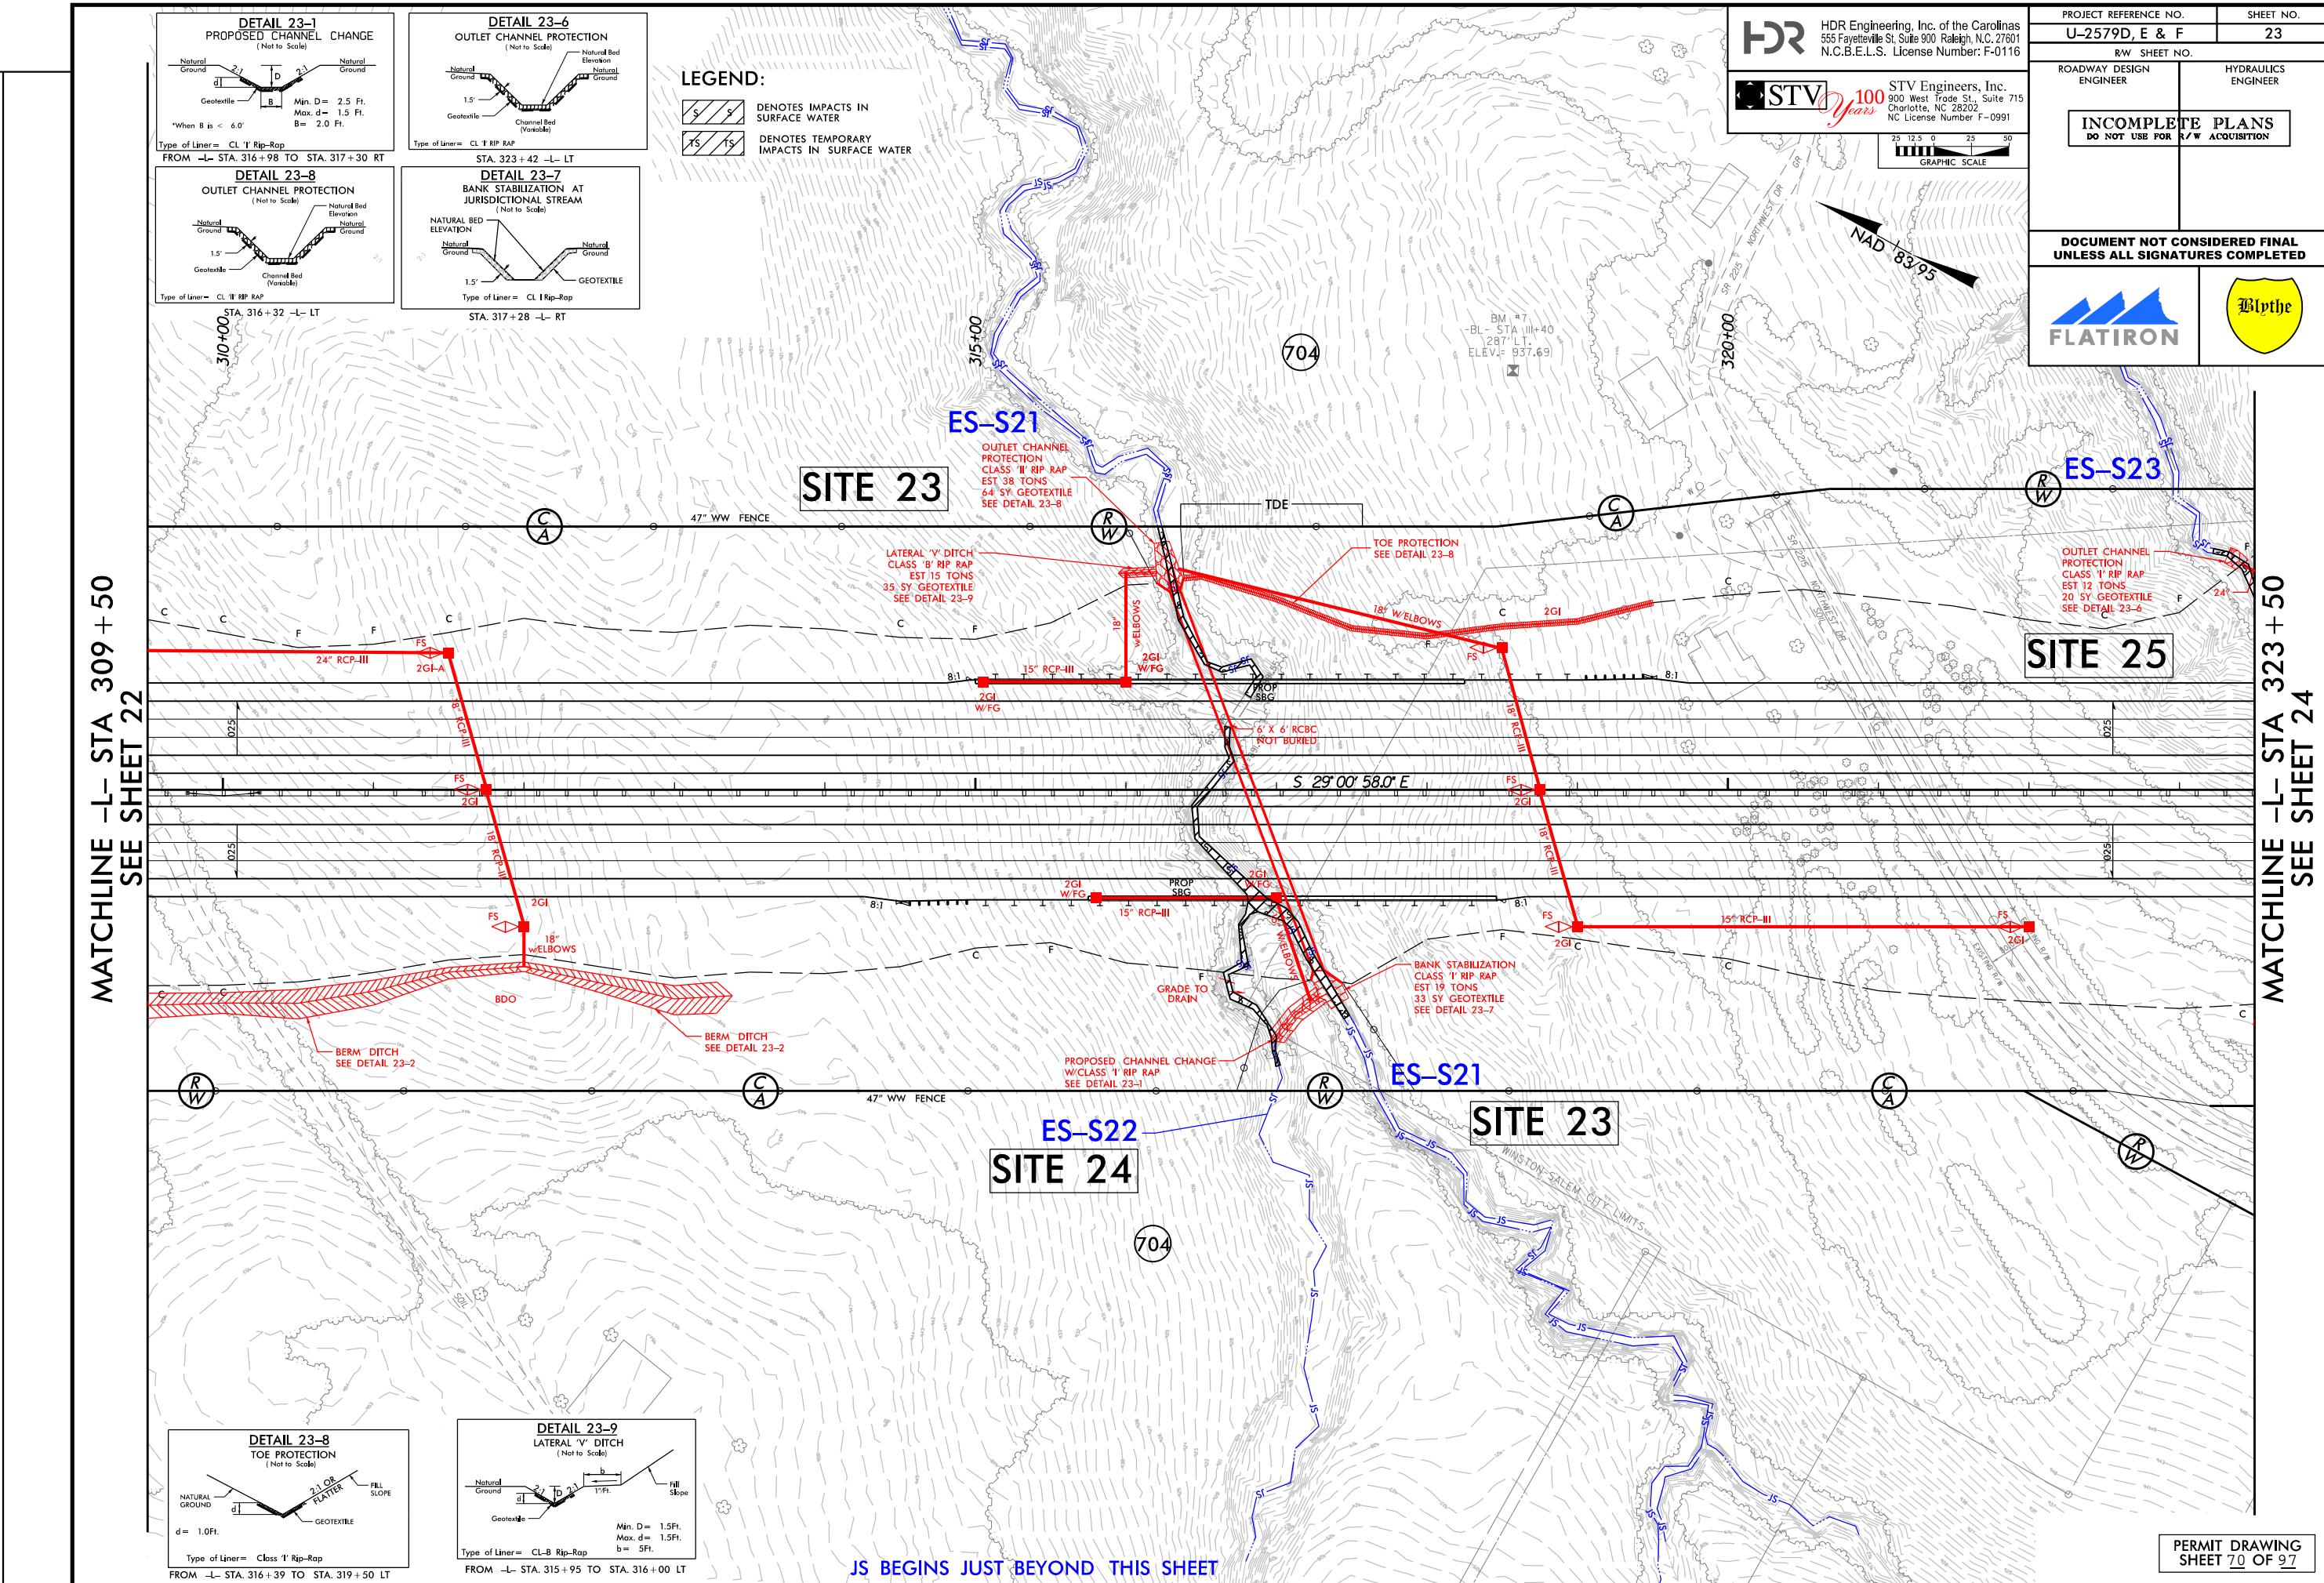


PROJECT REFERENCE NO.		SHEET NO.
U-2579D,E & F		
ROADWAY DESIGN ENGINEER	HYDRAULICS ENGINEER	
DOCUMENT NOT CONSIDERED FINAL UNLESS ALL SIGNATURES COMPLETED		

SCALE:
1" = 50' HORIZONTAL
1" = 10' VERTICAL


250 200 150 100 50 0 50 100 150 200


SITE 23


930
920
910
900
890
880

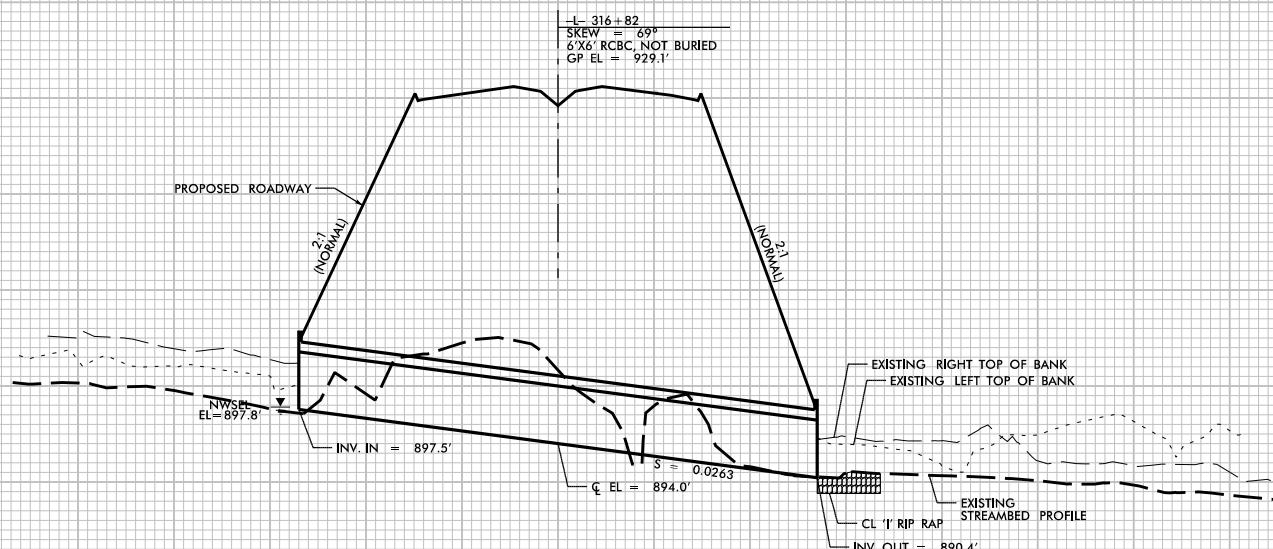

PROFILE ALONG C OF CULVERT

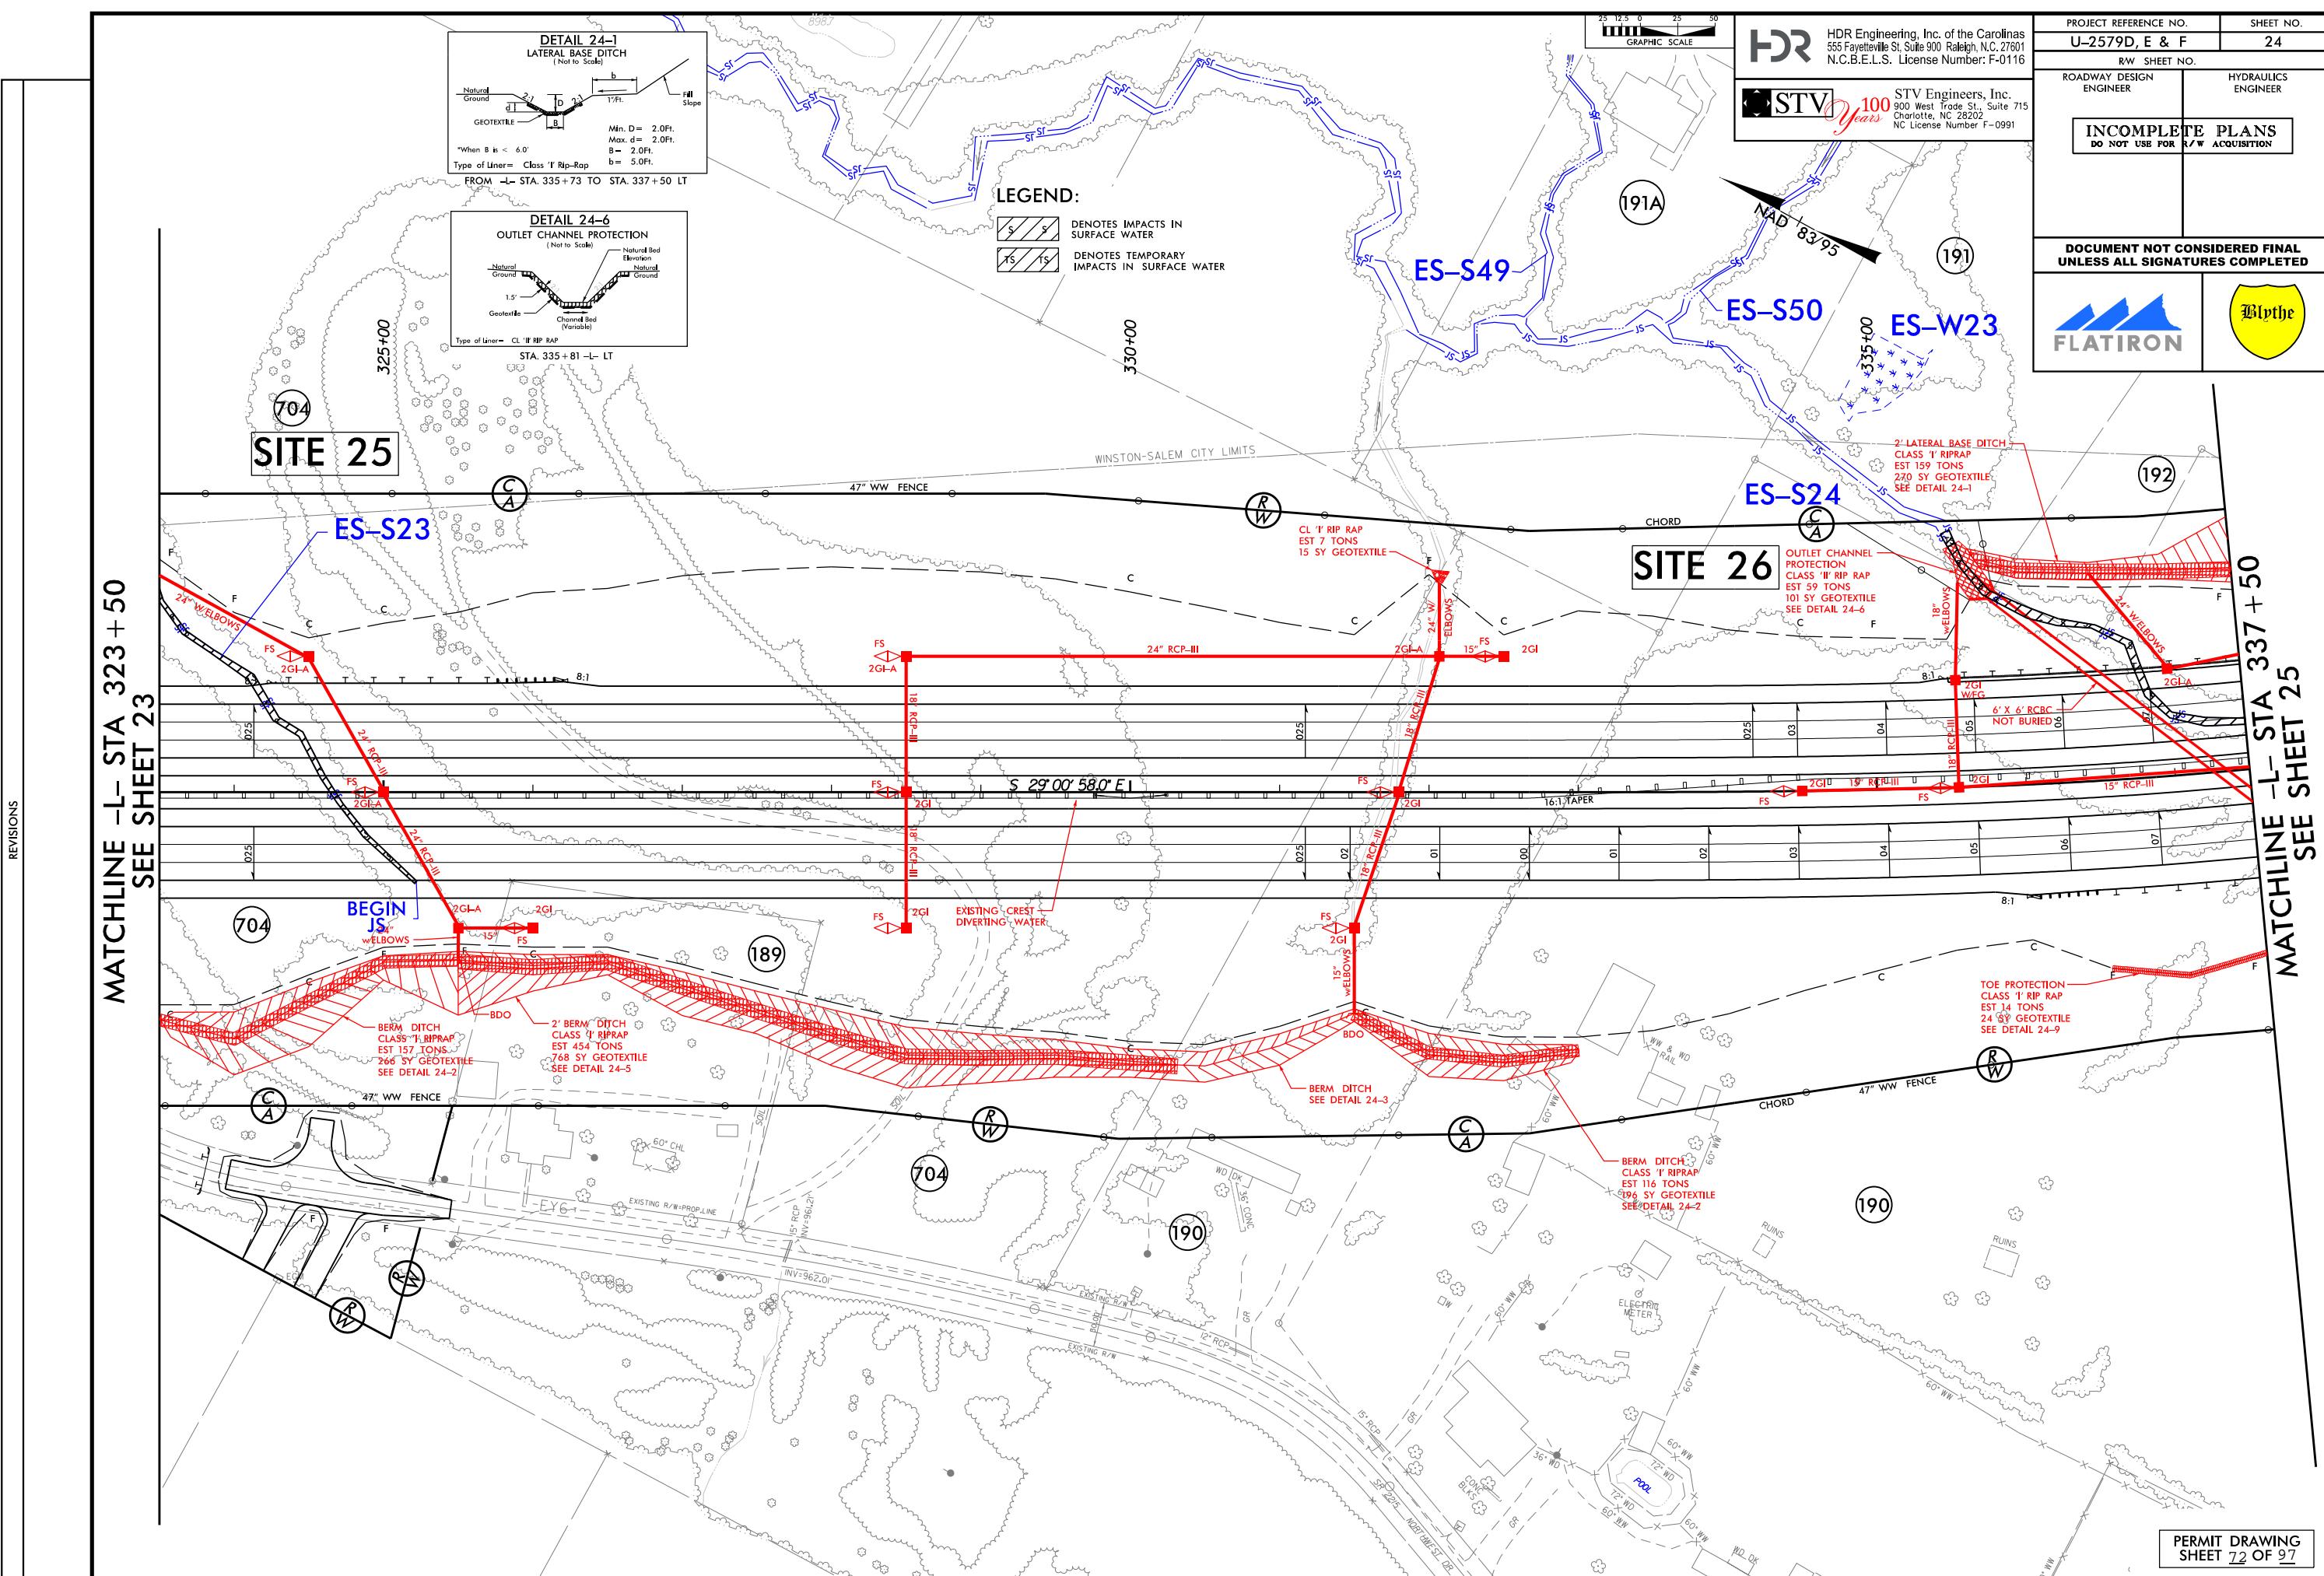


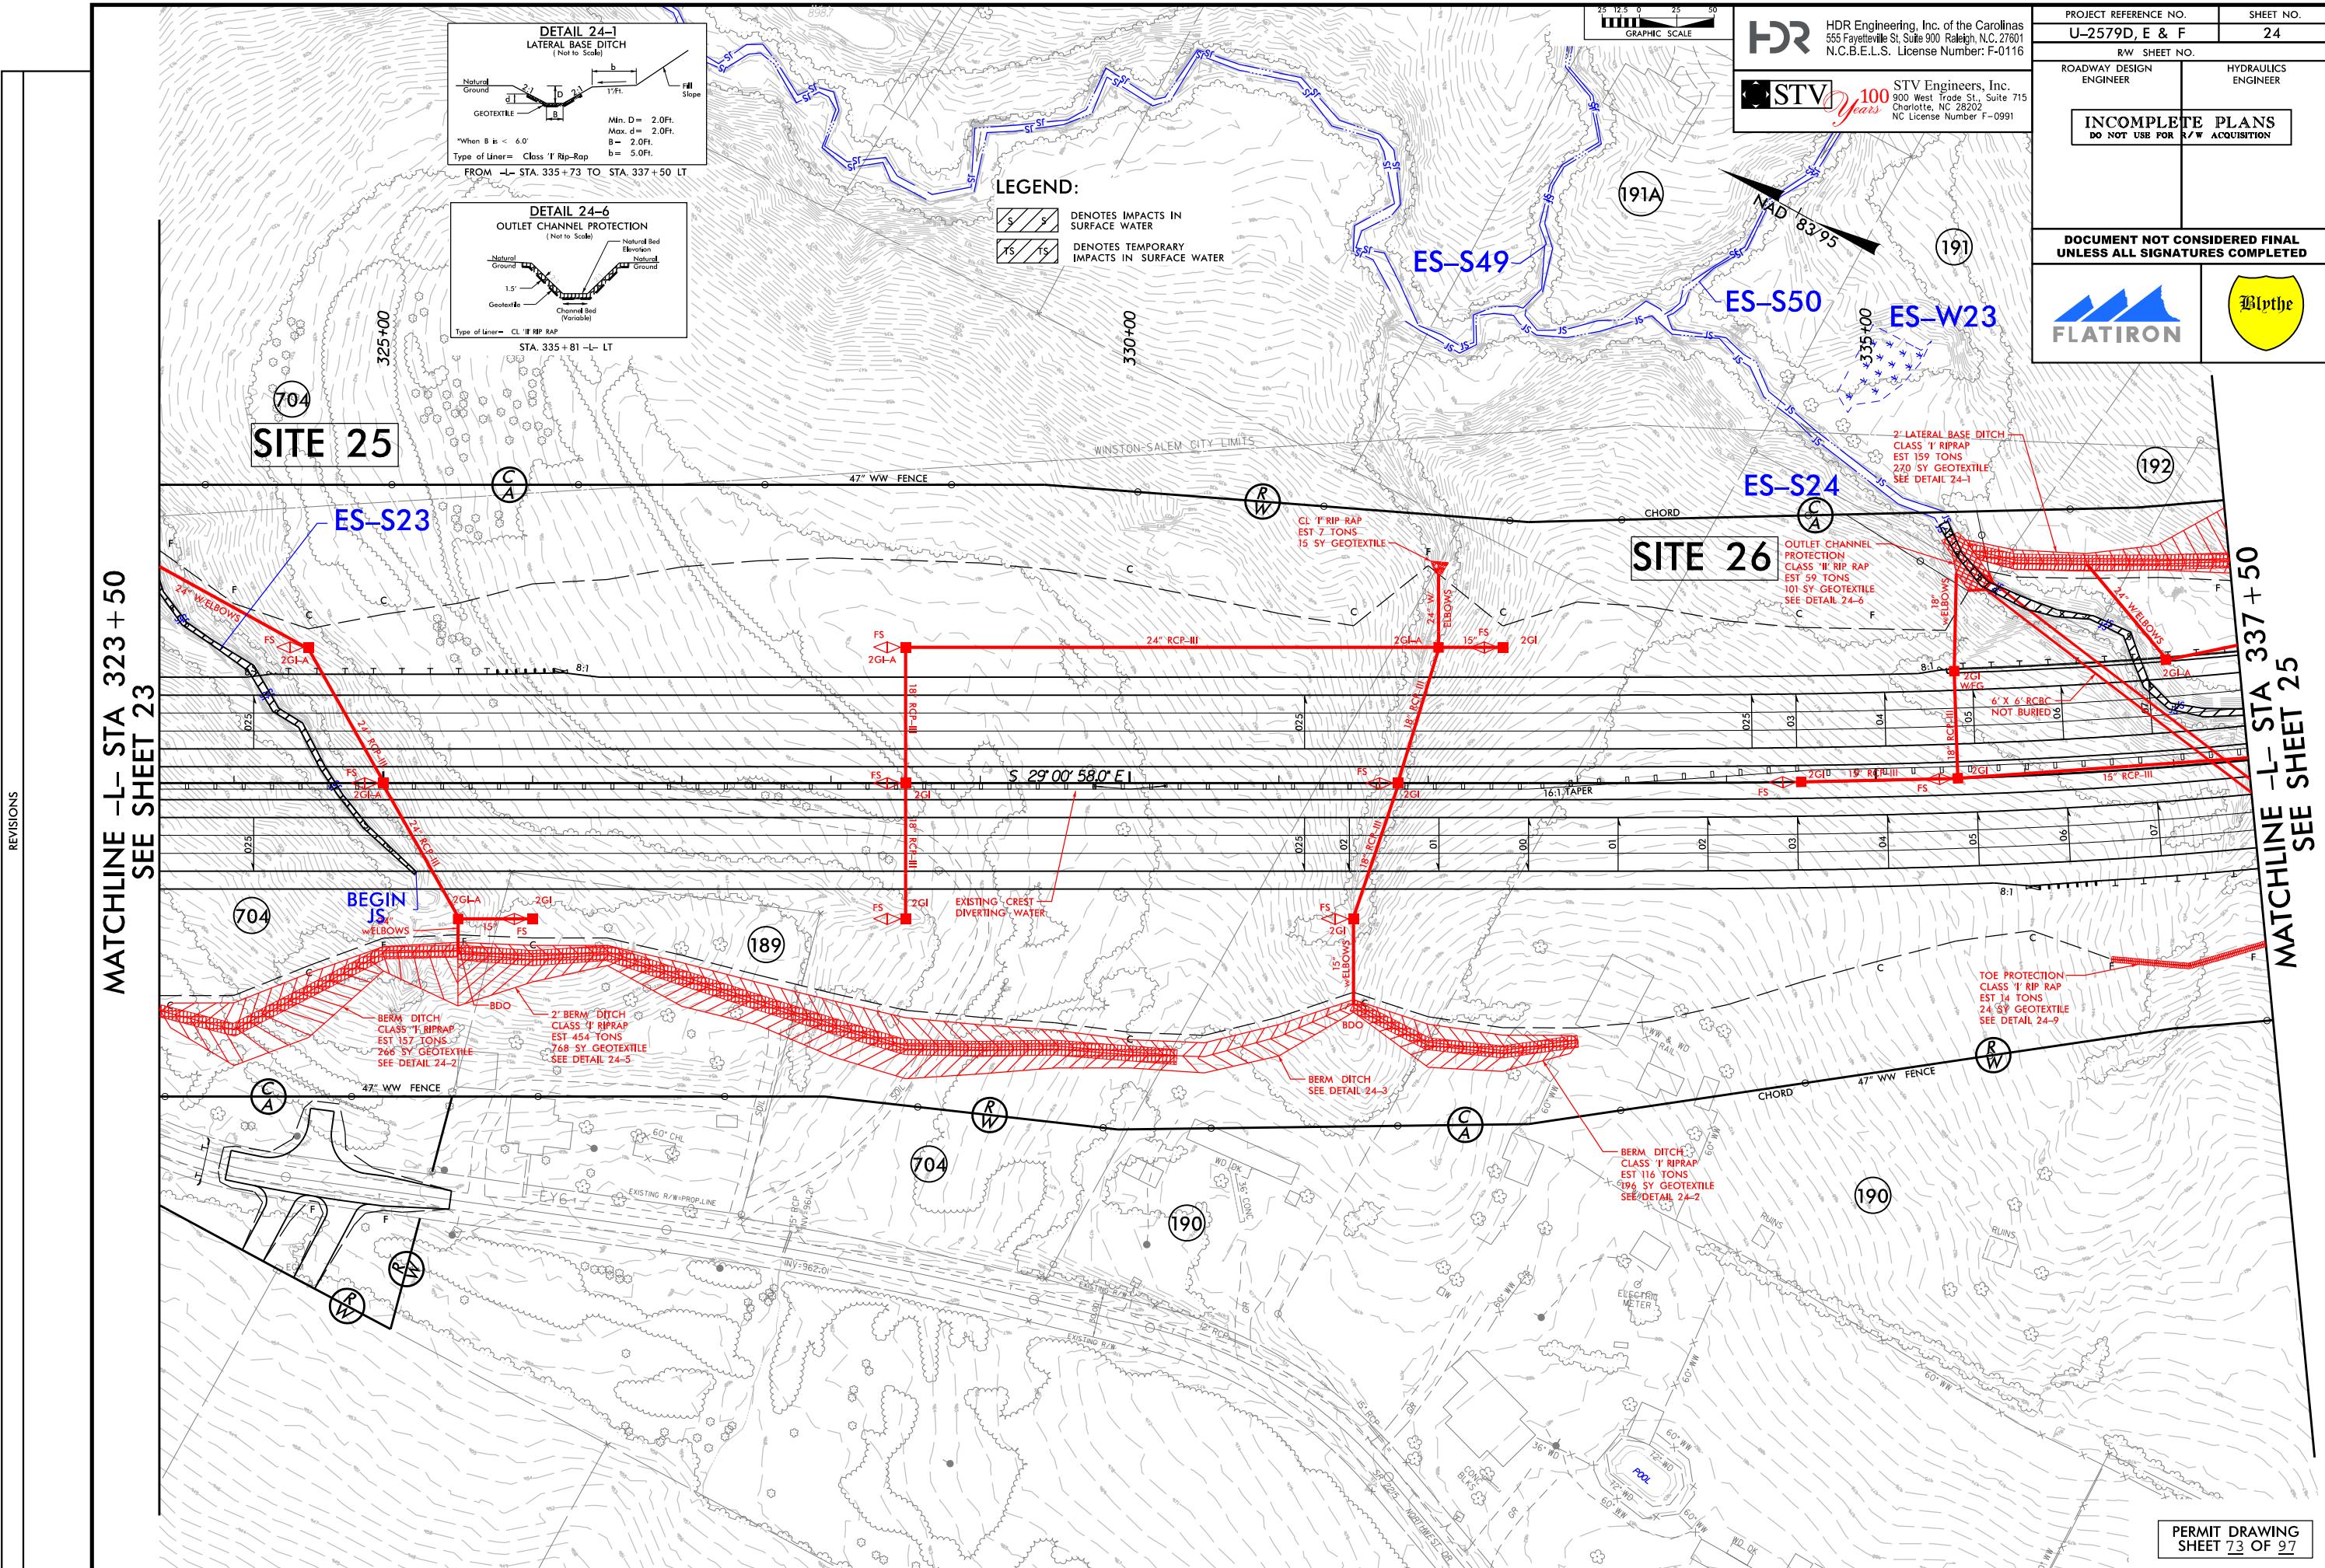

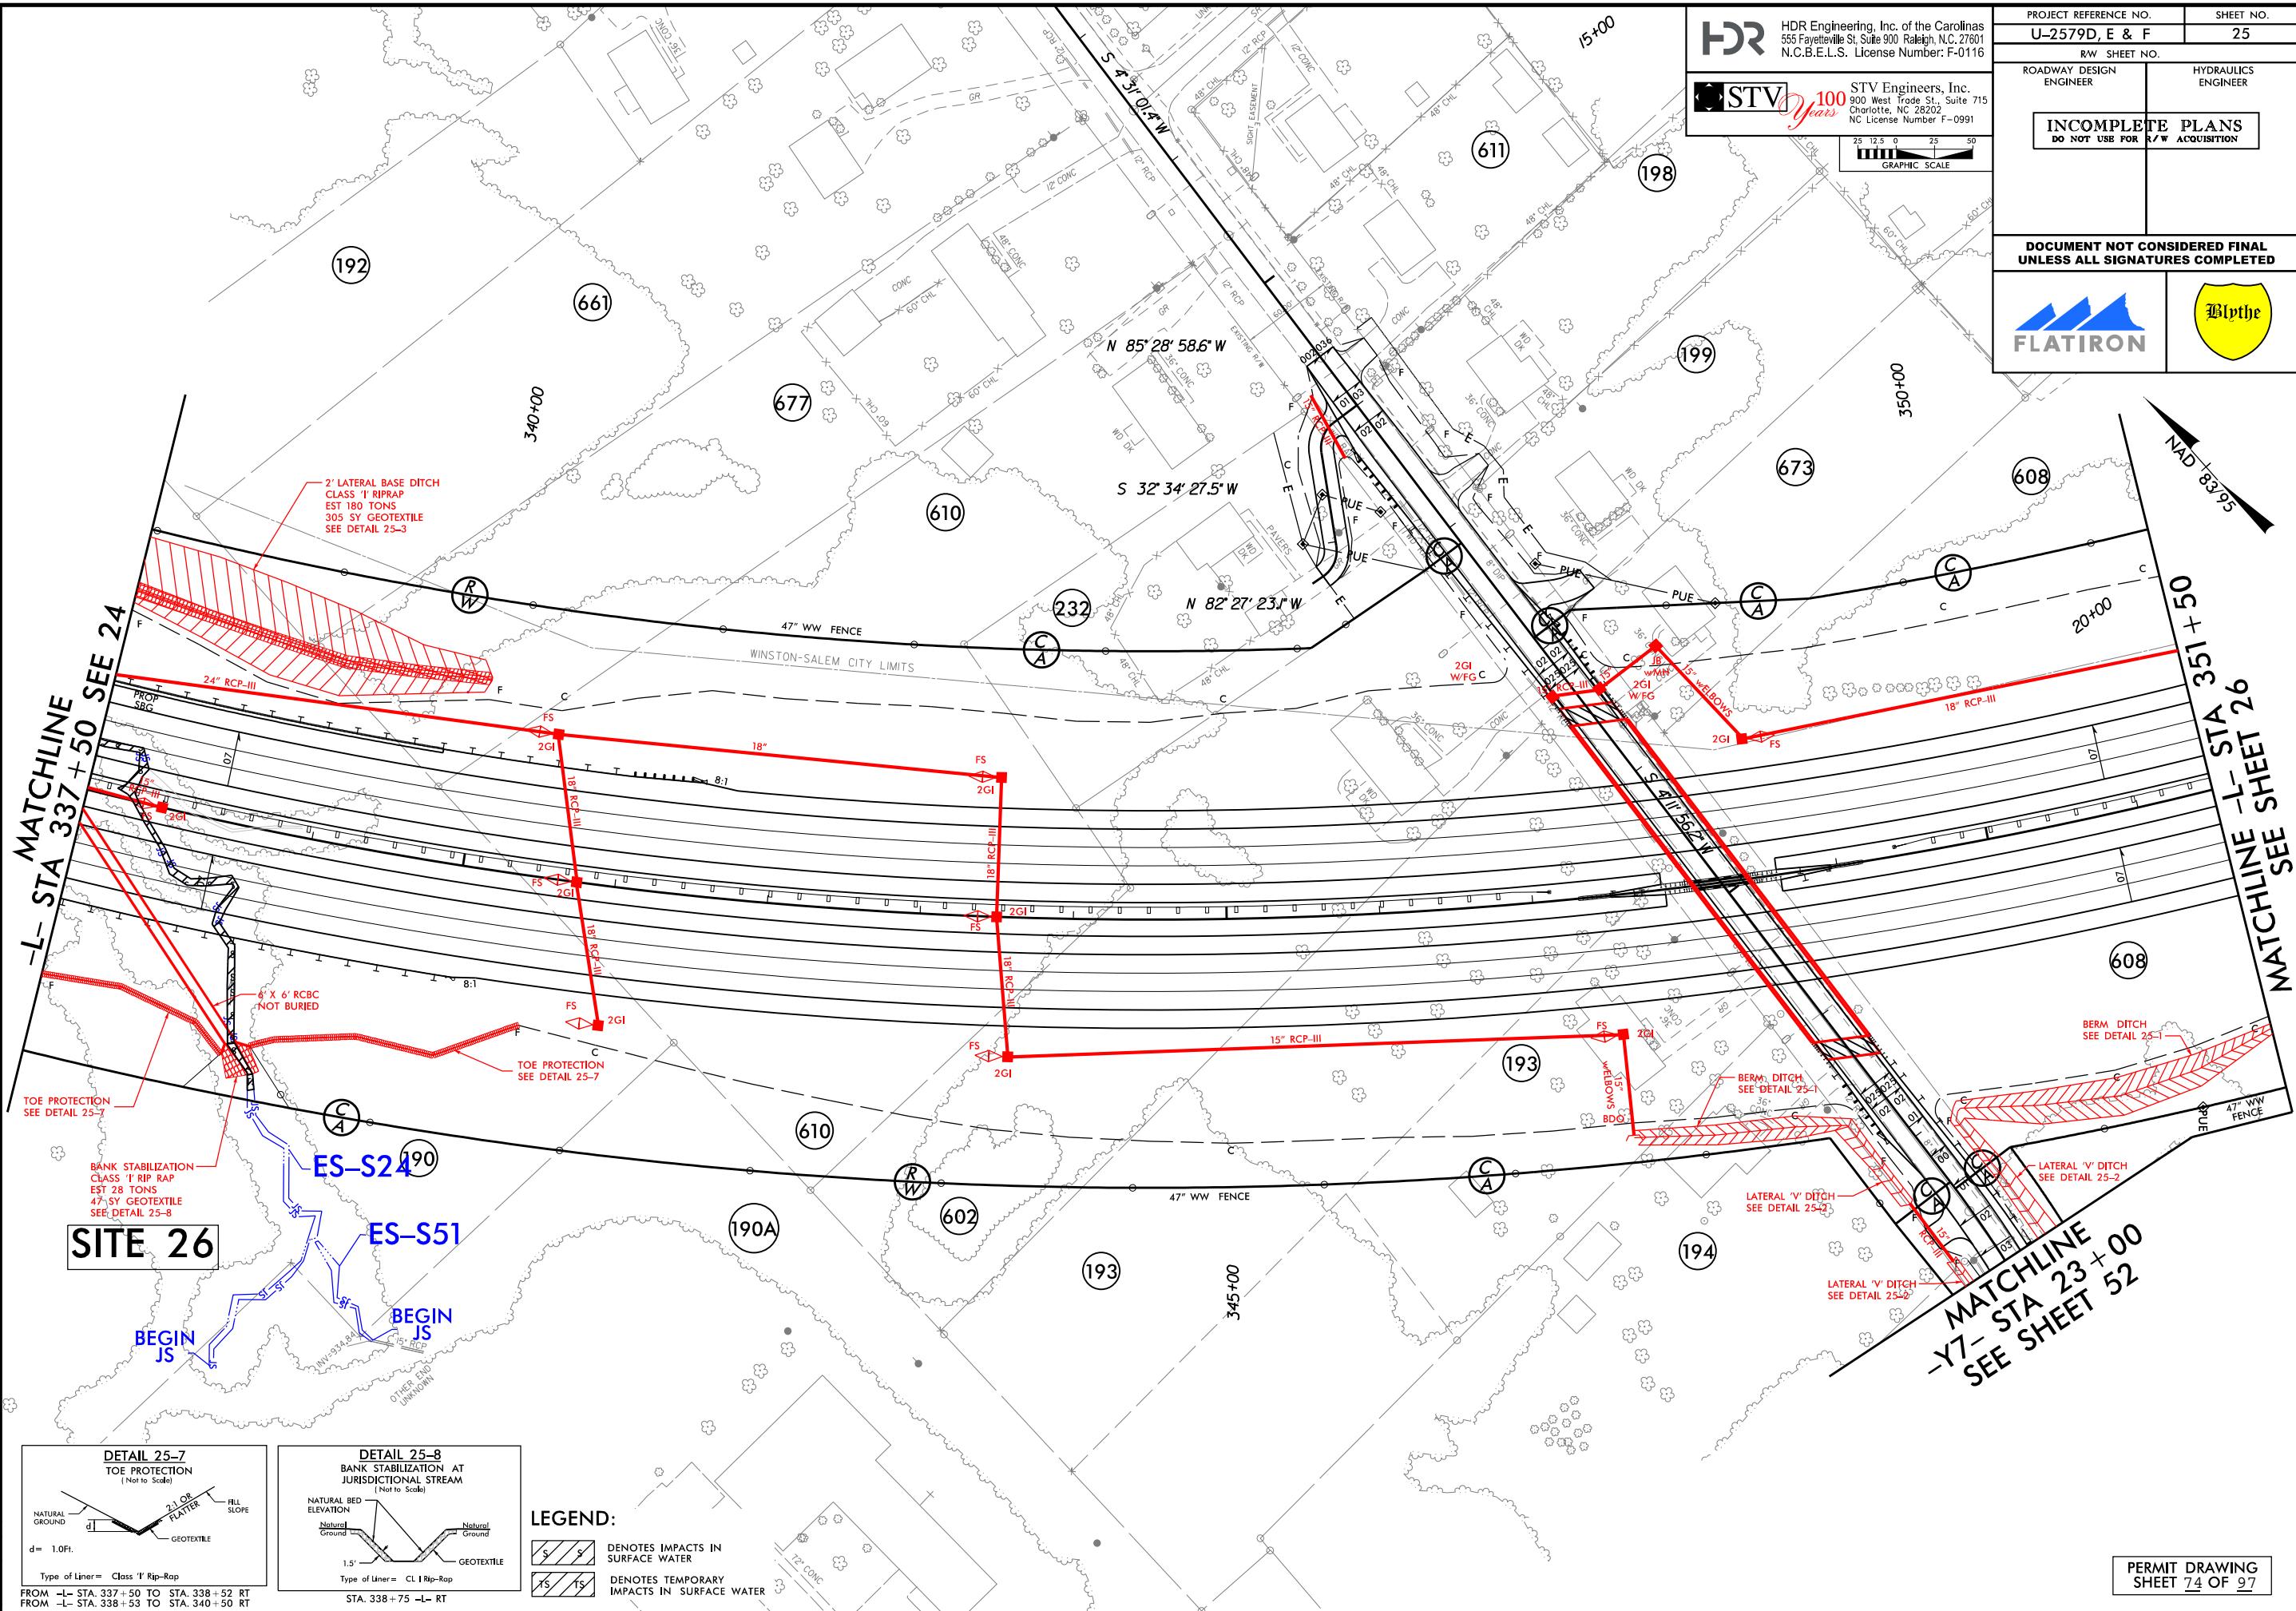

PLOT DRIVER: NCDOT.pdf-color-100.pit PENTABLE: NCDOT_permit.s_NOCON.tbi
USER: CMYERS DATE: 10/26/2018 TIME: 10:09:07 AM
TITLE: Flatiron_Construction_Corp.\Flatiron-U-2579.D.E.F\WS\6.O.CAD.BIN\6.2.WIP-U-2579DEF\Hydraulics\PERMITS_Environment\Drawings\U2579DEF.PRM_4C.PSH.dgn

REVISIONS

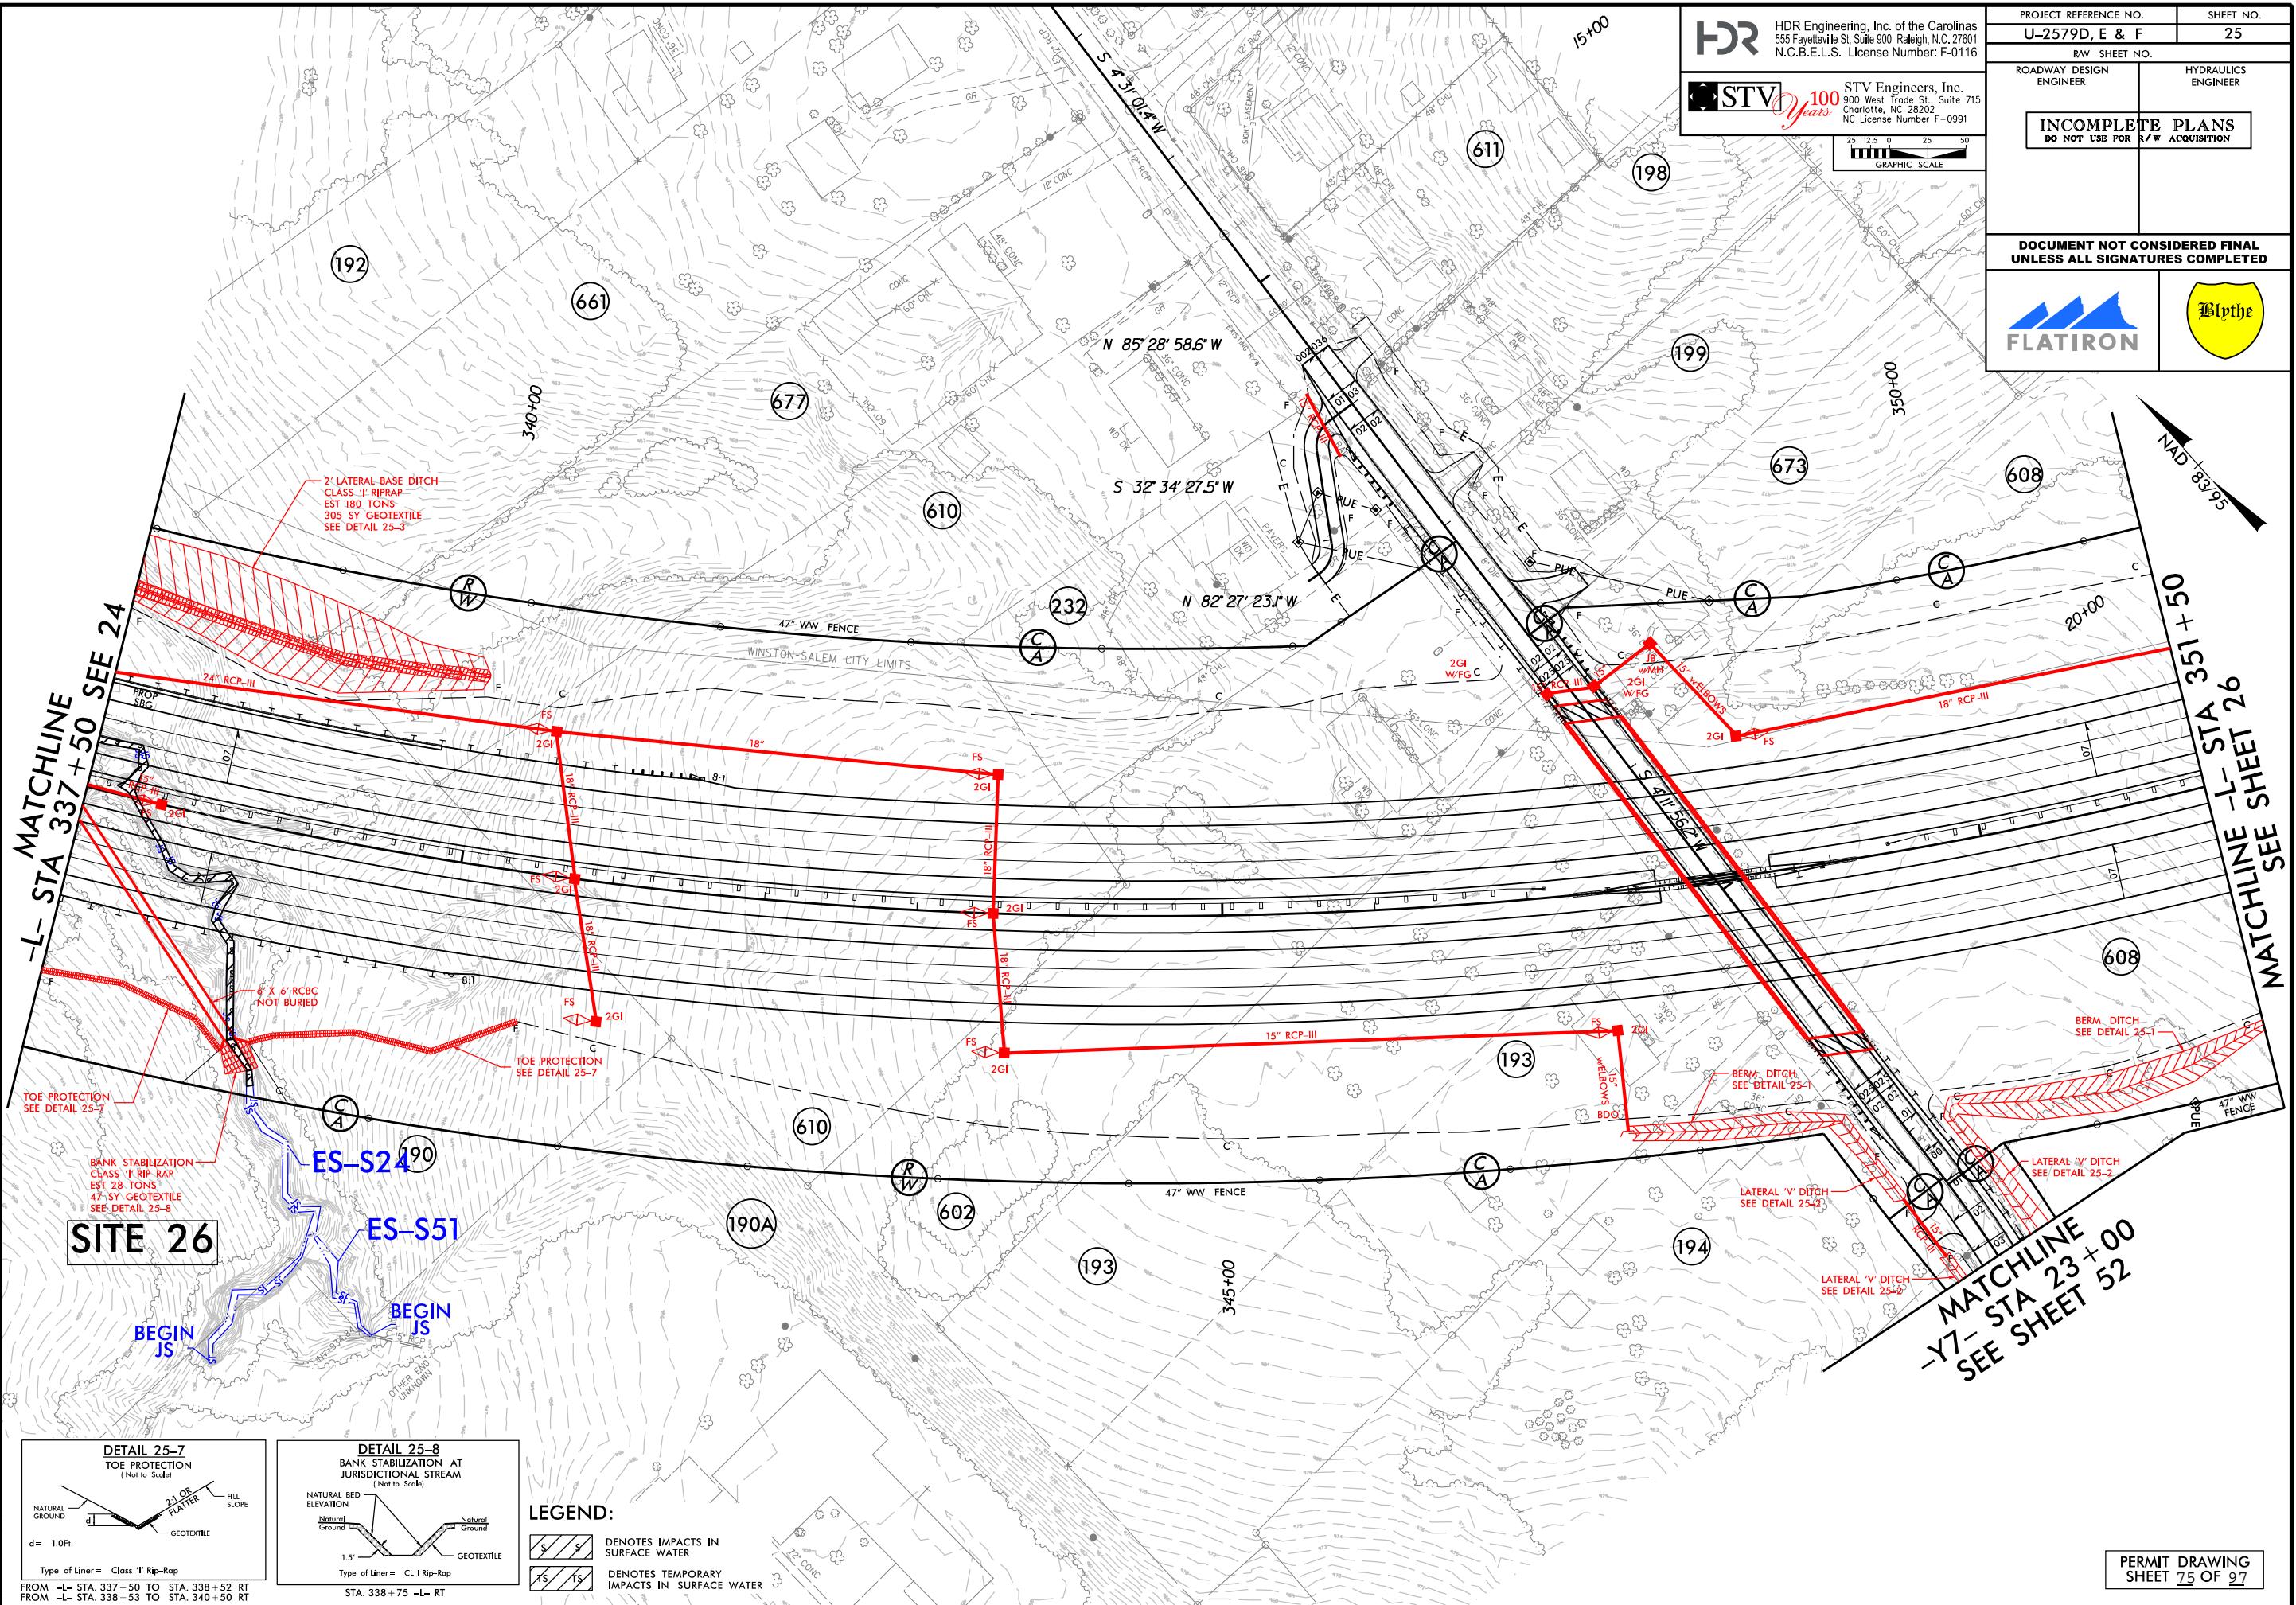

PLOT DRIVER: NCDOT.pdf_color_eng-100.pit
PLOT TITLE: Flatiron_Construction_Corp.Flatiron-U-2579.D_E_F_WS\6.0.CAD.BIM\6.2.WIP_U-2579DEF\Hydraulics\PERMITS_Environmental\Drawings\U2579DEF_PRM_4C_PSh.dgn
PRINTABLE: NCDOT_permit_s.CON.tbi
TIME: 10:15:32 AM
DATE: 10/26/2018
USER: CMYERS
TITLE: Flatiron_Construction_Corp.Flatiron-U-2579.D_E_F_WS\6.0.CAD.BIM\6.2.WIP_U-2579DEF\Hydraulics\PERMITS_Environmental\Drawings\U2579DEF_PRM_4C_PSh.dgn

REVISIONS


PROJECT REFERENCE NO.		SHEET NO.
U-2579D,E & F		
ROADWAY DESIGN ENGINEER	HYDRAULICS ENGINEER	
DOCUMENT NOT CONSIDERED FINAL UNLESS ALL SIGNATURES COMPLETED		

SCALE:
1" = 50' HORIZONTAL
1" = 10' VERTICAL


SITE 26


250 200 150 100 50 0 50 100 150 200

960
950
940
930
920
910

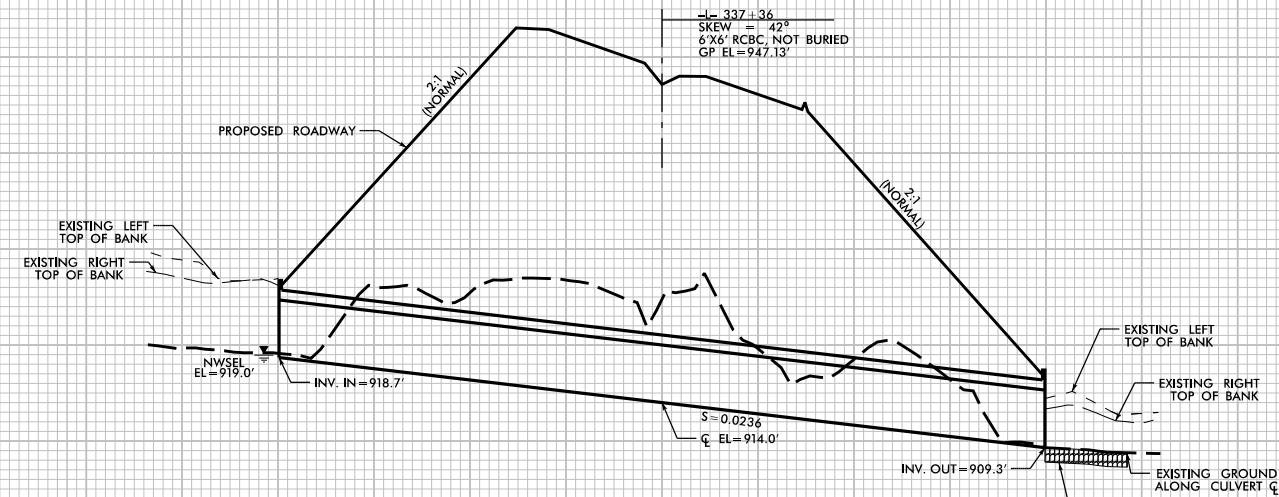

PROFILE ALONG CULVERT

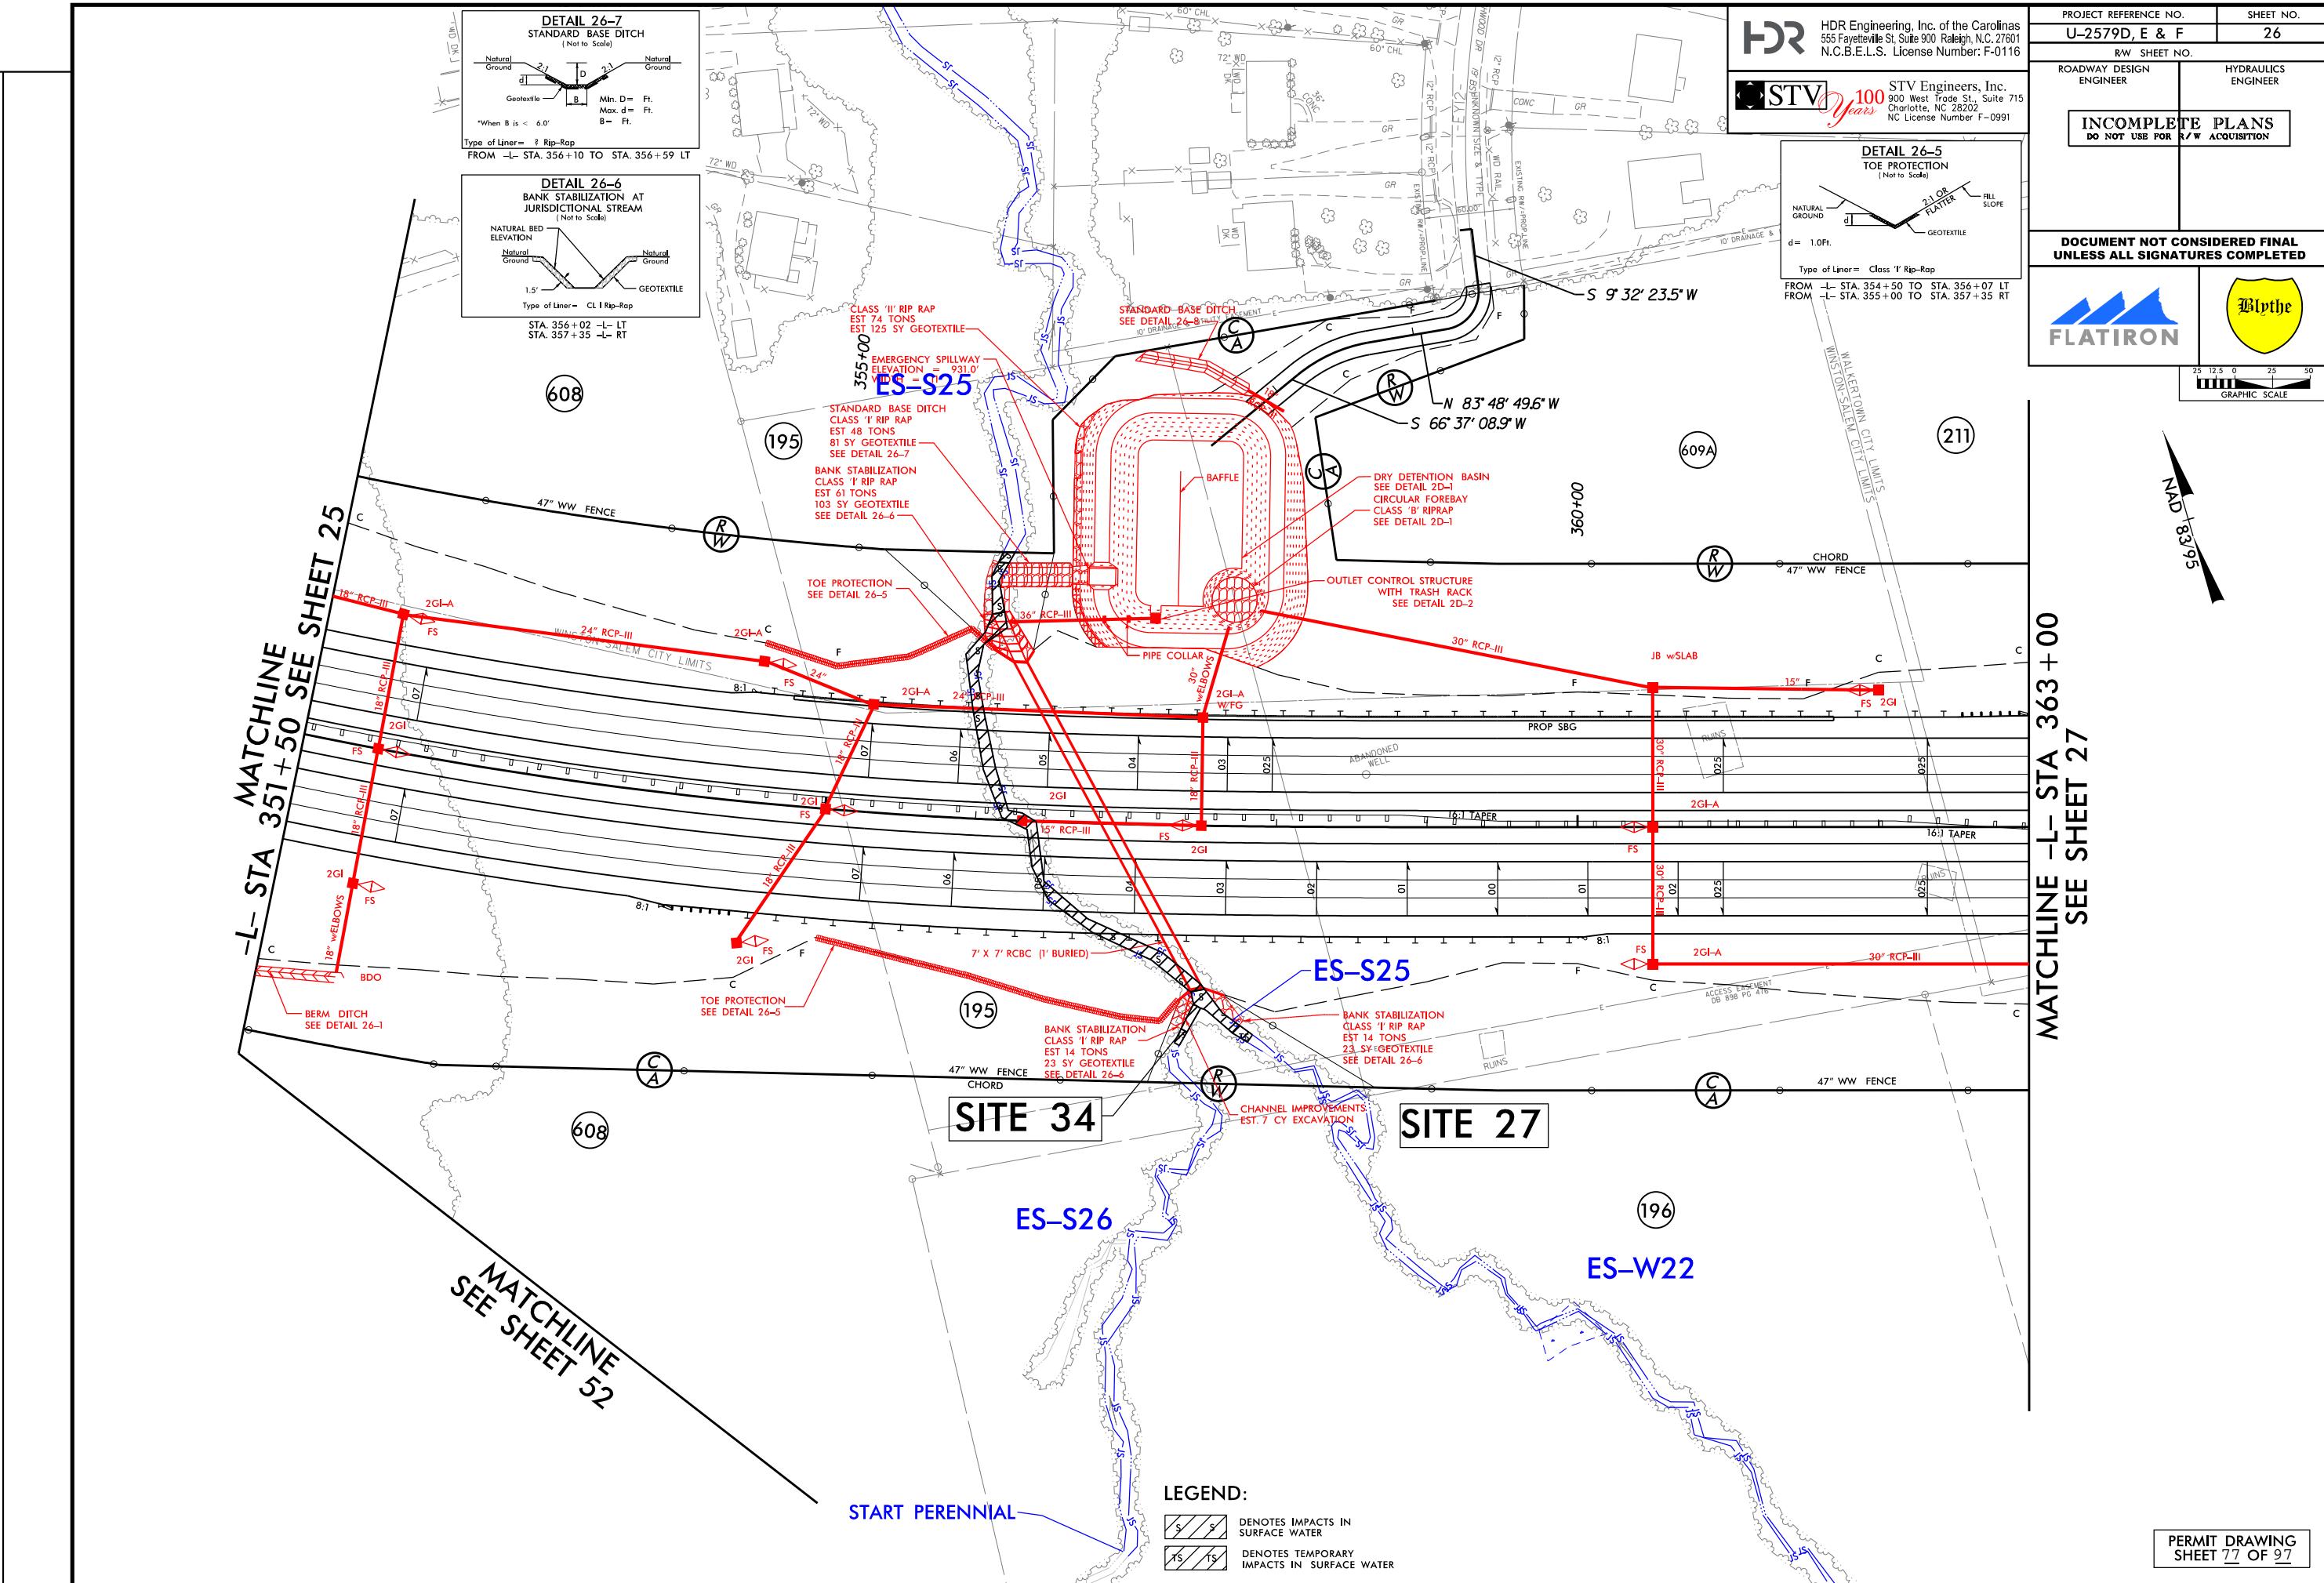


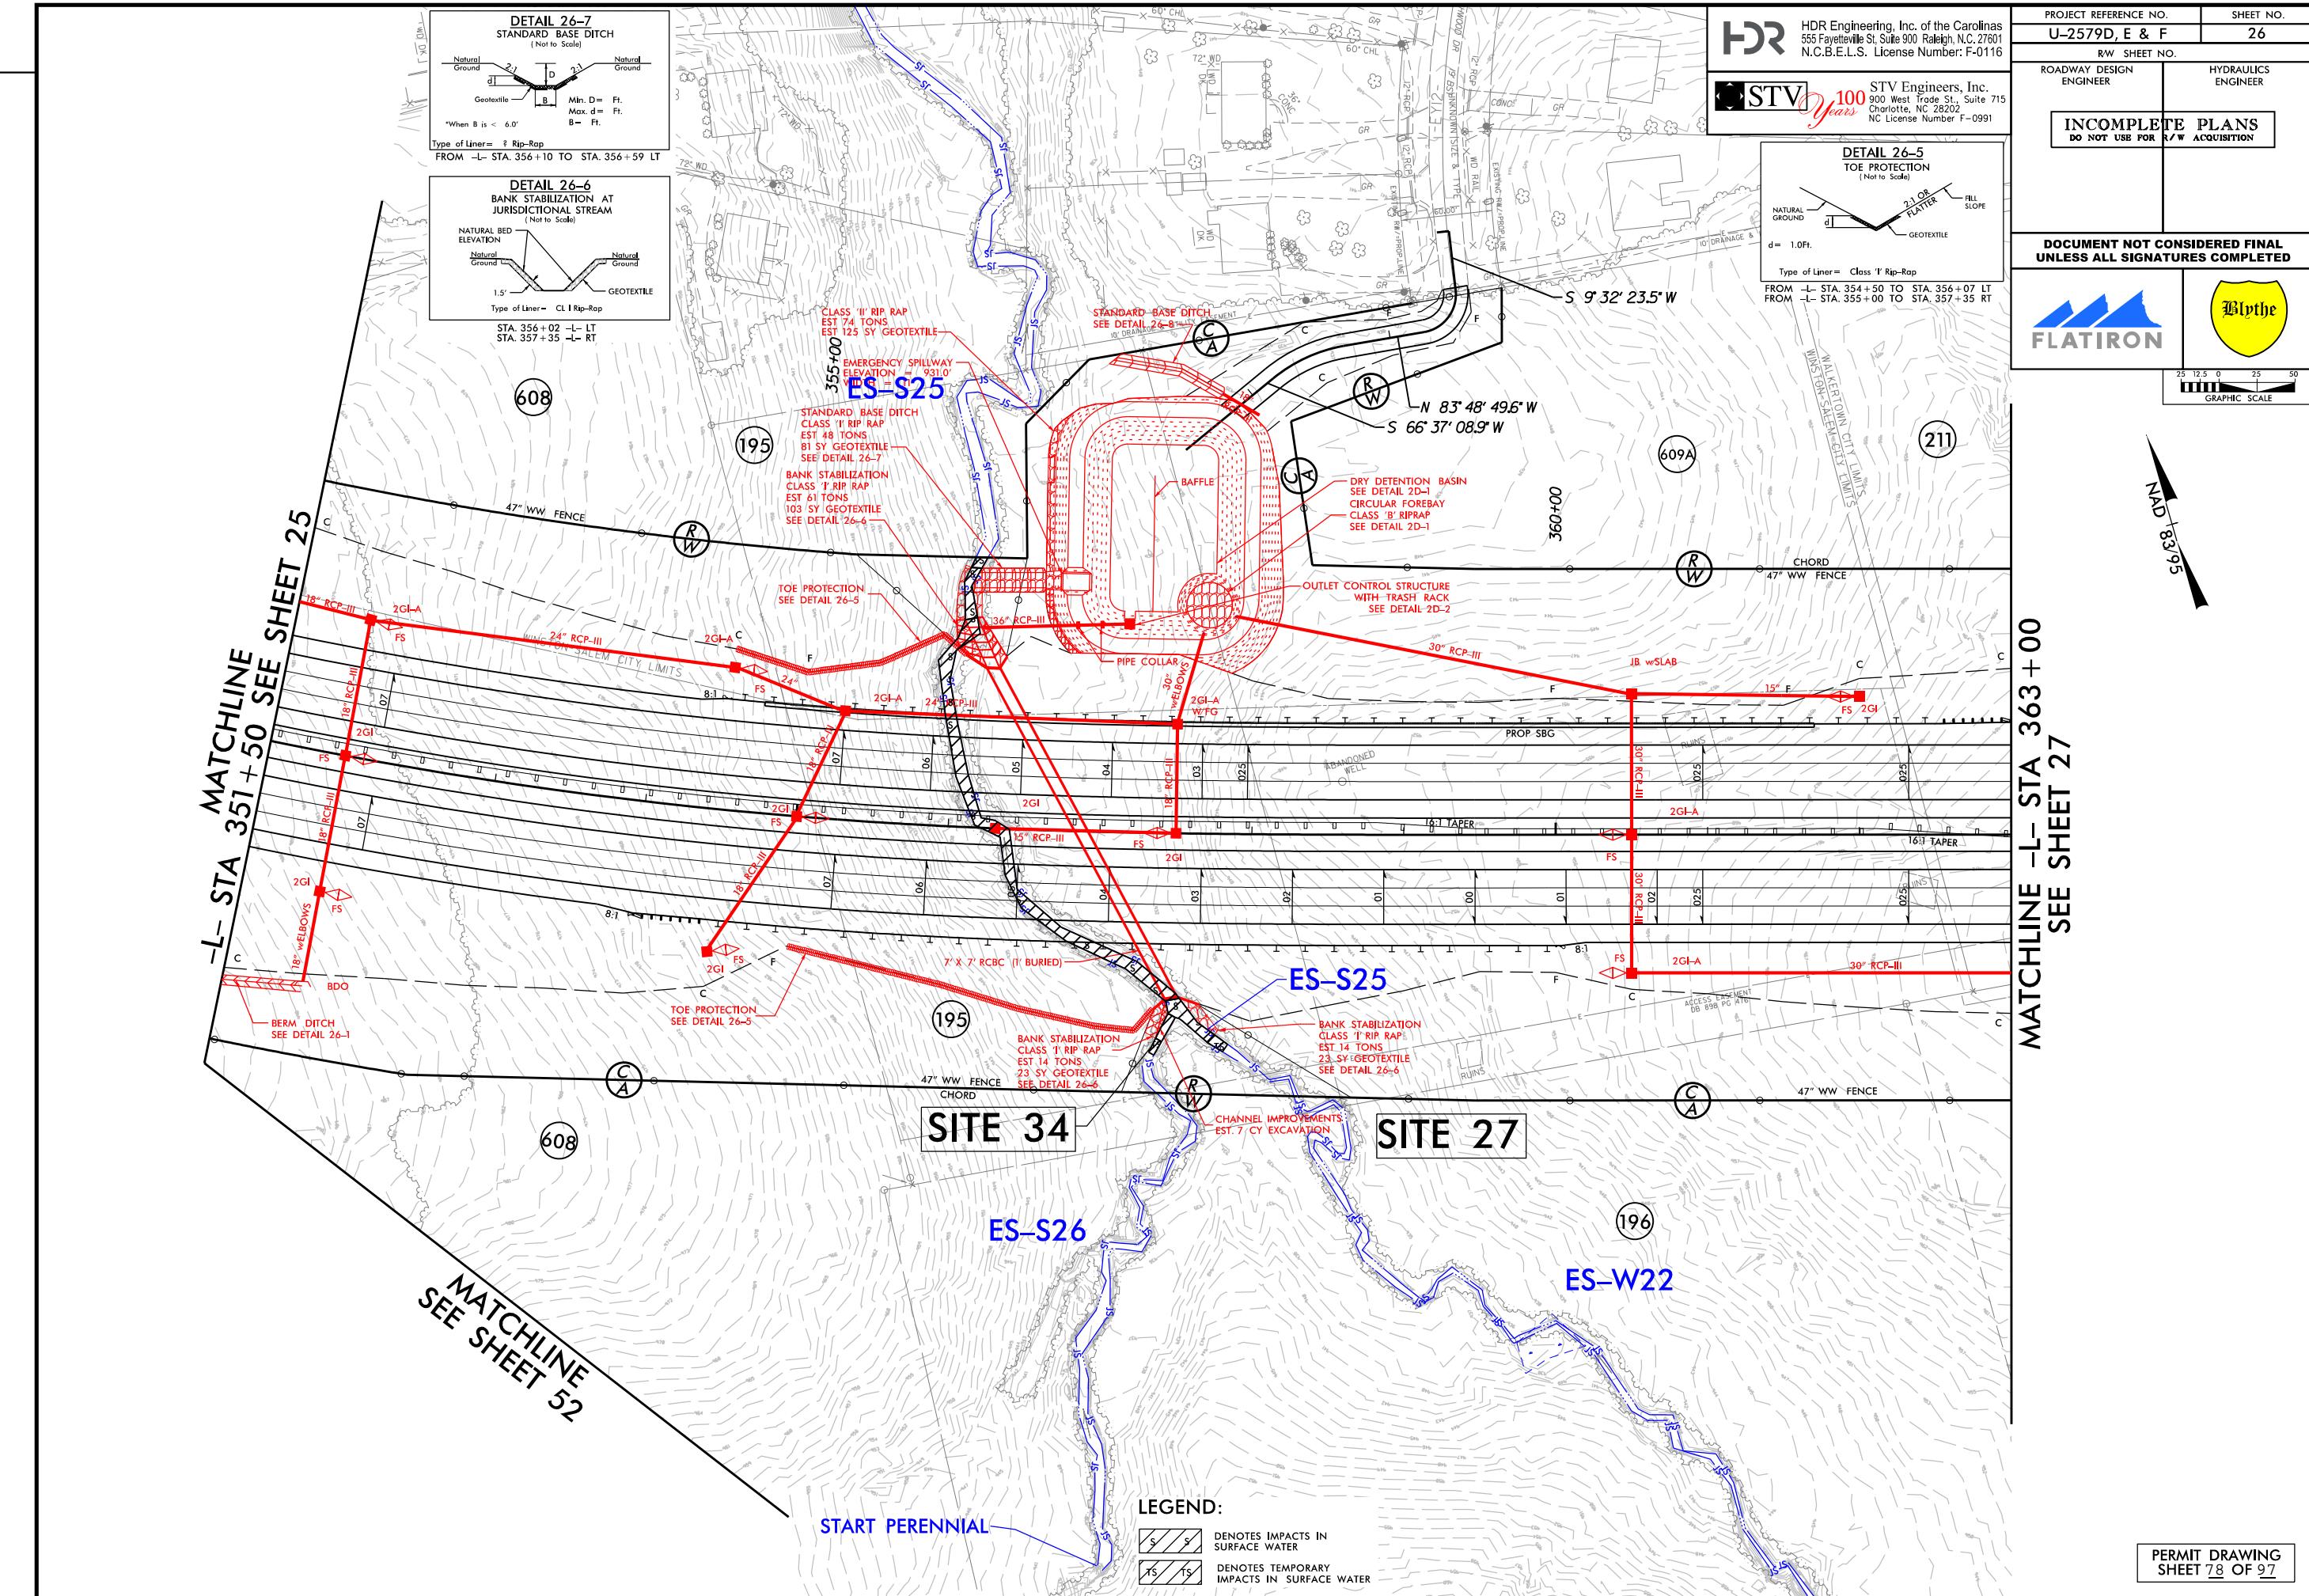


PROJECT REFERENCE NO.		SHEET NO.
U-2579D,E & F		
ROADWAY DESIGN ENGINEER	HYDRAULICS ENGINEER	
DOCUMENT NOT CONSIDERED FINAL UNLESS ALL SIGNATURES COMPLETED		


SCALE:
1" = 50' HORIZONTAL
1" = 10' VERTICAL

SITE 27

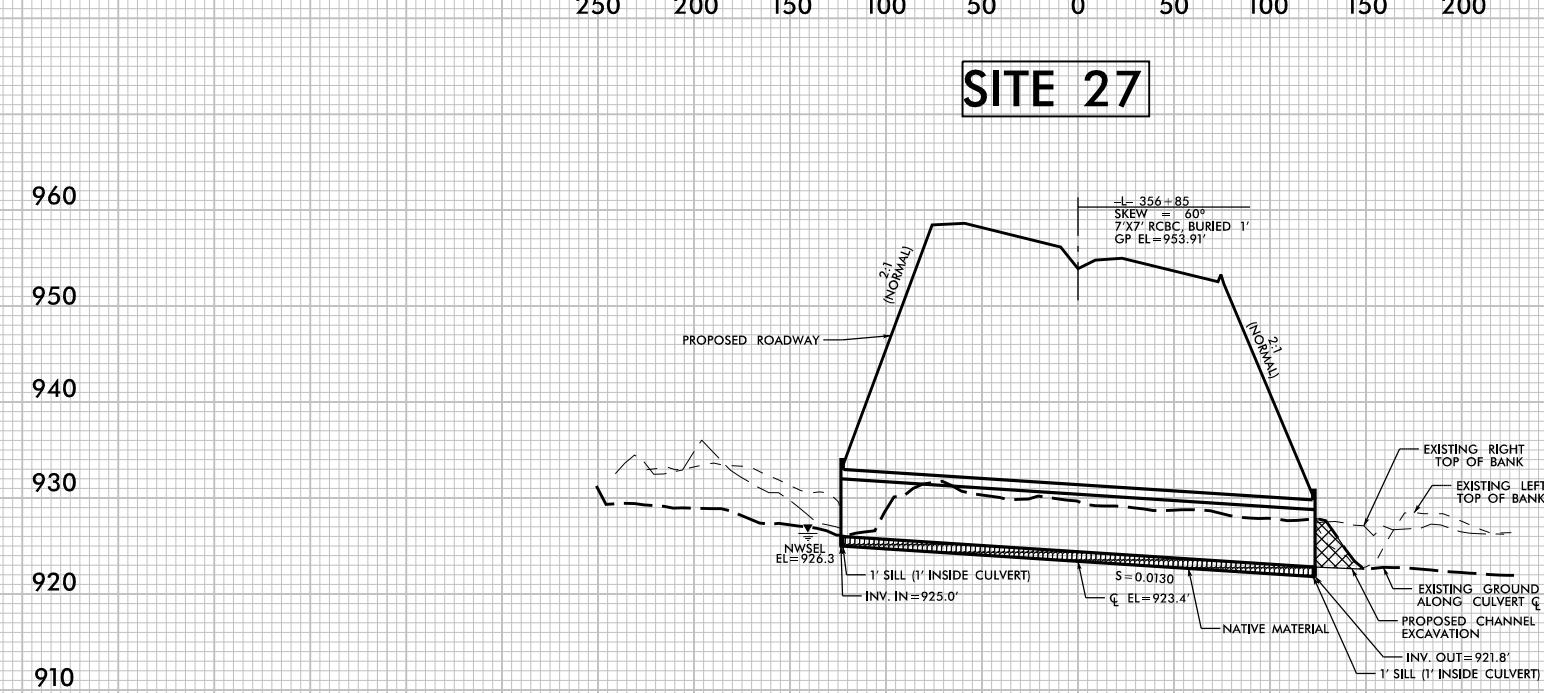

PROFILE ALONG C OF CULVERT

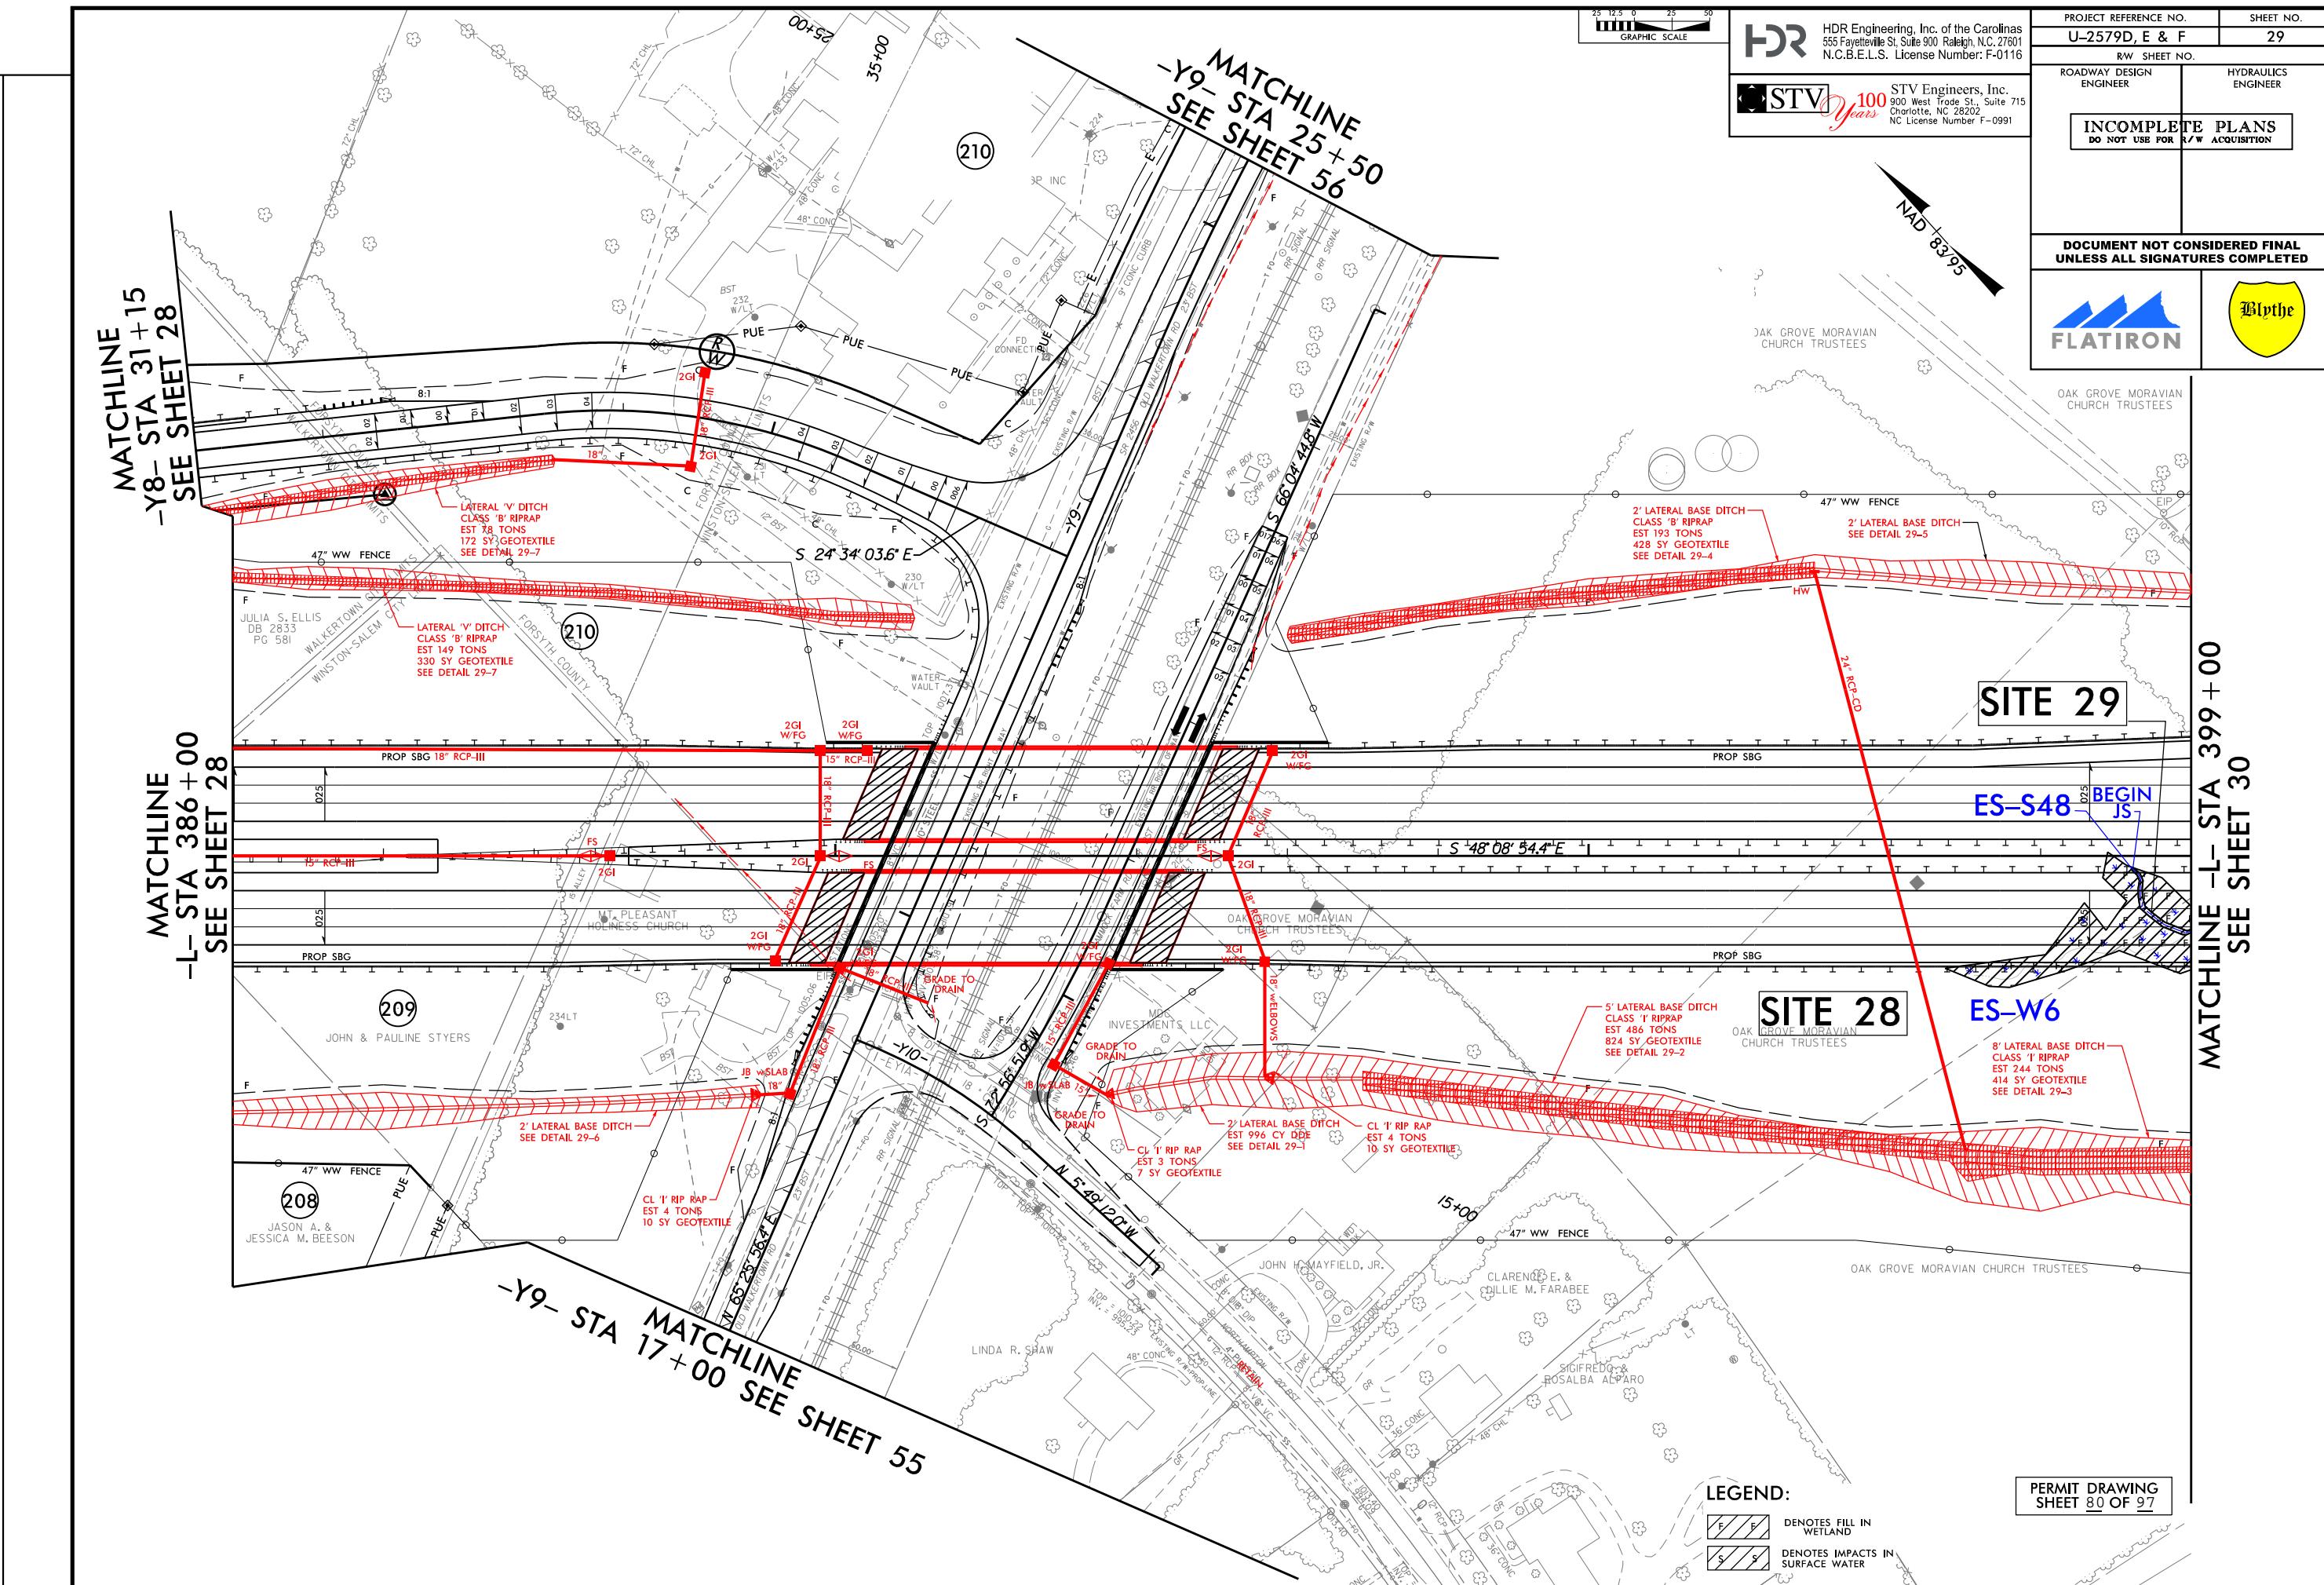

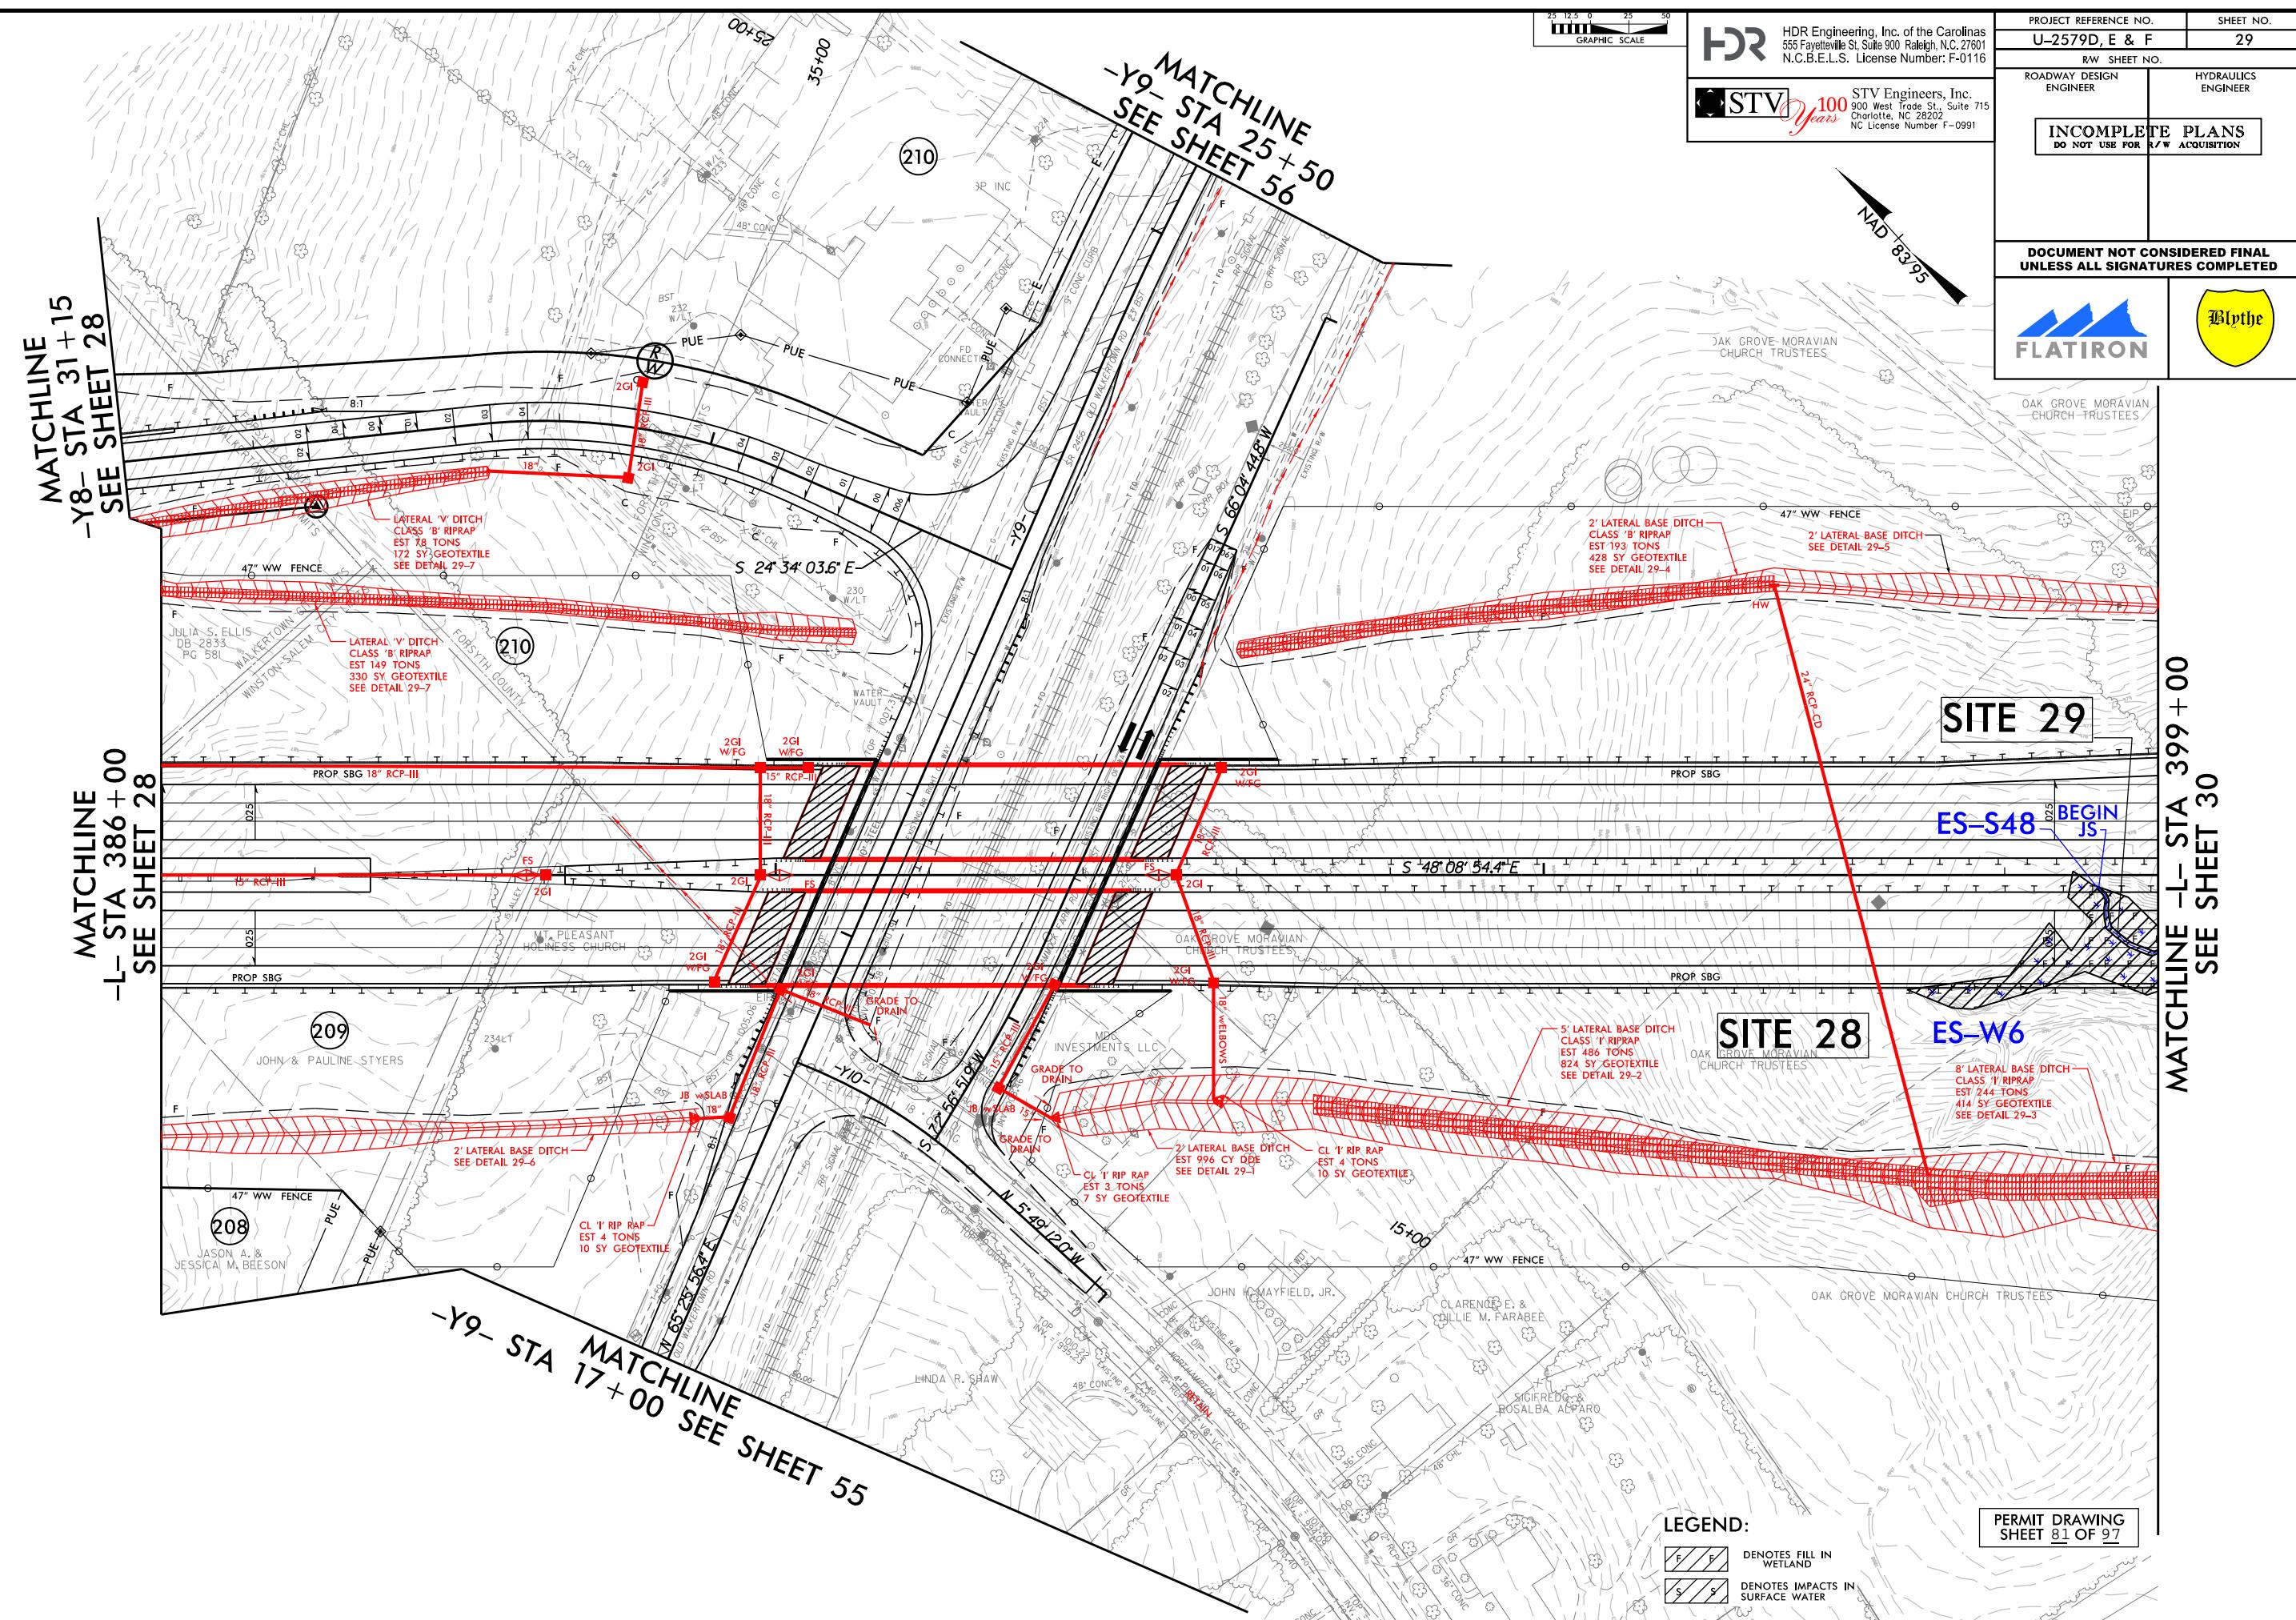


MATCHLINE
-L- STA 399 + 00 SEE SHEET 29

SITE 29B

LEGEND:

- [S S] DENOTES IMPACTS IN SURFACE WATER
- [TS TS] DENOTES TEMPORARY IMPACTS IN SURFACE WATER
- [F F] DENOTES FILL IN WETLAND
- [• •] DENOTES MECHANIZED CLEARING
- [E E] DENOTES EXCAVATION IN WETLAND

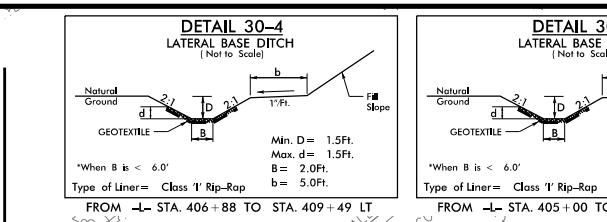

HDR Engineering, Inc. of the Carolinas
555 Fayetteville St, Suite 900 Raleigh, NC 27601
N.C.B.E.L.S. License Number: F-0116

STV 100 Years STV Engineers, Inc.
900 West Trade St., Suite 715 Charlotte, NC 28202
NC License Number F-0991

PROJECT REFERENCE NO. U-2579D, E & F	HEET NO. 30
RW SHEET NO.	
ROADWAY DESIGN ENGINEER	HYDRAULICS ENGINEER
INCOMPLETE PLANS DO NOT USE FOR R/W ACQUISITION	

DOCUMENT NOT CONSIDERED FINAL
UNLESS ALL SIGNATURES COMPLETED



GRAPHIC SCALE

MARGARET H. HOERNER &
MARY E. HAMMOCK

BANK STABILIZATION
CLASS 'I' RIP RAP
EST 8 TONS
14 SY GEOTEXTILE
SEE DETAIL 30-7

2' LATERAL BASE DITCH
CLASS 'I' RIPRAP
EST 151 TONS
255 SY GEOTEXTILE
SEE DETAIL 30-4


2' LATERAL BASE DITCH
CLASS 'I' RIPRAP
EST 193 TONS
428 SY GEOTEXTILE
SEE DETAIL 30-2

JB
w/MH
2GI
W/FG
15'

MATCHLINE
-L- STA 399 + 00 SEE SHEET 29

LEGEND:

- [S] [S] DENOTES IMPACTS IN SURFACE WATER
- [TS] [TS] DENOTES TEMPORARY IMPACTS IN SURFACE WATER
- [F] [F] DENOTES FILL IN WETLAND
- [•] [•] DENOTES MECHANIZED CLEARING
- [E] [E] DENOTES EXCAVATION IN WETLAND

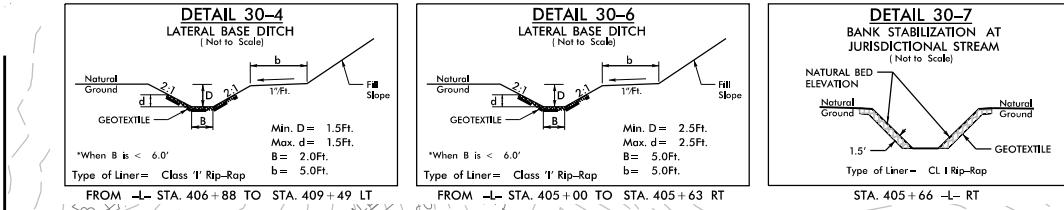

HDR Engineering, Inc. of the Carolinas
555 Fayetteville St, Suite 900 Raleigh, NC 27601
N.C.B.E.L.S. License Number: F-0116


STV Engineers, Inc.
900 West Trade St., Suite 715
Charlotte, NC 28202
NC License Number F-0991

PROJECT REFERENCE NO.	SHEET NO.
U-2579D, E & F	30
RW SHEET NO.	
ROADWAY DESIGN ENGINEER	HYDRAULICS ENGINEER
INCOMPLETE PLANS DO NOT USE FOR R/W ACQUISITION	

DOCUMENT NOT CONSIDERED FINAL
UNLESS ALL SIGNATURES COMPLETED




25 12.5 0 25 50
GRAPHIC SCALE

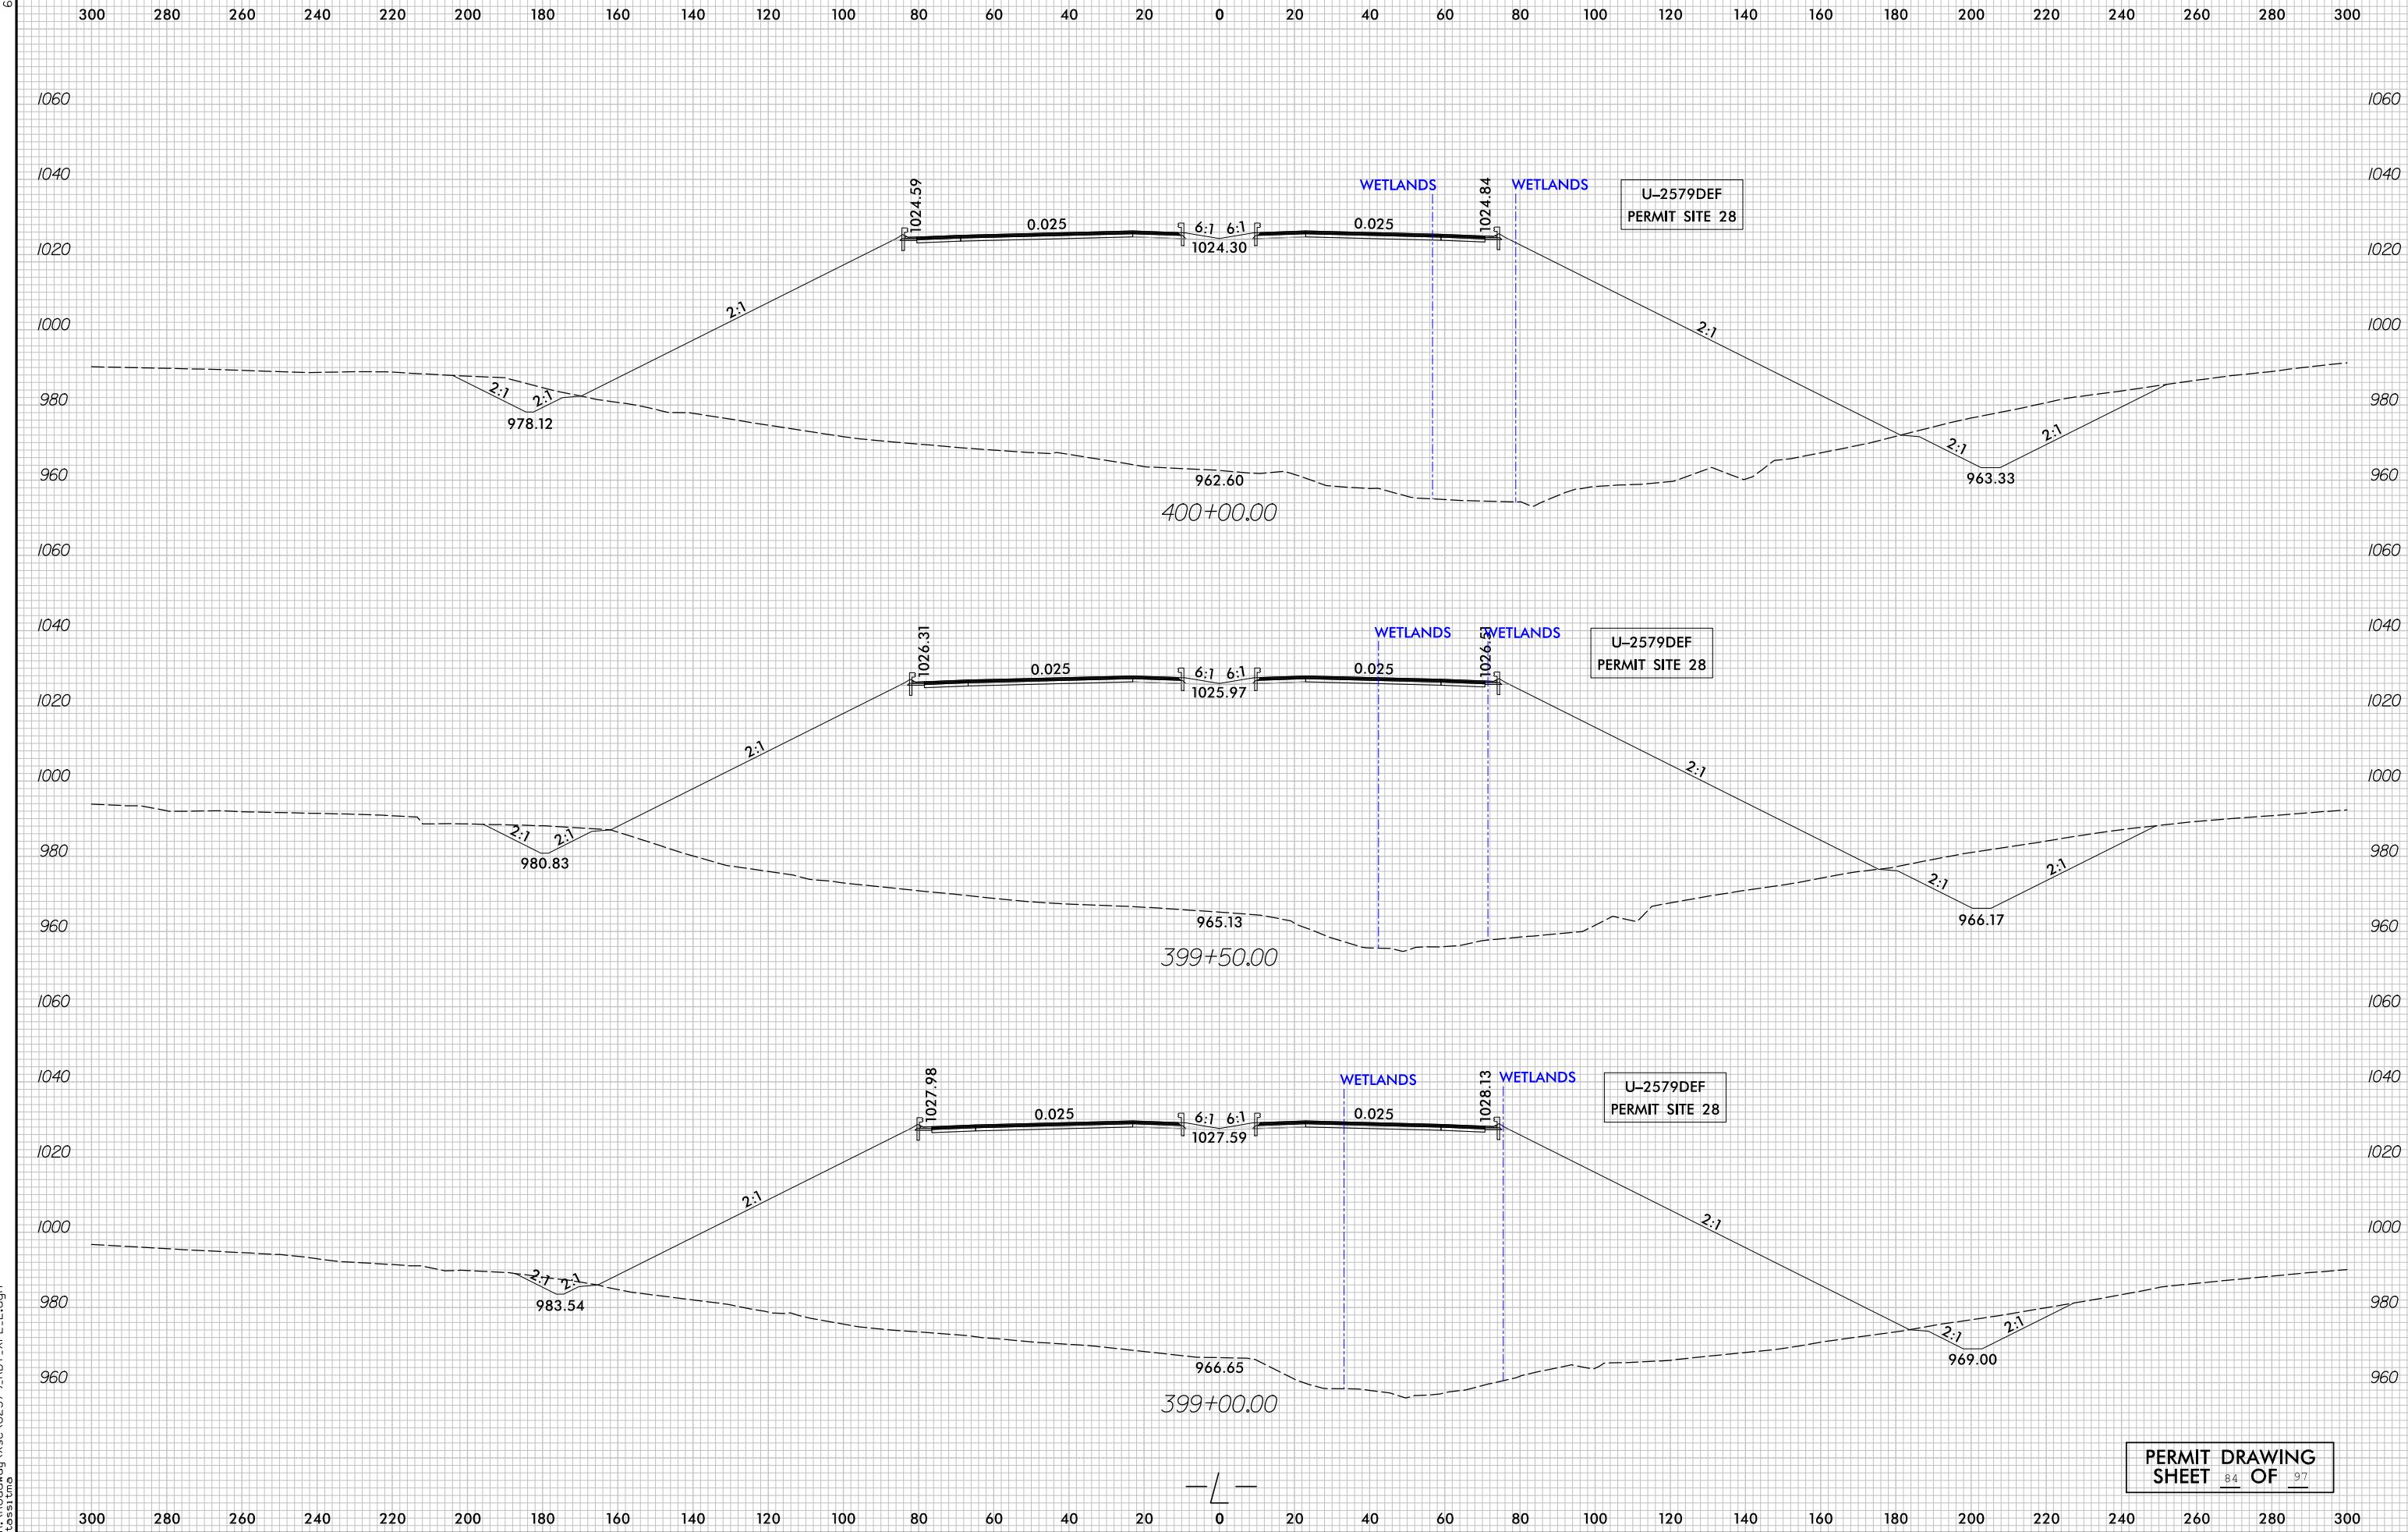


300 280 260 240 220 200 180 160 140 120 100 80 60 40 20 0 20 40 60 80 100 120 140 160 180 200 220 240 260 280 300

1040 1020 1000 980 960 940 1040 1020 1000 980 960 940

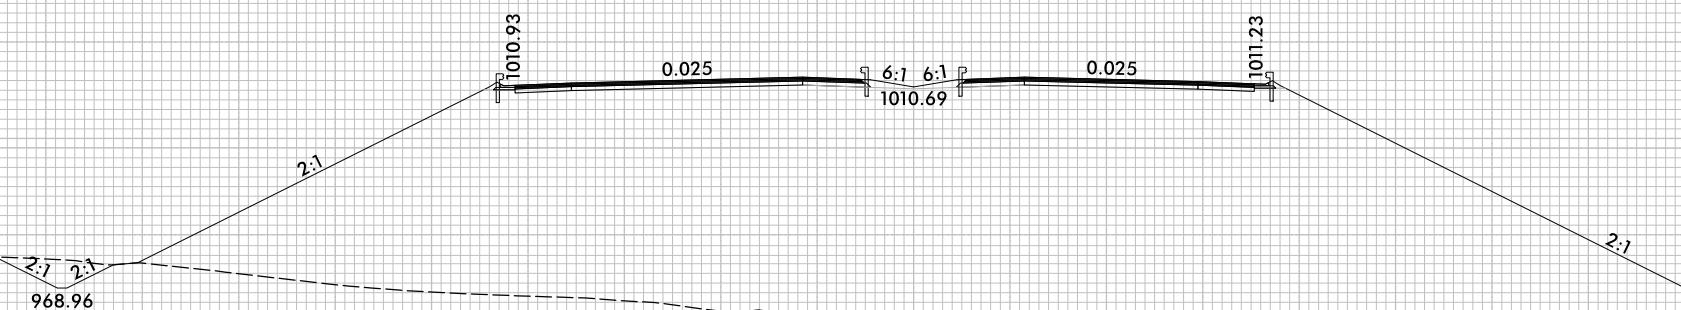


WETLANDS
U-2579DEF
PERMIT SITE 29B

1040 1020 1000 980 960 940 1040 1020 1000 980 960 940

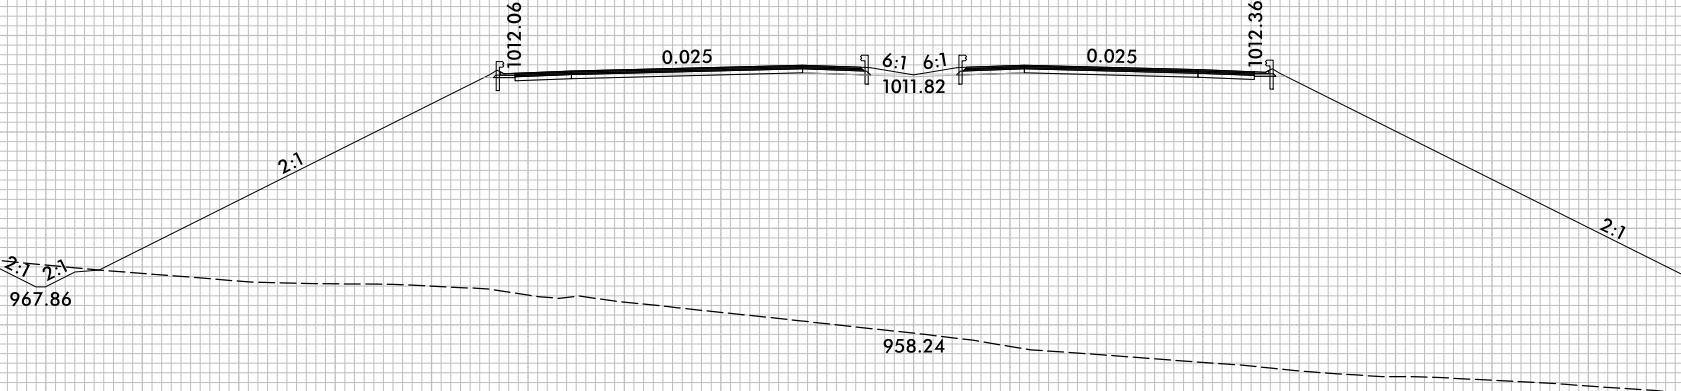


WETLANDS
U-2579DEF
PERMIT SITE 29B


1040 1020 1000 980 960 940 1040 1020 1000 980 960 940

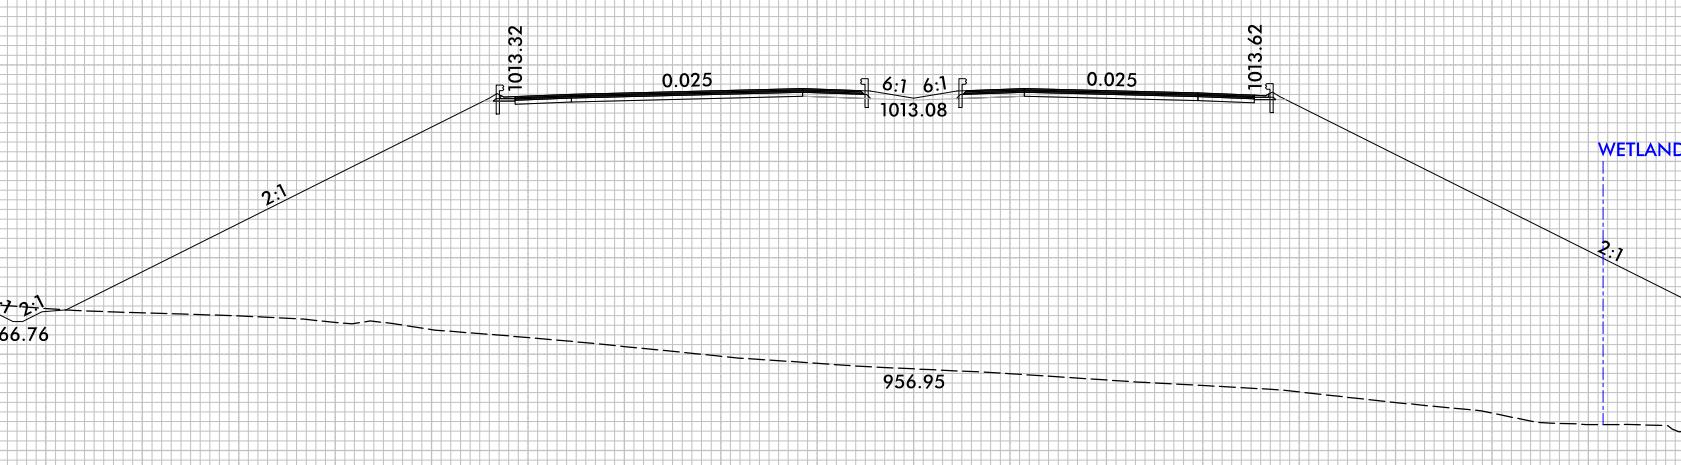

WETLANDS
U-2579DEF
PERMIT SITE 29B

300 280 260 240 220 200 180 160 140 120 100 80 60 40 20 0 20 40 60 80 100 120 140 160 180 200 220 240 260 280 300

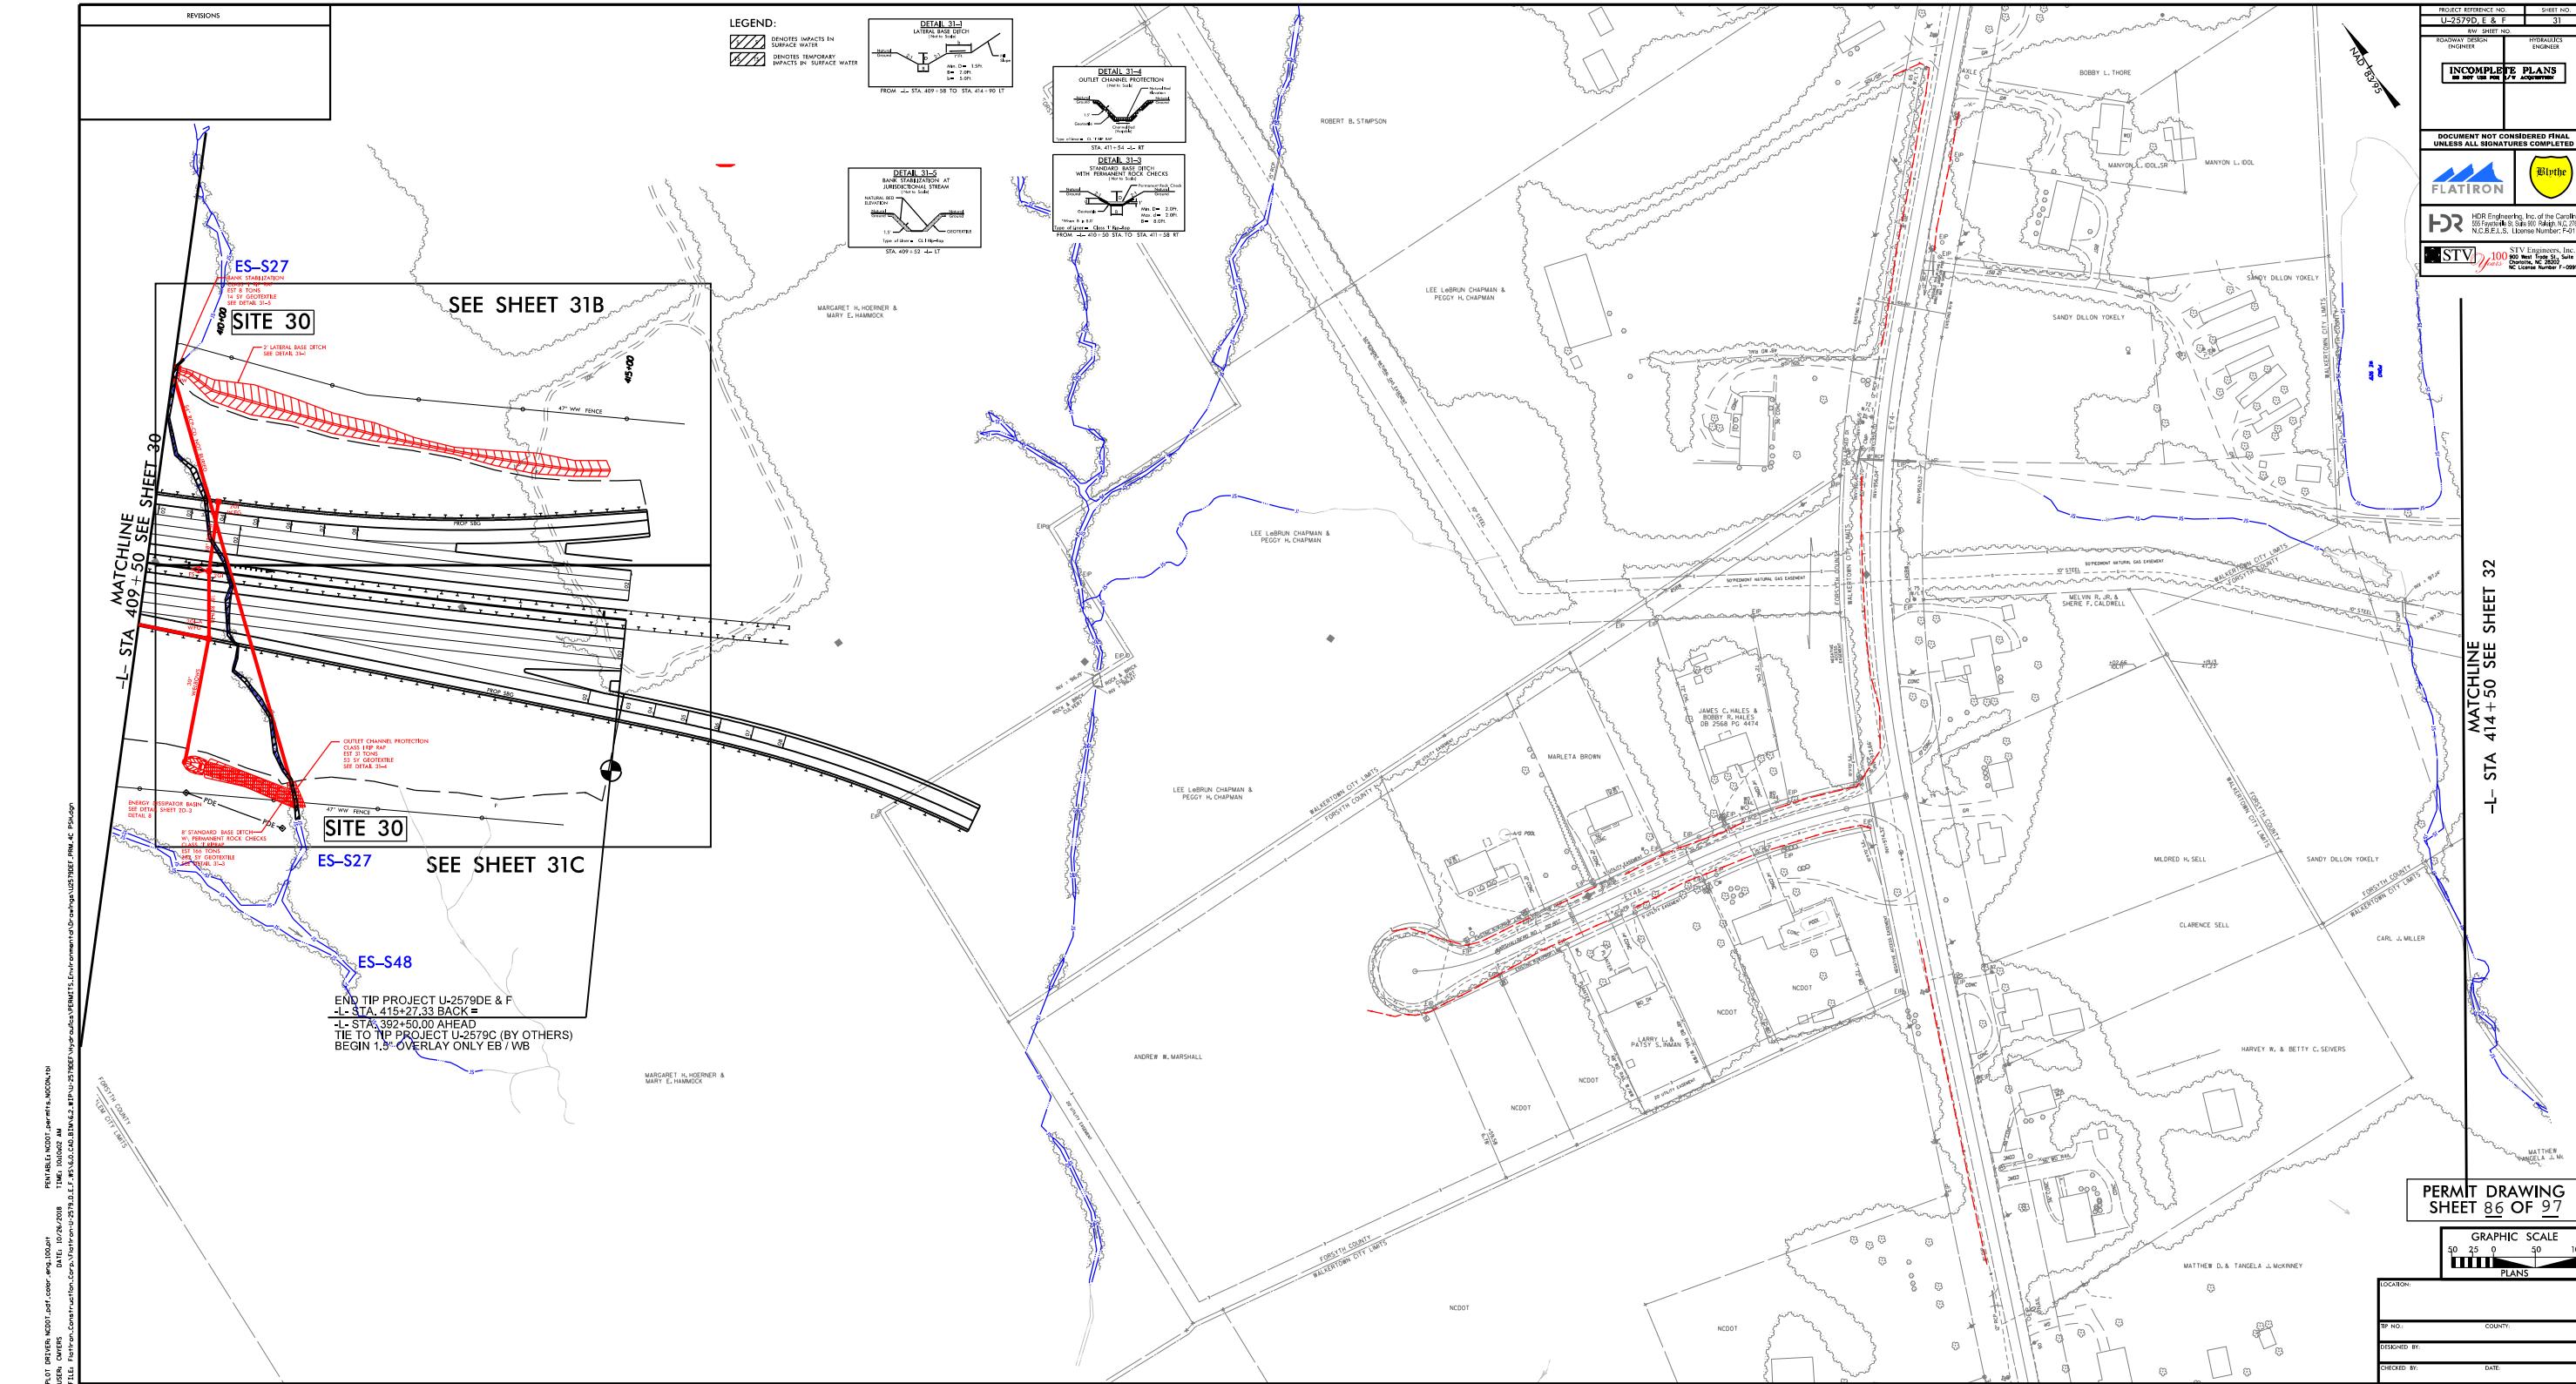

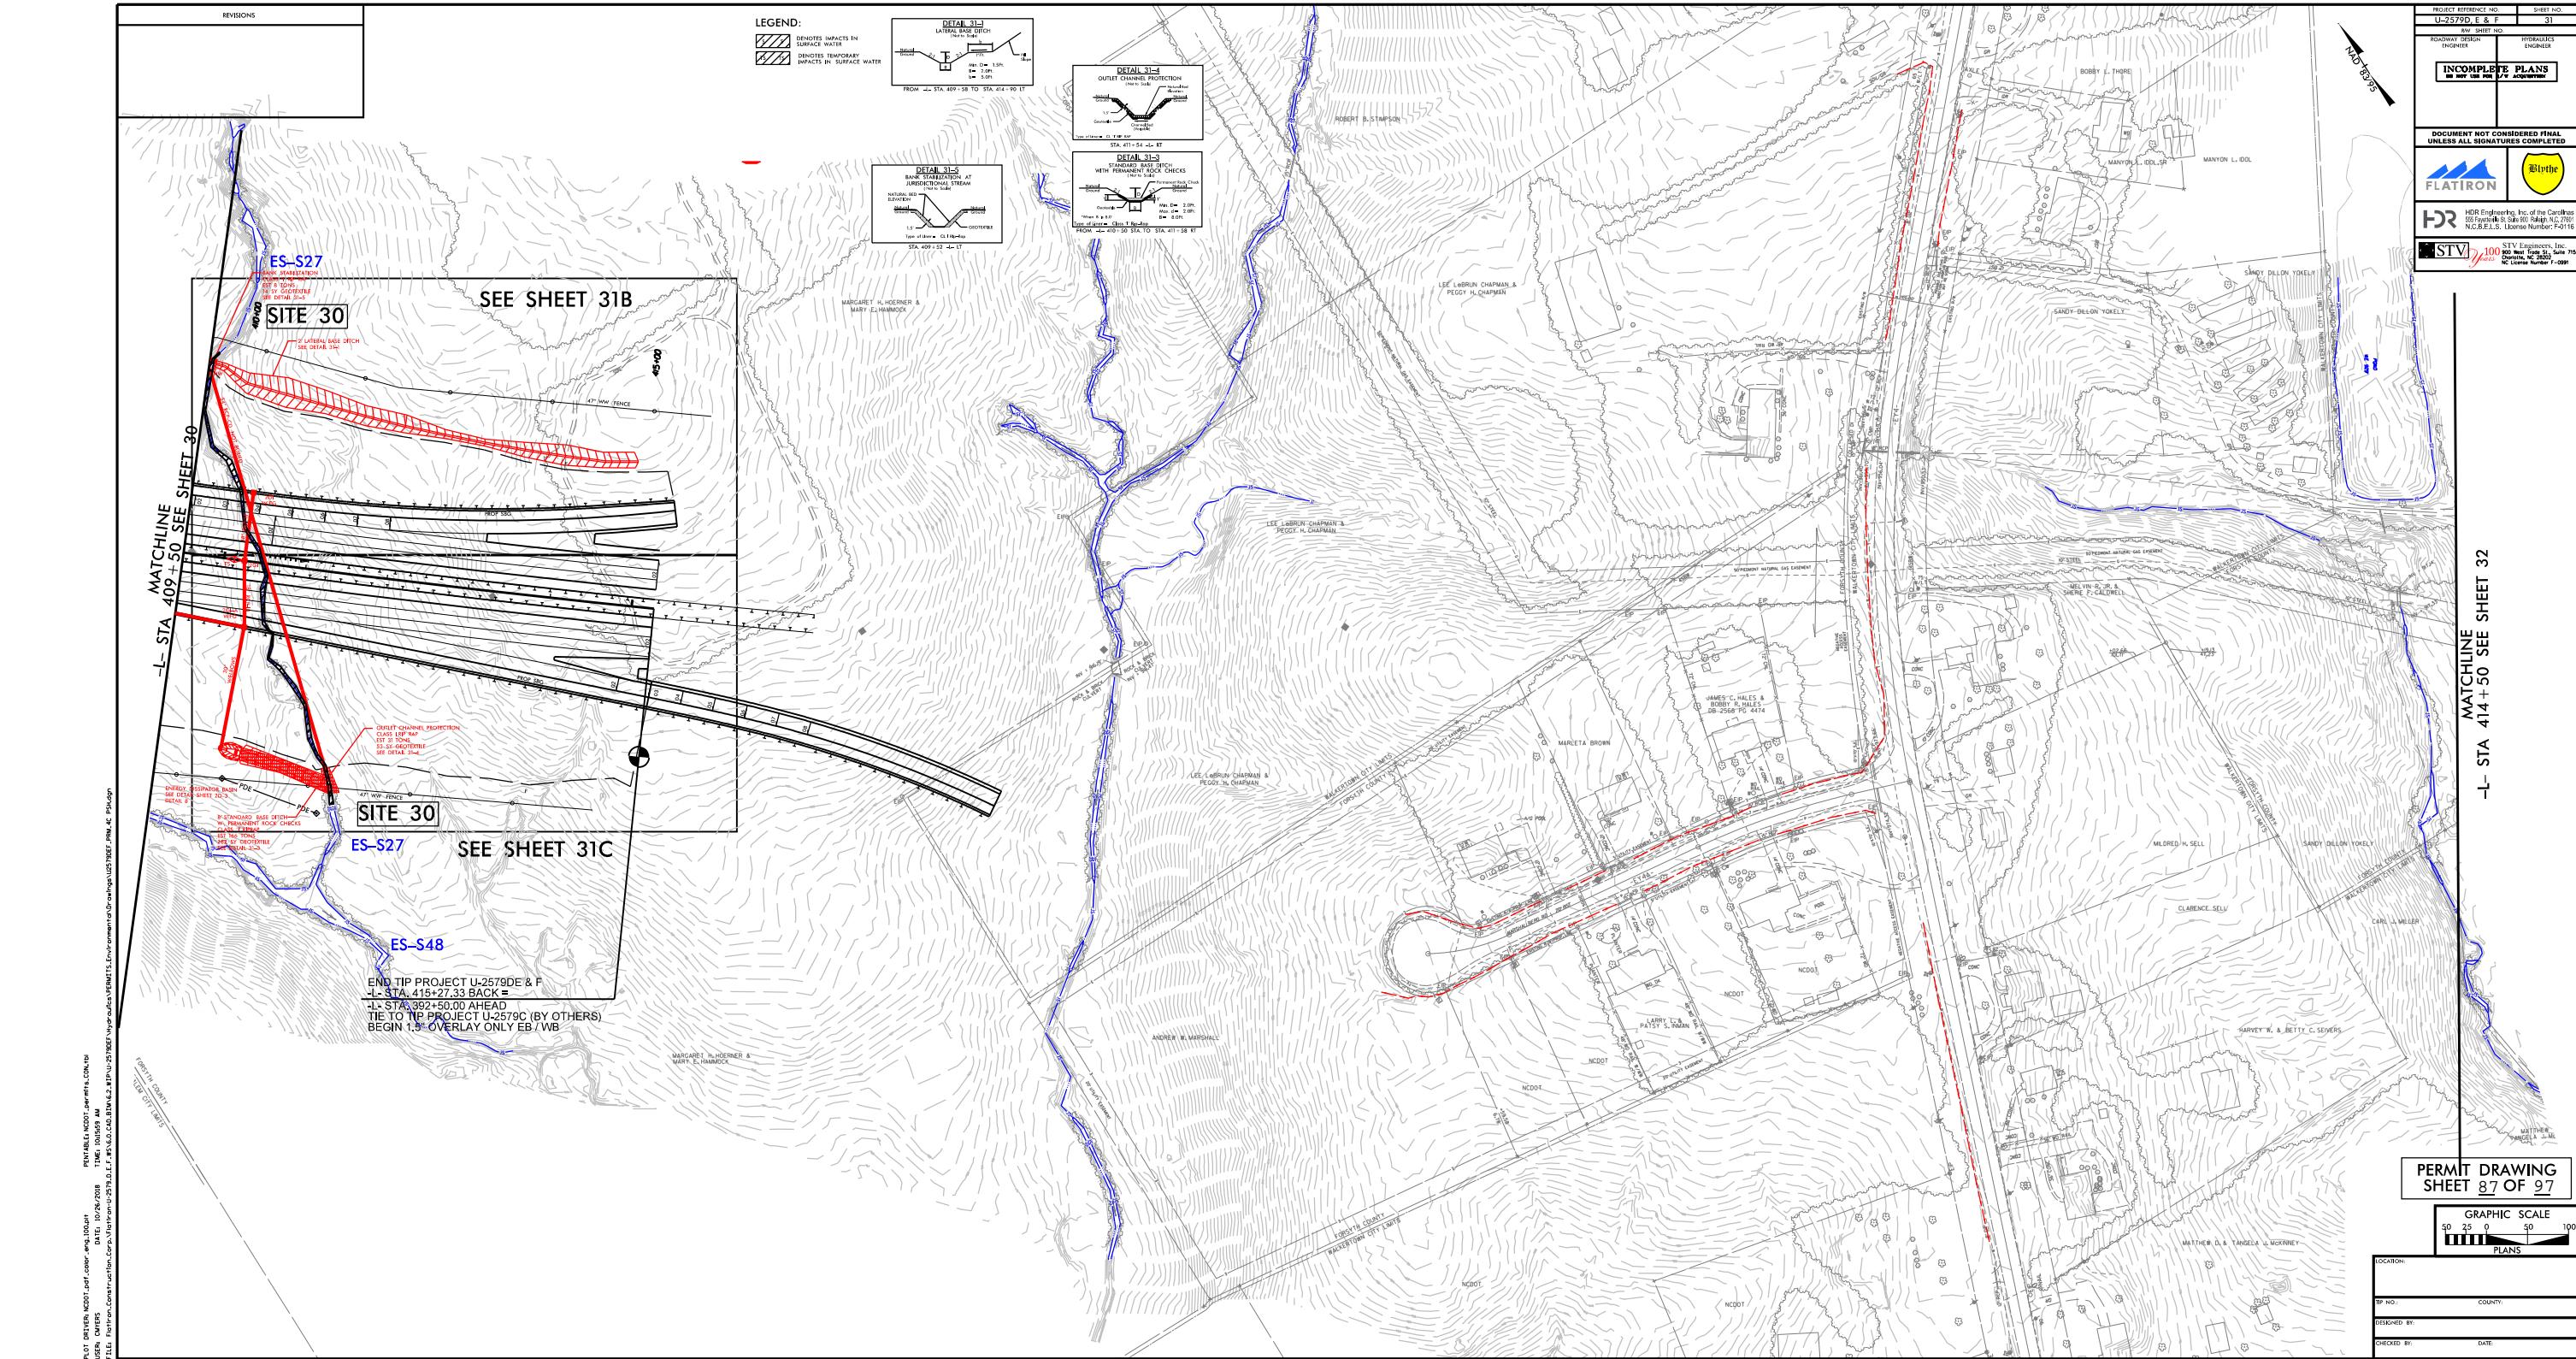


DOCUMENT NOT CONSIDERED FINAL
UNLESS ALL SIGNATURES COMPLETED

HDR HDR Engineering, Inc. of the Carolinas
555 Fayetteville St. Suite 900 Raleigh, N.C. 27601
N.C.B.E.L.S. License Number: F-0116

LEGEND


- [S/S] DENOTES IMPACTS IN SURFACE WATER
- [TS/TS] DENOTES TEMPORARY IMPACTS IN SURFACE WATER

END TIP PROJECT U-2579DE & F
 -L- STA. 415+27.33 BACK =
 -L- STA. 392+50.00 AHEAD
 TIE TO TIP PROJECT U-2579C (BY OTHERS)
 BEGIN 1.5" OVERLAY ONLY EB / WB

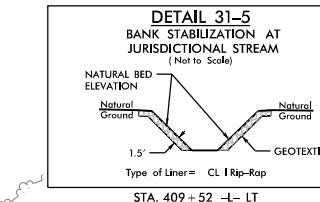

MARGARET H. HOERNER &
MARY E. HAMMICK

LEE LeBRUN CHAPMAN &
PEGGY H. CHAPMAN

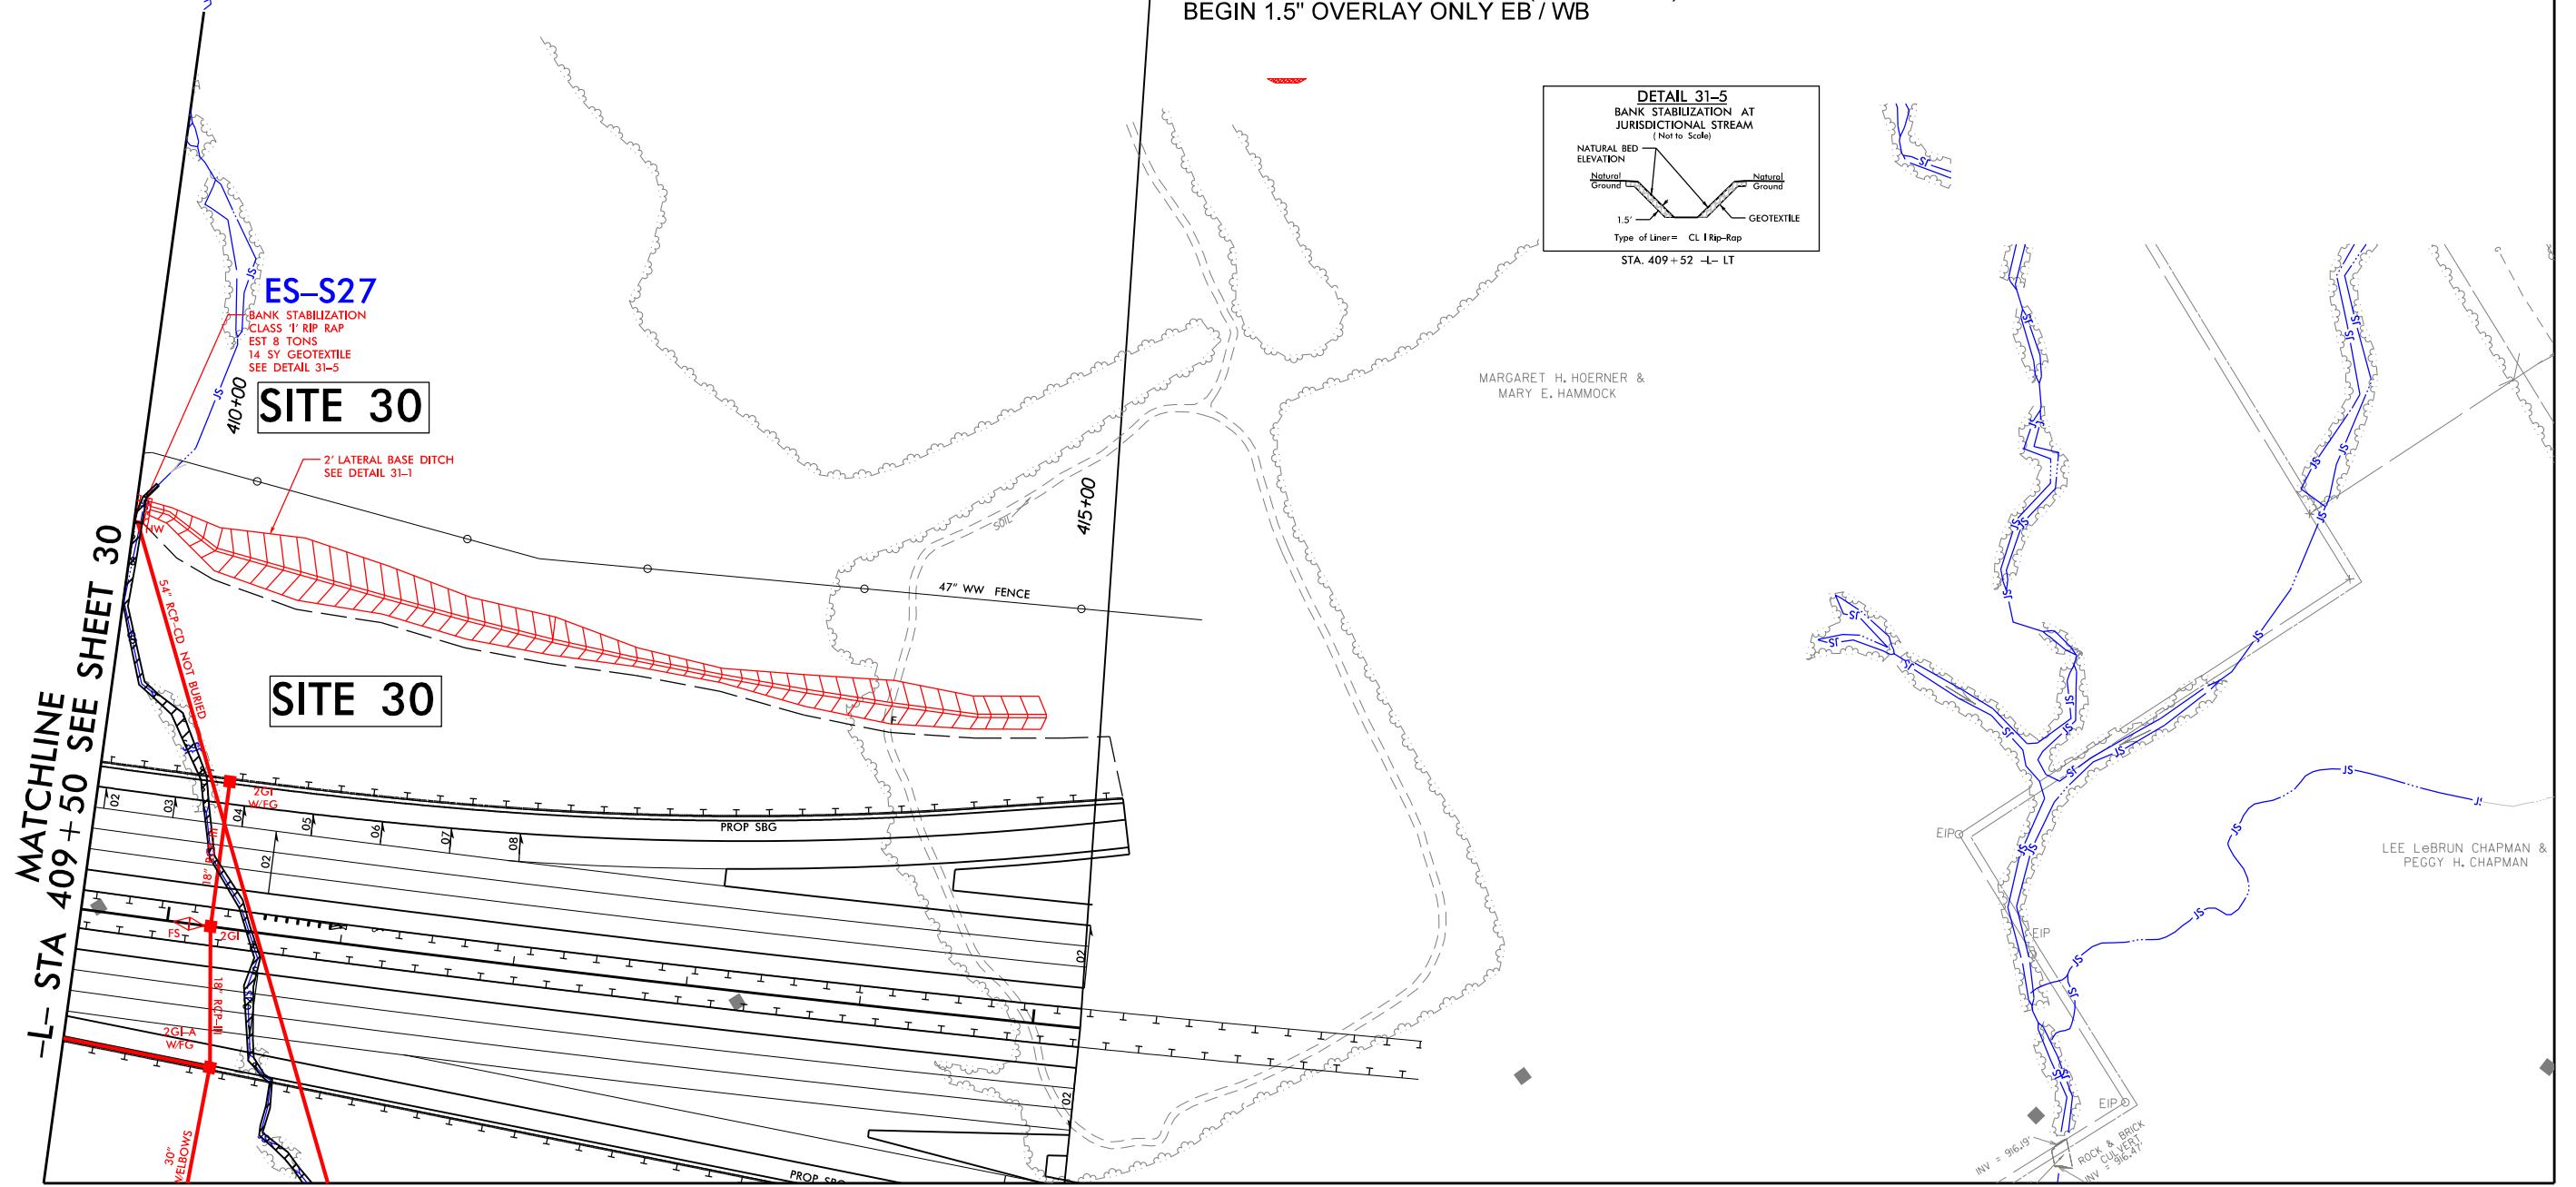


LEGEND

 DENOTES IMPACTS IN SURFACE WATER
 DENOTES TEMPORARY IMPACTS IN SURFACE WATER

MATCHLINE SEE SHEET 31B

A graphic element consisting of a black horizontal line with a small circle at its left end, representing a coordinate axis.

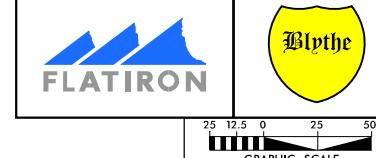



**DOCUMENT NOT CONSIDERED FINAL
UNLESS ALL SIGNATURES COMPLETED**


HDR HDR Engineering, Inc. of the Carolinas
555 Fayetteville St, Suite 900 Raleigh, NC 27601
N.C.B.E.L.S. License Number: F-0116

LEE LeBRUN CHAPMAN &
PEGGY H. CHAPMAN

MIT DRAWING
EET 89 OF 97

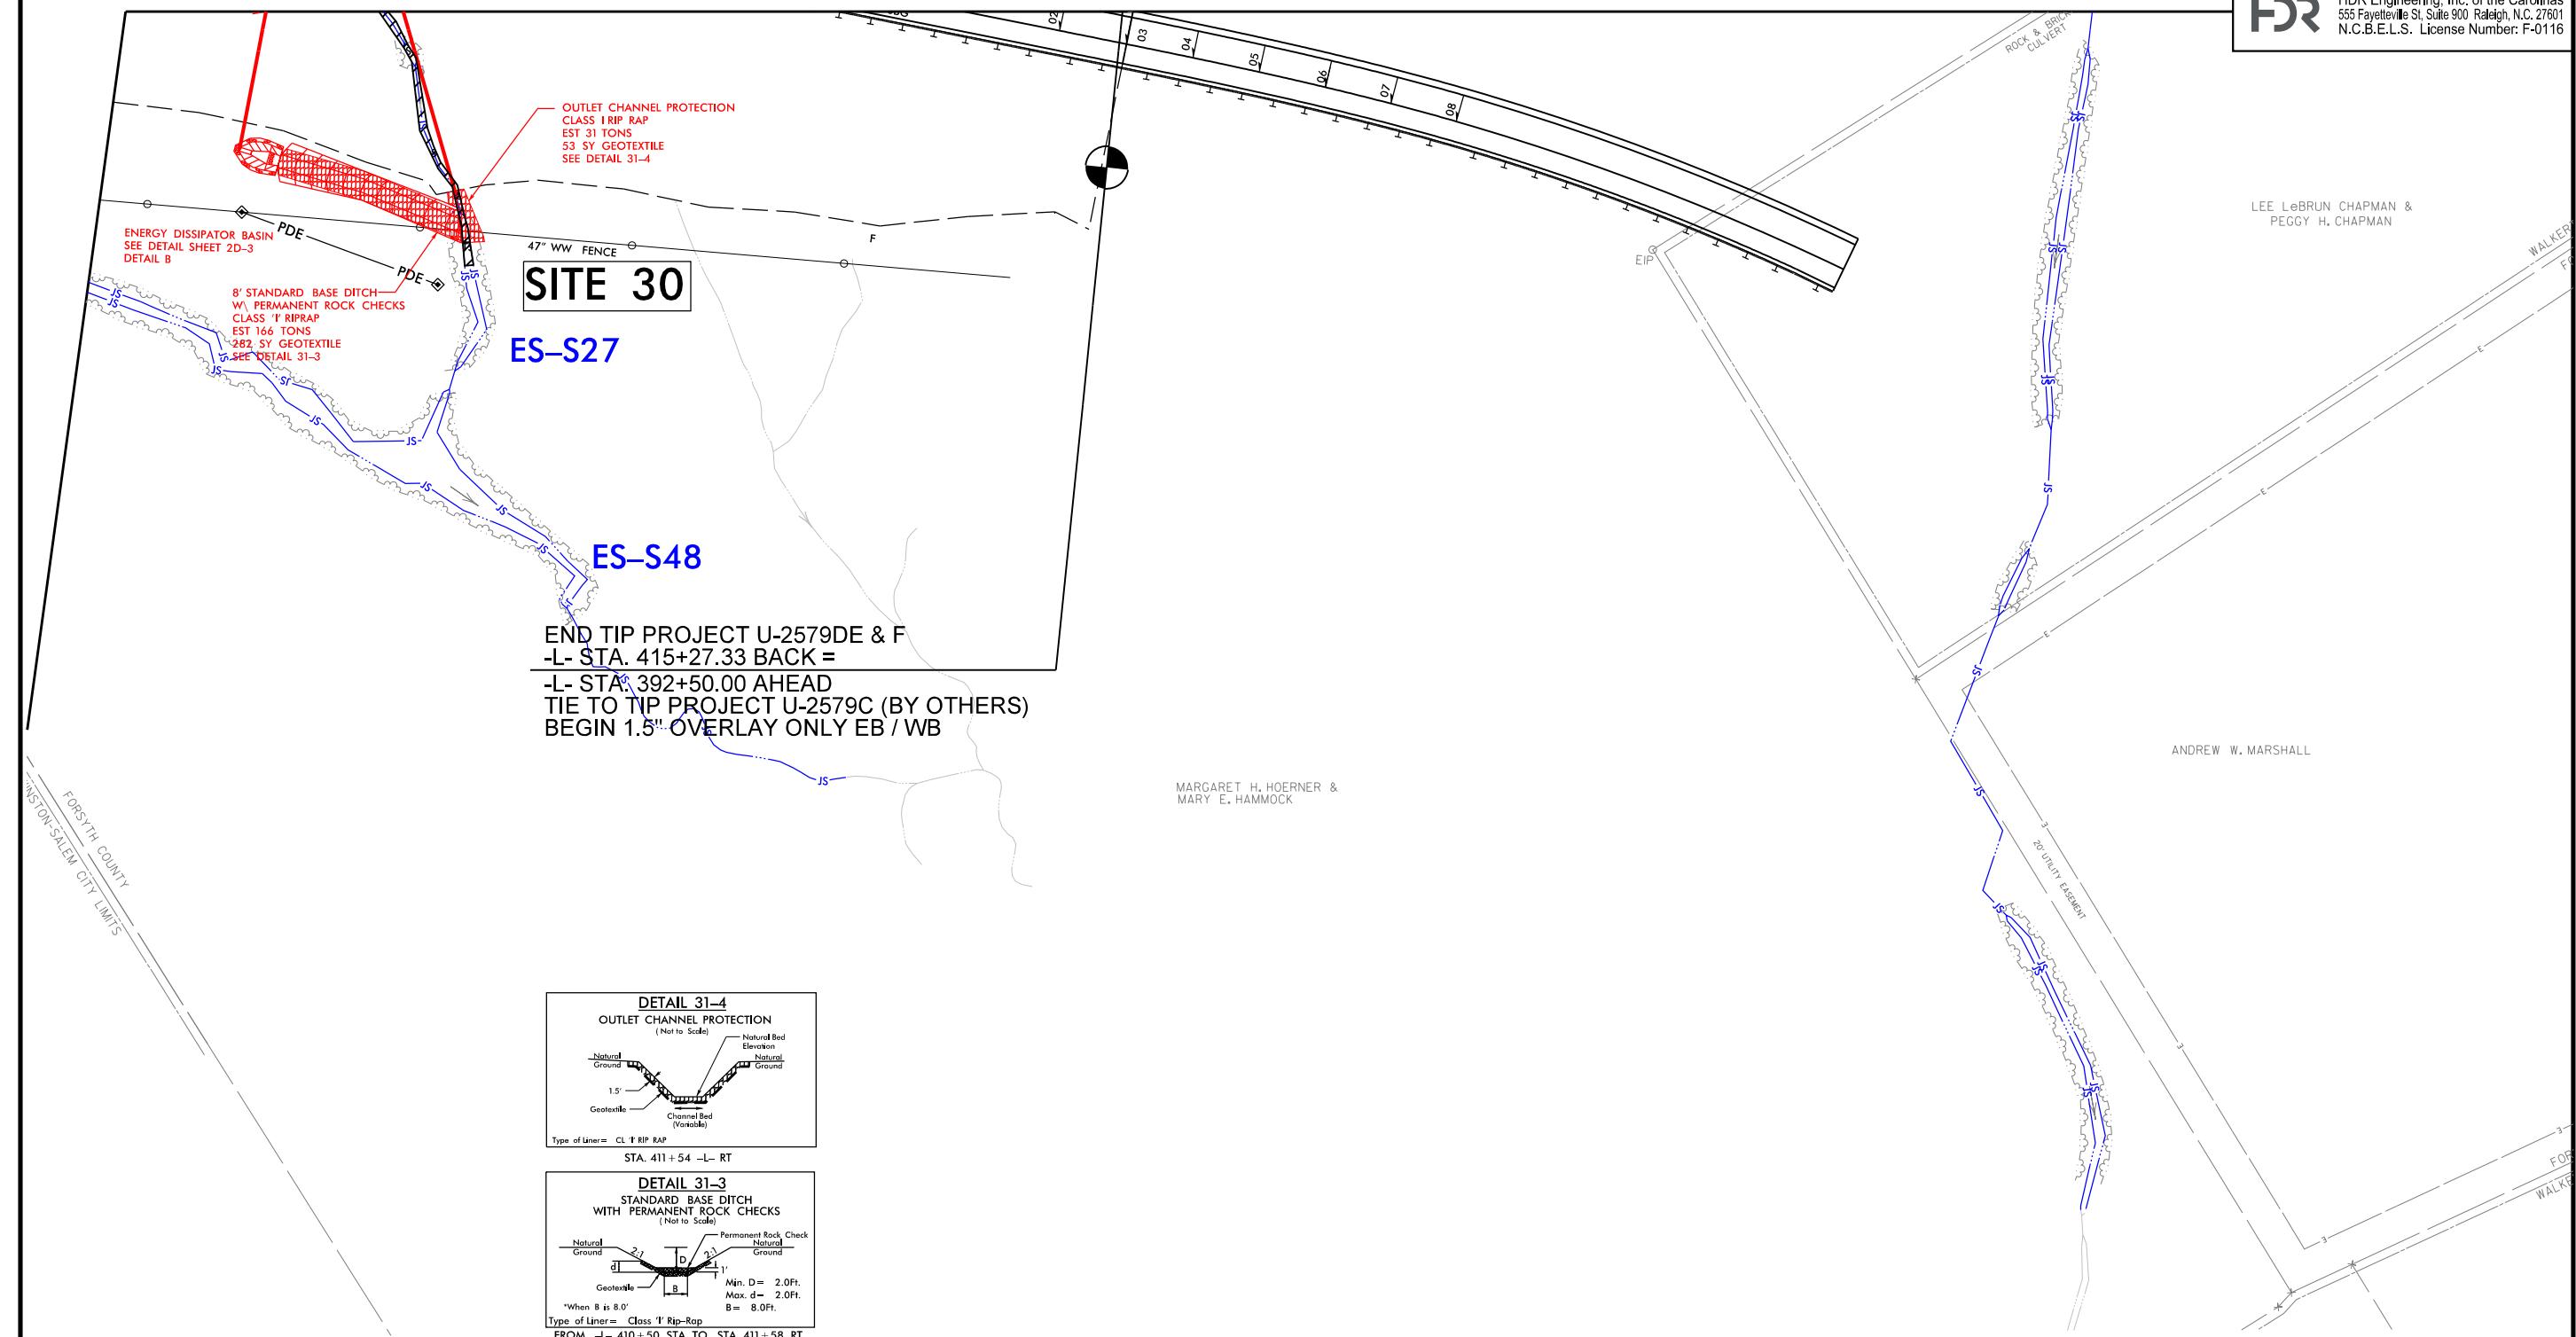

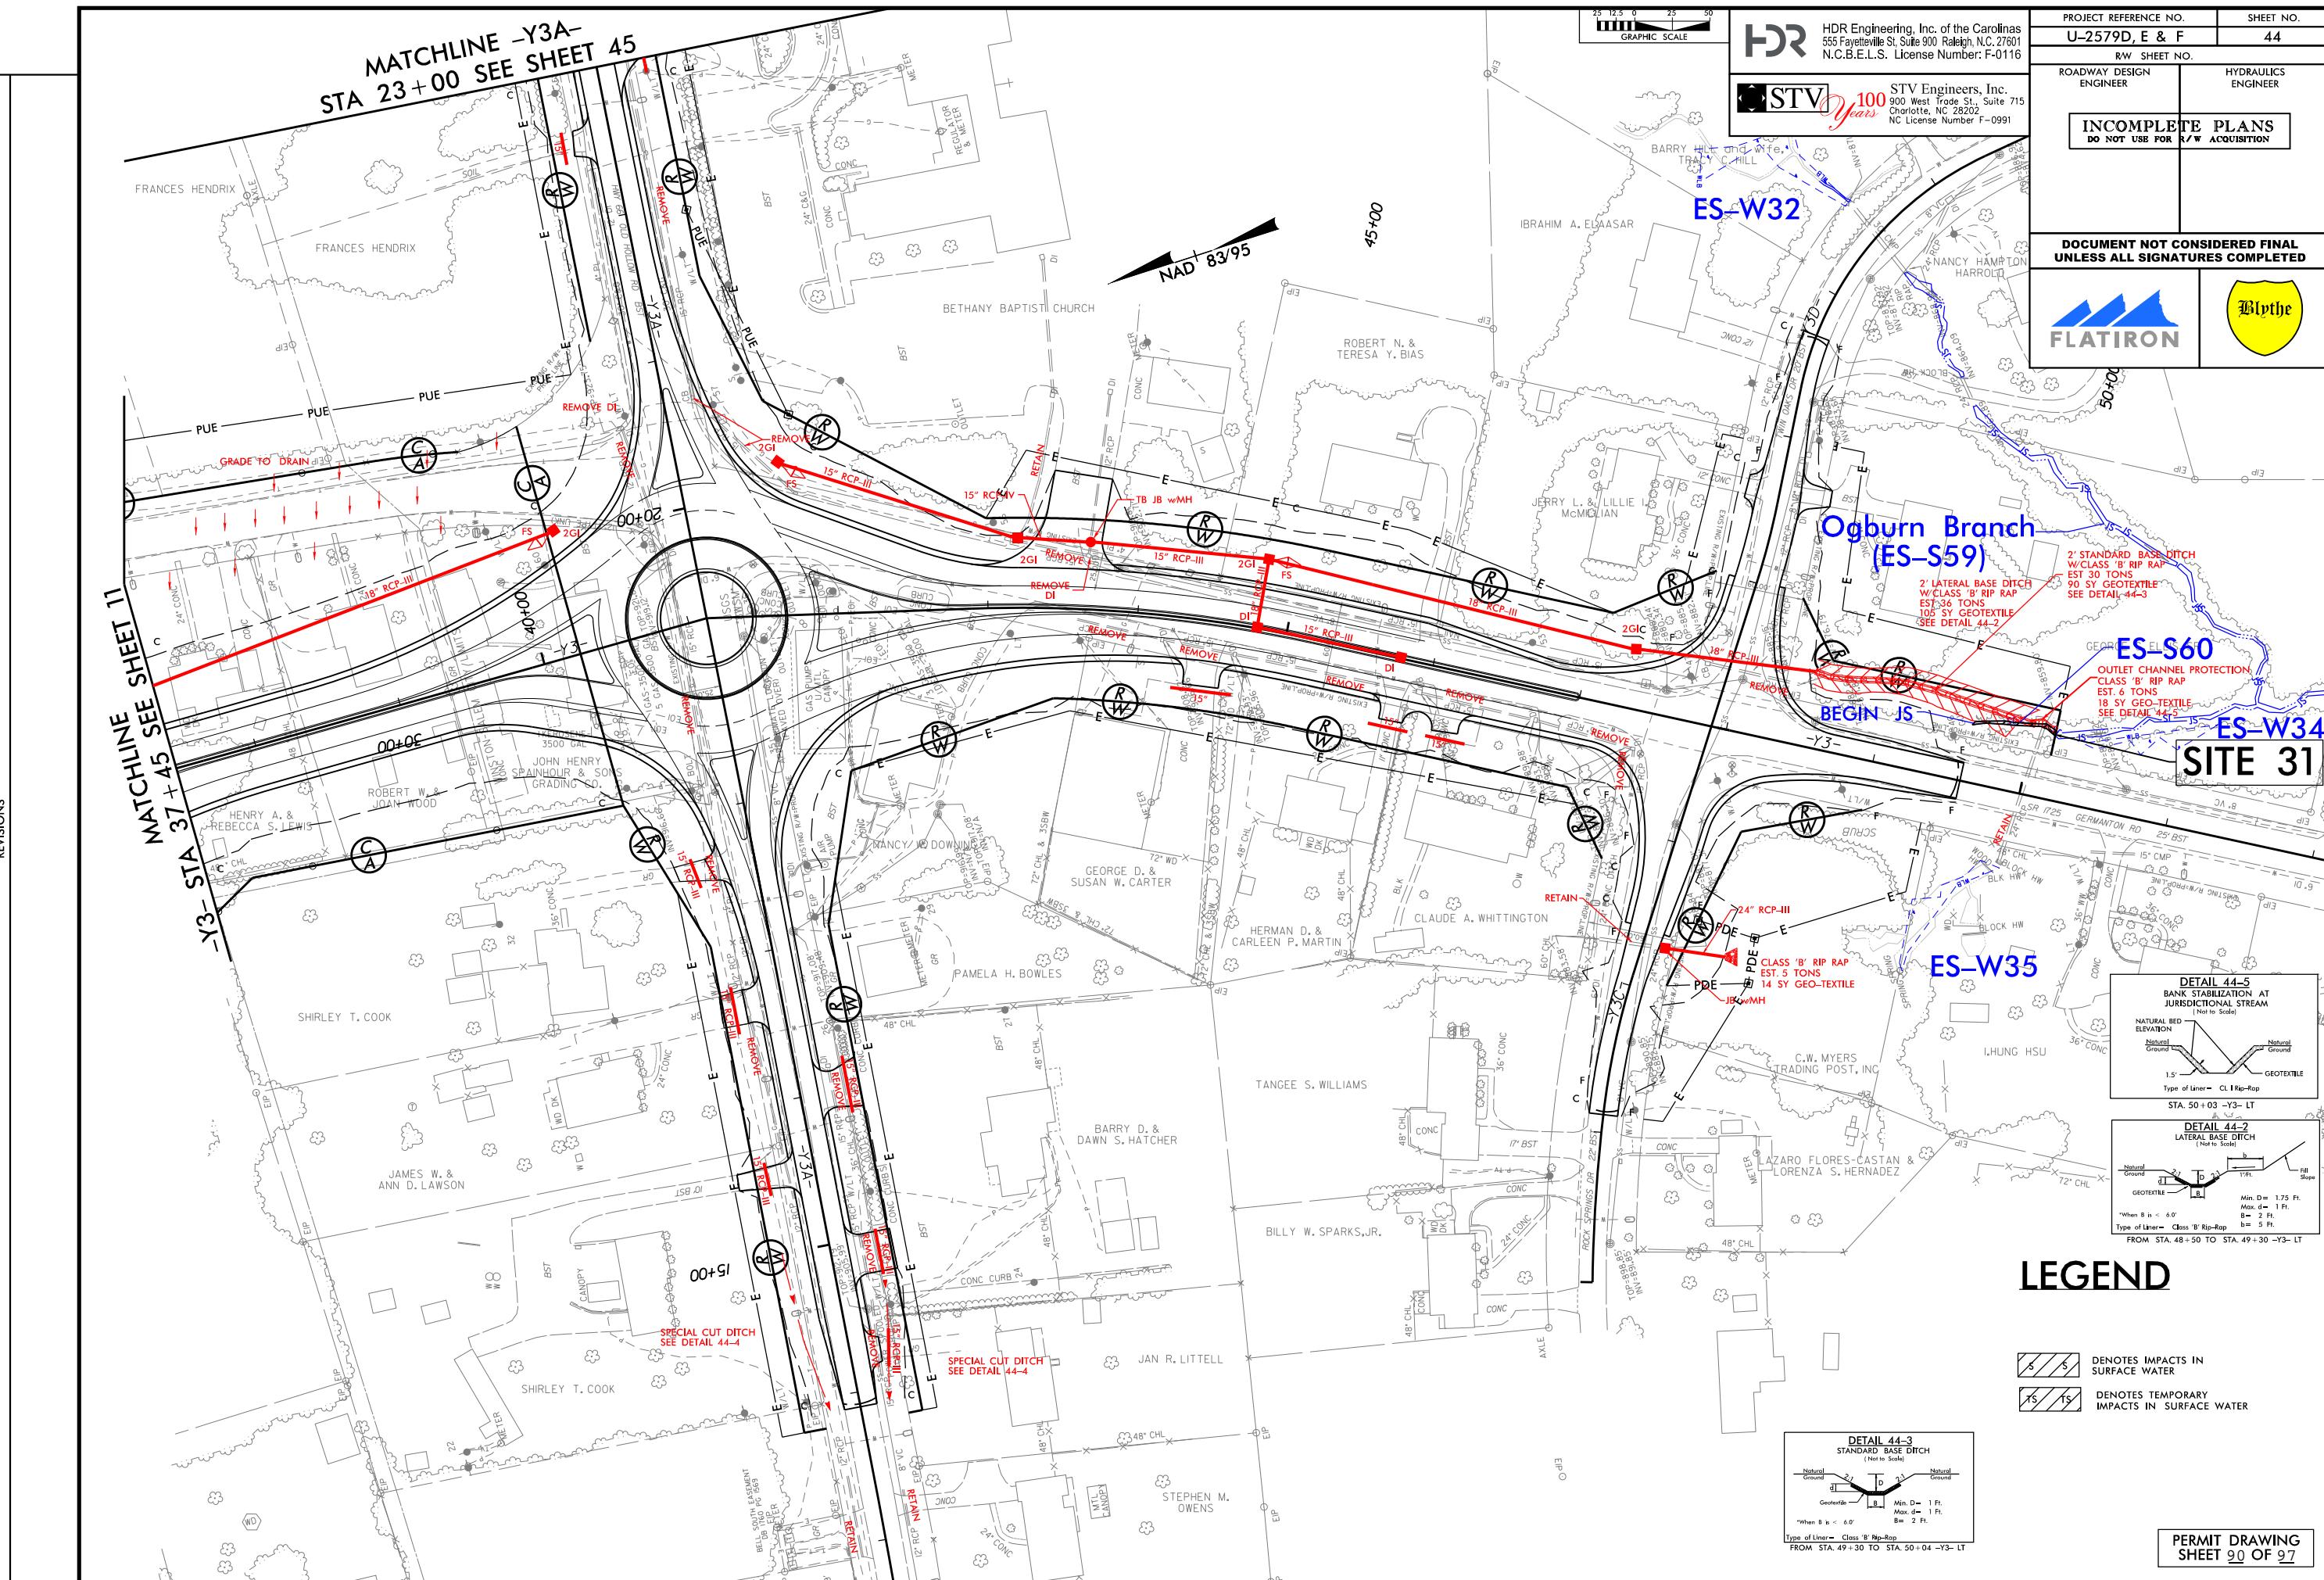

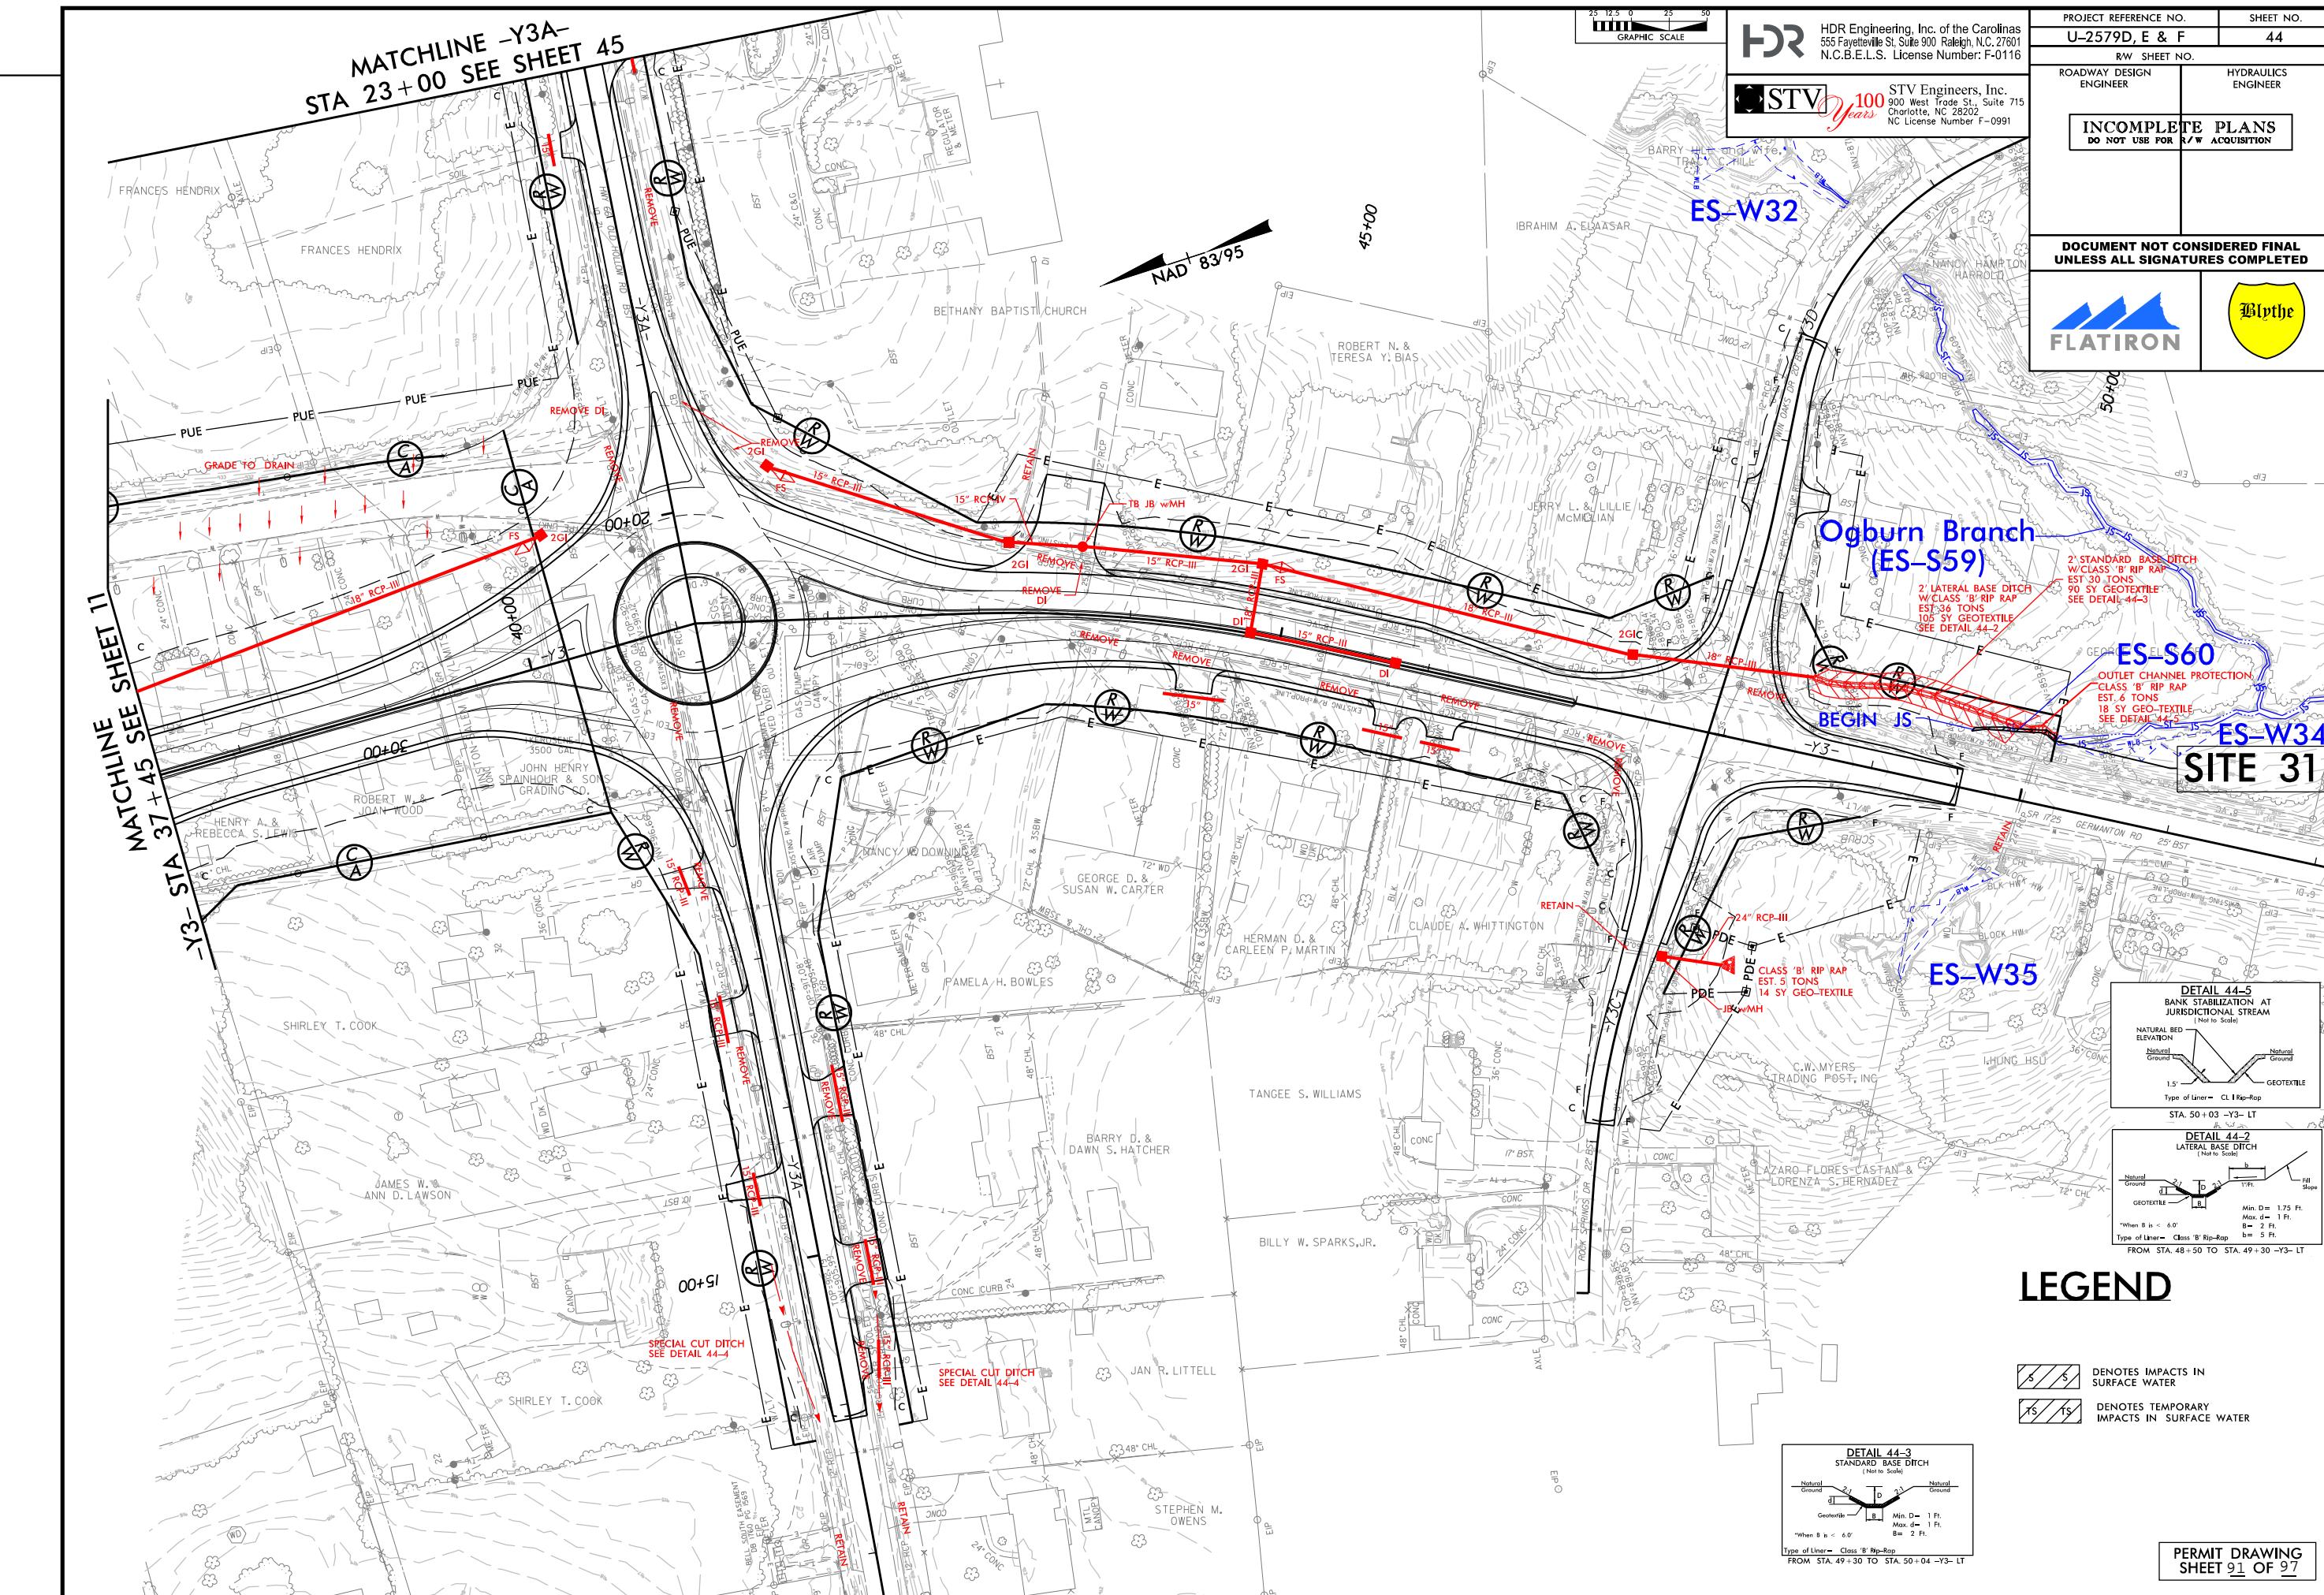

PLOT DRIVER: NCDOT-pdf-color_eng-100.pdf
PENTABLE: NCDOT-permits.CON.tdb
TIME: 8:23:15 AM
DATE: 12/20/2018
FILE: Flatiron_Construction_Corp\Flatiron_U-2579D_E\Hydraulics\PERMITS_Environmental Drawings\U-2579DEF_PRM_4C_PSH.dgn

REVISIONS

PENTABLE: NCDOT-permits.CON.tdb

TIME: 8:23:15 AM

DATE: 12/20/2018

FILE: Flatiron_Construction_Corp\Flatiron_U-2579D_E\Hydraulics\PERMITS_Environmental Drawings\U-2579DEF_PRM_4C_PSH.dgn

REVISIONS




MATCHLINE SEE SHEET 19
-Y6- STA 35 + 00

167

MILL CREEK
(ES-S17)

SITE 32

ES-S16
(166)

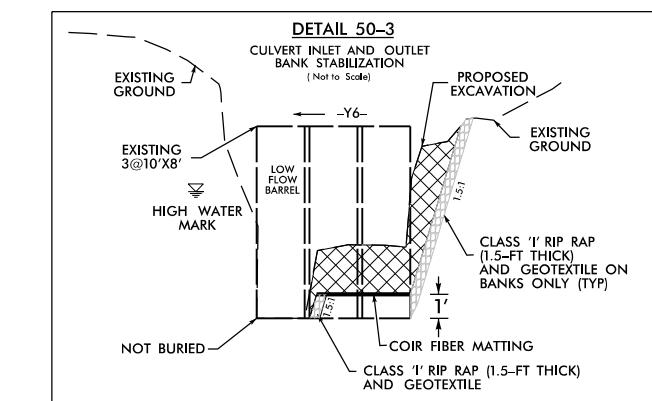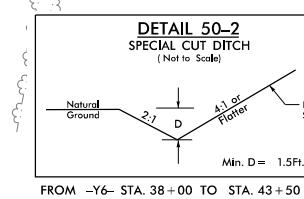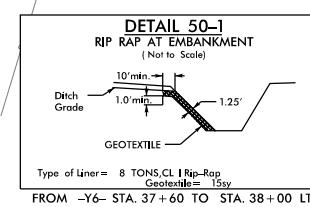

LEGEND:

DENOTES IMPACTS IN SURFACE WATER
 DENOTES TEMPORARY IMPACTS IN SURFACE WATER



HDR Engineering, Inc. of the Carolinas
555 Fayetteville St, Suite 900 Raleigh, NC 27601
N.C.B.E.L.S. License Number: F-0116

STV 100 Years
STV Engineers, Inc.
900 West Trade St., Suite 715
Charlotte, NC 28202
NC License Number F-0991

PROJECT REFERENCE NO.	SHEET NO.
U-2579D, E & F	50
R/W SHEET NO.	
ROADWAY DESIGN ENGINEER	HYDRAULICS ENGINEER
INCOMPLETE PLANS DO NOT USE FOR R/W ACQUISITION	

DOCUMENT NOT CONSIDERED FINAL
UNLESS ALL SIGNATURES COMPLETED



REVISIONS

MATCHLINE SEE SHEET 19
-Y6- STA 35 + 00

167

MILL CREEK
(ES-S17)

SITE 32

166

DETAIL 50-1
RIP RAP AT EMBANKMENT
(Not to Scale)
Type of liner = 8 TONS, CL I Rip-Rap
Geotextile = 15sy
FROM -Y6- STA. 37 + 60 TO STA. 38 + 00 LT

DETAIL 50-2
SPECIAL CUT DITCH
(Not to Scale)
Min. D = 1.5ft.
FROM -Y6- STA. 38 + 00 TO STA. 43 + 50 LT

DETAIL 50-3
CULVERT INLET AND OUTLET
BANK STABILIZATION
(Not to Scale)
EXISTING GROUND
EXISTING 3@10'X8'
HIGH WATER MARK
NOT BURIED
PROPOSED EXCAVATION
EXISTING GROUND
LOW FLOW BARREL
CLASS 'I' RIP RAP (1.5-FT THICK)
AND GEOTEXTILE ON BANKS ONLY (TYP)
COIR FIBER MATTING
CLASS 'I' RIP RAP (1.5-FT THICK)
AND GEOTEXTILE

LEGEND:
 DENOTES IMPACTS IN SURFACE WATER
 DENOTES TEMPORARY IMPACTS IN SURFACE WATER

GRAPHIC SCALE
25 12.5 0 25 50



HDR Engineering, Inc. of the Carolinas
555 Fayetteville St, Suite 900 Raleigh, NC 27601
N.C.B.E.L.S. License Number: F-0116



STV Engineers, Inc.
900 West Trade St., Suite 715
Charlotte, NC 28202
NC License Number F-0991

PROJECT REFERENCE NO. U-2579D, E & F	HEET NO. 50
R/W SHEET NO.	
ROADWAY DESIGN ENGINEER	HYDRAULICS ENGINEER
INCOMPLETE PLANS DO NOT USE FOR R/W ACQUISITION	

DOCUMENT NOT CONSIDERED FINAL
UNLESS ALL SIGNATURES COMPLETED



PERMIT DRAWING
SHEET 93 OF 97

PROJECT REFERENCE NO.		SHEET NO.
U-2579D,E & F		
ROADWAY DESIGN ENGINEER	HYDRAULICS ENGINEER	


DOCUMENT NOT CONSIDERED FINAL
UNLESS ALL SIGNATURES COMPLETED

SCALE:
1" = 50' HORIZONTAL
1" = 10' VERTICAL

250 200 150 100 50 0 50 100 150 200

SITE 32

870
860
850
840
830
820

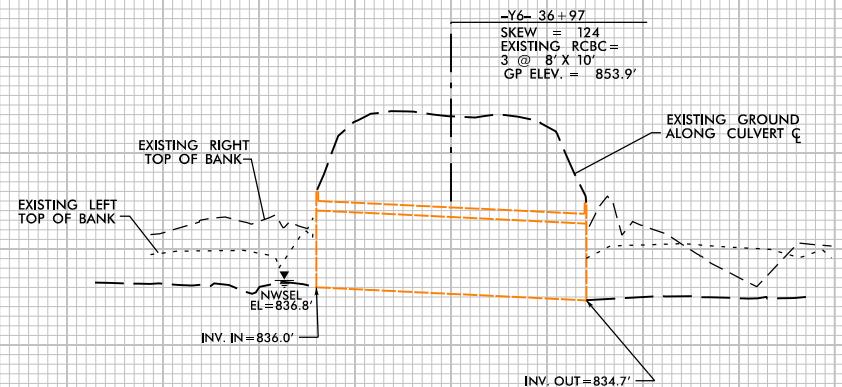

PROFILE ALONG C OF CULVERT

WETLAND PERMIT IMPACT SUMMARY												
Site No.	Station (From/To)	Structure Size / Type	WETLAND IMPACTS					SURFACE WATER IMPACTS				
			Permanent Fill In Wetlands (ac)	Temp. Fill In Wetlands (ac)	Excavation in Wetlands (ac)	Mechanized Clearing in Wetlands (ac)	Hand Clearing in Wetlands (ac)	Permanent SW impacts (ac)	Temp. SW impacts (ac)	Existing Channel Impacts Permanent (ft)	Existing Channel Impacts Temp. (ft)	Natural Stream Design (ft)
1	68+33 -L-	54" RCP						0.13		1522		
1	26+22 -Y1RPD LT	BANK STABILIZATION						< 0.01		20		
1A	68+85 -L- LT	ROADWAY FILL/ 54" RCP	0.06									
1B	68+33 -L-	ROADWAY FILL / 54" RCP	0.07									
1C	14+35 - Y1LPD- LT	ROADWAY FILL / 54" RCP	0.02									
1D	25+73 - Y1RPD- RT	ROADWAY FILL / 54" RCP	< 0.01									
2	20+56 - 20+97 -Y1RPA- RT	ROADWAY FILL / 66" RCP						< 0.01		86		
2A	20+79 -Y1RPA- RT	ROADWAY FILL / 66" RCP	0.01									
3	20+32 - 21+17 -Y1RPA- LT	ROADWAY FILL / 66" RCP						< 0.01		120		
4	69+66 -L- LT	ROADWAY FILL / 54" RCP						0.01		132		
5	77+90 -L-	6x6 RCBC						0.06	< 0.01	642	10	
5A	12+39 -Y1RPA- RT	6x6 RCBC	0.02									
5B	82+90 -L- LT	ROADWAY FILL / 36" RCP	< 0.01		< 0.01							
6	124+45 - 130+16 -L-	42" RCP						0.08	< 0.01	824	7	
6A	125+65 -L- RT	42" RCP	0.11		< 0.01	0.01						
7	130+19 -L-	6x6 RCBC						0.02		266		
8	137+73 -L-	42" RCP						0.06	< 0.01	918	19	
8A	138+12 -L- RT	42" RCP	< 0.01									
8B**	142+04 -L- RT	42" RCP/2' BASE DITCH	0.51									
9	150+71 -L-	36" RCP / 42" RCP						0.06		786		
9	21+60 -Y3RPA- RT	BANK STABILIZATION						< 0.01		14		
10	160+35 -L-	42" RCP						0.06	< 0.01	364	13	
10A	159+72 -L- LT	42" RCP	0.03			< 0.01						
10B	160+46 -L- RT	ROADWAY FILL	< 0.01									
TOTALS SHEET 1*:			0.87		< 0.01	0.01		0.49	< 0.01	5694	49	0

*Rounded totals are sum of actual impacts

NOTES:

**Wetland ES-W4 is a total take

- SITE 12 IS A CHANNEL RELOCATION
- SITE 21 IS A CHANNEL RELOCATION

NC DEPARTMENT OF TRANSPORTATION

DIVISION OF HIGHWAYS

10/29/2018

FORSYTH

U-2579D, E & F

34839.3.GV7

WETLAND PERMIT IMPACT SUMMARY											
Site No.	Station (From/To)	Structure Size / Type	WETLAND IMPACTS					SURFACE WATER IMPACTS			
			Permanent Fill In Wetlands (ac)	Temp. Fill In Wetlands (ac)	Excavation in Wetlands (ac)	Mechanized Clearing in Wetlands (ac)	Hand Clearing in Wetlands (ac)	Permanent SW impacts (ac)	Temp. SW impacts (ac)	Existing Channel Impacts Permanent (ft)	Natural Stream Design (ft)
11	173+80 -L-	48" RCP						0.04		615	
11A**	174+23 -L- RT	48" RCP	0.08								
12	203+75 - 207+10 -L- RT	ROADWAY FILL						0.02	< 0.01	410	10
12A	205+69 -L- RT	FILL IN WETLAND	0.08								
13	207+24 -L-	5x6 CULVERT						0.03	< 0.01	337	22
13A	209+14 -L- LT	4' BASE DITCH				< 0.01					
14	222+50 - 223+56 -L- RT	48" RCP						0.01	< 0.01	220	11
14A	222+65 -L- LT	POND						3.06			
15	242+86/244+20 -L-	5'x6' RCBC						0.05	< 0.01	520	15
15A	243+60/244+00 -L-	5'x6' RCBC	0.04								
16	253+92/255+58 -L-	42" RCP AND DITCH						0.05	< 0.01	513	20
17	261+02/262+96 -L-	6'x6' RCBC						0.08	< 0.01	928	23
18	275+75/276+78 -L-	42" RCP						0.03	< 0.01	161	11
19	279+30/280+86 -L-	5'x7' RCBC						0.04	< 0.01	250	11
19	280+86/281+71 -L-	5' STANDARD BASE DITCH						< 0.01	< 0.01	91	15
20	280+61/281+66 -L-	REMOVE 2 - 72" CMP						0.02	< 0.01	35	31
20A	286+51/286+74 -L-	BANK STABILIZATION						< 0.01	< 0.01	16	21
20B	285+56/285+81 -L-	BANK STABILIZATION						< 0.01	< 0.01	20	21
20C	285+19/285+65 -L-	TEMPORARY WORK PAD						0.06			165
21	285+19/285+65 -L-	CHANNEL CHANGE						< 0.01		133	
21	285+19 -L-	BANK STABILIZATION						< 0.01	< 0.01	10	10
22	303+57/304+09 -L-	30" RCP/ 36" RCP						< 0.01	< 0.01	97	7
23	316+25/317+41 -L-	6'x6' RCBC						0.04	< 0.01	348	11
23	317+40/317+49 -L-	BANK STABILIZATION						< 0.01	< 0.01	26	10
TOTALS SHEET 2*:			0.20			< 0.01		3.50	0.09	4730	414
*Rounded totals are sum of actual impacts											
NOTES: -**Wetland ES-W33 is total take -Site 24 is a Channel Relocation											
NC DEPARTMENT OF TRANSPORTATION DIVISION OF HIGHWAYS 10/29/2018 FORSYTH U-2579D, E & F 34839.3.GV7											
SHEET 96 OF 97											

WETLAND PERMIT IMPACT SUMMARY											
Site No.	Station (From/To)	Structure Size / Type	WETLAND IMPACTS					SURFACE WATER IMPACTS			
			Permanent Fill In Wetlands (ac)	Temp. Fill In Wetlands (ac)	Excavation in Wetlands (ac)	Mechanized Clearing in Wetlands (ac)	Hand Clearing in Wetlands (ac)	Permanent SW impacts (ac)	Temp. SW impacts (ac)	Existing Channel Impacts Permanent (ft)	Natural Stream Design (ft)
24	316+84/317+01 -L-	CHANNEL CHANGE						< 0.01	< 0.01	120	10
25	323+23/325+22 -L-	24" RCP						0.02	< 0.01	294	10
26	335+66/338+74 -L-	6'x6' RCBC						0.05	< 0.01	519	10
26	338+82 -L-	BANK STABILIZATION						< 0.01	< 0.01	24	10
27	356+07/357+64 -L-	7'x7' RCBC						0.05		328	
27	356+07 -L- LT	BANK STABILIZATION						< 0.01	< 0.01	35	8
27	357+63 -L- RT	BANK STABILIZATION						< 0.01	< 0.01	37	12
28**	397+37/400+85 -L-	ROADWAY FILL	0.26								
29**	398+61/405+73 -L-	ROADWAY FILL / 5' BASE DITCH						0.06		906	
29**	398+61/405+73 -L-	BANK STABILIZATION						< 0.01	< 0.01	40	10
29A**	401+96 -L-	ROADWAY FILL	< 0.01								
29B**	402+33/405+59 -L-	ROADWAY FILL / 5' BASE DITCH	0.26		0.03	0.01					
30***	409+52/411+61 -L-	54" RCP						0.05	< 0.01	563	14
30***	409+53 -L-	BANK STABILIZATION						< 0.01	< 0.01	15	10
31	49+59 - 50+28 -Y3- LT	2' BASE DITCH						< 0.01		57	
32	35+68/37+32 -Y6-	BANK STABILIZATION						0.03	< 0.01	172	19
33	173+50 -L- LT	CHANNEL IMPROVEMENT TIE-IN						0.03	< 0.01	20	21
34	357+38/357+49 -L-	BANK STABILIZATION						< 0.01	< 0.01	24	11
		TOTAL SHEET 1	0.87		< 0.01	0.01		0.49	< 0.01	5694	49
		TOTAL SHEET 2	0.20			< 0.01		3.50	0.09	4730	414
		TOTAL SHEET 3	0.53		0.03	0.01		0.30	0.02	3154	145
TOTALS ALL SHEETS*:			1.60	0.00	0.03	0.03	0.00	4.30	0.11	13578	608

*Rounded totals are sum of actual impacts
** SITE 28, 29, 29A, AND 29B - SITE 1 IN U-2579C PHASE 2 PERMIT
*** SITE 30 - SITE 2 IN U-2579C PHASE 2 PERMIT

NOTES
- ISOLATED WETLANDS SITE
- SITE 24 IS A CHANNEL RELOCATION

NC DEPARTMENT OF TRANSPORTATION
DIVISION OF HIGHWAYS
10/29/2018
FORSYTH
U-2579D, E & F
34839.3.GV7