

PROJECT COMMITMENTS

T.I.P Project No. I-3819B
Proposed I-40/I-77 Interchange Area Improvements
Iredell County
WBS Element 34192.1.2

COMMITMENTS FROM PROJECT DEVELOPMENT AND DESIGN

In addition to the Section 404 Conditions, Regional Conditions, State Consistency, North Carolina Department of Transportation's (NCDOT) Guidance for Best Management Practices for the Protection of Surface Waters, General Certification Conditions, and Section 401 Conditions for Certification, State Stormwater Permit, NCDOT has agreed to the following special commitments:

Roadway Design Unit

Wetlands: Additional area of wetlands in the southwest quadrant of the I-40/I-77 interchange will be bridged to minimize impacts. Fill slopes will not encroach into the jurisdictional wetland boundaries any more than practicable as shown in the preliminary design.

Structures over Fourth Creek will accommodate the existing Museum Greenway path: The new and widened structures at SR 1934 (Hillside Lane) extension, I-40 and I-77, and their associated ramps shall be designed to span the existing greenway that follows Fourth Creek.

Retaining walls at Pressly Elementary School and Northview Elementary School: In order to minimize the impact to the grounds of these schools, a retaining wall along the proposed shoulder of I-40 and I-77 shall be constructed in accordance with NCDOT construction standards.

The retaining wall for Northview Elementary School was constructed as part of the I-3819A project.

Noise Mitigation:

A final design noise report will be performed based on the results of the planning noise study. Noise mitigation will be provided as required in accordance with the NCDOT Noise Abatement Policy.

COMMITMENTS FROM PERMITTING

See 404 Permit and 401 Certification for special conditions developed during permitting.



DEPARTMENT OF THE ARMY
WILMINGTON DISTRICT, CORPS OF ENGINEERS
69 DARLINGTON AVENUE
WILMINGTON, NORTH CAROLINA 28403-1343

February 25, 2021

Regulatory Division

DA No. SAW-2018-01504

Philip S. Harris III, P.E., C.P.M.
Project Development and Environmental Analysis Branch
North Carolina Department of Transportation
1598 Mail Service Center
Raleigh, NC, 27699-1598

Dear Mr. Harris:

Reference the Department of the Army (DA) individual permit issued on January 21, 2020, to the North Carolina Department of Transportation (NCDOT), for impacts associated with the I-40/I-77 interchange improvements project (TIP Nos. I-3819B/U-6039), including I-40 from west of SR 2003 (Radio Road) to SR 2158 (Old Mocksville Road) and I-77 from south of SR 2321 (East Broad Street) to south of SR 2171 (Jane Sowers Road), in Iredell County, North Carolina.

On November 24, 2020, the U.S. Army Corps of Engineers (Corps) received your request to modify the standard permit for the I-3819B/U-6039 project. The request included a variance request for specific cross-pipes that will not be embedded, revisions to the drainage design, minor modifications to permitted impacts, and a revised mitigation proposal. The total waters of the U.S. impacts, including utilities, for I-3819B/U-6039 modified design are: 1.55 acres of permanent wetland impacts (including 0.33 acre mechanized clearing), 2.66 acres of temporary wetland impacts, 3,213 linear feet of permanent stream impacts, of which 1,047 linear feet are bank stabilization, and 471 linear feet of temporary stream impacts. Non-404 wetland impacts are less than 0.01 acre of hand clearing.

The Corps has completed the evaluation of your request and has determined that it is appropriate and reasonable, and no public notice is required for this modification. Therefore, the permit is modified as requested, including requested exemptions from pipe burial and revised mitigation (revised Mitigation Responsibility Transfer form is enclosed), and as shown on the revised PERMIT DRAWINGS, Sheets 1 through 67 (I-3819B/U-6039), Rev. 11/02/2020, and UTILITY PERMIT DRAWINGS, Sheets 1 through 8 (I-3819B/U-6039), Rev. 11/02/2020.

For your information, the following special conditions from the original authorization have been updated to include the new compensatory mitigation requirements (enclosed), and the new modified permit drawings:

Special Conditions

1. Work Limits: All work authorized by this permit shall be performed in strict compliance with the following sets of plans: PERMIT DRAWINGS, Sheets 1 through 67 (I-3819B/U-6039), Rev. 11/02/2020, and UTILITY PERMIT DRAWINGS, Sheets 1 through 8 (I-3819B/U-6039), Rev. 11/02/2020; which are part of this permit. The Permittee shall ensure the construction design plans for this project do not deviate from the specified permit drawings. Any modification to the attached permit plans must be approved by the U.S. Army Corps of Engineers prior to any active construction in waters or wetlands.

14. In order to compensate for impacts associated with this permit, mitigation shall be provided in accordance with the provisions outlined on the most recent version of the attached Compensatory Mitigation Responsibility Transfer Form. The requirements of this form, including any special conditions listed on this form, are hereby incorporated as special conditions of this permit.

15. You must comply with the following conditions specified in the February 12, 2021 water quality certification:

Condition(s) of Certification

1. Exemption for pipe burial at Permitted Sites 16, 17, 18, 19, 21, 22, 24, 25, and 27 are granted as requested based on the condition of the existing pipe. The existing pipes are perched and meeting burial requirements will be impossible within current right of way lines. However, the permittee will be expected to incorporate acceptable stream structures, such as rock ladders, at these sites to restore aquatic passage to the maximum extent practicable.

2. This modification is applicable only to the additional proposed activities. All of the authorized activities and conditions of certification associated with the original Water Quality Certification dated November 19, 2019 and subsequent modification dated January 30, 2020 still apply except where superseded by this certification.

All other conditions of the permit, including the permit expiration date of December 31, 2025, remain in effect as written. Should you have any questions, contact Mr. Eric Alsmeyer, via email at Eric.C.Alsmeier@usace.army.mil or by telephone at (919) 554-4884, extension 23.

FOR THE COMMANDER

 Date: 2021.02.25
15:00:57 -05'00'

Monte Matthews
Lead Project Manager
Wilmington District

Enclosures

Electronic Copies Furnished with Enclosures:

Ms. Beth Harmon
NC Division of Mitigation Services
beth.harmon@ncdenr.gov

Ms. Erin Cheely
NCDOT
ekcheely@ncdot.gov

U.S. ARMY CORPS OF ENGINEERS
Wilmington District
Compensatory Mitigation Responsibility Transfer Form

Permittee: NCDOT

Action ID: SAW-2018-01504

Project Name: TIPS I-3819B/U-6039_I-77_I-40 Interchange_Div12 (Mod01)

County: Iredell

Instructions to Permittee: The Permittee must provide a copy of this form to the Mitigation Sponsor, either an approved Mitigation Bank or the North Carolina Division of Mitigation Services (NCDMS), who will then sign the form to verify the transfer of the mitigation responsibility. Once the Sponsor has signed this form, it is the Permittee's responsibility to ensure that to the U.S. Army Corps of Engineers (USACE) Project Manager identified on page two is in receipt of a signed copy of this form before conducting authorized impacts, unless otherwise specified below. If more than one mitigation Sponsor will be used to provide the mitigation associated with the permit, or if the impacts and/or the mitigation will occur in more than one 8-digit Hydrologic Unit Code (HUC), multiple forms will be attached to the permit, and the separate forms for each Sponsor and/or HUC must be provided to the appropriate mitigation Sponsors.

Instructions to Sponsor: The Sponsor must verify that the mitigation requirements (credits) shown below are available at the identified site. By signing below, the Sponsor is accepting full responsibility for the identified mitigation, regardless of whether or not they have received payment from the Permittee. Once the form is signed, the Sponsor must update the bank ledger and provide a copy of the signed form and the updated bank ledger to the Permittee, the USACE Project Manager, and the Wilmington District Mitigation Office (see contact information on page 2). The Sponsor must also comply with all reporting requirements established in their authorizing instrument.

Permitted Impacts and Compensatory Mitigation Requirements

Permitted Impacts Requiring Mitigation*:

8-digit HUC and Basin: Choose the 8-digit HUC

Stream Impacts (linear feet)			Wetland Impacts (acres)			
Warm	Cool	Cold	Riparian Riverine	Riparian Non-Riverine	Non-Riparian	Coastal
2,166				1.55		

*If more than one mitigation sponsor will be used for the permit, only include impacts to be mitigated by this sponsor.

Compensatory Mitigation Requirements:

8-digit HUC and Basin: Choose the 8-digit HUC

Stream Mitigation (credits)			Wetland Mitigation (credits)			
Warm	Cool	Cold	Riparian Riverine	Riparian Non-Riverine	Non-Riparian	Coastal
4,332				3.10		

Mitigation Site Debited: _____

(List the name of the bank to be debited. For umbrella banks, also list the specific site. For NCDMS, list NCDMS. If the NCDMS acceptance letter identifies a specific site, also list the specific site to be debited).

Section to be completed by the Mitigation Sponsor

Statement of Mitigation Liability Acceptance: I, the undersigned, verify that I am authorized to approve mitigation transactions for the Mitigation Sponsor shown below, and I certify that the Sponsor agrees to accept full responsibility for providing the mitigation identified in this document (see the table above), associated with the USACE Permittee and Action ID number shown. I also verify that released credits (and/or advance credits for NCDMS), as approved by the USACE, are currently available at the mitigation site identified above. Further, I understand that if the Sponsor fails to provide the required compensatory mitigation, the USACE Wilmington District Engineer may pursue measures against the Sponsor to ensure compliance associated with the mitigation requirements.

Mitigation Sponsor Name: _____

Name of Sponsor's Authorized Representative: _____

Signature of Sponsor's Authorized Representative

Date of Signature

**USACE Wilmington District
Compensatory Mitigation Responsibility Transfer Form, Page 2**

Conditions for Transfer of Compensatory Mitigation Credit:

- Once this document has been signed by the Mitigation Sponsor and the USACE is in receipt of the signed form, the Permittee is no longer responsible for providing the mitigation identified in this form, though the Permittee remains responsible for any other mitigation requirements stated in the permit conditions.
- Construction within jurisdictional areas authorized by the permit identified on page one of this form can begin only after the USACE is in receipt of a copy of this document signed by the Sponsor, confirming that the Sponsor has accepted responsibility for providing the mitigation requirements listed herein. For authorized impacts conducted by the North Carolina Department of Transportation (NCDOT), construction within jurisdictional areas may proceed upon permit issuance; however, a copy of this form signed by the Sponsor must be provided to the USACE within 30 days of permit issuance. NCDOT remains fully responsible for the mitigation until the USACE has received this form, confirming that the Sponsor has accepted responsibility for providing the mitigation requirements listed herein.
- Signed copies of this document must be retained by the Permittee, Mitigation Sponsor, and in the USACE administrative records for both the permit and the Bank/ILF Instrument. It is the Permittee's responsibility to ensure that the USACE Project Manager (address below) is provided with a signed copy of this form.
- If changes are proposed to the type, amount, or location of mitigation after this form has been signed and returned to the USACE, the Sponsor must obtain case-by-case approval from the USACE Project Manager and/or North Carolina Interagency Review Team (NCIRT). If approved, higher mitigation ratios may be applied, as per current District guidance and a new version of this form must be completed and included in the USACE administrative records for both the permit and the Bank/ILF Instrument.

Comments/Additional Conditions: This form replaces any previous forms for this project.

This form is not valid unless signed below by the USACE Project Manager and by the Mitigation Sponsor on Page 1. ***Once signed, the Sponsor should provide copies of this form along with an updated bank ledger to: 1) the Permittee, 2) the USACE Project Manager at the address below, and 3) the Wilmington District Mitigation Office, Attn: Todd Tugwell, 3331 Heritage Trade Drive, Suite 105, Wake Forest, NC 27587 (email: todd.tugwell@usace.army.mil).*** Questions regarding this form or any of the permit conditions may be directed to the USACE Project Manager below.

USACE Project Manager: Eric Alsmeyer
USACE Field Office: Raleigh Regulatory Field Office
US Army Corps of Engineers
3331 Heritage Trade Drive, Suite 105
Wake Forest, NC 27587
Email: eric.c.alsmeyer@usace.army.mil



USACE Project Manager Signature

February 25, 2021

Date of Signature

Current Wilmington District mitigation guidance, including information on mitigation ratios, functional assessments, and mitigation bank location and availability, and credit classifications (including stream temperature and wetland groupings) is available at <http://ribits.usace.army.mil>.



ROY COOPER

Governor

MICHAEL S. REGAN

Secretary

S. DANIEL SMITH

Director

February 12, 2021

Mr. Philip S. Harris, III, P.E., CPM
Environment Analysis Unit Head
North Carolina Department of Transportation
1598 Mail Service Center
Raleigh, North Carolina, 27699-1598

Subject: Modification to the 401 Water Quality Certification Pursuant to Section 401 of the Federal Clean Water Act with ADDITIONAL CONDITIONS for Proposed improvements to the I-77 and I-40 interchange in Iredell County, including Broad Street improvements, TIP I-3819B, U-6039, WBS 34192.3.2. NCDWR Project No. 20191006 v.2

Dear Mr. Harris:

Attached hereto is a modification of Certification No. WQC004203 issued to The North Carolina Department of Transportation (NCDOT) dated November 19, 2019 and Addendum and Correction issued on January 20, 2020.

If we can be of further assistance, do not hesitate to contact us.

Sincerely,

DocuSigned by:

Amy Chapman

9C9886312DCD474...

S. Daniel Smith, Director

Division of Water Resources

Attachments

Electronic copy only distribution:

Eric Alsmeyer, US Army Corps of Engineers, Raleigh Field Office
Jeff Wyatt, Division 12 Environmental Officer
Michael Turchy, NC Department of Transportation
Amanetta Somerville, US Environmental Protection Agency
Janet Mizzi, US Fish and Wildlife Service
Marla Chambers, NC Wildlife Resources Commission
Donna Hood, NC Division of Water Resources Mooresville Regional Office
File Copy



North Carolina Department of Environmental Quality | Division of Water Resources
512 North Salisbury Street | 1617 Mail Service Center | Raleigh, North Carolina 27699-1617
919.707.9000

**Modification to the 401 Water Quality Certification Pursuant to Section 401 of the Federal Clean Water Act
with ADDITIONAL CONDITIONS**

THIS CERTIFICATION is issued in conformity with the requirements of Section 401 Public Laws 92-500 and 95-217 of the United States and subject to the North Carolina Division of Water Resources (NCDWR) Regulations in 15 NCAC 2H .0500 This certification authorizes the NCDOT to impact an additional **2.66 acres** of jurisdictional wetlands and **105 linear feet** of jurisdictional streams in Iredell County. The project shall be constructed pursuant to the modification dated received December 2, 2020. The authorized impacts are as described below:

Site	Bank Stabilization (linear feet)	Permanent Fill in Intermittent Stream (linear ft)	Temporary Fill in Intermittent Stream (linear ft)	Permanent Fill in Perennial Stream (linear ft)	Temporary Fill in Perennial Stream (linear ft)	Total Stream Impact (linear ft)	Stream Impacts Requiring Mitigation (linear ft)
<u>2</u> 16+70-21+50YRP CA	42				20	62	
<u>3</u> 15+75-YRPC				206	10	216	
<u>5</u> 70+00-73+85 YRPAC					40 77	40 77	
<u>6</u> 121+50-Y-LT	12				20	32	
<u>7</u> 120+90-Y-RT	12				20	32	
<u>9</u> 28+50-34+00-YRPAC				747	10	757	747
<u>9A</u>					+50	50	
<u>10</u> 28+00-YRPAC	25				20	45	
<u>12</u> 149+00-150+00 L				10	54	64	
<u>13</u> 167+00 RT	44			17	10	71	17
<u>14</u> 28+50-Y		17	10			27	
<u>15</u> 33+75-Y	11		20			31	
<u>16</u> 35+90-37+20-Y		112 113	10			122 123	
<u>17</u> 37+70-38+50-Y				115 114	14	129 128	
<u>18</u> 47+50-Y				72	10	82	
<u>19</u> 46+00-Y				34		34	
<u>20</u> 68+50-Y				61	10	71	
<u>21</u> 69+20-70+20-Y				176	21	197	176
<u>22</u> 71+30-84+00-Y	873 901			467 455	10	1350	467 455

23 87+70-Y					33	33	
24 93+75-Y				49	10	59	
25 94+50				44 31	32 21	76 52	
27 210+00-Y				48	10	58	
28				16	11	27	
Total	1019 1047	129 130	40	2046 2036	354 441	3588 3678	1407 1395

Total Stream Impact for Project: ~~3588 linear feet~~, 3778 linear feet
DWR Required Mitigation: ~~1407 linear feet~~, 1395 linear feet
ACOE Mitigation: ~~2175 linear feet~~, 2166 linear feet

Wetland Impacts in the Yadkin-PeeDee River Basin

Site	Fill (ac)	Fill (temporary) (ac)	Excavation (ac)	Mechanized Clearing (ac)	Hand Clearing (ac)	Area under Bridge (ac)	Total Wetland Impact (ac)
2 14+00-21+50 YRPCA	0.32			0.09			0.41
2 16+70-21+50YRPC A	0.02	0.62		0.02	0.62 0		0.66
3 15+75-YRPC	<0.01			0.01			0.02
4 24+00-YRPC				0.02			0.02
5 70+00-76+25 YRPAC	0.03	2.04		0.05	1.94 0		2.03 2.12
8 19+00-YRPDB	<0.01			<0.01			0.01
9 28+50-34+00-YRPAC	0.40			0.08			0.47
11 26+50-26+50-YRPAC	0.19			0.02			0.21

<u>26</u> 116+70-120+10-Y	0.09			0.04			0.13
<u>U-1</u> 31+50-YRPD	0.02						0.02
<u>U-2</u> 75+00-YRPAC	<0.01	0.25		0.02			0.27
<u>U-3</u> 18+92 YRPDB					<0.01		0.01
<u>U-4</u>				0.14			0.14
Total	1.08	0.27 2.93	0	0.37 0.49	2.57 0		1.41 1.55

Total Wetland Impact for Project: 1.41 acres, 1.55 acres

Additional Wetland Impacts: +0.14

The application provides adequate assurance that the discharge of fill material into the waters of the Catawba River Basin in conjunction with the proposed development will not result in a violation of applicable Water Quality Standards and discharge guidelines. Therefore, the State of North Carolina certifies that this activity will not violate the applicable portions of Sections 301, 302, 303, 306, 307 of PL 92-500 and PL 95-217 if conducted in accordance with the application and conditions hereinafter set forth.

This approval is only valid for the purpose and design that you submitted in your modified application dated received November 24, 2020. All the authorized activities and conditions of certification associated with the original Water Quality Certification dated November 19, 2019 and January 30, 2020 still apply except where superseded by this certification. Should your project change, you are required to notify the NCDWR and submit a new application. If the property is sold, the new owner must be given a copy of this Certification and approval letter, and is thereby responsible for complying with all the conditions. If any additional wetland impacts, or stream impacts, for this project (now or in the future) exceed one acre or 150 linear feet, respectively, additional compensatory mitigation may be required as described in 15A NCAC 2H .0506 (h) (6) and (7). For this approval to remain valid, you are required to comply with all the conditions listed below. In addition, you should obtain all other federal, state or local permits before proceeding with your project including (but not limited to) Sediment and Erosion control, Coastal Stormwater, Non-discharge and Water Supply watershed regulations. This Certification shall expire on the same day as the expiration date of the corresponding Corps of Engineers Permit.

Condition(s) of Certification:

1. Exemption for pipe burial at Permitted Sites 16, 17, 18, 19, 21, 22, 24, 25, and 27 are granted as requested based on the condition of the existing pipe. The existing pipes are perched and meeting burial requirements will be impossible within current right of way lines. However, the permittee will be expected to incorporate acceptable stream structures, such as rock ladders, at these sites to restore aquatic passage to the maximum extent practicable.
2. This modification is applicable only to the additional proposed activities. All of the authorized activities and conditions of certification associated with the original Water Quality Certification dated November 19, 2019 and subsequent modification dated January 30, 2020 still apply except where superseded by this certification.

Violations of any condition herein set forth may result in revocation of this Certification and may result in criminal and/or civil penalties. This Certification shall become null and void unless the above conditions are made conditions of the Federal 404 and/or Coastal Area Management Act Permit. This Certification shall expire upon the

expiration of the 404 or CAMA permit.

If you wish to contest any statement in the attached Certification you must file a petition for an administrative hearing. You may obtain the petition form from the office of Administrative hearings. You must file the petition with the office of Administrative Hearings within sixty (60) days of receipt of this notice. A petition is considered filed when it is received in the office of Administrative Hearings during normal office hours. The Office of Administrative Hearings accepts filings Monday through Friday between the hours of 8:00am and 5:00pm, except for official state holidays. The original and one (1) copy of the petition must be filed with the Office of Administrative Hearings.

The petition may be faxed-provided the original and one copy of the document is received by the Office of Administrative Hearings within five (5) business days following the faxed transmission.
The mailing address for the Office of Administrative Hearings is:

Office of Administrative Hearings
6714 Mail Service Center
Raleigh, NC 27699-6714
Telephone: (919) 431-3000, Facsimile: (919) 431-3100

A copy of the petition must also be served on DEQ as follows:

Mr. Bill F. Lane, General Counsel
Department of Environmental Quality
1601 Mail Service Center

This the 12th day of February 2021

DIVISION OF WATER RESOURCES

DocuSigned by:

Amy Chapman

9C9886312DCD474...

S. Daniel Smith, Director

WQC No. 004203



NORTH CAROLINA
Environmental Quality

ROY COOPER

Governor

MICHAEL S. REGAN

Secretary

S. DANIEL SMITH

Director

NCDWR Project No.: _____ **County:** _____

Applicant: _____

Project Name: _____

Date of Issuance of 401 Water Quality Certification: _____

Certificate of Completion

Upon completion of all work approved within the 401 Water Quality Certification or applicable Buffer Rules, and any subsequent modifications, the applicant is required to return this certificate to the 401 Transportation Permitting Unit, North Carolina Division of Water Resources, 1617 Mail Service Center, Raleigh, NC, 27699-1617. This form may be returned to NCDWR by the applicant, the applicant's authorized agent, **or** the project engineer. It is not necessary to send certificates from all of these.

Applicant's Certification

I, _____, hereby state that, to the best of my abilities, due care and diligence was used in the observation of the construction such that the construction was observed to be built within substantial compliance and intent of the 401 Water Quality Certification and Buffer Rules, the approved plans and specifications, and other supporting materials.

Signature: _____ Date: _____

Agent's Certification

I, _____, hereby state that, to the best of my abilities, due care and diligence was used in the observation of the construction such that the construction was observed to be built within substantial compliance and intent of the 401 Water Quality Certification and Buffer Rules, the approved plans and specifications, and other supporting materials.

Signature: _____ Date: _____

Engineer's Certification

_____ Partial _____ Final

I, _____, as a duly registered Professional Engineer in the State of North Carolina, having been authorized to observe (periodically, weekly, full time) the construction of the project for the Permittee hereby state that, to the best of my abilities, due care and diligence was used in the observation of the construction such that the construction was observed to be built within substantial compliance and intent of the 401 Water Quality Certification and Buffer Rules, the approved plans and specifications, and other supporting materials.

Signature _____ Registration No. _____
Date _____



North Carolina Department of Environmental Quality | Division of Water Resources
512 North Salisbury Street | 1617 Mail Service Center | Raleigh, North Carolina 27699-1617
919.707.9000

Pre-Filing Time Clock has been reached for I-3819 B - 20191006 Ver 3

laserfiche@ncdenr.gov <laserfiche@ncdenr.gov>

Wed 4/14/2021 12:00 AM

To: Turchy, Michael A <maturchy@ncdot.gov>

Cc: Hood, Donna <donna.hood@ncdenr.gov>

 1 attachments (52 KB)

DWR Pre-Filing Meeting Request Form.pdf;

The North Carolina Division of Water Resources has received the Pre-Filing Meeting Request Form for I-3819 B that you submitted on 3/14/2021. The ID number for that project is 20191006, Version 3.

Your Pre-Filing Meeting Request has now reached the 30 calendar days' requirement and your application can now be accepted.

When you submit your application please upload a copy of the attached document in this email.

This email was automatically generated by Laserfiche workflow. Please do not respond to this email address, as responses are not monitored.

For internal use only: Transportation Project

DWR Pre-Filing Meeting Request Form



ID#* 20191006 **Version*** 3

Regional Office* Mooresville Regional Office - (704) 663-1699

Reviewer List* Donna Hood

Pre-Filing Meeting Request submitted 3/14/2021

Contact Name* Michael Turchy

Contact Email Address* maturchy@ncdot.gov

Project Name* I-3819 B

Project Owner* NCDOT

Project County* Iredell

Owner Address:

Street Address	
1598 Mail Service Center	
Address Line 2	
City	State / Province / Region
Raleigh	NC
Postal / Zip Code	Country
27699	US

Is this a transportation project?* ☒ Yes ☐ No

Type(s) of approval sought from the DWR:

- | | |
|--|--|
| ☐ 401 Water Quality Certification - Regular | ☐ 401 Water Quality Certification - Express |
| ☒ Individual Permit | ☒ Modification |
| ☐ Shoreline Stabilization | |

Does this project have an existing project ID#?*

☒ Yes ☐ No

Please list all existing project ID's associated with this projects.*

20191006v2

Do you know the name of the staff member you would like to request a meeting with?

No Meeting Requested

Please give a brief project description below and include location information.*

This is a future/anticipated modification request. No meeting is requested.

Please give a couple of dates you are available for a meeting.

Please attach the documentation you would like to have the meeting about.

pdf only

By digitally signing below, I certify that I have read and understood that per the Federal Clean Water Act Section 401 Certification Rule the following statements:

- This form completes the requirement of the Pre-Filing Meeting Request in the Clean Water Act Section 401 Certification Rule.
- I understand by signing this form that I cannot submit my application until 30 calendar days after this pre-filing meeting request.
- I also understand that DWR is not required to respond or grant the meeting request.

Your project's thirty-day clock started upon receipt of this application. You will receive notification regarding meeting location and time if a meeting is necessary. You will receive notification when the thirty-day clock has expired, and you can submit an application.

Signature

A rectangular box containing a handwritten signature in black ink that reads "Michael Tunchy".


Submittal Date

3/14/2021

11/2/2020 c:\projects\wise\project\wise\becker\jw\0339329\3819_nyd_prm_TSH.dgn becker\jw


TIP PROJECT: I-3819BU-6039

PROJECT: 34192.1.2

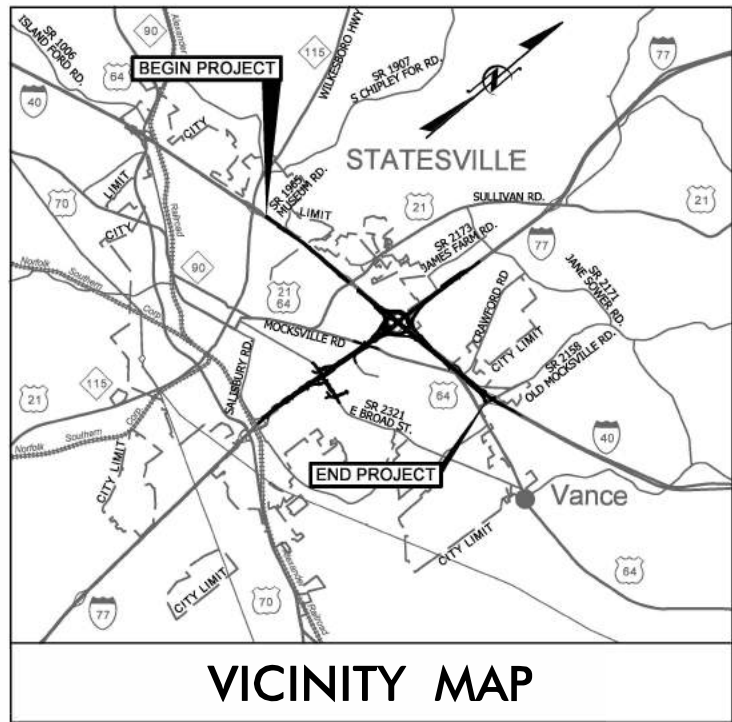

VICINITY MAP

THIS PROJECT IS WITHIN THE MUNICIPAL BOUNDARIES OF THE CITY OF STATESVILLE AND THE TOWNSHIP OF BETHANY

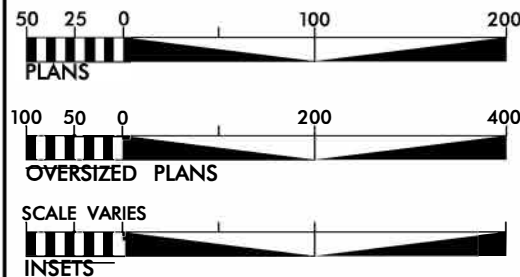


BEGIN SEGMENT "A"
END SEGMENT "B"
-L- STA. 92+00

BEGIN SEGMENT "A"
END SEGMENT "B"
-Y_S- STA. 111+00

BEGIN SEGMENT "B"
-Y_S- STA. 25+00.09

CLEARING ON THIS PROJECT SHALL BE PERFORMED TO THE LIMITS ESTABLISHED BY METHOD III.

THIS IS A CONTROLLED ACCESS PROJECT WITH ACCESS BEING LIMITED TO INTERCHANGES

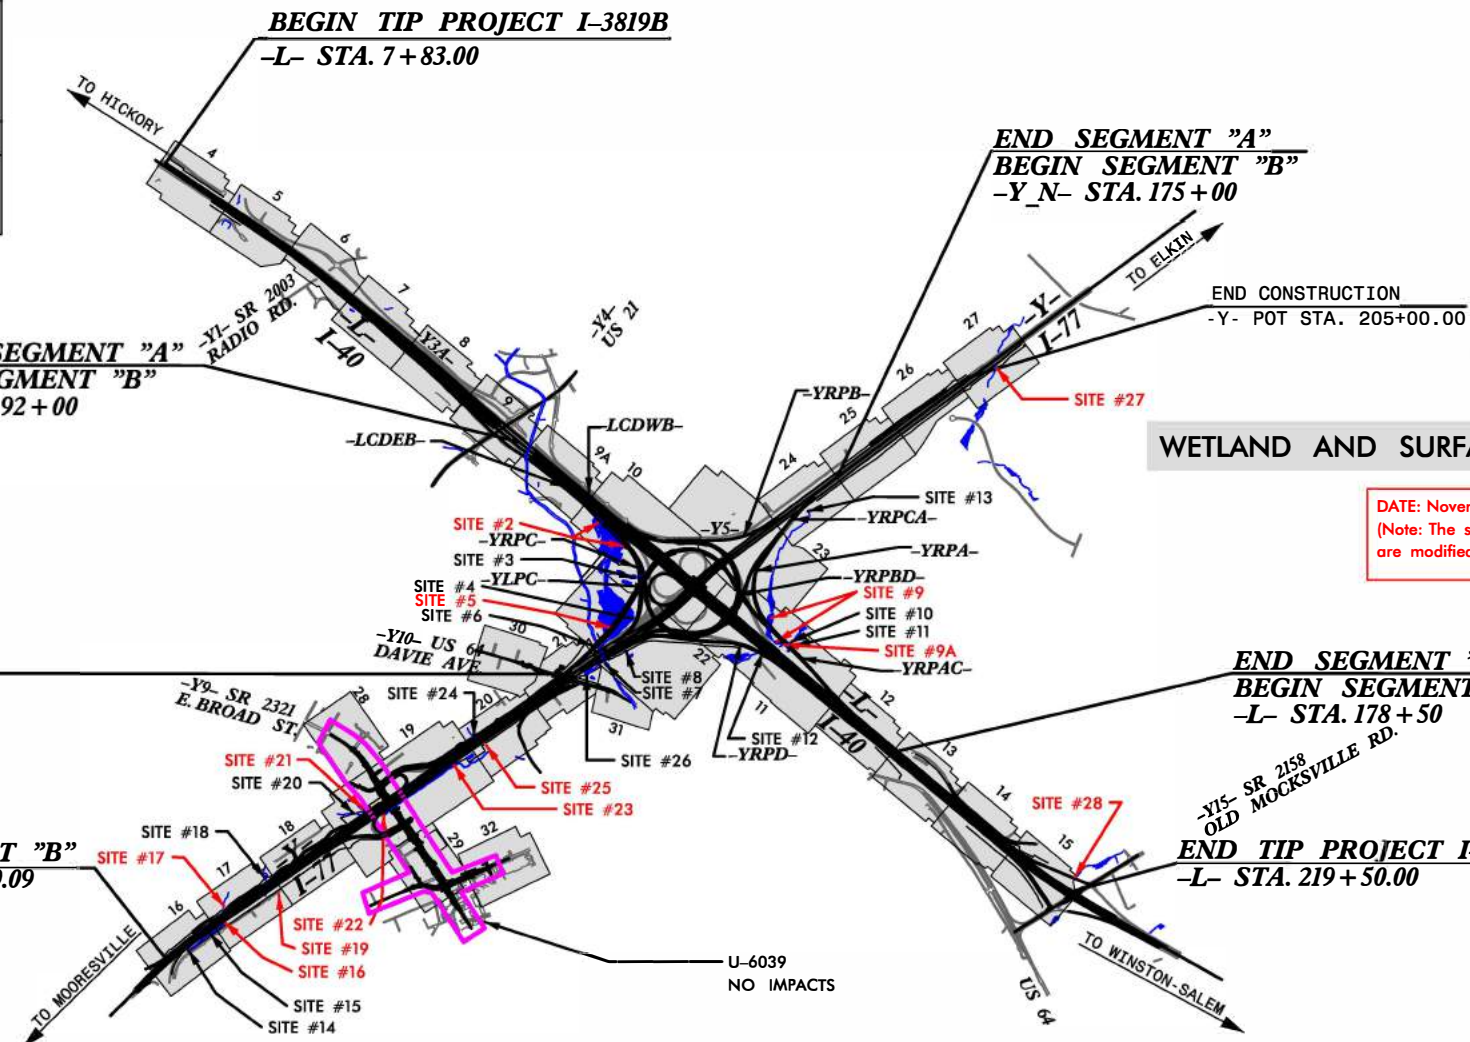

WETLAND AND SURFACE WATER IMPACT PERMITS

DATE: November 2, 2020
(Note: The sites highlighted in RED are modified in this submittal.)

PERMIT DRAWING
SHEET 1 OF 67
Rev. 11/02/2020



LANE

INCOMPLETE PLANS
DO NOT USE FOR R/W ACQUISITION

GRAPHIC SCALES

SEE ABOVE

DESIGN DATA

	I-40	I-77
ADT 2018	= 57,300	62,900
ADT 2040	= 72,500	77,500
DHV	= 5,800	6,200
D	= 55 %	55 %
T	= 16 % *	19 % **
V	= 60 MPH	60 MPH
* TTST 13 + DUAL 3 (I-40)		
** TTST 16 + DUAL 3 (I-77)		
CLASSIFICATION:	INTERSTATE	

PROJECT LENGTH

LENGTH ROADWAY TIP PROJECT I-3819B	=	3.885
LENGTH STRUCTURES TIP PROJECT I-3819B	=	0.124
TOTAL LENGTH OF TIP PROJECT I-3819B	=	4.009

Prepared In the Office of:

WSP

1001 Morehead Square Dr., Suite 610, Charlotte, NC 28203
NC LIC NO. F-0165

2018 STANDARD SPECIFICATIONS

RIGHT OF WAY DATE:
OCTOBER 30, 2018

LETTING DATE:
OCTOBER 30, 2018

CHRISTOPHER D. DAVIS, P.E.
PROJECT ENGINEER

ERIC W. SECKINGER, P.E.
PROJECT DESIGN ENGINEER

HYDRAULICS ENGINEER

SIGNATURE: P.E.

ROADWAY DESIGN
ENGINEER

SIGNATURE: P.E.

DIVISION OF HIGHWAYS
STATE OF NORTH CAROLINA





STATE HIGHWAY DESIGN ENGINEER P.E.

SITE #2


wsp 1001 Morehead Square Dr.,
Suite 610, Charlotte, NC 28203
NC LIC NO. F-0165

PROJECT REFERENCE NO.	SHEET NO.
1-3819B	10A
R/W SHEET NO.	
ROADWAY DESIGN ENGINEER	HYDRAULICS ENGINEER
DOCUMENT NOT CONSIDERED FINAL UNLESS ALL SIGNATURES COMPLETED	

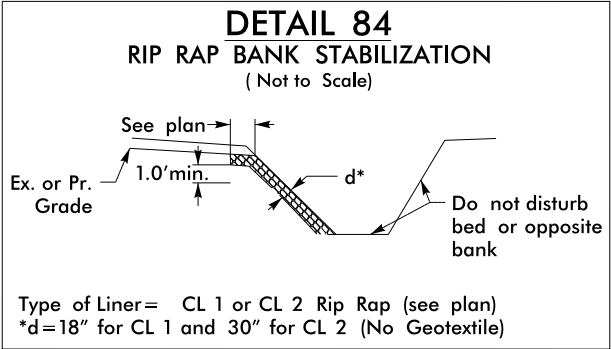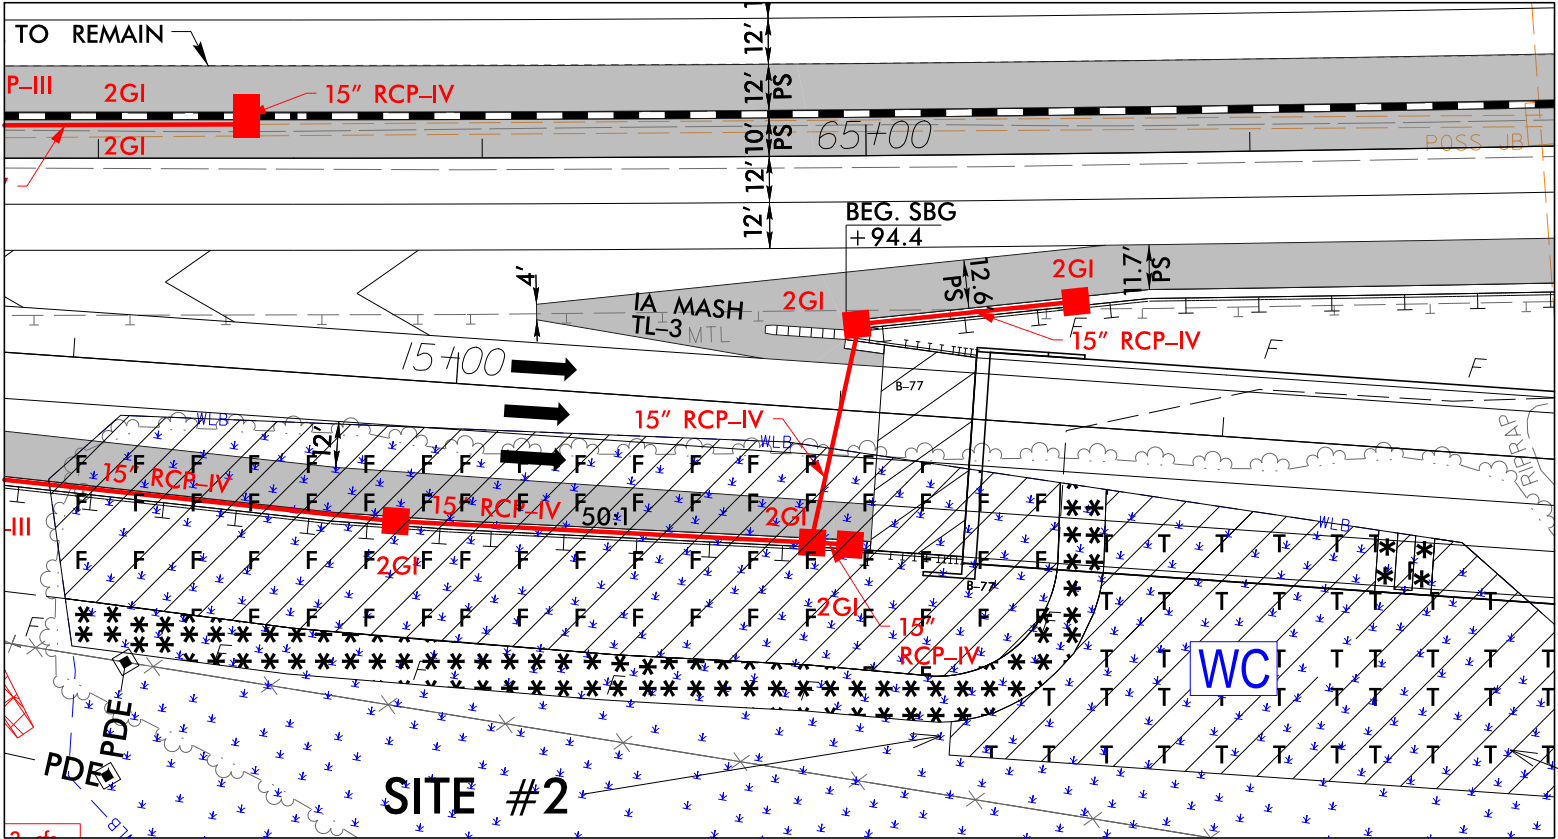

-YRPCA- STA. 18+65 RT
-YRPCA- STA. 77+00 RT

TEMPORARY FILL
IN WETLAND
(MATTING FOR
CONSTRUCTION
ACCESS - BRIDGE
STRUCTURE #12)

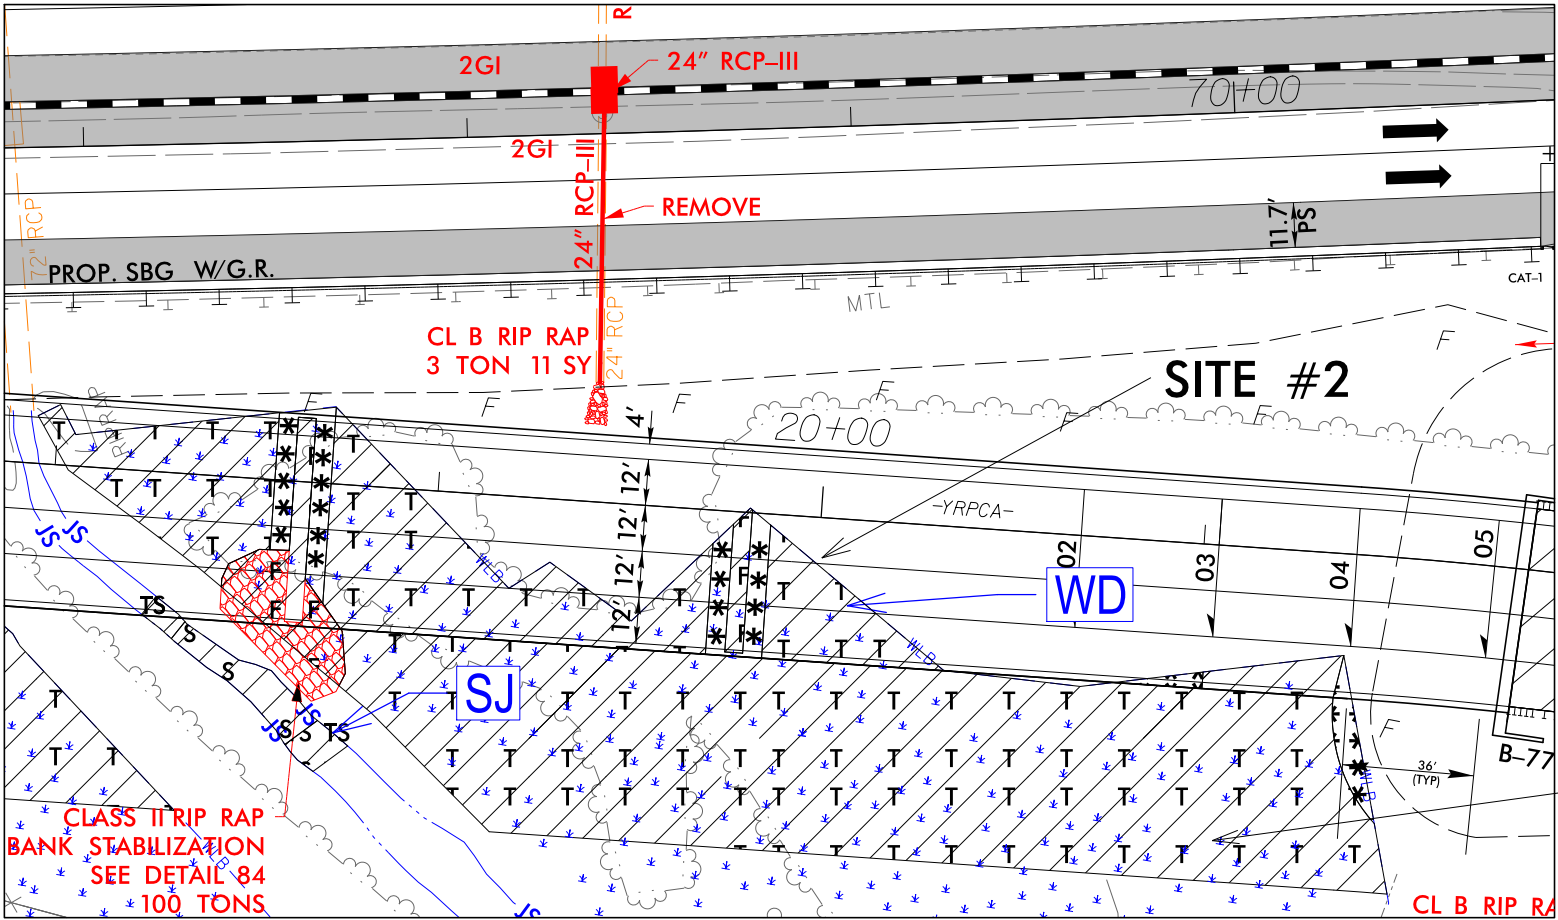


PERMIT DRAWING
SHEET 4 OF 67
Rev. 11/02/2020

- DENOTES FILL IN WETLAND
- DENOTES MECHANIZED CLEARING
- DENOTES TEMPORARY FILL IN WETLAND

TEMPORARY FILL
IN WETLAND
(MATTING FOR
CONSTRUCTION
ACCESS - BRIDGE
STRUCTURE #12)



NC GRID NAD 8395

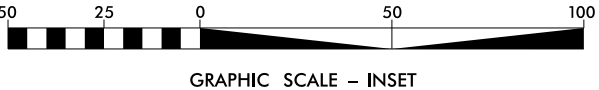

SITE #2


wsp 1001 Morehead Square Dr.,
Suite 610, Charlotte, NC 28203
NC LIC NO. F-0165

PROJECT REFERENCE NO.	SHEET NO.
1-3819B	10A
R/W SHEET NO.	
ROADWAY DESIGN ENGINEER	HYDRAULICS ENGINEER
DOCUMENT NOT CONSIDERED FINAL UNLESS ALL SIGNATURES COMPLETED	

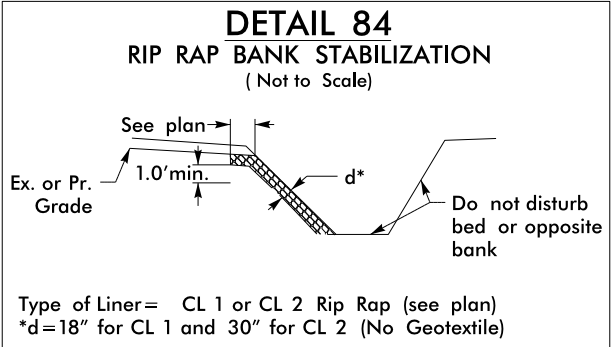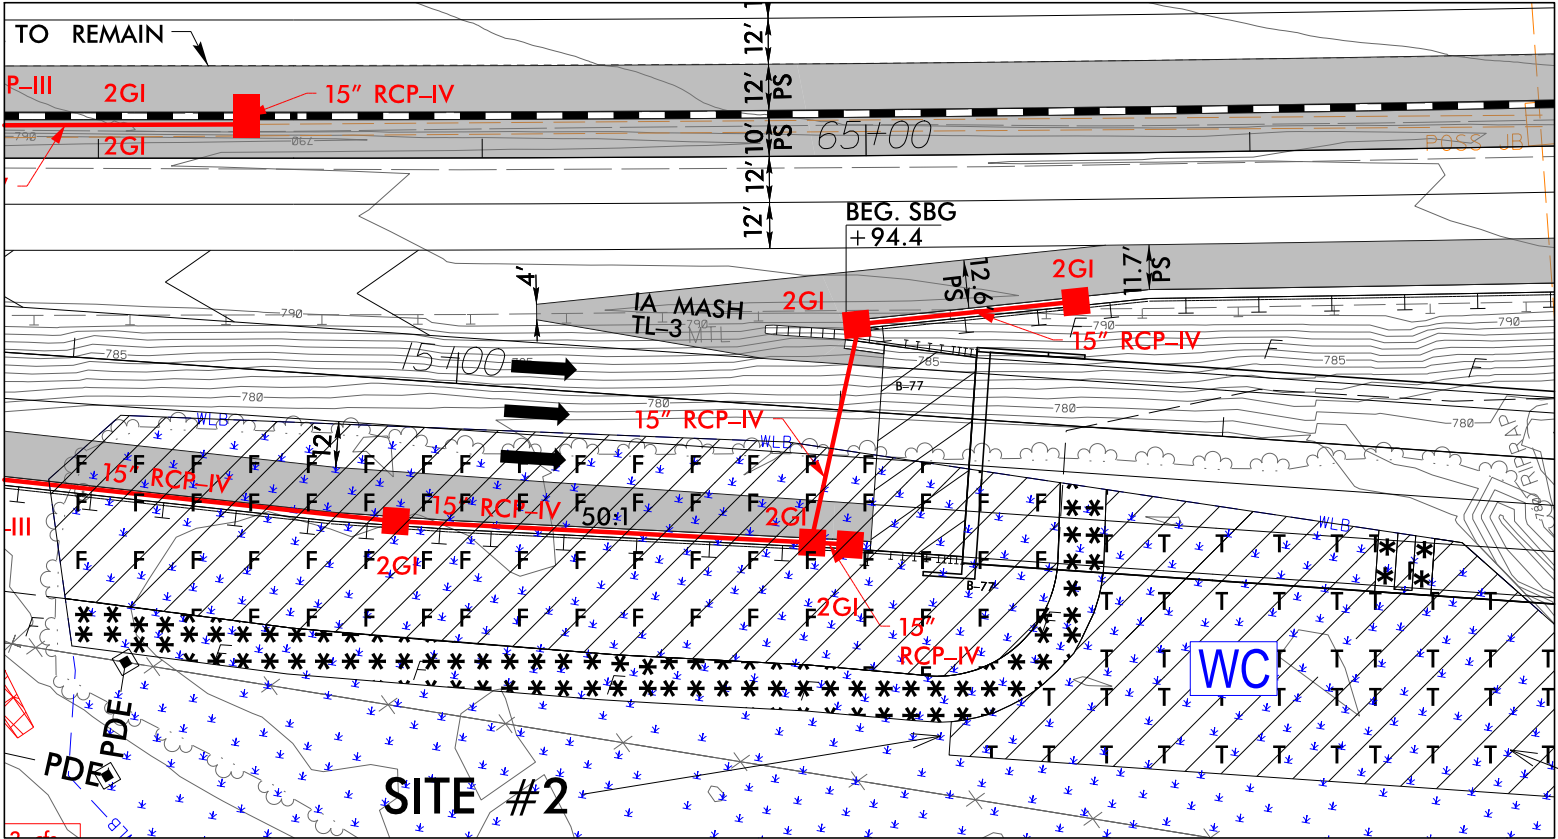

-YRPCA- STA. 18+65 RT
-YRPCA- STA. 77+00 RT

TEMPORARY FILL
IN WETLAND
(MATting FOR
CONSTRUCTION
ACCESS - BRIDGE
STRUCTURE #12)

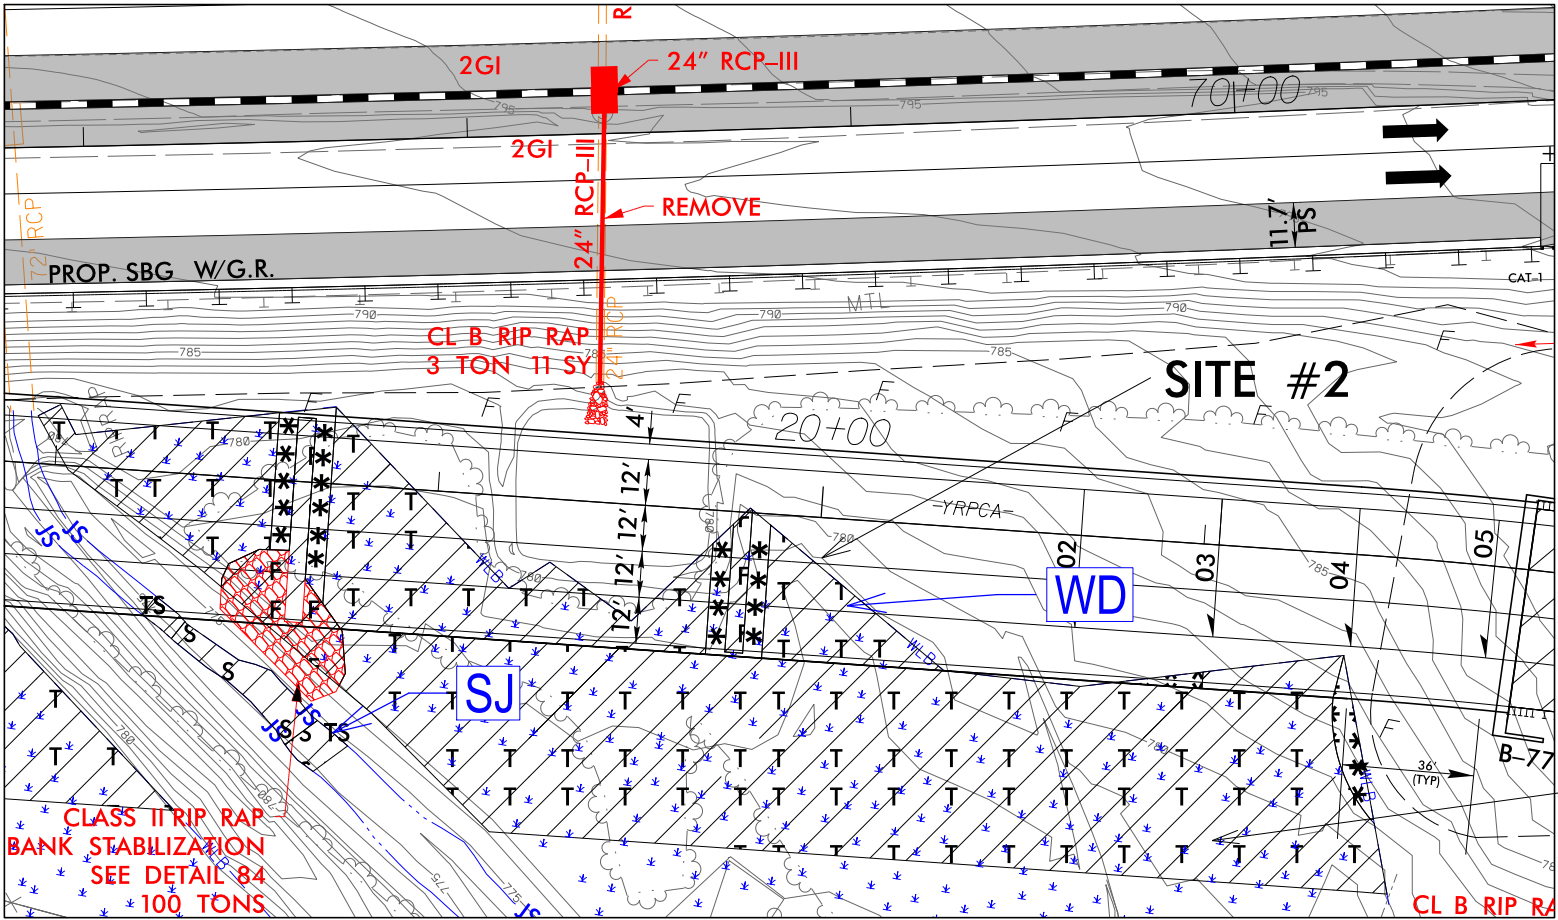

PERMIT DRAWING
SHEET 5 OF 67
Rev. 11/02/2020

- DENOTES FILL IN WETLAND
- DENOTES MECHANIZED CLEARING
- DENOTES TEMPORARY FILL IN WETLAND



TEMPORARY FILL
IN WETLAND
(MATting FOR
CONSTRUCTION
ACCESS - BRIDGE
STRUCTURE #12)

NC GRID NAD 8395



GRAPHIC SCALE - INSET

—MATCHLINE— STA. 164 + 50.00 —L— SEE SHEET NO. 12

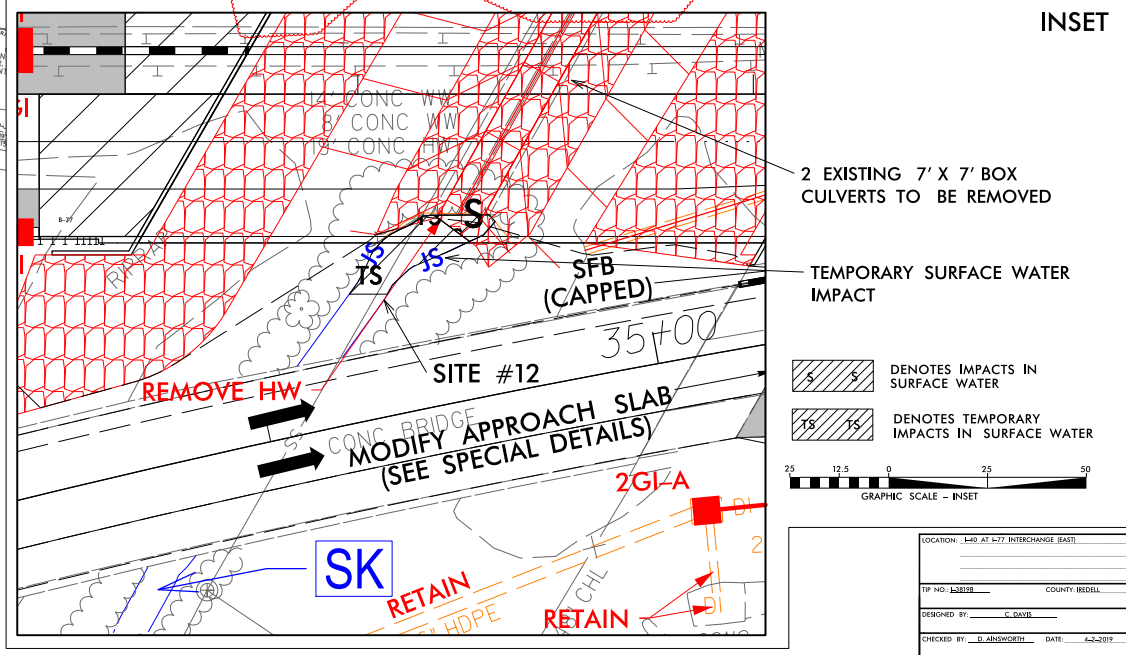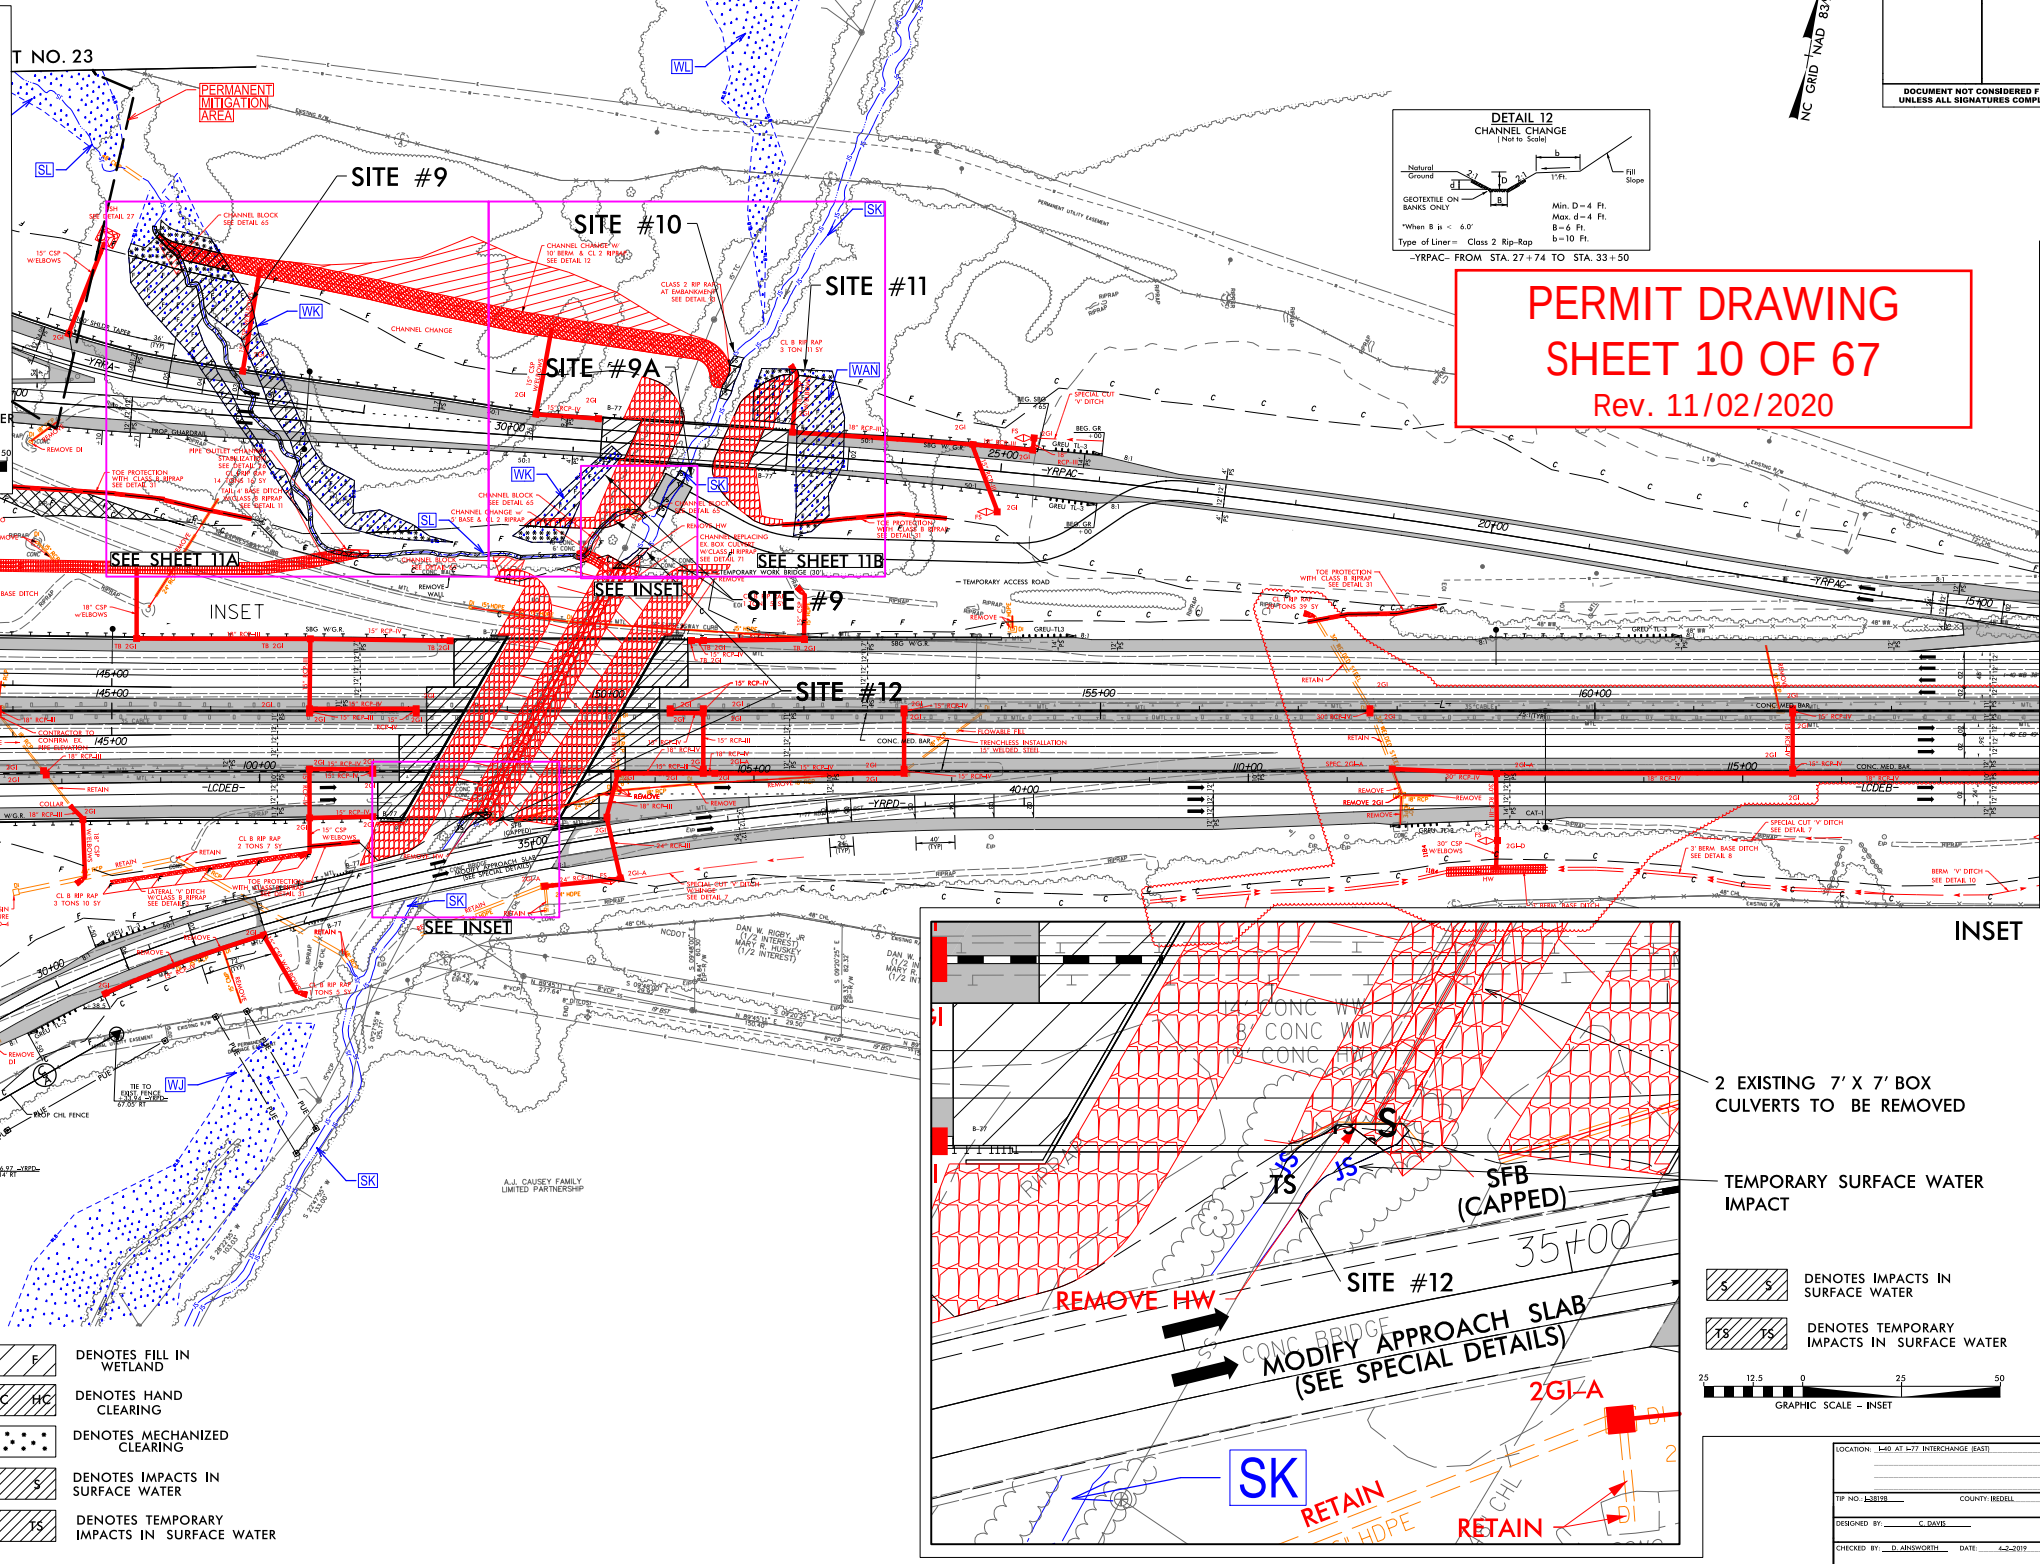

LOCATION: I-40 AT I-77 INTERCHANGE (EAST)

TIP NO.: L38198 COUNTY: BREDELL

DESIGNED BY: C. DAVIS

CHECKED BY: D. AINSWORTH DATE: 4-2-2019

	07/20/2020 C:\Program Files\Microsoft Visual Studio\Tools for Win8-RT\bin\x64-microsoft.common-service-tool.exe -victor@chickadee.us...victor@chickadee.us:CD339327N1UMHJyd_gsm_auth_13550-16450.dgn	
2.	REHED DAMAGE -- 135150 - 164150 [KAZOTO]	

DETAIL 12
CHANNEL CHANGE
(Not to Scale)


Diagram illustrating a Channel Change detail. The cross-section shows a channel with a width of b and a depth of D . The channel is lined with Class 2 Rip-Rap. The banks are reinforced with Geotextile on the outside and Class 2 Rip-Rap on the inside. The channel is shown transitioning from a Natural Ground line to a Fill Slope. The channel width is defined as $b = 10$ Ft. The depth is defined as $D = 4$ Ft. The channel is lined with Class 2 Rip-Rap. The channel is shown transitioning from a Natural Ground line to a Fill Slope.

When B is $< 6.0'$

Type of Liner = Class 2 Rip-Rap

Min. $D = 4$ Ft.
Max. $d = 4$ Ft.
 $B = 6$ Ft.
 $b = 10$ Ft.

—YRPAC— FROM STA. 27 + 74 TO STA. 33 + 50

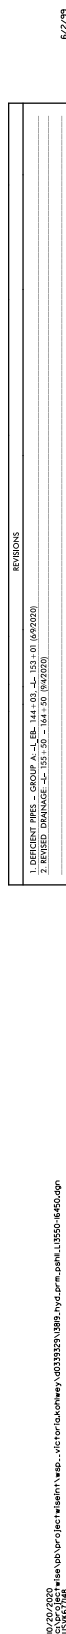

PERMIT DRAWING SHEET 12 OF 67

WSP

1001 Morehead Square Dr.,
Suite 610, Charlotte, NC 28203
NC LIC NO. F-0165

PROJECT REFERENCE NO.

SHEET NO.

1-3819B


//A

R/W SHEET N

ROADWAY DESIGN
ENGINEER

**HYDRAULICS
ENGINEER**

**DOCUMENT NOT CONSIDERED FINAL
UNLESS ALL SIGNATURES COMPLETED**

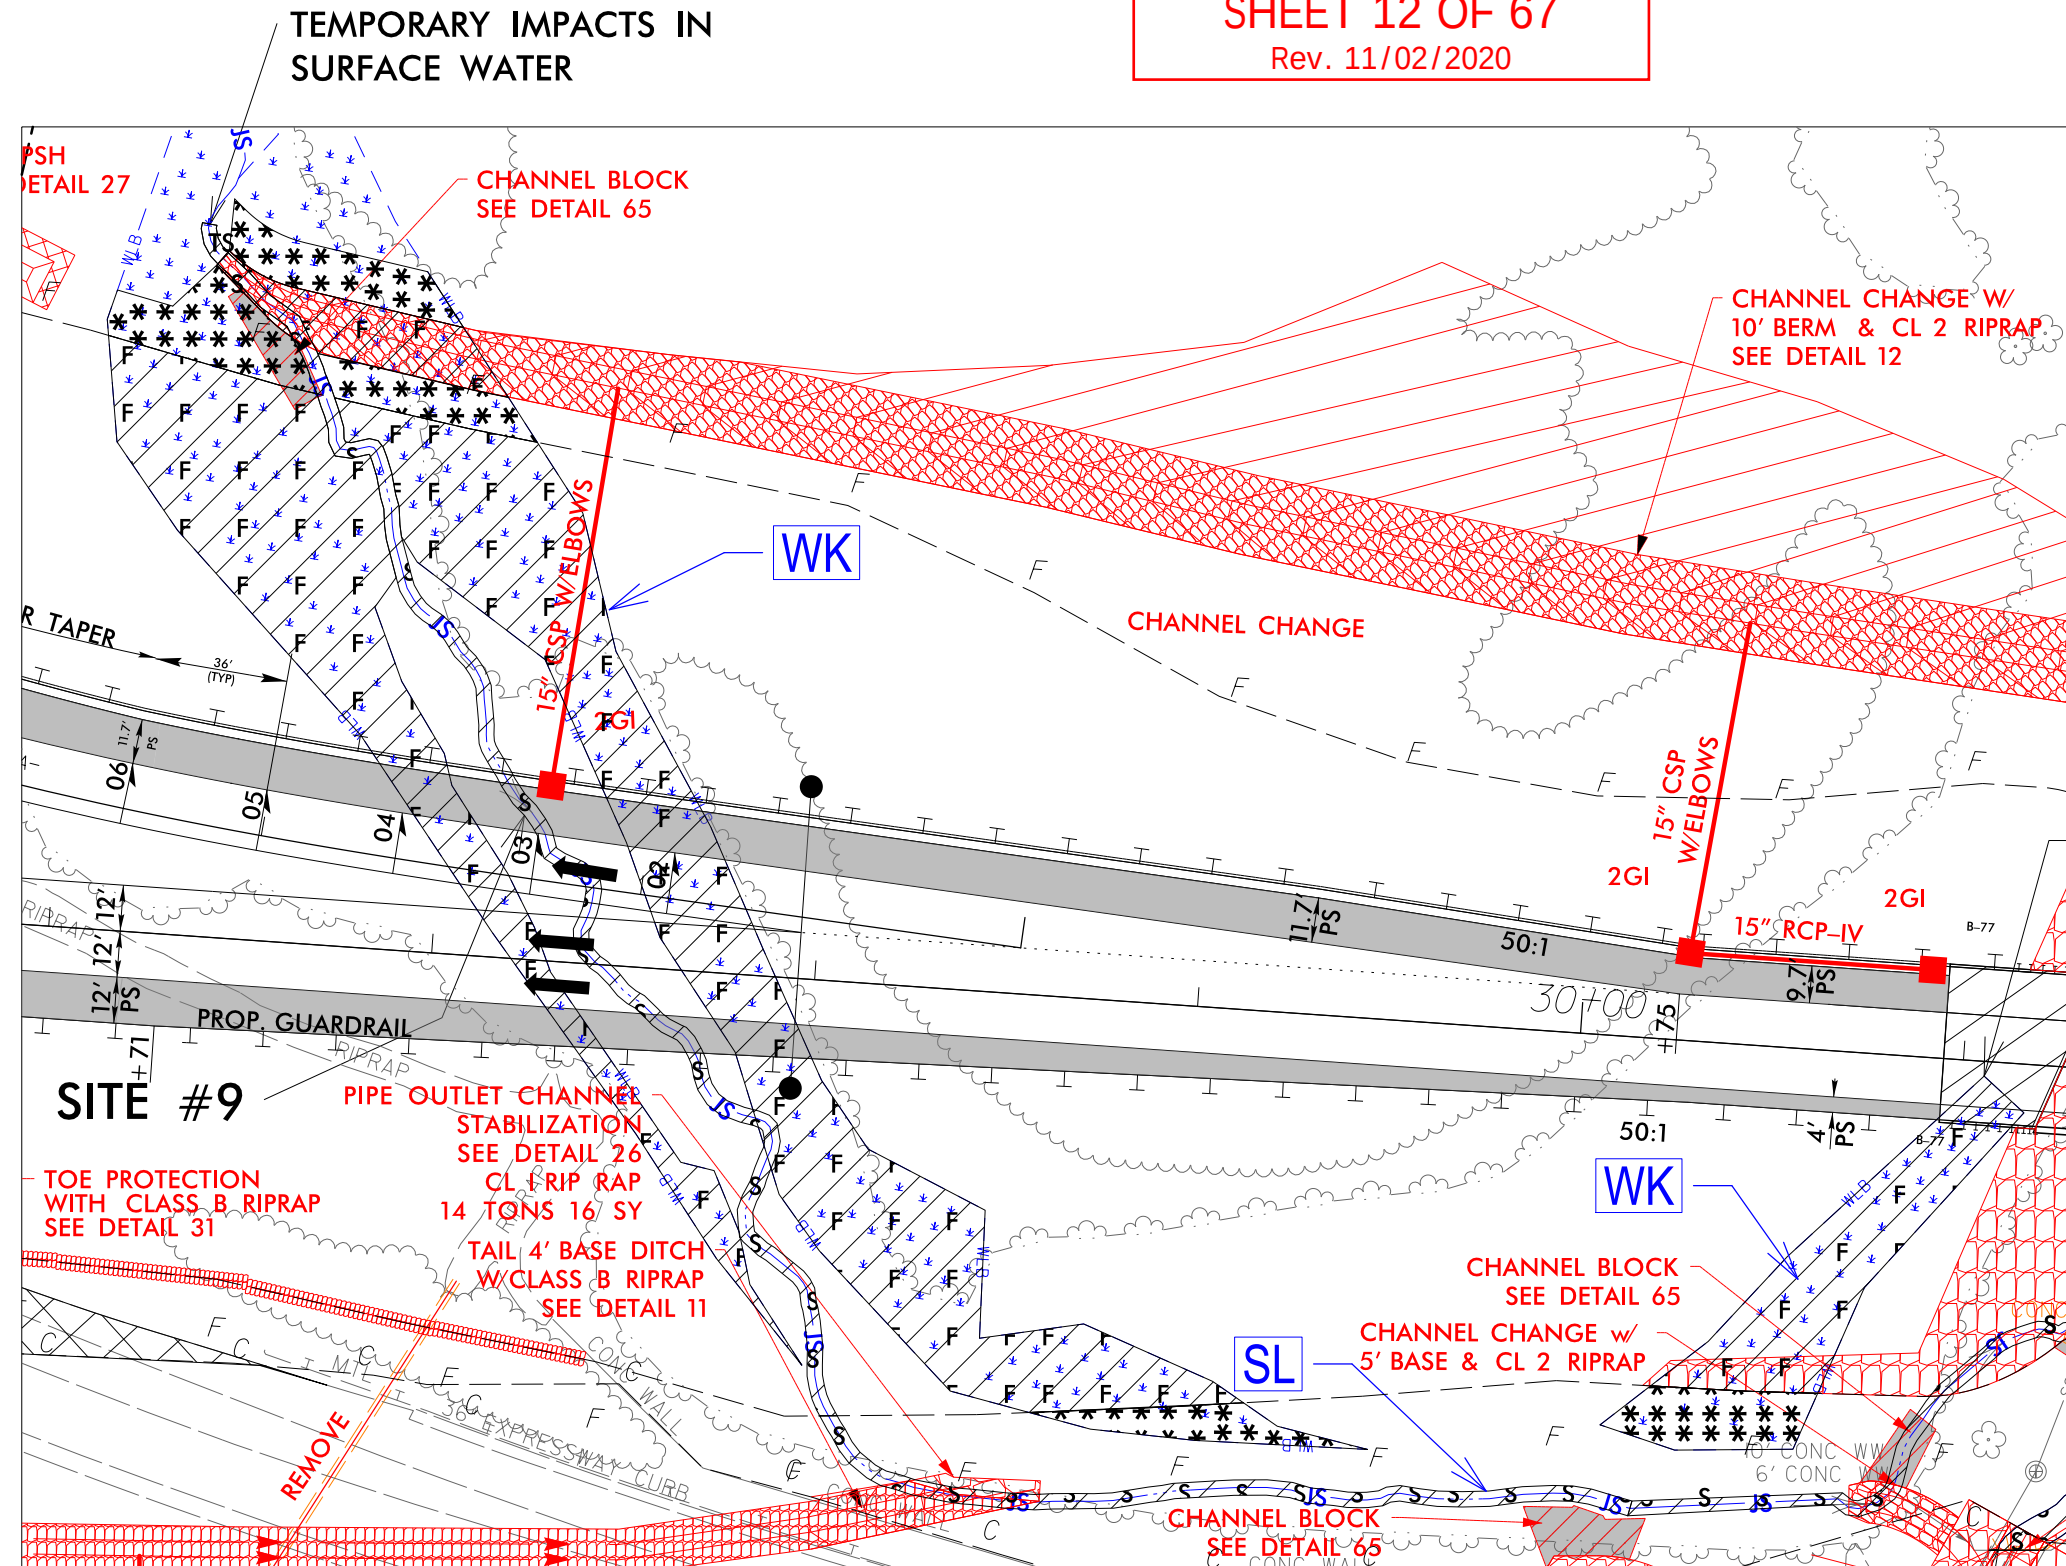

SITE #9

SITE #12




10/21/2020
c:\projectwise\pb\projectwise\becker\jw\d0339329\13819_hyd_prm_psh11A-L13550-16450.dgn
becker.jw

PERMIT DRAWING
SHEET 13 OF 67
Rev. 11/02/2020

wsp 1001 Morehead Square Dr.,
Suite 610, Charlotte, NC 28203
NC LIC NO. F-0165

PROJECT REFERENCE NO.	SHEET NO.
1-3819B	11A
R/W SHEET NO.	
ROADWAY DESIGN ENGINEER	HYDRAULICS ENGINEER
DOCUMENT NOT CONSIDERED FINAL UNLESS ALL SIGNATURES COMPLETED	

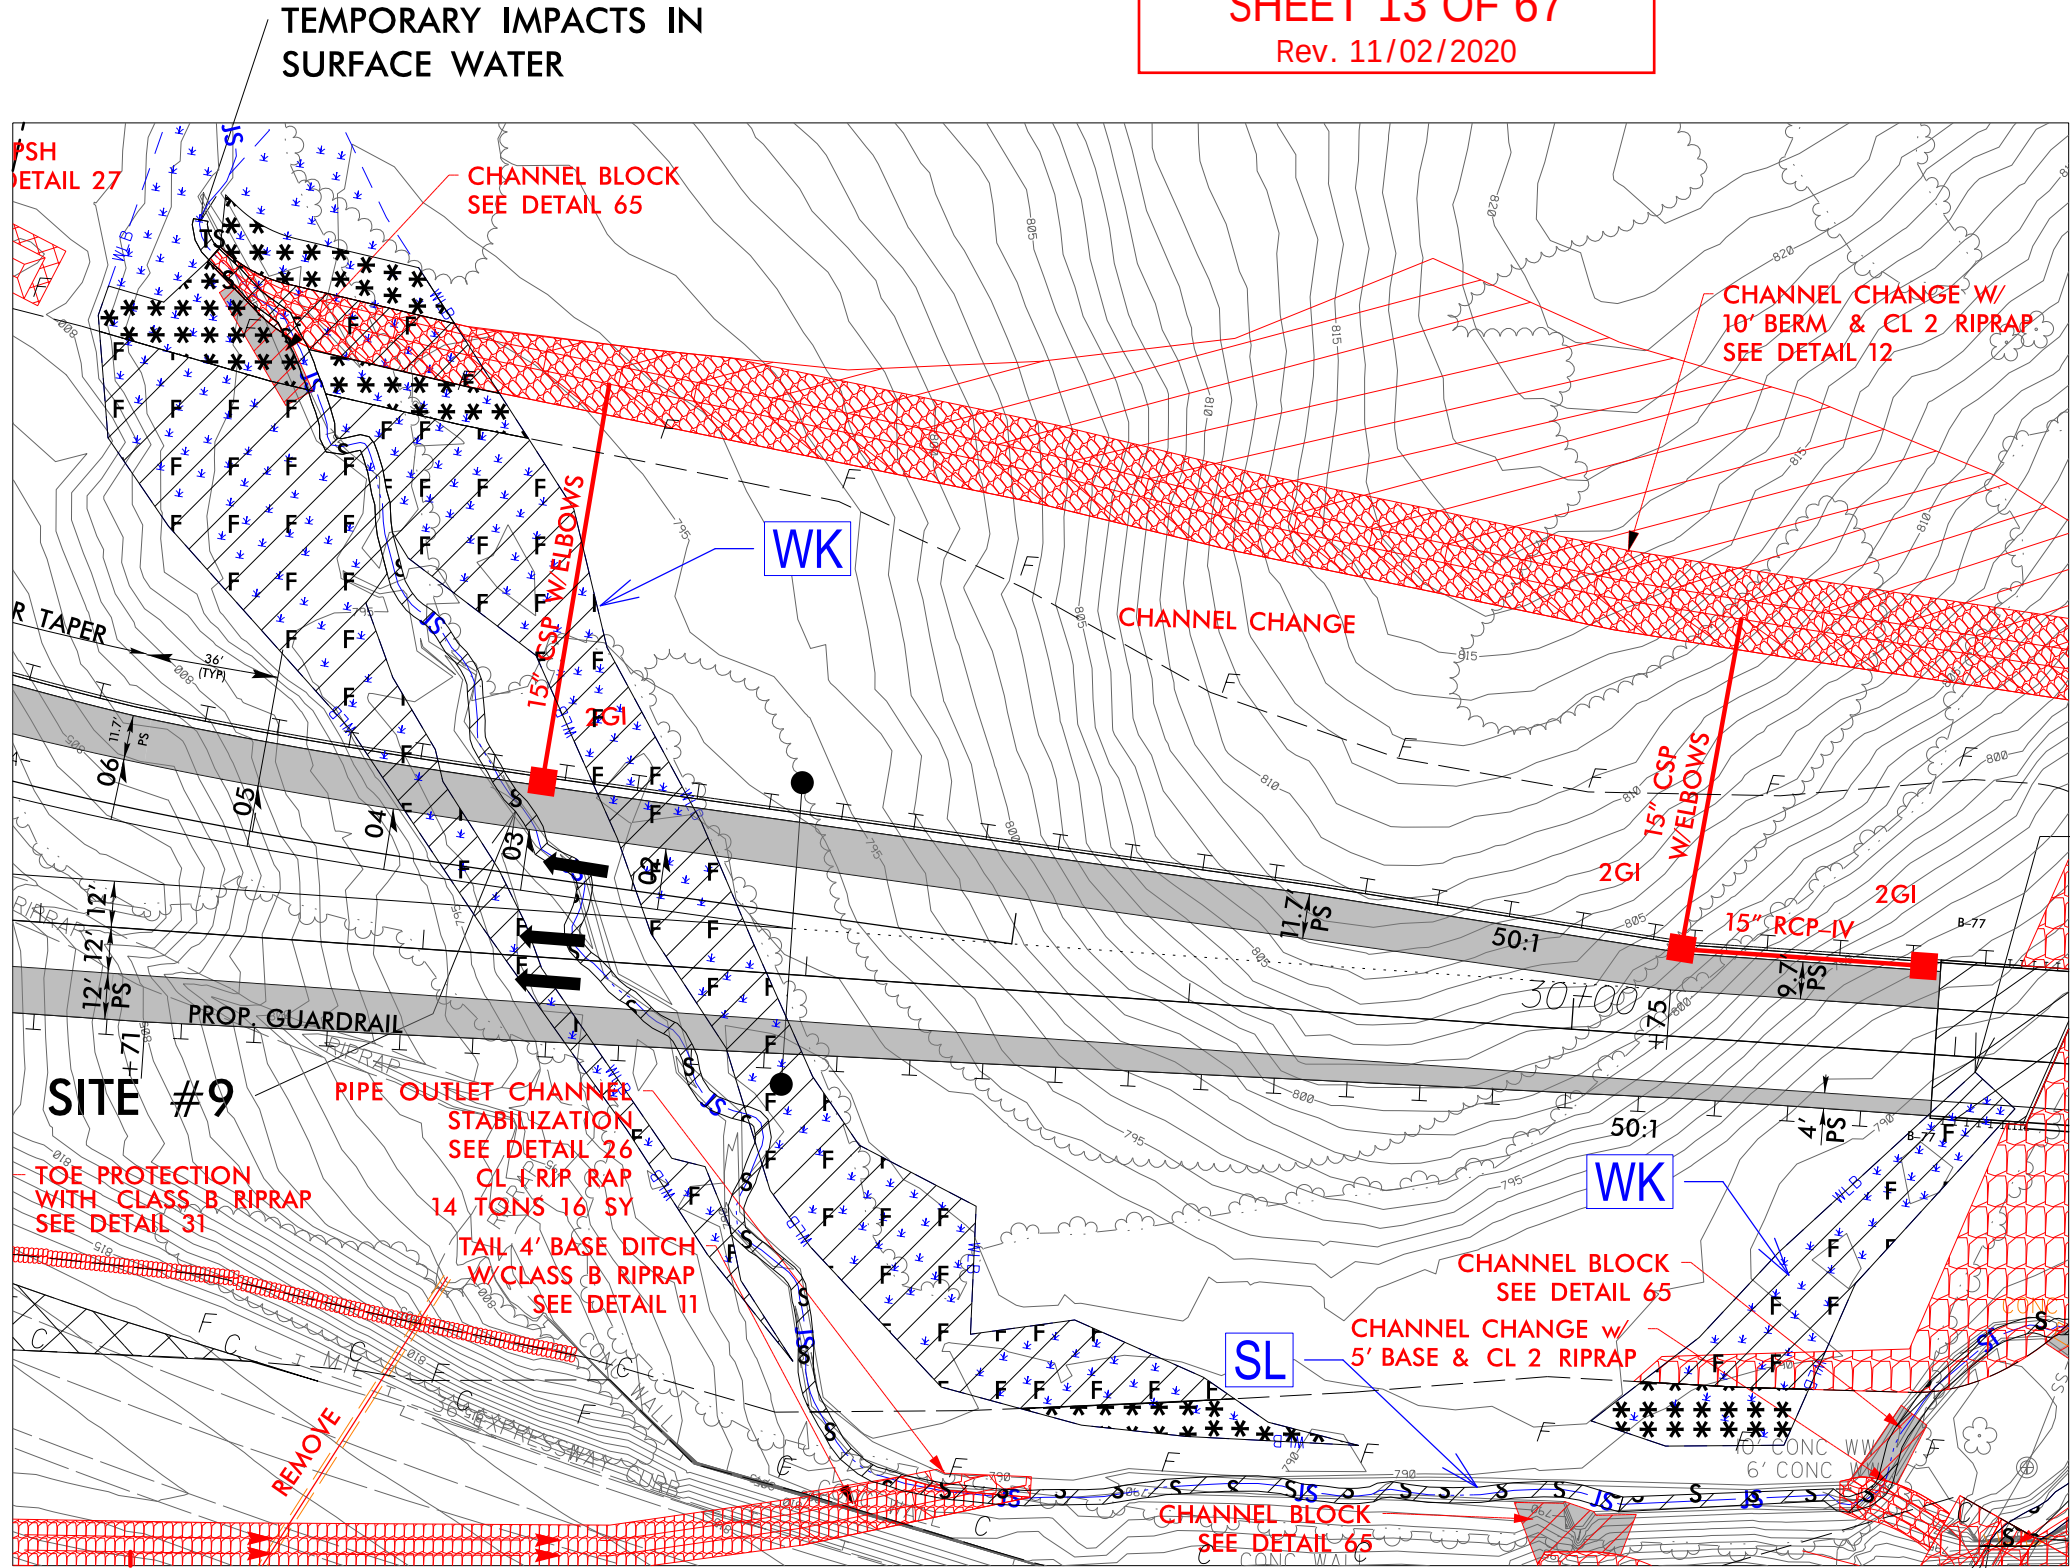

SITE #9

NC GRID NAD 8395

- DENOTES IMPACTS IN SURFACE WATER
- DENOTES TEMPORARY IMPACTS IN SURFACE WATER
- DENOTES FILL IN WETLAND
- DENOTES MECHANIZED CLEARING





SITE #12



PERMIT DRAWING
SHEET 14 OF 67
Rev. 11/02/2020

wsp 1001 Morehead Square Dr.,
Suite 610, Charlotte, NC 28203
NC LIC NO. F-0165

PROJECT REFERENCE NO.		SHEET NO.
1-3819B		11B
RW SHEET NO.		
ROADWAY DESIGN ENGINEER		HYDRAULICS ENGINEER
DOCUMENT NOT CONSIDERED FINAL UNLESS ALL SIGNATURES COMPLETED		

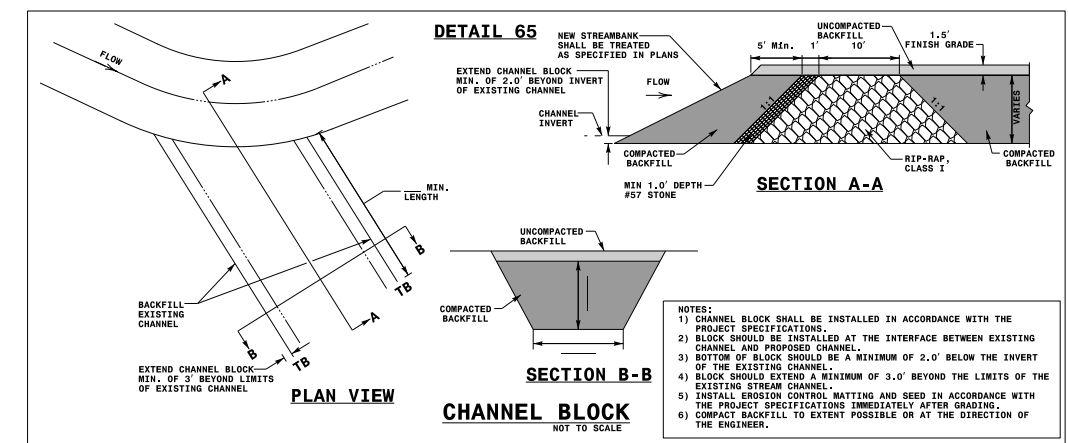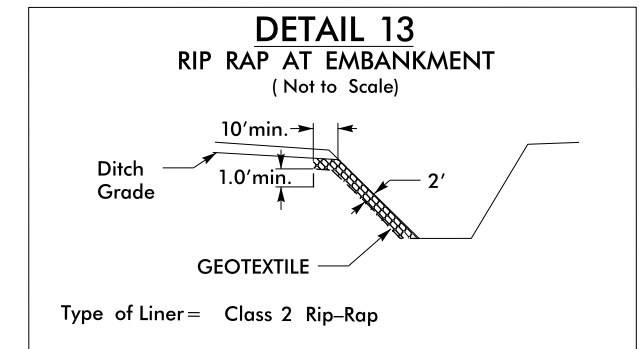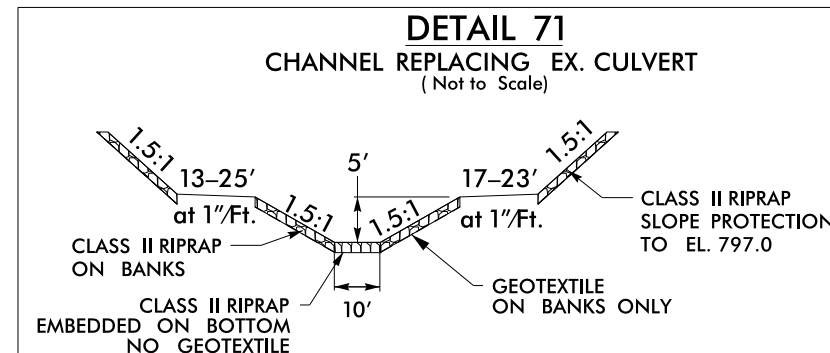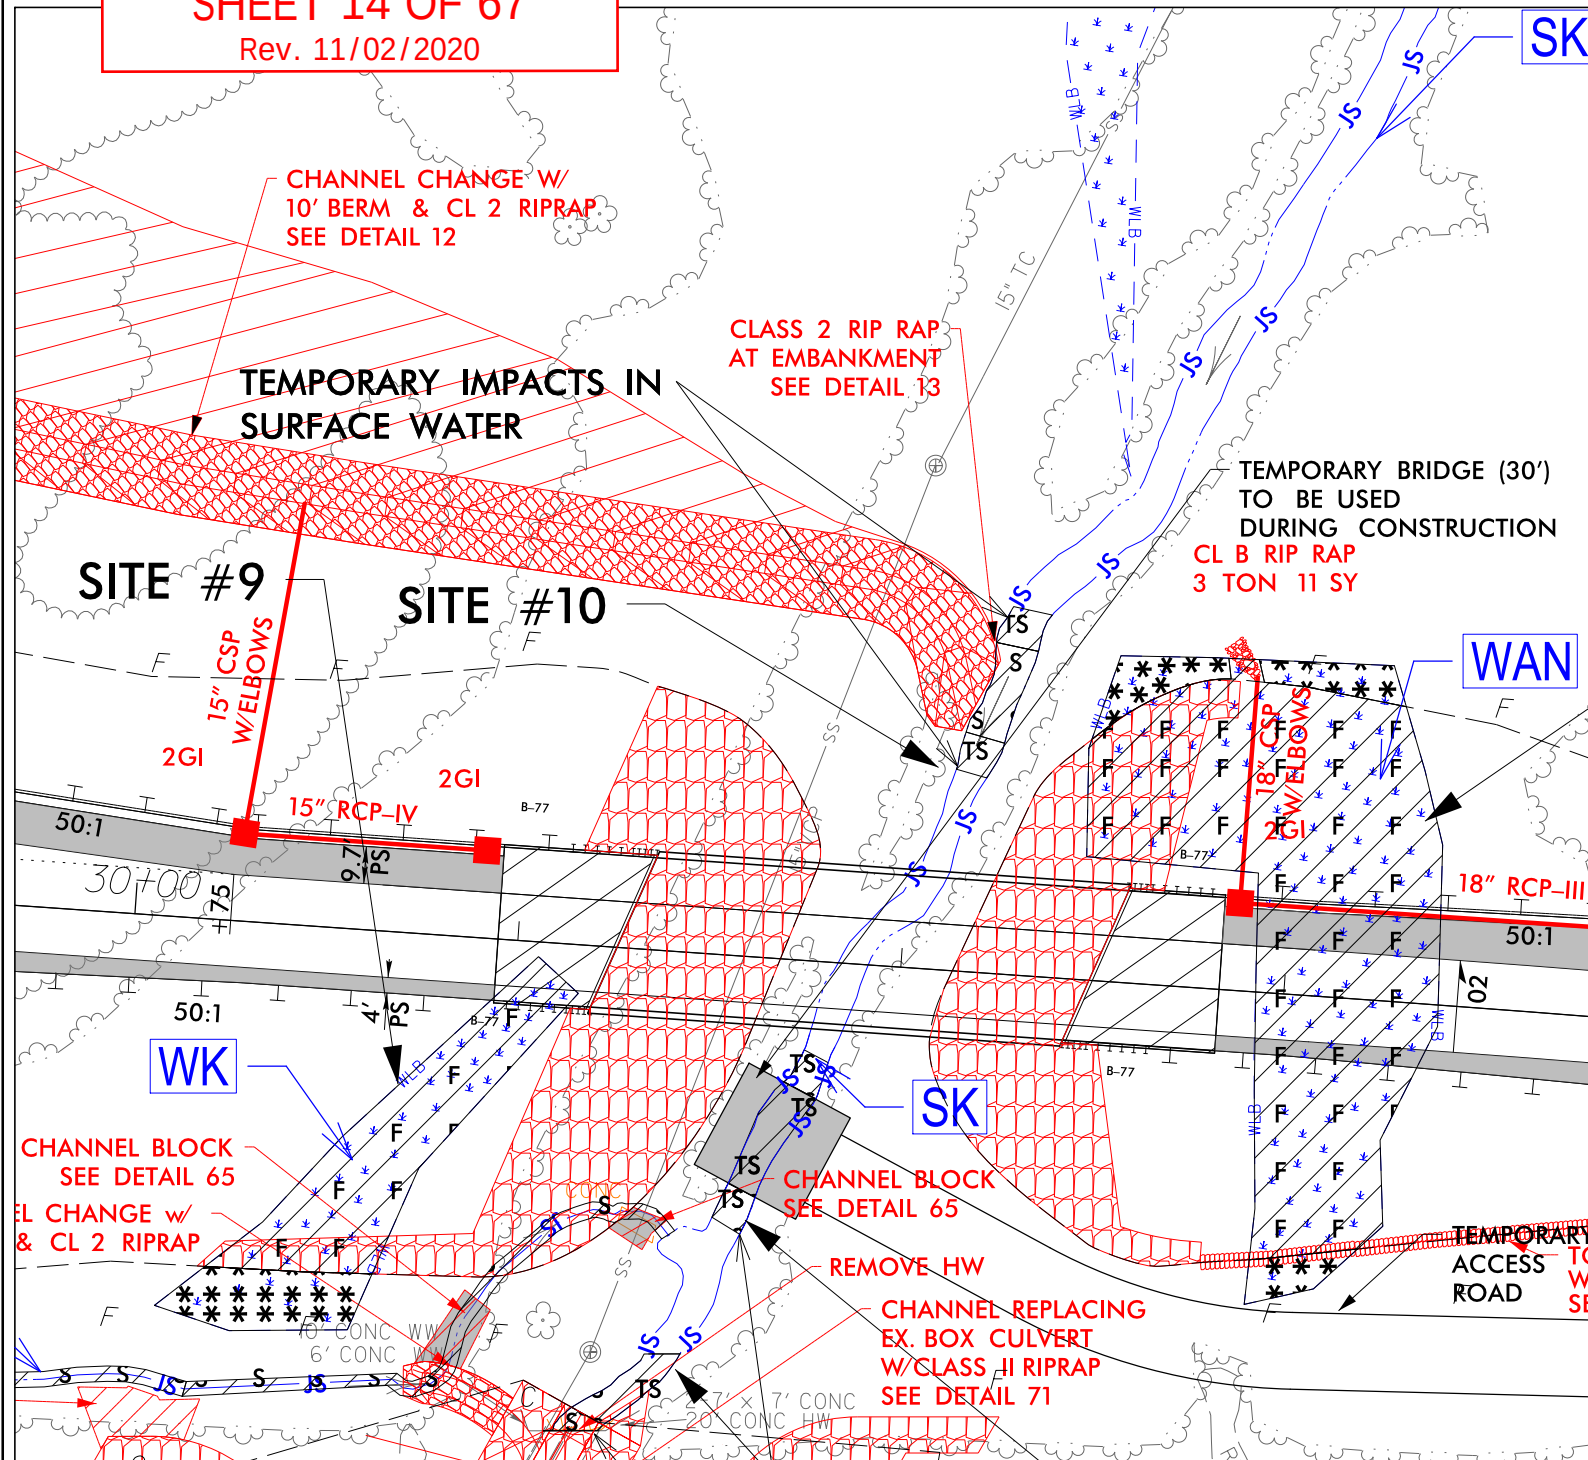

- DENOTES IMPACTS IN SURFACE WATER
- DENOTES TEMPORARY IMPACTS IN SURFACE WATER
- DENOTES FILL IN WETLAND
- DENOTES MECHANIZED CLEARING




GRAPHIC SCALE - INSETS




PERMIT DRAWING
SHEET 15 OF 67
Rev. 11/02/2020

WSP 1001 Morehead Square Dr.,
Suite 610, Charlotte, NC 28203
NC LIC NO. F-0165

PROJECT REFERENCE NO.		SHEET NO.	
1-3819B		11B	
R/W SHEET NO.			
ROADWAY DESIGN ENGINEER		HYDRAULICS ENGINEER	
DOCUMENT NOT CONSIDERED FINAL UNLESS ALL SIGNATURES COMPLETED			

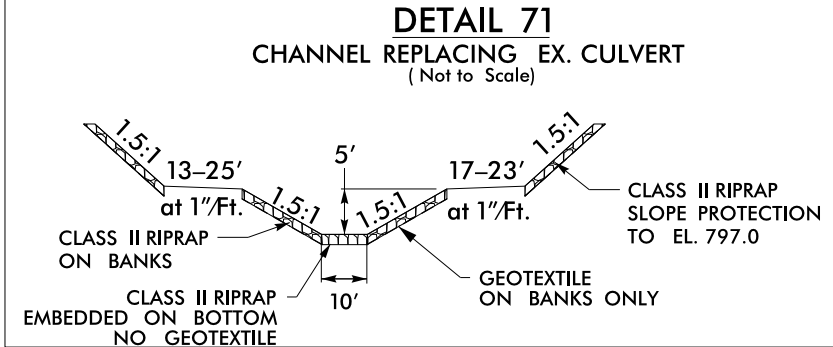

-L- STA. 149+36

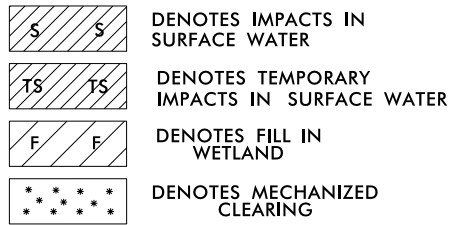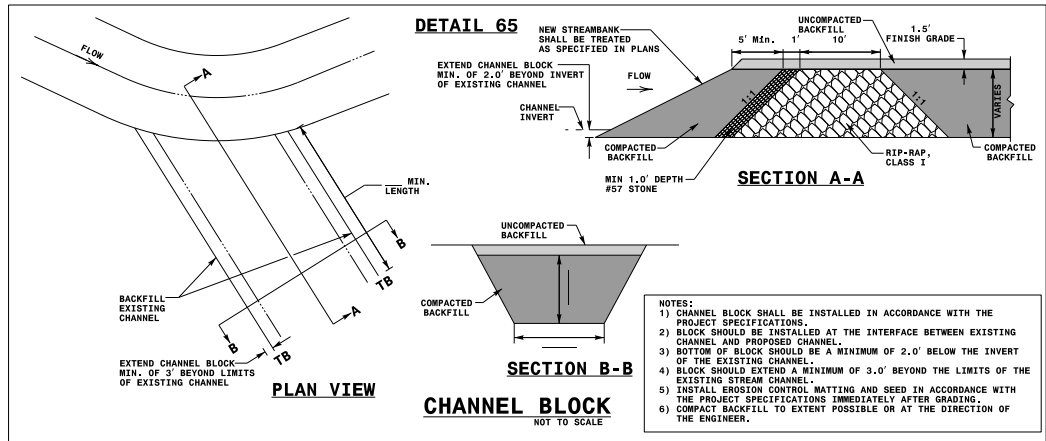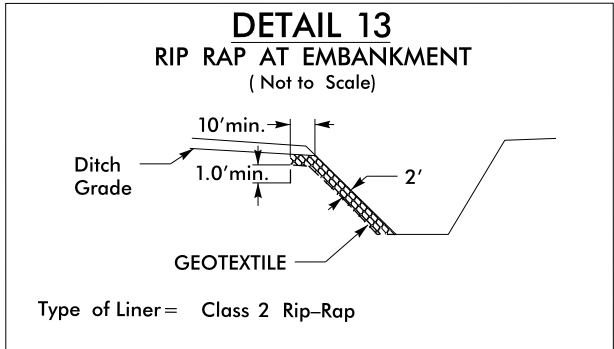

GRAPHIC SCALE – INSETS

0/2/2020
projectwise\pb\projectwise\becker.jw\d0339329\I3819_hyd-prm_psh1B_LI3550-16450.dgn
becker.jw

PERMIT DRAWING
SHEET 21a OF 67
Rev. 11/02/2020

DETAIL 98
PIPE OUTLET CHANNEL STABILIZATION
 (Not to Scale)

Natural Ground Elevation

Natural Ground

1.25'

Channel Bed (Variable)

Length = 14 Ft.

Type of Lining = CL 1 Rip-Rap - Keyed-In (No Geotextile)

DENOTES TEMPORARY
IMPACTS IN SURFACE WATER

A rectangular block with diagonal hatching (lines from top-left to bottom-right). Inside the block, there are two 'S' labels, one on the left and one on the right.

DENOTES IMPACTS IN
SURFACE WATER

SITE #28

SEE INSET

PROJECT REFERENCE NO.	SHEET NO.
1-3819B	15
RW SHEET NO.	
ROADWAY DESIGN ENGINEER	HYDRAULICS ENGINEER
DOCUMENT NOT CONSIDERED FINAL UNLESS ALL SIGNATURES COMPLETED	

**DOCUMENT NOT CONSIDERED FINAL
UNLESS ALL SIGNATURES COMPLETED**

MATCHLINE STA 206+50.00 -L- SEE SHEET NO. 14

SITE #28 INSET

PIPE OUTLET CHANNEL
STABILIZATION
SEE DETAIL 98
CL 1 RIP RAP
27 TONS 42 SY

so

TEMPORARY SURFACE WATER IMPACT

42" RCP-III

JB w/MH

WO.

PLAN

PROPOSED GUARDRAIL
GREY TLE


RETAIN & LINE

RI-PR

-MATCHLINE- STA. 220 + 50.00 -L- SEE SHEET NO. 15A



PERMIT DRAWING
SHEET 21b OF 67
Rev. 11/02/2020

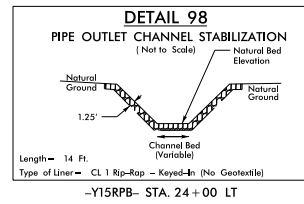

wsp 1001 Morehead Square Dr.,
Suite 610, Charlotte, NC 28203
NC LIC NO. F-0165



DENOTES TEMPORARY
IMPACTS IN SURFACE WATER



DENOTES IMPACTS IN
SURFACE WATER

SITE #28


SEE INSET

PROJECT REFERENCE NO.	SHEET NO.
I-3819B	15
RW SHEET NO.	
ROADWAY DESIGN ENGINEER	HYDRAULICS ENGINEER

DOCUMENT NOT CONSIDERED FINAL
UNLESS ALL SIGNATURES COMPLETED


-MATCHLINE- STA. 206+50.00 -L- SEE SHEET NO. 14

SITE #28 INSET

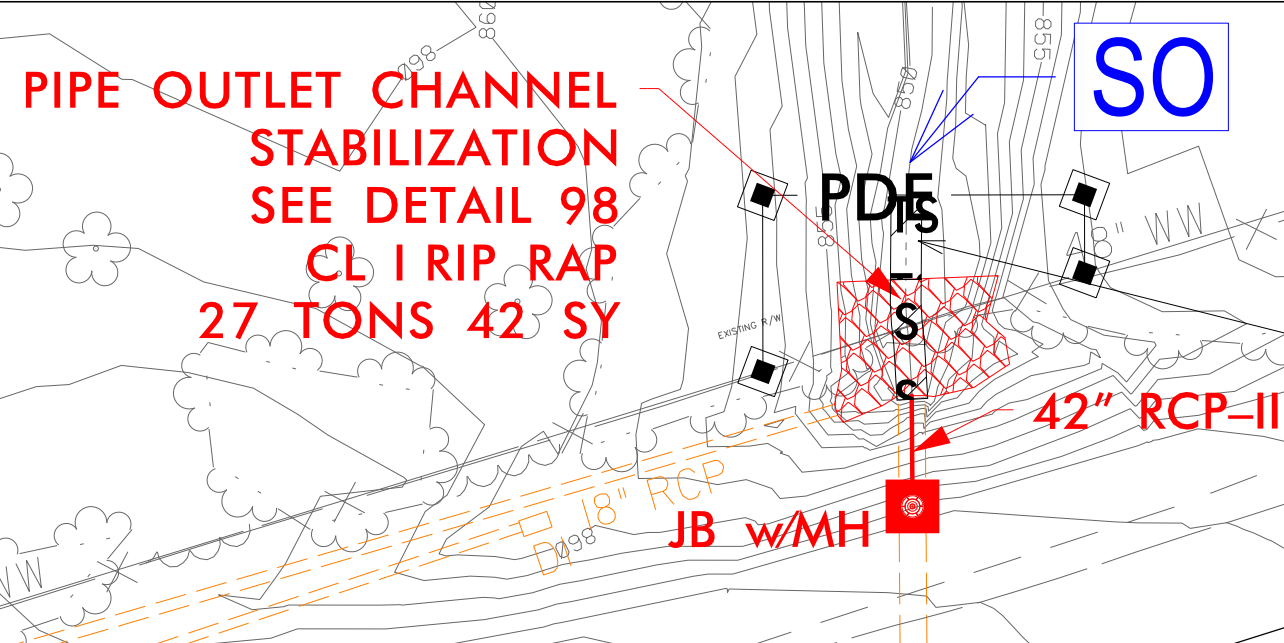

TEMPORARY SURFACE WATER
IMPACT




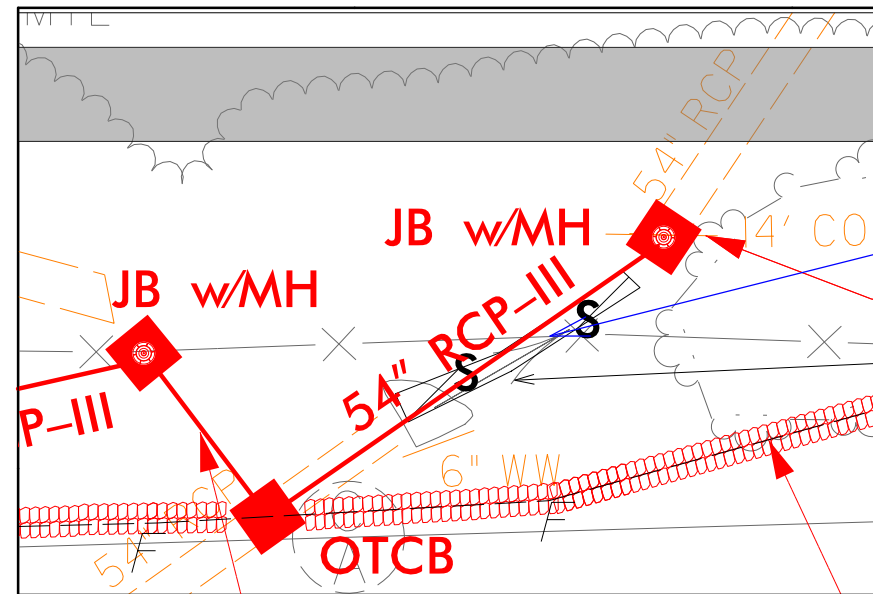


INSET

SW


SITE #19

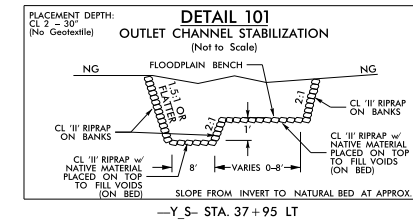

NC GRID NAD 83/95

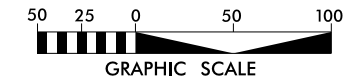


PERMIT DRAWING
SHEET 26 OF 67
Rev. 11/02/2020

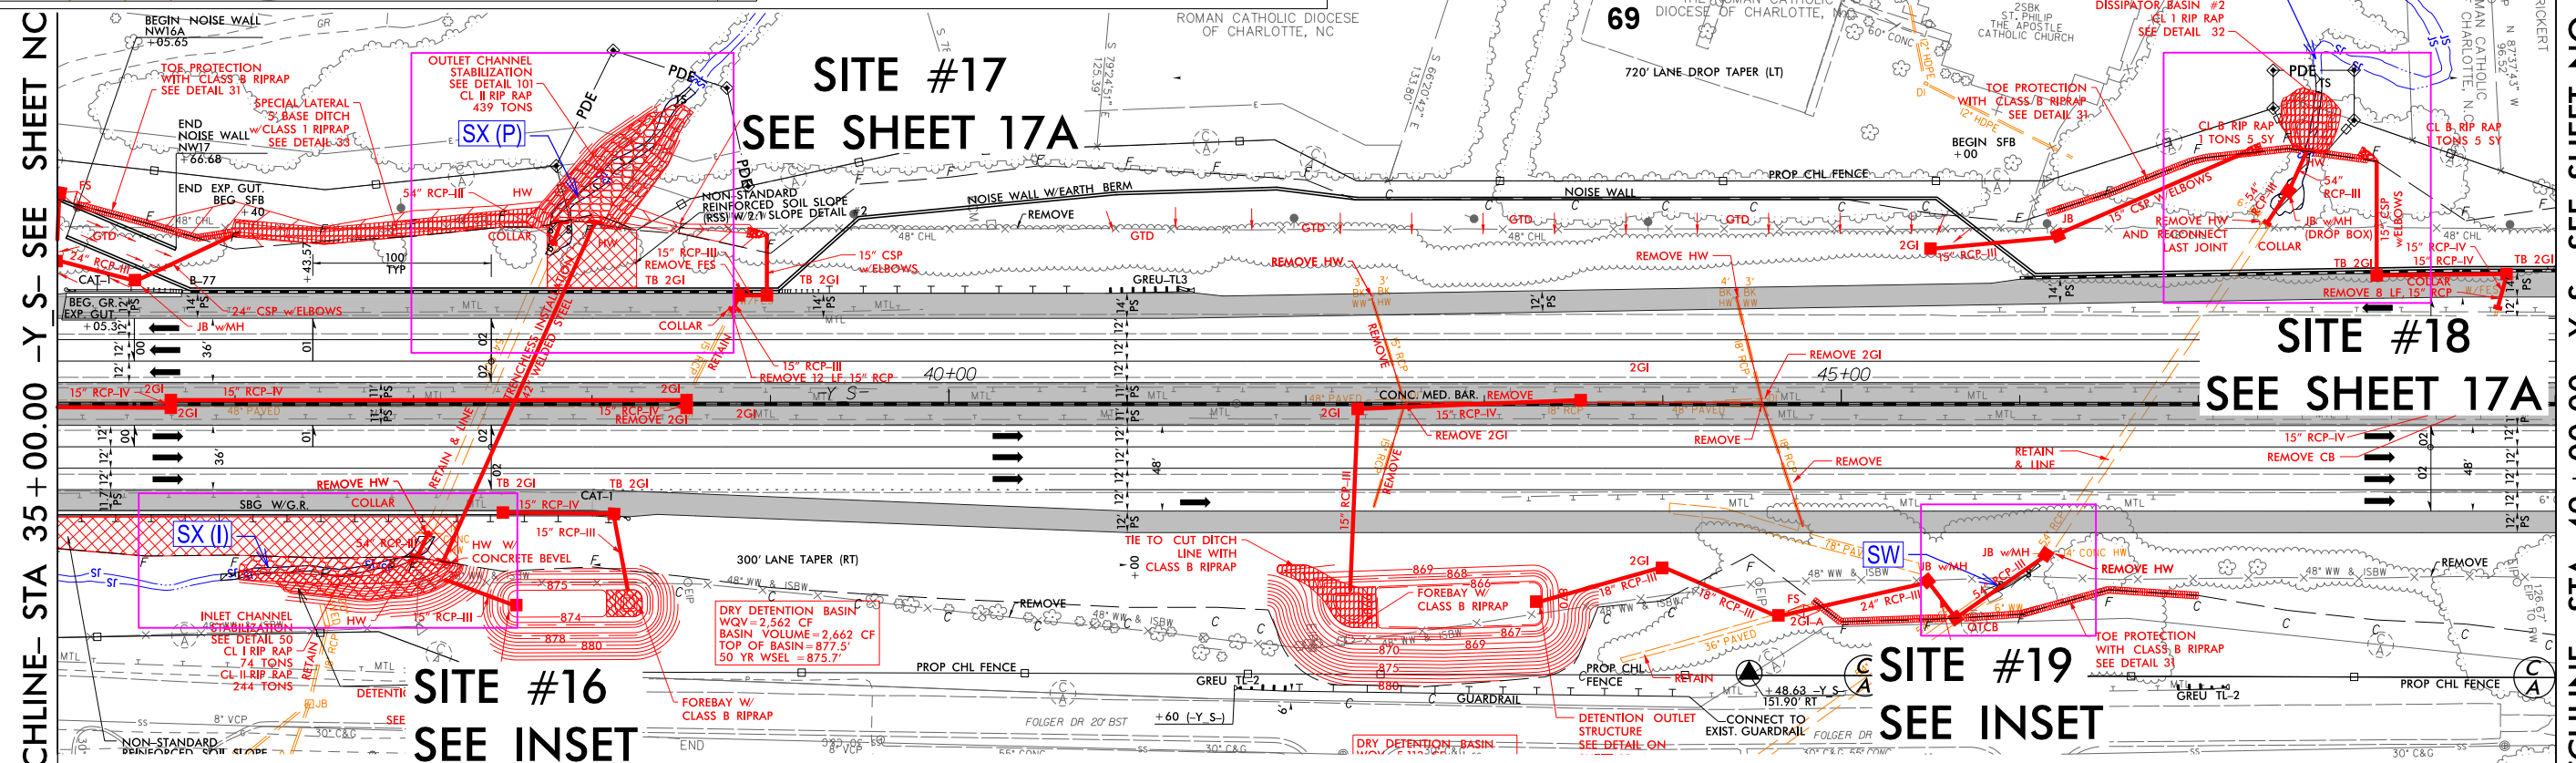


—MATCHLINE— STA 35 + 00.00 —Y S— SEE SHEET NC

-MA1CHLINE- SIA 49+00.00 -Y 5- SEE SHEET NO. 18

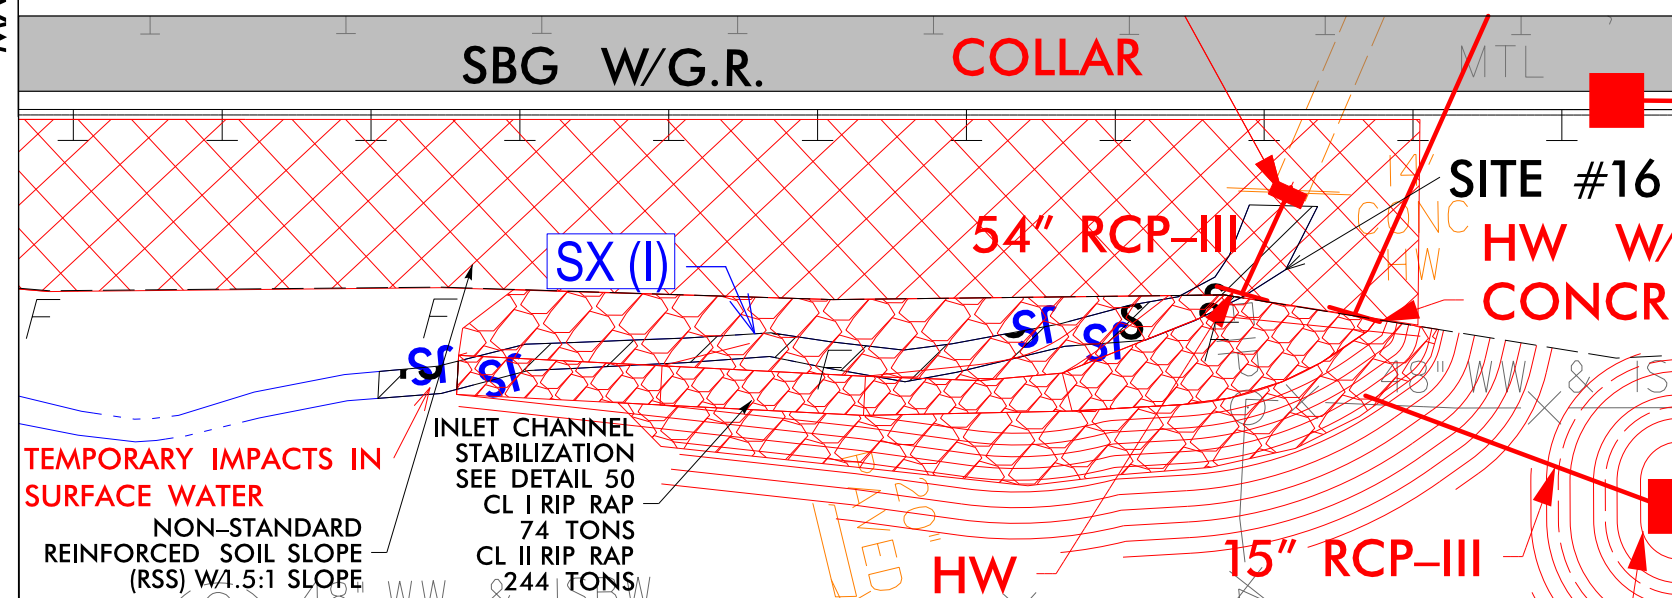

INSET

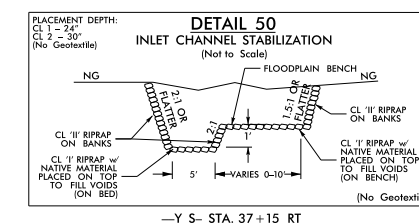

DENOTES IMPACTS IN
SURFACE WATER

DENOTES TEMPORARY
IMPACTS IN SURFACE WATER







1001 Morehead Square Dr.,
Suite 610, Charlotte, NC 28203
NC LIC NO. F-0165

PROJECT REFERENCE NO. <i>I-3819B</i>		SHEET NO. <i>17</i>
RW SHEET NO. _____		
ROADWAY DESIGN ENGINEER		HYDRAULICS ENGINEER
DOCUMENT NOT CONSIDERED FINAL UNLESS ALL SIGNATURES COMPLETED		

NC GRID NAD 83/95

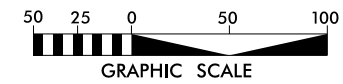


PERMIT DRAWING
SHEET 27 OF 67
Rev. 11/02/2020

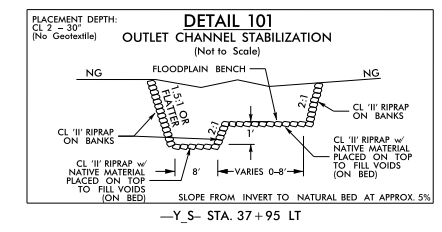

INSET

SW

SITE #19

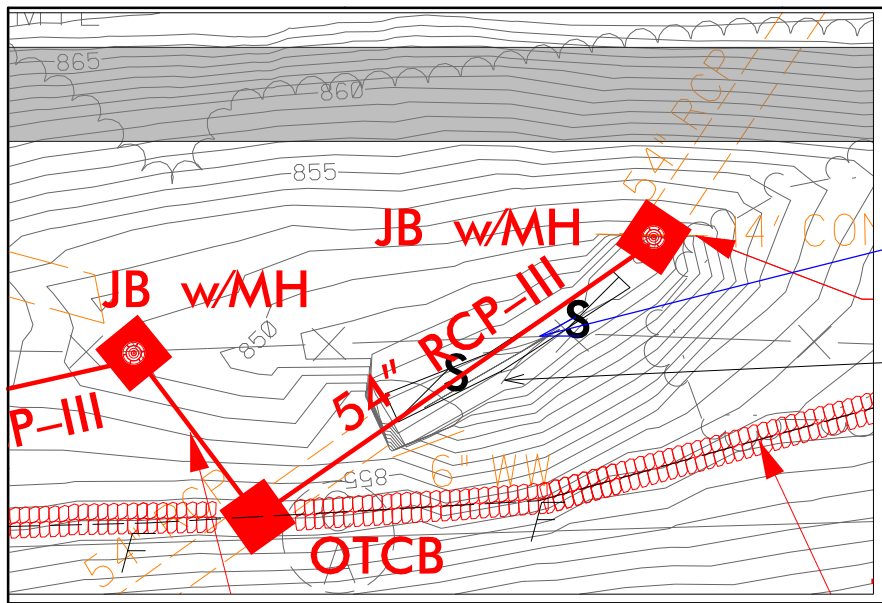

SITE #17
SEE SHEET 17A

SITE #18
SEE SHEET 17A



SITE #19
SEE INSET

SITE #16
SEE INSET

-MATCHLINE- STA 35+00.00 -Y S- SEE SHEET NC


-MATCHLINE- STA 49+00.00 -Y S- SEE SHEET NO.18

INSET

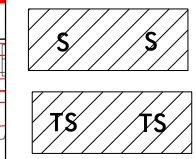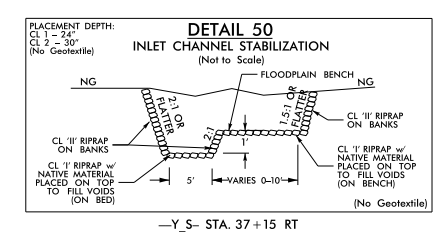


DENOTES IMPACTS IN
SURFACE WATER

DENOTES TEMPORARY
IMPACTS IN SURFACE WATER

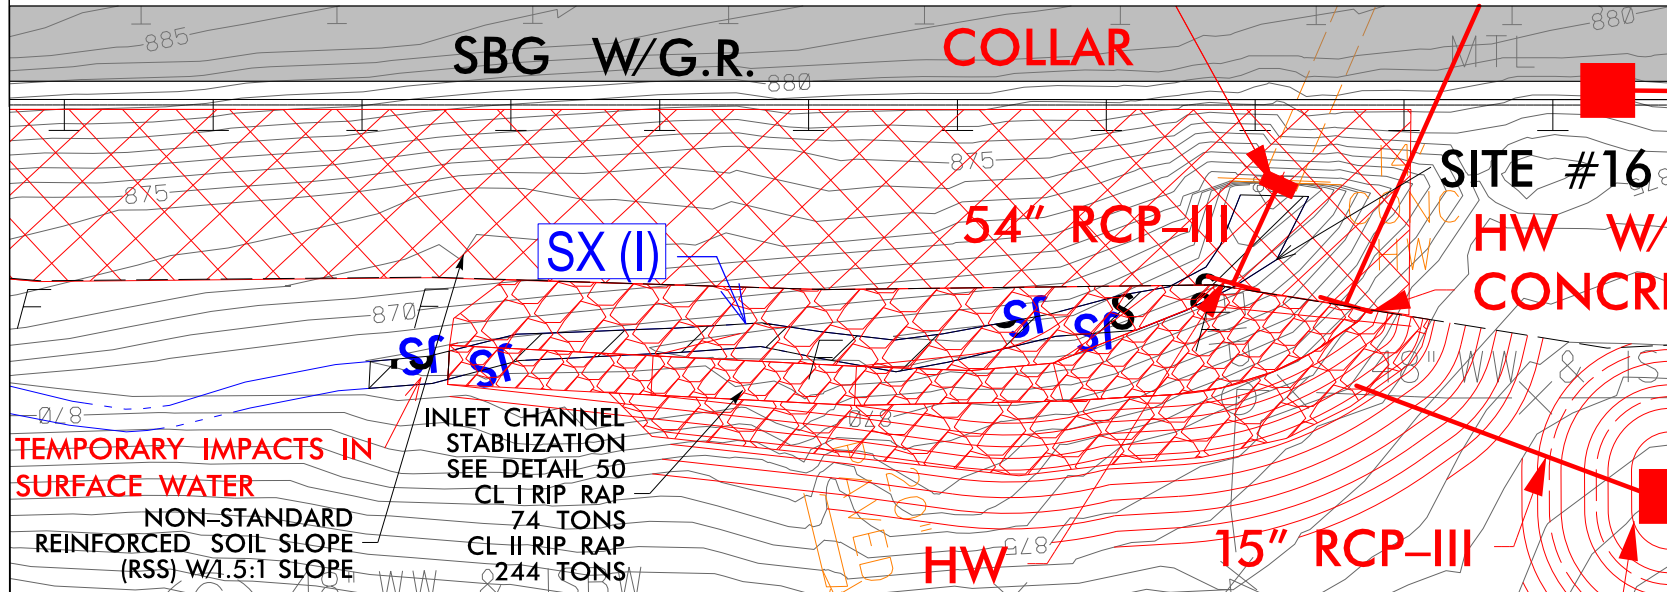

10/13/2020
GIS:\projects\wise\pb\project\wise\wsp_victoria\kohli\way_d03333329\13819_hyd_prm_pah17_Y3500-4900.dgn
13819_hyd_prm_pah17_Y3500-4900.dgn

RIP-RAPPED ENERGY DISSIPATOR BASIN

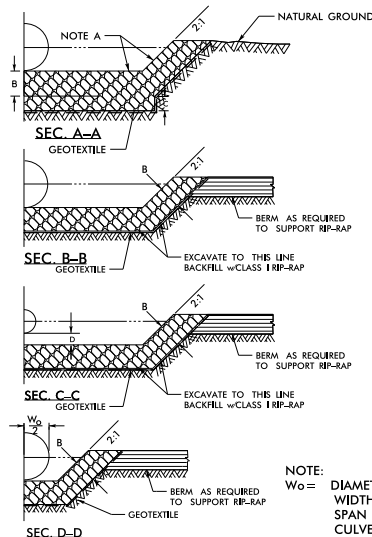

DIM.	RIP RAP BASIN #							
	1	2	3	4	5	6	7	8
A	30"	30"						
B	20"	20"						
C	16"	16"						
D	1'	1.25'						
E	3.5'	5.5'						
F	6.3'	10'						
G	10'	15'						
H	5'	7'						


BASIN #	LOCATION (AT OUTLET)
1	-YRPC- 10 + 82, 127 RT
2	-Y_S- 47 + 61, 142 LT
3	
4	
5	
6	
7	
8	

NOTE:
 W_0 = DIAMETER OF PIPE,
 WIDTH OF BOX OR
 SPAN OF PIPE ARCH

505

OUTLET CHANNEL STABILIZATION

PLACEMENT DEPTH:
CL 2 - 30"
(No Geotextile)

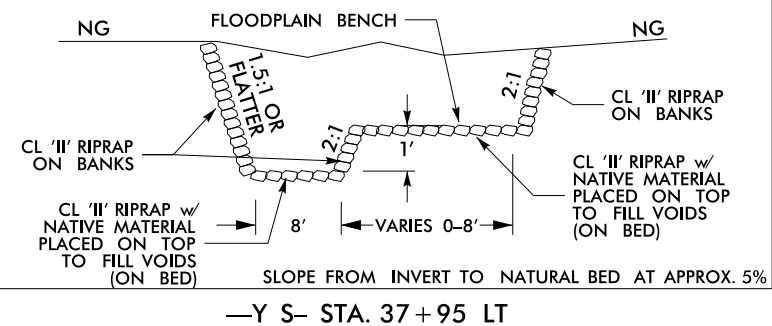

NC GRID + NAD 83/95

A rectangular block with diagonal hatching (lines from top-left to bottom-right). Inside the block, there are two 'S' symbols, one on the left and one on the right.

DENOTES IMPACTS IN
SURFACE WATERDENOTES TEMPORARY
IMPACTS IN SURFACE WATER

INSET SITE #18

RIP RAP ENERGY
DISSIPATOR BASIN #2
CL 1 RIP RAP
SEE DETAIL 32

CL B RIP RAP
1 TONS 5 SY

ELBOWS

REMOVE HW
ECONNECT
LAST JOINT

COLLAR

TB 2GI

REMOVE 8 LF, 15"

INSET

OUTLET CHANNEL
STABILIZATION
SEE DETAIL 101
CL II RIP RAP
439 TONS

SX (P)

4" RCP-III

HW

COLLAR

15" RCP-III
REMOVE FES
TB 2GI

COLLAR

SITE #17

TEMPORARY IMPACTS IN SURFACE WATER

NON-STANDARD REINFORCED SOIL SLOPE (RSS) W/2:1 SLOPE

1001 Morehead Square Dr.,
Suite 610, Charlotte, NC 28203
NC LIC NO. F-0165

PROJECT REFERENCE NO.

1-3819B

SHEET NO.

17A

RW SHEET NO.



ROADWAY DESIGN
ENGINEER

HYDRAULICS
ENGINEER

**DOCUMENT NOT CONSIDERED FINAL
UNLESS ALL SIGNATURES COMPLETED**

PERMIT DRAWING
SHEET 30 OF 67
Rev. 11/02/2020

PROJECT REFERENCE NO. 17-3898		SHEET NO. 30
ROADWAY DESIGN ENGINEER		HYDRAULICS ENGINEER
DOCUMENT NOT CONSIDERED FINAL UNLESS ALL SIGNATURES COMPLETED		

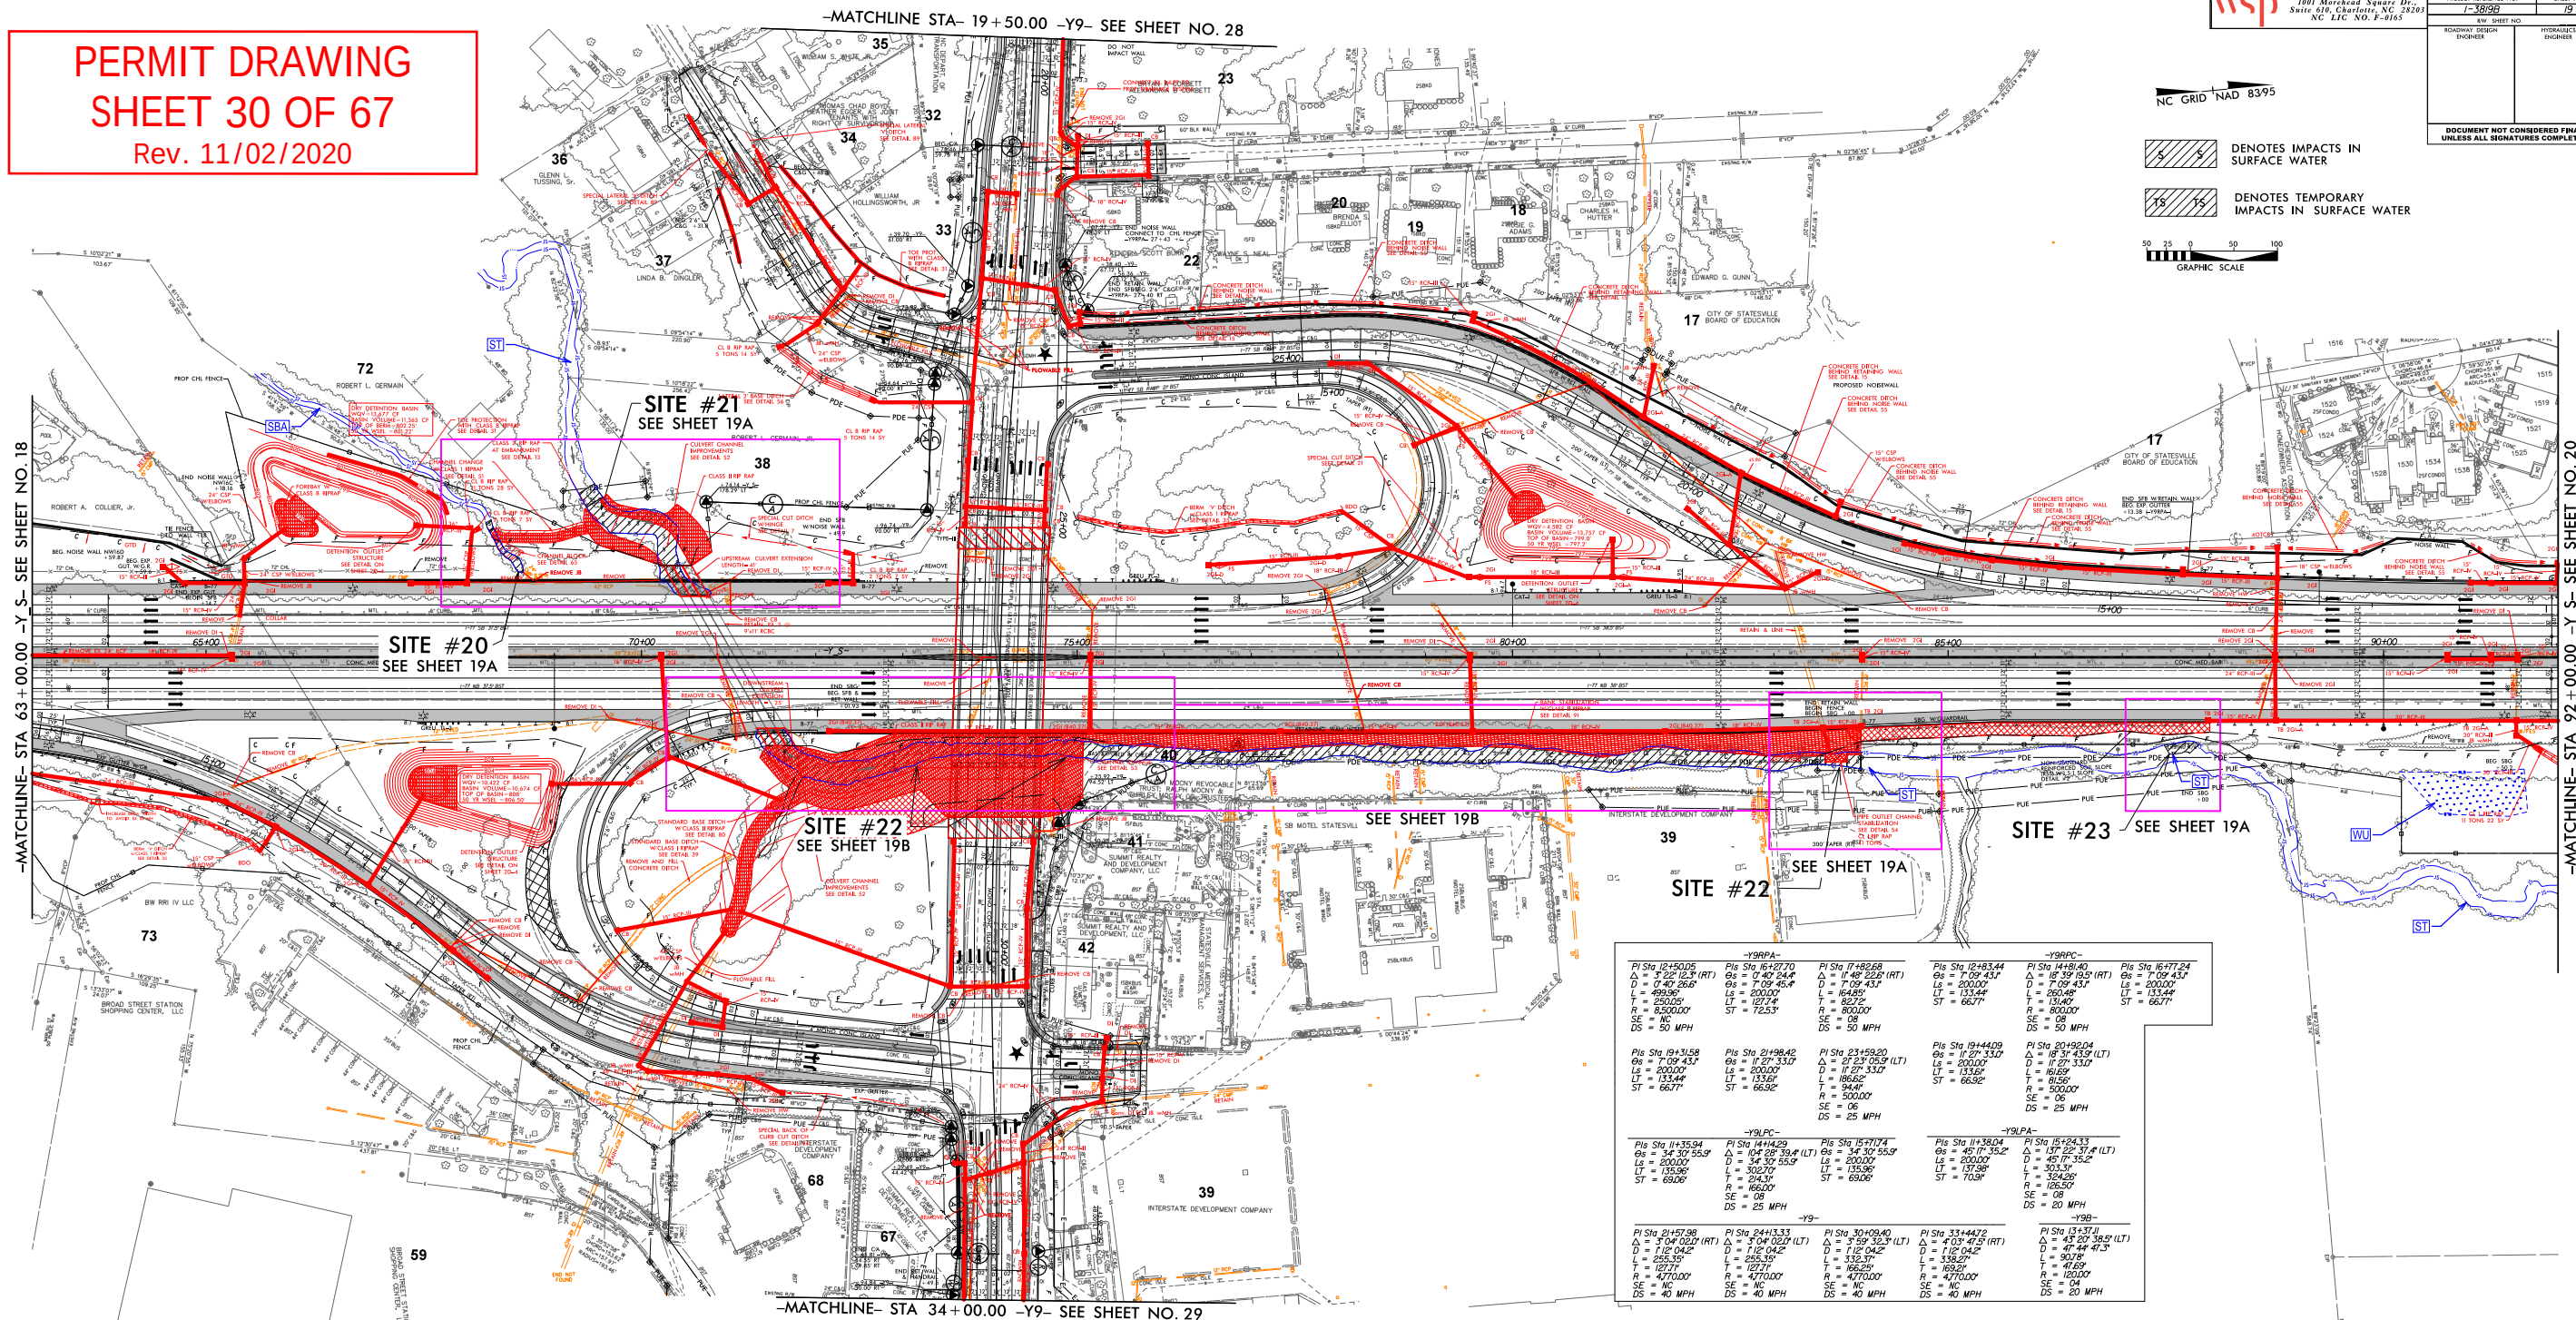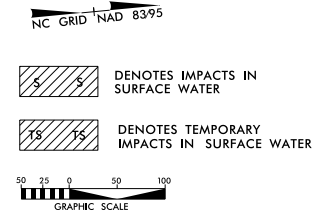

-Y9RPA-		-Y9RPA-		-Y9RPA-	
PI Sta 12+50.05	PI Sta 16+21.70	PI Sta 17+82.68	PI Sta 12+83.44	PI Sta 14+81.40	PI Sta 16+77.24
Δ = 3° 22' 12.3" (RT)	Δ = 0° 40' 24.4"	Δ = 1° 48' 22.6" (RT)	Δ = 7° 09' 43.1"	Δ = 18° 39' 19.5" (RT)	Δ = 7° 09' 43.1"
Es = 7° 09' 43.1"	Es = 7° 09' 43.1"	D = 709.431'	Es = 7° 09' 43.1"	D = 709.431'	Es = 7° 09' 43.1"
L = 493.96'	L = 200.00'	L = 164.95'	L = 200.00'	L = 133.44'	L = 200.00'
T = 250.00'	T = 127.14'	T = 82.72'	T = 133.44'	T = 133.44'	T = 133.44'
R = 8500.00'	R = 8500.00'	R = 8500.00'	R = 8500.00'	R = 8500.00'	R = 8500.00'
SE = 08	SE = 08	SE = 08	SE = 08	SE = 08	SE = 08
DS = 50 MPH	DS = 50 MPH	DS = 50 MPH	DS = 50 MPH	DS = 50 MPH	DS = 50 MPH
-Y9LPC-		-Y9LPC-		-Y9LPC-	
PI Sta 19+31.58	PI Sta 21+98.42	PI Sta 23+59.20	PI Sta 19+44.09	PI Sta 20+92.04	PI Sta 21+34.33
Δ = 1° 27' 33.0" (LT)	Δ = 1° 27' 33.0" (LT)	Δ = 1° 27' 33.0" (LT)	Δ = 1° 27' 33.0" (LT)	Δ = 1° 27' 33.0" (LT)	Δ = 1° 27' 33.0" (LT)
Es = 1° 27' 33.0"	Es = 1° 27' 33.0"	Es = 1° 27' 33.0"	Es = 1° 27' 33.0"	Es = 1° 27' 33.0"	Es = 1° 27' 33.0"
L = 200.00'	L = 200.00'	L = 200.00'	L = 200.00'	L = 200.00'	L = 200.00'
T = 133.44'	T = 133.44'	T = 133.44'	T = 133.44'	T = 133.44'	T = 133.44'
R = 8500.00'	R = 8500.00'	R = 8500.00'	R = 8500.00'	R = 8500.00'	R = 8500.00'
SE = 08	SE = 08	SE = 08	SE = 08	SE = 08	SE = 08
DS = 50 MPH	DS = 50 MPH	DS = 50 MPH	DS = 50 MPH	DS = 50 MPH	DS = 50 MPH
-Y9LPC-		-Y9LPC-		-Y9LPC-	
PI Sta 11+35.94	PI Sta 14+14.29	PI Sta 15+71.74	PI Sta 11+38.04	PI Sta 15+24.33	PI Sta 15+24.33
Δ = 3° 30' 55.9" (RT)	Δ = 1° 04' 39.94" (LT)	Δ = 3° 30' 55.9" (RT)	Δ = 3° 30' 55.9" (RT)	Δ = 1° 04' 39.94" (LT)	Δ = 1° 04' 39.94" (LT)
Es = 3° 30' 55.9"	Es = 1° 04' 39.94"	Es = 3° 30' 55.9"	Es = 3° 30' 55.9"	Es = 1° 04' 39.94"	Es = 1° 04' 39.94"
L = 200.00'	L = 34.30' 55.9"	L = 200.00'	L = 200.00'	L = 34.30' 55.9"	L = 34.30' 55.9"
T = 135.96'	T = 302.70'	T = 135.96'	T = 135.96'	T = 302.70'	T = 302.70'
R = 690.00'	R = 166.00'	R = 690.00'	R = 690.00'	R = 166.00'	R = 166.00'
SE = 08	SE = 08	SE = 08	SE = 08	SE = 08	SE = 08
DS = 25 MPH	DS = 25 MPH	DS = 25 MPH	DS = 25 MPH	DS = 25 MPH	DS = 25 MPH
-Y9B-		-Y9B-		-Y9B-	
PI Sta 21+57.98	PI Sta 24+13.33	PI Sta 30+08.40	PI Sta 33+44.72	PI Sta 13+37.11	PI Sta 13+37.11
Δ = 1° 12' 04.2" (LT)	Δ = 1° 12' 04.2" (LT)	Δ = 1° 12' 04.2" (LT)	Δ = 1° 12' 04.2" (LT)	Δ = 1° 12' 04.2" (LT)	Δ = 1° 12' 04.2" (LT)
Es = 1° 12' 04.2"	Es = 1° 12' 04.2"	Es = 1° 12' 04.2"	Es = 1° 12' 04.2"	Es = 1° 12' 04.2"	Es = 1° 12' 04.2"
L = 335.37'	L = 335.37'	L = 335.37'	L = 335.37'	L = 335.37'	L = 335.37'
T = 169.25'	T = 169.25'	T = 169.25'	T = 169.25'	T = 169.25'	T = 169.25'
R = 4770.00'	R = 4770.00'	R = 4770.00'	R = 4770.00'	R = 4770.00'	R = 4770.00'
SE = 04	SE = 04	SE = 04	SE = 04	SE = 04	SE = 04
DS = 20 MPH	DS = 20 MPH	DS = 20 MPH	DS = 20 MPH	DS = 20 MPH	DS = 20 MPH

NOTE: PER COMMENTS RECEIVED FROM NCDOT ON 10/16/20, JS LINES HAVE BEEN MODIFIED ALONG SITES 21, 22, AND 23 TO FOLLOW THE SURVEYED TOPOGRAPHY. NO RIPRAP WILL BE PLACED IN THE STREAM BED ALONG AREAS OF BANK STABILIZATION.

LOCATION: 1/7 AT E. BROAD STREET

TP NO. 1-3898 COUNTY: WELLS

DESIGNED BY: C. DAVE

CHECKED BY: D. ANDREWS DATE: 6-3-2019

PERMIT DRAWING
SHEET 31 OF 67
Rev. 11/02/2020

1801 Morehead Square Dr.,
Suite 410, Charlotte, NC 28203

NC LIC. NO. F-0165

PROJECT REFERENCE NO. 17-3839

SHEET NO. 31

ROADWAY DESIGN
ENGINEER

HYDRAULICS
ENGINEER

DOCUMENT NOT CONSIDERED FINAL
UNLESS ALL SIGNATURES COMPLETED

NC GRID NAD 8395

DENOTES IMPACTS IN
SURFACE WATER

DENOTES TEMPORARY
IMPACTS IN SURFACE WATER

50 10 50 100

GRAPHIC SCALE

The figure is a detailed topographic map for a permit drawing. It shows a proposed stream channel (red lines) flowing through a landscape with existing topography (contour lines). Key features include:
- **Matchlines:** STA 63+00.00 -Y- SEE SHEET NO. 18 (left), STA 19+50.00 -Y9- SEE SHEET NO. 28 (top), STA 34+00.00 -Y9- SEE SHEET NO. 29 (bottom), STA 92+00.00 -Y- SEE SHEET NO. 20 (right).
- **Sites:** SITE #20, SITE #21, SITE #22, and SITE #23 are marked with red outlines and labels.
- **Structures:** Various bridge structures are shown, including a large bridge over the stream and smaller culverts.
- **Engineering Details:** Numerous annotations provide specific engineering data, such as stationing, elevations, and structural specifications.
- **Legend:** A legend in the top right corner explains the symbols used for impacts in surface water.
- **Scale:** A graphic scale bar is provided in the top right corner.

NOTE: PER COMMENTS RECEIVED FROM NCDOT ON 10/16/20, JS LINES HAVE BEEN MODIFIED ALONG SITES 21, 22, AND 23 TO FOLLOW THE SURVEYED TOPOGRAPHY. NO RIPRAP WILL BE PLACED IN THE STREAM BED ALONG AREAS OF BANK STABILIZATION.

LOCATION: 1/7 AT E. BRIDGE STREET

TP NO. 1-3839 COUNTY: BURLINGTON

DESIGNED BY: C. DAVE




CHECKED BY: D. BARNWORTH DATE: 1-3-2019

NOTE: PER COMMENTS RECEIVED FROM NCDOT ON 10/16/20, JS LINES HAVE BEEN MODIFIED ALONG SITES 21, 22, AND 23 TO FOLLOW THE SURVEYED TOPOGRAPHY. NO RIPRAP WILL BE PLACED IN THE STREAM BED ALONG AREAS OF BANK STABILIZATION.


wsp 1001 Morehead Square Dr., Suite 610, Charlotte, NC 28203
NC LIC NO. F-0165

PROJECT REFERENCE NO.		SHEET NO.
1-3819B		19A
R/W SHEET NO.		
ROADWAY DESIGN ENGINEER		HYDRAULICS ENGINEER
DOCUMENT NOT CONSIDERED FINAL UNLESS ALL SIGNATURES COMPLETED		

INSET

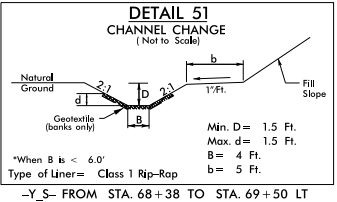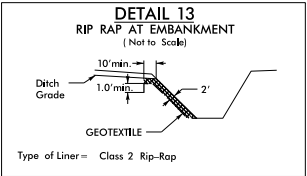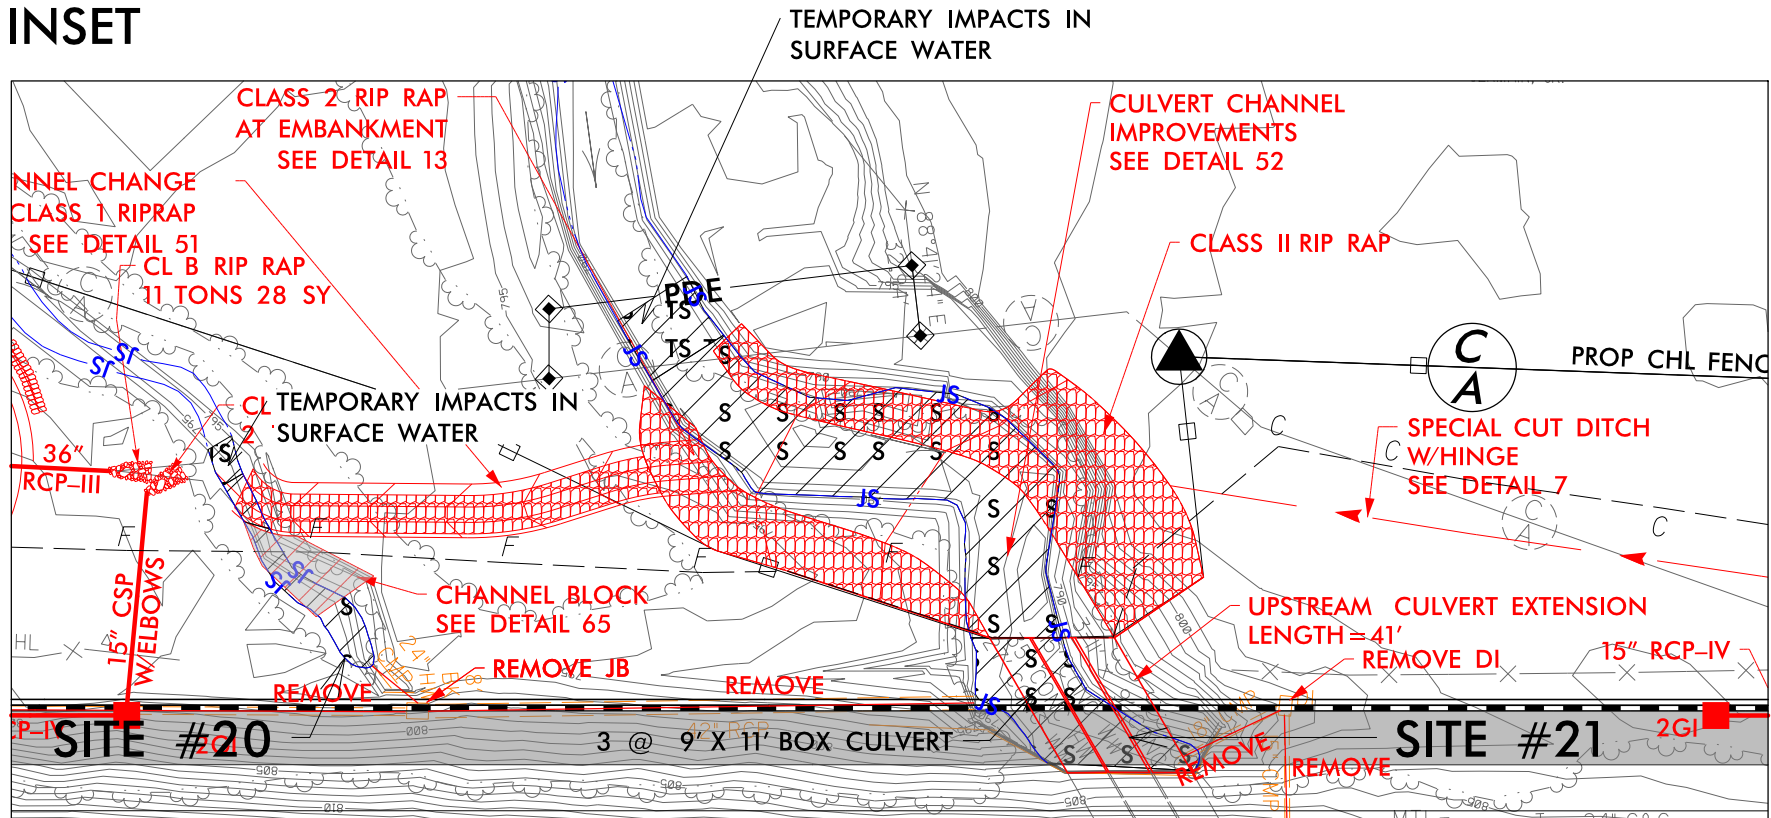


PERMIT DRAWING
SHEET 33 OF 67
Rev. 11/02/2020




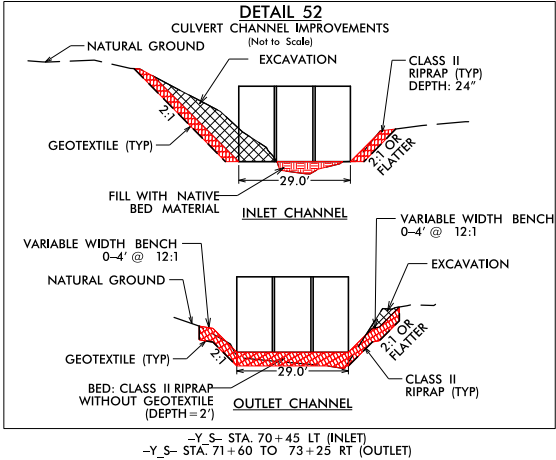


IMPACTS IN SURFACE WATER (BANK STABILIZATION)

INSET

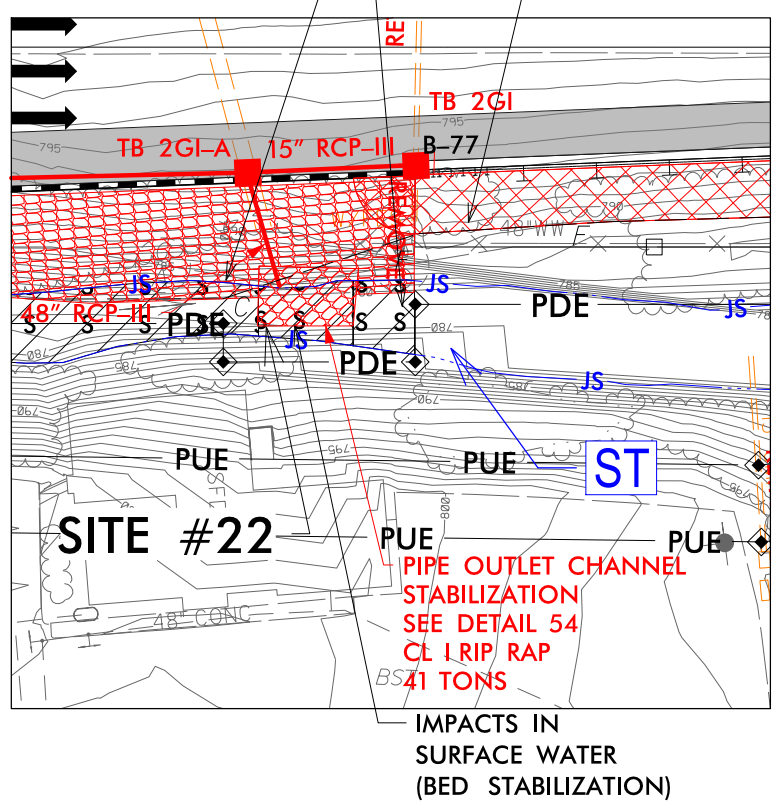

INSET

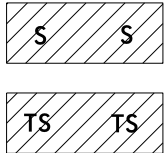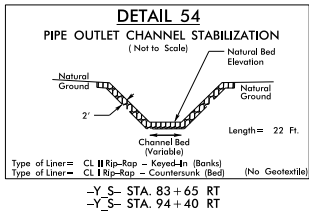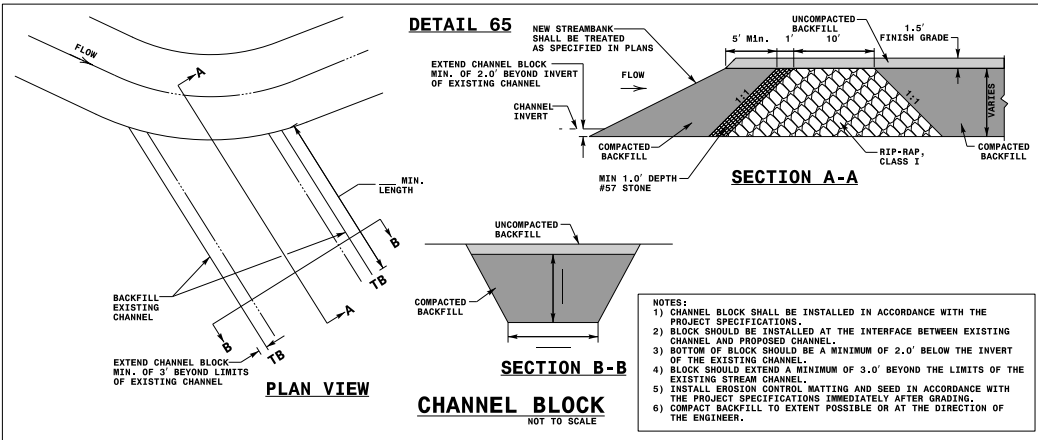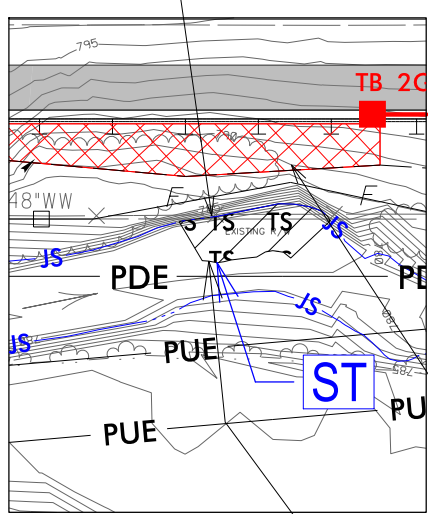

S DENOTES IMPACTS IN SURFACE WATER

TS DENOTES TEMPORARY IMPACTS IN SURFACE WATER


NC GRID NAD 8395



WSP 1001 Morehead Square Dr.,
Suite 610, Charlotte, NC 28203
NC LIC NO. F-0165

3	PROJECT REFERENCE NO.	SHEET NO.
	1-38/19B	19B
	R/W SHEET NO.	
	ROADWAY DESIGN ENGINEER	HYDRAULICS ENGINEER
	DOCUMENT NOT CONSIDERED FINAL UNLESS ALL SIGNATURES COMPLETED	

PERMIT DRAWING
SHEET 34 OF 67
Rev. 11/02/2020




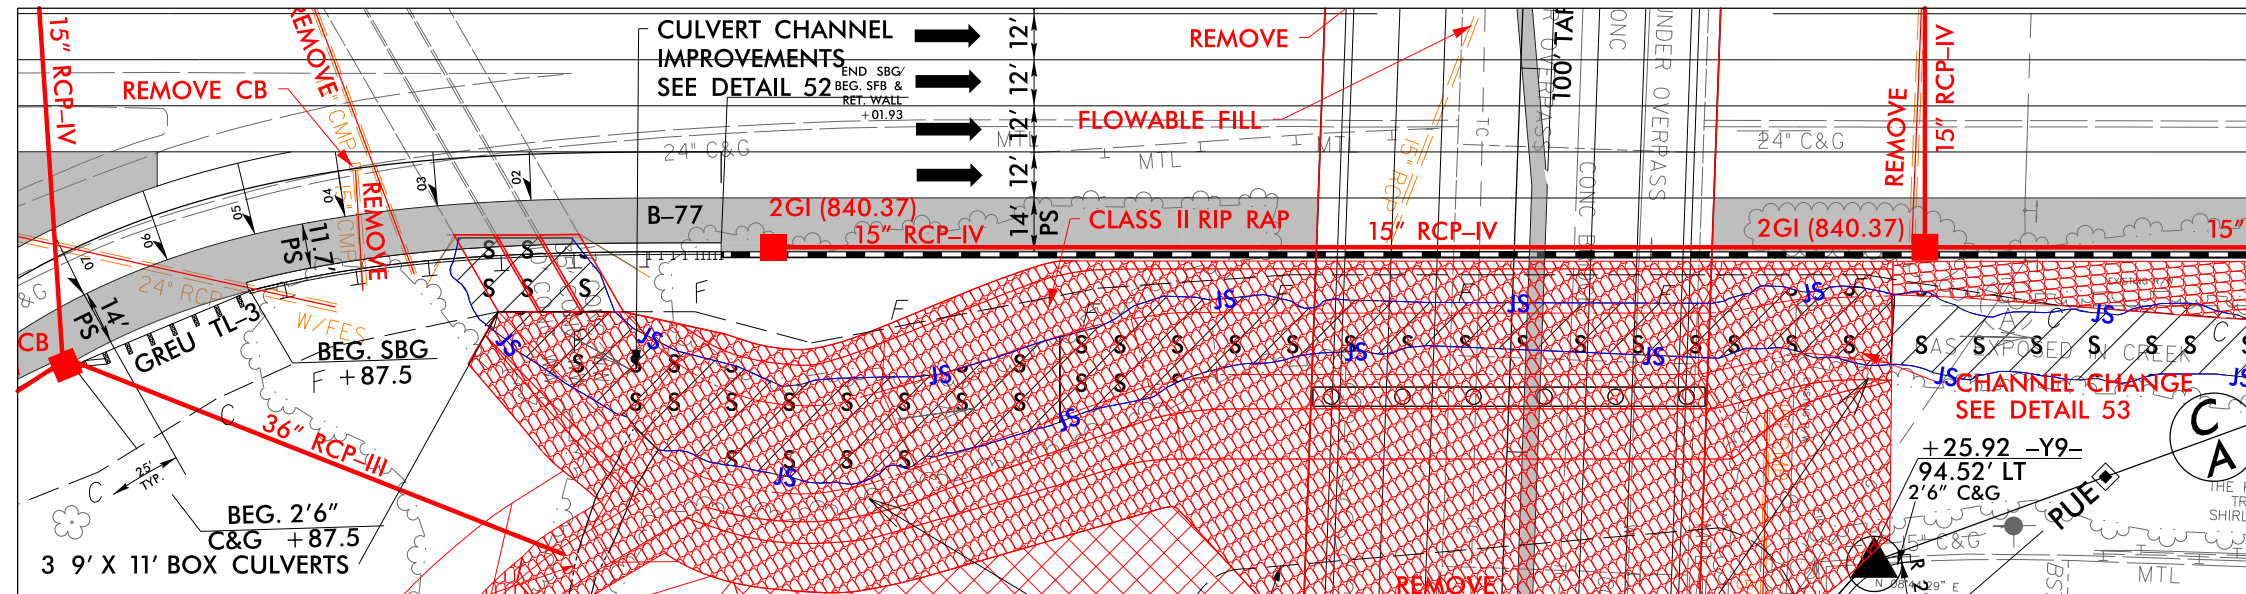


INSET

BANK STABILIZATION
SEE DETAIL 91

SITE #22

SITE #22

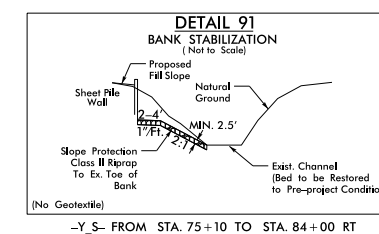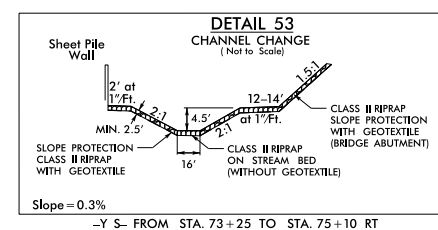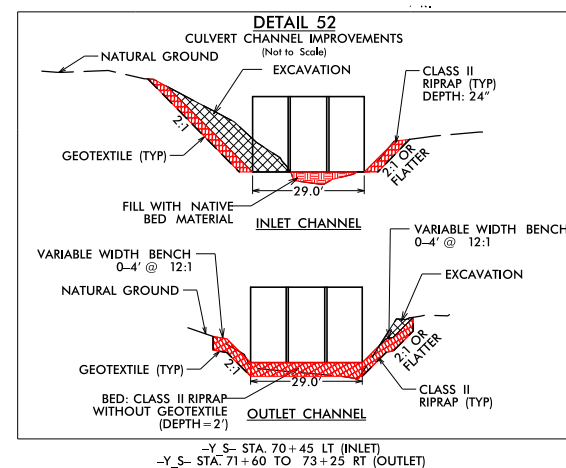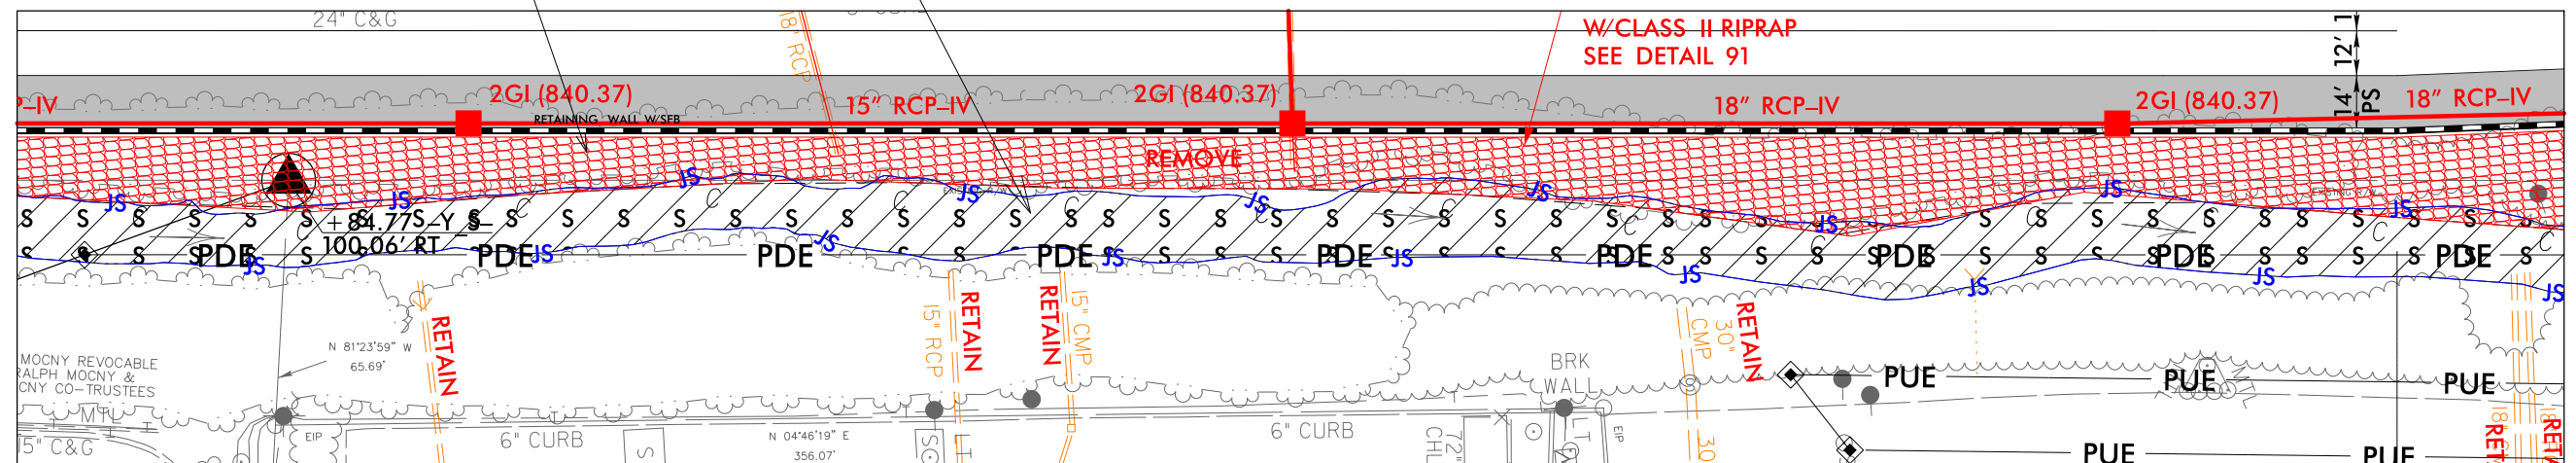

NC GRID + NAD 83/95

 DENOTES IMPACTS IN SURFACE WATER

DENOTES TEMPORARY
IMPACTS IN SURFACE WATER




0/30/2020
C:\projects\wsp_omondo_johnson\d0339329\13819_hjd-prm_psh198_v2100-3500.dgn
USA1675035

WSP 1001 Morehead Square Dr.,
Suite 610, Charlotte, NC 28203
NC LIC NO. F-0165

3	PROJECT REFERENCE NO.	SHEET NO.
	1-38/19B	19B
	R/W SHEET NO.	
	ROADWAY DESIGN ENGINEER	HYDRAULICS ENGINEER
	DOCUMENT NOT CONSIDERED FINAL UNLESS ALL SIGNATURES COMPLETED	

PERMIT DRAWING
SHEET 35 OF 67
Rev. 11/02/2020




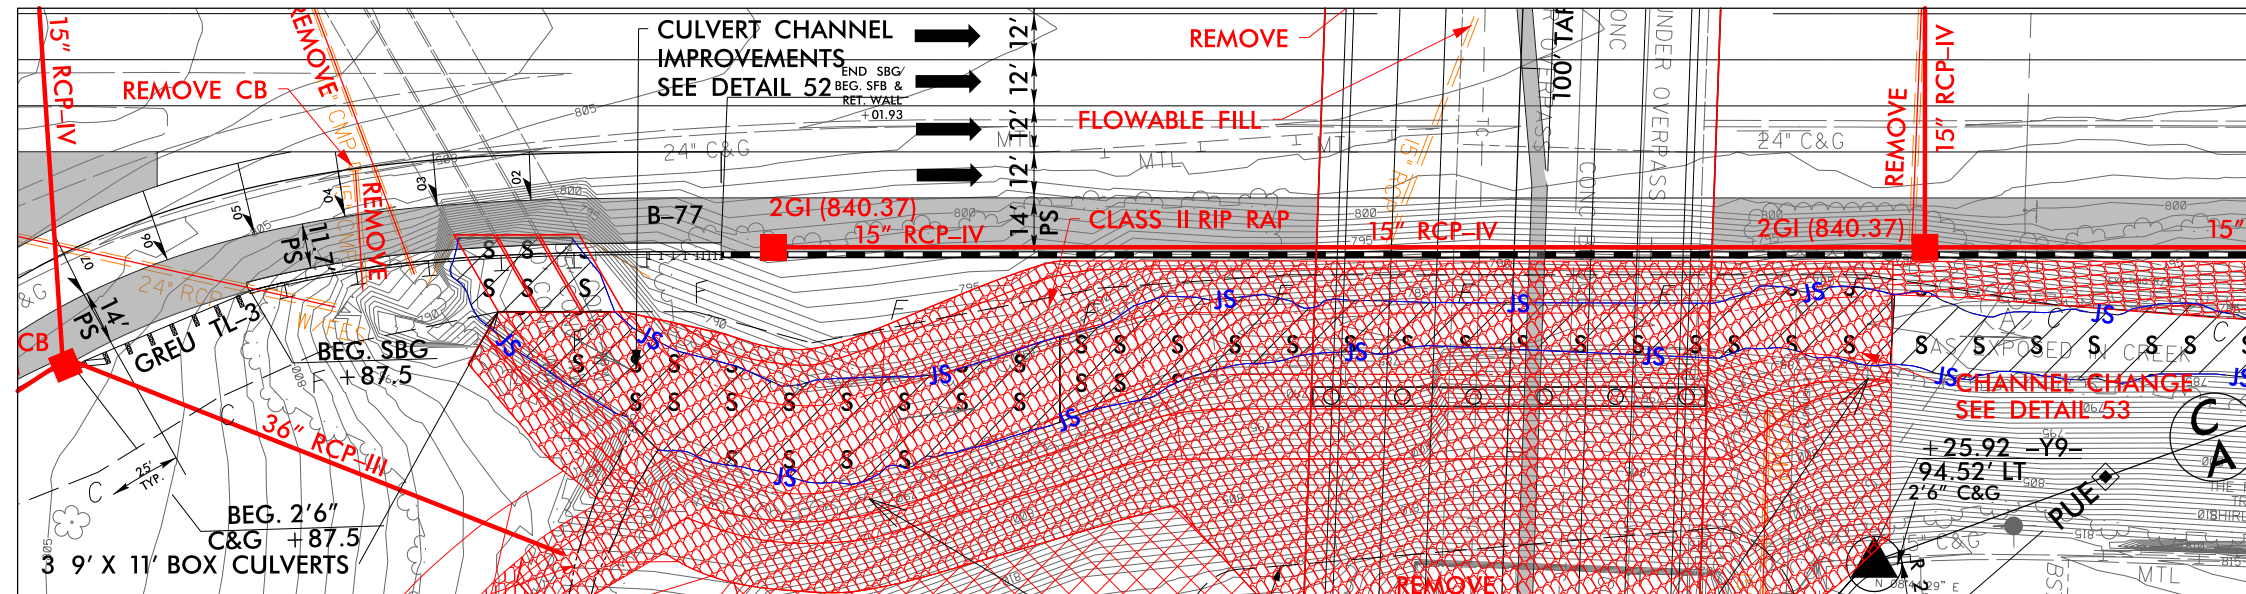


SITE #22

SITE #22

INSET

BANK STABILIZATION
SEE DETAIL 91

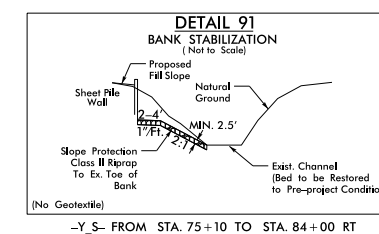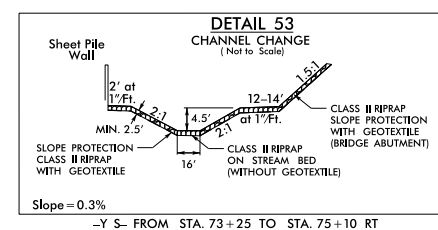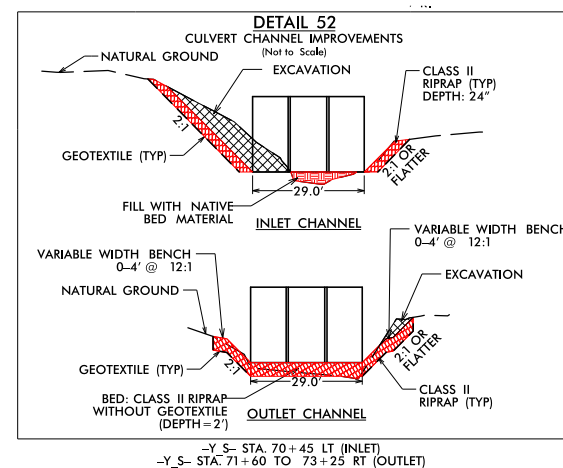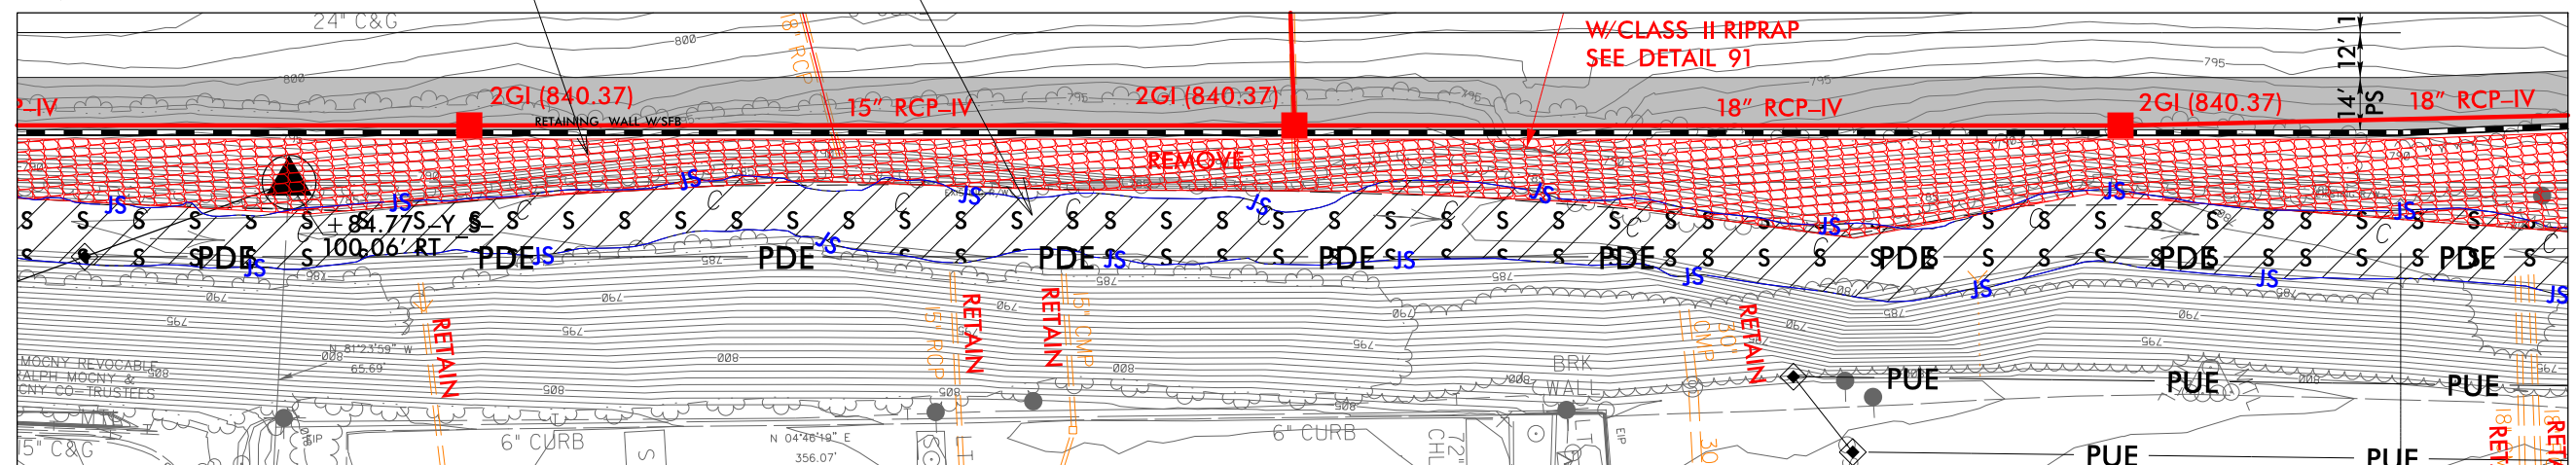

NC GRID | NAD 83/95

A rectangular block with diagonal hatching (lines from top-left to bottom-right). Inside the block, there are two 'S' labels, one on the left and one on the right.

DENOTES IMPACTS IN
SURFACE WATER

TS TS

DENOTES TEMPORARY
IMPACTS IN SURFACE WATER

0/30/2020
C:\projectwise\projectwise\wsp_omanda_johnson\d0339329\13819_hyd_prm-psl19B_Y2100-3500.dgn
USA675035




1001 Morehead Square Dr.,
Suite 610, Charlotte, NC 28203
NC LIC NO. F-0165

PROJECT REFERENCE NO.		SHEET NO.
I-3819B		20
R/W SHEET NO.		
ROADWAY DESIGN ENGINEER		HYDRAULICS ENGINEER
DOCUMENT NOT CONSIDERED FINAL UNLESS ALL SIGNATURES COMPLETED		

-MATCHLINE- STA 92+00.00 -Y_S- SEE SHEET NO. 19

-MATCHLINE- STA. 106+00 -Y_S- SEE SHEET NO. 21

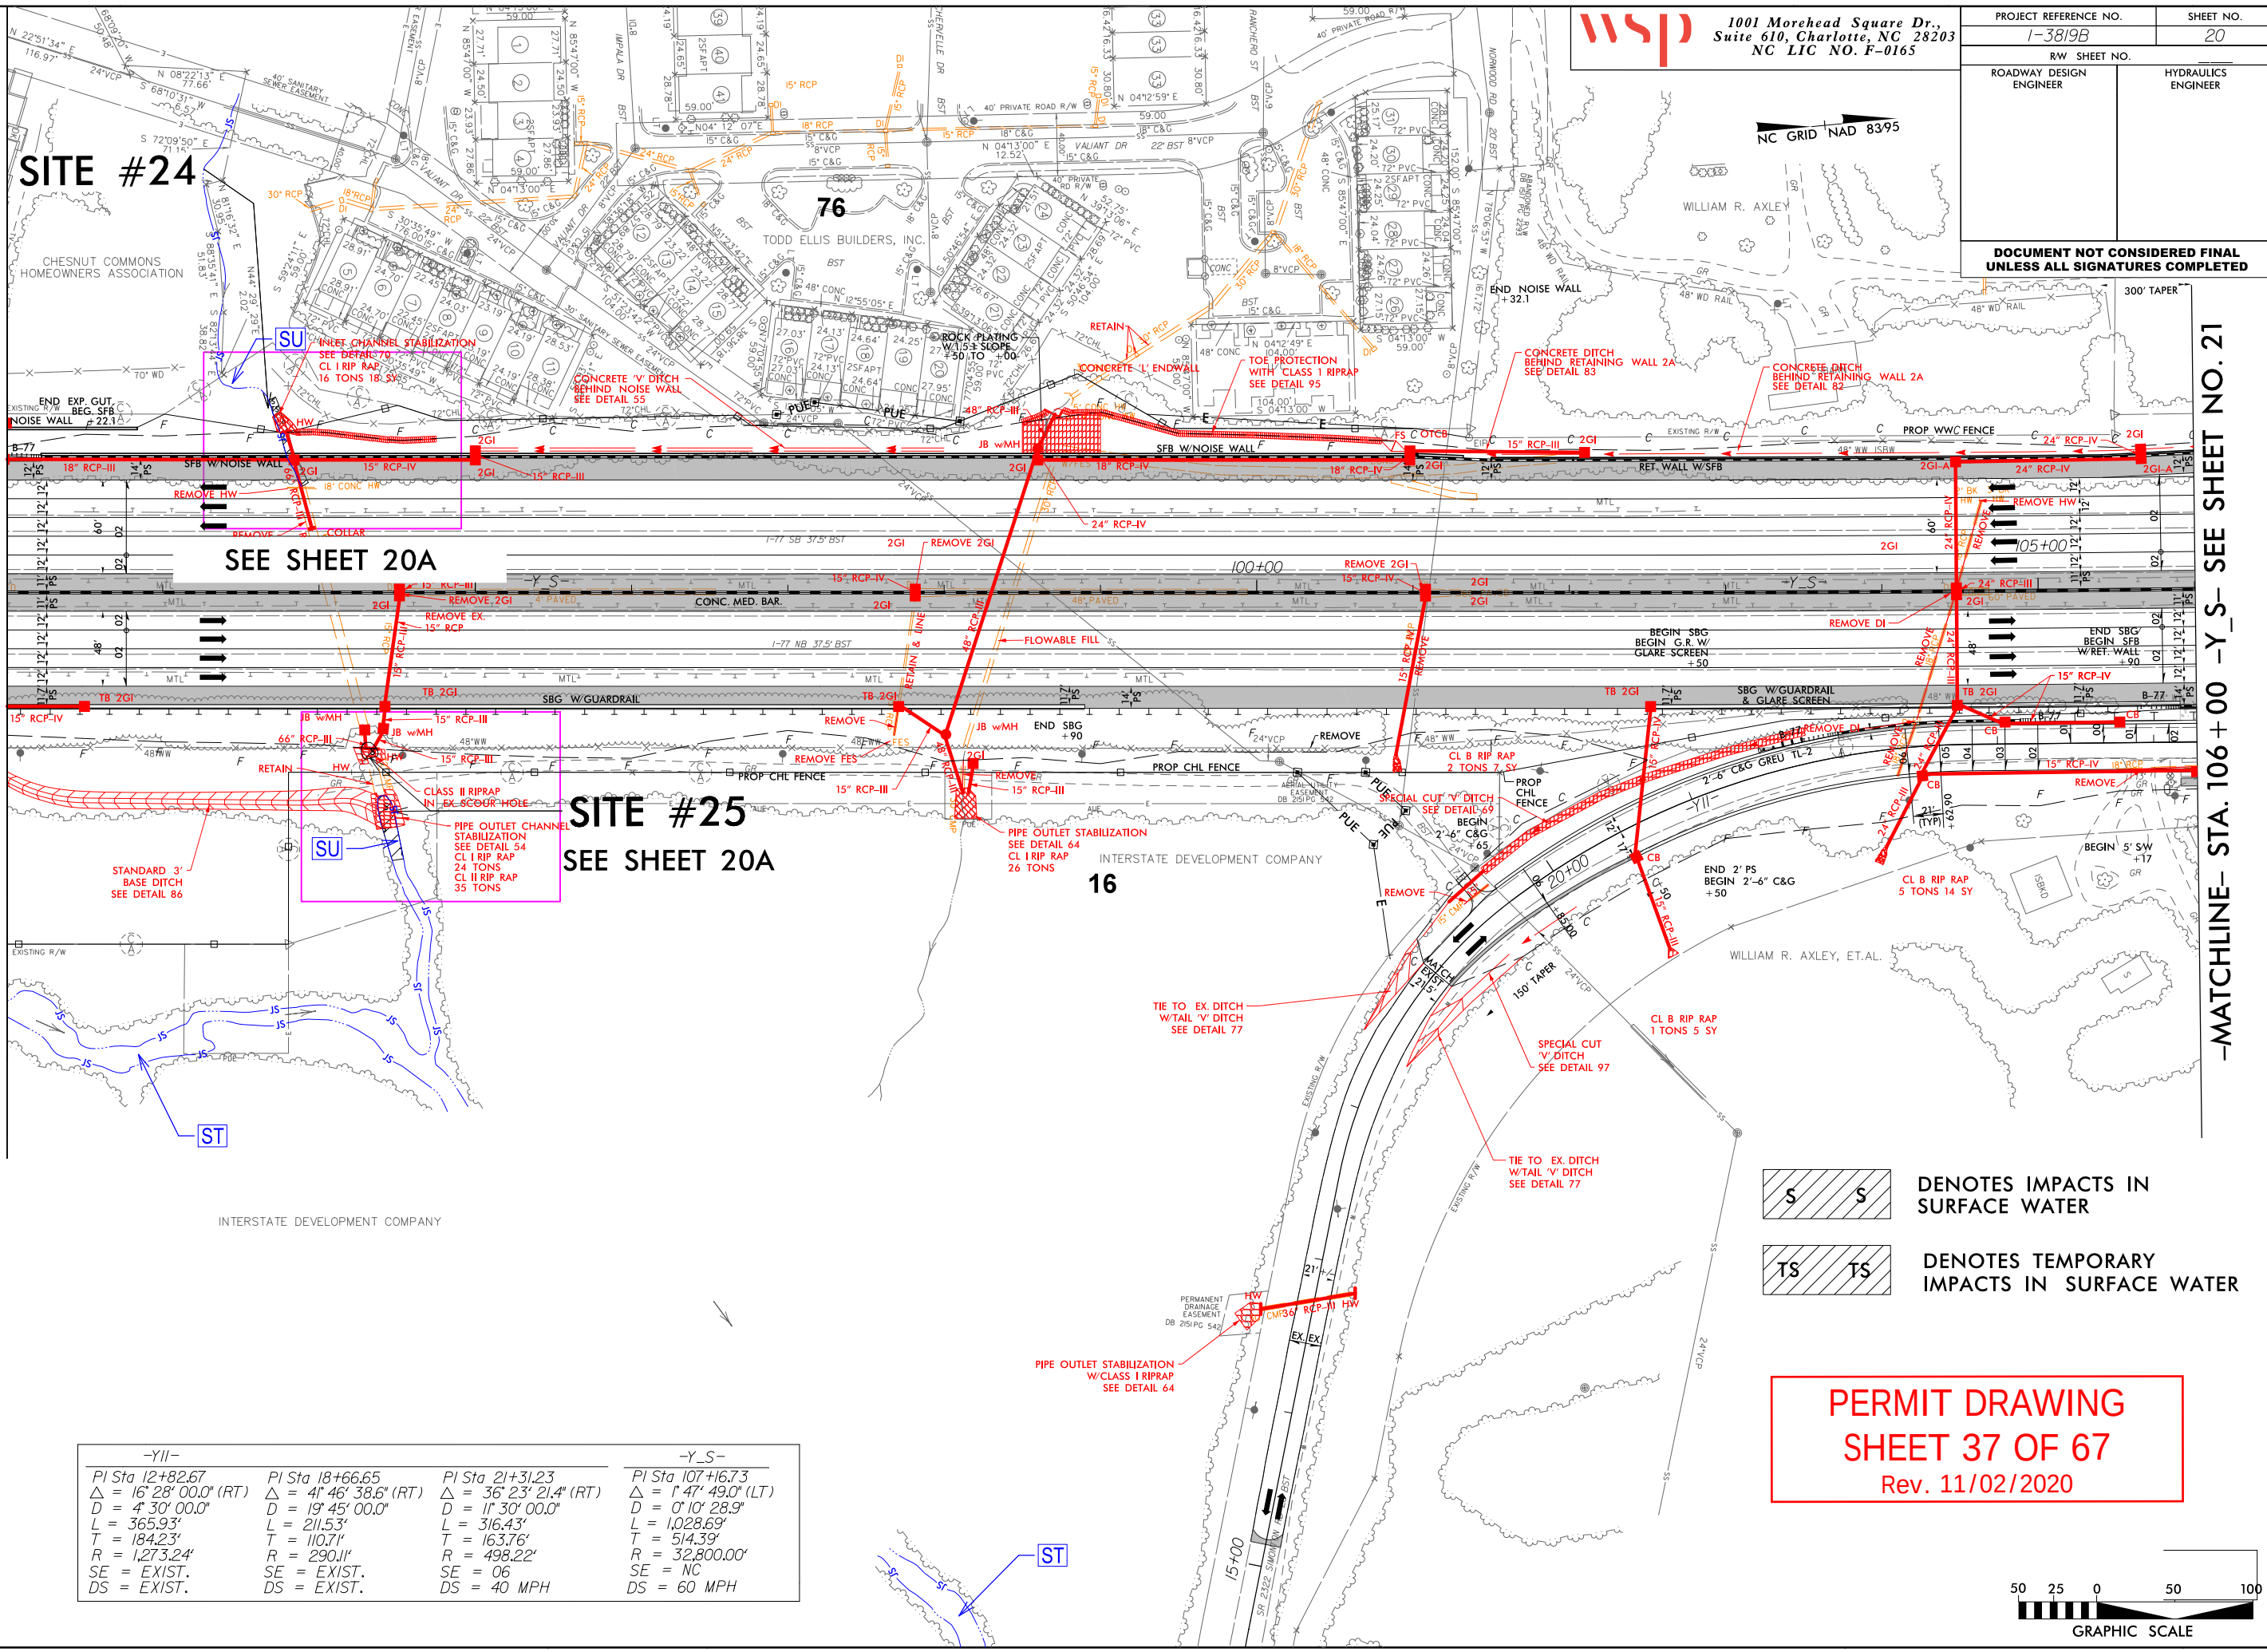

SITE #24


SITE #25
SEE SHEET 20A

-YII-	-Y_S-
PI Sta 12+82.67 Δ = 16° 28' 00.0" (RT) D = 4° 30' 00.0" L = 365.93' T = 184.23' R = 1,273.24' SE = EXIST. DS = EXIST.	PI Sta 18+66.65 Δ = 4° 46' 38.6" (RT) D = 19° 45' 00.0" L = 211.53' T = 110.71' R = 498.22' SE = EXIST. DS = EXIST.
PI Sta 21+31.23 Δ = 36° 23' 21.4" (RT) D = 1° 30' 00.0" L = 316.43' T = 163.76' R = 32,800.00' SE = 06 DS = 40 MPH	PI Sta 107+16.73 Δ = 1° 47' 49.0" (LT) D = 0° 10' 28.9" L = 1,028.69' T = 514.39' R = 32,800.00' SE = NC DS = 60 MPH

DENOTES IMPACTS IN SURFACE WATER


DENOTES TEMPORARY IMPACTS IN SURFACE WATER

PERMIT DRAWING
SHEET 37 OF 67
Rev. 11/02/2020

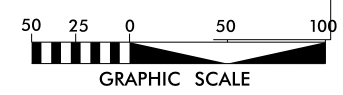


I:\2020
c:\p\c\wise\pb\project\wise\wsp...amanda.johnson\d0339329\13819_hyd_prm_psh20_Y9200-10500.dgn
11/2/2020
15:16:50


—MATCHLINE— STA. 106+00 —Y S— SEE SHEET NO. 21

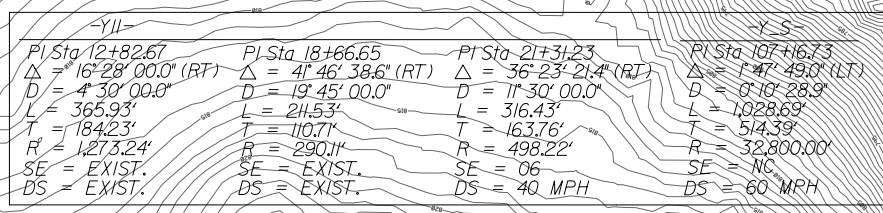


PERMIT DRAWING
SHEET 38 OF 67
Rev. 11/02/2020

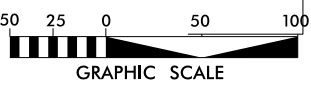

**DOCUMENT NOT CONSIDERED FINAL
UNLESS ALL SIGNATURES COMPLETED**

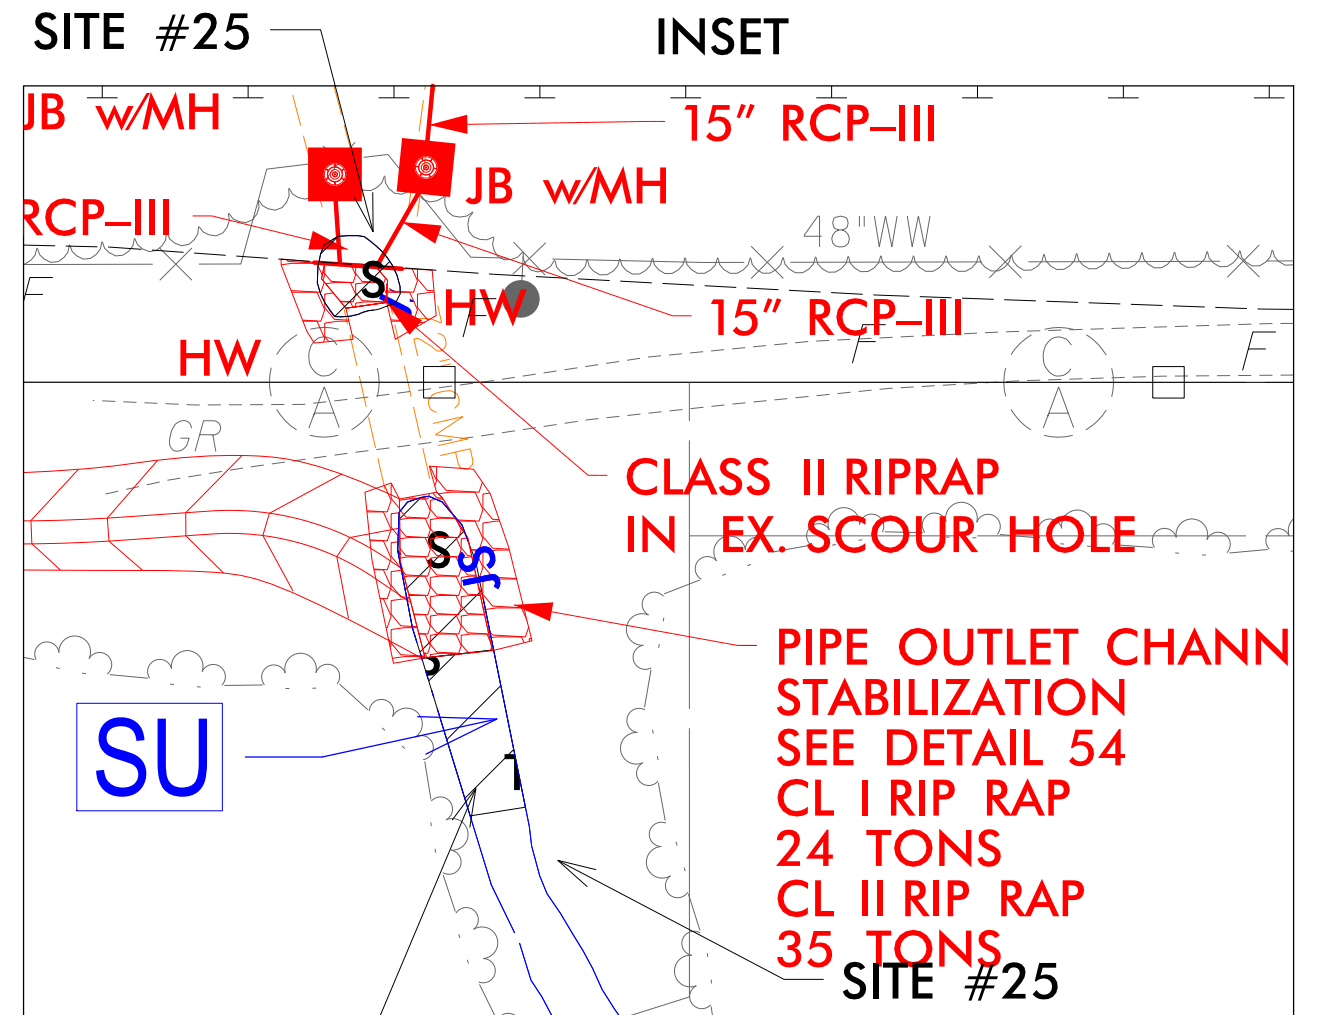

NC GRID NAD 83/95

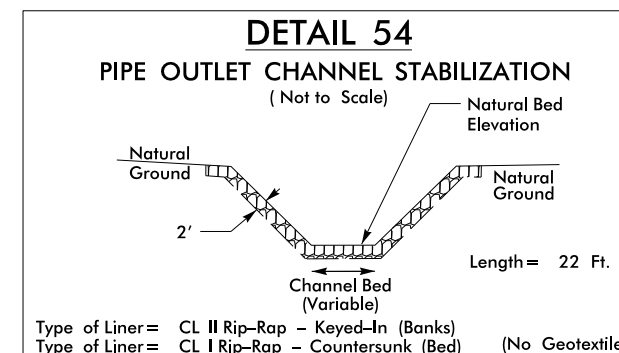


 DENOTES IMPACTS IN SURFACE WATER


 DENOTES TEMPORARY IMPACTS IN SURFACE WATER



**DOCUMENT NOT CONSIDERED FINAL
UNLESS ALL SIGNATURES COMPLETED**

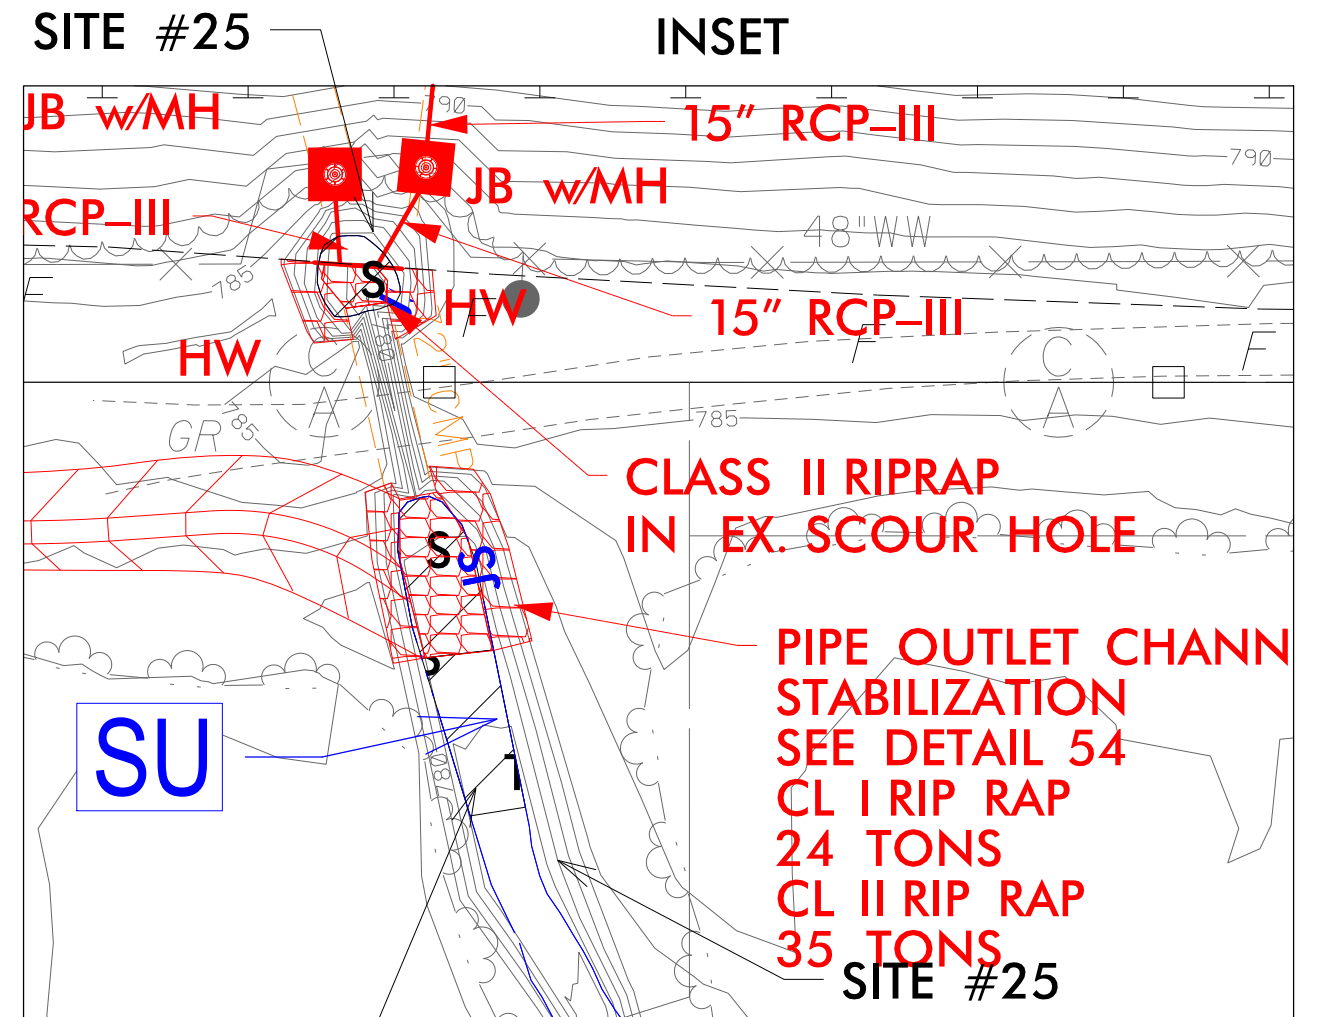

NC GRID + NAD 83/95

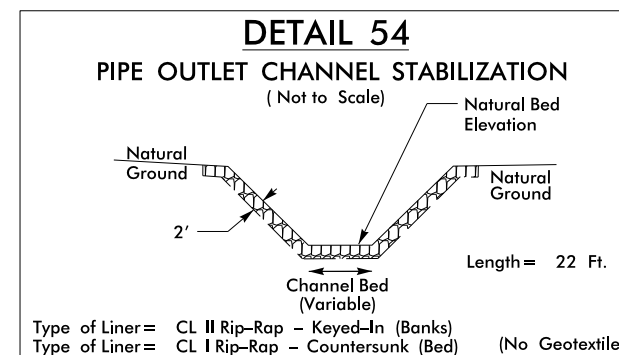

 DENOTES IMPACTS IN SURFACE WATER

 DENOTES TEMPORARY IMPACTS IN SURFACE WATER



PERMIT DRAWING
SHEET 46 OF 67
Rev. 11/02/2020

-YR40B-

Pis S14 14+2403	Pis S14 23+7430	Pis S14 26+4337	Pis S14 29+0334	Pis S14 30+945
$\Delta = 2^{\circ} 30' 05.3''$ (RT)	$\Delta = 4^{\circ} 52' 55.2''$	$\Delta = 22^{\circ} 24' 11''$ (RT)	$\Delta = 4^{\circ} 52' 55.2''$	$\Delta = 4^{\circ} 57' 08.4''$
D = 0° 39' 13.6"	L = 1440.3°	D = 46° 30.0"	L = 1440.3°	L = 1440.3°
L = 192.82°	LT = 96.04°	L = 413.54°	LT = 96.04°	LT = 96.04°
R = 10200.00°	ST = 480.3°	R = 2217.4°	ST = 480.3°	ST = 480.3°
R = 9,000.00°	SE = 50 MPH	R = 845.00°	SE = 50 MPH	
DS = 50 MPH		DS = 50 MPH		

-Y S-

-YR40C-

Pis S14 11+5863	Pis S14 74+012
$\Delta = 5^{\circ} 21' 11''$ (RT)	$\Delta = 13^{\circ} 12' 36.0''$ (RT)
D = 0° 29' 53.6"	D = 2° 14' 48.8"
L = 107.443°	L = 331.5°
L = 57.62°	T = 297.32°
R = 10200.00°	R = 833.00°
SE = 50 MPH	SE = 50 MPH
DS = 50 MPH	

-Y T-1

-Y T-2

-YR40C-

Pis S14 33+13.61	Pis S14 23+62.32	Pis S14 23+53.32
$\Delta = 5^{\circ} 46' 35.6''$	$\Delta = 16^{\circ} 57' 49.3''$ (LT)	$\Delta = 17^{\circ} 57' 49.3''$ (LT)
L = 270.71°	L = 460.02°	L = 460.02°
L = 54.35°	L = 7.54 35.5°	L = 7.54 35.5°
L = 1440.3°	L = 13.334°	L = 26.334°
LT = 96.04°	LT = 96.04°	LT = 96.04°
ST = 180.02°	ST = 66.67°	ST = 3,000.00°
R = 833.00°	R = 833.00°	R = 833.00°
SE = 50 MPH	SE = 50 MPH	SE = 50 MPH
DS = 50 MPH		

Pis S14 11+93.35	Pis S14 14+07.08
$\Delta = 4^{\circ} 57' 08.4''$	$\Delta = 23^{\circ} 36' 36.4''$ (RT)
D = 0° 39' 13.6"	D = 0° 39' 13.6"
L = 1440.3°	L = 84.57 30.0°
LT = 96.04°	LT = 96.04°
ST = 180.02°	ST = 73.333°
R = 833.00°	R = 833.00°
SE = 50 MPH	SE = 50 MPH
DS = 50 MPH	

-YR40D-

Pis S14 11+93.35	Pis S14 14+07.08
$\Delta = 4^{\circ} 57' 08.4''$	$\Delta = 23^{\circ} 36' 36.4''$ (RT)
D = 0° 39' 13.6"	D = 0° 39' 13.6"
L = 1440.3°	L = 84.57 30.0°
LT = 96.04°	LT = 96.04°
ST = 180.02°	ST = 73.333°
R = 833.00°	R = 833.00°
SE = 50 MPH	SE = 50 MPH
DS = 50 MPH	

Pis S14 16+46.61	Pis S14 22+11.11
$\Delta = 57^{\circ} 05' 16.1''$ (LT)	$\Delta = 57^{\circ} 05' 16.1''$ (LT)
D = 0° 39' 13.6"	D = 0° 39' 13.6"
L = 84.57 30.0°	L = 73.04°
LT = 96.04°	L = 365.52°
ST = 480.3°	ST = 7.270.00°
R = 833.00°	R = 833.00°
SE = 50 MPH	SE = 50 MPH
DS = 50 MPH	

Pis S14 33+66.93	Pis S14 43+32.81
$\Delta = 95^{\circ} 31' 35.3''$ (LT)	$\Delta = 95^{\circ} 31' 35.3''$ (LT)
D = 0° 39' 13.6"	D = 0° 39' 13.6"
L = 84.57 30.0°	L = 138.92°
LT = 96.04°	L = 913.00°
ST = 480.3°	ST = 913.00°
R = 833.00°	R = 833.00°
SE = 50 MPH	SE = 50 MPH
DS = 50 MPH	

- | | |
|---|--|
|  | DENOTES FILL IN WETLAND |
|  | DENOTES MECHANIZED CLEARING |
|  | DENOTES TEMPORARY FILL IN WETLAND |
|  | DENOTES IMPACTS IN SURFACE WATER |
|  | DENOTES TEMPORARY IMPACTS IN SURFACE WATER |

LOCATION: _____


TP NO.: L-38108 COUNTY: BREDEL

DESIGNED BY: _____ C. DAVIS _____

CHECKED BY: D. ARNSWORTH DATE: 6-2-2019

INSET

SITE #5

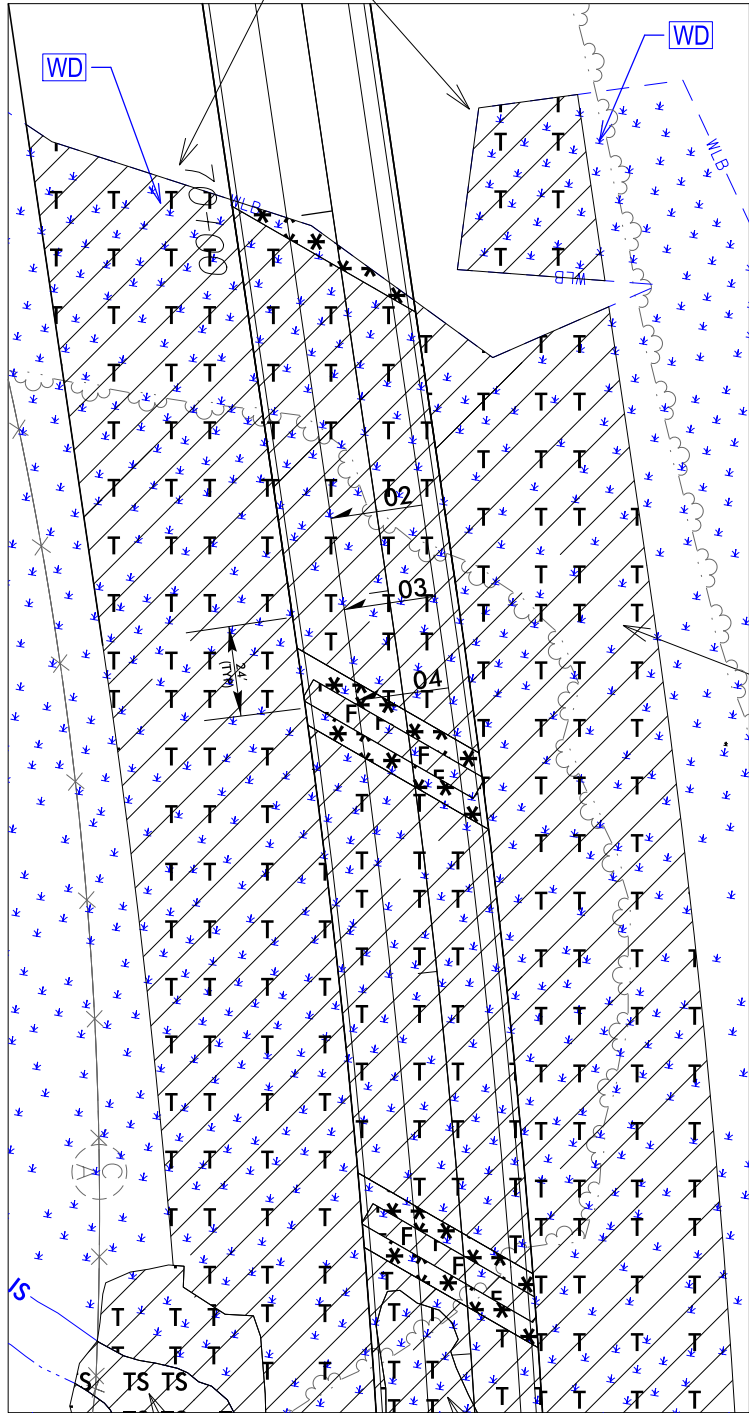


TEMPORARY IMPACTS IN
SURFACE WATER

TEMPORARY FILL
IN WETLAND
(RESTORATION SITE)

TEMPORARY FILL
IN WETLAND
(MATTING FOR
CONSTRUCTION
ACCESS - BRIDGE
STRUCTURE #10)

TEMPORARY FILL
IN WETLAND
(RESTORATION SITE)

TEMPORARY IMPACTS IN
SURFACE WATER

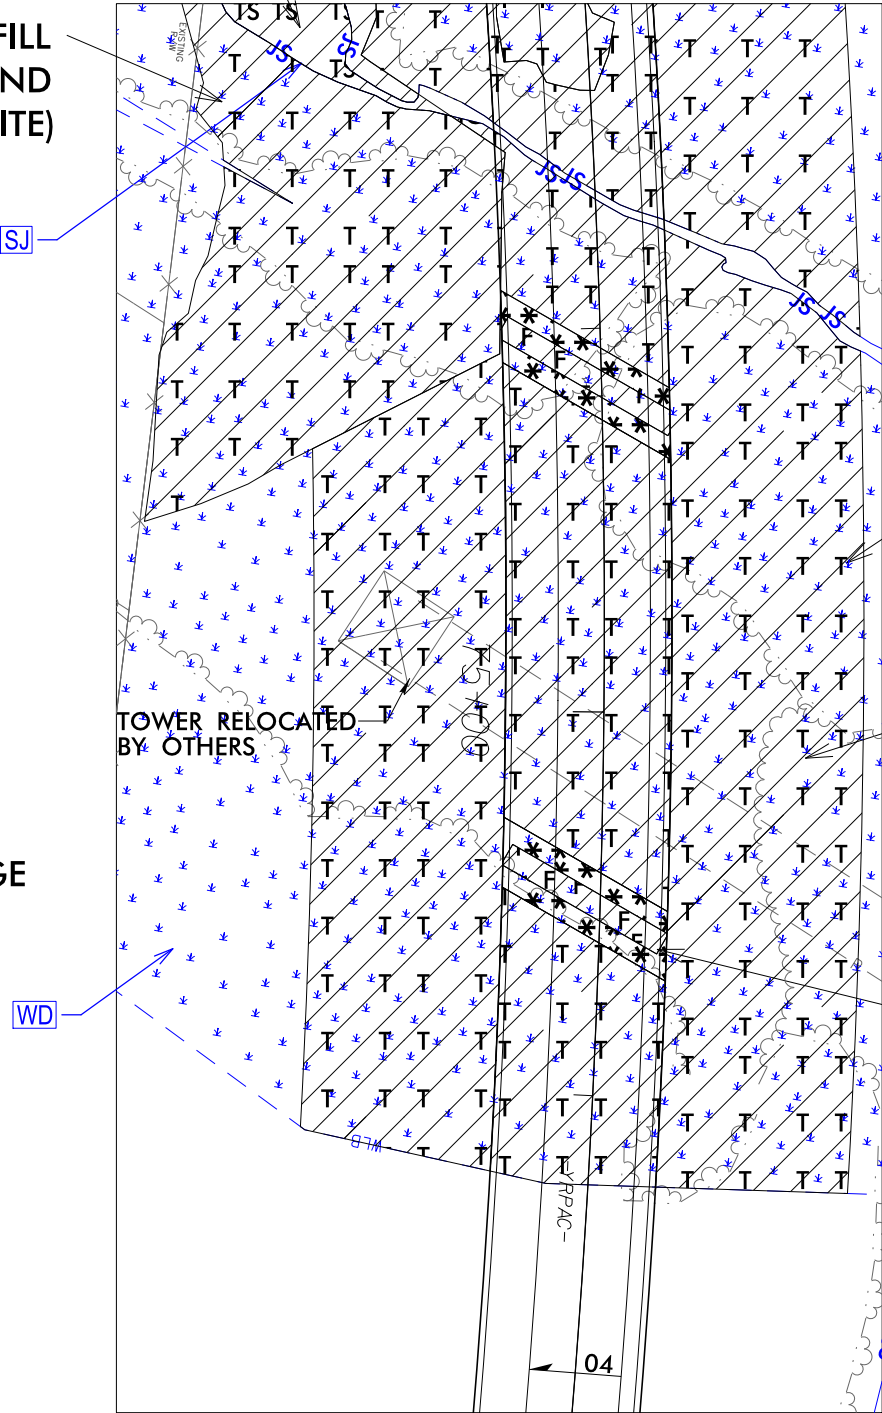

TOWER RELOCATED
BY OTHERS

SITE #5

TEMPORARY FILL
IN WETLAND
(MATTING FOR
CONSTRUCTION
ACCESS - BRIDGE
STRUCTURE #10)

PERMANENT FILL AND
MECHANIZED CLEARING
FOR PROPOSED BENT (TYP)

- TS TS DENOTES TEMPORARY IMPACTS IN SURFACE WATER
- F F DENOTES FILL IN WETLAND
- DENOTES MECHANIZED CLEARING
- T T DENOTES TEMPORARY FILL IN WETLAND

PERMIT DRAWING
SHEET 50 OF 67
Rev. 11/02/2020



GRAPHIC SCALE - INSETS




PROJECT REFERENCE NO.	SHEET NO.
1-3819B	22B
R/W SHEET NO.	
ROADWAY DESIGN ENGINEER	HYDRAULICS ENGINEER
DOCUMENT NOT CONSIDERED FINAL UNLESS ALL SIGNATURES COMPLETED	

NC GRID NAD 8395

10/22/2020
c:\projectwise\pb\projectwise\becker_jw\0339329\13819_hyd-prm-psh-22B_112000-13500.dgn
becker_jw

INSET

SITE #5

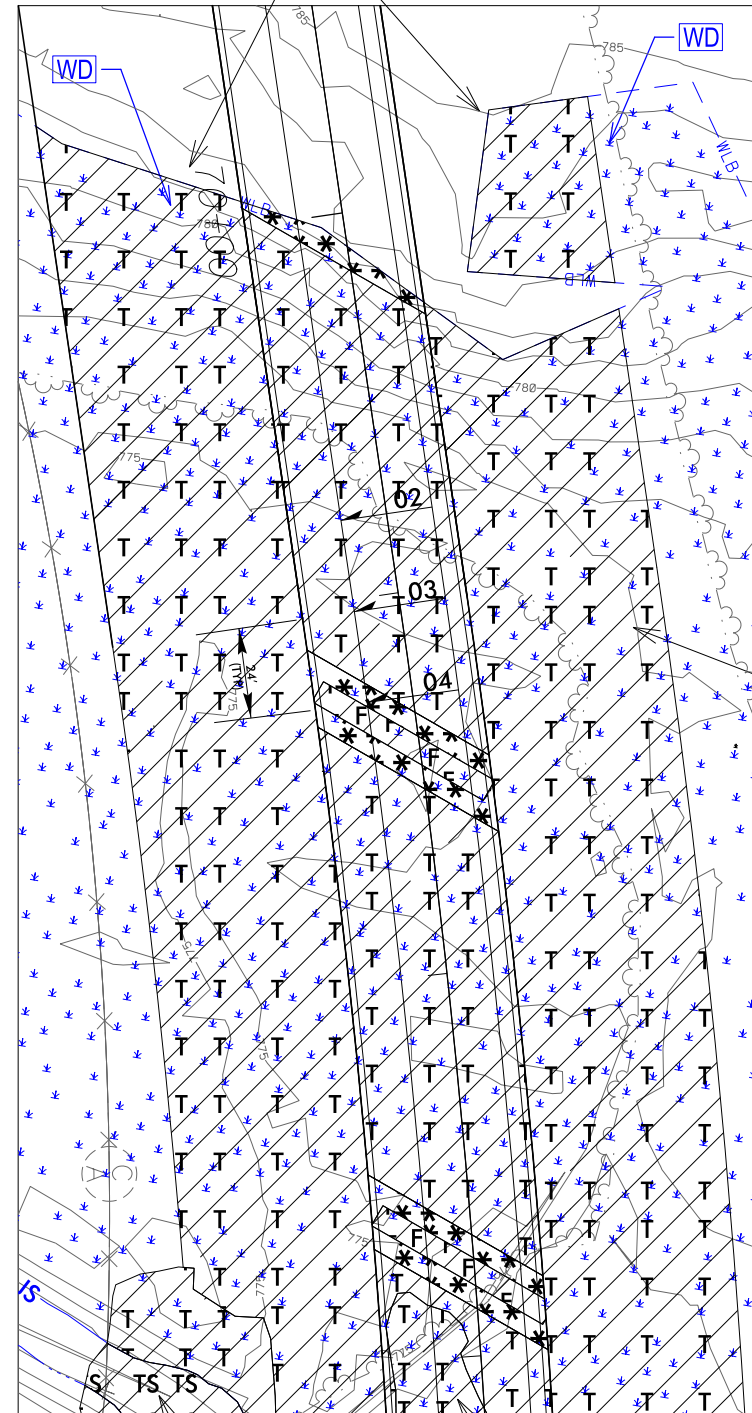


TEMPORARY IMPACTS IN
SURFACE WATER

TEMPORARY FILL
IN WETLAND
(RESTORATION SITE)

TEMPORARY FILL
IN WETLAND
(MATTING FOR
CONSTRUCTION
ACCESS - BRIDGE
STRUCTURE #10)

TEMPORARY FILL
IN WETLAND
(RESTORATION SITE)

TEMPORARY IMPACTS IN
SURFACE WATER

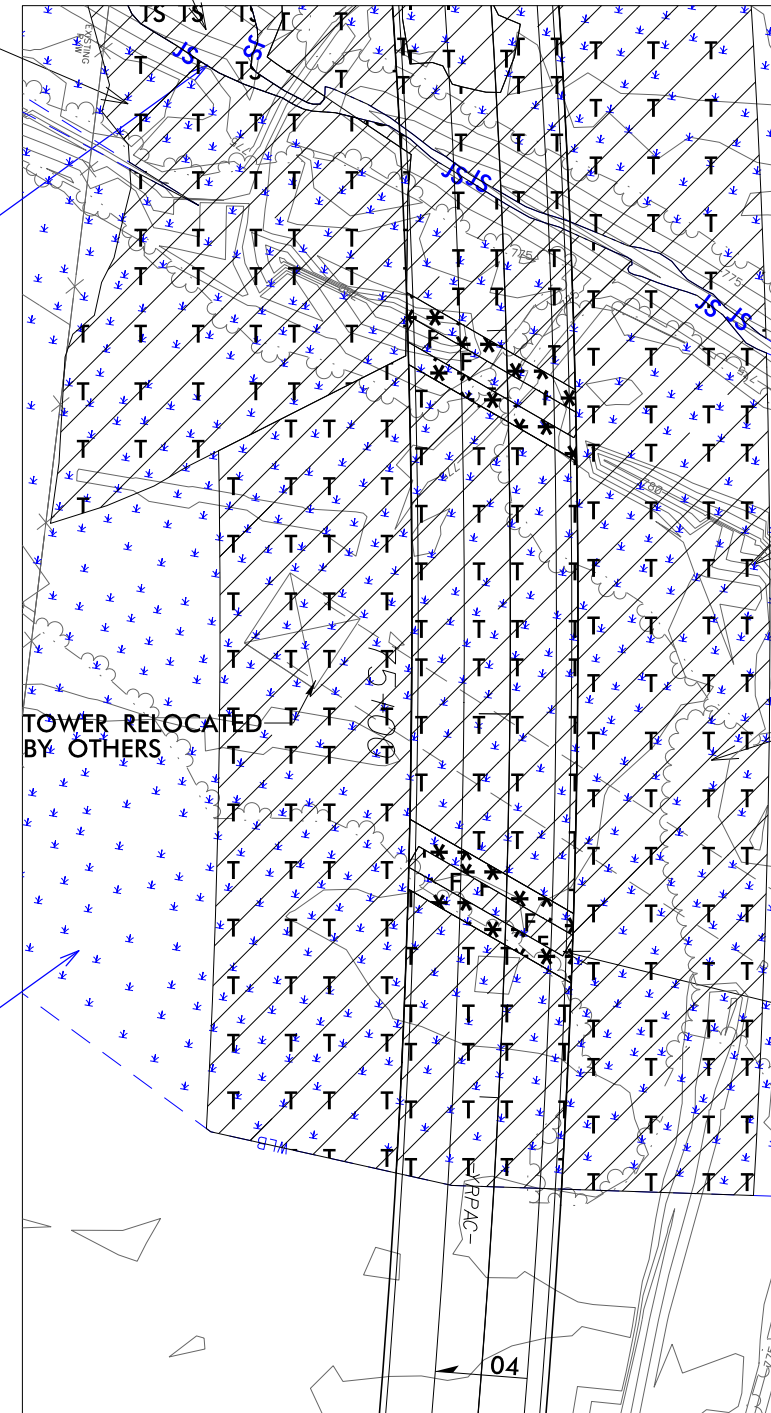

TOWER RELOCATED
BY OTHERS

SITE #5

TEMPORARY FILL
IN WETLAND
(MATTING FOR
CONSTRUCTION
ACCESS - BRIDGE
STRUCTURE #10)

PERMANENT FILL AND
MECHANIZED CLEARING
FOR PROPOSED BENT (TYP)

- TS TS DENOTES TEMPORARY IMPACTS IN SURFACE WATER
- F F DENOTES FILL IN WETLAND
- DENOTES MECHANIZED CLEARING
- T T DENOTES TEMPORARY FILL IN WETLAND

PERMIT DRAWING
SHEET 51 OF 67
Rev. 11/02/2020



GRAPHIC SCALE - INSETS



PROJECT REFERENCE NO.	SHEET NO.
1-3819B	22B
R/W SHEET NO.	
ROADWAY DESIGN ENGINEER	HYDRAULICS ENGINEER
DOCUMENT NOT CONSIDERED FINAL UNLESS ALL SIGNATURES COMPLETED	


NC GRID NAD 8395

PROJECT REFERENCE NO.	SHEET NO.
1-3819B	27
R/W SHEET NO.	
ROADWAY DESIGN ENGINEER	HYDRAULICS ENGINEER

DOCUMENT NOT CONSIDERED FINAL
UNLESS ALL SIGNATURES COMPLETED

PERMIT DRAWING
SHEET 62 OF 67
Rev. 11/02/2020

-MATCHLINE- STA. 217+00 -Y_N-
THIS SHEET

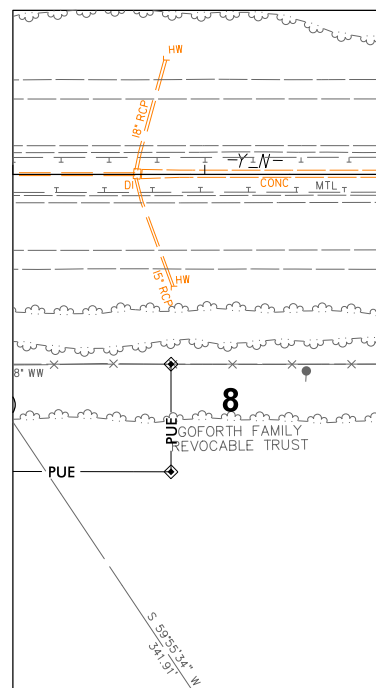


INSET
END NB RECONSTRUCTION
BEG. NB WIDENING & RESURF.
-Y_N- POT STA. 209+50.00

END CONSTRUCTION
END NB WIDENING & RESURF.
-Y_N- POT STA. 216+70.00

-MATCHLINE- STA. 217+00 -Y_N-
SEE INSET THIS SHEET

-MATCHLINE- STA. 203+00 -Y_N- SEE SHEET NO. 26

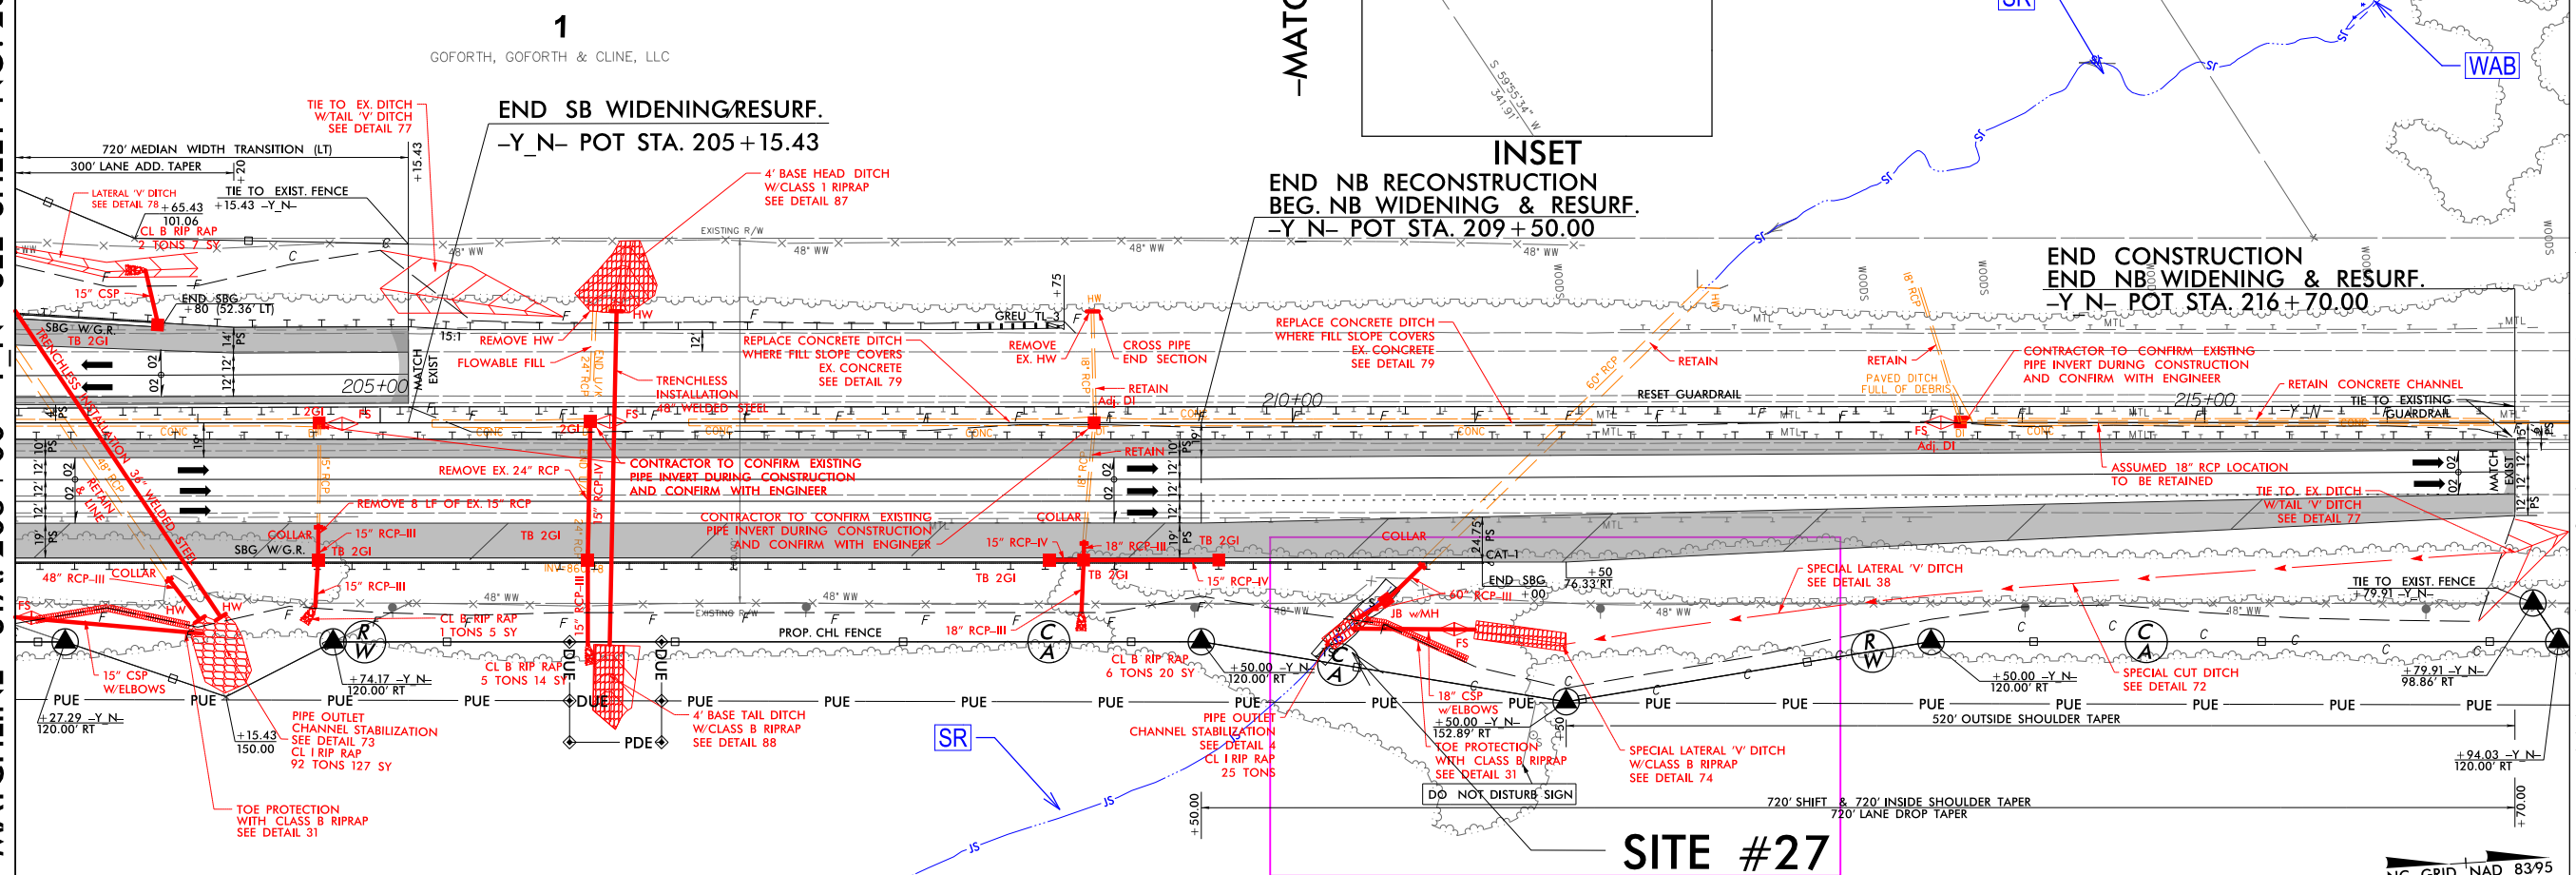


SITE #27

SEE SHEET 27A

NC GRID NAD 83/95

DENOTES IMPACTS IN SURFACE WATER

DENOTES TEMPORARY IMPACTS IN SURFACE WATER

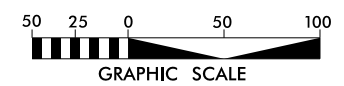




1001 Morehead Square Dr.,
Suite 610, Charlotte, NC 28203
NC LIC NO. F-0165

PROJECT REFERENCE NO.		SHEET NO.
1-3819B		27
R/W SHEET NO.		
ROADWAY DESIGN ENGINEER		HYDRAULICS ENGINEER
DOCUMENT NOT CONSIDERED FINAL UNLESS ALL SIGNATURES COMPLETED		

PERMIT DRAWING
SHEET 63 OF 67
Rev. 11/02/2020

MATCHLINE- STA. 217+00 -Y N-
THIS SHEET

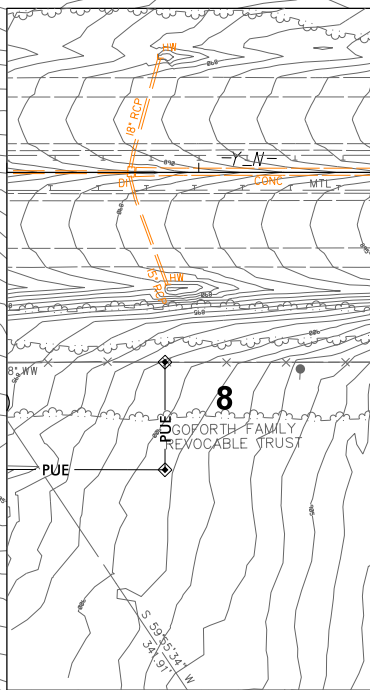


INSET
END NB RECONSTRUCTION
BEG. NB WIDENING & RESURF.
-Y N- POT STA. 209+50.00

END CONSTRUCTION
END NB WIDENING & RESURF.
-Y N- POT STA. 216+70.00

MATCHLINE- STA. 217+00 -Y N-
SEE INSET THIS SHEET

MATCHLINE- STA. 203+00 -Y N- SEE SHEET NO. 26

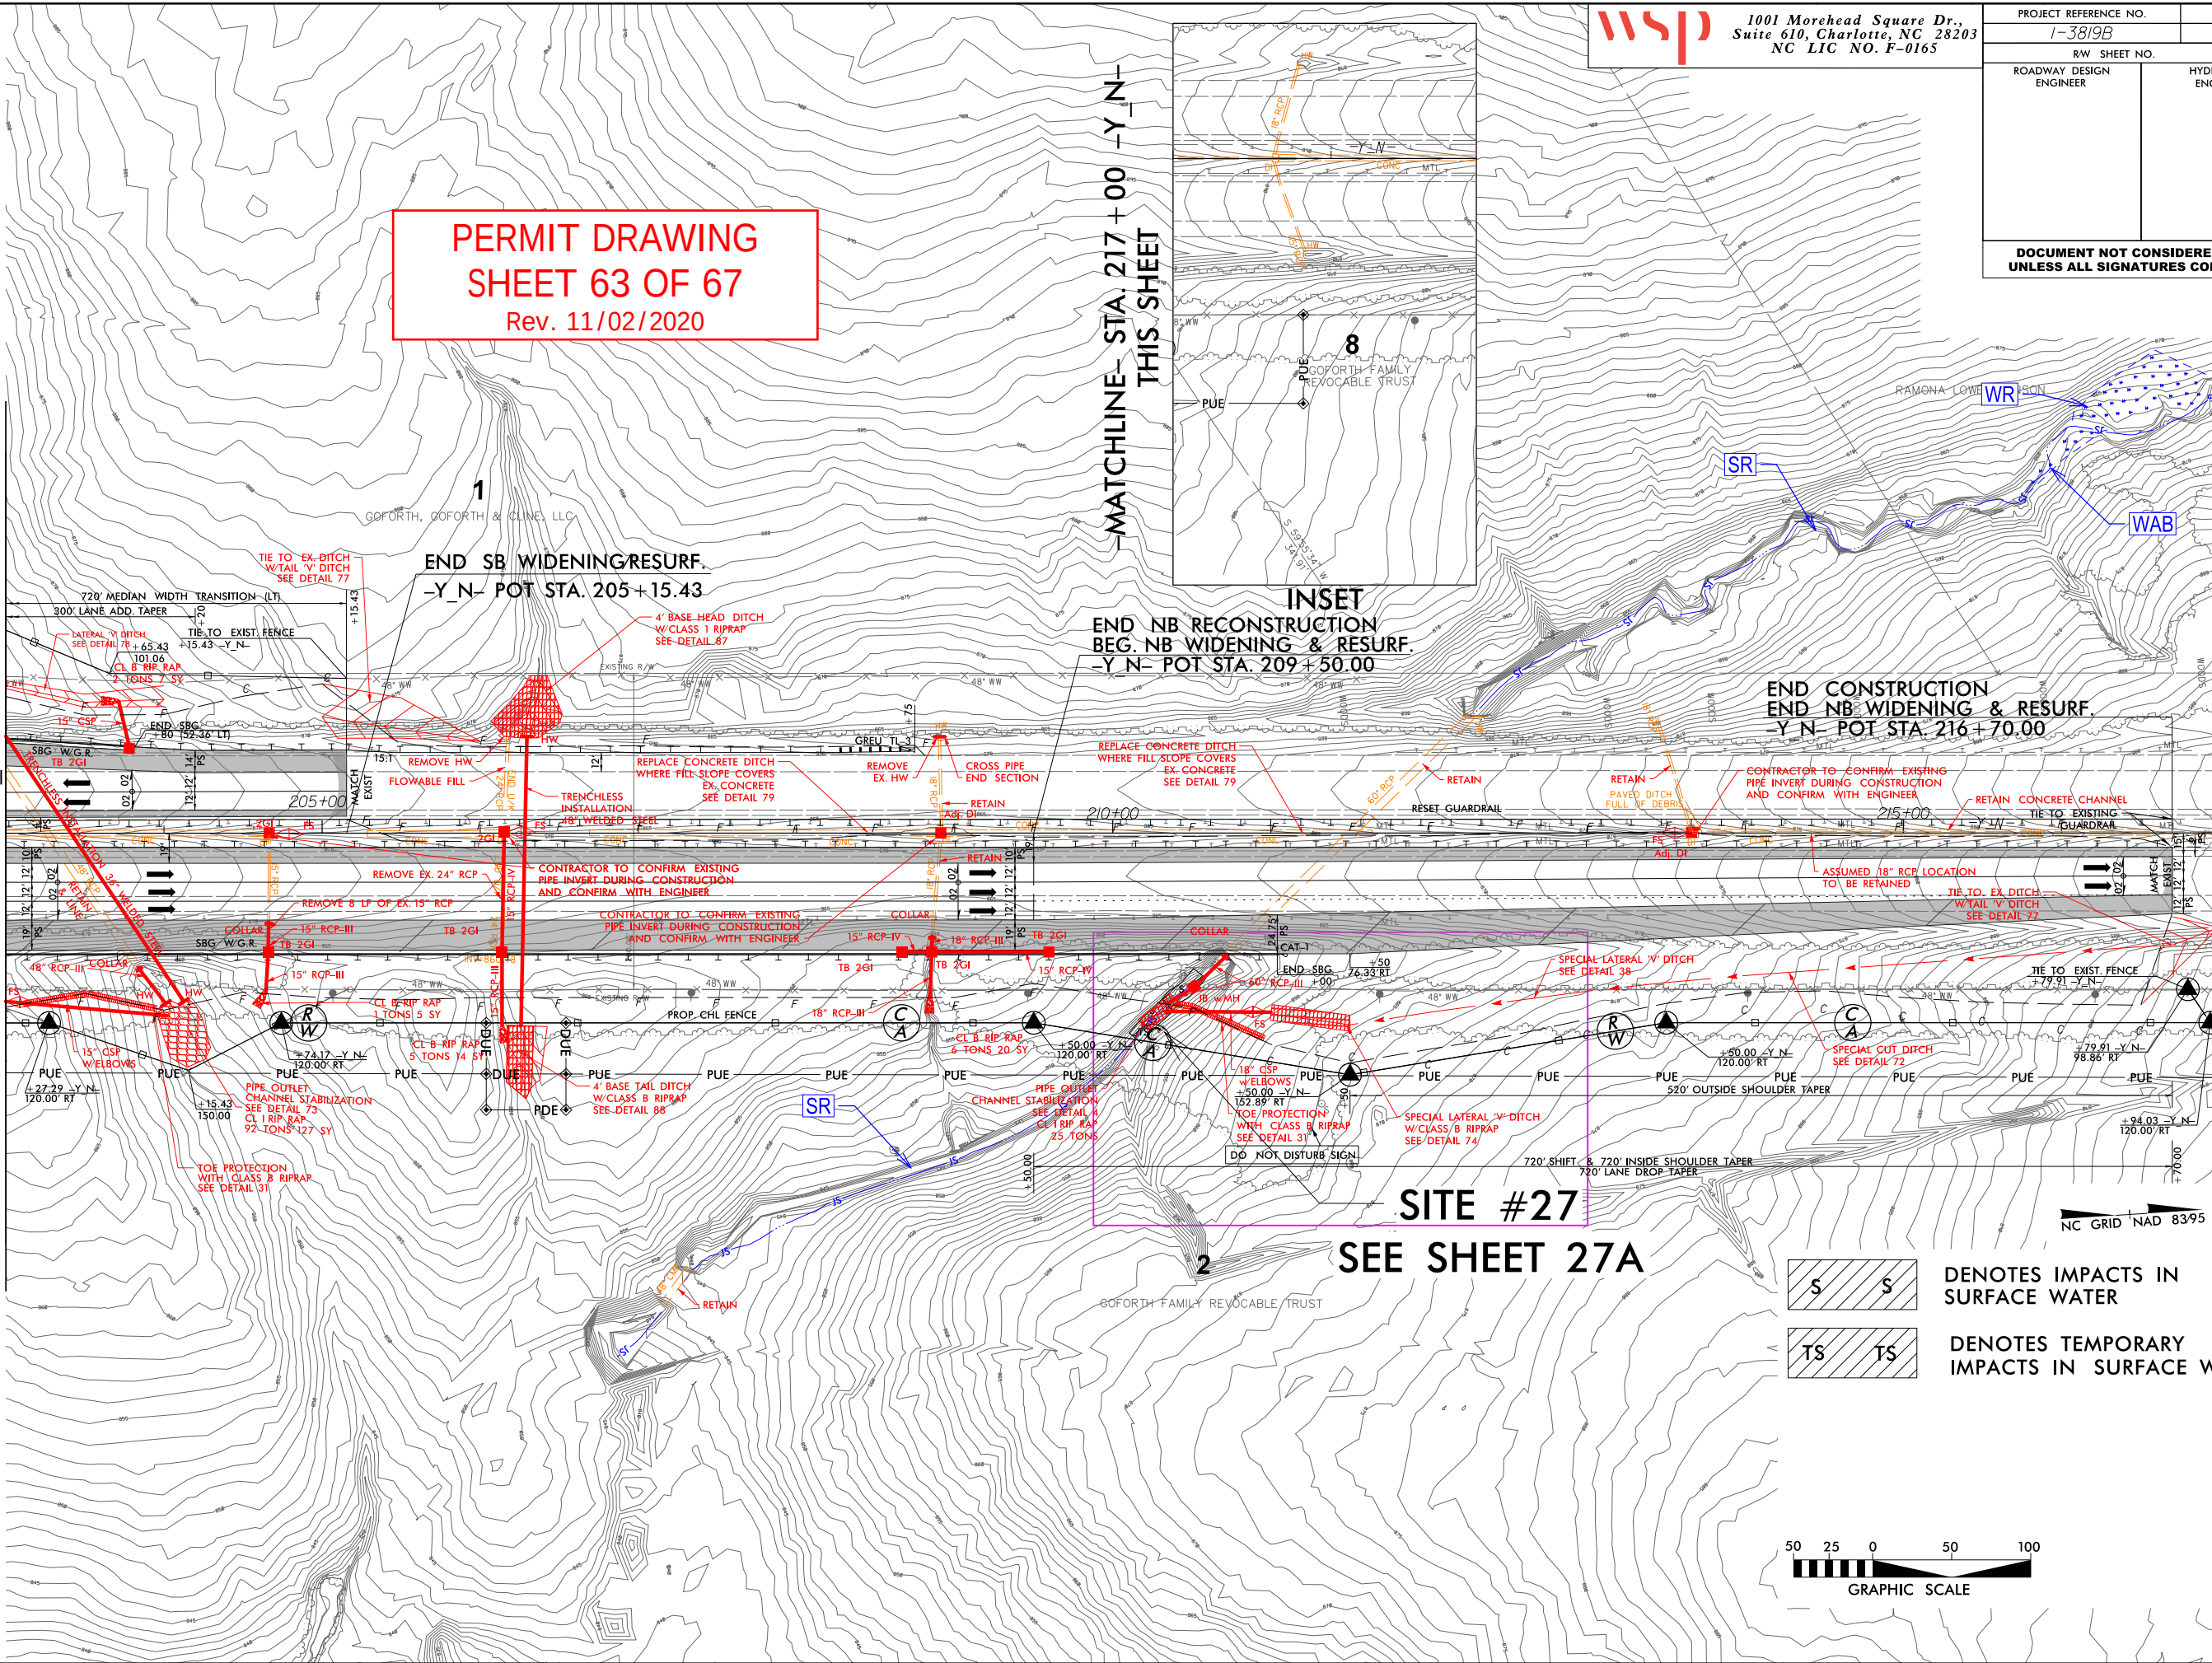

SITE #27

SEE SHEET 27A



DENOTES IMPACTS IN
SURFACE WATER





DENOTES TEMPORARY
IMPACTS IN SURFACE WATER




GRAPHIC SCALE

PROJECT REFERENCE NO.	SHEET NO.
1-3819B	27A
R/W SHEET NO.	
ROADWAY DESIGN ENGINEER	HYDRAULICS ENGINEER
DOCUMENT NOT CONSIDERED FINAL UNLESS ALL SIGNATURES COMPLETED	

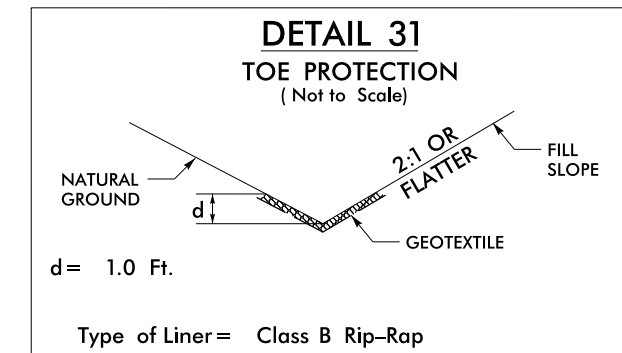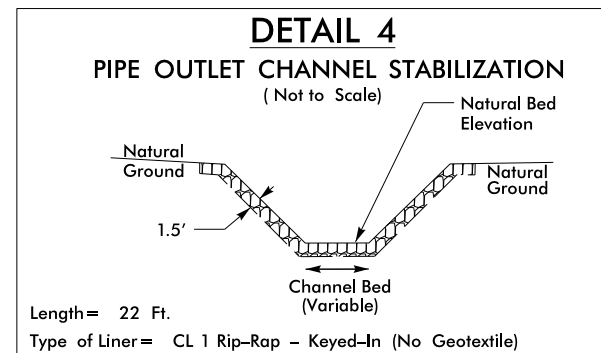

INSET

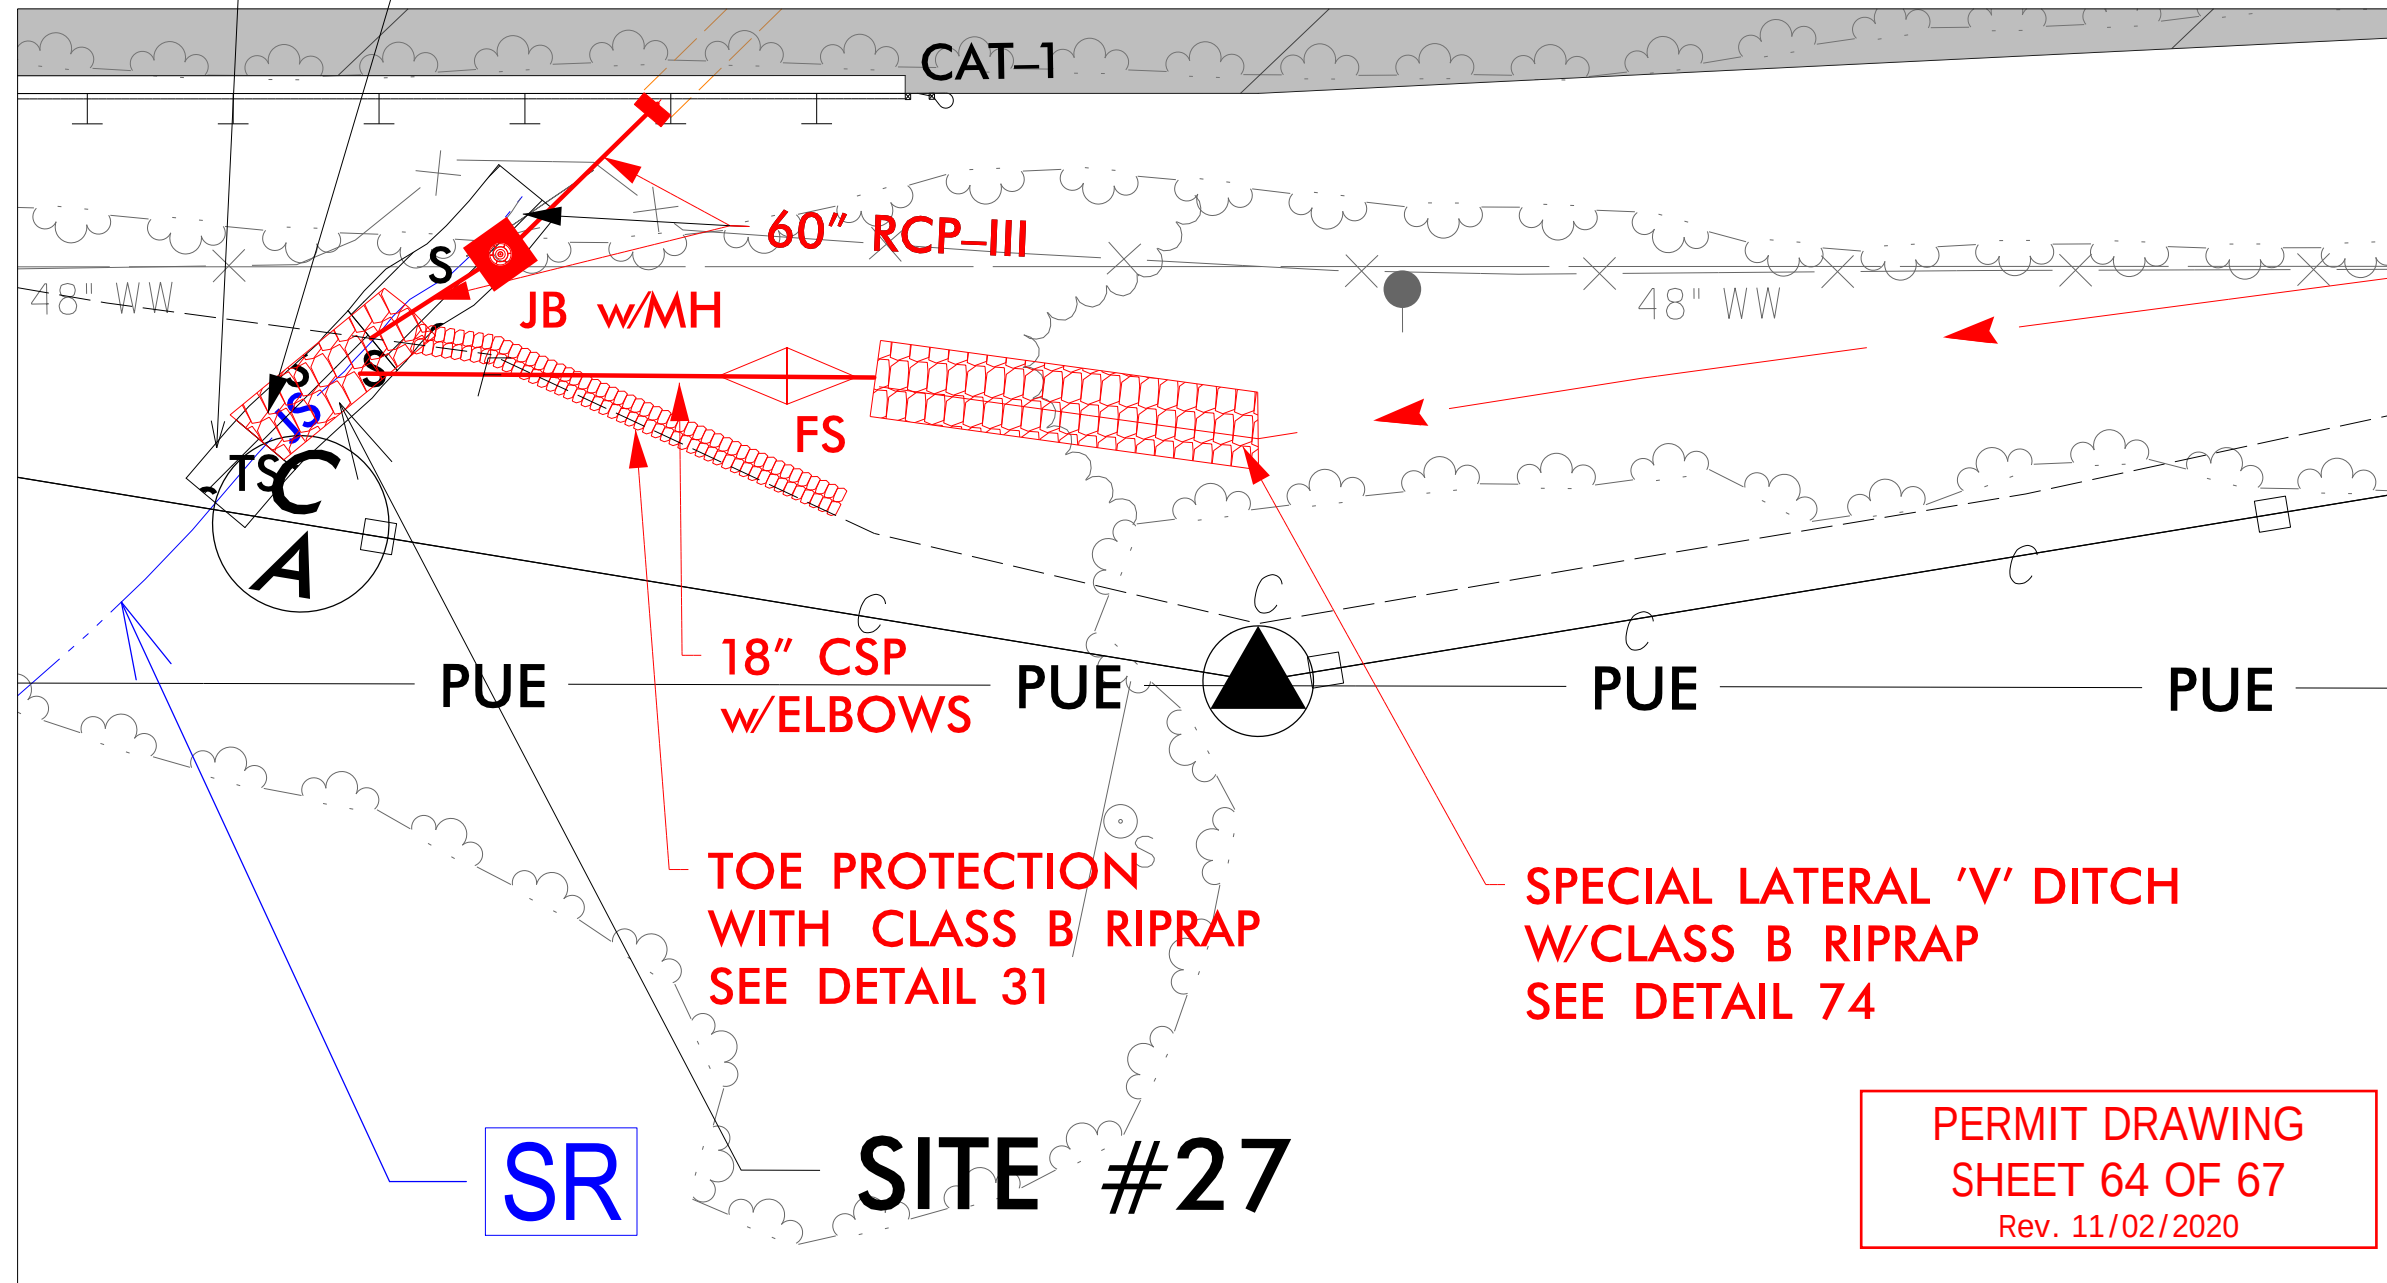

PERMIT DRAWING
SHEET 64 OF 67
Rev. 11/02/2020



NC GRID NAD 8395

DENOTES IMPACTS IN SURFACE WATER
 DENOTES TEMPORARY IMPACTS IN SURFACE WATER




GRAPHIC SCALE - INSETS


PROJECT REFERENCE NO.	SHEET NO.
1-3819B	27A
R/W SHEET NO.	
ROADWAY DESIGN ENGINEER	HYDRAULICS ENGINEER
DOCUMENT NOT CONSIDERED FINAL UNLESS ALL SIGNATURES COMPLETED	

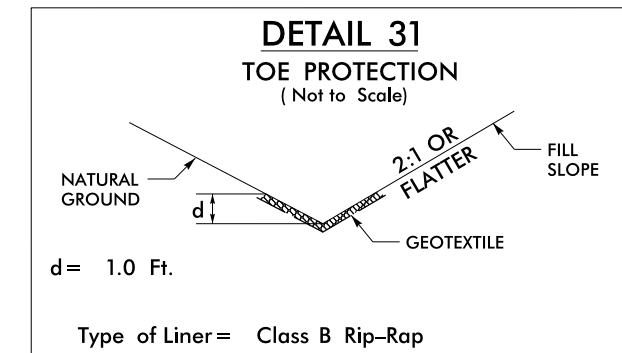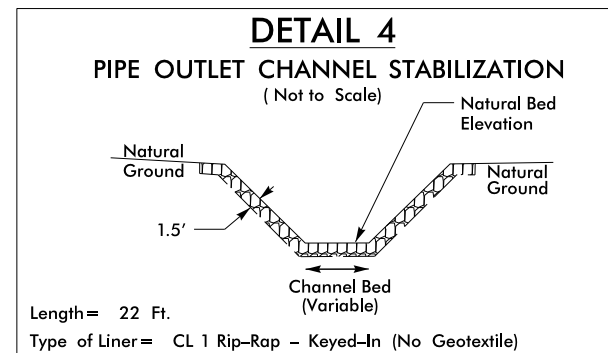

INSET

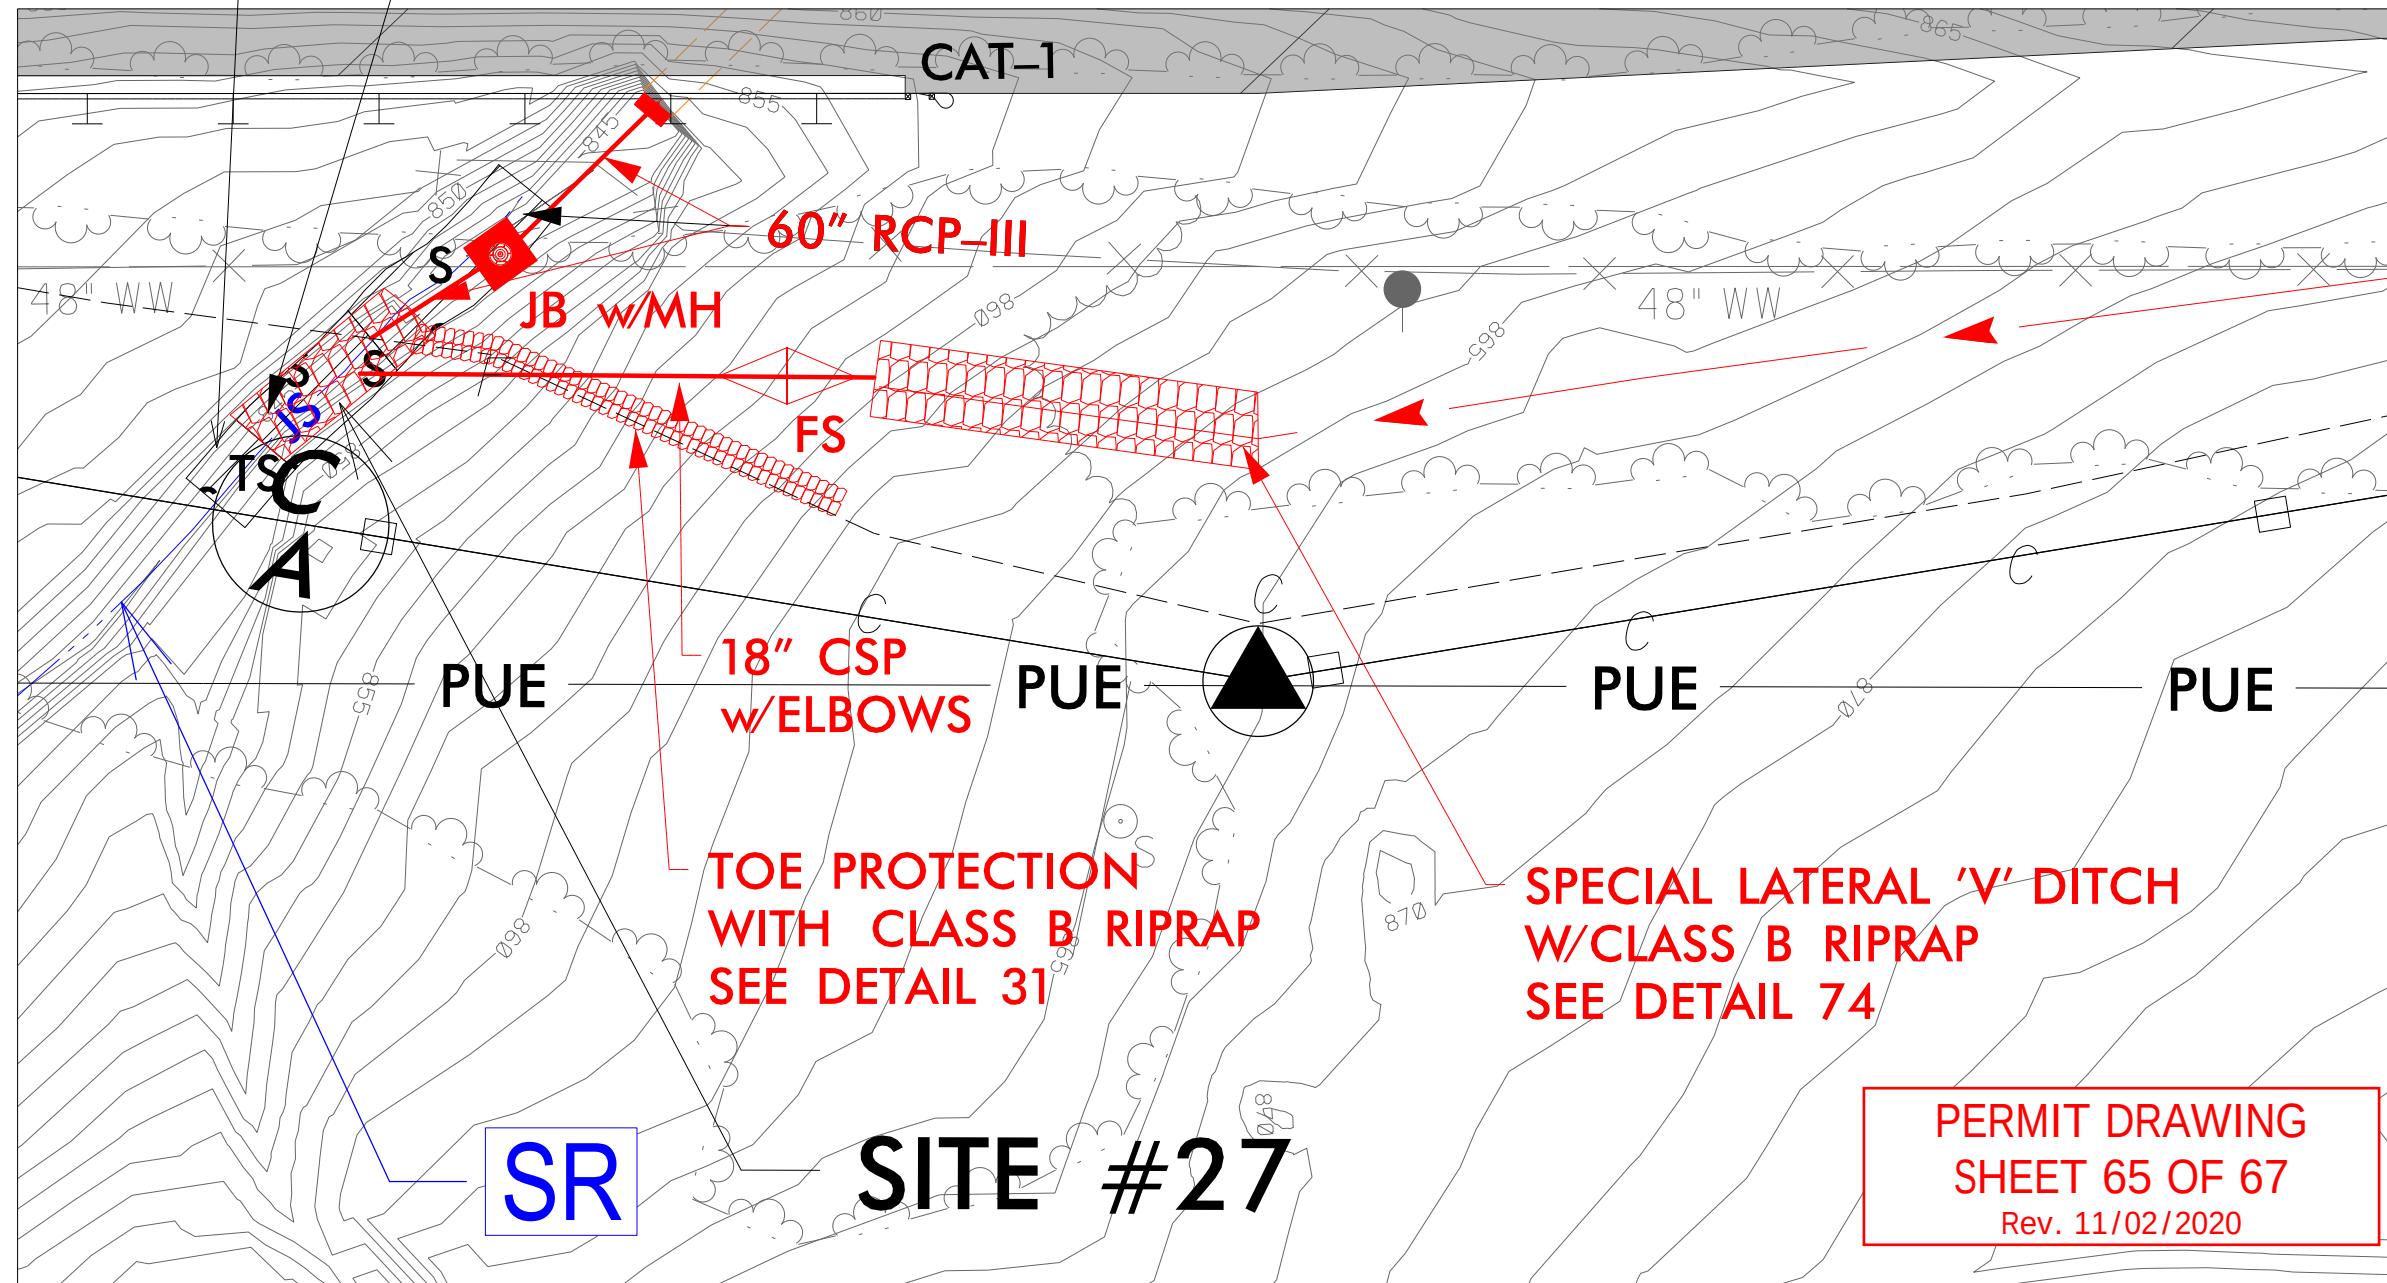

PERMIT DRAWING
SHEET 65 OF 67
Rev. 11/02/2020

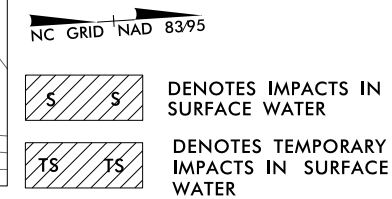

WETLAND AND SURFACE WATER IMPACTS SUMMARY												
			WETLAND IMPACTS					SURFACE WATER IMPACTS				
Site No.	Station (From/To)	Structure Size / Type	Permanent Fill In Wetlands (ac)	Temp. Fill In Wetlands (ac)	Excavation in Wetlands (ac)	Mechanized Clearing in Wetlands (ac)	Hand Clearing in Wetlands (ac)	Permanent SW impacts (ac)	Temp. SW impacts (ac)	Existing Channel Impacts Permanent (ft)	Existing Channel Impacts Temp. (ft)	Natural Stream Design (ft)
1	Site 1 Eliminated											
2	14+00 -21+50-YRPCA-	Roadway Fill	0.32			0.09						
2	16+70 - 21+50-YRPCA-	Bridge/Stream Bank Stabilization**	0.02	0.62		0.02		< 0.01	< 0.01	42	20	
3	15+75-YRPC-	Roadway Fill	< 0.01			0.01		0.02	< 0.01	206	10	
4	24+00-YRPC-	Roadway Fill				0.02						
5	70+00 - 76+25 -YRPAC-	Bridge**	0.03	1.81		0.05						
5	72+70 - 74+50 -YRPAC-	Construction Access		0.23					0.02		77	
6	121+50-Y_LT-	Stream Bank Stabilization						< 0.01	< 0.01	12	20	
7	120+90-Y_RT-	Stream Bank Stabilization						< 0.01	< 0.01	12	20	
8	19+00-YRPDB-	Roadway Fill	< 0.01			< 0.01						
9	28+50 - 34+00-YRPAC-	Roadway Fill	0.40			0.08		0.07	< 0.01	747	10	
9A	28+10 - 28+30-YRPAC-	Construction Access							0.01		50	
10	28+00-YRPAC-	Stream Bank Stabilization						< 0.01	< 0.01	25	20	
11	27+50 - 26+50-YRPAC	Roadway Fill	0.19			0.02						
12	149+00-150+00-L-	Bridge						< 0.01	0.01	10	54	
13	167+00-Y_RT-	Stream Bed Stabilization						< 0.01		17		
13	167+00-Y_RT-	Stream Bank Stabilization						< 0.01	< 0.01	44	10	
14	28+50-Y-	Stream Bed Stabilization						< 0.01	< 0.01	17	10	
15	33+75-Y-	Stream Bank Stabilization						< 0.01	< 0.01	11	20	
16	37+10-37+20-Y-	54" RCP Extension						< 0.01		15		
16	35+90-37+10-Y-	Stream Bed Stabilization						< 0.01	< 0.01	98	10	
17	37+70-37+80-Y-	54" RCP Extension						< 0.01		20		
17	37+80-38+50-Y-	Stream Bed Stabilization						0.01	< 0.01	94	14	
18	47+50-Y-	54" RCP Extension						< 0.01		39		
SHEET 66 SUBTOTALS*:			0.97	2.66	0.00	0.29	0.00	0.16	0.07	1409	345	0.00

*Rounded totals are sum of actual impacts for sites listed on Sheet 66. See Sheet 67 for project total.

**Temporary fill in wetlands includes impacts previously classified as hand clearing, changed per NCDEQ comment (matting for construction access)


WETLAND AND SURFACE WATER IMPACTS SUMMARY												
			WETLAND IMPACTS					SURFACE WATER IMPACTS				
Site No.	Station (From/To)	Structure Size / Type	Permanent Fill In Wetlands (ac)	Temp. Fill In Wetlands (ac)	Excavation in Wetlands (ac)	Mechanized Clearing in Wetlands (ac)	Hand Clearing in Wetlands (ac)	Permanent SW impacts (ac)	Temp. SW impacts (ac)	Existing Channel Impacts Permanent (ft)	Existing Channel Impacts Temp. (ft)	Natural Stream Design (ft)
18	47+50-Y-	Stream Bed Stabilization						< 0.01	< 0.01	33	10	
19	46+00-Y-	Roadway Fill						< 0.01		34		
20	68+50-Y-	New Channel						< 0.01	< 0.01	13	10	
20	68+50-Y-	Roadway Fill						< 0.01		48		
21	70+20-Y-	3@9'X11" RCBC Extension						0.02		39		
21	69+20-70+20-Y-	Stream Bed Stabilization						0.08	< 0.01	137	21	
22	71+30-71+90-Y-	3@9'X11" RCBC Extension						0.02		45		
22	71+90-72+89-Y-	Stream Bed Stabilization						0.08		160		
22	72+89-75+10-Y-	New Channel						0.08		225		
22	75+10-84+00-Y-	Stream Bank Stabilization						0.34		901		
22	83+59-83+85-Y-	Stream Bed Stabilization						< 0.01		25		
23	87+70-Y-	Roadway Fill							< 0.01		33	
24	93+75-Y-	66" RCP Extension						< 0.01	< 0.01	49	10	
25	94+50-Y-	66" RCP Extension						< 0.01		10		
25	94+50-Y-	Stream Bed Stabilization						< 0.01	< 0.01	21	21	
26	116+70-120+10-Y-	Roadway Fill	0.09			0.04						
27	210+00-Y-	60" RCP Extension						< 0.01		29		
27	210+00-Y-	Stream Bed Stabilization						< 0.01	< 0.01	19	10	
28	24+00-Y15RPB-	Stream Bed Stabilization						< 0.01	< 0.01	16	11	
SHEET 66 SUBTOTAL			0.97	2.66	0.00	0.29	0.00	0.16	0.07	1409	345	0.00
SHEET 67 SUBTOTAL			0.09	0.00	0.00	0.04	0.00	0.67	0.03	1804	126	0.00
PROJECT TOTALS*:			1.06	2.66	0.00	0.33	0.00	0.83	0.10	3213	471	0.00

*Rounded totals are sum of actual impacts for entire project area

9/17/2020 c:\projectwise\pb\projectwise\becker\jw\3819BU-6039\hyd_prm_TSH_Utility.dgn becker\jw


TIP PROJECT: I-3819BU-6039

PROJECT: 34192.1.2

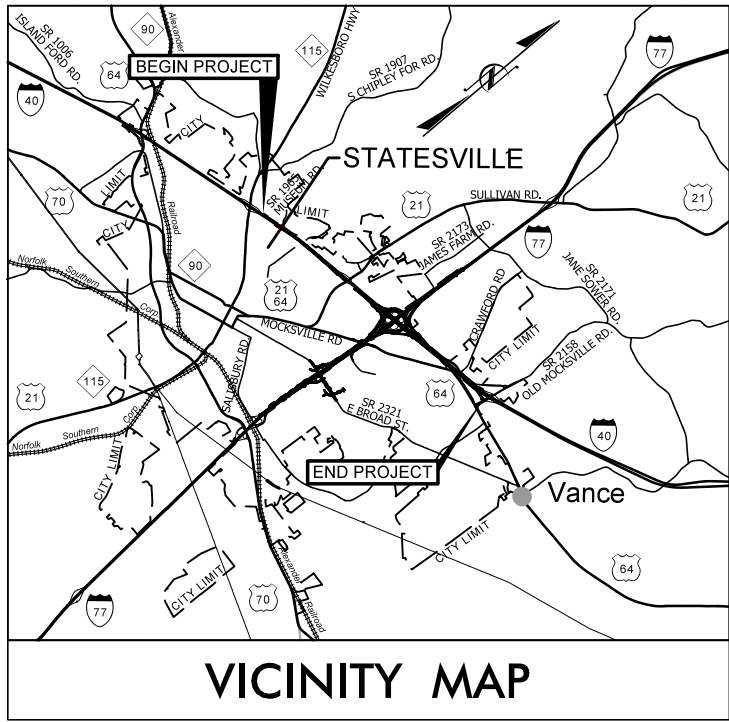

VICINITY MAP

THIS PROJECT IS WITHIN THE MUNICIPAL BOUNDARIES OF THE CITY OF STATESVILLE AND THE TOWNSHIP OF BETHANY

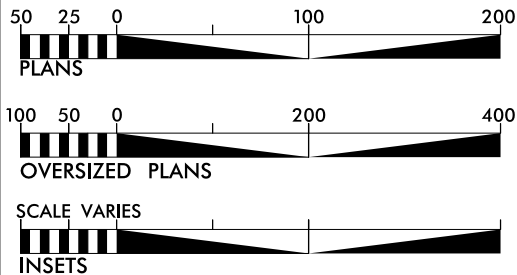

UTILITY PERMIT
DRAWING
SHEET 1 OF 8
Rev. 11/02/2020

CLEARING ON THIS PROJECT SHALL BE PERFORMED TO THE LIMITS ESTABLISHED BY METHOD III.

THIS IS A CONTROLLED ACCESS PROJECT WITH ACCESS BEING LIMITED TO INTERCHANGES

GRAPHIC SCALES

SEE ABOVE

DESIGN DATA


	I-40	I-77
ADT 2018	= 57,300	62,900
ADT 2040	= 72,500	77,500
DHV	= 5,800	6,200
D	= 55 %	55 %
T	= 16 % *	19 % **
V	= 60 MPH	60 MPH
* TTST 13	+ DUAL 3 (I-40)	
** TTST 16	+ DUAL 3 (I-77)	
CLASSIFICATION:	INTERSTATE	

STATE OF NORTH CAROLINA
DIVISION OF HIGHWAYS

IREDELL COUNTY

LOCATION: I-40/I-77 INTERCHANGE INCLUDING I-40 FROM WEST OF SR 2003 (RADIO RD.) TO SR 2158 (OLD MOCKSVILLE RD.) & I-77 FROM SOUTH OF SR 2321 (EAST BROAD ST.) TO SOUTH OF SR 2171 (JANE SOWERS RD.)

TYPE OF WORK: GRADING, DRAINAGE, PAVING, STRUCTURES, RETAINING WALLS, NOISE WALLS, AND TRAFFIC CONTROL

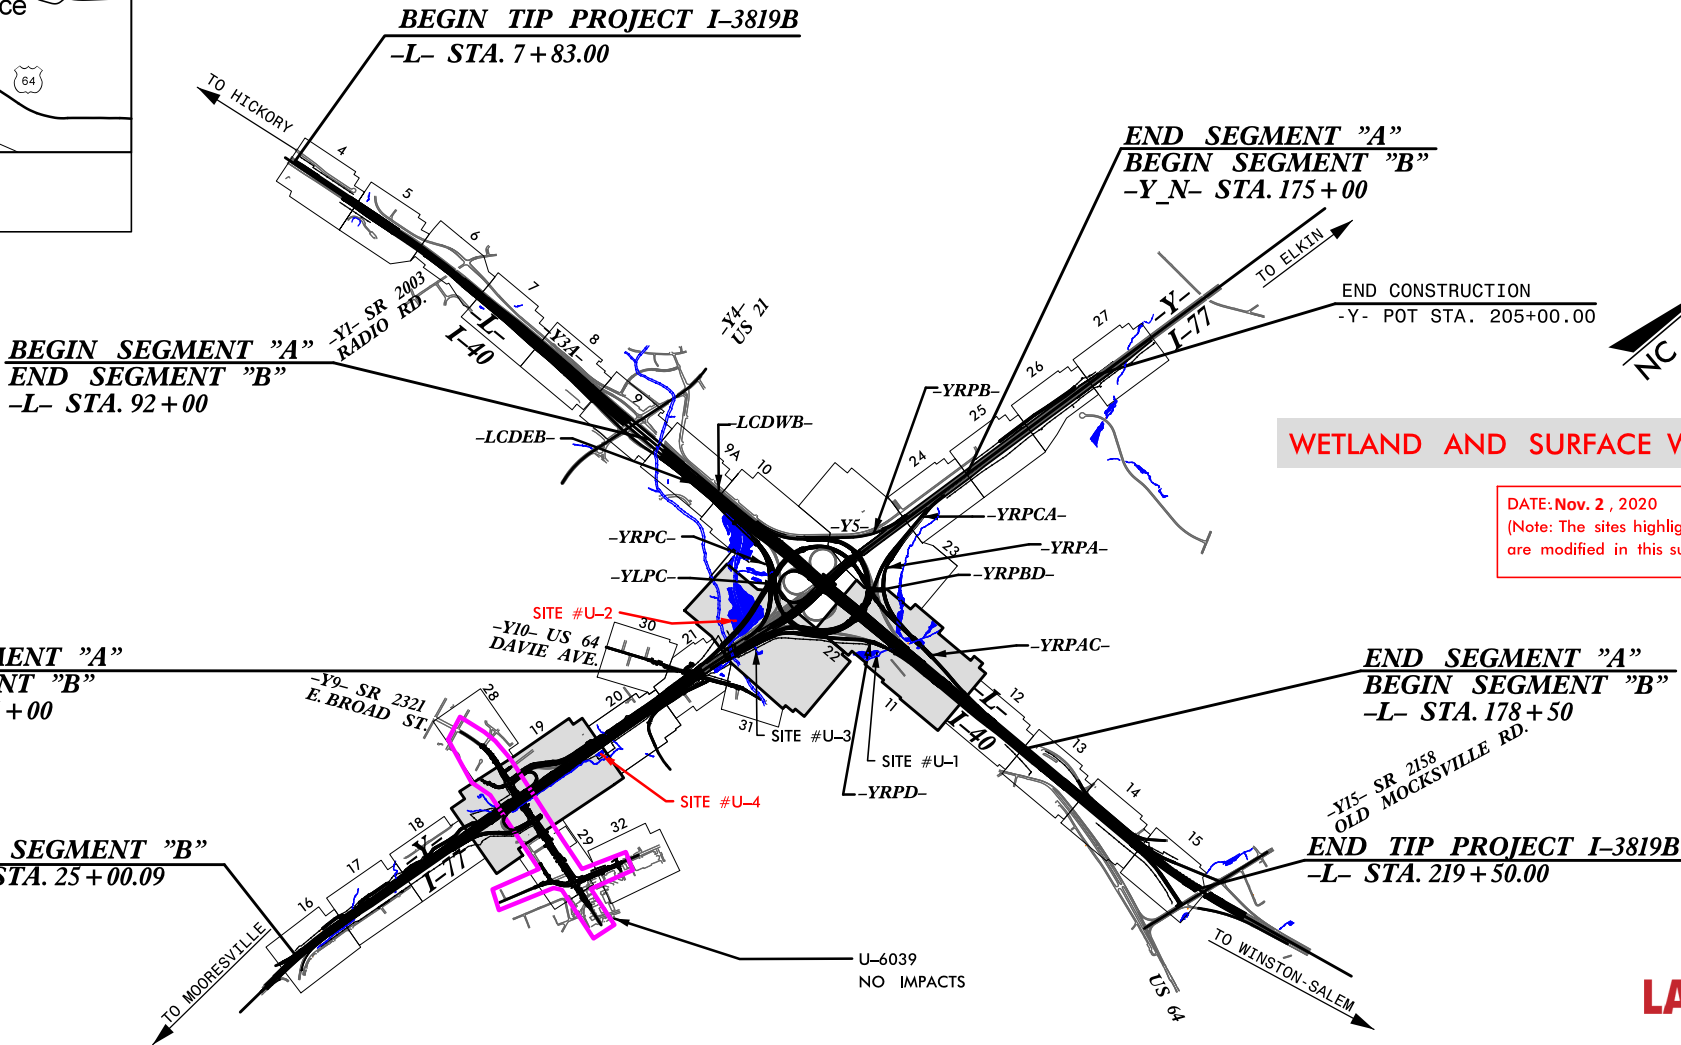

WETLAND AND SURFACE WATER IMPACT PERMITS

DATE: Nov. 2, 2020
(Note: The sites highlighted in RED are modified in this submittal.)

LANE

INCOMPLETE PLANS
DO NOT USE FOR R/W ACQUISITION

Prepared In the Office of:

WSP

1001 Morehead Square Dr., Suite 610, Charlotte, NC 28203
NC LIC. NO. F-0165

2018 STANDARD SPECIFICATIONS

RIGHT OF WAY DATE:
OCTOBER 30, 2018

LETTING DATE:
OCTOBER 30, 2018

CHRISTOPHER D. DAVIS, P.E.
PROJECT ENGINEER

ERIC W. SECKINGER, P.E.
PROJECT DESIGN ENGINEER


HYDRAULICS ENGINEER

SIGNATURE: P.E.

ROADWAY DESIGN
ENGINEER

SIGNATURE: P.E.

DIVISION OF HIGHWAYS
STATE OF NORTH CAROLINA

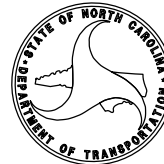

STATE HIGHWAY DESIGN ENGINEER

UTILITY PERMIT
DRAWING
SHEET 3a OF 8
Rev. 11/02/2020


-MATCHLINE STA- 19+50.00 -Y9- SEE SHEET NO. 28

PROJECT REFERENCE NO. 19	
SHEET NO. 3a	
1801 Morehead Square Dr., Suite 410, Charlotte, NC 28203 NC LIC. NO. F-0165	
ROADWAY DESIGN ENGINEER	HYDRAULICS ENGINEER
DOCUMENT NOT CONSIDERED FINAL UNLESS ALL SIGNATURES COMPLETED	

GRID NAD 8395

DENOTES MECHANIZED
CLEARING

GRAPHIC SCALE

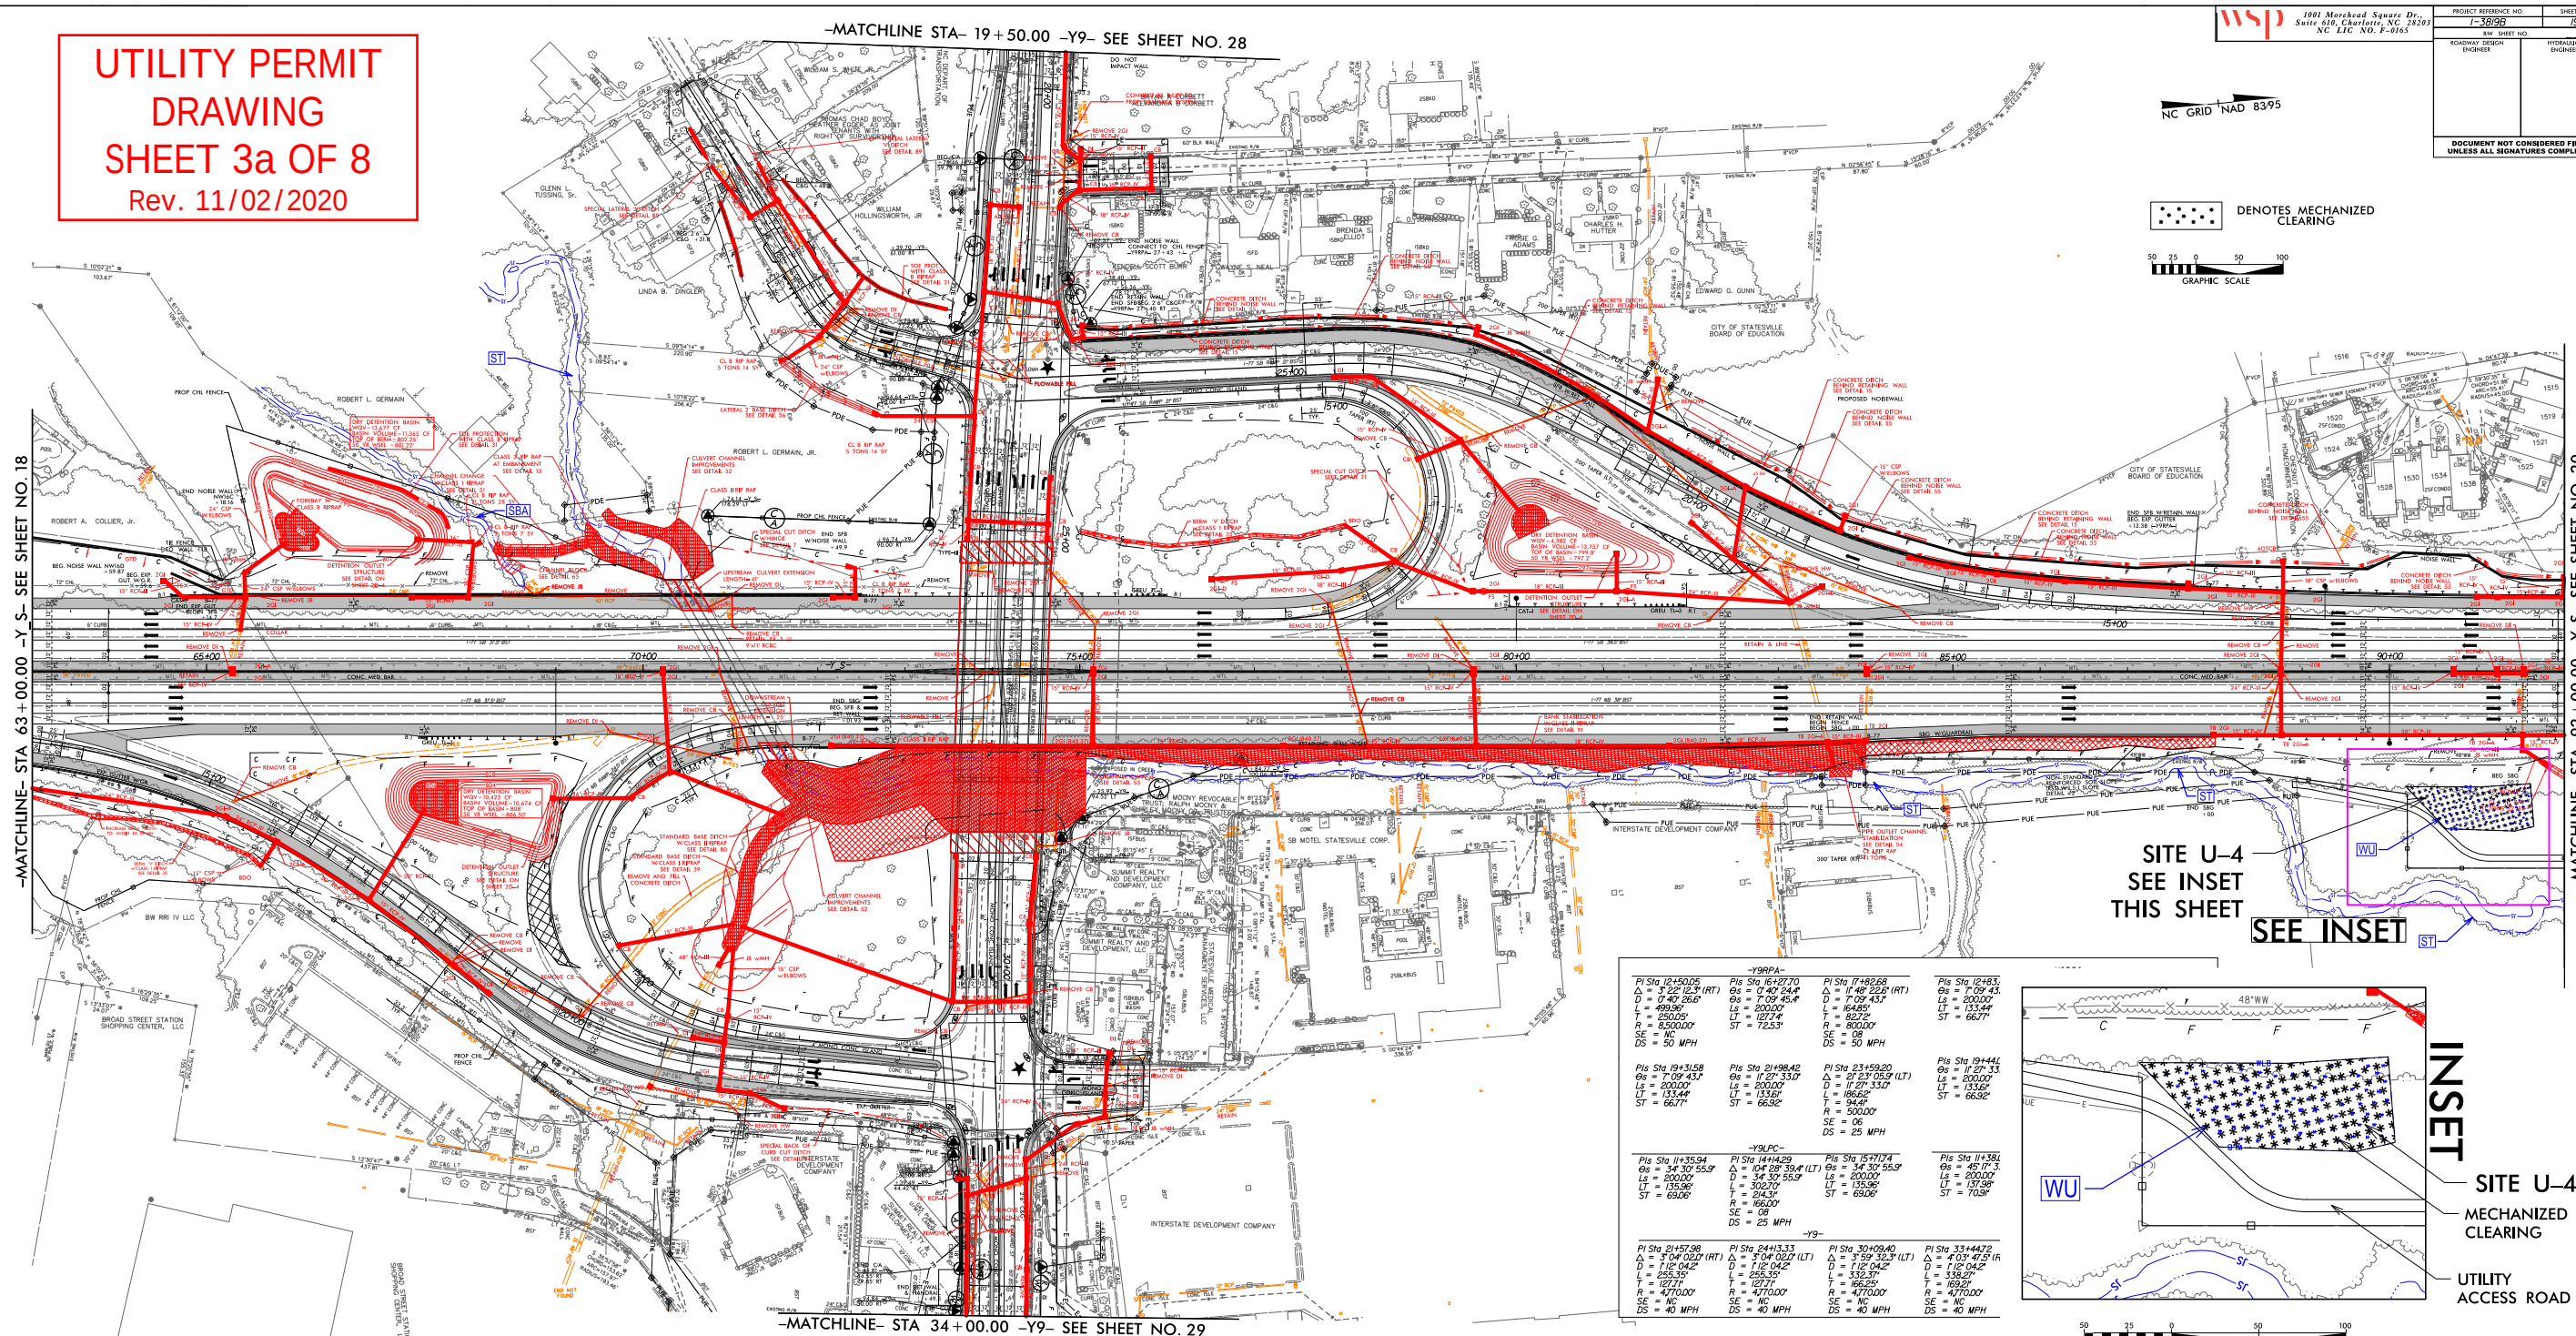


-MATCHLINE- STA 34+00.00 -Y9- SEE SHEET NO. 29

-MATCHLINE- STA 92+00.00 -Y9- SEE SHEET NO. 20

SITE U-4
SEE INSET
THIS SHEET

SEE INSET

-Y9PA-			
Pls Sta 12+50.05	Pls Sta 16+21.70	Pls Sta 17+82.68	Pls Sta 12+83.1
$\Delta = 3^{\circ}22'12.3"$ (RT)	$\Delta = 0^{\circ}40'24.4"$	$\Delta = 1^{\circ}48'22.6"$ (RT)	$\Delta = 7^{\circ}09'43.1"$
$L = 49.936'$	$L = 7.09'45.4"$	$L = 7.09'45.4"$	$L = 133.44'$
$T = 25.000'$	$T = 12.714'$	$T = 82.72'$	$T = 66.71'$
$R = 8200.00'$	$R = 8200.00'$	$R = 8200.00'$	$R = 8200.00'$
$SE = 08$	$SE = 08$	$SE = 08$	$SE = 08$
$DS = 50$ MPH	$DS = 50$ MPH	$DS = 50$ MPH	$DS = 50$ MPH
-Y9LPC-			
Pls Sta 11+35.94	Pls Sta 14+14.29	Pls Sta 15+71.74	Pls Sta 11+36.1
$\Delta = 3^{\circ}22'12.3"$ (RT)	$\Delta = 1^{\circ}04'39.94"$ (LT)	$\Delta = 3^{\circ}22'12.3"$ (RT)	$\Delta = 3^{\circ}22'12.3"$ (RT)
$L = 200.00'$	$L = 34.30'55.9"$	$L = 200.00'$	$L = 200.00'$
$T = 133.44'$	$T = 30.210'$	$T = 133.44'$	$T = 133.44'$
$R = 8200.00'$	$R = 8200.00'$	$R = 8200.00'$	$R = 8200.00'$
$SE = 08$	$SE = 08$	$SE = 08$	$SE = 08$
$DS = 40$ MPH	$DS = 40$ MPH	$DS = 40$ MPH	$DS = 40$ MPH
-Y9-			
Pls Sta 21+57.96	Pls Sta 24+13.33	Pls Sta 30+08.40	Pls Sta 33+44.72
$\Delta = 1^{\circ}04'39.94"$ (LT)	$\Delta = 1^{\circ}04'39.94"$ (LT)	$\Delta = 1^{\circ}04'39.94"$ (LT)	$\Delta = 1^{\circ}04'39.94"$ (LT)
$L = 112.042'$	$L = 112.042'$	$L = 112.042'$	$L = 112.042'$
$T = 25.000'$	$T = 25.000'$	$T = 25.000'$	$T = 25.000'$
$R = 8200.00'$	$R = 8200.00'$	$R = 8200.00'$	$R = 8200.00'$
$SE = 08$	$SE = 08$	$SE = 08$	$SE = 08$
$DS = 40$ MPH	$DS = 40$ MPH	$DS = 40$ MPH	$DS = 40$ MPH

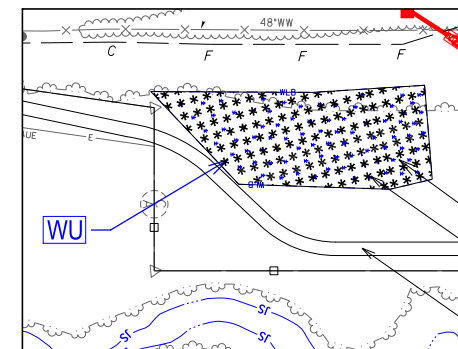

INSET

SITE U-4
MECHANIZED
CLEARING

UTILITY
ACCESS ROAD

GRAPHIC SCALE - INSET

LOCATION: 1/7 AT E. BROAD STREET	
TP NO. 1-3319	COUNTY: BURL
DESIGNED BY: C. DAVE	
CHECKED BY: J. ANDREWS	DATE: 6-3-2019

UTILITY PERMIT
DRAWING
SHEET 3b OF 8
Rev. 11/02/2020

-MATCHLINE STA- 19+50.00 -Y9- SEE SHEET NO. 28

WSP 1001 Morehead Square Dr.
Suite 610, Charlotte, NC 28202
NC LIC NO. F-0165

03	PROJECT REFERENCE NO.	SHEET NO.
	1-3819B	19
	R/W SHEET NO.	
	ROADWAY DESIGN	HYDRAULICS

ENGINEER

--	--	--

 
DOCUMENT NOT CONSIDERED FINAL
UNLESS ALL SIGNATURES COMPLETED

NC GRID + NAD 83/95

 DENOTES MECHANIZED CLEARING

0 25 50 100
GRAPHIC SCALE

-MATCHLINE- STA 63+00.00 -Y S- SEE SHEET NO. 18



MATCHLINE- STA 92+00.00 -Y S- SEE SHEET NO. 20

**SITE U-4
SEE INSET
THIS SHEET**

SEE INSET

INSET

SITE U-4
MECHANIZED
CLEARING

UTILITY
ACCESS ROAD

LOCATION: 177 AT E. BROAD STREET

TIP NO: 138198 COUNTY: BEDELL
DESIGNED BY: C. DAVIS
CHECKED BY: D. ABNSWORTH DATE: 6-2-2019

-MATCHLINE- STA 34+00.00 -Y9- SEE SHEET NO. 29

50 25 0 50 100

GRAPHIC SCALE - INSET

UTILITY PERMIT DRAWING SHEET 4 OF 8 Rev. 11/02/2020



1001 Morehead Square Dr.,
Suite 610, Charlotte, NC 28203
NC LIC NO. F-0165


PROJECT REFERENCE NO.	SHEET NO.
1-3819B	22
R/W SHEET NO.	
ROADWAY DESIGN	HYDRAULICS

ENGINEER

[illegible]

**DOCUMENT NOT CONSIDERED FINAL
UNLESS ALL SIGNATURES COMPLETED**

NC GRID + NAD 83/95

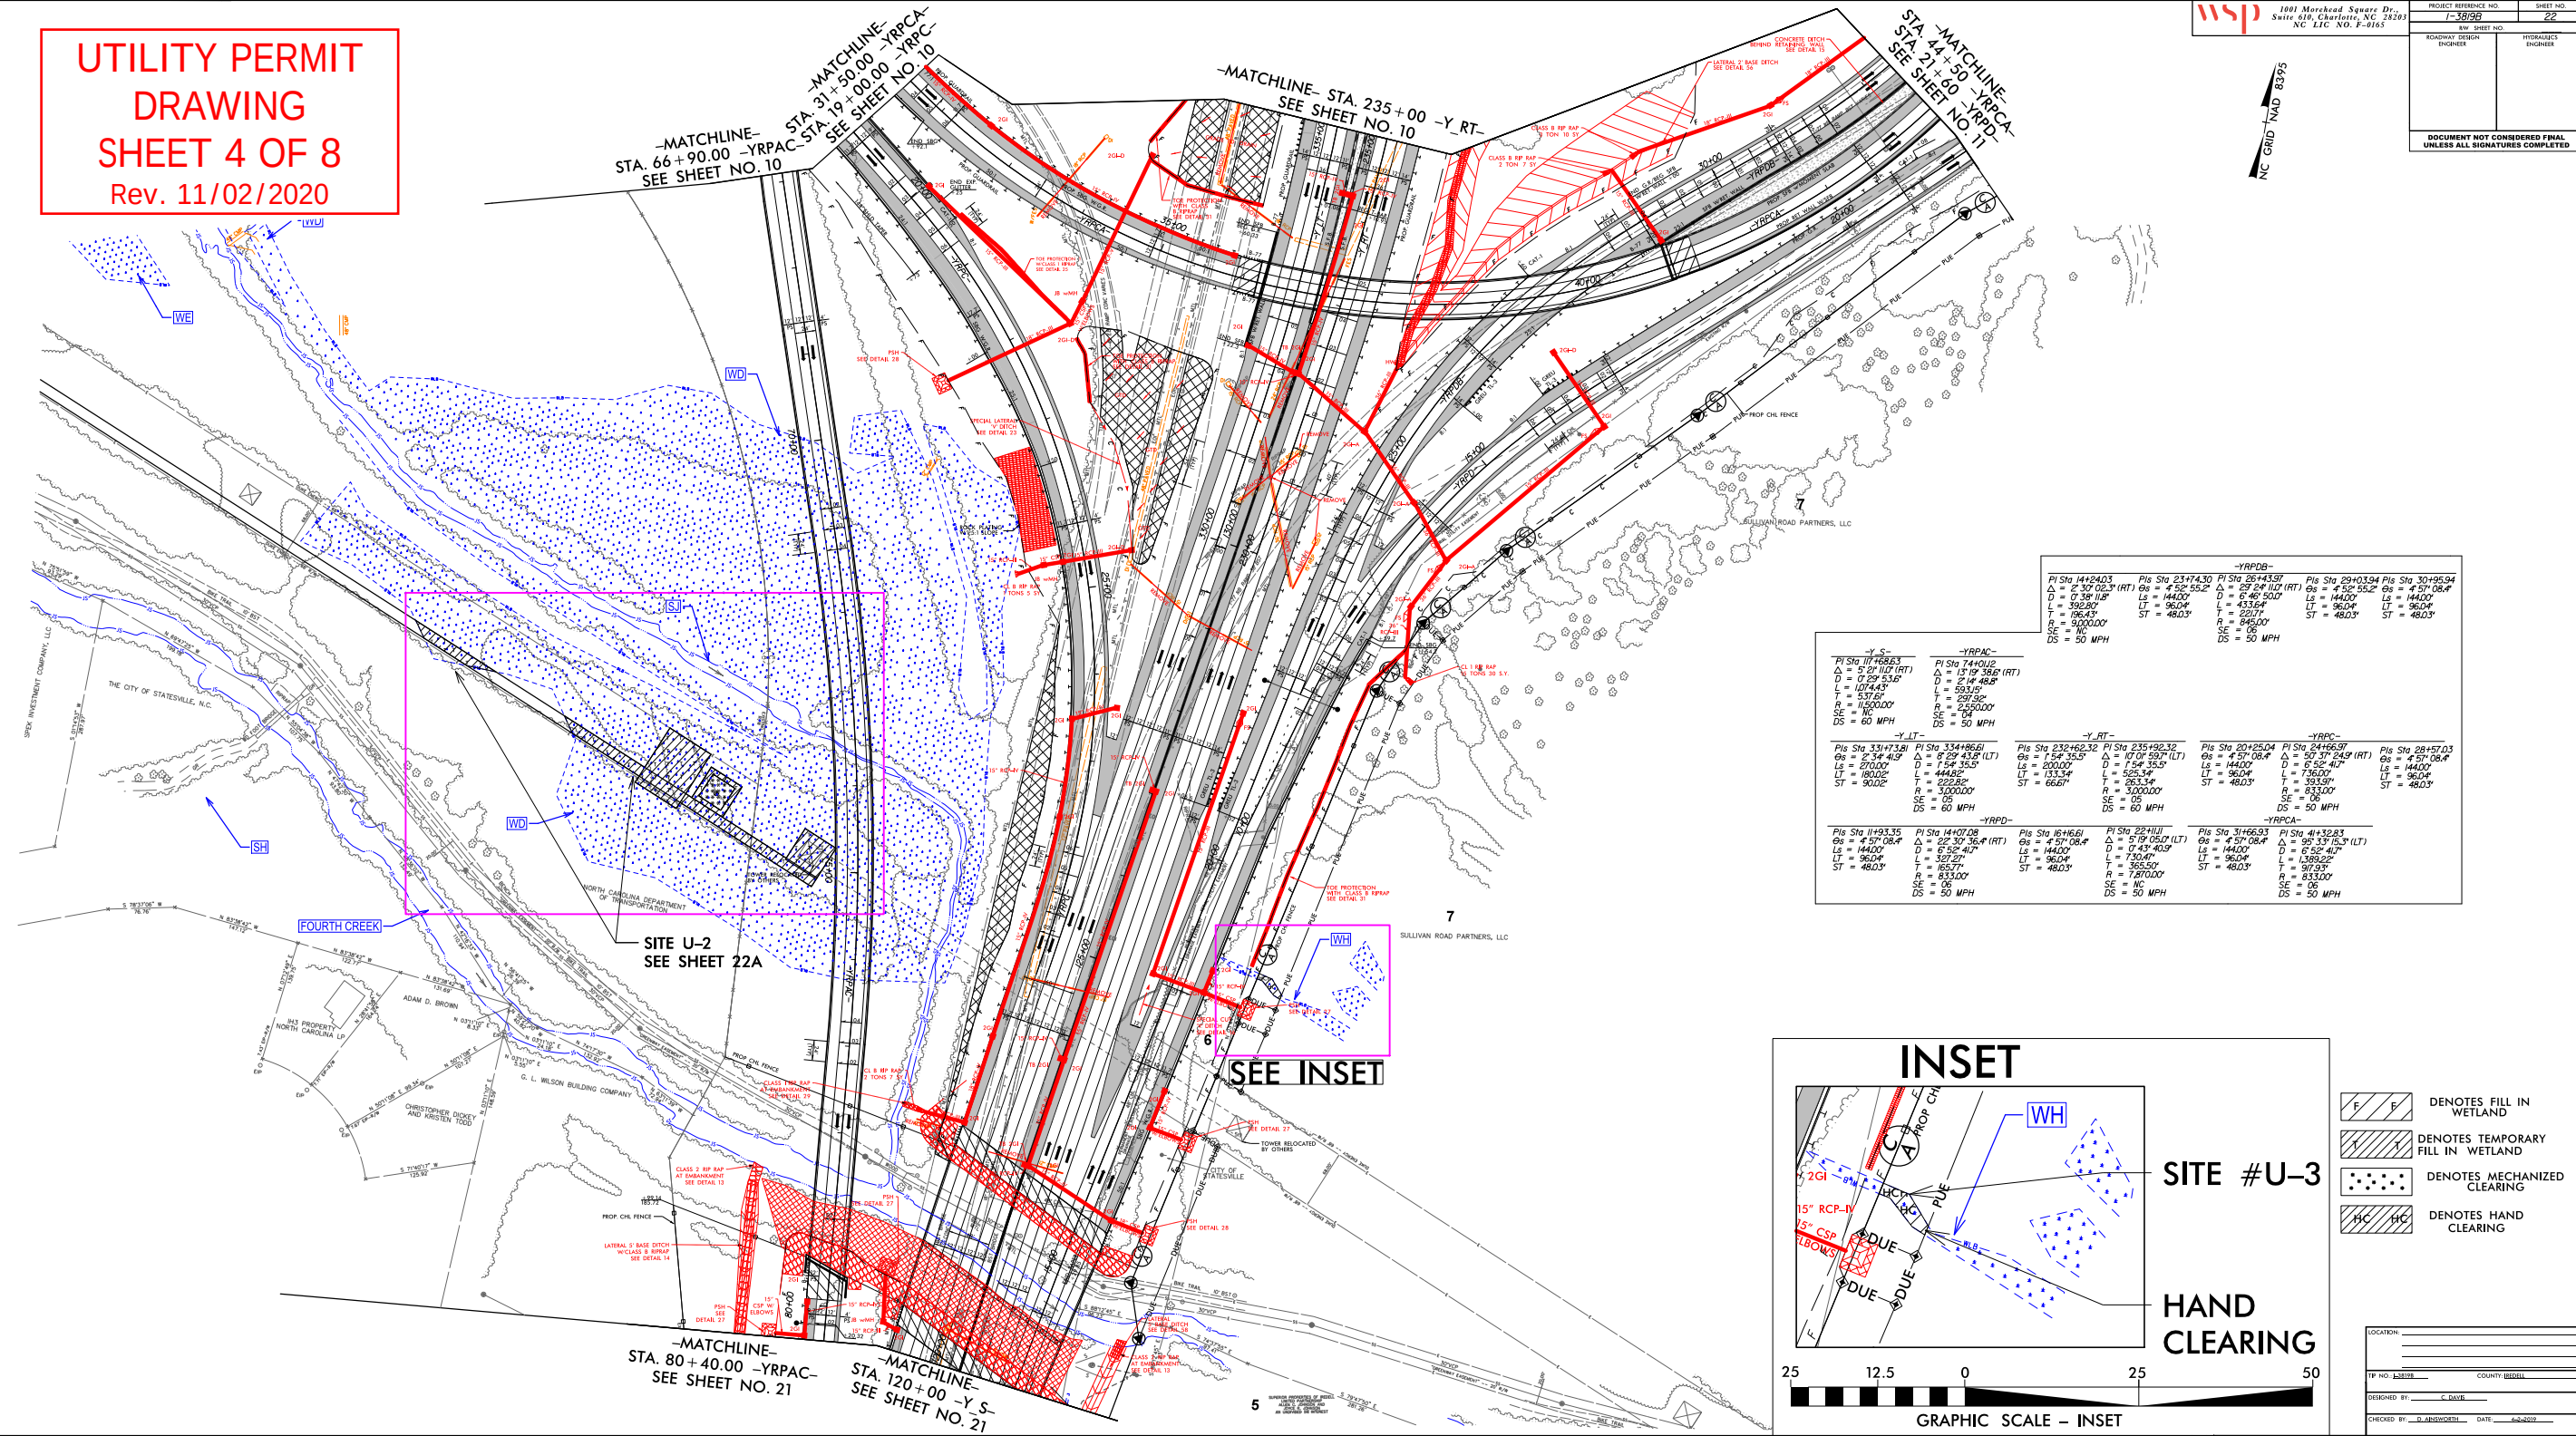

-VPDDB-					
Pls Sta 14+24.03	Pls Sta 24+73.430	Pls Sta 26+143.97	Pls Sta 29+03.94	Pls Sta 30+95.94	
$\Delta = 2.30^{\circ} 02.3'$ (RT)	$\Delta = 4.52^{\circ} 55.2'$	$\Delta = 29.24^{\circ} 10.0'$ (RT)	$\Delta = 4.52^{\circ} 55.2'$	$\Delta = 4.57^{\circ} 08.4'$	
$D = 0.738^{\circ}$ (117)	LS = 14400"	$D = 6.45^{\circ} 50.0'$	LS = 14400"	LS = 14400"	
L = 392.80'	LT = 96.04'	L = 433.64'	LT = 96.04'	LT = 96.04'	
T = 3.77'	ST = 48.03"	T = 7.77'	ST = 48.03"	ST = 48.03"	
R = 9000.00'		R = 845.00'			
SE = 06		SE = 06			
DS = 50 MPH		DS = 50 MPH			

-Y-S-	-YRPAC-
PI Sta 117+68.63	PI Sta 74+01.12
$\Delta = 5^\circ 21' 11.0" (RT)$	$\Delta = 13^\circ 19' 36.6" (R)$
D = 0' 29" 53.6"	D = 2' 14" 48.8"
L = 107.443'	L = 593.15'
T = 537.61'	T = 297.92'
R = 11,500.00'	R = 2,550.00'
SE = NC	SE = 04
DS = 60 MPH	DS = 50 MPH

$$\frac{DS}{DS} = \frac{RC}{50 \text{ MPH}}$$

$DS = 50 \text{ MPH}$

-Y_LT-

Pls Sta 331+73.81	Pl Sta 334+86.61
Gs = 2' 34" 41.9'	$\Delta = 8' 29" 43.8' (LT)$
Ls = 270.00'	D = 1' 54" 35.5'
LT = 180.02'	L = 444.82'
ST = 90.02'	T = 222.82'
	R = 3,000.00'
	SE = 05
	DS = 60 MPH

-YRPD-

-Y_RT-		
Pls Sta 232+62.32	Pl Sta 235+92.32	Pls
Θs = 1°54'35.5"	Δ = 10°0'59.7" (LT)	Θs
Ls = 200.00'	D = 1°54'35.5"	Ls
LT = 133.34'	L = 525.34'	LT
ST = 66.67'	T = 263.34'	ST
	R = 3,000.00'	
	SE = 05	
	DS = 60 MPH	


-YRPC-			
Sta 20+25.04	PI Sta 24+66.97		Pis Sta 28+57.03
4° 57' 08.4"	Δ = 50° 37' 24.9" (RT)		Es = 4° 57' 08.4"
LA = 144.00°	L = 6° 52' 41.7"		Ls = 144.00°
SE = 96.04°	T = 736.00'		LT = 96.04°
Δ = 48.03°	L = 393.97'		ST = 48.03°
	R = 833.00'		
	SE = 06		
	DS = 50 MPH		
-YRPC-			

Pls Sta 11+93.35	Pl Sta 14+07.08
Gs = 4° 57' 08.4"	Δ = 22° 30' 36.4" (RT)
Ls = 144.00'	D = 6° 52' 41.7"
LT = 96.04'	L = 327.27'
ST = 48.03'	T = 165.77'
	R = 833.00'
	SE = 06
	DS = 50 MPH

Pls Sta 16+16.61	Pls Sta 22+11.11	Pls Sta 28+00.00
Øs = 4° 57' 08.4"	Δ = 5° 19' 05.0" (LT)	Øs = 4° 57' 08.4"
Ls = 144.00'	D = 0° 43' 40.9"	Ls = 144.00'
LT = 96.04'	L = 730.47'	LT = 96.04'
ST = 48.03'	T = 365.50'	ST = 48.03'
	R = 7,870.00'	
	SE = NC	
	DS = 50 MPH	

Sta 31+66.93 PI Sta 41+32.83
 $\Delta = 95^{\circ} 33' 15.3''$ (LT)
 $D = 6^{\circ} 52' 40.7''$
 $L = 1,389.22'$
 $T = 917.93'$
 $R = 833.00'$
 $SE = 06$
 $DS = 50$ MPH

INSET

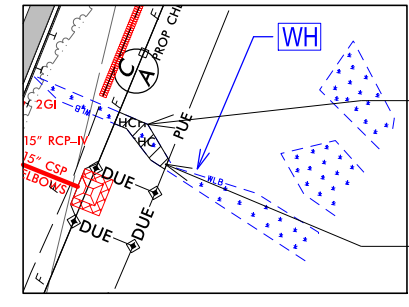

SITE #U-3

HAND CLEARING

- | | |
|---|-----------------------------------|
|  | DENOTES FILL IN WETLAND |
|  | DENOTES TEMPORARY FILL IN WETLAND |
|  | DENOTES MECHANIZED CLEARING |
|  | DENOTES HAND CLEARING |



LOCATION: _____

TP NO.: L-38119 COUNTY: BEDFORD

DESIGNED BY: C DAVE

CHECKED BY: D AINSWORTH DATE: 6-2-2019

UTILITY PERMIT
DRAWING
SHEET 5 OF 8
Rev. 11/02/2020

1801 Morehead Square Dr.,
Suite 510, Charlotte, NC 28203

NC LIC. NO. F-0165

WSP

WSP

PROJECT REFERENCE NO.
17-3639

SHEET NO.
22

NEW SHEET NO.

ROADWAY DESIGN
ENGINEER

HYDRAULICS
ENGINEER

DOCUMENT NOT CONSIDERED FINAL
UNLESS ALL SIGNATURES COMPLETED

Y-S		YRPC		Y_RT		YRPC		YRPC	
PI Sta 11+68.63	Δ = 5° 51' 00" (RT)	PI Sta 74+00.00	Δ = 1° 12' 30" (RT)	PI Sta 235+00.00	Δ = 4° 52' 52" (RT)	PI Sta 26+44.30	Δ = 2° 52' 10" (RT)	PI Sta 29+03.94	Δ = 4° 52' 52" (RT)
D = 0° 52' 52" (RT)	L = 107.45	D = 2° 14' 48" (RT)	L = 60.30	D = 4° 52' 52" (RT)	L = 144.00	D = 4° 52' 52" (RT)	L = 144.00	D = 4° 52' 52" (RT)	L = 144.00
T = 53.75	SE = 15.00	T = 28.50	SE = 15.00	T = 28.50	SE = 15.00	T = 28.50	SE = 15.00	T = 28.50	SE = 15.00
DS = 60 MPH		DS = 60 MPH		DS = 60 MPH		DS = 60 MPH		DS = 60 MPH	
Y_RT		YRPC		YRPC		YRPC		YRPC	
PI Sta 131+71.81	Δ = 8° 29' 43" (LT)	PI Sta 134+46.61	Δ = 8° 29' 43" (LT)	PI Sta 235+00.00	Δ = 4° 52' 52" (RT)	PI Sta 26+44.30	Δ = 2° 52' 10" (RT)	PI Sta 29+03.94	Δ = 4° 52' 52" (RT)
D = 8° 29' 43" (LT)	L = 270.00	D = 8° 29' 43" (LT)	L = 270.00	D = 4° 52' 52" (RT)	L = 144.00	D = 4° 52' 52" (RT)	L = 144.00	D = 4° 52' 52" (RT)	L = 144.00
T = 135.00	SE = 15.00	T = 135.00	SE = 15.00	T = 28.50	SE = 15.00	T = 28.50	SE = 15.00	T = 28.50	SE = 15.00
DS = 60 MPH		DS = 60 MPH		DS = 60 MPH		DS = 60 MPH		DS = 60 MPH	
YRPC		YRPC		YRPC		YRPC		YRPC	
PI Sta 11+93.35	Δ = 4° 52' 52" (RT)	PI Sta 147+07.08	Δ = 4° 52' 52" (RT)	PI Sta 16+66.61	Δ = 4° 52' 52" (RT)	PI Sta 32+11.11	Δ = 4° 52' 52" (RT)	PI Sta 34+46.61	Δ = 4° 52' 52" (RT)
D = 4° 52' 52" (RT)	L = 144.00	D = 4° 52' 52" (RT)	L = 144.00	D = 4° 52' 52" (RT)	L = 144.00	D = 4° 52' 52" (RT)	L = 144.00	D = 4° 52' 52" (RT)	L = 144.00
T = 96.00	SE = 15.00	T = 96.00	SE = 15.00	T = 96.00	SE = 15.00	T = 96.00	SE = 15.00	T = 96.00	SE = 15.00
DS = 60 MPH		DS = 60 MPH		DS = 60 MPH		DS = 60 MPH		DS = 60 MPH	
YRPC		YRPC		YRPC		YRPC		YRPC	
PI Sta 11+93.35	Δ = 4° 52' 52" (RT)	PI Sta 147+07.08	Δ = 4° 52' 52" (RT)	PI Sta 16+66.61	Δ = 4° 52' 52" (RT)	PI Sta 32+11.11	Δ = 4° 52' 52" (RT)	PI Sta 34+46.61	Δ = 4° 52' 52" (RT)
D = 4° 52' 52" (RT)	L = 144.00	D = 4° 52' 52" (RT)	L = 144.00	D = 4° 52' 52" (RT)	L = 144.00	D = 4° 52' 52" (RT)	L = 144.00	D = 4° 52' 52" (RT)	L = 144.00
T = 96.00	SE = 15.00	T = 96.00	SE = 15.00	T = 96.00	SE = 15.00	T = 96.00	SE = 15.00	T = 96.00	SE = 15.00
DS = 60 MPH		DS = 60 MPH		DS = 60 MPH		DS = 60 MPH		DS = 60 MPH	

- DENOTES FILL IN WETLAND
- DENOTES TEMPORARY FILL IN WETLAND
- DENOTES MECHANIZED CLEARING
- DENOTES HAND CLEARING

LOCATION: _____

TP NO. 1-3018 _____ COUNTY 18000


DESIGNED BY: C. DAVE _____

CHECKED BY: D. BROWN _____ DATE: 6-3-2017

UTILITY PERMIT
DRAWING
SHEET 6 OF 8
Rev. 11/02/2020


SITE U-2

INSET

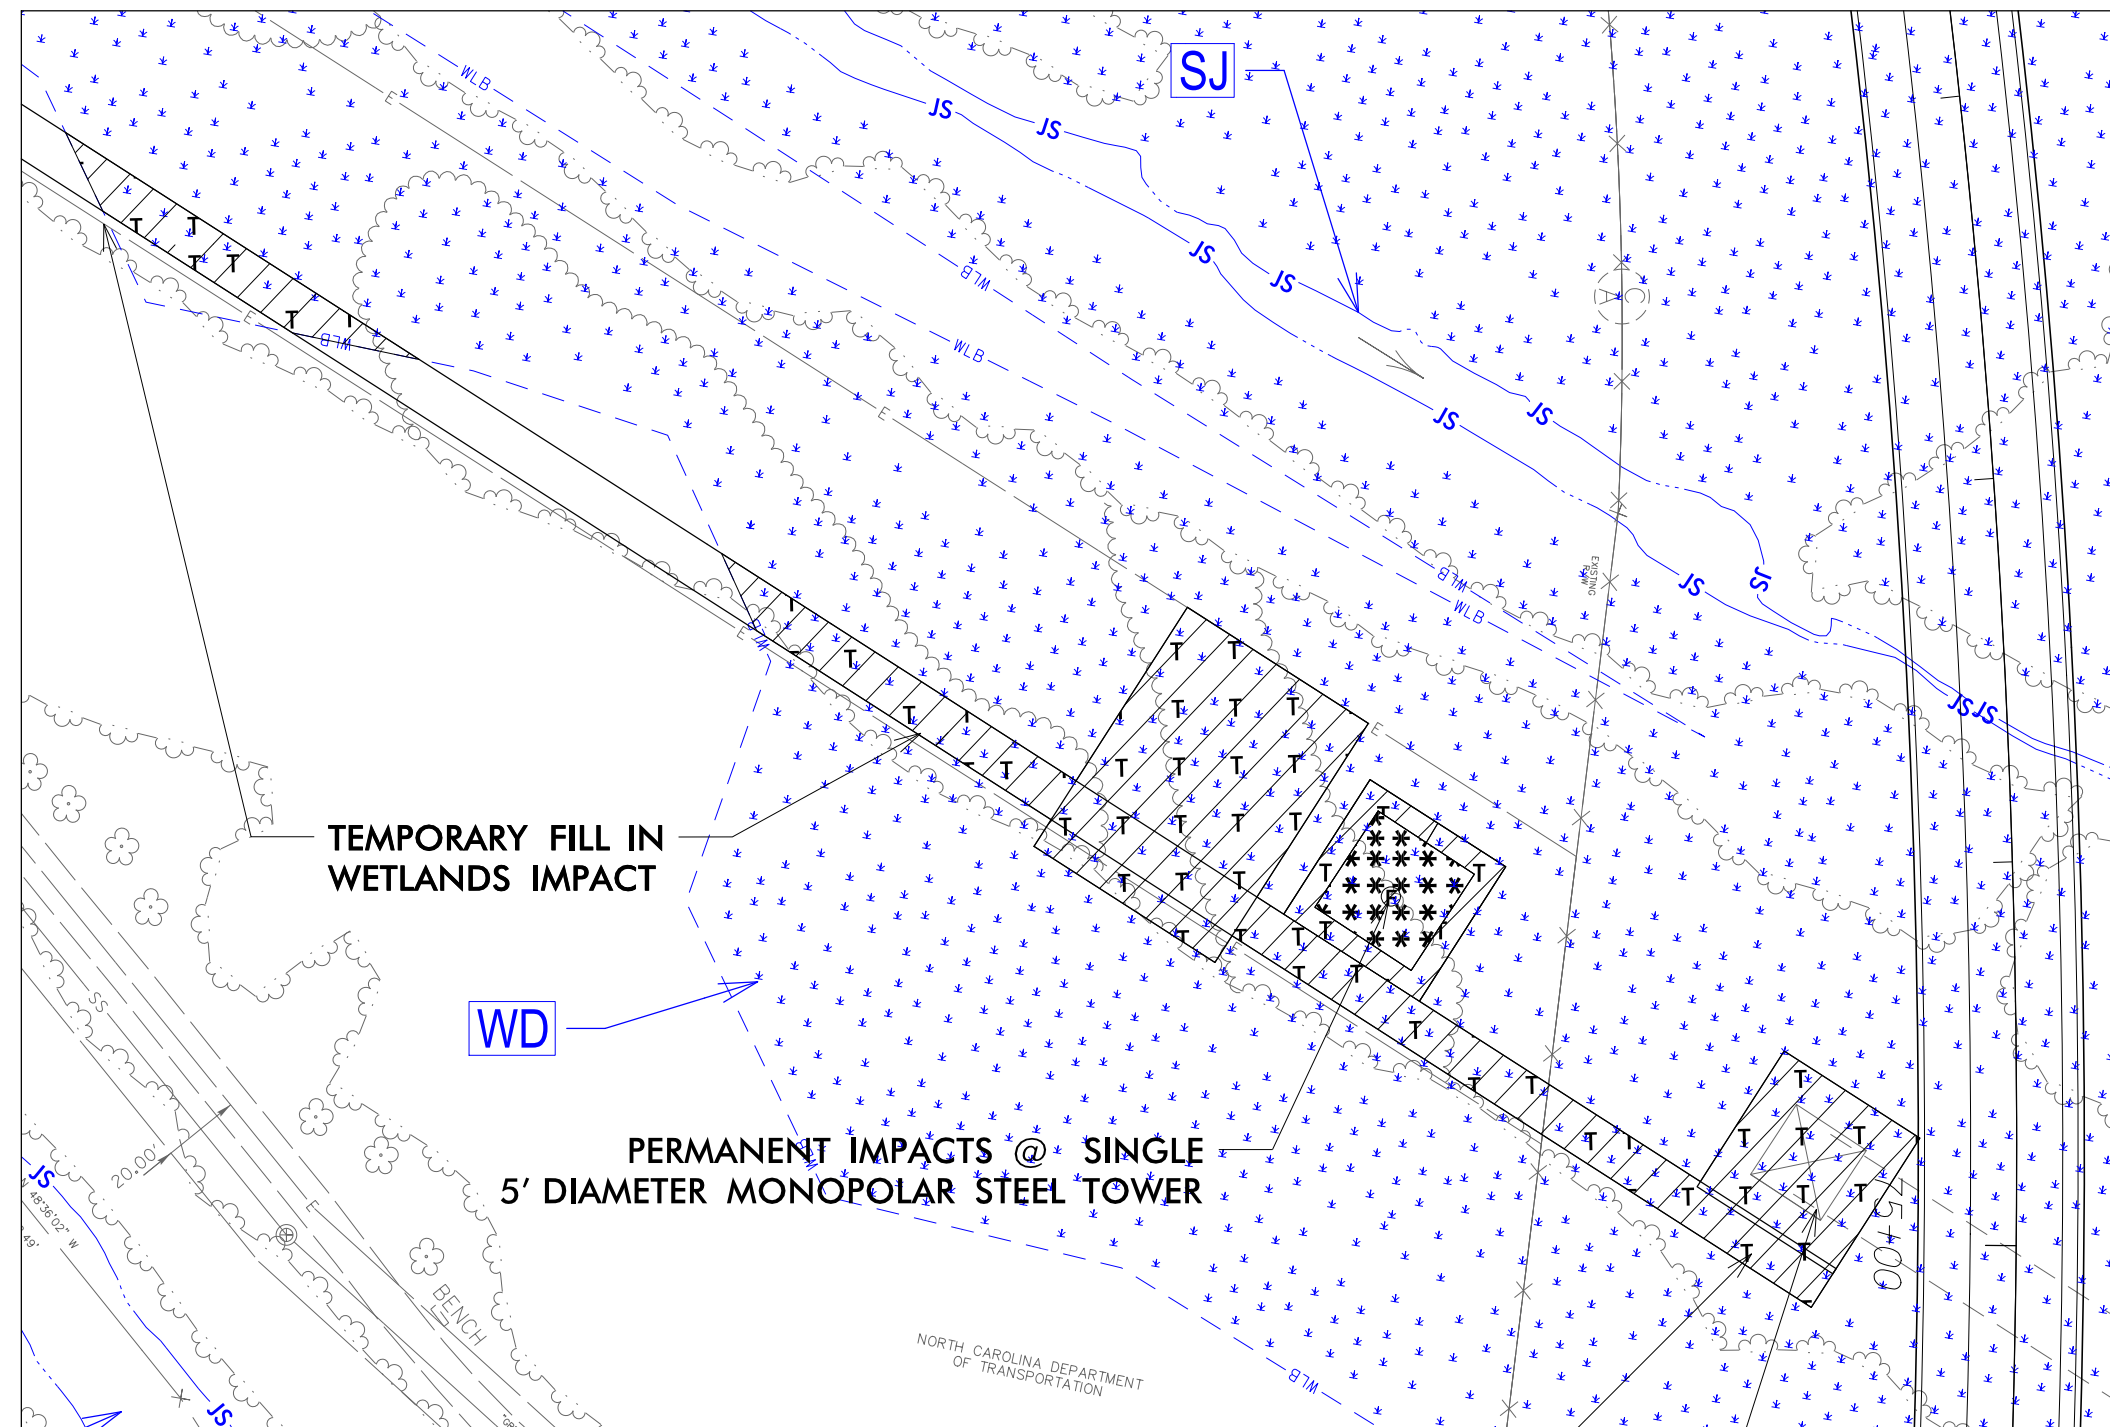


NC GRID NAD 8395

-  DENOTES FILL IN WETLAND
-  DENOTES TEMPORARY FILL IN WETLAND
-  DENOTES MECHANIZED CLEARING

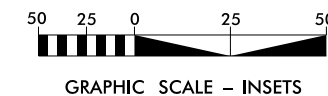

PROJECT REFERENCE NO.	SHEET NO.
1-3819B	22A
RW SHEET NO.	
ROADWAY DESIGN ENGINEER	HYDRAULICS ENGINEER
DOCUMENT NOT CONSIDERED FINAL UNLESS ALL SIGNATURES COMPLETED	

SITE U-2 INSET

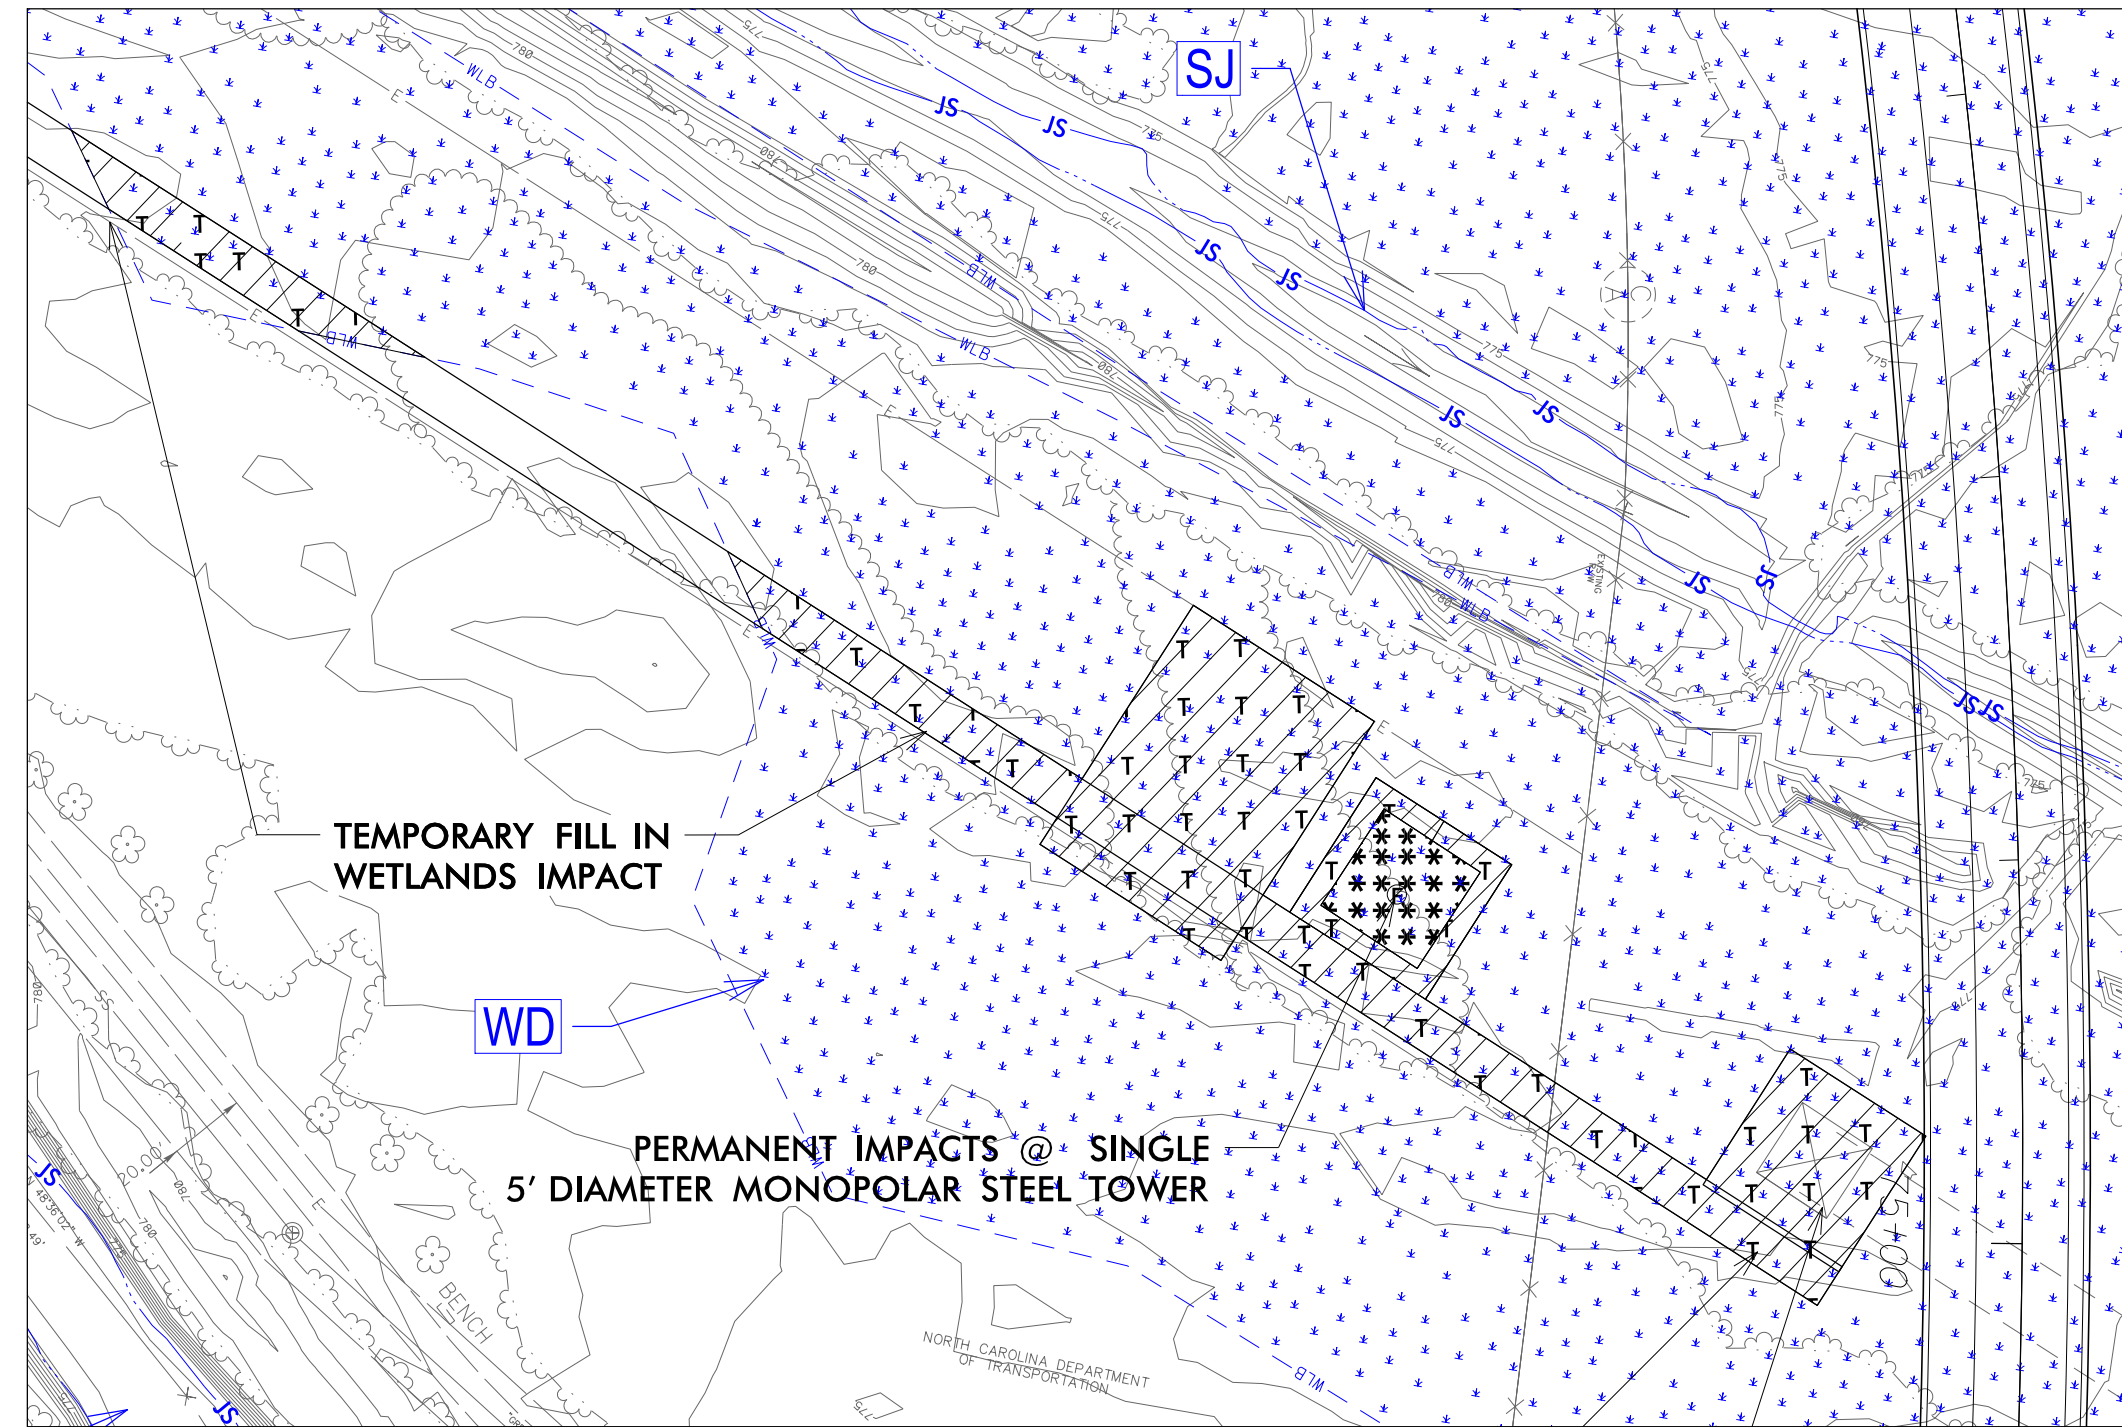


UTILITY PERMIT
DRAWING
SHEET 7 OF 8
Rev. 11/02/2020

NC GRID NAD 8395

- DENOTES FILL IN WETLAND
- DENOTES TEMPORARY FILL IN WETLAND
- DENOTES MECHANIZED CLEARING

AREA WITHIN 50' OF BRIDGE
ALSO COUNTED AS TEMPORARY FILL
IMPACT IN ROADWAY & DRAINAGE
PERMIT PLANS

EXISTING TOWER
TO BE REMOVED

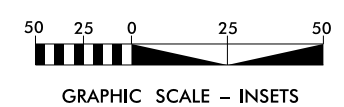

7/15/2020
c:\projectwise\pb\projectwiseint\becker_jw\0350035\13819_hyd_prm-psh22A_Utility.dgn
becker_jw

WETLAND AND SURACE WATER IMPACTS SUMMARY												
			WETLAND IMPACTS					SURFACE WATER IMPACTS				
Site No.	Station (From/To)	Structure Size / Type	Permanent Fill In Wetlands (ac)	Temp. Fill In Wetlands (ac)	Excavation in Wetlands (ac)	Mechanized Clearing in Wetlands (ac)	Hand Clearing in Wetlands (ac)	Permanent SW impacts (ac)	Temp. SW impacts (ac)	Existing Channel Impacts Permanent (ft)	Existing Channel Impacts Temp. (ft)	Natural Stream Design (ft)
U-1	31+50-YRPD-	Utility		0.02								
U-2	75+00-YRPAC-**	Utility	< 0.01	0.25		0.02						
U-3	18+92-YRPDB-	Utility					< 0.01					
U-4	91+00-Y_S-	Utility				0.14						
TOTALS*:			< 0.01	0.27		0.16	< 0.01					

*Rounded totals are sum of actual impacts for entire project area

**Permanent Impact from a single 5 ft diameter monopole foundation for new transmission tower location.

NC DEPARTMENT OF TRANSPORTATION
DIVISION OF HIGHWAYS
11/02/2020
IREDELL
TIP NO. I-3819B
WBS NO.
SHEET 8 OF 8