



STATE OF NORTH CAROLINA  
DEPARTMENT OF TRANSPORTATION

BEVERLY PERDUE  
GOVERNOR

EUGENE CONTI  
SECRETARY

September 21, 2010

MEMORANDUM TO: Mr. J. Wally Bowman , PE  
Division Five Engineer  
*E.f. fischer*

FROM: Philip S. Harris, III, P.E., Unit Head  
Natural Environment Unit  
Project Development and Environmental Analysis Branch

SUBJECT: Wake County, US 401 (Rolesville Bypass) from SR 2226 to NC 96; T.I.P.  
Number R-2814B; Federal Aid Project No. STP-401(4); State Project 8.1403001

Attached are the modifications to the U.S. Army Corps of Engineers Section 404 Individual Permit, N.C. Division of Water Quality Section 401 Individual Water Quality Certification, Riparian Buffer Authorization and DWQ Isolated Wetlands Permit for the above referenced project. All environmental permits have been received for the construction of this project.

A copy of this permit package will be posted on the NCDOT website at:  
<http://www.ncdot.gov/doh/preconstruct/pe/neu/permit.html>

PSH/gyb

Attachment

Cc: W/attachment  
Mr. Randy Garris, P.E. State Contract Officer  
Mr. Chris Murray, Division Environmental Officer

Cc: W/o attachment (see website for attachments)  
Mr. Majed Alghandour, P. E., Programming and TIP  
Mr. Jay Bennett, P.E., Roadway Design  
Dr. David Chang, P.E., Hydraulics  
Mr. Art McMillan, P.E., Highway Design  
Mr. Tom Koch, P.E., Structure Design  
Mr. Dewayne Sykes, P.E., Utilities Unit  
Mr. Mark Staley, Roadside Environmental  
Mr. John F. Sullivan, FHWA  
Mr. Ron Hancock, P.E., State Roadway Construction Engineer  
Mr. Mike Robinson, P.E., State Bridge Construction Engineer  
Ms. Beth Harmon, EEP  
Mr. Eric Midkiff, P.E., PDEA Central Region Unit Head

## **PROJECT COMMITMENTS**

US 401 ( Rolesville Bypass) from SR 2226  
To NC 96  
Wake County  
Federal-Aid Project STP-401(4)  
State Project 8.1403001  
WBS Element 34506.1.1  
TIP Project R-2814B

Current status, changes or additions to the project commitments as shown in the environmental document for the project are printed in *italics*.

### **Commitments Developed Through Project Development and Design**

No new commitments were developed for the Section B permit modification. See R-2814 permit greensheet dated August 2009. All these commitments still apply.

### **Commitments Developed Through Permitting**

Commitments listed below are commitments that differ from original permits or condition language has changed slightly. Original conditions still apply.

#### **Natural Environment Unit**

Debiting 2,873 linear feet of stream restoration from Marks Creek, Phase II, Mitigation Site (AID 8008-02072), described in the September 2001 "Stream and Wetland Mitigation Plan, Marks Creek, Phase II, Wake County, North Carolina".

*This has been completed.*

NCDOT will debit 2.49 acres of Riverine Wetland Restoration, 1.96 acres of Non-Riverine Wetland Restoration, and 3.05 acres Riverine Wetland Preservation from the Jefferey's Warehouse Mitigation Site.

*This has been completed*

Compensatory mitigation for impacts to Neuse Riparian Buffers is required. The mitigation requirements include 752,085 square feet of Zone 1 Buffers and 233,240 square feet of Zone 2 Buffers. We understand that you have chosen to debit mitigation from the Wiggins Mill Mitigation Site in order to satisfy the wetland mitigation requirements of R-2814 A and B.

*This has been completed*

Compensatory mitigation shall be provided by the Ecosystem Enhancement Program (EEP), as outlined in the letter dated May 27, 2009 from William D. Gilmore, R-2814B Permit Modification

EEP Director; pursuant to the EEP Memorandum of Agreement (MOA) between the State of North Carolina and the US Army Corps of Engineers signed on July 22, 2003, the EEP will provide 2,538 linear feet of restoration equivalent warm-water stream channel in the Upper Neuse River basin (Hydrologic Cataloging Unit 03020201) in accordance with Section X of the MOA. The NCDOT shall, within 30 days of the issue date of this permit, certify that sufficient funds have been provided to EEP to complete the required mitigation, pursuant to Paragraph V. of the MOA.

*This has been completed.*

### **Natural Environment Unit, Division 5, Hydraulics Unit and Roadway Design Unit**

When final design plans are completed of R-2814 Sections C & D, a modification to the 401 Water Quality Certification and the Neuse River Riparian Buffer Certification shall be submitted with five copies and fees to the NC Division of Water Quality. Final designs shall reflect all appropriate avoidance, minimization, and mitigation for impacts to wetlands, streams, and other surface waters and buffers. No construction activities that impact any waters, streams, surface waters, or buffers located in R-2814 Section C and D shall begin until after the permittee applies for, and receives a written modification of the 401 Water Quality Certification and the Neuse River Riparian Buffer Authorization from the NC Division of Water Quality.

#### **Hydraulics Unit**

For project sites impacting waters classified by the NC Environmental Management Commission as High Quality Waters (HQW), or Water Supply I or II (WSI. WSII), (i.e., Cedar Fork Creek, Perry Creek, and their tributaries in Section B), stormwater shall be directed to vegetated buffer areas, grass-lined ditches or other means appropriate to the site for the purpose of pre-treating stormwater runoff prior to discharging directly into streams. Mowing of existing vegetated buffers is strongly discouraged.

#### **Roadside Environmental Unit**

The permittee shall use Design Standards in Sensitive Watersheds [15A NCAC 4B.0124(a)-(e)] in areas draining to WS-II HQW waters (i.e., Cedar Fork Creek, Perry Creel and their tributaries in Section B). However, due to the size of the project, NCDOT shall not be required to meet 15A NCAC 4B.0124(a) regarding the maximum amount of uncovered areas. Temporary cover (wheat, millet, or similar annual grain) or permanent herbaceous cover shall be planted on all bare soil within 15 business days of ground disturbing activities to provide erosion control.

Tall fescue shall not be used in the establishment of temporary or permanent groundcover within riparian zones. For the establishment of permanent herbaceous cover, erosion control matting shall be used in conjunction with appropriate seeding on disturbed soils within the riparian area and on disturbed steep slopes with the following exception. Erosion control matting is not necessary if the area is contained by perimeter

erosion control devices such as silt fence, temporary sediment ditches, basins, ect. Matting should be secured in place with staples, stakes, or wherever possible, live stakes of native trees. Erosions control matting placed in riparian areas shall not contain a nylon mesh grid, which can impinge and entrap small animals. For the establishment of temporary groundcover within riparian areas, hydroseeding along with wood or cellulose based hydro mulch applied from a fertilizer- and limestone-free tank is allowable at the appropriate rate in conjunction with erosion control measures. Discharging hydroseed mixtures and wood or cellulose mulch into surface waters is prohibited. Riparian areas are defined as a distance 25 feet landward from top of stream bank.

## **Division 5**

At locations where ponds will be drained, proper measures will be taken to drain the pond with limited impact to upstream and downstream channel stability as well as to native aquatic species. Proper measures will be taken to avoid sediment release and/or sediment accumulation downstream as a result of pond draining. If typical pond draining techniques will create significant disturbance to native aquatic species, additional measures such as collection and relocation may be necessary to prevent a significant fish kill. NCDOT shall consult with NC Wildlife Resources staff to determine if there are any sensitive species, and the most appropriate measures to limit impacts to these species. The permittee shall observe any natural channel re-establishment, or utilize natural channel construction techniques, to ensure that the jurisdictional stream channel above and below the drained pond remains stable, and that additional impacts occur within the natural steam channel as a result of draining the pond.



REPLY TO  
ATTENTION OF:

DEPARTMENT OF THE ARMY  
WILMINGTON DISTRICT, CORPS OF ENGINEERS  
69 DARLINGTON AVENUE  
WILMINGTON, NORTH CAROLINA 28403-1343

June 25, 2010

Regulatory Division

SUBJECT: Action ID 2008-01316; TIP No. R-2814

*Brauergard*

RECEIVED	
JUN 29 2010	
<i>[Signature]</i>	DIVISION OF HIGHWAYS PDEA-OFFICE OF NATURAL ENVIRONMENT

Gregory J. Thorpe, Ph.D  
North Carolina Department of Transportation  
Division of Highways  
1598 Mail Service Center  
Raleigh, North Carolina 27699-1598

Dear Dr. Thorpe:

Reference the Department of the Army permit issued to the North Carolina Department of Transportation on July 14, 2009, to authorize the discharge of fill material into waters of the United States, for construction of the Sections A, B, C and D of the US 401 Widening and Rolesville Bypass (TIP R-2814). The project location is an 18.5 mile corridor along and to the east of existing US 401, from SR 2044 (Ligon Mill Road) southeast of Rolesville, in Wake County, to SR 1700 (Fox Park Road) southeast of Louisburg, in Franklin County, North Carolina. Authorization for Section B was based on preliminary design. Also, please reference your May 14, 2010 letter, requesting modification of the permit to reflect the final design for Section B of this project.

The final design results in relatively minor changes in permanent impacts to streams and wetlands, some decreases and some increases, with a net decrease of 0.14 acres of wetlands, and 268 linear feet of stream. The increased impacts are necessary because of several factors related to the final design, including required bank stabilization, and a required sewer line relocation.

We have reviewed the requested modification, and determined that it is appropriate and reasonable, and that no public notice is required for this modification. Therefore, the permit is hereby modified to include the changes listed and shown in the modified drawings in the May 14, 2010 modification request, for a net decrease in permanent wetland impacts of 0.14 acres, and net decrease in permanent stream impacts of 268 linear feet in Section B. Total impacts for all four sections will now be 5.96 acres of permanent impacts to 404 wetlands, 4,768 linear feet of permanent impact to streams, 0.03 acre of temporary impact to wetlands, and 204 linear feet of temporary impact to streams. There is a net reduction of 0.12 acres of mitigable impacts to 404 wetlands, and a net decrease of 268 linear feet of impacts to streams requiring mitigation; therefore, special conditions *k*) and *l*) are modified as follows:  
*m*

| *k*) NCDOT shall provide compensatory mitigation for the unavoidable impacts to 4.25 acres of wetlands, associated with Sections A and B of TIP R-2814, by debiting 2.48 acres of riverine and 1.77 acres of non-riverine wetland restoration, and 3.05 acres of riverine wetland

preservation, from the Jeffreys Warehouse Mitigation Site (aka JALO), described in the September 17, 2004 "Jeffreys Warehouse Conceptual Mitigation Plan, Wayne County, North Carolina".


**m 1)** NCDOT shall provide compensatory mitigation for the unavoidable impacts to 2,873 linear feet of warm-water streams with more than minimal aquatic function, associated with Sections A and B of TIP R-2814, as follows:

1. By debiting 2,873 linear feet of stream restoration from the Marks Creek, Phase II, Mitigation Site (AID 2008-02072), described in the September 2001 "Stream and Wetland Mitigation Plan, Marks Creek, Phase II, Wake County, North Carolina".

2. Compensatory mitigation shall be provided by the Ecosystem Enhancement Program (EEP), as outlined in the letter dated May 27, 2009 from William D. Gilmore, EEP Manager. Pursuant to the EEP Memorandum of Agreement (MOA) between the State of North Carolina and the US Army Corps of Engineers signed on July 22, 2003, the EEP will provide 2,538 linear feet of restoration equivalent warm water stream channel in the Upper Neuse River basin (Hydrologic Cataloging Unit 03020201) in accordance with Section X of the MOA. The NCDOT shall, within 30 days of the issue date of this permit, certify that sufficient funds have been provided to EEP to complete the required mitigation, pursuant to Paragraph V. of the MOA.

All other conditions of the permit, including the permit expiration date of December 31, 2014, remain applicable.

Should you have any questions, please call Mr. Eric Alsmeyer at (919) 554-4884, extension 23.

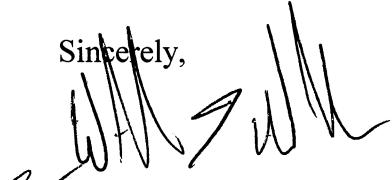Sincerely,  
  
Jefferson M. Ryscavage  
Colonel, U.S. Army  
District Commander

Copies Furnished:

Mr. Brian Wrenn  
Division of Water Quality  
North Carolina Department of  
Environment and Natural Resources  
1650 Mail Service Center  
Raleigh, NC 27699-1650

Mr. Clarence Coleman  
Federal Highway Administration  
310 New Bern Ave., Rm 410  
Raleigh, North Carolina 27601-1442

NC-EEP  
1652 Mail Service Center  
Raleigh, NC 27699-1652



North Carolina Department of Environment and Natural Resources

Division of Water Quality


Coleen H. Sullins  
Director

Beverly Eaves Perdue  
Governor

August 30, 2010

Dr. Greg Thorpe, PhD., Manager  
Project Development and Environmental Analysis  
North Carolina Department of Transportation  
1548 Mail Service Center  
Raleigh, North Carolina, 27699-1548

Dee Freeman  
Secretary

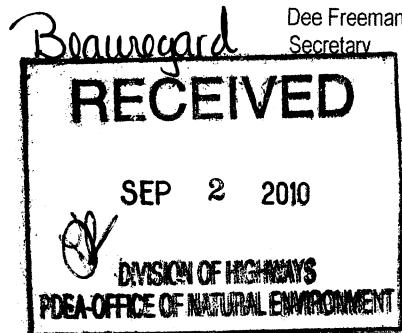

Subject: CORRECTION to Modification to the 401 Water Quality Certification Pursuant to Section 401 of the Federal Clean Water Act, NEUSE BUFFER RULES, and ISOLATED WETLANDS PERMIT Pursuant to IWGP100000 with ADDITIONAL CONDITIONS for Proposed improvements to US 401 in Wake County, Federal Aid Project No. STP-401(4), State Project No. 81403001, TIP No. R-2814 (B).  
NCDWQ Project No. 20090104 ver.2.

Dear Dr. Thorpe:

Attached hereto is a modification of Certification No. 3790 issued to The North Carolina Department of Transportation (NCDOT) originally dated June 16, 2009.

If we can be of further assistance, do not hesitate to contact us.

Sincerely,

Coleen H. Sullins  
Director

Attachments

cc: Eric Alsmeyer, US Army Corps of Engineers, Raleigh Field Office  
Chris Murray, Division 5 Environmental Officer  
Ecosystem Enhancement Program  
Rachelle Beauregard, NCDOT NEU  
File Copy

Transportation Permitting Unit  
1650 Mail Service Center, Raleigh, North Carolina 27699-1650  
Location: 2321 Crabtree Blvd., Raleigh, North Carolina 27604  
Phone: 919-733-1786 | FAX: 919-733-6893  
Internet: <http://h2o.enr.state.nc.us/ncwetlands/>

An Equal Opportunity \ Affirmative Action Employer

One  
North Carolina  
*Naturally*

**Modification to the 401 Water Quality Certification Pursuant to Section 401 of the Federal Clean Water Act,  
NEUSE BUFFER RULES, and ISOLATED WETLANDS PERMIT Pursuant to IWGP100000 with  
ADDITIONAL CONDITIONS**

**THIS CERTIFICATION** is issued in conformity with the requirements of Section 401 Public Laws 92-500 and 95-217 of the United States and subject to the North Carolina Division of Water Quality (NCDWQ) Regulations in 15 NCAC 2H .0500 and 15A NCAC 2B.0233 and ISOLATED WETLANDS PERMIT Pursuant to IWGP100000. This certification authorized the NCDOT to impact 2.68 acres of jurisdictional wetlands, 1.58 acres of isolated wetlands, 3,824 linear feet of jurisdictional streams and 496,980 square feet of protected riparian buffers in Wake County. The project shall be constructed pursuant to the modification dated received May 19, 2010. The corrected revised authorized impacts are as described below:

**Revised Final Section B Stream Impacts in the Neuse River Basin**

Site	Permanent Fill in Intermittent Stream (linear ft)	Temporary Impacts to Intermittent Stream (linear ft)	Bank Stabilization to Intermittent Stream (linear ft)	Permanent Fill in Perennial Stream (linear ft)	Temporary Impacts to Perennial Stream (linear ft)	Bank Stabilization to Perennial Stream (linear ft)	Total Stream Impact (linear ft)	Stream Impacts Requiring Mitigation (linear ft)
1	243	18	0	0	0	0	261	0
4	0	0	0	95	10	20	125	0
6	0	0	0	0	25	14	39	0
7	0	0	0	321	66	47	434	368
7- Utility	0	0	0	0	3	0	3	0
8	0	0	0	355	18	153	526	508
9	0	0	0	610	20	0	630	610
11	0	0	0	0	10	0	10	0
12	258	0	0	0	0	0	258	0
16	0	0	0	189	23	135	347	324
18	36	14	33	0	0	0	83	0
<b>Total</b>	<b>537</b>	<b>32</b>	<b>33</b>	<b>1570</b>	<b>175</b>	<b>369</b>	<b>2716</b>	<b>1810</b>

Total Revised Section B Stream Impact: 2716 linear feet.

**Revised Final Section B Wetland Impacts in the Neuse River Basin**

Site	Permanent Fill (ac)	Excavation (ac)	Mechanized Clearing (ac)	Total Wetland Impact (ac)	Mitigation Ratio	Wetland Mitigation Required (ac)
2	0.17	<0.01	0.02	0.19	1:1	0.19
3	0.22	0	<0.01	0.22	1:1	0.22
4	0.24	<0.01	0.01	0.25	1:1	0.25
5	0	0.01	0	0.01	2:1	0.02
7	0.65	0.10	0.09	0.84	1:1	0.84
7- Utility	<0.01	0	0.02	0.02	1:1	0.02
13	0.19	0	0	0.19	2:1	0.38
14	0.36	<0.01	0.06	0.42	2:1	0.84
17	0.38	0	0	0.38	1:1	0.38
<b>Total</b>	<b>2.21</b>	<b>0.11</b>	<b>0.20</b>	<b>2.52</b>		<b>3.14</b>

Total Revised Section B Wetland Impact: 2.52 acres.

**Final Section B Isolated Wetland Impacts in the Neuse River Basin**

Site	Permanent Fill (ac)	Total Wetland Impact (ac)	Mitigation Ratio	Wetland Mitigation Required (ac)
15	1.58	1.58	1:1	1.58
<b>Total</b>	<b>1.58</b>	<b>1.58</b>		<b>1.58</b>

**Total Section B Isolated Wetland Impact:** 1.58 acres.

**Final Section B Open Water (Ponds) Impacts in the Neuse River Basin**

Site	Fill in Open Waters (ac)
5	1.53
9	1.31
11	7.29
<b>Total</b>	<b>10.13</b>

**Total Revised Section B Open Water Impact:** 10.13 acres.

**Final Section B Neuse Riparian Buffer Impacts**

Site	Zone 1 Impact (sq ft)	minus Wetlands in Zone 1 (sq ft)	= Zone 1 Buffers (not wetlands) (sq ft)	Zone 1 Buffer Mitigation Required (using 3:1 ratio)	Zone 2 Impact (sq ft)	minus Wetlands in Zone 2 (sq ft)	= Zone 2 Buffers (not wetlands) (sq ft)	Zone 2 Buffer Mitigation Required (using 1.5:1 ratio)
1	13743	0	13743	41229	9262	0	9262	13893
2	0	0	0	0	6	6	0	0
5	24086	3937	20149	60447	16852	1399	15453	23180
6	856	0	856	N/A	0	0	0	N/A
7	31468	26830	4638	13914	16685	8158	8527	12790
7- Utility	208	0	208	N/A	835	0	835	N/A
8	28702	0	28702	86106	15200	0	15200	22800
9	53503	0	53503	160509	31621	0	31621	47432
10	2133	0	2133	6399	4772	0	4772	7158
11	25288	0	25288	75864	14205	0	14205	21307
12	17088	0	17088	51264	15041	0	15041	22562
15	19154	16637	2517	7551	15890	8113	7777	11665
16	19724	0	19724	59172	10366	0	10366	15549
18	3475	0	3475	N/A	1585	0	1585	N/A
<b>Totals</b>	<b>239428</b>	<b>47404</b>	<b>192024</b>	<b>562455</b>	<b>152320</b>	<b>17676</b>	<b>134644</b>	<b>198336</b>

\* n/a = Total for road crossing site is less than 1/3 acre and 150 linear feet of impact, no mitigation required

**Total Revised Section B Buffer Impact:** 391,748 square feet.

**Note:** *Revised impact tables for Section B replace the preliminary section B impacts in the original Water Quality Certification. No changes have been made for Section A in this modification.*

The application provides adequate assurance that the discharge of fill material into the waters of the Neuse River Basin in conjunction with the proposed development will not result in a violation of applicable Water Quality Standards and discharge guidelines. Therefore, the State of North Carolina certifies that this activity will not violate the applicable portions of Sections 301, 302, 303, 306, 307 of PL 92-500 and PL 95-217 if conducted in accordance with the application and conditions hereinafter set forth.

This approval is only valid for the purpose and design that you submitted in your modified application dated received May 19, 2010. All the authorized activities and conditions of certification associated with the original Water Quality Certification dated June 16, 2009 still apply except where superceded by this certification. Should your project change, you are required to notify NCDWQ and submit a new application. If the property is sold, the new owner must be given a copy of this Certification and approval letter, and is thereby responsible for complying with all the conditions. If any additional wetland impacts, or stream impacts, for this project (now or in the future) exceed one acre or 150 linear feet, respectively, additional compensatory mitigation may be required as described in 15A NCAC 2H .0506 (h) (6) and (7). Additional buffer impacts may require compensatory mitigation as described in 15A NCAC.0242. For this approval to remain valid, you are required to comply with all the conditions listed below. In addition, you should obtain all other federal, state or local permits before proceeding with your project including (but not limited to) Sediment and Erosion control, Coastal Stormwater, Non-discharge and Water Supply watershed regulations. This Certification shall expire on the same day as the expiration date of the corresponding Corps of Engineers Permit. **This corrected approval replaces the one issued May 26, 2010.**

#### **Conditions of Certification:**

1. When final design plans are completed for R-2814 Sections C & D, a modification to the 401 Water Quality Certification and the Neuse River Riparian Buffer Certification shall be submitted with five copies and fees to the NC Division of Water Quality. Final designs shall reflect all appropriate avoidance, minimization, and mitigation for impacts to wetlands, streams, and other surface waters, and buffers. No construction activities that impact any wetlands, streams, surface waters, or buffers located in R-2814 Section C and D shall begin until after the permittee applies for, and receives a written modification of the 401 Water Quality Certification and the Neuse River Riparian Buffer Authorization from the NC Division of Water Quality.
2. Compensatory mitigation for 2,371 linear feet of impact to perennial streams is required. We understand that you have chosen to debit mitigation from the Marks Creek Mitigation Bank. This certification gives approval to the debiting of 2,371 linear feet of stream mitigation from the Marks Creek Mitigation Site in order to satisfy the stream mitigation requirements of R-2814 A and B.
3. Compensatory mitigation for impacts to jurisdictional and isolated wetlands is required. The mitigation requirement includes 3.37 acres of jurisdictional wetlands and 1.58 acres of isolated wetlands. We understand that you have chosen to debit mitigation from the Jefferey's Warehouse Mitigation Bank. This certification gives approval to debiting following wetland acres from the Jefferey's Warehouse Mitigation Site in order to satisfy the wetland mitigation requirements of R-2814 A and B:

Riverine Wetland Restoration: 2.49 acres

Non-Riverine Wetland Restoration: 1.96 acres

Riverine Wetland Preservation: 3.05 acres

4. Compensatory mitigation for impacts to Neuse Riparian Buffers is required. The mitigation requirement includes 744,690 square feet of Zone 1 Buffers and 245,057 square feet of Zone 2 Buffers.
  - (a) We understand that you have chosen to debit mitigation from the Wiggins Mill Mitigation Bank. This certification gives approval to the debiting of 985,325 square feet of Neuse Buffer from the Wiggins Mill Mitigation Site in order to partially satisfy the riparian buffer mitigation requirements of R-2814 A and B.
  - (b) We understand that you have chosen to perform the 4,422 square feet of remaining compensatory mitigation for impacts to protected buffers through use of the North Carolina Ecosystem Enhancement Program (EEP). Mitigation for unavoidable impacts to Neuse Riparian Buffers shall be provided in the Neuse River Basin and done in accordance with 15A NCAC 2B.0233. EEP has indicated in a letter dated May 11, 2010 that they will assume responsibility for satisfying the remaining compensatory mitigation requirements of 4,422 square feet for the above-referenced project, in accordance with the Tri-Party MOA signed on July 22, 2003 and the Dual-Party MOA signed on April 12, 2004.

5. At locations where ponds will be drained, proper measures will be taken to drain the pond with limited impact to upstream and downstream channel stability as well as to native aquatic species. Proper measures will be taken to avoid sediment release and/or sediment accumulation downstream as a result of pond draining. If typical pond draining techniques will create significant disturbance to native aquatic species, additional measures such as collection and relocation may be necessary to prevent a significant fish kill. NCDOT shall consult with NC Wildlife Resources staff to determine if there are any sensitive species, and the most appropriate measures to limit impacts to these species. The permittee shall observe any natural channel re-establishment, or utilize natural channel construction techniques, to ensure that the jurisdictional stream channel above and below the drained pond remains stable, and that no additional impacts occur within the natural stream channel as a result of draining the pond.

6. Prior to the pre-construction meeting, the permittee shall provide written verification that the final construction drawings comply with the permit drawings contained in the application dated received May 19, 2010. Any deviations from the approved drawings are not authorized unless approved by the NC Division of Water Quality.

7. Unless otherwise approved in this certification, placement of culverts and other structures in open waters and streams shall be placed below the elevation of the streambed by one foot for all culverts with a diameter greater than 48 inches, and 20 percent of the culvert diameter for culverts having a diameter less than 48 inches, to allow low flow passage of water and aquatic life. Design and placement of culverts and other structures including temporary erosion control measures shall not be conducted in a manner that may result in dis-equilibrium of wetlands or streambeds or banks, adjacent to or upstream and downstream of the above structures. The applicant is required to provide evidence that the equilibrium is being maintained if requested in writing by NCDWQ. If this condition is unable to be met due to bedrock or other limiting features encountered during construction, please contact NCDWQ for guidance on how to proceed and to determine whether or not a permit modification will be required.

8. If multiple pipes or barrels are required, they shall be designed to mimic natural stream cross section as closely as possible including pipes or barrels at flood plain elevation and/or sills where appropriate. Widening the stream channel should be avoided. Stream channel widening at the inlet or outlet end of structures typically decreases water velocity causing sediment deposition that requires increased maintenance and disrupts aquatic life passage.

9. Riprap shall not be placed in the active thalweg channel or placed in the streambed in a manner that precludes aquatic life passage. Bioengineering boulders or structures should be properly designed, sized and installed.

10. For all streams being impacted due to site dewatering activities, the site shall be graded to its preconstruction contours and revegetated with appropriate native species.

11. For project sites impacting waters classified by the NC Environmental Management Commission as High Quality Waters (HQW), or Water Supply I or II (WSI, WSII), (i.e., Cedar Fork Creek, Perry Creek, and their tributaries in Section B), stormwater shall be directed to vegetated buffer areas, grass-lined ditches or other means appropriate to the site for the purpose of pre-treating storm water runoff prior to discharging directly into streams. Mowing of existing vegetated buffers is strongly discouraged.

12. The permittee shall use /Design Standards in Sensitive Watersheds/[15A NCAC 4B.0124(a)-(e)] in areas draining to WS-II, HQW waters (i.e., Cedar Fork Creek, Perry Creek and their tributaries). However, due to the size of the project, NC DOT shall not be required to meet 15A NCAC 4B .0124(a) regarding the maximum amount of uncovered acres. Temporary cover (wheat, millet, or similar annual grain) or permanent herbaceous cover shall be planted on all bare soil within 15 business days of ground disturbing activities to provide erosion control.

13. Tall fescue shall not be used in the establishment of temporary or permanent groundcover within riparian areas. For the establishment of permanent herbaceous cover, erosion control matting shall be used in conjunction with appropriate seeding on disturbed soils within the riparian area and on disturbed steep slopes with the following exception. Erosion control matting is not necessary if the area is contained by perimeter erosion control devices such as silt fence, temporary sediment ditches, basins, etc. Matting should be secured in place with staples, stakes, or wherever possible, live stakes of native trees. Erosion control matting placed in riparian areas shall not contain a nylon mesh grid, which can impinge and entrap small animals. For the establishment of temporary groundcover within riparian areas, hydroseeding along with wood or cellulose based hydro mulch applied from a fertilizer- and limestone-free tank is allowable at the appropriate rate in conjunction with the erosion control measures. Discharging hydroseed mixtures and wood or cellulose mulch into surface waters is prohibited. Riparian areas are defined as a distance 25 feet landward from top of stream bank.

14. All riparian buffers impacted by the placement of temporary fill or clearing activities shall be restored to the preconstruction contours and revegetated. Maintained buffers shall be permanently revegetated with non-woody species by the end of the growing season following completion of construction. For the purpose of this condition, maintained buffer areas are defined as areas within the transportation corridor that will be subject to regular NCDOT maintenance activities including mowing. The area with non-maintained buffers shall be permanently revegetated with native woody species before the next growing season following completion of construction. However, due to the size of the project, NC DOT shall not be required to meet 15A NCAC 4B .0124(a) regarding the maximum amount of uncovered acres.

15. All stormwater runoff shall be directed as sheetflow through stream buffers at nonerosive velocities, unless otherwise approved by this certification.

16. Pursuant to NCAC15A 2B.0233(6), sediment and erosion control devices shall not be placed in Zone 1 of any Neuse Buffer without prior approval by NCDWQ. At this time, NCDWQ has approved no sediment and erosion control devices in Zone 1, outside of the approved project impacts, anywhere on this project. Moreover, sediment and erosion control devices shall be allowed in Zone 2 of the buffers provided that Zone 1 is not compromised and that discharge is released as diffuse flow.

17. If concrete is used during construction, a dry work area shall be maintained to prevent direct contact between curing concrete and stream water. Water that inadvertently contacts uncured concrete shall not be discharged to surface waters due to the potential for elevated pH and possible aquatic life and fish kills.

18. During the construction of the project, no staging of equipment of any kind is permitted in waters of the U.S., or protected riparian buffers.

19. The dimension, pattern and profile of the stream above and below the crossing shall not be modified. Disturbed floodplains and streams shall be restored to natural geomorphic conditions.

20. The use of rip-rap above the Normal High Water Mark shall be minimized. Any rip-rap placed for stream stabilization shall be placed in stream channels in such a manner that it does not impede aquatic life passage.

21. All work in or adjacent to stream waters shall be conducted in a dry work area. Approved BMP measures from the most current version of NCDOT Construction and Maintenance Activities manual such as sandbags, rock berms, cofferdams and other diversion structures shall be used to prevent excavation in flowing water.

22. Heavy equipment shall be operated from the banks rather than in the stream channel in order to minimize sedimentation and reduce the introduction of other pollutants into the stream.

23. All mechanized equipment operated near surface waters must be regularly inspected and maintained to prevent contamination of stream waters from fuels, lubricants, hydraulic fluids, or other toxic materials.

24. No rock, sand or other materials shall be dredged from the stream channel except where authorized by this certification.

25. Discharging hydroseed mixtures and washing out hydroseeders and other equipment in or adjacent to surface waters is prohibited.

26. The permittee and its authorized agents shall conduct its activities in a manner consistent with State water quality standards (including any requirements resulting from compliance with §303(d) of the Clean Water Act) and any other appropriate requirements of State and Federal law. If NCDWQ determines that such standards or laws are not being met (including the failure to sustain a designated or achieved use) or that State or federal law is being violated, or that further conditions are necessary to assure compliance, NCDWQ may reevaluate and modify this certification.

27. All fill slopes located in jurisdictional wetlands shall be placed at slopes no flatter than 3:1, unless otherwise authorized by this certification..

28. A copy of this Water Quality Certification shall be maintained on the construction site at all times. In addition, the Water Quality Certification and all subsequent modifications, if any, shall be maintained with the Division Engineer and the on-site project manager.

29. The outside buffer, wetland or water boundary located within the construction corridor approved by this authorization shall be clearly marked by highly visible fencing prior to any land disturbing activities. Impacts to areas within the fencing are prohibited unless otherwise authorized by this certification.

30. The issuance of this certification does not exempt the Permittee from complying with any and all statutes, rules, regulations, or ordinances that may be imposed by other government agencies (i.e. local, state, and federal) having jurisdiction, including but not limited to applicable buffer rules, stormwater management rules, soil erosion and sedimentation control requirements, etc.

31. The Permittee shall report any violations of this certification to the Division of Water Quality within 24 hours of discovery.

32. Upon completion of the project (including any impacts at associated borrow or waste sites), the NCDOT Division Engineer shall complete and return the enclosed "Certification of Completion Form" to notify NCDWQ when all work included in the 401 Certification has been completed.

33. Native woody riparian vegetation (i.e., trees and shrubs native to your geographic region) must be reestablished within the construction limits of the project by the end of the growing season following completion of construction.

34. There shall be no excavation from, or waste disposal into, jurisdictional wetlands or waters associated with this permit without appropriate modification. Should waste or borrow sites, or access roads to waste or borrow sites, be located in wetlands or streams, compensatory mitigation will be required since that is a direct impact from road construction activities.

35. Erosion and sediment control practices must be in full compliance with all specifications governing the proper design, installation and operation and maintenance of such Best Management Practices in order to protect surface waters standards:

- a. The erosion and sediment control measures for the project must be designed, installed, operated, and maintained in accordance with the most recent version of the *North Carolina Sediment and Erosion Control Planning and Design Manual*.
- b. The design, installation, operation, and maintenance of the sediment and erosion control measures must be such that they equal, or exceed, the requirements specified in the most recent version of the *North Carolina Sediment and Erosion Control Manual*. The devices shall be maintained on all construction sites, borrow sites, and waste pile (spoil) projects, including contractor-owned or leased borrow pits associated with the project.
- c. For borrow pit sites, the erosion and sediment control measures must be designed, installed, operated, and maintained in accordance with the most recent version of the *North Carolina Surface Mining Manual*.
- d. The reclamation measures and implementation must comply with the reclamation in accordance with the requirements of the Sedimentation Pollution Control Act.

36. Sediment and erosion control measures shall not be placed in wetlands or waters unless otherwise approved by this Certification.

Violations of any condition herein set forth may result in revocation of this Certification and may result in criminal and/or civil penalties. This Certification shall become null and void unless the above conditions are made a part of the conditions of the Federal 404 and/or Coastal Area Management Act Permit. This Certification shall expire upon the expiration of the 404 or CAMA permit.

If this Certification is unacceptable to you have the right to an adjudicatory hearing upon written request within sixty (60) days following receipt of this Certification. This request must be in the form of a written petition conforming to Chapter 150B of the North Carolina General Statutes and filed with the Office of Administrative Hearings, 6714 Mail Service Center, Raleigh, N.C. 27699-6714. If modifications are made to an original Certification, you have the right to an adjudicatory hearing on the modifications upon written request within sixty (60) days following receipt of the Certification. Unless such demands are made, this Certification shall be final and binding.

This the 30th day of August 2010

DIVISION OF WATER QUALITY



 Coleen H. Sullins  
Director

NCDWQ Project No.: \_\_\_\_\_

County: \_\_\_\_\_

Applicant: \_\_\_\_\_

Project Name: \_\_\_\_\_

Date of Issuance of 401 Water Quality Certification: \_\_\_\_\_

**Certificate of Completion**

Upon completion of all work approved within the 401 Water Quality Certification or applicable Buffer Rules, and any subsequent modifications, the applicant is required to return this certificate to the 401 Transportation Permitting Unit, North Carolina Division of Water Quality, 1650 Mail Service Center, Raleigh, NC, 27699-1650. This form may be returned to NCDWQ by the applicant, the applicant's authorized agent, or the project engineer. It is not necessary to send certificates from all of these.

***Applicant's Certification***

I, \_\_\_\_\_, hereby state that, to the best of my abilities, due care and diligence was used in the observation of the construction such that the construction was observed to be built within substantial compliance and intent of the 401 Water Quality Certification and Buffer Rules, the approved plans and specifications, and other supporting materials.

Signature: \_\_\_\_\_ Date: \_\_\_\_\_

***Agent's Certification***

I, \_\_\_\_\_, hereby state that, to the best of my abilities, due care and diligence was used in the observation of the construction such that the construction was observed to be built within substantial compliance and intent of the 401 Water Quality Certification and Buffer Rules, the approved plans and specifications, and other supporting materials.

Signature: \_\_\_\_\_ Date: \_\_\_\_\_

***Engineer's Certification***


Partial \_\_\_\_\_ Final \_\_\_\_\_

I, \_\_\_\_\_, as a duly registered Professional Engineer in the State of North Carolina, having been authorized to observe (periodically, weekly, full time) the construction of the project, for the Permittee hereby state that, to the best of my abilities, due care and diligence was used in the observation of the construction such that the construction was observed to be built within substantial compliance and intent of the 401 Water Quality Certification and Buffer Rules, the approved plans and specifications, and other supporting materials.


Signature \_\_\_\_\_ Registration No. \_\_\_\_\_

Date \_\_\_\_\_

# NORTH CAROLINA

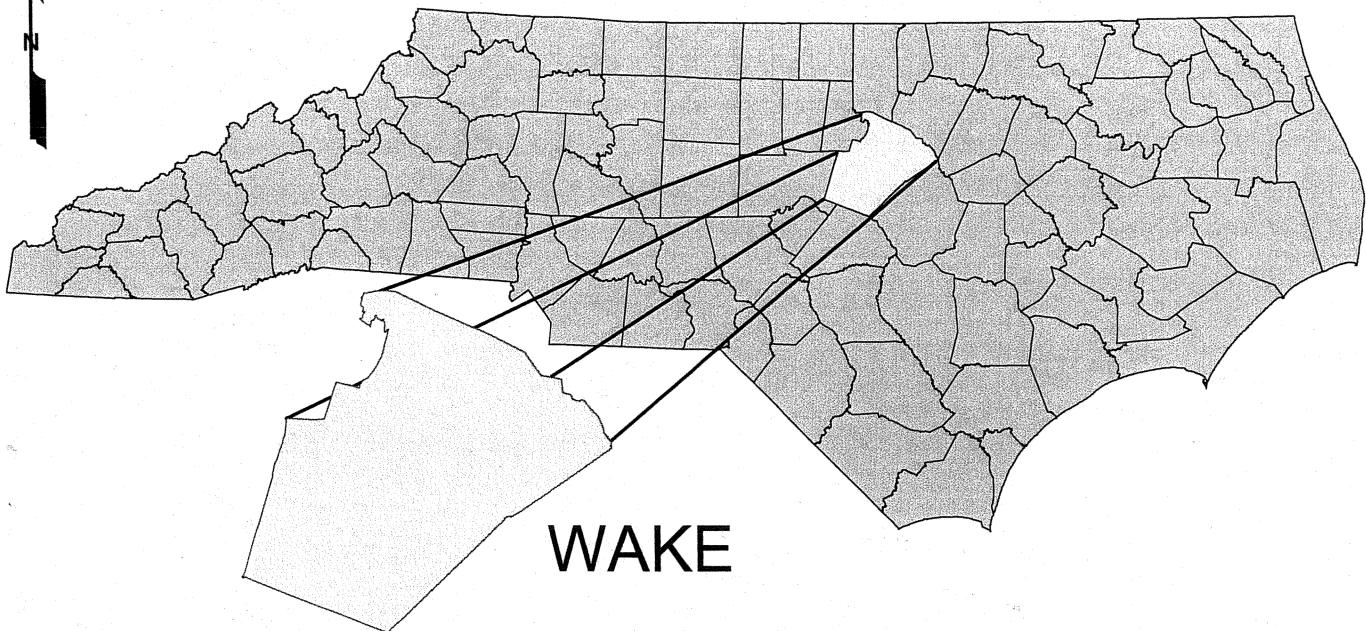

SITE

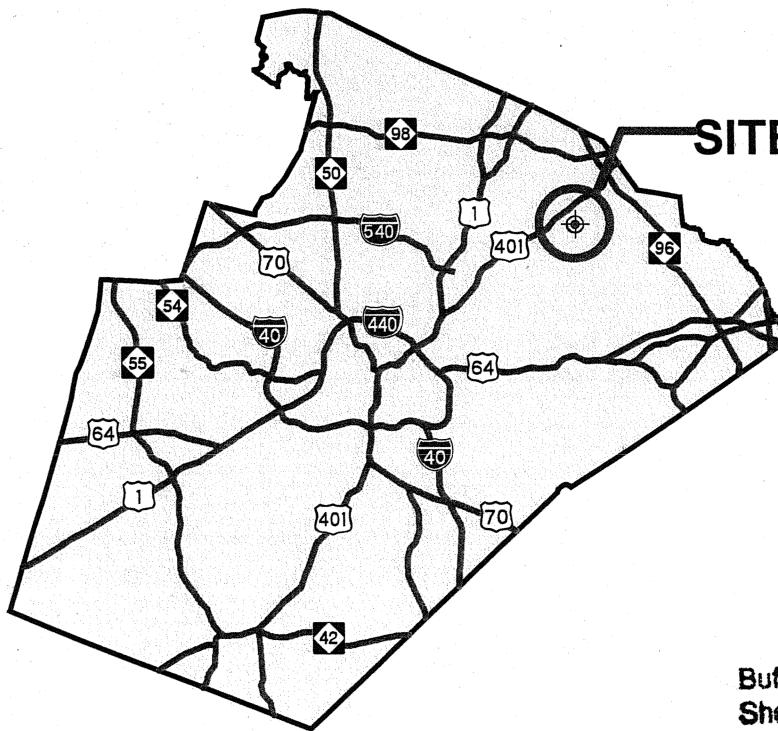


Buffer Drawing  
Sheet 1 of 20

## BUFFER VICINITY MAP

NCDOT  
DIVISION OF HIGHWAYS  
WAKE COUNTY  
PROJECT: 34506.1.1 (R-2814B)  
US 401 ROLESVILLE BYPASS  
FROM SR 2225, LOUISBURG ROAD  
TO NC 96, ZEBULON ROAD

NOVEMBER 2009

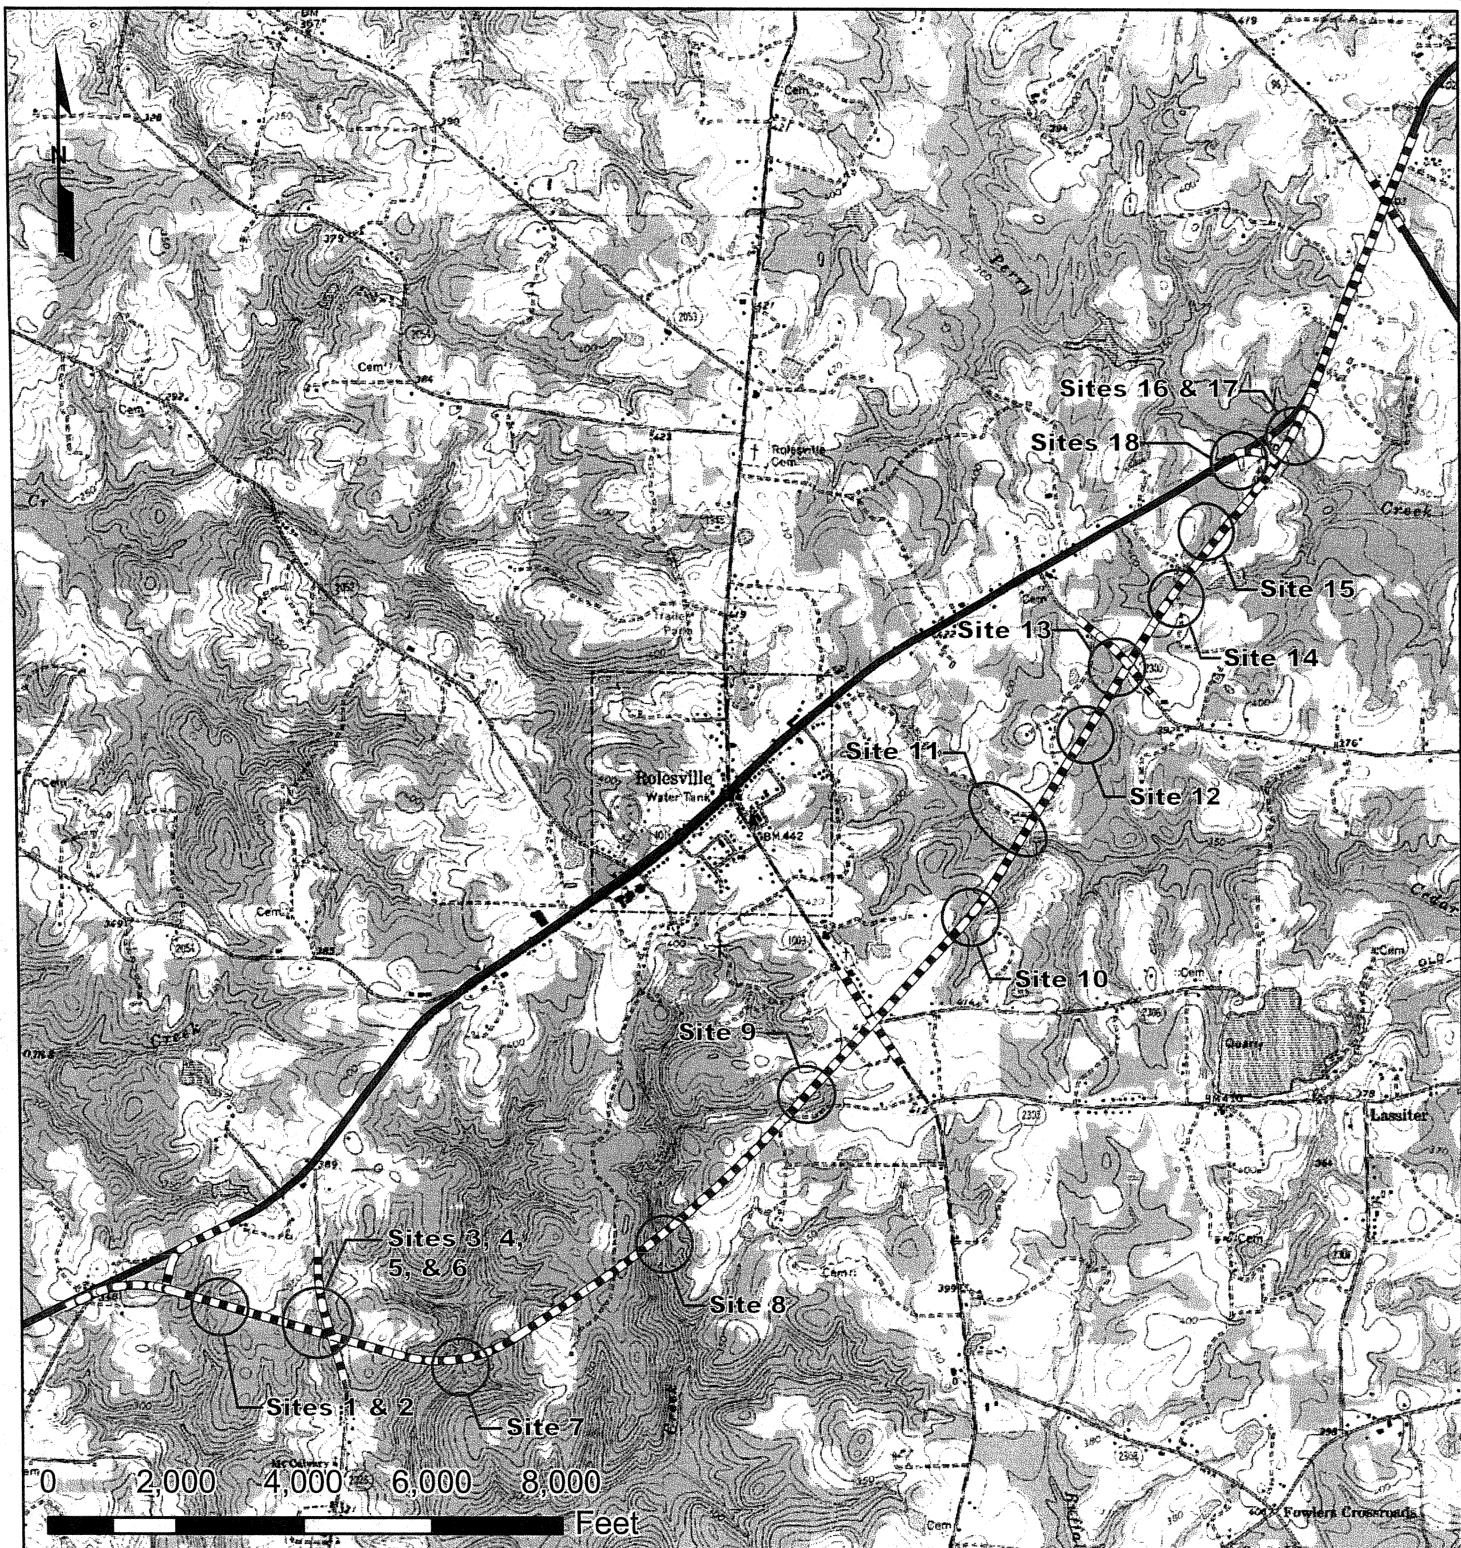

1 inch = 3,000 feet

# BUFFER LOCATION MAP

Source: USGS 7.5 Minute Quadrangle, Rolesville, NC

NCDOT

DIVISION OF HIGHWAYS  
WAKE COUNTY  
PROJECT: 34506.1.1 (R-2814B)  
US 401 ROLESVILLE BYPASS  
FROM SR 2225, LOUISBURY ROAD  
TO NC 96, ZEBULON ROAD

NOVEMBER 2009

Buffer Drawing  
Sheet 2 of 20

<b>PROP. NO.</b>	<b>PROPERTY OWNER NAME</b>	<b>PROP. OWNER ADDRESS</b>
7	Neuse Baptist Church	8700 Capital Blvd., Raleigh, NC 27587
8	Alexander Family Investments, LLC	906 Washington St., Cary, NC 27511
9	Scarboro , E. Walter and Claire P.	9412 Louisburg Rd., Wake Forest, NC 27587
12	Bobby L. Murray Heirs (J Brent King Exec.)	PO Box 40639, Raleigh, NC 27629
13	Spencer, Pulley Heirs	9412 Louisburg Rd., Wake Forest, NC 27587
14	Scarboro , E. Walter and Claire P.	9412 Louisburg Rd., Wake Forest, NC 27587
20	Shearon, Cameron E.& Beverly W.	4325 Galax Dr., Raleigh, NC 27612
21	Mitchell F. Rabil Family Irrevocable Trust	3321 Gondola Dr., Lexington KY, 40513
22	Shearon, Cameron E. & Beverly W.	4325 Galax Dr., Raleigh, NC 27612
34	Scarboro Family Limited Partnership	PO Box 84, Rolesville, NC 27571
35	Wall, Joe	7317 Pulley Town Rd., Wake Forest, NC 27587
36	Wall, Joe	7318 Pulley Town Rd., Wake Forest, NC 27587
38	Bobie Joe Wall & Vickie D. Wall	7309 Pulley Town Rd. Wake Forest, NC 27587
39	The SBJ Growth, L.P	PO Box 19067, Raleigh, NC
51	Bartholomew, Michael	PO BOX 573, Rolesville, NC 27571
52	Bartholomew, Richard C & Shirley B.	PO BOX 6, Rolesville, NC 27571
54	Keith, Jerry W. and Mary P	1124 Louisburg Rd., Wake Forest, NC 27587
54A	Bartholomew, Richard C. & Shirley B.	PO BOX 6, Rolesville, NC 27571
55	Stell, Meith & Mary Sue Et. Al.	1132 Louisburg Rd., Wake Forest, NC 27587
57	Sylvania Frazier & Lula Barnes McGhee	2725 Wait Ave., Wake Forest, NC 27857

N.C. DEPT. OF TRANSPORTATION  
DIVISION OF HIGHWAYS

WAKE COUNTY  
PROJECT: 34506.1.1 (R-2814B)

2/22/2010

Buffer Drawing  
Sheet 3 of 28

## **WETLANDS IN BUFFER IMPACTS SUMMARY**

ALL IN ISOLATED WETLANDS

N.C. DEPT. OF TRANSPORTATION  
DIVISION OF HIGHWAYS

WAKE COUNTY

PROJECT: 34506.1.1 (R-2814B)

2/22/2010 SHEET OF

Buffer Drawing 20  
Sheet 4 of 20

## BUFFER IMPACTS SUMMARY

SITE NO.	STRUCTURE SIZE / TYPE	STATION (FROM/TO)	TYPE	IMPACT				MITIGABLE		BUFFER REPLACEMENT	
				ROAD CROSSING	BRIDGE	PARALLEL IMPACT	ZONE 1 (ft <sup>2</sup> )	ZONE 2 (ft <sup>2</sup> )	TOTAL (ft <sup>2</sup> )	ZONE 1 (ft <sup>2</sup> )	ZONE 2 (ft <sup>2</sup> )
1	60" RCP	-L- 38+11	X						13743	9262	23005
2	30" RCP	-L- 41+07 RT	X						6	6	
5	78" RCP	-L- 55+00	X						24086	16852	40938
6	2@42" RCP	-Y2- 17+31	X			856	856				
7	10X10' RCBC	-L- 77+89	X						31468	16685	48153
8	10X10' RCBC	-L- 115+74	X						28702	15200	43902
9	72" RCP	-L- 147+00	X						53503	31621	85124
10	N/A	-L- 187+00 RT	X						2133	4772	6905
11	10X9' RCBC	-L- 200+04	X						25288	14205	39493
12	42" RCP	-L- 219+03	X						17088	15041	32129
15	N/A	-L- 255+00	X						19154	15890	35044
16	2@12X12' RCBC	-L- 275+39	X						19724	10366	30090
18	2@36" RCP	-Y6- 15+17	X			3475	1585	5060			
<b>TOTAL:</b>									4331	1585	5916
									234889	149900	384789

N.C. DEPT. OF TRANSPORTATION  
DIVISION OF HIGHWAYS

WAKE COUNTY  
PROJECT: 34506.1.1 (R-2814B)


2/22/2010  
SHEET OF

Master Drawing  
Sheet 5 of 20

## **CONTRACT:**

**TIP PROJECT: R-2814B**

10. *Georgian*  
is 4 studies, one with 285 incomplete drawings, 183 of which are  
sketches.

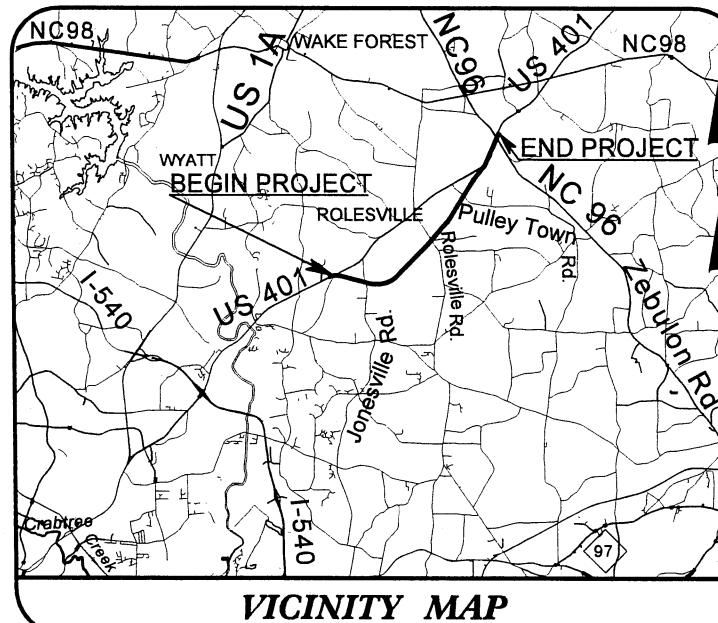


STATE OF NORTH CAROLINA  
DIVISION OF HIGHWAYS

# **WAKE COUNTY**


**LOCATION: US 401 ROLESVILLE BYPASS FROM SR 2225,  
LOUISBURY ROAD TO NC 96, ZEBULON ROAD**

BUFFER IMPACTS

Buffer Drawing  
Sheet 6 of 20

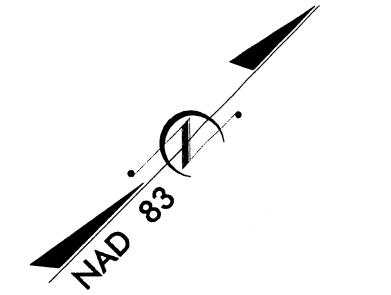


*TO RALEIGH* -L- STA 16+31 BEGIN STATE PROJECT R-2814E

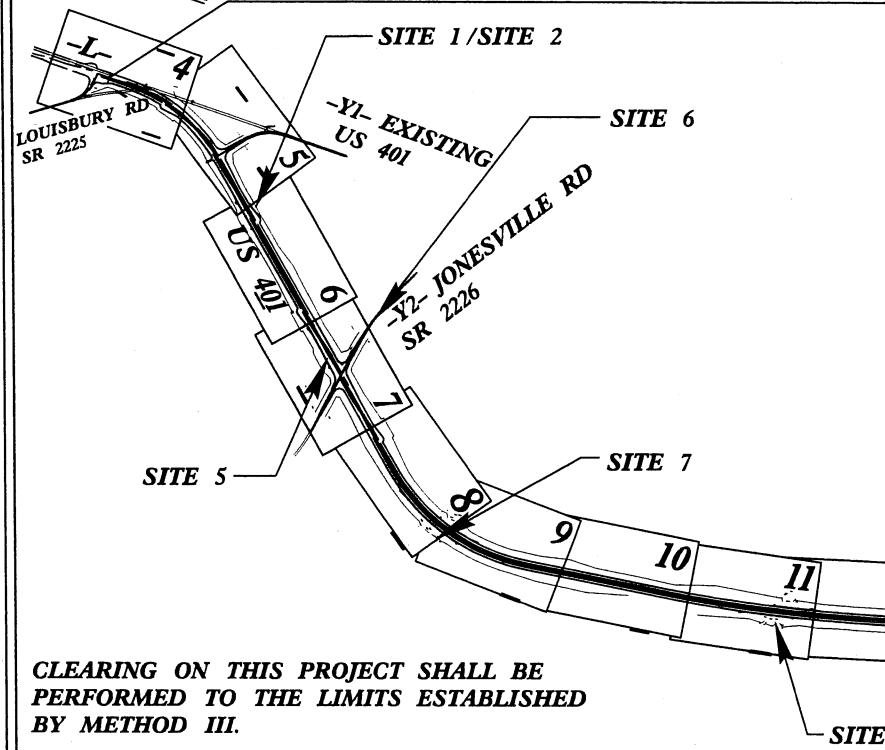

**CLEARING ON THIS PROJECT SHALL BE  
PERFORMED TO THE LIMITS ESTABLISHED  
BY METHOD III.**

**NOTE: THIS IS A PARTIALLY CONTROLLED ACCESS PROJECT WITH ACCESS POINTS SHOWN ON THE PLAN.**

**NOTE: THIS PROJECT IS NOT WITHIN ANY MUNICIPAL BOUNDARIES**

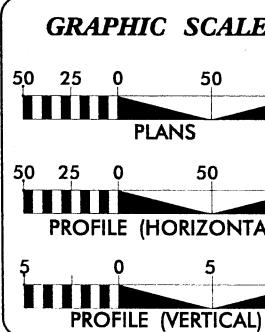

**DESIGN DATA**

ADT 2030 =	24600
ADT =	
DHV =	55 %
D ≈	13 %
T =	7 %
V =	60 MP

\* TTST 2      DUAL

## **PROJECT LENGTH**

**TOTAL LENGTH TIP PROJECT R-2814B = 5.696 MILES**

PROJECT LENGTH



**STANDARD SPECIFICATION**

DATE  
APRIL 17, 2009

**ETTING DATE:**  
APRIL 19, 2011

---

**HYDRAULICS ENGINEER**

P.E.

**ROADWAY DESIGN  
ENGINEER**

P.E.










**DIVISION OF HIGHWAYS  
STATE OF NORTH CAROLINA**

## **STATE HIGHWAY DESIGN ENGINEER**

PROJECT REFERENCE NO.		SHEET NO.
R-2814B		2-C
ROADWAY DESIGN ENGINEER	PAVEMENT DESIGN ENGINEER	
INCOMPLETE PLANS DO NOT USE FOR R/W ACQUISITION		
PRELIMINARY PLANS DO NOT USE FOR CONSTRUCTION		

Buffer Drawing  
Sheet 7 of 20

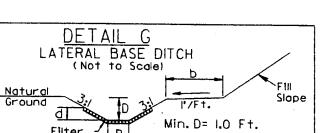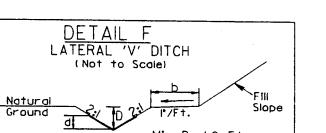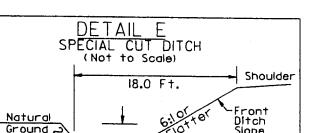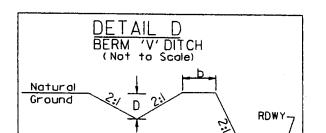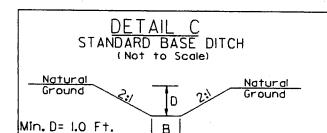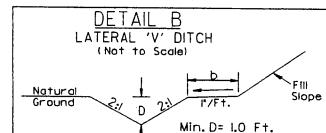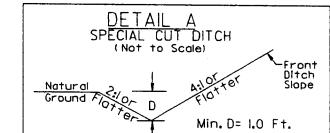

Y1 STA. 16+50 TO STA. 20+50 LT  
Y3 STA. 23+50 TO STA. 24+35 LT  
Y4 STA. 10+45 TO STA. 13+00 RT  
Y4 STA. 20+00 TO STA. 22+29 LT  
Y4 STA. 20+50 TO STA. 22+20 RT  
Y5 STA. 21+17 TO STA. 26+90 LT  
Y6 STA. 15+08 TO STA. 17+00 RT  
Y6 STA. 18+25 TO STA. 20+79 LT  
Y8 STA. 10+52 TO STA. 12+55 RT

L STA. 32+40 TO STA. 33+00 LT  
L STA. 139+50 TO STA. 143+00 RT  
L STA. 190+75 TO STA. 191+50 LT  
L STA. 237+00 TO STA. 239+00 RT  
L STA. 257+25 TO STA. 258+25 RT  
L STA. 261+50 TO STA. 263+50 RT  
L STA. 279+50 TO STA. 281+25 RT  
L STA. 285+50 TO STA. 286+50 RT  
L STA. 305+70 TO STA. 308+50 LT  
L STA. 319+35 TO STA. 321+00 RT  
L STA. 319+75 TO STA. 320+50 LT  
L STA. 233+00 TO STA. 237+00 RT  
Y6 STA. 14+95 TO STA. 17+85 RT

L STA. 100+44 TO STA. 101+00 LT  
Y6 STA. 14+94 TO STA. 15+05 RT









L STA. 28+00 TO STA. 30+35 LT  
L STA. 33+00 TO STA. 34+50 LT  
L STA. 39+50 TO STA. 41+00 LT  
L STA. 42+00 TO STA. 51+50 LT  
L STA. 70+50 TO STA. 75+00 LT  
L STA. 95+00 TO STA. 97+50 RT  
L STA. 99+50 TO STA. 106+00 RT  
L STA. 109+50 TO STA. 113+50 LT  
L STA. 119+50 TO STA. 123+00 RT  
L STA. 180+00 TO STA. 190+00 LT  
L STA. 205+00 TO STA. 217+50 LT  
L STA. 231+00 TO STA. 237+00 RT  
Y6 STA. 25+40 TO STA. 26+00 RT

L STA. 22+03 TO STA. 22+81 RT  
L STA. 28+00 TO STA. 30+35 LT  
L STA. 41+00 TO STA. 43+50 LT  
L STA. 44+00 TO STA. 45+50 LT  
L STA. 196+00 TO STA. 196+50 LT  
L STA. 195+00 TO STA. 197+50 RT  
L STA. 233+00 TO STA. 234+00 RT  
L STA. 239+50 TO STA. 240+00 LT  
L STA. 291+00 TO STA. 291+50 RT  
L STA. 320+50 TO STA. 323+50 LT  
L STA. 321+00 TO STA. 323+50 RT  
Y2 STA. 21+50 TO STA. 22+05 LT  
Y3 STA. 21+20 TO STA. 22+20 RT

L STA. 24+50 TO STA. 25+00 RT  
L STA. 29+00 TO STA. 29+50 RT  
L STA. 29+70 TO STA. Y1 23+50 RT  
L STA. 41+00 TO STA. 41+50 LT  
L STA. 98+50 TO STA. 99+50 RT  
L STA. 133+50 TO STA. 135+50 RT  
L STA. 190+00 TO STA. 190+75 LT  
L STA. 202+80 TO STA. 205+00 LT  
L STA. 250+00 TO STA. 252+00 LT  
L STA. 284+88 TO STA. 287+50 LT  
L STA. 298+01 TO STA. 300+50 LT  
Y2 STA. 21+50 TO STA. 22+05 LT  
Y3 STA. 21+20 TO STA. 22+20 RT

Type of Liner: PSRM

Type of Liner: Class B Rip-Rap

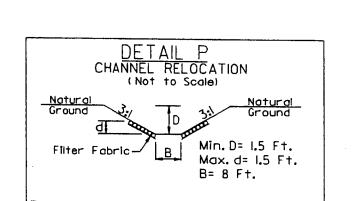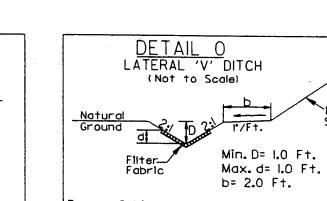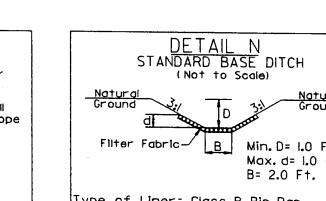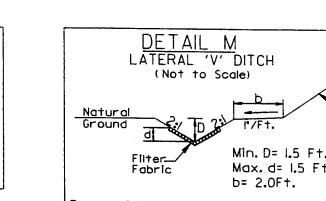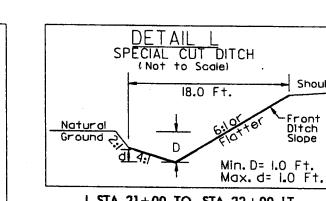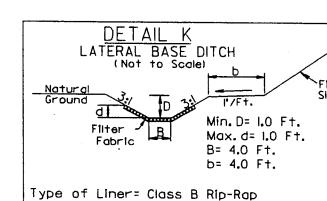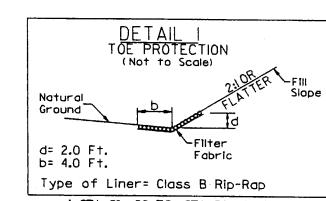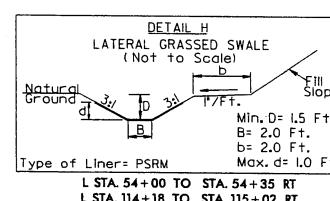

Type of Liner: Class IRip Rap

L STA. 54+00 TO STA. 54+35 RT  
L STA. 114+18 TO STA. 115+02 RT

L STA. 51+51 TO STA. 52+60 LT  
L STA. 77+27 TO STA. 78+60 RT  
L STA. 113+75 TO STA. 115+52 LT  
L STA. 115+20 TO STA. 117+50 RT  
L STA. 138+50 TO STA. 142+00 LT  
L STA. 147+20 TO STA. 151+00 RT  
L STA. 164+50 TO STA. 168+00 RT  
L STA. 244+75 TO STA. 207+00 LT  
L STA. 229+00 LT TO STA. Y5 19+00 RT

L STA. 52+21 TO STA. 54+80 LT  
L STA. 275+15 TO STA. 276+00 RT

L STA. 21+00 TO STA. 22+00 LT  
L STA. 41+00 TO STA. 41+50 LT  
L STA. 99+50 TO STA. 99+50 RT  
L STA. 189+50 TO STA. 190+00 LT  
L STA. 249+00 TO STA. 250+00 LT  
L STA. 250+00 TO STA. 250+50 RT

L STA. 21+00 TO STA. 22+05 TO STA. 22+95 LT  
Y2 STA. 22+05 TO STA. 22+95 LT

Type of Liner: Class B Rip-Rap

Type of Liner: Class B Rip-Rap

Type of Liner: Class B Rip-Rap

L STA. 22+81 TO STA. 24+00 RT  
L STA. 41+00 TO STA. 41+50 LT  
L STA. 83+50 TO STA. 85+50 LT  
L STA. 286+50 TO STA. 287+00 RT  
L STA. 298+00 TO STA. 299+00 RT

Type of Liner: Class IRip Rap

L STA. 73+67 TO STA. 74+88 LT

Type of Liner: PSRM

L STA. 108+50 TO STA. 111+50 RT  
L STA. 124+50 TO STA. 128+50 LT  
L STA. 124+50 TO STA. 128+50 RT

Type of Liner: Class B Rip-Rap

Type of Liner: Class B Rip-Rap

Type of Liner: Class B Rip Rap

L STA. 143+00 TO STA. 145+00 RT  
L STA. 148+00 TO STA. 149+00 LT  
L STA. 152+50 TO STA. 154+00 LT

L STA. 108+50 TO STA. 111+50 RT  
L STA. 124+50 TO STA. 128+50 LT  
L STA. 124+50 TO STA. 128+50 RT

L STA. 148+00 TO STA. 149+00 LT  
L STA. 157+00 TO STA. 158+00 LT  
L STA. 199+80 TO STA. 201+50 LT  
L STA. 281+25 TO STA. 283+50 RT (B=0.0)

L STA. 164+00 TO STA. 164+20 RT  
L STA. 164+00 TO STA. 164+97 RT  
L STA. 269+65 TO STA. 270+30 RT  
Y3 STA. 25+05 TO STA. 26+50 LT

L STA. 164+00 TO STA. 164+20 RT  
L STA. 164+00 TO STA. 164+97 RT  
L STA. 269+65 TO STA. 270+30 RT  
Y3 STA. 22+20 TO STA. 22+40 RT

L STA. 30+00 TO STA. 30+32 RT  
L STA. 134+00 TO STA. 138+00 LT  
L STA. 137+00 TO STA. 138+50 RT  
L STA. 217+50 TO STA. 221+00 LT  
L STA. 224+50 TO STA. 227+00 LT  
L STA. 239+00 TO STA. 246+15 RT  
L STA. 251+50 TO STA. 257+25 RT  
L STA. 276+00 TO STA. 278+00 RT  
Y5 STA. 17+50 TO STA. 18+75 RT  
Y7 STA. 17+50 TO STA. 19+30 RT

L STA. 30+00 TO STA. 30+32 RT  
L STA. 134+00 TO STA. 138+00 LT  
L STA. 137+00 TO STA. 138+50 RT  
L STA. 217+50 TO STA. 221+00 LT  
L STA. 224+50 TO STA. 227+00 LT  
L STA. 239+00 TO STA. 246+15 RT  
L STA. 251+50 TO STA. 257+25 RT  
L STA. 276+00 TO STA. 278+00 RT  
Y5 STA. 17+50 TO STA. 18+75 RT  
Y7 STA. 17+50 TO STA. 19+30 RT

A= 10.0 Ft.  
b= 2.0 Ft.  
B= 4.0 Ft.  
C= 5.0 Ft.  
D= 10.0 Ft.  
d= 10.0 Max.  
Note: b=0.0 L Sta. I47+50 to I48+50 Rt.  
Type of Liner: Class B Rip Rap

L STA. 296+88 TO STA. 298+01 LT

L STA. 54+80 TO STA. 54+81 LT

Type of Liner: PSRM

L STA. 138+50 TO STA. 139+50 RT

L STA. 203+50 TO STA. 206+00 RT

L STA. 250+50 TO STA. 251+50 RT

L STA. 278+00 TO STA. 279+50 RT

L STA. 290+47 TO STA. 291+00 LT

L STA. 22+20 TO STA. 22+61.82 LT

Y5 STA. 26+00 TO STA. 26+90 RT

L STA. 290+47 TO STA. 291+00 LT

L STA. 22+20 TO STA. 22+61.82 LT

Y5 STA. 26+00 TO STA. 26+90 RT

Y3 STA. 22+20 TO STA. 22+61.82 LT

Y5 STA. 26+00 TO STA. 26+90 RT

Y3 STA. 22+20 TO STA. 22+61.82 LT

Y5 STA. 26+00 TO STA. 26+90 RT





S = Ditch Slope  
G = etc.  
C = Proposed Ditch

S = Ditch Slope  
G = etc.  
C = Proposed Ditch

Ditch Grade L Ditch Grade L  
0.0% To 2.0% 20' Over 4.0% To 6.0% 40'  
Over 2.0% To 4.0% 30' Over 6.0% 50'



PROJECT REFERENCE NO.		SHEET NO.
R-2814B		2-D
ROADWAY DESIGN ENGINEER	PAVEMENT DESIGN ENGINEER	
INCOMPLETE PLANS DO NOT USE FOR ACQUISITION	PRELIMINARY PLANS DO NOT USE FOR CONSTRUCTION	

Buffer Drawing  
Sheet 8 of 20

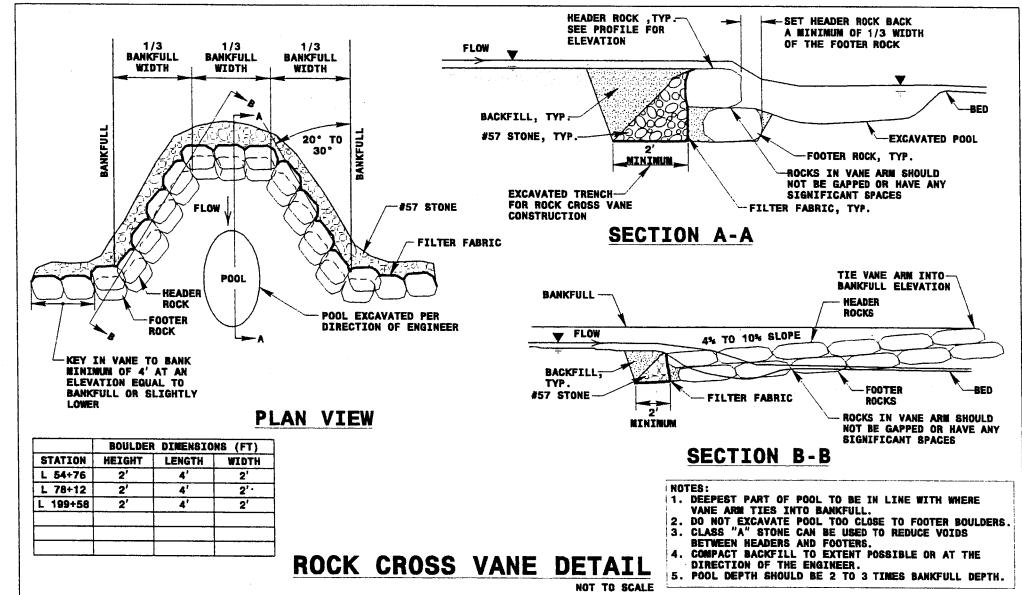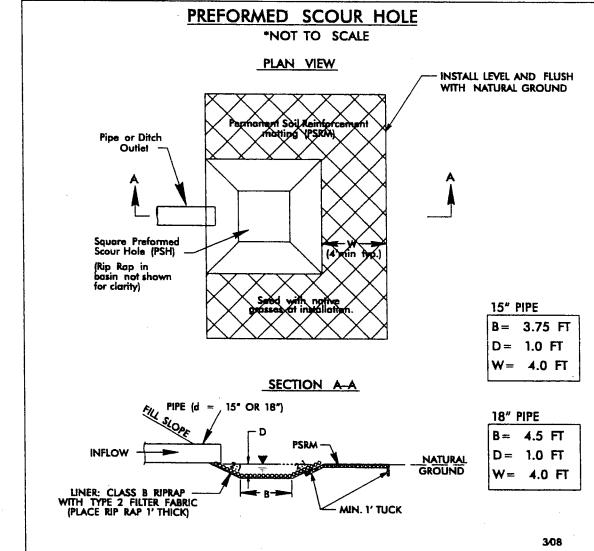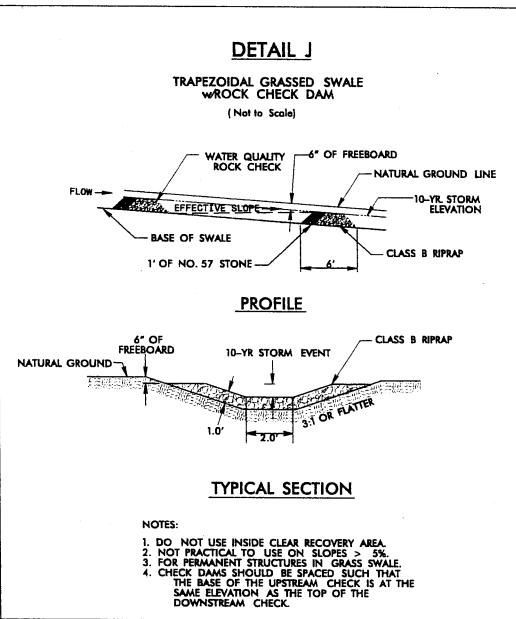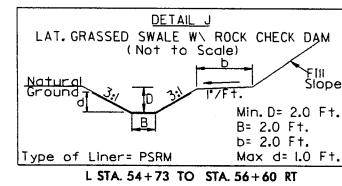


### ROCK CROSS VANE DETAIL


#### CULVERT INLET\OUTLET DETAILS HARRIS CREEK TRIBUTARY -L- STA 77+89

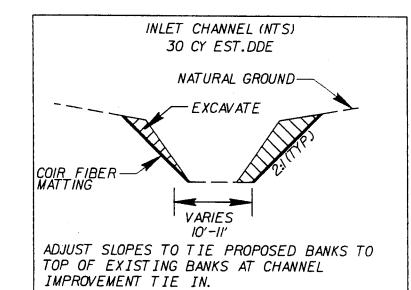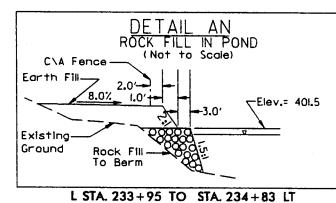






#### CULVERT INLET\OUTLET DETAILS HARRIS CREEK -L- STA 115+74

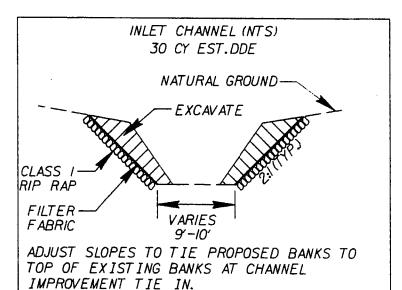


#### CULVERT INLET\OUTLET DETAILS CEDAR FORK -L- STA 200+04

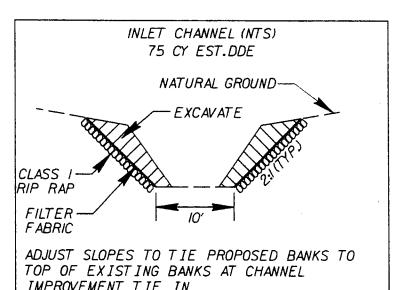

#### CULVERT INLET\OUTLET DETAILS PERRY CREEK -L- STA 275+39

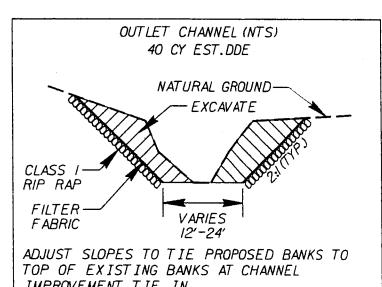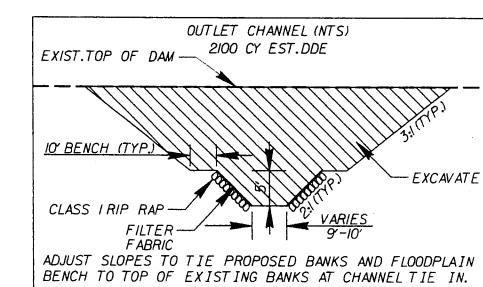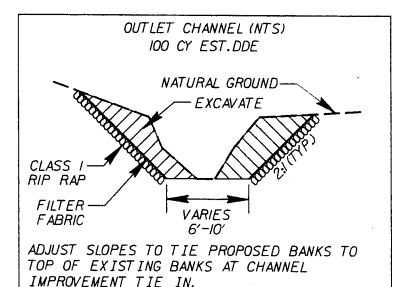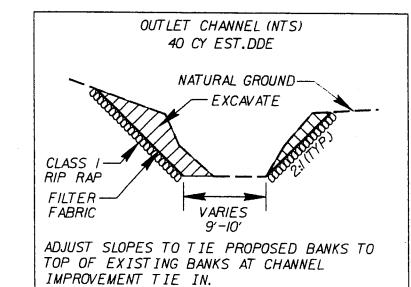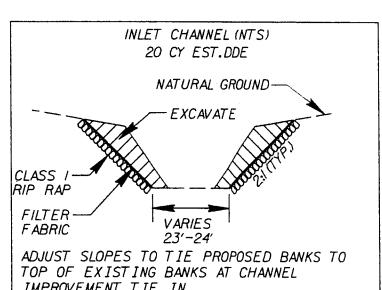


ALEXANDER FAMILY INVESTMENTS, LLC

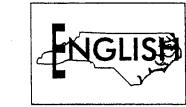

Buffer Drawing  
Sheet 9 of 20

REVISED

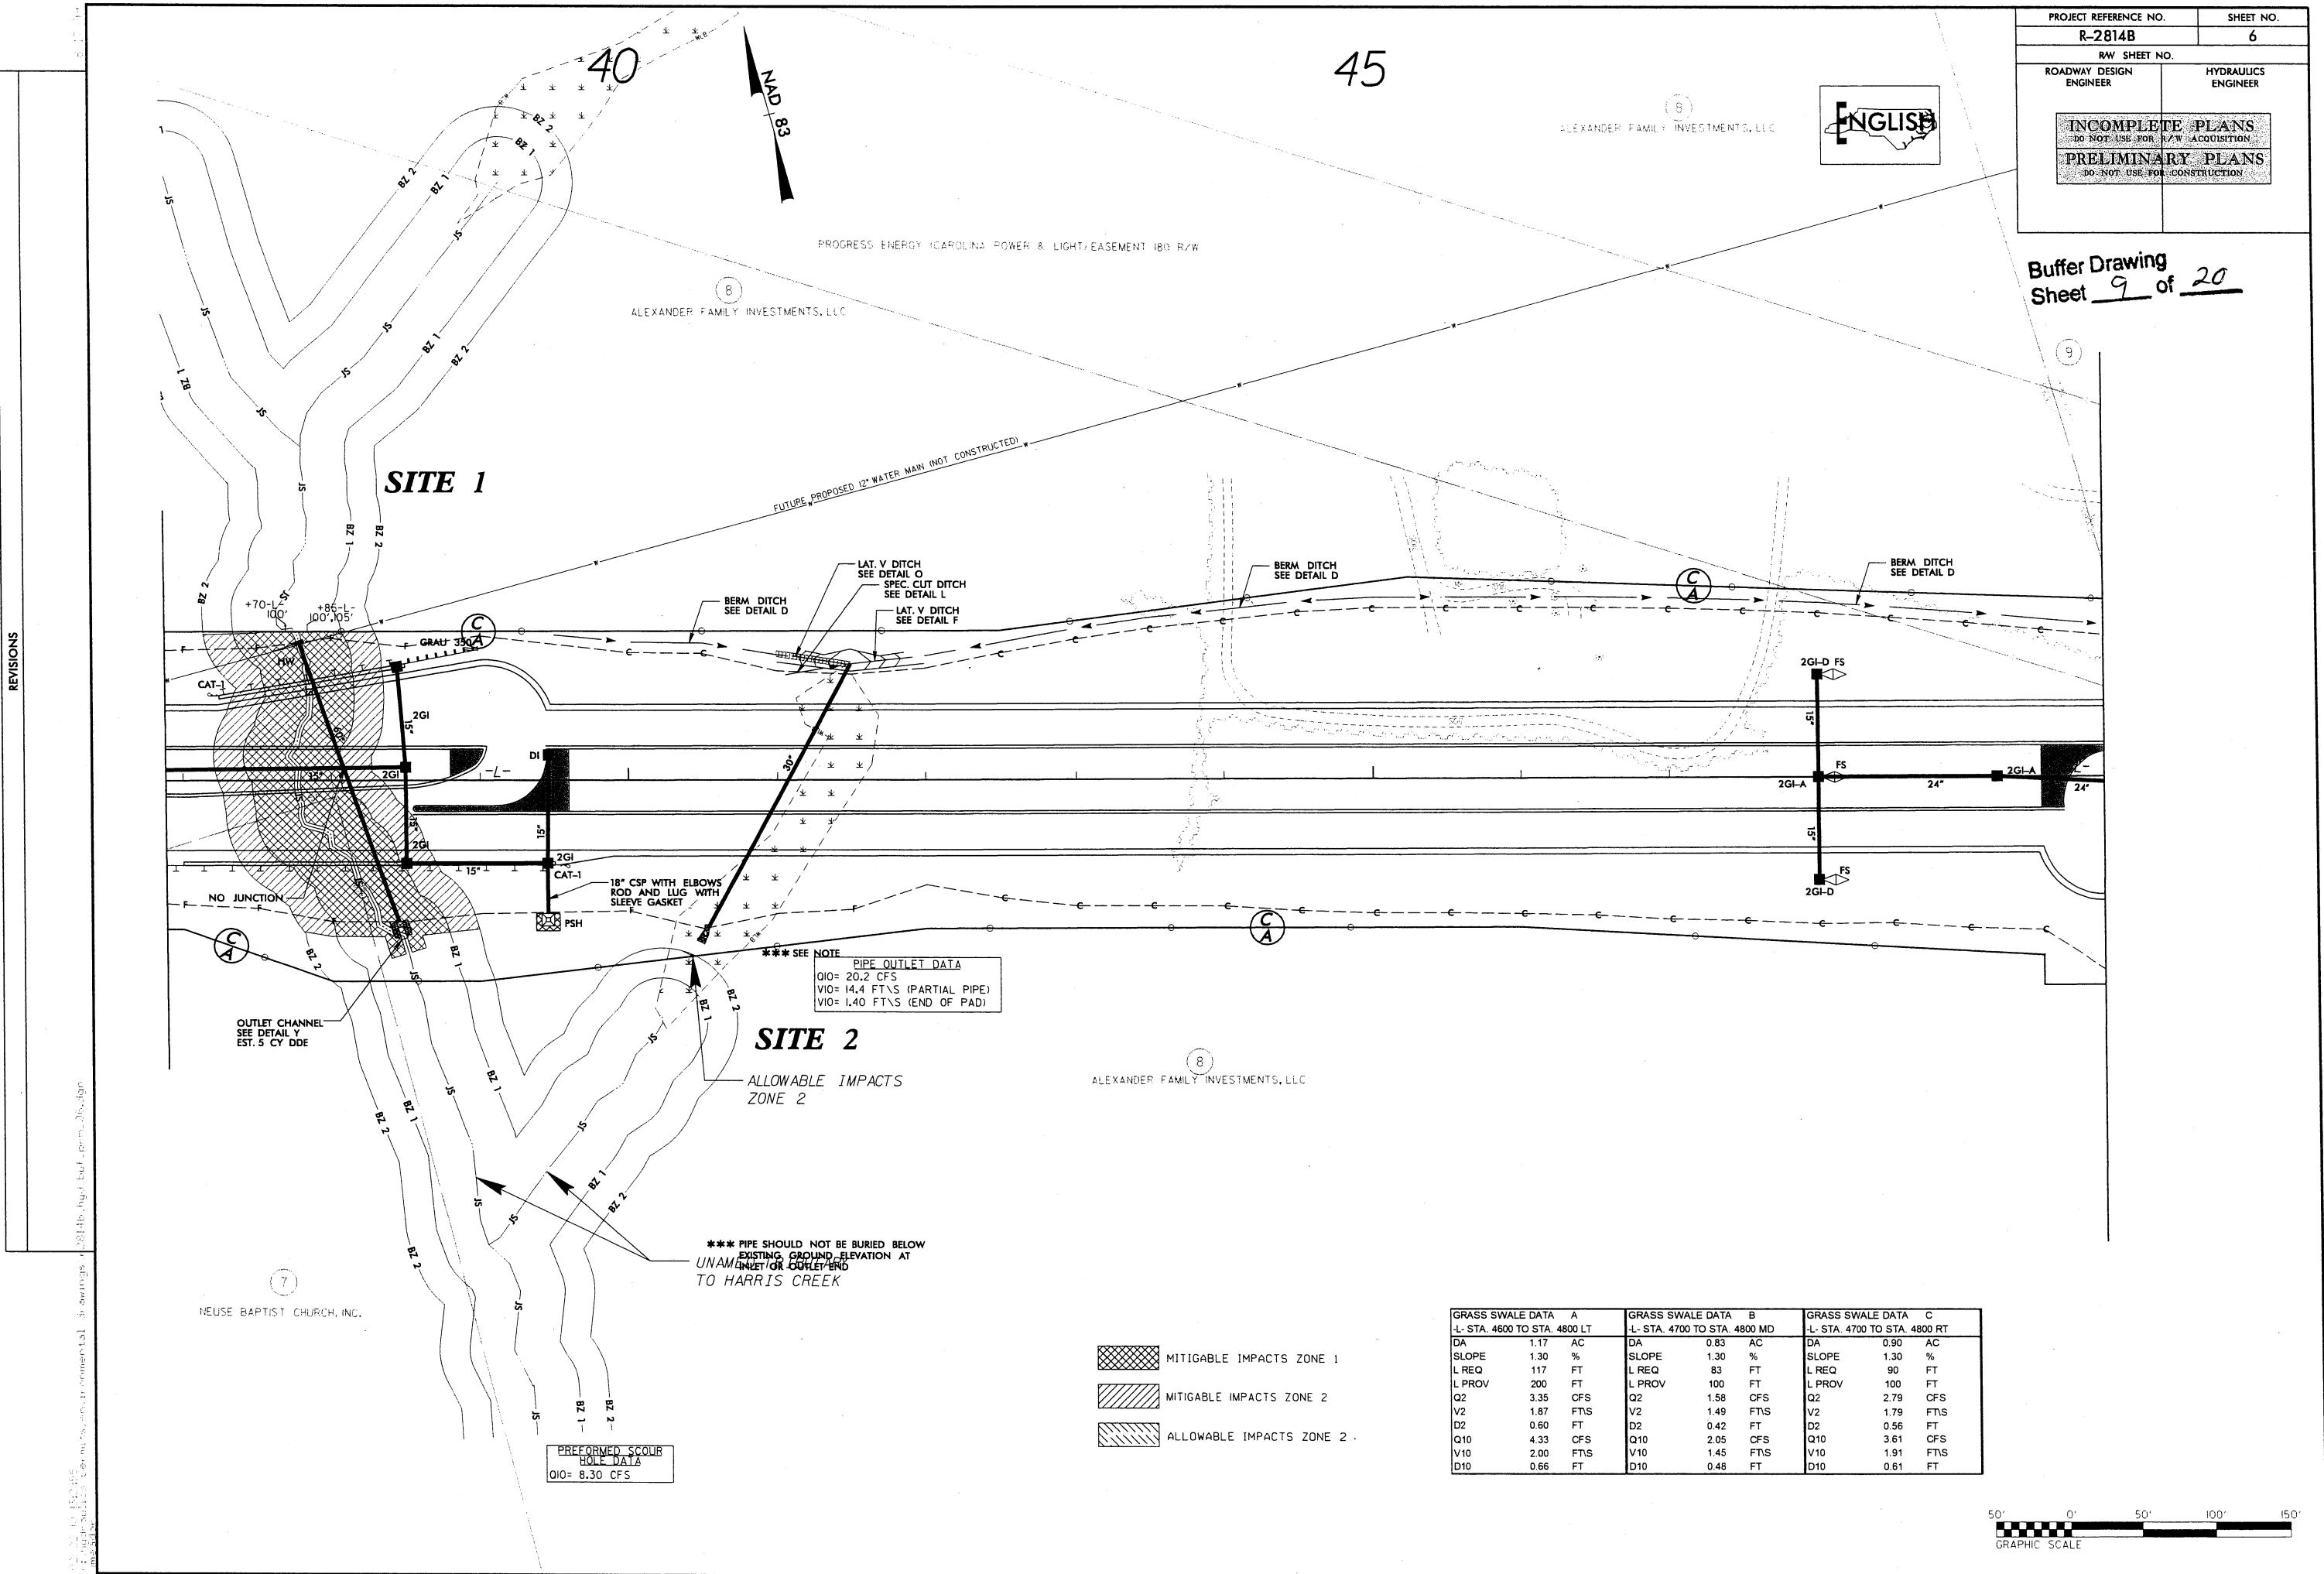


50

60

## REVISIONS

ALEXANDER FAMIL  
INVESTMENTS, LL

卷之三

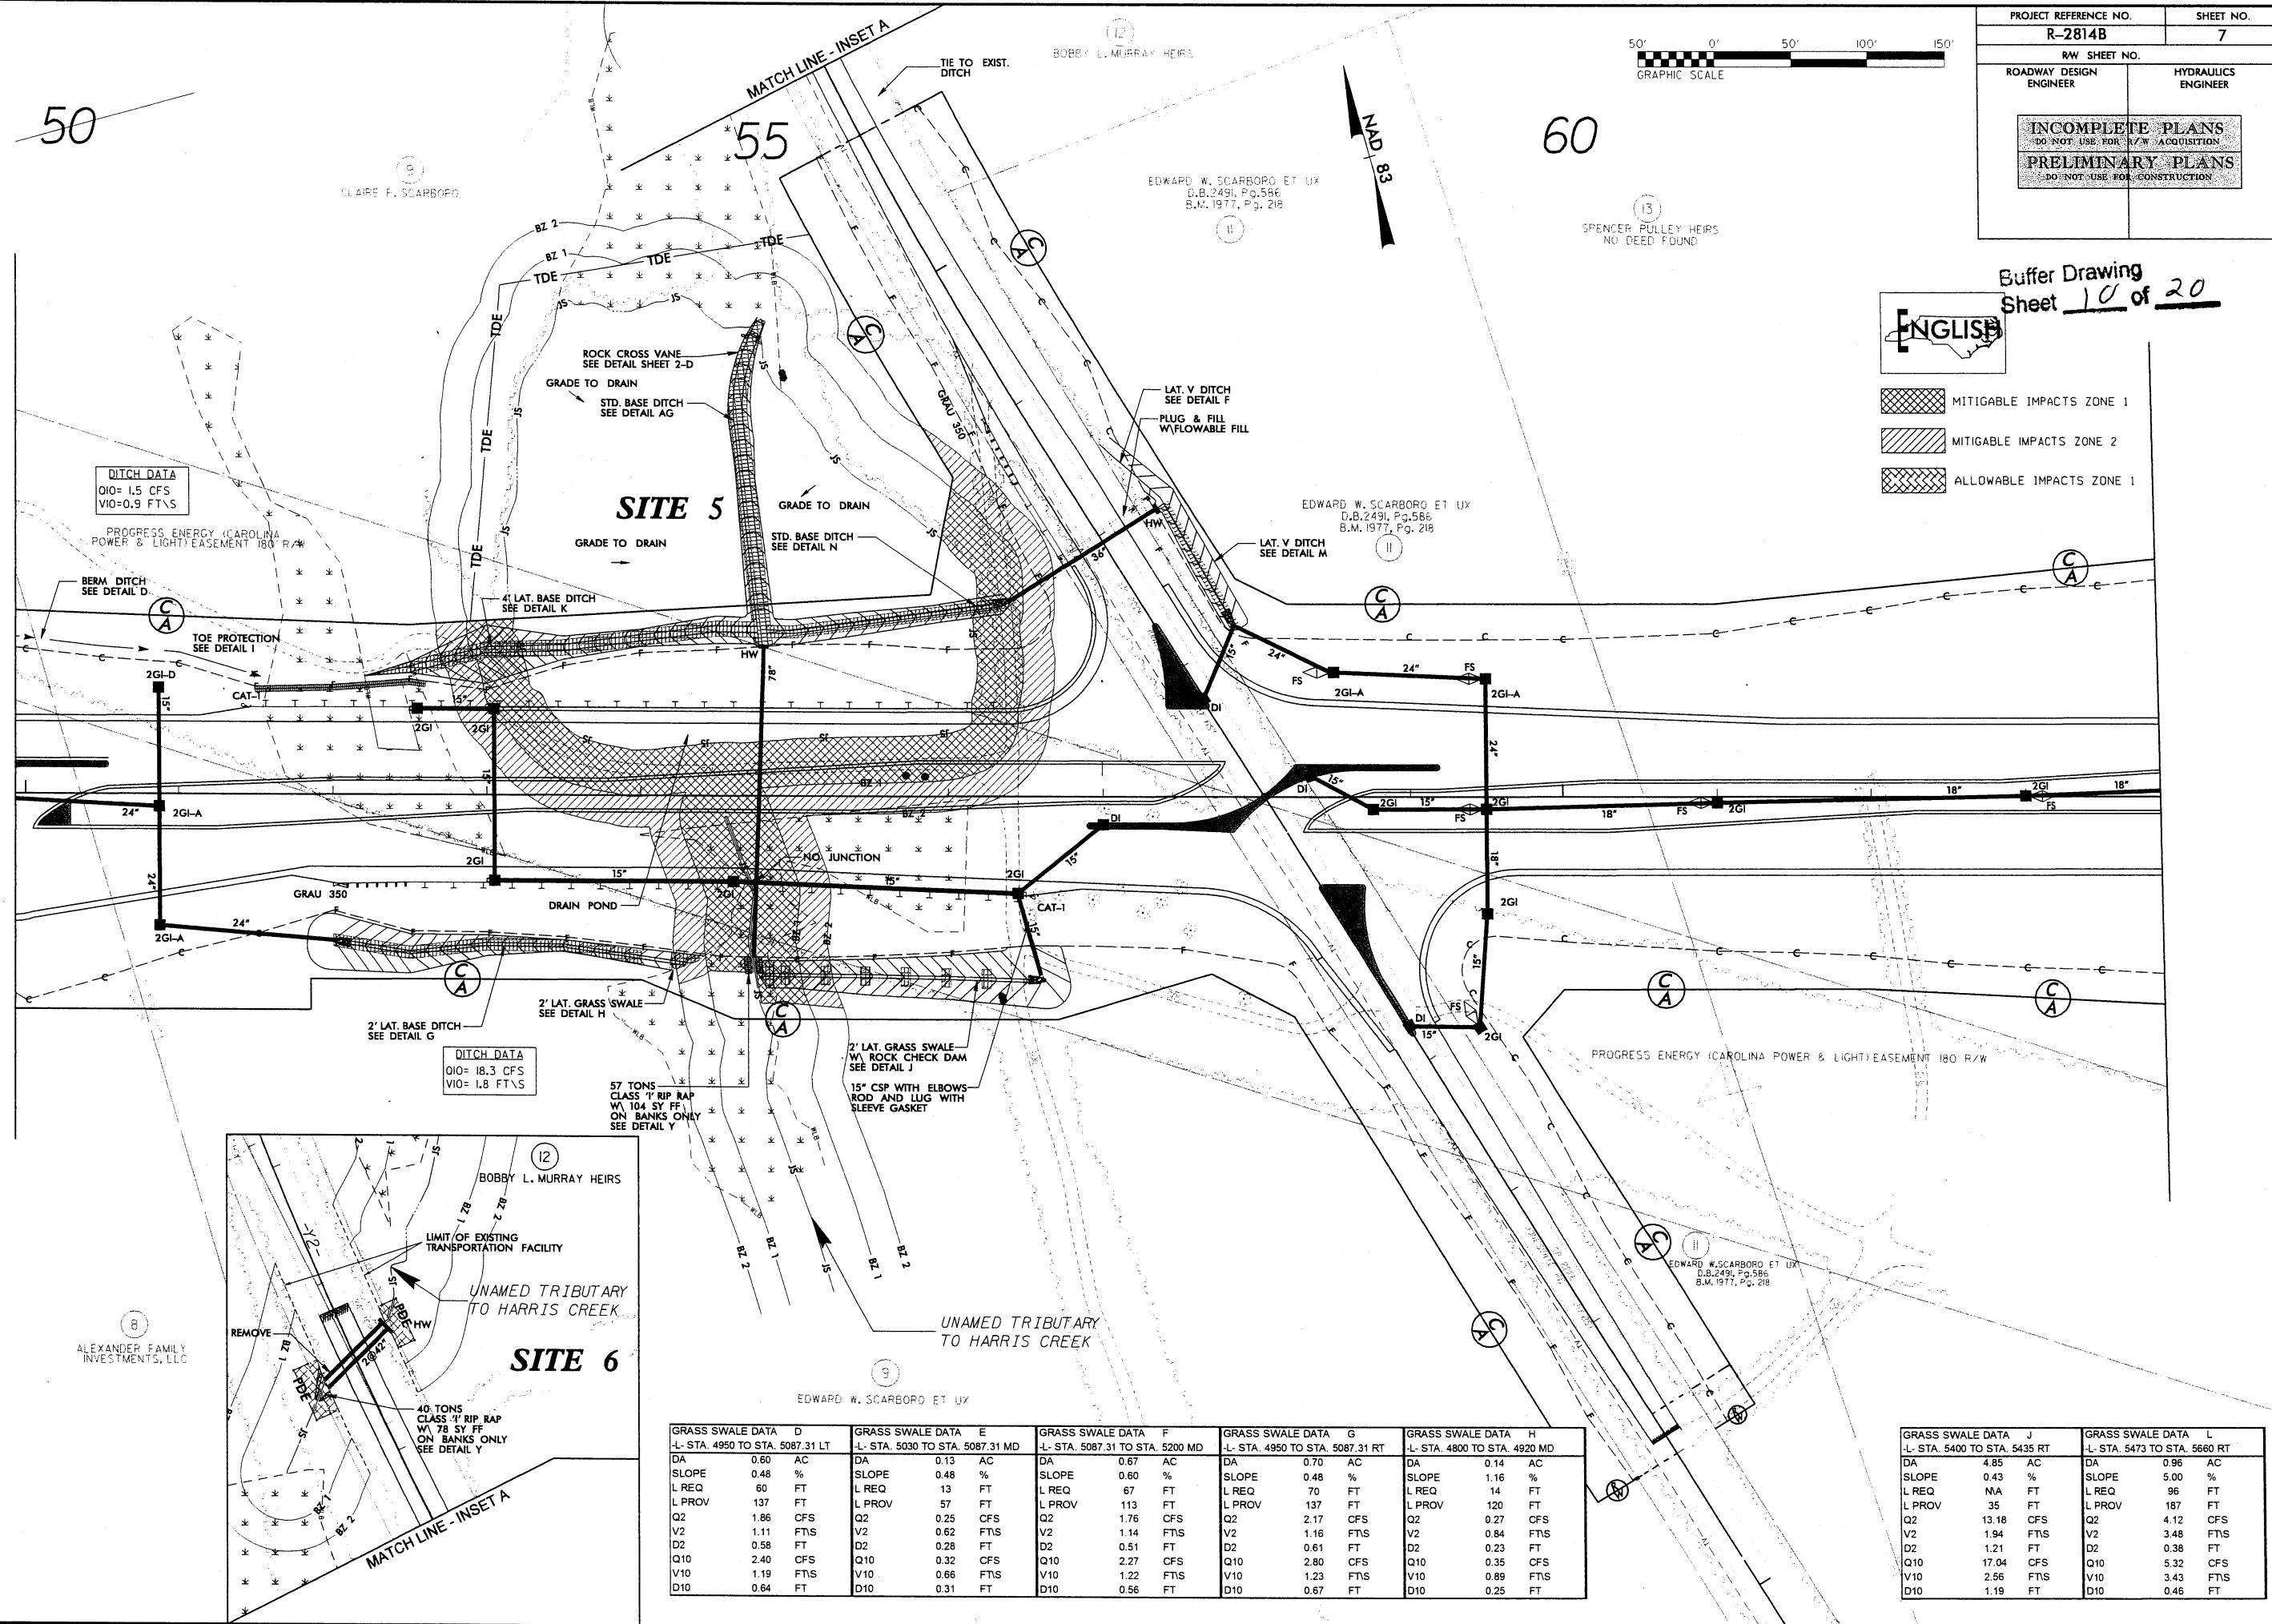

65

70

75

A graphic scale bar consisting of a horizontal line with black and white checkered segments. Above the bar, the text "50'", "0'", "50'", and "100'" is printed. Below the bar, the words "GRAPHIC SCALE" are printed.

REVISI観

PROGRESS ENERGY (CAROLINA POWER & LIGHT) EASEMENT 180' E

(13)  
SPENCER PULLEY H  
DB 2964 PG 565

SPENCER PULLEY HE  
DB 2964 PG 569




MITIGABLE IMPACTS ZONE 1

**MITIGABLE IMPACTS ZONE 2**

PROJECT REFERENCE NO.		SHEET NO.
<b>R-2814B</b>		<b>8</b>
RW SHEET NO.		
ROADWAY DESIGN ENGINEER	HYDRAULICS ENGINEER	
<b>INCOMPLETE PLANS</b> DO NOT USE FOR R/W ACQUISITION		
<b>PRELIMINARY PLANS</b> DO NOT USE FOR CONSTRUCTION		

Buffer Drawing  
Sheet 11 of 20

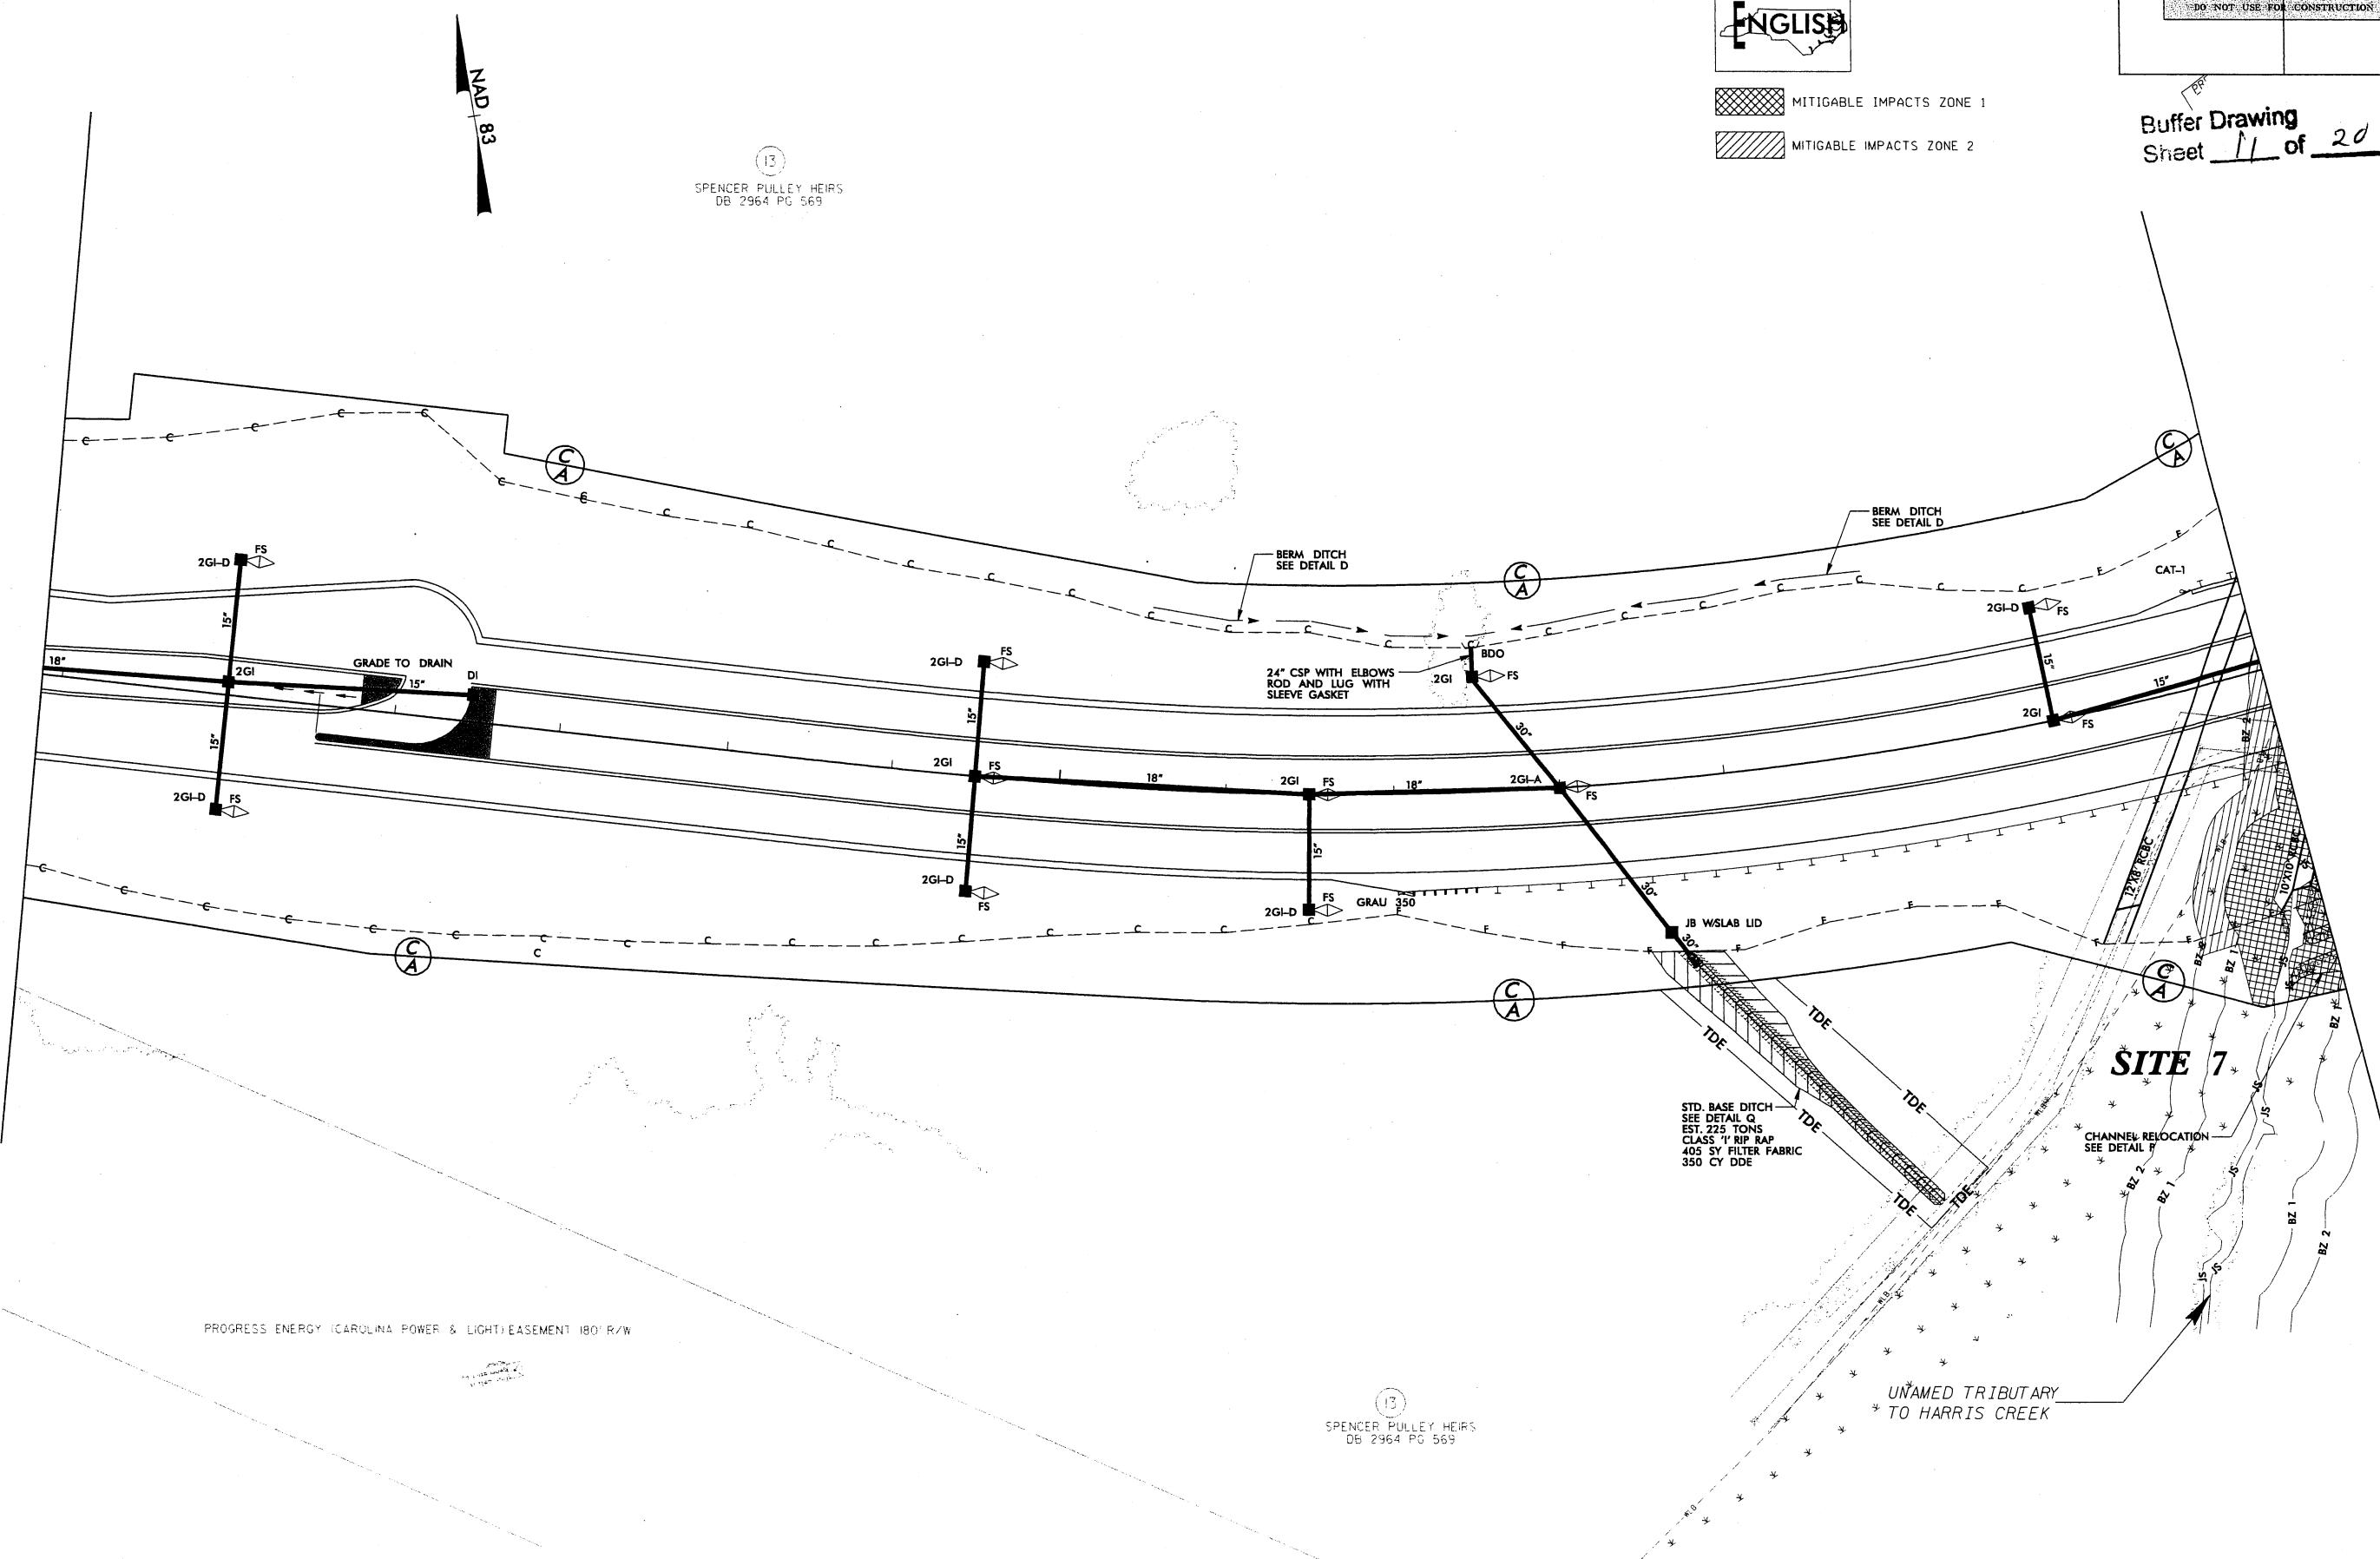


PROJECT REFERENCE NO.		SHEET NO.
R-2814B		9
RW SHEET NO.		
ROADWAY DESIGN ENGINEER	HYDRAULICS ENGINEER	
<b>INCOMPLETE PLANS</b> <small>DO NOT USE FOR R/W ACQUISITION</small>	<b>PRELIMINARY PLANS</b> <small>DO NOT USE FOR CONSTRUCTION</small>	

Buffer Drawing  
Sheet 12 of 20

80

85

90

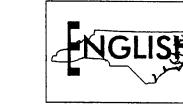

MITIGABLE IMPACTS ZONE 1

MITIGABLE IMPACTS ZONE 2

REVISIONS

SITE 7

PREFORMED SCOUR  
HOLE DATA  
Q10= 9.47 CFS

SPENCER PULLEY HEIRS  
NO DEED FOUND

UNAMED TRIBUTARY  
TO HARRIS CREEK

TDE

PSH

12'X8' RCBC  
3% 2%

10'X10' RSCC  
3% 2%

18" CSP WITH ELBOWS  
ROD AND LUG WITH SLEEVE GASKET

GRAU 350

CAT-1

JB WSLAB LID

FILL EXISTING  
CHANNEL

ROCK CROSS VANE  
SEE DETAIL SHEET 2-D

CHANNEL RELOCATION  
SEE DETAIL P

TOE PROTECTION  
SEE DETAIL I

BZ 1

BZ 2

06/06/08: Added TDE 'upstream' and 'downstream' around the culvert on page 20.

105

1

115

ROBERT C. RHEIN INTERES

1

ENGLIS

MITIGABLE IMPACTS ZONE

MITIGABLE IMPACTS ZONE

PROJECT REFERENCE NO.		SHEET NO.
<b>R-2814B</b>		11
RW SHEET NO.		
<b>RROADWAY DESIGN ENGINEER</b>		<b>HYDRAULICS ENGINEER</b>
<div style="text-align: center; border: 2px solid black; padding: 5px;"> <b>PRELIMINARY PLANS</b>            DO NOT USE FOR CONSTRUCTION         </div>		

Buffer Drawing  
Sheet 1 of 20

REVISIONS

PROJECT REFERENCE NO.  
R-2814B  
RW SHEET NO.  
ROADWAY DESIGN  
ENGINEER  
  
PRELIMINARY  
DO NOT USE FOR CONSTRUCTION

105 110 115

ROBERT C. PHEIN INTERESTS, INC.

NAD 83/2001

**SITE 8**

CAMERON E. SHEARON & BEVERLY H. SHEARON

TOE PROTECTION SEE DETAIL I

BERM DITCH SEE DETAIL D

15" CSP WITH ELBOWS, ROD AND LUG WITH SLEEVE GASKET

2GI-D FS

2GI-D FS

2GI-A FS

2GI-A FS

2GI-A FS

2GI-D FS

GRAU 350

SPEC. CUT GRASS SWALE SEE DETAIL R

JB w/MH

2' LAT. GRASS SWALE SEE DETAIL H

4OTCB

TOE PROTECTION SEE DETAIL I

BERM DITCH SEE DETAIL D

TOE PROTECTION SEE DETAIL I

GRASS SWALE DATA B DA DA DA  
L- STA. 11800 TO STA. 11900 RT SLOPE 0.73 % SLOPE 3.10 % SLOPE  
L REQ 73 FT L REQ 60 FT L REQ  
L PROV 100 FT L PROV 60 FT L PROV  
Q2 2.09 CFS Q2 1.72 CFS Q2  
V2 1.26 FT/S V2 1.62 FT/S V2  
D2 0.58 FT D2 0.46 FT D2  
Q10 2.70 CFS Q10 2.22 CFS Q10  
V10 1.70 FT/S V10 2.14 FT/S V10

GRASS SWALE DATA D DA DA DA  
L- STA. 12150 TO STA. 12210 RT SLOPE 0.60 % SLOPE 3.10 % SLOPE  
L REQ 60 FT L REQ 60 FT L REQ  
L PROV 60 FT L PROV 60 FT L PROV  
Q2 1.72 CFS Q2 1.72 CFS Q2  
V2 1.62 FT/S V2 1.62 FT/S V2  
D2 0.46 FT D2 0.46 FT D2  
Q10 2.22 CFS Q10 2.22 CFS Q10  
V10 2.14 FT/S V10 2.14 FT/S V10

GRASS SWALE DATA E DA DA DA  
L- STA. 12400 TO STA. 12500 RT SLOPE 0.60 % SLOPE 3.10 % SLOPE  
L REQ 60 FT L REQ 60 FT L REQ  
L PROV 60 FT L PROV 60 FT L PROV  
Q2 1.72 CFS Q2 1.72 CFS Q2  
V2 1.62 FT/S V2 1.62 FT/S V2  
D2 0.46 FT D2 0.46 FT D2  
Q10 2.22 CFS Q10 2.22 CFS Q10  
V10 2.14 FT/S V10 2.14 FT/S V10

ENGLISH


MITIGABLE IMPACTS ZONE 1

MITIGABLE IMPACTS ZONE 2

Buffer Drawing Sheet 13

DONALD R. E. WILLIAMS & ROBERT H. G.

GRASS SWALE DATA A -L STA. 10700 TO STA. 10850 LT		GRASS SWALE DATA B -L STA. 10700 TO STA. 10850 RT		GRASS SWALE DATA D -L STA. 11050 TO STA. 11150 RT		GRASS SWALE DATA F -L STA. 11200 TO STA. 11350 RT		
DA	0.62	AC	DA	0.60	AC	DA	0.58	AC
SLOPE	2.90	%	SLOPE	2.90	%	SLOPE	4.00	%
L REQ	62	FT	L REQ	60	FT	L REQ	58	FT
L PROV	150	FT	L PROV	150	FT	L PROV	100	FT
Q2	1.77	CFS	Q2	1.72	CFS	Q2	1.66	CFS
V2	1.59	FTNS	V2	1.58	FTNS	V2	1.77	FTNS
D2	0.47	FT	D2	0.47	FT	D2	0.43	FT
Q10	2.29	CFS	Q10	2.22	CFS	Q10	2.14	CFS
V10	2.30	FTNS	V10	2.28	FTNS	V10	2.34	FTNS
D10	0.45	FT	D10	0.44	FT	D10	0.43	FT

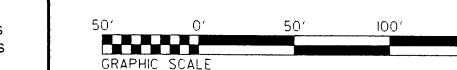

GRASS SWALE DATA B -L STA. 11800 TO STA. 11900 RT		GRASS SWALE DATA D -L STA. 12150 TO STA. 12210 RT		GRASS SWALE DATA F -L STA. 12450 TO STA. 12550 LT	
DA	0.73	AC	DA	0.60	AC
SLOPE	1.16	%	SLOPE	3.10	%
L REQ	73	FT	L REQ	60	FT
L PROV	100	FT	L PROV	60	FT
Q2	2.09	CFS	Q2	1.72	CFS
V2	1.26	FT/S	V2	1.62	FT/S
D2	0.58	FT	D2	0.46	FT
Q10	2.70	CFS	Q10	2.22	CFS
V10	1.70	FT/S	V10	2.14	FT/S
D10	0.56	FT	D10	0.45	FT


GRASS SWALE DATA		G	GRASS SWALE DATA		I	GRASS SWALE DATA		J
-L STA. 12450 TO STA. 12550 RT			-L STA. 12850 TO STA. 12950 LT			-L STA. 12850 TO STA. 12950 RT		
DA	0.79	AC	DA	0.59	AC	DA	0.39	AC
SLOPE	4.00	%	SLOPE	3.84	%	SLOPE	3.84	%
L REQ	79	FT	L REQ	59	FT	L REQ	39	FT
L PROV	100	FT	L PROV	100	FT	L PROV	100	FT
Q2	2.26	CFS	Q2	1.69	CFS	Q2	1.12	CFS
V2	1.91	FT/S	V2	1.75	FT/S	V2	1.58	FT/S
D2	0.49	FT	D2	0.44	FT	D2	0.38	FT
Q10	2.92	CFS	Q10	2.18	CFS	Q10	1.44	CFS
V10	2.53	FT/S	V10	2.31	FT/S	V10	2.08	FT/S
D10	0.48	FT	D10	0.43	FT	D10	0.37	FT

PROJECT REFERENCE NO. R-2814B	SHEET NO. 13
RW SHEET NO.	
ROADWAY DESIGN ENGINEER	HYDRAULICS ENGINEER

PRELIMINARY PLANS  
DO NOT USE FOR CONSTRUCTION

Buffer Drawing  
Sheet 14 of 20

Mitchell F. Rabil Family  
Irrevocable Trust

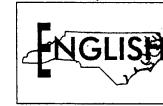

MITIGABLE IMPACTS ZONE 1

MITIGABLE IMPACTS ZONE 2

REVISIONS

REVISED NAMES ON PARCEL 22 PER LOCATION AND SURVEY REQUEST 4/23/09 DOL 7/29/09


NAD 83 2001

135

140

(19)  
RUBY L. BYRUM

(22)  
CAMERON E. SHEARON  
&  
BEVERLY W. SHEARON  
DB 12258 PG 1051

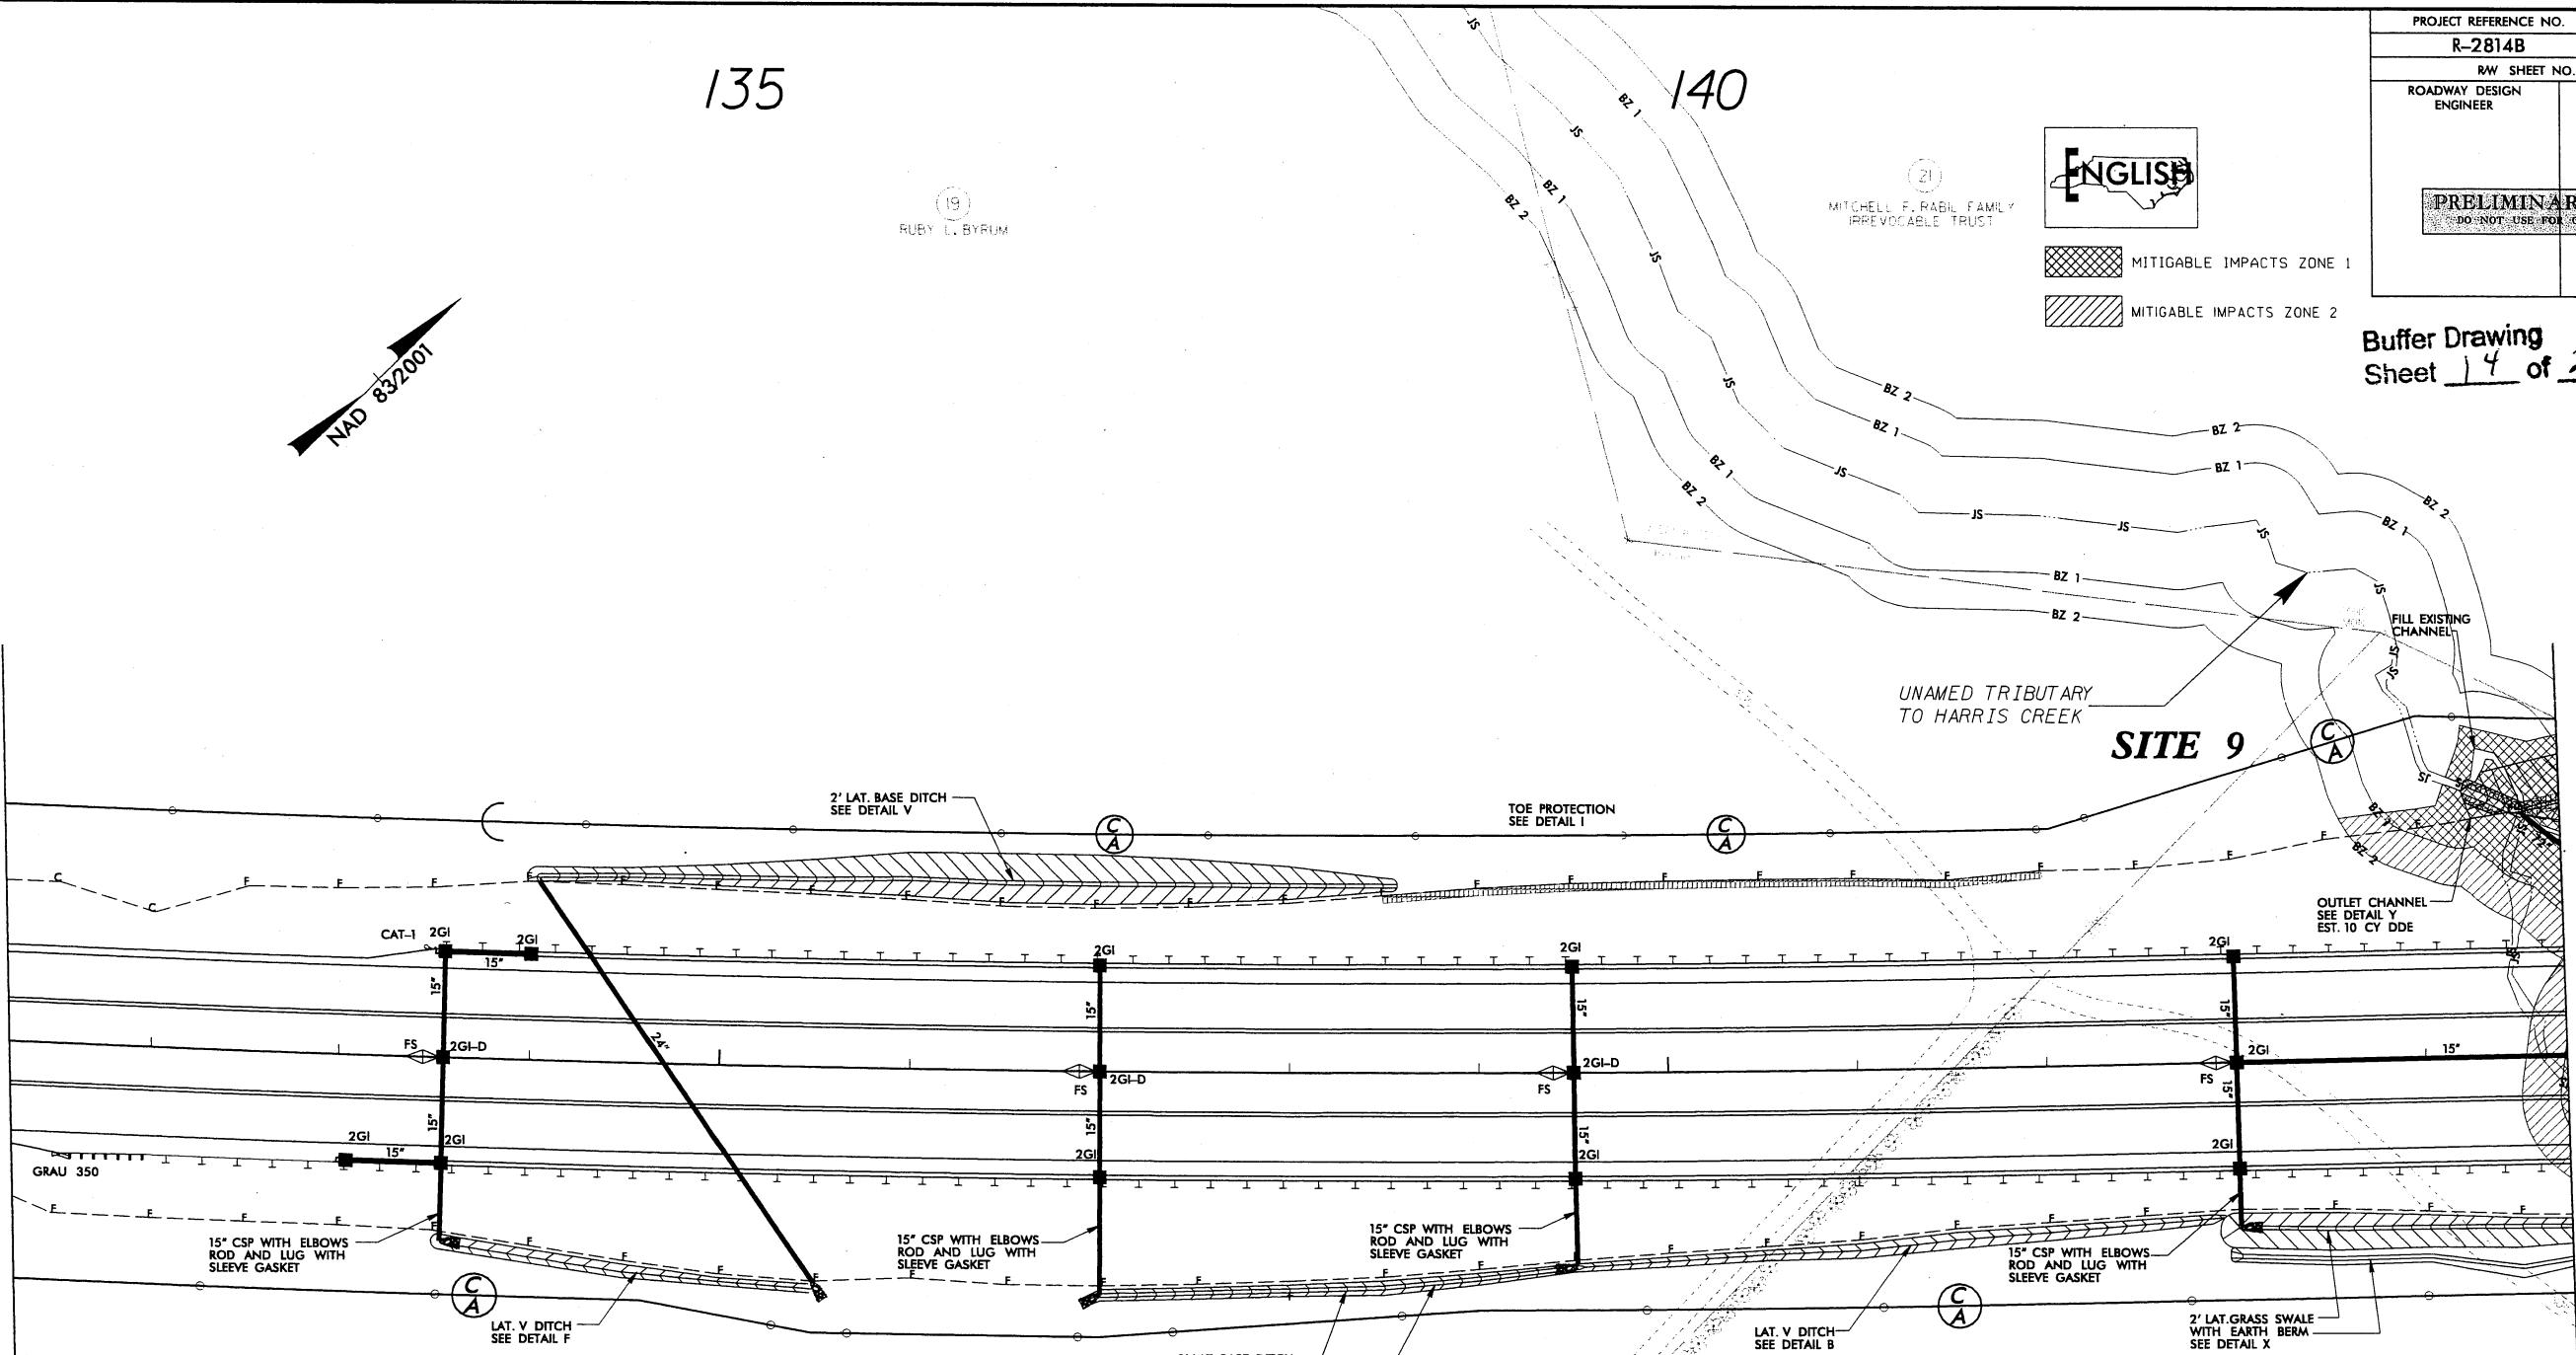

GRASS SWALE DATA B		
L STA.	14300	TO STA. 14500 RT
DA	1.75	AC
SLOPE	0.80	%
L REQ	175	FT
L PROV	200	FT
Q2	5.42	CFS
V2	1.93	FT/S
D2	0.69	FT
Q10	7.02	CFS
V10	2.07	FT/S
D10	0.78	FT

50' 0' 50' 100' 150'  
GRAPHIC SCALE


PROJECT REFERENCE NO. R-2814B	SHEET NO. 14
RW SHEET NO.	
ROADWAY DESIGN ENGINEER	HYDRAULICS ENGINEER
PRELIMINARY PLANS DO NOT USE FOR CONSTRUCTION	

145

150

155

NAD 83/2001

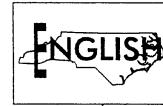
(21)  
MITCHELL F. RABIL FAMILY  
IRREVOCABLE TRUST

MITIGABLE IMPACTS ZONE 1  
MITIGABLE IMPACTS ZONE 2

Buffer Drawing  
Sheet 15 of 20

REVISIONS

REVISED NAMES ON PARCEL 22 PER LOCATION AND SURVEY REQUEST 4/23/09 DDL 7/29/09

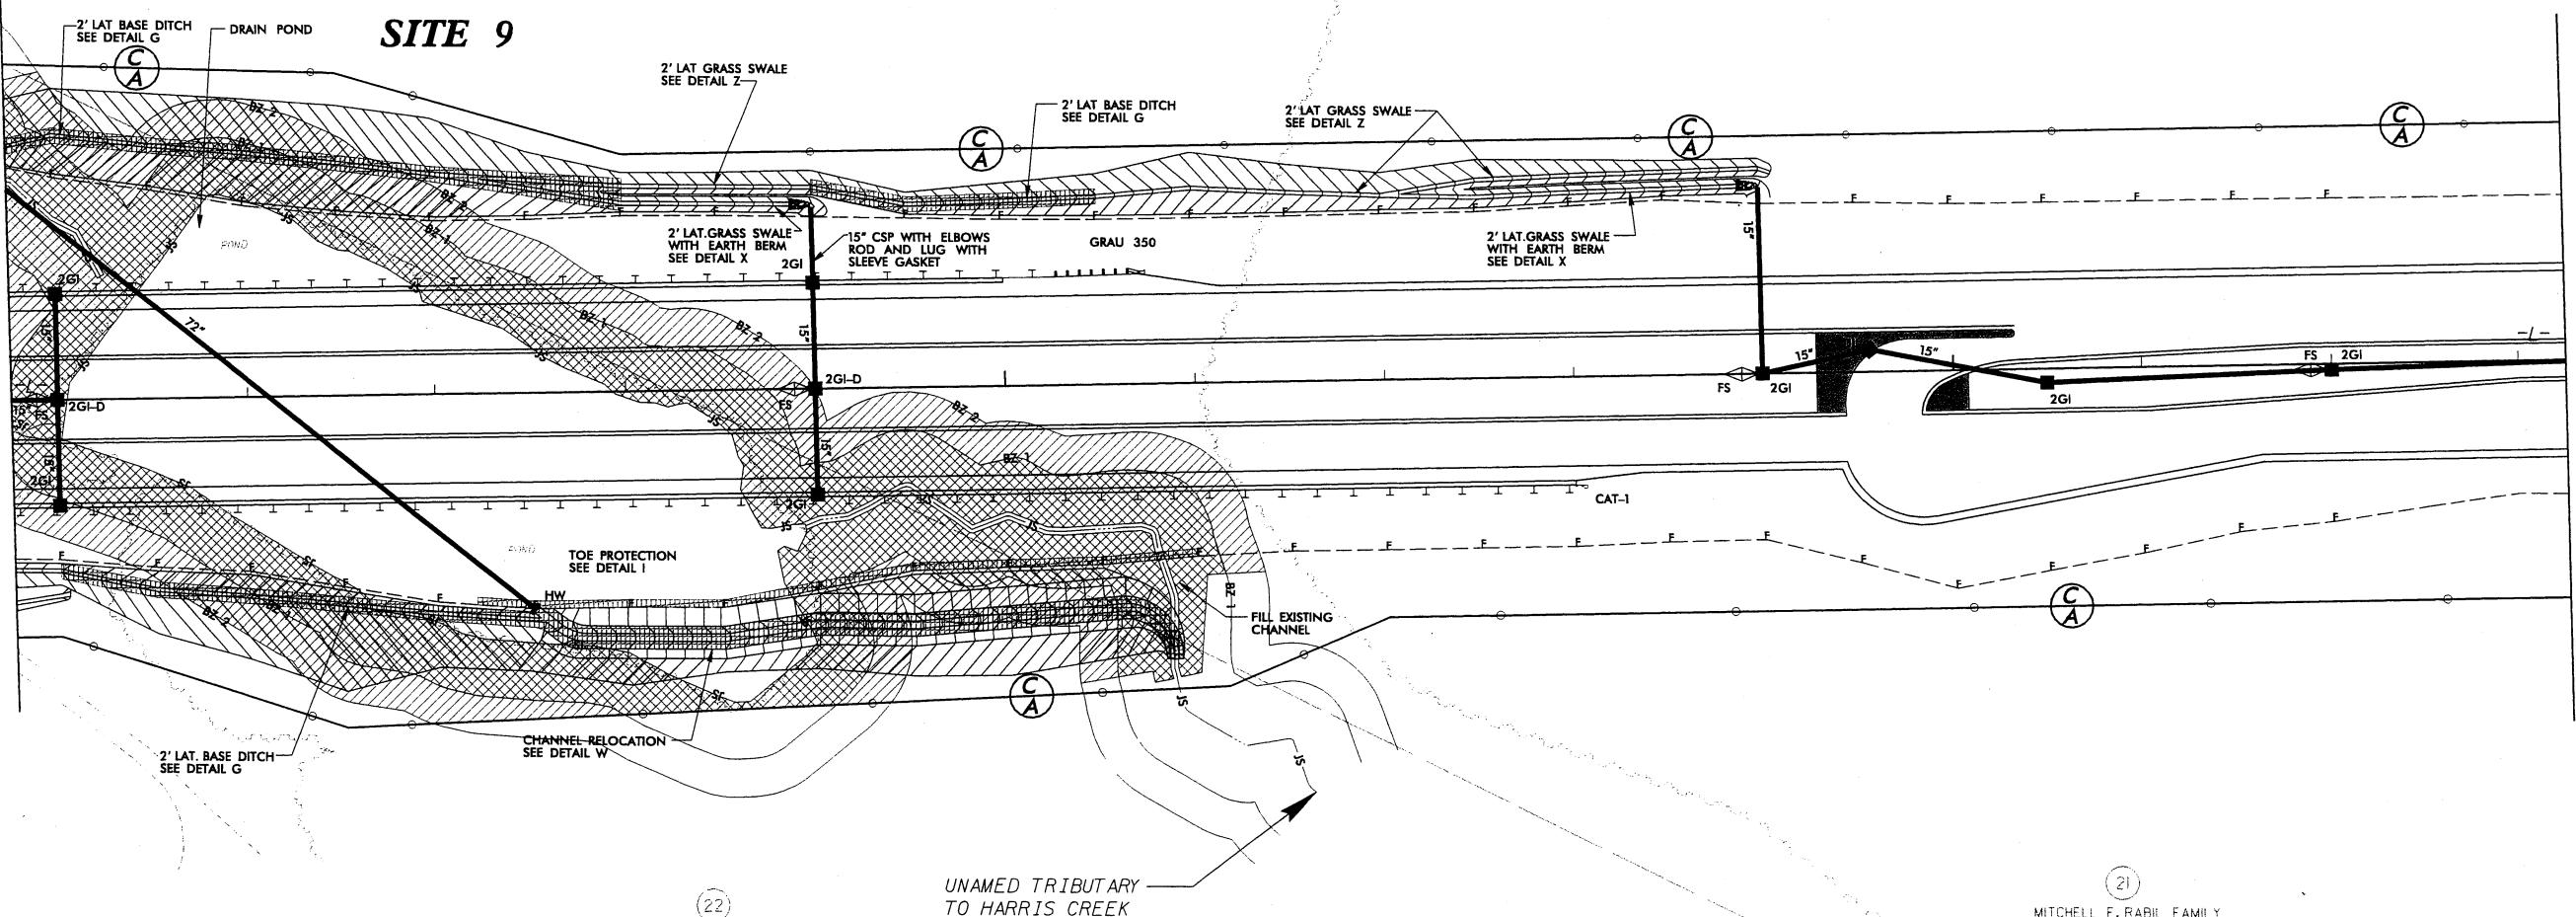

GRASS SWALE DATA D		GRASS SWALE DATA F	
-L STA. 14800 TO STA. 14900 LT		-L STA. 15250 TO STA. 15400 LT	
DA	1.00 AC	DA	1.41 AC
SLOPE	2.20 %	SLOPE	0.50 %
L REQ	100 FT	L REQ	141 FT
L PROV	100 FT	L PROV	150 FT
Q2	2.86 CFS	Q2	3.57 CFS
V2	1.75 FT/S	V2	1.45 FT/S
D2	0.48 FT	D2	0.63 FT
Q10	3.70 CFS	Q10	4.63 CFS
V10	2.80 FT/S	V10	1.56 FT/S
D10	0.54 FT	D10	0.72 FT

50' 0' 50' 100' 150'  
GRAPHIC SCALE

185

19

195

NAD 83/2001

33



MITIGABLE IMPACTS ZONE

#### MITIGABLE IMPACTS ZONE

SCABBARD FAMILY LIMITED PARTNERSHIP

GRASS SWALE DATA -L STA. 19550 TO STA. 19600 LT	B	GRASS SWALE DATA -L STA. 19600 TO STA. 19650 LT	C	GRASS SWALE DATA -L STA. 19550 TO STA. 19650 CL	E	GRASS SWALE DATA -L STA. 19500 TO STA. 19850 RT	G	GRASS SWALE DATA -L STA. 19850 TO STA. 19750 RT	H					
DA	0.73	AC	DA	0.73	AC	DA	0.54	AC	DA	0.42	AC	DA	0.14	AC
SLOPE	1.76	%	SLOPE	2.34	%	SLOPE	1.78	%	SLOPE	3.16	%	SLOPE	0.30	%
L REQ	50	FT	L REQ	23	FT	L REQ	54	FT	L REQ	42	FT	L REQ	14	FT
L PROV	50	FT	L PROV	50	FT	L PROV	100	FT	L PROV	150	FT	L PROV	100	FT
Q2	2.44	CFS	Q2	2.44	CFS	Q2	1.03	CFS	Q2	1.40	CFS	Q2	0.47	CFS
V2	1.94	FTS	V2	1.97	FTS	V2	1.38	FTS	V2	1.92	FTS	V2	0.60	FTS
D2	0.50	FT	D2	0.50	FT	D2	0.35	FT	D2	0.38	FT	D2	0.39	FT
Q10	3.15	CFS	Q10	3.15	CFS	Q10	1.33	CFS	Q10	1.81	CFS	Q10	0.60	CFS
V10	2.07	FTS	V10	2.30	FTS	V10	1.47	FTS	V10	2.05	FTS	V10	0.64	FTS
D10	0.55	FT	D10	0.52	FT	D10	0.39	FT	D10	0.42	FT	D10	0.43	FT

REVISED

REVISED NAMES ON PARCEL 35 PER LOCATION AND SURVEY REQUEST 4/23/09 DDL 7/29/09

**SITE 10**

UNAMED TRIBU  
TO CEDAR FOR

(34) SCARBORO FAMILY LIMITED PARTNERS

A graphic scale bar consisting of a black and white checkered pattern followed by the text "GRAPHIC SCALE".

MATCHLINE SEE SHEET 18



### **SITE II**

卷之三

REVISIONS 03/09 001 7/29/09

REVISED NAMES ON PARCELS 35 AND 36 PER LOCATION AND SURVEY REQUEST 4/23/09 DDL 7/29/09

**MATCHLINE**

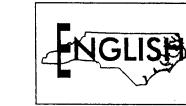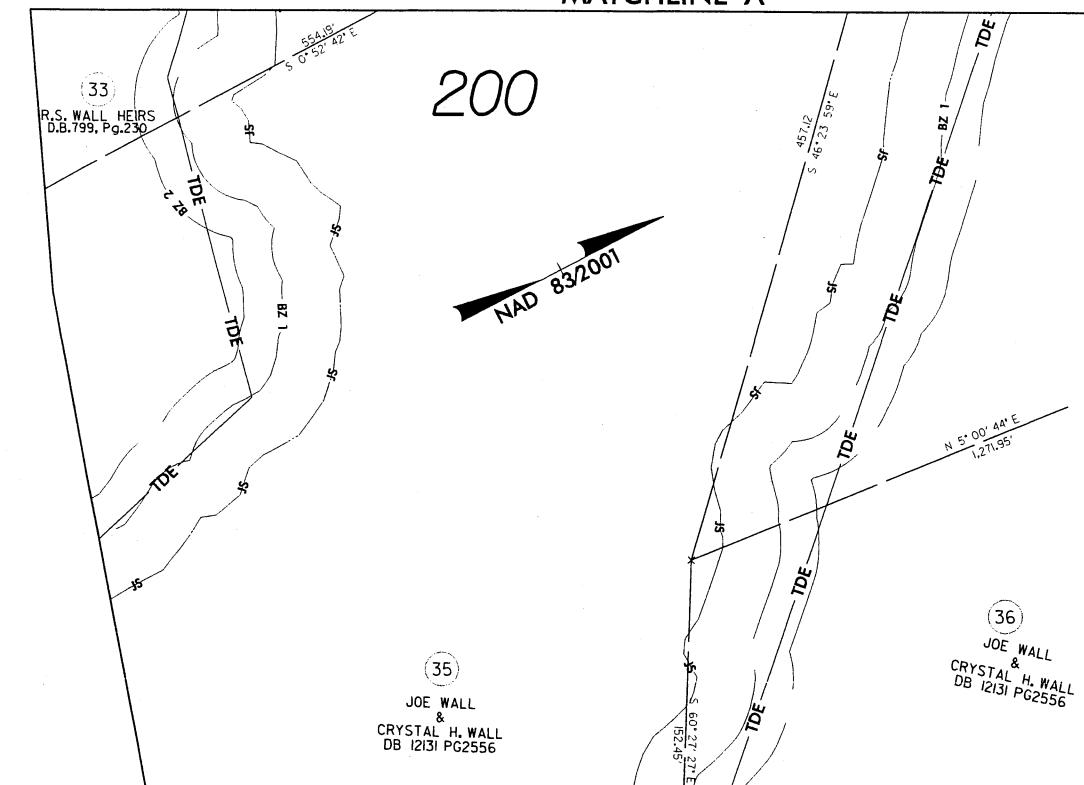


37  
JOE WALL  
NO DEED EQUIN

N 5° 00' 44" E  
1,271.95'

PROJECT REFERENCE NO.	SHEET NO.
R-2814B	18
RW SHEET NO.	
ROADWAY DESIGN ENGINEER	HYDRAULICS ENGINEER
<p><b>Buffer Drawing</b></p> <p><b>Sheet 17 of 20</b></p>	
<b>PRELIMINARY PLANS</b> <small>DO NOT USE FOR CONSTRUCTION</small>	


GRASS SWALE DATA		B
-L STA. 19980 TO STA. 20150 LT		
DA	0.75	AC
SLOPE	0.40	%
L REQ	75	FT
L PROV	170	FT
Q2	3.22	CFS
V2	1.30	FT/S
D2	0.63	FT
Q10	4.16	CFS
V10	1.39	FT/S
D10	0.72	FT
GRASS SWALE DATA		D
-L STA. 20500 TO STA. 20600 LT		
DA	0.88	AC
SLOPE	1.10	%
L REQ	88	FT
L PROV	100	FT
Q2	2.94	CFS
V2	1.70	FT/S
D2	0.59	FT
Q10	3.80	CFS
V10	1.82	FT/S
D10	0.65	FT
GRASS SWALE DATA		E
-L STA. 20700 TO STA. 20800 RT		
DA	0.51	AC
SLOPE	1.10	%
L REQ	51	FT
L PROV	100	FT
Q2	1.70	CFS
V2	1.36	FT/S
D2	0.50	FT
Q10	2.20	CFS
V10	1.58	FT/S
D10	0.53	FT
GRASS SWALE DATA		F
-L STA. 21050 TO STA. 21150 LT		
DA	0.44	AC
SLOPE	1.10	%
L REQ	44	FT
L PROV	100	FT
Q2	1.47	CFS
V2	1.31	FT/S
D2	0.47	FT
Q10	1.90	CFS
V10	1.53	FT/S
D10	0.50	FT

POND  
**SITE II**

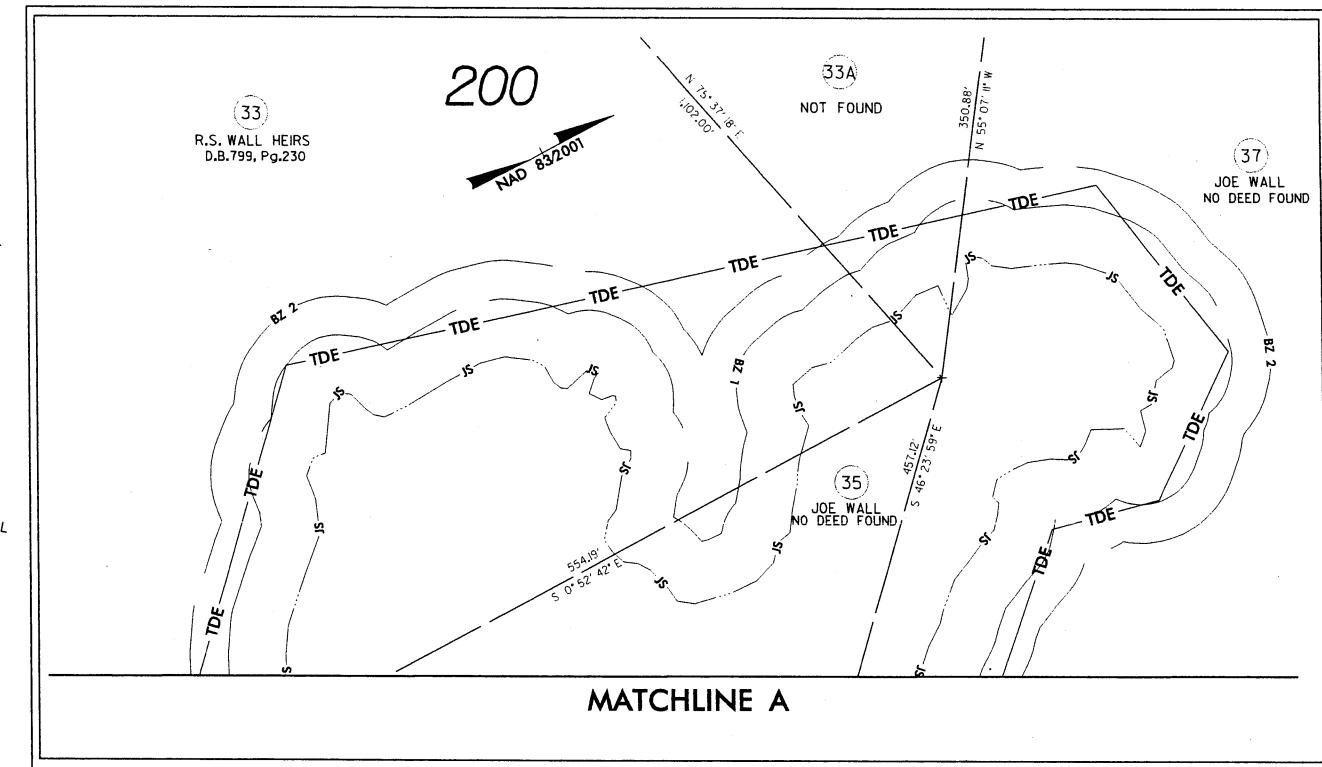

MATCHLINE

**MATCHLINE SEE SHEET 17**

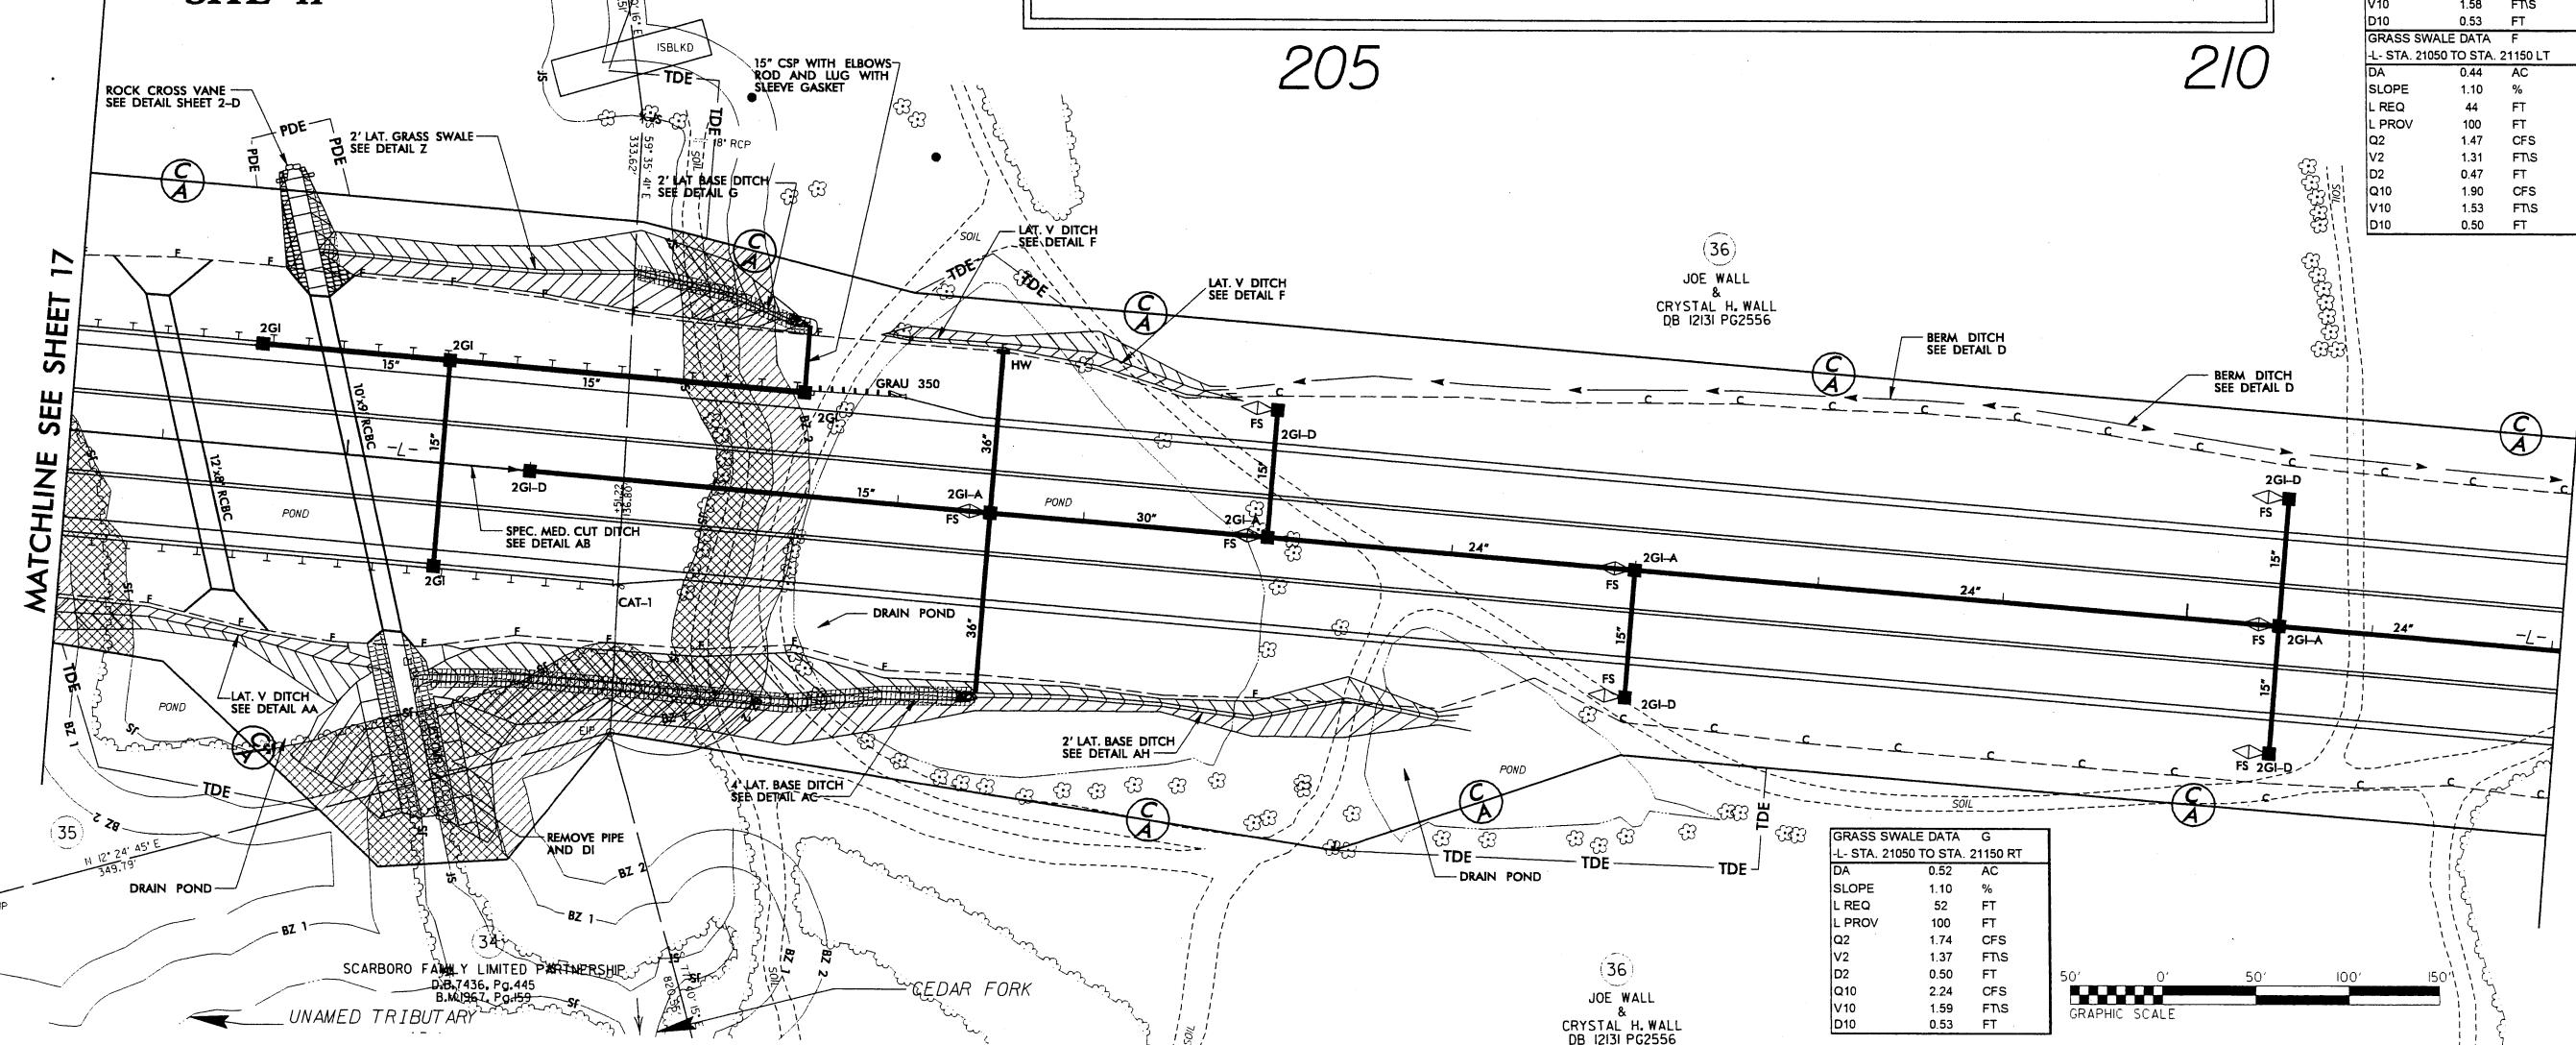

PROJECT REFERENCE NO.	SHEET NO.
R-2814B	19
RW SHEET NO.	
ROADWAY DESIGN ENGINEER	HYDRAULICS ENGINEER
<b>PRELIMINARY PLANS</b> <small>DO NOT USE FOR CONSTRUCTION</small>	

Buffer Drawing  
Sheet 18 of 20

215

220

NAD 83 2001

(36)  
JOE WALL  
&  
CRYSTAL H. WALL  
DB 12131 PG2556

(37)  
JOE WALL



MITIGABLE IMPACTS ZONE 1

MITIGABLE IMPACTS ZONE 2


**PRELIMINARY PLANS**

DO NOT USE FOR CONSTRUCTION

REVISIONS

January 11, 2010: Adjusted R/W CA lines, R/W markers and the proposed woven wire fence on parcel no. 39, N.W.A.

GRASS SWALE DATA H	
-L STA. 21350 TO STA. 21450 LT	
DA	0.49 AC
SLOPE	1.10 %
L REQ	49 FT
L PROV	100 FT
Q2	1.64 CFS
V2	1.35 FTS
D2	0.49 FT
Q10	2.11 CFS
V10	1.57 FTS
D10	0.52 FT

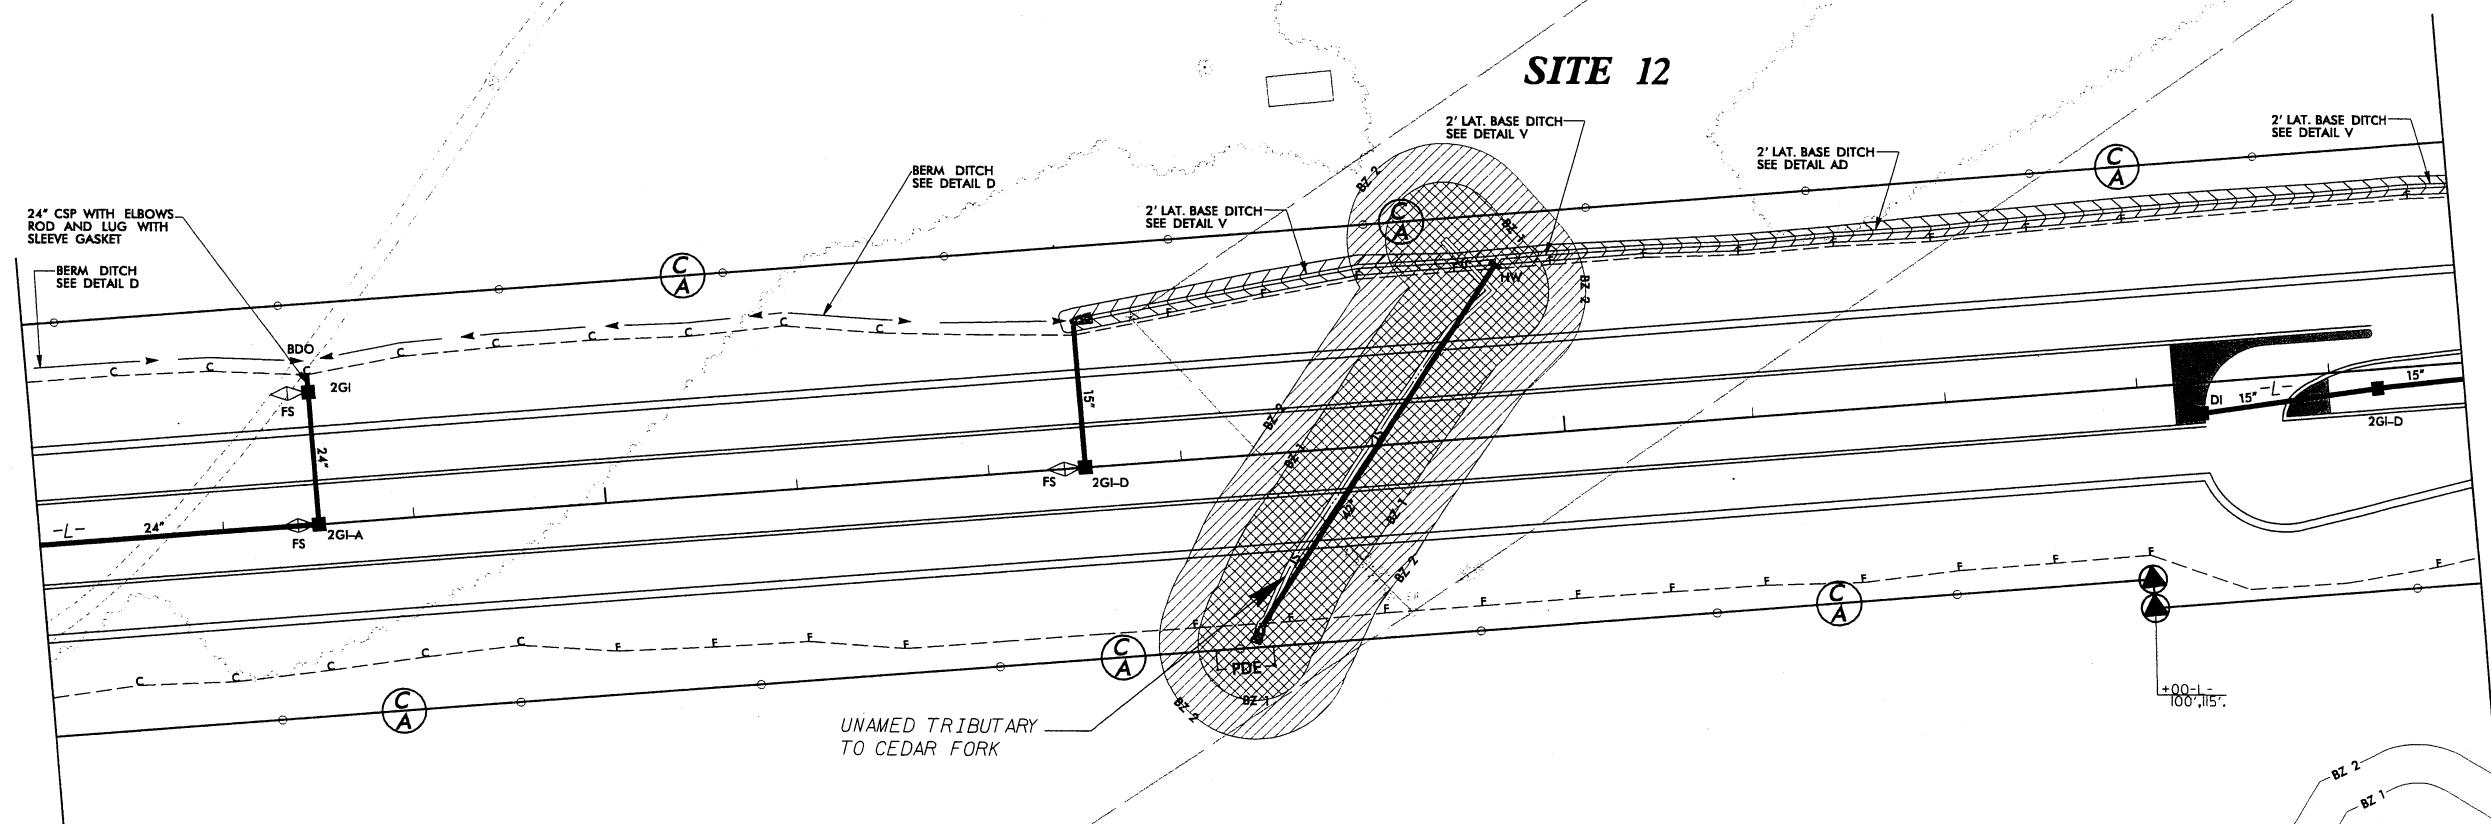

(36)  
JOE WALL  
&  
CRYSTAL H. WALL  
DB 12131 PG2556

(39)  
THE SBI GROWTH, L.P.

PROJECT REFERENCE NO.	SHEET NO.
R-2814B	22
RW SHEET NO.	
ROADWAY DESIGN ENGINEER	HYDRAULICS ENGINEER
<b>PRELIMINARY PLANS</b> <small>DO NOT USE FOR CONSTRUCTION</small>	

255

260

MICHAEL C. BARTHOLOMEW

(51)

NAD 83/2001




MITIGABLE IMPACTS ZONE 1


MITIGABLE IMPACTS ZONE 2

**PRELIMINARY PLANS**DO NOT USE FOR CONSTRUCTIONBuffer Drawing  
Sheet 19 of 20


## REVISIONS

January 11, 2010: Adjusted R/W CA lines, R/W markers and the proposed woven wire fence on parcel no. 52 NNA.

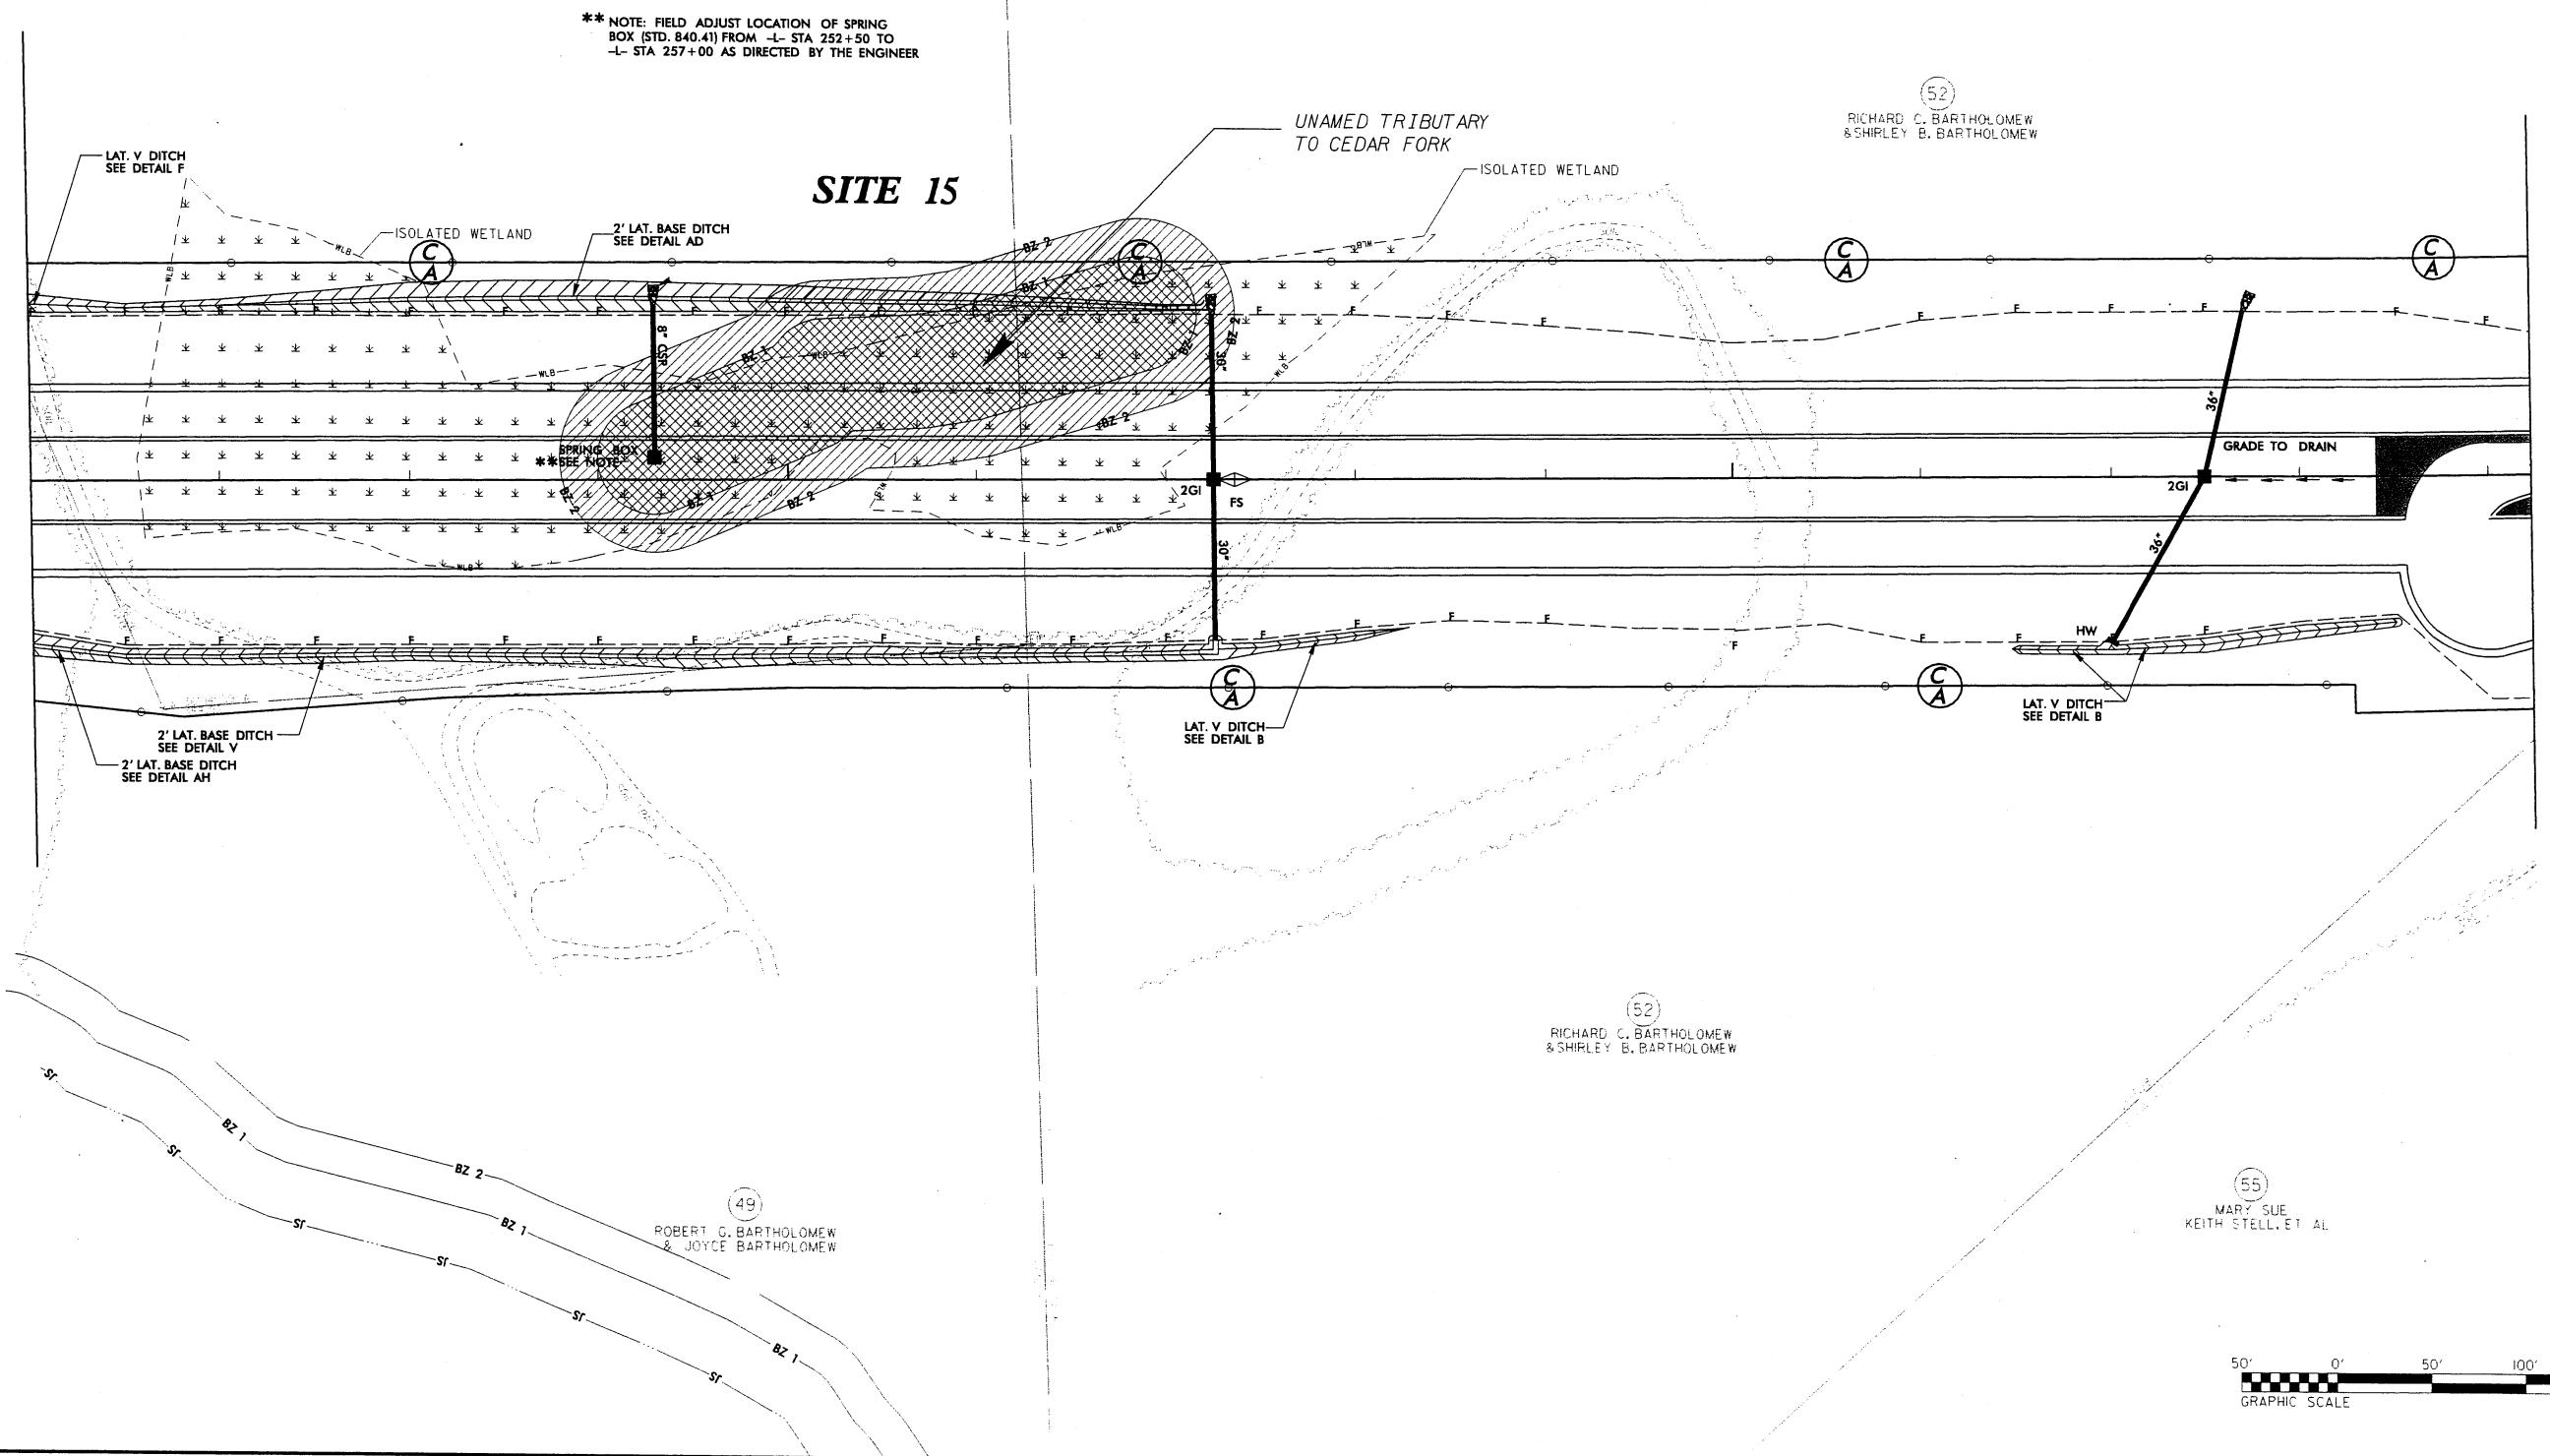


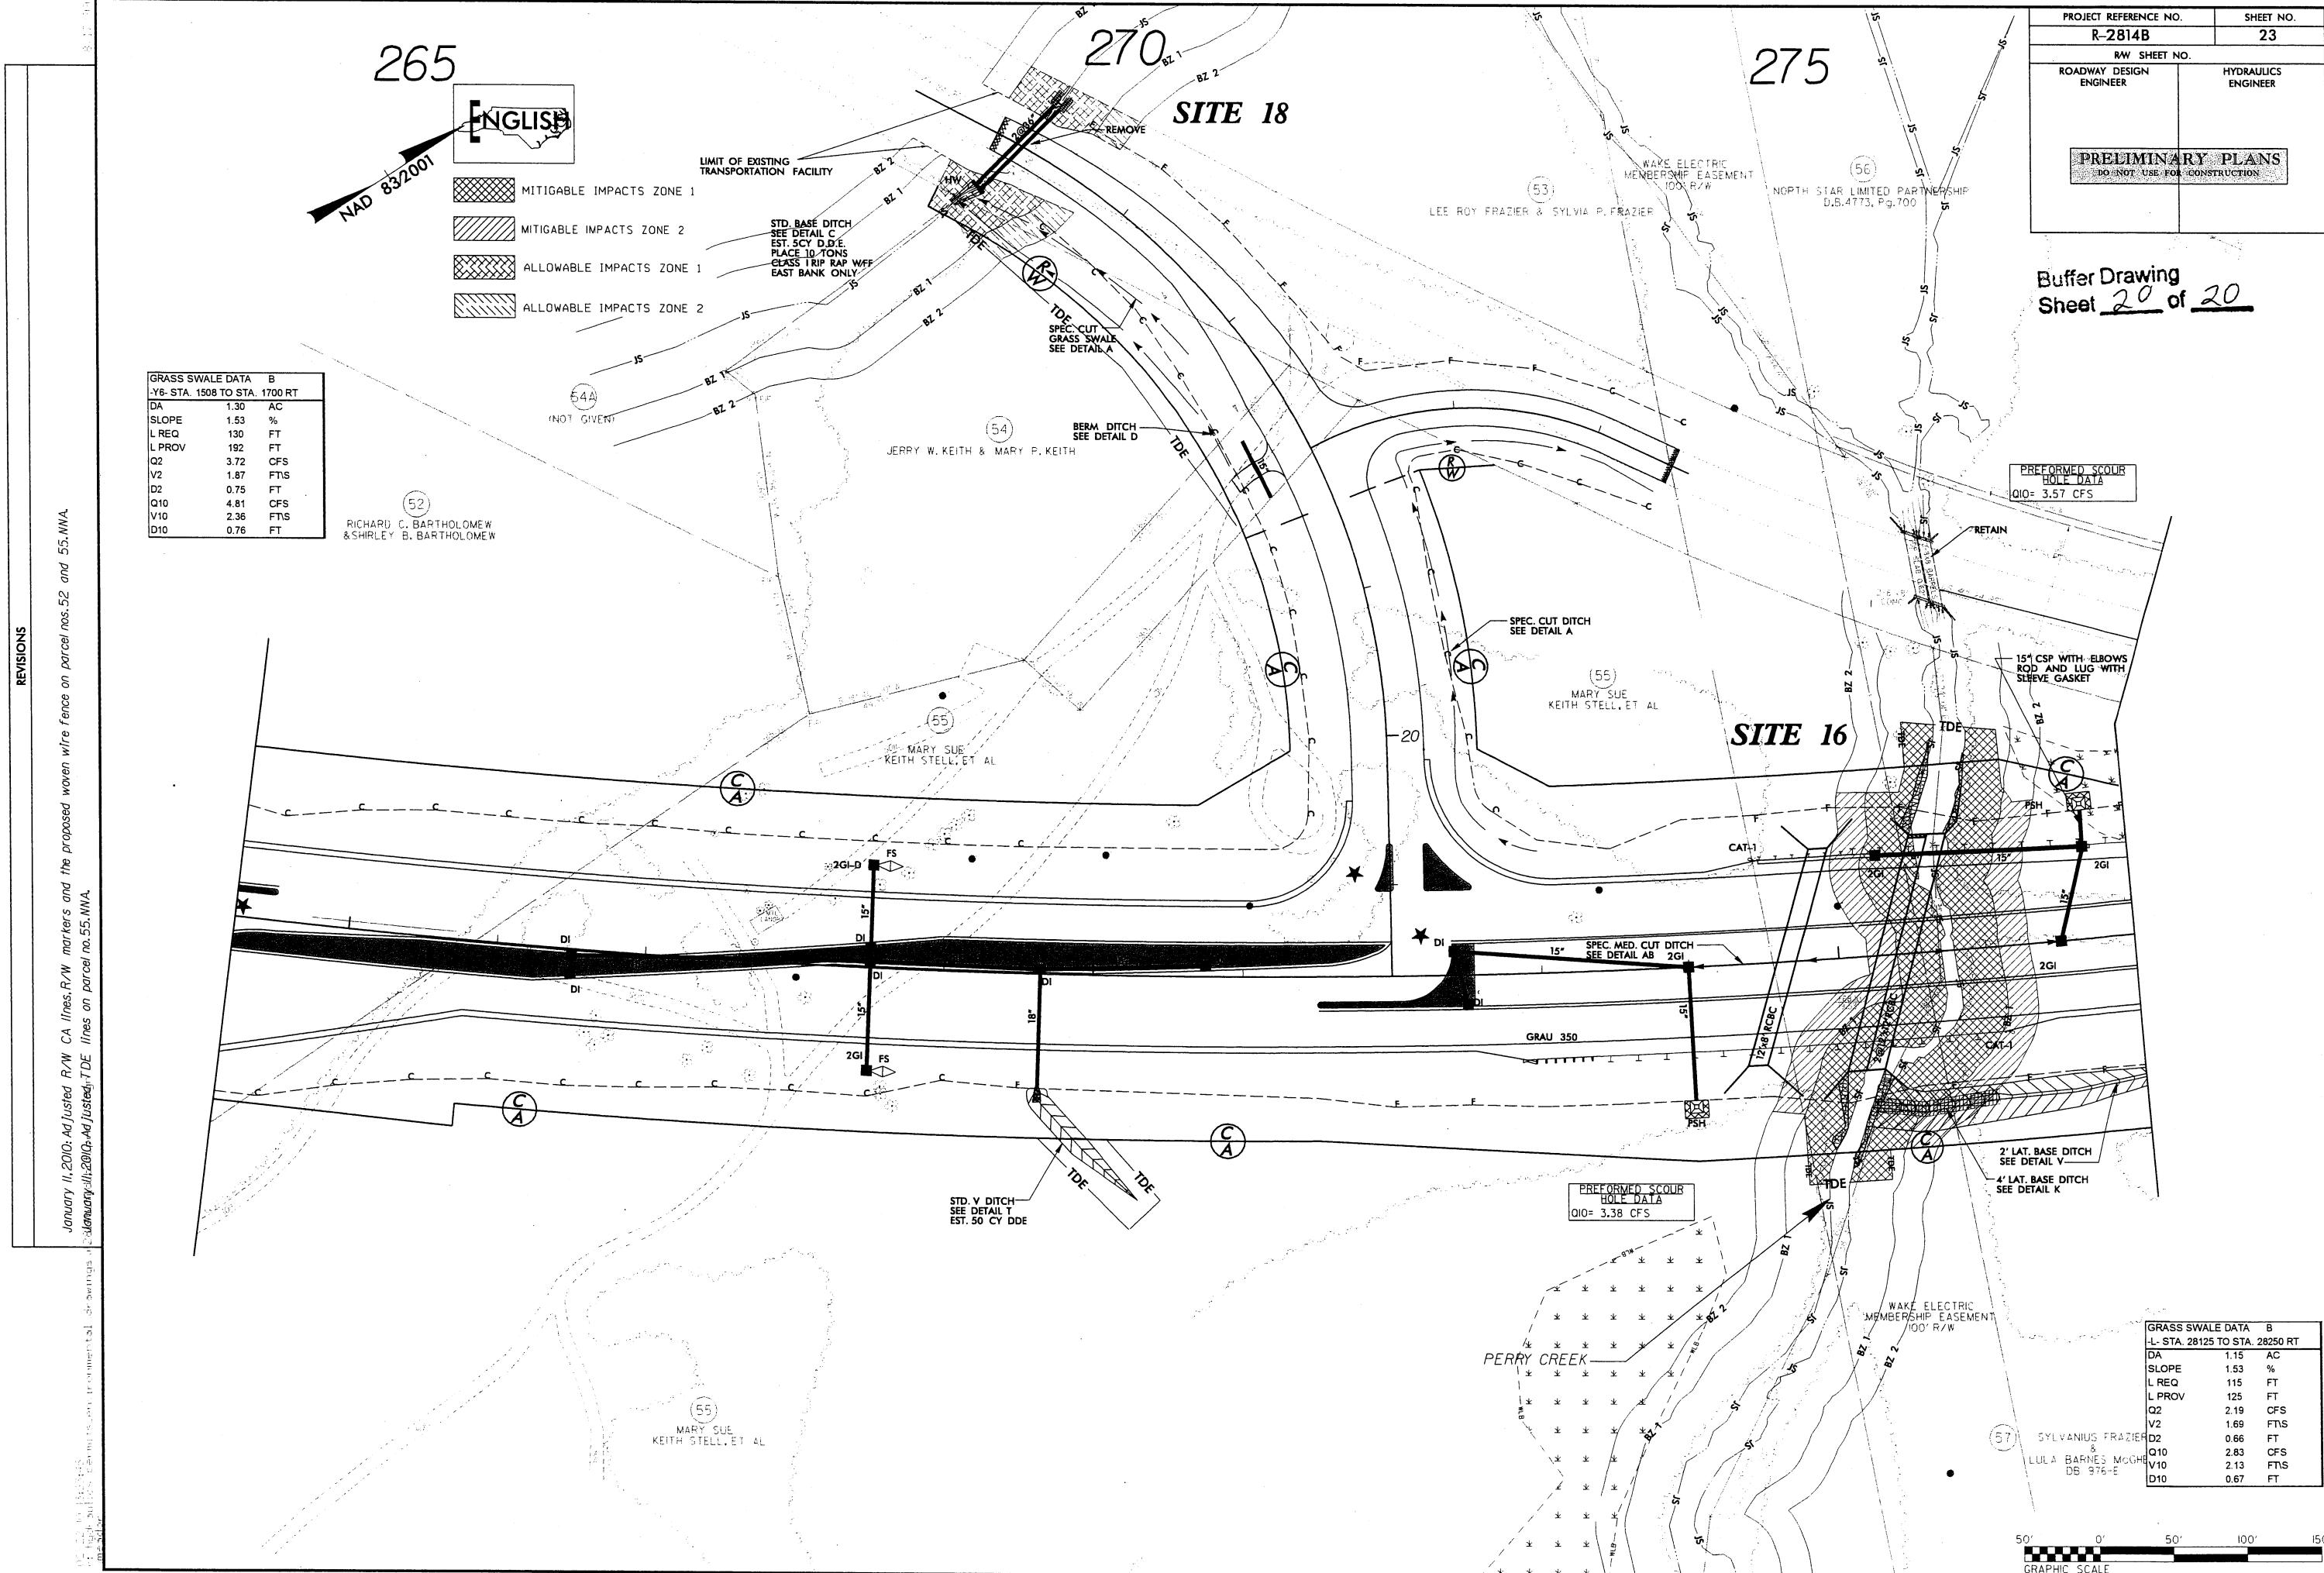

# NORTH CAROLINA

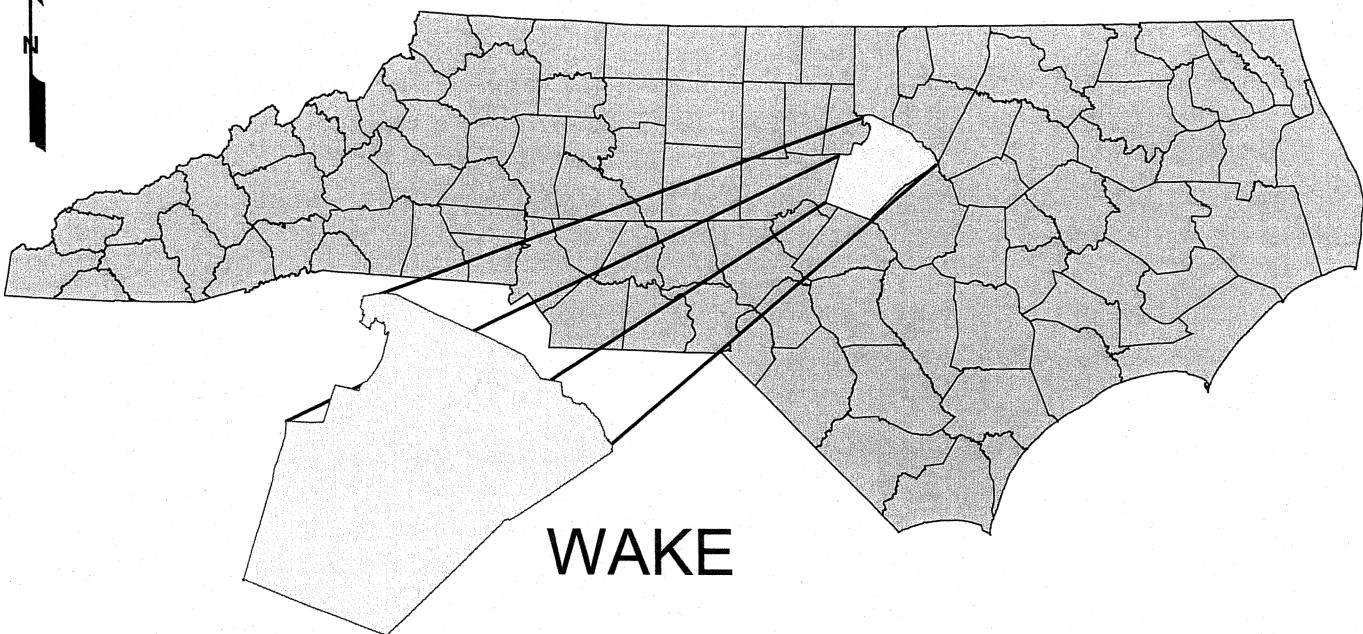

WAKE

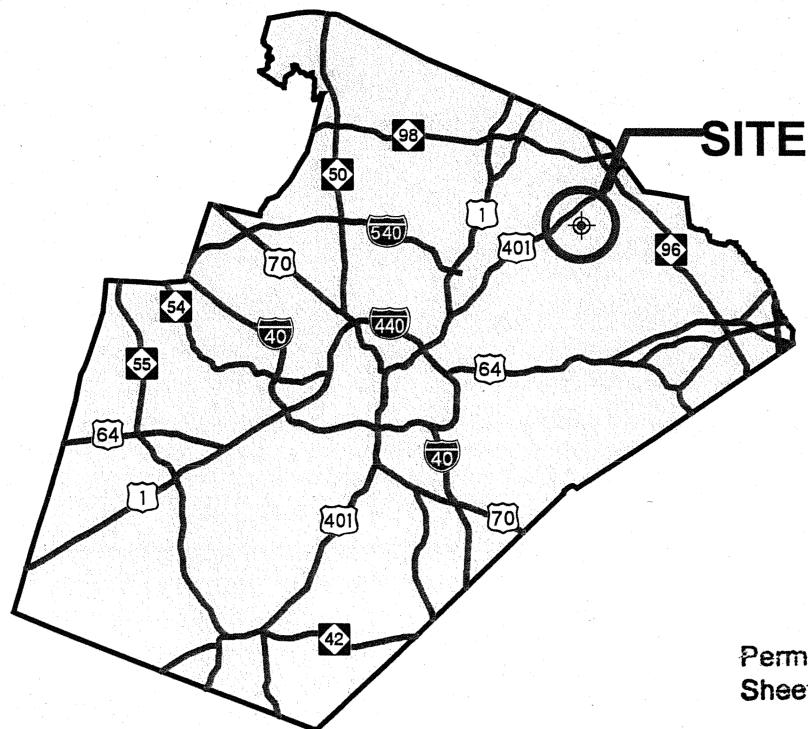


Permit Drawing  
Sheet 1 of 64

**STREAM  
AND WETLAND  
VICINITY  
MAP**

**NCDOT**  
DIVISION OF HIGHWAYS  
WAKE COUNTY  
PROJECT: 34506.1.1 (R-2814B)  
US 401 ROLESVILLE BYPASS  
FROM SR 2225, LOUISBURY ROAD  
TO NC 96, ZEBULON ROAD

NOVEMBER 2009

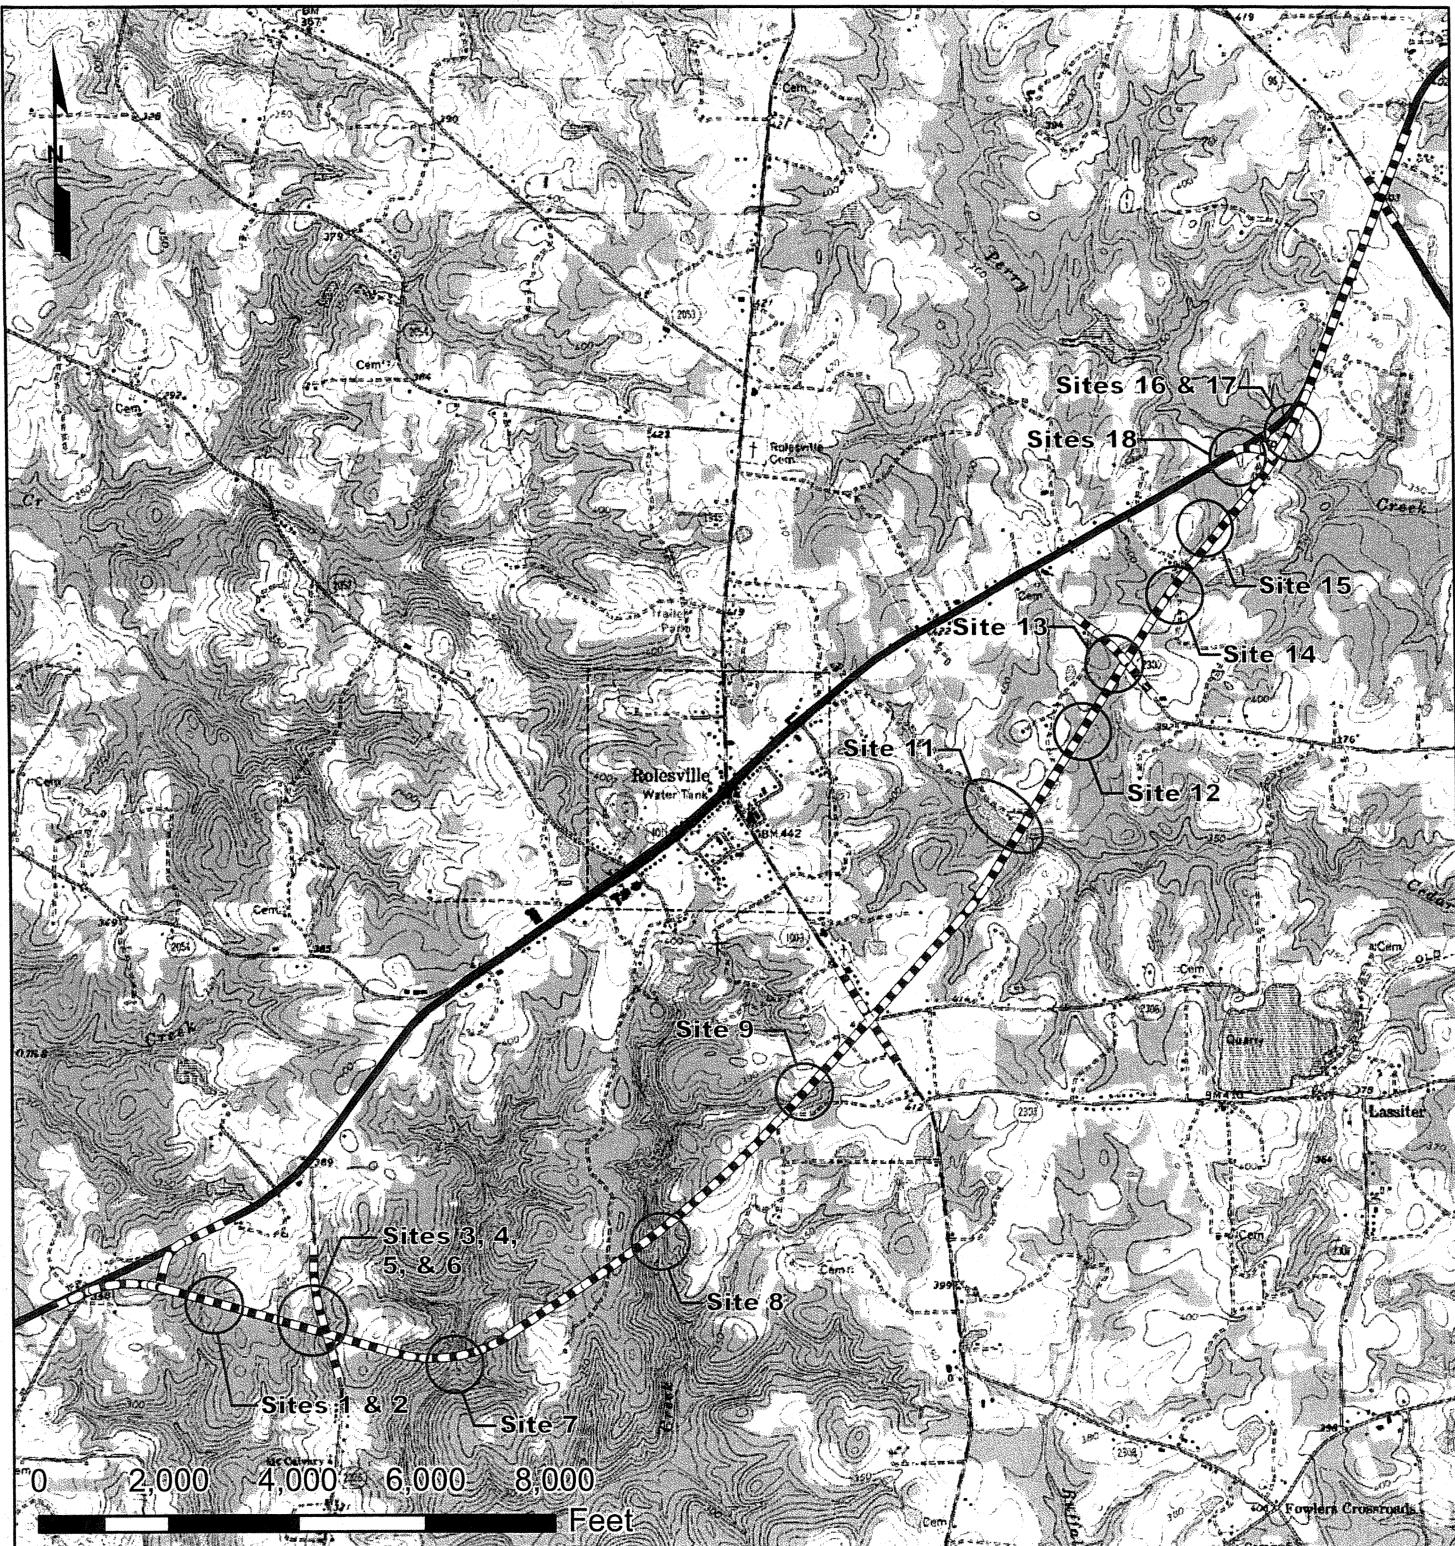

1 inch = 3,000 feet

# STREAM AND WETLAND LOCATION MAP

Source: USGS 7.5 Minute Quadrangle, Rolesville, NC

NCDOT  
DIVISION OF HIGHWAYS  
WAKE COUNTY  
PROJECT: 34506.1.1 (R-2814B)  
US 401 ROLESVILLE BYPASS  
FROM SR 2225, LOUISBURY ROAD  
TO NC 96, ZEBULON ROAD

NOVEMBER 2009

Permit Drawing  
Sheet 2 of 64

PROP. NO.	PROPERTY OWNER NAME	PROP. OWNER ADDRESS
7	Neuse Baptist Church	8700 Capital Blvd., Raleigh, NC 27587
8	Alexander Family Investments, LLC	906 Washington St., Cary, NC 27511
9	Scarbboro , E. Walter and Claire P.	9412 Louisburg Rd., Wake Forest, NC 27587
12	Bobby L. Murray Heirs (J Brent King Exec.)	PO Box 40639, Raleigh, NC 27629
13	Spencer, Pulley Heirs	9412 Louisburg Rd., Wake Forest, NC 27587
14	Scarbboro , E. Walter and Claire P.	9412 Louisburg Rd., Wake Forest, NC 27587
20	Shearon, Cameron E. & Beverly W.	4325 Galax Dr., Raleigh, NC 27612
21	Mitchell F. Rabil Family Irrevocable Trust	3321 Gondola Dr., Lexington KY, 40513
22	Shearon, Cameron E. & Beverly W.	4325 Galax Dr., Raleigh, NC 27612
33	R.S. Wall Heirs	1608 Falls Ct., Raleigh, NC 27615
33A	Wall, Alice W.	405 N. Main St., Rolesville, NC 27571
34	Scarbboro Family Limited Partnership	PO Box 84, Rolesville, NC 27571
35	Wall, Joe & Crystal H.	7317 Pulley Town Rd., Wake Forest, NC 27587
36	Wall, Joe & Crystal H.	7318 Pulley Town Rd., Wake Forest, NC 27587
37	Wall, Joe	7318 Pulley Town Rd., Wake Forest, NC 27587
38	Bobie Joe Wall & Vickie D. Wall	7309 Pulley Town Rd. Wake Forest, NC 27587
39	The SBJ Growth, L.P	PO Box 19067, Raleigh, NC
49	Bartholomew, Robert G. & Joyce C.	No Known Address
50	Bartholomew, Richard C. & Shirley B.	PO BOX 6, Rolesville, NC 27571
51	Bartholomew, Michael	PO BOX 573, Rolesville, NC 27571
52	Bartholomew, Richard C & Shirley B.	PO BOX 6, Rolesville, NC 27571
54	Keith, Jerry W. and Mary P	1124 Louisburg Rd., Wake Forest, NC 27587
54A	Bartholomew, Richard C. & Shirley B.	PO BOX 6, Rolesville, NC 27571
55	Stell, Meith & Mary Sue Et. Al.	1132 Louisburg Rd., Wake Forest, NC 27587
57	Sylvania Frazier & Lula Barnes McGhee	2725 Wait Ave., Wake Forest, NC 27557

N.C. DEPT. OF TRANSPORTATION  
DIVISION OF HIGHWAYS

WAKE COUNTY  
WBS - 34506.1.1 (R-2814B)

2/22/2010

Permit Drawing  
Sheet 3 of 64

### WETLAND PERMIT IMPACT SUMMARY

Site No.	Station (From/To)	Structure Size / Type	WETLAND IMPACTS				SURFACE WATER IMPACTS			
			Permanent Fill In Wetlands (ac)	Temp. Fill In Wetlands (ac)	Excavation in Wetlands (ac)	Mechanized Clearing in Wetlands (ac)	Hand Clearing in Wetlands (ac)	Permanent SW Impacts (ac)	Temp. SW Impacts (ac)	Existing Channel Impacts Permanent (ft)
1	-L- 38+11	60" RCP			<0.01	0.02		0.02	<0.01	243
2	-L- 41+07	30" RCP	0.17		<0.01	0.02				18
3	-L- 52+50 LT	N/A	0.22		<0.01					
4	-L- 55+00 RT	78" RCP	0.24		<0.01	0.01		<0.01	<0.01	95
4	-L- 55+00 RT	BANK STABILIZATION <sup>1</sup>						<0.01		20
5	-L- 55+00 LT <sup>1</sup>	78" RCP		0.01				1.51		
6	-Y2- 17+31 LT	2@42" RCP						<0.01		17
6	-Y2- 17+31 RT	2@42" RCP						<0.01		8
6	-Y2- 17+31 RT	BANK STABILIZATION						<0.01		14
7	-L- 77+89	10X10' RCBC	0.65		0.10	0.09		0.12	0.02	321
7	-L- 77+89	BANK STABILIZATION						<0.01		47
8	-L- 115+74	10X10' RCBC						0.05	<0.01	355
8	-L- 115+74	BANK STABILIZATION						0.03		153
9	-L- 147+00 <sup>2</sup>	72" RCP						1.31	<0.01	610
11	-L- 200+04 <sup>3</sup>	10X9' RCBC						7.29	<0.01	0
12	-L- 219+03	42" RCP						0.02		258
13	-L- 229+75	36" RCP	0.19							
14	-L- 246+87	48" RCP	0.36		<0.01	0.06				
15	-L- 255+00 <sup>4</sup>	30" RCP	1.58							
16	-L- 275+39	2@12X12' RCBC						0.05	<0.01	189
16	-L- 275+39	BANK STABILIZATION						0.06		135
17	-L- 277+50 LT	N/A	0.38							
18	-Y6- 15+17	2@36" RCP						<0.01	<0.01	36
18	-Y6- 15+17	BANK STABILIZATION								33
<b>TOTALS:</b>			3.79	0.00	0.12	0.19	0.00	10.47	0.04	2509
										205

<sup>1</sup> ENTIRE AREA IS IMPACT IN SURFACE WATER (POND)


<sup>2</sup> IMPACT IN SURFACE WATER (POND) IS 1.25 AC

<sup>3</sup> ENTIRE PERMANENT IMPACT AREA IS SURFACE WATER (POND)

<sup>4</sup> ISOLATED WETLAND TOTAL TAKE (1.58 AC)

## **CONTRACT:**

**TIP PROJECT: R-2814B**

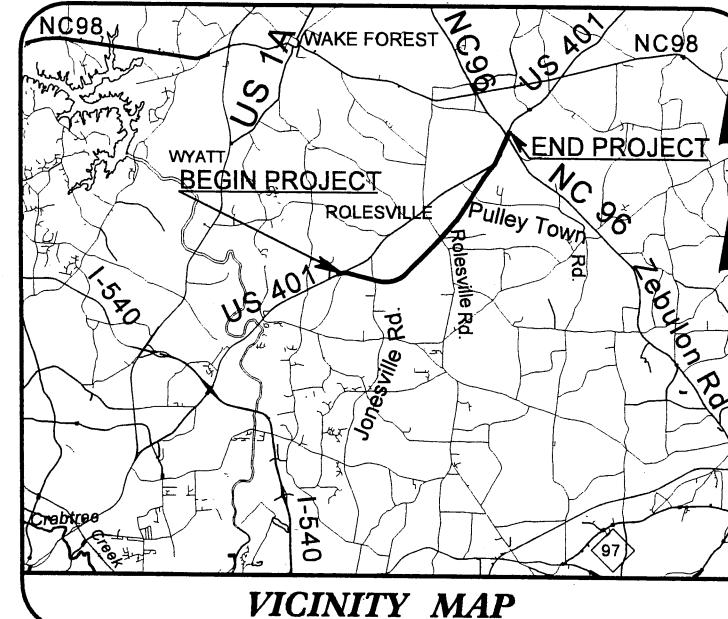


STATE OF NORTH CAROLINA  
DIVISION OF HIGHWAYS

# **WAKE COUNTY**


**LOCATION: US 401 ROLESVILLE BYPASS FROM SR 2225,  
LOUISBURY ROAD TO NC 96, ZEBULON ROAD**

**WETLAND AND STREAM IMPACTS**

**Permit Drawing  
Sheet 5 of 64**

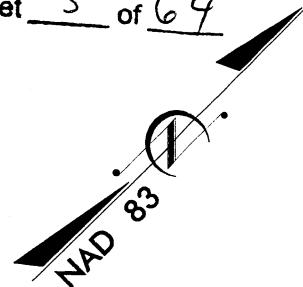


*TO RALEIGH* -L- STA 16+31 BEGIN STATE PROJECT R-2814E

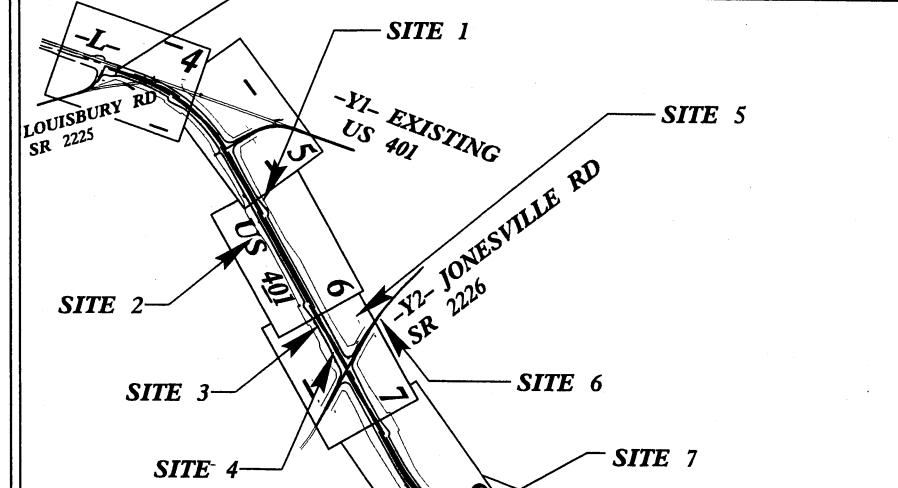

**CLEARING ON THIS PROJECT SHALL BE  
PERFORMED TO THE LIMITS ESTABLISHED  
BY METHOD III.**

**NOTE: THIS IS A PARTIALLY CONTROLLED ACCESS  
PROJECT WITH ACCESS POINTS SHOWN ON THE PLAN.**

**NOTE: THIS PROJECT IS NOT WITHIN ANY MUNICIPAL BOUNDARIES**

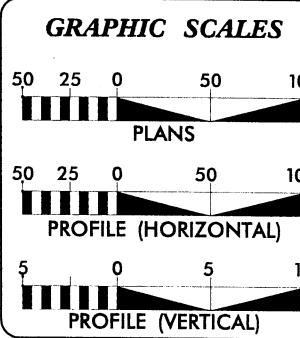

**DESIGN DATA**

ADT 2030 =	24600
ADT =	
DHV =	55 %
D ≈	13 %
T =	7 % *
V =	60 MPH

\* TTST 2 DUAL

#### **PROJECT LENGTH**

**LENGTH ROADWAY F.A. PROJECT STP-401(4) = 5.696 MILES**  
**TOTAL LENGTH TIP PROJECT R-2814B = 5.696 MILES**

PERMIT DRAWINGS PREPARED BY :	
 <b>RUMMEL, KLEPPER &amp; KAHL, LLP</b> 900 RIDGEFIELD DRIVE, SUITE 350 RALEIGH, NORTH CAROLINA 27609 NC LICENSE NO. F-0112	
FOR THE DIVISION OF HIGHWAYS	
2006 STANDARD SPECIFICATIONS	
<b>RIGHT OF WAY DATE:</b>	<u>APRIL 17, 2009</u>
<b>LETTING DATE:</b>	<u>APRIL 19, 2011</u>
<u>JS GOODNIGHT</u> PROJECT ENGINEER	
<u>TD GOINS</u> PROJECT DESIGN ENGINEER	

<b>HYDRAULICS ENGINEER</b>	P.E.
<hr/>	
<b>SIGNATURE:</b>	<hr/>
<b>ROADWAY DESIGN ENGINEER</b>	
<hr/>	
<b>SIGNATURE:</b>	<hr/>

**INCOMPLETE PLANS**  
DO NOT USE FOR R/W ACQUISITION

**PRELIMINARY PLANS**  
DO NOT USE FOR CONSTRUCTION






































DIVISION OF HIGHWAYS  
STATE OF NORTH CAROLINA



P.E.





PROJECT REFERENCE NO.		SHEET NO.
R-2814B	2-C	
ROADWAY DESIGN ENGINEER	PAVEMENT DESIGN ENGINEER	
<b>INCOMPLETE PLANS</b> <small>DO NOT USE FOR R/W ACQUISITION</small>		
<b>PRELIMINARY PLANS</b> <small>DO NOT USE FOR CONSTRUCTION</small>		

Permit Drawing  
Sheet 6 of 64

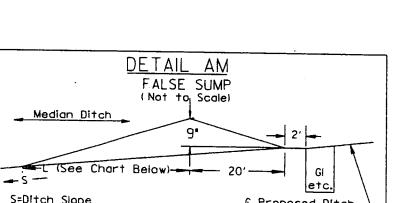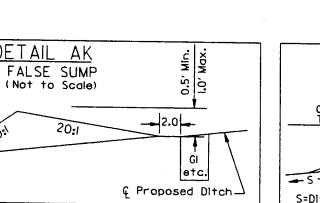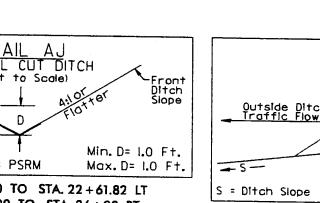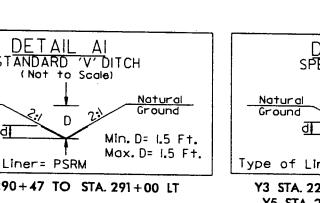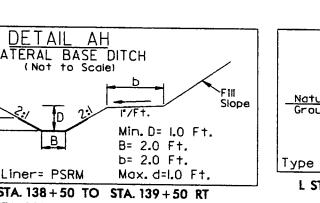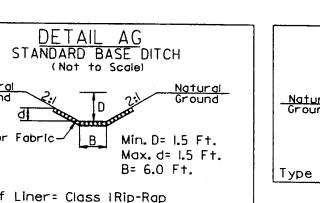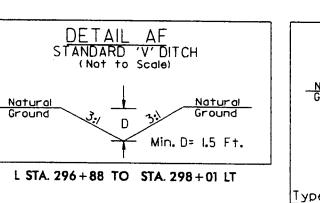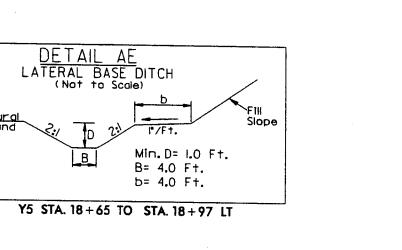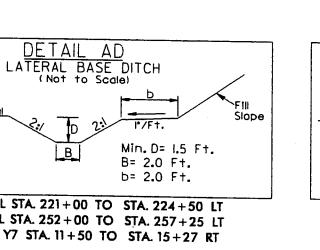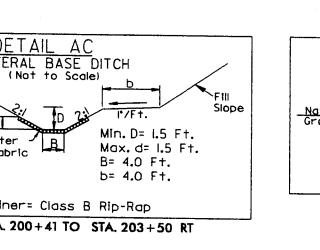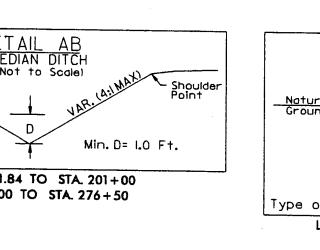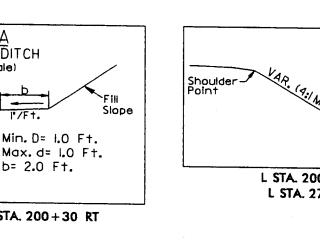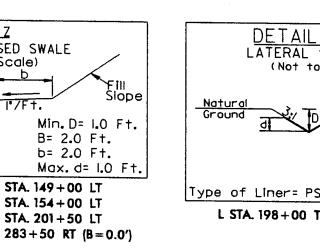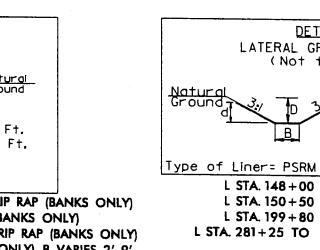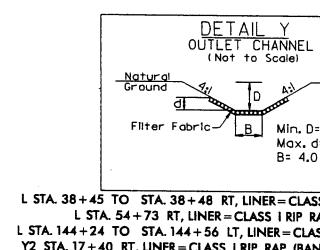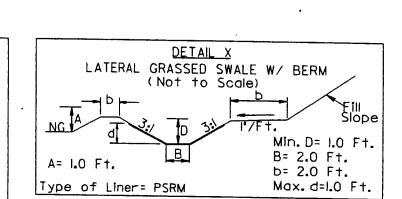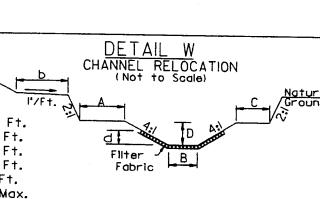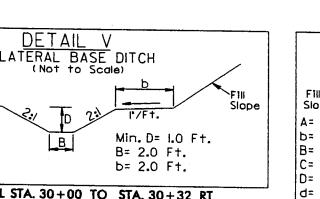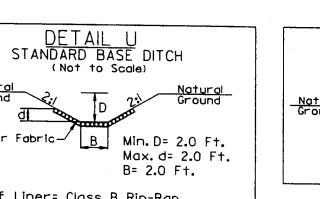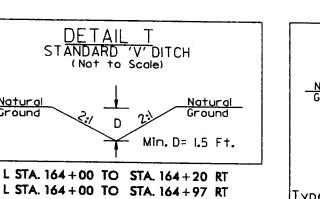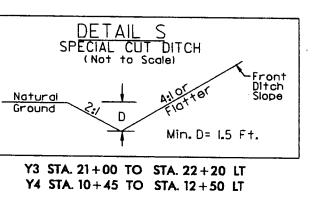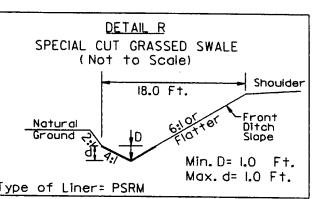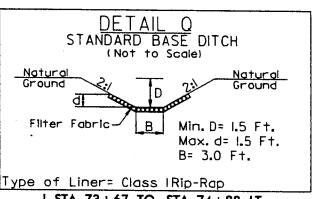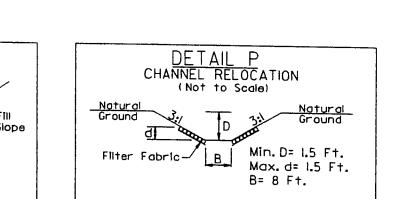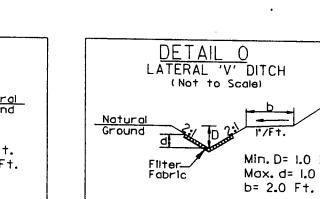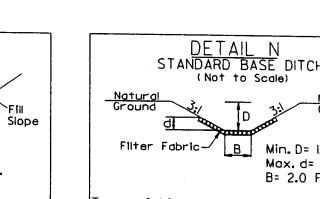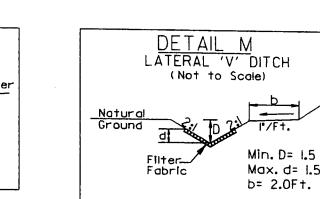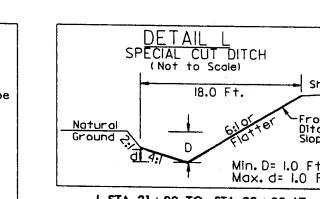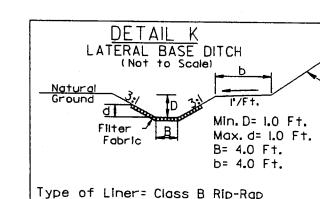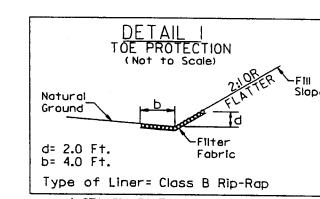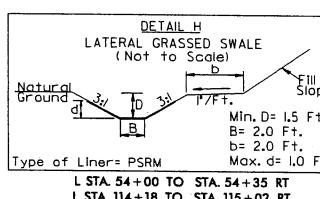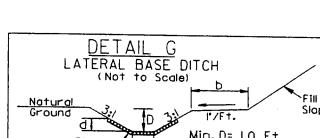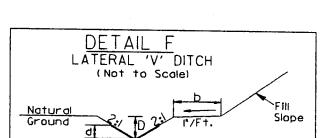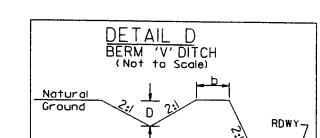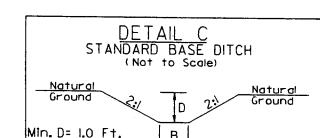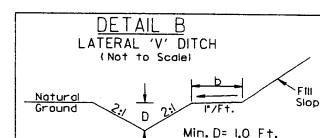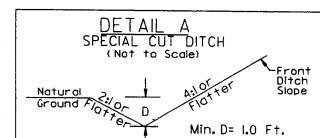



PROJECT REFERENCE NO.	SHEET NO.
R-2814B	2-D
ROADWAY DESIGN ENGINEER	PAVEMENT DESIGN ENGINEER
INCOMPLETE PLANS DO NOT USE FOR I/W ACQUISITION	PRELIMINARY PLANS DO NOT USE FOR CONSTRUCTION

Permit Drawing  
Sheet 7 of 64

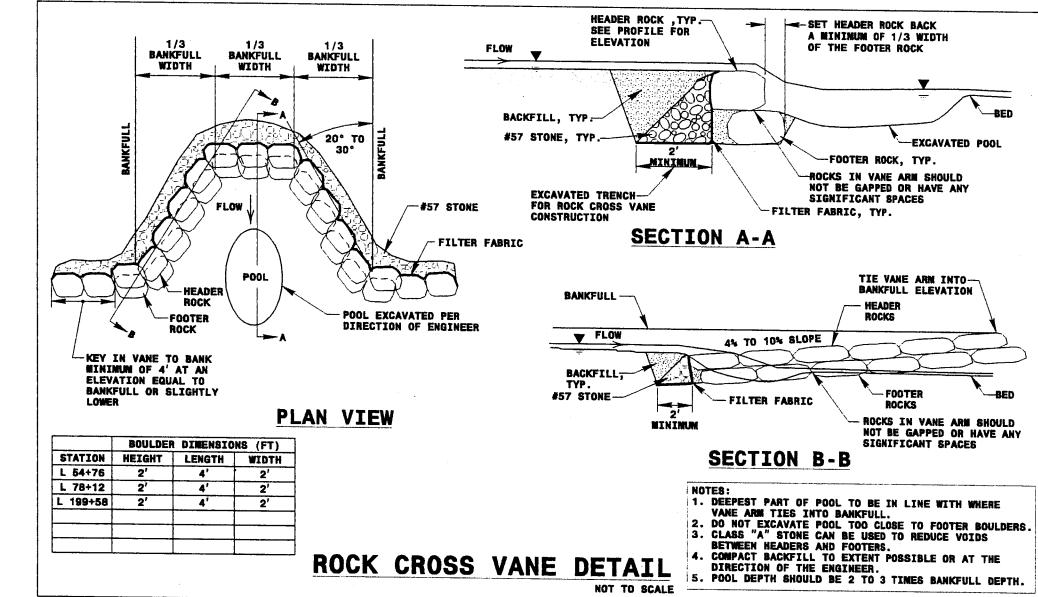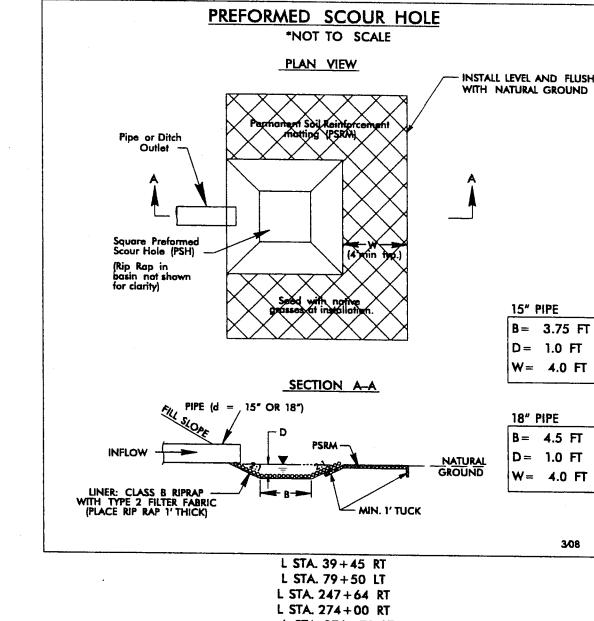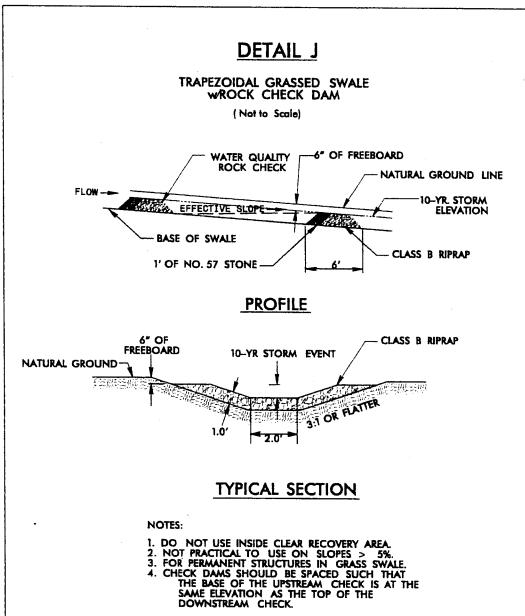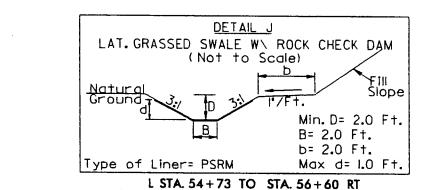


### ROCK CROSS VANE DETAIL


#### CULVERT INLET\OUTLET DETAILS HARRIS CREEK TRIBUTARY -L- STA 77+89

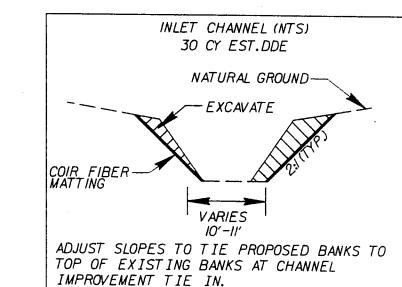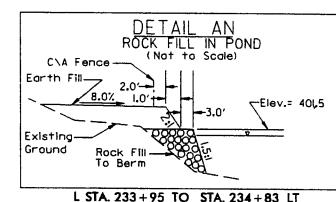






#### CULVERT INLET\OUTLET DETAILS HARRIS CREEK -L- STA 115+74

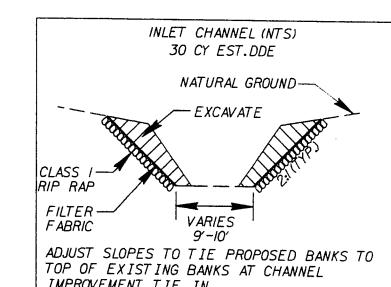

#### CULVERT INLET\OUTLET DETAILS CEDAR FORK -L- STA 200+04

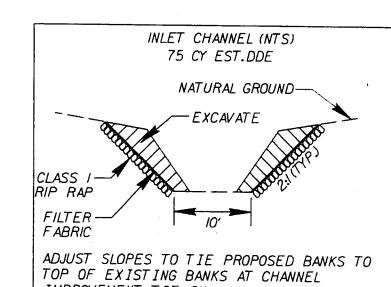

#### CULVERT INLET\OUTLET DETAILS PERRY CREEK -L- STA 275+39

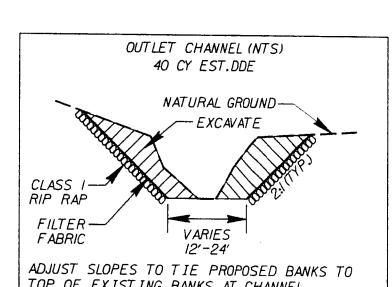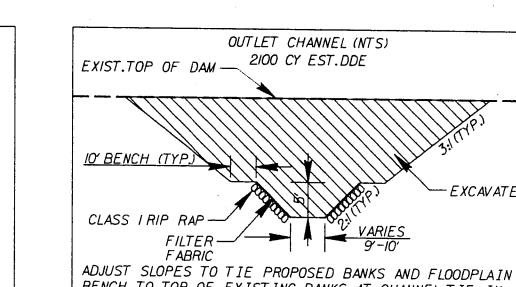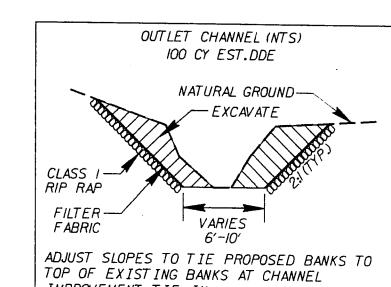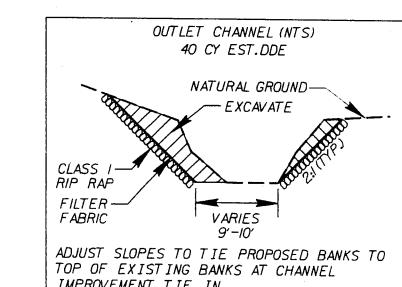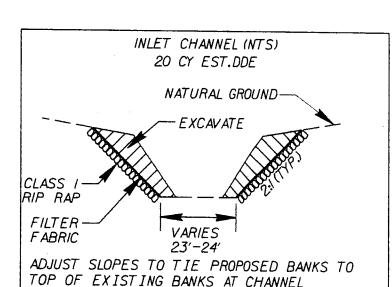


Permit Drawing  
Sheet 8 of 64

ALEXANDER FAMILY INVESTMENTS, LLC




---

**REVISIONS**

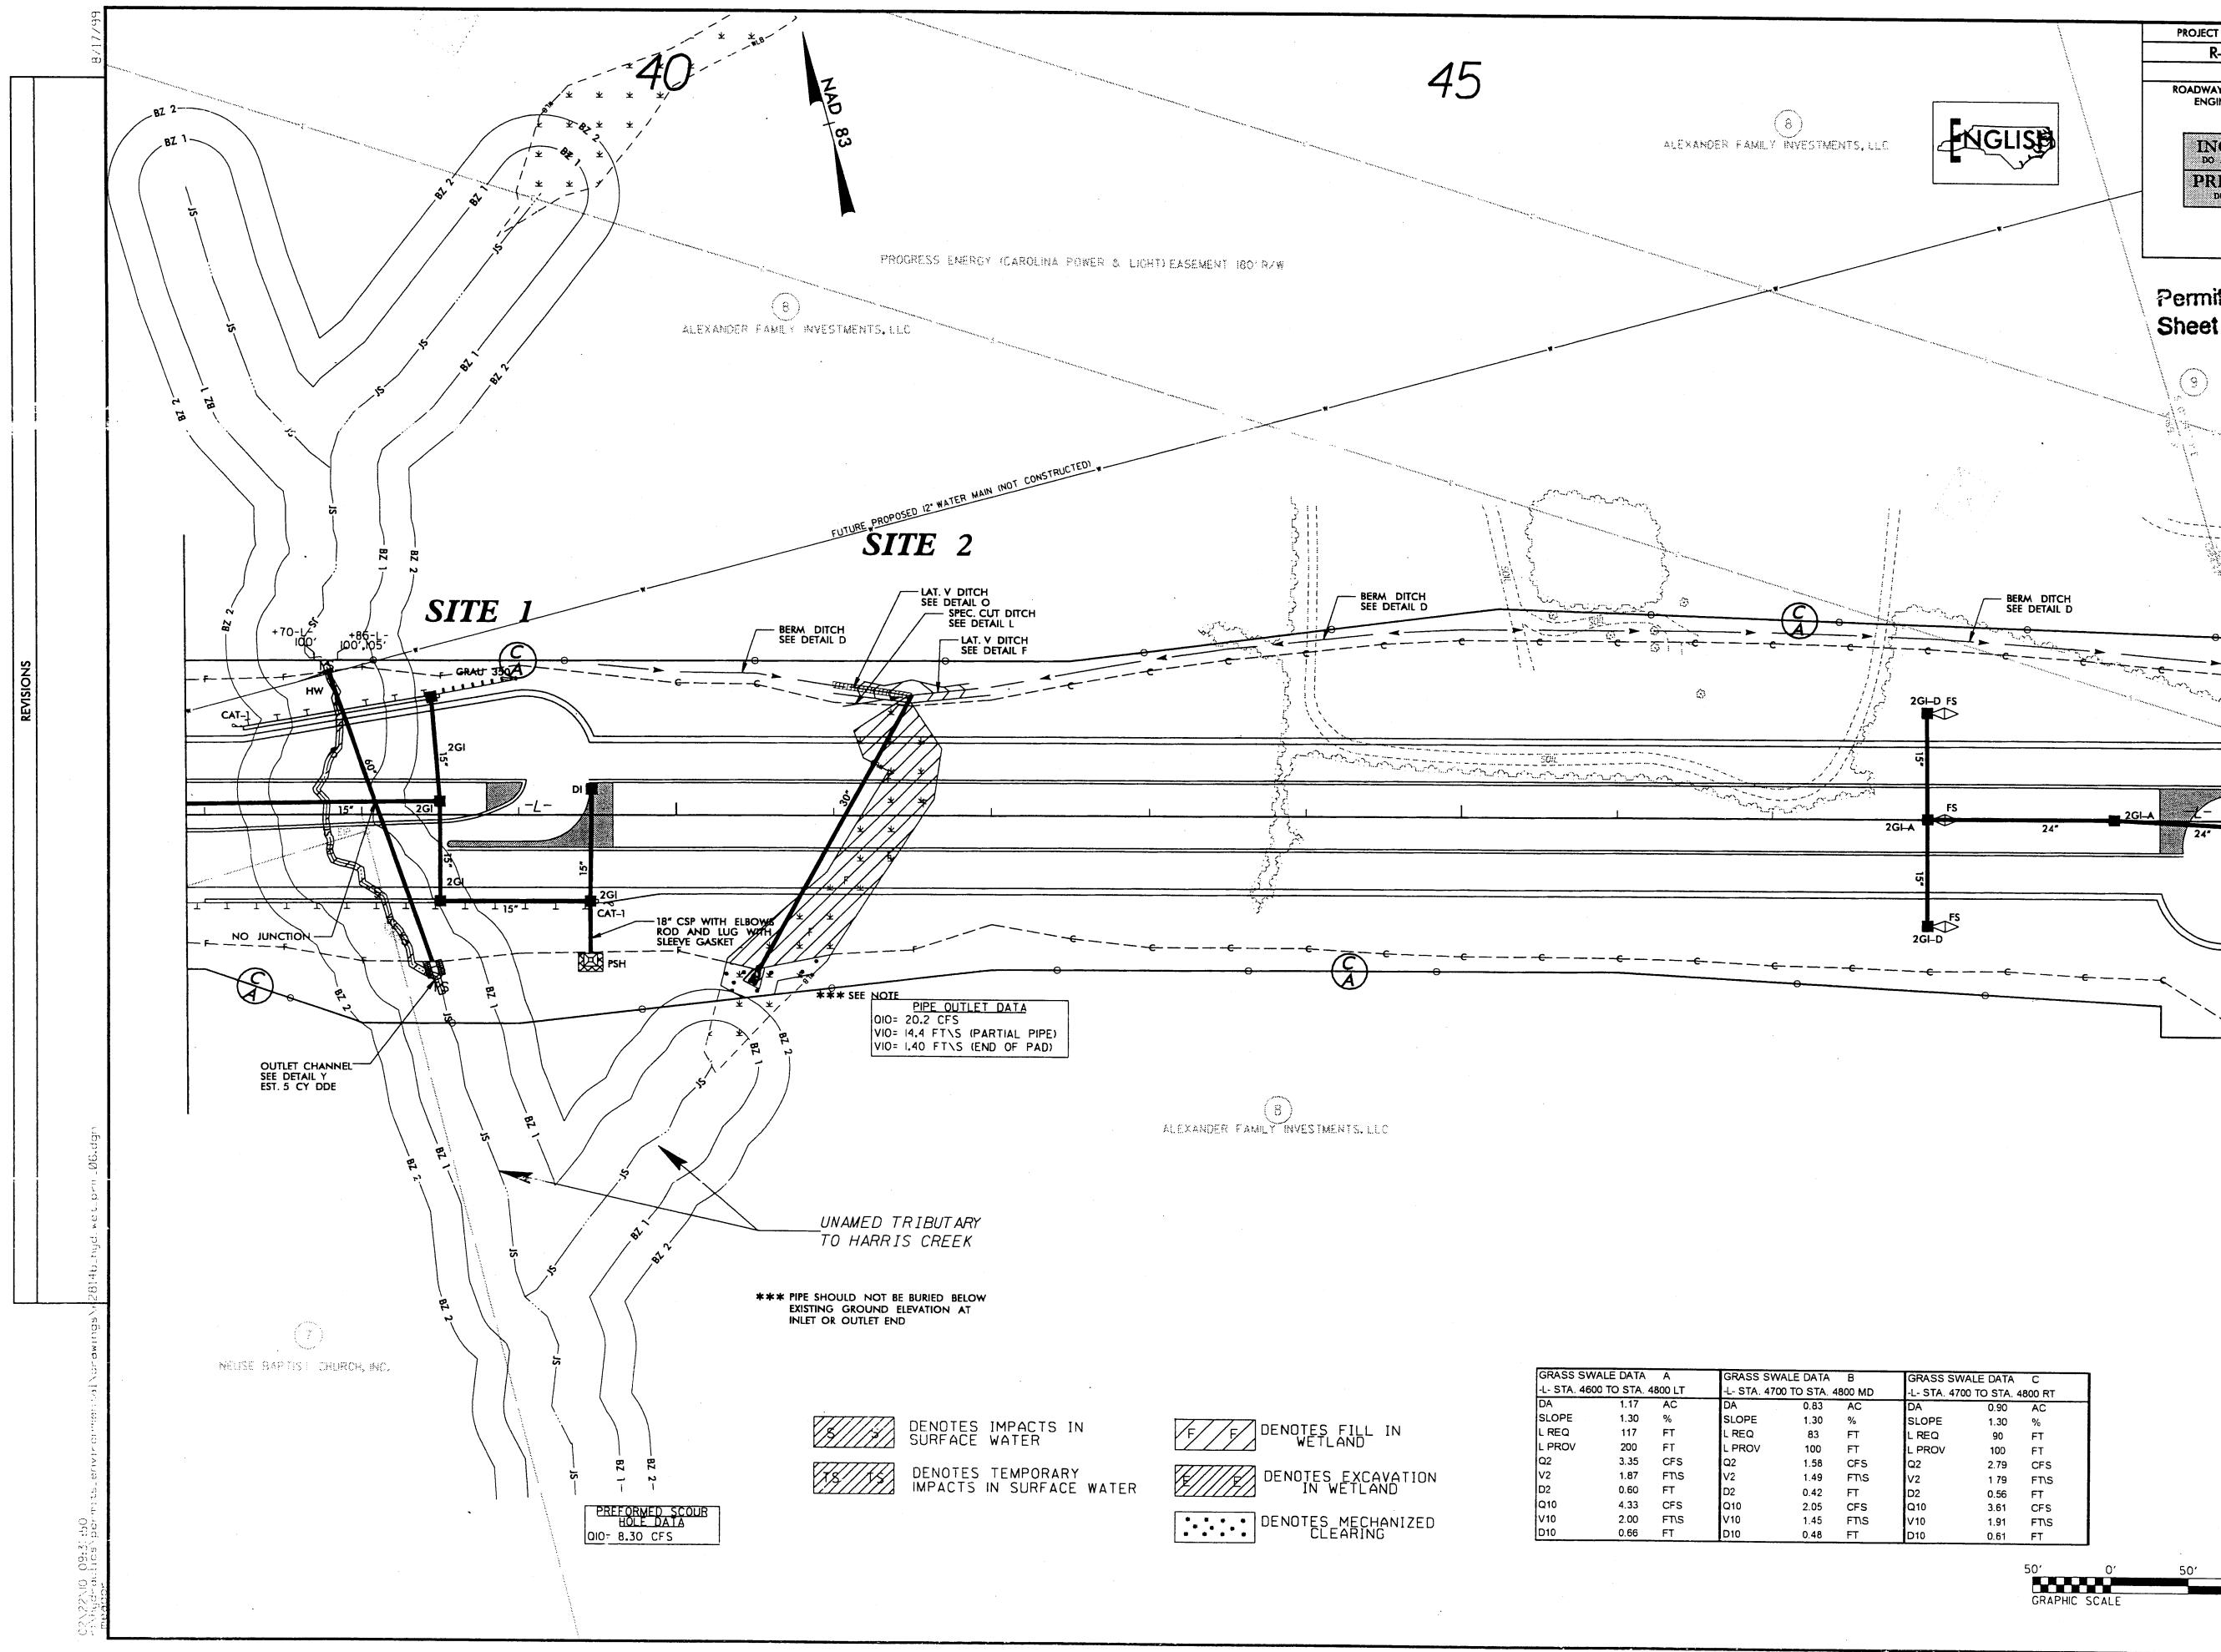

REVISIONS

2017-09-06\PermitDrawings\PermitDrawings\PermitDrawings.dwg

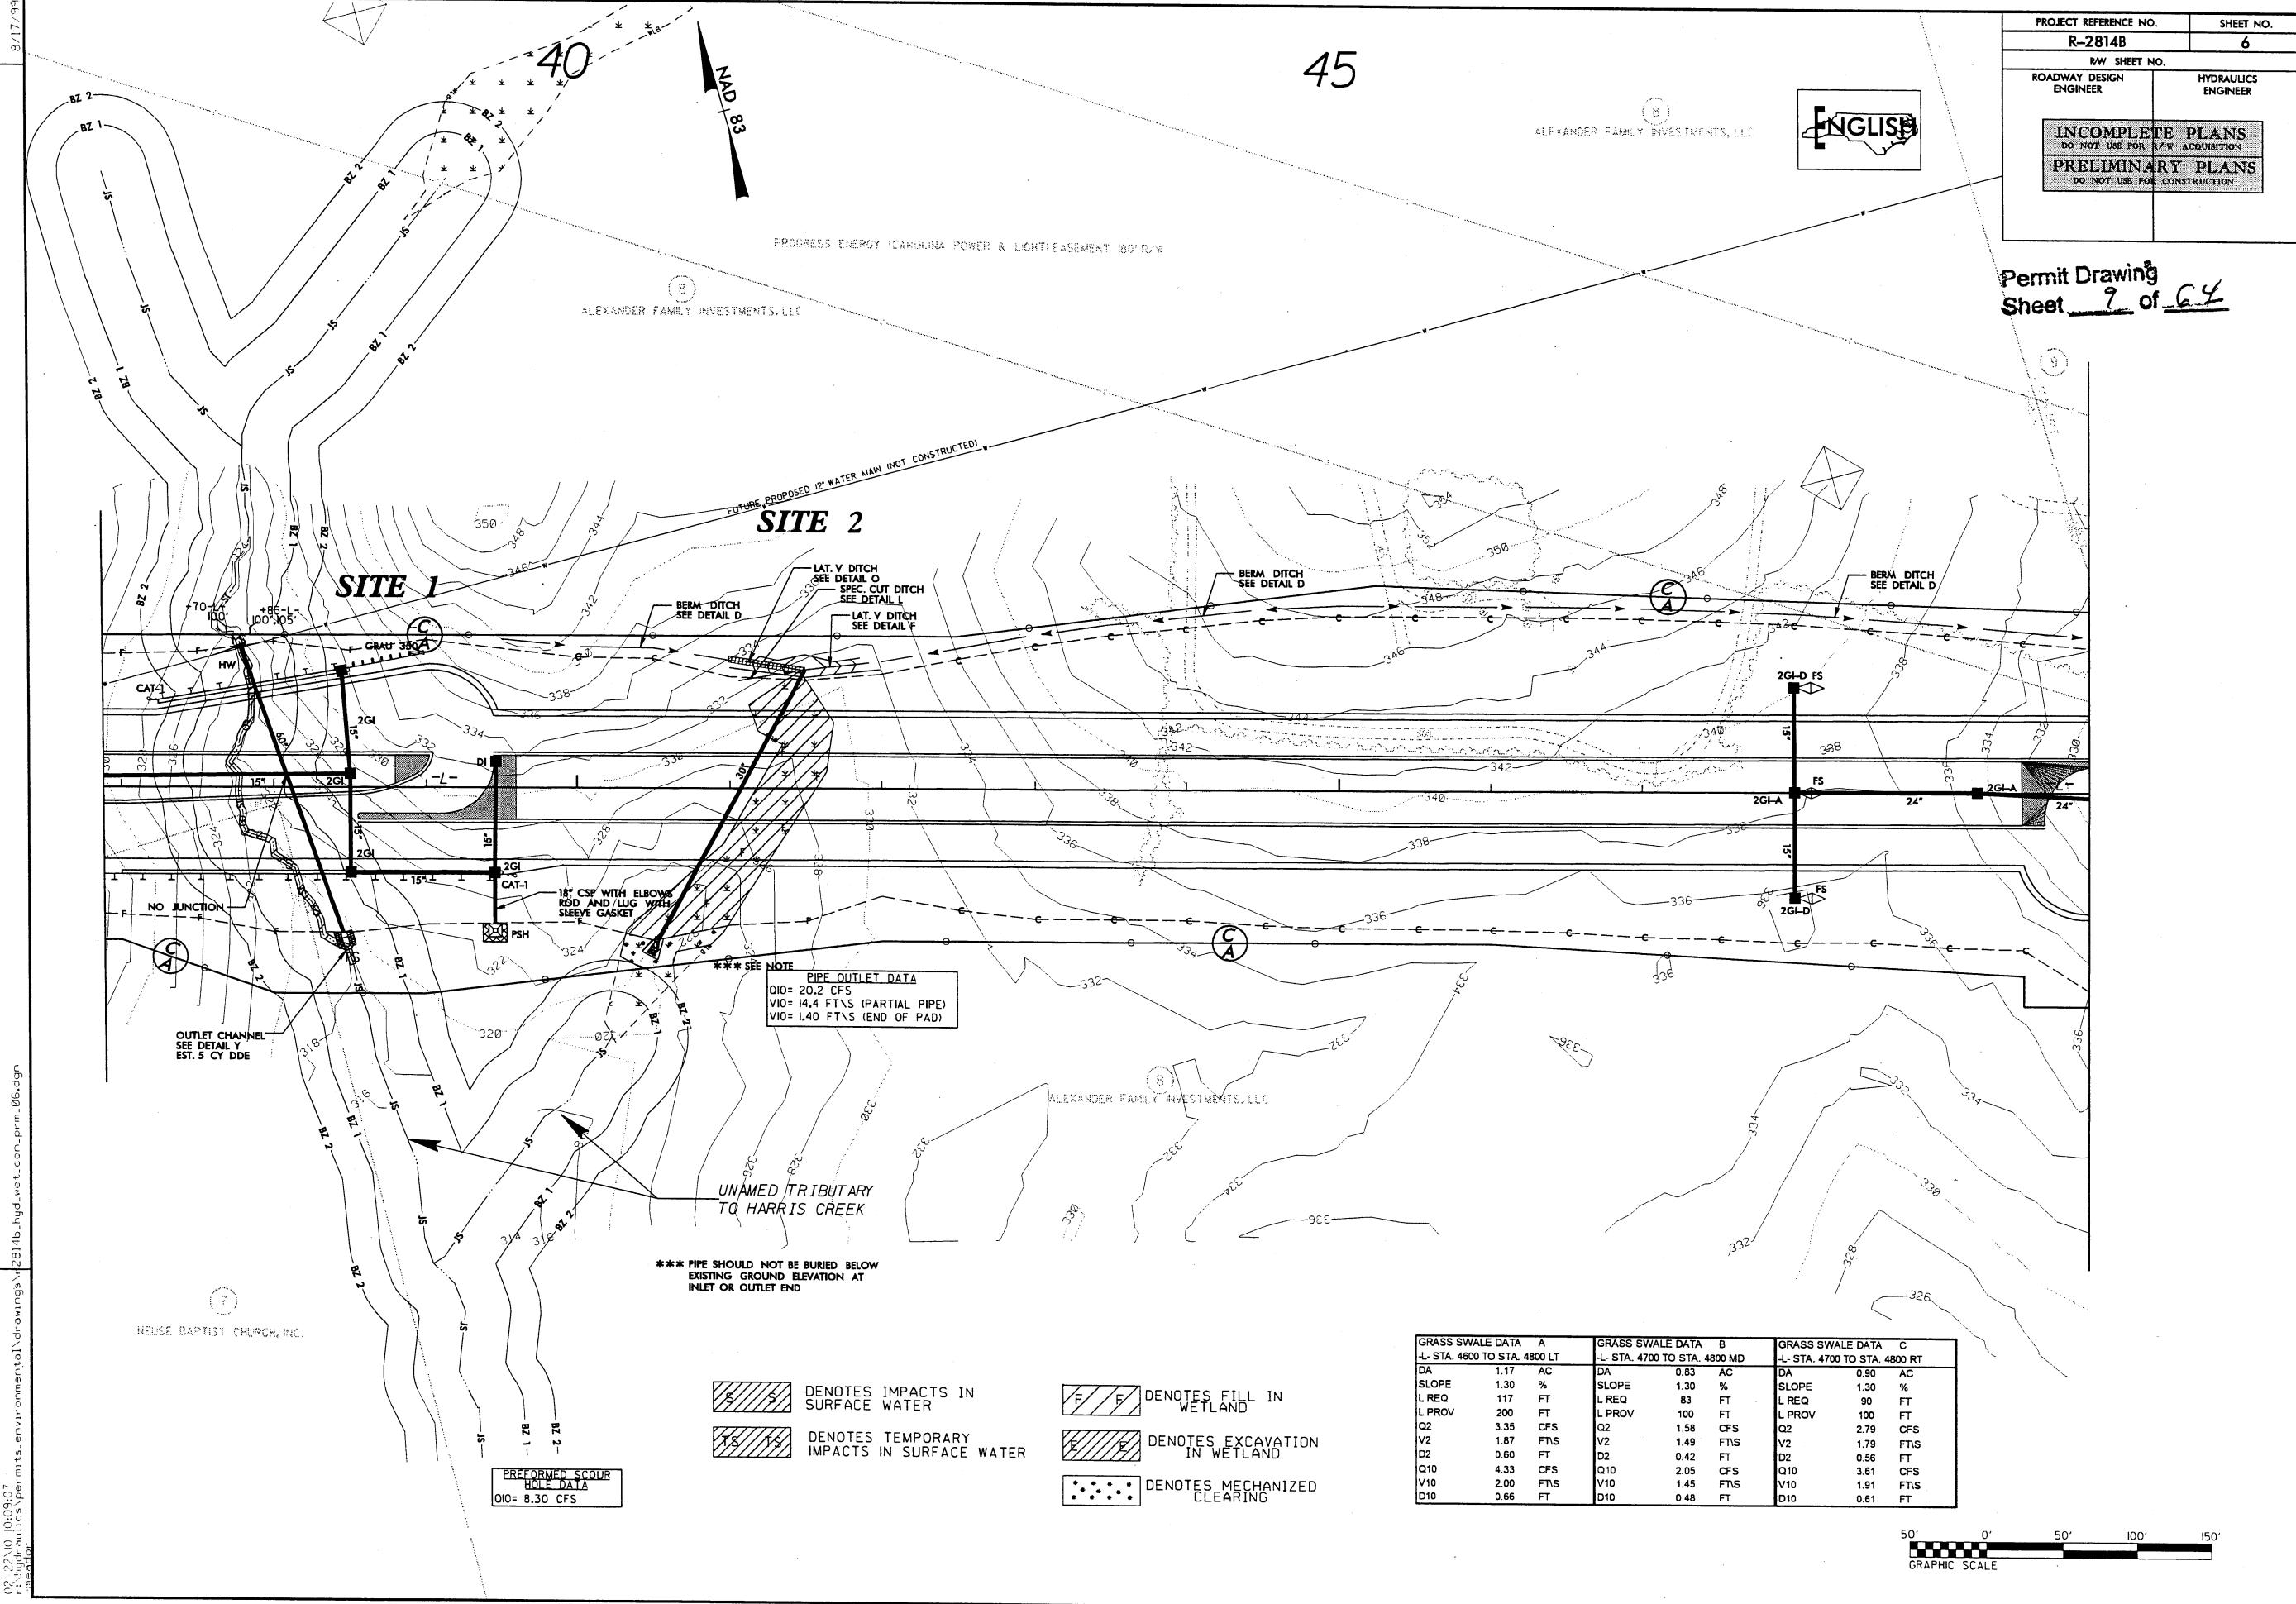



# SITE 1

60" RCP  
C-L- 38+11  
PGL ELEV.= 339.24'  
SKEW = 70°42'06"

50' 0' 50'

HORIZONTAL SCALE

5' 0' 5'

VERTICAL SCALE

Permit Drawing  
Sheet 10 of 64

335

330

325

320


315


310

305


300


295

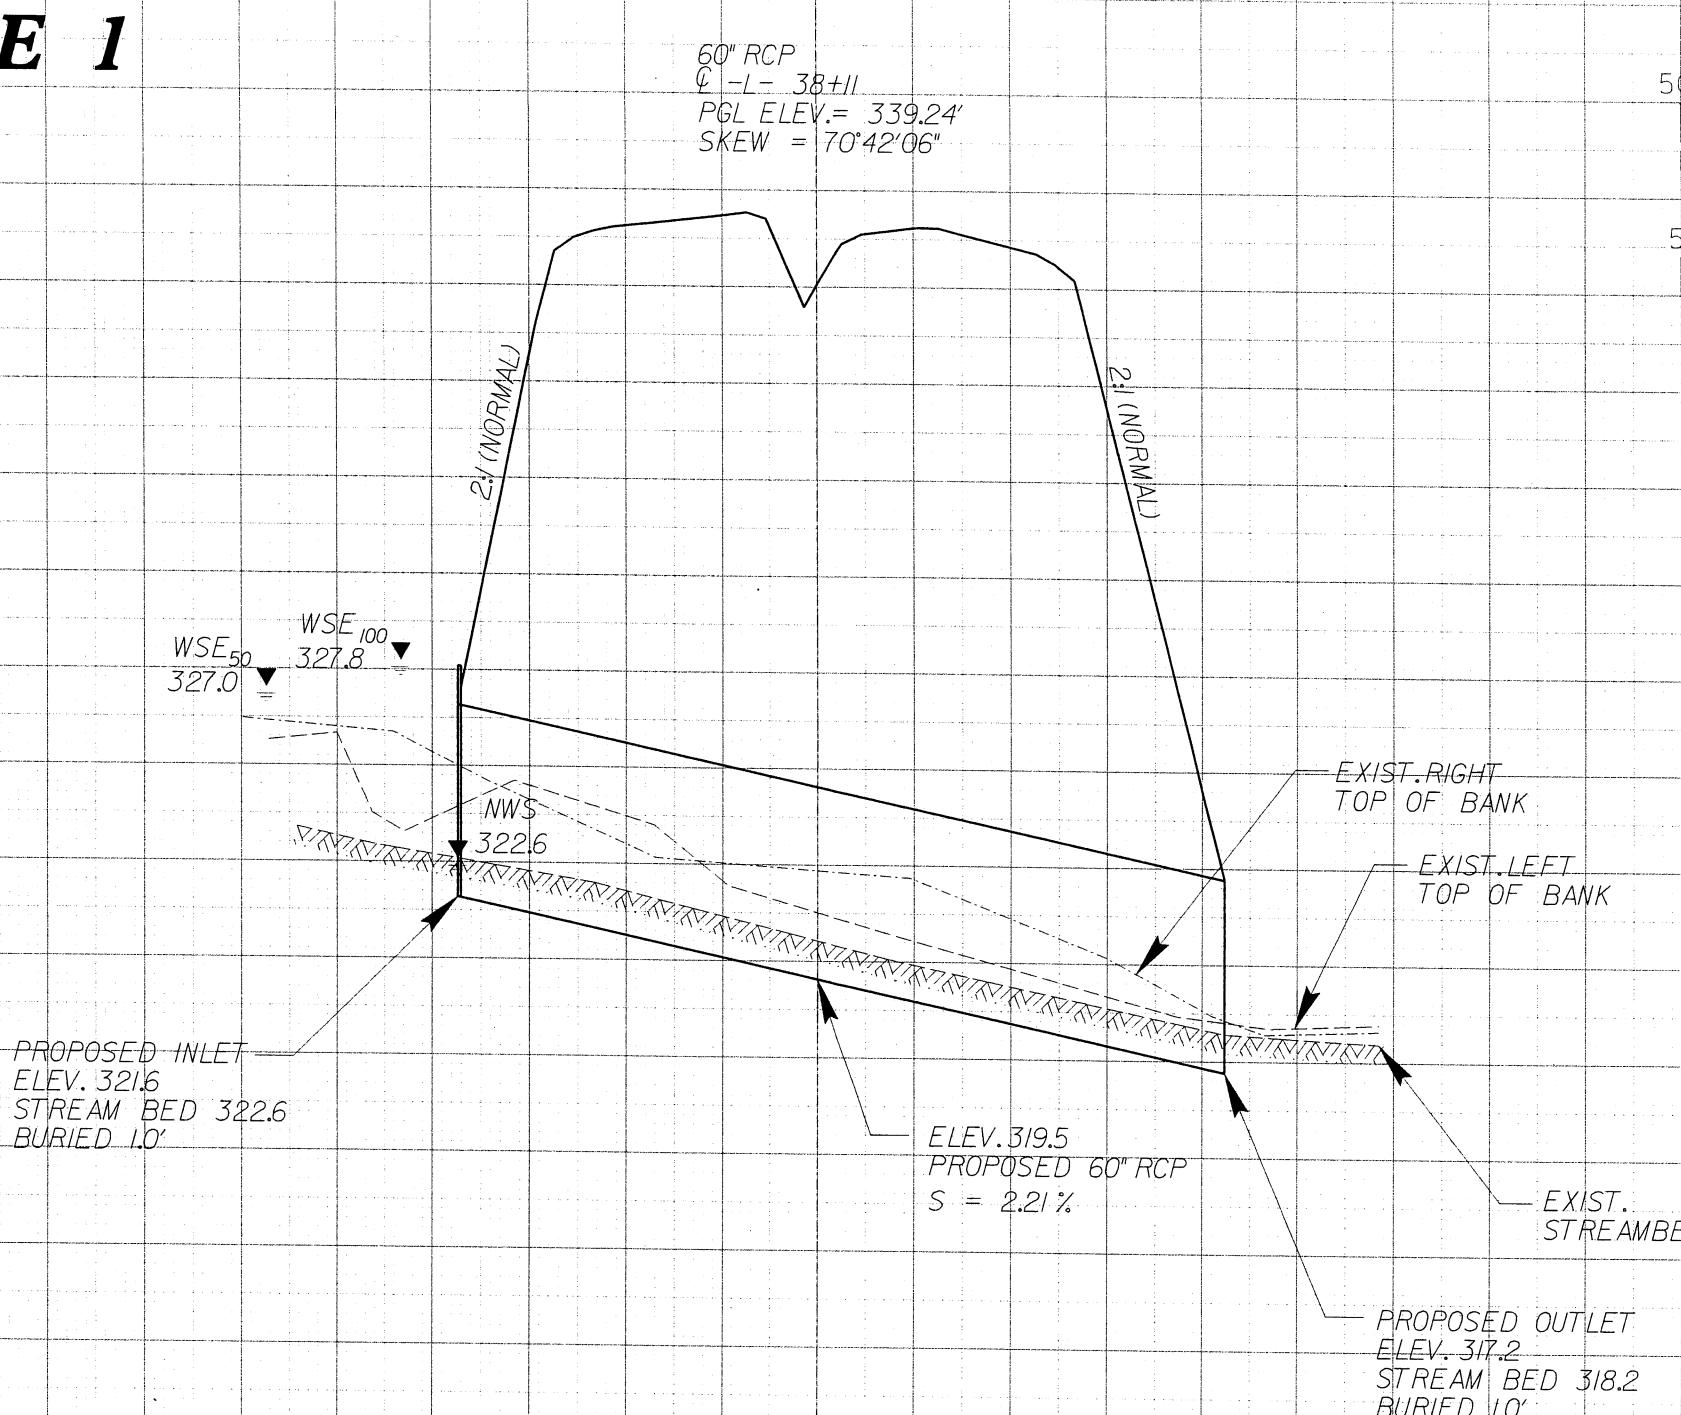

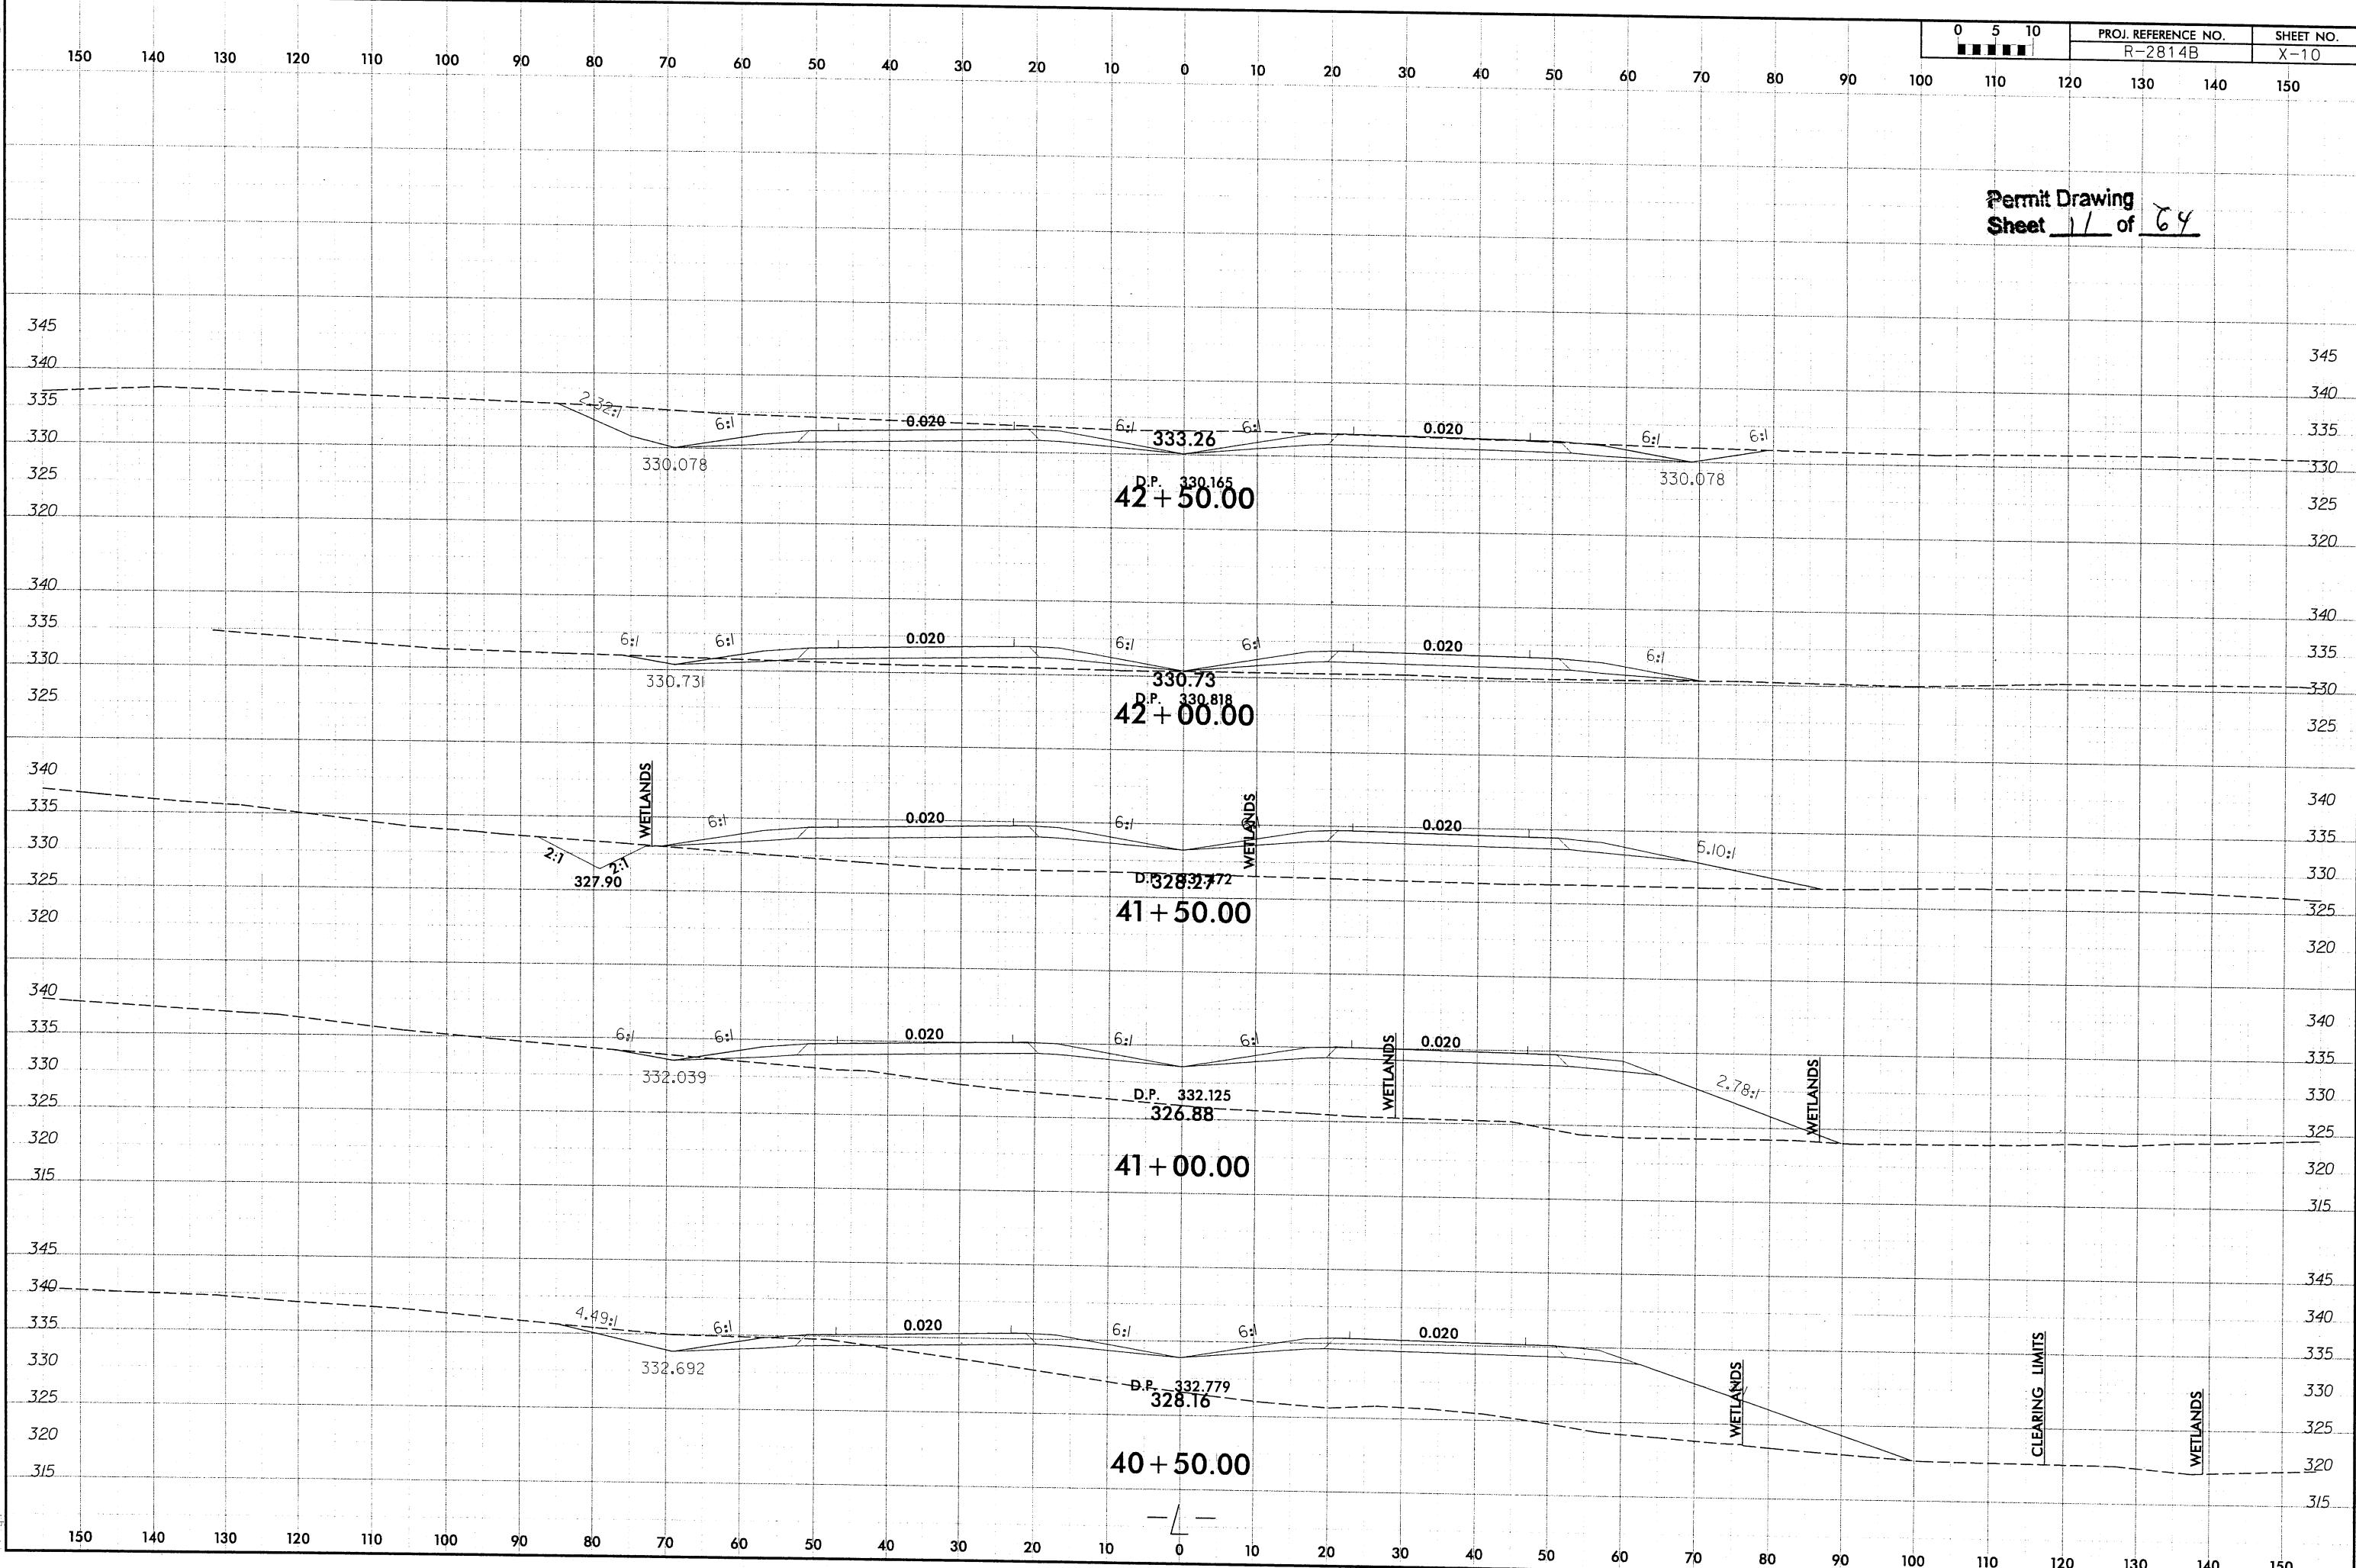

Permit Drawing  
Sheet 12 of 64

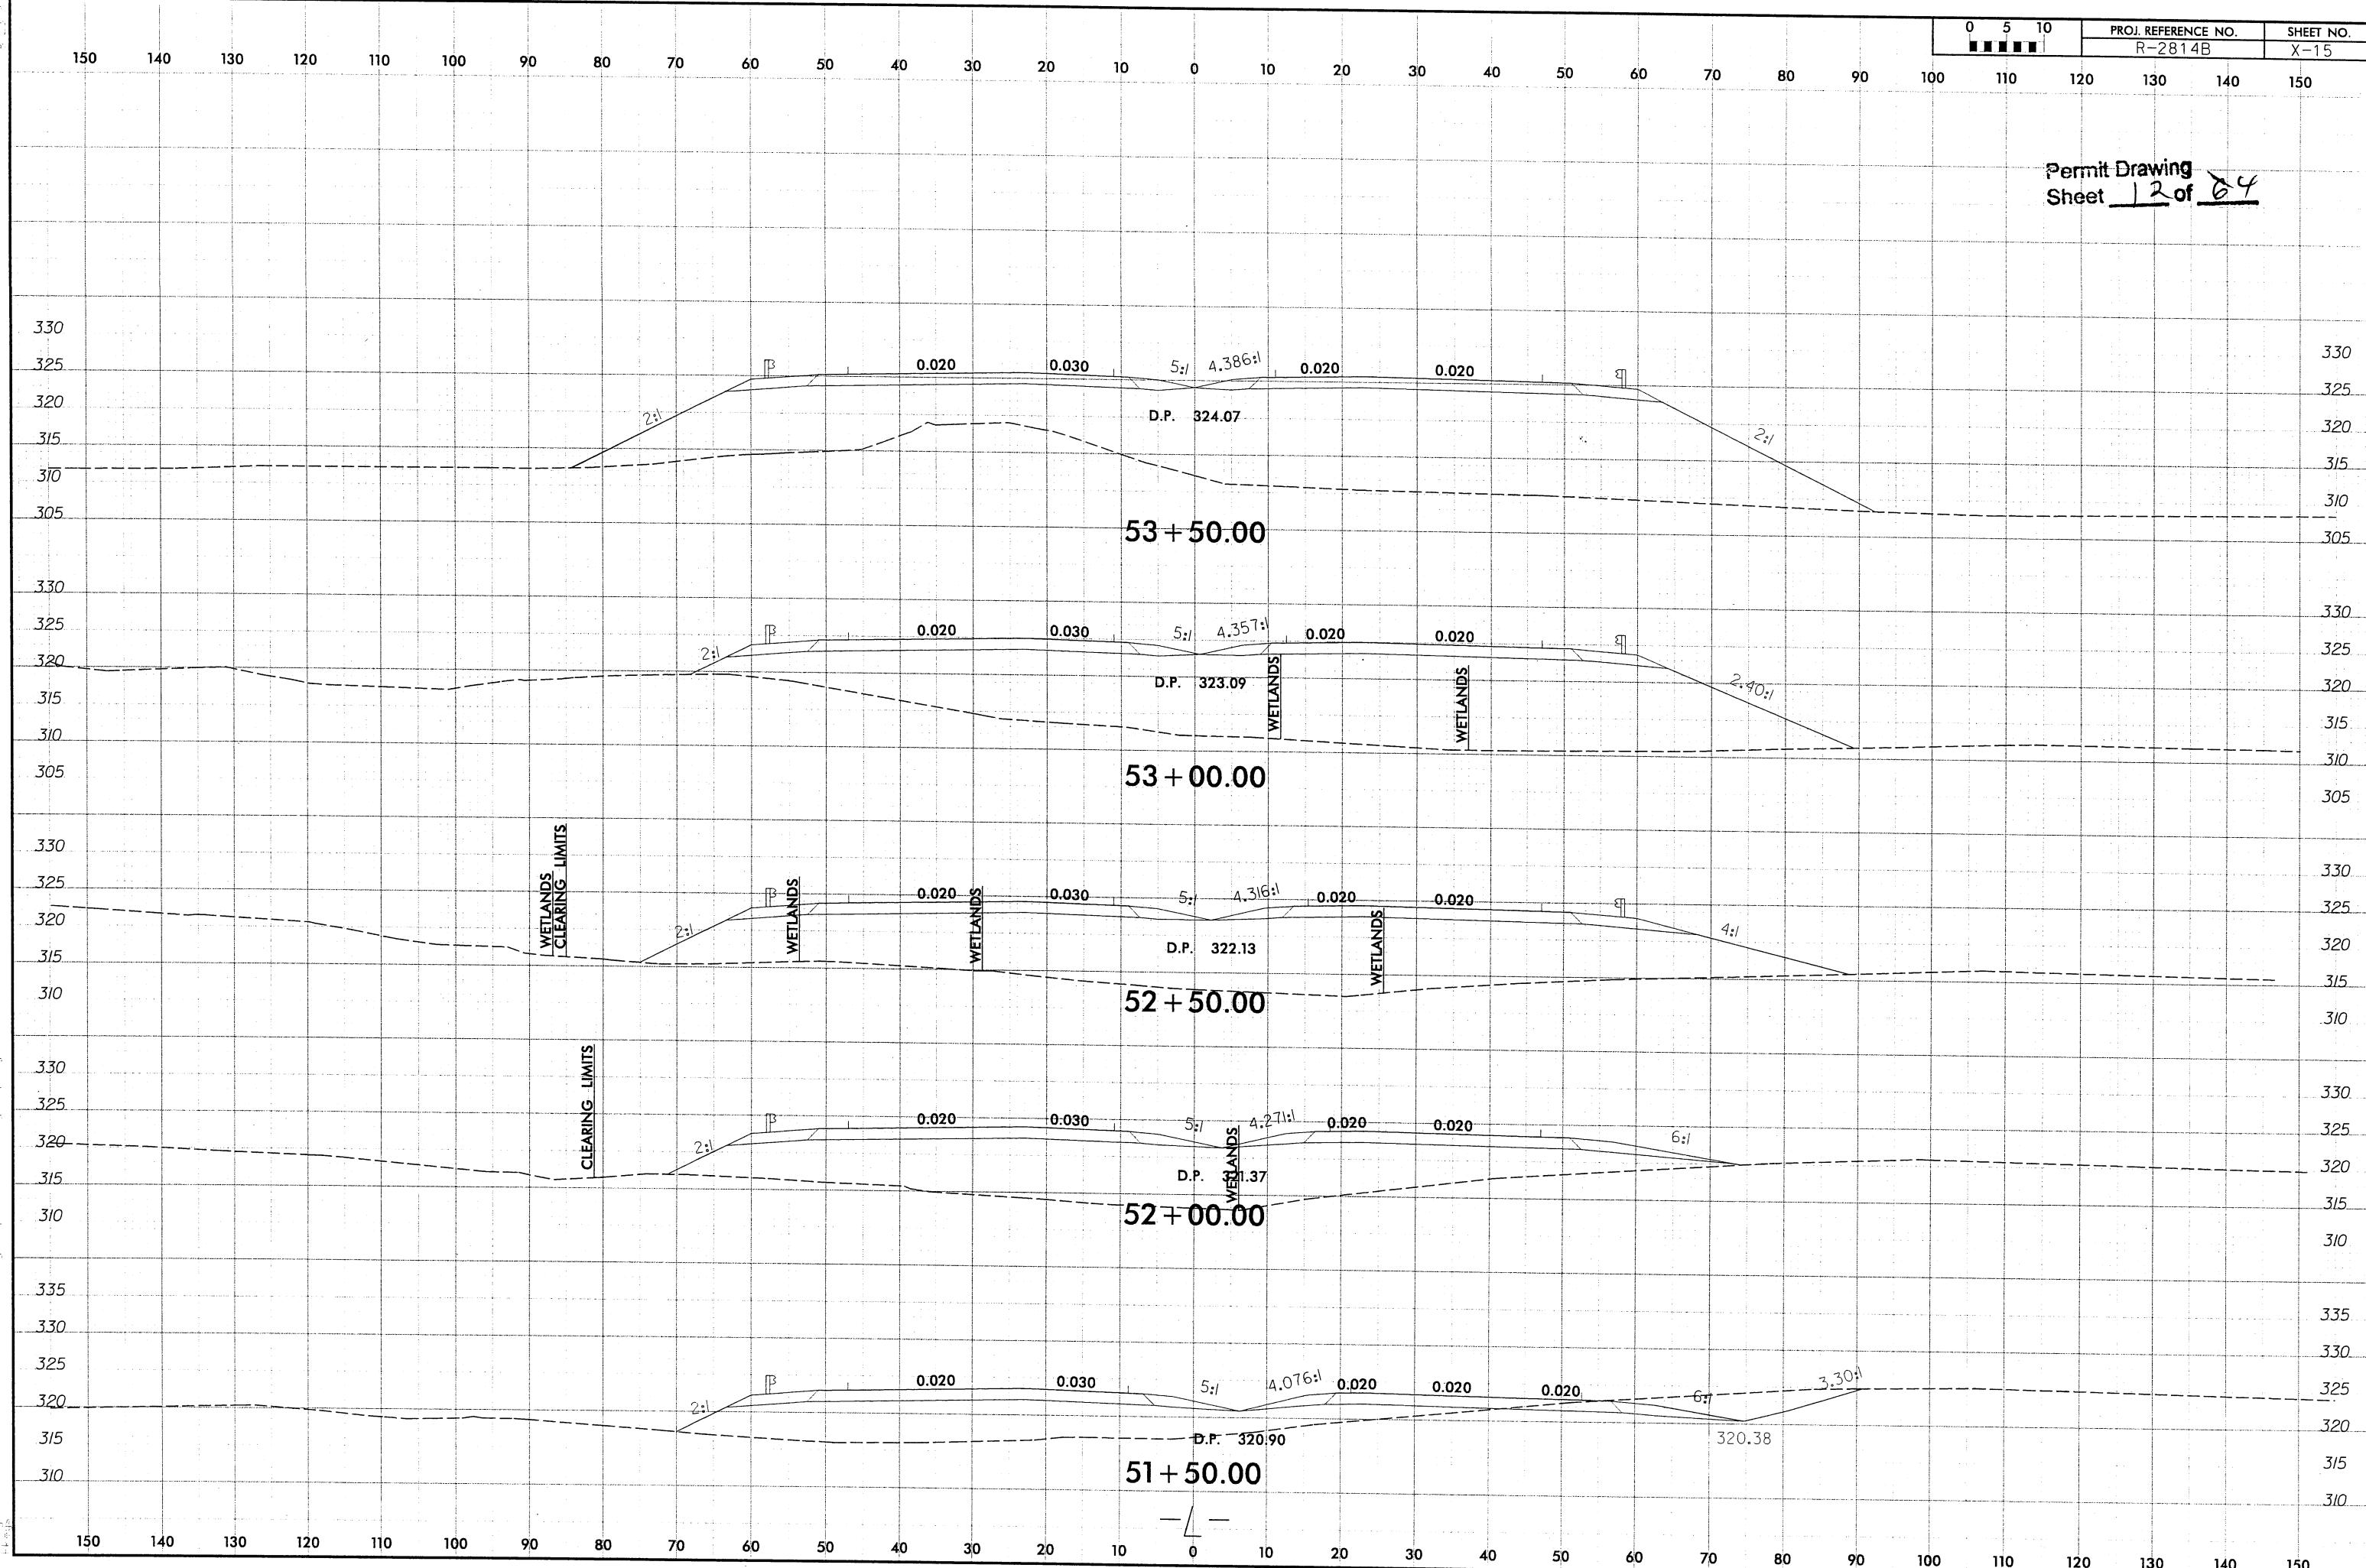


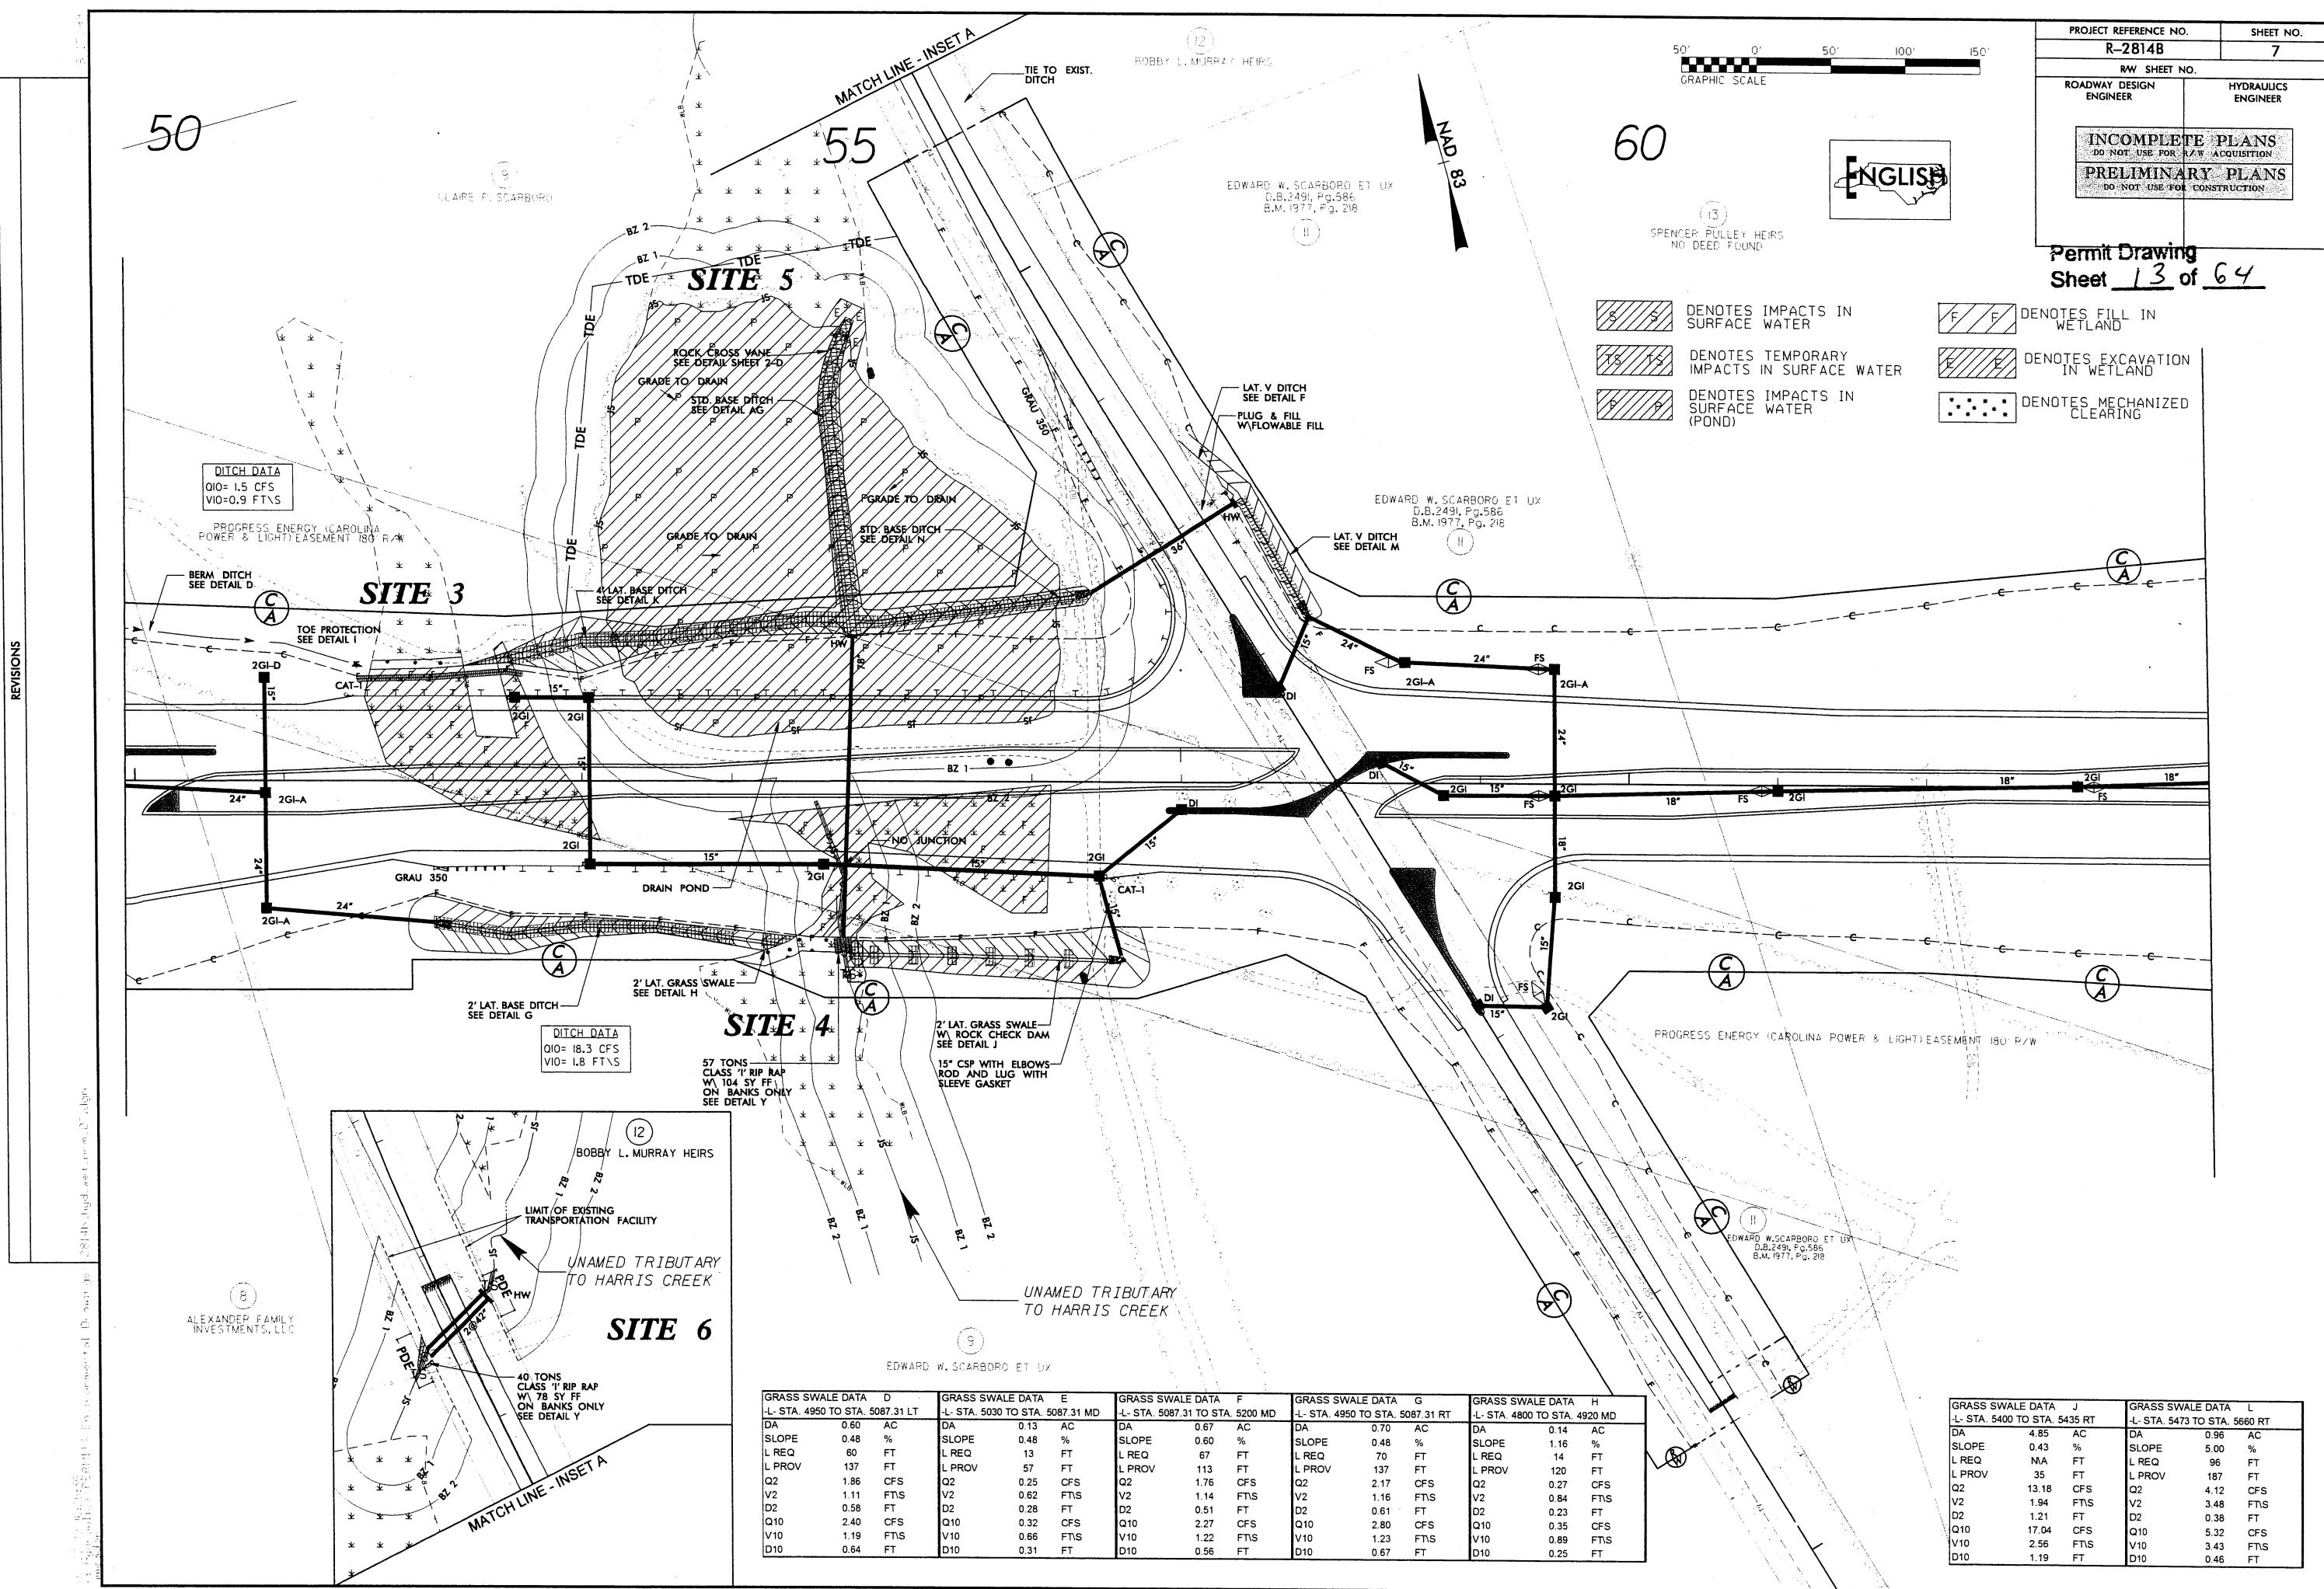

REVISIONS

02/22/10 16:29:47  
hydr-audits permits, environments\drawings\r2814b\_hyd-wet.com.prm.07.dgn

8/17/09

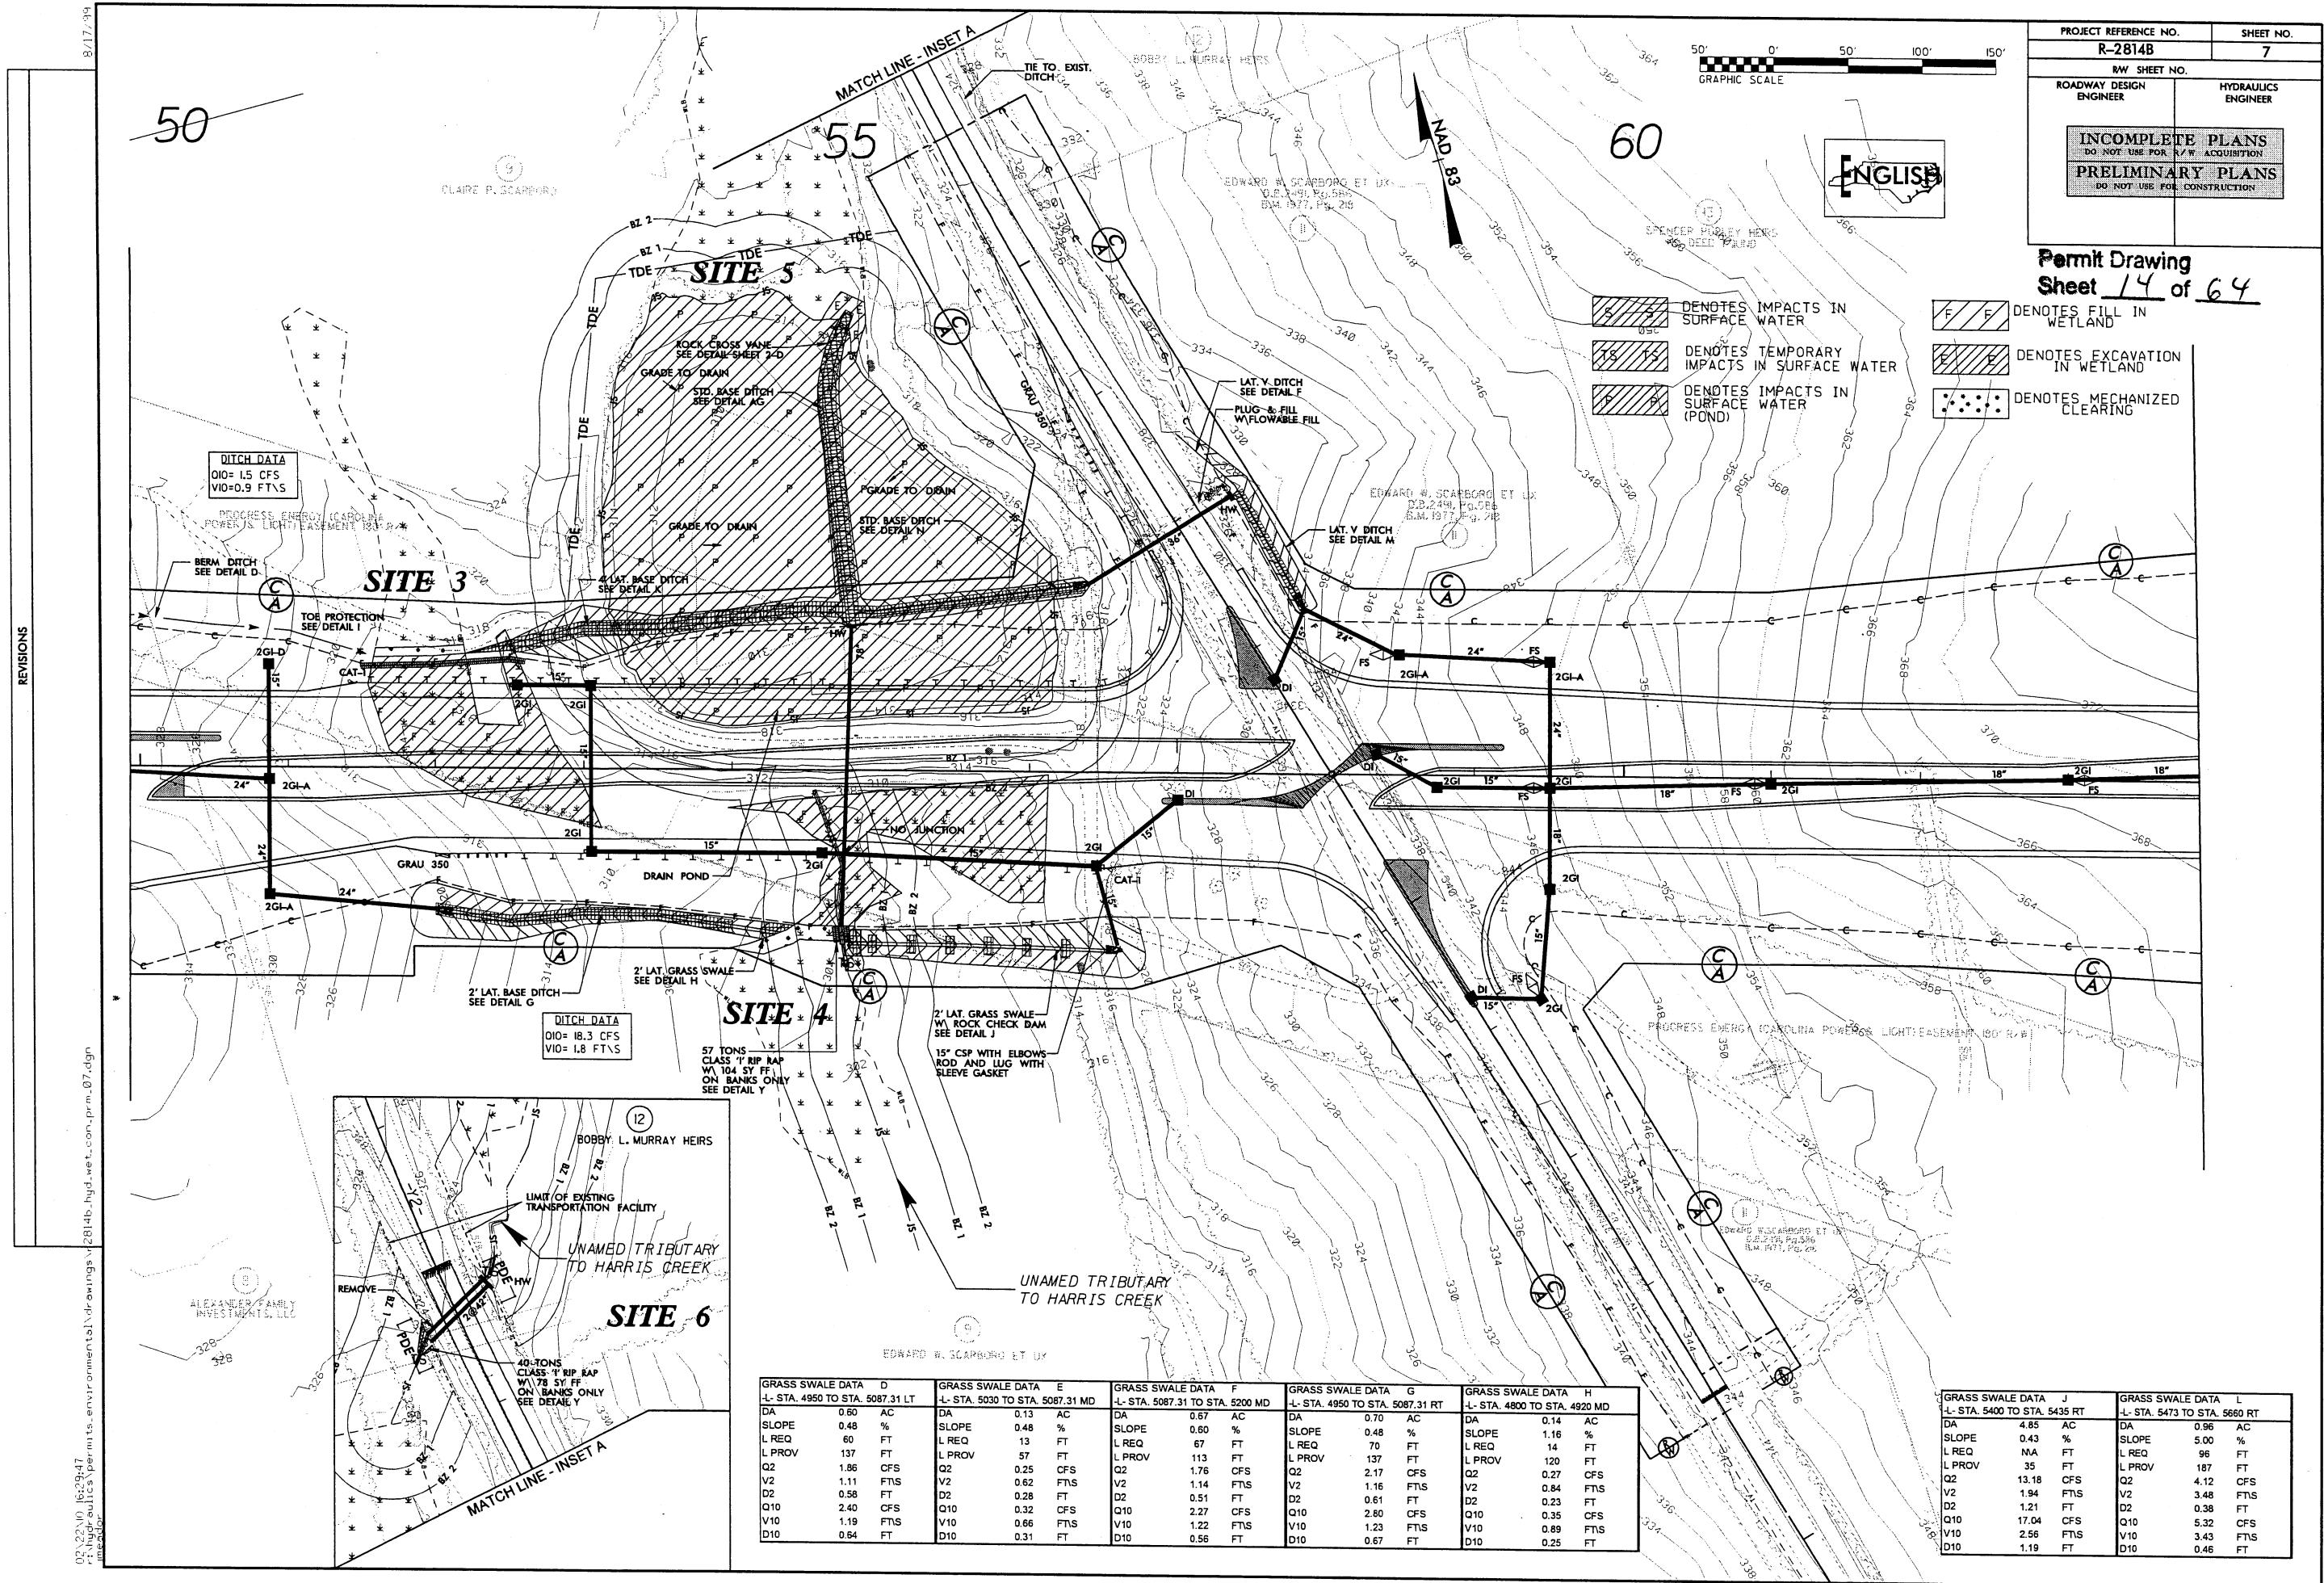

ENGLISH

# SITE 4 & 5

78" RCP  
L-L- 54+77  
PGL ELEV.= 328.67'  
SKEW = 92°14'30"

330

325

320

315

310

305

300

250 200 150 100 50 Q 50 100 150 200 250


50' 0' 50'

HORIZONTAL SCALE


5' 0' 5'

VERTICAL SCALE


Permit Drawing  
Sheet 15 of 64

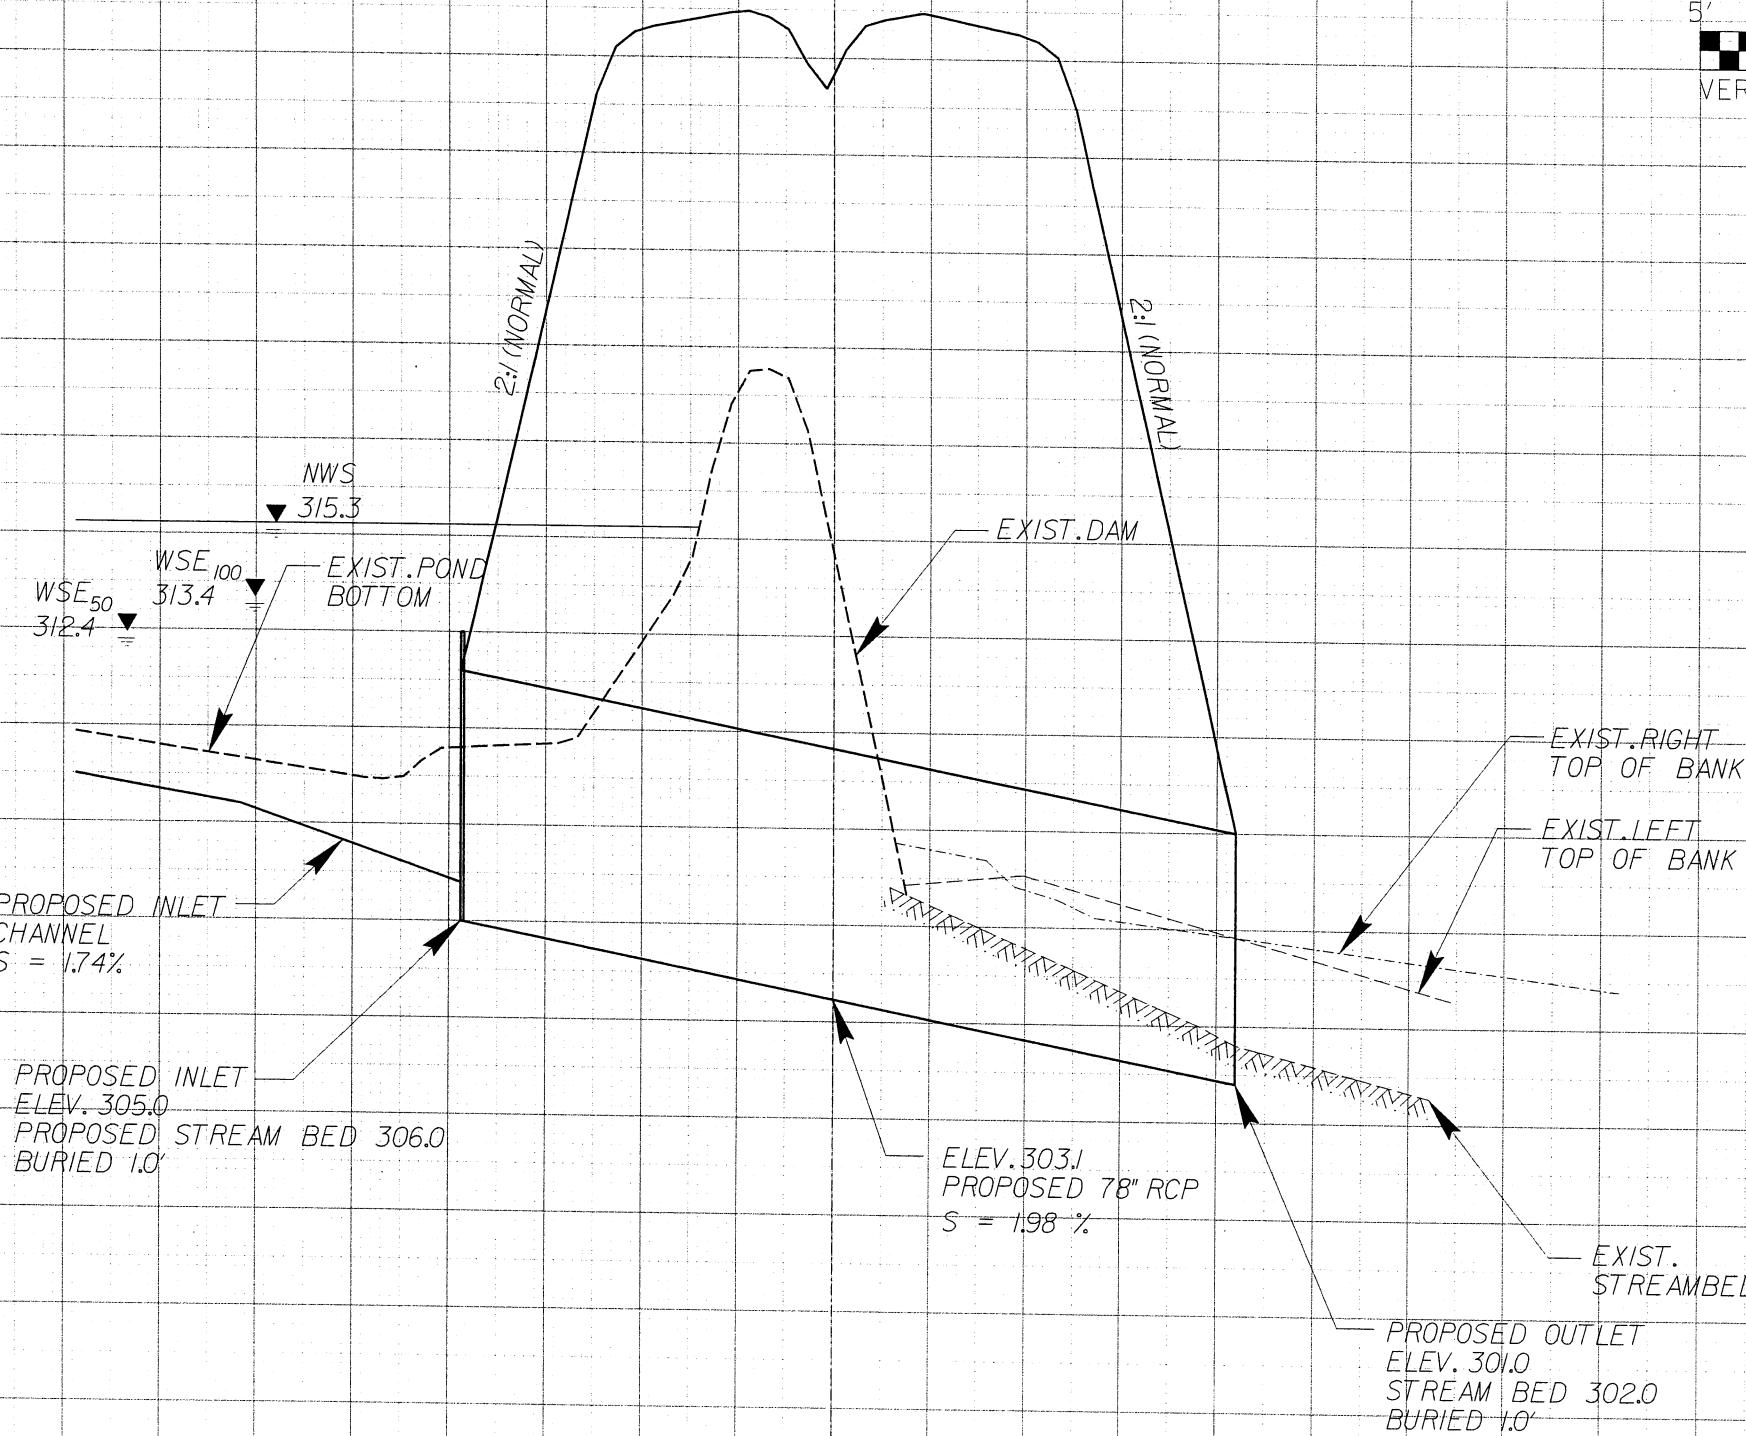

Permit Drawing  
Sheet 16 of 64

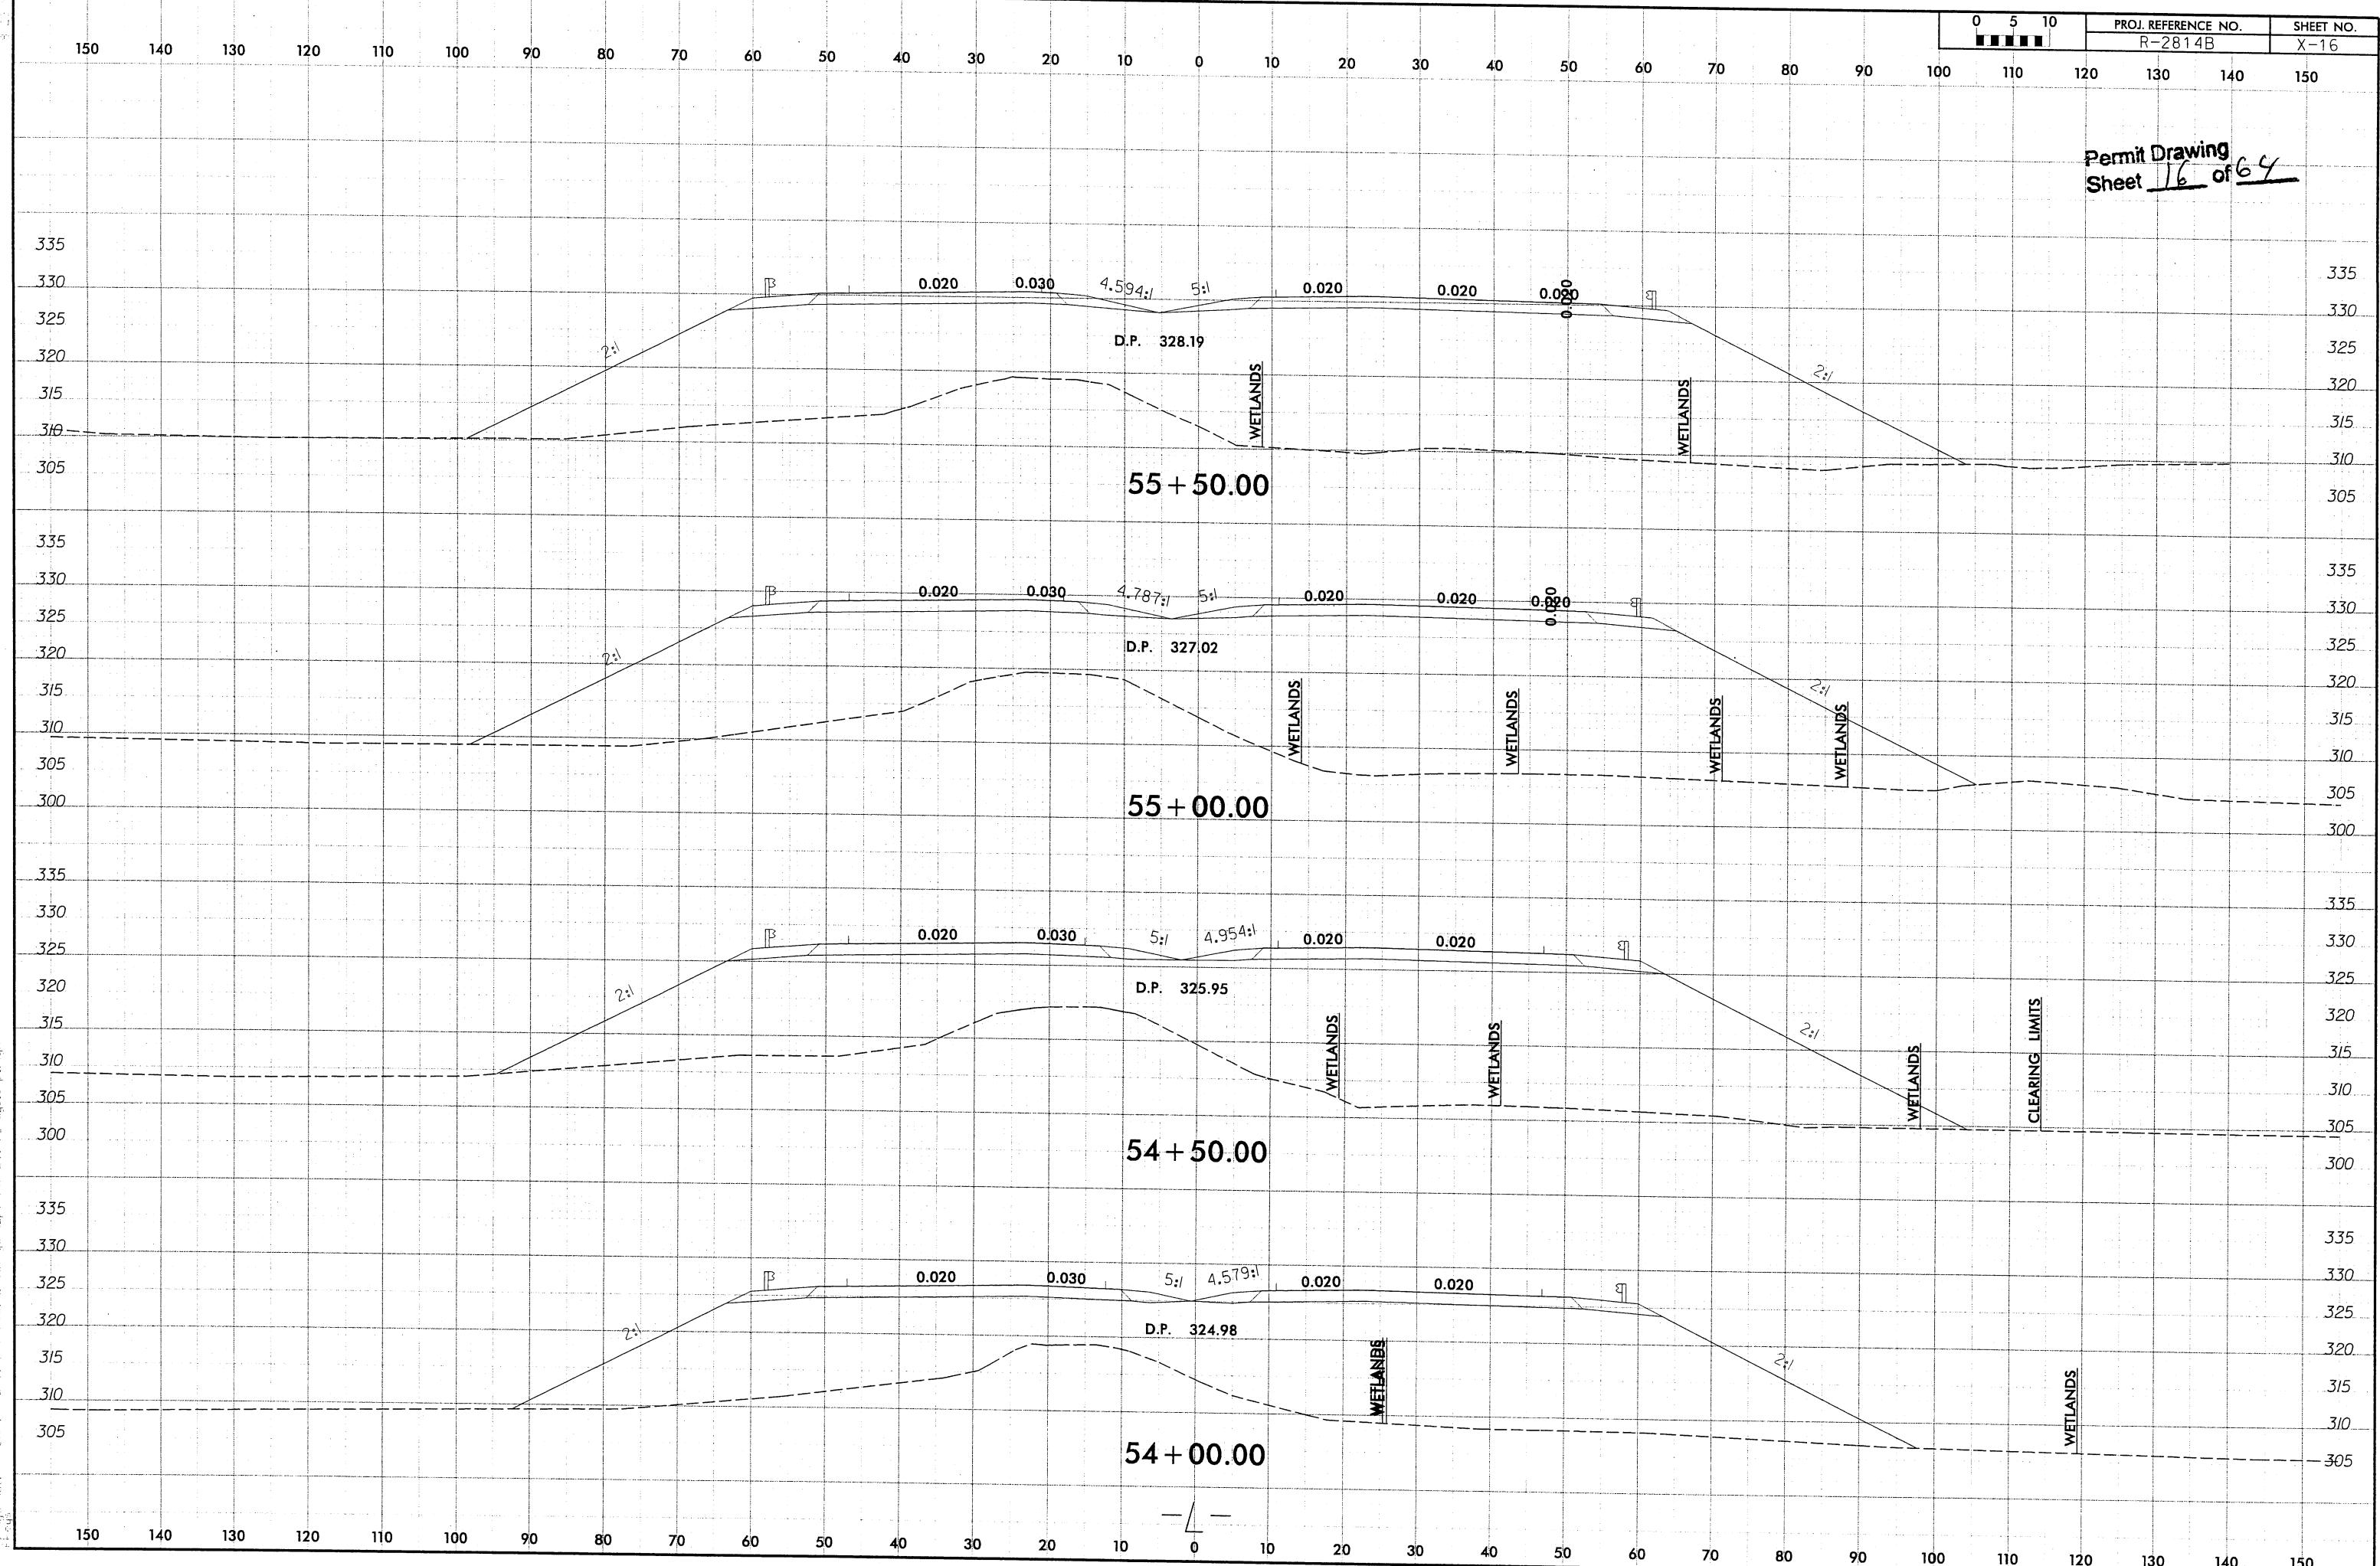

Permit Drawing  
Sheet 17 of 64

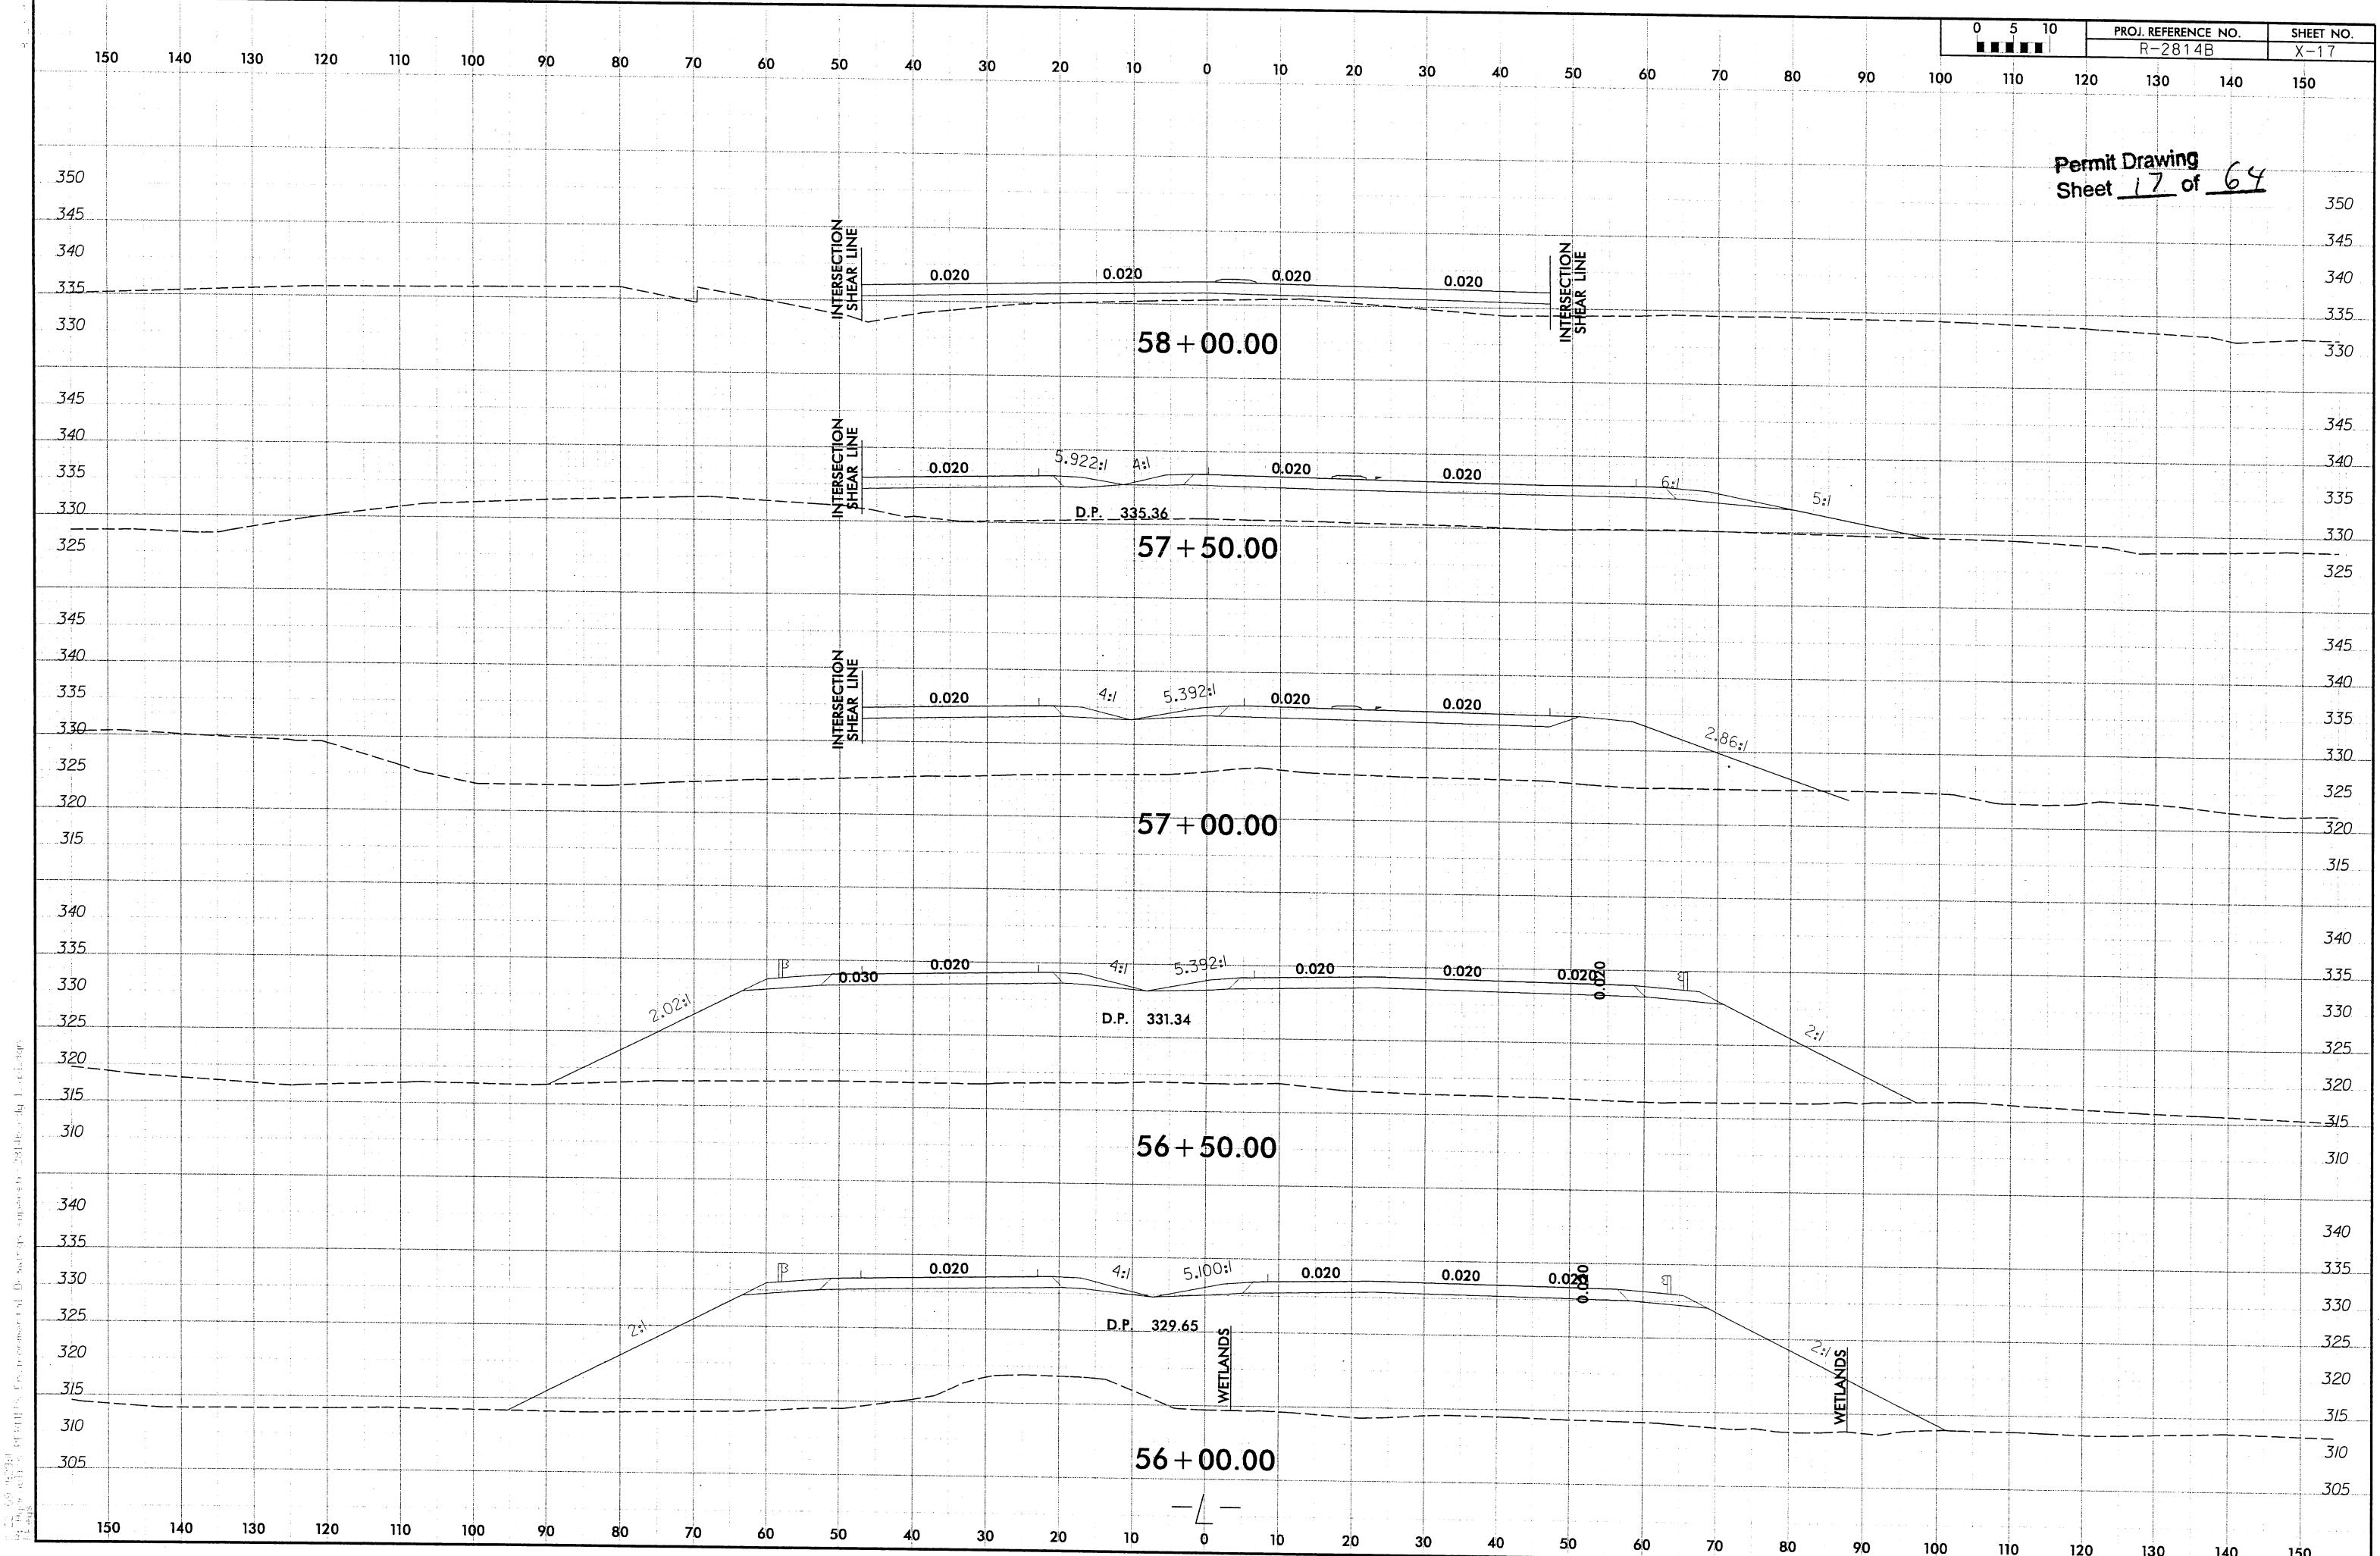

REVISIONS

THE JOURNAL OF CLIMATE

GRESS ENERGY (CAROLINA POWER & LIGHT) EASEMENT 180'

SPENCER PULLEY  
DB 2964 PG 9

(13.)

 DENOTES IMPACTS IN SURFACE WATER

 DENOTES TEMPORARY IMPACTS IN SURFACE WATERS


 DENOTES FILL  
WETLAND

E E DENOTES EXCAVATION IN WETLAND

PROJECT REFERENCE NO.		SHEET NO.
<b>R-2814B</b>		<b>8</b>
RW SHEET NO.		
ROADWAY DESIGN ENGINEER	HYDRAULICS ENGINEER	
<b>INCOMPLETE PLANS</b> DO NOT USE FOR R/W ACQUISITION		
<b>PRELIMINARY PLANS</b> DO NOT USE FOR CONSTRUCTION		

Permit Drawing  
Sheet 18 of 64

75

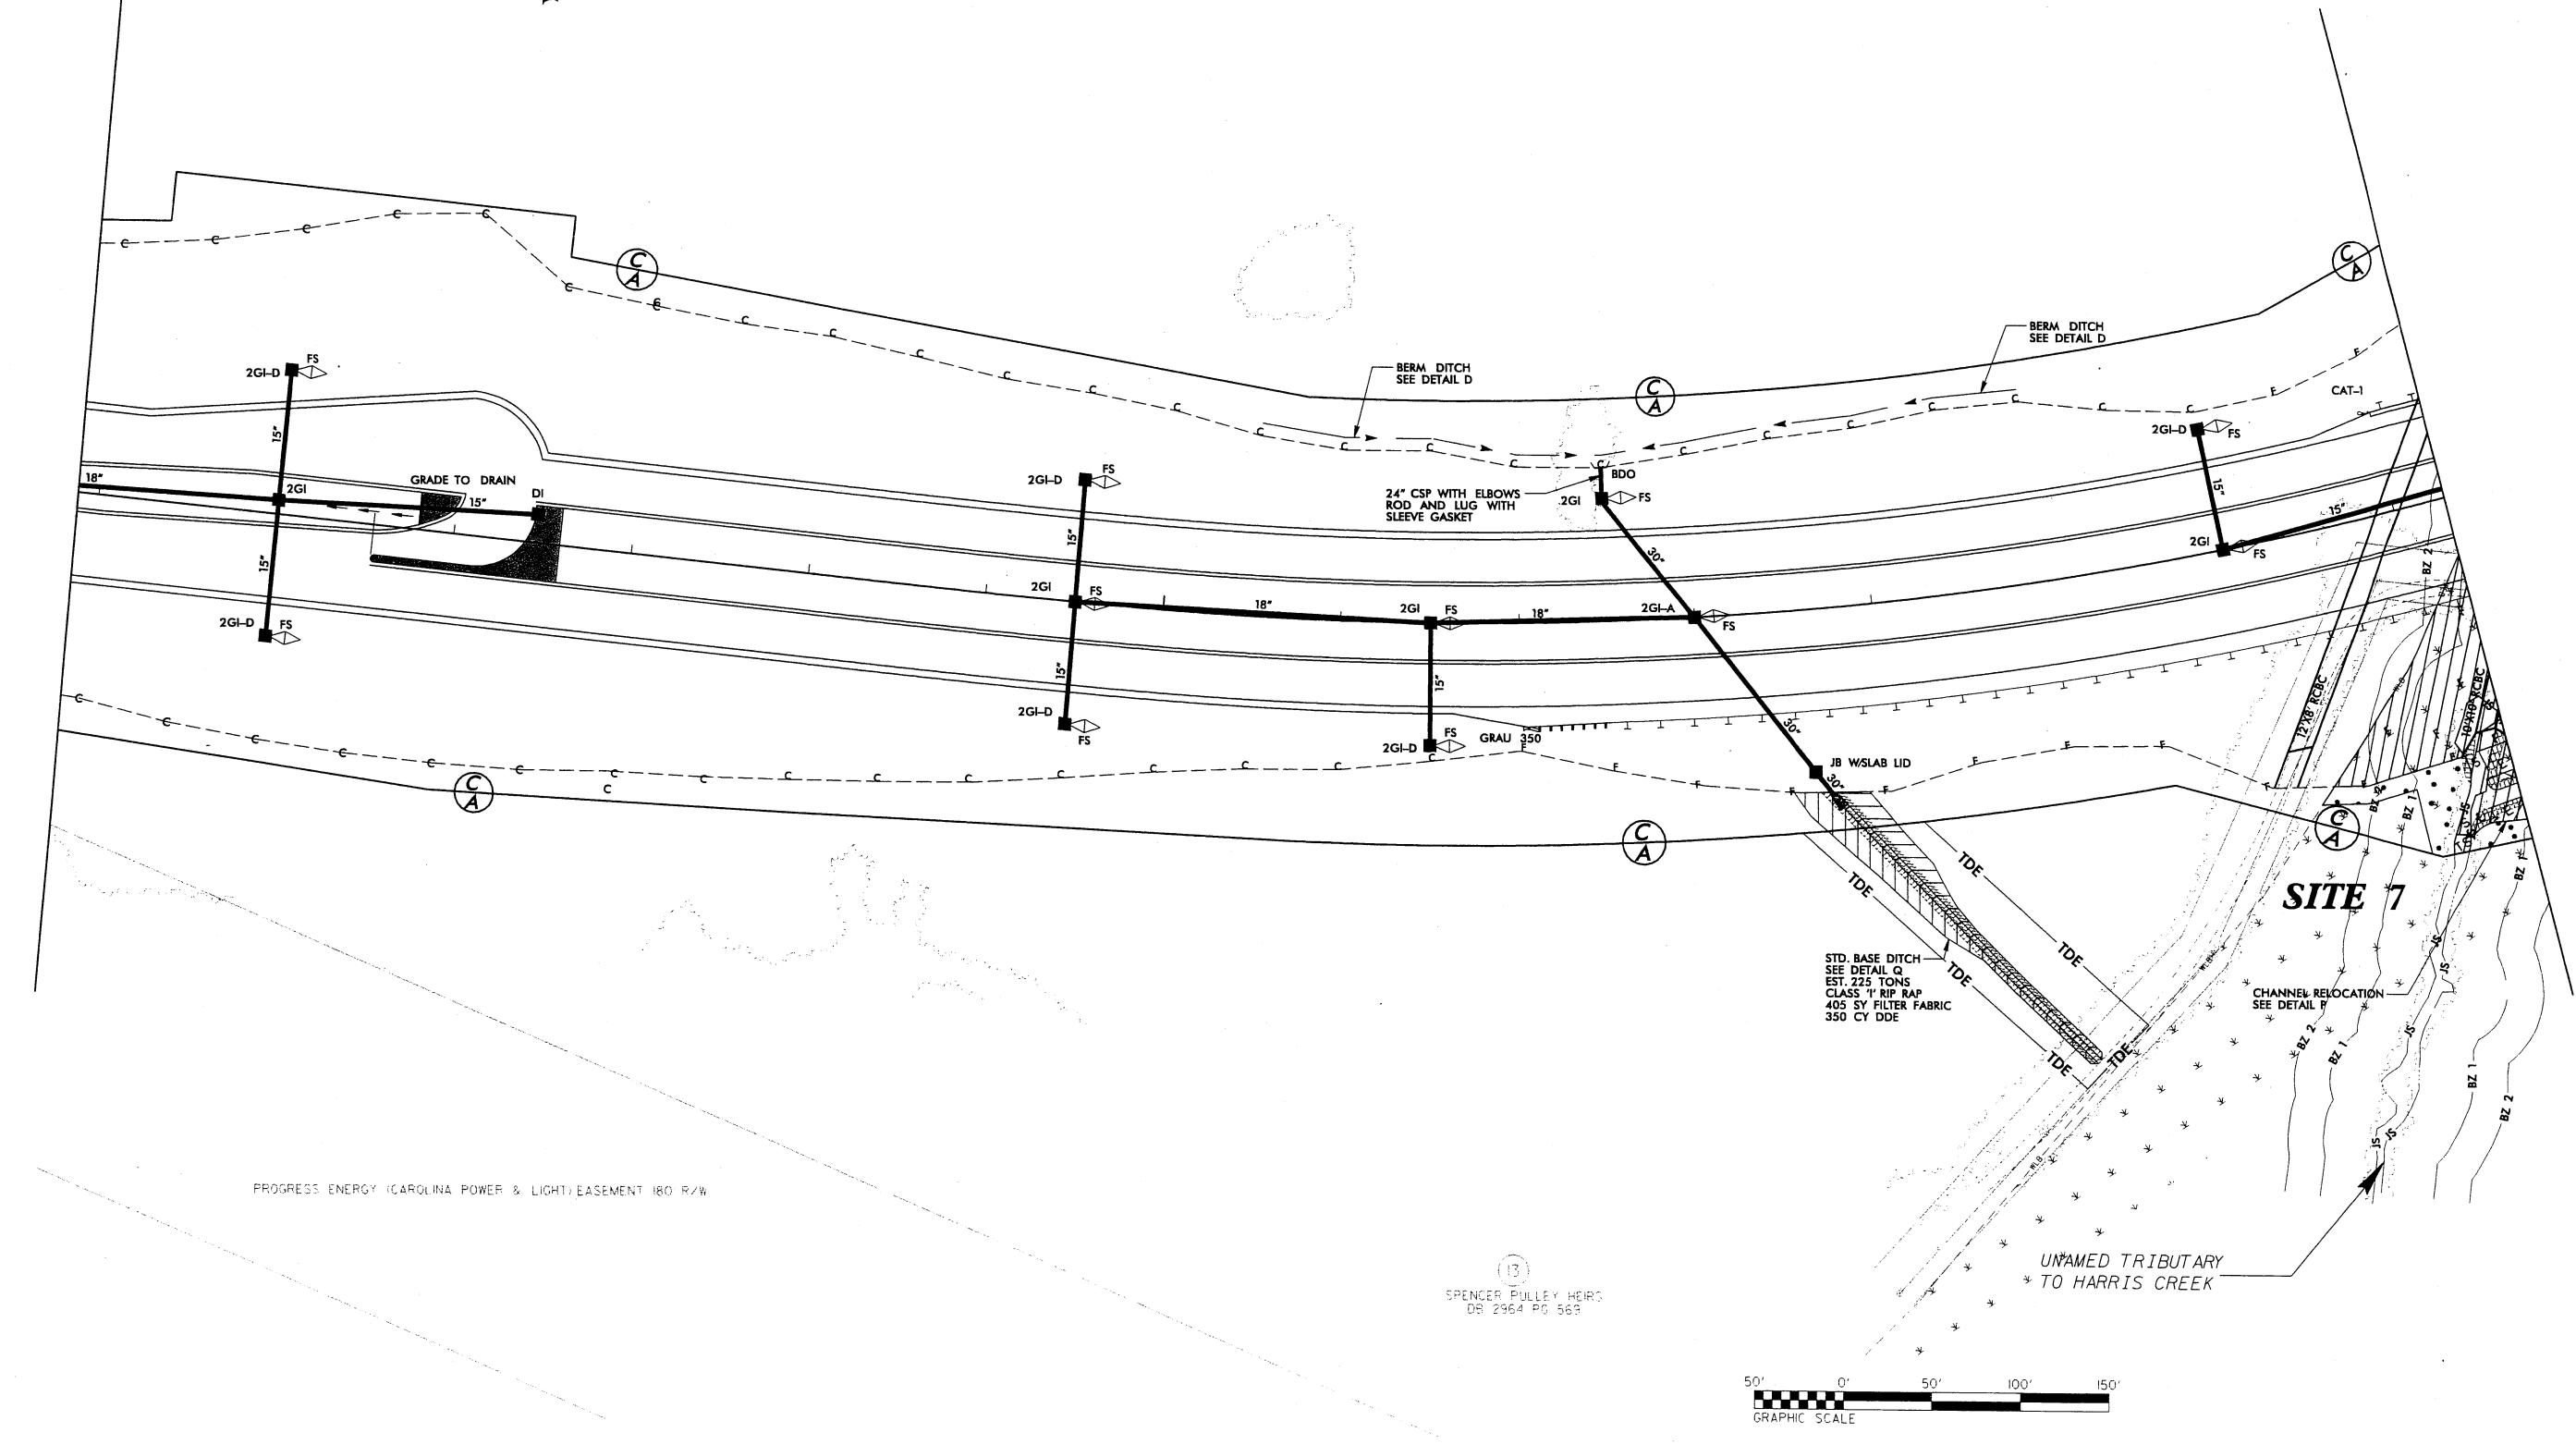

65

70

75



 DENOTES IMPACTS IN SURFACE WATER

 DENOTES TEMPORARY IMPACTS IN SURFACE WATERS

 DENOTES FILL WETLAND

 DENOTES EXCAVATION  
IN WETLAND


PROJECT REFERENCE NO.		SHEET NO.
<b>R-2814B</b>		<b>8</b>
ROW SHEET NO.		
ROADWAY DESIGN ENGINEER	HYDRAULICS ENGINEER	
<div style="border: 1px solid black; padding: 10px; text-align: center;"> <b>INCOMPLETE PLANS</b>            DO NOT USE FOR Z/W ACQUISITION         </div>		
<div style="border: 1px solid black; padding: 10px; text-align: center;"> <b>PRELIMINARY PLANS</b>            DO NOT USE FOR CONSTRUCTION         </div>		

Permit Drawing  
Sheet 19 of 64

---

## **REVISIONS**


289ab-hyd-met-conn-prm-08.dgn

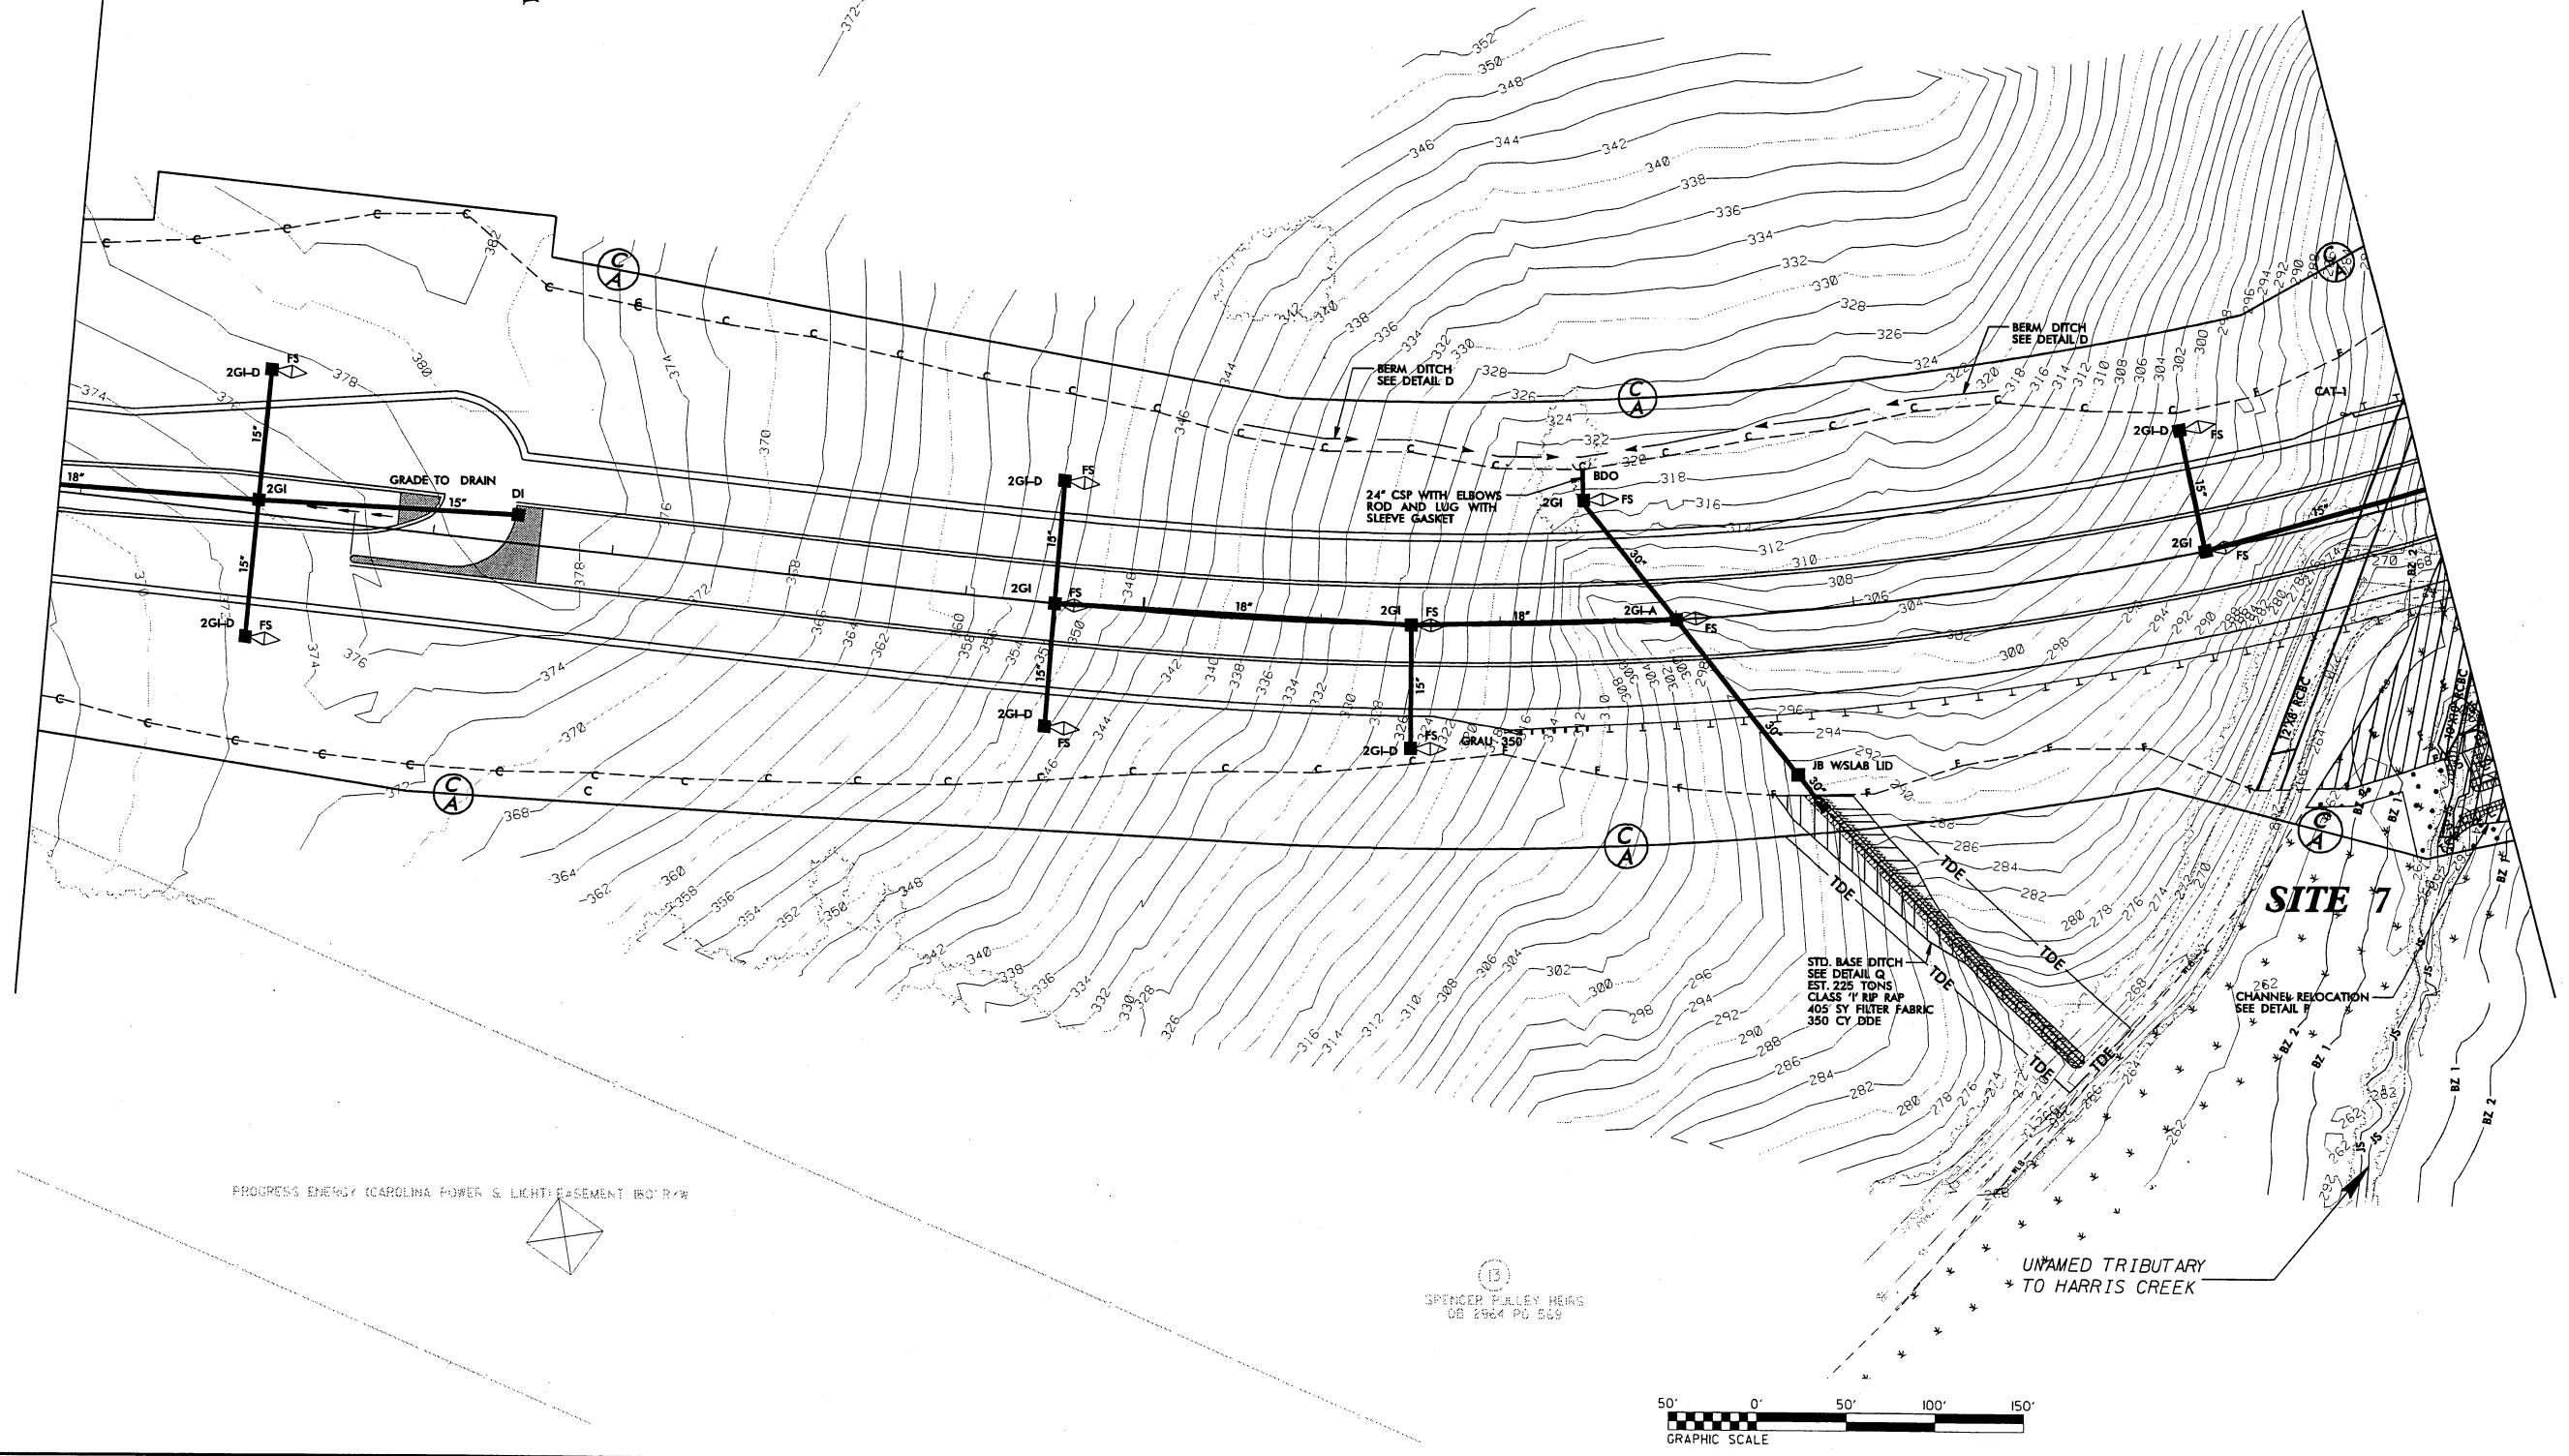

Permit Drawing  
Sheet 20 of 64

90


REVISED

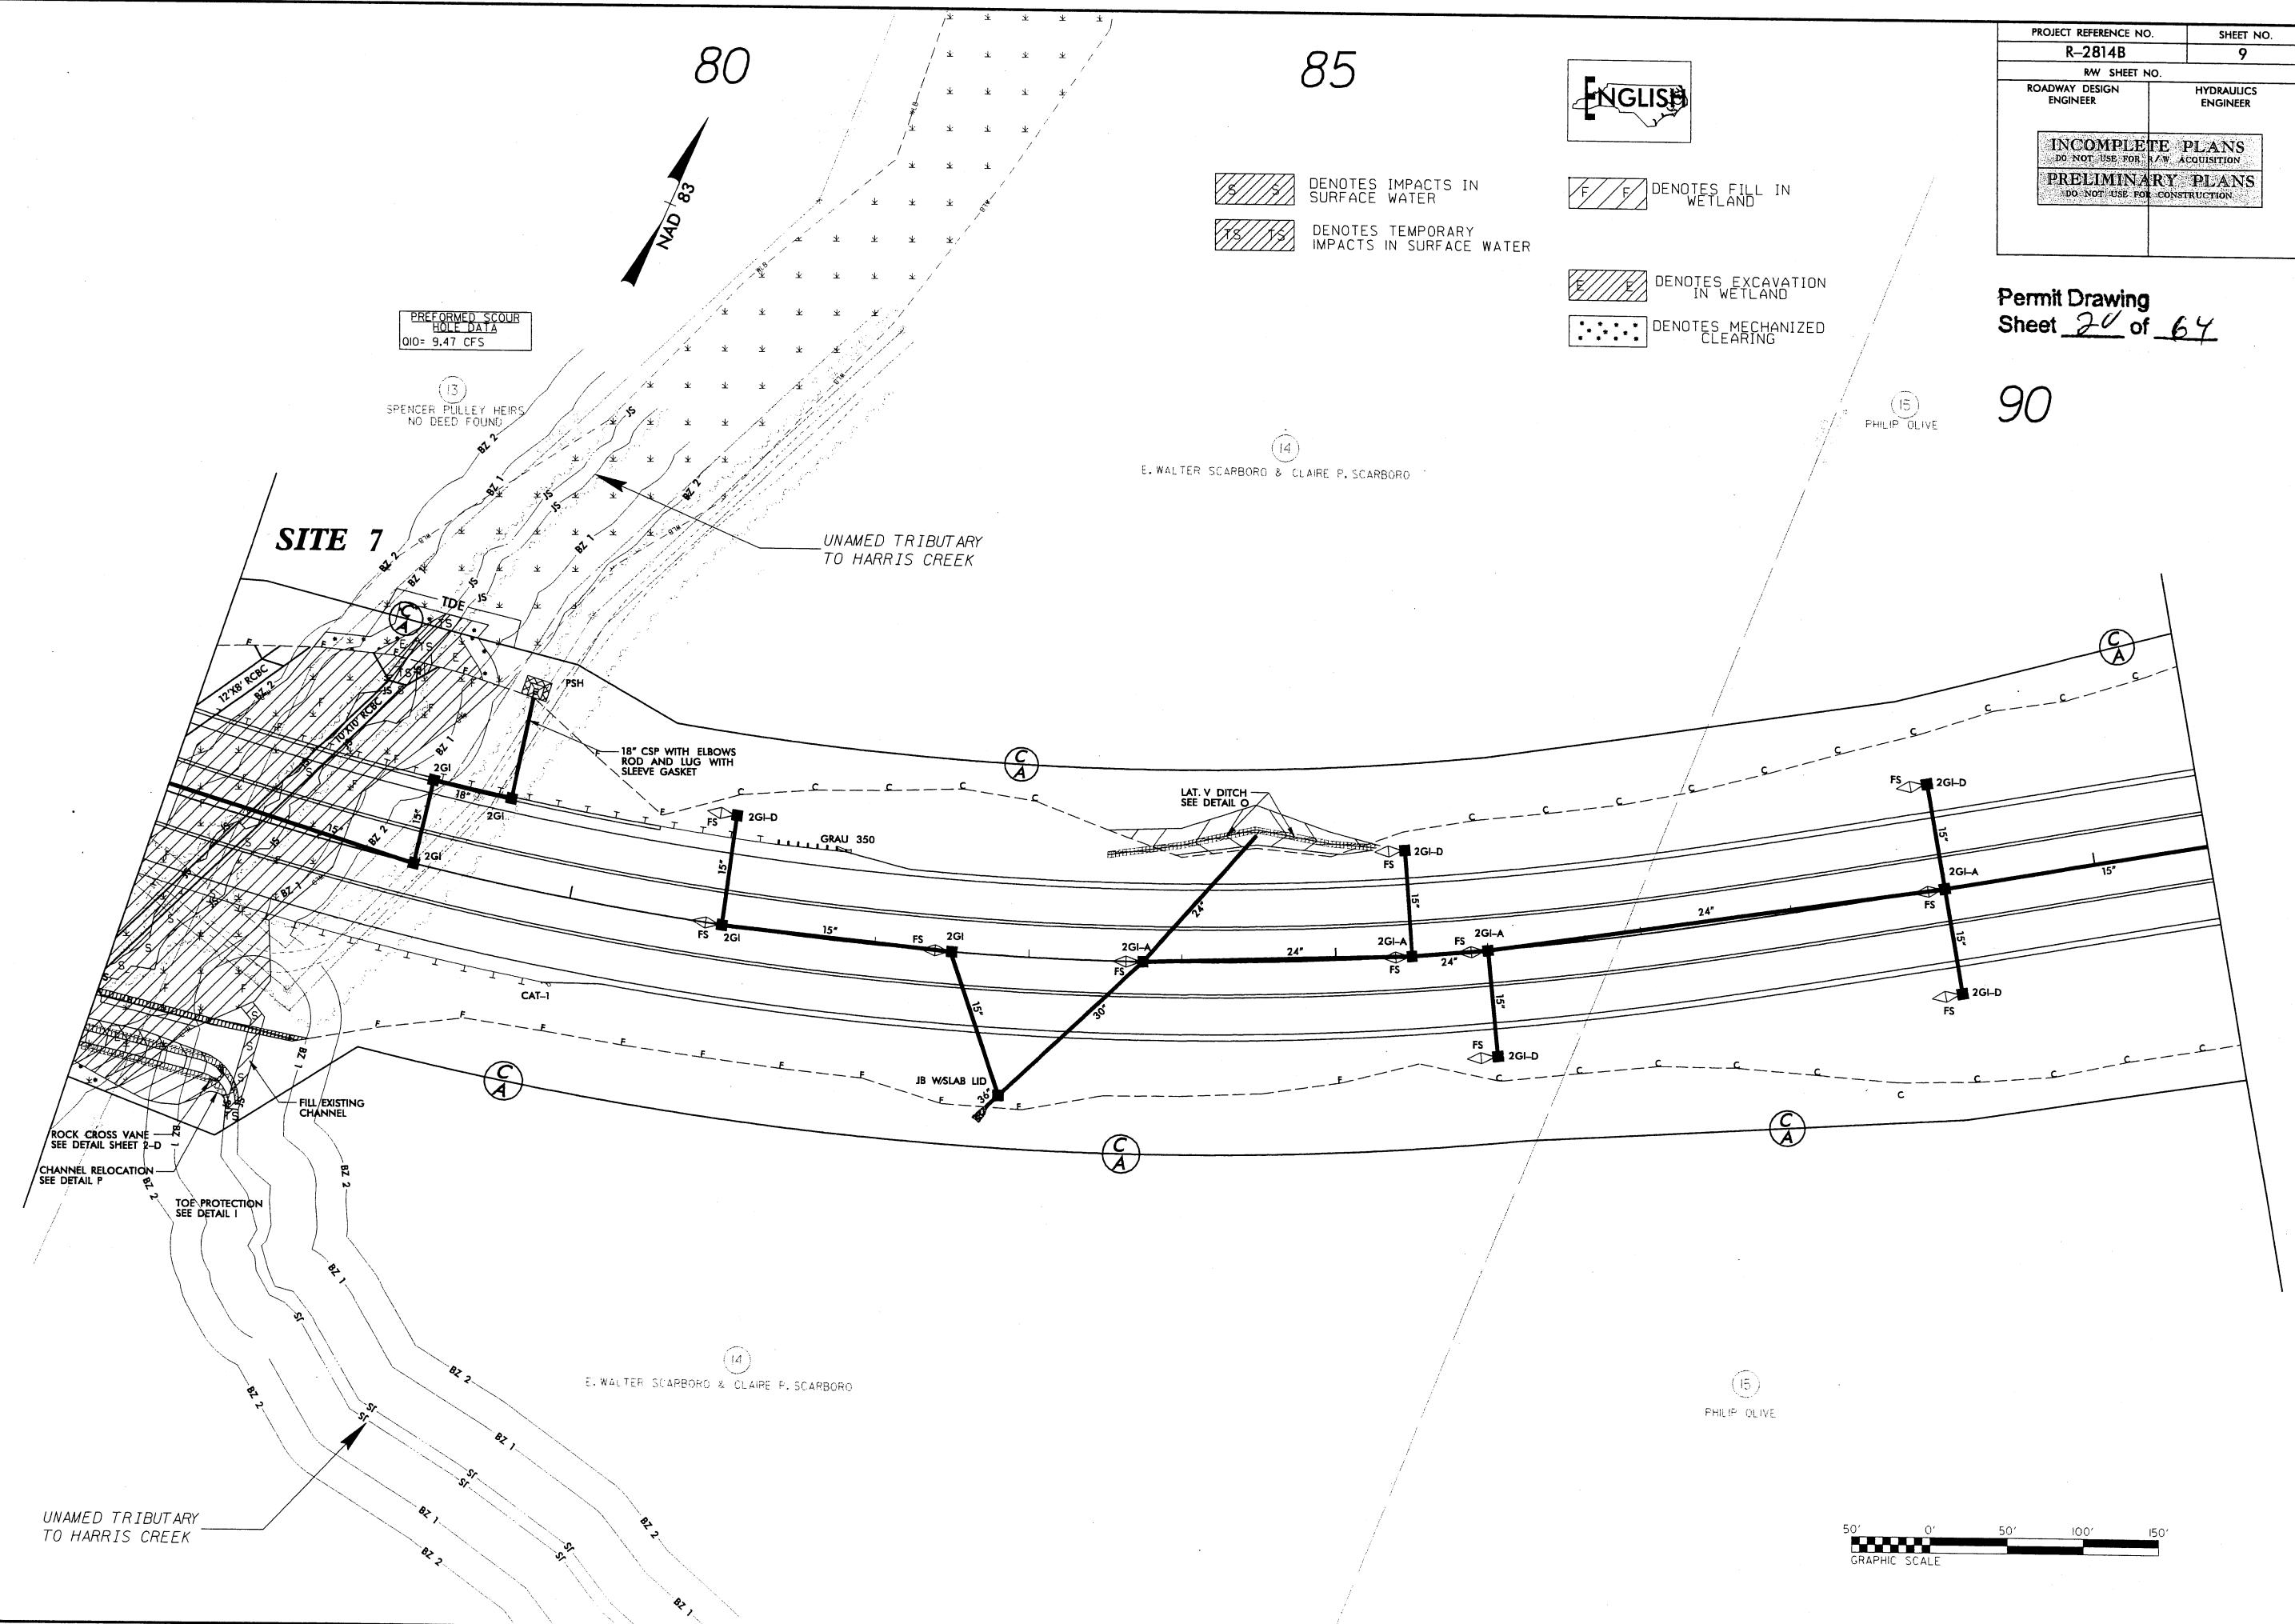


REVISIONS


R-2814B-hyd-wet.con-prm-089.dwg  
10/16/2011 10:54:54 AM Sheet 2 of 11 Environmental Drawings

8/17/99

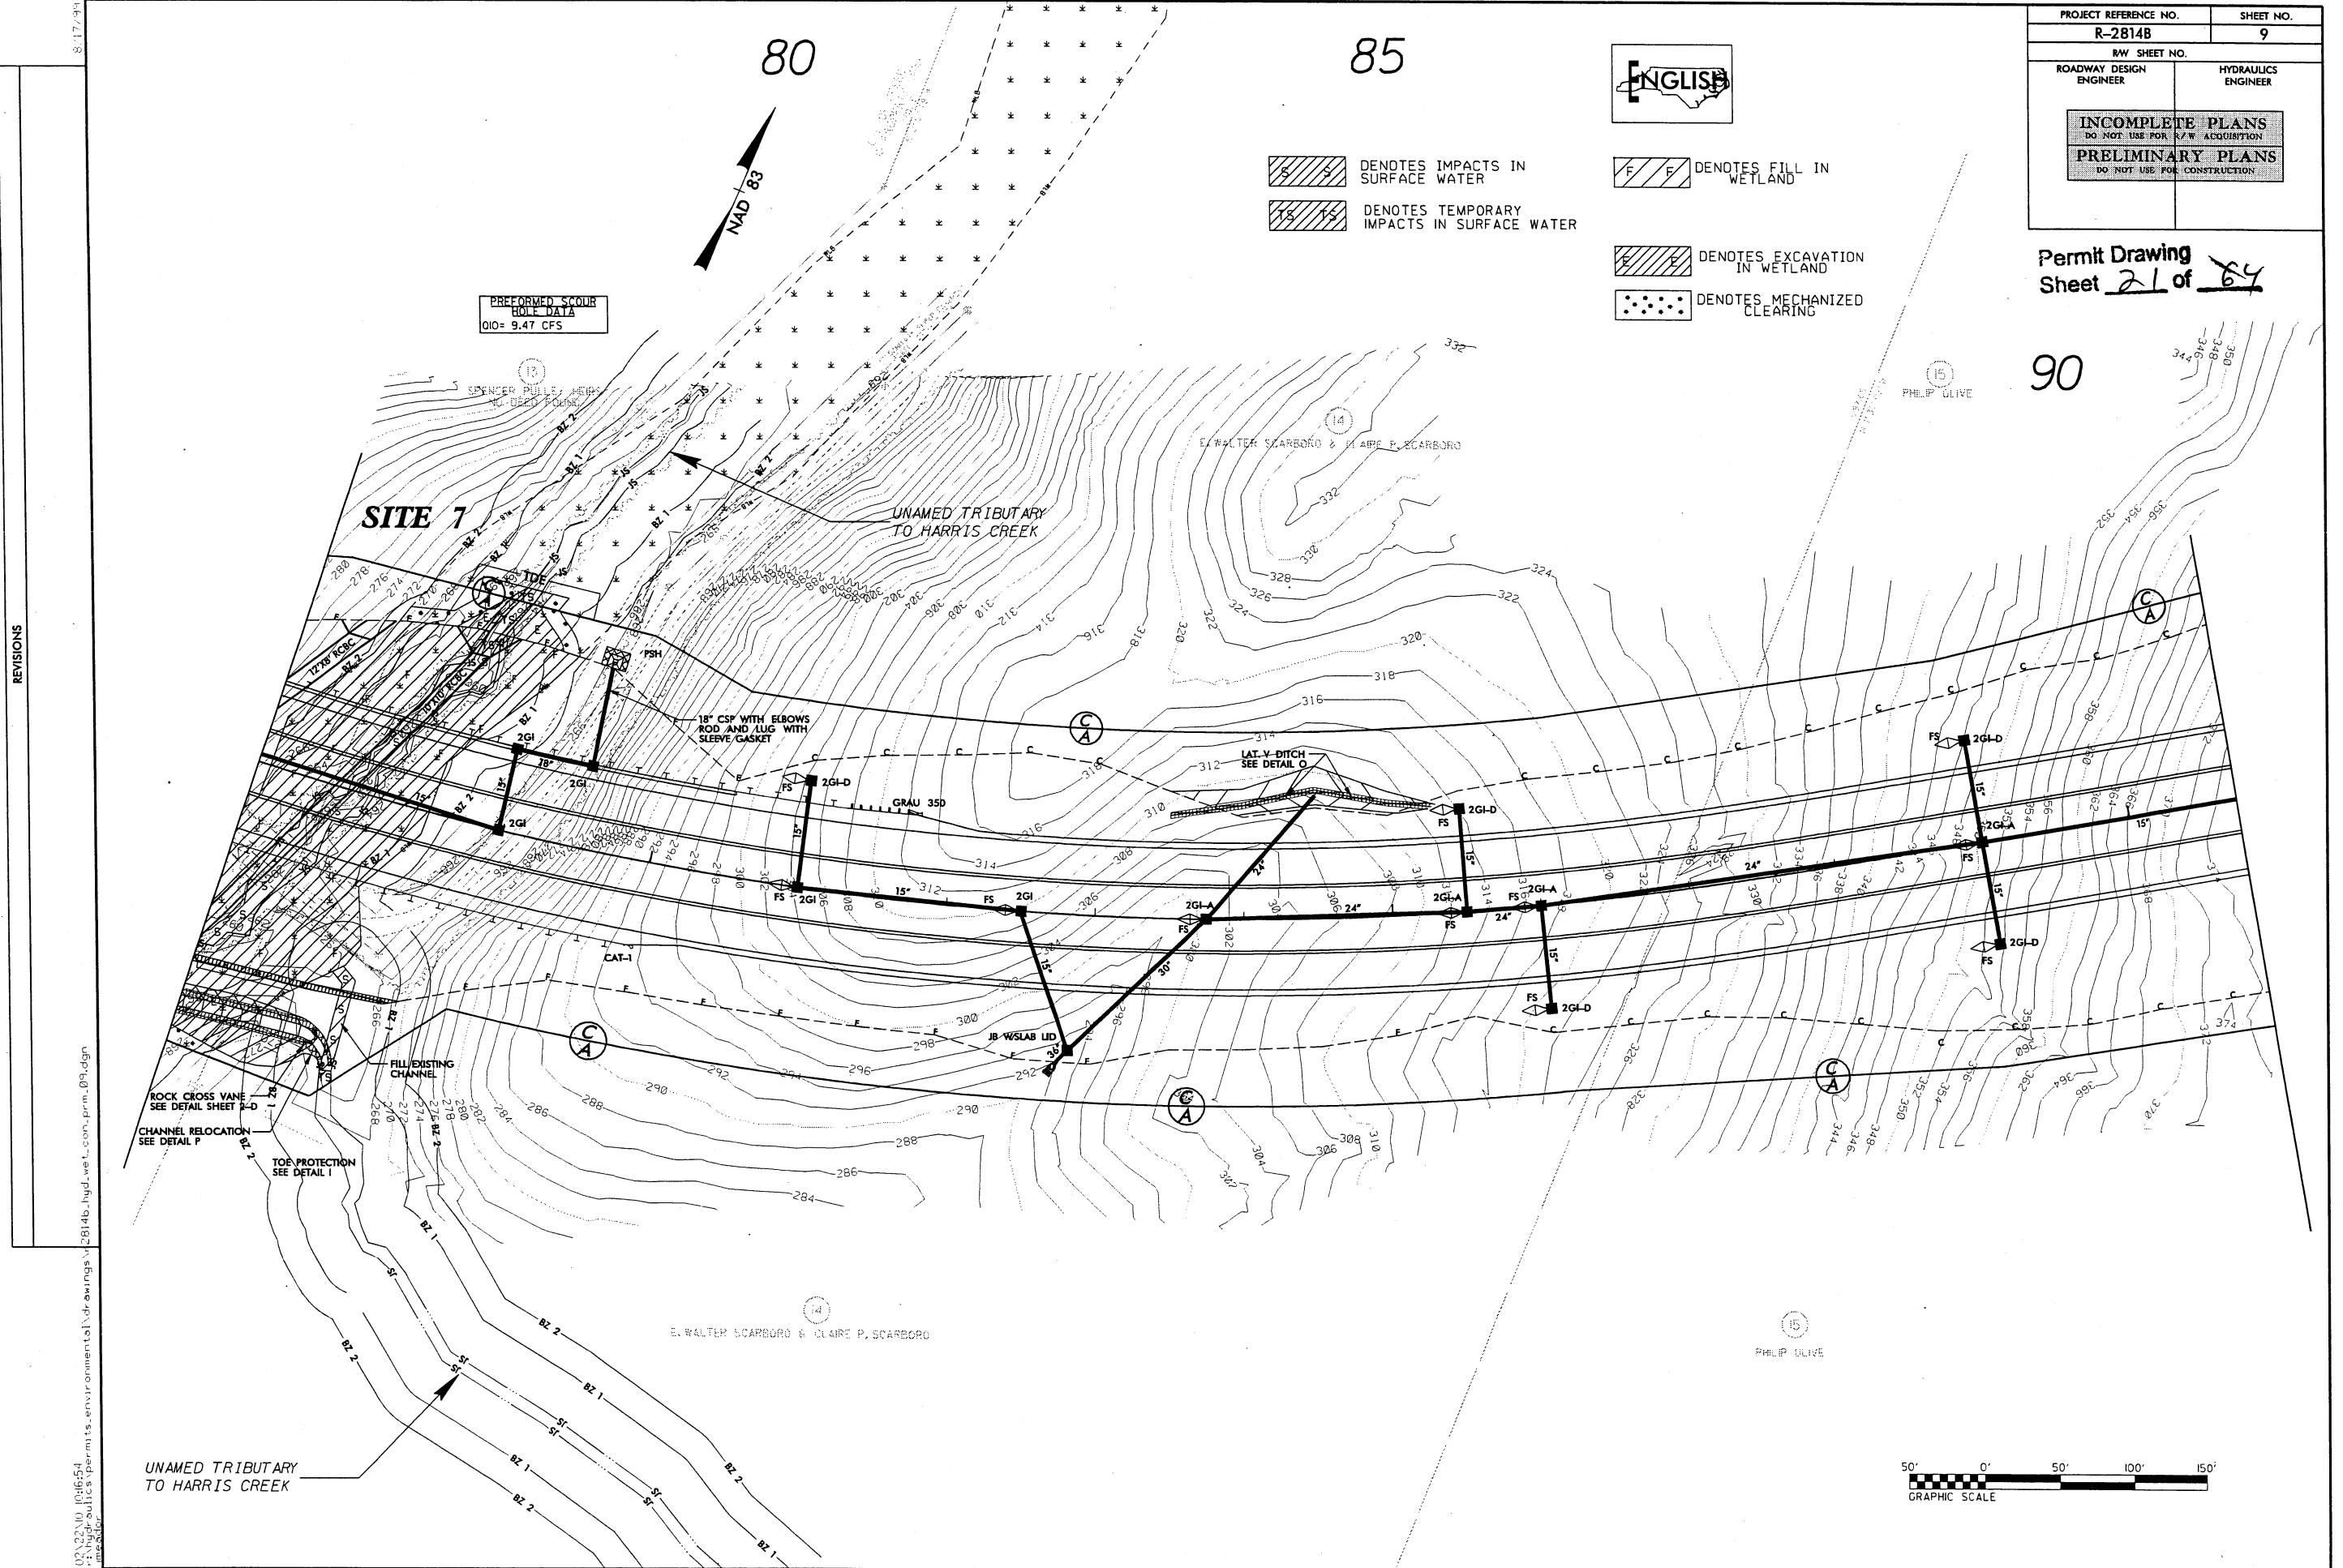


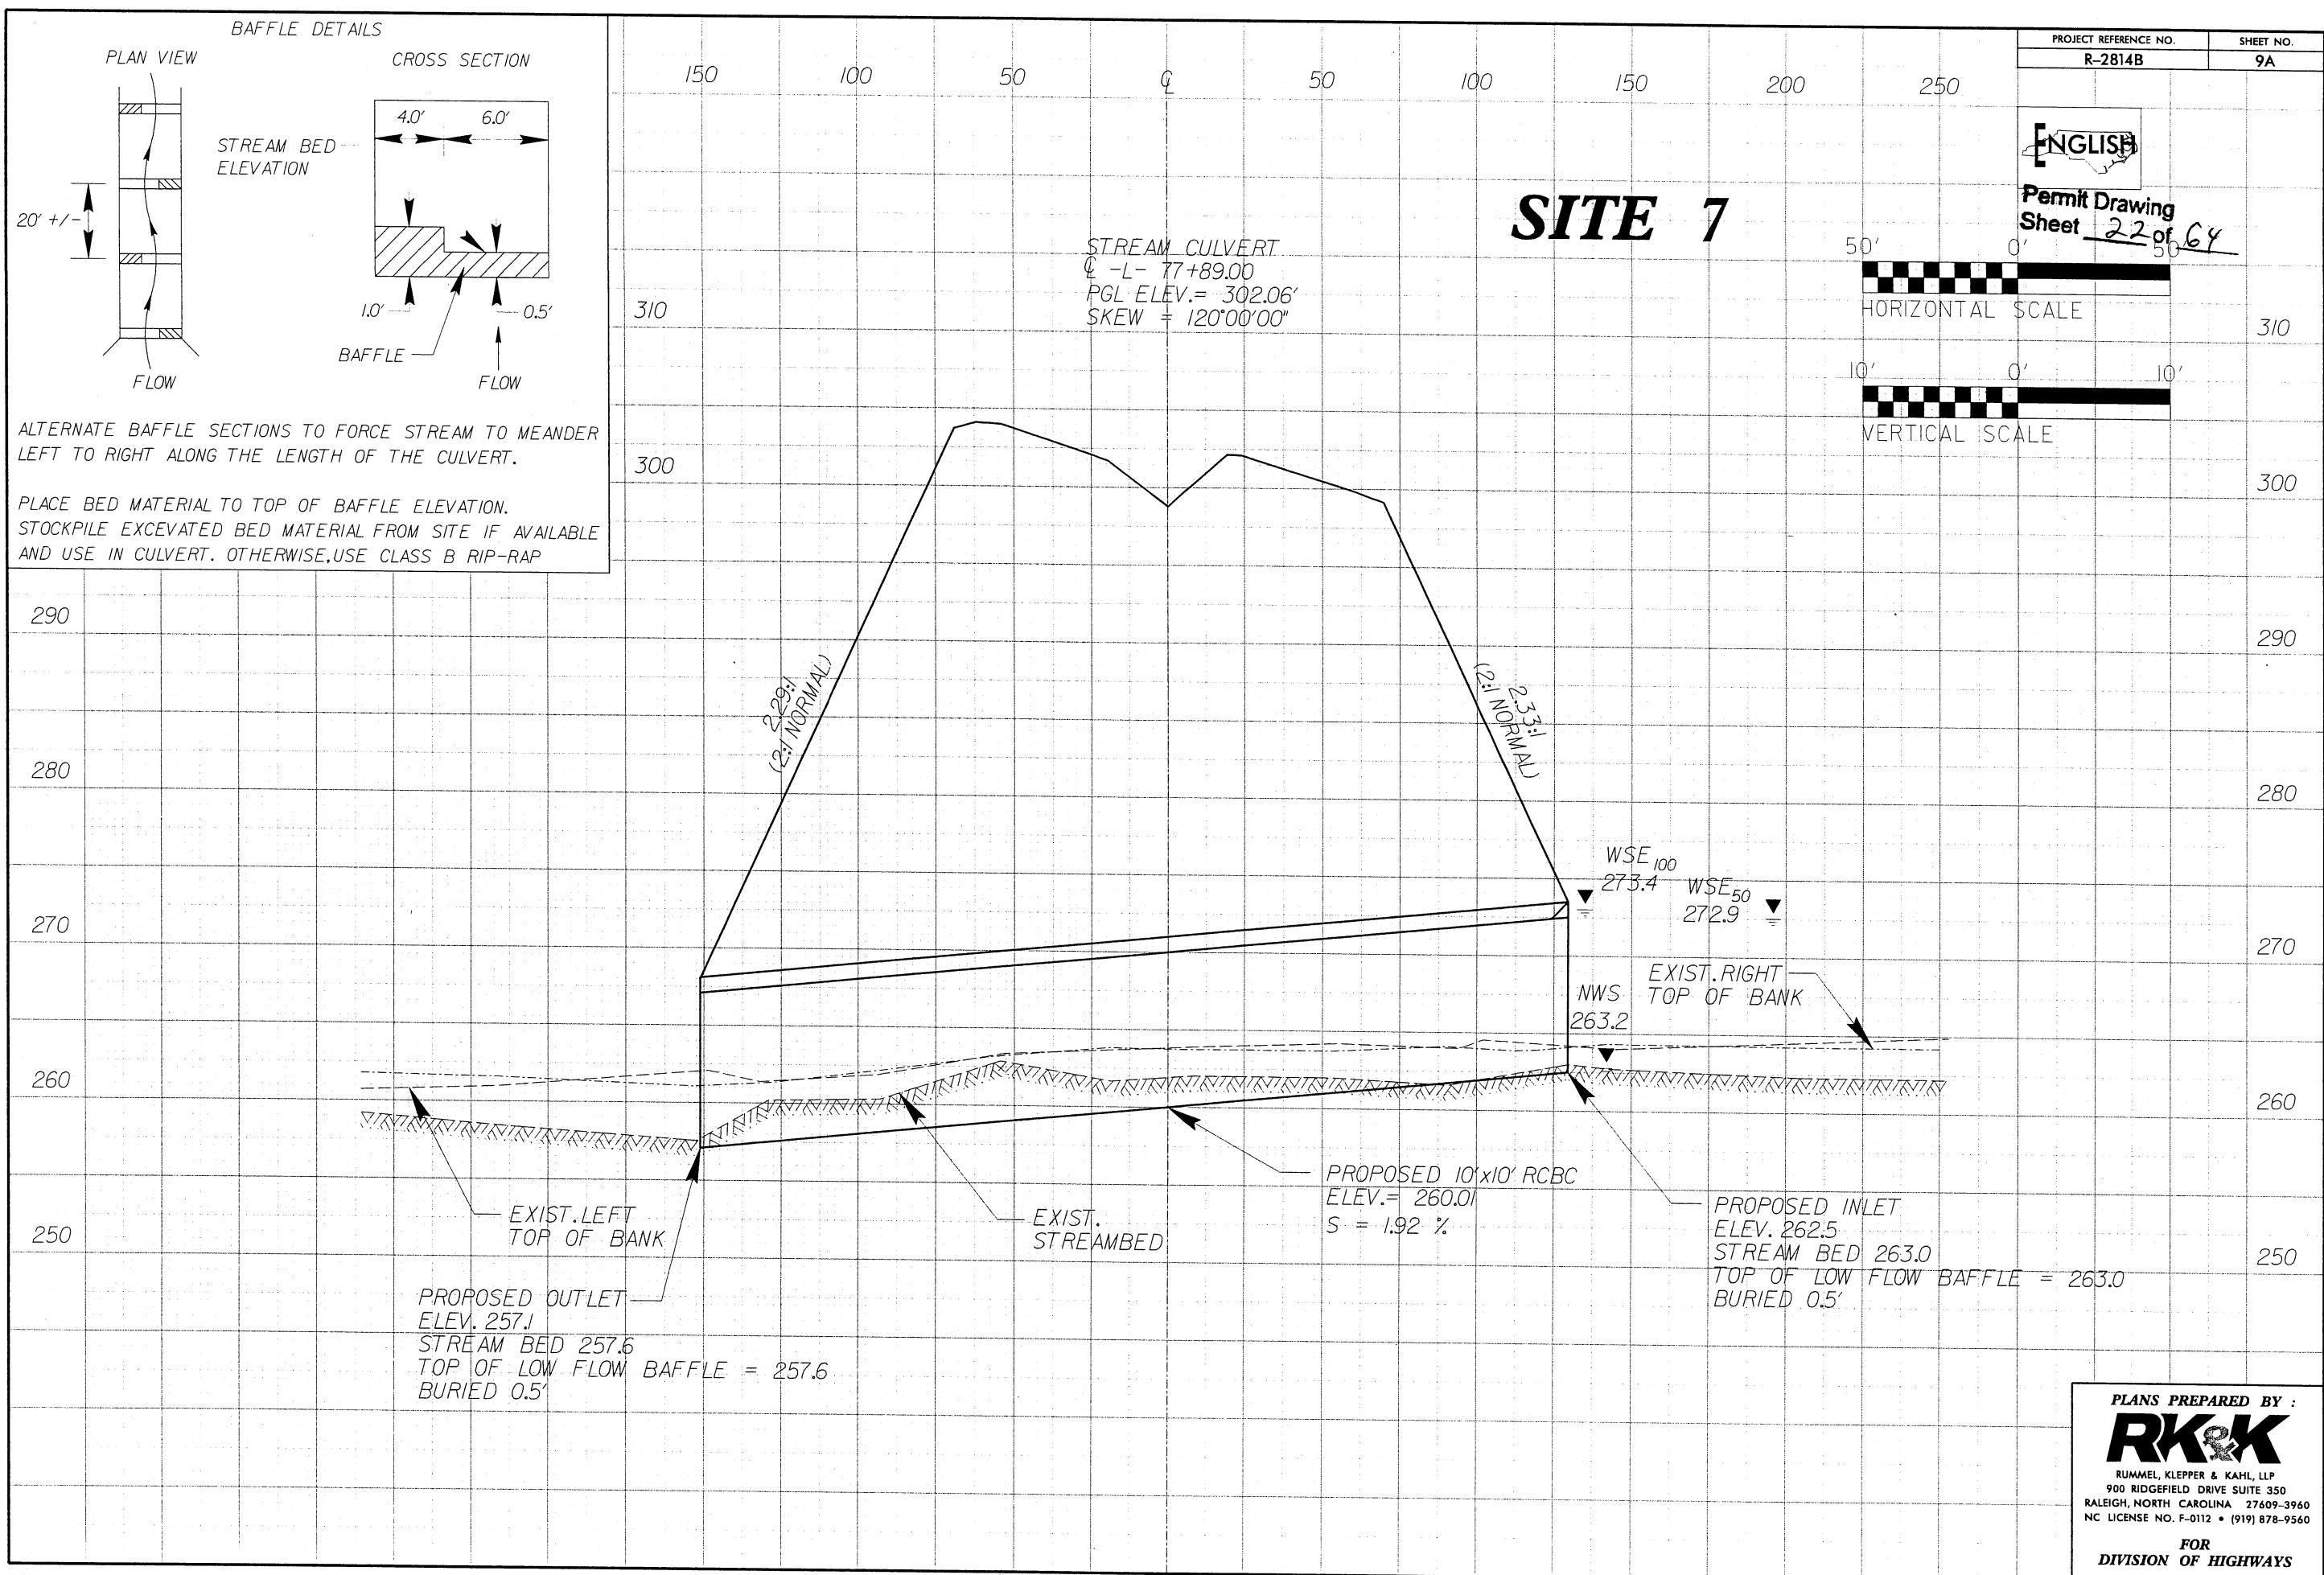

0 5 10

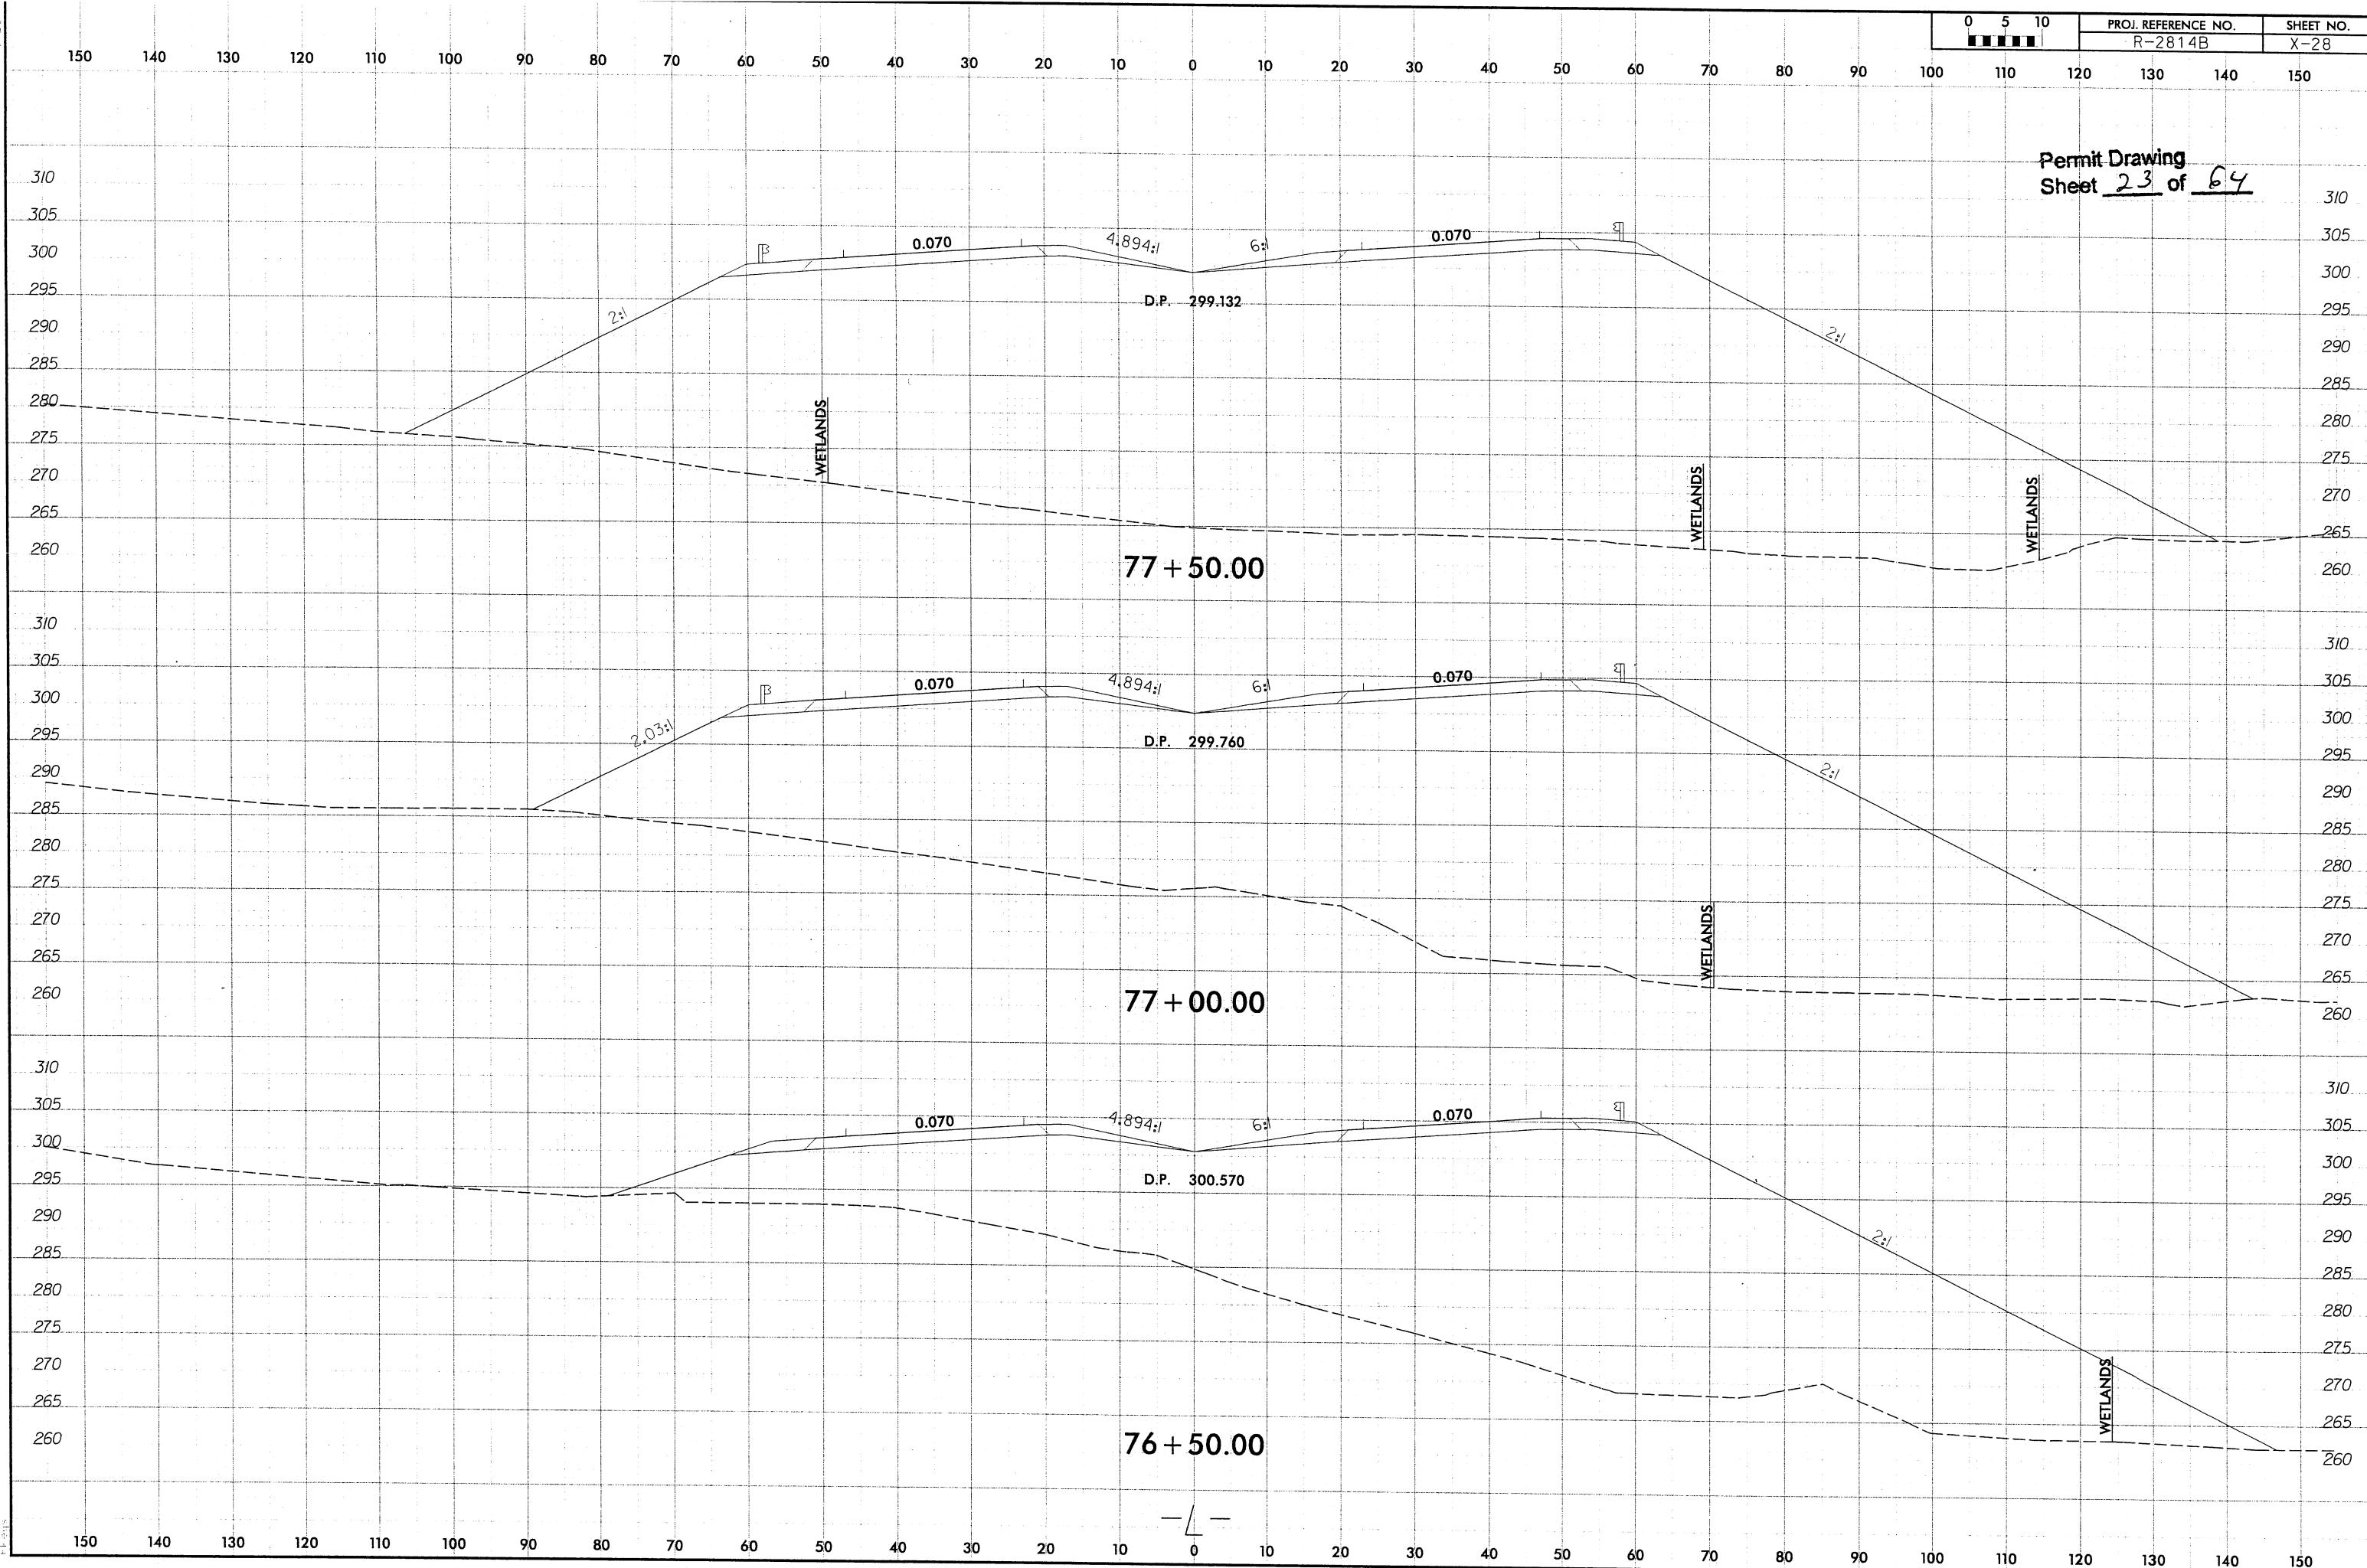PROJ. REFERENCE NO.  
R-2814BSHEET NO.  
X-28Permit Drawing  
Sheet 23 of 64

Permit Drawing  
Sheet 24 of 64

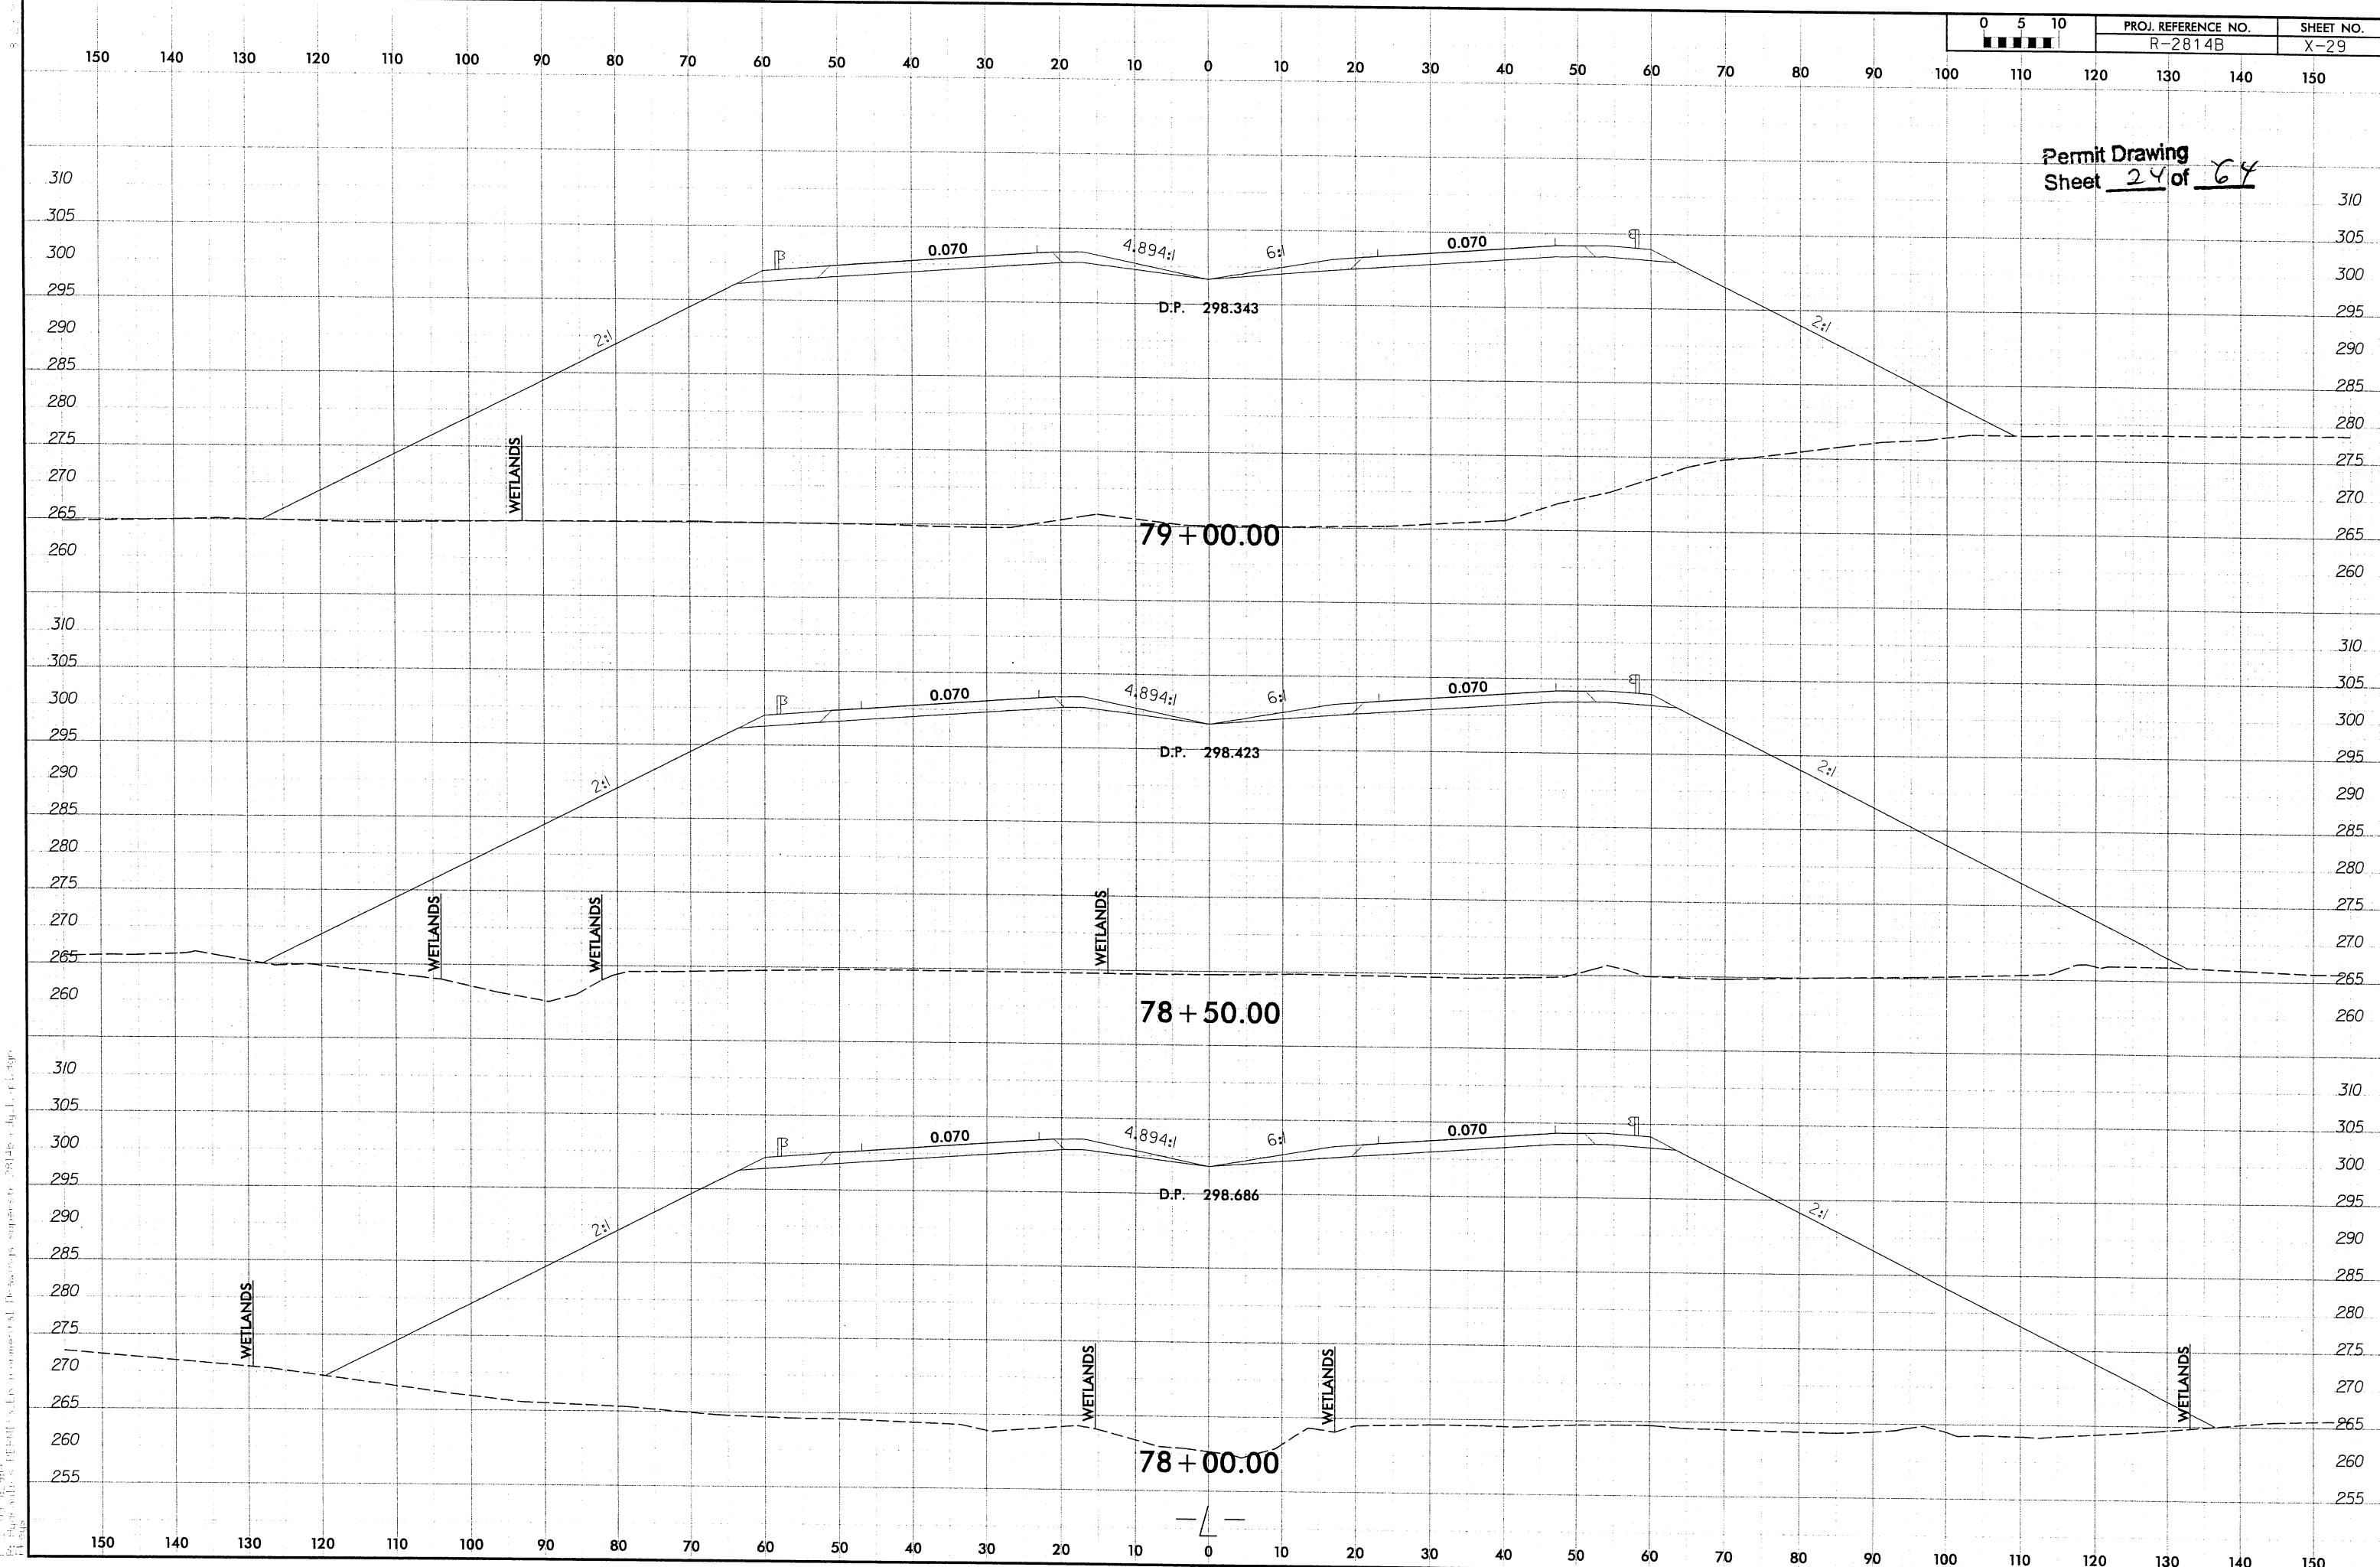

06/16/09: Added TDE upstream and downstream around the culvert on parcel 20.

105

110

115




ROBERT C. RHEIN INTERESTS,

NAD 83/2

**ENGLISH**

PROJECT REFERENCE NO.		SHEET NO.
<b>R-2814B</b>		<b>11</b>
RW SHEET NO.		
ROADWAY DESIGN ENGINEER	HYDRAULICS ENGINEER	
<b>PRELIMINARY PLANS</b> DO NOT USE FOR CONSTRUCTION		

Permit Drawing  
Sheet 2 of 64

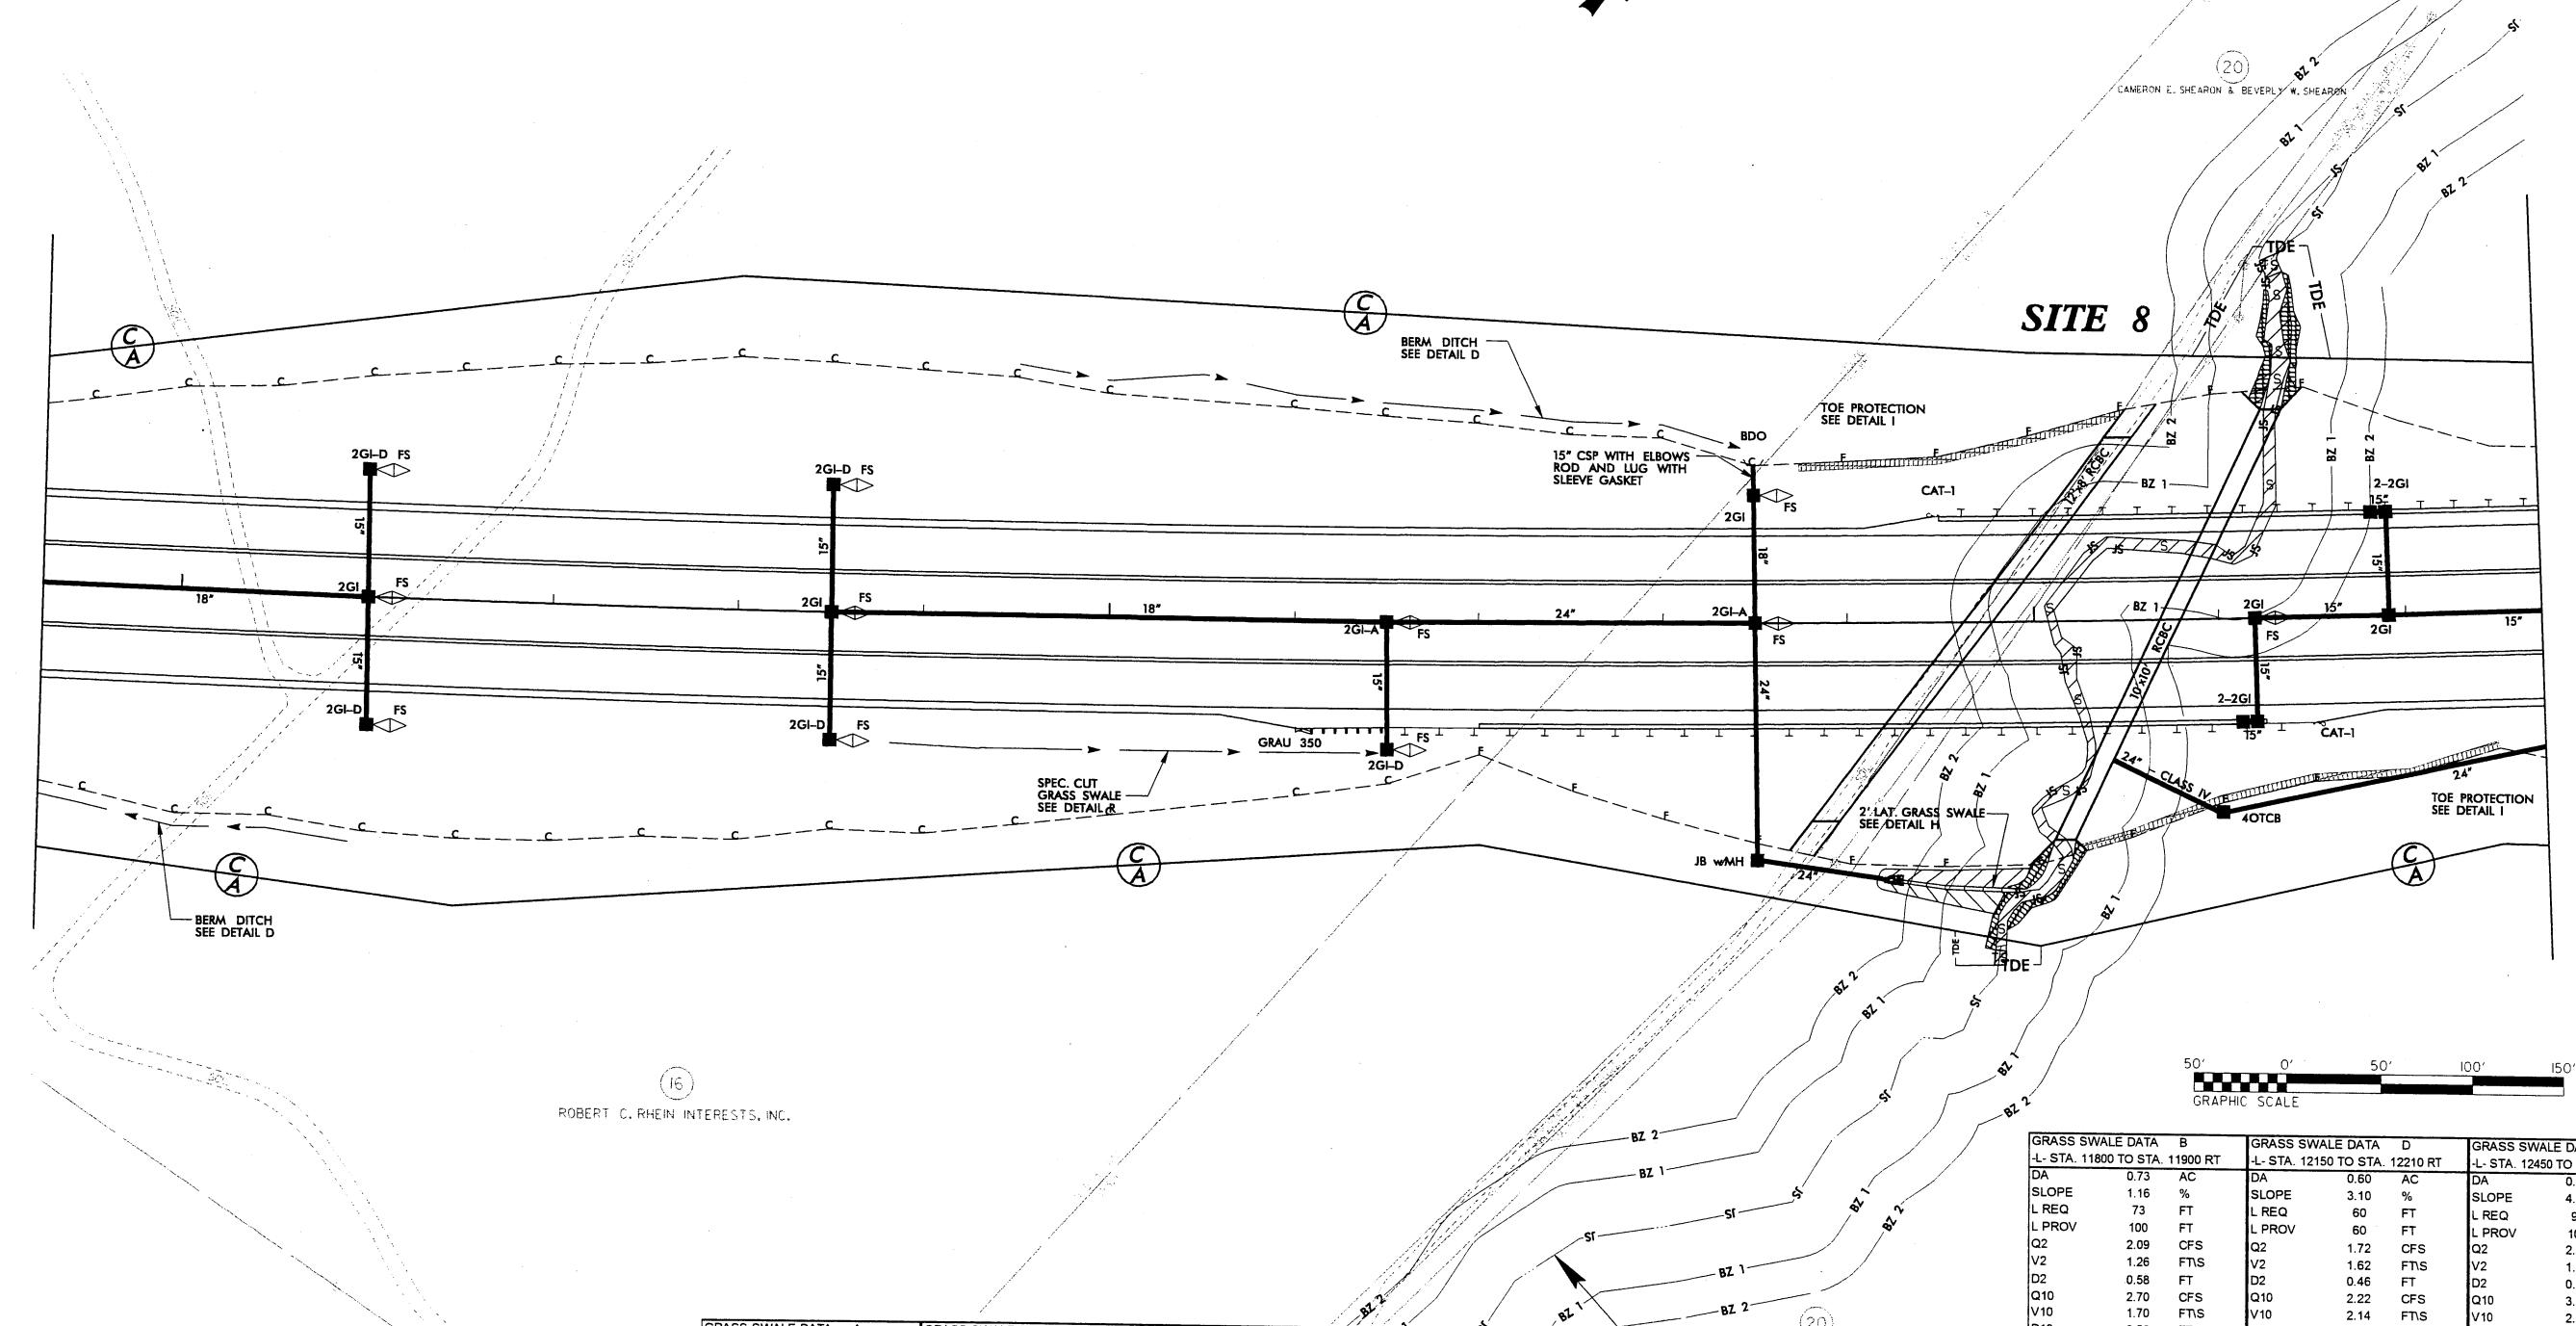


GRASS SWALE DATA	A	GRASS SWALE DATA	B	GRASS SWALE DATA	D	GRASS SWALE DATA	F	
-L- STA. 10700 TO STA. 10850 LT		-L- STA. 10700 TO STA. 10850 RT		-L- STA. 11050 TO STA. 11150 RT		-L- STA. 11200 TO STA. 11350 RT		
DA	0.62	AC	DA	0.60	AC	DA	0.58	AC
SLOPE	2.90	%	SLOPE	2.90	%	SLOPE	4.00	%
L REQ	62	FT	L REQ	60	FT	L REQ	58	FT
L PROV	150	FT	L PROV	150	FT	L PROV	100	FT
Q2	1.77	CFS	Q2	1.72	CFS	Q2	1.66	CFS
V2	1.59	FTNS	V2	1.58	FTNS	V2	1.77	FTNS
D2	0.47	FT	D2	0.47	FT	D2	0.43	FT
Q10	2.29	CFS	Q10	2.22	CFS	Q10	2.14	CFS
V10	2.30	FTNS	V10	2.28	FTNS	V10	2.34	FTNS
D10	0.45	FT	D10	0.44	FT	D10	0.43	FT

GRASS SWALE DATA		B	GRASS SWALE DATA		D	GRASS SWALE DATA		F
-L STA. 11800 TO STA. 11900 RT			-L STA. 12150 TO STA. 12210 RT			-L STA. 12450 TO STA. 12550 LT		
DA	0.73	AC	DA	0.60	AC	DA	0.91	AC
SLOPE	1.16	%	SLOPE	3.10	%	SLOPE	4.00	%
L REQ	73	FT	L REQ	60	FT	L REQ	91	FT
L PROV	100	FT	L PROV	60	FT	L PROV	100	FT
Q2	2.09	CFS	Q2	1.72	CFS	Q2	2.60	CFS
V2	1.26	FT/S	V2	1.62	FT/S	V2	1.98	FT/S
D2	0.58	FT	D2	0.46	FT	D2	0.51	FT
Q10	2.70	CFS	Q10	2.22	CFS	Q10	3.36	CFS
V10	1.70	FT/S	V10	2.14	FT/S	V10	2.62	FT/S
D10	0.56	FT	D10	0.45	FT	D10	0.51	FT
GRASS SWALE DATA		G	GRASS SWALE DATA		I	GRASS SWALE DATA		J
-L STA. 12450 TO STA. 12550 RT			-L STA. 12850 TO STA. 12950 LT			-L STA. 12850 TO STA. 12950 RT		
DA	0.79	AC	DA	0.59	AC	DA	0.39	AC
SLOPE	4.00	%	SLOPE	3.84	%	SLOPE	3.84	%
L REQ	79	FT	L REQ	59	FT	L REQ	39	FT
L PROV	100	FT	L PROV	100	FT	L PROV	100	FT
Q2	2.26	CFS	Q2	1.69	CFS	Q2	1.12	CFS
V2	1.91	FT/S	V2	1.75	FT/S	V2	1.58	FT/S
D2	0.49	FT	D2	0.44	FT	D2	0.38	FT
Q10	2.92	CFS	Q10	2.18	CFS	Q10	1.44	CFS
V10	2.53	FT/S	V10	2.31	FT/S	V10	2.08	FT/S
D10	0.48	FT	D10	0.43	FT	D10	0.37	FT

105

110

115

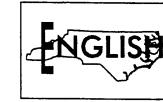

PROJECT REFERENCE NO.		SHEET NO.
<b>R-2814B</b>		<b>11</b>
RW SHEET NO.		
<b>RROADWAY DESIGN ENGINEER</b>	<b>HYDRAULICS ENGINEER</b>	
<div style="text-align: center; background-color: black; color: white; padding: 5px;"> <b>PRELIMINARY PLANS</b>  <b>DO NOT USE FOR CONSTRUCTION</b> </div>		

Permit Drawing  
Sheet 26 of 64

REVISIONS  
06/16/00 Added TDE 'upstream' and downstream around the culvert on range 20.

**ENGLISH**

PRELIMINARIES  
DO NOT USE FOR CONSTRUCTION

Permit Draw Sheet 2

DENOTES IMPACTS IN SURFACE WATER

DENOTES TEMPORARY IMPACTS IN SURFACE WATER

ROBERT C. PHEIN INTERESTS, INC.

NAD 83/2001

**SITE 8**

BERM DITCH SEE DETAIL D

TOE PROTECTION SEE DETAIL I

15" CSP WITH ELBOWS ROD AND LUG WITH SLEEVE GASKET

BDO

CAT-1

2GI

2GI-D FS

PS

18"

15"

2GI

FS

18"

2GI-A

FS

24"

2GI-D FS

FS

15"

2GI-D FS

FS

15"

GRAU 350

2GI-D

FS

SPEC CUT GRASS SWALE SEE DETAIL R

JB w/MH

24"

2GI

FS

15"

2GI

FS

15"

2-2GI

CAT-1

24"

CLASS IV

4OTCB

TOE PROTECTION SEE DETAIL I

BERM DITCH SEE DETAIL D

GRASS SWALE DATA B

L-STA. 11800 TO STA. 11900 RT

DA 0.73 AC

SLOPE 1.16 %

L REQ 73 FT

L PROV 100 FT

Q2 2.09 CFS

V2 1.26 FTS

D2 0.58 FT

Q10 2.70 CFS

V10 1.70 FTS

D10 0.56 FT

GRASS SWALE DATA D

L-STA. 12150 TO STA. 12210 RT

DA 0.60 AC

SLOPE 3.10 %

L REQ 60 FT

L PROV 60 FT

Q2 1.72 CFS

V2 1.62 FTS

D2 0.46 FT

Q10 2.22 CFS

V10 2.14 FTS

D10 0.45 FT

GRASS SWALE DATA A

GRASS SWALE DATA E


GRASS SWALE DATA F

GRAPHIC SCALE

50' 0' 50' 100'

ROBERT C. PHEIN INTERESTS, INC.

GRASS SWALE DATA A -L STA. 10700 TO STA. 10850 LT		GRASS SWALE DATA B -L STA. 10700 TO STA. 10850 RT		GRASS SWALE DATA D -L STA. 11050 TO STA. 11150 RT		GRASS SWALE DATA F -L STA. 11200 TO STA. 11350 LT	
DA	0.62 AC	DA	0.60 AC	DA	0.58 AC	DA	1.08 AC
SLOPE	2.90 %	SLOPE	2.90 %	SLOPE	4.00 %	SLOPE	3.05 %
L REQ	52 FT	L REQ	60 FT	L REQ	58 FT	L REQ	108 FT
L PROV	150 FT	L PROV	150 FT	L PROV	100 FT	L PROV	150 FT
Q2	1.77 CFS	Q2	1.72 CFS	Q2	1.66 CFS	Q2	3.09 CFS
V2	1.59 FT/S	V2	1.58 FT/S	V2	1.77 FT/S	V2	1.87 FT/S
D2	0.47 FT	D2	0.47 FT	D2	0.43 FT	D2	0.58 FT
Q10	2.29 CFS	Q10	2.22 CFS	Q10	2.14 CFS	Q10	3.99 CFS
V10	2.30 FT/S	V10	2.28 FT/S	V10	2.34 FT/S	V10	2.70 FT/S
D10	0.45 FT	D10	0.44 FT	D10	0.43 FT	D10	0.54 FT

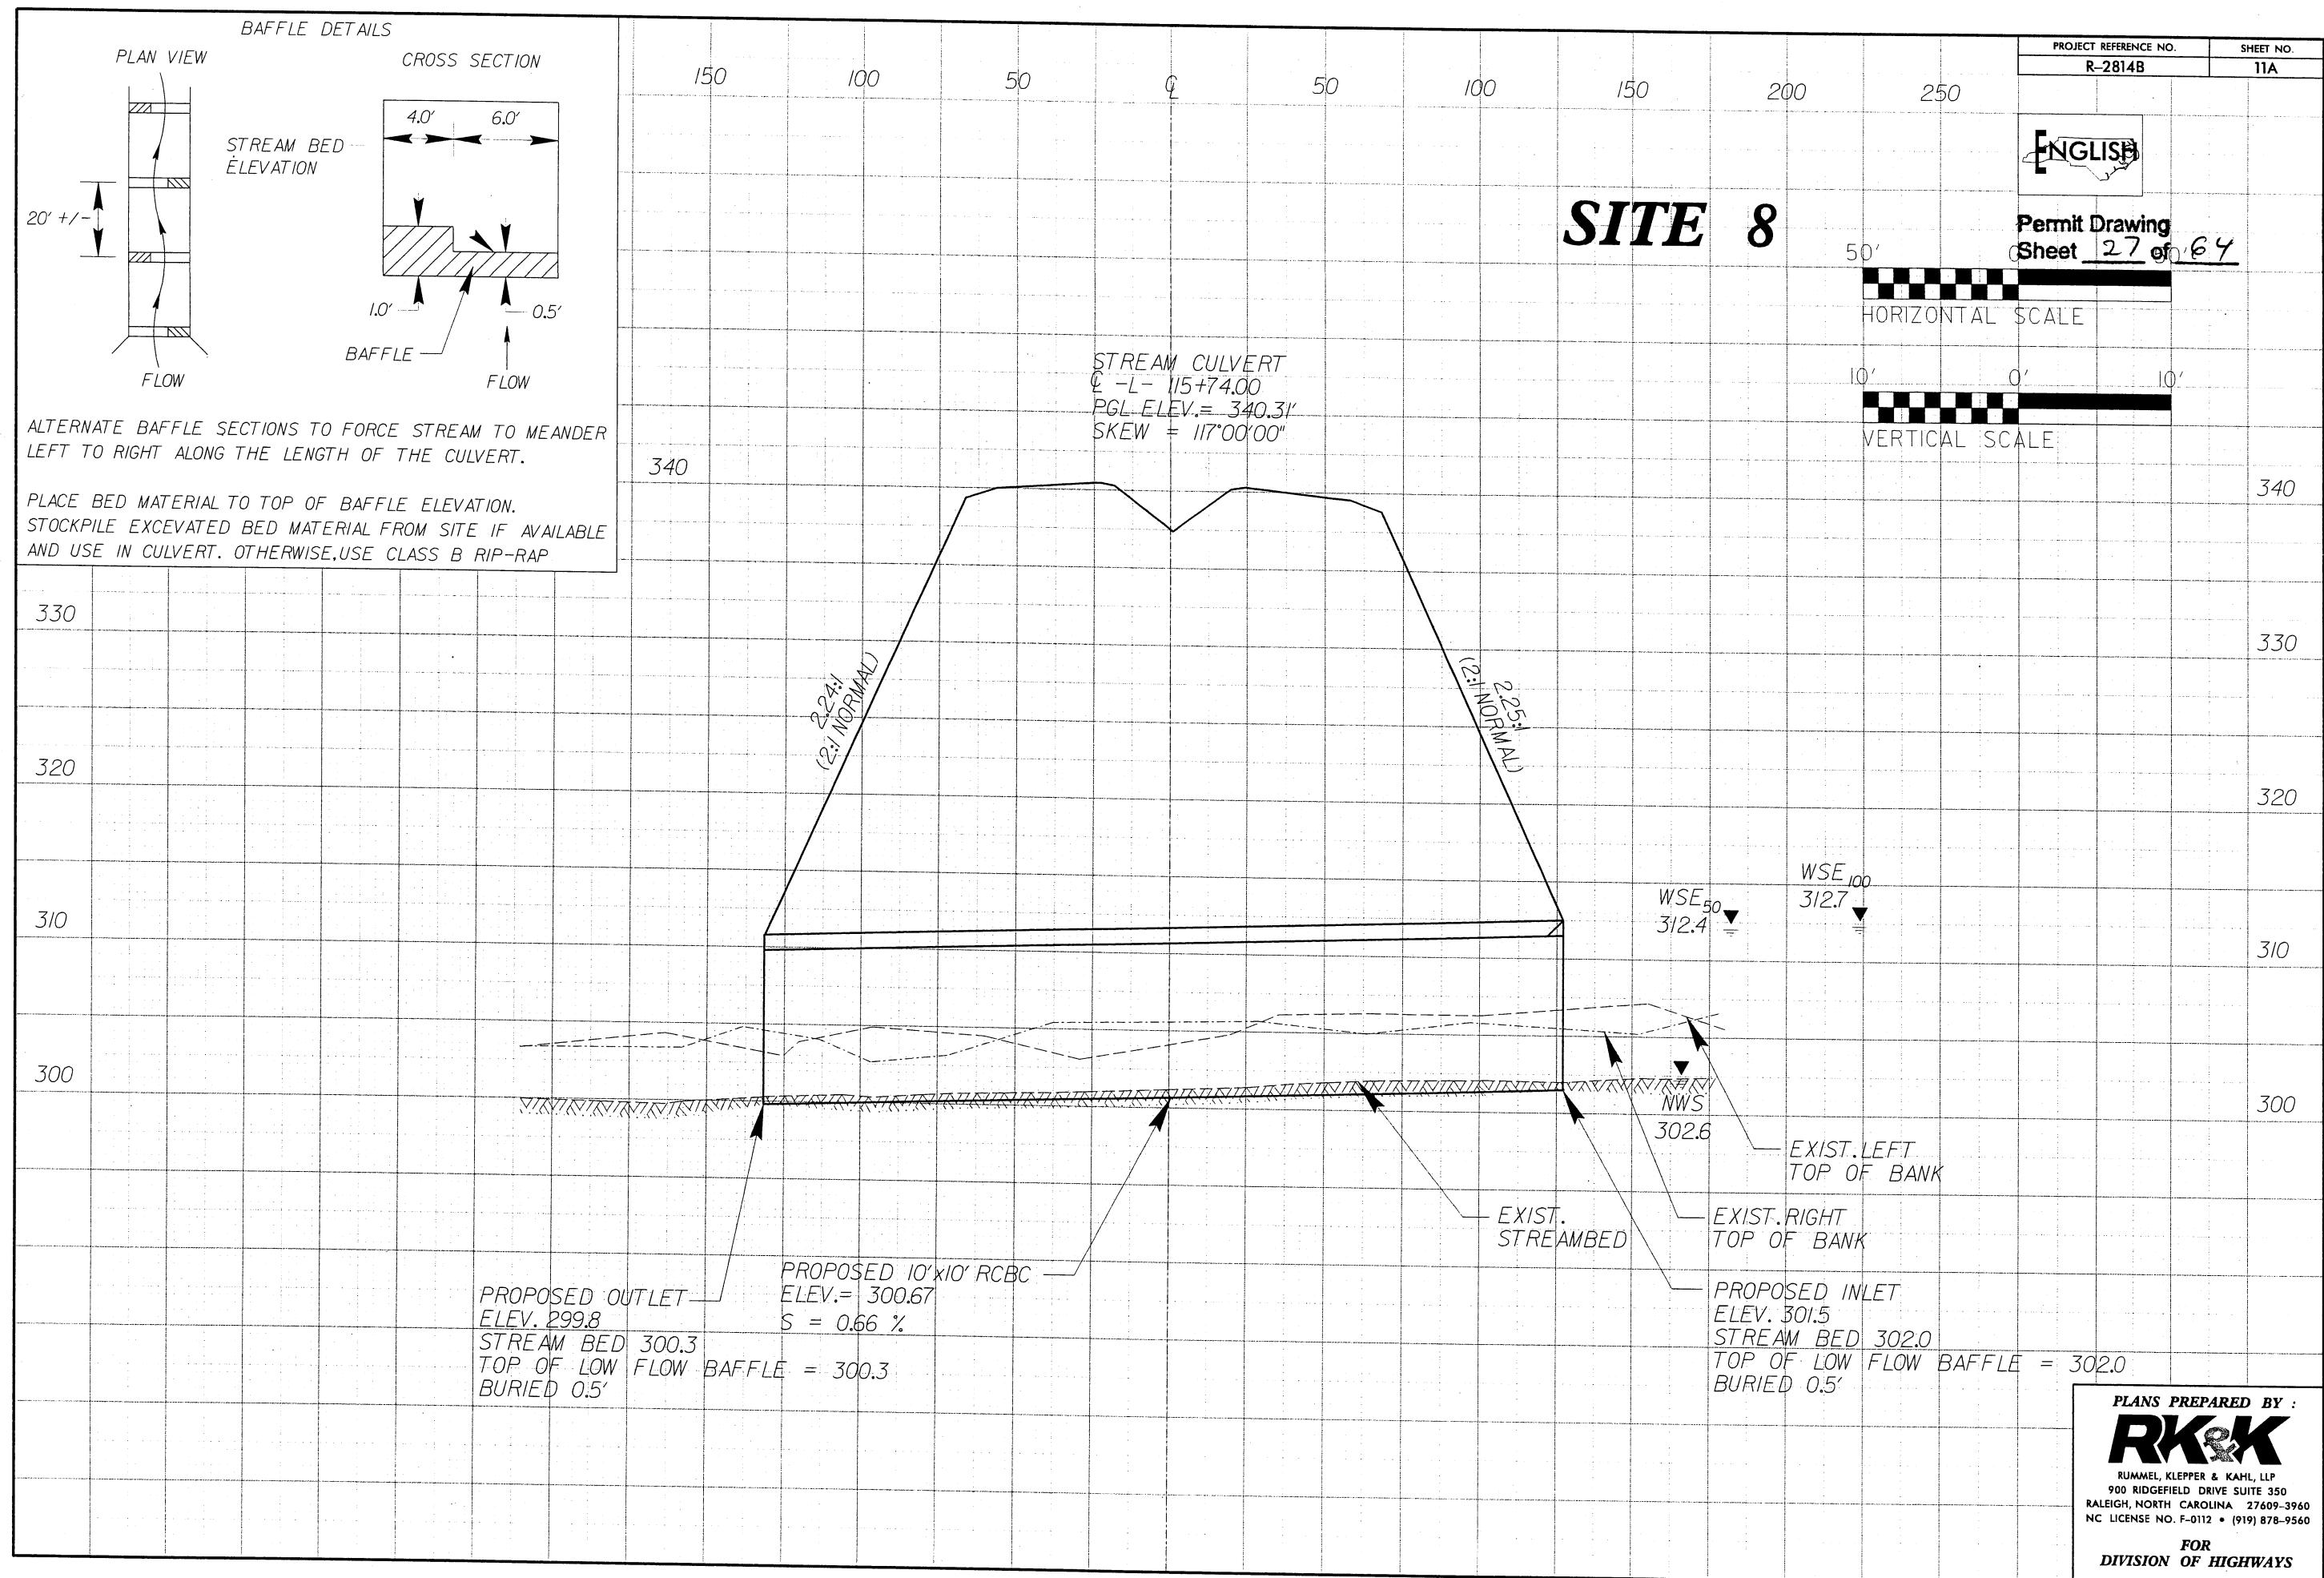


135

14

**Permit Drawing  
Sheet 28 of 64**

SITE 9

MITCHELL F. RABIL FAMILY  
IRREVOCABLE TRUST

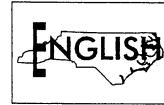


BURGESS

The legend consists of three rows of symbols. Row 1: A box containing diagonal hatching with the number '5' in the top-left corner, followed by the text 'DENOTES IMPACTS IN SURFACE WATER'. Row 2: A box containing diagonal hatching with the letters 'TS' in the top-left and bottom-right corners, followed by the text 'DENOTES TEMPORARY IMPACTS IN SURFACE WAT'. Row 3: A box containing diagonal hatching with the letter 'P' in the top-left and bottom-right corners, followed by the text 'DENOTES IMPACTS IN SURFACE WATER (POND)'.

REVISI観

REVISED NAMES ON PARCEL 22 PER LOCATION AND SURVEY REQUEST 4/23/09 DDL 7/29/09

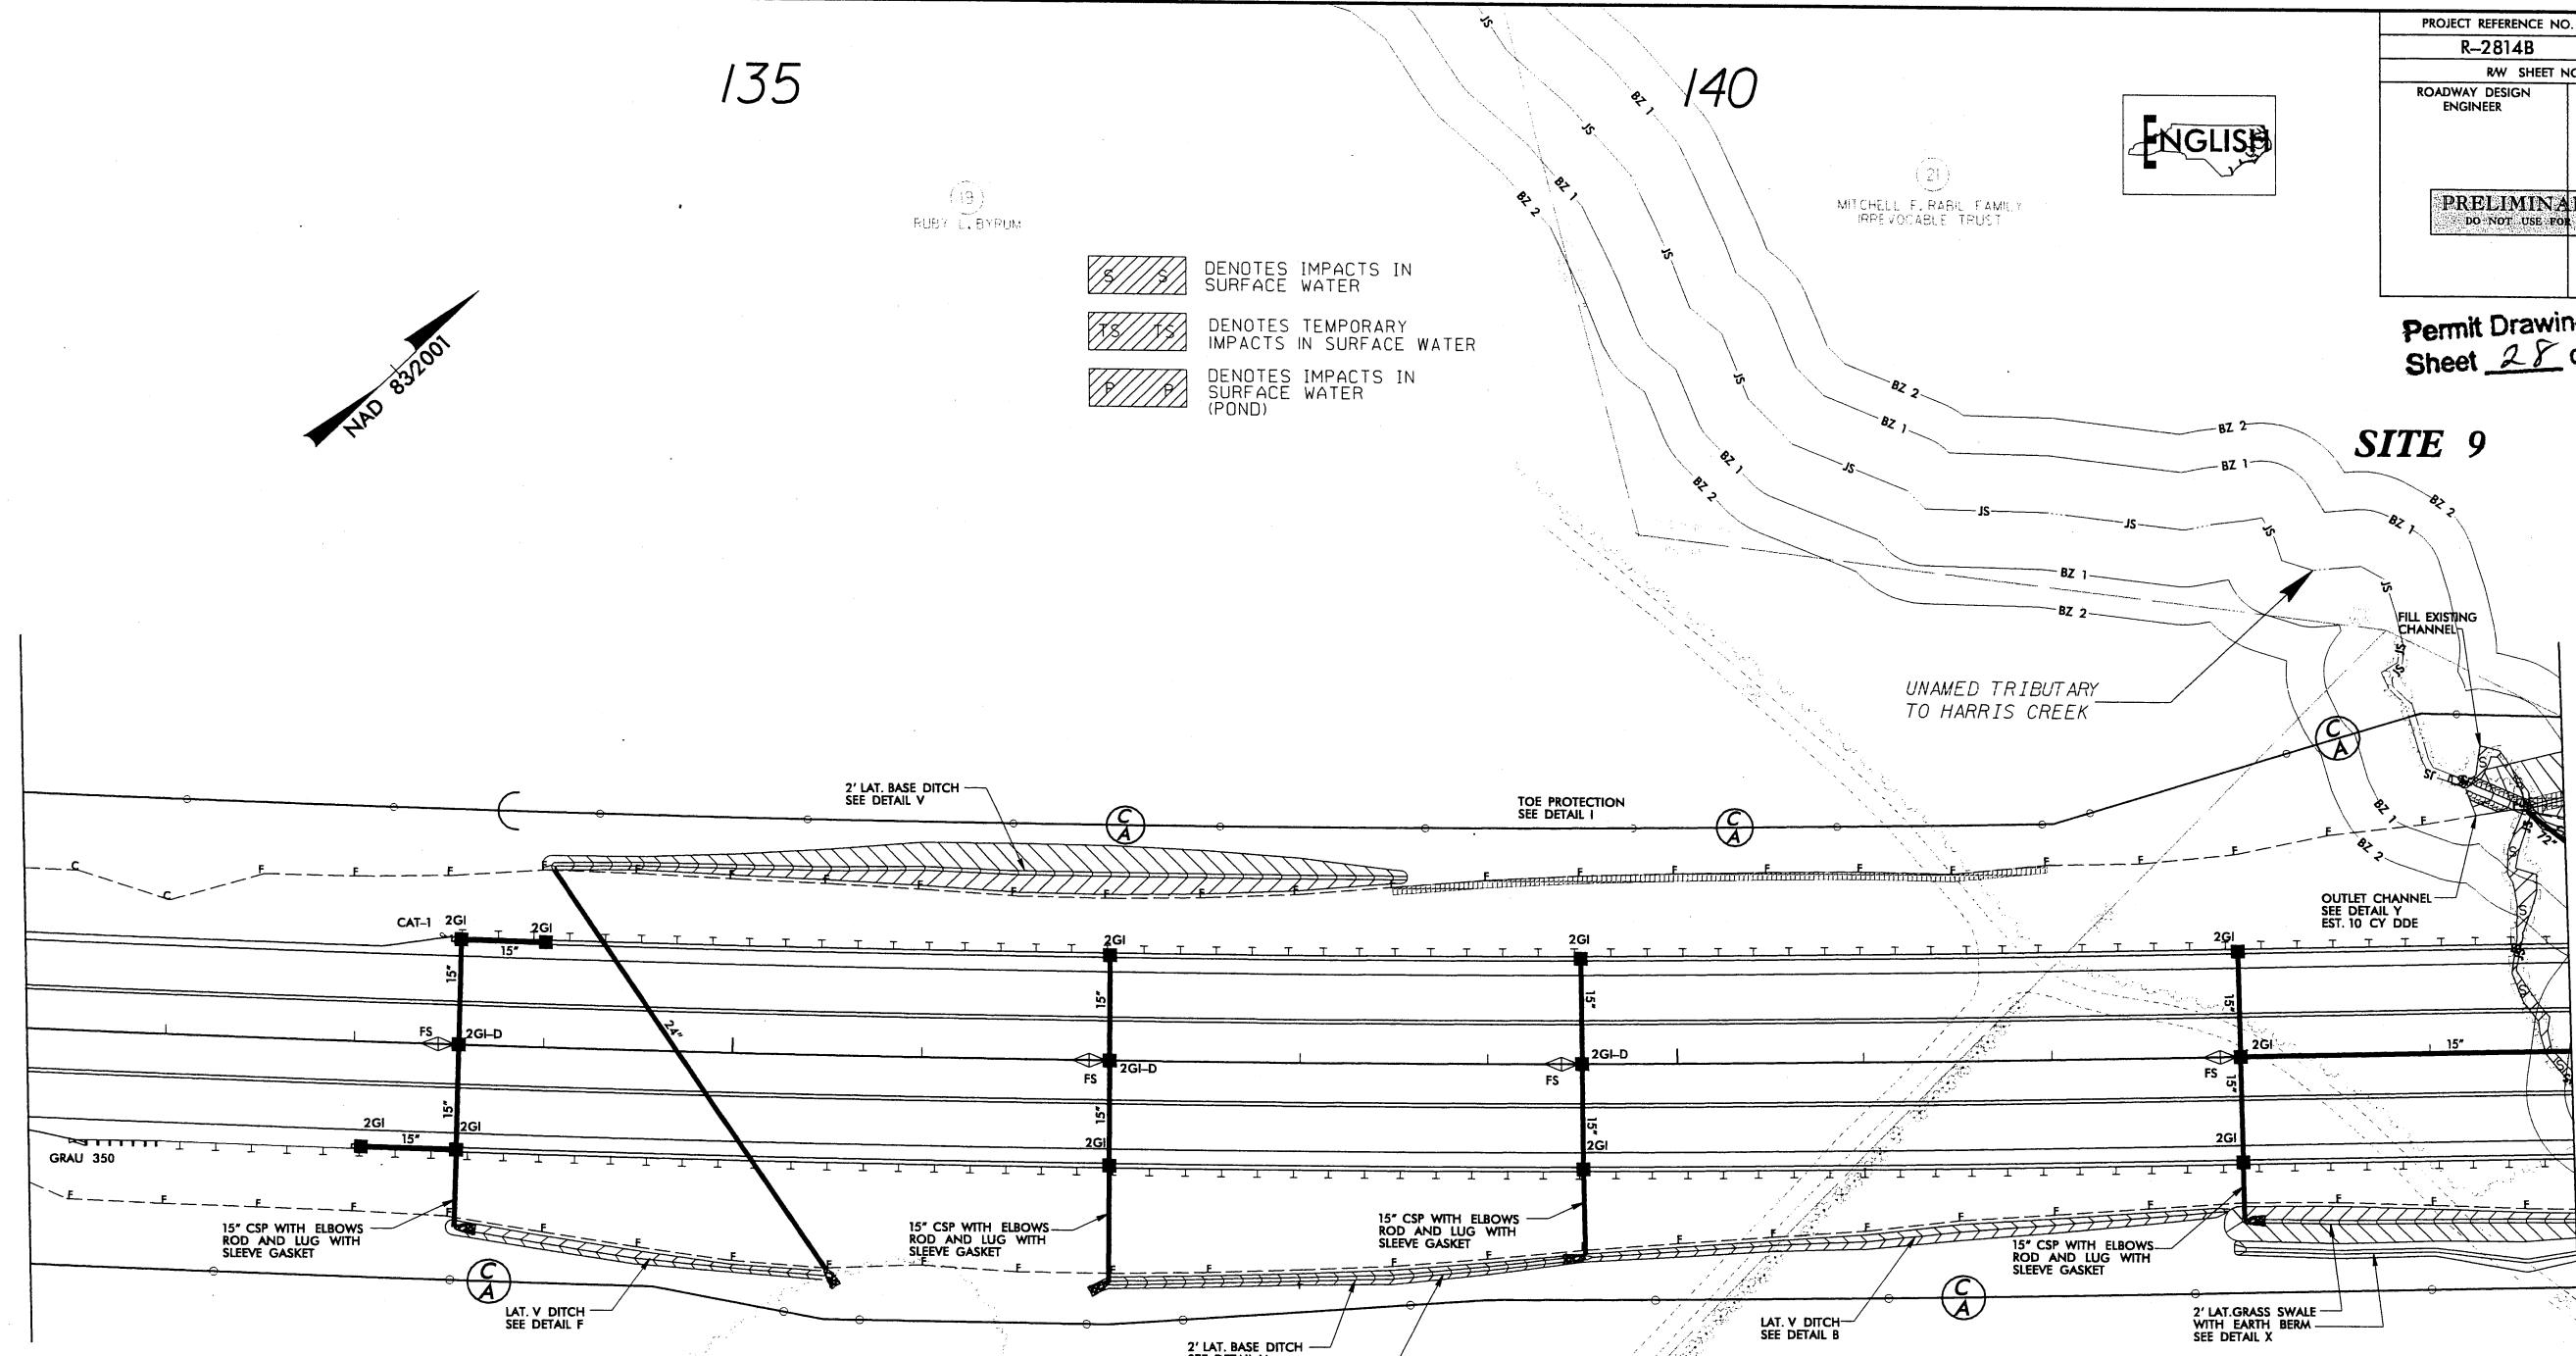

BURGESS

CAMERON E. SHEARO  
&  
BEVERLY W. SHEARO  
DB 12258 PG 105

GRASS SWALE DATA		B		
L- STA.	14300	TO STA.	14500	RT
DA	1.75	AC		
SLOPE	0.80	%		
L REQ	175	FT		
L PROV	200	FT		
Q2	5.42	CFS		
V2	1.93	FTS		
D2	0.69	FT		
Q10	7.02	CFS		
V10	2.07	FTS		
D10	0.78	FT		

A graphic scale bar with tick marks at 50', 0', 50', 100', and 150'. The first 50' segment is black, followed by a white segment, then another black segment, and so on. Below the scale bar, the words "GRAPHIC SCALE" are printed.


Permit Drawing  
Sheet 29 of 64

SITE 9


REVISED

REVISED NAMES ON PARCEL 222 PER LOCATION AND SURVEY REQUEST 4/23/09 DDL 7/29/09

02\22\0 10:23:45 28145 had some time | 2 days

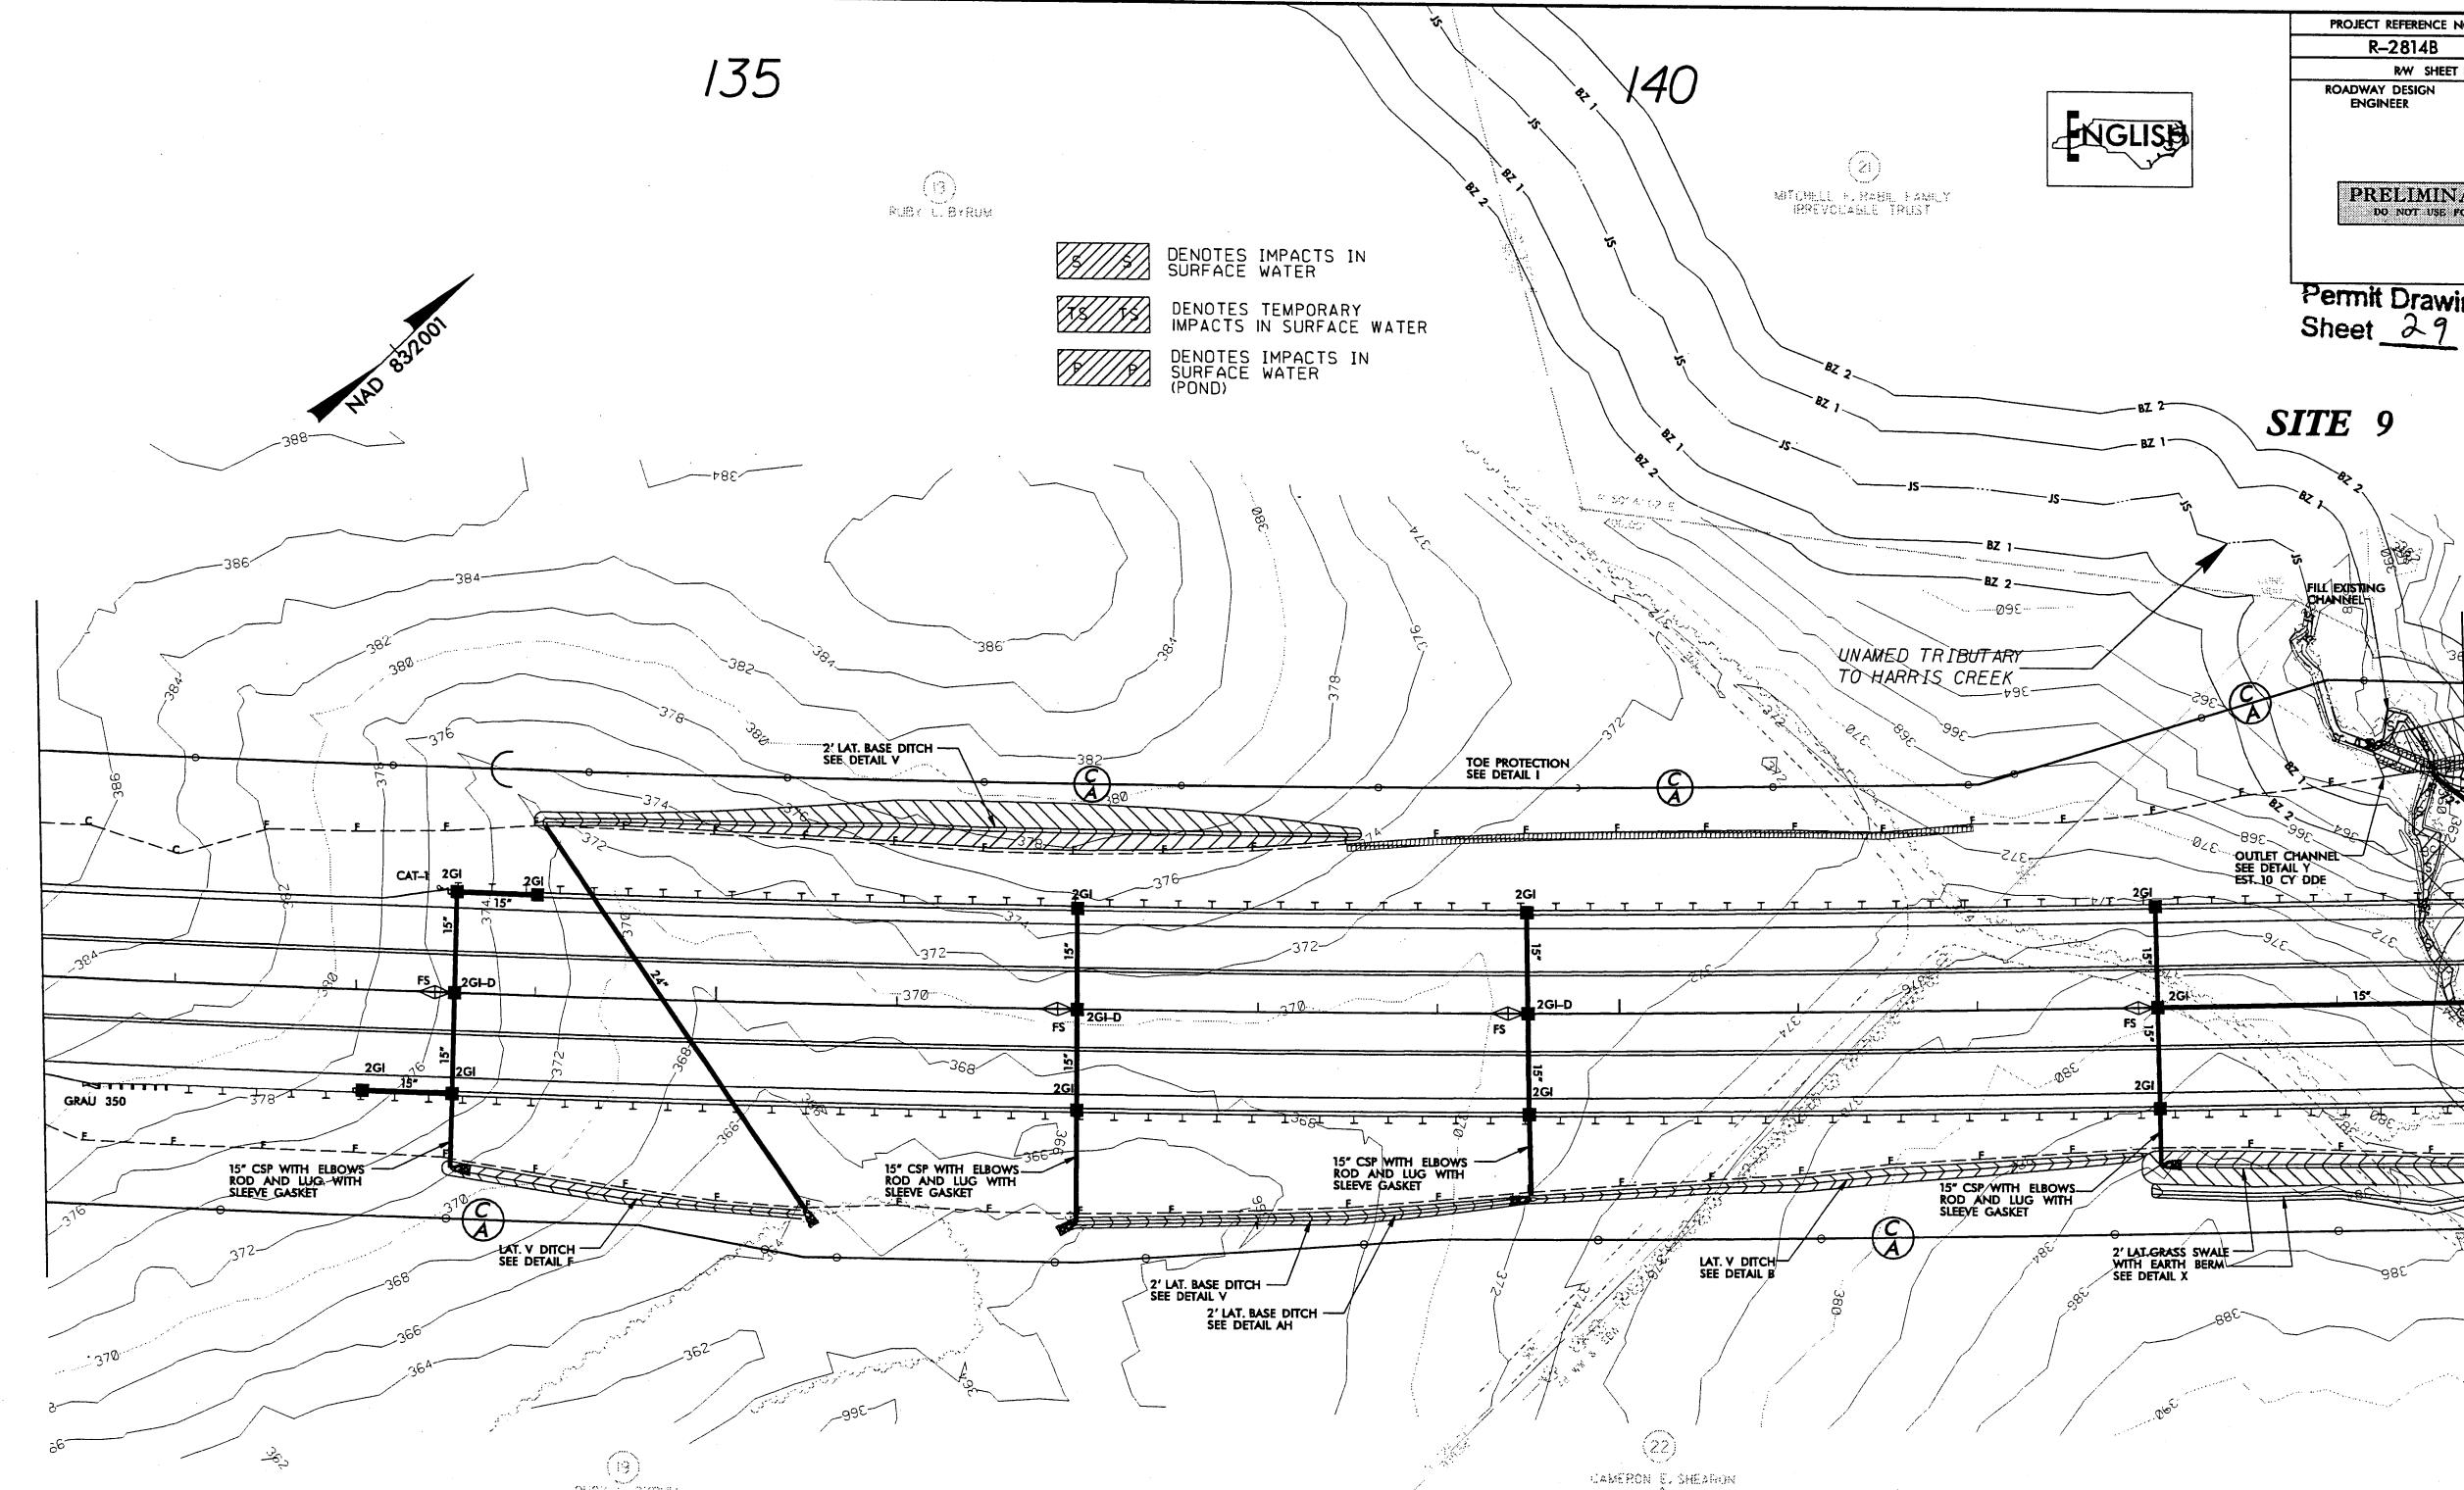

GRASS SWALE DATA		B
L- STA.	14300 TO STA.	14500 RT
DA	1.75	AC
SLOPE	0.80	%
L REQ	175	FT
L PROV	200	FT
Q2	5.42	CFS
V2	1.93	FTS
D2	0.69	FT
Q10	7.02	CFS
V10	2.07	FTS
D10	0.78	FT

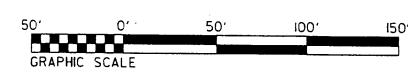

REVISIONS

REVISED NAMES ON PARCEL 22 PER LOCATION AND SURVEY REQUEST 4/23/09 DDL 7/29/09

145

150


155

A black diamond-shaped logo containing the text "NAD 83/2001".

MITCHELL F. RABIL FAMILY  
IRREVOCABLE TRUST

 DENOTES IMPACTS IN SURFACE WATER  
 DENOTES TEMPORARY IMPACTS IN SURFACE WATE  
 DENOTES IMPACTS IN SURFACE WATER (POND)

SITE 9

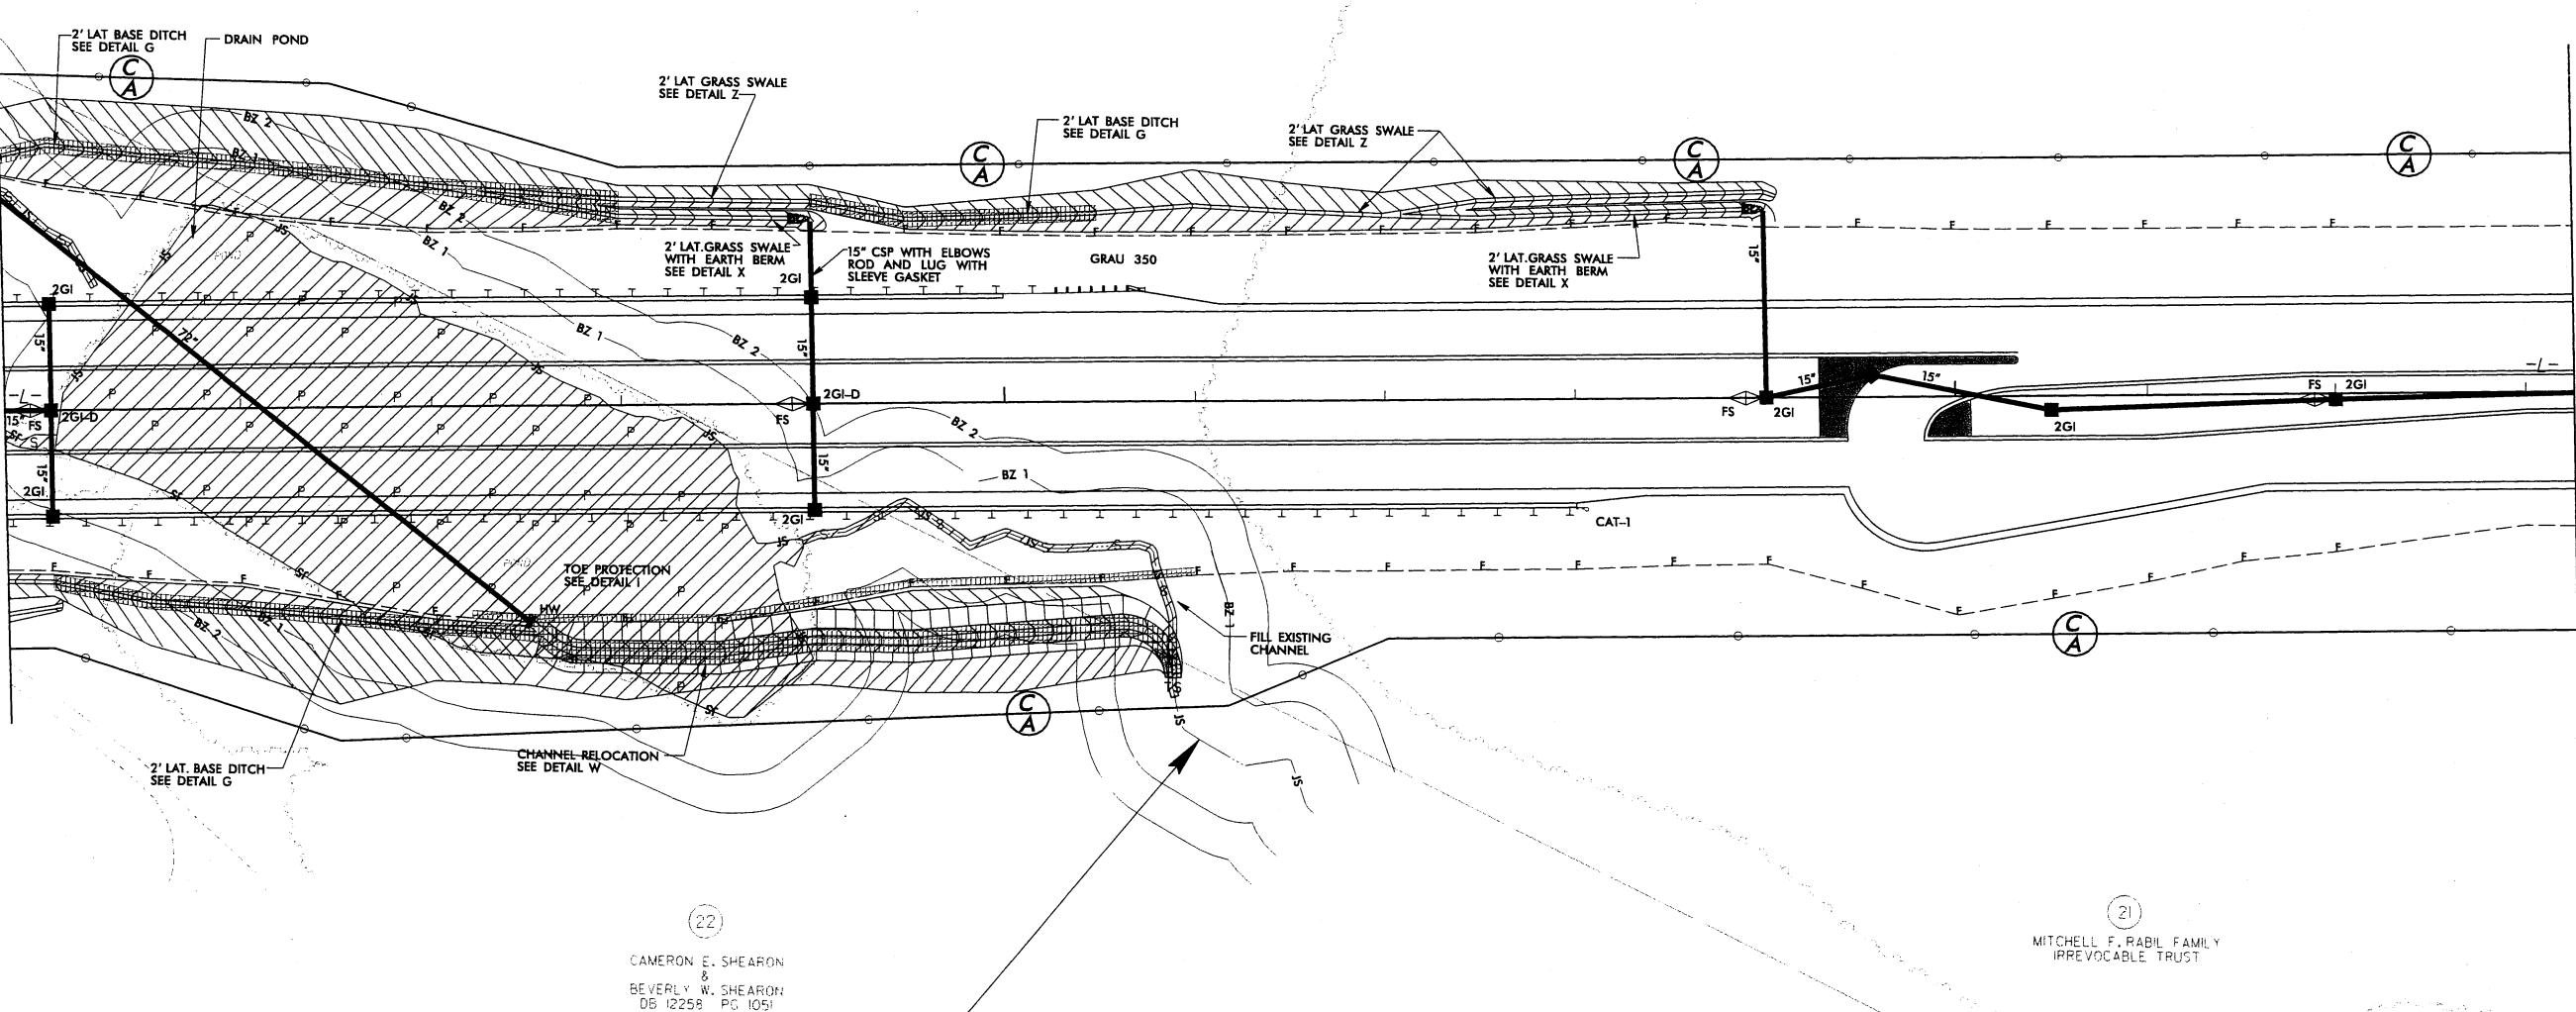

GRASS SWALE DATA D		GRASS SWALE DATA F			
-L STA. 14800 TO STA. 14900 LT		-L STA. 15250 TO STA. 15400 LT			
DA	1.00	AC	DA	1.41	AC
SLOPE	2.20	%	SLOPE	0.50	%
L REQ	100	FT	L REQ	141	FT
L PROV	100	FT	L PROV	150	FT
Q2	2.86	CFS	Q2	3.57	CFS
V2	1.75	FT/S	V2	1.45	FT/S
D2	0.48	FT	D2	0.63	FT
Q10	3.70	CFS	Q10	4.63	CFS
V10	2.80	FT/S	V10	1.56	FT/S
D10	0.54	FT	D10	0.72	FT

AMERON E. SHEARON  
&  
EVERLY W. SHEARON  
DB 12258 PG 1051

MITCHELL F. RABIL FAMILY  
IRREVOCABLE TRUST

Mitchell F. Rabil Family  
Irrevocable Trust

A graphic scale bar consisting of a series of black and white horizontal bars. The scale is labeled with numerical values: 50', 0', 50', 100', and 150'. Below the scale, the word "GRAPHIC" is written above the word "SCALE".

PROJECT REFERENCE NO.		SHEET NO.
<b>R-2814B</b>		<b>14</b>
RW SHEET NO.		
<b>ROADWAY DESIGN ENGINEER</b>	<b>HYDRAULICS ENGINEER</b>	
<div style="text-align: center;"> <b>PRELIMINARY PLANS</b>  <b>DO NOT USE FOR CONSTRUCTION</b> </div>		

Permit Drawing  
Sheet 30 of 64

145

150

155

Permit Drawing  
Sheet 31 of 64

---

## **REVISIONS**

REVISED NAMES ON PARCEL 22 PER LOCATION AND SURVEY REQUEST 4/23/09 DDL 7/29/09

卷之三


GRASS SWALE DATA		D	GRASS SWALE DATA		F	
-L- STA. 14800 TO STA. 14900 LT			-L- STA. 15250 TO STA. 15400 LT			
DA		1.00	AC	DA	1.41	AC
SLOPE		2.20	%	SLOPE	0.50	%
L REQ		100	FT	L REQ	141	FT
L PROV		100	FT	L PROV	150	FT
Q2		2.86	CFS	Q2	3.57	CFS
V2		1.75	FT/S	V2	1.45	FT/S
D2		0.48	FT	D2	0.63	FT
Q10		3.70	CFS	Q10	4.63	CFS
V10		2.80	FT/S	V10	1.56	FT/S
D10		0.54	FT	D10	0.72	FT

CAMERON &  
VERITY

UNA  
TO

*UNAMED  
TO HARR*

PROJECT REFERENCE NO.	SHEET NO.
R-2814B	14A

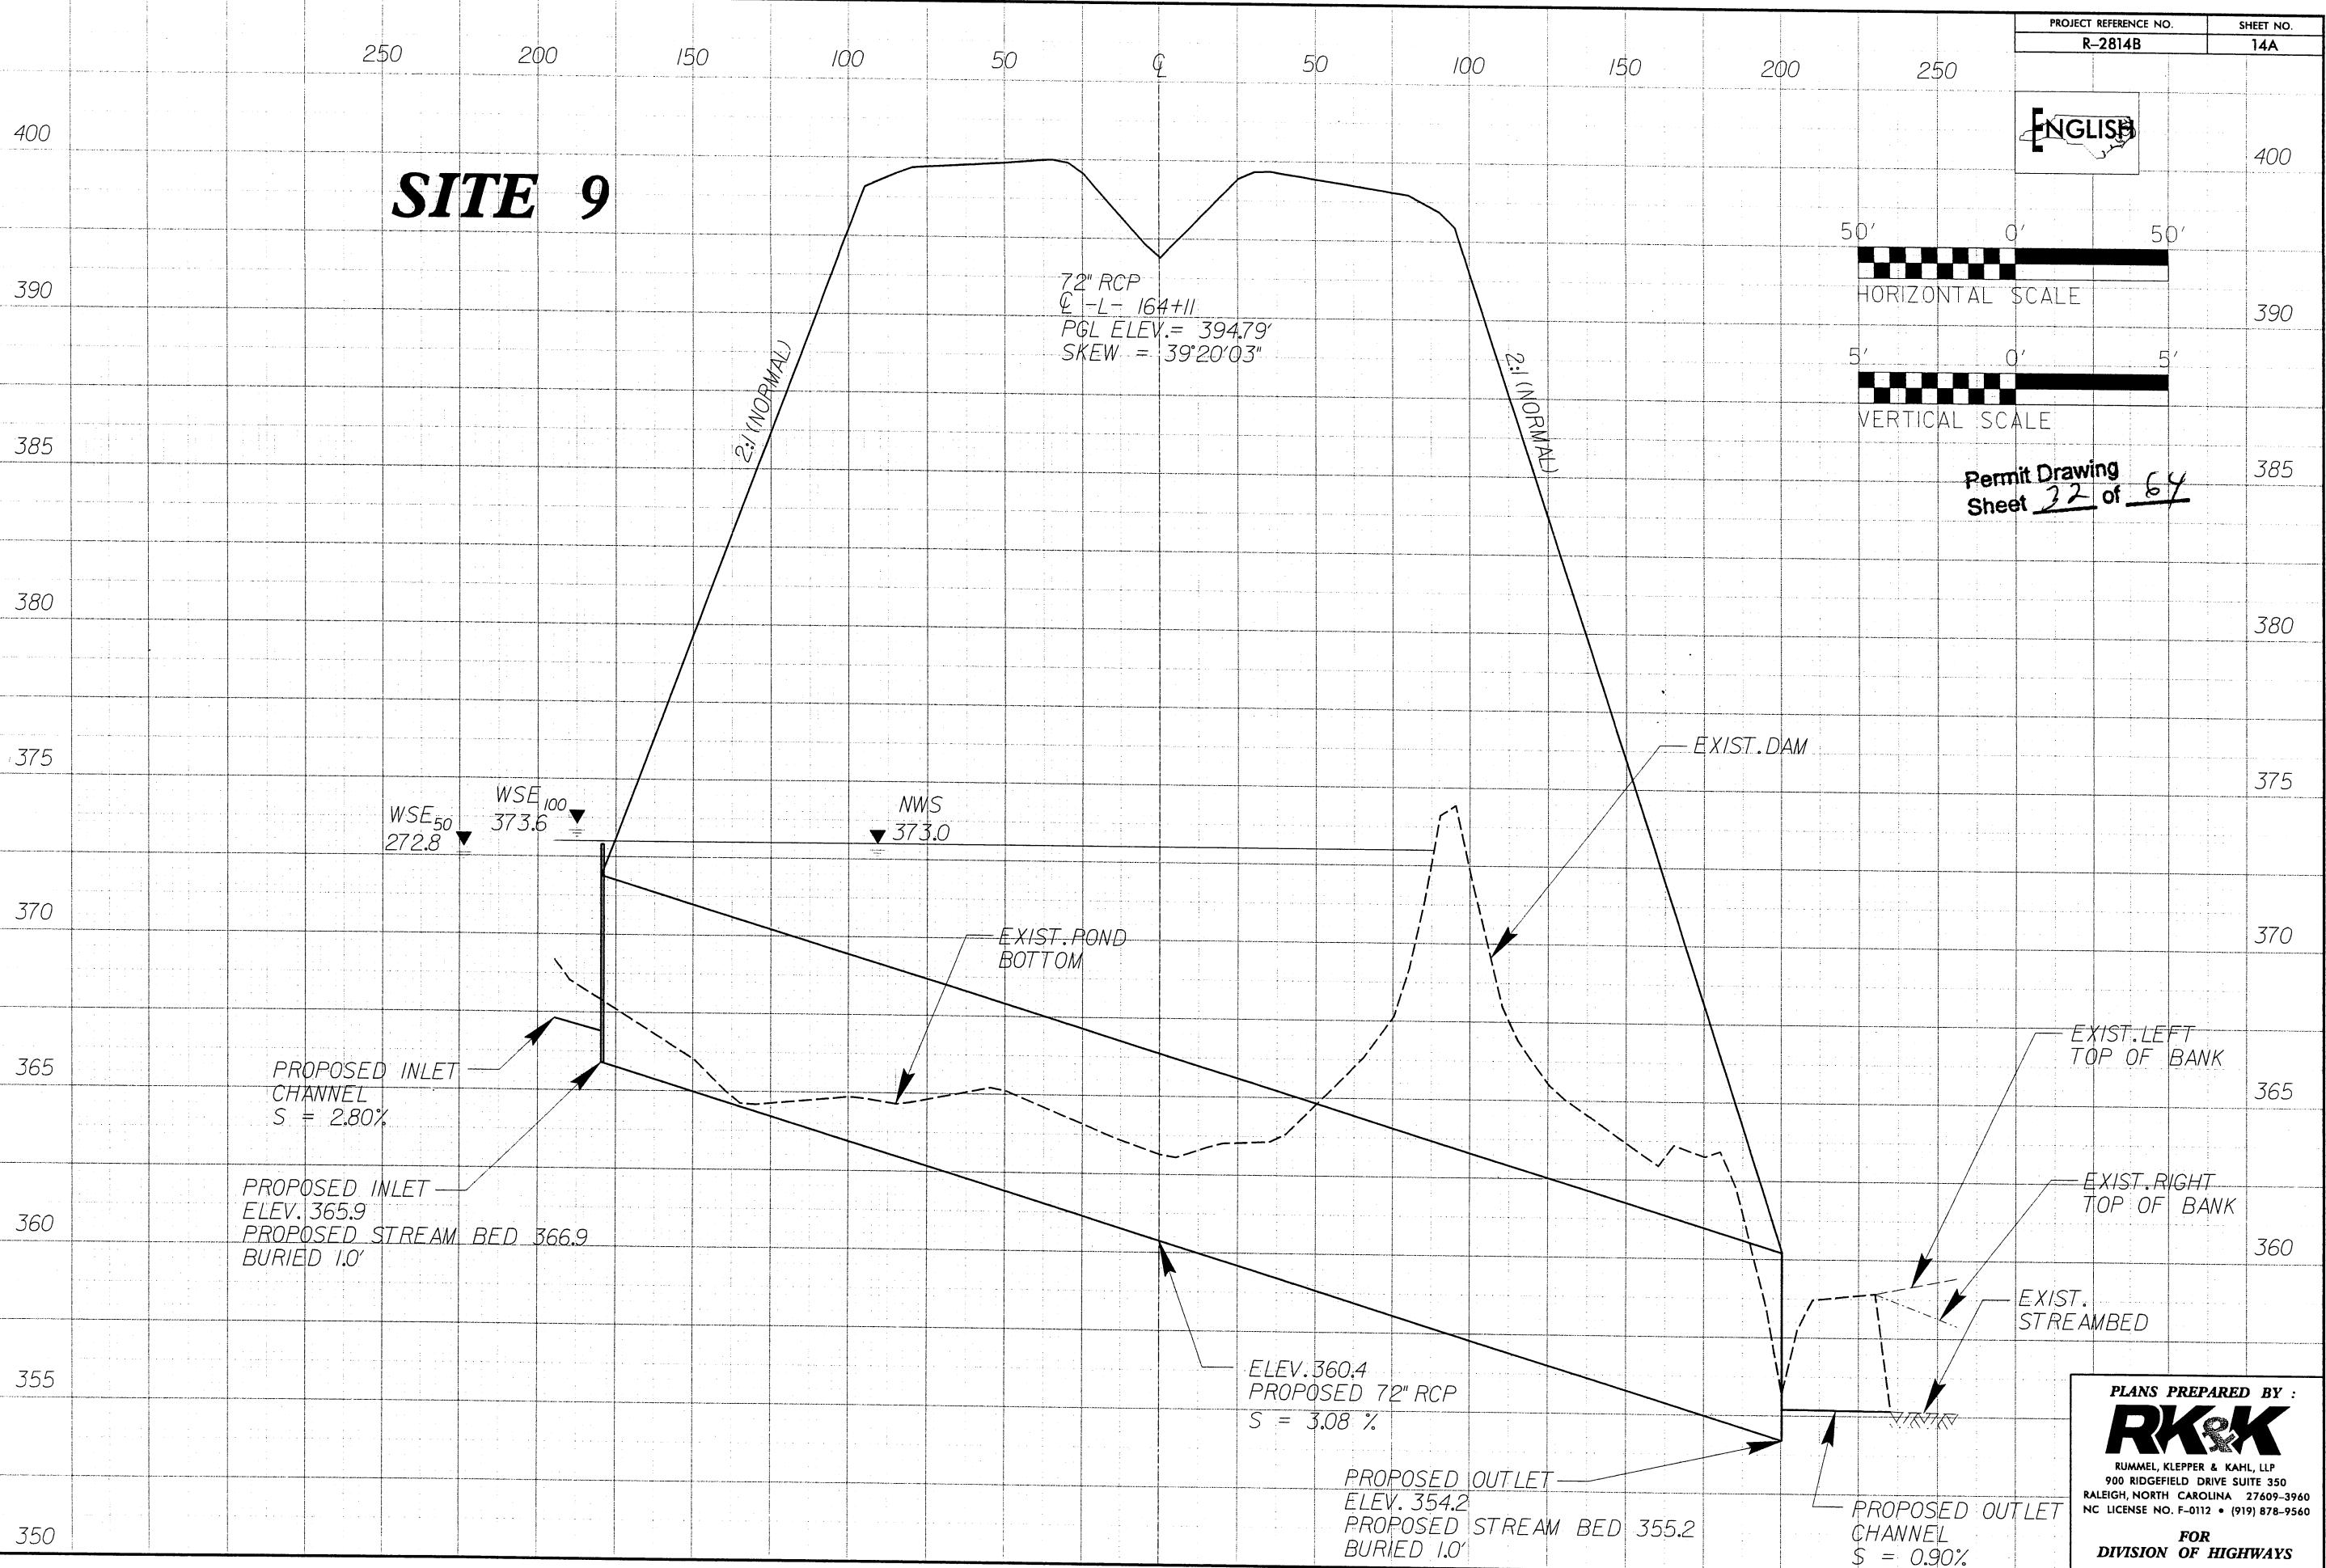

35

190

195


NAD 83/2001

(33)  
R.S. WALL HEIRS(34)  
SCARBOROUGH FAMILY LIMITED PARTNERSHIPP P  
DENOTES IMPACTS IN  
SURFACE WATER  
(POND)

PROJECT REFERENCE NO.	SHEET NO.
R-2814B	17
RW SHEET NO.	
ROADWAY DESIGN ENGINEER	HYDRAULICS ENGINEER

PRELIMINARY PLANS  
DO NOT USE FOR CONSTRUCTIONPermit Drawing  
Sheet 33 of 64

GRASS SWALE DATA B		GRASS SWALE DATA C		GRASS SWALE DATA E		GRASS SWALE DATA G		GRASS SWALE DATA H			
-L STA. 19550 TO STA. 19600 LT		-L STA. 19600 TO STA. 19650 LT		-L STA. 19550 TO STA. 19650 CL		-L STA. 19550 TO STA. 19650 RT		-L STA. 19650 TO STA. 19750 RT			
DA	0.73	AC	DA	0.73	AC	DA	0.42	AC	DA	0.14	AC
SLOPE	1.76	%	SLOPE	2.34	%	SLOPE	1.78	%	SLOPE	3.16	%
L REQ	50	FT	L REQ	23	FT	L REQ	54	FT	L REQ	42	FT
L PROV	50	FT	L PROV	50	FT	L PROV	100	FT	L PROV	150	FT
Q2	2.44	CFS	Q2	2.44	CFS	Q2	1.03	CFS	Q2	1.40	CFS
V2	1.94	FT/S	V2	1.97	FT/S	V2	1.38	FT/S	V2	1.92	FT/S
D2	0.50	FT	D2	0.50	FT	D2	0.35	FT	D2	0.38	FT
Q10	3.15	CFS	Q10	3.15	CFS	Q10	1.33	CFS	Q10	1.81	CFS
V10	2.07	FT/S	V10	2.30	FT/S	V10	1.47	FT/S	V10	2.05	FT/S
D10	0.55	FT	D10	0.52	FT	D10	0.39	FT	D10	0.42	FT

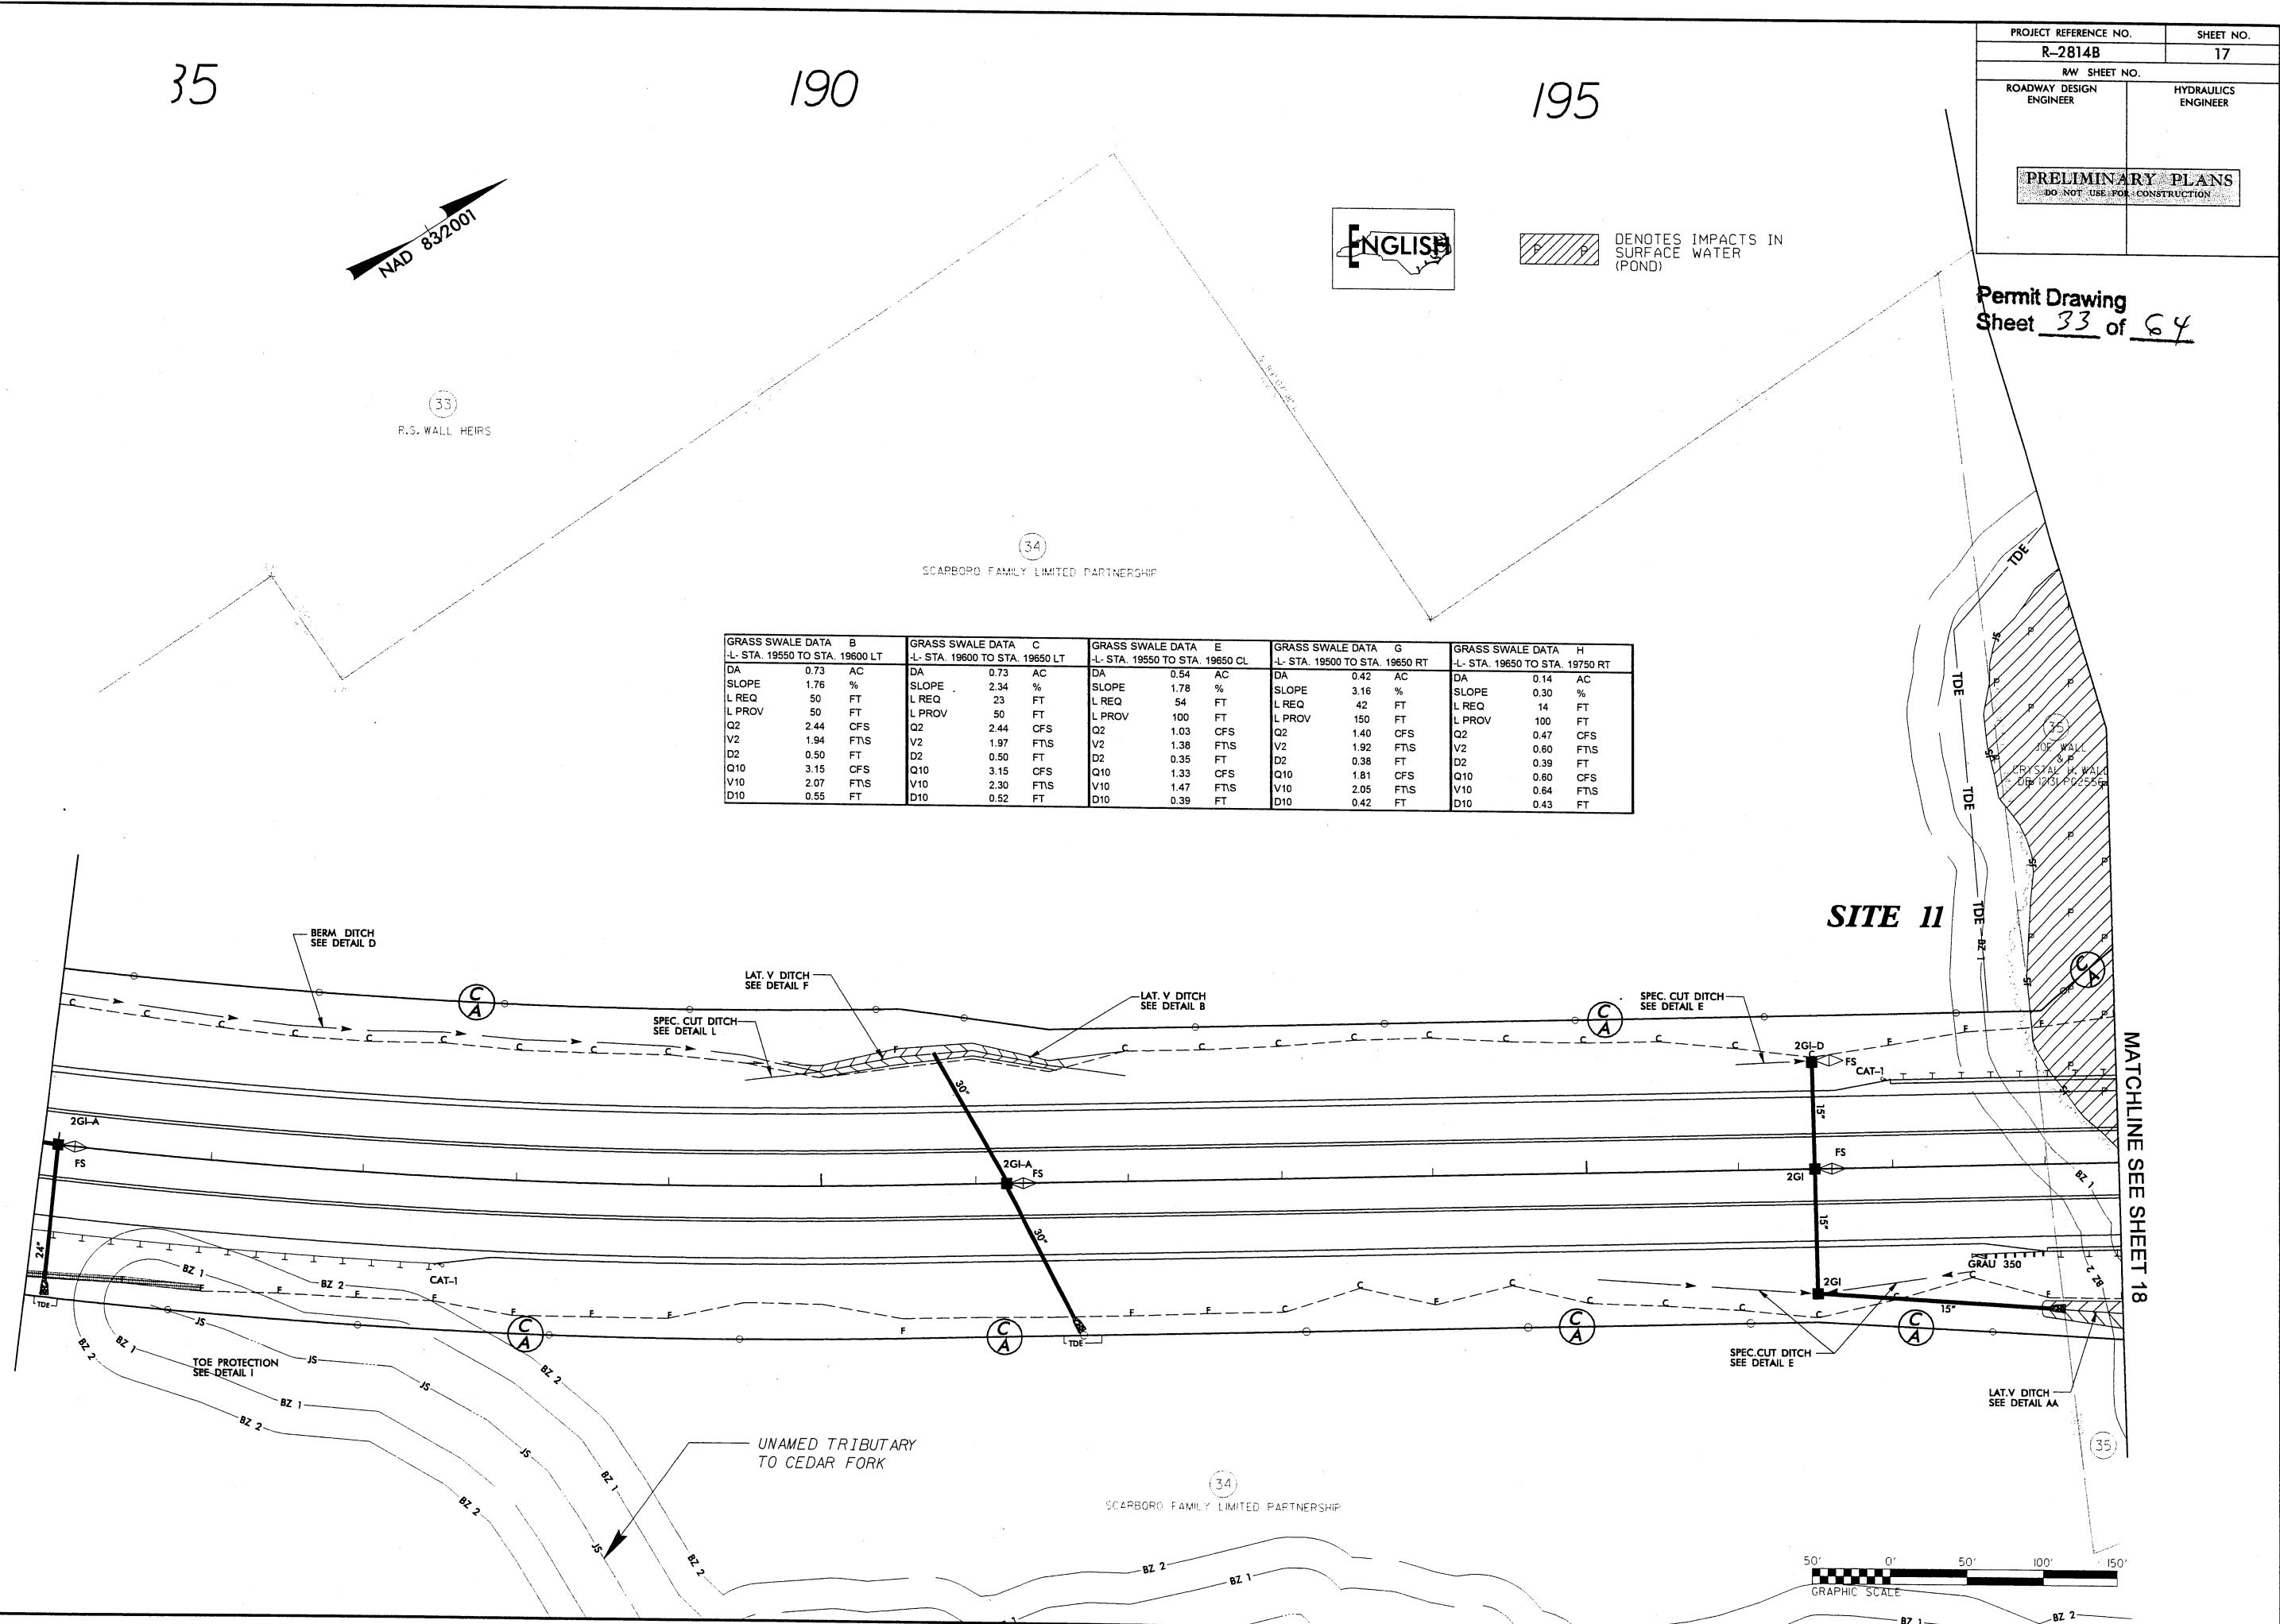






REVISIONS


REVISED NAMES ON PARCELS 35 AND 36 PER LOCATION AND SURVEY REQUEST 4/23/09 DDL 7/29/09

02-32210-7A55  
R:\\hdwet\\permits\_environmental\\drawings\\2814b\_hyd-wet.con.prm-18.dgn

8/17/99

### MATCHLINE SEE SHEET 17

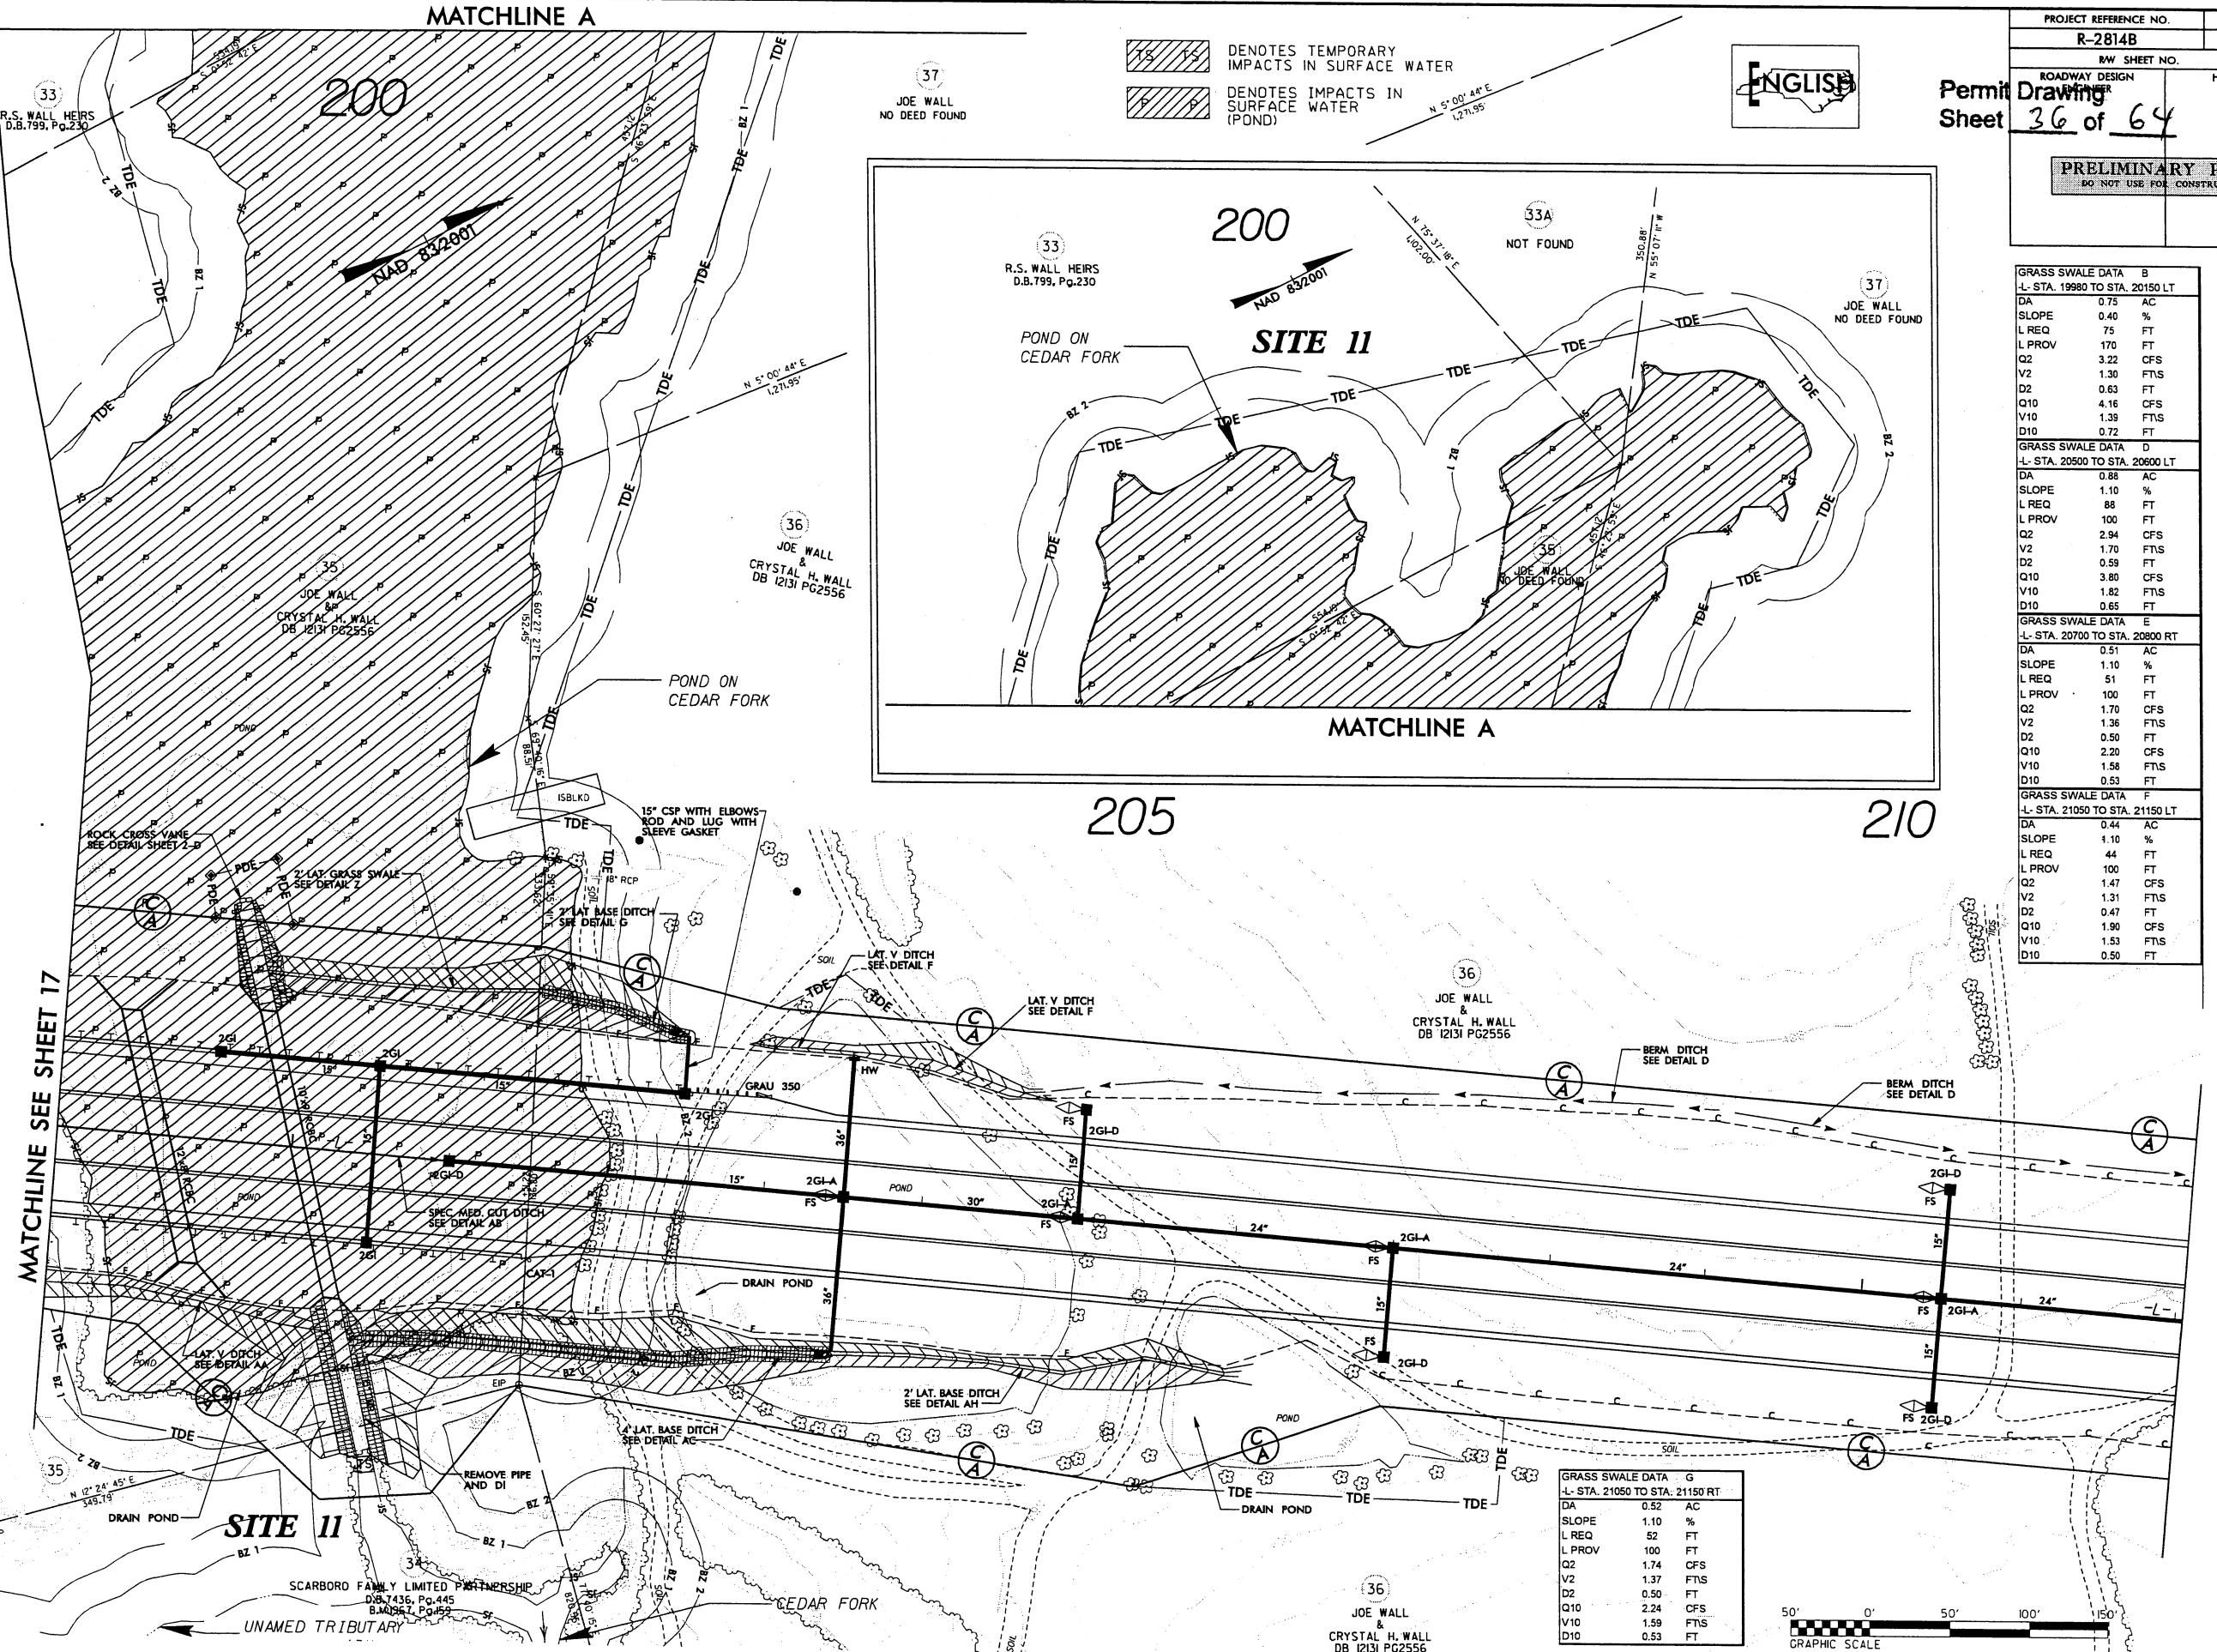

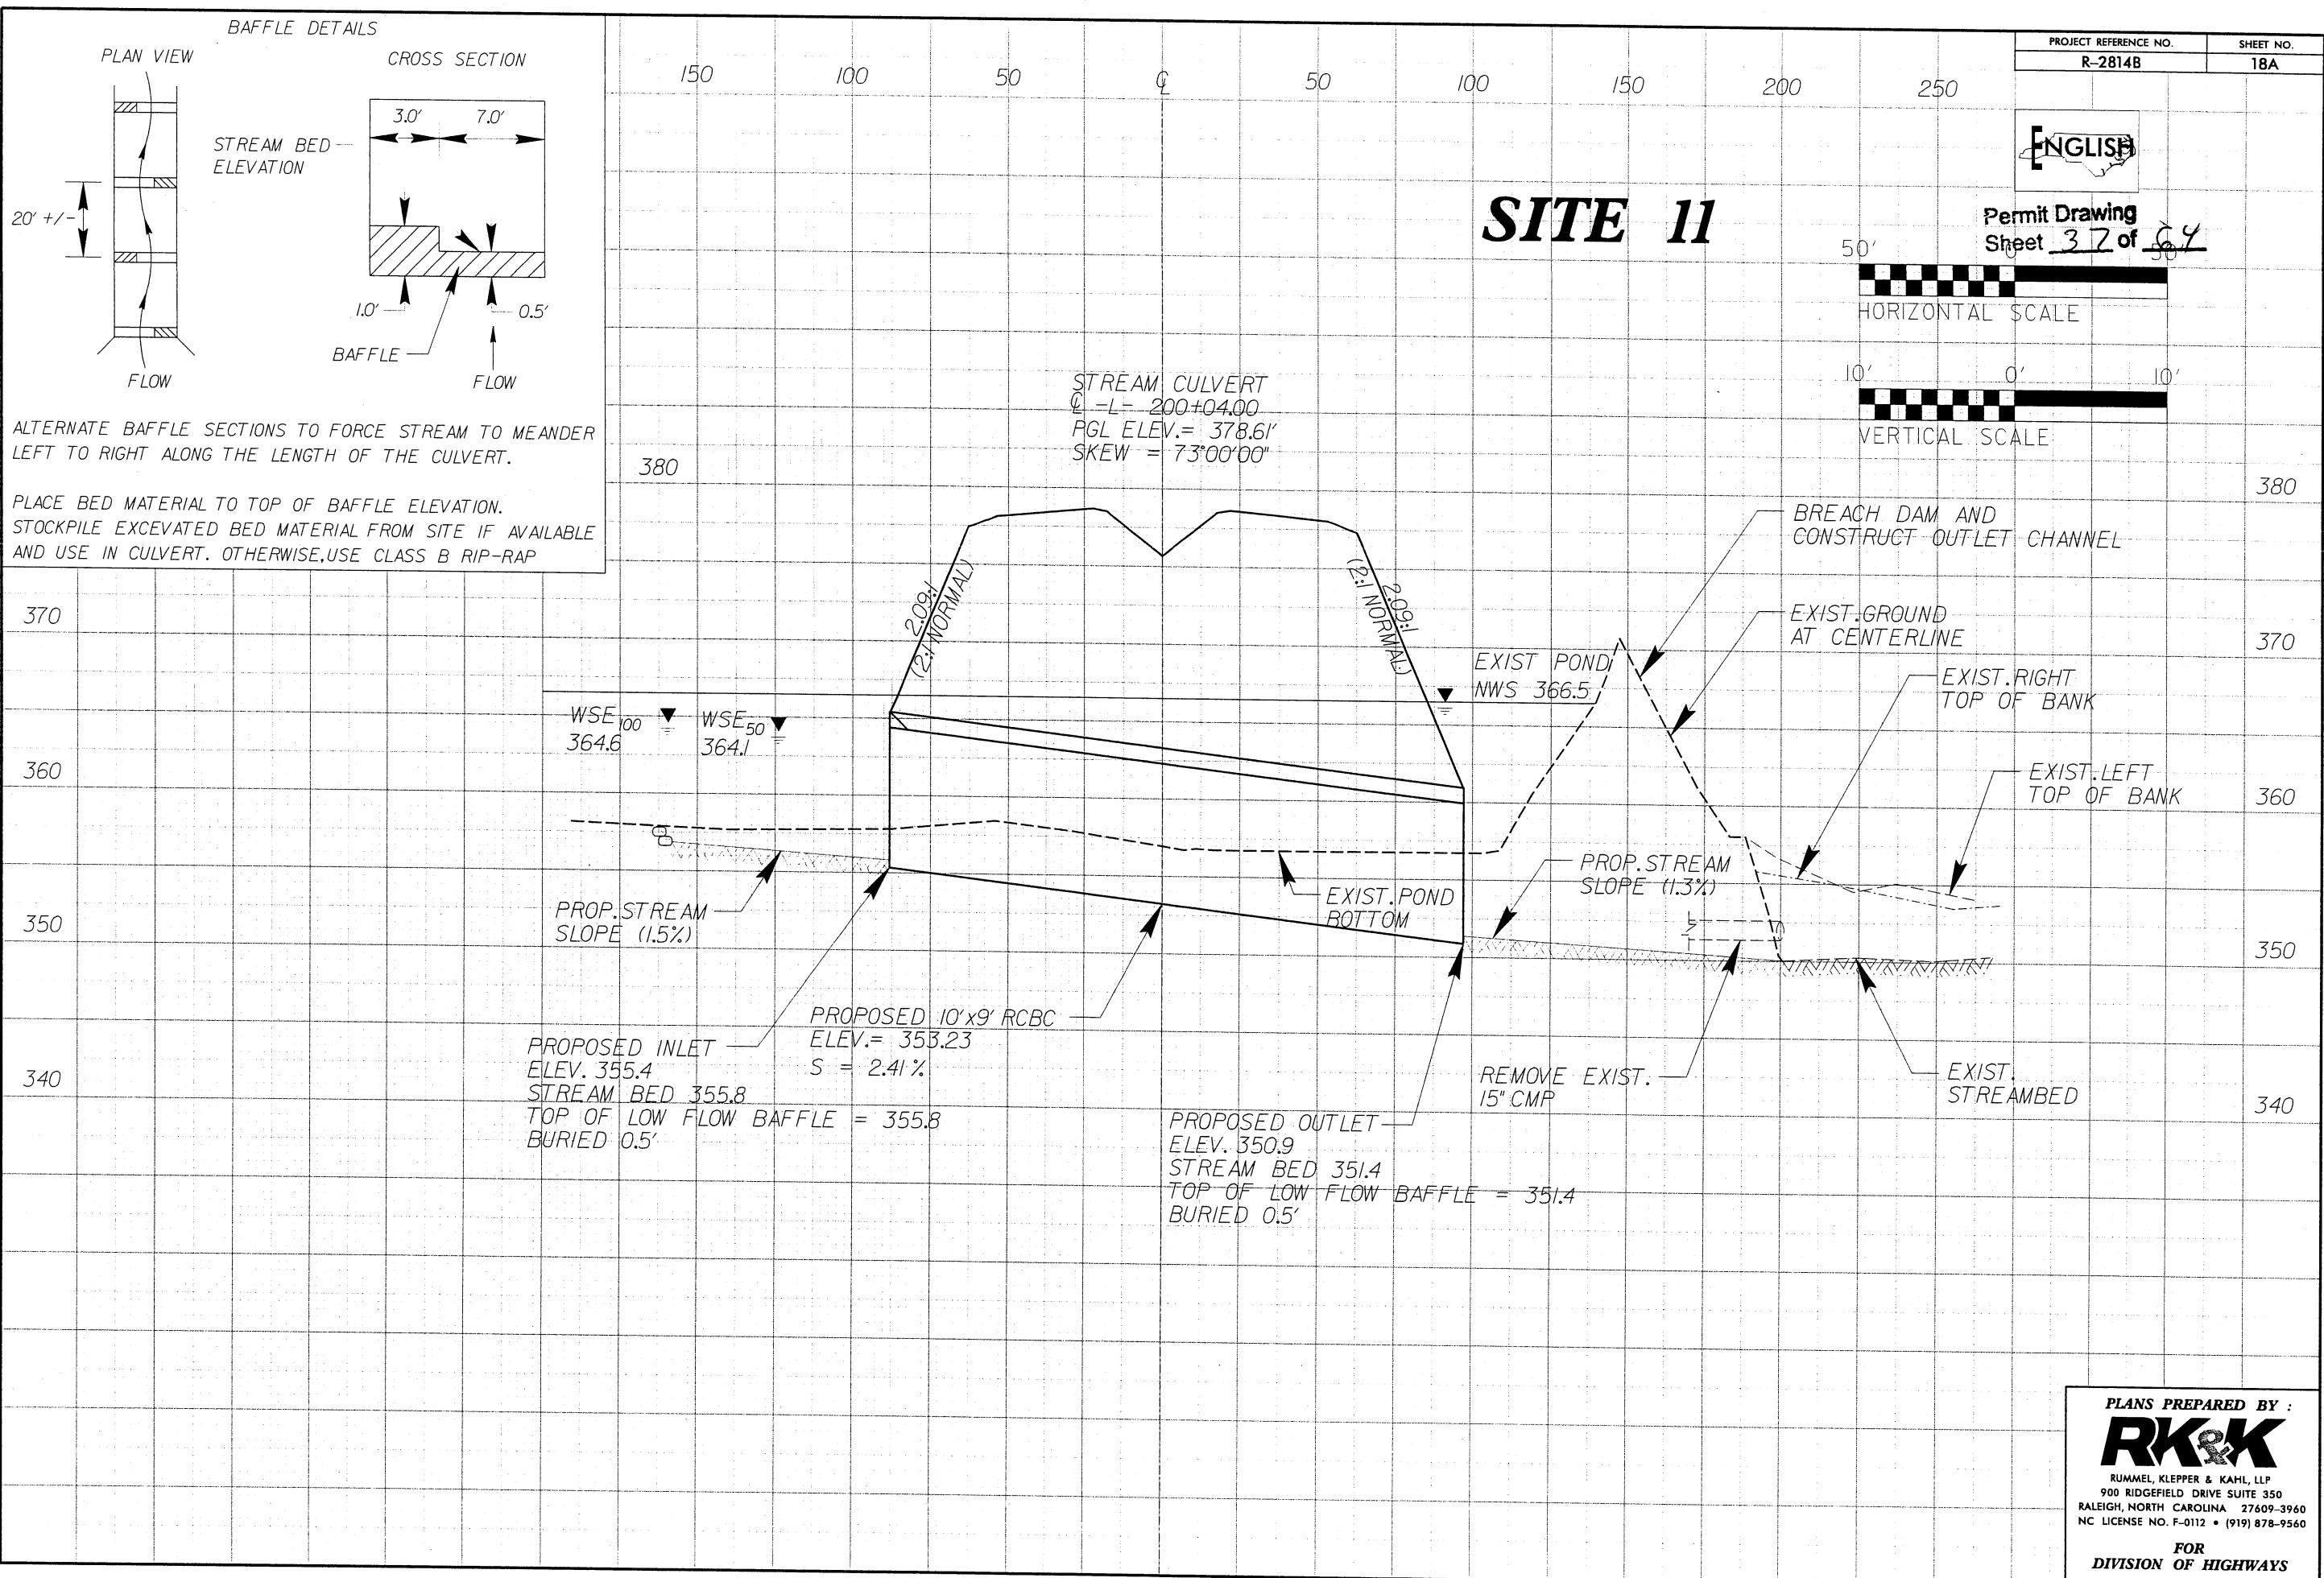

REVISIONS

January 11, 2010: Adjusted R/W CA lines, R/W markers and the proposed woven wire fence on parcel no. 39, MVA.

36  
JOE WALL  
CRYSTAL H. WALL  
DB 12131 PG2556

NAD 83/2001

215

220



DENOTES IMPACTS IN SURFACE WATER

GRASS SWALE DATA H	
L STA. 21350 TO STA. 21450 LT	
DA	0.49 AC
SLOPE	1.10 %
L REQ	49 FT
L PROV	100 FT
Q2	1.64 CFS
V2	1.35 FTS
D2	0.49 FT
Q10	2.11 CFS
V10	1.57 FTS
D10	0.52 FT


36  
JOE WALL  
CRYSTAL H. WALL  
DB 12131 PG2556

PROJECT REFERENCE NO.	SHEET NO.
R-2814B	19
RW SHEET NO.	
ROADWAY DESIGN ENGINEER	HYDRAULICS ENGINEER
PRELIMINARY PLANS DO NOT USE FOR CONSTRUCTION	

Permit Drawing  
Sheet 38 of 64

38  
BOBBIE JOE WALL & VICKIE D. WALL

SITE 12

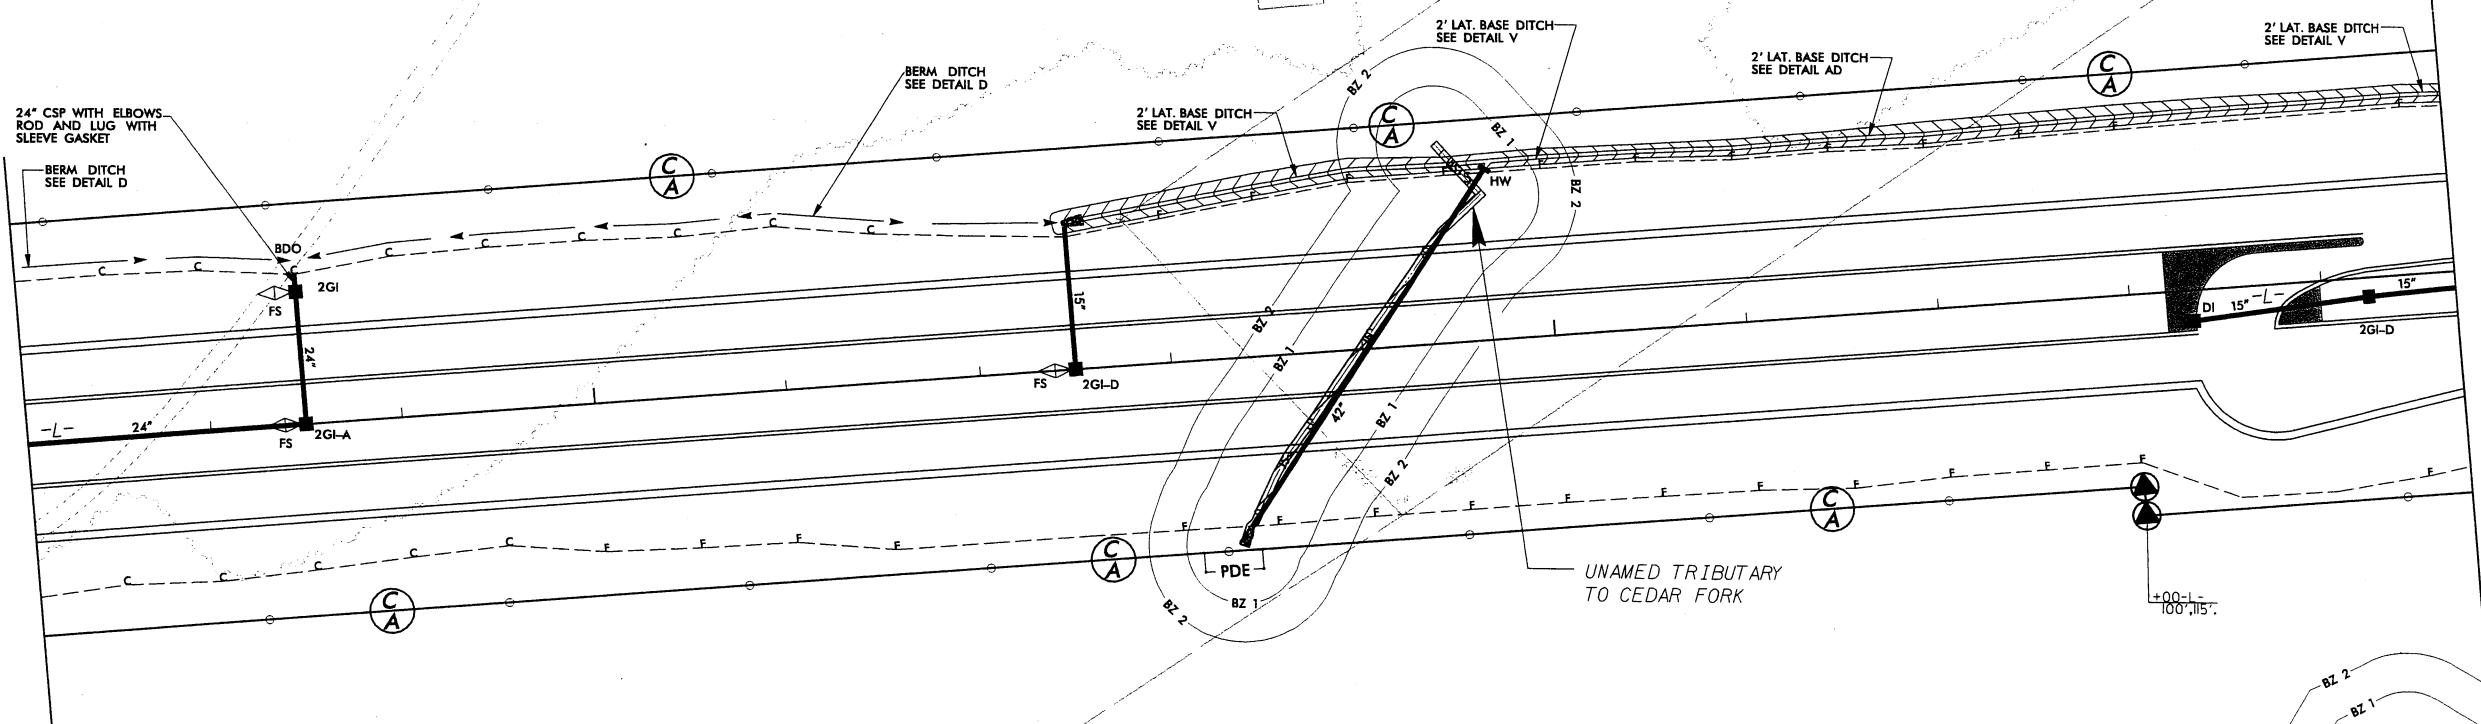

39  
THE SEI GROWTH, L.P.

50' 0' 50' 100' 150'  
GRAPHIC SCALE

36  
JOE WALL  
CRYSTAL H. WALL  
DB 12131 PG2556

12131 PG2556

## REVISIONS

January 11, 2010-Adjusted R/W CA lines, R/W markers and the proposed woven wire fence on parcel no.39, N/A.

2814b-hyd-wet-con-prm-prim-19.dwg

8/17/10

215

220




PROJECT REFERENCE NO.	SHEET NO.
R-2814B	19
RW SHEET NO.	19
ROADWAY DESIGN ENGINEER	HYDRAULICS ENGINEER
<b>PRELIMINARY PLANS</b>	
DO NOT USE FOR CONSTRUCTION	

Permit Drawing  
Sheet 39 of 64

GRASS SWALE DATA H	
L- STA. 21350 TO STA. 21450 LT	
DA	0.49 AC
SLOPE	1.10 %
L REQ	49 FT
L PROV	100 FT
Q2	1.64 CFS
V2	1.35 FT/S
D2	0.49 FT
Q10	2.11 CFS
V10	1.57 FT/S
D10	0.52 FT

NAD 83/2001  
JOE WALL  
CRYSTAL H. WALL  
08/10/01 PG2556

[Hatched area] DENOTES IMPACTS IN SURFACE WATER

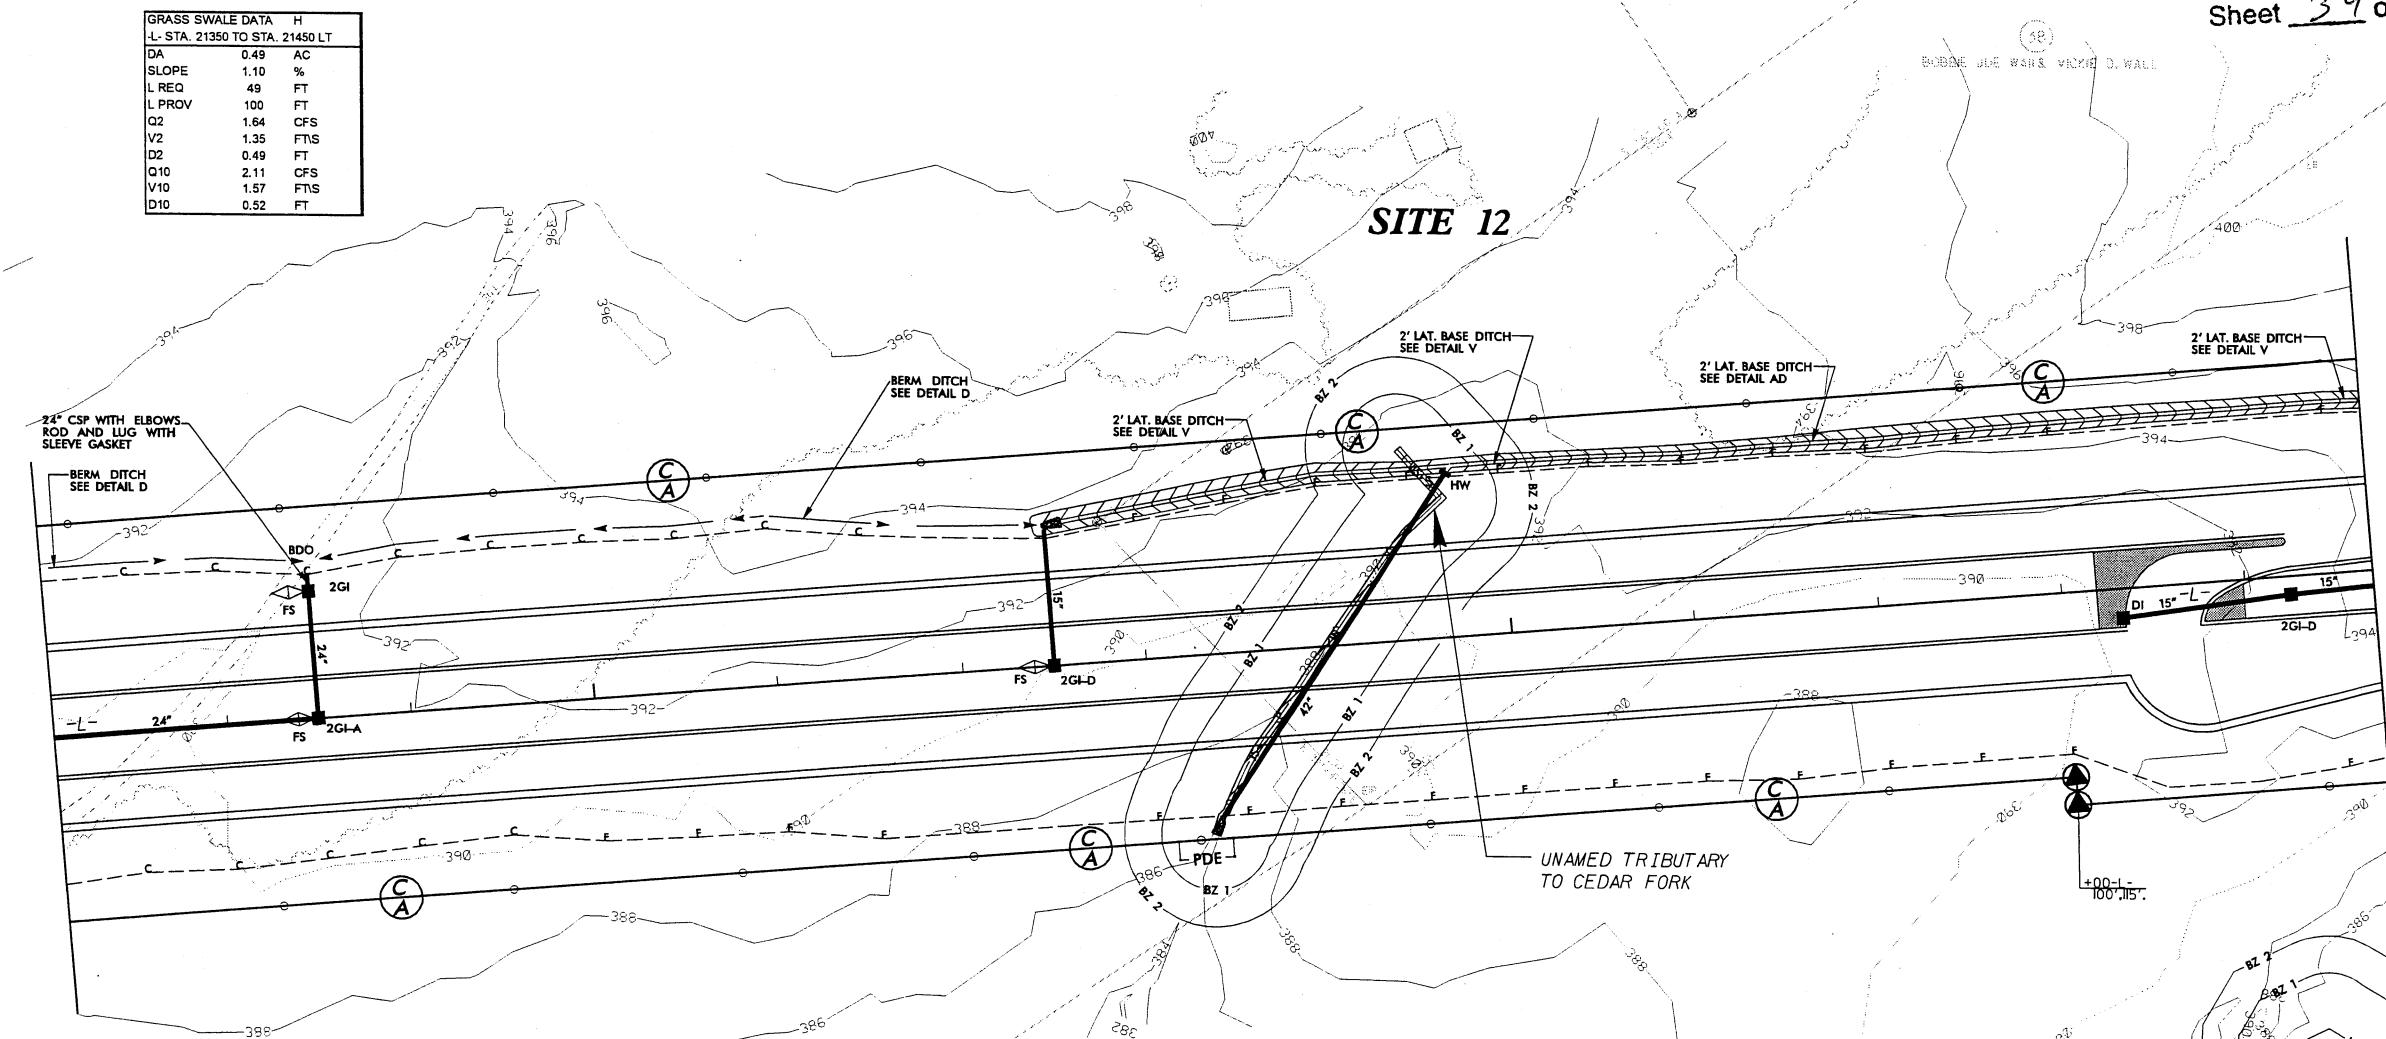


JOE WALL  
CRYSTAL H. WALL  
08/10/01 PG2556

(12) 22-10-10-5443  
Hydro-Sources permits environmental drawings

## REVISIONS

January 11, 2010: Adjusted R/W CA lines, R/W markers and the proposed woven wire fence on parcel no. 39, NWA.

ZC14B-Submittal-2010-01-11.dwg

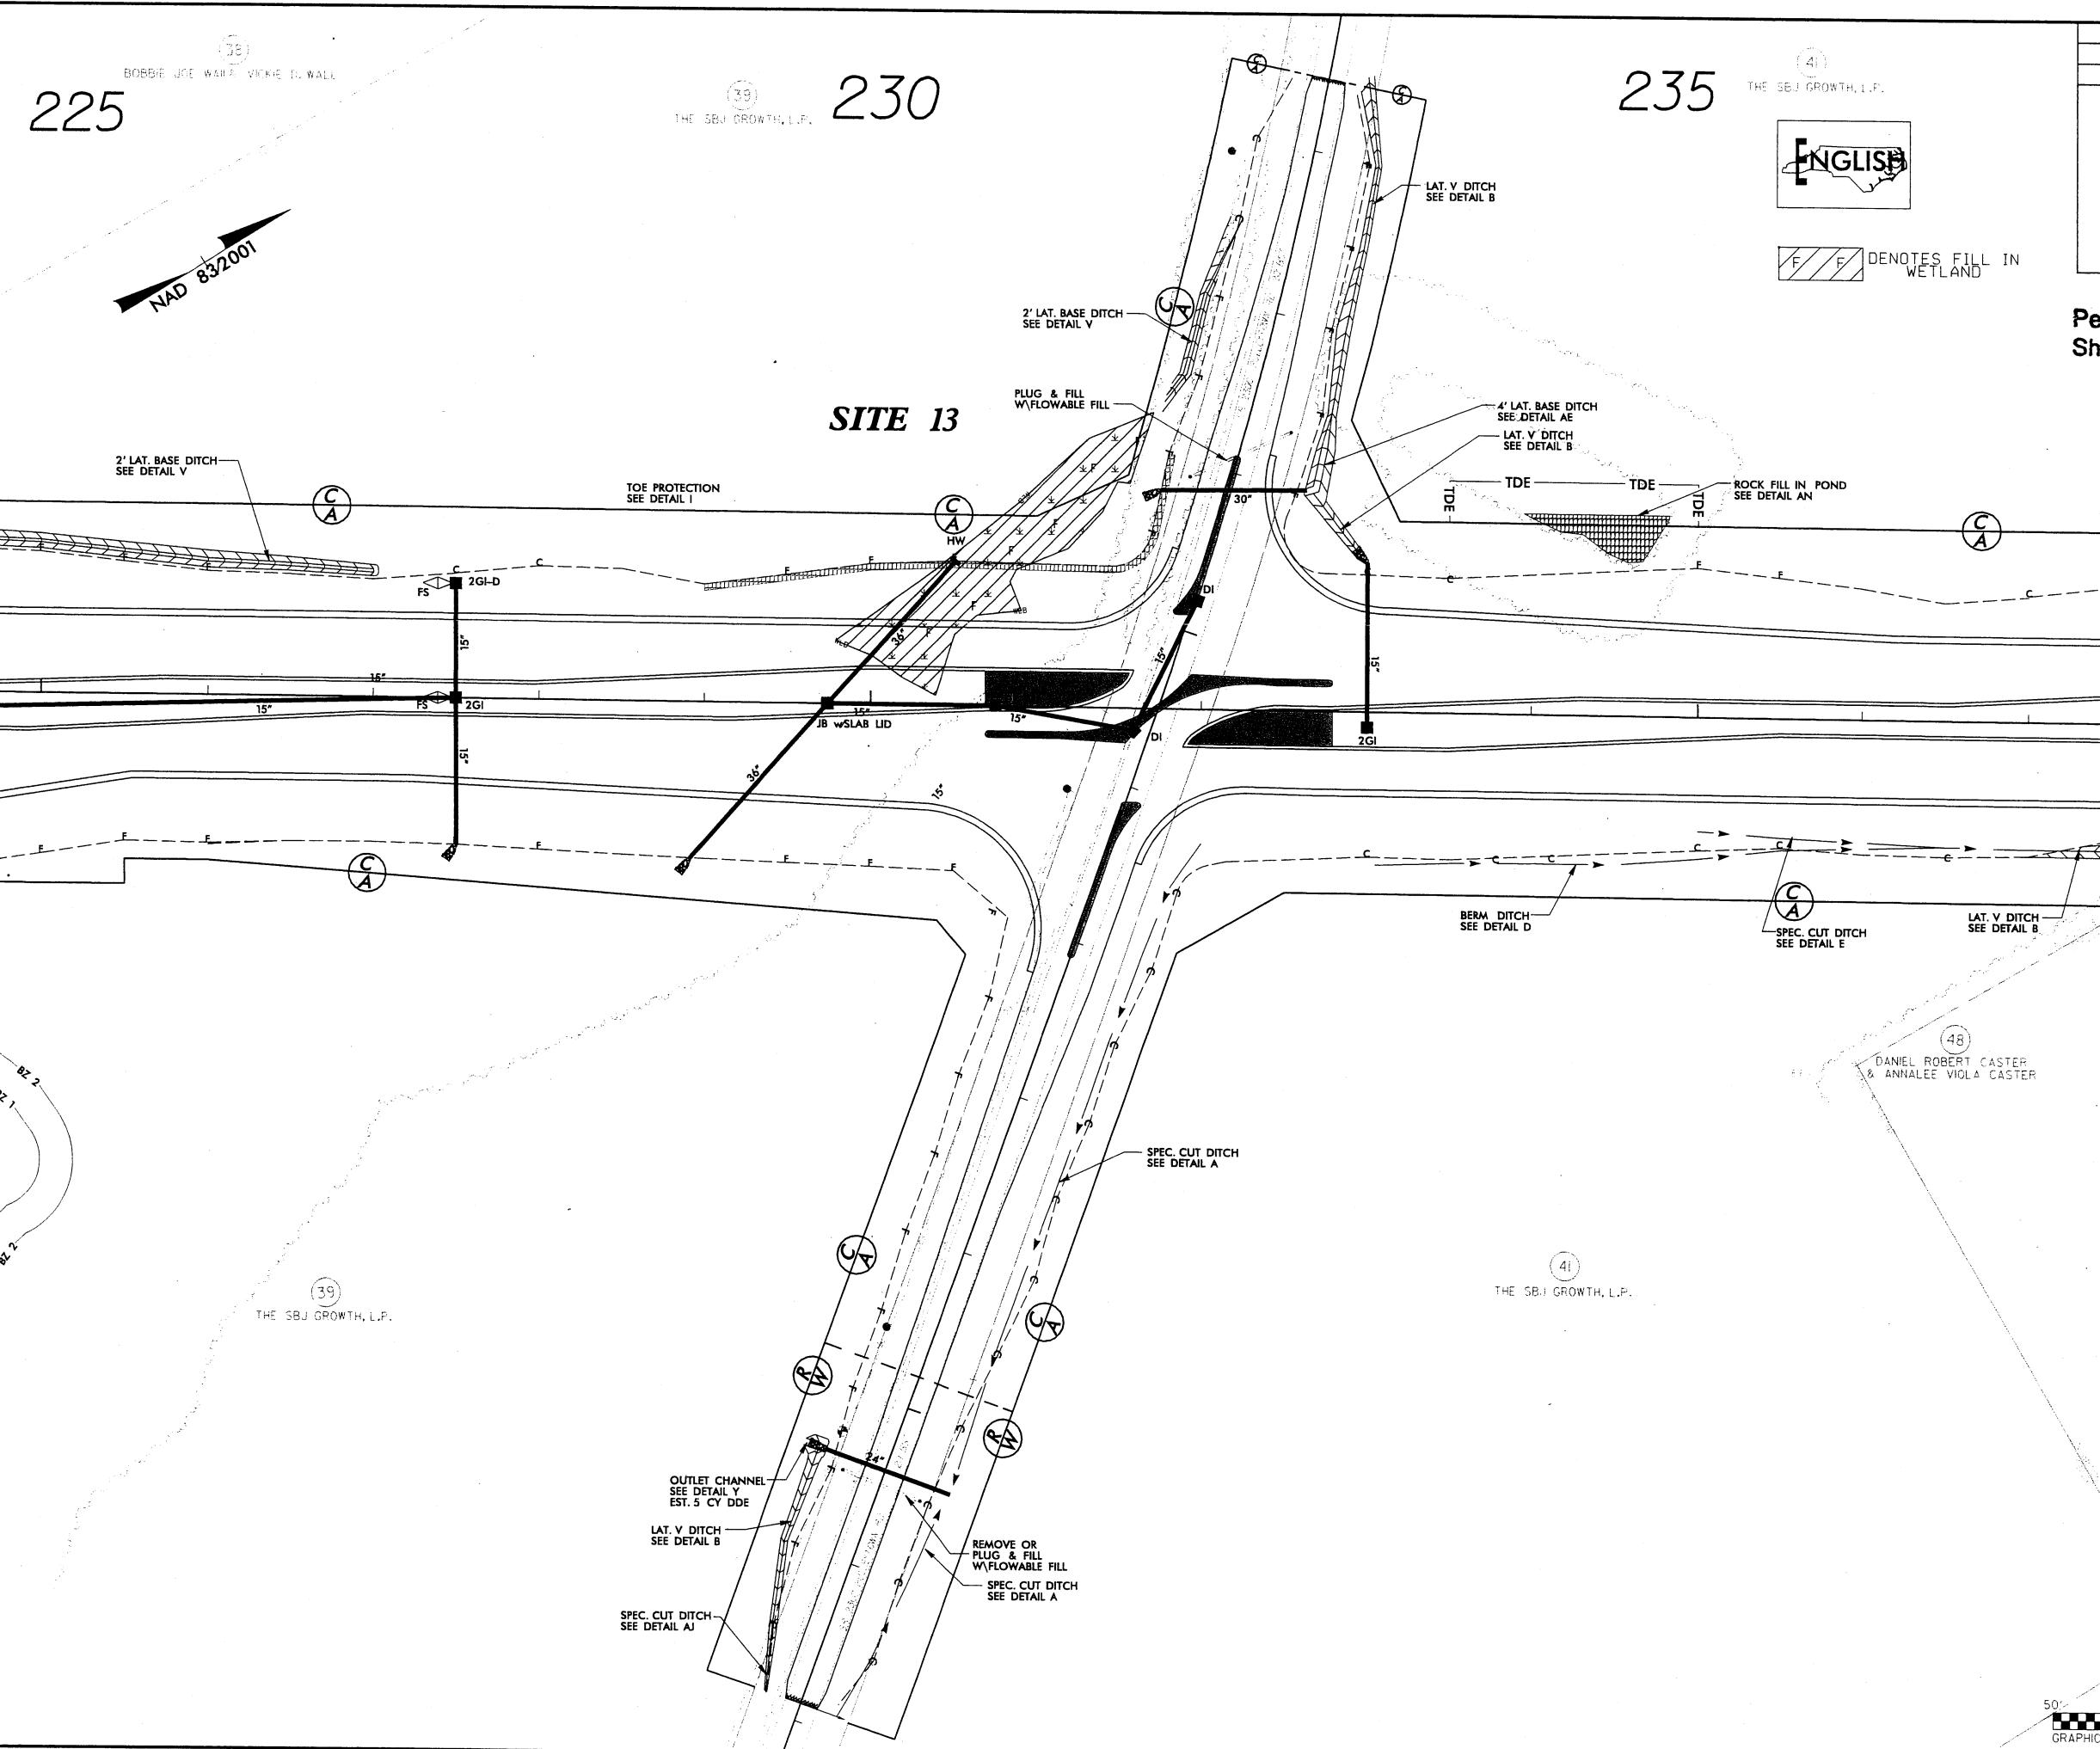


PROJECT REFERENCE NO.		SHEET NO.
R-2814B		20
RW SHEET NO.		
ROADWAY DESIGN ENGINEER	HYDRAULICS ENGINEER	
<b>PRELIMINARY PLANS</b> DO NOT USE FOR CONSTRUCTION		

REVISI観


January 11, 2010: Adjusted R/W CA lines, R/W markers and the proposed woven wire fence on parcel no. 39, NNA.

2146


10

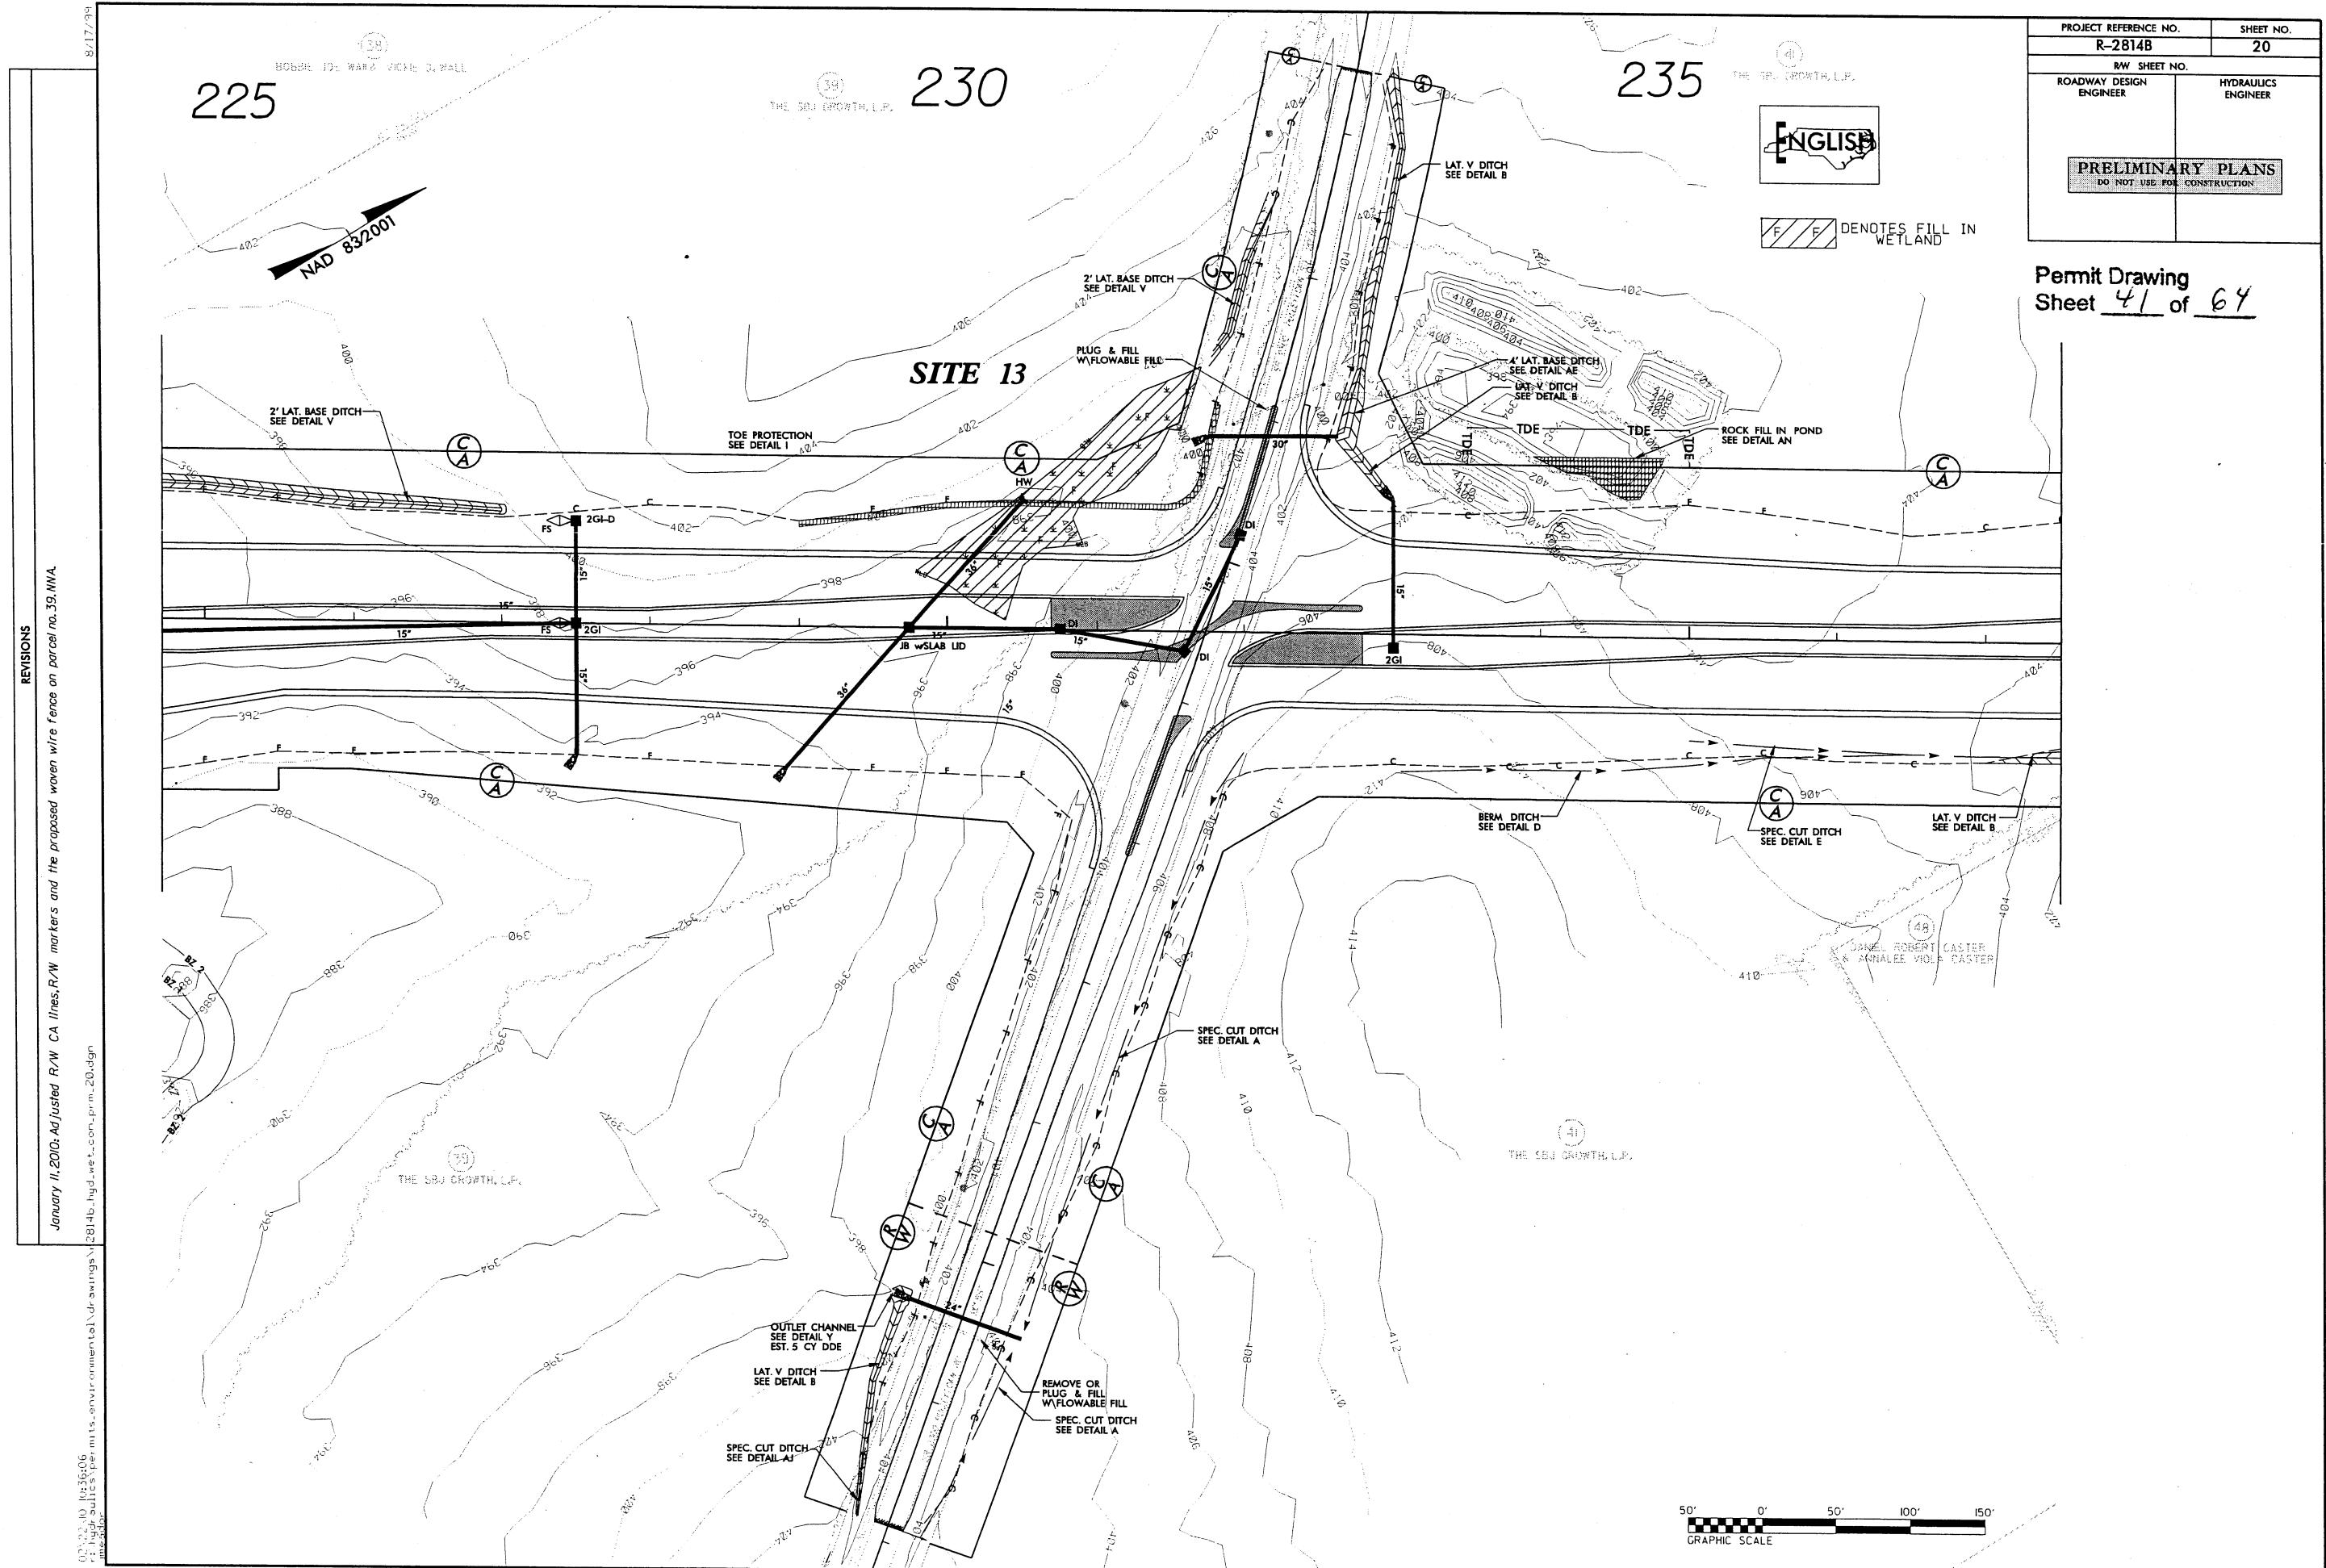

Permit Drawing  
Sheet 42 of 64

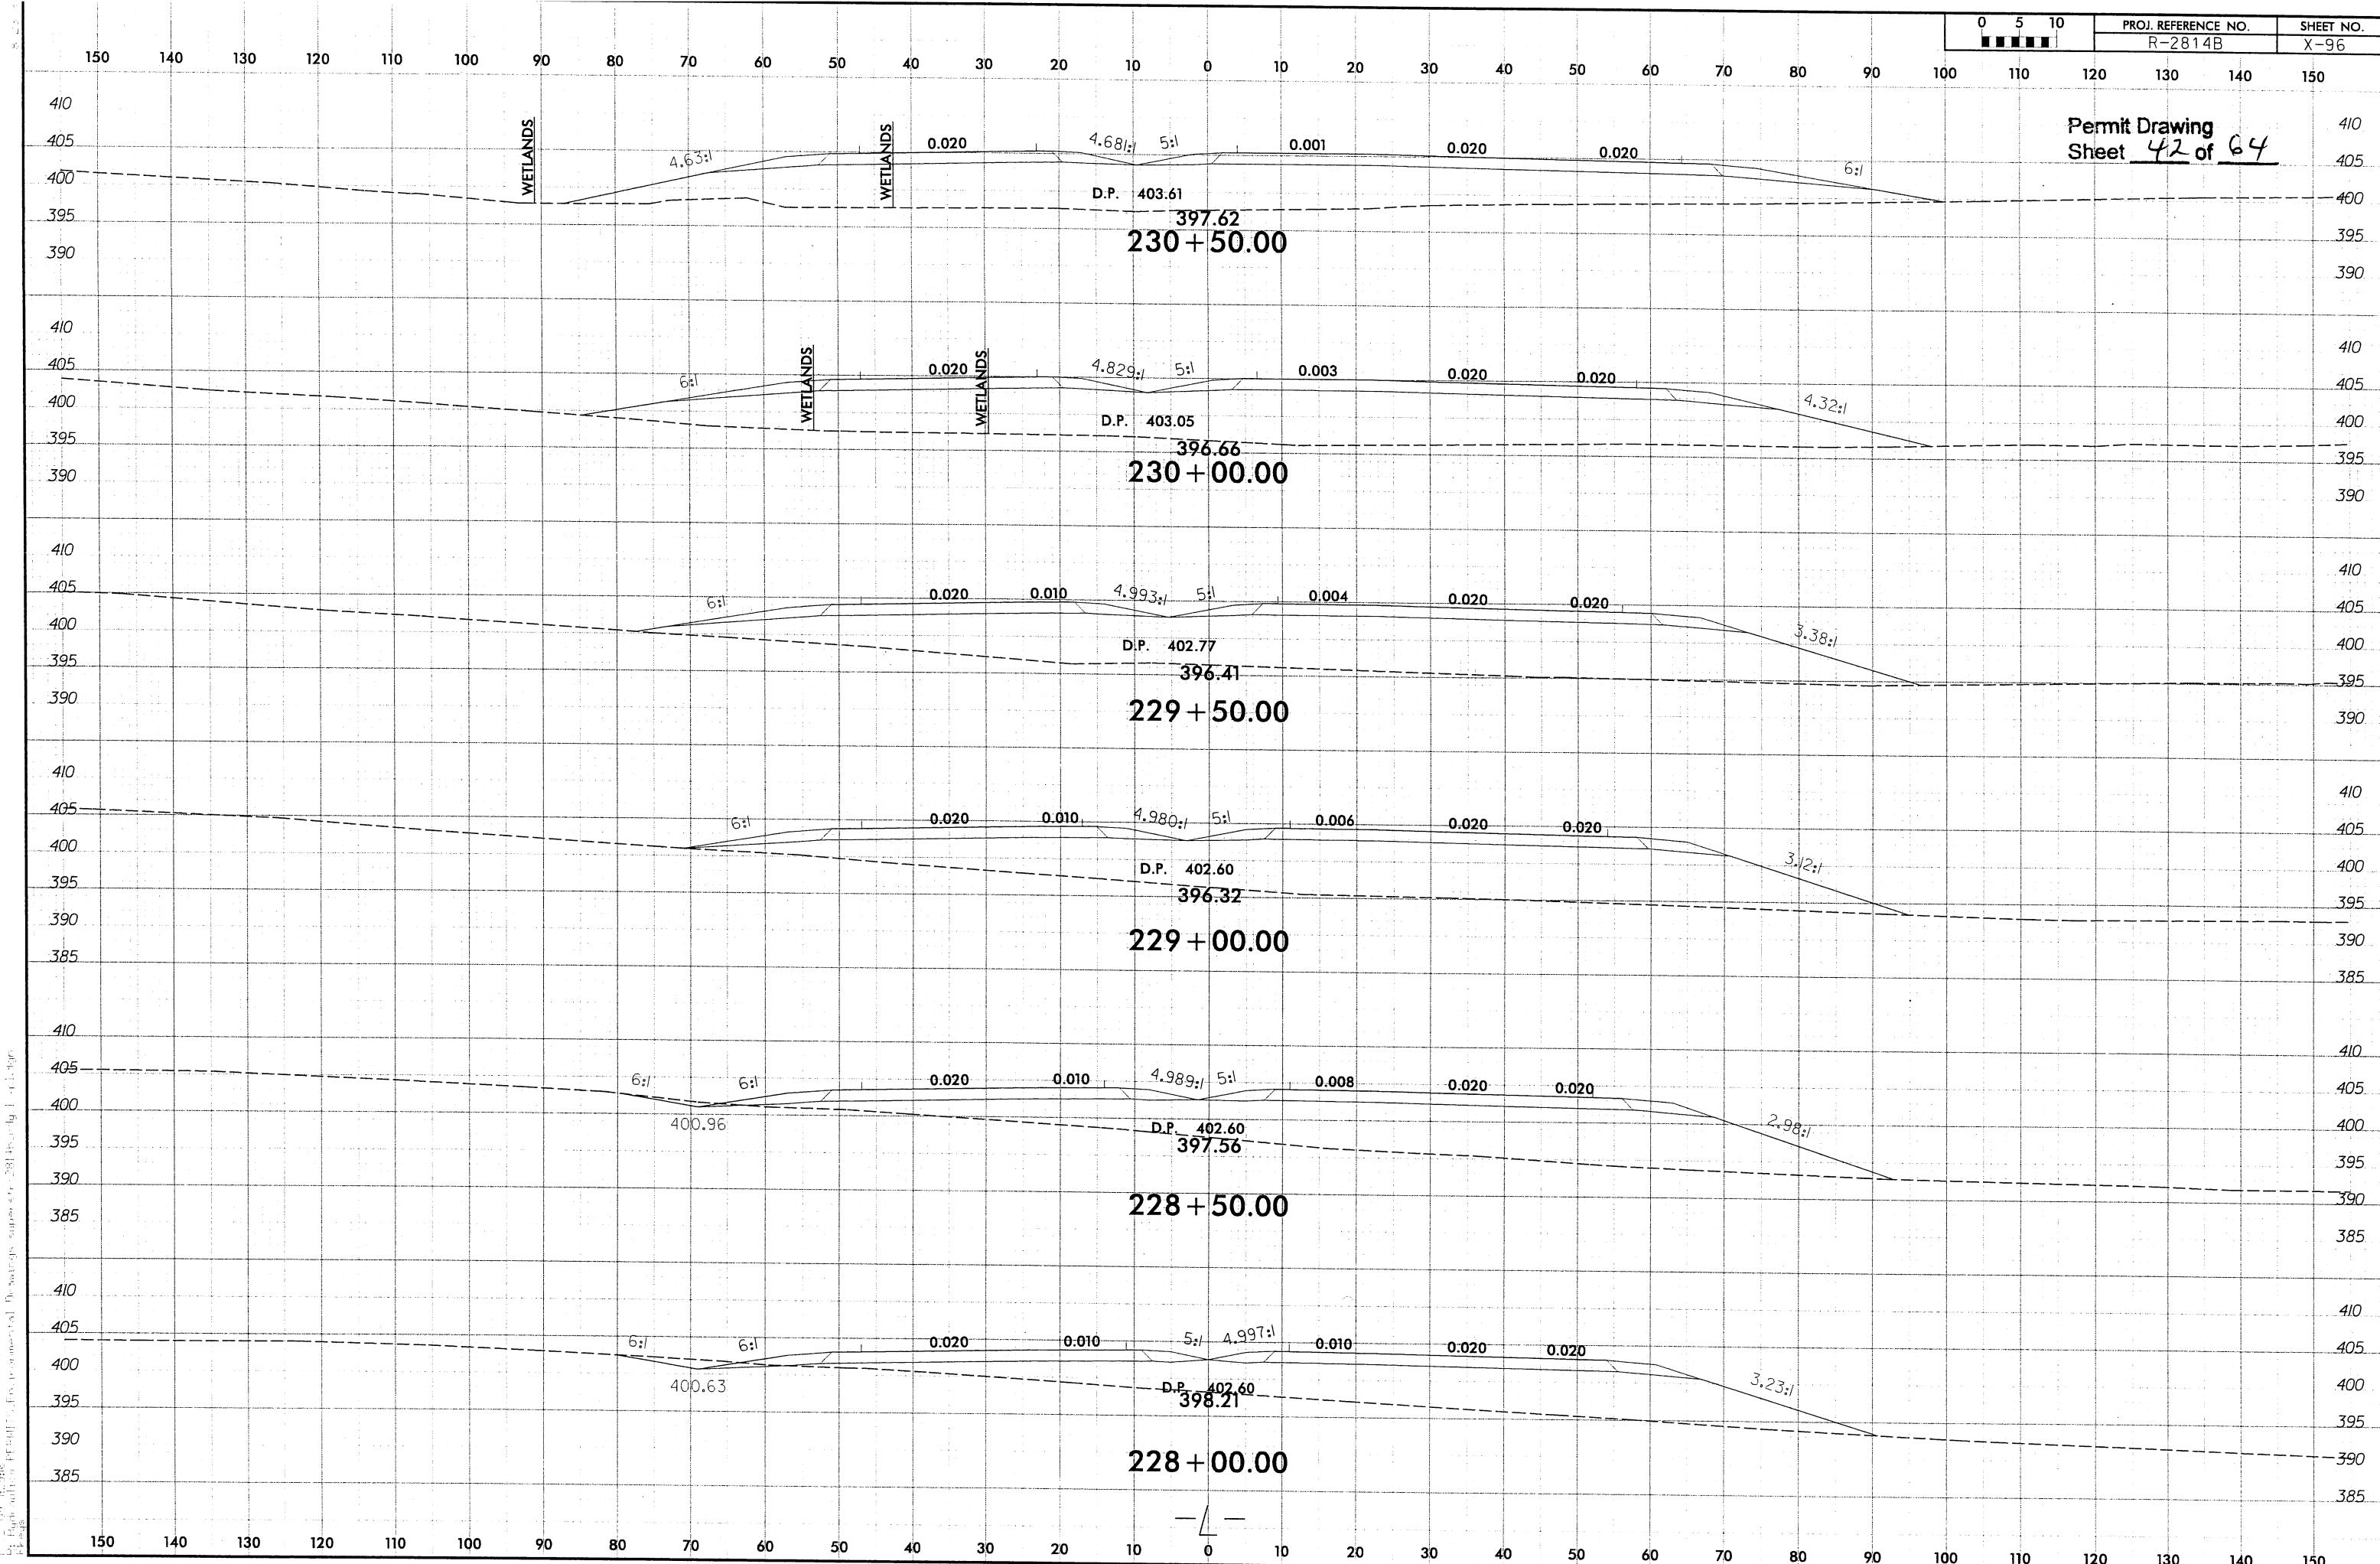

Permit Drawing  
Sheet 43 of 64

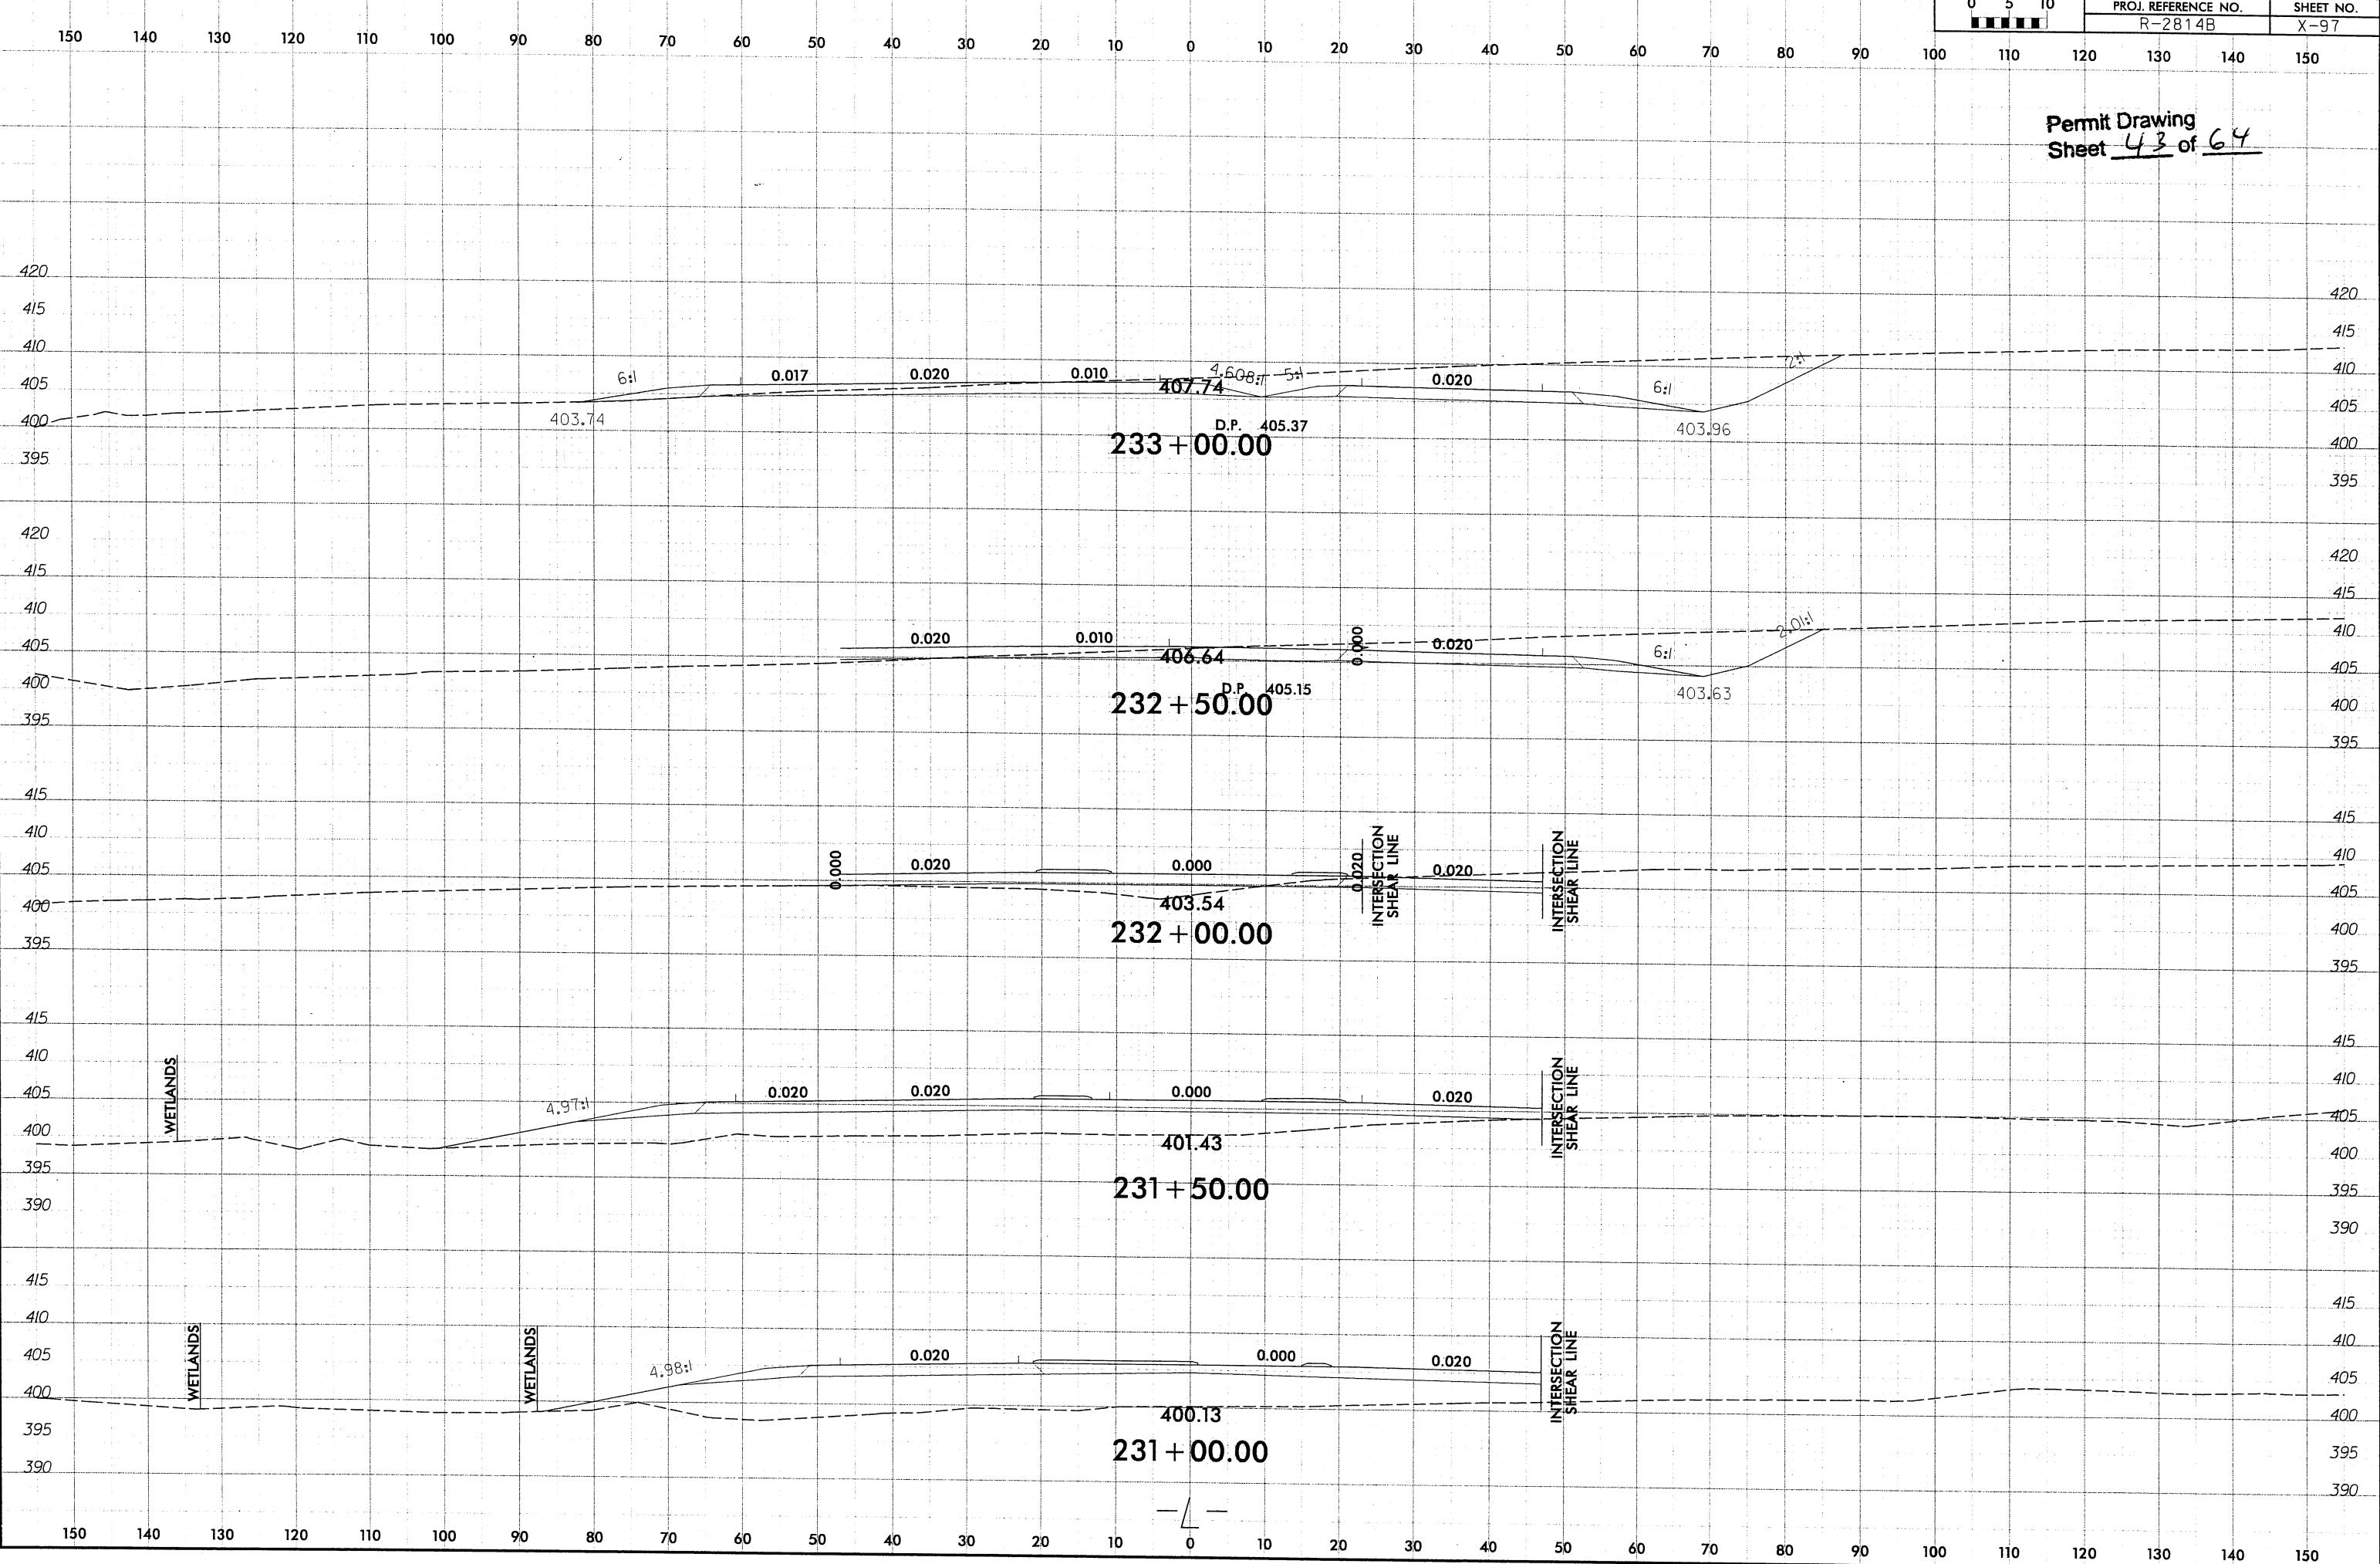

PROJECT REFERENCE NO.	SHEET NO.
R-2814B	21
RAW SHEET NO.	
ROADWAY DESIGN ENGINEER	HYDRAULICS ENGINEER
PRELIMINARY PLANS DO NOT USE FOR CONSTRUCTION	



245

240

41  
THE SBJ GROWTH, L.P.

NAD 83/2001

49  
ROBERT C. BARTHOLOMEW  
& JOYCE BARTHOLOMEW

\*\*\* NOTE: THE INLET INVERT OF THE PROPOSED PIPE AT  
-L 246+87 SHOULD BE SET TO 385.3 TO MAINTAIN  
NORMAL WATER LEVEL IN THE EXISTING WETLAND.  
THE INLET INVERT OF THE PIPE SHOULD NOT BE  
FIELD ADJUSTED. DO NOT BURY OUTLET OF PIPE  
BELOW EXISTING GROUND.

- [F/F] DENOTES FILL IN WETLAND
- [•••••] DENOTES MECHANIZED CLEARING
- [E] DENOTES EXCAVATION IN WETLAND


Permit Drawing  
Sheet 44 of 64

250

SITE 14

REVISIONS

REVISED PARCELS 49 AND 50 PER LOCATION AND SURVEY REQUEST 4/23/09 DCL 7/29/09

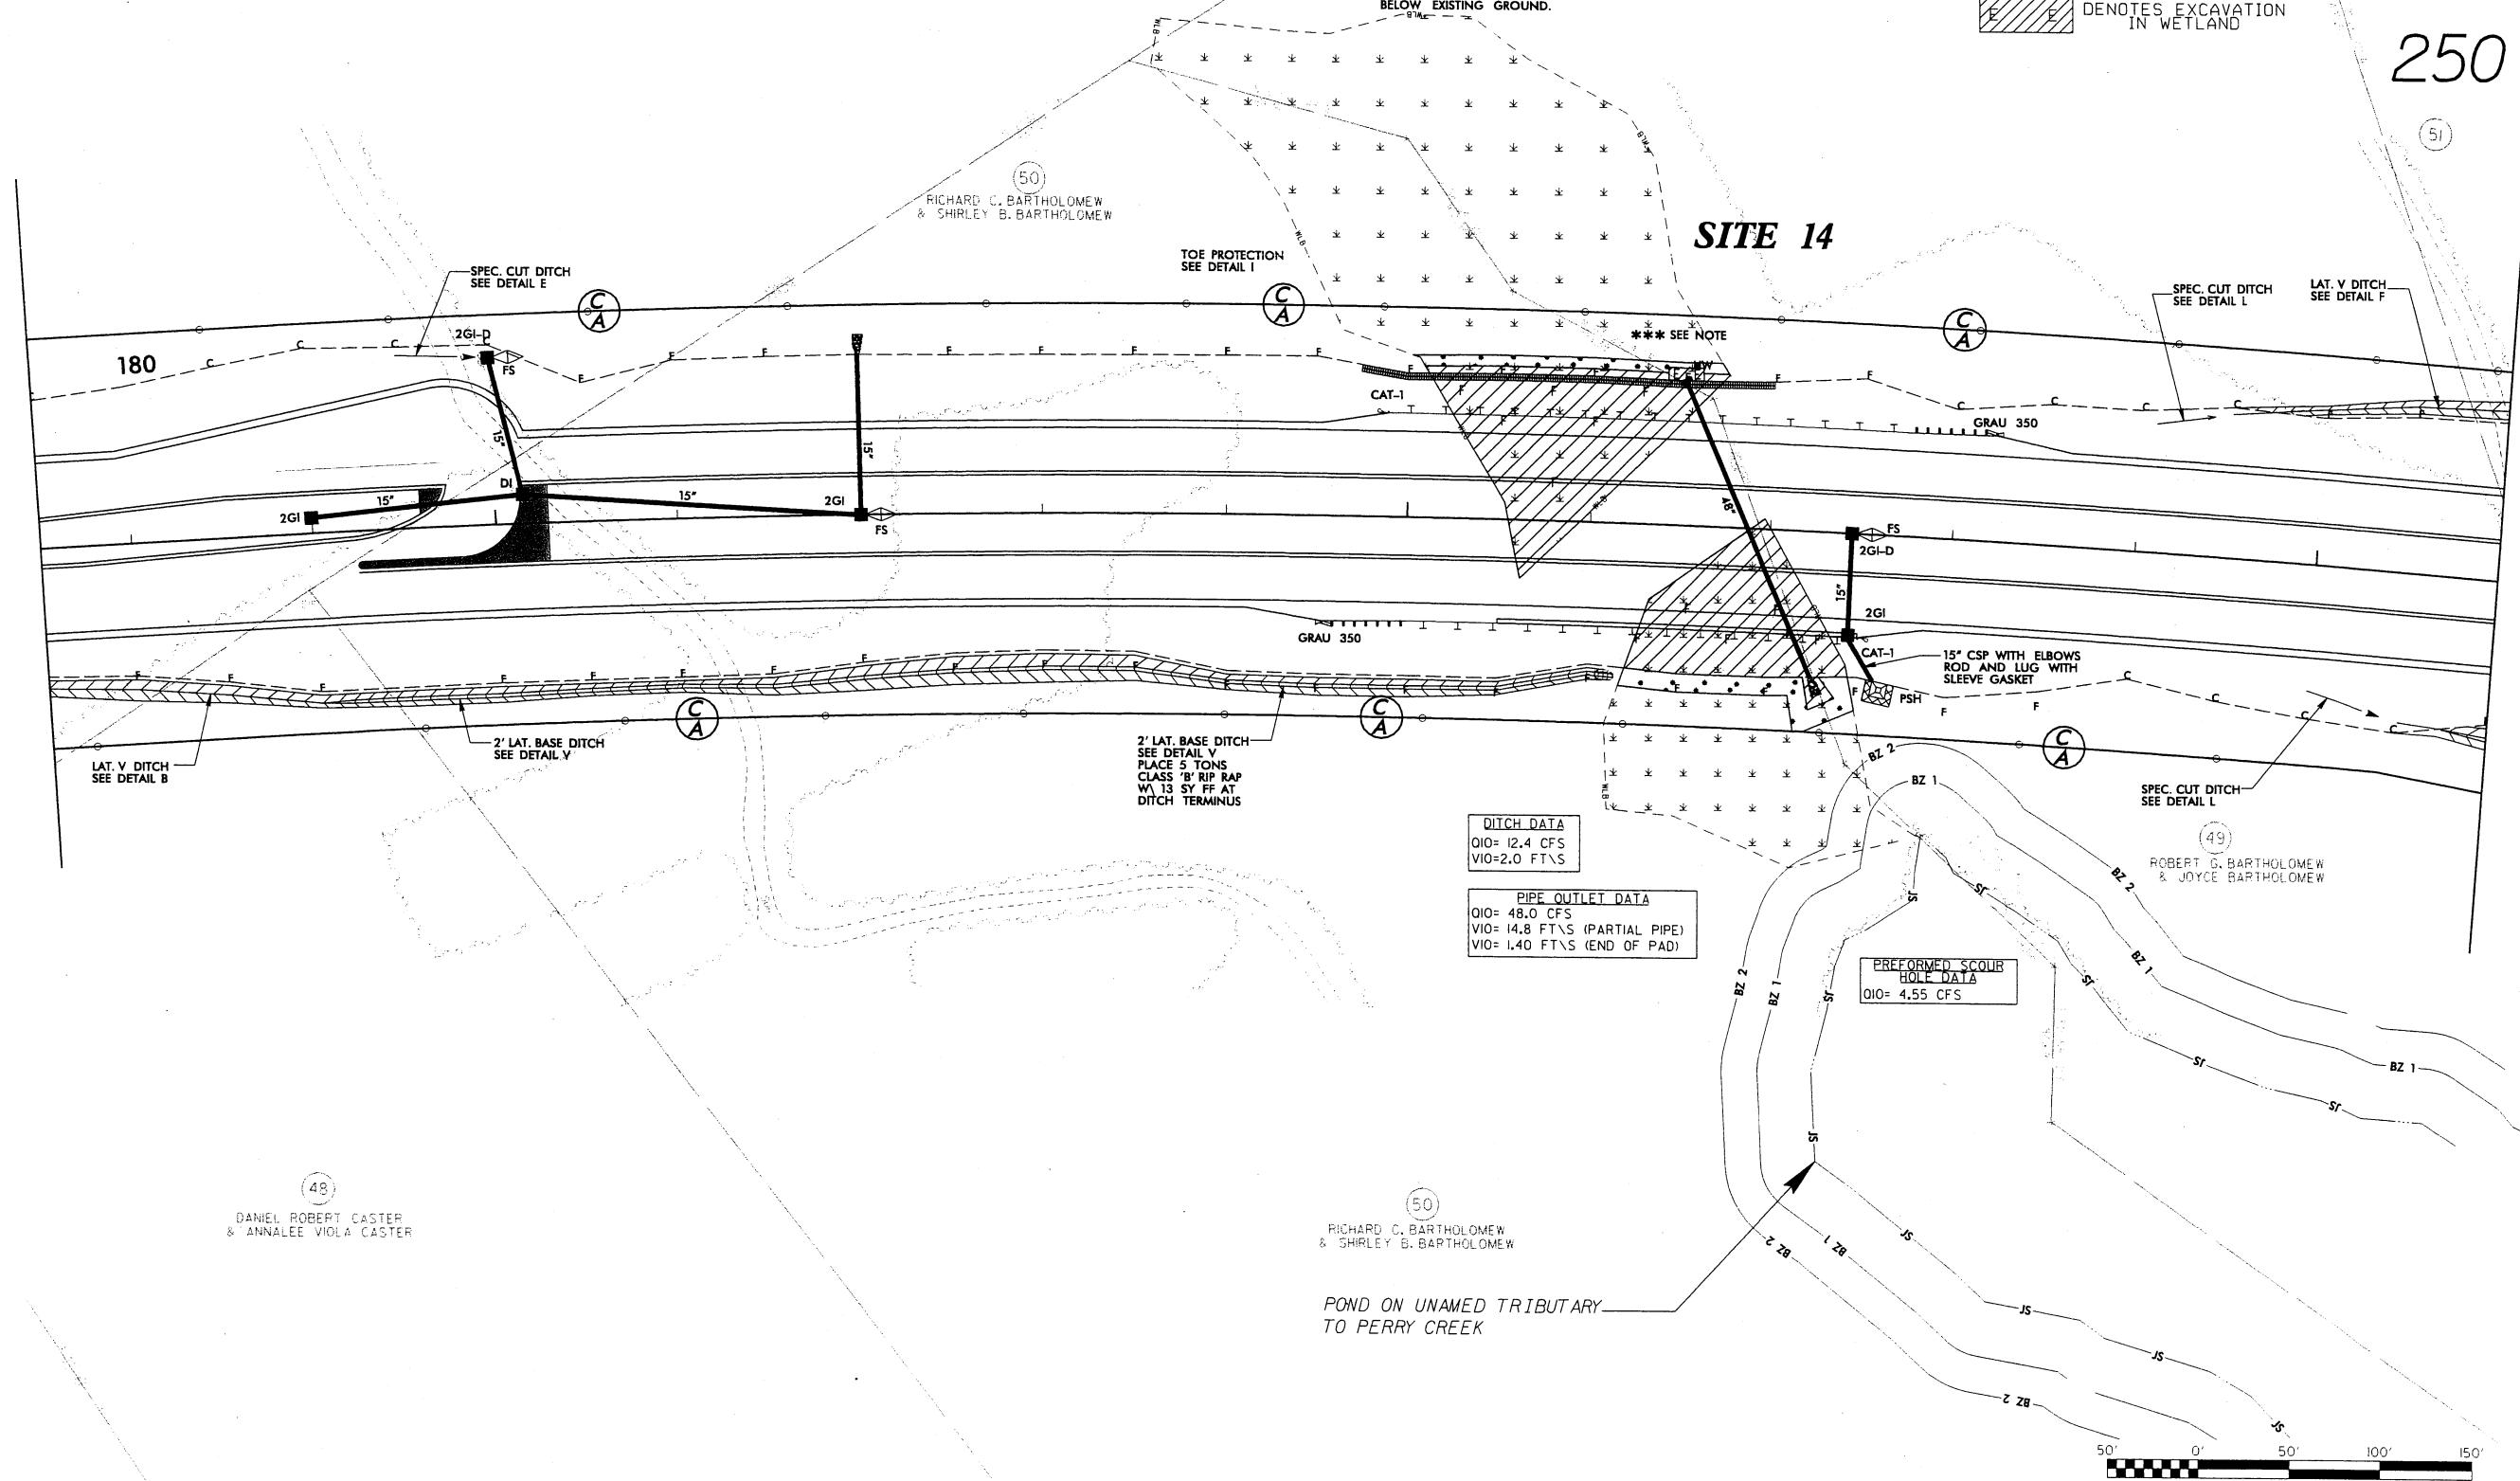


## REVISIONS


REVISED PARCELS 49 AND 50 PER LOCATION AND SURVEY REQUEST 4/23/09 DDL 7/29/09


8-17-99

R-2814B-hyd-wet-con-prm-21.dwg

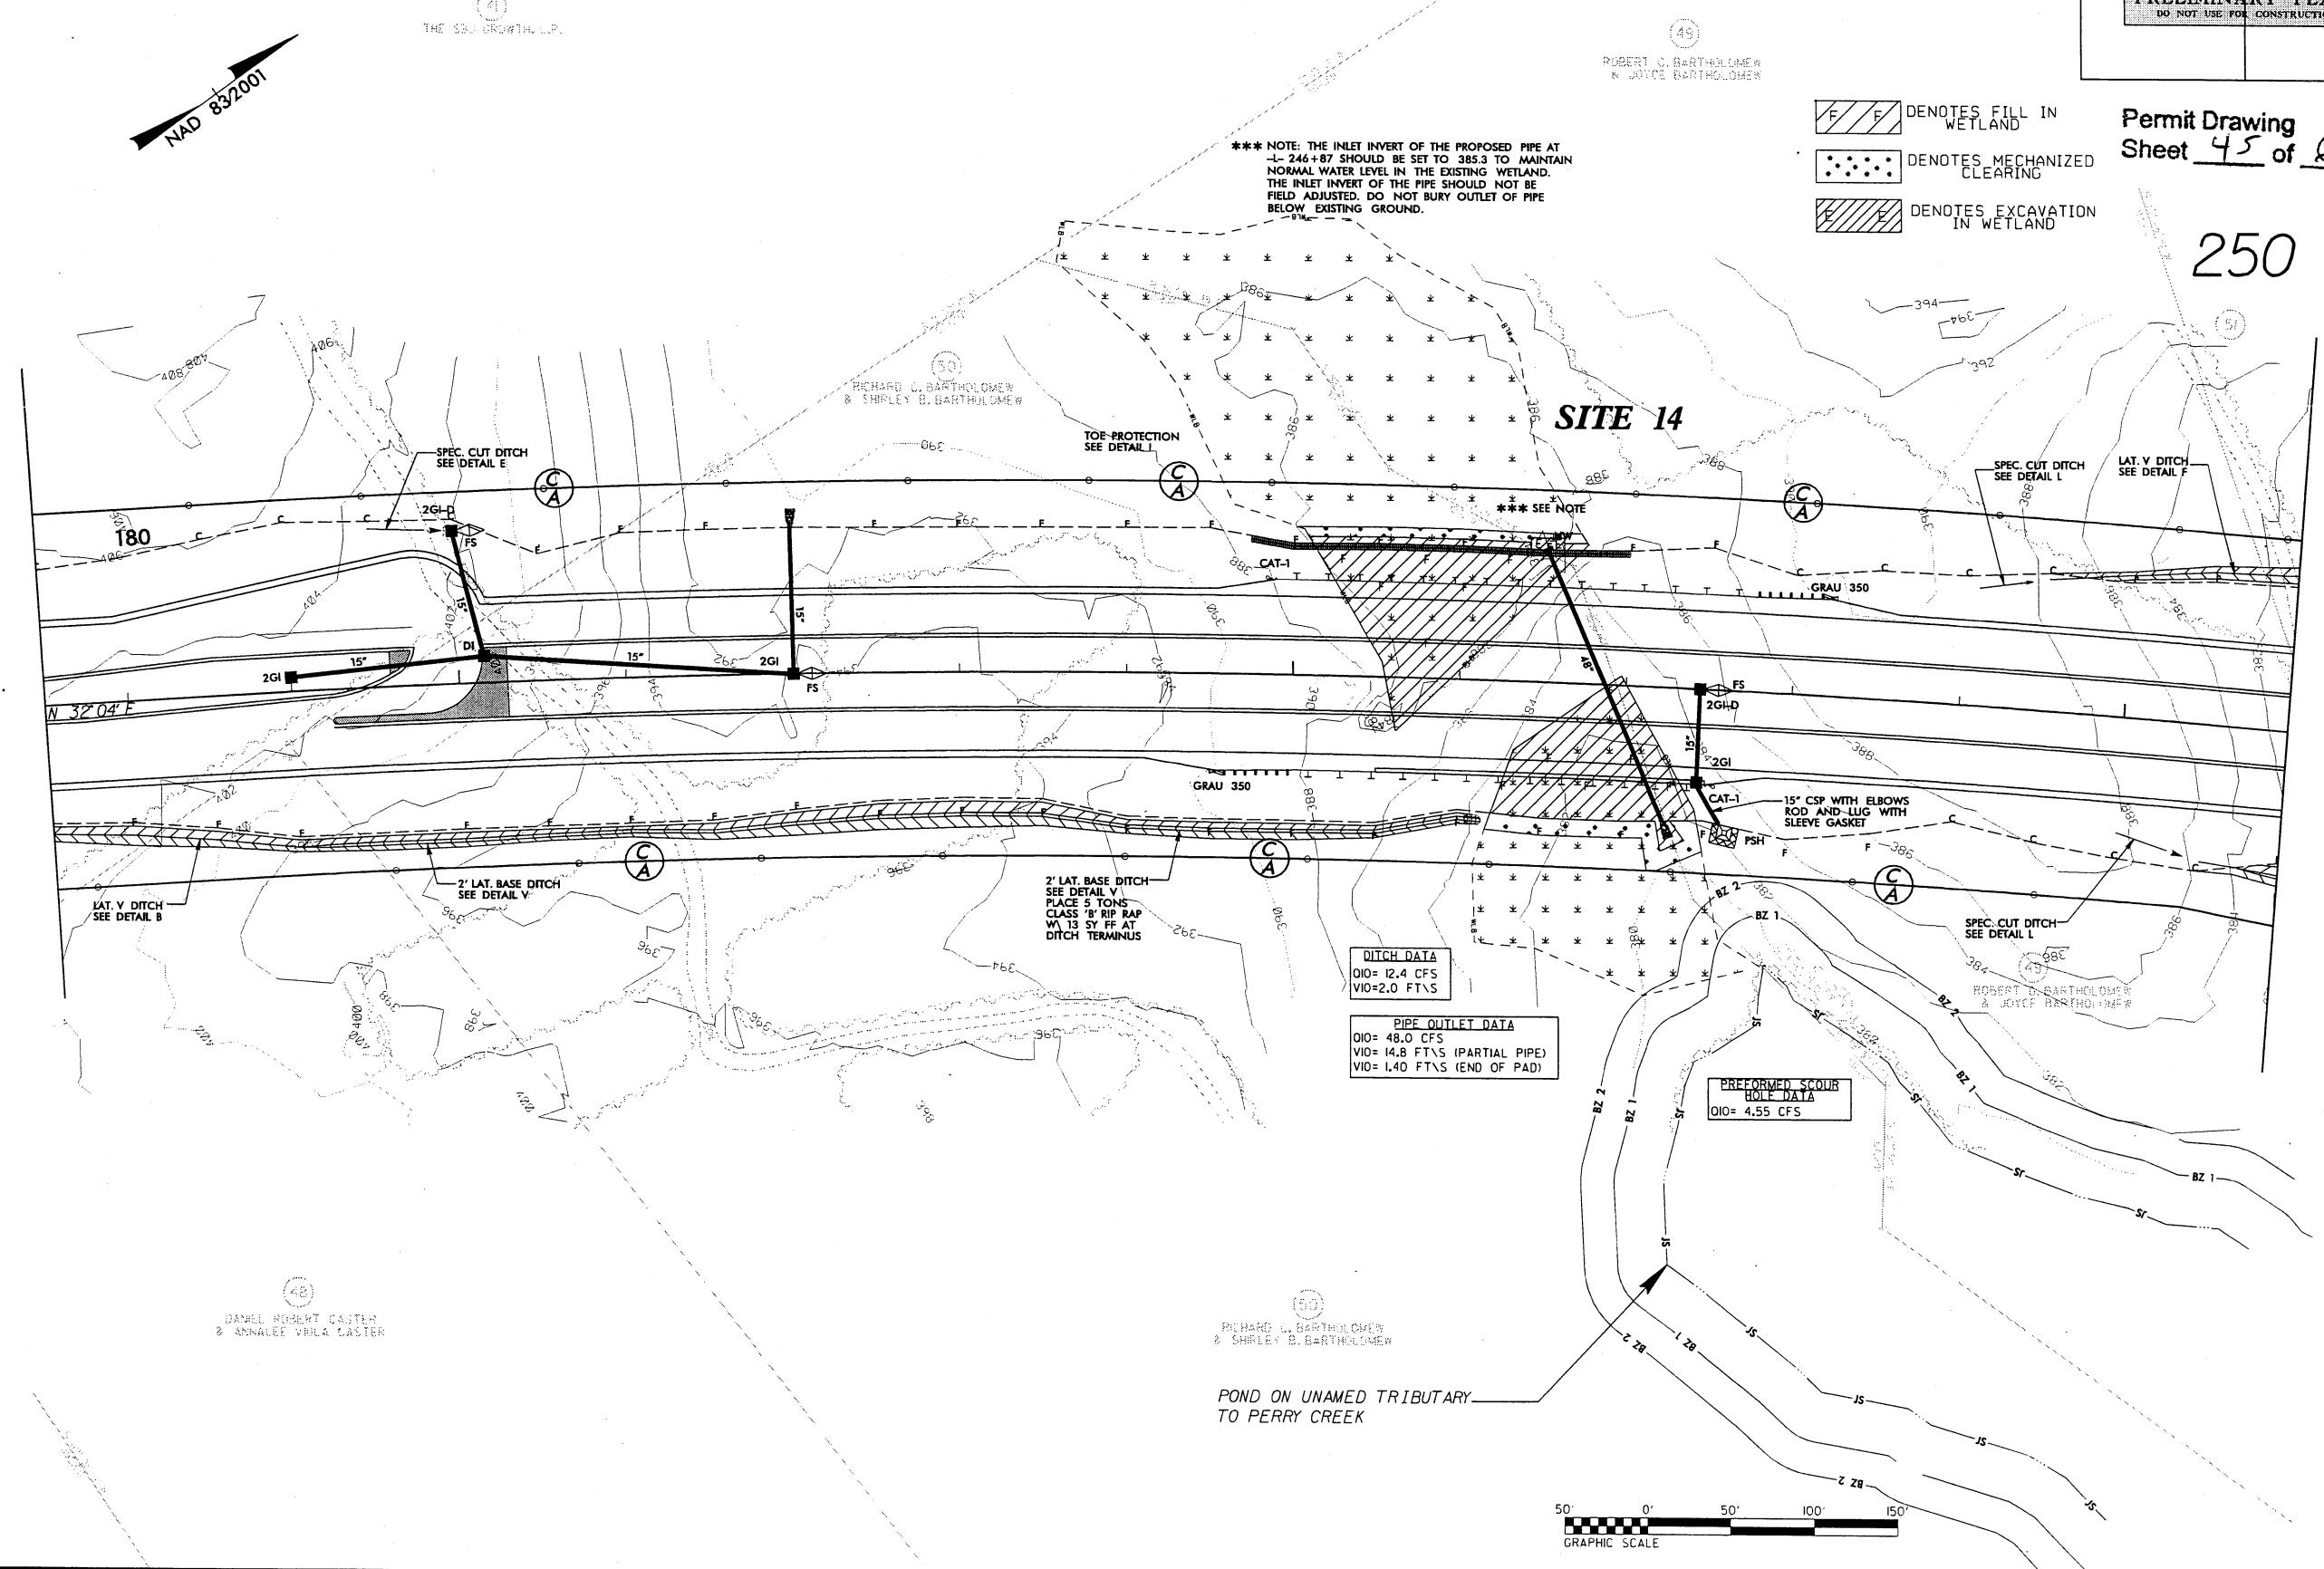

Permit Drawing  
Sheet 46 of 64

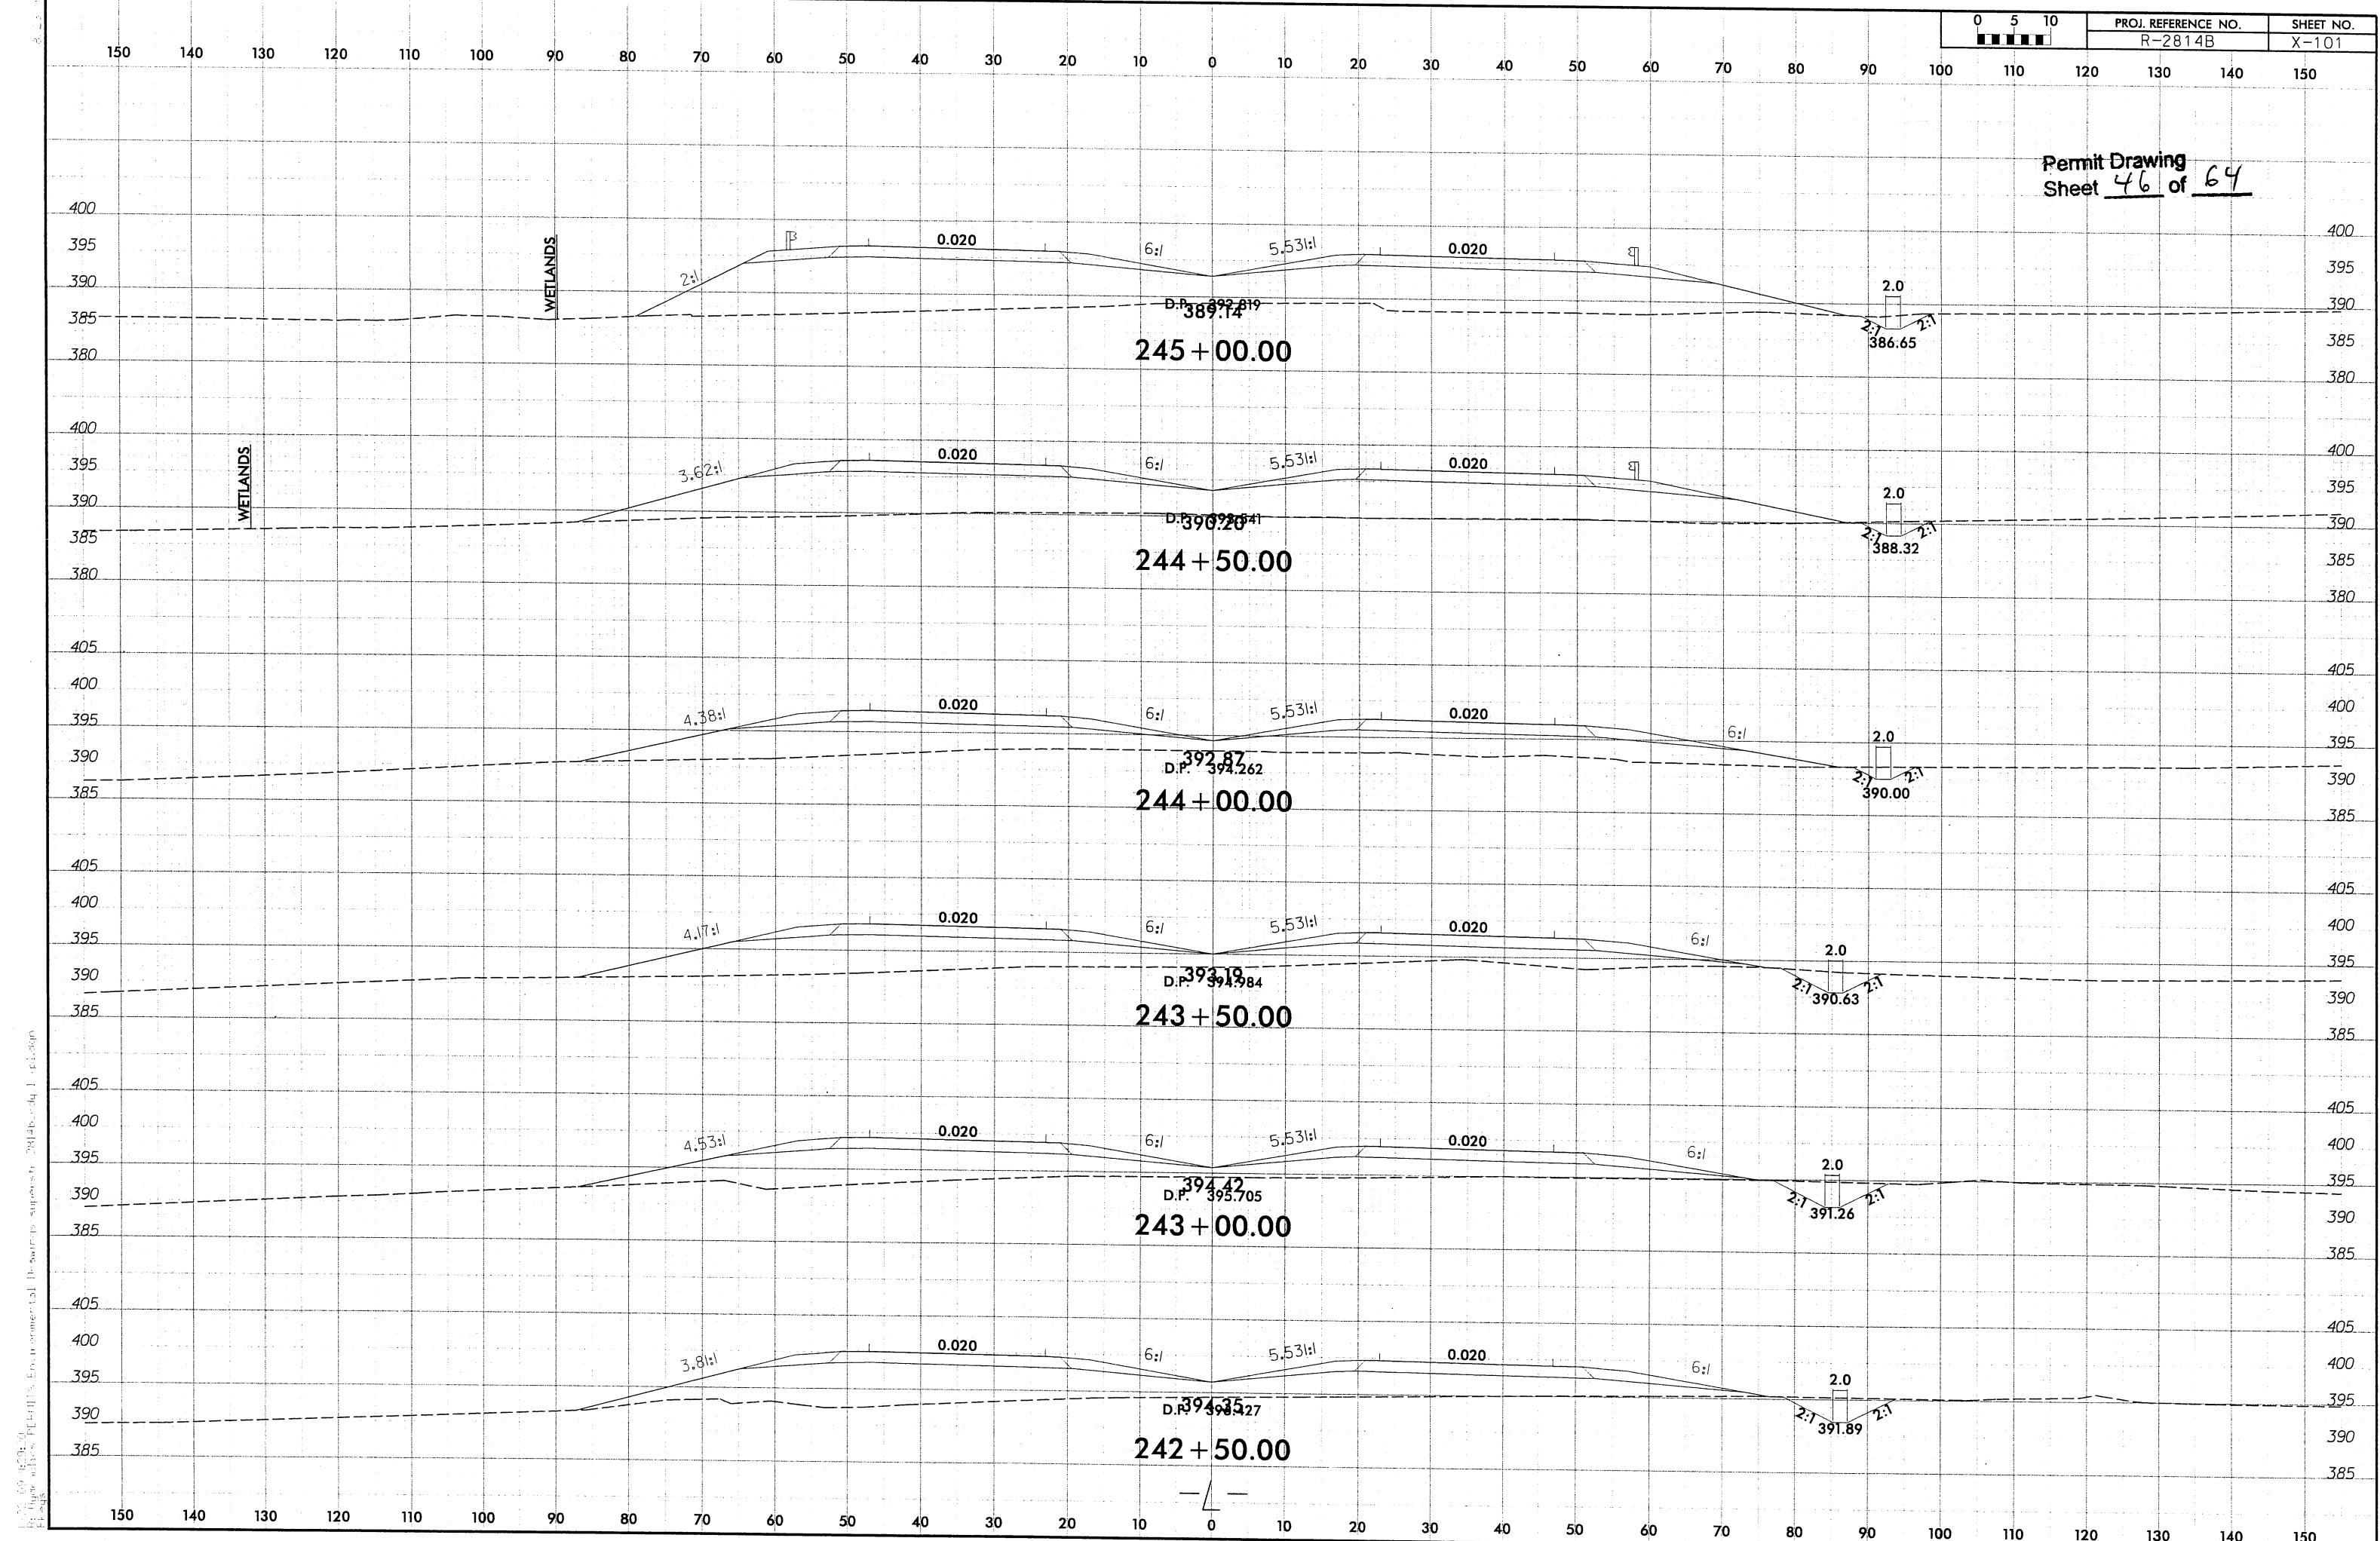

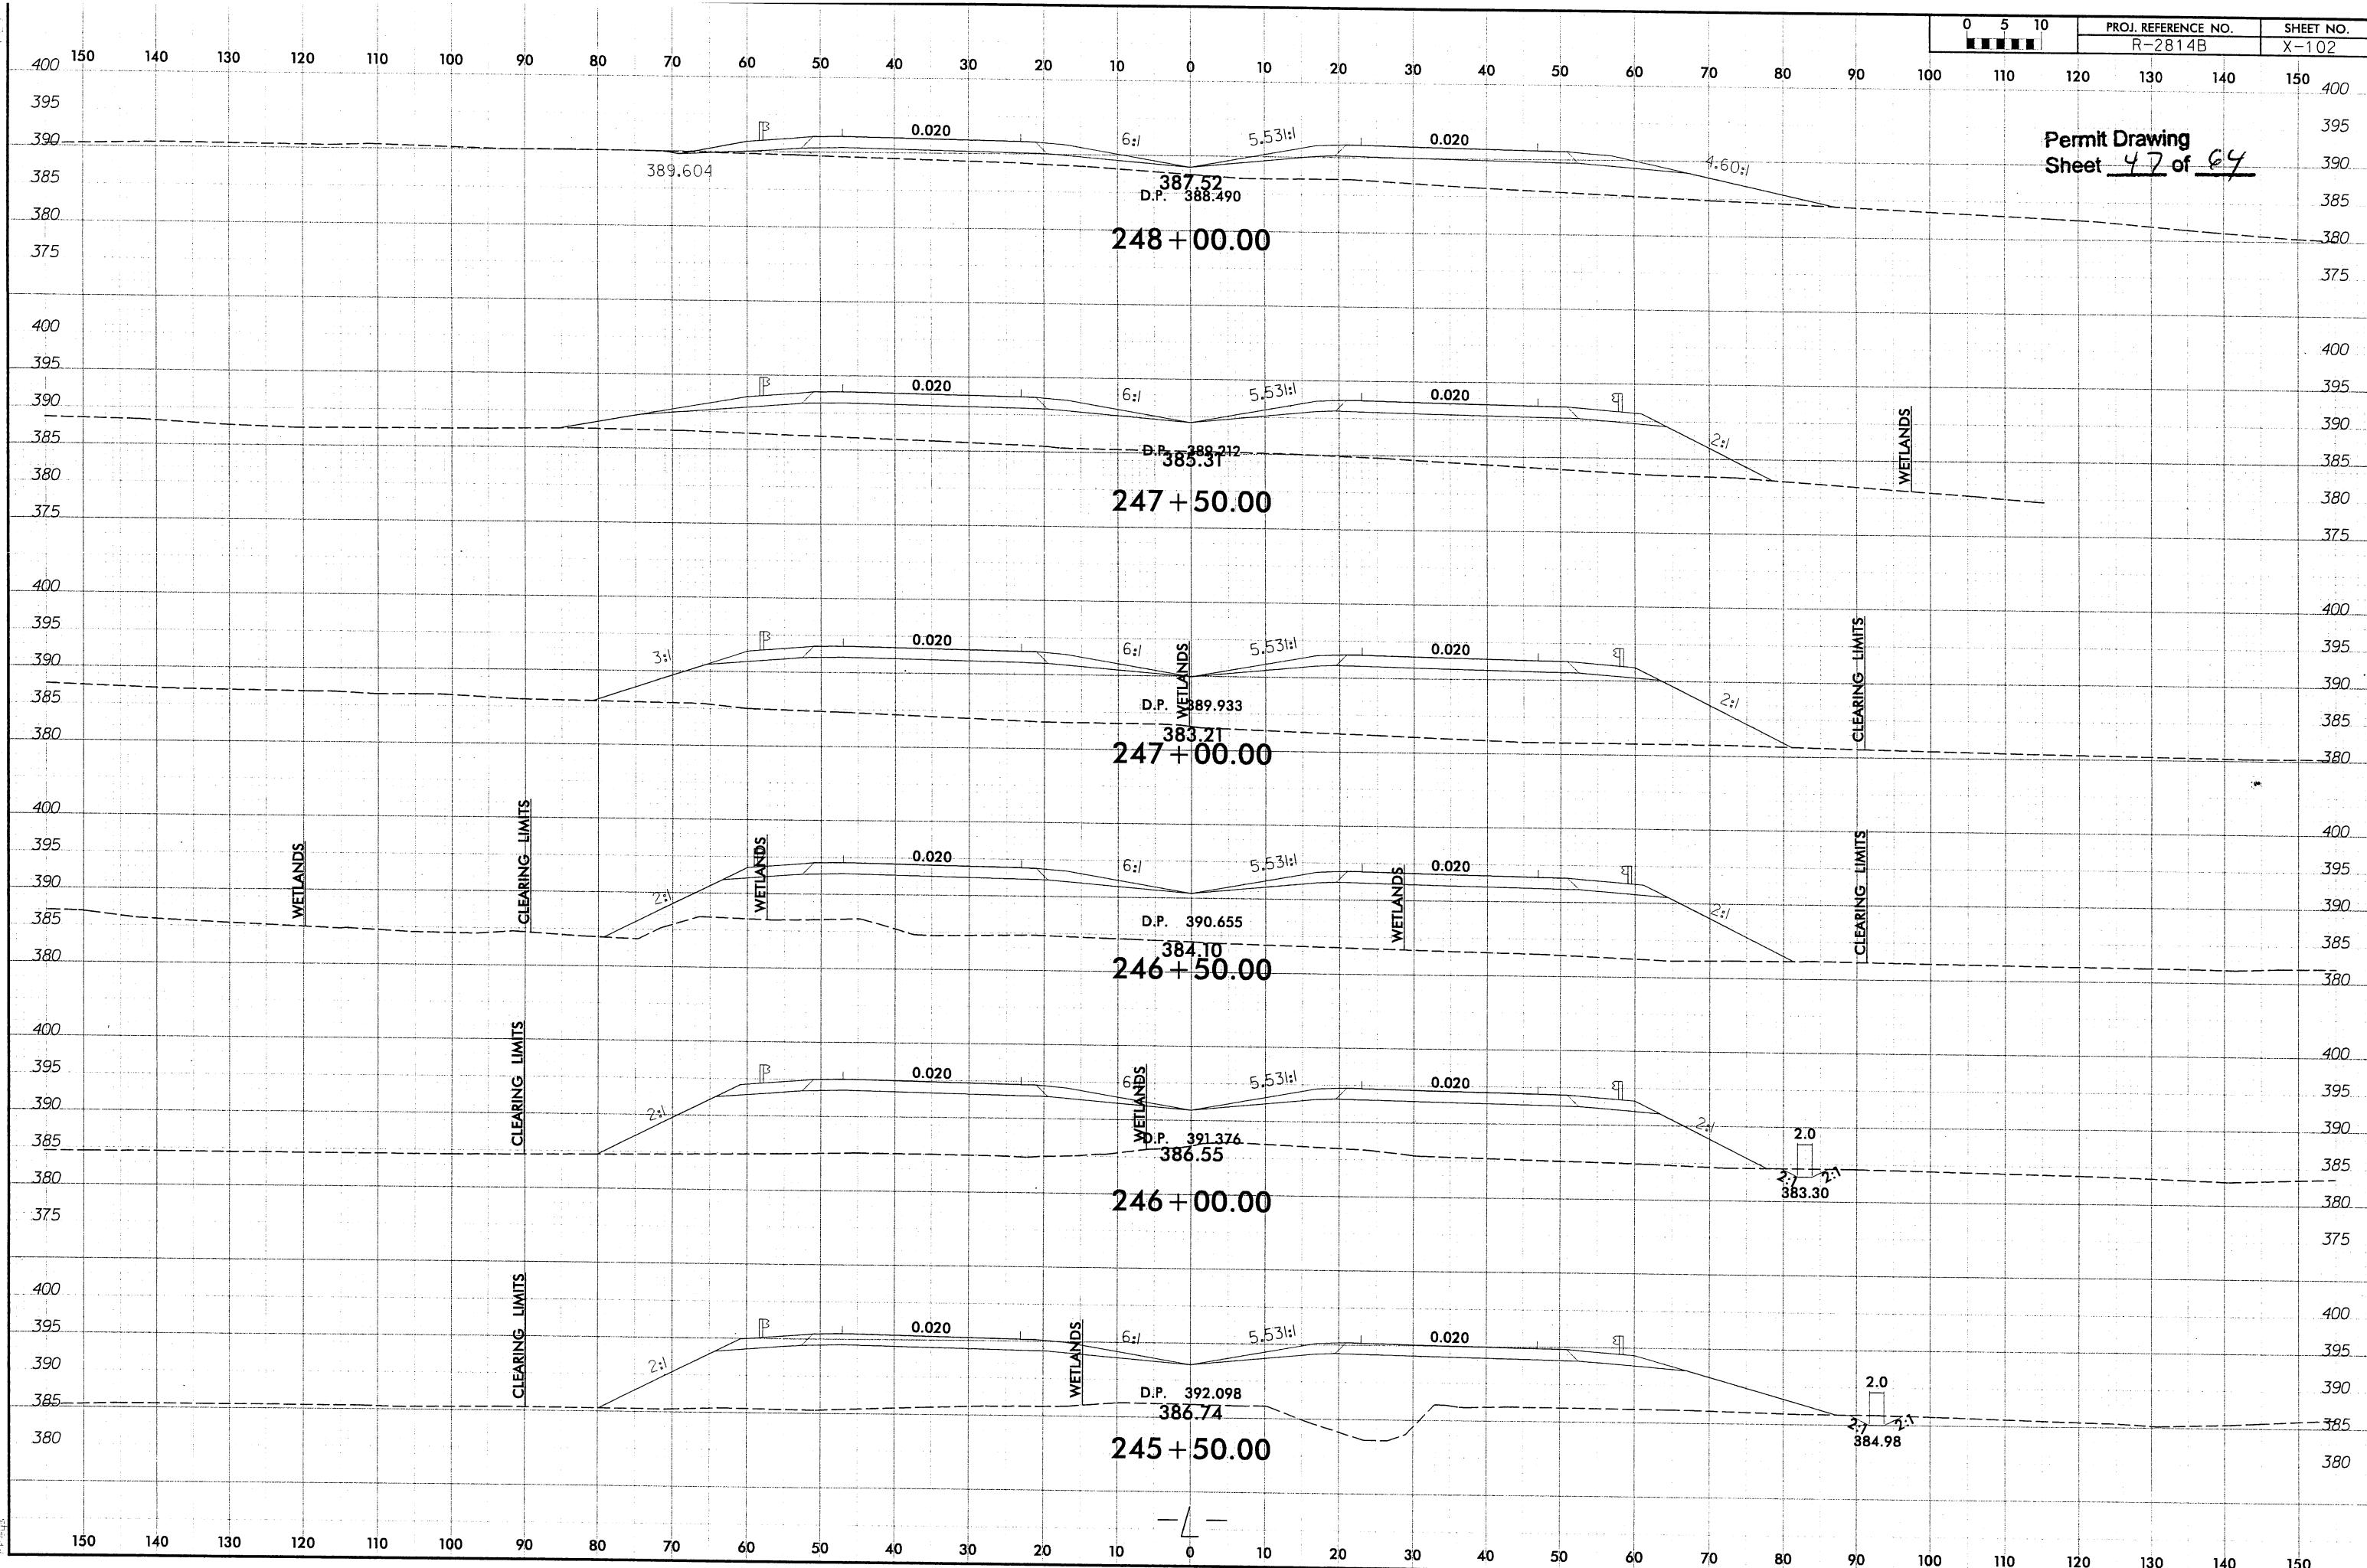

PROJECT REFERENCE NO.	
R-2814B	SHEET NO. 22
RW SHEET NO.	
ROADWAY DESIGN ENGINEER	HYDRAULICS ENGINEER
PRELIMINARY PLANS <small>DO NOT USE FOR CONSTRUCTION</small>	

255

260

MICHAEL C. BARTHOLOMEW

NAD 83/2001



Permit Drawing  
Sheet 48 of 64


DENOTES FILL IN WETLAND

\*\* NOTE: FIELD ADJUST LOCATION OF SPRING  
BOX (STD. 840.41) FROM -L STA 252+50 TO  
-L STA 257+00 AS DIRECTED BY THE ENGINEER

### SITE 15

REVISIONS

January 11, 2010: Adjusted R/W CA lines, R/W markers and the proposed woven wire fence on parcel no. 52-NNA.

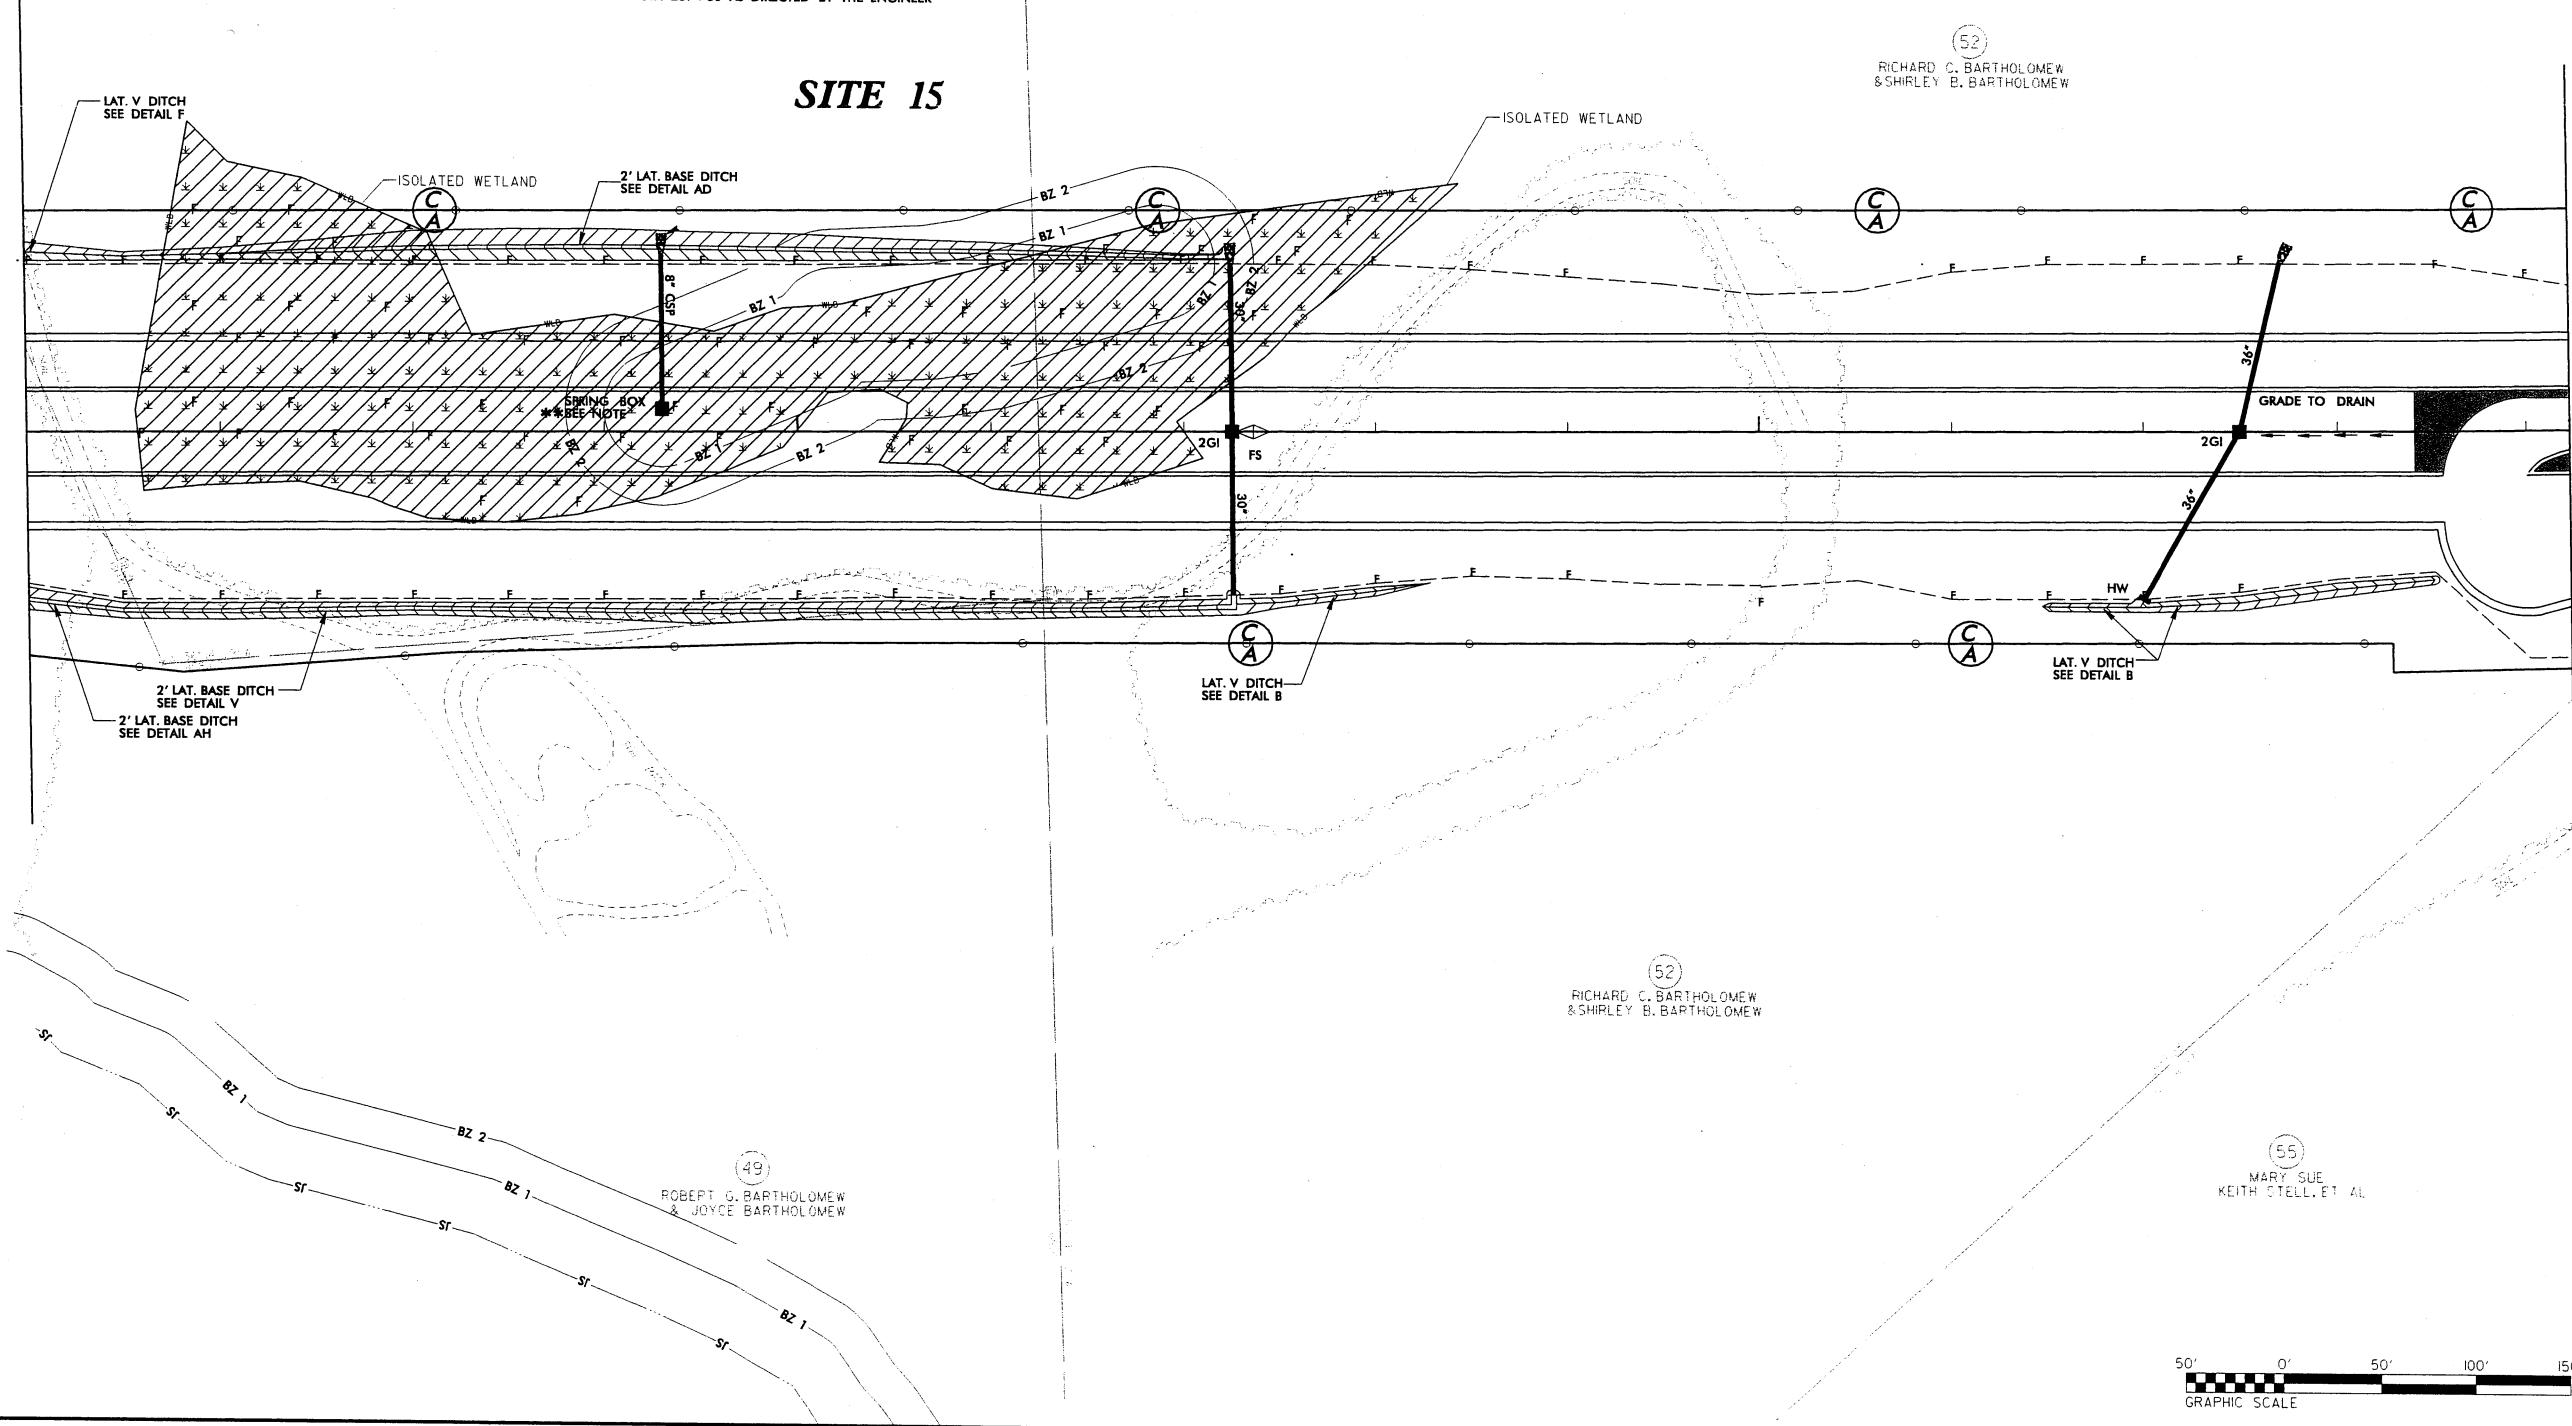


## REVISIONS

January 11, 2010: Adjusted R/W CA lines, R/W markers and the proposed woven wire fence on parcel no. 52, NWA.


R-2814b-hyd-wet.con-prm-222.dgn

(C) Hydraulics Permits - Environmental Drawings

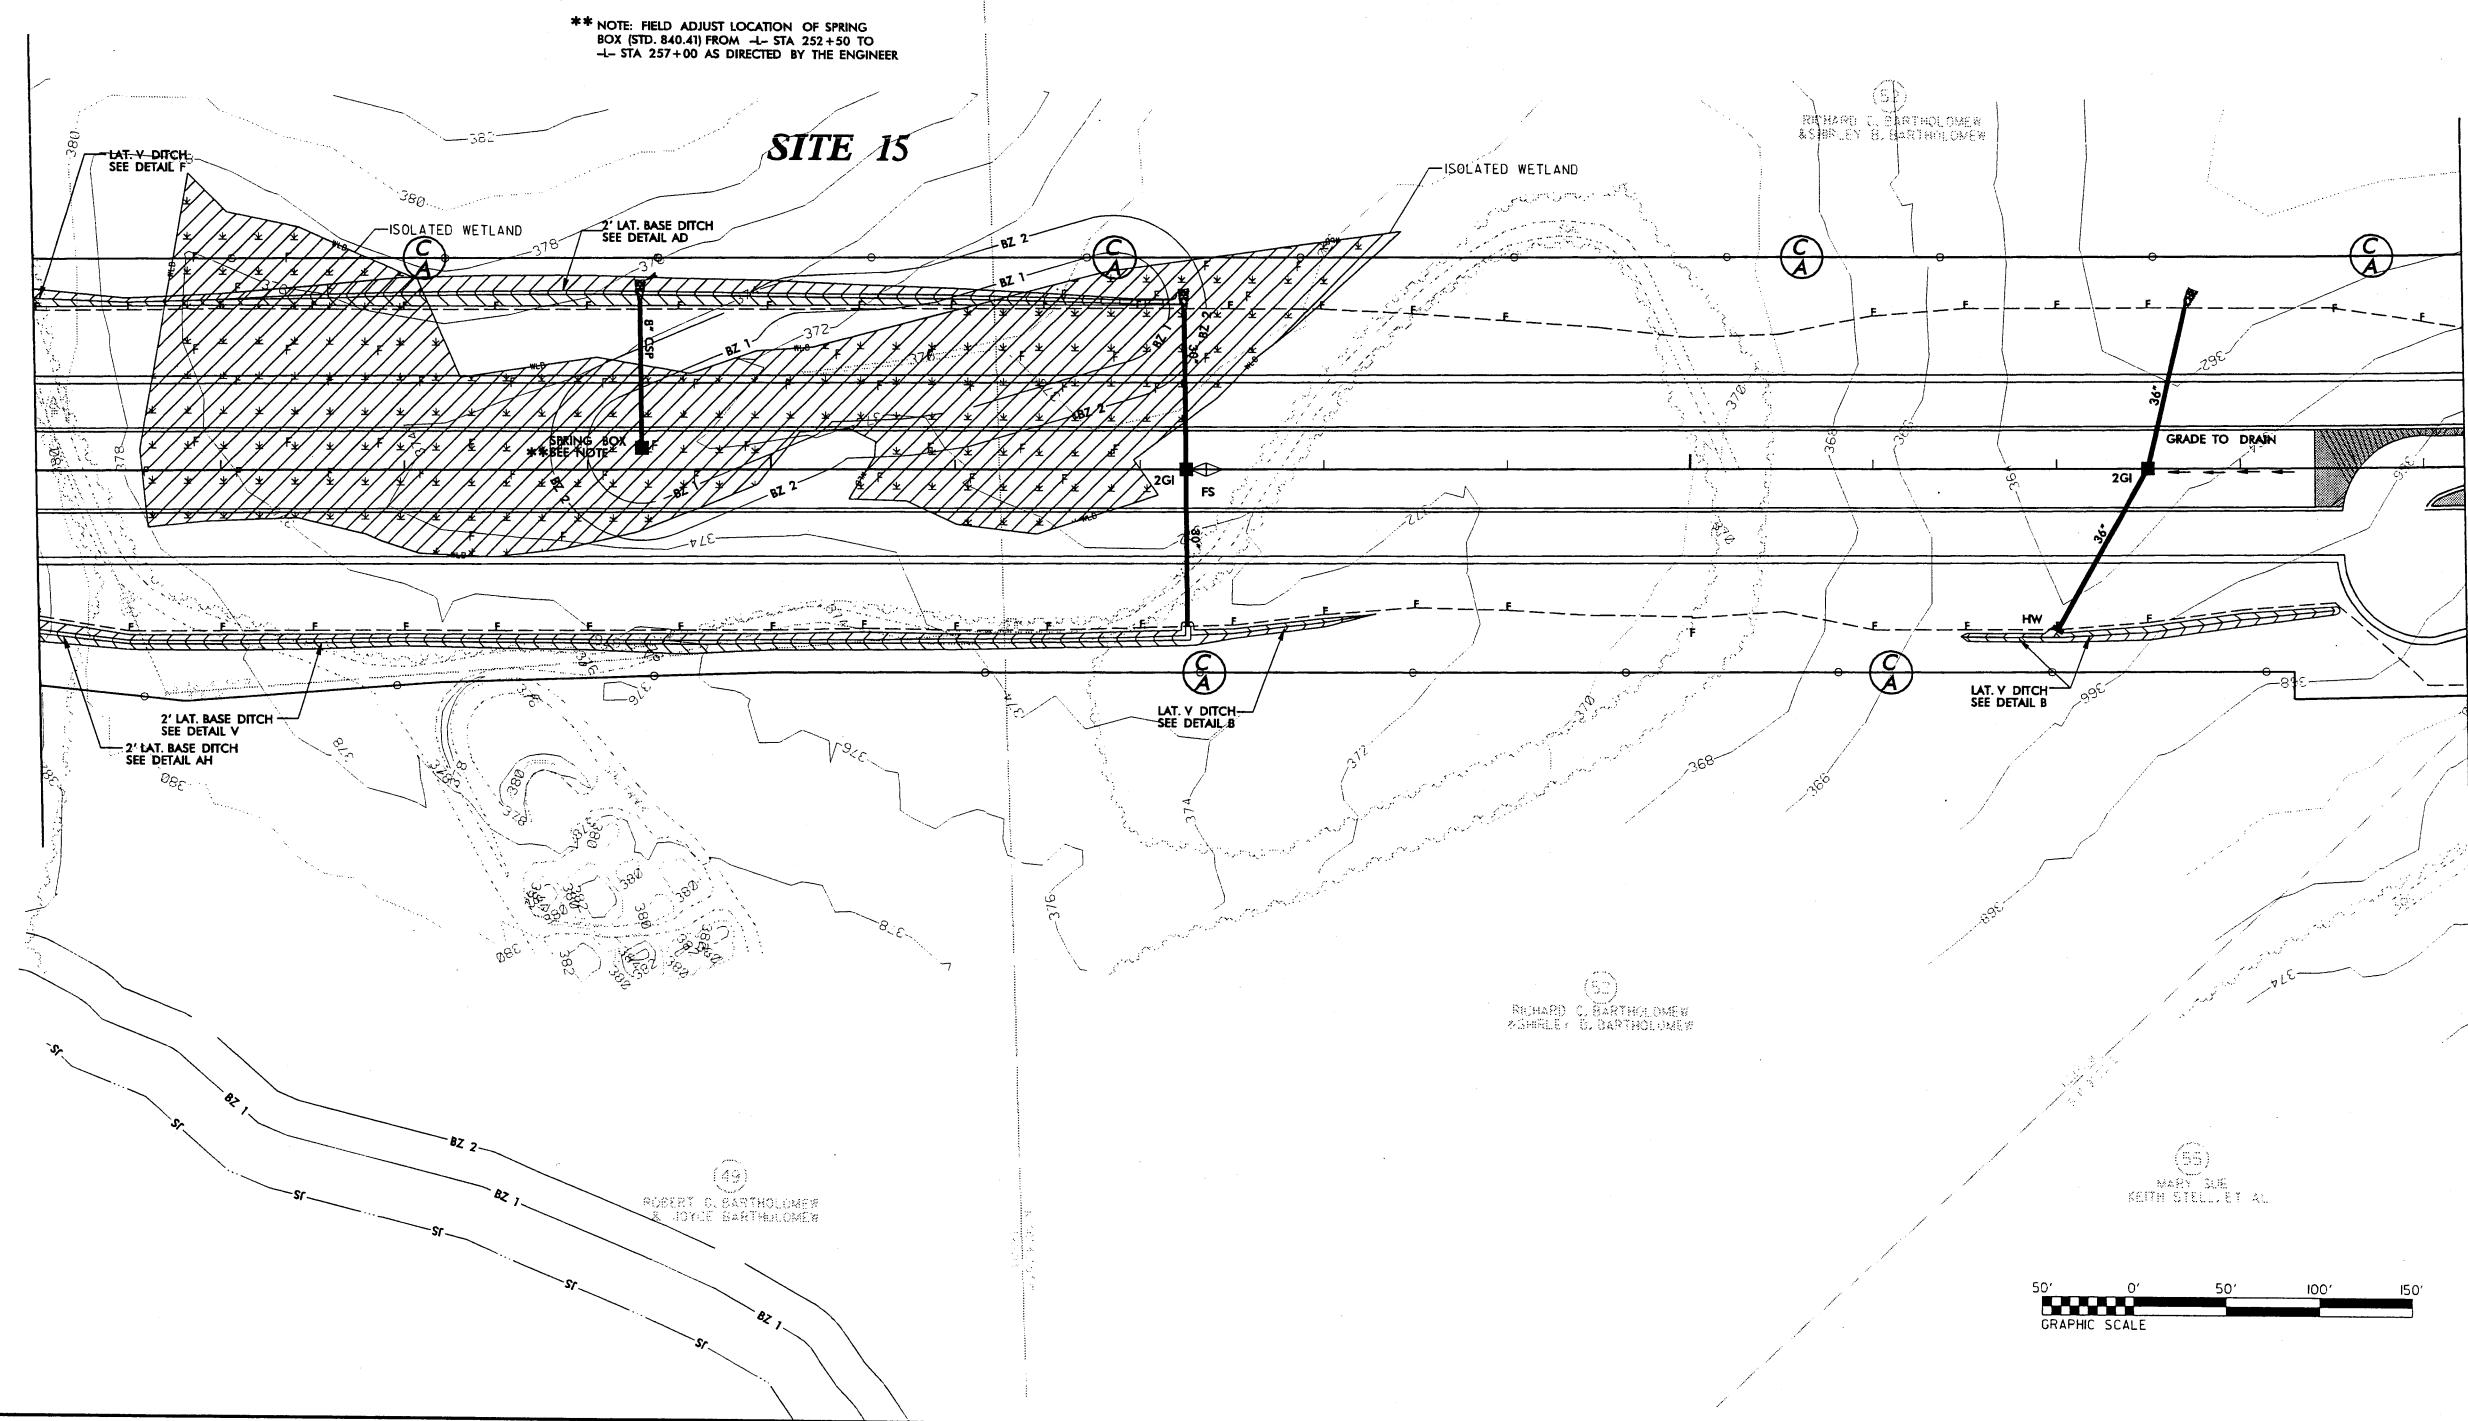


PROJECT REFERENCE NO.		SHEET NO.
R-2814B		22
RW SHEET NO.		
ROADWAY DESIGN ENGINEER		HYDRAULICS ENGINEER
<b>PRELIMINARY PLANS</b> DO NOT USE FOR CONSTRUCTION		


Permit Drawing  
Sheet 50 of 64

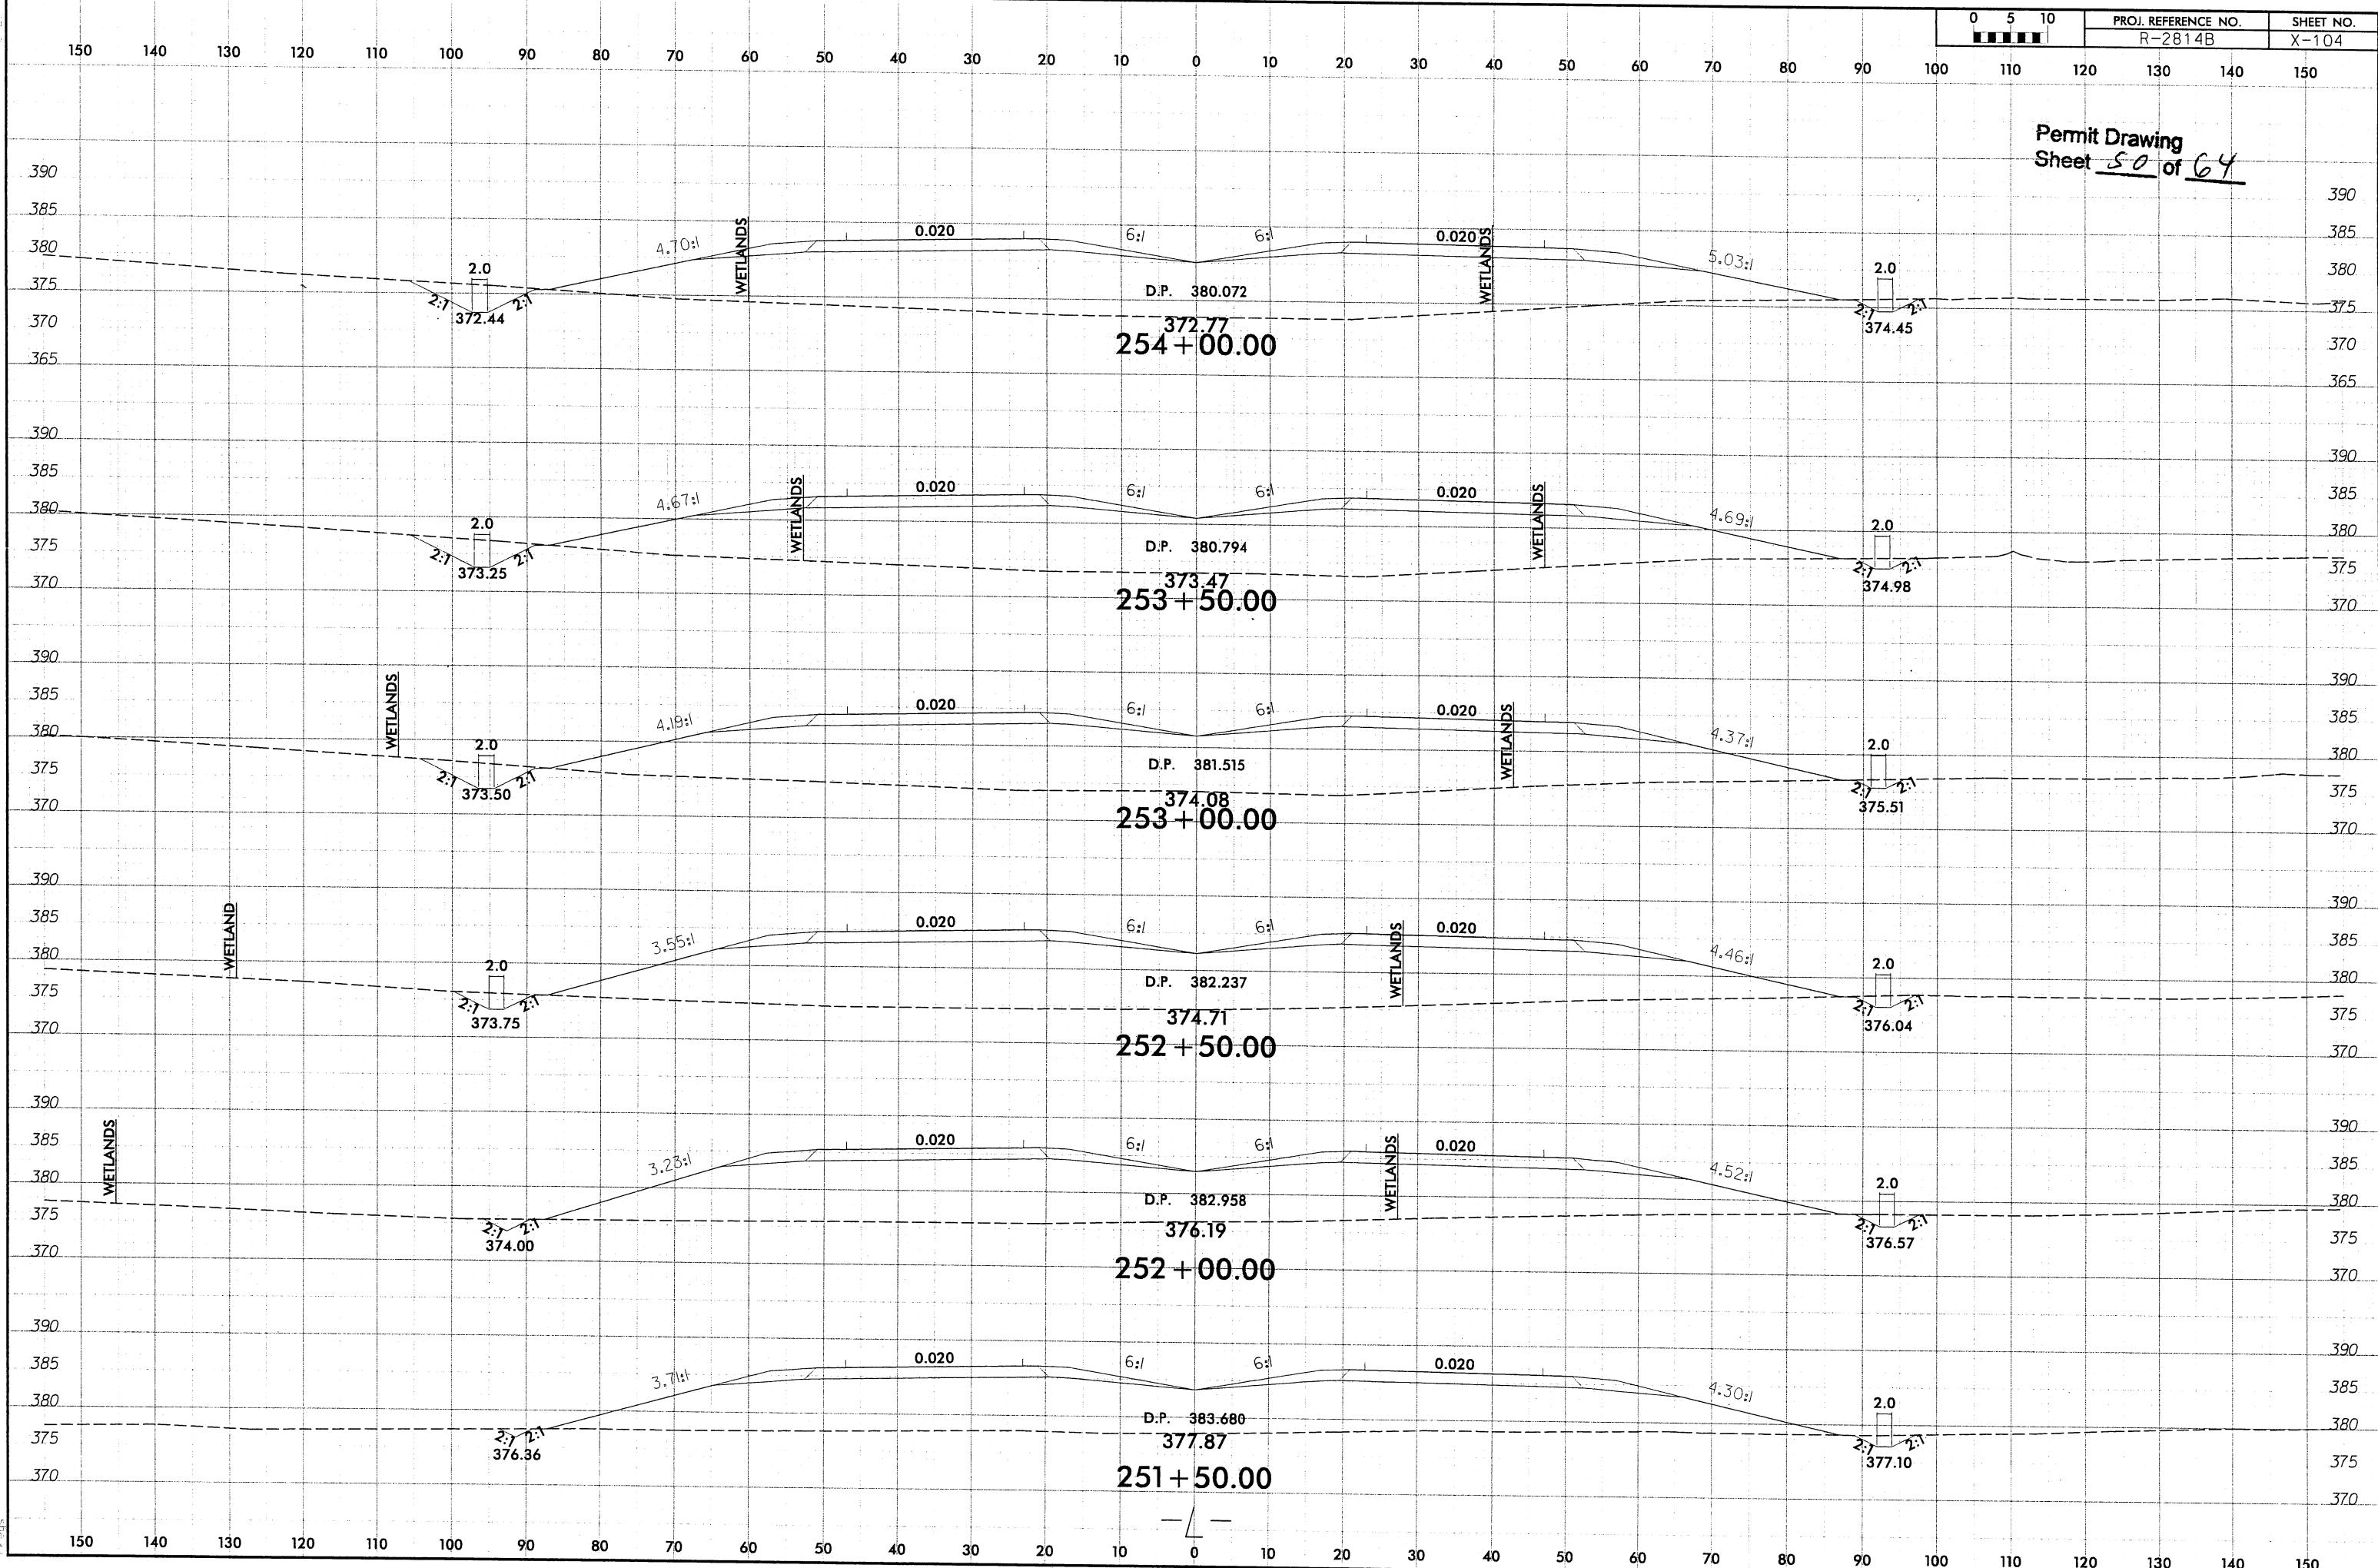

Permit Drawing  
Sheet S1 of 64

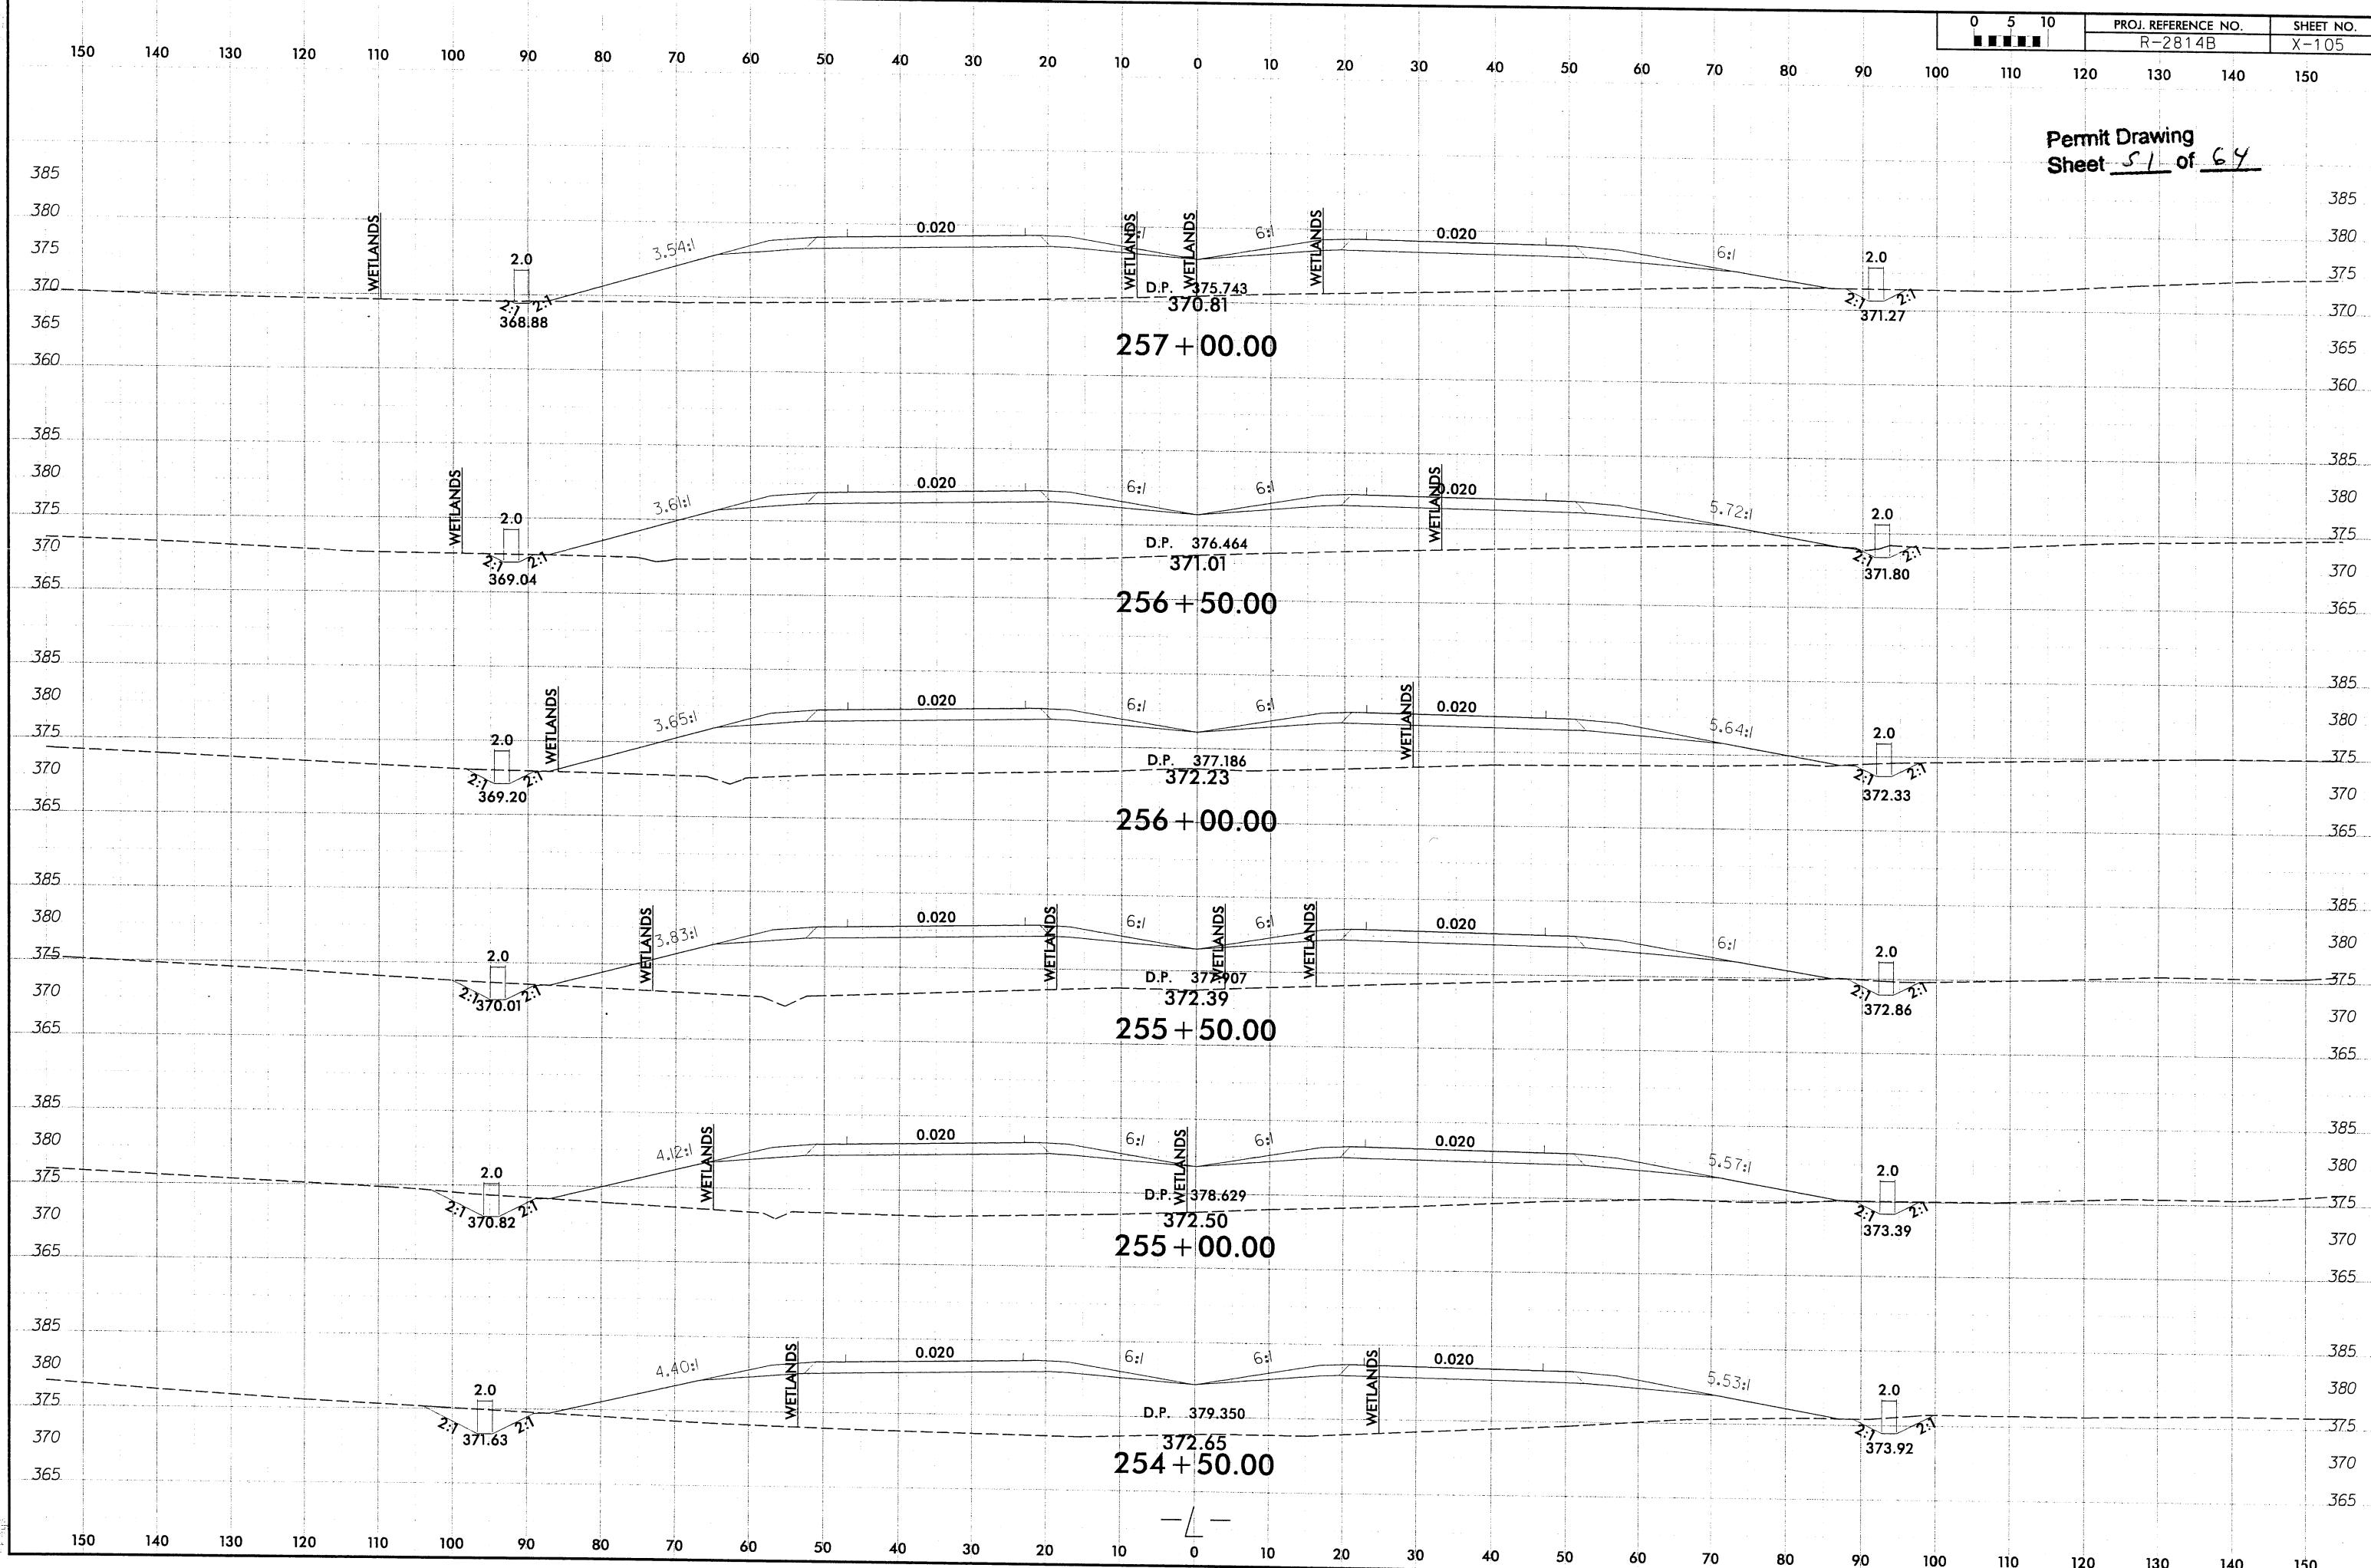

Permit Drawing  
Sheet 52 of 64

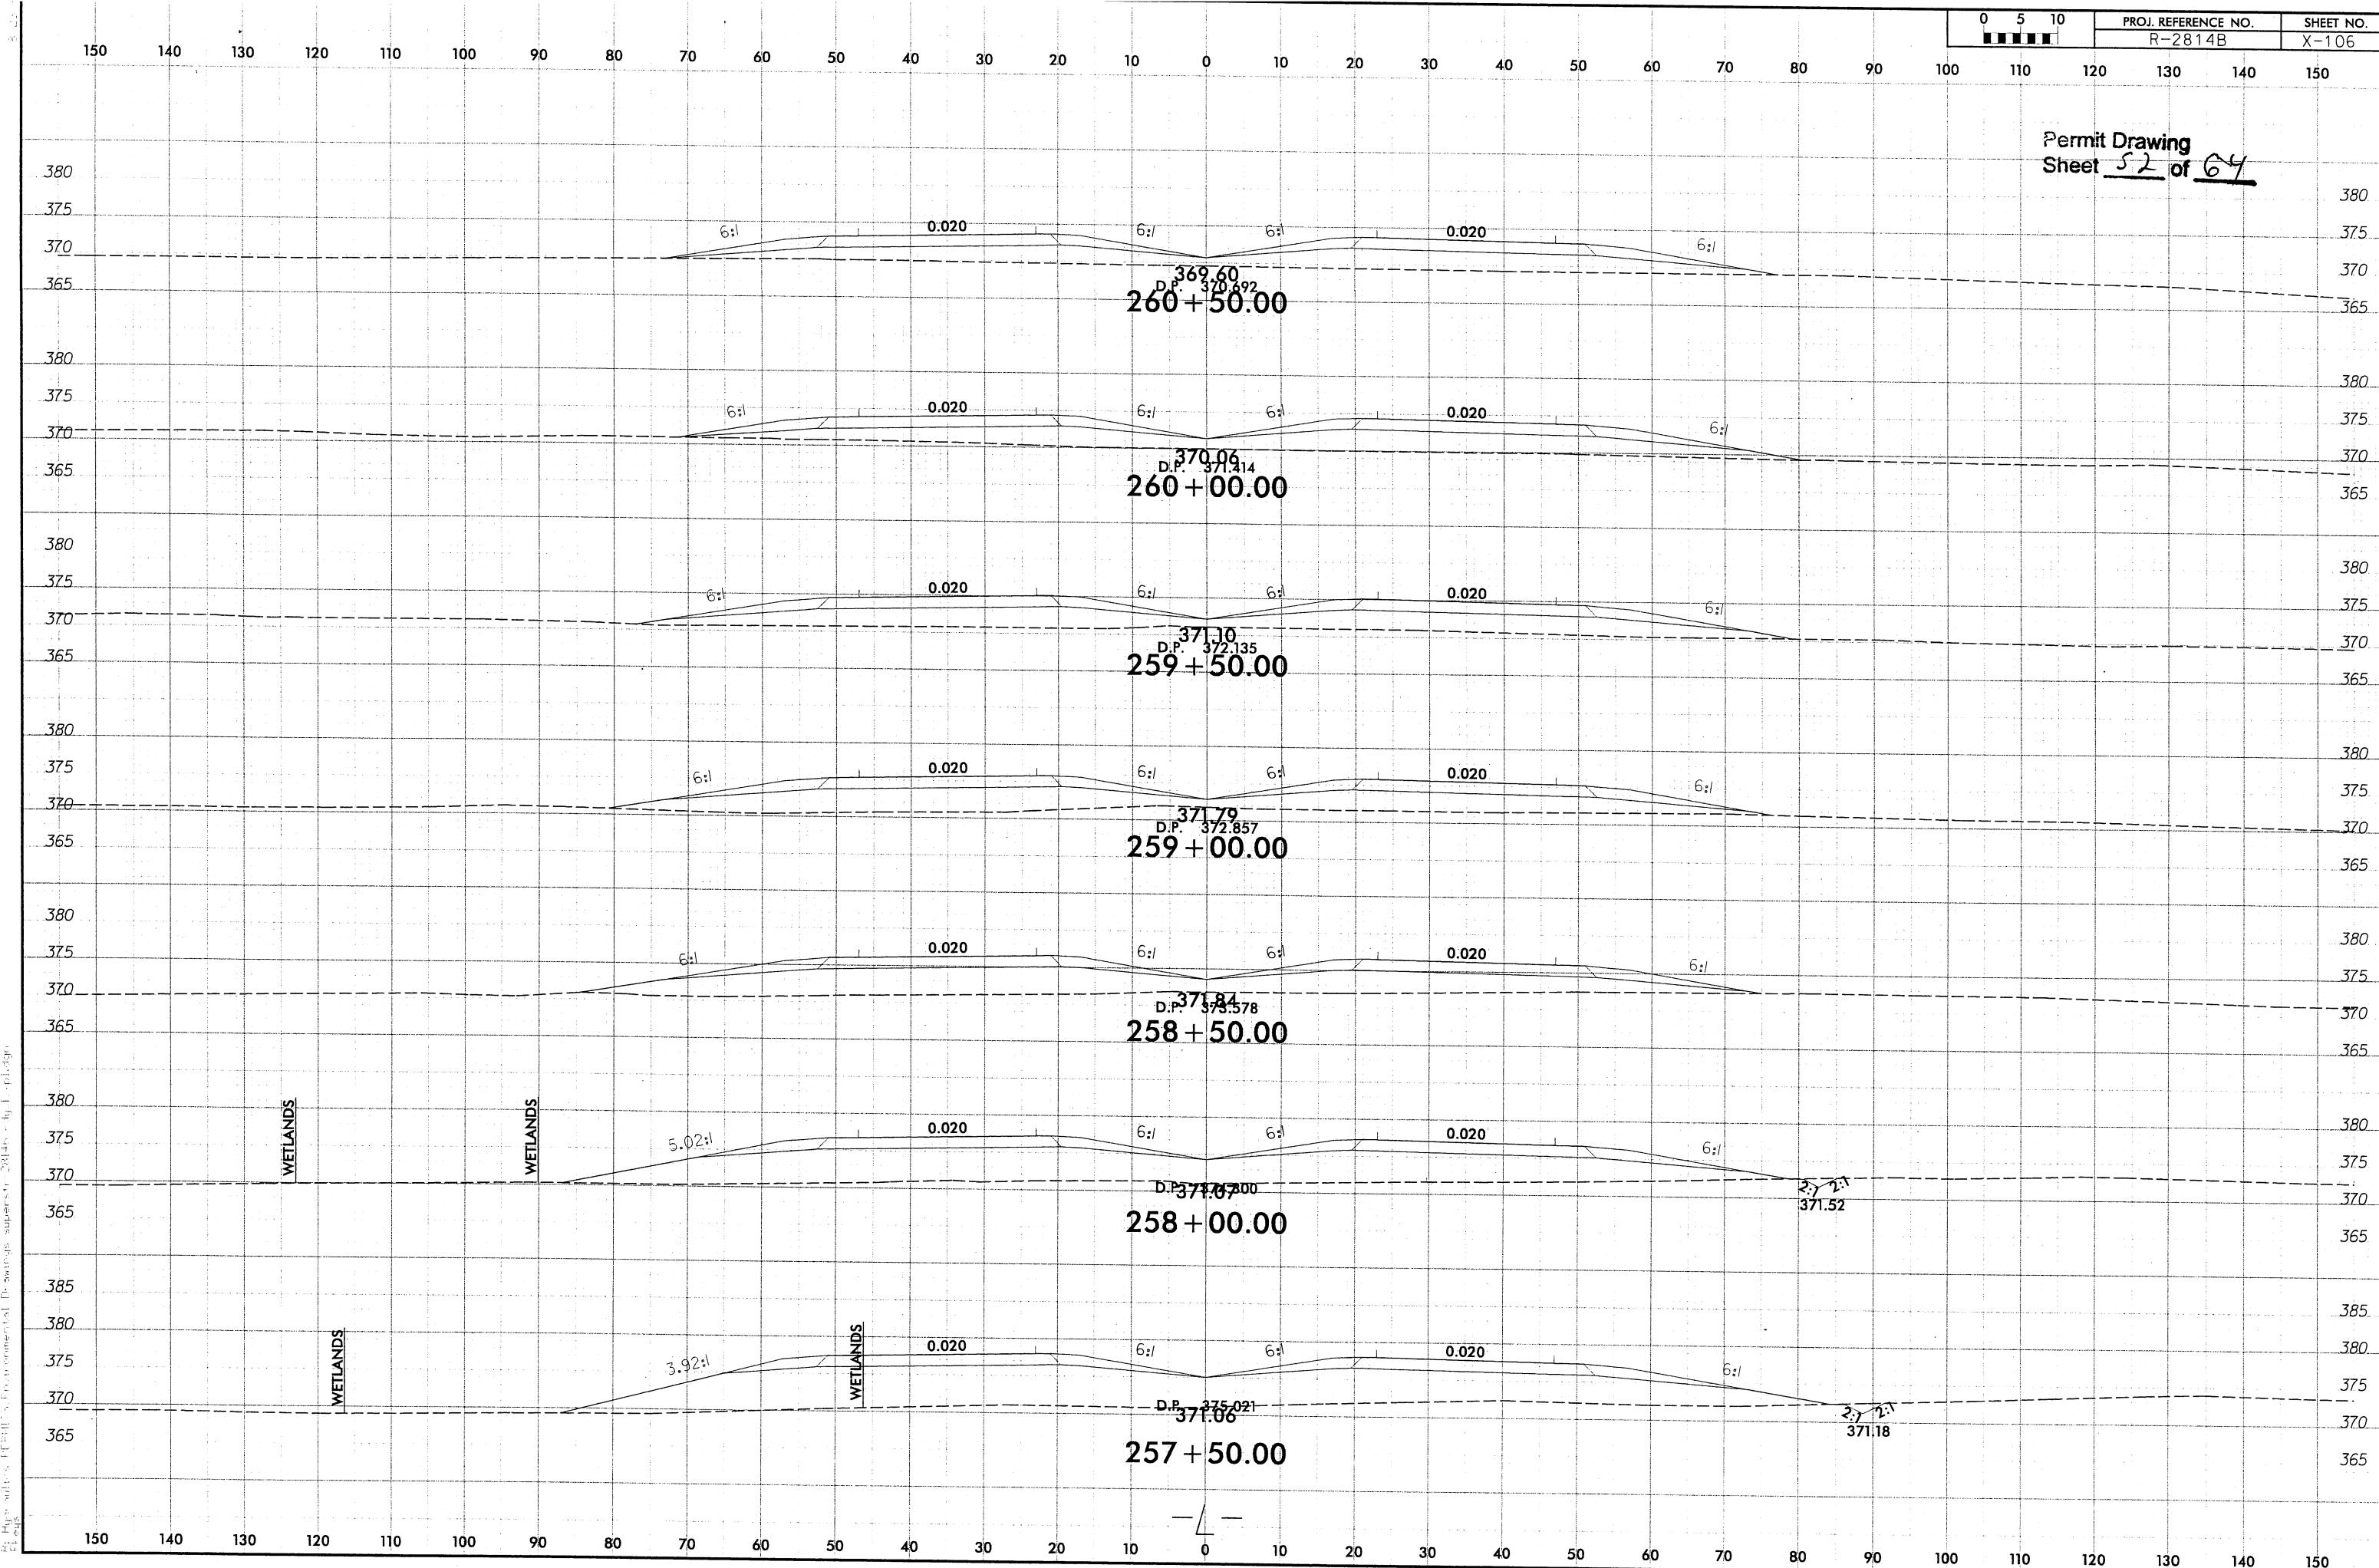

265

NAD 83/2001

SITE 18

275

PROJECT REFERENCE NO.		SHEET NO.
<b>R-2814B</b>		<b>23</b>
RW SHEET NO.		
ROADWAY DESIGN ENGINEER	HYDRAULICS ENGINEER	
<b>PRELIMINARY PLANS</b> DO NOT USE FOR CONSTRUCTION		

Permit Drawing  
Sheet 53 of 64

LEE ROY FRAZIER & SYLVIA P. FRAZIER


NORTH STAR LIMITED PARTNERSHIP  
D.B.4773, Pg.700


GRASS SWALE DATA		B
-Y6 STA. 1505 TO STA. 1700 RT		
DA	1.30	AC
SLOPE	1.53	%
L REQ	130	FT
L PROV	192	FT
Q2	3.72	CFS
V2	1.87	FT/S
D2	0.75	FT
Q10	4.81	CFS
V10	2.36	FT/S
D10	0.76	FT

RICHARD C. BARTHOLOMEW  
& SHIRLEY B. BARTHOLOMEW

## **REVISIONS**


January 11, 2010: Adjusted R/W CA lines, R/W markers and the proposed woven wire fence on parcel nos. 52 and 55, N.W.A.  
January 11, 2010: Adjusted TDE lines on parcel no. 55, N.W.A.

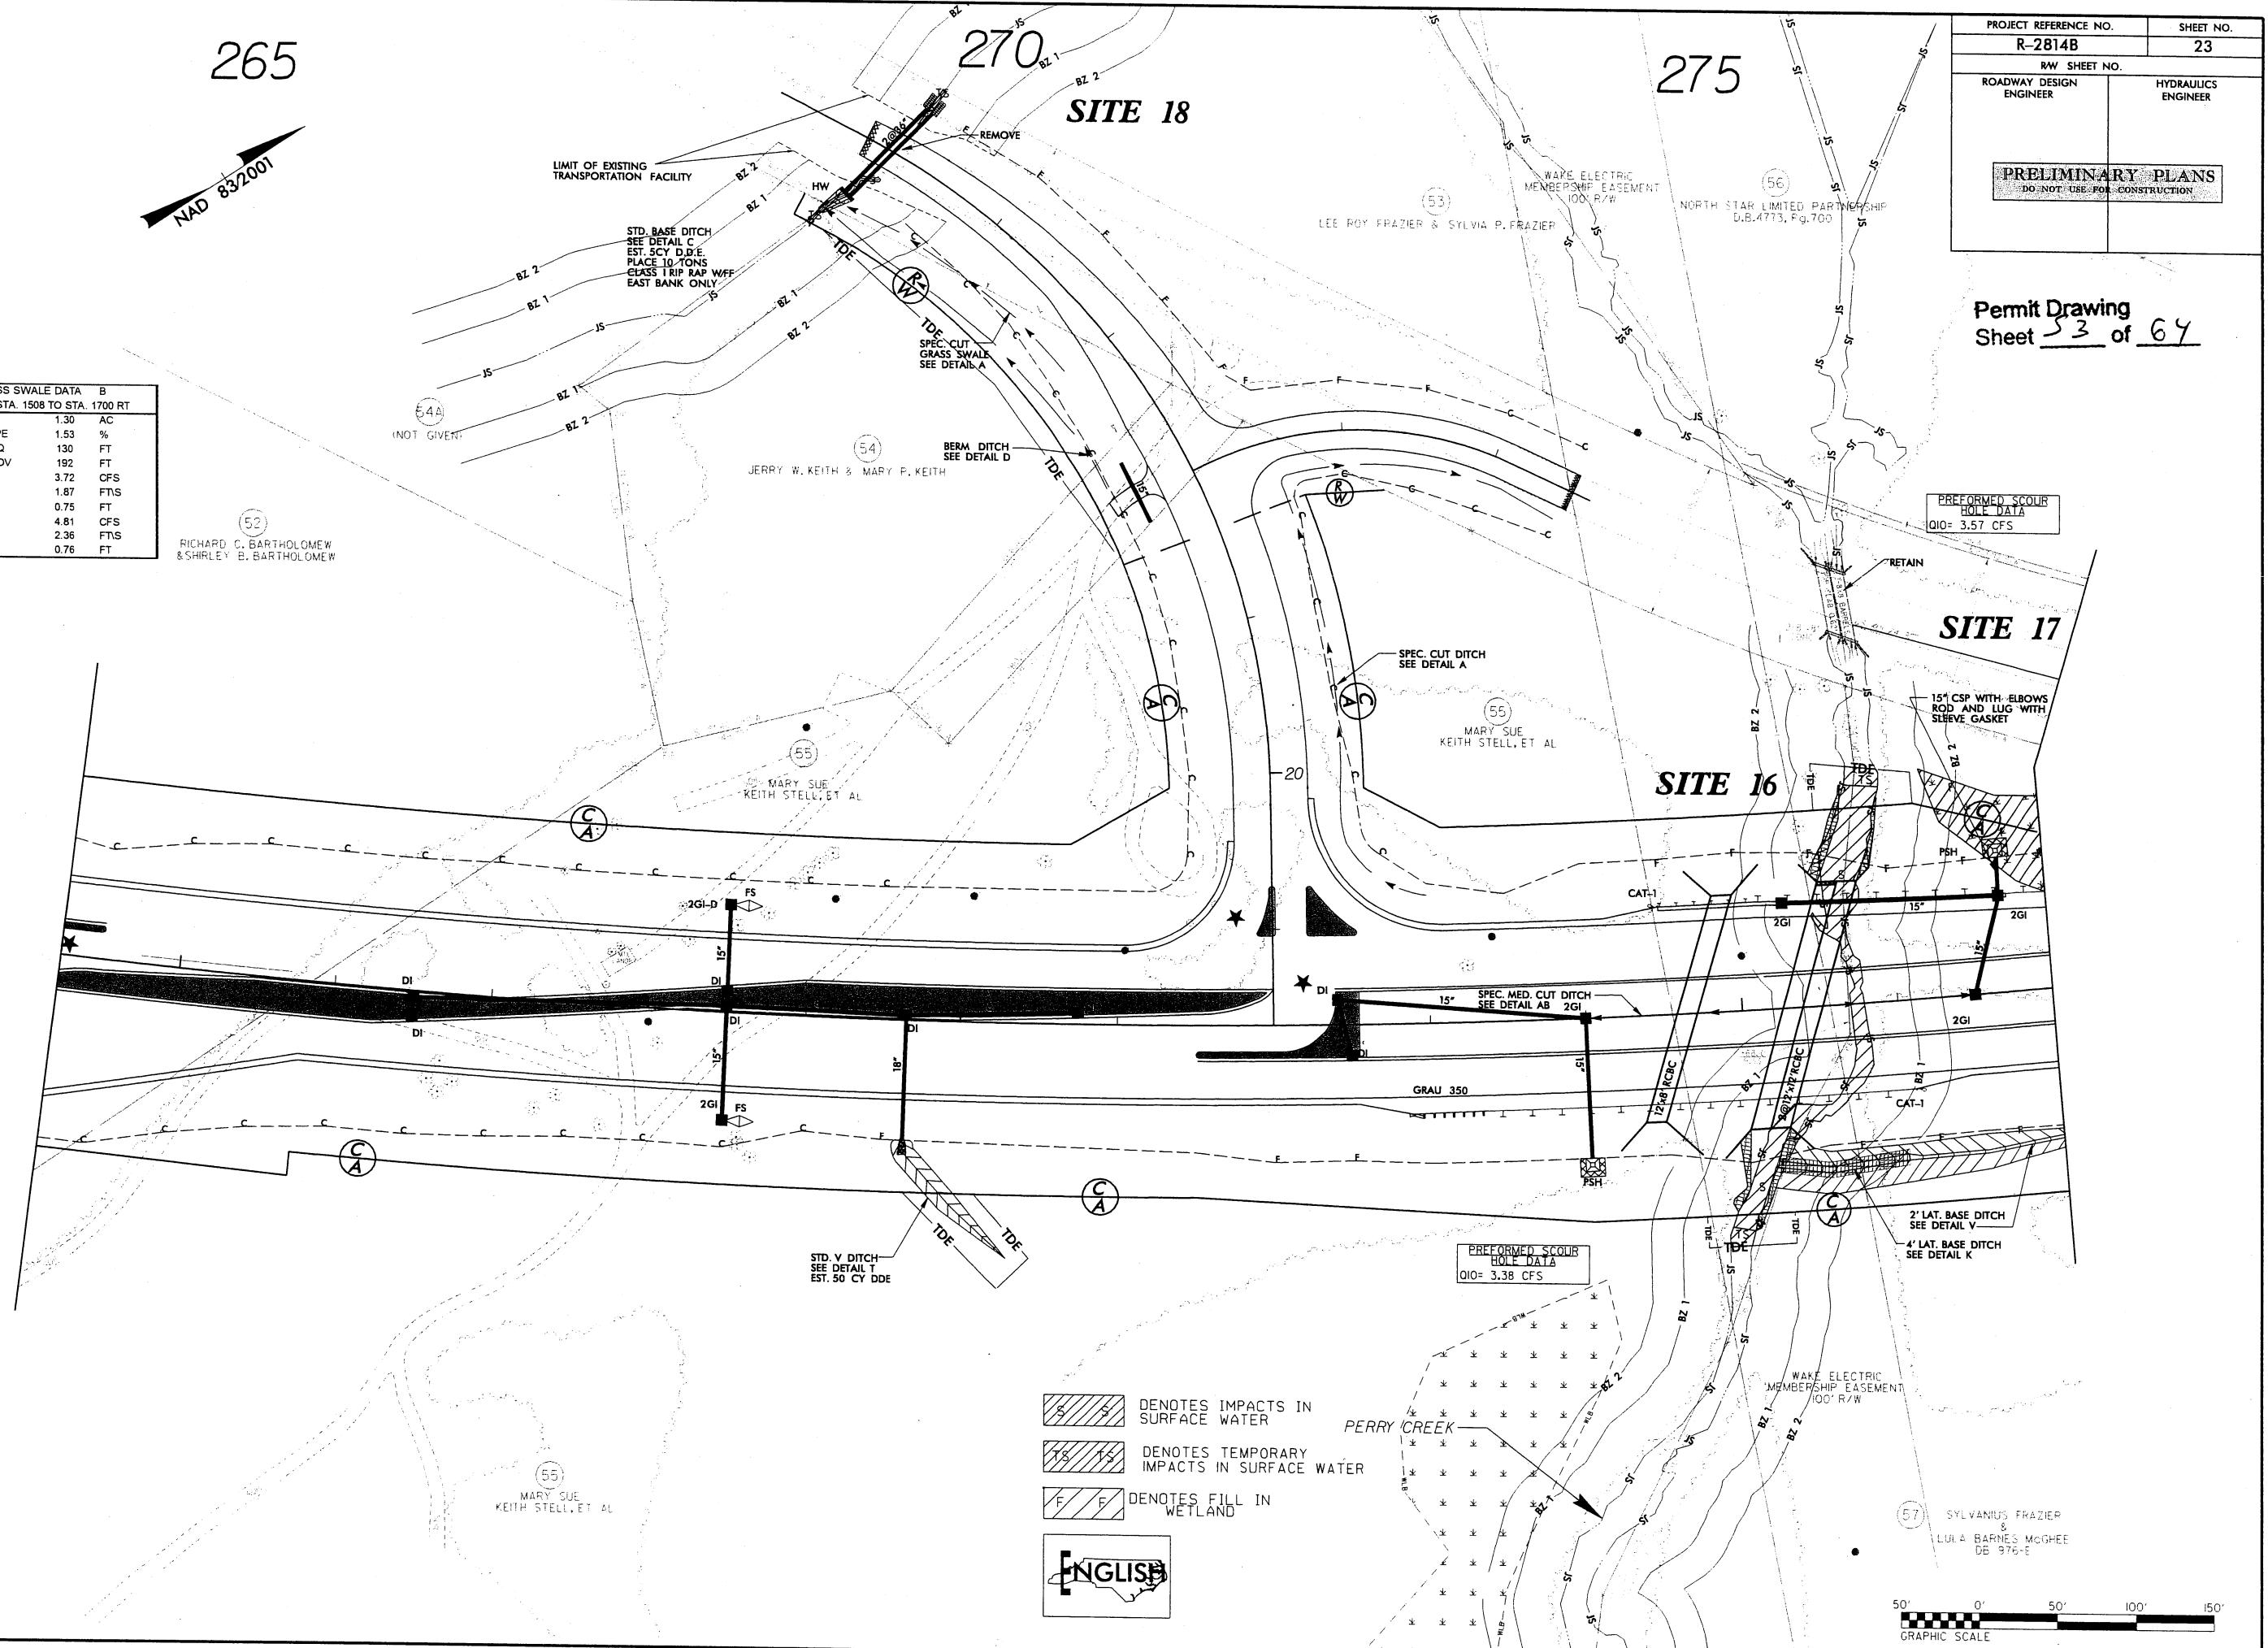

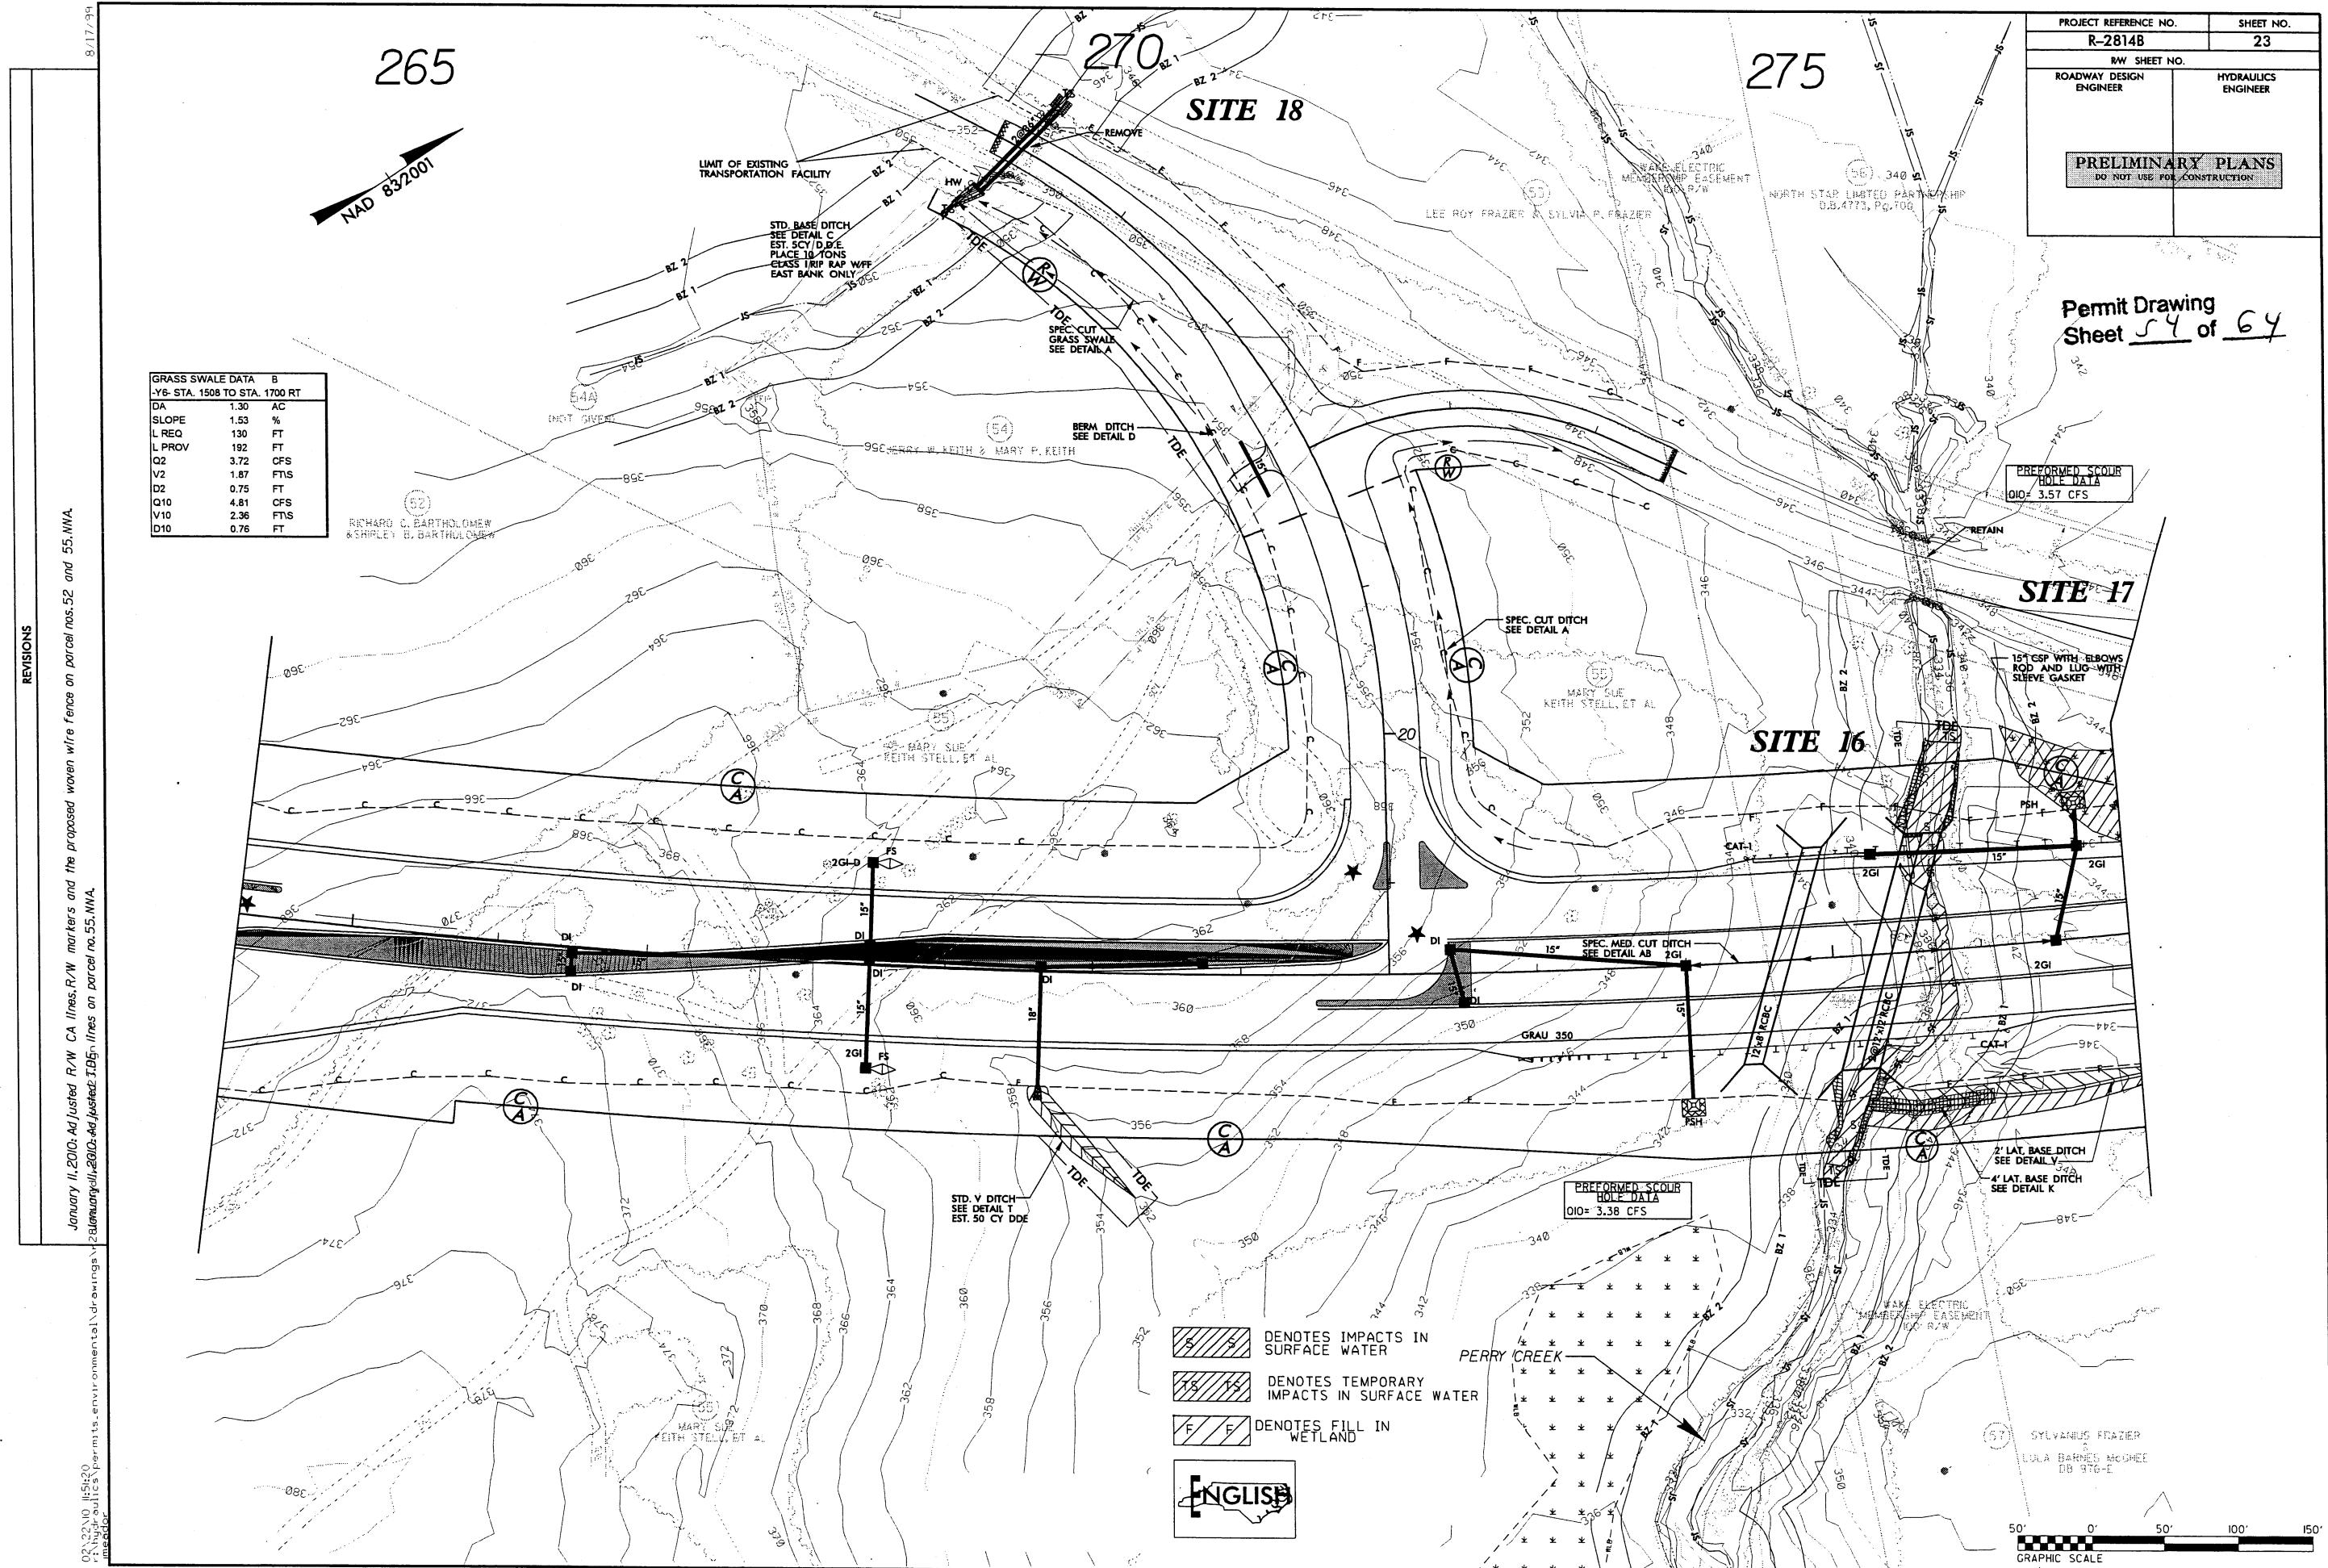

ENGLISH

Permit Drawing  
Sheet S 550 of 64

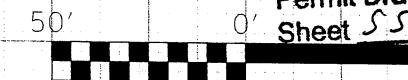

HORIZONTAL SCALE



VERTICAL SCALE

# SITE 16

C-L- 275+39.00  
ELEV.= 353.95'  
SKEW = 109°00'00"

360

350

340

330

360

350

340

330

EXIST. 2@8'X8' RCBC AND  
ROADWAY TO REMAIN

2.09:1  
(2:1 NORMAL)

WSE<sub>100</sub> 348.6  
WSE<sub>50</sub> 348.0

BEVELED HW

2.09:1  
(2:1 NORMAL)

EXIST. RIGHT  
TOP OF BANK

EXIST. LEFT  
TOP OF BANK


EXIST.  
STREAMBED

PROPOSED INLET  
ELEV. 334.8  
STREAM BED 335.3  
TOP OF LOW FLOW BAFFLE = 335.3  
BURIED 0.5'

PROPOSED OUTLET  
ELEV. 332.9  
STREAM BED 333.4  
TOP OF LOW FLOW BAFFLE = 333.4  
BURIED 0.5'

STREAM CULVERT  
PROPOSED 2@12'X12' RCBC

ELEV.= 333.83  
S = 1.16 %

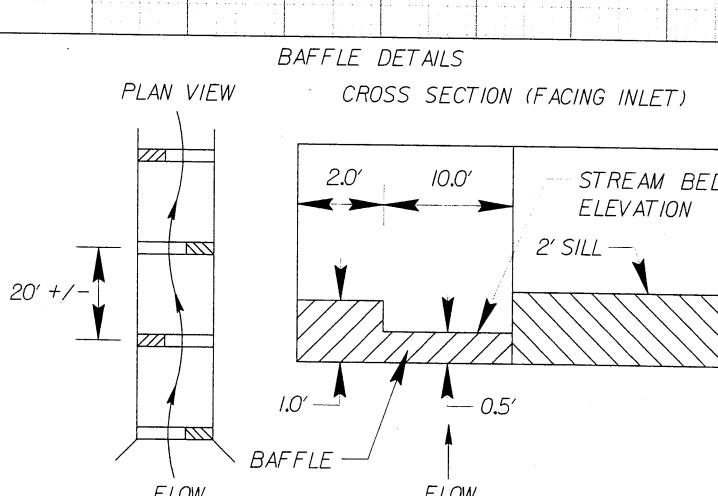

ALTERNATE BAFFLE SECTIONS TO FORCE STREAM TO MEANDER  
LEFT TO RIGHT ALONG THE LENGTH OF THE CULVERT. SILL AT  
INLET END ONLY

PLACE BED MATERIAL TO TOP OF BAFFLE ELEVATION.  
STOCKPILE EXCAVATED BED MATERIAL FROM SITE IF AVAILABLE  
AND USE IN CULVERT. OTHERWISE, USE CLASS B RIP-RAP




814b-hyd-wt-con-prm-24.dgr

REVISED NAMES ON PARCEL 57 PER LOCATION AND SURVEY REQUEST 4/23/09 DDL 7/29/09

814

814-B-Hyd-Meta-Cut-Print-24x36in

卷之三

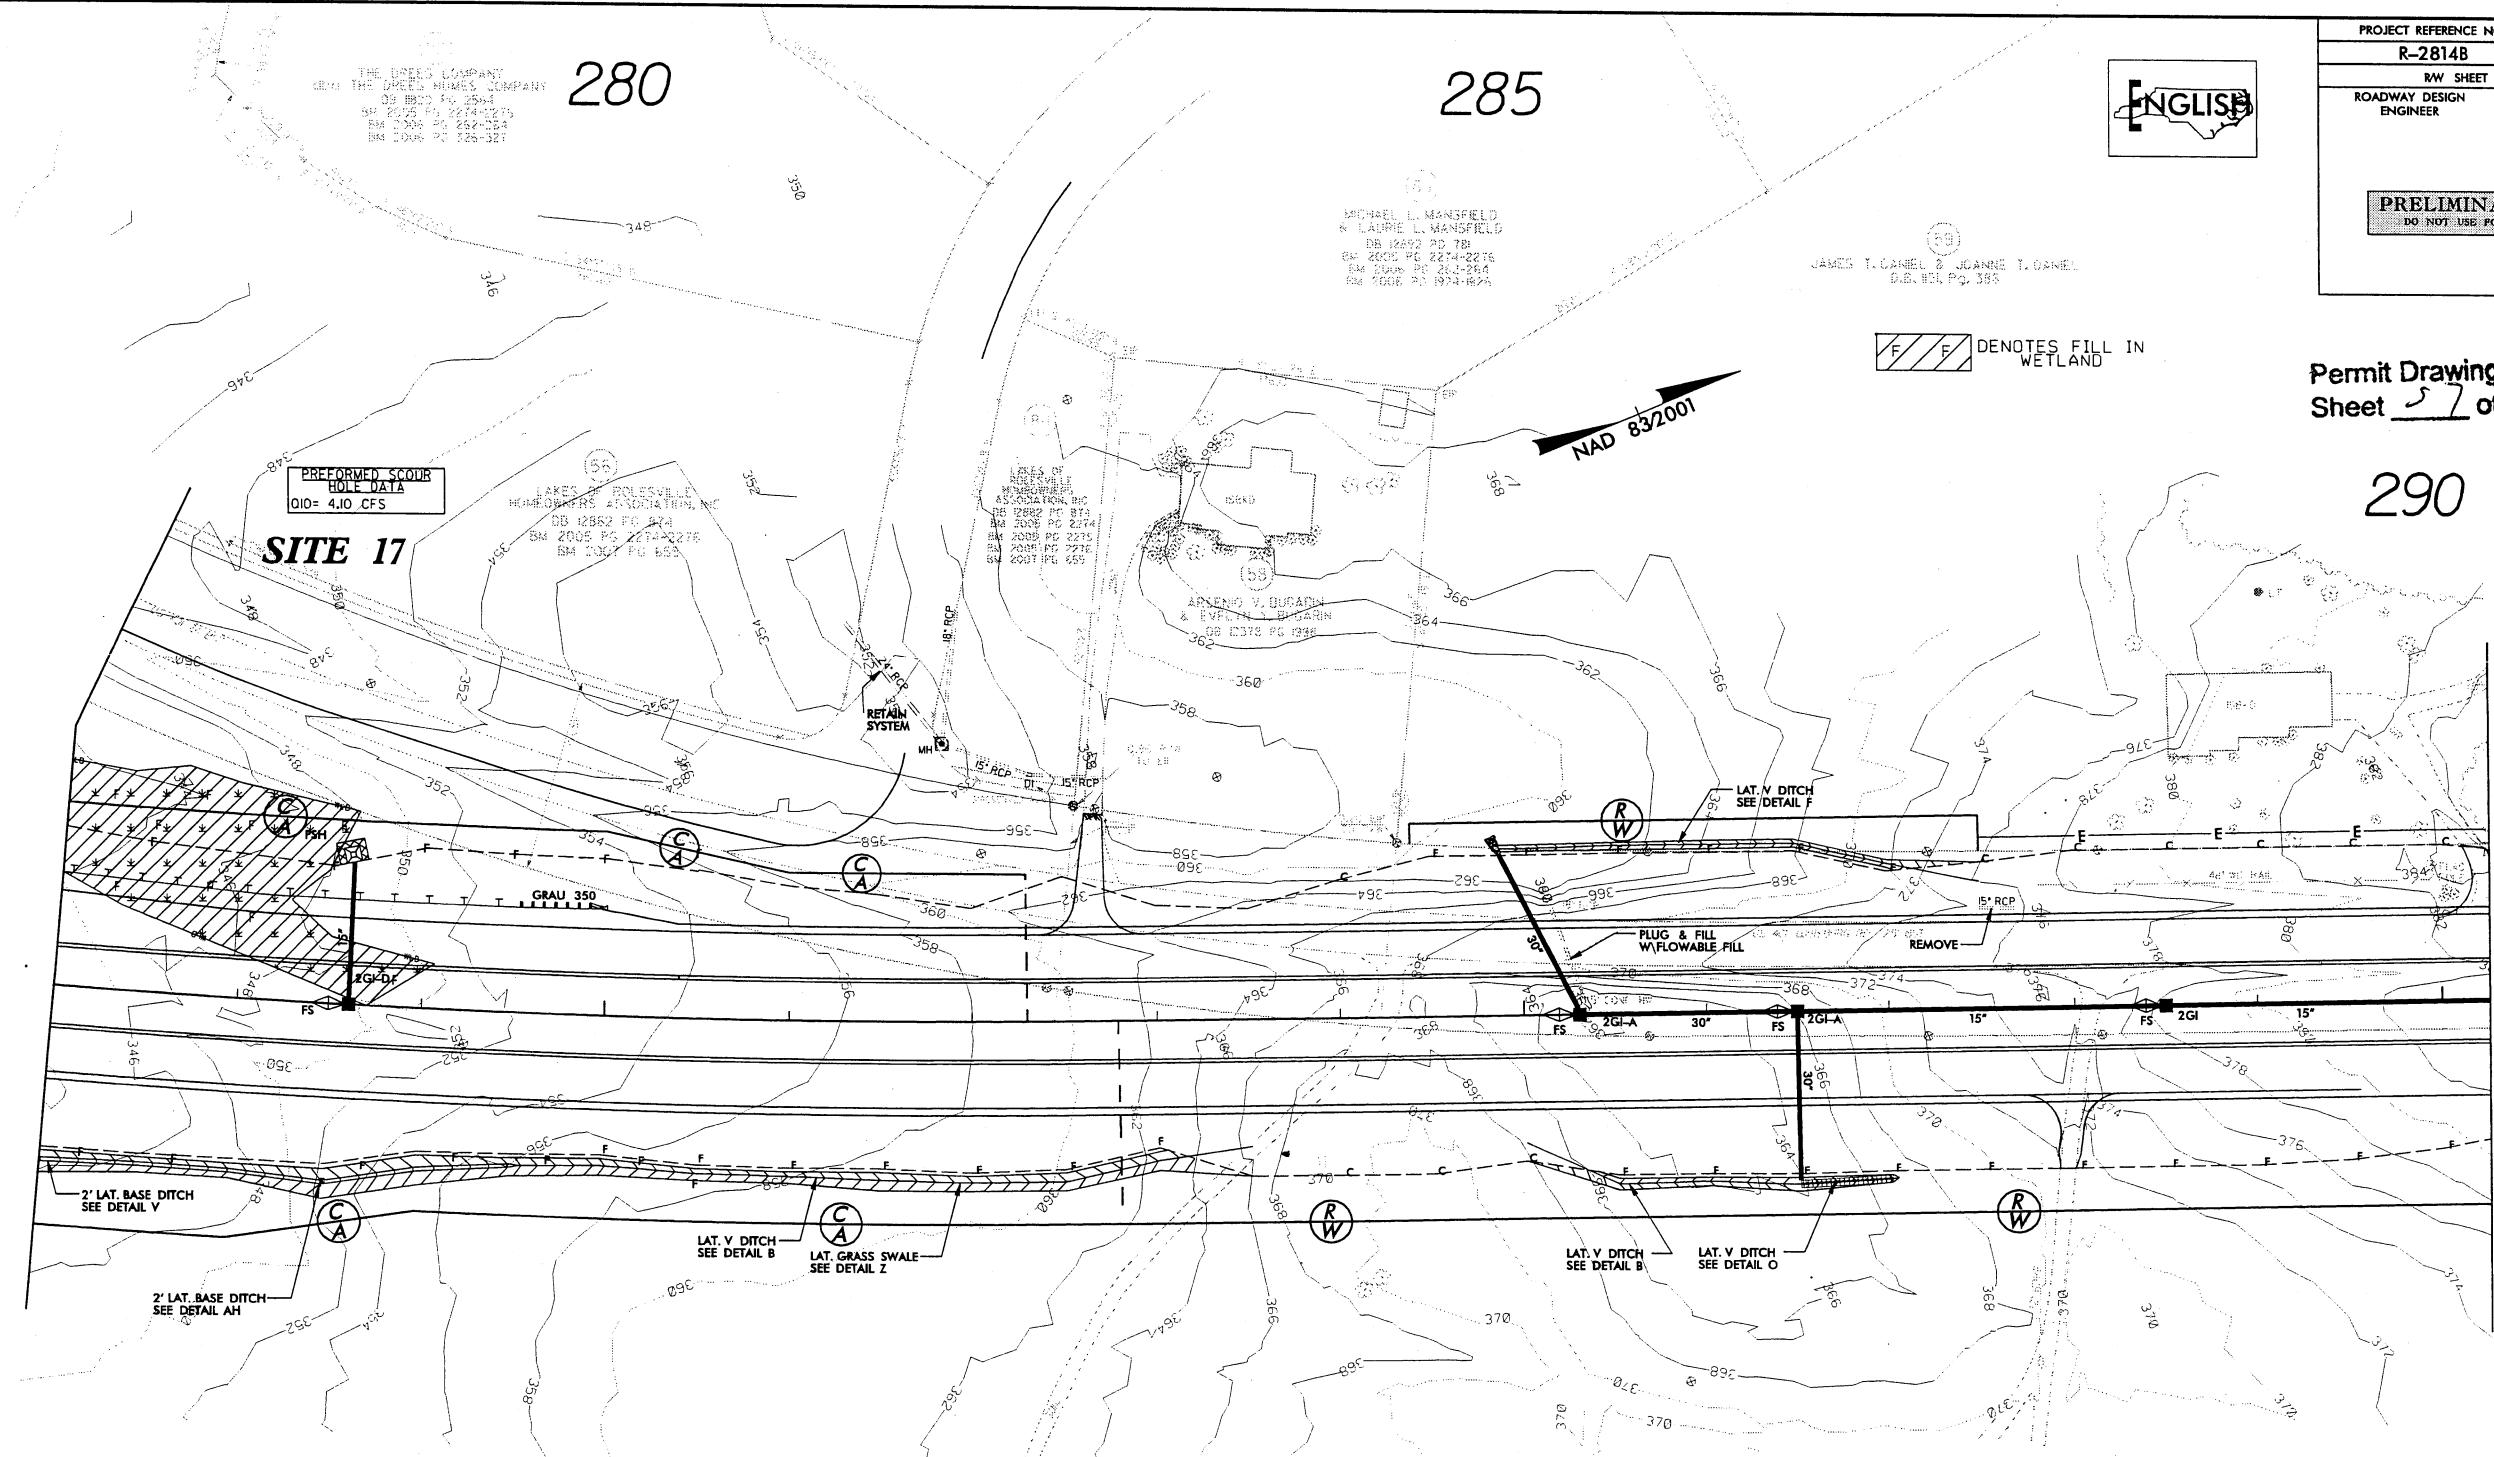


GRASS SWALE DATA B	
L- STA. 28125 TO STA. 28250 RT	
DA	1.15 AC
SLOPE	1.53 %
L REQ	115 FT
L PROV	125 FT
Q2	2.19 CFS
V2	1.69 FT/S
D2	0.66 FT
Q10	2.83 CFS
V10	2.13 FT/S
D10	0.67 FT

SYLVANUS ER  
MEL BARNES


卷之三

PROJECT REFERENCE NO.		SHEET NO.
<b>R-2814B</b>		<b>24</b>
RW SHEET NO.		
<b>RROADWAY DESIGN ENGINEER</b>		<b>HYDRAULICS ENGINEER</b>
<div style="text-align: center; background-color: black; color: white; padding: 5px;"> <b>PRELIMINARY PLANS</b>  <b>DO NOT USE FOR CONSTRUCTION</b> </div>		


Permit Drawing  
Sheet 5 of 64

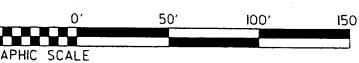

Permit Drawing  
Sheet 58 of 64


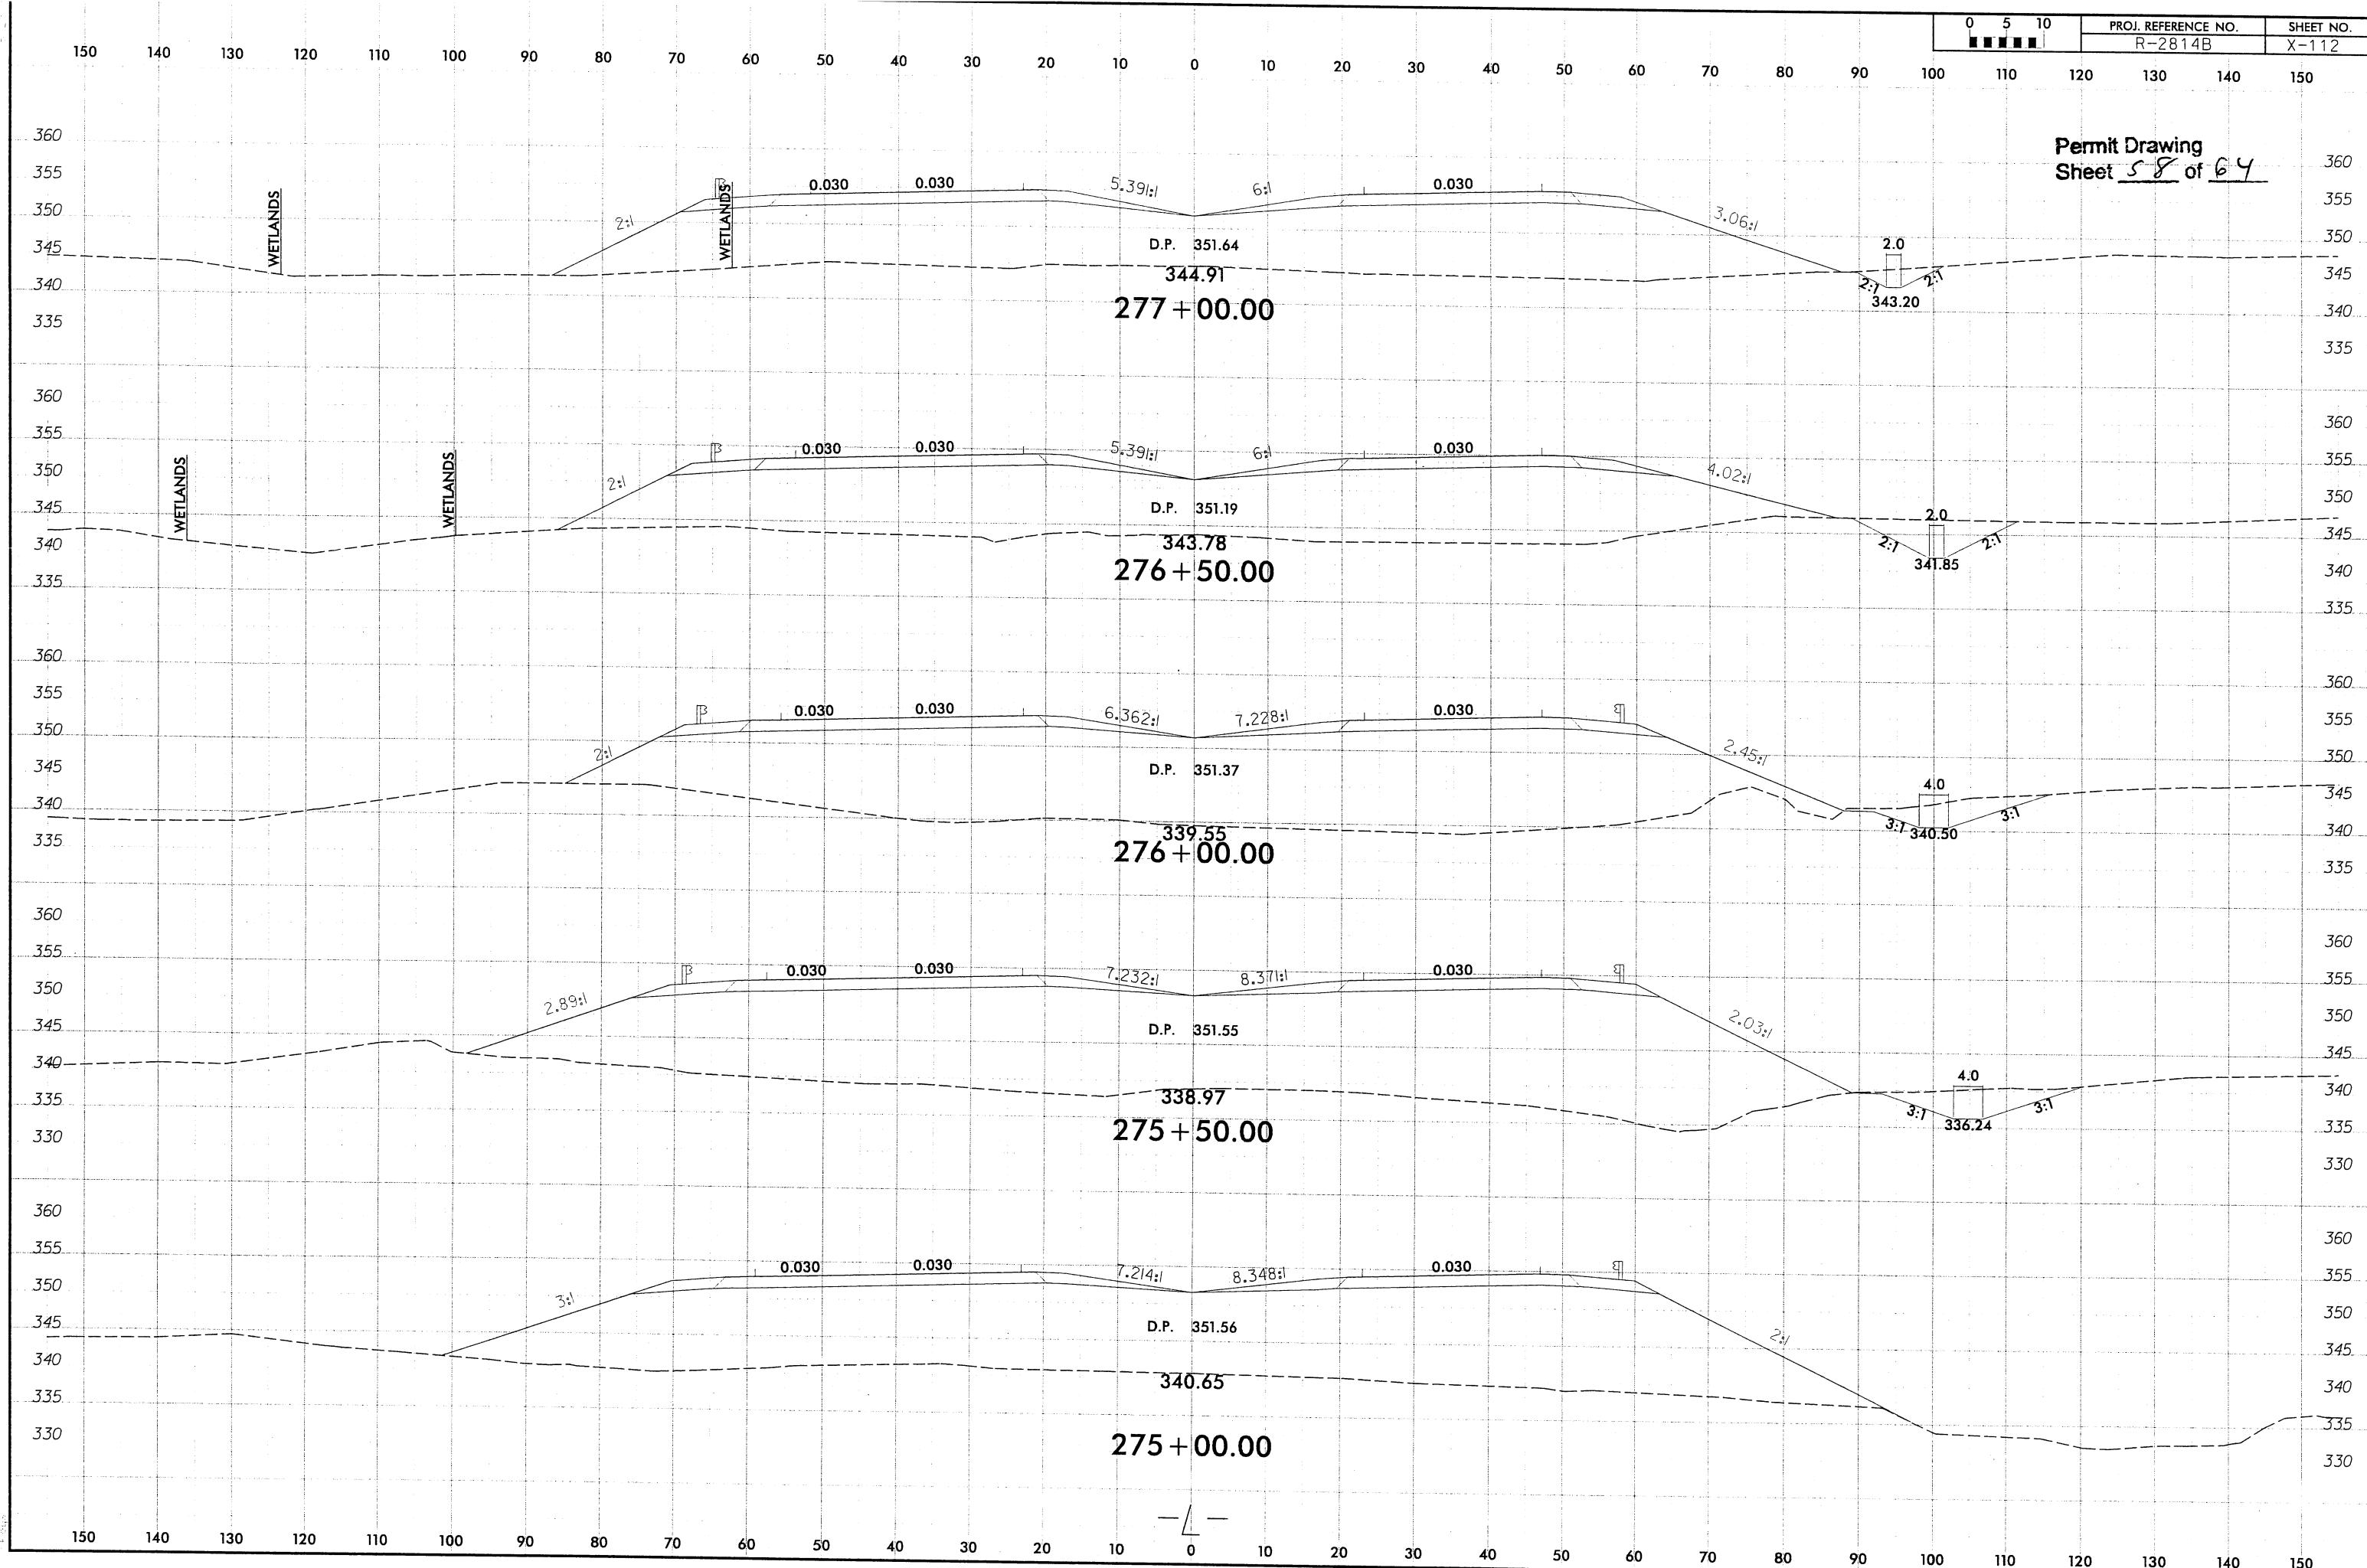



Permit Drawing  
Sheet 59 of 64


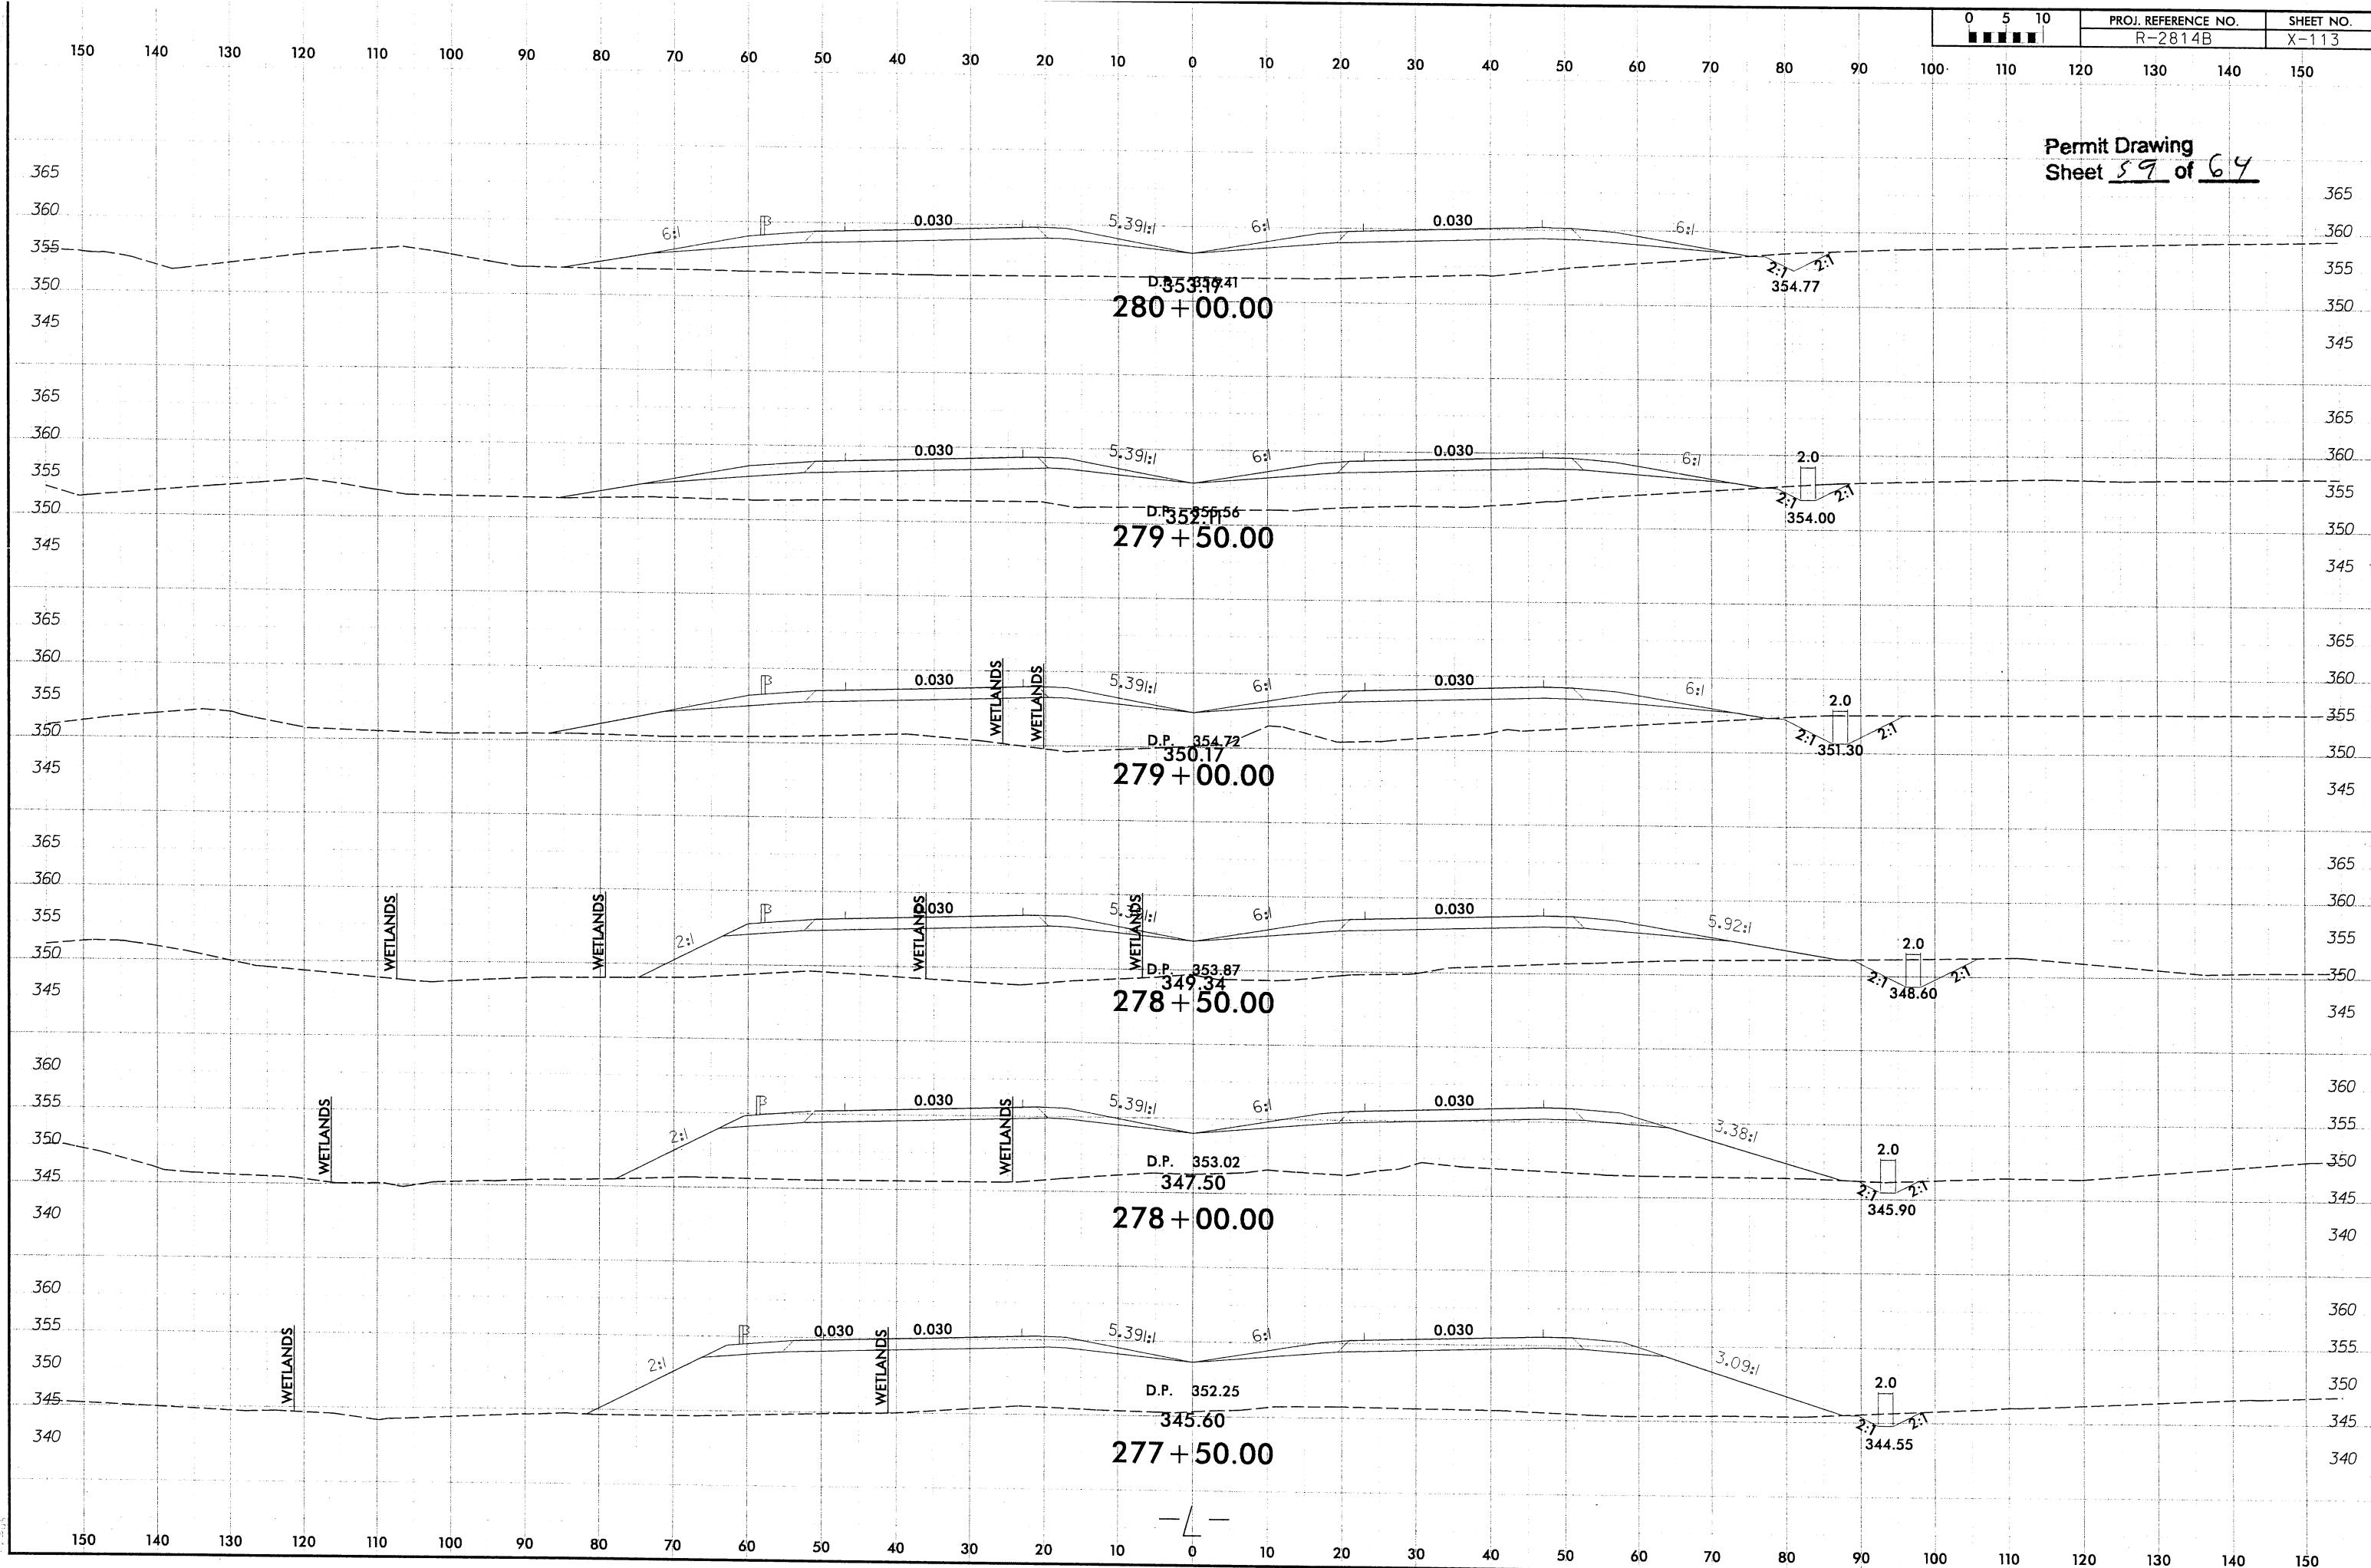




PROJECT REFERENCE NO.		SHEET NO.
R-2814B		30
ROADWAY DESIGN ENGINEER	HYDRAULICS ENGINEER	

PRELIMINARY PLANS  
DO NOT USE FOR CONSTRUCTION

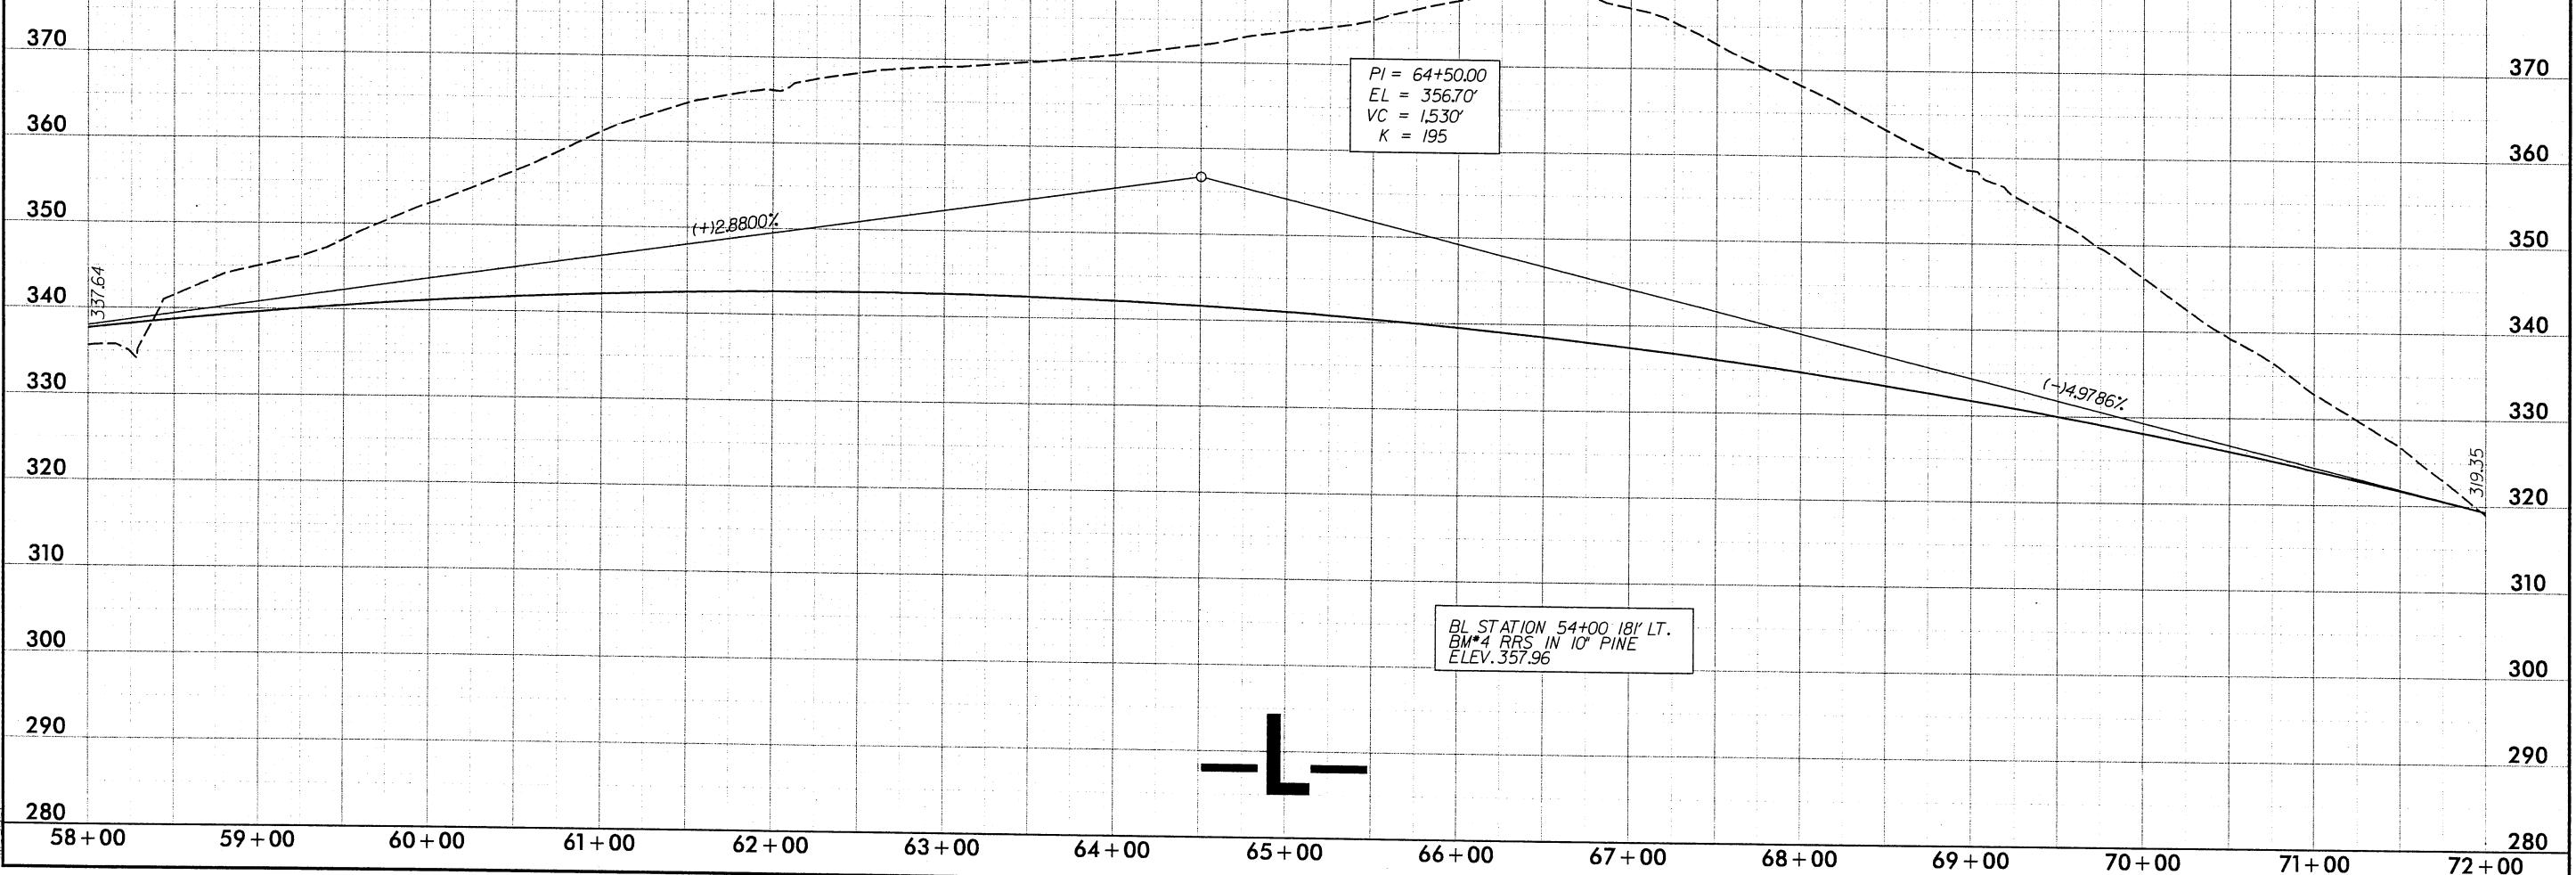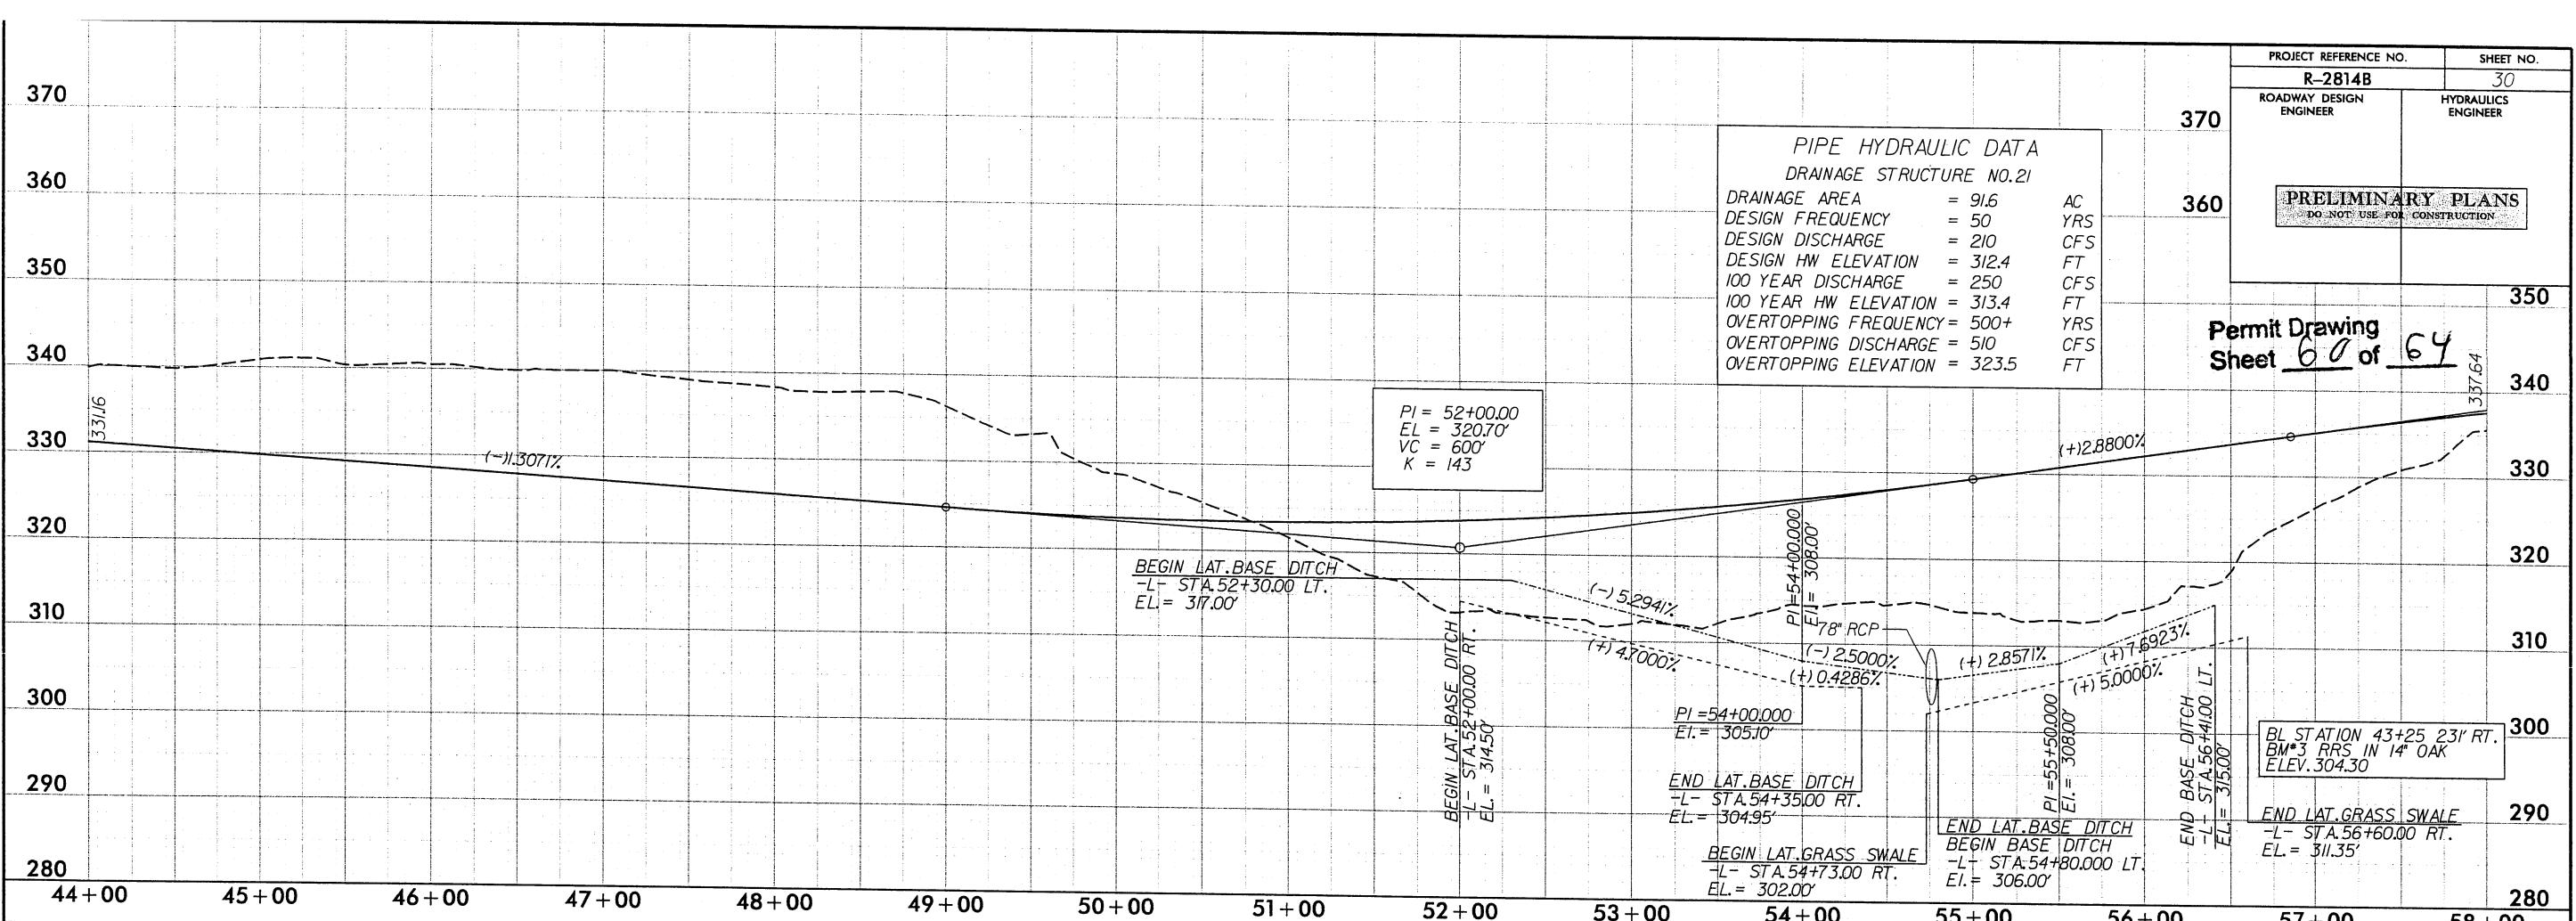

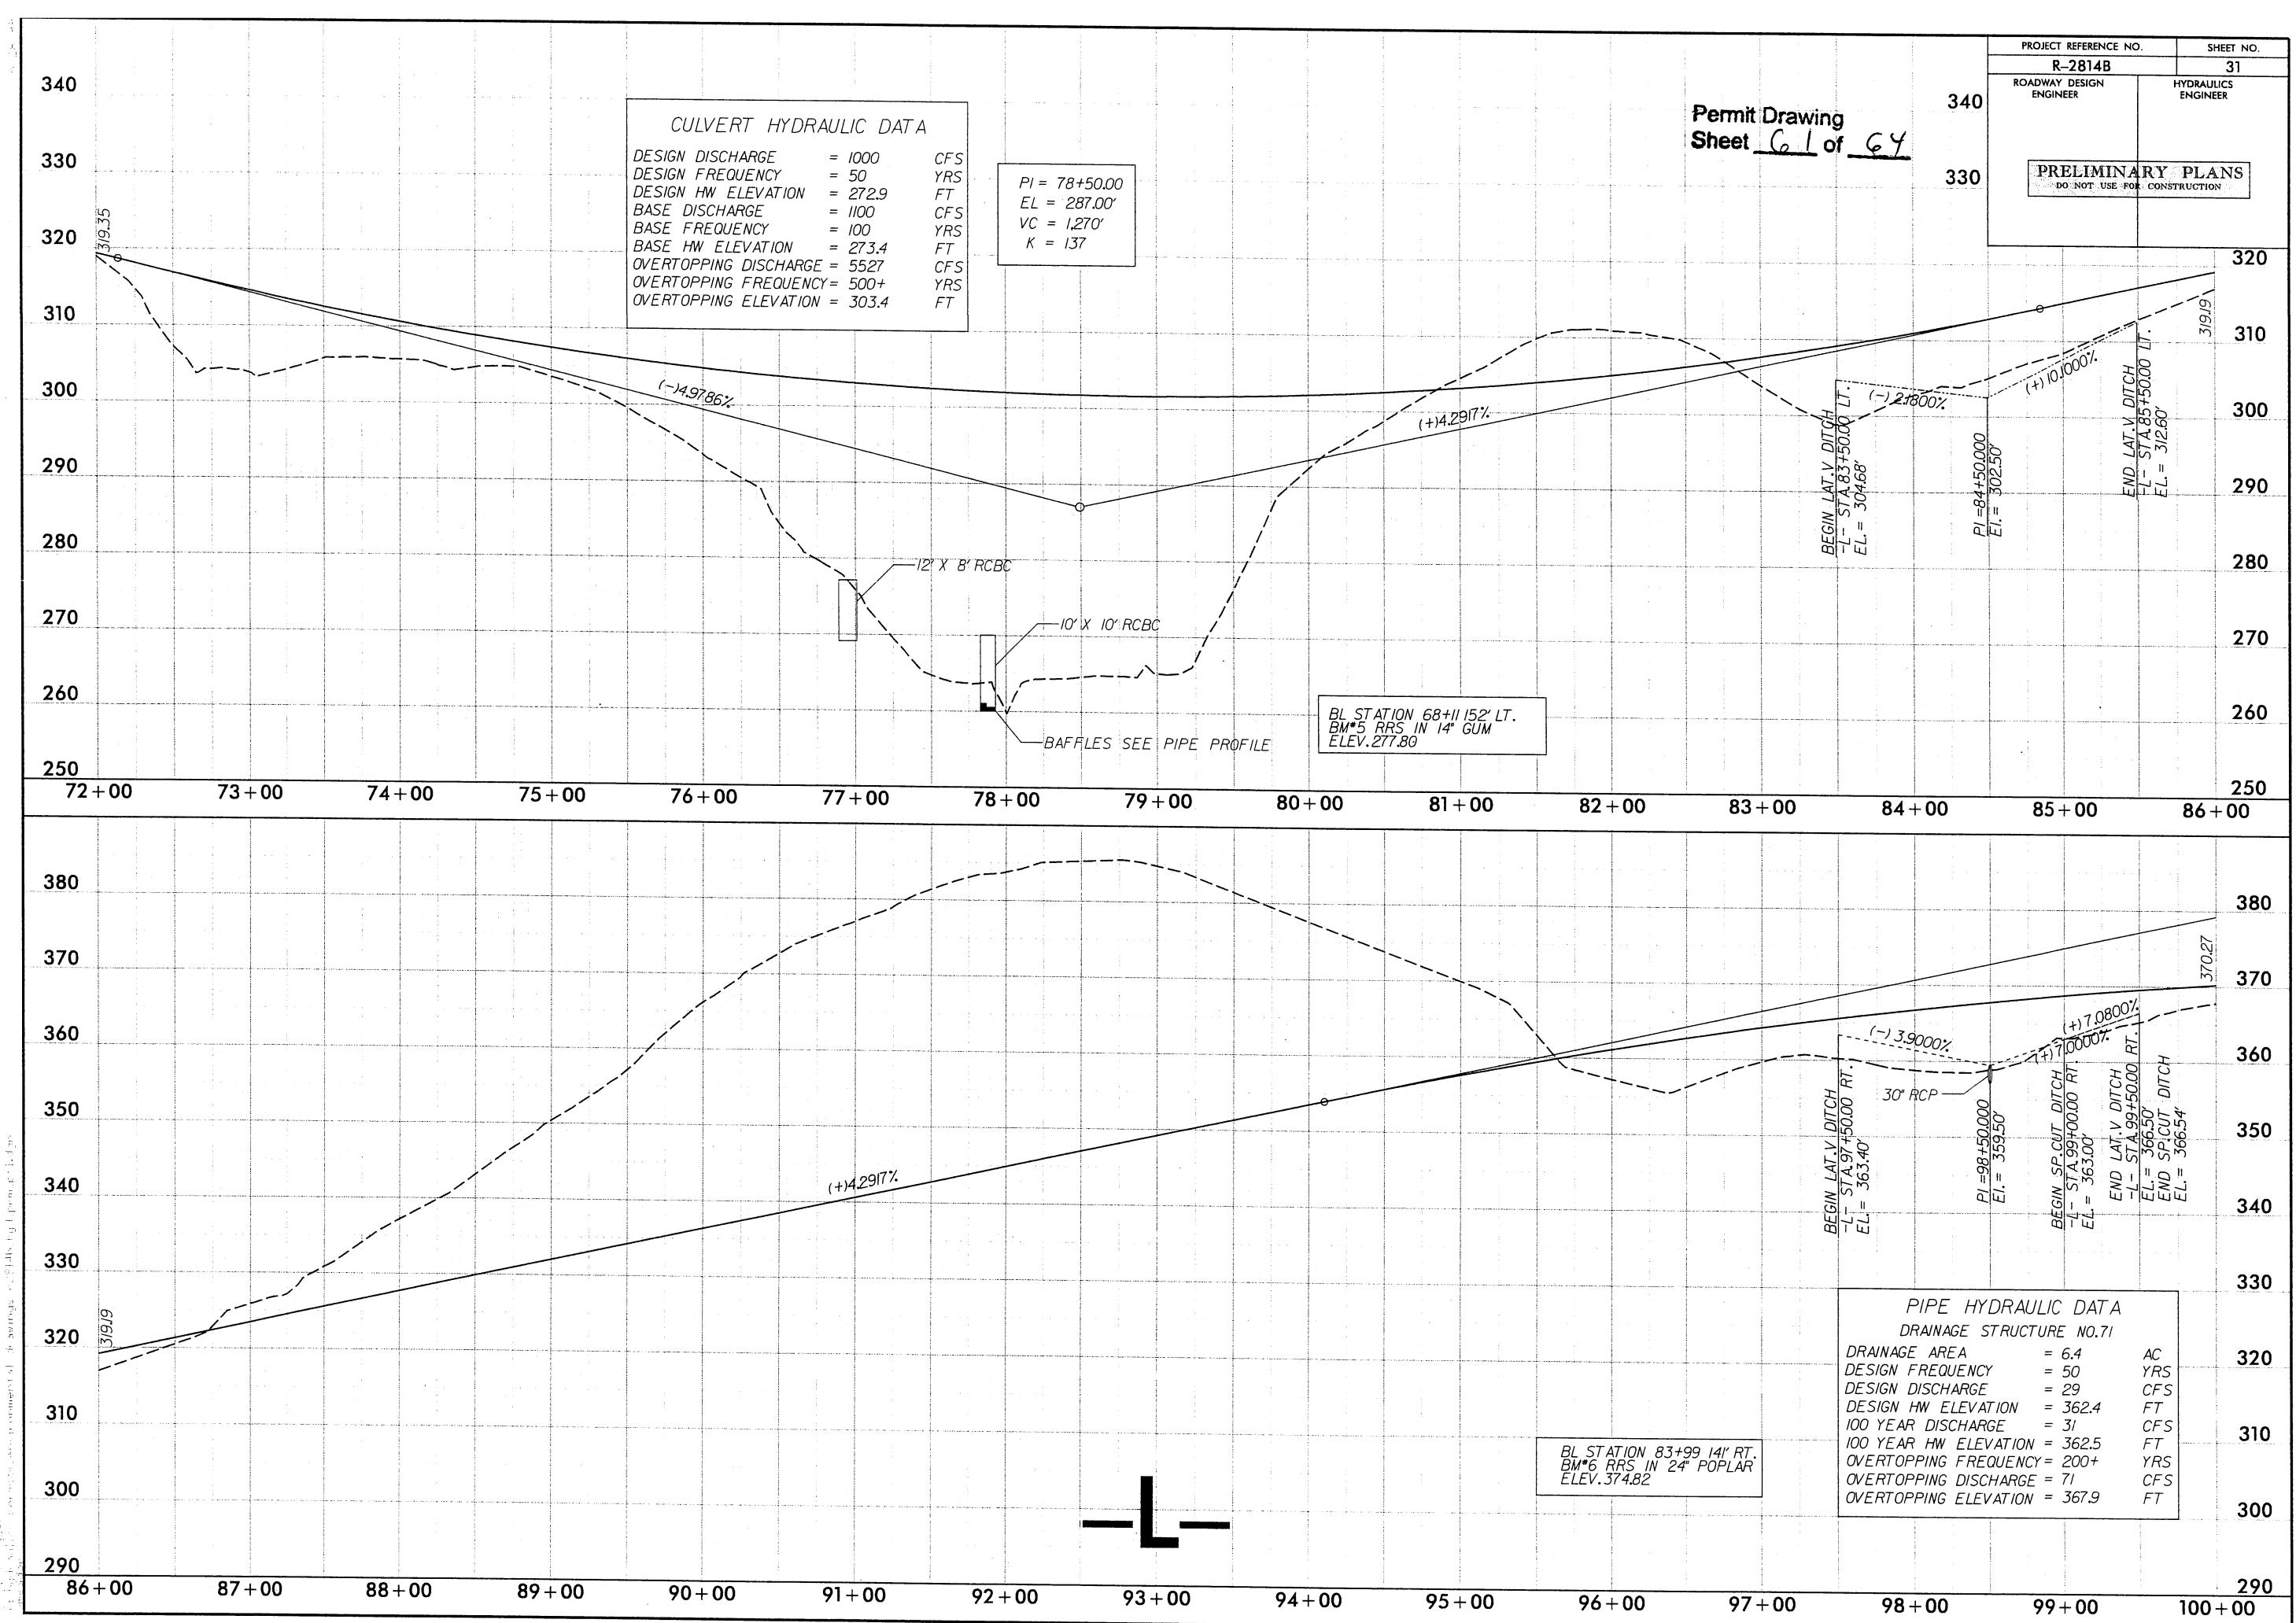

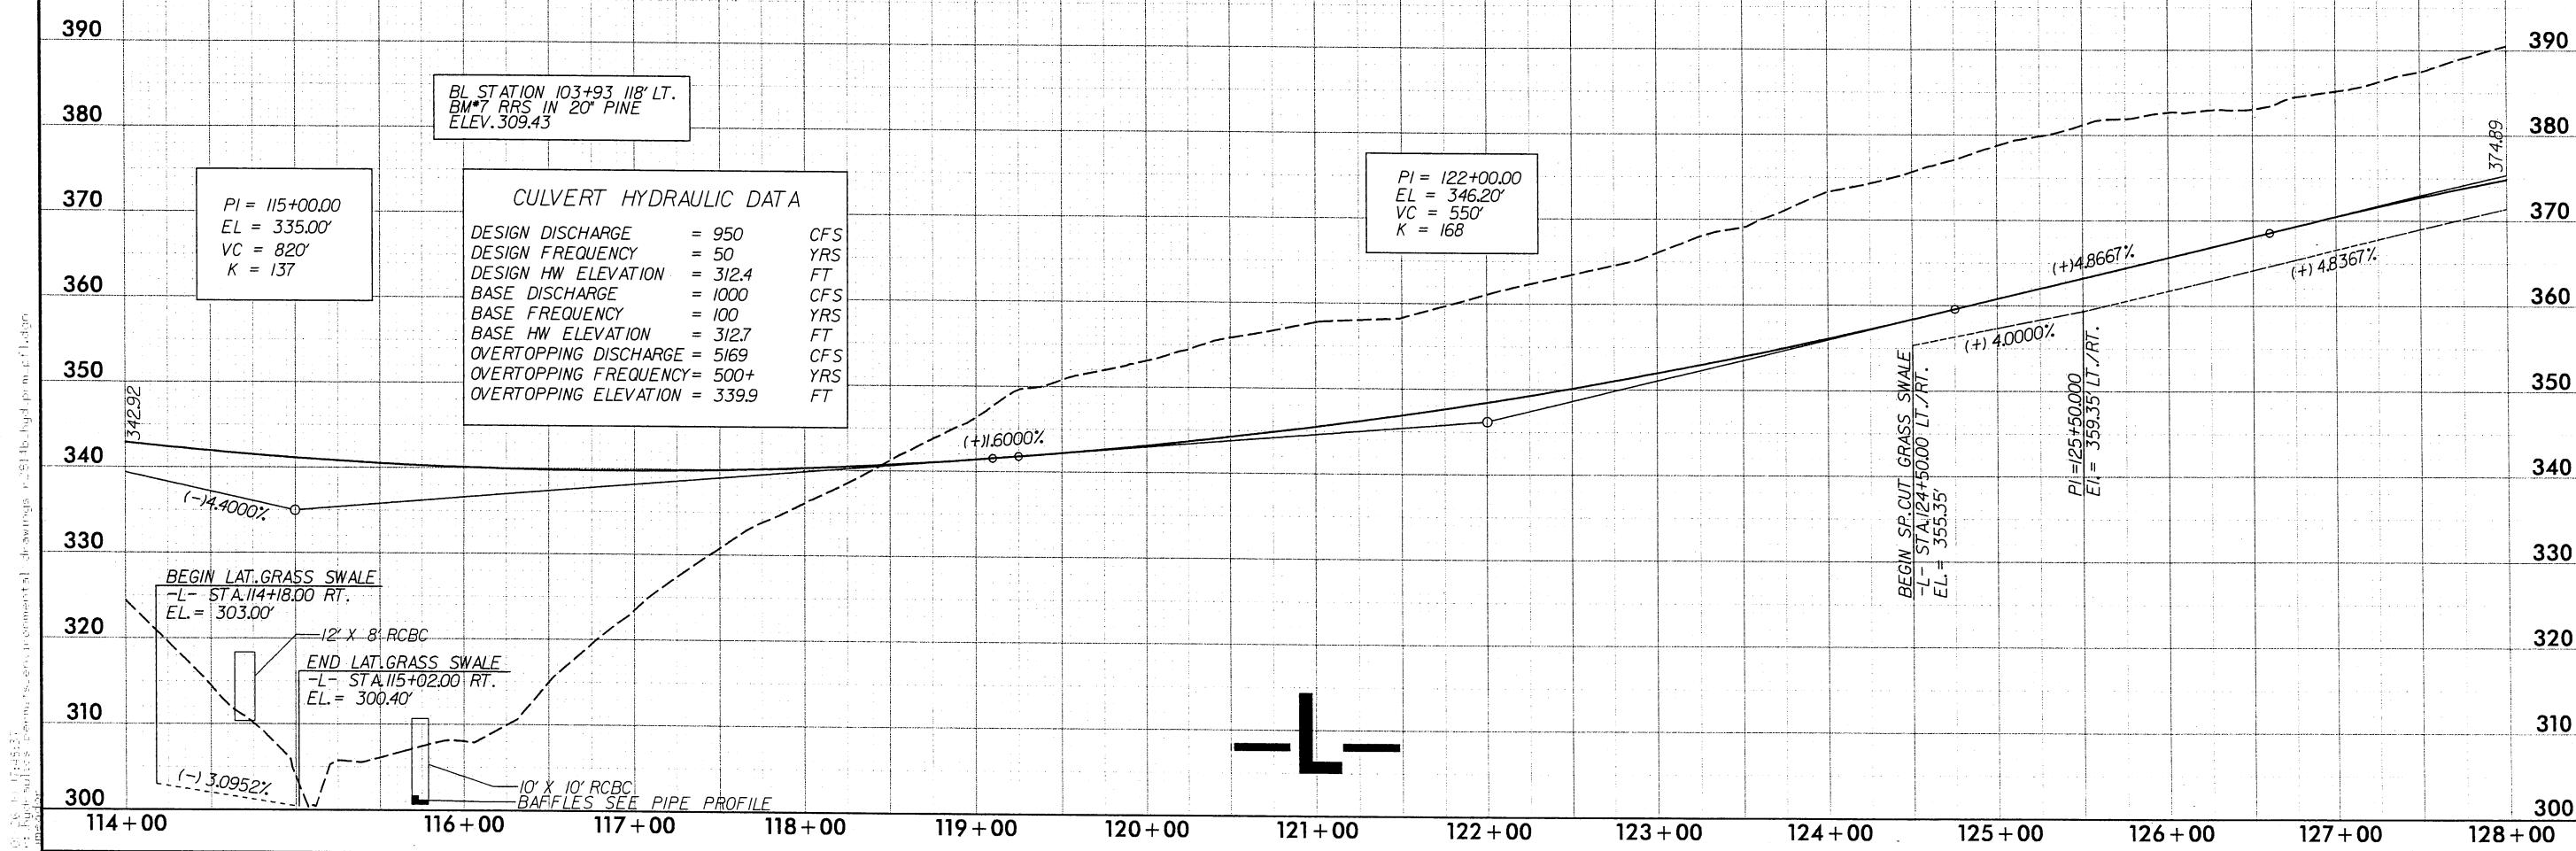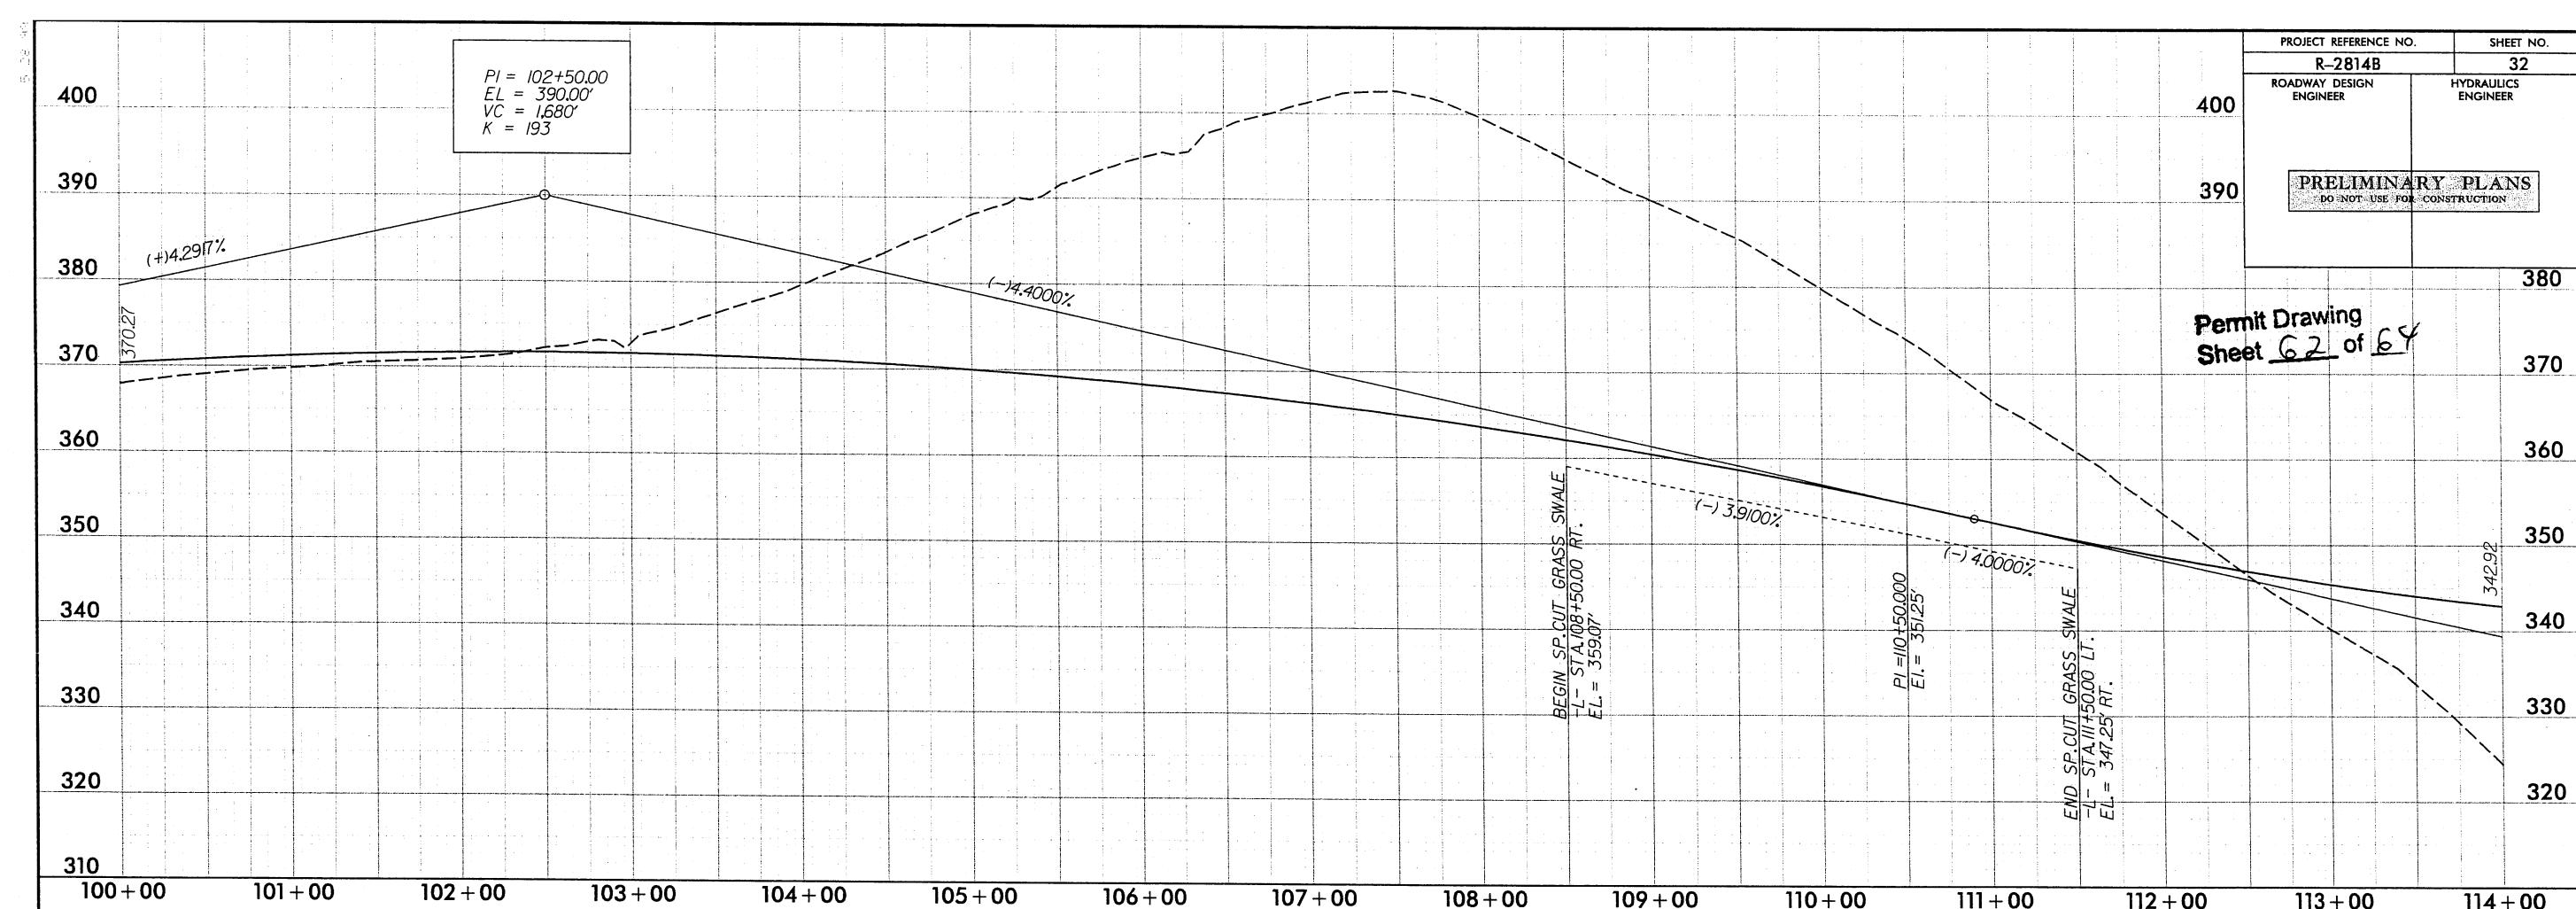

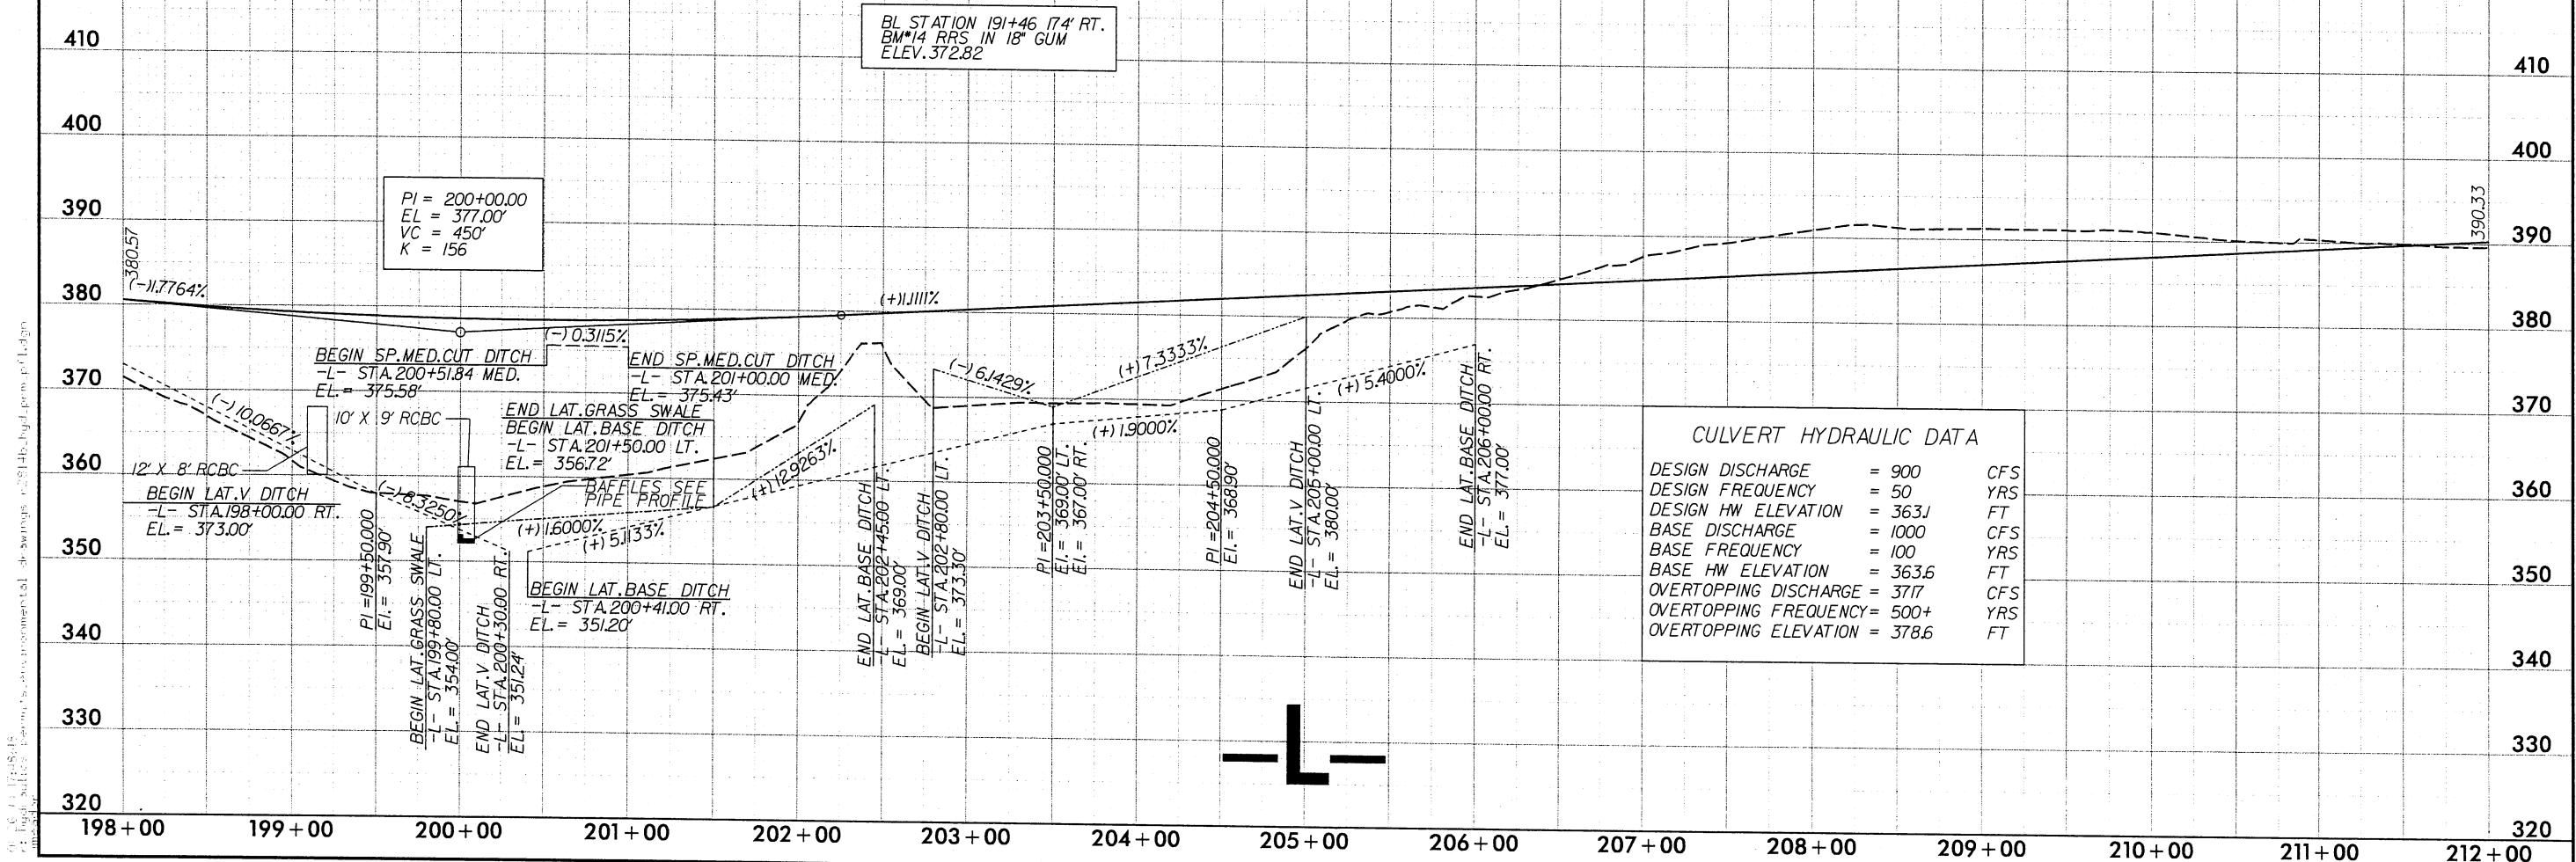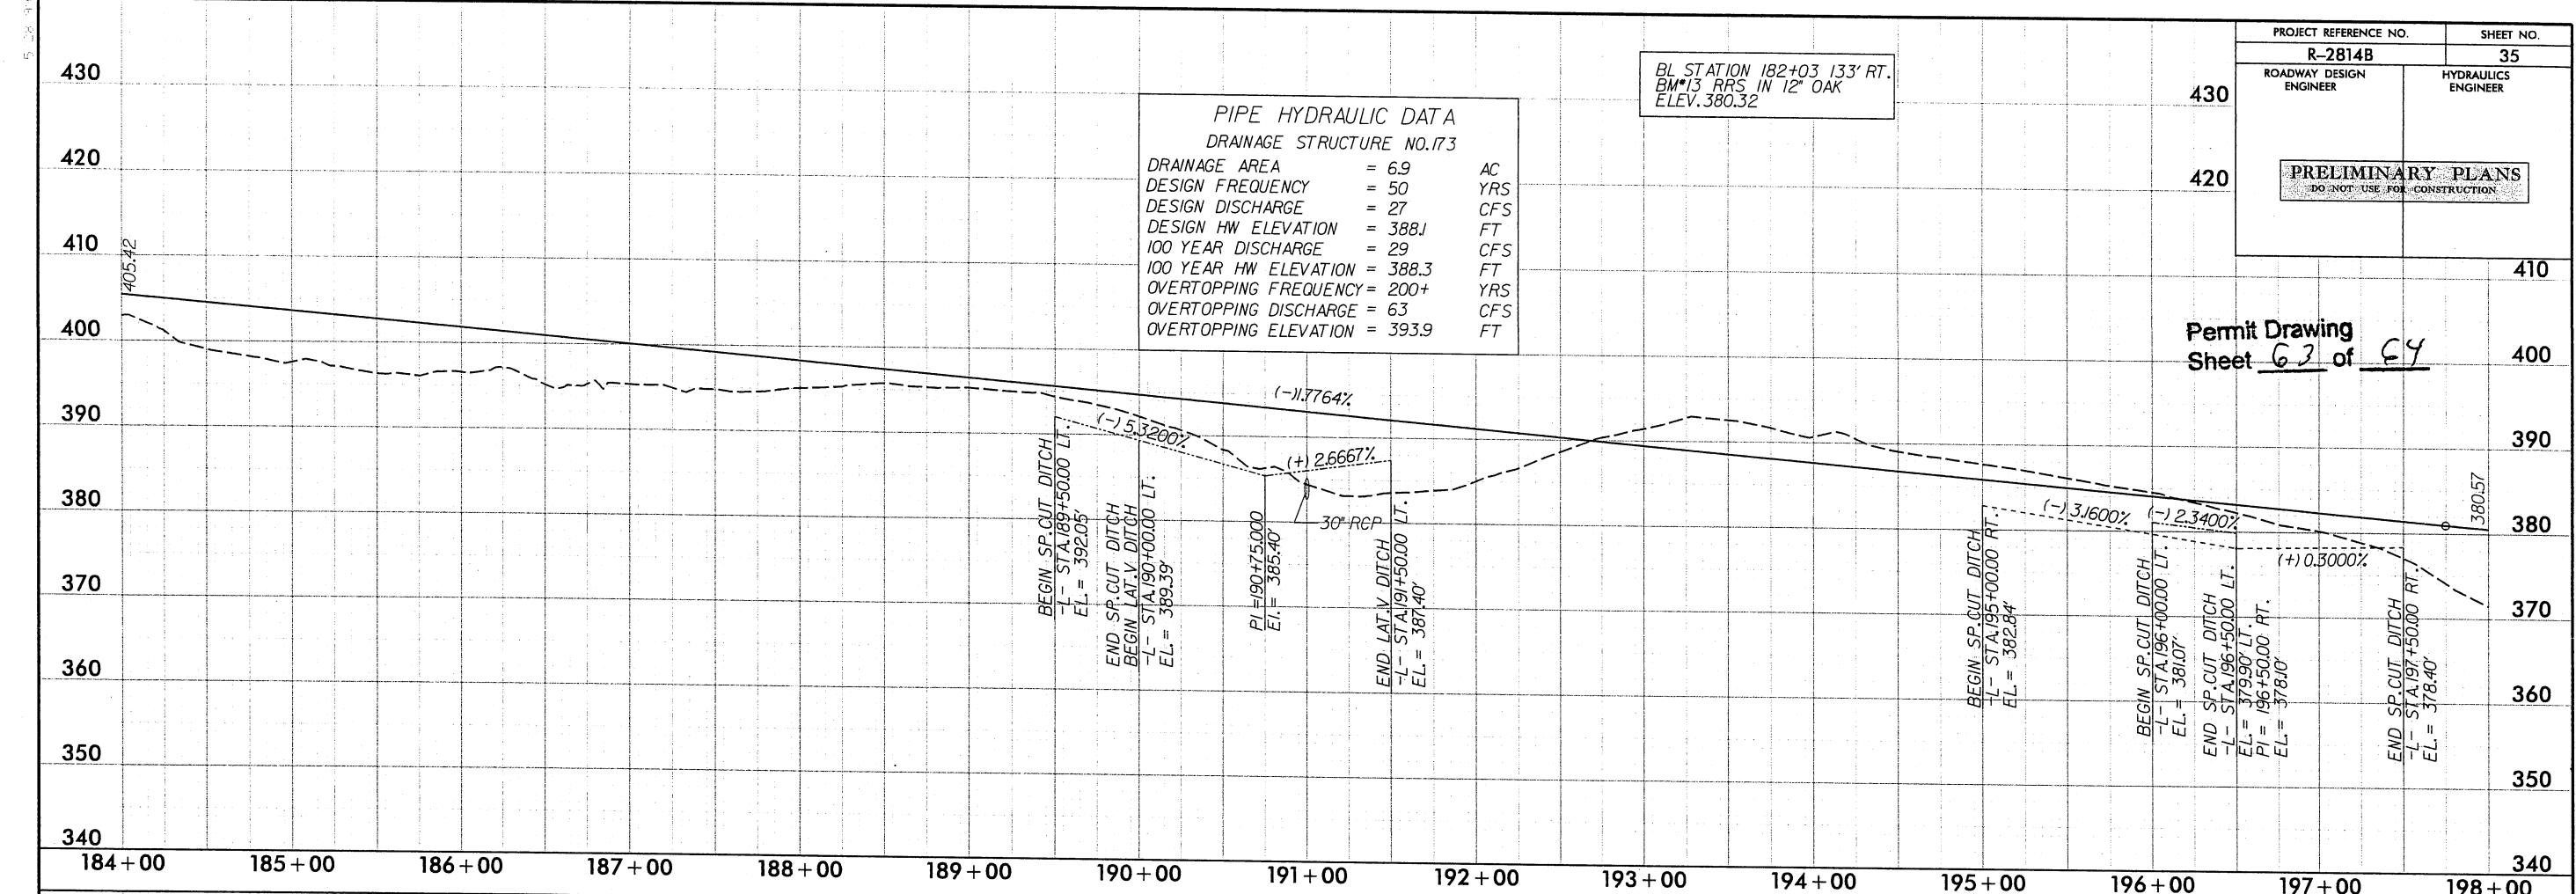

PROJECT REFERENCE NO.		SHEET NO.
R-2814B		38
ROADWAY DESIGN ENGINEER	HYDRAULICS ENGINEER	

PRELIMINARY PLANS  
DO NOT USE FOR CONSTRUCTION

Permit Drawing  
Sheet 64 of 64

