

## Turchy, Michael A

---

**From:** Turchy, Michael A  
**Sent:** Monday, July 7, 2025 10:05 AM  
**To:** Annino, Amy; Jamison, John  
**Cc:** Amschler, Crystal C CIV USARMY CESAW (US); McHenry, David G; Wojski, Paul A; Pjetraj, Michael; Bukowy (HNTB), Kat A  
**Subject:** RE: Request for Additional Information: DWR 20250109 V3 - Hurricane Helene I-40 Pigeon River Gorge Emergency Relief Project

Hi Amy,

Please see NCDOT's responses to DWR's questions in the table below. Due to the size of the attachments, they are located in one response package at the following link:

<https://xfer.services.ncdot.gov/pdea/Temp/I-40/DWR%20Additional%20Information.pdf>

### DWR Question:

1. Please provide a more detailed justification as to why a haul road adjacent to S1-SAA would result in more impacts to water resources and stream S1-SAA and S1-SAB than the proposed option of the haul road on top of stream S1-SAA and S1-SAB. If the preferred alternative of placing the haul road on the stream is the selected alternative, DWR will require mitigation for stream loss as provided in the application. [15A NCAC 02H .0506(b)(1)]

### NCDOT Response:

Although this method of temporary impact to a stream is atypical, NCDOT believes in this situation, it provides the least overall impact and provides for the best opportunity for a successful restoration. Justification for this method includes the following:

-Minimization to National Forest resources using this corridor:

By using this valley to access the borrow site, this path would provide the most direct path to the borrow site and the project. The alternative to using this valley, would be to improve miles of existing US Forest Service roads. This alternative would have significantly higher impacts to water resources as well as significant and undesirable impacts to the National Forest.

-The valley carrying this stream is quite steep. If NCDOT used traditional methods of cutting a road adjacent to the stream, this impact would result in significant vertical cuts (measured in 100's of feet) and would have a disturbance width of near 1,000 linear feet in the valley.

Additionally, steep rock cuts will continue to be an erosion and sedimentation control issue throughout the life of the project for this method. By avoiding the need to introduce these unstable cuts, the haul road corridor will be easier to maintain from a sedimentation and erosion control standpoint.

By temporarily piping and covering the stream, then placing the road on top of this facility, this reduces the horizontal disturbance width to this valley to approximately 110 linear feet.

### DWR Question:

2. Will the mining operation generate wastewater or stormwater that will be discharged to surface waters?

### NCDOT Response:

The borrow site will have stormwater that will eventually be discharged into surface waters after treatment.

### DWR Question (sub-divided):

Please provide a plan sheet that indicates the location of proposed stormwater measures for the borrow pit area. [15A NCAC 02H .0506(b)(1) and 15A NCAC 02H .0502(a)(9)].

**NCDOT Response:**

Please find attached “**Erosion Control at Borrow Site**”.

**DWR Question:**

3. Please show the footprint of the proposed retaining wall through the project area

**NCDOT Response:**

The proposed wall is located on the submitted set of drawings, and attached is a marked up set of drawings highlighting the wall for clarity, titled “**Drawings with Wall Highlighted**.”

The wall is highlighted in yellow. Wall impacts are highlighted in red.

Additionally, the impact summary table has been excerpted on each page to clarify the quantify the wall impact.

As previously noted, impacts are shown using the “scour zone limits” of the Pigeon River, as locating the ordinary high water mark post-Helene is not possible. Therefore, these drawings display a “worst case scenario” and are likely much lower than indicated.

The total proposed wall impacts to the Pigeon River are 12,116 linear feet.

**DWR Question (sub-divided):**

and provide a detail of the proposed retaining wall where the wall will be constructed below the ordinary high water mark, resulting in stream or wetland impacts, on your plan sheet.

**NCDOT Response:**

Please find attached “**Wall- River Impact Detail**”

**DWR Question (sub-divided):**

Please also include information as to how tributaries to the Pigeon River will flow to and through the proposed retaining wall. [15A NCAC 02H .0506(b)(1) and 15A NCAC 02H .0502(a)(9)]

**NCDOT Response:**

Tributaries that flow from I-40 through various structures will discharge into the Pigeon River in a similar manner as the Pre-Helene Condition.

Pipes will be extended or modified so they flow through the proposed wall.

NCDOT will ensure discharge does not cause erosion or destabilization of the streambank, if appropriate.

**DWR Question:**

4. Mitigation is required for losses of equal to or greater than 300 linear feet of perennial stream and (equal to or greater than 1/10 acre of wetlands). Stream S1-SAD is a perennial stream, which NCDOT has proposed a total of 414 linear feet of permanent fill in two locations – Site 34 (244 LF) and Site 37 (170 LF). Please provide a mitigation plan that conforms to the requirements of 15A NCAC 02H.

**NCDOT Response:**

The final impact table from the permit application cover letter has been updated and included as an attachment titled, “**Revised Cover Letter Impact Summary for DWR Mitigation**.”

Updated values are depicted in red for clarity.

Note, this does not change the requested mitigation for the project.

**Michael Turchy**

Environmental Coordination and Permitting [ECAP] Group Leader  
Environmental Analysis Unit  
North Carolina Department of Transportation

919 707 6157 office

919 818 7427 mobile

[maturchy@ncdot.gov](mailto:maturchy@ncdot.gov)

1598 Mail Service Center (Mail)

Raleigh, NC 27699-1598

1000 Birch Ridge Drive (Delivery)

Raleigh, NC 27610



*Email correspondence to and from this address is subject to the North Carolina Public Records Law and may be disclosed to third parties.*

---

**From:** Annino, Amy <amy.annino@deq.nc.gov>

**Sent:** Friday, June 27, 2025 3:38 PM

**To:** Turchy, Michael A <maturchy@ncdot.gov>; Jamison, John <johnjamison@ncdot.gov>

**Cc:** Amschler, Crystal C CIV USARMY CESAW (US) <crystal.c.amschler@usace.army.mil>; McHenry, David G

<david.mchenry@ncwildlife.gov>; Wojski, Paul A <Paul.Wojski@deq.nc.gov>; Pjetraj, Michael

<michael.pjetraj@deq.nc.gov>

**Subject:** Request for Additional Information: DWR 20250109 V3 - Hurricane Helene I-40 Pigeon River Gorge Emergency Relief Project

Dear Mr. Turchy,

On June 5, 2025, the Division of Water Resources (Division) received your application requesting an Individual Water Quality Certification from the Division for the subject project. The Division has determined that your application is incomplete and cannot be processed. The application is on-hold until all of the following information is received:

1. Please provide a more detailed justification as to why a haul road adjacent to S1-SAA would result in more impacts to water resources and stream S1-SAA and S1-SAB than the proposed option of the haul road on top of stream S1-SAA and S1-SAB. If the preferred alternative of placing the haul road on the stream is the selected alternative, DWR will require mitigation for stream loss as provided in the application. [15A NCAC 02H .0506(b)(1)]
2. Will the mining operation generate wastewater or stormwater that will be discharged to surface waters? Please provide a plan sheet that indicates the location of proposed stormwater measures for the borrow pit area. [15A NCAC 02H .0506(b)(1) and 15A NCAC 02H .0502(a)(9)]
3. Please show the footprint of the proposed retaining wall through the project area and provide a detail of the proposed retaining wall where the wall will be constructed below the ordinary high water mark, resulting in stream or wetland impacts, on your plan sheet. Please also include information as to how tributaries to the Pigeon River will flow to and through the proposed retaining wall. [15A NCAC 02H .0506(b)(1) and 15A NCAC 02H .0502(a)(9)]

4. Mitigation is required for losses of equal to or greater than 300 linear feet of perennial stream and (equal to or greater than 1/10 acre of wetlands). Stream S1-SAD is a perennial stream, which NCDOT has proposed a total of 414 linear feet of permanent fill in two locations – Site 34 (244 LF) and Site 37 (170 LF). Please provide a mitigation plan that conforms to the requirements of 15A NCAC 02H.

Pursuant to Title 15A NCAC 02H .0502(e), the applicant shall furnish all of the above requested information for the proper consideration of the application. Please respond in writing within 30 calendar days of receipt of this letter by sending one (1) copy of all of the above requested information to the 401 & Buffer Permitting Branch, 1617 Mail Service Center, Raleigh, NC 27699-1617 OR by submitting all of the above requested information through this link: <https://edocs.deq.nc.gov/Forms/Supplemental-Information-Form> (note the DWR# requested on the link is referenced above).

If all of the requested information is not received within 30 calendar days of receipt of this letter, the Division will be unable to approve the application and it will be denied as incomplete. The denial of this project will necessitate reapplication to the Division for approval, including a complete application package and the appropriate fee.

Please be aware that you have no authorization under the Section 401 of the Clean Water Act/ Isolated Wetlands and Isolated Waters Rules/Buffer Rules for this activity and any work done within waters of the state may be a violation of North Carolina General Statutes and Administrative Code.

Please contact me if you have any questions or concerns.

Sincerely,

**Amy Annino**  
Environmental Specialist II  
401 and Buffer Transportation Permitting Branch  
North Carolina Department of Environmental Quality  
Office: (828) 296-4668  
[amy.annino@deq.nc.gov](mailto:amy.annino@deq.nc.gov)

# Erosion and Sedimentation Control Plans

**NOTES:**  
 - MINIMUM 10' SETBACK FROM ALL PROPERTY LINES.  
 - SKAGGS METHOD HAS BEEN USED FOR THIS BORROW PIT AND IT WAS DETERMINED THAT EXCAVATION OF THE BORROW PIT IS OUTSIDE THE LATENT OFFSET OF THE WETLAND.  
 - NO ACTIVITIES WITHIN HIGH QUALITY WATER ZONES.  
 - THE CONSTRUCTION OF THE HAUL ROAD WILL ALWAYS BE IN A MANNER THAT DOES NOT TRAP DRAINAGE BEHIND IT. THIS CAN BE ACHIEVED BY:  
 1) NOT USING CUT DITCHES ALONG THE ROAD;  
 2) USING THE NORMAL CROWN TYPICAL CROSS SECTION PROVIDED.

**CALCULATIONS:**  
 - RISER BASIN  
 $Q = Q_{10\text{peak}} \cdot C_{IA} = 0.2 \cdot 3.97 \text{ in/hr} \cdot 39.1 \text{ ac} = 31.1 \text{ cfs}$

Adisturb = 25.8 ac  
 AREA REQUIRED =  $A = 435 \cdot Q = 435 \cdot 31.1 = 13,529 \text{ ft}^2$   
 AREA PROVIDED = 13,530  $\text{ft}^2$

VOLUME REQUIRED =  $V = 1,800 \cdot \text{Adisturb}$

= 1,800 \* 25.8 ac = 46,440  $\text{ft}^3$

VOLUME PROVIDED = 68,490  $\text{ft}^3$

DEPTH (D) = 8'

H=1', T=6', E=6.0', F=1.0', B=8'

X=5.5', Y=1.0', X1=5.0', Y1=1.0'

ORIFICE DIAMETER = 3.875"

SKIMMER SIZE = 4"

OUTLET PIPE = 24"

DITCH SHEAR STRESS = 62.4 \* SLOPE \* DEPTH

CWD1: 62.4 \* 0.36 \* 0.22 = 4.93  $\text{lbf/ft}^2$

V = 5.56  $\text{ft/s}$ , USE EC MATTING LINER

CWD2: 62.4 \* 0.06 \* 0.37 = 1.40  $\text{lbf/ft}^2$

V = 5.56  $\text{ft/s}$ , USE EC MATTING LINER

TSD1: 62.4 \* 0.015 \* 0.70 = 0.64  $\text{lbf/ft}^2$

V = 4.0  $\text{ft/s}$ , EC MATTING LINER

TSD2: 62.4 \* 0.262 \* 0.34 = 5.6  $\text{lbf/ft}^2$

V = 11.4  $\text{ft/s}$ , EC MATTING LINER

SEE TEMPORARY RIVER CROSSING DETAILS IN PERMIT DRAWINGS

WASTE PILE CROSS SECTION

N.T.S.

EXIST. GROUND

1.5:1 SIDE SLOPES

EXIST. GROUND

1.5:1 SIDE SLOPES

EXIST. GROUND


# Permit Drawings with Wall Highlighted

**CONTRACT: C#**

6/3/2025 c:\dw\working\rkk\production\dms73276\I-40 Pigeon River\_hyd.prm\_tsh.dgn

# TIP PROJECT: I-40 PIGEON RIVER

09/08/99

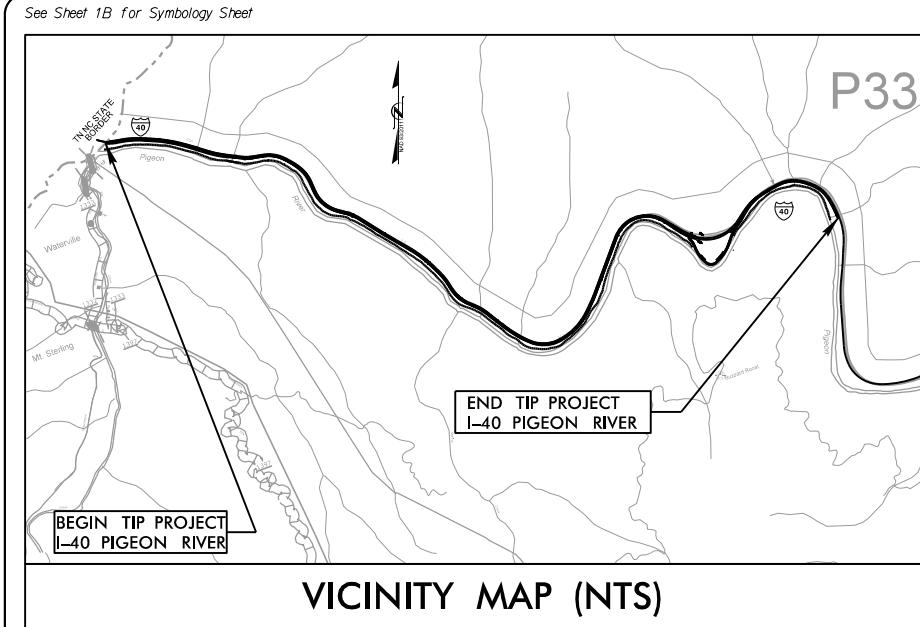

## STATE OF NORTH CAROLINA DIVISION OF HIGHWAYS

### HAYWOOD COUNTY


STATE	STATE PROJECT REFERENCE NO.	SHEET NO.	TOTAL SHEETS
N.C. I-40 PIGEON RIVER		1	
STATE PROJ. NO.	F. A. PROJ. NO.	DESCRIPTION	
18314.1044057.PRO1			



NAD 83/NA 2011

**LOCATION: I-40 PIGEON RIVER GORGE EMERGENCY REPAIRS FROM THE TENNESSEE STATE LINE TO JUST WEST OF MILE MARKER 5**

**TYPE OF WORK: GRADING, DRAINAGE, PAVING, SIGNING, & RETAINING WALLS**

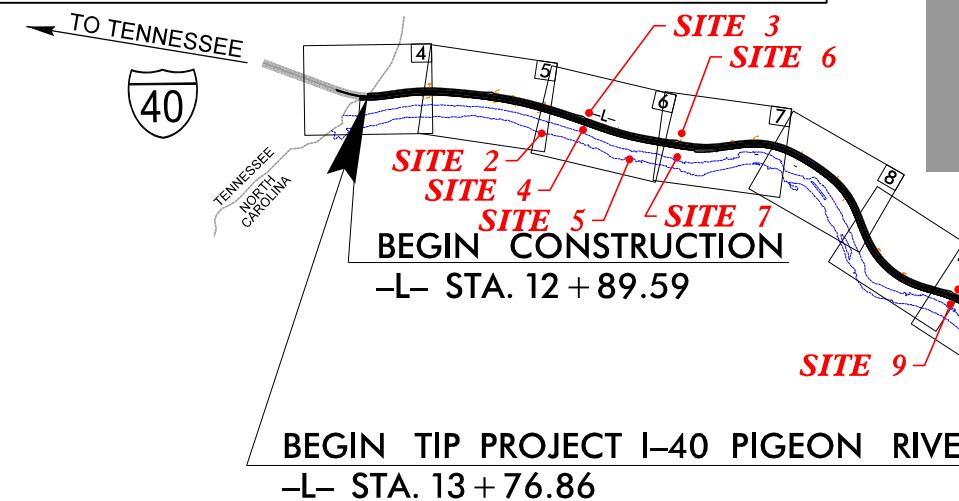


**SITE 1 - PIGEON RIVER**

**REVISED 5/28/2025**

**S-006R3: REVISED PERMIT DRAWINGS**  
**DATE: 06/03/2025**

**NOTES:**  
1. CLEARING ON THIS PROJECT SHALL BE PERFORMED TO THE LIMITS ESTABLISHED BY METHOD III MODIFIED.  
2. THIS IS A CONTROLLED-ACCESS PROJECT WITH ACCESS BEING LIMITED TO INTERCHANGES.  
3. THIS PROJECT IS NOT WITHIN MUNICIPAL LIMITS.  
4. DESIGN EXCEPTION FOR SHOULDER WIDTH, MINIMAL HORIZONTAL CURVE RADIUS, AND MINIMUM HORIZONTAL SIGHT DISTANCE.

#### GRAPHIC SCALES

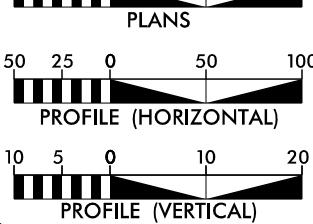

#### DESIGN DATA

ADT 2025 = 26,500  
V = 55 MPH

FUNC CLASS: INTERSTATE

#### PROJECT LENGTH

LENGTH ROADWAY TIP PROJECT I-40 PIGEON RIVER.....4.810 MILES  
LENGTH STRUCTURE TIP PROJECT I-40 PIGEON RIVER.....0.000 MILES  
TOTAL LENGTH TIP PROJECT I-40 PIGEON RIVER.....4.810 MILES

#### NCDOT CONTACT

JOSH B. DEYTON, P.E.  
DIVISION CONSTRUCTION ENGINEER

#### PLANS PREPARED BY:



RUMMEL, KLEPPER & KAHN, LLP  
8601 SIX FORKS ROAD, FORTRESS 1, SUITE 700  
RALEIGH, NORTH CAROLINA 27615-3960  
NC LICENSE NO. F-0112



1001 Morehead Square Dr.,  
Suite 610, Charlotte, NC 28203  
NC LIC NO. F-0165

2024 STANDARD SPECIFICATIONS

LETTING DATE:  
MARCH XX, 2025

#### HYDRAULICS ENGINEER



GREG GOINS, P.E.  
PROJECT ENGINEER

CATHY HOUSER, P.E.  
PROJECT DESIGN ENGINEER

P.E.


SIGNATURE:

ROADWAY DESIGN ENGINEER

P.E.

SIGNATURE:

INCOMPLETE PLANS  
DO NOT USE FOR R/W ACQUISITION  
DOCUMENT NOT CONSIDERED FINAL  
UNLESS ALL SIGNATURES COMPLETED

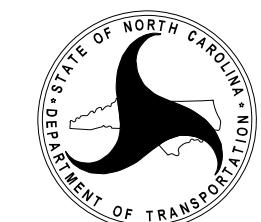

Site No.	Station (From/To)	Structure Size / Type	Permanent Fill In Wetlands (ac)	Temp. Fill In Wetlands (ac)	Excavation in Wetlands (ac)	Mechanized Clearing in Wetlands (ac)	Hand Clearing in Wetlands (ac)	Permanent SW impacts (ac)	Temp. SW impacts (ac)	Existing Channel Impacts Permanent (ft)	Existing Channel Impacts Temp. (ft)	Natural Stream Design (ft)
1 (PSH 4)	-L- Sta. 10+00 to 21+00	PR; Causeway						0.067	0.357	542	458	
1 (PSH 4)	-L- Sta. 10+00 to 21+00	PR; Non-Causeway							2.773			

\* DESIGN EXCEPTION


PROJECT REFERENCE NO.		SHEET NO.
<i>I-40 PIGEON RIVER</i>		<i>4</i>
R/W SHEET NO.		
ROADWAY DESIGN ENGINEER	HYDRAULICS ENGINEER	
<b>INCOMPLETE PLANS</b> <b>DO NOT USE FOR R/W ACQUISITION</b>		

**DOCUMENT NOT CONSIDERED FINAL  
UNLESS ALL SIGNATURES COMPLETED**

# PERMIT DRAWING SHEET 5 OF 62

REVISED 5/28/2025

**MATCHLINE -L- STA. 21+00 SEE SHEET 05**

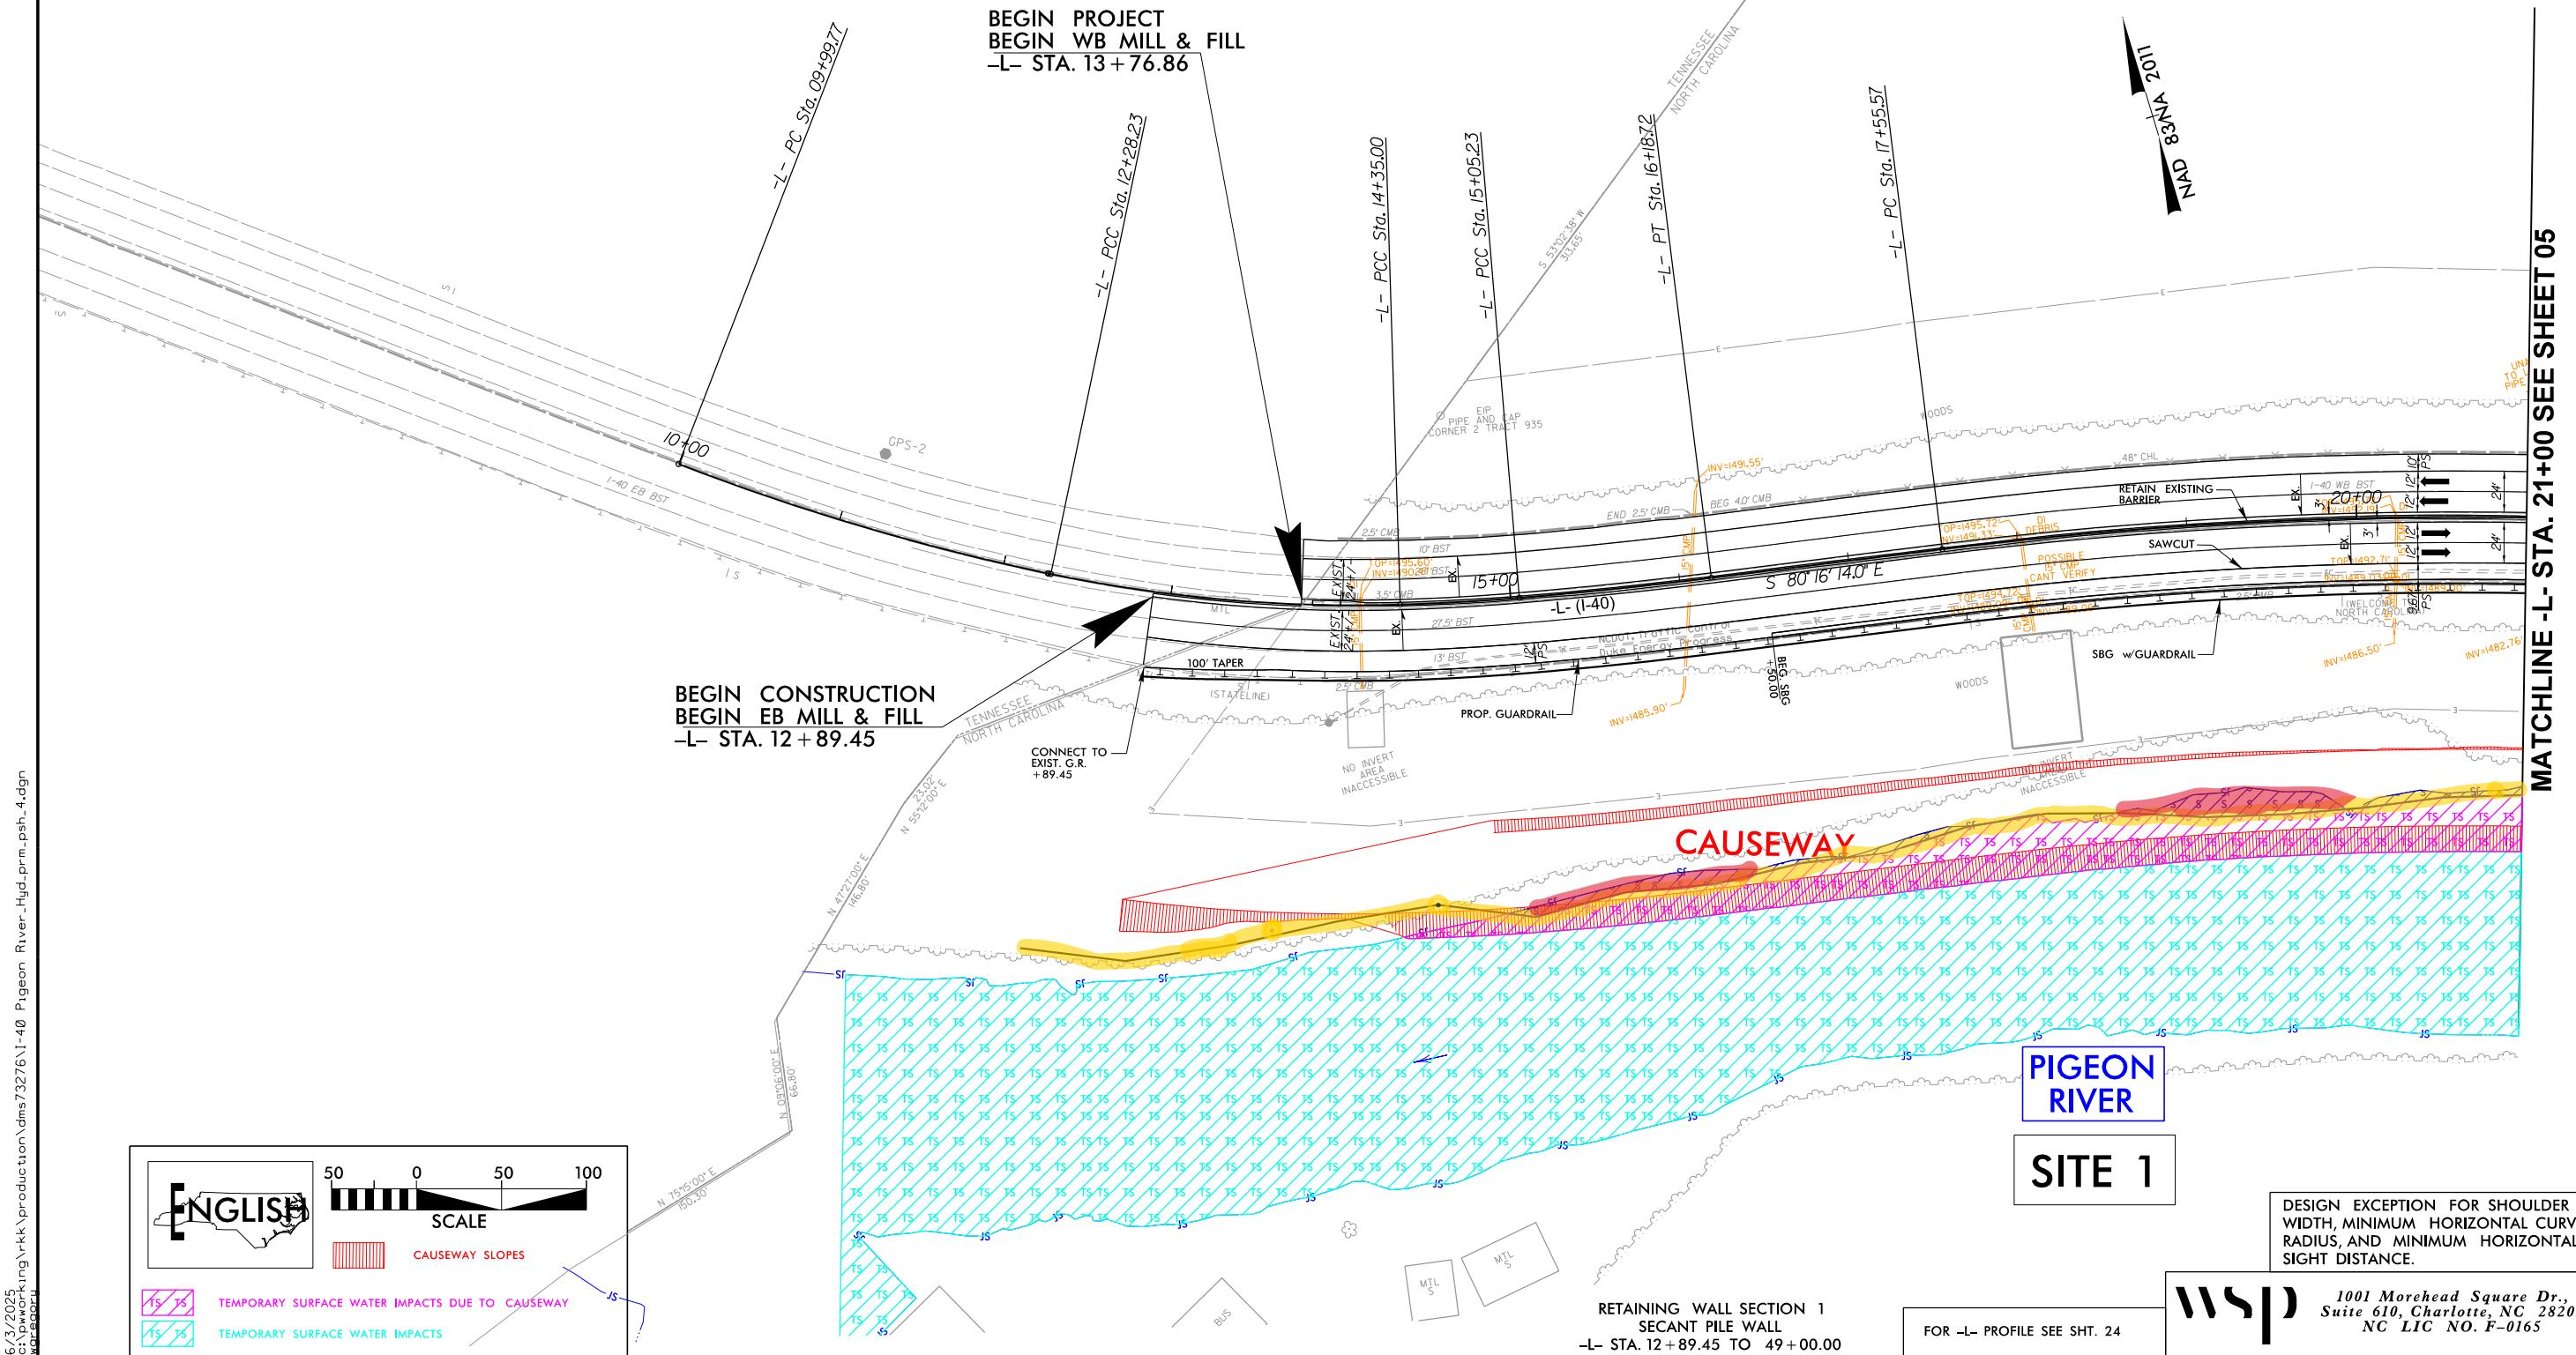

### WETLAND AND SURFACE WATER IMPACTS SUMMARY


Site No.	Station (From/To)	Structure Size / Type	WETLAND IMPACTS					SURFACE WATER IMPACTS				
			Permanent Fill In Wetlands (ac)	Temp. Fill In Wetlands (ac)	Excavation in Wetlands (ac)	Mechanized Clearing in Wetlands (ac)	Hand Clearing in Wetlands (ac)	Permanent SW impacts (ac)	Temp. SW impacts (ac)	Existing Channel Impacts Permanent (ft)	Existing Channel Impacts Temp. (ft)	Natural Stream Design (ft)
1 (PSH 5)	-L- Sta. 21+00 to 35+00	PR; Causeway						0.125	1.587	916	430	
1 (PSH 5)	-L- Sta. 21+00 to 35+00	PR; Non-Causeway						2.183				

PROJECT REFERENCE NO. I-40 PIGEON RIVER	SHEET NO. 5
RW SHEET NO.	
ROADWAY DESIGN ENGINEER	HYDRAULICS ENGINEER
INCOMPLETE PLANS DO NOT USE FOR R/W ACQUISITION	

DOCUMENT NOT CONSIDERED FINAL  
UNLESS ALL SIGNATURES COMPLETED

**PERMIT DRAWING  
SHEET 7 OF 62**

**REVISED 5/28/2025**

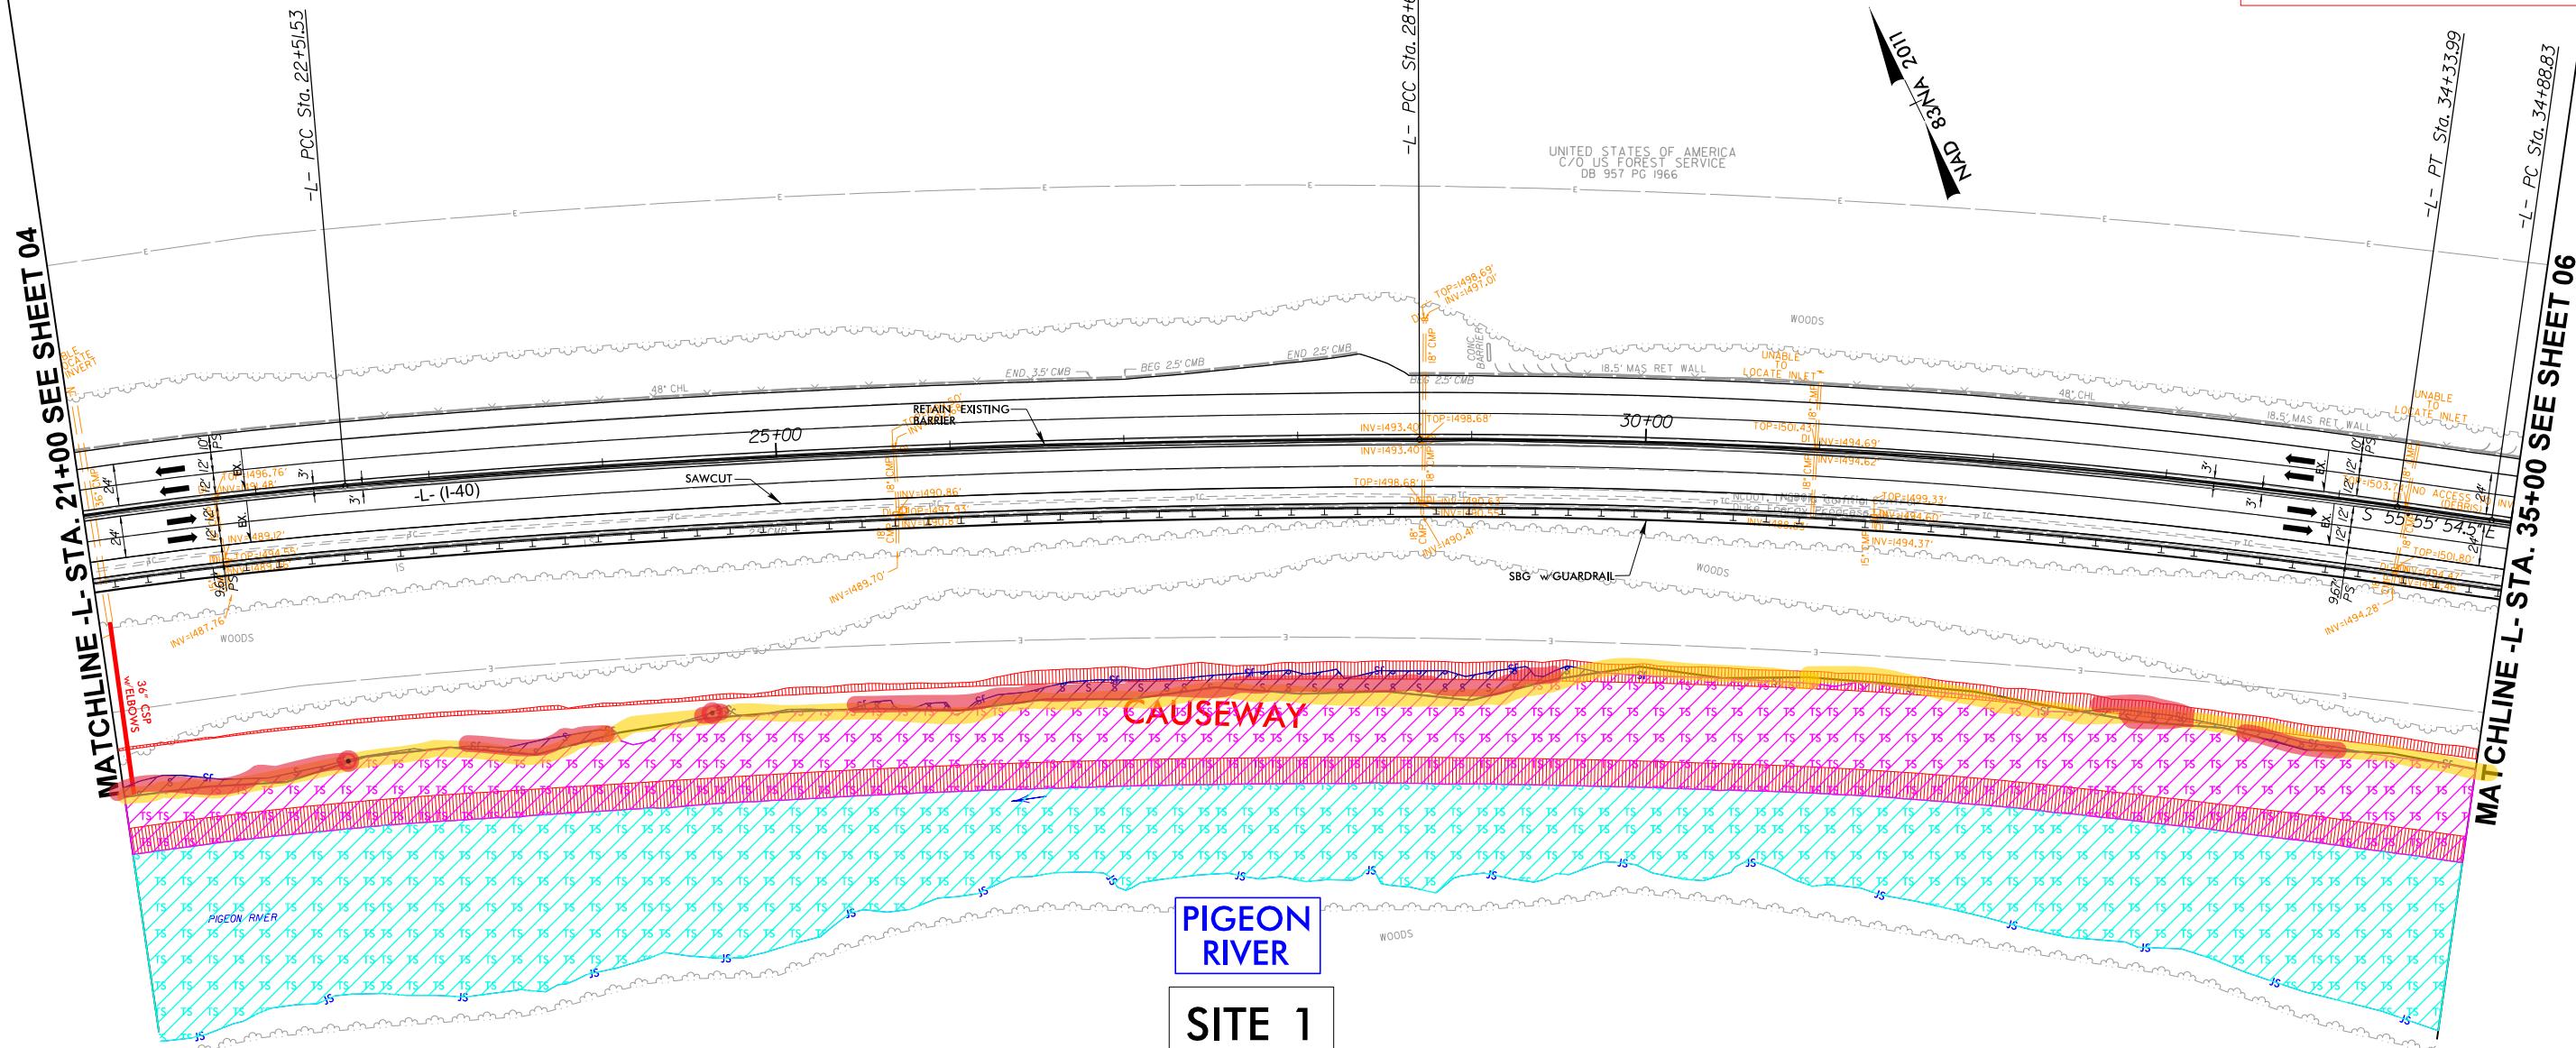


DESIGN EXCEPTION FOR SHOULDER WIDTH, AND MINIMUM HORIZONTAL SIGHT DISTANCE.

1001 Morehead Square Dr.,  
Suite 610, Charlotte, NC 28203  
NC LIC NO. F-0165

PROJECT REFERENCE NO.		SHEET NO.
I-40 PIGEON RIVER		6
RW SHEET NO.		
ROADWAY DESIGN ENGINEER	HYDRAULICS ENGINEER	
INCOMPLETE PLANS DO NOT USE FOR R/W ACQUISITION		
DOCUMENT NOT CONSIDERED FINAL UNLESS ALL SIGNATURES COMPLETED		
<b>PERMIT DRAWING SHEET 9 OF 62</b>		
<b>REVISED 5/28/2025</b>		

### WETLAND AND SURFACE WATER IMPACTS SUMMARY

Site No.	Station (From/To)	Structure Size / Type	WETLAND IMPACTS					SURFACE WATER IMPACTS				
			Permanent Fill In Wetlands (ac)	Temp. Fill In Wetlands (ac)	Excavation in Wetlands (ac)	Mechanized Clearing in Wetlands (ac)	Hand Clearing in Wetlands (ac)	Permanent SW impacts (ac)	Temp. SW impacts (ac)	Existing Channel Impacts Permanent (ft)	Existing Channel Impacts Temp. (ft)	Natural Stream Design (ft)
1 (PSH 6)	-L- Sta. 35+00 to 49+00	PR; Causeway						0.064	1.554	856	578	
1 (PSH 6)	-L- Sta. 35+00 to 49+00	PR; Non-Causeway							2.286			

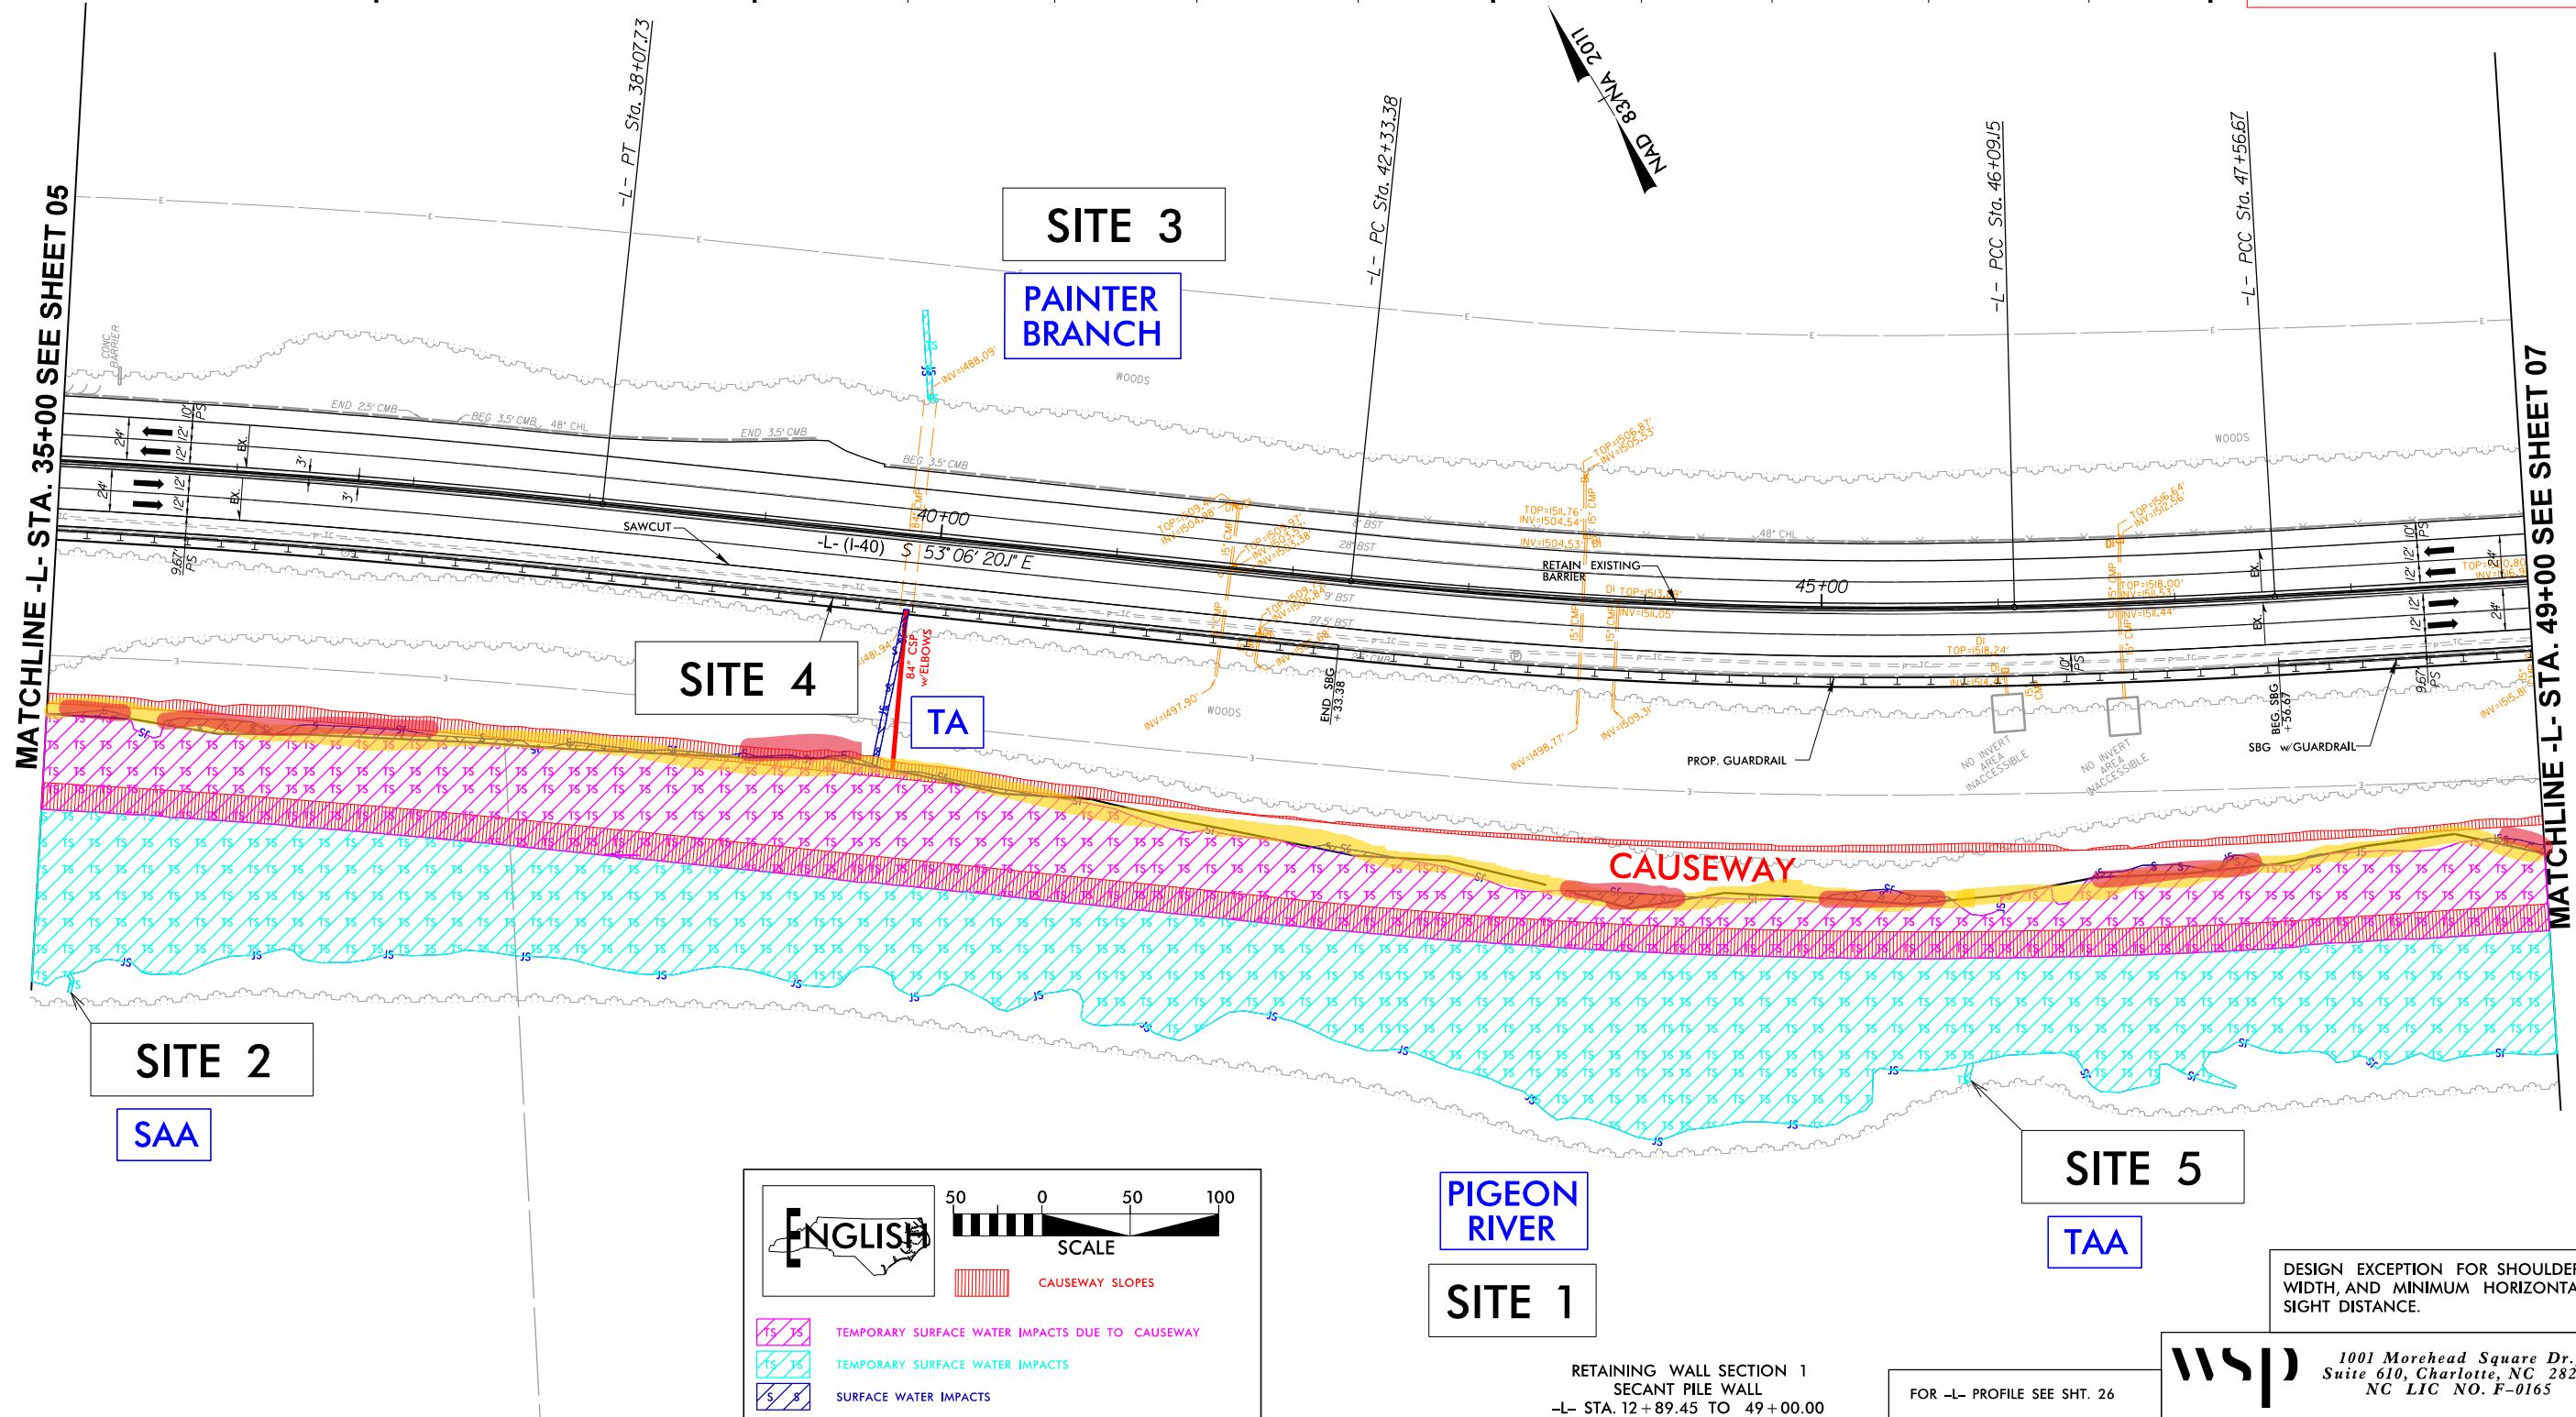

# WETLAND AND SURFACE WATER IMPACTS SUMMARY


Site No.	Station (From/To)	Structure Size / Type	WETLAND IMPACTS					SURFACE WATER IMPACTS			
			Permanent Fill In Wetlands (ac)	Temp. Fill In Wetlands (ac)	Excavation in Wetlands (ac)	Mechanized Clearing in Wetlands (ac)	Hand Clearing in Wetlands (ac)	Permanent SW impacts (ac)	Temp. SW impacts (ac)	Existing Channel Impacts Permanent (ft)	Natural Stream Design (ft)
1 (PSH 7)	-L- Sta. 49+00 to 63+00	PR; Causeway; Wall						0.509	1.064	854	551
1 (PSH 7)	-L- Sta. 49+00 to 63+00	PR; Non-Causeway						2.367			

PROJECT REFERENCE NO. I-40 PIGEON RIVER	SHEET NO. 7
RW SHEET NO.	
ROADWAY DESIGN ENGINEER	HYDRAULICS ENGINEER
INCOMPLETE PLANS DO NOT USE FOR R/W ACQUISITION	

DOCUMENT NOT CONSIDERED FINAL  
UNLESS ALL SIGNATURES COMPLETED

**PERMIT DRAWING  
SHEET 11 OF 62**

**REVISED 5/28/2025**

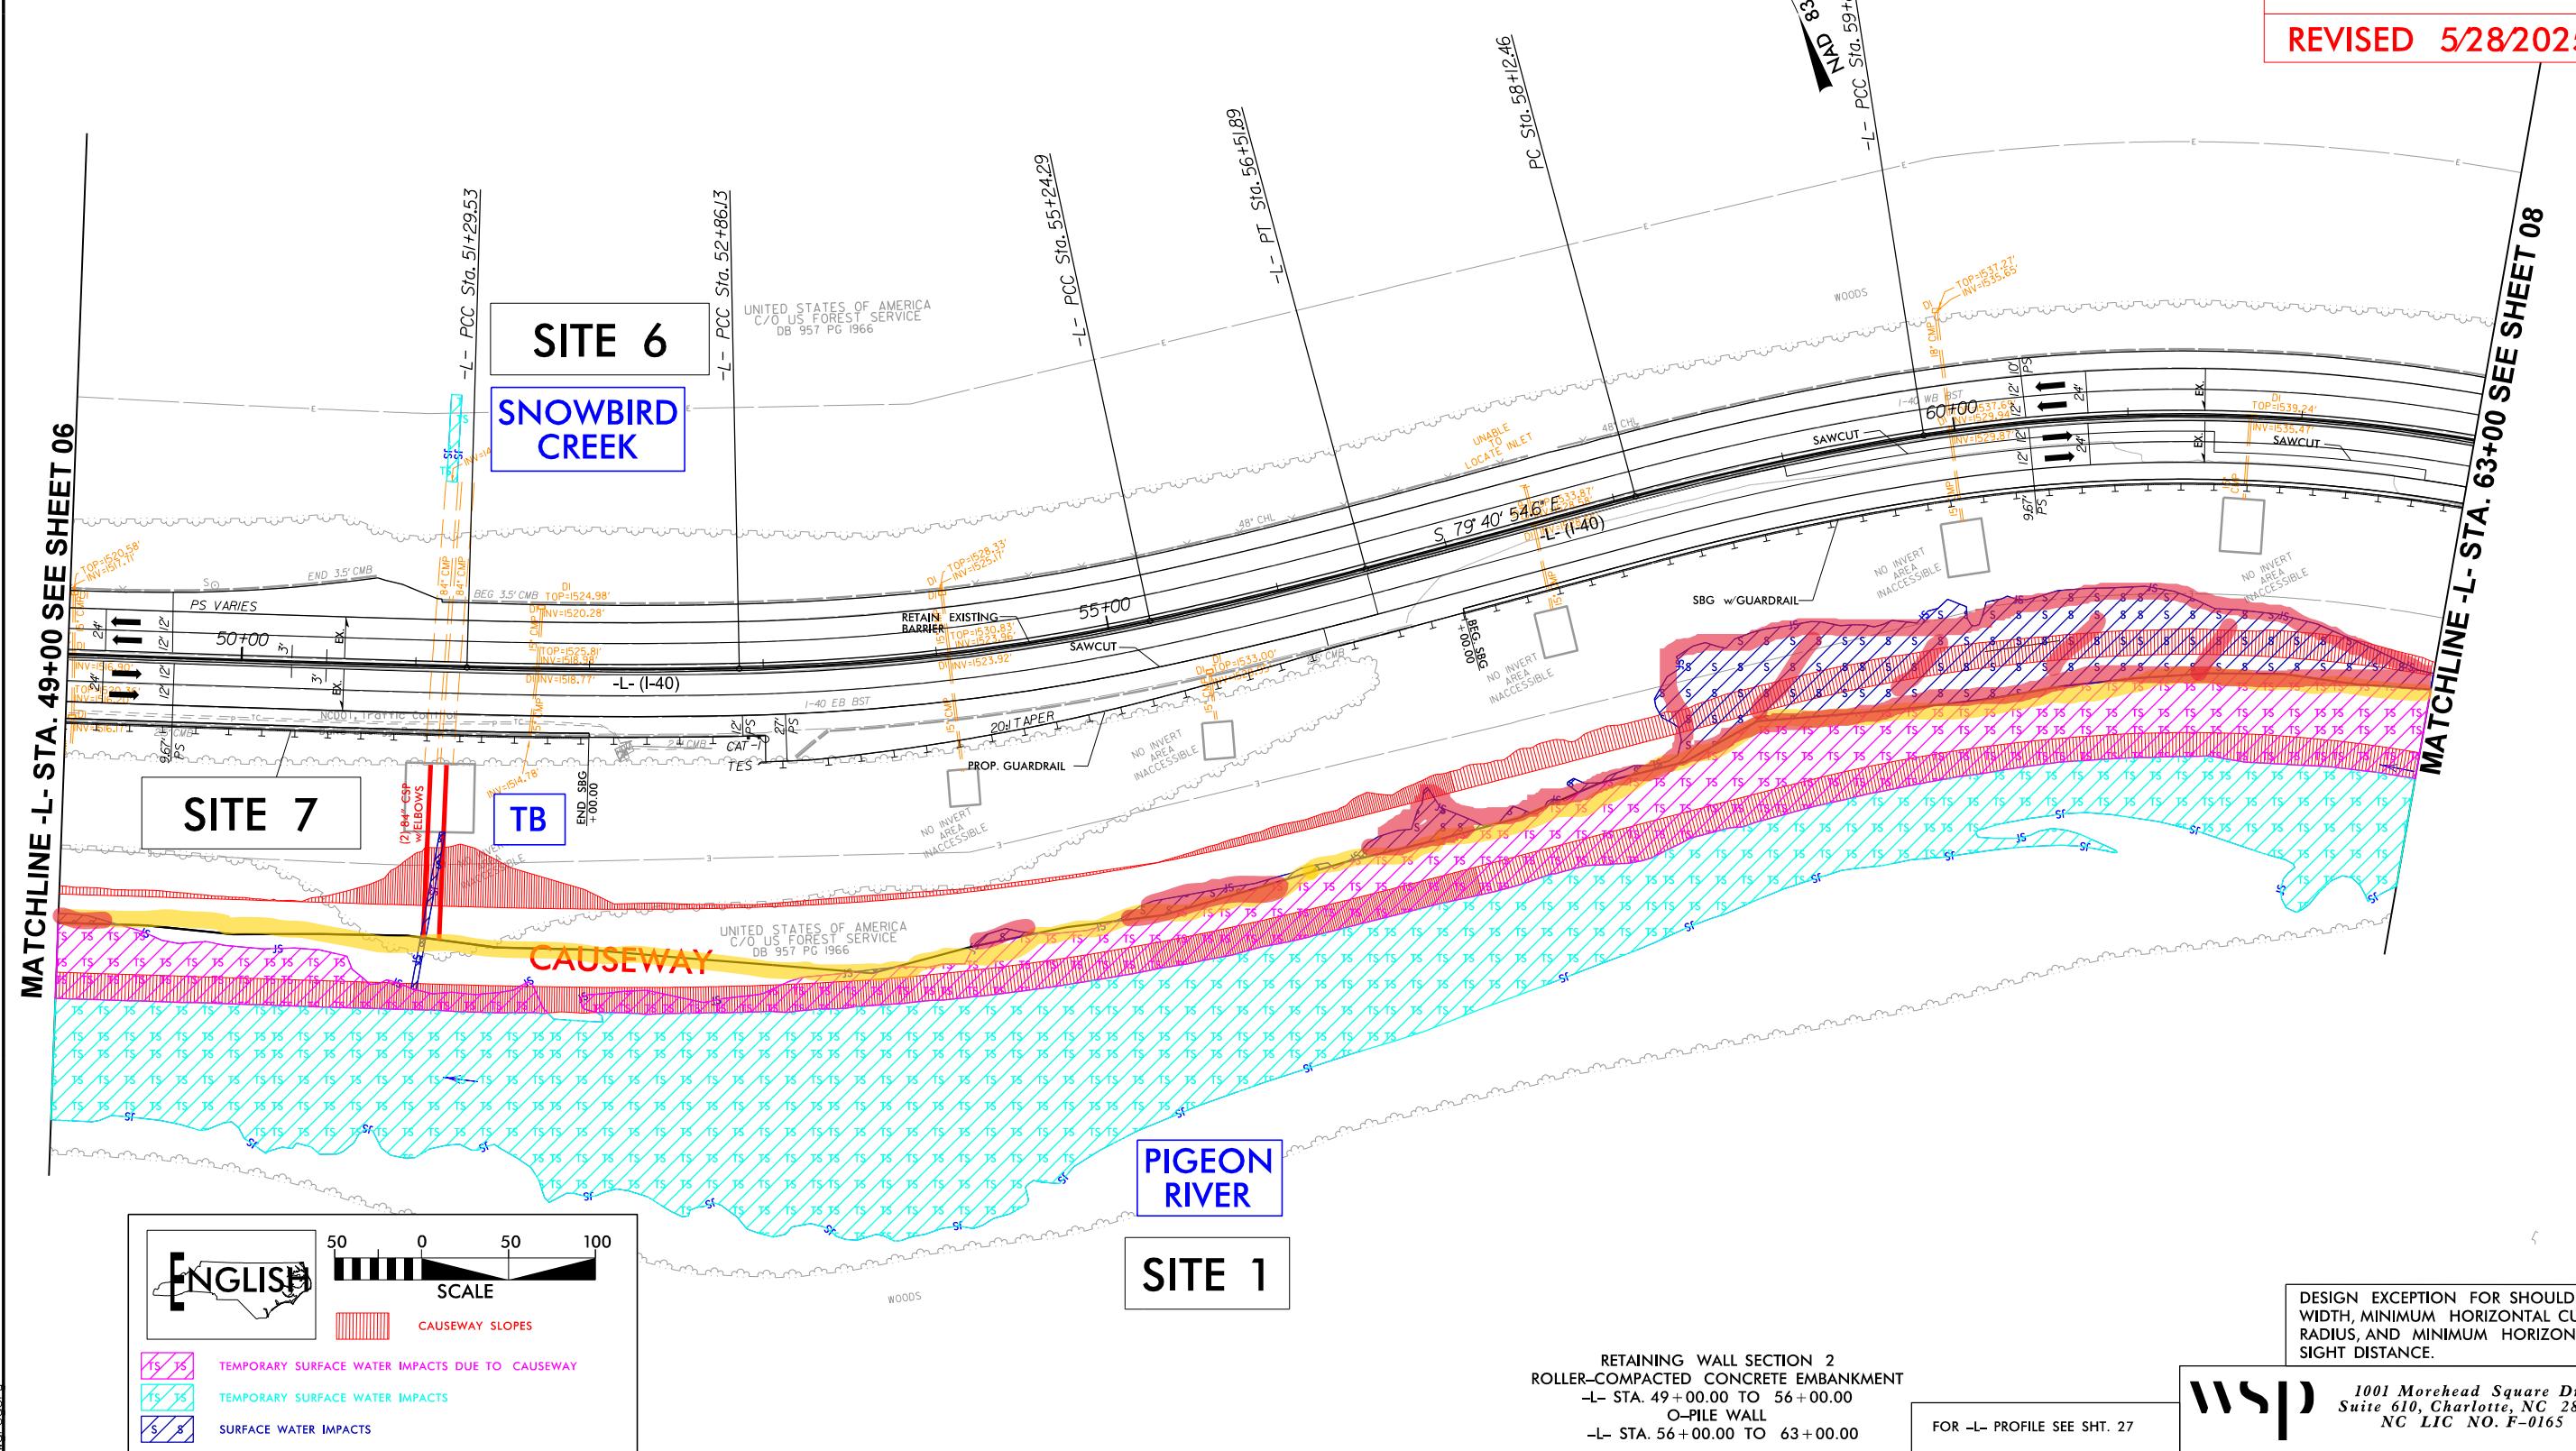


PROJECT REFERENCE NO. I-40 PIGEON RIVER	SHEET NO. 8
RW SHEET NO.	
ROADWAY DESIGN ENGINEER	HYDRAULICS ENGINEER
INCOMPLETE PLANS DO NOT USE FOR R/W ACQUISITION	

DOCUMENT NOT CONSIDERED FINAL  
UNLESS ALL SIGNATURES COMPLETED

PERMIT DRAWING  
SHEET 13 OF 62

REVISED 5/28/2025

Site No.	Station (From/To)	Structure Size / Type	WETLAND IMPACTS					SURFACE WATER IMPACTS				
			Permanent Fill In Wetlands (ac)	Temp. Fill In Wetlands (ac)	Excavation in Wetlands (ac)	Mechanized Clearing in Wetlands (ac)	Hand Clearing in Wetlands (ac)	Permanent SW impacts (ac)	Temp. SW impacts (ac)	Existing Channel Impacts Permanent (ft)	Existing Channel Impacts Temp. (ft)	Natural Stream Design (ft)
1 (PSH 8)	-L- Sta. 63+00 to 76+50	PR; Causeway; Wall						0.301	0.556	639	544	
1 (PSH 8)	-L- Sta. 63+00 to 76+50	PR; Non-Causeway						2.633				

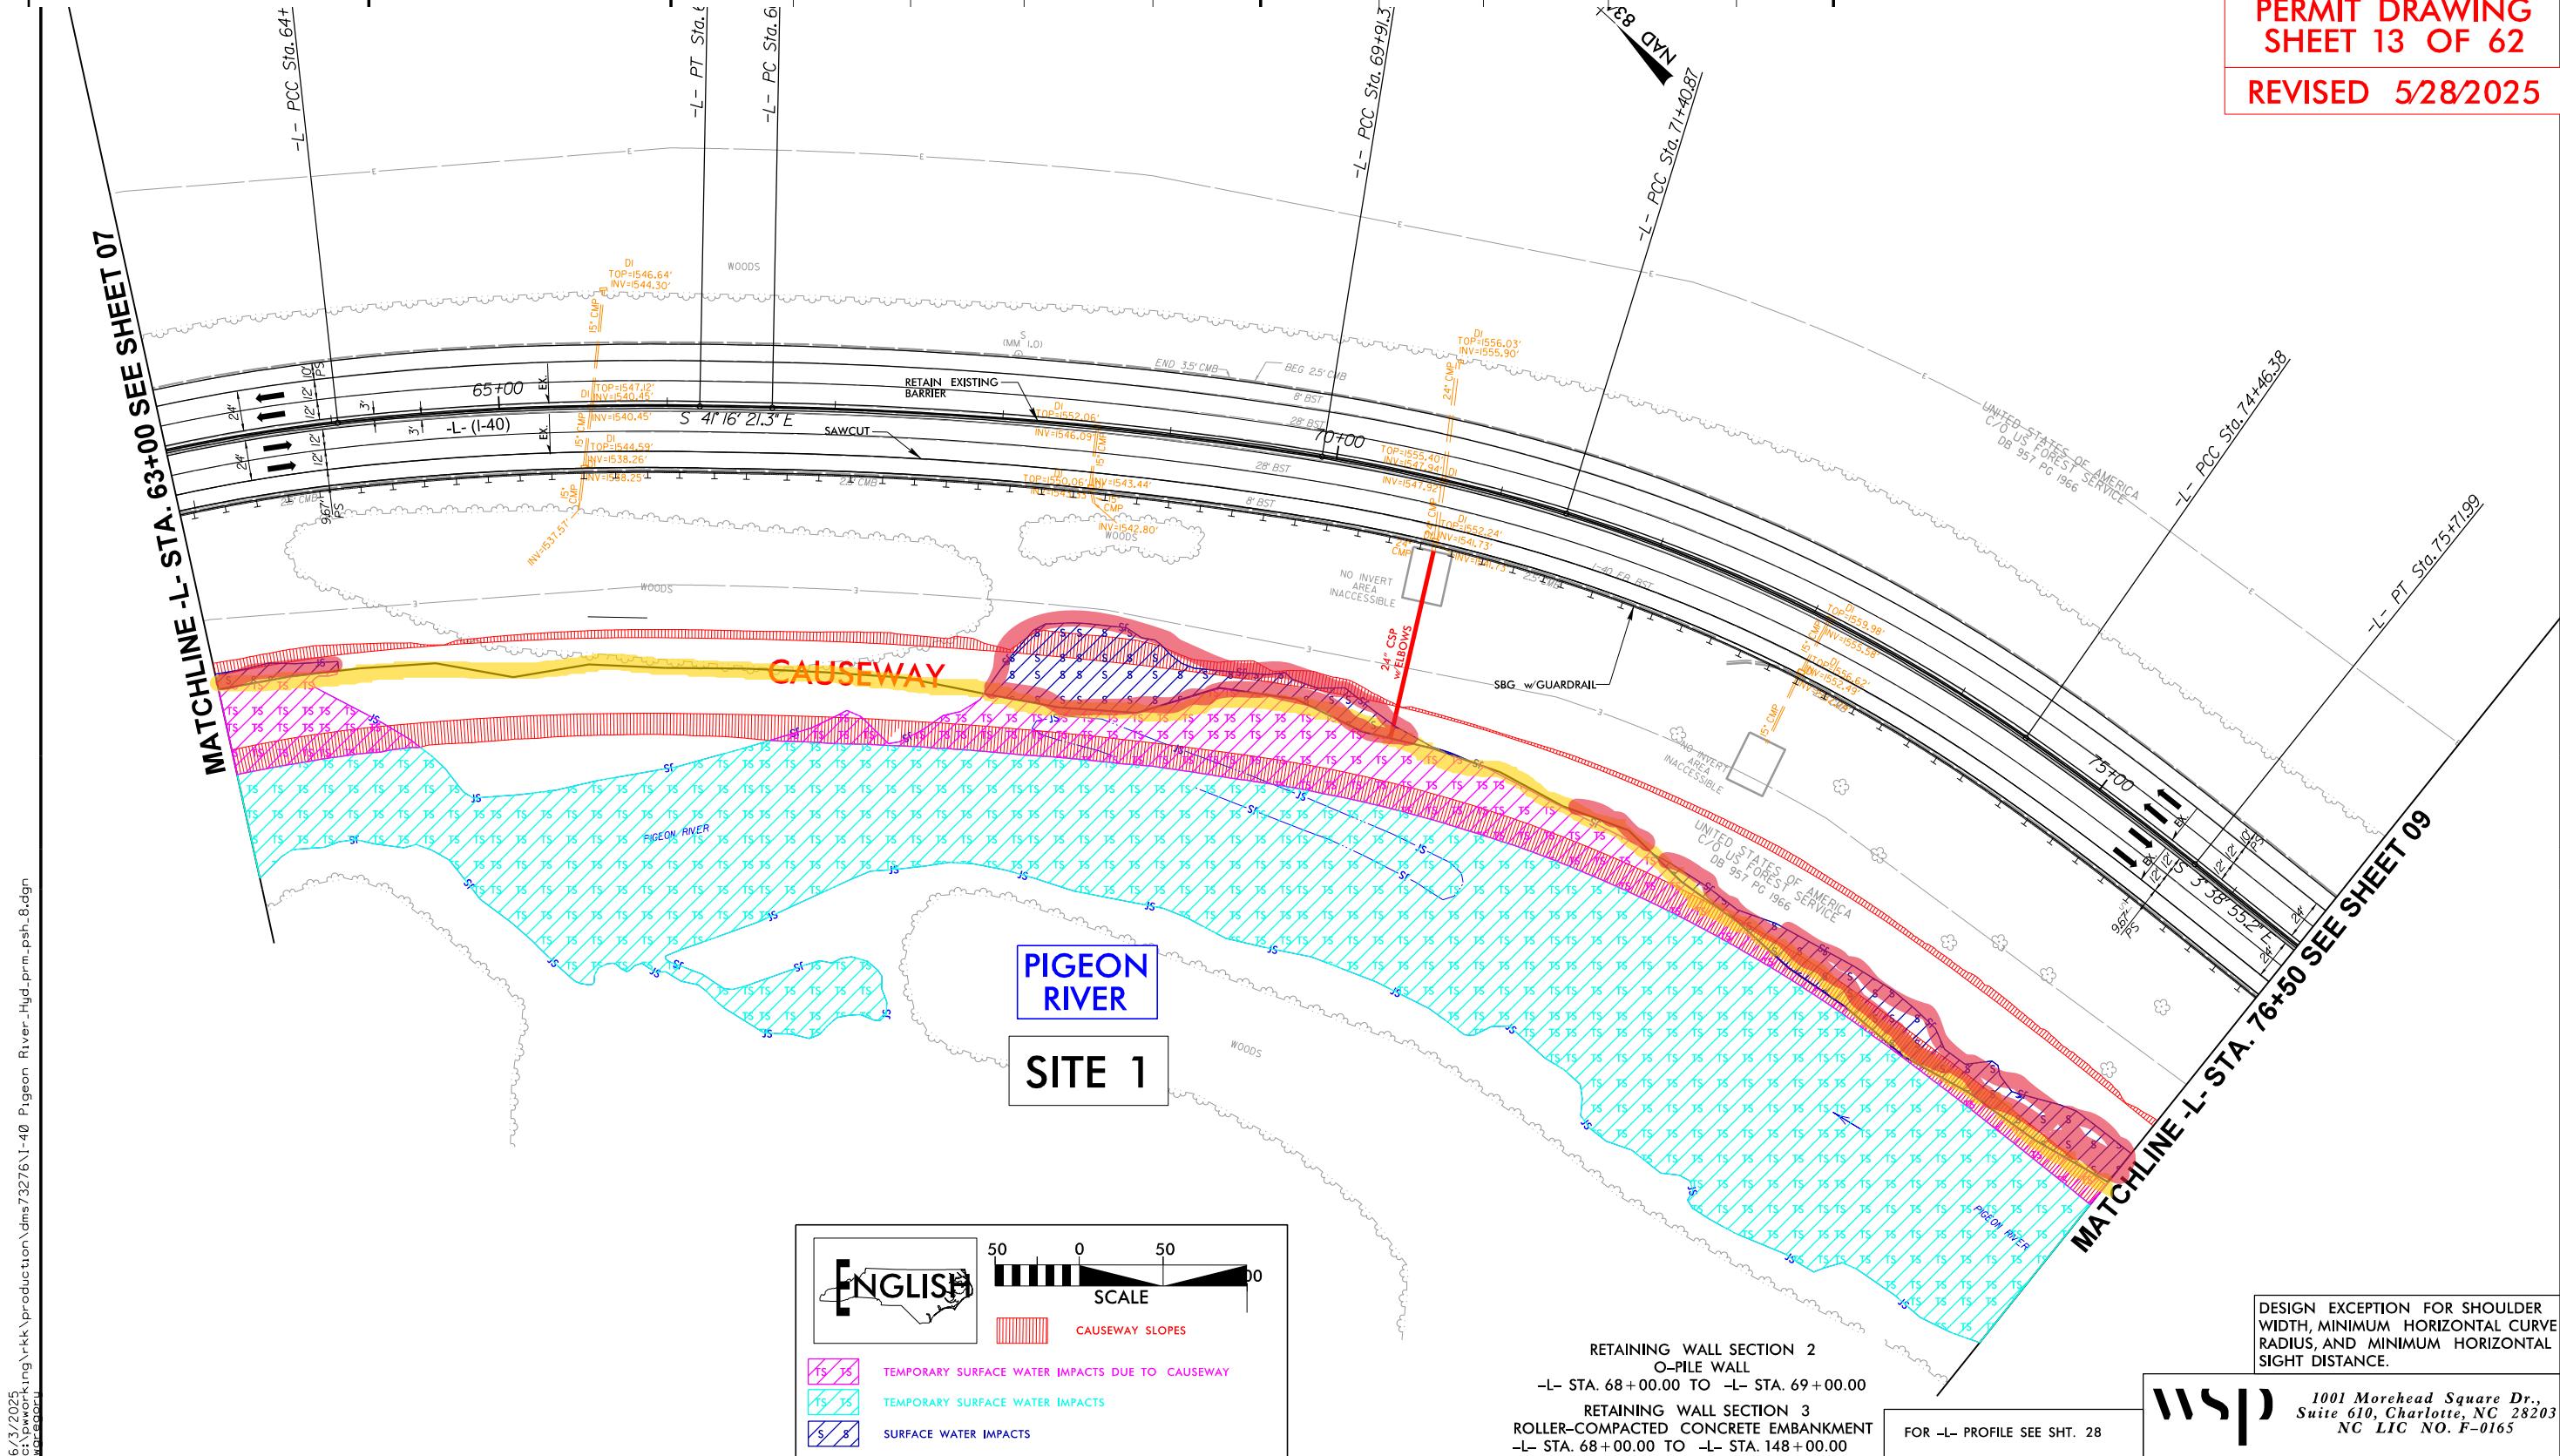

PROJECT REFERENCE NO. I-40 PIGEON RIVER	SHEET NO. 9
RW SHEET NO.	
ROADWAY DESIGN ENGINEER	HYDRAULICS ENGINEER
INCOMPLETE PLANS DO NOT USE FOR R/W ACQUISITION	


DOCUMENT NOT CONSIDERED FINAL  
UNLESS ALL SIGNATURES COMPLETED

**PERMIT DRAWING  
SHEET 15 OF 62**

**REVISED 5/28/2025**

### WETLAND AND SURFACE WATER IMPACTS SUMMARY

Site No.	Station (From/To)	Structure Size / Type	WETLAND IMPACTS					SURFACE WATER IMPACTS				
			Permanent Fill In Wetlands (ac)	Temp. Fill In Wetlands (ac)	Excavation in Wetlands (ac)	Mechanized Clearing in Wetlands (ac)	Hand Clearing in Wetlands (ac)	Permanent SW impacts (ac)	Temp. SW impacts (ac)	Existing Channel Impacts Permanent (ft)	Existing Channel Impacts Temp. (ft)	Natural Stream Design (ft)
1 (PSH 9)	-L- Sta. 76+50 to 91+00	PR; Causeway; Wall						0.531	1.061	1050	646	
1 (PSH 9)	-L- Sta. 76+50 to 91+00	PR; Non-Causeway							3.725			

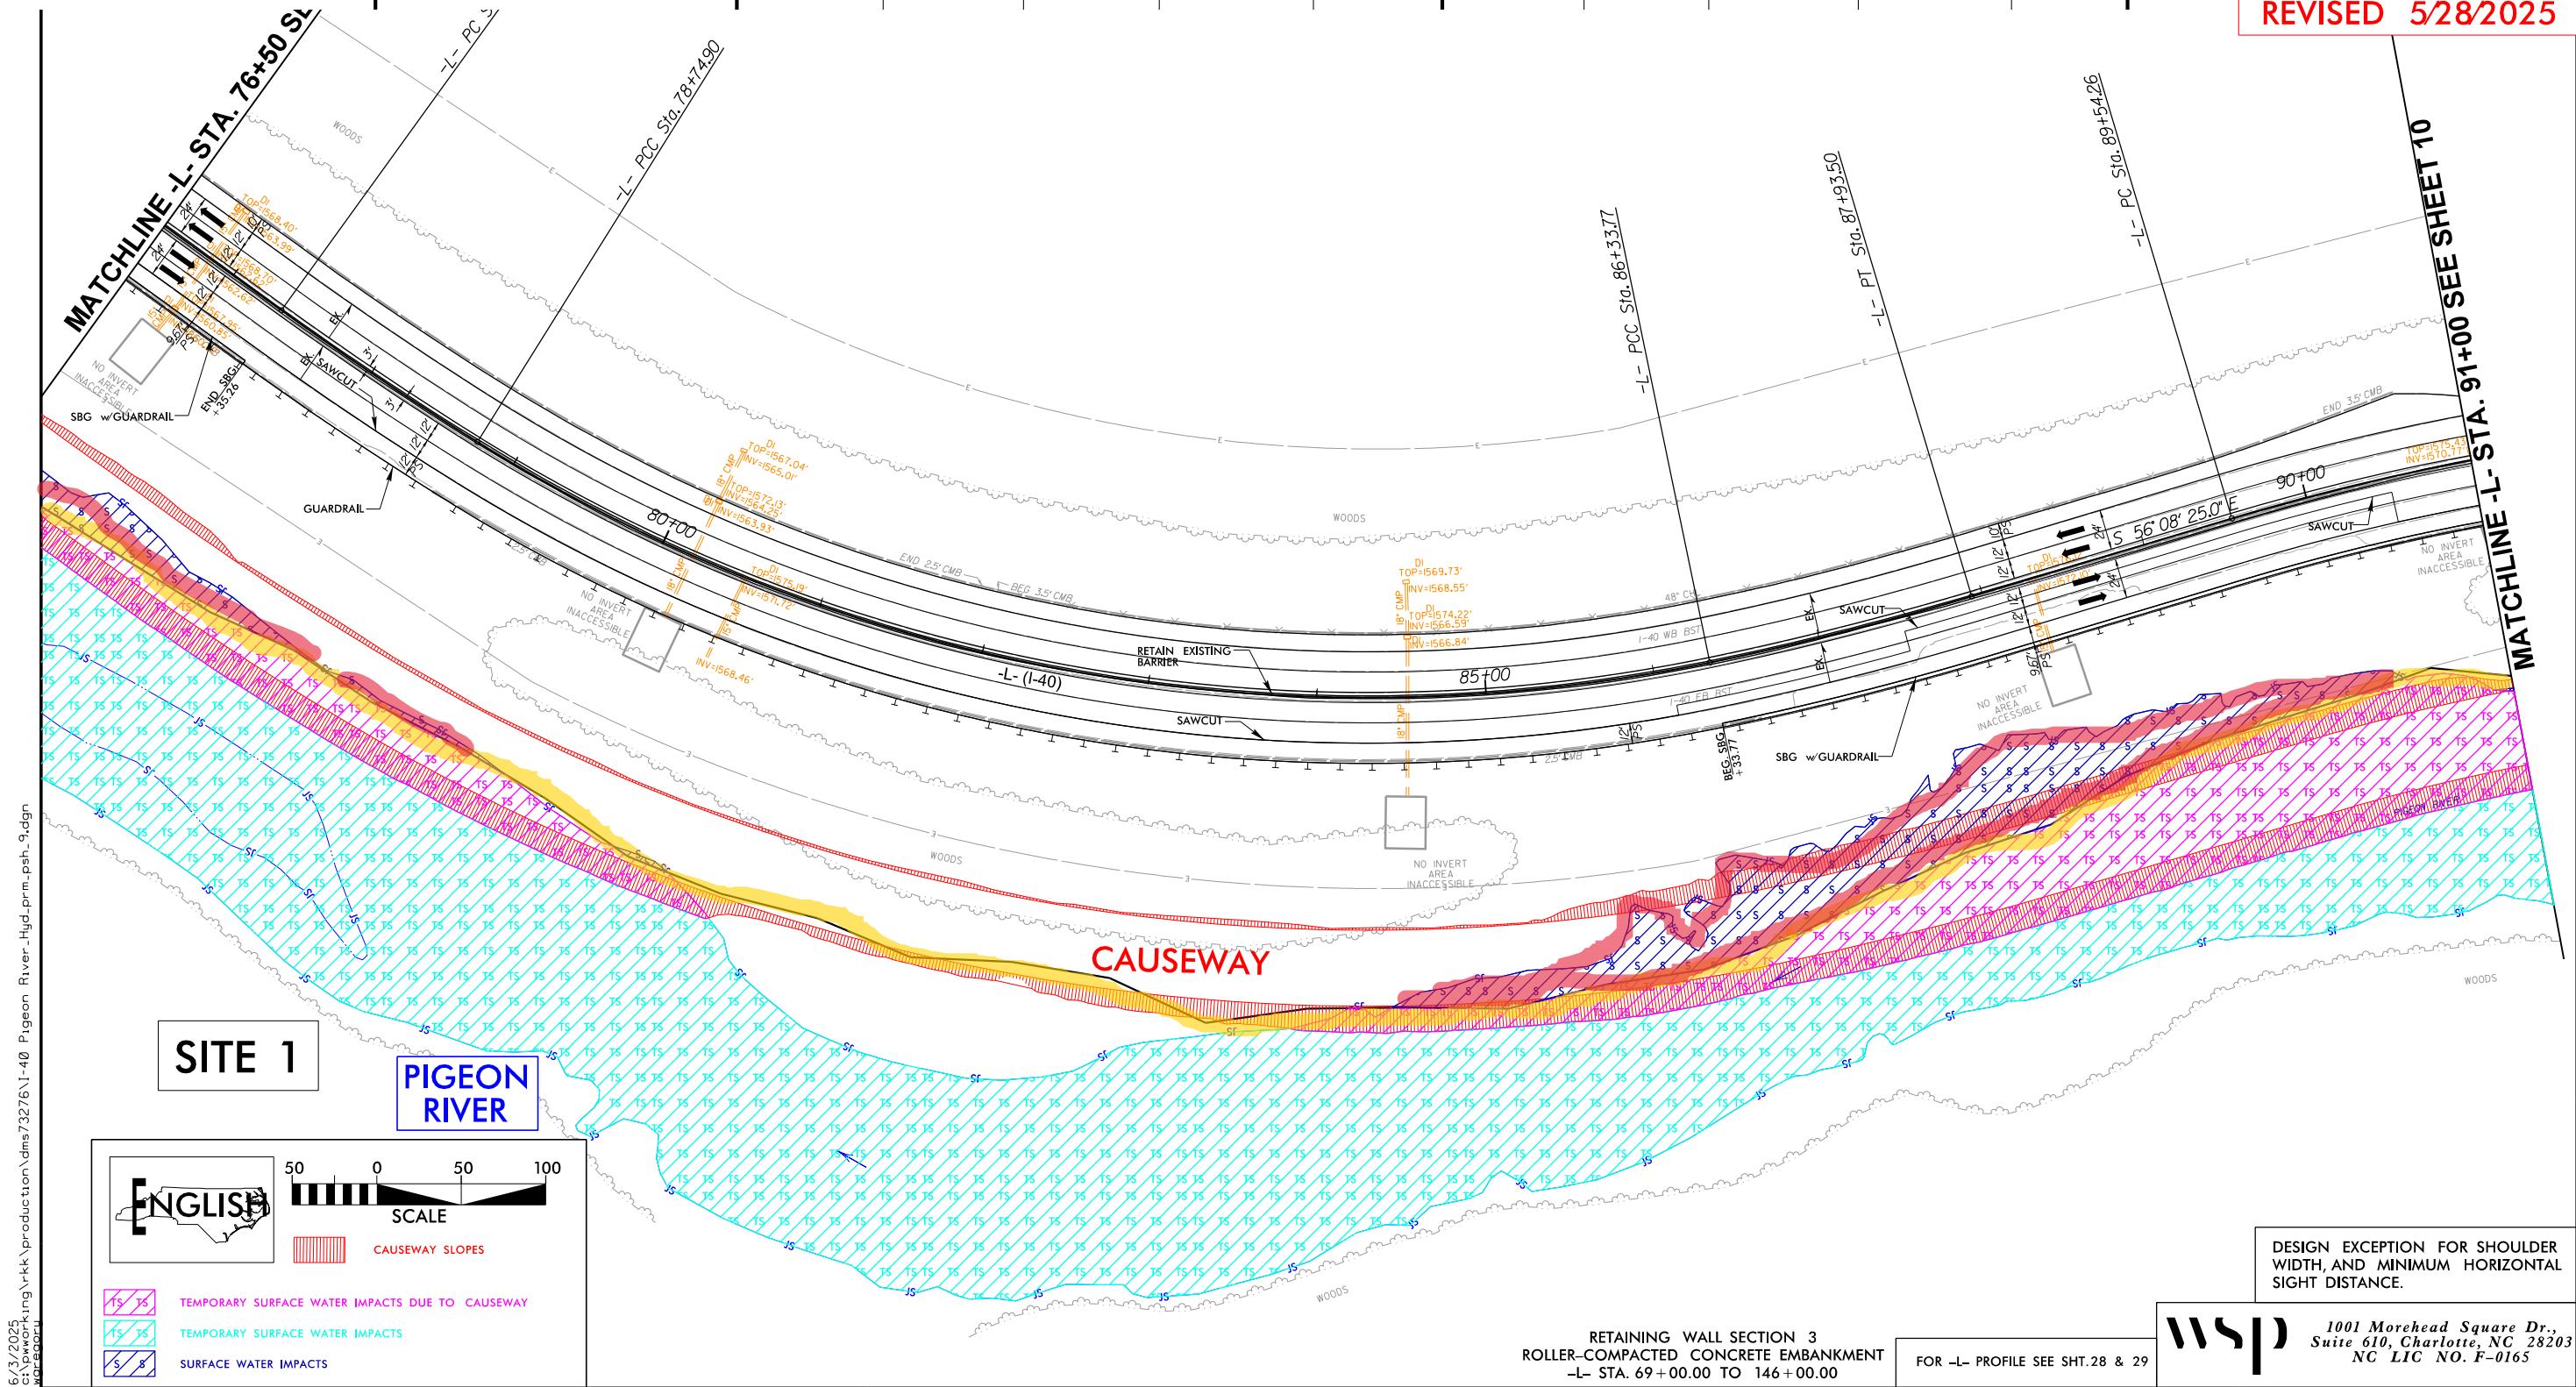

PROJECT REFERENCE NO. I-40 PIGEON RIVER	SHEET NO. 10
RW SHEET NO.	
ROADWAY DESIGN ENGINEER	HYDRAULICS ENGINEER
<b>INCOMPLETE PLANS DO NOT USE FOR R/W ACQUISITION</b>	

DOCUMENT NOT CONSIDERED FINAL  
UNLESS ALL SIGNATURES COMPLETED



**PERMIT DRAWING  
SHEET 17 OF 62**

**REVISED 5/28/2025**

### WETLAND AND SURFACE WATER IMPACTS SUMMARY


Site No.	Station (From/To)	Structure Size / Type	WETLAND IMPACTS					SURFACE WATER IMPACTS			
			Permanent Fill In Wetlands (ac)	Temp. Fill In Wetlands (ac)	Excavation in Wetlands (ac)	Mechanized Clearing in Wetlands (ac)	Hand Clearing in Wetlands (ac)	Permanent SW impacts (ac)	Temp. SW impacts (ac)	Existing Channel Impacts Permanent (ft)	Natural Stream Design (ft)
1 (PSH 10)	-L- Sta. 91+00 to 103+00	PR; Causeway; Wall						0.068	1.665	444	717
1 (PSH 10)	-L- Sta. 91+00 to 103+00	PR; Non-Causeway							2.156		

U.S. FOREST SERVICE  
DB 957 PG 1966

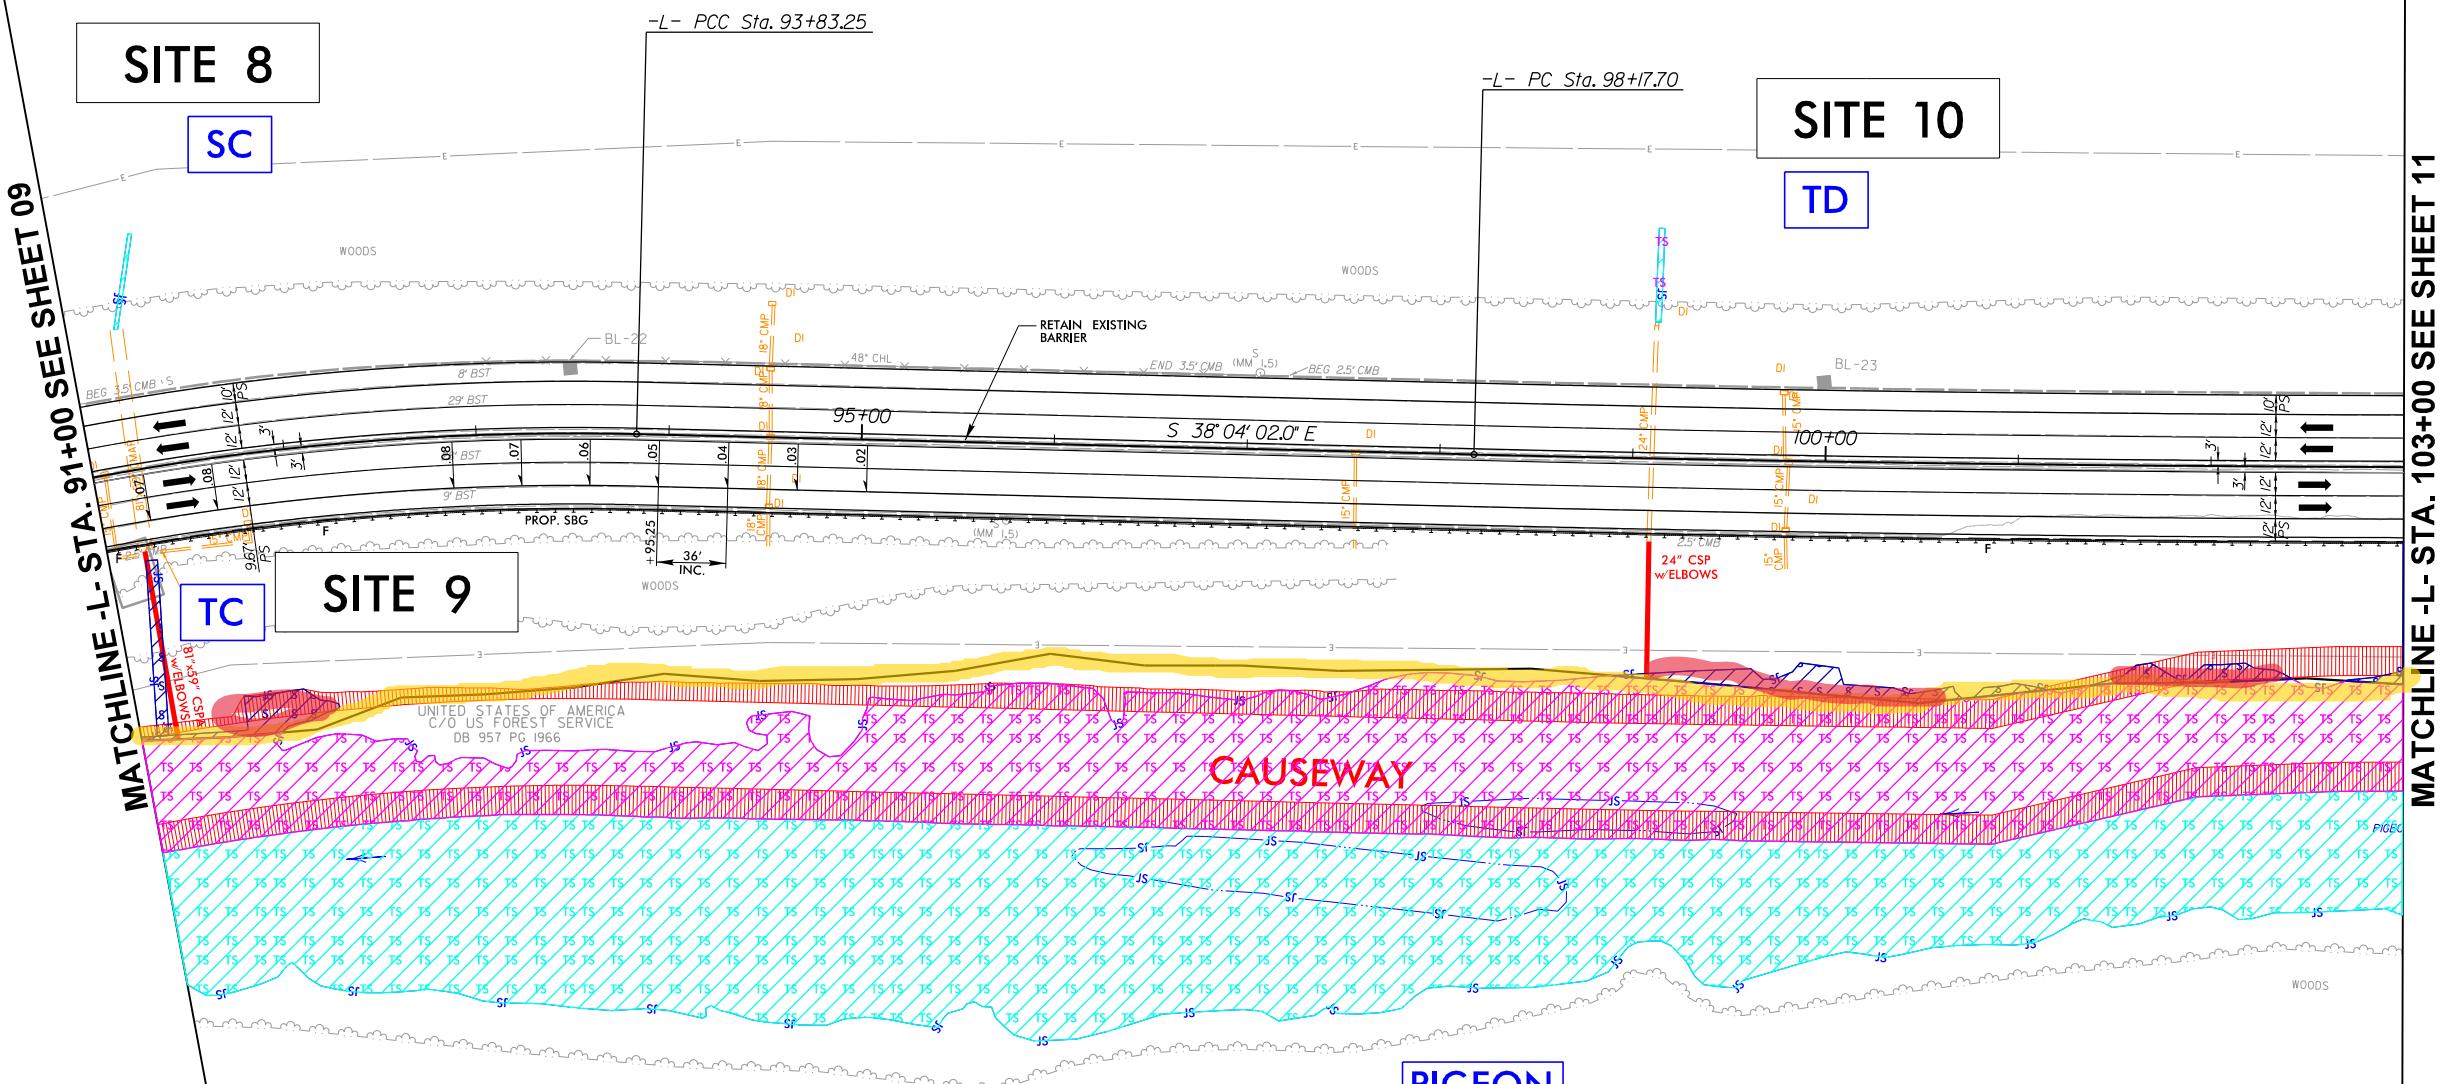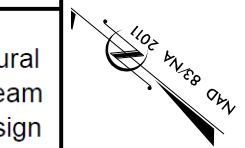

MATCHLINE L- STA. 91+00 SEE SHEET 09

MATCHLINE -L- STA. 103+00 SEE SHEET 11

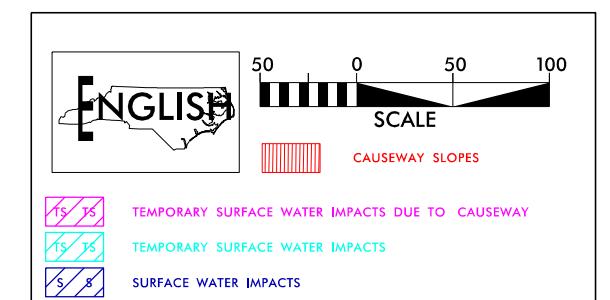

DESIGN EXCEPTION FOR SHOULDER  
WIDTH AND MINIMUM HORIZONTAL  
SIGHT DISTANCE.

FOR -L\_LT- PROFILE SEE SHEET 30  
FOR -L\_RT- PROFILE SEE SHEET 30

PROJECT REFERENCE NO. I-40 PIGEON RIVER	SHEET NO. II
RW SHEET NO.	
ROADWAY DESIGN ENGINEER	HYDRAULICS ENGINEER

INCOMPLETE PLANS  
DO NOT USE FOR R/W ACQUISITION

DOCUMENT NOT CONSIDERED FINAL  
UNLESS ALL SIGNATURES COMPLETED

PERMIT DRAWING  
SHEET 19 OF 62


REVISED 5/28/2025

### WETLAND AND SURFACE WATER IMPACTS SUMMARY

Site No.	Station (From/To)	Structure Size / Type	WETLAND IMPACTS					SURFACE WATER IMPACTS				
			Permanent Fill In Wetlands (ac)	Temp. Fill In Wetlands (ac)	Excavation in Wetlands (ac)	Mechanized Clearing in Wetlands (ac)	Hand Clearing in Wetlands (ac)	Permanent SW impacts (ac)	Temp. SW impacts (ac)	Existing Channel Impacts Permanent (ft)	Existing Channel Impacts Temp. (ft)	Natural Stream Design (ft)
1 (PSH 11)	-L- Sta. 103+00 to 117+00	PR; Causeway; Wall						0.434	1.860	891	481	
1 (PSH 11)	-L- Sta. 103+00 to 117+00	PR, Non-Causeway							1.915			

C/O US FOREST SERVICE  
DB 957 PG 1966

NA 83 NA 20°

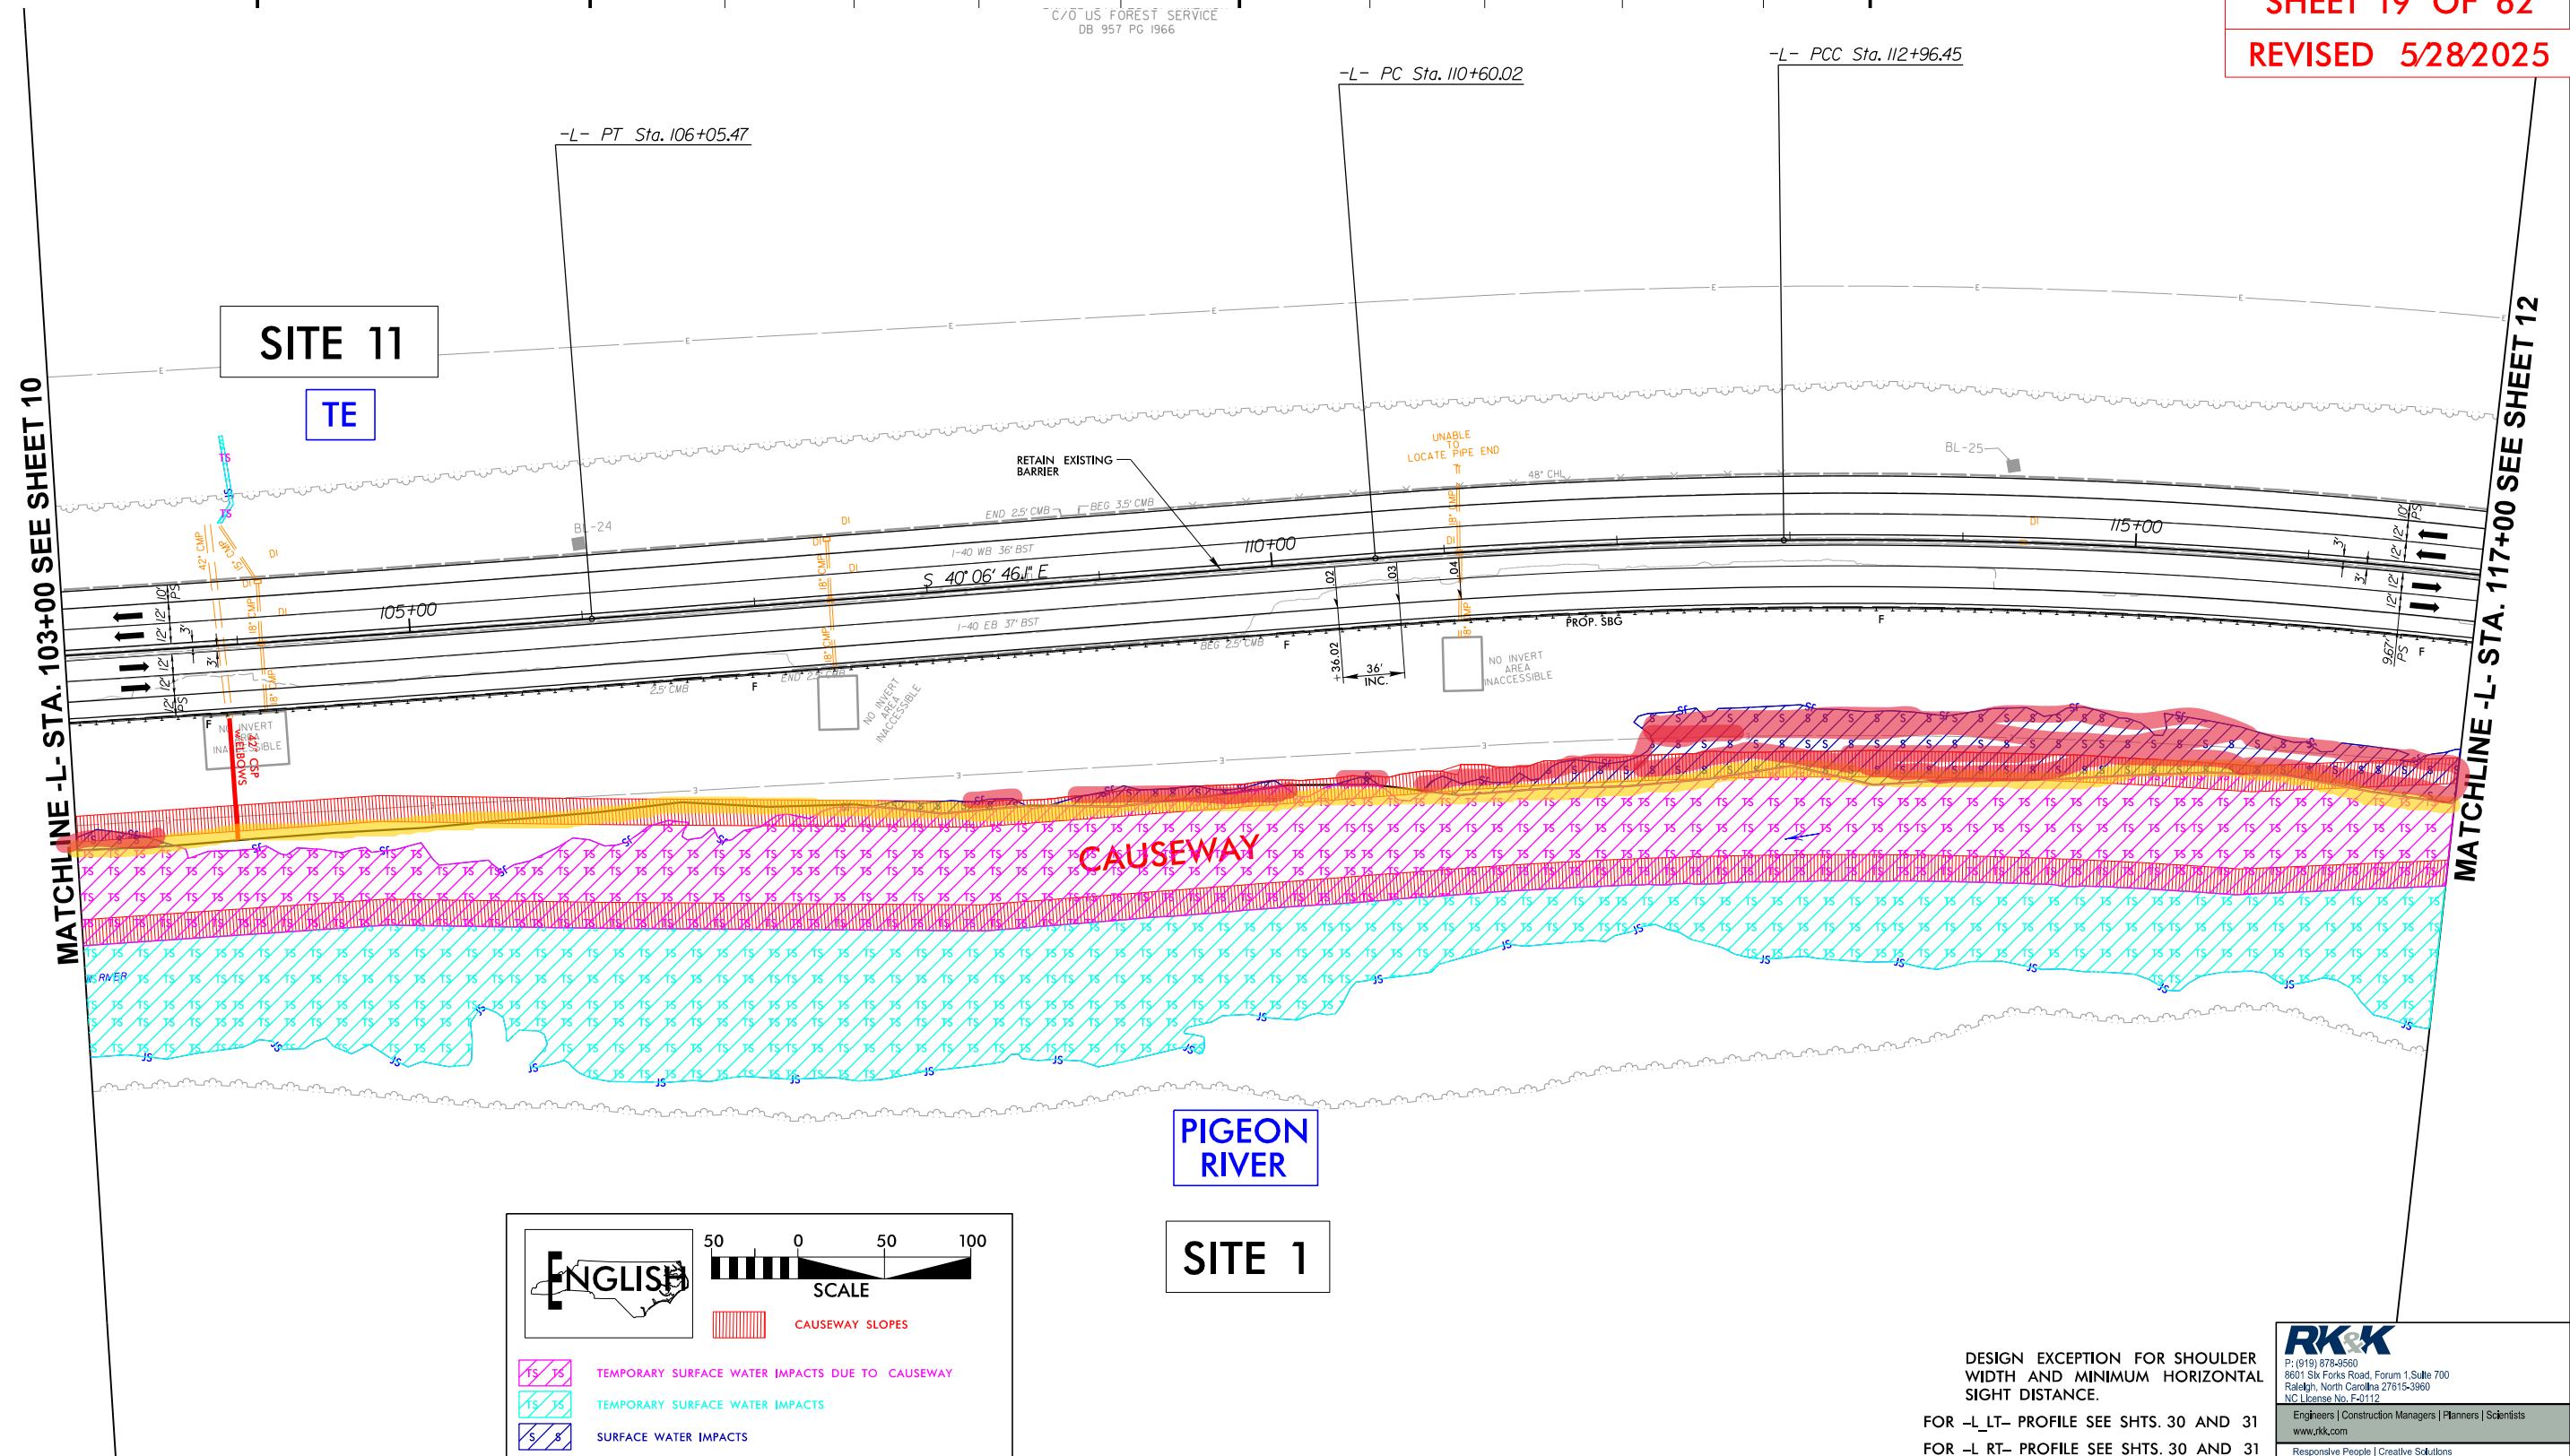


WETLAND AND SURFACE WATER IMPACTS SUMMARY											ROADWAY DESIGN ENGINEER	HYDRAULICS ENGINEER	
WETLAND IMPACTS													
Site No.	Station (From/To)	Structure Size / Type	Permanent Fill In Wetlands (ac)	Temp. Fill In Wetlands (ac)	Excavation in Wetlands (ac)	Mechanized Clearing in Wetlands (ac)	Hand Clearing in Wetlands (ac)	Permanent SW impacts (ac)	Temp. SW impacts (ac)	Existing Channel Impacts Permanent (ft)	Existing Channel Impacts Temp. (ft)	Natural Stream Design (ft)	
1 (PSH 12)	-L- Sta. 117+00 to 131+00	PR; Causeway; Wall						0.519	0.449	838	653		
1 (PSH 12)	-L- Sta. 117+00 to 131+00	PR; Non-Causeway							2.030				

PROJECT REFERENCE NO.		SHEET NO.
<b>NO PIGEON RIVER</b>		<b>12</b>
RW SHEET NO.		
DADWAY DESIGN ENGINEER		HYDRAULICS ENGINEER
<b>INCOMPLETE PLANS</b> DO NOT USE FOR R/W ACQUISITION		

**DOCUMENT NOT CONSIDERED FINAL  
UNLESS ALL SIGNATURES COMPLETED**


PERMIT DRAWING  
SHEET 21 OF 62

REVISED 5/28/2025

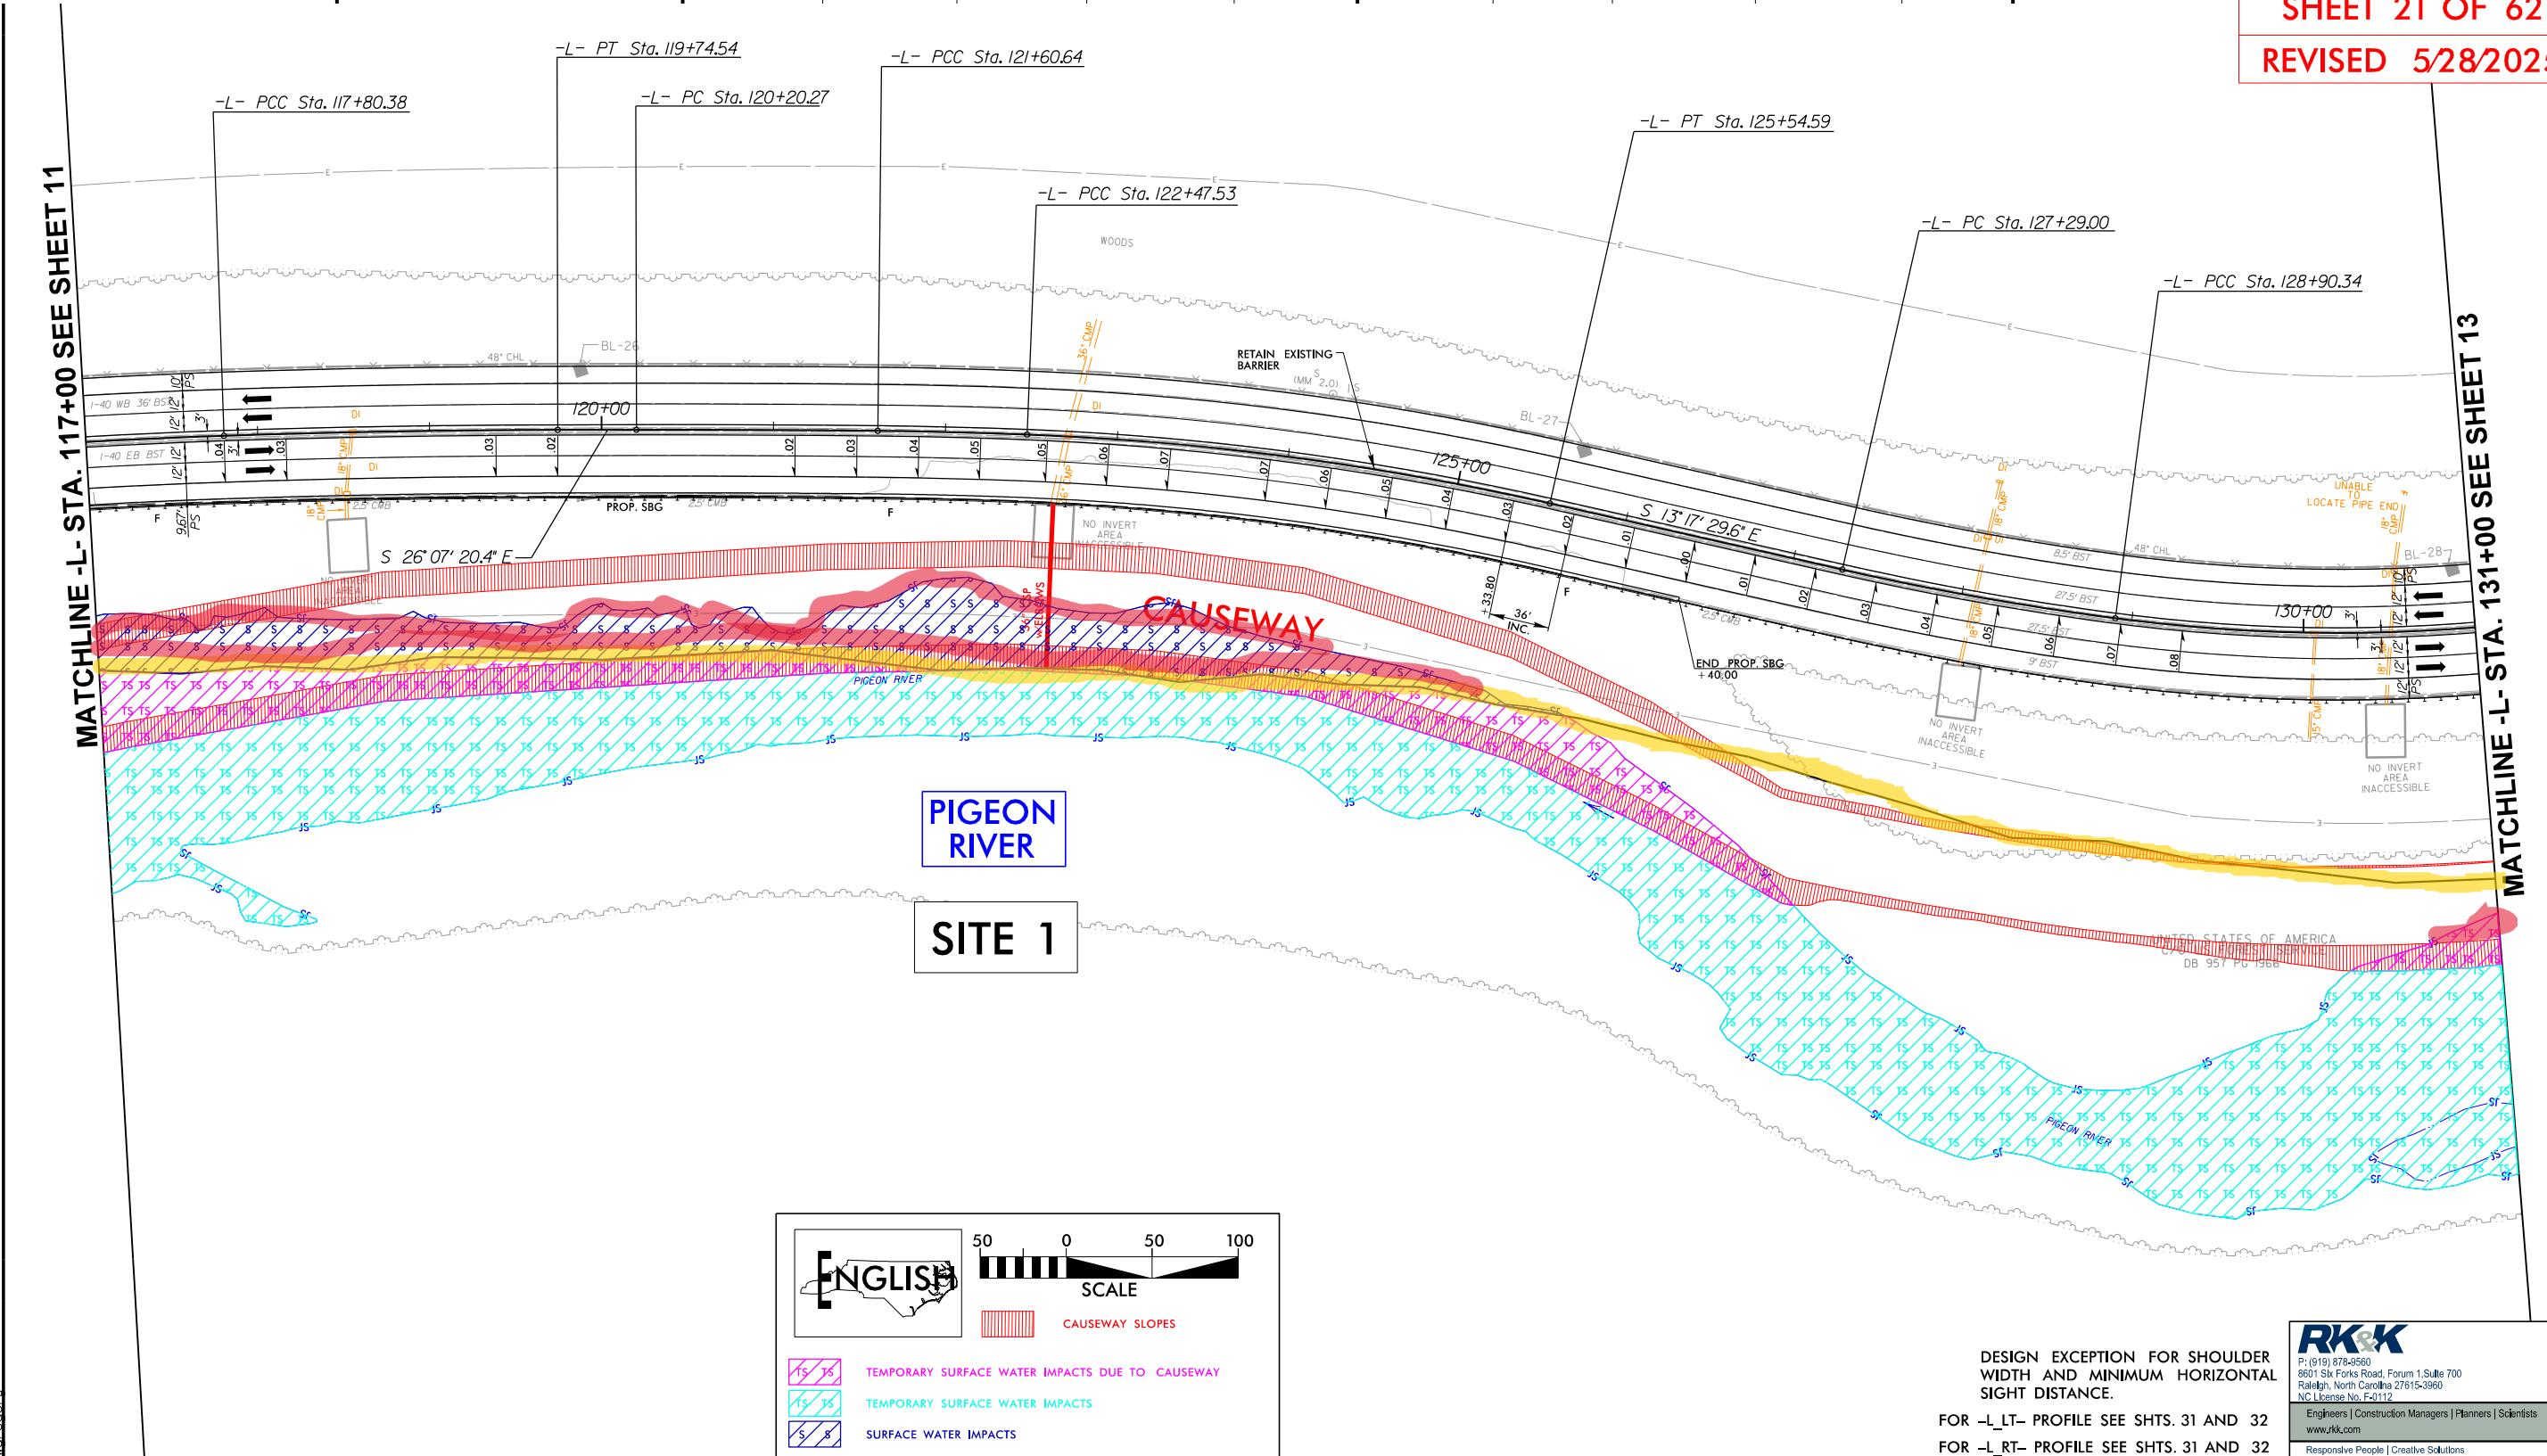


PROJECT REFERENCE NO.		SHEET NO.
I-40 PIGEON RIVER		13
RW SHEET NO.		
ROADWAY DESIGN ENGINEER		HYDRAULICS ENGINEER
INCOMPLETE PLANS DO NOT USE FOR R/W ACQUISITION		
DOCUMENT NOT CONSIDERED FINAL UNLESS ALL SIGNATURES COMPLETED		
<b>PERMIT DRAWING SHEET 23 OF 62</b>		
<b>REVISED 5/28/2025</b>		

Site No.	Station (From/To)	Structure Size / Type	WETLAND IMPACTS					SURFACE WATER IMPACTS				
			Permanent Fill In Wetlands (ac)	Temp. Fill In Wetlands (ac)	Excavation in Wetlands (ac)	Mechanized Clearing in Wetlands (ac)	Hand Clearing in Wetlands (ac)	Permanent SW impacts (ac)	Temp. SW impacts (ac)	Existing Channel Impacts Permanent (ft)	Existing Channel Impacts Temp. (ft)	Natural Stream Design (ft)
1 (PSH 13)	-L- Sta. 131+00 to 145+00	PR; Causeway; Wall						0.733	2.113	1322	97	
1 (PSH 13)	-L- Sta. 131+00 to 145+00	PR; Non-Causeway						2.772				

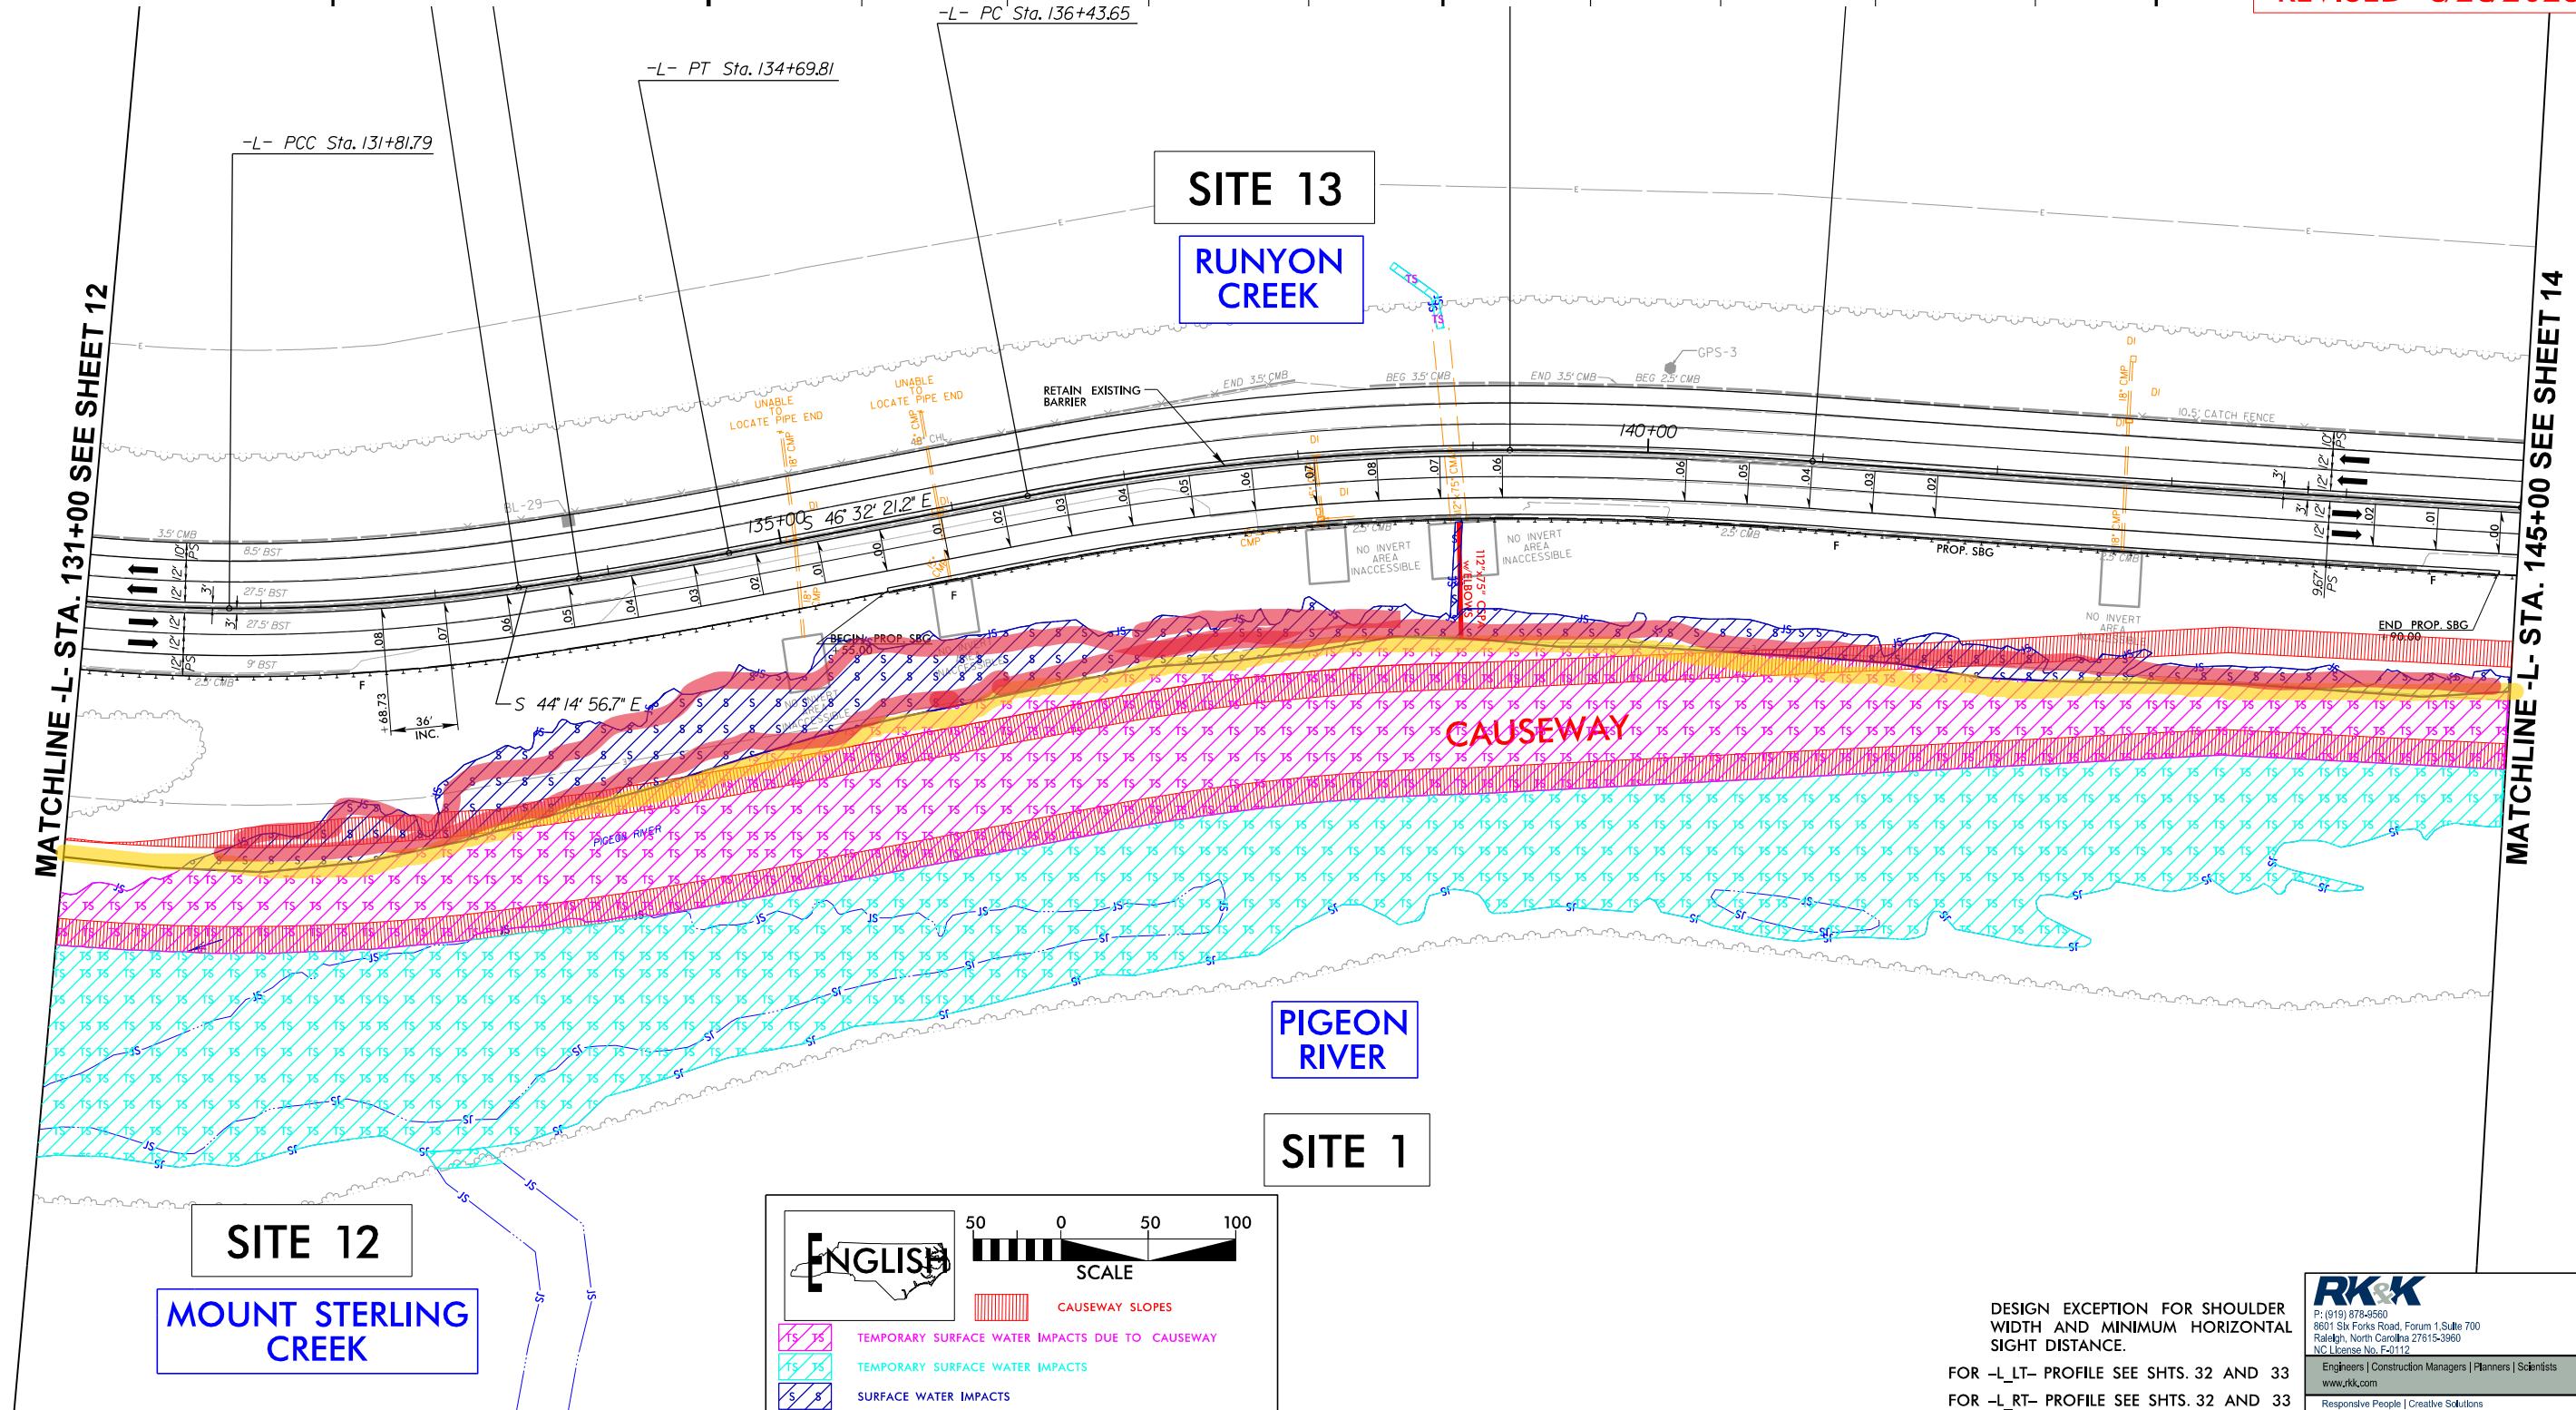

## WETLAND AND SURFACE WATER IMPACTS SUMMARY

WETLAND AND SURACE WATER IMPACTS SUMMARY												
Site No.	Station (From/To)	Structure Size / Type	WETLAND IMPACTS					SURFACE WATER IMPACTS				
			Permanent Fill In Wetlands (ac)	Temp. Fill In Wetlands (ac)	Excavation in Wetlands (ac)	Mechanized Clearing in Wetlands (ac)	Hand Clearing in Wetlands (ac)	Permanent SW impacts (ac)	Temp. SW impacts (ac)	Existing Channel Impacts Permanent (ft)	Existing Channel Impacts Temp. (ft)	Natural Stream Design (ft)
1 (PSH 14)	-L- Sta. 145+00 to 158+50	PR; Causeway; Wall						0.038	0.714	275	1229	
1 (PSH 14)	-L- Sta. 145+00 to 158+50	PR; Non-Causeway							3.085			

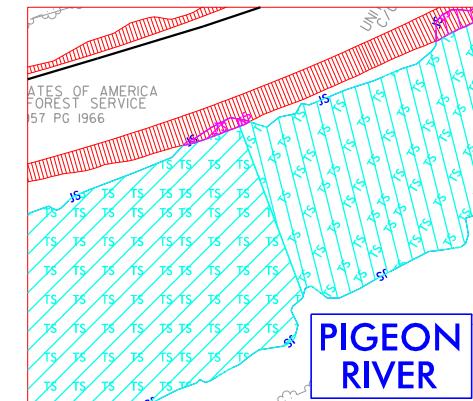

INSET A

**PERMIT DRAWING  
SHEET 25 OF 62**

REVISED 5/28/2025

**PERMIT DRAWING SHEET 25 OF 62**

**REVISED 5/28/2025**

**SITE 14 COUNTERFEIT BRANCH**

**SITE 1 CAUSEWAY**

**SEE INSET A**

**SCALE**

**DESIGN EXCEPTION FOR SHOULDER WIDTH AND MINIMUM HORIZONTAL SIGHT DISTANCE.**

**FOR -L\_LT- PROFILE SEE SHTS. 33 AND 34**

**FOR -L\_RT- PROFILE SEE SHTS. 33 AND 34**

**RK&K**  
P: (919) 878-9560  
6601 Six Forks Road, Forum 1, Suite 700  
Raleigh, North Carolina 27615-3960  
NC License No. F-0112  
www.rkk.com  
Engineers | Construction Managers | Planners | Scientists  
Responsive People | Creative Solutions

PROJECT REFERENCE NO. I-40 PIGEON RIVER	SHEET NO. 15
RW SHEET NO.	
ROADWAY DESIGN ENGINEER	HYDRAULICS ENGINEER
<b>INCOMPLETE PLANS DO NOT USE FOR R/W ACQUISITION</b>	

**DOCUMENT NOT CONSIDERED FINAL  
UNLESS ALL SIGNATURES COMPLETED**

**PERMIT DRAWING  
SHEET 27 OF 62**

**REVISED 5/28/2025**


### WETLAND AND SURFACE WATER IMPACTS SUMMARY

Site No.	Station (From/To)	Structure Size / Type	WETLAND IMPACTS					SURFACE WATER IMPACTS			
			Permanent Fill In Wetlands (ac)	Temp. Fill In Wetlands (ac)	Excavation in Wetlands (ac)	Mechanized Clearing in Wetlands (ac)	Hand Clearing in Wetlands (ac)	Permanent SW impacts (ac)	Temp. SW impacts (ac)	Existing Channel Impacts Permanent (ft)	Natural Stream Design (ft)
1 (PSH 15)	-L- Sta. 158+50 to 172+00	PR; Causeway; Wall						0.013	1.310	126	1419
1 (PSH 15)	-L- Sta. 158+50 to 172+00	PR; Non-Causeway						2.220			



UNITED STATES OF AMERICA  
C/O US FOREST SERVICE  
DB 957 PG 1966


**INSET A**

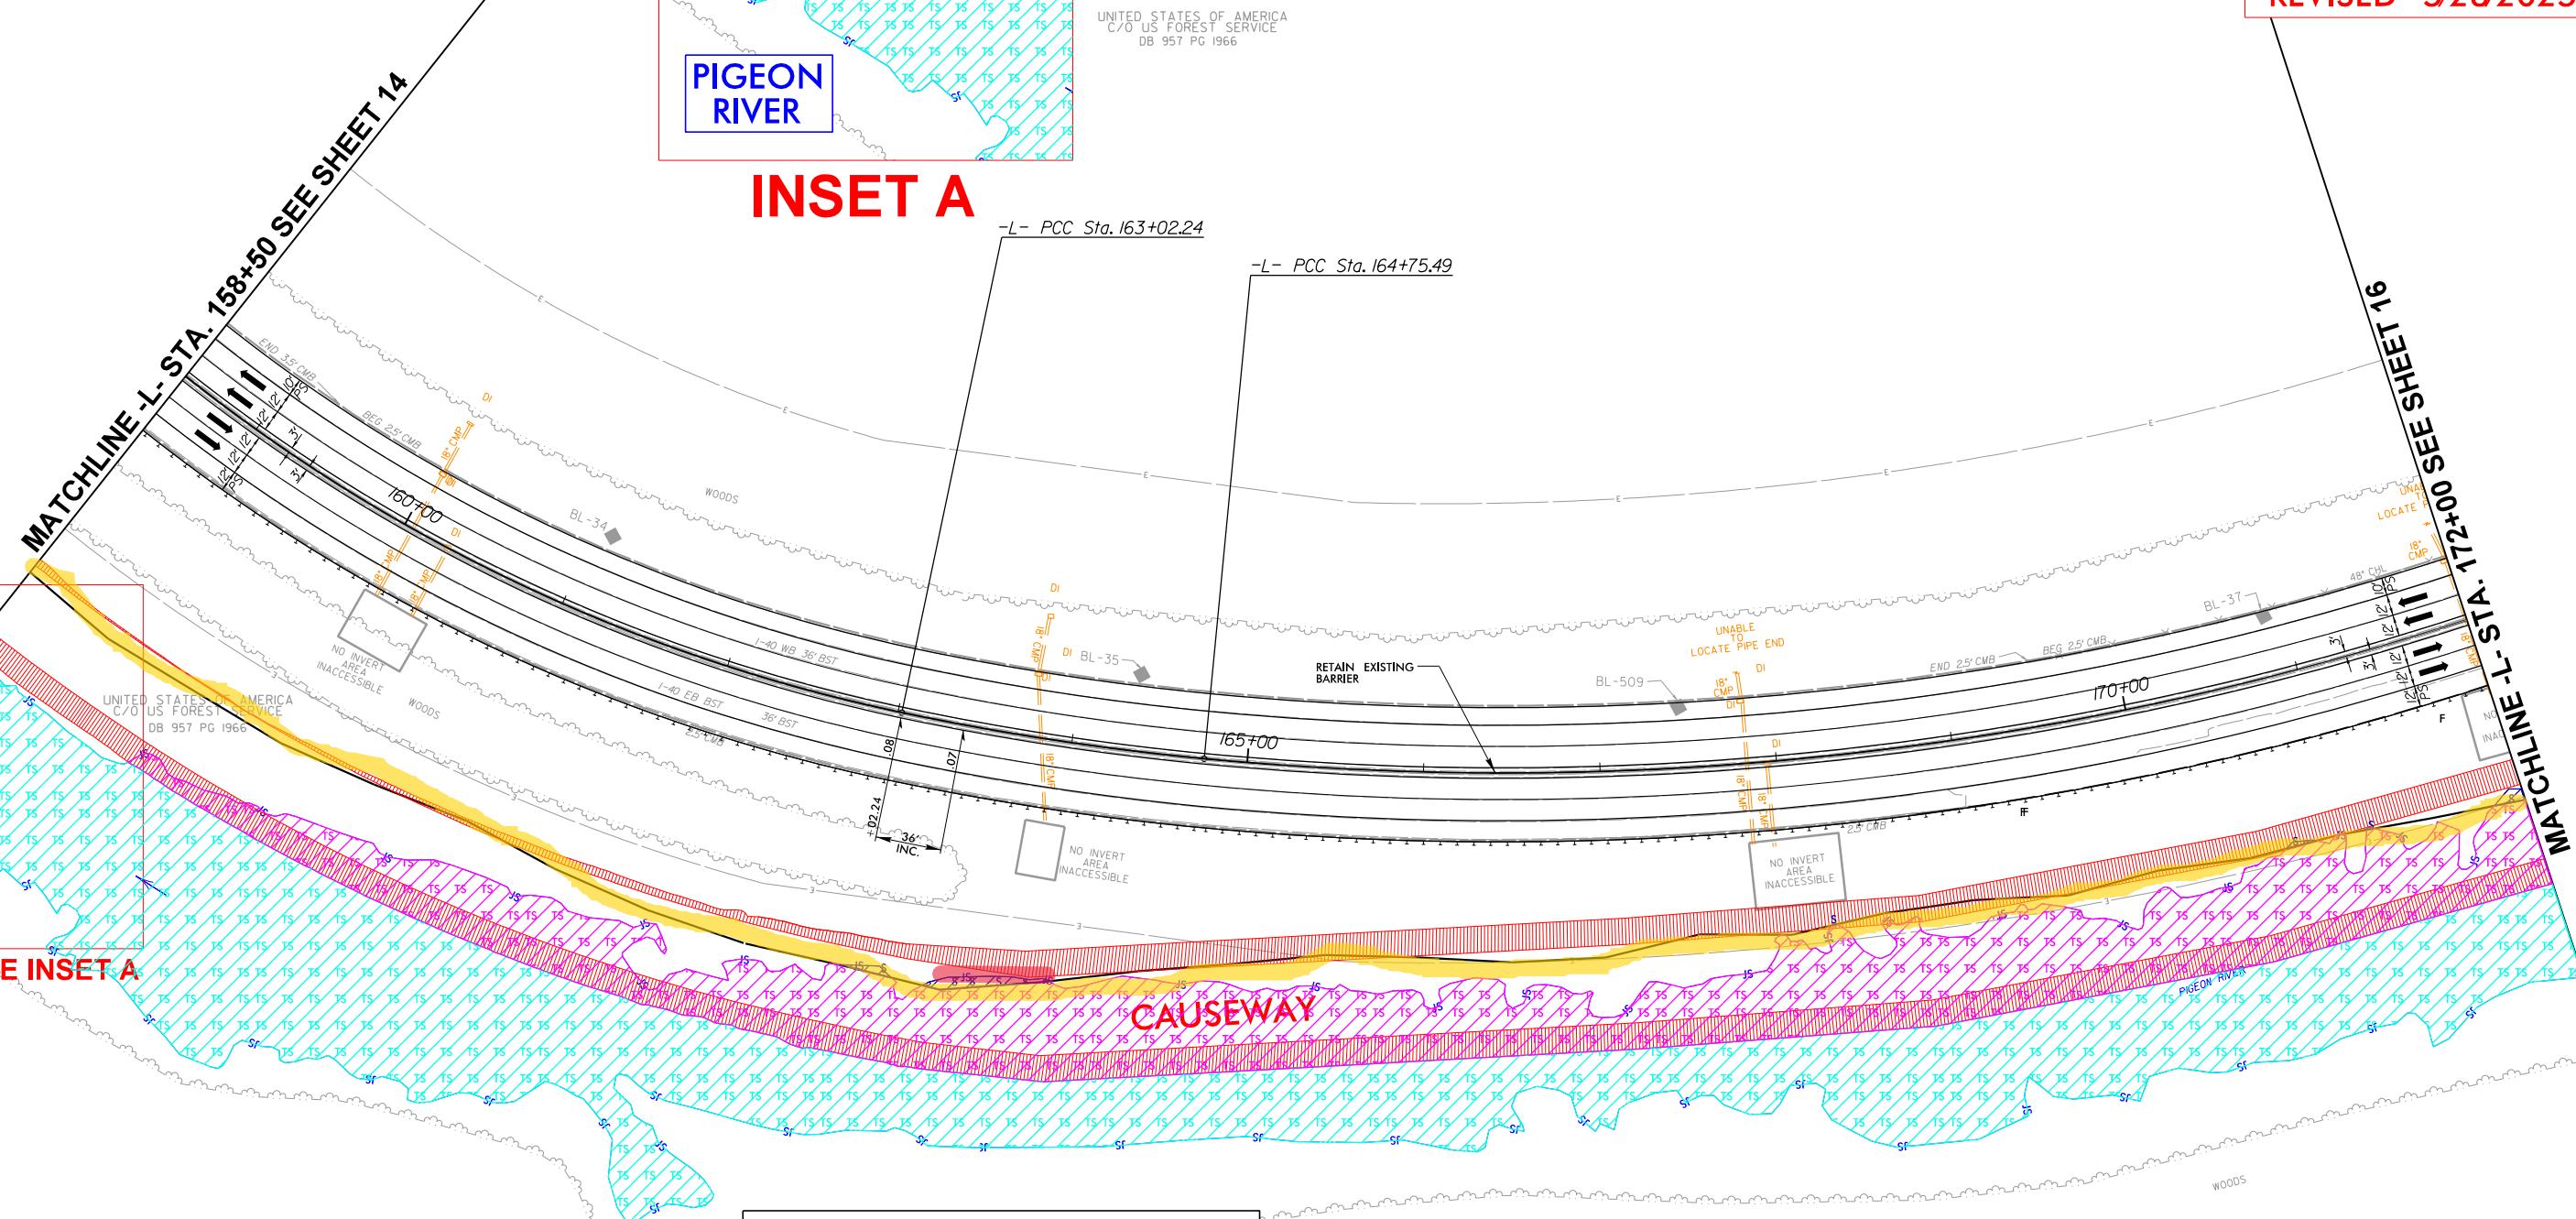

### WETLAND AND SURFACE WATER IMPACTS SUMMARY

Site No.	Station (From/To)	Structure Size / Type	WETLAND IMPACTS					SURFACE WATER IMPACTS				
			Permanent Fill In Wetlands (ac)	Temp. Fill In Wetlands (ac)	Excavation in Wetlands (ac)	Mechanized Clearing in Wetlands (ac)	Hand Clearing in Wetlands (ac)	Permanent SW impacts (ac)	Temp. SW impacts (ac)	Existing Channel Impacts Permanent (ft)	Existing Channel Impacts Temp. (ft)	Natural Stream Design (ft)
1 (PSH 16)	-L- Sta. 172+00 to 186+00	PR; Causeway; Wall						0.195	1.180	418	1044	
1 (PSH 16)	-L- Sta. 172+00 to 186+00	PR; Non-Causeway						2.461				

PROJECT REFERENCE NO. I-40 PIGEON RIVER	SHEET NO. 16
RW SHEET NO.	
ROADWAY DESIGN ENGINEER	HYDRAULICS ENGINEER
<b>INCOMPLETE PLANS DO NOT USE FOR R/W ACQUISITION</b>	
<b>DOCUMENT NOT CONSIDERED FINAL UNLESS ALL SIGNATURES COMPLETED</b>	
<b>PERMIT DRAWING SHEET 29 OF 62</b>	
<b>REVISED 5/28/2025</b>	

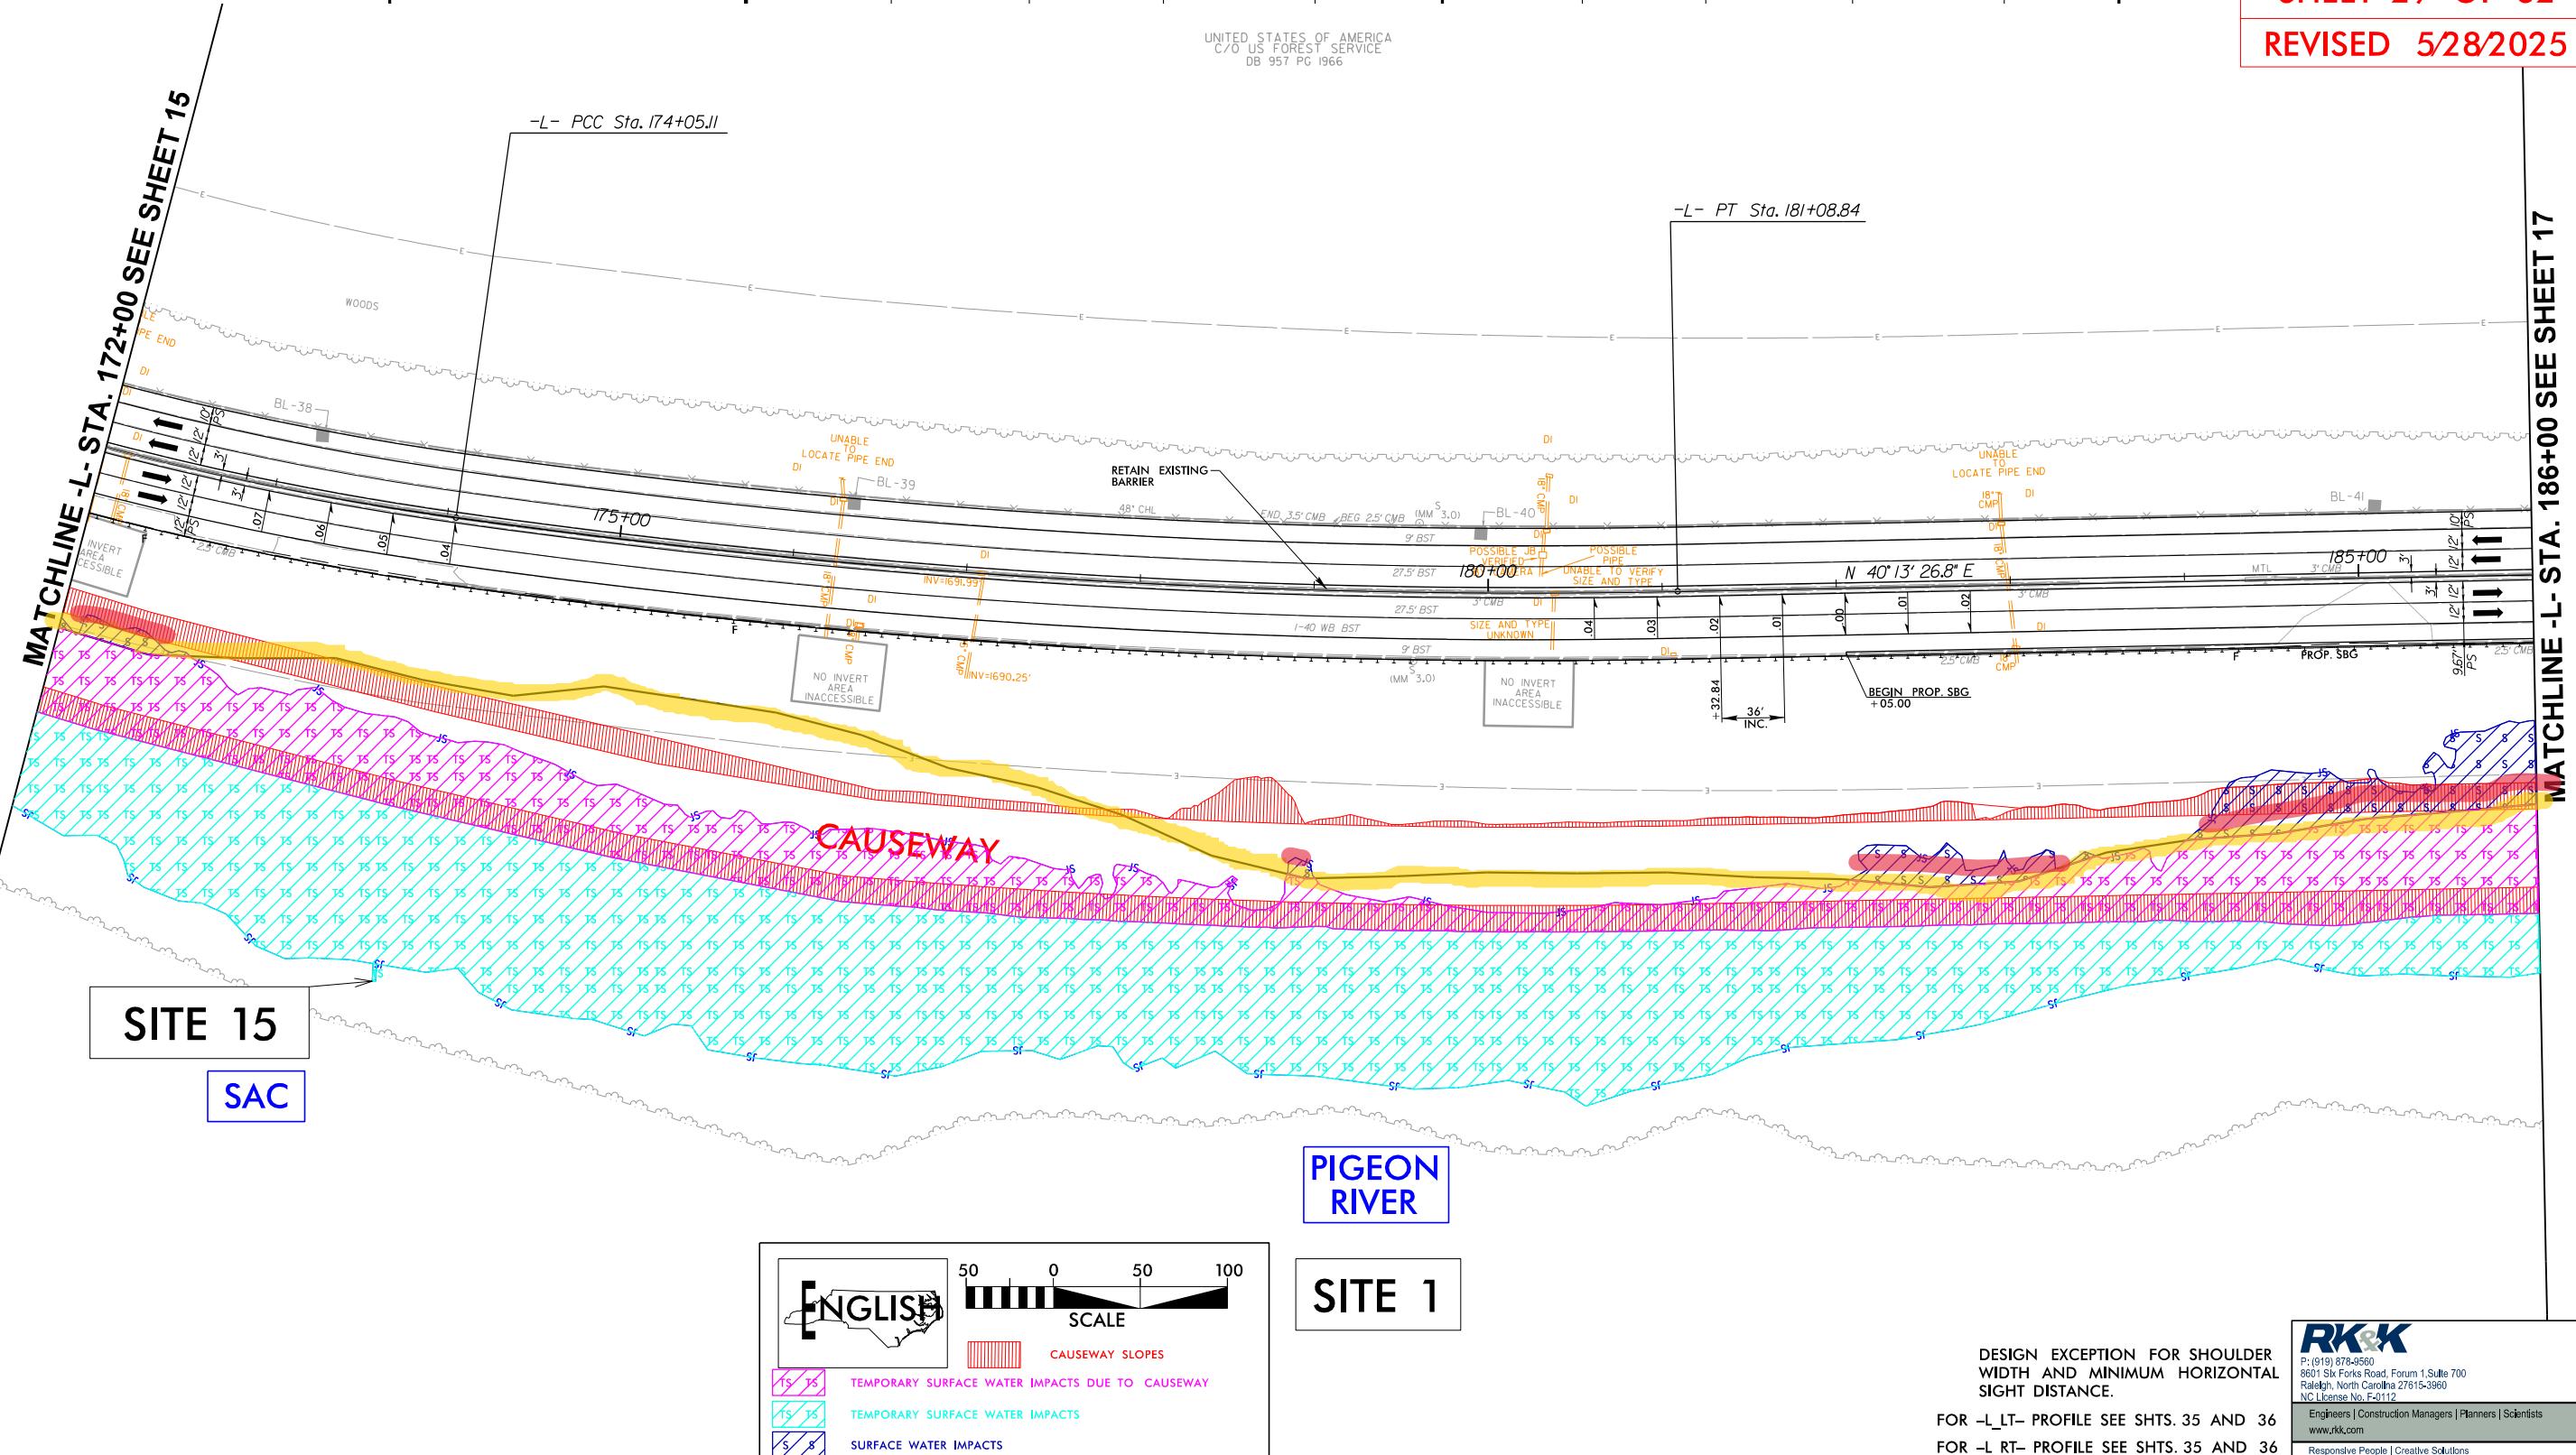


INCOMPLETE PLANS  
DO NOT USE FOR R/W ACQUISITIONDOCUMENT NOT CONSIDERED FINAL  
UNLESS ALL SIGNATURES COMPLETEDPERMIT DRAWING  
SHEET 31 OF 62

REVISED 5/28/2025


WETLAND AND SURFACE WATER IMPACTS SUMMARY												
Site No.	Station (From/To)	Structure Size / Type	WETLAND IMPACTS					SURFACE WATER IMPACTS				
			Permanent Fill In Wetlands (ac)	Temp. Fill In Wetlands (ac)	Excavation in Wetlands (ac)	Mechanized Clearing in Wetlands (ac)	Hand Clearing in Wetlands (ac)	Permanent SW impacts (ac)	Temp. SW impacts (ac)	Existing Channel Impacts Permanent (ft)	Existing Channel Impacts Temp. (ft)	Natural Stream Design (ft)
1 (PSH 17)	-L- Sta. 186+00 to 200+00	PR; Causeway; Wall						0.113	1.278	193	1176	
1 (PSH 17)	-L- Sta. 186+00 to 200+00	PR; Non-Causeway						2.277				

NAD 83/NA 2011

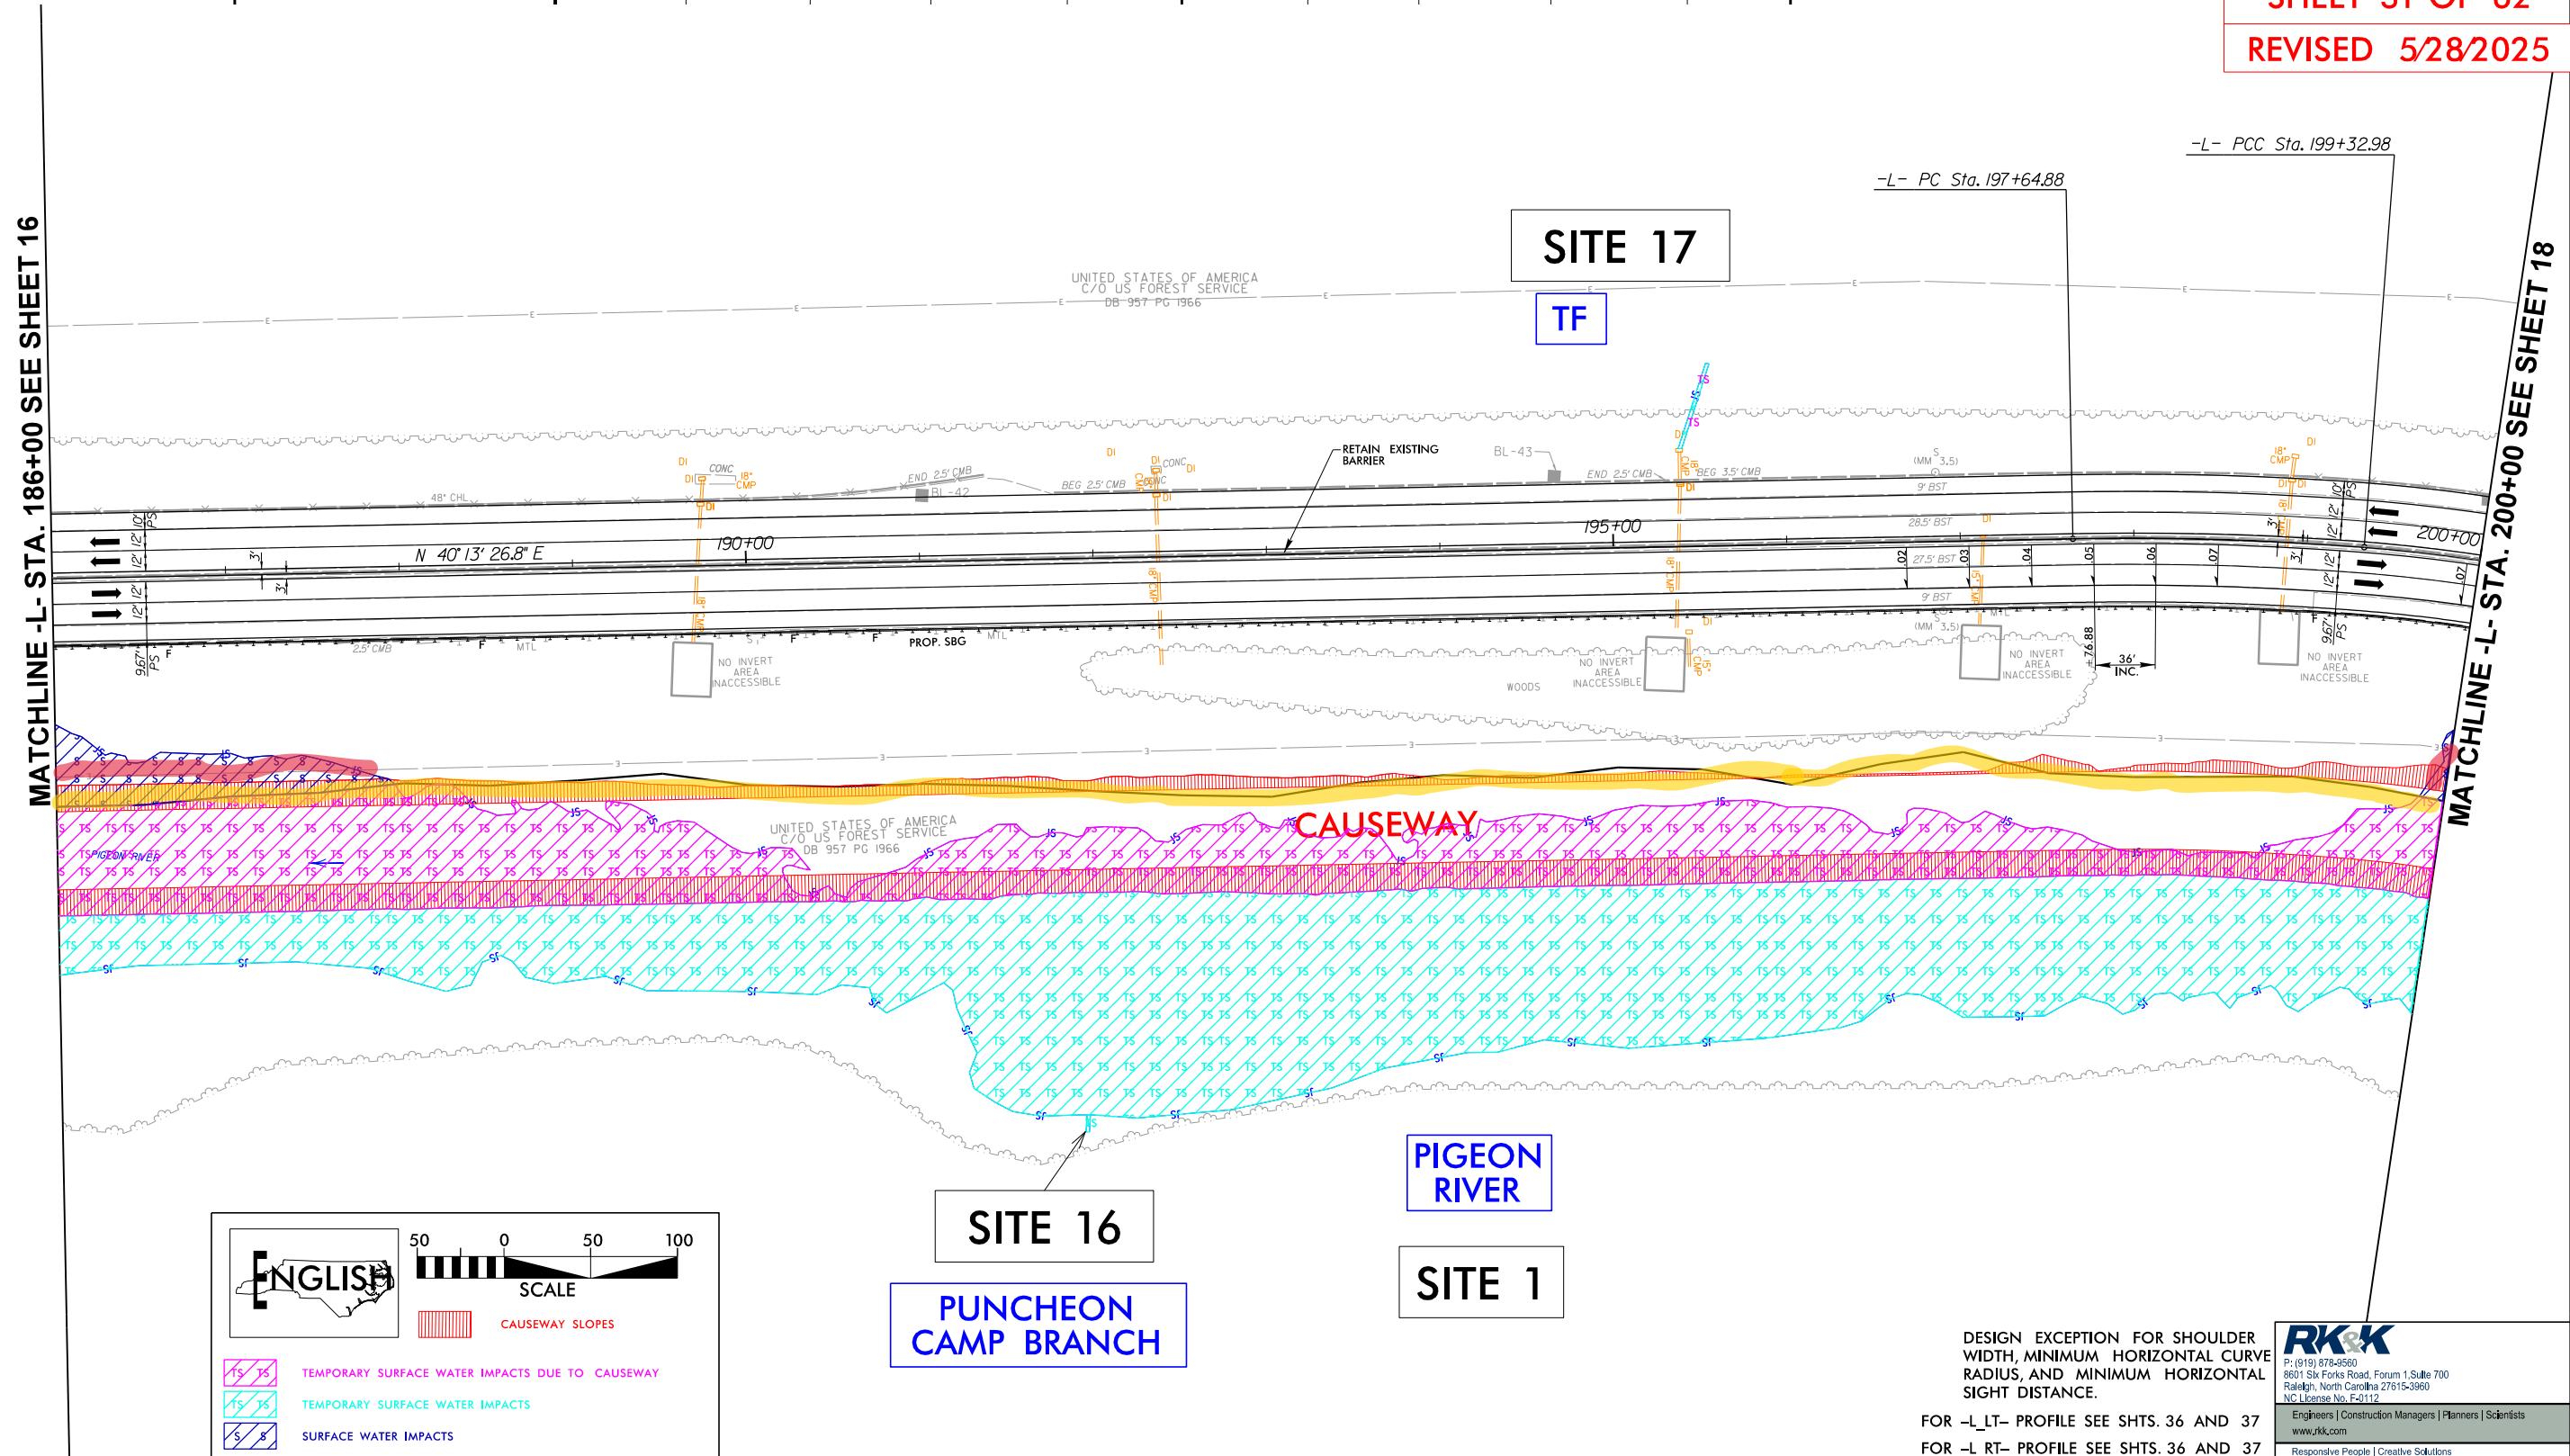

WETLAND AND SURFACE WATER IMPACTS SUMMARY											
Site No.	Station (From/To)	Structure Size / Type	WETLAND IMPACTS					SURFACE WATER IMPACTS			
			Permanent Fill In Wetlands (ac)	Temp. Fill In Wetlands (ac)	Excavation in Wetlands (ac)	Mechanized Clearing in Wetlands (ac)	Hand Clearing in Wetlands (ac)	Permanent SW impacts (ac)	Temp. SW impacts (ac)	Existing Channel Impacts Permanent (ft)	Natural Stream Design (ft)
1 (PSH 18)	-L- Sta. 200+00 to -L_EB- 11+00	PR; Causeway; Wall						0.853	1.668	723	491
1 (PSH 18)	-L- Sta. 200+00 to -L_EB- 11+00	PR; Non-Causeway						1.572			

PROJECT REFERENCE NO. I-40 PIGEON RIVER	SHEET NO. 18
RW SHEET NO.	
ROADWAY DESIGN ENGINEER	HYDRAULICS ENGINEER
INCOMPLETE PLANS DO NOT USE FOR R/W ACQUISITION	
DOCUMENT NOT CONSIDERED FINAL UNLESS ALL SIGNATURES COMPLETED	
NAD 83 NA 2011	
PERMIT DRAWING SHEET 33 OF 62	
REVISED 5/28/2025	

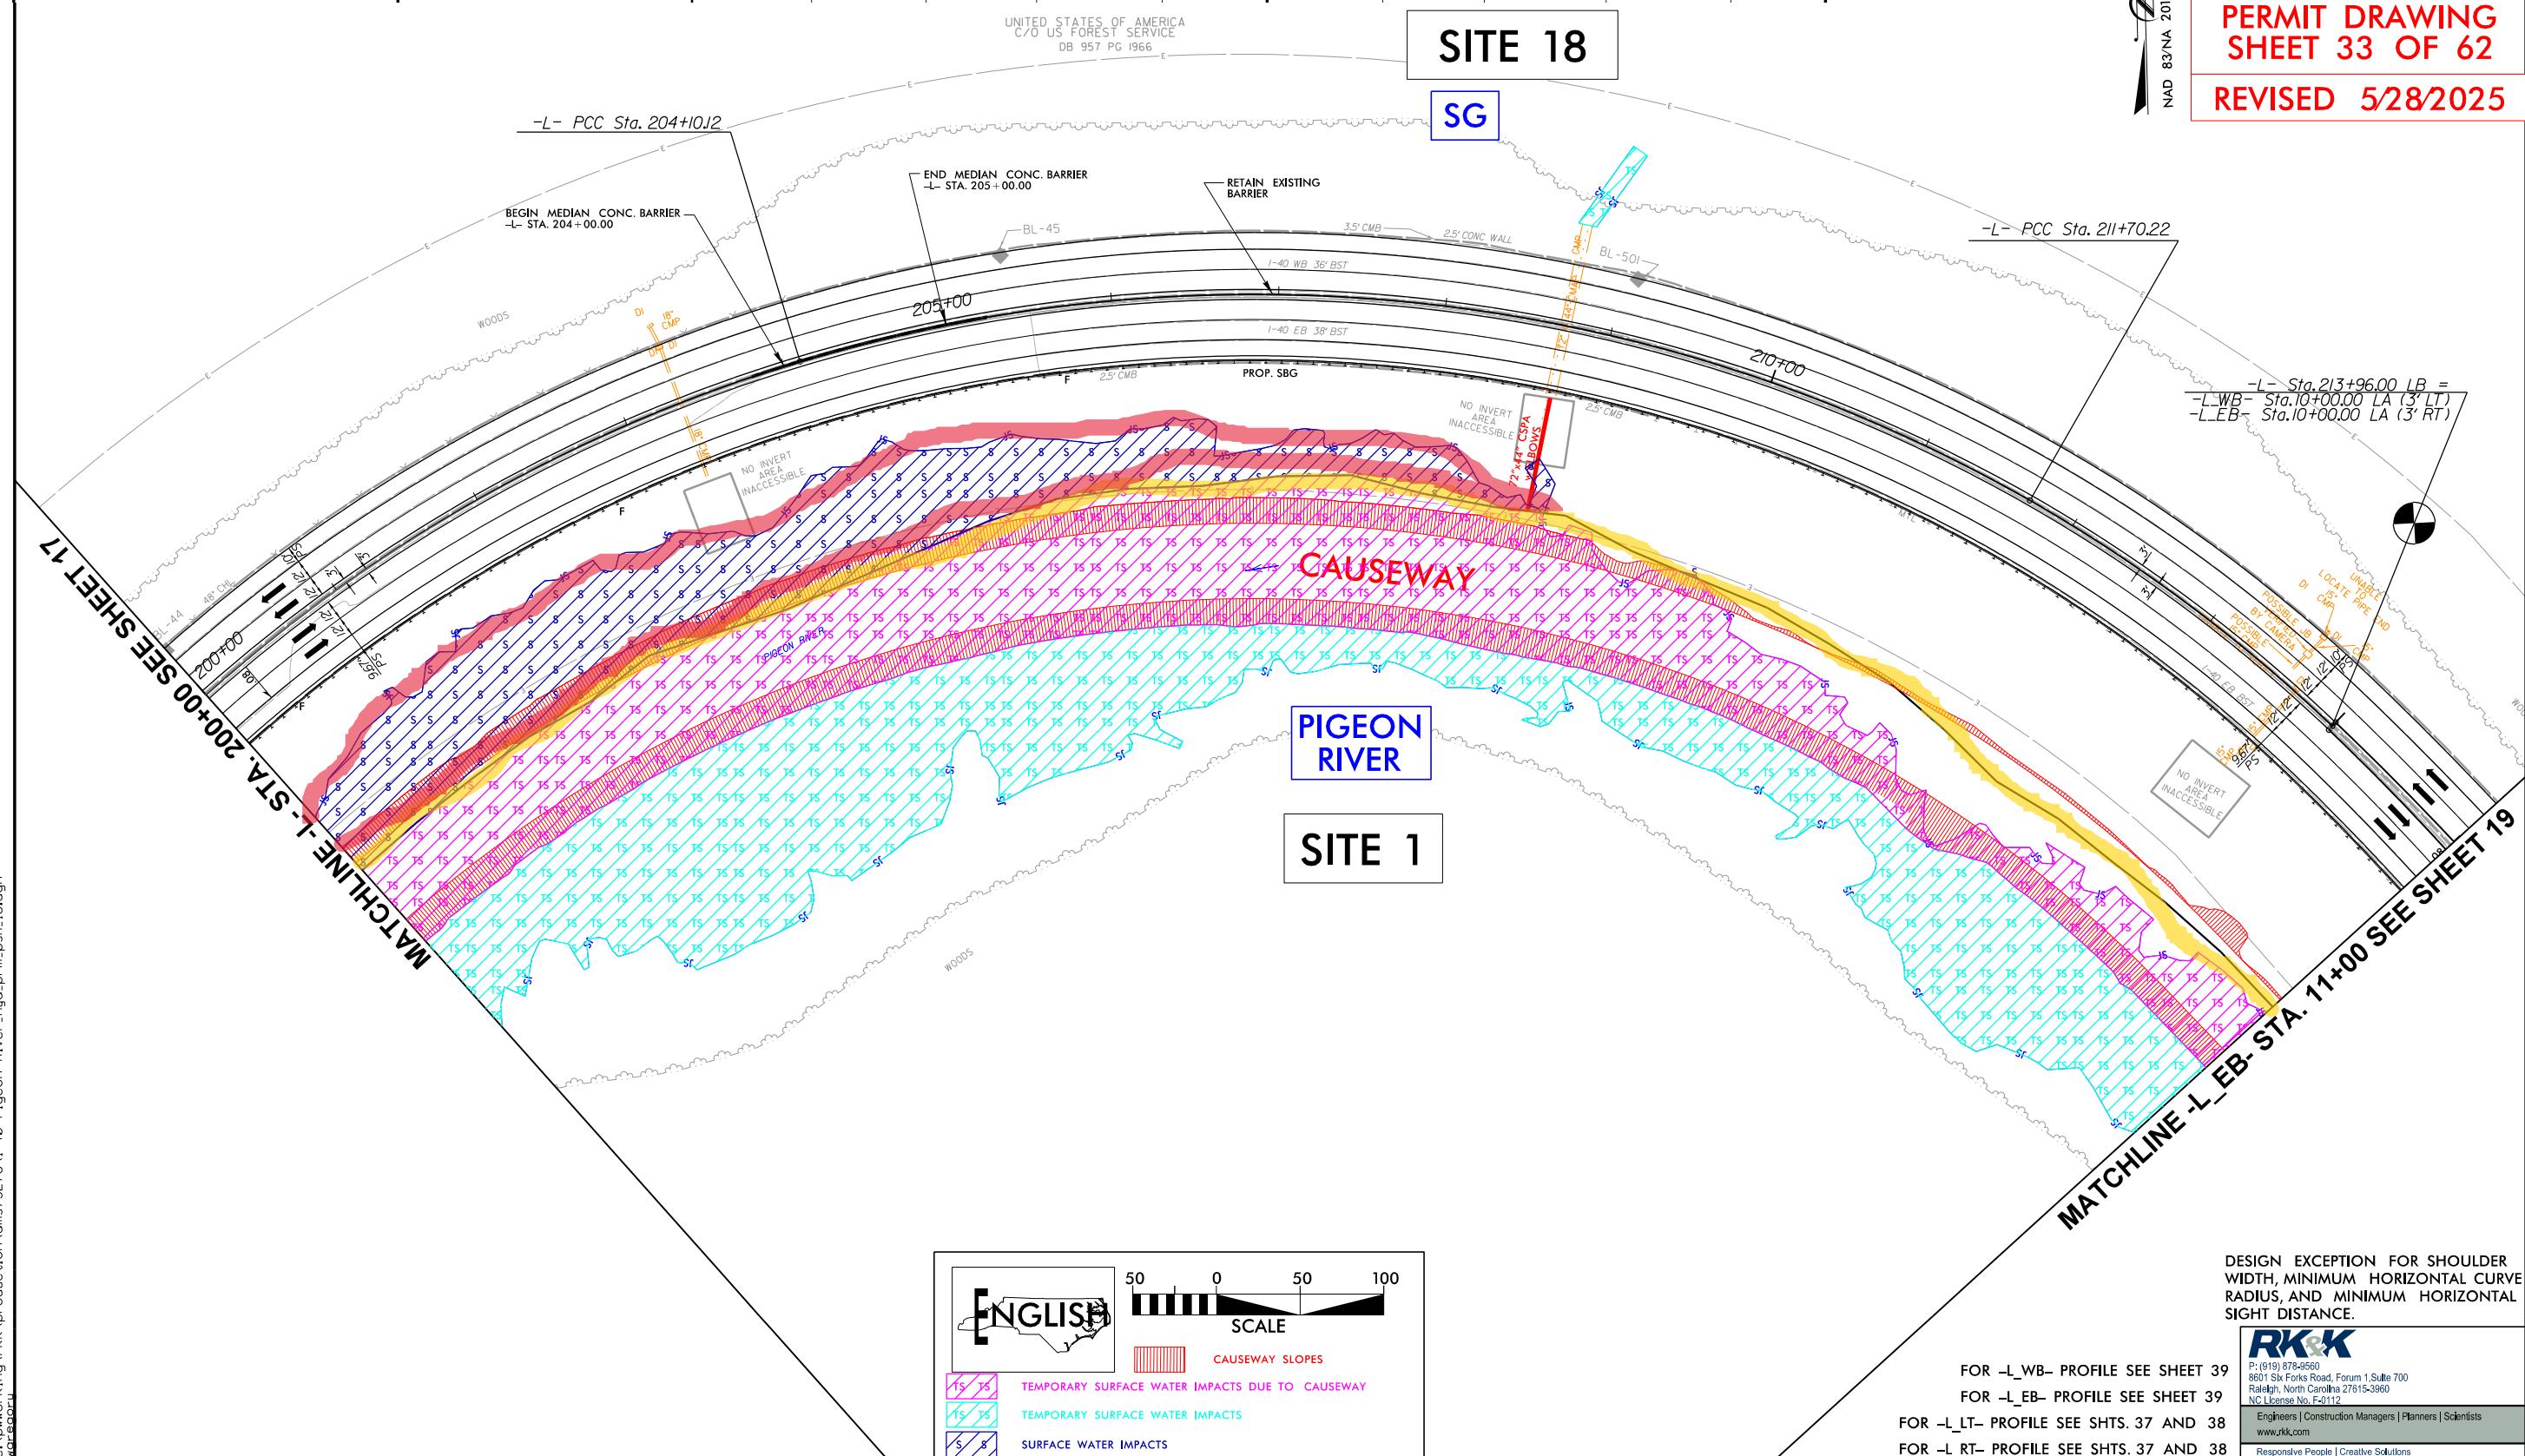

PROJECT REFERENCE NO. I-40 PIGEON RIVER SHEET NO. 19  
 RW SHEET NO.  
 ROADWAY DESIGN ENGINEER HYDRAULICS ENGINEER  
 INCOMPLETE PLANS DO NOT USE FOR R/W ACQUISITION  
 DOCUMENT NOT CONSIDERED FINAL UNLESS ALL SIGNATURES COMPLETED  
**PERMIT DRAWING SHEET 35 OF 62**  
**REVISED 5/28/2025**

Site No.	Station (From/To)	Structure Size / Type	WETLAND IMPACTS				SURFACE WATER IMPACTS					
			Permanent Fill In Wetlands (ac)	Temp. Fill In Wetlands (ac)	Excavation in Wetlands (ac)	Mechanized Clearing in Wetlands (ac)	Hand Clearing in Wetlands (ac)	Permanent SW impacts (ac)	Temp. SW impacts (ac)	Existing Channel Impacts Permanent (ft)	Existing Channel Impacts Temp. (ft)	Natural Stream Design (ft)
1 (PSH 19)	-L_EB- Sta. 11+00 to 21+57.61	PR; Causeway; Wall						0.271	0.581	448	756	
1 (PSH 19)	-L_EB- Sta. 11+00 to 21+57.61	PR; Non-Causeway							2.088			


$R = 680.00'$   
 DS = 20 MPH  
 SE = EXIST.

$R = 1,250.00'$   
 DS = 20 MPH  
 SE = EXIST.

UNITED STATES OF AMERICA  
 C/O US FOREST SERVICE  
 DB 957 PG 1966

### MATCHLINE -L\_EB- STA. 11+00 SEE SHEET 18

6/3/2025 c:\pw\working\rkk\production\dms\3276\I-40\_Pigeon\_River-Hydr-prm-psn.19.dgn

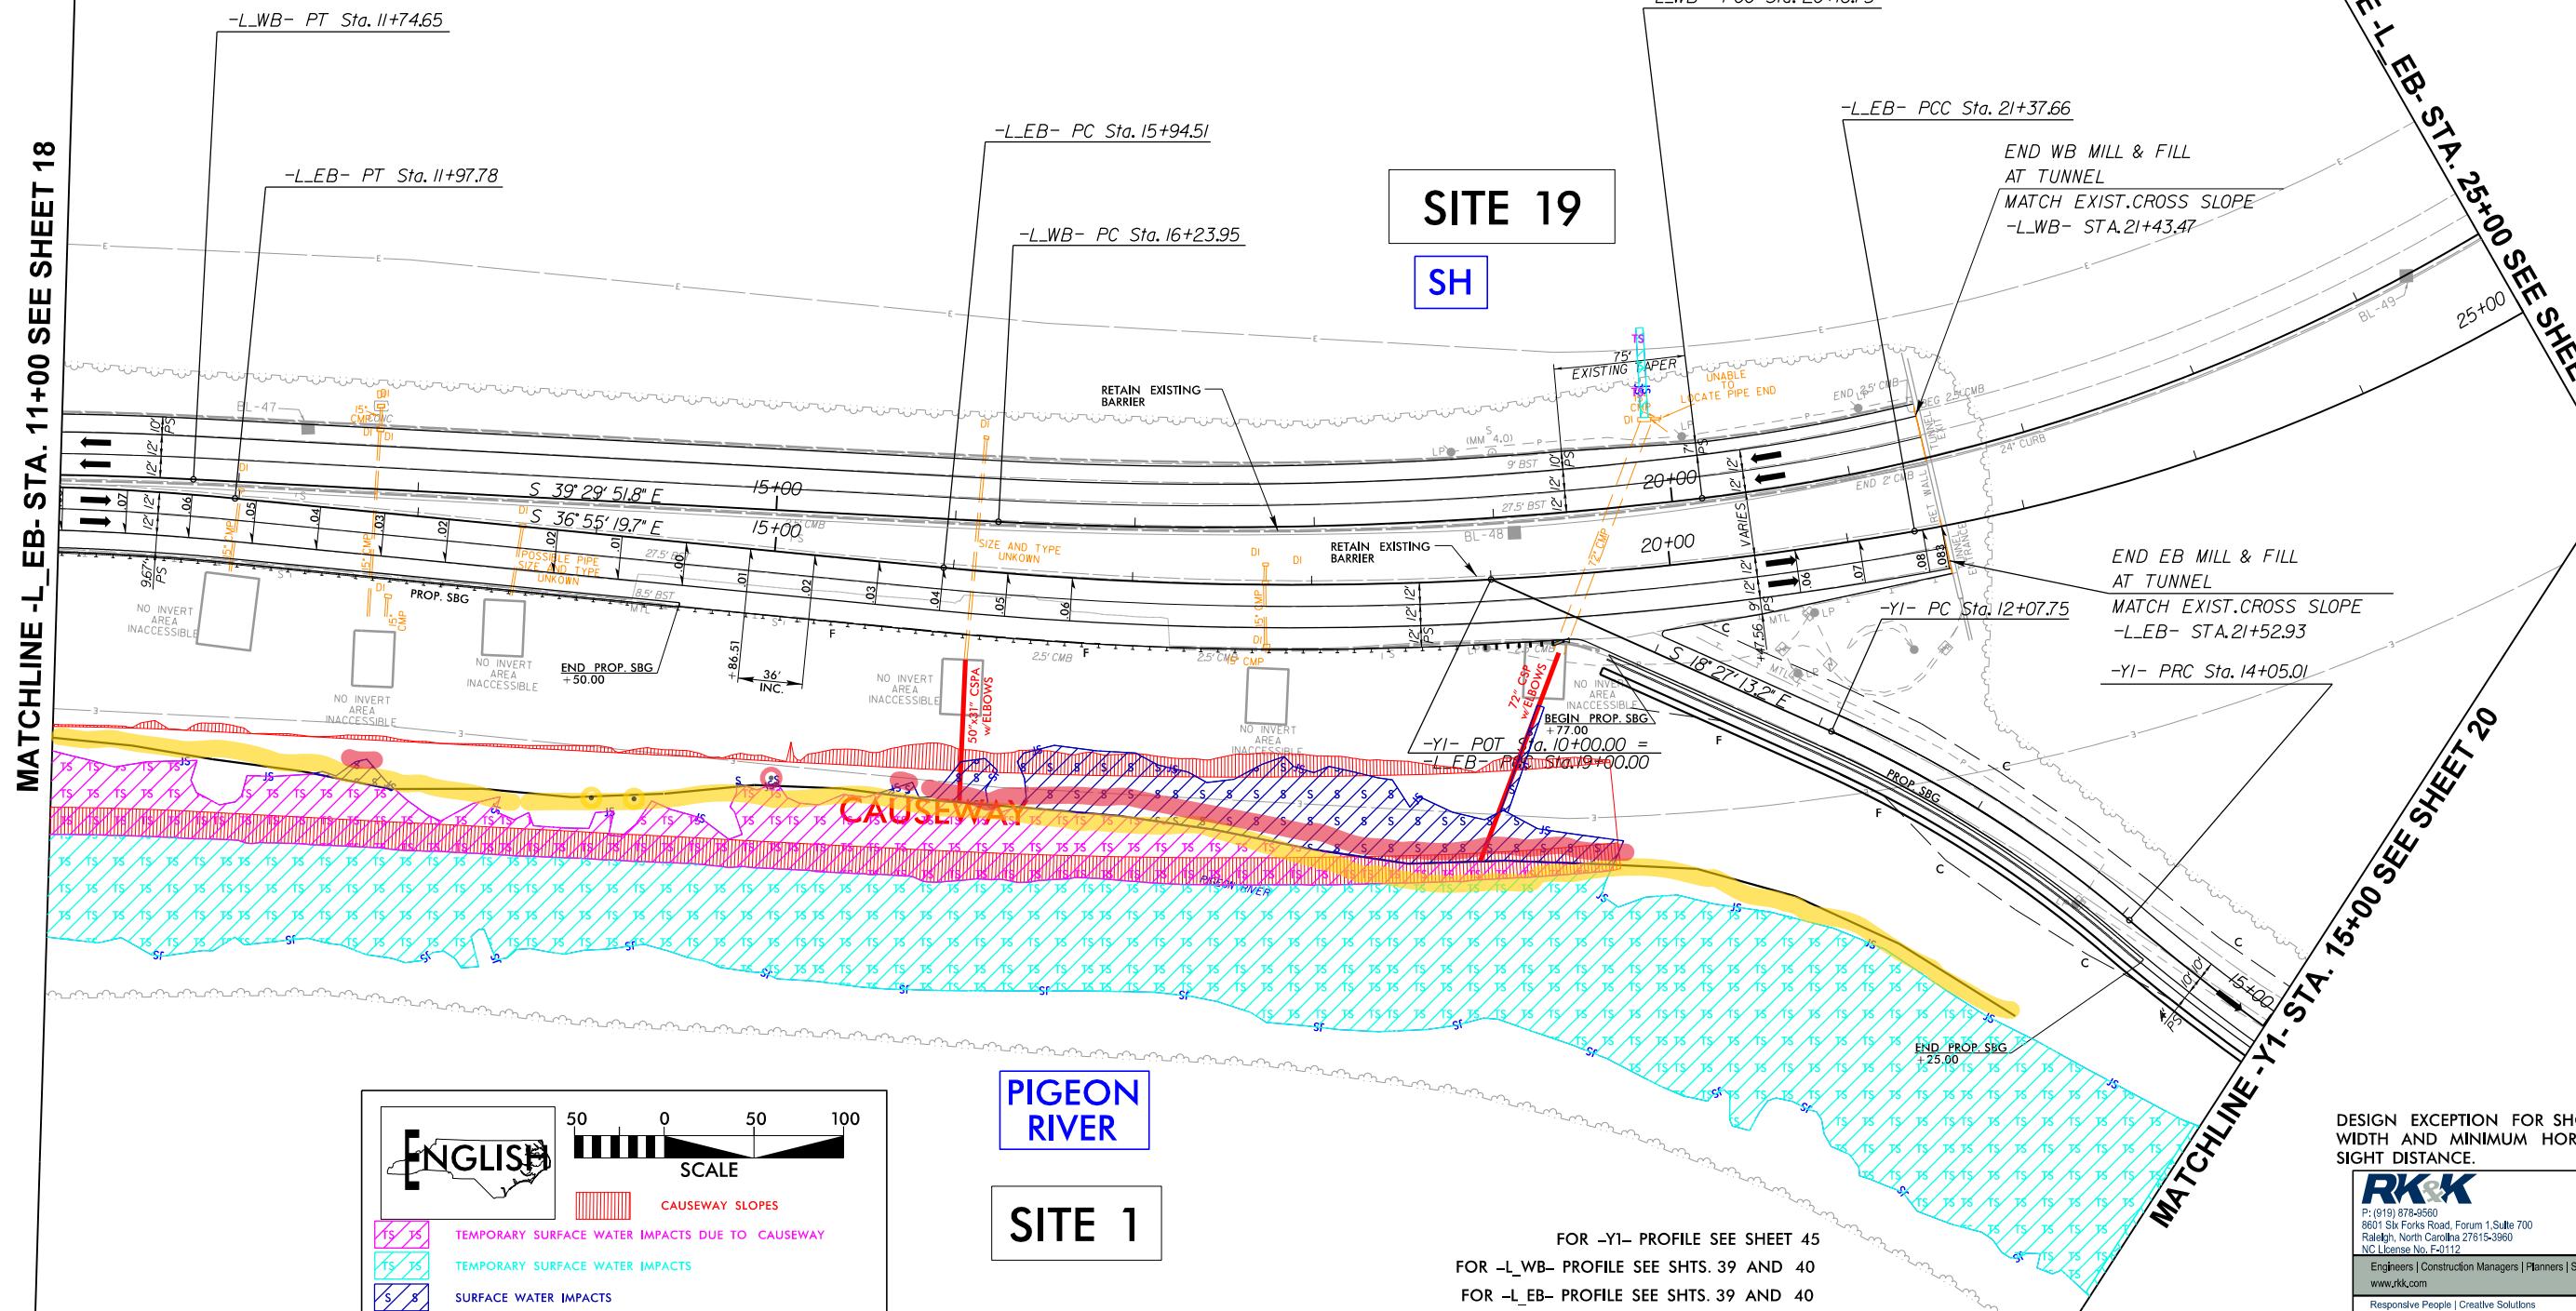

REVISED 5/28/2025

PROJECT REFERENCE NO. I-40 PIGEON RIVER	SHEET NO. 20
RW SHEET NO.	
ROADWAY DESIGN ENGINEER	HYDRAULICS ENGINEER
INCOMPLETE PLANS DO NOT USE FOR R/W ACQUISITION	

DOCUMENT NOT CONSIDERED FINAL  
UNLESS ALL SIGNATURES COMPLETEDPERMIT DRAWING  
SHEET 37 OF 62


MATCHLINE -L\_EB- STA. 33+50 SEE SHEET 21

SEE SHEET 20 INSET  
(PERMIT DRAWING SHEET 37 OF 44)

UNITED STATES OF AMERICA

## WETLAND AND SURFACE WATER IMPACTS SUMMARY

Site No.	Station (From/To)	Structure Size / Type	WETLAND IMPACTS				SURFACE WATER IMPACTS			
			Permanent Fill In Wetlands (ac)	Temp. Fill In Wetlands (ac)	Excavation in Wetlands (ac)	Mechanized Clearing in Wetlands (ac)	Hand Clearing in Wetlands (ac)	Permanent SW impacts (ac)	Temp. SW impacts (ac)	Existing Channel Impacts Permanent (ft)
1 (PSH 20)	-L_EB- Sta. 32+35.77 to 33+50	PR; Causeway; Wall						0.242	1.043	484
1 (PSH 20)	-L_EB- Sta. 32+35.77 to 33+50	PR; Non-Causeway						4.157		1648

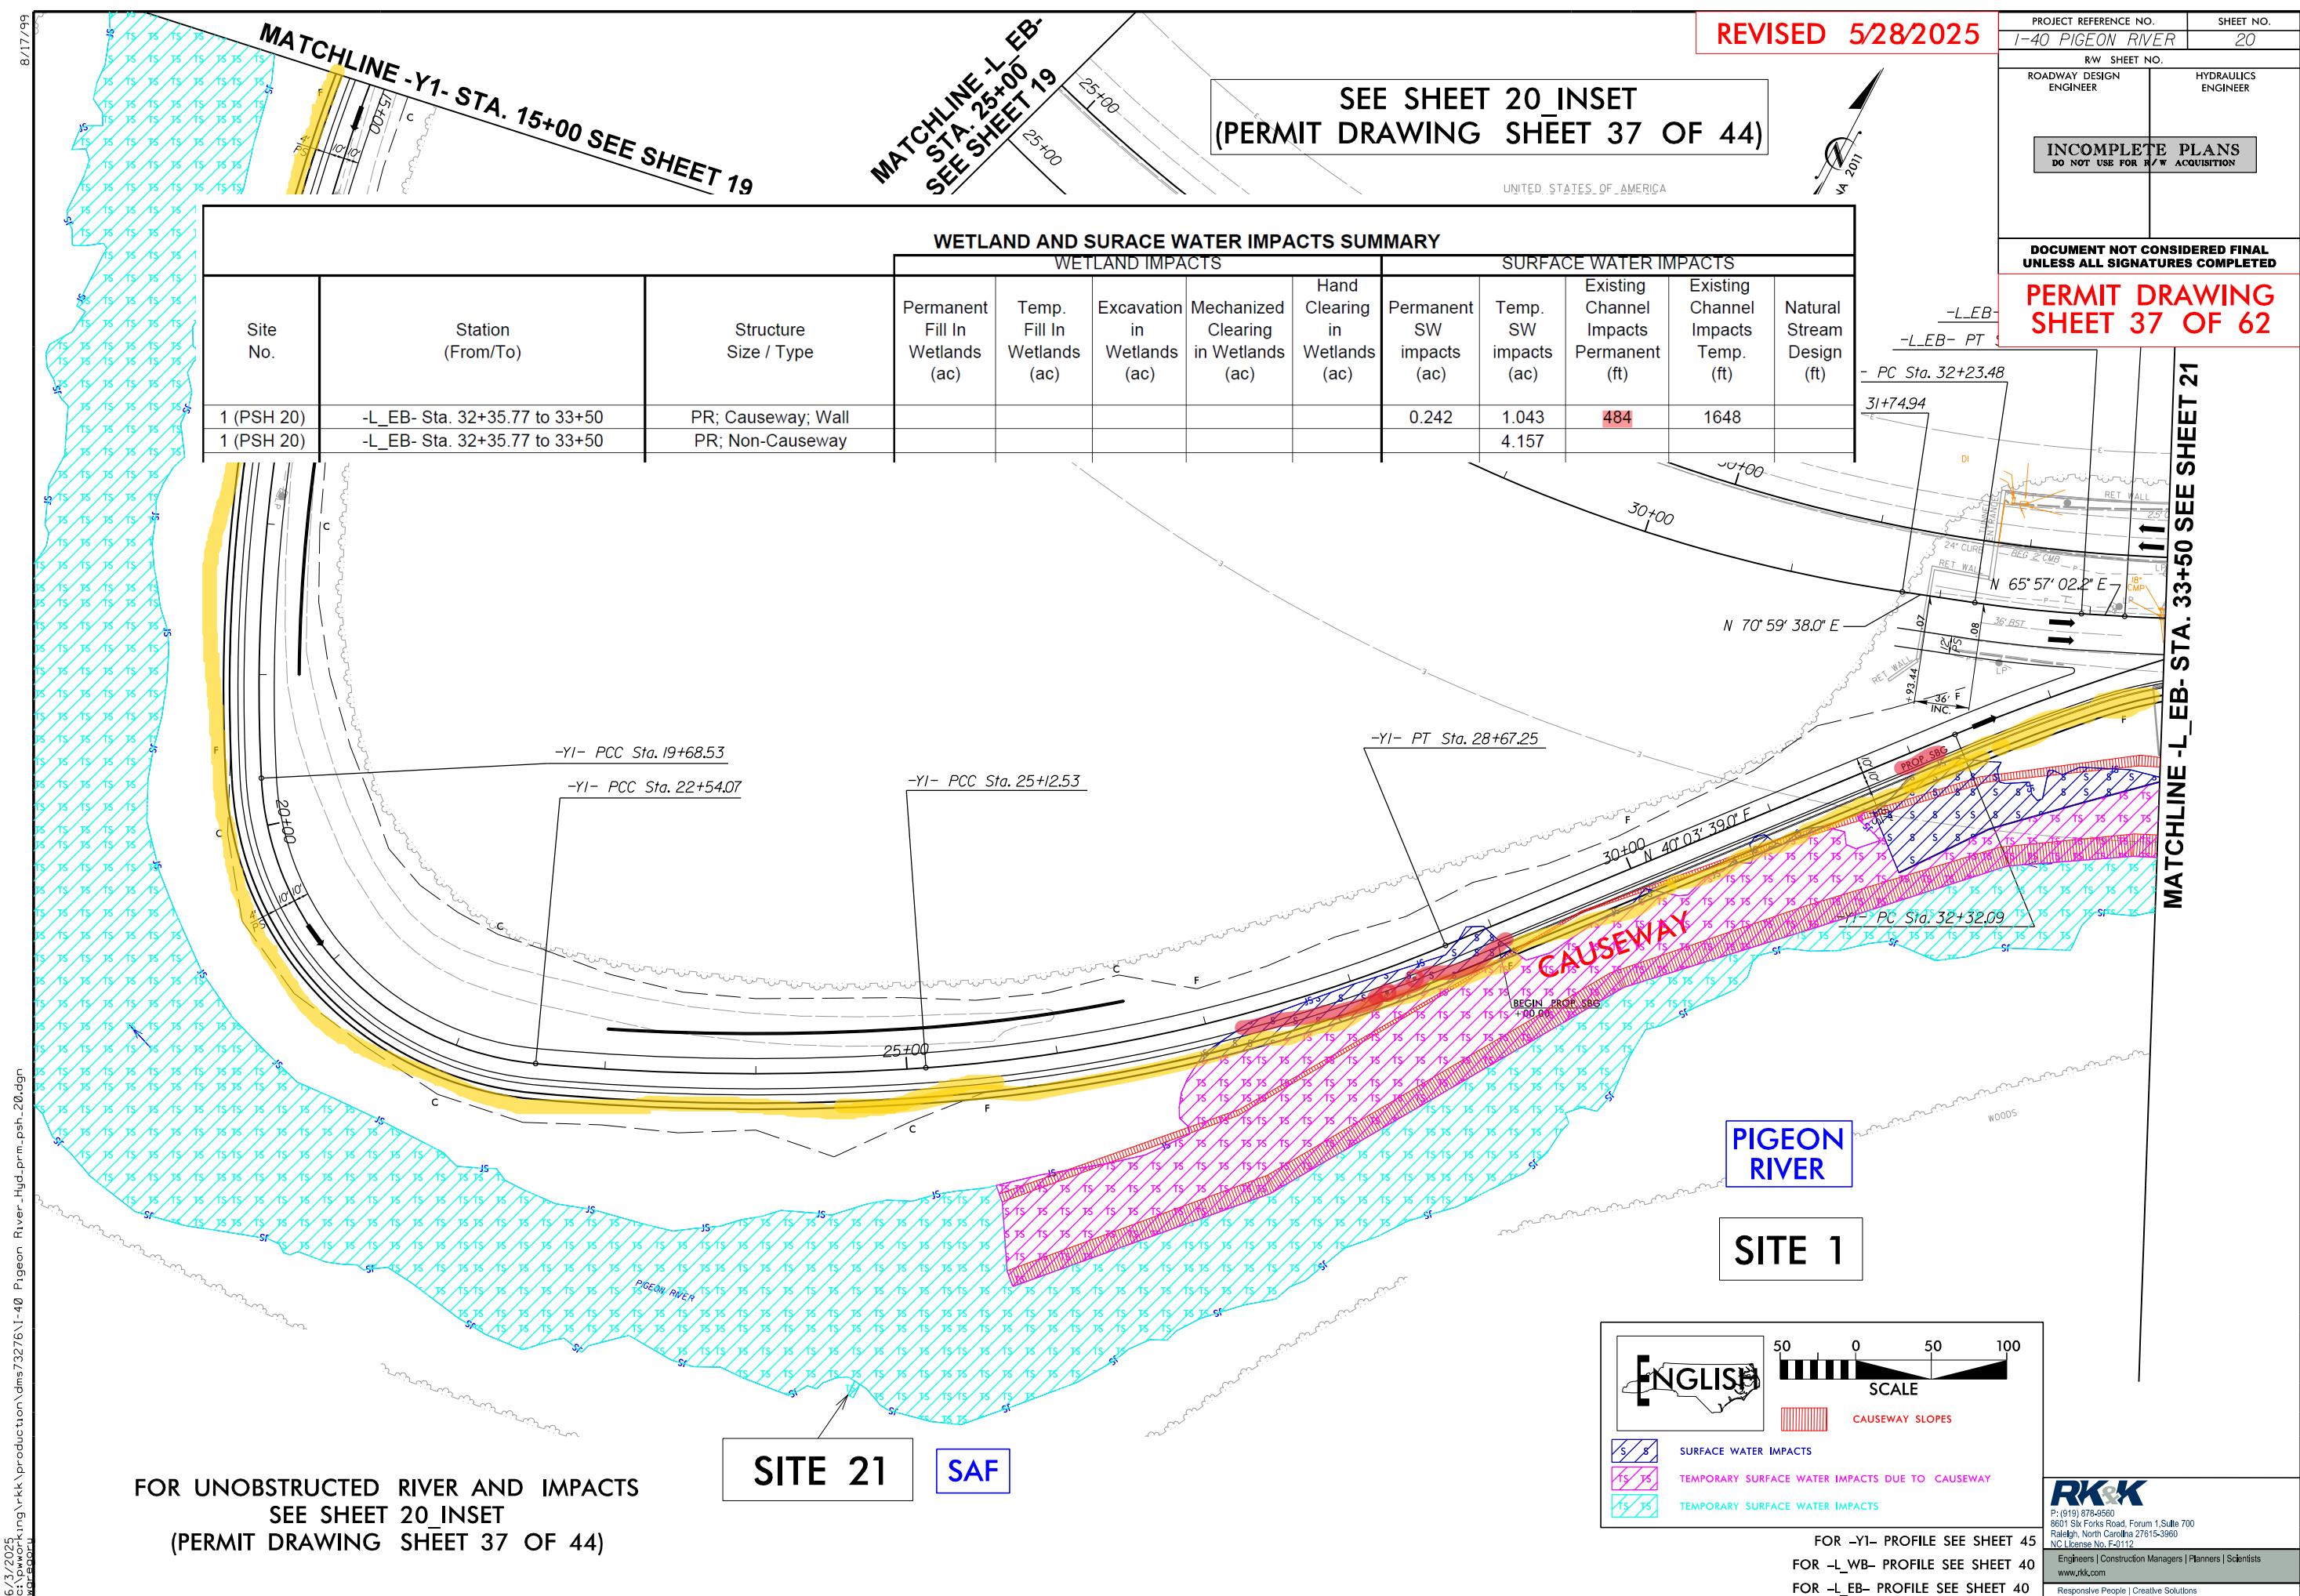

PROJECT REFERENCE NO. I-40 PIGEON RIVER	SHEET NO. 21
RW SHEET NO.	
ROADWAY DESIGN ENGINEER	HYDRAULICS ENGINEER
INCOMPLETE PLANS DO NOT USE FOR R/W ACQUISITION	

DOCUMENT NOT CONSIDERED FINAL  
UNLESS ALL SIGNATURES COMPLETED


**PERMIT DRAWING  
SHEET 40 OF 62**

**REVISED 5/28/2025**


### WETLAND AND SURFACE WATER IMPACTS SUMMARY

Site No.	Station (From/To)	Structure Size / Type	WETLAND IMPACTS					SURFACE WATER IMPACTS				
			Permanent Fill In Wetlands (ac)	Temp. Fill In Wetlands (ac)	Excavation in Wetlands (ac)	Mechanized Clearing in Wetlands (ac)	Hand Clearing in Wetlands (ac)	Permanent SW impacts (ac)	Temp. SW impacts (ac)	Existing Channel Impacts Permanent (ft)	Existing Channel Impacts Temp. (ft)	Natural Stream Design (ft)
1 (PSH 21)	-L_EB- Sta. 33+50 to -L1- Sta. 13+50	PR; Causeway; Wall						0.040	0.821	208	1142	
1 (PSH 21)	-L_EB- Sta. 33+50 to -L1- Sta. 13+50	PR; Non-Causeway							2.484			

**MATCHLINE -L\_EB- STA. 33+50 SEE SHEET 20**

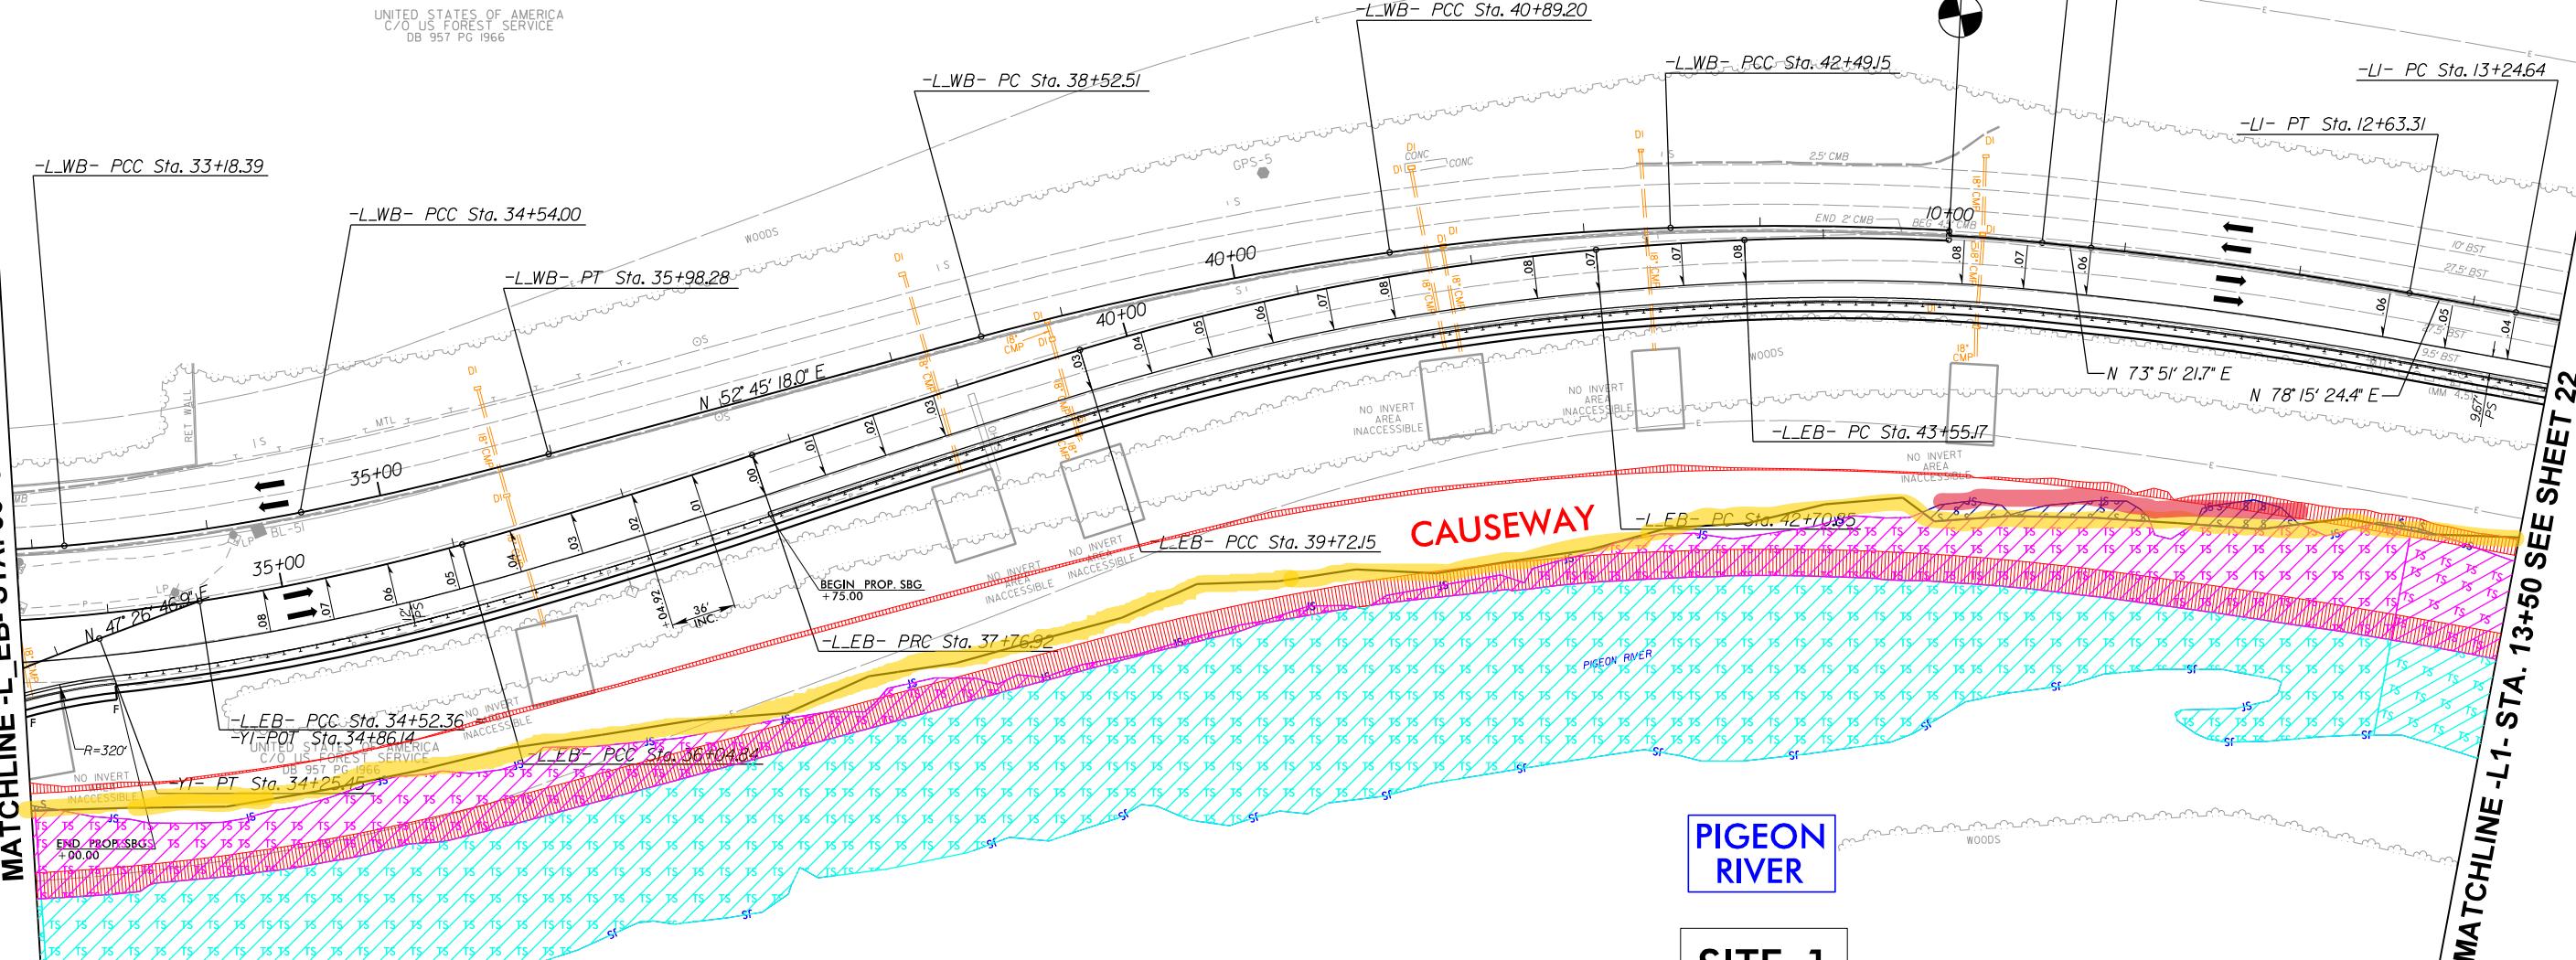

6/3/2025  
C:\pw\working\rkk\production\dms73276\I-40\_Pigeon\_River-Hydr-prm-psh-21.dwg

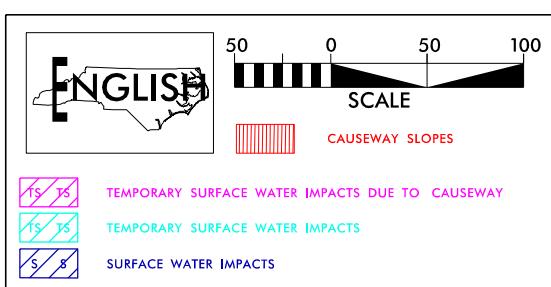

FOR -Y1- PROFILE SEE SHEET 45  
FOR -L1- PROFILE SEE SHEET 42  
FOR -L\_WB- PROFILE SEE SHTS. 40 AND 41  
FOR -L\_EB- PROFILE SEE SHTS. 40 AND 41

**RK&K**  
P: (919) 876-9560  
8601 Sh Forks Road, Forum 1 Suite 700  
Raleigh, North Carolina 27615-3960  
NC License No. F-0112  
Engineers | Construction Managers | Planners | Scientists  
[www.rkk.com](http://www.rkk.com)  
Responsive People | Creative Solutions

PROJECT REFERENCE NO. I-40 PIGEON RIVER	SHEET NO. 22
RW SHEET NO.	
ROADWAY DESIGN ENGINEER	HYDRAULICS ENGINEER
INCOMPLETE PLANS DO NOT USE FOR R/W ACQUISITION	

DOCUMENT NOT CONSIDERED FINAL  
UNLESS ALL SIGNATURES COMPLETEDPERMIT DRAWING  
SHEET 42 OF 62

REVISED 5/28/2025

NAD 83 NA 2011

MATCHLINE -L1- STA. 13+50 SEE SHEET 21

SITE 22

SKIFFLEY  
CREEK

-L1- PT Sta. 14+98.34

WETLAND AND SURFACE WATER IMPACTS SUMMARY												
WETLAND IMPACTS							SURFACE WATER IMPACTS					
Site No.	Station (From/To)	Structure Size / Type	Permanent Fill In Wetlands (ac)	Temp. Fill In Wetlands (ac)	Excavation in Wetlands (ac)	Mechanized Clearing in Wetlands (ac)	Hand Clearing in Wetlands (ac)	Permanent SW Impacts (ac)	Temp. SW Impacts (ac)	Existing Channel Impacts Permanent (ft)	Existing Channel Impacts Temp. (ft)	Natural Stream Design (ft)
1 (PSH 22)	-L1- Sta. 13+50 to 27+00	PR; Causeway; Wall						0.081	1.047	353	849	
1 (PSH 22)	-L1- Sta. 13+50 to 27+00	PR; Non-Causeway							2.523			

UNITED STATES OF AMERICA  
C/O US FOREST SERVICE  
DB 957 PG 1966

SITE 23

GROUNDHOG  
CREEK

-L1- PC Sta. 23+26.28

-L1- PC Sta. 26+26.27


-L1- PT Sta. 25+73.46

MATCHLINE -L1- STA. 27+00 SEE SHEET 23

CAUSEWAY

PIGEON  
RIVER

SITE 1

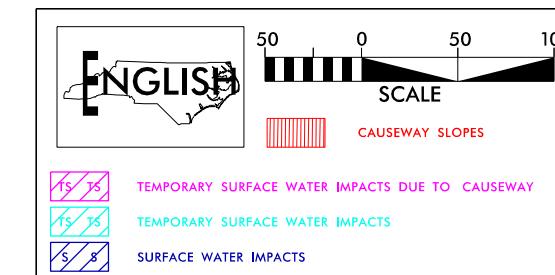

**RK&K**  
P: (919) 876-9560  
8601 St. Forks Road, Forum 1, Suite 700  
Raleigh, North Carolina 27615-3960  
NC License No. F-2112  
Engineers | Construction Managers | Planners | Scientists  
[www.rkk.com](http://www.rkk.com)  
Responsive People | Creative Solutions



WETLAND AND SURACE WATER IMPACTS SUMMARY												
Site No.	Station (From/To)	Structure Size / Type	WETLAND IMPACTS					SURFACE WATER IMPACTS				
			Permanent Fill In Wetlands (ac)	Temp. Fill In Wetlands (ac)	Excavation in Wetlands (ac)	Mechanized Clearing in Wetlands (ac)	Hand Clearing in Wetlands (ac)	Permanent SW impacts (ac)	Temp. SW impacts (ac)	Existing Channel Impacts Permanent (ft)	Existing Channel Impacts Temp. (ft)	Natural Stream Design (ft)
1 (PSH 4)	-L- Sta. 10+00 to 21+00	PR; Causeway						0.067	0.357	542	458	
1 (PSH 4)	-L- Sta. 10+00 to 21+00	PR; Non-Causeway							2.773			
1 (PSH 5)	-L- Sta. 21+00 to 35+00	PR; Causeway						0.125	1.587	916	430	
1 (PSH 5)	-L- Sta. 21+00 to 35+00	PR; Non-Causeway							2.183			
1 (PSH 6)	-L- Sta. 35+00 to 49+00	PR; Causeway						0.064	1.554	856	578	
1 (PSH 6)	-L- Sta. 35+00 to 49+00	PR; Non-Causeway							2.286			
2	-L- Sta. 35+24 RT	SAA; Non-Causeway							0.001		11	
3	-L- Sta. 39+82 LT	Painter Branch; 84" CMP							0.004		51	
4	-L- Sta. 39+83 RT	TA; 84" CMP; Wall						0.006				
5	-L- Sta. 45+79 RT	TAA; Non-Causeway							0.001			
1 (PSH 7)	-L- Sta. 49+00 to 63+00	PR; Causeway; Wall						0.509	1.064	854	551	
1 (PSH 7)	-L- Sta. 49+00 to 63+00	PR; Non-Causeway							2.367			
6	-L- Sta. 51+19 LT	Snowbird Creek; (2) 84" CMP							0.007		50	
7	-L- Sta. 51+11 RT	TB; (2) 84" CMP						0.006				
SHEET TOTALS:			0.000	0.000	0.000	0.000	0.000	0.777	14.184	3168	2129	0
REVIS 3,168												
NOTES: PR: Pigeon River										NC DEPARTMENT OF TRANSPORTATION DIVISION OF HIGHWAYS DECEMBER 17, 2024 HAYWOOD COUNTY I-40 PIGEON RIVER		
Revised 2018 Feb										SHEET	57	OF
											62	

WETLAND AND SURACE WATER IMPACTS SUMMARY												
Site No.	Station (From/To)	Structure Size / Type	WETLAND IMPACTS					SURFACE WATER IMPACTS				
			Permanent Fill In Wetlands (ac)	Temp. Fill In Wetlands (ac)	Excavation in Wetlands (ac)	Mechanized Clearing in Wetlands (ac)	Hand Clearing in Wetlands (ac)	Permanent SW impacts (ac)	Temp. SW impacts (ac)	Existing Channel Impacts Permanent (ft)	Existing Channel Impacts Temp. (ft)	Natural Stream Design (ft)
1 (PSH 8)	-L- Sta. 63+00 to 76+50	PR; Causeway; Wall						0.301	0.556	639	544	
1 (PSH 8)	-L- Sta. 63+00 to 76+50	PR; Non-Causeway							2.633			
1 (PSH 9)	-L- Sta. 76+50 to 91+00	PR; Causeway; Wall						0.531	1.061	1050	646	
1 (PSH 9)	-L- Sta. 76+50 to 91+00	PR; Non-Causeway							3.725			
1 (PSH 10)	-L- Sta. 91+00 to 103+00	PR; Causeway; Wall						0.068	1.665	444	717	
1 (PSH 10)	-L- Sta. 91+00 to 103+00	PR; Non-Causeway							2.156			
8	-L- Sta. 91+32 LT	SC; 81"x59" CMAP							0.002		50	
9	-L- Sta. 91+19 RT	TC; 81"x59" CMAP; Wall						0.013				
10	-L- Sta. 99+12 LT	TD; 24" CMP							0.003			
1 (PSH 11)	-L- Sta. 103+00 to 117+00	PR; Causeway; Wall						0.434	1.860	891	481	
1 (PSH 11)	-L- Sta. 103+00 to 117+00	PR; Non-Causeway							1.915			
11	-L- 104+00 LT	TE; 42" CMP							0.002			
1 (PSH 12)	-L- Sta. 117+00 to 131+00	PR; Causeway; Wall						0.519	0.449	838	653	
1 (PSH 12)	-L- Sta. 117+00 to 131+00	PR; Non-Causeway							2.030			
SHEET TOTALS:			0.000	0.000	0.000	0.000	0.000	1.866	18.057	3862	3091	0
REVISE <span style="background-color: yellow; padding: 2px;">3,862</span>										NC DEPARTMENT OF TRANSPORTATION DIVISION OF HIGHWAYS DECEMBER 17, 2024 HAYWOOD COUNTY I-40 PIGEON RIVER		
Revised 2018 Feb										SHEET	58	OF
												62

WETLAND AND SURACE WATER IMPACTS SUMMARY											
Site No.	Station (From/To)	Structure Size / Type	WETLAND IMPACTS					SURFACE WATER IMPACTS			
			Permanent Fill In Wetlands (ac)	Temp. Fill In Wetlands (ac)	Excavation in Wetlands (ac)	Mechanized Clearing in Wetlands (ac)	Hand Clearing in Wetlands (ac)	Permanent SW impacts (ac)	Temp. SW impacts (ac)	Existing Channel Impacts Permanent (ft)	Natural Stream Design (ft)
1 (PSH 13)	-L- Sta. 131+00 to 145+00	PR; Causeway; Wall						0.733	2.113	1322	97
1 (PSH 13)	-L- Sta. 131+00 to 145+00	PR; Non-Causeway							2.772		
12	-L- Sta. 132+85 RT	Mount Sterling Creek; Non-Causeway							0.008		13
13	-L- Sta. 138+88	Runyon Creek; 112"x75" CMAP; Wall						0.005	0.005	55	49
1 (PSH 14)	-L- Sta. 145+00 to 158+50	PR; Causeway; Wall						0.038	0.714	275	1229
1 (PSH 14)	-L- Sta. 145+00 to 158+50	PR; Non-Causeway							3.085		
14	-L- 151+56	Counterfeit Branch; 84"x61" CMAP; Wall						0.007	0.005	79	50
1 (PSH 15)	-L- Sta. 158+50 to 172+00	PR; Causeway; Wall						0.013	1.310	126	1419
1 (PSH 15)	-L- Sta. 158+50 to 172+00	PR; Non-Causeway							2.220		
1 (PSH 16)	-L- Sta. 172+00 to 186+00	PR; Causeway; Wall						0.195	1.180	418	1044
1 (PSH 16)	-L- Sta. 172+00 to 186+00	PR; Non-Causeway							2.461		
15	-L- Sta. 173+96 RT	SAC; Non-Causeway							0.001		10
1 (PSH 17)	-L- Sta. 186+00 to 200+00	PR; Causeway; Wall						0.113	1.278	193	1176
1 (PSH 17)	-L- Sta. 186+00 to 200+00	PR; Non-Causeway							2.277		
16	-L- 191+91 RT	Puncheon Camp Branch; Non-Causeway							0.001		10
SHEET TOTALS:			0.000	0.000	0.000	0.000	0.000	1.104	19.430	2468	5097
									2,468		
NOTES: PR: Pigeon River											
REVIS NC DEPARTMENT OF TRANSPORTATION DIVISION OF HIGHWAYS DECEMBER 17, 2024 HAYWOOD COUNTY I-40 PIGEON RIVER											
Revised 2018 Feb				SHEET		59	OF		62		

			WETLAND AND SURACE WATER IMPACTS SUMMARY									
Site No.	Station (From/To)	Structure Size / Type	WETLAND IMPACTS					SURFACE WATER IMPACTS				
			Permanent Fill In Wetlands (ac)	Temp. Fill In Wetlands (ac)	Excavation in Wetlands (ac)	Mechanized Clearing in Wetlands (ac)	Hand Clearing in Wetlands (ac)	Permanent SW impacts (ac)	Temp. SW impacts (ac)	Existing Channel Impacts Permanent (ft)	Existing Channel Impacts Temp. (ft)	Natural Stream Design (ft)
17	-L- Sta. 195+45 LT	TF; 18" CMP							0.002			
1 (PSH 18)	-L- Sta. 200+00 to -L_EB- 11+00	PR; Causeway; Wall						0.853	1.668	723	491	
1 (PSH 18)	-L- Sta. 200+00 to -L_EB- 11+00	PR; Non-Causeway							1.572			
18	-L- Sta. 208+73	SG; 72"x44" CMAP; Wall						0.007	0.013	30	55	
1 (PSH 19)	-L_EB- Sta. 11+00 to 21+57.61	PR; Causeway; Wall						0.271	0.581	448	756	
1 (PSH 19)	-L_EB- Sta. 11+00 to 21+57.61	PR; Non-Causeway							2.088			
19	-L_EB- Sta. 19+61	SH; 72" CMP; Wall						0.006	0.005	62	50	
1 (PSH 20)	-L_EB- Sta. 32+35.77 to 33+50	PR; Causeway; Wall						0.242	1.043	484	1648	
1 (PSH 20)	-L_EB- Sta. 32+35.77 to 33+50	PR; Non-Causeway							4.157			
20	-Y1- 20+69 RT	SAE; Non-Causeway							0.002		11	
21	-Y1- 24+57 RT	SAF; Non-Causeway							0.001		10	
1 (PSH 21)	-L_EB- Sta. 33+50 to -L1- Sta. 13+50	PR; Causeway; Wall						0.040	0.821	208	1142	
1 (PSH 21)	-L_EB- Sta. 33+50 to -L1- Sta. 13+50	PR; Non-Causeway							2.484			
1 (PSH 22)	-L1- Sta. 13+50 to 27+00	PR; Causeway; Wall						0.081	1.047	353	849	
1 (PSH 22)	-L1- Sta. 13+50 to 27+00	PR; Non-Causeway							2.523			
SHEET TOTALS:			0.000	0.000	0.000	0.000	0.000	1.500	18.007	2308	5012	0

REVISE

2,308

## NOTES:

PR: Pigeon River

NC DEPARTMENT OF TRANSPORTATION  
 DIVISION OF HIGHWAYS  
 DECEMBER 17, 2024  
 HAYWOOD COUNTY  
 I-40 PIGEON RIVER

WETLAND AND SURACE WATER IMPACTS SUMMARY												
Site No.	Station (From/To)	Structure Size / Type	WETLAND IMPACTS					SURFACE WATER IMPACTS				
			Permanent Fill In Wetlands (ac)	Temp. Fill In Wetlands (ac)	Excavation in Wetlands (ac)	Mechanized Clearing in Wetlands (ac)	Hand Clearing in Wetlands (ac)	Permanent SW impacts (ac)	Temp. SW impacts (ac)	Existing Channel Impacts Permanent (ft)	Existing Channel Impacts Temp. (ft)	Natural Stream Design (ft)
22	-L1- Sta. 15+40	Skiffley Creek; 96" CMP; Wall						0.020	0.009	109	51	
23	-L1- Sta. 21+31 LT	Groundhog Creek; (3) 84" CMP						0.050		67		
1 (PSH 23)	-L1- Sta. 27+00 to 29+71	PR; Causeway: Wall						0.022	0.231	134	1117	
1 (PSH 23)	-L1- Sta. 27+00 to 29+71	PR; Non-Causeway						3.491				
24	-L1- Sta. 28+80	Rube Rock Branch; 84" CMP; Wall						0.009	0.016	67	67	
25	-L1- Sta. 29+00 LT	SKA; 84" CMP							0.009		66	
26	-L1- Sta. 35+32 RT	TG; 24" CMP						0.005				
27	-L1- Sta. 40+08 LT	Tom Hall Branch; 72" CMP							0.007		38	
28	-L1- Sta. 40+11 LT	SLB; 72" CMP							0.007		45	
29	-L1- Sta. 40+32 LT	SLC; 72" CMP							0.009		63	
30	-L1- Sta. 36+96 RT	TH; 72" CMP; Wall							0.014			
1A	-HAULRD- Sta. 100+66 to 102+39	PR; Temp. Access Road Crossing							0.607		268	
31	Cotton Patch	WA; Staging Area	0.038									
SHEET TOTALS:			0.038	0.000	0.000	0.000	0.000	0.056	4.450	310	1782	0

REVISE

310

NOTES:  
PR: Pigeon River

NC DEPARTMENT OF TRANSPORTATION  
DIVISION OF HIGHWAYS  
DECEMBER 17, 2024  
HAYWOOD COUNTY  
I-40 PIGEON RIVER

WETLAND AND SURACE WATER IMPACTS SUMMARY											
Site No.	Station (From/To)	Structure Size / Type	WETLAND IMPACTS					SURFACE WATER IMPACTS			
			Permanent Fill In Wetlands (ac)	Temp. Fill In Wetlands (ac)	Excavation in Wetlands (ac)	Mechanized Clearing in Wetlands (ac)	Hand Clearing in Wetlands (ac)	Permanent SW impacts (ac)	Temp. SW impacts (ac)	Existing Channel Impacts Permanent (ft)	Existing Channel Impacts Temp. (ft)
32	Borrow Site #1	S1-SAA, S1-WA2; Temp. Access Road	0.007						0.326		960
33	Borrow Site #1	SAB; Temp. Access Road							0.021		121
34	Borrow Site #1	S1-SAD; Borrow Pit						0.006		244	
35	Borrow Site #1	S1-SAE/S1-SAE-INT; Borrow Pit						0.012		517	
36	Borrow Site #1	S1-SAE12 INT; Borrow Pit						0.001		48	
37	Borrow Site #1	S1-SAD; Borrow Pit						0.004		170	
no wall on this page.											
SHEET TOTALS:			0.007	0.000	0.000	0.000	0.000	0.023	0.347	979	1081
PROJECT TOTALS:			0.045	0.000	0.000	0.000	0.000	5.326	74.475	13095	18192
REVISED MAY 28, 2025											
NOTES: PR: Pigeon River											
NC DEPARTMENT OF TRANSPORTATION DIVISION OF HIGHWAYS DECEMBER 17, 2024 HAYWOOD COUNTY I-40 PIGEON RIVER											
Revised 2018 Feb											
SHEET 62 OF 62											

3,168

3,862

2,468

2,308


310

=12,116

# Wall-River Impact Detail

**TEMPORARY CAUSEWAY TO BE RETAINED DETAIL**

NOT TO SCALE

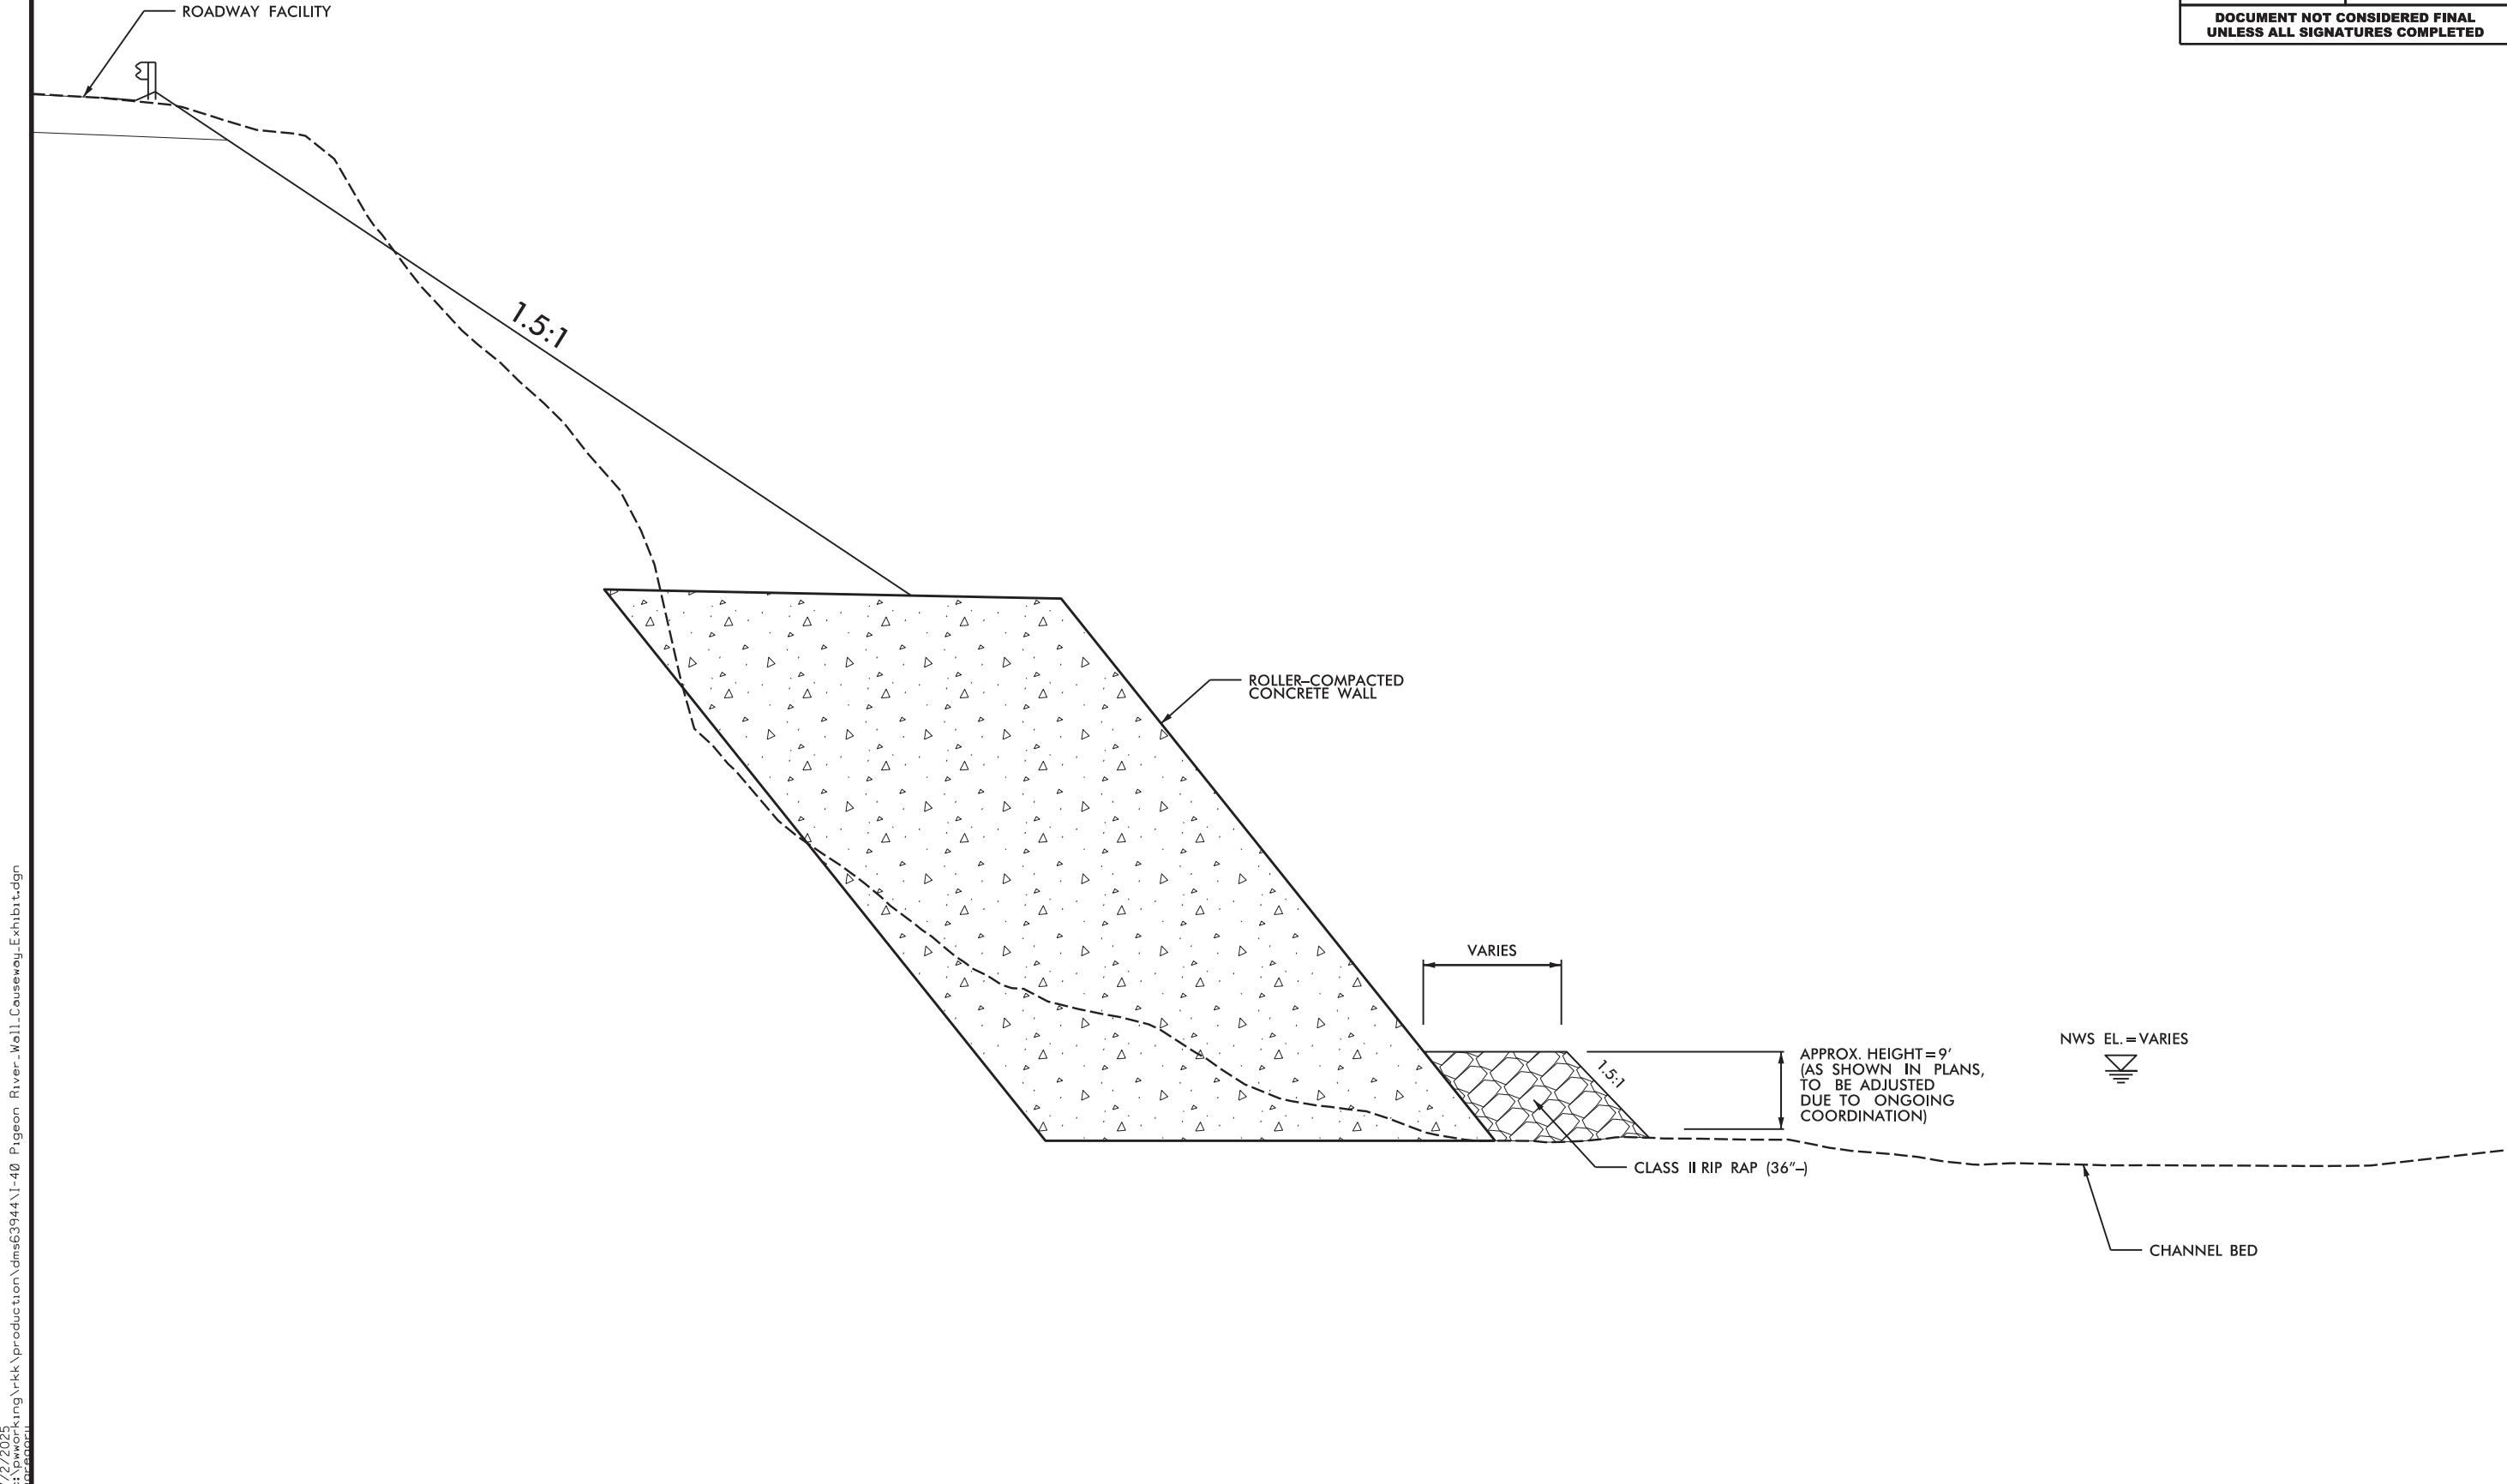

PROJECT REFERENCE NO. <b>I-40 PIGEON RIVER</b>	SHEET NO.
RW SHEET NO.	
ROADWAY DESIGN ENGINEER	HYDRAULICS ENGINEER
<b>INCOMPLETE PLANS</b> DO NOT USE FOR R/W ACQUISITION	

DOCUMENT NOT CONSIDERED FINAL  
UNLESS ALL SIGNATURES COMPLETED

# Revised Cover Letter

## Impact Summary

Permit Site / Plan sheet Page	Stream Name/Status	Status/Class	Perm Fill	Bank Stabilization	Temporary Impact	ACOE Mitigation Required	DWR Mitigation Required	Impact Description/ Avoidance and Minimization
32	S1-SAA	Perennial	--	--	960 (0.326)	960 (1:1)	960 (1:1)	This impact is for the temporary haul road from the Cotton Patch construction yard to the borrow site. NCDOT Proposes 1:1 mitigation for this activity for the temporal loss of stream function during the construction period, potentially lasting 4 years.
33	SAB	Perennial	--	--	121 (0.021)	121 (1:1)	0	NCDOT commits to pre-impact stream data collection, including photographs and cross-sections, for reference for stream restoration, and for use to assist in the determination of a successful restoration.
34	S1-SAD	Perennial	244 (0.006)	--	--	244 (2:1)	<b>0 244 (1:1)</b>	This stream is located inside the borrow pit. It is considered a total loss of waters.
35	S-SAE/S1-SAE-INT	Perennial/ Intermittent	517 (0.012)	--	--	517 (2:1)	517 (1:1)	This stream is located inside the borrow pit. It is considered a total loss of waters.
36	S1-SAE2 INT	Intermittent	48 (0.001)	--	--	48 (2:1)	0	This stream is located inside the borrow pit. It is considered a total loss of waters.
37	S1-SAD	Perennial	170 (0.004)	--	--	170 (2:1)	<b>0 170 (1:1)</b>	This stream is located inside the borrow pit. It is considered a total loss of waters.
<b>Sheet Totals:</b>			<b>979 (0.23)</b>	--	<b>1,081 lf 0.347 ac</b>	<b>1,081 (1:1) 979 (2:1)</b>	<b>1,477 (1:1) 1,891 (1:1)</b>	<i>Tables/ Pages Break with Impact Summary Tables in Permit Drawings</i>
<b>979 lf 0.23 ac</b>								