



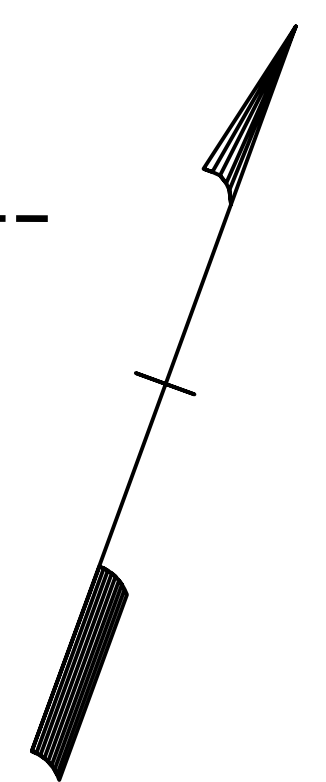

(SECTION TAKEN AT RIGHT ANGLES TO END BENTS AND BENTS)

I HEREBY CERTIFY THESE PLANS
ARE THE AS-BUILT PLANS

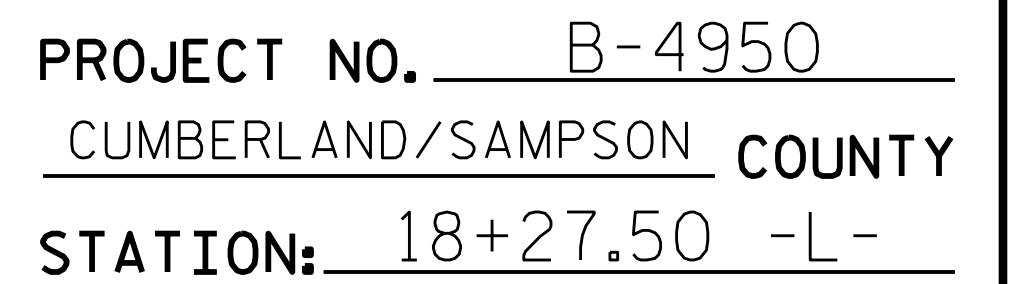

SHEET 1 OF 3 REPLACES BRIDGE NO.172

STATE OF NORTH CAROLINA
DEPARTMENT OF TRANSPORTATION
RALEIGH

BRIDGE 172 ON SR 1851
OVER SOUTH RIVER
BETWEEN SR 1848 & SR 1424

REVISIONS						SHEET NO. S2-1
NO.	BY:	DATE:	NO.	BY:	DATE:	
1			3			TOTAL SHEETS 27
2			4			

STR. 2



ms consultants, inc.
920 Main Campus Drive
Suite 430
Raleigh, NC 27606
NC License Number : C-3239

