


STATE	PROJECT NO.	SHEET NO.	TOTAL SHEETS
N.C.	7CR.10011.18, ETC.	1	
F.A. PROJ. NO.			

NOTE:  
MAP 4 & 5 - HAVE BEEN DELETED

# ALAMANCE COUNTY



STATE	PROJECT NO.	SHEET NO.	TOTAL SHEETS
N.C.	7CR.10011.18, ETC.	2	
F.A. PROJ. NO.			

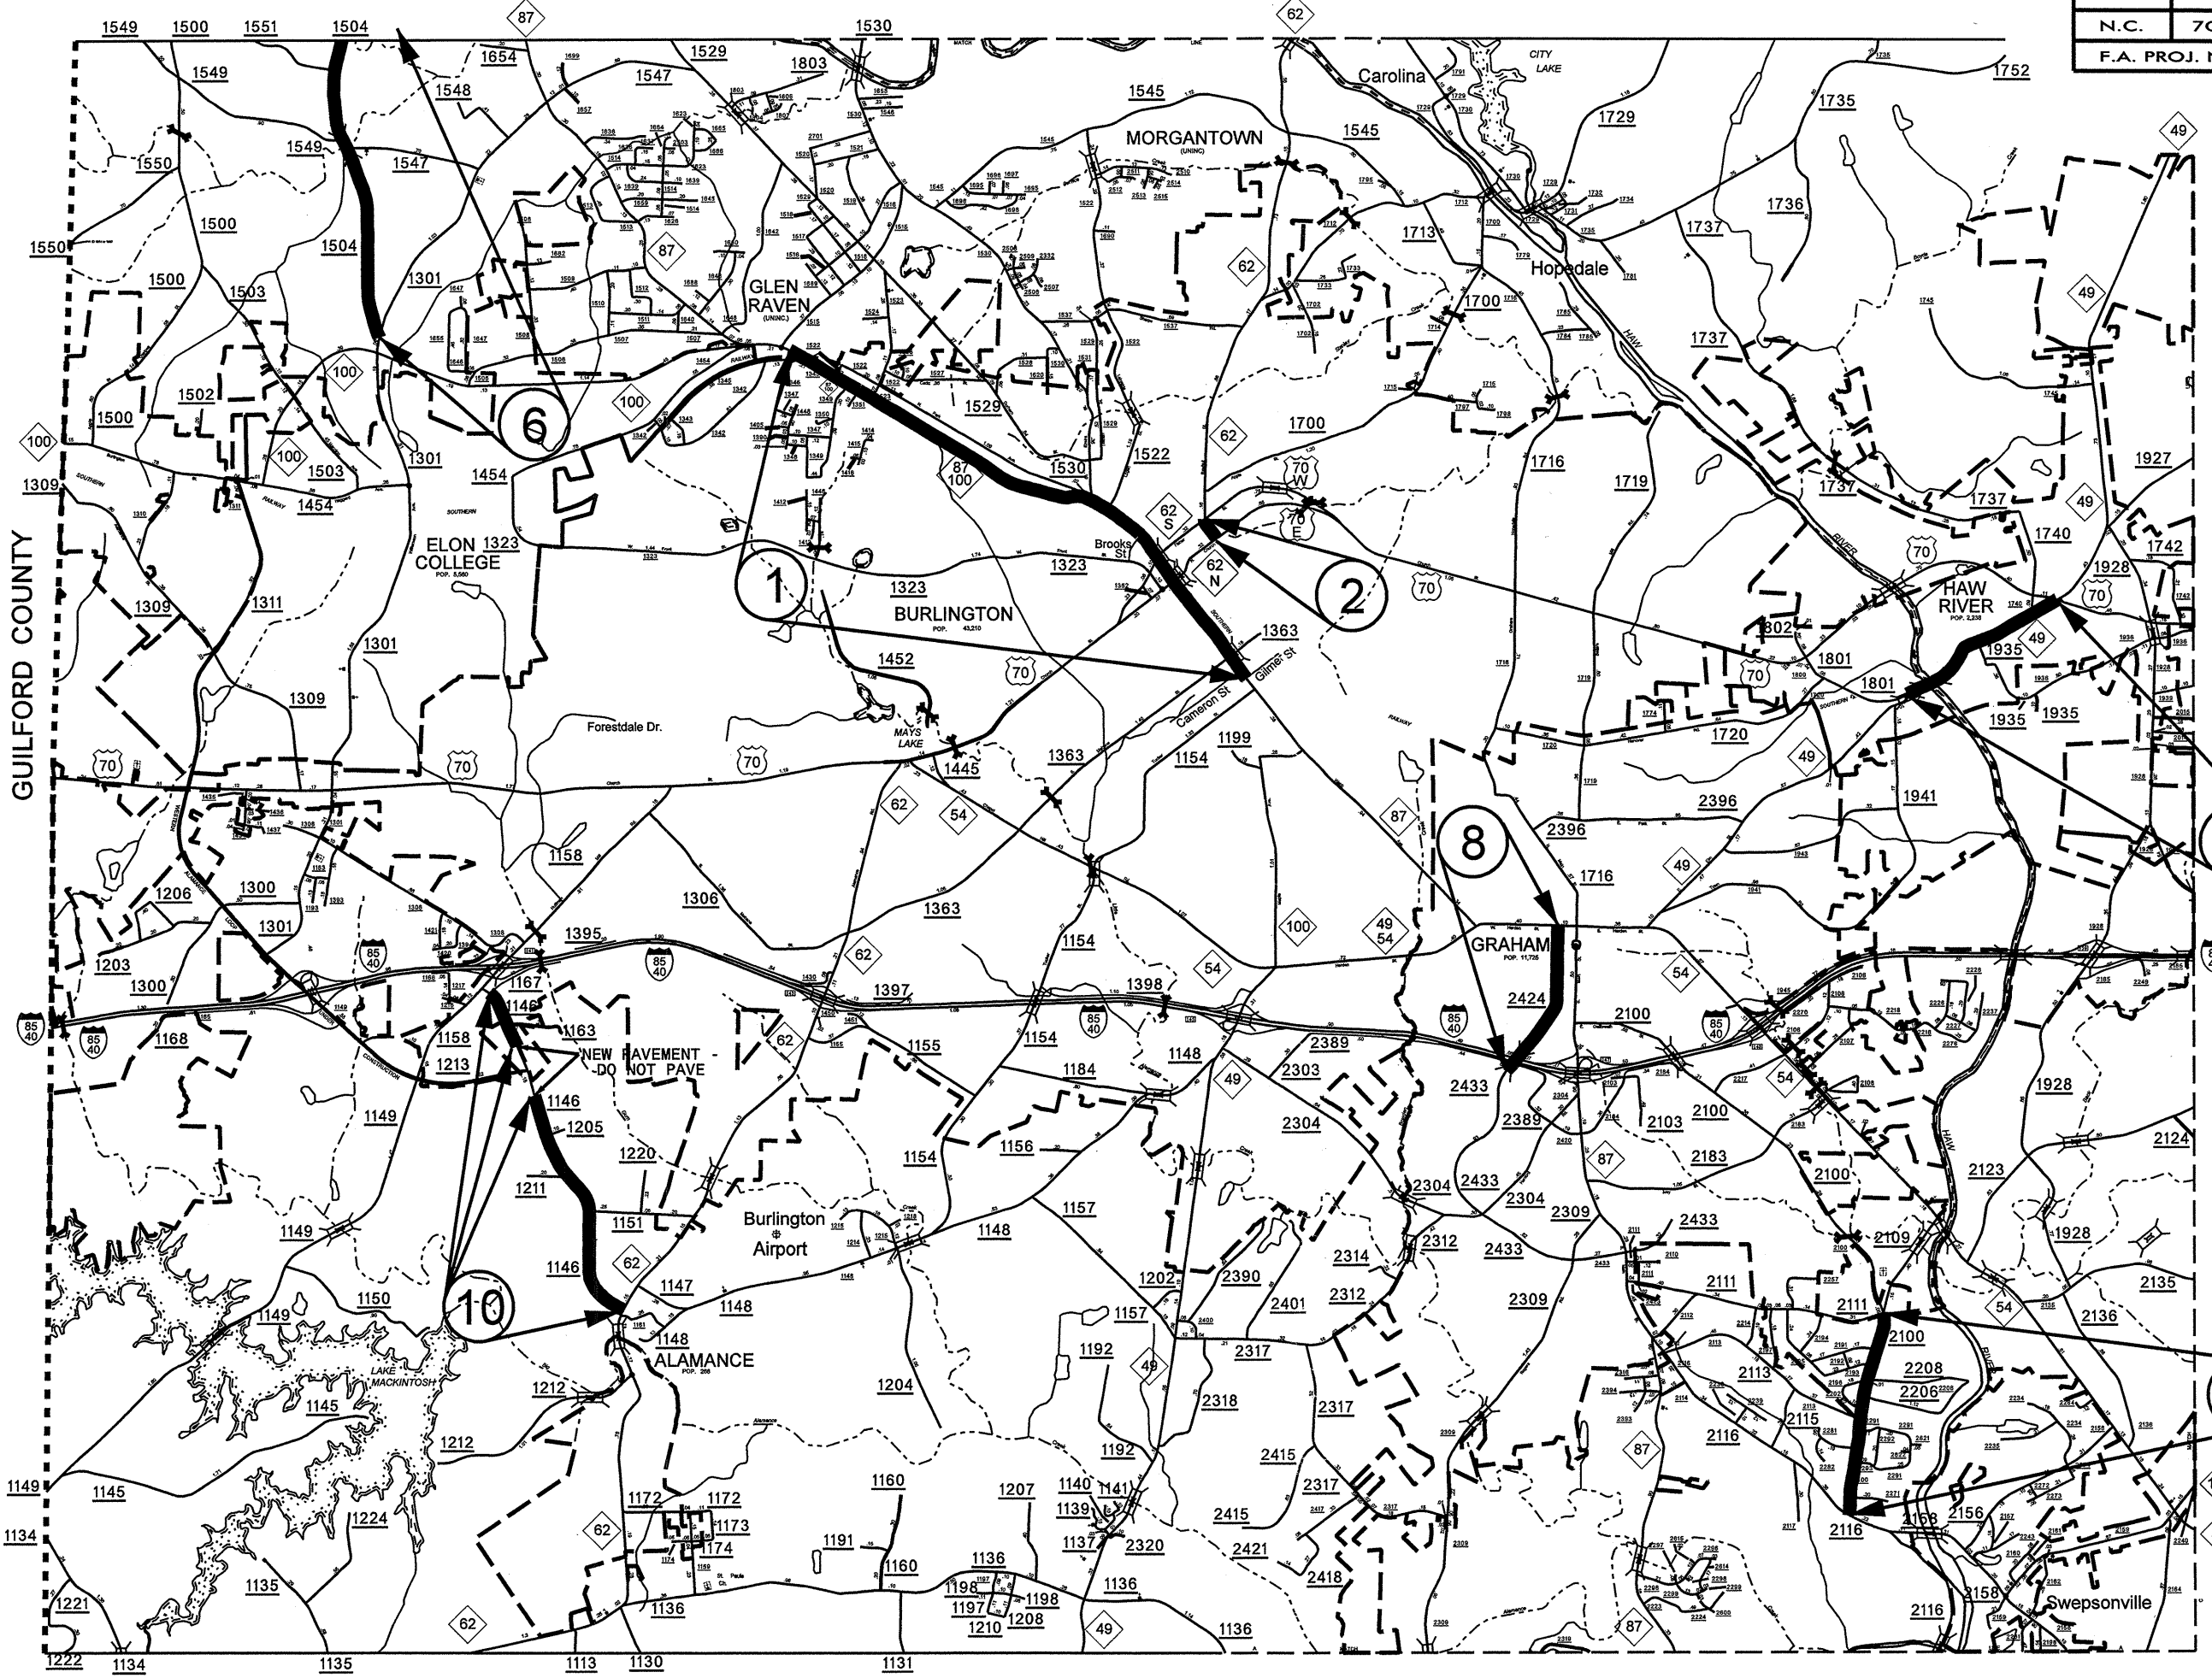

NOTE:  
MAP 4 & 5  
HAVE  
BEEN DELETED


# ALAMANCE COUNTY




GUILFORD COUNTY

# ALAMANCE COUNTY


STATE	PROJECT NO.	SHEET NO.	TOTAL SHEETS
N.C.	7CR.10011.18, ETC.	3	
F.A. PROJ. NO.			

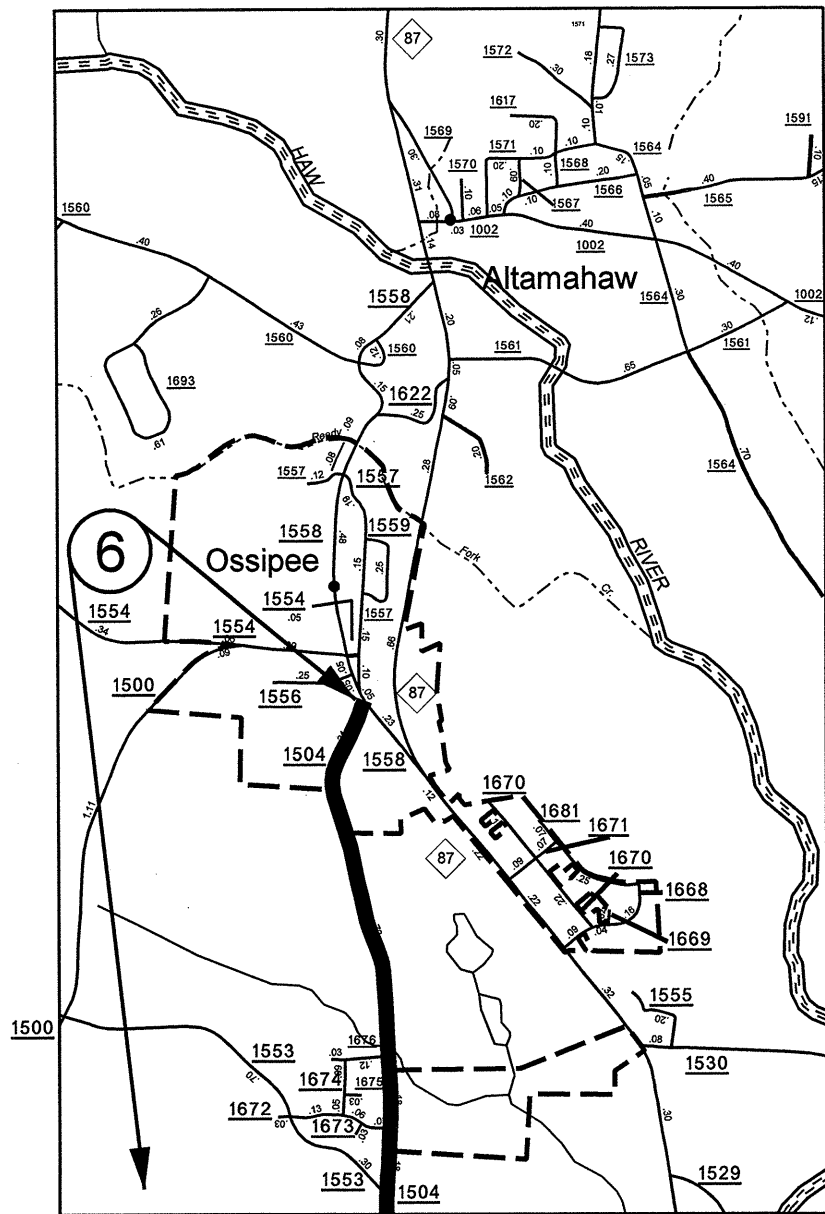

Altamahaw and Ossipee

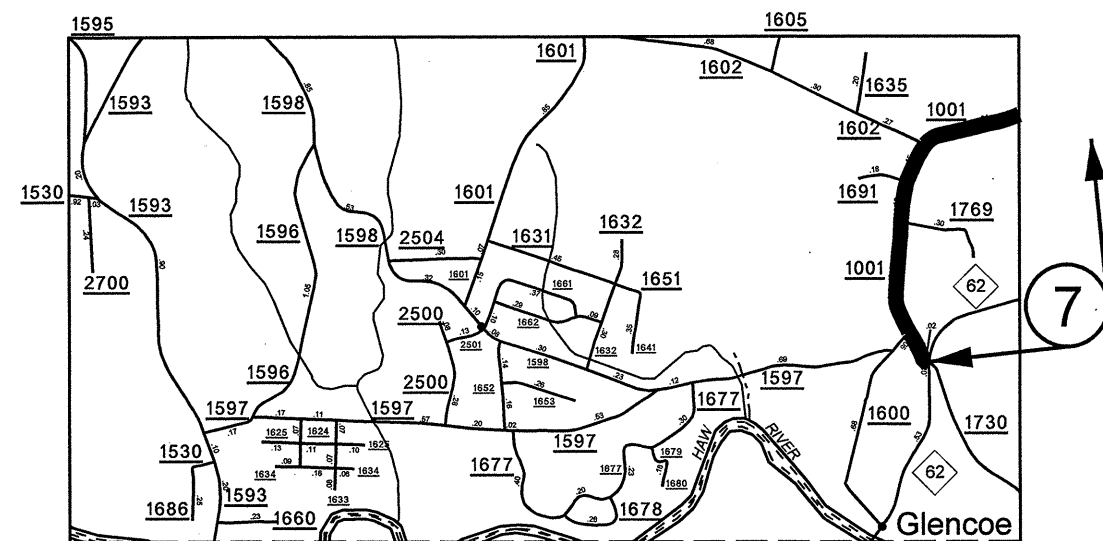

Glencoe

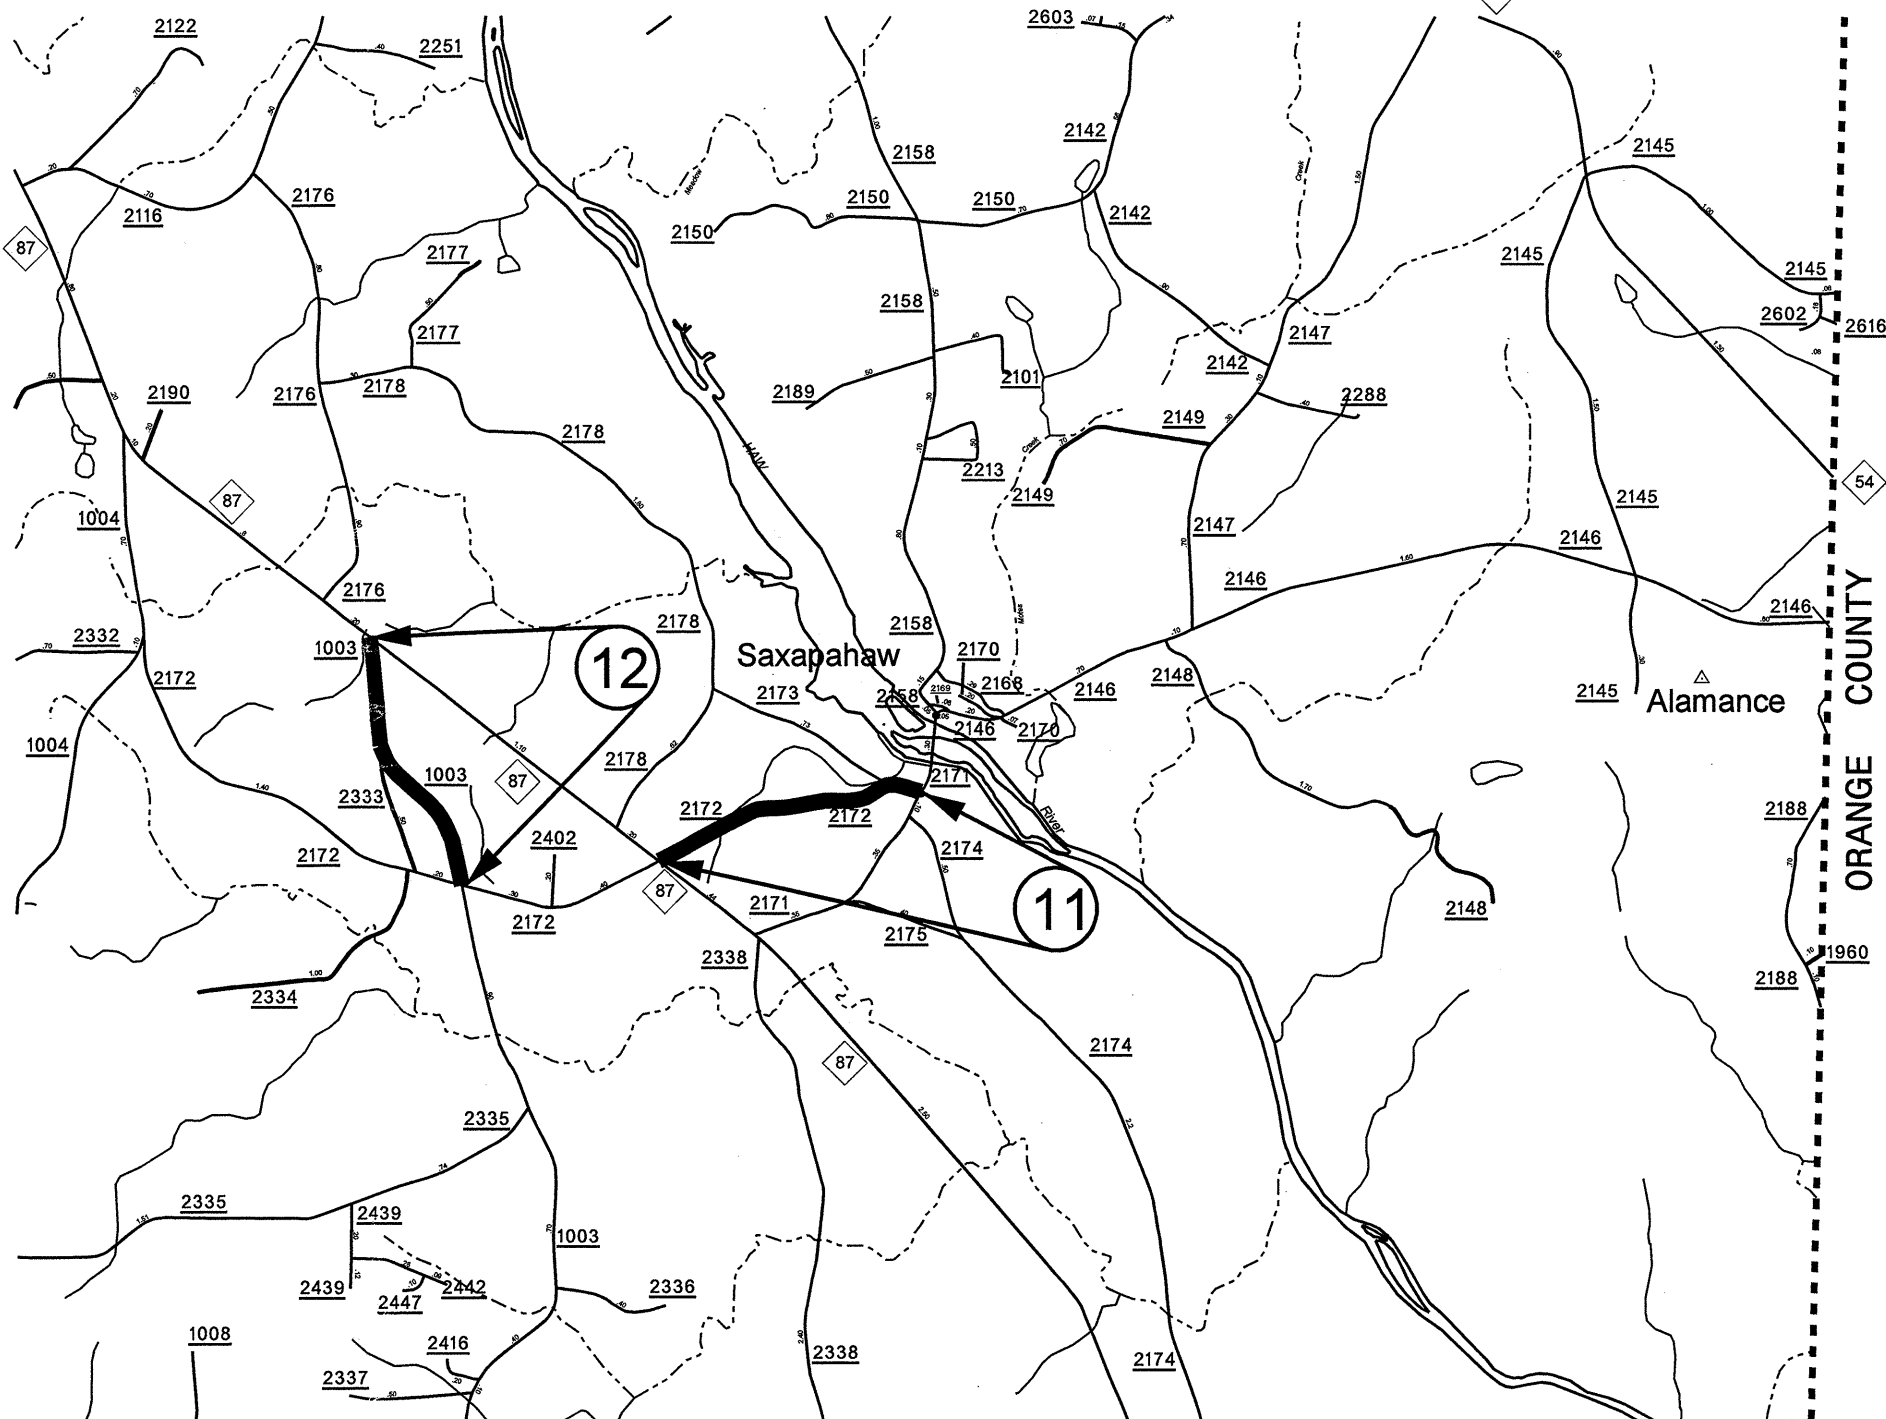

Saxapahaw


Alamance

ORANGE COUNTY

NOTE:  
MAP 4 & 5 - HAVE BEEN DELETED

STATE	PROJECT NO.	SHEET NO.	TOTAL SHEETS
N.C.	7CR.10011.18 & 7CR.20011.18	4	

NOTE: MAP 4 & 5 HAVE BEEN DELETED

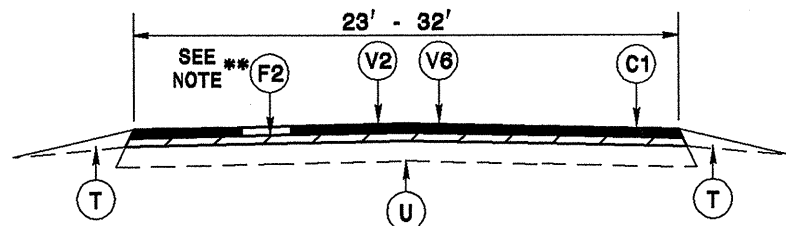


**TYPICAL SECTION NO. 1**


TO BE USED ON:  
 MAP 1 STA. 000+00 TO STA. 000+55  
 STA. 003+20 TO STA. 013+35  
 STA. 014+40 TO STA. 017+25  
 STA. 035+05 TO STA. 054+15  
 STA. 055+75 TO STA. 076+95  
 MAP 3 STA. 000+00 TO STA. 006+70  
 STA. 022+00 TO STA. 022+75  
~~MAP 5 STA. 005+42 TO STA. 007+93~~

DO NOT PAVE - BRIDGES  
 MAP 3 STA. 08+70 TO STA. 10+40  
 MAP 5 STA. 07+93 TO STA. 11+60


NOTE:  
 \*\* DO NOT PLACE F2 ON INCIDENTAL MILLING

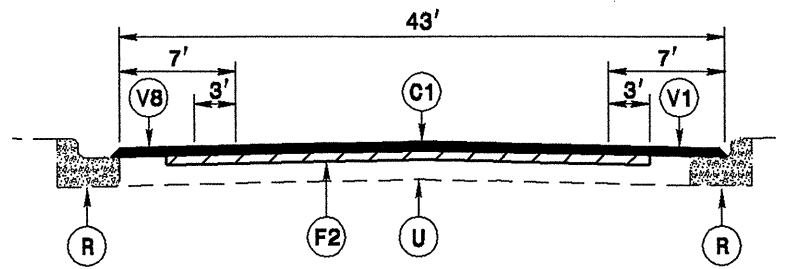

**TYPICAL SECTION NO. 5**  
 MAP 1 STA. 18+85 TO STA. 20+15

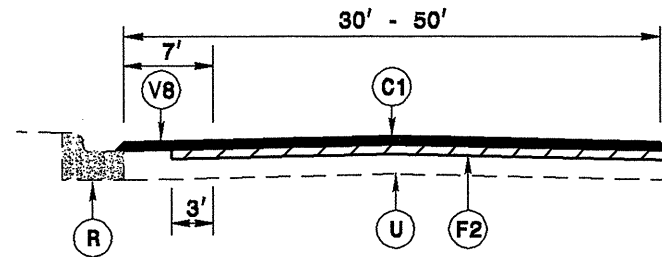


**TYPICAL SECTION NO. 6**  
 TO BE USED ON:  
 MAP 1 STA. 20+15 TO STA. 21+25  
 MAP 3 STA. 14+45 TO STA. 22+00

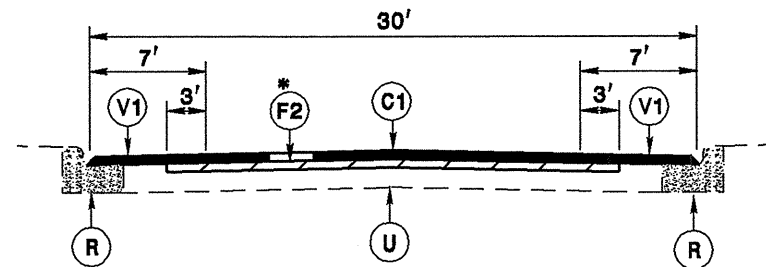


**TYPICAL SECTION NO. 2**

MAP 1 STA. 00+55 TO STA. 03+20  
 \* NOTE: DO NOT PLACE F2 ON INCIDENTAL MILLING

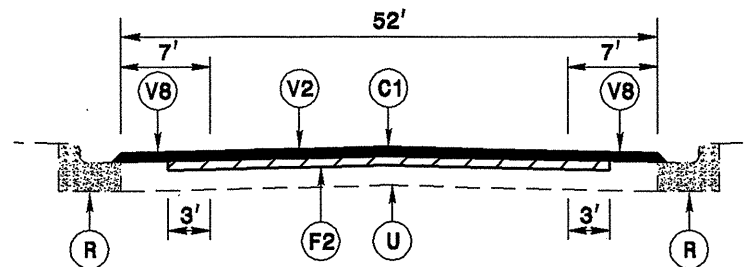


**TYPICAL SECTION NO. 7**  
 TO BE USED ON:  
 MAP 1 STA. 21+25 TO STA. 25+95

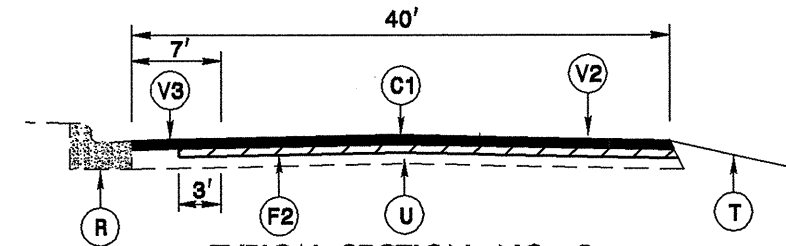


**TYPICAL SECTION NO. 3**

MAP 1 STA. 13+35 TO STA. 14+40  
 MAP 3 STA. 10+40 TO STA. 11+05 \*  
 NOTE:  
 \* DO NOT PLACE 78M ON THIS MAP

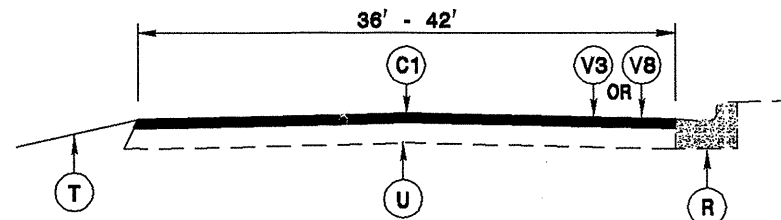


**TYPICAL SECTION NO. 8**

TO BE USED ON:  
 MAP 1 STA. 25+95 TO STA. 29+85 (USE WITH V8)  
 MAP 3 STA. 11+20 TO STA. 12+05 (USE WITH V3)

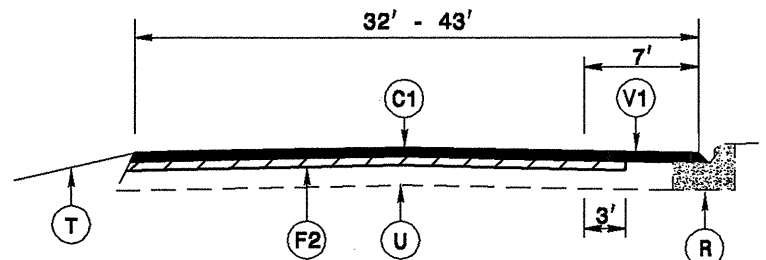

**TYPICAL SECTION NO. 4**

TO BE USED ON:  
 MAP 1 STA. 17+25 TO STA. 18+85  
 STA. 54+15 TO STA. 55+75  
 MAP 3 STA. 12+05 TO STA. 14+45

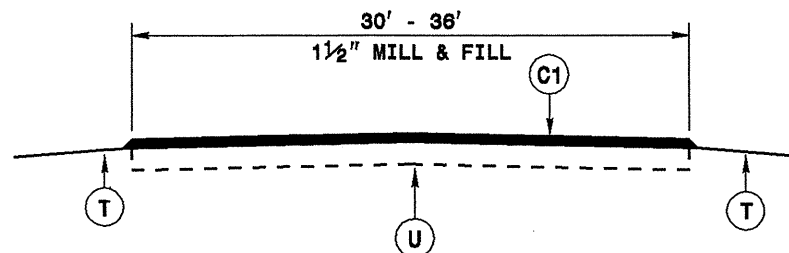


**TYPICAL SECTION NO. 9**


TO BE USED ON:  
 MAP 1 STA. 29+65 TO STA. 35+05

REFER TO SHEET 8  
 FOR MILLING DETAILS


PAVEMENT SCHEDULE	
C1	PROP. APPROX. 1 1/2" ASPHALT CONCRETE SURFACE COURSE, TYPE S9.5B, AT AN AVERAGE RATE OF 168 LBS. PER SQ. YD.
C2	PROP. APPROX. 2" ASPHALT CONCRETE SURFACE COURSE, TYPE S9.5B, AT AN AVERAGE RATE OF 224 LBS. PER SQ. YD.
C3	DELETED
C4	PROP. APPROX. 1 1/4" ASPHALT CONCRETE SURFACE COURSE, TYPE S9.5A, AT AN AVERAGE RATE OF 137.5 LBS. PER SQ. YD.
C5	PROP. APPROX. 1 1/2" ASPHALT CONCRETE SURFACE COURSE, TYPE S9.5A, AT AN AVERAGE RATE OF 165 LBS. PER SQ. YD.
D	PROP. APPROX. 3" ASPHALT CONCRETE INTERMEDIATE COURSE, TYPE I9.0B, AT AN AVERAGE RATE OF 342 LBS. PER SQ. YD.
F1	DELETED
F2	AST MAT COAT, 78M
R	EXISTING CONCRETE CURB & GUTTER OR EXISTING CONCRETE GUTTER
R1	EXISTING CONCRETE ISLAND
T	SHOULDER RECONSTRUCTION, AS DIRECTED BY THE ENGINEER.
U	EXISTING PAVEMENT.
V1	0 - 1 1/2" MILLING FOR 7 FT FROM THE FACE OF CURB TO THE ROADWAY
V2	MILLING FROM 4FT TO 12 FT, 1 1/2" IN DEPTH AT LOCATIONS AS DIRECTED BY THE ENGINEER
V3	0 - 1 1/2" MILLING FOR 7 FT FROM THE FRONT OF THE GUTTER TO THE ROADWAY
V4	0 - 2 1/4" MILLING FOR 7 FT FROM THE FRONT OF THE GUTTER TO THE ROADWAY
V5	0 - 2 1/2" MILLING FOR 7 FT FROM THE FRONT OF THE GUTTER TO THE ROADWAY
V6	MILLING FROM 4FT TO 12 FT, 2" IN DEPTH AT LOCATIONS AS DIRECTED BY THE ENGINEER
V7	0 - 1 1/4" MILLING FOR 7 FT FROM THE FRONT OF THE GUTTER TO THE ROADWAY
V8	0 - 1 1/2" MILLING FOR 7 FT FROM THE FRONT OF THE GUTTER TO THE ROADWAY
V9	MILLING 4FT, 3" IN DEPTH AT LOCATIONS AS DIRECTED BY THE ENGINEER
V10	MILLING 4FT, 6" IN DEPTH AT LOCATIONS AS DIRECTED BY THE ENGINEER

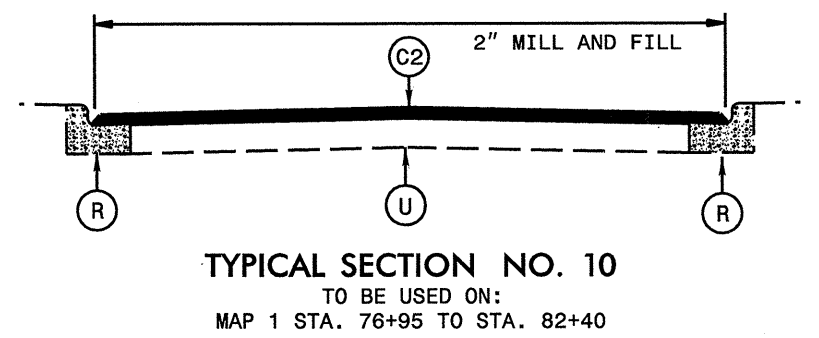

**TYPICAL SECTION NO. 10**  
TO BE USED ON:  
MAP 1 STA. 76+95 TO STA. 82+40

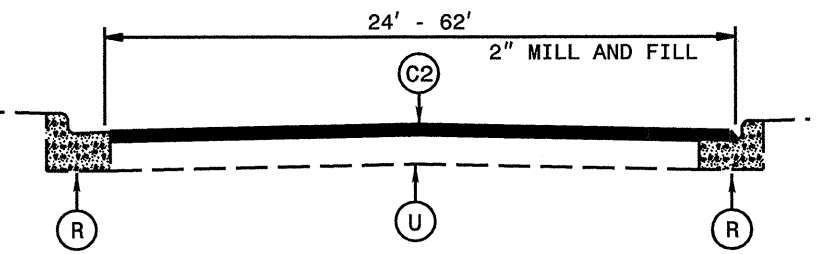


**TYPICAL SECTION NO. 11**  
TO BE USED ON:  
MAP 1 STA. 082+40 TO STA. 083+90

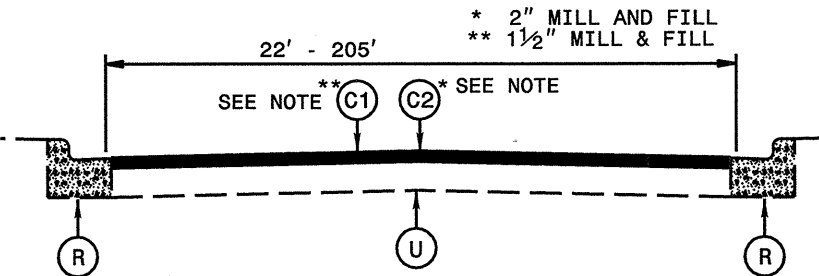


**TYPICAL SECTION NO. 12**  
TO BE USED ON:  
MAP 1 STA. 083+90 TO STA. 085+70 \*  
STA. 105+66 TO STA. 110+35 \*  
MAP 3 STA. 011+05 TO STA. 011+20 \*\*  
STA. 022+75 TO STA. 047+80 \*\*  
~~MAP 5 STA. 019+35 TO STA. 019+40 \*~~  
~~STA. 020+00 TO STA. 060+20 \*~~  
~~MAP 5A STA. 000+00 TO STA. 004+30 \*~~

**NOTE:**  
\* 2" MILL AND FILL  
\*\* 1 1/2" MILL & FILL

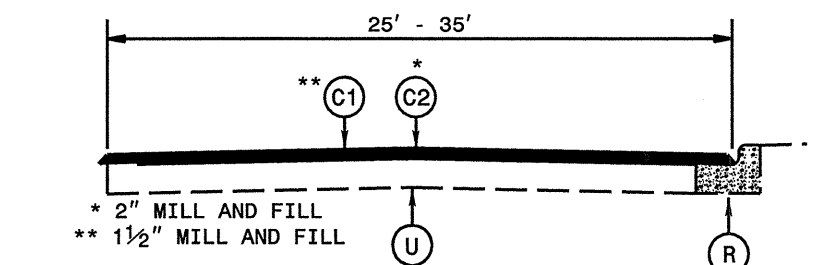

**TYPICAL SECTION NO. 13**  
TO BE USED ON:  
MAP 1 STA. 85+70 TO STA. 091+35 \*  
STA. 91+35 TO STA. 105+66 \*\*

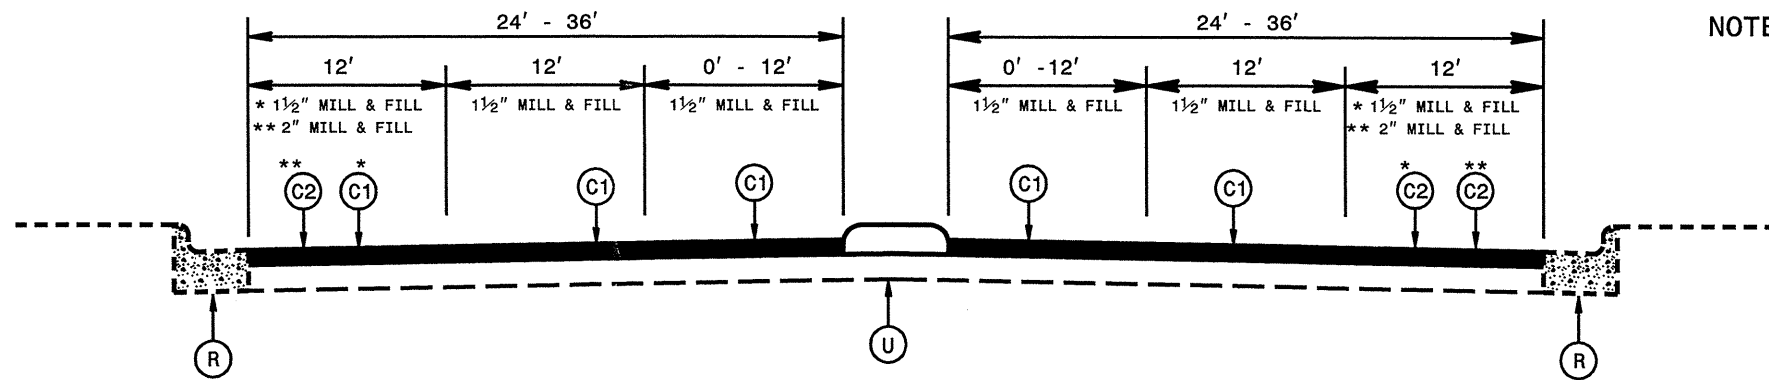


**TYPICAL SECTION NO. 14**  
TO BE USED ON MAP 1  
STA. 110+35 TO STA. 113+20  
STA. 114+50 TO STA. 120+75  
STA. 122+15 TO STA. 125+55  
STA. 128+85 TO STA. 141+40


**NOTE:**  
NEW PAVEMENT IN INTERSECTION -  
DO NOT PAVE  
MAP 1 STA. 113+20 TO STA. 114+50  
MAP 1 STA. 120+75 TO STA. 122+75

**\* NOTE 1 1/2" MILLING:**  
STA. 110+35 TO STA. 113+20 LT. & RT.  
STA. 122+15 TO STA. 125+55 LT.  
STA. 128+85 TO STA. 141+40 LT.

**\*\* NOTE 2" MILLING:**  
STA. 114+50 TO STA. 120+75 LT. & RT.  
STA. 122+15 TO STA. 125+55 RT.  
STA. 128+85 TO STA. 141+40 RT.

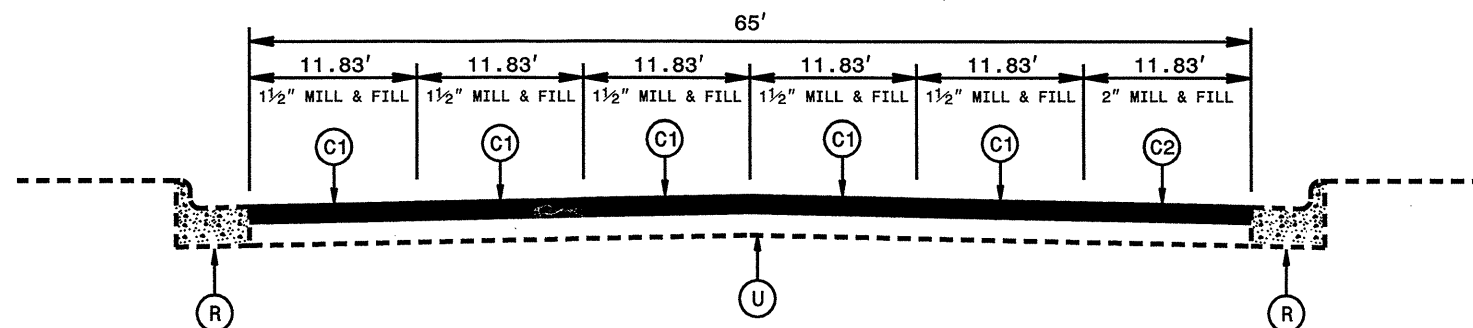

**TYPICAL SECTION NO. 15**  
TO BE USED ON:  
MAP 1 STA. 125+55 TO STA. 128+85

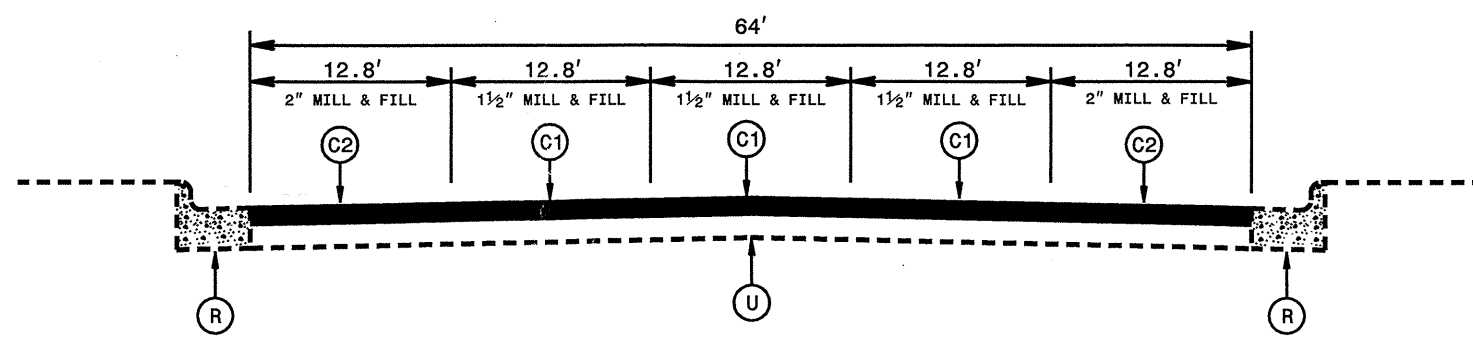

**TYPICAL SECTION NO. 16**  
TO BE USED ON:  
MAP 1 STA. 141+40 TO STA. 146+05


**NOTE: MAPS 4 & 5 HAVE BEEN DELETED**

PAVEMENT SCHEDULE	
C1	PROP. APPROX. 1 1/2" ASPHALT CONCRETE SURFACE COURSE, TYPE S9.5B, AT AN AVERAGE RATE OF 168 LBS. PER SQ. YD.
C2	PROP. APPROX. 2" ASPHALT CONCRETE SURFACE COURSE, TYPE S9.5B, AT AN AVERAGE RATE OF 224 LBS. PER SQ. YD.
C3	DELETED
C4	PROP. APPROX. 1 1/4" ASPHALT CONCRETE SURFACE COURSE, TYPE SF9.5A, AT AN AVERAGE RATE OF 137.5 LBS. PER SQ. YD.
C5	PROP. APPROX. 1 1/2" ASPHALT CONCRETE SURFACE COURSE, TYPE SF9.5A, AT AN AVERAGE RATE OF 165 LBS. PER SQ. YD.
D	PROP. APPROX. 3" ASPHALT CONCRETE INTERMEDIATE COURSE, TYPE I19.0B, AT AN AVERAGE RATE OF 342 LBS. PER SQ. YD.
F1	DELETED
F2	AST MAT COAT, 78M
R	EXISTING CONCRETE CURB & GUTTER OR EXISTING CONCRETE GUTTER
R1	EXISTING CONCRETE ISLAND
T	SHOULDER RECONSTRUCTION, AS DIRECTED BY THE ENGINEER.
U	EXISTING PAVEMENT.
V1	0 - 1 1/2" MILLING FOR 7 FT FROM THE FACE OF CURB TO THE ROADWAY
V2	MILLING FROM 4FT TO 12 FT, 1 1/2" IN DEPTH AT LOCATIONS AS DIRECTED BY THE ENGINEER
V3	0 - 1 1/2" MILLING FOR 7 FT FROM THE FRONT OF THE GUTTER TO THE ROADWAY
V4	0 - 2 1/4" MILLING FOR 7 FT FROM THE FRONT OF THE GUTTER TO THE ROADWAY
V5	0 - 2 1/2" MILLING FOR 7 FT FROM THE FRONT OF THE GUTTER TO THE ROADWAY
V6	MILLING FROM 4FT TO 12 FT, 2" IN DEPTH AT LOCATIONS AS DIRECTED BY THE ENGINEER
V7	0 - 1 1/4" MILLING FOR 7 FT FROM THE FRONT OF THE GUTTER TO THE ROADWAY
V8	0 - 1 1/2" MILLING FOR 7 FT FROM THE FRONT OF THE GUTTER TO THE ROADWAY
V9	MILLING 4FT, 3" IN DEPTH AT LOCATIONS AS DIRECTED BY THE ENGINEER
V10	MILLING 4FT, 8" IN DEPTH AT LOCATIONS AS DIRECTED BY THE ENGINEER

\$\$\$\$\$DGN\$\$\$\$\$  
\$\$\$\$\$USERNAM\$\$\$\$\$




NOTE: MAPS 4 & 5 HAVE BEEN DELETED

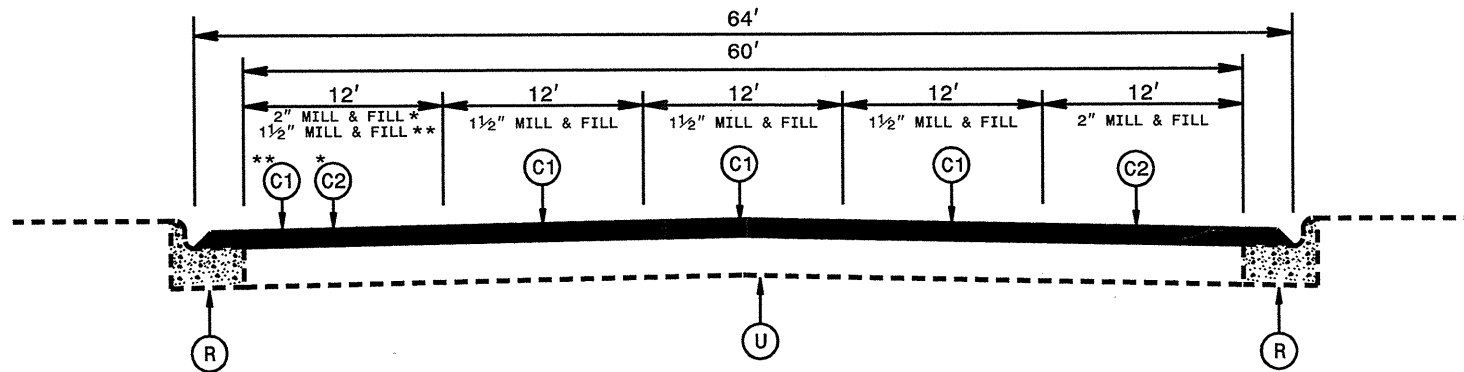

**TYPICAL SECTION NO. 17**

TO BE USED ON MAP 1  
STA. 146+05 TO STA. 156+00


NOTE:  
\* 2" MILL & FILL STA. 146+05 TO STA. 148+95 LT.  
\*\* 1 1/2" MILL & FILL STA. 148+95 TO STA. 156+00 LT.

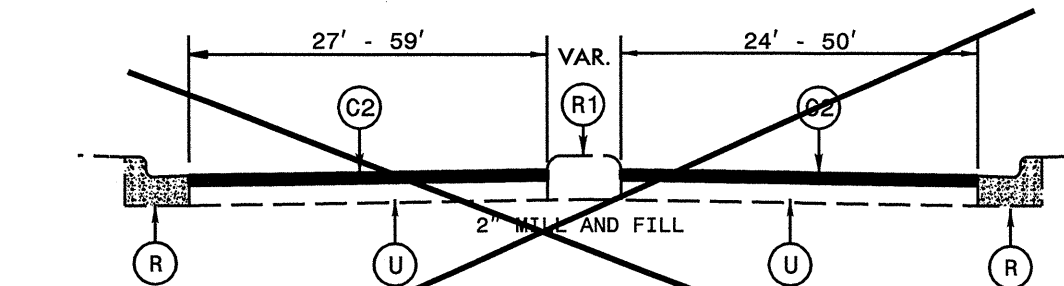

**DELETED**

**TYPICAL SECTION NO. 21**


TO BE USED ON:  
MAP 5 STA. 13+55 TO STA. 18+35  
STA. 19+40 TO STA. 23+80

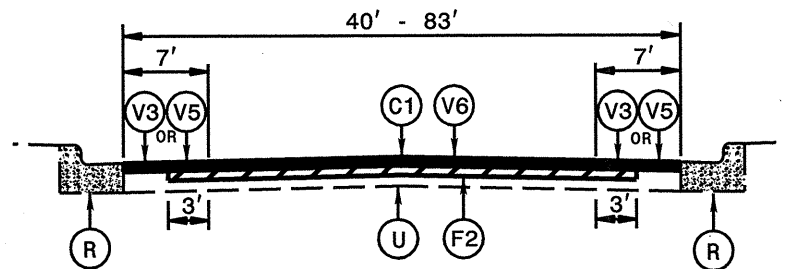

**TYPICAL SECTION NO. 18**

TO BE USED ON:  
MAP 2 STA. 00+00 TO STA. 05+78 (USE WITH V5)  
MAP 3 STA. 11+05 TO STA. 11+20 (USE WITH V3)  
MAP 5 STA. 00+00 TO STA. 02+27 (USE WITH V3)

**DELETED**

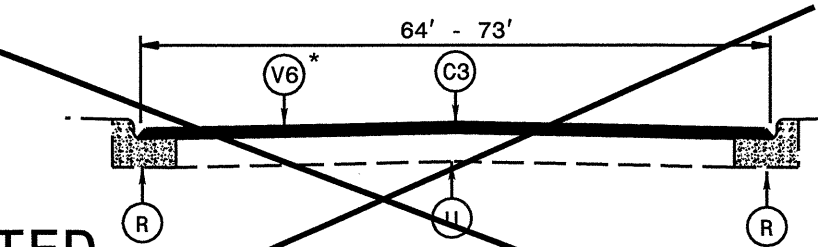


**DELETED**

**TYPICAL SECTION NO. 22**

TO BE USED ON:  
MAP 4 STA. 00+00 TO STA. 55+25  
STA. 60+25 TO STA. 95+00

\* NOTE: SEE MILLING DETAIL FOR MORE INFORMATION

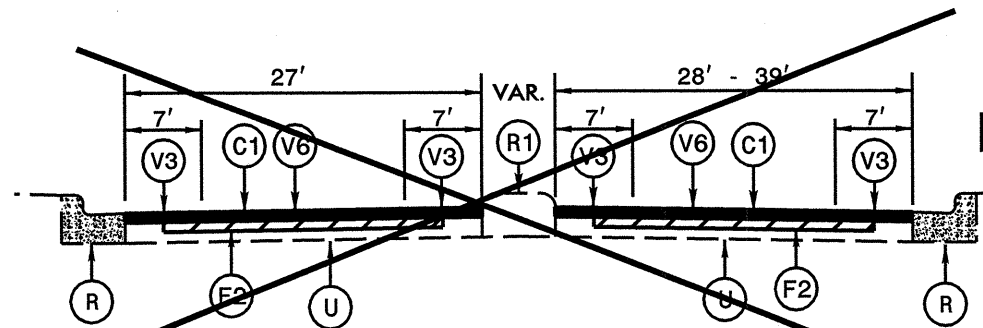


**DELETED**

**TYPICAL SECTION NO. 19**

TO BE USED ON:  
MAP 5 STA. 2+27 TO STA. 5+42


**DELETED**

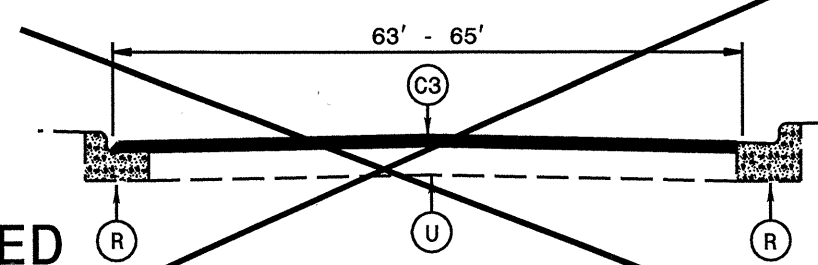

**DELETED**

**TYPICAL SECTION NO. 23**

TO BE USED ON:  
MAP 4 STA. 55+25 TO STA. 55+80

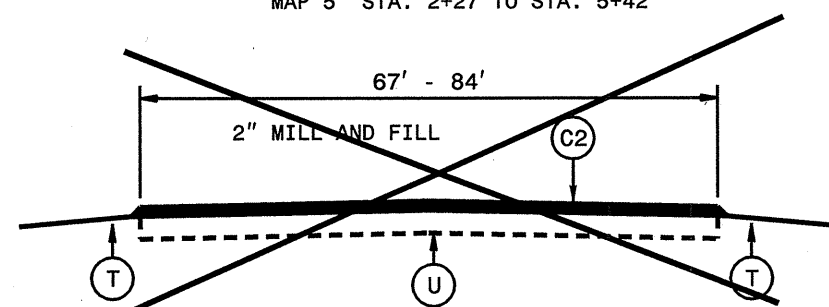


**DELETED**

**TYPICAL SECTION NO. 20**

TO BE USED ON:  
MAP 5 STA. 11+60 TO STA. 13+55  
STA. 18+35 TO STA. 19+40

**DELETED**

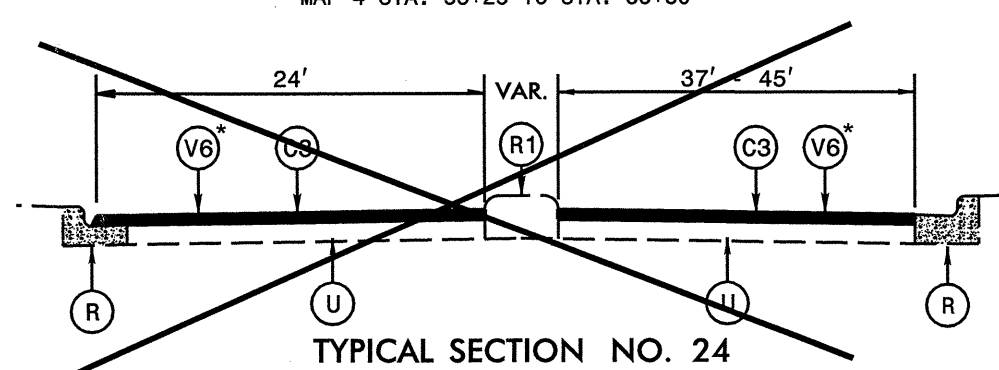

**DELETED**

**TYPICAL SECTION NO. 24**

TO BE USED ON:  
MAP 4 STA. 55+80 TO STA. 60+25

\* NOTE: SEE MILLING DETAIL FOR MORE INFORMATION


**PAVEMENT SCHEDULE**

C1	PROP. APPROX. 1 1/2" ASPHALT CONCRETE SURFACE COURSE, TYPE S9.5B, AT AN AVERAGE RATE OF 168 LBS. PER SQ. YD.
C2	PROP. APPROX. 2" ASPHALT CONCRETE SURFACE COURSE, TYPE S9.5B, AT AN AVERAGE RATE OF 224 LBS. PER SQ. YD.
C3	DELETED
C4	PROP. APPROX. 1 1/4" ASPHALT CONCRETE SURFACE COURSE, TYPE SF9.5A, AT AN AVERAGE RATE OF 137.5 LBS. PER SQ. YD.
C5	PROP. APPROX. 1 1/2" ASPHALT CONCRETE SURFACE COURSE, TYPE SF9.5A, AT AN AVERAGE RATE OF 165 LBS. PER SQ. YD.
D	PROP. APPROX. 3" ASPHALT CONCRETE INTERMEDIATE COURSE, TYPE I19.0B, AT AN AVERAGE RATE OF 342 LBS. PER SQ. YD.
F1	DELETED
F2	AST MAT COAT, 78M
R	EXISTING CONCRETE CURB & GUTTER OR EXISTING CONCRETE GUTTER
R1	EXISTING CONCRETE ISLAND
T	SHOULDER RECONSTRUCTION, AS DIRECTED BY THE ENGINEER.
U	EXISTING PAVEMENT.
V1	0 - 1 1/2" MILLING FOR 7 FT FROM THE FACE OF CURB TO THE ROADWAY
V2	MILLING FROM 4 FT TO 12 FT, 1 1/2" IN DEPTH AT LOCATIONS AS DIRECTED BY THE ENGINEER
V3	0 - 1 1/2" MILLING FOR 7 FT FROM THE FRONT OF THE GUTTER TO THE ROADWAY
V4	0 - 2 1/4" MILLING FOR 7 FT FROM THE FRONT OF THE GUTTER TO THE ROADWAY
V5	0 - 2 1/2" MILLING FOR 7 FT FROM THE FRONT OF THE GUTTER TO THE ROADWAY
V6	MILLING FROM 4 FT TO 12 FT, 2" IN DEPTH AT LOCATIONS AS DIRECTED BY THE ENGINEER
V7	0 - 1 1/4" MILLING FOR 7 FT FROM THE FRONT OF THE GUTTER TO THE ROADWAY
V8	0 - 1 1/2" MILLING FOR 7 FT FROM THE FRONT OF THE GUTTER TO THE ROADWAY
V9	MILLING 4 FT, 3" IN DEPTH AT LOCATIONS AS DIRECTED BY THE ENGINEER
V10	MILLING 4 FT, 8" IN DEPTH AT LOCATIONS AS DIRECTED BY THE ENGINEER

ala\_typical\_sht2.dgn 11/13/2009 10:24:07 AM

STATE	PROJECT NO.	SHEET NO.	TOTAL SHEETS
N.C.	7CR.10011.18 & 7CR.20011.18	7	


NOTE: MAPS 4 & 5 HAVE BEEN DELETED

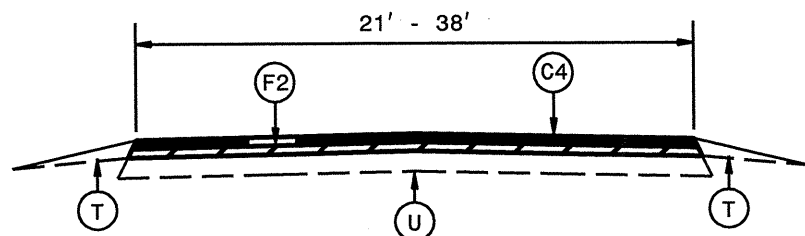

**TYPICAL SECTION NO. 25**


TO BE USED ON:  
MAP 6 STA. 000+00 TO STA. 106+30  
STA. 107+00 TO STA. 143+15  
STA. 147+20 TO STA. 198+10  
MAP 7 STA. 000+00 TO STA. 157+75  
STA. 159+55 TO STA. 190+00  
STA. 190+35 TO STA. 252+40  
MAP 12 STA. 000+00 TO STA. 049+80

\* NOTE: THE FOLLOWING STATIONS WILL NOT BE PAVED DUE TO BRIDGES:  
MAP 6 STA. 106+30 TO STA. 107+00  
MAP 7 STA. 157+75 TO STA. 159+55  
MAP 7 STA. 190+00 TO STA. 190+35

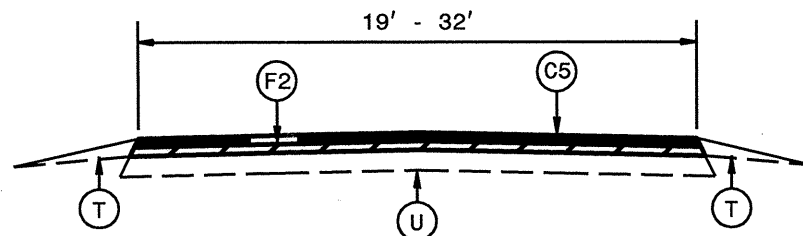

**TYPICAL SECTION NO. 29**

TO BE USED ON:  
MAP 9 STA. 00+00 TO STA. 54+00  
MAP 11 STA. 00+00 TO STA. 50+38

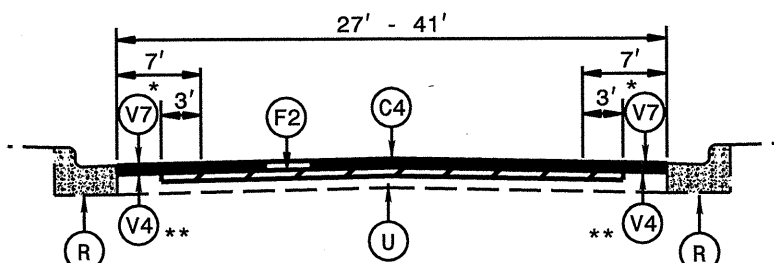


**TYPICAL SECTION NO. 26**

TO BE USED ON:  
MAP 6 STA. 143+15 TO STA. 144+50  
MAP 8 STA. 000+00 TO STA. 038+45

NOTE:  
\* 0 - 1 1/4" MILLING  
\*\* 0 - 2 1/4" MILLING


MAP 6 STA. 143+15 TO STA. 144+50 (USE WITH V7)  
MAP 8 STA. 000+00 TO STA. 005+07 (USE WITH V7)  
MAP 8 STA. 005+07 TO STA. 038+45 (USE WITH V4)

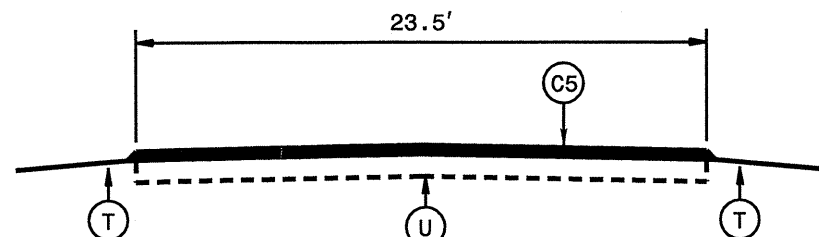

**TYPICAL SECTION NO. 30**


TO BE USED ON:  
MAP 10 STA. 00+00 TO STA. 05+84  
STA. 11+12 TO STA. 56+88  
STA. 76+70 TO STA. 88+77

\* NOTE:  
STA. 56+88 TO STA. 76+70 DO NOT PAVE - NEW PAVEMENT

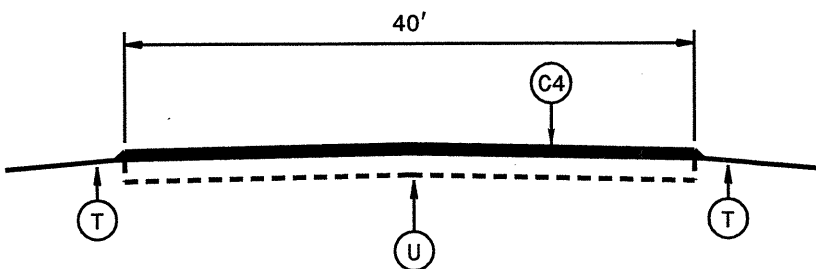


**TYPICAL SECTION NO. 27**

TO BE USED ON:  
MAP 6 STA. 144+50 TO STA. 145+55

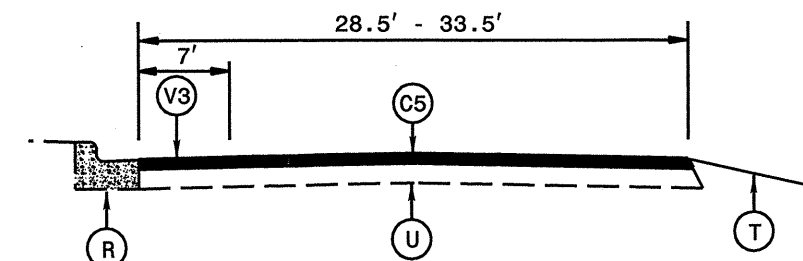

**TYPICAL SECTION NO. 31**

TO BE USED ON:  
MAP 10 STA. 05+84 TO STA. 11+12

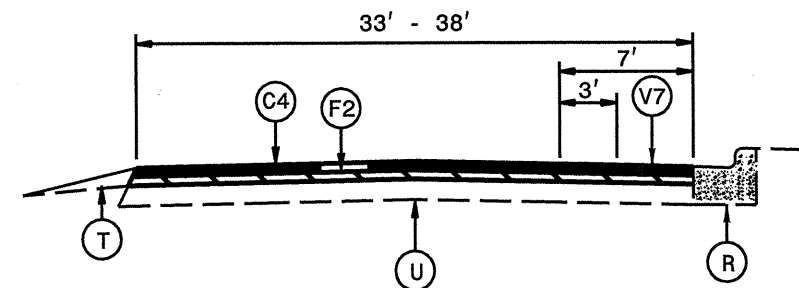

**TYPICAL SECTION NO. 28**


TO BE USED ON:  
MAP 6 STA. 145+55 TO STA. 147+20

PAVEMENT SCHEDULE	
C1	PROP. APPROX. 1 1/2" ASPHALT CONCRETE SURFACE COURSE, TYPE S9.5B, AT AN AVERAGE RATE OF 168 LBS. PER SQ. YD.
C2	PROP. APPROX. 2" ASPHALT CONCRETE SURFACE COURSE, TYPE S9.5B, AT AN AVERAGE RATE OF 224 LBS. PER SQ. YD.
C3	DELETED
C4	PROP. APPROX. 1 1/4" ASPHALT CONCRETE SURFACE COURSE, TYPE SF9.5A, AT AN AVERAGE RATE OF 137.5 LBS. PER SQ. YD.
C5	PROP. APPROX. 1 1/2" ASPHALT CONCRETE SURFACE COURSE, TYPE SF9.5A, AT AN AVERAGE RATE OF 165 LBS. PER SQ. YD.
D	PROP. APPROX. 3" ASPHALT CONCRETE INTERMEDIATE COURSE, TYPE I19.0B, AT AN AVERAGE RATE OF 342 LBS. PER SQ. YD.
F1	DELETED
F2	AST MAT COAT, 78M
R	EXISTING CONCRETE CURB & GUTTER OR EXISTING CONCRETE GUTTER
R1	EXISTING CONCRETE ISLAND
T	SHOULDER RECONSTRUCTION, AS DIRECTED BY THE ENGINEER.
U	EXISTING PAVEMENT.
V1	0 - 1 1/2" MILLING FOR 7 FT FROM THE FACE OF CURB TO THE ROADWAY
V2	MILLING FROM 4FT TO 12 FT, 1 1/2" IN DEPTH AT LOCATIONS AS DIRECTED BY THE ENGINEER
V3	0 - 1 1/2" MILLING FOR 7 FT FROM THE FRONT OF THE GUTTER TO THE ROADWAY
V4	0 - 2 1/4" MILLING FOR 7 FT FROM THE FRONT OF THE GUTTER TO THE ROADWAY
V5	0 - 2 1/2" MILLING FOR 7 FT FROM THE FRONT OF THE GUTTER TO THE ROADWAY
V6	MILLING FROM 4FT TO 12 FT, 2" IN DEPTH AT LOCATIONS AS DIRECTED BY THE ENGINEER
V7	0 - 1 1/4" MILLING FOR 7 FT FROM THE FRONT OF THE GUTTER TO THE ROADWAY
V8	0 - 1 1/2" MILLING FOR 7 FT FROM THE FRONT OF THE GUTTER TO THE ROADWAY
V9	MILLING 4FT, 3" IN DEPTH AT LOCATIONS AS DIRECTED BY THE ENGINEER
V10	MILLING 4FT, 8" IN DEPTH AT LOCATIONS AS DIRECTED BY THE ENGINEER

ala\_typical\_sht3.dgn 11/13/2009 10:24:36 AM

STATE	PROJECT NO.	SHEET NO.	TOTAL SHEETS
N.C.	7CR.10011.18 & 7CR.20011.18	8	


**MILLING DETAIL 1**

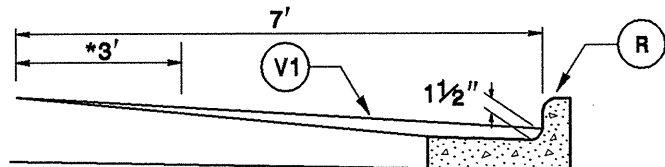

\* IF 78M SEAL IS INVOLVED OVERLAP 3'  
MILL EXISTING ASPHALT PAVEMENT 0-1 1/2" AT  
LOCATIONS AS DIRECTED BY THE ENGINEER

NOTE: TO BE USED IN CONJUNCTION WITH  
TS. NO. 2 ON MAP 1 STA. 00+55 TO STA. 03+20 LT./RT.  
TS. NO. 4 & 5 ON MAP 1 STA. 17+25 TO STA. 20+15 RT.  
TS. NO. 4 ON MAP 1 STA. 54+15 TO STA. 55+75


**MILLING DETAIL 5**

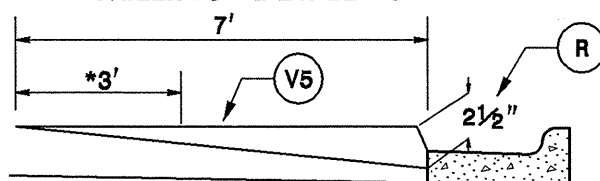

\* IF 78M SEAL IS INVOLVED OVERLAP 3'  
MILL EXISTING ASPHALT PAVEMENT 0" - 2 1/2" AT  
LOCATIONS AS DIRECTED BY THE ENGINEER

NOTE: TO BE USED IN CONJUNCTION WITH  
TS. NO. 18 ON MAP 2 STA. 00+00 TO STA. 05+78


**MILLING DETAIL 8**

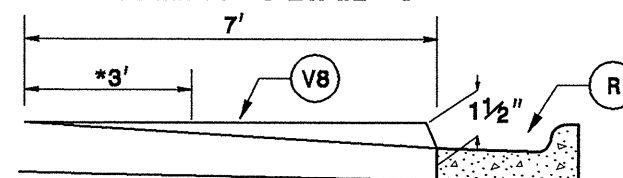

\* IF 78M SEAL IS INVOLVED OVERLAP 3'  
MILL EXISTING ASPHALT PAVEMENT 0" - 1 1/2" AT  
LOCATIONS AS DIRECTED BY THE ENGINEER

NOTE: TO BE USED IN CONJUNCTION WITH  
TS. NO. 5, 6 & 7 ON MAP 1 STA. 18+85 TO STA. 23+70 LT.  
TS. NO. 7 & 8 ON MAP 1 STA. 21+25 TO STA. 29+65 RT.  
TS. NO. 6 ON MAP 3 STA. 14+45 TO STA. 22+00


**MILLING DETAIL 2**

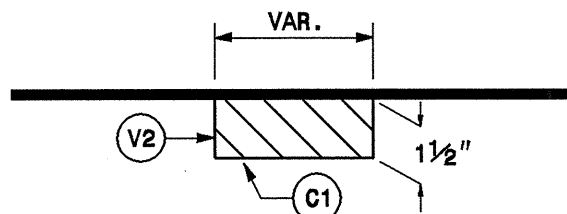

MILL EXISTING ASPHALT PAVEMENT 1 1/2" IN DEPTH  
AT LOCATIONS AS DIRECTED BY THE ENGINEER.

NOTE: TO BE USED IN CONJUNCTION WITH  
T.S. NO. 1 & 3 ON MAP 1 STA. 008+35 TO STA. 016+60  
T.S. NO. 7 ON MAP 1 STA. 021+25 TO STA. 022+75


**MILLING DETAIL 6**

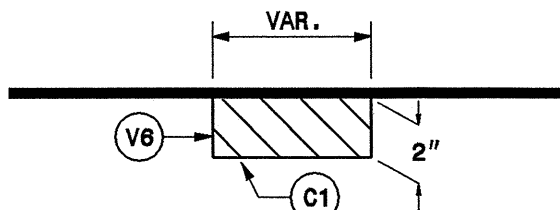

MILL EXISTING ASPHALT PAVEMENT 2" IN DEPTH  
AT LOCATIONS AS DIRECTED BY THE ENGINEER.


NOTE: TO BE USED IN CONJUNCTION WITH  
T.S. NO. 18 ON MAP 2 STA. 004+53 TO STA. 005+78  
T.S. NO. 1 ON MAP 3 STA. 001+15 TO STA. 004+25  
T.S. NO. 19 ON MAP 5 STA. 004+17 TO STA. 005+42

**MILLING DETAIL 9**

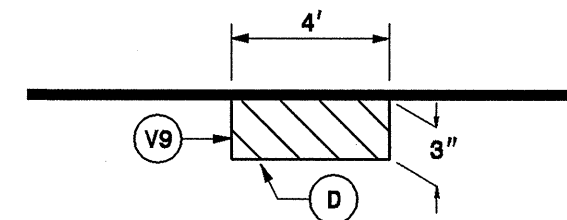

MILL EXISTING ASPHALT PAVEMENT 3" IN DEPTH  
AT LOCATIONS AS DIRECTED BY THE ENGINEER.  
NOTE: THIS ITEM IS CONTIGENT FOR MAPS 1 AND 8


**MILLING DETAIL 3**

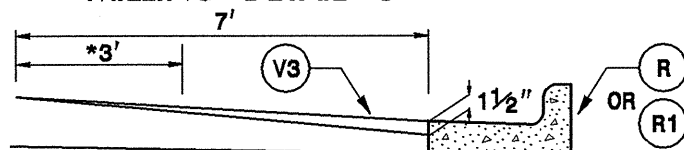

\* IF 78M SEAL IS INVOLVED OVERLAP 3'  
MILL EXISTING ASPHALT PAVEMENT 0-1 1/2" AT  
LOCATIONS AS DIRECTED BY THE ENGINEER

NOTE: TO BE USED IN CONJUNCTION WITH  
TS. NO. 3 ON MAP 1 STA. 013+35 TO STA. 014+40 LT.  
TS. NO. 8 ON MAP 3 STA. 011+20 TO STA. 014+45 RT.  
~~TS. NO. 18 & 19 ON MAP 5 STA. 000+00 TO STA. 005+42~~  
TS. NO. 31 ON MAP 10 STA. 005+84 TO STA. 011+12


**MILLING DETAIL 7**

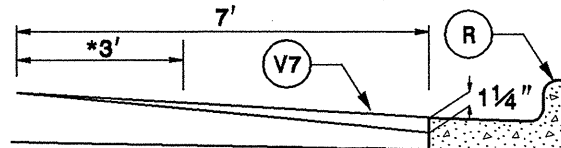

\* IF 78M SEAL IS INVOLVED OVERLAP 3'  
MILL EXISTING ASPHALT PAVEMENT 0-1 1/4" AT  
LOCATIONS AS DIRECTED BY THE ENGINEER

NOTE: TO BE USED IN CONJUNCTION WITH  
TS. NO. 26 ON MAP 6 STA. 143+15 TO STA. 144+50  
TS. NO. 28 ON MAP 6 STA. 145+55 TO STA. 147+20  
TS. NO. 26 ON MAP 8 STA. 000+00 TO STA. 005+07


**MILLING DETAIL 4**

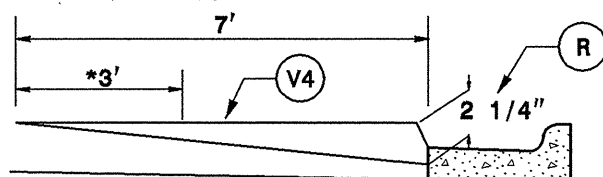

\* IF 78M SEAL IS INVOLVED OVERLAP 3'  
MILL EXISTING ASPHALT PAVEMENT 0" - 2 1/4" AT  
LOCATIONS AS DIRECTED BY THE ENGINEER

NOTE: TO BE USED IN CONJUNCTION WITH  
TS. NO. 28 ON MAP 8 STA. 005+07 TO STA. 038+45

**MILLING DETAIL 10**

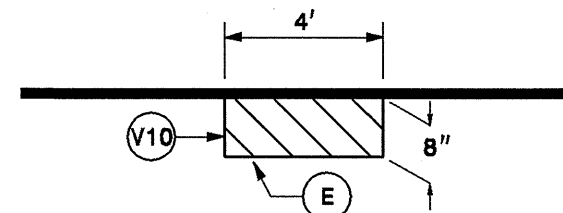


MILL EXISTING ASPHALT PAVEMENT 8" IN DEPTH, FOR  
PATCHING, AT LOCATIONS AS DIRECTED BY THE ENGINEER.  
NOTE: THIS ITEM IS CONTIGENT FOR MAP 1

NOTE: MAPS 4 & 5 HAVE BEEN DELETED




STATE	PROJECT NO.	SHEET NO.	TOTAL SHEETS
N.C.	7CR.10011.18 & 7CR.20011.18	9	

STANDARD CONCRETE ENCASEMENT FOR MANHOLE & VALVE CASTINGS IN PAVEMENT  
DETAIL DRAWING NO. 858.01

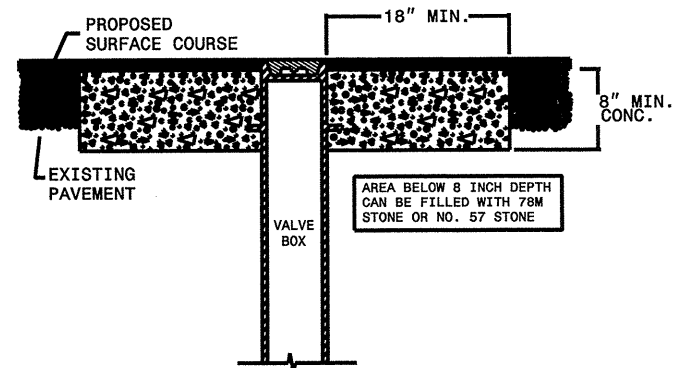


USE RAPID SET GROUT, MORTAR, OR CONCRETE CLASS B CONCRETE MAY BE USED WHEN ADJUSTMENTS ARE NOT IN THE TRAVEL LANE.

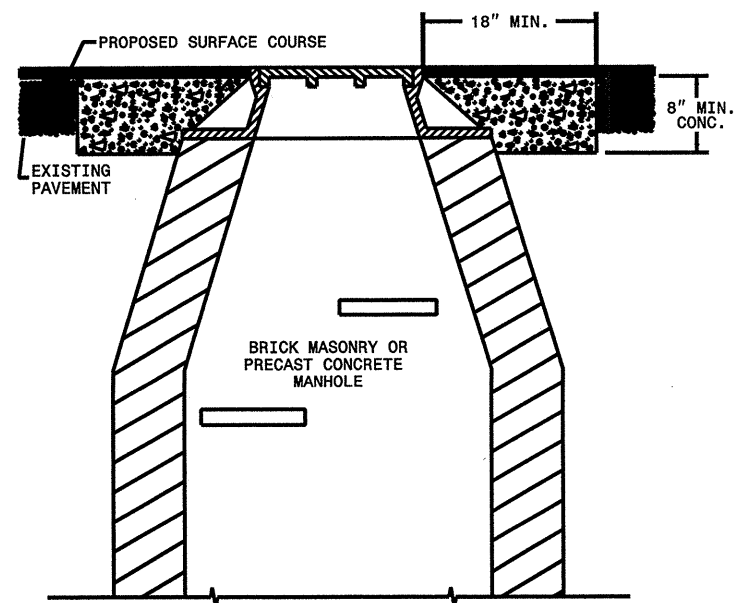

NOTES:


1. MORTAR SHALL BE MIXED TO NCDOT SPECIFICATIONS.
2. ALL FAULTY EXISTING BRICKWORK TO BE REMOVED AND REPLACED WITH NEW BRICK MASONRY.
3. EXCAVATION FOR THE ADJUSTMENT SHALL BE SHEER CUT ON ALL SIDES.
4. RAPID SET GROUT, MORTAR, OR CONCRETE SHALL BE USED

PAVING DETAIL 1  
MAIN LINE IS NOT BEING RESURFACED

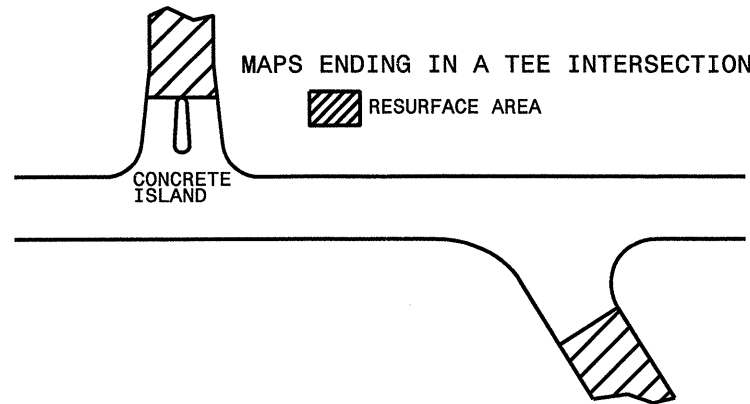


PAVING DETAIL 2  
MAIN LINE IS BEING RESURFACED

NOTE: NON-SYSTEM (CITY STREET, PRIVATE DRIVE, SCHOOL BUS DRIVE)

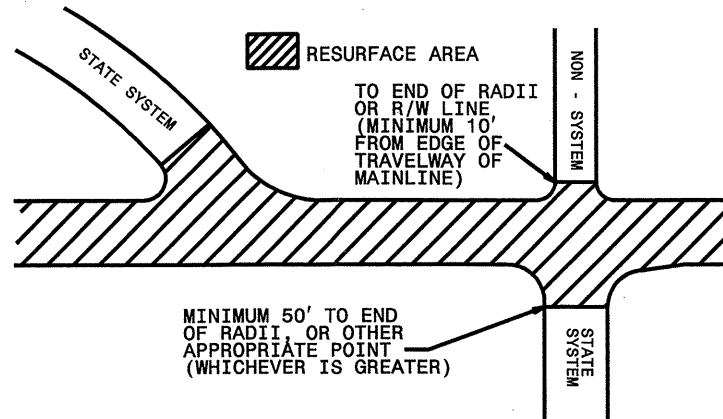


TO BE USED AT ALL  
NON-SIGNALIZED INTERSECTIONS

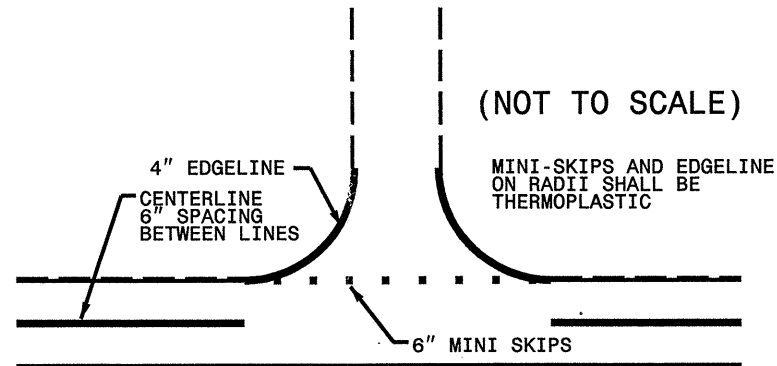

NOTE: MINI SKIPS SHALL BE PLACED ON A 10' CYCLE, CONTAINING AN 8' AND 2' SKIP, THE WIDTH OF THE SKIP SHALL BE 6'.

NOTE: MAPS 4 & 5 HAVE BEEN DELETED

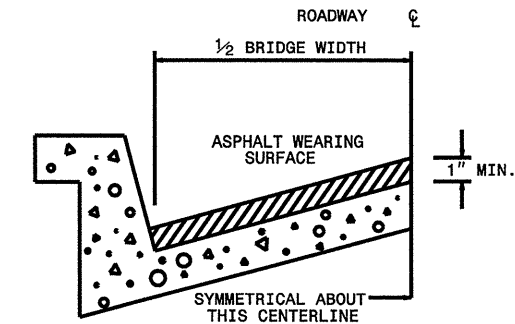

BRIDGE HALF TYPICAL SECTION

FOR BRIDGES WITH FLOOR DRAINS, CARE SHALL BE EXERCISED IN PLACING THE WEARING SURFACE AROUND FLOOR DRAINS SO AS NOT TO HINDER EFFECTIVE DRAINAGE. ALL DRAINS SHALL BE LEFT OPEN. THE PROPOSED WEARING SURFACE SHALL VARY IN THICKNESS AS NECESSARY TO PROVIDE A SMOOTH RIDING SURFACE. A THICKNESS OF NOT LESS THAN 1" SHALL BE PROVIDED. THE MAXIMUM THICKNESS SHALL PREFERABLY BE 1-1/2" UNLESS IT IS IMPRACTICAL TO PROVIDE A SMOOTH RIDING SURFACE OTHERWISE.

NOTES


ALL UNPAVED S.R. ROUTES TO BE SURFACED 50' FROM EDGE OF PAVEMENT OF MAIN PROJECT. ALL PAVED S.R. ROUTES TO BE RESURFACED TO END OF RADII, OR AS DIRECTED BY THE ENGINEER. EDGES, PAVEMENT WIDENING, INTERSECTIONS AND BRIDGE FLARES ARE INCLUDED IN THE SUMMARY OF QUANTITIES. BRIDGES TO BE RESURFACED AT LOCATIONS AND DEPTH AS DIRECTED BY THE ENGINEER.

ala\_typical\_sht4a.dgn 11/13/2009 10:25:29 AM






**TWO-WAY UNDIVIDED \*\* (L-LINES)**

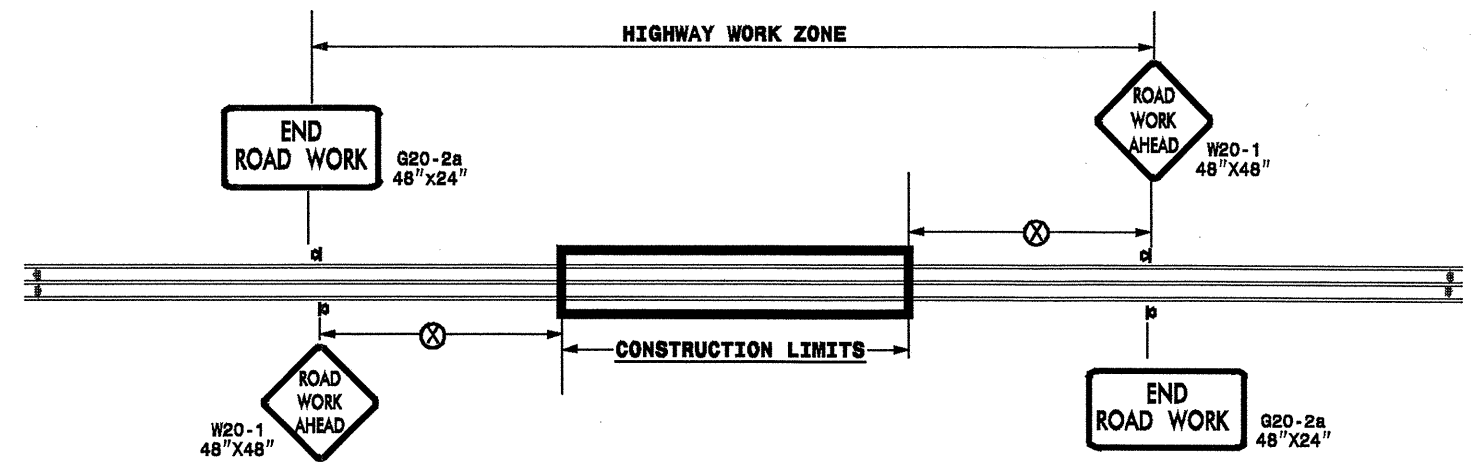

POSTED SPEED LIMIT (M.P.H.)	RECOMMENDED MINIMUM SIGN SPACING
≤ 50	500'
≥ 55	1000'

STATE OF NORTH CAROLINA  
DEPT. OF TRANSPORTATION  
DIVISION OF HIGHWAYS  
RALEIGH, N.C.

**ROADWAYS INTERSECTING ALONG 2 WAY UNDIVIDED WORK ZONE (Y-LINES)**

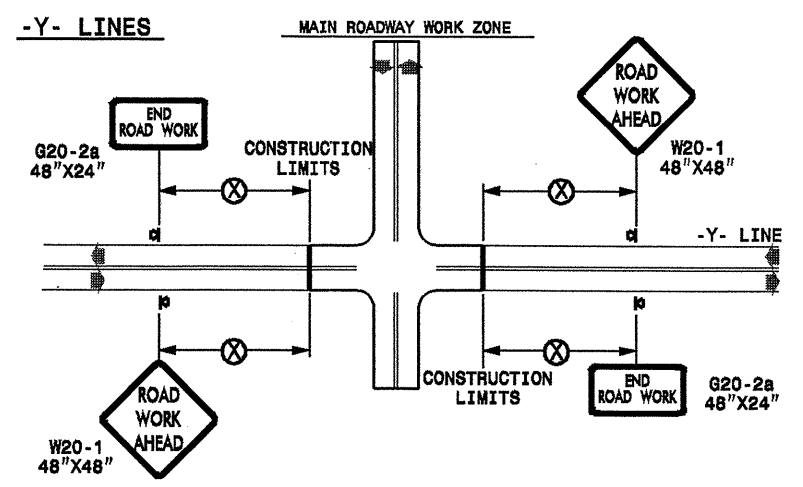

DETAIL DRAWING  
FOR TWO-WAY UNDIVIDED  
WORK ZONE WARNING SIGNS

**GENERAL NOTES**

- USE FLUORESCENT ORANGE SHEETING (TYPE VII OR HIGHER) ON ALL ADVANCE WORK ZONE SIGNS.
- DO NOT INSTALL ADVANCE WARNING SIGNS MORE THAN 3 DAYS PRIOR TO BEGINNING OF WORK.
- ALL SIGN SPACING DIMENSIONS ARE APPROXIMATE, FIELD ADJUST AS NECESSARY OR AS DIRECTED.
- USE PORTABLE WORK ZONE SIGNS ONLY WITH PORTABLE WORK ZONE SIGN STANDS SPECIFICALLY DESIGNED FOR ONE ANOTHER. PORTABLE WORK ZONE SIGNS MAY BE ROLL UP OR APPROVED COMPOSITE.
- PROVIDE PORTABLE WORK ZONE SIGN STANDS, PORTABLE SIGNS AND SIGN SHEETING WHICH ARE LISTED ON THE NORTH CAROLINA DEPARTMENT OF TRANSPORTATION'S APPROVED PRODUCT LIST OR ACCEPTED AS TRAFFIC QUALIFIED BY THE TRAFFIC CONTROL UNIT.
- \*\* TWO-WAY UNDIVIDED ADVANCE WARNING SIGN CONFIGURATION MAY BE USED ON URBAN MULTI-LANE FACILITIES WHERE CONDITIONS LIMIT THE USE OF DUAL MOUNTED SIGNS AS DETERMINED BY THE ENGINEER.

**LEGEND**

⊞ PORTABLE SIGN

➔ DIRECTION OF TRAFFIC FLOW


SHEET 1 OF 1

APPROVED: _____ DATE: _____	DETAIL DRAWING FOR TWO-WAY UNDIVIDED ADVANCED WORK ZONE WARNING SIGNS	SCALE: NONE		REVISIONS
SEAL		DATE: _____		DWG. BY: _____
		DESIGN BY: _____		10-98 03/04
		REVIEWED BY: _____		01/01 11/04

25-NOV-2009 11:27  
 ssalging\resurfacing\_030509\resurfacing2010\dlv07\c202525a-b-7cr100118x2-2wayundivurbfrwysjuly2006.por-table.dgn  
 AT WZTC237502

**ADVANCE WORK ZONE WARNING SIGNING FOR FREEWAYS (4 LANES OR GREATER)**


**DETAIL A**

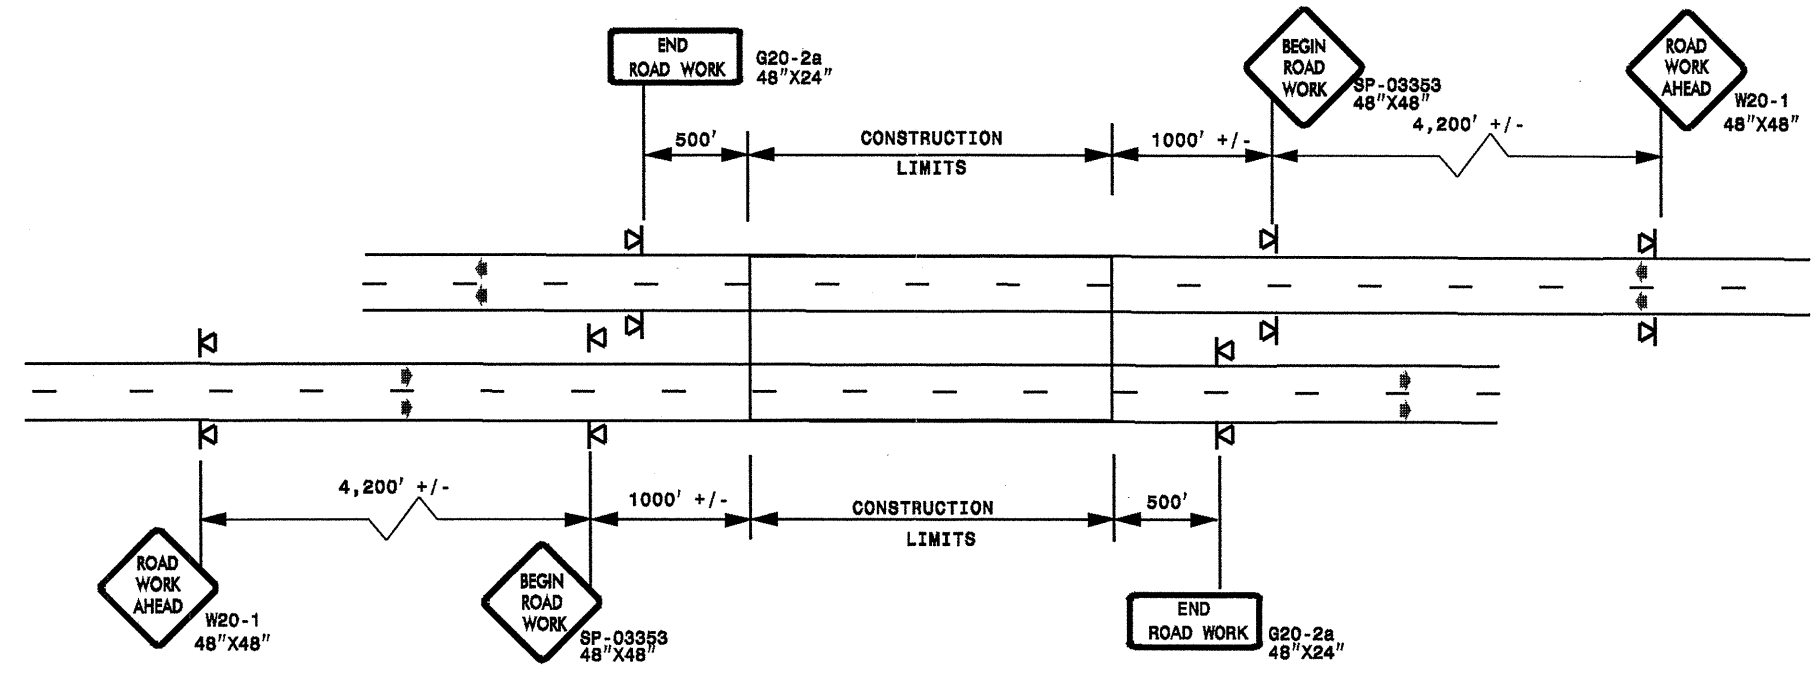

STATE OF NORTH CAROLINA  
DEPT. OF TRANSPORTATION  
DIVISION OF HIGHWAYS  
RALEIGH, N.C.


**ROADWAYS INTERSECTING ALONG FREEWAY WORK ZONE (Y-LINES)**

**DETAIL B**

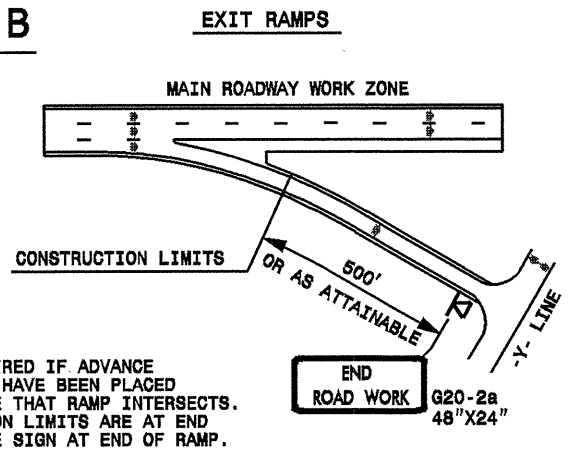


**NOTE:**  
SIGN NOT REQUIRED IF ADVANCE WARNING SIGNS HAVE BEEN PLACED ALONG -Y- LINE THAT RAMP INTERSECTS. IF CONSTRUCTION LIMITS ARE AT END OF RAMP, PLACE SIGN AT END OF RAMP.

**DETAIL C**

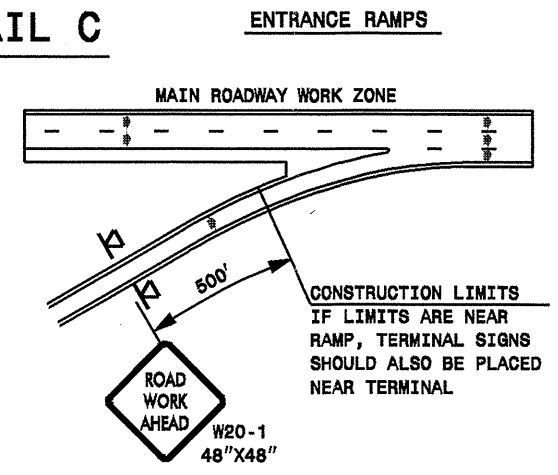

**DETAIL D**

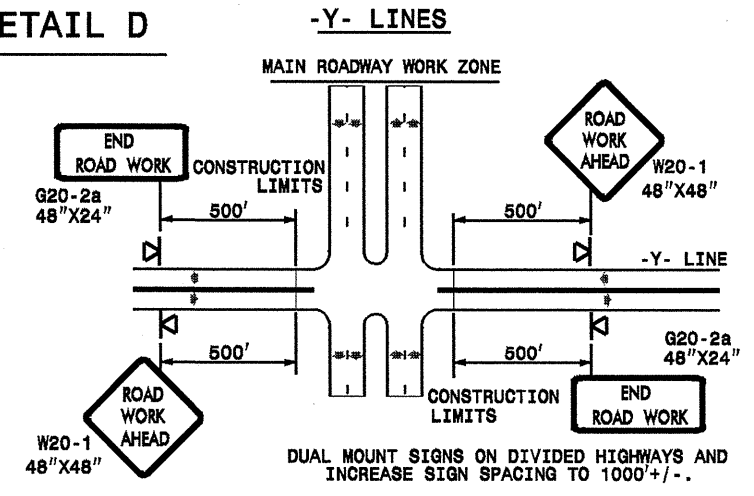

**DETAIL DRAWING  
FOR FREEWAYS  
WORK ZONE WARNING SIGNS  
(SHORT-DURATION LANE CLOSURES)**

**GENERAL NOTES**

- USE FLUORESCENT ORANGE SHEETING (TYPE VII OR HIGHER) ON ALL ADVANCE WORK ZONE SIGNS.
- DO NOT INSTALL ADVANCE WARNING SIGNS MORE THAN 3 DAYS PRIOR TO BEGINNING OF WORK.
- ALL SIGN SPACING DIMENSIONS ARE APPROXIMATE, FIELD ADJUST AS NECESSARY OR AS DIRECTED.
- USE PORTABLE WORK ZONE SIGNS ONLY WITH PORTABLE WORK ZONE SIGN STANDS SPECIFICALLY DESIGNED FOR ONE ANOTHER. PORTABLE WORK ZONE SIGNS MAY BE ROLL UP OR APPROVED COMPOSITE.
- PROVIDE PORTABLE WORK ZONE SIGN STANDS, PORTABLE SIGNS AND SIGN SHEETING WHICH ARE LISTED ON THE NORTH CAROLINA DEPARTMENT OF TRANSPORTATION'S APPROVED PRODUCT LIST OR ACCEPTED AS TRAFFIC QUALIFIED BY THE TRAFFIC CONTROL UNIT.
- \*\* TWO-WAY UNDIVIDED ADVANCE WARNING SIGN CONFIGURATION MAY BE USED ON MULTI-LANE FACILITIES WHERE CONDITIONS LIMIT THE USE OF DUAL MOUNTED SIGNS AS DETERMINED BY THE ENGINEER.

**LEGEND**

◁ PORTABLE SIGN


➡ DIRECTION OF TRAFFIC FLOW

SHEET 1 OF 1

APPROVED: _____	DATE: _____	<b>DETAIL DRAWING FOR FREEWAYS WORK ZONE WARNING SIGNS</b>	
SEAL	SCALE: NONE		REVISIONS
	DATE: 7-98		10/01
	DWG. BY:		10-98 09/04
	DESIGN BY:		01/01 11/04
REVIEWED BY:			

25-NOV-2009 14:29 sa:\signing\resurfacing\_030509\resurfacing2010\div07\c202525a-b-7cr100118x2-free4lanesgreat-july2006-portable.dgn AT WZTC237602 psymore

### High Speed Detection [≥40 mph (64 km/hr)]

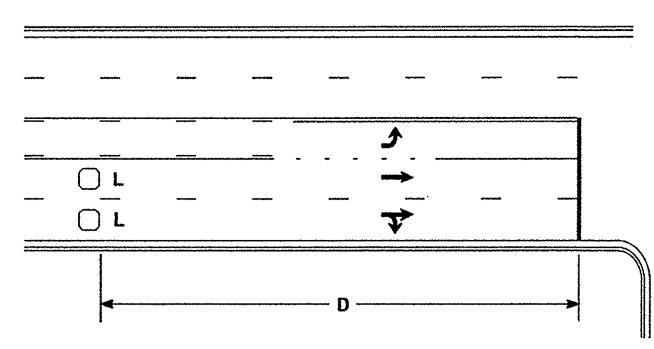


Speed Limit mph (km/hr)	D ft (m)
40 (64)	250 (75)
45 (72)	300 (90)
50 (80)	355 (110)
55 (88)	420 (130)

L = 6ft X 6ft (1.8m X 1.8m)  
Wired in series for TS1  
Controllers  
Wired separately for TS2,  
170, and 2070L Controllers

Volume Density Operation

OR

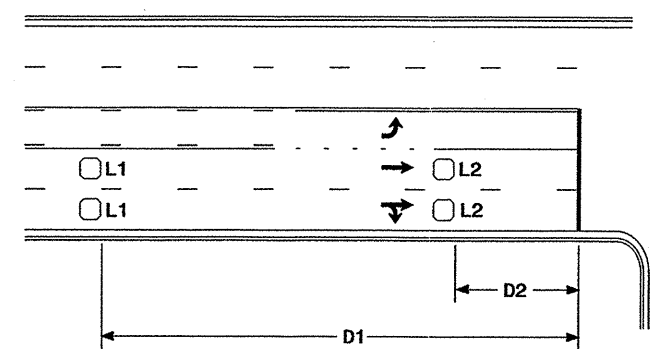


Speed Limit mph (km/hr)	D1 ft (m)	D2 ft (m)
40 (64)	250 (75)	80 (25)
45 (72)	300 (90)	90 (27)
50 (80)	355 (110)	100 (30)
55 (88)	420 (130)	110 (35)

L1 = 6ft X 6ft  
(1.8m X 1.8m)  
Wired in series  
L2 = 6ft X 6ft  
(1.8m X 1.8m)  
Wired in series


"Stretch" Operation

### Low Speed Detection [≤35 mph (56 km/hr)]

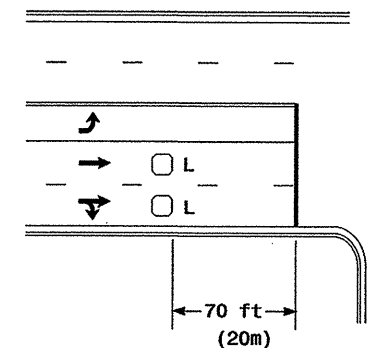


L = 6ft X 6ft (1.8m X 1.8m)  
Wired in series

OR

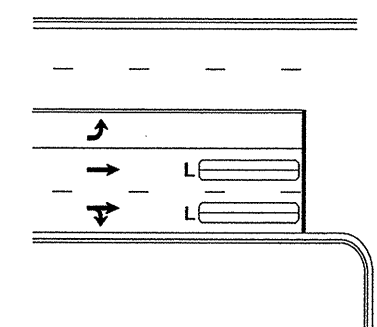

L = 6ft X 40ft (1.8m X 12.0m)  
Quadrupole loop, wired separately


### Left Turn Lane Detection

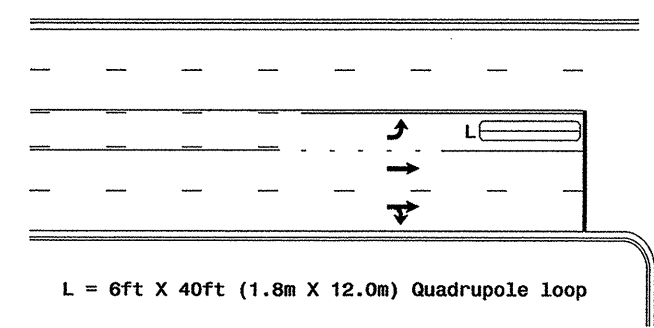

L = 6ft X 40ft (1.8m X 12.0m) Quadrupole loop

Presence Loop Detection


OR

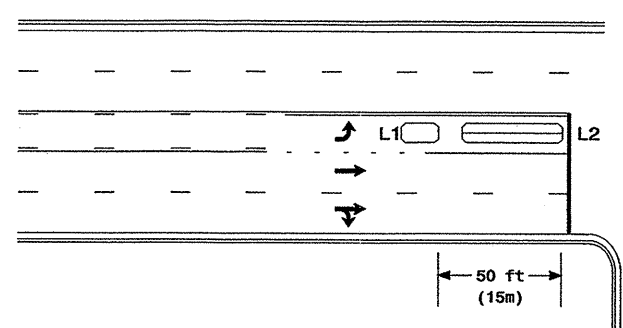

L1 = 6ft X 15ft (1.8m X 4.6m) Queue detector  
L2 = 6ft X 40ft (1.8m X 12.0m) Quadrupole loop


Queue Loop Detection

### Right Turn Lane Detection

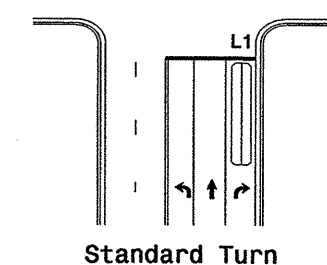


Standard Turn

L1 = 6ft X 40ft (1.8m X 12.0m) Quadrupole loop  
L2 = 6ft X 6ft (1.8m X 1.8m) [Minimum] Presence loop  
Wired separately  
L3 = 6ft X 20ft (1.8m X 6.0m) Quadrupole loop  
Wired in series

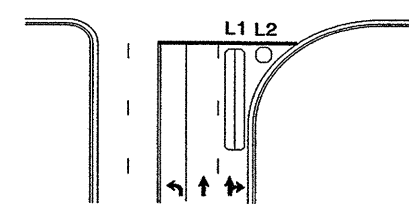


Wide Radius Turn

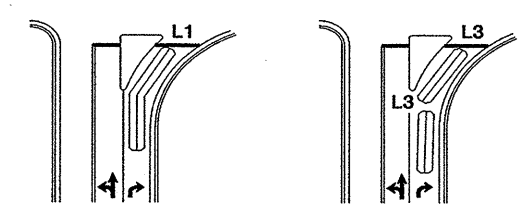


Channelized Turn

### Side Street Detection

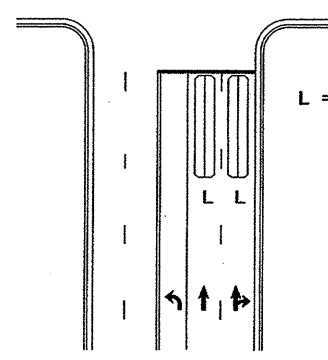

L = 6ft X 40ft (1.8m X 12.0m)  
Quadrupole loop  
Wired to separate  
detectors/channels

### Presence Loop Placement at Stop Lines

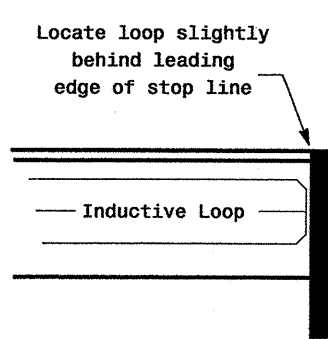

Locate loop slightly  
behind leading  
edge of stop line

Note:  
Loop may be located in advance  
of stop line when stop line is  
greater than 15' (4.5m) from edge  
of intersecting roadway; or, when  
loop detects a permissive or  
protected/permissive left turn.

### Recommended Number of Turns

Single 6' X 6' (1.8m X 1.8m)  
loop (wired separately):

Length of Lead-in ft (m)	Number of Turns
< 250 (75)	3
250-375 (75-115)	4
375-525 (115-160)	5
> 525 (160)	6

Quadrupole loops: Use 2-4-2 turns  
6' X 15' (1.8m X 4.6m) Loops:  
Lead-in < 150' (45 m), use 2 turns  
Lead-in > 150' (45 m), use 3 turns

19-DEC-2006 14:29 s:\pfs\signal\1b\turn\_inmisc\loop\typical\2006.dgn

	<p>Typical Loop Locations</p>	
	<p>PLAN DATE: June 2006</p> <p>PREPARED BY: P. L. Alexander</p> <p>SCALE: N/A</p>	<p>REVIEWED BY:</p> <p>REVISIONS</p> <p>INIT. DATE</p> <p>DATE</p>



STATE OF NORTH CAROLINA  
DEPT. OF TRANSPORTATION  
DIVISION OF HIGHWAYS  
RALEIGH, N.C.


11-08

ENGLISH DETAIL DRAWING FOR  
**INDUCTIVE DETECTION LOOPS**

SHEET 1 OF 3  
**1725D01**



**SAW SLOT DEPTH CHART**

DEPTH (IN)	NO. OF WIRE TURNS				
	2	3	4	5	6
CONCRETE	2.0	2.0	2.5	2.5	3.0
ASPHALT	2.0	2.5	3.0	3.0	3.0

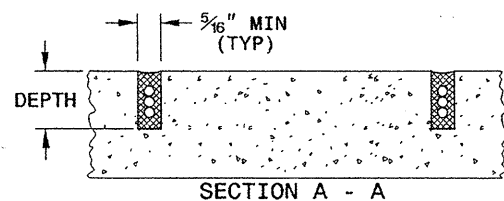


**CONVENTIONAL 4-SIDED LOOP**

**SAW CUT OPTIONS**

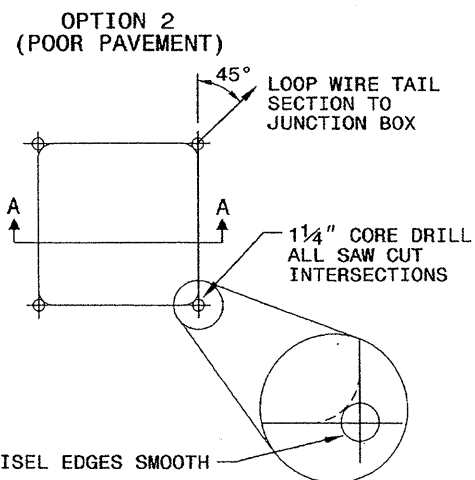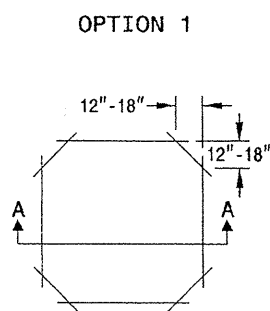

**LOOP WINDING METHOD**

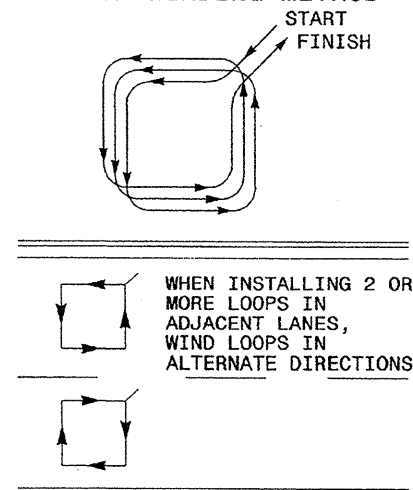

**LOOP WIRE TWISTING METHOD**

INCORRECT WAY TO TWIST WIRE



CORRECT WAY TO TWIST WIRE






**NOTES**

- OVERLAP SAW CUTS AT CORNERS AND INTERSECTION POINTS TO ENSURE UNIFORM SAW SLOT DEPTH.
- MAINTAIN 12" SPACING BETWEEN LOOP WIRE TAIL SECTIONS.
- WIRE LOOPS CONNECTED TO THE SAME DETECTOR CHANNEL IN SERIES.
- LOCATE LOOPS IN CENTER OF LANES UNLESS OTHERWISE SHOWN ON PLANS OR APPROVED BY ENGINEER.


**QUADRUPOLE LOOP**

**SAW CUT OPTIONS**

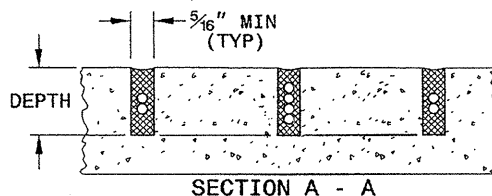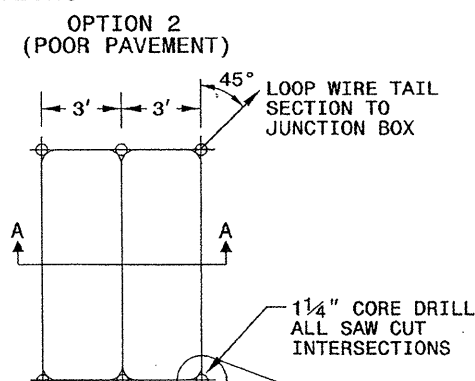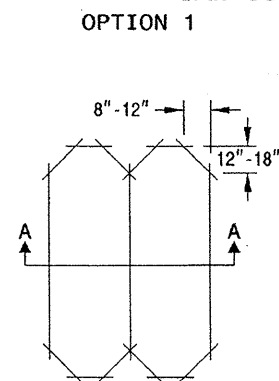

DEPTH IS 2.5" FOR CONCRETE AND 3.0" FOR ASPHALT

**LOOP WINDING METHOD**

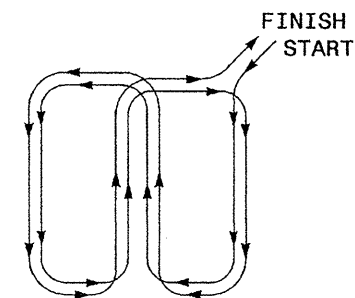


STATE OF NORTH CAROLINA  
DEPT. OF TRANSPORTATION  
DIVISION OF HIGHWAYS  
RALEIGH, N.C.

11-08

ENGLISH DETAIL DRAWING FOR  
**INDUCTIVE DETECTION LOOPS**

SHEET 1 OF 3  
**1725D01**

See Plate for Title

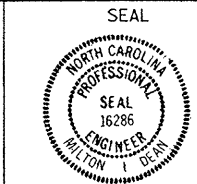


SIGNATURE: Milton I. Dean  
DATE: 11/24/08

STATE OF NORTH CAROLINA  
 DEPT. OF TRANSPORTATION  
 DIVISION OF HIGHWAYS  
 RALEIGH, N.C.

11-08  
 ENGLISH DETAIL DRAWING FOR  
**INDUCTIVE DETECTION LOOPS**  
 LOOP WIRE DETAILS


SHEET 2 OF 3  
**1725D01**

**LOOP WIRE SPLICE POINT DETAILS**

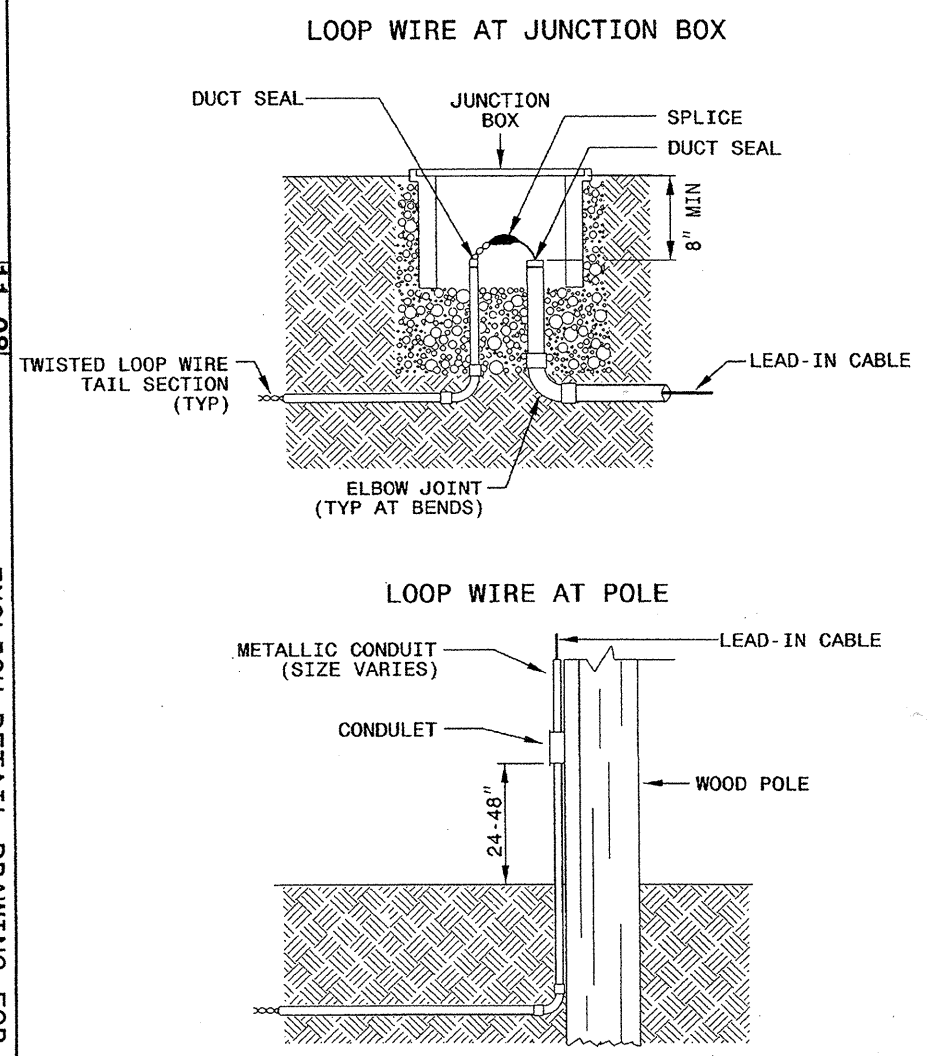

**NOTE**  
 SPLICE ALL LOOP WIRE TAIL SECTIONS/LEAD-IN CABLE IN JUNCTION BOXES OR APPROVED CONDULETS.

**LOOP WIRE PAVEMENT EDGE DETAILS**

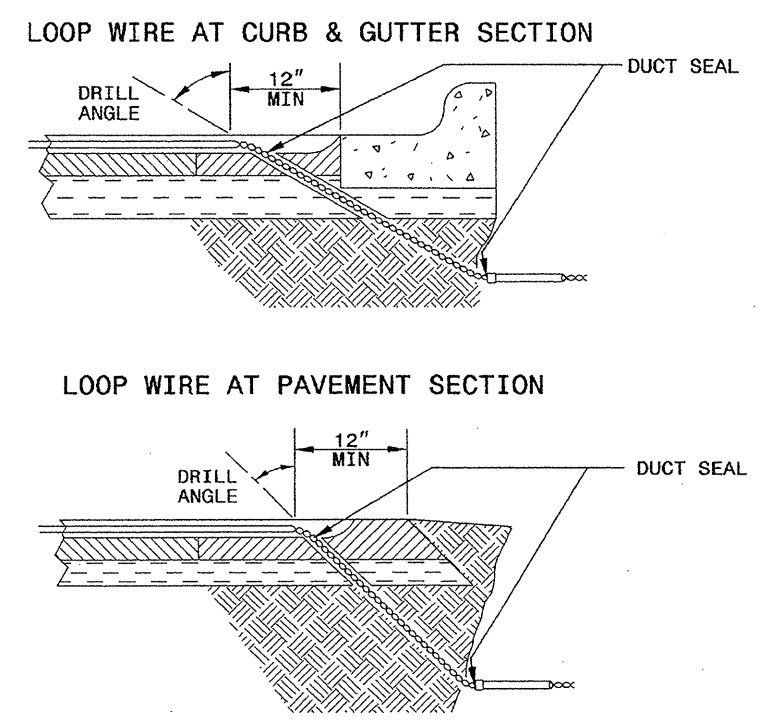

- NOTES**
- DO NOT EXCAVATE UNDER CURB AND GUTTER SECTIONS FOR CONDUIT INSTALLATION.
  - TWIST LOOP WIRE TAIL SECTIONS FROM WHERE LOOP WIRE TAIL LEAVES SAW CUT TO JUNCTION BOX, INCLUDING THROUGH CONDUIT.
  - BEFORE SEALING LOOPS, INSTALL DUCT SEAL WHERE LOOP WIRE TAIL SECTION LEAVES SAW CUT IN PAVEMENT AND AT ENTRANCE OF CONDUIT TO JUNCTION BOX.

STATE OF NORTH CAROLINA  
 DEPT. OF TRANSPORTATION  
 DIVISION OF HIGHWAYS  
 RALEIGH, N.C.

11-08  
 ENGLISH DETAIL DRAWING FOR  
**INDUCTIVE DETECTION LOOPS**  
 LOOP WIRE DETAILS

SHEET 2 OF 3  
**1725D01**

See Plate for Title

Prepared in the Offices of:

750 N. Greenfield Parkway  
 Garner, NC 27529

SEAL

*Milton Dean* 11/24/08  
 SIGNATURE DATE

24-NOV-2008 09:29  
 c:\work\111880-stp\std\plate sheets\1725D01.dwg  
 ml1118


STATE OF NORTH CAROLINA  
DEPT. OF TRANSPORTATION  
DIVISION OF HIGHWAYS  
RALEIGH, N.C.

11-08


ENGLISH DETAIL DRAWING FOR  
**INDUCTIVE DETECTION LOOPS**  
SPlicing FOR LEAD-IN CABLE AND LOOP WIRE

SHEET 3 OF 3  
**1725D01**

**STEP 1. STRIP LOOP WIRE AND LEAD-IN CABLE**

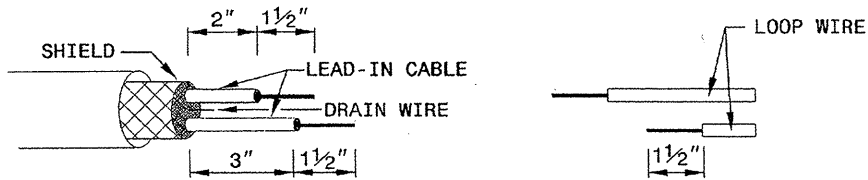


**STEP 2. CONNECT AND SOLDER**

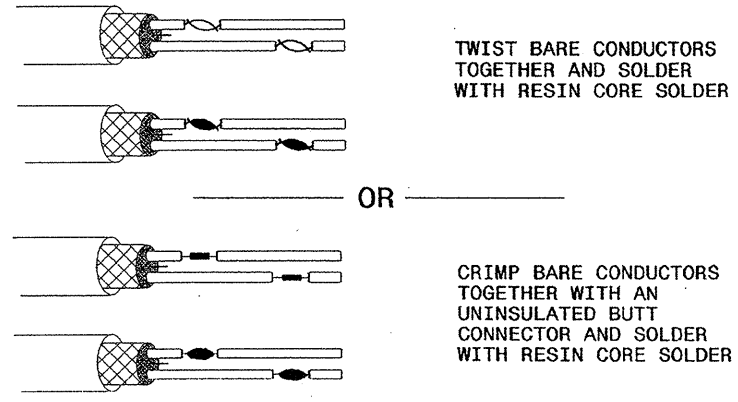


BOND SHIELD DRAIN WIRE AT SPLICE SECTIONS (DO NOT GROUND)


**LOOP WIRE AND LEAD-IN CABLE CONNECTION DETAILS**

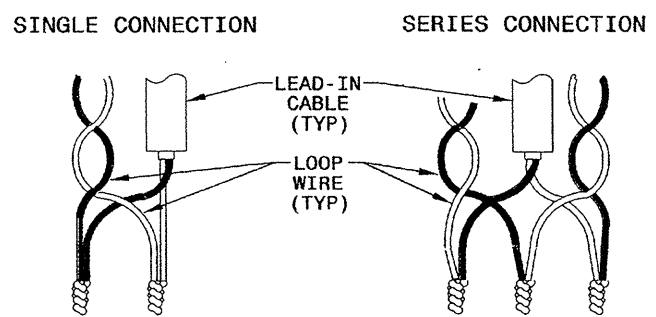

**STEP 3. INSULATE EACH SOLDER JOINT SEPARATELY**

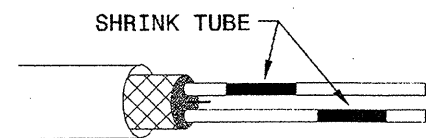

**STEP 4. ENVIRONMENTALLY PROTECT SPLICE**

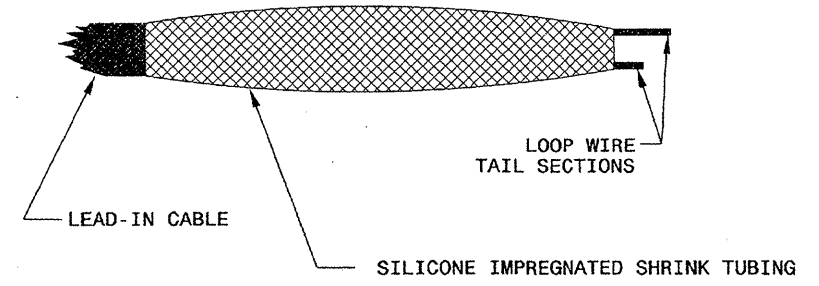

STATE OF NORTH CAROLINA  
DEPT. OF TRANSPORTATION  
DIVISION OF HIGHWAYS  
RALEIGH, N.C.

11-08

ENGLISH DETAIL DRAWING FOR  
**INDUCTIVE DETECTION LOOPS**  
SPlicing FOR LEAD-IN CABLE AND LOOP WIRE

SHEET 3 OF 3  
**1725D01**

See Plate for Title

Prepared in the Offices of:

750 N. Greenfield Parkway  
Garner, NC 27529

SEAL

*Milton I. Dean* 11/24/08  
SIGNATURE DATE

24-404-2008 05:35  
C:\wpl\110808\standard plate sheets\1725D01.mxd\2307.dgn  
zml:tlf