

9/09/99
 CONTRACT: C202623
 TIP PROJECT: B-4183
 CULVERTS




STATE OF NORTH CAROLINA
 DIVISION OF HIGHWAYS

MADISON COUNTY


LOCATION: BRIDGE NO. 29 OVER MIDDLE FORK CREEK ON
 SR 1526 AND BRIDGE NO. 28 OVER CROOKED
 CREEK ON SR 1526
 TYPE OF WORK: GRADING, DRAINAGE, PAVING AND CULVERTS

STATE	STATE PROJECT REFERENCE NO.	SHEET NO.	TOTAL SHEETS
N.C.	B-4183		
STATE PROJ. NO.	F.A. PROJ. NO.	DESCRIPTION	
33530.1.1	BRZ-1526(2)	PE	
33530.2.1	BRZ-1526(2)	RW & UTIL	
33530.3.1	BRZ-1526(2)	CONST.	

ALL DIMENSIONS IN
 THESE PLANS ARE IN METERS

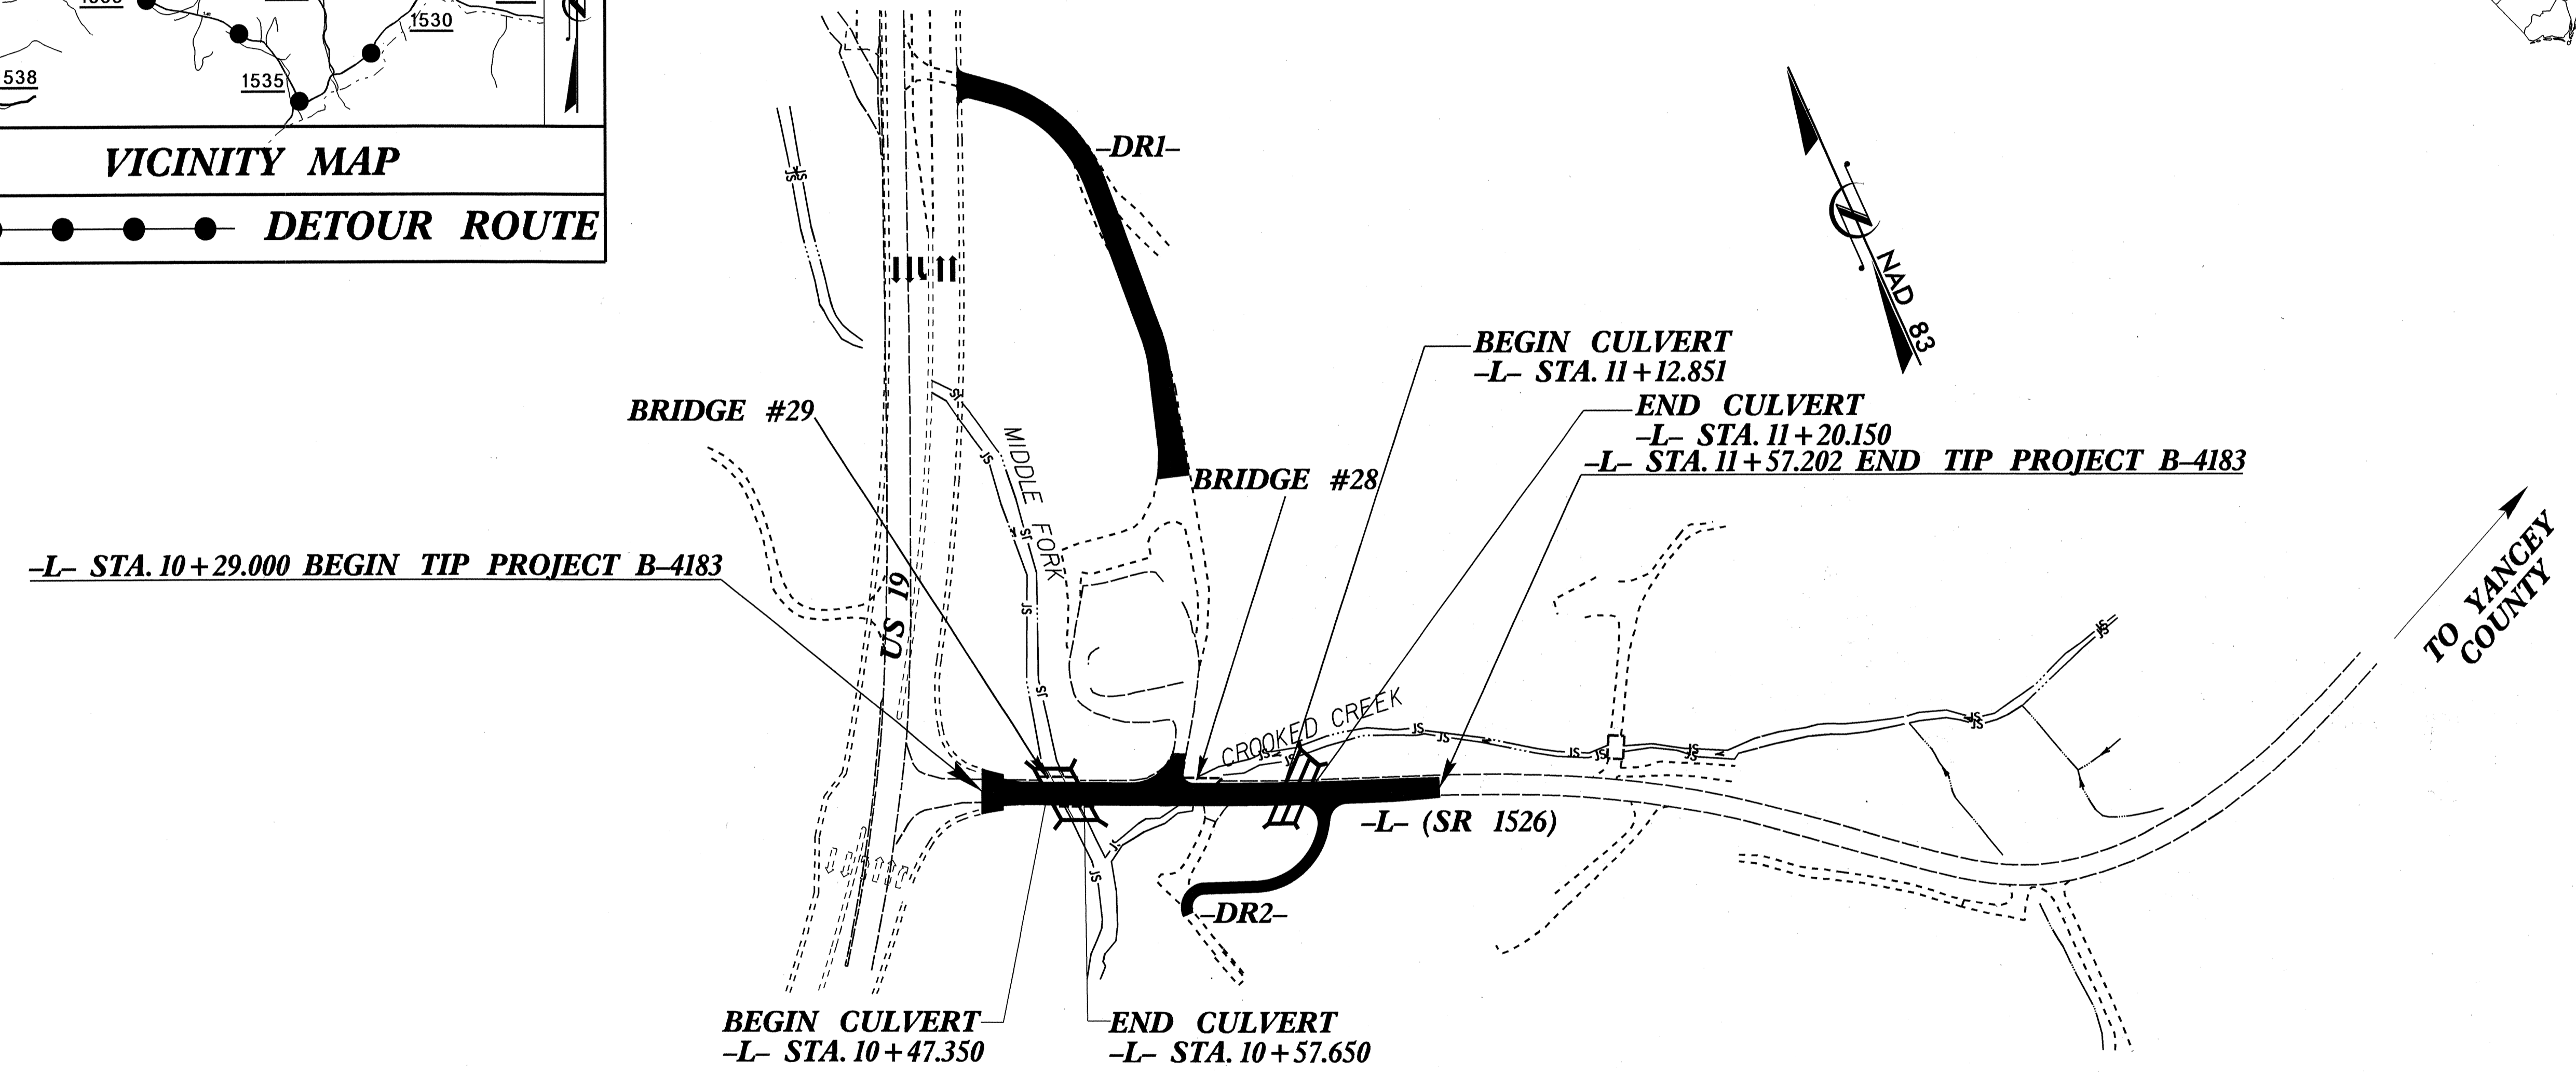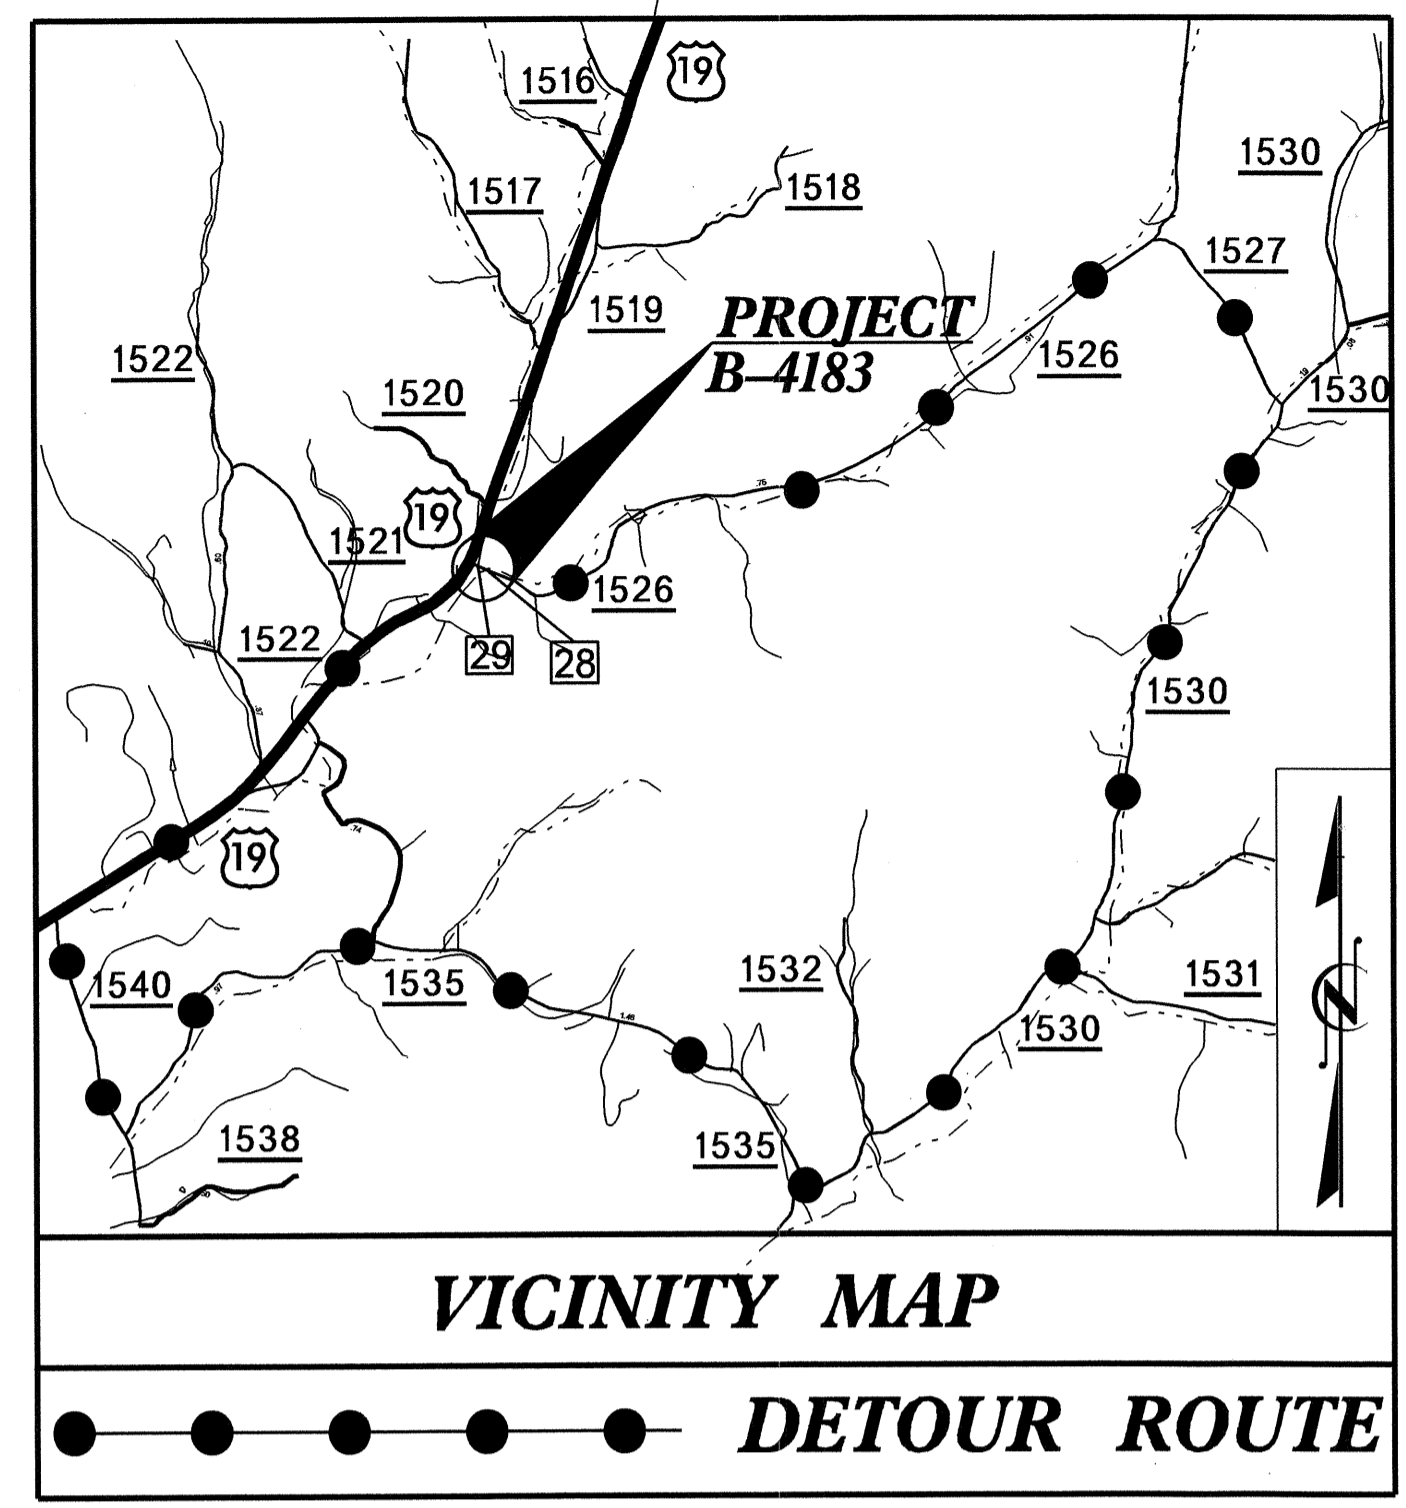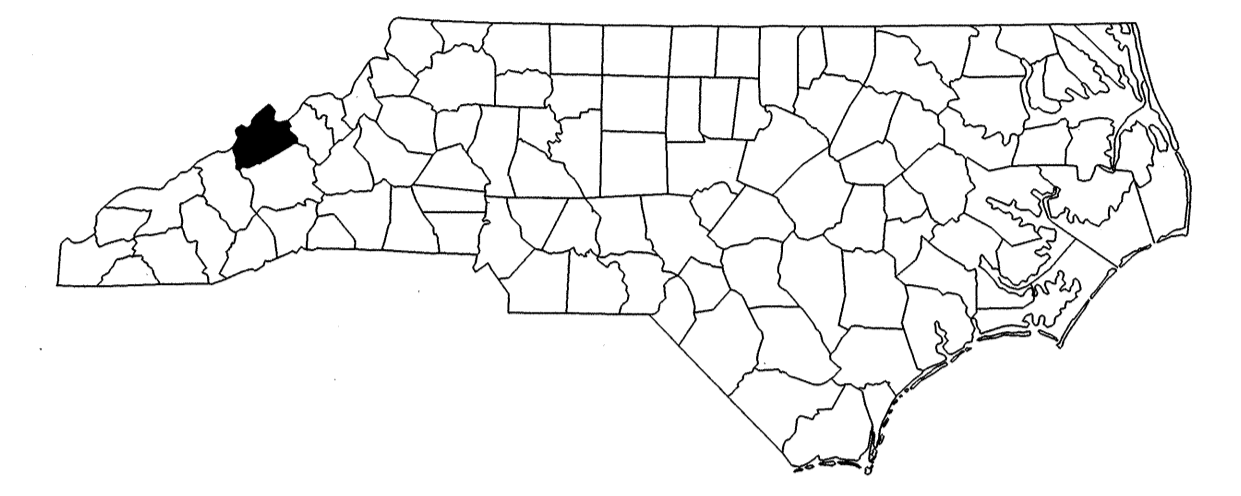

CULVERTS

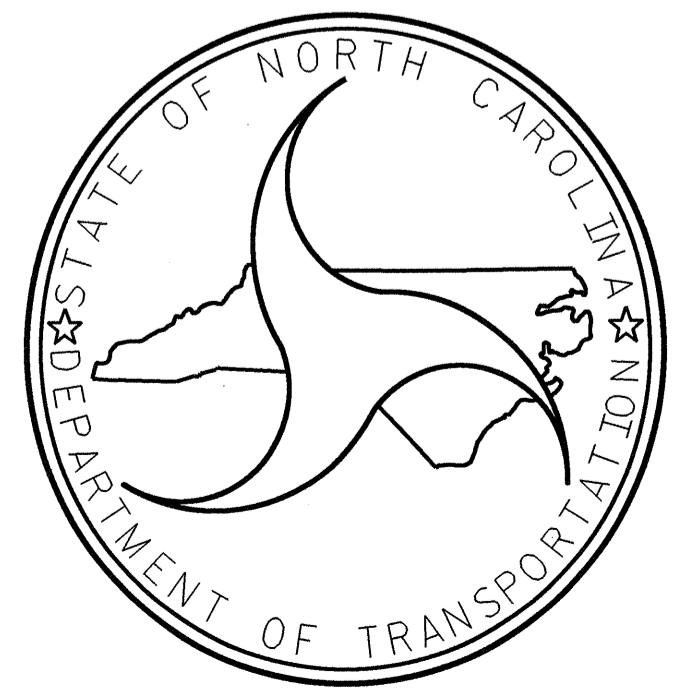

DESIGN DATA

ADT 2011 = 1,192
 ADT 2031 = 1,775
 DHV = 12 %
 D = 70 %
 T = 4 % *
 V = 50 km/h
 * TTST 1% DUAL 3%
 FUNC. CLASS = LOCAL

PROJECT LENGTH

LENGTH OF ROADWAY TIP PROJECT B-4183 = 0.110 km
 LENGTH STRUCTURES TIP PROJECT B-4183 = 0.018 km
 TOTAL LENGTH ROADWAY TIP PROJECT B-4183 = 0.128 km

Prepared in the Office of:
DIVISION OF HIGHWAYS
 1000 Birch Ridge Dr., Raleigh, NC 27610

2006 STANDARD SPECIFICATIONS

LETTING DATE:
 DECEMBER 20, 2011

QUANG H. NGUYEN, P.E.
 PROJECT ENGINEER

JOHN R. DUGGINS JR. P.E.
 PROJECT DESIGN ENGINEER

STRUCTURE DESIGN UNIT
 1000 BIRCH RIDGE DRIVE
 RALEIGH, N.C. 27610

DIVISION OF HIGHWAYS
 STATE OF NORTH CAROLINA

STATE DESIGN ENGINEER
 DEPARTMENT OF TRANSPORTATION
 FEDERAL HIGHWAY ADMINISTRATION

APPROVED
 DIVISION ADMINISTRATOR DATE

NOTES

ASSUMED LIVE LOAD -----MS18 OR ALTERNATE LOADING.
 MAXIMUM DESIGN FILL -----1.290m
 MINIMUM DESIGN FILL -----1.180m
 FOR OTHER DESIGN DATA AND NOTES SEE STANDARD NOTE SHEET.
 76mm Ø WEEP HOLES INDICATED TO BE IN ACCORDANCE WITH THE SPECIFICATIONS.
 CONCRETE IN CULVERTS TO BE POURED IN THE FOLLOWING ORDER:
 1. PHASE I WING FOOTINGS AND FLOOR SLAB INCLUDING 100mm OF PHASE I VERTICAL WALLS.
 2. THE REMAINING PORTIONS OF PHASE I WALLS AND PHASE I WINGS FULL HEIGHT.
 3. PHASE II WING FOOTINGS AND FLOOR SLAB INCLUDING 100mm OF PHASE II VERTICAL WALLS.
 4. THE REMAINING PORTIONS OF PHASE II WALLS AND PHASE II WINGS FULLHEIGHT.
 5. PHASE III THE ROOF SLAB AND HEADWALLS.
 THE RESIDENT ENGINEER SHALL CHECK THE LENGTH OF CULVERT BEFORE STAKING IT OUT TO MAKE CERTAIN THAT IT WILL PROPERLY TAKE CARE OF THE FILL.
 DIMENSIONS FOR WING LAYOUT AS WELL AS ADDITIONAL REINFORCING STEEL EMBEDDED IN BARREL ARE SHOWN ON WING SHEET.
 AT THE CONTRACTOR'S OPTION, HE MAY SPLICE THE VERTICAL REINFORCING STEEL IN THE INTERIOR FACE OF EXTERIOR WALL AND BOTH FACES OF INTERIOR WALLS ABOVE LOWER WALL CONSTRUCTION JOINT. THE SPLICE LENGTH SHALL BE AS PROVIDED IN THE SPLICE LENGTH CHART SHOWN ON THE PLANS. EXTRA WEIGHT OF STEEL DUE TO THE SPLICES SHALL BE PAID FOR BY THE CONTRACTOR.
 THE CONTRACTOR SHALL PROVIDE INDEPENDENT ASSURANCE SAMPLES OF REINFORCING STEEL AS FOLLOWS: FOR PROJECTS REQUIRING UP TO 36,000kg OF REINFORCING STEEL, ONE 760mm SAMPLE OF EACH SIZE BAR USED, AND FOR PROJECTS REQUIRING OVER 36,000kg OF REINFORCING STEEL, TWO 760mm SAMPLES OF EACH SIZE BAR USED. THE BARS FROM WHICH THE SAMPLES ARE TAKEN MUST THEN BE SPLICED WITH REPLACEMENT BARS OF THE SIZE AND LENGTH OF THE SAMPLE, PLUS A MINIMUM LAP SPLICE OF THIRTY BAR DIAMETERS. PAYMENT FOR THE SAMPLES OF REINFORCING STEEL SHALL BE CONSIDERED INCIDENTAL TO VARIOUS PAY ITEMS.
 A 900mm STRIP OF FILTER FABRIC SHALL BE ATTACHED TO THE FILL FACE OF THE WING COVERING THE ENTIRE LENGTH OF THE EXPANSION JOINT.
 FOR SUBMITTAL OF WORKING DRAWINGS, SEE SPECIAL PROVISIONS.
 FOR CRANE SAFETY, SEE SPECIAL PROVISIONS.
 FOR GROUT FOR STRUCTURES, SEE SPECIAL PROVISIONS.
 FOR CURING CONCRETE, SEE SPECIAL PROVISIONS.
 FOR FALSEWORK AND FORMWORK, SEE SPECIAL PROVISIONS.
 FOR CULVERT DIVERSION DETAILS AND PAY ITEM, SEE EROSION CONTROL PLANS.
 ALL DIMENSIONS ARE IN MILLIMETERS UNLESS OTHERWISE NOTED.
 ALL ELEVATIONS ARE IN METERS.
 THE EXISTING STRUCTURE CONSISTING OF 2-SPANS (5.5m EACH) WITH A TIMBER DECK ON CONTINUOUS I-BEAMS SUPERSTRUCTURE AND A CLEAR ROADWAY WIDTH OF 7.5m ON A SUBSTRUCTURE CONSISTING OF MASONRY ABUTMENTS AND A CRUTCH BENT CONSTRUCTED OF TIMBER CAP WITH TIMBER POST AND SILL AND LOCATED AT THE PROPOSED STRUCTURE SHALL BE REMOVED. FOR REMOVAL OF EXISTING STRUCTURE, SEE SPECIAL PROVISIONS.
 REMOVAL OF THE EXISTING BRIDGE SHALL BE PERFORMED SO AS NOT TO ALLOW DEBRIS TO FALL INTO THE WATER. THE CONTRACTOR SHALL REMOVE THE BRIDGE AND SUBMIT PLANS FOR DEMOLITION IN ACCORDANCE WITH ARTICLE 402-2 OF THE STANDARD SPECIFICATIONS.
 INASMUCH AS THE PAINT SYSTEM ON THE EXISTING STRUCTURAL STEEL CONTAINS LEAD, THE CONTRACTOR'S ATTENTION IS DIRECTED TO ARTICLE 107-1 OF THE STANDARD SPECIFICATIONS. ANY COSTS RESULTING FROM COMPLIANCE WITH APPLICABLE STATE OR FEDERAL REGULATIONS PERTAINING TO HANDLING OF MATERIALS CONTAINING LEAD BASED PAINT SHALL BE INCLUDED IN THE BID PRICE FOR "REMOVAL OF EXISTING STRUCTURE".

HYDRAULIC DATA

DESIGN DISCHARGE	= 49.80 m ³ /s
FREQUENCY OF DESIGN FLOOD	= 25 yrs.
DESIGN HIGH WATER ELEVATION	= 678.690
DRAINAGE AREA	= 19.700 km ²
BASE DISCHARGE (Q100)	= 74.90 m ³ /s
BASE HIGH WATER ELEVATION	= 679.420

OVERTOPPING FLOOD DATA


OVERTOPPING DISCHARGE	= 86.60 m ³ /s
FREQUENCY OF OVERTOPPING FLOOD	= 100+ yrs.
OVERTOPPING FLOOD ELEVATION	= 680.000

GRADE DATA

GRADE POINT ELEV. @ STA. 10+52.500 -L-	= 680.157
BED ELEV. @ STA. 10+52.500 -L-	= 675.900
ROADWAY FILL SLOPES	= 2 : 1


TOTAL STRUCTURE QUANTITIES	
CLASS A CONCRETE	
BARREL @ 6.66 m ³ /m	103.2 m ³
WINGS ETC.	30.5 m ³
SILL	0.6 m ³
TOTAL	134.3 m ³
REINFORCING STEEL	
BARREL	12,133 kg
WING ETC.	1,286 kg
TOTAL	13,419 kg
CULVERT EXCAVATION -----	LUMP SUM
FOUNDATION COND. MAT'L ----	94 METRIC TONS
REMOVAL OF EXISTING STRUCTURE-----	LUMP SUM

BM #5: RAILROAD SPIKE IN POWER POLE 27.836M LEFT OF -BL- STA. 5+74.742, ELEV. = 682.835, NGVD 29

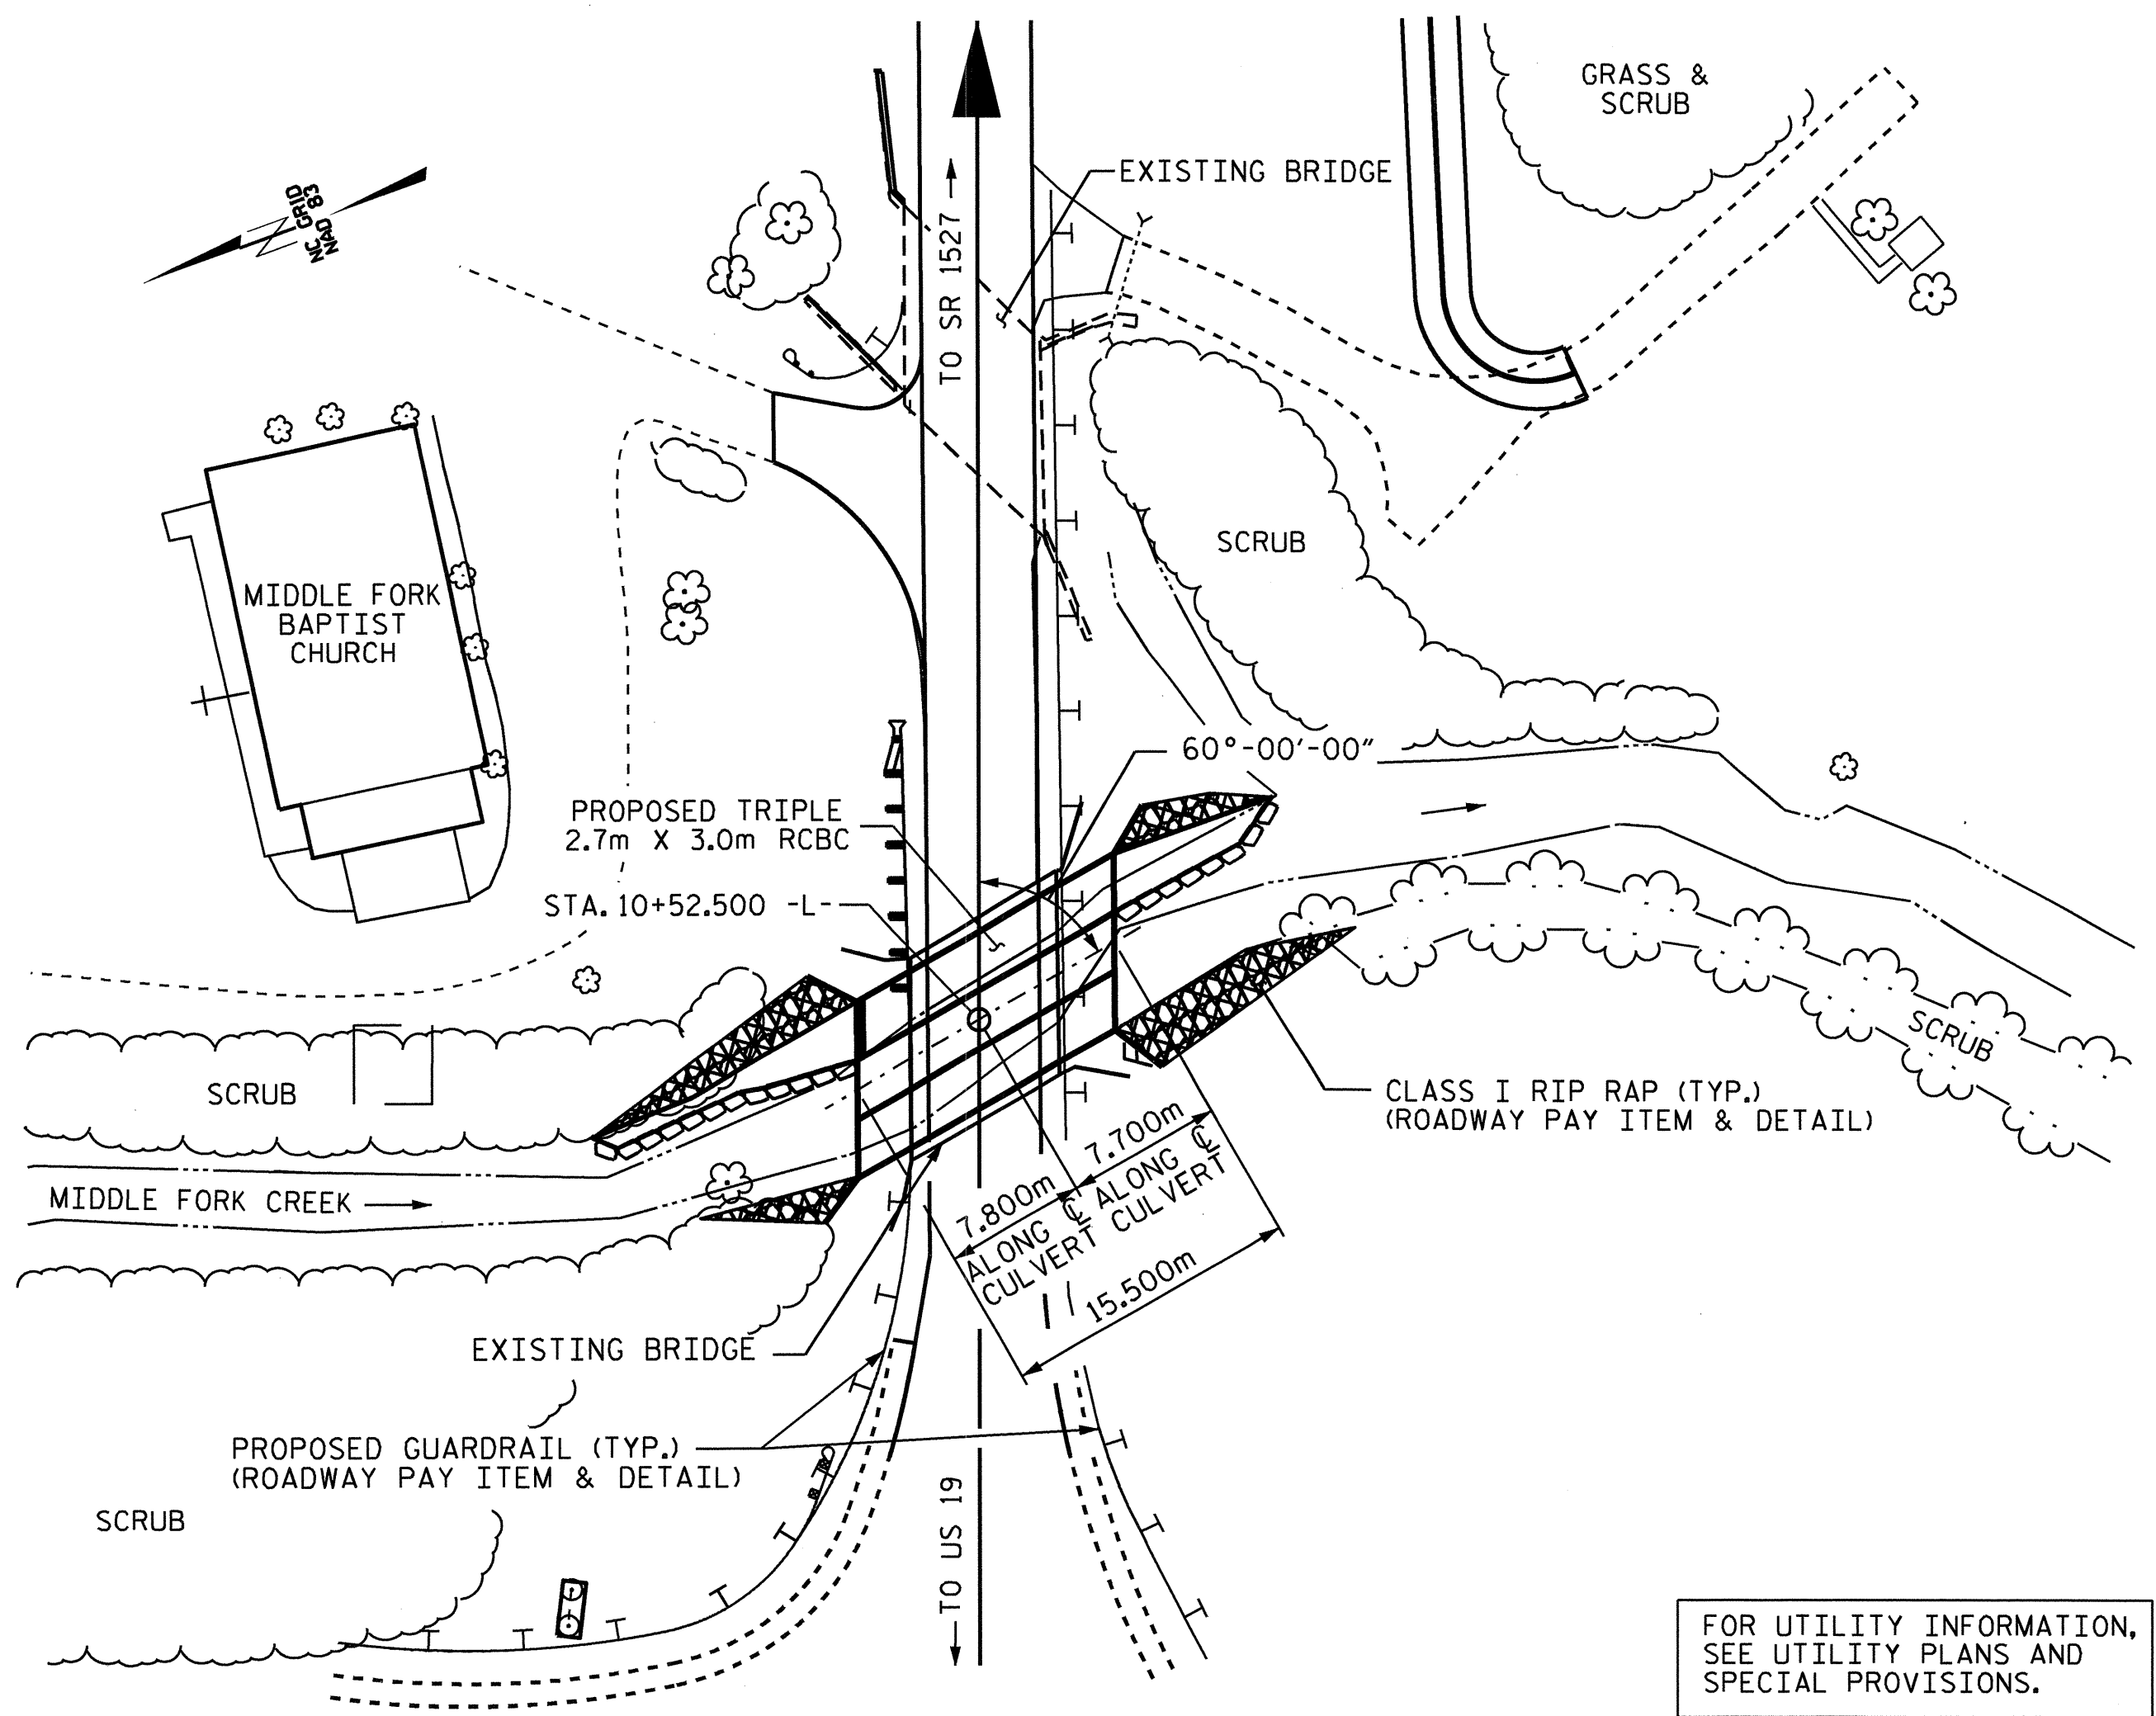

LOCATION SKETCH

FOR UTILITY INFORMATION, SEE UTILITY PLANS AND SPECIAL PROVISIONS.

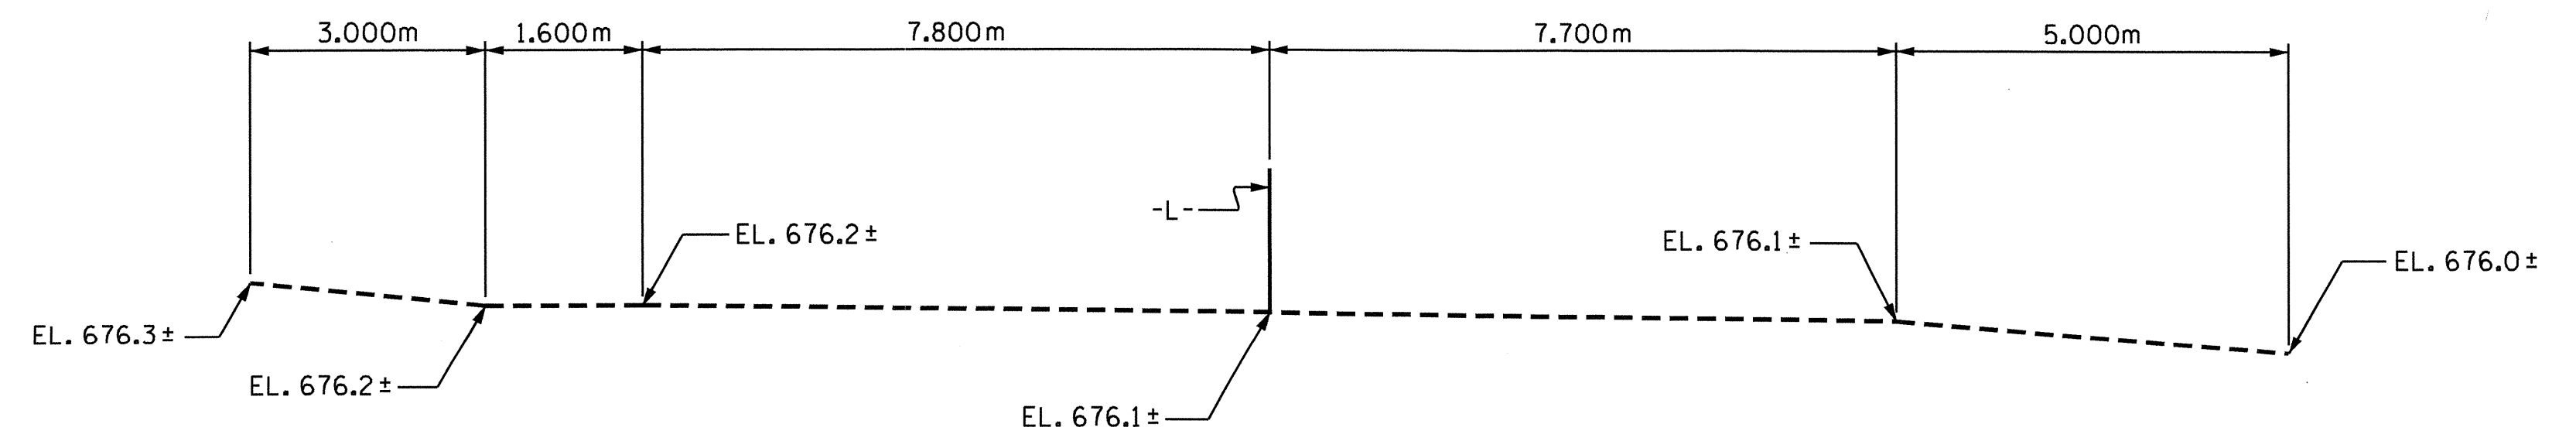

PROFILE ALONG C CULVERT

I HEREBY CERTIFY THESE PLANS ARE THE AS-BUILT PLANS

PROJECT NO. B-4183
MADISON COUNTY
 STATION: 10+52.500 -L-

SHEET 1 OF 7 REPLACES BRIDGE NO. 29

STATE OF NORTH CAROLINA
 DEPARTMENT OF TRANSPORTATION
 RALEIGH
**TRIPLE 2.700m X 3.000m
 CONCRETE BOX CULVERT
 60° SKEW**


ASSEMBLED BY : A. SORSENGINH	DATE : 2/3/09
CHECKED BY : J. LAMBERT	DATE : 2/10
DRAWN BY : EEM 6/97	
CHECKED BY : ARB 7/97	

METRIC


QUANG H. NGUYEN
 12-14-11

Professional Engineer Seal 15779
 Professional Engineer Seal 13014


REVISIONS						SHEET NO.
NO.	BY:	DATE:	NO.	BY:	DATE:	
1			3			C-1
2			4			TOTAL SHEETS 15

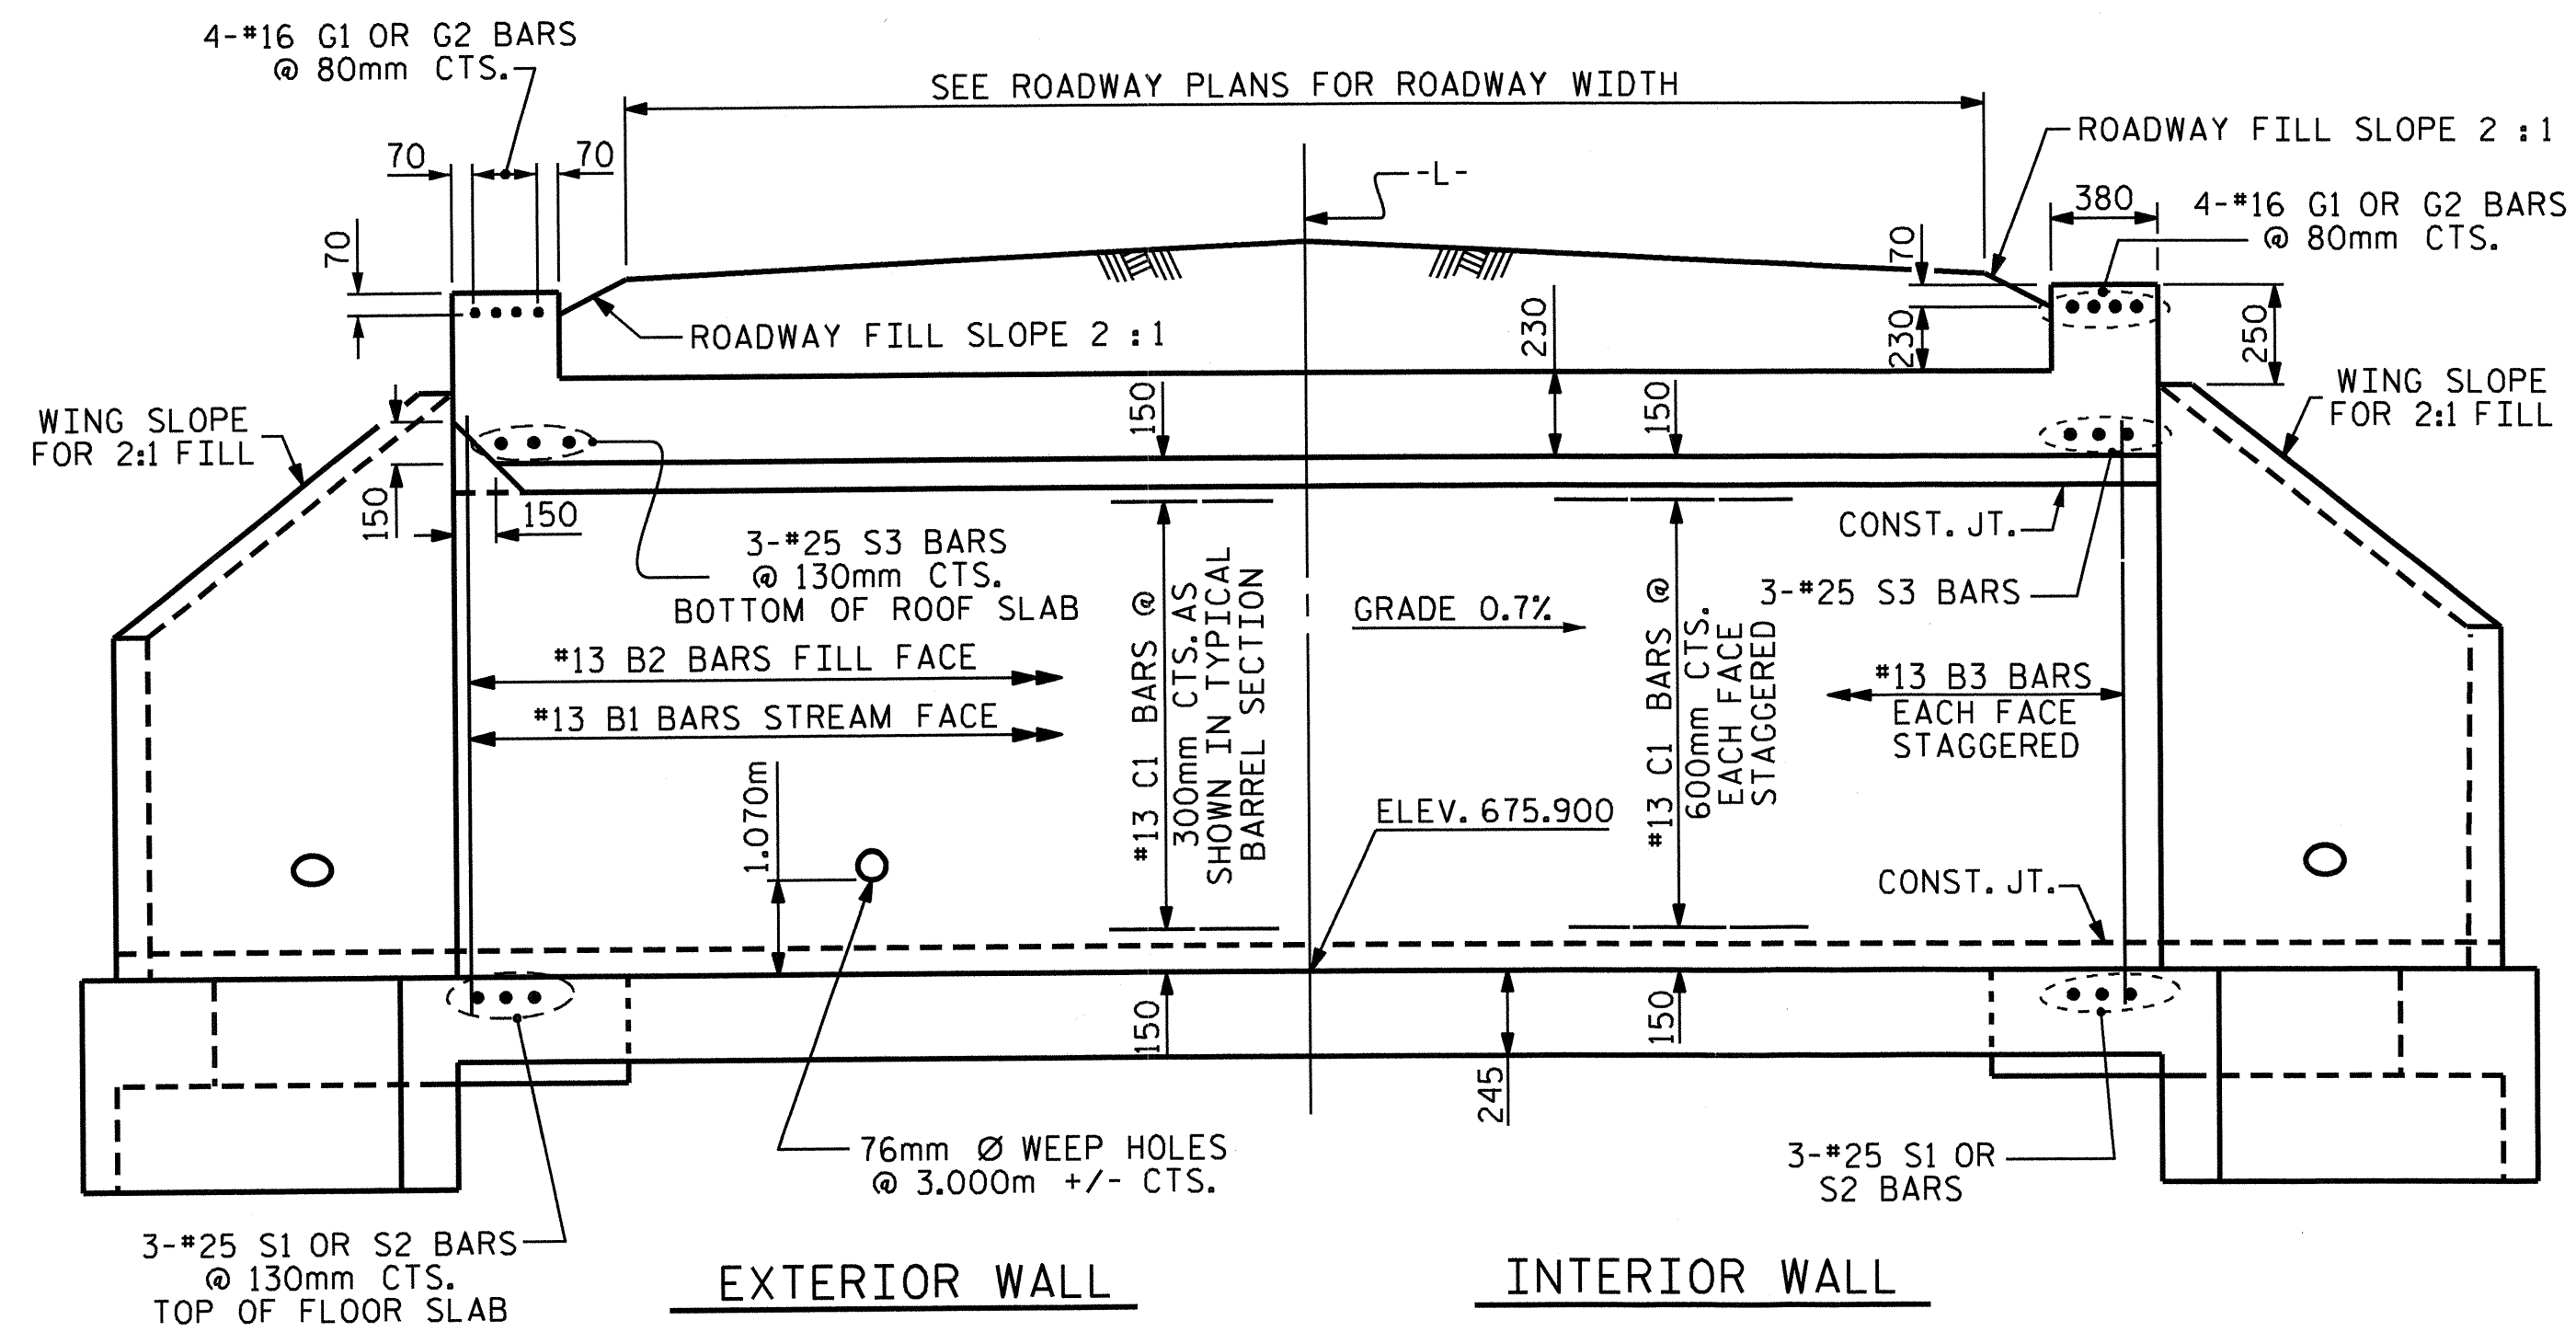

EXTERIOR WALL INTERIOR WALL
CULVERT SECTION NORMAL TO ROADWAY

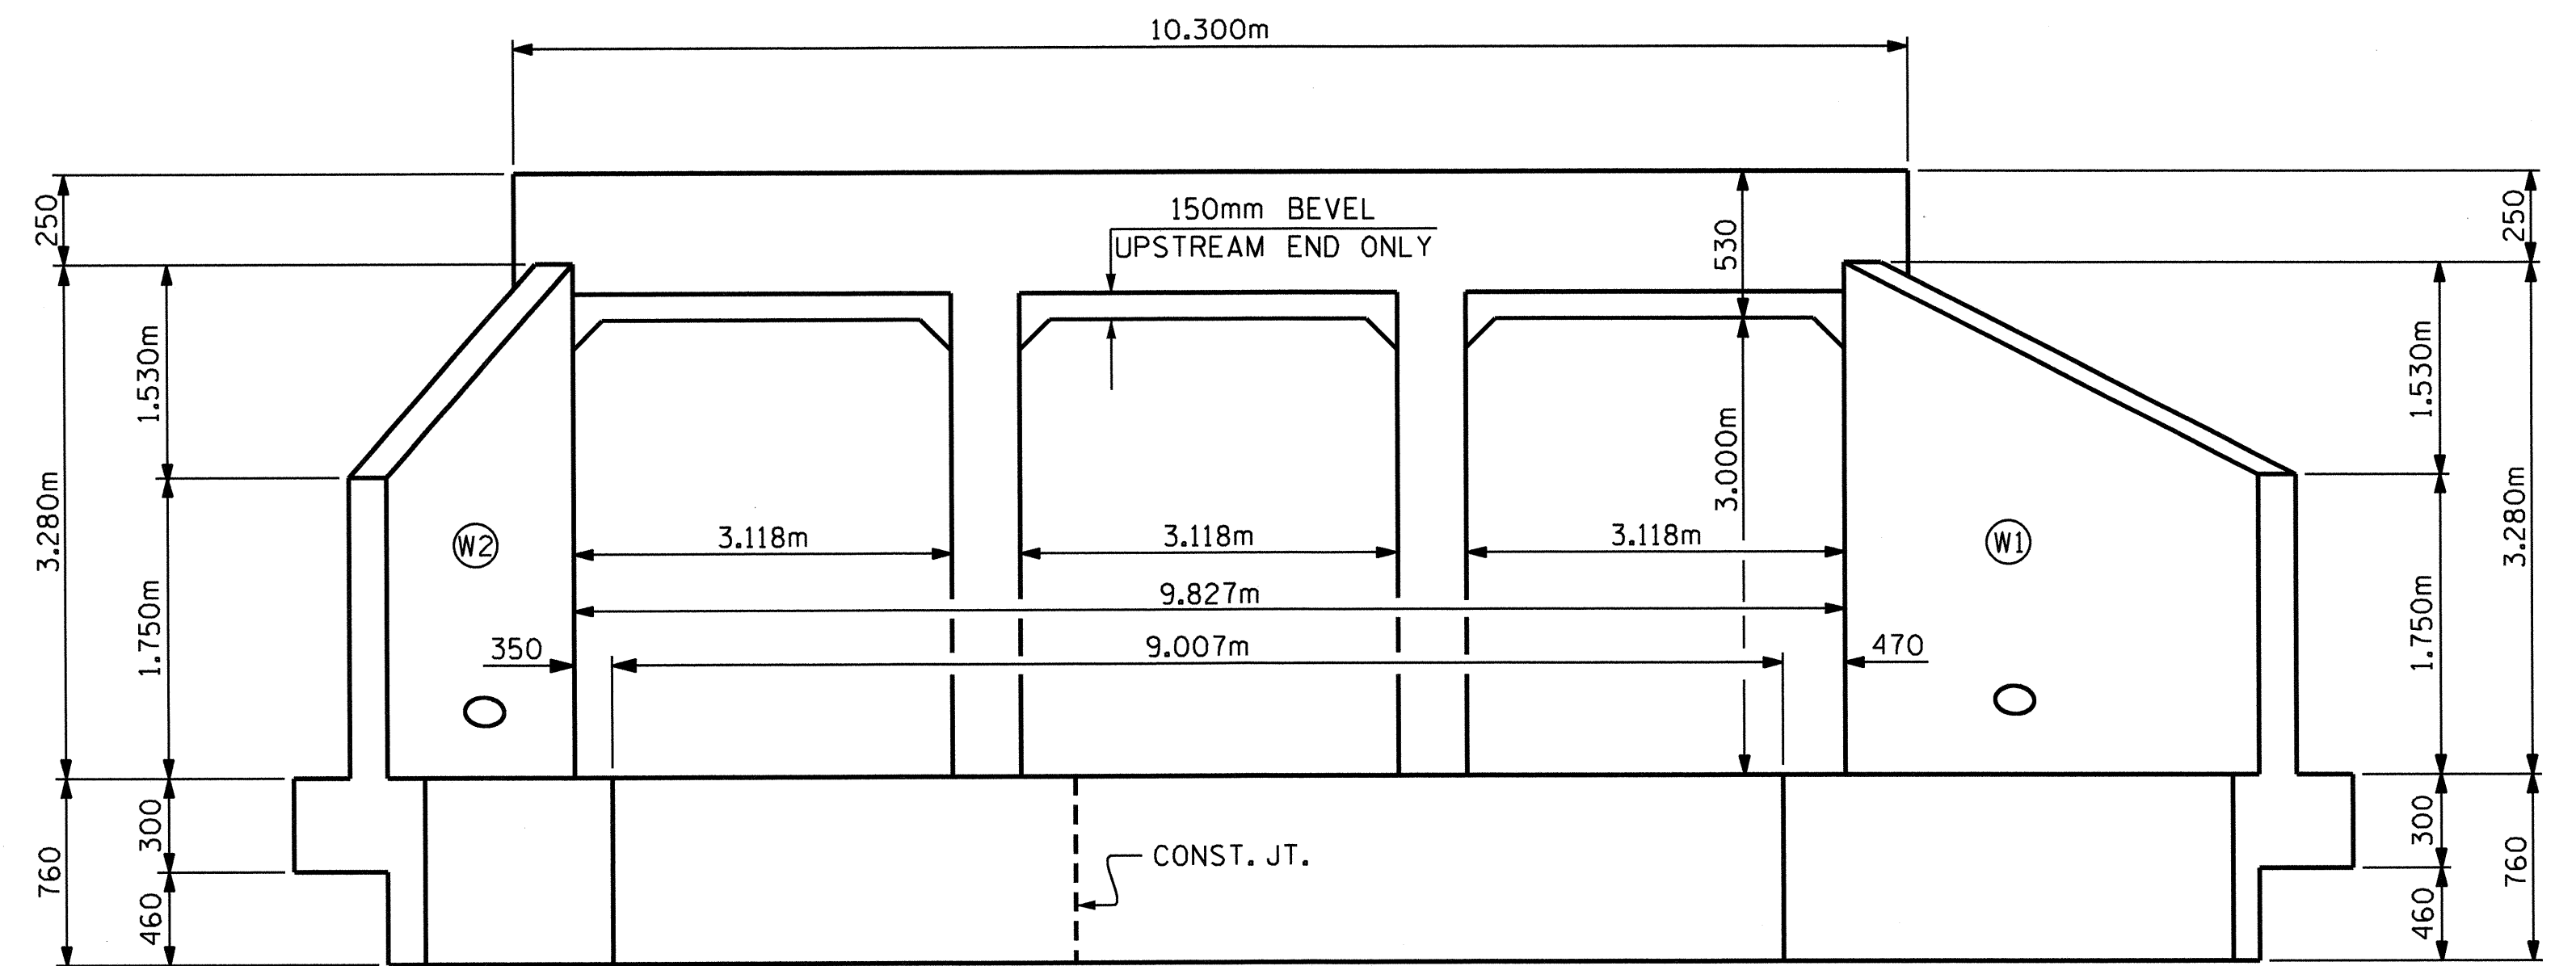

OUTLET END ELEVATION NORMAL TO SKEW

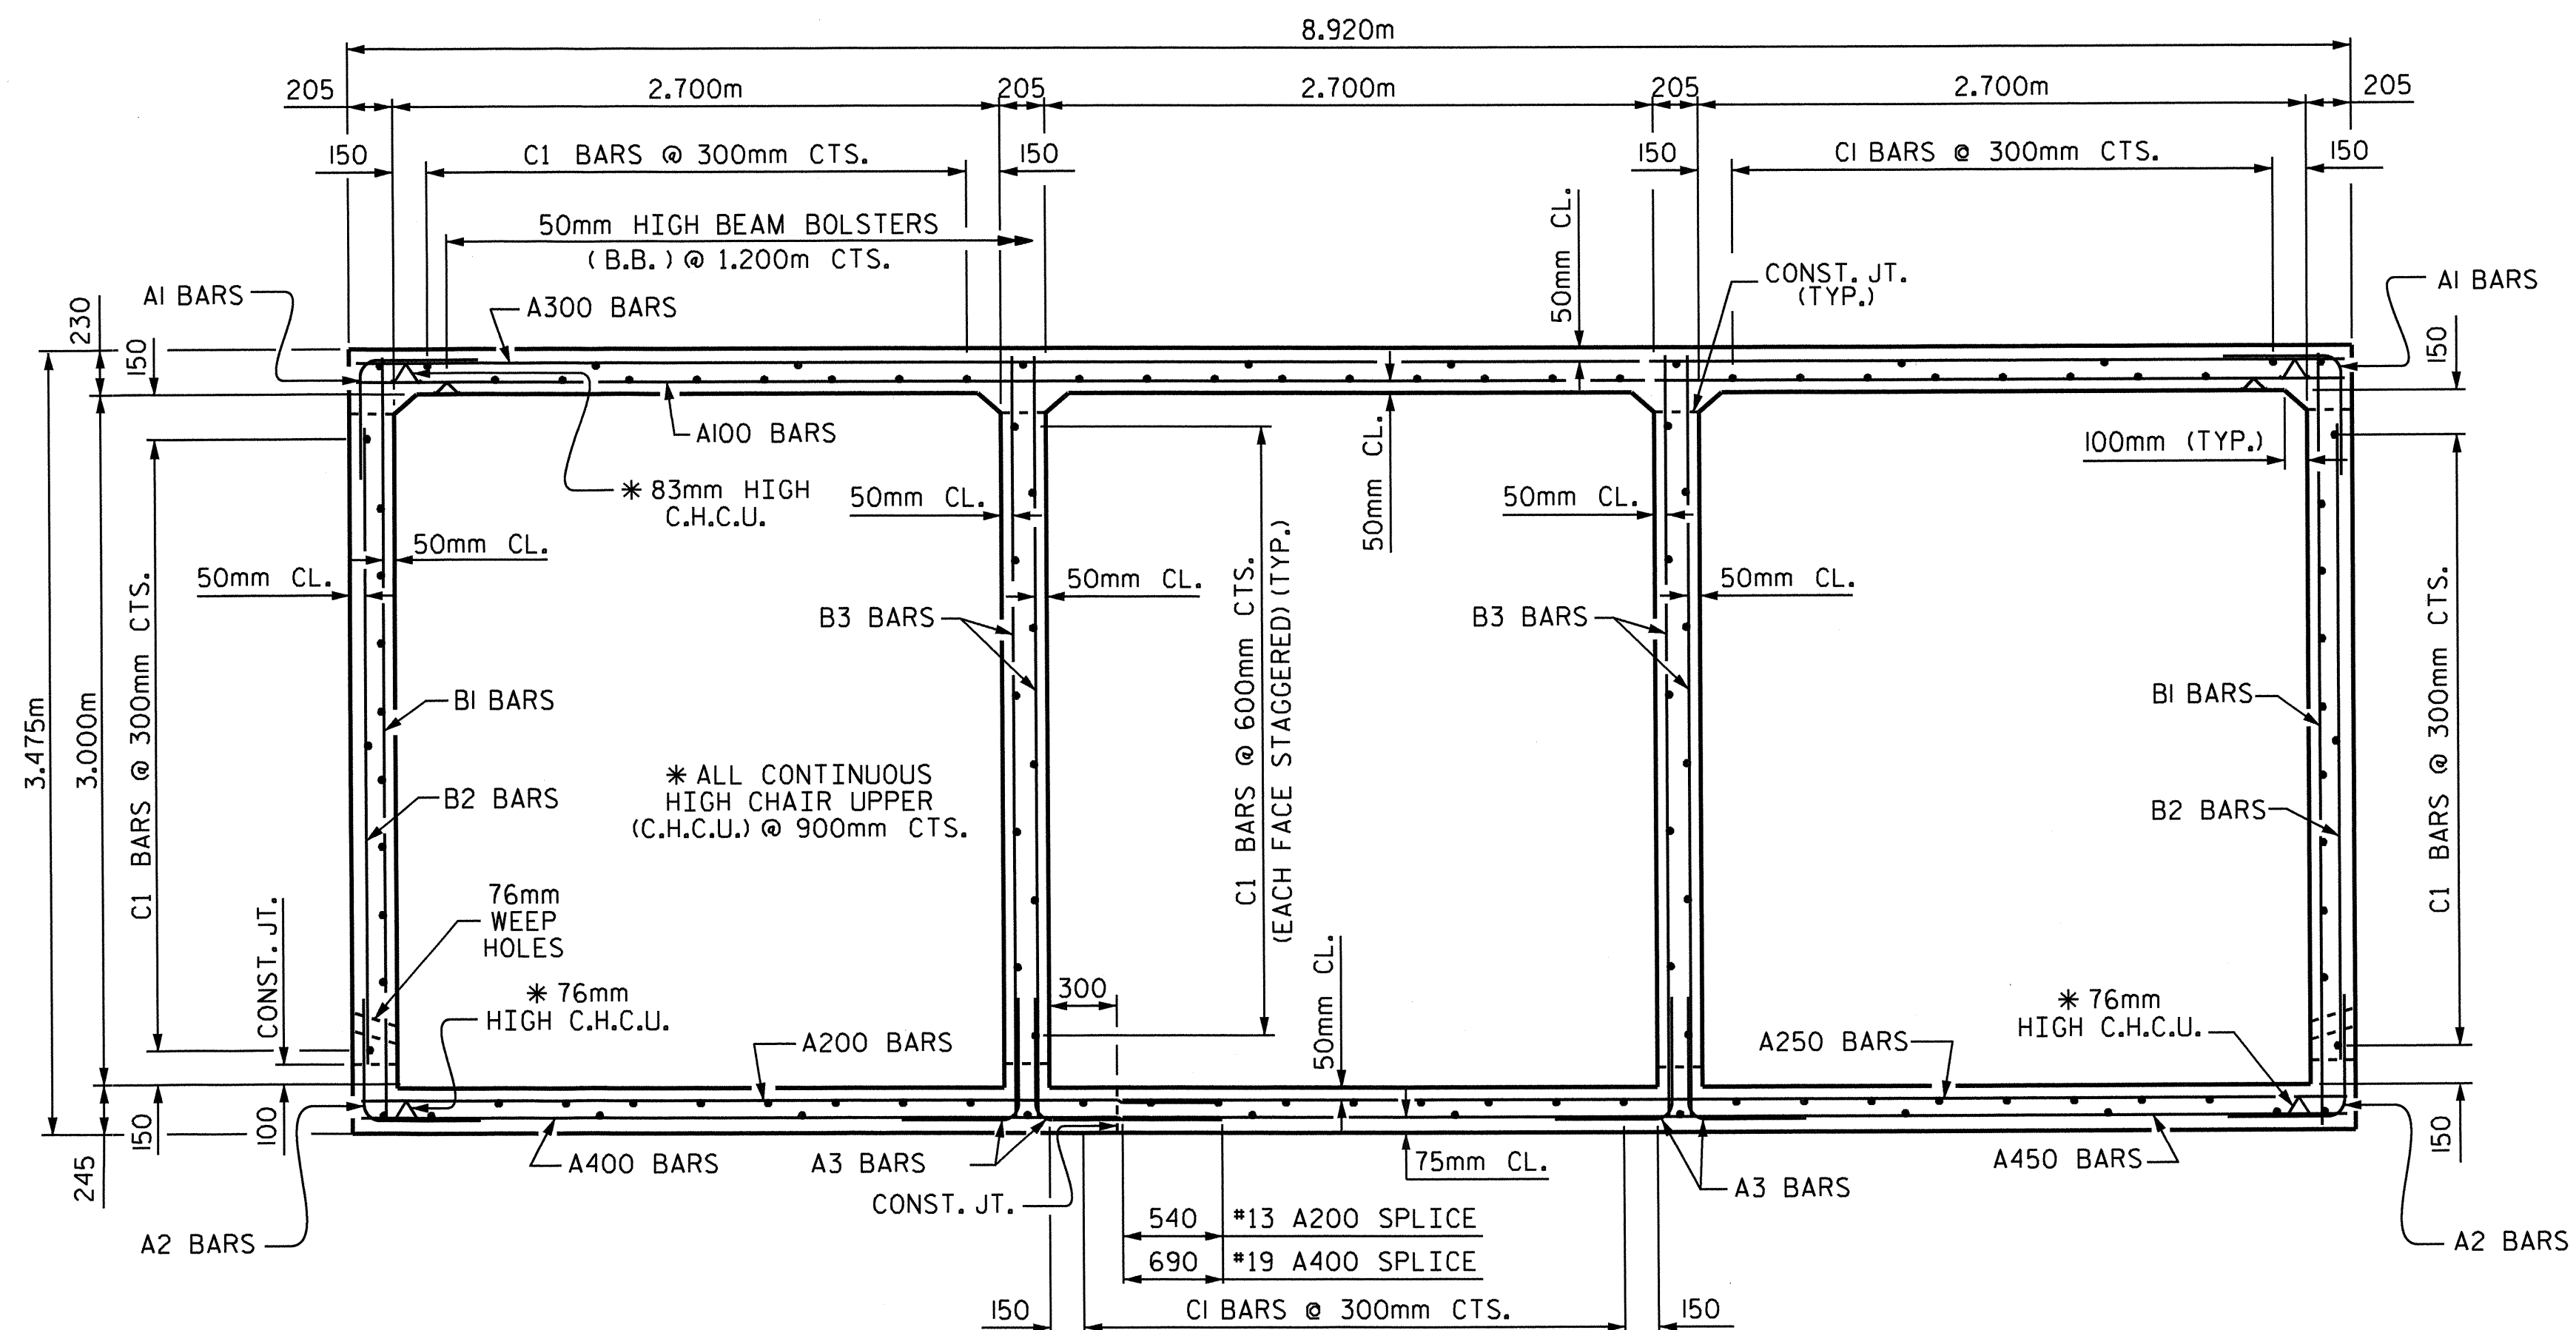


RIGHT ANGLE SECTION OF BARREL
 THERE ARE 116 "C" BARS IN SECTION OF BARREL.
 (LOOKING UPSTREAM)

PROJECT NO. B-4183
MADISON COUNTY
 STATION: 10+52.500 -L-

SHEET 2 OF 7

STATE OF NORTH CAROLINA
 DEPARTMENT OF TRANSPORTATION
 RALEIGH


TRIPLE 2.700m X 3.000m
 CONCRETE BOX CULVERT
 60° SKEW

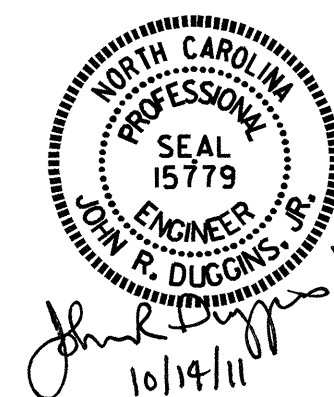

ASSEMBLED BY : A. SORSENGINH DATE : 2/3/09
 CHECKED BY : J. LAMBERT DATE : 2/10
 DRAWN BY : EEM 6/97
 CHECKED BY : ARB 7/97

REVISIONS					SHEET NO.
NO.	BY:	DATE:	NO.	BY:	DATE:
1			3		
2			4		

C-2
 TOTAL SHEETS 15

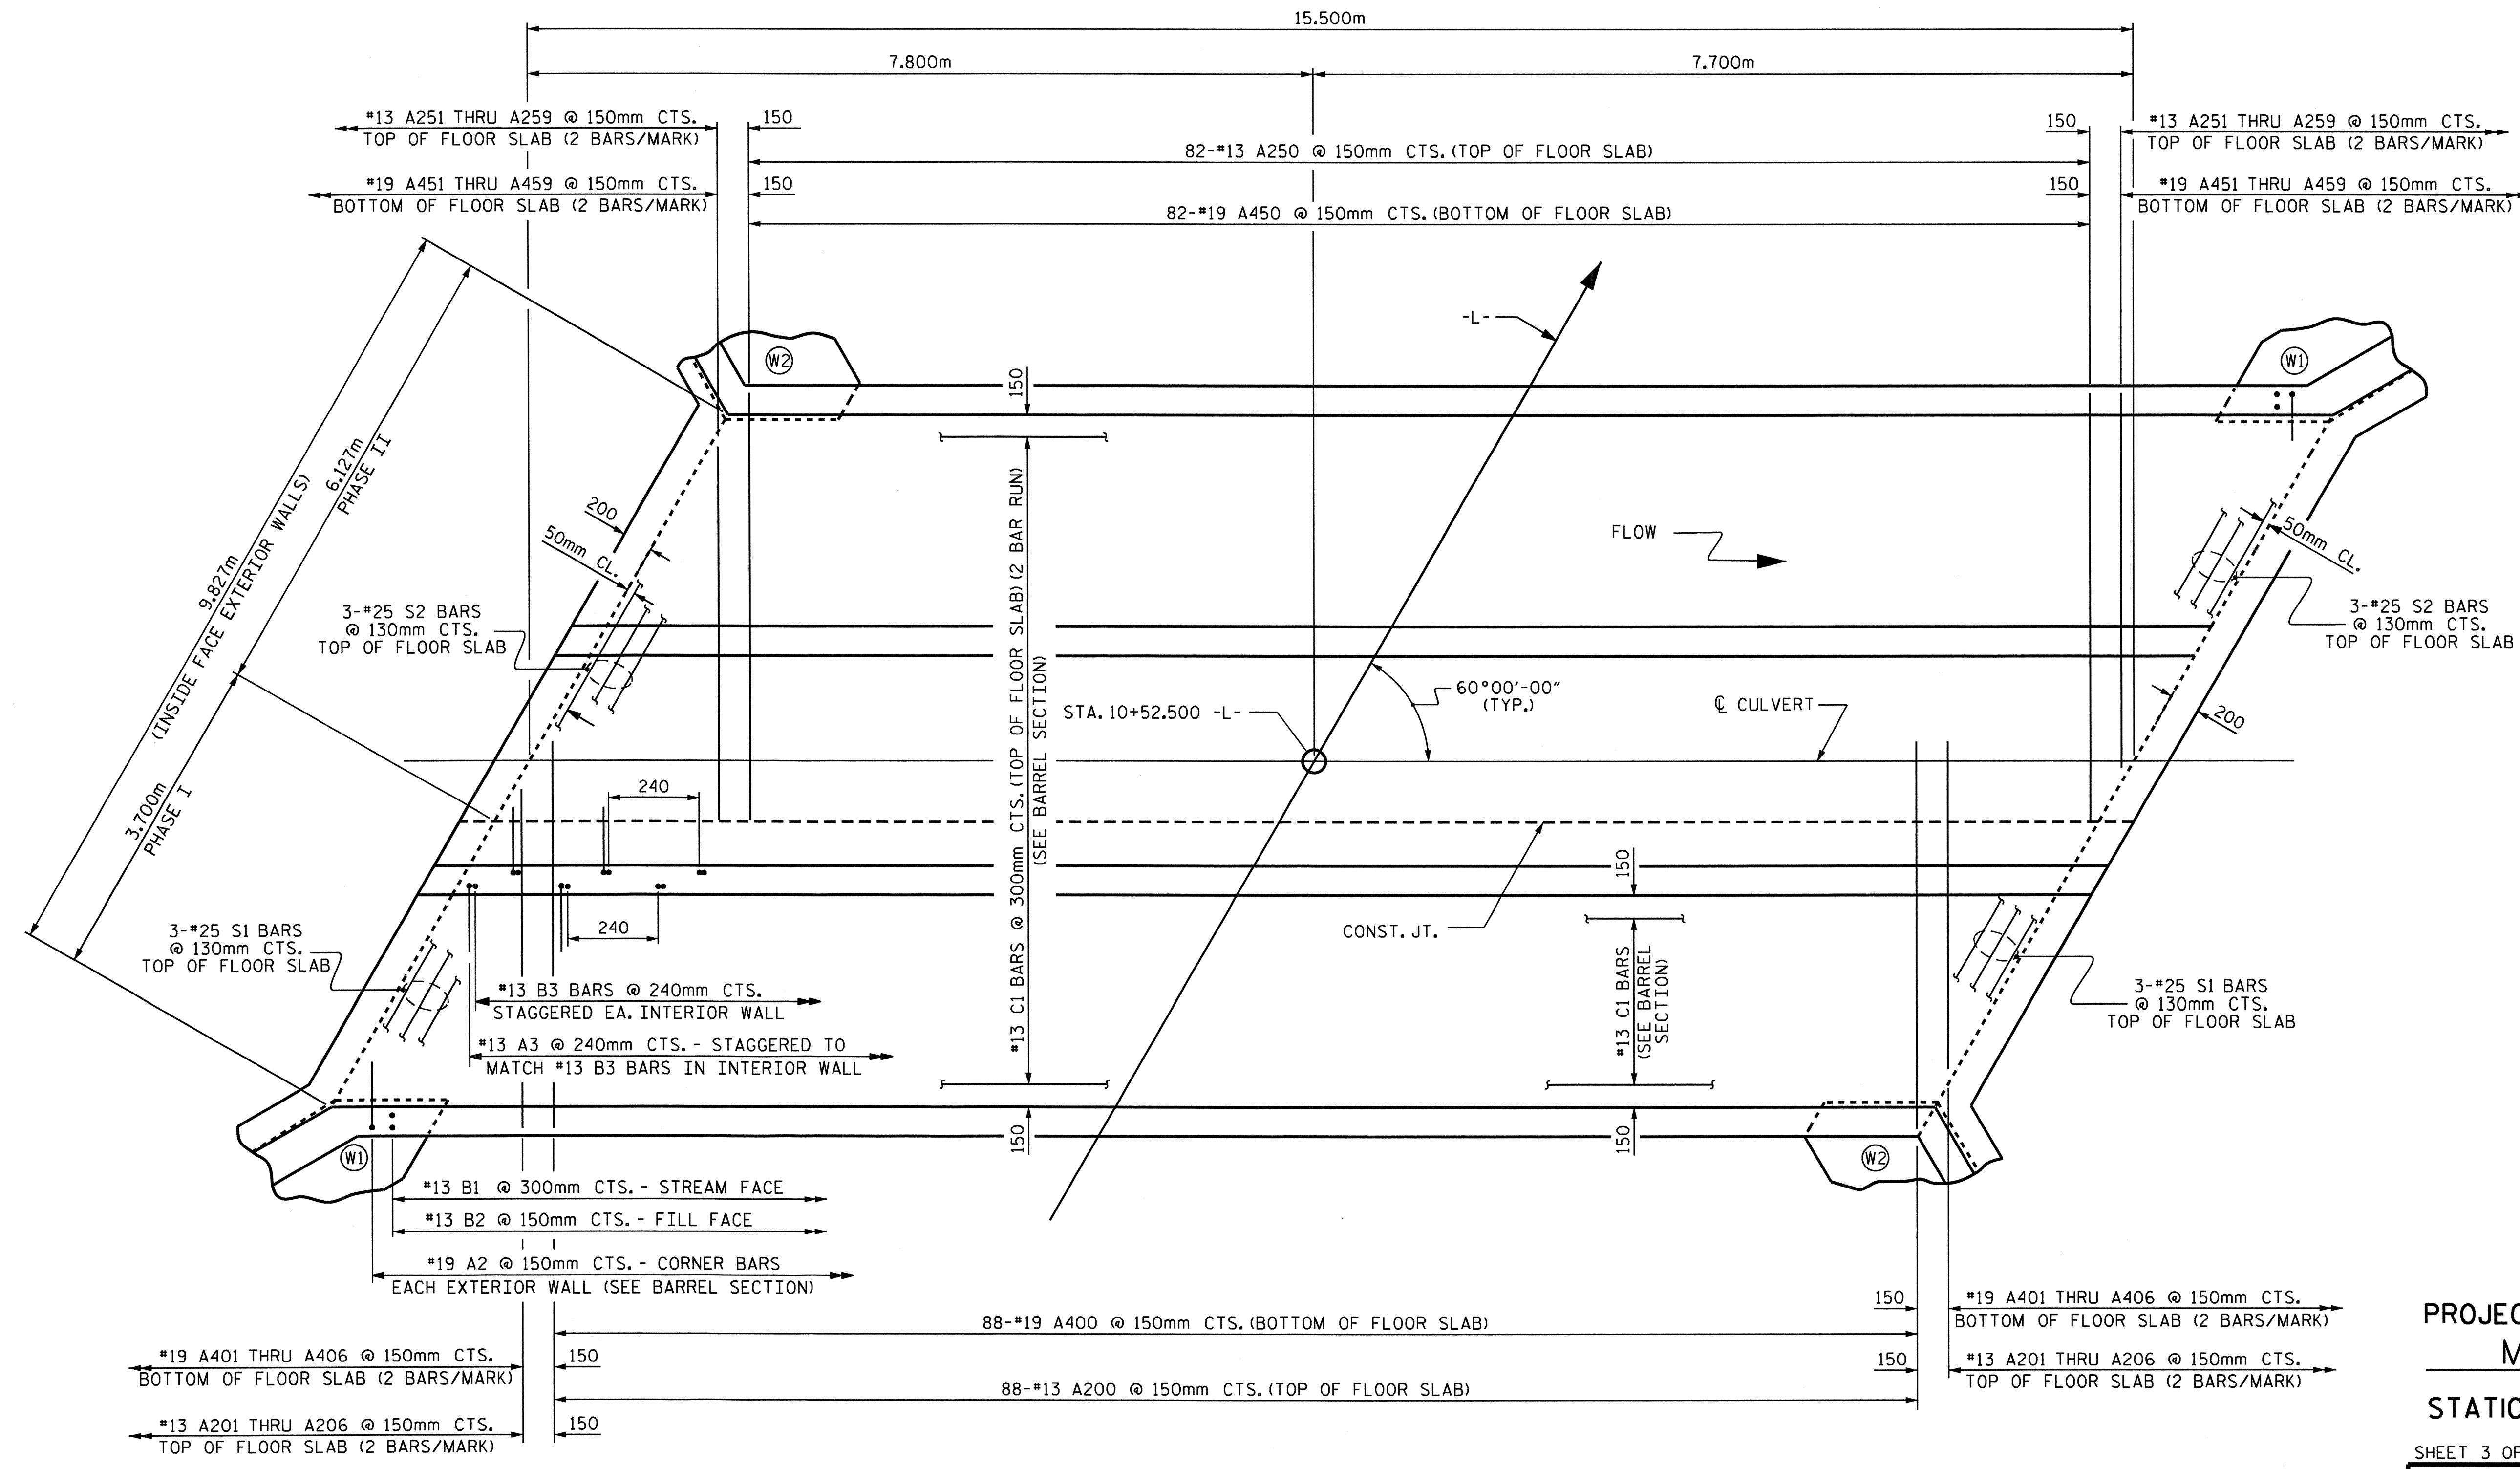


PLAN OF FLOOR SLAB

PROJECT NO. B-4183
 MADISON COUNTY
 STATION: 10+52.500 -L-


SHEET 3 OF 7

STATE OF NORTH CAROLINA
 DEPARTMENT OF TRANSPORTATION
 RALEIGH
 TRIPLE 2.700m X 3.000m
 CONCRETE BOX CULVERT
 60° SKEW

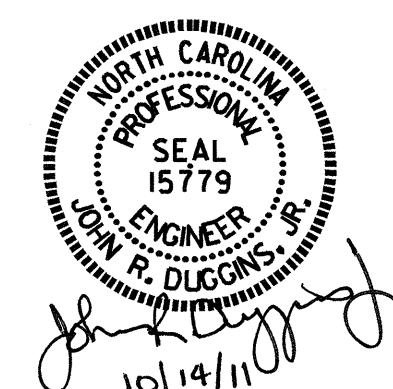

ASSEMBLED BY :	A. SORSENGINH	DATE :	2/4/09
CHECKED BY :	J. LAMBERT	DATE :	2/10
DRAWN BY :	EEM	6/97	
CHECKED BY :	ARB	7/97	

REVISIONS						SHEET NO.
NO.	BY:	DATE:	NO.	BY:	DATE:	C-3
1			3			TOTAL SHEETS
2			4			15

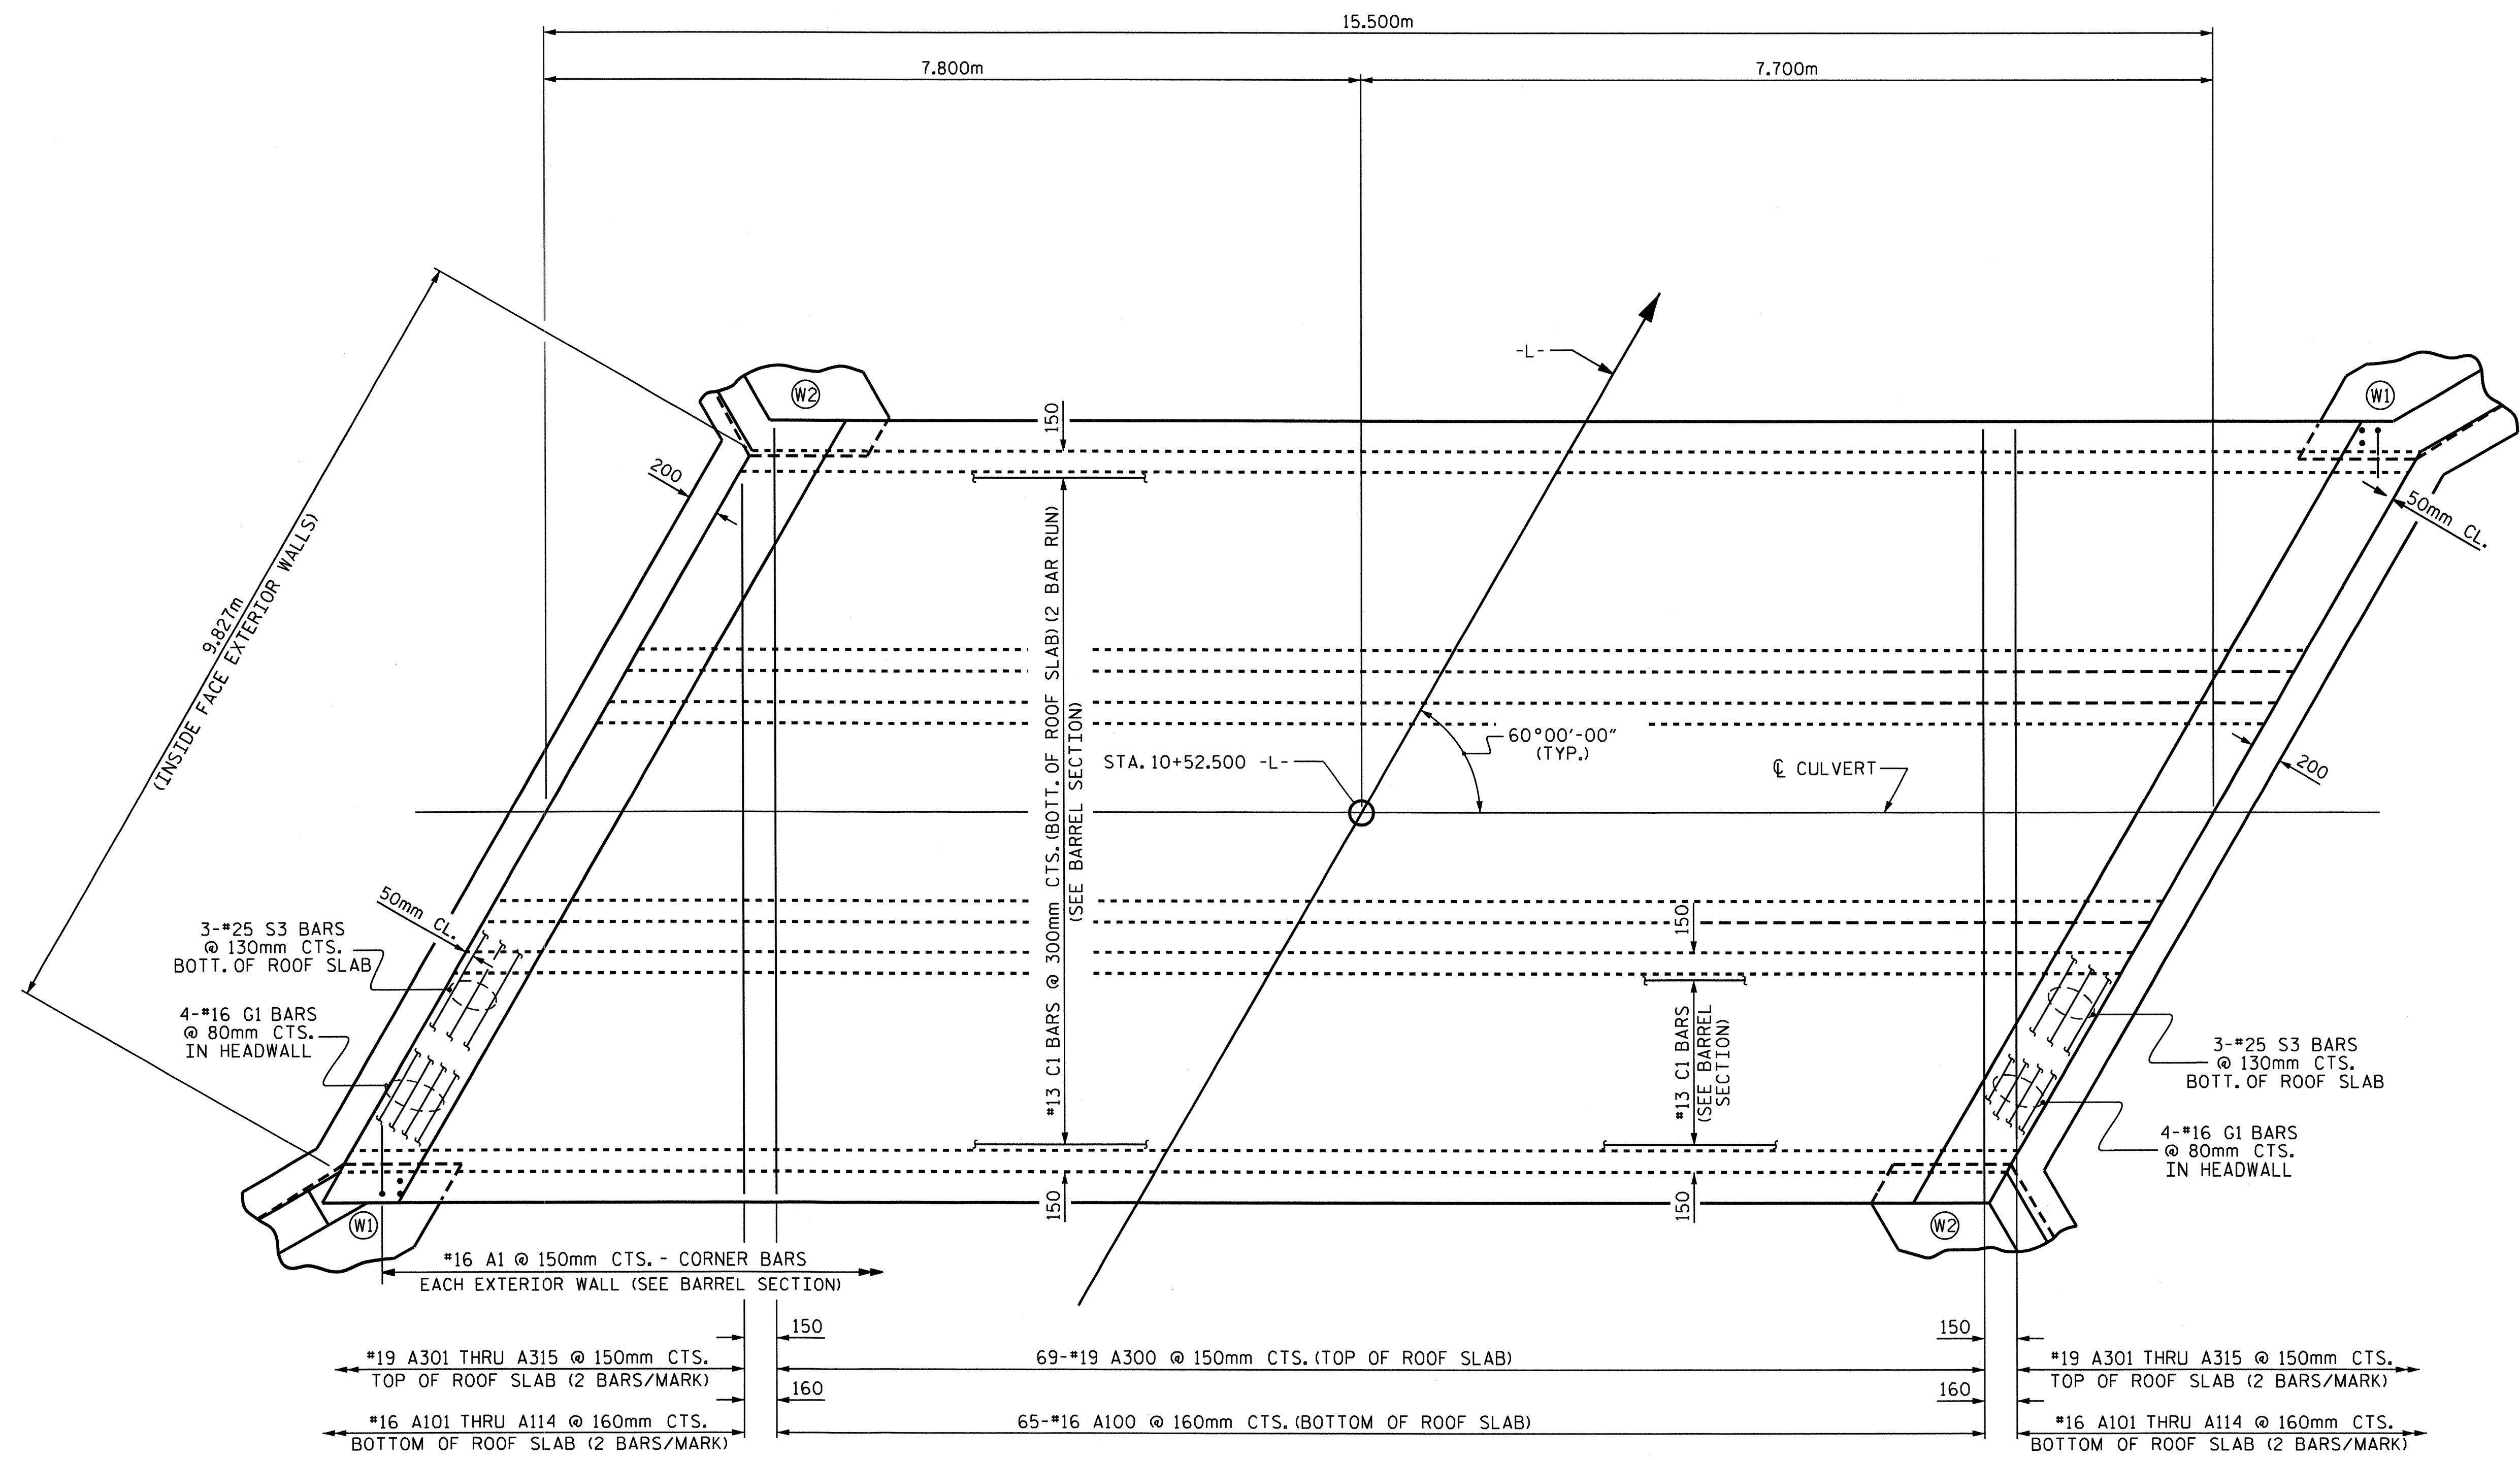


PLAN OF ROOF SLAB

PROJECT NO. B-4183
MADISON COUNTY
 STATION: 10+52.500 -L-

SHEET 4 OF 7


STATE OF NORTH CAROLINA
 DEPARTMENT OF TRANSPORTATION
 RALEIGH

TRIPLE 2.700m X 3.000m
 CONCRETE BOX CULVERT
 60° SKEW

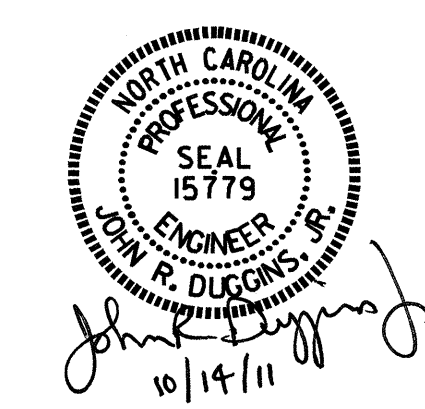


ASSEMBLED BY :	A. SORSENGINH	DATE :	2/4/09
CHECKED BY :	J. LAMBERT	DATE :	2/10
DRAWN BY :	EEM	6/97	
CHECKED BY :	ARB	7/97	


REVISIONS						SHEET NO.
NO.	BY:	DATE:	NO.	BY:	DATE:	C-4
1			3			TOTAL SHEETS
2			4			15

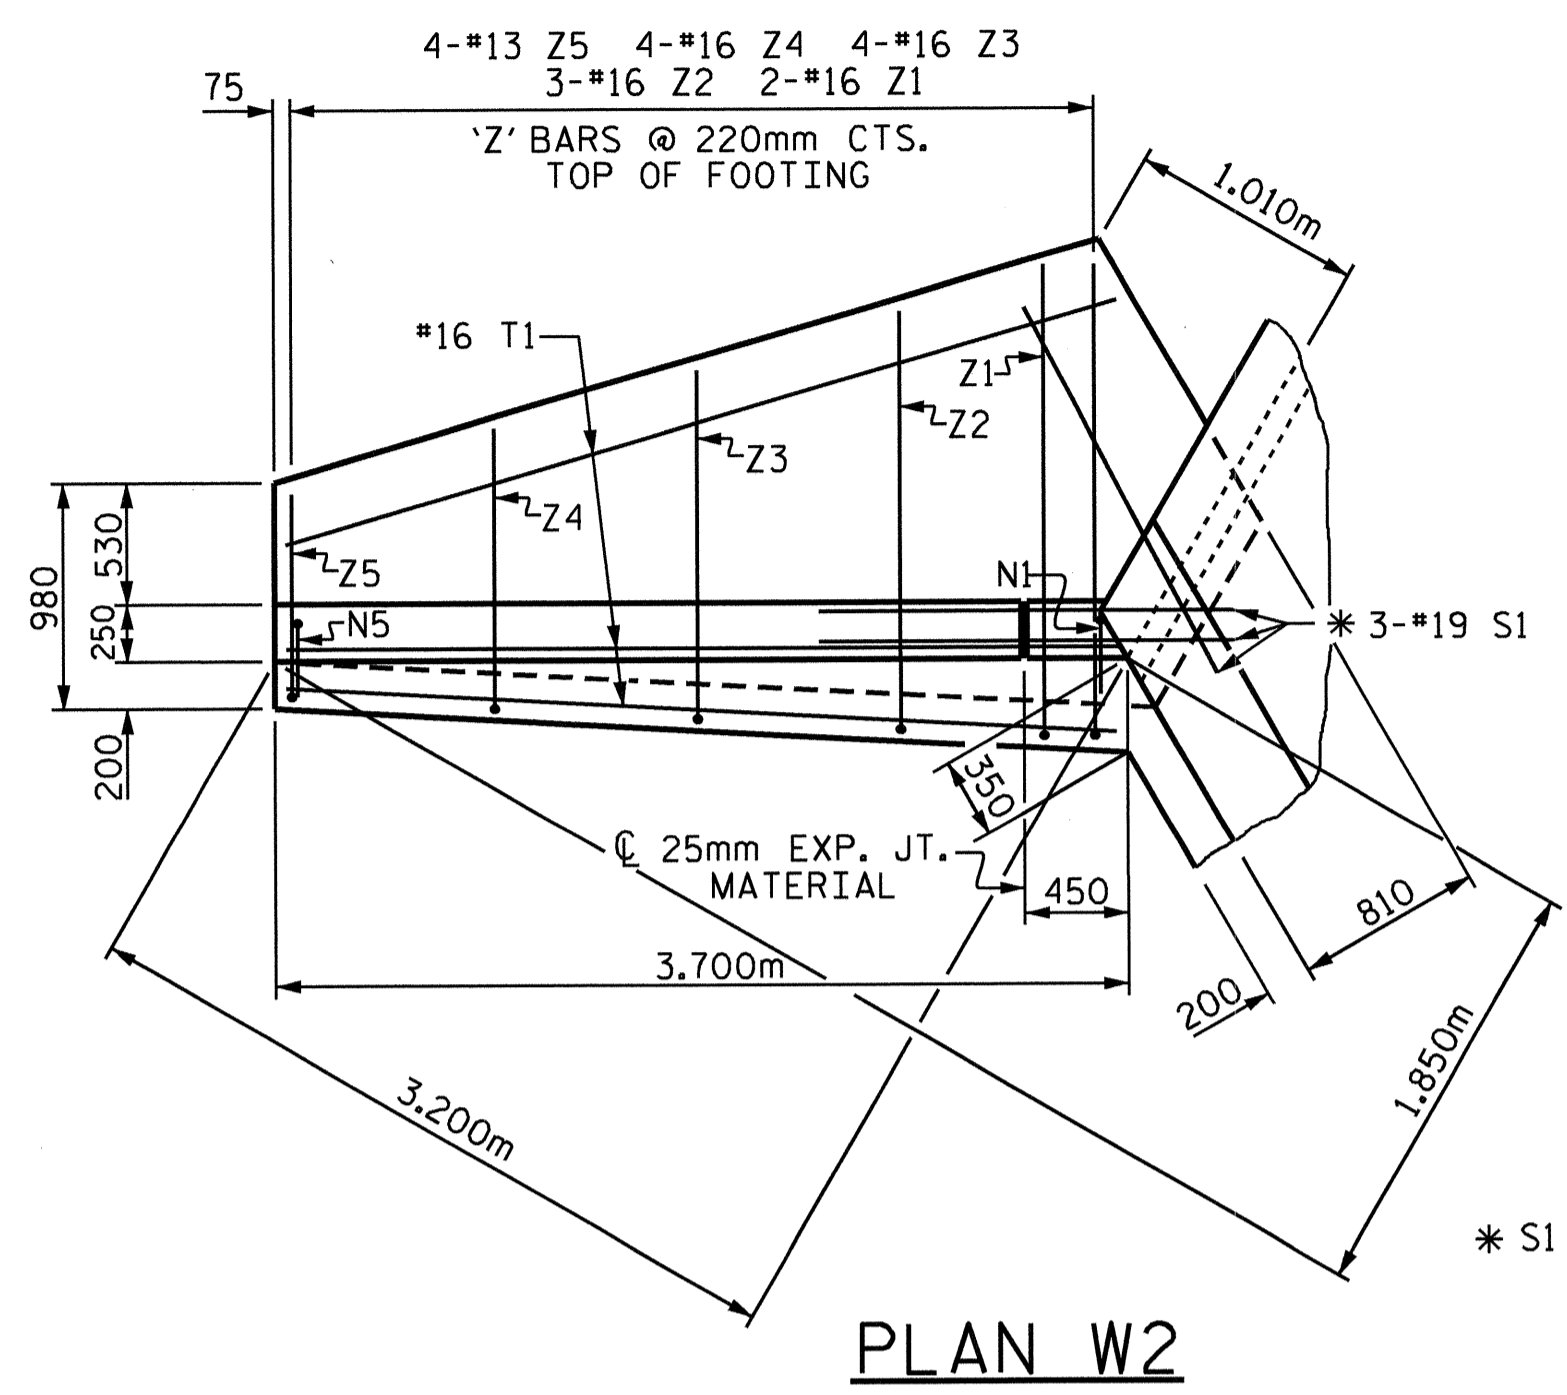


PLAN W2

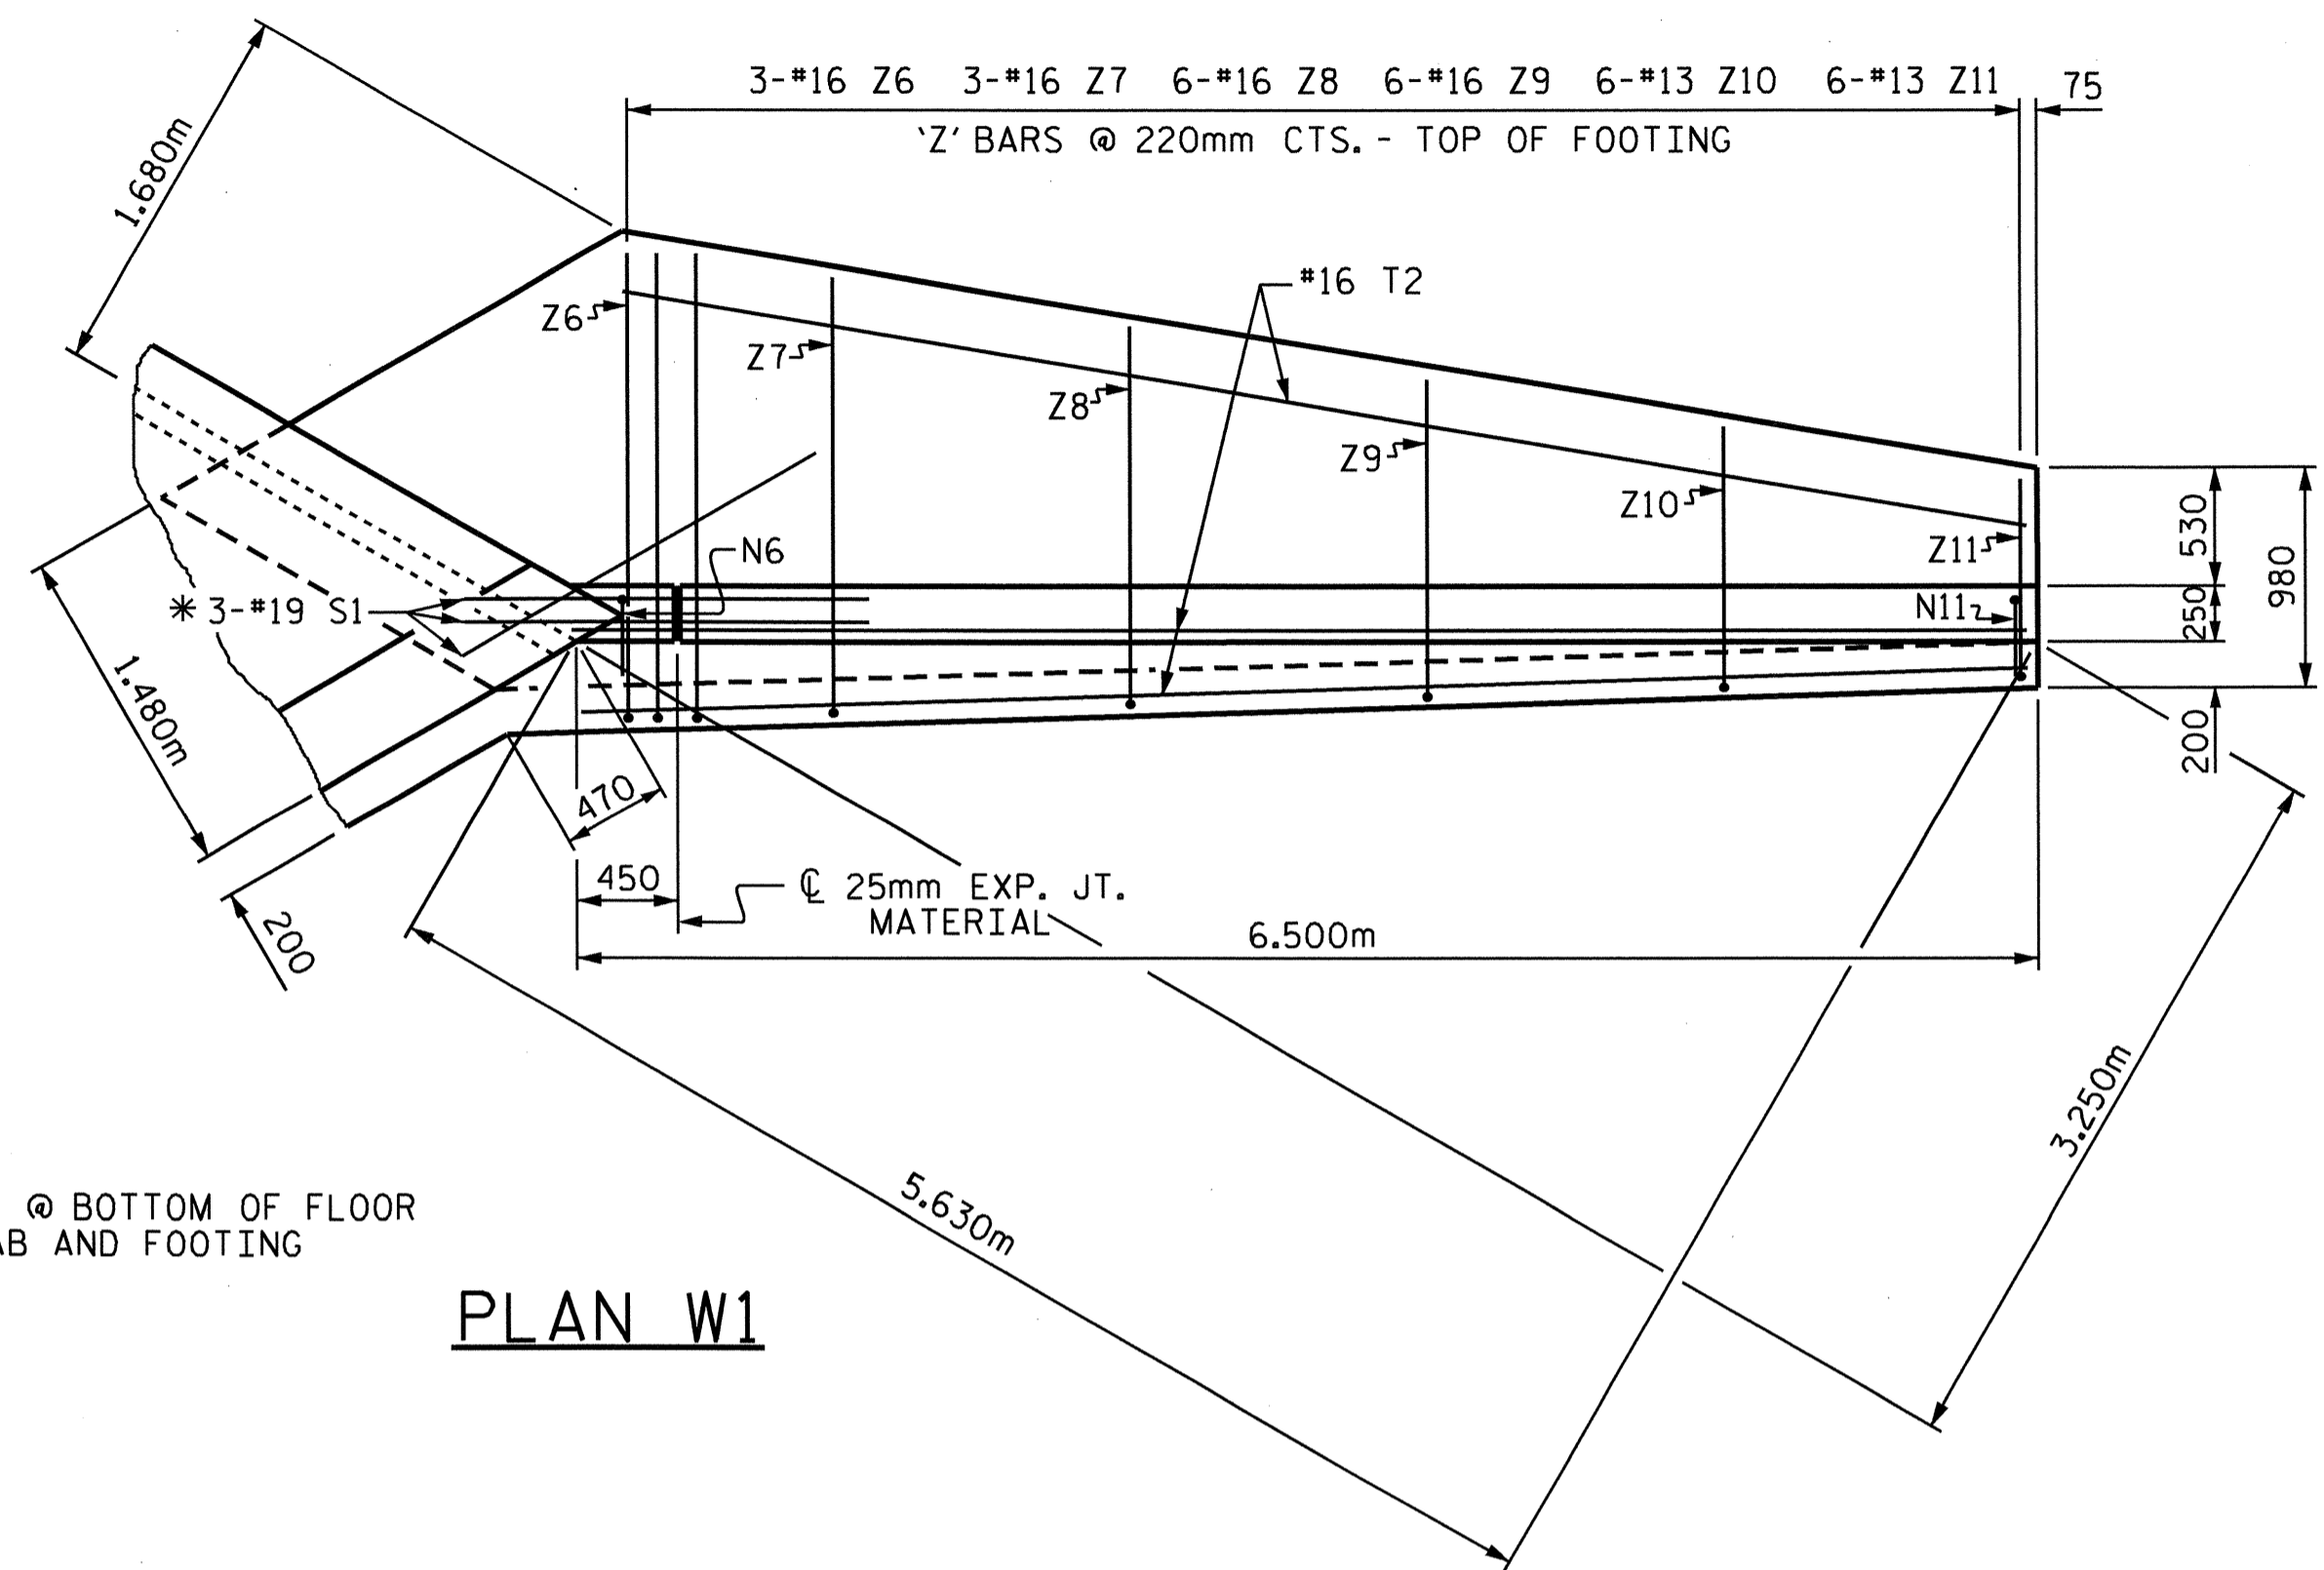


PLAN W1

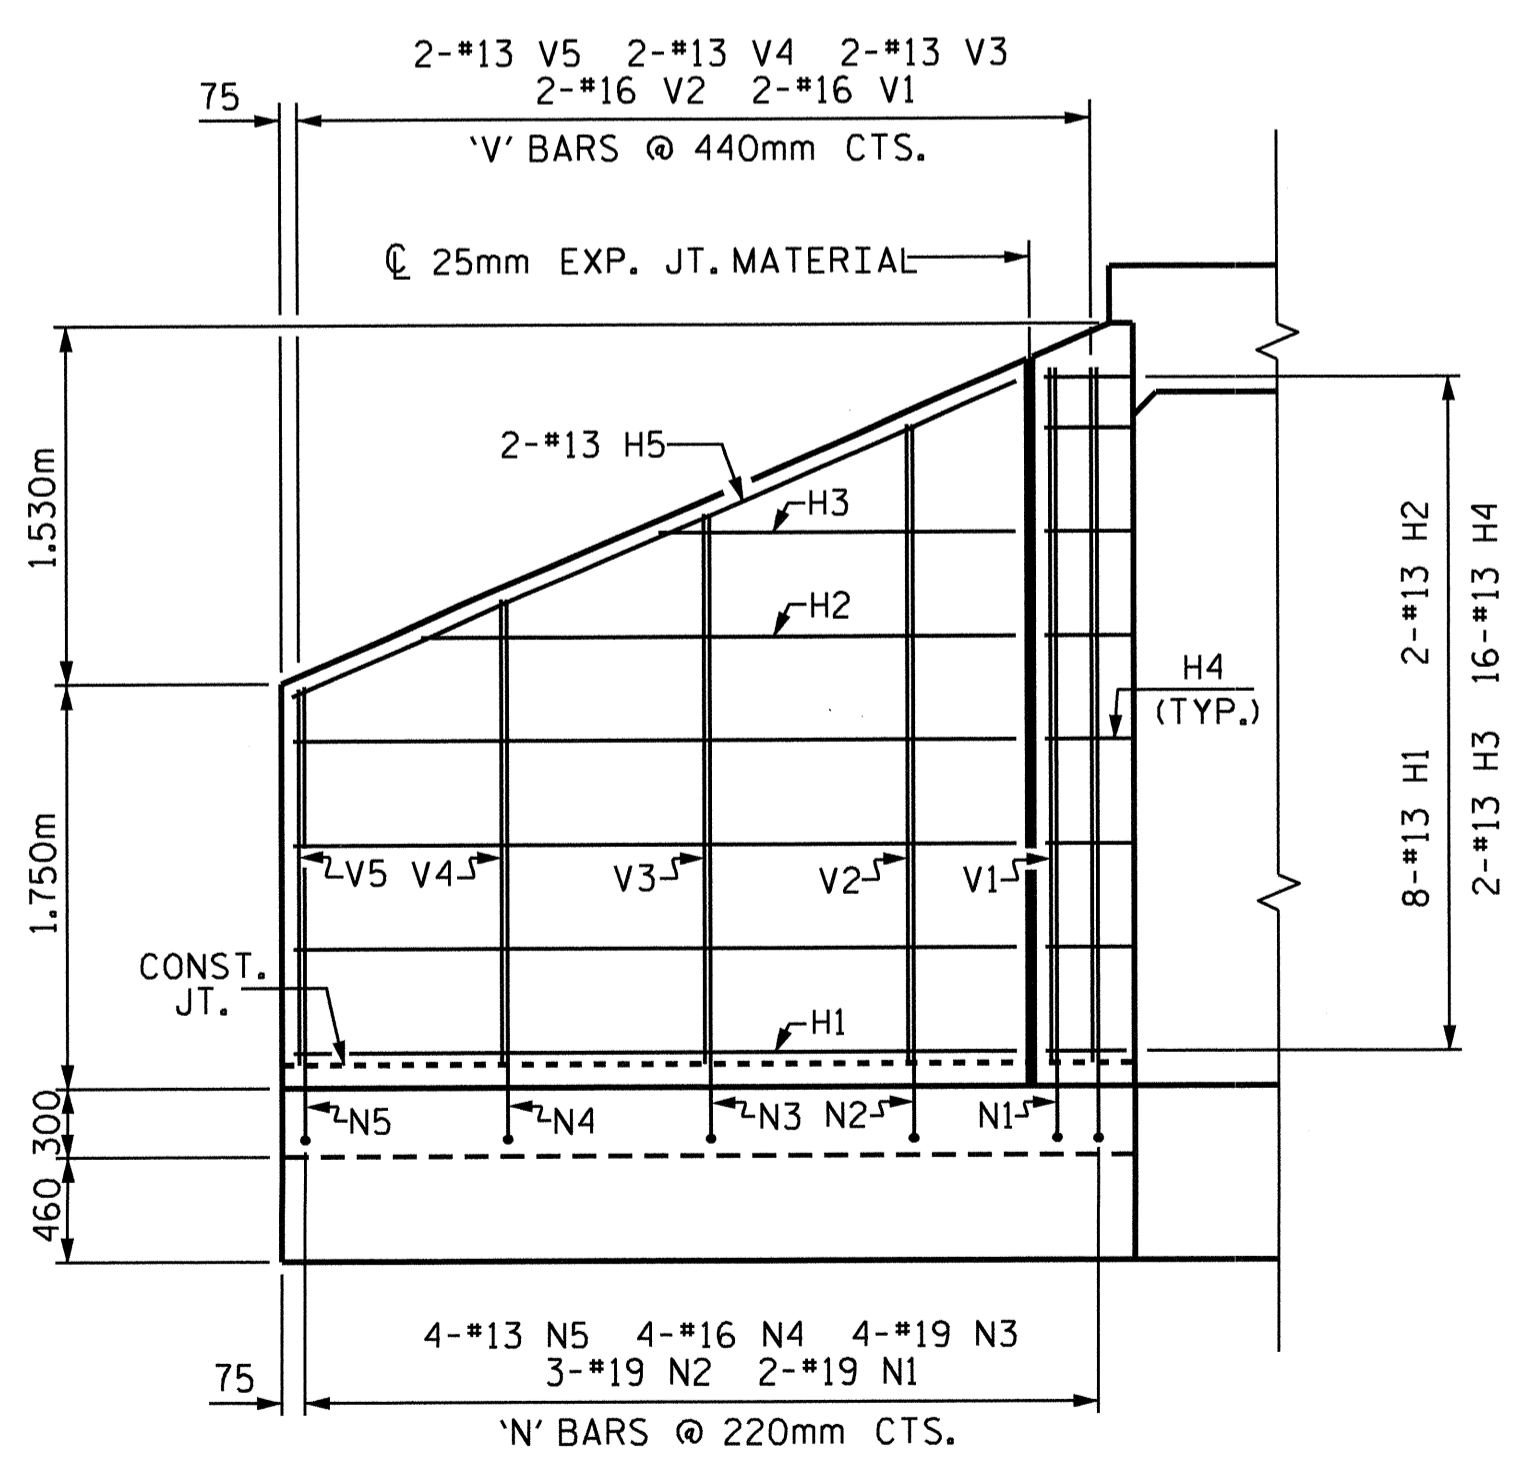

ELEVATION W2

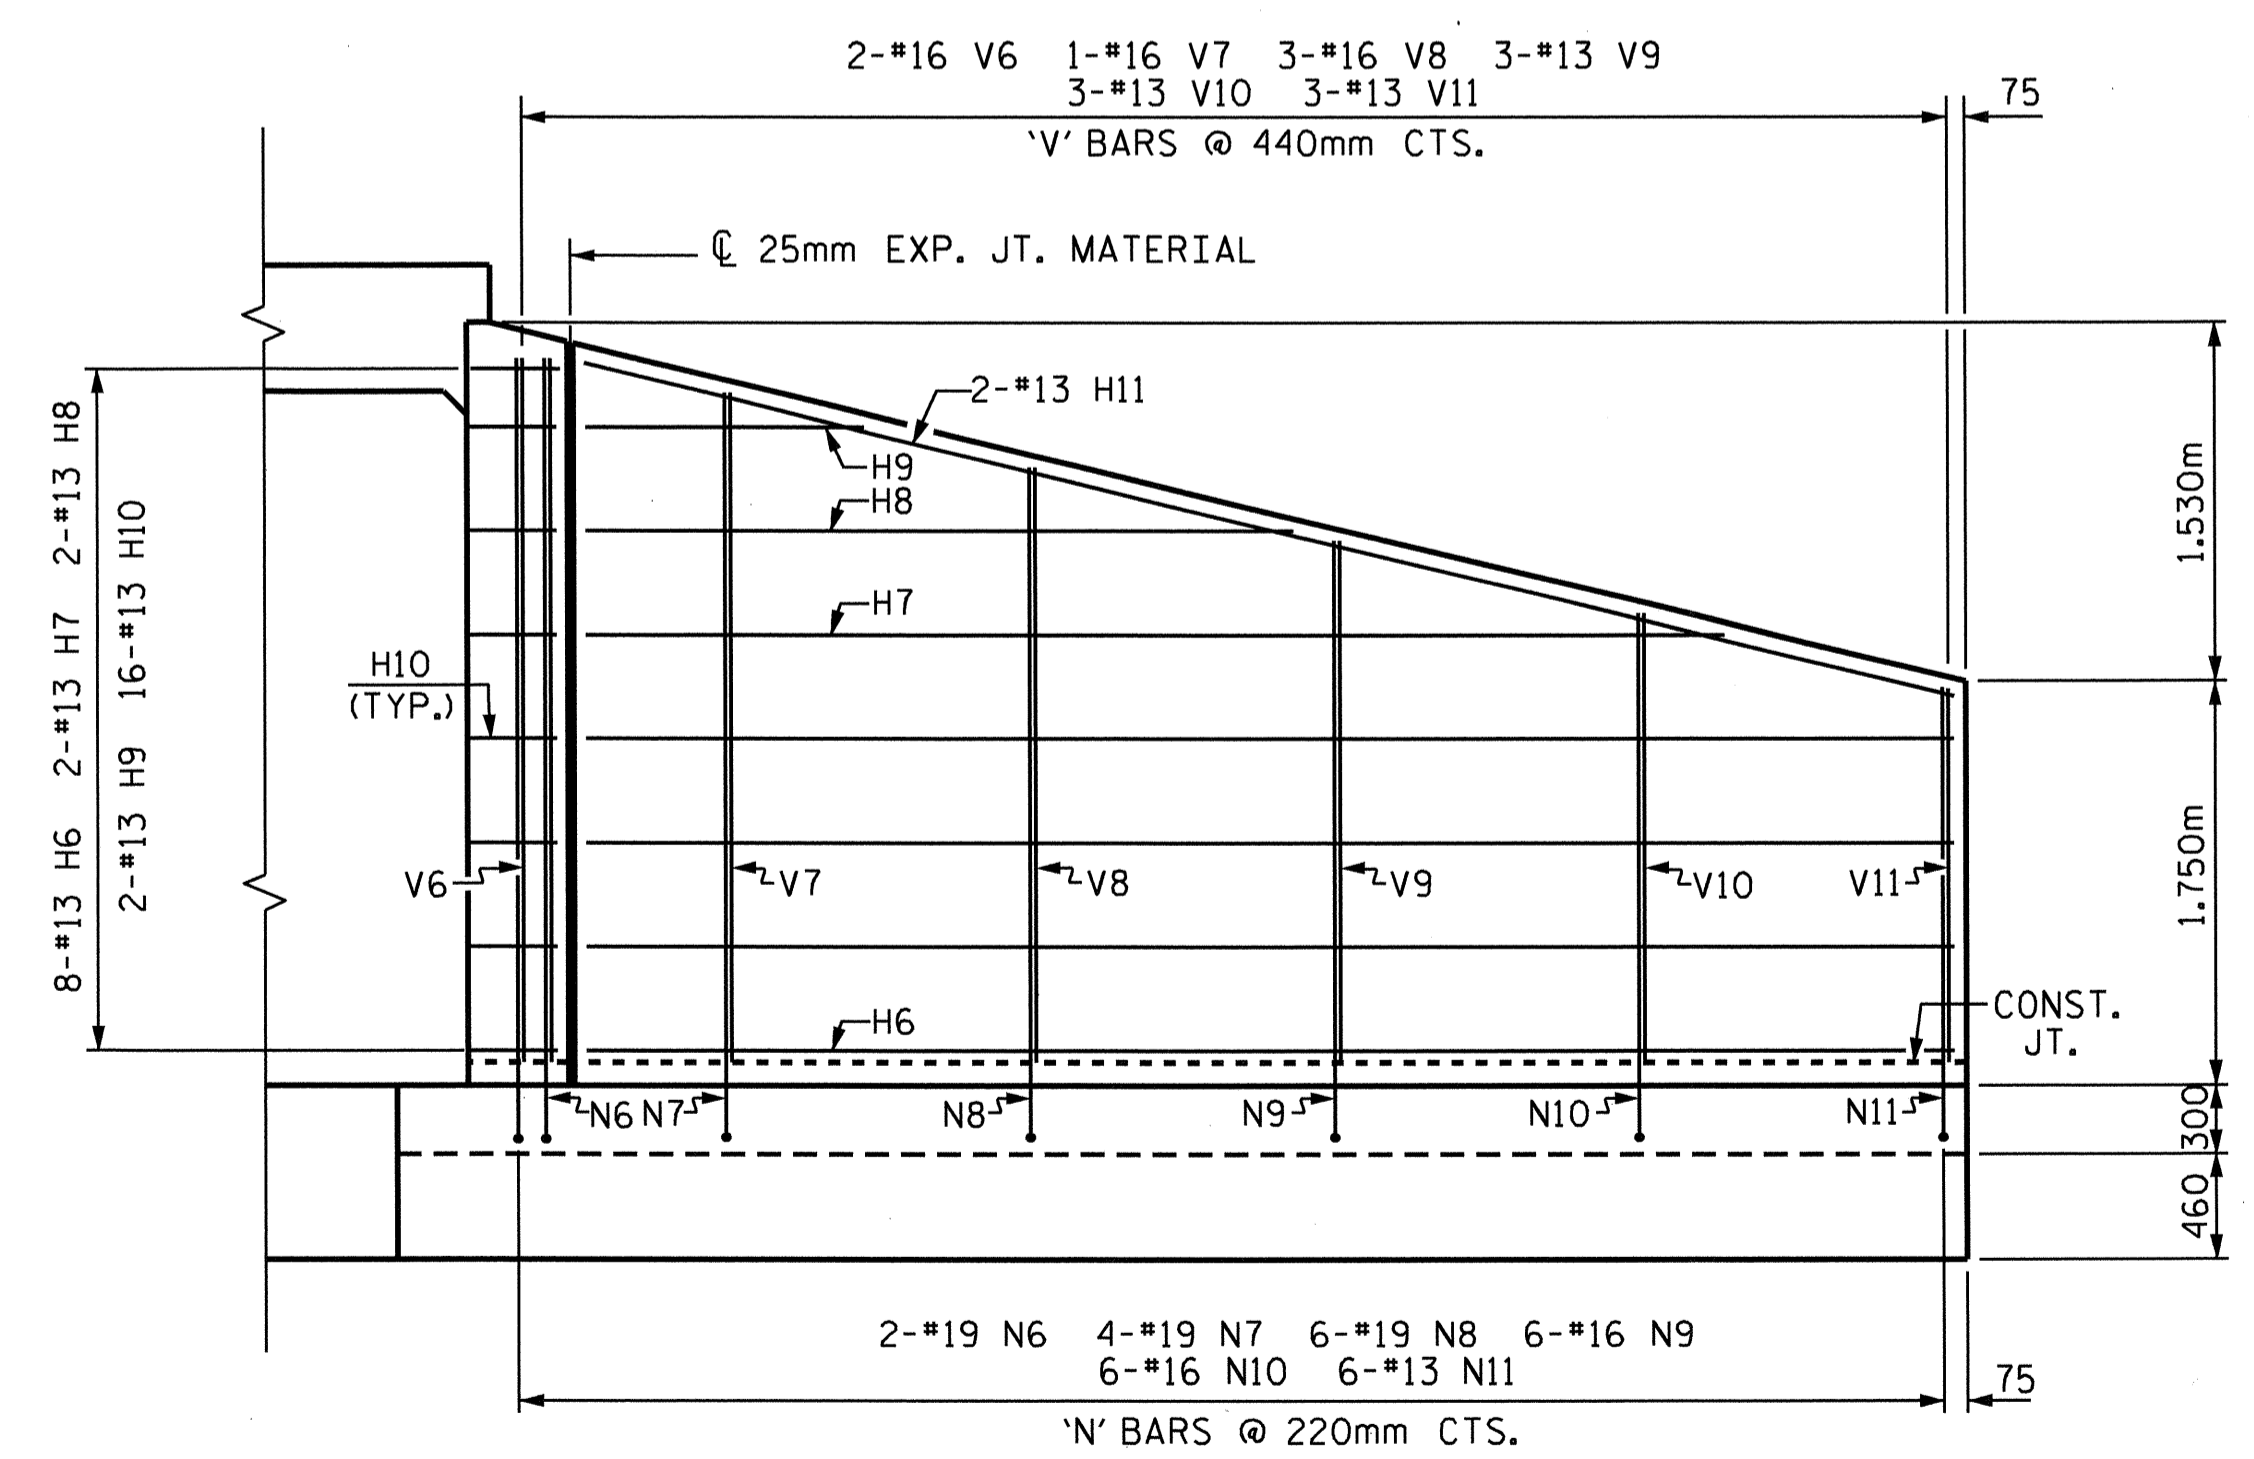


ELEVATION W1

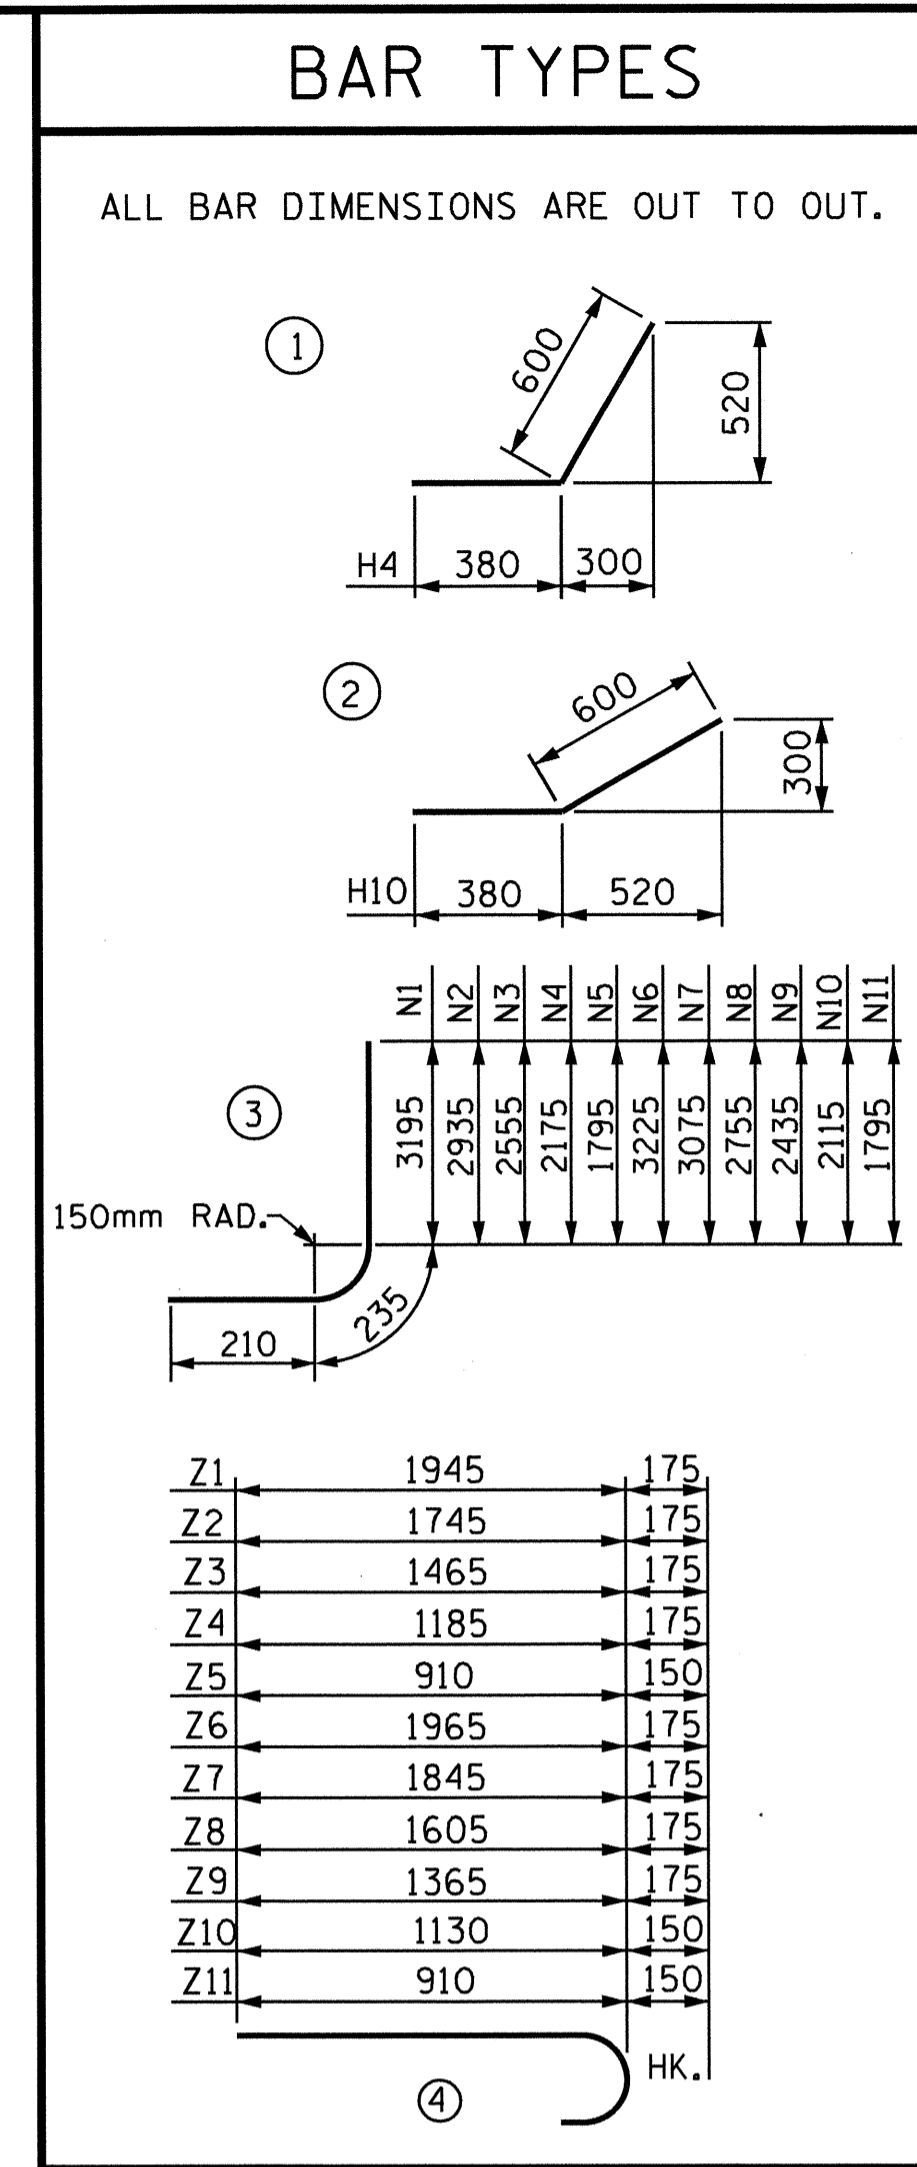


BILL OF MATERIAL					
BAR	NO.	SIZE	TYPE	LENGTH	WEIGHT
H1	16	13	STR	3140	50
H2	4	13	STR	2600	10
H3	4	13	STR	1540	6
H4	32	13	1	980	31
H5	4	13	STR	3400	14
H6	16	13	STR	5940	94
H7	4	13	STR	5040	20
H8	4	13	STR	3200	13
H9	4	13	STR	1360	5
H10	32	13	2	980	31
H11	4	13	STR	6100	24
N1	4	19	3	3640	33
N2	6	19	3	3380	45
N3	8	19	3	3000	54
N4	8	16	3	2620	33
N5	8	13	3	2240	18
N6	4	19	3	3680	33
N7	8	19	3	3520	63
N8	12	19	3	3200	86
N9	12	16	3	2880	54
N10	12	16	3	2560	48
N11	12	13	3	2240	27
S1	12	19	STR	1800	48
T1	6	16	STR	3700	34
T2	6	16	STR	6500	61
V1	4	16	STR	3020	19
V2	4	16	STR	2760	17
V3	4	13	STR	2380	9
V4	4	13	STR	2000	8
V5	4	13	STR	1620	6
V6	4	16	STR	3020	19
V7	2	16	STR	2900	9
V8	6	16	STR	2580	24
V9	6	13	STR	2260	13
V10	6	13	STR	1940	12
V11	6	13	STR	1620	10
Z1	4	16	4	2120	13
Z2	6	16	4	1920	18
Z3	8	16	4	1640	20
Z4	8	16	4	1360	17
Z5	8	13	4	1060	8
Z6	6	16	4	2140	20
Z7	6	16	4	2020	19
Z8	12	16	4	1780	33
Z9	12	16	4	1540	29
Z10	12	13	4	1280	15
Z11	12	13	4	1060	13

REINFORCING STEEL FOR 4 WING WALLS	1286	kg
CLASS A CONCRETE		
4 WINGS	25.5	m ³
2 HEADWALLS	2.3	m ³
2 END CURTAIN WALLS	2.7	m ³
TOTAL	30.5	m³

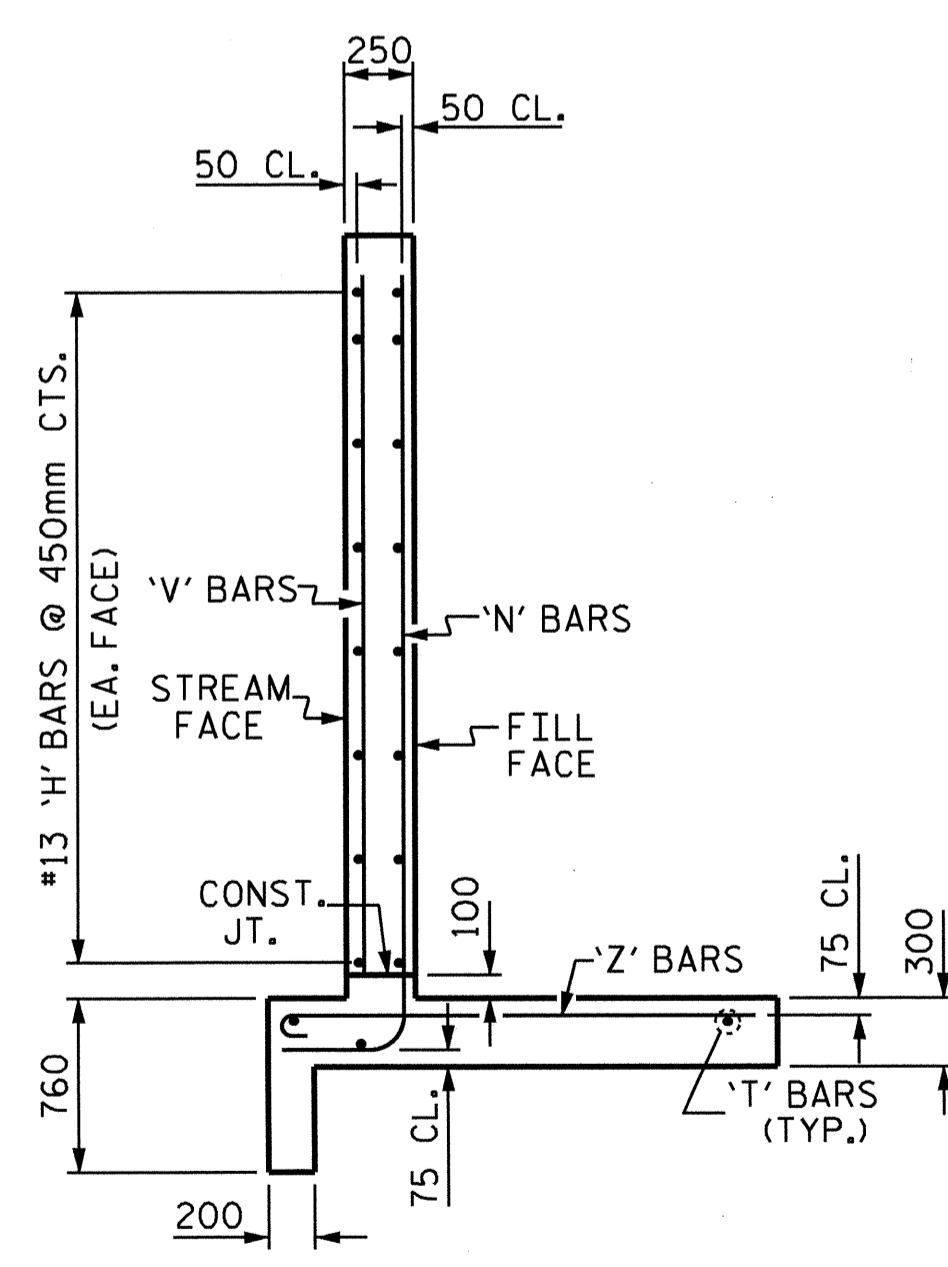

TYPICAL WING SECTION

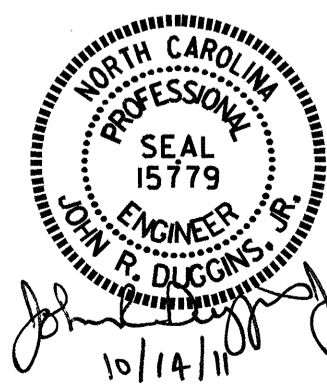

PROJECT NO. B-4183
MADISON COUNTY
 STATION: 10+52.500 -L-

SHEET 6 OF 7
 DEPARTMENT OF TRANSPORTATION
 RALEIGH
WINGS FOR CONCRETE BOX CULVERT
 H=3.000m SLOPE=2:1
 60° SKEW

REVISIONS						SHEET NO.
NO.	BY:	DATE:	NO.	BY:	DATE:	C-6
1			3			TOTAL SHEETS
2			4			15

ASSEMBLED BY : A. SORSENGINH DATE : 3/5/09
 CHECKED BY : J. LAMBERT DATE : 2/10
 DRAWN BY : JLR 6/97
 CHECKED BY : VAP 5/98

FOR WING ORIENTATION, SEE SHEET C-3.

THE GUARDRAIL ANCHOR ASSEMBLY FOR CULVERTS SHALL CONSIST OF THE FOLLOWING COMPONENTS :

- A. FERRULES SHALL BE MADE FROM STEEL MEETING THE REQUIREMENTS OF AASHTO M169, GRADE 12L14 AND SHALL HAVE A MINIMUM LENGTH OF 64mm.
- B. 4 - 25.40mm DIA. X 57mm BOLTS WITH WASHERS, BOLTS SHALL CONFORM TO THE REQUIREMENTS OF ASTM A307. BOLTS AND WASHERS SHALL BE GALVANIZED, (AT THE CONTRACTOR'S OPTION, STAINLESS STEEL BOLTS AND WASHERS MAY BE USED AS AN ALTERNATE FOR THE 25.40mm DIA. X 57mm GALVANIZED BOLTS AND WASHERS. THEY SHALL CONFORM TO OR EXCEED THE MECHANICAL REQUIREMENTS OF ASTM A307. THE USE OF THIS ALTERNATE SHALL BE APPROVED BY THE ENGINEER.)
- C. WIRE STRUTS SHOWN IN THE GUARDRAIL ANCHOR ASSEMBLY FOR CULVERTS DETAIL ARE MINIMUM ALLOWABLE SIZE AND SHALL HAVE A MINIMUM TENSILE STRENGTH OF 689 MPa. AS AN OPTION, A 11mm Ø WIRE STRUT WITH A MINIMUM TENSILE STRENGTH OF 620 MPa. IS ACCEPTABLE.

GUARDRAIL ANCHOR ASSEMBLY WITH BOLTS SHALL BE ASSEMBLED IN THE SHOP. BOLT THREADS MAY BE RECUT AS NECESSARY TO INSURE FIT.


THE COST OF THE GUARDRAIL ANCHOR ASSEMBLY FOR CULVERTS COMPLETE IN PLACE, SHALL BE INCLUDED IN THE UNIT CONTRACT PRICE BID FOR CLASS "A" CONCRETE.

FERRULES TO BE PLUGGED DURING POURING OF SLAB AS RECOMMENDED BY THE MANUFACTURER.
AT THE CONTRACTOR'S OPTION, FERRULES WITH OPEN OR CLOSED ENDS MAY BE USED.

PAYMENT FOR GUARDRAIL, POSTS, AND POST BASE PLATES IS INCLUDED IN ROADWAY PAY ITEMS.


SLAB REINFORCING STEEL MAY BE SHIFTED AS NECESSARY TO CLEAR GUARDRAIL ANCHOR ASSEMBLY. CARE SHOULD BE TAKEN TO KEEP THE SHIFTING OF REINFORCING STEEL TO A MINIMUM.

THE CONTRACTOR MAY USE ADHESIVELY ANCHORED ANCHOR BOLTS IN PLACE OF GUARDRAIL ANCHOR ASSEMBLY. LEVEL TWO FIELD TESTING IS REQUIRED, AND THE YIELD LOAD OF THE 25.40mm Ø BOLT IS 97.0 kN. FOR ADHESIVELY ANCHORED ANCHOR BOLTS OR DOWELS, SEE SPECIAL PROVISIONS.

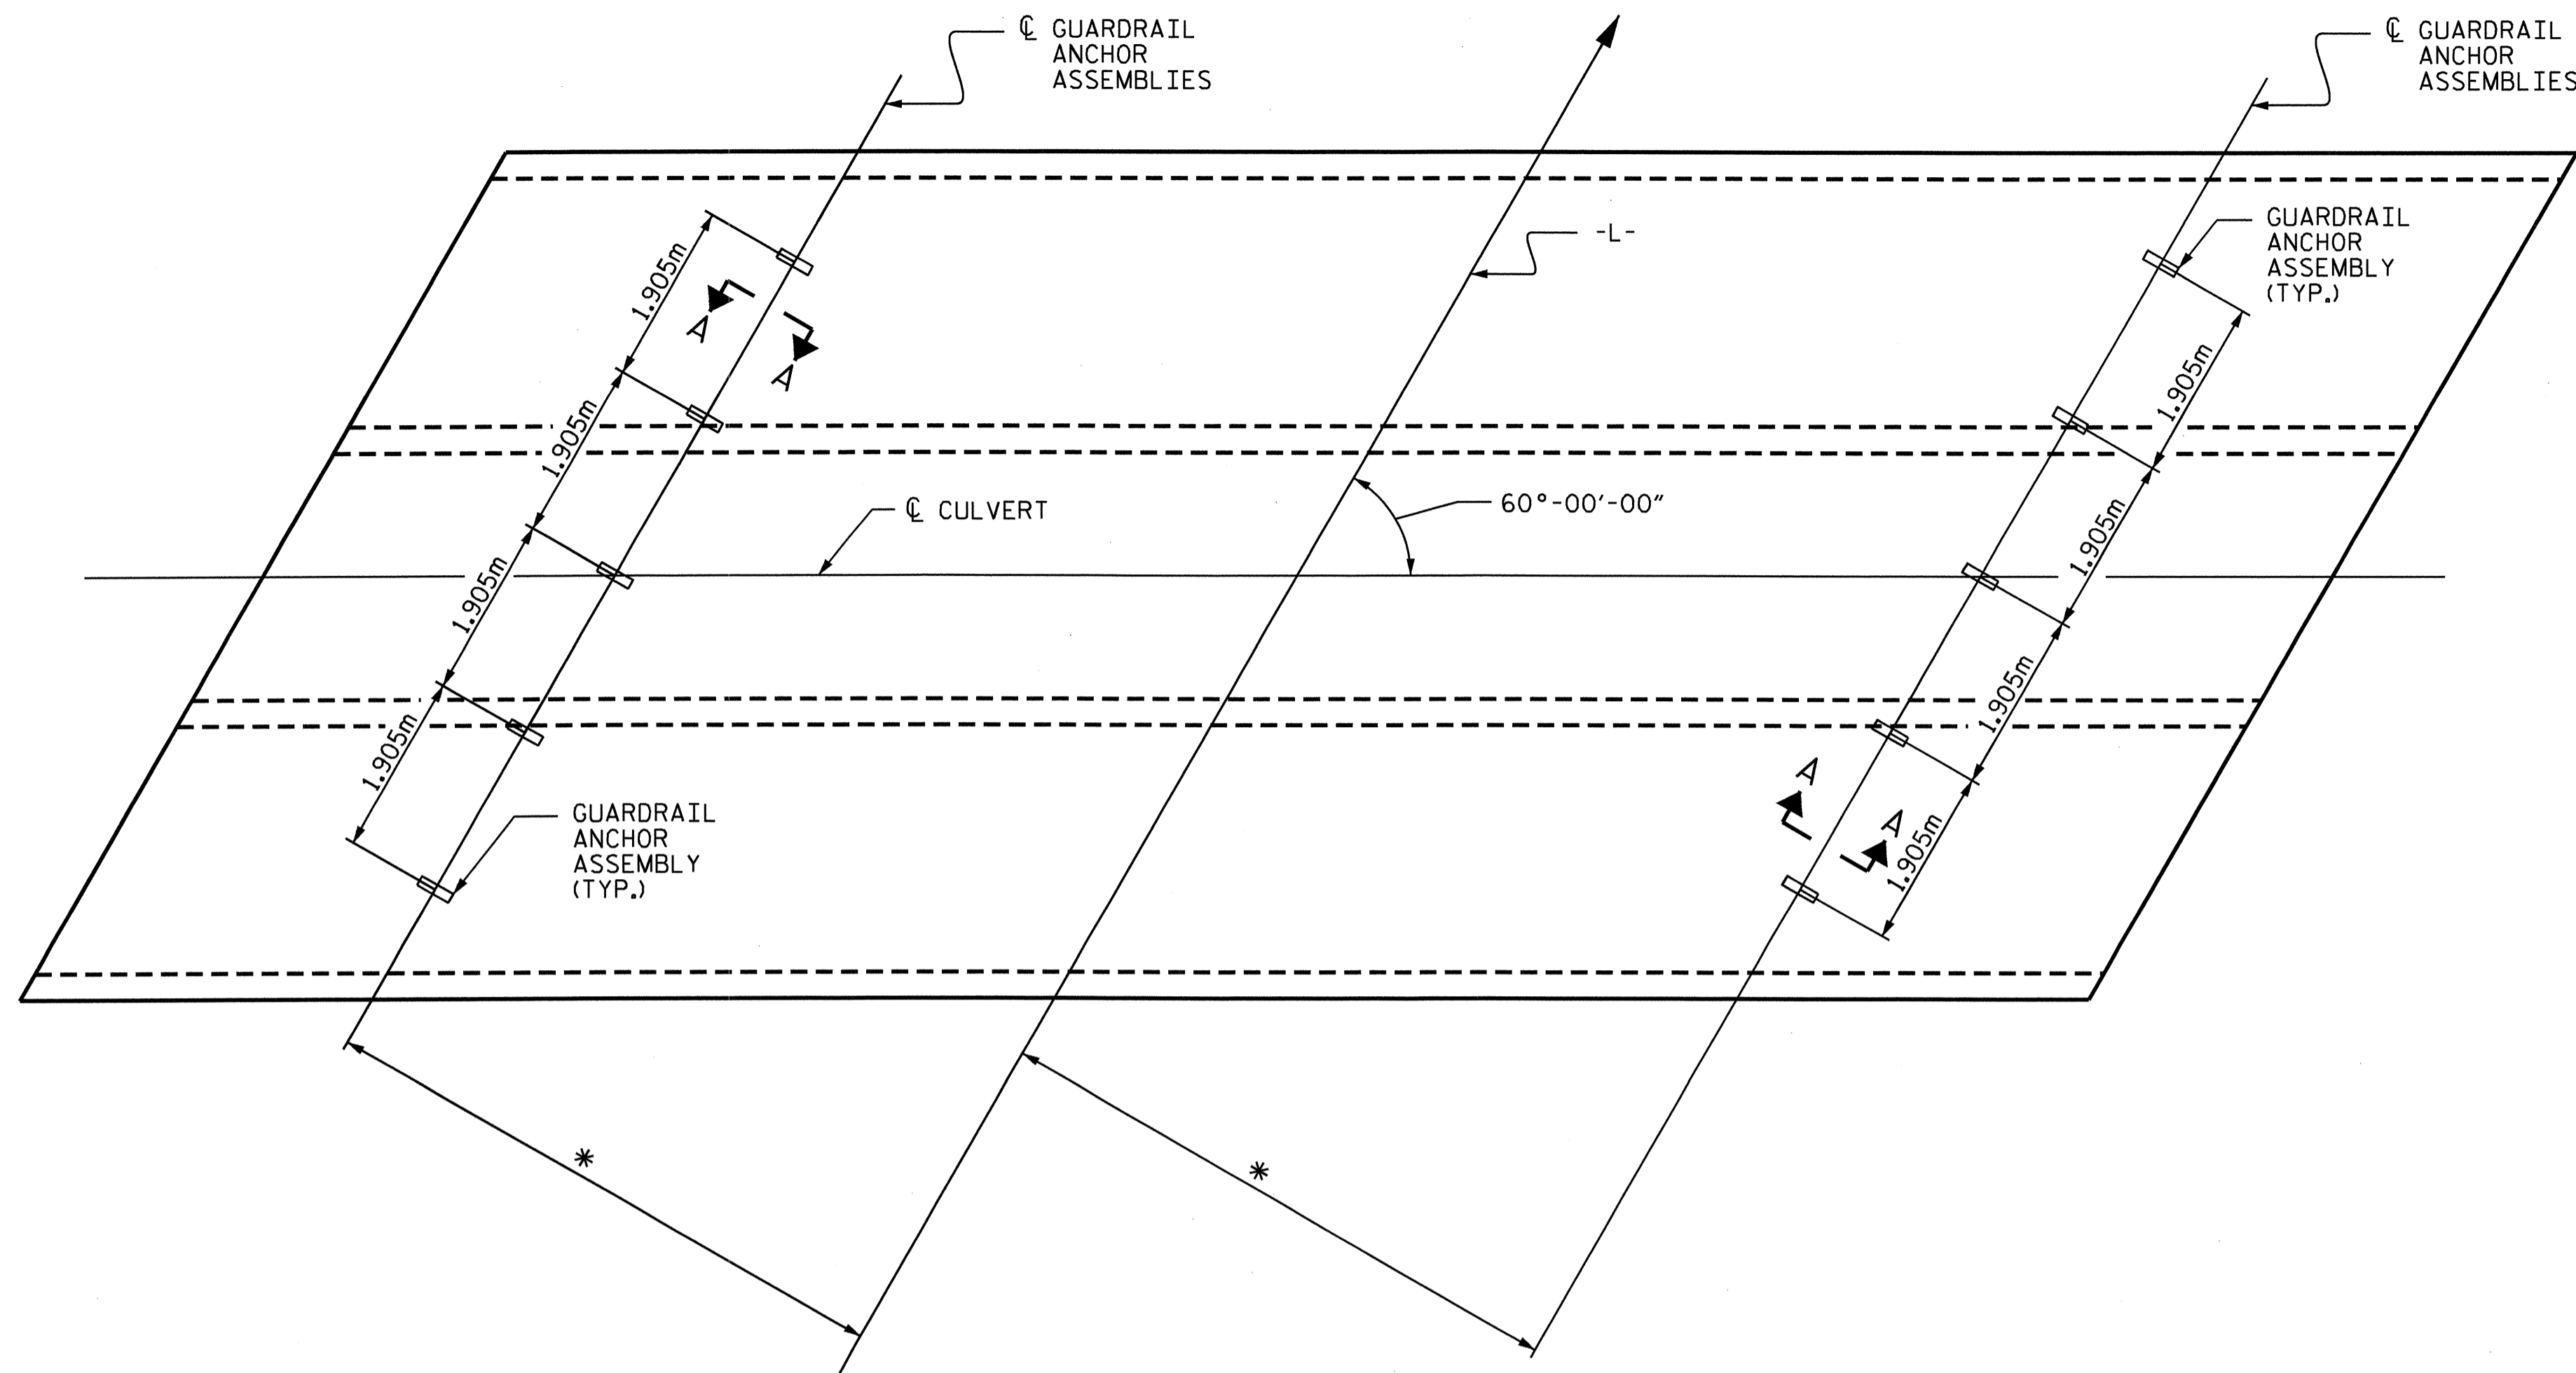


PLAN

SHOWING : GUARDRAIL ANCHOR ASSEMBLY SPACING.
* THIS DIMENSION TO BE FURNISHED BY THE ENGINEER.

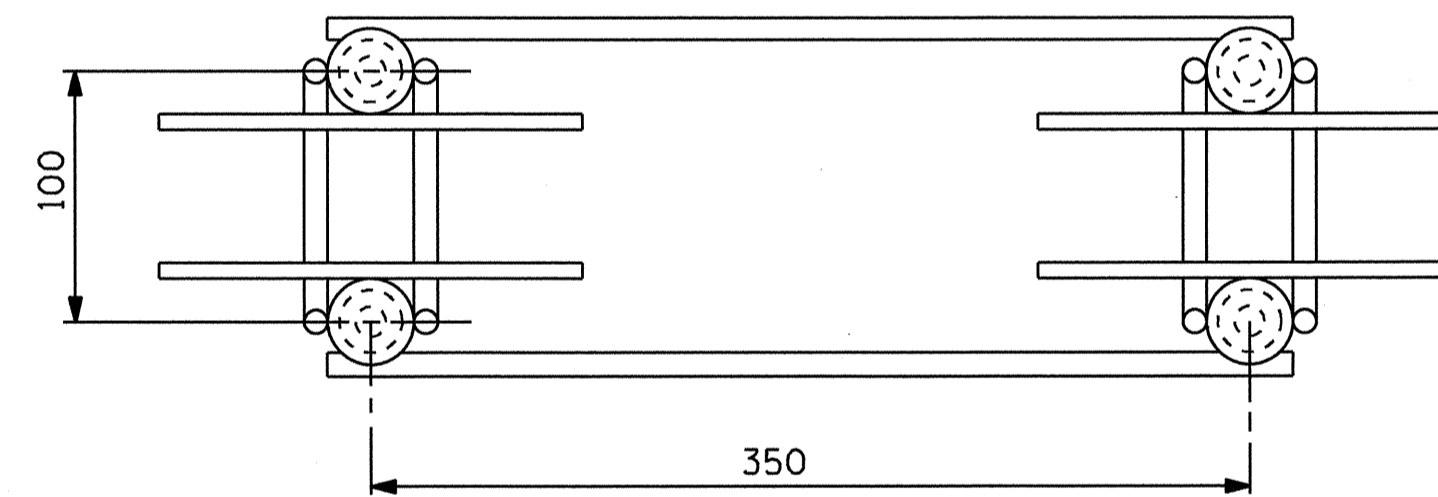


PLAN

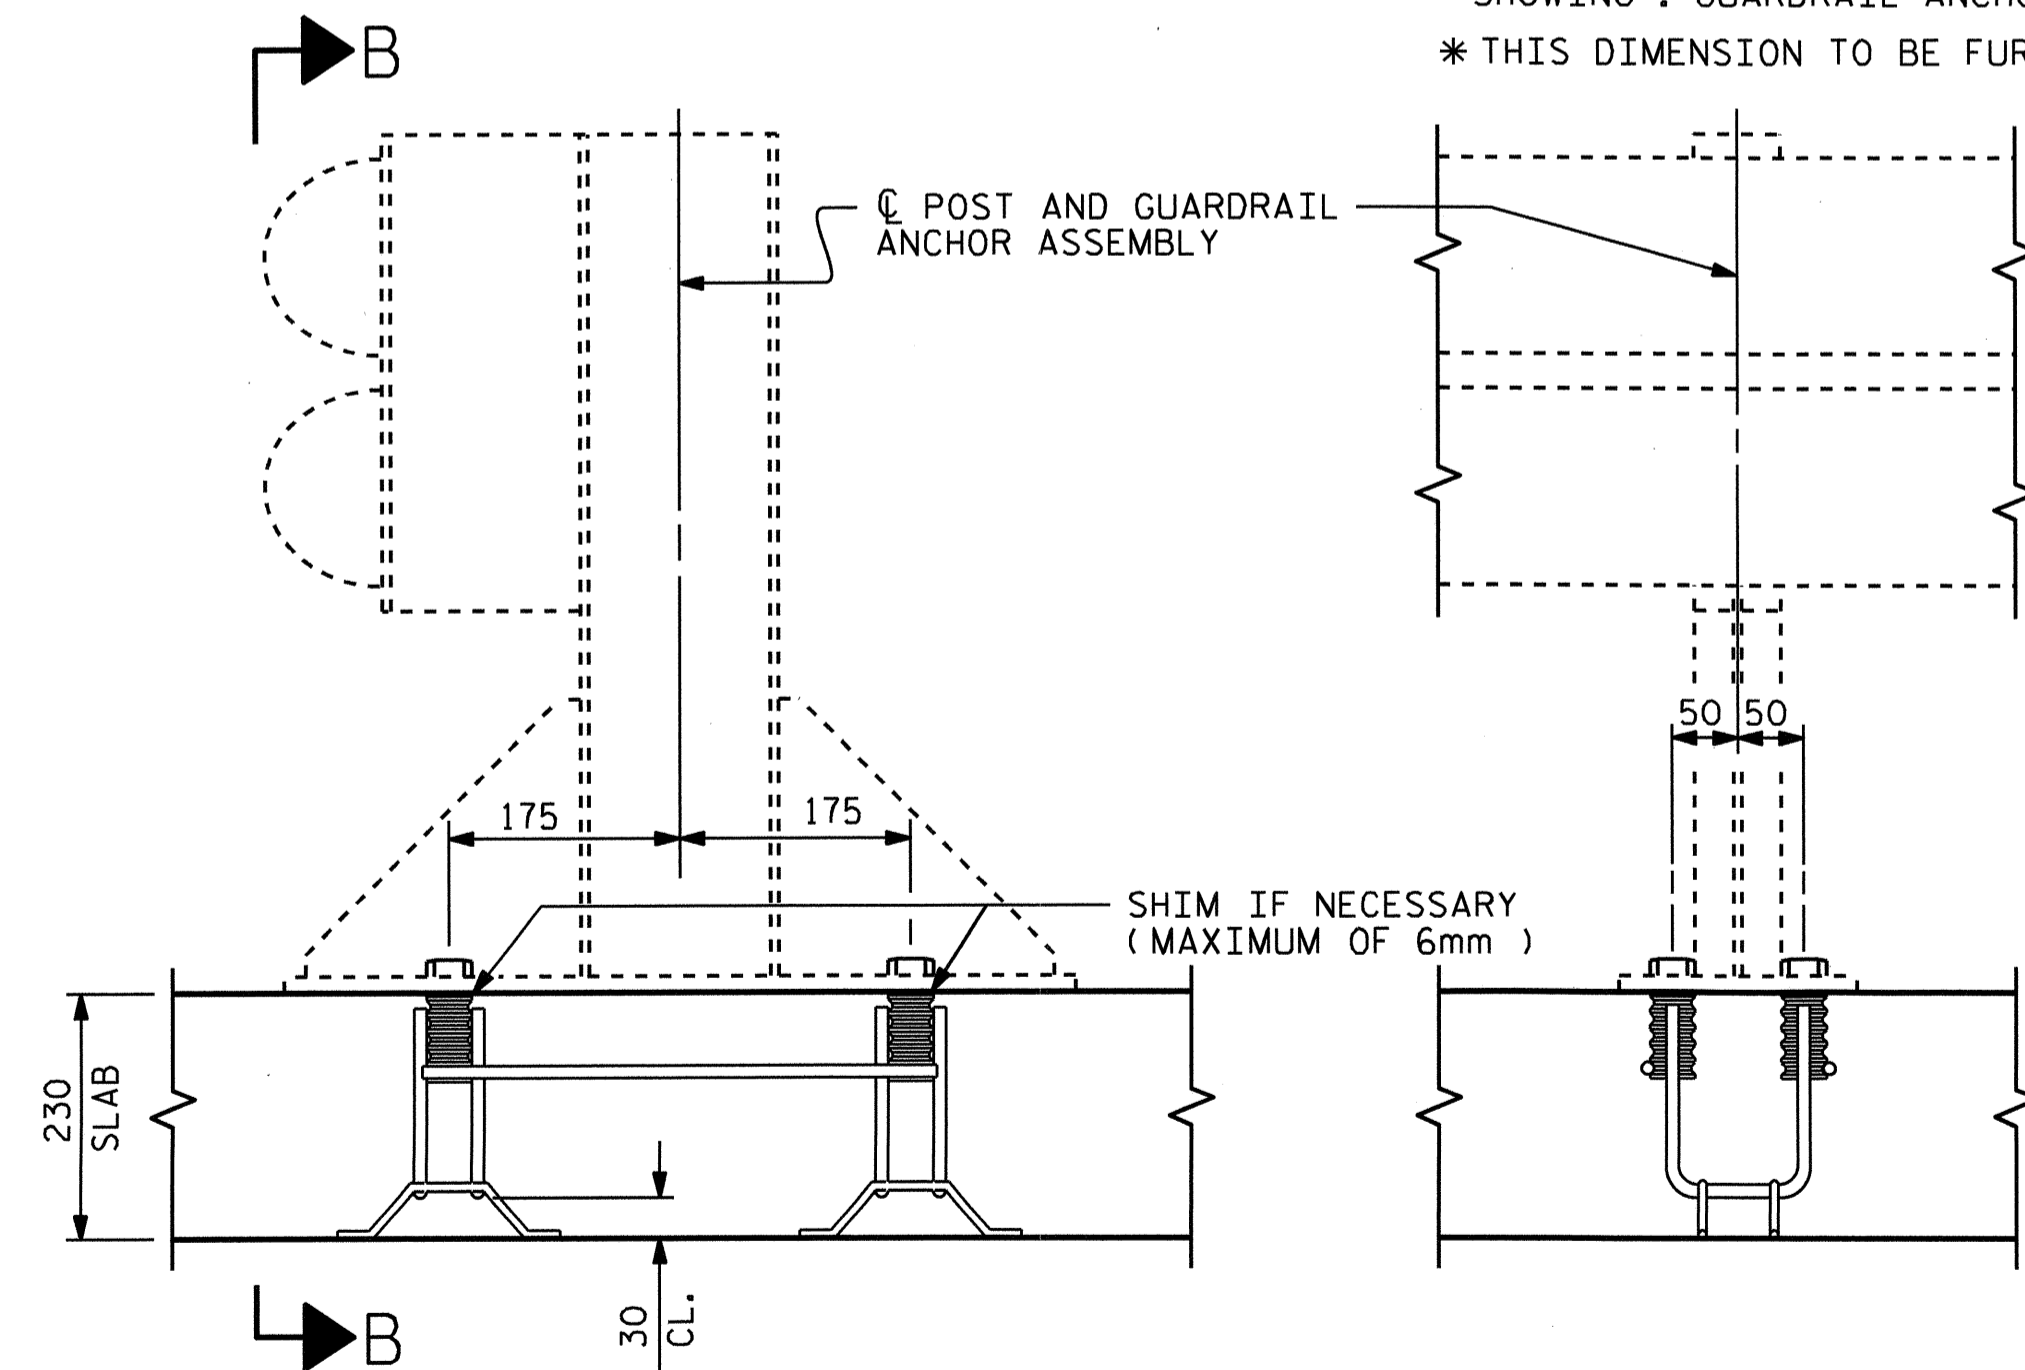


SECTION A-A

SECTION B-B

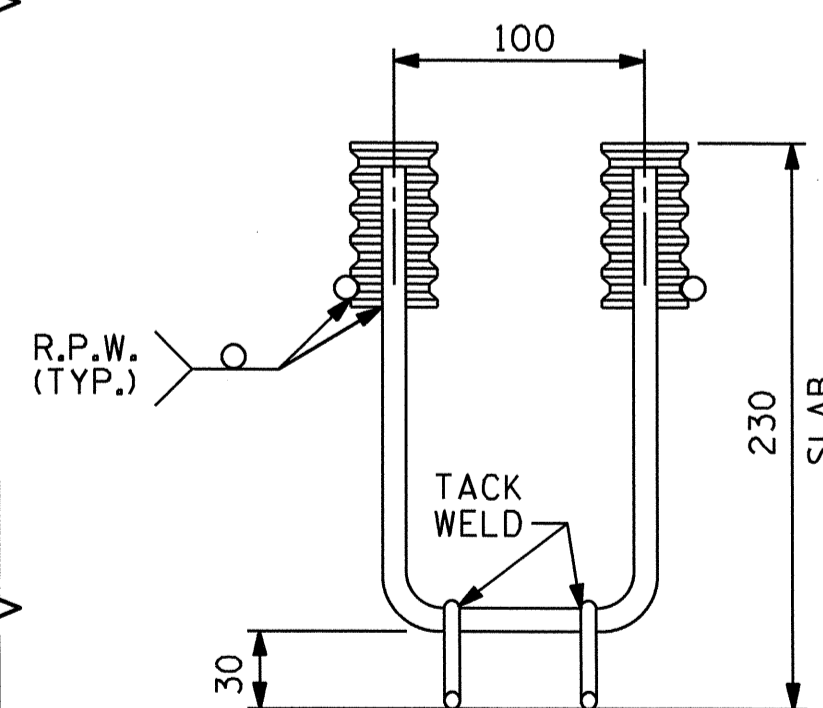

ELEVATION

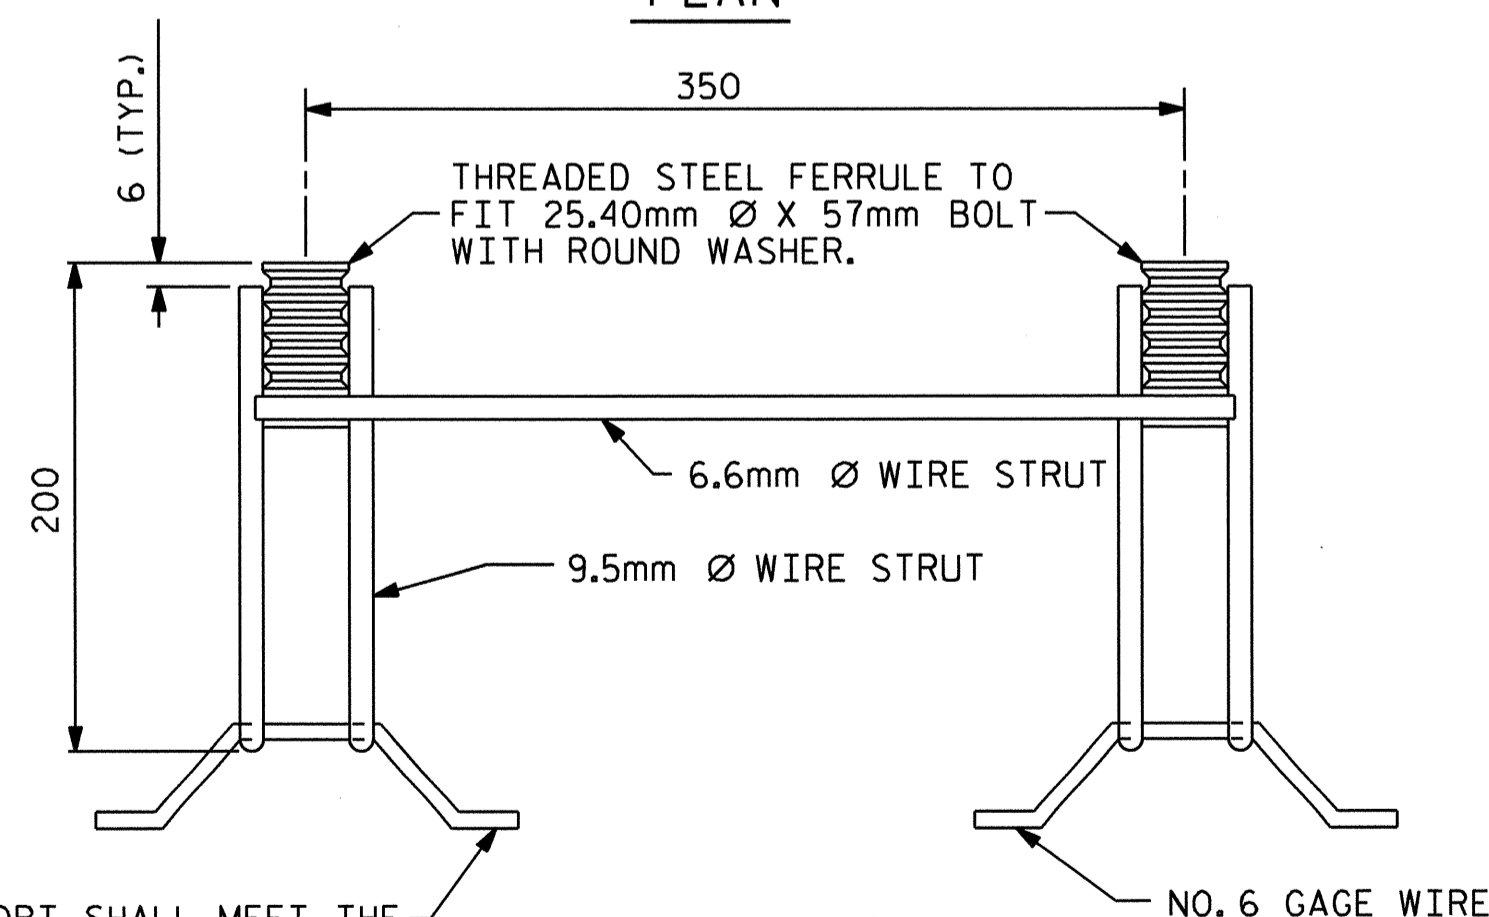

SIDE VIEW

THIS SUPPORT SHALL MEET THE REQUIREMENTS AS SPECIFIED FOR SUPPORTS FOR REINFORCING STEEL. SEE SPECIFICATIONS.

GUARDRAIL ANCHOR ASSEMBLY FOR CULVERTS


PROJECT NO. B-4183
MADISON COUNTY
STATION: 10+52.500 -L-

SHEET 7 OF 7

STATE OF NORTH CAROLINA
DEPARTMENT OF TRANSPORTATION
RALEIGH

STANDARD

ANCHORAGE DETAILS FOR
GUARDRAIL ANCHOR ASSEMBLY
FOR CULVERTS

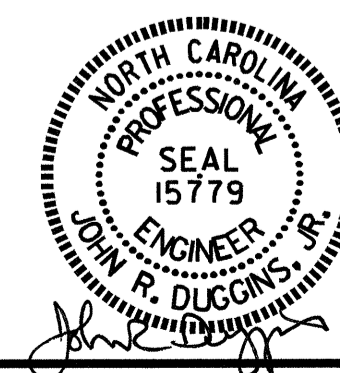

ASSEMBLED BY : D. HODGE	DATE : 9/11
CHECKED BY : J.R. DUGGINS	DATE : 9/11
DRAWN BY : FCJ 6/88	REV. 7/10/01 LES/RDR
CHECKED BY : ARB 6/88	REV. 5/7/03 RWW/JTE
	REV. 5/1/06R KMM/GM

REVISIONS						SHEET NO.
NO.	BY:	DATE:	NO.	BY:	DATE:	C-7
1			3			TOTAL SHEETS
2			4			15

NOTES

ASSUMED LIVE LOAD -----MS18 OR ALTERNATE LOADING.
 MAXIMUM DESIGN FILL -----1.480m
 MINIMUM DESIGN FILL -----1.260m
 FOR OTHER DESIGN DATA AND NOTES SEE STANDARD NOTE SHEET.
 76mm Ø WEEP HOLES INDICATED TO BE IN ACCORDANCE WITH THE SPECIFICATIONS.
 CONCRETE IN CULVERTS TO BE POURED IN THE FOLLOWING ORDER:
 1. PHASE I WING FOOTINGS AND FLOOR SLAB INCLUDING 100mm OF PHASE I VERTICAL WALLS.
 2. THE REMAINING PORTIONS OF PHASE I WALLS AND PHASE I WINGS FULL HEIGHT.
 3. PHASE II WING FOOTINGS AND FLOOR SLAB INCLUDING 100mm OF PHASE II VERTICAL WALLS.
 4. THE REMAINING PORTIONS OF PHASE II WALLS AND PHASE II WINGS FULL HEIGHT.
 5. PHASE III THE ROOF SLAB AND HEADWALLS.
 THE RESIDENT ENGINEER SHALL CHECK THE LENGTH OF CULVERT BEFORE STAKING IT OUT TO MAKE CERTAIN THAT IT WILL PROPERLY TAKE CARE OF THE FILL.
 DIMENSIONS FOR WING LAYOUT AS WELL AS ADDITIONAL REINFORCING STEEL EMBEDDED IN BARREL ARE SHOWN ON WING SHEET.
 AT THE CONTRACTOR'S OPTION, HE MAY SPLICE THE VERTICAL REINFORCING STEEL IN THE INTERIOR FACE OF EXTERIOR WALL AND BOTH FACES OF INTERIOR WALLS ABOVE LOWER WALL CONSTRUCTION JOINT. THE SPLICE LENGTH SHALL BE AS PROVIDED IN THE SPLICE LENGTH CHART SHOWN ON THE PLANS. EXTRA WEIGHT OF STEEL DUE TO THE SPLICES SHALL BE PAID FOR BY THE CONTRACTOR.
 THE CONTRACTOR SHALL PROVIDE INDEPENDENT ASSURANCE SAMPLES OF REINFORCING STEEL AS FOLLOWS: FOR PROJECTS REQUIRING UP TO 36,000kg OF REINFORCING STEEL, ONE 760mm SAMPLE OF EACH SIZE BAR USED, AND FOR PROJECTS REQUIRING OVER 360,000kg OF REINFORCING STEEL, TWO 760mm SAMPLES OF EACH SIZE BAR USED. THE BARS FROM WHICH THE SAMPLES ARE TAKEN MUST THEN BE SPLICED WITH REPLACEMENT BARS OF THE SIZE AND LENGTH OF THE SAMPLE, PLUS A MINIMUM LAP SPLICE OF THIRTY BAR DIAMETERS. PAYMENT FOR THE SAMPLES OF REINFORCING STEEL SHALL BE CONSIDERED INCIDENTAL TO VARIOUS PAY ITEMS.
 A 900mm STRIP OF FILTER FABRIC SHALL BE ATTACHED TO THE FILL FACE OF THE WING COVERING THE ENTIRE LENGTH OF THE EXPANSION JOINT.
 FOR SUBMITTAL OF WORKING DRAWINGS, SEE SPECIAL PROVISIONS.
 FOR CRANE SAFETY, SEE SPECIAL PROVISIONS.
 FOR GROUT FOR STRUCTURES, SEE SPECIAL PROVISIONS.
 FOR CURING CONCRETE, SEE SPECIAL PROVISIONS.
 FOR FALSEWORK AND FORMWORK, SEE SPECIAL PROVISIONS.
 FOR CULVERT DIVERSION DETAILS AND PAY ITEM, SEE EROSION CONTROL PLANS.
 ALL DIMENSIONS ARE IN MILLIMETERS UNLESS OTHERWISE NOTED.
 ALL ELEVATIONS ARE IN METERS.
 THE EXISTING STRUCTURE CONSISTING OF 2-SPANS (5.5m EACH) WITH A TIMBER DECK ON CONTINUOUS I-BEAMS AND CHANNELS SUPERSTRUCTURE AND A CLEAR ROADWAY WIDTH OF 7.5m ON A SUBSTRUCTURE CONSISTING OF YOUNG MASONRY ABUTMENTS AND A CRUTCH BENT CONSTRUCTED OF TIMBER CAP WITH TIMBER POST AND SILL AND LOCATED 29.7m WEST OF THE PROPOSED STRUCTURE SHALL BE REMOVED. FOR REMOVAL OF EXISTING STRUCTURE, SEE SPECIAL PROVISIONS.
 REMOVAL OF THE EXISTING BRIDGE SHALL BE PERFORMED SO AS NOT TO ALLOW DEBRIS TO FALL INTO THE WATER. THE CONTRACTOR SHALL REMOVE THE BRIDGE AND SUBMIT PLANS FOR DEMOLITION IN ACCORDANCE WITH ARTICLE 402-2 OF THE STANDARD SPECIFICATIONS.
 INASMUCH AS THE PAINT SYSTEM ON THE EXISTING STRUCTURAL STEEL CONTAINS LEAD, THE CONTRACTOR'S ATTENTION IS DIRECTED TO ARTICLE 107-1 OF THE STANDARD SPECIFICATIONS. ANY COSTS RESULTING FROM COMPLIANCE WITH APPLICABLE STATE OR FEDERAL REGULATIONS PERTAINING TO HANDLING OF MATERIALS CONTAINING LEAD BASED PAINT SHALL BE INCLUDED IN THE BID PRICE FOR "REMOVAL OF EXISTING STRUCTURE".

BM #5: RAILROAD SPIKE IN POWER POLE 27.836m LEFT OF -BL- STA. 5+74.742, ELEV. = 682.835, NGVD 29

HYDRAULIC DATA

DESIGN DISCHARGE = 25.00 m³/s
 FREQUENCY OF DESIGN FLOOD = 25 yrs.
 DESIGN HIGH WATER ELEVATION = 679.080
 DRAINAGE AREA = 6.720 km²
 BASE DISCHARGE (Q100) = 38.50 m³/s
 BASE HIGH WATER ELEVATION = 679.830


OVERTOPPING FLOOD DATA

OVERTOPPING DISCHARGE = 41.10 m³/s
 FREQUENCY OF OVERTOPPING FLOOD = 100+ yrs.
 OVERTOPPING FLOOD ELEVATION = 680.000


GRADE DATA

GRADE POINT ELEV. @ STA. 11+16.500 -L- = 680.048
 BED ELEV. @ STA. 11+16.500 -L- = 676.520
 ROADWAY FILL SLOPES = 2 : 1

TOTAL STRUCTURE QUANTITIES	
CLASS A CONCRETE	
BARREL @ 4.41 m ³ /m	78.5 m ³
WINGS ETC.	16.9 m ³
SILL	0.6 m ³
TOTAL	96.0 m ³
REINFORCING STEEL	
BARREL	10,154 kg
WING ETC.	570 kg
TOTAL	10,724 kg
CULVERT EXCAVATION	----- LUMP SUM
FOUNDATION COND. MAT'L	---- 80 METRIC TONS
REMOVAL OF EXISTING STR.	----- LUMP SUM

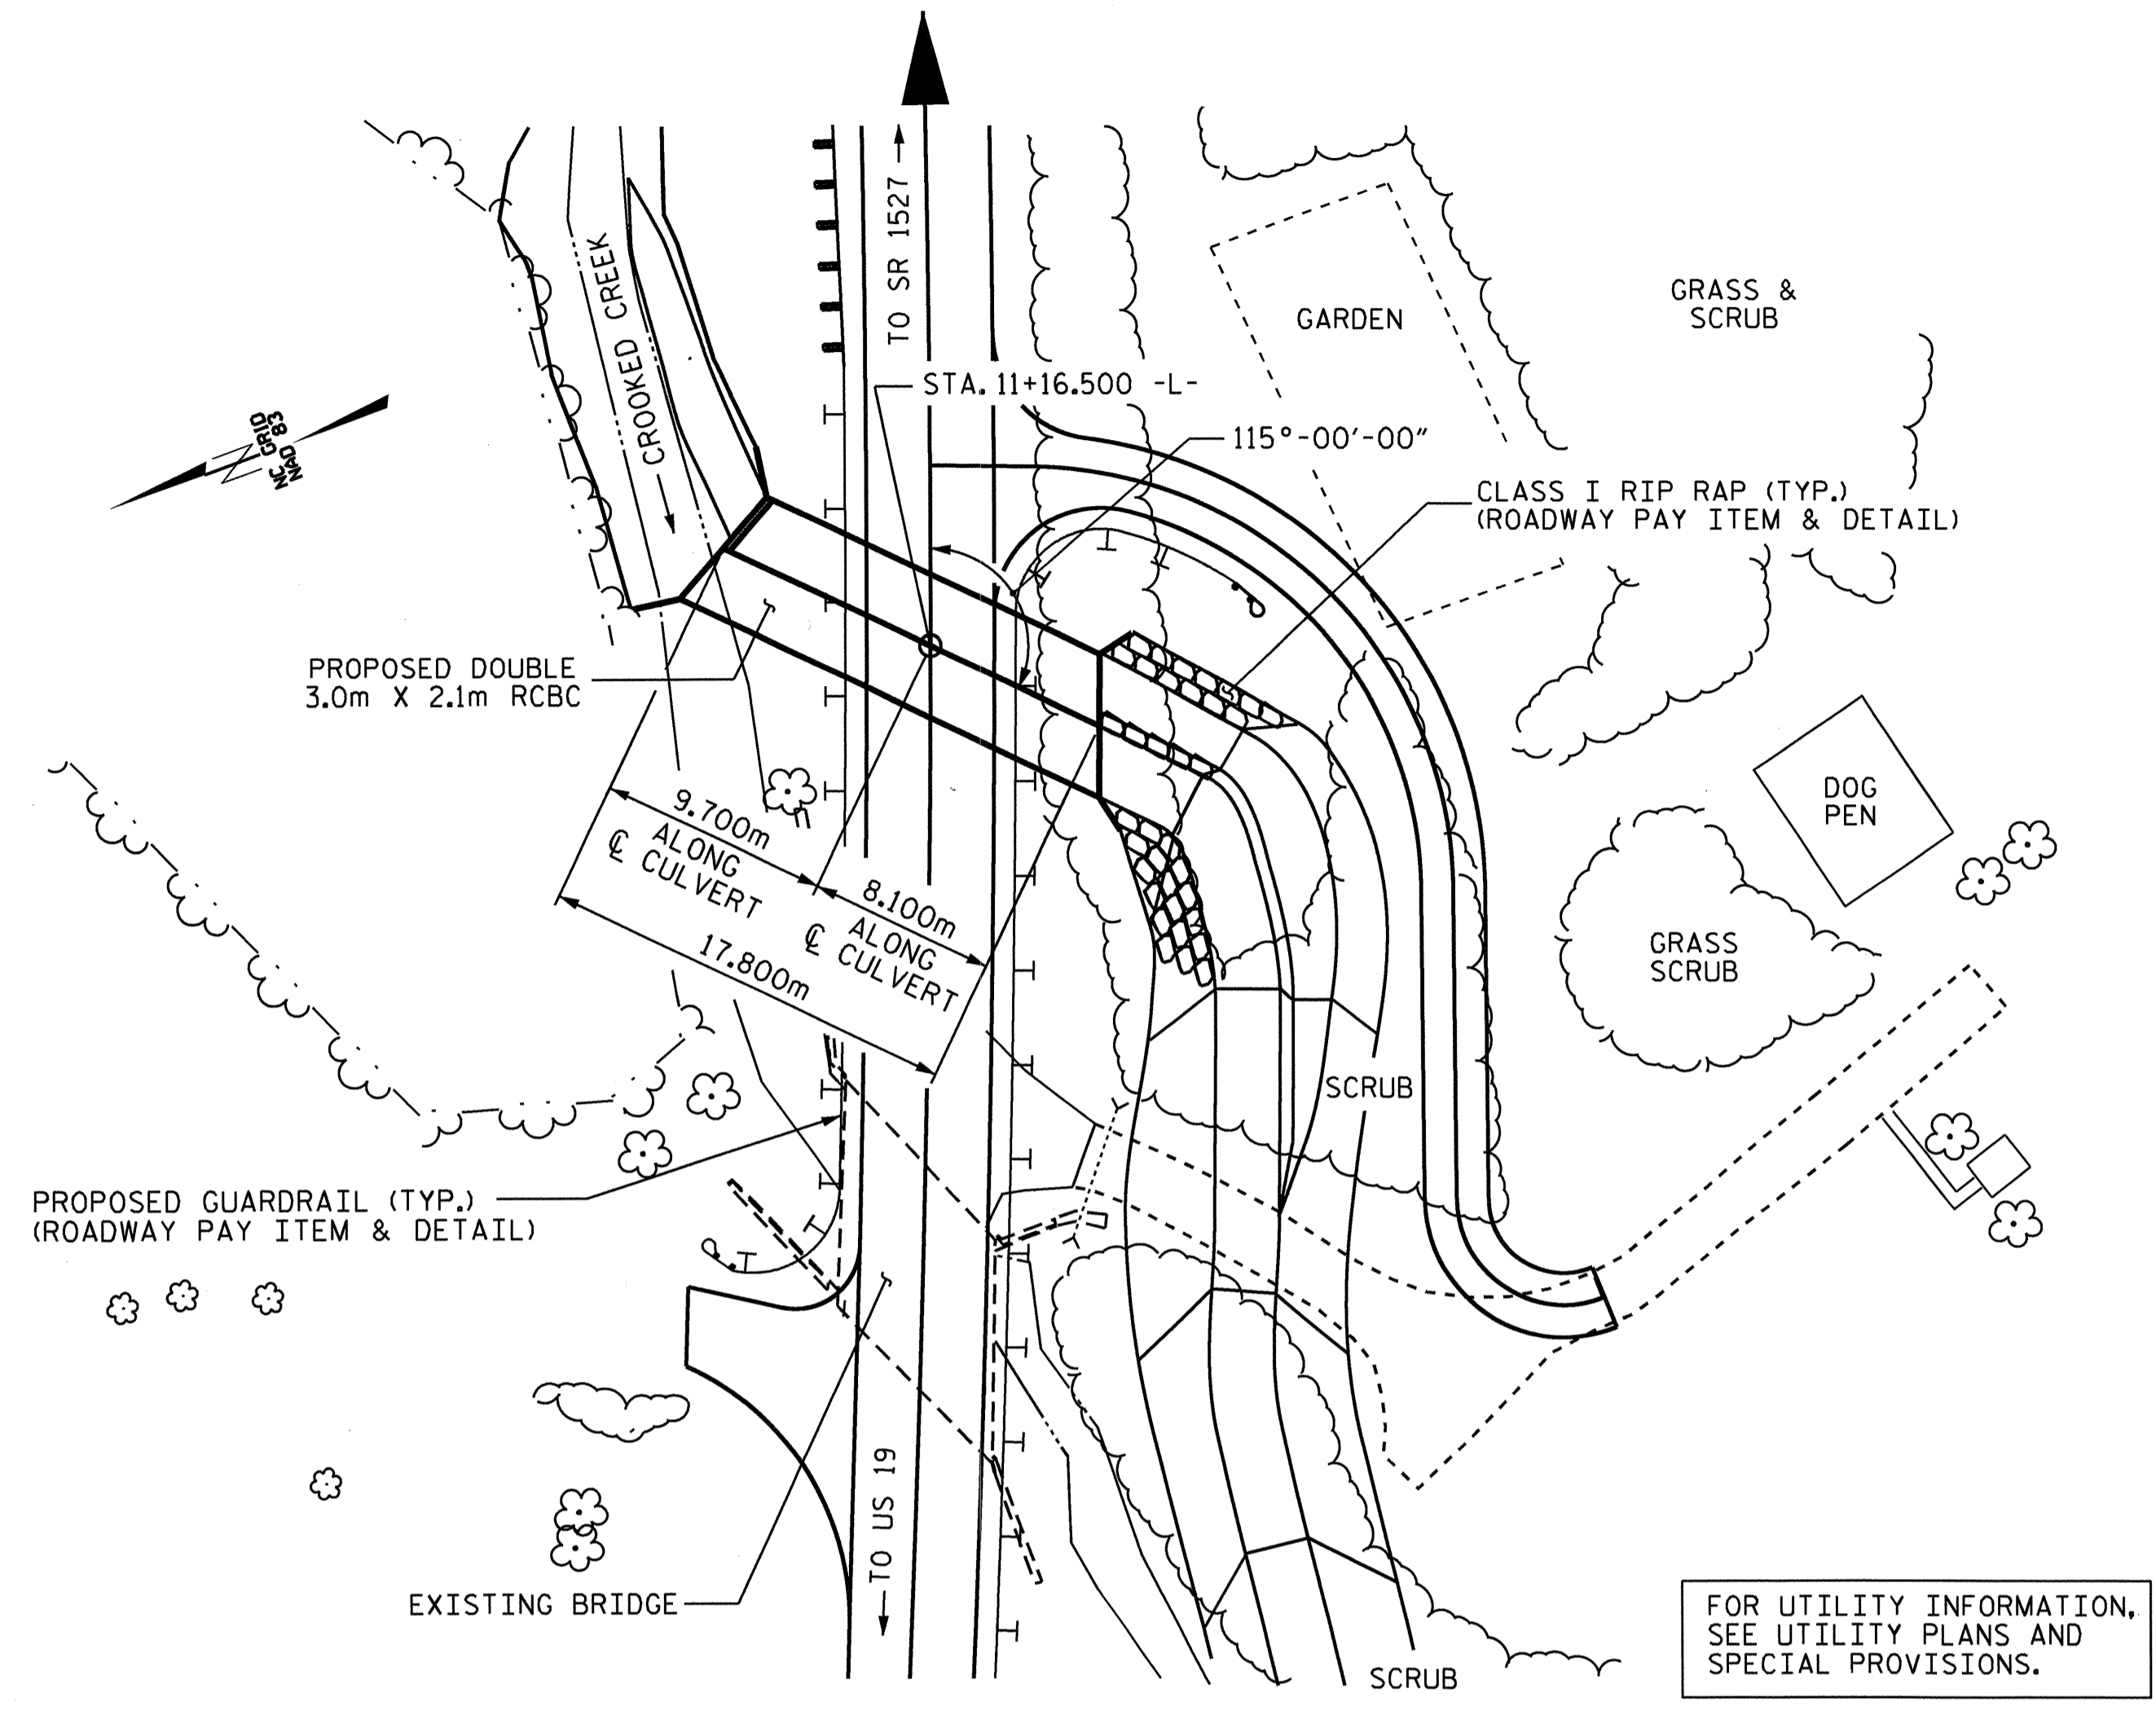

LOCATION SKETCH

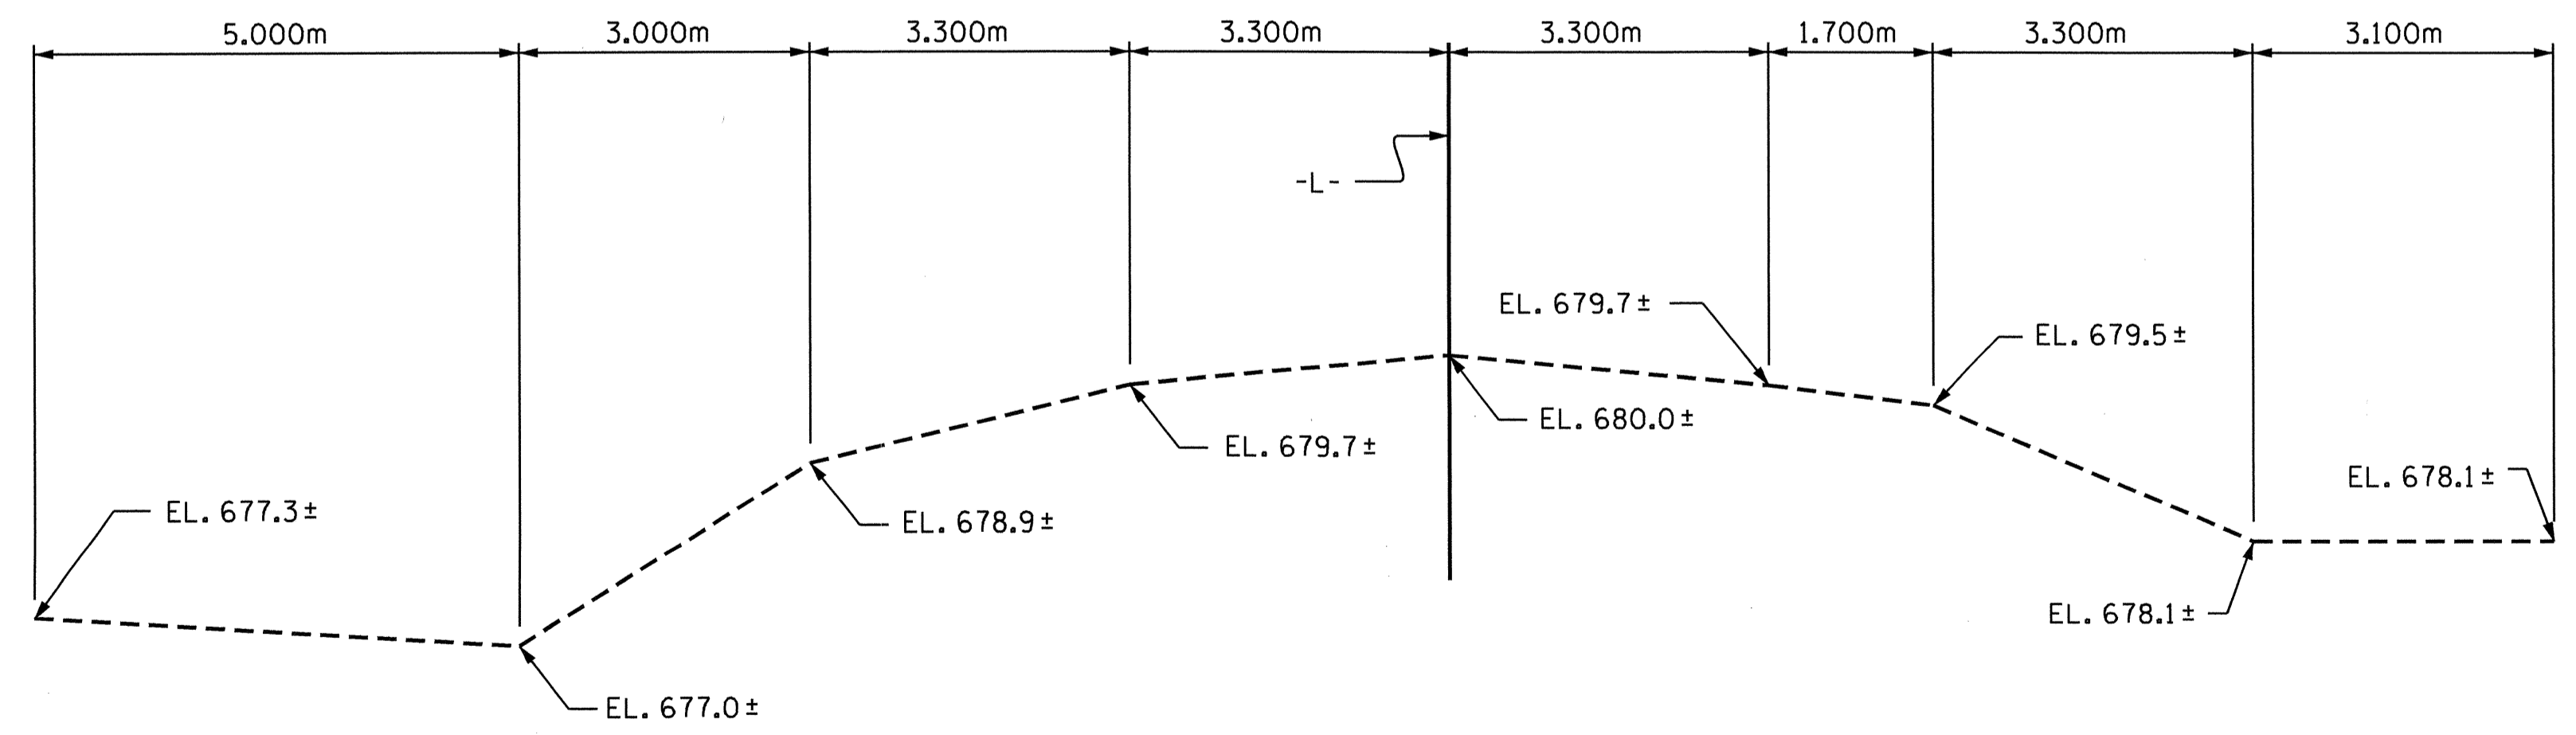

PROFILE ALONG CULVERT

ASSEMBLED BY : A. SORSENGINH DATE : 1/28/09
 CHECKED BY : J. LAMBERT DATE : 2/10
 DRAWN BY : EEM 6/97
 CHECKED BY : ARB 7/97

I HEREBY CERTIFY THESE PLANS ARE THE AS-BUILT PLANS

METRIC


PROJECT NO. B-4183
MADISON COUNTY
 STATION: 11+16.500 -L-
 SHEET 1 OF 8 REPLACES BRIDGE No. 28

STATE OF NORTH CAROLINA
 DEPARTMENT OF TRANSPORTATION
 RALEIGH


**DOUBLE 3.000m X 2.100m
 CONCRETE BOX CULVERT
 115° SKEW**

REVISIONS				SHEET NO.	
NO.	BY:	DATE:	NO.	BY:	DATE:
1			3		
2			4		


TOTAL SHEETS: 15

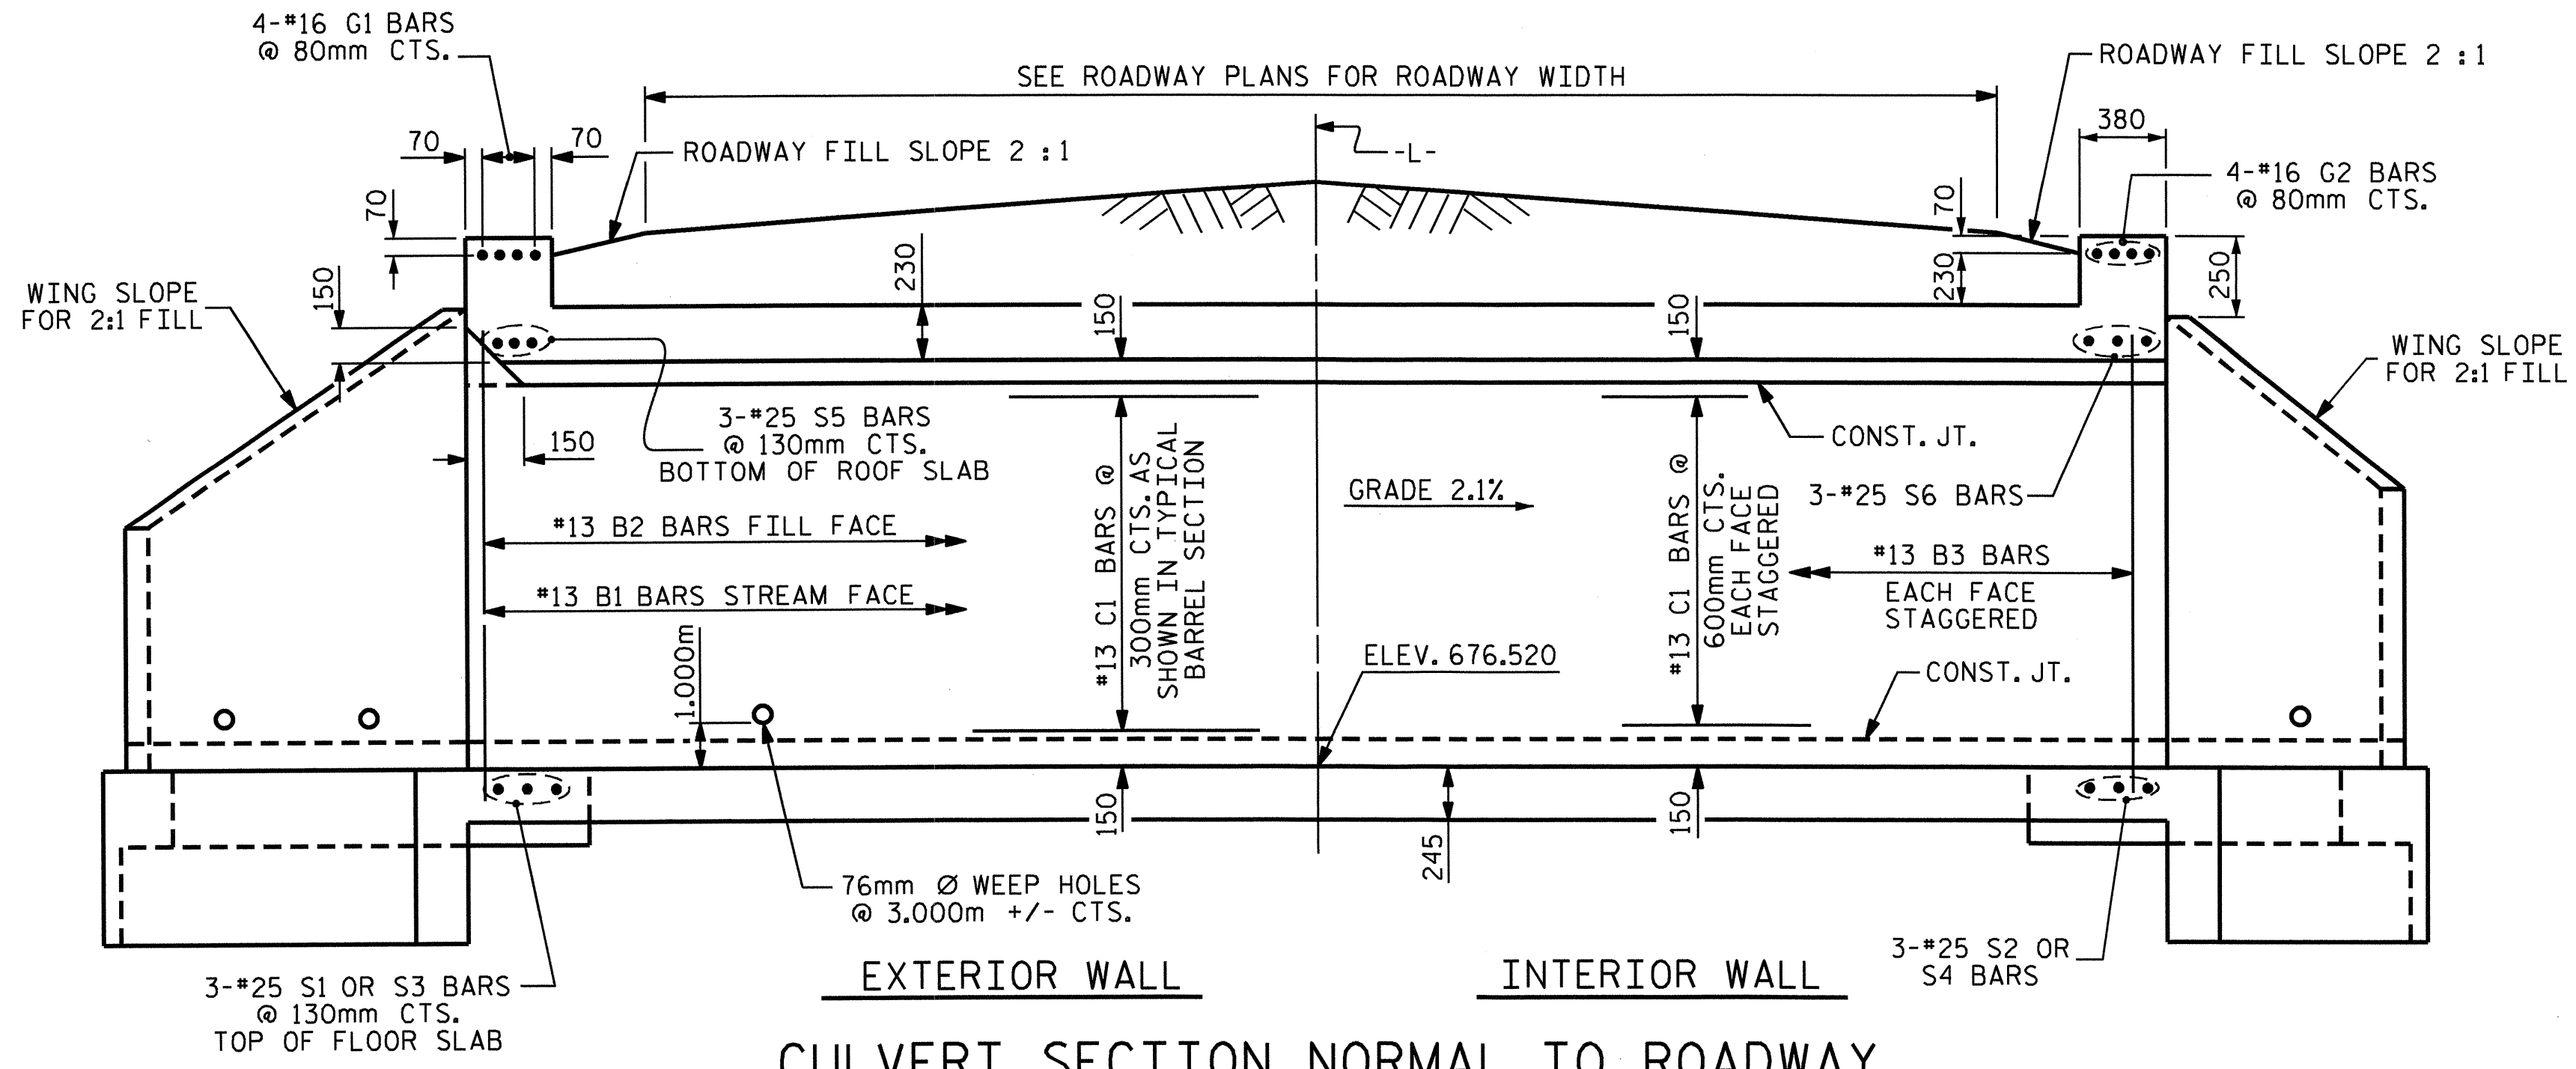


CULVERT SECTION NORMAL TO ROADWAY

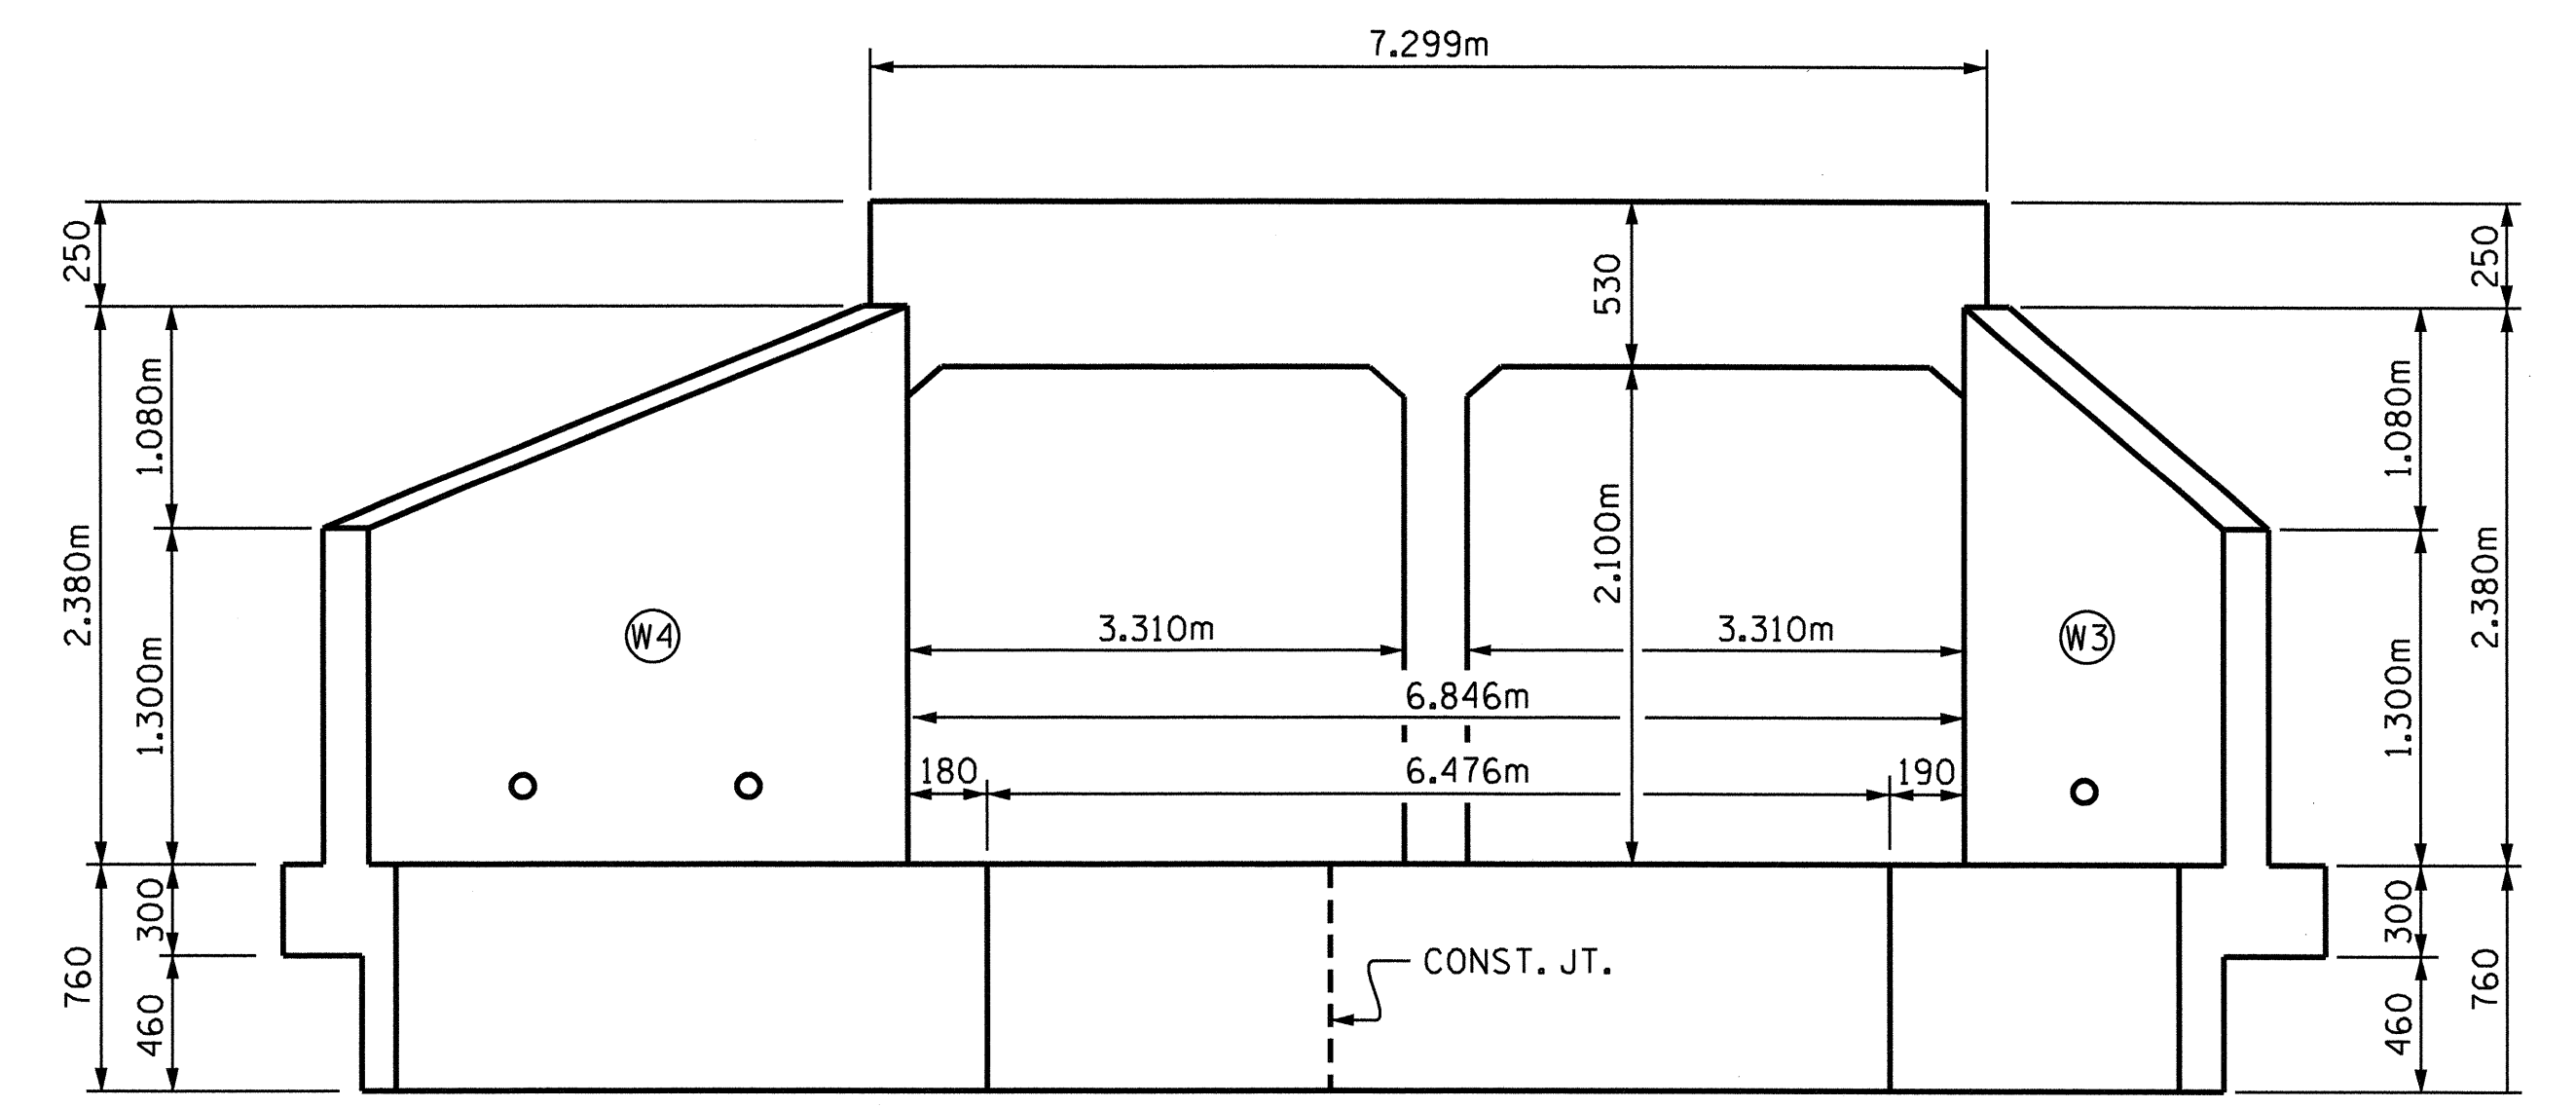

OUTLET END ELEVATION NORMAL TO SKEW

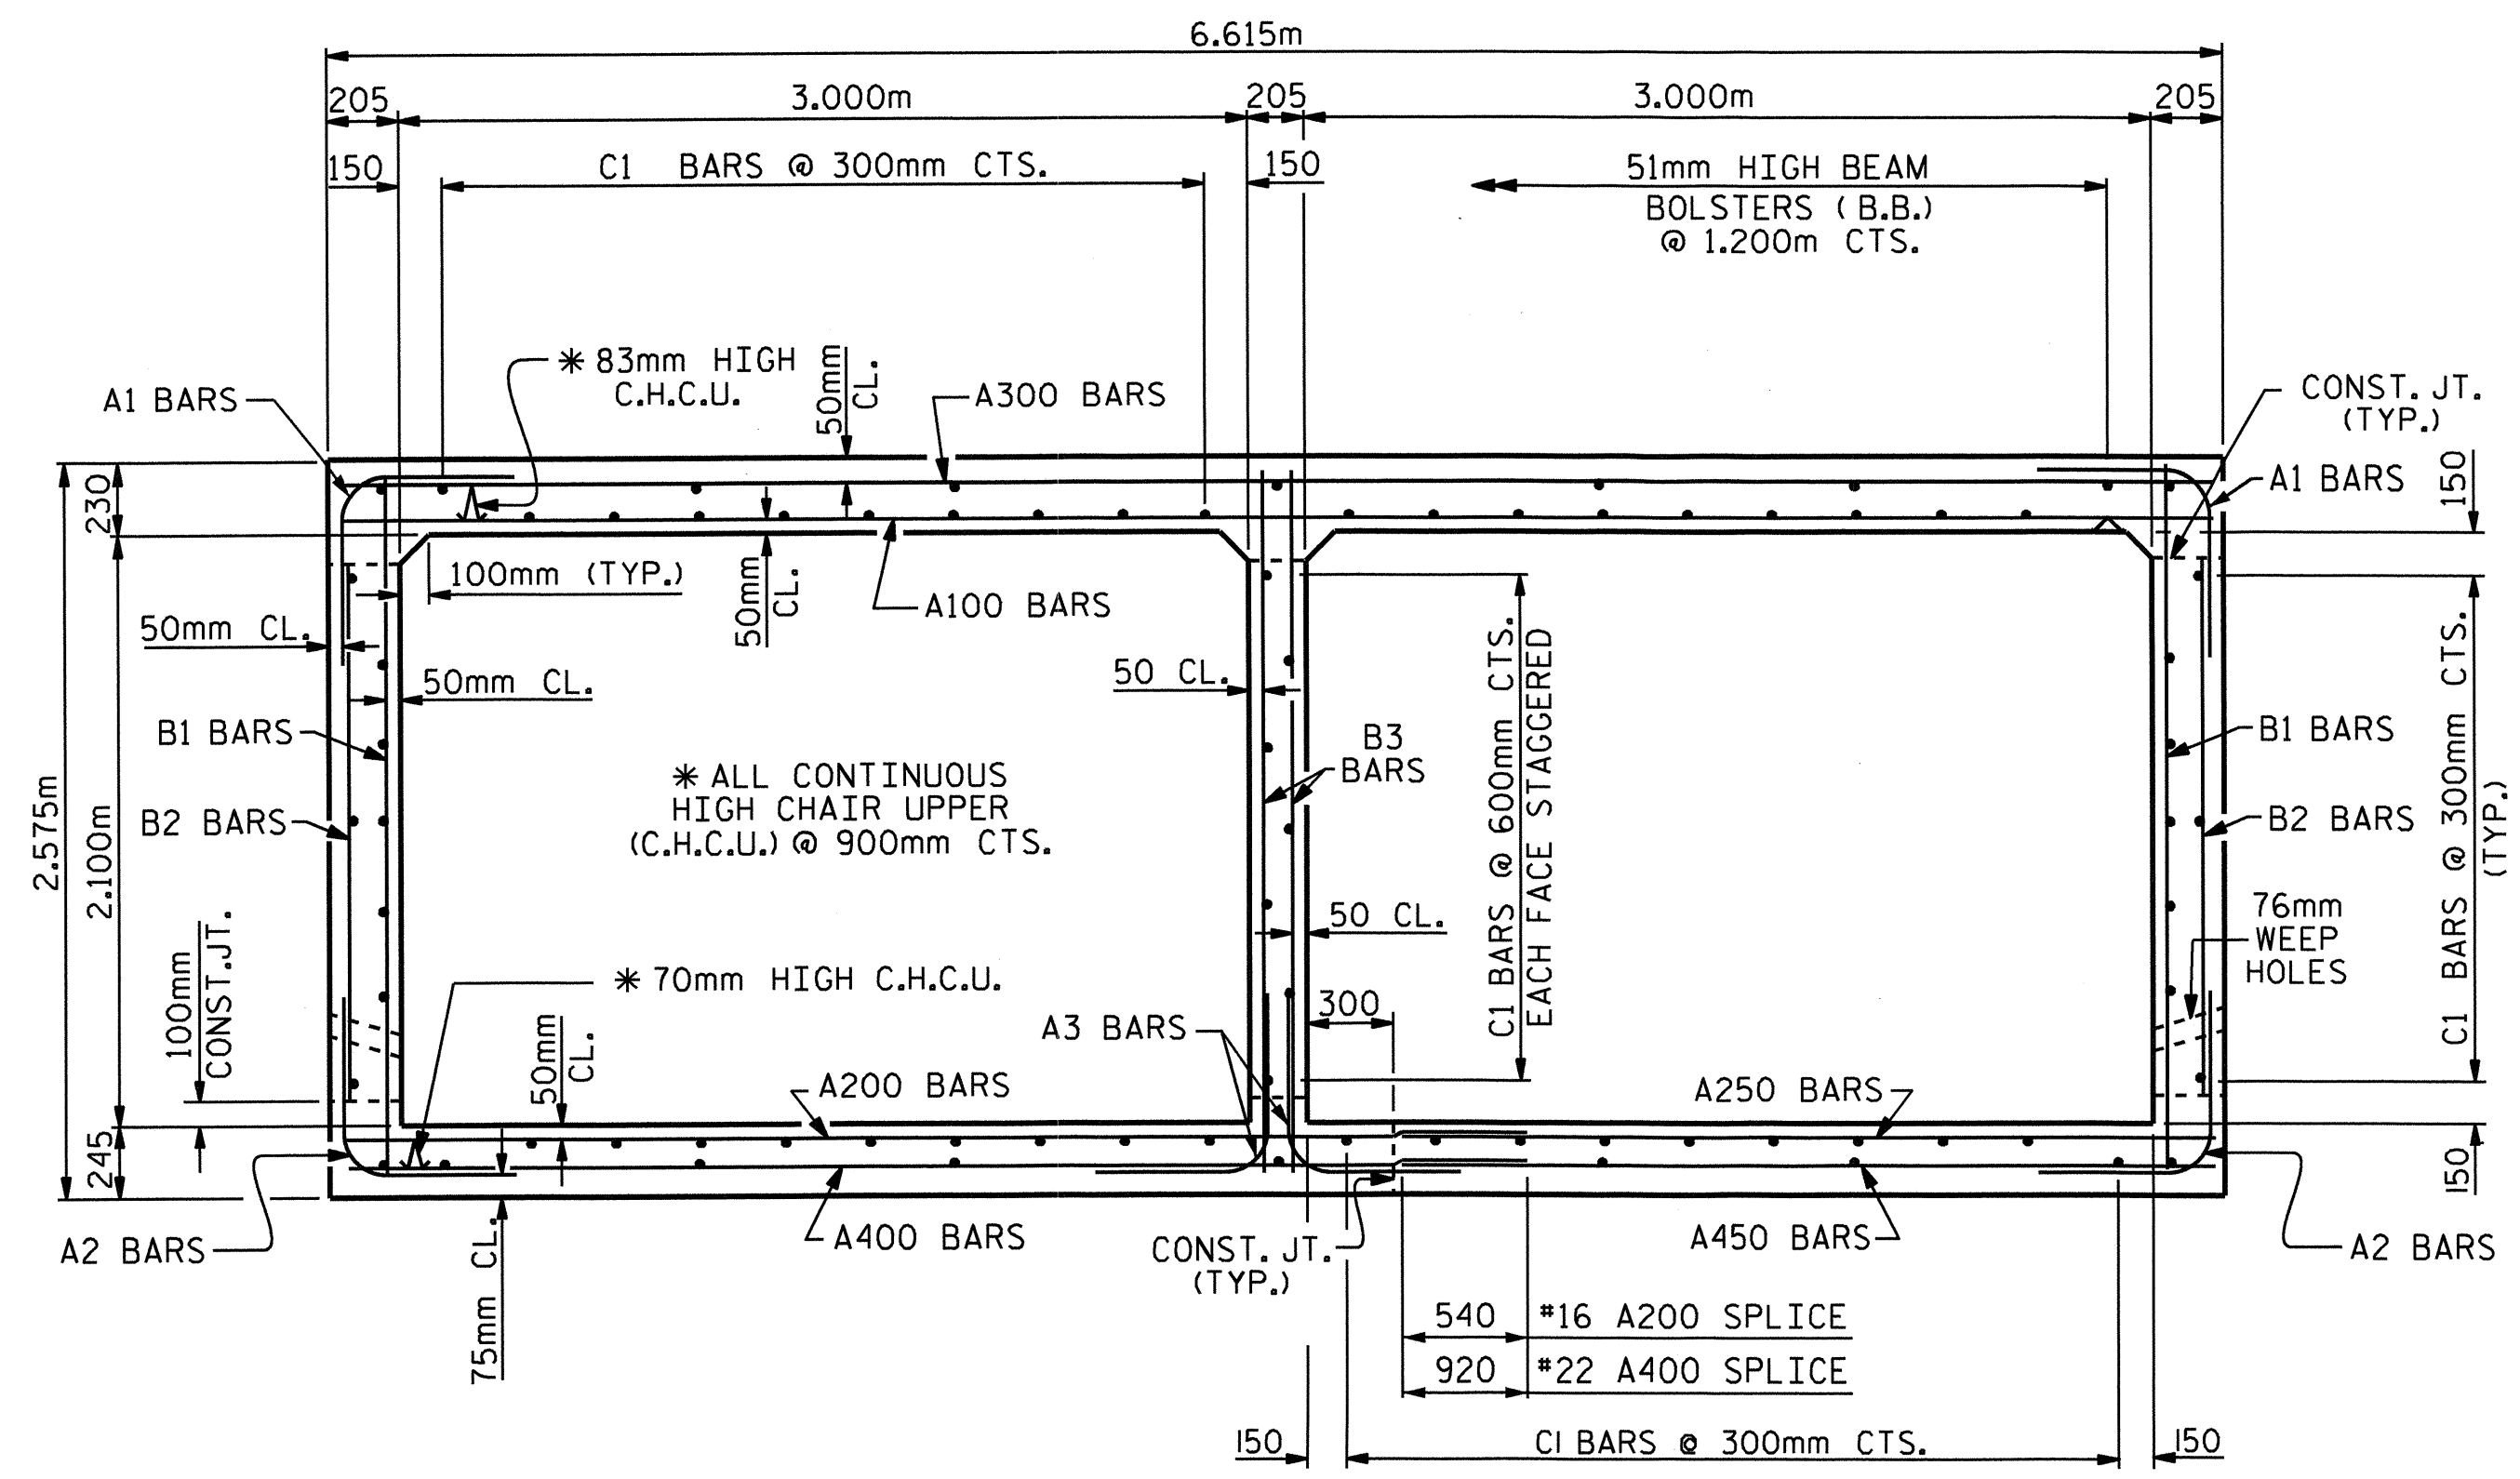

RIGHT ANGLE SECTION OF BARREL
 THERE ARE 77 "C" BARS IN SECTION OF BARREL.
 (LOOKING DOWNSTREAM)

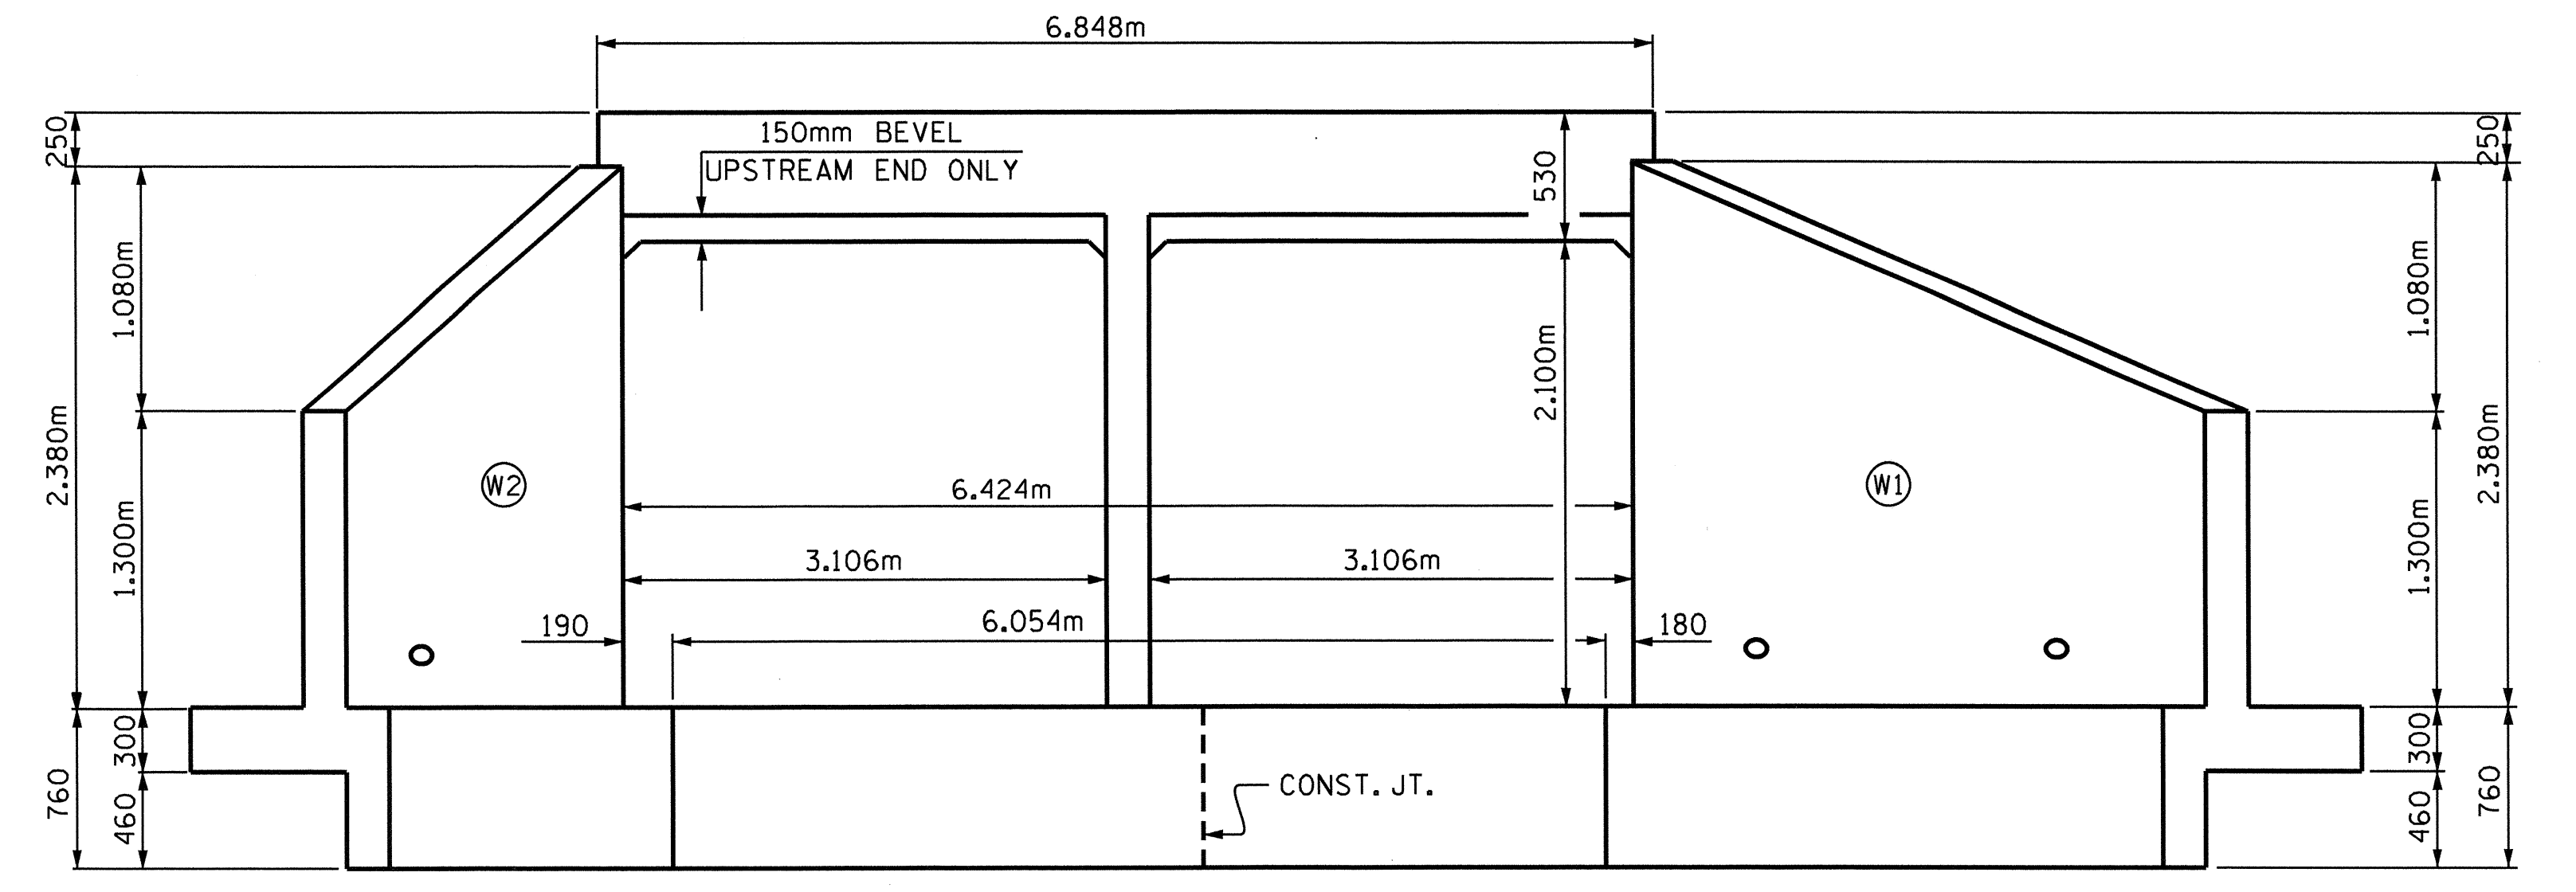


INLET END ELEVATION NORMAL TO SKEW

PROJECT NO. B-4183
MADISON COUNTY
 STATION: 11+16.500 -L-

SHEET 2 OF 8


STATE OF NORTH CAROLINA
 DEPARTMENT OF TRANSPORTATION
 RALEIGH
 DOUBLE 3.000m X 2.100m
 CONCRETE BOX CULVERT
 115° SKEW

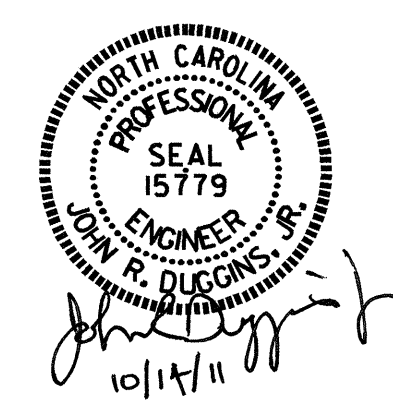

ASSEMBLED BY :	A. SORSENGINH	DATE :	1/28/09
CHECKED BY :	J. LAMBERT	DATE :	2/10
DRAWN BY :	EEM	DATE :	6/97
CHECKED BY :	ARB	DATE :	7/97

REVISIONS				SHEET NO.	
NO.	BY:	DATE:	NO.	BY:	DATE:
1			3		
2			4		

TOTAL SHEETS: 15

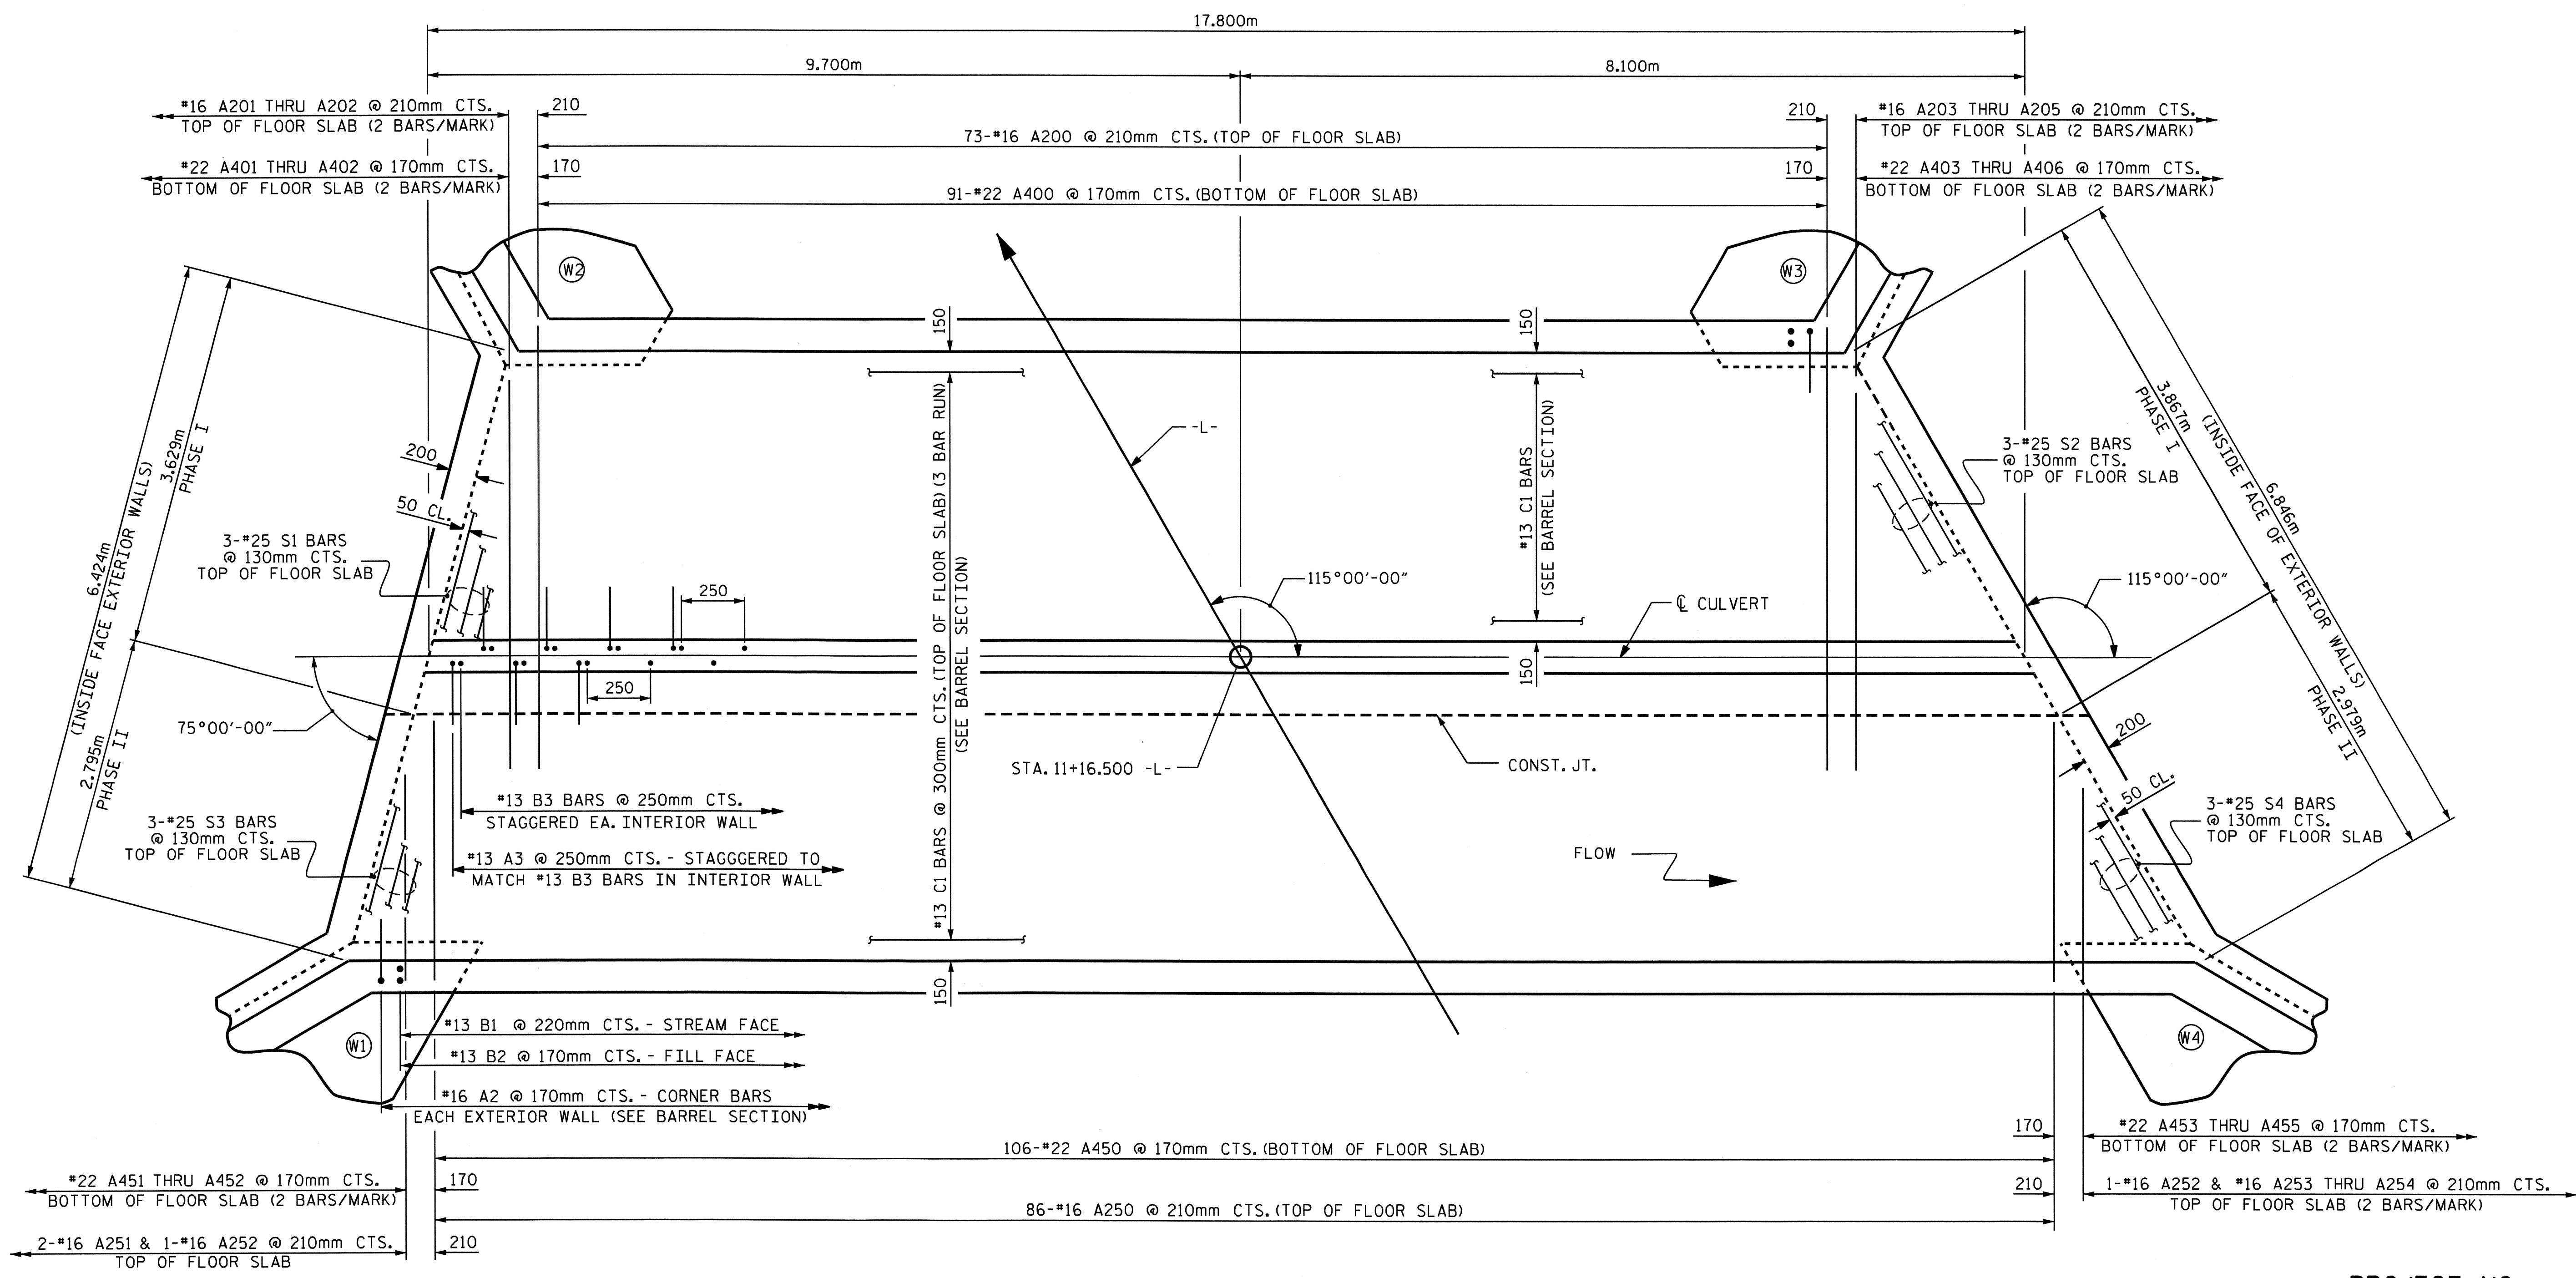


PLAN OF FLOOR SLAB

PROJECT NO. B-4183
MADISON COUNTY
 STATION: 11+16.500 -L-

SHEET 3 OF 8


STATE OF NORTH CAROLINA
 DEPARTMENT OF TRANSPORTATION
 RALEIGH

DOUBLE 3.000m X 2.100m
 CONCRETE BOX CULVERT
 115° SKEW

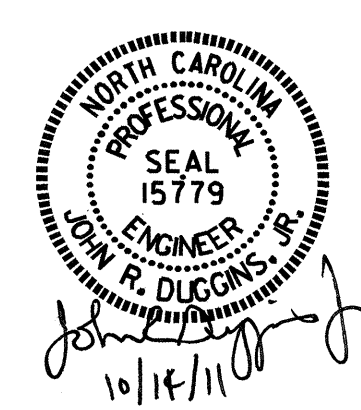

ASSEMBLED BY : A. SORSENGINH DATE : 1/28/09
 CHECKED BY : J. LAMBERT DATE : 2/10
 DRAWN BY : EEM 6/97
 CHECKED BY : ARB 7/97


REVISIONS						SHEET NO.
NO.	BY:	DATE:	NO.	BY:	DATE:	C-10
1			3			TOTAL SHEETS
2			4			15

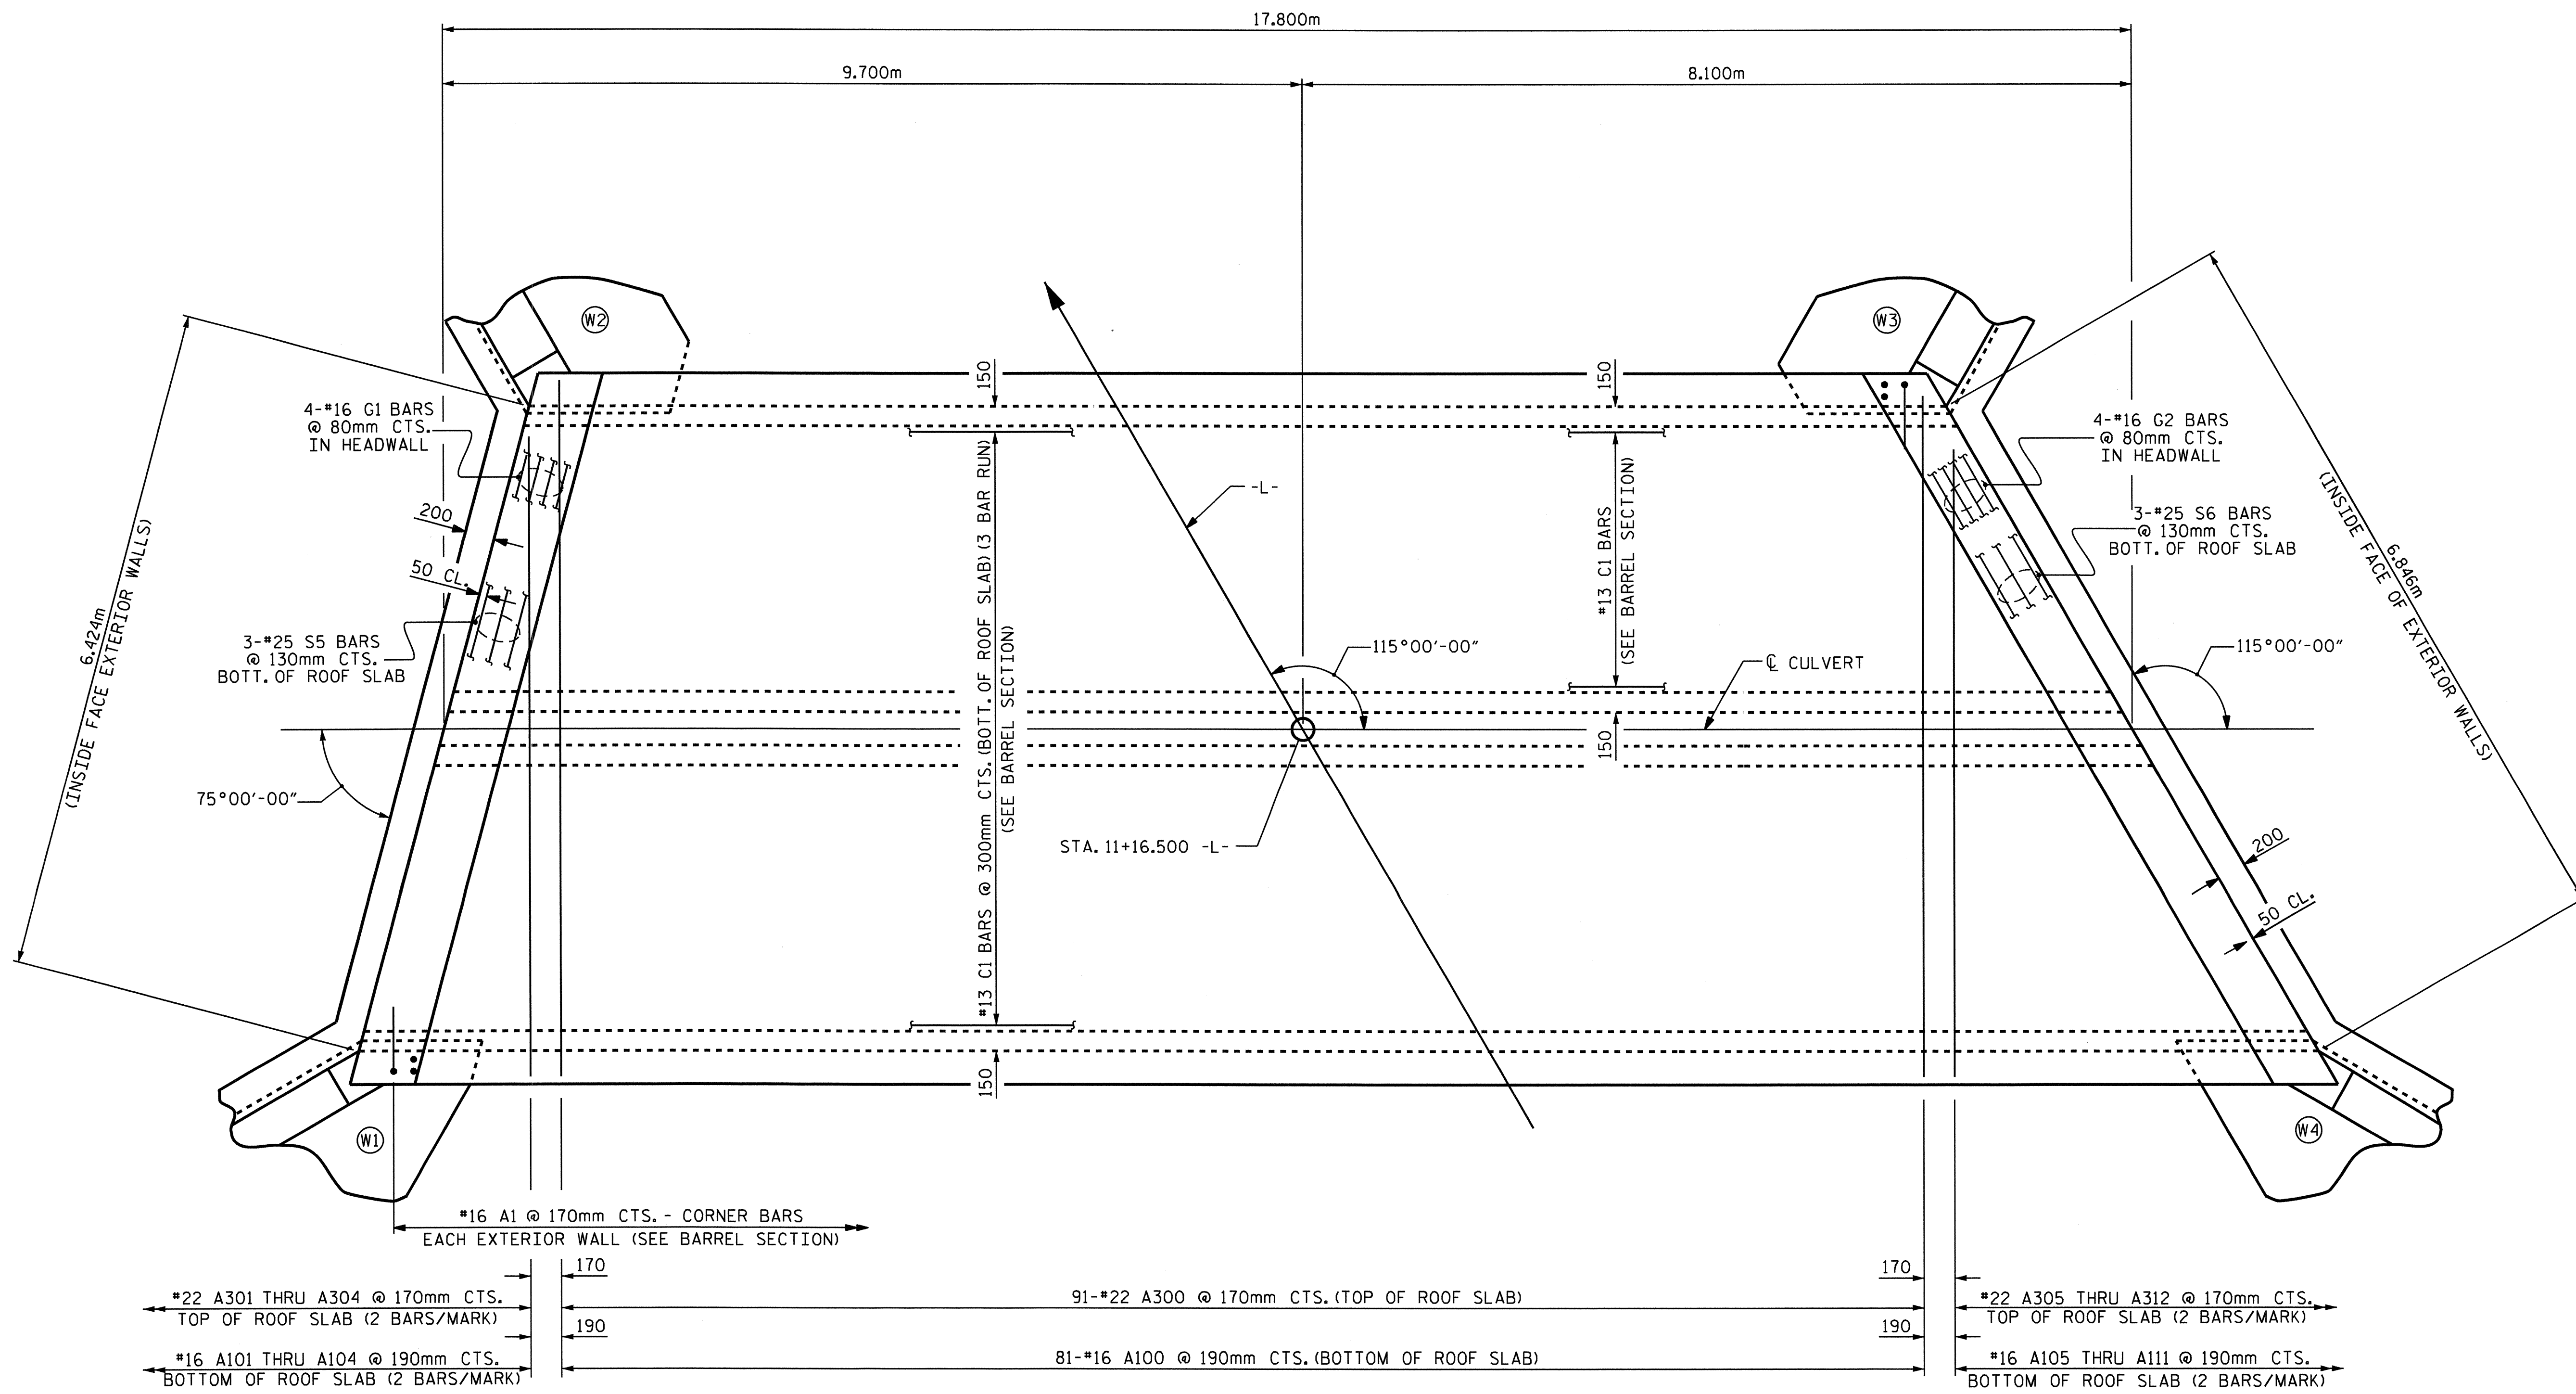

PLAN OF ROOF SLAB

PROJECT NO. B-4183
MADISON COUNTY
 STATION: 11+16.500 -L-

SHEET 4 OF 8

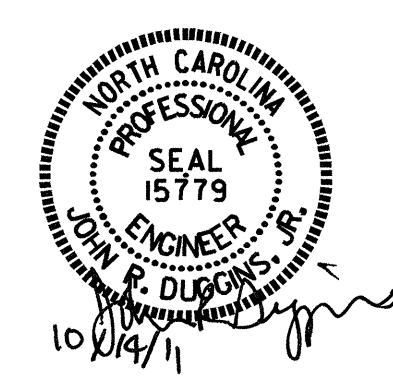

STATE OF NORTH CAROLINA
 DEPARTMENT OF TRANSPORTATION
 RALEIGH
 DOUBLE 3.000m X 2.100m
 CONCRETE BOX CULVERT
 115° SKEW


ASSEMBLED BY : A. SORSENGINH DATE : 1/28/09
 CHECKED BY : J. LAMBERT DATE : 2/10
 DRAWN BY : EEM 6/97
 CHECKED BY : ARB 7/97

REVISIONS						SHEET NO.
NO.	BY:	DATE:	NO.	BY:	DATE:	C-11
1			3			TOTAL SHEETS
2			4			15

BAR TYPE

BILL OF MATERIAL


SPLICE LENGTH CHART		
BAR	SIZE	SPLICE LENGTH
A100	16	540
A200	16	540
A300	22	920
A400	22	920
B1	13	540
B2	13	540
B3	13	540
C1	13	590
S1	25	1500
S2	25	1500

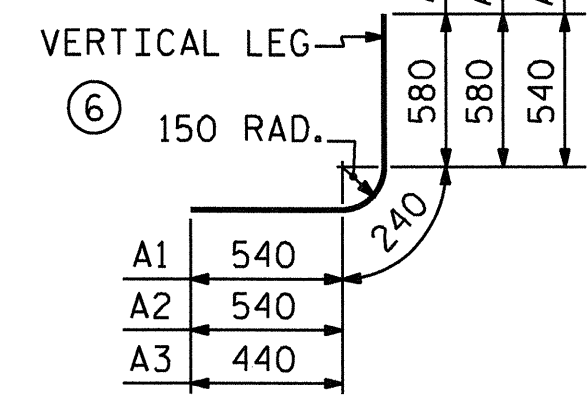



DIMENSIONS ARE OUT TO OUT

BARS	NO.	SIZE	TYPE	LENGTH	WEIGHT	BARS	NO.	SIZE	TYPE	LENGTH	WEIGHT	BARS	NO.	SIZE	TYPE	LENGTH	WEIGHT
A1	210	16	6	1360	443	A250	86	16	STR	2860	382	A405	2	22	STR	2400	15
A2	210	16	6	1360	443	A251	2	16	STR	1560	5	A406	2	22	STR	1680	10
A3	71	13	6	1220	86	A252	2	16	STR	760	2						
						A253	2	16	STR	2100	7	A450	106	22	STR	2860	922
A100	81	16	STR	6480	815	A254	2	16	STR	1200	4	A451	2	22	STR	1880	11
A101	2	16	STR	5280	16							A452	2	22	STR	580	4
A102	2	16	STR	3920	12	A300	91	22	STR	6480	1794	A453	2	22	STR	2280	14
A103	2	16	STR	2380	7	A301	2	22	STR	5240	32	A454	2	22	STR	1560	9
A104	2	16	STR	960	3	A302	2	22	STR	3980	24	A455	2	22	STR	820	5
A105	2	16	STR	5800	18	A303	2	22	STR	2700	16						
A106	2	16	STR	5000	16	A304	2	22	STR	1440	9	B1	144	13	STR	2420	346
A107	2	16	STR	4180	13	A305	2	22	STR	5780	35	B2	210	13	STR	1880	392
A108	2	16	STR	3360	10	A306	2	22	STR	5060	31	B3	120	13	STR	2420	289
A109	2	16	STR	2540	8	A307	2	22	STR	4320	26						
A110	2	16	STR	1740	5	A308	2	22	STR	3600	22	C1	231	13	STR	6500	1492
A111	2	16	STR	920	3	A309	2	22	STR	2880	18						
						A310	2	22	STR	2140	13	D1	4	19	STR	720	6
A200	73	16	STR	4200	476	A311	2	22	STR	1420	9						
A201	2	16	STR	2980	9	A312	2	22	STR	680	4	G1	4	16	STR	6740	42
A202	2	16	STR	1420	4							G2	4	16	STR	7160	44
A203	2	16	STR	3500	11	A400	91	22	STR	4580	1268						
A204	2	16	STR	2600	8	A401	2	22	STR	3320	20	S1	3	25	STR	5280	63
A205	2	16	STR	1700	5	A402	2	22	STR	2060	13	S2	3	25	STR	5540	66
						A403	2	22	STR	3860	23	S3	3	25	STR	2960	35
						A404	2	22	STR	3140	19	S4	3	25	STR	3140	37
												S5	3	25	STR	6740	80
												S6	3	25	STR	7160	85

REINFORCING STEEL = 10,154 kg

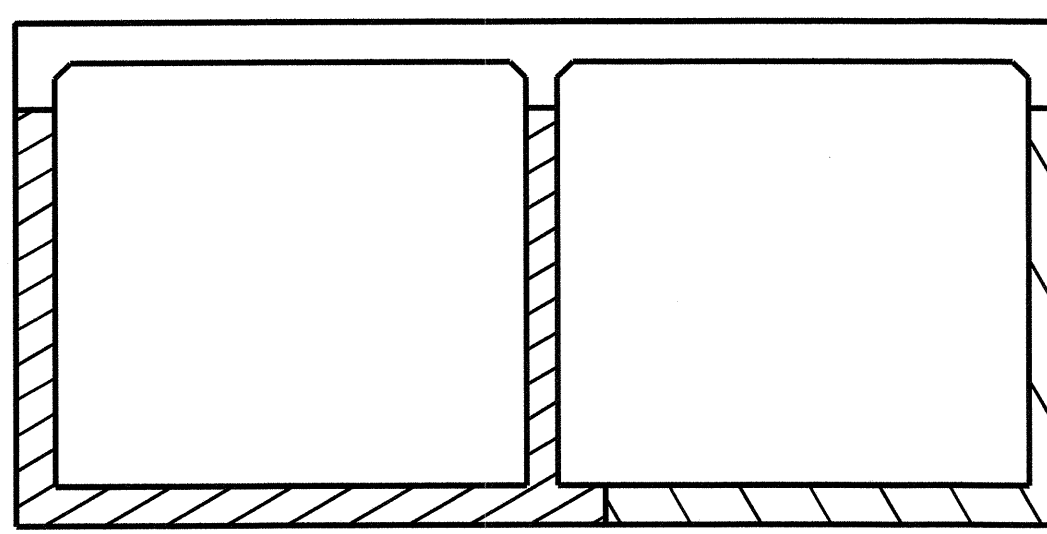


CONSTRUCTION PHASING

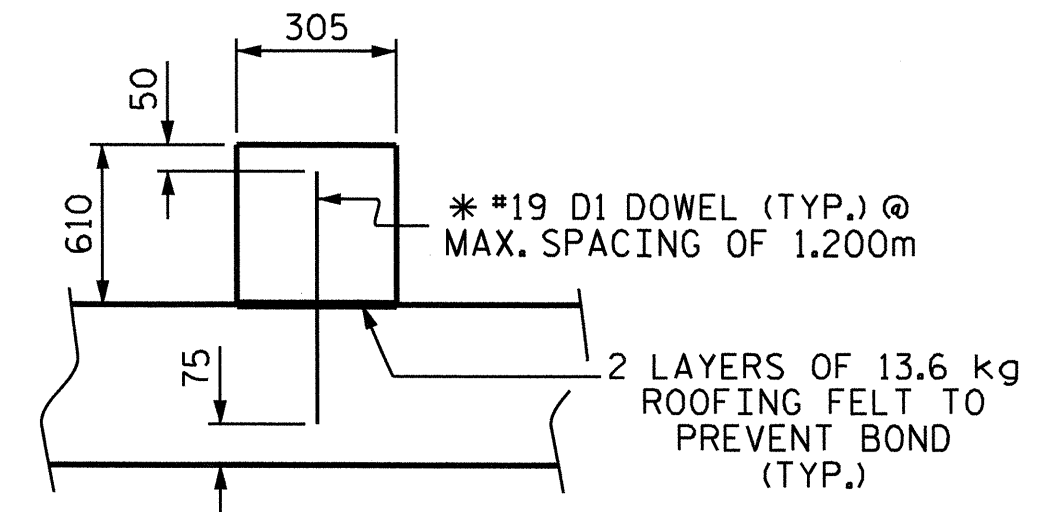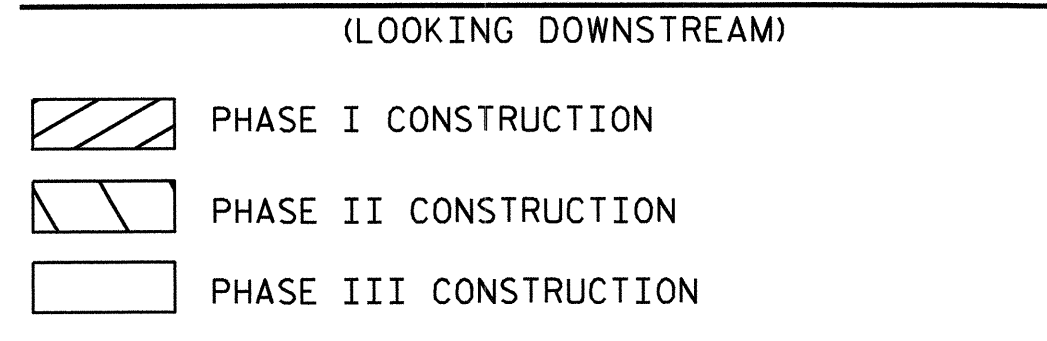


* DOWELS MAY BE PUSHED INTO GREEN CONCRETE AFTER SLAB HAS BEEN FLOAT FINISHED.

SECTION THRU SILL

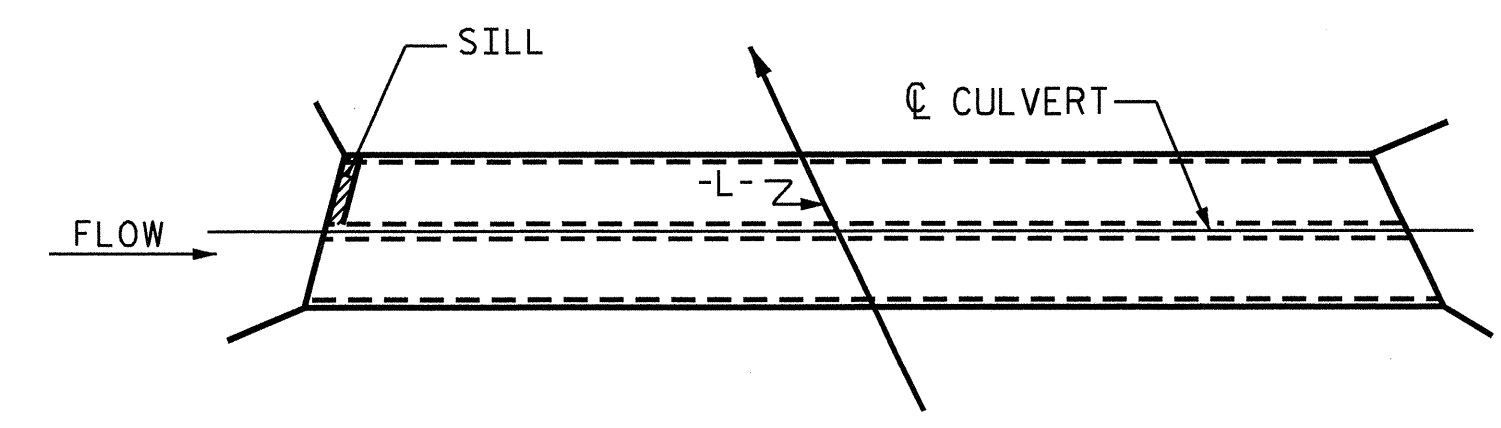

PLAN OF SILL LOCATION

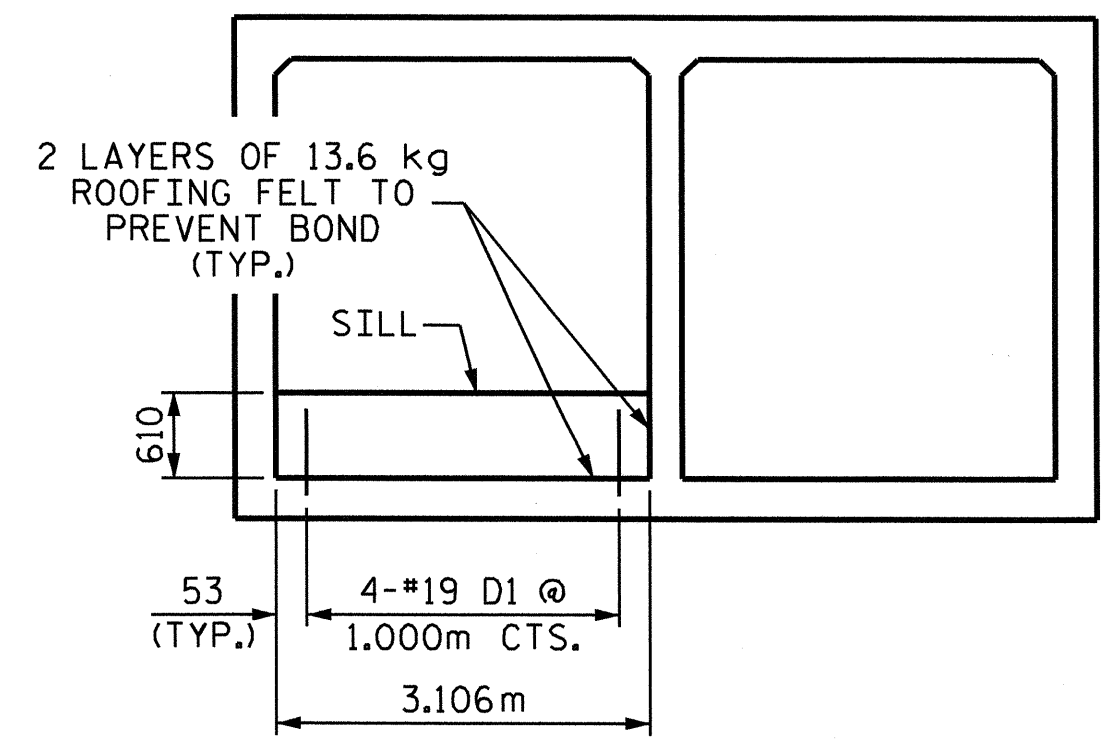


ELEVATION (LOOKING DOWNSTREAM)

CULVERT SILL DETAILS

PROJECT NO. B-4183
MADISON COUNTY
 STATION: 11+16.500 -L-


SHEET 5 OF 8

STATE OF NORTH CAROLINA
 DEPARTMENT OF TRANSPORTATION
 RALEIGH
 DOUBLE 3.000m X 2.100m
 CONCRETE BOX CULVERT
 115° SKEW

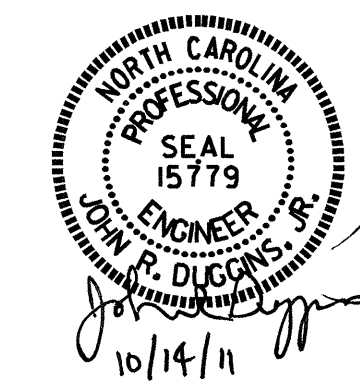


REVISIONS						SHEET NO.
NO.	BY:	DATE:	NO.	BY:	DATE:	C-12
1			3			TOTAL SHEETS
2			4			15


DRAWN BY : A. SORSENGINH DATE : 1/28/09
 CHECKED BY : J. LAMBERT DATE : 2/10

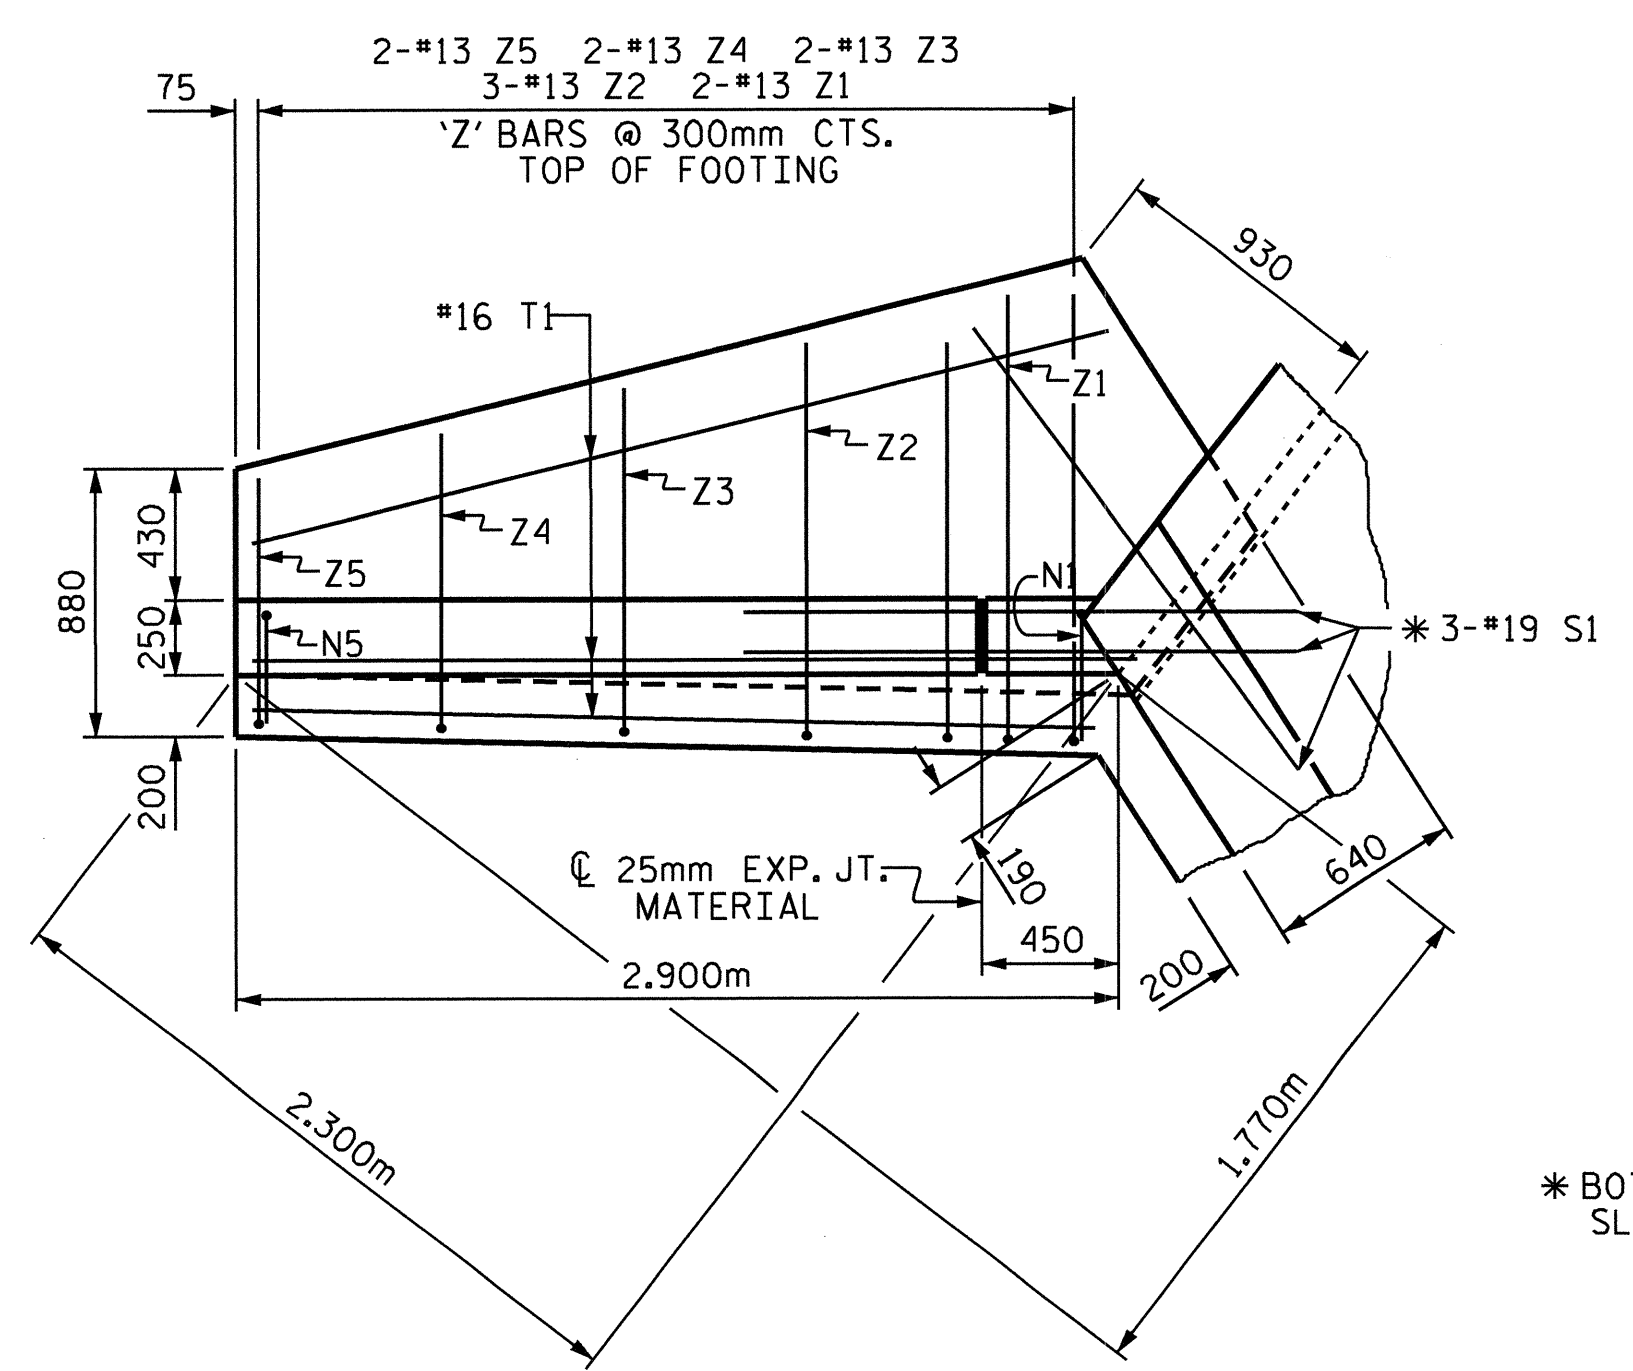


PLAN W2

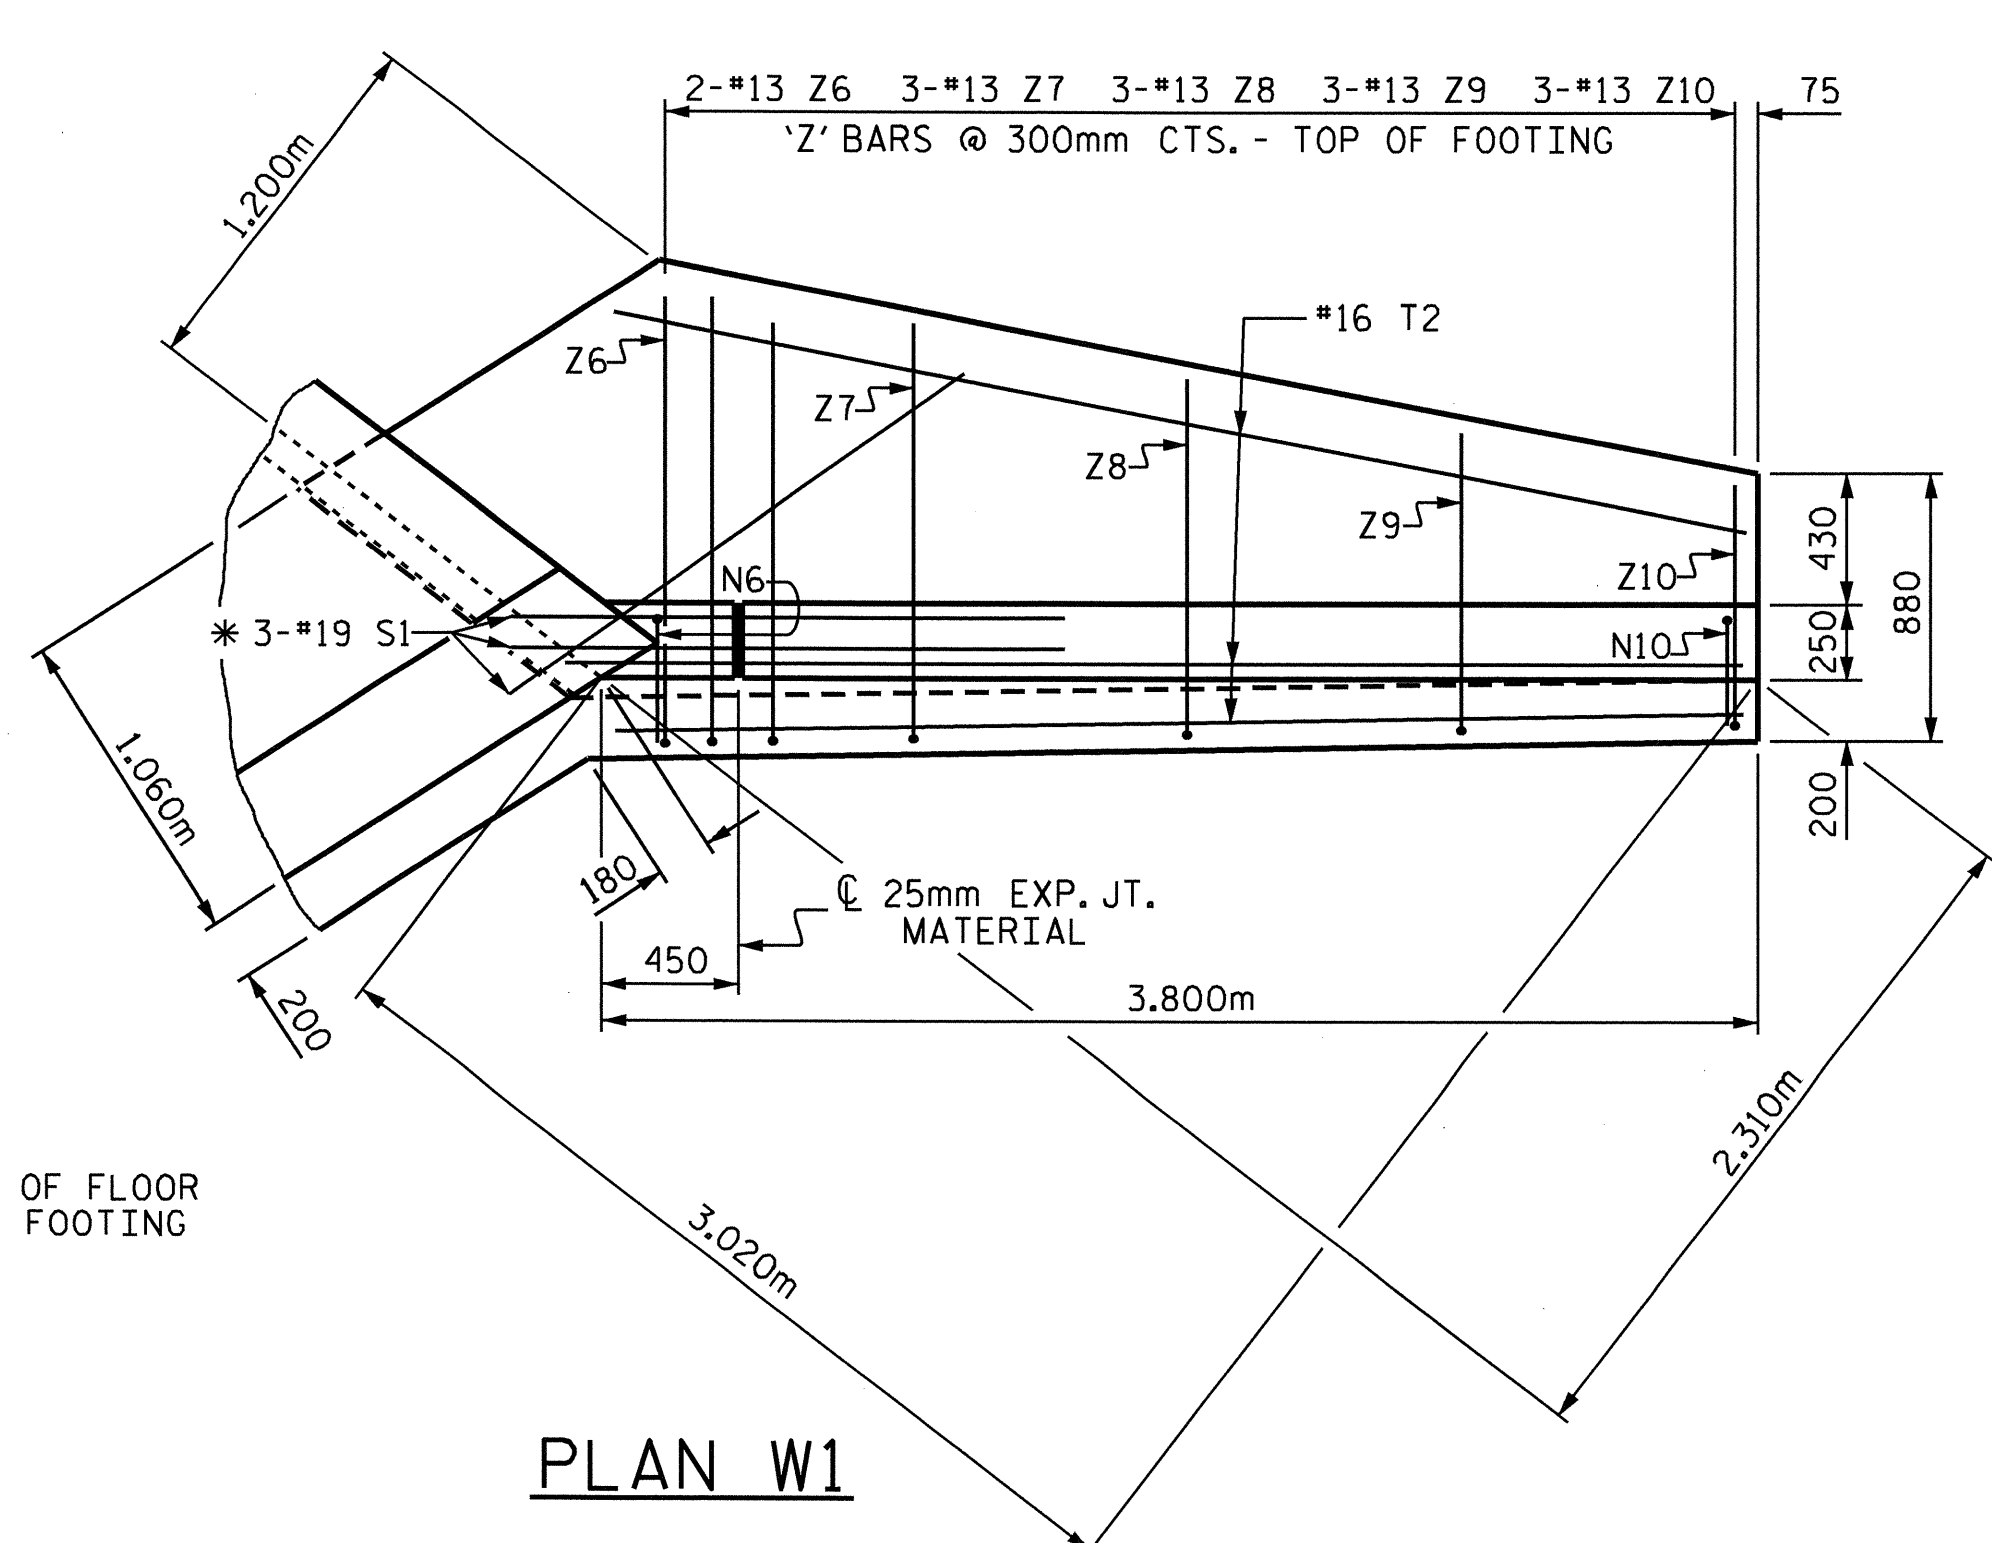

PLAN W1

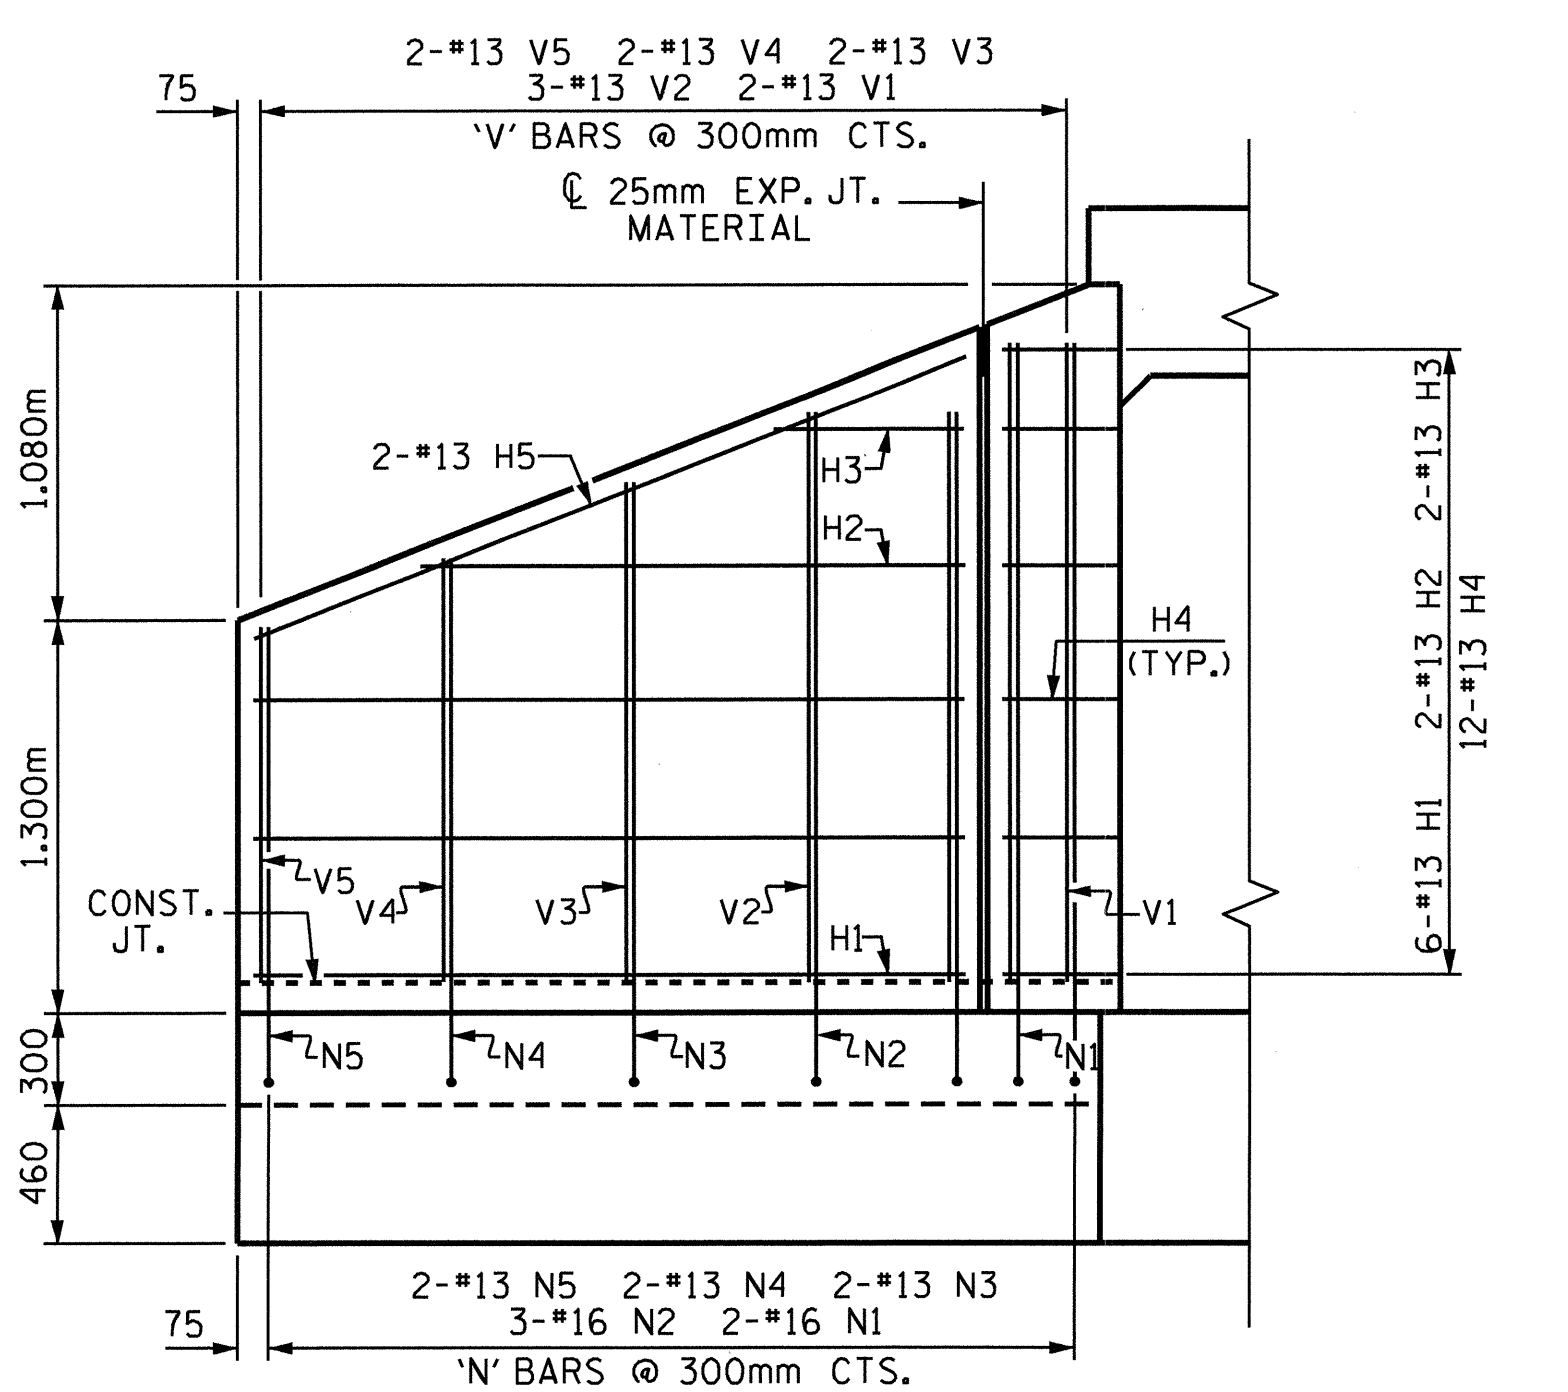


ELEVATION W2

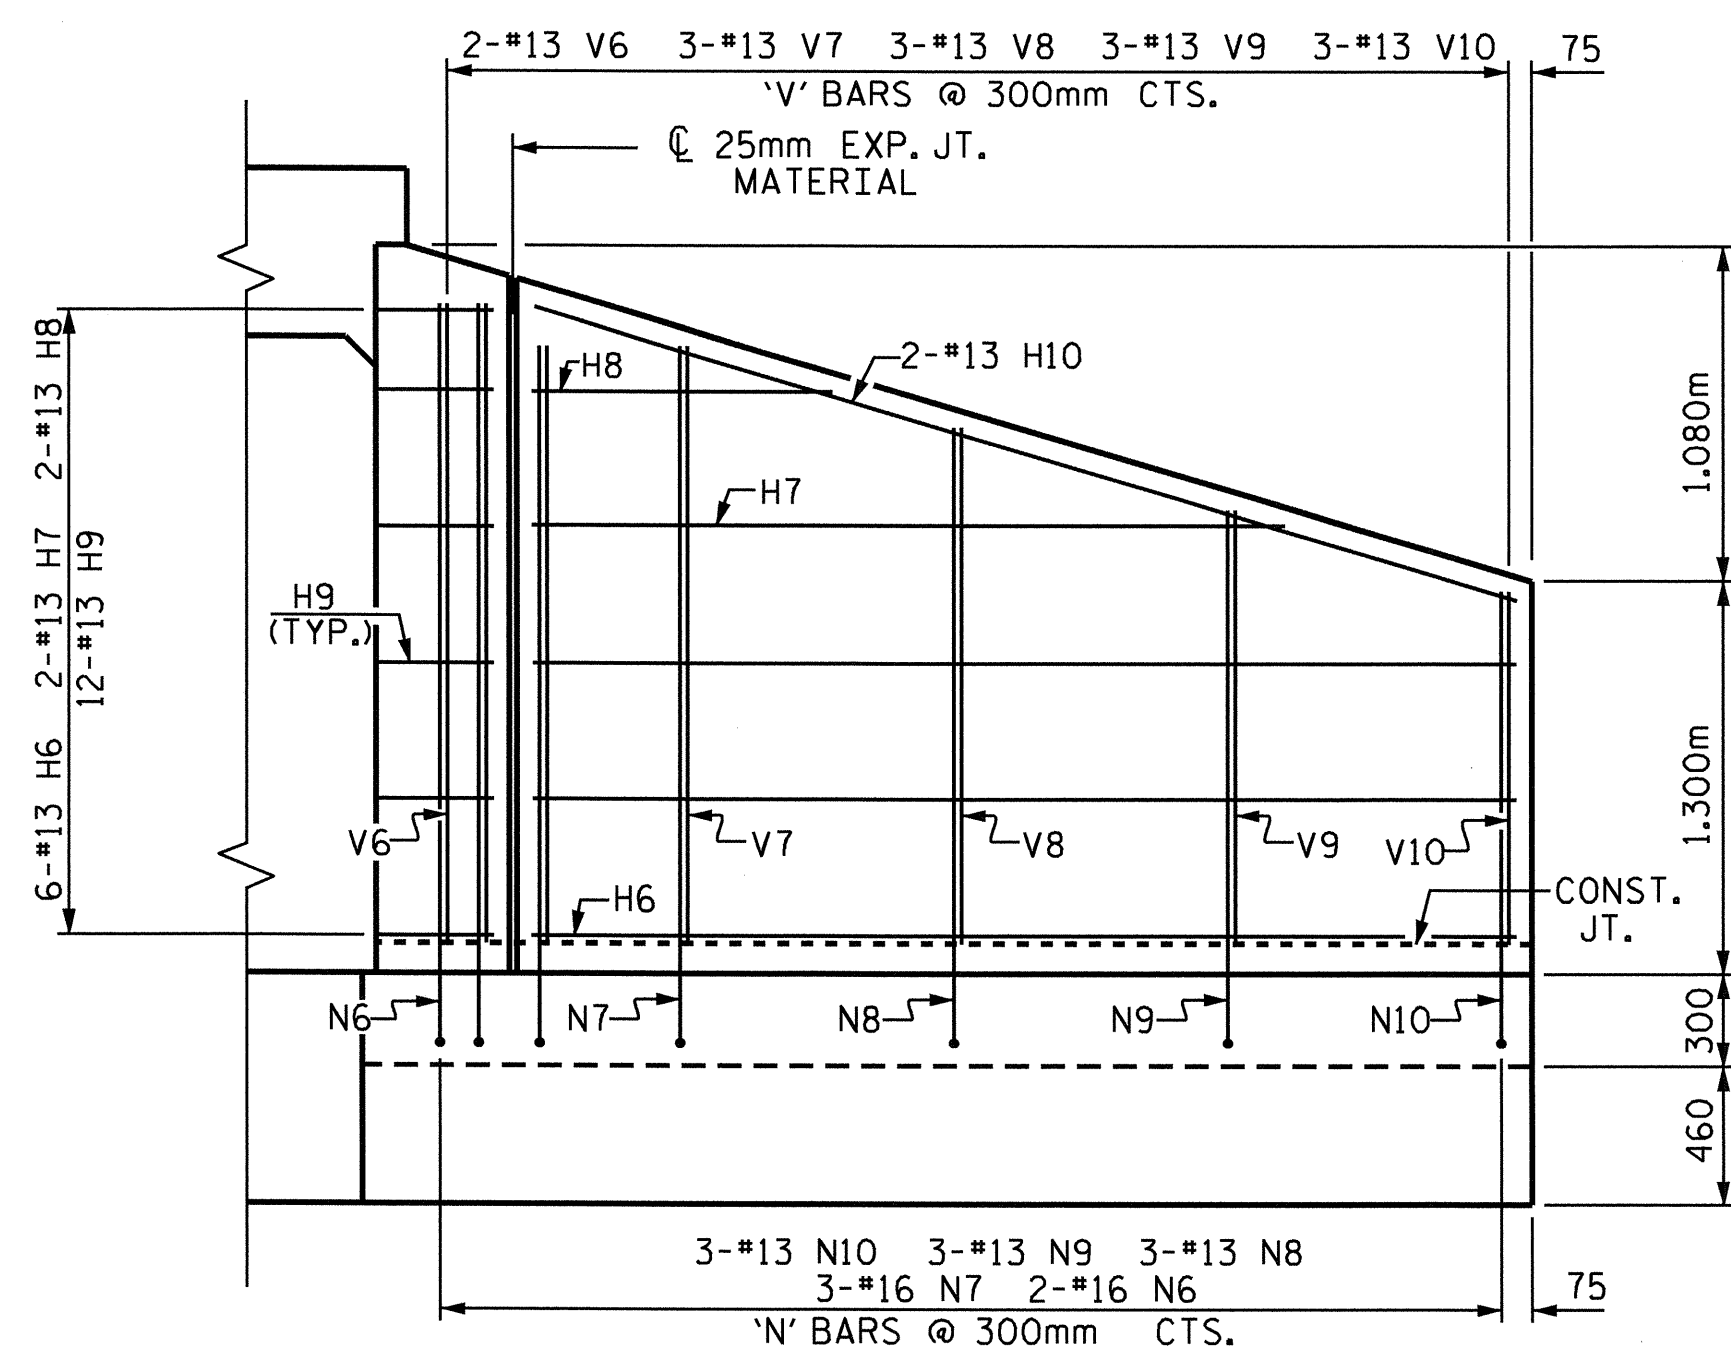

ELEVATION W1

BAR TYPES

ALL BAR DIMENSIONS ARE OUT TO OUT.

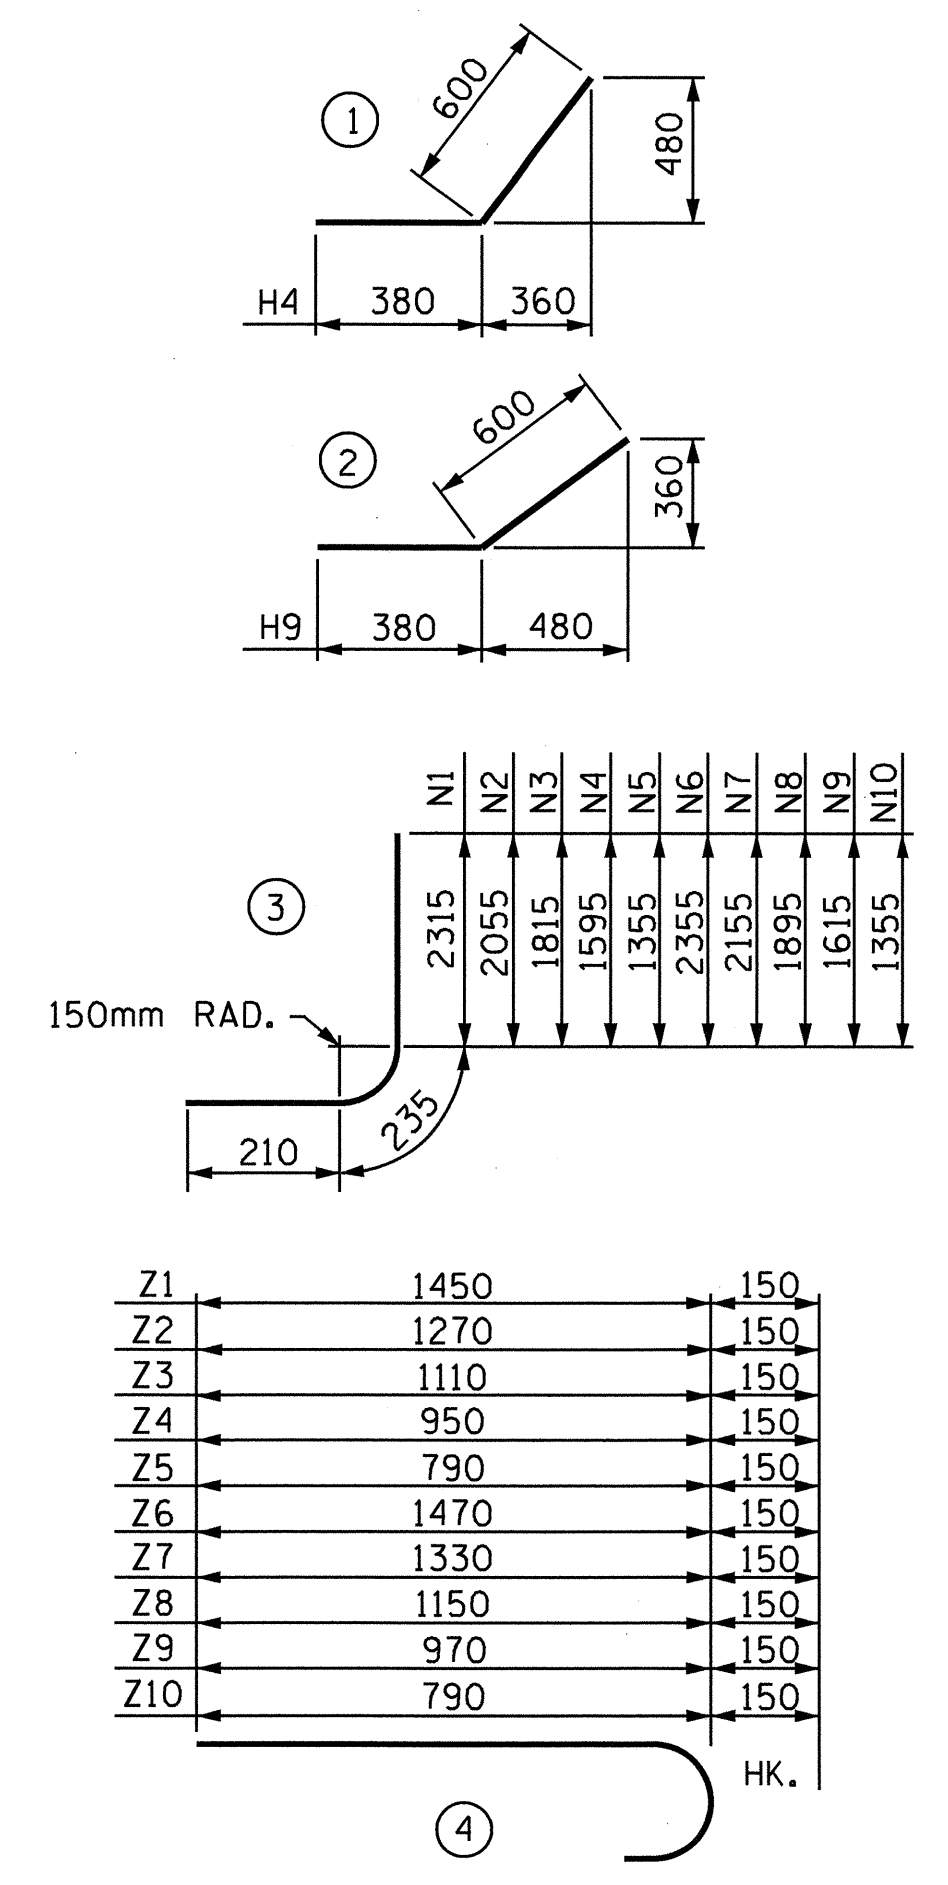


BILL OF MATERIAL

BAR NO.	SIZE	TYPE	LENGTH	WEIGHT	
H1	6	13	STR	2340	14
H2	2	13	STR	1740	3
H3	2	13	STR	600	1
H4	12	13	1	980	12
H5	2	13	STR	2500	5
H6	6	13	STR	3240	19
H7	2	13	STR	2500	5
H8	2	13	STR	1000	2
H9	12	13	2	980	12
H10	2	13	STR	3360	7
N1	2	16	3	2760	9
N2	3	16	3	2500	12
N3	3	13	3	2260	4
N4	3	13	3	2040	4
N5	2	13	3	1800	4
N6	2	16	3	2800	9
N7	3	16	3	2600	12
N8	3	13	3	2340	7
N9	3	13	3	2060	6
N10	3	13	3	1800	5
S1	6	19	STR	1800	24
T1	3	16	STR	2900	14
T2	3	16	STR	3800	18
V1	2	13	STR	2140	4
V2	3	13	STR	1880	6
V3	3	13	STR	1640	3
V4	2	13	STR	1420	3
V5	2	13	STR	1180	2
V6	2	13	STR	2180	4
V7	3	13	STR	1980	6
V8	3	13	STR	1720	5
V9	3	13	STR	1440	4
V10	3	13	STR	1180	4
Z1	2	13	4	1600	3
Z2	3	13	4	1420	4
Z3	2	13	4	1260	3
Z4	2	13	4	1100	2
Z5	2	13	4	940	2
Z6	2	13	4	1620	3
Z7	3	13	4	1480	4
Z8	3	13	4	1300	4
Z9	3	13	4	1120	3
Z10	3	13	4	940	3

REINFORCING STEEL FOR 2 WING WALLS 280 kg

CLASS A CONCRETE
 2 WINGS 6.4 m³
 1 HEADWALL 0.8 m³
 1 END CURTAIN WALL 0.9 m³
 TOTAL 8.1 m³

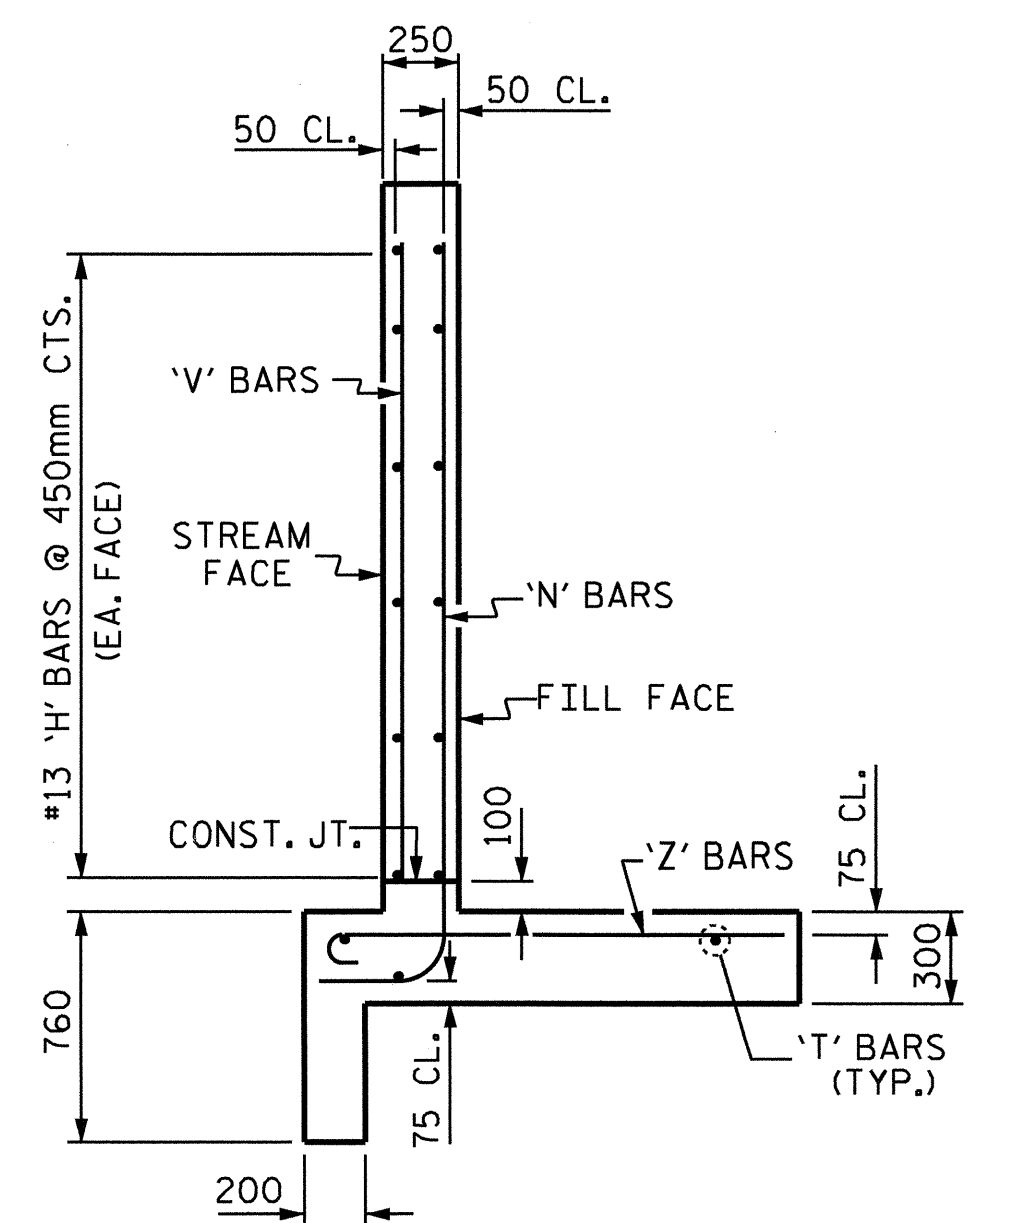


TYPICAL WING SECTION

PROJECT NO. B-4183
MADISON COUNTY
 STATION: 11+16.500 -L-

SHEET 6 OF 8


STATE OF NORTH CAROLINA
 DEPARTMENT OF TRANSPORTATION
 RALEIGH
WING FOR CONCRETE BOX CULVERT
 H=2.100m SLOPE=2:1
 75° OR 105° SKEW

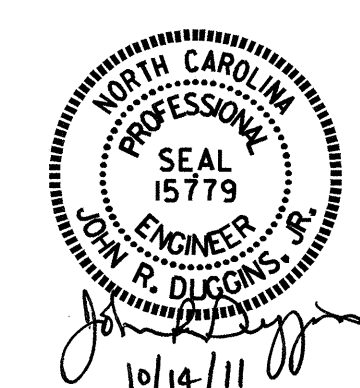

ASSEMBLED BY : A. SORSENGINH DATE : 2/3/09
 CHECKED BY : J. LAMBERT DATE : 2/10
 DRAWN BY : JLR 5/97
 CHECKED BY : VAP 10/97

FOR WING ORIENTATION, SEE SHEET C-10.

REVISIONS						SHEET NO.	
NO.	BY:	DATE:	NO.	BY:	DATE:	C-13	
1			3			TOTAL SHEETS	
2			4			15	

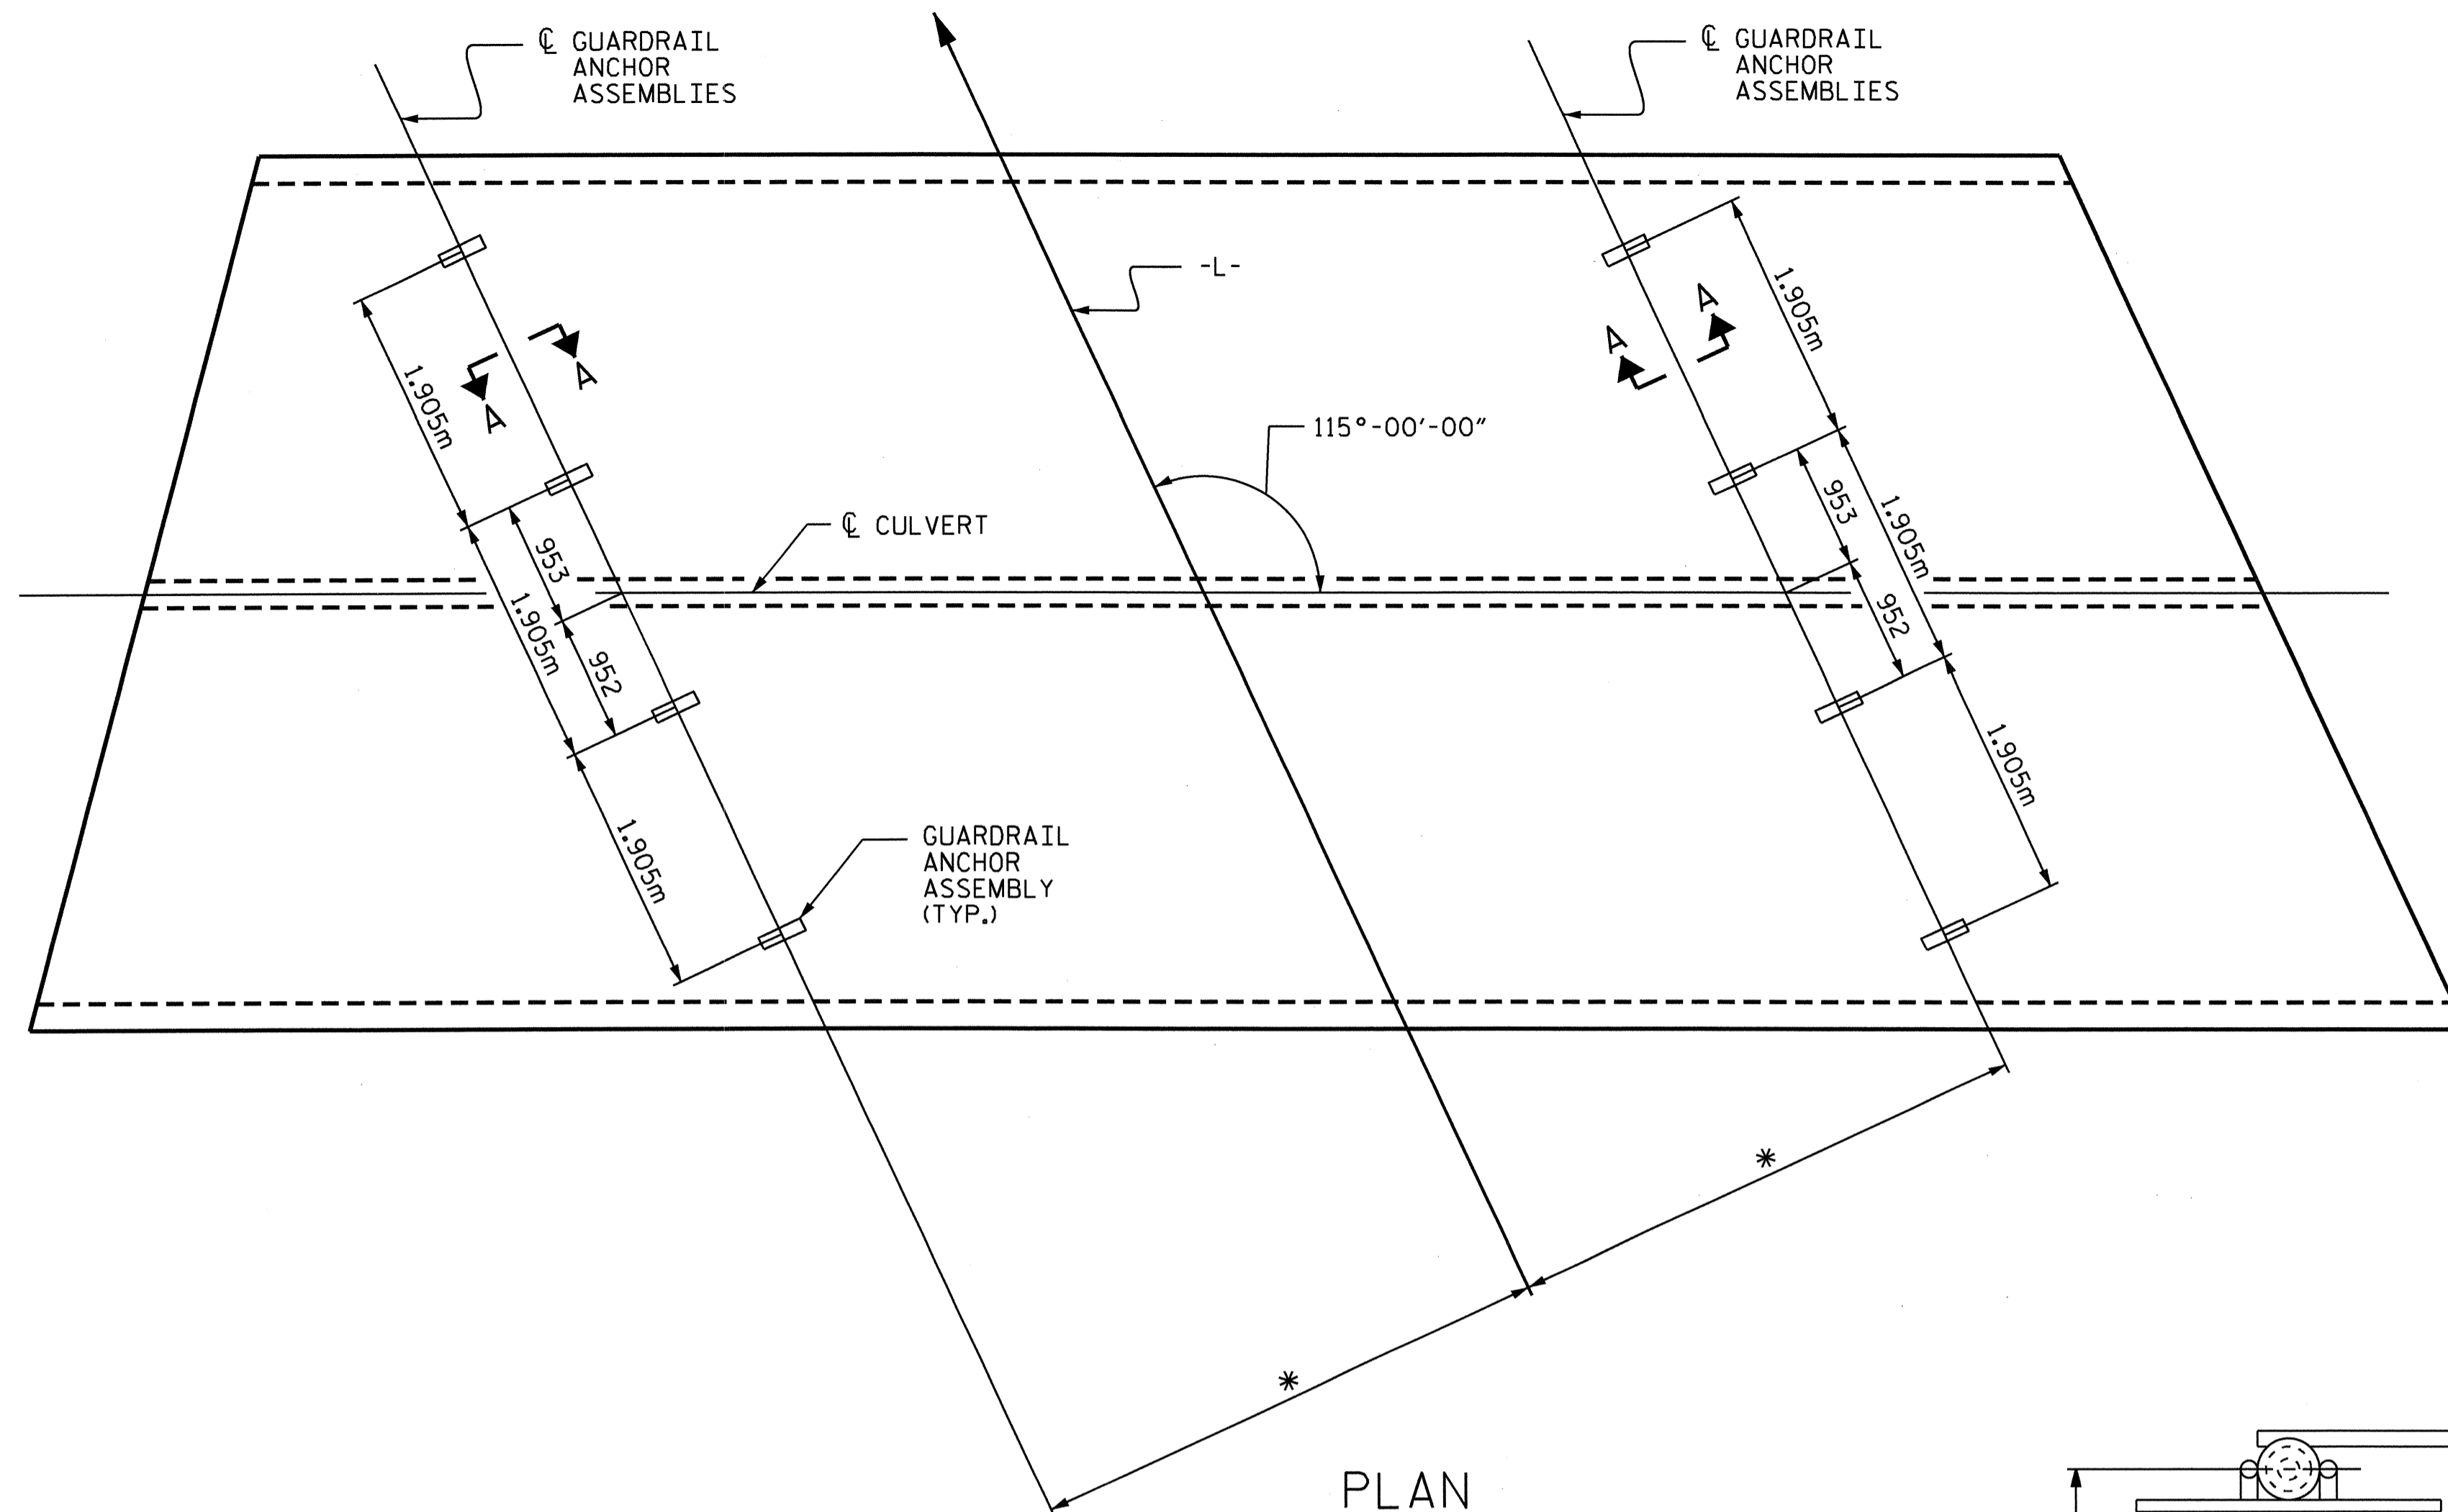

PLAN

SHOWING : GUARDRAIL ANCHOR ASSEMBLY SPACING.
* THIS DIMENSION TO BE FURNISHED BY THE ENGINEER.

- THE GUARDRAIL ANCHOR ASSEMBLY FOR CULVERTS SHALL CONSIST OF THE FOLLOWING COMPONENTS :
- A. FERRULES SHALL BE MADE FROM STEEL MEETING THE REQUIREMENTS OF AASHTO M169, GRADE 12L14 AND SHALL HAVE A MINIMUM LENGTH OF 64mm.
 - B. 4 - 25.40mm DIA. X 57mm BOLTS WITH WASHERS, BOLTS SHALL CONFORM TO THE REQUIREMENTS OF ASTM A307. BOLTS AND WASHERS SHALL BE GALVANIZED. (AT THE CONTRACTOR'S OPTION, STAINLESS STEEL BOLTS AND WASHERS MAY BE USED AS AN ALTERNATE FOR THE 25.40mm DIA. X 57mm GALVANIZED BOLTS AND WASHERS. THEY SHALL CONFORM TO OR EXCEED THE MECHANICAL REQUIREMENTS OF ASTM A307. THE USE OF THIS ALTERNATE SHALL BE APPROVED BY THE ENGINEER.)
 - C. WIRE STRUTS SHOWN IN THE GUARDRAIL ANCHOR ASSEMBLY FOR CULVERTS DETAIL ARE MINIMUM ALLOWABLE SIZE AND SHALL HAVE A MINIMUM TENSILE STRENGTH OF 689 MPa. AS AN OPTION, A 11mm Ø WIRE STRUT WITH A MINIMUM TENSILE STRENGTH OF 620 MPa. IS ACCEPTABLE.


GUARDRAIL ANCHOR ASSEMBLY WITH BOLTS SHALL BE ASSEMBLED IN THE SHOP. BOLT THREADS MAY BE RECUT AS NECESSARY TO INSURE FIT.

THE COST OF THE GUARDRAIL ANCHOR ASSEMBLY FOR CULVERTS COMPLETE IN PLACE, SHALL BE INCLUDED IN THE UNIT CONTRACT PRICE BID FOR CLASS "A" CONCRETE.

FERRULES TO BE PLUGGED DURING POURING OF SLAB AS RECOMMENDED BY THE MANUFACTURER.
AT THE CONTRACTOR'S OPTION, FERRULES WITH OPEN OR CLOSED ENDS MAY BE USED.
PAYMENT FOR GUARDRAIL, POSTS, AND POST BASE PLATES IS INCLUDED IN ROADWAY PAY ITEMS.


SLAB REINFORCING STEEL MAY BE SHIFTED AS NECESSARY TO CLEAR GUARDRAIL ANCHOR ASSEMBLY. CARE SHOULD BE TAKEN TO KEEP THE SHIFTING OF REINFORCING STEEL TO A MINIMUM.

THE CONTRACTOR MAY USE ADHESIVELY ANCHORED ANCHOR BOLTS IN PLACE OF GUARDRAIL ANCHOR ASSEMBLY. LEVEL TWO FIELD TESTING IS REQUIRED, AND THE YIELD LOAD OF THE 25.40mm Ø BOLT IS 97.0 kN. FOR ADHESIVELY ANCHORED ANCHOR BOLTS OR DOWELS, SEE SPECIAL PROVISIONS.

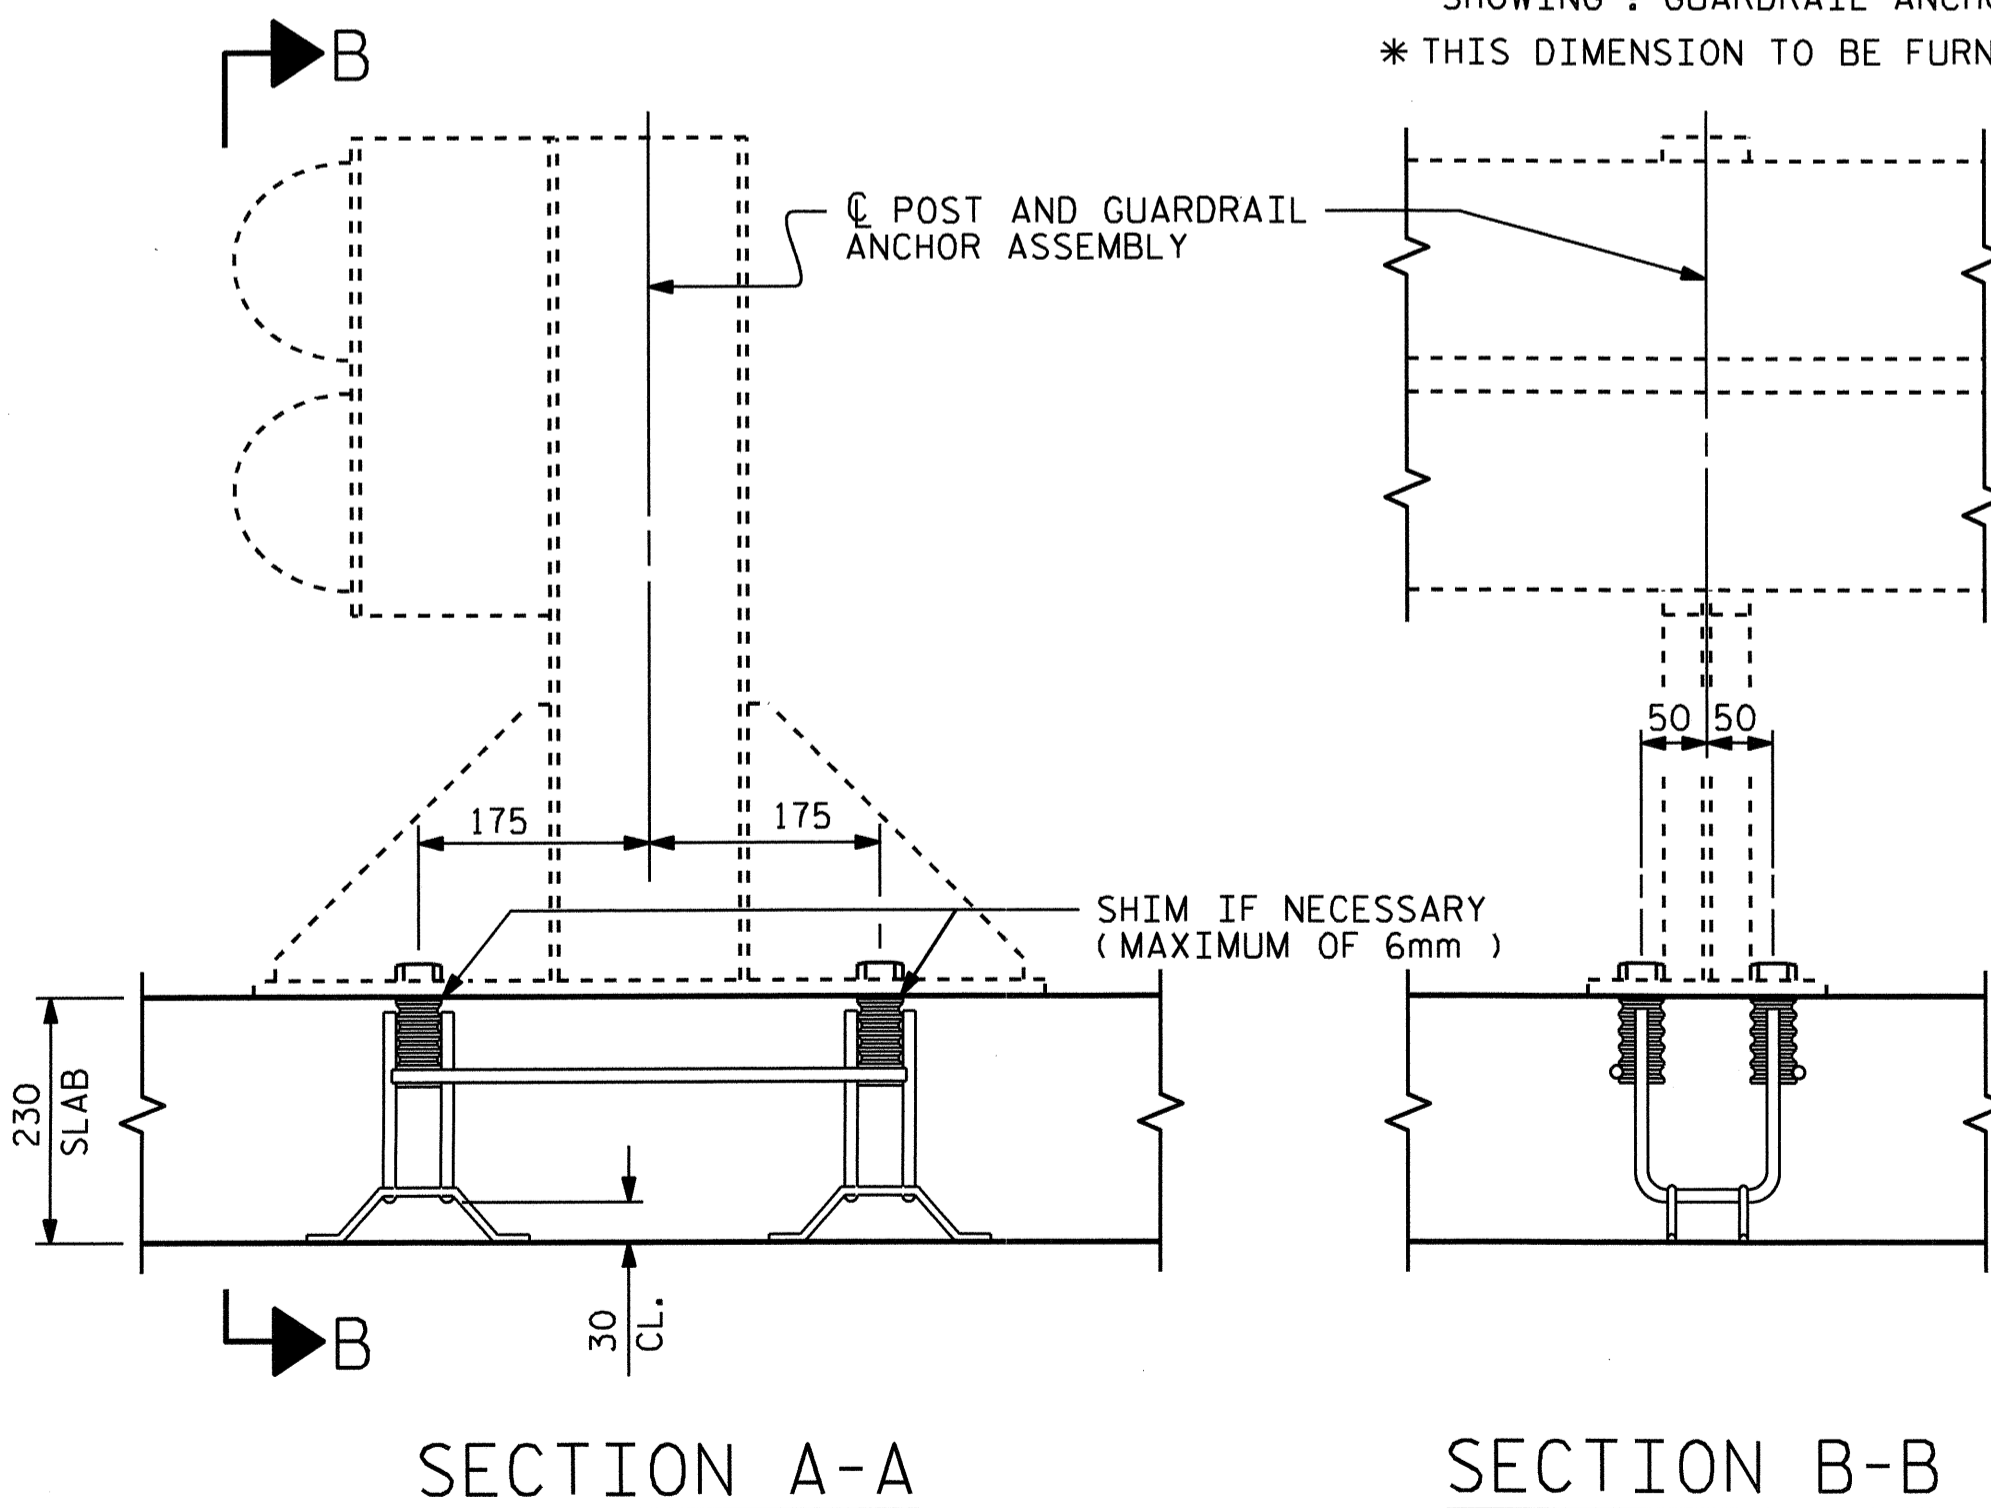


SECTION A-A

SECTION B-B

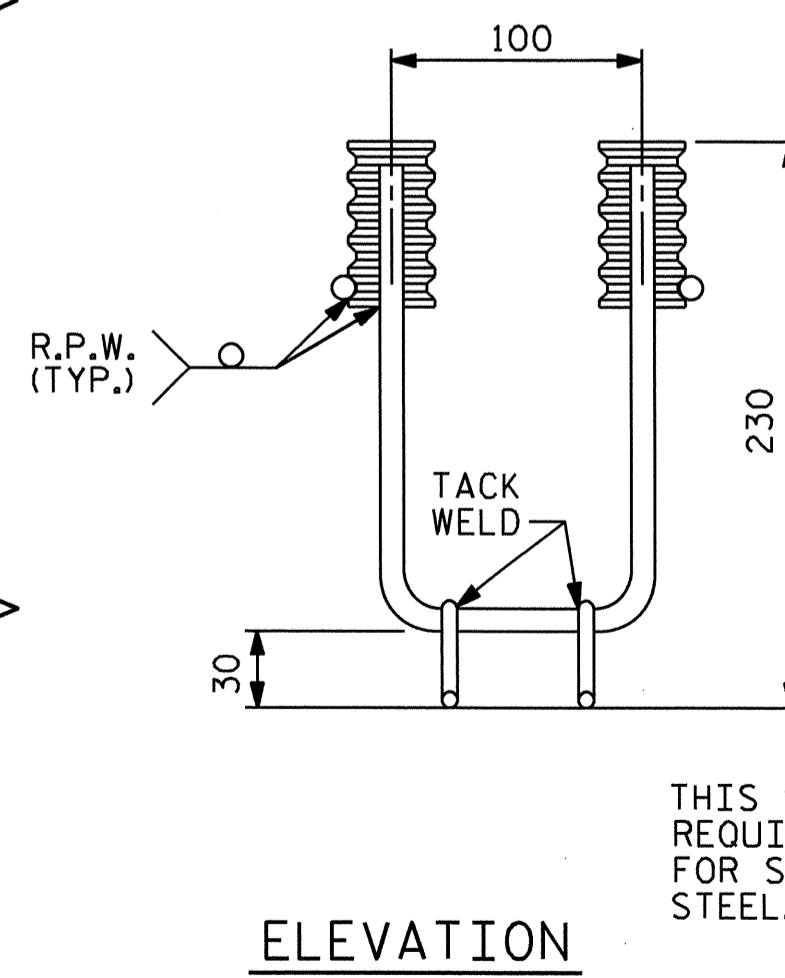

ELEVATION

THIS SUPPORT SHALL MEET THE REQUIREMENTS AS SPECIFIED FOR SUPPORTS FOR REINFORCING STEEL. SEE SPECIFICATIONS.

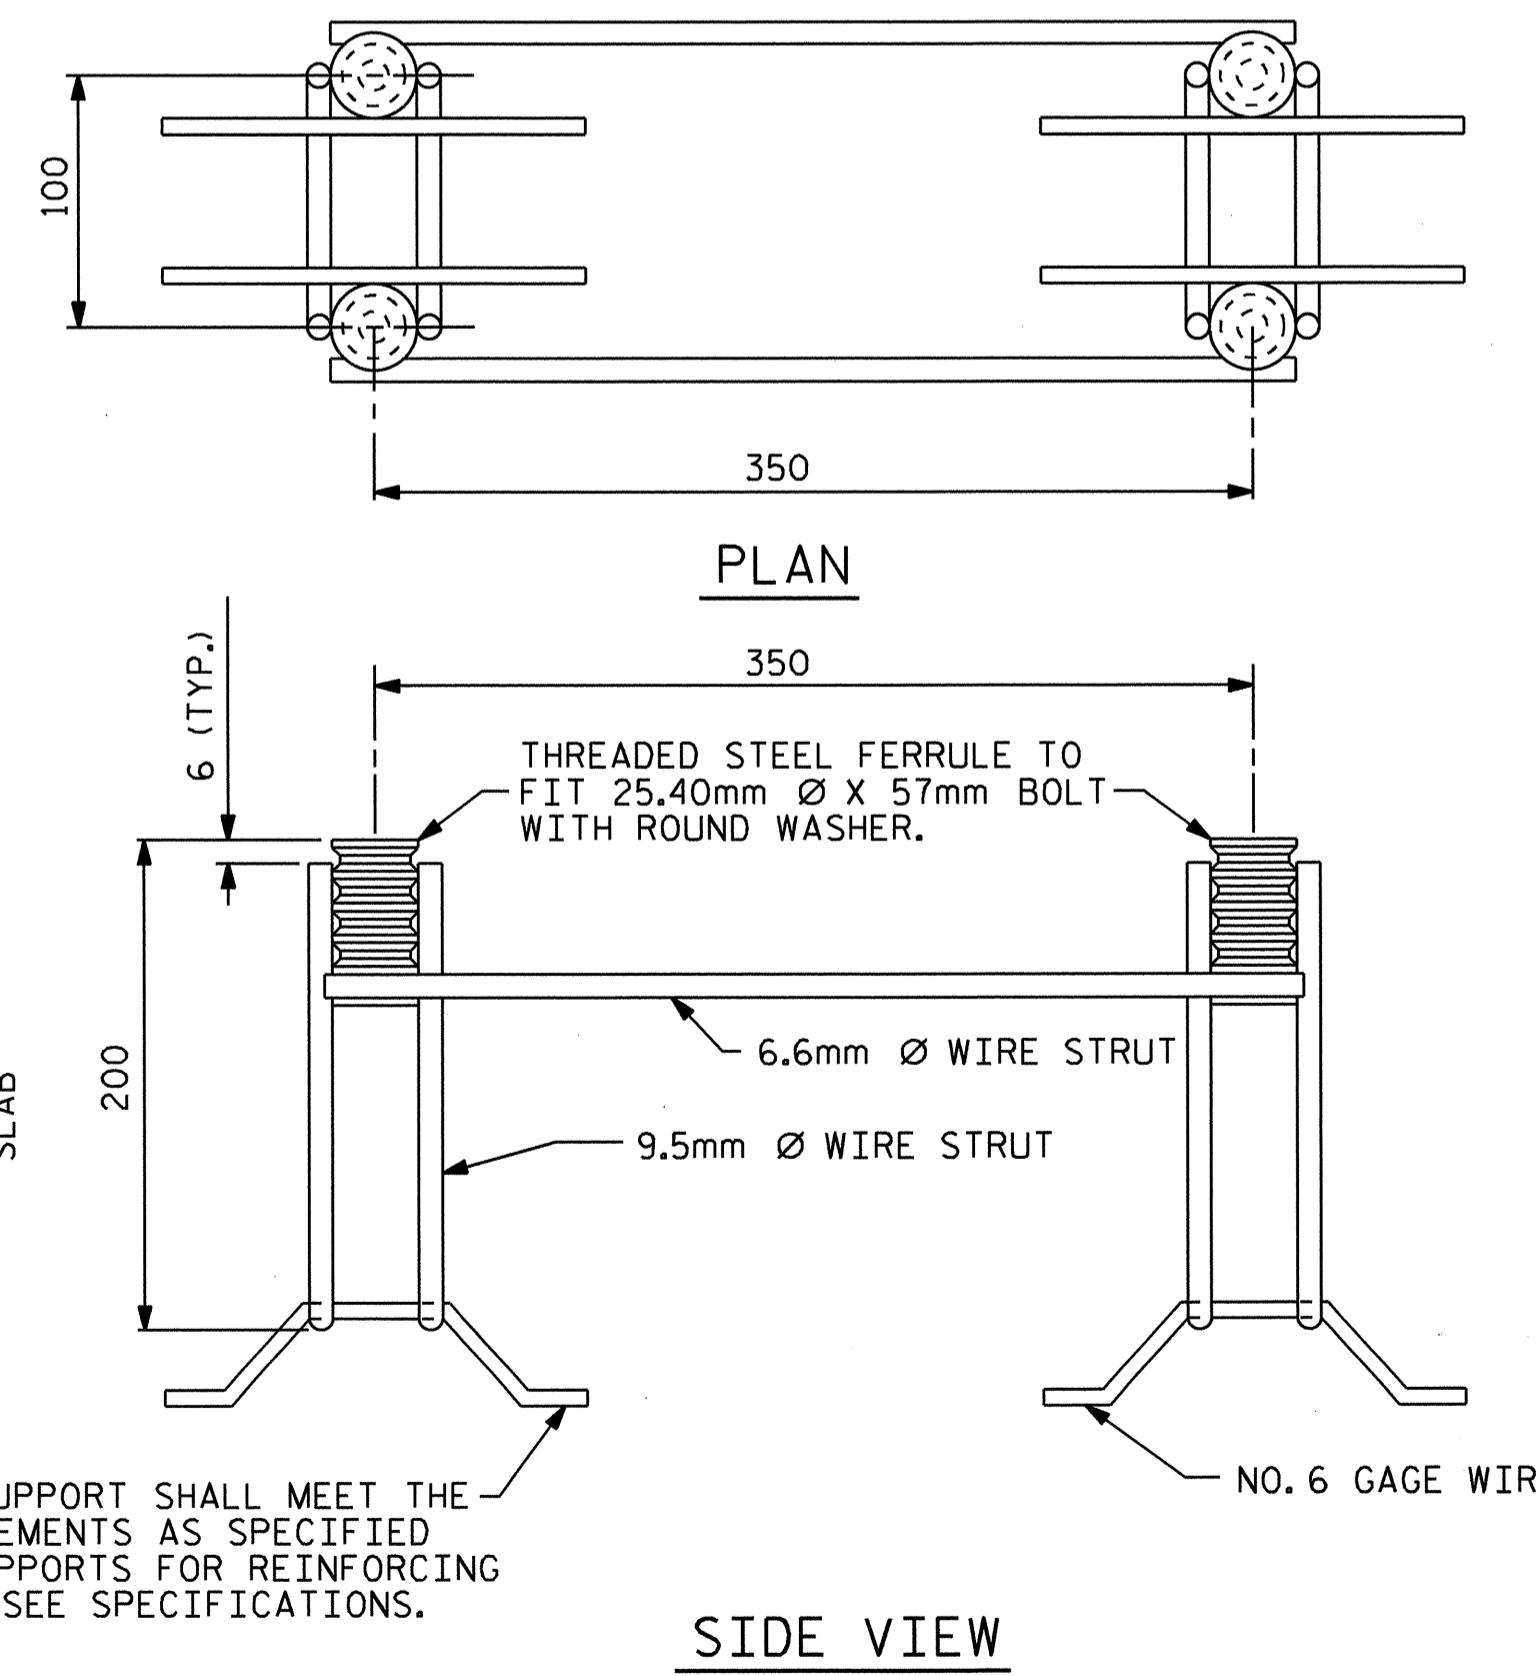

SIDE VIEW


GUARDRAIL ANCHOR ASSEMBLY FOR CULVERTS

PROJECT NO. B-4183
MADISON COUNTY
STATION: 11+16.500 -L-

SHEET 8 OF 8

STATE OF NORTH CAROLINA
DEPARTMENT OF TRANSPORTATION
RALEIGH
STANDARD
ANCHORAGE DETAILS FOR
GUARDRAIL ANCHOR ASSEMBLY
FOR CULVERTS

ASSEMBLED BY : D. HODGE	DATE : 9/11
CHECKED BY : J.R. DUGGINS	DATE : 9/11
DRAWN BY : FCJ 6/88	REV. 7/10/01 LES/RDR
CHECKED BY : ARB 6/88	REV. 5/7/03 RWW/JTE
	REV. 5/1/06R KMM/GM

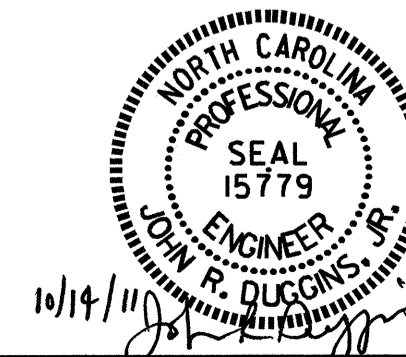

REVISIONS						SHEET NO.
NO.	BY:	DATE:	NO.	BY:	DATE:	C-15
1			3			TOTAL SHEETS 15
2			4			

