


CONTRACT: C203258 TIP PROJECT: B-4730

STRUCTURE



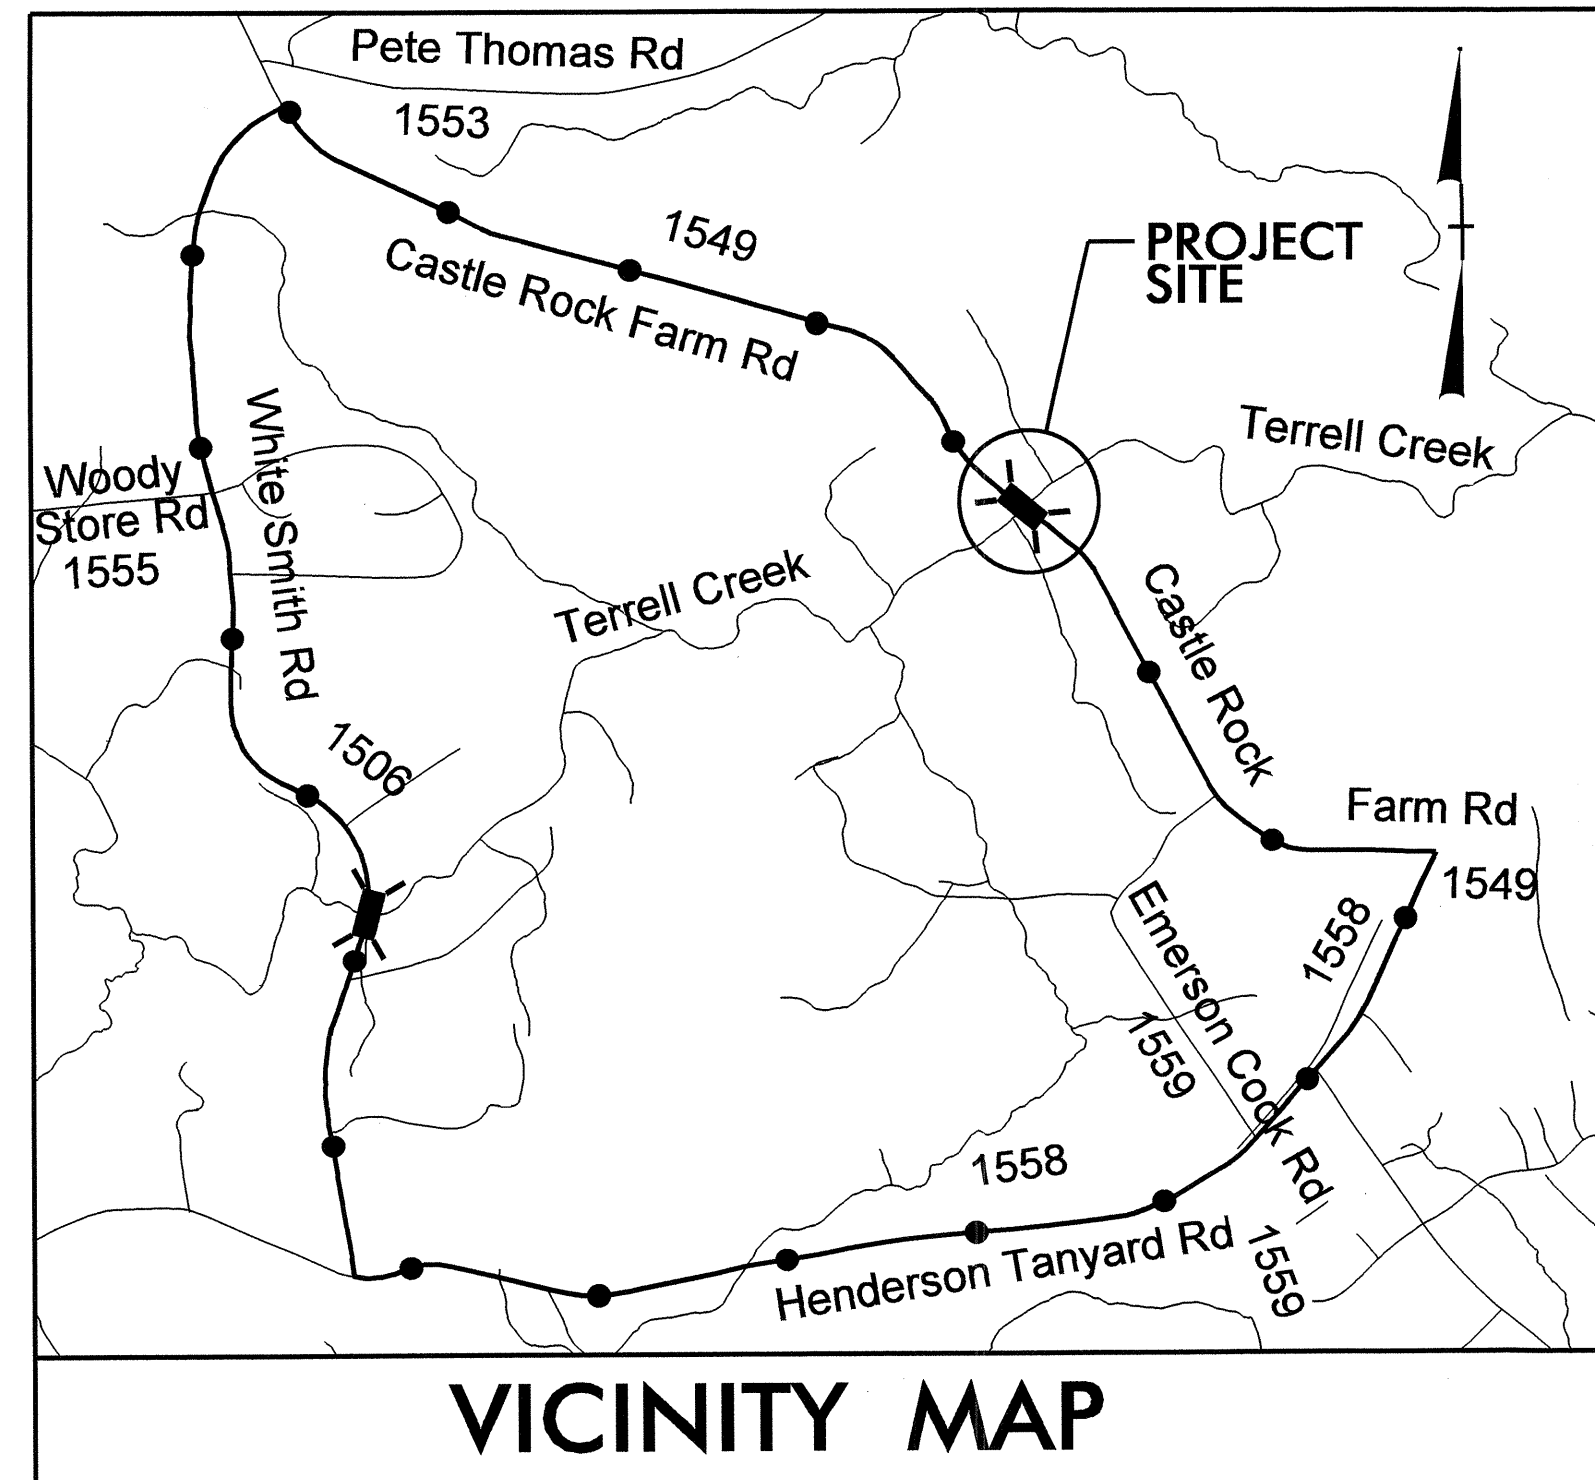


—•••••— DETOUR ROUTE

STATE OF NORTH CAROLINA
 DIVISION OF HIGHWAYS
CHATHAM COUNTY

LOCATION: BRIDGE NO. 108 OVER TERRELL CREEK ON SR 1549
 TYPE OF WORK: GRADING, DRAINAGE, PAVING, AND STRUCTURE

STATE	STATE PROJECT REFERENCE NO.	SHEET NO.	TOTAL SHEETS
N.C.	B-4730		
STATE PROJ. NO.	F.A. PROJ. NO.	DESCRIPTION	
38503.1.1	BRZ-1549(6)	P.E.	
38503.2.1	BRZ-1549(6)	UTIL. & RW	
38503.3.FD1	BRZ-1549(6)	CONST.	

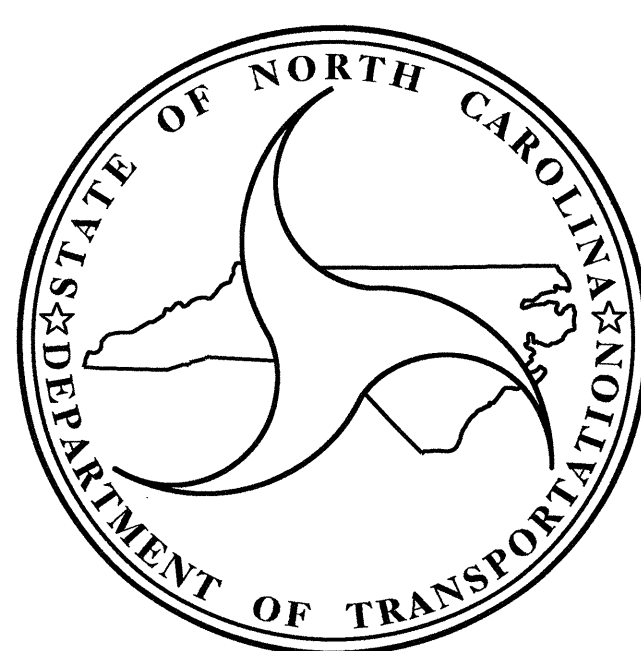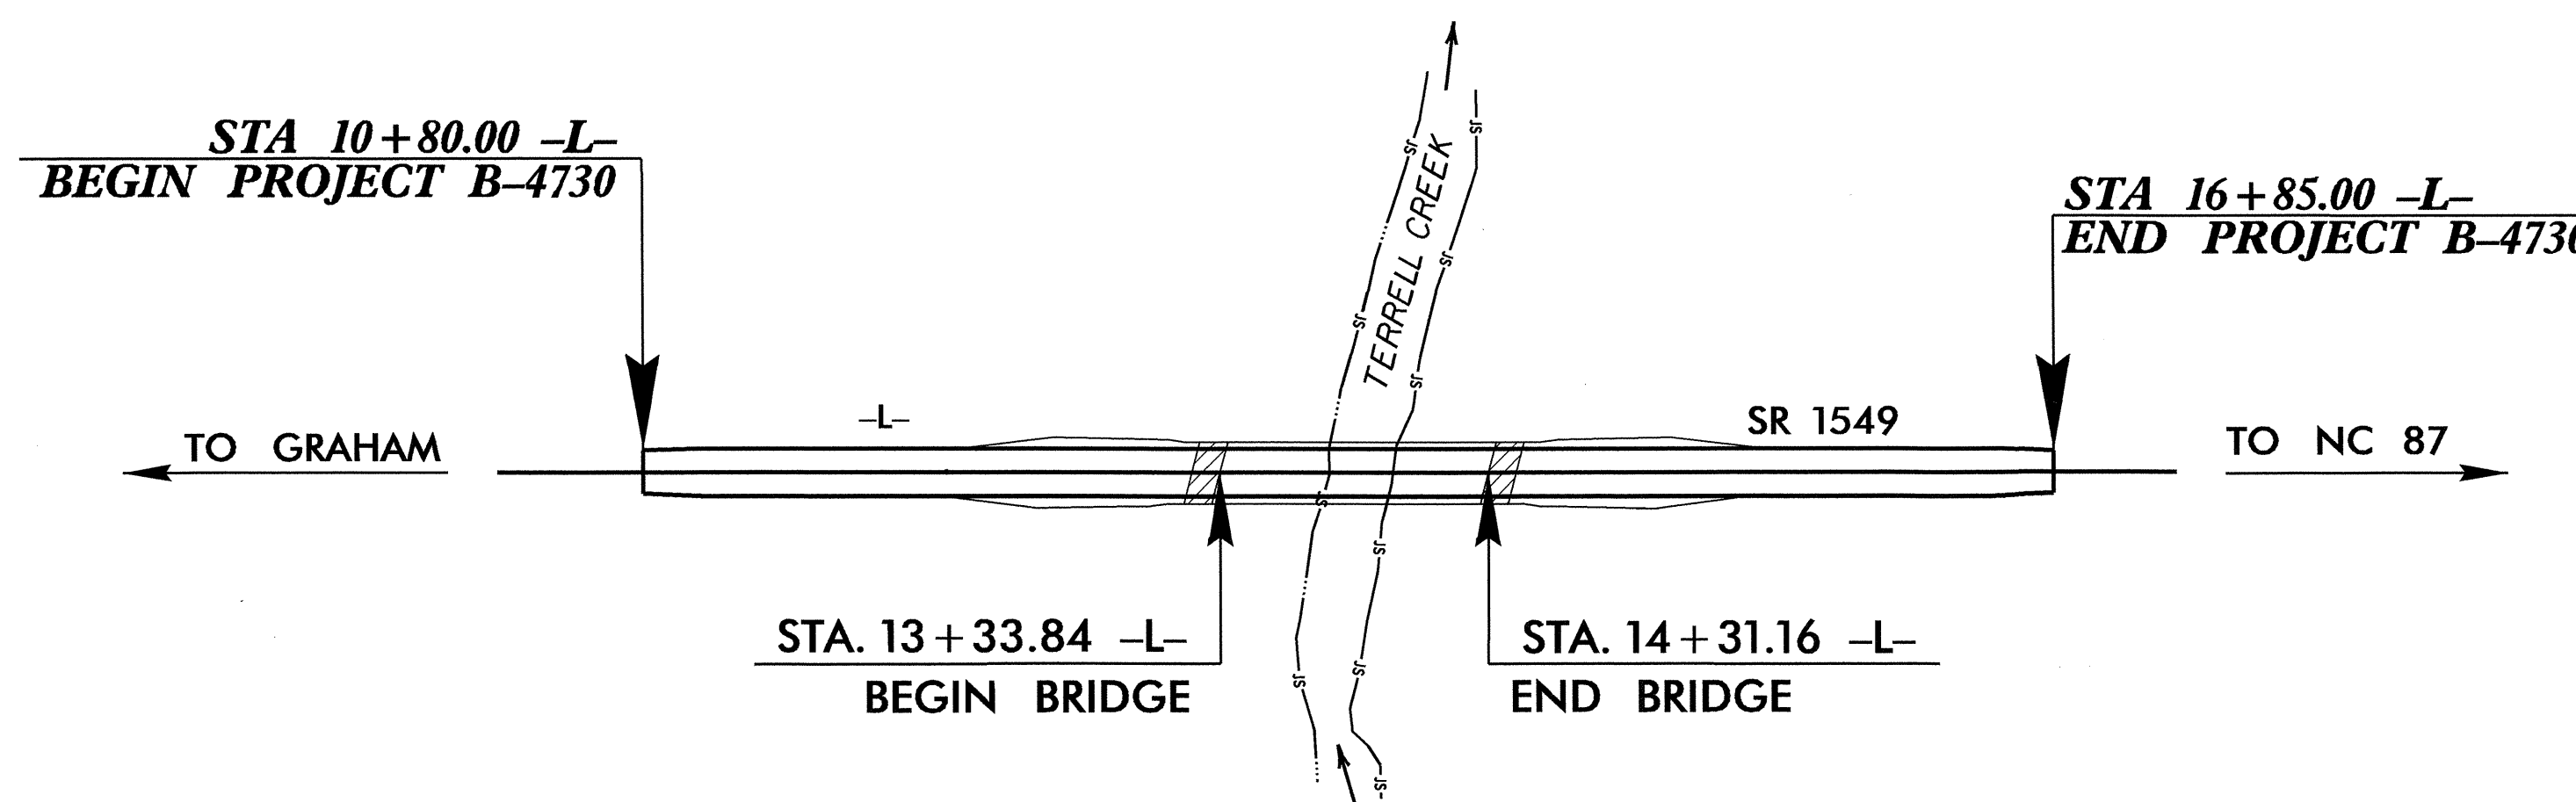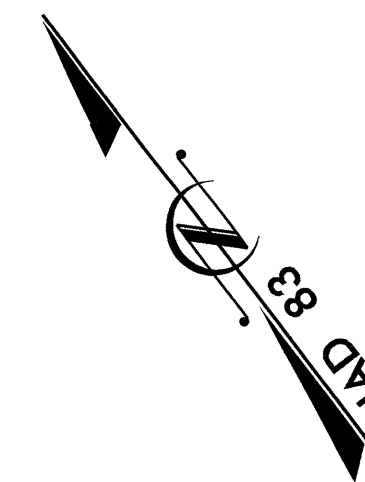

DESIGN DATA

ADT 2013 = 336
 ADT 2033 = 576
 DHV = 9 %
 D = 65 %
 T = 4 % *
 V = 60 MPH
 * (TTST = 1% + DUAL 3%)
 FUNC CLASS =
 RURAL LOCAL
 SUBREGIONAL TIER

PROJECT LENGTH

LENGTH ROADWAY TIP PROJECT B-4730 = 0.097 MI
 LENGTH STRUCTURE TIP PROJECT B-4730 = 0.018 MI
 TOTAL LENGTH TIP PROJECT B-4730 = 0.115 MI

Prepared In the Office of:

DIVISION OF HIGHWAYS

2012 STANDARD SPECIFICATIONS

LETTING DATE :
 NOVEMBER 19, 2013

J. M. BAILEY, P.E.
 PROJECT ENGINEER

T. H. FANG, P.E.
 PROJECT DESIGN ENGINEER

STRUCTURES MANAGEMENT UNIT
 1000 BIRCH RIDGE DR.
 RALEIGH, N.C. 27610

DIVISION OF HIGHWAYS
 STATE OF NORTH CAROLINA

STATE DESIGN ENGINEER _____ P.E.
 DEPARTMENT OF TRANSPORTATION
 FEDERAL HIGHWAY ADMINISTRATION

APPROVED _____ DATE _____
 DIVISION ADMINISTRATOR

-1.5861% +0.6307%

13+50

14+00

14+50


GRADE DATA

P.I. STA. = 11+55.00 -L-
EL. = 473.27
V.C. = 150'


+0.6307% 3.5136%

GRADE DATA

P.I. STA. = 15+80.00 -L-
EL. = 475.95
V.C. = 190'

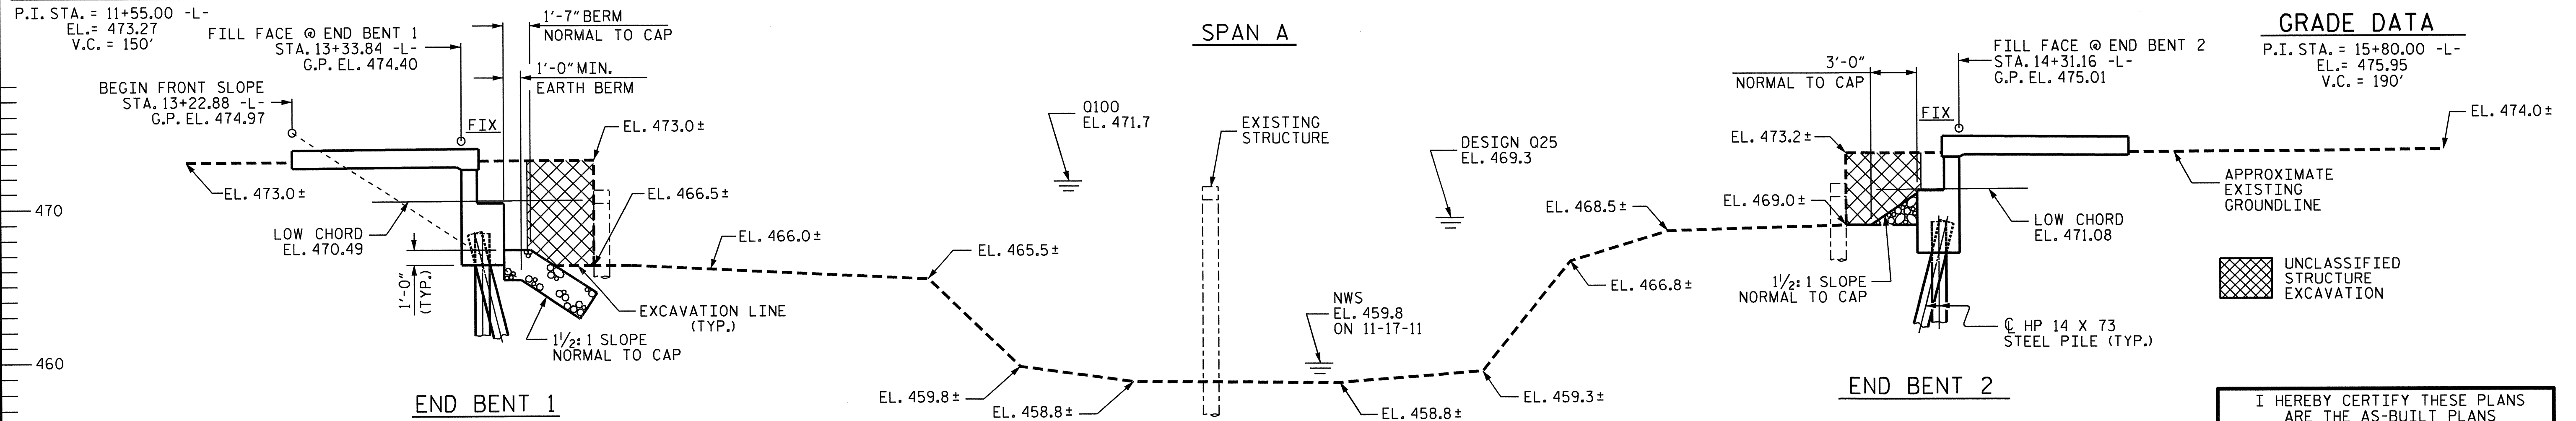


I HEREBY CERTIFY THESE PLANS ARE THE AS-BUILT PLANS

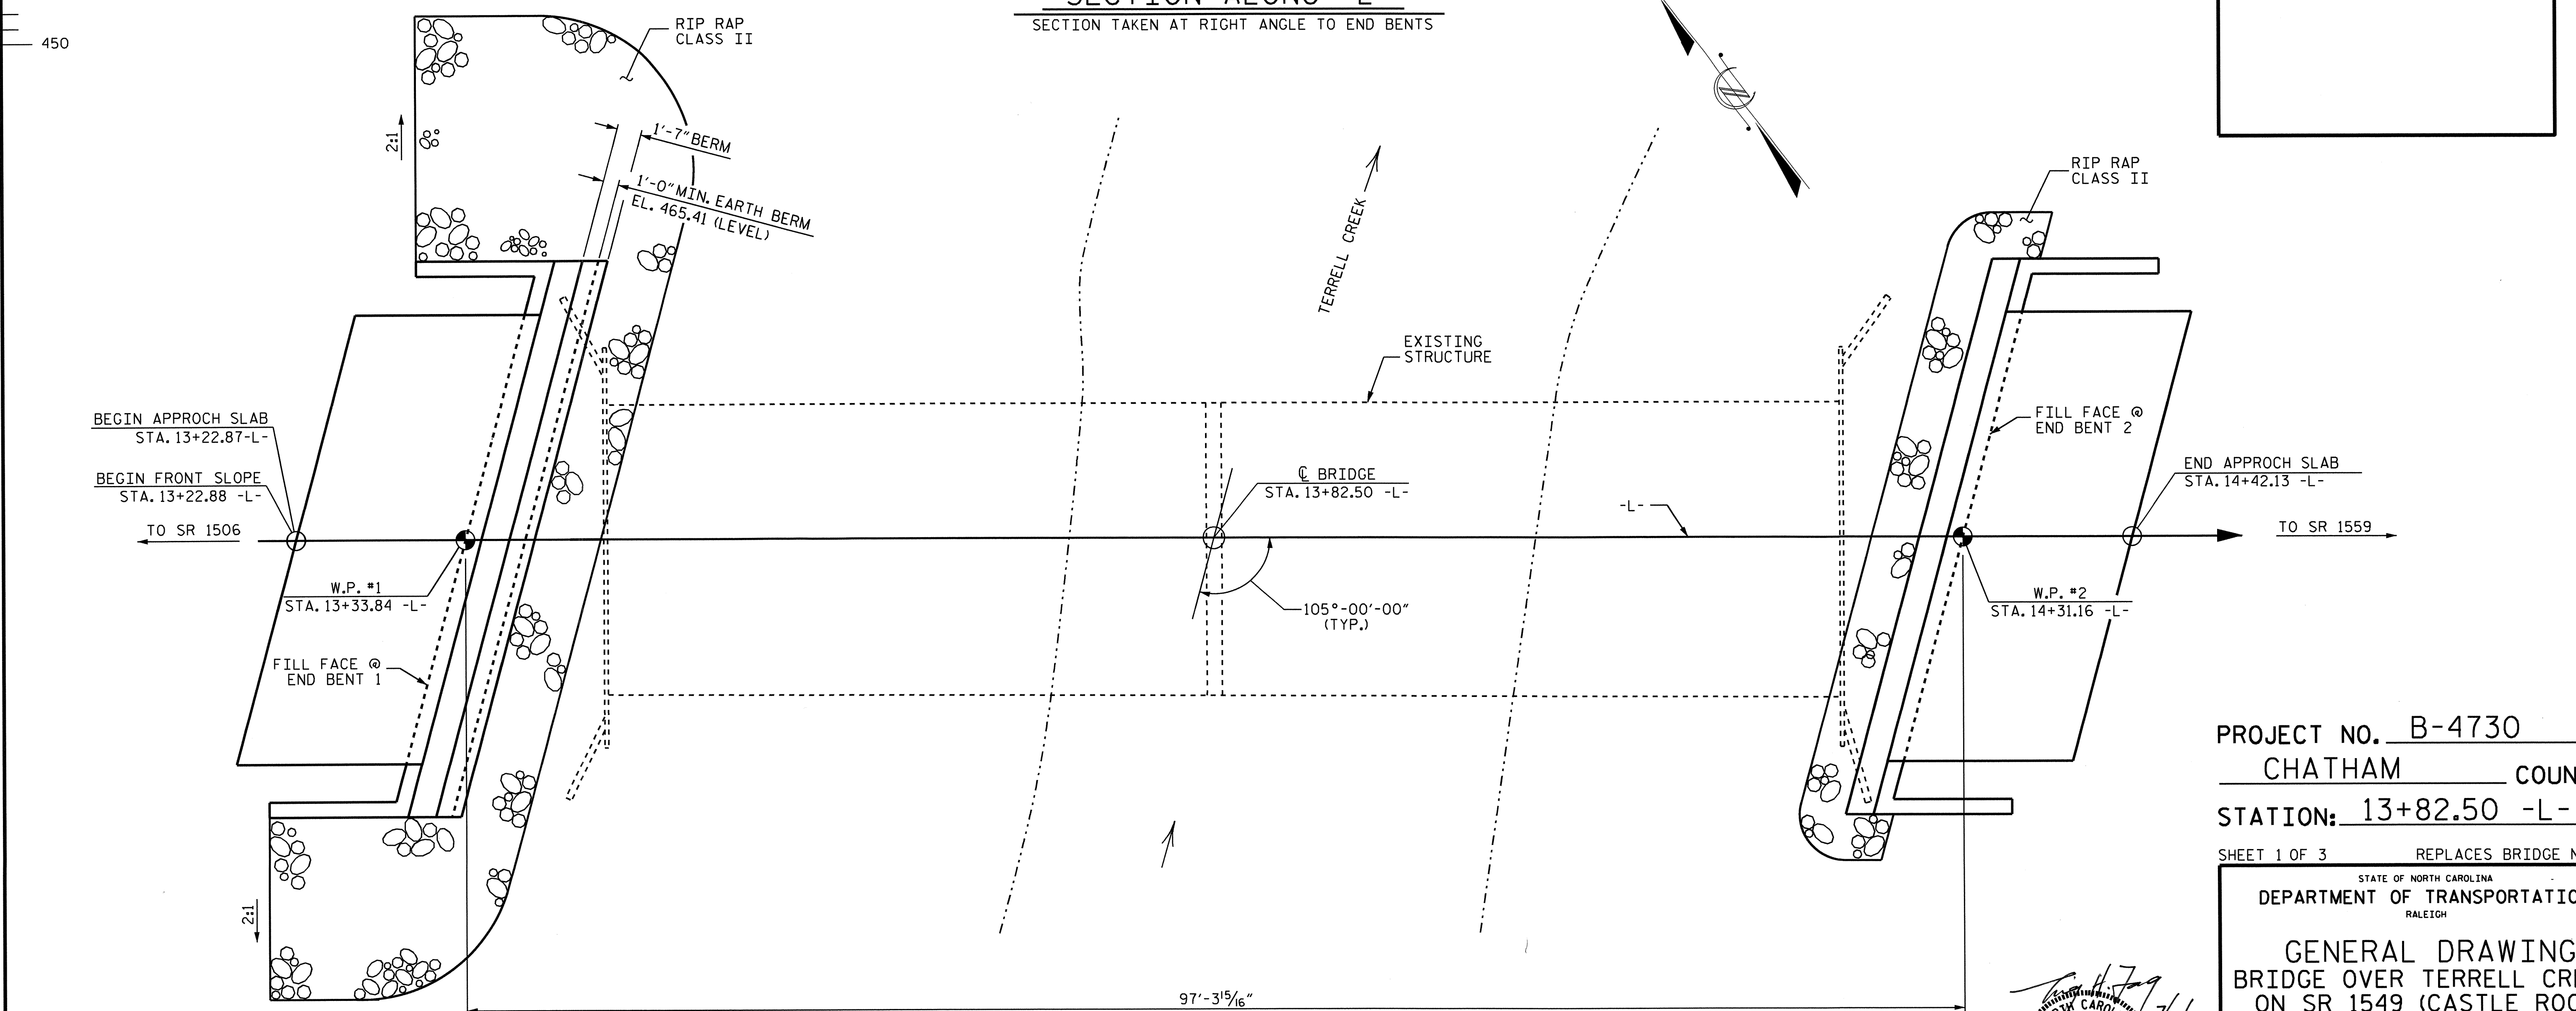

PROJECT NO. B-4730
CHATHAM COUNTY
STATION: 13+82.50 -L-

SHEET 1 OF 3 REPLACES BRIDGE NO. 108

STATE OF NORTH CAROLINA
DEPARTMENT OF TRANSPORTATION
RALEIGH
GENERAL DRAWING
BRIDGE OVER TERRELL CREEK
ON SR 1549 (CASTLE ROCK
FARM ROAD) BETWEEN
SR 1506 AND SR 1559

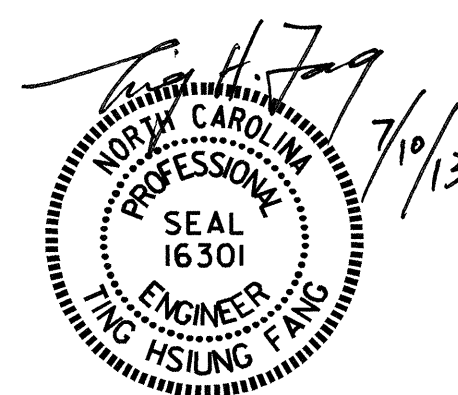

DRAWN BY: R. P. PATEL DATE: 5-24-12
CHECKED BY: I. H. FANG DATE: 5-29-12

REVISIONS						SHEET NO.
NO.	BY:	DATE:	NO.	BY:	DATE:	S-1
1			3			TOTAL SHEETS
2			4			16


NOTES

FOR PILES, SEE SECTION 450 OF THE STANDARD SPECIFICATIONS.

PILES AT END BENTS 1 AND 2 ARE DESIGNED FOR A FACTORED RESISTANCE OF 135 TONS PER PILE.

DRIVE PILES AT END BENTS 1 AND 2 TO A REQUIRED DRIVING RESISTANCE OF 225 TONS PER PILE.

STEEL H-PILE POINTS ARE REQUIRED FOR STEEL H-PILES AT END BENTS 1 AND 2. FOR STEEL PILE POINTS, SEE SECTION 450 OF THE STANDARD SPECIFICATIONS.

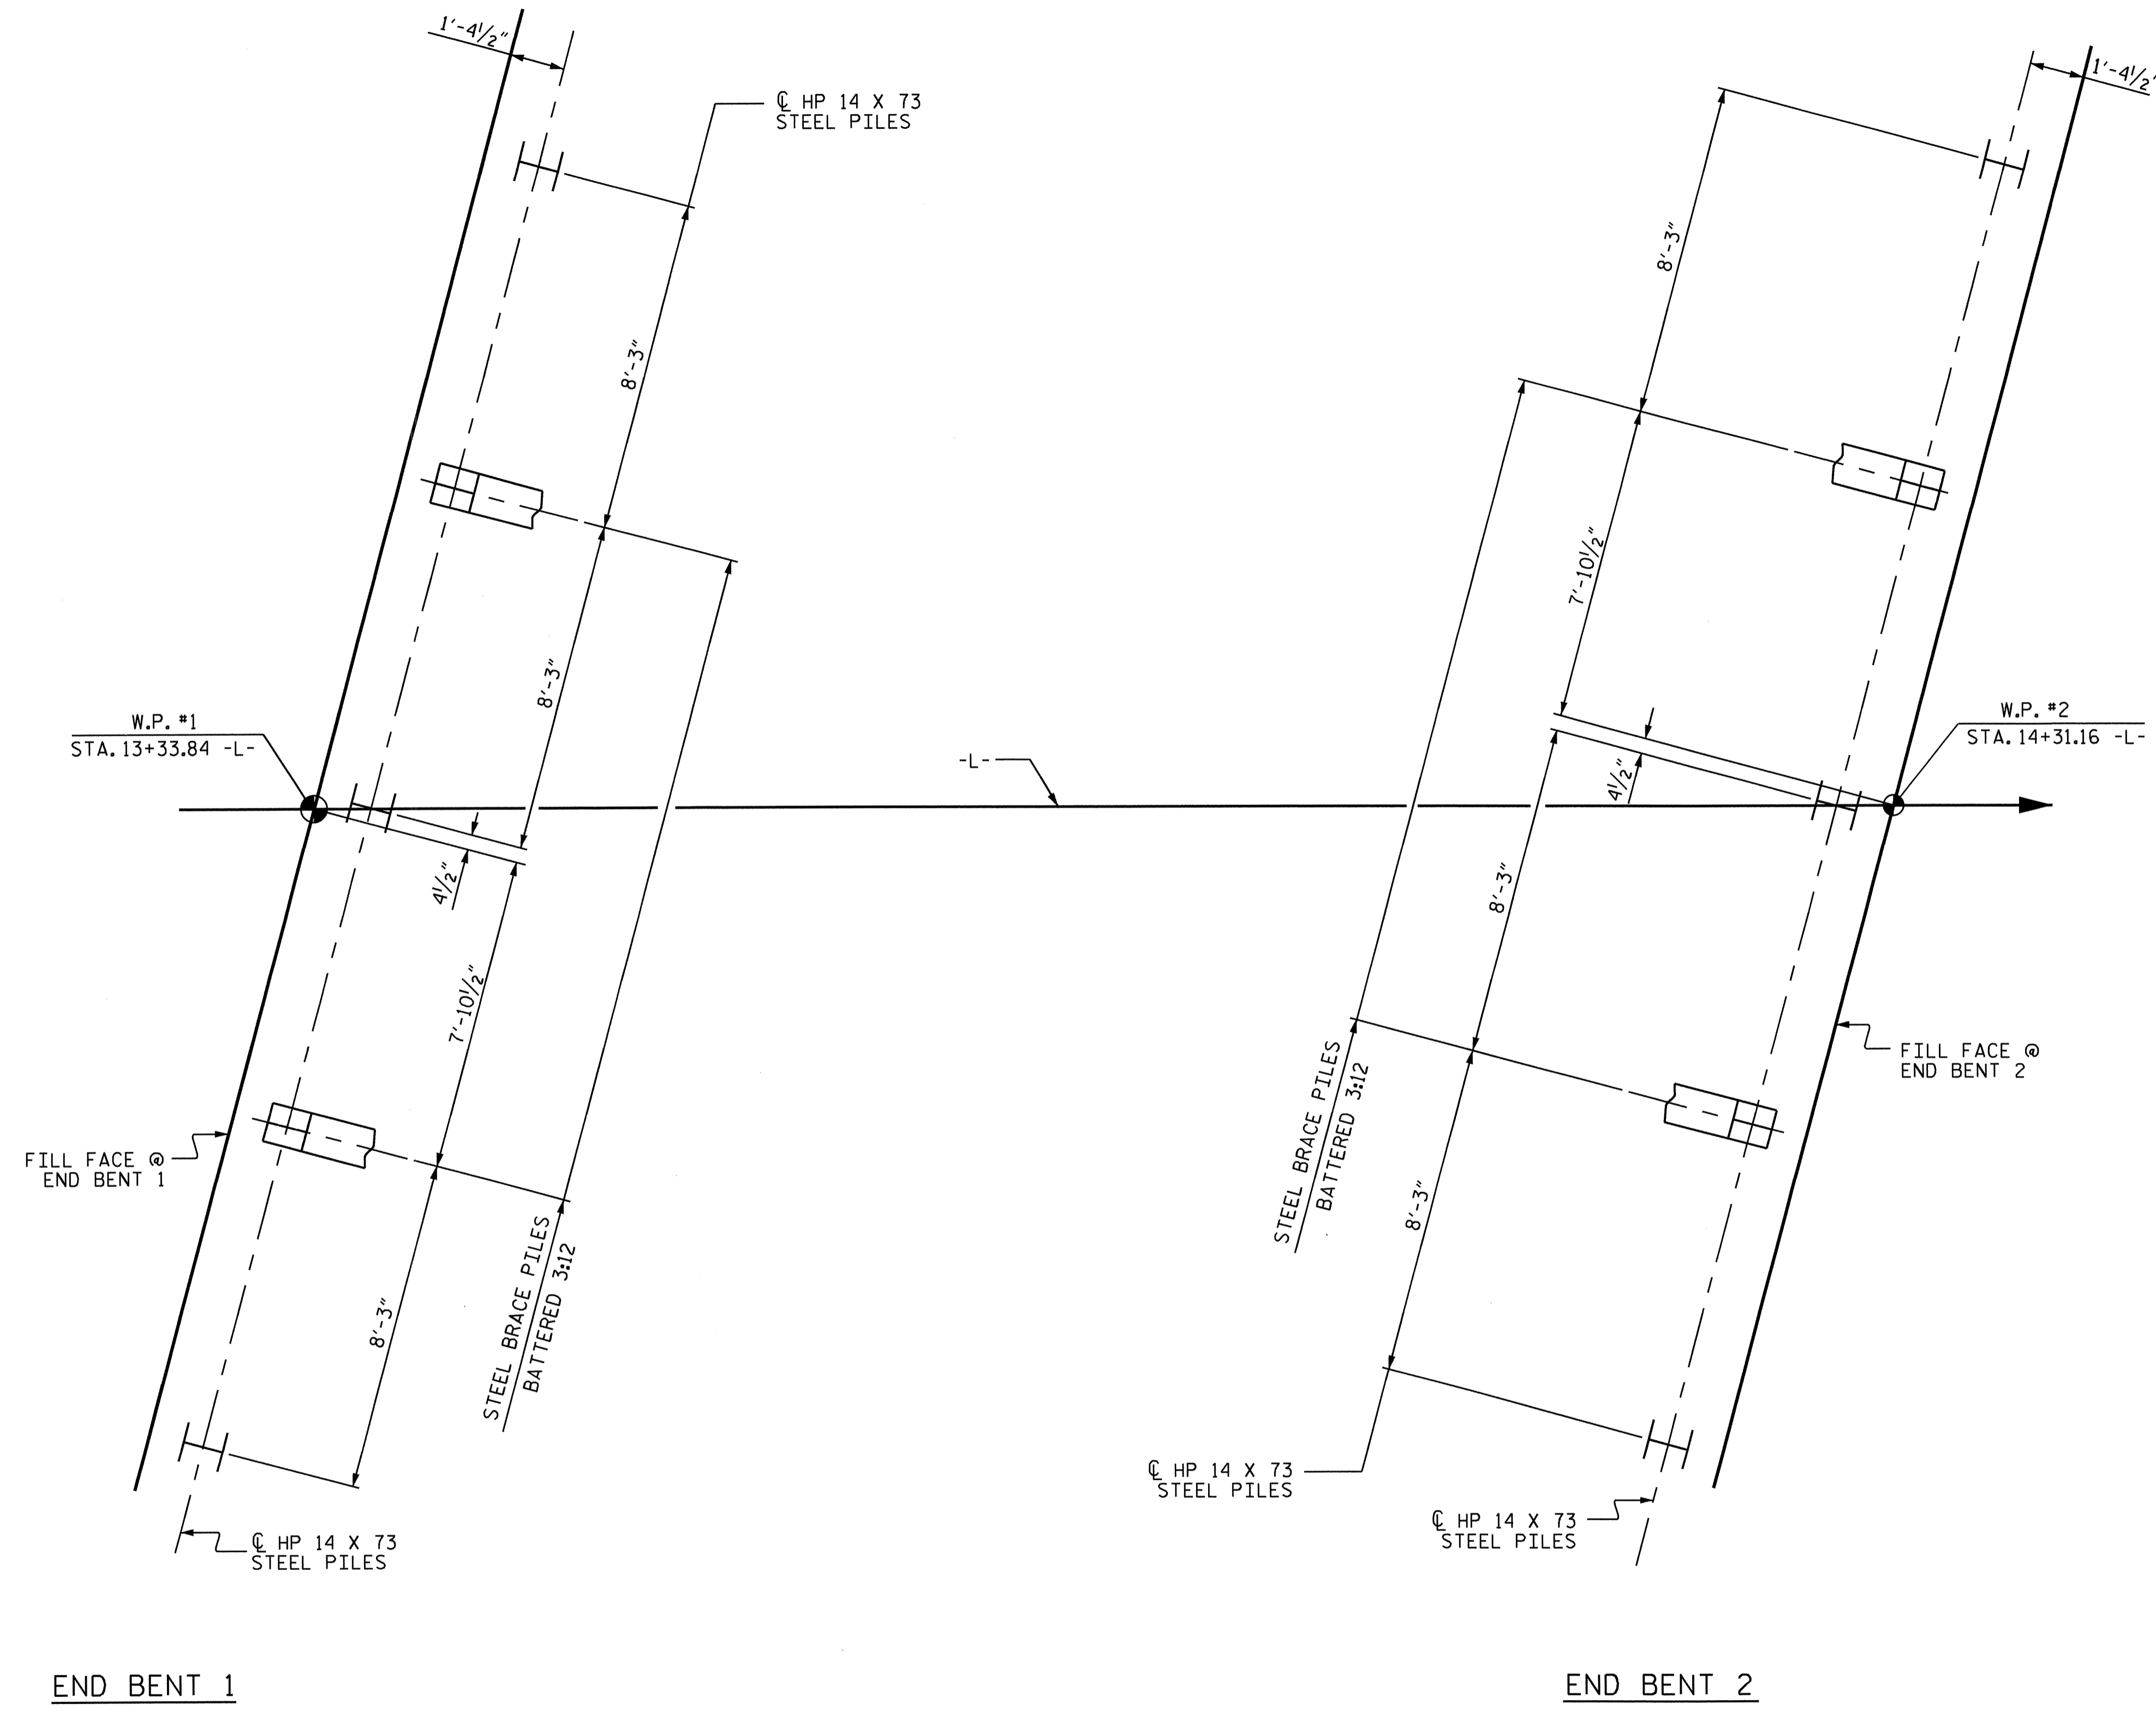

FOUNDATION LAYOUT


DIMENSIONS LOCATING PILES ARE SHOWN TO THE CENTERLINE OF PILES.

PROJECT NO. B-4730
CHATHAM COUNTY
 STATION: 13+82.50 -L-

SHEET 2 OF 3

STATE OF NORTH CAROLINA
 DEPARTMENT OF TRANSPORTATION
 RALEIGH

GENERAL DRAWING
 BRIDGE OVER TERRELL CREEK
 ON SR 1549 (CASTLE ROCK
 FARM ROAD) BETWEEN
 SR 1506 AND SR 1559

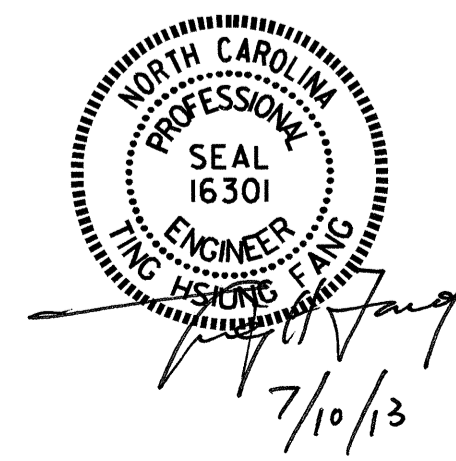


DRAWN BY : R.P.PATEL DATE : 5-25-12
 CHECKED BY : T. H. FANG DATE : 6-17-13

10-JUL-2013 12:59
 K:\TIP\Projects-B\B4730\Structures\Plans\Final Plans\b4730_sd_plans.dgn
 tjkirschbaum

REVISIONS						SHEET NO.
NO.	BY:	DATE:	NO.	BY:	DATE:	S-2
1			3			TOTAL SHEETS
2			4			16

TOTAL BILL OF MATERIAL														
	REMOVAL OF EXISTING STRUCTURE	UNCLASSIFIED STRUCTURE EXCAVATION	CLASS A CONCRETE	BRIDGE APPROACH SLABS	REINFORCING STEEL	HP 14 X 73 STEEL PILES		STEEL PILE POINTS	VERTICAL CONCRETE BARRIER RAIL	RIP RAP CLASS II (2'-0" THICK)	GEOTEXTILE FOR DRAINAGE	ELASTOMERIC BEARINGS	3'-0" X 3'-3" PRESTRESSED CONCRETE BOX BEAMS	
	LUMP SUM	LUMP SUM	CU. YDS.	LUMP SUM	LBS.	NO.	LIN. FT.	EACH	LIN. FT.	TON	SO. YD.	LUMP SUM	NO.	LIN. FT.
SUPERSTRUCTURE									190			LUMP SUM	10	950
END BENT 1		LUMP SUM	28.0		4,461	5	75	5		75	85			
END BENT 2		LUMP SUM	28.0		4,461	5	75	5		10				
TOTAL	LUMP SUM	LUMP SUM	56.0	LUMP SUM	8,922	10	150	10	190	85	85	LUMP SUM	10	950

BM 1: RR SPIKE SET IN BASE OF 18" HICKORY TREE, -L- STA. 14+53.65, 63.59 FT. RIGHT, ELEV.= 471.40'

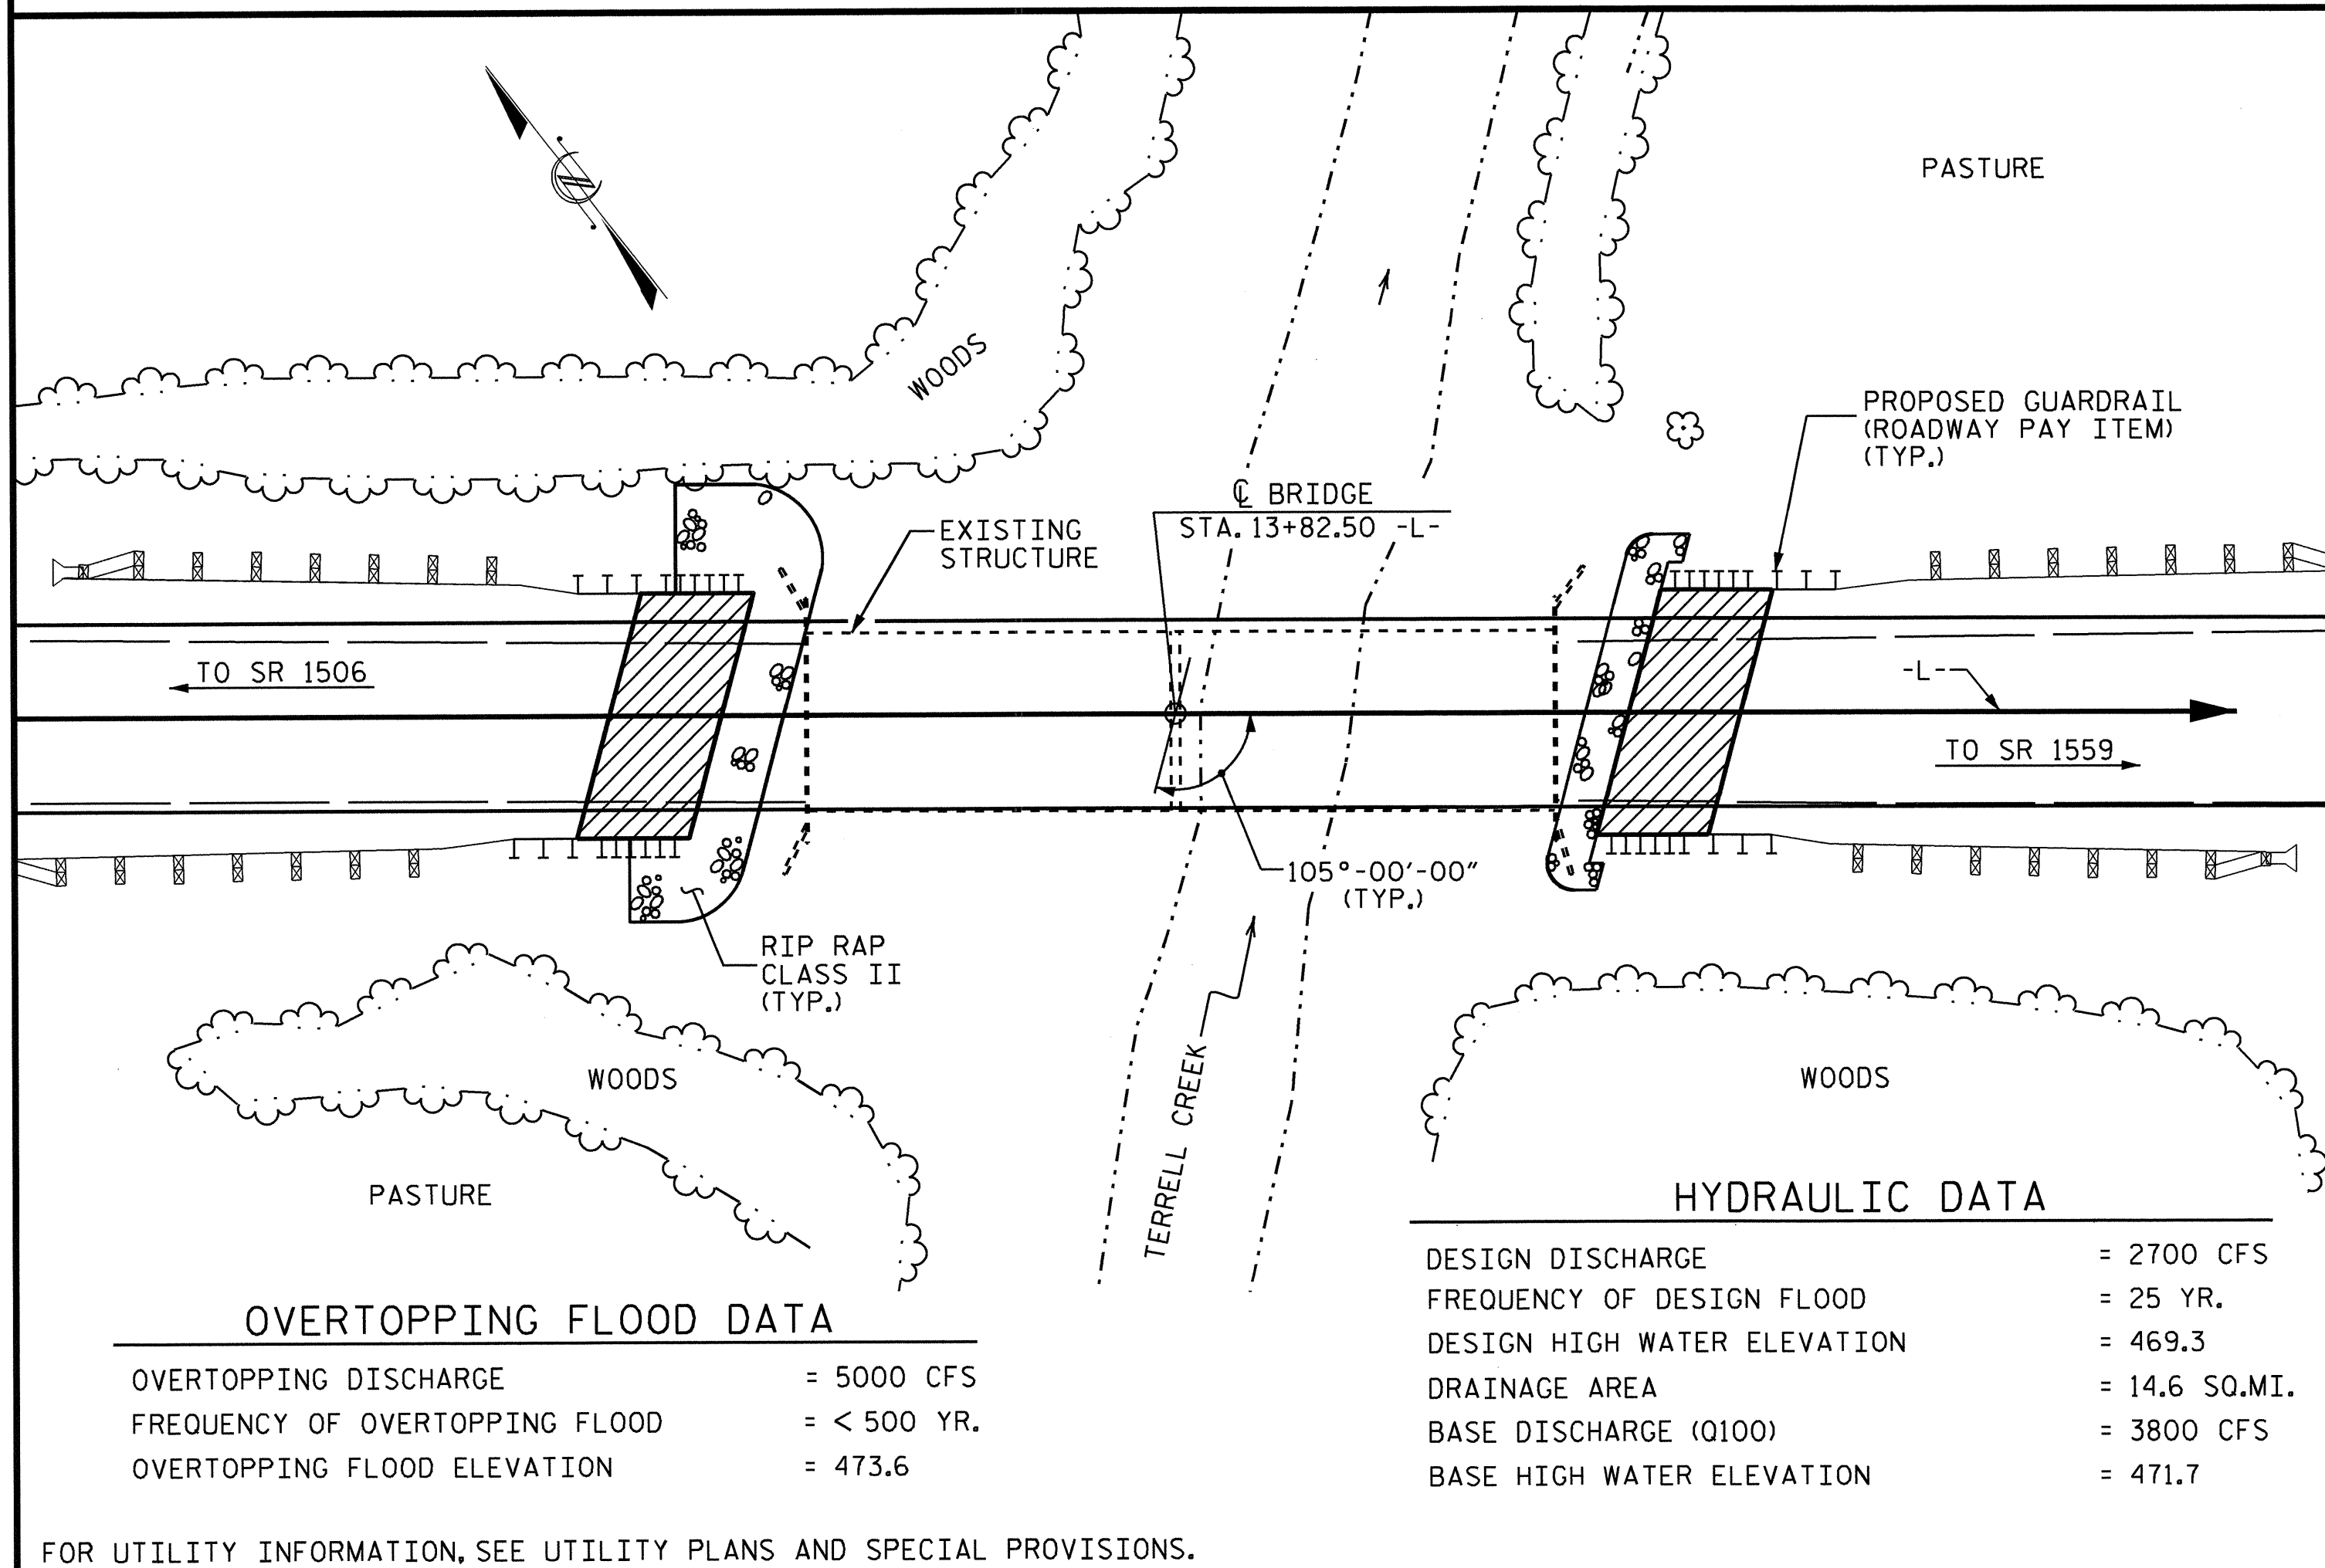

DESIGN DISCHARGE	= 2700 CFS
FREQUENCY OF DESIGN FLOOD	= 25 YR.
DESIGN HIGH WATER ELEVATION	= 469.3
DRAINAGE AREA	= 14.6 SQ. MI.
BASE DISCHARGE (Q100)	= 3800 CFS
BASE HIGH WATER ELEVATION	= 471.7

OVERTOPPING DISCHARGE	= 5000 CFS
FREQUENCY OF OVERTOPPING FLOOD	= < 500 YR.
OVERTOPPING FLOOD ELEVATION	= 473.6

FOR UTILITY INFORMATION, SEE UTILITY PLANS AND SPECIAL PROVISIONS.

LOCATION SKETCH

NOTES:

ASSUMED LIVE LOAD = HL-93 OR ALTERNATE LOADING.
 THIS BRIDGE HAS BEEN DESIGNED IN ACCORDANCE WITH THE AASHTO LRFD BRIDGE DESIGN SPECIFICATIONS.
 THIS BRIDGE IS LOCATED IN SEISMIC ZONE 1.
 FOR OTHER DESIGN DATA AND GENERAL NOTES, SEE SHEET SN.
 FOR EROSION CONTROL MEASURES SEE EROSION CONTROL PLANS.
 THIS STRUCTURE HAS BEEN DESIGNED IN ACCORDANCE WITH "HEC 18 - EVALUATING SCOUR AT BRIDGES".

THE CONTRACTOR SHALL PROVIDE INDEPENDENT ASSURANCE SAMPLES OF REINFORCING STEEL AS FOLLOWS: FOR PROJECTS REQUIRING UP TO 400 TONS OF REINFORCING STEEL, ONE 30 INCH SAMPLE OF EACH SIZE BAR USED, AND FOR PROJECTS REQUIRING OVER 400 TONS OF REINFORCING STEEL, TWO 30 INCH SAMPLES OF EACH SIZE BAR USED. THE BARS FROM WHICH THE SAMPLES ARE TAKEN MUST THEN BE SPLICED WITH REPLACEMENT BARS OF THE SIZE AND LENGTH OF THE SAMPLE, PLUS A MINIMUM LAP SPLICE OF THIRTY BAR DIAMETERS. PAYMENT FOR THE SAMPLES OF REINFORCING STEEL SHOULD BE CONSIDERED INCIDENTAL TO VARIOUS PAY ITEMS.

IN AS MUCH AS THE PAINT SYSTEM ON THE EXISTING STRUCTURAL STEEL CONTAINS LEAD, THE CONTRACTOR'S ATTENTION IS DIRECTED TO ARTICLE 107-1 OF THE STANDARD SPECIFICATIONS. ANY COSTS RESULTING FROM COMPLIANCE WITH APPLICABLE STATE OR FEDERAL REGULATIONS PERTAINING TO HANDLING OF MATERIALS CONTAINING LEAD BASED PAINT SHALL BE INCLUDED IN THE BID PRICE FOR "REMOVAL OF EXISTING STRUCTURE AT STATION 13+82.50 -L-".


THE EXISTING STRUCTURE CONSISTING OF 2 SPANS, 2 @ 40'-6", WITH A CLEAR ROADWAY WIDTH OF 19'-1" AND TIMBER DECK ON I-BEAMS WITH 3" AWS; SUBSTRUCTURE END BENTS 1 & 2 CONSISTING TIMBER CAP AND PILES, INTERIOR BENT CONSISTING OF TIMBER CAP AND PILES WITH CONCRETE ENCASEMENT AND LOCATED AT THE PROPOSED STRUCTURE SHALL BE REMOVED. THE EXISTING BRIDGE IS PRESENTLY POSTED BELOW THE LEGAL LOAD LIMIT.

THE SUBSTRUCTURE OF THE EXISTING BRIDGE INDICATED ON THE PLANS IS FROM THE BEST INFORMATION AVAILABLE. SINCE THIS INFORMATION IS SHOWN FOR THE CONVENIENCE OF THE CONTRACTOR, THE CONTRACTOR SHALL HAVE NO CLAIM WHATSOEVER AGAINST THE DEPARTMENT OF TRANSPORTATION FOR ANY DELAYS OR ADDITIONAL COST INCURRED BASED ON DIFFERENCES BETWEEN THE EXISTING BRIDGE SUBSTRUCTURE SHOWN ON THE PLANS AND THE ACTUAL CONDITIONS AT THE PROJECT SITE.

REMOVAL OF THE EXISTING BRIDGE SHALL BE PERFORMED SO AS NOT TO ALLOW DEBRIS TO FALL INTO THE WATER. THE CONTRACTOR SHALL REMOVE THE BRIDGE AND SUBMIT PLANS FOR DEMOLITION IN ACCORDANCE WITH ARTICLE 402-2 OF STANDARD SPECIFICATIONS.

THE MATERIAL SHOWN IN THE CROSS-HATCHED AREA ON SHEET S-1 SHALL BE EXCAVATED FOR A DISTANCE OF 30 FT. LEFT SIDE, 35 FT. RIGHT SIDE OF CENTERLINE ROADWAY AT END BENT 1 AND 20 FT. LEFT SIDE, 35 FT. RIGHT SIDE OF CENTERLINE ROADWAY AT END BENT 2 AS DIRECTED BY THE ENGINEER. THIS WORK WILL BE PAID FOR AT THE CONTRACT LUMP SUM PRICE FOR UNCLASSIFIED STRUCTURE EXCAVATION. SEE SECTION 412 OF THE STANDARD SPECIFICATION.

FOR CRANE SAFETY, SEE SPECIAL PROVISIONS.
 FOR FALSEWORK AND FORMWORK, SEE SPECIAL PROVISIONS.
 FOR GROUT FOR STRUCTURES, SEE SPECIAL PROVISIONS.
 FOR SUBMITTAL OF WORKING DRAWINGS, SEE SPECIAL PROVISIONS.
 ASPHALT WEARING SURFACE IS INCLUDED IN ROADWAY QUANTITY ON ROADWAY PLANS.

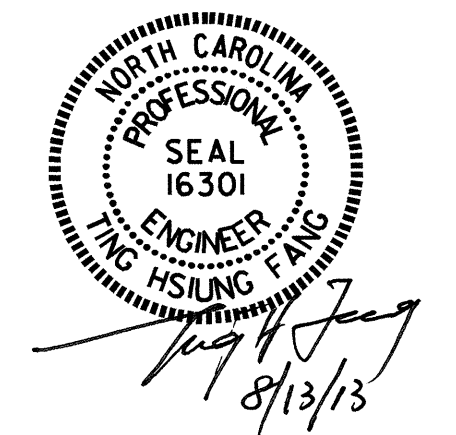

PROJECT NO. B-4730
 CHATHAM COUNTY
 STATION: 13+82.50 -L-

SHEET 3 OF 3
 STATE OF NORTH CAROLINA
 DEPARTMENT OF TRANSPORTATION
 RALEIGH
 GENERAL DRAWING
 BRIDGE OVER TERRELL CREEK
 ON SR 1549 (CASTLE ROCK FARM ROAD) BETWEEN SR 1506 AND SR 1559

DRAWN BY: S. B. WILLIAMS DATE: 6-29-12
 CHECKED BY: P. K. NEWTON DATE: 10-12

REVISIONS						SHEET NO.	
NO.	BY:	DATE:	NO.	BY:	DATE:	S-3	
1			3			TOTAL SHEETS	
2			4			16	

LOAD AND RESISTANCE FACTOR RATING (LRFD) SUMMARY FOR PRESTRESSED CONCRETE GIRDERS

LEVEL	VEHICLE	WEIGHT (W) (TONS)	CONTROLLING LOAD RATING	MINIMUM RATING FACTORS (RF)	TONS = W X RF	STRENGTH I LIMIT STATE										SERVICE III LIMIT STATE					COMMENT NUMBER			
						LIVELOAD FACTORS	MOMENT					SHEAR					LIVELOAD FACTORS	MOMENT						
							DISTRIBUTION FACTORS (DF)	RATING FACTOR	SPAN	GIRDER LOCATION	DISTANCE FROM LEFT END OF SPAN (ft)	DISTRIBUTION FACTORS (DF)	RATING FACTOR	SPAN	GIRDER LOCATION	DISTANCE FROM LEFT END OF SPAN (ft)		DISTRIBUTION FACTORS (DF)	RATING FACTOR	SPAN		GIRDER LOCATION	DISTANCE FROM LEFT END OF SPAN (ft)	
DESIGN LOAD RATING	HL-93(Inv)	N/A	1	1.335	--	1.75	0.268	1.52	A	EL	46.724	0.574	1.35	A	EL	9.345	0.80	0.268	1.34	A	EL	46.724		
	HL-93(0pr)	N/A	--	1.752	--	1.35	0.268	1.97	A	EL	46.724	0.574	1.75	A	EL	9.345	N/A	--	--	--	--	--		
	HS-20(Inv)	36.000	2	1.784	64.228	1.75	0.268	2.09	A	EL	46.724	0.574	1.78	A	EL	9.345	0.80	0.268	1.84	A	EL	46.724		
	HS-20(0pr)	36.000	--	2.313	83.258	1.35	0.268	2.71	A	EL	46.724	0.574	2.31	A	EL	9.345	N/A	--	--	--	--	--		
LEGAL LOAD RATING	SV	SNSH	13.500	--	4.320	58.323	1.4	0.268	6.14	A	EL	46.724	0.574	5.46	A	EL	9.345	0.80	0.268	4.32	A	EL	46.724	
		SNGARBS2	20.000	--	3.143	62.855	1.4	0.268	4.47	A	EL	46.724	0.574	3.83	A	EL	9.345	0.80	0.268	3.14	A	EL	46.724	
		SNAGRIS2	22.000	--	2.945	64.794	1.4	0.268	4.19	A	EL	46.724	0.574	3.54	A	EL	9.345	0.80	0.268	2.95	A	EL	46.724	
		SNCOTTS3	27.250	--	2.148	58.522	1.4	0.268	3.05	A	EL	46.724	0.574	2.72	A	EL	9.345	0.80	0.268	2.15	A	EL	46.724	
		SNAGGRS4	34.925	--	1.765	61.649	1.4	0.268	2.51	A	EL	46.724	0.574	2.22	A	EL	9.345	0.80	0.268	1.77	A	EL	46.724	
		SNS5A	35.550	--	1.728	61.435	1.4	0.268	2.46	A	EL	46.724	0.574	2.24	A	EL	9.345	0.80	0.268	1.73	A	EL	46.724	
		SNS6A	39.950	--	1.573	62.861	1.4	0.268	2.24	A	EL	46.724	0.574	2.03	A	EL	9.345	0.80	0.268	1.57	A	EL	46.724	
	SNS7B	42.000	--	1.498	62.916	1.4	0.268	2.13	A	EL	46.724	0.574	1.97	A	EL	9.345	0.80	0.268	1.50	A	EL	46.724		
	TTST	TNAGRIT3	33.000	--	1.915	63.203	1.4	0.268	2.72	A	EL	46.724	0.574	2.42	A	EL	9.345	0.80	0.268	1.92	A	EL	46.724	
		TNT4A	33.075	--	1.920	63.518	1.4	0.268	2.73	A	EL	46.724	0.574	2.37	A	EL	9.345	0.80	0.268	1.92	A	EL	46.724	
		TNT6A	41.600	--	1.559	64.849	1.4	0.268	2.22	A	EL	46.724	0.574	2.07	A	EL	9.345	0.80	0.268	1.56	A	EL	46.724	
		TNT7A	42.000	--	1.561	65.548	1.4	0.268	2.22	A	EL	46.724	0.574	2.04	A	EL	9.345	0.80	0.268	1.56	A	EL	46.724	
		TNT7B	42.000	--	1.600	67.198	1.4	0.268	2.28	A	EL	46.724	0.574	1.94	A	EL	9.345	0.80	0.268	1.60	A	EL	46.724	
		TNAGRIT4	43.000	--	1.533	65.913	1.4	0.268	2.18	A	EL	46.724	0.574	1.88	A	EL	9.345	0.80	0.268	1.53	A	EL	46.724	
TNAGT5A		45.000	--	1.450	65.269	1.4	0.268	2.06	A	EL	46.724	0.574	1.85	A	EL	9.345	0.80	0.268	1.45	A	EL	46.724		
TNAGT5B	45.000	3	1.437	64.685	1.4	0.268	2.04	A	EL	46.724	0.574	1.79	A	EL	9.345	0.80	0.268	1.44	A	EL	46.724			

LOAD FACTORS:

DESIGN LOAD RATING FACTORS	LIMIT STATE	γ _{DC}	γ _{DW}
	STRENGTH I	1.25	1.50
	SERVICE III	1.00	1.00

NOTES:


MINIMUM RATING FACTORS ARE BASED ON THE STRENGTH I AND SERVICE III LIMIT STATES.

ALLOWABLE STRESSES FOR SERVICE III LIMIT STATE ARE AS REQUIRED FOR DESIGN.


COMMENTS:

-
-
-
-

#	CONTROLLING LOAD RATING
1	DESIGN LOAD RATING (HL-93)
2	DESIGN LOAD RATING (HS-20)
3	LEGAL LOAD RATING **
** SEE CHART FOR VEHICLE TYPE	
GIRDER LOCATION	
I - INTERIOR GIRDER EL - EXTERIOR LEFT GIRDER ER - EXTERIOR RIGHT GIRDER	

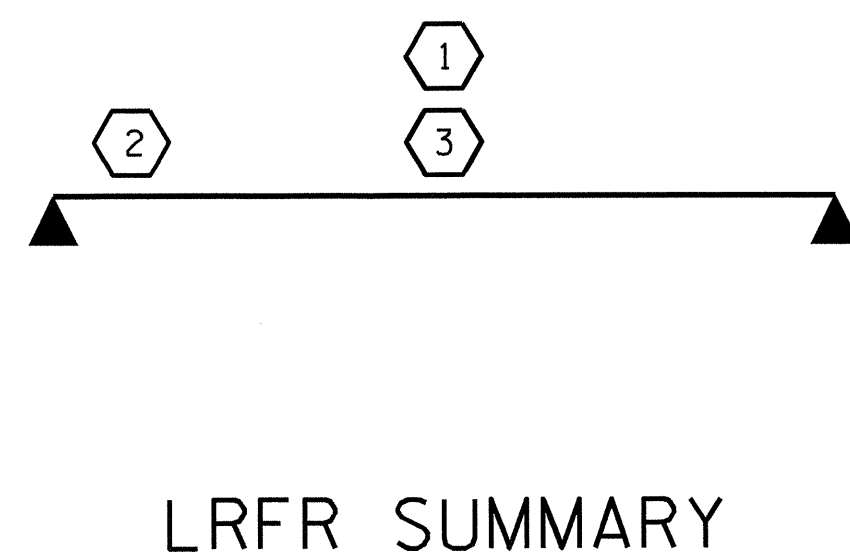

PROJECT NO. B-4730
CHATHAM COUNTY
 STATION: 13+82.50 -L-

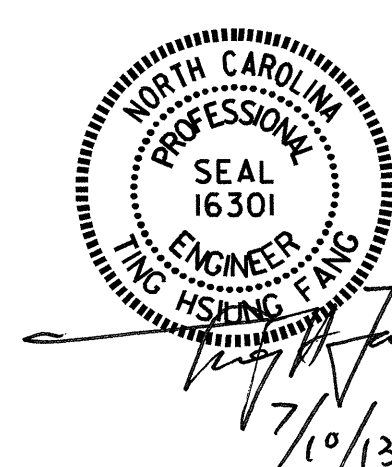

STATE OF NORTH CAROLINA
 DEPARTMENT OF TRANSPORTATION
 RALEIGH
 STANDARD
 LRFR SUMMARY FOR
 95' BOX BEAM UNIT
 105° SKEW
 (NON-INTERSTATE TRAFFIC)

REVISIONS						SHEET NO.
NO.	BY:	DATE:	NO.	BY:	DATE:	S-4
1			3			TOTAL SHEETS 16
2			4			

ASSEMBLED BY : R.P.PATEL DATE : 5-25-12
 CHECKED BY : P.K. NEWTON DATE : 10-12
 DRAWN BY : TMG II/II
 CHECKED BY : AAC II/II

NOTES

ALL PRESTRESSING STRANDS SHALL BE 7-WIRE LOW RELAXATION GRADE 270 STRANDS AND SHALL CONFORM TO AASHTO M203 EXCEPT FOR SAMPLING REQUIREMENTS WHICH SHALL BE IN ACCORDANCE WITH THE STANDARD SPECIFICATIONS.

ALL REINFORCING STEEL CAST WITH THE BOX BEAM SECTIONS SHALL BE GRADE 60 AND SHALL BE INCLUDED IN THE UNIT PRICE BID FOR PRESTRESSED CONCRETE BOX BEAMS.

RECESSES FOR TRANSVERSE STRANDS SHALL BE GROUTED AFTER THE TENSIONING OF THE STRANDS.

THE 2 1/2" Ø DOWEL HOLES AT FIXED ENDS OF BOX BEAM SECTIONS SHALL BE FILLED WITH NON-SHRINK GROUT.

THE BACKER ROD SHALL CONFORM TO THE REQUIREMENTS OF TYPE M BOND BREAKER, SEE SECTION 1028 OF THE STANDARD SPECIFICATIONS.

THE TRANSFER OF LOAD FROM THE ANCHORAGES TO THE BOX BEAM UNIT SHALL BE DONE WHEN THE CONCRETE HAS REACHED A COMPRESSIVE STRENGTH OF NOT LESS THAN 5500 PSI.

ALL REINFORCING STEEL IN VERTICAL CONCRETE BARRIER RAILS SHALL BE EPOXY COATED.


PRESTRESSING STRANDS SHALL BE CUT FLUSH WITH THE BOX BEAM UNIT ENDS.

APPLY EPOXY PROTECTIVE COATING TO BOX BEAM UNIT ENDS.

VERTICAL GROOVED CONTRACTION JOINTS, 1/2" IN DEPTH, SHALL BE TOOLED IN ALL EXPOSED FACES OF THE BARRIER RAIL AND IN ACCORDANCE WITH ARTICLE 825-10(B) OF THE STANDARD SPECIFICATIONS. A VERTICAL CONTRACTION JOINT SHALL BE LOCATED AT EACH THIRD POINT BETWEEN BARRIER RAIL EXPANSION JOINTS. ONLY ONE CONTRACTION JOINT IS REQUIRED AT MIDPOINT OF BARRIER RAIL SEGMENTS LESS THAN 20 FEET IN LENGTH AND NO CONTRACTION JOINTS ARE REQUIRED FOR THOSE SEGMENTS LESS THAN 10 FEET IN LENGTH.

THE LOCATION OF THE VOID DRAINS MAY BE SHIFTED SLIGHTLY WHERE NECESSARY TO CLEAR PRESTRESSING STRANDS OR TRANSVERSE REINFORCING STEEL.


FOR GROUT FOR STRUCTURES, SEE SPECIAL PROVISIONS.

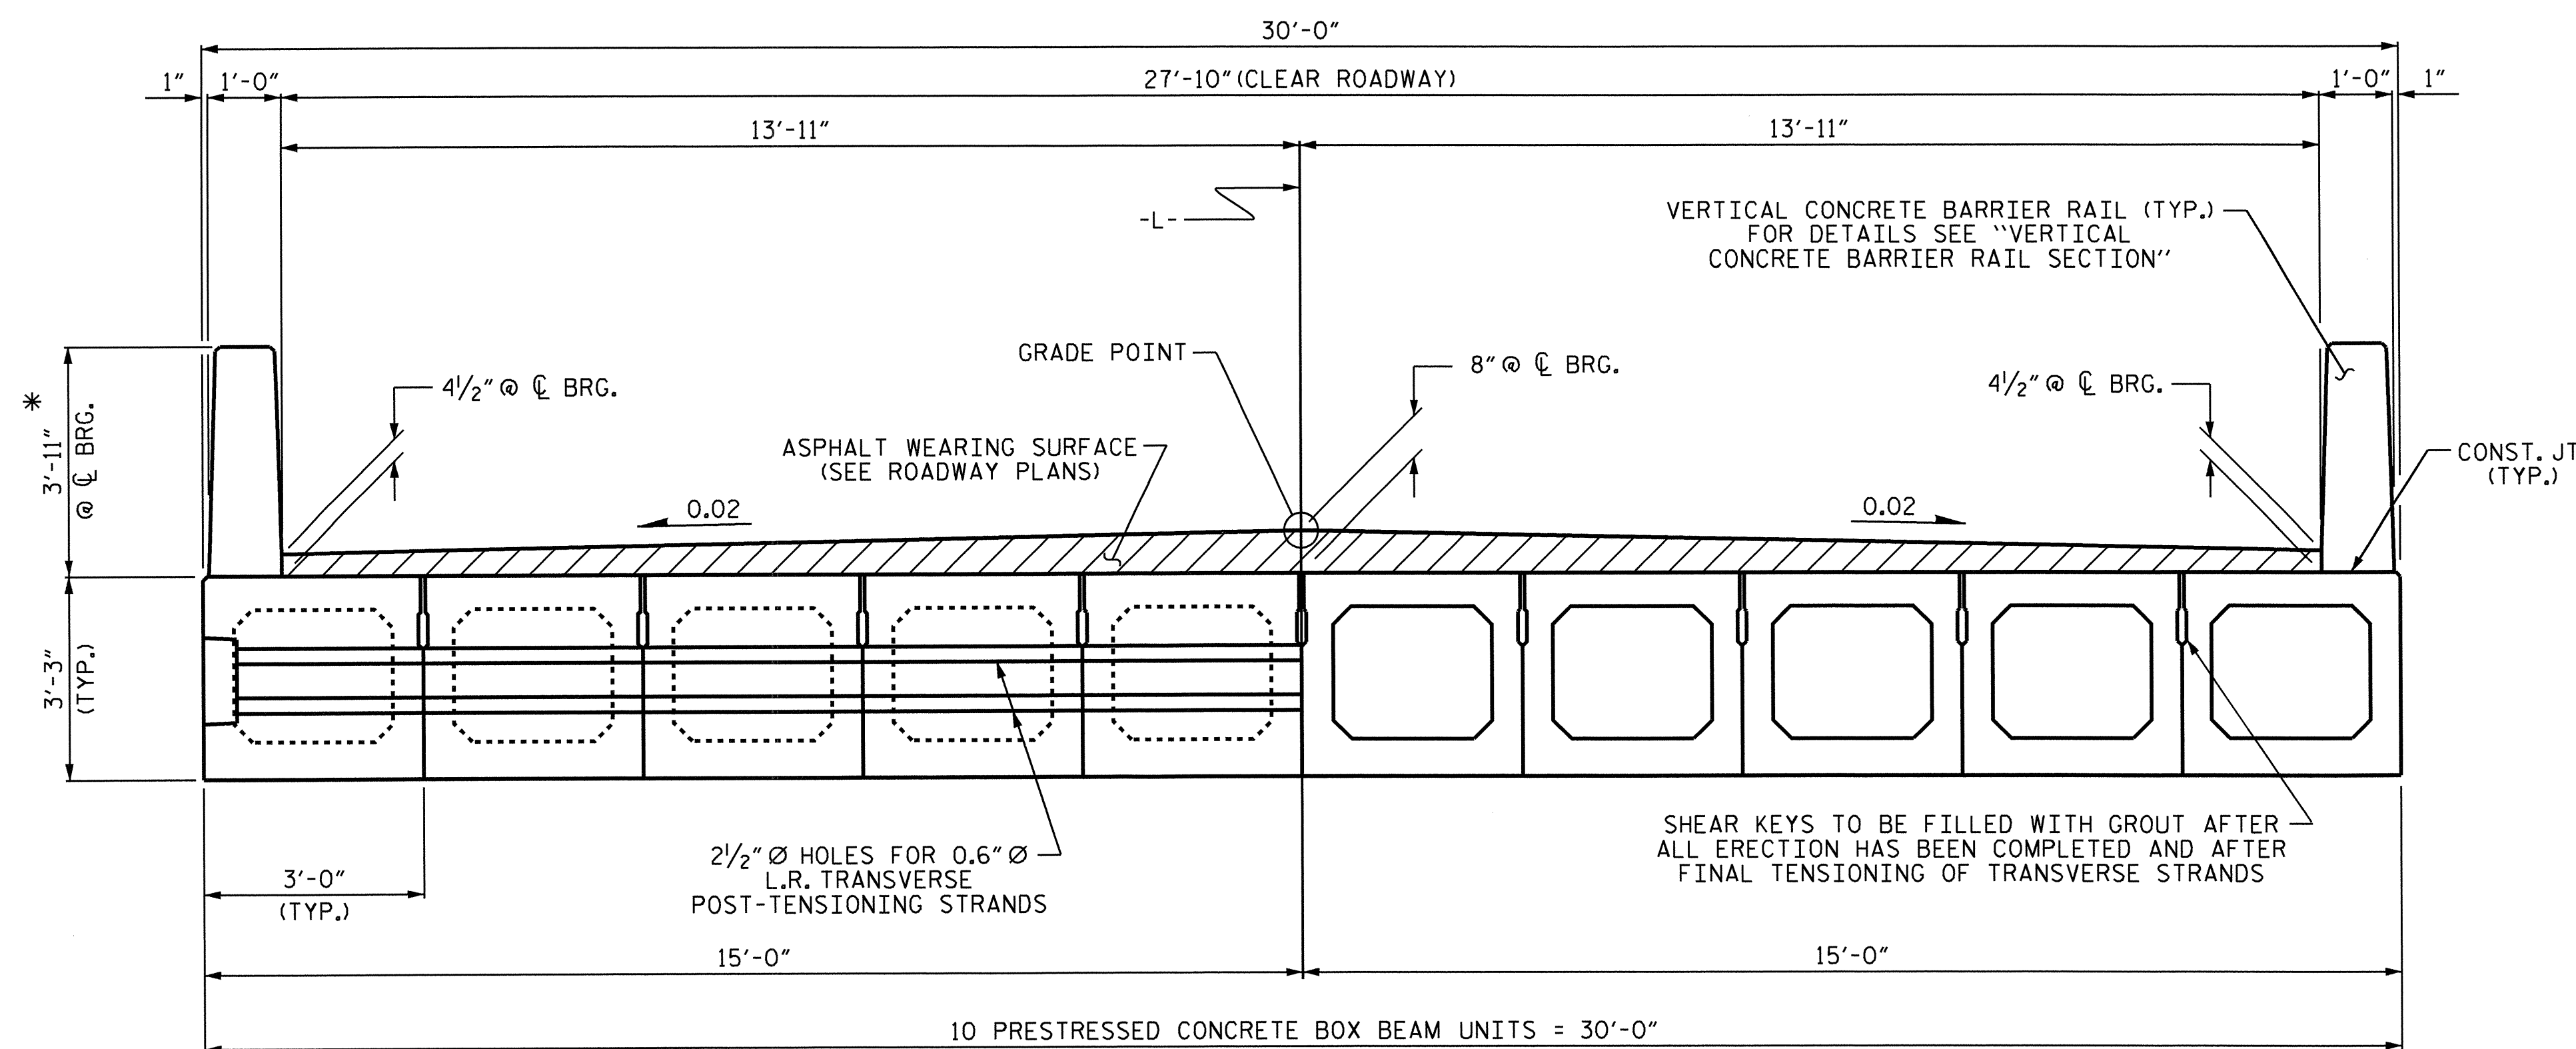


HALF SECTION AT INTERMEDIATE DIAPHRAGMS
 HALF SECTION THROUGH VOIDS
TYPICAL SECTION

* THE MAXIMUM BARRIER RAIL HEIGHT AND ASPHALT THICKNESS IS SHOWN. THE HEIGHT OF THE BARRIER RAIL AND ASPHALT THICKNESS VARIES WHILE THE TOP OF THE BARRIER RAIL FOLLOWS THE PROFILE OF THE GUTTERLINE. FOR RAIL HEIGHT DETAILS AND ASPHALT THICKNESS, SEE THE "VERTICAL CONCRETE BARRIER RAIL SECTION" DETAIL.

FIXED END

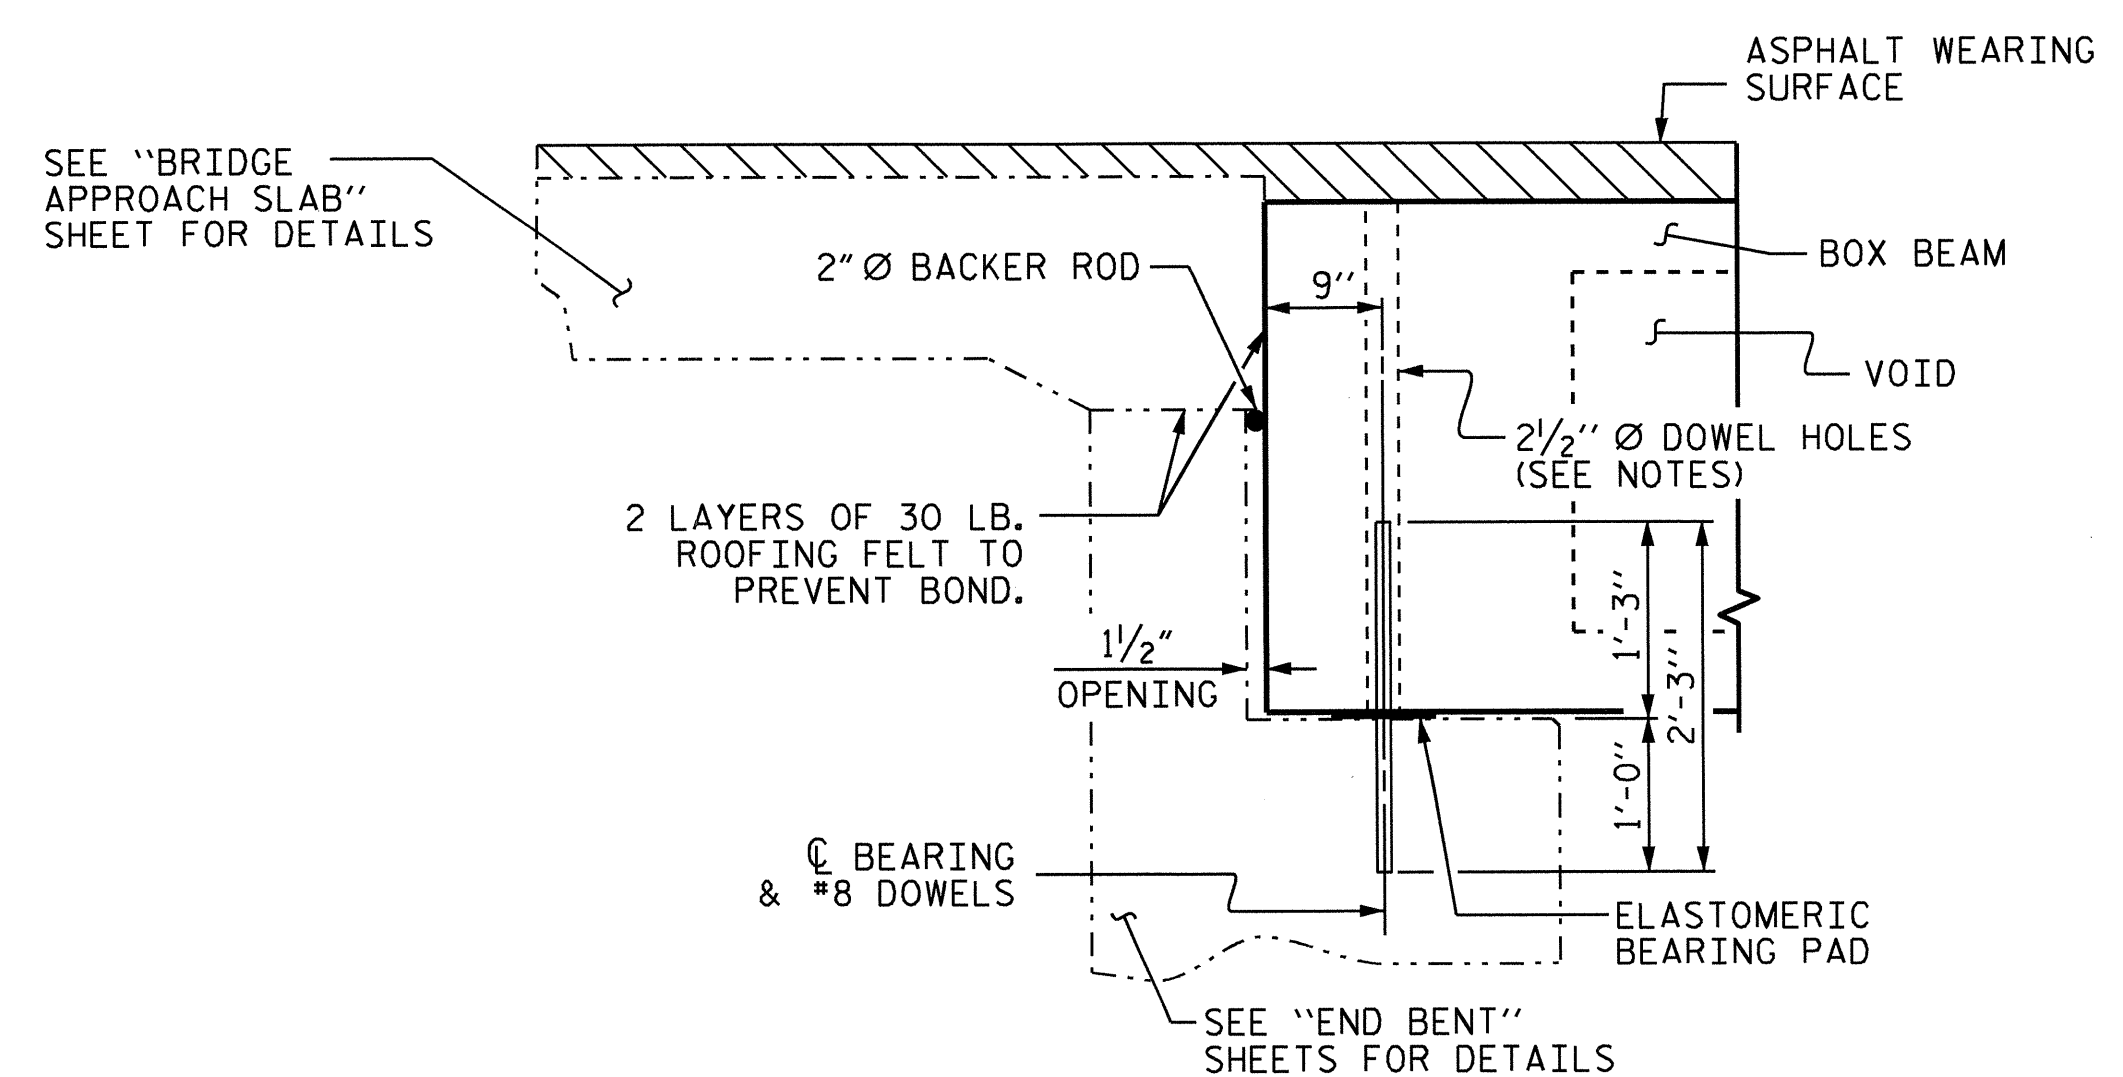

SECTION AT END BENT

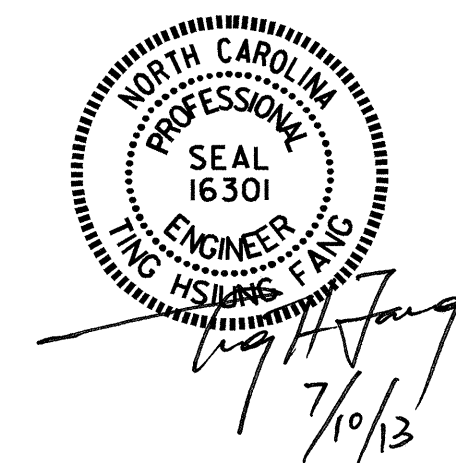

PROJECT NO. B-4730
CHATHAM COUNTY
 STATION: 13+82.50 -L-

SHEET 1 OF 5


STATE OF NORTH CAROLINA
 DEPARTMENT OF TRANSPORTATION
 RALEIGH
 STANDARD
 3'-0" X 3'-3"
 PRESTRESSED CONCRETE
 BOX BEAM UNIT

ASSEMBLED BY : R. P. PATEL	DATE : 5-24-12
CHECKED BY : T. H. FANG	DATE : 5-29-12
DRAWN BY : DGE 8/II	
CHECKED BY : TMG 11/II	


REVISIONS						SHEET NO.
NO.	BY:	DATE:	NO.	BY:	DATE:	S-5
1			3			TOTAL SHEETS
2			4			16

FIX.

FIX.

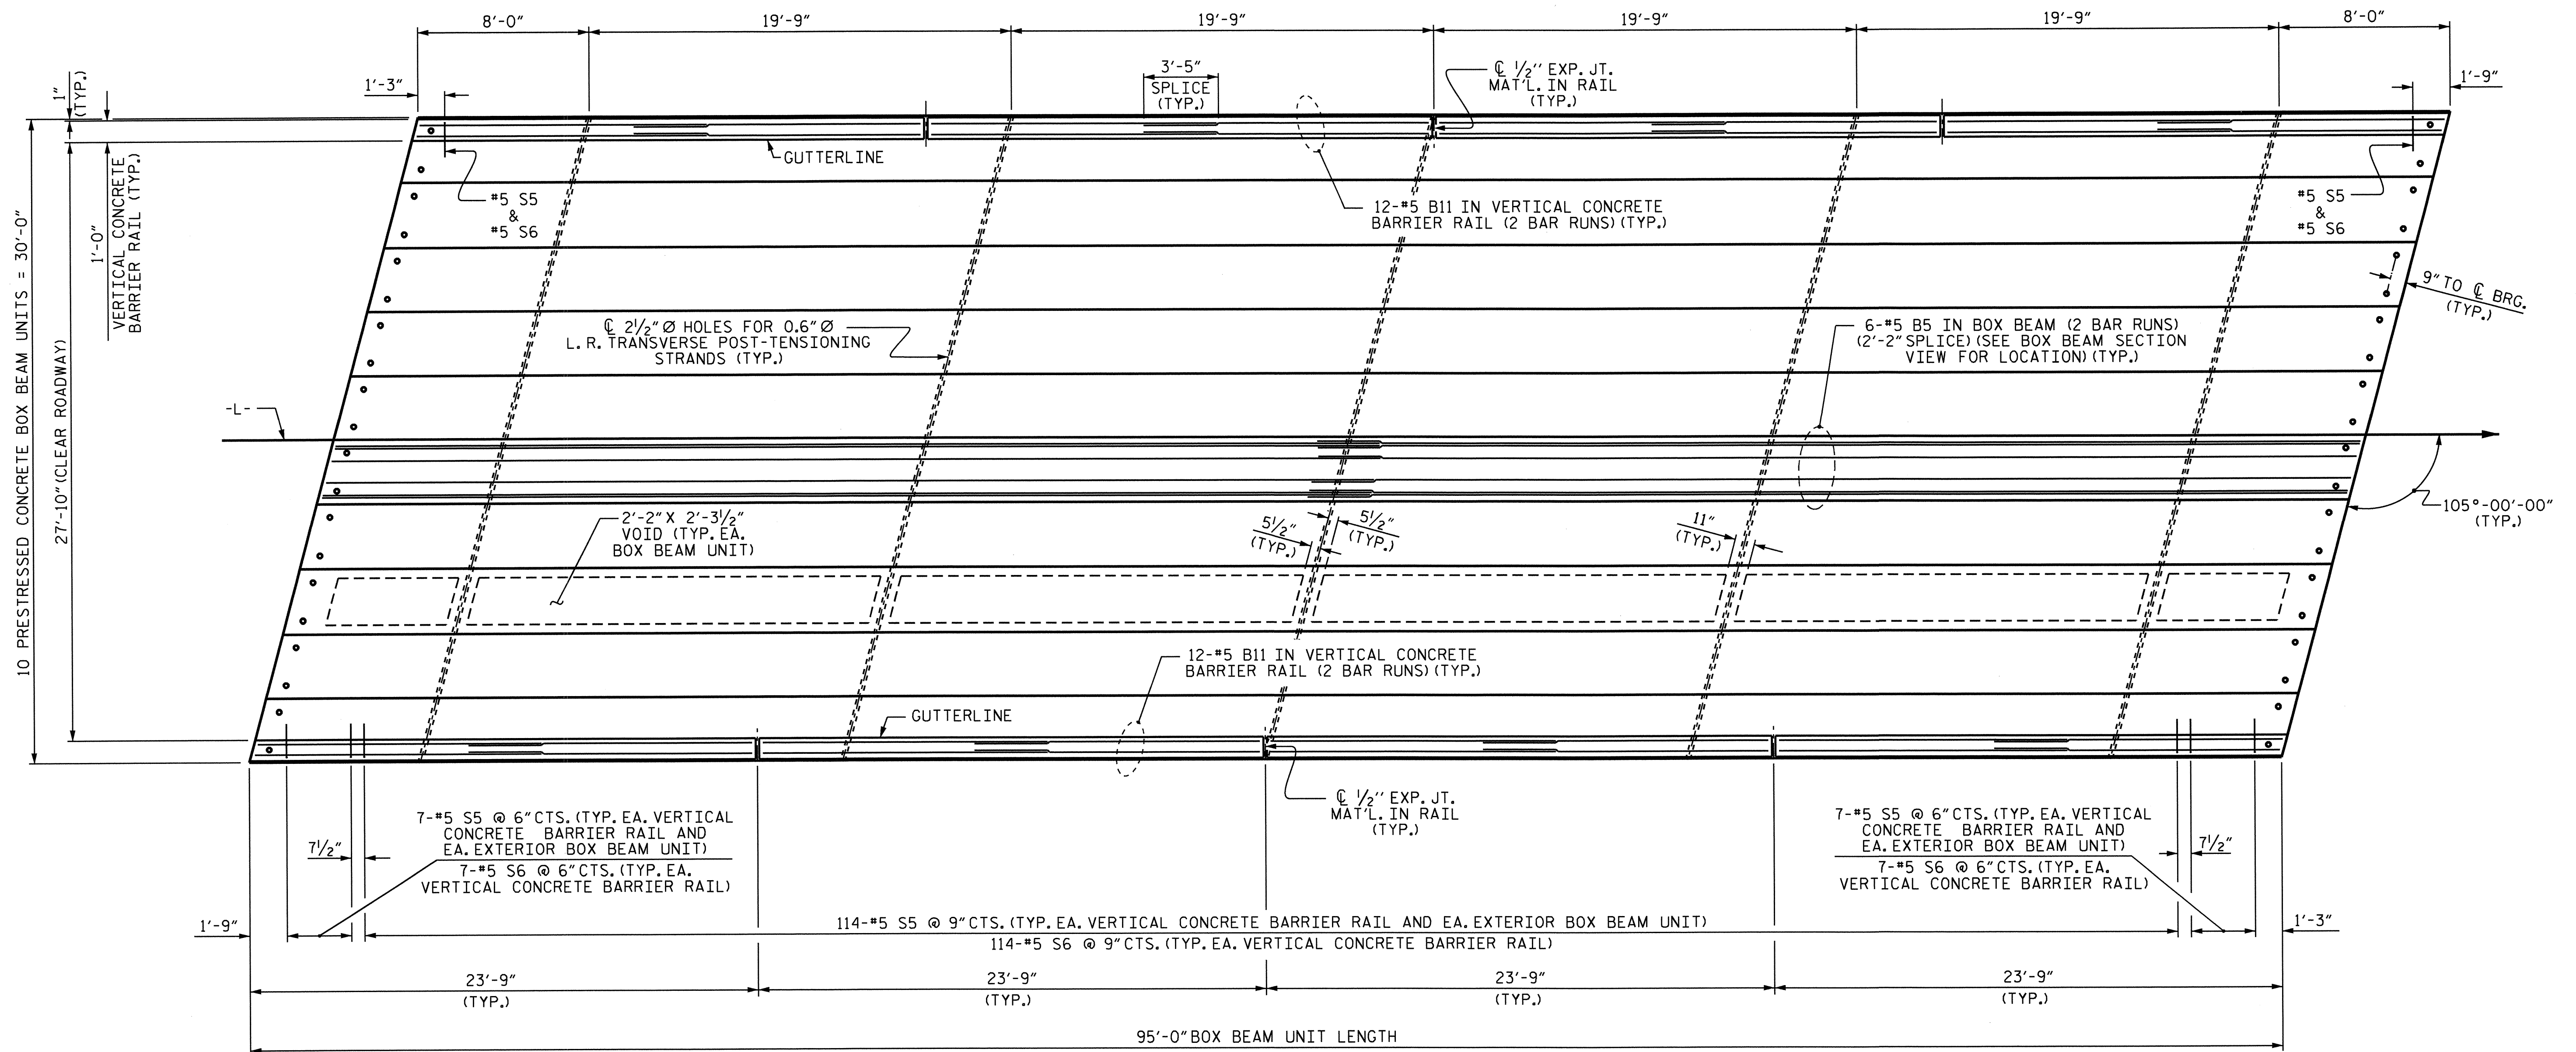

PLAN OF SPAN A

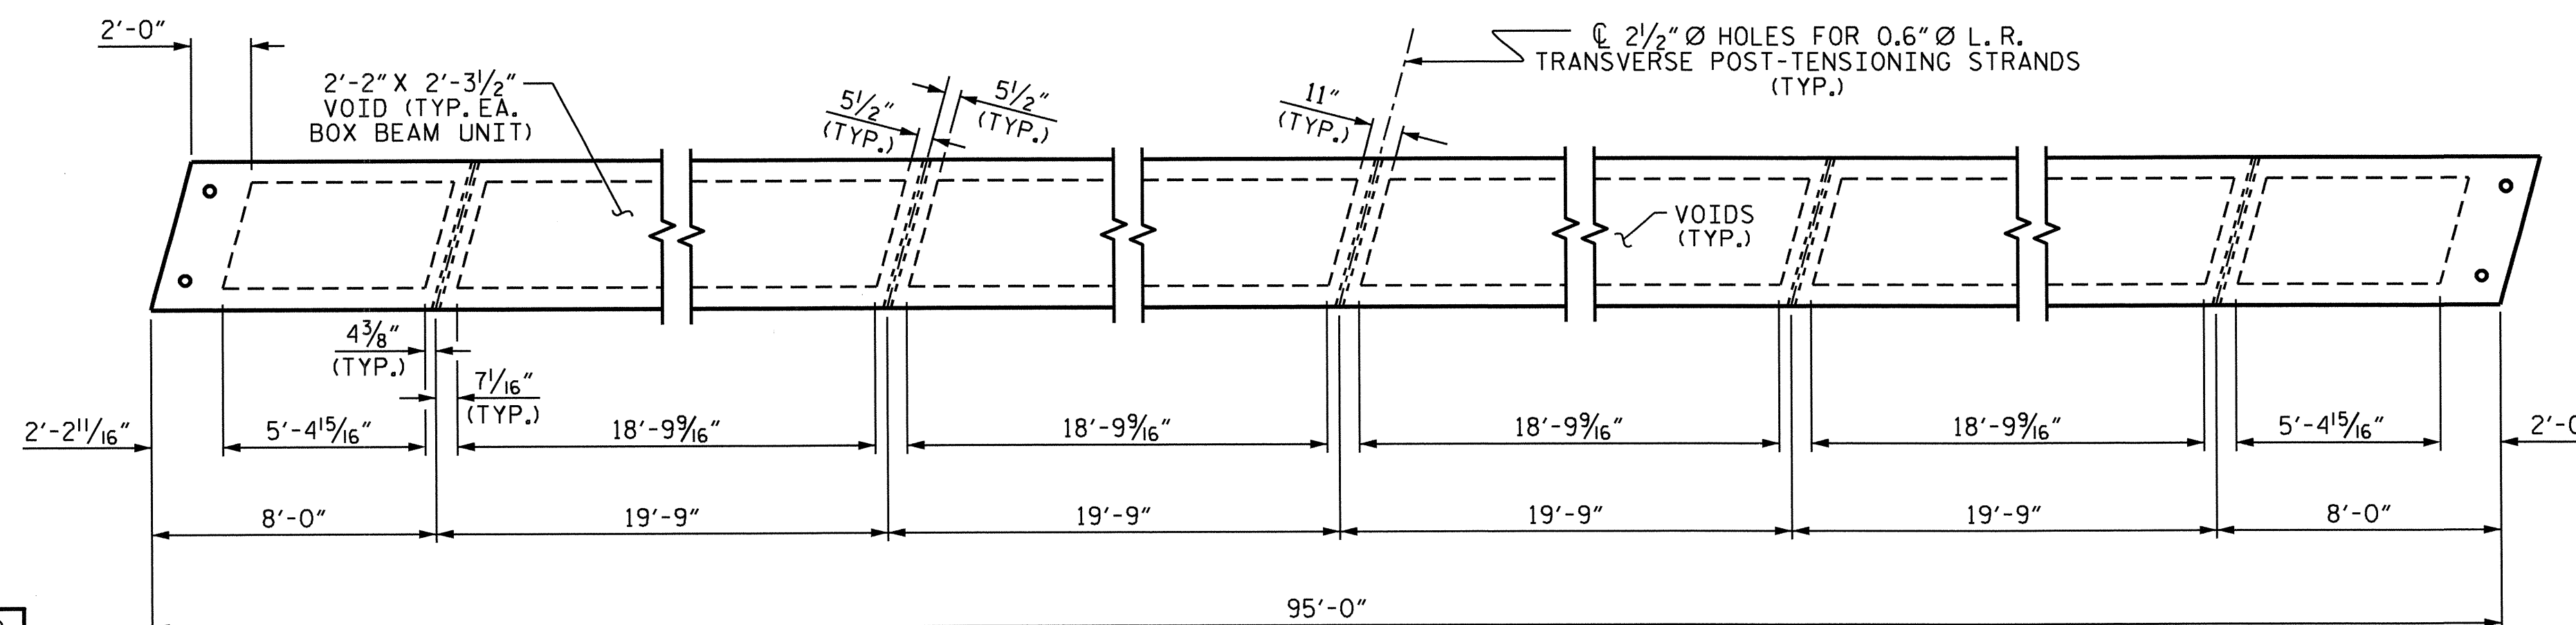

DIAPHRAGM AND VOID LAYOUT


PROJECT NO. B-4730
CHATHAM COUNTY
 STATION: 13+82.50 -L-

SHEET 2 OF 5

STATE OF NORTH CAROLINA
 DEPARTMENT OF TRANSPORTATION
 RALEIGH

PLAN OF 95' UNIT
 27'-10" CLEAR ROADWAY
 105° SKEW


SPAN A

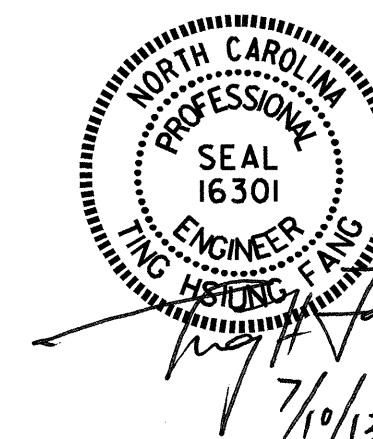


ASSEMBLED BY : R.P.PATEL DATE : 5-24-12
 CHECKED BY : P.K.NEWTON DATE : 10-12
 DRAWN BY : DGE 8/11
 CHECKED BY : TMC 11/11

REVISIONS						SHEET NO.
NO.	BY:	DATE:	NO.	BY:	DATE:	5-6
1			3			TOTAL SHEETS
2			4			16


STD.NO.39PCBB_30_105S_95L

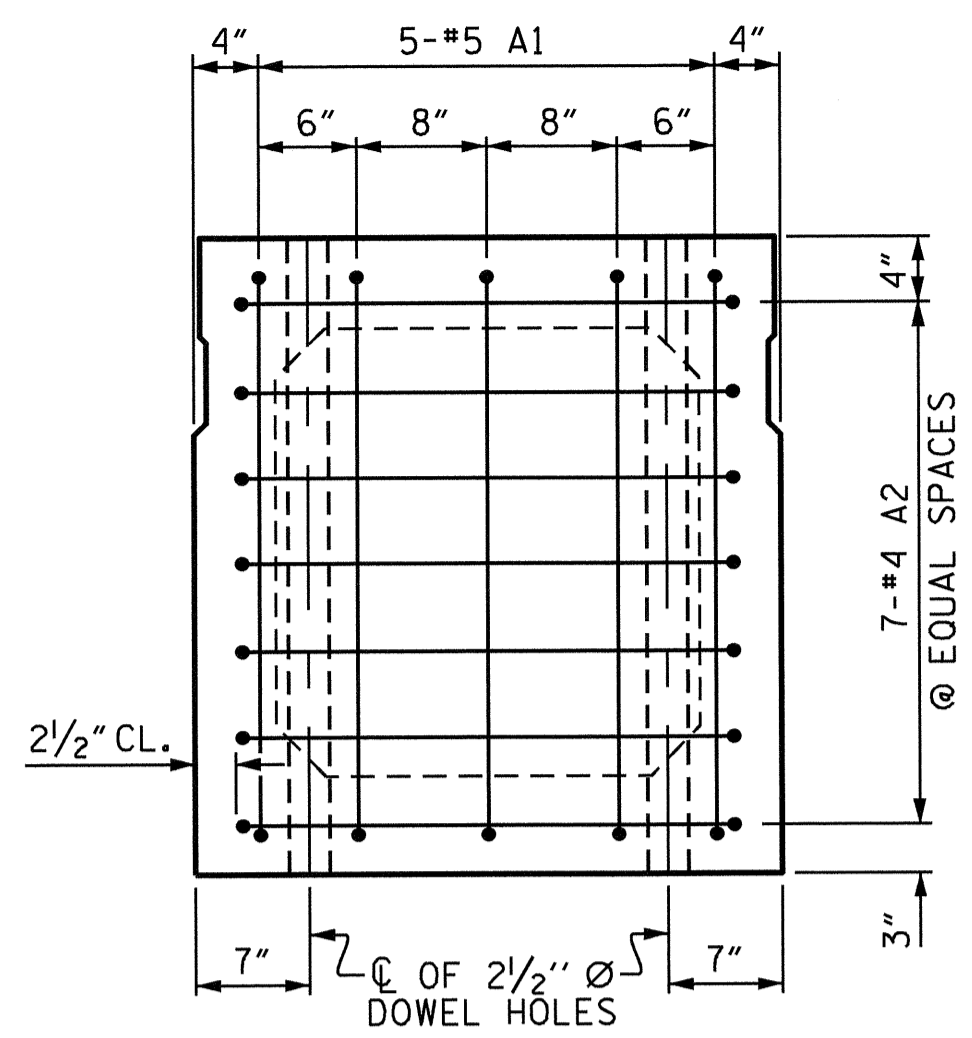


END ELEVATION
 SHOWING PLACEMENT OF #5 & #4 "A" BARS AND LOCATION OF DOWEL HOLES. (INTERIOR BOX BEAM SECTION SHOWN-EXTERIOR SECTION SIMILAR EXCEPT SHEAR KEY LOCATION, STRAND LAYOUT NOT SHOWN.)

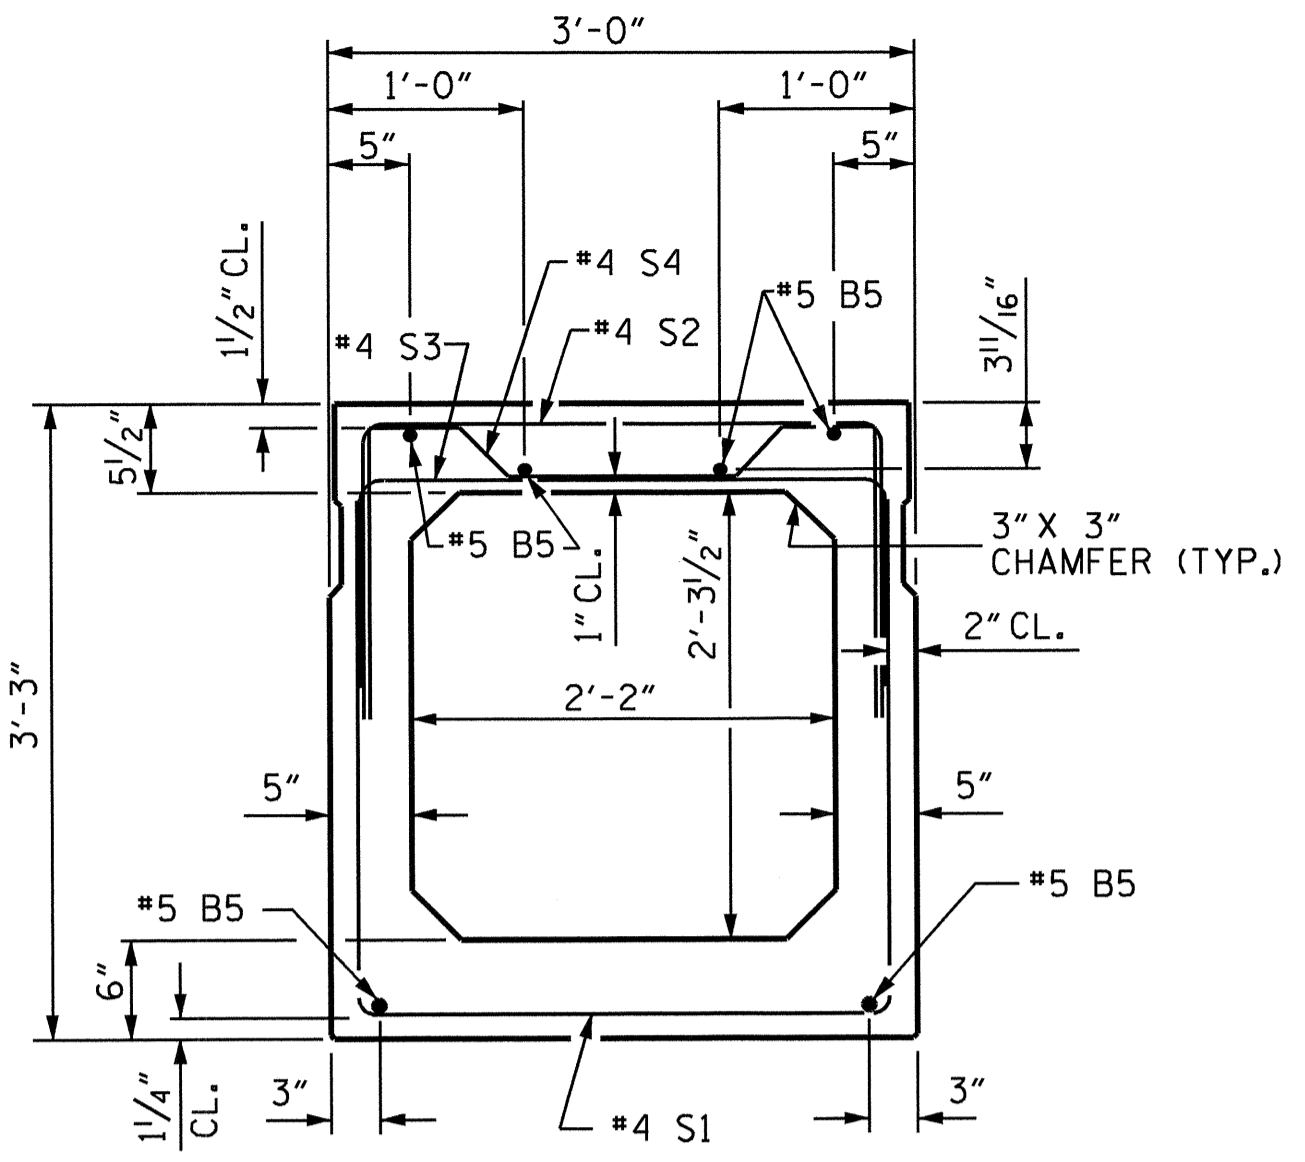

INTERIOR BOX BEAM SECTION
 (STRAND LAYOUT NOT SHOWN)

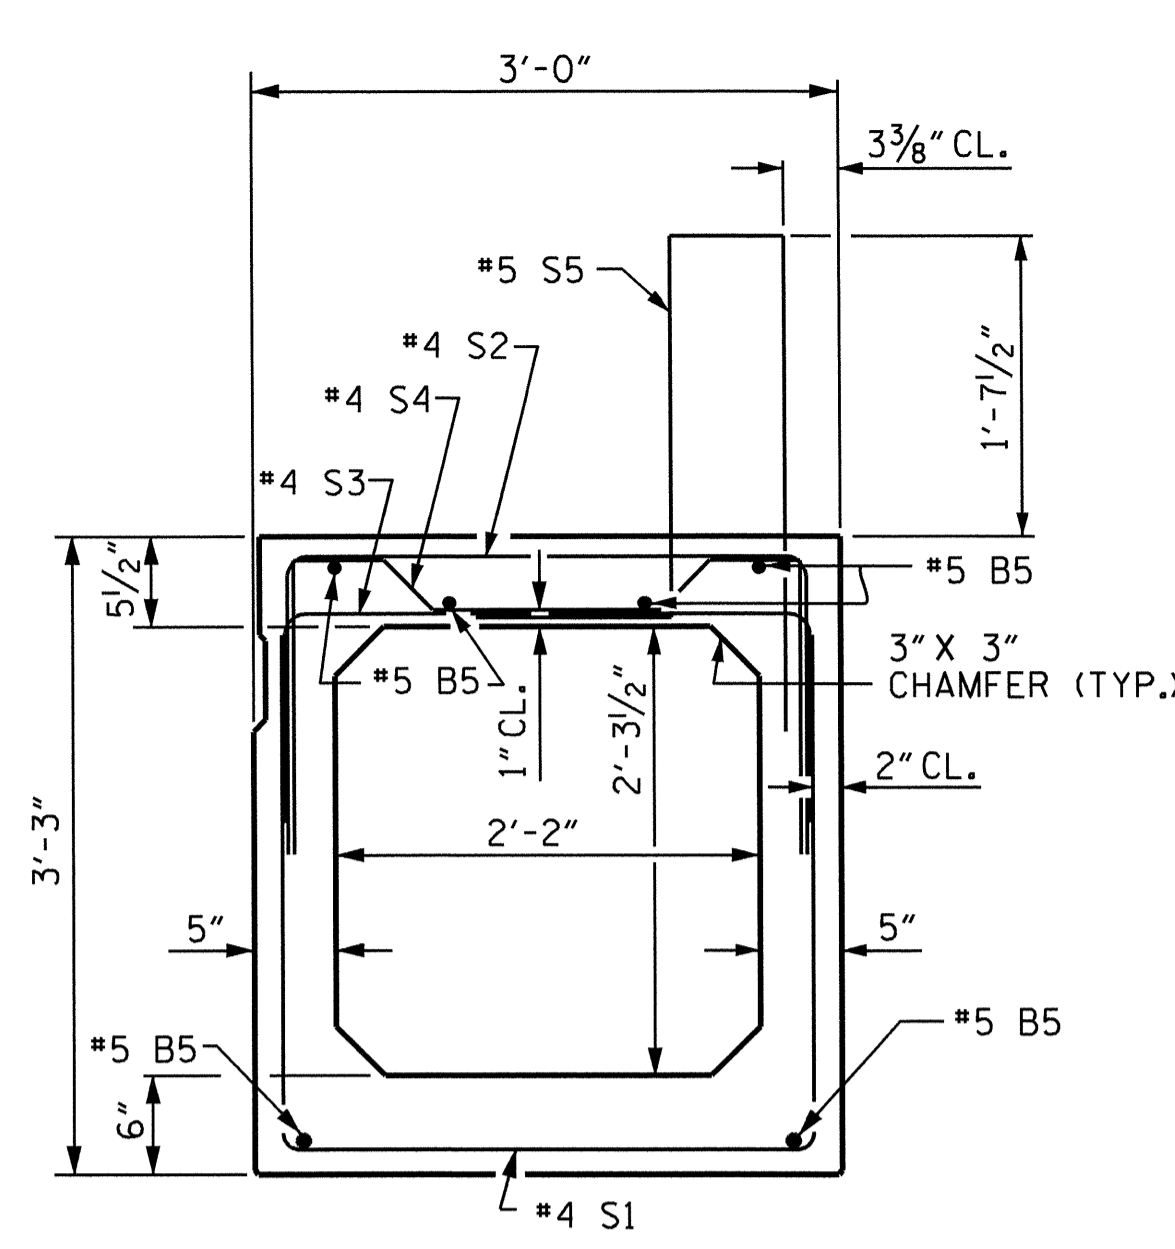


EXTERIOR BOX BEAM SECTION
 (STRAND LAYOUT NOT SHOWN)

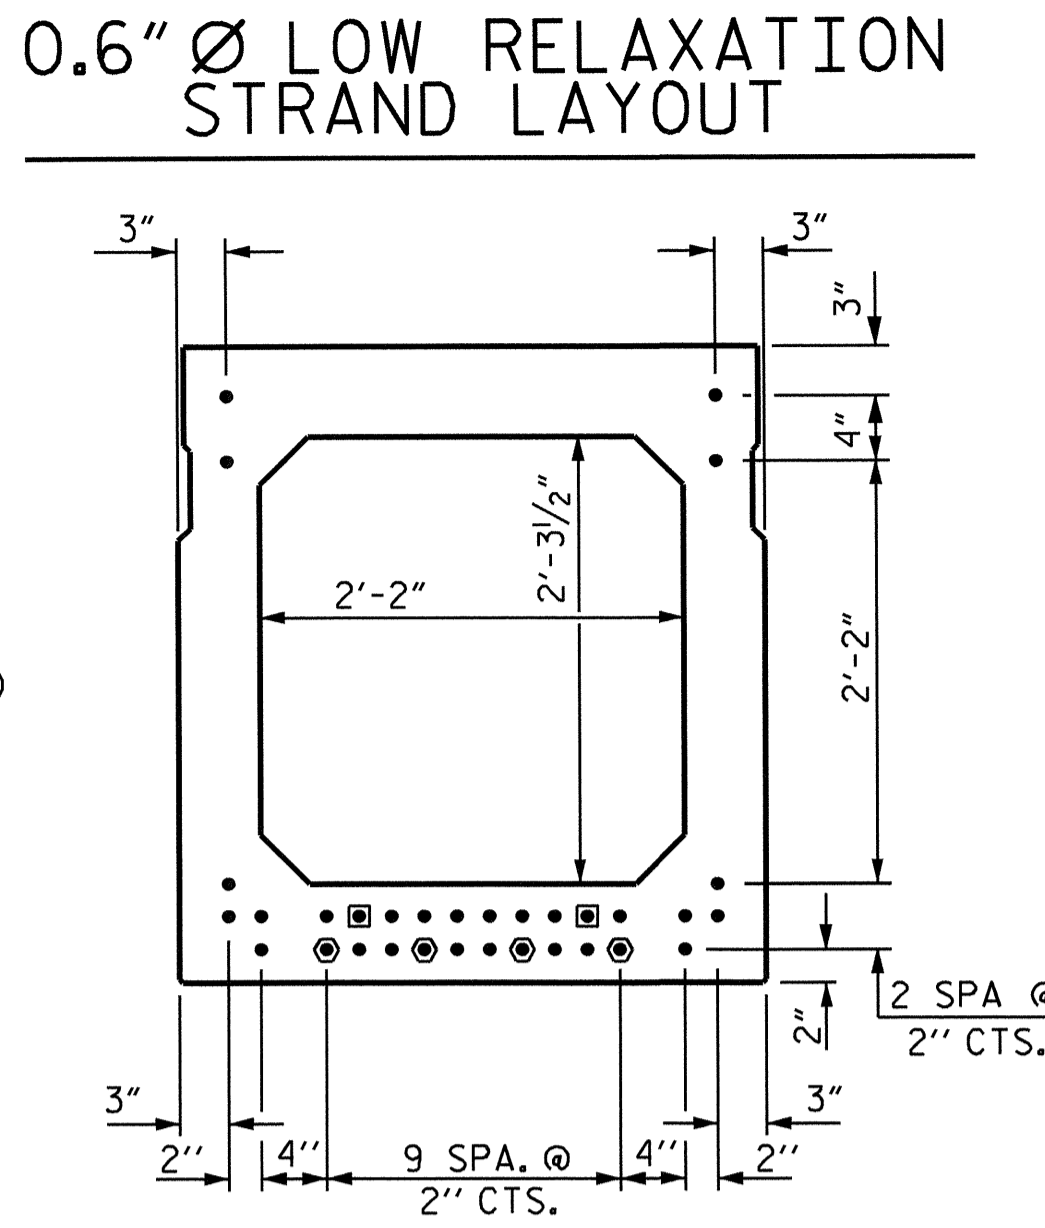


TYPICAL STRAND LOCATION
 (32 STRANDS REQUIRED)
DEBONDING LEGEND

- FULLY BONDED STRANDS
 - ◐ STRANDS DEBONDED FOR 4'-0" FROM END OF BOX BEAM
 - ◑ STRANDS DEBONDED FOR 12'-0" FROM END OF BOX BEAM
- BOND SHALL BE BROKEN ON STRANDS AS SHOWN FOR THE SPECIFIED LENGTH FROM EACH END OF THE BOX BEAM. SEE STANDARD SPECIFICATIONS ARTICLE 1078-7.


GRADE 270 STRANDS	
	0.6" Ø L.R.
AREA (SQUARE INCHES)	0.217
ULTIMATE STRENGTH (LBS. PER STRAND)	58,600
APPLIED PRESTRESS (LBS. PER STRAND)	43,950

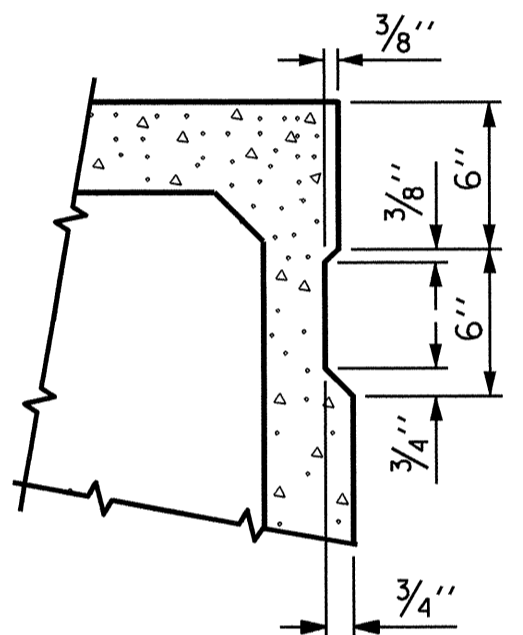


SHEAR KEY DETAIL
 NOTE: OMIT SHEAR KEY ON OUTSIDE FACE OF EXTERIOR BOX BEAMS.

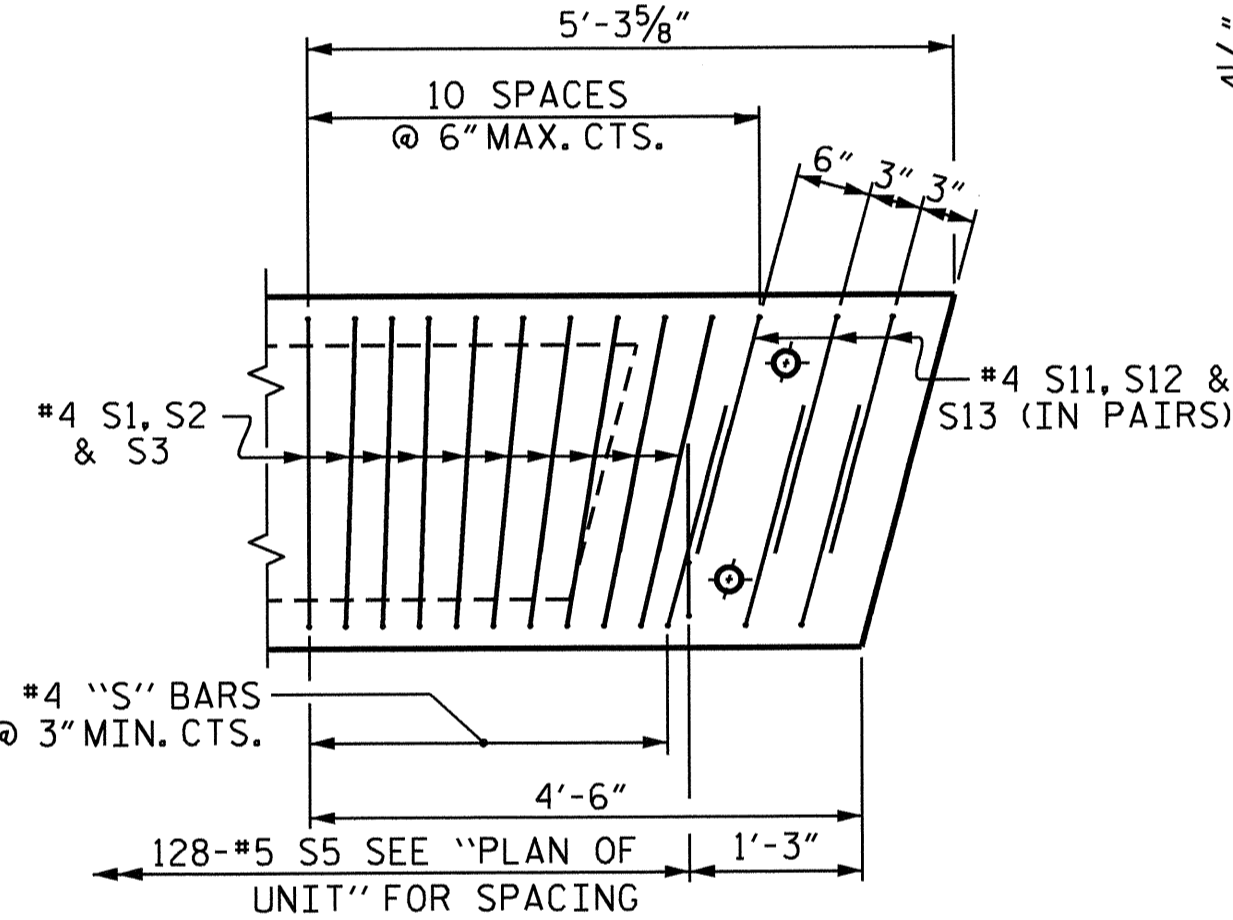

DETAIL "B"
 EXTERIOR UNIT SHOWN, INTERIOR UNIT SIMILAR EXCEPT OMIT #5 S5 BARS. "B" BARS AND "A" BARS NOT SHOWN.

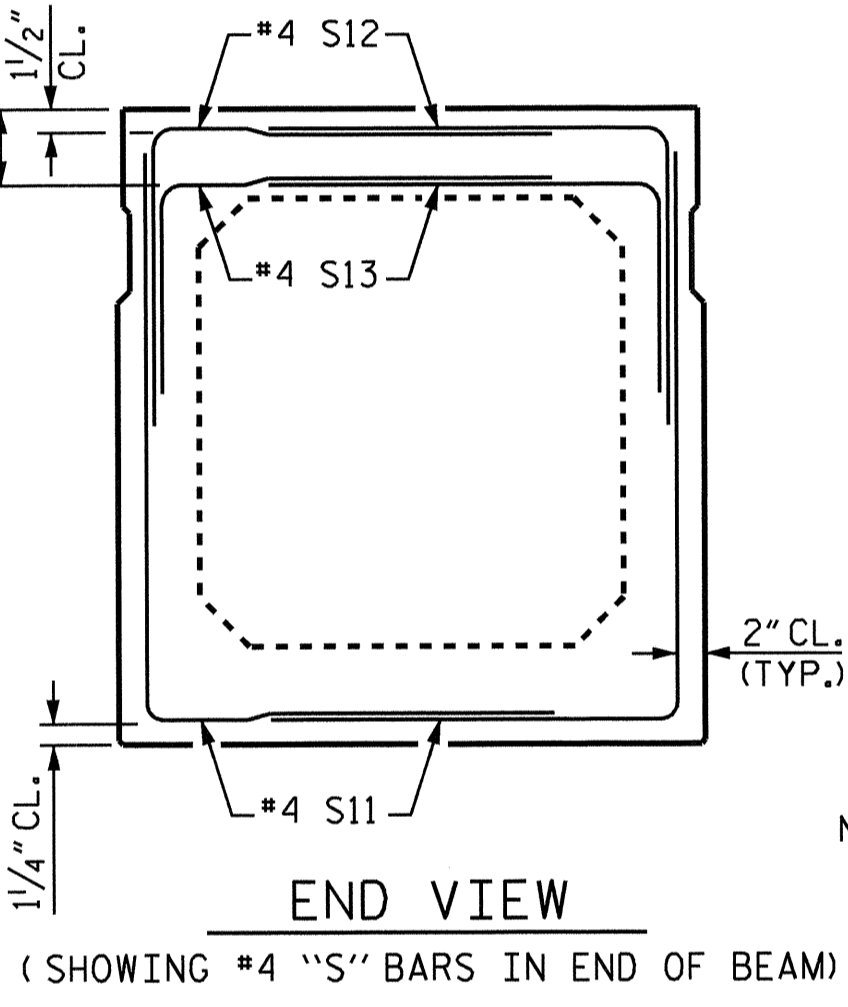


END VIEW
 (SHOWING #4 "S" BARS IN END OF BEAM)

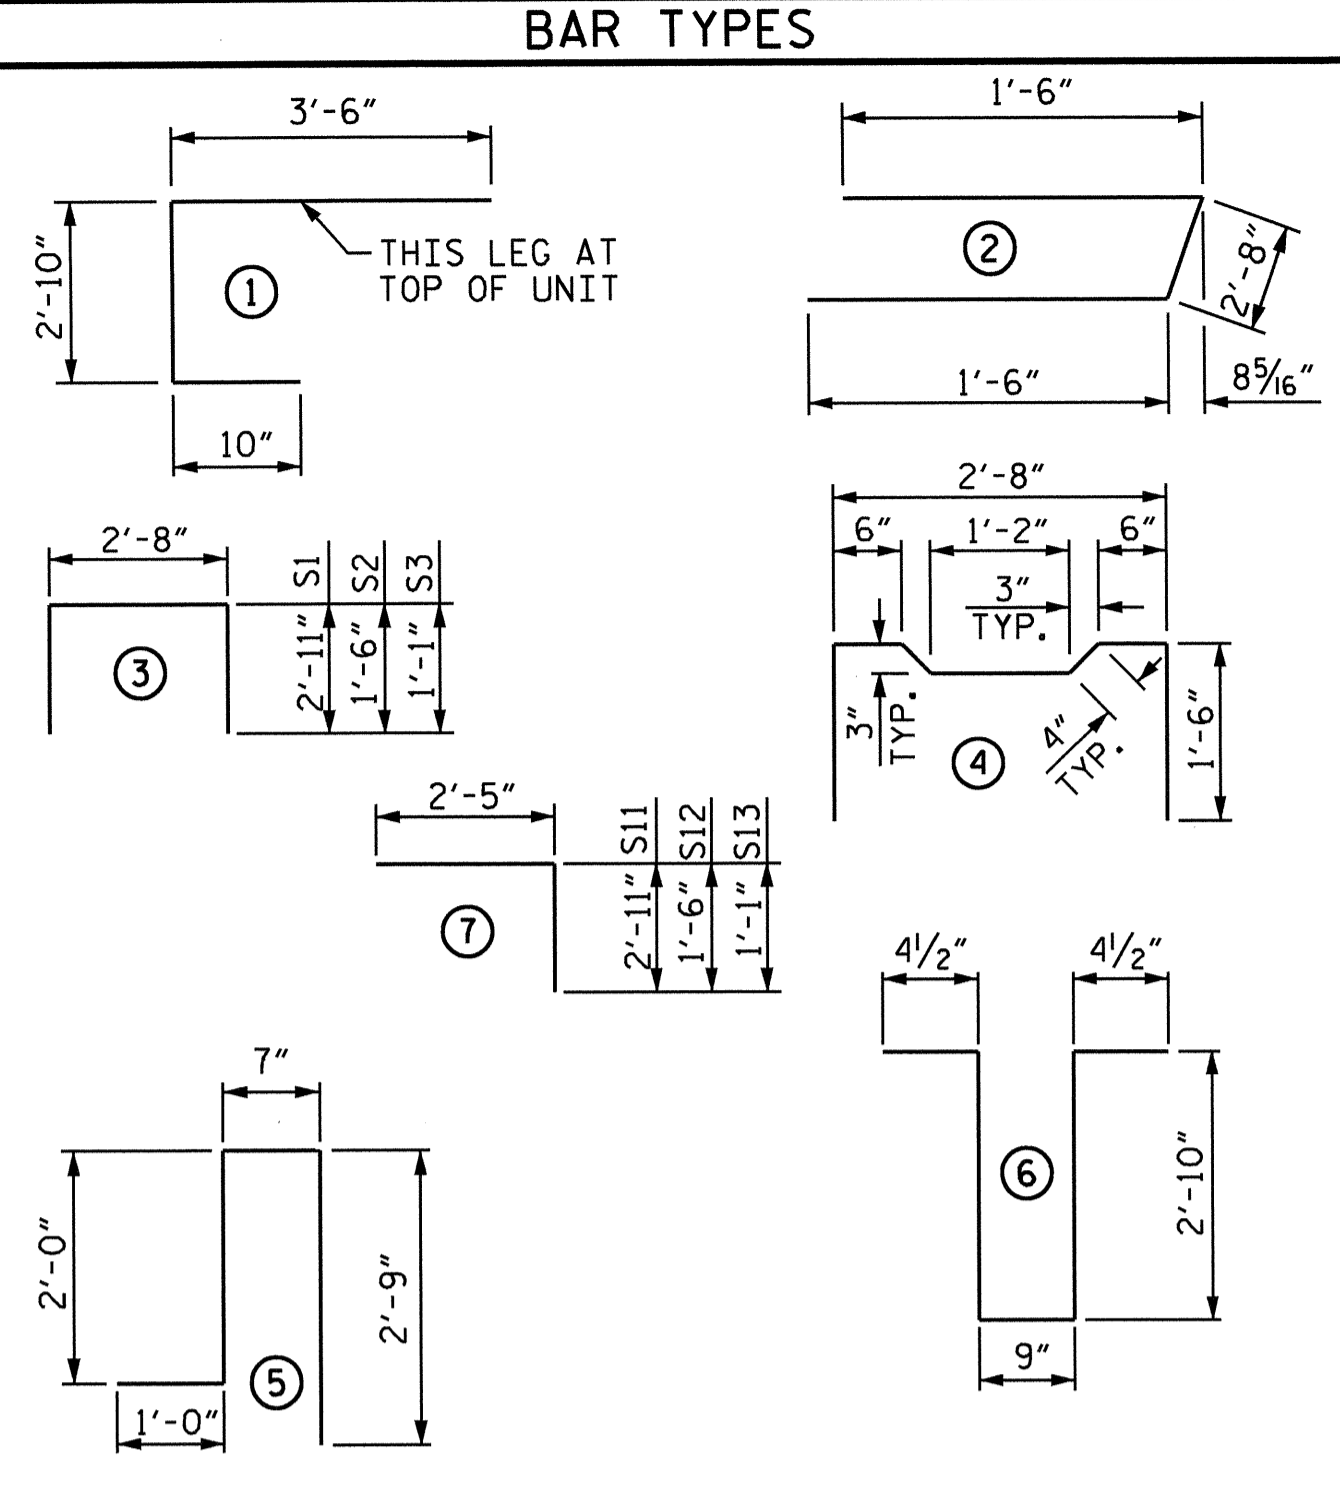

ALL BAR DIMENSIONS ARE OUT TO OUT

BILL OF MATERIAL FOR ONE BOX BEAM SECTION


BAR	NUMBER	SIZE	TYPE	EXTERIOR UNIT LENGTH	EXTERIOR UNIT WEIGHT	INTERIOR UNIT LENGTH	INTERIOR UNIT WEIGHT
A1	10	#5	1	7'-2"	75	7'-2"	75
A2	44	#4	2	5'-8"	167	5'-8"	167
B5	12	#5	STR	48'-5"	606	48'-5"	606
K1	15	#4	6	7'-2"	72	7'-2"	72
K2	10	#4	STR	2'-7"	17	2'-7"	17
S1	77	#4	3	8'-6"	437	8'-6"	437
S2	77	#4	3	5'-8"	291	5'-8"	291
S3	133	#4	3	4'-10"	429	4'-10"	429
S4	56	#4	4	5'-10"	218	5'-10"	218
S11	12	#4	7	5'-4"	43	5'-4"	43
S12	12	#4	7	3'-11"	31	3'-11"	31
S13	12	#4	7	3'-6"	28	3'-6"	28
* S5	128	#5	5	6'-4"	846	--	--
REINFORCING STEEL				2414	LBS.	2414	LBS.
* EPOXY COATED REINF. STEEL				846	LBS.		
7500 P.S.I. CONCRETE				18.7	CU. YDS.	18.5	CU. YDS.
0.6" Ø L.R. STRANDS				No. 32		No. 32	

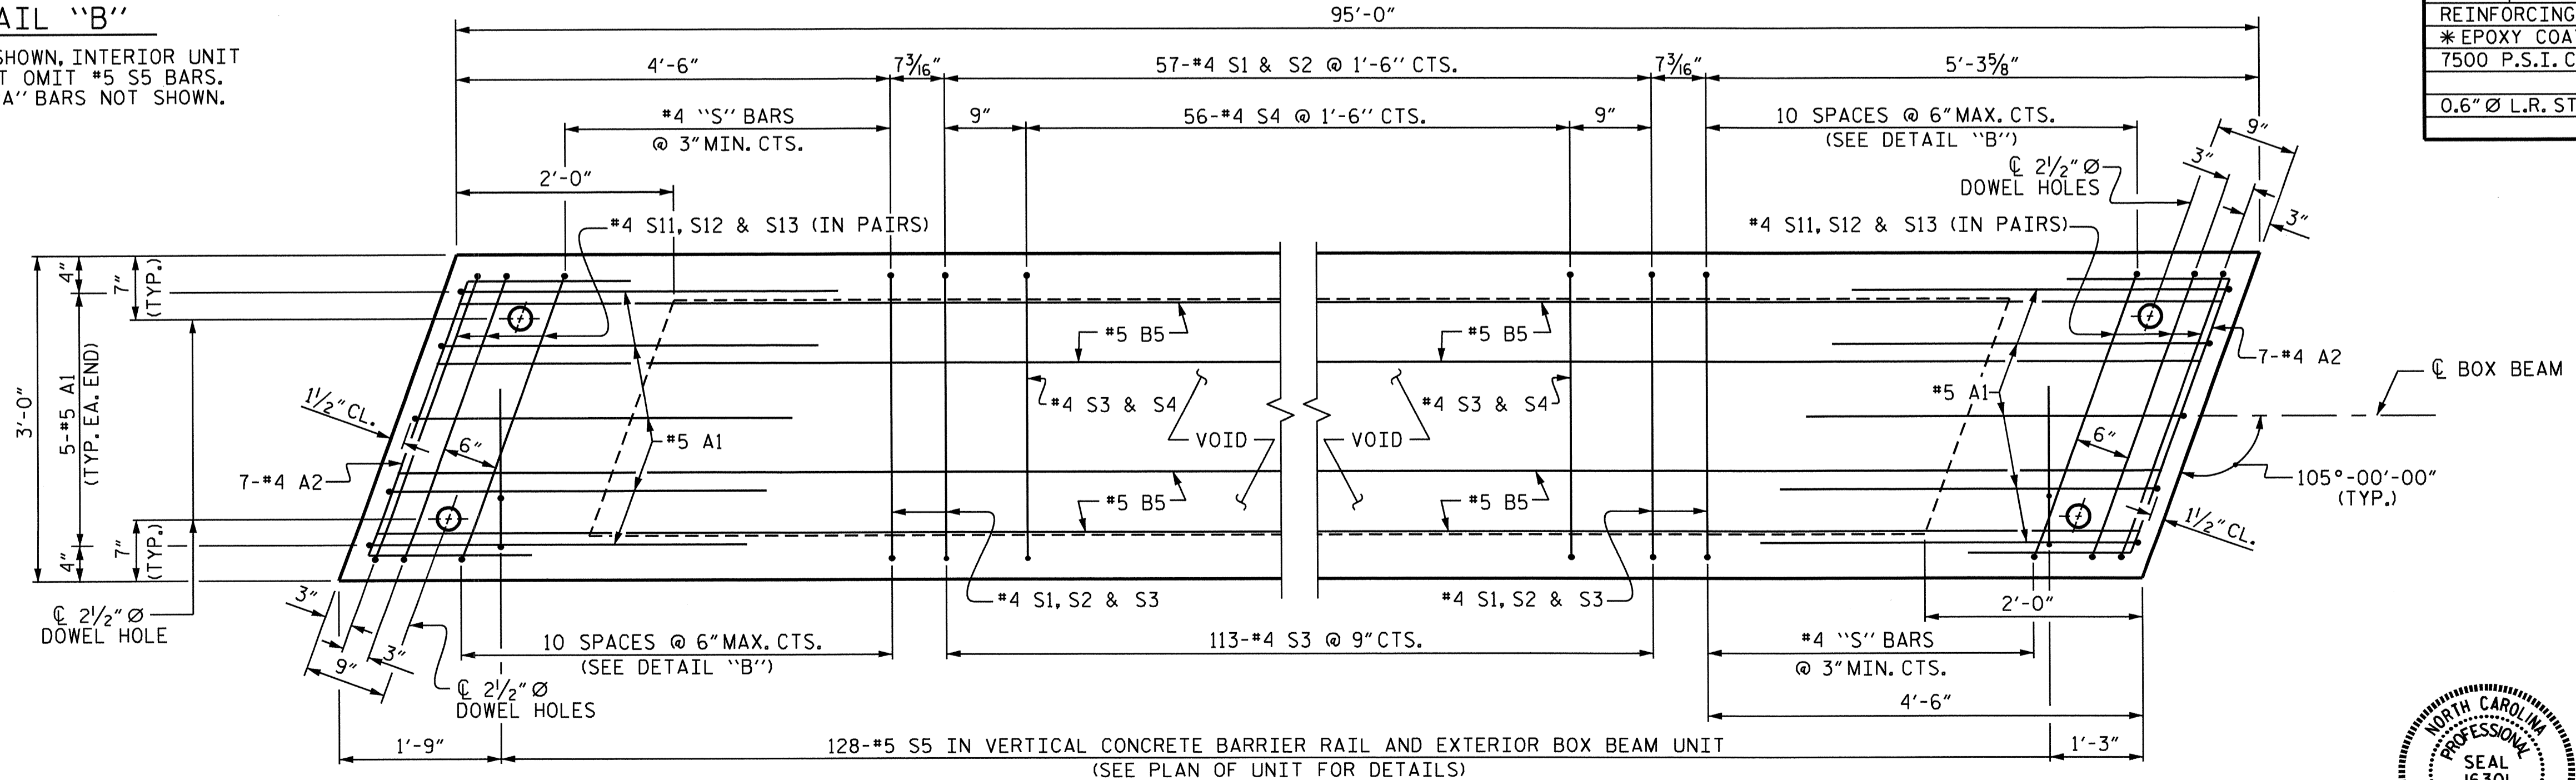

PLAN OF BOX BEAM
 EXTERIOR UNIT SHOWN, INTERIOR UNIT SIMILAR EXCEPT OMIT #5 S5 BARS. FOR LOCATION OF DIAPHRAGMS, SEE PLAN OF UNIT. FOR REINFORCING STEEL IN DIAPHRAGMS, SEE DIAPHRAGM DETAILS.


PROJECT NO. B-4730
 CHATHAM COUNTY
 STATION: 13+82.50 -L-

SHEET 3 OF 5
 STATE OF NORTH CAROLINA
 DEPARTMENT OF TRANSPORTATION
 RALEIGH
 STANDARD
 3'-0" X 3'-3"
 PRESTRESSED CONCRETE
 BOX BEAM UNIT

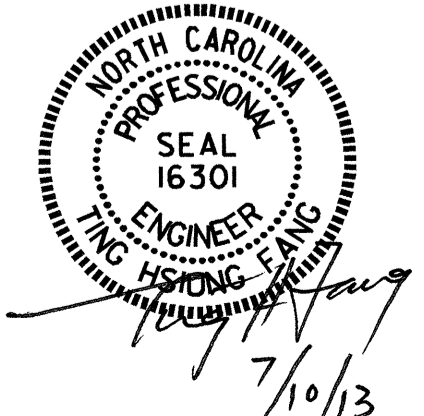


REVISIONS			SHEET NO.		
NO.	BY:	DATE:	NO.	BY:	DATE:
1			3		
2			4		

ASSEMBLED BY : R. P. PATEL DATE : 5-24-12
 CHECKED BY : P. K. NEWTON DATE : 10-12
 DRAWN BY : DGE II/II
 CHECKED BY : TMG II/II

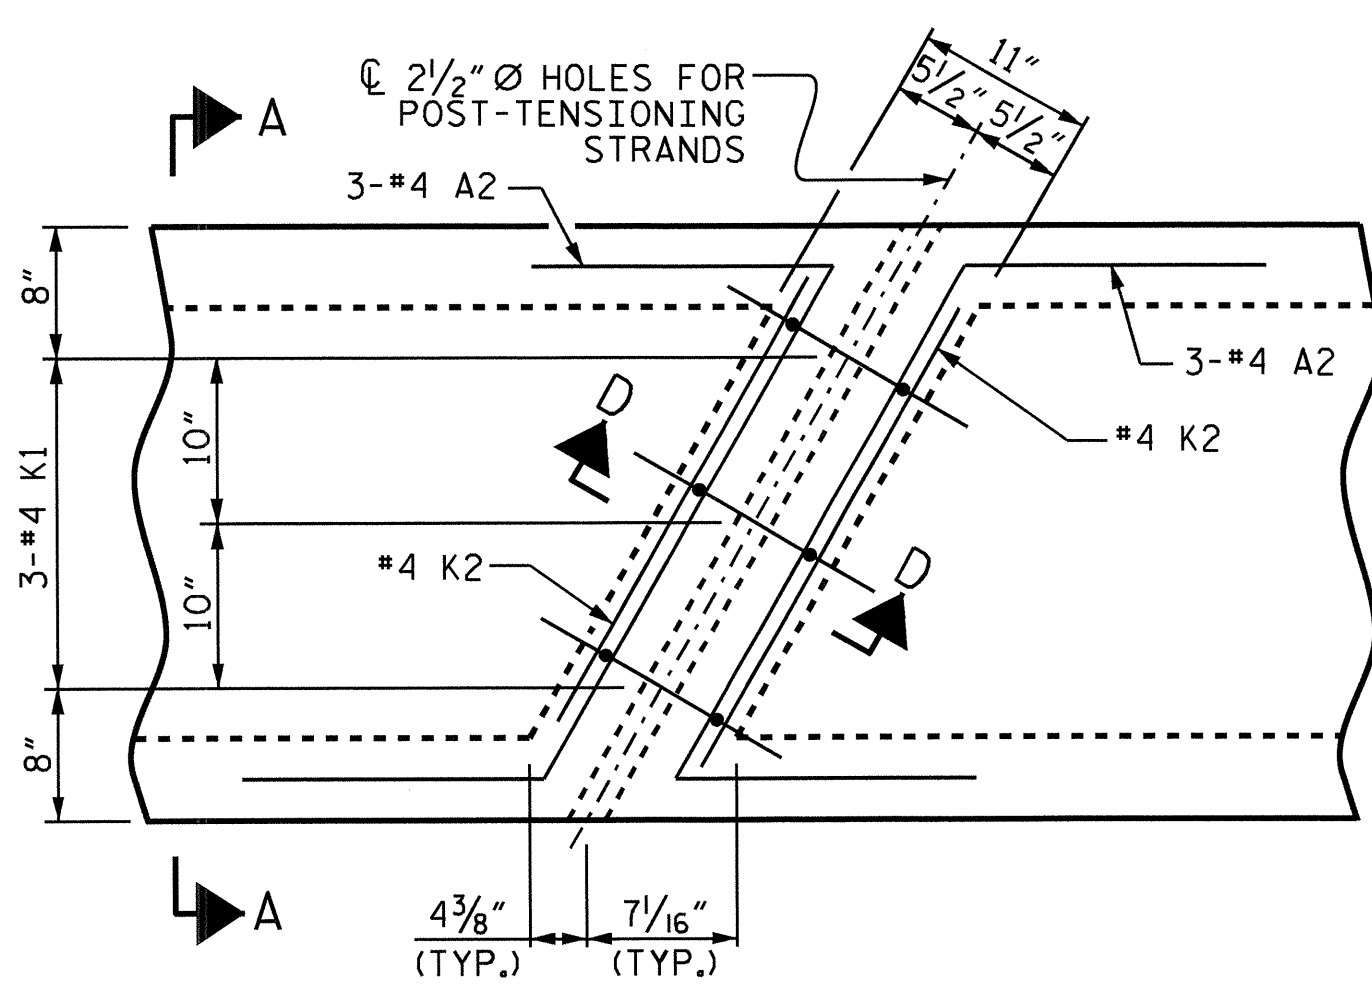

PLAN

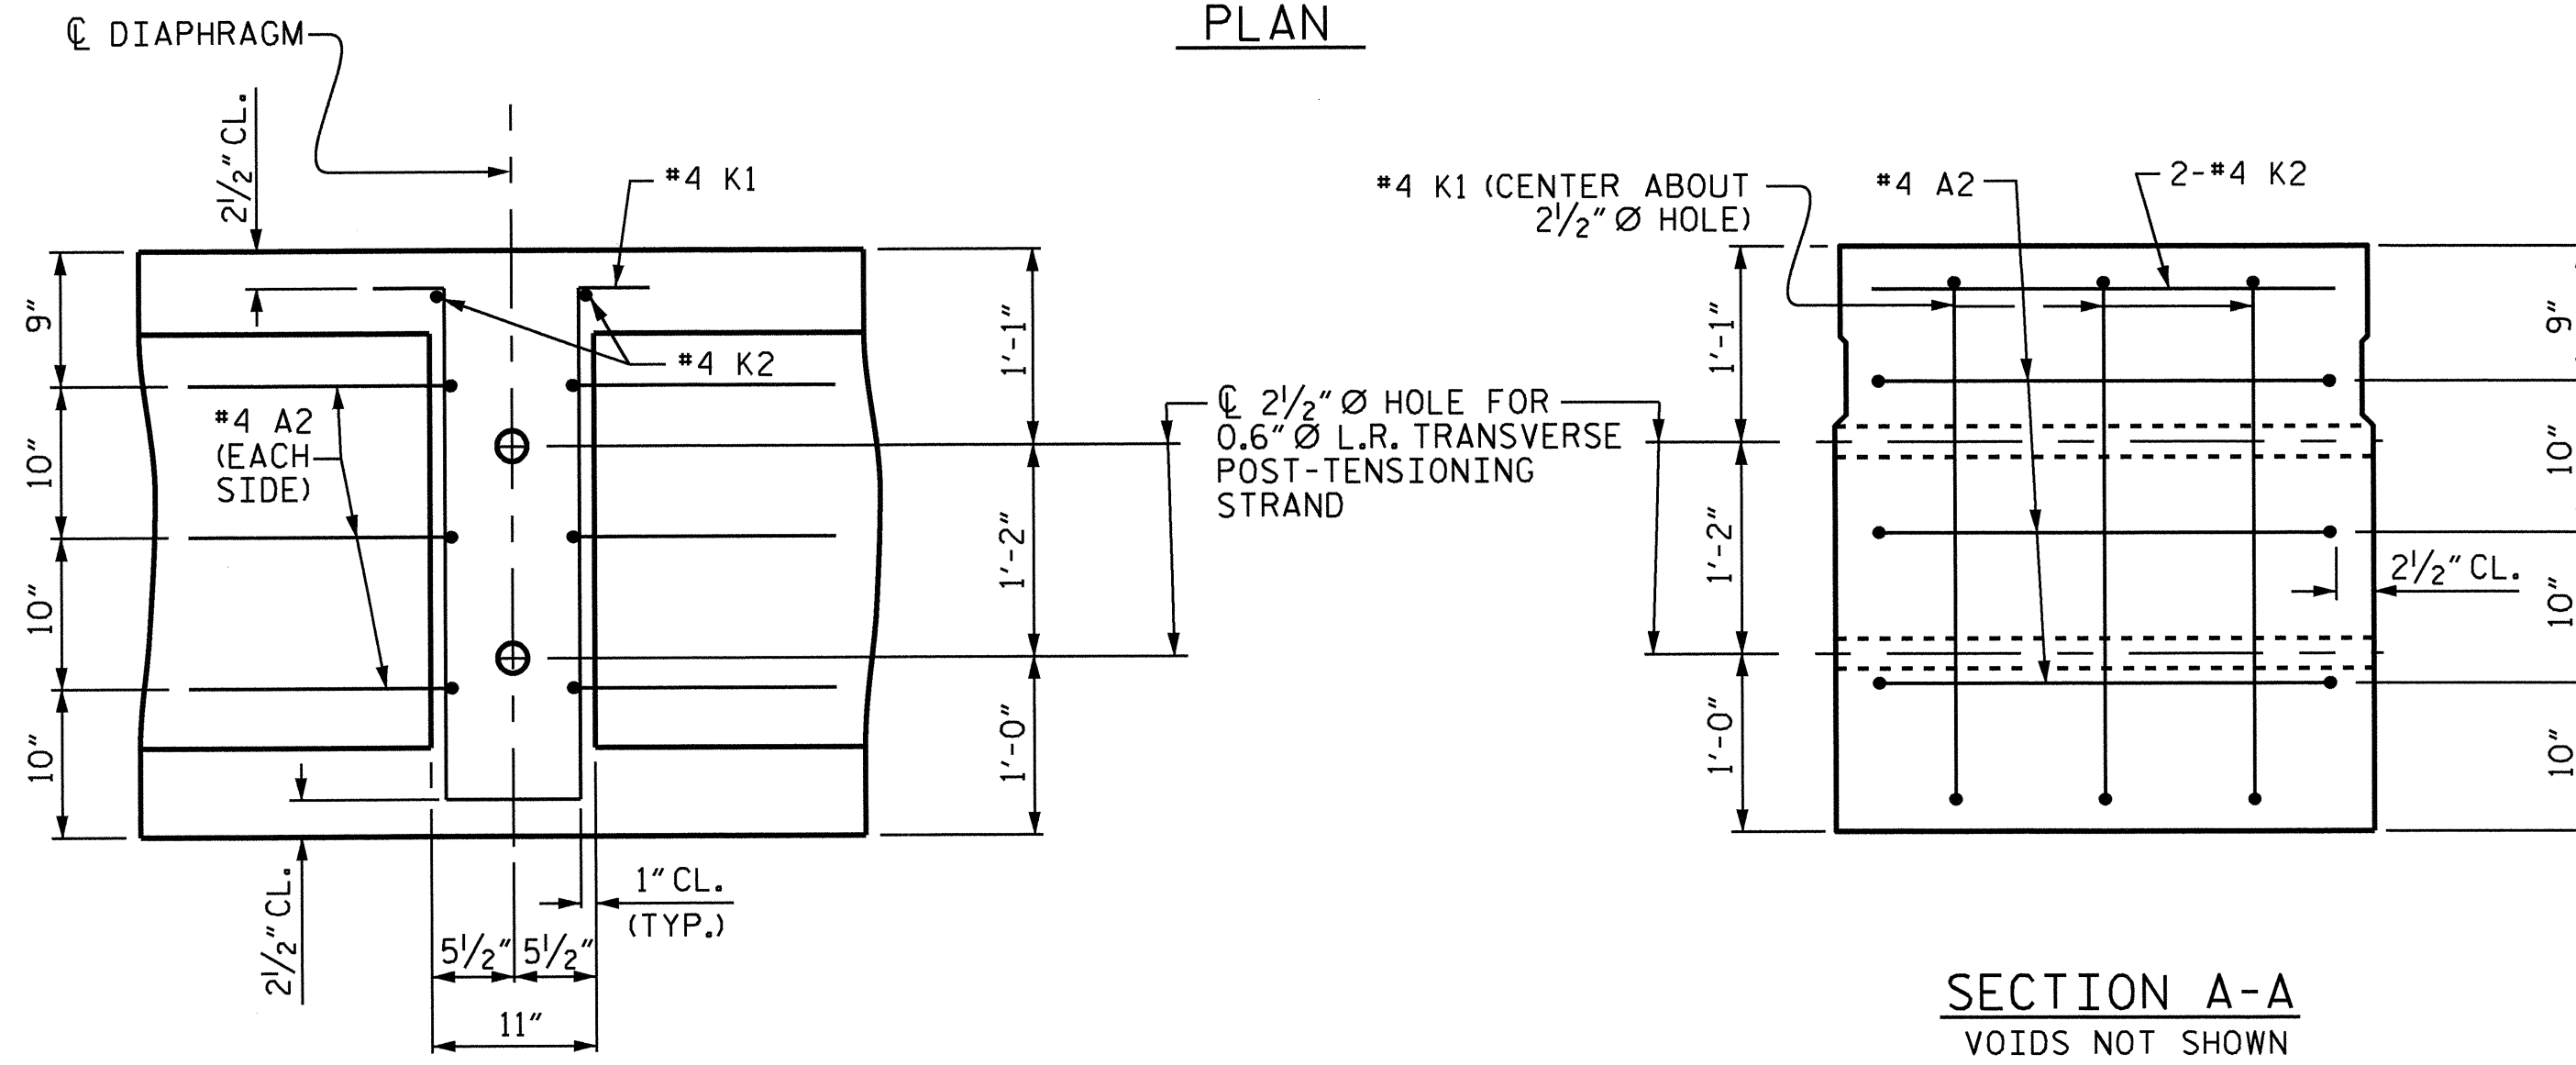


SECTION D-D


SECTION A-A
VOIDS NOT SHOWN

DOUBLE DIAPHRAGM DETAILS


#4 "S" BARS NOT SHOWN. #4 "S" BARS MAY BE SHIFTED SLIGHTLY TO CLEAR 2 1/2" Ø HOLES.

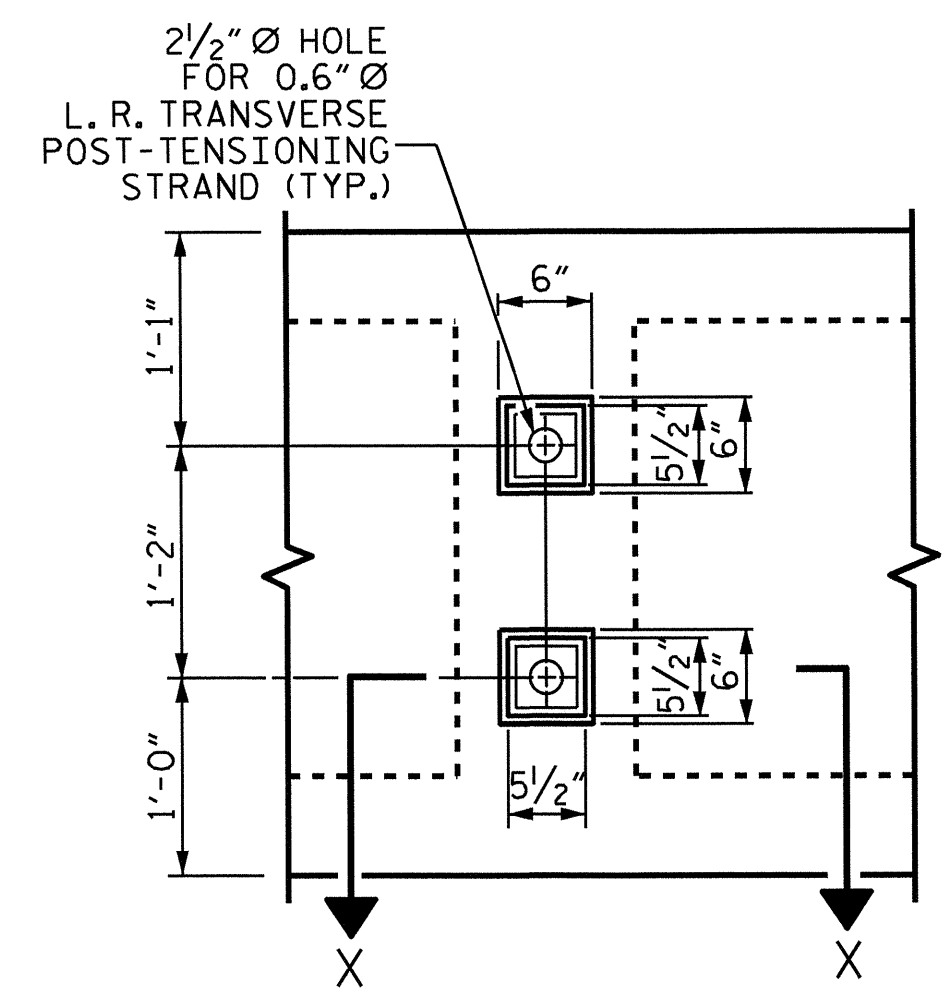


VIEW Y-Y
SHOWING ELEVATION VIEW OF GROUDED RECESS

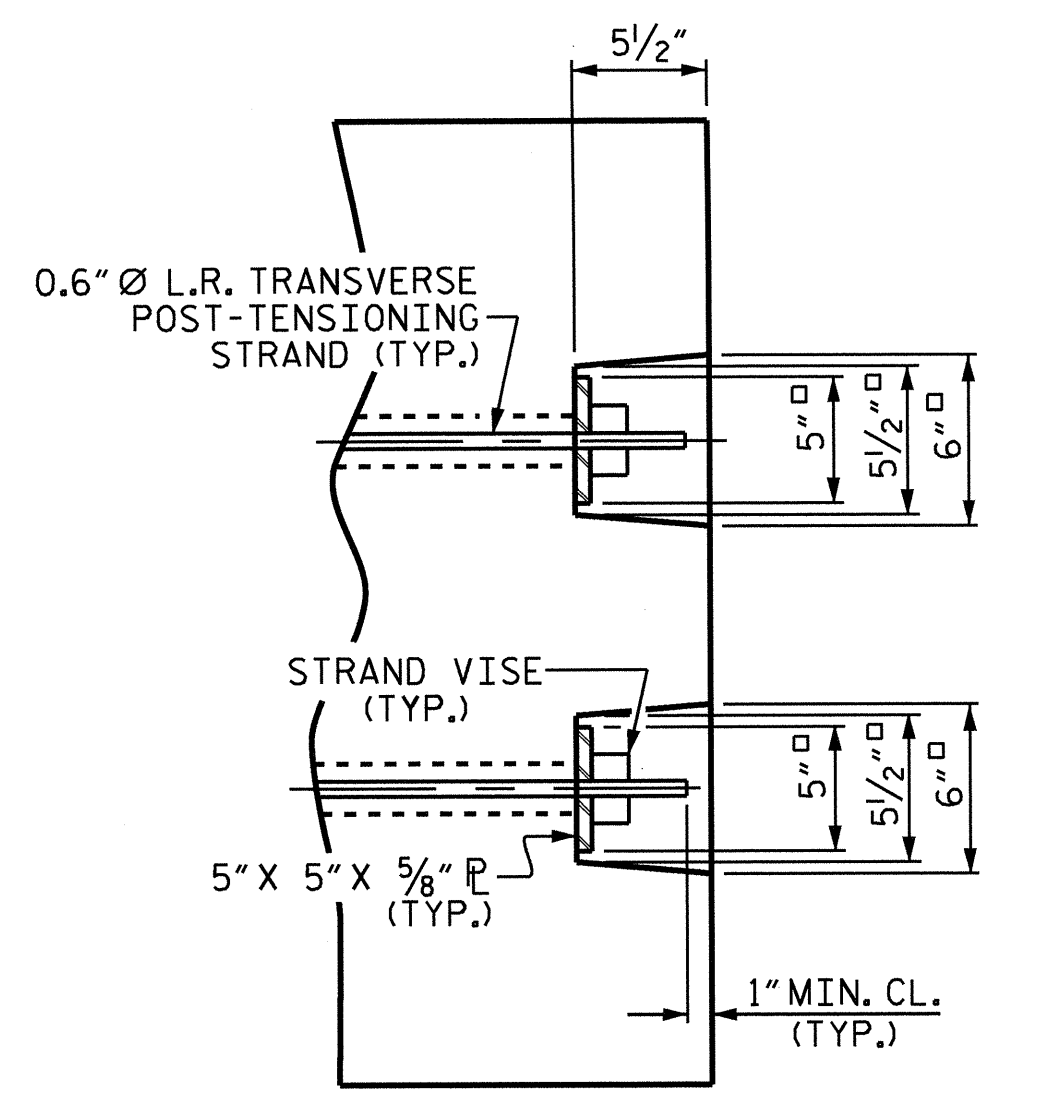

DETAIL "C"

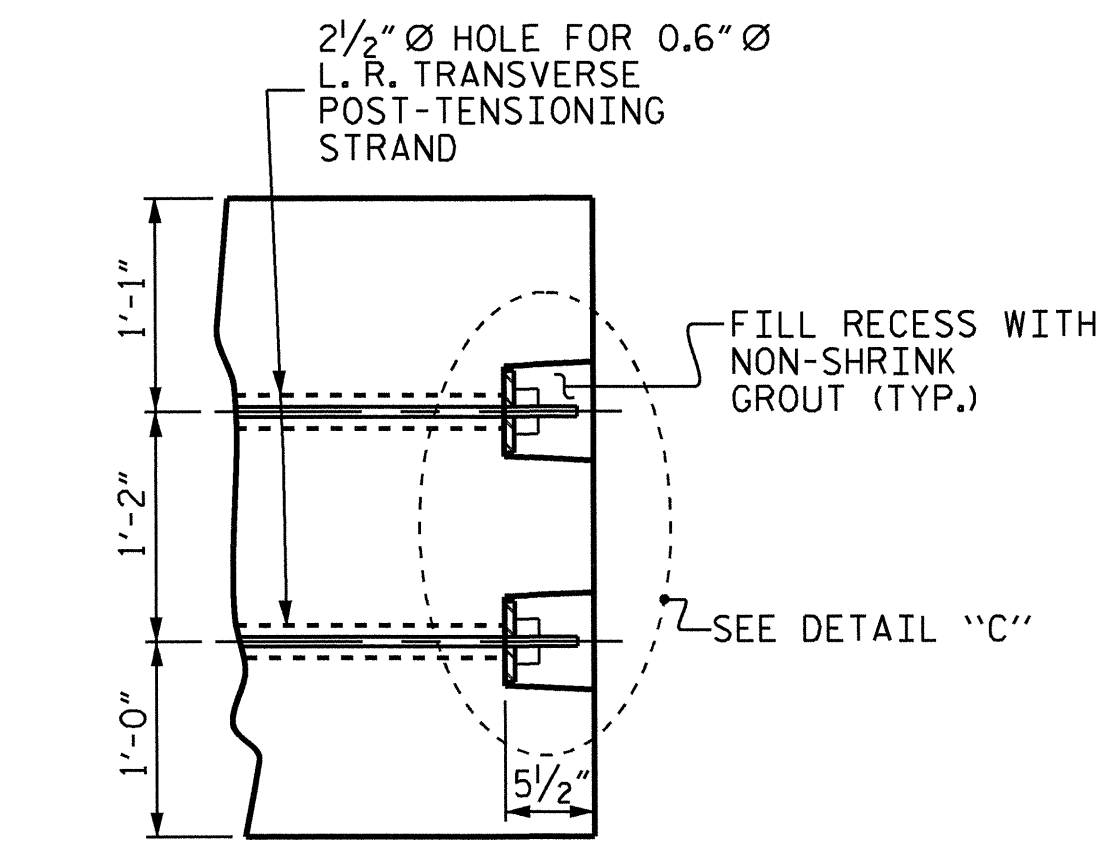


PART SECTION AT RECESS

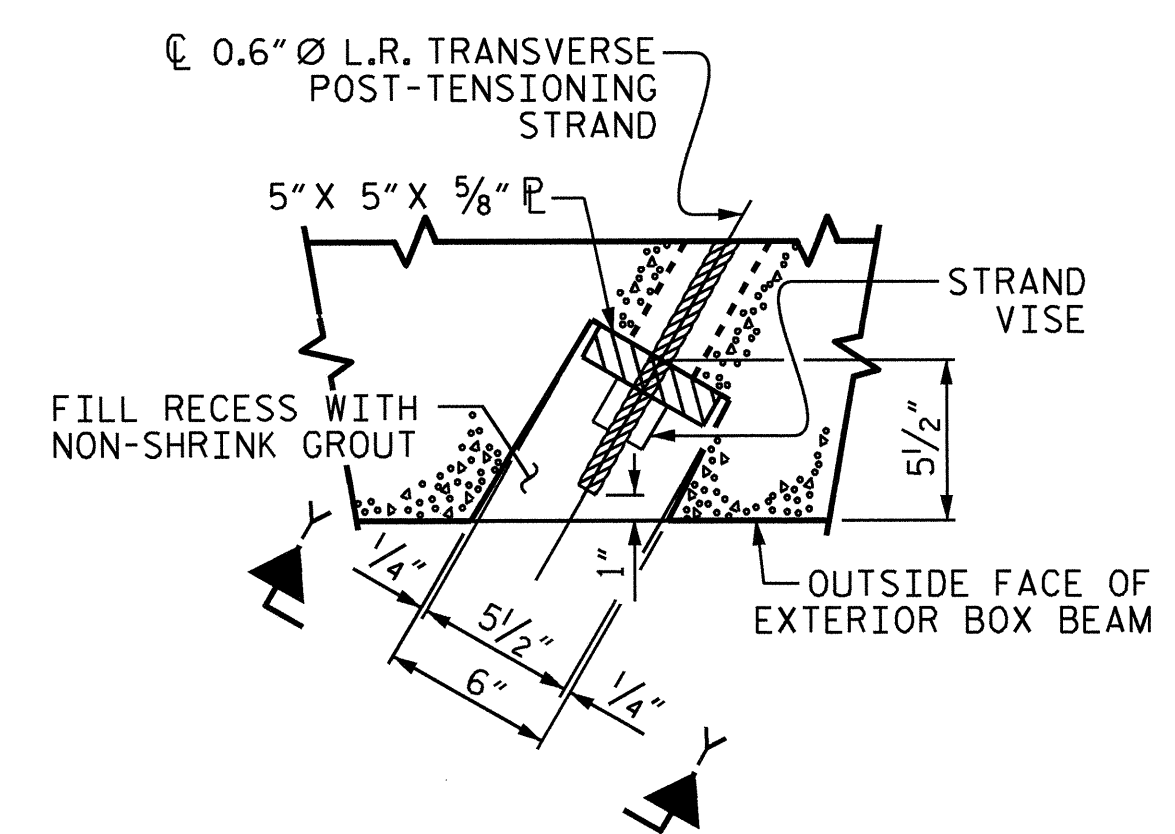

SECTION X-X
SHOWING PLAN VIEW OF GROUDED RECESS

**GROUDED RECESS DETAIL AT
END OF POST-TENSIONED STRANDS
OF EXTERIOR BOX BEAM**

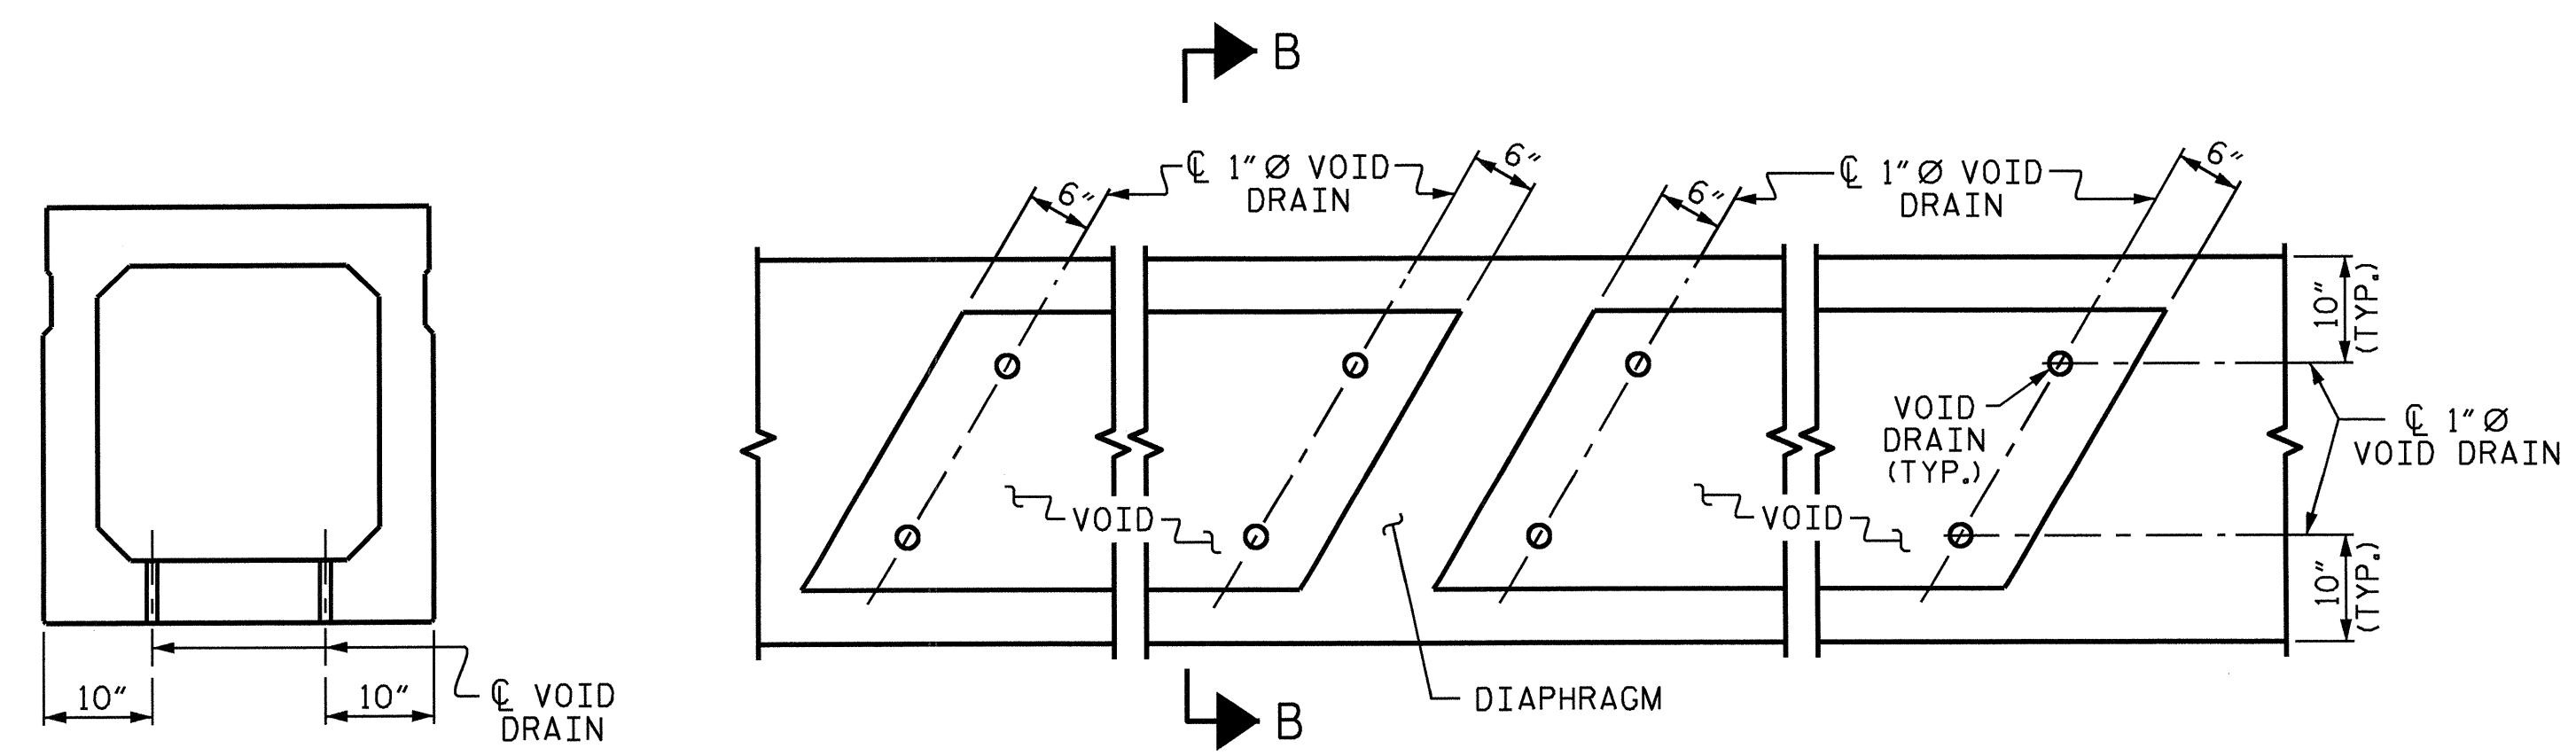

SECTION B-B

PART PLAN

VOID DRAIN DETAILS


(DIMENSIONS SHOWN ARE TYPICAL FOR EACH VOID)

DEAD LOAD DEFLECTION AND CAMBER	
3'-0" x 3'-3"	
95' BOX BEAM UNIT (NC & SE)	0.6" Ø L.R. STRAND
CAMBER (BEAM ALONE IN PLACE)	3/2" ↑
DEFLECTION DUE TO SUPERIMPOSED DEAD LOAD **	1" ↓
FINAL CAMBER	2 1/2" ↑

** INCLUDES FUTURE WEARING SURFACE

PROJECT NO. B-4730
CHATHAM COUNTY
 STATION: 13+82.50 -L-


SHEET 4 OF 5

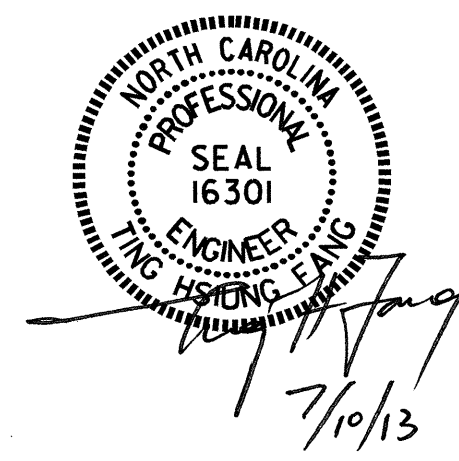

STATE OF NORTH CAROLINA
 DEPARTMENT OF TRANSPORTATION
 RALEIGH
 STANDARD
 3'-0" X 3'-3"
 PRESTRESSED CONCRETE
 BOX BEAM UNIT

REVISIONS						SHEET NO.
NO.	BY:	DATE:	NO.	BY:	DATE:	S-8
1			3			TOTAL SHEETS 16
2			4			

ASSEMBLED BY : R. P. PATEL DATE : 5-24-12
 CHECKED BY : P. K. NEWTON DATE : 10-12
 DRAWN BY : DGE II/II
 CHECKED BY : TMG II/II

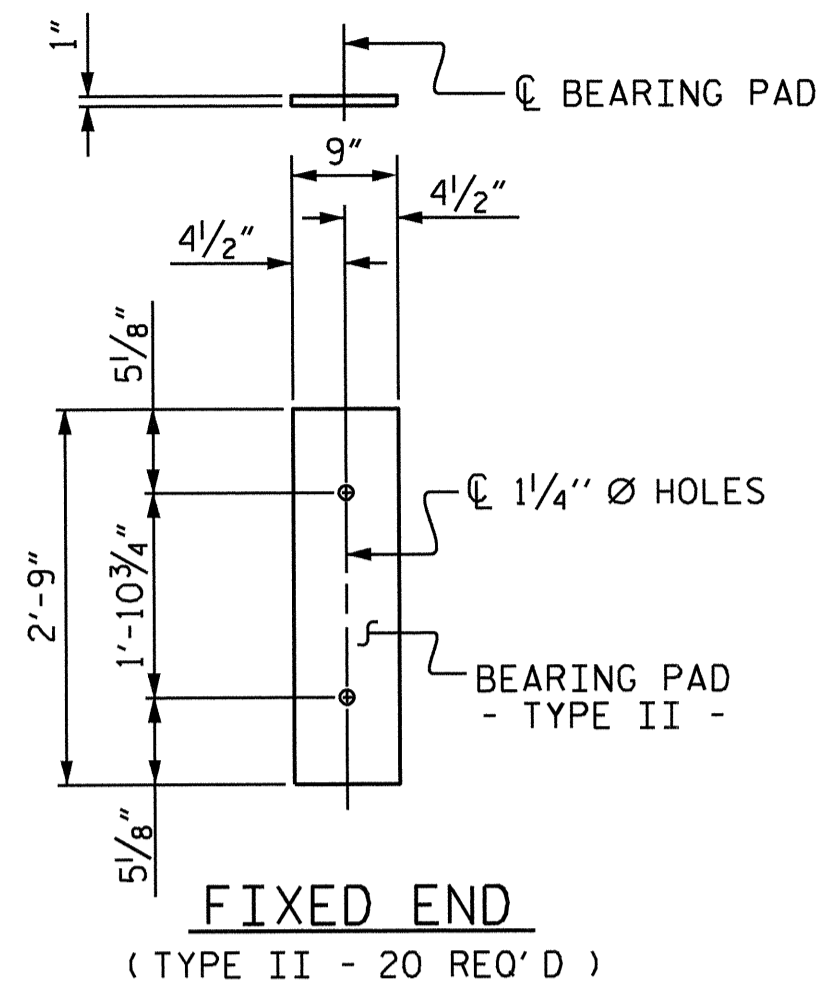


ELASTOMERIC BEARING DETAILS

ELASTOMER IN ALL BEARINGS SHALL BE 60 DUROMETER HARDNESS.

BOX BEAM UNITS REQUIRED

	NUMBER	LENGTH	TOTAL LENGTH
EXTERIOR B.B.	2	95'-0"	190'-0"
INTERIOR B.B.	8	95'-0"	760'-0"
TOTAL	10		950'-0"

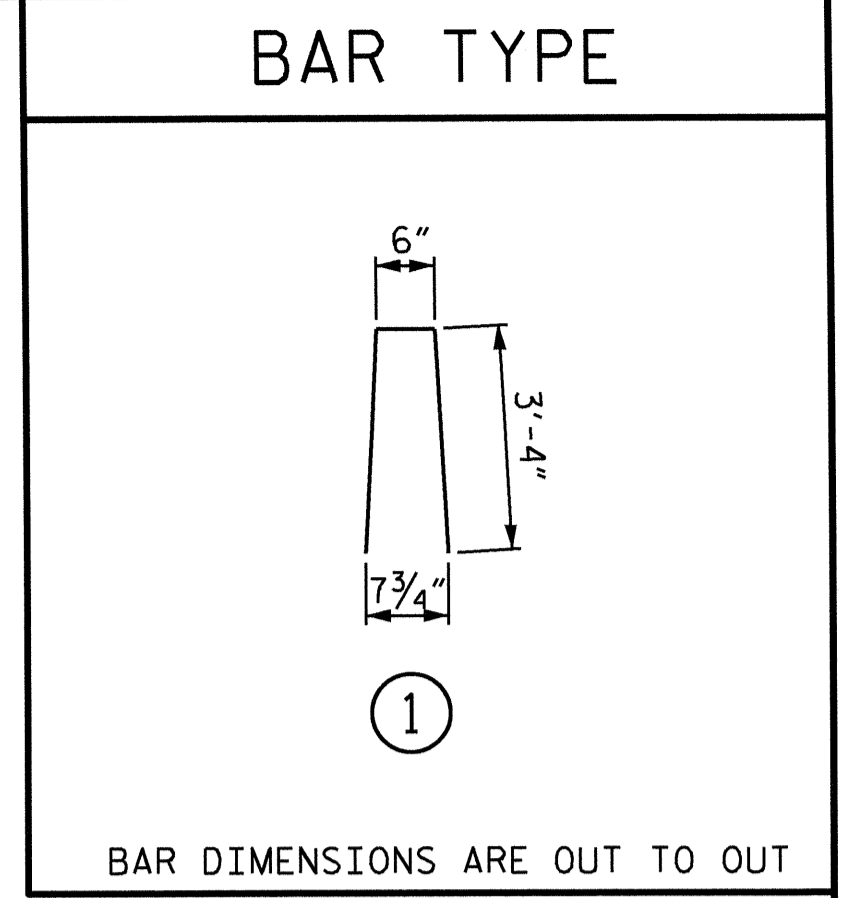


BILL OF MATERIAL FOR VERTICAL CONCRETE BARRIER RAIL


BAR	BARS PER PAIR OF EXTERIOR UNITS	SIZE	TYPE	LENGTH	WEIGHT
95' UNIT					
*B11	192	#5	STR	13'-6"	2703
*S6	256	#5	1	7'-2"	1914
* EPOXY COATED REINFORCING STEEL				LBS.	4617
CLASS AA CONCRETE				CU.YDS.	25.5
TOTAL VERTICAL CONCRETE BARRIER RAIL				LIN. FT.	190.00

GUTTERLINE ASPHALT THICKNESS & RAIL HEIGHT


	ASPHALT OVERLAY THICKNESS @ MID-SPAN	RAIL HEIGHT @ MID-SPAN
95' UNITS	2"	3'-8 1/2"

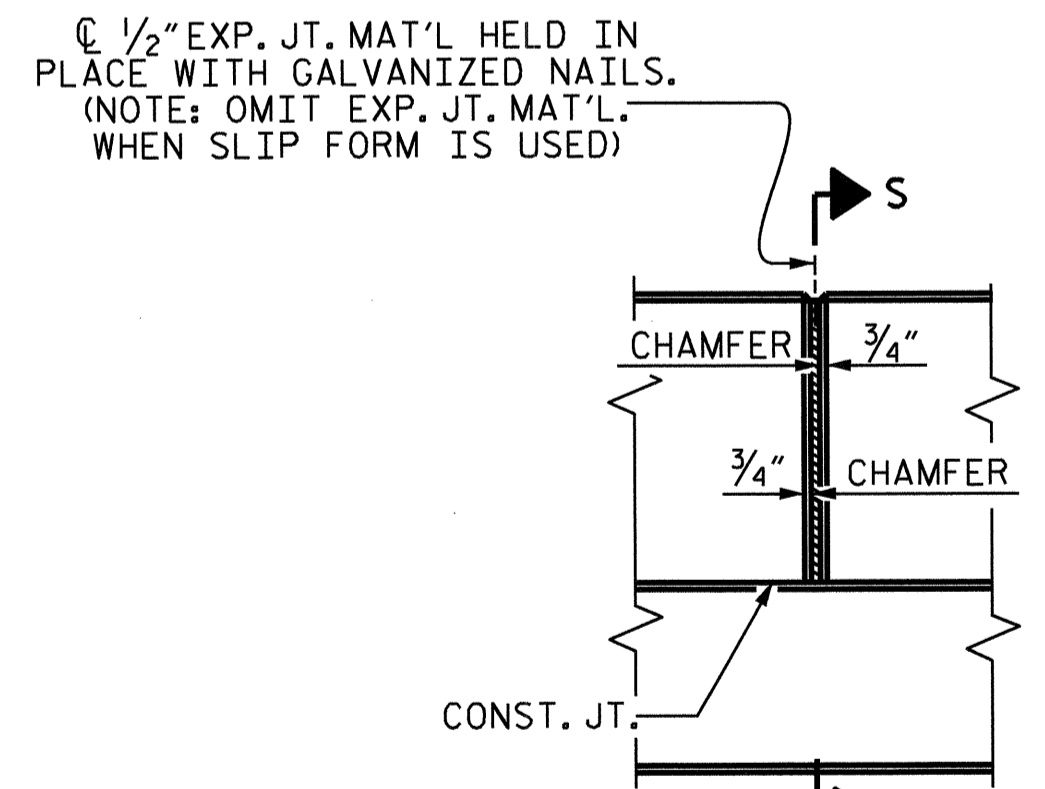

ELEVATION AT EXPANSION JOINTS

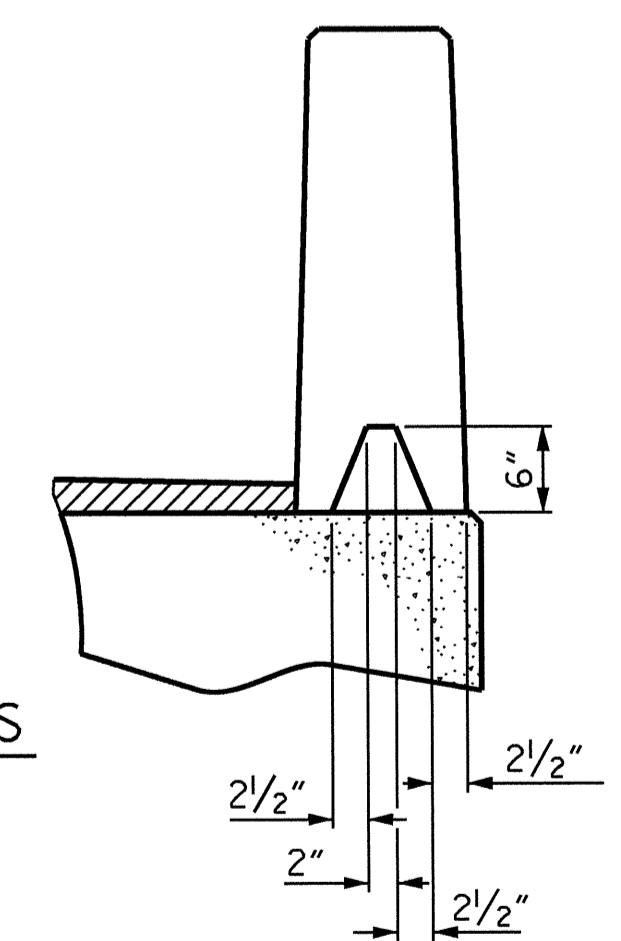

SECTION S-S
AT DAM IN OPEN JOINT
(THIS IS TO BE USED ONLY WHEN SLIP FORM IS USED)

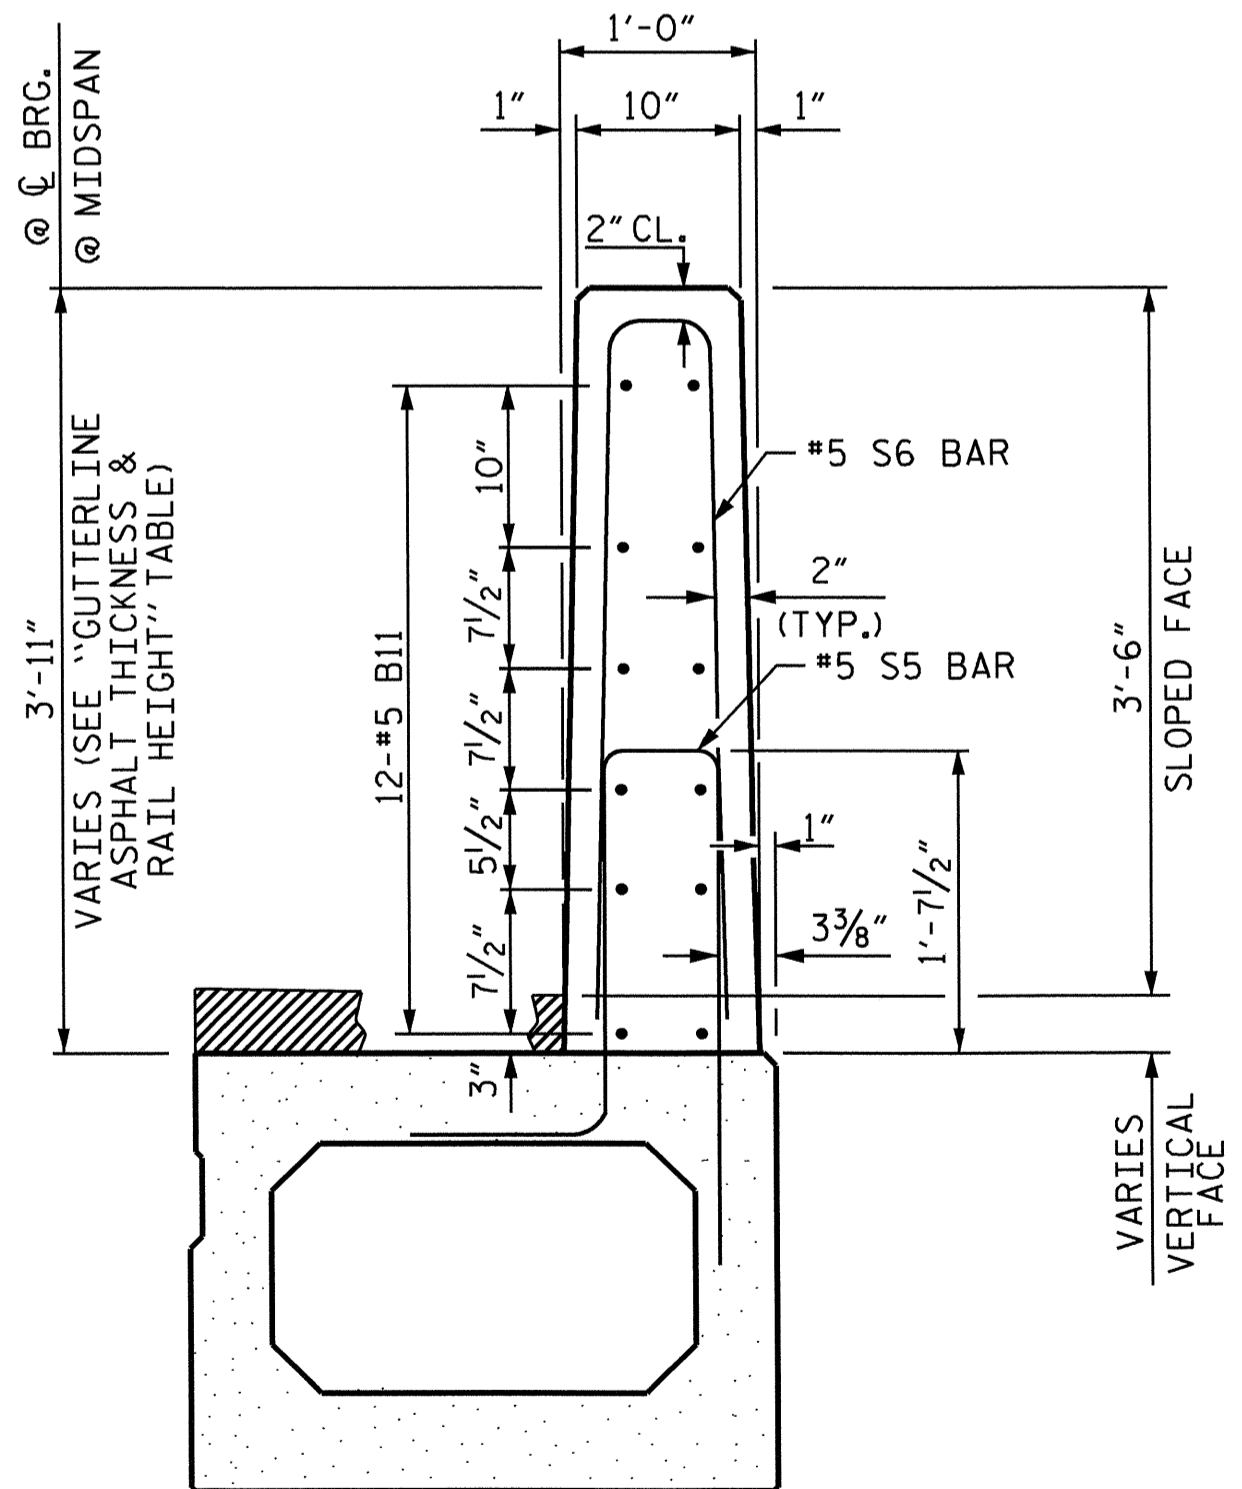


SECTION THRU RAIL

VERTICAL CONCRETE BARRIER RAIL DETAILS

PROJECT NO. B-4730
CHATHAM COUNTY
 STATION: 13+82.50 -L-

SHEET 5 OF 5

STATE OF NORTH CAROLINA
 DEPARTMENT OF TRANSPORTATION
 RALEIGH
 STANDARD
 3'-0" X 3'-3"
 PRESTRESSED CONCRETE
 BOX BEAM UNIT

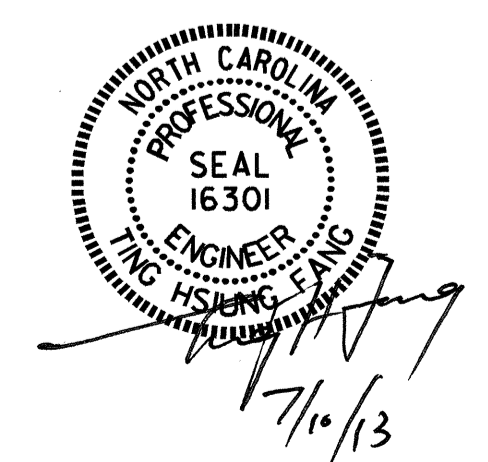

ASSEMBLED BY : R. P. PATEL DATE : 5-24-12
 CHECKED BY : P. K. NEWTON DATE : 10-12
 DRAWN BY : DGE 10/11
 CHECKED BY : TMG 11/11

REVISIONS						SHEET NO.
NO.	BY:	DATE:	NO.	BY:	DATE:	S-9
1			3			TOTAL SHEETS 16
2			4			

NOTES

THE GUARDRAIL ANCHOR ASSEMBLY SHALL CONSIST OF A 1/4" HOLD DOWN PLATE AND 7 - 7/8" Ø BOLTS WITH NUTS AND WASHERS.

THE HOLD-DOWN PLATE SHALL CONFORM TO AASHTO M270 GRADE 36. AFTER FABRICATION, THE HOLD-DOWN PLATE SHALL BE HOT-DIP GALVANIZED IN ACCORDANCE WITH AASHTO M111.

BOLTS SHALL CONFORM TO THE REQUIREMENTS OF ASTM A307 AND NUTS SHALL CONFORM TO THE REQUIREMENTS OF AASHTO M291. BOLTS, NUTS AND WASHERS SHALL BE GALVANIZED. (AT THE CONTRACTOR'S OPTION, STAINLESS STEEL BOLTS, NUTS AND WASHERS MAY BE USED AS AN ALTERNATE FOR THE 7/8" Ø GALVANIZED BOLTS, NUTS AND WASHERS, THEY SHALL CONFORM TO OR EXCEED THE MECHANICAL REQUIREMENTS OF ASTM A307. THE USE OF THIS ALTERNATE SHALL BE APPROVED BY THE ENGINEER.)


THE GUARDRAIL ANCHOR ASSEMBLY IS REQUIRED AT ALL POINTS WHERE APPROACH GUARDRAIL IS TO BE ATTACHED TO THE END OF BARRIER RAIL. FOR POINTS OF ATTACHMENT, SEE SKETCH.

AFTER INSTALLATION, THE EXPOSED THREAD OF THE BOLT SHALL BE BURRED WITH A SHARP POINTED TOOL.


THE COST OF THE GUARDRAIL ANCHOR ASSEMBLY SHALL BE INCLUDED IN THE UNIT CONTRACT PRICE BID FOR VERTICAL CONCRETE BARRIER RAIL.

THE VERTICAL REINFORCING BARS MAY BE SHIFTED SLIGHTLY IN THE VERTICAL CONCRETE BARRIER RAIL TO CLEAR ASSEMBLY BOLTS.

THE 1 1/4" Ø HOLES SHALL BE FORMED OR DRILLED WITH A CORE BIT. IMPACT TOOLS WILL NOT BE PERMITTED. ANY CONCRETE DAMAGED BY THIS WORK SHALL BE REPAIRED TO THE SATISFACTION OF THE ENGINEER.

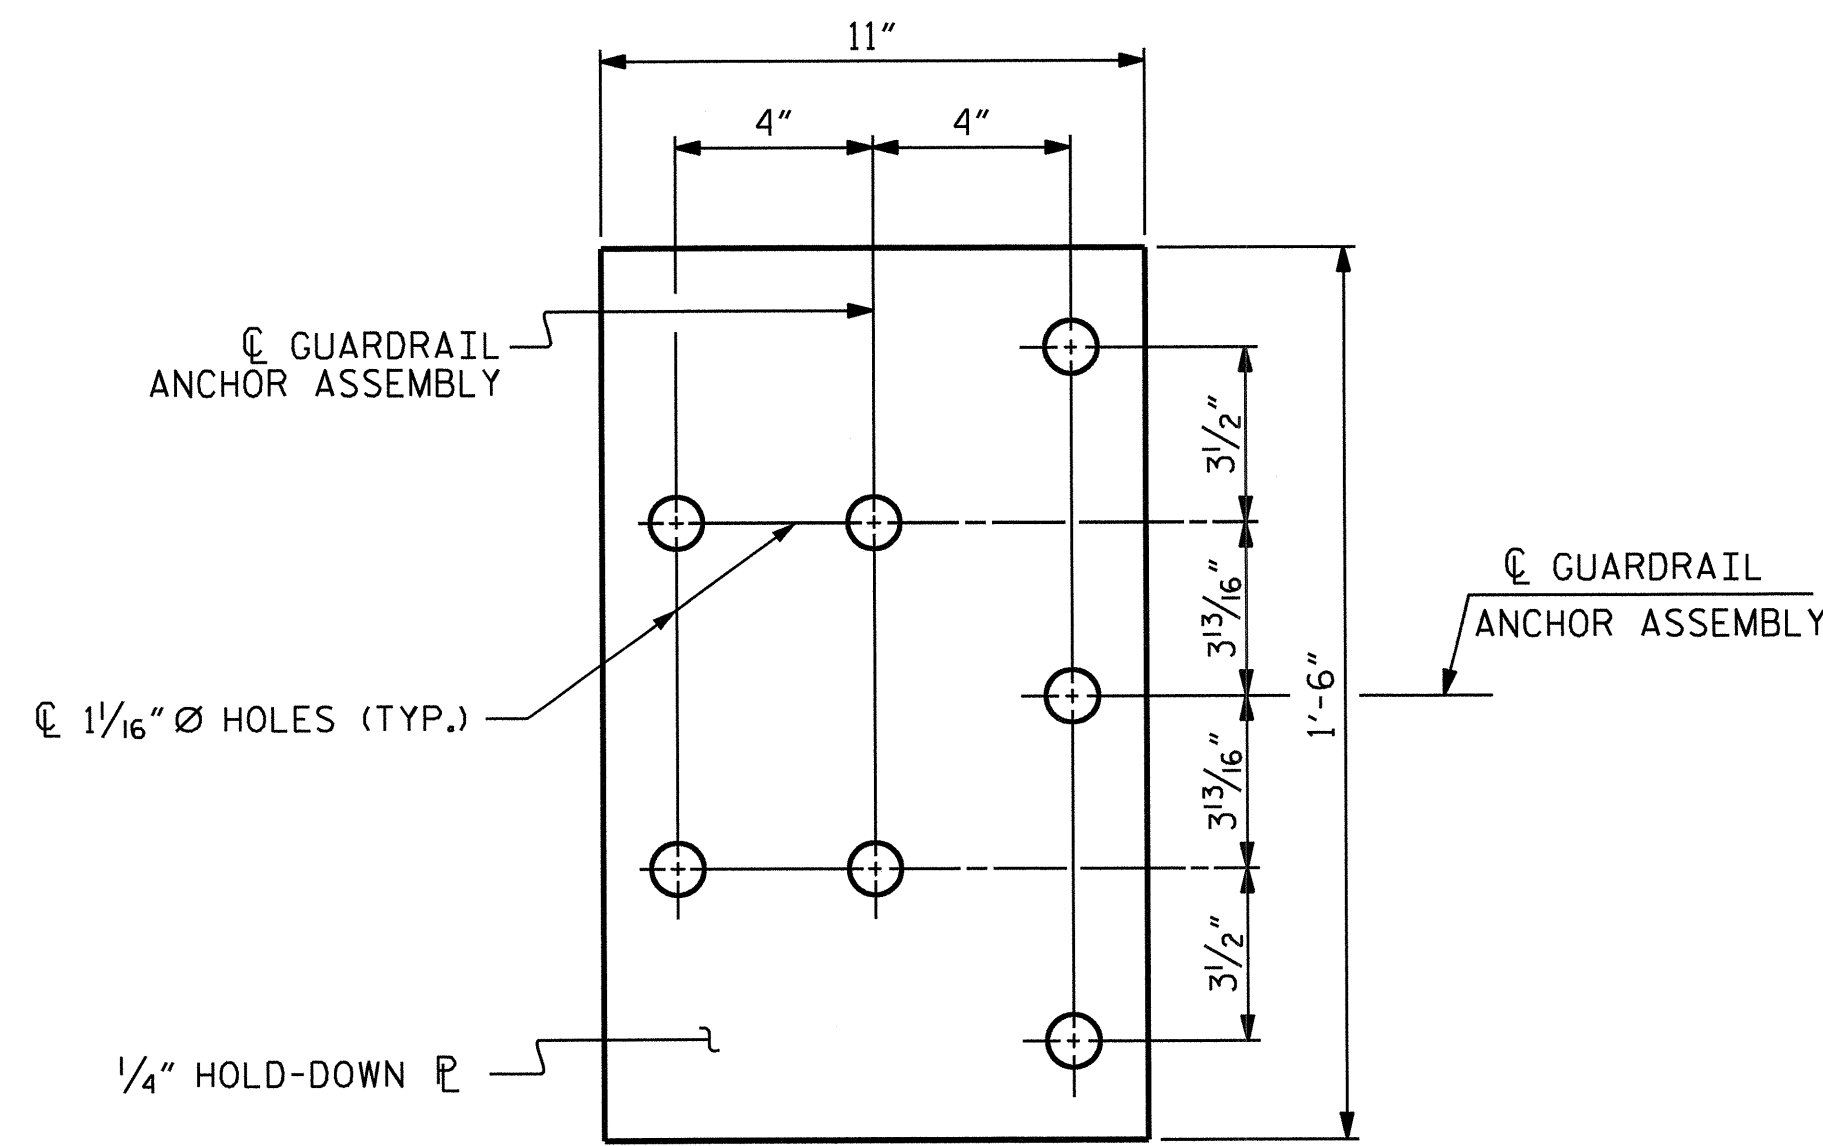


PLAN

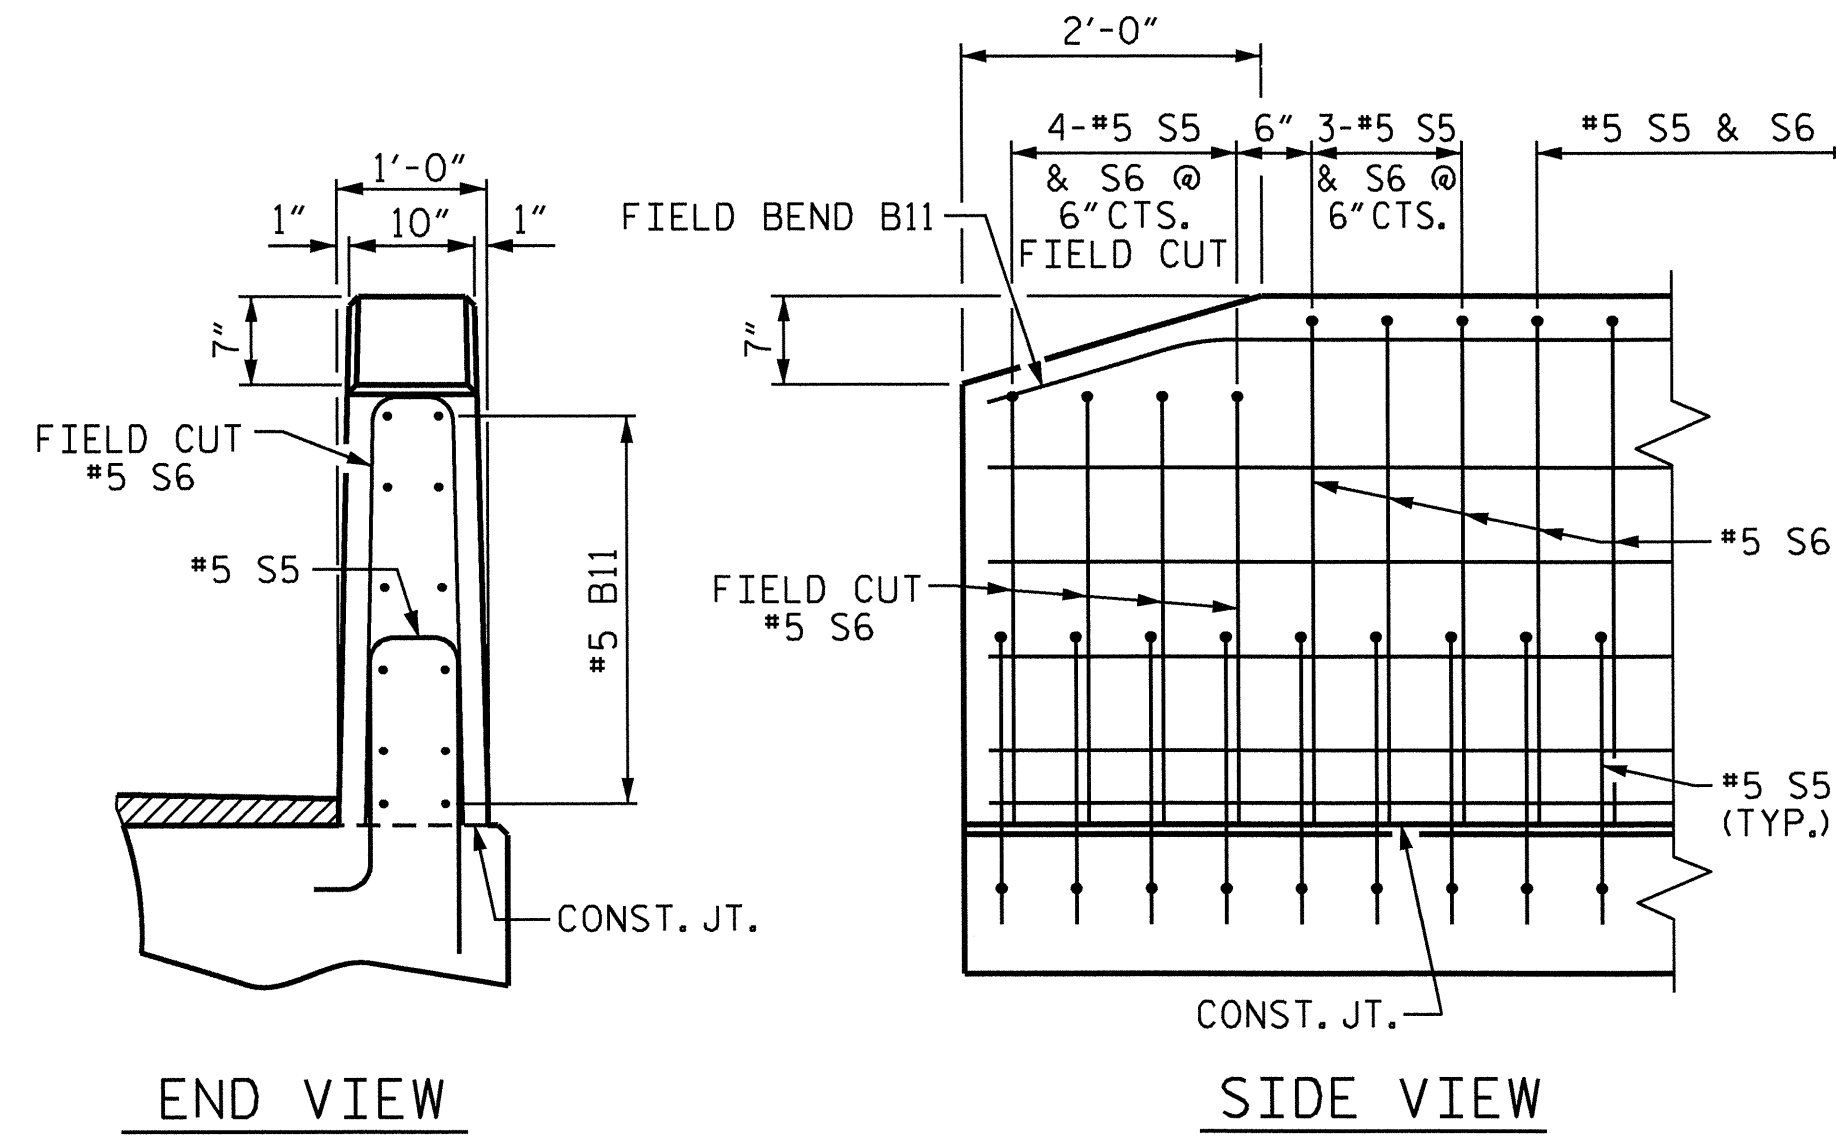


END OF BARRIER RAIL DETAILS

END BENT 1 SHOWN, END BENT 2 SIMILAR.

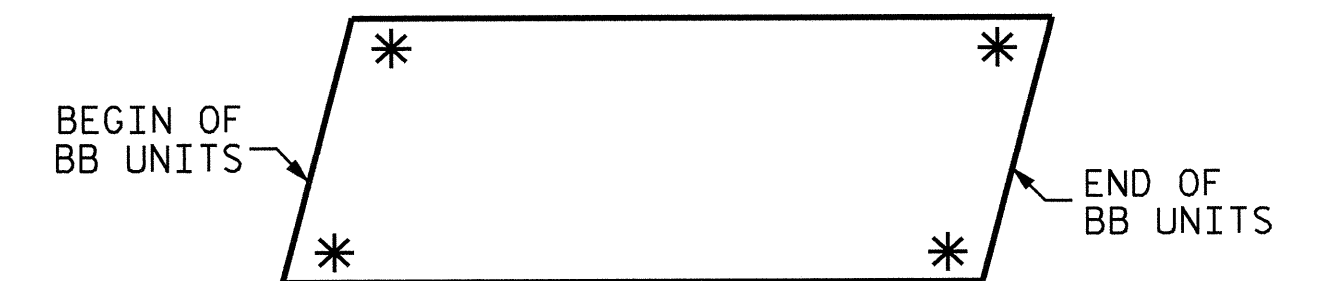


SKETCH SHOWING POINTS OF ATTACHMENT

* DENOTES GUARDRAIL ANCHOR ASSEMBLY

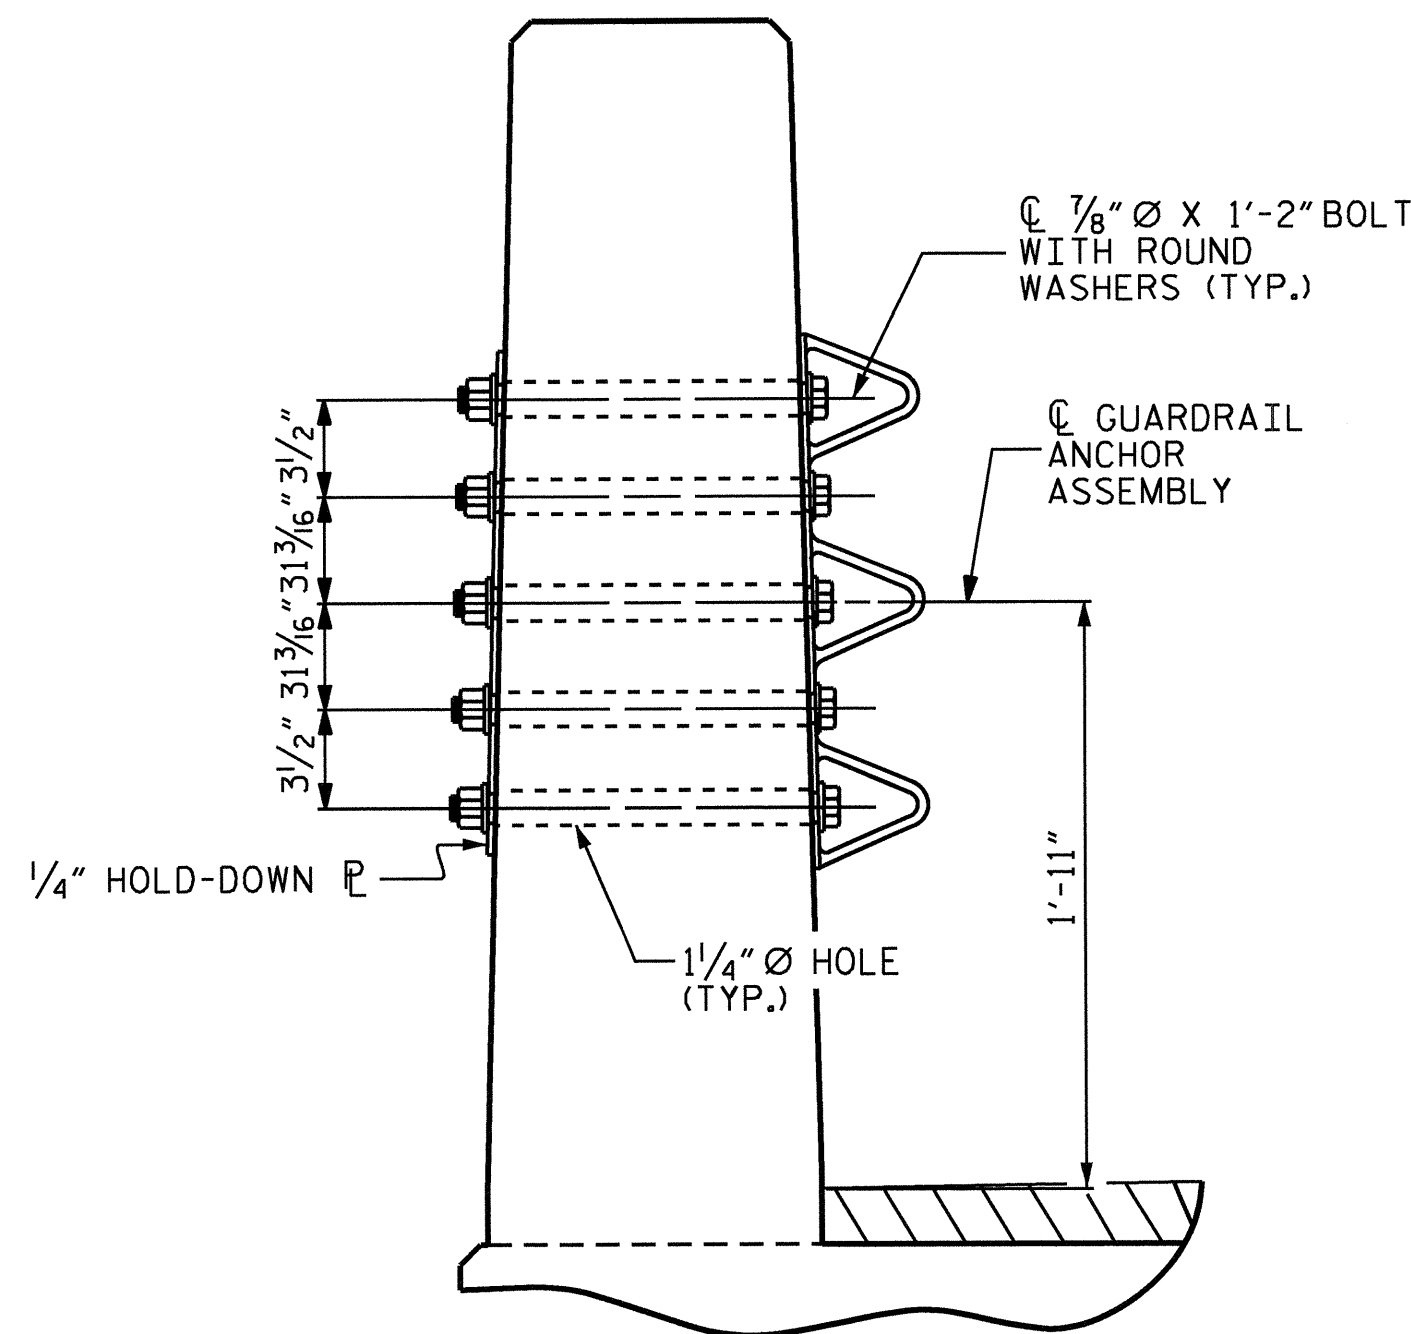

SECTION E-E

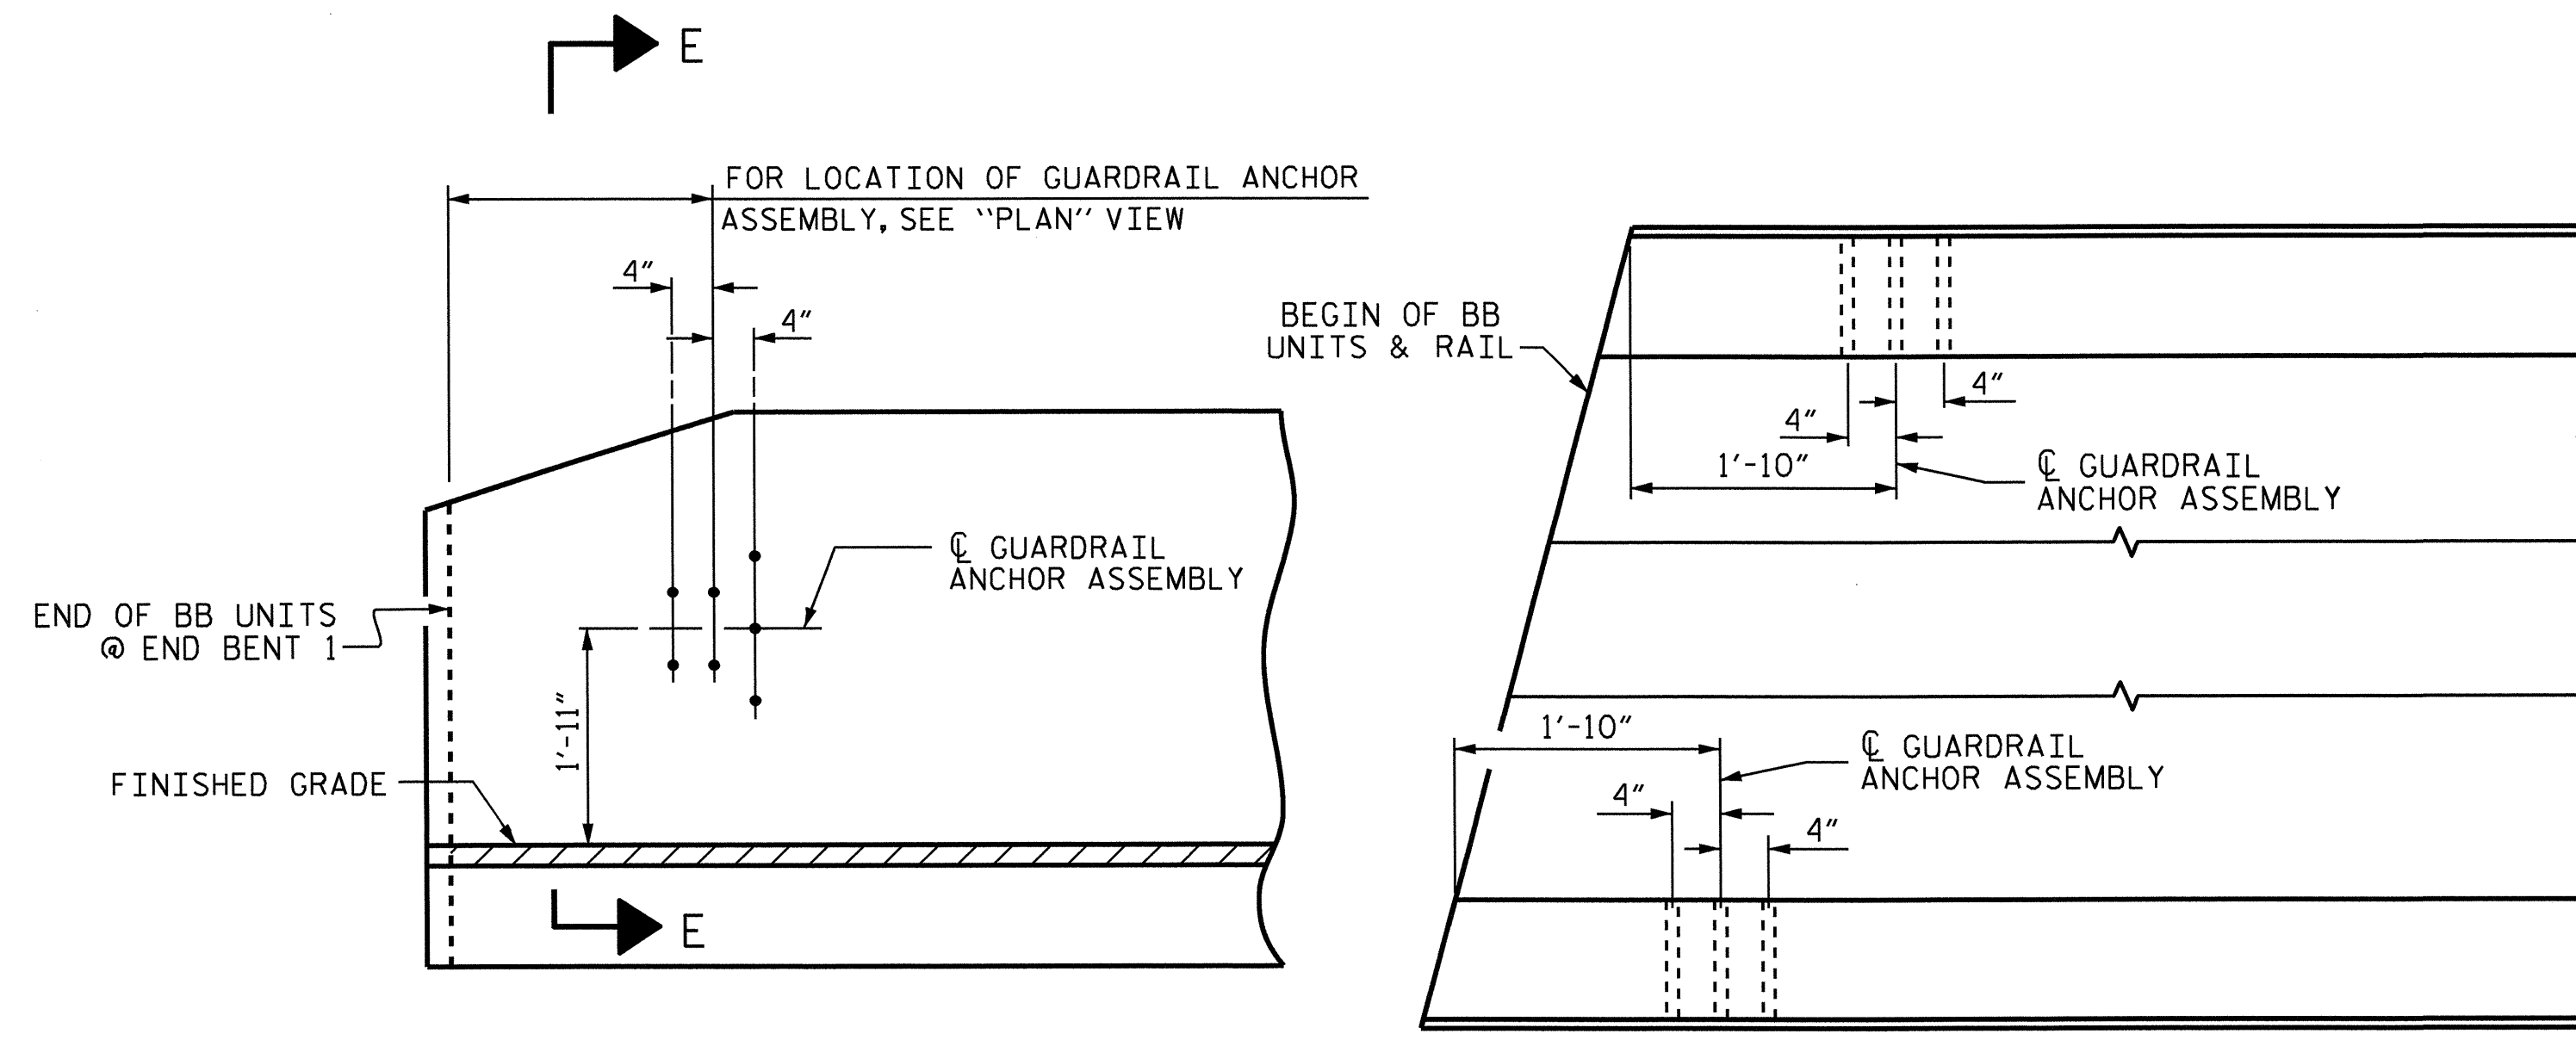

ELEVATION


PLAN

GUARDRAIL ANCHOR ASSEMBLY DETAILS

LOCATION OF ANCHORS FOR GUARDRAIL

END BENT 1 SHOWN, END BENT 2 SIMILAR.

PROJECT NO. B-4730
CHATHAM COUNTY
STATION: 13+82.50 -L-

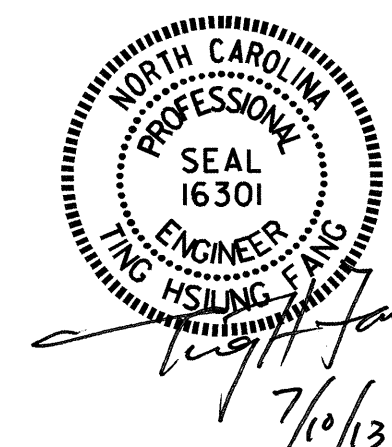

STATE OF NORTH CAROLINA
DEPARTMENT OF TRANSPORTATION
RALEIGH
STANDARD
GUARDRAIL ANCHORAGE
FOR VERTICAL CONCRETE
BARRIER RAIL

REVISIONS						SHEET NO.
NO.	BY:	DATE:	NO.	BY:	DATE:	TOTAL SHEETS
1			3			16
2			4			

ASSEMBLED BY : R. P. PATEL	DATE : 5/25/12
CHECKED BY : P. K. NEWTON	DATE : 10-12
DRAWN BY : MAA 5/10	ADDED 5/6/10
CHECKED BY : GM 5/10	REV. 10/1/11
	REV. 12/5/11


NOTES

STIRRUPS IN CAP MAY BE SHIFTED AS NECESSARY TO CLEAR DOWELS.


THE CONCRETE IN THE SHADED AREA OF THE WING SHALL BE POURED AFTER THE VERTICAL CONCRETE BARRIER RAIL IS CAST IF SLIP FORMING IS USED.

FOR PILE SPLICE DETAILS, SEE SHEET 4 OF 4.

FOR WING DETAILS, SEE SHEET 3 OF 4.

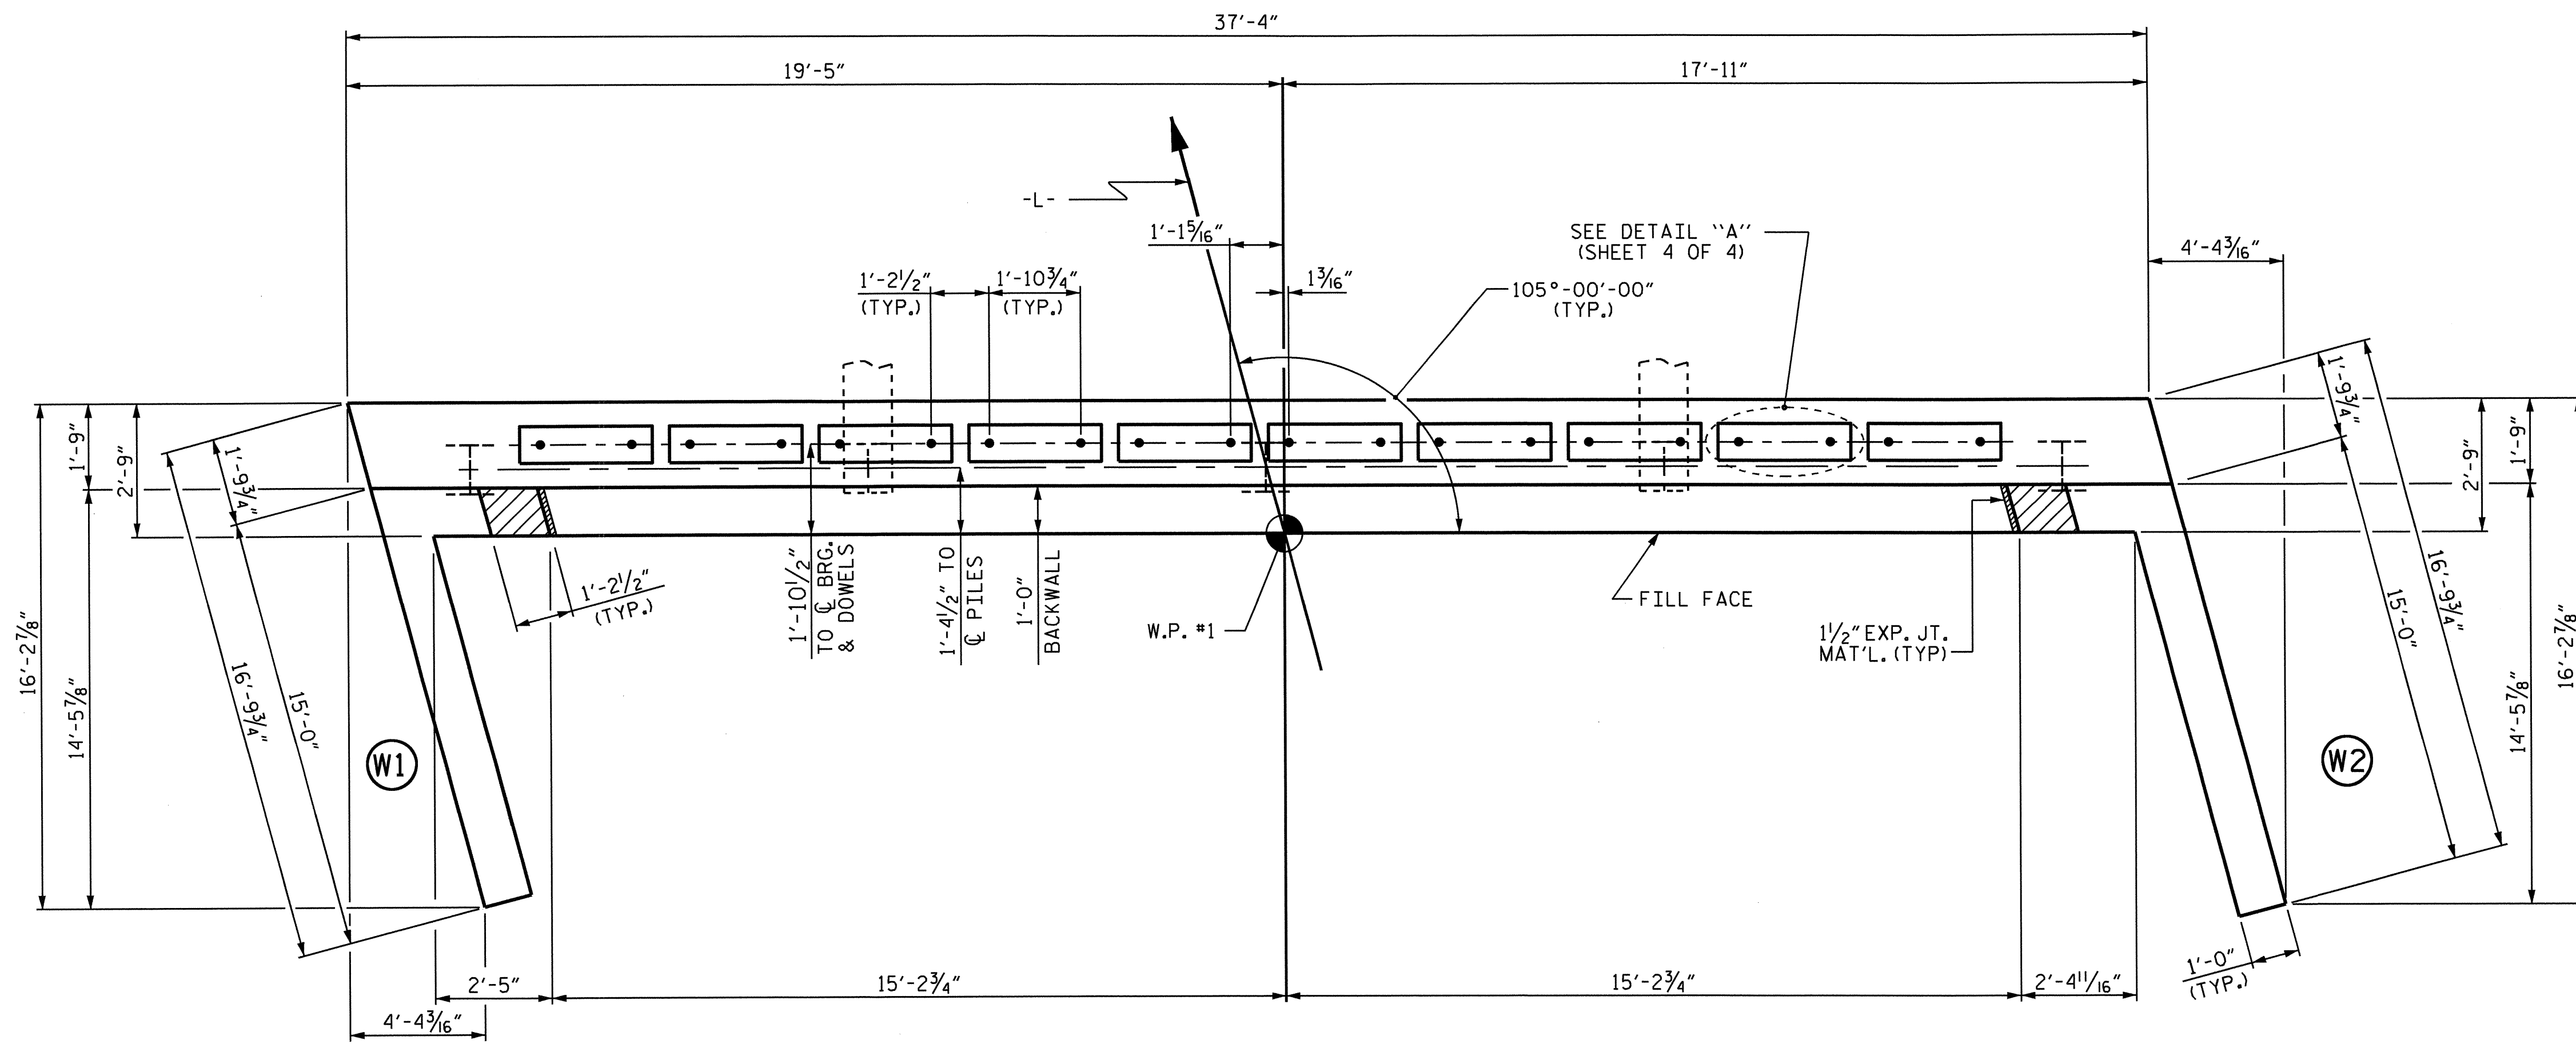

PLAN

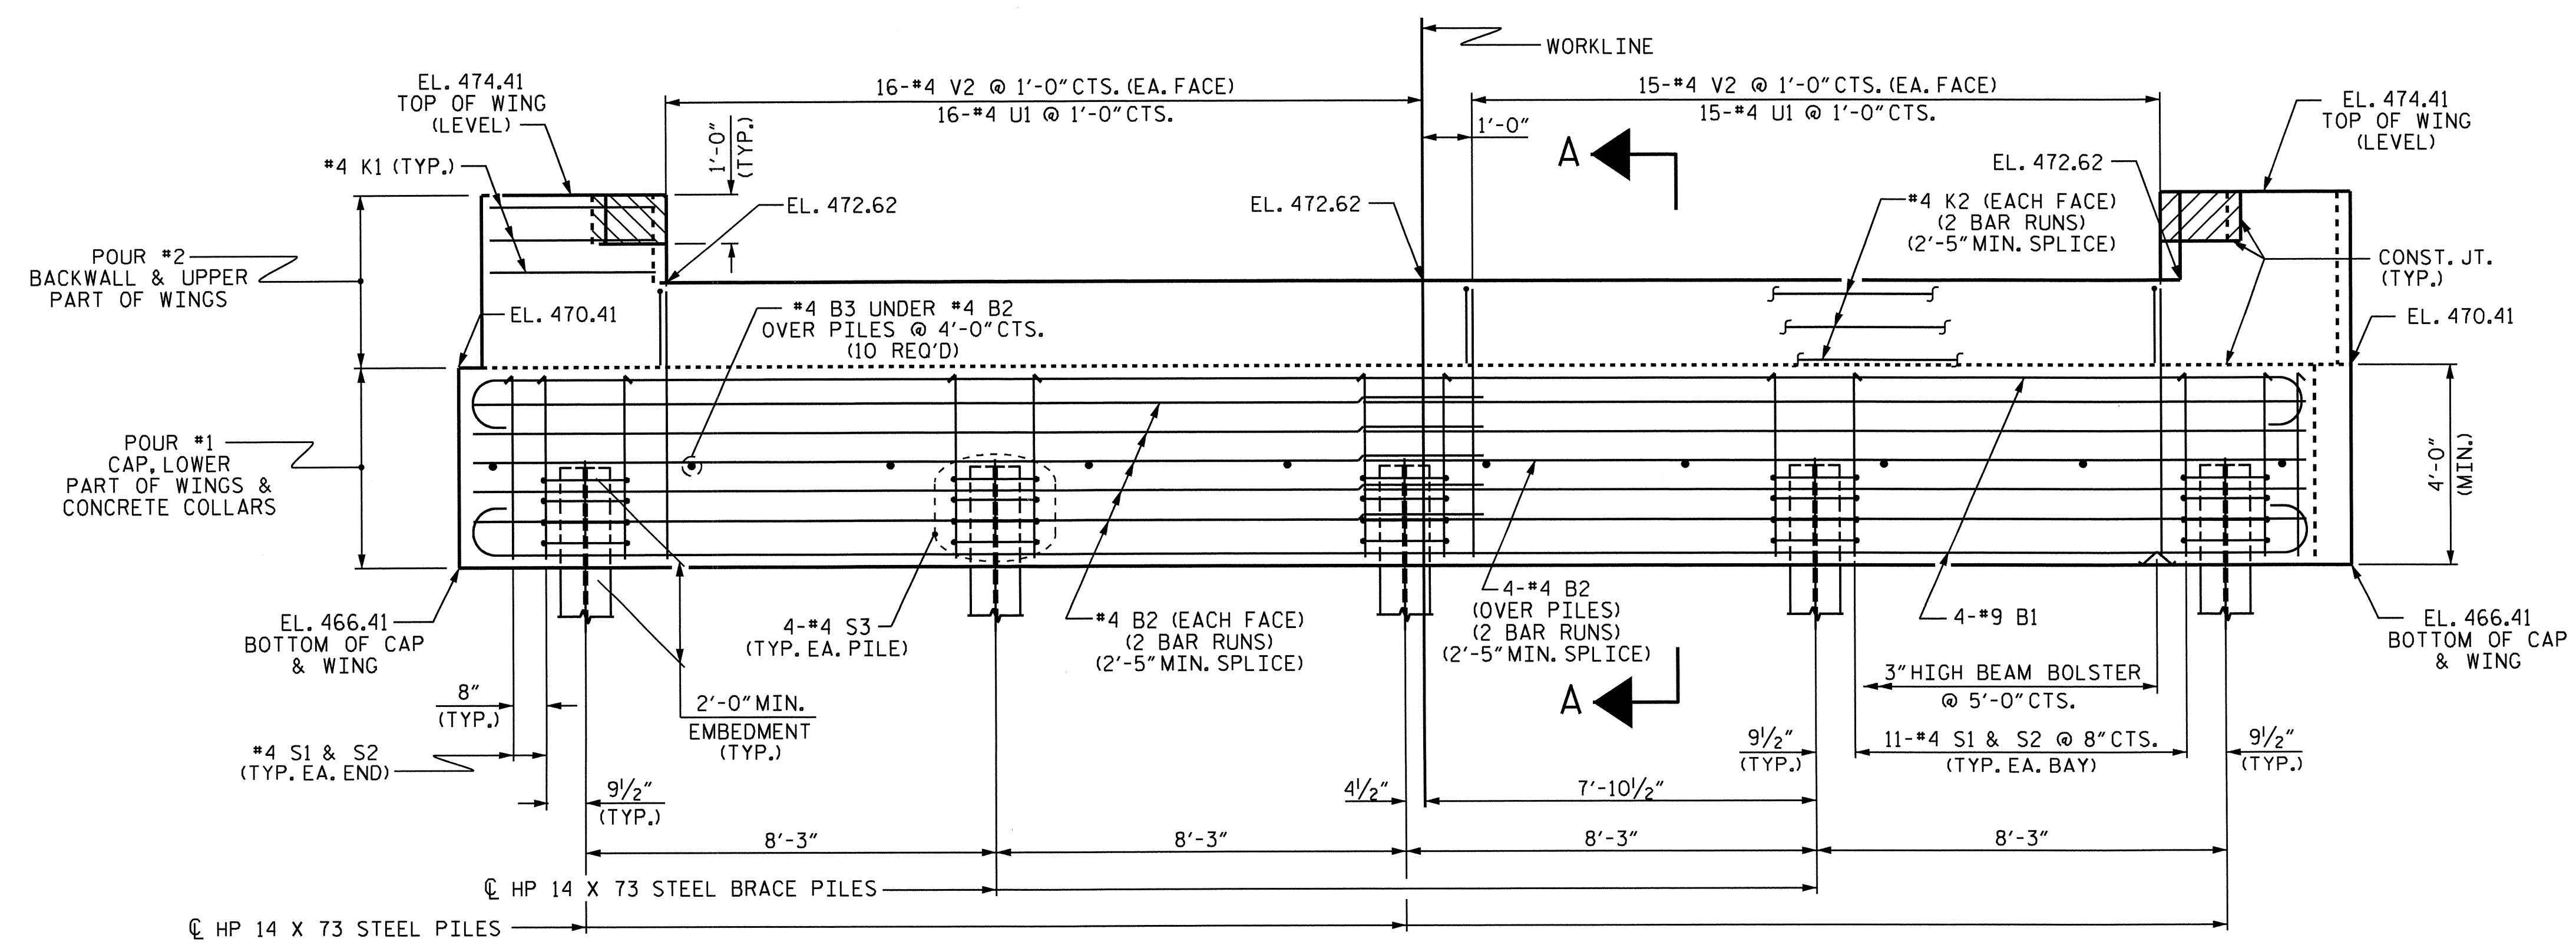


ELEVATION

WINGS NOT SHOWN FOR CLARITY.
 FOR SECTION A-A, SEE SHEET 4 OF 4.
 CONCRETE COLLARS FOR STEEL PILES NOT SHOWN IN PLAN AND ELEVATION VIEWS FOR CLARITY.
 SEE "CORROSION PROTECTION FOR STEEL PILES DETAIL", SHEET 4 OF 4.

PROJECT NO. B-4730
CHATHAM COUNTY
 STATION: 13+82.50 -L-

SHEET 1 OF 4

STATE OF NORTH CAROLINA
 DEPARTMENT OF TRANSPORTATION
 RALEIGH
 SUBSTRUCTURE
 END BENT 1

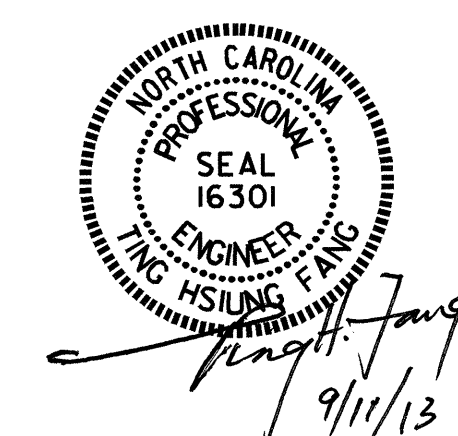

ASSEMBLED BY : R.P.PATEL DATE : 5-25-12
 CHECKED BY : P.K. NEWTON DATE : 9-12
 DRAWN BY : WJH 12/11
 CHECKED BY : AAC 12/11

REVISIONS						SHEET NO.
NO.	BY:	DATE:	NO.	BY:	DATE:	S-11
1			3			TOTAL SHEETS
2			4			16


NOTES

STIRRUPS IN CAP MAY BE SHIFTED AS NECESSARY TO CLEAR DOWELS.


THE CONCRETE IN THE SHADED AREA OF THE WING SHALL BE POURED AFTER THE VERTICAL CONCRETE BARRIER RAIL IS CAST IF SLIP FORMING IS USED.

FOR PILE SPLICE DETAILS, SEE SHEET 4 OF 4.

FOR WING DETAILS, SEE SHEET 3 OF 4.

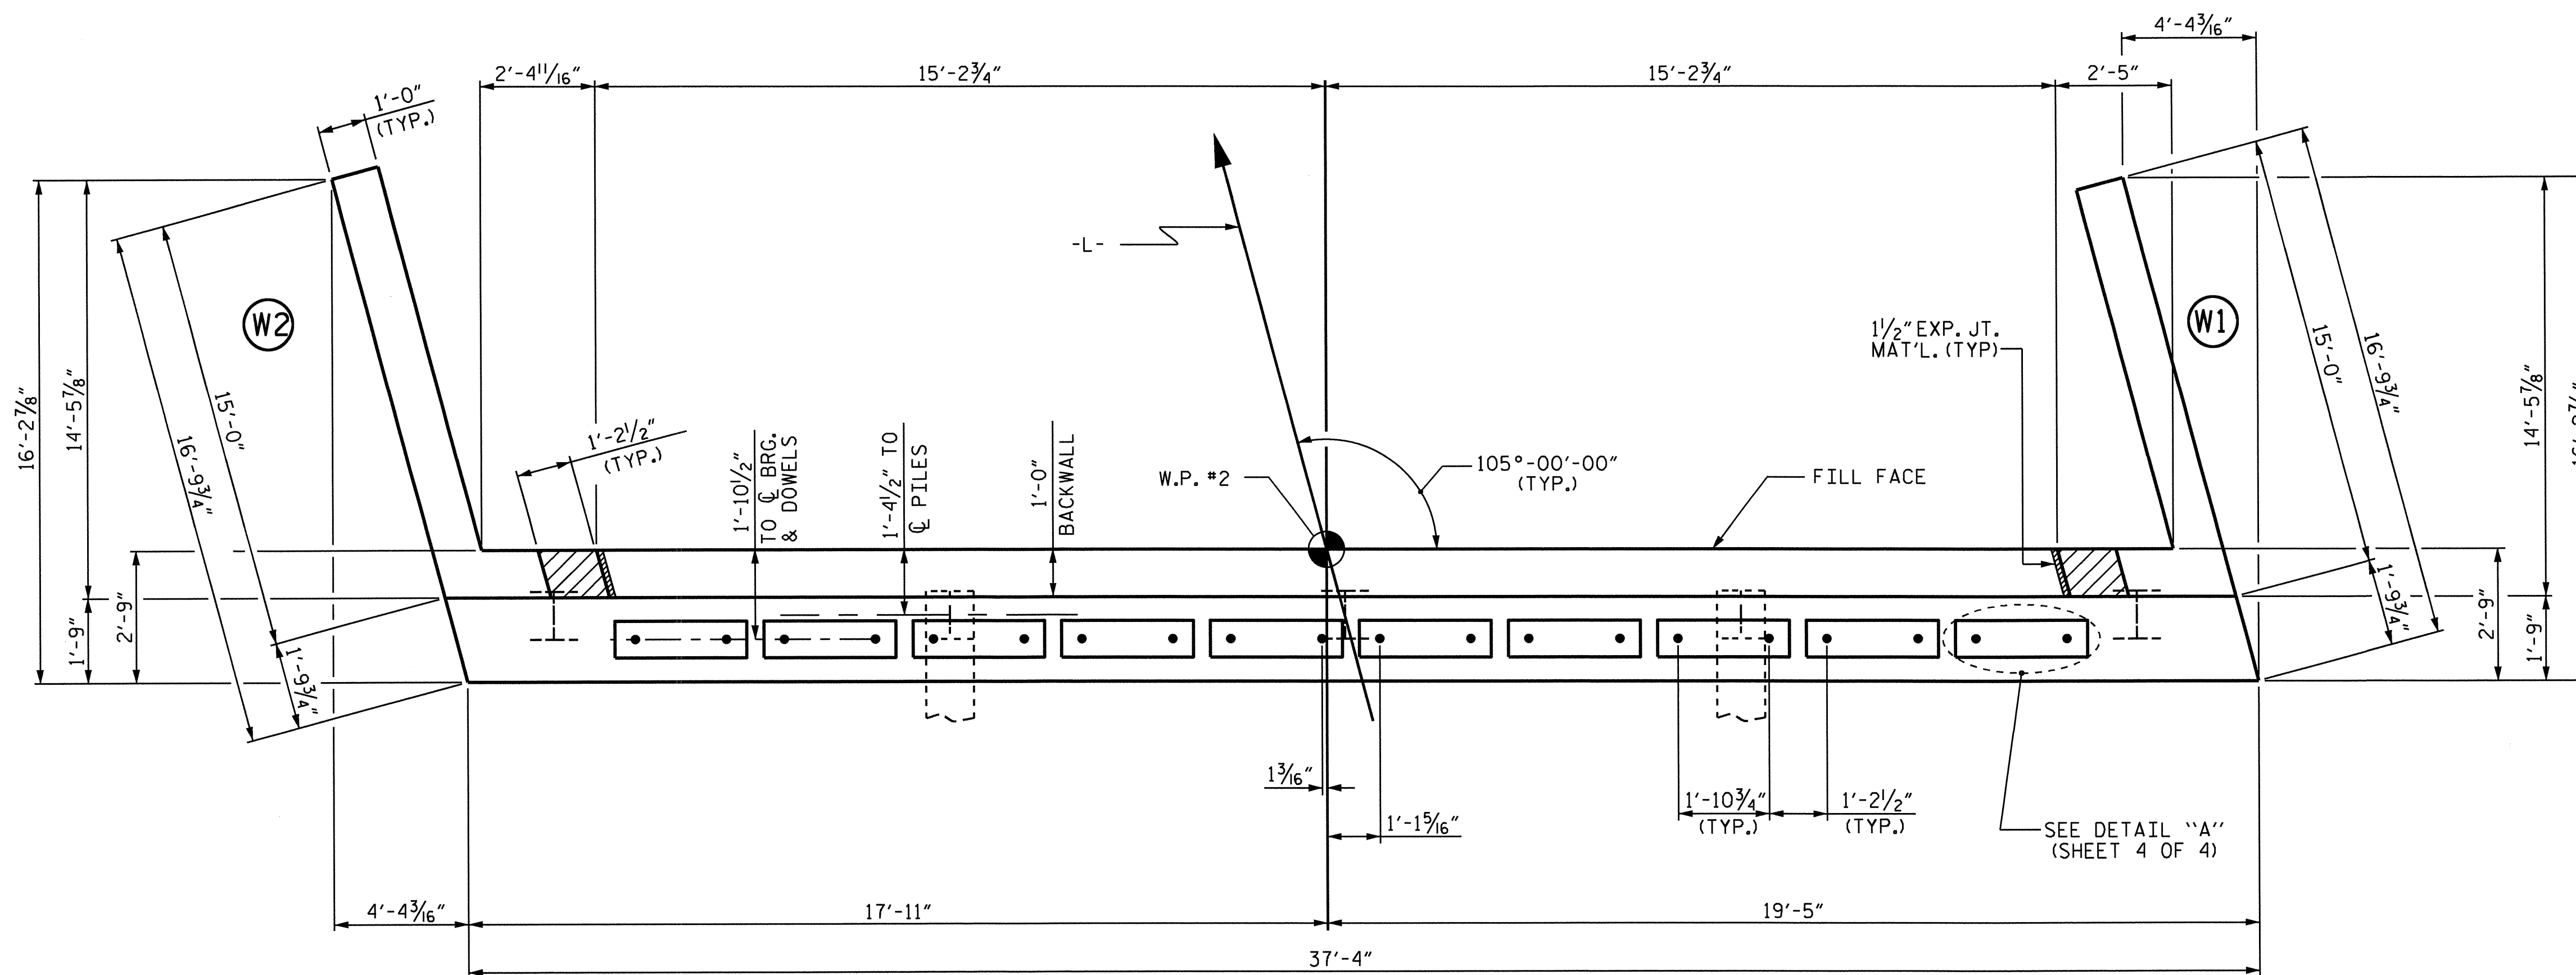

PLAN

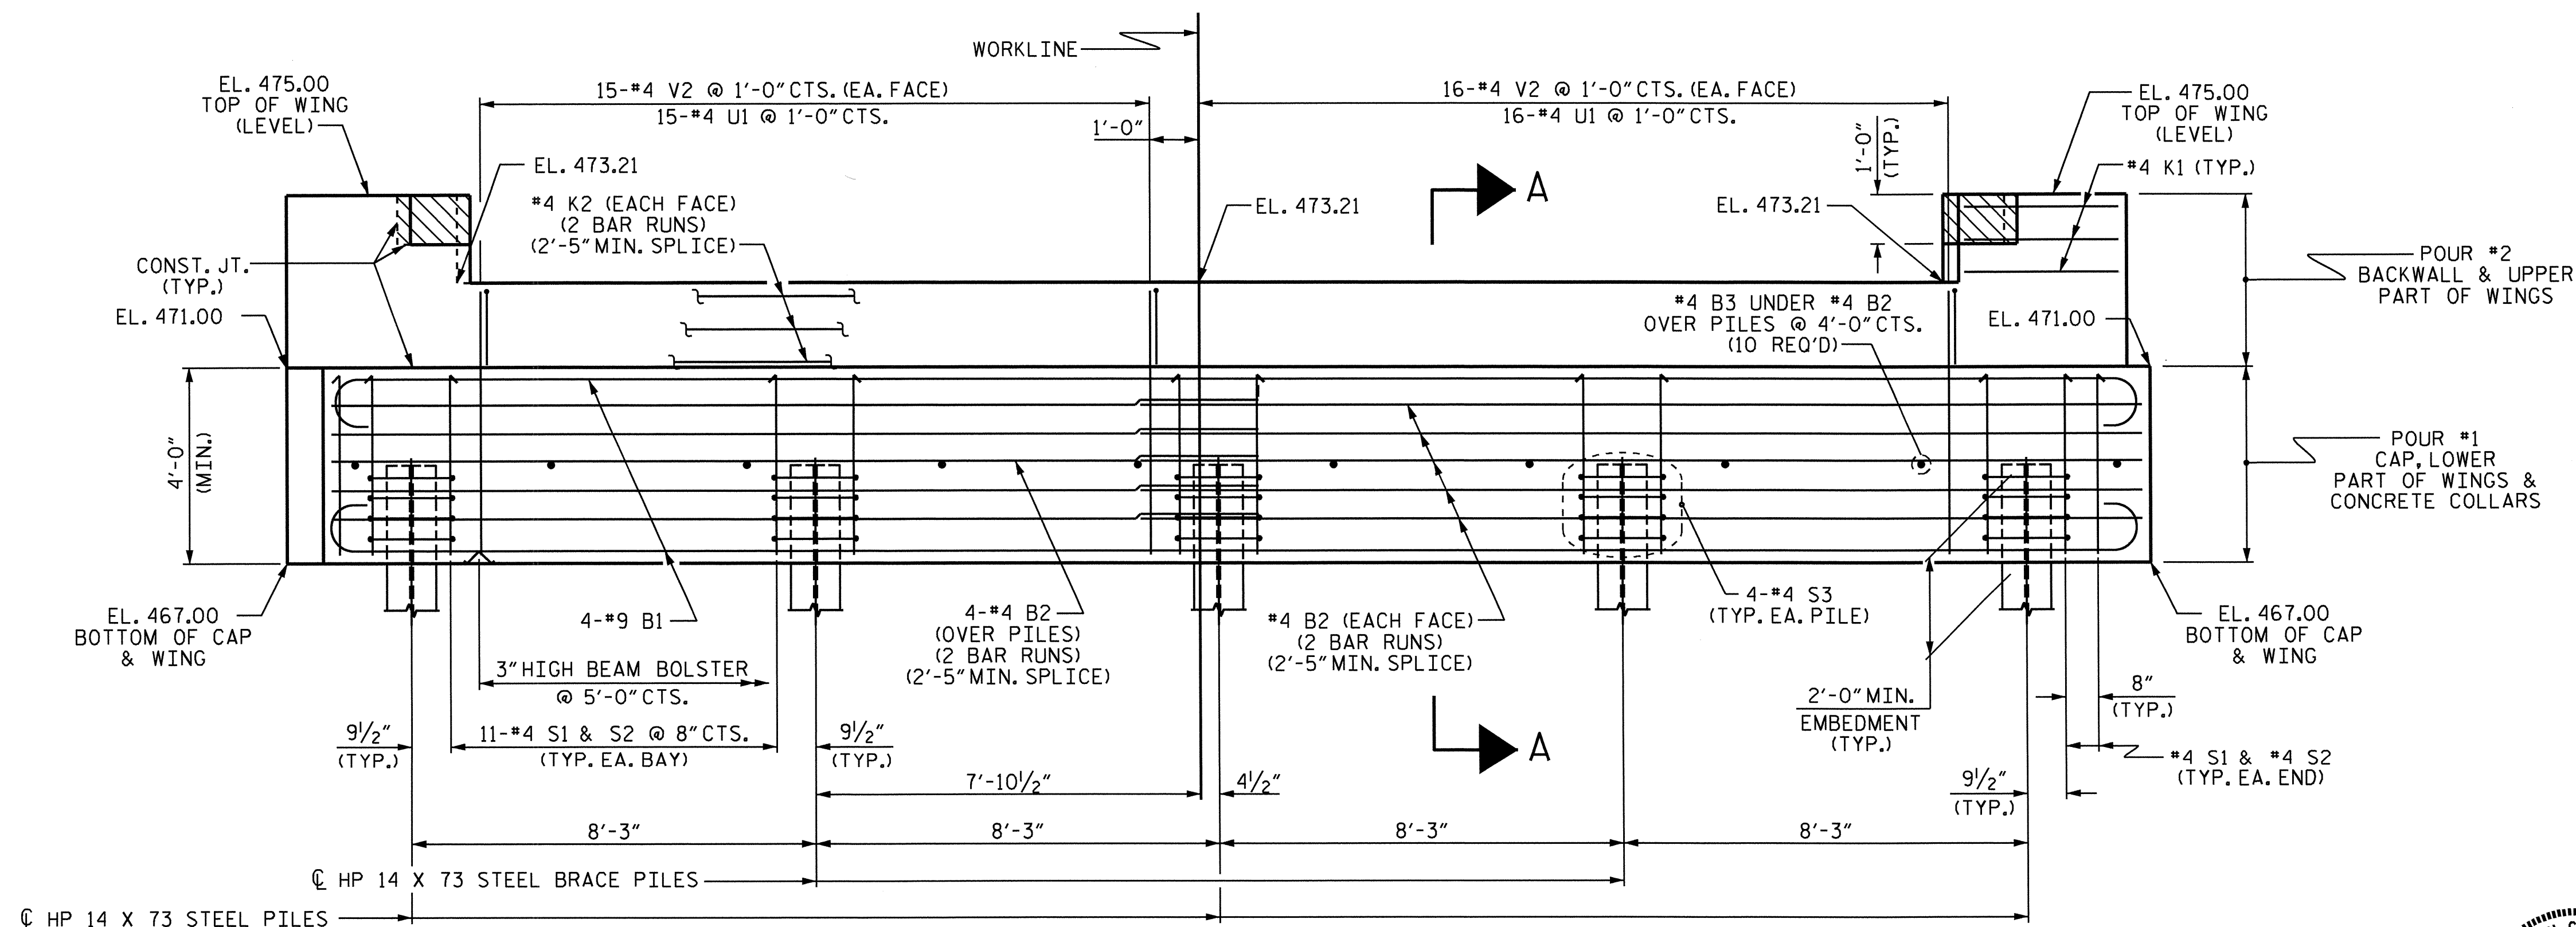


ELEVATION

WINGS NOT SHOWN FOR CLARITY.
FOR SECTION A-A, SEE SHEET 4 OF 4.
CONCRETE COLLARS FOR STEEL PILES NOT SHOWN IN PLAN AND ELEVATION VIEWS FOR CLARITY.
SEE "CORROSION PROTECTION FOR STEEL PILES DETAIL", SHEET 4 OF 4.

ASSEMBLED BY : R.P.PATEL DATE : 5-25-12
CHECKED BY : P. K. NEWTON DATE : 9-12
DRAWN BY : WJH 12/11
CHECKED BY : AAC 12/11

10-JUL-2013 12:58
K:\TIP\Projects\B4730\Structures\Plans\Final Plans\B4730.sd.plans.dgn
tjkirschbaum

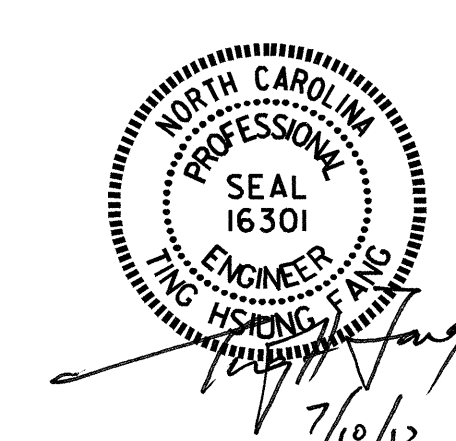

PROJECT NO. B-4730
CHATHAM COUNTY
STATION: 13+82.50 -L-


SHEET 2 OF 4

STATE OF NORTH CAROLINA
DEPARTMENT OF TRANSPORTATION
RALEIGH


SUBSTRUCTURE
END BENT 2

REVISIONS						SHEET NO.
NO.	BY:	DATE:	NO.	BY:	DATE:	TOTAL SHEETS
1			3			S-12
2			4			16


STD. NO. EB_30_105S_39BB

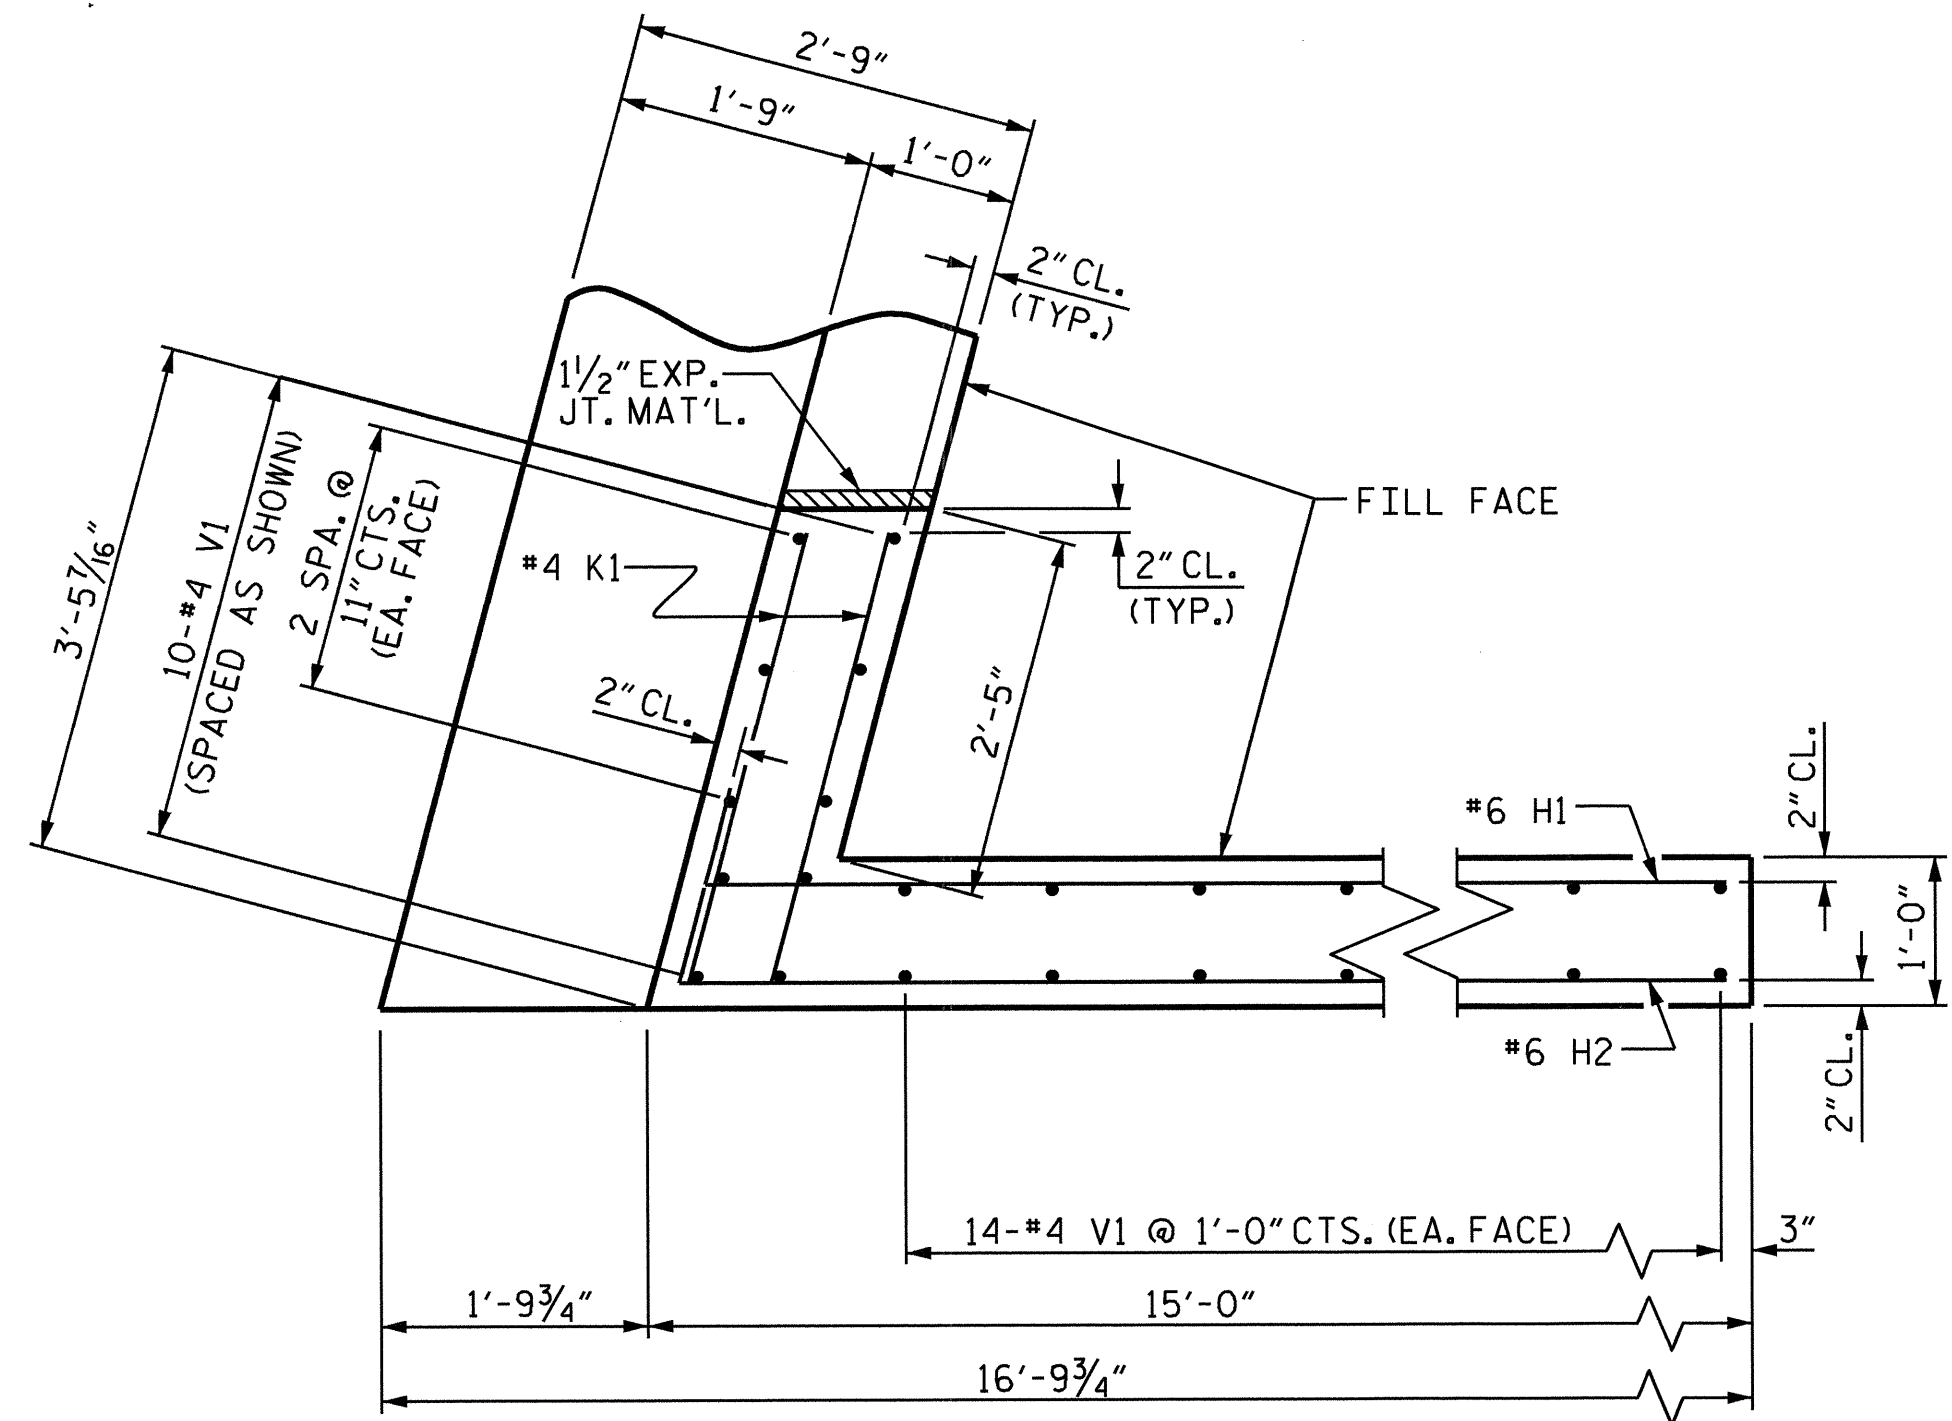


PLAN OF WING (W1)

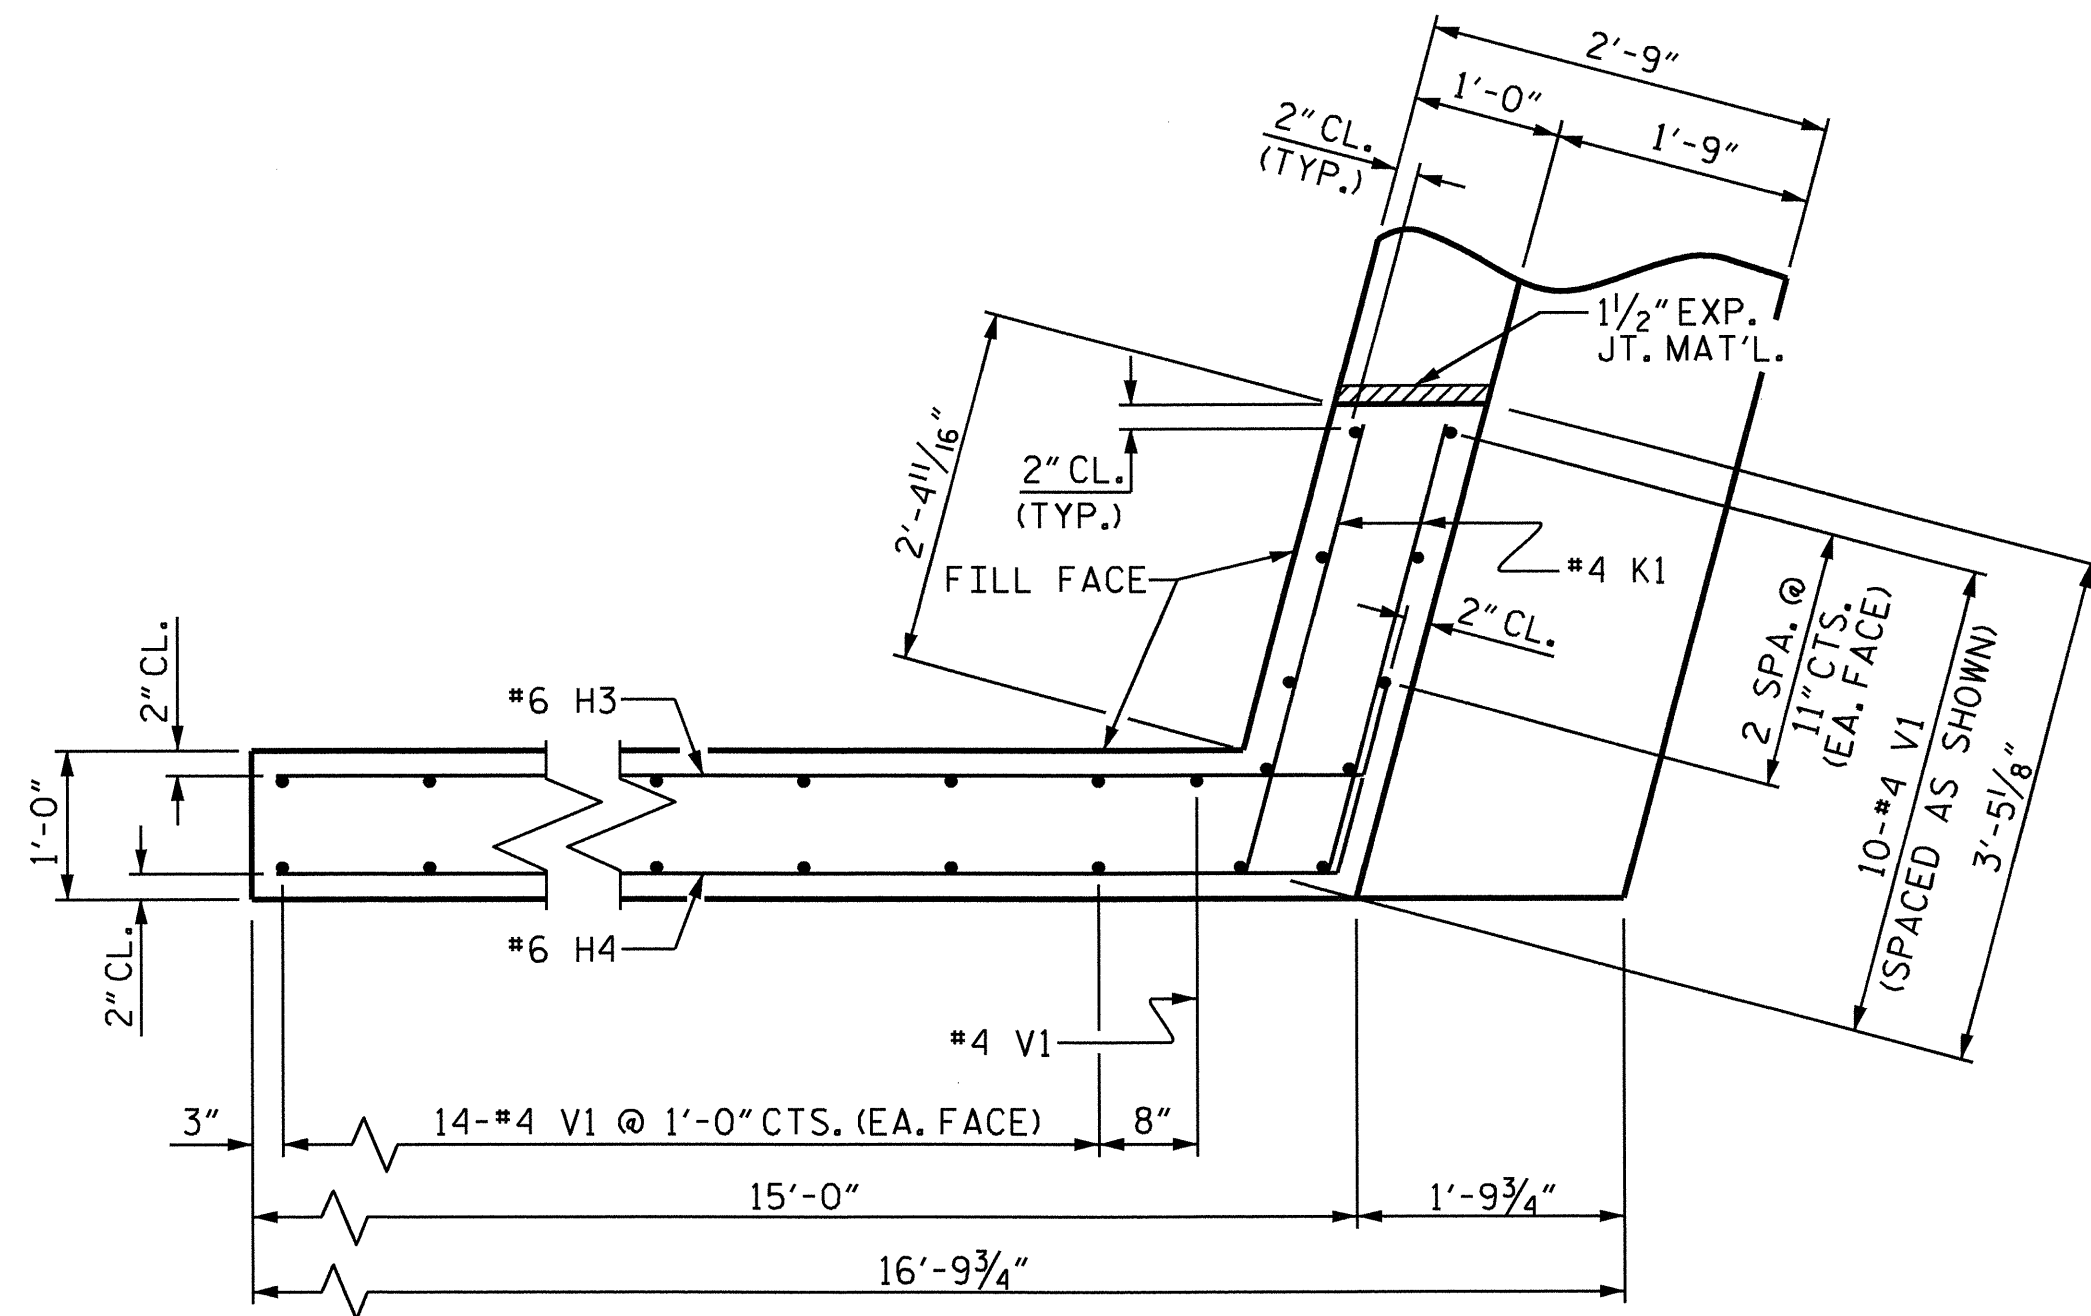


PLAN OF WING (W2)

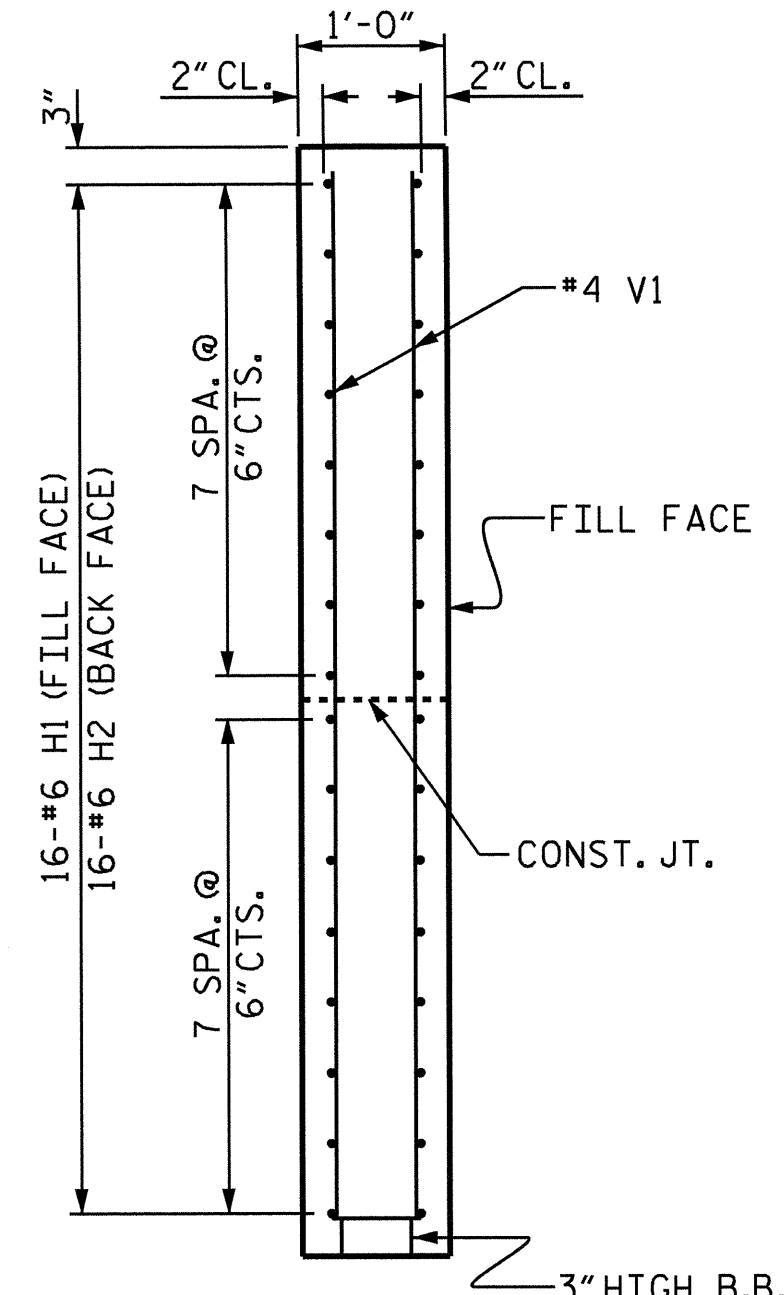


SECTION X-X

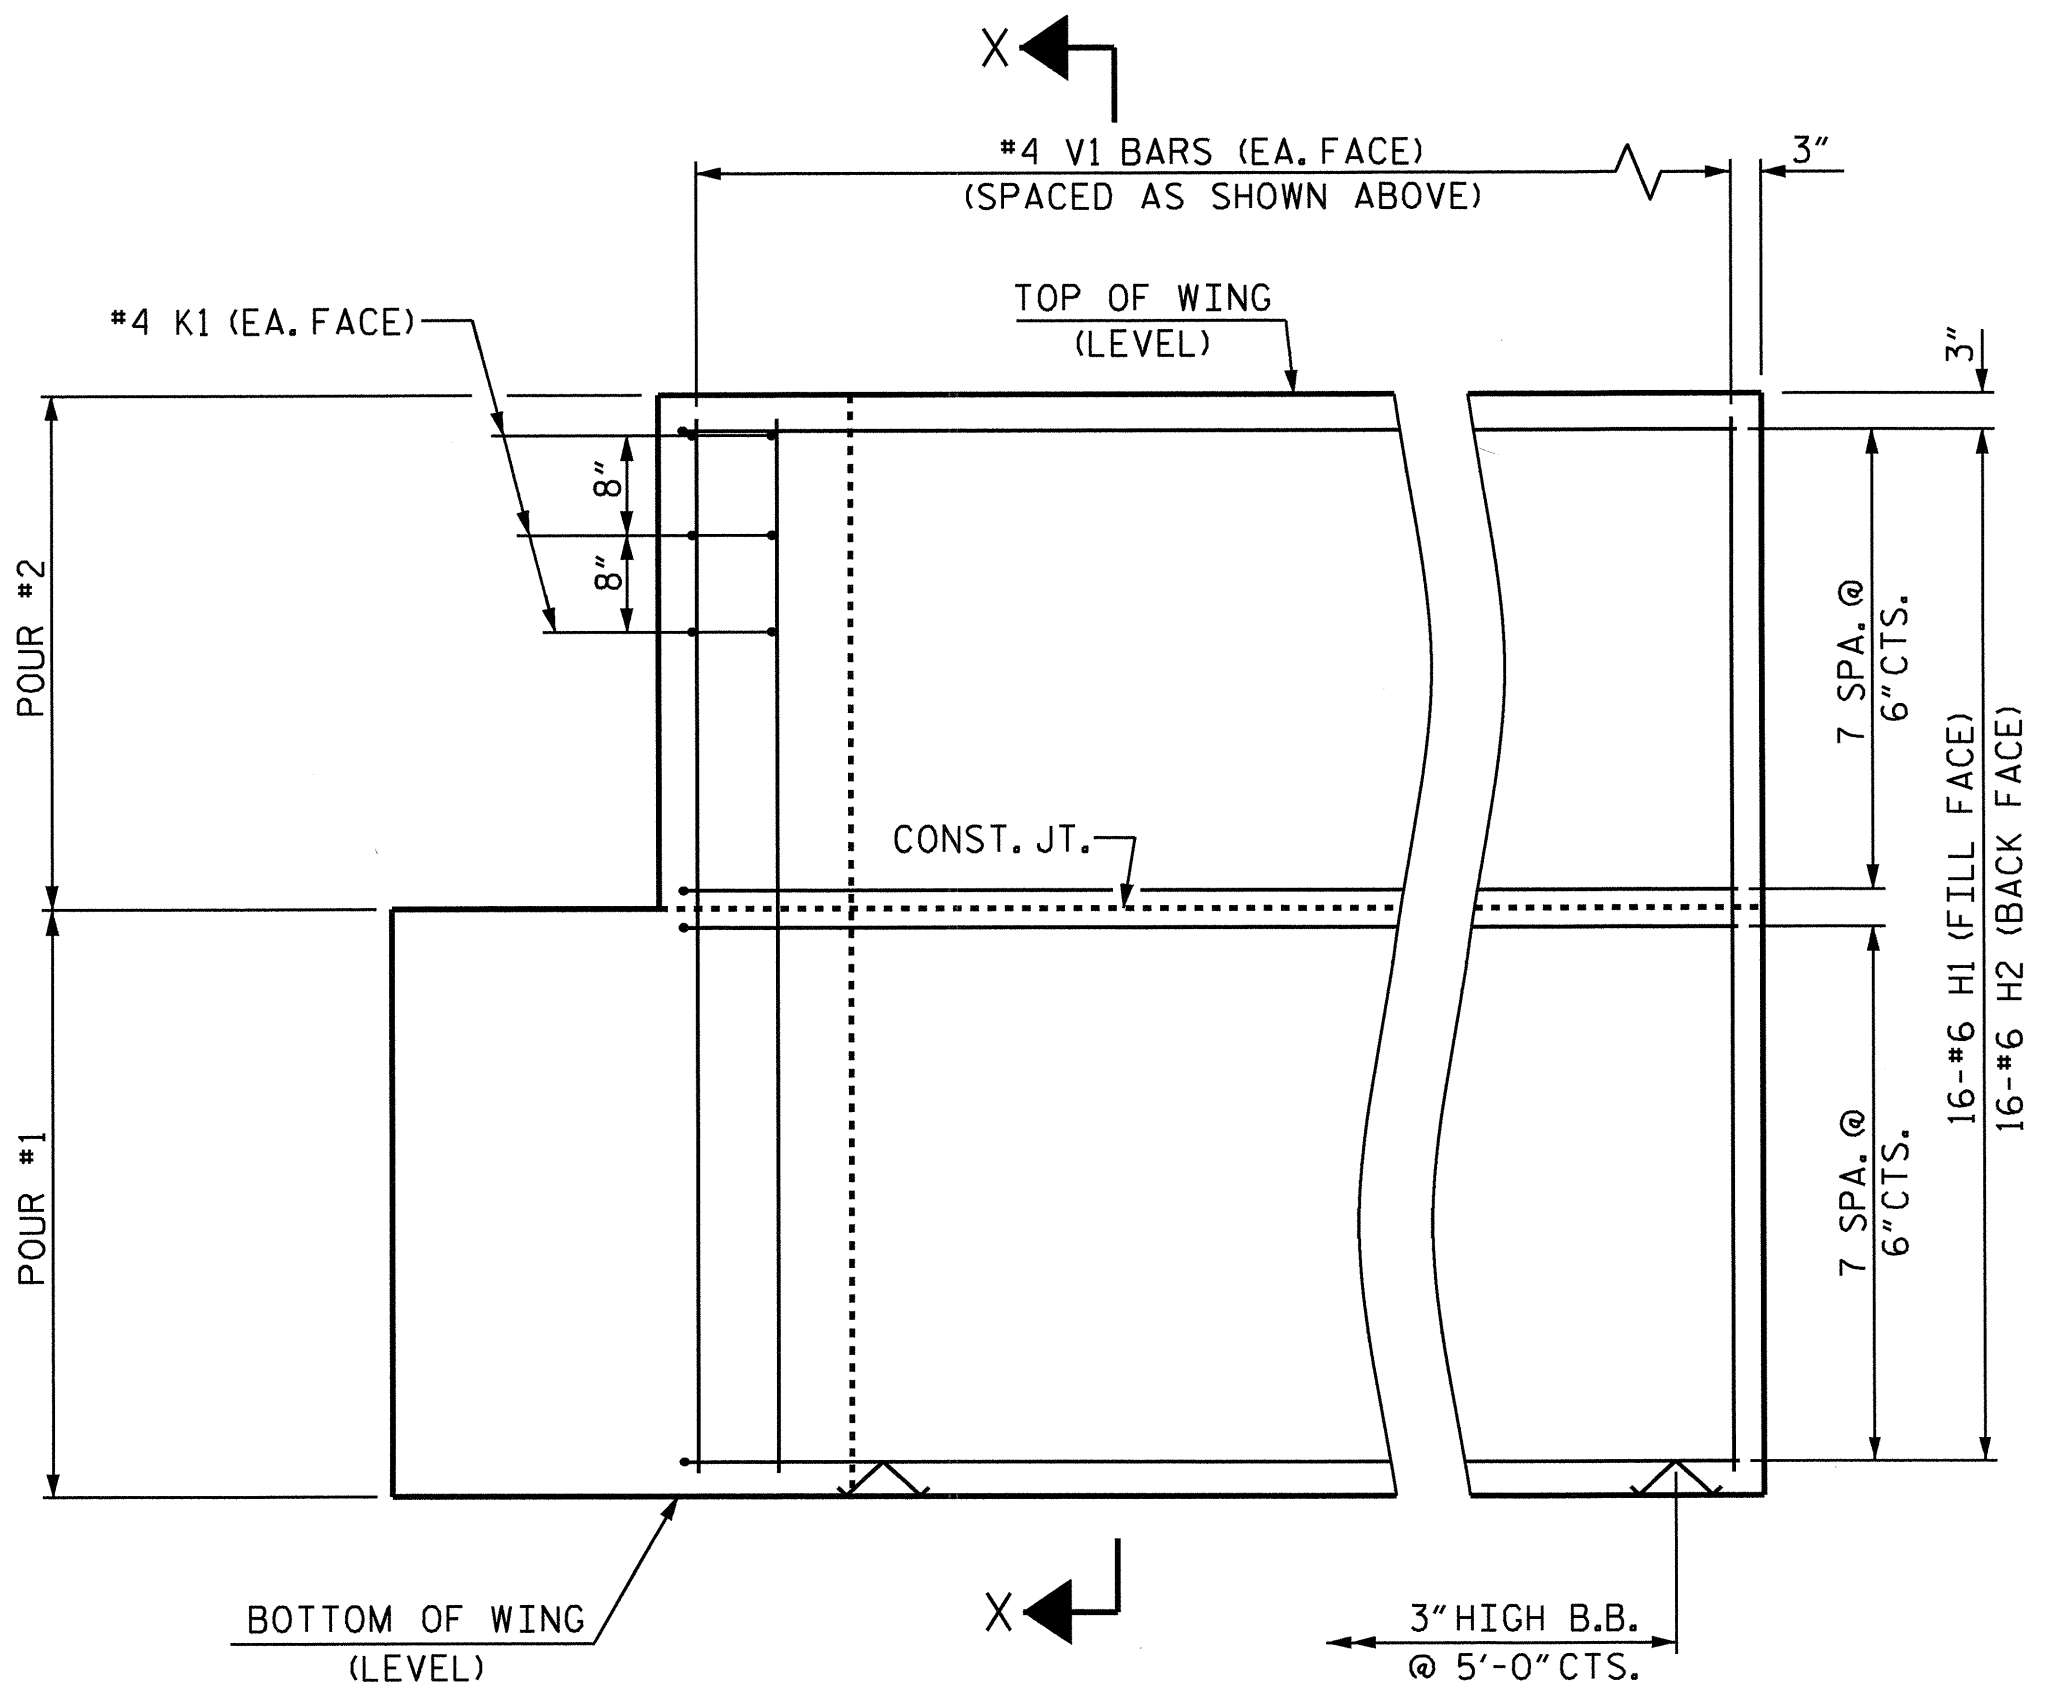

ELEVATION OF WING (W1)

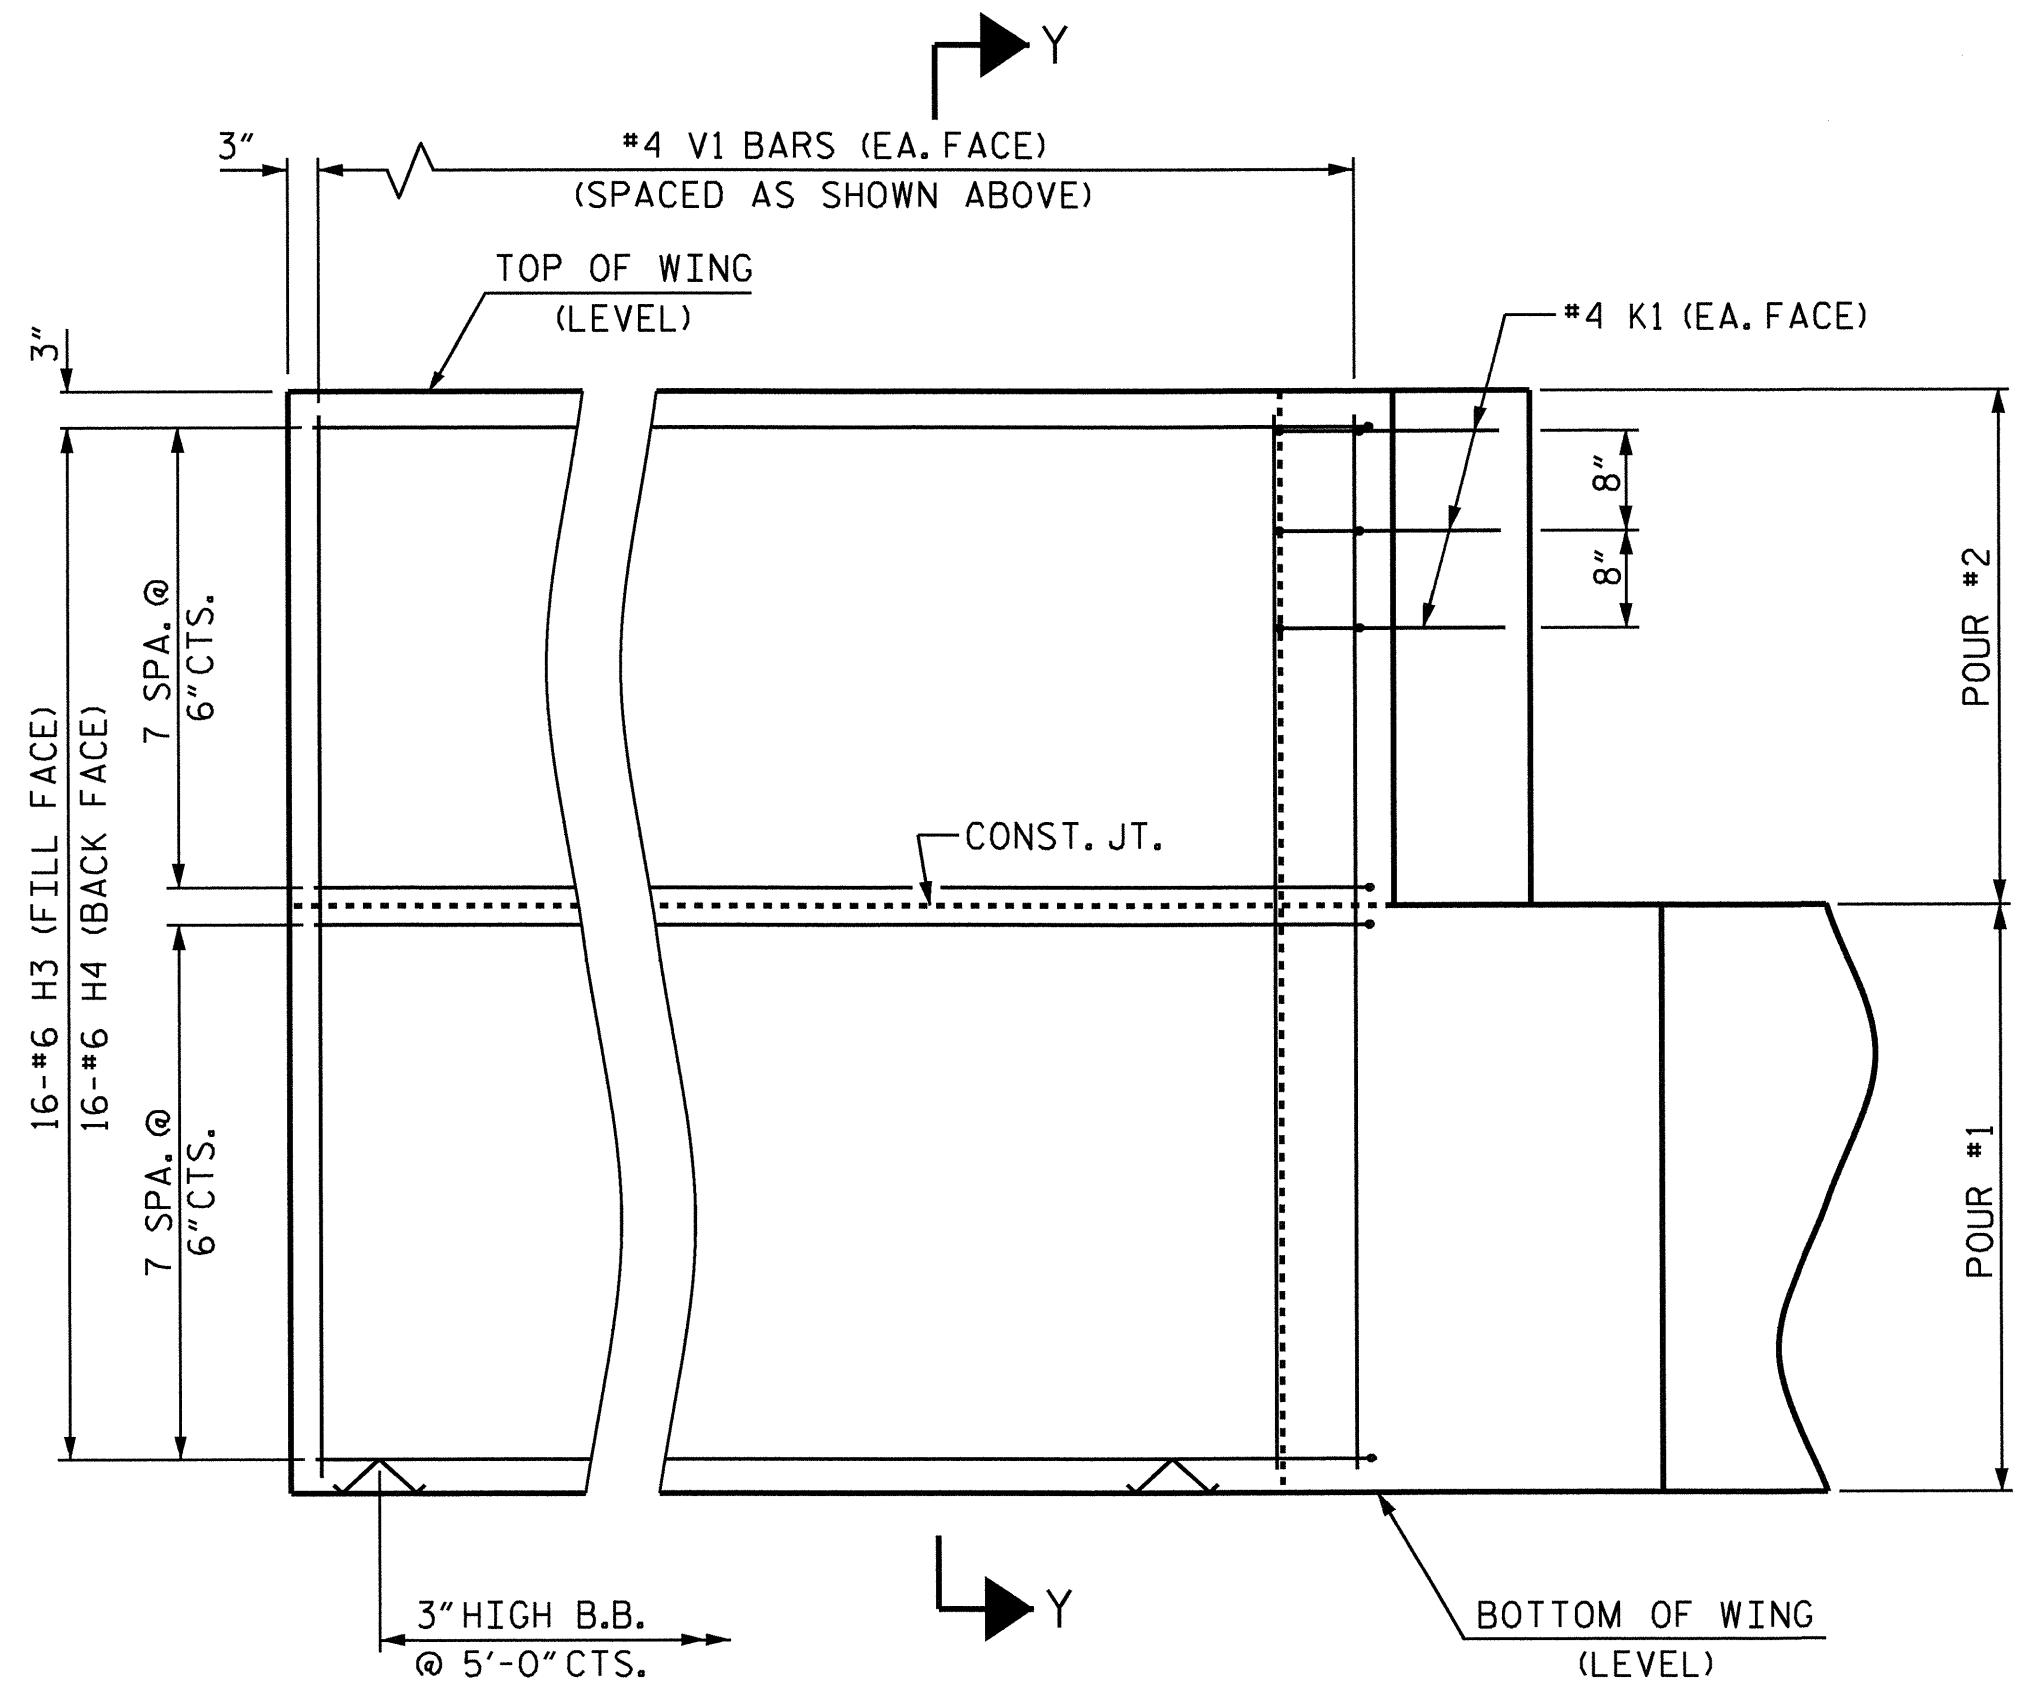

ELEVATION OF WING (W2)

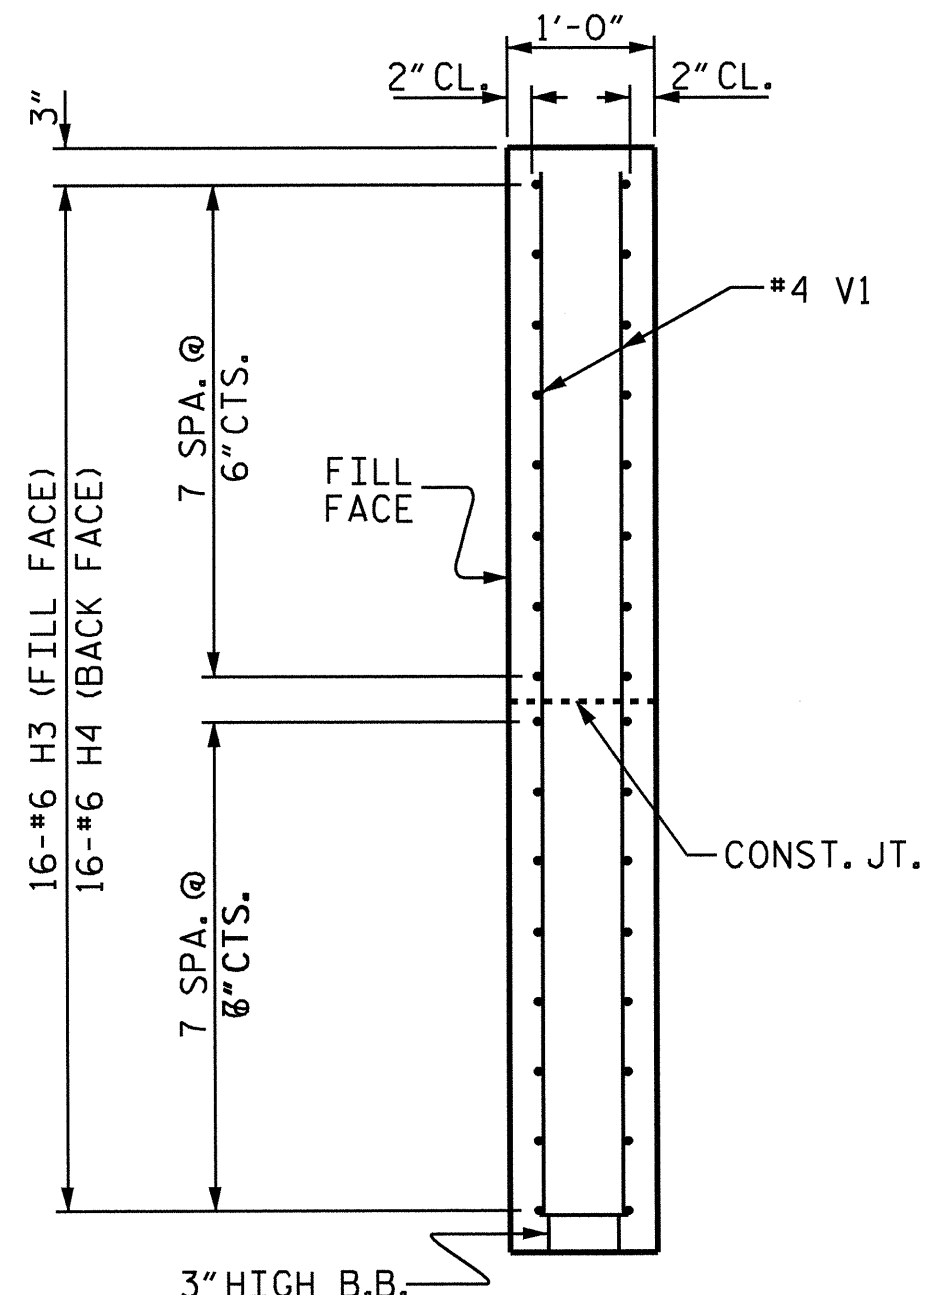


SECTION Y-Y

WING DETAILS

ASSEMBLED BY : R.P.PATEL	DATE : 5-24-12
CHECKED BY : P. K. NEWTON	DATE : 9-12
DRAWN BY : WJH 12/11	
CHECKED BY : AAC 12/11	


10-JUL-2013 12:58
 K:\TIP\Projects-B\B4730\Structures\Plans\Final Plans\B4730.sd.plans.dgn
 tjkirschbaum

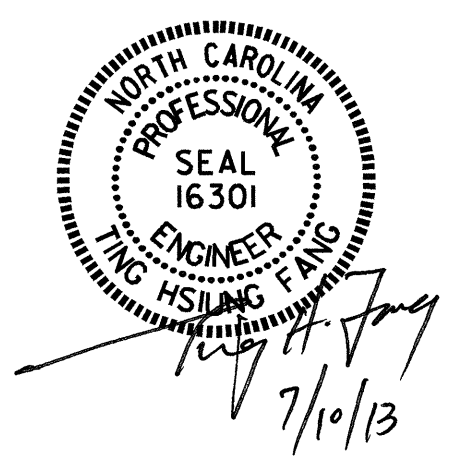

PROJECT NO. B-4730
 CHATHAM COUNTY
 STATION: 13+82.50 -L-

SHEET 3 OF 4

REVISIONS						SHEET NO.
NO.	BY:	DATE:	NO.	BY:	DATE:	S-13
1			3			TOTAL SHEETS 16
2			4			

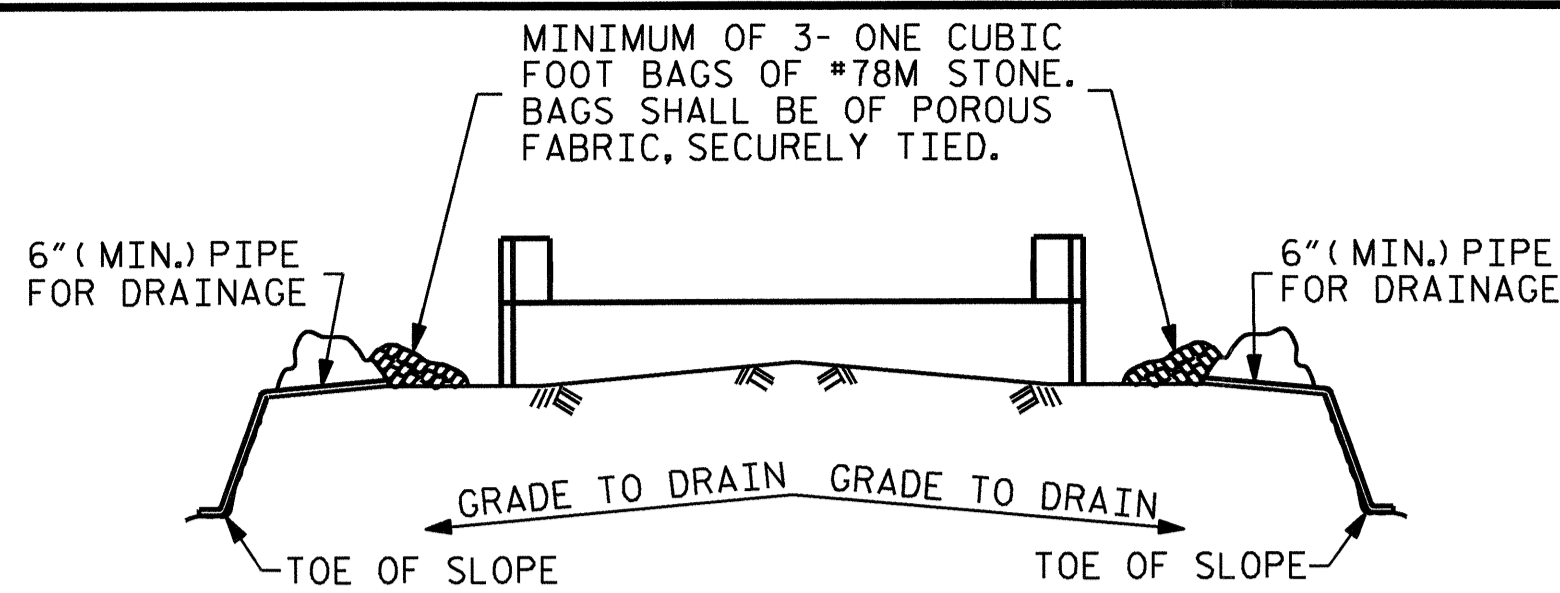


BAGGED STONE AND PIPE SHALL BE PLACED IMMEDIATELY AFTER COMPLETION OF END BENT EXCAVATION. PIPE MAY BE EITHER CONCRETE, CORRUGATED STEEL, CORRUGATED ALUMINUM ALLOY, OR CORRUGATED PLASTIC. PERFORATED PIPE WILL NOT BE ALLOWED.

BAGGED STONE SHALL REMAIN IN PLACE UNTIL THE ENGINEER DIRECTS THAT IT BE REMOVED. THE CONTRACTOR SHALL REMOVE AND DISPOSE OF SILT ACCUMULATIONS AT BAGGED STONE WHEN SO DIRECTED BY THE ENGINEER. BAGS SHALL BE REMOVED AND REPLACED WHENEVER THE ENGINEER DETERMINES THAT THEY HAVE DETERIORATED AND LOST THEIR EFFECTIVENESS.


NO SEPARATE PAYMENT WILL BE MADE FOR THIS WORK AND THE ENTIRE COST OF THIS WORK SHALL BE INCLUDED IN THE UNIT CONTRACT PRICE BID FOR THE SEVERAL PAY ITEMS.

TEMPORARY DRAINAGE AT END BENT

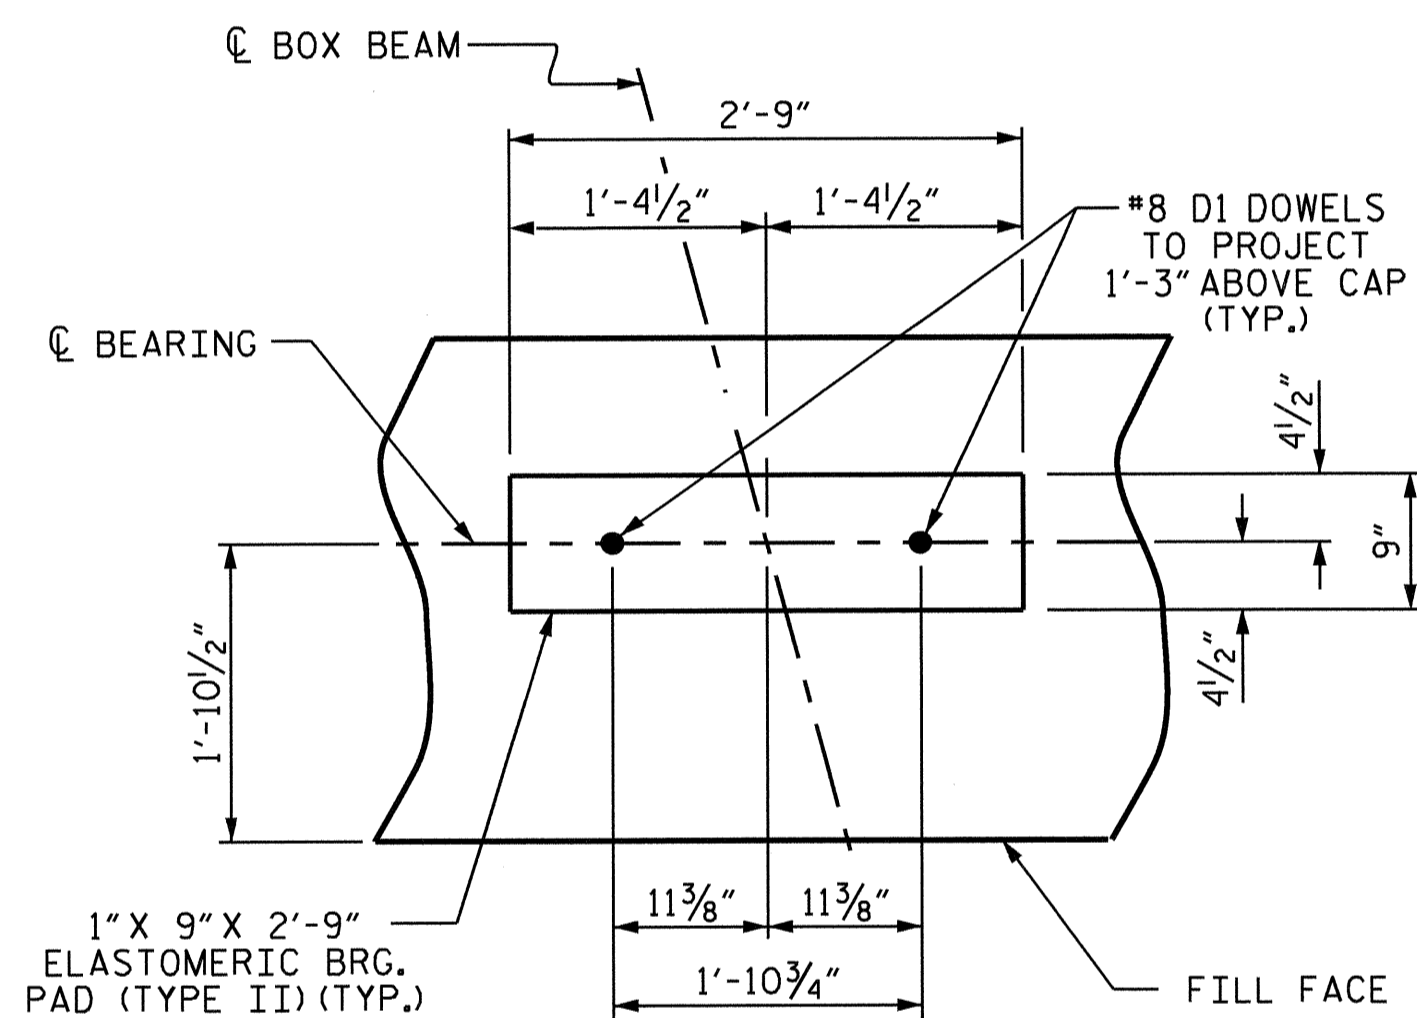


DETAIL "A"

(END BENT 1 SHOWN, END BENT 2 SIMILAR BY ROTATION)

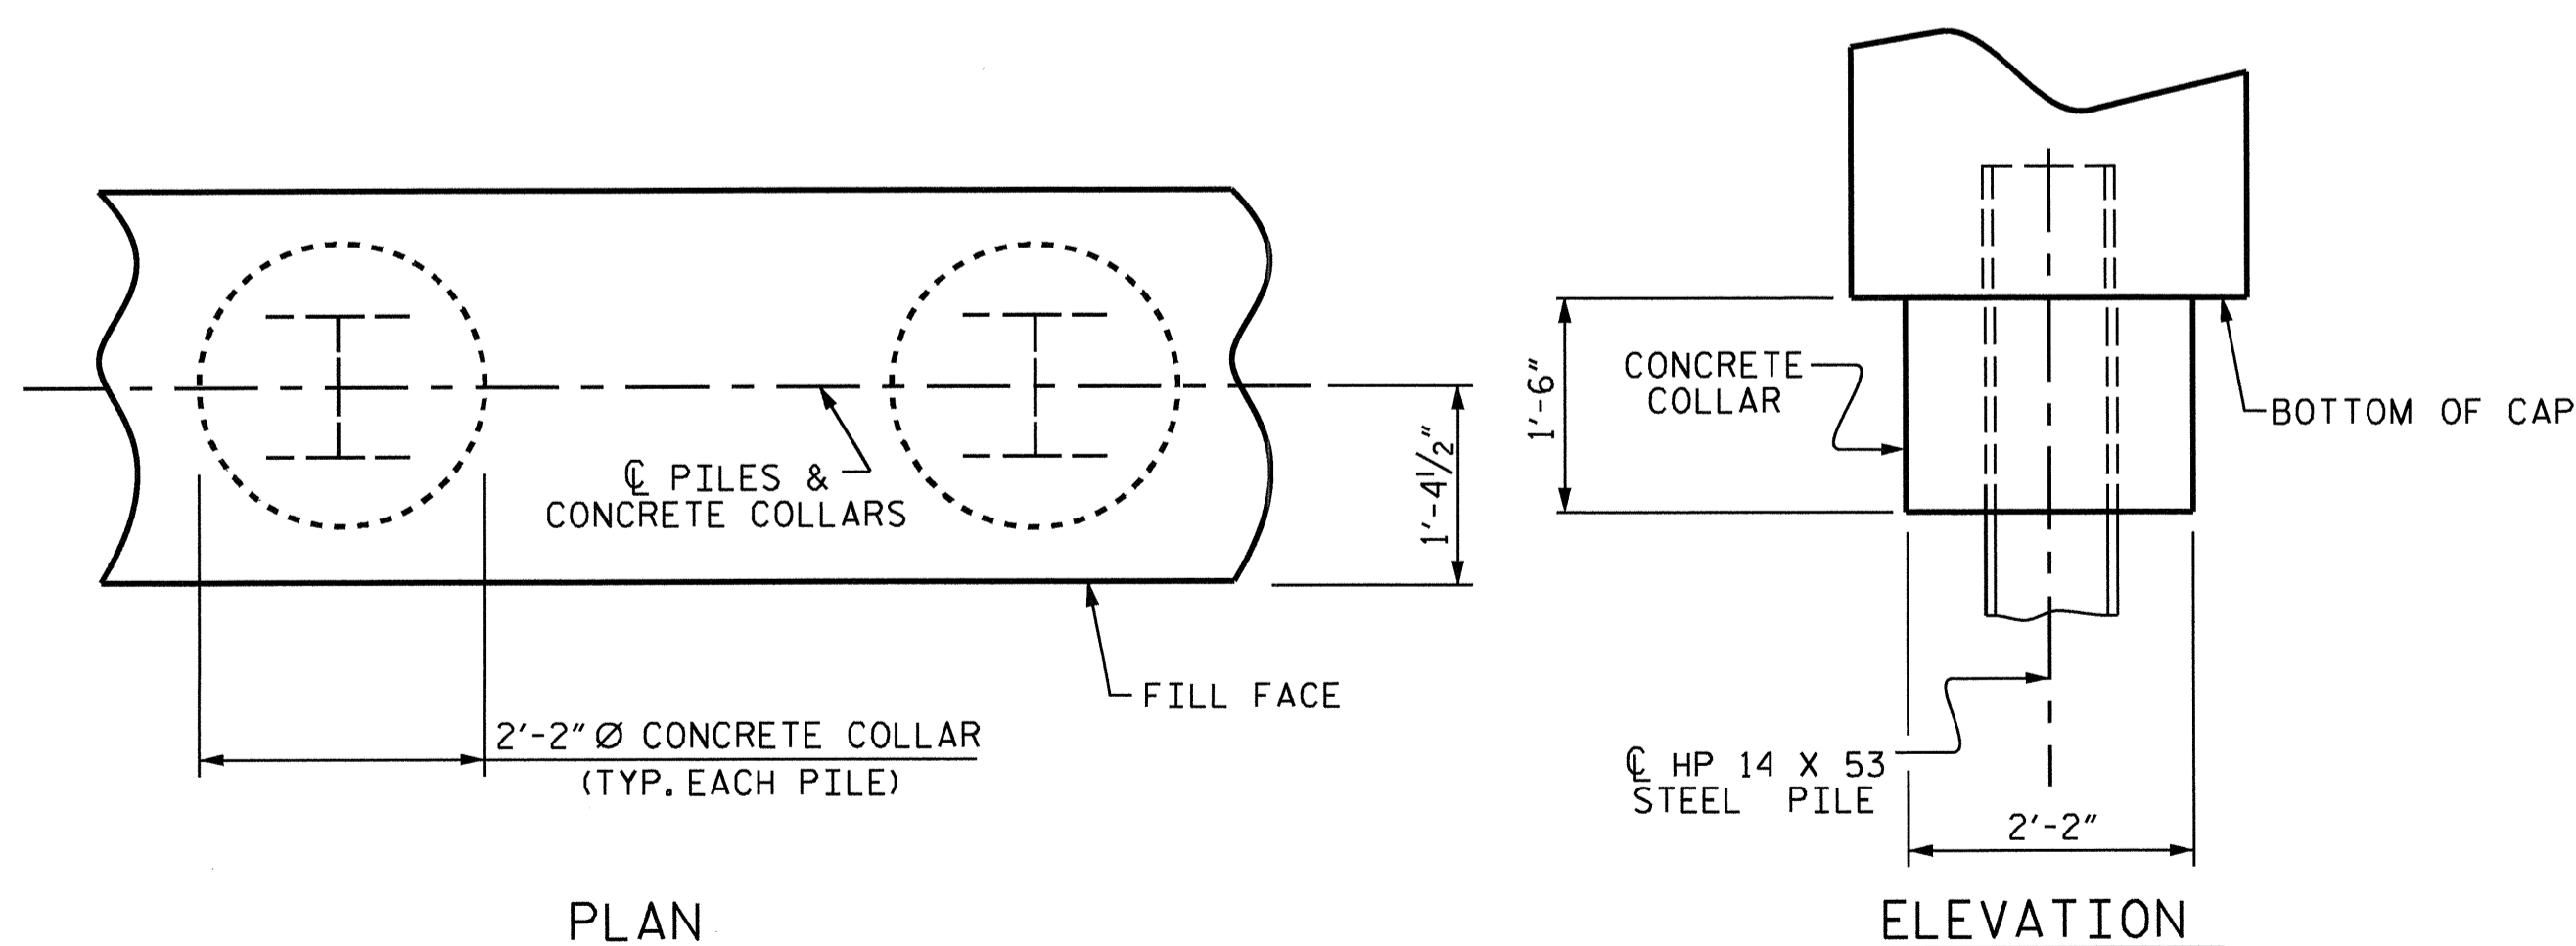

CORROSION PROTECTION FOR STEEL PILES DETAIL

(END BENT 1 SHOWN, END BENT 2 SIMILAR BY ROTATION)

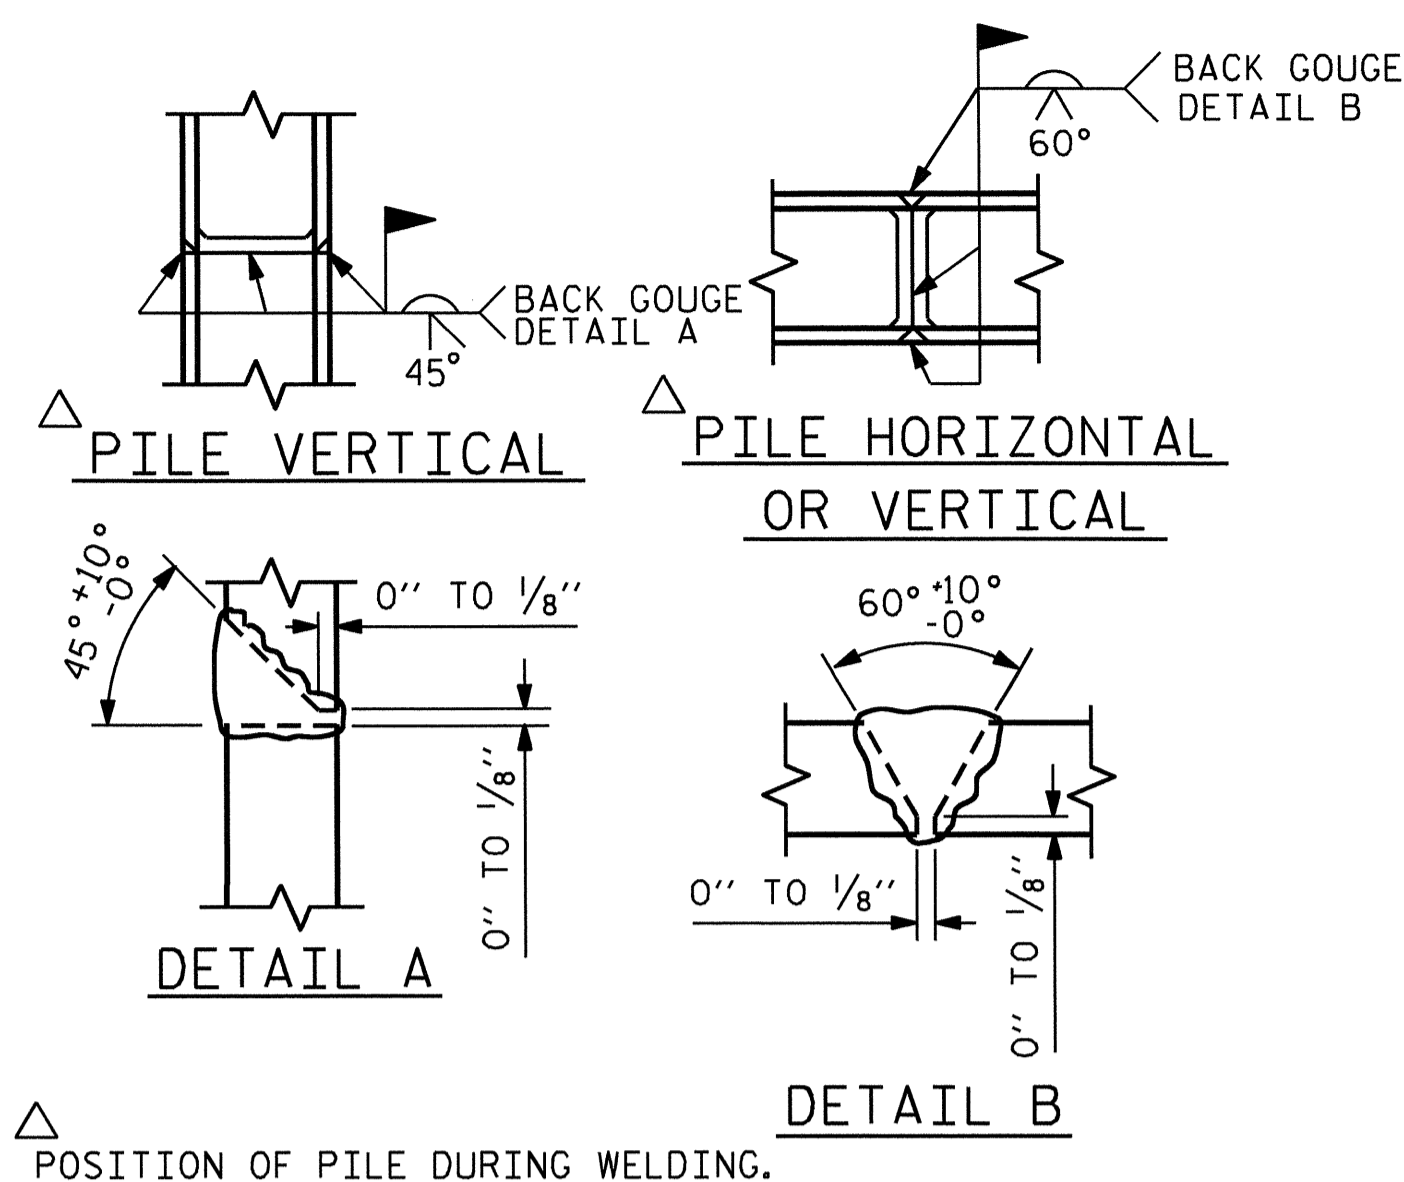


PILE SPLICE DETAILS

BAR TYPES	
<p>1</p> <p>HK.</p> <p>1'-3"</p> <p>36'-10"</p> <p>1'-3"</p>	<p>2</p> <p>2 1/16"</p> <p>8"</p> <p>H1</p> <p>14'-5"</p> <p>H2</p> <p>14'-7"</p>
<p>3</p> <p>2 1/16"</p> <p>8"</p> <p>14'-10"</p> <p>H3</p> <p>14'-8"</p> <p>H4</p>	<p>4</p> <p>4 1/2"</p> <p>3'-7 1/2"</p> <p>HK.</p> <p>2'-5"</p>
<p>5</p> <p>4 1/2"</p> <p>2'-5"</p> <p>4 1/2"</p> <p>HK.</p> <p>1'-3" LAP</p>	<p>7</p> <p>8"</p> <p>1'-6"</p>
<p>6</p> <p>2'-0" Ø</p>	

ALL BAR DIMENSIONS ARE OUT TO OUT.


END BENT 1		END BENT 2	
HP 14 X 53 STEEL PILES	NO: 5	HP 14 X 53 STEEL PILES	NO: 5
LIN. FT. = 75		LIN. FT. = 75	
HP 14 X 53 STEEL PILE POINTS	NO: 5	HP 14 X 53 STEEL PILE POINTS	NO: 5
EACH		EACH	

BILL OF MATERIAL FOR ONE END BENT					
BAR NO.	NO.	SIZE	TYPE	LENGTH	WEIGHT
B1	8	#9	1	39'-4"	1070
B2	28	#4	STR	19'-9"	369
B3	10	#4	STR	2'-5"	16
D1	20	#8	STR	2'-3"	120
H1	16	#6	2	15'-1"	362
H2	16	#6	2	15'-3"	366
H3	16	#6	3	15'-6"	372
H4	16	#6	3	15'-4"	368
K1	12	#4	STR	3'-1"	25
K2	12	#4	STR	19'-9"	158
S1	48	#4	4	10'-5"	334
S2	48	#4	5	3'-2"	102
S3	20	#4	6	7'-7"	101
U1	31	#4	7	3'-8"	76
V1	77	#4	STR	7'-8"	394
V2	62	#4	STR	5'-10"	242
REINFORCING STEEL (FOR ONE END BENT)					4461 LBS.
CLASS A CONCRETE BREAKDOWN (FOR ONE END BENT)					
POUR #1 CAP, LOWER PART OF WINGS & COLLARS					20.3 C.Y.
POUR #2 BACKWALL & UPPER PART OF WINGS					7.7 C.Y.
TOTAL CLASS A CONCRETE					28.0 C.Y.

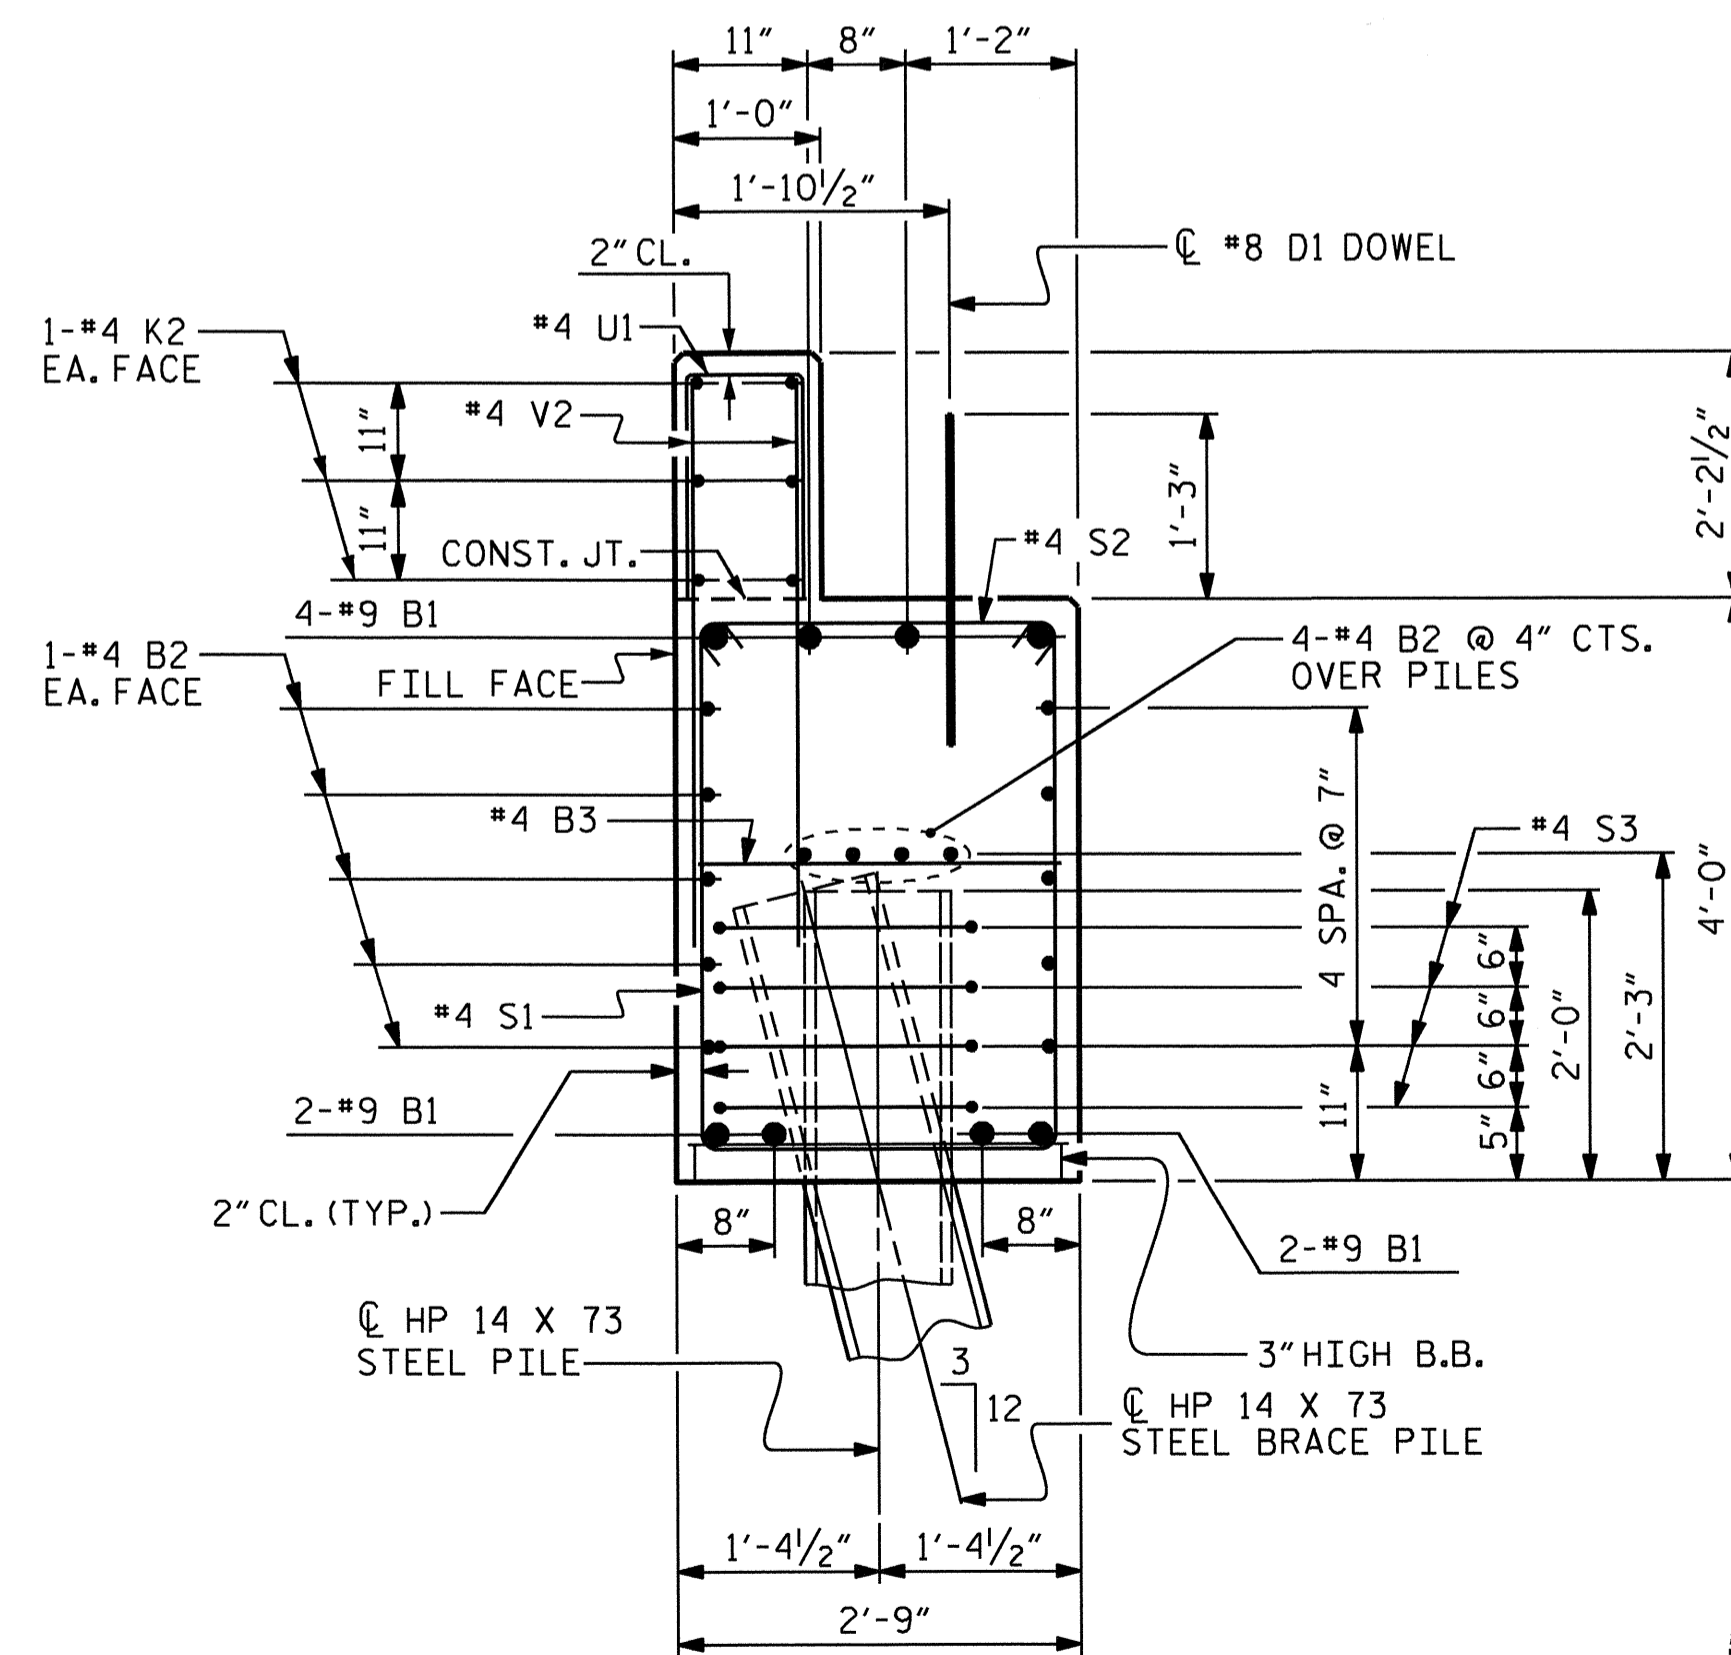

SECTION A-A

(CONCRETE COLLAR NOT SHOWN FOR CLARITY. SEE "CORROSION PROTECTION FOR STEEL PILES DETAIL.")

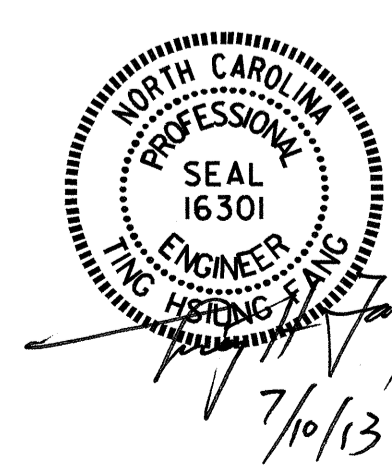

PROJECT NO. B-4730
CHATHAM COUNTY
STATION: 13+82.50 -L-

SHEET 4 OF 4

STATE OF NORTH CAROLINA
DEPARTMENT OF TRANSPORTATION
RALEIGH

SUBSTRUCTURE


END BENTS 1 & 2
DETAILS

REVISIONS						SHEET NO.
NO.	BY:	DATE:	NO.	BY:	DATE:	S-14
1			3			TOTAL SHEETS 16
2			4			


ASSEMBLED BY : R.P.PATEL	DATE : 5-25-12
CHECKED BY : P.K.NEWTON	DATE : 9-12
DRAWN BY : WJH 12/11	
CHECKED BY : AAC 12/11	

ESTIMATED QUANTITIES


BRIDGE @ STA. 13+82.50 -L-	RIP RAP CLASS II (2'-0" THICK)	GEOTEXTILE FOR DRAINAGE
	TONS	SQUARE YARDS
END BENT 1	75	85
END BENT 2	10	0

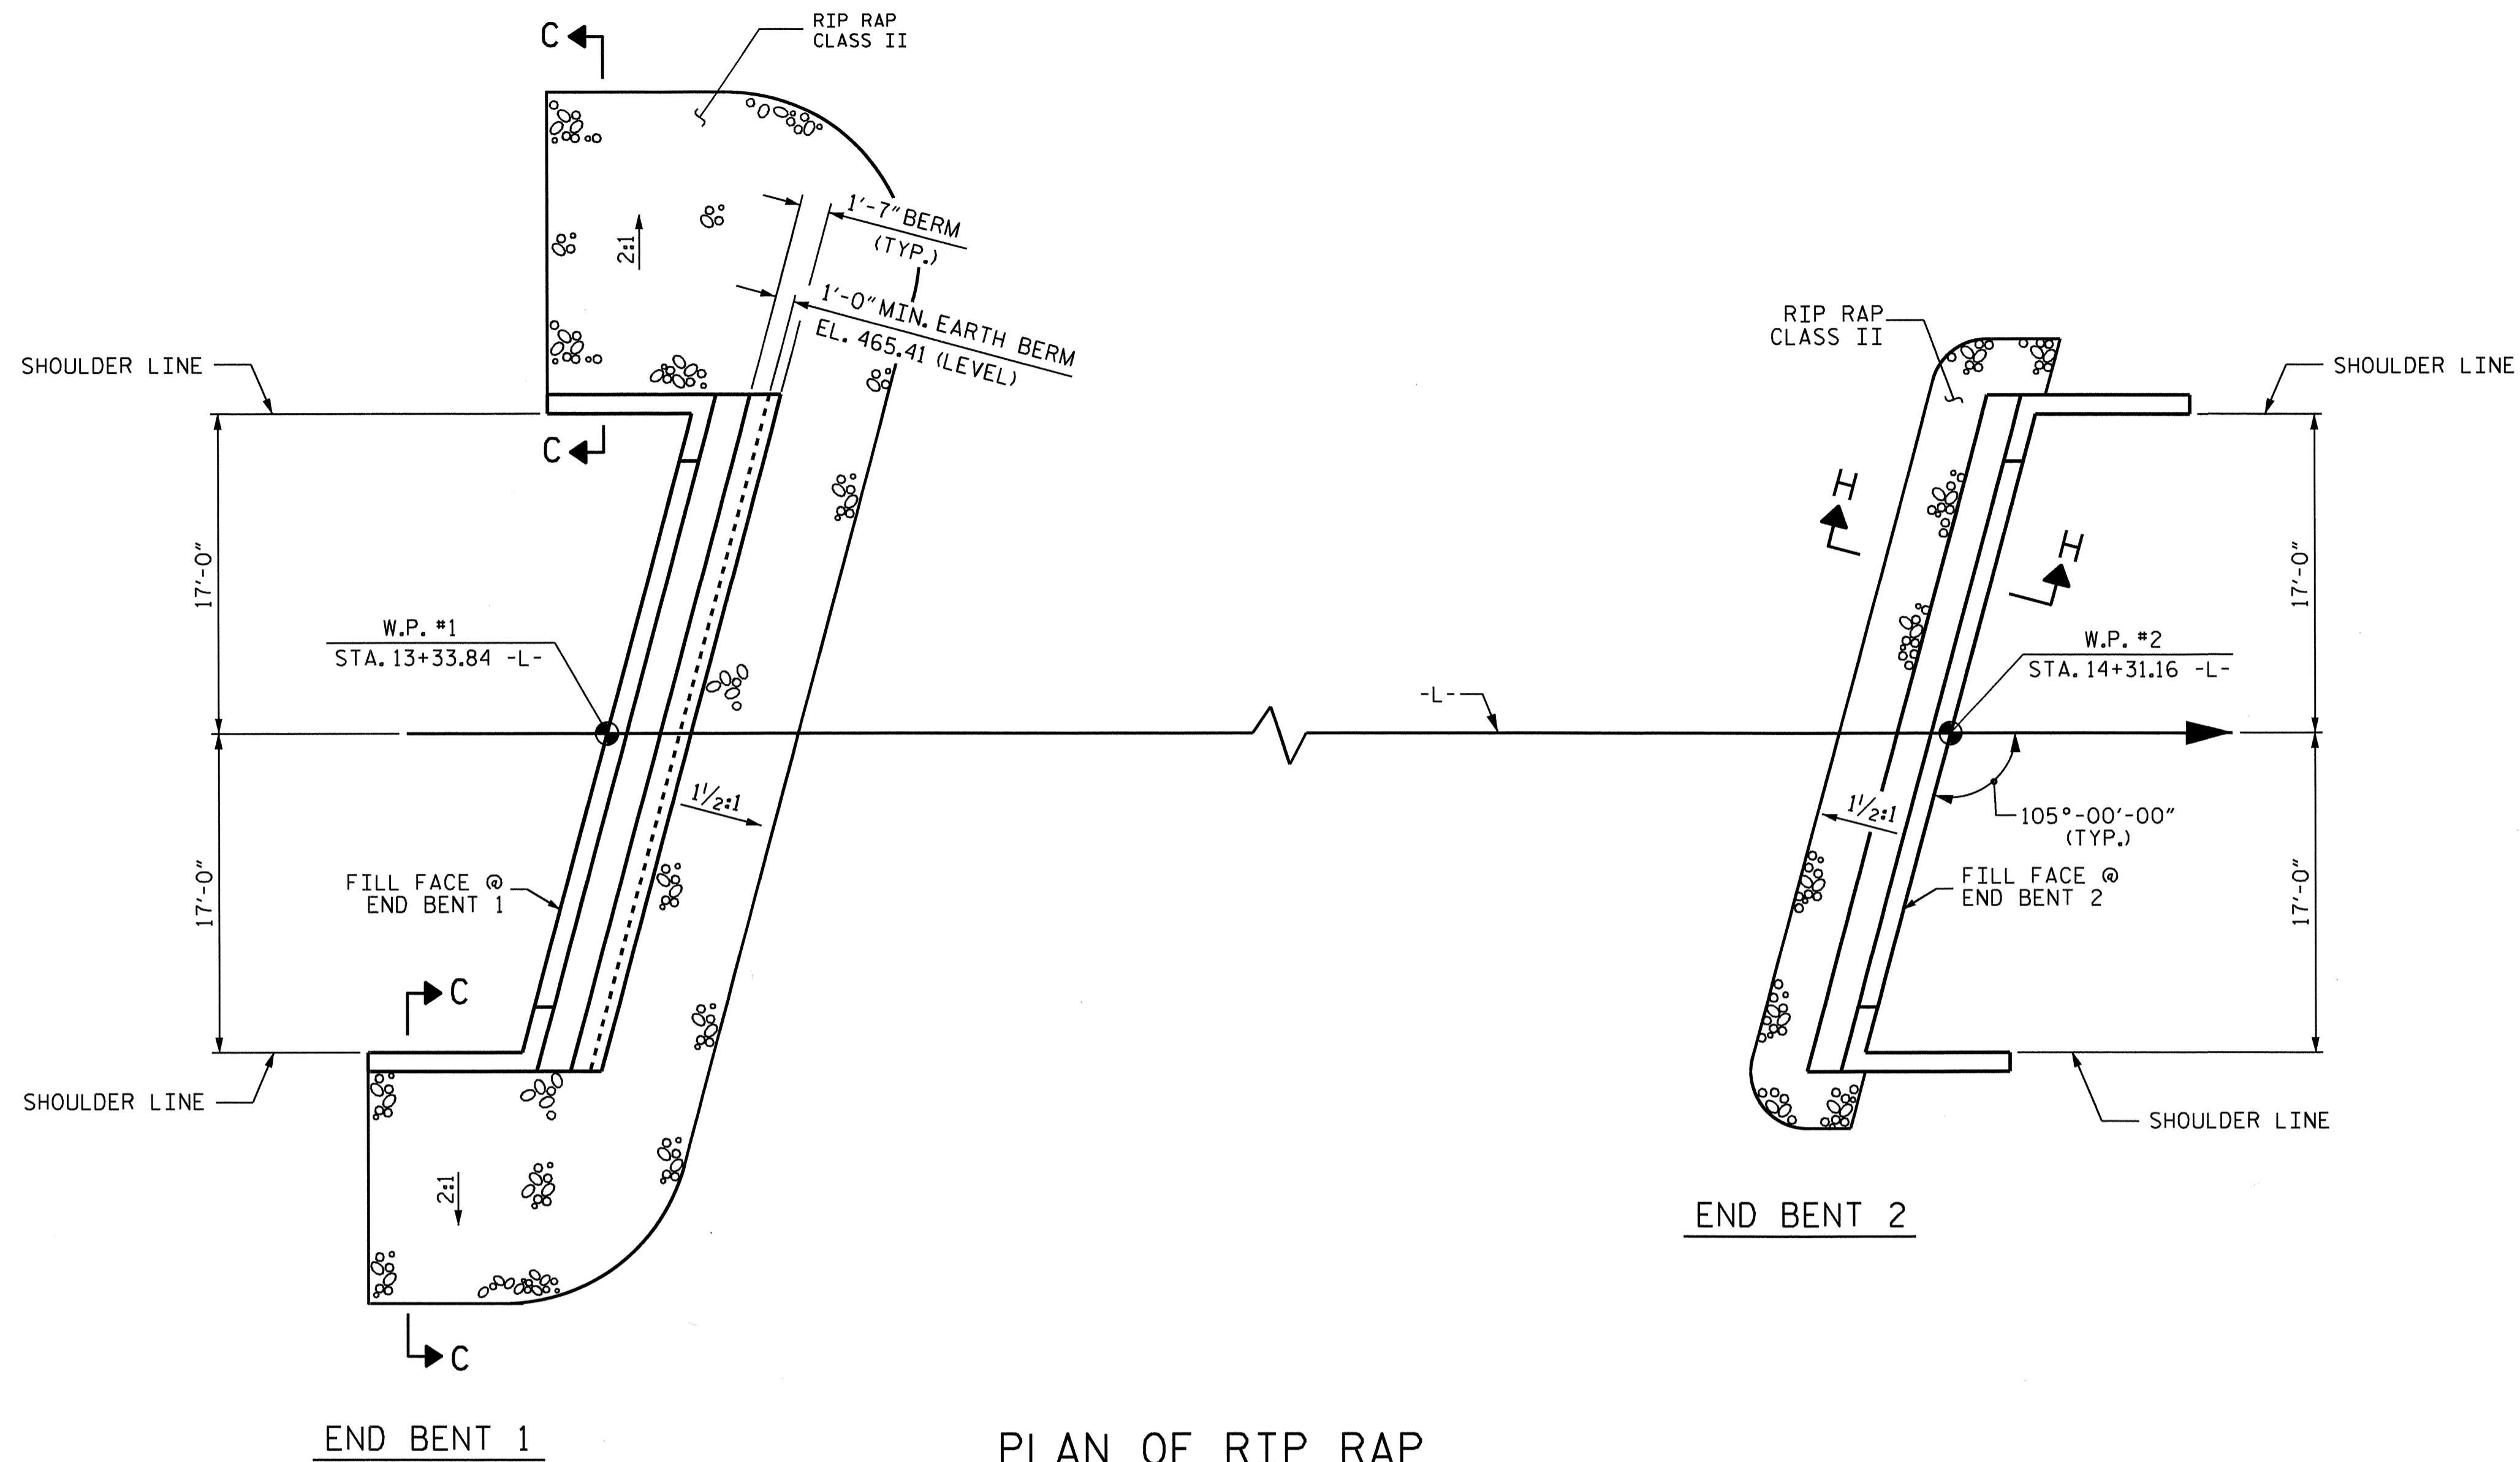


PLAN OF RIP RAP

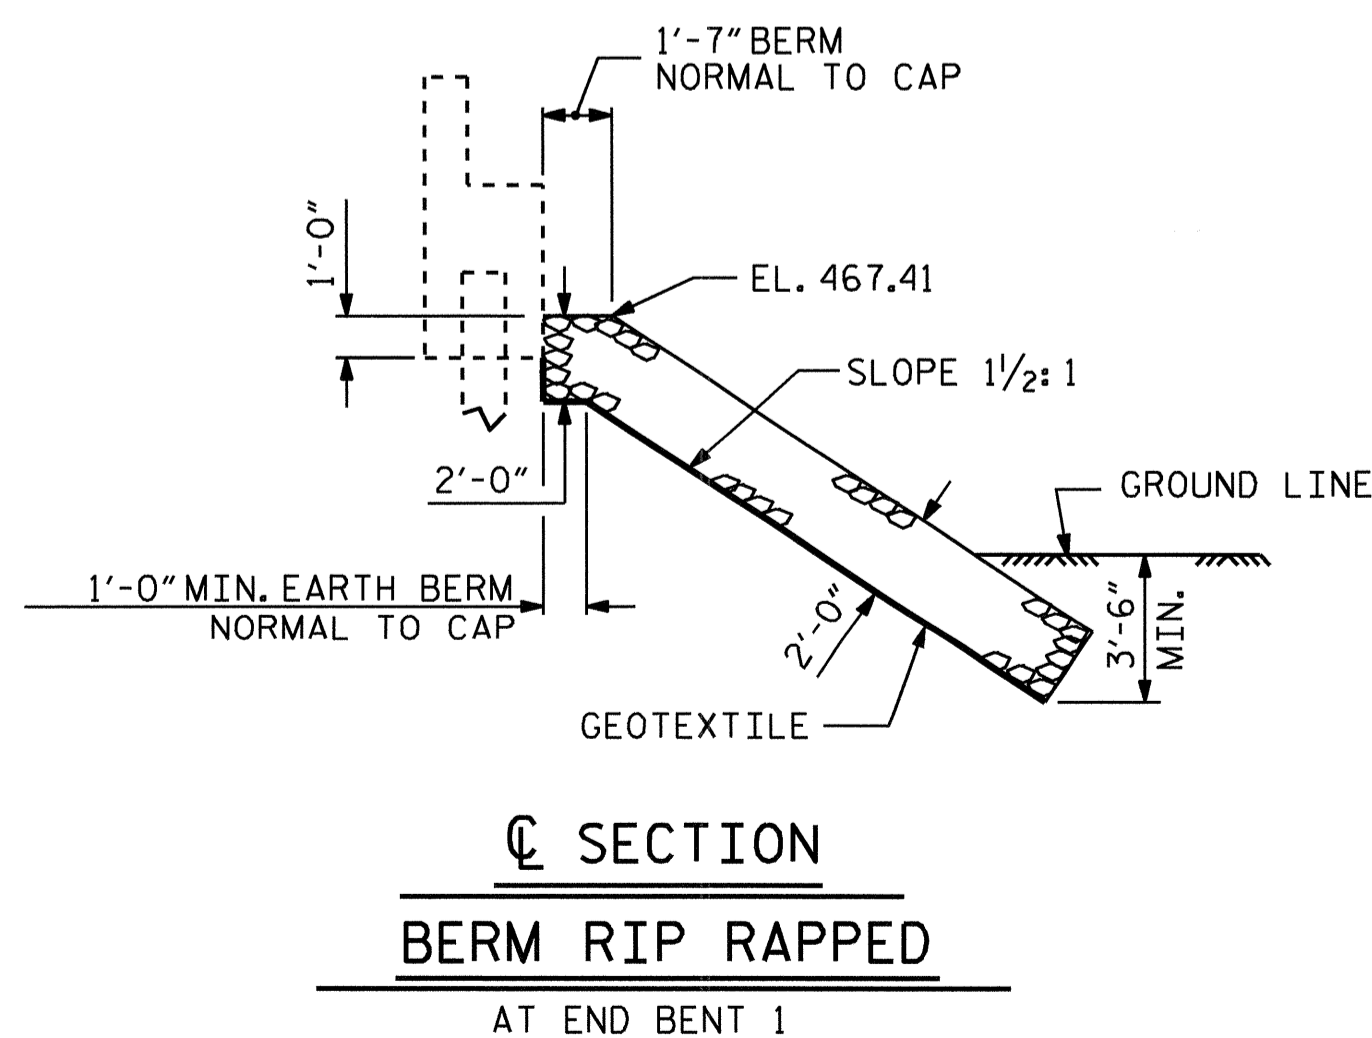


SECTION C-C
BERM RIP RAPPED
AT END BENT 1

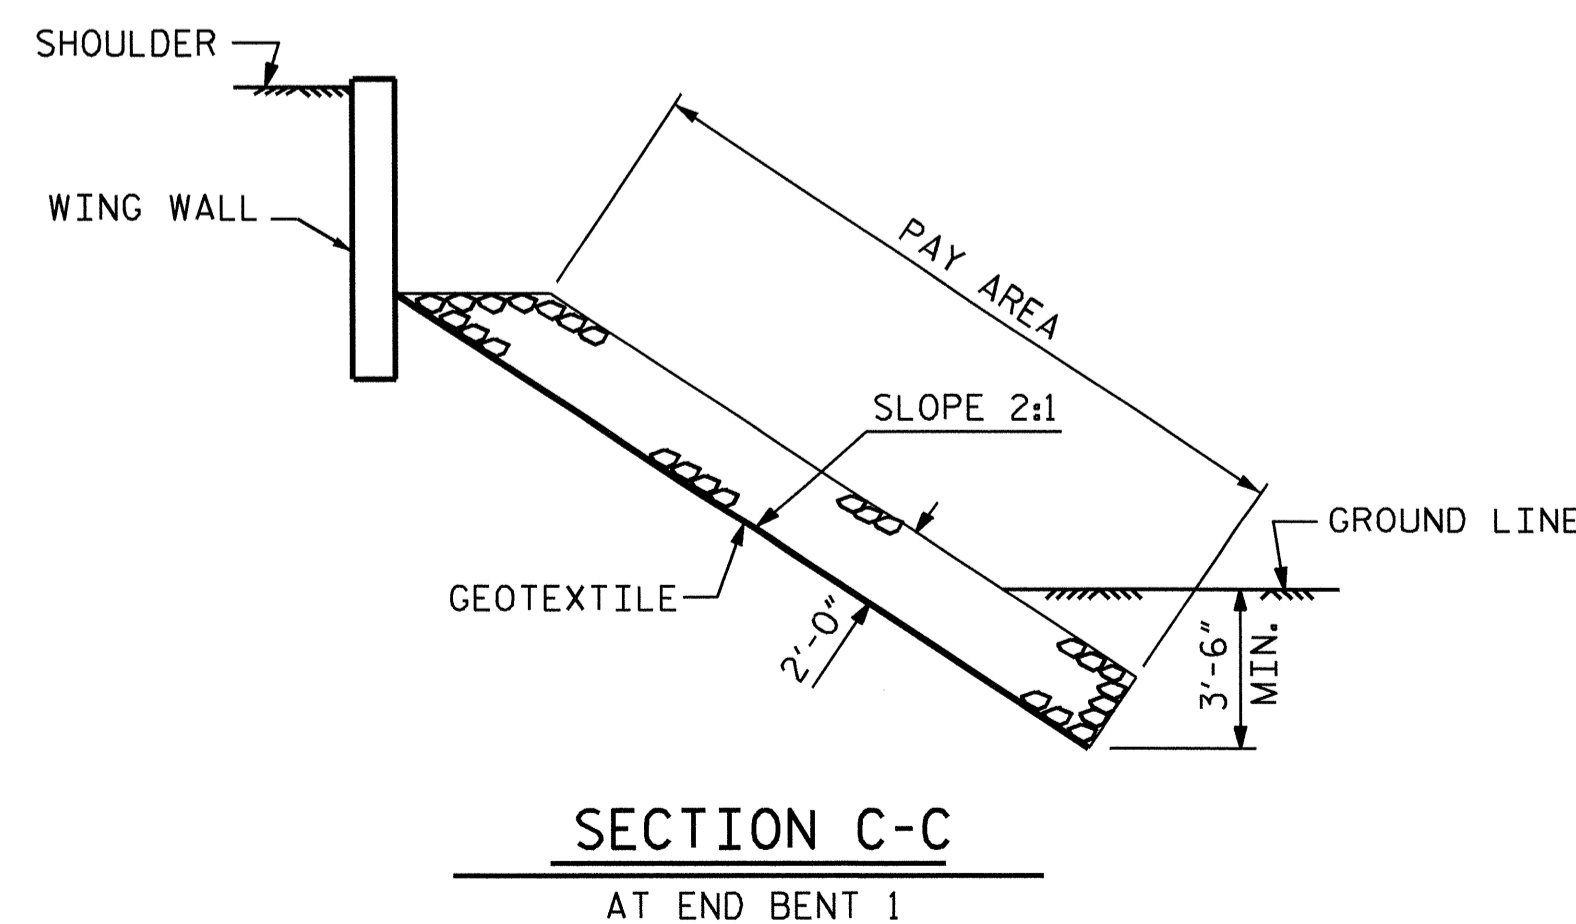

SECTION C-C
AT END BENT 1

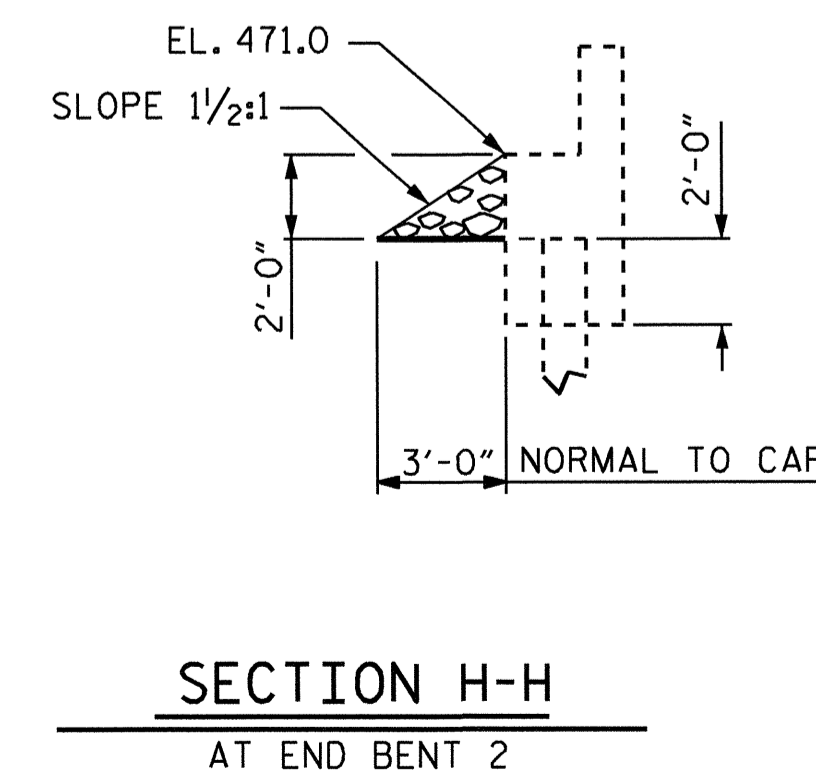

SECTION H-H
AT END BENT 2

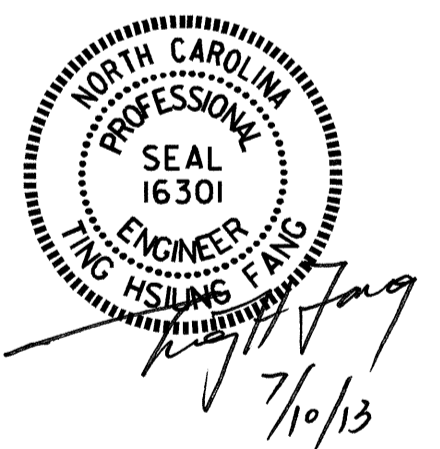

PROJECT NO. B-4730
CHATHAM COUNTY
STATION: 13+82.50 -L-

STATE OF NORTH CAROLINA DEPARTMENT OF TRANSPORTATION RALEIGH					
STANDARD RIP RAP DETAILS					
REVISIONS					
NO.	BY:	DATE:	NO.	BY:	DATE:
1			3		
2			4		

ASSEMBLED BY : R.P.PATEL	DATE : 5-24-12
CHECKED BY : P. K. NEWTON	DATE : 10-12
DRAWN BY : REK 1/84	REV. 5/1/06R TLA/GM
CHECKED BY : RDU 1/84	REV. 10/1/11 MAA/GM
	REV. 12/21/11 MAA/GM

10-JUL-2013 12:58
K:\TIP\Projects-B\B4730\Structures\Plans\FinalPlans\b4730_sd.plans.dgn
tjkirschbaum

STD. NO. RR1

NOTES

FOR BRIDGE APPROACH FILL INCLUDING GEOTEXTILE, 4" Ø DRAINAGE PIPE, AND #78M STONE BACKFILL, SEE ROADWAY PLANS.

GEOTEXTILE SHALL BE TYPE 1 IN ACCORDANCE WITH THE STANDARD SPECIFICATIONS SECTION 1056.


#78M STONE BACKFILL (CLASS V SELECT MATERIAL) SHALL BE IN ACCORDANCE WITH STANDARD SPECIFICATIONS SECTION 1016.

#78M STONE BACKFILL IS TO BE CONTINUOUS ALONG FILL FACE OF BACKWALL FROM OUTSIDE EDGE TO OUTSIDE EDGE OF APPROACH SLAB.

FOR THE 4" Ø DRAINAGE PIPE OUTLET(S), SEE ROADWAY STANDARD DRAWINGS.


AREA BETWEEN THE WINGWALL AND APPROACH SLAB SHALL BE GRADED TO DRAIN THE WATER AWAY FROM THE FILL FACE OF THE BRIDGE AND SHALL BE PAVED. SEE ROADWAY PLANS.

APPROACH SLAB GROOVING IS NOT REQUIRED.

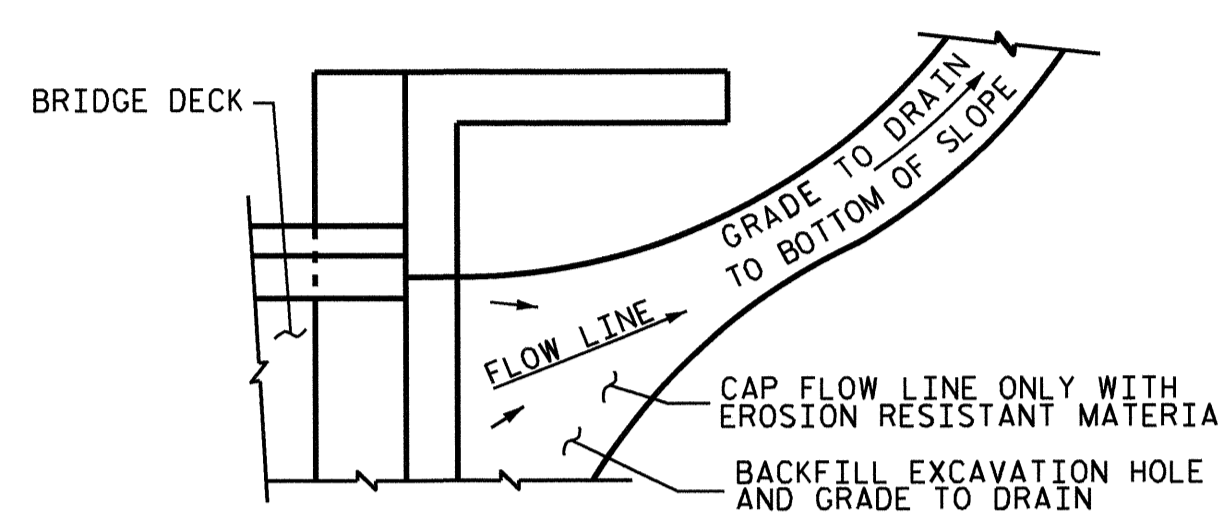


NOTE: IF THE APPROACH SLAB IS NOT CONSTRUCTED IMMEDIATELY AFTER THE BACKFILLING OF THE END BENT EXCAVATION, GRADE TO DRAIN TO THE BOTTOM OF THE SLOPE AND PROVIDE EROSION RESISTANT MATERIAL, SUCH AS FIBERGLASS ROVING OR AS DIRECTED BY THE ENGINEER TO PREVENT SOIL EROSION AND TO PROTECT THE AREA ADJACENT TO THE STRUCTURE. THE CONTRACTOR WILL BE REQUIRED TO REMOVE THESE MATERIALS PRIOR TO CONSTRUCTION OF THE APPROACH SLAB.

TEMPORARY DRAINAGE DETAIL

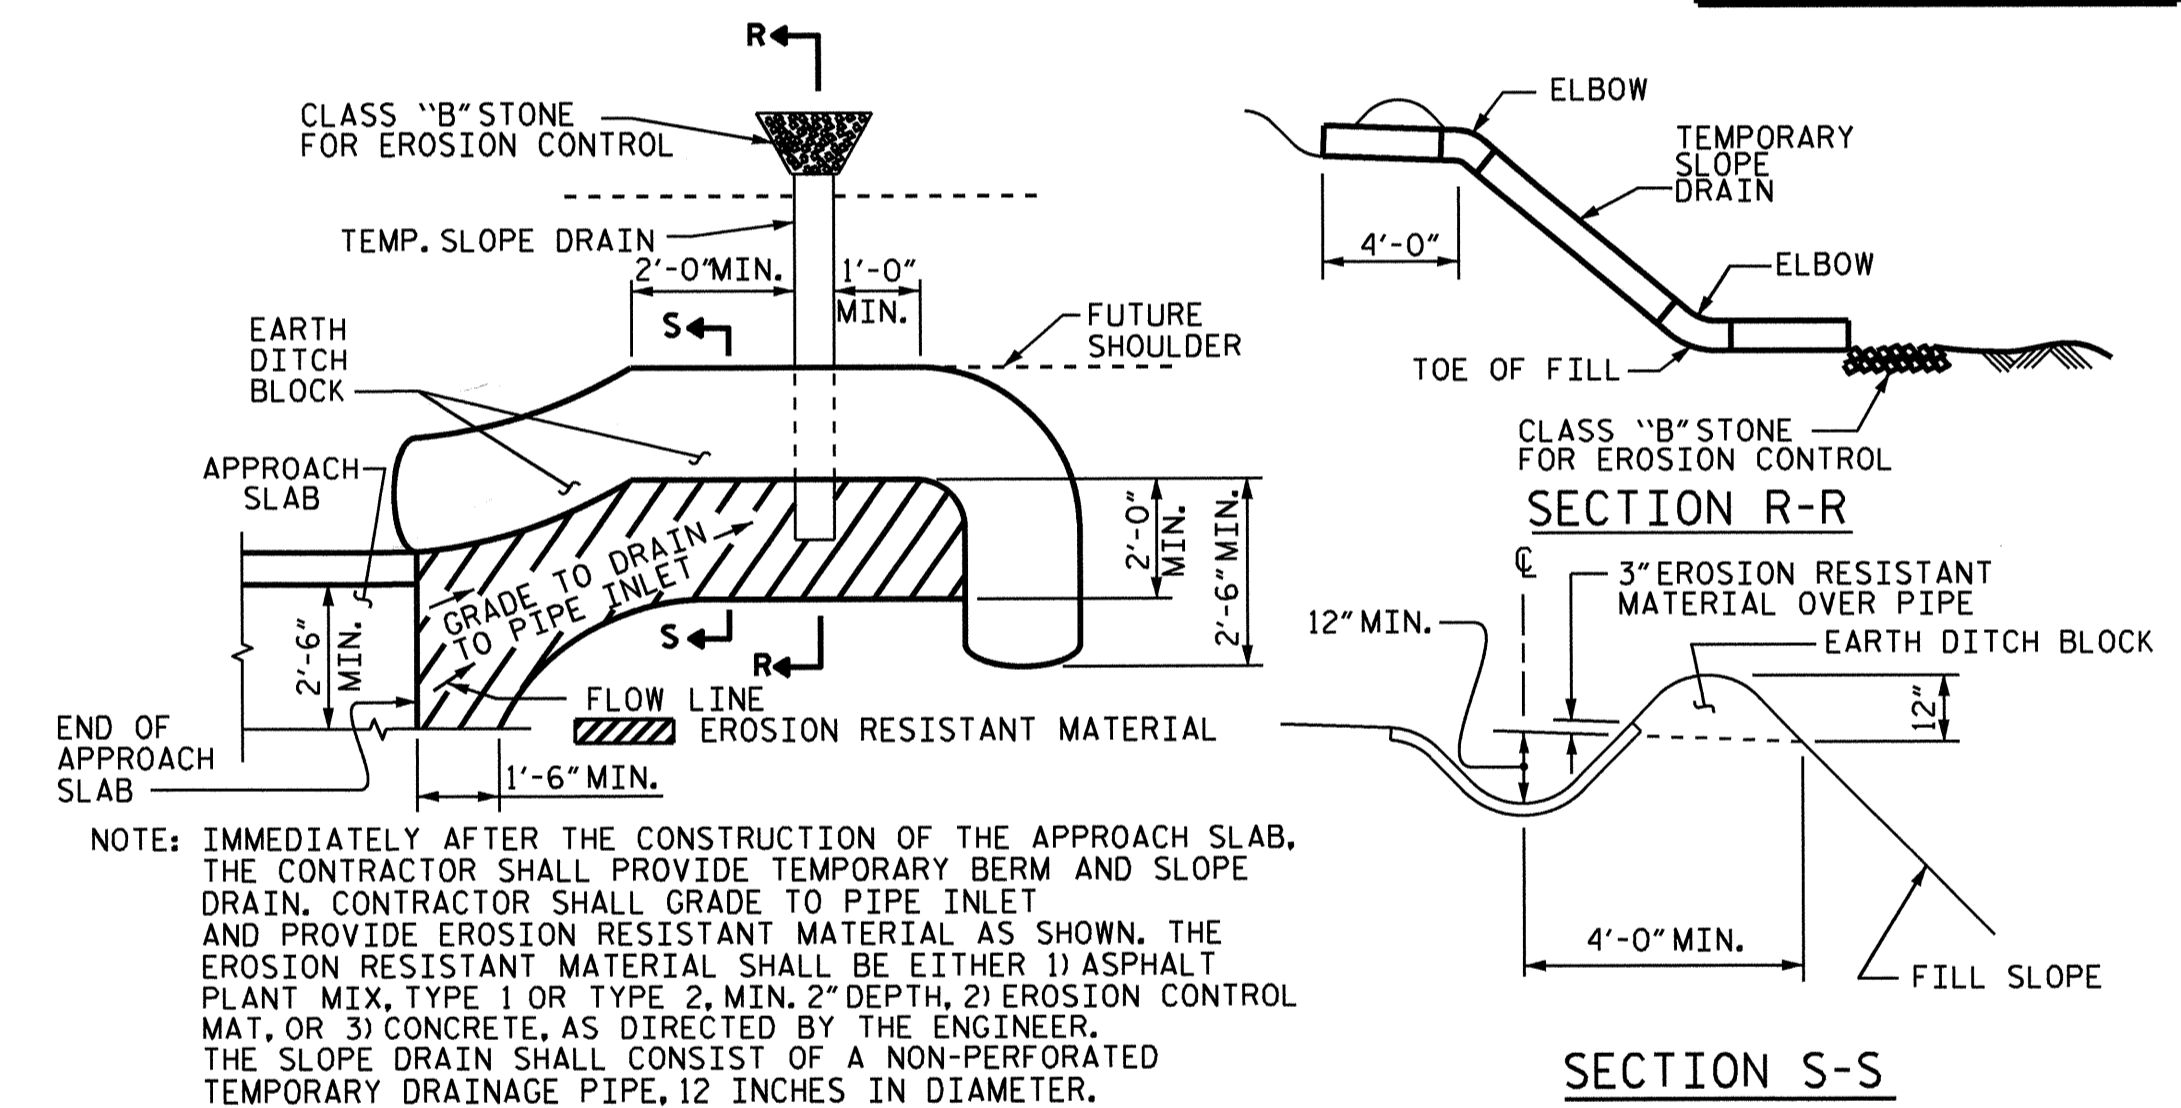


TEMPORARY BERM AND SLOPE DRAIN DETAILS
(TO BE USED WHEN SHOULDER BERM GUTTER IS REQUIRED)

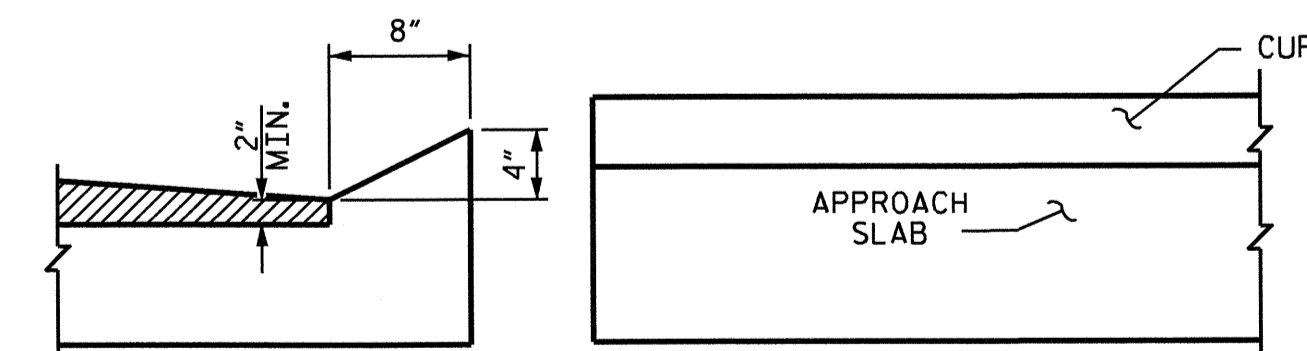


CURB DETAILS

BILL OF MATERIAL					
APPROACH SLAB AT EB 1					
BAR	NO.	SIZE	TYPE	LENGTH	WEIGHT
*A1	13	#4	STR	29'-10"	259
A2	13	#4	STR	29'-10"	259
*B1	58	#5	STR	11'-1"	670
B2	58	#6	STR	11'-7"	1009
REINFORCING STEEL				LBS.	1268
* EPOXY COATED REINFORCING STEEL				LBS.	929
CLASS AA CONCRETE				C.Y.	15.6
APPROACH SLAB AT EB 2					
BAR	NO.	SIZE	TYPE	LENGTH	WEIGHT
*A1	13	#4	STR	29'-10"	259
A2	13	#4	STR	29'-10"	259
*B1	58	#5	STR	11'-1"	670
B2	58	#6	STR	11'-7"	1009
REINFORCING STEEL				LBS.	1268
* EPOXY COATED REINFORCING STEEL				LBS.	929
CLASS AA CONCRETE				C.Y.	15.6

SPlice LENGTHS		
BAR SIZE	EPOXY COATED	UNCOATED
#4	2'-0"	1'-9"
#5	2'-6"	2'-2"
#6	3'-10"	2'-7"

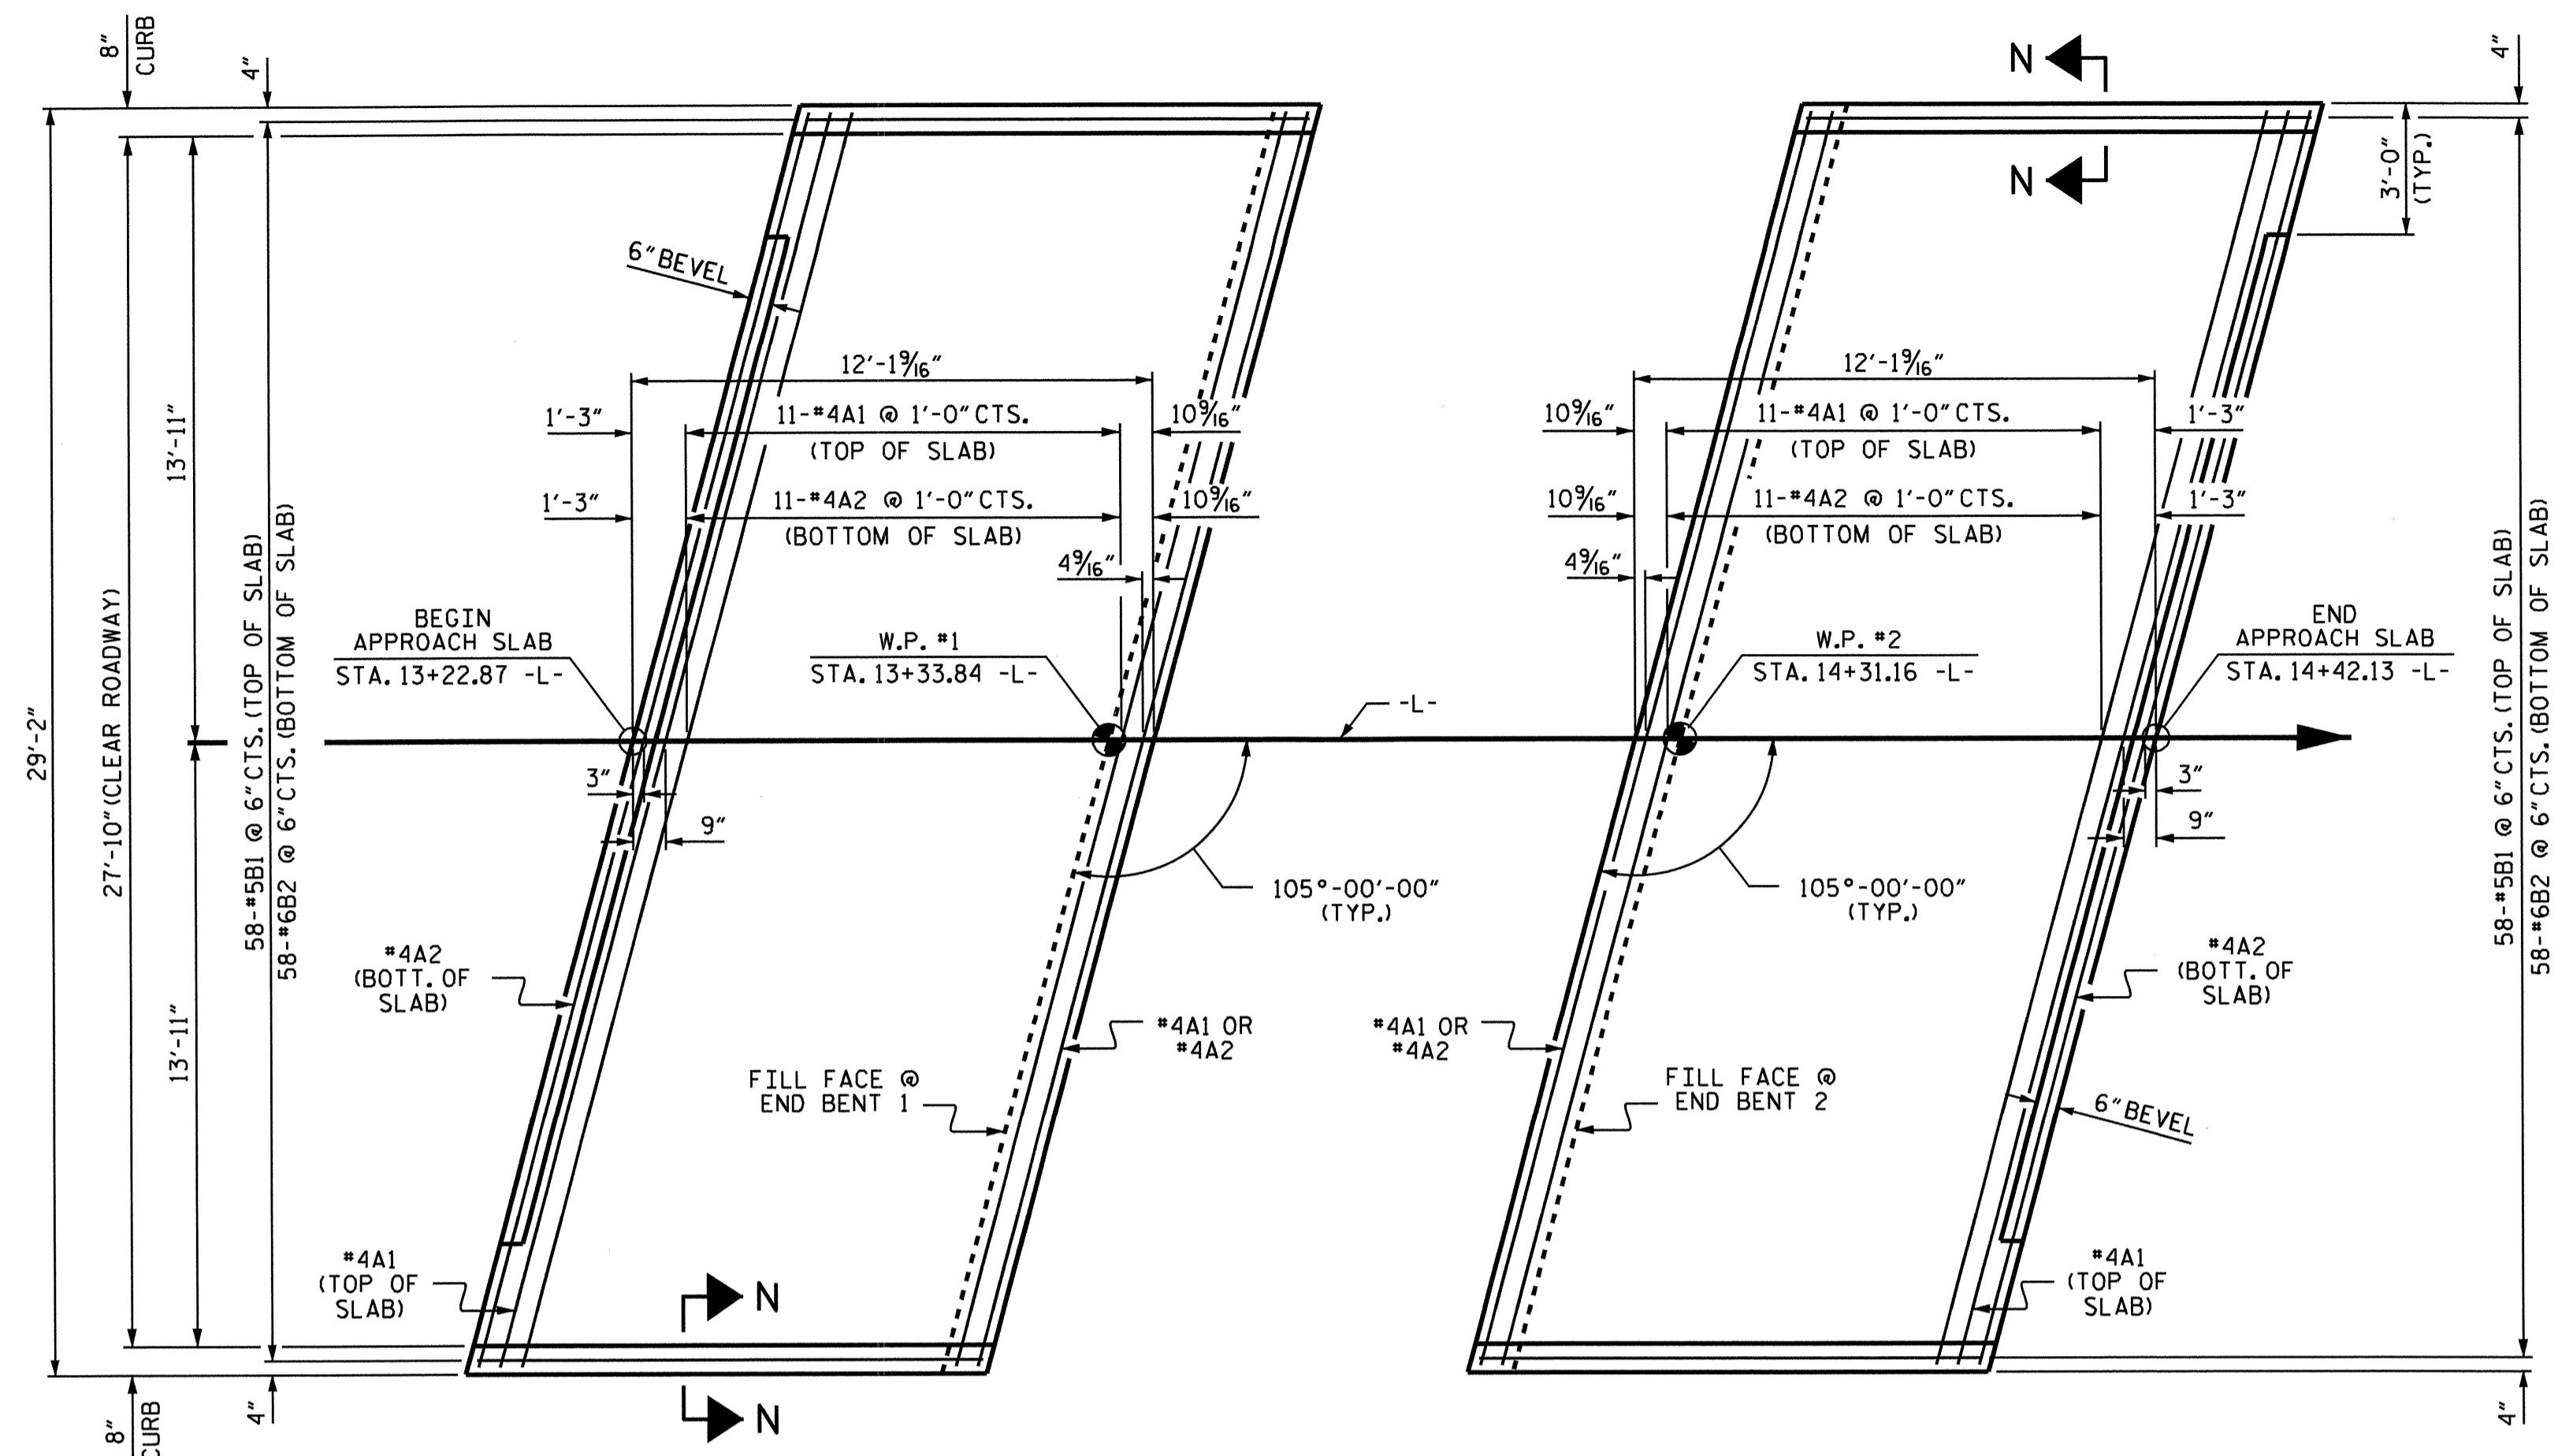


PLAN @ END BENT 1 **PLAN @ END BENT 2**
DIMENSIONS SHOWN ARE TYPICAL FOR BOTH APPROACH SLABS

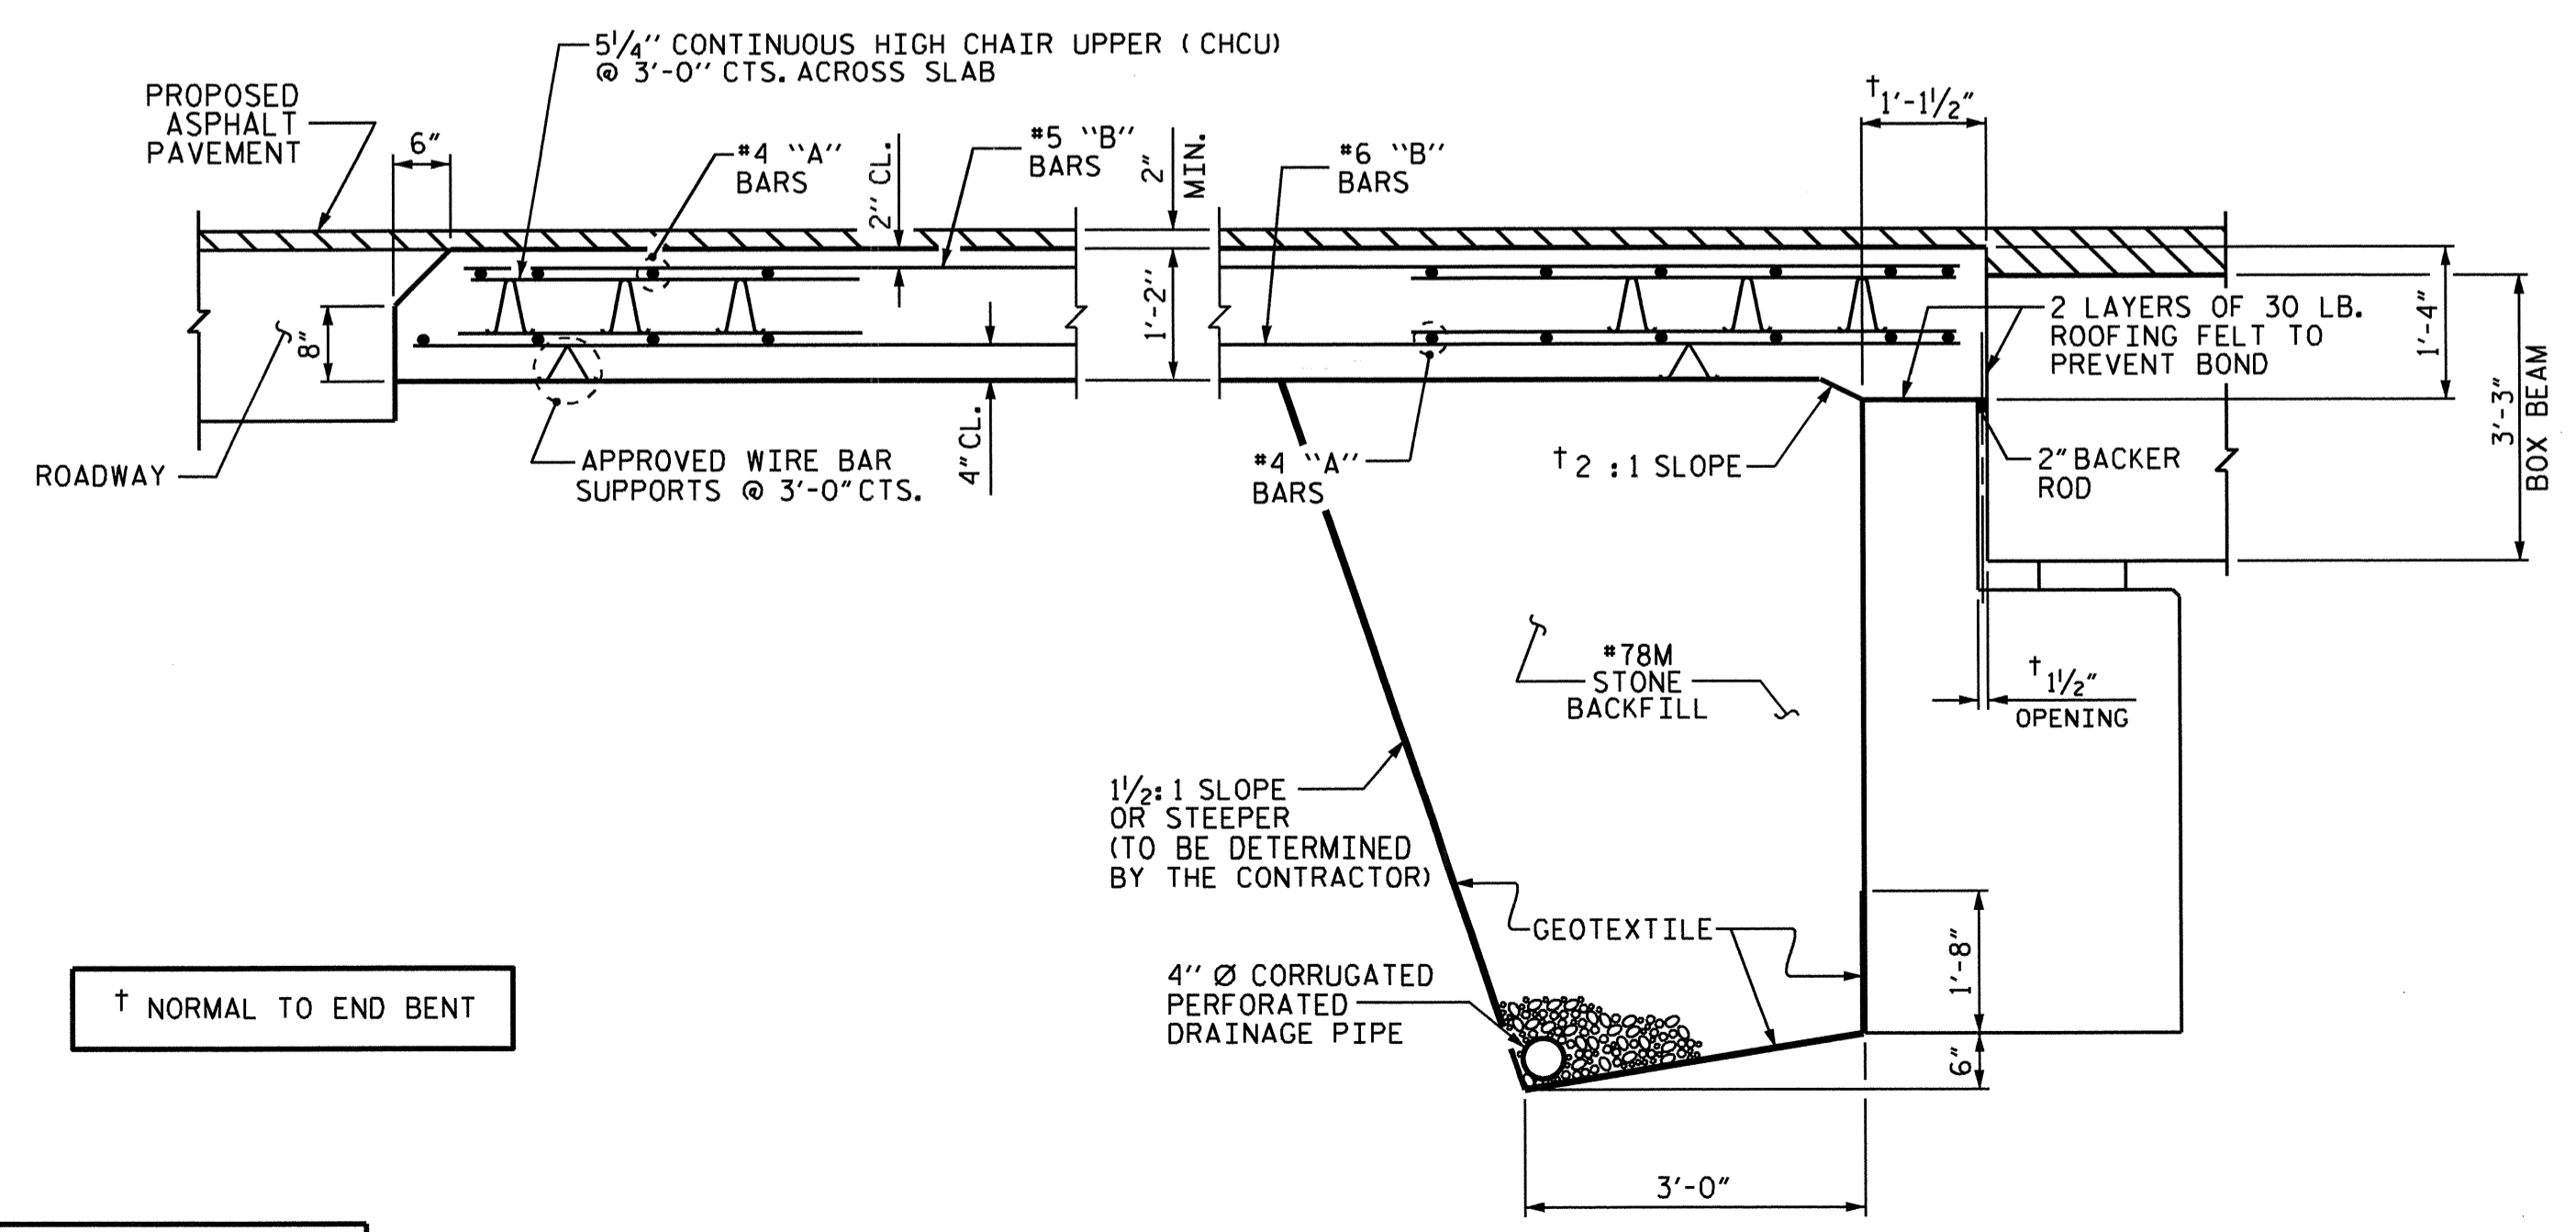

SECTION THRU SLAB

ASSEMBLED BY : R.P.PATEL DATE : 5-25-12
CHECKED BY : P. K. NEWTON DATE : 10-12
DRAWN BY : MAA 11/11
CHECKED BY : AAC 11/11

10-JUL-2013 12:55
K:\TIP\Projects\B4730\Structures\Plans\Final Plans\b4730_sd_plans.dgn
tjkfscbbum

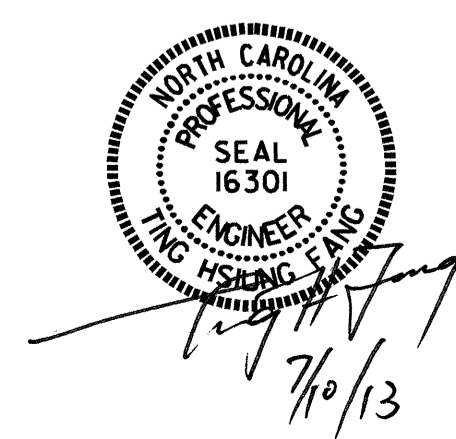

PROJECT NO. B-4730
CHATHAM COUNTY
STATION: 13+82.50 -L-

STATE OF NORTH CAROLINA DEPARTMENT OF TRANSPORTATION RALEIGH					
STANDARD BRIDGE APPROACH SLAB FOR PRESTRESSED CONCRETE BOX BEAM UNIT (SUB-REGIONAL TIER) 105° SKEW					
REVISIONS					SHEET NO.
NO.	BY:	DATE:	NO.	BY:	DATE:
1			3		
2			4		
					TOTAL SHEETS 16

STANDARD NOTES

DESIGN DATA:

SPECIFICATIONS	-----	A.A.S.H.T.O. (CURRENT)
LIVE LOAD	-----	SEE PLANS
IMPACT ALLOWANCE	-----	SEE A.A.S.H.T.O.
STRESS IN EXTREME FIBER OF		
STRUCTURAL STEEL - AASHTO M270 GRADE 36	-	20,000 LBS. PER SQ. IN.
- AASHTO M270 GRADE 50W	-	27,000 LBS. PER SQ. IN.
- AASHTO M270 GRADE 50	-	27,000 LBS. PER SQ. IN.
REINFORCING STEEL IN TENSION		
GRADE 60	--	24,000 LBS. PER SQ. IN.
CONCRETE IN COMPRESSION	-----	1,200 LBS. PER SQ. IN.
CONCRETE IN SHEAR	-----	SEE A.A.S.H.T.O.
STRUCTURAL TIMBER - TREATED OR		
UNTREATED - EXTREME FIBER STRESS	-----	1,800 LBS. PER SQ. IN.
COMPRESSION PERPENDICULAR TO GRAIN OF TIMBER	-----	375 LBS. PER SQ. IN.
EQUIVALENT FLUID PRESSURE OF EARTH	-----	30 LBS. PER CU. FT. (MINIMUM)

MATERIAL AND WORKMANSHIP:

EXCEPT AS MAY OTHERWISE BE SPECIFIED ON PLANS OR IN THE SPECIAL PROVISIONS, ALL MATERIAL AND WORKMANSHIP SHALL BE IN ACCORDANCE WITH THE 2012 "STANDARD SPECIFICATIONS FOR ROADS AND STRUCTURES" OF THE N. C. DEPARTMENT OF TRANSPORTATION.

STEEL SHEET PILING FOR PERMANENT OR TEMPORARY APPLICATIONS SHALL BE HOT ROLLED.

CONCRETE:

UNLESS OTHERWISE REQUIRED ON PLANS, CLASS A CONCRETE SHALL BE USED FOR ALL PORTIONS OF ALL STRUCTURES WITH THE EXCEPTION THAT: CLASS AA CONCRETE SHALL BE USED IN BRIDGE SUPERSTRUCTURES, ABUTMENT BACKWALLS, AND APPROACH SLABS; AND CLASS B CONCRETE SHALL BE USED FOR SLOPE PROTECTION AND RIP RAP.

CONCRETE CHAMFERS:

UNLESS OTHERWISE NOTED ON THE PLANS, ALL EXPOSED CORNERS ON STRUCTURES SHALL BE CHAMFERED 3/4" WITH THE FOLLOWING EXCEPTIONS: TOP CORNERS OF CURBS MAY BE ROUNDED TO 1-1/2" RADIUS WHICH IS BUILT INTO CURB FORMS; CORNERS OF TRANSVERSE FLOOR EXPANSION JOINTS SHALL BE ROUNDED WITH A 1/4" FINISHING TOOL UNLESS OTHERWISE REQUIRED ON PLANS; AND CORNERS OF EXPANSION JOINTS IN THE ROADWAY FACES AND TOPS OF CURBS AND SIDEWALKS SHALL BE ROUNDED TO A 1/4" RADIUS WITH A FINISHING STONE OR TOOL UNLESS OTHERWISE REQUIRED ON PLANS.

DOWELS:

DOWELS WHEN INDICATED ON PLANS AS FOR CULVERT EXTENSIONS, SHALL BE EMBEDDED AT LEAST 12" INTO THE OLD CONCRETE AND GROUTED INTO PLACE WITH 1:2 CEMENT MORTAR.

ALLOWANCE FOR DEAD LOAD DEFLECTION, SETTLEMENT, ETC. IN CASTING SUPERSTRUCTURES:

BRIDGES SHALL BE BUILT ON THE GRADE OR VERTICAL CURVE SHOWN ON PLANS. SLABS, CURBS AND PARAPETS SHALL CONFORM TO THE GRADE OR CURVE.

ALL DIMENSIONS WHICH ARE GIVEN IN SECTION AND ARE AFFECTED BY DEAD LOAD DEFLECTIONS ARE DIMENSIONS AT CENTER LINE OF BEARING UNLESS OTHERWISE NOTED ON PLANS. IN SETTING FORMS FOR STEEL BEAM BRIDGES AND PRESTRESSED CONCRETE GIRDER BRIDGES, ADJUSTMENTS SHALL BE MADE DUE TO THE DEAD LOAD DEFLECTIONS FOR THE ELEVATIONS SHOWN. WHERE BLOCKS ARE SHOWN OVER BEAMS FOR BUILDING UP TO THE SLAB, THE VERTICAL DIMENSIONS OF THE BLOCKS SHALL BE ADJUSTED BETWEEN BEARINGS TO COMPENSATE FOR DEAD LOAD DEFLECTIONS, VERTICAL CURVE ORDINATE, AND ACTUAL BEAM CAMBER. WHERE BOTTOM OF SLAB IS IN LINE WITH BOTTOM OF TOP FLANGES, DEPTH OF SLAB BETWEEN BEARINGS SHALL BE ADJUSTED TO COMPENSATE FOR DEAD LOAD DEFLECTION, VERTICAL CURVE ORDINATE, AND ACTUAL BEAM CAMBER.

IN SETTING FALSEWORK AND FORMS FOR REINFORCED CONCRETE SPANS, AN ALLOWANCE SHALL BE MADE FOR DEAD LOAD DEFLECTIONS, SETTLEMENT OF FALSEWORK, AND PERMANENT CAMBER WHICH SHALL BE PROVIDED FOR IN ADDITION TO THE ELEVATIONS SHOWN. AFTER REMOVAL OF THE FALSEWORK, THE FINISHED STRUCTURES SHALL CONFORM TO THE PROFILE AND ELEVATIONS SHOWN ON THE PLANS AND CONSTRUCTION ELEVATIONS FURNISHED BY THE ENGINEER.

DETAILED DRAWINGS FOR FALSEWORK OR FORMS FOR BRIDGE SUPERSTRUCTURE AND ANY STRUCTURE OR PARTS OF A STRUCTURE AS NOTED ON THE PLANS SHALL BE SUBMITTED TO THE ENGINEER FOR APPROVAL BEFORE CONSTRUCTION OF THE FALSEWORK OR FORMS IS STARTED.

REINFORCING STEEL:

ALL REINFORCING STEEL SHALL BE DEFORMED. DIMENSIONS RELATIVE TO PLACEMENT OF REINFORCING ARE TO CENTERS OF BARS UNLESS OTHERWISE INDICATED IN THE PLANS. DIMENSIONS ON BAR DETAILS ARE TO CENTERS OF BARS OR ARE OUT TO OUT AS INDICATED ON PLANS.

WIRE BAR SUPPORTS SHALL BE PROVIDED FOR REINFORCING STEEL WHERE INDICATED ON THE PLANS. WHEN BAR SUPPORT PIECES ARE PLACED IN CONTINUOUS LINES, THEY SHALL BE SO PLACED THAT THE ENDS OF THE SUPPORTING WIRES SHALL BE LAPPED TO LOCK LEGS ON ADJOINING PIECES.

STRUCTURAL STEEL:

AT THE CONTRACTOR'S OPTION, HE MAY SUBSTITUTE 7/8" Ø SHEAR STUDS FOR THE 3/4" Ø STUDS SPECIFIED ON THE PLANS. THIS SUBSTITUTION SHALL BE MADE AT THE RATE OF 3 - 7/8" Ø STUDS FOR 4 - 3/4" Ø STUDS, AND STUD SPACING CHANGES SHALL BE MADE AS NECESSARY TO PROVIDE THE SAME EQUIVALENT NUMBER OF 7/8" Ø STUDS ALONG THE BEAM AS SHOWN FOR 3/4" Ø STUDS BASED ON THE RATIO OF 3 - 7/8" Ø STUDS FOR 4 - 3/4" Ø STUDS. STUDS OF THE LENGTH SPECIFIED ON THE PLANS MUST BE PROVIDED. THE MAXIMUM SPACING SHALL BE 2'-0".

EXCEPT AT THE INTERIOR SUPPORTS OF CONTINUOUS BEAMS WHERE THE COVER PLATE IS IN CONTACT WITH BEARING PLATE, THE CONTRACTOR MAY, AT HIS OPTION, SUBSTITUTE FOR THE COVER PLATES DESIGNATED ON THE PLANS COVER PLATES OF THE EQUIVALENT AREA PROVIDED THESE PLATES ARE AT LEAST 5/16" IN THICKNESS AND DO NOT EXCEED A WIDTH EQUAL TO THE FLANGE WIDTH LESS 2" OR A THICKNESS EQUAL TO 2 TIMES THE FLANGE THICKNESS. THE SIZE OF FILLET WELDS SHALL CONFORM TO THE REQUIREMENTS OF THE CURRENT ANSI/AASHTO/AWS "BRIDGE WELDING CODE". ELECTROSLAG WELDING WILL NOT BE PERMITTED.

WITH THE SOLE EXCEPTION OF EDGES AT SURFACES WHICH BEAR ON OTHER SURFACES, ALL SHARP EDGES AND ENDS OF SHAPES AND PLATES SHALL BE SLIGHTLY ROUNDED BY SUITABLE MEANS TO A RADIUS OF APPROXIMATELY 1/16 INCH OR EQUIVALENT FLAT SURFACE AT A SUITABLE ANGLE PRIOR TO PAINTING, GALVANIZING, OR METALLIZING.

HANDRAILS AND POSTS:

METAL STANDARDS AND FACES OF THE CONCRETE END POSTS FOR THE METAL RAIL SHALL BE SET NORMAL TO THE GRADE OF THE CURB, UNLESS OTHERWISE SHOWN ON PLANS. THE METAL RAIL AND TOPS OF CONCRETE POSTS USED WITH THE ALUMINUM RAIL SHALL BE BUILT PARALLEL TO THE GRADE OF THE CURB.

METAL HANDRAILS SHALL BE IN ACCORDANCE WITH THE PLANS. RAILS SHALL BE AS MANUFACTURED FOR BRIDGE RAILING. CASTINGS SHALL BE OF A UNIFORM APPEARANCE. FINIS AND OTHER DEFORMATIONS RESULTING FROM CASTING OR OTHERWISE SHALL BE REMOVED IN A MANNER SO THAT A UNIFORM COLORING OF THE COMPLETED CASTING SHALL BE OBTAINED. CASTINGS WITH DISCOLORATIONS OR OF NON-UNIFORM COLORING WILL NOT BE ACCEPTED. CERTIFIED MILL REPORTS ARE REQUIRED FOR METAL RAILS AND POSTS.

SPECIAL NOTES:

GENERALLY, IN CASE OF DISCREPANCY, THIS STANDARD SHEET OF NOTES SHALL GOVERN OVER THE SPECIFICATIONS, BUT THE REMAINDER OF THE PLANS SHALL GOVERN OVER NOTES HEREON, AND SPECIAL PROVISIONS SHALL GOVERN OVER ALL. SEE SPECIFICATIONS ARTICLE 105-4.

ENGLISH

JANUARY, 1990