



EXTERIOR WALL INTERIOR WALL
CULVERT SECTION NORMAL TO ROADWAY

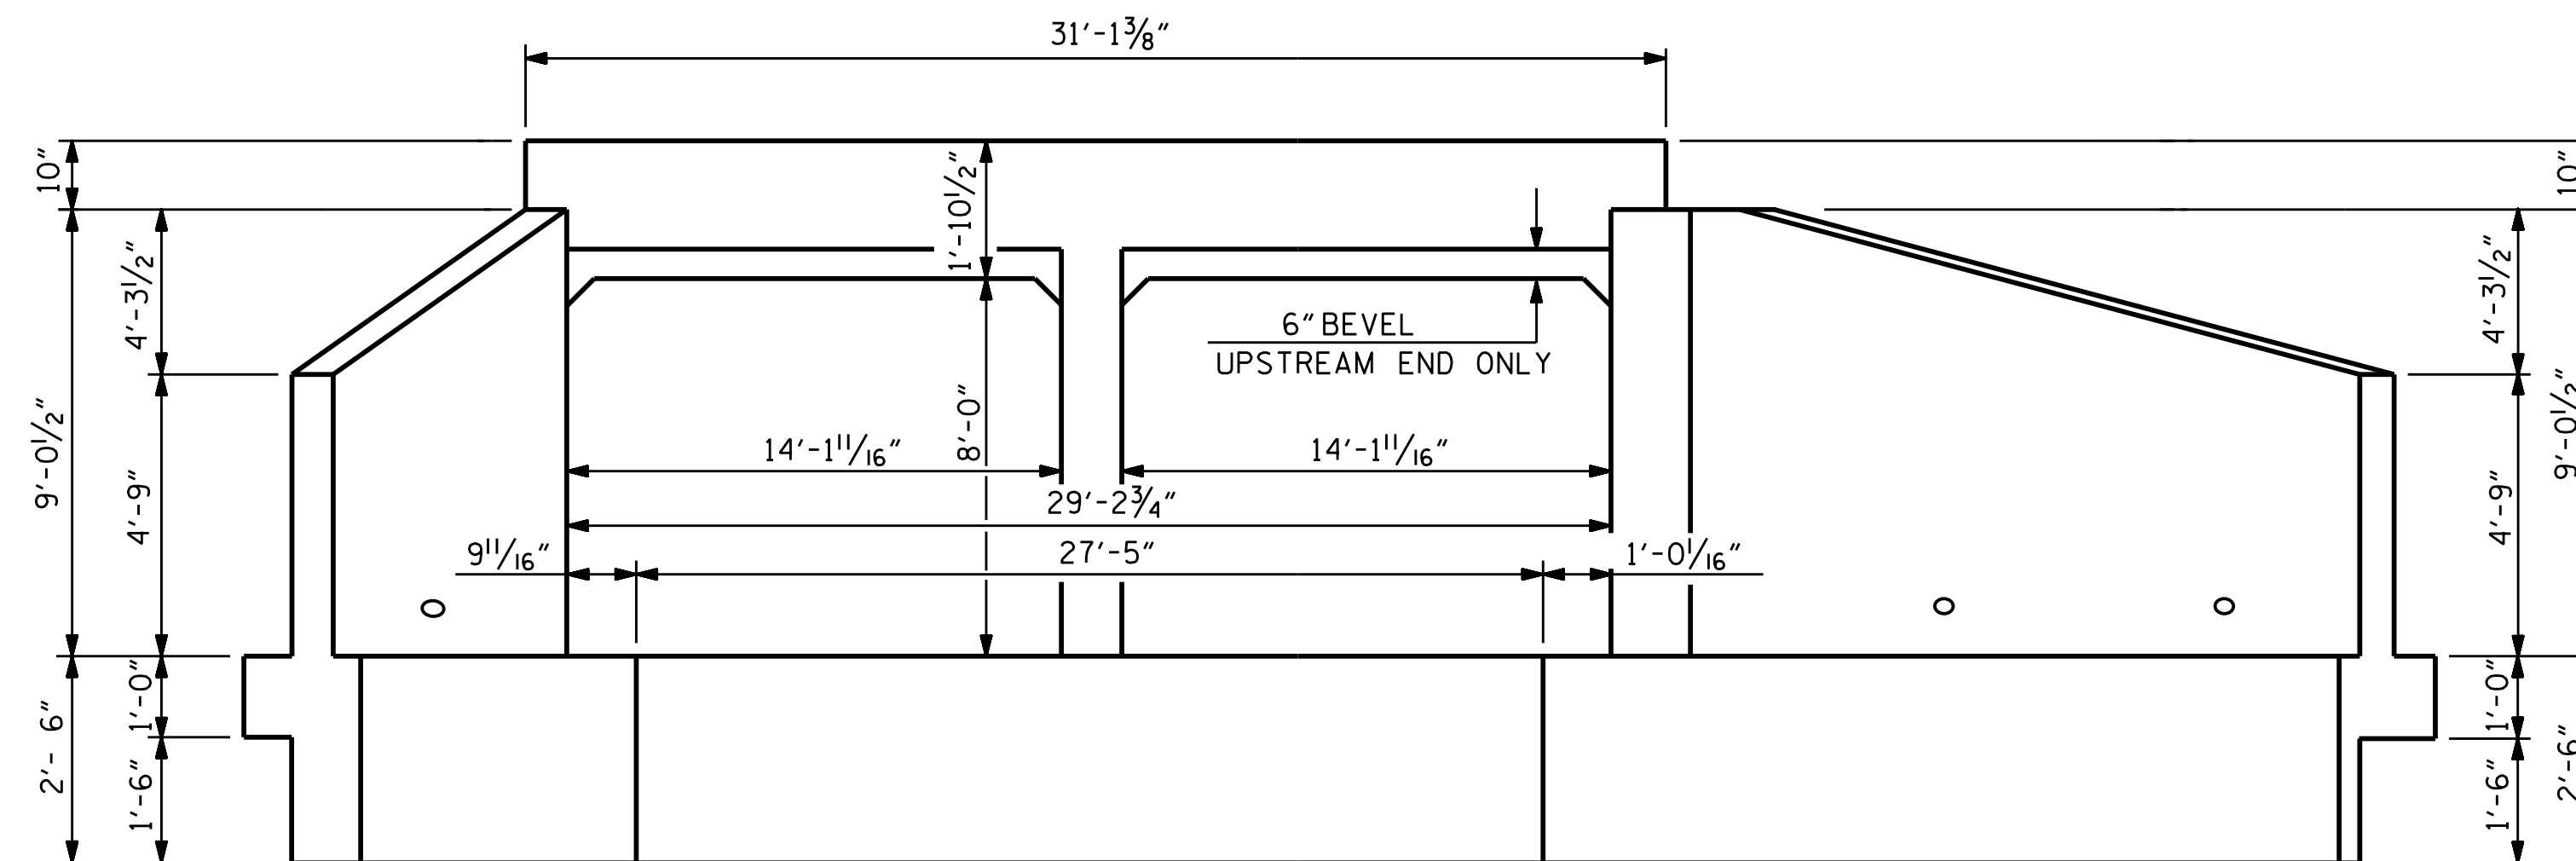

END ELEVATION NORMAL TO SKEW

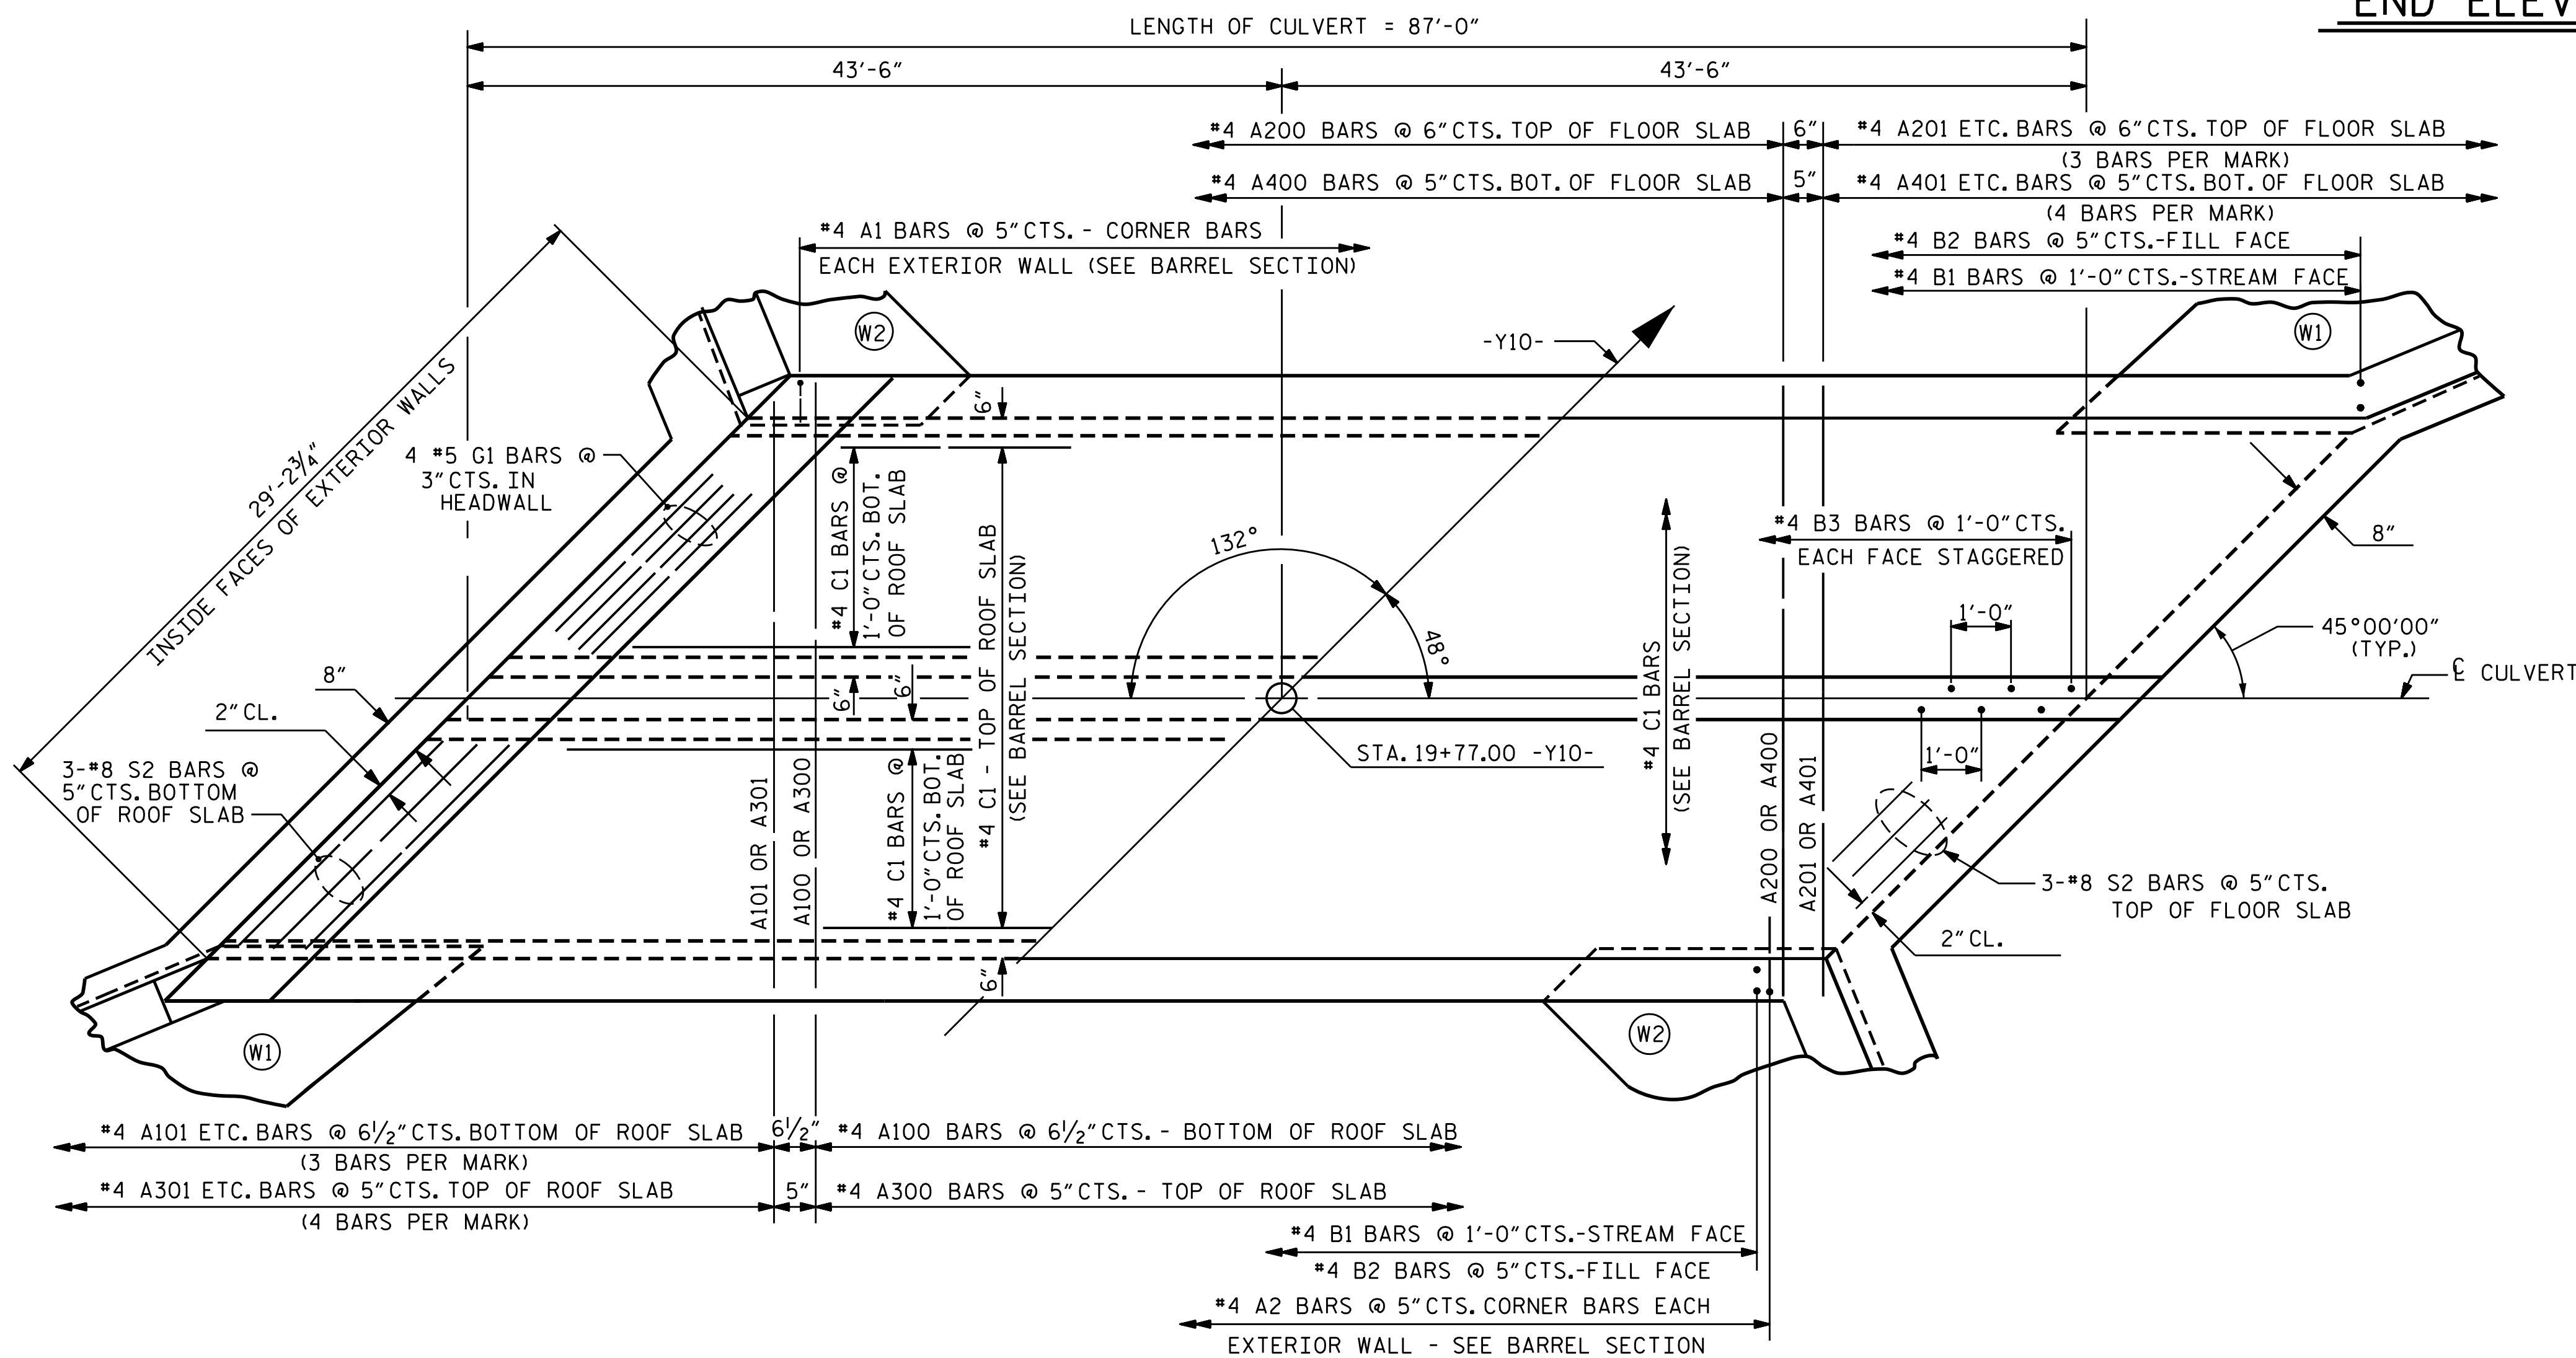

PART PLAN - ROOF SLAB

PART PLAN - FLOOR SLAB

SILLS NOT SHOWN FOR CLARITY
 SEE SHEET 3 OF 5 FOR SILL DETAILS

I HEREBY CERTIFY THESE PLANS
 ARE THE AS-BUILT PLANS



DocuSigned by:
 Kristy W. Alford
 3/16/2017

PROJECT NO. U-3109A
ALAMANCE COUNTY
 STATION: 19+77.00 -Y10-

SHEET 2 OF 5

STATE OF NORTH CAROLINA
 DEPARTMENT OF TRANSPORTATION
 RALEIGH
**BARREL STANDARD
 DOUBLE 10 FT. X 8 FT.
 CONCRETE BOX CULVERT**
 48° SKEW

REVISIONS						SHEET NO.
NO.	BY:	DATE:	NO.	BY:	DATE:	C3-2
1			3			TOTAL SHEETS
2			4			5

DOCUMENT NOT CONSIDERED FINAL
 UNLESS ALL SIGNATURES COMPLETED

REVISED 11-19-99 BY M.M. CHECKED BY R.W.W.
 REDRAWN 11-90 BY C.O.C. CHECKED BY M.A.J.

ASSEMBLED BY: A.C. OUTLAW DATE: 4/25/14
 CHECKED BY: W.F. PARKER DATE: 5/14
 DRAWN BY: DANNY SHERRED DATE: 4-11-72
 CHECKED BY: HASON A. JUDEH DATE: 4-17-72

SPECIAL
STANDARD