

TRAFFIC CONTROL DEVICES, INC.
 710 Long Meadow Dr.
 Salisbury, NC 28147

TRANSMITTAL NOTICE

Job No. 16014

Project C203635 Transmittal No. F-41
 Location Wake County Sheet 1 Of 1
 Work Signing, Lighting, ITS, Signals Date 6/20/2016

TO: Blythe Construction, Inc.
2911 North Graham Street
Charlotte, NC 28206
Attn: Matt Adams

Items listed are being sent:
 Enclosed
 Under Separate Cover
 E-Mail

Gentlemen:

We are transmittin
 Plans
 Prints

If these Items are

Item	Quan.	Dwg. #
1		

Status Code: A. Appro
 B. Appro


Remarks: Please return at lea

APPROVED RESUBMIT
 APPROVED AS NOTED NOT APPROVED

REVIEW OF THIS SHOP DRAWING IS LIMITED TO CONFORMANCE WITH THE DESIGN CONCEPT OF THE PROJECT AND FOR COMPLIANCE WITH THE INFORMATION GIVEN IN THE CONTRACT PLANS AND SPECIFICATIONS (INCLUDING SUPPLEMENTAL AND SPECIAL PROVISIONS), AND IS NOT INTENDED TO BE A VERIFICATION OF TOTAL MATERIAL REQUIRED OR THAT ALL ITEMS REQUIRED ARE SHOWN. REVIEW SHALL NOT RELIEVE THE CONTRACTOR FROM THE RESPONSIBILITY OF DETAILS OF DESIGN, DIMENSIONS, JOB CONDITIONS, CONSTRUCTION MEANS AND METHODS, COORDINATION WITH OTHER TRADES, OR ANY OTHER REQUIREMENTS OF THE PLANS, SPECIFICATIONS OR CONTRACT. ANY NOTATIONS ON THIS SHOP DRAWING MADE BY ATKINS NORTH AMERICA SHALL NOT BE CONSTRUED TO AUTHORIZE ADDITIONAL WORK OR COST.

REVIEW OF DESIGN CALCULATIONS AND DRAWINGS PREPARED BY SPECIALTY ENGINEERS IS LIMITED TO DESIGN INTENT AND DOES NOT CONSTITUTE A DETAILED CHECK OF CALCULATIONS, NOR DOES IT RELIEVE THE SPECIALTY ENGINEERS FROM THE RESPONSIBILITY OF THE DETAILING OF THE SPECIALTY COMPONENT OR SYSTEM.

BY: D.L. Jones , PE
 DATE: 7/1/16



Technical Data
 Quotation

Status

C, F


es
 marks

Reply to: Traffic Control Devices, Inc.
710 Long Meadow Drive
Salisbury, NC 28147

Sincerely,
 Traffic Control Devices, Inc.

By: B.J. Robertson
 B.J. Robertson

SHIPPING LIST		C1791-EC7
QTY	MARK	DESCRIPTION
4	TG1.1	CLADDING PANELS
48	17P1	BACKING PLATES
48	(U3d)	1/2" U-Bolts w/(4)HN/(2)LW/(2)FW (GALV)

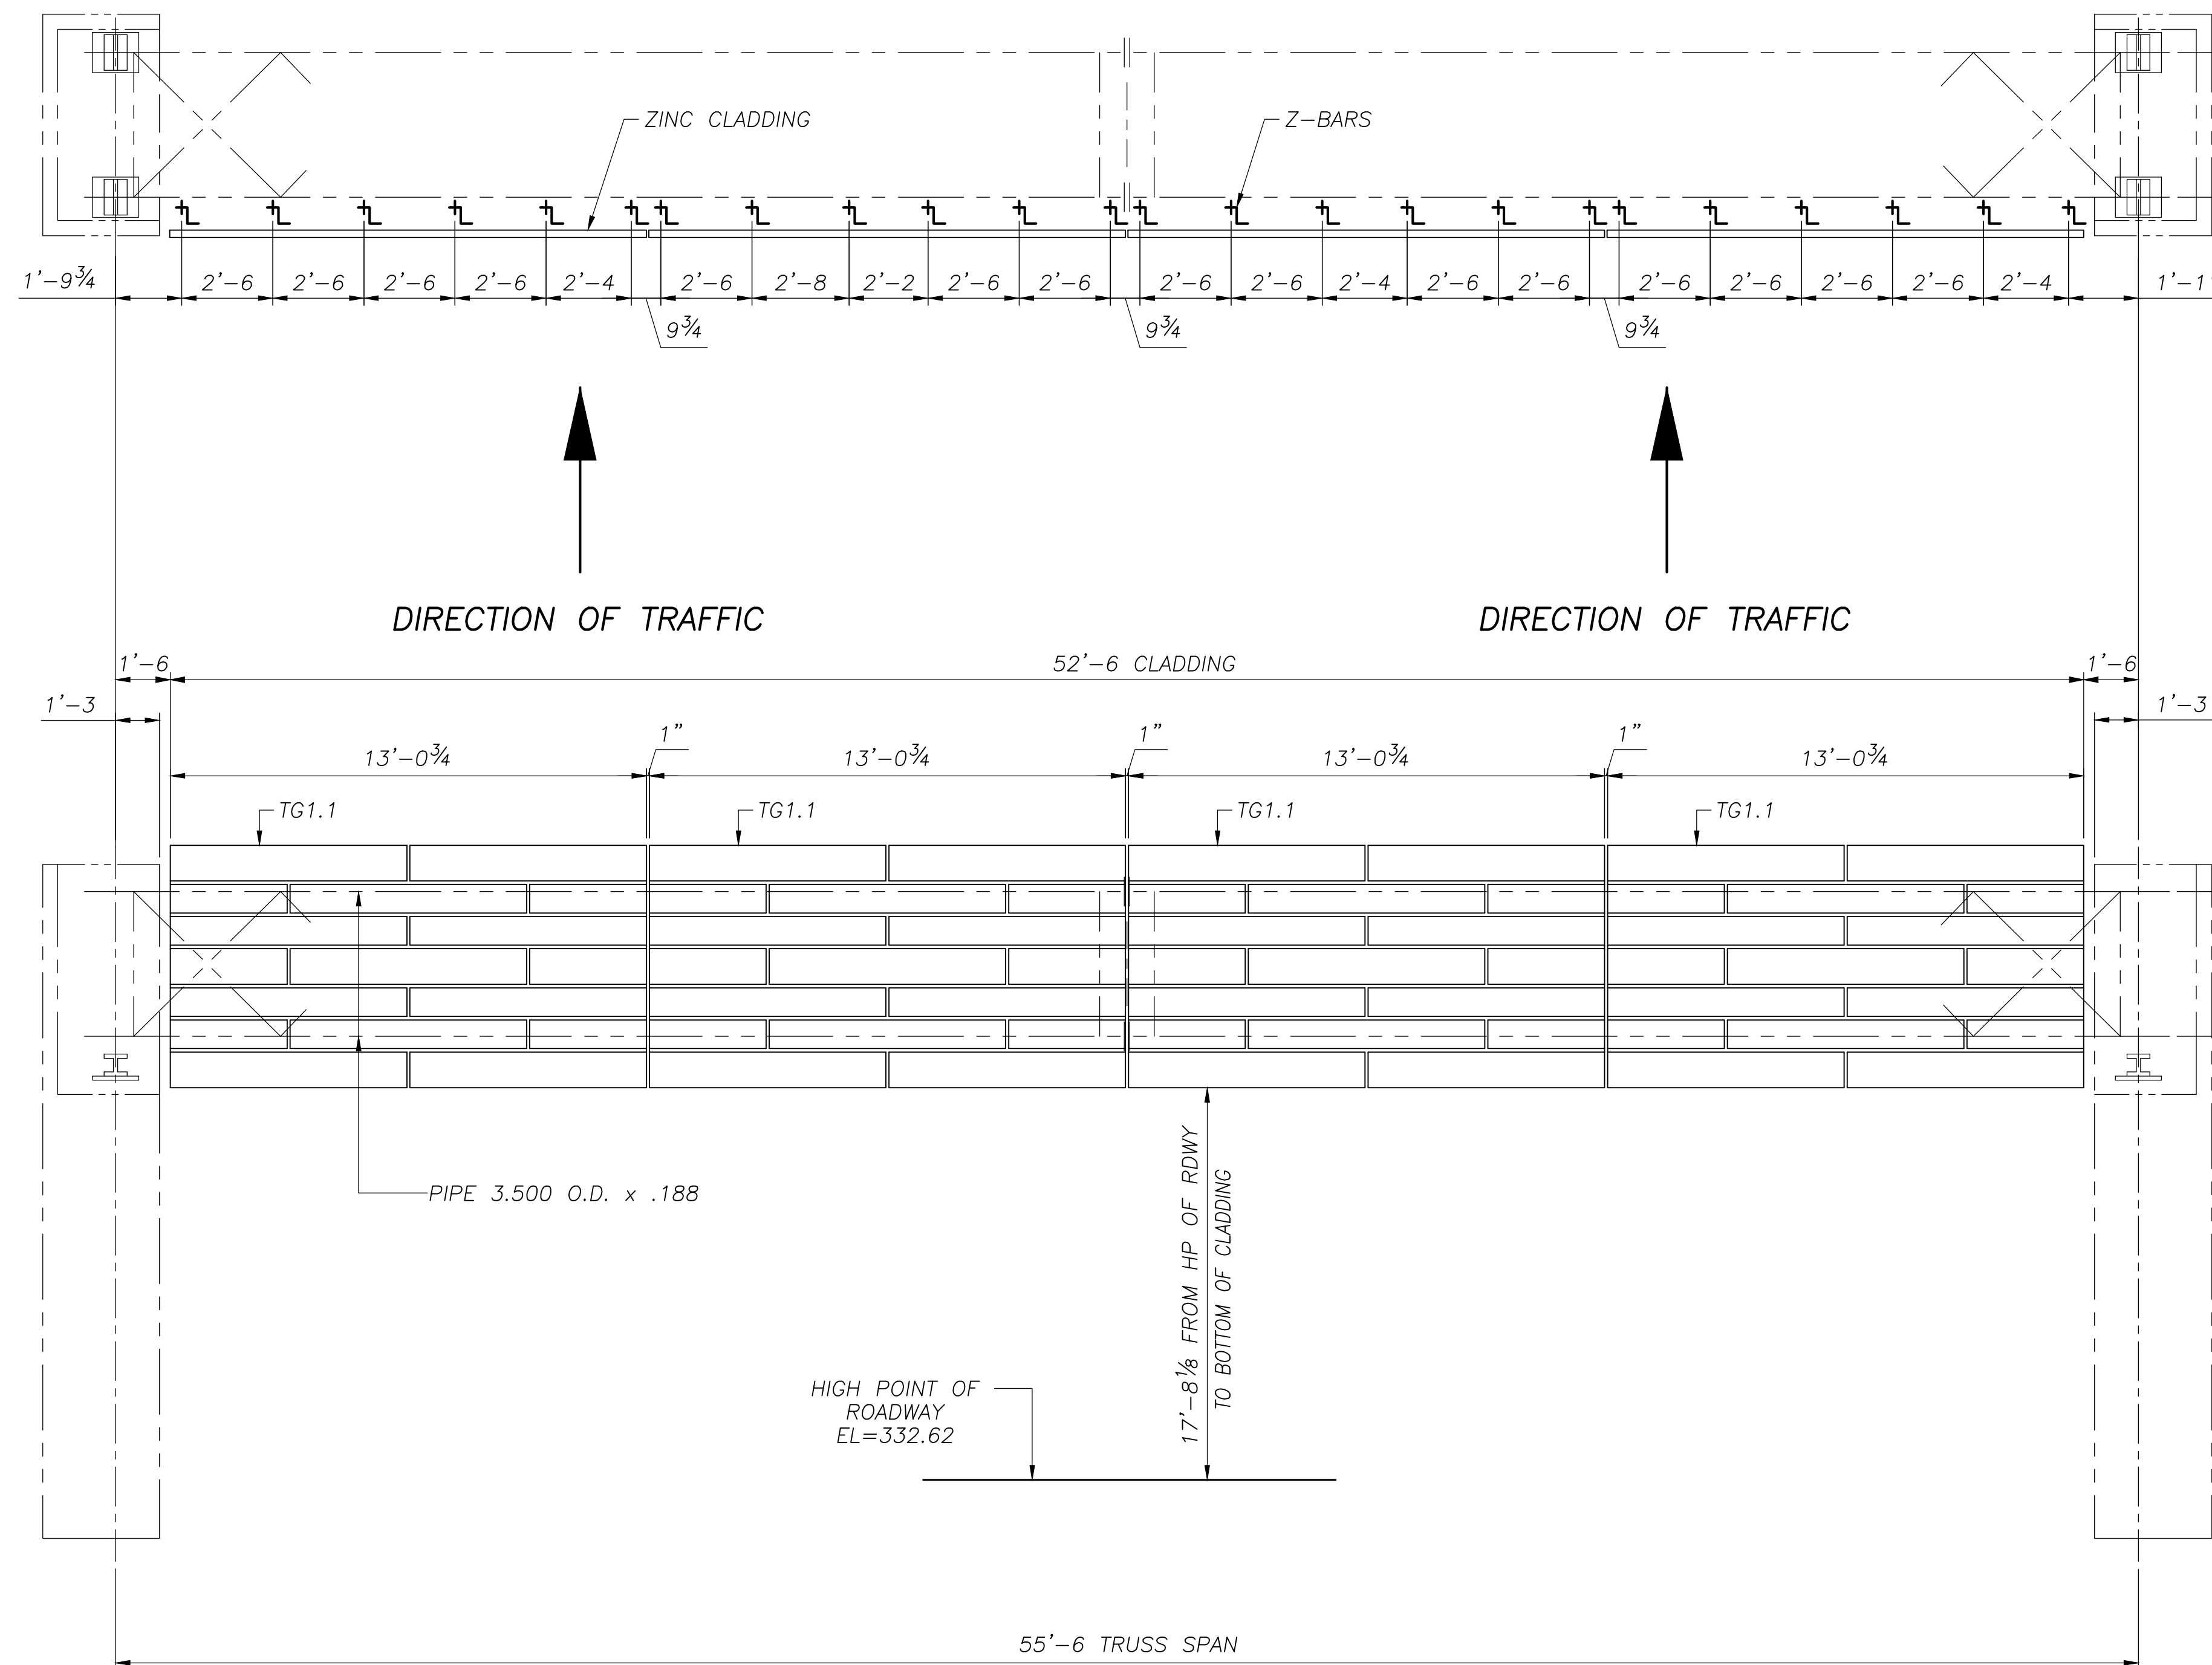


APPROVED RESUBMIT
 APPROVED AS NOTED NOT APPROVED

REVIEW OF THIS SHOP DRAWING IS LIMITED TO CONFORMANCE WITH THE DESIGN CONCEPT OF THE PROJECT AND FOR COMPLIANCE WITH THE INFORMATION GIVEN IN THE CONTRACT PLANS AND SPECIFICATIONS (INCLUDING SUPPLEMENTAL AND SPECIAL PROVISIONS), AND IS NOT INTENDED TO BE A VERIFICATION OF TOTAL MATERIAL REQUIRED OR THAT ALL ITEMS REQUIRED ARE SHOWN. REVIEW SHALL NOT RELIEVE THE CONTRACTOR FROM THE RESPONSIBILITY OF DETAILS OF DESIGN, DIMENSIONS, JOB CONDITIONS, CONSTRUCTION MEANS AND METHODS, COORDINATION WITH OTHER TRADES, OR ANY OTHER REQUIREMENTS OF THE PLANS, SPECIFICATIONS OR CONTRACT. ANY NOTATIONS ON THIS SHOP DRAWING MADE BY ATKINS NORTH AMERICA SHALL NOT BE CONSTRUED TO AUTHORIZE ADDITIONAL WORK OR COST.

REVIEW OF DESIGN CALCULATIONS AND DRAWINGS PREPARED BY SPECIALTY ENGINEERS IS LIMITED TO DESIGN INTENT AND DOES NOT CONSTITUTE A DETAILED CHECK OF CALCULATIONS, NOR DOES IT RELIEVE THE SPECIALTY ENGINEERS FROM THE RESPONSIBILITY OF THE DETAILING OF THE SPECIALTY COMPONENT OR SYSTEM.

BY: D.L. Jones, PE
 DATE: 7/1/16

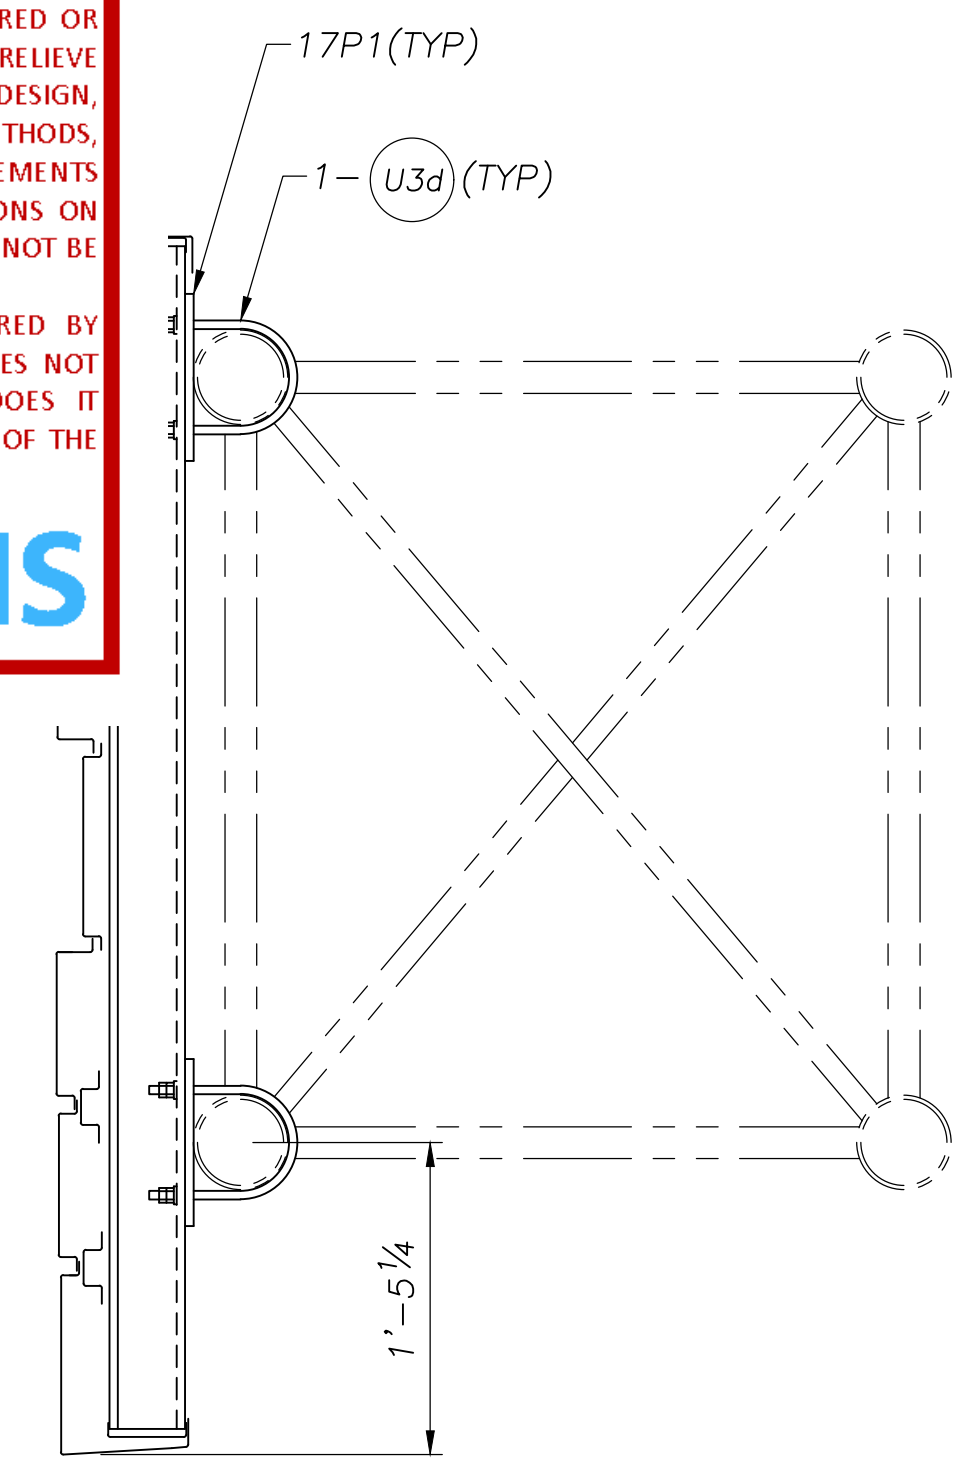

TYP ATTACHMENT DETAIL



06/20/16

ELEVATION
 STR NO: TG1-1
 STA NO: 19+53 -Y3LPA- (EB)
 (LOOKING IN DIRECTION OF TRAFFIC FLOW)



POST OFFICE BOX 28650
 BIRMINGHAM ALABAMA 35228
 4200 JEFFERSON AVENUE
 BIRMINGHAM ALABAMA 35221
 PHONE (205)-925-4990
 FAX (205) 925-7273

STATE: North Carolina
 FED PROJ: Design Build - 540 Toll Road
 ST PROJ: R-2635D / C203635
 COUNTY: Wake
 ROUTE: Toll NC-540 at SR-1153

SUBJECT: OVERHEAD BOX TRUSS STRUCTURE
CLADDING ERECTION DRAWING
 FOR: Traffic Control Devices, Inc


DRAWN BY: JSD DATE: 5/25/16
 CHECKED BY: JSD DATE: 5/25/16

DWG NO: C1791-EC7

NO.	REVISIONS	DATE	MADE	CHECKED
1	FOR APPROVAL	5/25/16	---	JSD

BT-E


SHIPPING LIST		C1791-EC8
QTY	MARK	DESCRIPTION
4	TG1.2	CLADDING PANELS
48	17P1	BACKING PLATES
48	(U3d)	1/2" U-Bolts w/(4)HN/(2)LW/(2)FW (GALV)

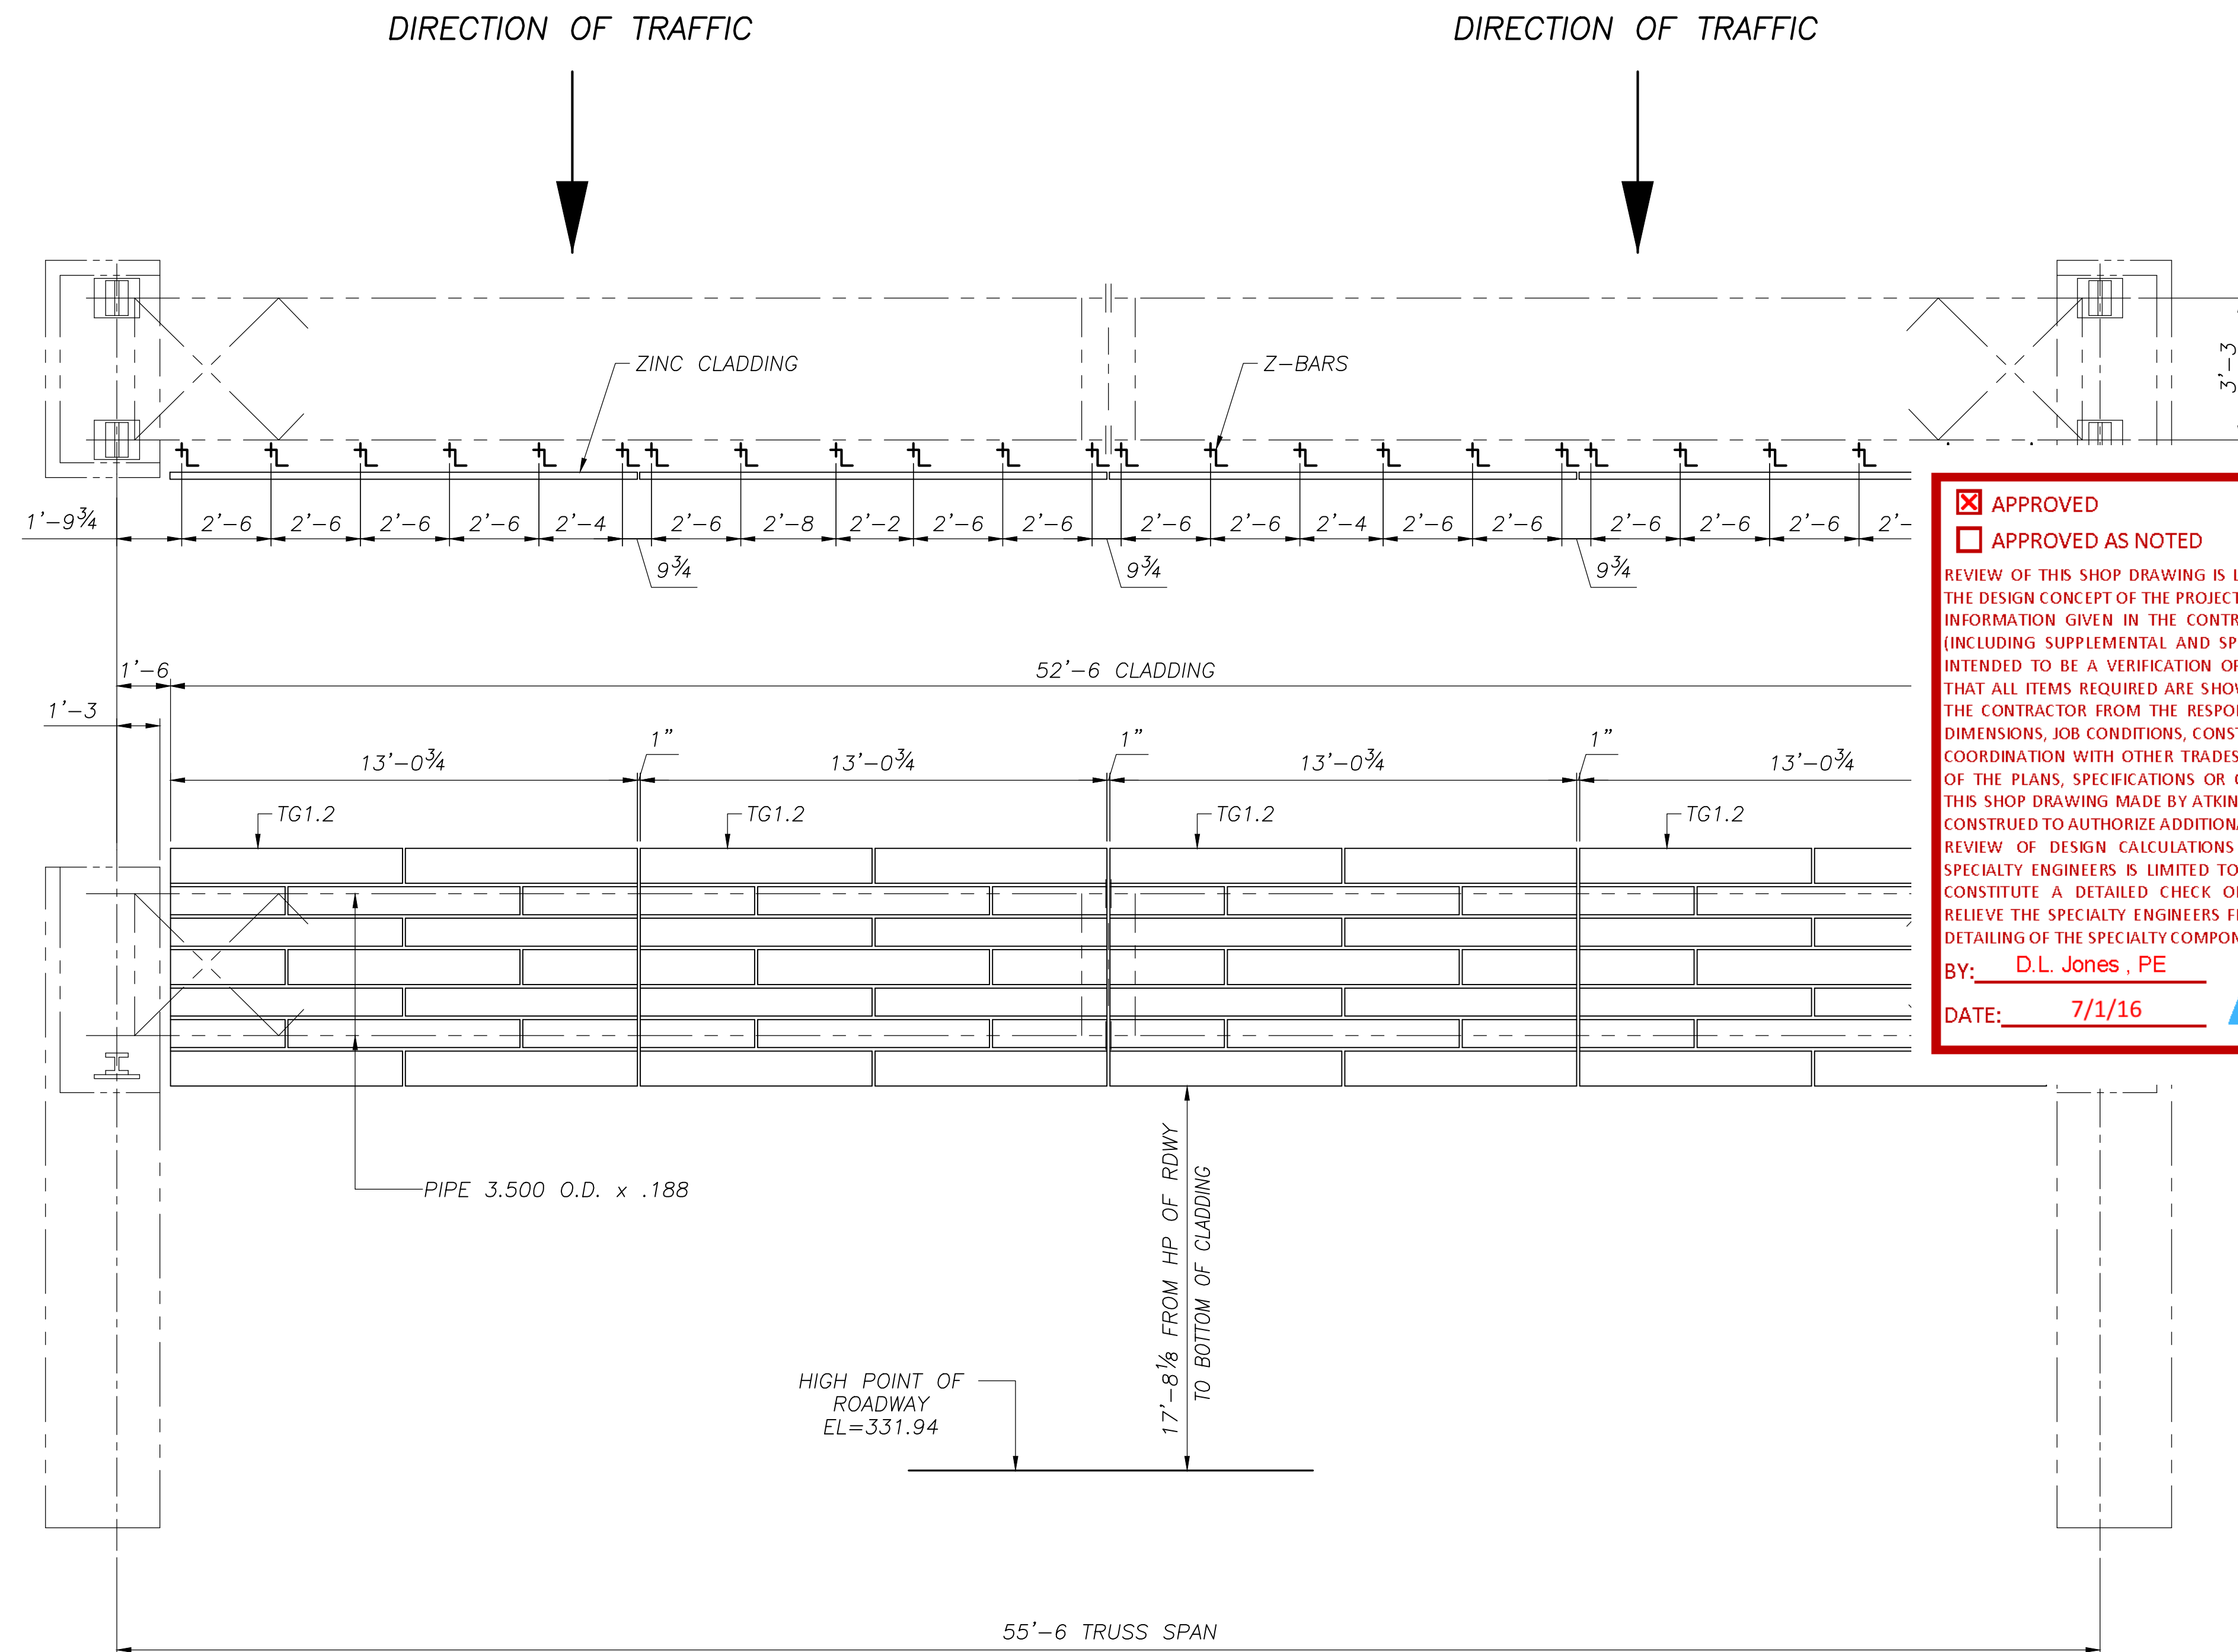

APPROVED RESUBMIT
 APPROVED AS NOTED NOT APPROVED

REVIEW OF THIS SHOP DRAWING IS LIMITED TO CONFORMANCE WITH THE DESIGN CONCEPT OF THE PROJECT AND FOR COMPLIANCE WITH THE INFORMATION GIVEN IN THE CONTRACT PLANS AND SPECIFICATIONS (INCLUDING SUPPLEMENTAL AND SPECIAL PROVISIONS), AND IS NOT INTENDED TO BE A VERIFICATION OF TOTAL MATERIAL REQUIRED OR THAT ALL ITEMS REQUIRED ARE SHOWN. REVIEW SHALL NOT RELIEVE THE CONTRACTOR FROM THE RESPONSIBILITY OF DETAILS OF DESIGN, DIMENSIONS, JOB CONDITIONS, CONSTRUCTION MEANS AND METHODS, COORDINATION WITH OTHER TRADES, OR ANY OTHER REQUIREMENTS OF THE PLANS, SPECIFICATIONS OR CONTRACT. ANY NOTATIONS ON THIS SHOP DRAWING MADE BY ATKINS NORTH AMERICA SHALL NOT BE CONSTRUED TO AUTHORIZE ADDITIONAL WORK OR COST. REVIEW OF DESIGN CALCULATIONS AND DRAWINGS PREPARED BY SPECIALTY ENGINEERS IS LIMITED TO DESIGN INTENT AND DOES NOT CONSTITUTE A DETAILED CHECK OF CALCULATIONS, NOR DOES IT RELIEVE THE SPECIALTY ENGINEERS FROM THE RESPONSIBILITY OF THE DETAILING OF THE SPECIALTY COMPONENT OR SYSTEM.

BY: D.L. Jones, PE
 DATE: 7/1/16

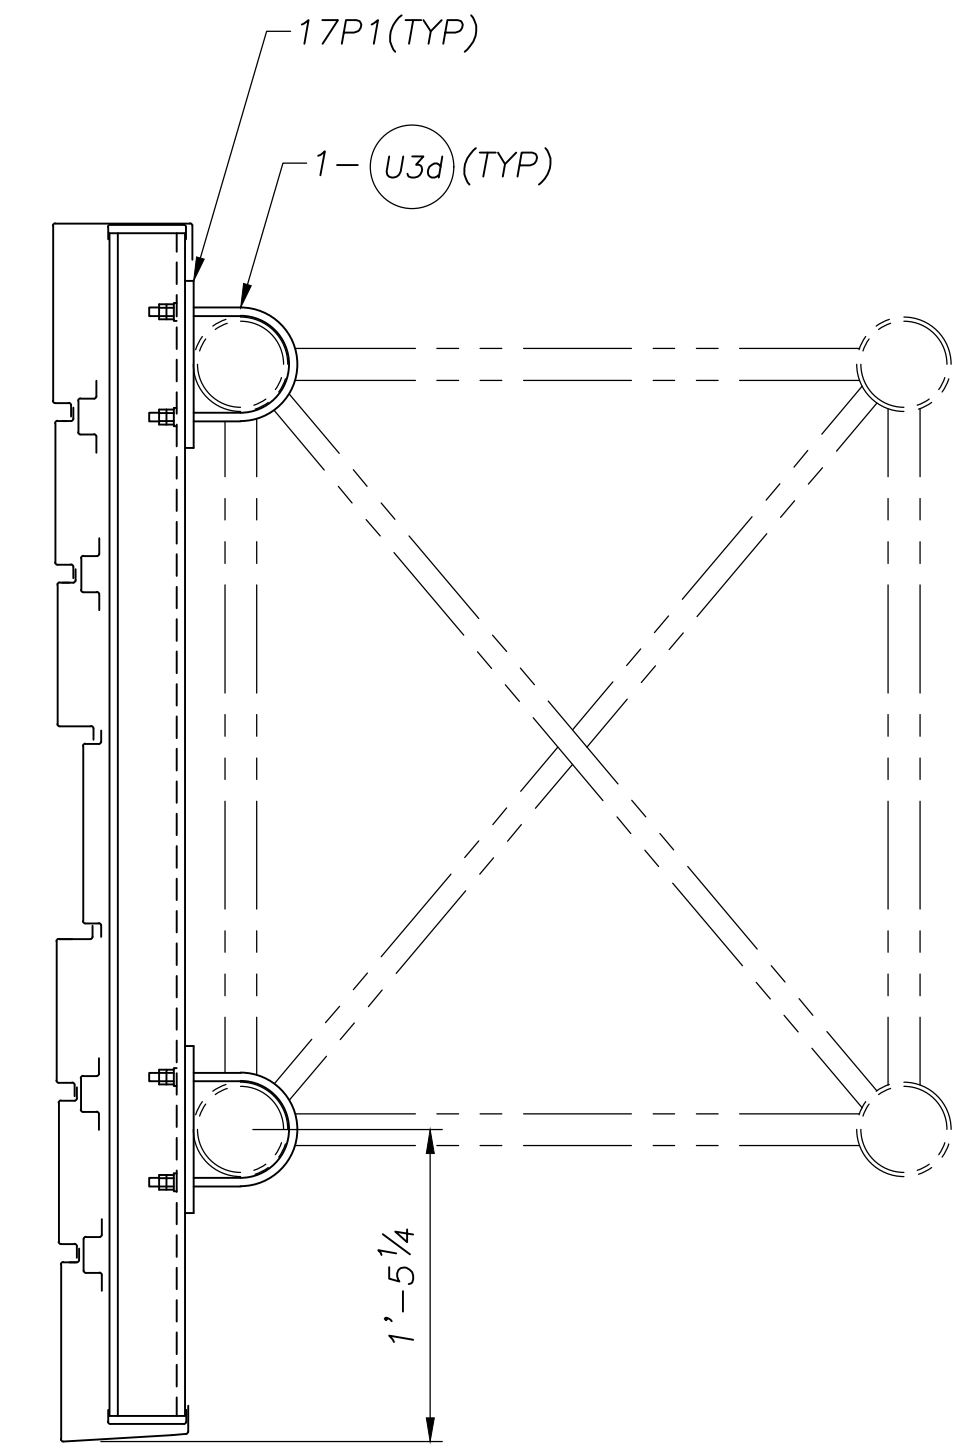

TYP ATTACHMENT DETAIL



06/20/16

ELEVATION
 STR NO: TG1-2
 STA NO: 19+03 -Y3LPA- (WB)
 (LOOKING IN OPP DIRECTION OF TRAFFIC FLOW)



POST OFFICE BOX 28650
 BIRMINGHAM ALABAMA 35228
 4200 JEFFERSON AVENUE
 BIRMINGHAM ALABAMA 35221
 PHONE (205)-925-4990
 FAX (205) 925-7273



STATE: North Carolina
 FED PROJ: Design Build - 540 Toll Road
 ST PROJ: R-2635D / C203635
 COUNTY: Wake
 ROUTE: Toll NC-540 at SR-1153

SUBJECT: OVERHEAD BOX TRUSS STRUCTURE
CLADDING ERECTION DRAWING
 FOR: Traffic Control Devices, Inc
 DRAWN BY: JSD DATE: 5/25/16
 CHECKED BY: JSD DATE: 5/25/16
 DWG NO: C1791-EC8

NO.	REVISIONS	DATE	MADE	CHECKED
1	FOR APPROVAL	5/25/16	---	JSD

BT-E

SHIPPING LIST		C1791-EC9
QTY	MARK	DESCRIPTION
4	TG2.1	CLADDING PANELS
48	17P1	BACKING PLATES
48	(U3d)	1/2" U-Bolts w/(4)HN/(2)LW/(2)FW (GALV)

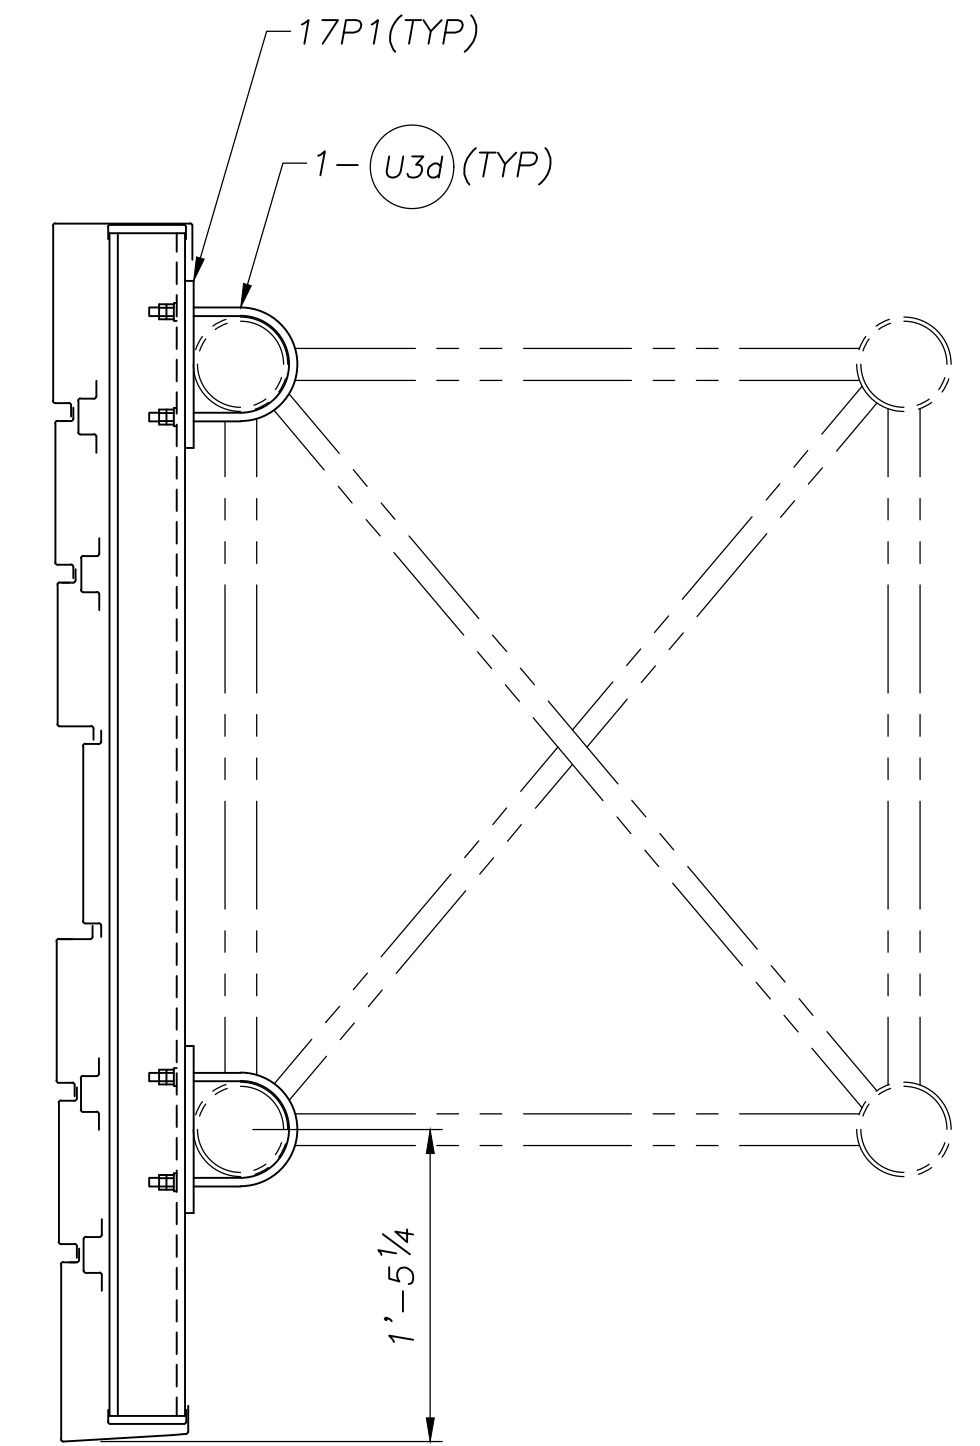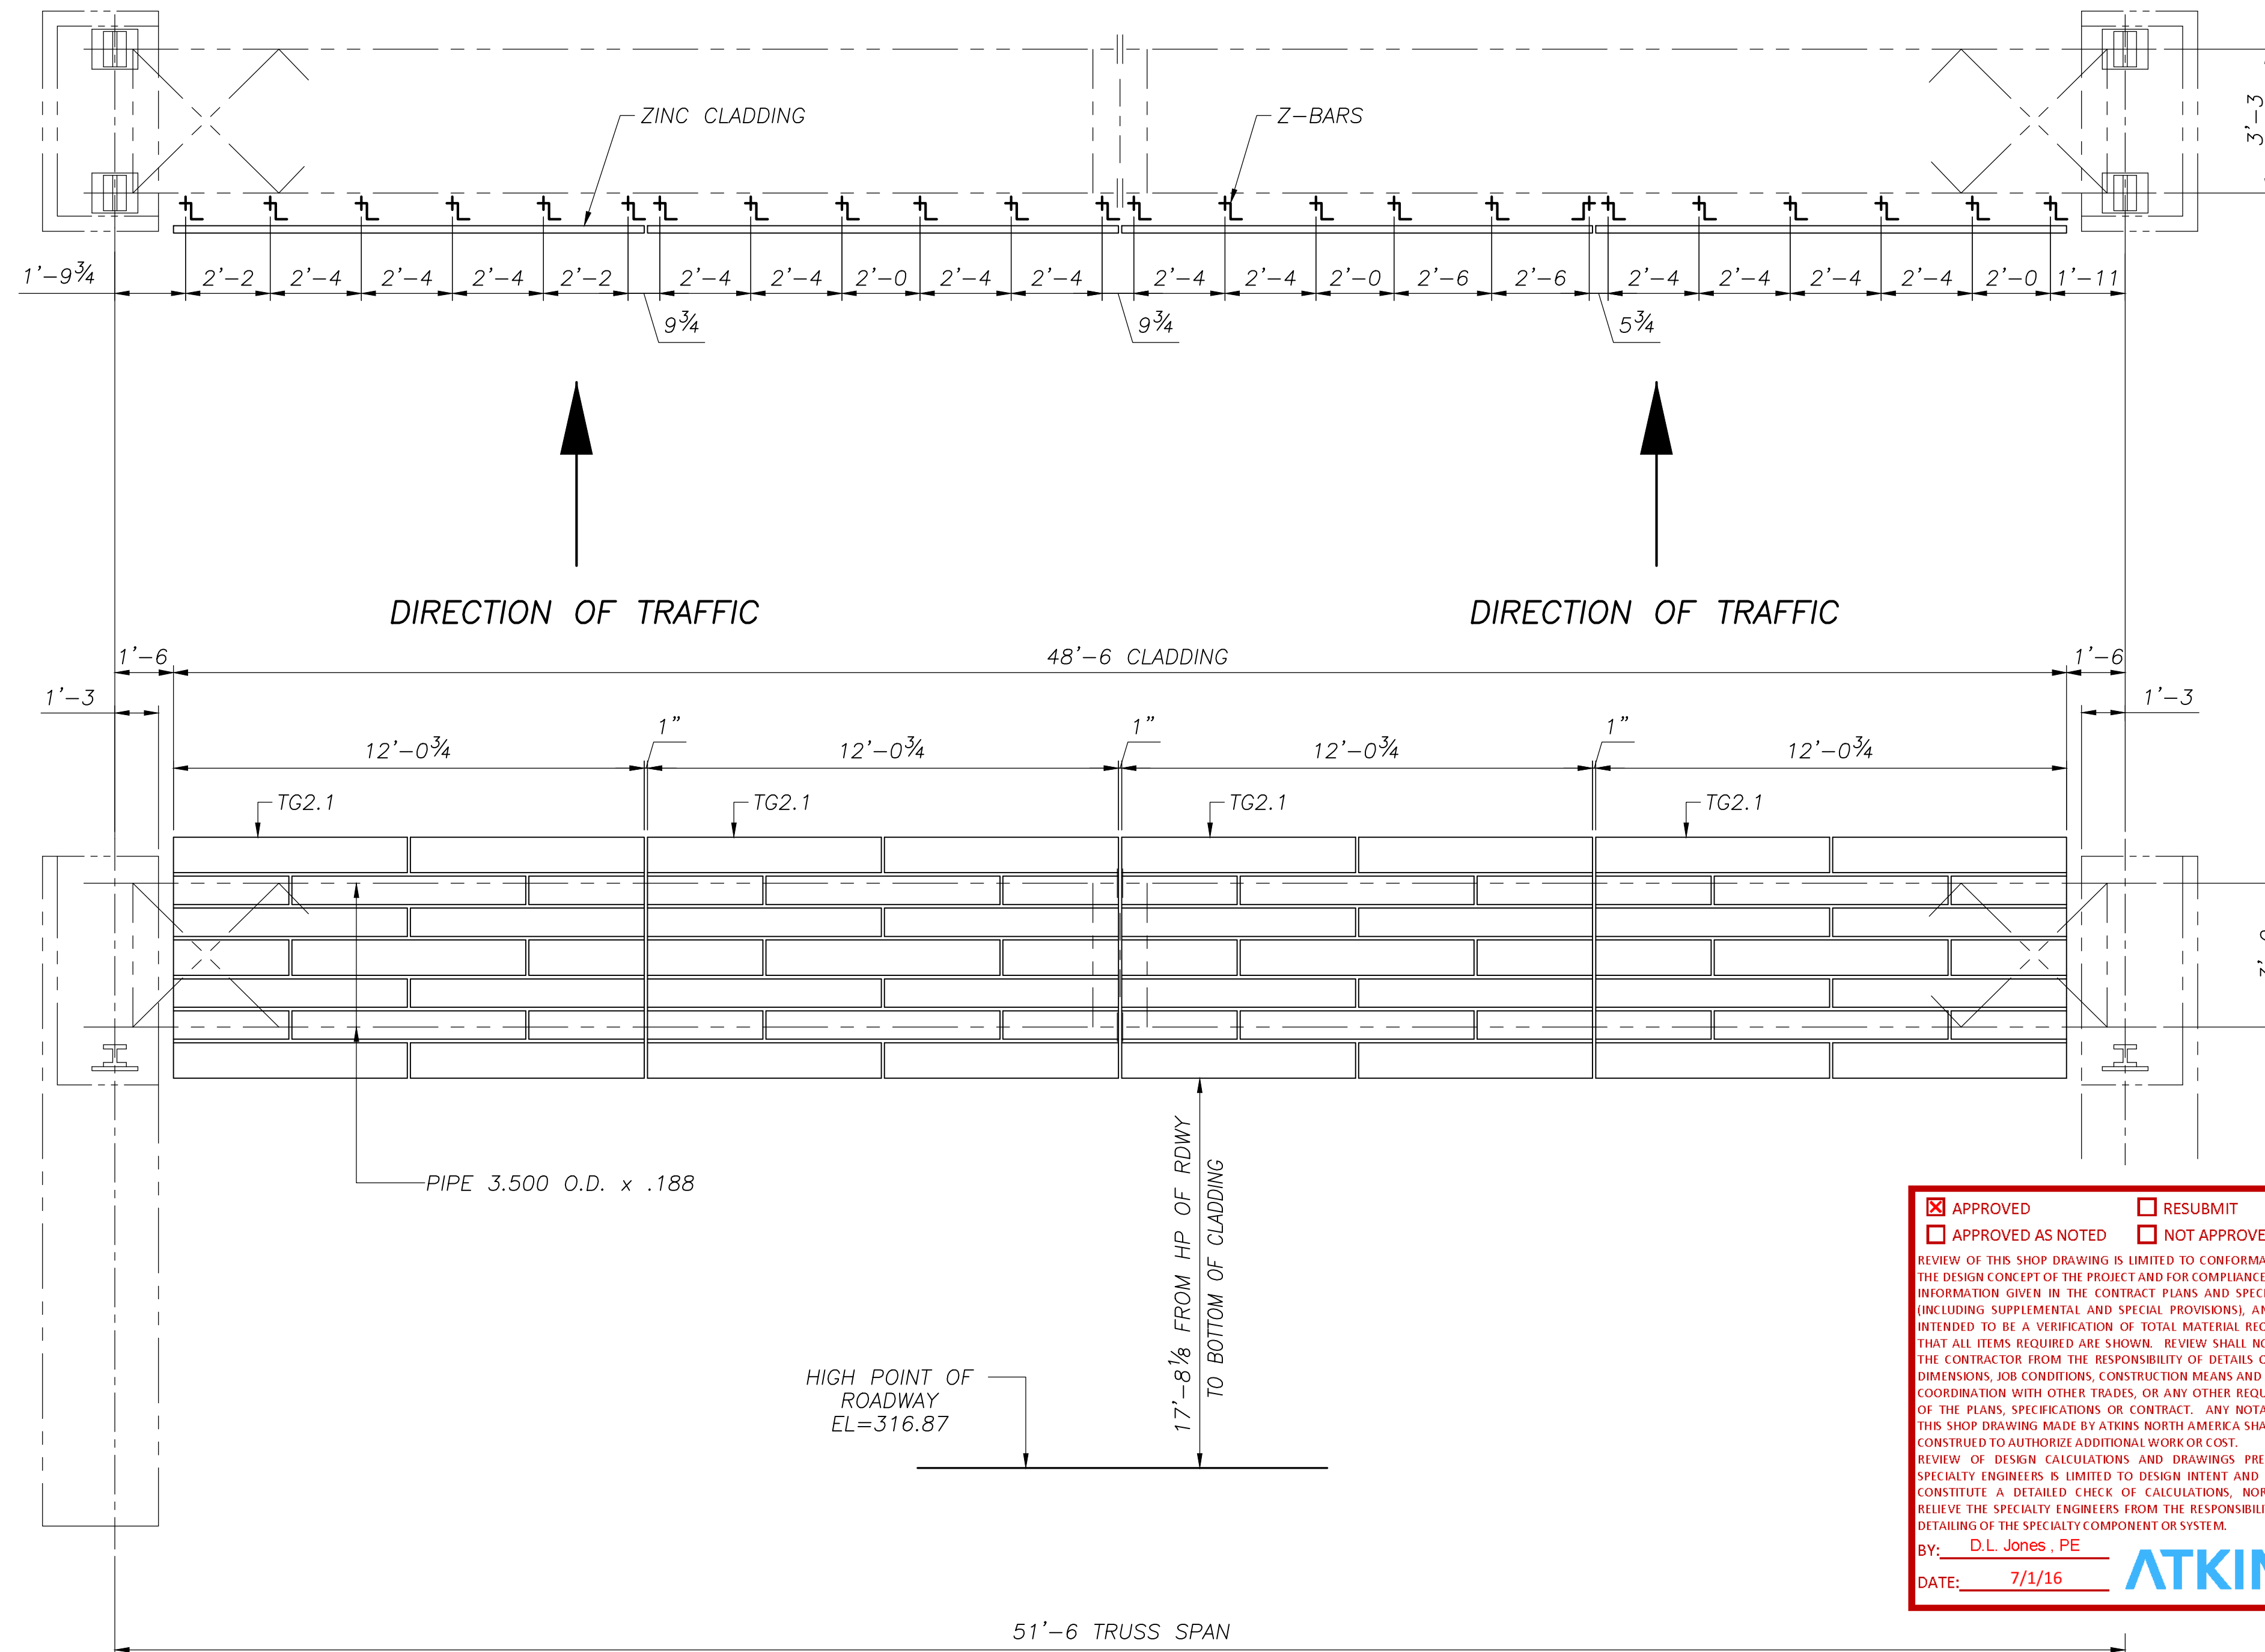

TYP ATTACHMENT DETAIL

<input checked="" type="checkbox"/> APPROVED	<input type="checkbox"/> RESUBMIT
<input type="checkbox"/> APPROVED AS NOTED	<input type="checkbox"/> NOT APPROVED

REVIEW OF THIS SHOP DRAWING IS LIMITED TO CONFORMANCE WITH THE DESIGN CONCEPT OF THE PROJECT AND FOR COMPLIANCE WITH THE INFORMATION GIVEN IN THE CONTRACT PLANS AND SPECIFICATIONS (INCLUDING SUPPLEMENTAL AND SPECIAL PROVISIONS), AND IS NOT INTENDED TO BE A VERIFICATION OF TOTAL MATERIAL REQUIRED OR THAT ALL ITEMS REQUIRED ARE SHOWN. REVIEW SHALL NOT RELIEVE THE CONTRACTOR FROM THE RESPONSIBILITY OF DETAILS OF DESIGN, DIMENSIONS, JOB CONDITIONS, CONSTRUCTION MEANS AND METHODS, COORDINATION WITH OTHER TRADES, OR ANY OTHER REQUIREMENTS OF THE PLANS, SPECIFICATIONS OR CONTRACT. ANY NOTATIONS ON THIS SHOP DRAWING MADE BY ATKINS NORTH AMERICA SHALL NOT BE CONSTRUED TO AUTHORIZE ADDITIONAL WORK OR COST.

REVIEW OF DESIGN CALCULATIONS AND DRAWINGS PREPARED BY SPECIALTY ENGINEERS IS LIMITED TO DESIGN INTENT AND DOES NOT CONSTITUTE A DETAILED CHECK OF CALCULATIONS, NOR DOES IT RELIEVE THE SPECIALTY ENGINEERS FROM THE RESPONSIBILITY OF THE DETAILING OF THE SPECIALTY COMPONENT OR SYSTEM.

BY: D.L. Jones, PE
 DATE: 7/1/16 **ATKINS**



06/20/16

ELEVATION
 STR NO: TG2-1
 STA NO: 18+56 -Y3LPD- (EB)
 (LOOKING IN DIRECTION OF TRAFFIC FLOW)

STATE: North Carolina
 FED PROJ: Design Build - 540 Toll Road
 ST PROJ: R-2635D / C203635
 COUNTY: Wake
 ROUTE: Toll NC-540 at SR-1153

SUBJECT: OVERHEAD BOX TRUSS STRUCTURE
CLADDING ERECTION DRAWING

FOR: Traffic Control Devices, Inc

DRAWN BY: JSD DATE: 5/25/16
 CHECKED BY: JSD DATE: 5/25/16



DWG NO: C1791-EC9

POST OFFICE BOX 28650
 BIRMINGHAM ALABAMA 35228
 4200 JEFFERSON AVENUE
 BIRMINGHAM ALABAMA 35221
 PHONE (205)-925-4990
 FAX (205) 925-7273

NO.	REVISIONS	DATE	MADE	CHECKED
1	FOR APPROVAL	5/25/16	---	JSD

BT-E

SHIPPING LIST		C1791-EC10
QTY	MARK	DESCRIPTION
4	TG2.2	CLADDING PANELS
48	17P1	BACKING PLATES
48	(U3d)	1/2" U-Bolts w/(4)HN/(2)LW/(2)FW (GALV)

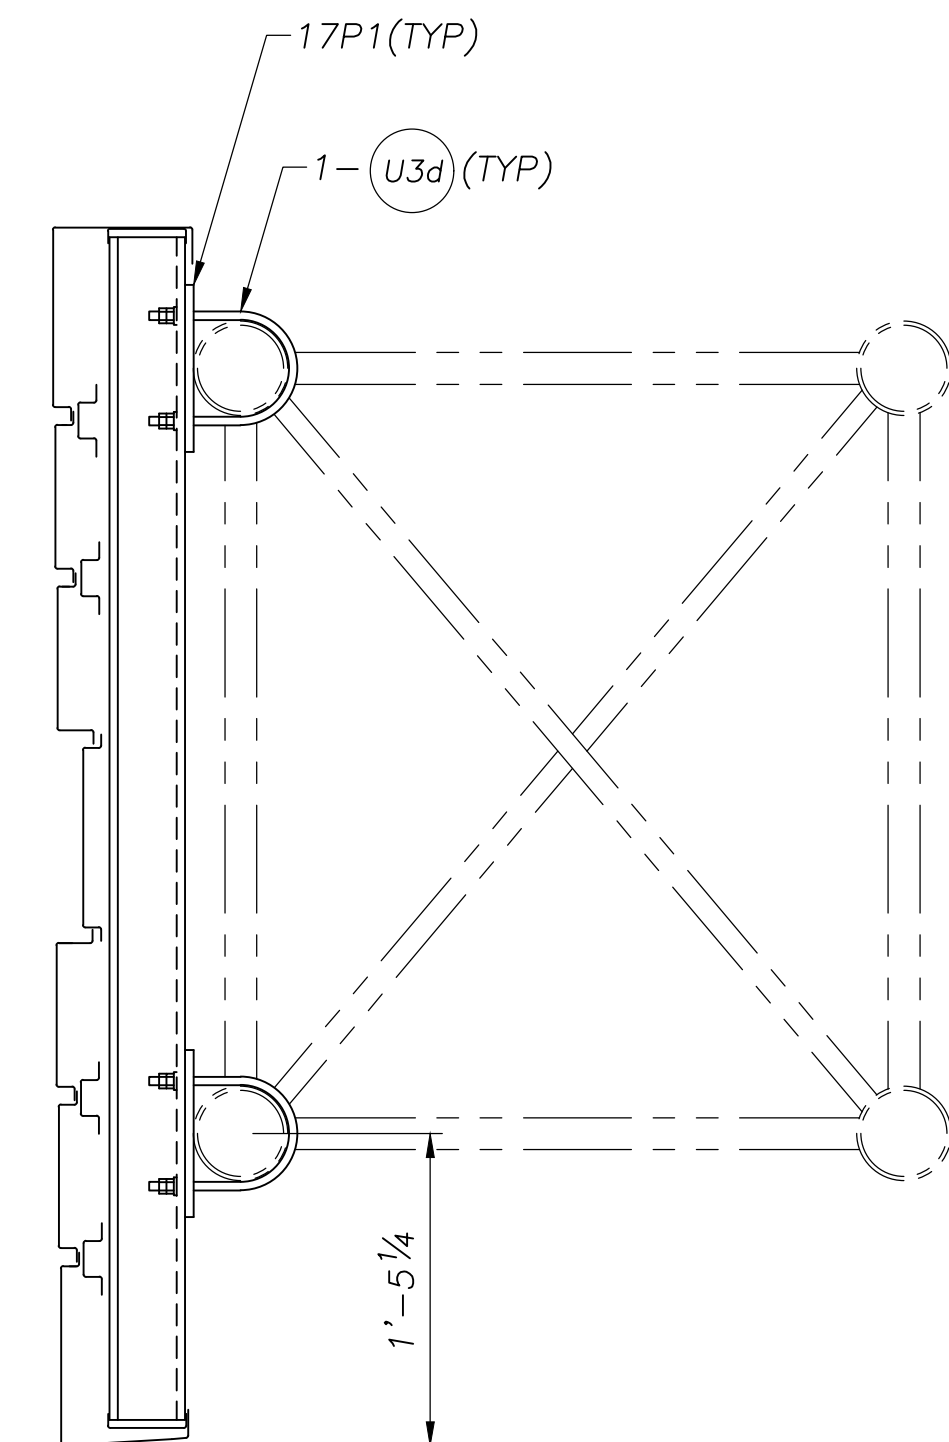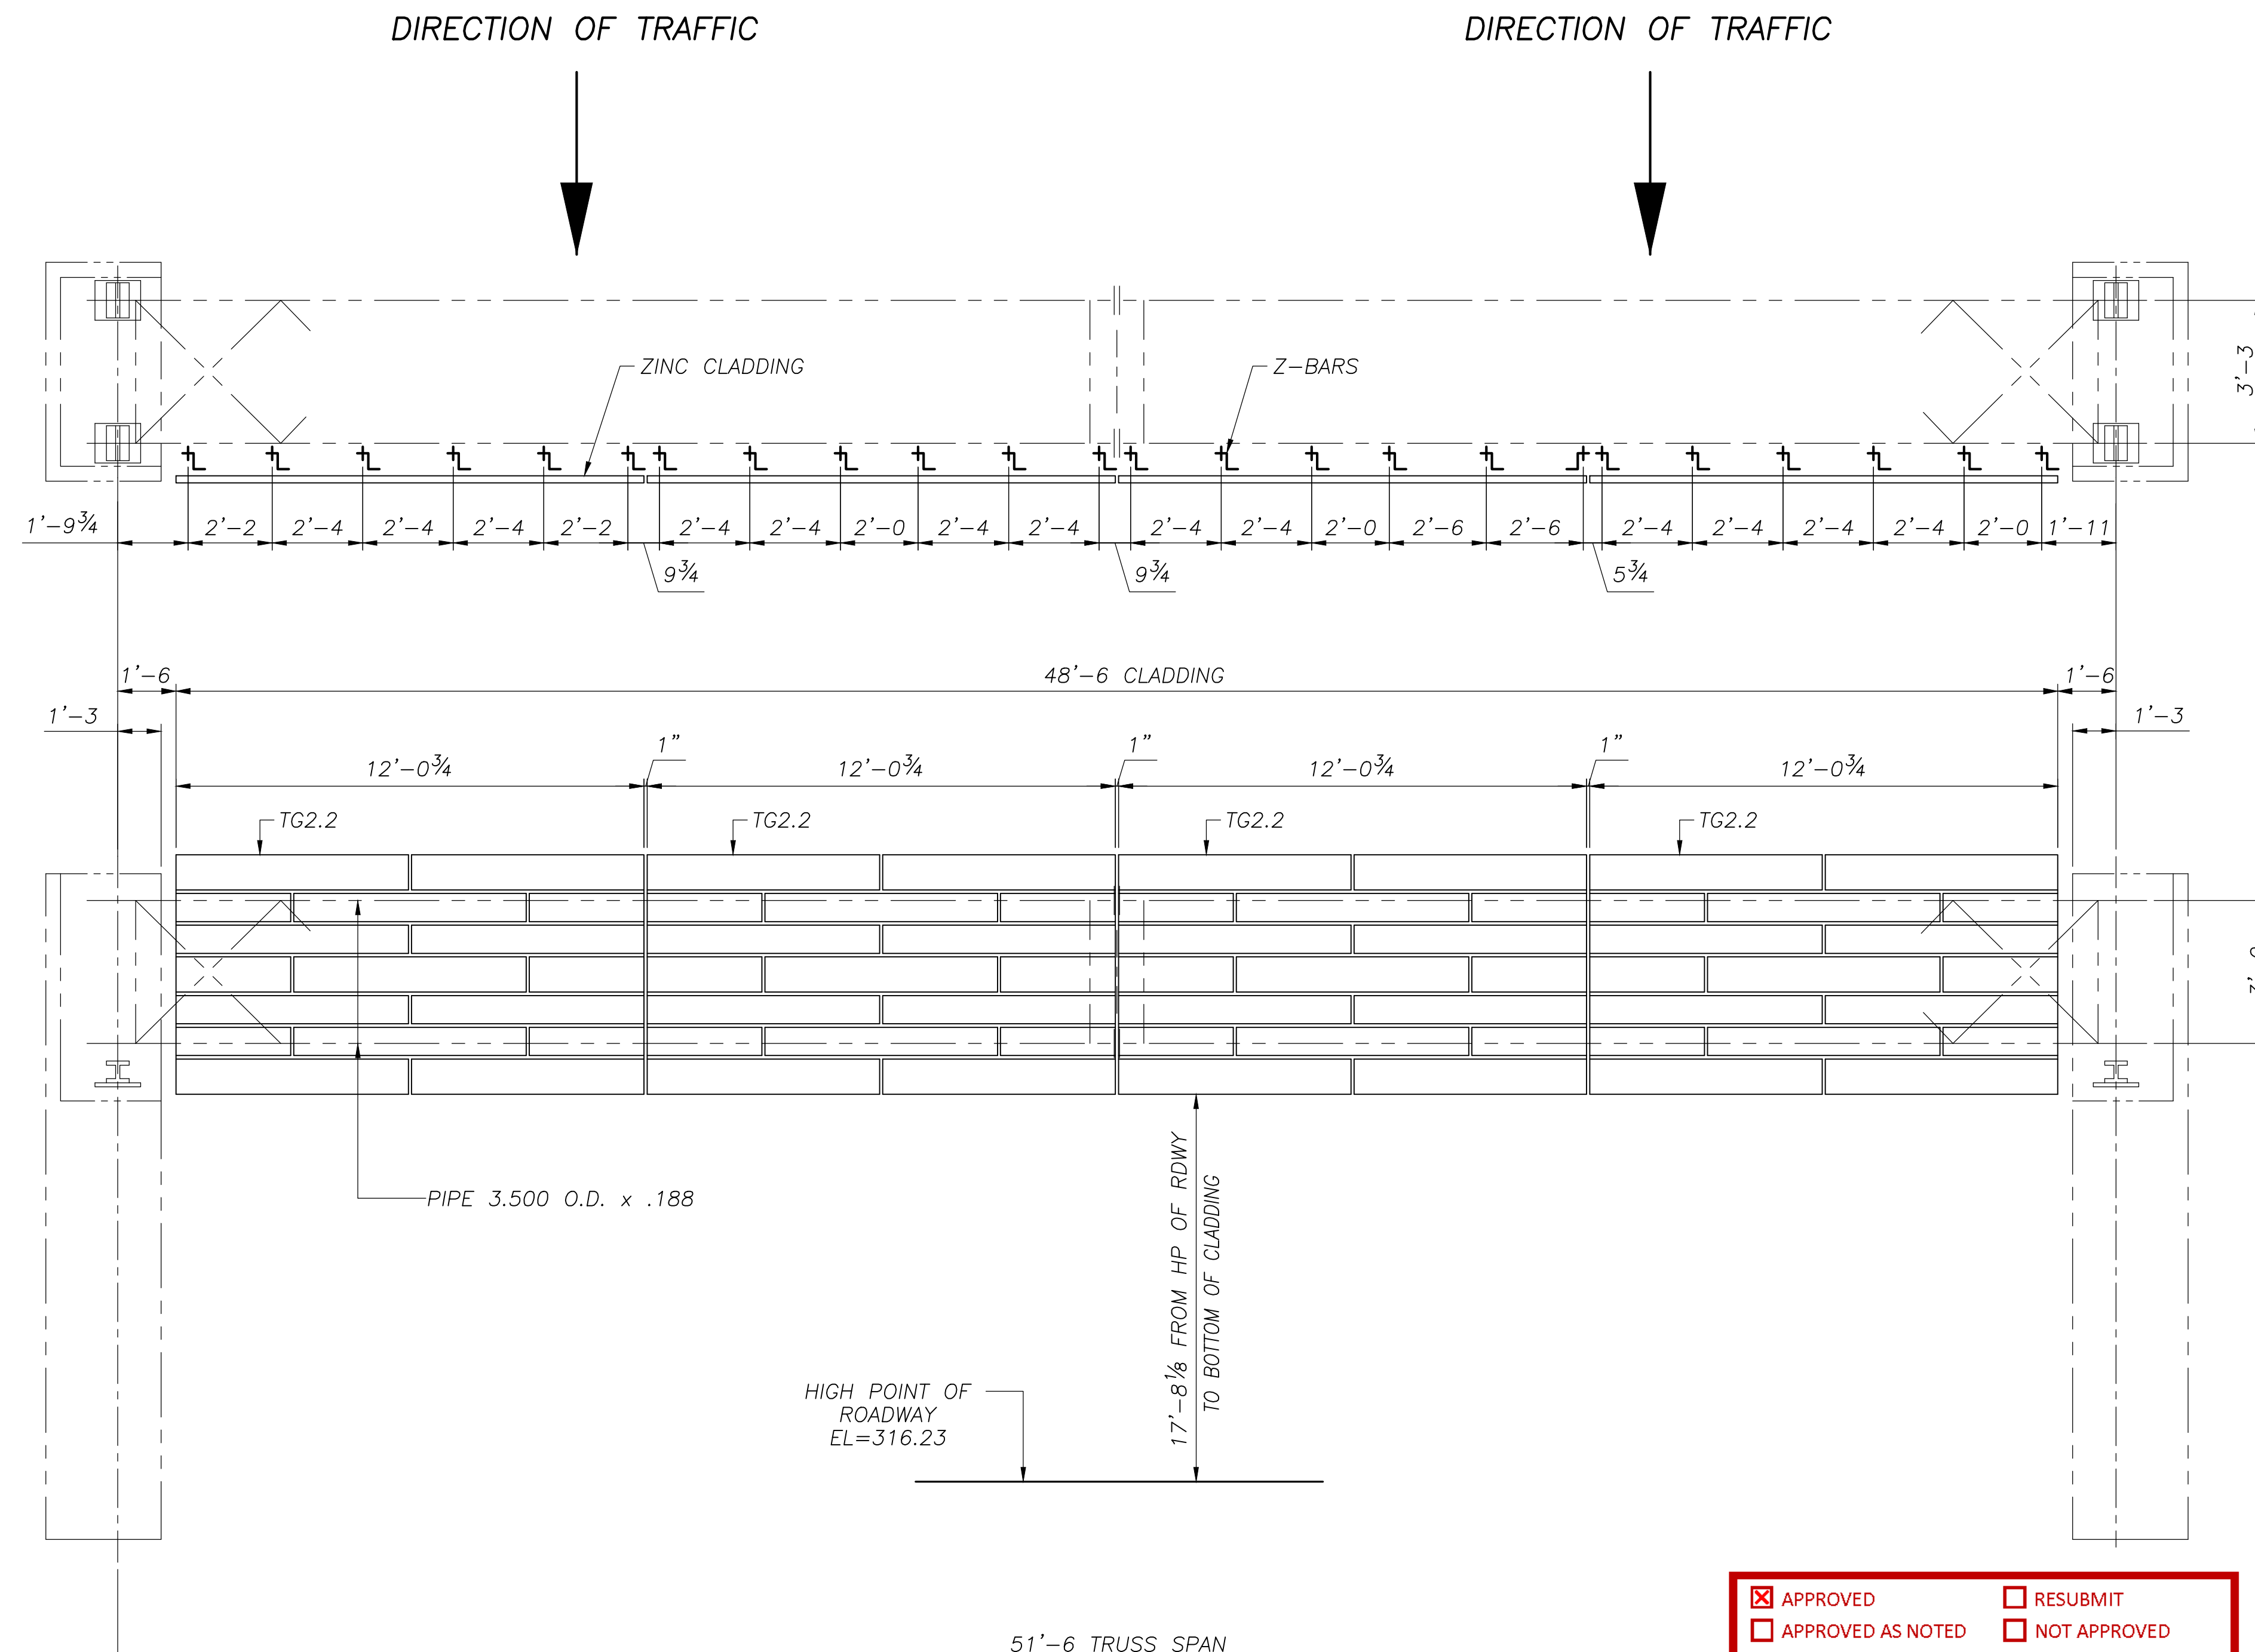

TYP ATTACHMENT DETAIL

ELEVATION
 STR NO: TG2-2
 STA NO: 19+06 -Y3LPD- (WB)
 (LOOKING IN OPP DIRECTION OF TRAFFIC FLOW)

<input checked="" type="checkbox"/> APPROVED	<input type="checkbox"/> RESUBMIT
<input type="checkbox"/> APPROVED AS NOTED	<input type="checkbox"/> NOT APPROVED

REVIEW OF THIS SHOP DRAWING IS LIMITED TO CONFORMANCE WITH THE DESIGN CONCEPT OF THE PROJECT AND FOR COMPLIANCE WITH THE INFORMATION GIVEN IN THE CONTRACT PLANS AND SPECIFICATIONS (INCLUDING SUPPLEMENTAL AND SPECIAL PROVISIONS), AND IS NOT INTENDED TO BE A VERIFICATION OF TOTAL MATERIAL REQUIRED OR THAT ALL ITEMS REQUIRED ARE SHOWN. REVIEW SHALL NOT RELIEVE THE CONTRACTOR FROM THE RESPONSIBILITY OF DETAILS OF DESIGN, DIMENSIONS, JOB CONDITIONS, CONSTRUCTION MEANS AND METHODS, COORDINATION WITH OTHER TRADES, OR ANY OTHER REQUIREMENTS OF THE PLANS, SPECIFICATIONS OR CONTRACT. ANY NOTATIONS ON THIS SHOP DRAWING MADE BY ATKINS NORTH AMERICA SHALL NOT BE CONSTRUED TO AUTHORIZE ADDITIONAL WORK OR COST.
 REVIEW OF DESIGN CALCULATIONS AND DRAWINGS PREPARED BY SPECIALTY ENGINEERS IS LIMITED TO DESIGN INTENT AND DOES NOT CONSTITUTE A DETAILED CHECK OF CALCULATIONS, NOR DOES IT RELIEVE THE SPECIALTY ENGINEERS FROM THE RESPONSIBILITY OF THE DETAILING OF THE SPECIALTY COMPONENT OR SYSTEM.

BY: D.L. Jones, PE
 DATE: 7/1/16

ATKINS



06/20/16



POST OFFICE BOX 28650
 BIRMINGHAM ALABAMA 35228
 4200 JEFFERSON AVENUE
 BIRMINGHAM ALABAMA 35221
 PHONE (205)-925-4990
 FAX (205) 925-7273

STATE: North Carolina
 FED PROJ: Design Build - 540 Toll Road
 ST PROJ: R-2635D / C203635
 COUNTY: Wake
 ROUTE: Toll NC-540 at SR-1153

SUBJECT: OVERHEAD BOX TRUSS STRUCTURE
CLADDING ERECTION DRAWING
 FOR: Traffic Control Devices, Inc


DRAWN BY: JSD DATE: 5/25/16
 CHECKED BY: JSD DATE: 5/25/16

DWG NO: **C1791-EC10**

NO.	REVISIONS	DATE	MADE	CHECKED
1	FOR APPROVAL	5/25/16	---	JSD

BT-E

PARTS PER GOVT	PART MARK NO	NO OF PIECES REQ'D	SECTION SYM	DESCRIPTION OF MATERIAL	LENGTH		PARTS FOR ONE UNIT
					FEET	INCHES	
	17P1	192		BACKING PLATES			
	a	192	PL	1/4 x 1 1/2	0	8	

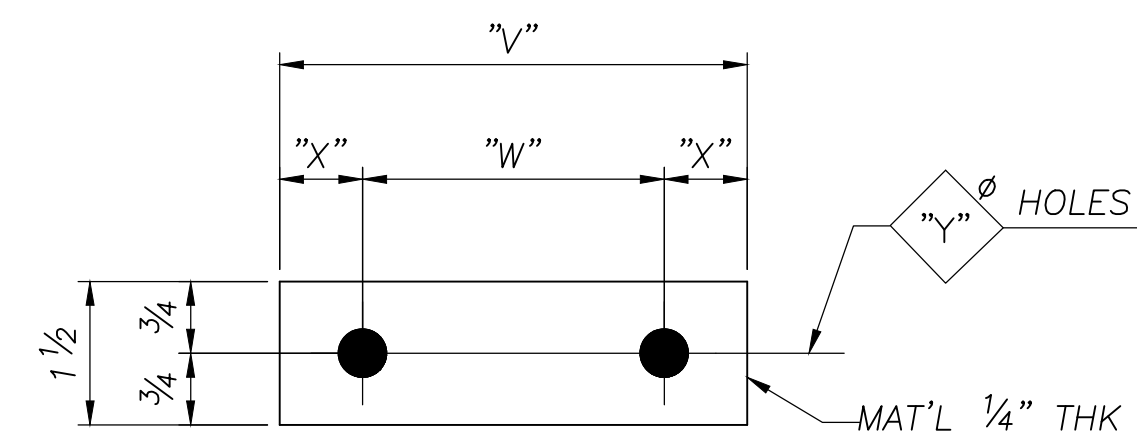


~ SHIMS ~

MARK	QTY	"V"	"W"	"X"	"Y"
17P1	192	8	4 1/8	1 15/16	1 1/16

C1791-17
NORTH CAROLINA

NOTE 1:

- UBOLT MATERIAL PROPERTIES TO MEET OR EXCEED A307
- GALV PER A153

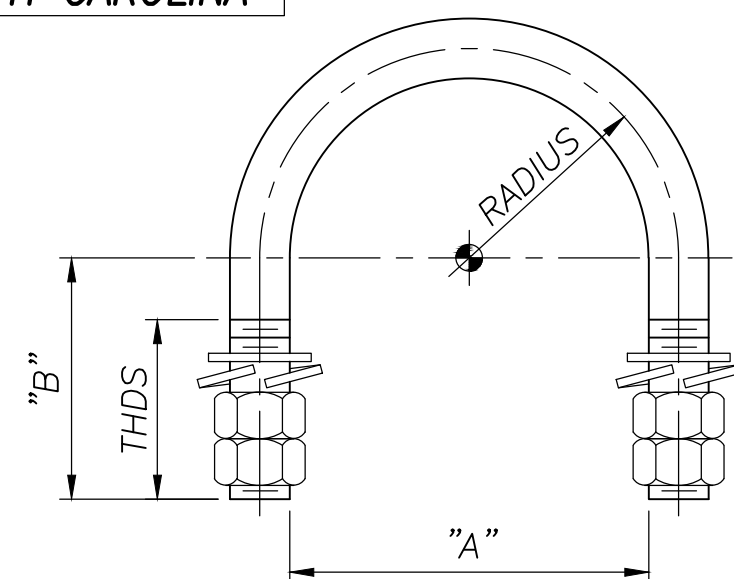

~ U-BOLTS w/(4)HN/(2)LW/(2)FW ~

NUTS: ASTM A563,GR.DH OR ASTM A194,GR.2H

WASHERS: ASTM F436 & ANSI-B18.21.1

MARK	QTY	DIA	"A"	"B"	RADIUS	THDS	MATERIAL
U3d	192	1/2	3 3/8	3 3/4	2 1/16	2	NOTE 1

APPROVED RESUBMIT
 APPROVED AS NOTED NOT APPROVED

REVIEW OF THIS SHOP DRAWING IS LIMITED TO CONFORMANCE WITH THE DESIGN CONCEPT OF THE PROJECT AND FOR COMPLIANCE WITH THE INFORMATION GIVEN IN THE CONTRACT PLANS AND SPECIFICATIONS (INCLUDING SUPPLEMENTAL AND SPECIAL PROVISIONS), AND IS NOT INTENDED TO BE A VERIFICATION OF TOTAL MATERIAL REQUIRED OR THAT ALL ITEMS REQUIRED ARE SHOWN. REVIEW SHALL NOT RELIEVE THE CONTRACTOR FROM THE RESPONSIBILITY OF DETAILS OF DESIGN, DIMENSIONS, JOB CONDITIONS, CONSTRUCTION MEANS AND METHODS, COORDINATION WITH OTHER TRADES, OR ANY OTHER REQUIREMENTS OF THE PLANS, SPECIFICATIONS OR CONTRACT. ANY NOTATIONS ON THIS SHOP DRAWING MADE BY ATKINS NORTH AMERICA SHALL NOT BE CONSTRUED TO AUTHORIZE ADDITIONAL WORK OR COST.

REVIEW OF DESIGN CALCULATIONS AND DRAWINGS PREPARED BY SPECIALTY ENGINEERS IS LIMITED TO DESIGN INTENT AND DOES NOT CONSTITUTE A DETAILED CHECK OF CALCULATIONS, NOR DOES IT RELIEVE THE SPECIALTY ENGINEERS FROM THE RESPONSIBILITY OF THE DETAILING OF THE SPECIALTY COMPONENT OR SYSTEM.

BY: D.L. Jones, PE
 DATE: 7/1/16

ATKINS



06/20/16

MAT'L SPECS: AS NOTED
REF DWGS: EC7-EC10



POST OFFICE BOX 28650
BIRMINGHAM ALABAMA 35228
4200 JEFFERSON AVENUE
BIRMINGHAM ALABAMA 35221
PHONE (205)-925-4990
FAX (205) 925-7273

STATE: North Carolina
 FED PROJ: Design Build - 540 Toll Road
 ST PROJ: R-2635D / C203635
 COUNTY: Wake
 ROUTE: Toll NC-540 at SR-1153

SUBJECT: SIGN STRUCTURES
MISC DETAILS


FOR: Traffic Control Devices, Inc

DRAWN BY: JSD DATE: 5/25/16
 CHECKED BY: JSD DATE: 5/25/16

DWG NO: C1791-17

NO.	REVISIONS	DATE	MADE	CHECKED
1	FOR APPROVAL	5/25/16	---	JSD

KITDWG3

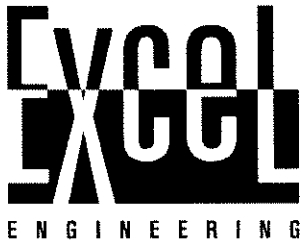

- Structural Engineering
- Commercial/Residential Design & Inspection
- Forensic Investigations

PO Box 1264 • Carrboro, NC 27510-1264 • 919-542-7578 • Fax: 919-542-6757

CLADDING STRUCTURE CALCULATIONS

TRIANGLE EXPRESSWAY

- | | |
|--|---------------------------------------|
| <input checked="" type="checkbox"/> APPROVED | <input type="checkbox"/> RESUBMIT |
| <input type="checkbox"/> APPROVED AS NOTED | <input type="checkbox"/> NOT APPROVED |

REVIEW OF THIS SHOP DRAWING IS LIMITED TO CONFORMANCE WITH THE DESIGN CONCEPT OF THE PROJECT AND FOR COMPLIANCE WITH THE INFORMATION GIVEN IN THE CONTRACT PLANS AND SPECIFICATIONS (INCLUDING SUPPLEMENTAL AND SPECIAL PROVISIONS), AND IS NOT INTENDED TO BE A VERIFICATION OF TOTAL MATERIAL REQUIRED OR THAT ALL ITEMS REQUIRED ARE SHOWN. REVIEW SHALL NOT RELIEVE THE CONTRACTOR FROM THE RESPONSIBILITY OF DETAILS OF DESIGN, DIMENSIONS, JOB CONDITIONS, CONSTRUCTION MEANS AND METHODS, COORDINATION WITH OTHER TRADES, OR ANY OTHER REQUIREMENTS OF THE PLANS, SPECIFICATIONS OR CONTRACT. ANY NOTATIONS ON THIS SHOP DRAWING MADE BY ATKINS NORTH AMERICA SHALL NOT BE CONSTRUED TO AUTHORIZE ADDITIONAL WORK OR COST.

REVIEW OF DESIGN CALCULATIONS AND DRAWINGS PREPARED BY SPECIALTY ENGINEERS IS LIMITED TO DESIGN INTENT AND DOES NOT CONSTITUTE A DETAILED CHECK OF CALCULATIONS, NOR DOES IT RELIEVE THE SPECIALTY ENGINEERS FROM THE RESPONSIBILITY OF THE DETAILING OF THE SPECIALTY COMPONENT OR SYSTEM.

BY: D.L. Jones , PE

DATE: 7/1/16

TRIA ~~CANTY~~ FASCIA PANEL

DESIGN LOADS

DL - NEGLIGIBLE (N 30 PLF)

LL - NEGLIGIBLE

WIND LOAD ASCE 7-05

100 MPH, EXPOSURE C, ...

$S_{M} C_f = 1.5 \quad I = 1.0 \quad H = 30'$

$q_z = .00256 (100)^2 \times 1.0 = 26 \text{ PSF}$

$G = 0.85$


$P = 26 \text{ PSF} (0.85) (1.5) = 33 \text{ PSF}$

DESIGN FOR 50 PSF

PER AASHTO SPEC FOR NATURAL WIND LOAD:

$P = 5.2 \text{ PSF} \times 1.3 \times 0.75 = 5 \text{ PSF}$
CF - IMPORTANCE FOR FATIGUE CAT II


∴ DESIGN LOAD = 10 X AASHTO LOAD

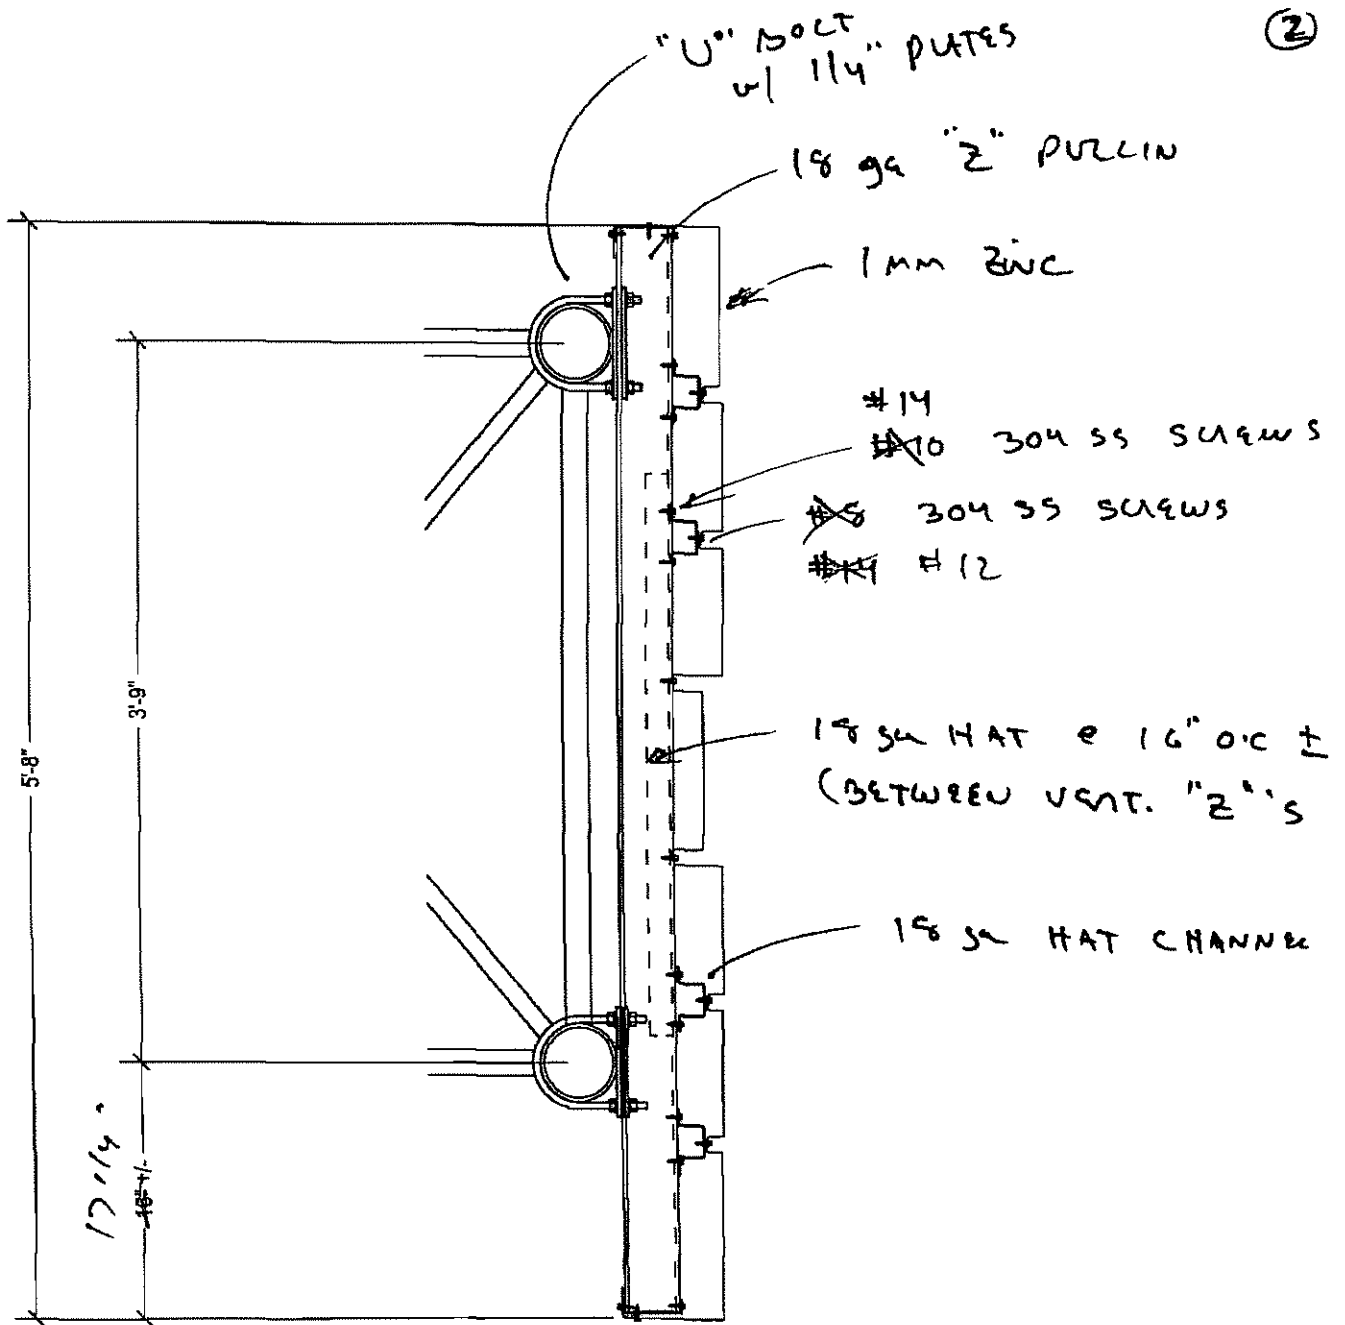

1 SECTION @ "Z" PURLIN (32" O.C. MAX.)
 S1 SCALE 1" = 1'-0"

CHECK Z-PURLIN - 32" O.C (USE 36")

50 PSF WIND LOAD x 3' O.C = 150 PLF

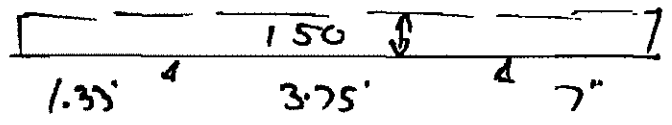


FOR 18 GA, INTERACTION = 0.734 ≤ 1.0 OK

$I_x = 0.385 \text{ IN}^3$

$S = .04" \rightarrow 4/1125 \text{ OK}$

CHECK FLANGE BOWING ON "Z" PURLIN @ U-BOCT

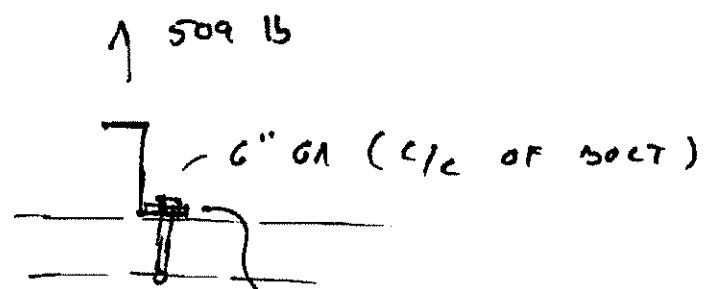


$e = 5.114"$

$l = 8" \quad M_c = 509 \times 1/8" = 64 \text{ IN-LB}$

$S = (0.048)^2 \times \frac{8"}{2} = .0031 \text{ IN}^3 \quad f_b = 20.0 \text{ KSI OK}$

SECTION MODULUS OF Z-BAR LIP

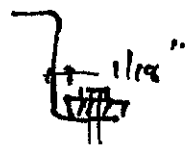


Rob Munach, PE Excel Engineering 27510-1264

FRAME MAC file: FrameMac Template; Last modified at 8:58:34 AM on Tue, Oct 26, 2010

Node 1	Elem 1,2	Node 2	FReact	Elem 2,3	Node 3	FReact	Elem 3,4	Node 4
0.0	L=1.3	1.3	0	L=3.8	5.1	0	L=0.6	5.7
0.0	S250162-54	0.0	509	S250162-54	0.0	341	S250162-54	0.0
---	E=29000000	---	---	E=29000000	---	---	E=29000000	---

DL1L	DL1R	DL1L	DL1R	DL1L	DL1R
0.0	0.0	0.0	0.0	0.0	0.0
150.0	150.0	150.0	150.0	150.0	150.0
---	---	---	---	---	---

I = 0.37 ~ SAME AS 18 GA 2' PURLIN

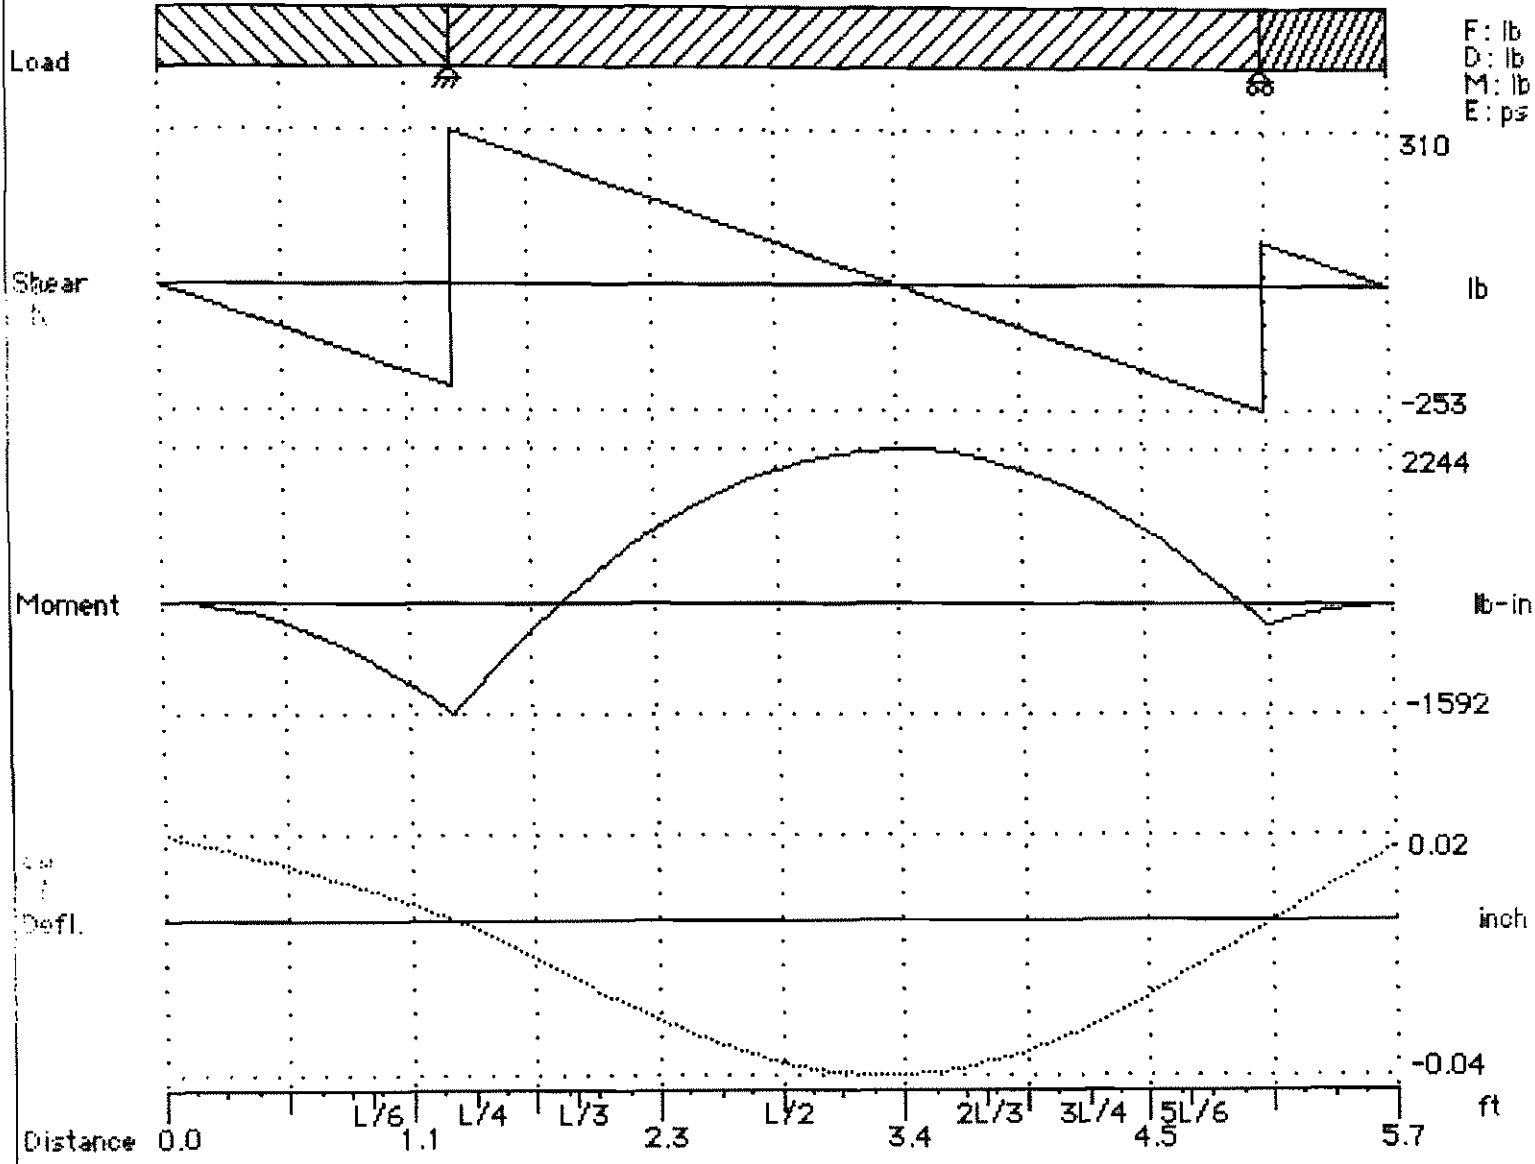

F: lb
D: lb
M: lb
E: ps

Rev. Date: 10/26/2010 8:52:47 AM

Member Check - 2007 North American Specification - US (ASD)

Material Type: A653 SS Grade 33, Fy=33 ksi

Design Parameters:

Lx	3.7500 ft	Ly	3.7500 ft	Lt	3.7500 ft
Kx	1.0000	Ky	1.0000	Kt	1.0000
Cbx	1.0000	Cby	1.0000	ex	0.0000 in
Cmx	1.0000	Cmy	1.0000	ey	0.0000 in
Braced Flange:	None	Red. Factor, R:	0	Stiffness, k _φ :	0 k

Loads:	P (k)	Mx (k-in)	Vy (k)	My (k-in)	Vx (k)
Entered	0.0000	<u>2.2400</u>	0.0000	0.0000	0.0000
Applied	0.0000	2.2400	0.0000	0.0000	0.0000
Strength	1.9736	3.0500	1.5193	0.6905	1.5193

Effective section properties at applied loads:

Ae	0.25335 in ²	Ixe	0.35825 in ⁴	Iye	0.07983 in ⁴
		Sxe(t)	0.23103 in ³	Sye(l)	0.05582 in ³
		Sxe(b)	0.24718 in ³	Sye(r)	0.05236 in ³

Interaction Equations

NAS Eq. C5.2.1-1	(P, Mx, My)	$0.000 + 0.734 + 0.000 = 0.734 \leq 1.0$
NAS Eq. C5.2.1-2	(P, Mx, My)	$0.000 + 0.734 + 0.000 = 0.734 \leq 1.0$
NAS Eq. C3.3.1-1	(Mx, Vy)	$\text{Sqrt}(0.382 + 0.000) = 0.618 \leq 1.0$
NAS Eq. C3.3.1-1	(My, Vx)	$\text{Sqrt}(0.000 + 0.000) = 0.000 \leq 1.0$


(6)

(1 1/2")

CHECK 18 GA HAT CHANNEL 150F 125

$$L = 36" \text{ MAX (SPAN)}$$

$$W = \frac{3.75'}{2} \times 50 \text{ PSF} = 94 \text{ LBF}$$

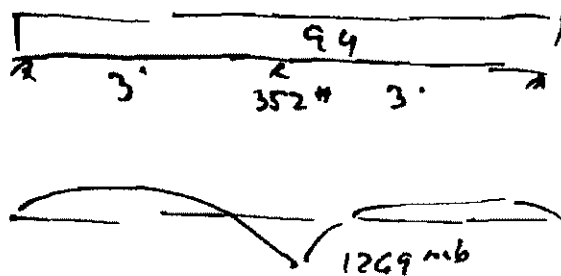

$$\text{Interaction} = 0.723 \leq 1.0 \quad \underline{OK}$$

CONNECTION OF NAT TO Z-PURLIN

FOR 3-4 SPAN CONDITION (ACTUAL)

$$P = 352\# \times \frac{1.14}{1.25} = 321\#$$

SHEET STEEL

Try (2) #14 SCREWS, $F_U = 85-90 \text{ KSI}$ FOR 304 SS

PER 2001 AISI COLD FORMED STEEL SPEC,
#14 SCREW, 65 KSI YIELD BASE METAL, $P_{HL} = 221\#$

→ USE (2) #14 SCREWS

$$A_N = .045 \text{ IN}^2 \quad f_t = 3.6 \text{ KSI} \leq 7 \text{ KSI PER AASHTO} \quad \underline{OK}$$

CHECK ZWC TO MAT CONNECTION

$$P \approx \frac{1.8' \times 1215}{4} \times 2.67' \times 50 \text{ PSF} = 60 \text{ #}$$

CAC FOR ~~#14~~ SUEW
#12

Rev. Date: 10/26/2010 9:18:30 AM

Member Check - 2007 North American Specification - US (ASD)

Material Type: A653 SS Grade 33, Fy=33 ksi

Design Parameters:

Lx	3.0000 ft	Ly	3.0000 ft	Lt	3.0000 ft
Kx	1.0000	Ky	1.0000	Kt	1.0000
Cbx	1.0000	Cby	1.0000	ex	0.0000 in
Cmx	1.0000	Cmy	1.0000	ey	0.0000 in
Braced Flange: None		Red. Factor, R: 0		Stiffness, k _z : 0 k	

Loads:	P (k)	Mx (k-in)	Vy (k)	My (k-in)	Vx (k)
Entered	0.0000	1.2600	0.1760	0.0000	0.0000
Applied	0.0000	1.2600	0.1760	0.0000	0.0000
Strength	0.7411	1.7425	1.4094	1.5188	0.4712

Effective section properties at applied loads:

Ae	0.21413 in ²	Ixe	0.066135 in ⁴	Iye	0.093668 in ⁴
		Sxe(t)	0.088179 in ³	Sye(l)	0.076860 in ³
		Sxe(b)	0.088179 in ³	Sye(r)	0.076860 in ³

Interaction Equations

NAS Eq. C5.2.1-1	(P, Mx, My)	0.000 + 0.723 + 0.000 = 0.723	<= 1.0
NAS Eq. C5.2.1-2	(P, Mx, My)	0.000 + 0.723 + 0.000 = 0.723	<= 1.0
NAS Eq. C3.3.1-1	(Mx, Vy)	Sqrt(0.523 + 0.016) = 0.734	<= 1.0
NAS Eq. C3.3.1-1	(My, Vx)	Sqrt(0.000 + 0.000) = 0.000	<= 1.0

304/304L

STAINLESS STEEL

UNS S30400/UNS S30403



AK Steel Type 304 is a variation of the basic 18-8 grade, Type 302, with a higher chromium and lower carbon content. Lower carbon minimizes chromium carbide precipitation due to welding and its susceptibility to intergranular corrosion. In many instances, it can be used in the "as-welded" condition, while Type 302 must be annealed in order to retain adequate corrosion resistance.

Type 304L is an extra low-carbon variation of Type 304 with a 0.03% maximum carbon content that eliminates carbide precipitation due to welding. As a result, this alloy can be used in the "as-welded" condition, even in severe corrosive conditions. It often eliminates the need for annealing weldments except in applications specifying stress relief has slightly lower mechanical properties than Type 304.

Typical uses include architectural moldings and trim, kitchen equipment, welded components of chemical, textile, paper, pharmaceutical and chemical industry processing equipment.

AVAILABLE FORMS
AK Steel produces Type 304 Stainless

COMPOSITION

	Type 304 %	Type 304L %
Carbon	0.08 max.	0.03 max.
Manganese	2.00 max.	2.00 max.
Phosphorus	0.045 max.	0.045 max.
Sulfur	0.030 max.	0.030 max.
Silicon	0.75 max.	0.75 max.
Chromium	18.00-20.00	18.0-20.0
Nickel	8.00-12.00	8.0-12.0
	0.10 max.	0.10 max.
	Balance	Balance

APPROVED RESUBMIT
 APPROVED AS NOTED NOT APPROVED


REVIEW OF THIS SHOP DRAWING IS LIMITED TO CONFORMANCE WITH THE DESIGN CONCEPT OF THE PROJECT AND FOR COMPLIANCE WITH THE INFORMATION GIVEN IN THE CONTRACT PLANS AND SPECIFICATIONS (INCLUDING SUPPLEMENTAL AND SPECIAL PROVISIONS), AND IS NOT INTENDED TO BE A VERIFICATION OF TOTAL MATERIAL REQUIRED OR THAT ALL ITEMS REQUIRED ARE SHOWN. REVIEW SHALL NOT RELIEVE THE CONTRACTOR FROM THE RESPONSIBILITY OF DETAILS OF DESIGN, DIMENSIONS, JOB CONDITIONS, CONSTRUCTION MEANS AND METHODS, COORDINATION WITH OTHER TRADES, OR ANY OTHER REQUIREMENTS OF THE PLANS, SPECIFICATIONS OR CONTRACT. ANY NOTATIONS ON THIS SHOP DRAWING MADE BY ATKINS NORTH AMERICA SHALL NOT BE CONSTRUED TO AUTHORIZE ADDITIONAL WORK OR COST.

REVIEW OF DESIGN CALCULATIONS AND DRAWINGS PREPARED BY SPECIALTY ENGINEERS IS LIMITED TO DESIGN INTENT AND DOES NOT CONSTITUTE A DETAILED CHECK OF CALCULATIONS, NOR DOES IT RELIEVE THE SPECIALTY ENGINEERS FROM THE RESPONSIBILITY OF THE DETAILING OF THE SPECIALTY COMPONENT OR SYSTEM.


BY: D.L. Jones, PE
DATE: 7/1/16

Types 304 and 304L Stainless covered by the following:

Type 304L	
AMS 5511	
ASTM A 240	
ASTM A 666	
Elongation % in 2" 50.8 mm)	Hardness Rockwell
55	B80
55	B82

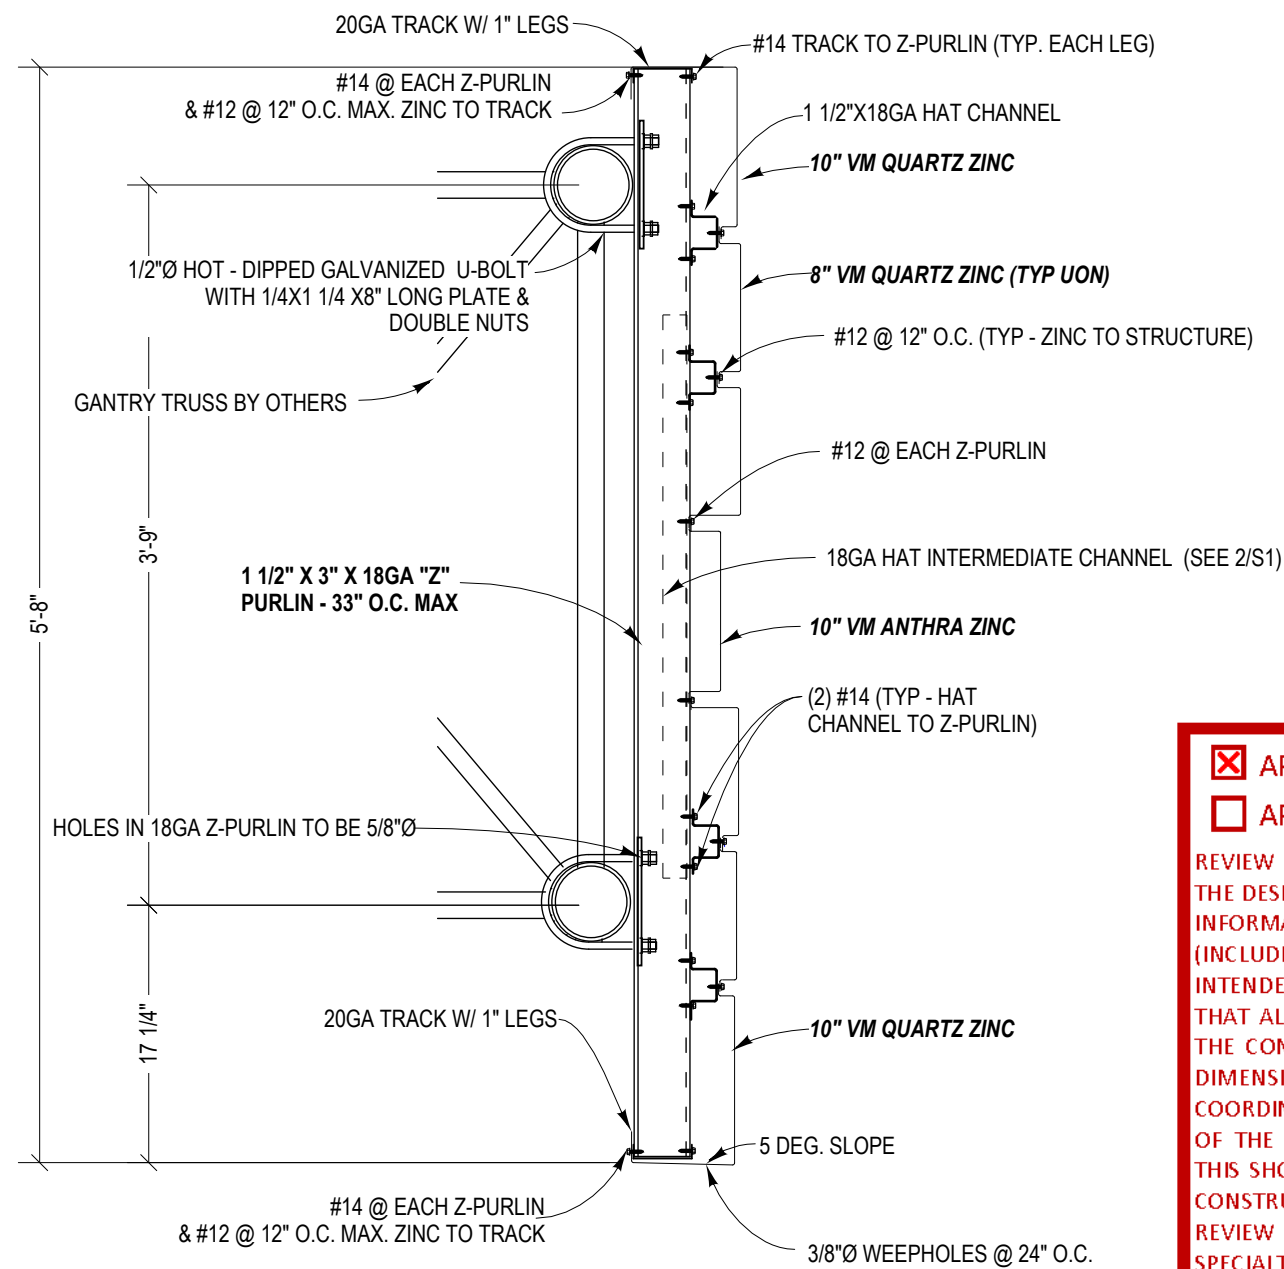

1 SECTION @ "Z" PURLIN (33" O.C. MAX.)
S1 SCALE: 1" = 1'-0"

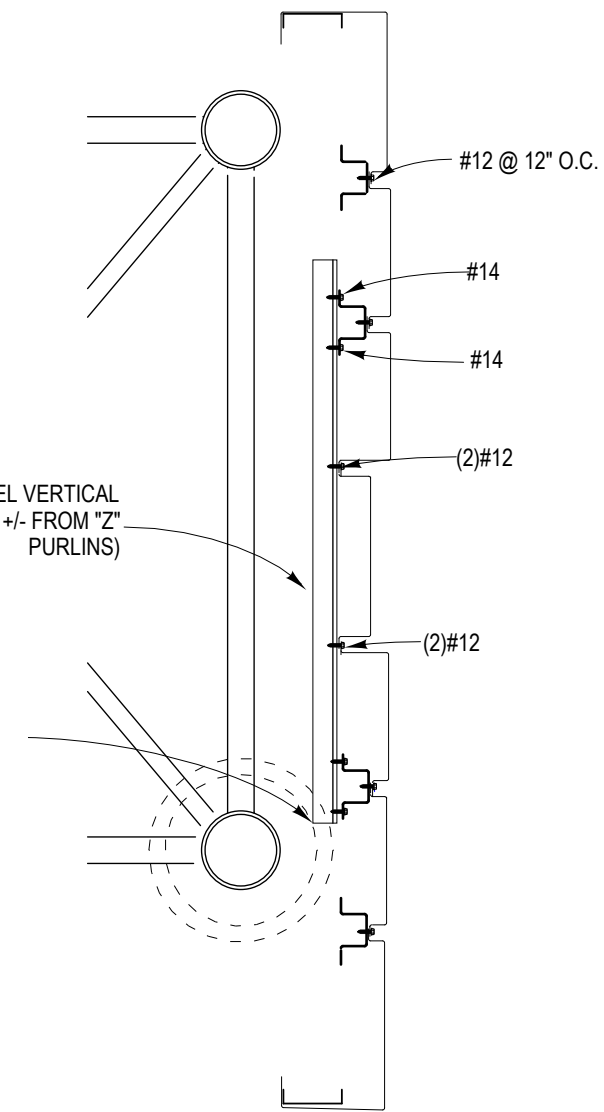

2 SECTION BETWEEN "Z" PURLINS
1 SCALE: 1" = 1'-0"

APPROVED RESUBMIT
 APPROVED AS NOTED NOT APPROVED

REVIEW OF THIS SHOP DRAWING IS LIMITED TO CONFORMANCE WITH THE DESIGN CONCEPT OF THE PROJECT AND FOR COMPLIANCE WITH THE INFORMATION GIVEN IN THE CONTRACT PLANS AND SPECIFICATIONS (INCLUDING SUPPLEMENTAL AND SPECIAL PROVISIONS), AND IS NOT INTENDED TO BE A VERIFICATION OF TOTAL MATERIAL REQUIRED OR THAT ALL ITEMS REQUIRED ARE SHOWN. REVIEW SHALL NOT RELIEVE THE CONTRACTOR FROM THE RESPONSIBILITY OF DETAILS OF DESIGN, DIMENSIONS, JOB CONDITIONS, CONSTRUCTION MEANS AND METHODS, COORDINATION WITH OTHER TRADES, OR ANY OTHER REQUIREMENTS OF THE PLANS, SPECIFICATIONS OR CONTRACT. ANY NOTATIONS ON THIS SHOP DRAWING MADE BY ATKINS NORTH AMERICA SHALL NOT BE CONSTRUED TO AUTHORIZE ADDITIONAL WORK OR COST.

REVIEW OF DESIGN CALCULATIONS AND DRAWINGS PREPARED BY SPECIALTY ENGINEERS IS LIMITED TO DESIGN INTENT AND DOES NOT CONSTITUTE A DETAILED CHECK OF CALCULATIONS, NOR DOES IT RELIEVE THE SPECIALTY ENGINEERS FROM THE RESPONSIBILITY OF THE DETAILING OF THE SPECIALTY COMPONENT OR SYSTEM.

BY: D.L. Jones, PE
 DATE: 7/1/16

ATKINS

NOTES:
 PANEL DEAD LOAD = 4.8 PSF (APPROX)
 ALL SELF-DRILLING SCREWS TO BE TYPE 304 STAINLESS STEEL
 ALL PURLINS, TRACK AND HAT CHANNEL TO BE 304 STAINLESS STEEL
 ZINC TO BE 1MM

CONTACT ENGINEER IF DISCREPANCIES ARE NOTED
 CONTRACTOR RESPONSIBLE FOR MEANS & METHODS OF CONSTRUCTION AND JOBSITE SAFETY
 VERIFY ALL DIMENSIONS. DO NOT SCALE DRAWING

