


PROJECT REFERENCE NO.	SHEET NO.
U-3334B	EC-12/CONST.2
RW SHEET NO.	
ROADWAY DESIGN ENGINEER	HYDRAULICS ENGINEER

8/17/99
 23-SEP-2017 14:34
 D:\s199\U-3334B-EC.ps12.dgn
 R:\s199\U-3334B-EC.ps12.dgn
 R:\s199\U-3334B-EC.ps12.dgn

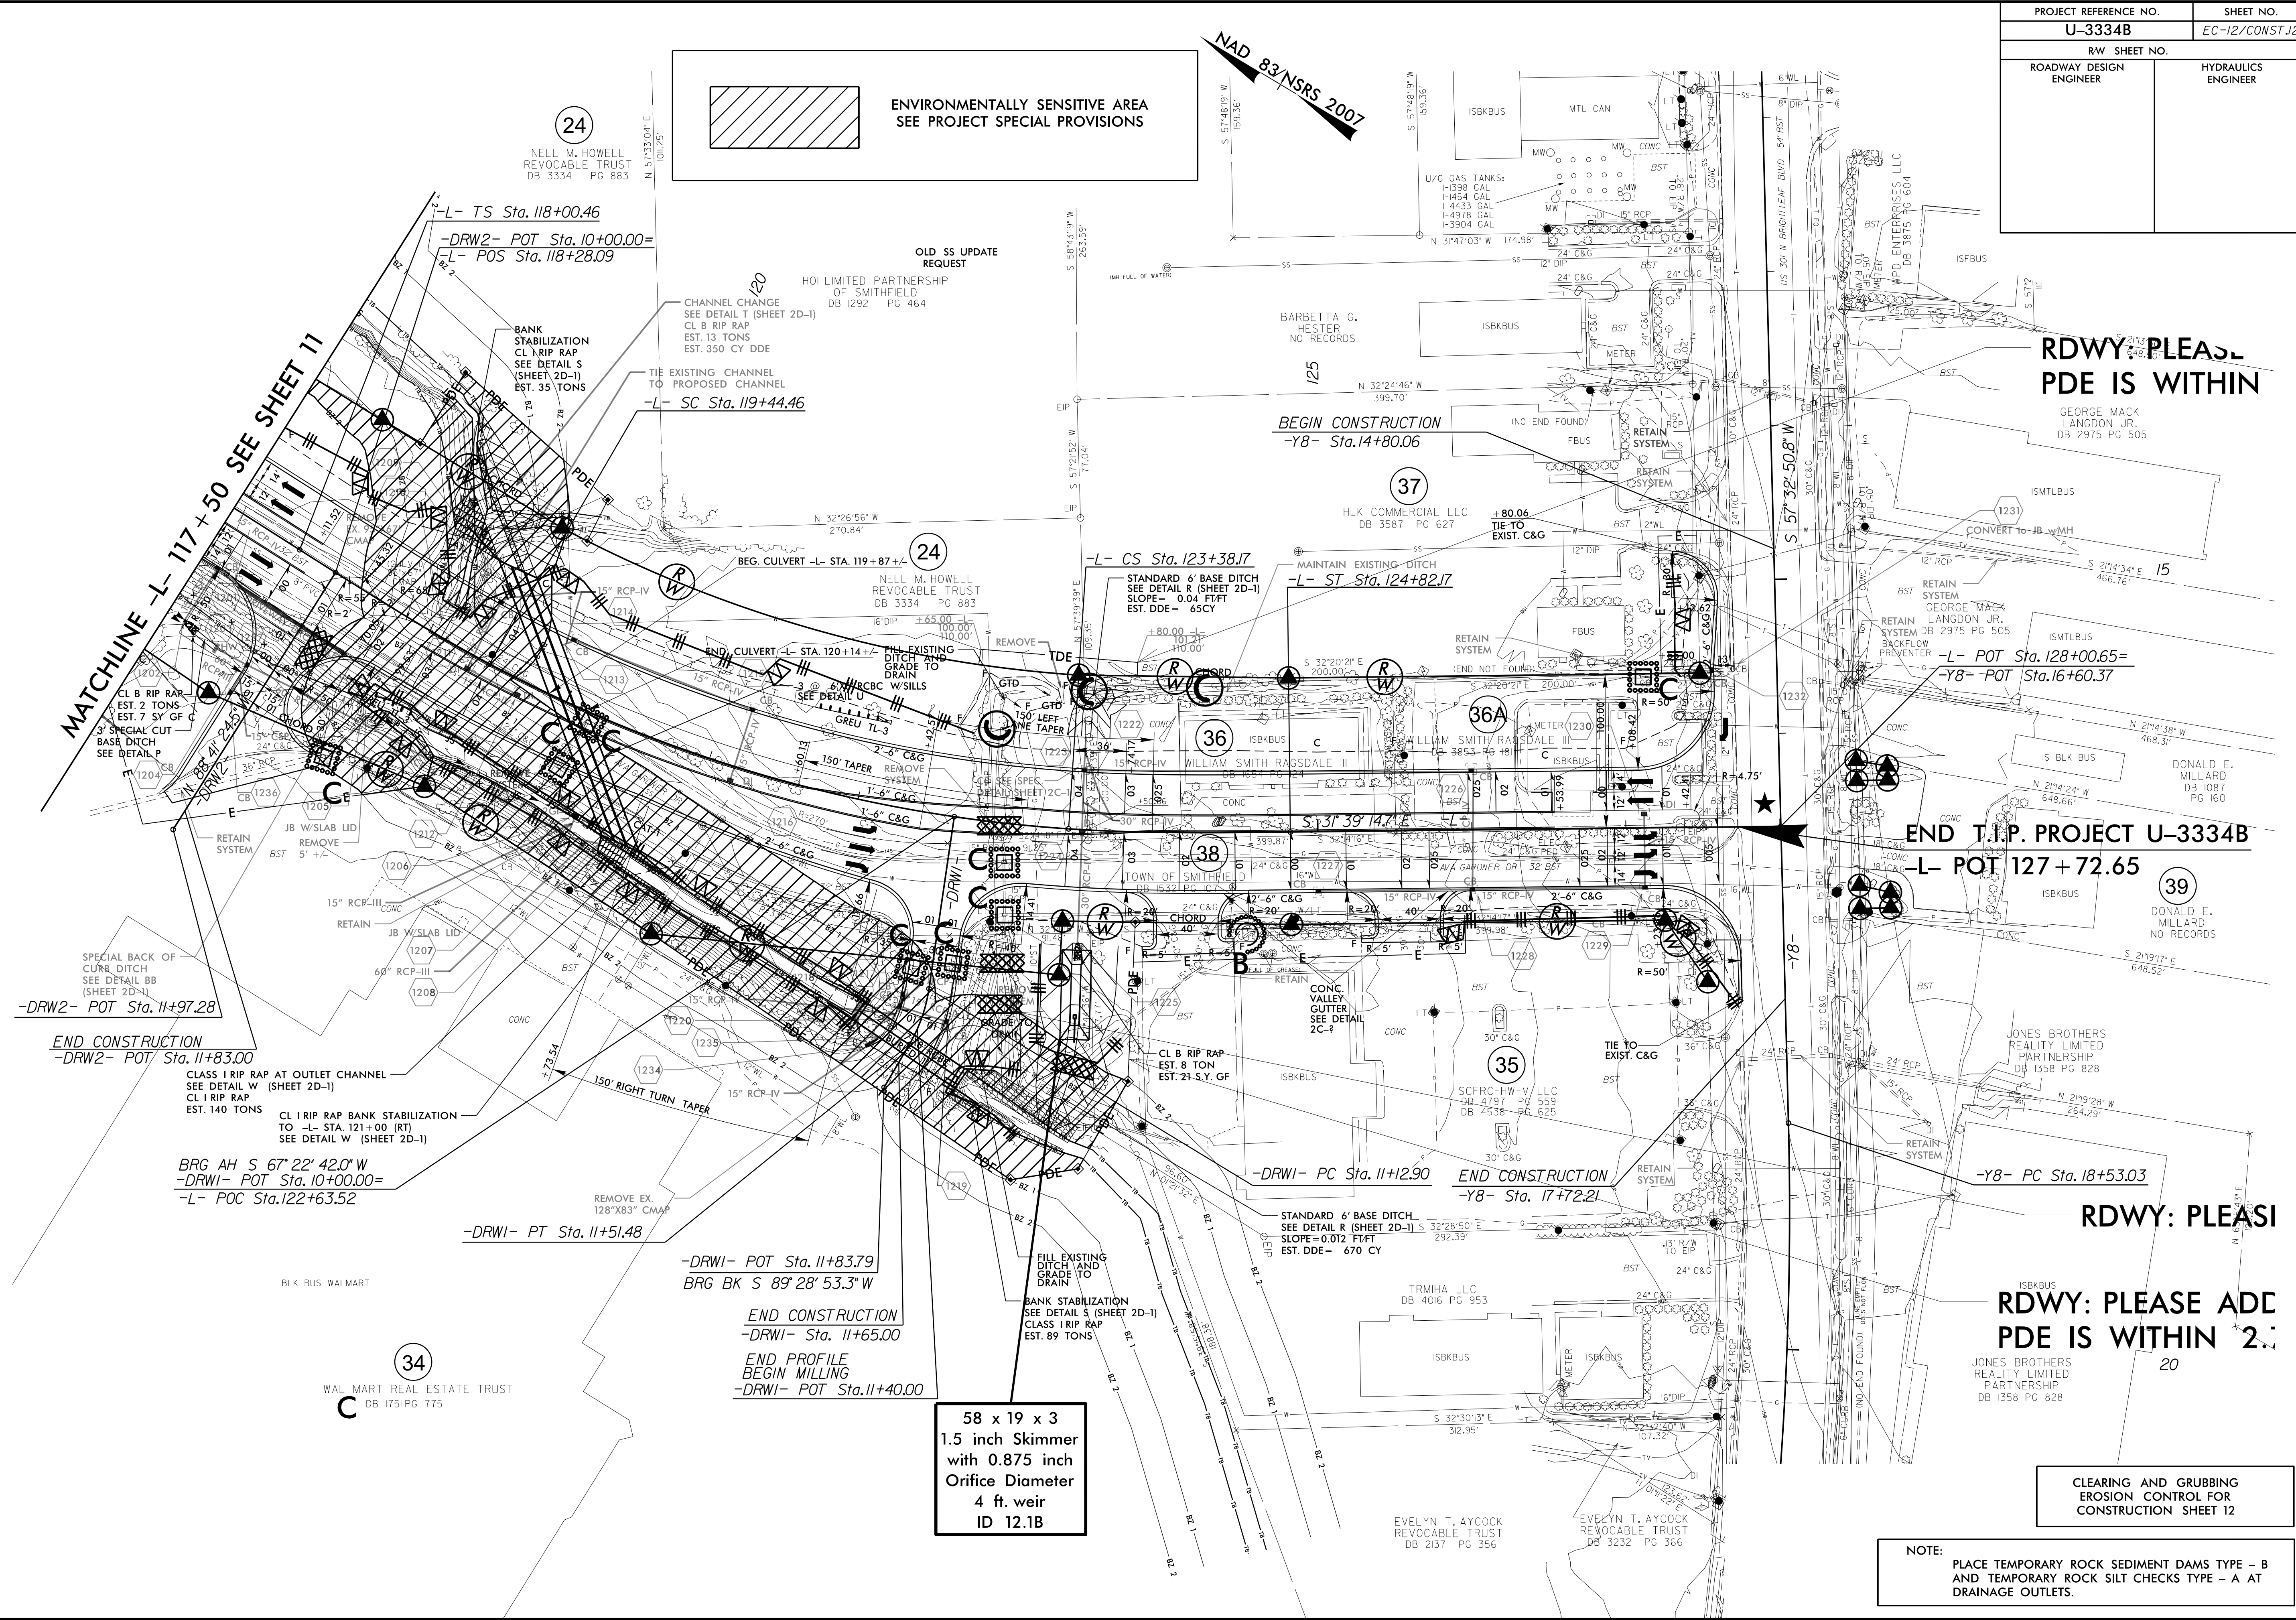

ENVIRONMENTALLY SENSITIVE AREA
SEE PROJECT SPECIAL PROVISIONS

RDWY: PLEASE PDE IS WITHIN

END T.I.P. PROJECT U-3334B
L- POT 127+72.65

RDWY: PLEASE

RDWY: PLEASE ADD PDE IS WITHIN 2.0'

58 x 19 x 3
1.5 inch Skimmer
with 0.875 inch
Orifice Diameter
4 ft. weir
ID 12.1B

NOTE:
PLACE TEMPORARY ROCK SEDIMENT DAMS TYPE - B
AND TEMPORARY ROCK SILT CHECKS TYPE - A AT
DRAINAGE OUTLETS.