



BID ITEMS	UNIT	QUANTITY
NEW BRIDGE STA. 153+55 (COMPLETE EXCEPT AS OTHERWISE INDICATED HERE IN)	L.S.	-
BRIDGE APPROACH SLAB (2-REQ'D.)	L.S.	-
FOUNDATION EXCAVATION	C.Y.	3,726
12" PRESTRESSED CONCRETE PILES (SQUARE)	L.F.	3,930
22" PRESTRESSED CONCRETE PILES (OCTAGONAL) OR 20" PRESTRESSED CONCRETE PILES (SQUARE)	L.F.	28,855
COFFERDAMS COMPLETE (2 REQ'D. BENTS IN ALL)	L.S.	-
FENDER SYSTEM COMPLETE (EXCLUDING PILES)	L.S.	-
TREATED TIMBER PILES (FENDER SYSTEM)	L.F.	13,714
NAVIGATIONAL LIGHTING SYSTEM	L.S.	-
REMOVAL OF EXISTING BRIDGE (STA. 153+55)	L.S.	-
PILE LOAD TESTS	E.A.	5
STONE SLOPE PROTECTION	S.Y.	2,529
TEST PILES	L.F.	555

Begin Approach Slab Sta. 140+01.5
TO BARCO
CJ-21 & CJ-35

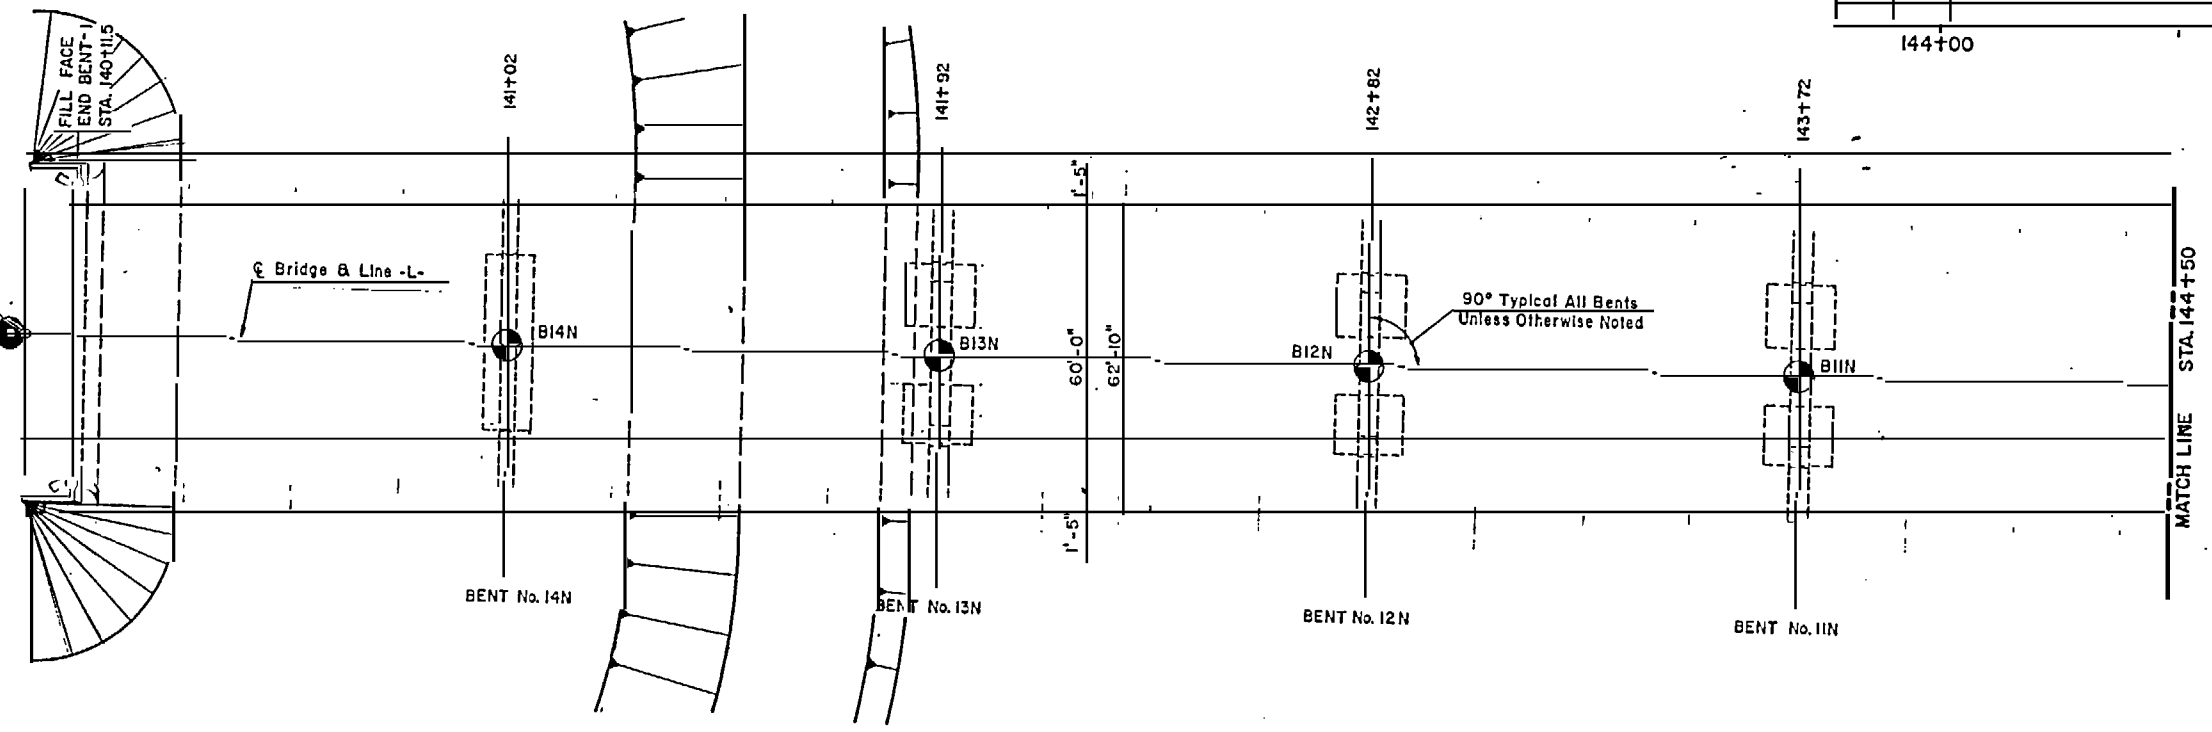

PLAN

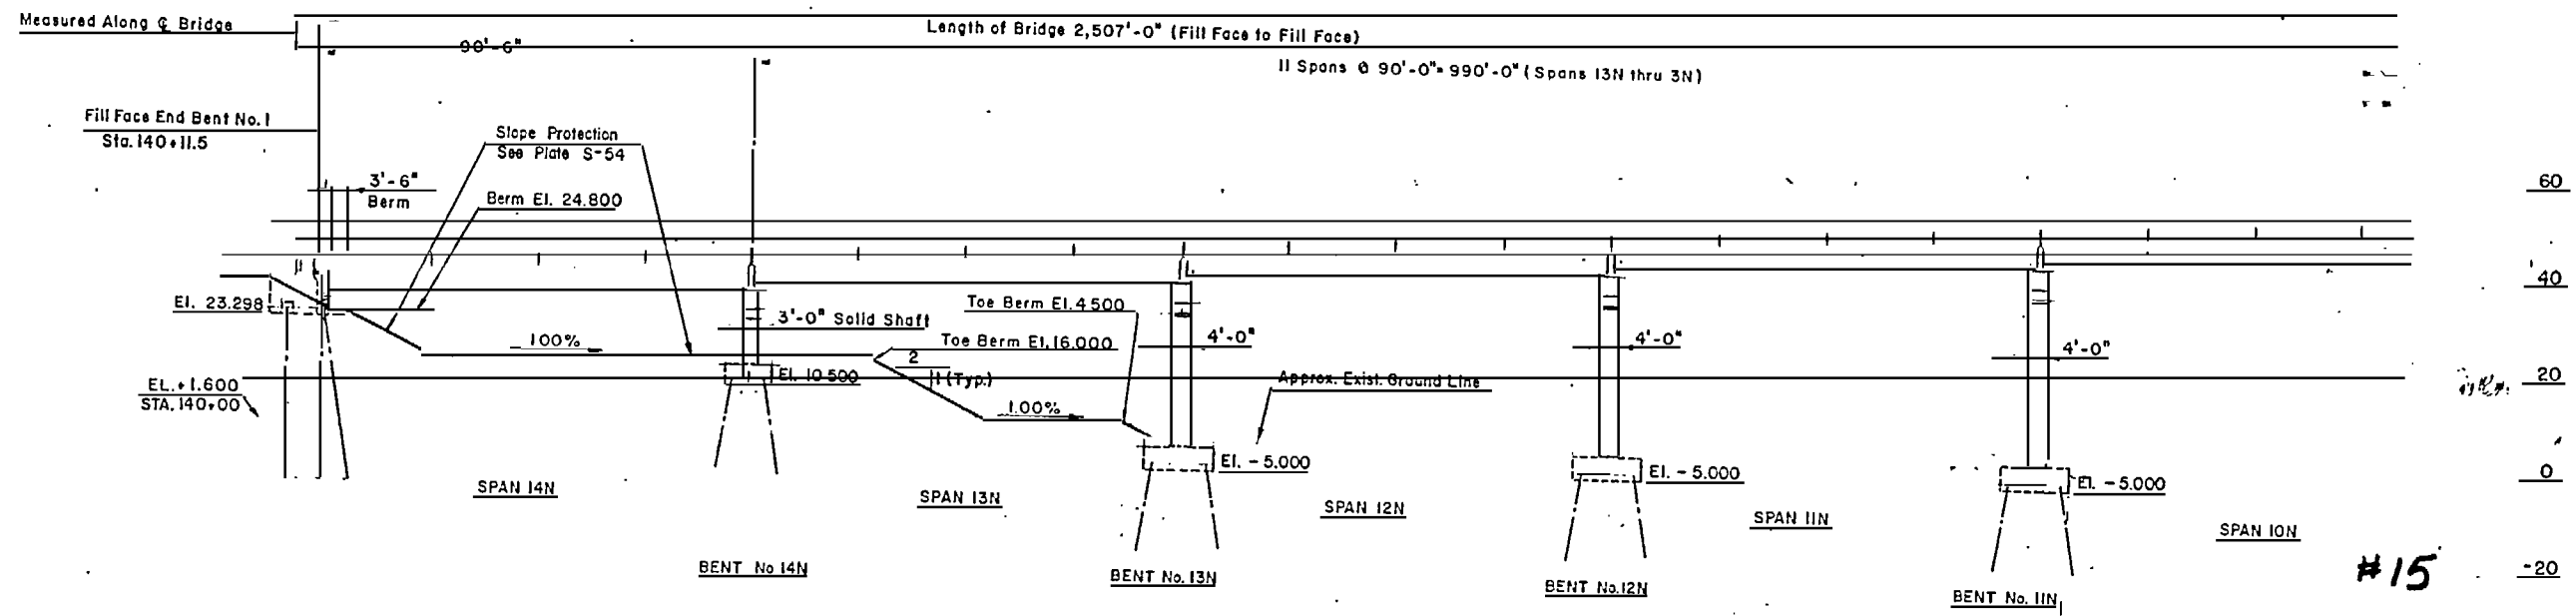

ELEVATION

LEGEND
 B(No.)/N/S - DENOTES BORING LOCATION OR NUMBER (SEE APPENDIX A OF THE SPECS. FOR BORING LOGS)
 CJ-(No.)

RECORD DRAWING

HNTB HOWARD NEEDLES TAMMEN & BERGENOFF ARCHITECTS ENGINEERS PLANNERS ATLANTA, GEORGIA
 U.S. ARMY ENGINEER DISTRICT, WASHINGTON CORPS OF ENGINEERS WILMINGTON, NORTH CAROLINA

ATLANTIC INTRACOASTAL WATERWAY
 GENERAL PLAN AND ELEVATION.
 COINJOCK BRIDGE REPLACEMENT PROJECT
 CURRITUCK COUNTY NORTH CAROLINA

DESIGNED BY: B.T.G. CHECKED BY: M.A.M.
 PREPARED BY: [Signature]
 PRINCIPAL OF FIRM HNTB

INVESTIGATION NO. DACW54-83-8-0014
 DRAWING NUMBER BR104+06-17
 SCALE 1"=20'
 DATE 22 JULY 1983
 SHEET 51 OF 126

145+00


146+00

147+00

148+00


149+00

NC STATE AID PROJECT NO.	
FEDERAL AID PROJECT NO.	FED. RD DIST. NO.

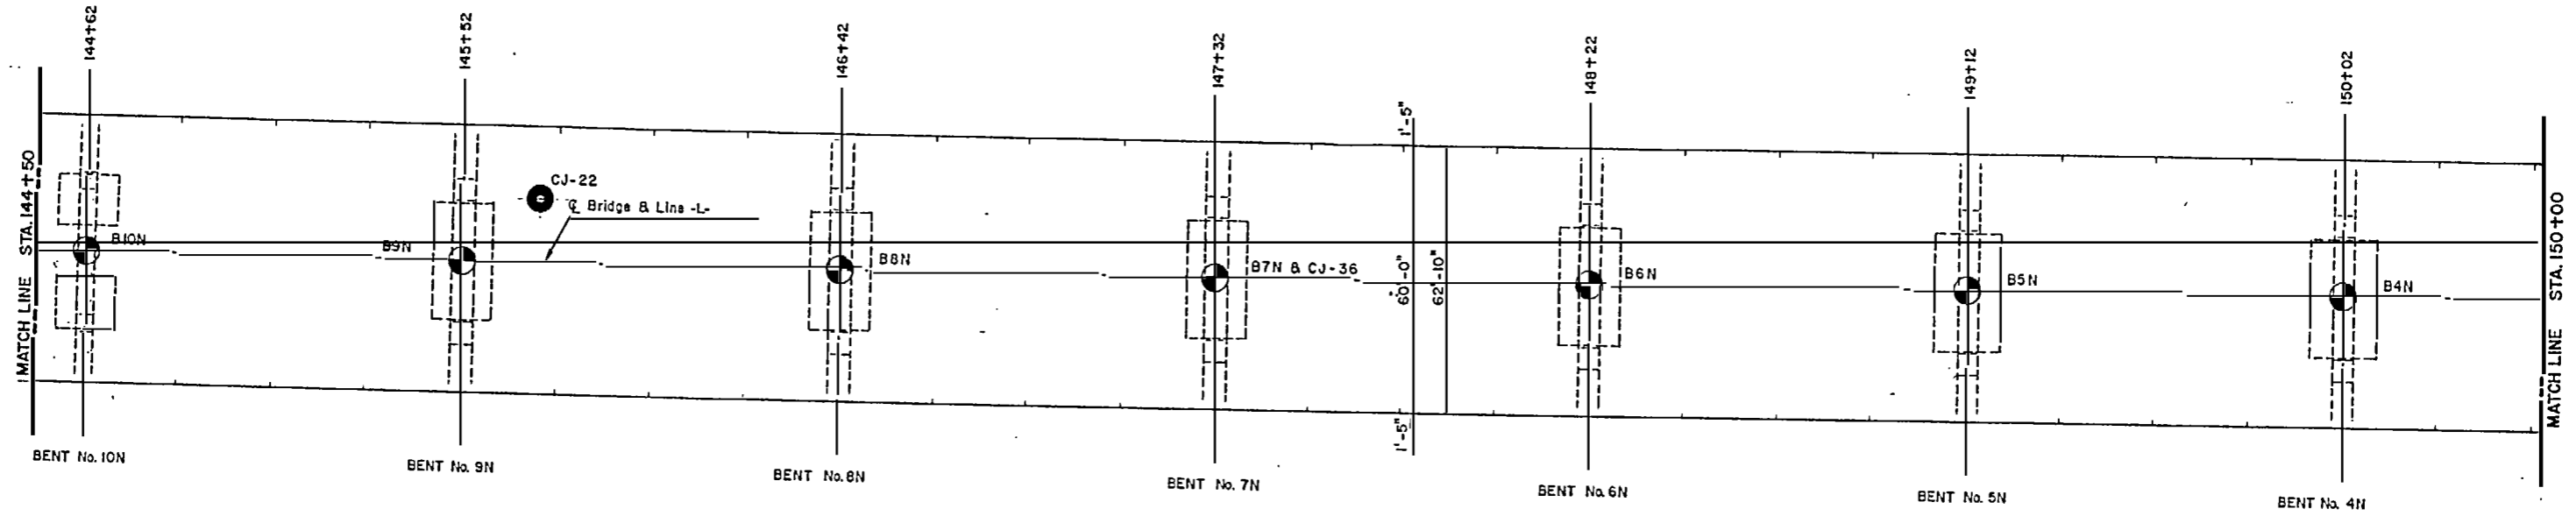

PLAN

Length of Bridge 2,507'-0" (Fill Face to Fill Face)

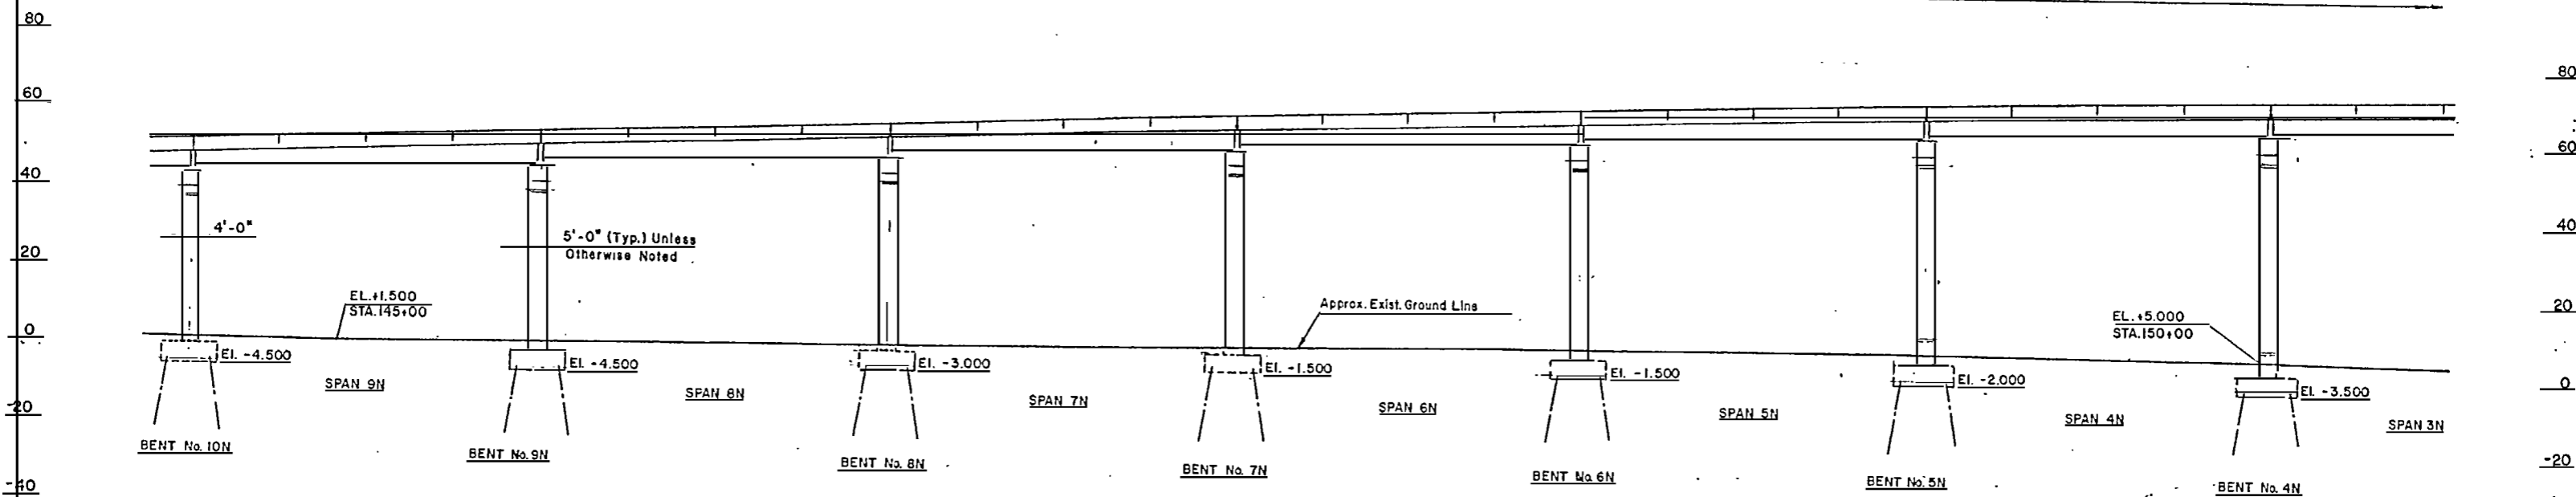

ELEVATION

LEGEND

● B(No.)/W/S - DENOTES BORING LOCATION OR B NUMBER (SEE APPENDIX A OF THE SPECS. FOR BORING LOGS)

○ CJ-(No.)

RECORD DRAWING


HNTB HOWARD NEEDLES TAMMEN & BERGENDOFF ARCHITECTS ENGINEERS PLANNERS ATLANTA, GEORGIA

U.S. ARMY ENGINEER DISTRICT, WILMINGTON CORPS OF ENGINEERS WILMINGTON, NORTH CAROLINA


ATLANTIC INTRACOASTAL WATERWAY
GENERAL PLAN AND ELEVATION

DESIGNED BY: B.T.G.	CHECKED BY: M.A.M.	INVESTIGATION NO. OACW54-83-B-0014	SIZE 8-1/2 X 11	DRAWING NUMBER BR104-06-17	PLATE NO. S-2
PRINCIPAL OF FIRM HNTB		SCALE 1" = 20'	DATE 22 JULY 1983	SHEET 52 OF 126	


34504000

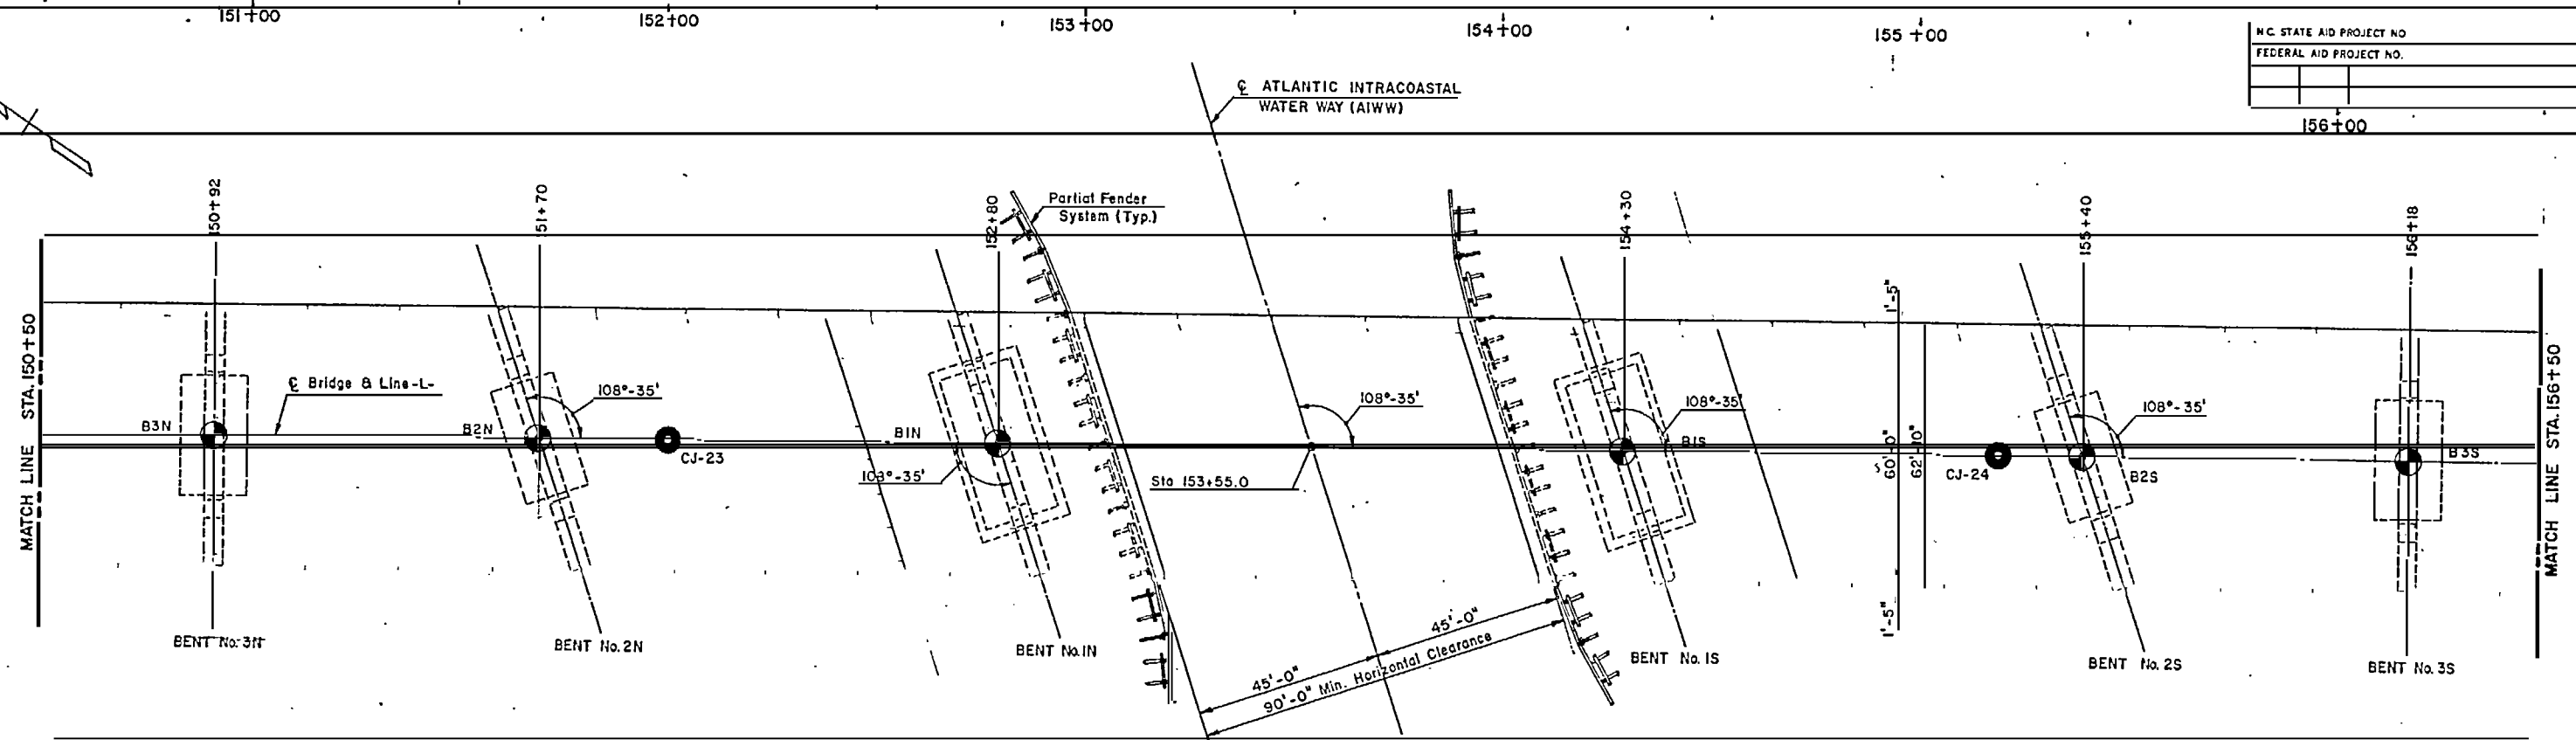

PLAN

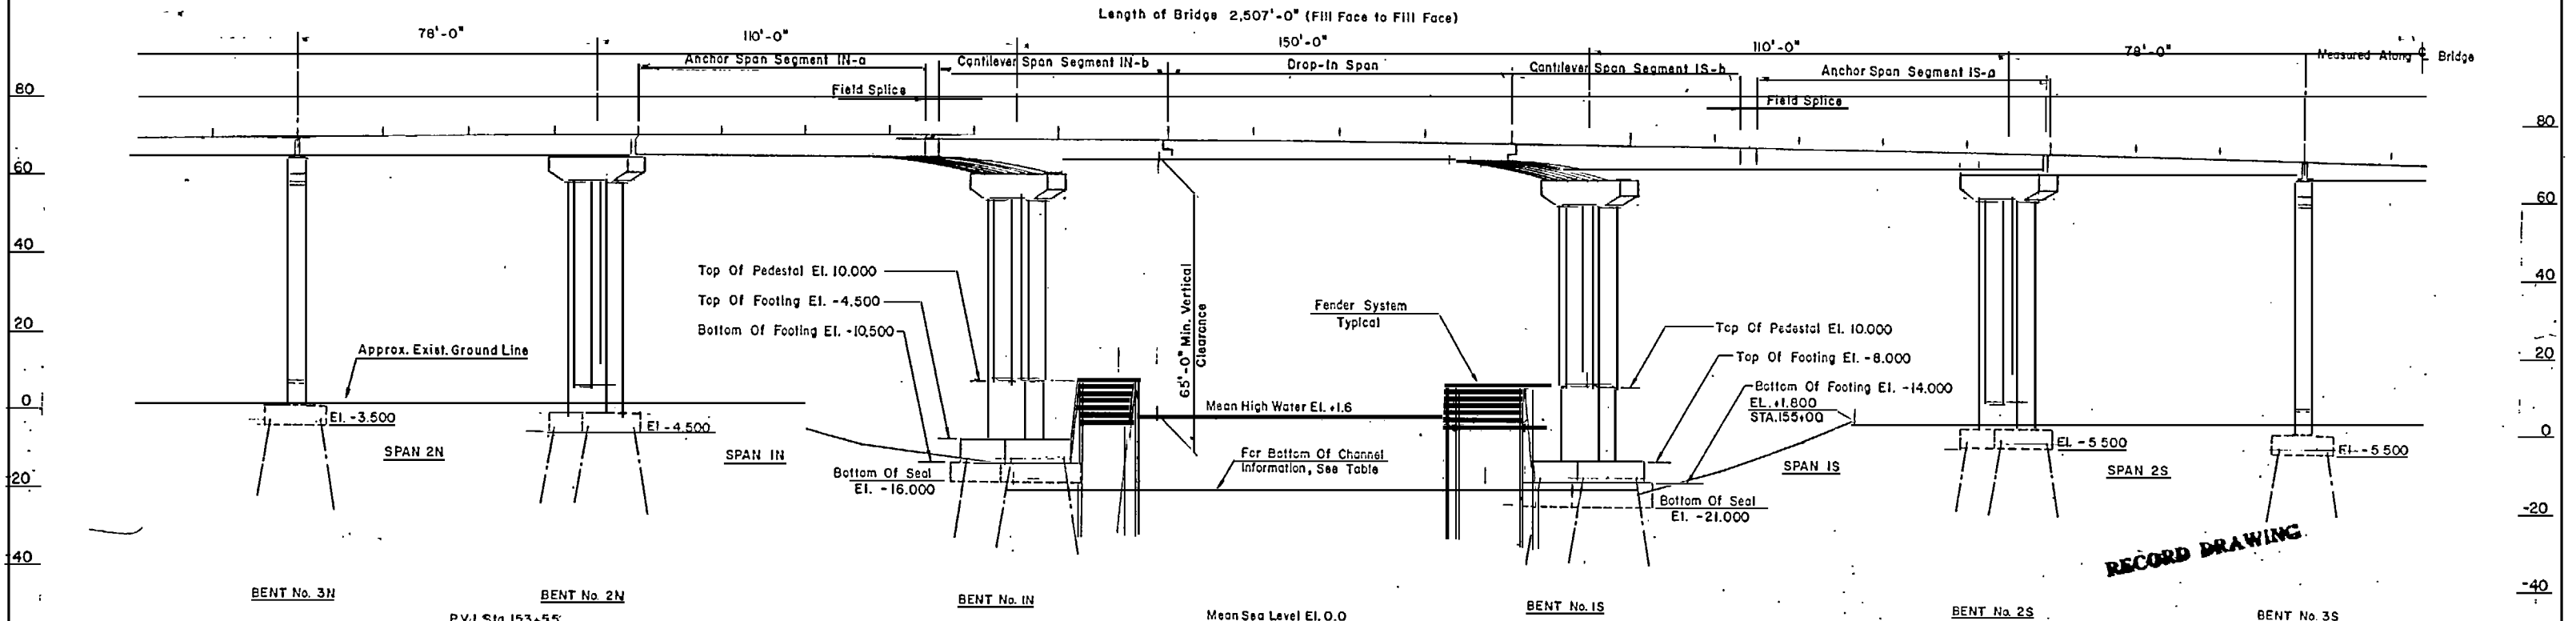

ELEVATION

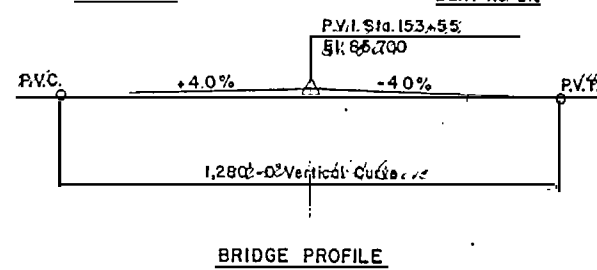

BRIDGE PROFILE

CHANNEL BOTTOM ELEVATION NOTES:

1. ORIENTATION FOR CHANNEL BOTTOM ELEVATIONS IS LOOKING UP STATION.
2. CHANNEL BOTTOM ELEVATIONS TABULATED FOR LEFT & RIGHT SIDES OF LINE "L" WERE MEASURED 50' PARALLEL TO & AIWW FROM INTERSECTION STATION SHOWN.
3. INFORMATION NOTED BASED ON SURVEY TAKEN JANUARY OF 1981.
4. ELEVATIONS ARE BASED ON MEAN SEA LEVEL O.O.

Mean Sea Level El. 0.0
Mean Low Water El. -0.1

CHANNEL BOTTOM ELEVATIONS			
STATION	LEFT	LINE "L"	RIGHT
152+15	-2.7	-0.7	-1.2
152+40	-7.7	-7.2	-8.2
152+90	-13.7	-13.7	-14.7
153+40	-18.7	-18.7	-19.7
153+90	-19.2	-19.7	-19.7
154+40	-18.7	-18.7	-19.2
154+65	-12.2	-11.7	-11.7
154+87	-4.2	-3.7	-3.7

LEGEND

- ⊙ B(No.)/S- DENOTES BORING LOCATION & NUMBER (SEE APPENDIX A- OF THE SPECS. FOR BORING LOGS)

DESIGNED BY: B.T.G.
CHECKED BY: M.A.M.
PREPARED BY: [Signature]
PRINCIPAL OF FIRM HNTB



HNTB HOWARD NEEDLES TAMMEN & BERGENDOFF ARCHITECTS ENGINEERS PLANNERS ATLANTA, GEORGIA
U.S. ARMY ENGINEER DISTRICT, WILMINGTON CORPS OF ENGINEERS WILMINGTON, NORTH CAROLINA

**ATLANTIC INTRACOASTAL WATERWAY
GENERAL PLAN AND ELEVATION**

COINJOCK BRIDGE REPLACEMENT PROJECT
CURRITUCK COUNTY NORTH CAROLINA

INVIATION NO. DACW 54-83-B-0014
DRAWING NUMBER BR104-06-17
PLATE NO. S-3

SCALE: 1/2" = 20'
DATE 22 JULY 1983
SHEET 53 OF 126

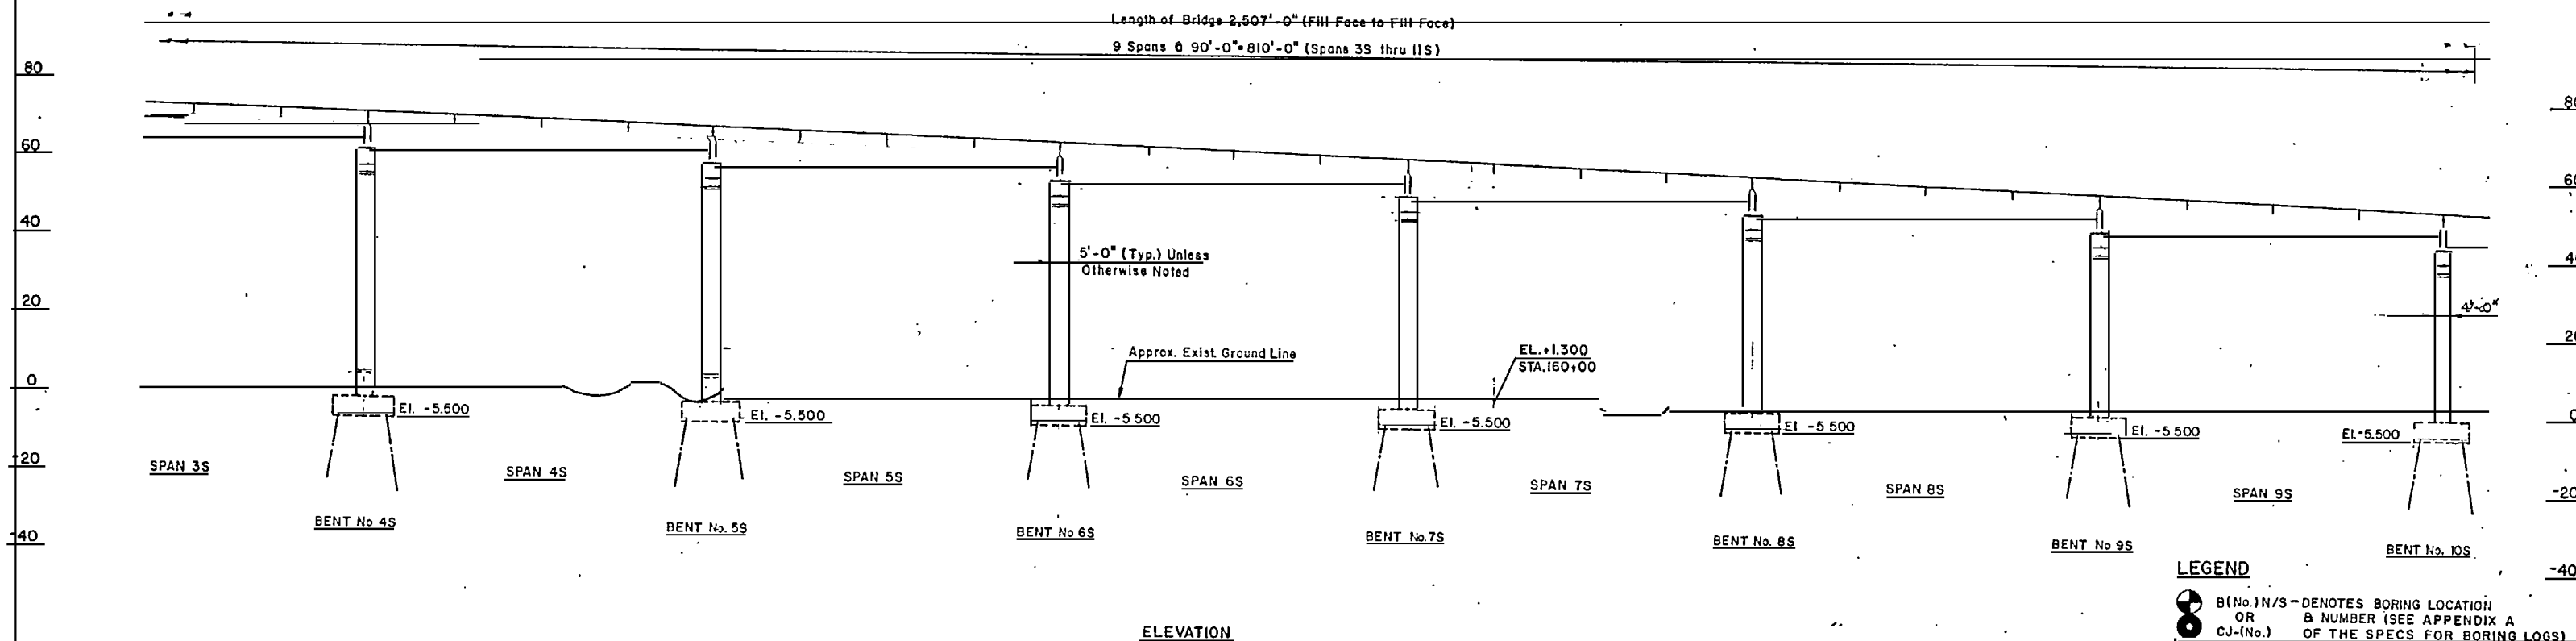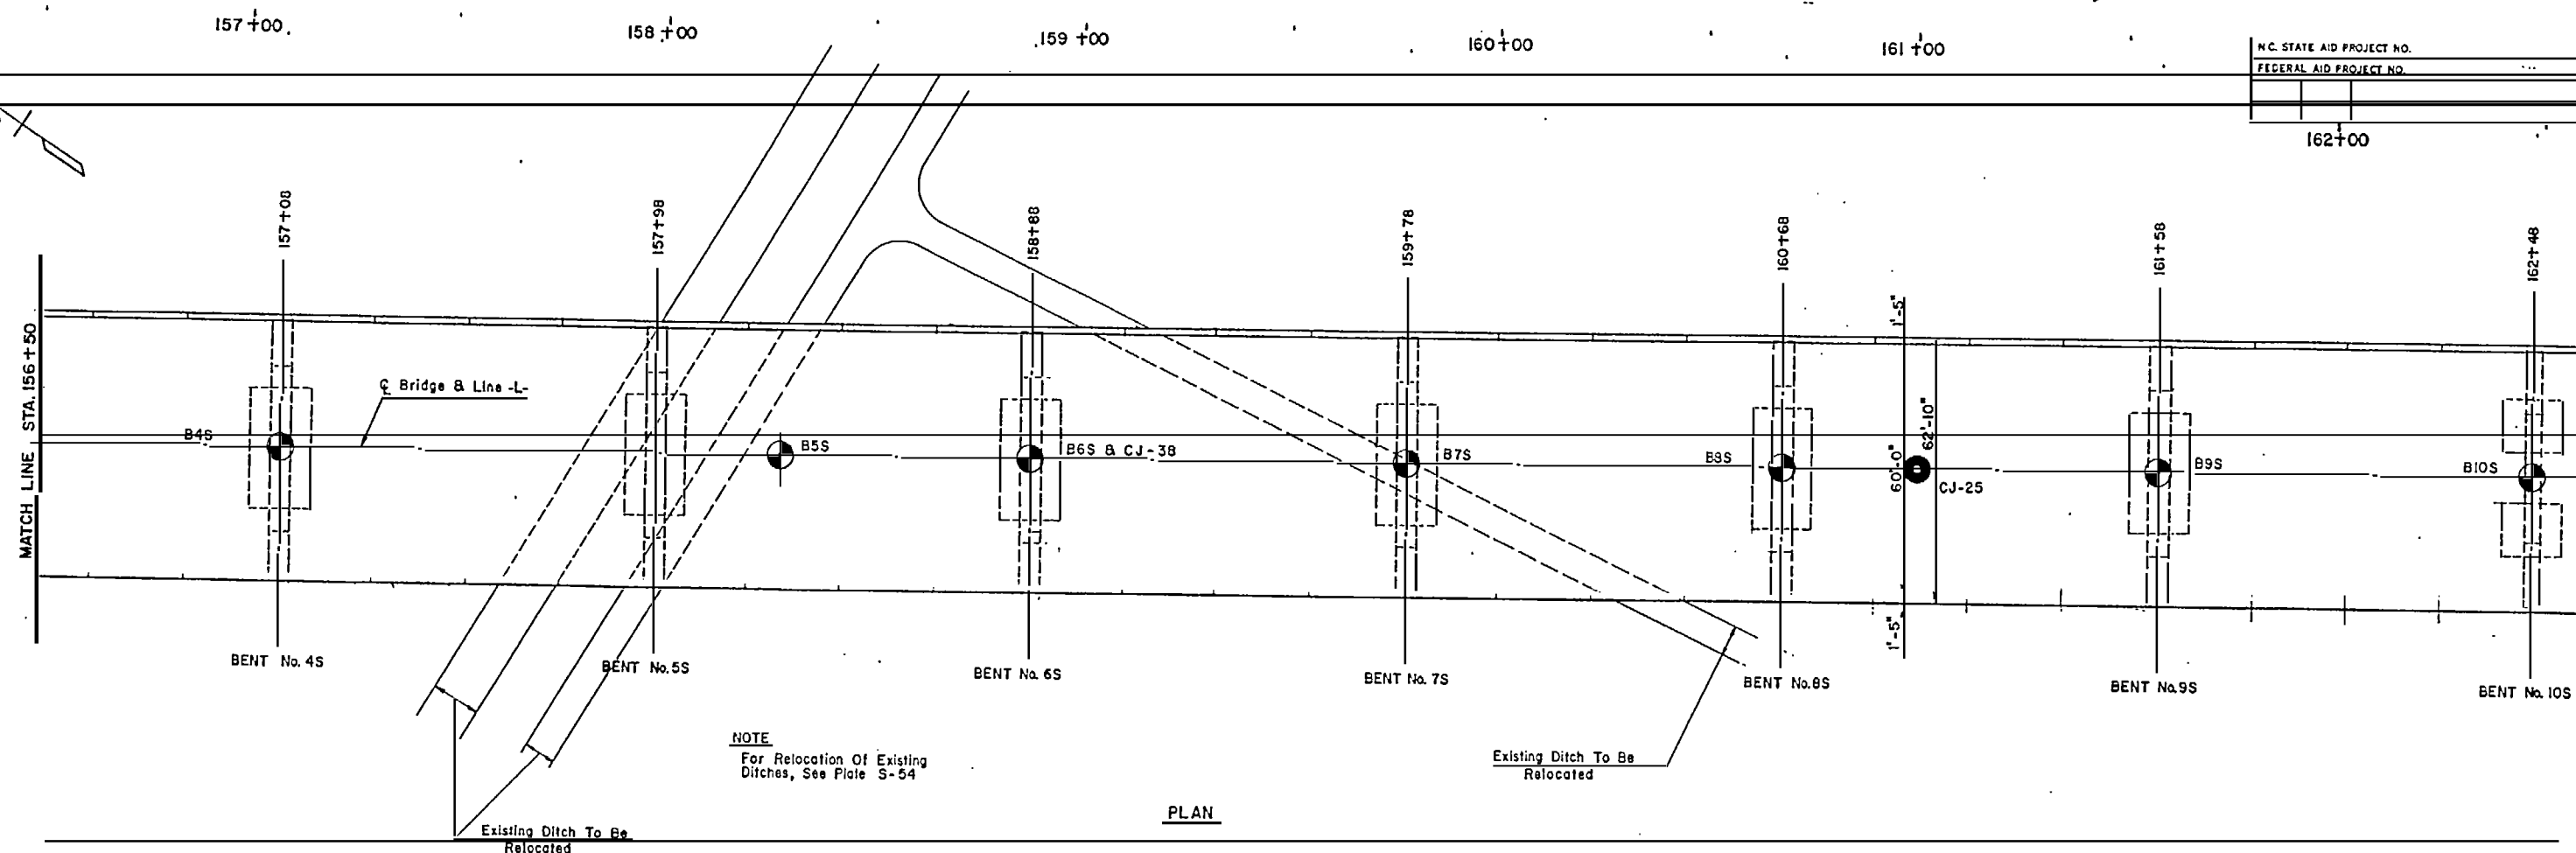

LEGEND


⊙ B(No.)N/S - DENOTES BORING LOCATION
OR
⊙ B NUMBER (SEE APPENDIX A
CJ-(No.) OF THE SPECS FOR BORING LOGS)

HNTB HOWARD NEEDLES TAMMEN & BERGENDOFF ARCHITECTS ENGINEERS PLANNERS ATLANTA, GEORGIA


U.S. ARMY ENGINEER DISTRICT, WILMINGTON CORPS OF ENGINEERS WILMINGTON, NORTH CAROLINA

RECORD DRAWING

DESIGNED BY: B.T.G.	CHECKED BY: M.A.M.	ATLANTIC INTRACOASTAL WATERWAY GENERAL PLAN AND ELEVATION	
COINJOCK BRIDGE REPLACEMENT PROJECT CURRITUCK COUNTY NORTH CAROLINA		INVITATION NO. DACW 54-83-B-0014	PLATE NO. S-4
PRINCIPAL OF FIRM HNTB		SCALE: 1" = 20'	DATE: 22 JULY 1983 SHEET 54 OF 126

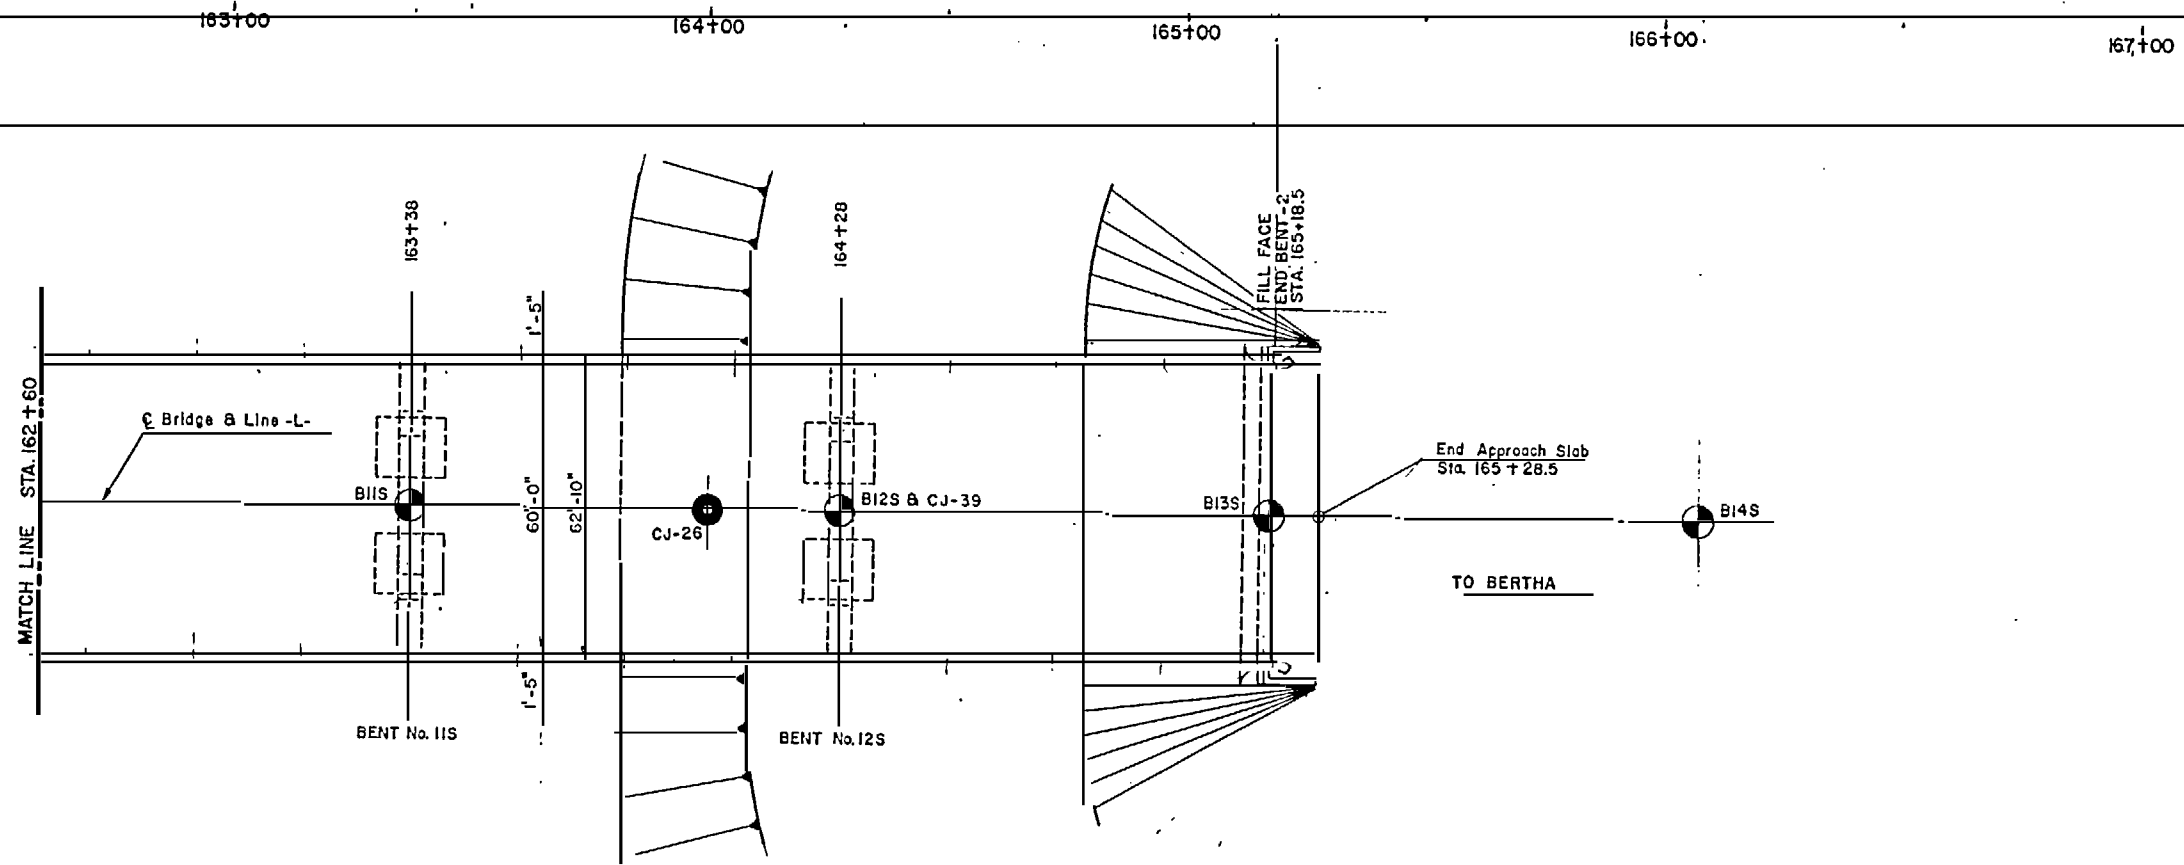

PLAN

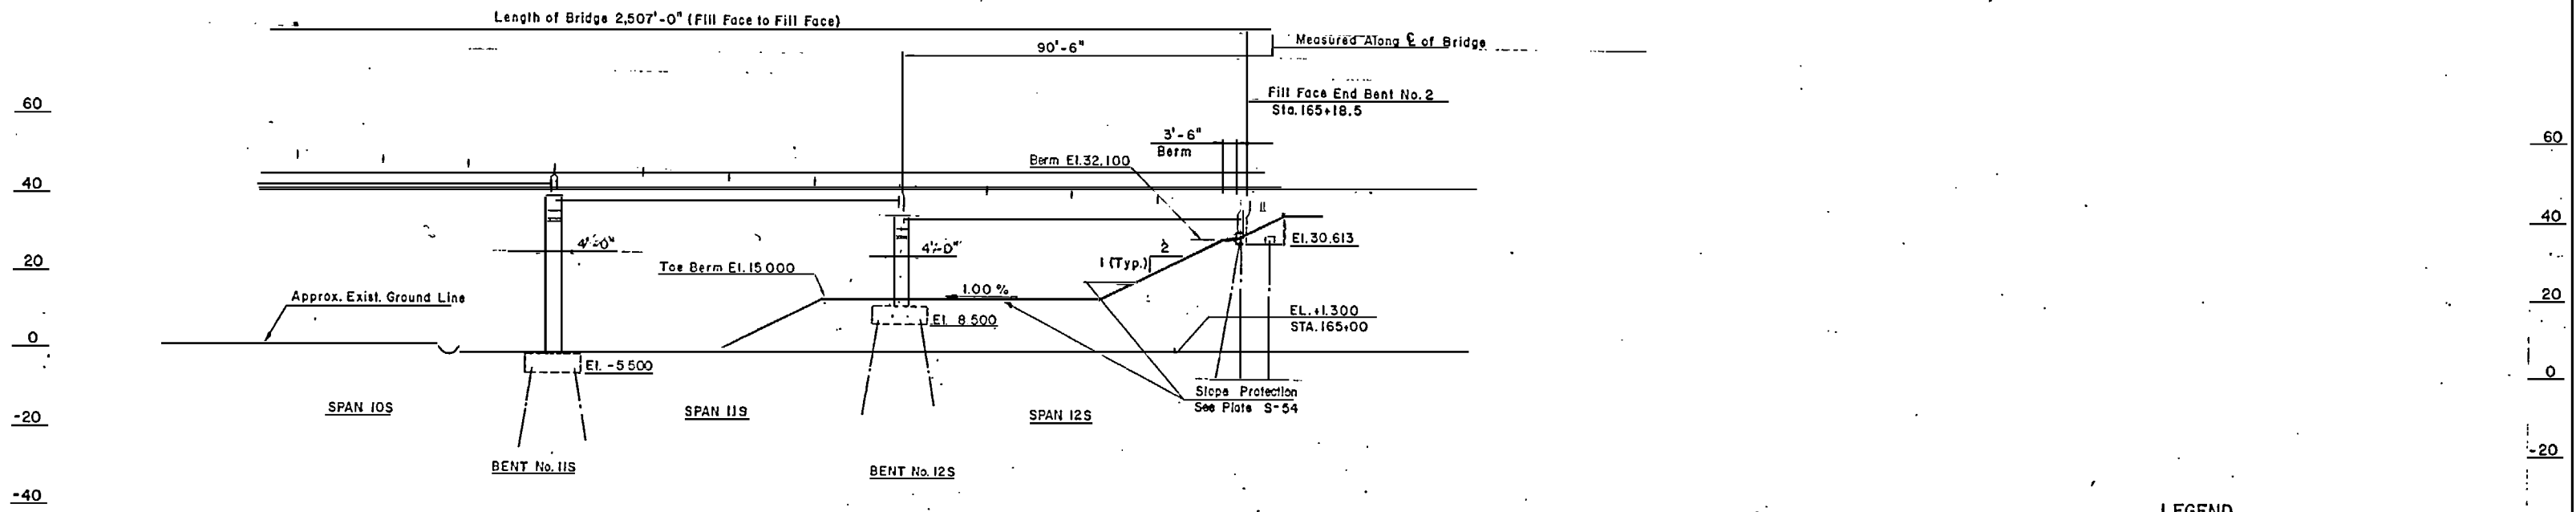

ELEVATION

N.C. STATE AID PROJECT NO.	FED. RD. DIST. NO.
FEDERAL AID PROJECT NO.	

LEGEND

- B(No.)/N/S - DENOTES BORING LOCATION OR B NUMBER (SEE APPENDIX A OF THE SPECS. FOR BORING LOGS)
- CJ-(No.) DENOTES BORING LOCATION OR B NUMBER (SEE APPENDIX A OF THE SPECS. FOR BORING LOGS)

RECORD DRAWING

HNTB HOWARD NEEDLES TAMMEN & BERENDOFF ARCHITECTS ENGINEERS PLANNERS ATLANTA, GEORGIA U.S. ARMY ENGINEER DISTRICT, WILMINGTON, NORTH CAROLINA CORPS OF ENGINEERS WILMINGTON, NORTH CAROLINA

ATLANTIC INTRACOASTAL WATERWAY
GENERAL PLAN AND ELEVATION

COINJOCK BRIDGE REPLACEMENT PROJECT
CURRITUCK COUNTY NORTH CAROLINA

DESIGNED BY: B.T.G.	CHECKED BY: M.A.M.	INVESTIGATION NO. DACW 54-83- B-0014	SIZE DRAWING NUMBER BR104-06-17	PLATE NO. S-5
PRINCIPAL OF FIRM HNTB		SCALE 1"=20'	DATE 22 JULY 1983	SHEET 55 OF 126

34504000

NOTE:

QUANTITIES LISTED IN THE BILL OF MATERIALS ARE ESTIMATED QUANTITIES AND ARE FOR INFORMATION ONLY.

N.C. STATE AID PROJECT NO.	FED. RD. DIV. NO.
FEDERAL AID PROJECT NO.	REV. NO.
8/10/83	1, REV. QTY. OF CLASS A CONC. & ADD NOTE 4
	G.M.C.

TOTAL BILL OF MATERIALS

	CLASS A CONCRETE	CLASS AA CONCRETE	CLASS S CONCRETE	REINFORCING STEEL	54" PRE-STRESSED CONCRETE GIRDERS	VARIABLE DEPTH PRESTRESSED CONCRETE GIRDERS	LINSEED OIL CONCRETE PROTECTION	FOUNDATION EXCAVATION	NAVIGATIONAL LIGHTING SYSTEM	BRIDGE APPROACH SLABS	ELASTOMERIC BEARINGS	TREATED STRUCTURAL TIMBER	STONE SLOPE PROTECTION	TREATED TIMBER PILES	12" SQUARE CONCRETE PILES	20" SQUARE OR 22" OCTAGONAL CONCRETE PILES	COFFERDAMS	REMOVAL OF EXISTING BRIDGE	TEST PILES	PILE LOAD TEST	PERFORMED COMPRESSION JOINT SEAL
	CU. YDS.	CU. YDS.	CU. YDS.	LBS.	LIN. FT.	LIN. FT.	GALS.	CU. YDS.	LUMP SUM	SQ. FT.	EACH	M. B.F.	SQ. YDS.	LIN. FT.	LIN. FT.	LIN. FT.	LUMP SUM	LUMP SUM	LIN. FT.	EACH	LUMP SUM
SUPERSTRUCTURE		4,965.6		1,210,873	18,985	960	375				16										
END BENT NO. 1	26.6			4,644						599	8		1,360		1,025						
BENT NO. 1N	406.7		188.2	61,214				75			8					1,655					
BENT NO. 2N	279.2			73,598				153			16										
BENT NO. 3N	253.2			47,731				148			16								95	1	
BENT NO. 4N	262.6			49,731				137			16										
BENT NO. 5N	257.0			46,073				153			16										
BENT NO. 6N	230.2			43,022				142			16										
BENT NO. 7N	224.1			42,110				133			16										
BENT NO. 8N	220.1			41,431				133			16								85	1	
BENT NO. 9N	216.2			40,773				136			16										
BENT NO. 10N	165.3			37,405				162			16										
BENT NO. 11N	161.9			36,895				161			16										
BENT NO. 12N	157.9			35,974				166			16										
BENT NO. 13N	153.8			33,526				171			16								85	1	
BENT NO. 14N	126.4			13,883				85			16										
BENT NO. 1S	429.3		239.6	62,653				79			8										
BENT NO. 2S	276.4			74,083				155			16										
BENT NO. 3S	268.2			48,346				151			16										
BENT NO. 4S	265.6			47,984				153			16								95	1	
BENT NO. 5S	262.2			47,158				153			16										
BENT NO. 6S	237.7			44,327				141			16										
BENT NO. 7S	231.6			43,382				137			16										
BENT NO. 8S	224.8			42,195				135			16										
BENT NO. 9S	218.1			40,996				135			16								100	1	
BENT NO. 10S	166.4			37,644				164			16										
BENT NO. 11S	162.5			36,891				165			16										
BENT NO. 12S	137.8			30,821				185			16										
END BENT NO. 2	26.6			4,644						599	8		1,149		2,095						
FENDER SYSTEM												29,624		13,714							
CURVED END BLOCKS	2.5			560																	
EXTRA TEST PILE																					
TOTAL	8083.0	4,965.6	427.8	2,380,464	18,985	960	375	3,726	LUMP SUM	1,198	432	29,624	2,529	13,714	3,930	28,855	LUMP SUM	LUMP SUM	555	5	LUMP SUM

ESTIMATED QUANTITIES IN DECK SLAB

	UNIT	SPAN 14N	SPANS 13N-3N (one span given)	SPAN 2N	SPAN 1N	SPAN DROP-IN	SPAN 1S	SPAN 2S	SPANS 3S-11S (one span given)	SPAN 12S
CLASS AA CONCRETE	CU. YDS.	191.3	176.37	152.6	285.5	179.4	285.5	152.6	176.37	191.3
REINFORCING STEEL	LBS.	42,289.0	41,147.0	36,042.0	91,901.0	47,469.0	91,901.0	36,042.0	41,147.0	42,289.0
LINSEED OIL CONCRETE PROTECTION	GALS.	13.5	13.5	11.5	20.8	13.4	20.8	11.5	13.5	13.5

RECORD DRAWING

HNTB HOWARD NEEDLES TAMMEN & BERGENSTADT ARCHITECTS ENGINEERS PLANNERS ATLANTA, GEORGIA

ATLANTIC INTRACOASTAL WATERWAY

BILL OF MATERIALS

COINJOCK BRIDGE REPLACEMENT PROJECT CURRITUCK COUNTY NORTH CAROLINA

DESIGNED BY: C.A.C. CHECKED BY: J.A.L.
 PREPARED BY: [Signature]
 PRINCIPAL OF FIRM HNTB

INVESTIGATION NO. DACW54-83-8-0014
 SCALE NONE
 DATE 22 JULY 1983
 DRAWING NUMBER BR104-06-17
 SHEET 56 OF 126

- ① INCLUDES QUANTITIES FOR DROP-IN SPAN AND CONSTANT DEPTH PORTION OF ANCHOR SPAN.
- ② INCLUDES QUANTITIES FOR CLOSURE-POUR.
- ③ INCLUDES QUANTITIES FOR CLOSURE-POUR.
- ④ VOLUME OF PILE HEADS HAS NOT BEEN DEDUCTED FROM QUANTITY OF CLASS A CONCRETE.

NC STATE AID PROJECT NO.		FED RD DIV NO.
FEDERAL AID PROJECT NO.		
1	8/10/83 Add 1 ^c For Prestressed Concrete	GMG

Design Criteria

Roadway: 60'-0" Clear

Loadings: Dead Load: Includes a uniform load of 20 lbs. per sq. ft. for future wearing surface; Includes a uniform load of 12.5 lbs. per sq. ft. for stay-in-place metal forms.

Live Load: HS20-44 (HS18) and Military Loading (two 24 kips axles 4'-0" center to center)

Specifications: North Carolina Department of Transportation Standard Specifications for Roads and Structures, 1978, as modified by revisions; Supplemental Specifications, and Special Provisions.

Design: AASHTO Standard Specifications for Highway Bridges, 1977, and current Interim Specifications as supplemented and modified by the latest North Carolina Department of Transportation standards and practices.

Materials: Concrete: Prestressed Concrete Members, $f'_c = 5,500$ psi, $f'_c = 4,400$ PSI (Except Cantilever Segment) $f'_c = 5,000$ PSI (Cantilever Segment)
 Seals - Class S, $f'_c = 3,000$ psi
 Substructure - Class A, $f'_c = 3,000$ psi
 Superstructure - Class AA, $f'_c = 4,500$ psi
 Reinforcement: ASTM A615 - Grade 60

Treated Timbers: Creosote Preservative Treatment
 Tiebe and Lumber - 18 lbs. retention per cu. ft.
 Piles - treat to refusal - min. retention 22 lbs. per cu. ft.
 Retention will be determined by the assay method.

Prestressing Strands:
 As noted on the plans, design, detail and properties of strands is based on stress relieved strands. Stress relieved strands must be used for Spans 1N and 1S. For all other spans, the Contractor, at his option, may use low-relaxation strands in lieu of stress relieved strands in accordance with the following:

Design and strand pattern must provide at least the same net compressive stress after the losses. The ultimate strength of the girder must meet the requirements of the applicable AASHTO specifications. Low-relaxation strands shall be tensioned and anchored at a load equal to 75% of its ultimate strength. This applied prestressed force shall be shown on the plans. Size of low-relaxation strands shall not be larger than those shown for stress relieved strands. Design and detail plans using low relaxation strands must be submitted to the Engineer for approval. Any additional cost due to the use of low relaxation strands will be paid for by the Contractor.

All prestressing strands shall be 7-wire stress relieved or low-relaxation Grade 270 strands and shall conform to ASTM A-416 except for sampling requirements which shall be in accordance with the standard specifications.

General Notes

Datum: Mean Sea Level - (1929) - Elevation 0.00

Concrete Surface Finish: All formed surfaces shall receive an Ordinary Surface Finish. Unless otherwise noted, all exposed edges shall be chamfered 3/4".

Dimensions: All dimensions are measured horizontally or vertically unless otherwise noted. All elevations refer to Mean Sea Level.

Excavation: There is no separate payment for end bent excavation or backfill, it is included as part of the lump sum bid price for the "New Bridge - Sta. 153+55".

Test Piles: The Contractor shall drive a 22" octagonal or 20" square prestressed concrete test pile, at the following locations and where shown on the plans:

		Estimated Length
Bent No. 12N	One pile	85.0'
Bent No. 7N	One pile	85.0'
Bent No. 2N	One pile	95.0'
Bent No. 3S	One pile	95.0'
Bent No. 8S	One pile	100.0'

Test piles shall have the same cross sectional dimensions as all other piles to be used in intermediate bents, shall be driven vertically and shall be load tested to a minimum of 250 tons as described in the technical provisions. After testing, they shall be cut off and become part of the completed structure, provided that they conform to the specifications and are driven in the presence of the Contracting Officer. Test piles shall be paid for at the contract unit price per linear foot for Test Piles. Loading tests shall be paid for at the contract unit price per each for pile load tests.


Piles: The piles for End Bents 1 and 2 shall be 12-inch square prestressed concrete, shall be driven to a minimum bearing capacity of 30 tons each, and shall be driven to at least the minimum pile tip elevations shown on the Drawings. Piles in end bents shall be pre-sugared to the bottom of the fill. The piles for the intermediate bents shall be (at the Contractor's option) either 20-inch square or 22-inch octagonal prestressed concrete, shall be driven to a minimum bearing capacity of 125 tons each, and shall be driven to at least the minimum pile tip elevations shown on the Drawings. All timber piles for the fender system shall be driven to a minimum bearing capacity of 10 tons each and to at least the minimum pile tip elevations shown on the Drawings. The minimum pile tip elevation shown refers to an elevation above which the pile tip is not intended to be stopped.

Waiting Period: No work shall begin on end bents 1 and 2, and on intermediate bents 14N, 13N and 12S until all embankment fill has been in place a minimum of 9 months. See the Technical Provisions.

Falsework: Care shall be taken to insure that falsework for the bent column forms is set to give the correct lines shown on the Drawings with proper allowance for shrinkage, deflections, and settlement. Falsework supporting the columns shall not be removed until the concrete in the bent cap has reached the strength specified in Article 420-18 of the Standard Specifications.

Removal of Existing Structure: Upon completion of the new bridge and roadway, and upon notice by the Engineer, the existing swing span bridge located approximately 950 feet northeast of the new waterway crossing and submerged portions of a former bridge shall be removed. See Special Provisions.


Epoxy Protective Coating: An epoxy protective coating for concrete shall be applied to the top surfaces and edge changers of all bent caps, except Bents 1N and 1S but including End Bents 1 and 2. The epoxy protective coating shall not be applied to the areas under the elastomeric bearings. The concrete surfaces to be epoxy coated shall be cured in accordance with the Standard Specifications except the Membrane Curing Compound Method shall not be used.

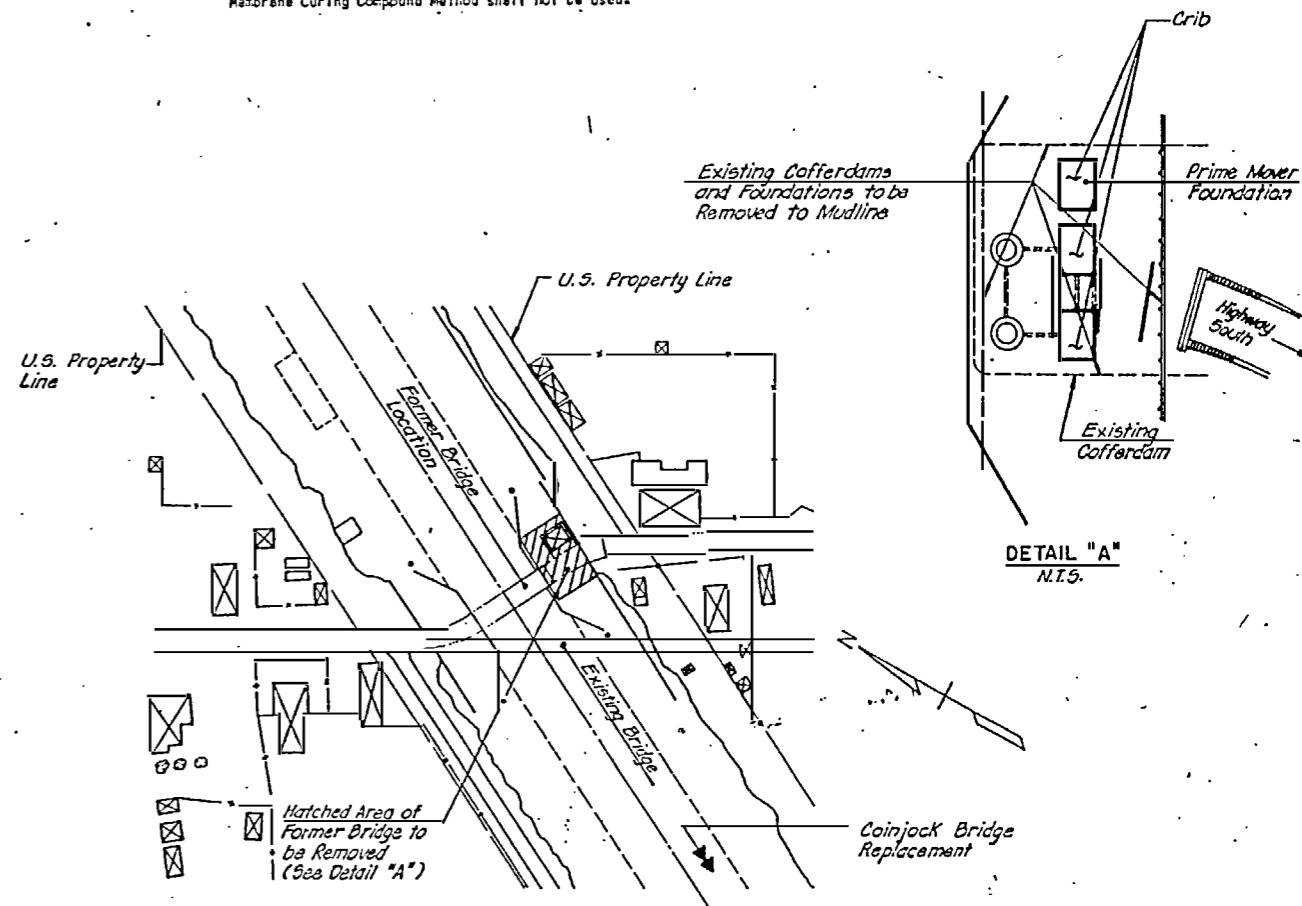


REMOVAL OF SUBMERGED PORTIONS OF FORMER BRIDGE
 N.T.S.



RECORD DRAWING

HNTB HOWARD NEEDLES TAMMEN & BERENSON ARCHITECTS ENGINEERS PLANNERS ATLANTA, GEORGIA		U.S. ARMY ENGINEER DISTRICT WILMINGTON CORPS OF ENGINEERS WILMINGTON, NORTH CAROLINA	
ATLANTIC INTRACOASTAL WATERWAY			
GENERAL NOTES			
COINJOCK BRIDGE REPLACEMENT PROJECT			
CURRITUCK COUNTY		NORTH CAROLINA	
DESIGNED BY: J.A.L.	CHECKED BY: J.E.W.	INVESTIGATION NO. DACW54-83- B-0014	DATE 22 JULY 1983
PREPARED BY: [Signature]	SCALE NONE	DRAWING NUMBER BR104-06-17	PLATE NO. S-7
PRINCIPAL OF FIRM HNTB		SHEET 57 OF 126	

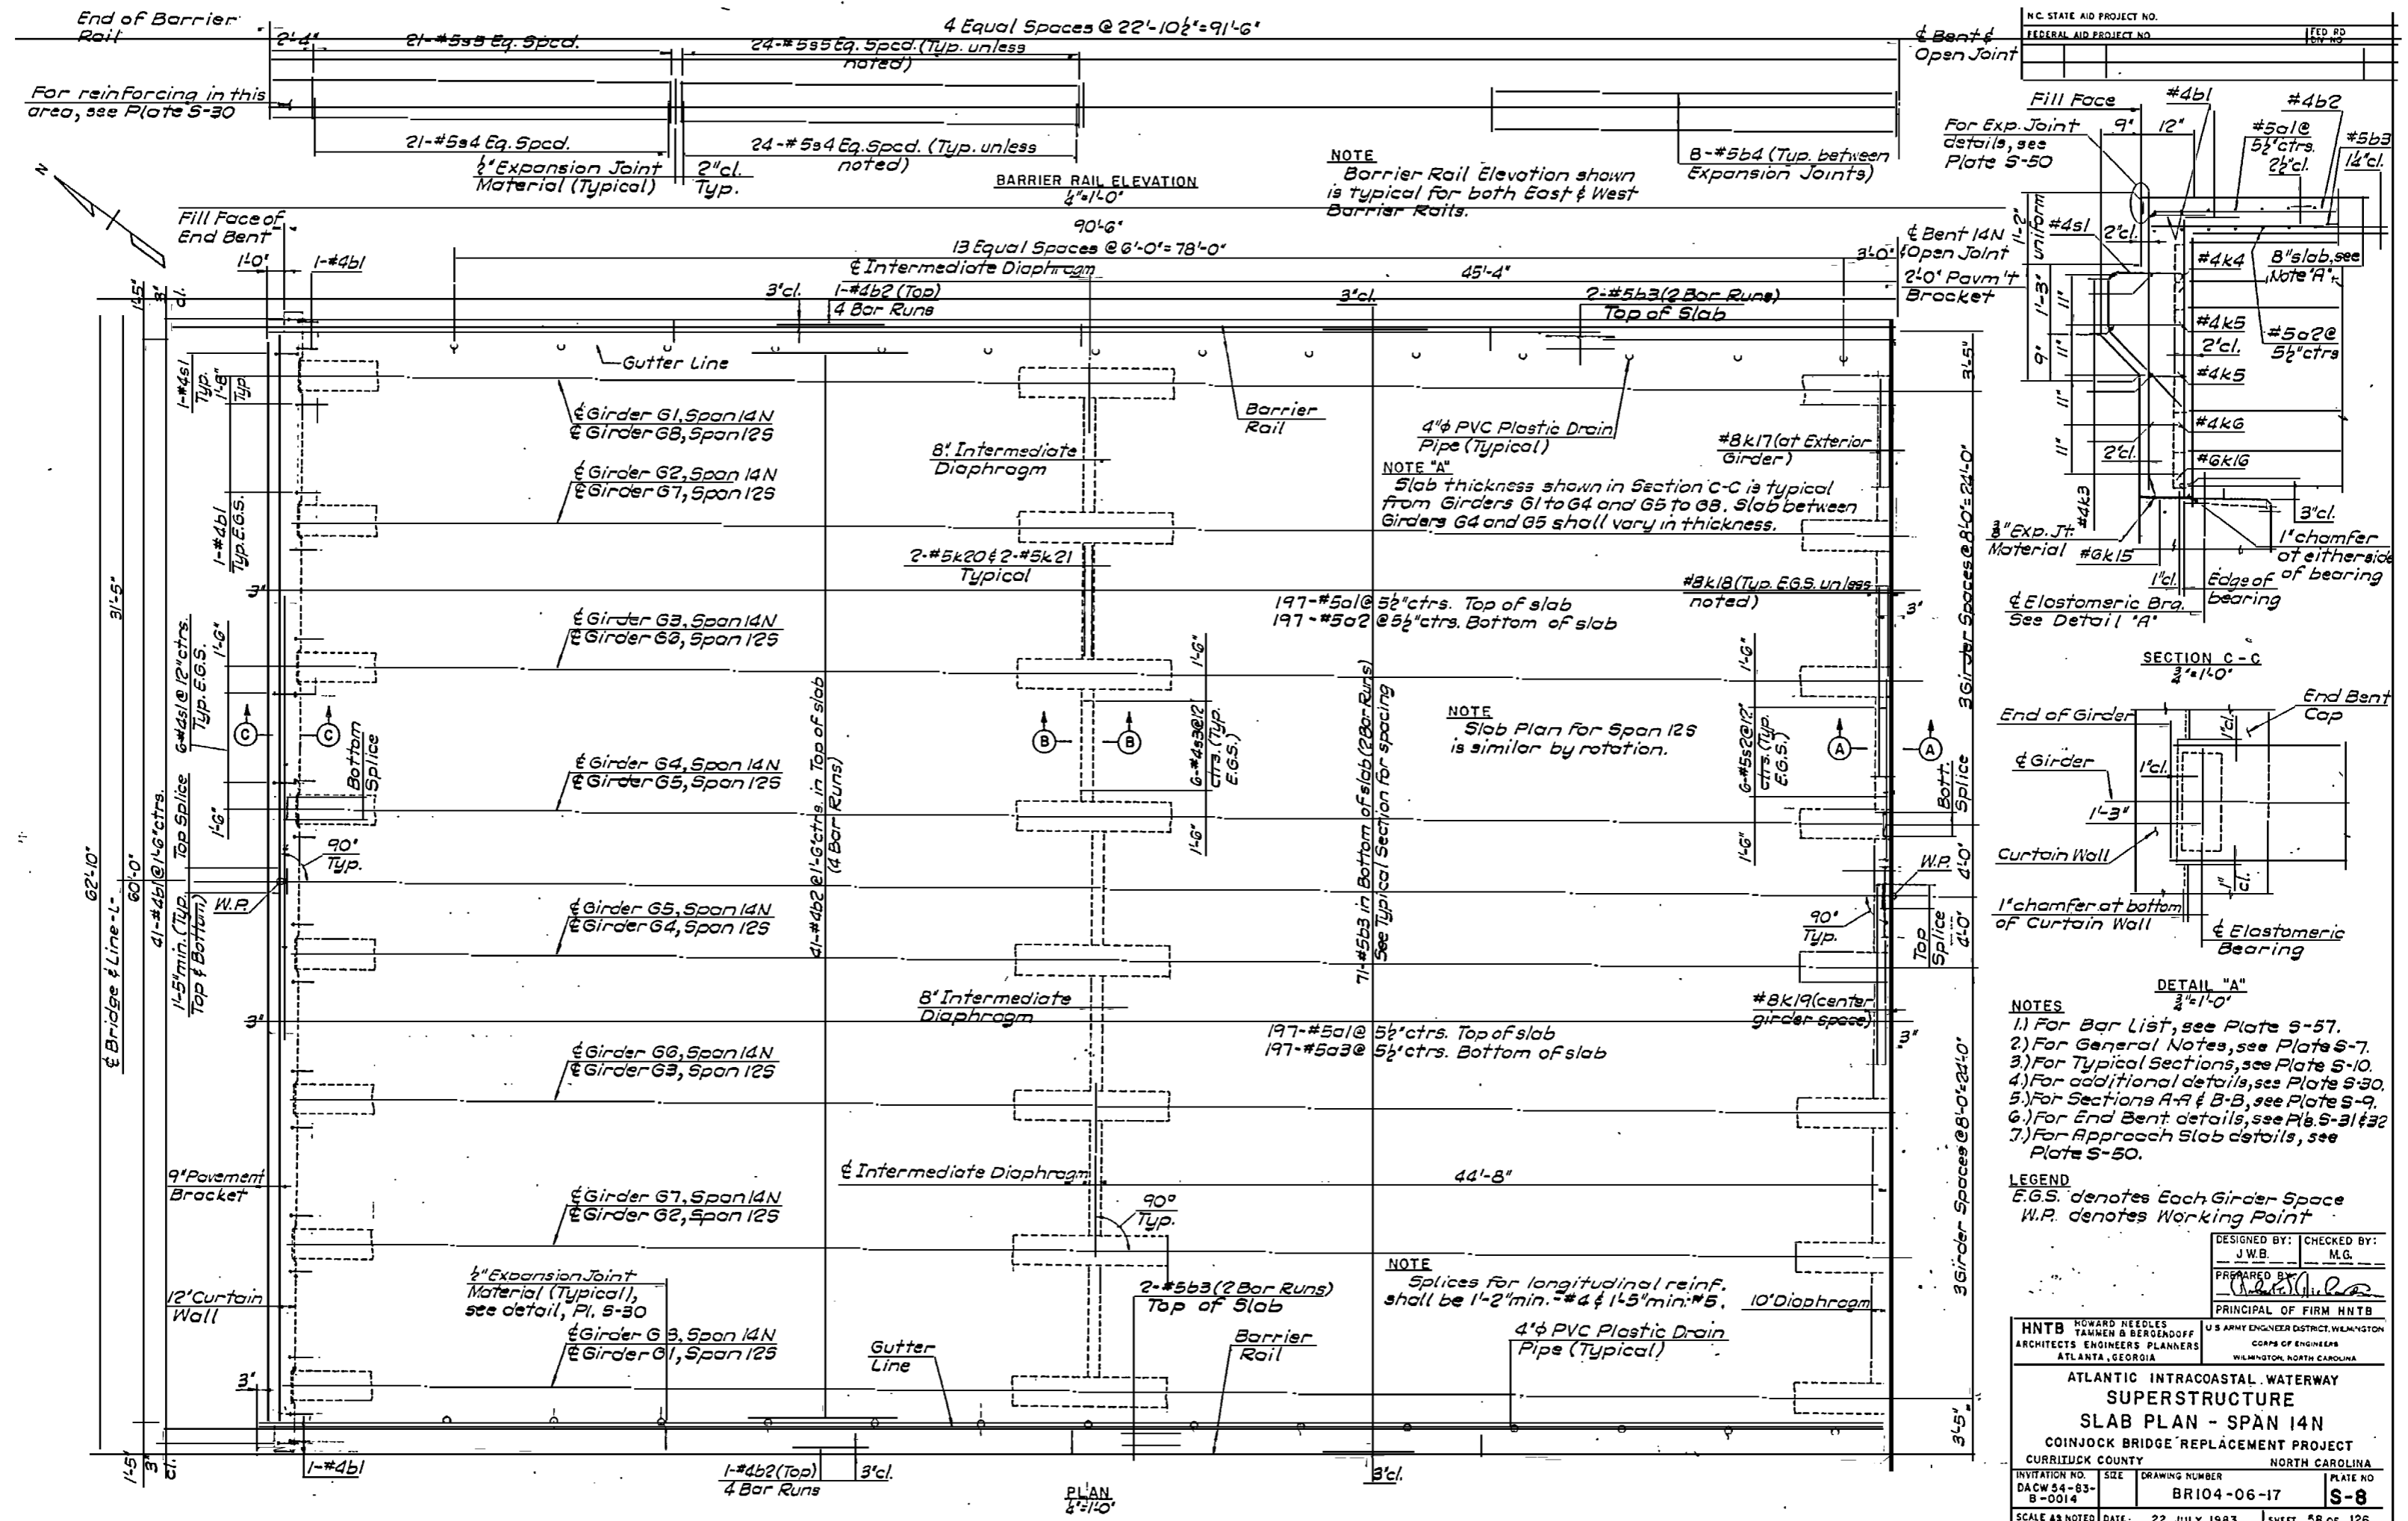

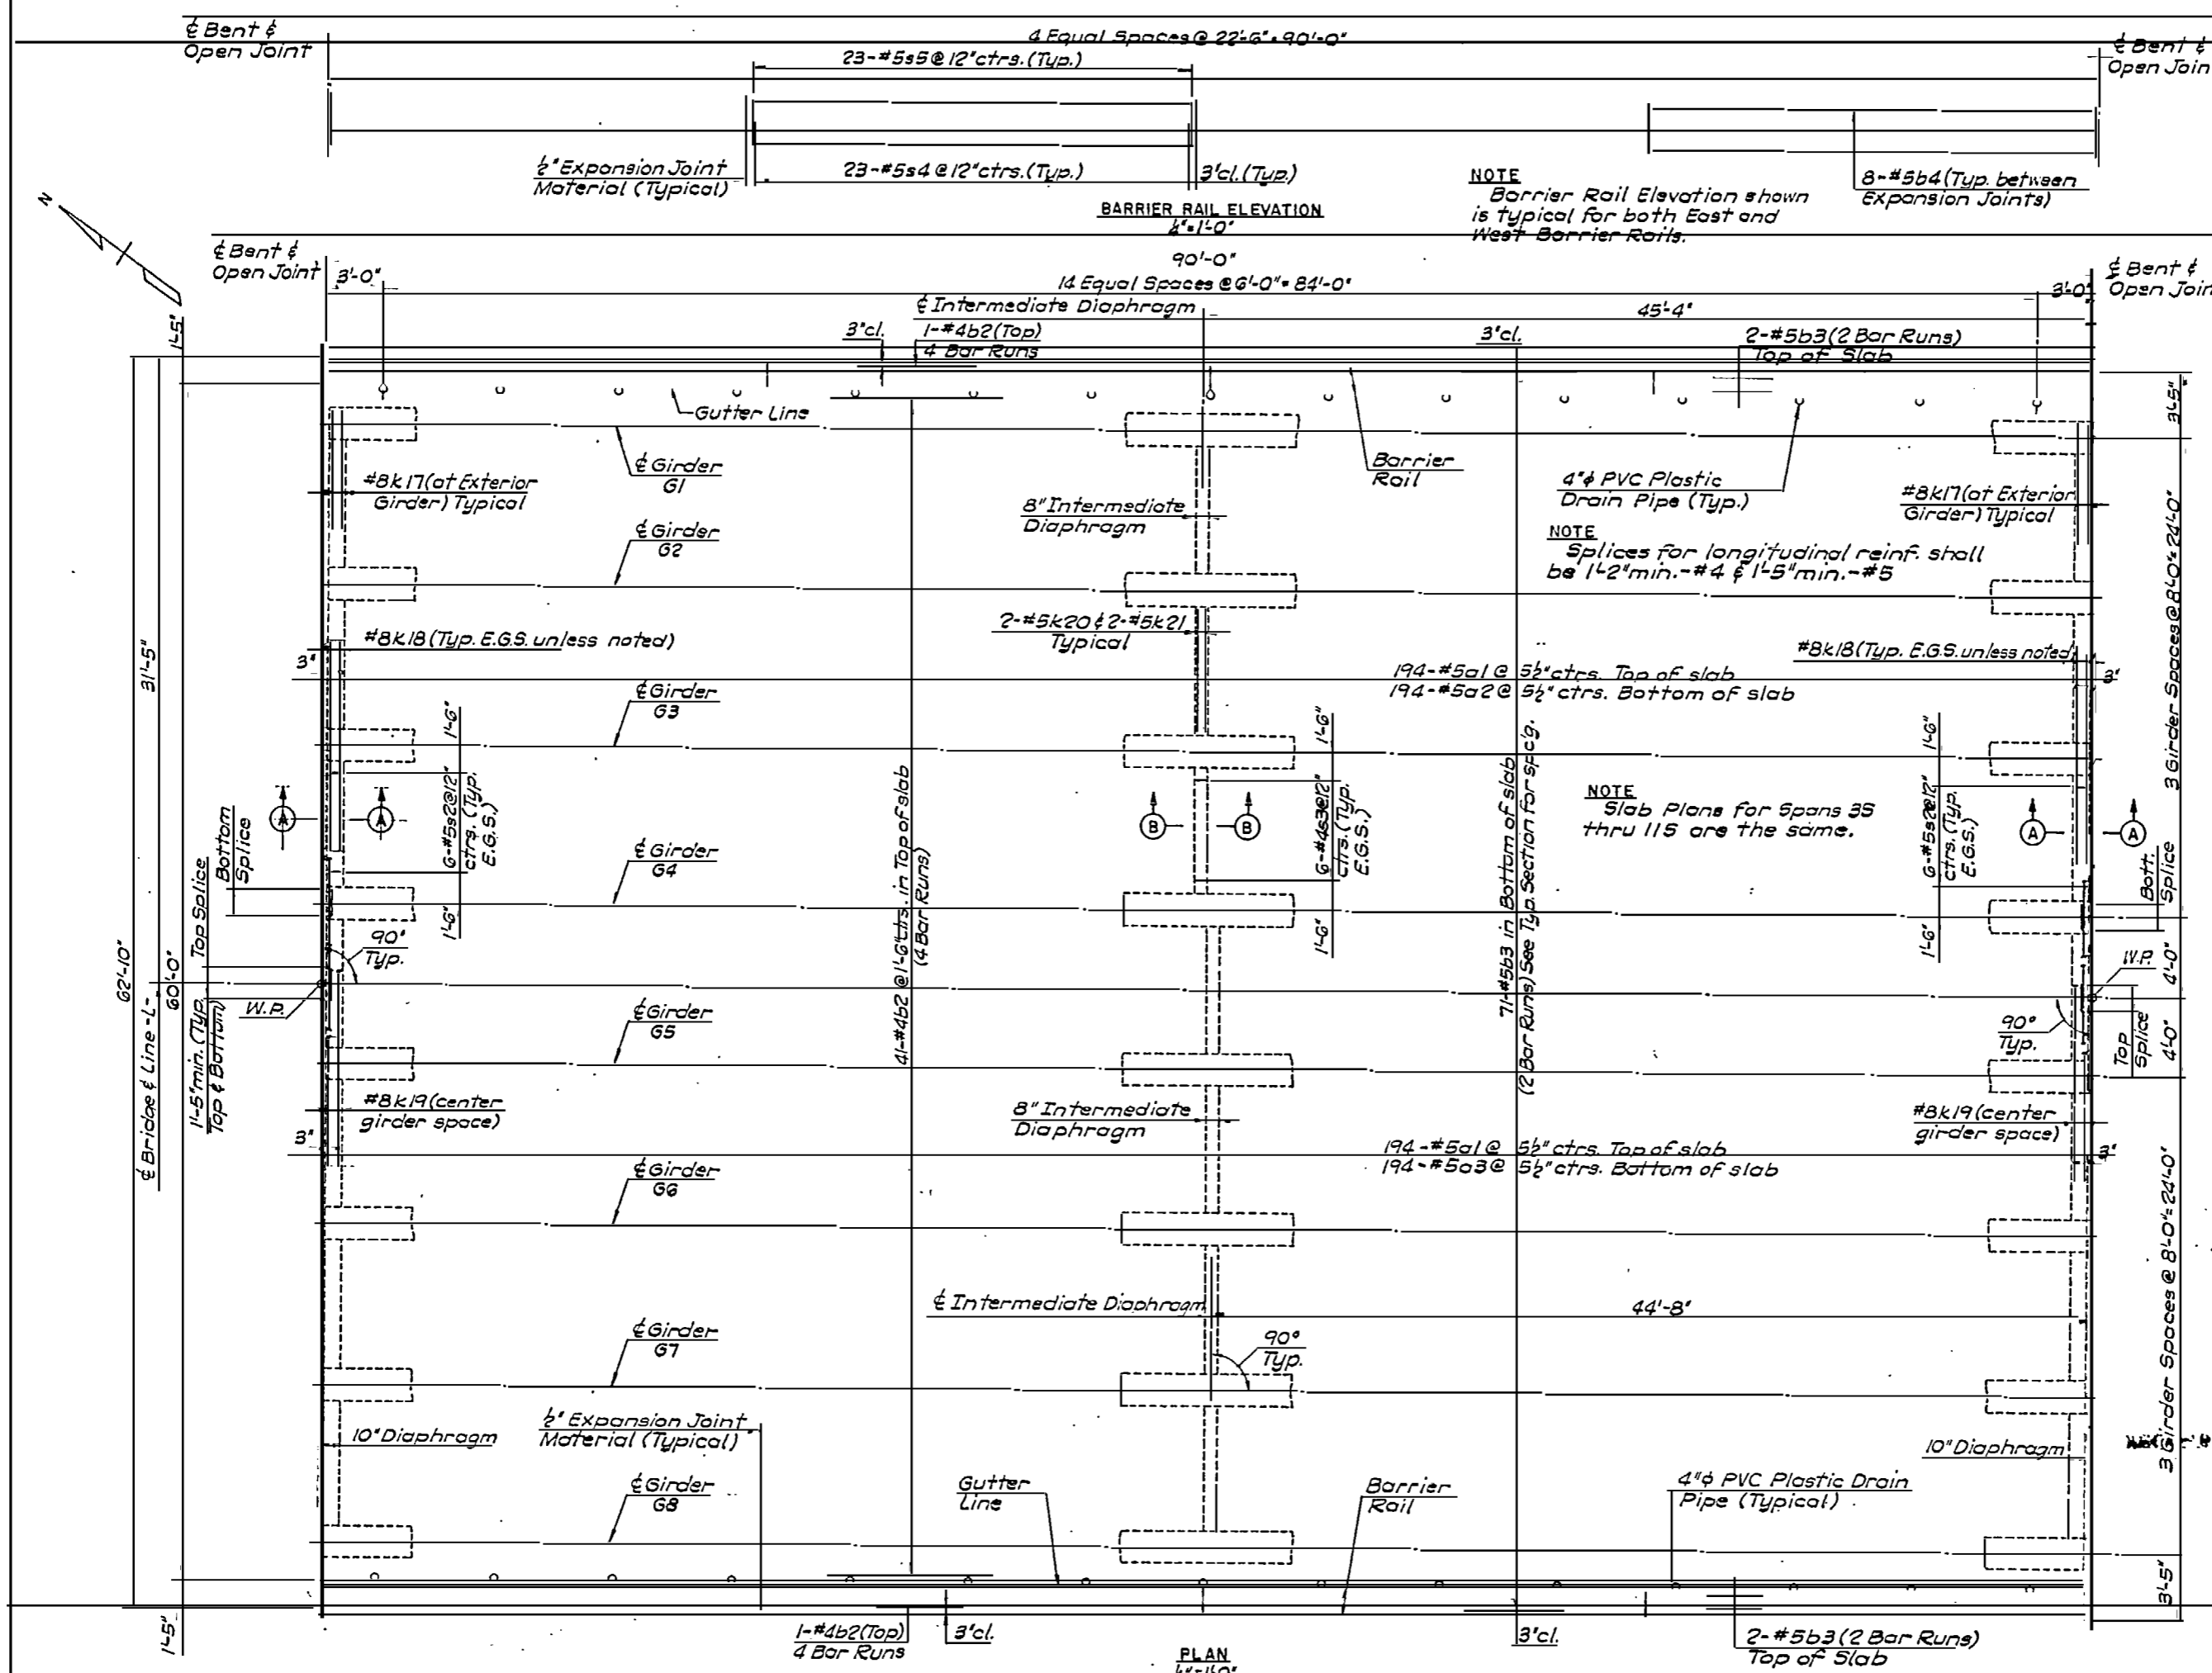

N.C. STATE AID PROJECT NO.	FEED NO.
FEDERAL AID PROJECT NO.	REV. NO.

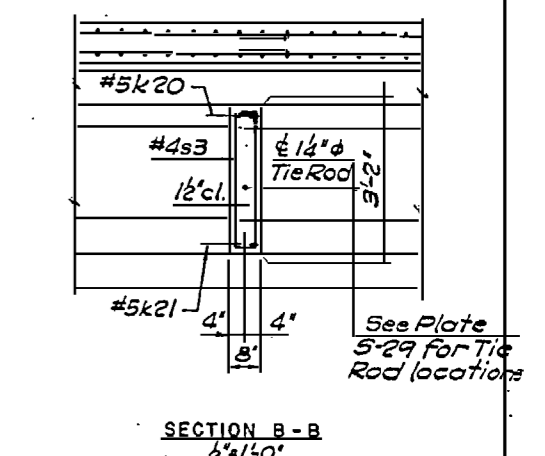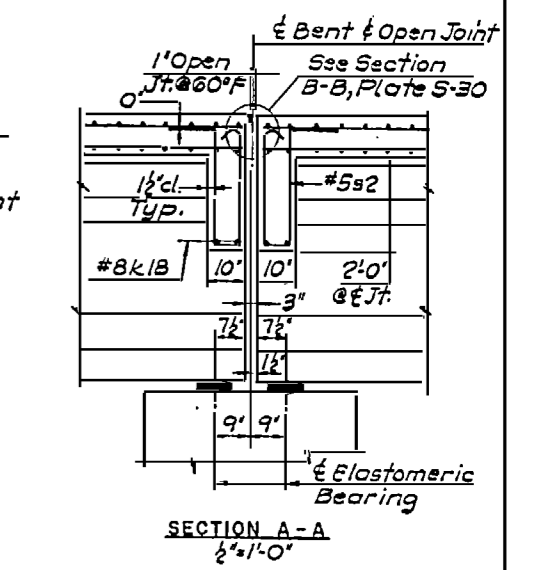

- NOTES**
- 1) For Bar List, see Plate S-57.
 - 2) For General Notes, see Plate S-7.
 - 3) For Typical Sections, see Plate S-10.
 - 4) For additional details, see Plate S-30.
 - 5) For Prestressed Girder details, see Plate S-22.
 - 6) For Expansion Joint details in Barrier Rails, see Plate S-30.

LEGEND
 E.G.S. denotes Each Girder Space
 W.P. denotes Working Point

RECORD DRAWING

DESIGNED BY: JWB.	CHECKED BY: M.G.
PREPARED BY: [Signature]	
PRINCIPAL OF FIRM HNTB	

HNTB HOWARD NEEDLES TAMMEN & BERGENDOFF ARCHITECTS ENGINEERS PLANNERS ATLANTA, GEORGIA

U.S. ARMY ENGINEER DISTRICT, WILMINGTON CORPS OF ENGINEERS WILMINGTON, NORTH CAROLINA

ATLANTIC INTRACOASTAL WATERWAY SUPERSTRUCTURE
SLAB PLAN - SPANS 3N THRU 13N
COINJOCK BRIDGE REPLACEMENT PROJECT


CURRITUCK COUNTY NORTH CAROLINA

INVITATION NO. DACW54-83-B-0014	SIZE	DRAWING NUMBER BR104-06-17	PLATE NO. S-9
---------------------------------	------	----------------------------	---------------

SCALE AS NOTED DATE 22 JULY 1983 SHEET 59 OF 126

PLAN
 1/4" = 1'-0"


N.C. STATE AID PROJECT NO.	FED. RD DIST. NO.
FEDERAL AID PROJECT NO.	

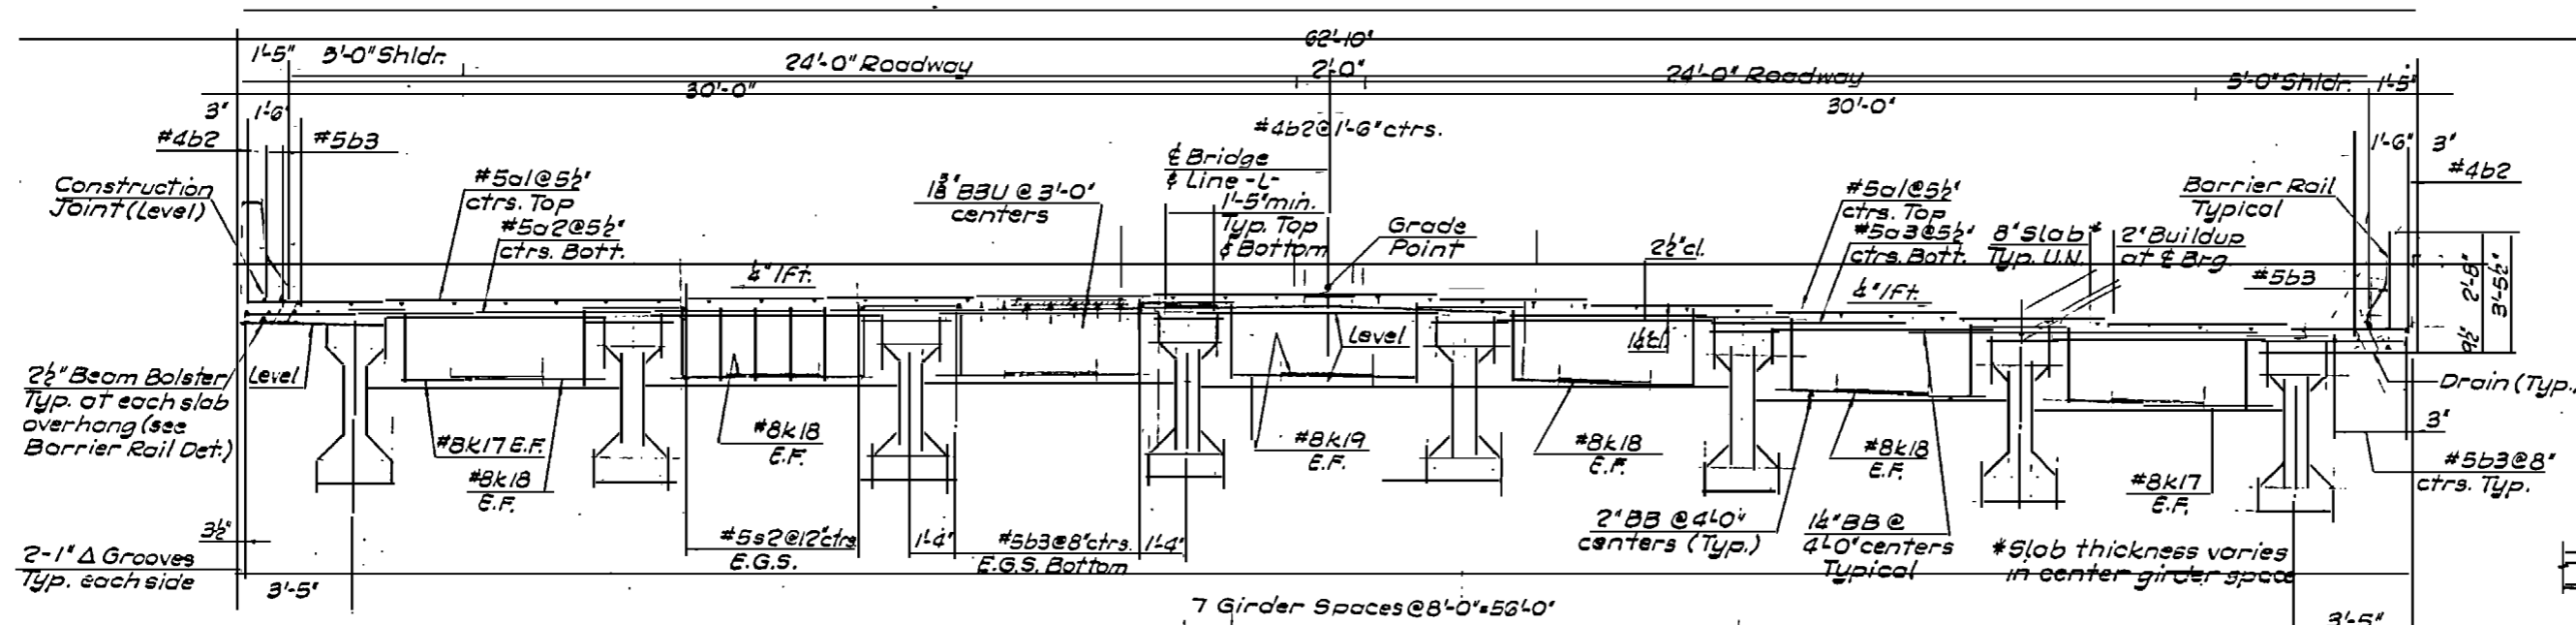


NOTES (CLASS AA CONCRETE)
1.) The quantity of all Class AA Concrete in Spans 14N and 12S averages 211 C.Y./Lin. Ft. of deck.
2.) The quantity of all Class AA Concrete in Spans 3N thru 14N and 3S thru 11S averages 1.96 C.Y./Lin. Ft. of deck.

TYPICAL SECTION (at Open Joint)
3/4" x 1'-0"

NOTE
Metal Stay-In-Place forms have not been shown on Cross Sections. For Typical Details, see Plate S-30.

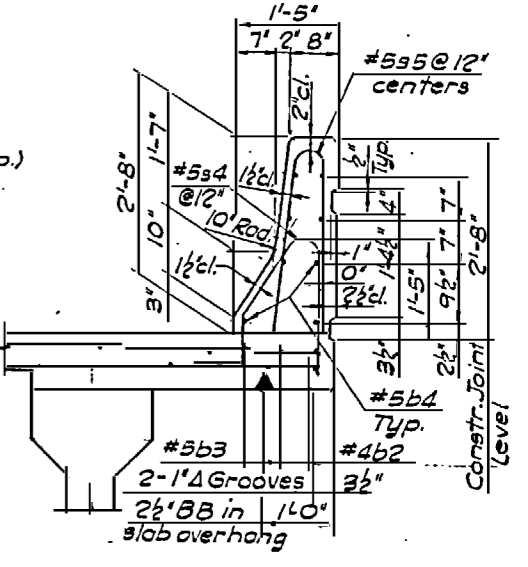


NOTE
At the Contractor's option he may use the alternate Barrier Rail Section shown on Plate No. S-30.

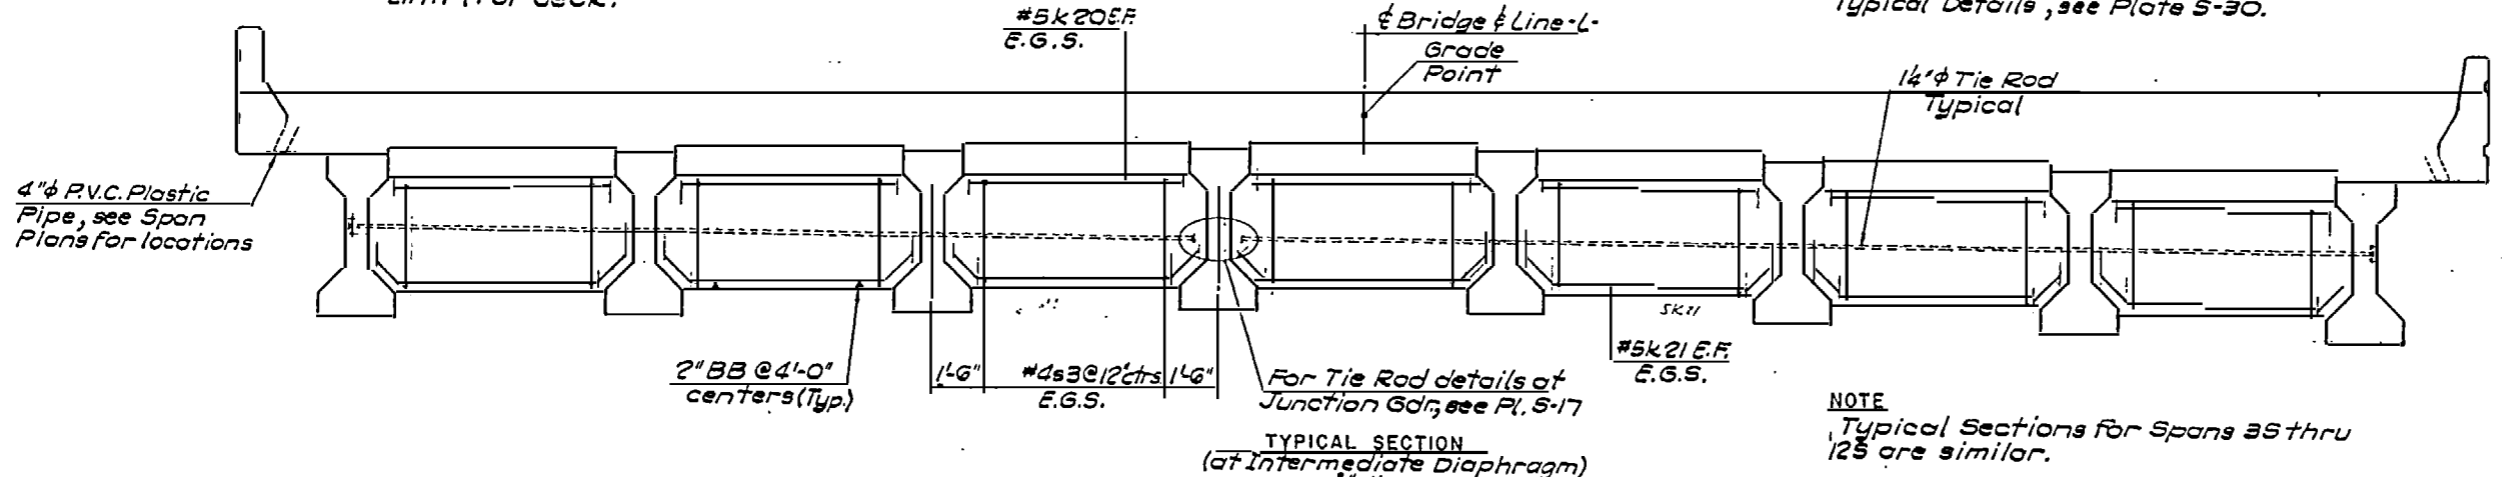

NOTE
Typical Sections for Spans 3S thru 12S are similar.

NOTES
1.) For General Notes, see Plate S-7.
2.) For additional details, see Pl's S-8 & 9.
3.) For End Bent details, see Pl's S-31 & 32.
4.) For Girder details, see Plate S-22.
5.) Temporary struts shall be placed between prestressed girders adjacent to the diaphragms and the nuts on the 14"φ Tie Rods shall be fully tightened before diaphragms are cast. Struts shall remain in place 3 days after concrete is placed. The Tie Rods shall be retightened after the struts have been removed.

LEGEND
F.F. denotes Fill Face
B.F. denotes Back Face
E.G.S. denotes Each Girder Space
B.B. denotes Beam Bolster
U.N. denotes Unless Noted
B.B. denotes Beam Bolster Upper Face
E.F. denotes Each Face

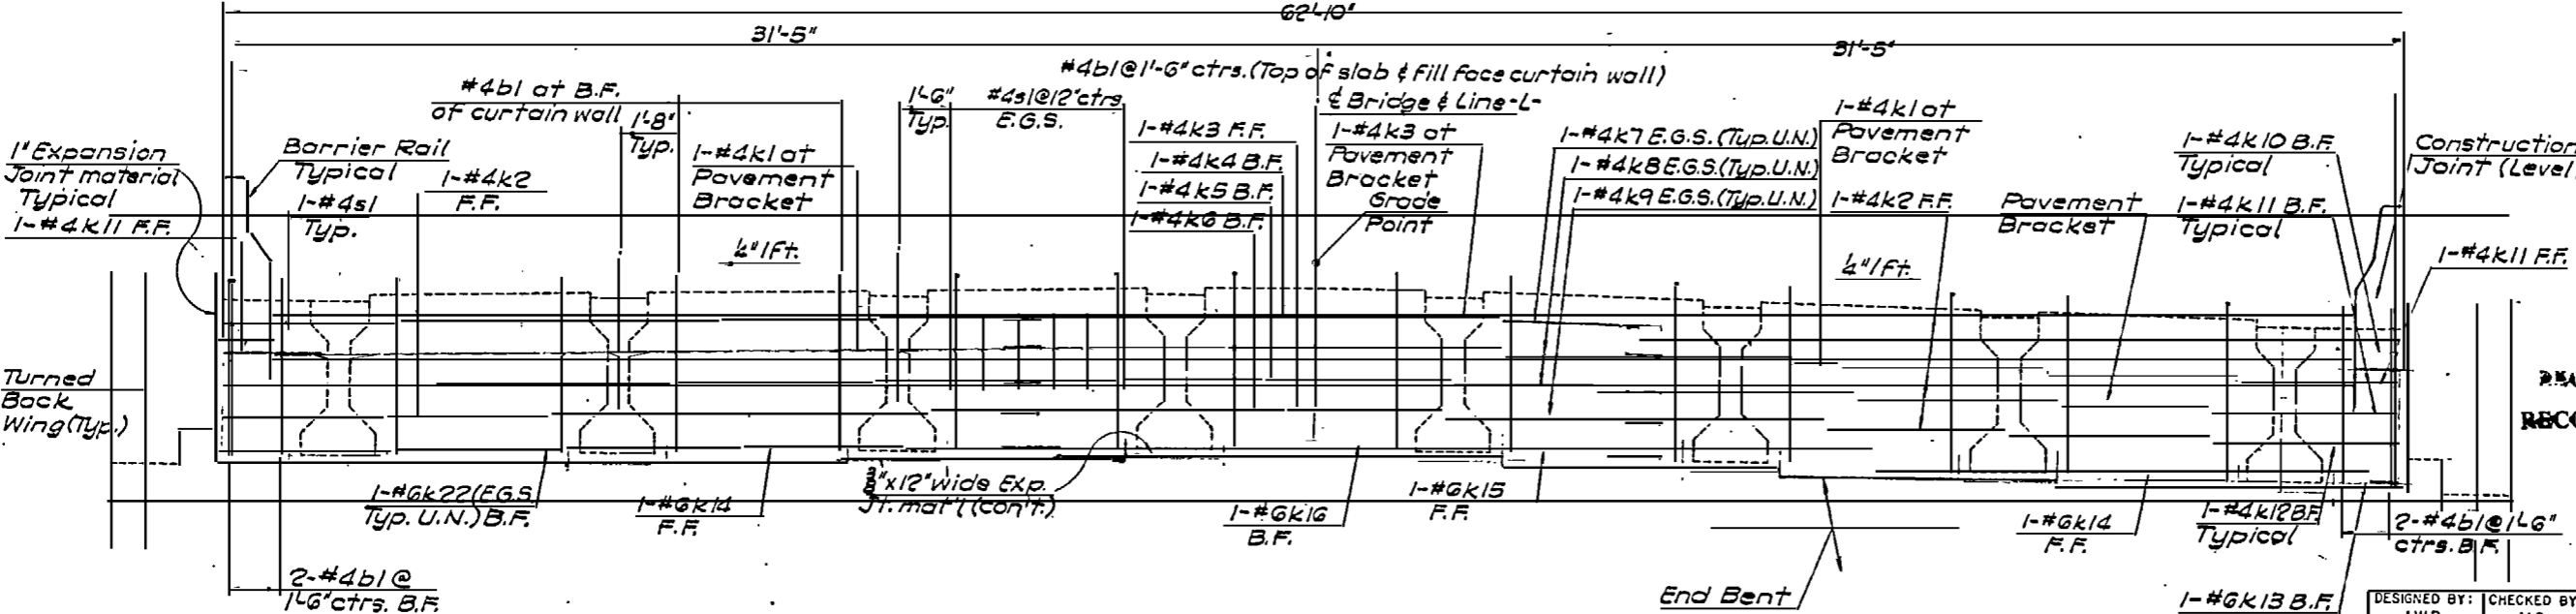



END ELEVATION (Curtain Wall)
3/4" x 1'-0"

DESIGNED BY: J.W.B.
CHECKED BY: M.G.
PREPARED BY: [Signature]
PRINCIPAL OF FIRM HNTB

RECORD DRAWING

HNTB HOWARD NEEDLES TAMMEN & BERGENDOFF ARCHITECTS ENGINEERS PLANNERS ATLANTA, GEORGIA	U.S. ARMY ENGINEER DISTRICT, WASHINGTON CORPS OF ENGINEERS WILMINGTON, NORTH CAROLINA
ATLANTIC INTRACOASTAL WATERWAY SUPERSTRUCTURE	
TYPICAL SECTIONS - SPANS 3N THRU 14N	
COINJOCK BRIDGE REPLACEMENT PROJECT	
CURRITUCK COUNTY NORTH CAROLINA	
INVITATION NO. DACW 54-83-B-0014	SIZE DRAWING NUMBER
	BRI04-06-17
SCALE AS NOTED	DATE 22 JULY 1983
	SHEET 60 OF 126

N.C. STATE AID PROJECT NO.	FED. RD. DIV. NO.
FEDERAL AID PROJECT NO.	

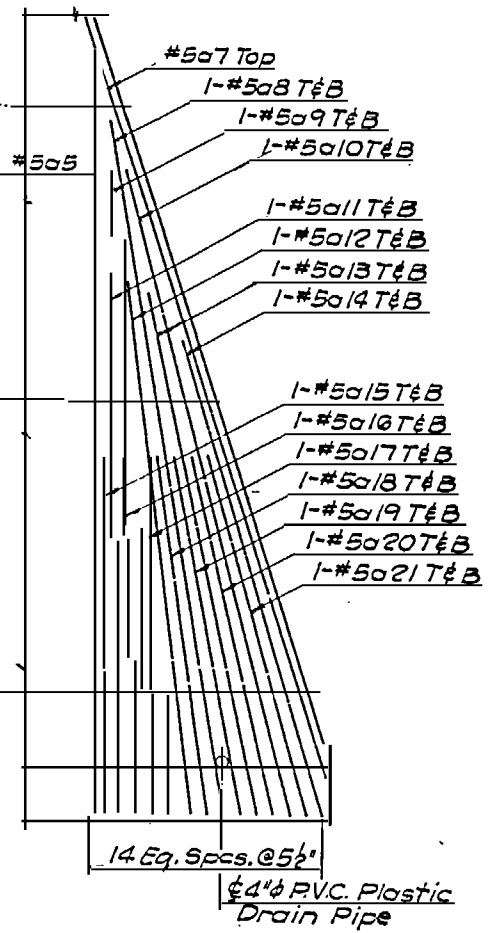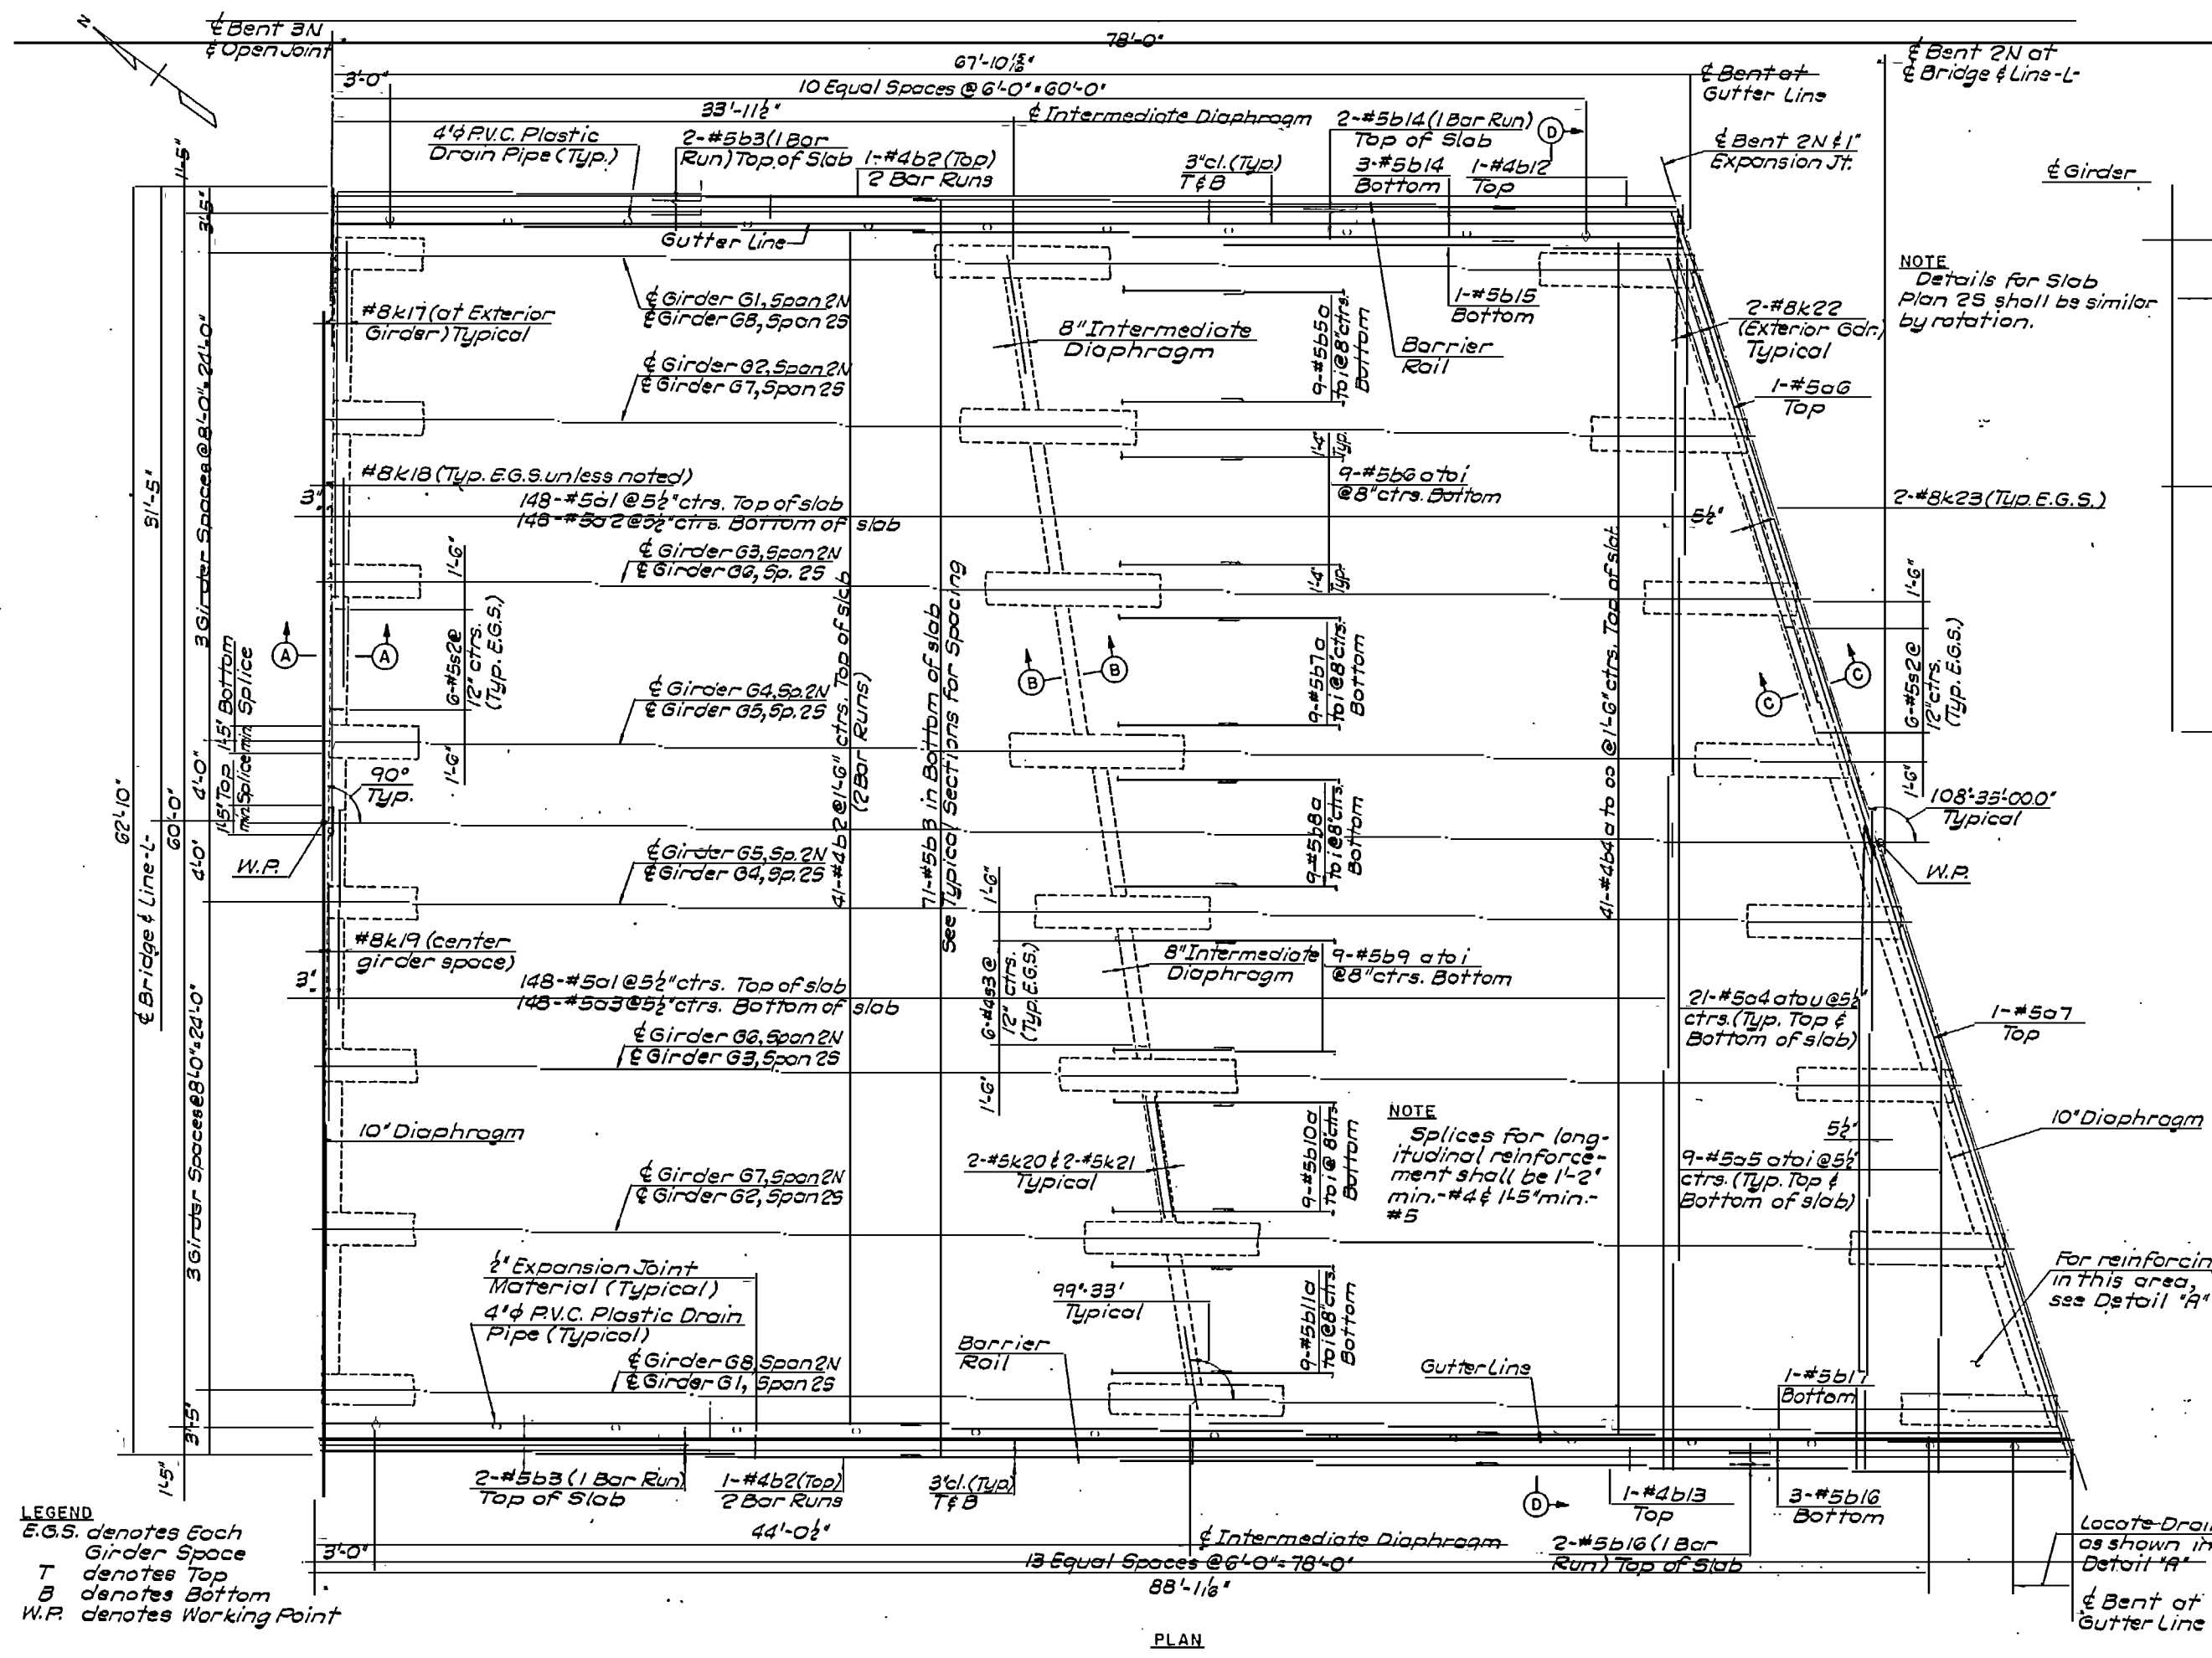

- DETAIL "A"**
3" x 14"
- NOTES**
- 1.) For Barrier Rail Elevations, see P. 5/12.
 - 2.) For Bar List, see Plate S-57.
 - 3.) For General Notes, see Plate S-7.
 - 4.) For Typical Sections (at Bent 3N and Intermediate Diaphragm), see Plate S-10.
 - 5.) For additional details, see Plate S-12.
 - 6.) For Sections A-A and B-B, see Plate S-9.
 - 7.) For Sections C-C and D-D, see Plate S-12.
 - 8.) For Prestressed Girders in this span, see Plate S-23.
 - 9.) For Expansion Joint details in Barrier Rail, see Plate S-30.

LEGEND
 E.G.S. denotes Each Girder Space
 T denotes Top
 B denotes Bottom
 W.P. denotes Working Point

DESIGNED BY: J.W.B. CHECKED BY: M.G.
 PREPARED BY: [Signature]
 PRINCIPAL OF FIRM HNTB

HNTB HOWARD NEEDLES TAMMEN & BERGENDOFF ARCHITECTS ENGINEERS PLANNERS ATLANTA, GEORGIA

U.S. ARMY ENGINEER DISTRICT, WILMINGTON CORPS OF ENGINEERS WILMINGTON NORTH CAROLINA

'ATLANTIC INTRACOASTAL WATERWAY SUPERSTRUCTURE SLAB PLAN - SPAN 2N'




COINJOCK BRIDGE REPLACEMENT PROJECT CURRITUCK COUNTY NORTH CAROLINA

INVESTIGATION NO. DACW54-83-B-0014	SEE DRAWING NUMBER B104-06-17	PLATE NO. S-11
------------------------------------	-------------------------------	----------------

SCALE AS NOTED DATE 22 JULY 1983 SHEET 61 OF 126

PLAN

N.C. STATE AID PROJECT NO.	FED. RD. DIV. NO.
FEDERAL AID PROJECT NO.	

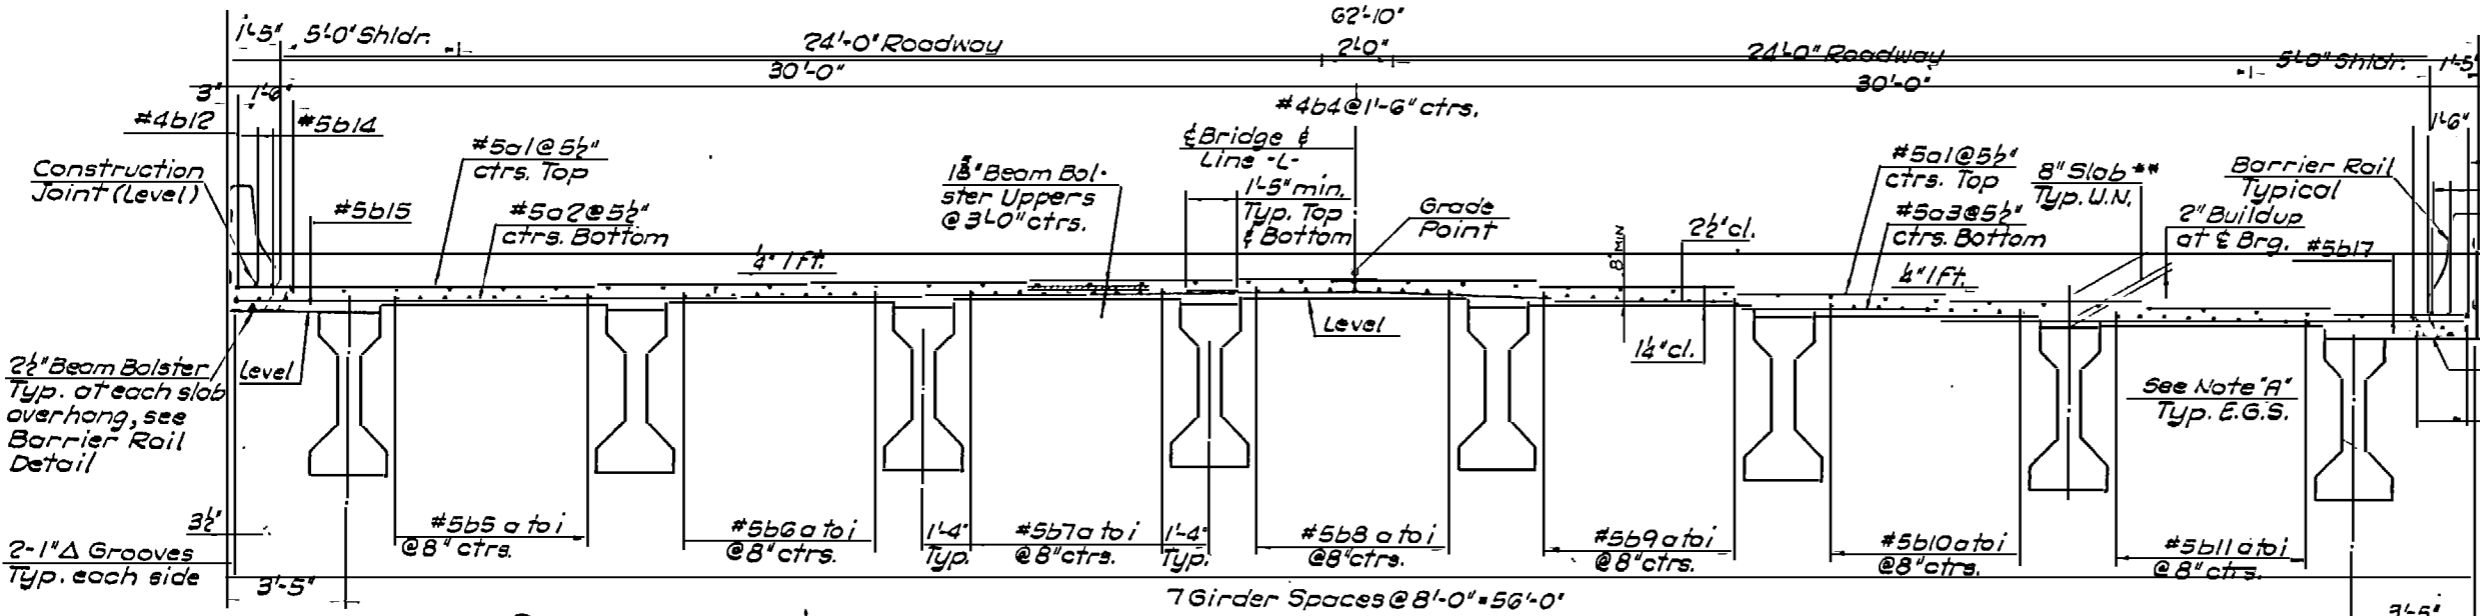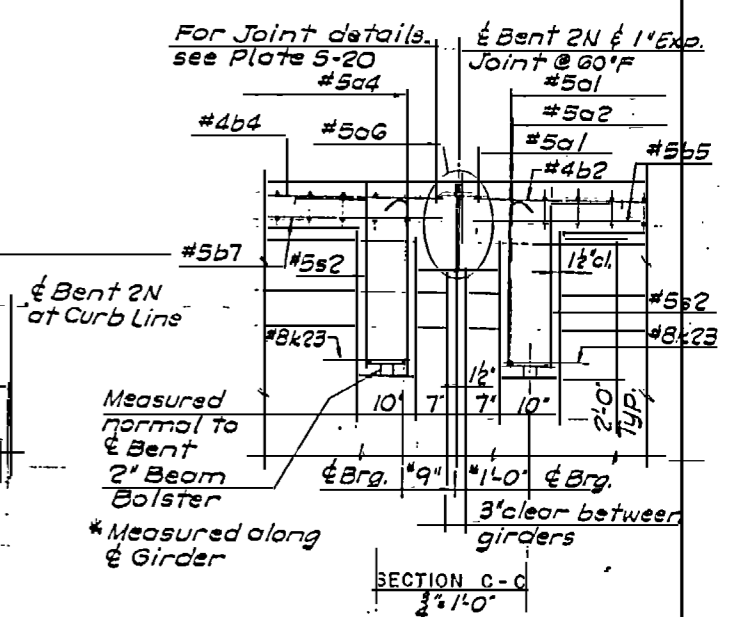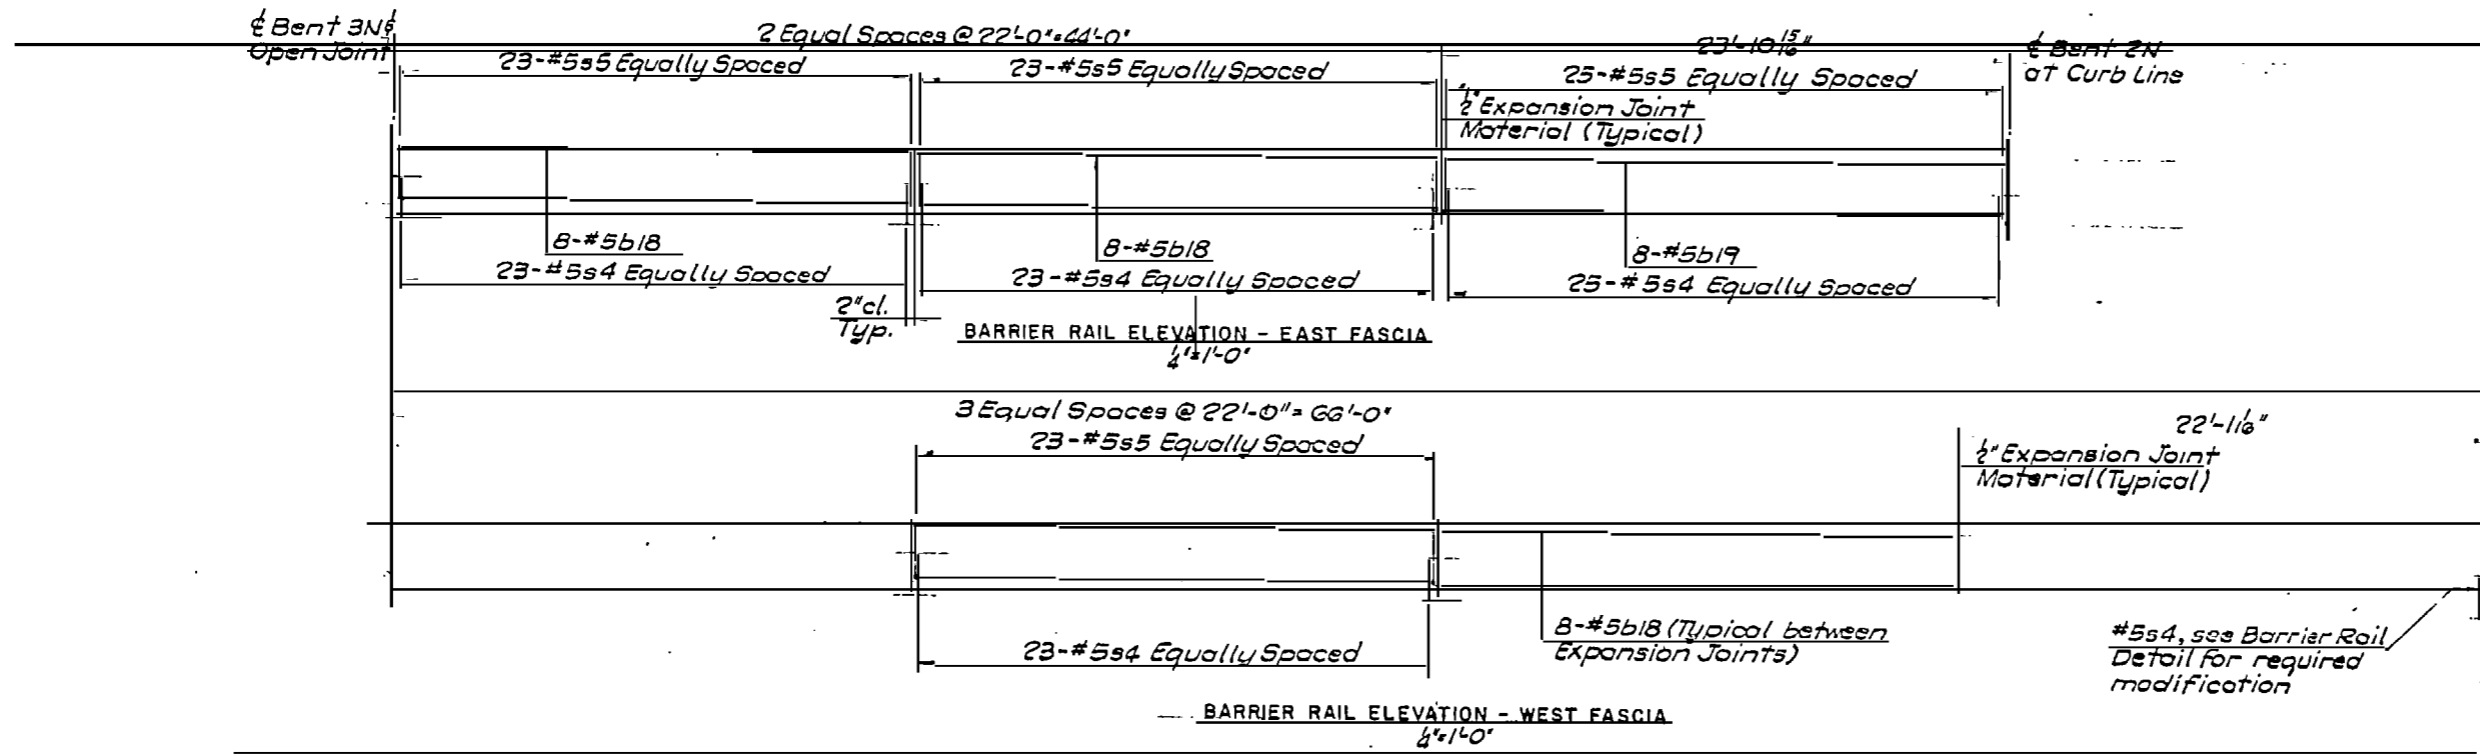


NOTE: Metal Stay-In-Place Forms have not been shown in Cross Section. For Typical Details, see Plate S-20.

NOTE "A": End diaphragms have not been shown, for details and reinforcement requirements, see Section D-D, Plate No. S-15.


NOTES:

- 1) For Slab Plan - Span 2N, see Pl. S-11.
- 2) For Deck Drain Detail and Exp. Jt. detail in Barrier Rail, see Pl. S-20.

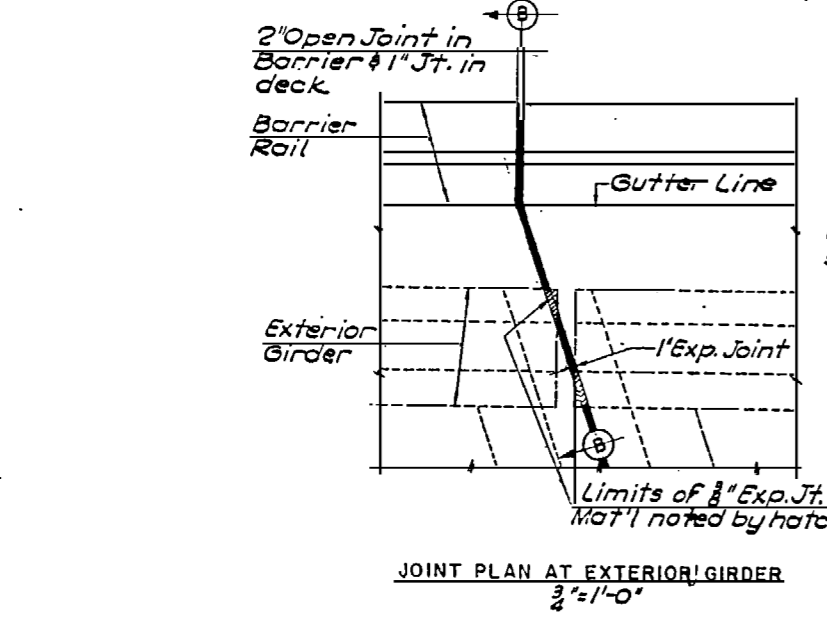

NOTE: For Section B-B and additional Joint details, see Plate S-20.

NOTE (CLASS AA CONCRETE): The quantity of all Class AA Concrete in spans 2N and 25 averages 1.98 C.Y. / Lin. Ft. of deck at Bridge.

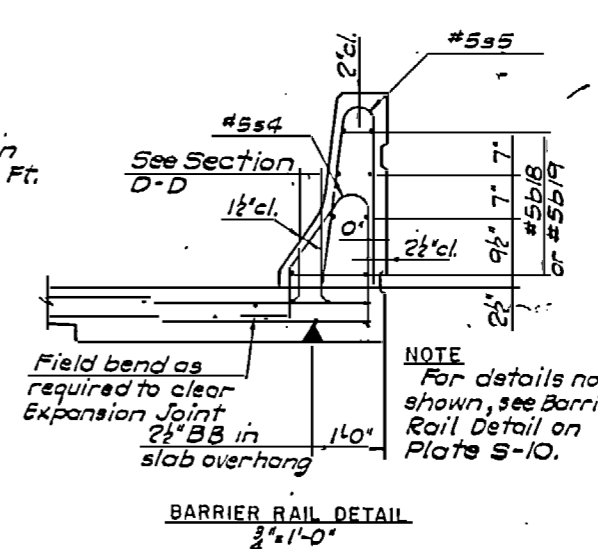

LEGEND:


- U.N. denotes Unless noted
- BB denotes Beam Bolster
- E.G.S. denotes Each Girder Space

DESIGNED BY: J.W.B. CHECKED BY: M.G.

PREPARED BY: [Signature]

PRINCIPAL OF FIRM HNTB

HNTB HOWARD NEEDLES TAMMEN & BERGENDOFF ARCHITECTS ENGINEERS PLANNERS ATLANTA, GEORGIA		U.S. ARMY ENGINEER DISTRICT, WILMINGTON CORPS OF ENGINEERS WILMINGTON, NORTH CAROLINA	
ATLANTIC INTRACOASTAL WATERWAY SUPERSTRUCTURE SPAN 2N - DETAILS			
COINJOCK BRIDGE REPLACEMENT PROJECT CURRITUCK COUNTY NORTH CAROLINA			
INVESTIGATION NO. DACW 54-83-B-0014	SIZE B-0014	DRAWING NUMBER BR104-06-17	PLATE NO. S-12
SCALE AS NOTED		DATE 22 JULY 1983	SHEET 62 of 126

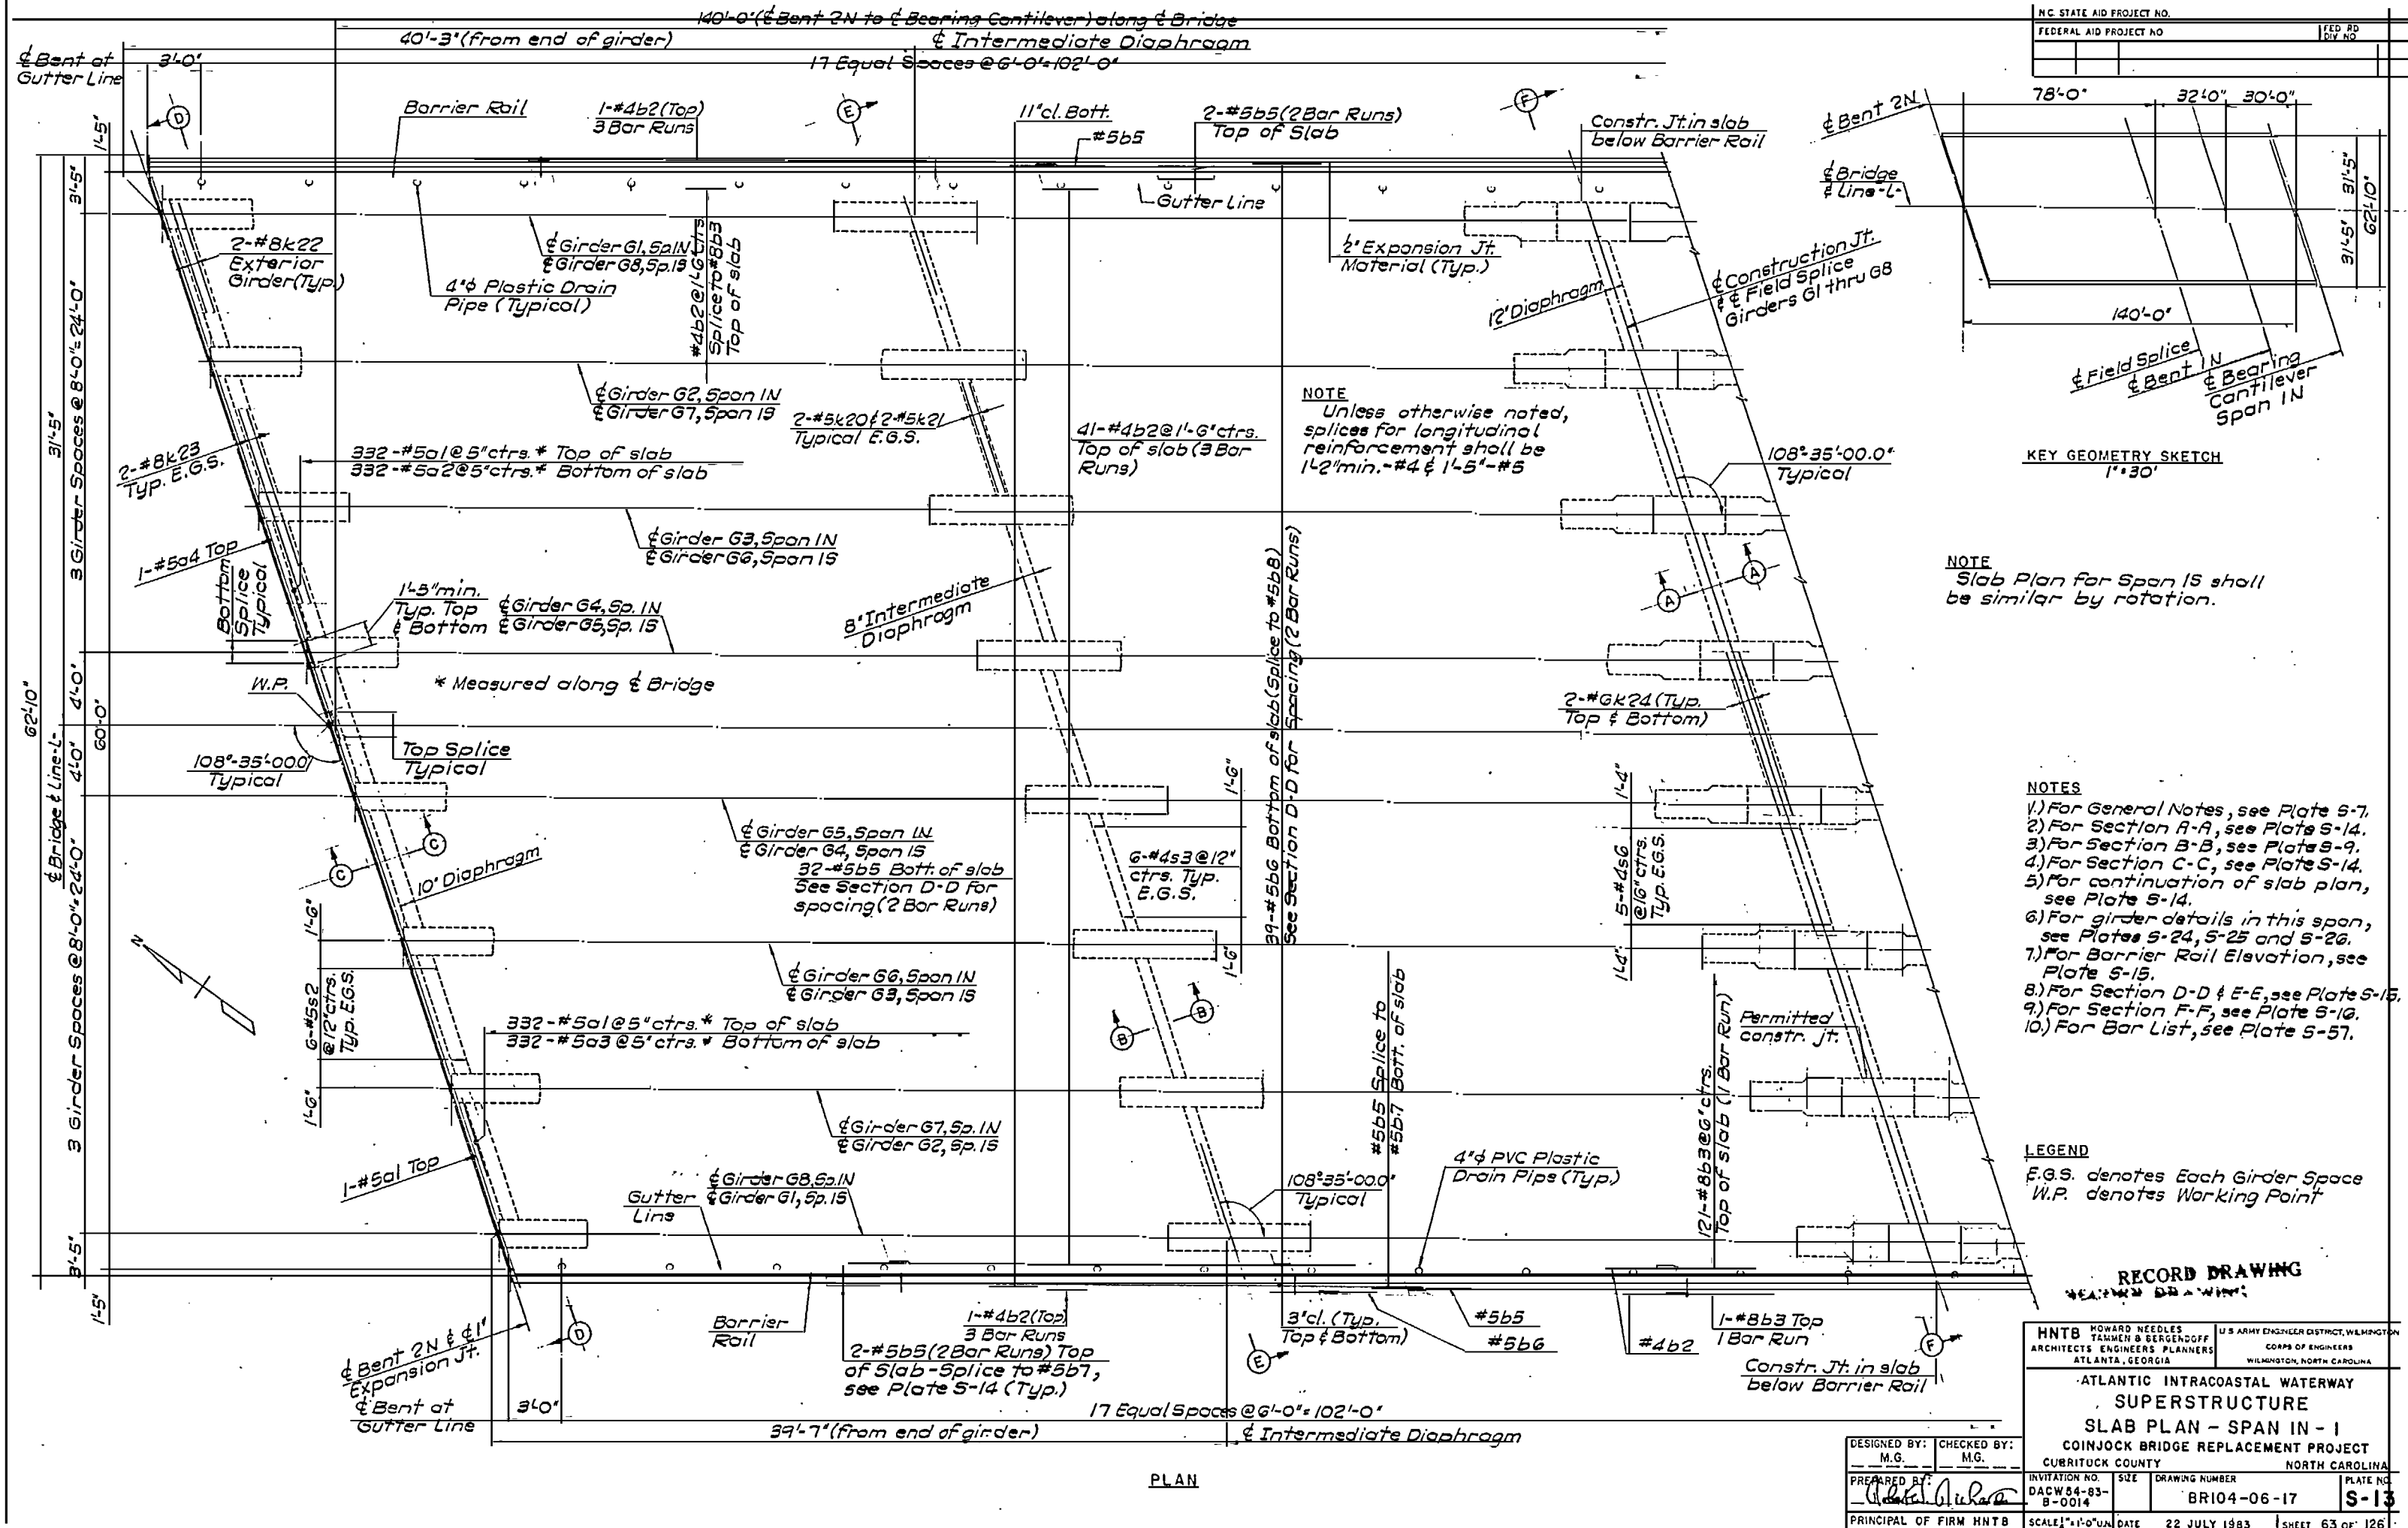

N.C. STATE AID PROJECT NO.		FED. RD. DIV. NO.
FEDERAL AID PROJECT NO.		

KEY GEOMETRY SKETCH
1"=30'

- NOTES**
- 1.) For General Notes, see Plate S-7.
 - 2.) For Section A-A, see Plate S-14.
 - 3.) For Section B-B, see Plate S-9.
 - 4.) For Section C-C, see Plate S-14.
 - 5.) For continuation of slab plan, see Plate S-14.
 - 6.) For girder details in this span, see Plates S-24, S-25 and S-26.
 - 7.) For Barrier Rail Elevation, see Plate S-15.
 - 8.) For Section D-D & E-E, see Plate S-15.
 - 9.) For Section F-F, see Plate S-10.
 - 10.) For Bar List, see Plate S-57.




LEGEND
E.G.S. denotes Each Girder Space
W.P. denotes Working Point

RECORD DRAWING

HNTB HOWARD NEEDLES TAMNER & BERGENSOFF ARCHITECTS ENGINEERS PLANNERS ATLANTA, GEORGIA		U.S. ARMY ENGINEER DISTRICT, WILMINGTON CORPS OF ENGINEERS WILMINGTON, NORTH CAROLINA	
ATLANTIC INTRACOASTAL WATERWAY SUPERSTRUCTURE SLAB PLAN - SPAN 15 COINJOCK BRIDGE REPLACEMENT PROJECT			
DESIGNED BY: M.G.	CHECKED BY: M.G.	INVESTIGATION NO. DACW84-83-B-0014	DRAWING NUMBER BR104-06-17
PREPARED BY: <i>[Signature]</i> PRINCIPAL OF FIRM HNTB		SCALE: 1"=10'-0"	DATE: 22 JULY 1983
		NORTH CAROLINA	PLATE NO. S-13

PLAN


N.C. STATE AID PROJECT NO.	FEA NO.
FEDERAL AID PROJECT NO.	DIV NO.

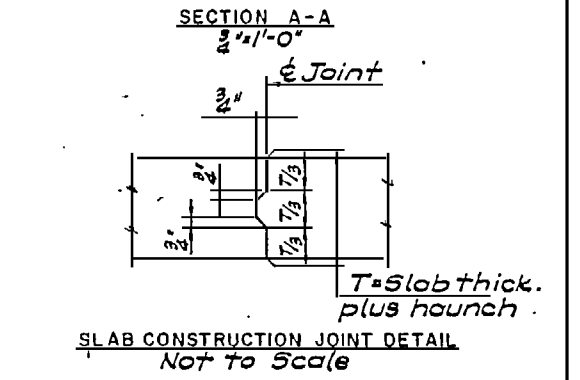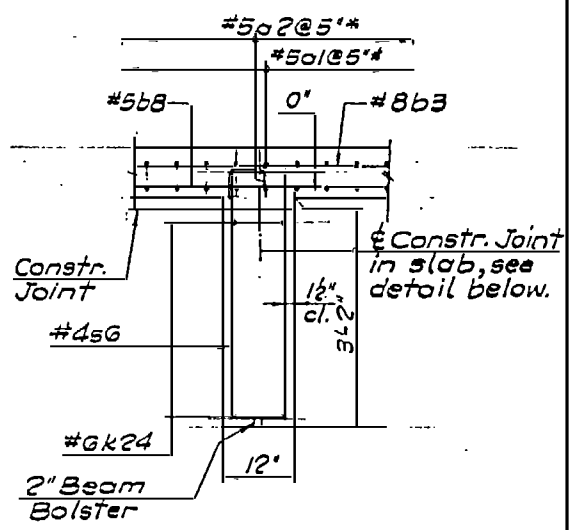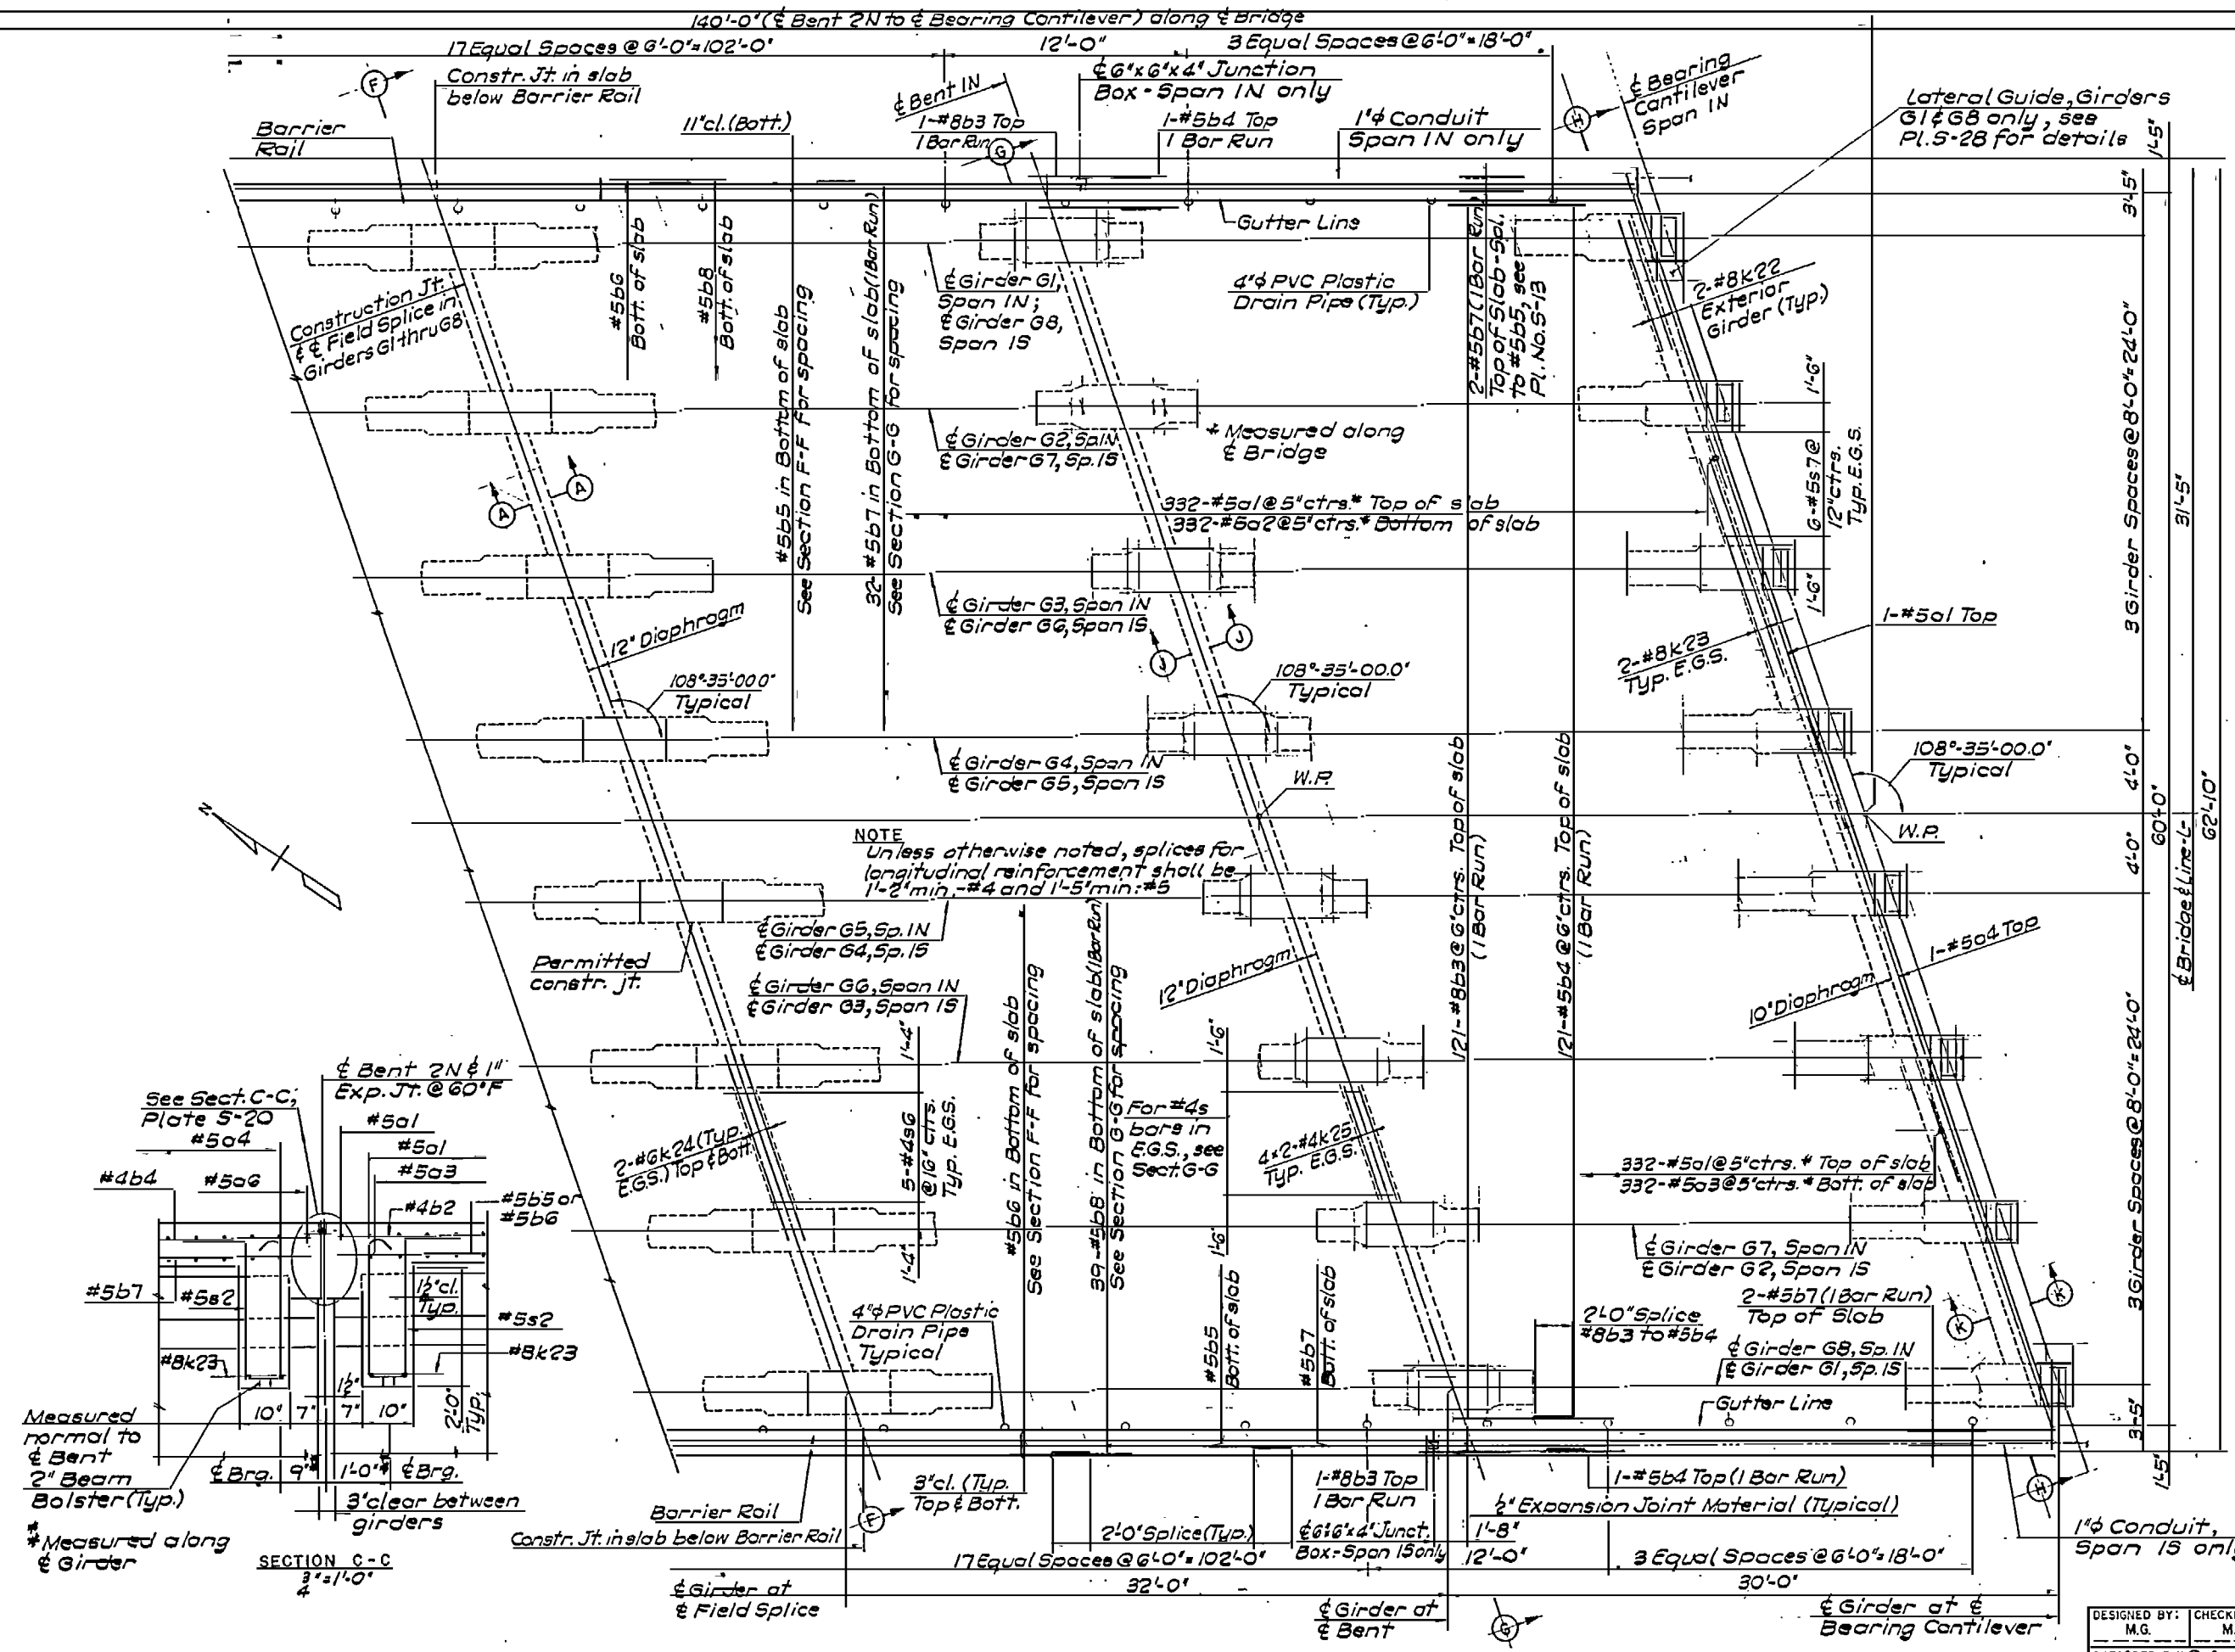

NOTE
Slab Plan for Span 15 shall be similar by rotation with exception of 1" Conduit and 6"x6"x4" Junction Box, see Plan.

NOTES
1) For portion of slab from Bent 2N to field splices, see Plate S-13.
2) For Sections F-F thru H-H, see Plate S-16.
3) For girder details in this span, see Plates S-24, S-25 and S-26.
4) For Barrier Rail Elevation, see Plate S-15.
5) For Sections J-J & K-K, see Plate S-17.
6) For Navigation Lighting, see Plate S-53

LEGEND
E.G.S. denotes Each Girder Space
W.P. denotes Working Point

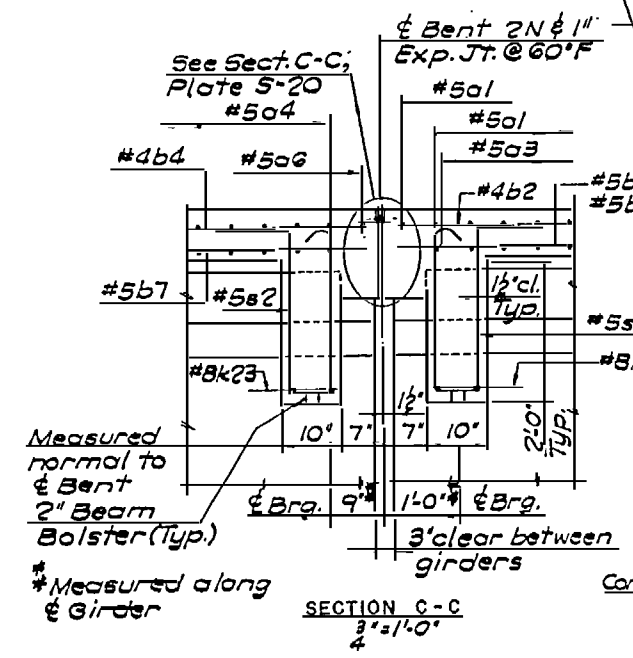




NOTE
Unless otherwise noted, splices for longitudinal reinforcement shall be 1'-2" min. #4 and 1'-5" min. #5

RECORD DRAWING

HNTB HOWARD NEEDLES TAMMEN & BERGENDOFF ARCHITECTS ENGINEERS PLANNERS ATLANTA, GEORGIA		U.S. ARMY ENGINEER DISTRICT, WILMINGTON CORPS OF ENGINEERS WILMINGTON, NORTH CAROLINA	
ATLANTIC INTRACOASTAL WATERWAY SUPERSTRUCTURE			
SLAB PLAN - SPAN IN - 2			
COINJOCK BRIDGE REPLACEMENT PROJECT			
DESIGNED BY: M.G.	CHECKED BY: M.G.	CURRITUCK COUNTY	NORTH CAROLINA
PREPARED BY: [Signature]	INVESTIGATION NO. DACW54-83-B-0014	SIZE DRAWING NUMBER BRI04-06-17	PLATE NO. S-14
PRINCIPAL OF FIRM HNTB		SCALE: 1/8"=1'-0"	DATE: 22 JULY 1983 SHEET: 64 OF 126

PLAN

N.C. STATE AID PROJECT NO.	FED. RD. DIST. NO.
FEDERAL AID PROJECT NO.	STATE ROAD NO.

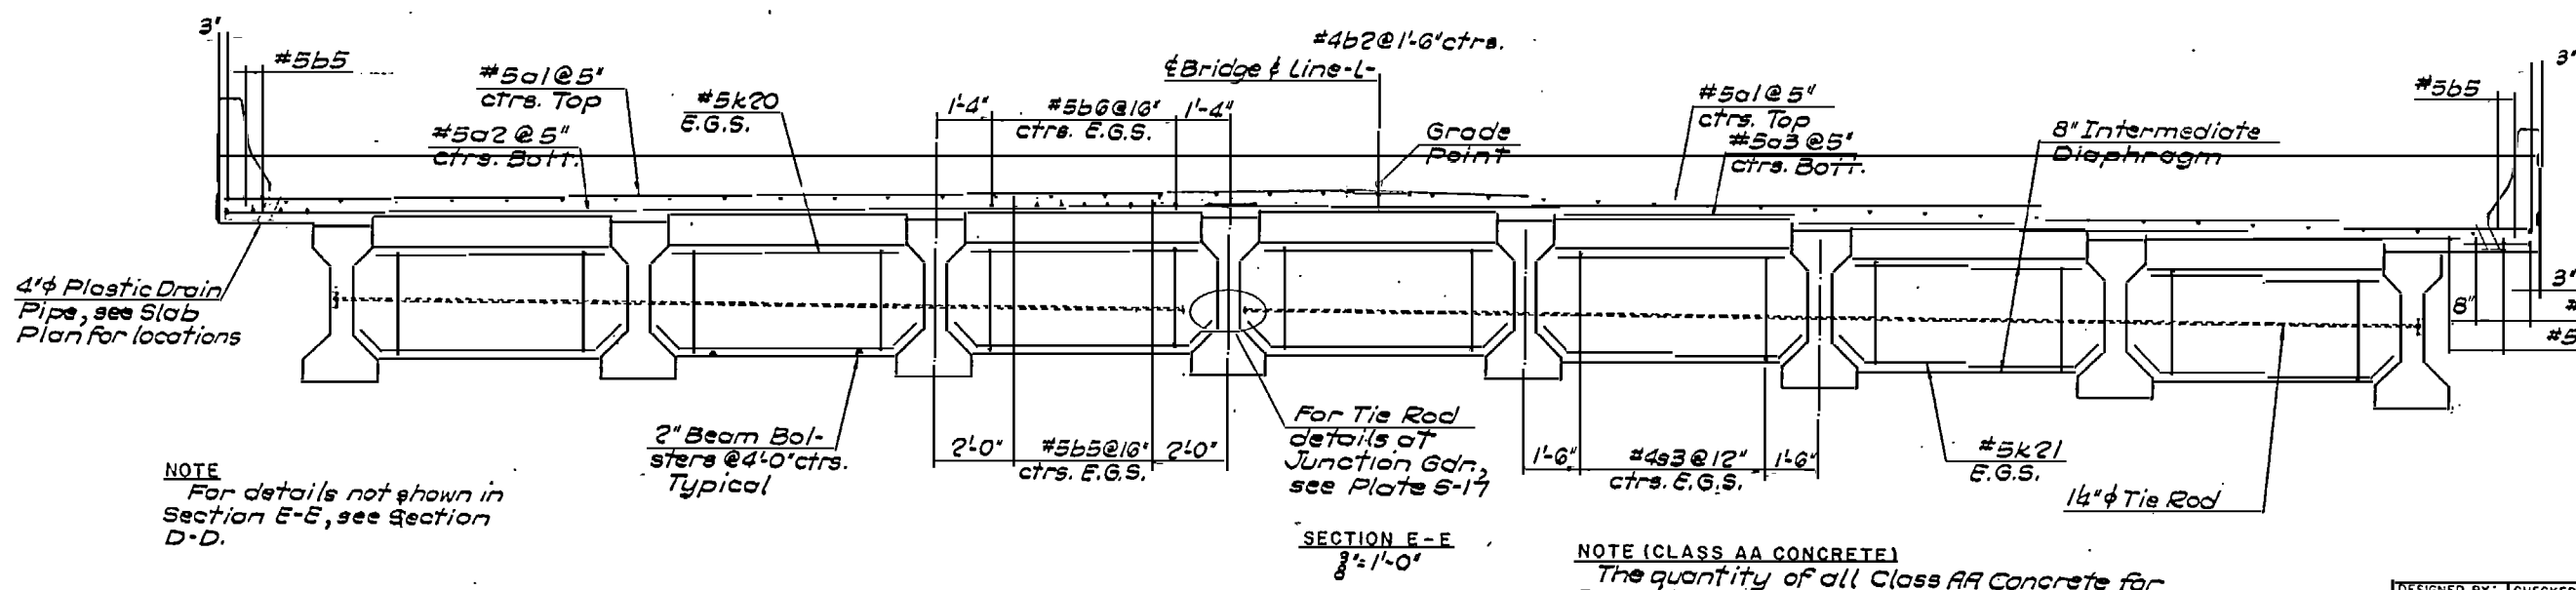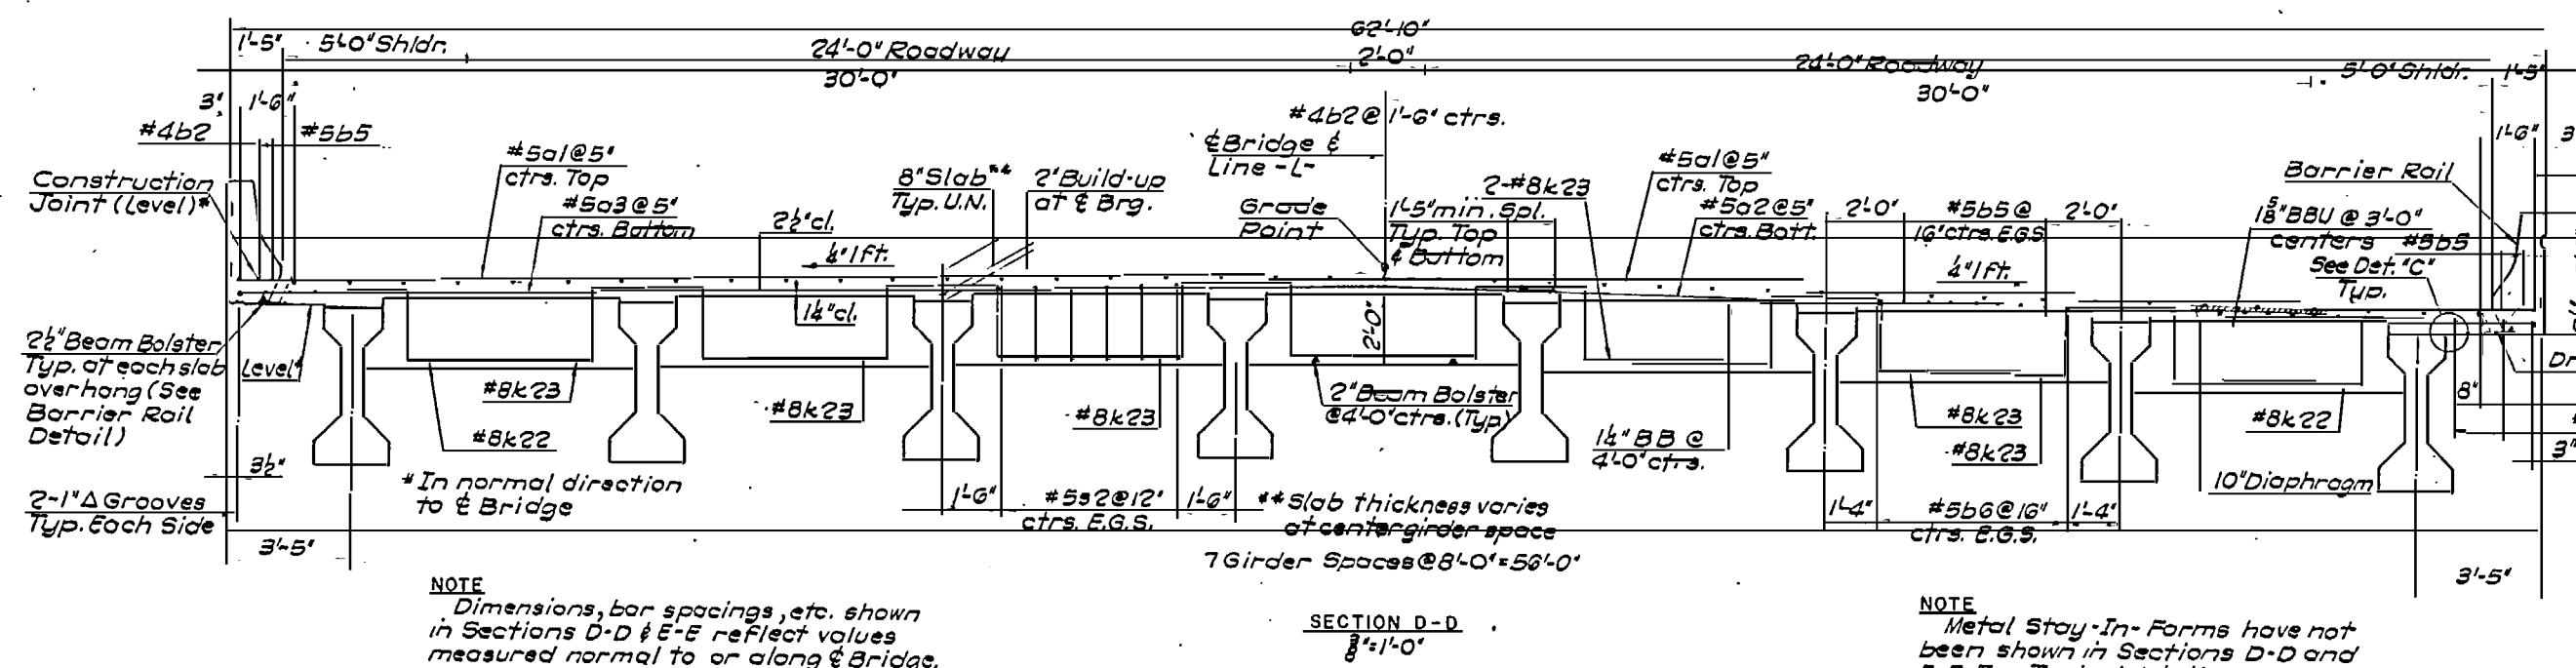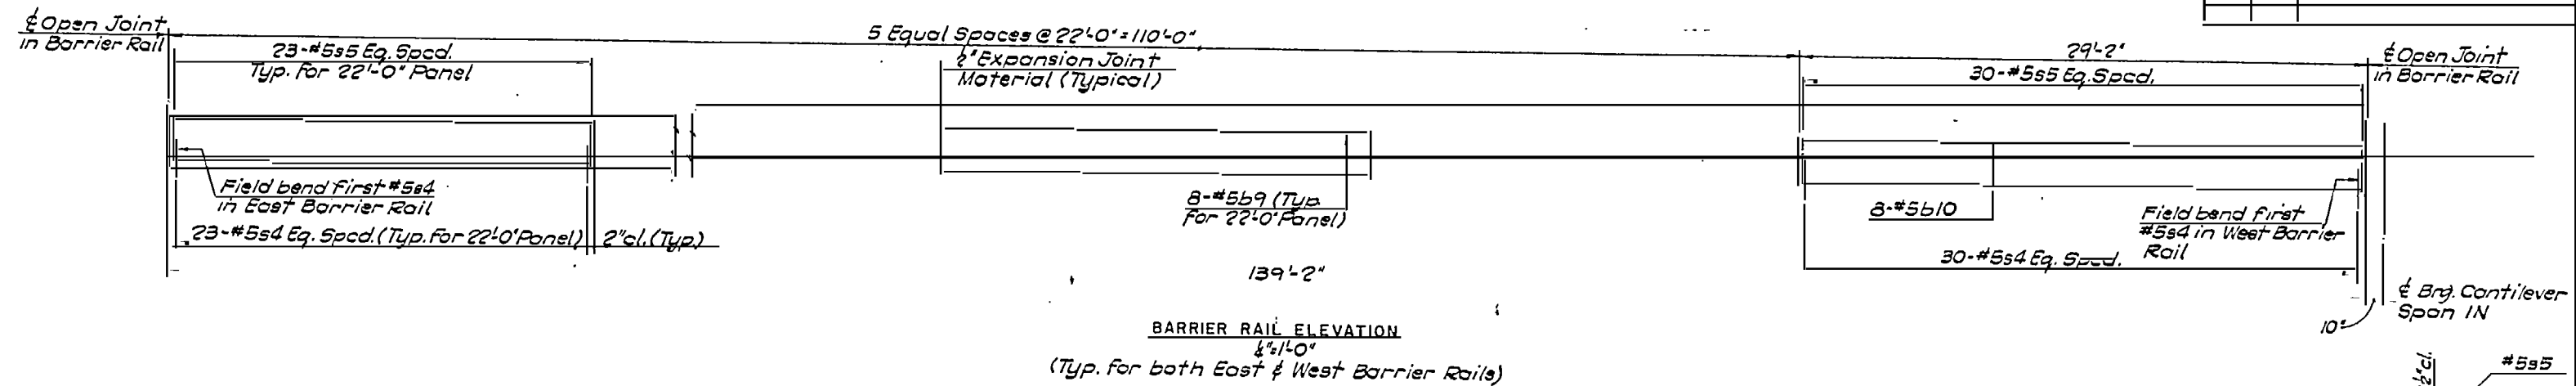

- NOTES
- 1) For General Notes, see Plate S-7.
 - 2) For additional details, see Pl. S-16 & 17.
 - 3) For Slab Plan of Span 1N, see Plates S-13 and S-14.
 - 4) For Girder Details, see Plates S-24, S-25 and S-26.
 - 5) For Erection Sequence, see Pl. S-26.
 - 6) For Tie Rod detail, see Plate S-17.
 - 7) For Detail "C", see Plate S-20.

- LEGEND
- E.G.S. denotes Each Girder Space
 - BB denotes Beam Bolster
 - B.B.U. denotes Beam Bolster Upper
 - U.N. denotes Unless Noted
 - #5b6@16" ctrs. (Typ.)
 - #5b5@16" ctrs. (Typ.)

RECORD DRAWING


HNTB HOWARD NEEDLES TAMMEN & BERGENDOFF ARCHITECTS ENGINEERS PLANNERS ATLANTA, GEORGIA U.S. ARMY ENGINEER DISTRICT, WILMINGTON CORPS OF ENGINEERS WILMINGTON, NORTH CAROLINA

ATLANTIC INTRACOASTAL WATERWAY SUPERSTRUCTURE. SPAN 1N - DETAILS I.

COINJOCK BRIDGE REPLACEMENT PROJECT CURRITUCK COUNTY NORTH CAROLINA

DESIGNED BY: M.G.	CHECKED BY: M.G.	INVESTIGATION NO. DACW 54-83-B-0014	SIZE	DRAWING NUMBER B104-06-17	PLATE NO. S-15
PREPARED BY: [Signature]	PRINCIPAL OF FIRM HNTB	SCALE AS NOTED	DATE 22 JULY 1983	SHEET 65 OF 128	

N.C. STATE AID PROJECT NO.	
FEDERAL AID PROJECT NO.	
FED. RD DIST. NO.	

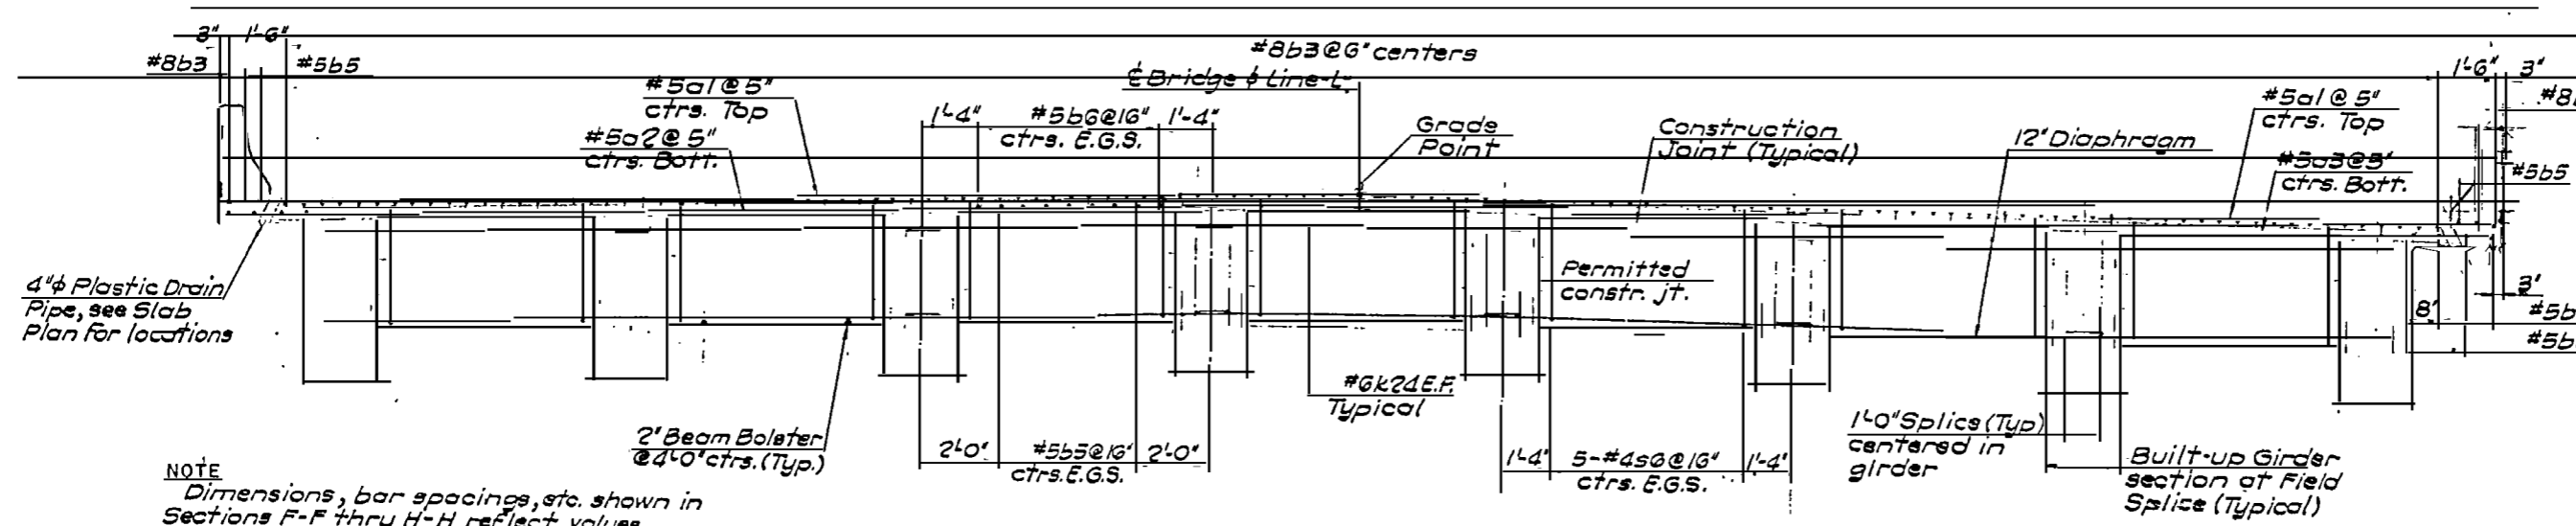


NOTE
Dimensions, bar spacings, etc. shown in Sections F-F thru H-H reflect values measured normal to or along \pm Bridge.

SECTION F-F
3'-11-0"

NOTE
For details not shown in Sections F-F, G-G and H-H, see Section D-D, Plate S-15.


NOTE "A"
For required Build-ups, see Plate S-25.

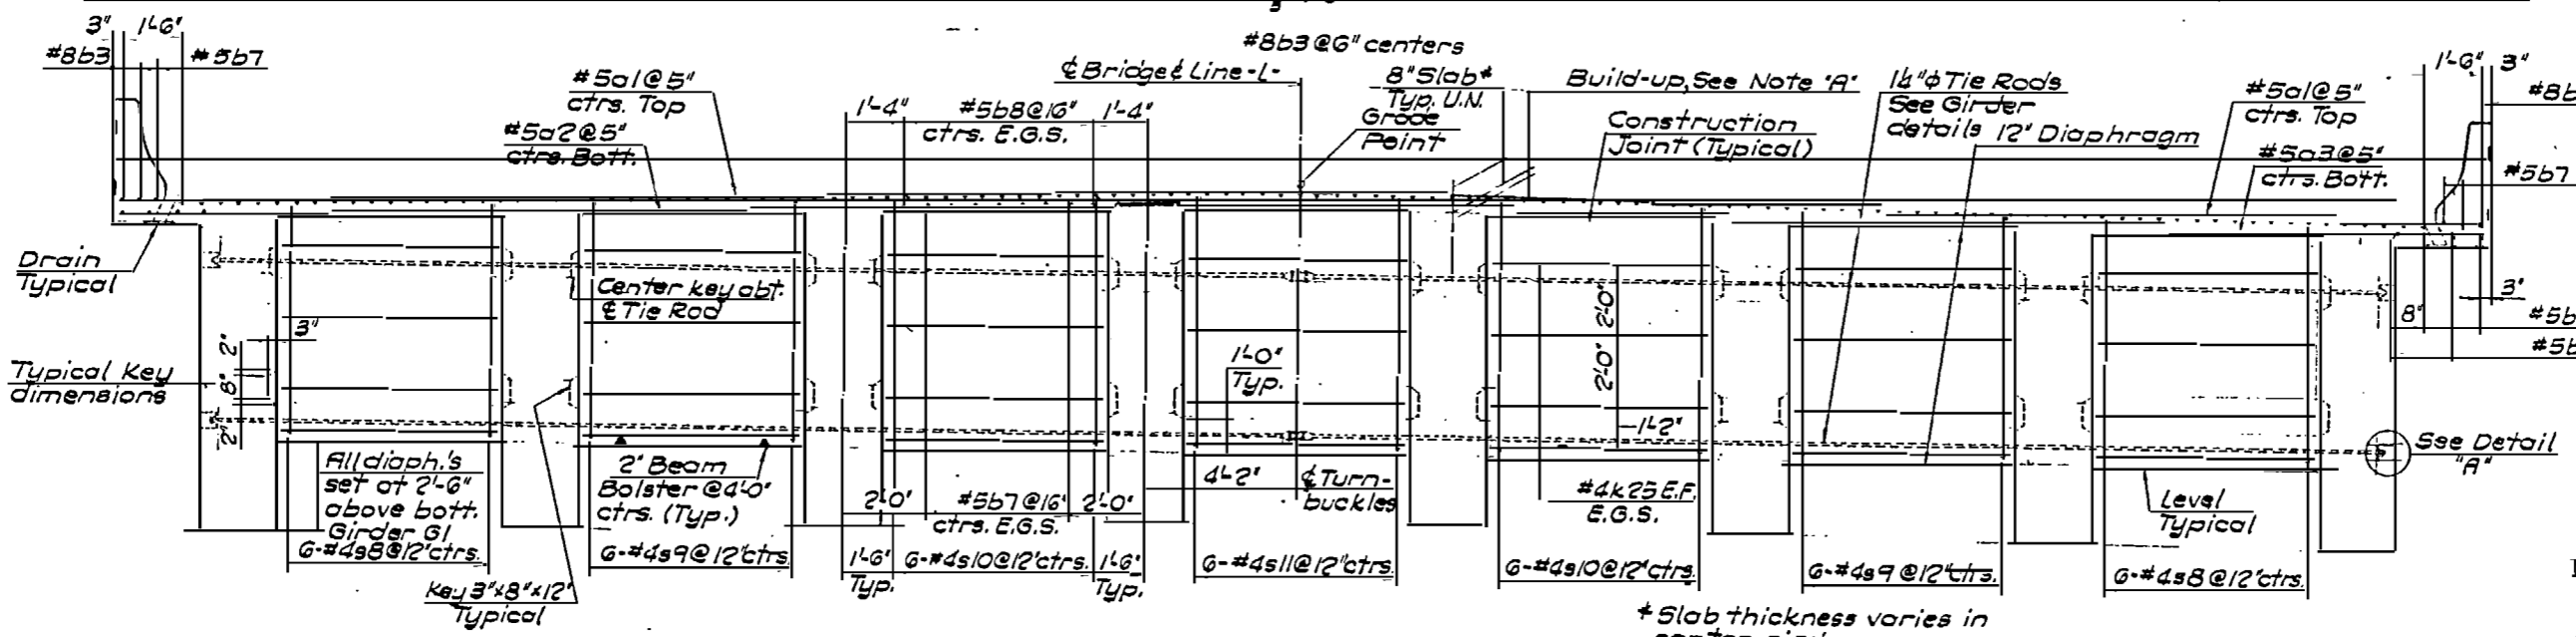

SECTION G-G
3'-11-0"

- NOTES
- 1) For locations of Sections F-F thru H-H, see Plate S-14.
 - 2) For Detail "A", see Plate S-17.
 - 3) For additional details, see Pl. S-15.
 - 4) For girder details, see Plates S-24, S-25 and S-26.
 - 5) For Erection Sequence, see Plate S-26.
 - 6) For location of Tie Rods shown in Section G-G, see Plates S-29.

LEGEND
E.G.S. denotes Each Girder Space
U.N. denotes Unless Noted

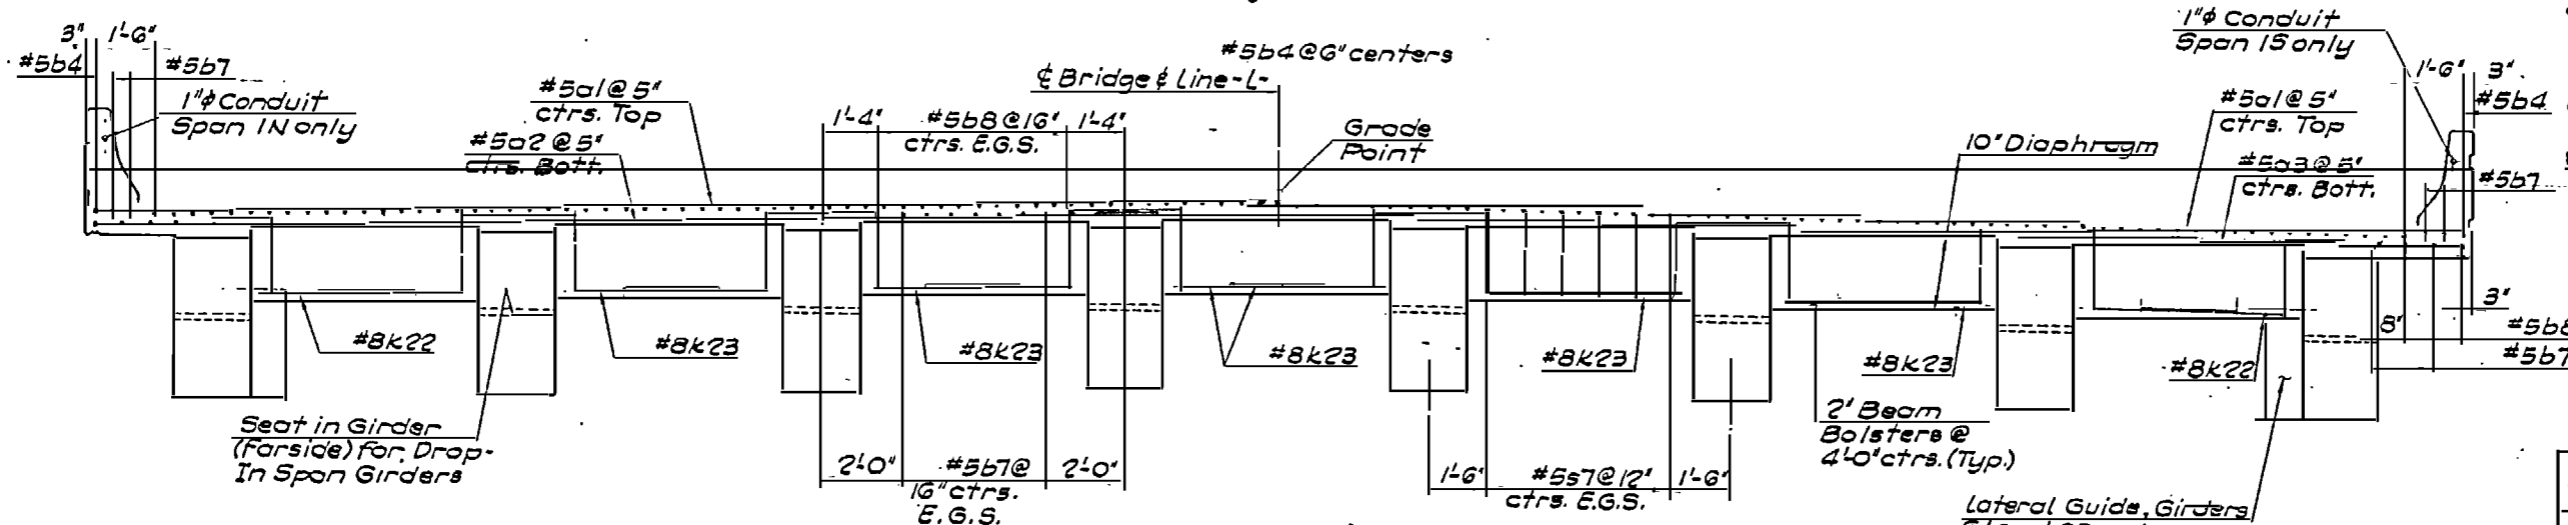

SECTION H-H
3'-11-0"

RECORD DRAWING

HNTB HOWARD NEEDLES TAMMEN & BERGENDOFF ARCHITECTS ENGINEERS PLANNERS ATLANTA, GEORGIA U.S. ARMY ENGINEER DISTRICT, WILMINGTON CORPS OF ENGINEERS WILMINGTON, NORTH CAROLINA



ATLANTIC INTRACOASTAL WATERWAY SUPERSTRUCTURE SPAN IN - DETAILS 2

COINJOCK BRIDGE REPLACEMENT PROJECT CURRITUCK COUNTY NORTH CAROLINA



DESIGNED BY: M.G.
CHECKED BY: M.G.
PREPARED BY: [Signature]
PRINCIPAL OF FIRM HNTB

INVITATION NO. DACW54-83-S-0014
SCALE AS NOTED
DATE 22 JULY 1983
DRAWING NUMBER BR104-06-17
SHEET 66 OF 126

NC STATE AID PROJECT NO	FED. RD. DIV. NO.
FEDERAL AID PROJECT NO	

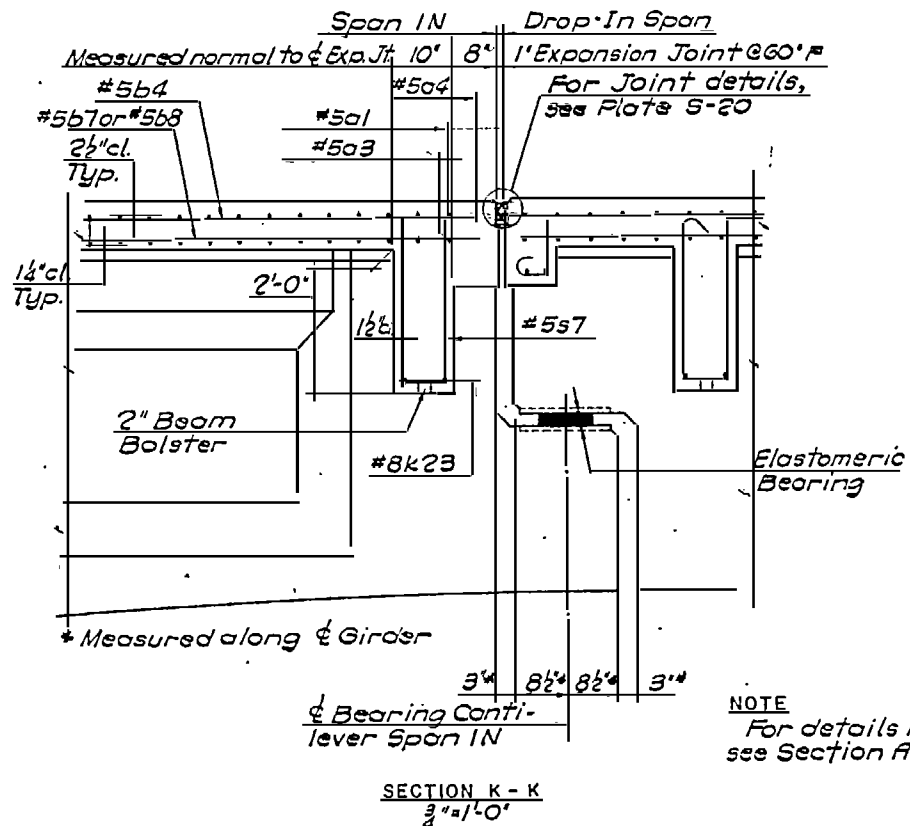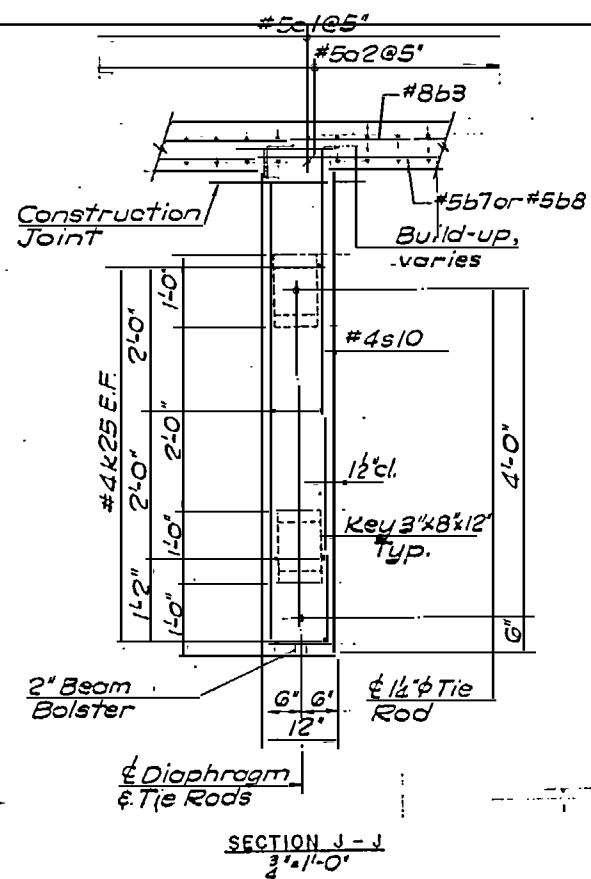

NOTE
For details not shown,
see Section A-A, Plate S-20.

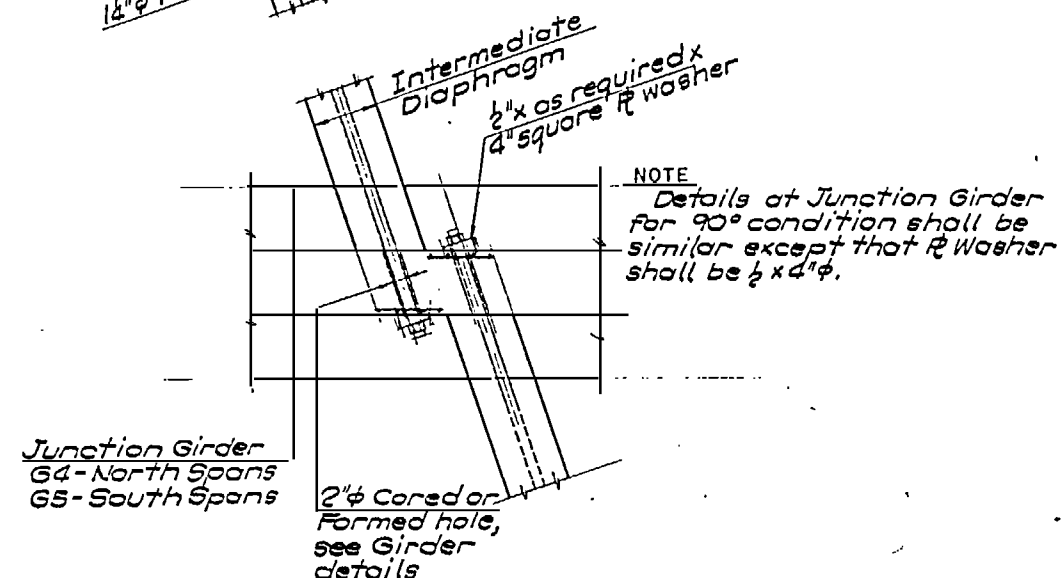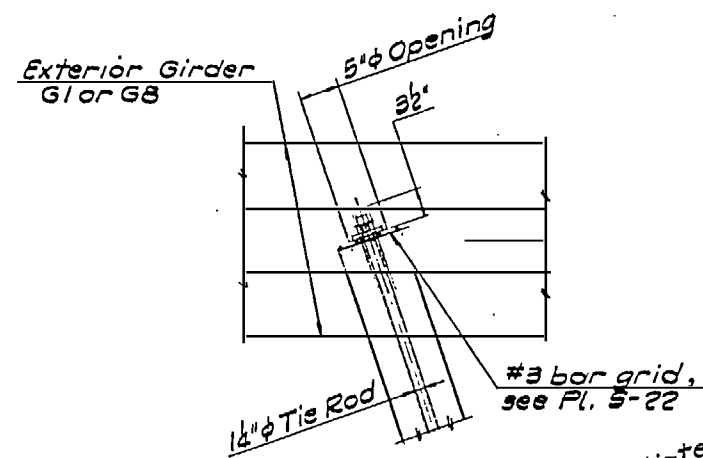


NOTE
Details at Junction Girder
for 90° condition shall be
similar except that φ Washer
shall be 1/2" x 4" φ.

NOTES
1.) For locations of Sections J-J
and K-K, see Plate S-14.
2.) For Tie Rod Detail, see Plate S-25.

RECORD DRAWING

HNTB HOWARD NEEDLES TAMMEN & BERGENDOFF ARCHITECTS ENGINEERS PLANNERS ATLANTA, GEORGIA		U.S. ARMY ENGINEER DISTRICT, WILMINGTON CORPS OF ENGINEERS WILMINGTON, NORTH CAROLINA	
ATLANTIC INTRACOASTAL WATERWAY SUPERSTRUCTURE SPAN IN - DETAILS 3			
COINJOCK BRIDGE REPLACEMENT PROJECT			
CURRITUCK COUNTY	NORTH CAROLINA		
DESIGNED BY: M.G.	CHECKED BY: M.G.	INVITATION NO. DACW54-83-B-0014	SIZE: 8-1/2" x 11"
PREPARED BY: [Signature]		DRAWING NUMBER: BR104-06-17	PLATE NO.: S-17
PRINCIPAL OF FIRM HNTB		SCALE AS NOTED	DATE: 22 JULY 1983
		SHEET 67 OF 126	

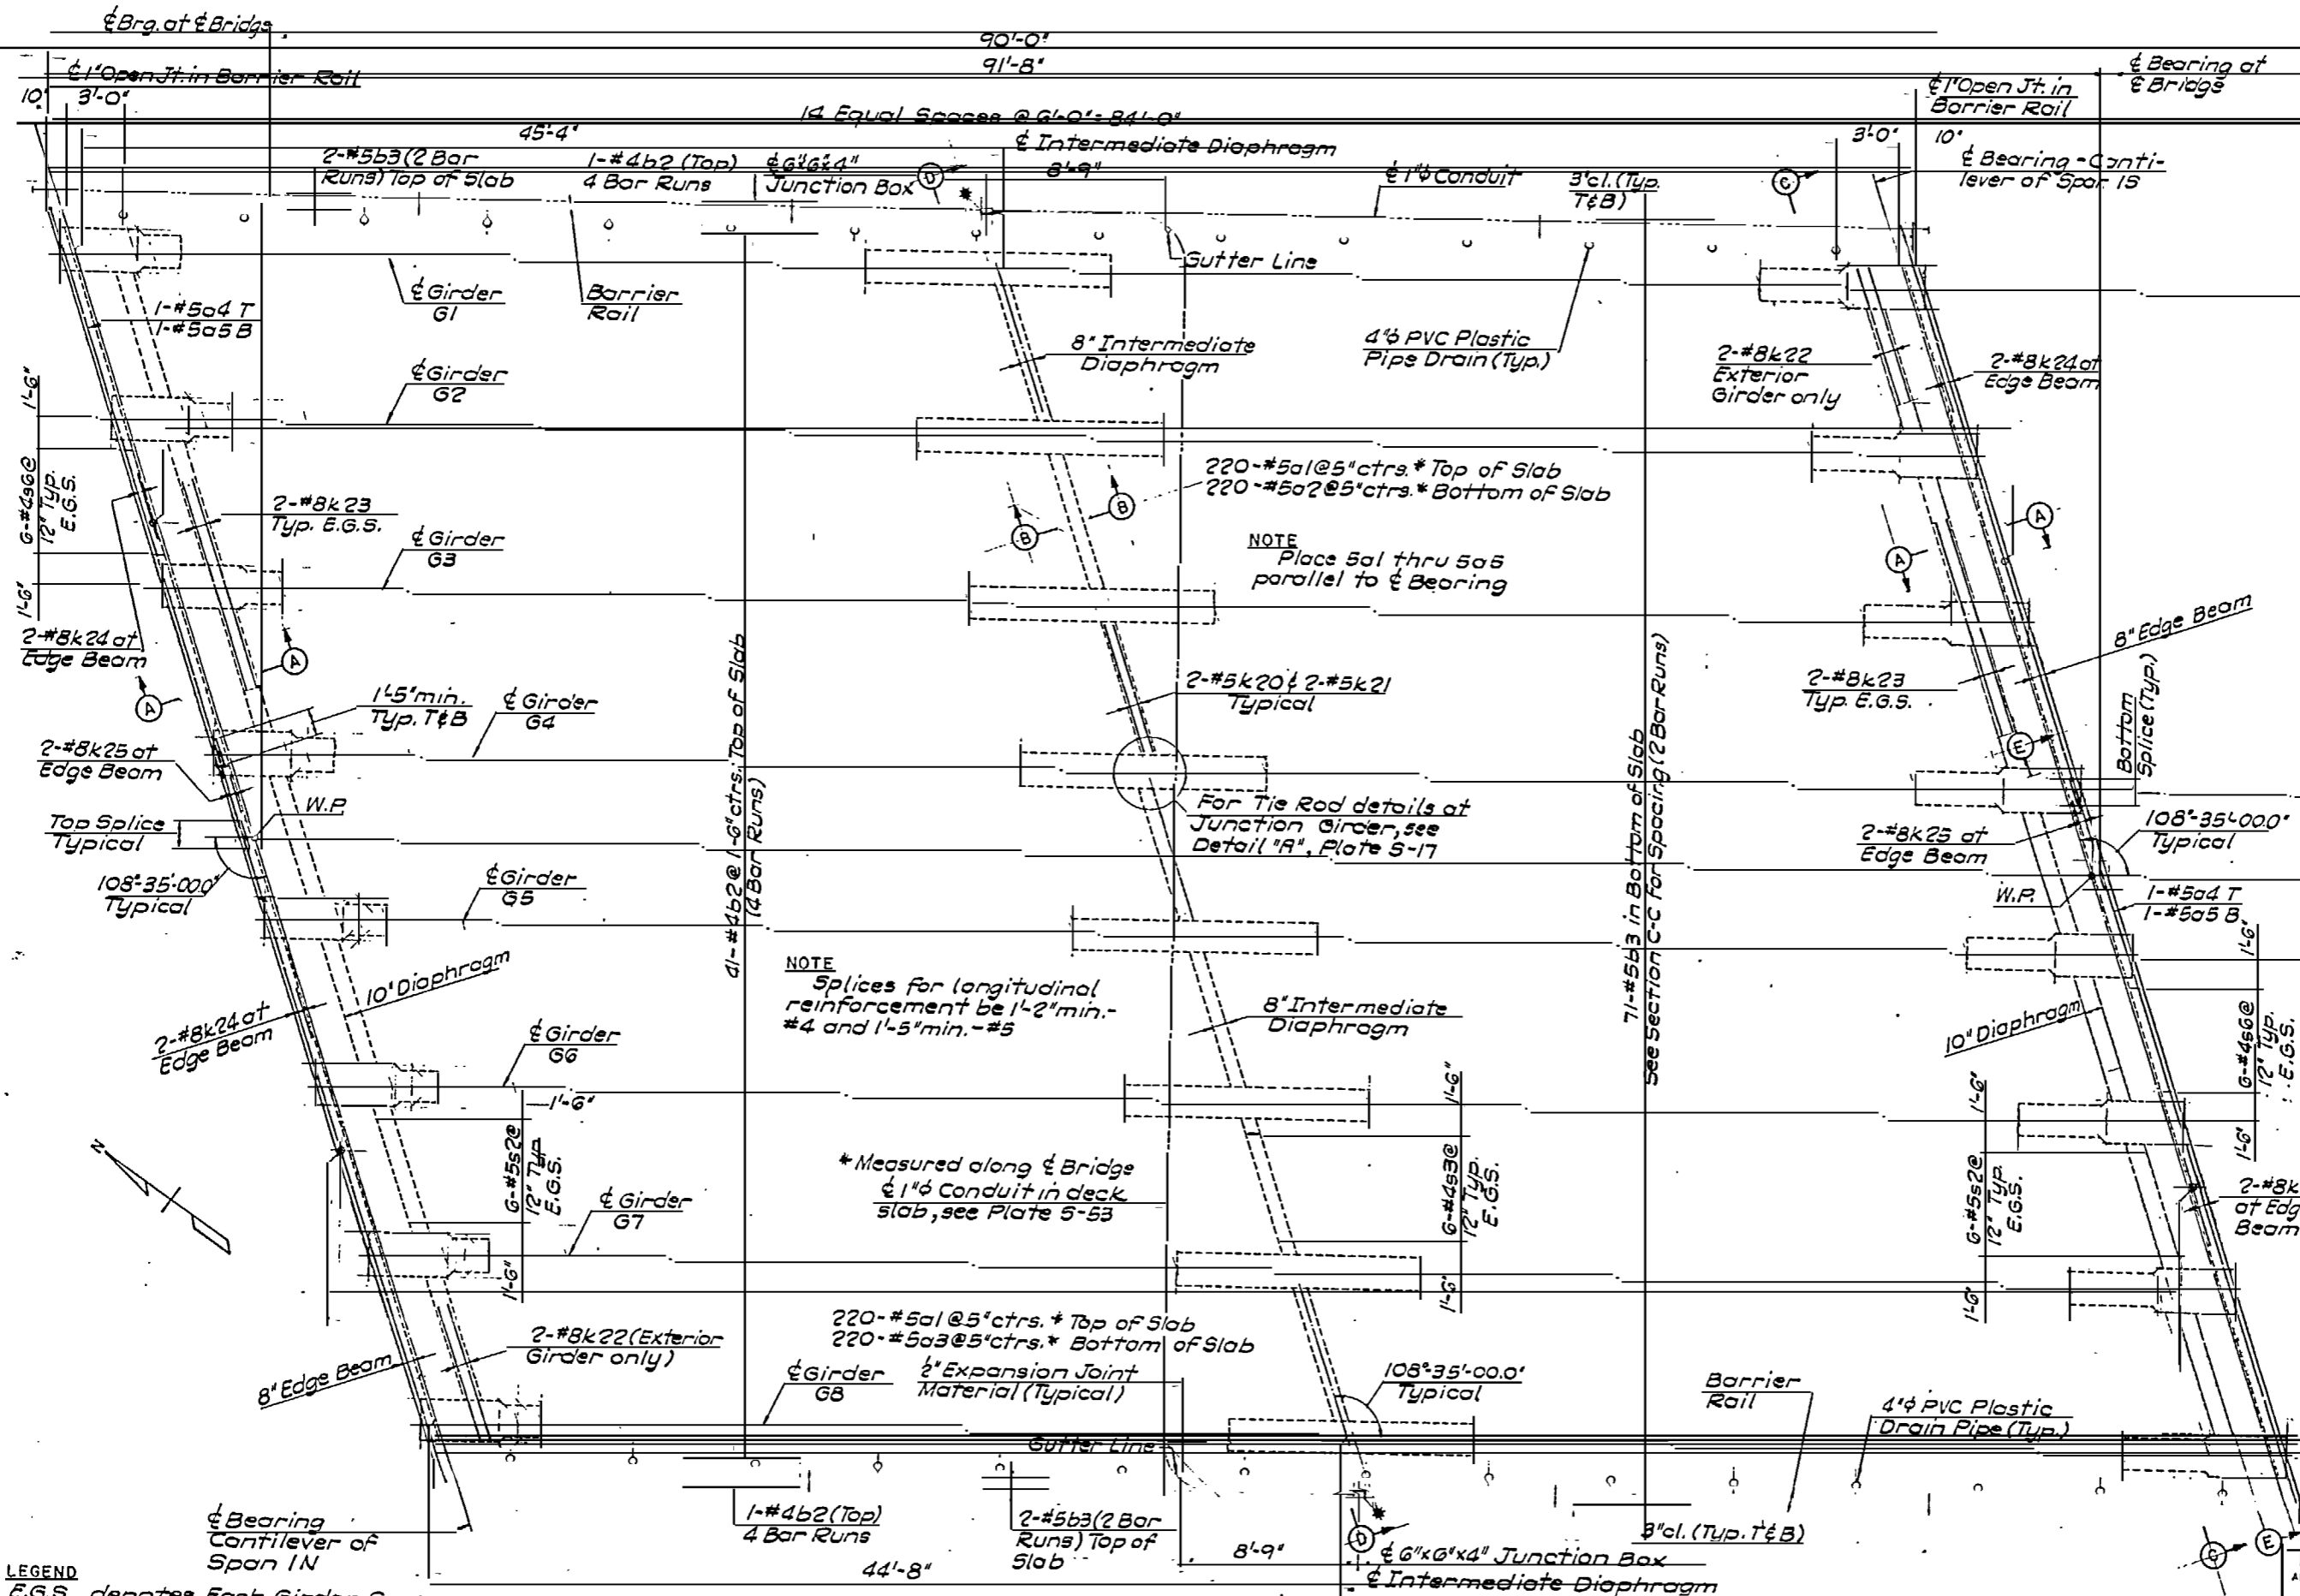

NC STATE AID PROJECT NO.	FED. RD. DIST. NO.
FEDERAL AID PROJECT NO.	ROUTE NO.

LEGEND
 E.G.S. denotes Each Girder Space
 W.P. denotes Working Point
 T denotes Top
 B denotes Bottom
 * denotes 360° Green Channel Center Navigation Light

NOTES
 1.) For Drop-In Span Bar List, see Pl. S-57.
 2.) For Section A-A, see Plate S-20.
 3.) For Section B-B, see Plate S-9.
 4.) For Sections C-C, D-D and Barrier Rail Elevation, see Plate S-19.
 5.) For Section E-E and additional details, see Plate S-20.

RECORD DRAWING

DESIGNED BY: M.G.	CHECKED BY: M.G.
PREPARED BY: [Signature]	
PRINCIPAL OF FIRM HNTB	



HNTB HOWARD NEEDLES TAMMEN & BERGENDOFF ARCHITECTS ENGINEERS PLANNERS ATLANTA, GEORGIA
 U.S. ARMY ENGINEER DISTRICT, WASHINGTON CORPS OF ENGINEERS WASHINGTON, NORTH CAROLINA

ATLANTIC INTRACOASTAL WATERWAY SUPERSTRUCTURE
 SLAB PLAN - DROP-IN SPAN
 COINJOCK BRIDGE REPLACEMENT PROJECT
 CURRITUCK COUNTY NORTH CAROLINA

INVITATION NO. DACW54-83-B-0014	SIZE 11" x 17"	DRAWING NUMBER BRI04-06-17	PLATE NO. S-18
SCALE 1" = 1'-0"	DATE 22 JULY 1983	SHEET 68 OF 126	

PLAN

N.C. STATE AID PROJECT NO.	FED. RD. EST. NO.
FEDERAL AID PROJECT NO.	EST. NO.

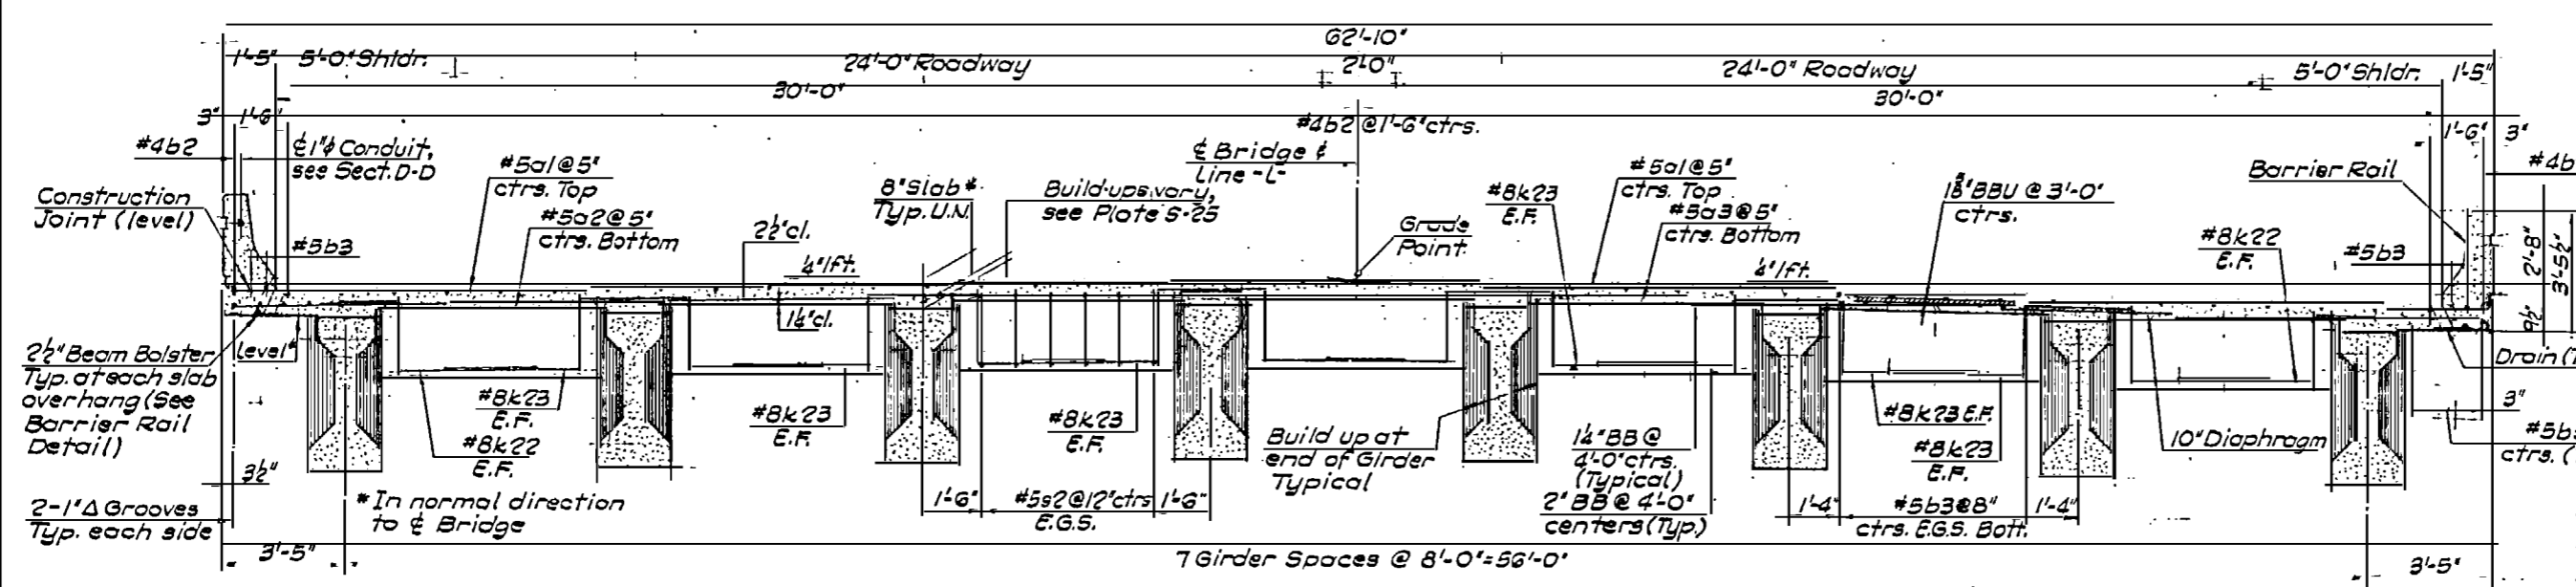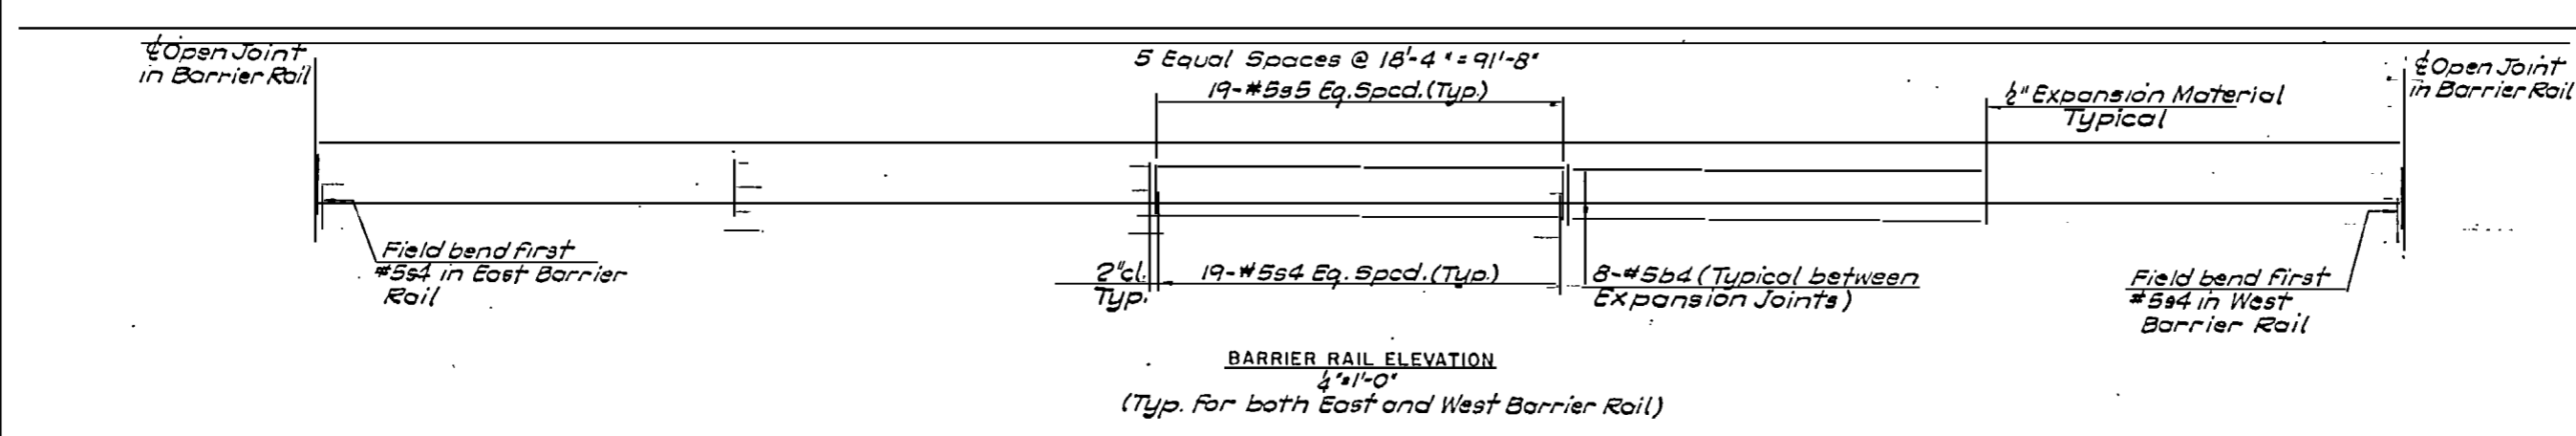


NOTE
Dimensions, bar spacings, etc. shown in Sections C-C and D-D reflect values measured normal to or along & Bridge.

SECTION C-C
8'-1'-0"

*Slab thickness varies in center girder space.

NOTE
Metal Stay-In-Place forms have not been shown on Sections C-C and D-D. For Typical details, see Plate S-30.

- NOTES
- 1) For General Notes, see Plate S-7,
 - 2) For additional details, see Pl. S-20,
 - 3) For Slab Plan of Drop-In Span, see Plate S-18,
 - 4) For Girder details, see Pl's. S-27 & 28,
 - 5) For Barrier Rail detail, see Pl. S-15,
 - 6) For Erection Sequence, see Pl. S-26,
 - 7) For Tie Rod detail, see Pl. S-27.

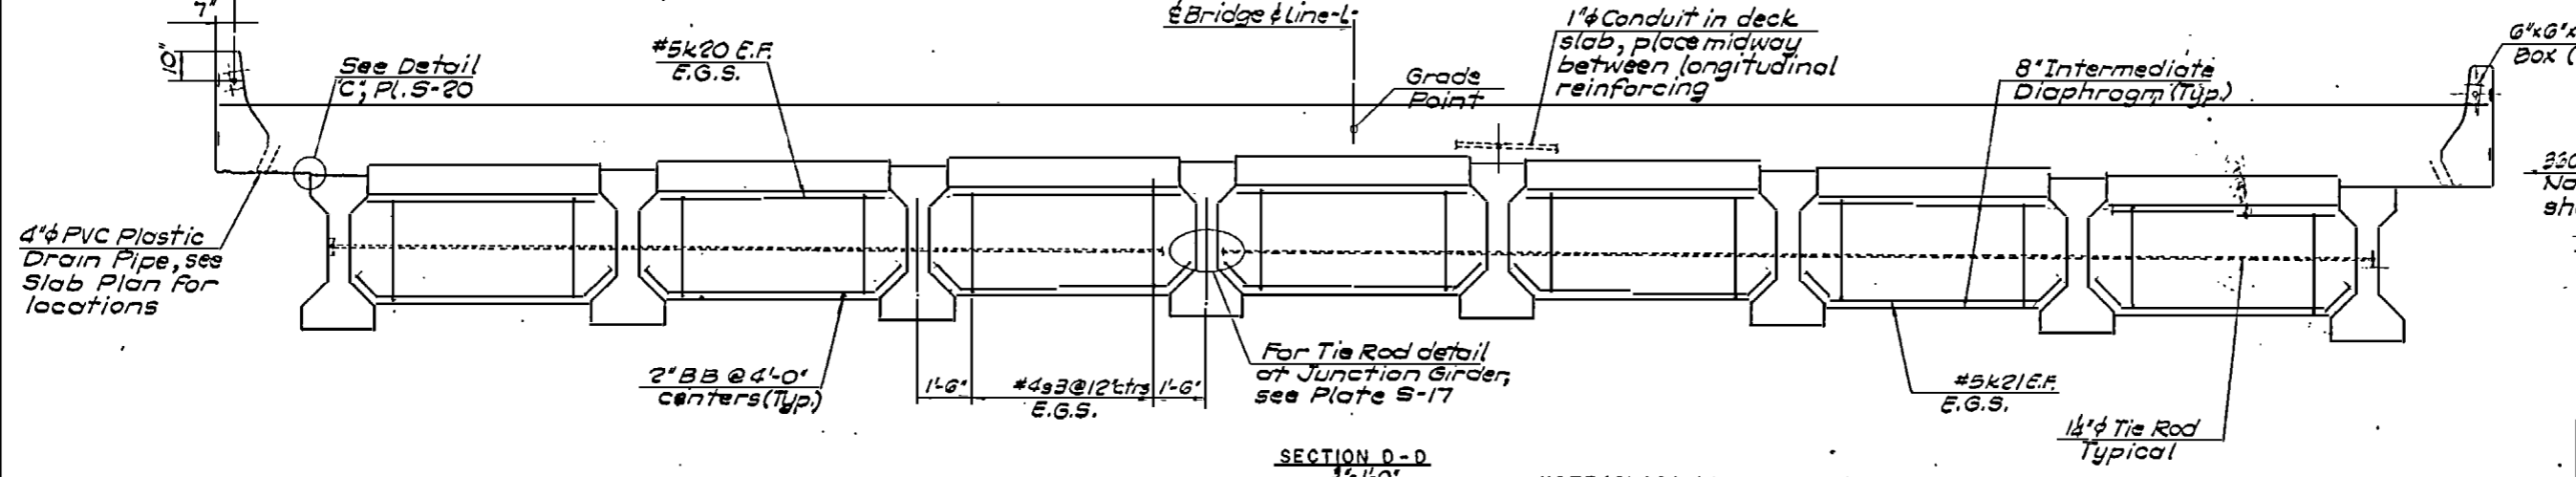

SECTION D-D
8'-1'-0"

NOTE (CLASS AA CONCRETE)
The quantity of all Class AA Concrete in Drop-In Span averages 1.96 C.Y./Lin. Ft. of deck.

- LEGEND
- E.G.S. denotes Each Girder Space
 - BB denotes Beam Bolster
 - BBU denotes Beam Bolster Upper
 - U.N. denotes Unless Noted
 - E.F. denotes Each Face






RECORD DRAWING

HNTB HOWARD NEEDLES TAMMEN & BERGENDOFF ARCHITECTS ENGINEERS PLANNERS ATLANTA, GEORGIA U.S. ARMY ENGINEER DISTRICT, WASHINGTON CORPS OF ENGINEERS WASHINGTON, NORTH CAROLINA

ATLANTIC INTRACOASTAL WATERWAY SUPERSTRUCTURE DROP-IN SPAN - DETAILS 1 COINJOCK BRIDGE REPLACEMENT PROJECT CURRITUCK COUNTY NORTH CAROLINA

DESIGNED BY: M.G.	CHECKED BY: M.G.	INVESTIGATION NO. DAC W54-83-B-0014	SIZE B-0014	DRAWING NUMBER BR104-06-17	PLATE NO S-19
PRINCIPAL OF FIRM HNTB		SCALE AS NOTED		DATE 22 JULY 1983	SHEET 69 OF 126


NC STATE AID PROJECT NO.	
FEDERAL AID PROJECT NO.	
FED. RD. DIST. NO.	
CONTRACT NO.	

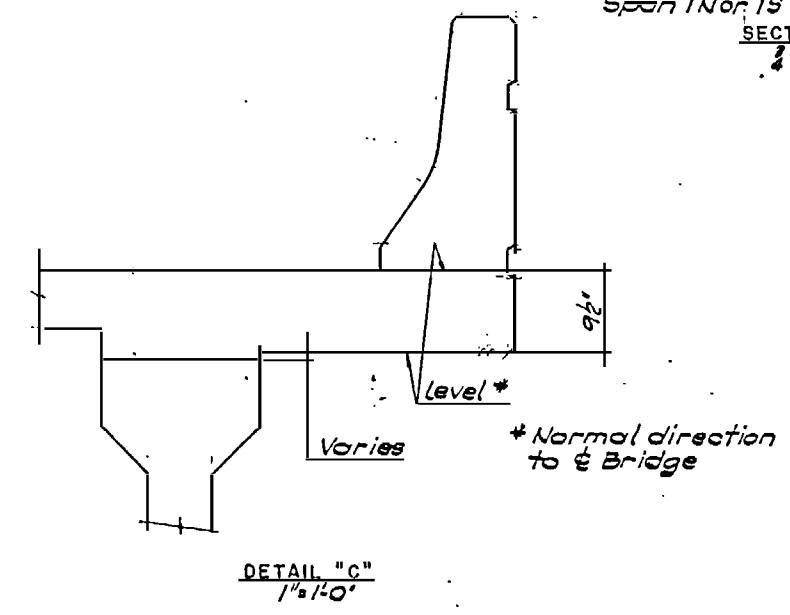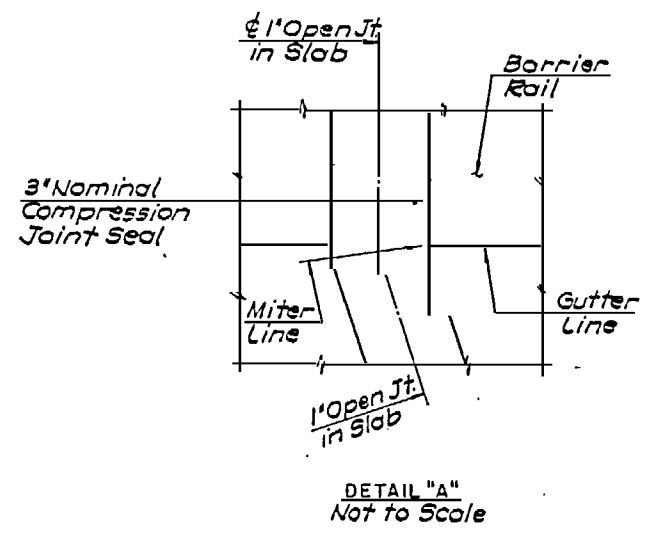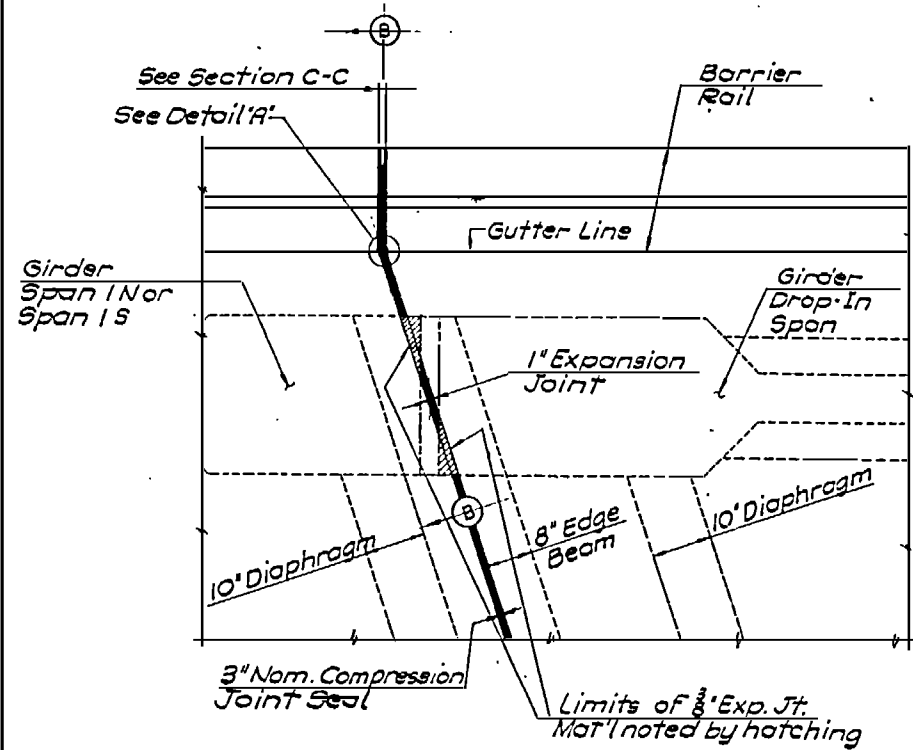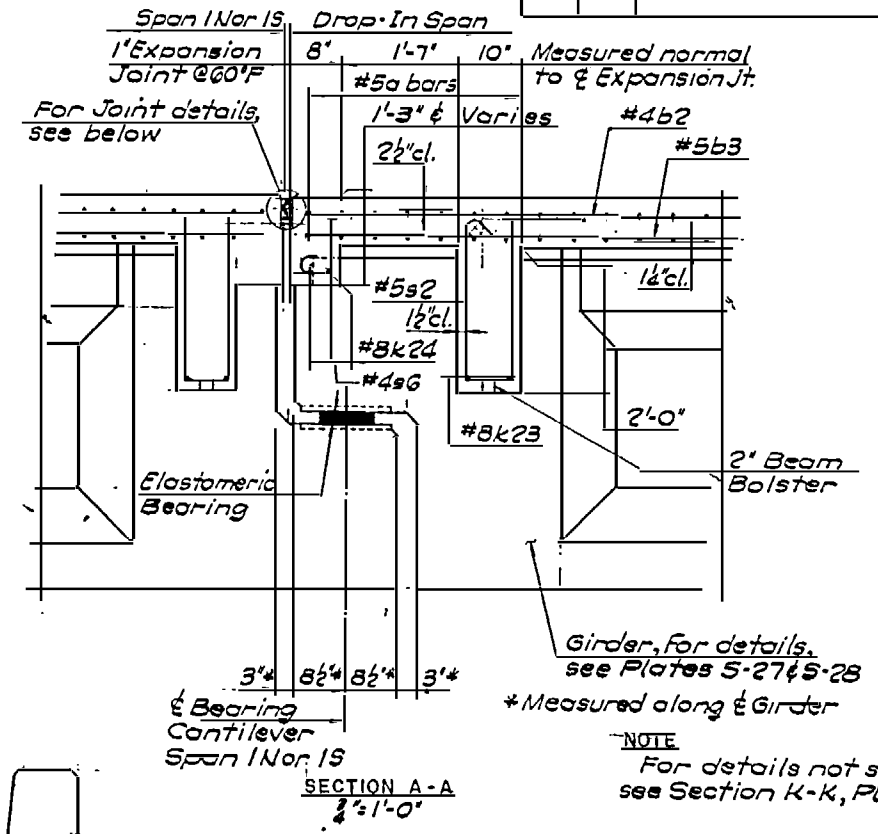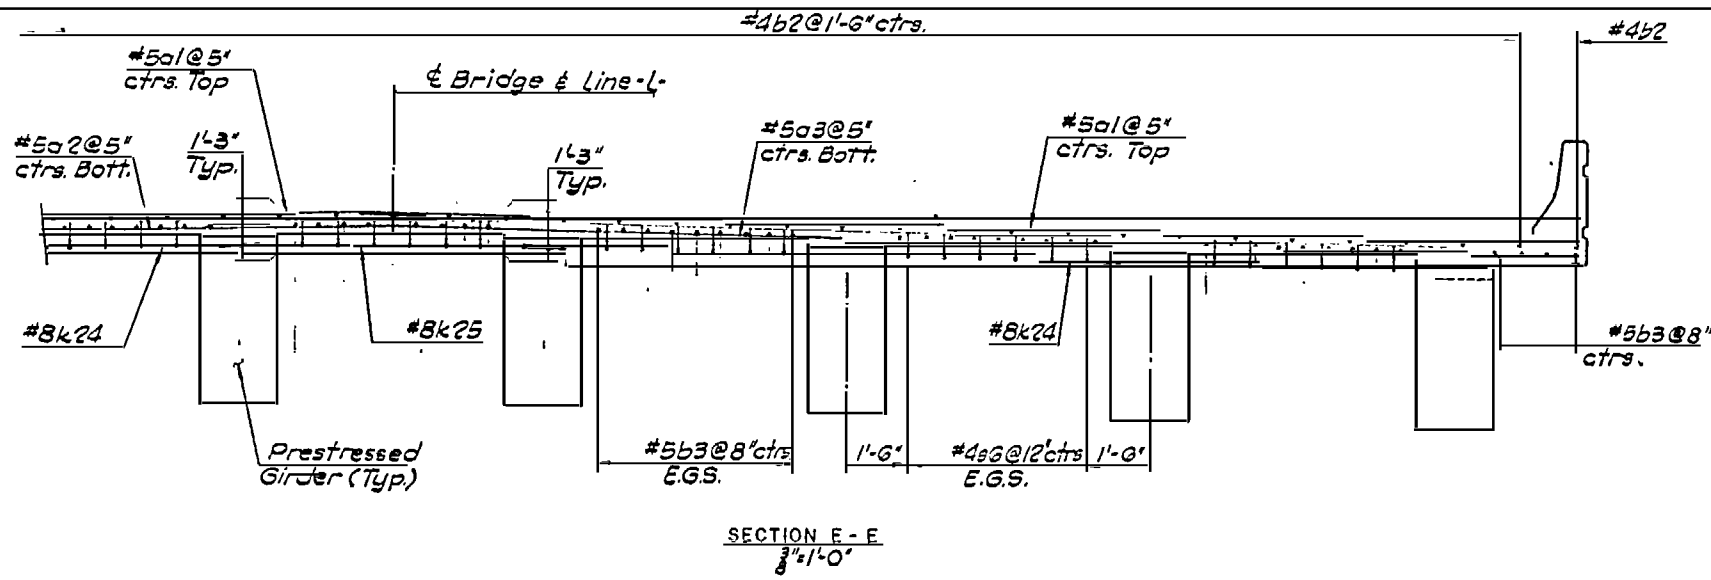

NOTES
 1.) For Slab Plan of Drop-In Span, see Plate S-18.
 2.) For Slab Plan 1N, see Plate S-14.

LEGEND
 E.G.S. denotes Each Girder Space

NOTES
 1.) Joint for Compression Joint Seal must be sawed and not formed.
 2.) Terminating ends of seal to be watertight as per manufacturer's recommendations.

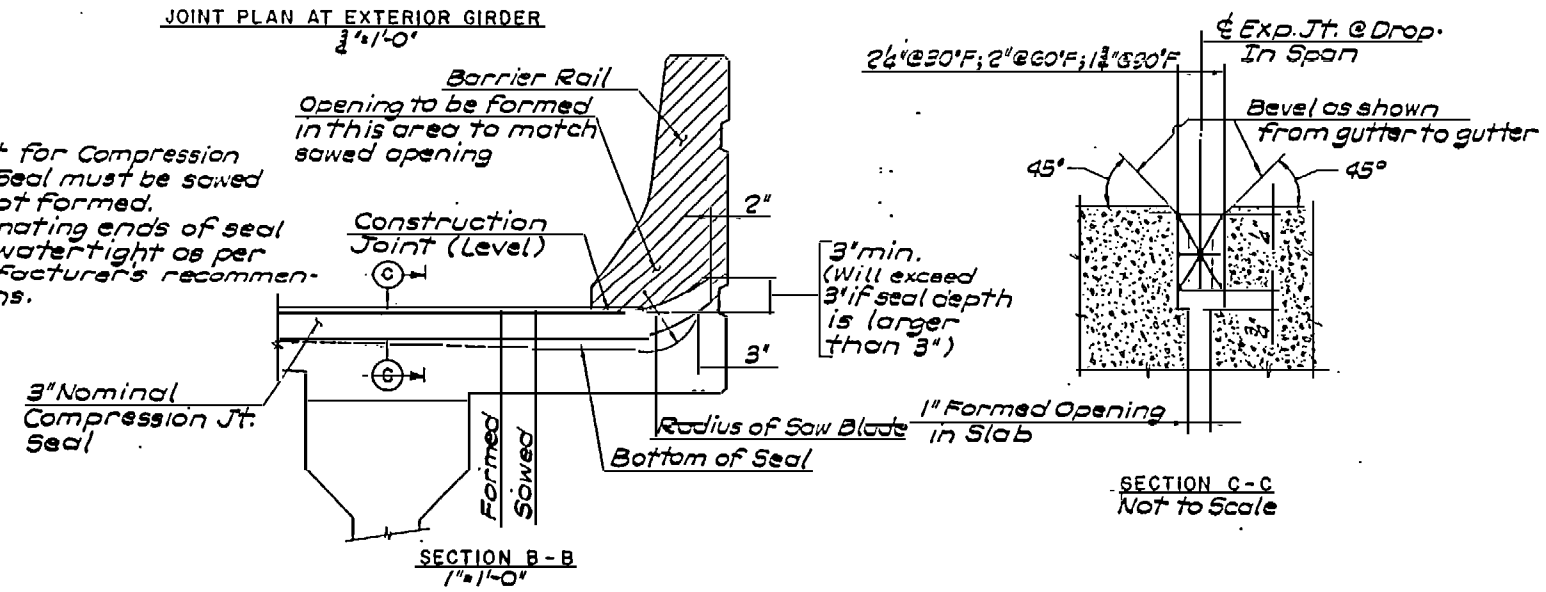


RECORD DRAWING

HNTB HOWARD NEEDLES TAMMEN & BERGENDOFF ARCHITECTS ENGINEERS PLANNERS ATLANTA, GEORGIA

U.S. ARMY ENGINEER DISTRICT, WILMINGTON, NORTH CAROLINA
 ATLANTIC INTRACOASTAL WATERWAY
 SUPERSTRUCTURE
 DROP-IN SPAN - DETAILS 2
 COINJOCK BRIDGE REPLACEMENT PROJECT
 CURRITUCK COUNTY NORTH CAROLINA

DESIGNED BY: M.G.	CHECKED BY: M.G.	INVIATION NO. DACW54-83-B-0014	SIZE B-0014	DRAWING NUMBER BR104-06-17	PLATE NO. S-20
PRINCIPAL OF FIRM HNTB		SCALE AS NOTED DATE 22 JULY 1983		SHEET 70 OF 126	

NC STATE AID PROJECT NO	FED. NO
FEDERAL AID PROJECT NO	DIV. NO

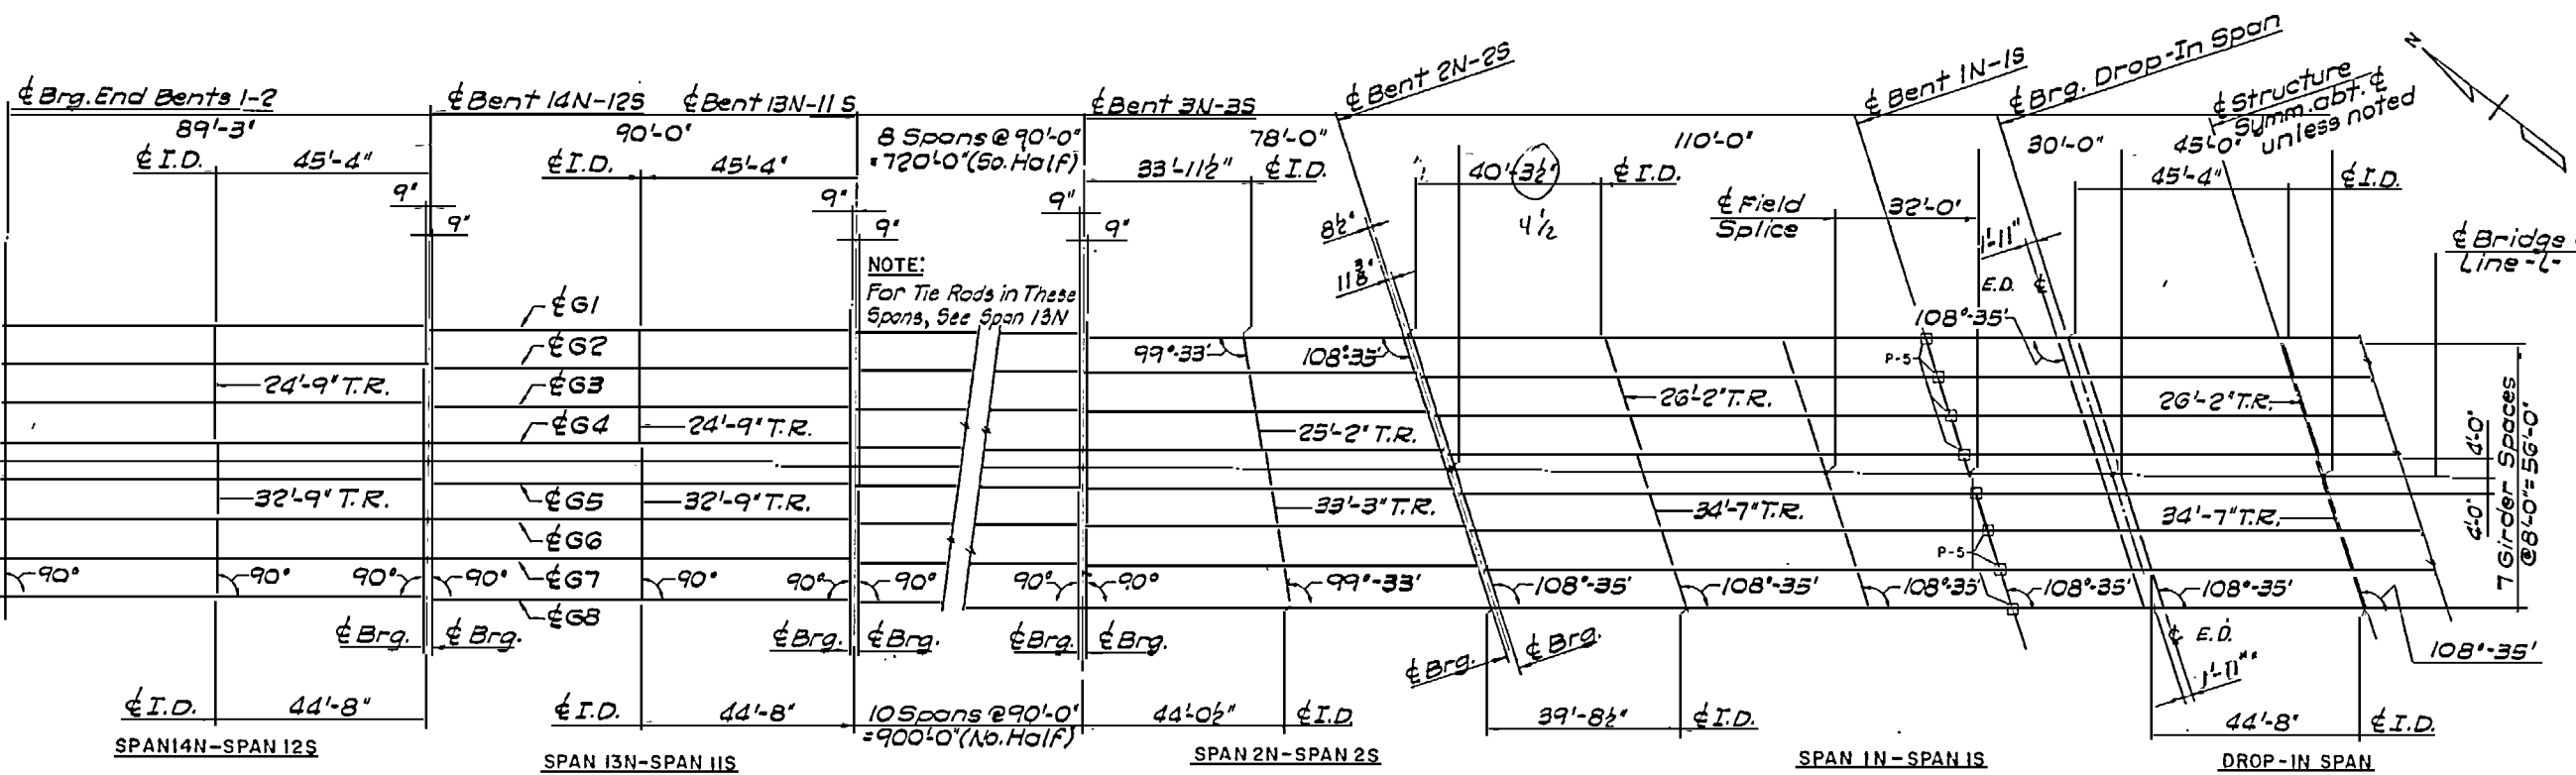





BEARING TYPES		
LOCATION	STATION	TYPE
End Bent 1	140+2.73	P-4
Bent 14N	141+02	
13N	141+92	
12N	142+82	
11N	143+72	
10N	144+62	
9N	145+52	
8N	146+42	
7N	147+32	P-4
6N	148+22	P-3
5N	149+12	P-3
4N	150+02	P-2
3N	150+92	P-2
2N	151+70	P-2
Bent 1N	152+80	P-5
Drop-In (No)	153+10	P-1
Drop-In (So)	154+00	P-1
Bent 1S	154+30	P-5
2S	155+40	P-2
3S	156+18	P-2
4S	157+08	P-2
5S	157+98	P-3
6S	158+88	P-3
7S	159+78	P-4
8S	160+68	
9S	161+58	
10S	162+48	
11S	163+38	
Bent 12S	164+28	
End Bent 2	165+17.25	P-4

NOTE:
For Tie Rods in These Spans, See Span 13N

LEGEND
I.D. denotes Intermediate Diaphragm
T.R. denotes Tie Rod

NOTE
The same bearing type shall be required at both North and South bearings of any one bent except where only one line of bearings is required.

E.D. = END DIAPHRAM

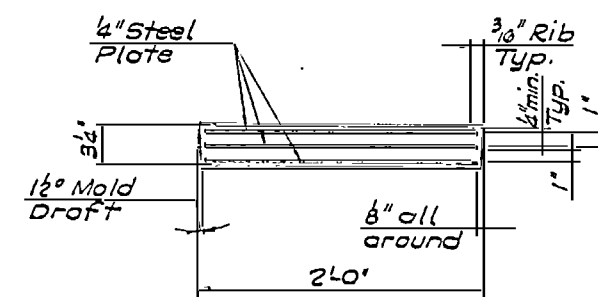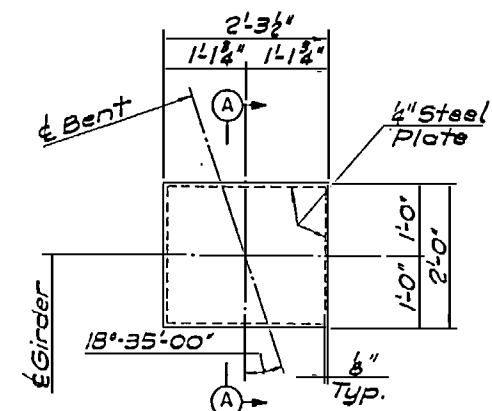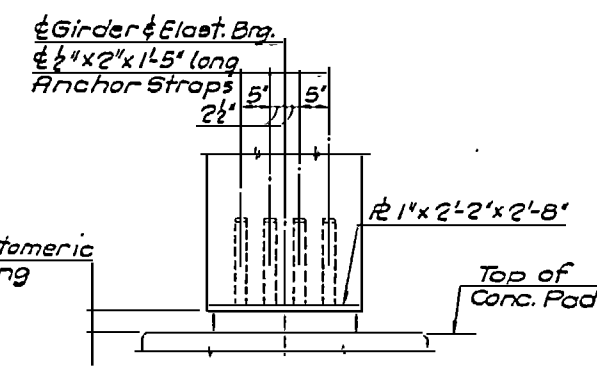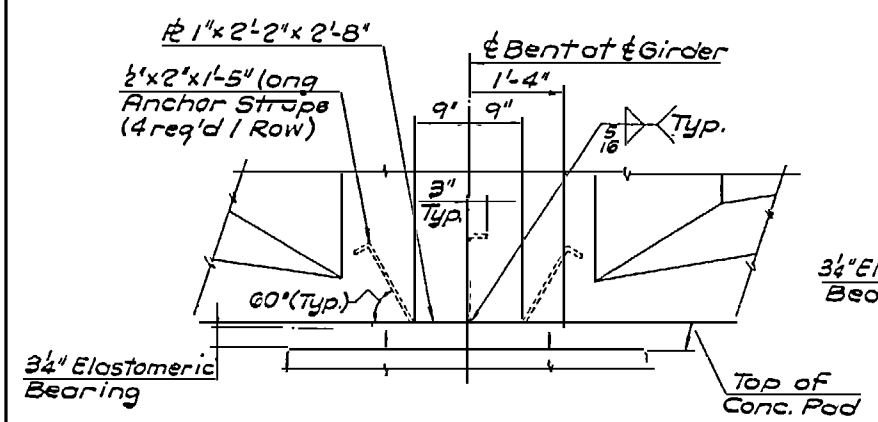

BEARING TYPE P-5 DETAILS

- NOTES (ELASTOMERIC BEARINGS AT BENTS IN & IS)
- 1.) Elastomer in all bearings shall have a Grade 50 Durometer hardness.
 - 2.) Steel plates in laminated bearing shall conform to A.S.T.M. A36.
 - 3.) Embedded Plate 1" x 2" x 2" x 2" shall be galvanized in accordance with A.S.T.M. A123. Weld 1/2" straps prior to galvanizing.

- NOTES
- 1.) For details of Bearing Types P-1 thru P-4, see Plate S-22.
 - 2.) For Girder Cambers, see Plate S-29.

RECORD DRAWING

DESIGNED BY: M.G.	CHECKED BY: M.A.M.
PREPARED BY: [Signature]	PRINCIPAL OF FIRM HNTB

HNTB HOWARD NEEDLES TAMMEN & BERGENOFF ARCHITECTS ENGINEERS PLANNERS ATLANTA, GEORGIA


U.S. ARMY ENGINEER DISTRICT WILMINGTON CORPS OF ENGINEERS WILMINGTON NORTH CAROLINA

ATLANTIC INTRACOASTAL WATERWAY SUPERSTRUCTURE FRAMING PLANS AND BEARING DETAILS COINJOCK BRIDGE REPLACEMENT PROJECT CURRITUCK COUNTY NORTH CAROLINA

INVITATION NO DACW54-83-B-0014	SIZE B	DRAWING NUMBER BR104-06-17	PLATE NO S-21
-----------------------------------	-----------	-------------------------------	------------------

SCALE AS NOTED | DATE 22 JULY 1983 | SHEET 71 OF 126


N.C. STATE AID PROJECT NO.	FED. RD. PROJ. NO.
FEDERAL AID PROJECT NO.	FED. RD. PROJ. NO.

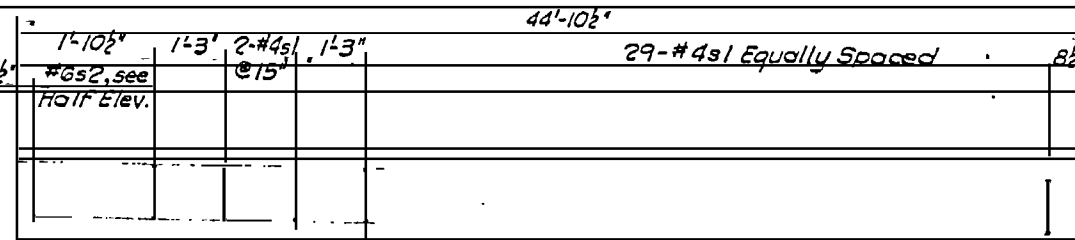


HALF PLAN

CABLE CHARACTERISTICS				
SIZE	GRADE	AREA	ULTIMATE STRENGTH	APPLIED PRESTRESS
Inches		sq. in.	lbs./cable	lbs./cable
1/2"	270	0.153	41,300	28,900


GIRDERS REQUIRED		
NO.	LENGTH	TOTAL LENGTH
176	894'	15,796

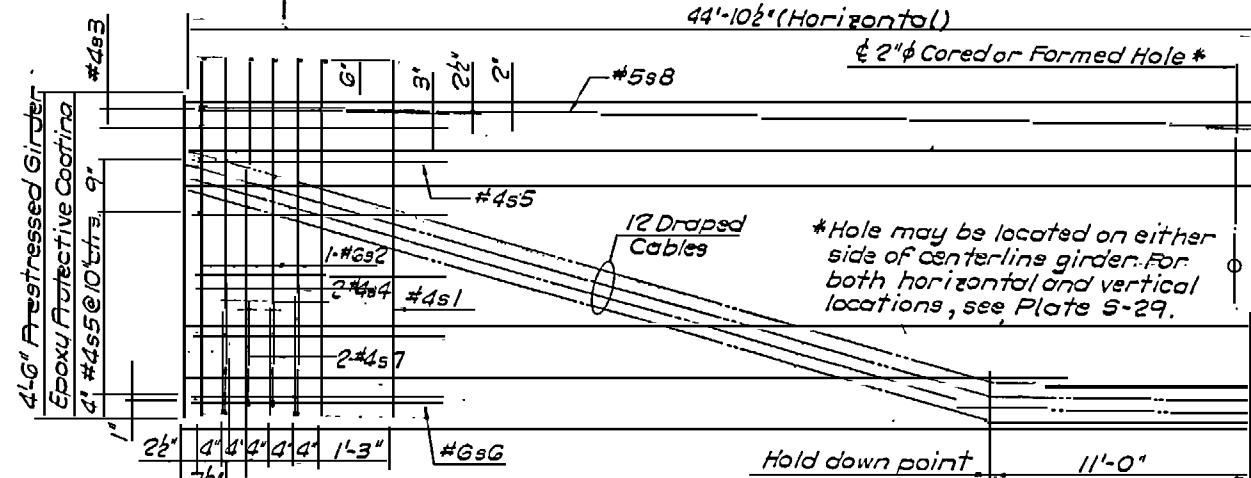


HALF ELEVATION

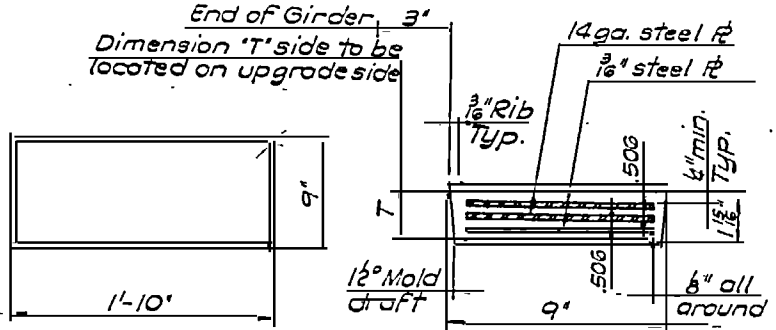


TYPICAL SECTION

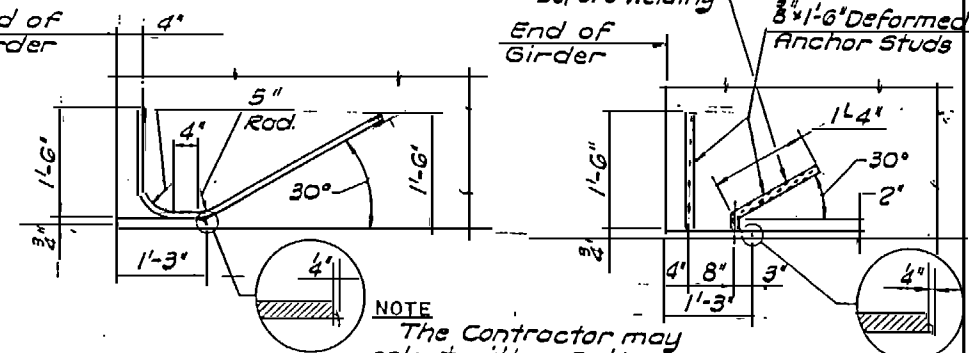

NOTE
The Contractor may select either Options 1 or 2 for embedded R B-1

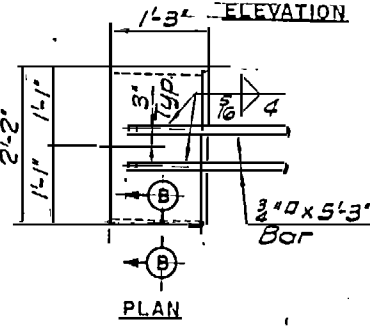

OPTION 1

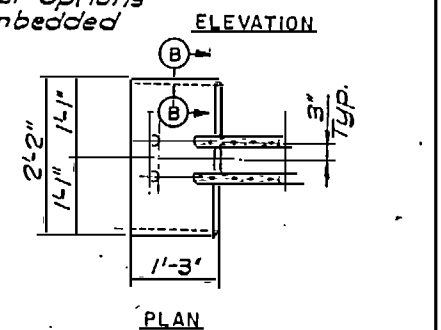


OPTION 2

SECTION B-B


NOTE
Bevel edges of R B-1 to give close fit but not tight fit to steel casting form.

ELASTOMERIC BEARINGS


BEAM-GRADE %	T (Inches)	BEARING TYPES
0.00 - 1.00	1 1/2"	P-1
1.01 - 2.25	2 1/8"	P-2
2.25 - 3.50	2 3/8"	P-3
3.51 - 5.00	2 7/8"	P-4

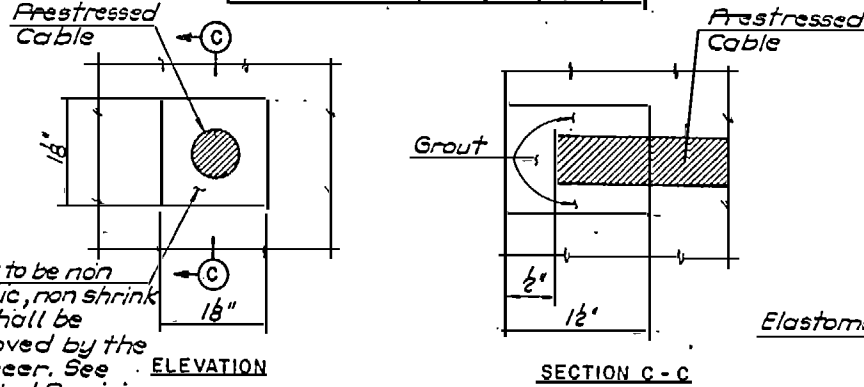

Grout to be non metallic, non shrink and shall be approved by the Engineer. See Technical Provisions

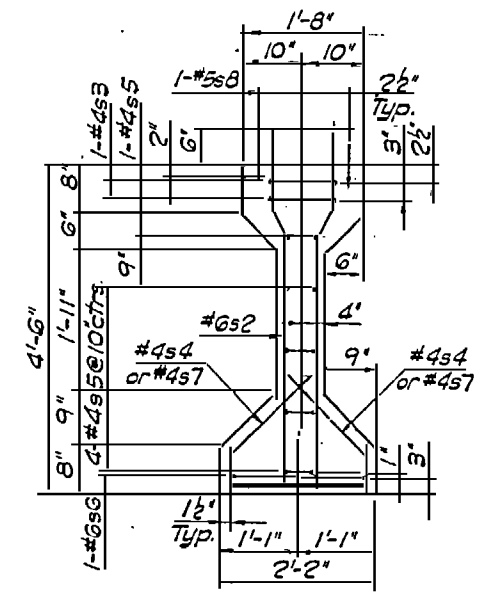


SECTION A-A
(Cables not shown)

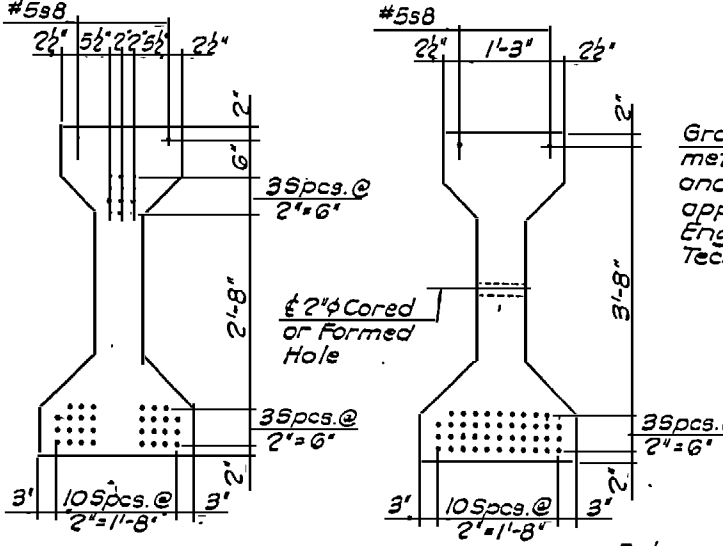


AT END
AT ϕ

PRESTRESS CABLE LAYOUT

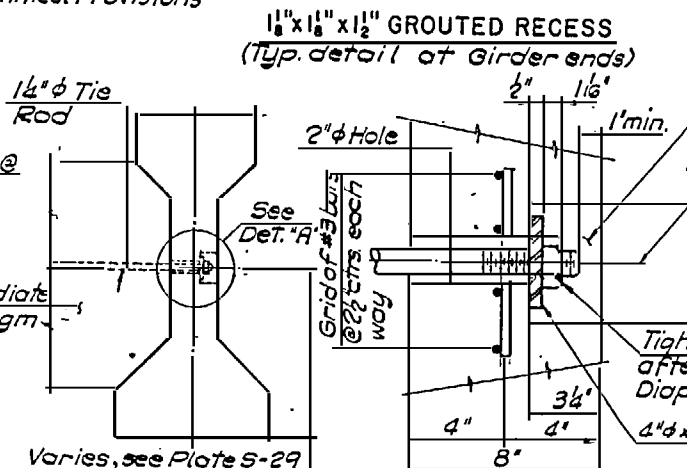

TYPICAL SECTION

DETAIL "A"
(At G1 and G8 only)

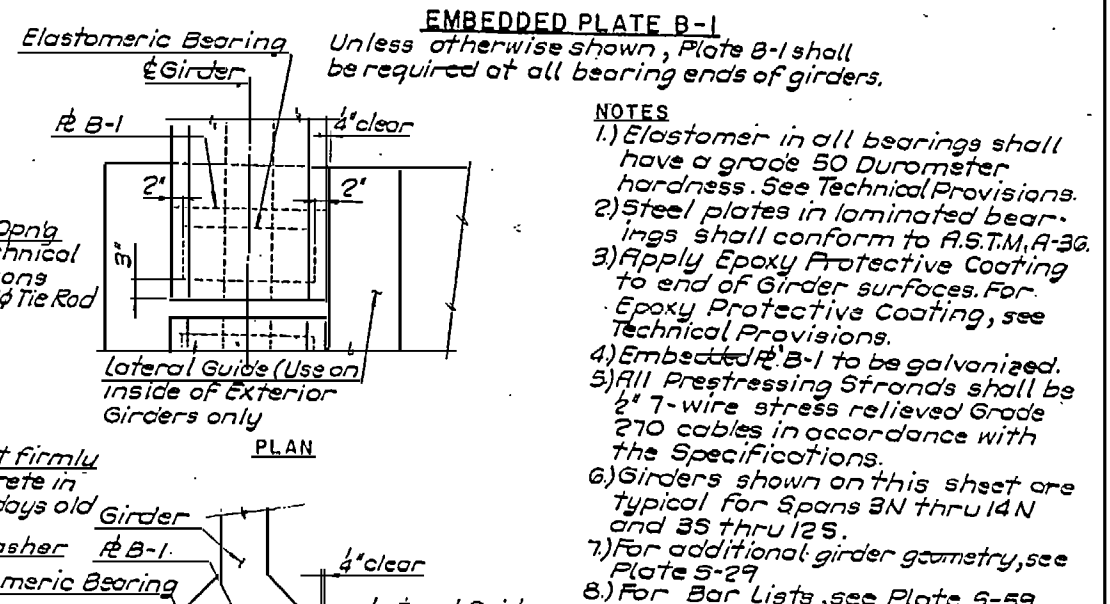


EMBEDDED PLATE B-1

Unless otherwise shown, Plate B-1 shall be required at all bearing ends of girders.

- NOTES
- 1.) Elastomer in all bearings shall have a grade 50 Durometer hardness. See Technical Provisions.
 - 2.) Steel plates in laminated bearings shall conform to A.S.T.M. A-36.
 - 3.) Apply Epoxy Protective Coating to end of Girder surfaces. For Epoxy Protective Coating, see Technical Provisions.
 - 4.) Embedded R B-1 to be galvanized.
 - 5.) All Prestressing Strands shall be 1/2" 7-wire stress relieved Grade 270 cables in accordance with the Specifications.
 - 6.) Girders shown on this sheet are typical for Spans 3N thru 14N and 3S thru 12S.
 - 7.) For additional girder geometry, see Plate S-29
 - 8.) For Bar Lists, see Plate S-59


QUANTITIES FOR ONE GIRDER			
	REINFORCING STEEL Lbs.	5,500 psi CONCRETE Cu. Yds.	GRADE 270 S.R. CABLES No.
EXTERIOR GIRDER	981	18.2	42
INTERIOR GIRDER	981	18.2	42

NOTE
Quantities shown are for the convenience of the bidder and are for information only.

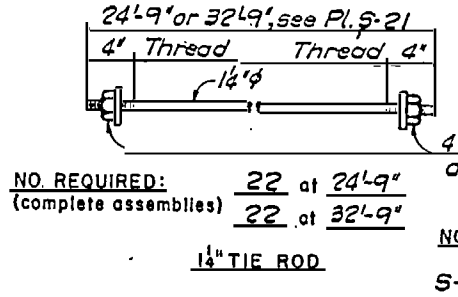


1/4" TIE ROD

NOTE
See note on Plate S-23 for material requirements.

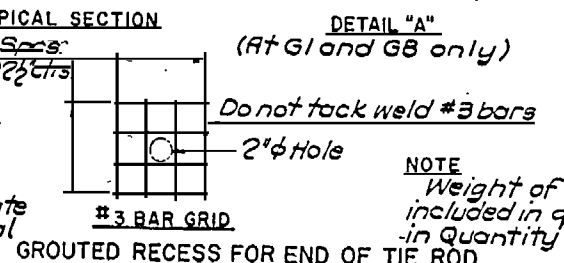

GROUTED RECESS FOR END OF TIE ROD

NOTE
Weight of #3 bars is not included in quantities noted in Quantity for one girder.

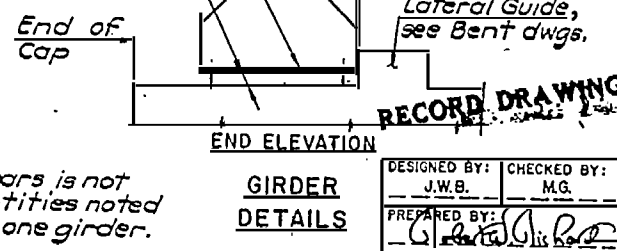

GIRDER DETAILS






RECORD DRAWING

DESIGNED BY: J.W.B.	CHECKED BY: M.G.
PREPARED BY: [Signature]	SCALE NONE

ATLANTIC INTRACOASTAL WATERWAY SUPERSTRUCTURE
GIRDER DETAILS I - APPROACH SPANS
COINJOCK BRIDGE REPLACEMENT PROJECT
CURRITUCK COUNTY NORTH CAROLINA

PLATE NO. S-22
DRAWING NUMBER BRI04-06-17
DATE 22 JULY 1983 SHEET 72 OF 126

N.C. STATE AID PROJECT NO.	FED. NO.
FEDERAL AID PROJECT NO.	1987-101

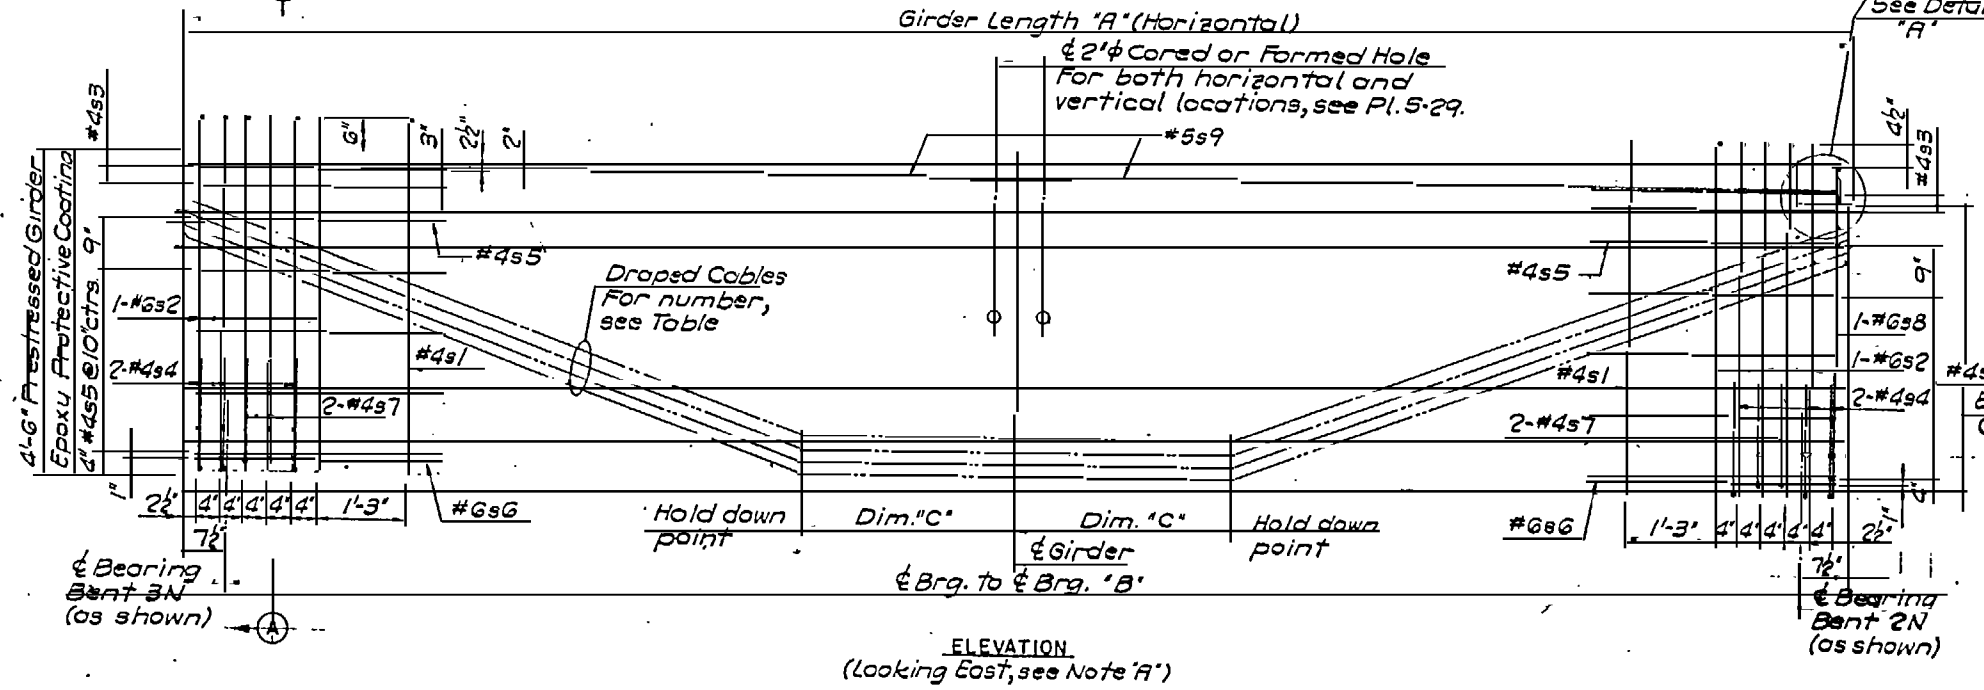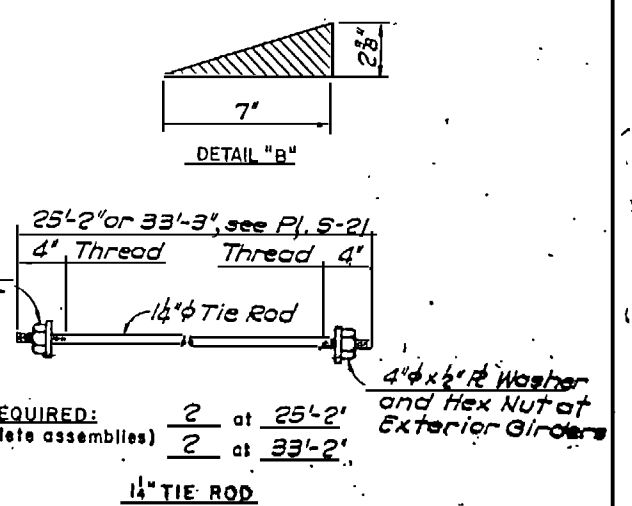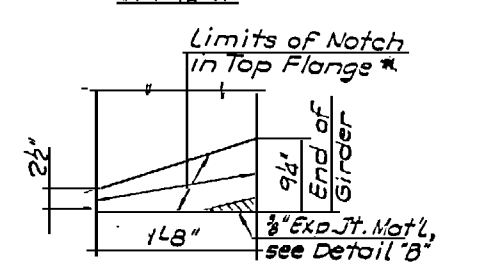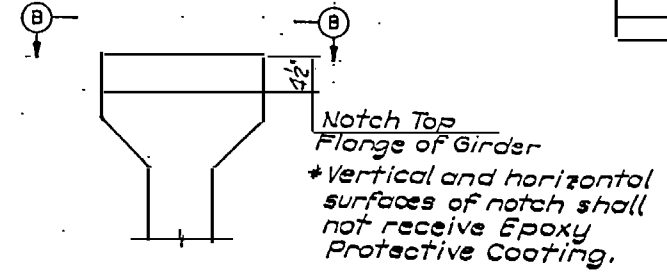
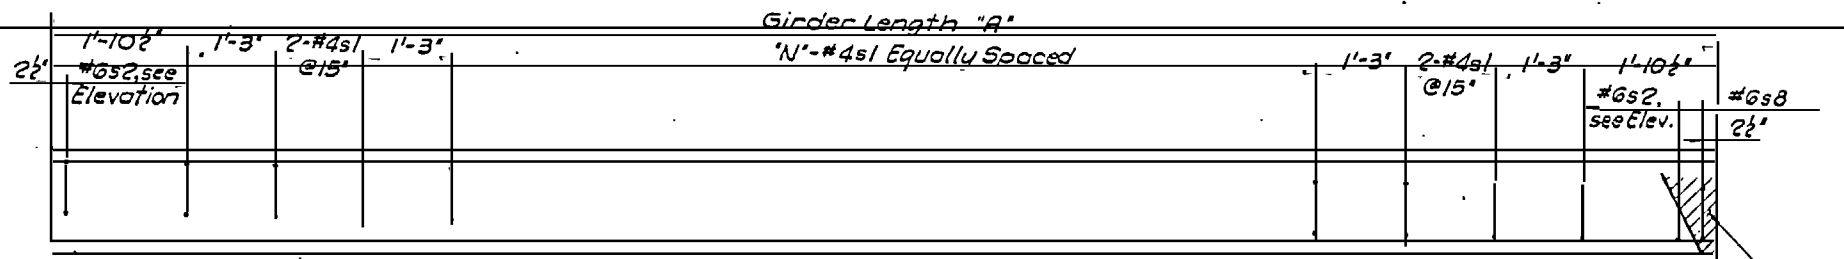


Epoxy Protective Coating
NOTE "A"
Girder in Span 2N shown, girder for Span 2S is similar by rotation.

NO. REQUIRED: 2 at 25'-2" (complete assemblies)
2 at 33'-2"
1/4" TIE ROD

NOTE
Tie Rod Assembly shall be A.S.T.M. A36 grade structural steel and be hot dipped galvanized in accordance with A.S.T.M. A153.

- NOTES
- For additional details and notes, see Plates 5-17 and 5-22.
 - For Span 2N Plan, see Plate 5-11.
 - For additional girder geometry, see Plate 5-29.
 - For Bar Lists, see Plates 5-59 and 5-60.

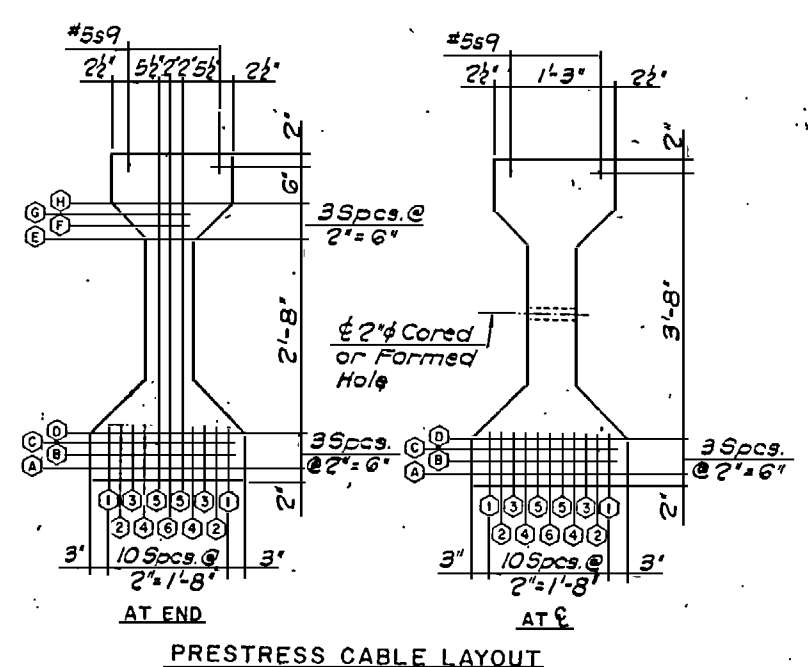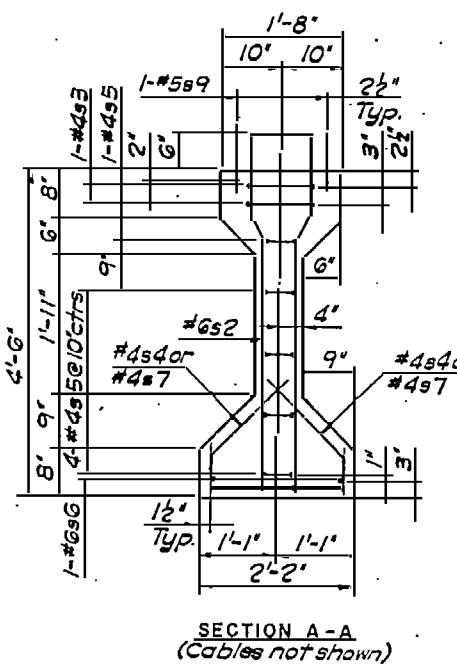


GIRDER NUMBER	SPAN 2N		SPAN 2S							
	B1	B2	B3	B4	B5	B6	B7	B8	B1	
NUMBER REQUIRED	2	2	2	2	2	2	2	2	2	
GIRDER LENGTH "A"	68'-4"	71'-0 1/2"	73'-8 1/2"	76'-4 1/2"	79'-1 1/2"	81'-9 1/2"	84'-5 1/2"	87'-2"		
BRG. TO BRG. "B"	67'-1"	69'-9 1/2"	72'-5 1/2"	75'-1 1/2"	77'-10 1/2"	80'-6 1/2"	83'-2 1/2"	85'-11"		
HOLD DOWN PT. "C"	8'-6"	8'-9"	9'-0"	9'-6"	9'-9"	10'-0"	10'-6"	10'-9"		
TOTAL NO. OF CABLES PER GIRDER	24	27	28	30	32	34	37	39		
NO. OF DRAPED CABLES PER GIRDER	5	6	7	7	7	7	8	11		
LOCATION OF PRESTRESS CABLES AT ENDS OF GIRDER	A	1 thru 6	1 thru 6	1 thru 6	1 thru 6	1 thru 6	1 thru 6	1 thru 6		
	B	1 thru 6	1 thru 6	1 thru 6	1 thru 6	1 thru 6	1 thru 6	1 thru 6		
	C	5	4,5,6	4,5,6	3 thru 6	2 thru 6	1 thru 6	2 thru 6	1 thru 6	
	D			6	6	6	6	3,4,5	3,4,5	
"N" - #4s1	E	3,6	5,6	5,6	5,6	5,6	5,6	5,6		
	F	5	5,6	5,6	5,6	5,6	5,6	5,6		
	G			6	6	6	6	5	5,6	
	H								5	
QUANTITIES FOR ONE GIRDER										
REINF. STEEL	Lbs.	820	840	860	880	900	920	940	961	
5,500 psi CONC. Cu. Yds.		13.9	14.4	15.0	15.5	16.1	16.6	17.1	17.7	

*Dimensions shown are measured horizontally.
NOTE
Quantities shown are for the convenience of the Bidder and for information only.

SIZE	GRADE	AREA	ULTIMATE STRENGTH	APPLIED PRESTRESS
Inches		sq. in.	lbs. / cable	lbs. / cable
1/2	270	0.153	41,300	28,900

DESIGNED BY: J.W.B. CHECKED BY: M.G.
 PREPARED BY: [Signature]
 HNTB HOWARD NEEDLES TAMNER & BERENDOFF ARCHITECTS ENGINEERS PLANNERS ATLANTA, GEORGIA
 U.S. ARMY ENGINEER DISTRICT WASHINGTON CORPS OF ENGINEERS WILMINGTON NORTH CAROLINA
 ATLANTIC INTRACOASTAL WATERWAY SUPERSTRUCTURE
 GIRDER DETAILS 2 - SPAN 2N COINJOCK BRIDGE REPLACEMENT PROJECT CURRITUCK COUNTY NORTH CAROLINA
 DRAWING NO. BR104-06-17
 DATE 22 JULY 1983 SHEET 73 OF 126

N.C. STATE AID PROJECT NO.	FED. RD. DIV. NO.
FEDERAL AID PROJECT NO.	

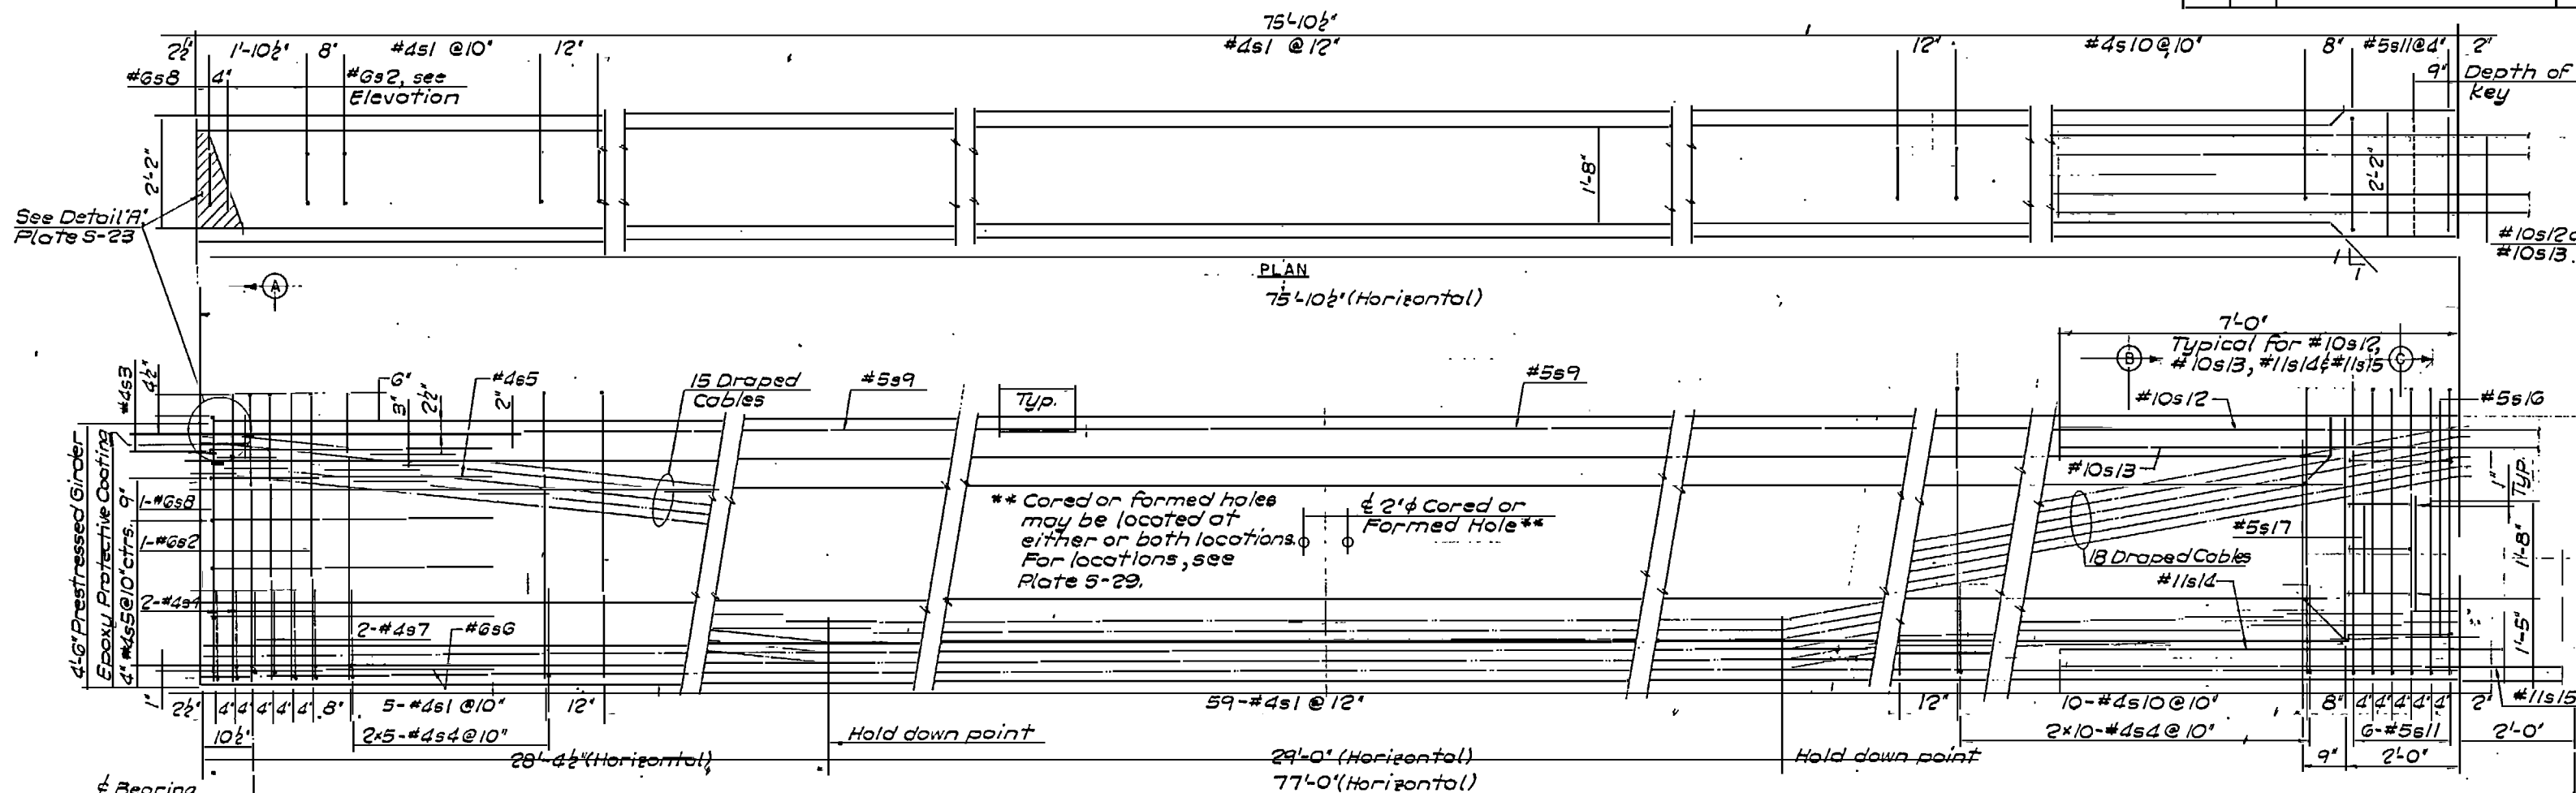


NOTE
Girder details shown on this drawing are typical for Girders G1 thru G8.

ELEVATION
(Looking East, see Note 'A')

GIRDERS REQUIRED		
NO.	LENGTH	TOTAL LENGTH
8	75'-10 1/2"	607'-0"

* Number req'd for Span 1N, Span 1S same

2" x 1 1/2" x 4" Square R Washer and Hex Nut at Junction Girder

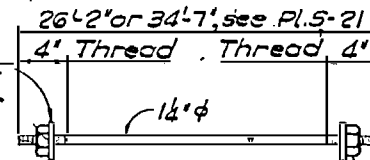


4" x 2" R Washer and Hex Nut at Exterior Girder


NO. REQUIRED:	2	26'-2"
(complete assemblies)	2	34'-7"

NOTE
For Tie Rod material requirements, see Plate 5-23.


- NOTES
- 1) For Bar List, see Plate 5-59.
 - 2) For Slab Plan - Span 1N, see Plates 5-13 and 5-14.
 - 3) For additional girder details, see Plates 5-17 and 5-22.
 - 4) From Erection Sequence, see Pl. 5-26.
 - 5) For Field Splice details, see Pl. 5-26.

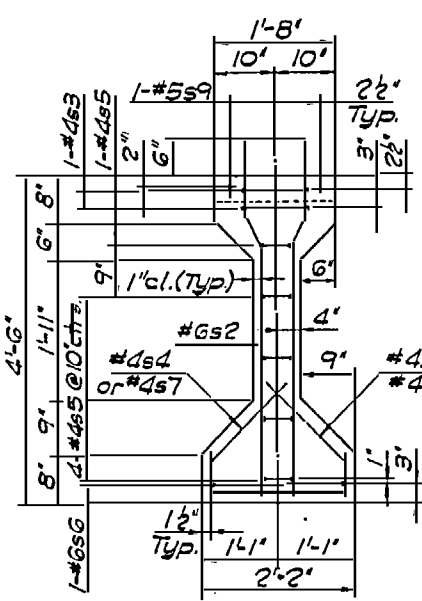

SECTION A-A

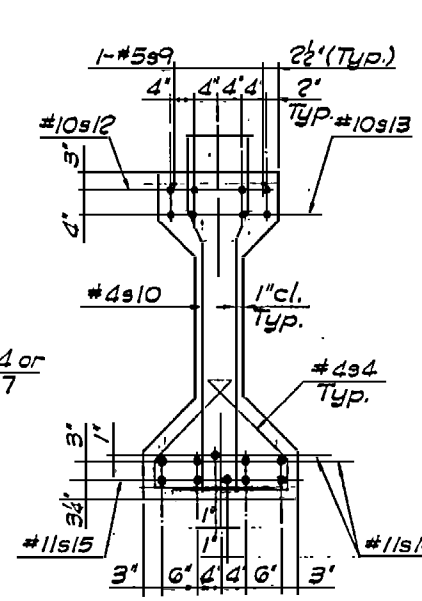


SECTION B-B

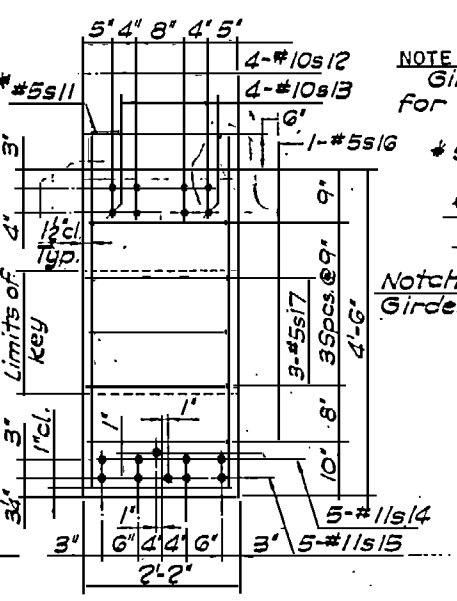

SECTION C-C

NOTE
Girders in Span 1N are composed of two prestressed segments (1N-a and 1N-b) and one cast-in-place segment. For details of segment 1N-b, see Plates 5-25 and 5-26.

CABLE CHARACTERISTICS				
SIZE	GRADE	AREA	ULTIMATE STRENGTH	APPLIED PRESTRESS
inches		sq. in.	lbs. / cable	lbs. / cable
1/2	270	0.153	41,300	28,900

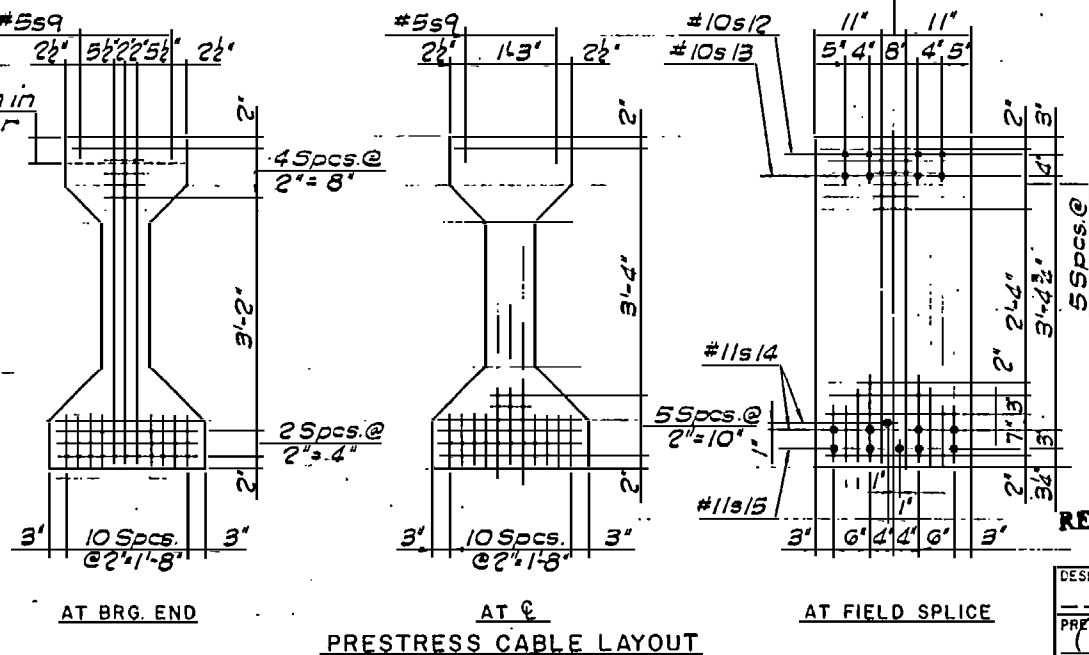

PRESTRESS CABLE LAYOUT

RECORD DRAWING


DESIGNED BY: M.G.
CHECKED BY: M.G.
PREPARED BY: [Signature]

HNTB HOWARD NEEDLES TAMMEN & BERGENDOFF ARCHITECTS ENGINEERS PLANNERS ATLANTA, GEORGIA



ATLANTIC INTRACOASTAL WATERWAY SUPERSTRUCTURE GIRDER DETAILS 3 - SPAN 1N - SEGMENT 1N-a COINJOCK BRIDGE REPLACEMENT PROJECT CURRITUCK COUNTY NORTH CAROLINA

INVESTIGATION NO. DACW54-83-B-0014
DRAWING NUMBER BR104-06-17
PLATE NO. S-24

NC STATE AID PROJECT NO.	
FEDERAL AID PROJECT NO.	

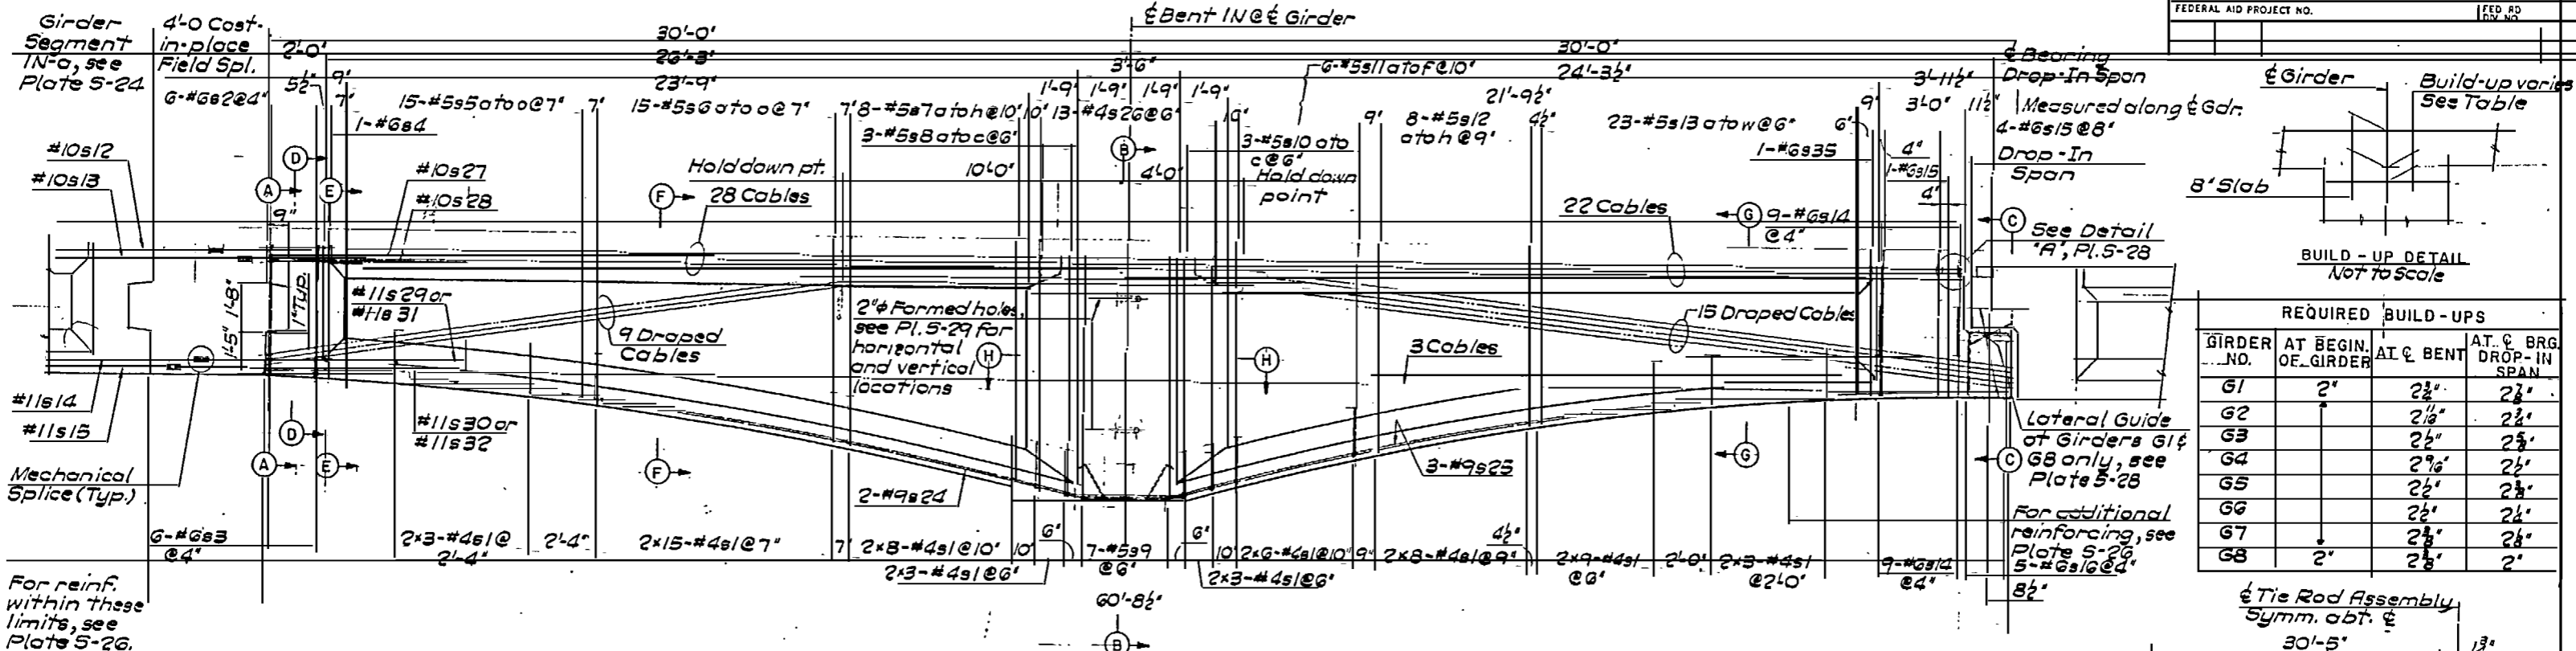


REQUIRED BUILD-UPS			
GIRDER NO.	AT BEGIN. OF GIRDER	AT BENT	AT C. BRG. DROP-IN SPAN
G1	2'	2 1/2'	2 1/2'
G2		2 1/2'	2 1/2'
G3		2 1/2'	2 1/2'
G4		2 1/2'	2 1/2'
G5		2 1/2'	2 1/2'
G6		2 1/2'	2 1/2'
G7		2 1/2'	2 1/2'
G8	2'	2 1/2'	2'

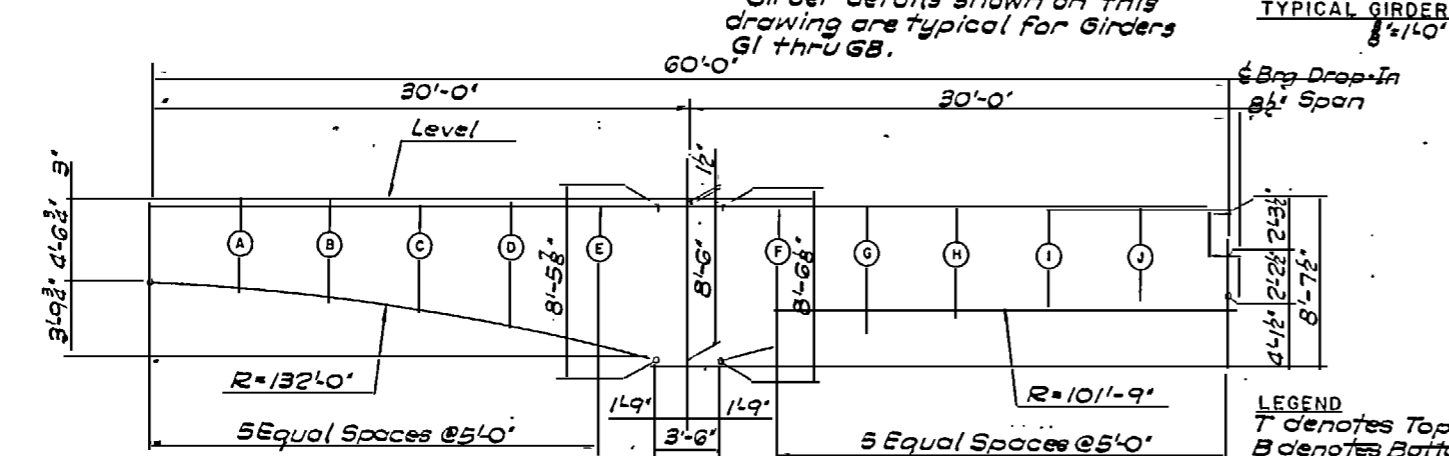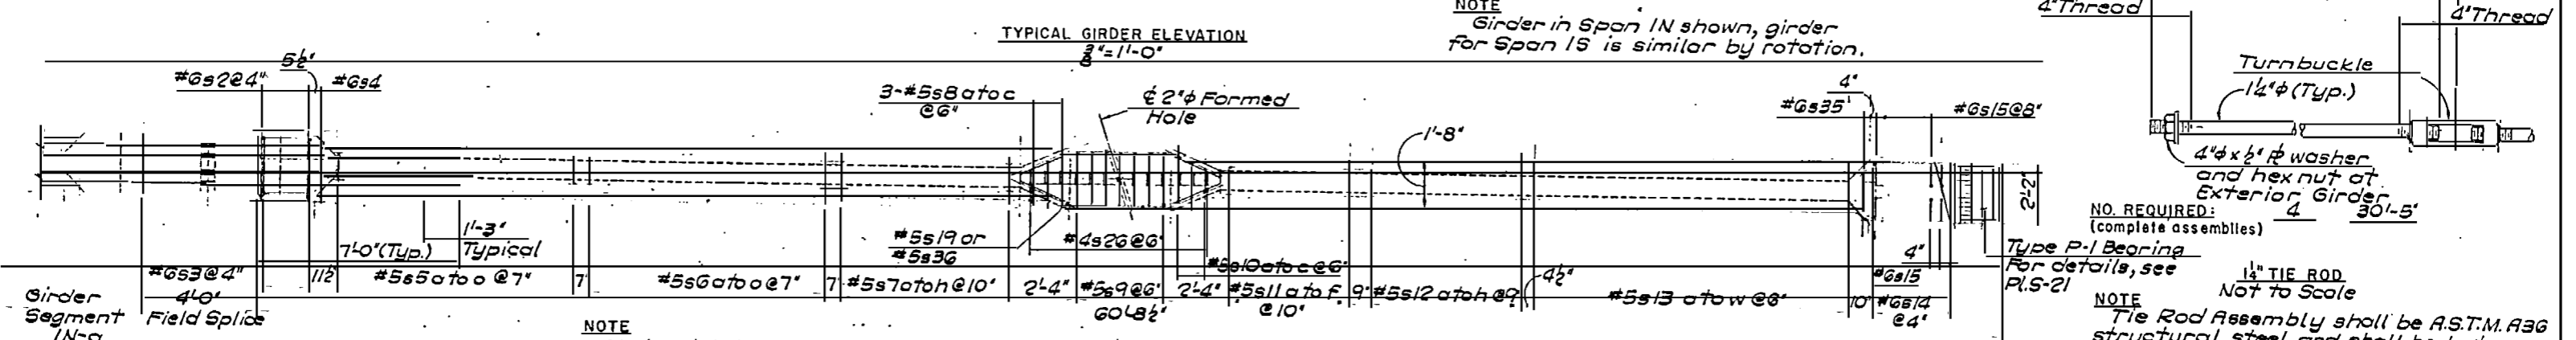


GIRDER DEPTHS			
LOCATION	DEPTH	LOCATION	DEPTH
A	4'-9 3/8"	F	7'-7 1/2"
B	5'-3"	G	6'-5 3/8"
C	5'-10 1/2"	H	5'-7 1/8"
D	6'-8 3/8"	I	5'-0"
E	7'-8 3/8"	J	4'-7"

NOTE: Girder geometry shown is typical for Girders G1 thru G8.

CABLE CHARACTERISTICS				
SIZE	GRADE	AREA	ULTIMATE STRENGTH	APPLIED PRESTRESS
Inches		sq. in.	lbs. / cable	lbs. / cable
2	270	0.153	41,300	28,900

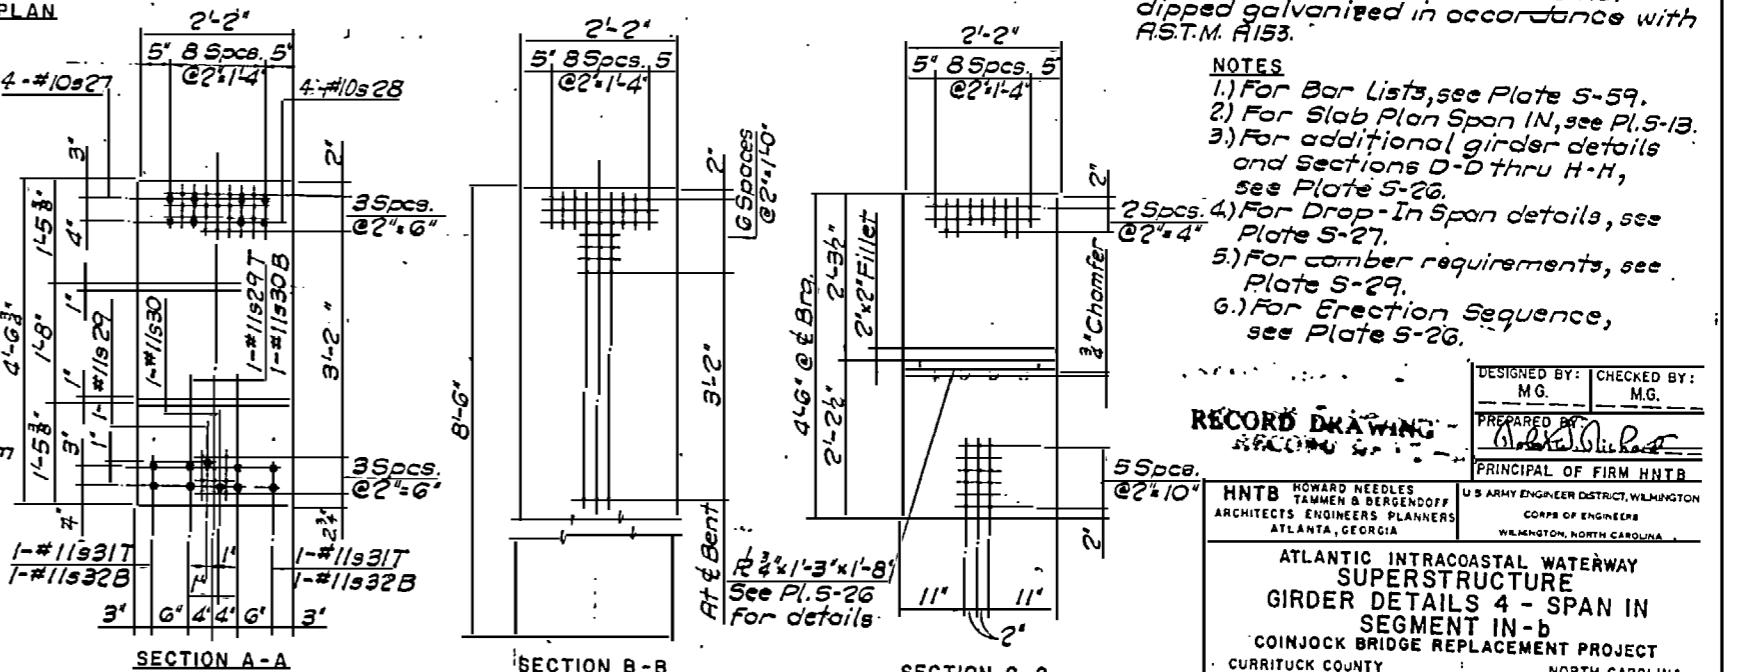

NOTE: Conc. to attain a min. compression strength of 5,000 psi before transfer of stress.

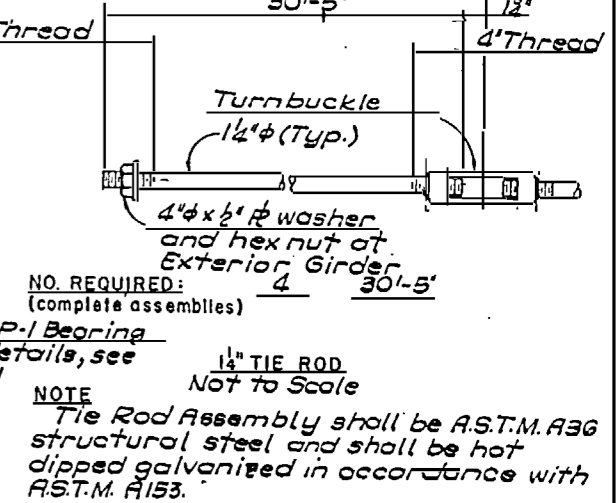

DESIGNED BY: M.G. CHECKED BY: M.G.

PREPARED BY: [Signature]

PRINCIPAL OF FIRM HNTB

HNTB HOWARD NEEDLES TAMMEN & BERGENDOFF ARCHITECTS ENGINEERS PLANNERS ATLANTA, GEORGIA

U.S. ARMY ENGINEER DISTRICT, WILMINGTON CORPS OF ENGINEERS WILMINGTON, NORTH CAROLINA

ATLANTIC INTRACOASTAL WATERWAY SUPERSTRUCTURE GIRDER DETAILS 4 - SPAN IN SEGMENT IN - b

COINJOCK BRIDGE REPLACEMENT PROJECT

CURRITUCK COUNTY NORTH CAROLINA







IBYATION NO. DAC W54-83-B-0014

DRAWING NUMBER BR104-06-17


PLATE NO. S-25

SCALE AS NOTED DATE 22 JULY 1983 SHEET 75 OF 126


N.C. STATE AID PROJECT NO.	
FEDERAL AID PROJECT NO.	

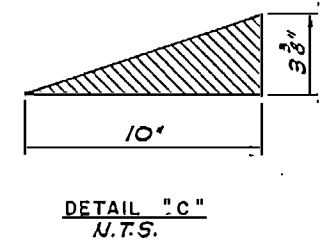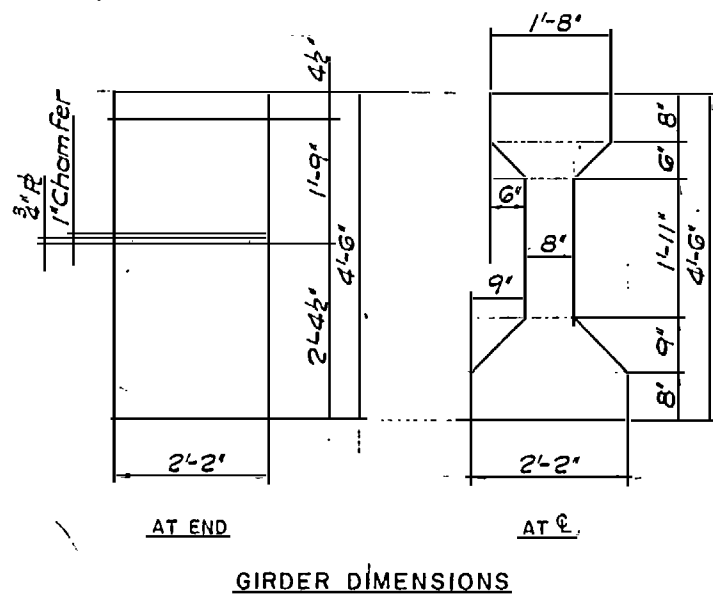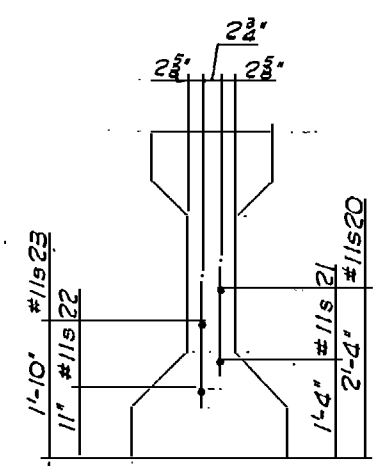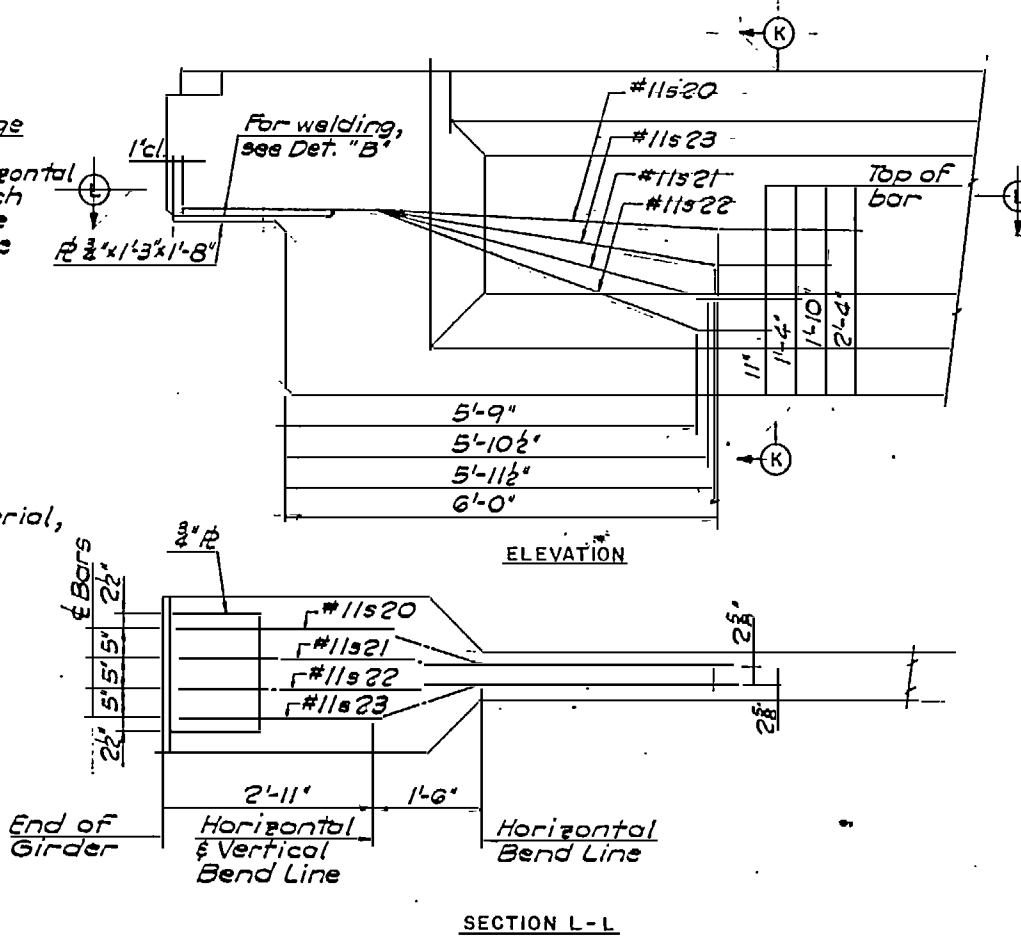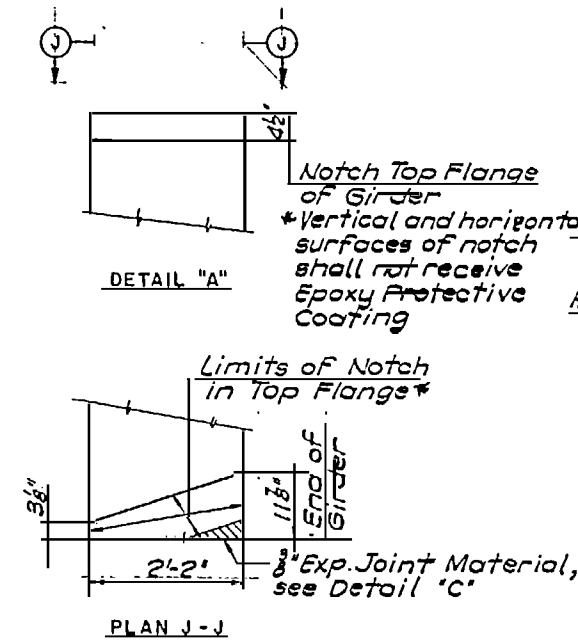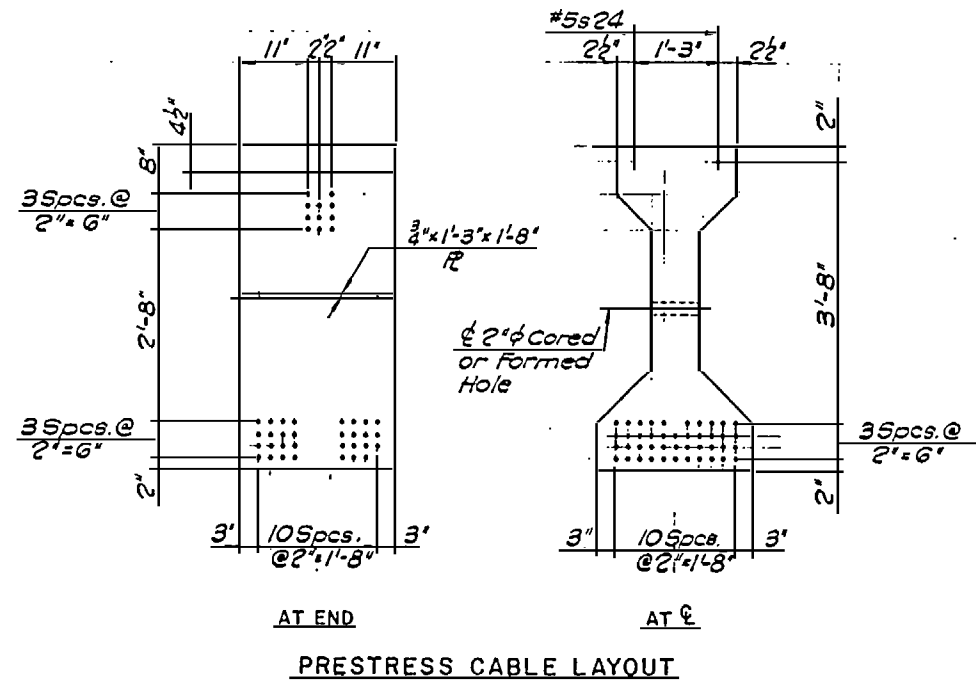

GEOMETRY AND DETAILS FOR 11s BARS

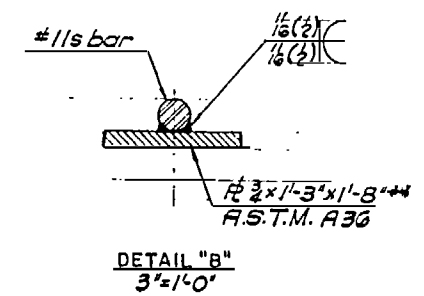


**Plate to be galvanized in accordance with A.S.T.M. A123.

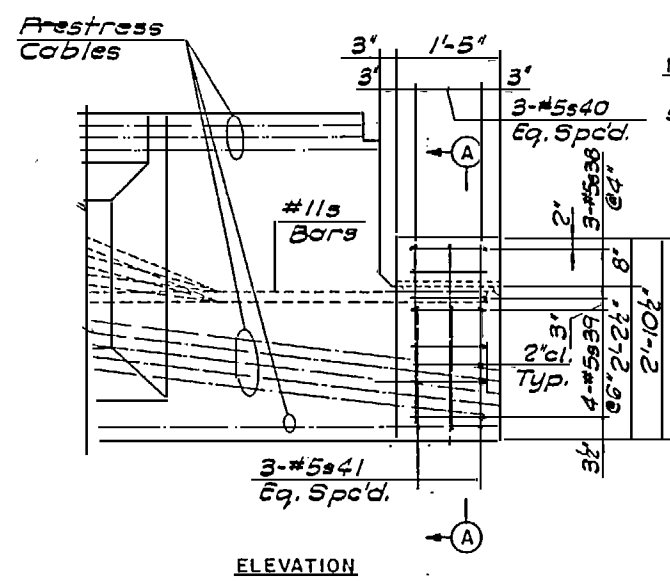

LATERAL GUIDE DETAIL AT GIRDERS G1 AND G8

NOTE: For details not shown, see Plate S-26.

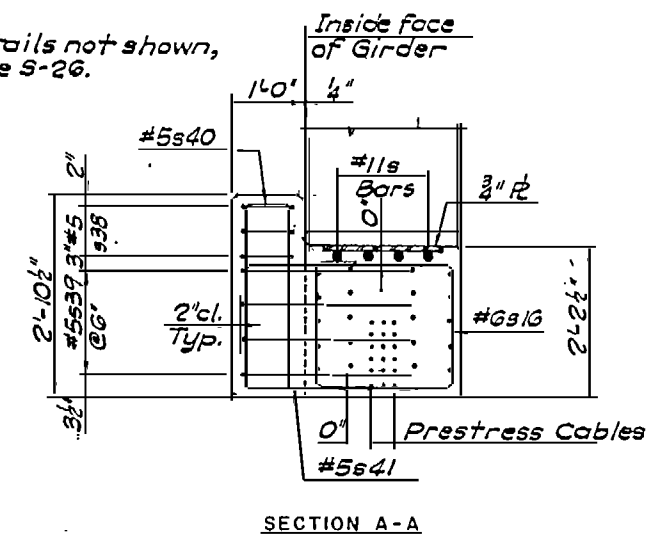

NOTE: Details at Girder G1-Span 1N shown. Details for Girder G8-Span 1N and Girders G1 & G8-Span 1S are similar.

- NOTES:**
- For additional girder details, see Plate S-27.
 - For Drop-In Slab Plan, see Plate S-18.



RECORD DRAWING

HNTB HOWARD NEEDLES TAMMEN & BERGENDOFF ARCHITECTS ENGINEERS PLANNERS ATLANTA, GEORGIA	U.S. ARMY ENGINEER DISTRICT, WELMINGTON, NORTH CAROLINA
--	---

ATLANTIC INTRACOASTAL WATERWAY SUPERSTRUCTURE
GIRDER DETAILS 7 - DROP-IN SPAN
COINJOCK BRIDGE REPLACEMENT PROJECT
CURRITUCK COUNTY NORTH CAROLINA

DESIGNED BY: M.G.	CHECKED BY: M.G.	INTEGRATION NO: DACHS 4-83-B-0014	SIZE: 8 1/2" x 11"	DRAWING NUMBER: BR104-06-17	PLATE NO.: S-28
PREPARED BY: [Signature]		PRINCIPAL OF FIRM HNTB		SCALE: 1/4" = 1'-0"	DATE: 22 JULY 1983

NC STATE AID PROJECT NO.	FED. RD. DIST. NO.
FEDERAL AID PROJECT NO.	CONTRACT NO.
1-7-85	BRIDGE CAMBER & DEFLECTION SPAN IN & IS

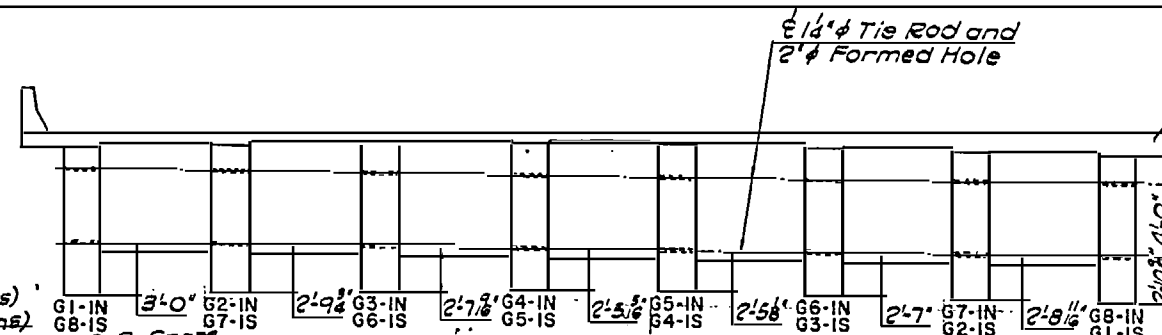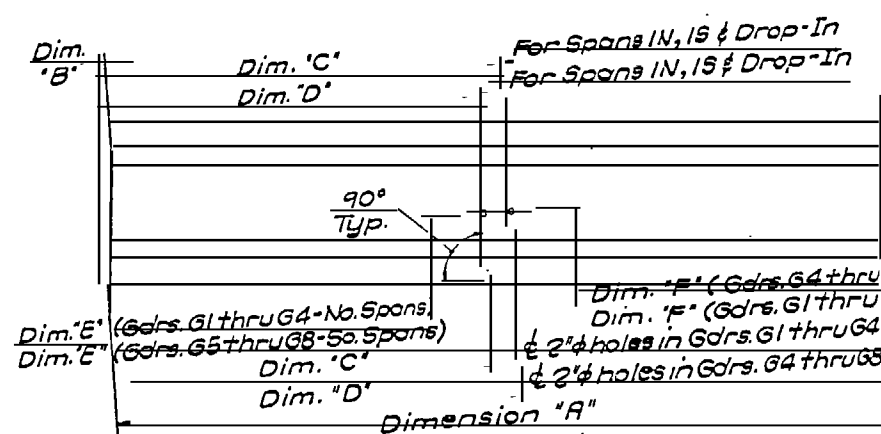

NOTE
Vertical locations of Tie Rods are shown at intersection of Girder with Diaphragm.

TIE ROD LOCATION IN DIAPHRAGM AT BENTS IN & IS
(Looking in direction of increasing stations Bent IN)
(Looking in direction of decreasing stations Bent IS)

SLOPED GIRDER ELEVATION
Girder Elevation shown is typical for girders in Spans 2N thru 14N, Drop-In and Segment 1N-a of Span 1N. Girder Elevation for girders in Spans 2S thru 12S & Segment 1S-a shall be similar but opposite hand.

SLOPED GIRDER DIMENSIONS										
SPAN NO.	GIRDER NO.	DIM. "A"		DIM. "C"	DIM. "D"	DIM. "E"	DIM. "F"	GIRDER NO.	SPAN NO.	
		"B"	"B1"							
14N to 7N	G1	89'-9 3/8"	2 3/8"	44'-6 1/8"	—	2'-6"	—	G8	12S to 7S	
	G2					2'-4"		G7		
	G3					2'-2"		G6		
	G4			44'-6 1/8"	45'-2 1/8"	2'-0"	2'-0"	G5		
	G5					2'-0"		G4		
	G6					2'-2"		G3		
	G7					2'-4"		G2		
14N to 1N	G8	89'-9 3/8"	2 3/8"	45'-2 1/8"	—	2'-6"	—	G1	12S to 7S	
6N	G1 to G8	89'-9 3/8"	2 3/8"	44'-6 1/8"	45'-2 1/8"	—	—	G1 to G8	6S	
5N		89'-9 3/8"	1 1/2"	44'-6 1/8"	45'-2 1/8"	—	—		5S	
4N		89'-9 3/8"	1 1/2"	44'-6 1/8"	45'-2 1/8"	—	—		4S	
3N	G1 to G8	89'-9 3/8"	1 1/2"	44'-6 1/8"	45'-2 1/8"	—	—	G1 to G8	3S	
2N	G1	68'-4 1/8"	—	33'-10"	—	2'-6 1/2"	—	G8	2S	
	G2	71'-0 1/8"	—	35'-2 1/8"	—	2'-4 1/2"	—	G7		
	G3	73'-8 1/8"	—	36'-6 1/8"	—	2'-2 1/2"	—	G6		
	G4	76'-4 1/8"	—	37'-10 1/8"	38'-6 1/8"	2'-0"	2'-0"	G5		
	G5	79'-1 1/8"	—	39'-10 1/8"	—	1'-11 1/2"	—	G4		
	G6	81'-9 3/8"	—	41'-2 1/8"	—	2'-1 1/2"	—	G3		
	G7	84'-5 3/8"	—	42'-6 1/8"	—	2'-3 1/2"	—	G2		
2N	G8	87'-2 1/8"	—	43'-11 1/8"	—	2'-5 1/2"	—	G1	2S	
1N	G1	75'-10 3/8"	—	40'-3"	—	2'-6 1/2"	—	G8	1S	
	G2					2'-4 1/2"		G7		
	G3					2'-2 1/2"		G6		
	G4			40'-3"	39'-7"	2'-0"	2'-0"	G5		
	G5					1'-11 1/2"		G4		
	G6					2'-1 1/2"		G3		
	G7					2'-3 1/2"		G2		
	G8	75'-10 3/8"	—	39'-7"	—	2'-4 1/2"	—	G1	1S	
Drop-In	G1 to G8	91'-5"	0"	46'-0 1/2"	45'-4 1/2"	—	—	G1 to G8	Drop-In	

TABLE OF CAMBERS AND DEFLECTIONS							
SPAN NO.	GIRDER NO.	INITIAL CAMBER	DEFLECTIONS			TOTAL	
			①	②	③		
14N to 3N	G1 to G8	+1.54	-1.21	-0.15		+0.18	
2N	G1	+0.66	-0.41	-0.05		+0.20	
	G2	+0.79	-0.48	-0.06		+0.25	
	G3	+0.84	-0.55	-0.07		+0.22	
	G4	+0.95	-0.64	-0.08		+0.23	
	G5	+1.08	-0.73	-0.09		+0.26	
2N	G6	+1.22	-0.83	-0.10		+0.29	
	G7	+1.35	-0.95	-0.11		+0.29	
	G8	+1.42	-1.07	-0.13		+0.22	
	Drop-In	G1 to G8	+1.68	-1.29	-0.15		+0.24
	2S	G1	+1.42	-1.07	-0.13		+0.22
2S	G2	+1.35	-0.95	-0.11		+0.29	
	G3	+1.22	-0.83	-0.10		+0.29	
	G4	+1.08	-0.73	-0.09		+0.26	
	G5	+0.95	-0.64	-0.08		+0.23	
	G6	+0.84	-0.55	-0.07		+0.22	
2S	G7	+0.79	-0.48	-0.06		+0.25	
	G8	+0.66	-0.41	-0.05		+0.20	
	3S to 12S	G1 to G8	+1.54	-1.21	-0.15		+0.18

LEGEND
Values given for Cambers and Deflections are in inches.


- Initial Camber: Beam Dead Load and Initial Stress.
- Deflection due to dead load of slab including Stay-in-Place forms, Build-up (Haunch) and Diaphragms.
- Deflection due to Barrier Rail and Future Wearing Surface (20 lbs./sq. Ft.)

Positive value Upward
Negative value Downward
D.L. denotes Dead Load


CAMBERS - SPANS IN AND IS				
CATEGORY	ANCHOR & CANTILEVER SPANS			END OF CANTILEVER
	1 ANCHOR 3 SPAN	2 ANCHOR 3 SPAN	3 ANCHOR 3 SPAN	
I Prestressing Force	+1.68	+0.84		+0.36
II Anchor & Cantilever Beam D.L.	-1.92	-1.80		+1.56
III Total I & II	-0.24	-0.96		+1.92
IV Drop-In Span Beam Dead Load	+1.20	+1.32		-1.80
Total Camber (III + IV)	+0.96	+0.36		+0.12

DECK D.L. DEFLECTIONS - SPANS IN AND IS				
CATEGORY	ANCHOR & CANTILEVER SPANS			END OF CANTILEVER
	1 ANCHOR 3 SPAN	2 ANCHOR 3 SPAN	3 ANCHOR 3 SPAN	
I Concrete Slab: Anchor & Cantilever Span	-1.92	-1.80		+1.56
II Concrete Slab: Drop-In Span	+1.08	+1.32		-1.68
III I + II	-0.84	-0.48		-0.12
IV Superimposed Dead Load Cantilever & Anchor Span	-0.36	+0.36		+0.24
V Superimposed Dead Load Drop-In Span	+0.24	+0.24		-0.36
VI IV + V	-0.12	-0.12		-0.12
Total Deflection III + VI	-0.96	-0.60		-0.24
Total Camber + Total Deflections	0.00	-0.24		-0.12

VERTICAL CURVE ORDINATES		
SPAN NUMBER	GIRDER NUMBER	ORDINATE
14N thru 7N	G1 thru G8	0.00'
6N thru 3N	G1 thru G8	0.73'
2N	G1	0.42'
	G2	0.46'
	G3	0.49'
	G4	0.53'
	G5	0.58'
	G6	0.61'
2N	G7	0.65'
	G8	0.70'
1N	See Girder Details	
Drop-In	G1 thru G8	0.76'
1S	See Girder Details	
2S	G1	0.70'
	G2	0.65'
	G3	0.61'
	G4	0.58'
2S	G5	0.53'
	G6	0.49'
	G7	0.46'
2S	G8	0.42'
3S thru 6S	G1 thru G8	0.73'
7S thru 12S	G1 thru G8	0.00'

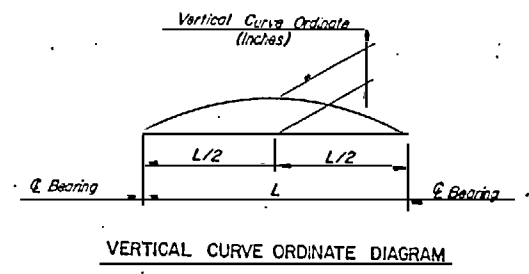

- NOTES
- For General Notes, see Pl. S-7.
 - For Span 1N & 1S Girder Details, see Plates S-24 thru S-26.
 - ACTUAL FIELD DIMENSIONS MAY VARY DUE TO CAMBER GROWTH AND ELASTIC SHRINKAGE.
 - DECK FORMS SHALL BE SET BASED ON ACTUAL IN-PLACE BEAM CAMBERS.

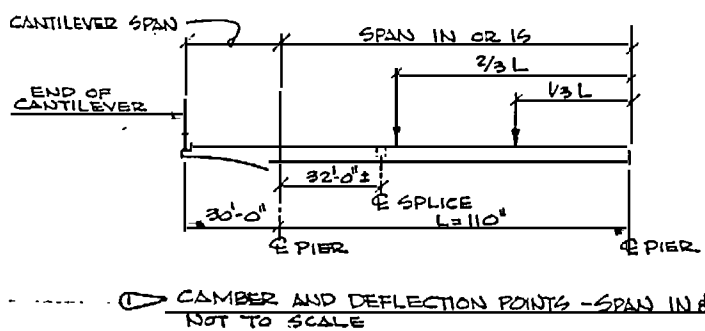

DESIGNED BY: M.G. CHECKED BY: M.G.

PREPARED BY: [Signature]

PRINCIPAL OF FIRM HNTB

HNTB HOWARD NEEDLES TAMKEN & BERGENOFF ARCHITECTS ENGINEERS PLANNERS ATLANTA, GEORGIA

U.S. ARMY ENGINEER DISTRICT, WILMINGTON CORPS OF ENGINEERS WILMINGTON, NORTH CAROLINA


ATLANTIC INTRACOASTAL WATERWAY SUPERSTRUCTURE GIRDER GEOMETRY

COINJOCK BRIDGE REPLACEMENT PROJECT CURRITUCK COUNTY NORTH CAROLINA


INVESTIGATION NO. DAW 44-83-B-0014	SIZE	DRAWING NUMBER BR 104-06-17	PLATE NO. S-29
------------------------------------	------	-----------------------------	----------------

SCALE NONE DATE: 22 JULY 1983 SHEET 79 OF 126


STATE AID PROJECT NO.	FED. RD.
FEDERAL AID PROJECT NO.	

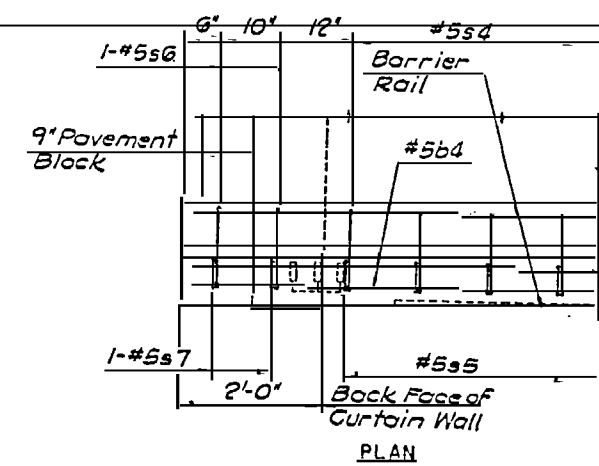

PLAN

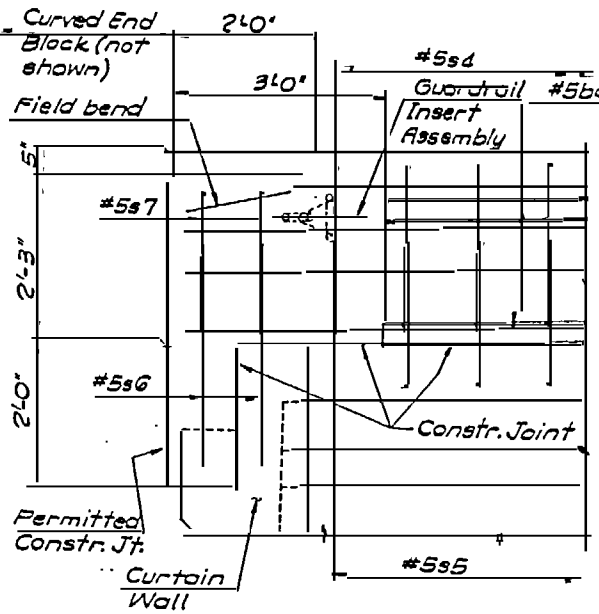


ELEVATION

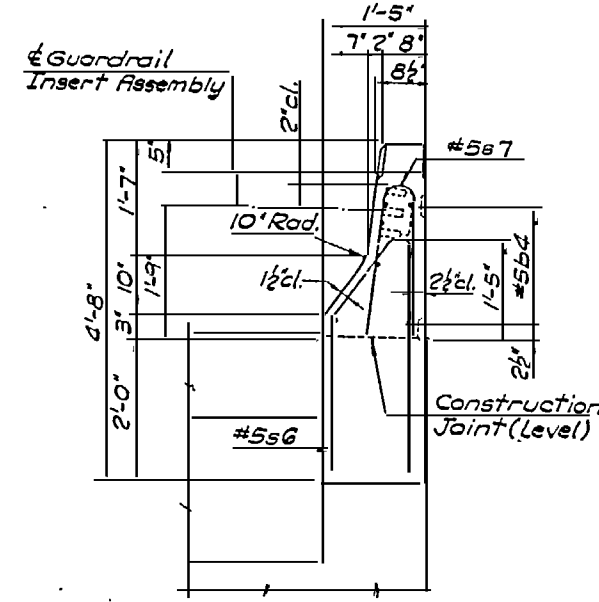


END VIEW

BARRIER RAIL END DETAILS

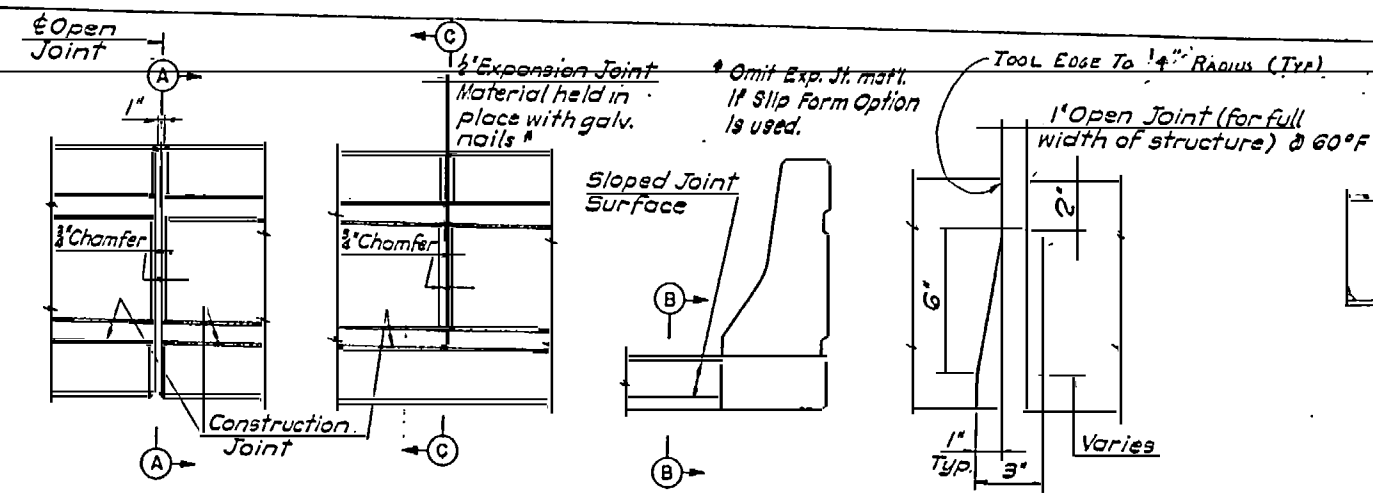


AT OPEN JOINT AT INTERMEDIATE JOINT SECTION A-A
BARRIER RAIL ELEVATIONS

EXPANSION JOINT DETAILS
For locations, see Deck Slab Plans
Not to Scale

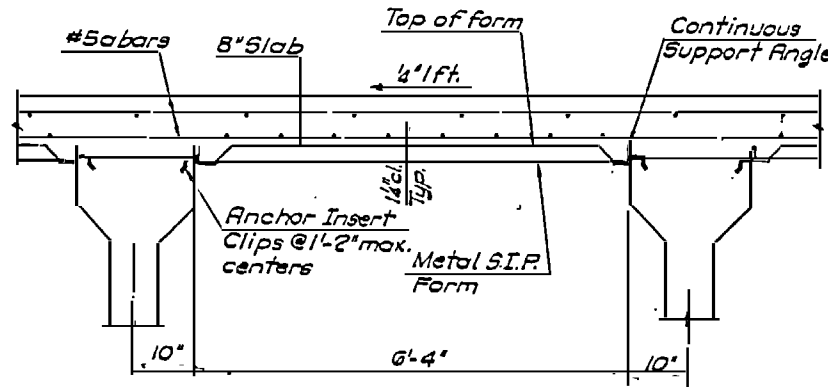


METAL STAY-IN-PLACE FORM DETAILS
Not to Scale

NOTE "A"
The Contractor has the option of using either fabricated Metal Stay-in-Place Forms as detailed or Prestressed Concrete Deck Panels, with the exception that Prestressed Concrete Deck Panels will not be permitted in Spans 24, 25, 1N, 1S or in the drop-in span. In the event he chooses to use deck panels, it shall be his responsibility to supply the Engineer with revisions to deck slab and girder reinforcing (bar lists), girder cambers and any vertical controls, including any necessary increase in build-up dimensions. In addition, see Technical Provisions.

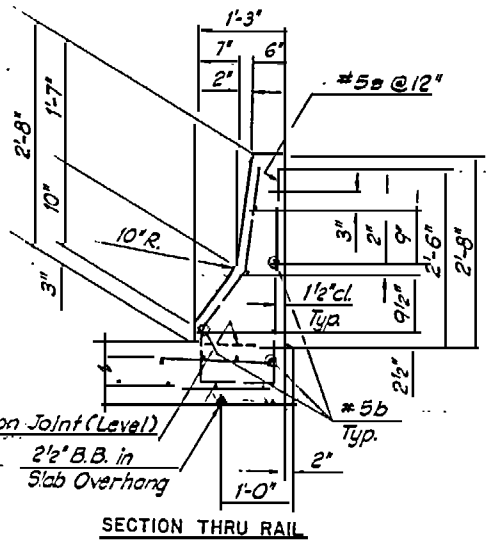


OPTIONAL BARRIER DETAIL


NOTE "B"
The Contractor has the option of using the Barrier Rail Detail as detailed on the plans (1'-5" or the Reduced Width Barrier (1'-3" as shown above. In addition, if the reduced barrier is constructed it may be done using the Slip Form Method. In the event he chooses to construct the reduced width barrier rail, it shall be his responsibility to supply the Engineer with revisions to the Barrier Rail Reinforcing (Bar Lists).

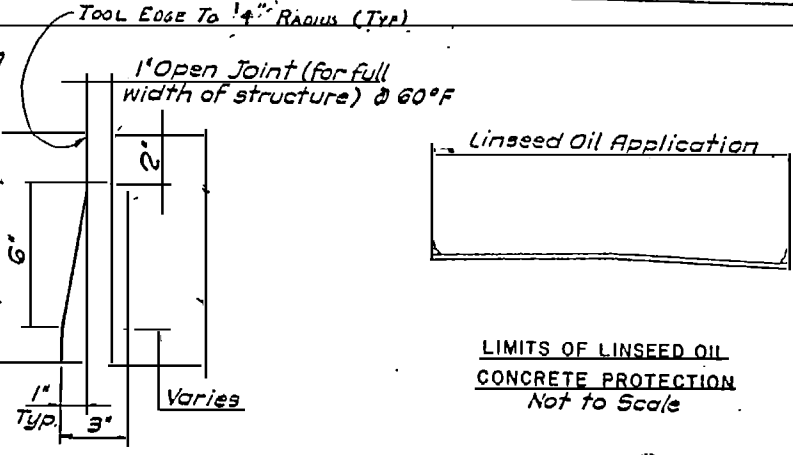


SECTION B-B
NOT to Scale

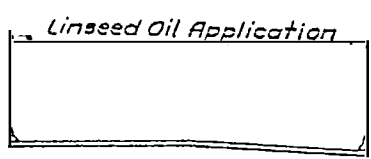


LIMITS OF LINSEED OIL CONCRETE PROTECTION
Not to Scale

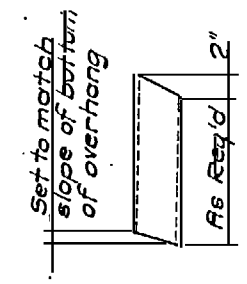

DRAIN DETAIL
Not to Scale

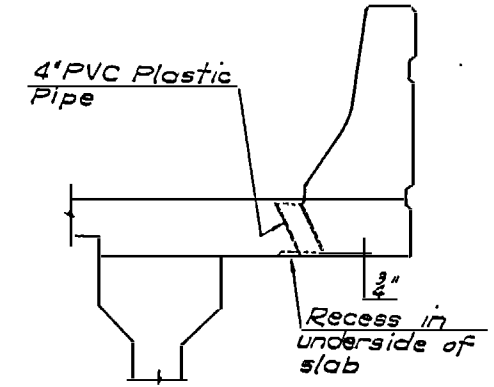

TYPICAL SECTION AT DRAIN

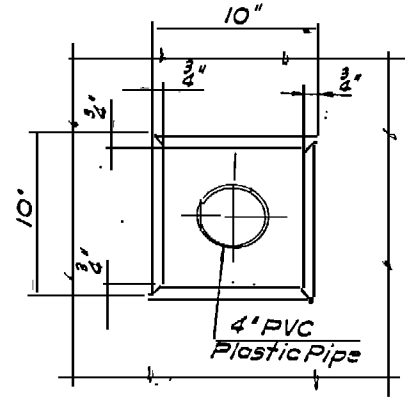

PLAN OF RECESS


SLAB DRAIN DETAILS
Not to Scale

NOTES
1) For General Notes, see Plate S-7.
2) For drain locations, see Slab Plans
3) For Curved End Block Details, see Plate S-49.


AS-CHECKED DRAWING

RECORD DRAWING





DESIGNED BY: J.A.L.	CHECKED BY: M.A.M.	HNTB HOWARD NEEDLES TAMMEN & BERGENDOFF ARCHITECTS ENGINEERS PLANNERS ATLANTA, GEORGIA	U.S. ARMY ENGINEER DISTRICT WASHINGTON CORPS OF ENGINEERS WASHINGTON, NORTH CAROLINA
PREPARED BY: [Signature]	PRINCIPAL OF FIRM HNTB		
ATLANTIC INTRACOASTAL WATERWAY SUPERSTRUCTURE MISCELLANEOUS DETAILS COINJOCK BRIDGE REPLACEMENT PROJECT CURRITUCK COUNTY NORTH CAROLINA		INVESTIGATION NO. DACWS 4-83-B-0014	DRAWING NUMBER BR104-06-17
SCALE AS NOTED		DATE 22 JULY 1983	SHEET 80 OF 126

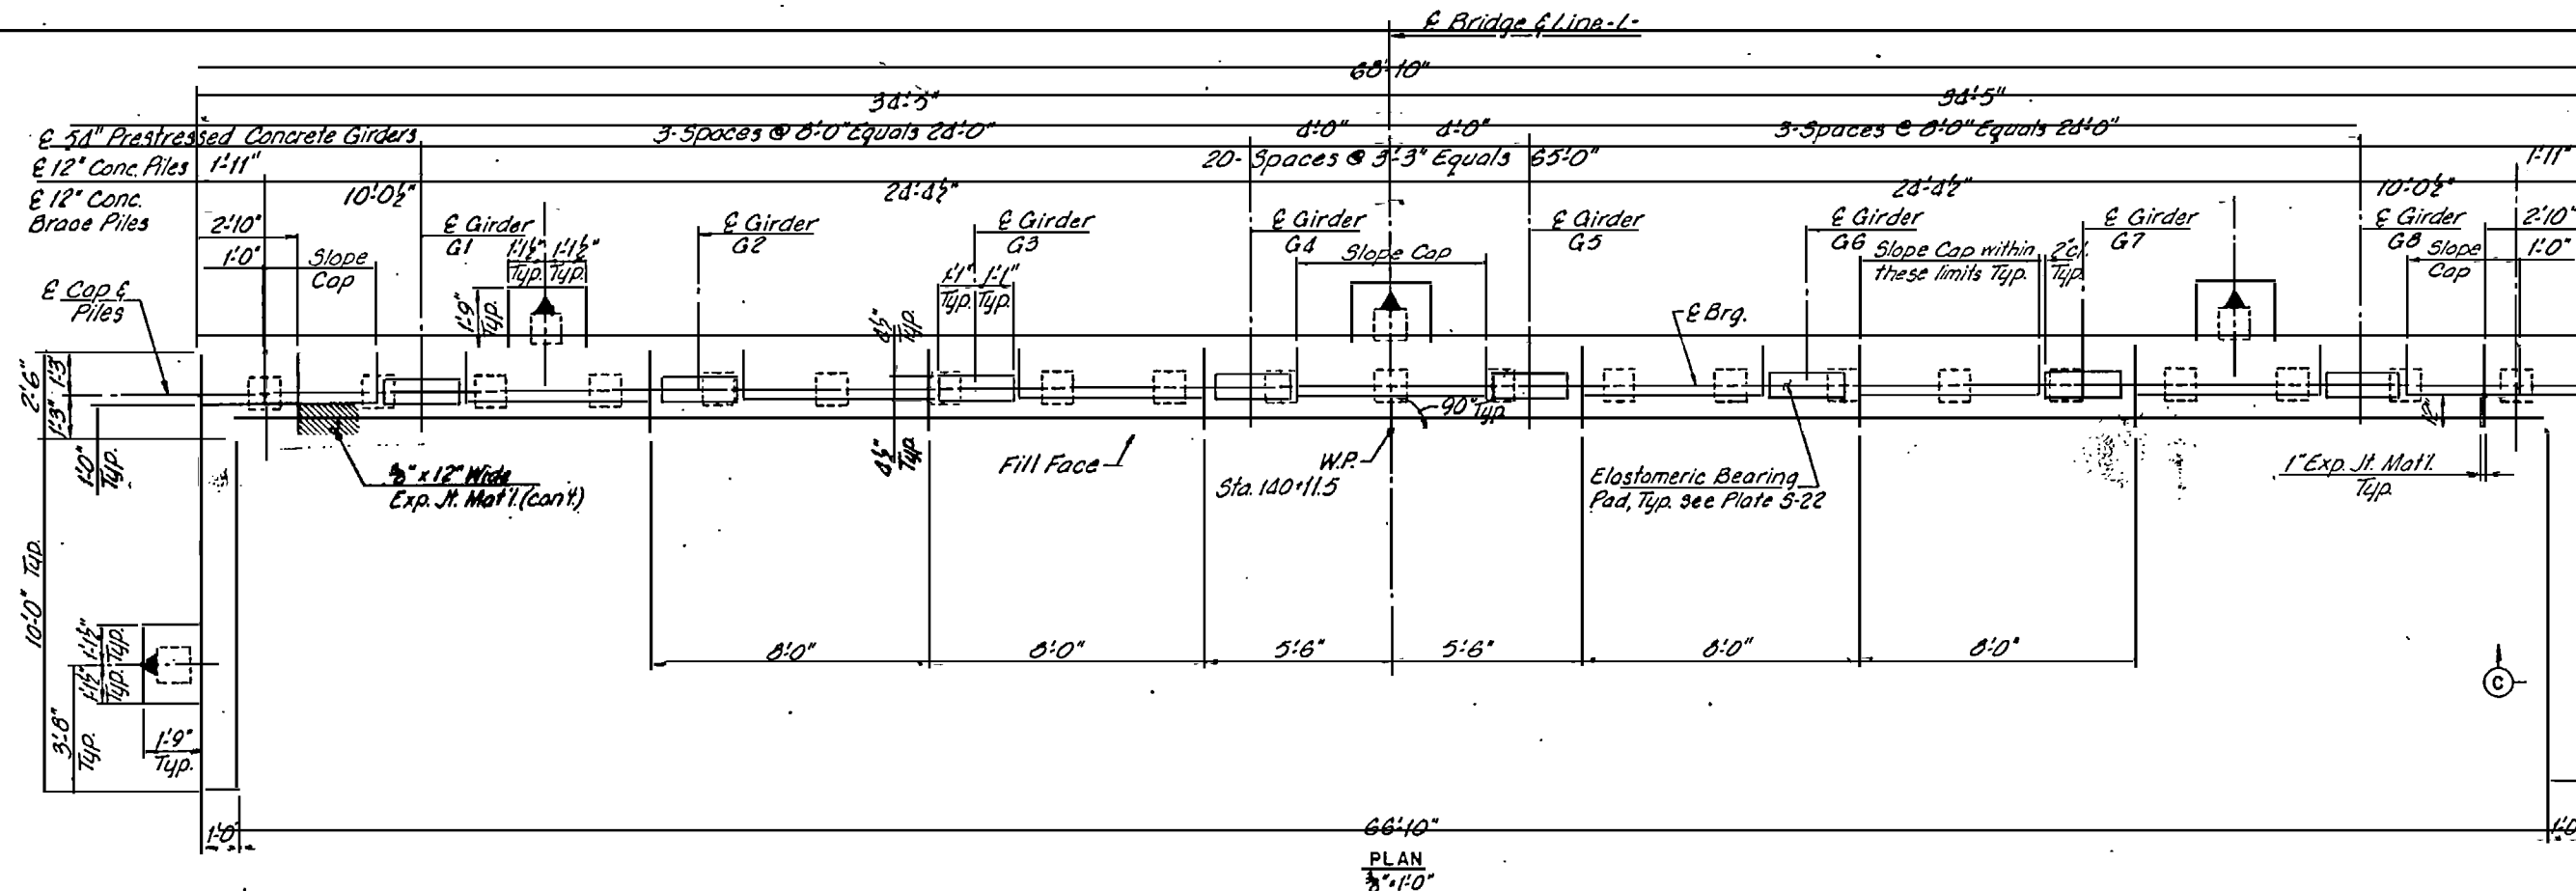

N.C. STATE AID PROJECT NO.	1740
FEDERAL AID PROJECT NO.	100

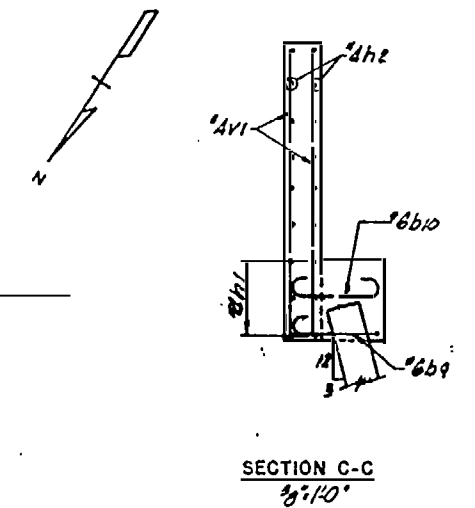

- NOTES:**
1. For General Notes, see Plate 5-7.
 2. For Pile Details, see Plate 5-46.
 3. For Girder and Pad Details, see Plate 5-22.
 4. For Bar Bending Diagrams, see Plates 5-55 and 5-56.
 5. For Reinforcing Bar List, see Plate 5-61.
 6. Pile Spacing is Measured at Bottom of Cap.
- LEGEND:**
- P.A.S. denotes Place as Shown.
 - E.F. denotes Each Face.
 - ▢ denotes Bolted Pile 3:12 in direction of arrow.
 - ▣ denotes Vertical Pile.
 - ▲ denotes 3" Beam Bolster (BB).

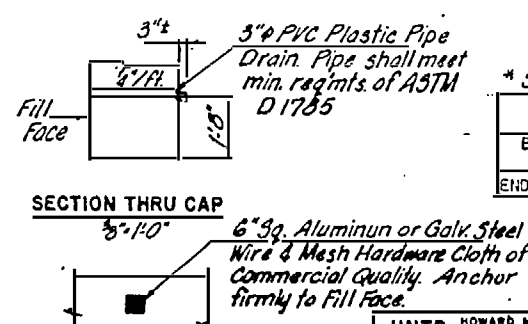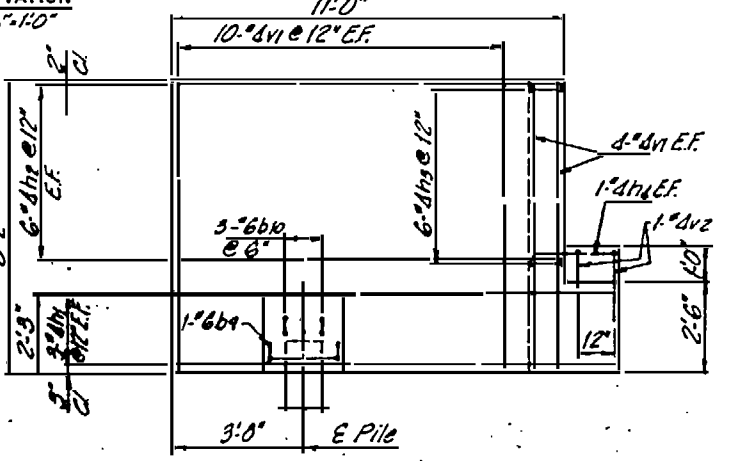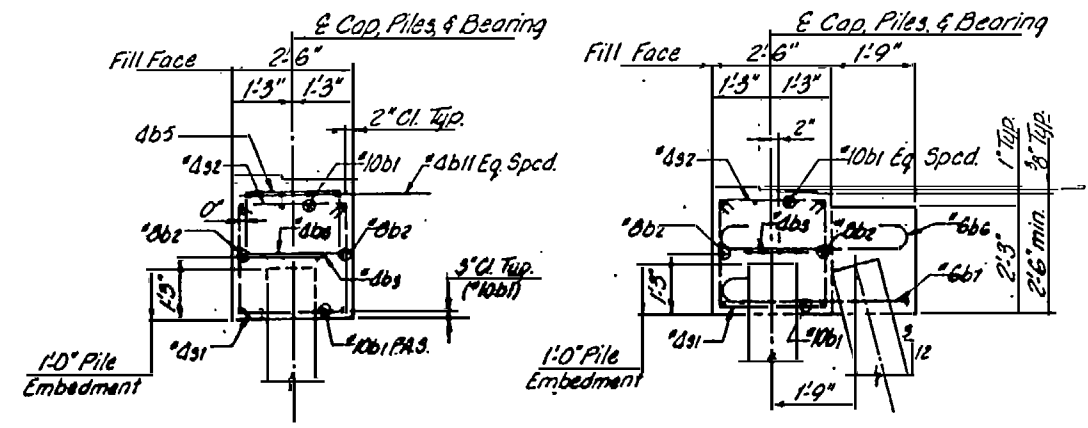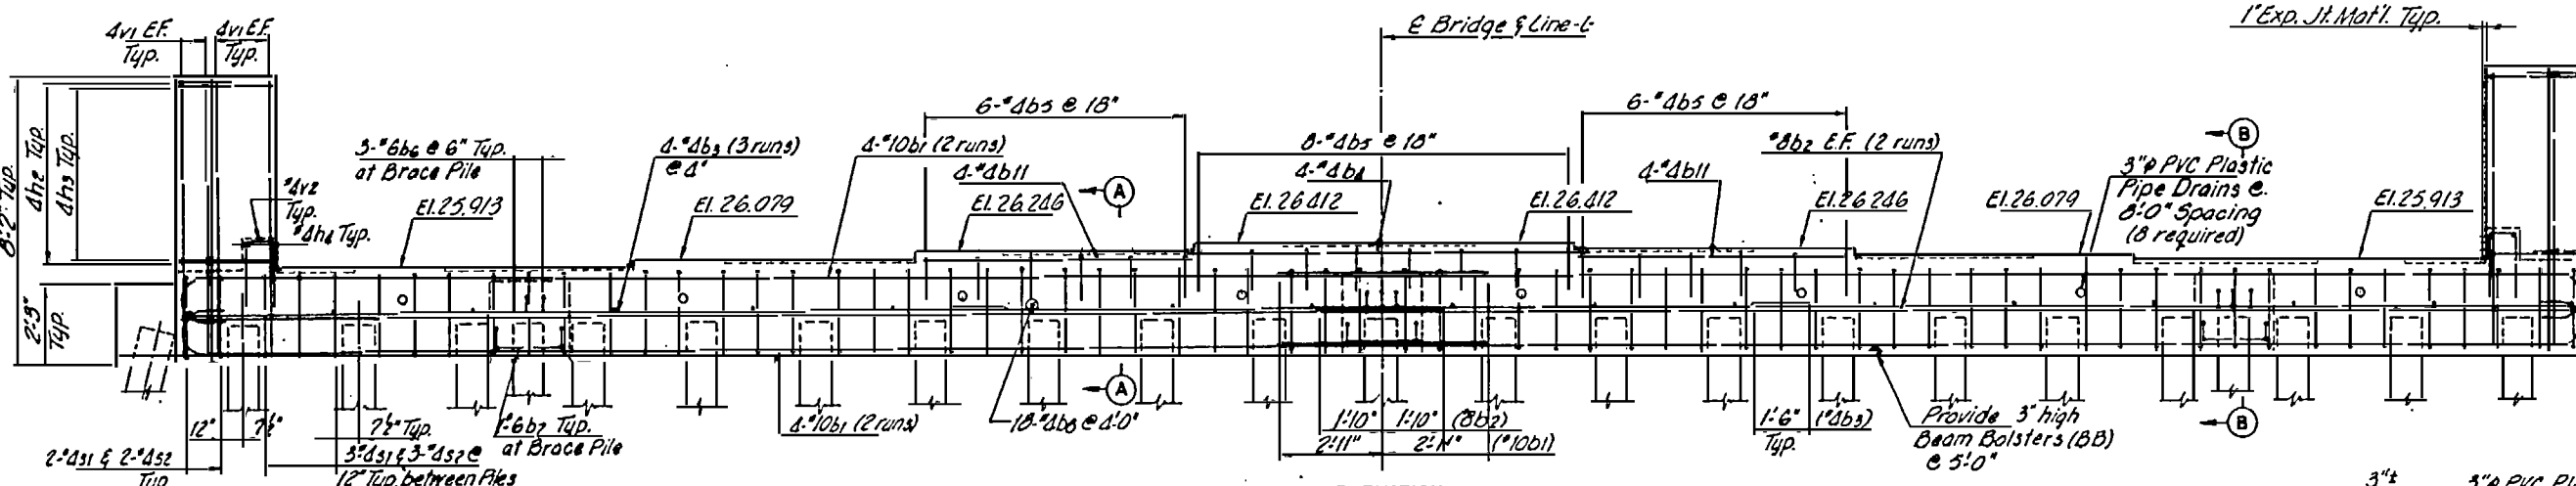

FILL FACE ELEVATION PIPE DRAIN DETAILS

Note: N.T.S.
No separate payment will be made for furnishing & installing the PVC Plastic Pipe Drains, Hardware Cloth & Fasteners.

RECORD DRAWING

* See General Notes, Pl. 5-7.

PILE REQUIREMENTS			
BENT NO.	MIN. PILE TIP ELEV.	NO. OF PILES	EST. TOTAL LENGTH
END BENT I	-40	26	1835

DESIGNED BY: F.E.L.
CHECKED BY: A.A.S.

PREPARED BY: *[Signature]*
PRINCIPAL OF FIRM HNTB

HNTB HOWARD NEEDLES TAMMEN & BERENSONOFF ARCHITECTS ENGINEERS PLANNERS ATLANTA, GEORGIA


U.S. ARMY ENGINEER DISTRICT WILMINGTON, NORTH CAROLINA

ATLANTIC INTRACOASTAL WATERWAY SUBSTRUCTURE END BENT I


COINJOCK BRIDGE REPLACEMENT PROJECT
CURRITUCK COUNTY NORTH CAROLINA

INVITATION NO. DAC W54-83-B-0014	SIZE	DRAWING NUMBER BR104-06-17	PLATE NO. S-31
----------------------------------	------	----------------------------	----------------





SCALE AS NOTED DATE 22 JULY 1983 SHEET 81 OF 126

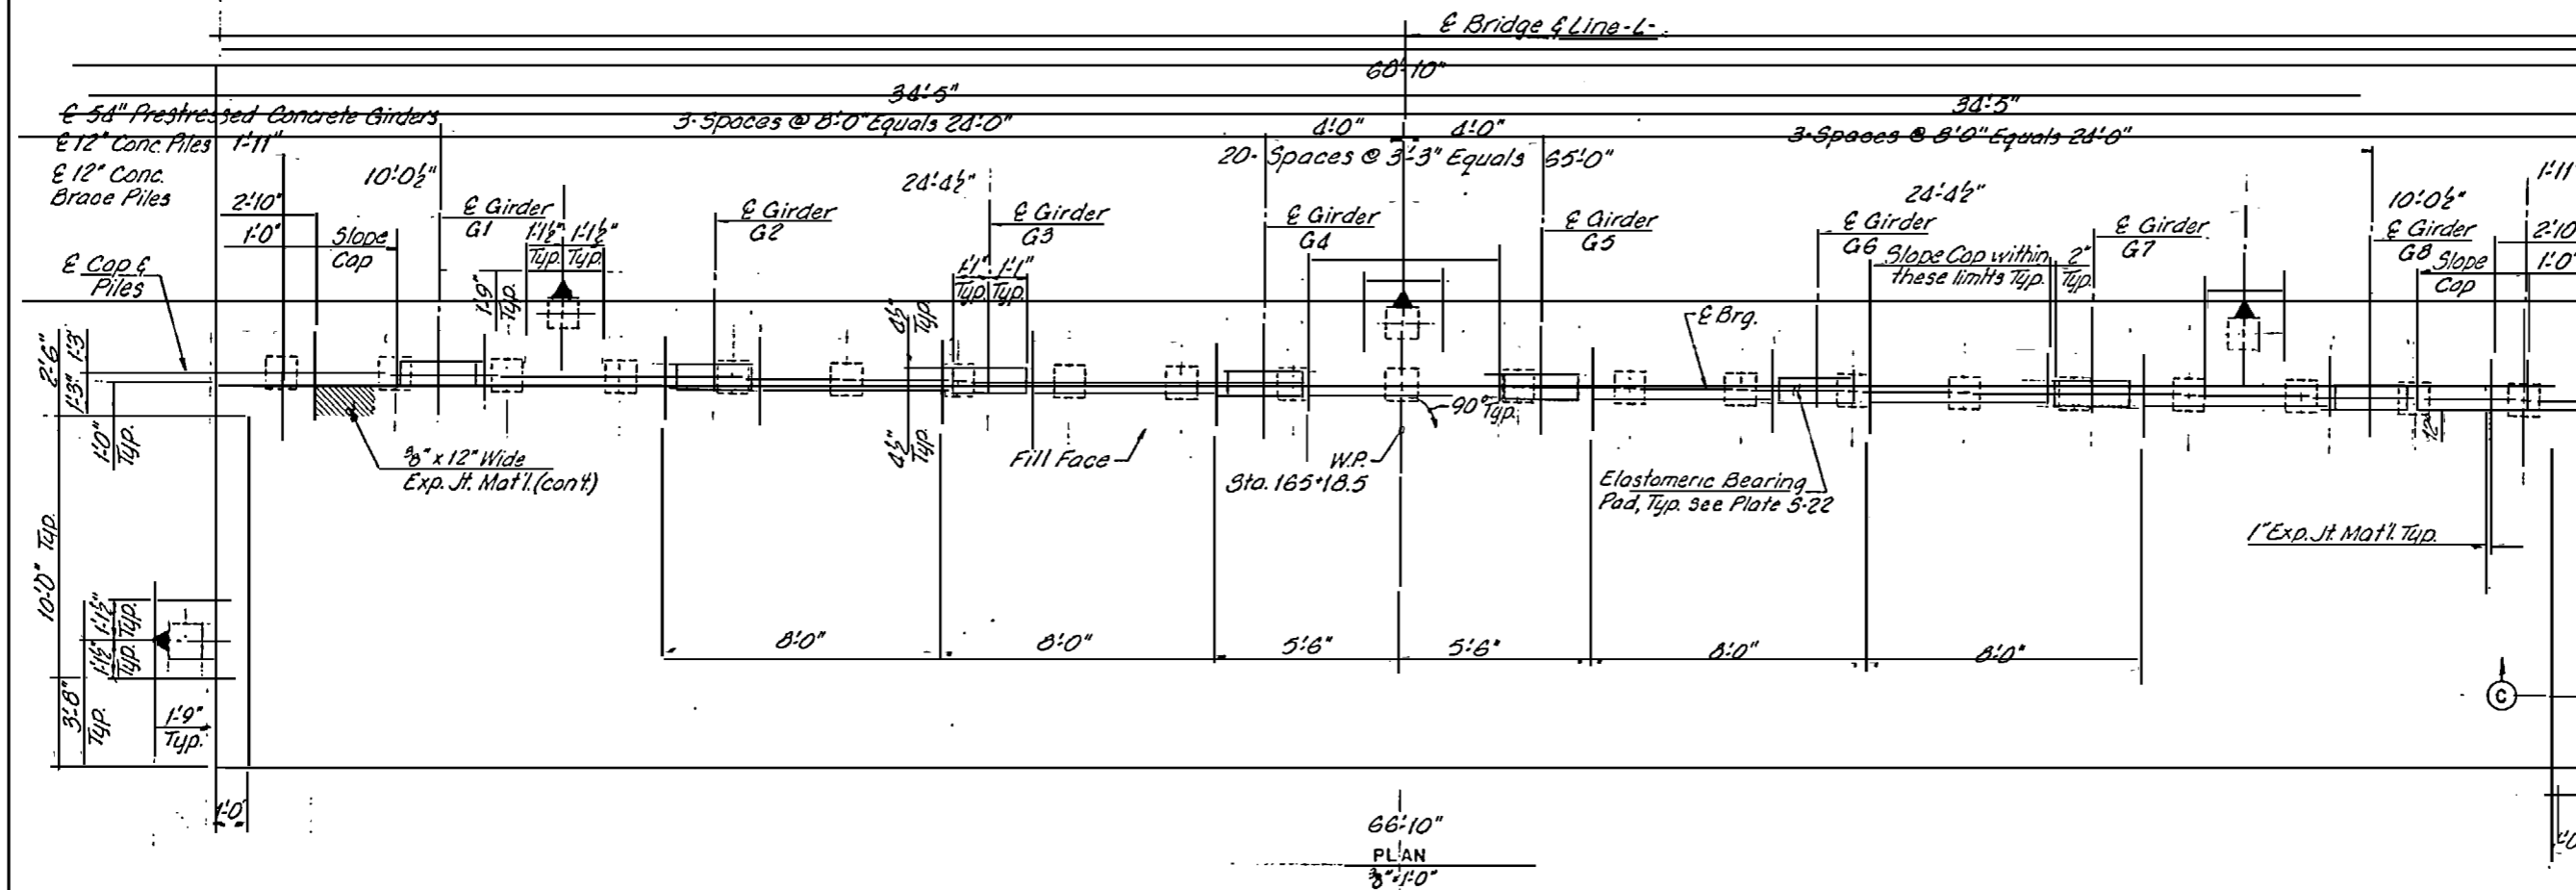

N.C. STATE AID PROJECT NO.	FED. RD. DIST. NO.
FEDERAL AID PROJECT NO.	

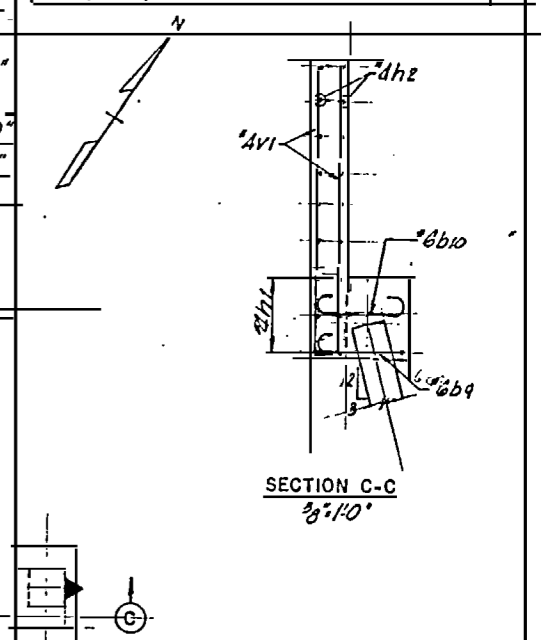

- NOTES:**
1. For General Notes, see Plate 5-7.
 2. For Pile Details, see Plate 5-46.
 3. For Girder and Pad Details, see Plate 5-22.
 4. For Bar Bending Diagrams, see Plates 5-55 and 5-56.
 5. For Reinforcing Bar List, see Plate 5-60.
 6. Pile Spacing is Measured at Bottom of Cap.
- LEGEND:**
- P.A.S. denotes Place as shown.
 - E.F. denotes Each Face.
 - denotes Battered Pile 3:12 in direction of arrow.
 - denotes Vertical Pile.
 - ▲ denotes 3" Beam Bolster (B.B.).

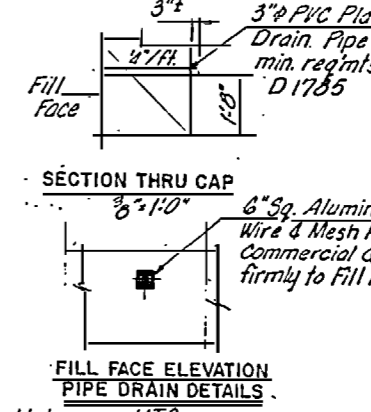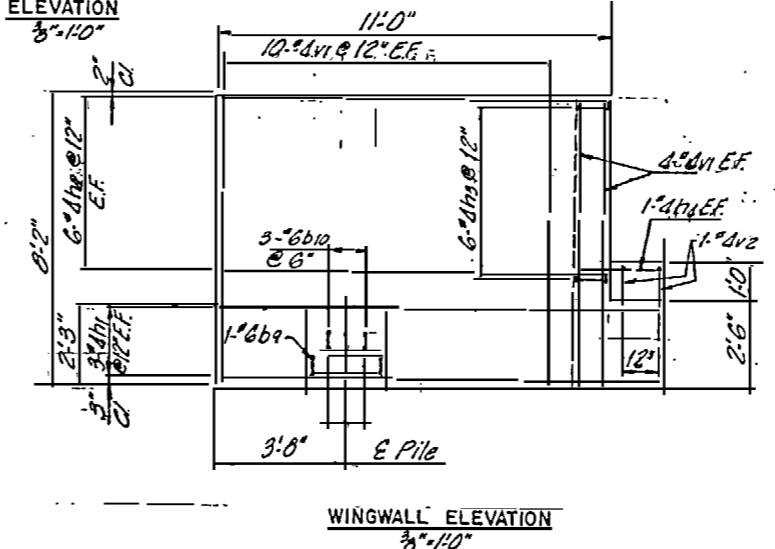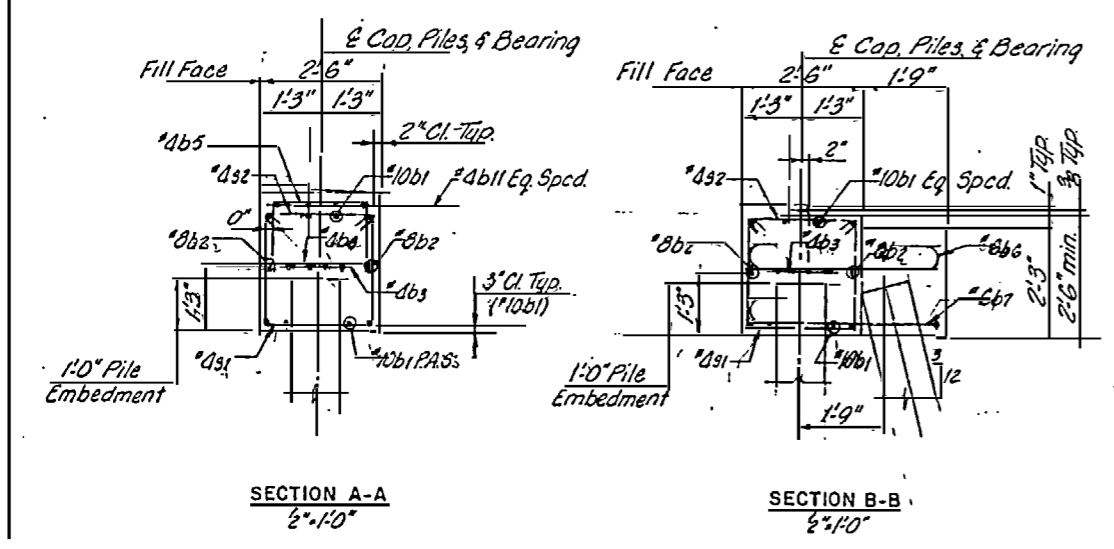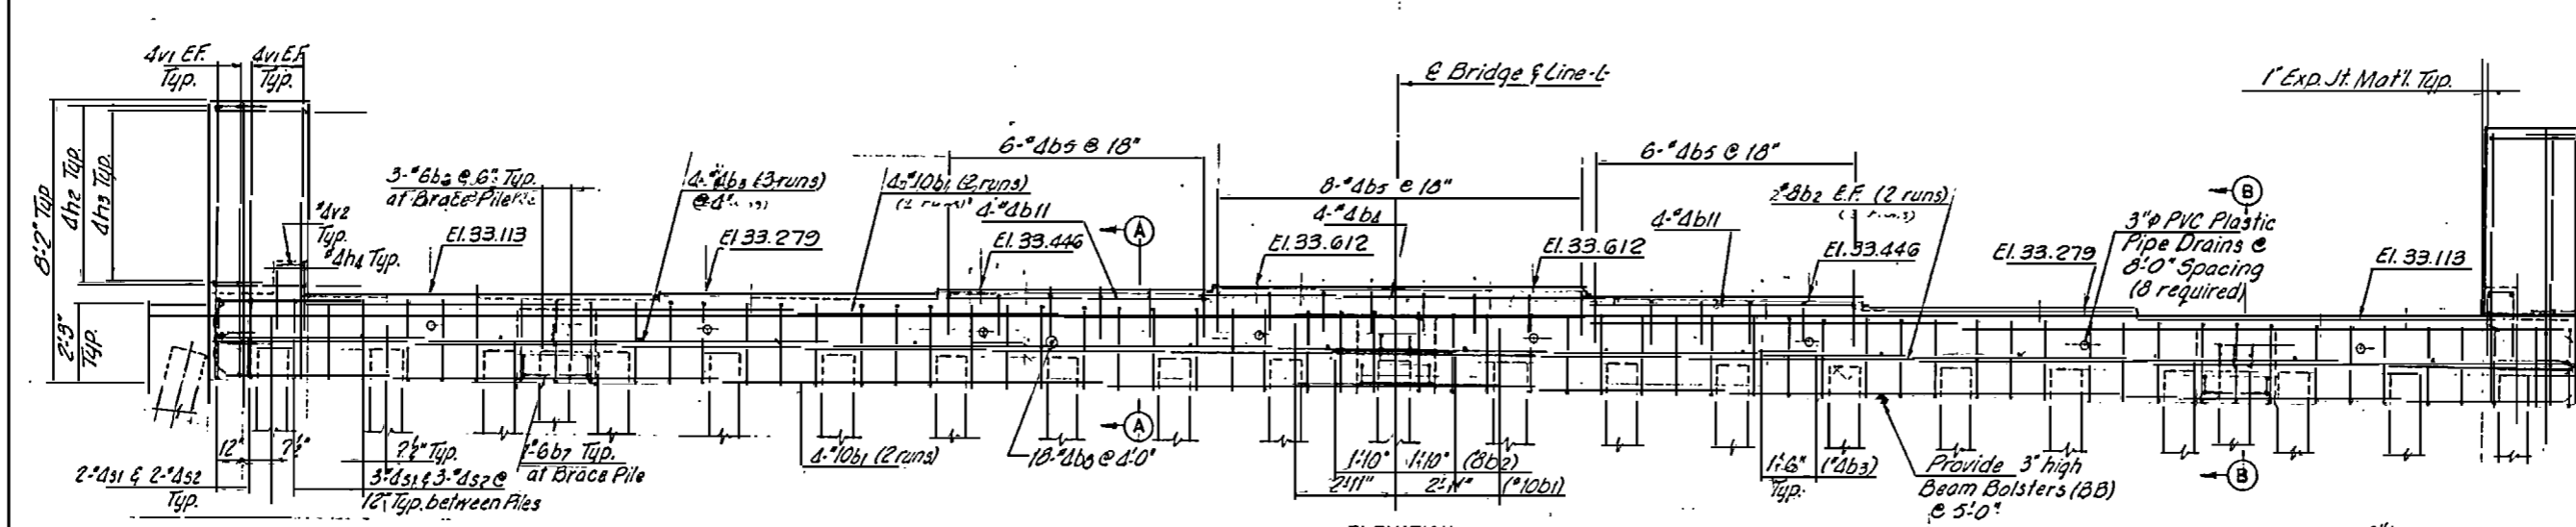

Note: N.T.S.
No separate payment will be made for furnishing & installing the PVC Plastic Pipe Drains, Hardware Cloth & Fasteners.

RECORD DRAWING

* See General Notes, 5-7.

PILE REQUIREMENTS			
BENT NO.	MIN. PILE TIP ELEV.	NO. OF PILES	EST. TOTAL LENGTH
END BENT 2	-40	26	2095

DESIGNED BY: F.F.L. | CHECKED BY: A.A.S.

PREPARED BY: [Signature]

PRINCIPAL OF FIRM HNTB

HNTB HOWARD NEEDLES TAMMEN & BERGENDOFF ARCHITECTS ENGINEERS PLANNERS ATLANTA, GEORGIA

U.S. ARMY ENGINEER DISTRICT WILMINGTON, NORTH CAROLINA

ATLANTIC INTRACOASTAL WATERWAY SUBSTRUCTURE


END: BENT 2

COINJOCK BRIDGE REPLACEMENT PROJECT

CORRITUCK COUNTY NORTH CAROLINA

INVESTIGATION NO. DACW54-63-B-0014 | DRAWING NUMBER BR104-06-17 | PLATE NO. S-32

SCALE AS NOTED | DATE 22 JULY 1983 | SHEET 82 OF 126

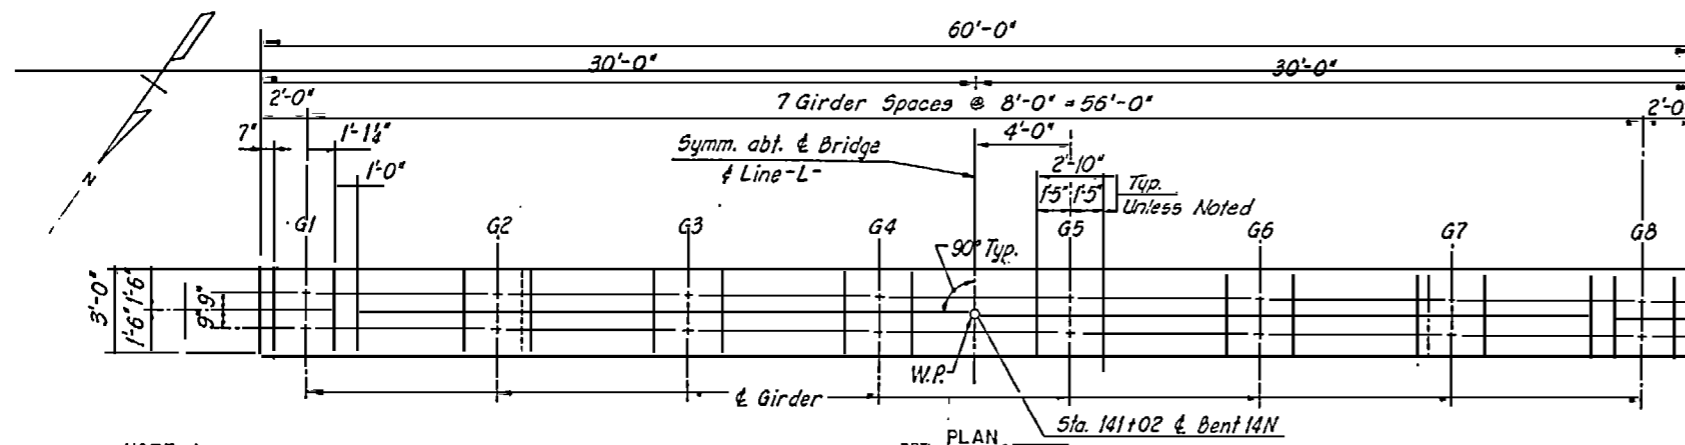


NOTE A:
Reinforce all concrete pads as shown except at girders G1 and G8.

NOTE B:
Adjust (#5st) stirrup bars inwardly as required to clear #7v4 bars.

PAD ELEVATIONS									
BENT NO.	BEARING	GDR. 1	GDR. 2	GDR. 3	GDR. 4	GDR. 5	GDR. 6	GDR. 7	GDR. 8
14N	13N S. BRG	29.513	29.679	29.846	30.012	30.012	29.846	29.679	29.513
	14N N. BRG	29.453	29.619	29.786	29.952	29.952	29.786	29.619	29.453


N.C. STATE AID PROJECT NO.		FED. RD. DIST. NO.
FEDERAL AID PROJECT NO.		BY NO.

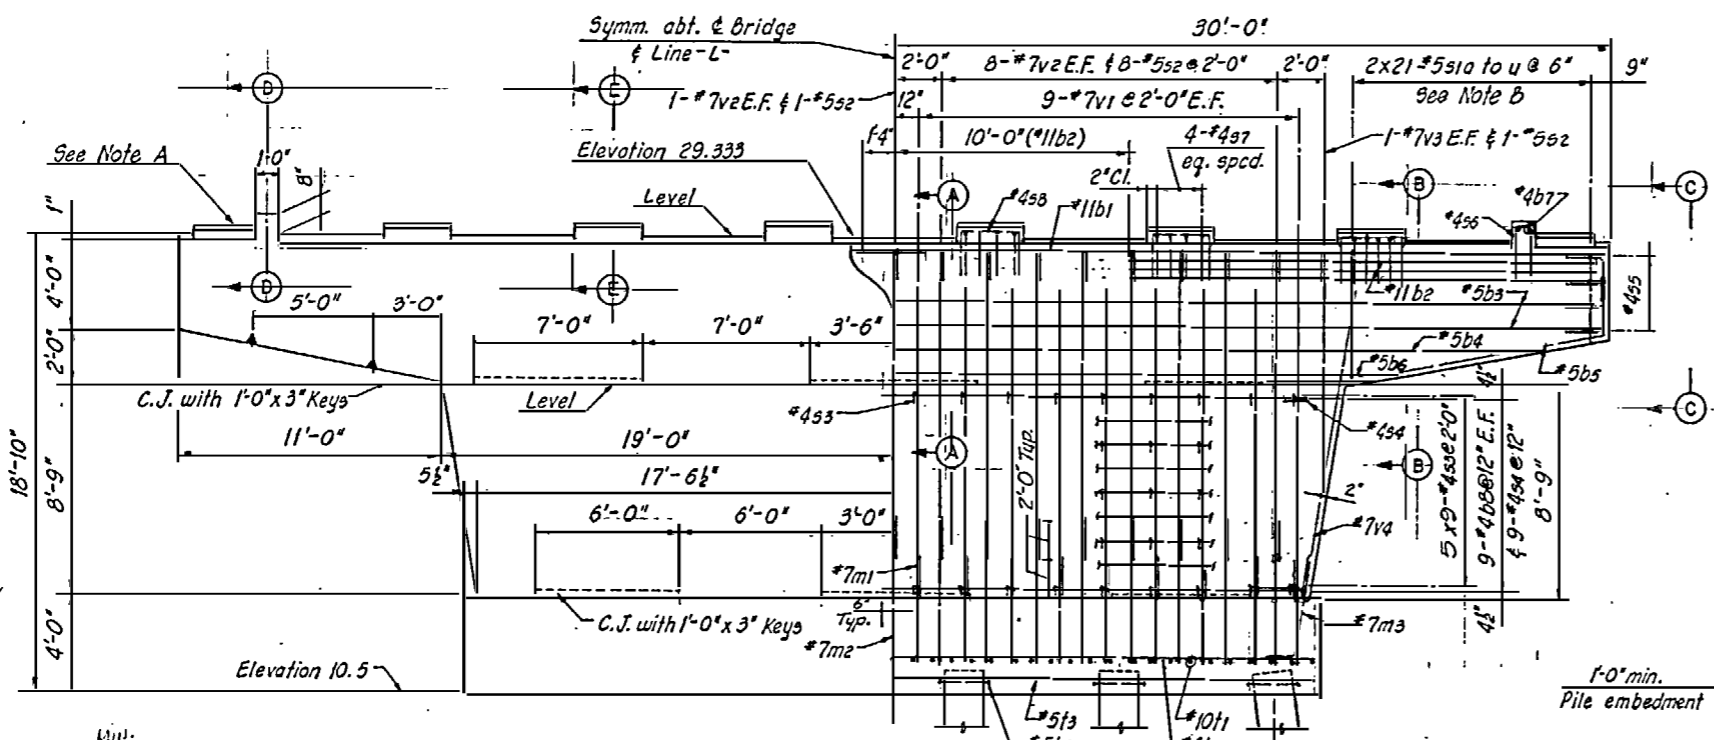

PILE REQUIREMENTS			
BENT NO.	MIN. PILE TIP ELEV.	NO. OF PILES	EST. TOTAL LENGTH
14N	-55.0	12	1105


-55.0

ELEVATION

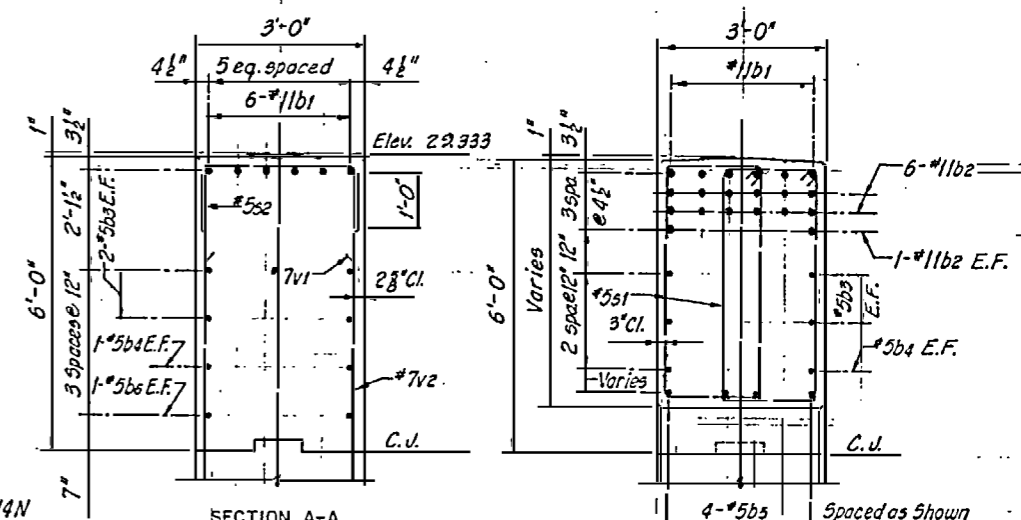


SECTION A-A

SECTION B-B

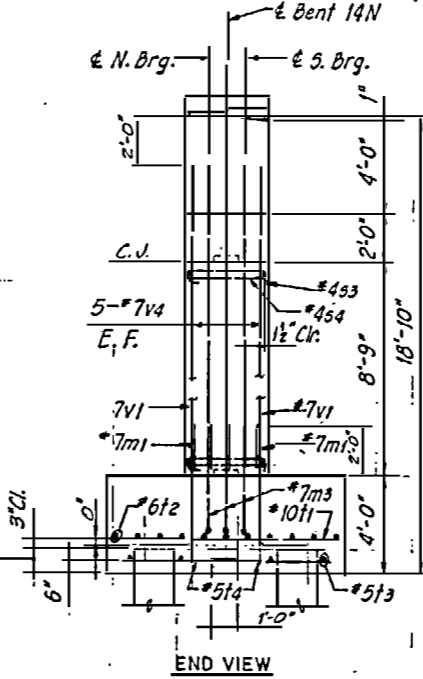


END VIEW

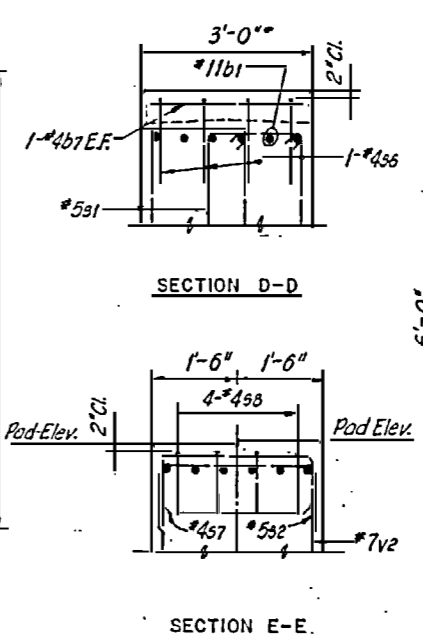

SECTION D-D


SECTION E-E

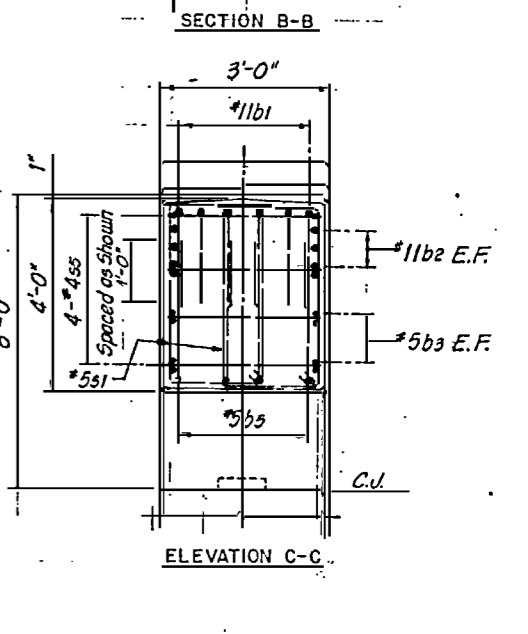

ELEVATION C-C

CAP. DETAILS
1/2" = 1'-0"

Note: Section E-E typical of Girders 2 thru 7 only.

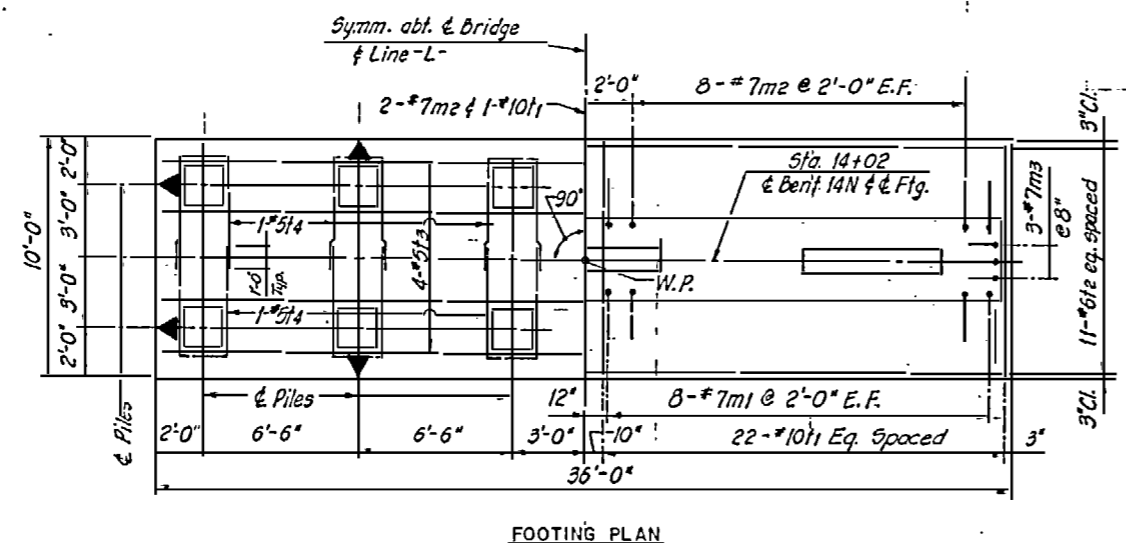

FOOTING PLAN

- NOTES:**
- See General Notes Plate No. 5-7
 - For Pile Details see Plate No. 5-47 or 5-48
 - For Girder and Pad Details see Plate No. 5-22
 - For Reinforcing Bar List see Plate No. 5-61
 - For Bar Bending Diagrams see Plates No. 5-55 and 5-56
 - Pile spacings are measured at bottom of footing


RECORD DRAWING

- LEGEND**
- N.P. denotes Working Point
 - E.F. denotes Each Face
 - C.J. denotes Construction Joint
 - ▣ denotes battered pile 1/2 : 12 in direction of arrow
 - ▢ denotes vertical pile
 - ▲ denotes 3" Beam Bolster (BB)

HNTB HOWARD NEEDLES TAMMEN & BERGENOFF ARCHITECTS ENGINEERS PLANNERS ATLANTA, GEORGIA U.S. ARMY ENGINEER DISTRICT, WILMINGTON CORPS OF ENGINEERS WILMINGTON, NORTH CAROLINA

ATLANTIC INTRACOASTAL WATERWAY
SUBSTRUCTURE
BENT 14N: DETAILS


DESIGNED BY: M.G.	CHECKED BY: M.A.M.	INTEGRATION NO. DACWS4-83-B-014	SIZE BRI04-06-17	PLATE NO. S-33
PRINCIPAL OF FIRM HNTB		SCALE 1" = 1'-0"	DATE 22 JULY 1983	SHEET 83 OF 126

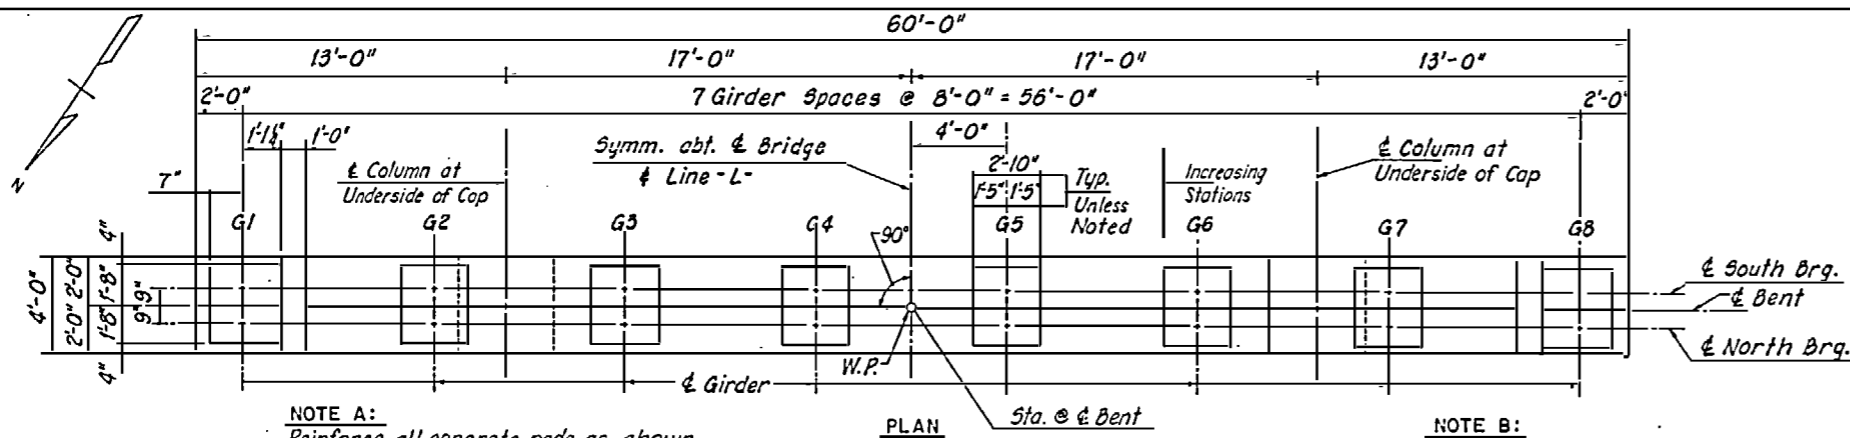


NOTE A:
Reinforce all concrete pads as shown except at girders G1 and G8.

NOTE B:
Adjust stirrups (*599 q and r) inwardly as required to clear column reinforcement (*11v bars).

BENT NO.	BEARING	GDR. 1	GDR. 2	GDR. 3	GDR. 4	GDR. 5	GDR. 6	GDR. 7	GDR. 8
10N	SOUTH	43.913	44.079	44.246	44.412	44.412	44.246	44.079	43.913
	NORTH	43.853	44.019	44.186	44.352	44.352	44.186	44.019	43.853
11N	SOUTH	40.313	40.479	40.646	40.812	40.812	40.646	40.479	40.313
	NORTH	40.253	40.419	40.586	40.752	40.752	40.586	40.419	40.253
12N	SOUTH	36.713	36.879	37.046	37.212	37.212	37.046	36.879	36.713
	NORTH	36.653	36.819	36.986	37.152	37.152	36.986	36.819	36.653
13N	SOUTH	33.113	33.279	33.446	33.612	33.612	33.446	33.279	33.113
	NORTH	33.053	33.219	33.386	33.552	33.552	33.386	33.219	33.053
10S	NORTH	43.913	44.079	44.246	44.412	44.412	44.246	44.079	43.913
	SOUTH	43.853	44.019	44.186	44.352	44.352	44.186	44.019	43.853
11S	NORTH	40.313	40.479	40.646	40.812	40.812	40.646	40.479	40.313
	SOUTH	40.253	40.419	40.586	40.752	40.752	40.586	40.419	40.253
12S	NORTH	36.713	36.879	37.046	37.212	37.212	37.046	36.879	36.713
	SOUTH	36.653	36.819	36.986	37.152	37.152	36.986	36.819	36.653

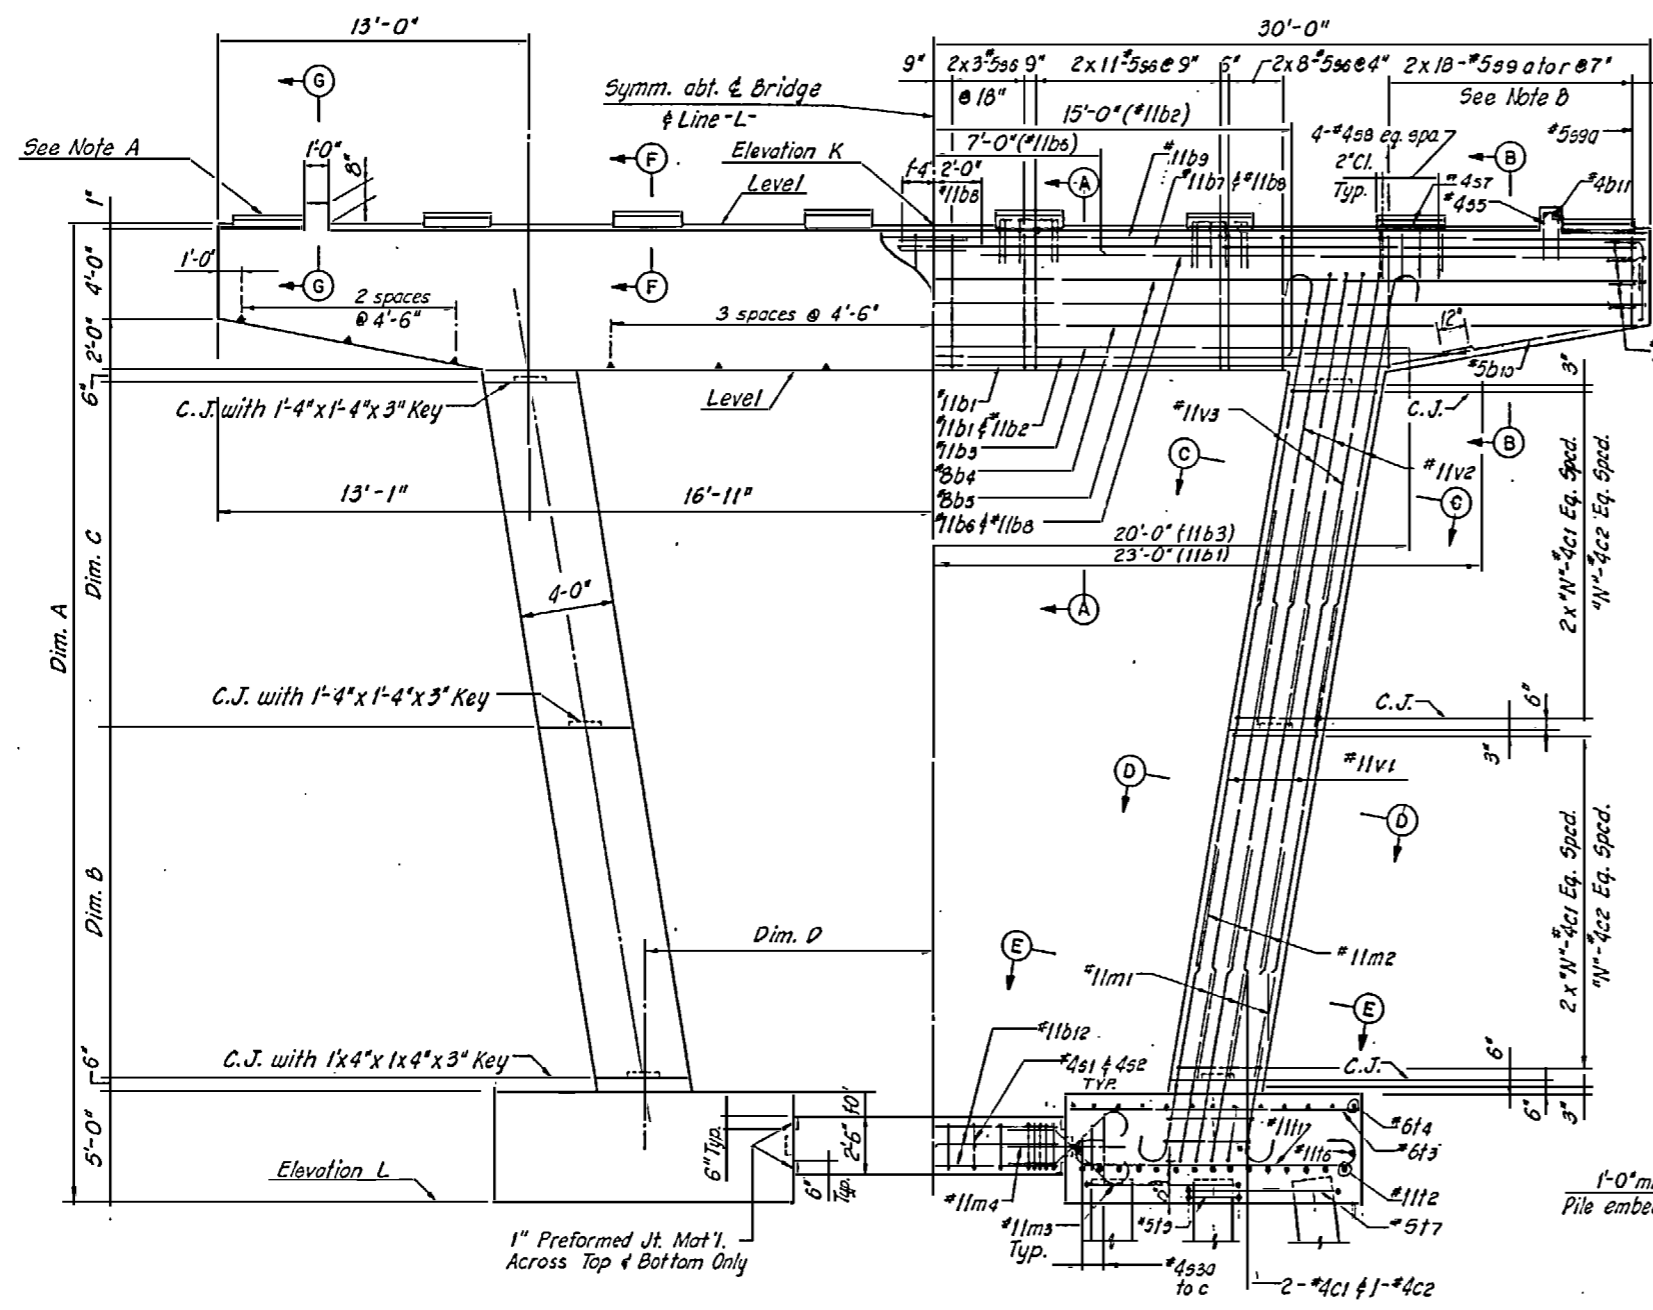

ELEVATION
Looking in direction of increasing stations

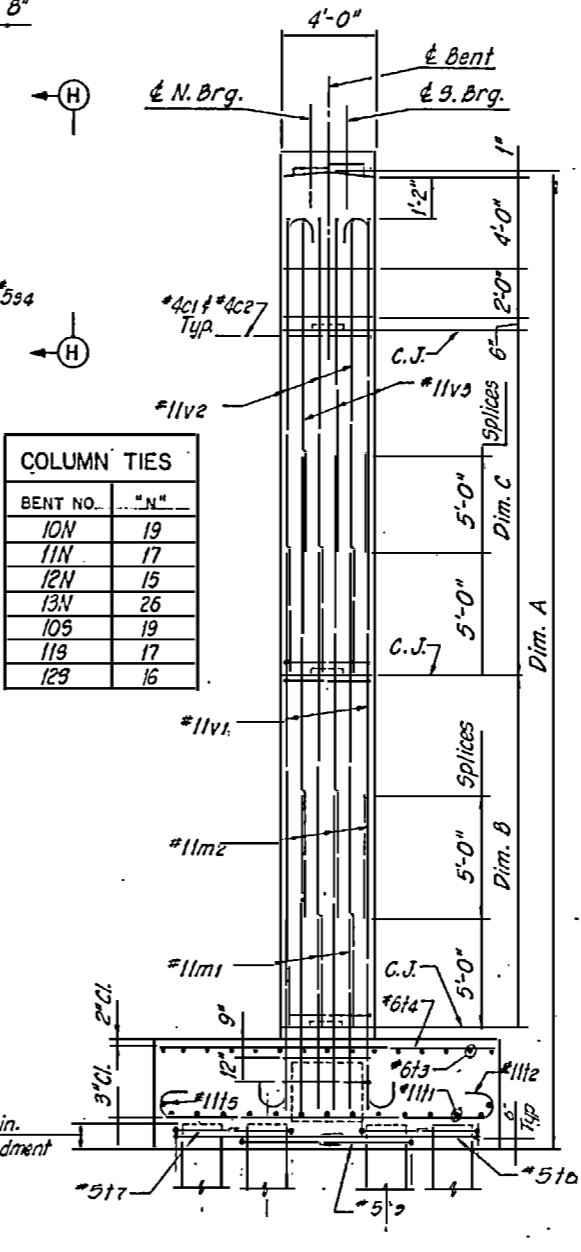

Note: No intermediate construction joints in columns at Bents 13N and 12S.

BENT NO.	ELEVATIONS		STA. @ BENT	DIMENSIONS			
	K	L		A	B	C	D
10N	43.750	-4.500	144+62	48'-3"	18'-1"	18'-1"	10'-9 1/2"
11N	40.157	-5.000	143+72	45'-2"	16'-6"	16'-7"	11'-3 1/2"
12N	36.500	-5.000	142+82	41'-6"	14'-8"	14'-9"	11'-11 1/2"
13N	32.917	-5.000	141+92	37'-11"	25'-10"	0'-0"	12'-6 1/2"
10S	43.750	-5.500	162+48	49'-3"	18'-7"	18'-7"	10'-7 1/2"
11S	40.167	-5.500	163+38	45'-8"	16'-9"	16'-10"	11'-2 1/2"
12S	36.500	8.500	164+28	28'-0"	15'-11"	0'-0"	14'-3 1/2"

- NOTES**
- See General Notes Plate No. S-7
 - See Plate No. S-35 for Sections A-A thru G-G and Elevation H-H
 - For Pile Details see Plate No.'s S-47 and S-48
 - For Girder and Pad Details see Plate No. S-21
 - For Reinforcing Bar List see Plate No.'s S-61, S-62 and S-67
 - For Footing Plan see Plate No. S-35
 - For Bar Bending Diagrams see Plate No.'s S-55 and S-56.

- LEGEND**
- E.F. denotes Each Face
 - C.J. denotes Construction Joint
 - ▤ denotes battered pile 1 1/2 : 12 in direction of arrow.
 - ▭ denotes vertical pile
 - W.P. denotes Working Point
 - ▲ denotes 3" Beam Bolster (BB)

RECORD DRAWING


HNTB HOWARD NEEDLES TAMER & BERGENDOFF ARCHITECTS ENGINEERS PLANNERS ATLANTA, GEORGIA U.S. ARMY ENGINEER DISTRICT, WASHINGTON CORPS OF ENGINEERS WASHINGTON, NORTH CAROLINA

ATLANTIC INTRACOASTAL WATERWAY SUBSTRUCTURE BENTS 10N-13N & 10S-12S


COINJOCK BRIDGE REPLACEMENT PROJECT CURRITUCK COUNTY NORTH CAROLINA

DESIGNED BY: M.G.	CHECKED BY: M.A.M.	INVESTIGATED BY: B.M.	DATE: 22 JULY 1983
PREPARED BY: [Signature]	DRAWING NUMBER: BR104-06-17	SCALE: 1/4" = 1'-0"	DATE: 22 JULY 1983
PRINCIPAL OF FIRM HNTB	SHEET 84 OF 126	PLATE NO. S-34	


N.C. STATE AID PROJECT NO.	FED. RD. DIV. NO.
FEDERAL AID PROJECT NO.	DIV. NO.

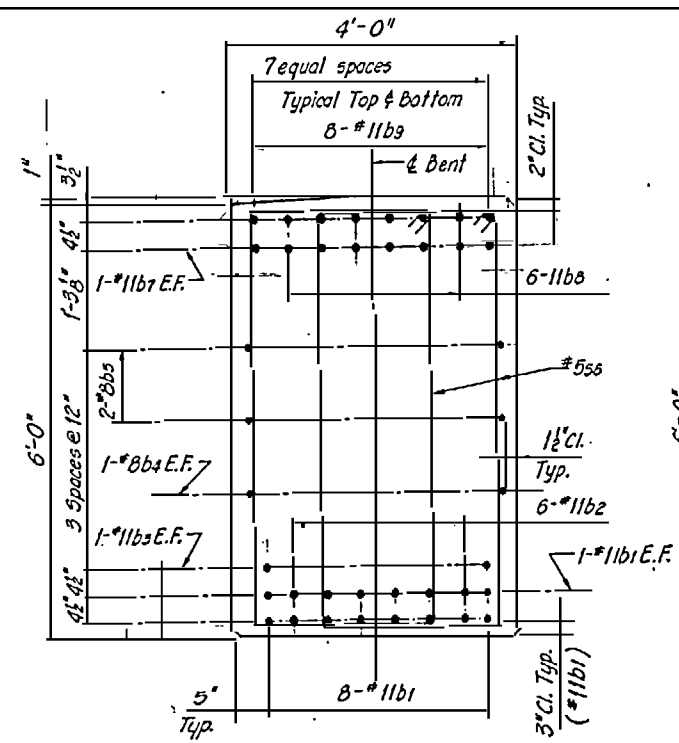


SECTION A-A

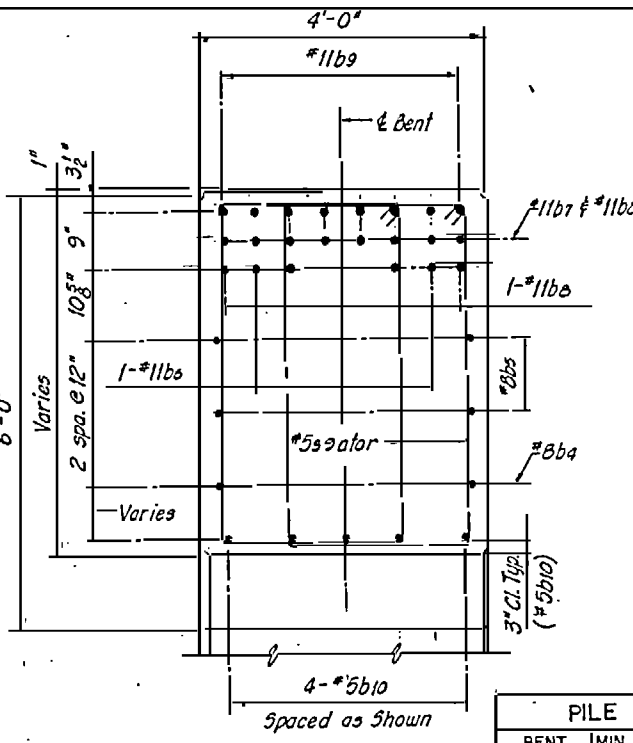


SECTION B-B

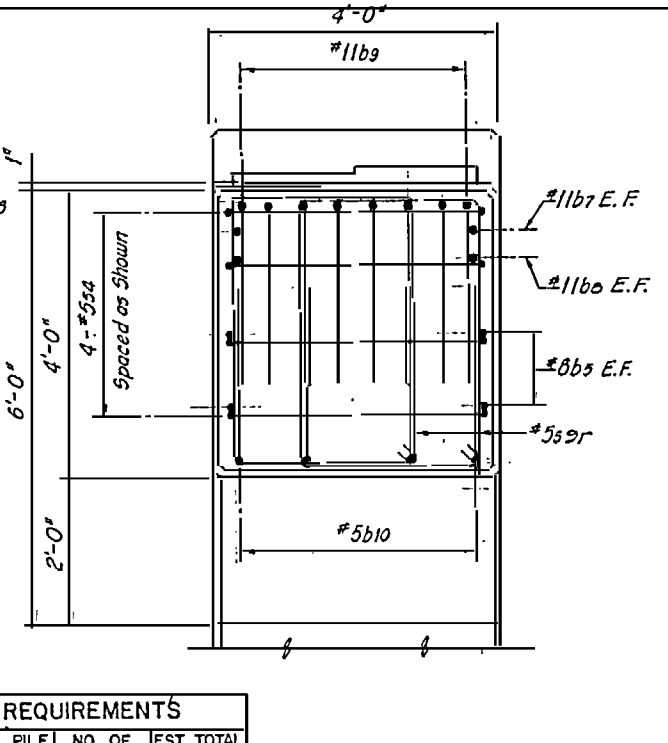

ELEVATION E-E

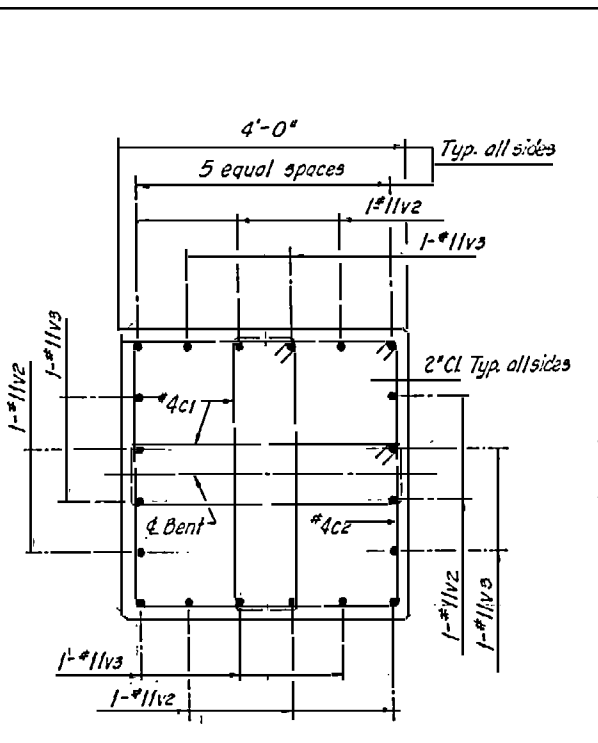

SECTION C-C

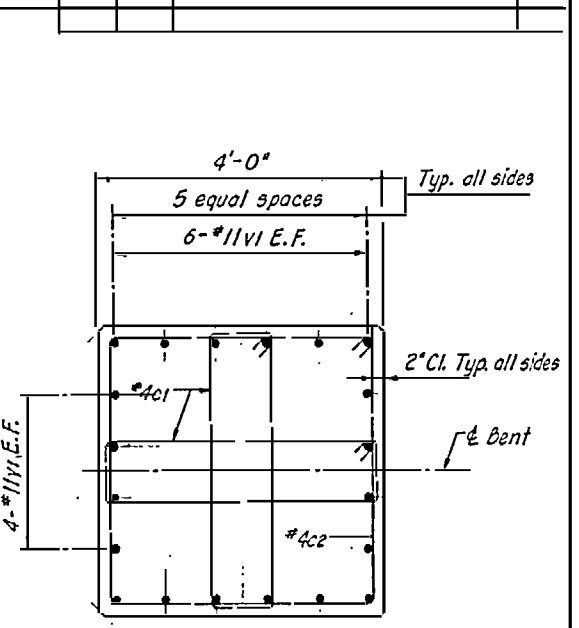


SECTION D-D

Note: Section D-D does not Apply to Columns in Bents 13N and 12S


PILE REQUIREMENTS			
BENT NO.	MIN. PILE TIP ELEV.	NO. OF PILES	EST. TOTAL LENGTH
10N	-55.0	12	980
11N	-55.0	12	920
12N	-55.0	12	835*
13N	-55.0	12	920
10S	-55.0	12	1105
11S	-55.0	12	1040
12S	-55.0	12	1165

See General Notes Plate No. 9-7
* Does not include 85' of Test Piles

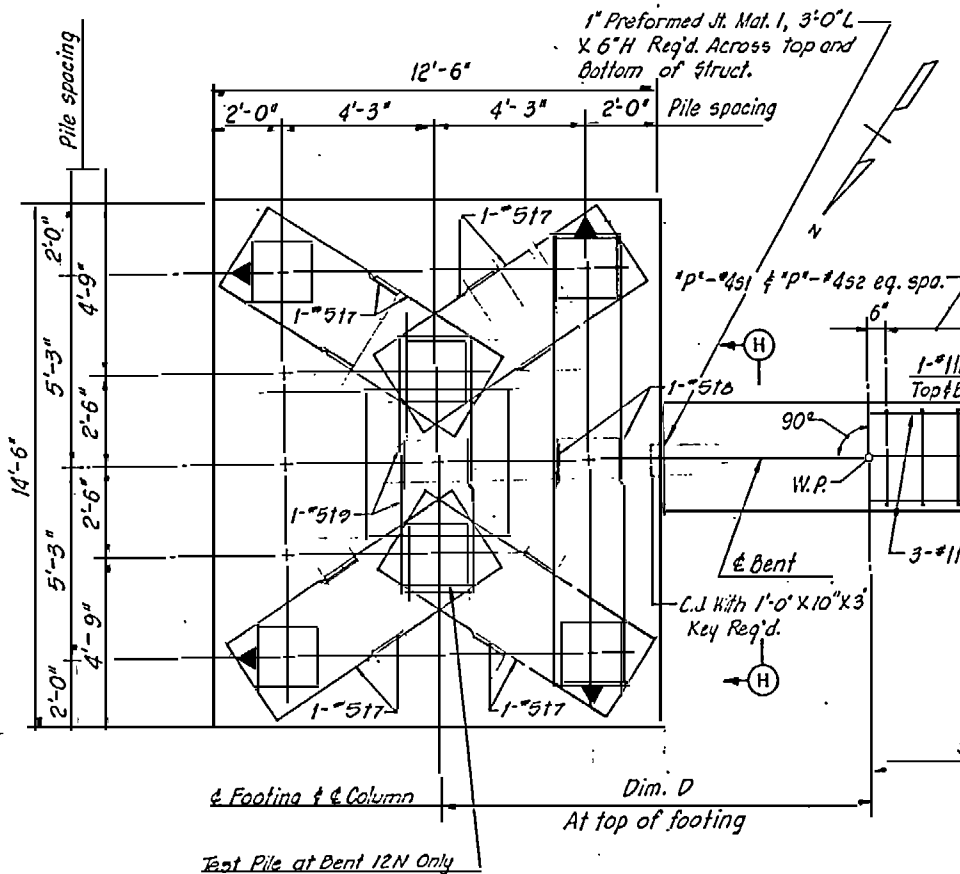


FOOTING PLAN

Note: Pile spacings are measured at Bottom of Footing

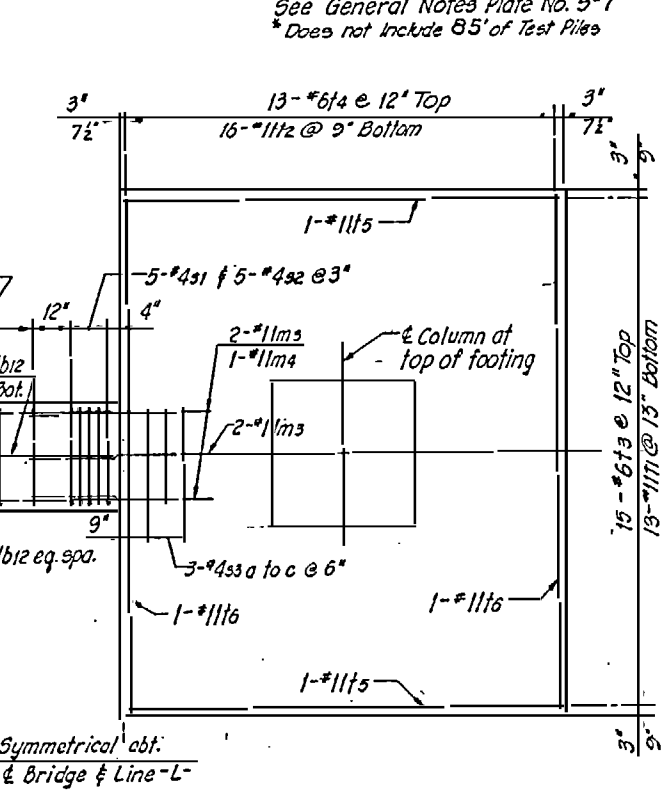


SECTION H-H

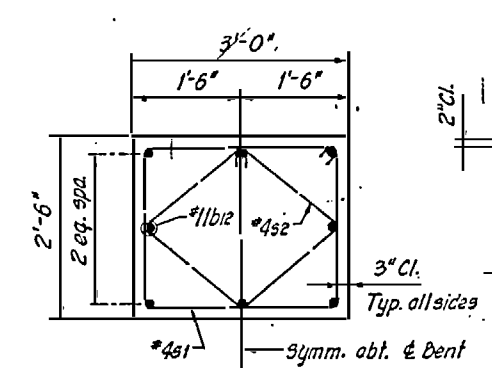

SECTION F-F

Note: Section F-F typical of Girders 2 thru 7 only

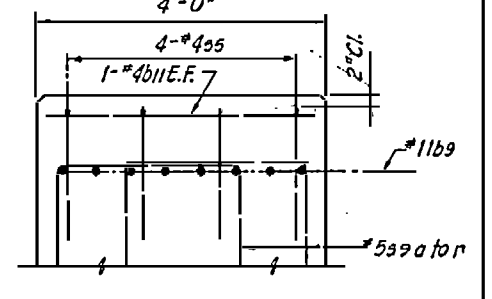

SECTION G-G

BENT NO.	"P"
10N	3
11N	4
12N	4
13N	5
10S	3
11S	4
12S	7

RECORD DRAWING

HNTB HOWARD NEEDLES TAMMEN & BERGENDOFF ARCHITECTS ENGINEERS PLANNERS ATLANTA, GEORGIA


U.S. ARMY ENGINEER DISTRICT, WASHINGTON CORPS OF ENGINEERS WASHINGTON, NORTH CAROLINA

ATLANTIC INTRACOASTAL WATERWAY SUBSTRUCTURE BENTS 10N-13N & 10S-12S. DETAILS


COINJOCK BRIDGE REPLACEMENT PROJECT CURRITUCK COUNTY NORTH CAROLINA

DESIGNED BY: M.G.	CHECKED BY: M.A.M.	INVESTIGATION NO. DACW 54-83-B-0014	SIZE	DRAWING NUMBER	PLATE NO.
PREPARED BY: [Signature]				BRI04-06-17	S-35
PRINCIPAL OF FIRM HNTB		SCALE 3/4"=1'-0"	DATE	22 JULY 1993	SHEET 85 OF 126


N.C. STATE AID PROJECT NO.	FED. RD. DIST. NO.
FEDERAL AID PROJECT NO.	CONTRACT NO.

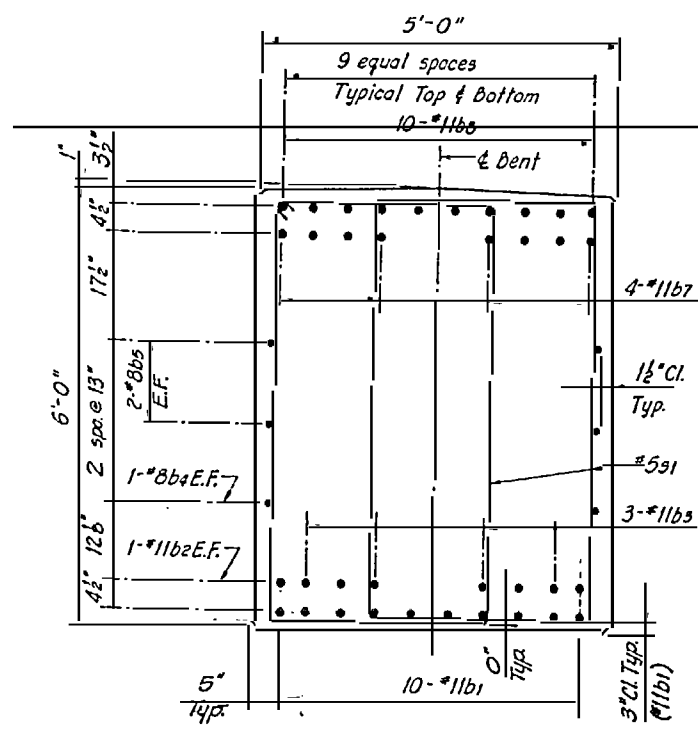


SECTION A-A

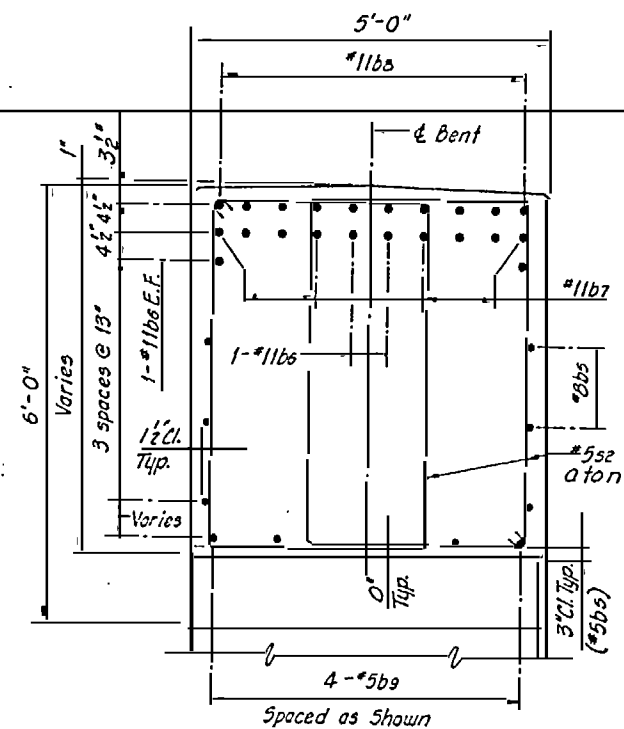


SECTION B-B

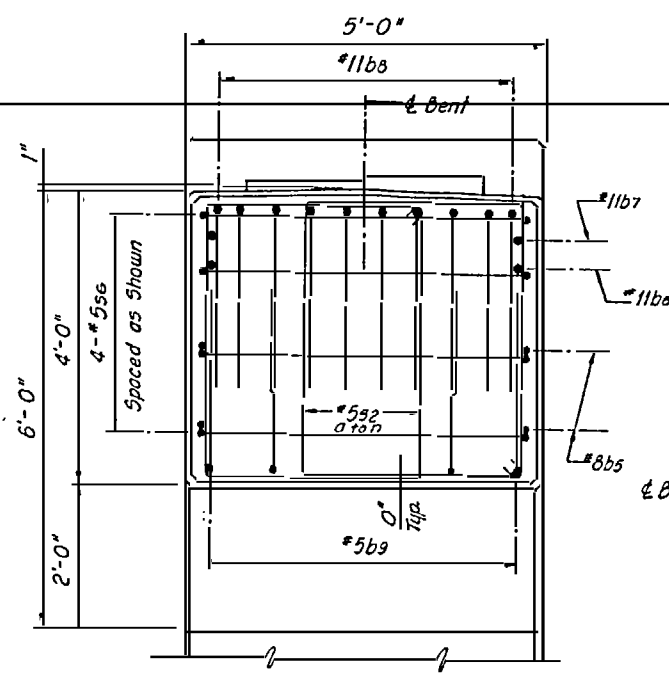


ELEVATION H-H

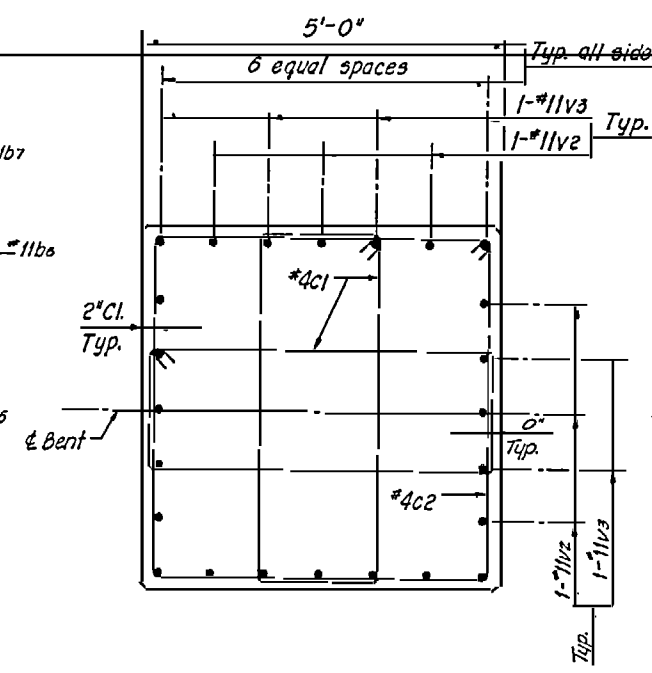


SECTION E-E

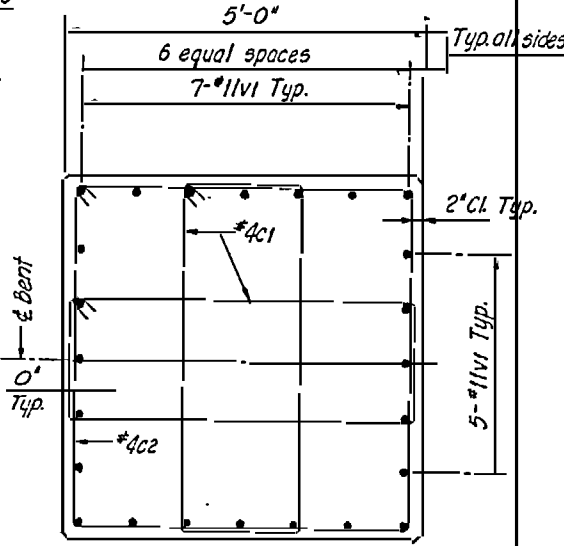


SECTION F-F

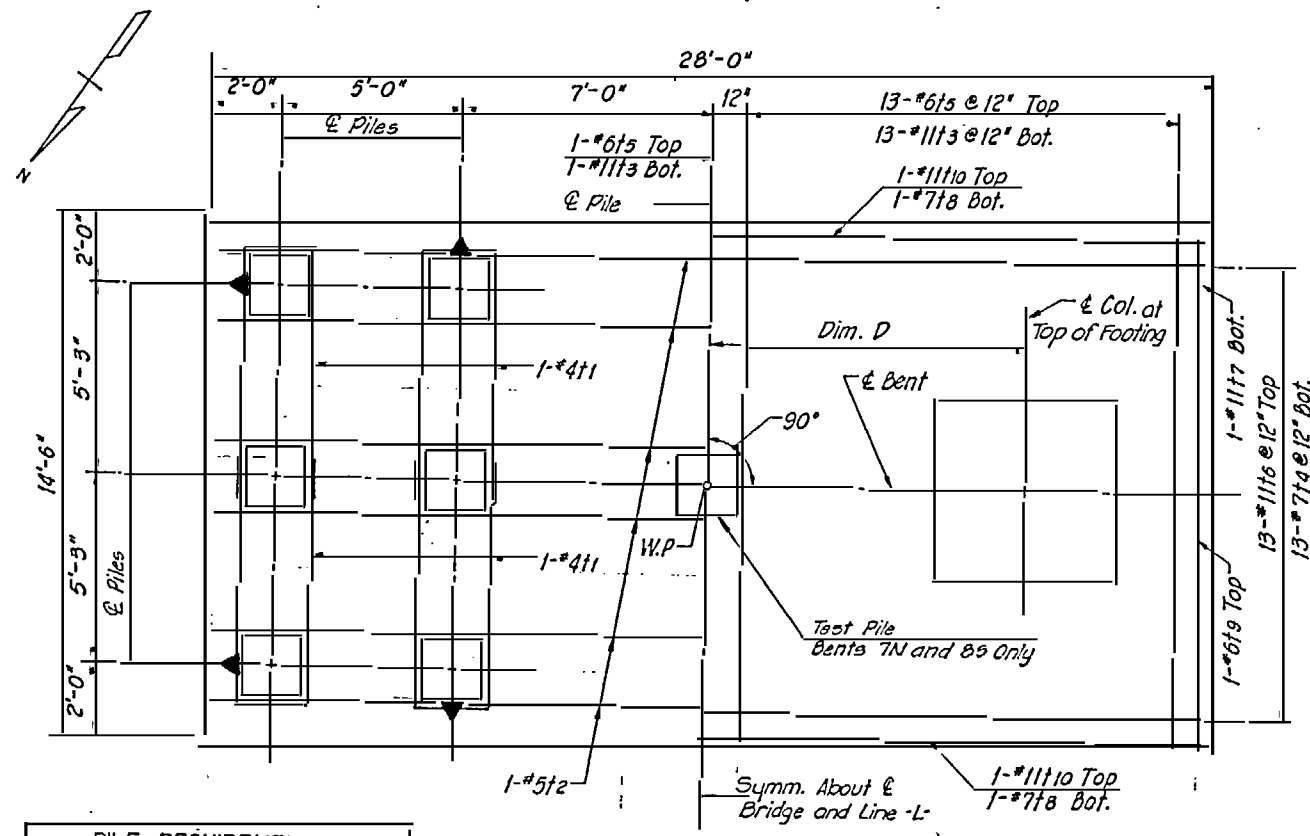


FOOTING PLAN

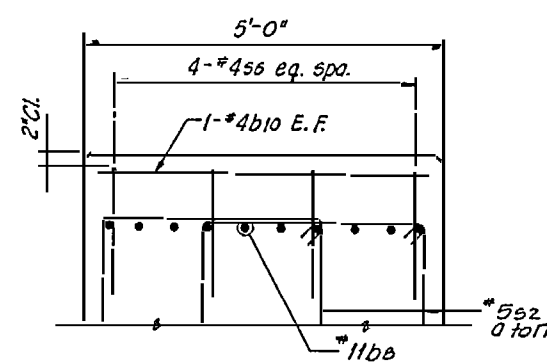

SECTION C-C

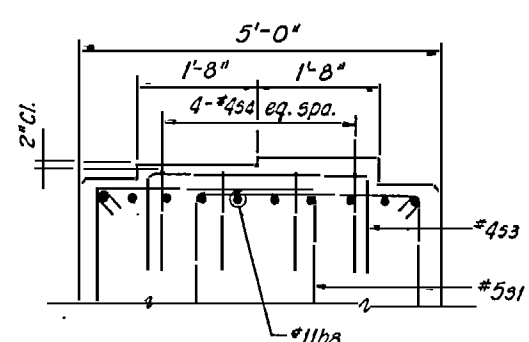

SECTION D-D

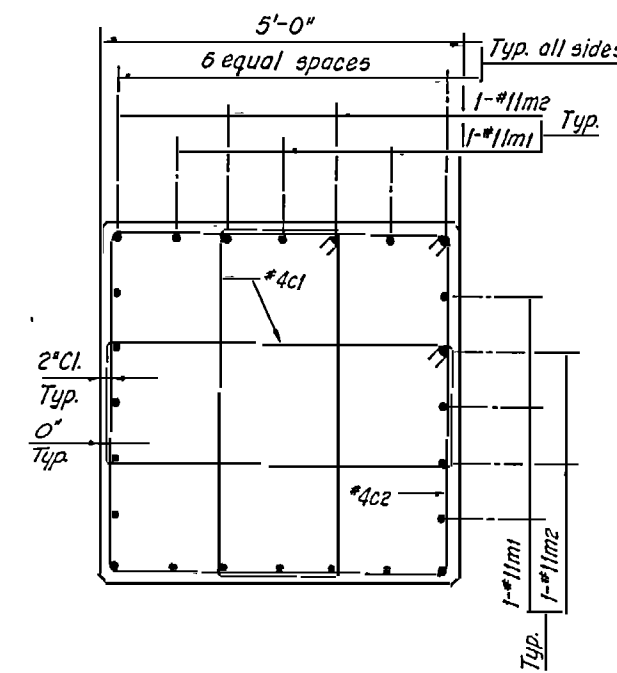

SECTION G-G

PILE REQUIREMENTS			
BENT NO.	MIN. PILE TIP ELEV.	NO. OF PILES	EST. TOTAL LENGTH
6N	-55.0	13	1060
7N	-55.0	13	910*
8N	-55.0	13	995
9N	-55.0	13	930
6S	-55.0	13	1060
7S	-55.0	13	1125
8S	-55.0	13	1160**
9S	-55.0	13	1125

NOTE: Pile Spacing Measured at Bottom of Footing

NOTE: See Plate No. 5-36 For Legend

NOTE: Section D-D typical of Girders 2 thru 7 only.

RECORD DRAWING


HNTB HOWARD NEEDLES TAMMEN & BERGENDOFF ARCHITECTS ENGINEERS PLANNERS ATLANTA, GEORGIA

ATLANTIC INTRACOASTAL WATERWAY SUBSTRUCTURE BENTS 6N-9N & 6S-9S DETAILS

DESIGNED BY: M.G.	CHECKED BY: M.A.M.	INVESTIGATION NO: DACW54-83-B-0014	SIZE: 11x17	DRAWING NUMBER: BR104-06-17	PLATE NO: S-37
PREPARED BY: [Signature]		DATE: 22 JULY 1983		SHEET 87 OF 126	

See General Notes Plate No. 5-7
* Does not include 65' Test Pile
** Does not include 100' Test Pile

N.C. STATE AID PROJECT NO.	
FEDERAL AID PROJECT NO.	FED. RD. DIST. NO.

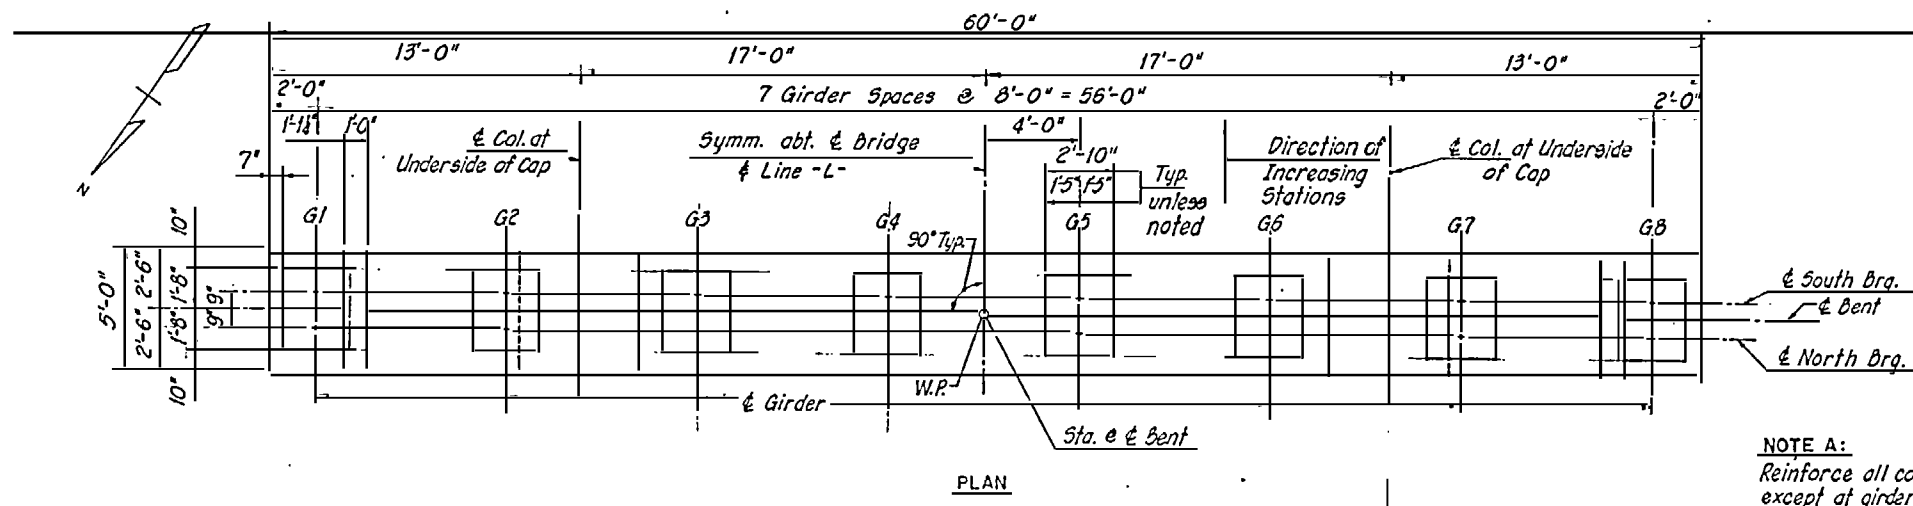

COLUMN TIES


BENT NO.	"N"
3N	26
4N	25
5N	23
3S	27
4S	26
5S	25

TABLE OF ELEVATIONS & DIMENSIONS

BENT NO.	ELEVATIONS		STA. @ BENT	DIMENSIONS				
	K	L		A	B	C	D	E
3N	64.500	-3.500	150 + 92	68'-0"	25'-0"	24'-11"	10'-0 1/2"	5'-11 1/2"
4N	62.792	-3.500	150 + 02	66'-3 1/2"	24'-1 1/2"	24'-1"	10'-3 1/2"	6'-3 3/4"
5N	60.542	-2.000	149 + 12	62'-6 1/2"	22'-3"	22'-2 1/2"	10'-11 1/2"	6'-10 1/4"
3S	64.50	-5.500	156 + 18	70'-0"	26'-0"	25'-11"	9'-8 1/2"	5'-7 1/2"
4S	62.792	-5.500	157 + 08	68'-3 1/2"	25'-1 1/2"	25'-1"	10'-0"	5'-11 1/2"
5S	60.542	-5.500	157 + 98	66'-0"	24'-0"	23'-11 1/2"	10'-4 1/2"	6'-3 1/2"

NOTE A:
Reinforce all concrete pads as shown except at girders G1 and G8.

NOTE B:
Adjust stirrups (#5 @ m & n) inwardly as required to clear column reinforcement (#11 bars).

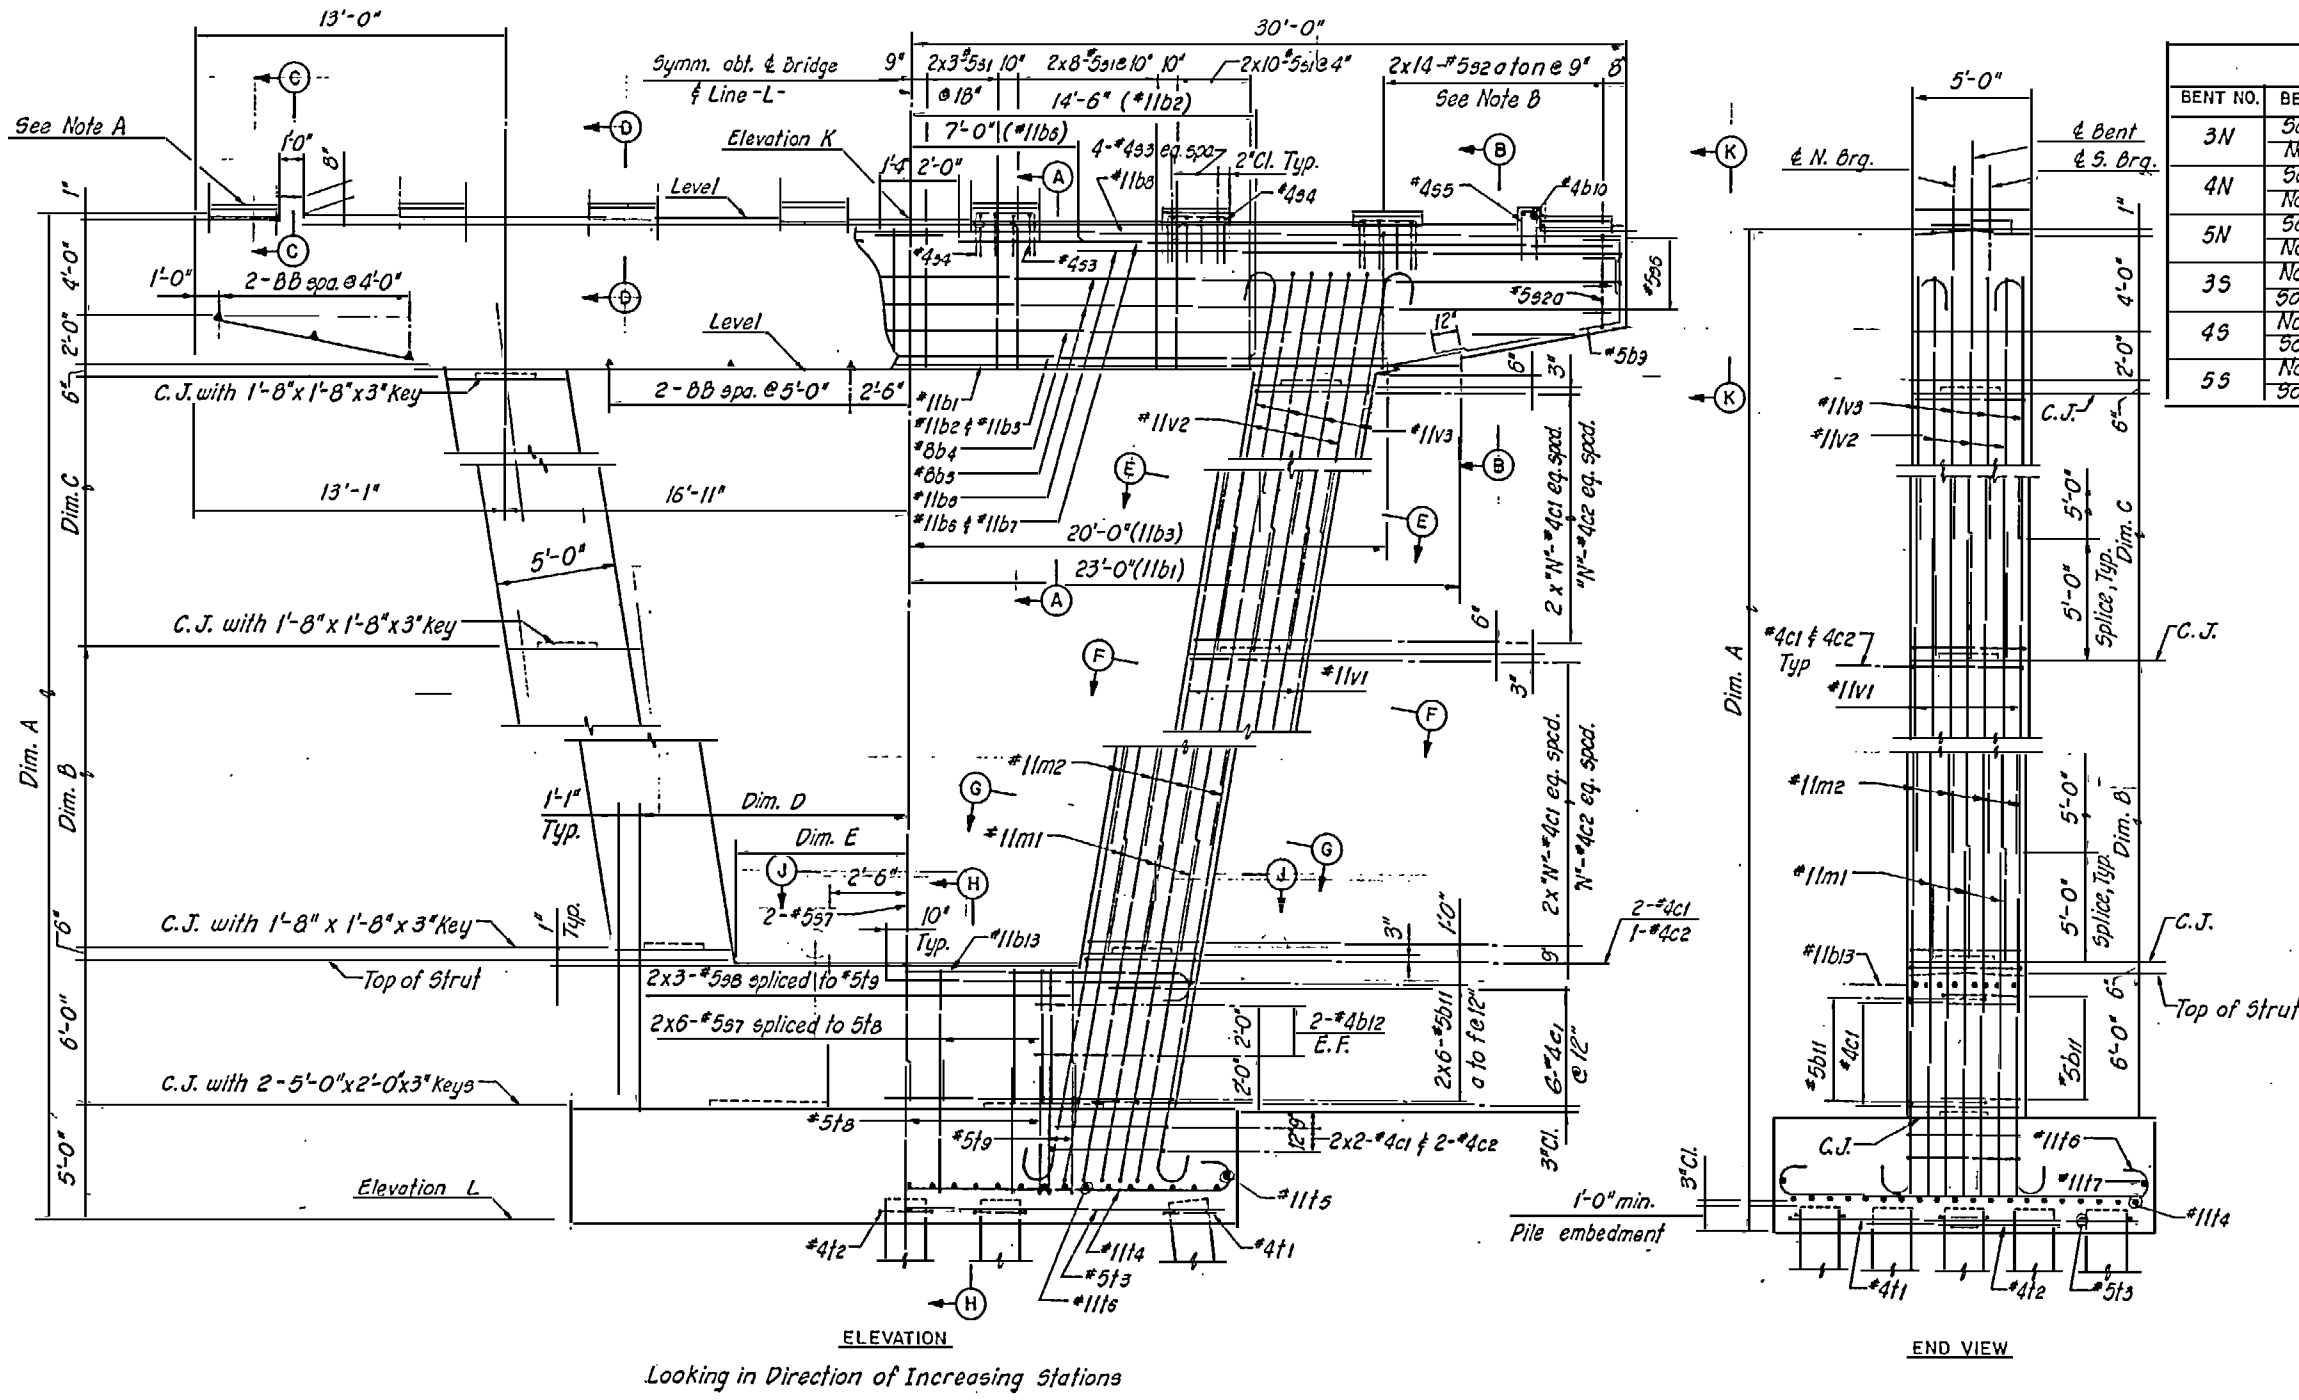

PAD ELEVATIONS

BENT NO.	BEARING	GDR. 1	GDR. 2	GDR. 3	GDR. 4	GDR. 5	GDR. 6	GDR. 7	GDR. 8
3N	South	64.667	64.834	65.000	65.167	65.167	65.000	64.834	64.667
	North	64.643	64.809	64.976	65.142	65.142	64.976	64.809	64.643
4N	South	62.939	63.106	63.272	63.438	63.438	63.272	63.106	62.939
	North	62.908	63.073	63.239	63.405	63.405	63.239	63.073	62.908
5N	South	60.699	60.865	61.031	61.198	61.198	61.031	60.865	60.699
	North	60.657	60.824	60.990	61.156	61.156	60.990	60.824	60.657
3S	North	64.667	64.834	65.000	65.167	65.167	65.000	64.834	64.667
	South	64.643	64.809	64.976	65.142	65.142	64.976	64.809	64.643
4S	North	62.939	63.106	63.272	63.438	63.438	63.272	63.106	62.939
	South	62.908	63.073	63.239	63.405	63.405	63.239	63.073	62.908
5S	North	60.699	60.865	61.031	61.198	61.198	61.031	60.865	60.699
	South	60.657	60.824	60.990	61.156	61.156	60.990	60.824	60.657

- NOTES**
- See General Notes Plate No. 5-7.
 - See Plate No. 5-39 for Sections A-A thru J-J and Elevation K-K.
 - For Pile Details see Plate Nos. 5-47 and 5-48.
 - For Girder and Pad Details see Plate No. 5-21.
 - For Reinforcing Bar List see Plate No's 5-63, 5-64, 5-65 and 5-66.
 - For Footing Plan see Plate No. 5-39.
 - For Bar Bending Diagram see Plate Nos. 5-55 and 5-56.

- LEGEND**
- E.F. denotes Each Face
 - C.J. denotes Construction Joint
 - ▤ denotes battered pile 1 1/2 : 12 in direction of arrow
 - denotes vertical pile
 - W.P. denotes Working Point
 - ▲ denotes 3" Beam Bolster (BB)

RECORD DRAWING






HNTB HOWARD NEEDLES TAMMEN & BERGENDOFF ARCHITECTS ENGINEERS PLANNERS ATLANTA, GEORGIA

U.S. ARMY ENGINEER DISTRICT, WILMINGTON CORPS OF ENGINEERS WILMINGTON, NORTH CAROLINA

ATLANTIC INTRACOASTAL WATERWAY SUBSTRUCTURE BENTS 3N-5N & 3S-5S COINJOCK BRIDGE REPLACEMENT PROJECT CURRITUCK COUNTY NORTH CAROLINA

DESIGNED BY: M.G.	CHECKED BY: M.A.M.	INVESTIGATION NO. DACW54-83-B-004	SCALE: 1"=1'-0"	DATE: 22 JULY 1983	SHEET 88 OF 126
PREPARED BY: [Signature]		DRAWING NUMBER: BR104-06-17			PLATE NO. S-38

NC STATE AID PROJECT NO.	
FEDERAL AID PROJECT NO.	FED RD DIST NO.

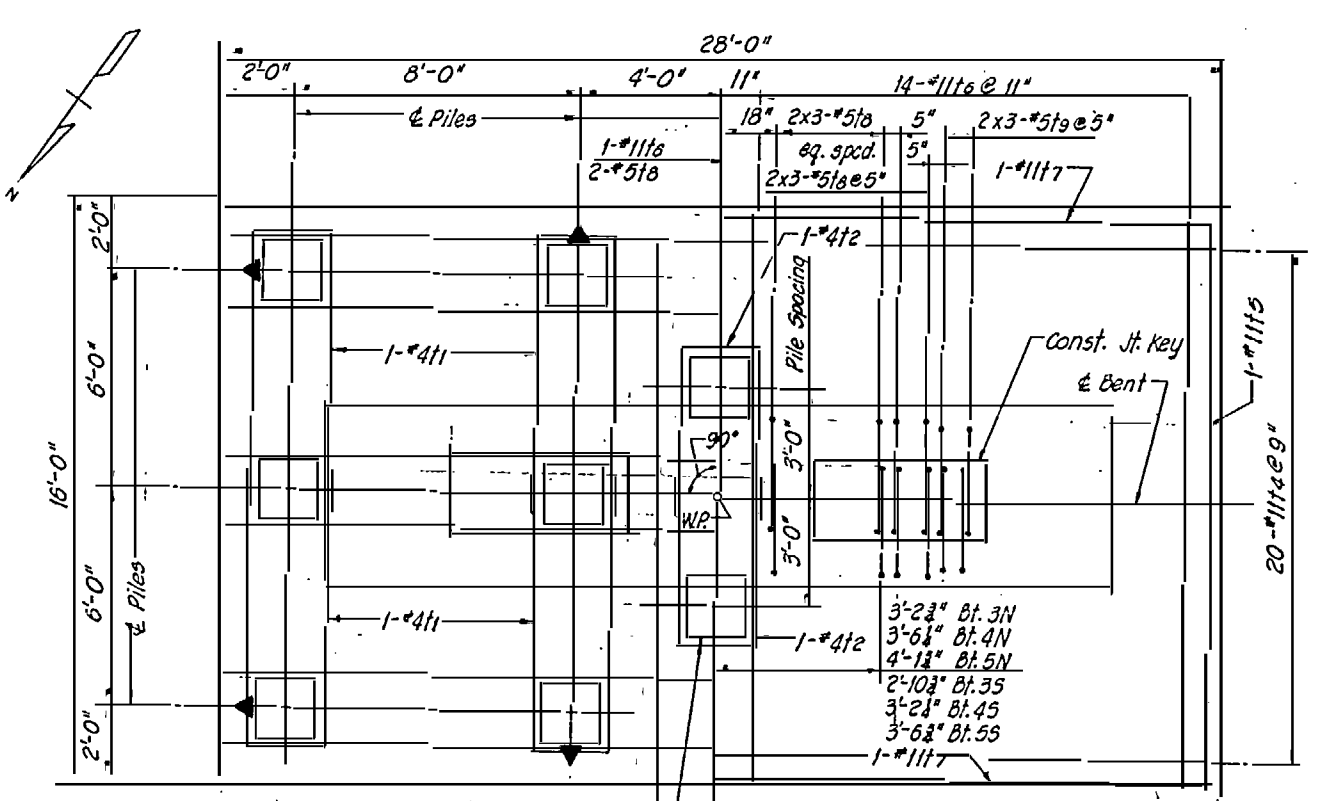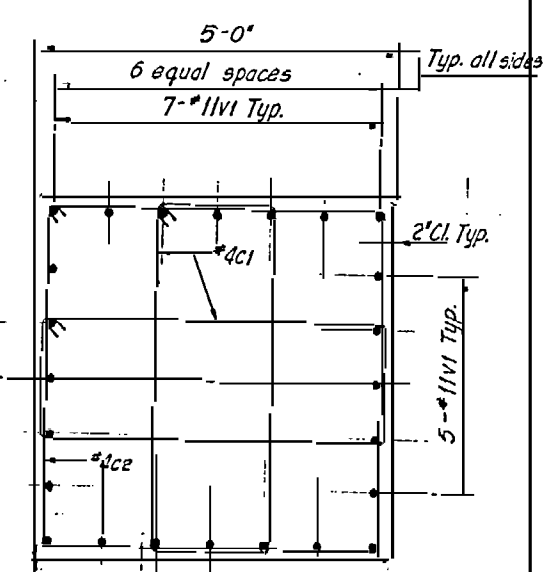
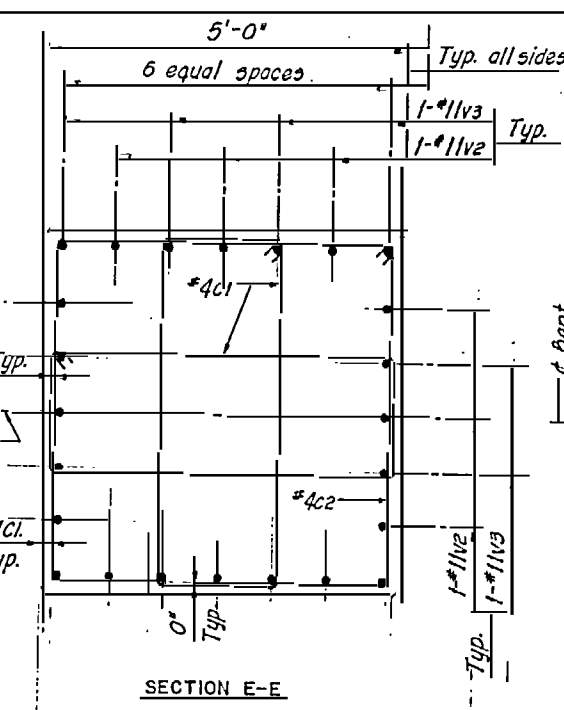
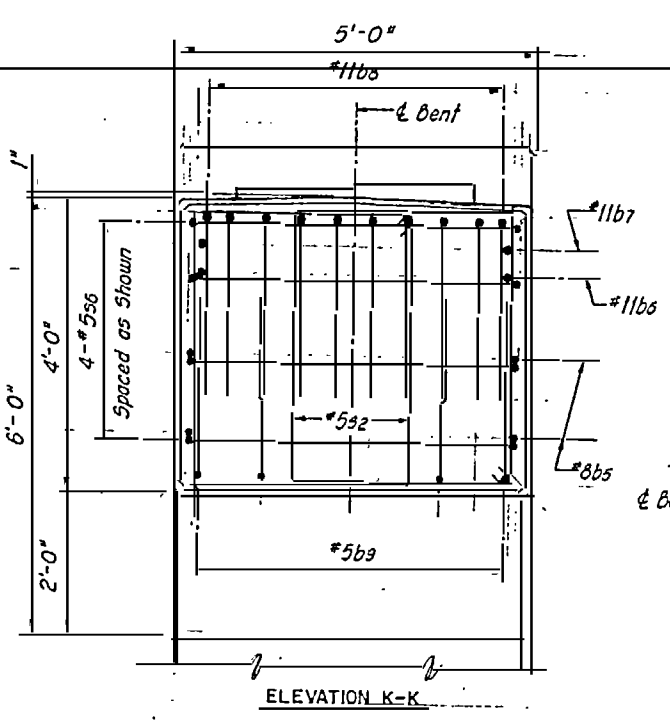
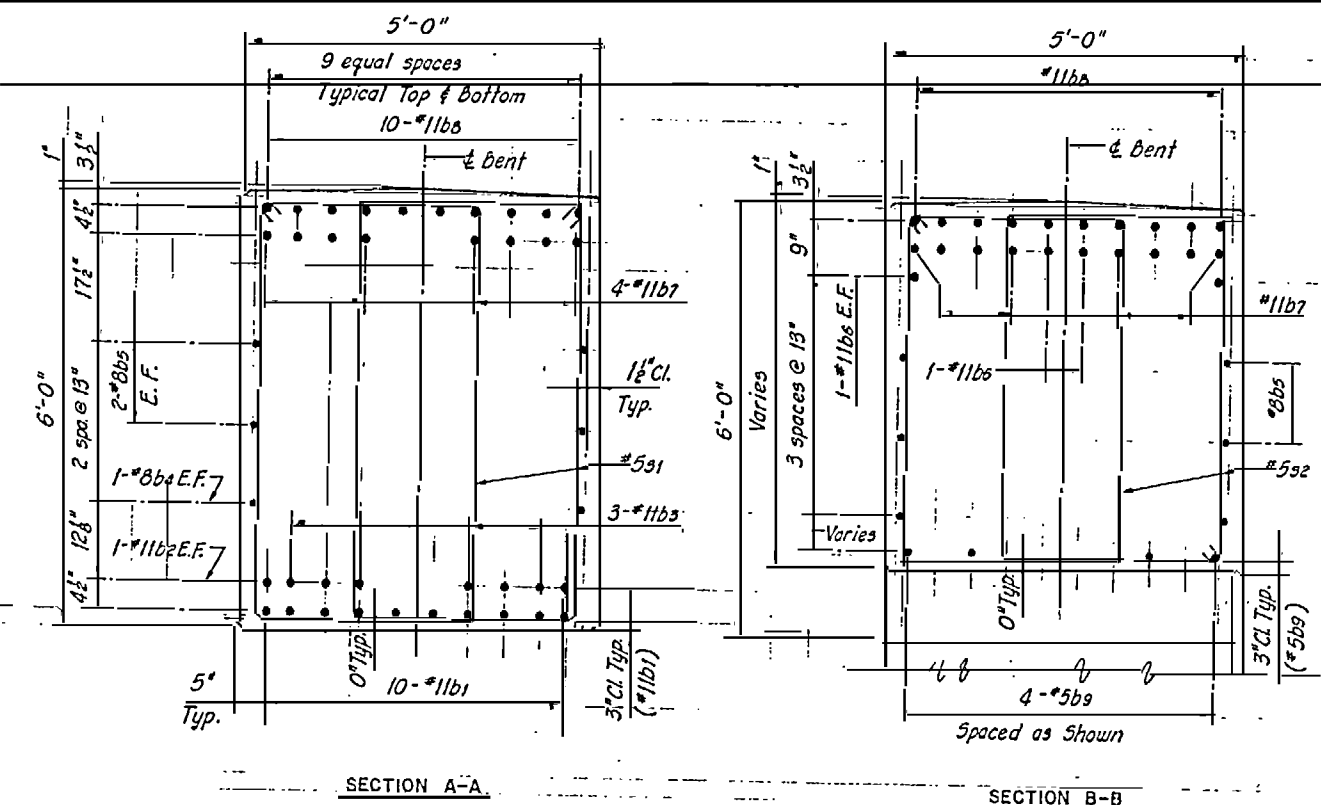


PILE REQUIREMENTS			
BENT NO.	MIN. PILE TIP ELEV.	NO. OF PILES	EST. TOTAL LENGTH
3N	-55.0	14	1125
4N	-55.0	14	1210
5N	-55.0	14	1210
3S	-55.0	14	1045*
4S	-55.0	14	1210
5S	-55.0	14	1210


* Does not include 0.5' Test Pile
See General Notes Plate No. 5-7

FOOTING PLAN
3'-1'-0"

NOTE:
Pile spacing measured at bottom of footing.

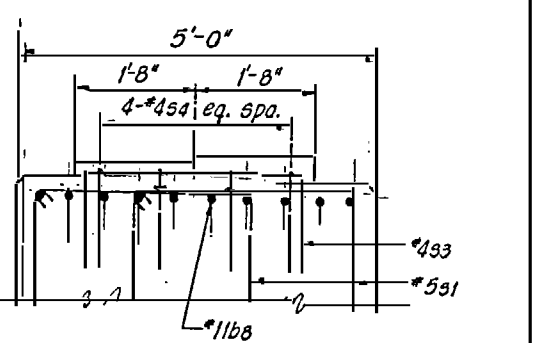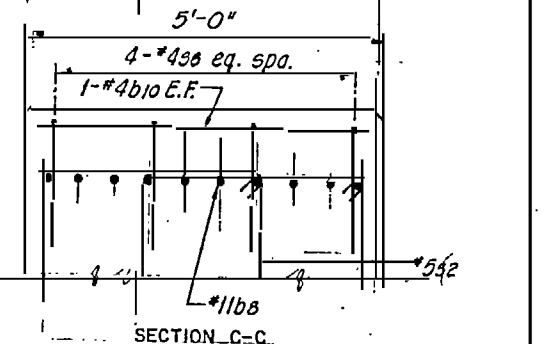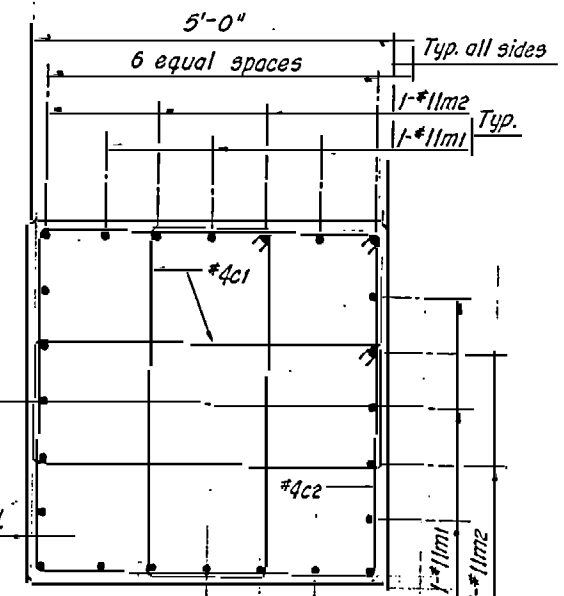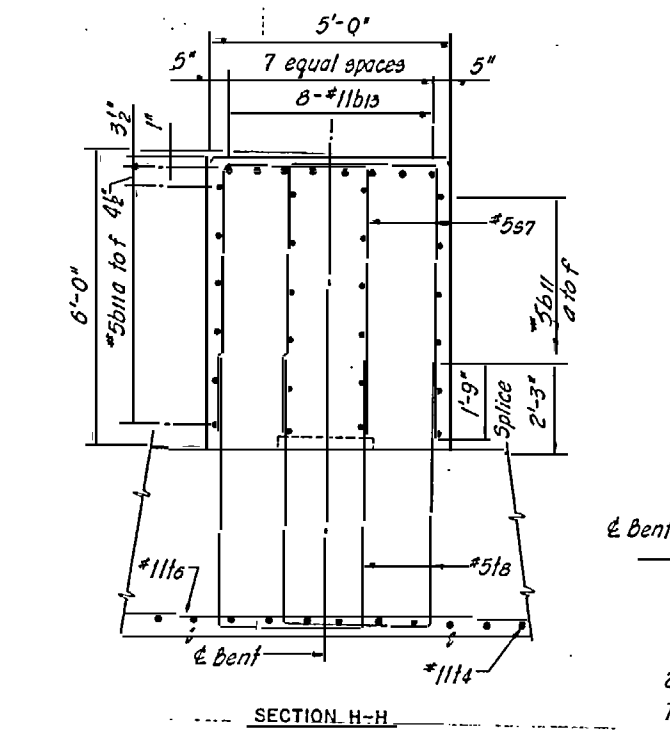

NOTE: Section D-D typical of Girders 2 thru 7 only.

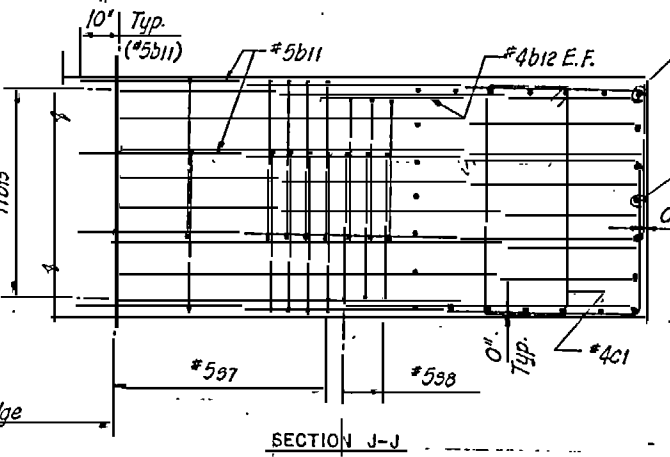

NOTE:
- See Plate No. 5-38 for Legend.


RECORD DRAWING

HNTB HOWARD NEEDLES TAMMEN & BERGENDOFF ARCHITECTS ENGINEERS PLANNERS ATLANTA, GEORGIA
U.S. ARMY ENGINEER DISTRICT, WILMINGTON CORPS OF ENGINEERS WILMINGTON NORTH CAROLINA

ATLANTIC INTRACOASTAL WATERWAY SUBSTRUCTURE BENTS 3N-5N & 3S-5S DETAILS COINJOCK BRIDGE REPLACEMENT PROJECT CURRITUCK COUNTY NORTH CAROLINA

DESIGNED BY: M.G.	CHECKED BY: MAM.	INVESTIGATION NO: DACW54-83-B-0014	SIZE: B-0014	DRAWING NUMBER: BR104-06-17	PLATE NO: S-39
PREPARED BY: [Signature]		DATE: 22 JULY 1983		SHEET 89 OF 126	


N.C. STATE AID PROJECT NO.	
FEDERAL AID PROJECT NO.	FED. RD. DIV. NO.

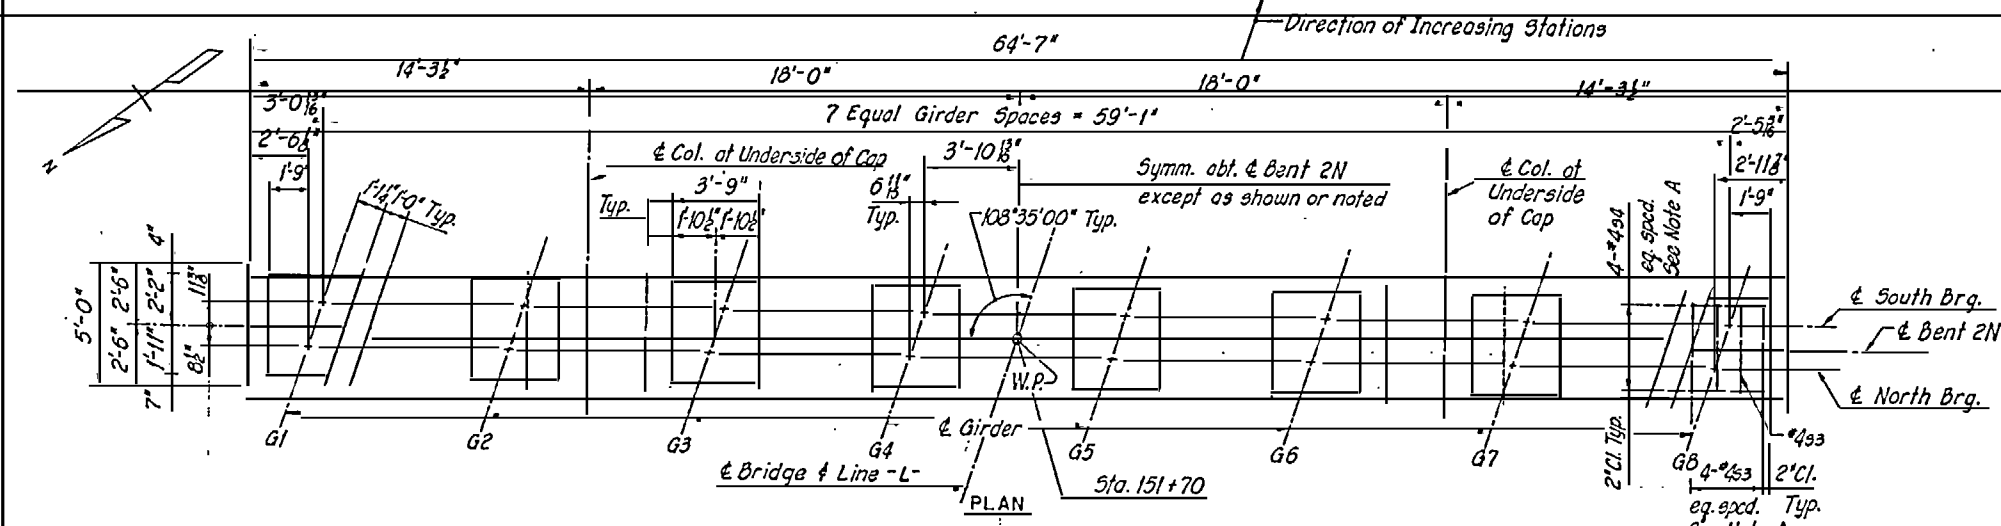

PAD ELEVATIONS									
BENT NO.	BEARING	SDR. 1	GDR. 2	GDR. 3	GDR. 4	GDR. 5	GDR. 6	GDR. 7	GDR. 8
2N	South	65.649	65.847	66.045	66.243	66.274	66.138	66.002	65.865
	North	65.827	65.826	66.025	66.223	66.254	66.119	65.983	65.846

NOTE A:
Reinforce all concrete pads as shown except at girder G1.

NOTE B:
Adjust stirrups (#5s2 v & w) inwardly as required to clear column reinforcement (#11v bars).

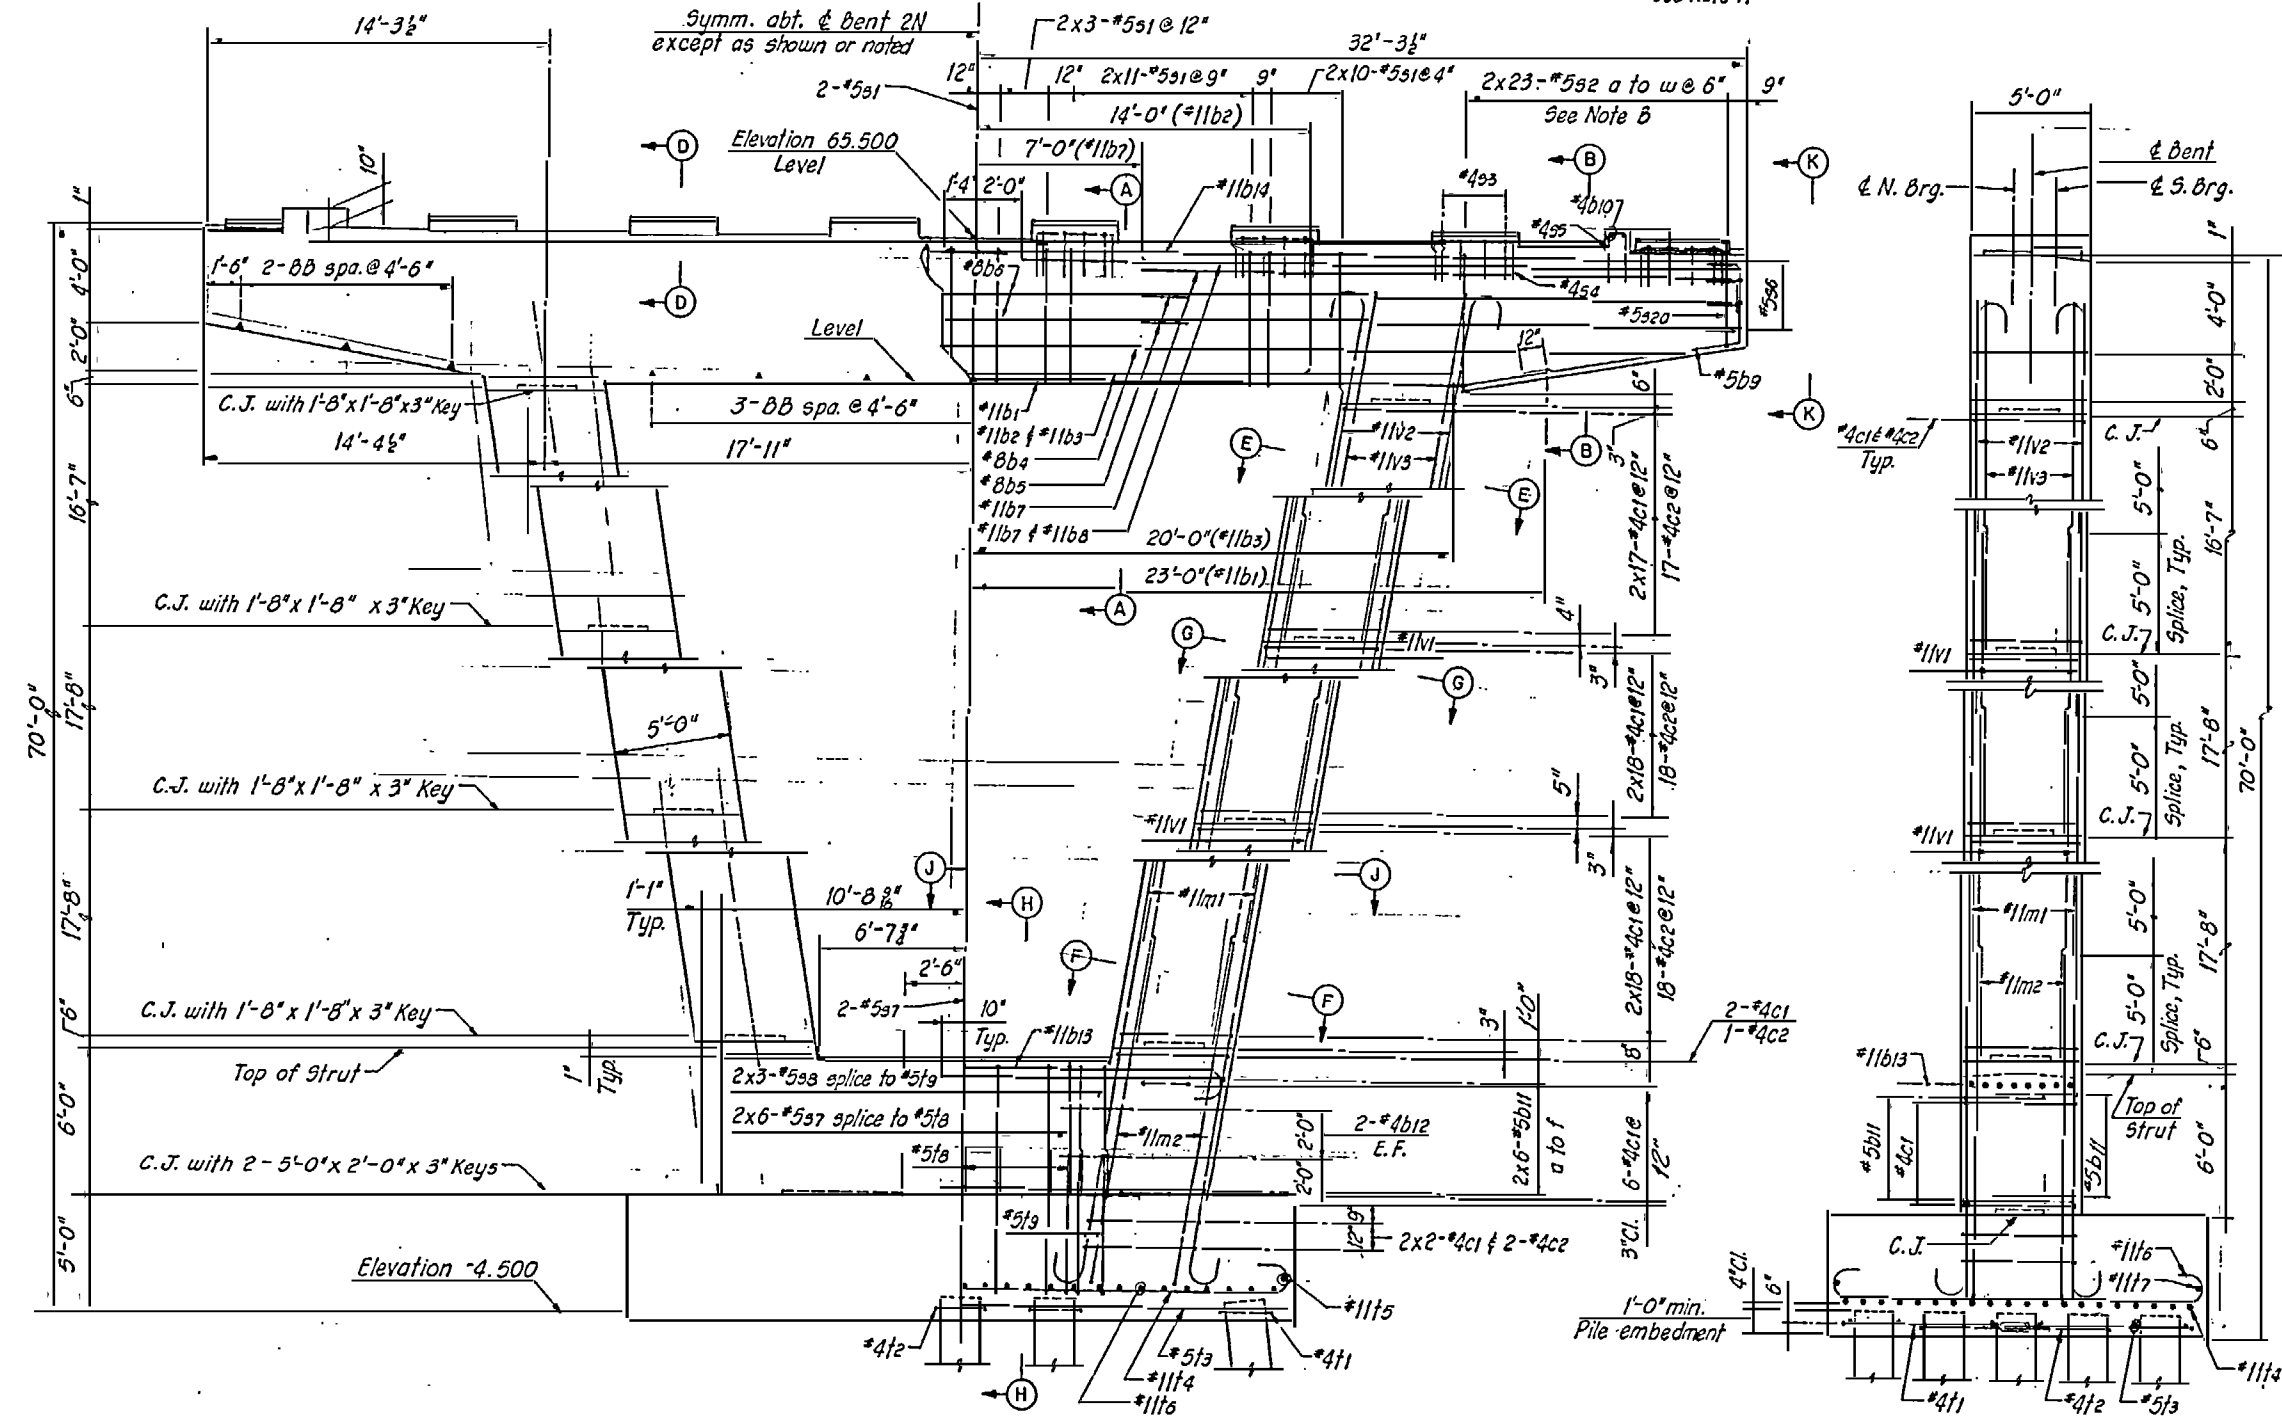

- NOTES**
1. See General Notes Plate No. 5-7.
 2. For Sections A-A thru J-J and Elevation K-K see Plate No. 5-42
 3. For Pile Details see Plate Nos. 5-47 and 5-48.
 4. For Girder and Pad Details see Plate No. 5-21
 5. For Reinforcing Bar List see Plate No. 5-64
 6. For Footing Plan see Plate No. 5-42
 7. For Bar Bending Diagrams see Plate Nos. 5-55 and 5-56.

- LEGEND**
- E.F. denotes Each Face
 - C.J. denotes Construction Joint
 - W.P. denotes Working Point
 - ▣ denotes battered pile 1 1/2 : 12 in direction of arrow.
 - denotes vertical pile
 - ▲ denotes 3" beam Bolster (BB)

RECORD DRAWING

HNTB HOWARD NEEDLES TAMMEN & BERGENDOFF ARCHITECTS ENGINEERS PLANNERS ATLANTA, GEORGIA

U.S. ARMY ENGINEER DISTRICT, WILMINGTON CORPS OF ENGINEERS WILMINGTON, NORTH CAROLINA


ATLANTIC INTRACOASTAL WATERWAY
SUBSTRUCTURE
BENT 2N

DESIGNED BY: M.G.	CHECKED BY: M.A.M.	INVIATION NO. DACW54-83-B-0014	SIZE B-0014	DRAWING NUMBER BRI04-06-17	PLATE NO. S-40
PRINCIPAL OF FIRM HNTB		DATE 22 JULY 1983	SHEET 90 OF 126		

ELEVATION
Looking in Direction of Increasing Stations

END VIEW

N.C. STATE AID PROJECT NO.	
FEDERAL AID PROJECT NO.	

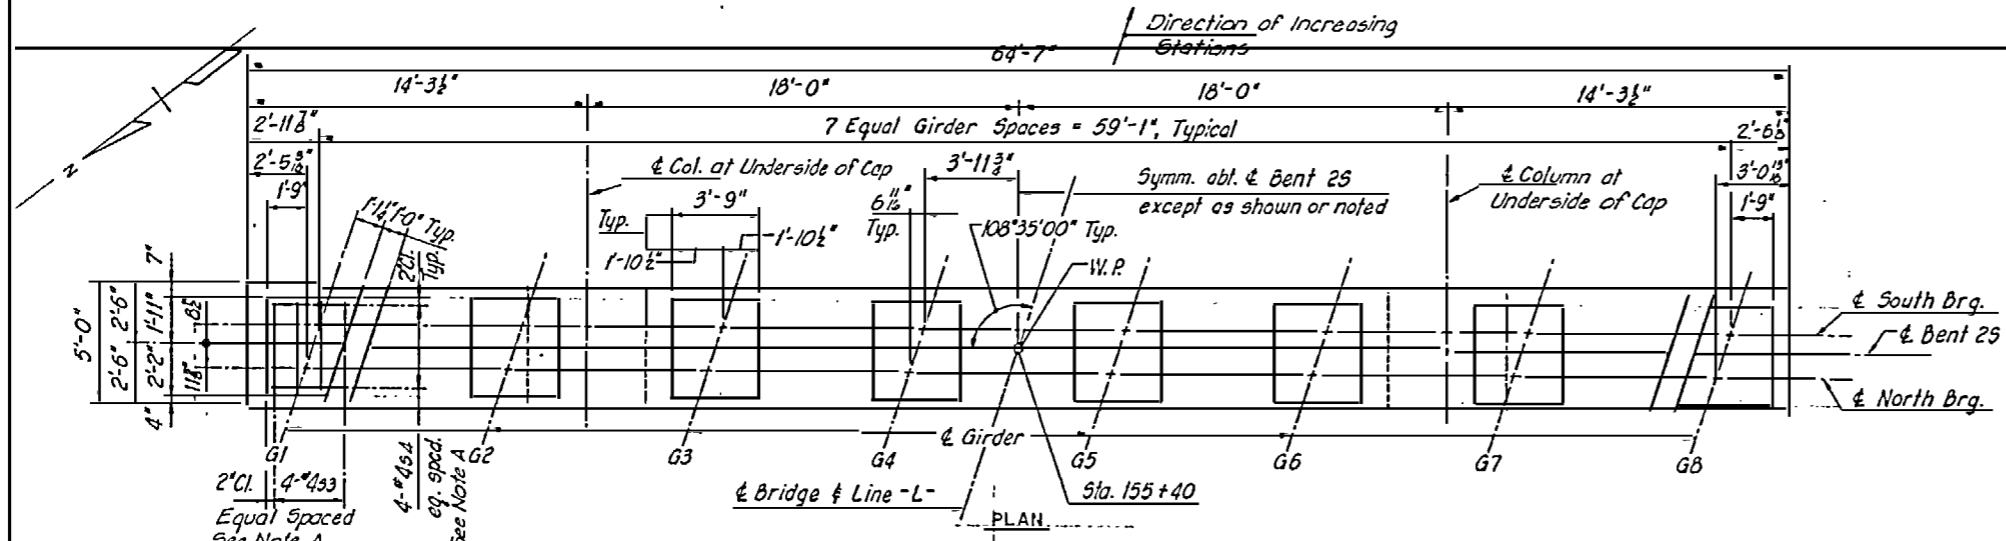


PAD ELEVATIONS									
BENT NO.	BEARING	GDR. 1	GDR. 2	GDR. 3	GDR. 4	GDR. 5	GDR. 6	GDR. 7	GDR. 8
25	North	65.865	66.002	66.138	66.274	66.243	66.046	65.847	65.649
	South	65.846	65.983	66.119	66.254	66.223	66.025	65.826	65.627

NOTE A:
Reinforce all concrete pads as shown except at girder G8.

NOTE B:
Adjust stirrups (#5s2 v #4w) inwardly as required to clear column reinforcement (#11v bars).

- NOTES**
- See General Notes Plate No. 5-7
 - For Sections A-A thru J-J and Elevation K-K see Plate No. 5-42
 - For Pile Details see Plate No. 5-41 and 5-46
 - For Girder and Pad Details see Plate No. 5-21
 - For Reinforcing Bar List see Plate No. 5-65
 - For Footing Plan see Plate No. 5-42
 - For Bar Banding Diagrams see Plate No. 5-55 and 5-56.

- LEGEND**
- E.F. denotes Each Face
 - C.J. denotes Construction Joint
 - W.P. denotes Working Point
 - denotes battered pile 1 1/2 : 12 in direction of arrow.
 - denotes vertical pile
 - denotes 3" beam bolster (BB)

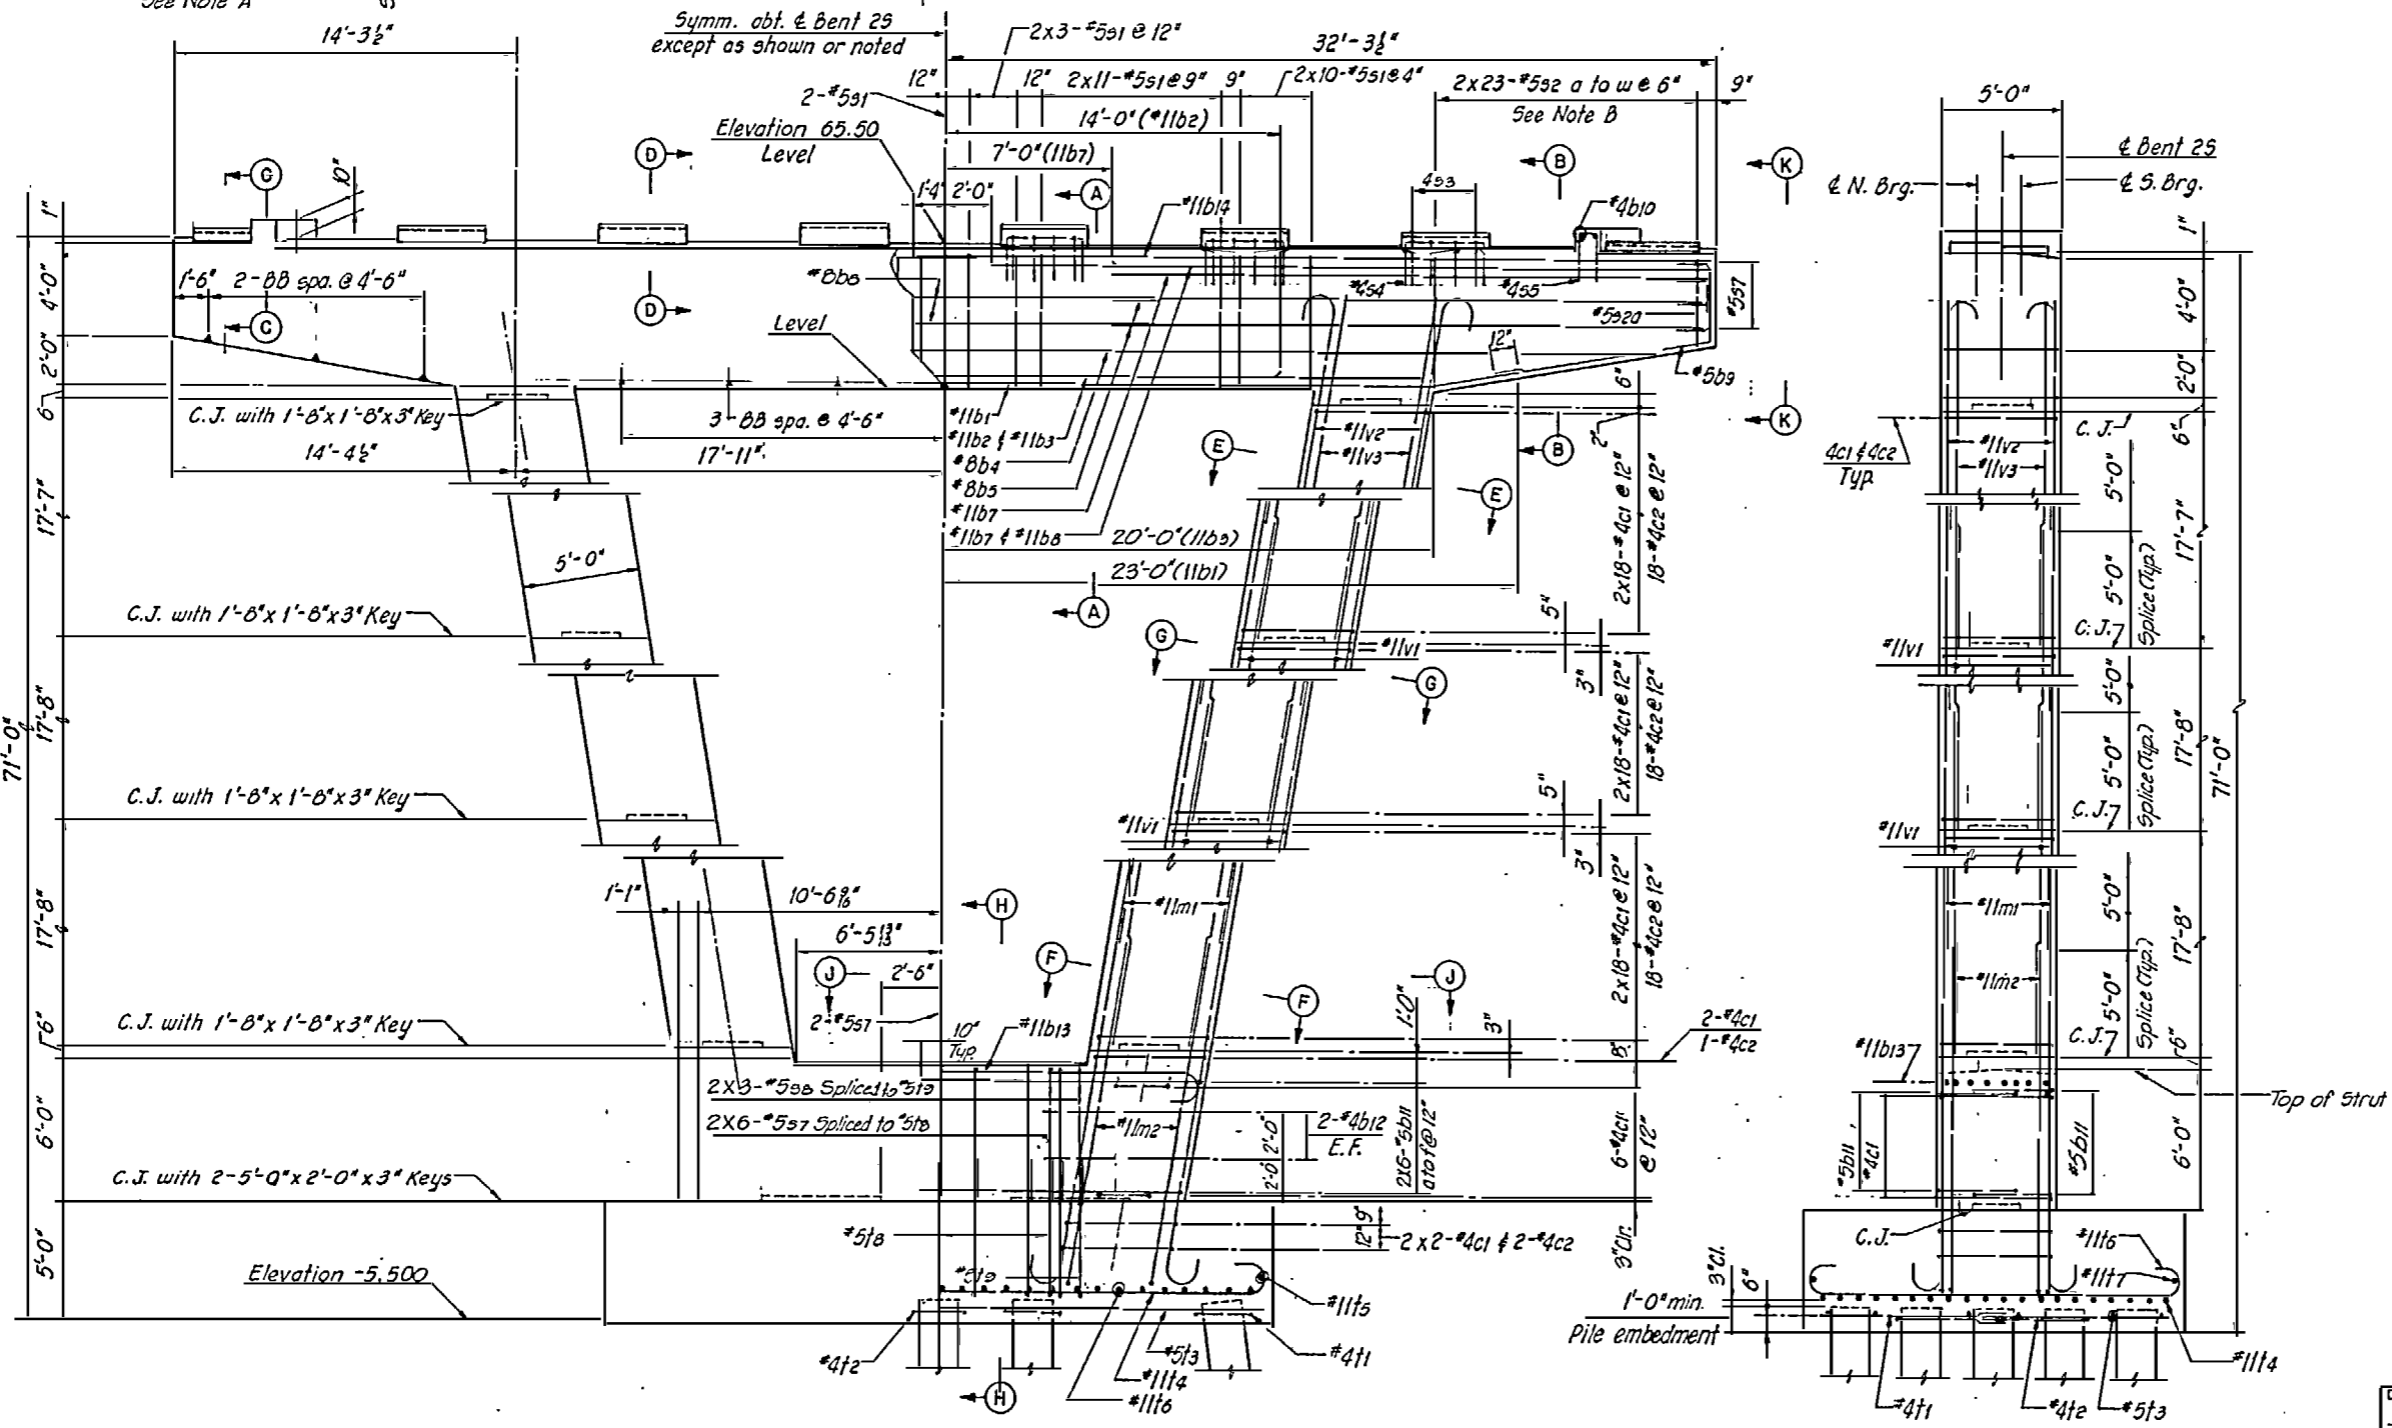


ELEVATION
Looking in Direction of Increasing Stationing


RECORD DRAWING

HNTB HOWARD NEEDLES TAMMEN & BERGENDOFF ARCHITECTS ENGINEERS PLANNERS ATLANTA, GEORGIA		U.S. ARMY ENGINEER DISTRICT, WILMINGTON CORPS OF ENGINEERS WILMINGTON, NORTH CAROLINA	
ATLANTIC INTRACOASTAL WATERWAY SUBSTRUCTURE BENT 25			
COINJOCK BRIDGE REPLACEMENT PROJECT CURRITUCK COUNTY NORTH CAROLINA			
DESIGNED BY: M.G.	CHECKED BY: M.A.M.	INVESTIGATION NO. DACW54-83-B-0014	DRAWING NUMBER BRI04-06-17
PREPARED BY: <i>[Signature]</i>		SCALE 1" = 1'-0"	DATE 22 JULY 1983
PRINCIPAL OF FIRM HNTB		SHEET 91	OF 126


NC STATE AID PROJECT NO.	FED. AID PROJECT NO.

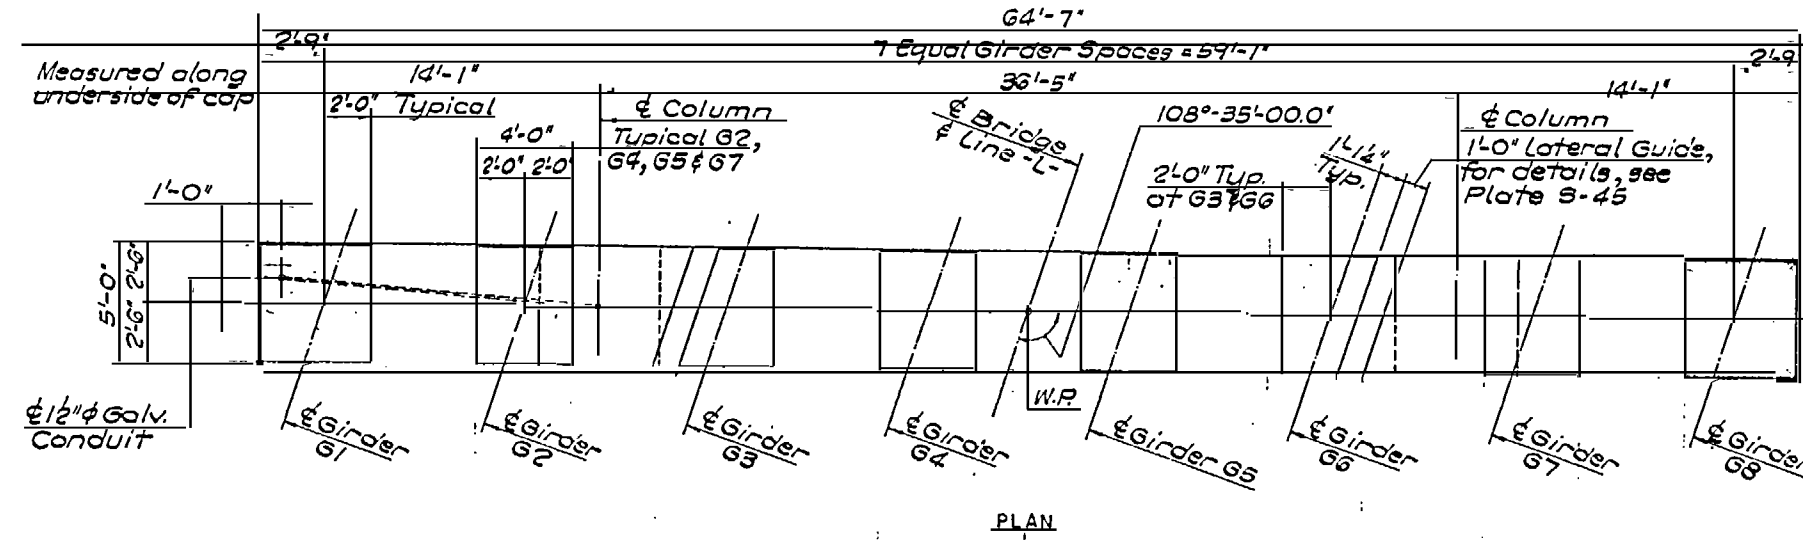

PLAN

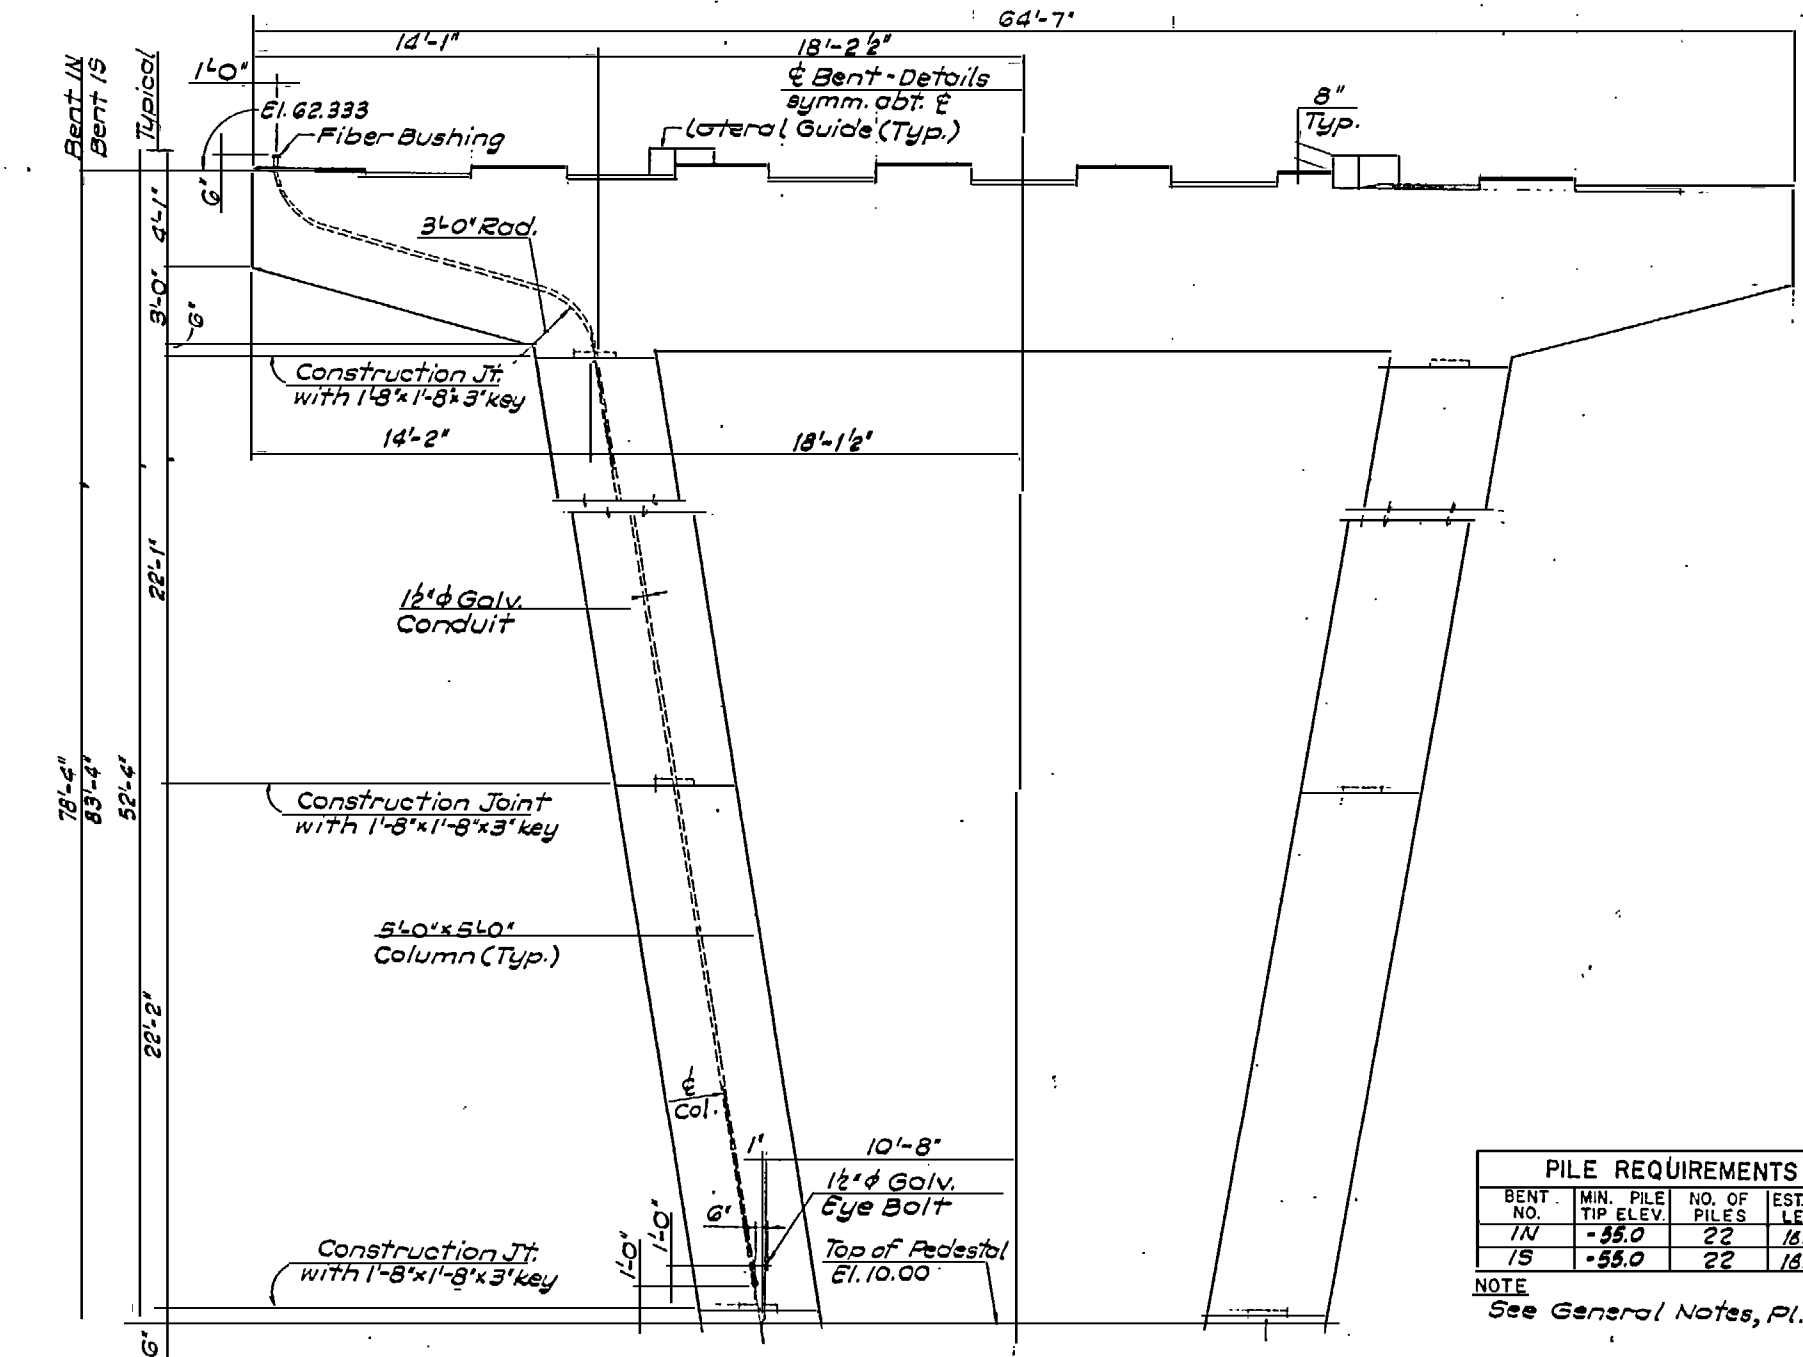

ELEVATION

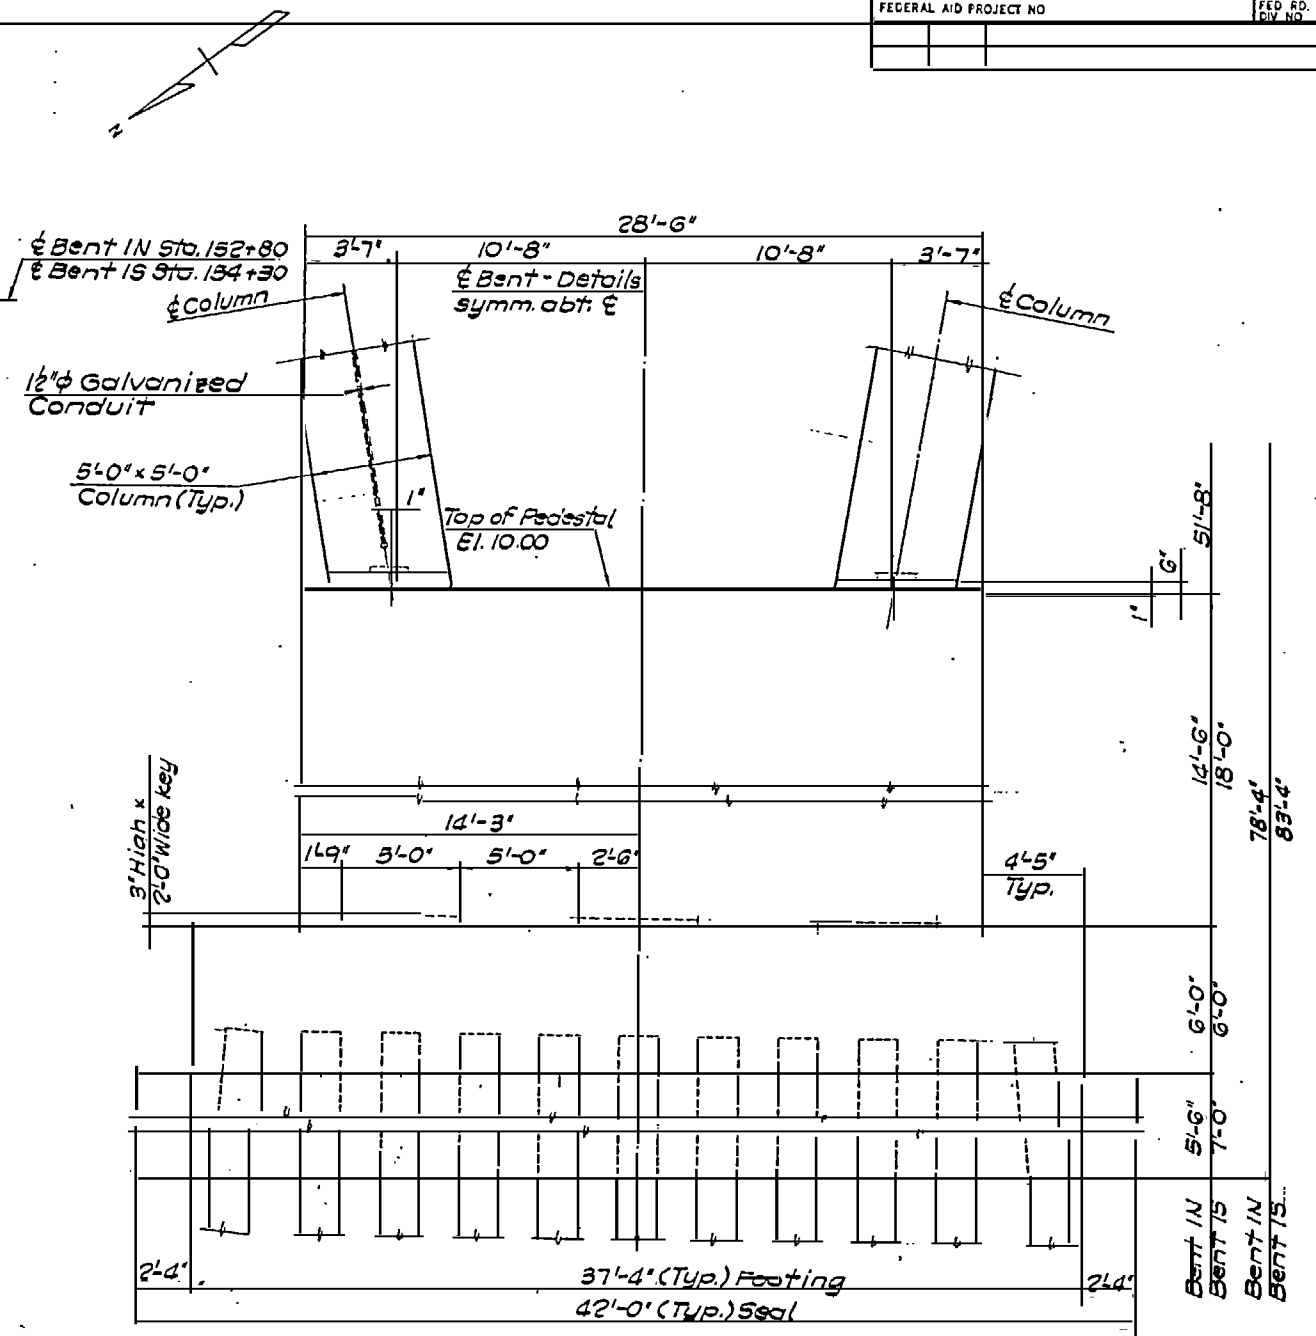

ELEVATION

NOTES
1.) For additional details, see Plates S-44 and S-45.

PAD ELEVATIONS			
BENT NO. IN		BENT NO. IS	
GIRDER NO.	ELEVATION	GIRDER NO.	ELEVATION
G1	62.428	G1	62.548
G2	62.614	G2	62.703
G3	62.799	G3	62.847
G4	62.984	G4	63.001
G5	63.001	G5	62.984
G6	62.847	G6	62.799
G7	62.703	G7	62.614
G8	62.548	G8	62.428

PILE REQUIREMENTS			
BENT NO.	MIN. PILE TIP ELEV.	NO. OF PILES	EST. TOTAL LENGTH
IN	-55.0	22	1855'
IS	-55.0	22	1855'

NOTE
See General Notes, Pl. S-7.

RECORD DRAWING

HNTB HOWARD NEEDLES TAMMEN & BERGENDOFF ARCHITECTS ENGINEERS PLANNERS ATLANTA, GEORGIA

U.S. ARMY ENGINEER DISTRICT, WILMINGTON CORPS OF ENGINEERS WILMINGTON, NORTH CAROLINA






ATLANTIC INTRACOASTAL WATERWAY

SUBSTRUCTURE BENTS IN AND IS

COINJOCK BRIDGE REPLACEMENT PROJECT CURRITUCK COUNTY NORTH CAROLINA

DESIGNED BY: N.G.	CHECKED BY: M.G.	INVESTIGATION NO. DACW54-83-8-0014	SIZE 8" x 11"	DRAWING NUMBER BR104-06-17	PLATE NO. S-43
PREPARED BY: [Signature]		SCALE: 1/4" = 1'-0"		DATE 22 JULY 1983	SHEET 93 OF 126

STATE AND PROJECT NO.	FED. NO.
FEDERAL AID PROJECT NO.	LOW NO.

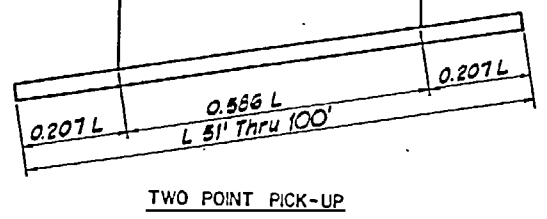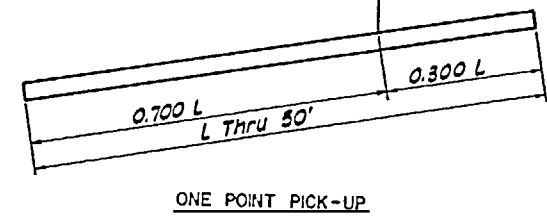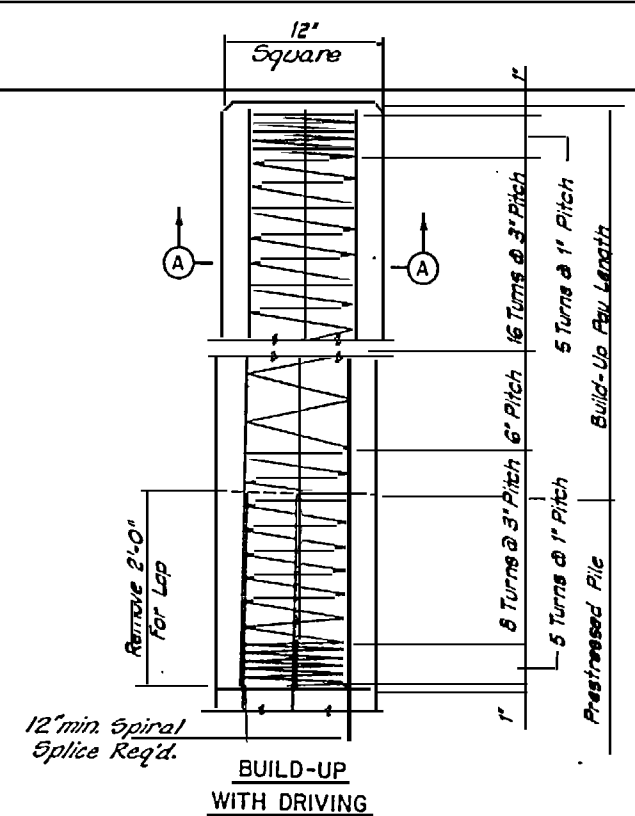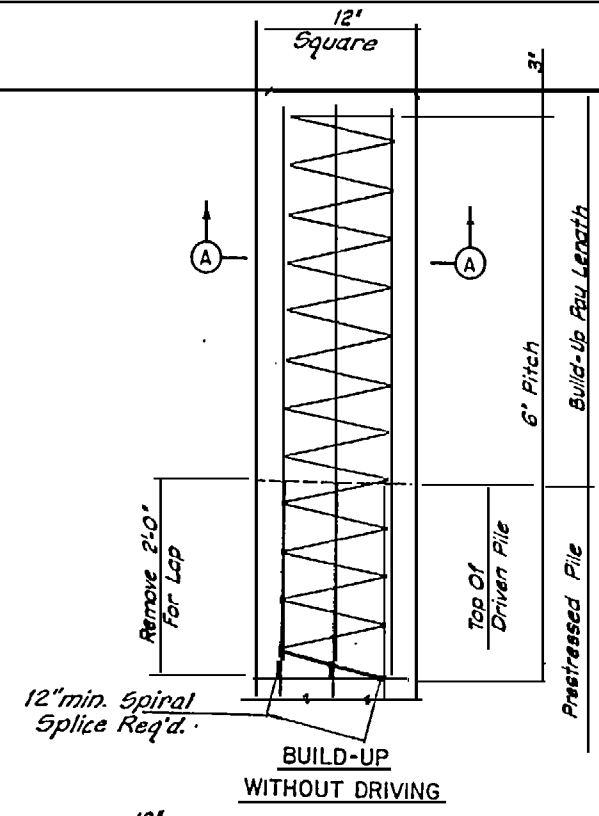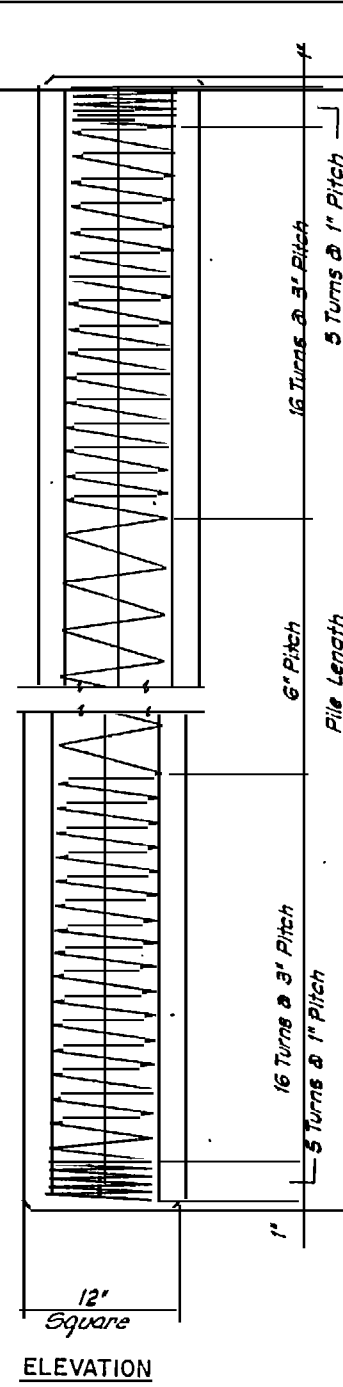

NOTES

CONCRETE DESIGN DATA: $f'_c = 5,000$ PSI; $f_c = 2,000$ PSI
 IMPACT IN HANDLING = 50%
 IN DRIVING PILES, A METHOD APPROVED BY THE ENGINEER SHALL BE USED, WHEREBY THE HEAD OF THE PILE IS NOT DAMAGED.
 DEVICES FOR LIFTING THE PILES SHALL BE APPROVED BY THE ENGINEER. LOOPS OF CABLE CAST IN THE PILES WILL NOT BE PERMITTED. INSERTS, CAST IN THE PILES TO RECEIVE THREADED EYE-BOLTS OR SIMILAR APPROVED DEVICES, MAY BE USED; OR WHERE IT IS PRACTICABLE, SATISFACTORY CLAMPS OR SLINGS MAY BE USED. WHERE PILES WILL BE EXPOSED TO VIEW IN THE STRUCTURE AND INSERTS ARE CAST IN THE PILES, THE OPENINGS SHALL BE REPAIRED AFTER THE EYE-BOLTS OR OTHER ATTACHMENTS HAVE BEEN REMOVED. THE OPENINGS SHALL BE REPAIRED IN A SATISFACTORY MANNER IN ORDER TO OBTAIN A UNIFORM APPEARANCE.

ALL PRESTRESSING STRANDS SHALL BE 7-WIRE CABLES AS PRESCRIBED IN THE SPECIFICATIONS. THE CONTRACTOR MAY, AT HIS OPTION, USE ONE OF THE THREE TYPES OF CABLES LISTED BELOW; HOWEVER, ALL CABLES IN A PILE SHALL BE OF THE SAME TYPE.




SIZE	GRADE	NO. OF CABLES	AREA	ULTIMATE STRENGTH	APPLIED PRESTRESS FORCE
5/8"	270	8	0.083 sq"	23,000# PER CABLE	16,100# PER CABLE
7/16"	270	6	0.115 sq"	31,000# PER CABLE	21,700# PER CABLE
1/2"	270	5	0.153 sq"	41,300# PER CABLE	28,900# PER CABLE

IF CABLE STRESS IS RELIEVED BY BURNING, THE CABLES SHALL BE BURNED IN PAIRS, EXCEPT WHERE 3 CABLES ARE USED THE LAST CABLE MAY BE BURNED SIMPLY, ACCORDING TO BURNING PATTERNS SHOWN. NOT MORE THAN 4 CABLES MAY BE BURNED AT ANY ONE SECTION BEFORE THE SAME CABLES ARE BURNED AT BOTH ENDS OF THE BED AND BETWEEN EACH PAIR OF PILES IN THE BED.

BUILD-UPS SHALL BE OF "CLASS A" CONCRETE WITH 20% ADDITIONAL CEMENT. NO DRIVING OF THE BUILT-UP PILE WILL BE PERMITTED UNTIL THE CONCRETE HAS REACHED A COMPRESSIVE STRENGTH OF 3,000 P.S.I. AND UNTIL A PERIOD OF SEVEN DAYS HAS ELAPSED SINCE CASTING OF THE BUILD-UP.

ALL CORNERS TO BE CHAMFERED 3/4".

WHERE CAST-IN-PLACE LIFTING DEVICES ARE NOT USED, PICK-UP POINTS TO BE INDICATED WITH A BLACK MARK 2" WIDE.

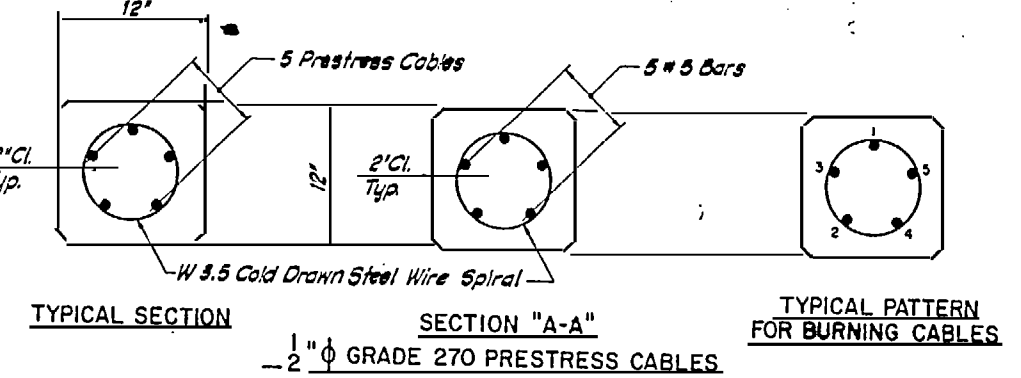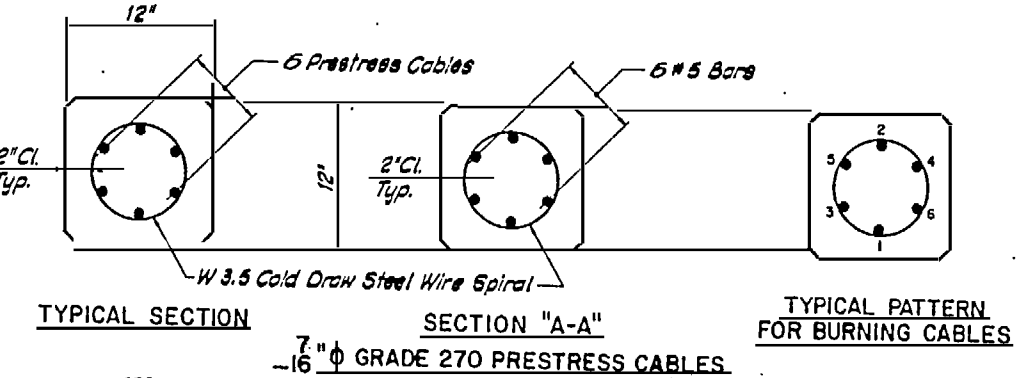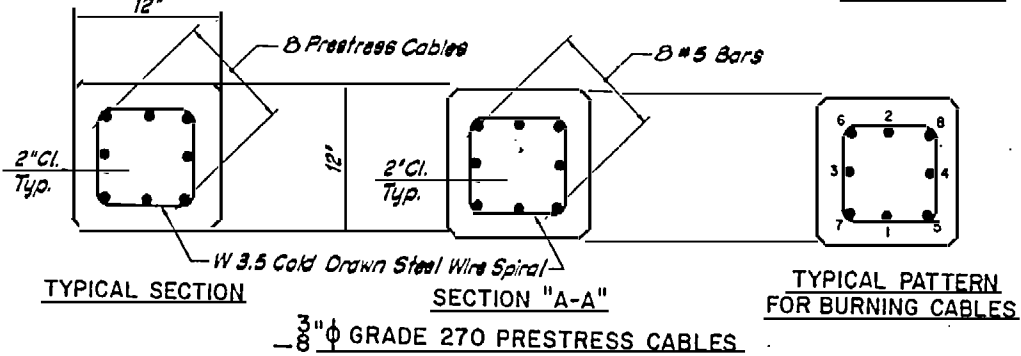

PILE SPLICES

TWO PRECAST PILE SECTIONS MAY BE SPLICED BY PROVIDING CORED OR DRILLED DOVEL HOLES ON BOTH SIDES OF THE SPLICE. THE DOVELS SHALL HAVE AN AREA EQUAL TO 1-1/2% OF THE GROSS CROSS-SECTION OF PILE AND SHALL BE ADEQUATELY BONDED INTO BOTH SECTIONS. THE DOVEL HOLES AND SPACE BETWEEN SPLICED SECTIONS SHALL BE FILLED WITH A MATERIAL HAVING PROPERTIES FULLY EQUAL TO THAT OF THE CONCRETE AND ADHESIVE STRENGTH EQUAL TO THE SHEAR AND TENSILE STRENGTH OF THE CONCRETE. SUCH PROPERTIES SHALL BE OBTAINED WITHIN A TIME LIMIT CONSISTENT WITH THE DRIVING REQUIREMENT OF THE PILE.

ANY ALTERNATE METHOD OF SPLICING PROVIDING EQUAL RESULTS MAY BE CONSIDERED FOR APPROVAL.

IF THE JOINT BETWEEN SECTIONS IS EXPOSED AND SUBJECT TO CONDITIONS WHICH WOULD CAUSE DETERIORATION, SUITABLE STEPS SATISFACTORY TO THE ENGINEER SHALL BE TAKEN TO PROTECT THE JOINT.

PILE SPLICES, IF USED, SHALL BE LOCATED WITHIN THE MIDDLE ONE-THIRD OF THE INSTALLED PILE LENGTH. NO SEPARATE PAYMENT WILL BE MADE FOR SPLICES OF SEPARATE PILE SECTIONS, BUT ALL SUCH COSTS SHALL BE INCLUDED IN THE PRICE BID FOR THE ITEM "PRESTRESSED CONCRETE PILES".

LENGTH	CONCRETE CU. YDS.	PILE WT. TONS	ONE PICK-UP POINT		TWO PICK-UP POINTS	
			0.3L	0.7L	0.207L	0.566L
25'-0"	0.51	1.05	7'-6"	17'-6"		
30'-0"	1.10	2.22	9'-0"	21'-0"		
35'-0"	1.28	2.59	10'-6"	24'-6"		
40'-0"	1.46	2.96	12'-0"	28'-0"		
45'-0"	1.64	3.33	13'-6"	31'-6"		
50'-0"	1.83	3.70	15'-0"	35'-0"		
55'-0"	2.01	4.07			11'-4"	32'-3"
60'-0"	2.19	4.44			12'-5"	35'-2"
65'-0"	2.37	4.81			13'-5"	38'-1"
70'-0"	2.56	5.18			14'-6"	41'-0"
75'-0"	2.74	5.55			15'-6"	43'-11"
80'-0"	2.92	5.92			16'-6"	46'-11"
85'-0"	3.10	6.29			17'-7"	49'-10"
90'-0"	3.29	6.66			18'-8"	52'-9"
95'-0"	3.47	7.03			19'-8"	55'-8"
100'-0"	3.65	7.40			20'-9"	58'-7"

SECOND DRAFTING

HNTB HOWARD NEEDLES TAMMEN & BERGENSOFF ARCHITECTS ENGINEERS PLANNERS ATLANTA, GEORGIA

U.S. ARMY ENGINEER DISTRICT, WILMINGTON CORPS OF ENGINEERS WILMINGTON, NORTH CAROLINA

ATLANTIC INTRACOASTAL WATERWAY PRECAST CONCRETE PILE DETAILS 12" SQUARE

COINJOCK BRIDGE REPLACEMENT PROJECT CURRITUCK COUNTY NORTH CAROLINA

DESIGNED BY: B.T.G. CHECKED BY: M.A.M.

PREPARED BY: [Signature]

PRINCIPAL OF FIRM HNTB

INVESTMENT NO. DAC WS 4-83-B-0014

SIZE: 11" x 17"

DRAWING NUMBER: BR104-06-17





SCALE: NONE

DATE: 22 JULY 1983

SHEET 96 OF 126

PLATE NO. S-46

N.C. STATE AID PROJECT NO.		FED. RD. DIST. NO.
FEDERAL AID PROJECT NO.		CONTRACT NO.

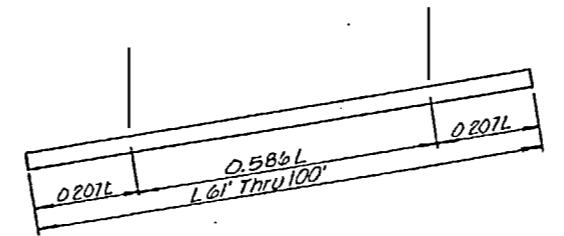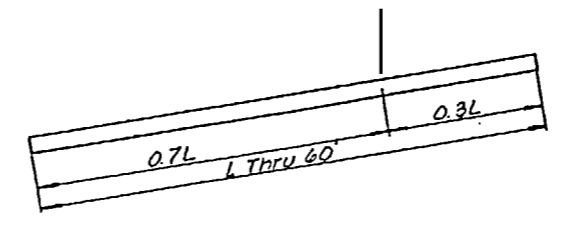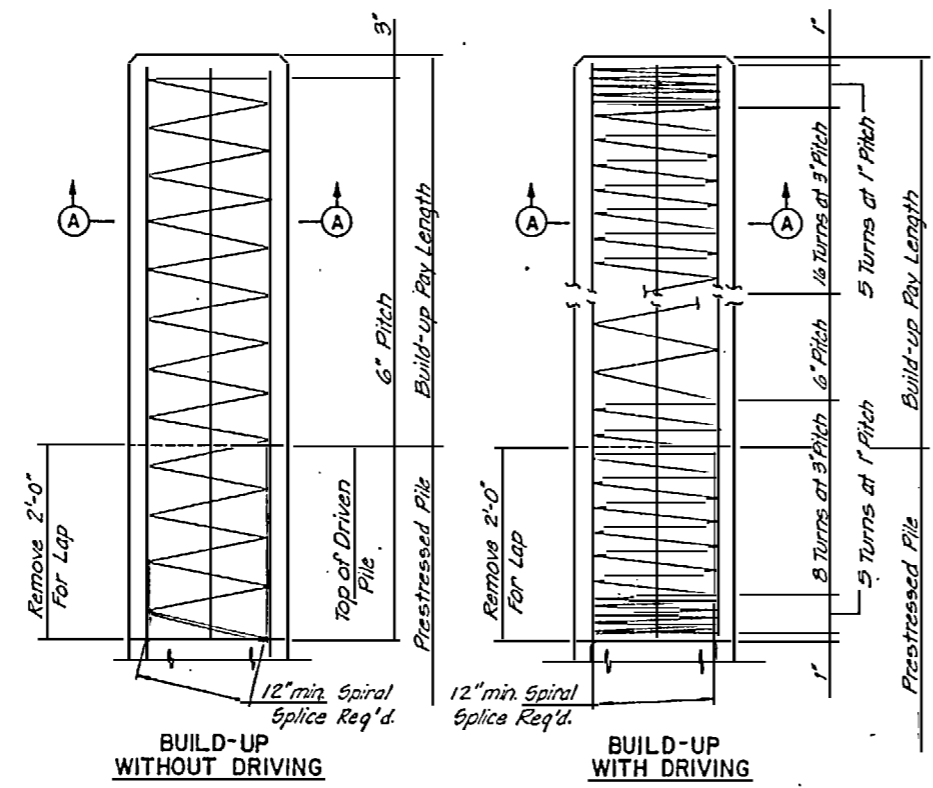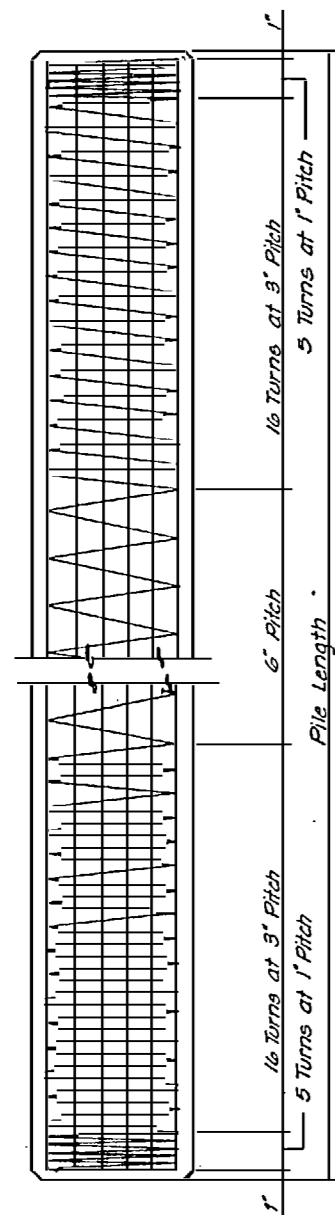

ONE POINT PICK-UP
TWO POINT PICK-UP
PICK-UP POINTS

NOTES

CONCRETE DESIGN DATA: $f'_c = 5,000$ PSI; $f'_t = 2,000$ PSI
IMPACT IN HANDLING = 50%
IN DRIVING PILES, A METHOD APPROVED BY THE ENGINEER SHALL BE USED, WHEREBY THE HEAD OF THE PILE IS NOT DAMAGED.
DEVICES FOR LIFTING THE PILES SHALL BE APPROVED BY THE ENGINEER. LOOPS OF CABLE CAST IN THE PILES WILL NOT BE PERMITTED. INSERTS, CAST IN THE PILES TO RECEIVE THREADED EYE-BOLTS OR SIMILAR APPROVED DEVICES, MAY BE USED; OR WHERE IT IS PRACTICABLE, SATISFACTORY CLAMPS OR SLINGS MAY BE USED. WHERE PILES WILL BE EXPOSED TO VIEW IN THE STRUCTURE AND INSERTS ARE CAST IN THE PILES, THE OPENINGS SHALL BE REPAIRED AFTER THE EYE-BOLTS OR OTHER ATTACHMENTS HAVE BEEN REMOVED. THE OPENINGS SHALL BE REPAIRED IN A SATISFACTORY MANNER IN ORDER TO OBTAIN A UNIFORM APPEARANCE.

ALL PRESTRESSING STRANDS SHALL BE 7-WIRE CABLES AS PRESCRIBED IN THE SPECIFICATIONS. THE CONTRACTOR MAY, AT HIS OPTION, USE ONE OF THE THREE TYPES OF CABLES LISTED BELOW; HOWEVER, ALL CABLES IN A PILE SHALL BE OF THE SAME TYPE.


SIZE	GRADE	NO. OF CABLES	AREA	ULTIMATE STRENGTH	APPLIED PRESTRESS FORCE
7/16"	250	20	0.108 sq in	27,000# PER CABLE	18,900# PER CABLE
7/16"	270	16	0.115 sq in	31,000# PER CABLE	21,700# PER CABLE
1/2"	270	12	0.153 sq in	41,300# PER CABLE	28,900# PER CABLE

CABLES SHALL BE EQUALLY SPACED AS SHOWN IN THE "TYPICAL SECTION".

THE SLIP-FORM METHOD OF CASTING PILES WILL NOT BE PERMITTED.



IF CABLE STRESS IS RELIEVED BY BURNING, THE CABLES SHALL BE BURNED IN OPPOSITE PAIRS AS INDICATED IN THE TYPICAL PATTERN SHOWN. FOR ANY NUMBER OF CABLES BURN IN OPPOSITE PAIRS AND SYMMETRICAL ABOUT BOTH VERTICAL AND HORIZONTAL AXES CABLES 1-1 SHALL BE BURNED BEFORE 2-2, ETC. NOT MORE THAN 4 CABLES, SAY 5-5 AND 6-6, MAY BE BURNED AT ANY ONE SECTION BEFORE THESE SAME PAIRS OF CABLES ARE BURNED AT BOTH ENDS OF THE BED AND BETWEEN EACH PAIR OF PILES IN THE BED.

BUILD-UPS SHALL BE OF "CLASS A" CONCRETE WITH 20% ADDITIONAL CEMENT. NO DRIVING OF THE BUILD-UP PILE WILL BE PERMITTED UNTIL THE CONCRETE HAS REACHED A COMPRESSIVE STRENGTH OF 3,000 P.S.I. AND UNTIL A PERIOD OF SEVEN DAYS HAS ELAPSED SINCE CASTING OF THE BUILD-UP.

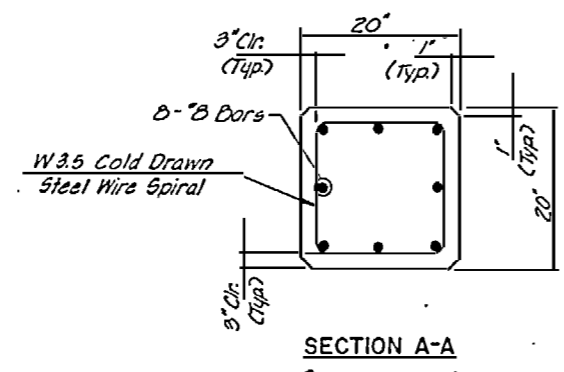

QUANTITIES FOR ONE 20" SQUARE PILE

PILE LENGTH	CONCRETE CU. YDS.	PILE WT. TONS	ONE PICK-UP POINT	TWO PICK-UP POINTS
25'-0"	2.56	5.18	7'-6"	37'-6"
30'-0"	3.07	6.22	9'-0"	45'-0"
35'-0"	3.58	7.26	10'-6"	52'-6"
40'-0"	4.09	8.29	12'-0"	60'-0"
45'-0"	4.61	9.33	13'-6"	67'-6"
50'-0"	5.12	10.36	15'-0"	75'-0"
55'-0"	5.63	11.40	16'-6"	82'-6"
60'-0"	6.14	12.44	18'-0"	90'-0"
65'-0"	6.65	13.47	19'-6"	97'-6"
70'-0"	7.17	14.51	21'-0"	105'-0"
75'-0"	7.68	15.55	22'-6"	112'-6"
80'-0"	8.19	16.58	24'-0"	120'-0"
85'-0"	8.70	17.62	25'-6"	127'-6"
90'-0"	9.21	18.66	27'-0"	135'-0"
95'-0"	9.73	19.69	28'-6"	142'-6"
100'-0"	10.24	20.72	30'-0"	150'-0"

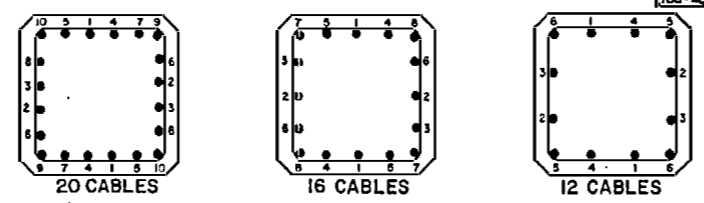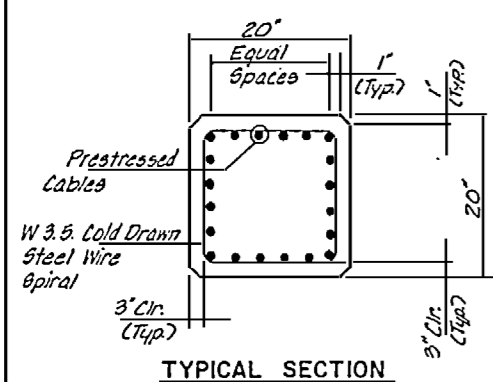

TYPICAL PATTERN FOR BURNING CABLES

PILE SPLICES

TWO PRECAST PILE SECTIONS MAY BE SPLICED BY PROVIDING CORED OR DRILLED DOWEL HOLES ON BOTH SIDES OF THE SPLICE. THE DOWELS SHALL HAVE AN AREA EQUAL TO 1-1/2% OF THE CROSS SECTION OF PILE AND SHALL BE ADEQUATELY BONDED INTO BOTH SECTIONS. THE DOWEL HOLES AND SPACE BETWEEN SPLICED SECTIONS SHALL BE FILLED WITH A MATERIAL HAVING PROPERTIES FULLY EQUAL TO THAT OF THE CONCRETE AND ADHESIVE STRENGTH EQUAL TO THE SHEAR AND TENSILE STRENGTH OF THE CONCRETE. SUCH PROPERTIES SHALL BE OBTAINED WITHIN A TIME LIMIT CONSISTENT WITH THE DRIVING REQUIREMENT OF THE PILE.

ANY ALTERNATE METHOD OF SPLICING PROVIDING EQUAL RESULTS MAY BE CONSIDERED FOR APPROVAL.
IF THE JOINT BETWEEN SECTIONS IS EXPOSED AND SUBJECT TO CONDITIONS WHICH WOULD CAUSE DETERIORATION, SUITABLE STEPS SATISFACTORY TO THE ENGINEER SHALL BE TAKEN TO PROTECT THE JOINT.

PILE SPLICES, IF USED, SHALL BE LOCATED WITHIN THE MIDDLE ONE-THIRD OF THE INSTALLED PILE LENGTH. NO SEPARATE PAYMENT WILL BE MADE FOR SPLICES OF SEPARATE PILE SECTIONS, BUT ALL SUCH COSTS SHALL BE INCLUDED IN THE PRICE BID FOR THE ITEM "PRESTRESSED CONCRETE PILES".

RECORD DRAWING


HNTB HOWARD NEEDLES TAMMEN & BERGENDOFF ARCHITECTS ENGINEERS PLANNERS ATLANTA, GEORGIA
U.S. ARMY ENGINEER DISTRICT WASHINGTON CORPS OF ENGINEERS WASHINGTON NORTH CAROLINA

ATLANTIC INTRACOASTAL WATERWAY PRECAST CONCRETE PILE DETAILS 20" SQUARE


COINJOCK BRIDGE REPLACEMENT PROJECT CURRITUCK COUNTY NORTH CAROLINA

DESIGNED BY: B.T.G.	CHECKED BY: M.A.M.	INVESTIGATION NO. DA CWS 4-83-8-0014	SCALE NONE	DATE 22 JULY 1983	SHEET 97 OF 125
PREPARED BY: [Signature]	PLATE NO. S-47	DRAWING NUMBER BR104-06-17			


NC STATE AID PROJECT NO	FED. RD DIST. NO.
FEDERAL AID PROJECT NO	FED. RD DIST. NO.

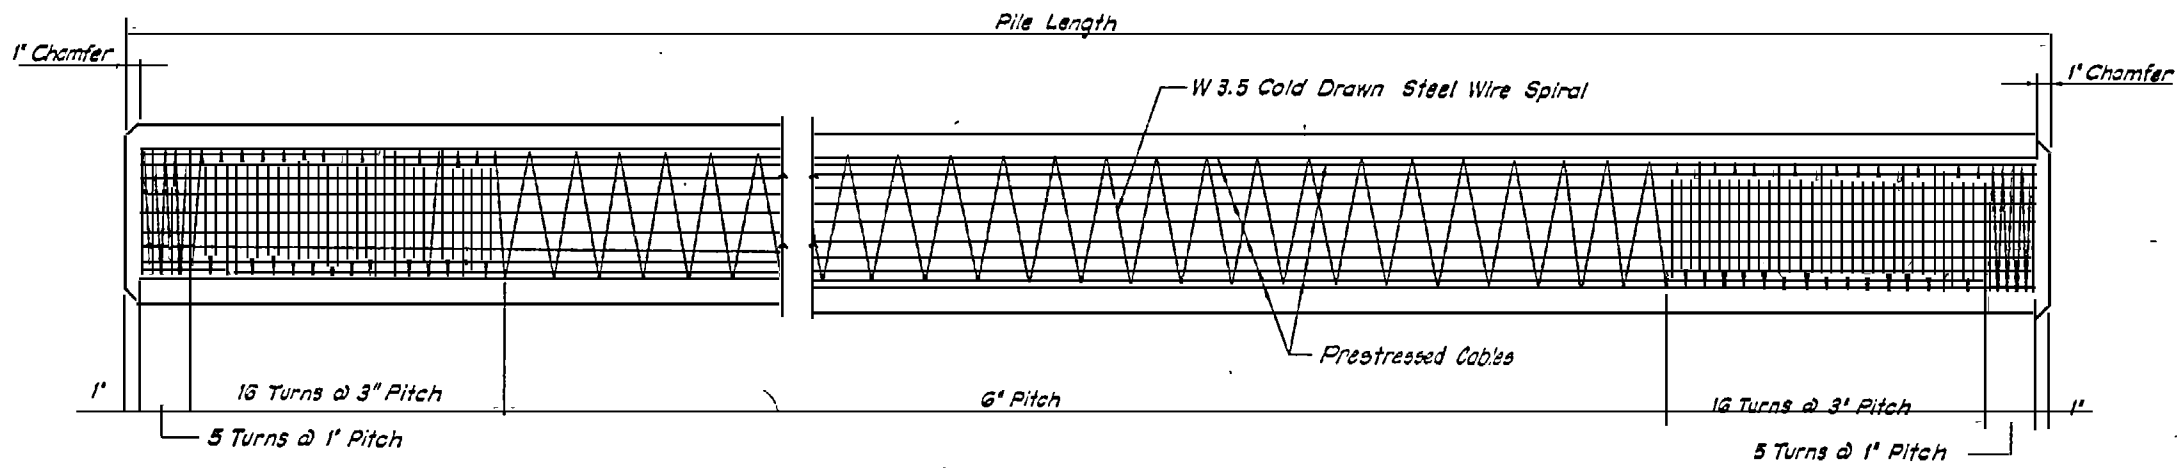

ELEVATION

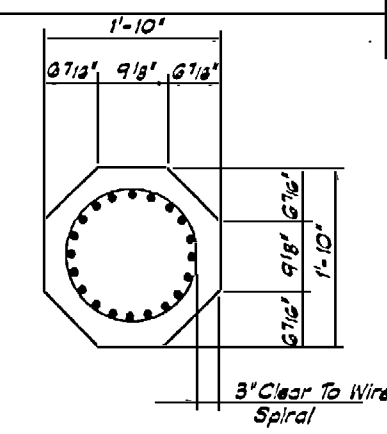

TYPICAL SECTION

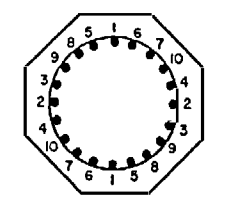

TYPICAL PATTERN FOR BURNING CABLES

PILE SPLICES

TWO PRECAST PILE SECTIONS MAY BE SPLICED BY PROVIDING CORED OR DRILLED DOWEL HOLES ON BOTH SIDES OF THE SPLICE. THE DOWELS SHALL HAVE AN AREA EQUAL TO 1-1/2% OF THE GROSS CROSS-SECTION OF PILE AND SHALL BE ADEQUATELY BONDED INTO BOTH SECTIONS. THE DOWEL HOLES AND SPACE BETWEEN SPLICED SECTIONS SHALL BE FILLED WITH A MATERIAL HAVING PROPERTIES FULLY EQUAL TO THAT OF THE CONCRETE AND ADHESIVE STRENGTH EQUAL TO THE SHEAR AND TENSILE STRENGTH OF THE CONCRETE. SUCH PROPERTIES SHALL BE OBTAINED WITHIN A TIME LIMIT CONSISTENT WITH THE DRIVING REQUIREMENT OF THE PILE.

ANY ALTERNATE METHOD OF SPLICING PROVIDING EQUAL RESULTS MAY BE CONSIDERED FOR APPROVAL.

IF THE JOINT BETWEEN SECTIONS IS EXPOSED AND SUBJECT TO CONDITIONS WHICH WOULD CAUSE DETERIORATION, SUITABLE STEPS SATISFACTORY TO THE ENGINEER SHALL BE TAKEN TO PROTECT THE JOINT.

PILE SPLICES, IF USED, SHALL BE LOCATED WITHIN THE MIDDLE ONE-THIRD OF THE INSTALLED PILE LENGTH. NO SEPARATE PAYMENT WILL BE MADE FOR SPLICES OF SEPARATE PILE SECTIONS, BUT ALL SUCH COSTS SHALL BE INCLUDED IN THE PRICE BID FOR THE ITEM "PRESTRESSED CONCRETE PILES".

IF CABLE STRESS IS RELIEVED BY BURNING, THE CABLES SHALL BE BURNED IN OPPOSITE PAIRS AS INDICATED IN THE TYPICAL PATTERN SHOWN. FOR ANY NUMBER OF CABLES BURN IN OPPOSITE PAIRS AND SYMMETRICAL ABOUT BOTH VERTICAL AND HORIZONTAL AXES, CABLES 1-1 SHALL BE BURNED BEFORE 2-2, ETC. NOT MORE THAN 4 CABLES, SAY 5-5 AND 6-6, MAY BE BURNED AT ANY ONE SECTION BEFORE THESE SAME PAIRS OF CABLES ARE BURNED AT BOTH ENDS OF THE BED AND BETWEEN EACH PAIR OF PILES IN THE BED.

NOTES

CONCRETE DESIGN DATA: $f'_c = 5,000$ PSI; $f_y = 2,000$ PSI

IMPACT IN HANDLING = 50%

IN DRIVING PILES, A METHOD APPROVED BY THE ENGINEER SHALL BE USED, WHEREBY THE HEAD OF THE PILE IS NOT DAMAGED


DEVICES FOR LIFTING THE PILES SHALL BE APPROVED BY THE ENGINEER. LOOPS OF CABLE CAST IN THE PILES WILL NOT BE PERMITTED. INSERTS, CAST IN THE PILES TO RECEIVE THREADED EYE-BOLTS OR SIMILAR APPROVED DEVICES, MAY BE USED; OR WHERE IT IS PRACTICABLE, SATISFACTORY CLAMPS OR SLINGS MAY BE USED. WHERE PILES WILL BE EXPOSED TO VIEW IN THE STRUCTURE AND INSERTS ARE CAST IN THE PILES, THE OPENINGS SHALL BE REPAIRED AFTER THE EYE-BOLTS OR OTHER ATTACHMENTS HAVE BEEN REMOVED. THE OPENINGS SHALL BE REPAIRED IN A SATISFACTORY MANNER IN ORDER TO OBTAIN A UNIFORM APPEARANCE.

ALL PRESTRESSING STRANDS SHALL BE 7-WIRE CABLES AS PRESCRIBED IN THE SPECIFICATIONS. THE CONTRACTOR MAY, AT HIS OPTION, USE ONE OF THE THREE TYPES OF CABLES LISTED BELOW; HOWEVER, ALL CABLES IN A PILE SHALL BE OF THE SAME TYPE.


SIZE	GRADE	NO. OF CABLES	AREA	ULTIMATE STRENGTH	APPLIED PRESTRESS FORCE
7/16"	250	20	0.108 sq	27,000# PER CABLE	18,900# PER CABLE
7/16"	270	16	0.115 sq	31,000# PER CABLE	21,700# PER CABLE
1/2"	270	13	0.153 sq	41,300# PER CABLE	28,900# PER CABLE

CABLES SHALL BE EQUALLY SPACED AS SHOWN IN THE "TYPICAL SECTION".


THE SLIP-FORM METHOD OF CASTING PILES WILL NOT BE PERMITTED.

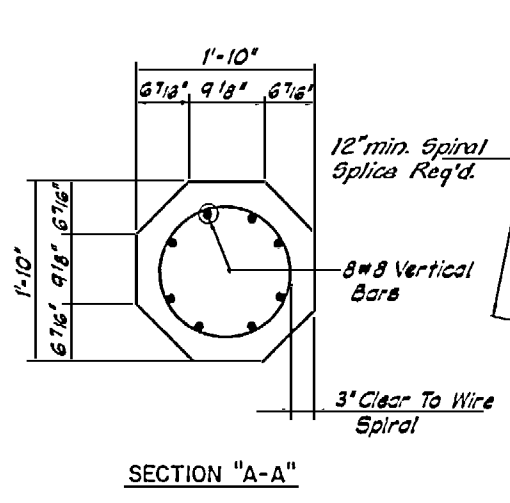

SECTION "A-A"

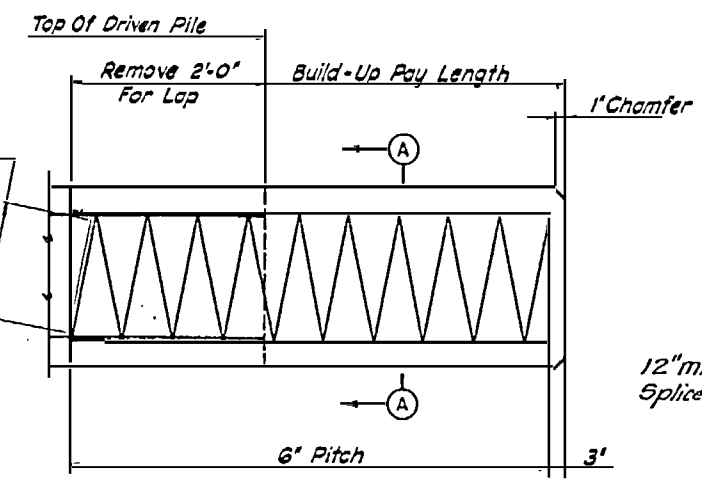


BUILD-UP WITHOUT DRIVING

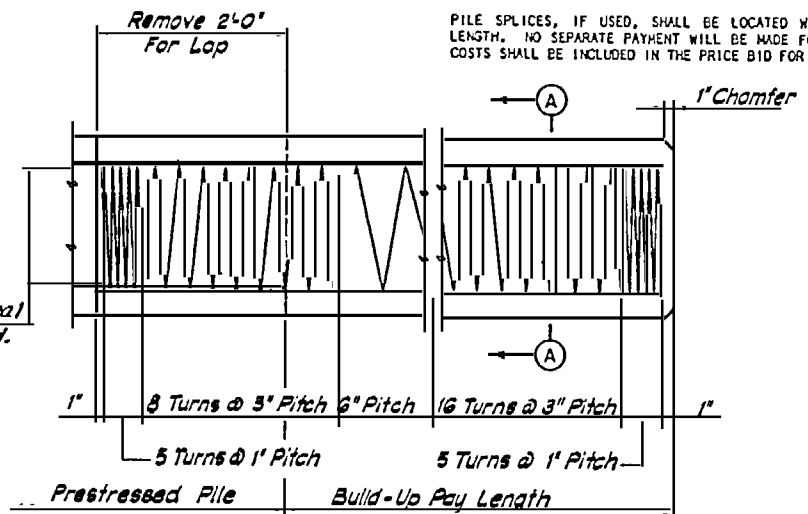


BUILD-UP WITH DRIVING

BUILD-UPS SHALL BE OF "CLASS A" CONCRETE WITH 20% ADDITIONAL CEMENT. NO DRIVING OF THE BUILT-UP PILE WILL BE PERMITTED UNTIL THE CONCRETE HAS REACHED A COMPRESSIVE STRENGTH OF 3,000 P.S.I. AND UNTIL A PERIOD OF SEVEN (7) DAYS HAS ELAPSED SINCE CASTING OF THE BUILD-UP.

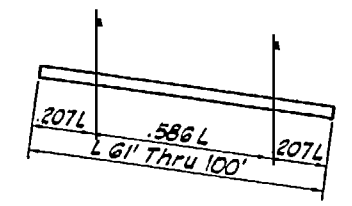

TWO POINT PICK-UP

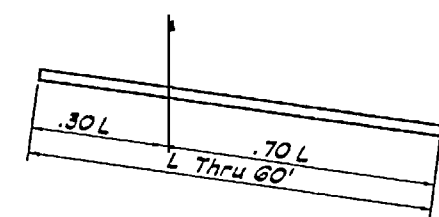

ONE POINT PICK-UP

PICK-UP POINTS


LENGTH	QUANTITIES FOR ONE 22" OCTAGONAL PILE			
	CONCRETE CU. YDS.	PILE WT. TONS	ONE PICK-UP POINT	TWO PICK-UP POINTS
25'-0"	2.58	5.22	7'-6"	17'-6"
30'-0"	3.09	6.27	9'-0"	21'-0"
35'-0"	3.61	7.31	10'-6"	24'-6"
40'-0"	4.13	8.36	12'-0"	28'-0"
45'-0"	4.64	9.40	13'-6"	31'-6"
50'-0"	5.16	10.45	15'-0"	35'-0"
55'-0"	5.67	11.49	16'-6"	38'-6"
60'-0"	6.19	12.53	18'-0"	42'-0"
65'-0"	6.71	13.58		45'-6"
70'-0"	7.22	14.62		49'-0"
75'-0"	7.74	15.67		52'-6"
80'-0"	8.25	16.71		56'-0"
85'-0"	8.77	17.76		59'-6"
90'-0"	9.27	18.81		63'-0"
95'-0"	9.80	19.85		66'-6"
100'-0"	10.32	20.89		70'-0"

HNTB HOWARD NEEDLES TAMMEN & BERGENDOFF ARCHITECTS ENGINEERS PLANNERS ATLANTA, GEORGIA


ATLANTIC INTRACOASTAL WATERWAY PRECAST CONCRETE PILE DETAILS 22" OCTAGONAL

DESIGNED BY: BTG. CHECKED BY: M.A.M. PREPARED BY: [Signature] INVIATION NO: DACW54-83-B-0014 SIZE: DRAWING NUMBER: BR104-06-17 SCALE: NONE. DATE: 22 JULY 1983 SHEET 98 OF 126


NC STATE AID PROJECT NO	FED. RD DIST. NO
FEDERAL AID PROJECT NO	BY NO

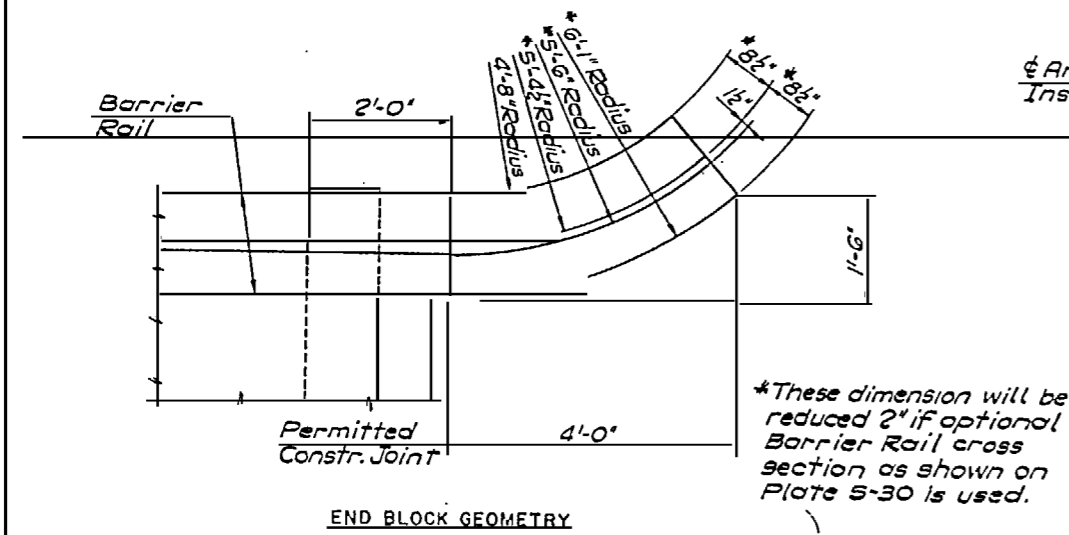


END BLOCK GEOMETRY

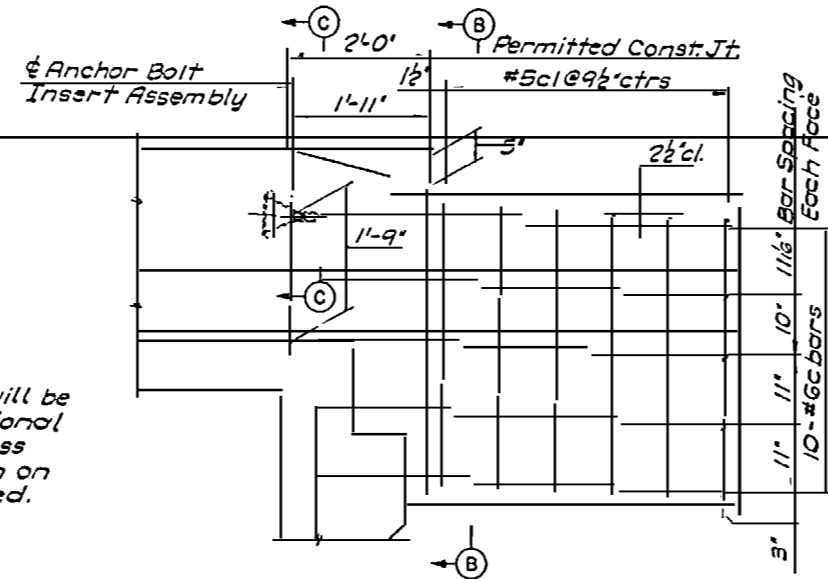

ELEVATION A-A

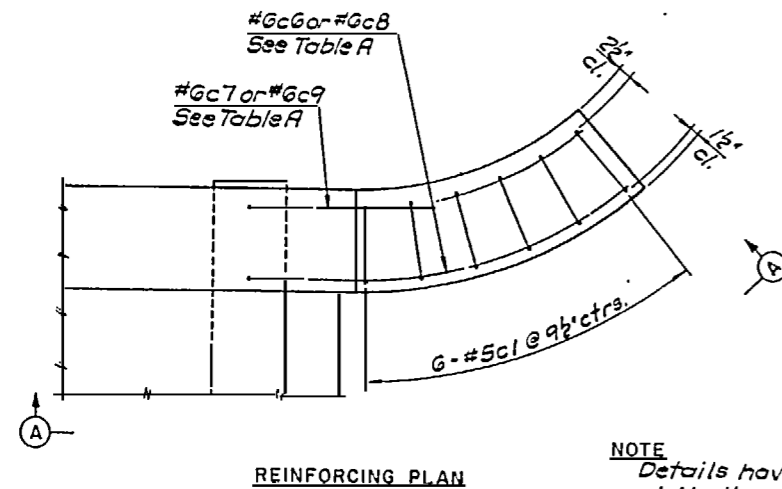

REINFORCING PLAN

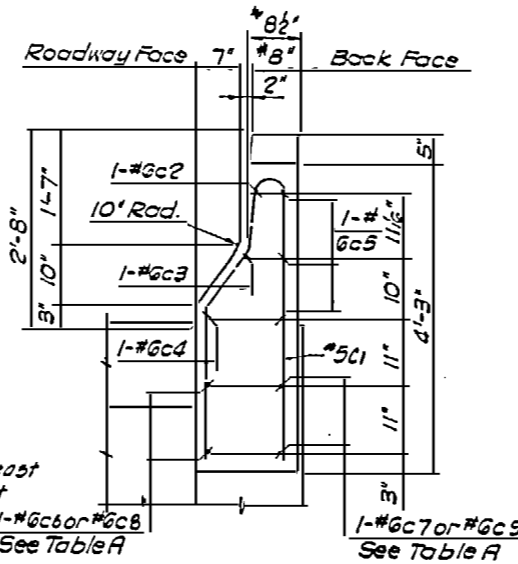


SECTION B-B


TABLE A	
END BLOCK	BAR MARK
Southeast	#Gc6 & #Gc7
Northwest	#Gc8 & #Gc7
Southwest	#Gc8 & #Gc9
Northeast	#Gc8 & #Gc9

NOTE
Details have been shown for the Southeast and Northwest End Blocks. The Southwest and Northeast are opposite hand. See 1-#Gc6a-#Gc8 Table A for differences in reinforcing. See Table A

END BLOCK DETAILS
3'-1'-0"

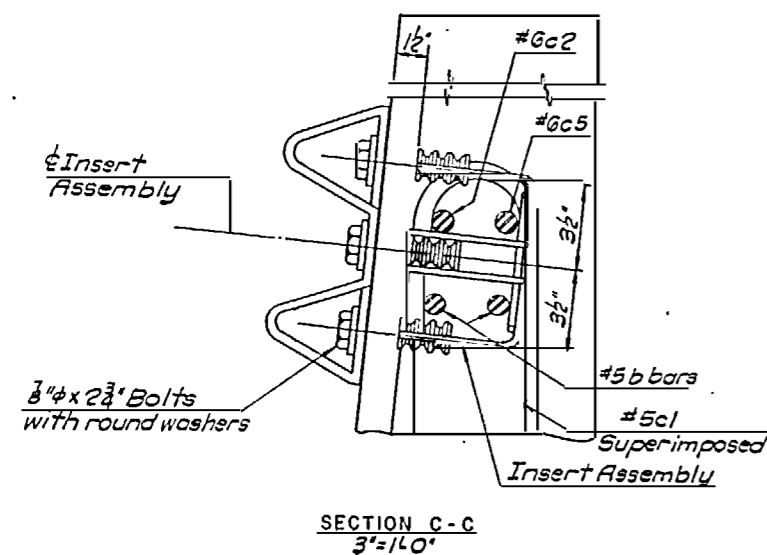

SECTION C-C
3'-1'-0"

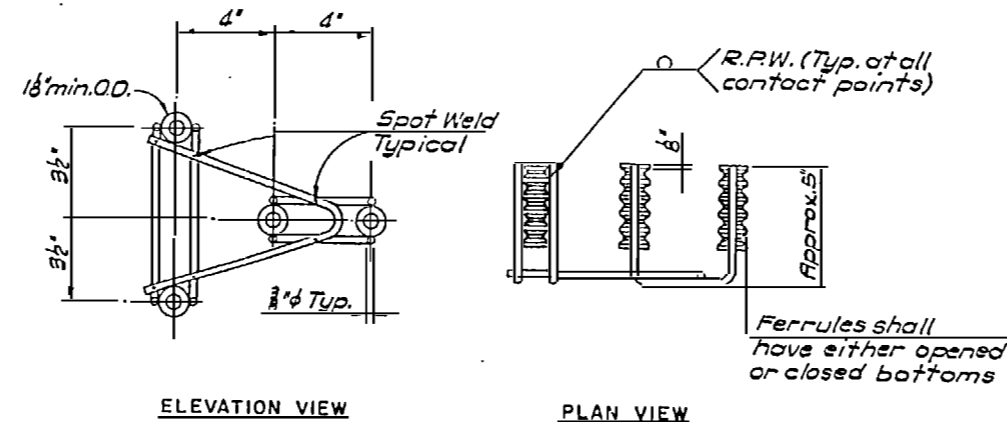

INSERT ASSEMBLY
3'-1'-0"

NOTES

- THE 4 - BOLT INSERT ASSEMBLY UNIT SHALL CONSIST OF THE FOLLOWING COMPONENTS:
 - FERRULES SHALL BE MADE FROM STEEL MEETING THE REQUIREMENTS OF A.S.T.M. A108, GRADE 12L14 AND SHALL HAVE A MINIMUM LENGTH OF THREADS OF 1 1/2".
 - 4 - 7/8"Ø x 2 3/4" BOLTS WITH WASHERS. BOLTS SHALL CONFORM TO THE REQUIREMENTS OF A.S.T.M. A307. BOLTS AND WASHERS SHALL BE GALVANIZED. (AT THE CONTRACTOR'S OPTION, STAINLESS STEEL BOLTS AND WASHERS MAY BE USED AS AN ALTERNATE FOR THE 7/8"Ø x 2 3/4" GALVANIZED BOLTS AND WASHERS. THEY SHALL CONFORM TO OR EXCEED THE MECHANICAL REQUIREMENTS OF A.S.T.M. A307. THE USE OF THIS ALTERNATE SHALL BE APPROVED BY THE ENGINEER).
 - WIRE STRUTS SHOWN IN THE INSERT ASSEMBLY DETAIL ARE MINIMUM ALLOWABLE SIZE AND SHALL HAVE A MINIMUM TENSILE STRENGTH OF 100,000 P.S.I.
- THE INSERT ASSEMBLY WITH BOLTS SHALL BE ASSEMBLED IN THE SHOP. BOLT THREADS MAY BE RECUT AS NECESSARY TO INSURE FIT.
- THE COST OF THE 4 - BOLT INSERT ASSEMBLY UNIT COMPLETE IN PLACE, SHALL BE INCLUDED IN THE UNIT CONTRACT PRICE BID FOR CONCRETE BARRIER RAIL.
- THE 4 - BOLT INSERT ASSEMBLY UNIT IS REQUIRED AT ALL POINTS WHERE APPROACH GUARDRAIL IS TO BE ATTACHED TO THE END POSTS. FOR POINTS OF ATTACHMENT, SEE PLANS.
- CURVED END BLOCKS ARE REQUIRED AT ALL END POSTS.
- THE COST OF THE FOUR CURVED END BLOCKS AND CURB BLOCK, WHEN USED, WHICH INCLUDES CLASS AA CONCRETE, REINFORCING STEEL, EXCAVATION, BACKFILL AND INCIDENTALS NECESSARY FOR THEIR CONSTRUCTION SHALL BE INCLUDED IN THE COST OF THE CONCRETE BARRIER RAIL.


RECORDED DRAWING

HNTB HOWARD NEEDLES TAMMEN & BERGENDOFF ARCHITECTS ENGINEERS PLANNERS ATLANTA, GEORGIA
U.S. ARMY ENGINEER DISTRICT WELMINGTON CORPS OF ENGINEERS WILMINGTON NORTH CAROLINA

ATLANTIC INTRACOASTAL WATERWAY
CURVED END BLOCK AND GUARDRAIL ANCHORAGES FOR BARRIER RAIL
COINJOCK BRIDGE REPLACEMENT PROJECT
CURRITUCK COUNTY NORTH CAROLINA

DESIGNED BY: J.A.L.	CHECKED BY: M.A.M.	INVIATION NO: DACW 54-83-B-0014	SIZE: B-0014	DRAWING NUMBER: BR104-06-17	PLATE NO: S-49
PRINCIPAL OF FIRM HNTB		SCALE AS NOTED	DATE: 22 JULY 1993	SHEET 99 OF 126	

N.C. STATE AID PROJECT NO.		FED. RD. DIST. NO.
FEDERAL AID PROJECT NO.		CONTRACT NO.

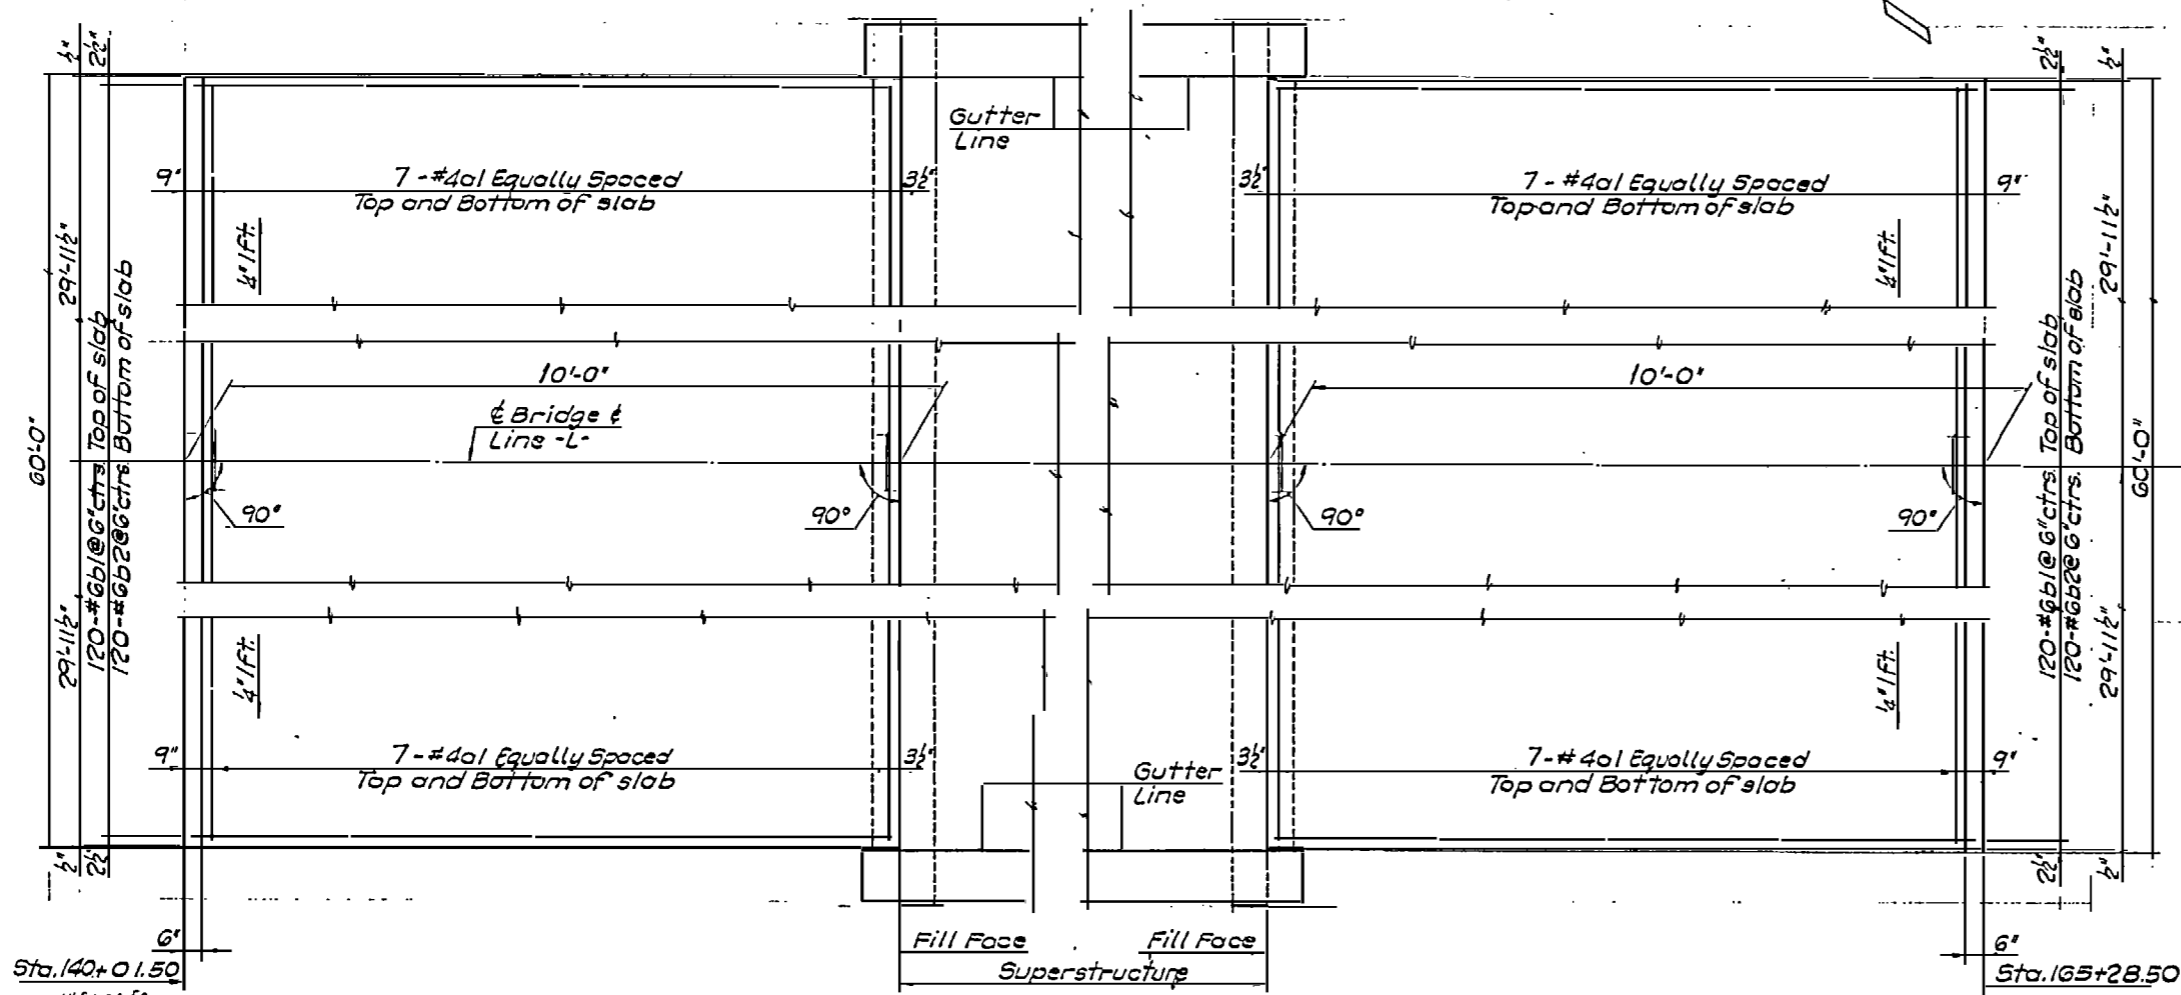


NORTH SLAB
SOUTH SLAB
APPROACH SLAB PLANS
N.T.S.


NOTE (QUANTITIES)
Approximate quantities shown are for two complete Approach Slabs and are given for the convenience of the bidder. Payment for Approach Slabs shall be made for under lump sum item Bridge Approach Slabs.

ITEM	UNIT	QUANTITY
REINFORCING STEEL	Lbs.	7900
CLASS AA CONCRETE	Cu.-Yds.	37.5


- NOTES**
- 1) The Contractor, at his option, may use 4" Bituminous Concrete Base Course, Type HB in lieu of 6" Aggregate Base Course. Any additional cost due to use of the option will be paid for by the Contractor.
 - 2) For preformed Compression Joint Seal, see Technical Provisions.
 - 3) Preformed Compression Joint Seal shall be paid for at the contract Lump Sum price bid.
 - 4) Opening shown is based on a nominal uncompressed seal width of 2".
 - 5) The installed compression seal shall be watertight.
 - 6) Provide watertight seal at end of compression seal as recommended by Manufacturer.
 - 7) Compression seal extends from gutter to gutter along bridge deck notch.

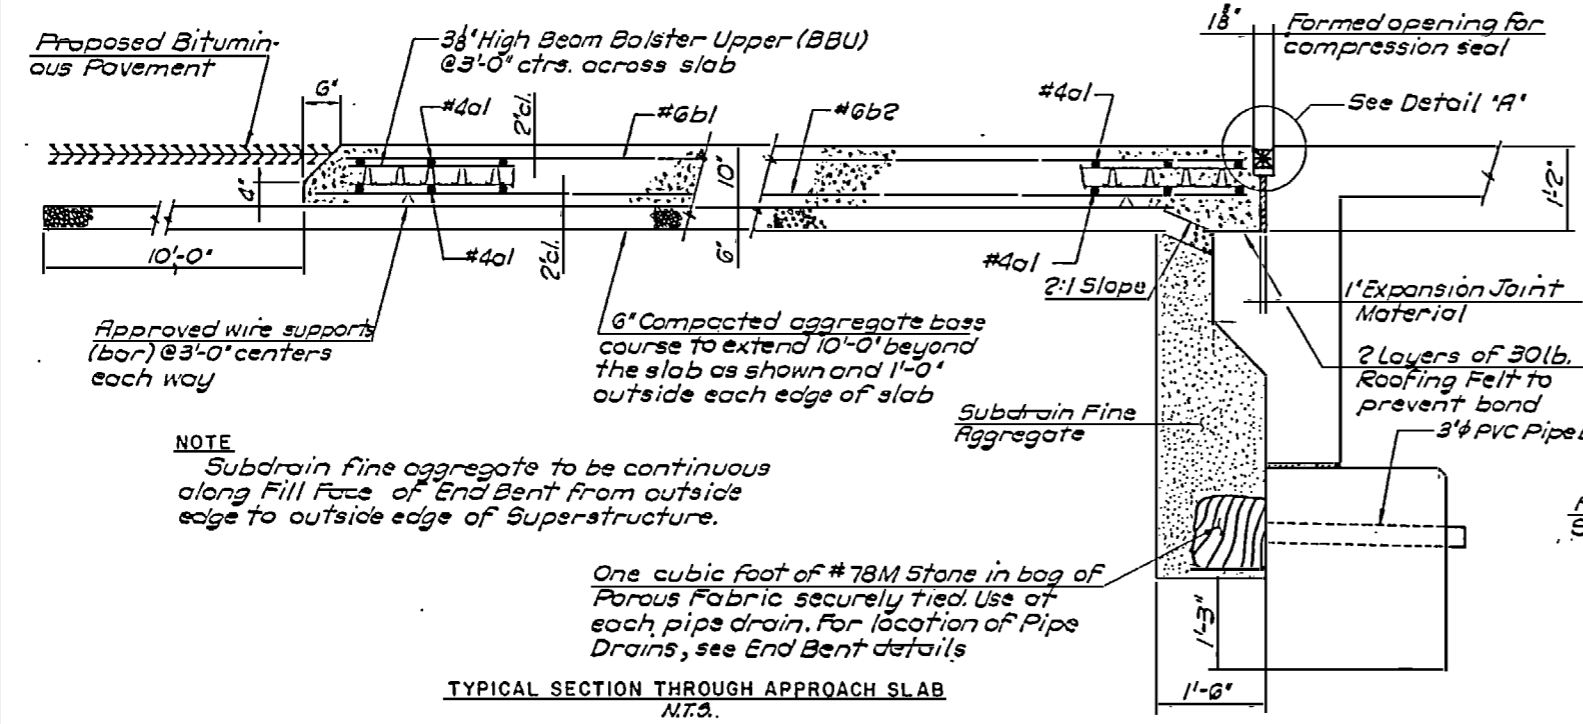

TYPICAL SECTION THROUGH APPROACH SLAB
N.T.S.

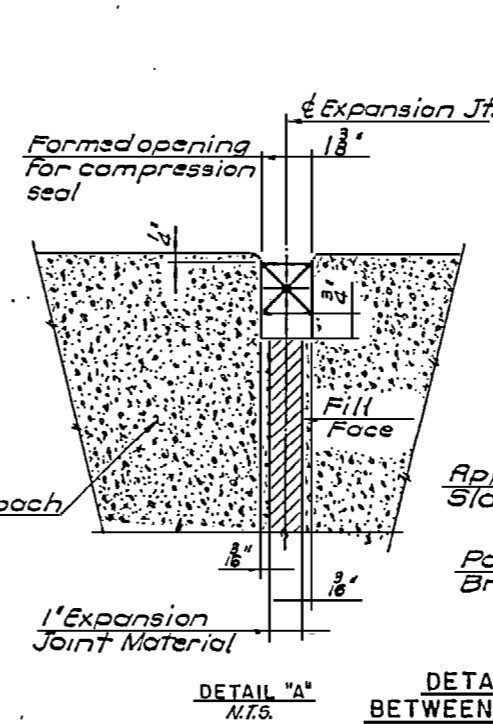

DETAIL "A"
N.T.S.

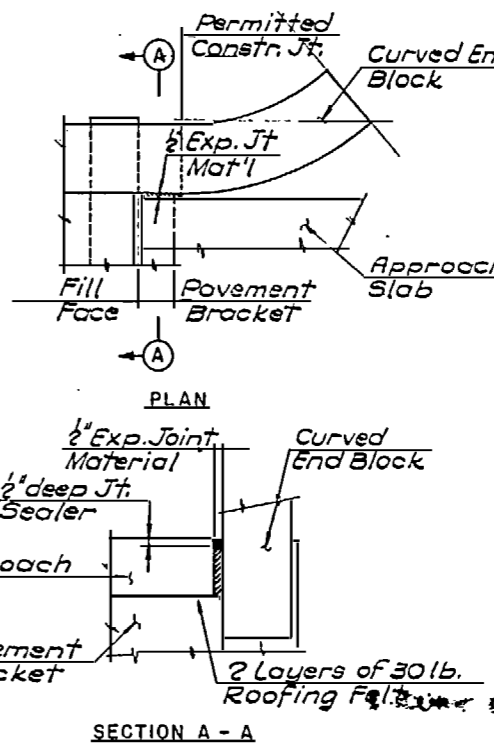

DETAIL OF EXPANSION JOINT MATERIAL BETWEEN APPROACH SLAB & CURVED END BLOCK
N.T.S.

NOTE
Subdrain fine aggregate to be continuous along Fill Face of End Bent from outside edge to outside edge of Superstructure.

One cubic foot of #78M Stone in bag of Porous Fabric securely tied. Use at each pipe drain. For location of Pipe Drains, see End Bent details.

RECORD DRAWING

DESIGNED BY:	CHECKED BY:
JAL.	MAM.
PREPARED BY:	
HNTB	


HNTB HOWARD NEEDLES TAMMEN & BERGENDOFF ARCHITECTS ENGINEERS PLANNERS ATLANTA, GEORGIA

ATLANTIC INTRACOASTAL WATERWAY SUBSTRUCTURE	
COINJOCK BRIDGE REPLACEMENT PROJECT	
INVESTIGATION NO. DACW 54-83-B-0014	DRAWING NUMBER BR104-06-17
PLATE NO. S-50	
SCALE AS NOTED DATE 22 JULY 1983 SHEET 100 OF 126	

N.C. STATE AID PROJECT NO.		FED. AID DIV. NO.
FEDERAL AID PROJECT NO.		


LEGEND

- ⊛ 180° Red Fender Light See Section A-A, Plate 5-52
- ⊙ 4-6" Dia. Red Reflector, See Special Provisions
- PVC-NEMA 4 Junction Box With 1/4" Strain Relief Connectors, Hubbell Type 6081 or Equal. (see plate 5-53)

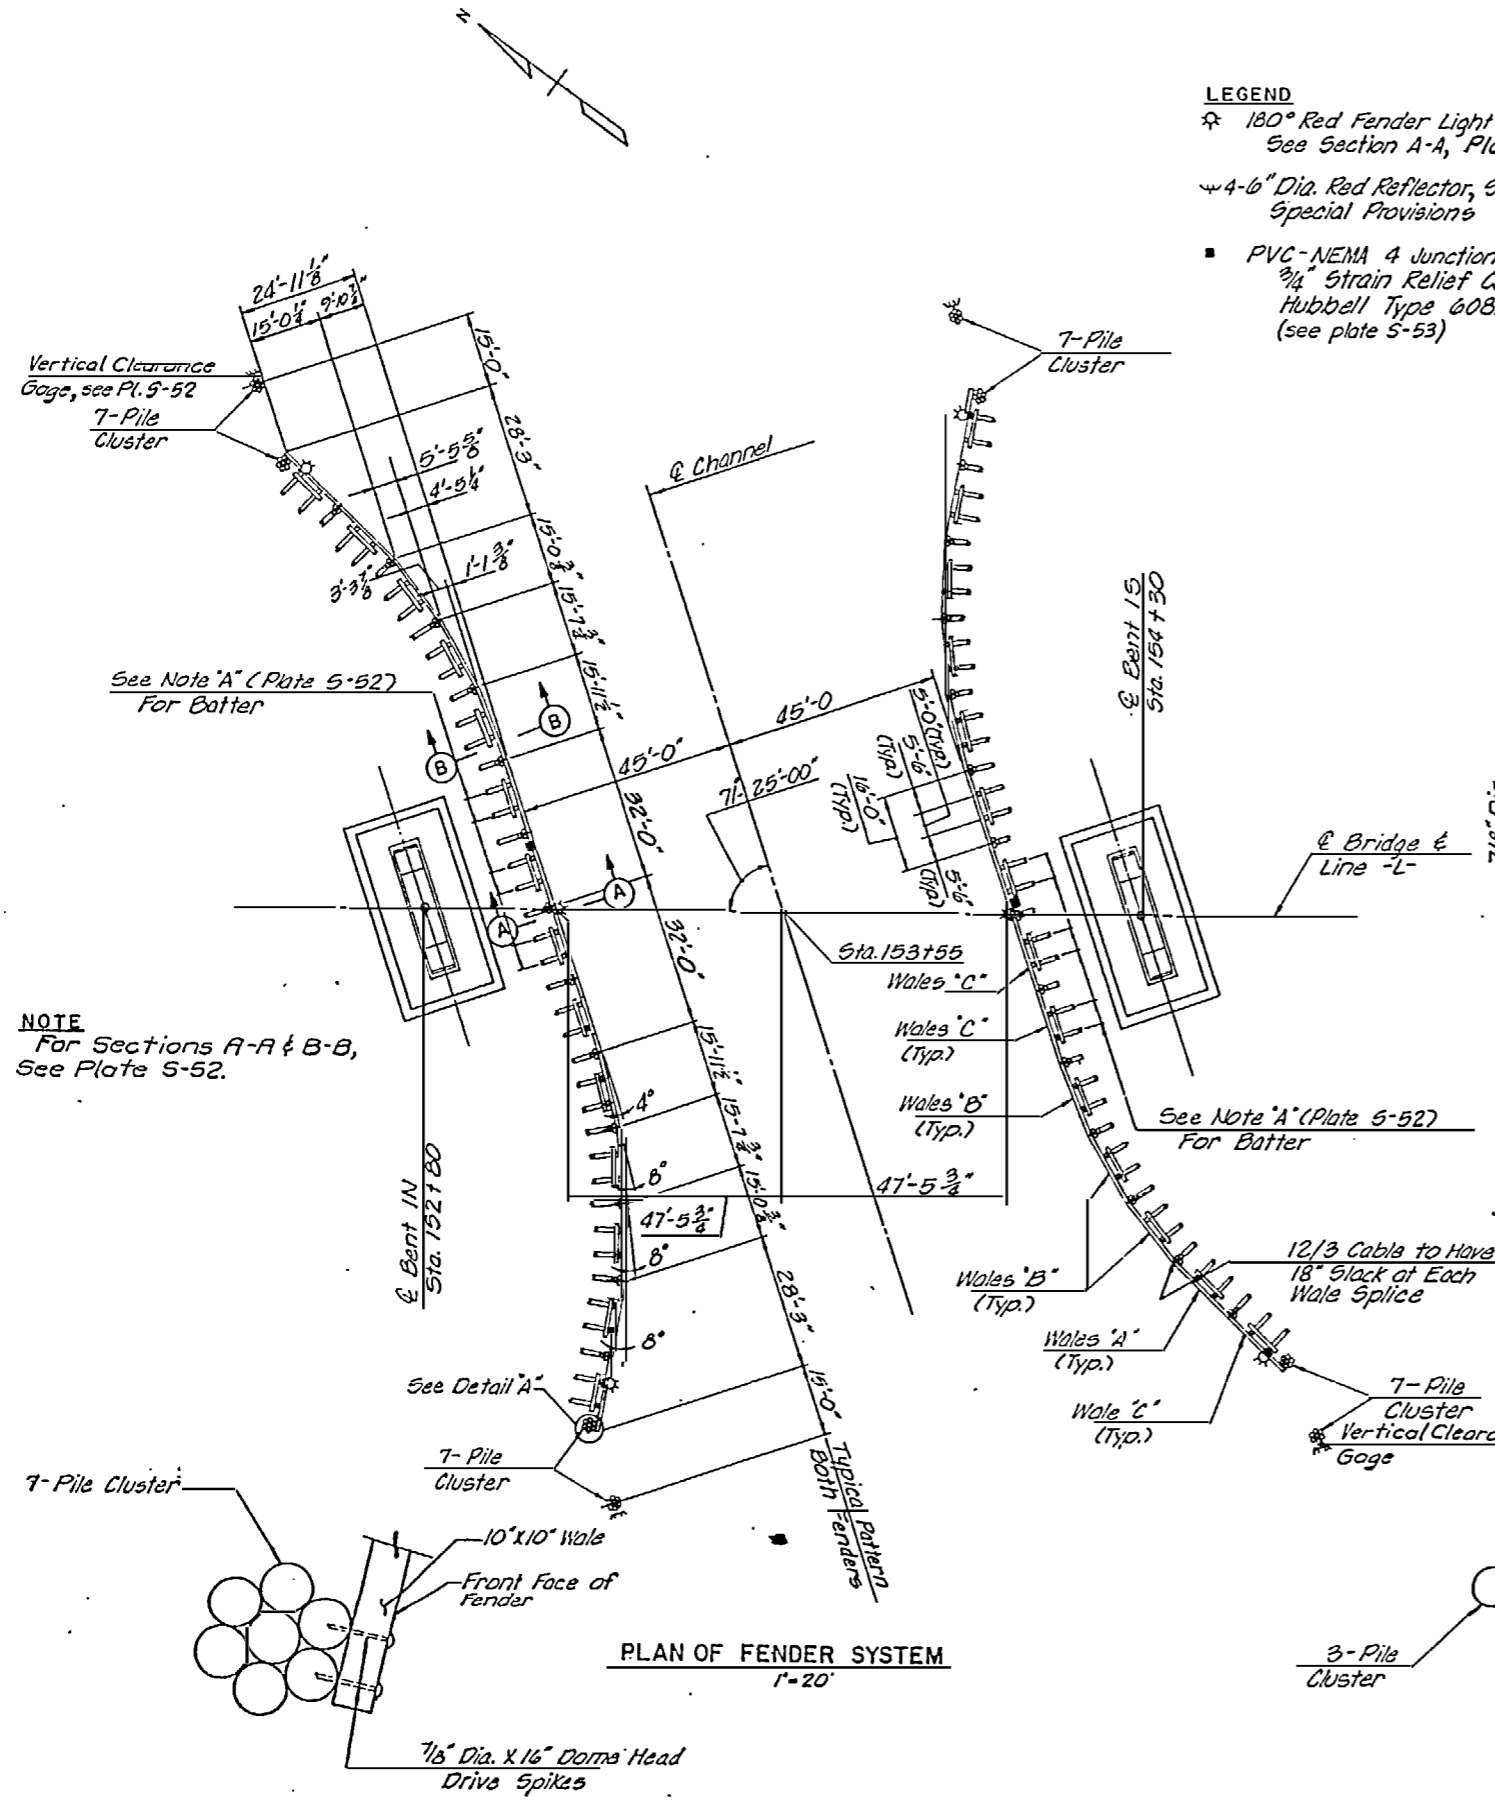


NOTE
For Sections A-A & B-B, See Plate 5-52.


DETAIL "A"
1/2" = 1'-0"

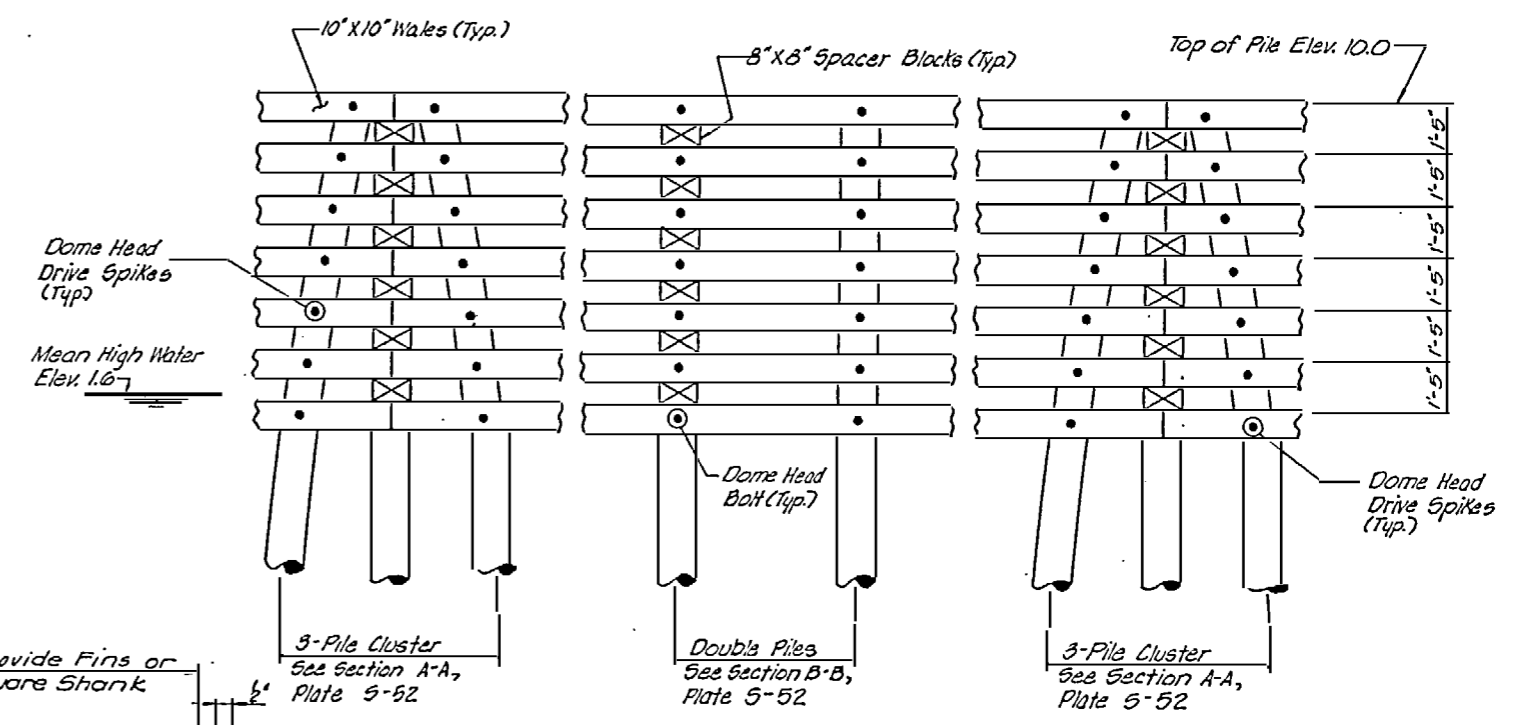

TYPICAL DOME HEAD BOLT
N.T.S.

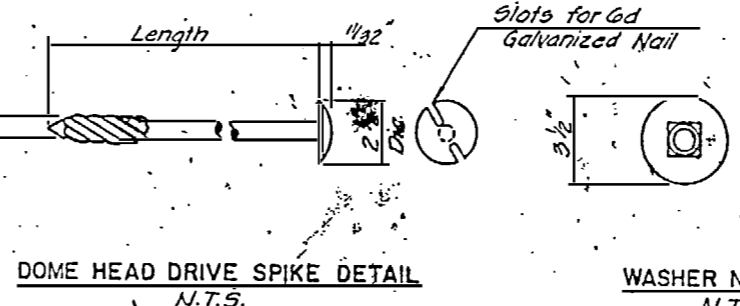

NOTES
Washer Nut as detailed above or equal, may be used in lieu of standard nut and washer.

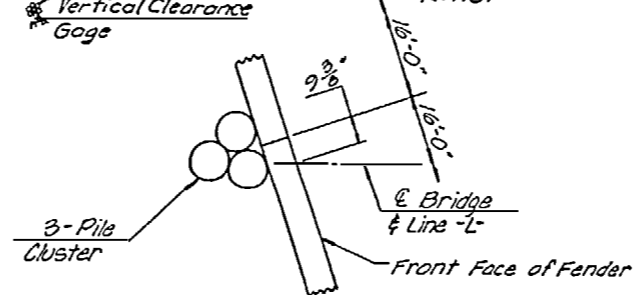

NOTE
Tie Detail Shown For North Fender System, South Tie Detail Similar by Rotation.

NOTE
Minimum Pile Tip Elevation for all Piles in Fender System shall be Elev. -35.00.

- NOTES**
- 1) All Hardware shall be Galvanized, All Nuts, Bolts Washers, and Spikes shall be as Manufactured by Lewis Bolt and Nut Co. or Approved Equal.
 - 2) Lengths of Bolts are Based on 13" Diameter Piles and are approximate Only. The Contractor shall Determine Exact Lengths in the Field.
 - 3) All Ends of Cables to be Secured With Three Standard Cable Clamps at 4" Minimum Spacing.
 - 4) 3/4" Dia. Cable shall be in Accordance With ASTM A475, 19 Strand, Common Grade, Class A Zinc Coated Steel Wire Strand.
 - 5) Piles shall be Min. 12" Dia. Creosoted Treated Piles See Plate 5-52, for Additional Details
 - 6) For Navigation Lighting Details, see Plate 5-53.

NOTE
Cut and sawn surfaces and ends of Treated Piles and Timbers shall be treated in accordance with Section 450-8(B) of N.C.D.O.T. Standard Specifications. All exposed pile ends shall be capped with approved flashing material in accordance with Section 450-8(B) of the N.C.D.O.T. Standard Specifications.

HNTB HOWARD NEEDLES TAMMEN & BERGENDOFF ARCHITECTS ENGINEERS PLANNERS ATLANTA, GEORGIA
U.S. ARMY ENGINEER DISTRICT WILMINGTON CORPS OF ENGINEERS WASHINGTON NORTH CAROLINA



ATLANTIC INTRACOASTAL WATERWAY
FENDER SYSTEM DETAILS-1

DESIGNED BY: B.T.G.	CHECKED BY: M.A.M.	COINJOCK BRIDGE REPLACEMENT PROJECT	
CURRITUCK COUNTY		NORTH CAROLINA	
PREPARED BY: [Signature]	INVTION NO. DACW 54-83-B-0014	DRAWING NUMBER BR104-06-17	PLATE NO. S-51
PRINCIPAL OF FIRM HNTB	SCALE AS NOTED	DATE 22 JULY 1983	SHEET 101 OF 126




M.C. STATE AID PROJECT NO.		FED. AID PROJECT NO.	

NOTE
 Quantities Shown are Approximate and are for Information Only. The Cost of all Items Except Piles Shall be Included in the Lump Sum Item Fender System Complete (Excluding Piles). Payment for Piles Shall be Made Under Treated Timber Piles (Fender System).

APPROXIMATE QUANTITIES FOR ONE FENDER (TWO REQUIRED)				
TREATED TIMBER				
ITEM	NO.	SIZE	SURFACE TO	LENGTH
WALES	98	10 X 10	S4S 9 1/2" X 9 1/2"	16'-0"
HEADERS	14	10 X 10	S4S 9 1/2" X 9 1/2"	7'-0"
SPACERS	174	8 X 8	S4S 7 1/2" X 7 1/2"	1'-0"
TOTAL TREATED TIMBER = 14,812 M.B.F.				
TREATED TIMBER PILES = No. 123 Lin. Ft. 6,857				
HARDWARE				
ITEM	NO.	SIZE	LENGTH	WEIGHT
DOME HEAD BOLTS	185	7/8" DIA.	25"	925
" " "	35	7/8" "	28"	193
" " "	35	7/8" "	34"	230
O.G. WASHERS	255	7/8" "		383
DOME HEAD DRIVE SPIKES	270	7/8" "	16"	810
CABLE		3/4" "	1400'-0"	1400
CABLE CLAMPS	204			153
STAPLES	400	3/8" "		200
NAILS	800	6d		5
"	400	16d		8
TOTAL HARDWARE = 4307 lbs.				

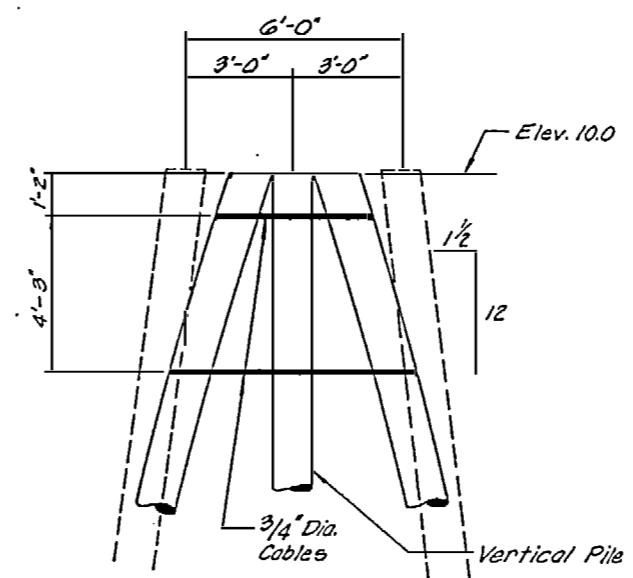
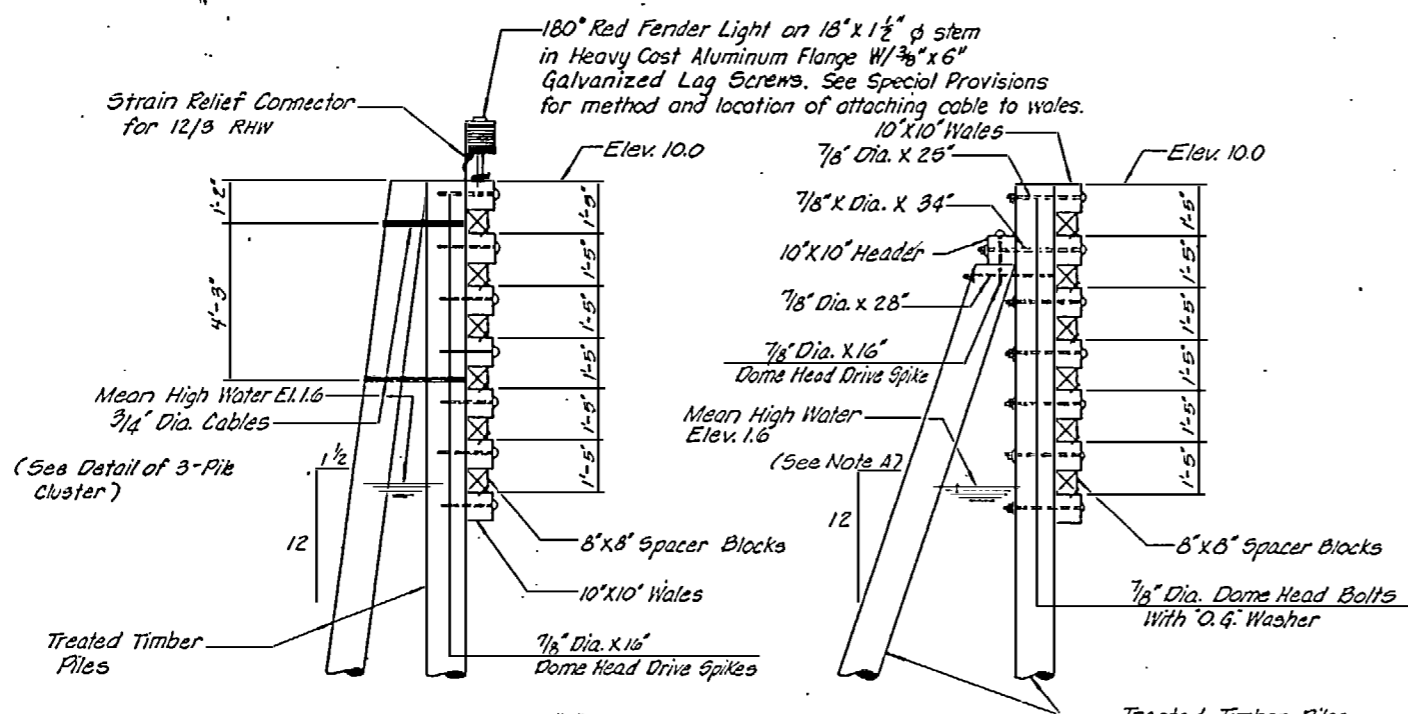


NOTE "A"
 Piles Adjacent to Cofferdams for Bents 1N and 1S shall be Driven at 3 on 12. See Plan on Plate 5-51 at Other Locations, Piles shall be Driven at 4 on 12.

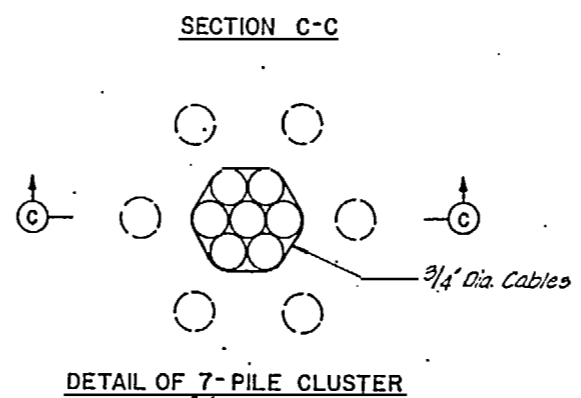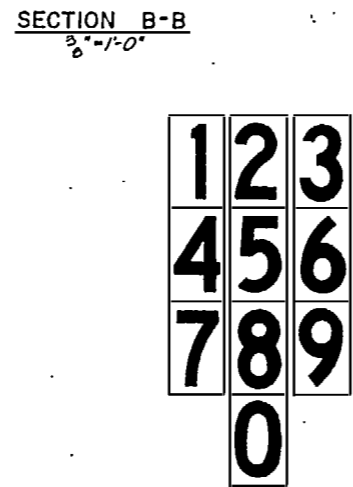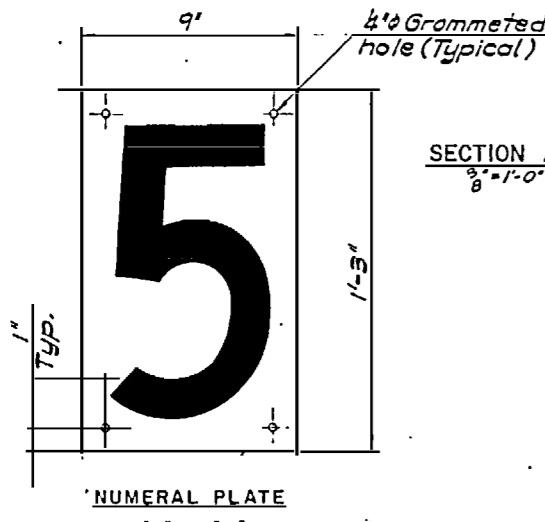


NOTES
 Six Outside Piles to be Equally Spaced on a 6'-0" Diameter Circle, Drawn Together at top and Wrapped With Three Turns of 3/4" Dia. Cable at two Points. Cable shall be Secured With 3/8" Staples and Clamps. Cables and Fastenings to be Galvanized and Included as Hardware. Batter Six Exterior Piles 1 1/2:12. The Center Pile is to be Driven Vertical.

- NOTES:**
- Gage Strip and Numeral Plates shall be 14 Gage (0.063 in.) Aluminum meeting ASTM B209, Alloy 6061-16.
 - Numerals shall be one digit per plate with black numbers on white background.
 - The plates shall be secured using standard corrosion resistant fasteners having a minimum diameter of 3/16 inch along with backing washers. Washers will be for round columns only.
 - Numerals shall be in accordance with U.S. Department of Transportation Federal Highway Administration "Standard Alphabets for Highway Signs," Series "C".
 - Gages to be installed on 7 pile clusters as shown on Plate 5-51.
 - Gages to be installed such that clearance is referenced to a point at El. +66.0.
 - Markings to extend from El. +6.0 down to El. +1.0.
 - Contractor shall provide corrosion resistant spacers or mounting frame to aid in installation.
 - Gage strips shall be at one (1) foot increments.
 - Number markings shall be at 4 foot increments.
 - The visible side of the gage strip and numeral plates shall receive two coats of porcelain enamel having a minimum total thickness of 0.007 inches.
 - Payment for gages will be made as part of the lump sum price for bridge.

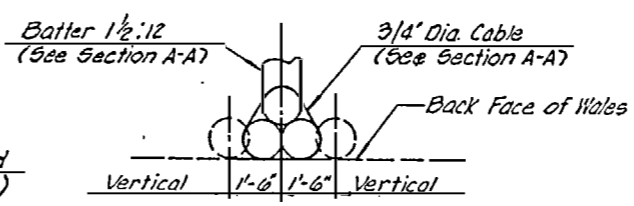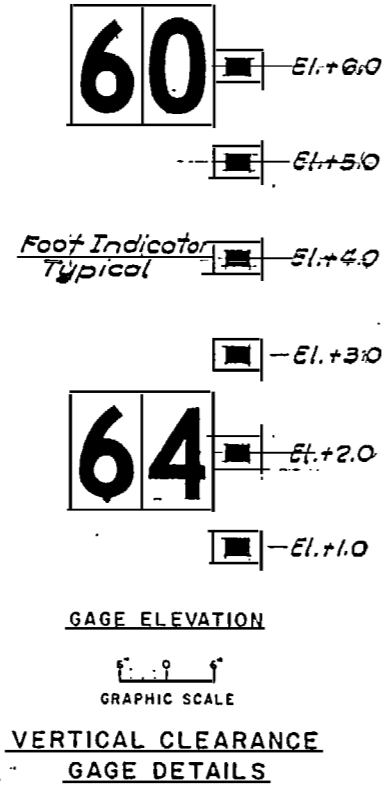

NOTES
 Three Piles to be Driven as Shown, Drawn Together at top and Wrapped With Three Turns of 3/4" Dia. Cable at two Points. Cable shall be Secured With 3/8" Staples and Cable Clamps. Cables and Fastenings to be Galvanized and Included as Hardware. Two Piles to be Driven Vertical; one Pile to be Battered as Shown.

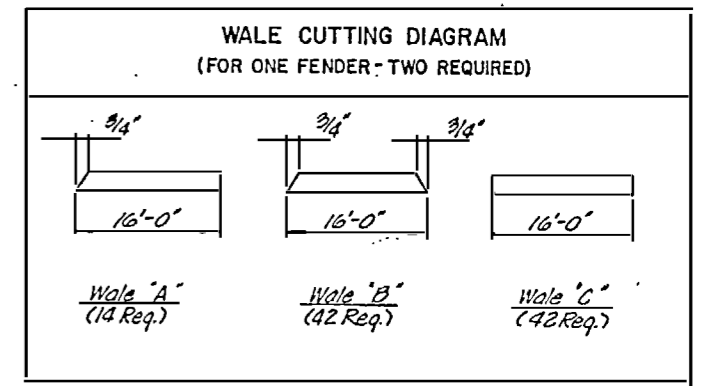

NOTE
 For Location of Sections "A-A" and "B-B", See Plate 5-51.


HNTB HOWARD NEEDLES TAMMEN & BERGENOFF ARCHITECTS ENGINEERS PLANNERS ATLANTA, GEORGIA

U.S. ARMY ENGINEER DISTRICT, WASHINGTON CORPS OF ENGINEERS WELMINGTON, NORTH CAROLINA

ATLANTIC INTRACOASTAL WATERWAY FENDER SYSTEM DETAILS-2








DESIGNED BY: B.T.G.	CHECKED BY: M.A.M.	COINJOCK BRIDGE REPLACEMENT PROJECT CURRITUCK COUNTY NORTH CAROLINA	
PREPARED BY: [Signature]	INVESTIGATION NO. DACW 54-83-B-0014	SIZE: B-0014	DRAWING NUMBER: BR104-06-17
PRINCIPAL OF FIRM HNTB	SCALE AS NOTED	DATE: 22 JULY 1983	SHEET 102 OF 126

N.C. STATE AID PROJECT NO	
FEDERAL AID PROJECT NO	FED RD

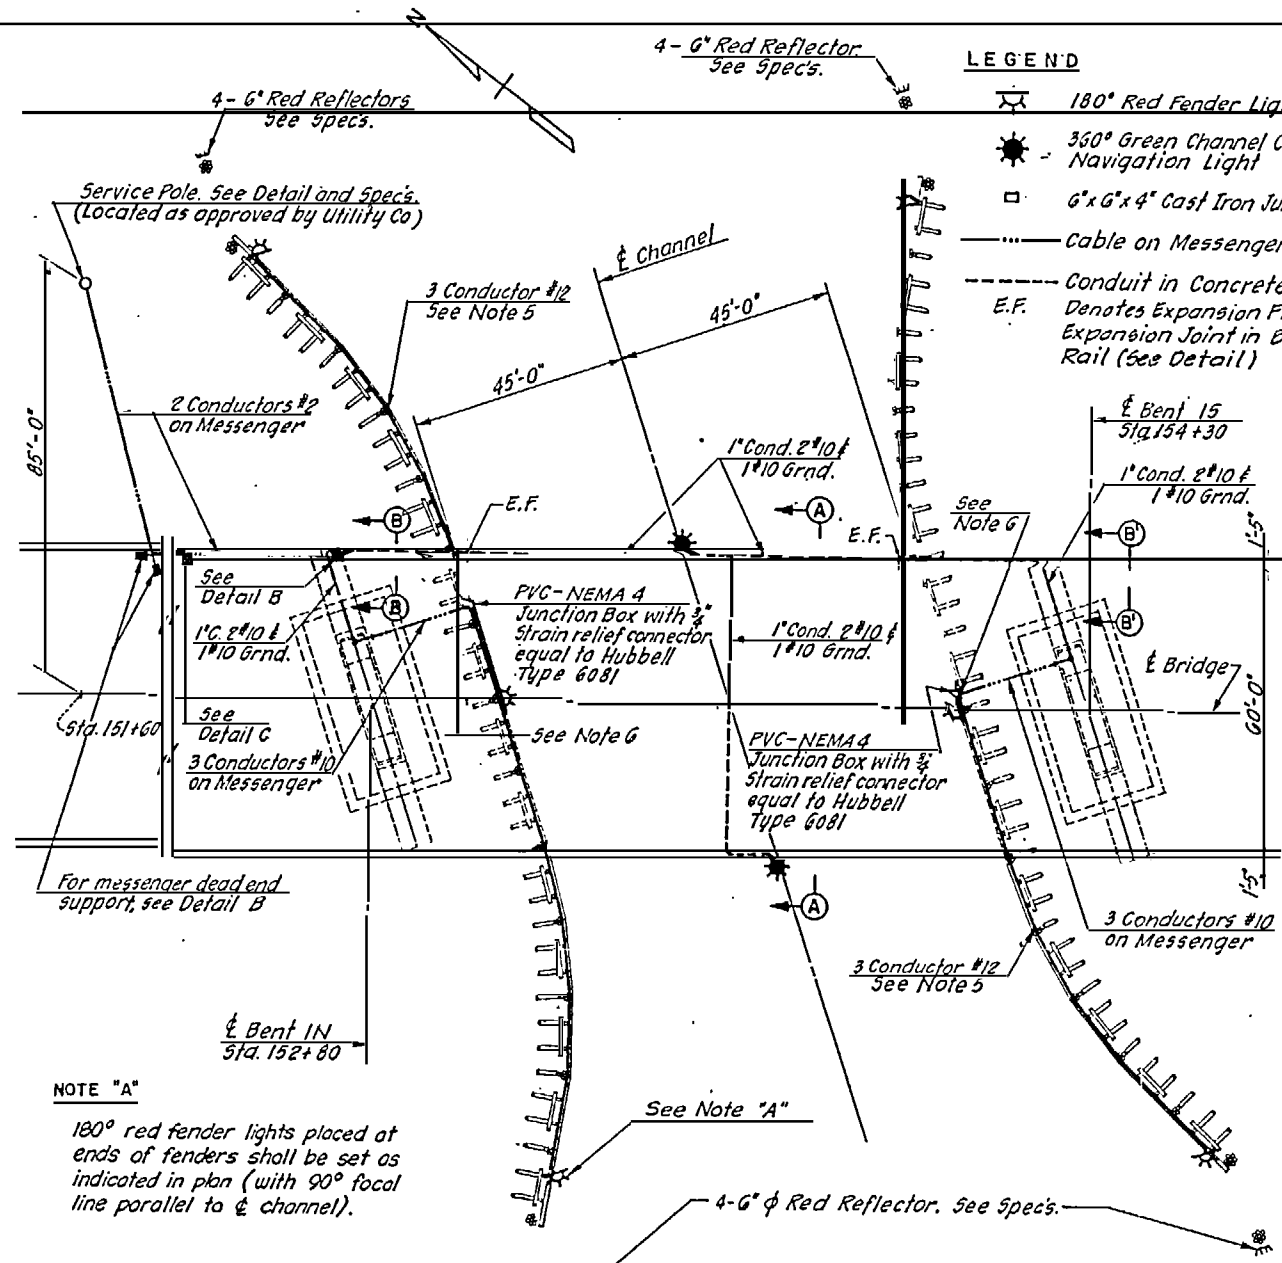


LEGEND

- 180° Red Fender Light
- 360° Green Channel Center Navigation Light
- 6" x 6" x 4" Cast Iron Junction Box
- Cable on Messenger
- Conduit in Concrete
- E.F. Denotes Expansion Fittings at Expansion Joint in Barrier Rail (See Detail)

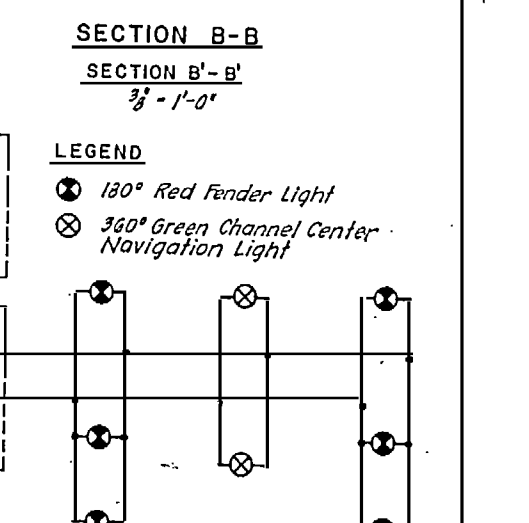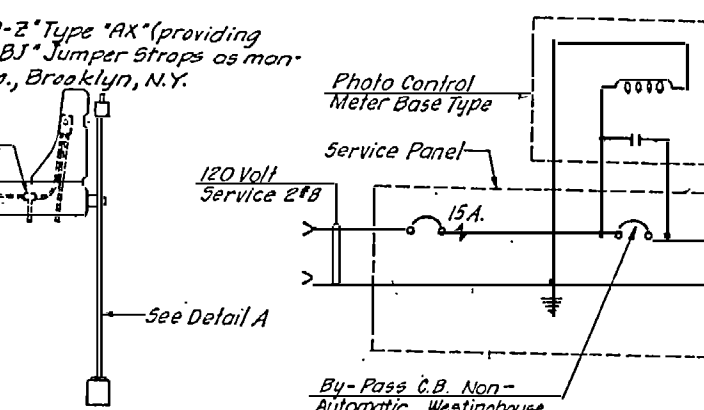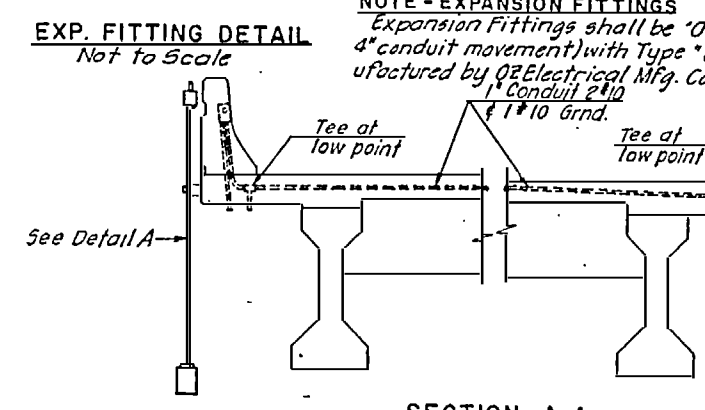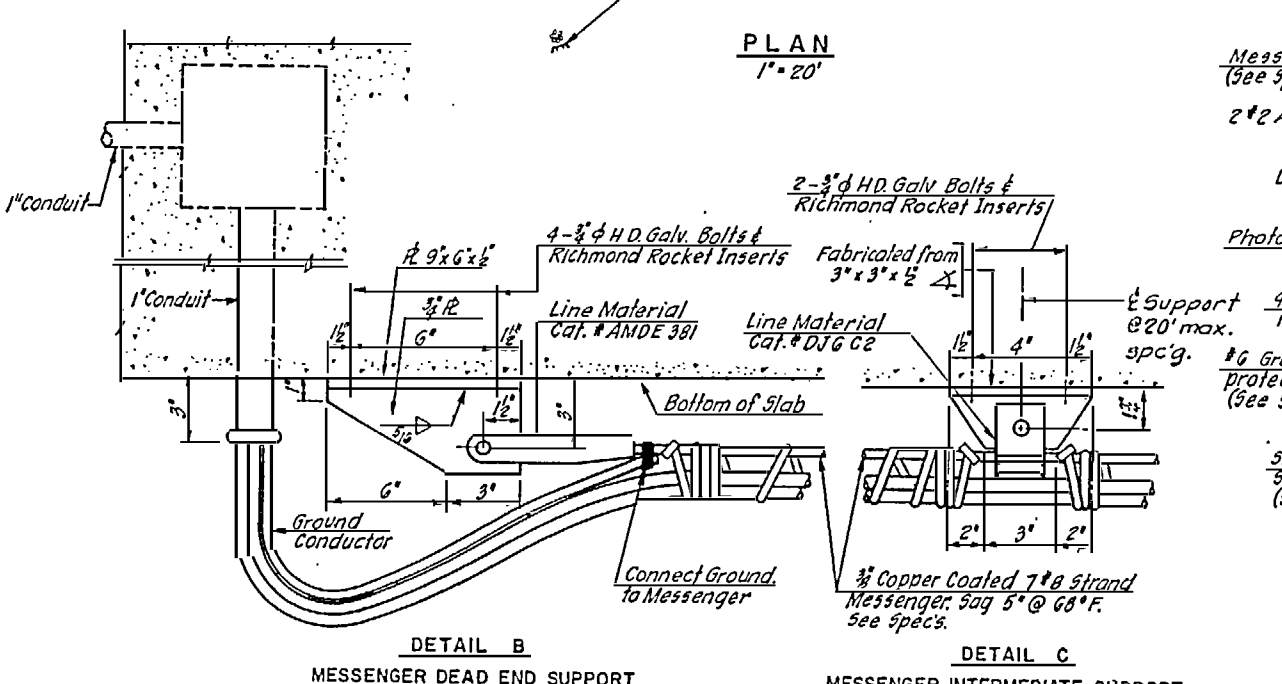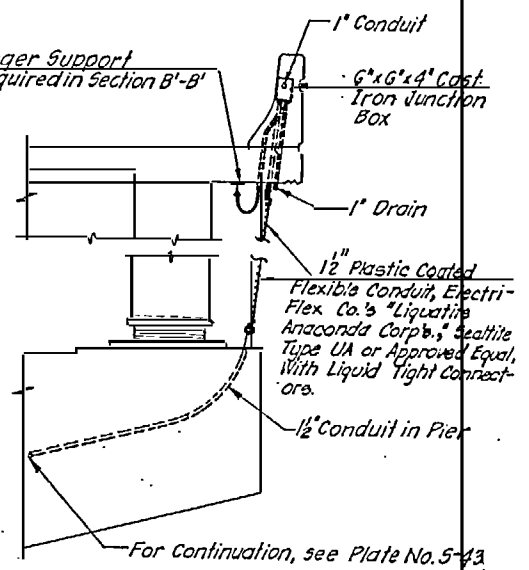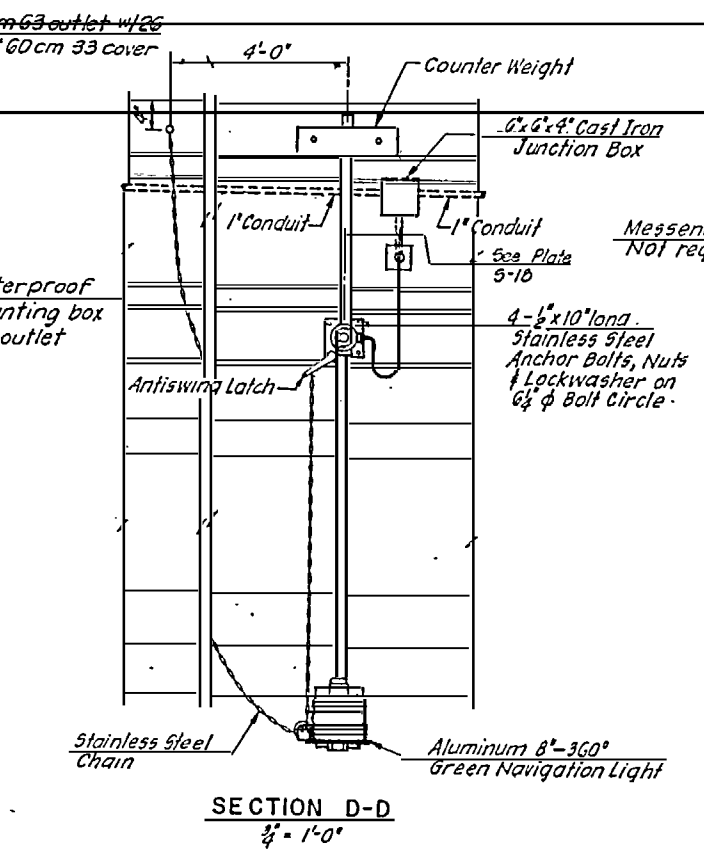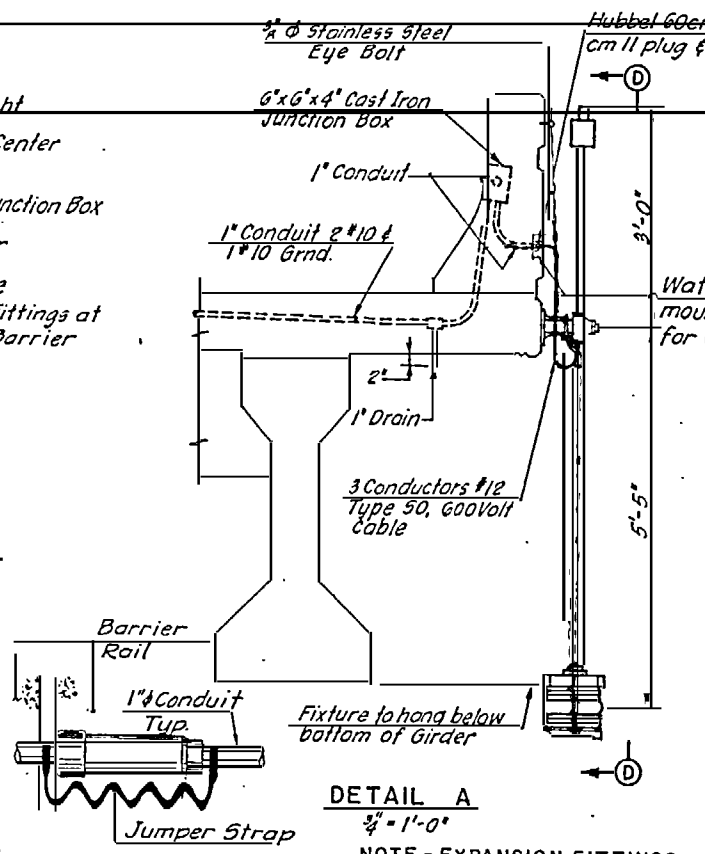

DETAIL B
MESSENGER DEAD END SUPPORT
INCOMING POWER CABLE INSTALLATION DETAIL
Not to Scale

DETAIL C
MESSENGER INTERMEDIATE SUPPORT
Not to Scale

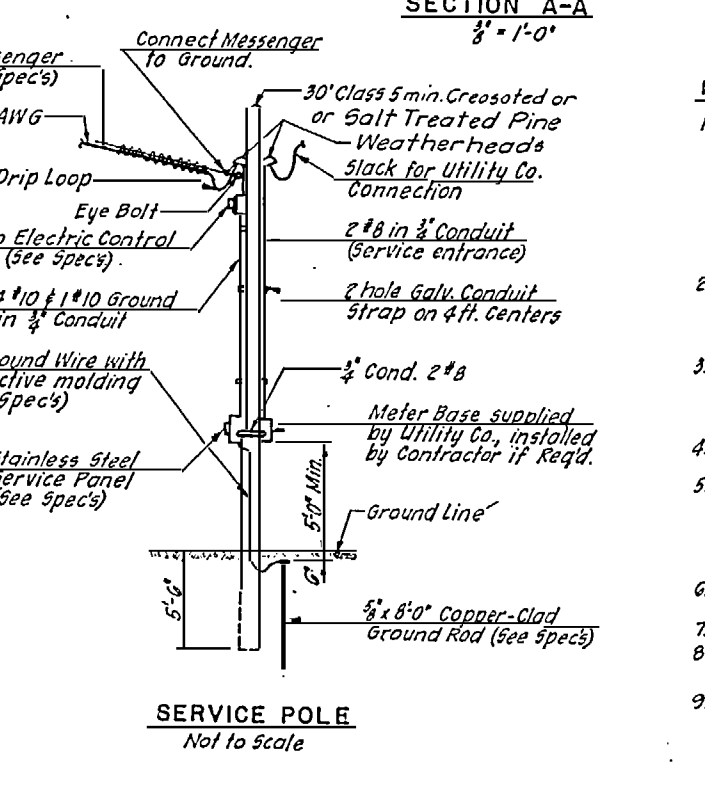

NOTES

- The navigation lighting shall be installed to conform to the following:
 - Standard Specifications for Road and Bridge Construction, N.C. Department of Transportation.
 - Current edition of the National Electric Code (1980).
 - Federal Regulation Title 33, Part 8.
- The Ground Conductor and all non-current carrying parts of the Navigation lighting system shall be connected to the service pole ground system via messenger cables.
- Drains shall be installed in all junction boxes. Conduits should be connected to boxes with threaded hubs or approved threaded hub fittings.
- All conduits should be heavy wall Hot Dipped Galvanized.
- Wiring on fenders shall be 3 Conductor #12 Cable. Fastened with approved clamps and stainless steel nails, on 18" centers. 18 inches of slack shall be provided at all wale splices.
- Install eye bolt on wale for messenger cable.
- See Plate No. 5-52 for fender lighting installation.
- Wire splicing shall only be permitted in fully accessible junction boxes.
- Manufactured items shown on this drawing may be substituted for with approved equals.

NOTES - INDICATOR LIGHT

- An Indicator Light shall be provided for each circuit and mounted on panel cover.
- Indicator Light shall be a "Dialco" Cat. No. 95-0410-09-031 with stovepipe transparent lens as manufactured by Dialight Corp., Brooklyn, N.Y.
- One spare light shall be supplied and stored in the service panel.

RECORD DRAWING

HOWARD NEEDLES TAMMEN & BERENSON U.S. ARMY ENGINEER DISTRICT, WILMINGTON ARCHITECTS ENGINEERS PLANNERS CORP. OF ENGINEERS ATLANTA, GEORGIA WILMINGTON, NORTH CAROLINA


ATLANTIC INTRACOASTAL WATERWAY

NAVIGATION LIGHTING

COINJOCK BRIDGE REPLACEMENT PROJECT CURRITUCK COUNTY NORTH CAROLINA

DESIGNED BY: P.E.P.	CHECKED BY: R.G.P.
PREPARED BY: [Signature]	PRINCIPAL OF FIRM HNTB
INVESTIGATION NO.	SIZE
DRAWING NUMBER	PLATE NO.
BRI04-06-17	S-53
SCALE AS NOTED	DATE 22 JULY 1983
SHEET 103 OF 126	


N.C. STATE AID PROJECT NO.	
FEDERAL AID PROJECT NO.	FED RD 129 NG

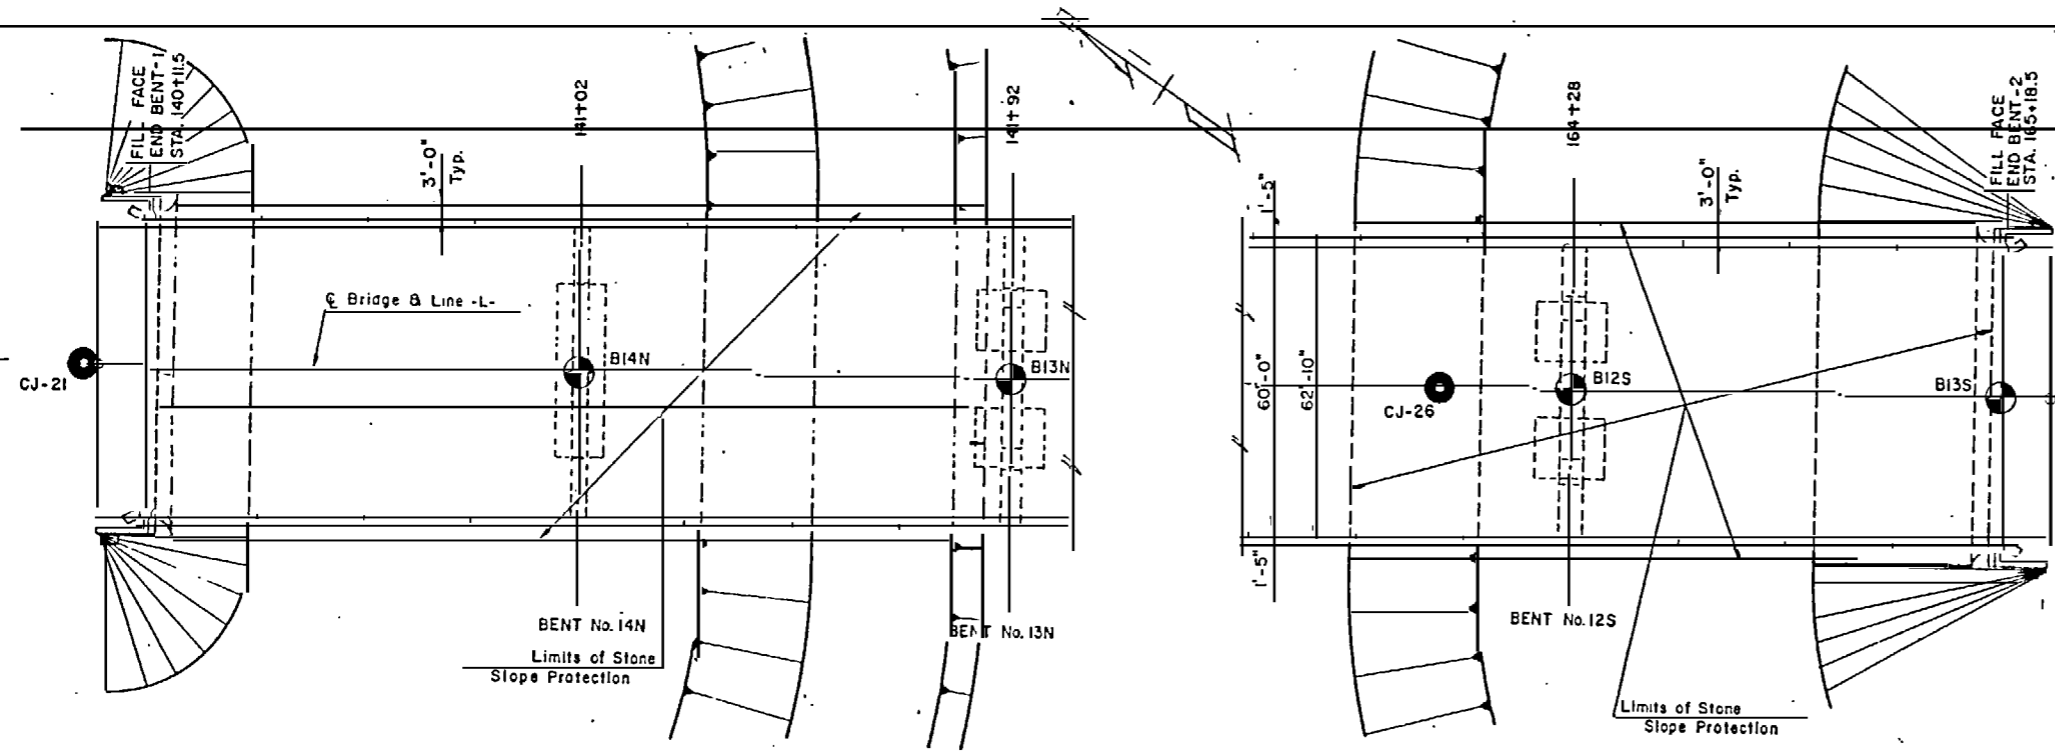


END BENT - 1

PLAN SLOPE PROTECTION
1" = 20'

END BENT - 2

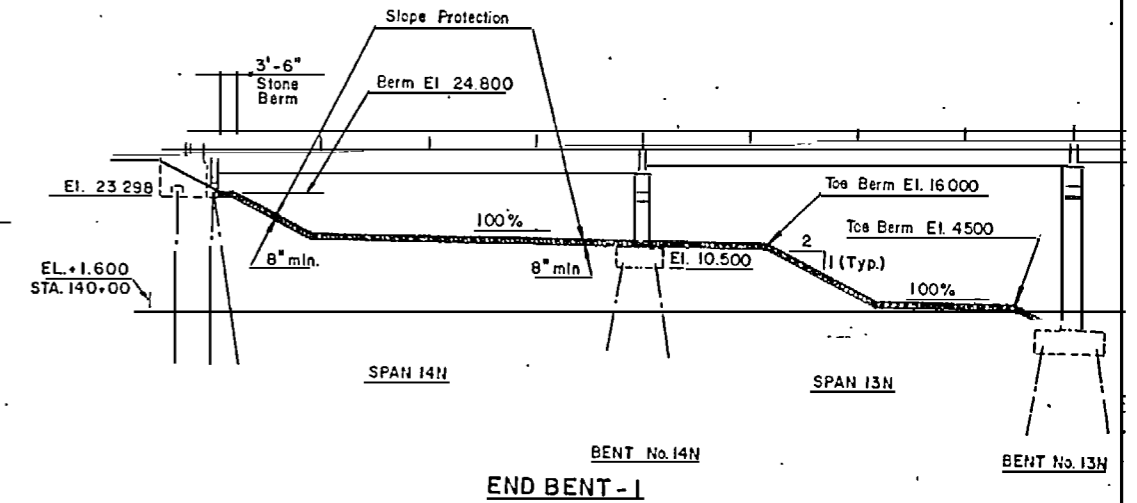


END BENT - 1

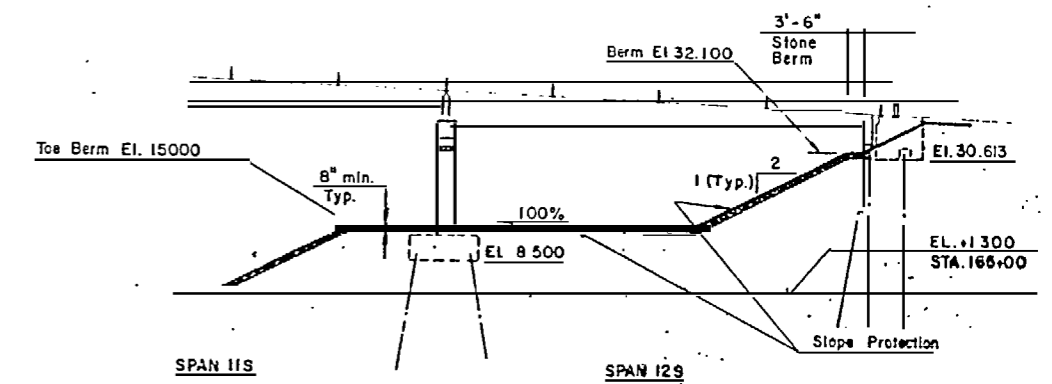


END BENT - 2

ELEVATION SLOPE PROTECTION
1" = 20'

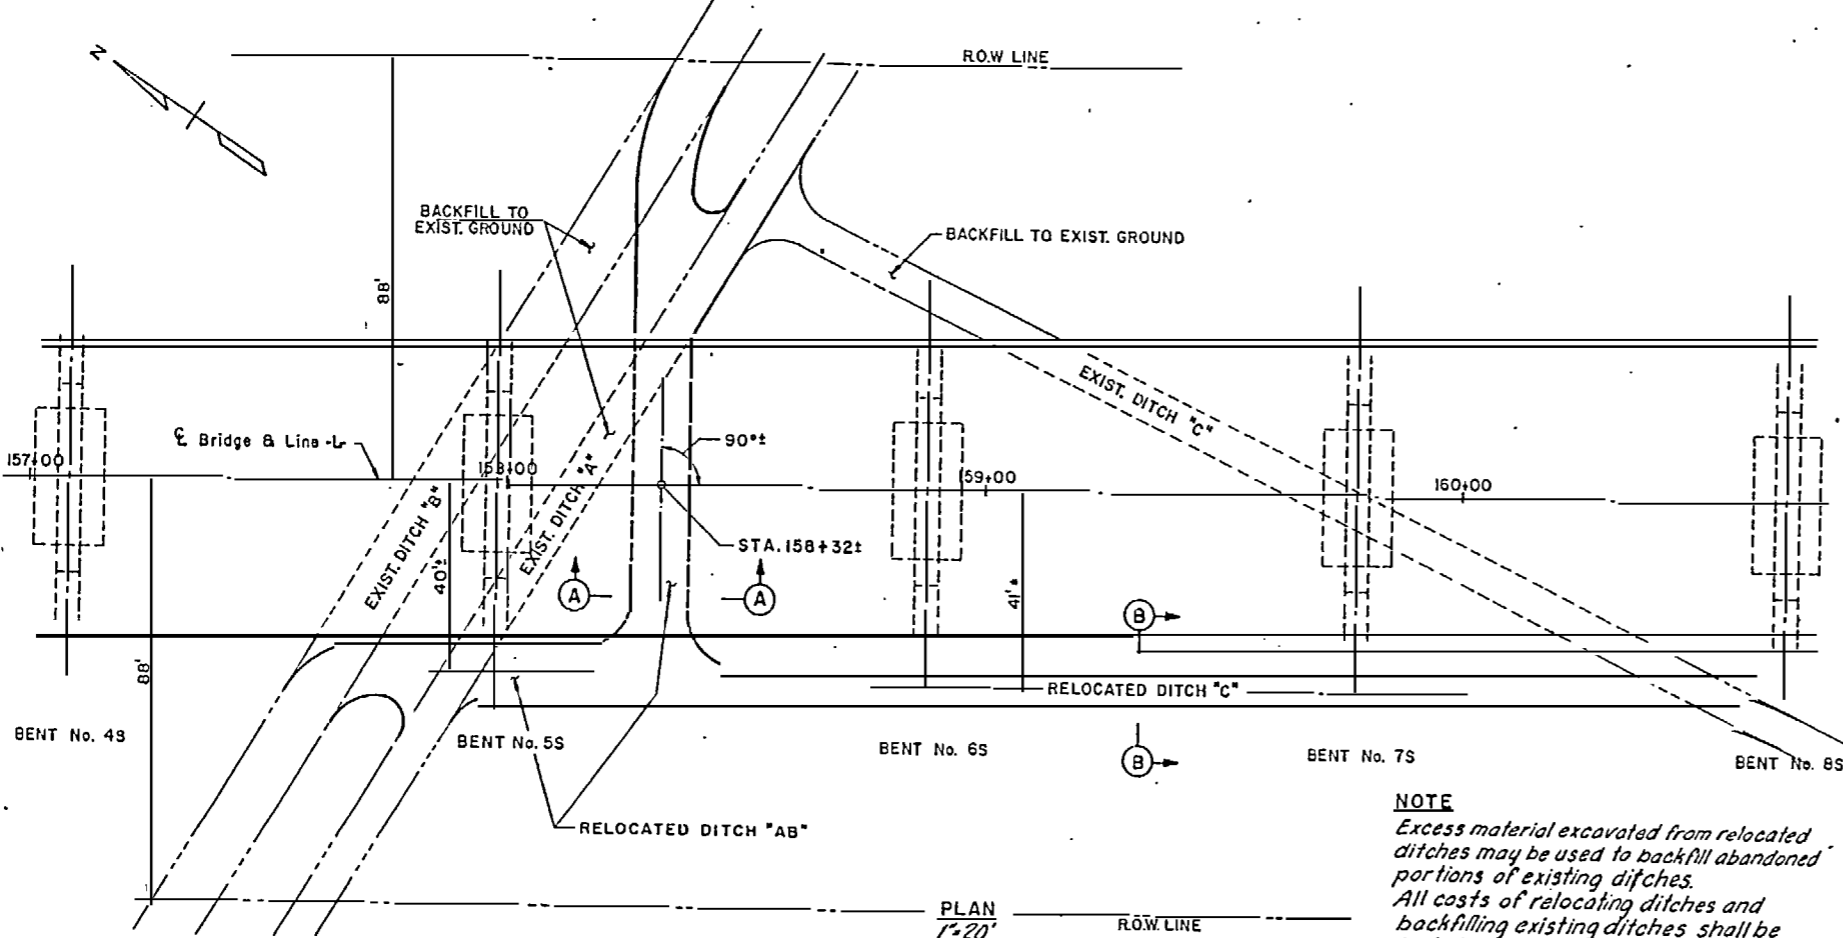


DITCH RELOCATION DETAILS
1" = 20'

NOTE
Excess material excavated from relocated ditches may be used to backfill abandoned portions of existing ditches. All costs of relocating ditches and backfilling existing ditches shall be included in Lump Sum Bid for Bridge.

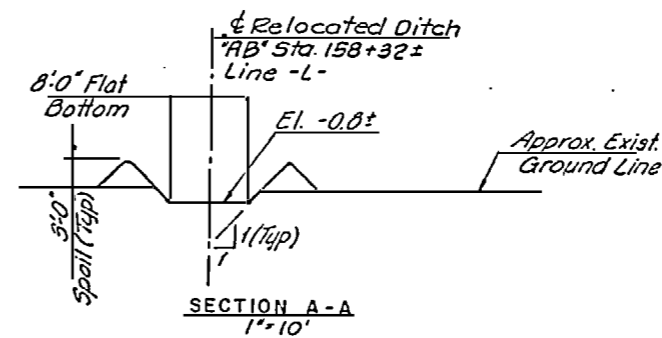

SECTION A-A
1" = 10'

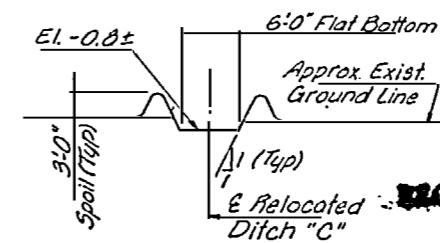

SECTION B-B
1" = 10'

APPROX. QUANTITIES	
LOCATION	SQ. YDS.
END BENT 1	1380
END BENT 2	1149

SLOPE PROTECTION NOTES:
For Requirements of Subgrading, Stone Type, Stone Slizing and Herbicide Protection, see Special Provisions. Stone Slope Protection shall have a minimum uniform thickness of 8".

RECORD DRAWING

DESIGNED BY: M.A.M. CHECKED BY: J.F.W.
PREPARED BY: [Signature] PRINCIPAL OF FIRM HNTB


HNTB HOWARD NEEDLES TAMMEN & BERGENDOFF ARCHITECTS ENGINEERS PLANNERS ATLANTA, GEORGIA
U.S. ARMY ENGINEER DISTRICT, WASHINGTON CORPS OF ENGINEERS WASHINGTON, NORTH CAROLINA

ATLANTIC INTRACOASTAL WATERWAY - SUBSTRUCTURE
STONE SLOPE PROTECTION DETAILS
COINJOCK BRIDGE REPLACEMENT PROJECT
CURRITUCK COUNTY NORTH CAROLINA

INVESTIGATION NO. DAGWS-83-8-0014	SIZE B	DRAWING NUMBER BR104-06-17	PLATE NO. S-54
SCALE AS NOTED	DATE 22 JULY 1993	SHEET 104 OF 126	

N.C. STATE AID PROJECT NO.	FED. PD. NO.
FEDERAL AID PROJECT NO.	PLATE NO.
3-10-83	5-55


STANDARD BAR DETAILS

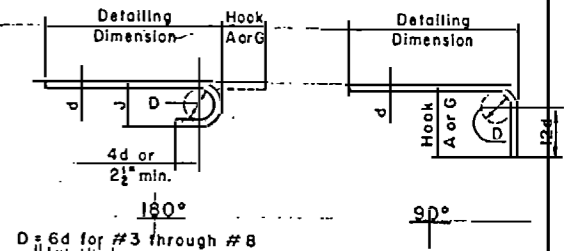

D = 6d for #3 through #8
 D = 4d for #9, #10 & #11
 D = 3d for #14 & #18

END HOOKS

BAR SIZE	WEIGHT Lbs./Ft.	APPROX. DIAMETER	NOMINAL DIAMETER	HOOK	
				180°	90°
#3	0.376	7/16"	0.375	5"	3"
#4	0.668	1/2"	0.500	6"	4"
#5	1.043	5/8"	0.625	7"	5"
#6	1.502	3/4"	0.750	8"	6"
#7	2.044	1"	0.875	10"	7"
#8	2.670	1 1/8"	1.000	11"	8"
#9	3.400	1 1/4"	1.128	13"	11"
#10	4.303	1 1/2"	1.270	15"	14"
#11	5.313	1 3/8"	1.410	17"	16"
#14	7.650	1 7/8"	1.693	21"	20"
#18	13.600	2 1/2"	2.257	31"	30"

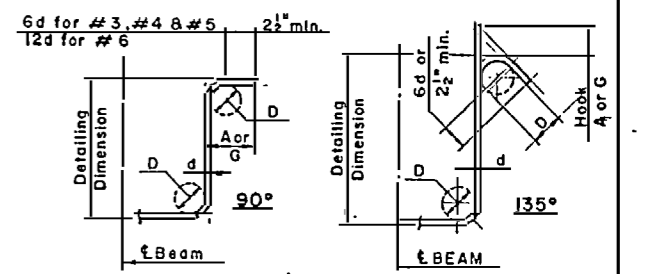

D = 4d for #5 & Smaller
 D = 5d for #6 to #8

BAR SIZE	D (in.)	STIRRUP or TIE	
		90°	135°
#3	1 1/2"	4"	4"
#4	2"	4 1/2"	4 1/2"
#5	2 1/2"	6"	5 1/2"
#6	4 1/2"	10"	7 1/2"


RECORD DRAWING

HNTB HOWARD NEEDLES TAMMEN & BERGENDOFF ARCHITECTS ENGINEERS PLANNERS ATLANTA, GEORGIA U.S. ARMY ENGINEER DISTRICT, WILMINGTON CORPS OF ENGINEERS WILMINGTON, NORTH CAROLINA

ATLANTIC INTRACOASTAL WATERWAY BAR BENDING DIAGRAMS


COINJOCK BRIDGE REPLACEMENT PROJECT CURRITUCK COUNTY NORTH CAROLINA

DESIGNED BY: J.A.L.	CHECKED BY: M.A.M.	INVESTIGATION NO. DACW 54-83-B-0014	SIZE B-0014	DRAWING NUMBER BR104-06-17	PLATE NO. S-55
PRINCIPAL OF FIRM HNTB		SCALE NONE	DATE 22 JULY 1983	SHEET 105 OF 126	

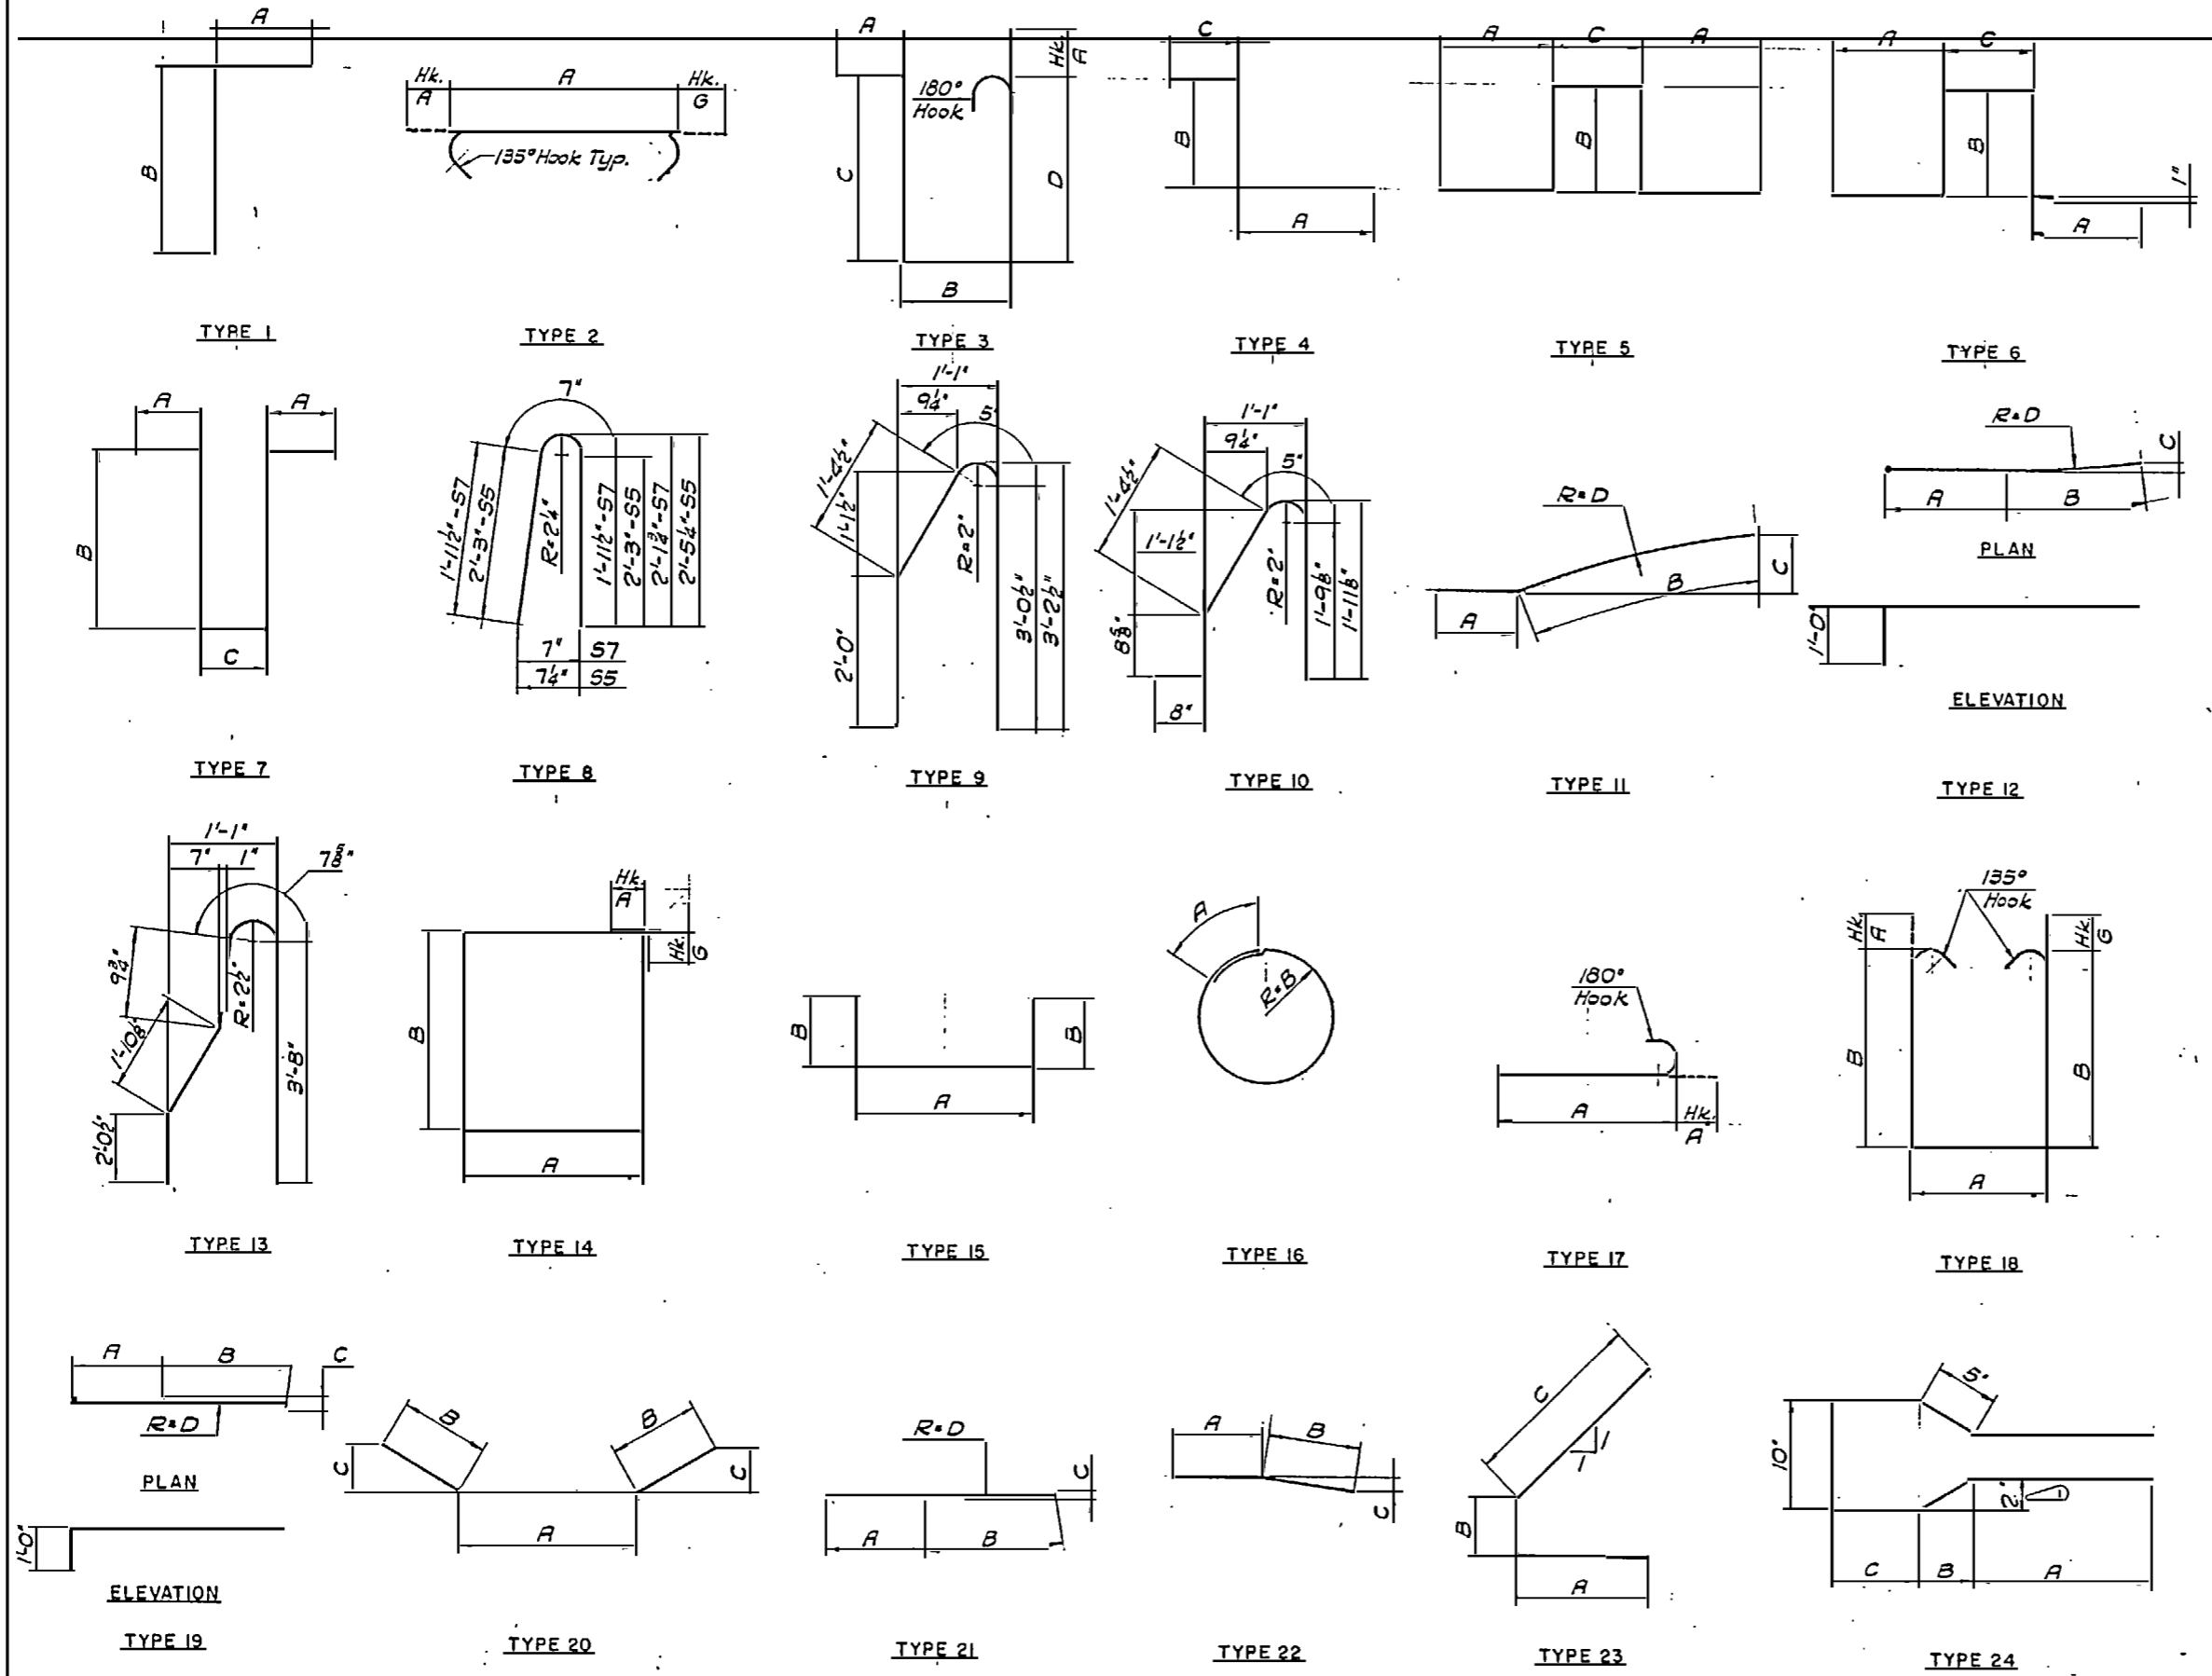


NOTES
 1) Unless otherwise noted, all dimensions are out to out.
 2) All radii are to inside of bar.
 3) Legend for bar mark system is shown on Plate S-55.


N.C. STATE AID PROJECT NO.	FED. RD. DIV. NO.
FEDERAL AID PROJECT NO.	

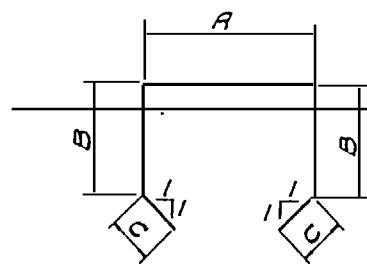

TYPE 25

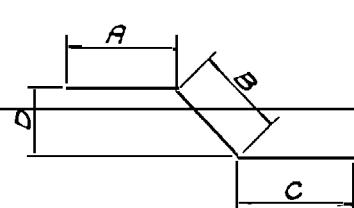


TYPE 26

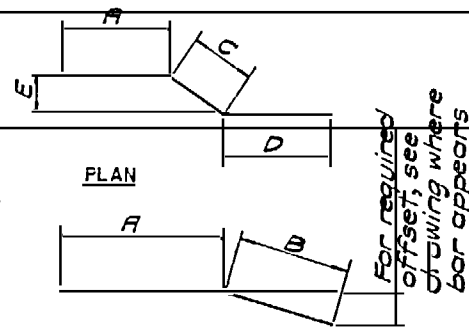


ELEVATION


TYPE 27

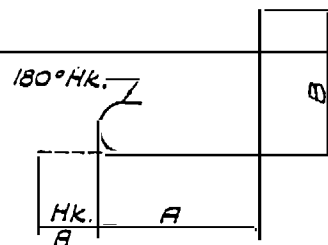


TYPE 28

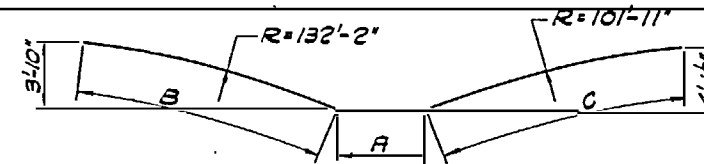


TYPE 29

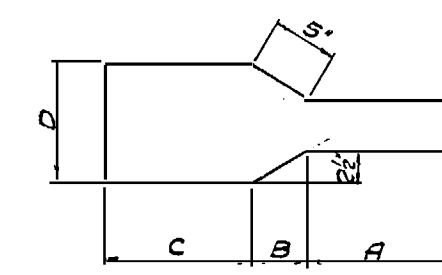


TYPE 30

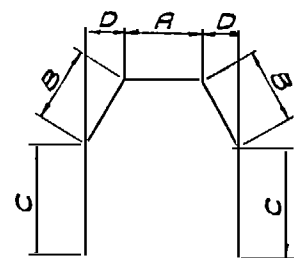


TYPE 31

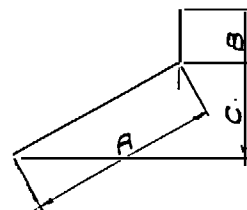


TYPE 32

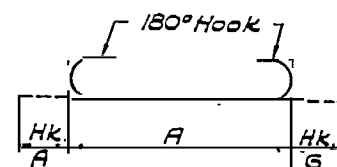


TYPE 33

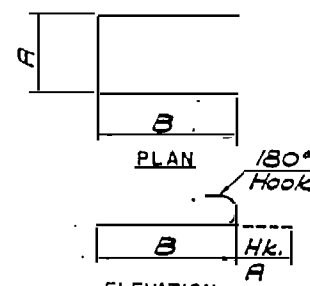


TYPE 34

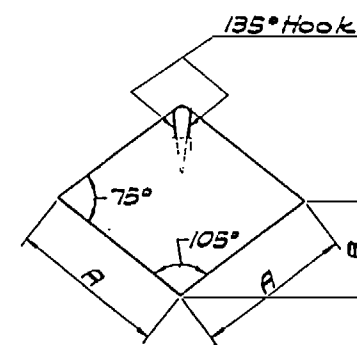


TYPE 35

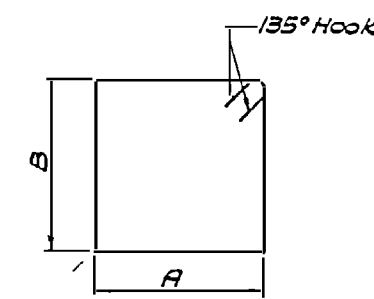


TYPE 36

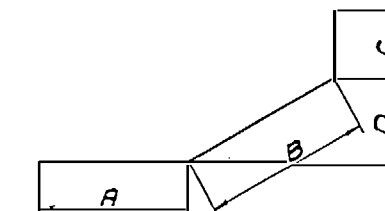


TYPE 37

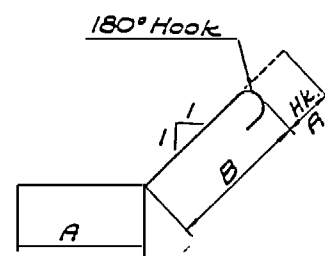

TYPE 38

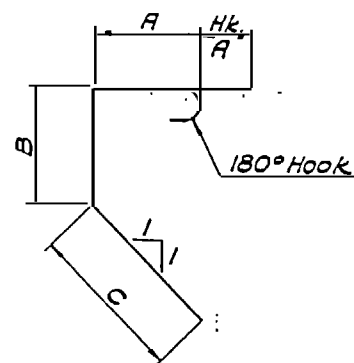

TYPE 39

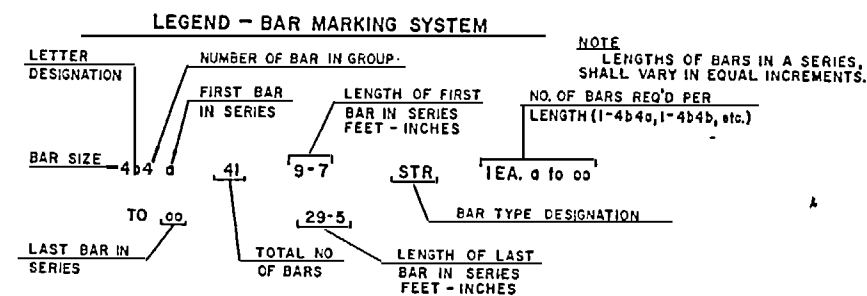

RECORD DRAWING

DESIGNED BY: J.A.L. CHECKED BY: M.A.M.

PREPARED BY: [Signature] PRINCIPAL OF FIRM HNTB

HNTB HOWARD NEEDLES TAMMEN & BERGENDOFF ARCHITECTS ENGINEERS PLANNERS ATLANTA, GEORGIA

U.S. ARMY ENGINEER DISTRICT, WILMINGTON CORPS OF ENGINEERS WILMINGTON, NORTH CAROLINA

ATLANTIC INTRACOASTAL WATERWAY

BAR BENDING DIAGRAMS

COINJOCK BRIDGE REPLACEMENT PROJECT

CURRITUCK COUNTY NORTH CAROLINA

INVITATION NO. DACW 54-83-B-0014	SIZE B-0014	DRAWING NUMBER BR104-06-17	PLATE NO. S-56
----------------------------------	-------------	----------------------------	----------------

SCALE NONE DATE 22 JULY 1983 SHEET 106 OF 126

BAR MARK	NO.	L'GTH	TYPE	DIMENSIONS				REMARKS
				A	B	C	D	
SUPERSTRUCTURE								
SPAN 14N-SLAB								
5a1	39	31-11	STR					
5a2	197	27-11	STR					
5a3	197	35-11	22	31-2	4-9	0-2 1/2		
4b1	51	6-3	1	1-3	5-0			
4b2	172	23-8	STR					
5b3	130	45-8	STR					
5b4	44	22-5	STR					
4k1	4	22-0	STR					
4k2	6	23-4	STR					
4k3	5	18-0	22	9-0	9-0	0-4 1/2		
4k4	1	6-0	22	3-0	3-0	0-1 1/2		
4k5	2	7-0	22	3-6	3-6	0-1 3/4		
4k6	1	6-6	22	3-3	3-3	0-1 5/8		
4k7	8	6-0	STR					
4k8	12	7-0	STR					
4k9	6	6-6	STR					
4k10	2	2-3	STR					
4k11	6	2-9	STR					
4k12	2	2-6	STR					
6k13	2	2-0	STR					
6k14	2	22-10	STR					
6k15	1	18-0	22	9-0	9-0	0-4 1/2		
6k16	1	5-6	22	2-9	2-9	0-1 3/8		
8k17	8	7-9	4	4-0	2-1 1/4	1-8		
8k18	16	15-0	5	5-0	2-1 1/4	2-9		
8k19	8	15-0	6	4-0	2-1 1/4	2-9		
5k20	14	6-0	STR					
5k21	14	7-6	20	5-6	1-0	0-8 1/2		
4k22	6	5-6	STR					
4s1	44	4-9	39	1-3	0-11	2-0		
5s2	42	6-10	3	1-0	0-7	2-4	2-4	
4s3	42	7-3	14	0-5	2-10			
5s4	84	4-11	10				SEE BAR TYPE	
5s5	84	5-1	8				SEE BAR TYPE	
5s6	4	6-10	9				SEE BAR TYPE	
5s7	4	4-6	8				SEE BAR TYPE	

SPANS 13N THRU 3N-SLAB							
5a1	308	31-11	STR				
5a2	194	27-11	STR				
5a3	194	35-11	22	31-2	4-9	0-2 1/2	
4b2	172	23-3	STR				
5b3	180	45-6	STR				
5b4	44	22-2	STR				
8k17	8	7-9	4	4-0	2-1 1/4	1-8	
8k18	16	15-0	5	4-0	2-1 1/4	2-9	
8k19	8	15-0	6	4-0	2-1 1/4	2-9	
5k20	14	6-0	STR				
5k21	14	7-6	20	5-6	1-0	0-8 1/2	
5s2	84	6-10	3	1-0	0-7	2-4	2-4
4s3	42	7-3	14	0-5	2-10		
5s4	184	4-11	10				SEE BAR TYPE
5s5	184	5-1	8				SEE BAR TYPE

BAR MARK	NO.	L'GTH	TYPE	DIMENSIONS				REMARKS
				A	B	C	D	
SPAN 2N-SLAB								
5a1	275	31-11	STR					
5a2	148	27-11	STR					
5a3	148	35-11	22	31-2	4-9	0-2 1/2		
5a4	48	59-11	22	31-2	28-9	1-2 3/4	2 EA TO 1	
TO		32-2		31-2	1-0	0-1 1/2		
5a5		31-2	STR				2 EA TO 1	
TO		20-4						
5a6		33-8	STR					
5a7		32-6	STR					
5a8		19-3	STR					
5a9		17-7	STR					
5a10		18-3	STR					
5a11		14-9	STR					
5a12		14-8	STR					
5a13		14-6	STR					
5a14		13-6	STR					
5a15		9-8	STR					
5a16		9-9	STR					
5a17		9-10	STR					
5a18		9-11	STR					
5a19		10-0	STR					
5a20		10-1	STR					
5a21		10-2	STR					
4b2	86	30-0	STR					
5b3	75	46-0	STR					
4b4	41	9-8	STR				1 EA TO 1	
TO		29-7						
5b5	9	24-1	STR				1 EA TO 1	
TO		25-11						
5b6	9	26-10	STR				1 EA TO 1	
TO		28-8						
5b7	9	29-6	STR				1 EA TO 1	
TO		31-4						
5b8	9	32-2	STR				1 EA TO 1	
TO		34-0						
5b9	9	34-10	STR				1 EA TO 1	
TO		36-8						
5b10	9	37-6	STR				1 EA TO 1	
TO		39-4						
5b11	9	40-2	STR				1 EA TO 1	
TO		42-0						
4b12	1	9-4	STR					
4b13	1	29-6	STR					
5b14	5	22-11	STR					
5b15	1	23-3	STR					
5b16	5	43-0	STR					
5b17	1	42-9	STR					
5b18	48	21-9	STR					
5b19	8	23-7	STR					
8k17	4	7-10	4	4-0	2-1 1/4	1-8		
8k18	8	15-0	5	4-0	2-1 1/4	2-9		
8k19	4	15-0	6	4-0	2-1 1/4	2-9		
5k20	14	6-2	STR					
5k21	14	7-8	20	5-8	1-0	0-8 1/2		
8k22	4	8-1	4	4-3	2-1 1/4	1-9		
8k23	12	5-8	5	4-3	2-1 1/4	2-11		
5s2	84	6-11	3	1-0	0-7 1/2	2-4	2-4	

BAR MARK	NO.	L'GTH	TYPE	DIMENSIONS				REMARKS
				A	B	C	D	
SPAN 2N-SLAB (CONTINUED)								
4s3	42	7-4	14	0-5 1/2	2-10			
5s4	163	4-11	10				SEE BAR TYPE	
5s5	163	5-1	8				SEE BAR TYPE	
SPAN 1N-SLAB								
5a1	666	33-8	STR					
5a2	332	29-6	STR					
5a3	332	37-11	22	32-11	5-0	0-2 1/2		
5a4	2	32-6	STR					
4b2	129	22-7	STR					
8b3	123	51-4	STR					
5b4	123	85-0	STR					
5b5	72	51-0	STR					
5b6	78	46-0	STR					
5b7	38	40-0	STR					
5b8	39	50-0	STR					
5b9	80	21-9	STR					
5b10	16	28-11	STR					
5k20	14	6-2	STR					
5k21	14	7-8	20	5-8	1-0	0-8 1/2		
8k22	8	7-11	4	4-0	2-1 1/4	1-10		
8k23	24	15-5	5	4-0	2-1 1/4	3-2		
4k24	28	9-6	STR					
4k25	56	5-10	STR					
5s2	84	6-11	3	1-0	0-7 1/2	2-4	2-4	
4s3	42	7-4	14	0-5 1/2	2-10			
5s4	290	4-11	10				SEE BAR TYPE	
5s5	290	5-1	8				SEE BAR TYPE	
4s6	35	8-11	14	0-9	3-4			
5s7	42	5-3	15	0-7	2-4			
4s8	6	14-11	14	0-9 1/2	4-4			
4s9	12	15-3	14	0-9 1/2	6-6			
4s10	12	15-9	14	0-9 1/2	6-9			
4s11	12	16-3	14	0-9 1/2	7-0			
DROP-IN SPAN - SLAB								
5a1	440	33-8	STR					
5a2	220	29-6	STR					
5a3	220	37-11	22	32-11	5-0	0-2 1/2		
5a4	2	32-6	STR					
5a5	2	36-8	22	31-8	5-0	0-2 1/2		
4b2	172	23-8	STR					
5b3	180	46-4	STR					
5b4	80	18-0	STR					
5k20	14	6-2	STR					
5k21	14	7-8	20	5-8	1-0	0-8 1/2		
8k22	8	7-11	4	4-0	2-1 1/4	1-10		
8k23	24	15-5	5	4-0	2-1 1/4	3-2		
8k24	8	27-1	STR					
8k25	4	10-2	STR					
5s2	84	6-11	3	1-0	0-7 1/2	2-4	2-4	
4s3	42	7-4	14	0-5 1/2	2-10			
5s4	190	4-11	10				SEE BAR TYPE	
5s5	190	5-1	8				SEE BAR TYPE	
4s6	84	1-8	28	0-5	0-9			

N.C. STATE AID PROJECT NO.		FED. NO.
FEDERAL AID PROJECT NO.		DR. NO.

NOTE:
FOR BAR BENDING DIAGRAMS, SEE PLATE
NUMBERS S-55 AND S-56.

RECORD DRAWING

DESIGNED BY: K.G. CHECKED BY: M.A.M.
 PREPARED BY: *[Signature]*
 PRINCIPAL OF FIRM HNTB

HNTB HOWARD NEEDLES TAMMEN & BERENDORFF
 ARCHITECTS ENGINEERS PLANNERS
 ATLANTA, GEORGIA

ATLANTIC INTRACOASTAL WATERWAY
REINFORCING BAR LIST
 COINJOCK BRIDGE REPLACEMENT PROJECT
 CURRITUCK COUNTY NORTH CAROLINA

DRAWING NO. BR104-06-17 PLATE NO. **8-57**
 DATE 22 JULY 1983 SHEET 107 OF 126

BAR MARK	NO.	LGTH	TYPE	DIMENSIONS			REMARKS
				A	B	C	
SUPERSTRUCTURE							
SPAN 1S-SLAB							
5a1	666	33-8	STR				
5a2	332	29-6	STR				
5a3	332	17-11	22	32-11	5-0	0-2 1/2	
5a4	2	32-6	STR				
4b2	129	22-7	STR				
6b3	123	51-6	STR				
5b4	123	25-0	STR				
5b5	72	51-0	STR				
5b6	78	46-0	STR				
5b7	36	40-0	STR				
5b8	39	60-0	STR				
5b9	80	21-9	STR				
5b10	16	28-11	STR				
5a20	14	6-2	STR				
5a21	14	7-8	20	5-8	1-0	0-8 1/2	
8a22	8	7-11	4	4-0	2-1 1/4	1-10	
8a23	24	15-5	5	4-0	2-1 1/4	3-2	
4a24	28	9-6	STR				
4a25	56	5-10	STR				
5a2	84	6-11	3	1-0	0-7 1/2	2-4	2-4
4a3	42	7-4	14	0-5 1/2	2-10		
5a4	290	4-11	10				SEE BAR TYPE
5a5	290	5-1	8				SEE BAR TYPE
4a6	35	8-11	14	0-9	3-4		
5a7	42	5-3	15	0-7	2-4		
4a8	6	14-11	14	0-9 1/2	6-4		
4a9	12	15-3	14	0-9 1/2	6-6		
4a10	12	15-9	14	0-9 1/2	6-9		
4a11	12	16-3	14	0-9 1/2	7-0		
SPAN 2S-SLAB							
5a1	296	31-11	STR				
5a2	148	27-11	STR				
5a3	148	35-11	22	31-2	4-9	0-2 1/2	
5a4	42	59-11	22	31-2	28-9	1-2 3/8	2 EA TO U
10 U		32-2		31-2	1-0	0-1 1/2	
5a5	9	31-2	STR				2 EA TO I
10 I		20-4					
5a6	1	33-8	STR				
5a7	1	32-6	STR				
5a8	2	19-3	STR				
5a9	2	17-7	STR				
5a10	2	18-3	STR				
5a11	2	14-9	STR				
5a12	2	14-8	STR				
5a13	2	14-6	STR				
5a14	2	13-6	STR				
5a15	2	9-8	STR				
5a16	2	9-9	STR				
5a17	2	9-10	STR				
5a18	2	9-11	STR				
5a19	2	10-0	STR				
5a20	2	0-1	STR				
5a21	2	10-2	STR				
4b2	86	30-0	STR				

BAR MARK	NO.	LGTH	TYPE	DIMENSIONS			REMARKS
				A	B	C	
SPAN 2S-SLAB (CONTINUED)							
5b3	78	46-0	STR				
4b4	41	9-9	STR				1 EA TO OO
10 OO		29-7					
5b5	9	24-1	STR				1 EA TO I
10 I		25-11					
5b6	9	26-10	STR				1 EA TO I
10 I		28-8					
5b7	9	29-6	STR				1 EA TO I
10 I		31-4					
5b8	9	32-2	STR				1 EA TO I
10 I		34-0					
5b9	9	34-10	STR				1 EA TO I
10 I		36-8					
5b10	9	37-6	STR				1 EA TO I
10 I		39-4					
5b11	9	40-2	STR				1 EA TO I
10 I		42-0					
4b12	1	9-4	STR				
4b13	1	29-6	STR				
5b14	5	22-11	STR				
5b15	1	23-3	STR				
5b16	5	43-0	STR				
5b17	1	42-9	STR				
5b18	48	21-9	STR				
5b19	8	23-7	STR				
8a17	4	7-10	4	4-0	2-1 1/4	1-8	
8a18	8	15-0	5	4-0	2-1 1/4	2-9	
8a19	4	15-0	6	4-0	2-1 1/4	2-9	
5a20	14	6-2	STR				
5a21	14	7-8	20	5-8	1-0	0-8 1/2	
8a22	4	8-1	4	4-3	2-1 1/4	1-9	
8a23	12	15-8	5	4-3	2-1 1/4	2-11	
5a2	84	6-11	3	1-0	0-7 1/2	2-4	2-4
4a3	42	7-4	14	0-5 1/2	2-10		
5a4	163	4-11	10				SEE BAR TYPE
5a5	163	5-1	8				SEE BAR TYPE
SPANS 1S THRU 3S-SLAB							
5a1	388	31-11	STR				
5a2	194	27-11	STR				
5a3	194	35-11	22	31-2	4-9	0-2 1/2	
4b2	172	23-3	STR				
5b3	150	45-8	STR				
5b4	64	22-2	STR				
8a17	8	7-9	4	4-0	2-1 1/4	1-8	
8a18	16	15-0	5	4-0	2-1 1/4	2-9	
8a19	8	15-0	6	4-0	2-1 1/4	2-9	
5a20	14	6-0	STR				
5a21	14	7-6	20	5-6	1-0	0-8 1/2	
5a2	84	6-10	3	1-0	0-7	2-4	2-4
4a3	42	7-3	14	0-5	2-10		
5a4	184	4-11	10				SEE BAR TYPE
5a5	184	5-1	8				SEE BAR TYPE

BAR MARK	NO.	LGTH	TYPE	DIMENSIONS			REMARKS
				A	B	C	
SPAN 12S-SLAB							
5a1	394	31-11	STR				
5a2	197	27-11	STR				
5a3	197	35-11	22	31-2	4-9	0-2 1/2	
4b1	59	6-3	1	1-3	5-0		
4b2	172	23-8	STR				
5b3	150	45-8	STR				
5b4	64	22-5	STR				
4a1	4	22-0	STR				
4a2	6	23-6	STR				
4a3	5	18-0	22	9-0	9-0	0-4 1/2	
4a4	1	6-0	22	3-0	3-0	0-1 1/2	
4a5	2	7-0	22	3-6	3-6	0-1 3/4	
4a6	1	6-6	22	3-3	3-3	0-1 5/8	
4a7	6	6-0	STR				
4a8	12	7-0	STR				
4a9	6	6-6	STR				
4a10	2	2-3	STR				
4a11	6	2-9	STR				
4a12	2	2-6	STR				
4a13	2	2-0	STR				
4a14	2	22-10	STR				
4a15	1	18-0	22	9-0	9-0	0-4 1/2	
4a16	1	5-6	22	2-9	2-9	0-1 3/8	
8a17	8	7-9	4	4-0	2-1 1/4	1-8	
8a18	16	15-0	5	5-0	2-1 1/4	2-9	
8a19	8	15-0	6	4-0	2-1 1/4	2-9	
5a20	14	6-0	STR				
5a21	14	7-6	20	5-6	1-0	0-8 1/2	
4a22	6	5-6	STR				
4a1	44	4-9	39	1-5	0-11	2-0	
5a2	42	6-10	3	1-0	0-7	2-4	2-4
4a3	42	7-3	14	0-5	2-10		
5a4	186	4-11	10				SEE BAR TYPE
5a5	186	5-1	8				SEE BAR TYPE
5a6	4	6-10	9				SEE BAR TYPE
5a7	4	4-6	8				SEE BAR TYPE

N.C. STATE AID PROJECT NO.	FEDERAL AID PROJECT NO.	ISS. NO.
		126 55

NOTE:
FOR BAR BENDING DIAGRAMS, SEE PLATE
NUMBERS S-55 AND S-56.

DESIGNED BY: K.G. CHECKED BY: M.A.M.
 PREPARED BY: *[Signature]*
 PRINCIPAL OF FIRM HNTB

RECORD DRAWING

HNTB HOWARD NEEDLES TAMMEN & BERGENDOFF ARCHITECTS ENGINEERS PLANNERS ATLANTA, GEORGIA
 U.S. ARMY ENGINEER DISTRICT, WILMINGTON CORPS OF ENGINEERS WILMINGTON, NORTH CAROLINA

**ATLANTIC INTRACOASTAL WATERWAY
 REINFORCING BAR LIST**

COINJOCK BRIDGE REPLACEMENT PROJECT
 CURRITUCK COUNTY NORTH CAROLINA

INVITATION NO. DATE: 4-83-5-0014
 SCALE: NONE DATE: 22 JULY 1983 SHEET 108 OF 126
 DRAWING NUMBER: BR104-06-17
 PLATE NO: S-58

BAR MARK	NO.	LGTH	TYPE	DIMENSIONS				REMARKS
				A	B	C	D	
SUPERSTRUCTURE								
SPANS 14N THRU 3N GIRDERS G1 THRU G8								
NO. SHOWN IS FOR (1) GIRDER, (6) REQUIRED OF EACH FOR (12) SPANS								
4s1	61	10-10	24	3-4	0-4 1/4	1-3		
4s2	12	10-10	24	3-7	0-4 1/4	1-0		
4s3	4	8-11	15	0-11	4-0			
4s4	12	3-5	23	1-6	0-7	1-4		
4s5	10	8-5	15	0-4 1/2	4-0			
4s6	2	9-10	15	1-10	4-0			
4s7	8	3-3	23	1-5 1/2	0-5 1/2	1-4		
4s8	4	45-6	STR					
SPAN 2N-GIRDERS G1 THRU G4								
4s1	45	10-10	24	3-4	0-4 1/4	1-3	GIRDER G 1	
4s2	11	10-10	24	3-7	0-4 1/4	1-0		
4s3	4	8-11	15	0-11	4-0			
4s4	12	3-5	23	1-6	0-7	1-4		
4s5	10	8-5	15	0-4 1/2	4-0			
4s6	2	9-10	15	1-10	4-0			
4s7	8	3-3	23	1-5 1/2	0-5 1/2	1-4		
4s8	1	10-1	24	3-7	0-4 1/4	0-7 1/2		
4s9	4	34-10	STR					
4s1	47	10-10	24	3-4	0-4 1/4	1-3	GIRDER G 2	
4s2	11	10-10	24	3-7	0-4 1/4	1-0		
4s3	4	8-11	15	0-11	4-0			
4s4	12	3-5	23	1-6	0-7	1-4		
4s5	10	8-5	15	0-4 1/2	4-0			
4s6	2	9-10	15	1-10	4-0			
4s7	8	3-3	23	1-5 1/2	0-5 1/2	1-4		
4s8	1	10-1	24	3-7	0-4 1/4	0-7 1/2		
4s9	4	36-2	STR					
4s1	49	10-10	24	3-4	0-4 1/4	1-3	GIRDER G 3	
4s2	11	10-10	24	3-7	0-4 1/4	1-0		
4s3	4	8-11	15	0-11	4-0			
4s4	12	3-5	23	1-6	0-7	1-4		
4s5	10	8-5	15	0-4 1/2	4-0			
4s6	2	9-10	15	1-10	4-0			
4s7	8	3-3	23	1-5 1/2	0-5 1/2	1-4		
4s8	1	10-1	24	3-7	0-4 1/4	0-7 1/2		
4s9	4	38-11	STR					
4s1	51	10-10	24	3-4	0-4 1/4	1-3	GIRDER G 4	
4s2	11	10-10	24	3-7	0-4 1/4	1-0		
4s3	4	8-11	15	0-11	4-0			
4s4	12	3-5	23	1-6	0-7	1-4		
4s5	10	8-5	15	0-4 1/2	4-0			
4s6	2	9-10	15	1-10	4-0			
4s7	8	3-3	23	1-5 1/2	0-5 1/2	1-4		
4s8	1	10-1	24	3-7	0-4 1/4	0-7 1/2		
4s9	4	38-11	STR					

BAR MARK	NO.	LGTH	TYPE	DIMENSIONS				REMARKS
				A	B	C	D	
SPAN 2N-GIRDERS G5 THRU G8								
4s1	53	10-10	24	3-4	0-4 1/4	1-3	GIRDER G 5	
4s2	11	10-10	24	3-7	0-4 1/4	1-0		
4s3	4	8-11	15	0-11	4-0			
4s4	12	3-5	23	1-6	0-7	1-4		
4s5	10	8-5	15	0-4 1/2	4-0			
4s6	2	9-10	15	1-10	4-0			
4s7	8	3-3	23	1-5 1/2	0-5 1/2	1-4		
4s8	1	10-1	24	3-7	0-4 1/4	0-7 1/2		
4s9	4	40-3	STR					
4s1	55	10-10	24	3-4	0-4 1/4	1-3	GIRDER G 6	
4s2	11	10-10	24	3-7	0-4 1/4	1-0		
4s3	4	8-11	15	0-11	4-0			
4s4	12	3-5	23	1-6	0-7	1-4		
4s5	10	8-5	15	0-4 1/2	4-0			
4s6	2	9-10	15	1-10	4-0			
4s7	8	3-3	23	1-5 1/2	0-5 1/2	1-4		
4s8	1	10-1	24	3-7	0-4 1/4	0-7 1/2		
4s9	4	41-7	STR					
4s1	57	10-10	24	3-4	0-4 1/4	1-3	GIRDER G 7	
4s2	11	10-10	24	3-7	0-4 1/4	1-0		
4s3	4	8-11	15	0-11	4-0			
4s4	12	3-5	23	1-6	0-7	1-4		
4s5	10	8-5	15	0-4 1/2	4-0			
4s6	2	9-10	15	1-10	4-0			
4s7	8	3-3	23	1-5 1/2	0-5 1/2	1-4		
4s8	1	10-1	24	3-7	0-4 1/4	0-7 1/2		
4s9	4	42-11	STR					
4s1	59	10-10	24	3-4	0-4 1/4	1-3	GIRDER G 8	
4s2	11	10-10	24	3-7	0-4 1/4	1-0		
4s3	4	8-11	15	0-11	4-0			
4s4	12	3-5	23	1-6	0-7	1-4		
4s5	10	8-5	15	0-4 1/2	4-0			
4s6	2	9-10	15	1-10	4-0			
4s7	8	3-3	23	1-5 1/2	0-5 1/2	1-4		
4s8	1	10-1	24	3-7	0-4 1/4	0-7 1/2		
4s9	4	44-3	STR					
SPAN IN-SEGMENT INa - GIRDERS								
4s1	64	10-10	24	3-4	0-4 1/4	1-3	TYPICAL FOR	
4s2	5	10-10	24	3-7	0-4 1/4	1-0	G1 THRU G8	
4s3	2	9-0	15	1-0	4-0			
4s4	38	3-5	23	1-6	0-7	1-4		
4s5	5	8-5	15	0-4 1/2	4-0			
4s6	1	9-9	15	1-9	4-0			
4s7	4	3-3	23	1-5 1/2	0-5 1/2	1-4		
4s8	1	10-1	24	3-4	0-4 1/4	0-7 1/2		
4s9	4	35-6	STR					
4s10	10	10-11	30	3-4	0-4 1/4	1-3	0-11	
4s11	6	14-7	14	1-11	4-11			
10s12	4	9-3	STR					
10s13	4	10-3	STR					
11s14	5	8-9	STR					
11s15	5	7-9	STR					
5s16	2	8-0	25	1-9 1/2	1-10	1-3		
5s17	3	6-6	25	1-9 1/2	1-1	1-3		

BAR MARK	NO.	LGTH	TYPE	DIMENSIONS				REMARKS
				A	B	C	D	
SPAN IN SPLICE - GIRDERS								
5s1	12	14-6	14	1-11	4-10		TYP. AT EA.	
5s2	8	8-7	31	1-3	1-8	2-0	0-2	
5s3	6	14-4	14	1-5	5-3			
5s4	4	3-9	STR					
5s5	9	2-7	2	1-11				
SPAN IN-SEGMENT INb - GIRDERS								
4s1	116	3-7	23	1-8	0-5	1-6	TYPICAL FOR	
4s2	6	10-11	7	1-0	4-0	0-11 1/2	G1 THRU G8 UN	
4s3	6	13-10	14	1-11	4-5			
4s4	1	14-2	14	1-5	5-1			
5s5 a	15	11-1	24	3-5	0-4 1/4	1-3 1/2	1 EA a to o	
to o		12-5		4-1	0-4 1/4	1-3 1/2		
5s6 a	15	12-7	24	4-2	0-4 1/4	1-3 1/2	1 EA a to o	
to o		15-1		5-5	0-4 1/4	1-3 1/2		
5s7 a	8	15-3	24	5-6	0-4 1/4	1-3 1/2	1 EA a to h	
to h		17-9		6-9	0-4 1/4	1-3 1/2		
5s8 a	3	18-3	24	7-0	0-4 1/4	1-3 1/2	1 EA a to c	
to c		18-9		7-3	0-4 1/4	1-3 1/2		
5s9	7	21-2	14	1-11	8-2			
5s10 a	3	18-1	24	6-11	0-4 1/4	1-3 1/2	1 EA a to c	
to c		18-9		7-3	0-4 1/4	1-3 1/2		
5s11 a	6	15-5	24	5-7	0-4 1/4	1-3 1/2	1 EA a to f	
to f		17-5		6-7	0-4 1/4	1-3 1/2		
5s12 a	8	13-3	24	4-6	0-4 1/4	1-3 1/2	1 EA a to h	
to h		15-3		5-6	0-4 1/4	1-3 1/2		
5s13 a	23	10-9	24	3-3	0-4 1/4	1-3 1/2	1 EA a to w	
to w		12-11		4-4	0-4 1/4	1-3 1/2		
4s14	18	8-1	15	1-11	3-1			
4s15	5	12-3	7	1-0	4-10	0-7		
4s16	5	8-8	14	1-11	1-10			
4s17	5	12-8	25	1-9 1/2	4-5	1-0		
5s18	3	9-4	25	1-9 1/2	2-9	1-0		
5s19	2	5-5	20	3-5	1-0	0-5		
11s20	1	7-6	27	3-9	3-9	1-7	2-2 E=0-61/B	
11s21	1	7-6	27	3-9	3-9	1-6	2-3 E=0-11/B	
11s22	1	7-6	27	3-9	3-9	1-6	2-3 E=0-11/B	
11s23	1	7-6	26	3-9	1-7	2-2	0-6 1/8	
9s24	2	39-10	29	4-0	26-10	29-0		
9s25	3	44-10	29	4-0	21-10	19-0		
4s26	7	3-9	15	0-6 1/2	1-7			
10s27	4	8-9	STR					
10s28	4	7-9	STR					
11s29	3	9-3	STR					
11s30	3	10-3	STR					
11s31	2	9-3	26	4-6	2-3	2-6	0-4	
11s32	2	10-3	26	5-6	2-3	2-6	0-1 1/2	
5s33	2	8-0	25	1-9 1/2	1-10	1-3		
5s34	3	6-6	25	1-9 1/2	0-1	1-3		
5s35	1	12-8	14	1-5	4-4			
5s36	16	9-3	20	3-5	2-11	1-1 1/2		
4s37	5	11-10	14	0-11	4-5			
5s38	3	4-7	36	0-9	1-1			
5s39	4	5-11	15	1-1	2-5			
5s40	3	5-8	15	0-7 1/2	2-5			
5s41	3	6-8	15	1-10	2-5			

N.C. STATE AID PROJECT NO.	
FEDERAL AID PROJECT NO.	

NOTE:
FOR BAR BENDING DIAGRAMS, SEE PLATE NUMBERS S-55 AND S-56.

RECORD DRAWING

DESIGNED BY: K.G. CHECKED BY: M.A.M.
 PREPARED BY: [Signature]
 PRINCIPAL OF FIRM HNTB

HNTB

N.C. STATE AID PROJECT NO.	FED. NO.
FEDERAL AID PROJECT NO.	DRY. NO.

BAR MARK	NO.	L'GTH	TYPE	DIMENSIONS				REMARKS
				A	B	C	D	
SUPERSTRUCTURE								
DROP-IN SPAN - GIRDERS								
4s1	84	10-10	24	3-4	0-4 1/4	1-3		8 REQUIRED
4s2	6	4-9	15	1-11	1-5			
4s3	6	4-11	15	1-11	1-6			
4s4	4	6-6	7	0-6	2-5	0-7 1/2		
3s5	22	2-7	2	1-11				
4s6	10	11-2	7	0-6	4-9	0-7 1/2		
4s7	14	13-6	14	1-11	4-3			
4s8	4	7-2	7	0-6	2-9	0-7 1/2		
4s9	4	8-3	14	1-7	1-11 1/4			
4s10	2	3-7	25	1-5	0-7	0-6		
6s11	2	12-0	14	1-2	4-3			
4s12	34	4-3	25	1-5	0-7	0-10		
4s13	28	5-7	25	1-11	0-7	1-3		
9s14	2	5-10	24	2-7	2-2	1-1	1-6 1/2	
9s15	2	6-6	24	3-3	2-2	1-1	1-6 1/2	
9s16	4	19-8	STR					
9s17	4	19-3	STR					
6s18	20	11-0	14	1-4	3-7			
5s19	8	4-7	24	1-10	1-6	1-3	1-1	
11s20	2	7-6	27	2-9	4-9	1-7	3-2	E=0-61/8
11s21	2	7-6	27	2-9	4-9	1-6	3-3	E=0-11/8
11s22	2	7-6	27	2-9	4-9	1-6	3-3	E=0-11/8
11s23	2	7-6	27	2-9	4-9	1-7	3-2	E=0-61/8
5s24	2	40-0	STR					
SPAN IS-SEGMENT ISb - GIRDERS								
4s1	116	3-7	23	1-8	0-5	1-6		TYPICAL FOR
6s2	6	10-11	7	1-0	4-0	0-11 1/2		G1 THRU GR11
4s3	6	13-10	14	1-11	4-5			
4s4	1	14-2	14	1-5	5-1			
5s5	a	15	11-1	24	3-5	0-4 1/4	1-3 1/2	1 EA # to g
			12-5		4-1	0-4 1/4	1-3 1/2	
5s6	a	15	12-7	24	4-2	0-4 1/4	1-3 1/2	1 EA # to o
			15-1		5-5	0-4 1/4	1-3 1/2	
5s7	a	8	15-3	24	5-6	0-4 1/4	1-3 1/2	1 EA # to h
			17-9		6-9	0-4 1/4	1-3 1/2	
5s8	a	3	18-3	24	7-0	0-4 1/4	1-3 1/2	1 EA # to c
			18-9		7-3	0-4 1/4	1-3 1/2	
5s9		7	21-2	14	1-11	8-2		
5s10	a	3	18-1	24	6-11	0-4 1/4	1-3 1/2	1 EA # to c
			18-9		7-3	0-4 1/4	1-3 1/2	
5s11	a	6	15-5	24	5-7	0-4 1/4	1-3 1/2	1 EA # to f
			17-5		6-7	0-4 1/4	1-3 1/2	
5s12	a	8	13-3	24	4-6	0-4 1/4	1-3 1/2	1 EA # to h
			15-3		5-6	0-4 1/4	1-3 1/2	
5s13	a	23	10-9	24	3-3	0-4 1/4	1-3 1/2	1 EA # to w
			12-11		4-4	0-4 1/4	1-3 1/2	
6s14	18	8-1	15	1-11	3-1			
6s15	5	12-3	7	1-0	4-10	0-7		
6s16	5	8-8	14	1-11	1-10			
6s17	5	12-8	25	1-9 1/2	4-5	1-0		
5s18	3	9-4	25	1-9 1/2	2-9	1-0		
5s19	2	5-5	20	3-5	1-0	0-5		
11s20	1	7-6	27	3-9	3-9	1-7	2-2	E=0-61/8
11s21	1	7-6	27	3-9	3-9	1-6	2-3	E=0-11/8

BAR MARK	NO.	L'GTH	TYPE	DIMENSIONS				REMARKS
				A	B	C	D	
SPAN IS-SEGMENT ISb - GIRDERS (Continued)								
11s22	1	7-6	27	3-9	3-9	1-6	2-3	E=0-11/8
11s23	1	7-6	26	3-9	1-7	2-2	0-6 1/8	
9s24	2	59-10	29	4-0	26-10	29-0		
9s25	3	44-10	29	4-0	21-10	19-0		
4s26	7	3-9	15	0-6 1/2	1-7			
10s27	4	8-9	STR					
10s28	4	7-9	STR					
11s29	3	9-3	STR					
11s30	3	10-3	STR					
11s31	2	9-3	26	4-6	2-3	2-6	0-4	
11s32	2	10-3	26	5-6	2-3	2-6	0-1 1/2	
5s33	2	8-0	25	1-9 1/2	1-10	1-3		
5s34	3	6-6	25	1-9 1/2	0-1	1-3		
6s35	1	12-8	14	1-5	4-4			
5s36	16	9-3	20	3-5	2-11	1-1 1/2		
6s37	5	11-10	14	0-11	4-5			
FOR CONTINUATION, SEE LISTING IN LOWER RIGHT CORNER								
SPAN IS-SPLICE - GIRDERS								
5s1	12	14-6	14	1-11	4-10			TYP. AT EA.
5s2	8	8-7	31	1-3	1-8	2-0	0-2	SPL. G1-08
5s3	6	14-4	14	1-5	5-3			
5s4	4	3-9	STR					
3s5	9	2-7	2	1-11				
SPAN IS-SEGMENT ISa - GIRDERS								
4s1	44	10-10	24	3-4	0-4 1/4	1-3		TYPICAL FOR
4s2	5	10-10	24	3-7	0-4 1/4	1-0		G1 THRU G8
4s3	2	9-0	15	1-0	4-0			
4s4	38	3-5	23	1-6	0-7	1-4		
4s5	5	8-5	15	0-4 1/2	4-0			
6s6	1	9-9	15	1-9	4-0			
4s7	4	3-3	23	1-5 1/2	0-5 1/2	1-4		
6s8	1	10-1	24	3-4	0-4 1/4	0-7 1/2		
5s9	4	35-6	STR					
4s10	10	10-11	30	3-4	0-4 1/4	1-3	0-11	
5s11	6	14-7	14	1-11	4-11			
10s12	4	9-3	STR					
10s13	4	10-3	STR					
11s14	5	8-9	STR					
11s15	5	7-9	STR					
5s16	2	8-0	25	1-9 1/2	1-10	1-3		
5s17	3	6-6	25	1-9 1/2	1-1	1-3		
SPAN 2S - GIRDER G1								
4s1	59	10-10	24	3-4	0-4 1/4	1-3		GIRDER G 1
6s2	11	10-10	24	3-7	0-4 1/4	1-0		
4s3	4	8-11	15	0-11	4-0			
4s4	12	3-5	23	1-6	0-7	1-4		
4s5	10	8-5	15	0-4 1/2	4-0			
6s6	2	9-10	15	1-10	4-0			
4s7	8	3-3	23	1-5 1/2	0-5 1/2	1-4		
6s8	1	10-1	24	3-7	0-4 1/4	0-7 1/2		
5s9	4	37-6	STR					
SPAN IS-SEGMENT ISb - GIRDERS (Continued)								
5s38	3	4-7	36	0-9	1-1			BARS 5s38
5s39	4	5-11	15	1-1	2-5			THRU 5s39
5s40	3	5-6	15	0-7 1/2	2-5			ARE REQ'D AT
5s41	3	6-8	15	1-10	2-5			G1 & G8 ONLY

BAR MARK	NO.	L'GTH	TYPE	DIMENSIONS				REMARKS
				A	B	C	D	
SPAN 2S-GIRDERS G2 THRU G6								
4s1	57	10-10	24	3-4	0-4 1/4	1-3		GIRDER G 2
6s2	11	10-10	24	3-7	0-4 1/4	1-0		
4s3	4	8-11	15	0-11	4-0			
4s4	12	3-5	23	1-6	0-7	1-4		
4s5	10	8-5	15	0-4 1/2	4-0			
6s6	2	9-10	15	1-10	4-0			
4s7	8	3-3	23	1-5 1/2	0-5 1/2	1-4		
6s8	1	10-1	24	3-7	0-4 1/4	0-7 1/2		
5s9	4	42-11	STR					
4s1	55	10-10	24	3-4	0-4 1/4	1-3		GIRDER G 3
6s2	11	10-10	24	3-7	0-4 1/4	1-0		
4s3	4	8-11	15	0-11	4-0			
4s4	12	3-5	23	1-6	0-7	1-4		
4s5	10	8-5	15	0-4 1/2	4-0			
6s6	2	9-10	15	1-10	4-0			
4s7	8	3-3	23	1-5 1/2	0-5 1/2	1-4		
6s8	1	10-1	24	3-7	0-4 1/4	0-7 1/2		
5s9	4	41-7	STR					
4s1	53	10-10	24	3-4	0-4 1/4	1-3		GIRDER G 4
6s2	11	10-10	24	3-7	0-4 1/4	1-0		
4s3	4	8-11	15	0-11	4-0			
4s4	12	3-5	23	1-6	0-7	1-4		
4s5	10	8-5	15	0-4 1/2	4-0			
6s6	2	9-10	15	1-10	4-0			
4s7	8	3-3	23	1-5 1/2	0-5 1/2	1-4		
6s8	1	10-1	24	3-7	0-4 1/4	0-7 1/2		
5s9	4	40-3	STR					
4s1	51	10-10	24	3-4	0-4 1/4	1-3		GIRDER G 5
6s2	11	10-10	24	3-7	0-4 1/4	1-0		
4s3	4	8-11	15	0-11	4-0			
4s4	12	3-5	23	1-6	0-7	1-4		
4s5	10	8-5	15	0-4 1/2	4-0			
6s6	2	9-10	15	1-10	4-0			
4s7	8	3-3	23	1-5 1/2	0-5 1/2	1-4		
6s8	1	10-1	24	3-7	0-4 1/4	0-7 1/2		
5s9	4	38-11	STR					
4s1	49	10-10	24	3-4	0-4 1/4	1-3		GIRDER G 6
6s2	11	10-10	24	3-7	0-4 1/4	1-0		
4s3	4	8-11	15	0-11	4-0			

BAR MARK	NO.	L'GTH	TYPE	DIMENSIONS				REMARKS
				A	B	C	D	
SUPERSTRUCTURE								
SPAN 2S - GIRDERS G7 AND G8								
4s1	47	10-10	24	3-4	0-4 1/4	1-3		GIRDER G 7
4s2	11	10-10	24	3-7	0-4 1/4	1-0		
4s3	4	8-11	15	0-11	4-0			
4s4	12	3-5	23	1-6	0-7	1-4		
4s5	10	8-5	15	0-4 1/2	4-0			
4s6	2	9-10	15	1-10	4-0			
4s7	8	3-3	23	1-5 1/2	0-5 1/2	1-4		
4s8	1	10-1	24	3-7	0-4 1/4	0-7 1/2		
5s9	4	34-2	STR					
SPAN 3S THRU 12S - GIRDERS G1 THRU G8								
NO. SHOWN IS FOR (1) GIRDER, (8) REQUIRED OF EACH FOR (10) SPANS								
4s1	45	10-10	24	3-4	0-4 1/4	1-3		GIRDER G 8
4s2	11	10-10	24	3-7	0-4 1/4	1-0		
4s3	4	8-11	15	0-11	4-0			
4s4	12	3-5	23	1-6	0-7	1-4		
4s5	10	8-5	15	0-4 1/2	4-0			
4s6	2	9-10	15	1-10	4-0			
4s7	8	3-3	23	1-5 1/2	0-5 1/2	1-4		
4s8	1	10-1	24	3-7	0-4 1/4	0-7 1/2		
5s9	4	34-10	STR					
SUBSTRUCTURE								
END BENT 1								
4s1	44	7-3	18	2-2	2-1 1/2			
4s2	44	2-11	2	2-2				
10b1	16	38-4	17	37-2				
8b2	4	36-1	STR					
4b3	12	23-8	STR					
4b4	4	10-8	STR					
4b5	20	5-2	15	2-2	1-6			
6b6	9	5-3	33	3-11				
6b7	3	11-1	34	1-11	3-11			
4b8	18	2-2	STR					
6b9	2	9-1	34	1-11	2-5			
6b10	6	3-9	33	2-5				
4b11	8	7-8	STR					
4h1	12	12-2	STR					
4h2	24	11-8	1	1-0	10-8			
4h3	12	5-8	15	0-8	2-6			
4h4	4	2-0	STR					
4v1	56	7-9	STR					
4v2	4	4-2	15	0-8	1-9			

BAR MARK	NO.	L'GTH	TYPE	DIMENSIONS				REMARKS
				A	B	C	D	
BENT 14N								
11b1	12	33-2	1	2-0	31-2			
11b2	28	17-10	STR					
5b3	4	59-8	STR					
5b4	2	52-8	STR					
5b5	8	15-1	37	1-6	11-0	2-7	1-11 3/4	
5b6	2	44-1	STR					
4b7	4	2-8	STR					
4b8	36	17-11	STR					
7a1	36	6-9	1	2-0	4-9			
7a2	34	8-9	1	2-0	6-9			
7a3	6	6-10	32	2-0	4-10	0-9 1/2		
5e1 a	84	11-9	36	1-7 1/2	3-9 1/4			4 EA e to u
to u		15-4		1-7 1/2	5-7			
5e2	19	5-0	15	2-6	1-3			
4e3	90	3-11	28	2-9	0-8			
4e4	18	7-8	15	2-8	2-6			
4e5	8	5-5	15	2-4 1/2	1-6			
4e6	8	4-3	15	0-9	1-9			
4e7	24	5-7	15	2-7	1-6			
4e8	24	5-6	15	2-6	1-6			
10t1	45	9-6	STR					
6t2	11	35-6	STR					
5t3	4	35-6	STR					
5t4	12	11-4	15	2-2	4-7			
7v1	34	12-10	STR					
7v2	34	12-6	STR					
7v3	4	10-3	STR					
7v4	10	13-0	STR					
BENT 13N								
11b1	10	46-2	20	38-0	4-11	0-8 3/4		
11b2	6	30-0	STR					
11b3	2	40-0	STR					
8b4	2	57-3	STR					
8b5	4	59-6	STR					
11b6	8	22-9	STR					
11b7	4	31-4	STR					
11b8	16	27-9	STR					
11b9	16	32-8	1	2-0	31-1			
5b10	8	10-6	32	7-11	2-7	1-5		
4b11	4	3-8	STR					
11b12	8	8-6	STR					
4c1	112	10-1	36	0-11	3-9			
4c2	56	15-9	36	3-9	3-9			
11a1	20	11-0	17	9-5				
11a2	20	16-1	17	14-6				
11a3	12	7-6	38	2-0	3-11			
11a4	4	5-0	STR					
4s1	16	9-9	36	2-6	2-0			
4s2	16	7-5	35	1-8	1-0			
4s3 a	6	7-9	36	2-6	1-0			2 EA e to c
to c		11-9		2-6	3-0			
5s4	8	5-8	15	3-8 1/4	1-0			
4s5	8	4-8	15	0-8	2-0			
5s6	88	17-4	36	2-6	5-8			
4s7	24	5-10	15	2-6	1-8			
4s8	24	6-4	15	3-0	1-8			
5s9 a	72	17-2	36	2-6	5-7			4 EA e to r
to r		13-8		2-6	3-10			
11t1	26	15-2	33	12-0				
11t2	32	17-2	33	14-0				
4t3	30	12-0	STR					
4t4	26	14-0	STR					
11t5	4	12-0	STR					
11t6	4	14-0	STR					
5t7	16	10-10	15	2-6	4-2			
5t8	4	15-10	15	2-2	6-10			
5t9	8	10-4	15	2-2	4-1			
11v1	20	33-0	17	31-7				
11v2	20	28-1	17	26-6				
11v3	20	16-11	17	15-4				

BAR MARK	NO.	L'GTH	TYPE	DIMENSIONS				REMARKS
				A	B	C	D	
BENT 13N (Continued)								
4s8	24	6-4	15	3-0	1-8			
5s9 a	72	17-2	36	2-6	5-7			4 EA e to r
to r		13-8		2-6	3-10			
11t1	26	15-2	33	12-0				
11t2	32	17-2	33	14-0				
4t3	30	12-0	STR					
4t4	26	14-0	STR					
11t5	4	12-0	STR					
11t6	4	14-0	STR					
5t7	16	10-10	15	2-6	4-2			
5t8	4	15-10	15	2-2	6-10			
5t9	8	10-4	15	2-2	4-1			
11v1	20	33-0	17	31-7				
11v2	20	28-1	17	26-6				
BENT 12N								
11b1	10	46-2	20	38-0	4-11	0-8 3/4		
11b2	6	30-0	STR					
11b3	2	40-0	STR					
8b4	2	57-3	STR					
8b5	4	59-6	STR					
11b6	8	22-9	STR					
11b7	4	31-4	STR					
11b8	16	27-9	STR					
11b9	16	32-8	1	2-0	31-1			
5b10	8	10-6	32	7-11	2-7	1-5		
4b11	4	3-8	STR					
11b12	8	8-6	STR					
4c1	112	10-1	36	0-11	3-9			
4c2	56	15-9	36	3-9	3-9			
11a1	20	11-0	17	9-5				
11a2	20	16-1	17	14-6				
11a3	12	7-6	38	2-0	3-11			
11a4	4	5-0	STR					
4s1	16	9-9	36	2-6	2-0			
4s2	16	7-5	35	1-8	1-0			
4s3 a	6	7-9	36	2-6	1-0			2 EA e to c
to c		11-9		2-6	3-0			
5s4	8	5-8	15	3-8 1/4	1-0			
4s5	8	4-8	15	0-8	2-0			
5s6	88	17-4	36	2-6	5-8			
4s7	24	5-10	15	2-6	1-8			
4s8	24	6-4	15	3-0	1-8			
5s9 a	72	17-2	36	2-6	5-7			4 EA e to r
to r		13-8		2-6	3-10			
11t1	26	15-2	33	12-0				
11t2	32	17-2	33	14-0				
4t3	30	12-0	STR					
4t4	26	14-0	STR					
11t5	4	12-0	STR					
11t6	4	14-0	STR					
5t7	16	10-10	15	2-6	4-2			
5t8	4	15-10	15	2-2	6-10			
5t9	8	10-4	15	2-2	4-1			
11v1	20							

N.C. STATE AID PROJECT NO		FED. RD. DIST. NO.
FEDERAL AID PROJECT NO		ROUTE NO.

BAR MARK	NO.	L'GTH	TYPE	DIMENSIONS				REMARKS
				A	B	C	D	
SUBSTRUCTURE								
BENT IIN								
11b1	10	46-2	20	38-0	4-11	0-8 3/4		
11b2	6	30-0	STR					
11b3	2	40-0	STR					
8b4	2	57-3	STR					
8b5	4	59-6	STR					
11b6	8	29-9	STR					
11b7	4	31-4	STR					
11b8	16	27-9	STR					
11b9	16	32-8	1	2-0	31-1			
5b10	8	10-6	32	7-11	2-7	1-5		
4b11	4	3-8	STR					
11b12	8	8-9	STR					
4c1	144	10-1	36	0-11	3-9			
4c2	72	15-9	36	3-9	3-9			
11a1	20	11-0	17	9-5				
11a2	20	16-1	17	14-6				
11a3	12	7-6	38	2-0	3-11			
11a4	4	5-0	STR					
4s1	16	9-9	36	2-6	2-0			
4s2	16	7-5	35	1-8	1-0			
4s3 a	4	7-9	36	2-6	1-0		2 EA a to c	
to c		11-9		2-6	3-0			
5s4	8	5-8	15	3-8 1/4	1-0			
4s5	8	4-8	15	0-8	2-0			
5s6	88	17-4	36	2-6	5-8			
4s7	24	5-10	15	2-6	1-8			
4s8	24	6-4	15	3-0	1-8			
5s9 a	72	17-2	36	2-6	5-7		4 EA a to r	
to r		13-8		2-6	3-10			
11t1	26	15-2	33	12-0				
11t2	32	17-2	33	14-0				
6t3	30	12-0	STR					
6t4	26	14-0	STR					
11t5	4	12-0	STR					
11t6	4	14-0	STR					
5t7	16	10-10	15	2-6	4-2			
5t8	4	15-10	15	2-2	6-10			
5t9	4	10-4	15	2-2	4-1			
11v1	40	23-5	STR					
11v2	20	23-10	17	23-10				
11v3	20	20-3	17	18-8				
BENT ION								
11b1	10	46-2	20	38-0	4-11	0-8 3/4		
11b2	6	30-0	STR					
11b3	2	40-0	STR					
8b4	2	57-3	STR					
8b5	4	59-6	STR					
11b6	8	29-9	STR					
11b7	4	31-4	STR					
11b8	16	27-9	STR					
11b9	16	32-8	1	2-0	31-1			
5b10	8	10-6	32	7-11	2-7	1-5		
4b11	4	3-8	STR					
11b12	8	8-9	STR					

BAR MARK	NO.	L'GTH	TYPE	DIMENSIONS				REMARKS
				A	B	C	D	
BENT ION (Continued)								
4c1	144	10-1	36	0-11	3-9			
4c2	72	15-9	36	3-9	3-9			
11a1	20	11-0	17	9-5				
11a2	20	16-1	17	14-6				
11a3	12	7-6	38	2-0	3-11			
11a4	4	5-0	STR					
4s1	16	9-9	36	2-6	2-0			
4s2	16	7-5	35	1-8	1-0			
4s3 a	4	8-5	36	2-6	1-4		2 EA a to c	
to c		12-5		2-6	3-4			
5s4	8	5-8	15	3-8 1/4	1-0			
4s5	8	4-8	15	0-8	2-0			
5s6	88	17-4	36	2-6	5-8			
4s7	24	5-10	15	2-6	1-8			
4s8	24	6-4	15	3-0	1-8			
5s9 a	72	17-1	36	2-6	5-7		4 EA a to r	
to r		13-7		2-6	3-10			
11t1	26	15-2	33	12-0				
11t2	32	17-2	33	14-0				
6t3	30	12-0	STR					
6t4	26	14-0	STR					
11t5	4	12-0	STR					
11t6	4	14-0	STR					
5t7	16	10-10	15	2-6	4-2			
5t8	4	15-10	15	2-2	6-10			
5t9	4	10-4	15	2-2	4-1			
11v1	40	23-5	STR					
11v2	20	23-5	17	23-10				
11v3	20	20-3	17	18-8				
BENT 9N								
11b1	10	46-2	20	39-0	3-7	0-8		
11b2	2	29-0	STR					
11b3	4	40-0	STR					
8b4	2	56-0	STR					
8b5	4	59-6	STR					
11b6	8	22-9	STR					
11b7	16	27-9	STR					
11b8	20	33-1	1	2-0	31-1			
5b9	8	10-6	32	7-10 1/2	2-7	1-5 3/4		
4b10	4	3-8	STR					
4c1	176	13-9	36	1-9	4-9			
4c2	88	19-9	36	4-9	4-9			
11a1	24	11-0	17	9-5				
11a2	24	16-1	17	14-6				
5a1	84	18-7	36	3-1 3/4	5-7 3/4			
5a2 a	56	14-8	36	3-1 3/4	3-8 3/4		4 EA a to n	
to n		18-5		3-1 3/4	5-7			
4s3	24	6-6	15	3-0	1-9			
4s4	24	6-0	15	2-6	1-9			
4s5	8	4-6	15	0-8	1-11			
5s6	8	7-6	15	4-5 3/4	1-6			
4t1	8	15-10	15	2-2	6-10			
5t2	6	27-6	STR					
11t3	27	17-2	33	14-0				
7t4	13	29-2	33	27-6				
6t5	27	15-4	33	14-0				

BAR MARK	NO.	L'GTH	TYPE	DIMENSIONS				REMARKS
				A	B	C	D	
BENT 9N (Continued)								
11t4	13	30-8	33	27-6				
11t7	2	14-0	STR					
11t8	2	27-6	STR					
6t9	2	14-0	STR					
11t10	2	27-6	STR					
11v1	48	25-4	STR					
11v2	24	27-2	17	23-7				
11v3	24	22-1	17	20-6				
BENT 8N								
11b1	10	46-2	20	39-0	3-7	0-8		
11b2	2	29-0	STR					
11b3	4	40-0	STR					
8b4	2	56-0	STR					
8b5	4	59-6	STR					
11b6	8	22-9	STR					
11b7	16	27-9	STR					
11b8	20	33-1	1	2-0	31-1			
5b9	8	10-6	32	7-10 1/2	2-7	1-5 3/4		
4b10	4	3-8	STR					
4c1	184	13-9	36	1-9	4-9			
4c2	92	19-9	36	4-9	4-9			
11a1	24	11-0	17	9-5				
11a2	24	16-1	17	14-6				
5a1	84	18-7	36	3-1 3/4	5-7 3/4			
5a2 a	56	14-8	36	3-1 3/4	3-8 3/4		4 EA a to n	
to n		18-5		3-1 3/4	5-7			
4s3	24	6-6	15	3-0	1-9			
4s4	24	6-0	15	2-6	1-9			
4s5	8	4-6	15	0-8	1-11			
5s6	8	7-6	15	4-5 3/4	1-6			
4t1	8	15-10	15	2-2	6-10			
5t2	6	27-6	STR					
11t3	27	17-2	33	14-0				
7t4	13	29-2	33	27-6				
6t5	27	15-4	33	14-0				

NOTE:
FOR BAR BENDING DIAGRAMS, SEE PLATE
NUMBERS S-55 AND S-56.

RECORD DRAWING

DESIGNED BY: K.G.	CHECKED BY: M.A.M.
PREPARED BY: <i>[Signature]</i>	
PRINCIPAL OF FIRM HNTB	

HNTB HOWARD NEEDLES TAMMEN & BERGENDOFF ARCHITECTS ENGINEERS PLANNERS ATLANTA, GEORGIA

U.S. ARMY ENGINEER DISTRICT, WILMINGTON, NORTH CAROLINA

ATLANTIC INTRACOASTAL WATERWAY

REINFORCING BAR LIST

COINJOCK BRIDGE REPLACEMENT PROJECT
CURRITUCK COUNTY NORTH CAROLINA

INVESTIGATION NO. DACW54-83-B-0014	SHEET 1	DRAWING NUMBER BR 104-06-17	PLATE NO. S-62
---------------------------------------	------------	--------------------------------	--------------------------

SCALE-NONE DATE 22-JULY 1983 SHEET 112 OF 126

BAR MARK	NO.	L'GTH	TYPE	DIMENSIONS				REMARKS
				A	B	C	D	
SUBSTRUCTURE								
BENT 7N								
11b1	10	46-2	20	39-0	3-7	0-8		
11b2	2	29-0	STR					
11b3	6	40-0	STR					
8b4	2	56-0	STR					
8b5	4	59-6	STR					
11b6	8	22-9	STR					
11b7	16	27-9	STR					
11b8	20	33-1	1	2-0	31-1			
5b9	8	10-6	32	7-10 1/2	2-7	1-5 3/4		
4b10	4	3-8	STR					
4c1	192	13-9	36	1-9	4-9			
4c2	96	19-9	36	4-9	4-9			
11a1	24	11-0	17	9-5				
11a2	24	16-1	17	14-6				
5a1	84	18-7	36	3-1 3/4	5-7 3/4			
5a2	56	14-8	36	3-1 3/4	3-8 3/4		4 EA a to n	
to n		18-5		3-1 3/4	5-7			
4a3	24	6-6	15	3-0	1-9			
4a4	24	6-0	15	2-6	1-9			
4a5	8	4-6	15	0-8	1-11			
5a6	8	7-6	15	4-5 3/4	1-6			
411	8	15-10	15	2-2	6-10			
512	6	27-6	STR					
1113	27	17-2	33	14-0				
714	13	29-2	33	27-6				
615	27	15-4	33	14-0				
1116	13	30-8	33	27-6				
1117	2	14-0	STR					
1118	2	27-6	STR					
619	2	14-0	STR					
11110	2	27-6	STR					
11v1	48	29-0	STR					
11v2	24	30-10	17	29-3				
11v3	24	25-9	17	24-2				
BENT 6N								
11b1	10	46-2	20	39-0	3-7	0-8		
11b2	2	29-0	STR					
11b3	6	40-0	STR					
8b4	2	56-0	STR					
8b5	4	59-6	STR					
11b6	8	22-9	STR					
11b7	16	27-9	STR					
11b8	20	33-1	1	2-0	31-1			
5b9	8	10-6	32	7-10 1/2	2-7	1-5 3/4		
4b10	4	3-8	STR					
4c1	200	13-9	36	1-9	4-9			
4c2	100	19-9	36	4-9	4-9			
11a1	24	11-0	17	9-5				
11a2	24	16-1	17	14-6				
5a1	84	18-7	36	3-1 3/4	5-7 3/4			
5a2	56	14-8	36	3-1 3/4	3-8 3/4		4 EA a to n	
to n		18-5		3-1 3/4	5-7			
4a3	24	6-6	15	3-0	1-9			
4a4	24	6-0	15	2-6	1-9			
4a5	8	4-6	15	0-8	1-11			
5a6	8	7-6	15	4-5 3/4	1-6			
5a7	26	14-3	15	3-3	5-6			
5a8	12	14-1	15	3-1	5-6			
411	8	17-2	15	2-2	7-6			
412	2	11-2	15	2-2	4-6			
513	6	27-6	STR					
1114	20	30-8	33	27-6				
1115	2	15-4	STR					
1116	29	18-8	33	15-6				
1117	2	27-6	STR					
518	26	15-2	15	3-2	6-0			
519	12	15-0	15	3-0	6-0			
11v1	48	29-0	STR					
11v2	24	31-4	17	29-9				
11v3	24	26-3	17	24-8				

BAR MARK	NO.	L'GTH	TYPE	DIMENSIONS				REMARKS
				A	B	C	D	
BENT 6N (Continued)								
4a5	8	4-6	15	0-8	1-11			
5a6	8	7-6	15	4-5 3/4	1-6			
411	8	15-10	15	2-2	6-10			
512	6	27-6	STR					
1113	27	17-2	33	14-0				
714	13	29-2	33	27-6				
615	27	15-4	33	14-0				
1116	13	30-8	33	27-6				
1117	2	14-0	STR					
1118	2	27-6	STR					
619	2	14-0	STR					
11110	2	27-6	STR					
11v1	48	29-0	STR					
11v2	24	30-10	17	29-3				
11v3	24	25-9	17	24-2				
BENT 5N								
11b1	10	46-2	20	39-0	3-7	0-8		
11b2	2	29-0	STR					
11b3	6	40-0	STR					
8b4	2	56-0	STR					
8b5	4	59-6	STR					
11b6	8	22-9	STR					
11b7	16	27-9	STR					
11b8	20	33-1	1	2-0	31-1			
5b9	8	10-6	32	7-10 1/2	2-7	1-5 3/4		
4b10	4	3-8	STR					
5b11	24	26-11	15	3-3	11-10		4 EA a to f	
to f		28-9		3-3	12-9			
4b12	8	3-0	STR					
11b13	8	26-6	33	23-4				
4c1	208	13-9	36	1-9	4-9			
4c2	98	19-9	36	4-9	4-9			
11a1	24	17-1	17	15-6				
11a2	24	22-2	17	20-7				
5a1	84	18-7	36	3-1 3/4	5-7 3/4			
5a2	56	14-8	36	3-1 3/4	3-8 3/4		4 EA a to n	
to n		18-5		3-1 3/4	5-7			
4a3	24	6-6	15	3-0	1-9			
4a4	24	6-0	15	2-6	1-9			
4a5	8	4-6	15	0-8	1-11			
5a6	8	7-6	15	4-5 3/4	1-6			
5a7	26	14-3	15	3-3	5-6			
5a8	12	14-1	15	3-1	5-6			
411	8	17-2	15	2-2	7-6			
412	2	11-2	15	2-2	4-6			
513	6	27-6	STR					
1114	20	30-8	33	27-6				
1115	2	15-4	STR					
1116	29	18-8	33	15-6				
1117	2	27-6	STR					
518	26	15-2	15	3-2	6-0			
519	12	15-0	15	3-0	6-0			
11v1	48	27-8	STR					
11v2	24	29-6	17	27-11				
11v3	24	24-5	17	22-10				

BAR MARK	NO.	L'GTH	TYPE	DIMENSIONS				REMARKS
				A	B	C	D	
BENT 4N								
11b1	10	46-2	20	39-0	3-7	0-8		
11b2	2	29-0	STR					
11b3	6	40-0	STR					
8b4	2	56-0	STR					
8b5	4	59-6	STR					
11b6	8	22-9	STR					
11b7	16	27-9	STR					
11b8	20	33-1	1	2-0	31-1			
5b9	8	10-6	32	7-10 1/2	2-7	1-5 3/4		
4b10	4	3-8	STR					
5b11	24	25-7	15	3-3	11-2		4 EA a to f	
to f		27-7		3-3	12-2			
4b12	8	3-0	STR					
11b13	8	25-3	33	22-1				
4c1	224	13-9	36	1-9	4-9			
4c2	106	19-9	36	4-9	4-9			
11a1	24	17-1	17	15-6				
11a2	24	22-2	17	20-7				
5a1	84	18-7	36	3-1 3/4	5-7 3/4			
5a2	56	14-8	36	3-1 3/4	3-8 3/4		4 EA a to n	
to n		18-5		3-1 3/4	5-7			
4a3	24	6-6	15	3-0	1-9			
4a4	24	6-0	15	2-6	1-9			
4a5	8	4-6	15	0-8	1-11			
5a6	8	7-6	15	4-5 3/4	1-6			
5a7	26	14-3	15	3-3	5-6			
5a8	12	14-1	15	3-1	5-6			
411	8	17-2	15	2-2	7-6			
412	2	11-2	15	2-2	4-6			
513	6	27-6	STR					
1114	20	30-8	33	27-6				
1115	2	15-6	STR					
1116	29	18-8	33	15-6				
1117	2	27-6	STR					
518	26	15-2	15	3-2	6-0			
519	12	15-0	15	3-0	6-0			
11v1	48	39-6	STR					
11v2	24	31-4	17	29-9				
11v3	24	26-3	17	24-8				

NORTH CAROLINA PROJECT NO.		FED. RD. PROJ. NO.
FEDERAL AID PROJECT NO.		LDV. NO.

NOTE:
FOR BAR BENDING DIAGRAMS, SEE PLATE
NUMBERS S-55 AND S-56.

RECORDED DRAWING

DESIGNED BY: K.G.	CHECKED BY: M.A.M.
PREPARED BY: <i>[Signature]</i>	
PRINCIPAL OF FIRM HNTB	
HNTB HOWARD NEEDLES TAMMEN & BERGENDOFF ARCHITECTS ENGINEERS PLANNERS ATLANTA, GEORGIA	
U.S. ARMY ENGINEER DISTRICT, WASHINGTON, NORTH CAROLINA CORPS OF ENGINEERS WASHINGTON, NORTH CAROLINA	

ATLANTIC INTRACOASTAL WATERWAY

REINFORCING BAR LIST

COINJOCK BRIDGE REPLACEMENT PROJECT
CURRITUCK COUNTY NORTH CAROLINA

INVITATION NO. DACW54-83-B-0014	SIZE B-0014	DRAWING NUMBER BR104-06-17	PLATE NO. S-63
SCALE NONE	DATE 22 JULY 1983	SHEET 113 OF 126	

BAR MARK	NO.	L'GTH	TYPE	DIMENSIONS				REMARKS
				A	B	C	D	
SUBSTRUCTURE								
BENT 3N								
11b1	10	46-2	20	39-0	3-7	0-8		
11b2	2	29-0	STR					
11b3	4	40-0	STR					
8b4	2	54-0	STR					
8b5	4	59-4	STR					
11b6	2	22-9	STR					
11b7	14	27-9	STR					
11b8	20	33-1	1	2-0	31-1			
5b9	8	10-6	12	7-10 1/2	2-7	1-5 3/4		
4b10	4	3-8	STR					
5b11	24	24-11	15	3-3	10-10		4 EA a to r	
to r		24-11		3-3	11-10			
4b12	8	3-0	STR					
11b13	8	24-8	33	21-6				
4c1	232	13-9	36	1-9	4-9			
4c2	110	19-9	36	4-9	4-9			
11a1	24	17-1	17	15-6				
11a2	24	22-2	17	20-7				
5a1	84	18-7	36	3-1 3/4	5-7 3/4			
5a2	34	14-8	36	3-1 3/4	3-8 3/4		4 EA a to n	
to n		18-5		3-1 3/4	5-7			
4a3	24	6-6	15	3-0	1-9			
4a4	24	6-0	15	2-6	1-9			
4a5	8	4-6	15	0-8	1-11			
5a6	8	7-6	15	4-5 3/4	1-6			
5a7	26	14-3	15	3-3	5-6			
5a8	12	14-1	15	3-1	5-6			
4a1	8	17-2	15	2-2	7-6			
4a2	2	11-2	15	2-2	4-6			
5a3	4	27-6	STR					
11a4	20	30-8	33	27-6				
11a5	2	15-6	STR					
11a6	29	18-8	33	15-6				
11a7	2	27-6	STR					
5a8	26	15-3	15	3-3	6-0			
5a9	12	15-0	15	3-0	6-0			
11a1	192	23-0	STR					
11a2	48	18-9	17	17-2				
11a3	48	23-10	17	22-3				
BENT 2N								
11b1	10	48-2	20	41-0	3-6 3/4	0-7 1/4		
11b2	2	28-0	STR					
11b3	4	40-0	STR					
8b4	2	58-2	STR					
8b5	4	25-0	STR					
8b6	4	41-0	STR					
11b7	12	25-2	STR					
11b8	12	30-2	STR					
5b9	8	12-1	32	9-6	2-7	1-7 1/2		
4b10	4	4-11	STR					
5b11	24	24-3	15	3-3	11-6		4 EA a to p	
to p		28-3		3-3	12-6			
4b12	8	3-0	STR					
11b13	8	24-0	33	22-10				

BAR MARK	NO.	L'GTH	TYPE	DIMENSIONS				REMARKS
				A	B	C	D	
BENT 2N (Continued)								
11b14	20	33-6	17	31-6				
4c1	234	13-11	36	1-10 1/2	4-9			
4c2	112	19-9	36	4-9	4-9			
11a1	48	22-2	17	20-7				
11a2	48	17-1	17	15-6				
5a1	98	18-6	36	3-1 3/4	5-7 3/4			
5a2	92	14-8	36	3-1 3/4	3-8 3/4		4 EA a to m	
to m		18-5		3-1 3/4	5-7			
4a3	28	7-7	15	3-9	1-11			
4a4	28	7-3	15	3-5	1-11			
4a5	8	4-8	15	0-8	2-0			
8a6	8	7-9	15	4-8 1/2	1-6			
8a7	26	13-11	15	8-3	5-4			
5a8	12	13-8	15	3-0	5-4			
4a1	8	17-4	15	2-2	7-7			
4a2	2	11-4	15	2-2	4-7			
5a3	4	27-6	STR					
11a4	20	30-8	33	27-6				
11a5	2	15-6	STR					
11a6	29	18-8	33	15-6				
11a7	2	27-6	STR					
5a8	26	15-3	15	3-3	6-0			
5a9	12	15-0	15	3-0	6-0			
11a1	192	23-0	STR					
11a2	48	18-9	17	17-2				
11a3	48	23-10	17	22-3				
BENT 1N								
5b1	32	34-11	15	5-7	14-8			
11b2	14	28-2	STR					
11b3	2	18-1	15	5-9	6-2			
4b4	112	6-7	28	5-8	0-4 1/2			
10b5	20	34-0	1	2-0	32-0			
10b6	12	31-7	STR					
10b7	28	24-7	STR					
8b8	8	33-1	STR					
11b9	8	31-0	STR					
11b10	10	35-0	STR					
11b11	10	50-6	20	41-0	4-9			
5b12	8	10-4	32	8-0	2-6	2-0		
8b13	4	32-3	STR					
8b14	4	28-6	STR					
4c1	200	13-8	36	4-9	1-8 1/2			
4c2	100	19-9	36	4-9	4-9			
10a1	34	10-3	STR					
10a2	34	7-0	STR					
10a3	34	11-0	STR					
10a4	34	14-3	STR					
11a5	24	11-2	STR					
11a6	24	16-3	STR					
5a7	29	7-5	15	5-5	1-0			
8a1	112	21-11	36	3-3 1/2	6-8			
6a2a	64	17-4	36	3-3 1/2	4-8 1/2		4 EA a to p	
10a	21-3			3-3 1/2	6-8			
6a3a	16	16-4	36	3-3 1/2	3-9 1/2		4 EA a to p	
10a		16-11		3-3 1/2	4-7			

BAR MARK	NO.	L'GTH	TYPE	DIMENSIONS				REMARKS
				A	B	C	D	
BENT 1N (Continued)								
5a4	6	6-4	15	4-9	1-0			
4a5	4	4-11	STR					
4a6	12	5-2	15	0-8	2-3			
4a7a	10	4-9	1	1-6	3-3		2EA a to g	
10		6-0		1-6	4-6			
4a8	6	7-9	15	4-9	1-6			
4a9	2	5-11	1	1-6	4-5			
4a10	30	6-8	15	3-8	1-6			
4a11	24	7-9	15	4-9	1-6			
4a1	19	36-10	STR					
11a2	22	36-10	STR					
6a3	38	17-6	STR					
8a4	38	17-6	STR					
4a5	12	19-2	15	2-2	8-6			
4a6	10	10-2	15	2-2	4-0			
4a7	8	36-0	STR					
11a1	48	27-7	STR					
11a2	24	30-8	17	29-1				
11a3	24	25-8	17	24-1				

N.C. STATE AID PROJECT NO.	
FEDERAL AID PROJECT NO.	

NOTE:
FOR BAR BENDING DIAGRAMS, SEE PLATE
NUMBERS S-55 AND S-56.

RECORD DRAWING

DESIGNED BY: K.G. CHECKED BY: M.A.M.
 PREPARED BY: *[Signature]*
 PRINCIPAL OF FIRM HNTB

HNTB HOWARD NEEDLES TAMMEN & BERGENDOFF
 ARCHITECTS ENGINEERS PLANNERS
 ATLANTA, GEORGIA

U.S. ARMY ENGINEER DISTRICT, WASHINGTON
 CORPS OF ENGINEERS
 WASHINGTON, NORTH CAROLINA

ATLANTIC INTRACOASTAL WATERWAY

REINFORCING BAR LIST

COINJOCK BRIDGE REPLACEMENT PROJECT
 CURRITUCK COUNTY NORTH CAROLINA

INVTATION NO. DACW54-83-B-0014
 DRAWING NUMBER BR104-06-17
 SCALE NONE DATE 22 JULY 1983 SHEET 114 OF 126

BAR MARK	NO.	L'GTH	TYPE	DIMENSIONS				REMARKS
				A	B	C	D	
SUBSTRUCTURE								
BENT 1S								
5b1	40	34-11	15	5-7	14-8			
11b2	14	28-2	STR					
11b3	2	18-1	15	5-9	6-2			
4b4	140	6-7	28	5-8	0-4 1/2			
10b5	20	34-0	1	2-0	32-0			
10b6	12	31-7	STR					
10b7	28	26-7	STR					
8b8	8	33-1	STR					
11b9	8	31-0	STR					
11b10	10	35-0	STR					
11b11	10	50-6	20	41-0	4-9			
5b12	8	10-6	32	8-0	2-6	2-0		
8b13	4	32-3	STR					
8b14	4	28-4	STR					
4c1	200	13-8	36	4-9	1-8 1/2			
4c2	100	19-9	36	4-9	4-9			
10a1	34	10-3	STR					
10a2	34	7-0	STR					
10a3	34	14-6	STR					
10a4	34	17-9	STR					
11a5	24	11-2	STR					
11a6	24	16-3	STR					
5a7	29	7-5	15	5-5	1-0			
6a1	112	21-11	36	3-3 1/2	6-8			
6a2 a	64	17-4	36	3-3 1/2	4-8 1/2		4 EA a to p	
to p		21-3		3-3 1/2	6-8			
6a3 a	16	15-4	36	3-3 1/2	3-9 1/2		4 EA a to d	
to d		16-11		3-3 1/2	4-7			
5a4	6	6-9	15	4-9	1-0			
4a5	4	4-11	STR					
4a6	12	5-2	15	0-8	2-3			
4a7 a	10	4-9	1	1-6	3-3		2 EA a to e	
to e		6-0		1-6	4-6			
4a8	6	7-9	15	4-9	1-6			
4a9	2	5-11	1	1-6	4-5			
4a10	30	6-8	15	3-8	1-6			
4a11	24	7-9	15	4-9	1-6			
4a1	19	36-10	STR					
11a2	22	36-10	STR					
6a3	38	17-6	STR					
8a4	38	17-6	STR					
4a5	12	19-2	15	2-2	8-6			
4a6	10	10-2	15	2-2	4-0			
4a7	8	36-0	STR					
11a1	48	27-1	STR					
11a2	24	30-8	17	29-1				
11a3	24	25-8	17	24-1				
BENT 2S								
1b1	10	48-2	20	41-0	3-6 3/4	0-7 1/4		
1b2	2	28-0	STR					
1b3	4	40-0	STR					
8b4	2	58-3	STR					
11a	4	25-0	STR					
1	4	41-0	STR					

BAR MARK	NO.	L'GTH	TYPE	DIMENSIONS				REMARKS
				A	B	C	D	
BENT 2S (Continued)								
11b7	12	25-2	STR					
11b8	12	30-2	STR					
5b9	8	12-1	32	9-6	2-7	1-7 1/2		
4b10	4	4-11	STR					
5b11	24	25-11	15	3-3	11-4		4 EA a to f	
to f		27-11		3-3	12-4			
4b12	8	3-0	STR					
11b13	8	25-7	33	22-5				
11b14	20	33-6	17	31-6				
4c1	236	13-11	36	1-10 1/2	4-9			
4c2	112	19-9	36	4-9	4-9			
11a1	48	22-2	17	20-7				
11a2	48	17-1	17	15-6				
5a1	98	10-6	36	3-1 3/4	5-7 3/4			
5a2 a	92	14-8	36	3-1 3/4	3-8 3/4		4 EA a to w	
to w		18-5		3-1 3/4	5-7			
4a3	28	7-7	15	3-9	1-11			
4a4	28	7-3	15	3-5	1-11			
4a5	8	4-8	15	0-8	2-0			
5a6	8	7-9	15	4-8 1/2	1-6			
5a7	26	13-11	15	3-3	5-4			
5a8	12	13-8	15	3-0	5-4			
4a1	8	17-4	15	2-2	7-7			
4a2	2	11-4	15	2-2	4-7			
5a3	6	27-6	STR					
11a4	20	30-8	33	27-6				
11a5	2	15-6	STR					
11a6	29	18-8	33	15-6				
11a7	2	27-6	STR					
5a8	26	15-3	15	3-3	6-0			
5a9	12	15-0	15	3-0	6-0			
11a1	192	23-0	STR					
11a2	48	19-9	17	18-2				
11a3	48	24-10	17	23-3				
BENT 3S								
11b1	10	46-2	20	39-0	3-7	0-8		
11b2	2	29-0	STR					
11b3	6	40-0	STR					
8b4	2	56-0	STR					
8b5	4	59-6	STR					
11b6	2	22-9	STR					
11b7	16	27-9	STR					
11b8	20	33-1	1	2-0	31-1			
5b9	8	10-6	32	7-10 1/2	2-7	1-5 3/4		
4b10	4	3-8	STR					
5b11	24	24-3	15	3-3	10-6		4 EA a to f	
to f		26-3		3-3	11-6			
4b12	8	3-0	STR					
11b13	8	23-10	33	20-11				
4c1	240	13-9	36	1-9	4-9			
4c2	114	19-9	36	4-9	4-9			
11a1	24	17-1	17	15-6				
11a2	24	22-2	17	20-7				
5a1	84	18-7	36	3-1 3/4	5-7 3/4			
5a2 a	56	14-8	36	3-1 3/4	3-8 3/4		4 EA a to n	
to n		18-5		3-1 3/4	5-7			
4a3	24	4-6	15	3-0	1-9			
4a4	24	6-0	15	2-6	1-9			
4a5	8	4-6	15	0-8	1-11			
5a6	8	7-6	15	4-5 3/4	1-6			
5a7	26	14-3	15	3-3	5-6			
5a8	12	14-1	15	3-1	5-6			
4a1	8	17-2	15	2-2	7-6			
4a2	2	11-2	15	2-2	4-6			
5a3	6	27-6	STR					
11a4	20	30-8	33	27-6				
11a5	2	15-6	STR					
11a6	29	18-8	33	15-6				
11a7	2	27-6	STR					
5a8	26	15-2	15	3-2	6-0			
5a9	12	15-0	15	3-0	6-0			
11a1	48	31-6	STR					
11a2	24	32-2	17	30-7				
11a3	24	27-1	17	25-6				

BAR MARK	NO.	L'GTH	TYPE	DIMENSIONS				REMARKS
				A	B	C	D	
BENT 3S (Continued)								
4a4	24	6-0	15	2-6	1-9			
4a5	8	4-6	15	0-8	1-11			
5a6	8	7-6	15	4-5 3/4	1-6			
5a7	26	14-6	15	3-3	5-6			
5a8	12	14-2	15	3-1	5-6			
4a1	8	17-2	15	2-2	7-6			
4a2	2	11-2	15	2-2	4-6			
5a3	6	27-6	STR					
11a4	20	30-8	33	27-6				
11a5	2	15-6	STR					
11a6	29	18-8	33	15-6				
11a7	2	27-6	STR					
5a8	26	15-2	15	3-2	6-0			
5a9	12	15-0	15	3-0	6-0			
11a1	48	31-5	STR					
11a2	24	33-4	17	31-9				
11a3	24	28-3	17	26-8				
BENT 4S								
11b1	10	46-2	20	39-0	3-7	0-8		
11b2	2	29-0	STR					
11b3	6	40-0	STR					
8b4	2	56-0	STR					
8b5	4	59-6	STR					
11b6	2	22-9	STR					
11b7	16	27-9	STR					
11b8	20	33-1	1	2-0	31-1			
5b9	8	10-6	32	7-10 1/2	2-7	1-5 3/4		
4b10	4	3-8	STR					
5b11	24	24-11	15	3-3	10-10		4 EA a to f	
to f		26-11		3-3	11-10			
4b12	8	3-0	STR					
11b13	8	24-7	33	21-5				
4c1	232	13-9	36	1-9	4-9			
4c2	110	19-9	36	4-9	4-9			
11a1	24	17-1	17	15-6				
11a2	24	22-2	17	20-7				
5a1	84	18-7	36	3-1 3/4	5-7 3/4			
5a2 a	56	14-8	36	3-1 3/4	3-8 3/4		4 EA a to n	
to n		18-5		3-1 3/4	5-7			
4a3	24	4-6	15	3-0	1-9			
4a4	24	6-0	15	2-6	1-9			
4a5	8	4-6	15	0-8	1-11			
5a6	8	7-6	15	4-5 3/4	1-6			
5a7	26	14-3	15	3-3	5-6			
5a8	12	14-1	15	3-1	5-6			
4a1	8	17-2	15	2-2	7-6			
4a2	2	11-2	15	2-2	4-6			
5a3	6	27-6	STR					
11a4	20	30-8	33	27-6				
11a5	2	15-6	STR					
11a6	29	18-8	33	15-6				
11a7	2	27-6	STR					
5a8	26	15-2	15	3-2	6-0			
5a9	12	15-0	15	3-0	6-0			
11a1	48	31-6	STR					
11a2	24	32-2	17	30-7				
11a3	24	27-1	17	25-6				

NC STATE AID PROJECT NO.	
FEDERAL AID PROJECT NO.	DWG NO.

NOTE:
FOR BAR BENDING DIAGRAMS, SEE PLATE
NUMBERS S-55 AND S-66.

RECORD DRAWING

DESIGNED BY: K.G. CHECKED BY: M.A.M.
 PREPARED BY: [Signature]
 PRINCIPAL OF FIRM [Signature]
HNTB HOWARD NEEDLES TAMMEN & BERGENDOFF ARCHITECTS ENGINEERS PLANNERS ATLANTA, GEORGIA
 U.S. ARMY ENGINEER DISTRICT WASHINGTON, D.C.
 CORPS OF ENGINEERS WASHINGTON, NORTH CAROLINA
ATLANTIC INTRACOASTAL WATERWAY
REINFORCING BAR LIST
COINJOCK BRIDGE REPLACEMENT PROJECT
 CURRITUCK COUNTY NORTH CAROLINA
 INVITATION NO. DACW54-83-B-0014 DRAWING NUMBER B104-06-17 SCALE NONE DATE 22 JULY 1983 SHEET 1 OF 2

STATE AND PROJECT NO.	FED. PROJ. NO.
FEDERAL AID PROJECT NO.	STATE PROJ. NO.

BAR MARK	NO.	L'GTH	TYPE	DIMENSIONS				REMARKS
				A	B	C	D	
SUBSTRUCTURE								
BENT 5S								
11b1	10	46-2	20	39-0	3-7	0-8		
11b2	2	29-0	STR					
11b3	6	40-0	STR					
8b4	2	56-0	STR					
8b5	4	59-6	STR					
11b6	2	22-9	STR					
11b7	16	27-9	STR					
11b8	20	33-1	1	2-0	31-1			
5b9	8	10-6	32	7-10 1/2	2-7	1-5 3/4		
4b10	4	3-8	STR					
5b11	24	25-6	15	3-3	11-2		4 EA a to f	
to f		27-6		3-3	12-2			
4b12	8	3-0	STR					
11b13	8	25-8	33					
4c1	224	13-9	36	1-9	4-9			
4c2	106	19-9	36	4-9	4-9			
11a1	24	17-1	17	15-6				
11a2	24	22-2	17	20-7				
5a1	84	18-7	36	3-1 3/4	5-7 3/4			
5a2	56	14-8	36	3-1 3/4	3-8 3/4		4 EA a to n	
to n		18-5		3-1 3/4	5-7			
4a3	24	6-6	15	3-0	1-9			
4a4	24	6-0	15	2-6	1-9			
4a5	8	4-6	15	0-8	1-11			
5a6	8	7-6	15	4-5 3/4	1-6			
5a7	26	14-3	15	3-3	5-6			
5a8	12	14-1	15	3-1	5-6			
4t1	8	17-2	15	2-2	7-6			
4t2	2	11-2	15	2-2	4-6			
5t3	6	27-6	STR					
11t4	20	30-8	33	27-				
11t5	2	15-6	STR					
11t6	29	18-8	33	15-6				
11t7	2	27-6	STR					
5t8	26	15-2	15	3-2	6-0			
5t9	12	14-6	15	3-0	6-0			
11v1	48	29-5	STR					
11v2	24	31-3	17	29-8				
11v3	24	26-3	17	24-8				
BENT 6S								
11b1	10	46-2	20	39-0	3-7	0-8		
11b2	2	29-0	STR					
11b3	6	40-0	STR					
8b4	2	56-0	STR					
8b5	4	59-6	STR					
11b6	8	22-9	STR					
11b7	16	27-9	STR					
11b8	20	33-1	1	2-0	31-1			
5b9	8	10-6	32	7-10 1/2	2-7	1-5 3/4		
4b10	4	3-8	STR					
4c1	216	13-9	36	1-9	4-9			
4c2	108	19-9	36	4-9	4-9			
11a1	24	11-0	17	9-5				
11a2	24	16-1	17	14-6				

BAR MARK	NO.	L'GTH	TYPE	DIMENSIONS				REMARKS
				A	B	C	D	
BENT 6S (Continued)								
5a1	84	18-7	36	3-1 3/4	5-7 3/4			
5a2	56	14-8	36	3-1 3/4	3-8 3/4		4 EA a to n	
to n		18-5		3-1 3/4	5-7			
4a3	24	6-6	15	3-0	1-9			
4a4	24	6-0	15	2-6	1-9			
4a5	8	4-6	15	0-8	1-11			
5a6	8	7-6	15	4-5 3/4	1-6			
4t1	8	15-10	15	2-2	6-10			
5t2	6	27-6	STR					
11t3	27	17-2	33	14-0				
7t4	13	29-2	33	27-6				
6t5	27	15-4	33	14-0				
11t6	13	30-8	33	27-6				
11t7	2	14-0	STR					
11t8	2	27-6	STR					
6t9	2	14-0	STR					
11t10	2	27-6	STR					
11v1	48	31-0	STR					
11v2	24	31-0	17	31-5				
11v3	24	27-10	17	26-3				
BENT 7S								
11b1	10	46-2	20	39-0	3-7	0-8		
11b2	2	29-0	STR					
11b3	6	40-0	STR					
8b4	2	56-0	STR					
8b5	4	59-6	STR					
11b6	8	22-9	STR					
11b7	16	27-9	STR					
11b8	20	33-1	1	2-0	31-1			
5b9	8	10-6	32	7-10 1/2	2-7	1-5 3/4		
4b10	4	3-8	STR					
4c1	208	13-9	36	1-9	4-9			
4c2	104	19-9	36	4-9	4-9			
11a1	24	11-0	17	9-5				
11a2	24	16-1	17	14-6				
5a1	84	18-7	36	3-1 3/4	5-7 3/4			
5a2	56	14-8	36	3-1 3/4	3-8 3/4		4 EA a to n	
to n		18-5		3-1 3/4	5-7			
4a3	24	6-6	15	3-0	1-9			
4a4	24	6-0	15	2-6	1-9			
4a5	8	4-6	15	0-8	1-11			
5a6	8	7-6	15	4-5 3/4	1-6			
4t1	8	15-10	15	2-2	6-10			
5t2	6	27-6	STR					
11t3	27	17-2	33	14-0				
7t4	13	29-2	33	27-6				
6t5	27	15-4	33	14-0				
11t6	13	30-8	33	27-6				
11t7	2	14-0	STR					
11t8	2	27-6	STR					
6t9	2	14-0	STR					
11t10	2	27-6	STR					
11v1	48	29-5	STR					
11v2	24	31-4	17	29-9				
11v3	24	26-3	17	24-8				

BAR MARK	NO.	L'GTH	TYPE	DIMENSIONS				REMARKS
				A	B	C	D	
BENT 8S (Continued)								
11b1	10	46-2	20	39-0	3-7	0-8		
11b2	2	29-0	STR					
11b3	6	40-0	STR					
8b4	2	56-0	STR					
8b5	4	59-6	STR					
11b6	8	22-9	STR					
11b7	16	27-9	STR					
11b8	20	33-1	1	2-0	31-1			
5b9	8	10-6	32	7-10 1/2	2-7	1-5 3/4		
4b10	4	3-8	STR					
4c1	192	13-9	36	1-9	4-9			
4c2	96	19-9	36	4-9	4-9			
11a1	24	11-0	17	9-5				
11a2	24	16-1	17	14-6				
5a1	84	18-7	36	3-1 3/4	5-7 3/4			
5a2	56	14-8	36	3-1 3/4	3-8 3/4		4 EA a to n	
to n		18-5		3-1 3/4	5-7			
4a3	24	6-6	15	3-0	1-9			
4a4	24	6-0	15	2-6	1-9			
4a5	8	4-6	15	0-8	1-11			
5a6	8	7-6	15	4-5 3/4	1-6			
4t1	8	15-10	15	2-2	6-10			
5t2	6	27-6	STR					
11t3	27	17-2	33	14-0				
7t4	13	29-2	33	27-6				
6t5	27	15-4	33	14-0				
11t6	13	30-8	33	27-6				
11t7	2	14-0	STR					
6t9	2	14-0	STR					
11t10	2	27-6	STR					
11v1	48	27-7	STR					
11v2	24	29-6	17	27-11				
11v3	24	24-5	17	22-10				

NOTE:
FOR BAR BENDING DIAGRAMS, SEE PLATE
NUMBERS S-55 AND S-56.

RECORD DRAWING

DESIGNED BY: K.G.	CHECKED BY: M.A.M.
PREPARED BY: <i>[Signature]</i>	
PRINCIPAL OF FIRM HNTB	
HNTB HOWARD NEEDLES TAMMEN & BERGENDOFF ARCHITECTS ENGINEERS PLANNERS ATLANTA, GEORGIA	
U.S. ARMY ENGINEER DISTRICT, WASHINGTON CORPS OF ENGINEERS WASHINGTON, NORTH CAROLINA	
ATLANTIC INTRACOASTAL WATERWAY	
REINFORCING BAR LIST	
COINJOCK BRIDGE REPLACEMENT PROJECT	
INVITATION NO. DACW54-83- B-0014	DRAWING NUMBER BR104-06-17 SCALE NONE DATE 22 JULY 1983 SHEET 116 OF 126
	8-66

M.C. STATE AID PROJECT NO		FED. RD. DIST. NO.
FEDERAL AID PROJECT NO		CONTRACT NO.

BAR MARK	NO.	L'GTH	TYPE	DIMENSIONS				REMARKS
				A	B	C	D	
SUBSTRUCTURE								
BENT 9S								
11b1	10	46-2	20	39-0	3-7	0-8		
11b2	2	29-0	STR					
11b3	2	40-0	STR					
8b4	2	56-0	STR					
8b5	4	59-6	STR					
11b6	8	22-9	STR					
11b7	16	27-9	STR					
11b8	20	33-1	1	2-0	31-1			
5b9	8	10-6	32	7-10 1/2	2-7	1-5 3/4		
4b10	4	3-8	STR					
4c1	176	13-9	36	1-9	4-9			
4c2	88	19-9	36	4-9	4-9			
11m1	24	11-0	17	9-5				
11m2	24	14-1	17	14-6				
5a1	84	18-7	36	3-1 3/4	5-7 3/4			
5a2	56	14-8	36	3-1 3/4	3-8 3/4		4 EA a to n	
to n		18-5		3-1 3/4	5-7			
4a3	24	6-6	15	3-0	1-9			
4a4	24	6-0	15	2-6	1-9			
4a5	8	4-6	15	0-8	1-11			
5a6	8	7-6	15	4-5 3/4	1-6			
4a1	8	15-10	15	2-2	6-10			
5a2	4	27-6	BTR					
11a3	27	17-2	33	14-0				
7a4	13	29-2	33	27-6				
4a5	27	15-4	33	14-0				
11a6	13	30-8	33	27-6				
11a7	2	14-0	STR					
11a8	2	27-6	STR					
4a9	2	14-0	STR					
11a10	2	27-6	STR					
11v1	48	25-9	STR					
11v2	24	27-7	17	26-0				
11v3	24	22-7	17	21-0				

BENT 10S								
11b1	10	46-2	20	38-0	4-11	0-8 3/4		
11b2	6	30-0	STR					
11b3	2	40-0	STR					
8b4	2	57-3	STR					
8b5	4	59-6	STR					
11b6	8	22-9	STR					
11b7	4	31-4	STR					
11b8	16	27-9	STR					
11b9	16	32-8	1	2-0	31-1			
5b10	8	10-6	32	7-11	2-7	1-5		
4b11	4	3-8	STR					
11b12	8	8-6	STR					
4c1	160	10-1	36	0-11	3-9			
4c2	80	15-9	36	3-9	3-9			
11a1	20	11-0	17	9-5				
11a2	20	16-1	17	14-6				
11a3	12	7-6	38	2-0	3-11			
11a4	4	5-0	STR					
4a1	16	9-9	36	2-6	2-0			
4a2	16	7-5	35	1-8	1-0			
4a3	6	7-9	36	2-6	1-0		2 EA a to c	
to c		11-9		2-6	3-0			
5a4	8	5-8	15	3-8 1/4	1-0			
4a5	8	4-8	15	0-8	2-0			
5a6	88	17-4	36	2-6	5-8			
4a7	24	5-10	15	2-6	1-8			
4a8	24	6-4	15	3-0	1-8			
5a9	72	17-2	36	2-6	5-7		4 EA a to f	
to f		13-8		2-6	3-10			
11a1	26	15-2	33	12-0				
11a2	32	17-2	33	14-0				
6a3	30	12-0	STR					
6a4	26	14-0	STR					
11a5	4	12-0	STR					
11a6	4	14-0	STR					
5a7	16	10-10	15	2-6	4-2			
5a8	4	15-10	15	2-2	6-10			
5a9	8	10-4	15	2-2	4-1			
11v1	20	23-1	17	21-6				
11v2	20	18-0	17	14-5				

BAR MARK	NO.	L'GTH	TYPE	DIMENSIONS				REMARKS
				A	B	C	D	
BENT 10S (Continued)								
4a2	16	7-5	35	1-8	1-0			
4a3	6	7-9	36	2-6	1-0		2 EA a to c	
to c		11-9		2-6	3-0			
5a4	8	5-8	15	3-8 1/4	1-0			
4a5	8	4-8	15	0-8	2-0			
5a6	88	17-4	36	2-6	5-8			
4a7	24	5-10	15	2-6	1-8			
4a8	24	6-4	15	1-0	1-8			
5a9	72	17-2	36	2-6	5-7		4 EA a to f	
to f		13-8		2-6	3-10			
11a1	26	15-2	33	12-0				
11a2	32	17-2	33	14-0				
6a3	30	12-0	STR					
6a4	26	14-0	STR					
11a5	4	12-0	STR					
11a6	4	14-0	STR					
5a7	16	10-10	15	2-6	4-2			
5a8	4	15-10	15	2-2	6-10			
5a9	8	10-4	15	2-2	4-1			
11v1	40	23-1	17	21-6				
11v2	20	25-10	17	24-3				
11v3	20	20-9	17	19-2				

BENT 11S								
11b1	10	46-2	20	38-0	4-11	0-8 3/4		
11b2	6	30-0	STR					
11b3	2	40-0	STR					
8b4	2	57-3	STR					
8b5	4	59-6	STR					
11b6	8	22-9	STR					
11b7	4	31-4	STR					
11b8	16	27-9	STR					
11b9	16	32-8	1	2-0	31-1			
5b10	8	10-6	32	7-11	2-7	1-5		
4b11	4	3-8	STR					
11b12	8	8-6	STR					
4c1	144	10-1	36	0-11	3-9			
4c2	72	15-9	36	3-9	3-9			
11a1	20	11-0	17	9-5				
11a2	20	16-1	17	14-6				
11a3	12	7-6	38	2-0	3-11			
11a4	4	5-0	STR					
4a1	16	9-9	36	2-6	2-0			
4a2	16	7-5	35	1-8	1-0			
4a3	6	7-9	36	2-6	1-0		2 EA a to c	
to c		11-9		2-6	3-0			
5a4	8	5-8	15	3-8 1/4	1-0			
4a5	8	4-8	15	0-8	2-0			
5a6	88	17-4	36	2-6	5-8			
4a7	24	5-10	15	2-6	1-8			
4a8	24	6-4	15	3-0	1-8			
5a9	72	17-2	36	2-6	5-7		4 EA a to f	
to f		13-8		2-6	3-10			
11a1	26	15-2	33	12-0				
11a2	32	17-2	33	14-0				
6a3	30	12-0	STR					
6a4	26	14-0	STR					

BAR MARK	NO.	L'GTH	TYPE	DIMENSIONS				REMARKS
				A	B	C	D	
BENT 11S (Continued)								
11a5	4	12-0	STR					
11a6	4	14-0	STR					
5a7	16	10-10	15	2-6	4-2			
5a8	4	15-10	15	2-2	6-10			
5a9	8	10-4	15	2-2	4-1			
11v1	40	22-1	STR					
11v2	20	24-1	17	22-6				
11v3	20	19-0	17	17-5				
BENT 12S								
11b1	10	46-2	20	38-0	4-11	0-8 3/4		
11b2	6	30-0	STR					
11b3	2	40-0	STR					
8b4	2	57-3	STR					
8b5	4	59-6	STR					
11b6	8	22-9	STR					
11b7	4	31-4	STR					
11b8	16	27-9	STR					
11b9	16	32-8	1	2-0	31-1			
5b10	8	10-6	32	7-11	2-7	1-5		
4b11	4	3-8	STR					
11b12	8	8-6	STR					
4c1	72	10-1	36	0-11	3-9			
4c2	36	15-9	36	3-9	3-9			
11a1	20	11-0	17	9-5				
11a2	20	16-1	17	14-6				
11a3	12	7-6	38	2-0	3-11			
11a4	4	5-0	STR					
4a1	16	9-9	36	2-6	2-0			
4a2	16	7-5	35	1-8	1-0			
4a3	6	7-9	36	2-6	1-0		2 EA a to c	
to c		11-9						

