

DATE	REVISED	BY	REASON
8.18.29			

PROJECT NO. 8.18293
 FEB. 10. PROJ. 3-26-10/12

NOTES

Loading: A.A.S.H.O. H15-44.

Future surfacing: 20 lb. per sq. ft.

Roadway width: 24'-0" curb to curb.

For other design data and general notes, see General Notes Sheet.

Concrete surfaces shall be given a surface finish in accordance with the specifications.

The Contractor will be required to drive one 12 BP 53 steel test pile in place of Bents 1 and 3. The test piles shall be paid for as linear feet of 12 BP 53 Steel Piles. The order lengths for all piles shall be given after the test piles have been driven. Test piles for Bents 1 & 3, are 25' long. All piles shall be driven through the roadway fill.

Piles for all Bents and End Bents shall be driven to a minimum bearing capacity of 30 tons.

Traffic on Johnson Bridge Road will be detoured over adjacent county roads during construction of the proposed structure.

⊙ Indicates 2 1/2" casing hole boring
 ▽ Indicates ground water
 Benchmark: R-R Spikes in place of 25' East of Johnson Bridge Road near Sta 1284+00, 125 ft. of Rte. 1-26. Elevation 2026.79
 Benchmark: 25' West of 125' E. of Sta. 1284+00. Elevation 2026.79

I certify that this structure was built according to Plans except as noted.


RESIDENT ENGINEER

PROJECT NO. 8.18293
 HENDERSON COUNTY
 STATION 1284+06 L 10+00 Y6

REVISIONS			
No.	BY	DATE	REASON
1	MOL	2-18-29	
2	CAF	4-17-29	

Station	Elevation	Station	Elevation	Station	Elevation
8+95	2104.66	9+95	2107.30	10+95	2108.81
	2104.82		2107.43		2108.85
	2104.98		2107.50		2108.89
	2105.13		2107.60		2108.93
	2105.28		2107.69		
	2105.43		2107.78		
	2105.57		2107.87		
	2105.71		2107.95		
	2105.85		2108.03		
	2105.99		2108.11		
	2106.12		2108.19		
	2106.25		2108.27		
	2106.38		2108.34		
	2106.50		2108.41		
	2106.62		2108.47		
	2106.74		2108.53		
	2106.86		2108.59		
	2106.97		2108.65		
	2107.08		2108.71		
9+90	2107.19	10+90	2108.78		

	Class II Concrete Cu. Yds	Reinforcing Steel Lbs	Structural Steel Approx Lbs	12 BP 53 Steel Piles No	Lin. Ft	Unclass Str Excav Cu. Yds	4' Deck Slope Protection Sq. Yds	Metal Rails Lin. Ft	Wonc Block Slope Protection Sq. Yds
Superstructure	169.7	35,997	119,900	9	466		267,771	410.99	
End Bent #1	15.8	2,676		9	466		184		
Bent #1	23.5	3,473		12	632		90,334		
Bent #2	24.3	3,772		12	632		82,302		
Bent #3	24.1	3,577		12	632		85,348		
End Bent #2	15.2	2,701		5	432		205		
Approach Curbs	5.3	10		5	432		226,304		208
Totals	276.2	52,272	119,900	64	4,556	98.8	652,271	410.99	208

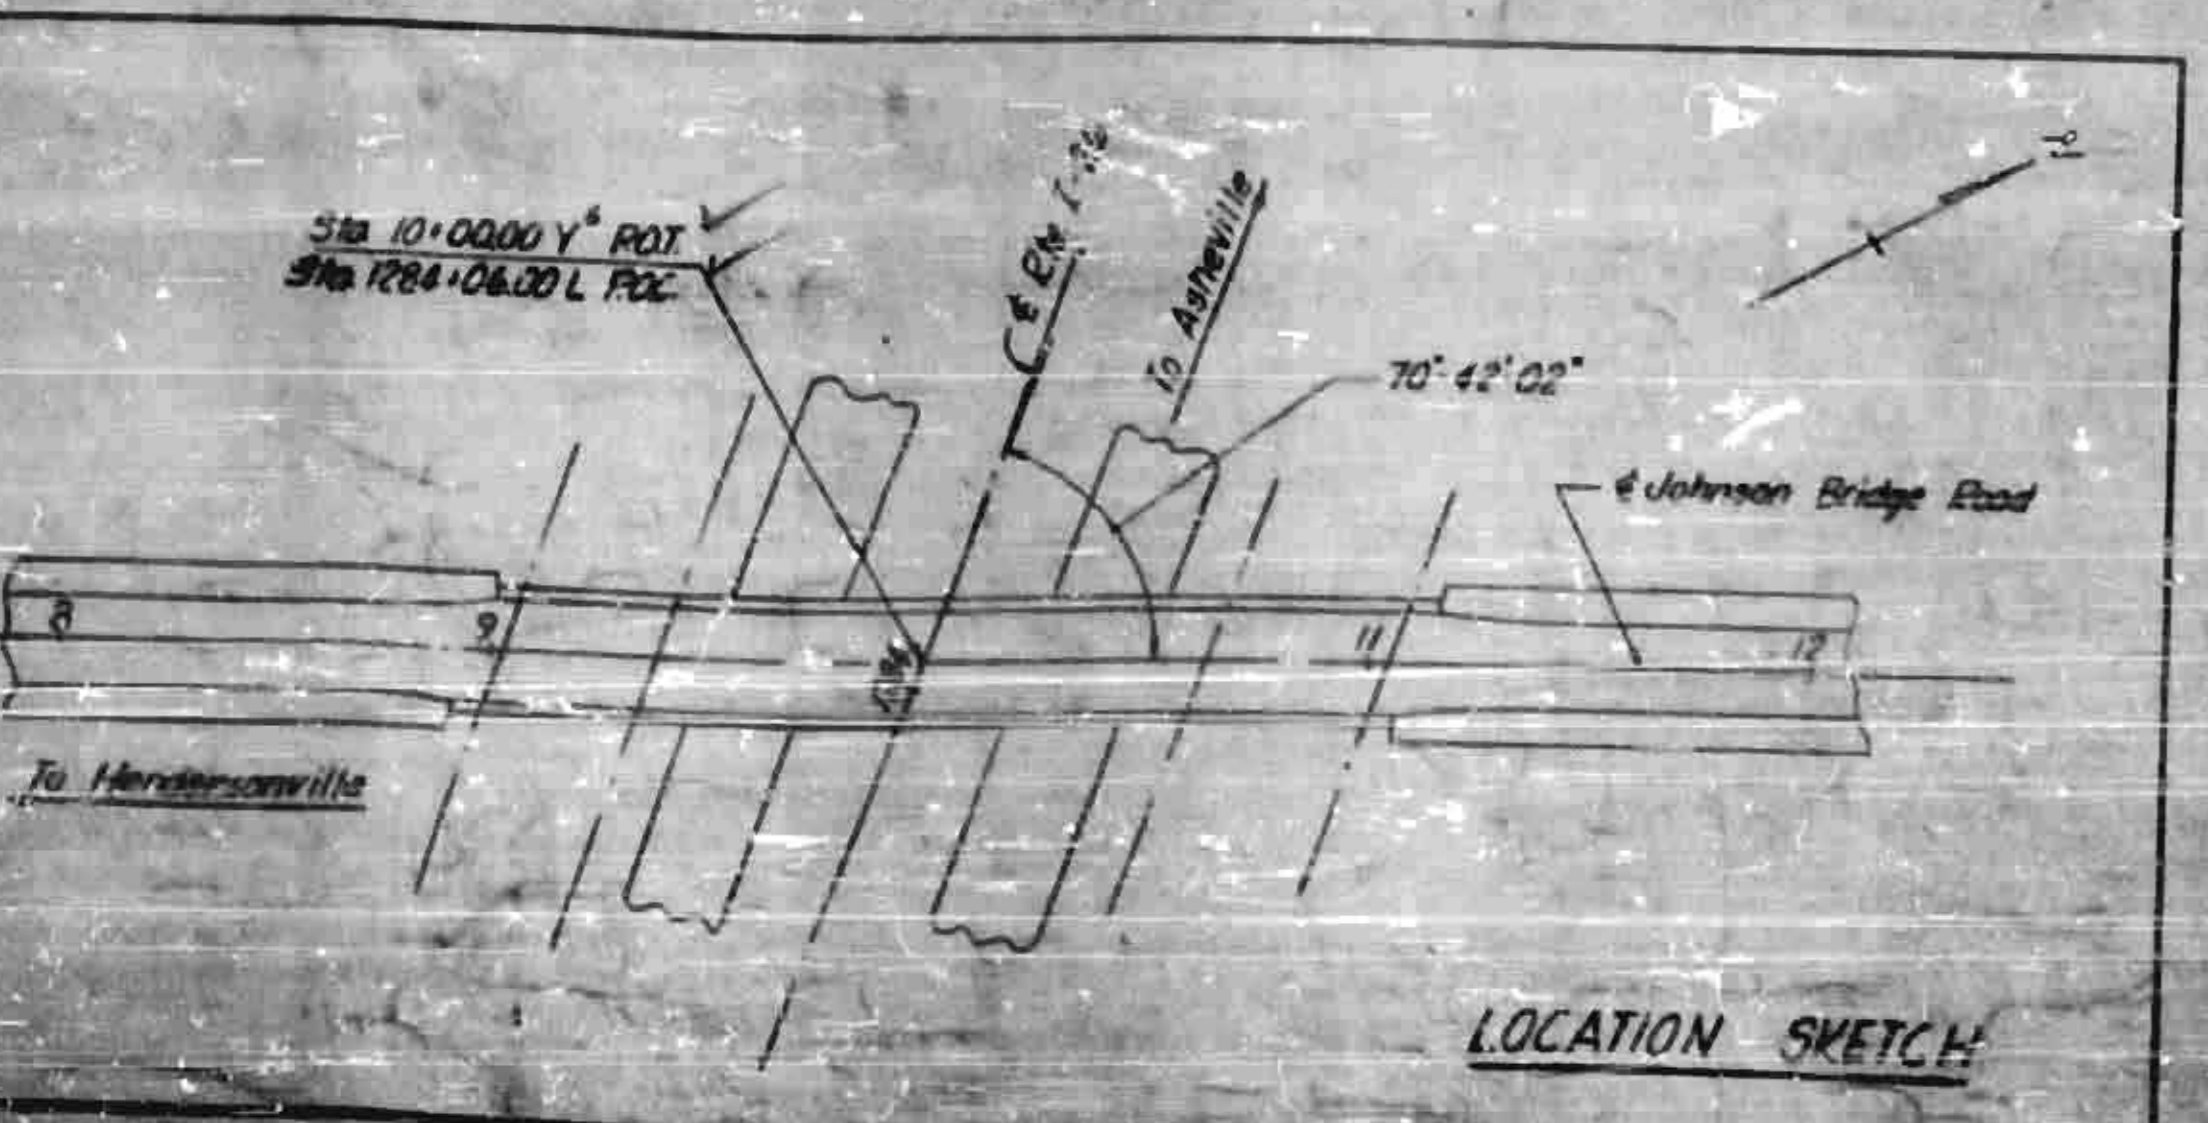

See list to correct quantities of reinforcing steel, class II concrete & metal rails for superstructure and change Plans 1 & 2.

STATE OF NORTH CAROLINA
 STATE HIGHWAY COMMISSION

GENERAL DRAWING
 BRIDGE OVER PROPOSED
 INTERSTATE ROUTE 26
 ON JOHNSON BRIDGE ROAD


DATE: 8.18.29
 DRAWN BY: [Signature]
 CHECKED BY: [Signature]

Column 1 bottom of overhang			Column 2 top of curb			Column 3 top of Beam			Column 4 top of Roadway			Column 5 top of Beam			Column 6 top of curb			Column 7 Bottom of Overhang		
Dist.	Elev.	Fill Face	Dist.	Elev.	Begin Curb	Dist.	Elev.	Fill Face	Dist.	Elev.	Fill Face	Dist.	Elev.	Fill Face	Dist.	Elev.	Begin Curb	Dist.	Elev.	Fill Face
4'-11"	2104.195	0 + 10				2'-5 1/2"	2105.150	9 + 10				3'-11 1/2"	2104.040	0 + 00				10'-0"	2104.345	+ 10
10'-0"	.645	+ 20				10'-0"	.417	+ 20				10'-0"	.645	+ 20				10'-0"	.645	+ 20
10'-0"	2104.951	+ 30				10'-0"	.717	+ 30				10'-0"	2104.931	+ 30				10'-0"	2104.931	+ 30
10'-0"	2105.206	+ 40				8'-6 1/2"	.948	+ Bent #1				10'-0"	2105.216	+ 40				10'-0"	2105.216	+ 40
5'-0 1/2"	.187	+ 50				10'-0"	.995	+ 50				10'-0"	2105.253	+ Bent #1				10'-0"	2105.253	+ Bent #1
10'-0"	.781	+ 60				10'-0"	.955	+ 60				5'-11 1/2"	.256	+ 40				10'-0"	.469	+ 30
10'-0"	2105.262	+ 70				10'-0"	.742	+ 70				10'-0"	.721	+ 60				10'-0"	.721	+ 60
10'-0"	2106.192	+ 80				10'-0"	2105.975	+ 80				10'-0"	2105.262	+ 70				10'-0"	2105.262	+ 70
10'-0"	.410	+ 90				10'-0"	2107.191	+ 90				10'-0"	2106.192	+ 80				10'-0"	2106.192	+ 80
10'-0"	.617	10 + 00				10'-0"	.999	+ Bent #2				10'-0"	.410	+ 90				10'-0"	.410	+ 90
4'-6 1/2"	.707	+ Bent #2				10'-0"	.995	10 + 10				5'-5 1/2"	.515	+ Bent #2				10'-0"	.617	10 + 00
5'-5 1/2"	.819	+ 10				10'-0"	.779	+ 20				10'-0"	.818	+ 10				10'-0"	.818	+ 10
10'-0"	2106.995	+ 20				10'-0"	2107.991	+ 30				10'-0"	2106.995	+ 20				10'-0"	2106.995	+ 20
10'-0"	2107.171	+ 30				10'-0"	2108.114	+ 40				10'-0"	2107.171	+ 30				10'-0"	2107.171	+ 30
10'-0"	.353	+ 40				10'-0"	.769	+ 50				10'-0"	.353	+ 40				10'-0"	.353	+ 40
10'-0"	.454	+ 50				10'-0"	.405	+ 60				10'-0"	.484	+ 50				10'-0"	.484	+ 50
10'-0"	.674	+ 60				10'-0"	.651	+ 70				10'-0"	.585	+ Bent #3				10'-0"	.585	+ Bent #3
5'-11 1/2"	.702	+ Bent #3				10'-0"	.757	+ 80				5'-0 3/4"	.624	+ 60				10'-0"	.757	+ 80
4'-0 3/4"	.792	+ 70				10'-0"	.852	11 + 00				10'-0"	.870	+ 80				10'-0"	.870	+ 80
10'-0"	.610	+ 80				10'-0"	.852	11 + 00				10'-0"	2107.976	+ 90				10'-0"	2107.976	+ 90
10'-0"	2107.976	+ 90				3'-7 1/2"	2108.655	Fill Face				0'-1 1/2"	2108.063	Fill Face				0'-1 1/2"	2108.063	Fill Face
10'-0"	2108.070	11 + 00																		
8'-2"	2108.153	Fill Face																		

GRADE DATA

P.I. Sta 10+00
 P.I. Elev 8112.50
 Length of Curve 620'
 G1 +5.50 % G2 -1.07 %

PROJECT NO.	818293
DATE	APR 1961

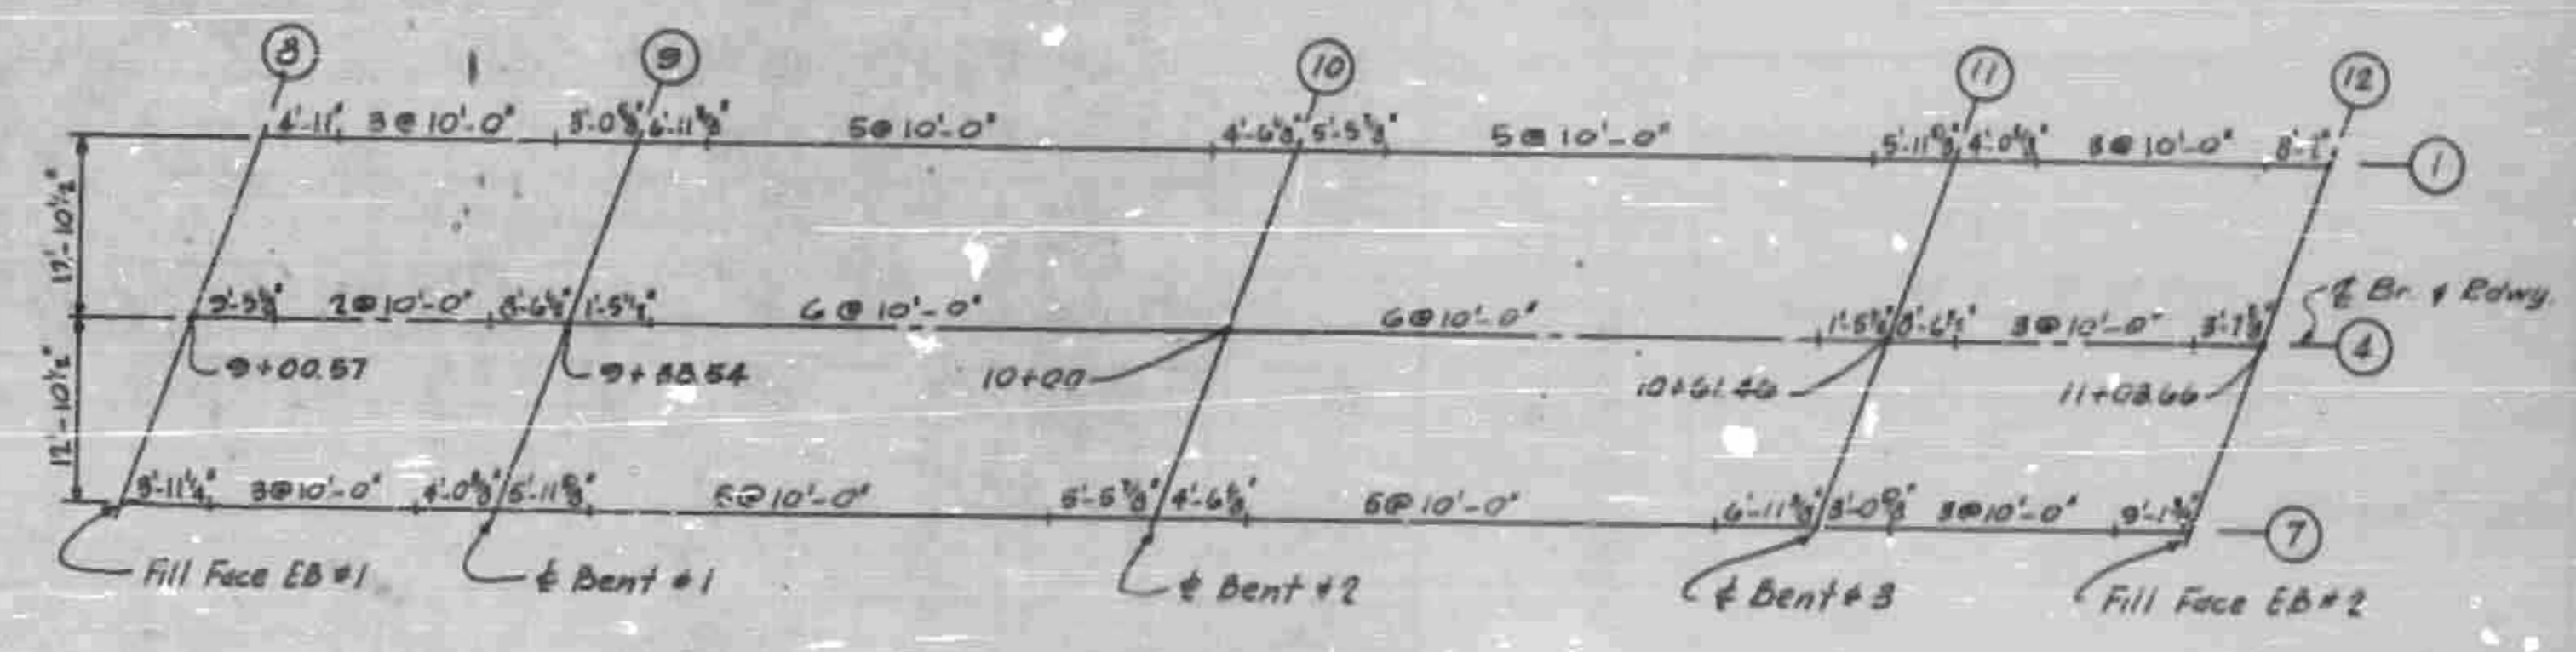

PLAN



TYPICAL SECTION

Elevations shown in these tables are final required elevations of the completed structure. In setting up form elevations and screed elevations, provisions must be made for deflections where required.

HEADERS

Column 8 Fill Face EB #1		Column 9 top of Bent 1		Column 10 top of Bent 2		Column 11 top of Bent 3		Column 12 Fill Face EB #2	
Point	Elev.	Point	Elev.	Point	Elev.	Point	Elev.	Point	Elev.
Lt. Gutter	2104.183	Lt. Gutter	2105.875	Lt. Gutter	2107.295	Lt. Gutter	2108.792	Lt. Gutter	2108.751
2'-1 1/2"	.792	2'-1 1/2"	.886	2'-1 1/2"	.912	2'-1 1/2"	.914	2'-1 1/2"	.786
	.802		.895		.930		.937		.781
	.811		.911		.947		.959		.807
	.821		.923		.964		.981		.835
	.830		.936		.981		.993		.861
	.839		.946		.999		.999		.885
	.850		.955		.999		.999		.885
	.855		.967		.999		.999		.885
	.860		.977		.999		.999		.885
	.866		.987		.999		.999		.885
	.873		.996		.999		.999		.885
2'-1 1/2"	.573	2'-1 1/2"	.696	2'-1 1/2"	.717	2'-1 1/2"	.722	2'-1 1/2"	.691
Rt. Gutter	2104.520	Rt. Gutter	2105.646	Rt. Gutter	2107.126	Rt. Gutter	2108.181	Rt. Gutter	2108.699

SUPERIMPOSED DEAD LOAD DEFLECTIONS (inches)				
Int.	SPAN	SPAN	SPAN	SPAN
Ext.				

PROJECT NO. 818293
 HENDERSON COUNTY
 STATION: 1284-06L 10+00 Y'

STATE OF NORTH CAROLINA
STATE HIGHWAY COMMISSION
 RALEIGH
 ELEVATIONS FOR SETTING UP FORMS AND SCREEDS


NO.	BY	DATE	NO.	BY	DATE
1			2		

DESIGNED BY G. Bergin
 CHECKED BY [Signature]
 DATE March 1961
 DATE Apr. 24, 1961

101

PROJECT NO.	8.18293
STATE	N. C.
DATE	8.10.29

PLAN NO.	478	569
----------	-----	-----

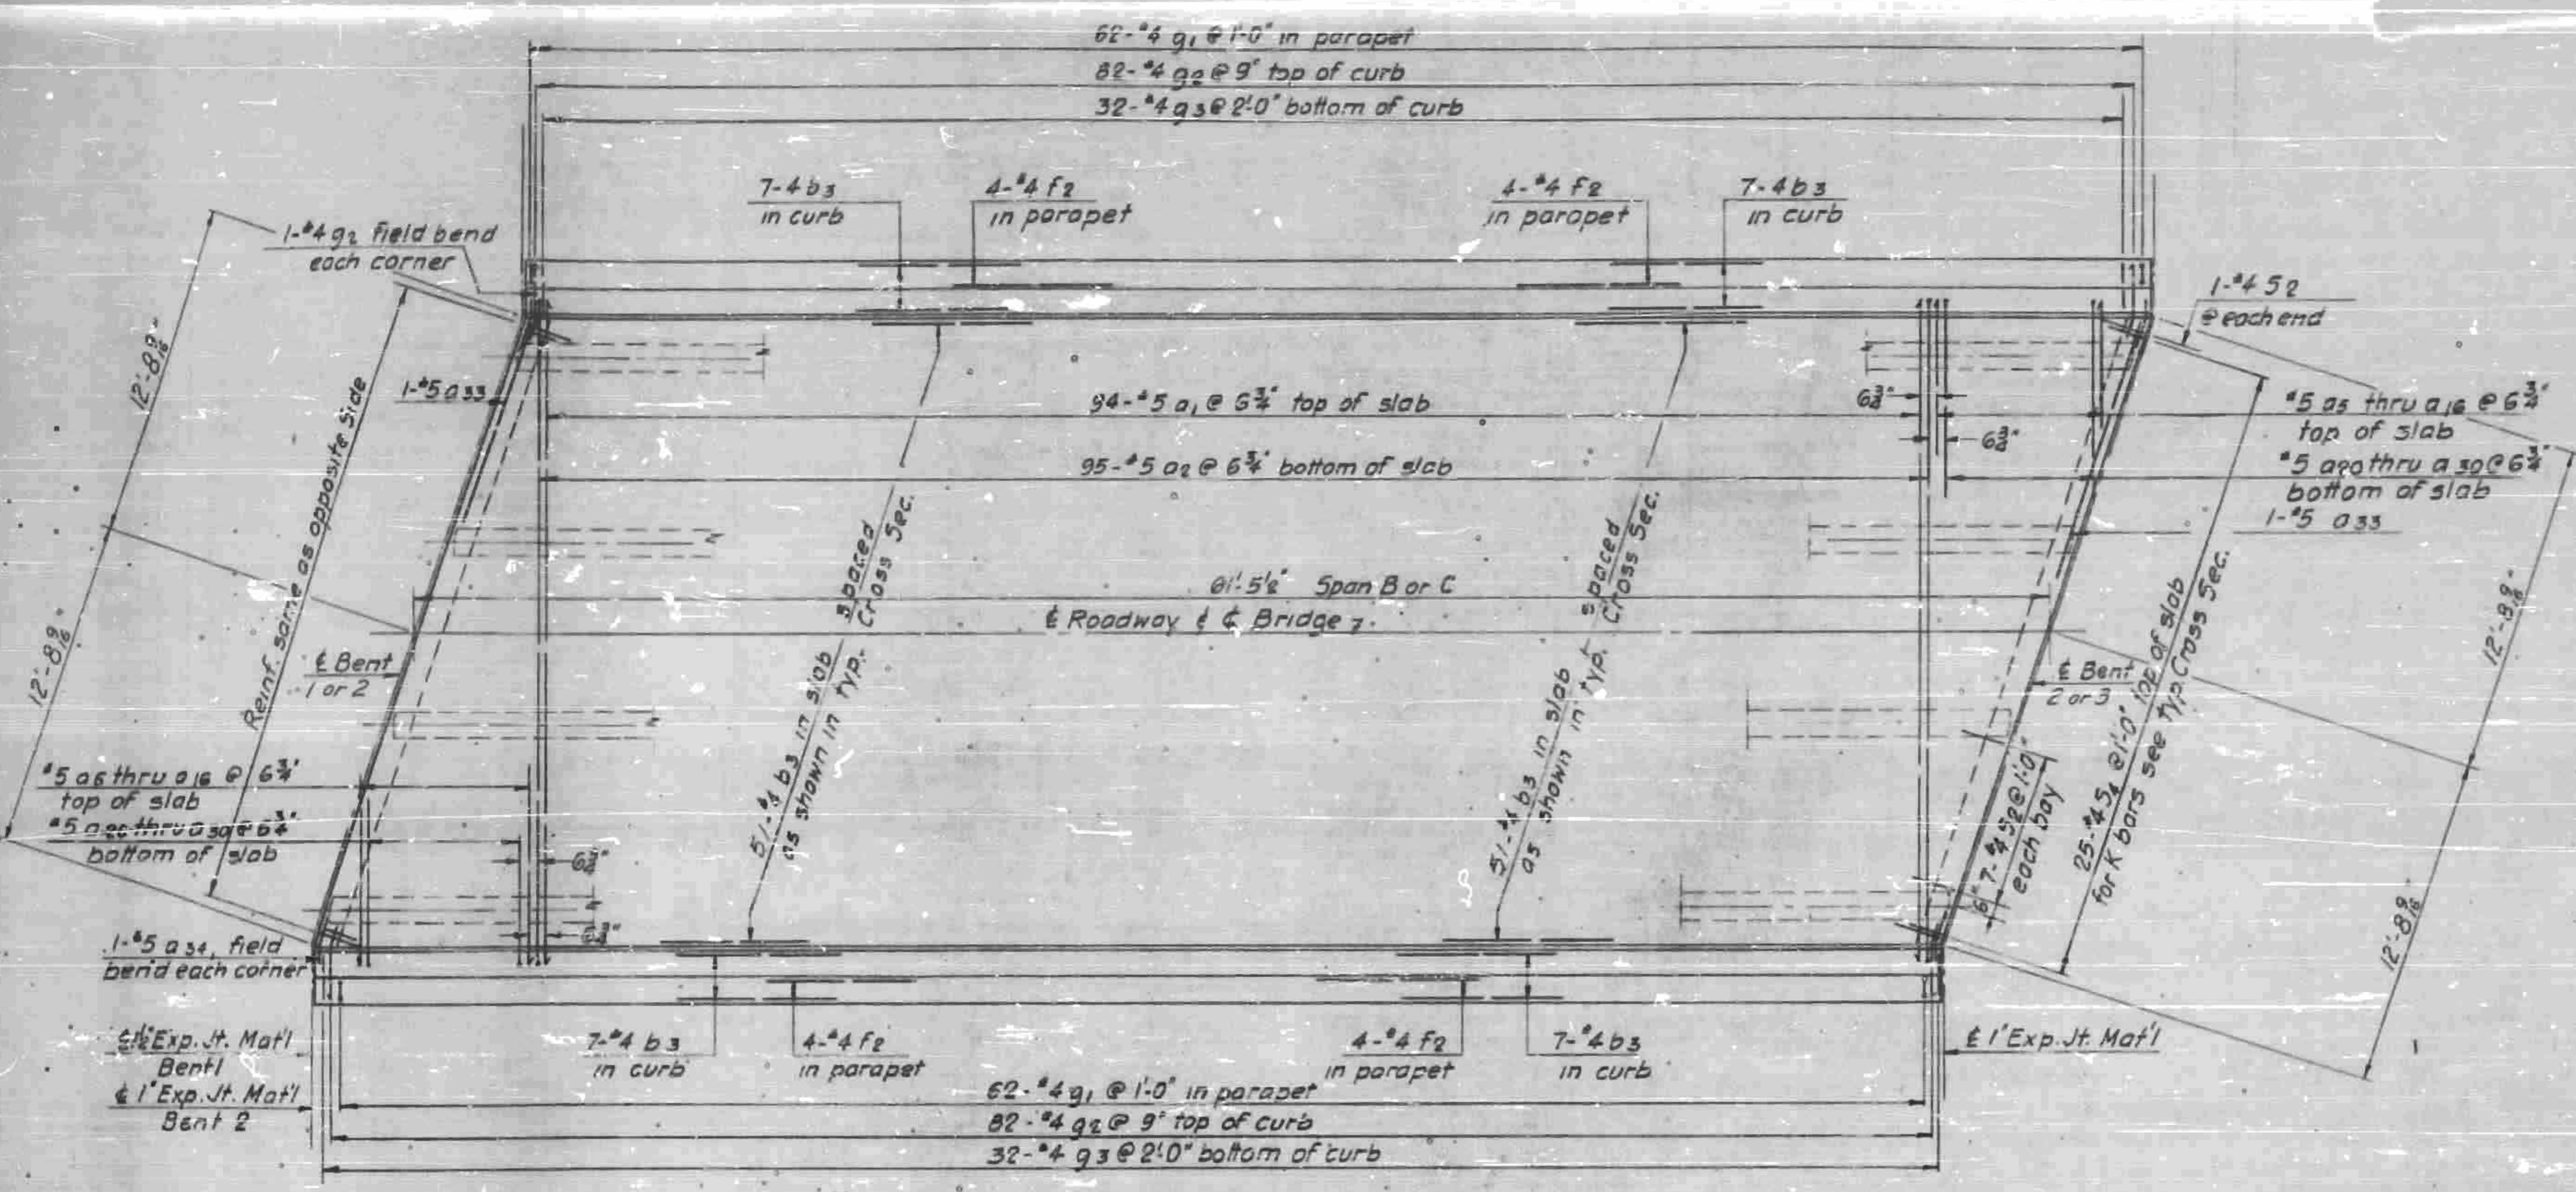

PLAN







PROJECT NO. 8.18293
 HENDERSON COUNTY
 STATION 1284 + 06 L.
 10 + 00 V6

STATE OF NORTH CAROLINA STATE HIGHWAY COMMISSION	
SUPERSTRUCTURE SPAN B OR C	
DATE	8-1-29
BY	CBP

Revision No. 1: To change 'b' bars in slab


PROJECT NO.	8 18293
DATE	8.18.29
BY	H. E. B.
CHECKED	H. E. B.

NO.	REV.	DATE	BY
1			
2			
3			
4			
5			
6			
7			
8			
9			
10			

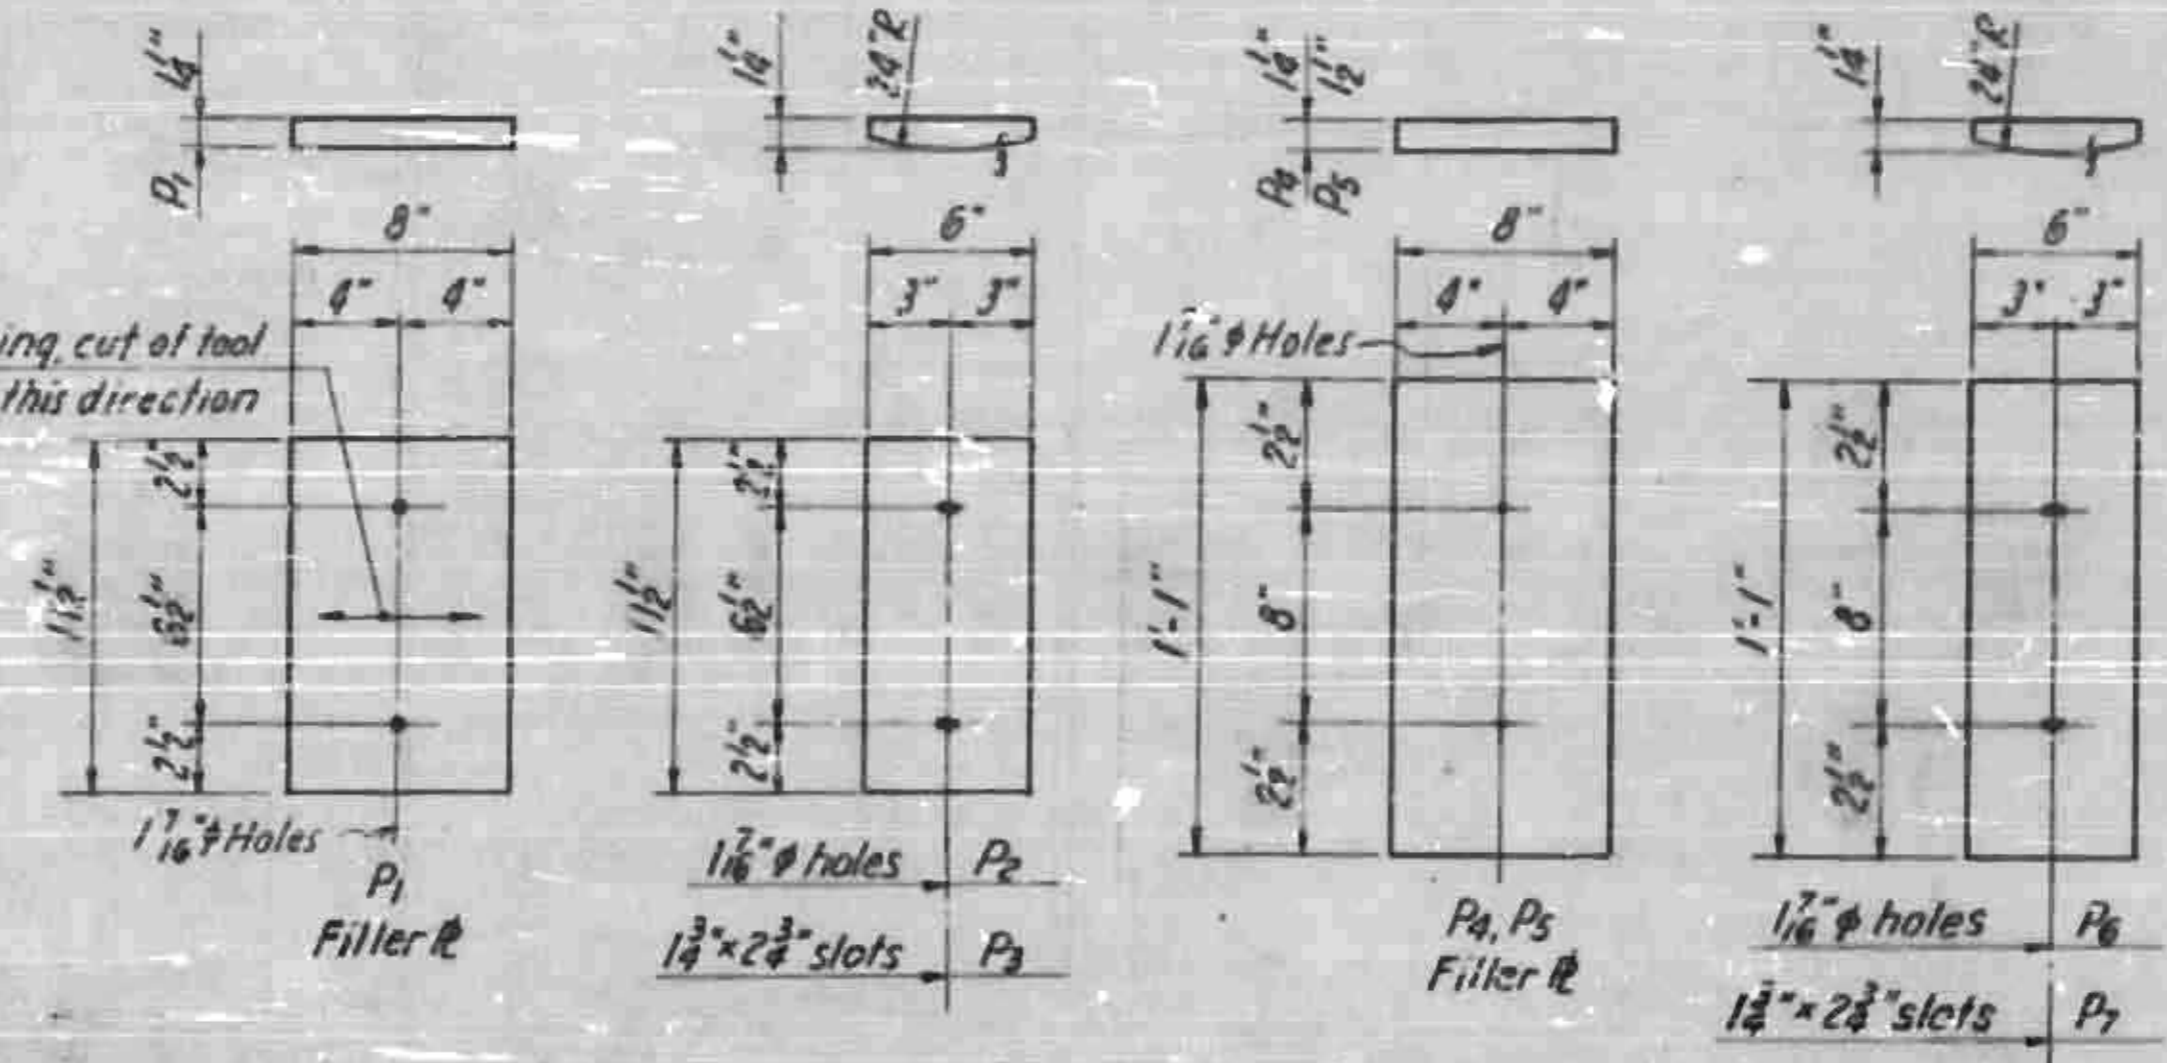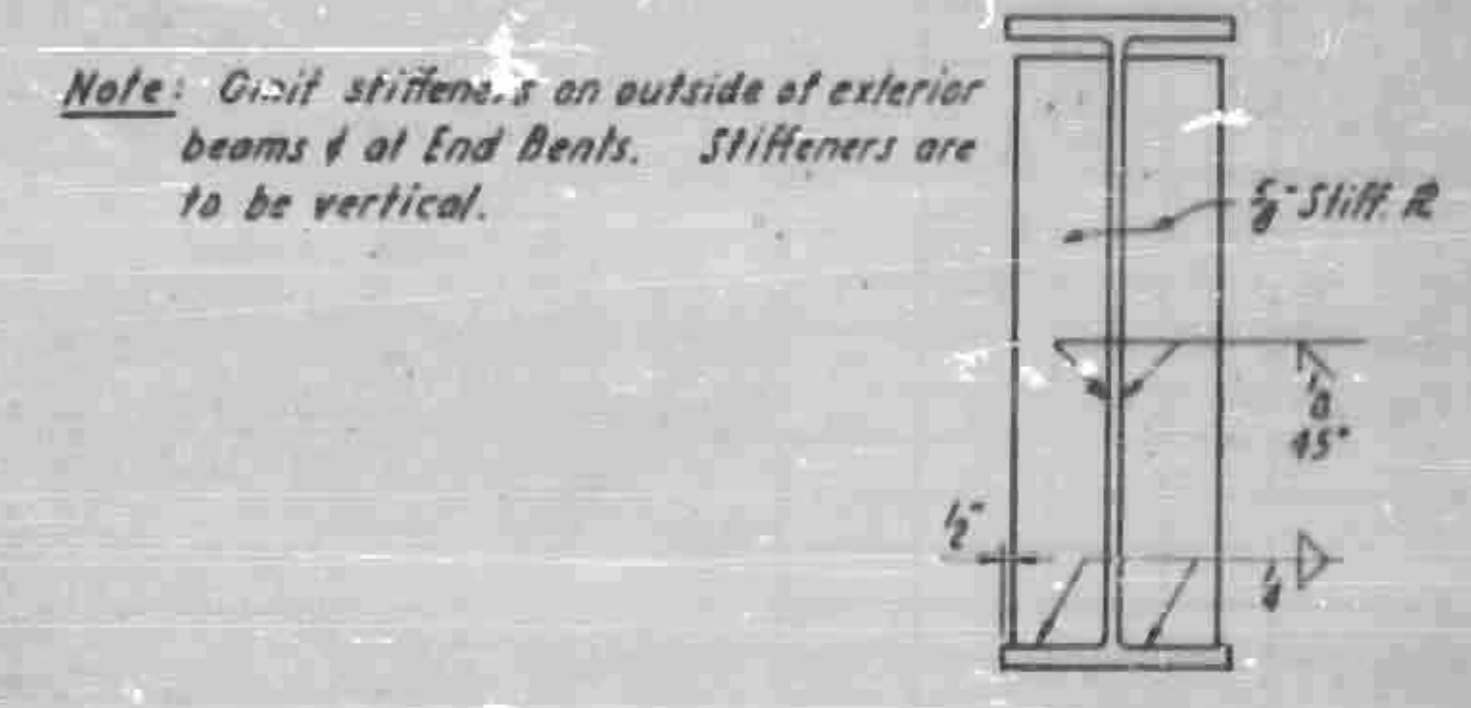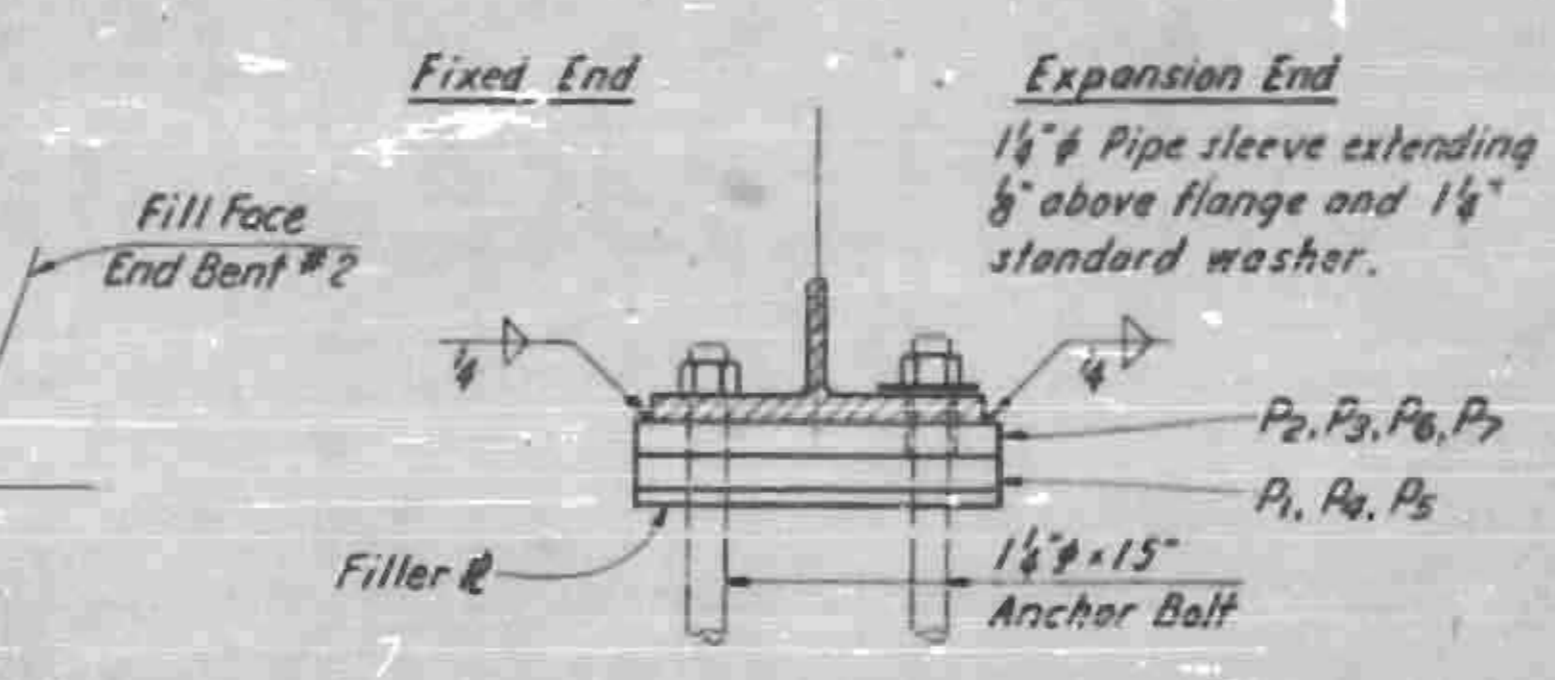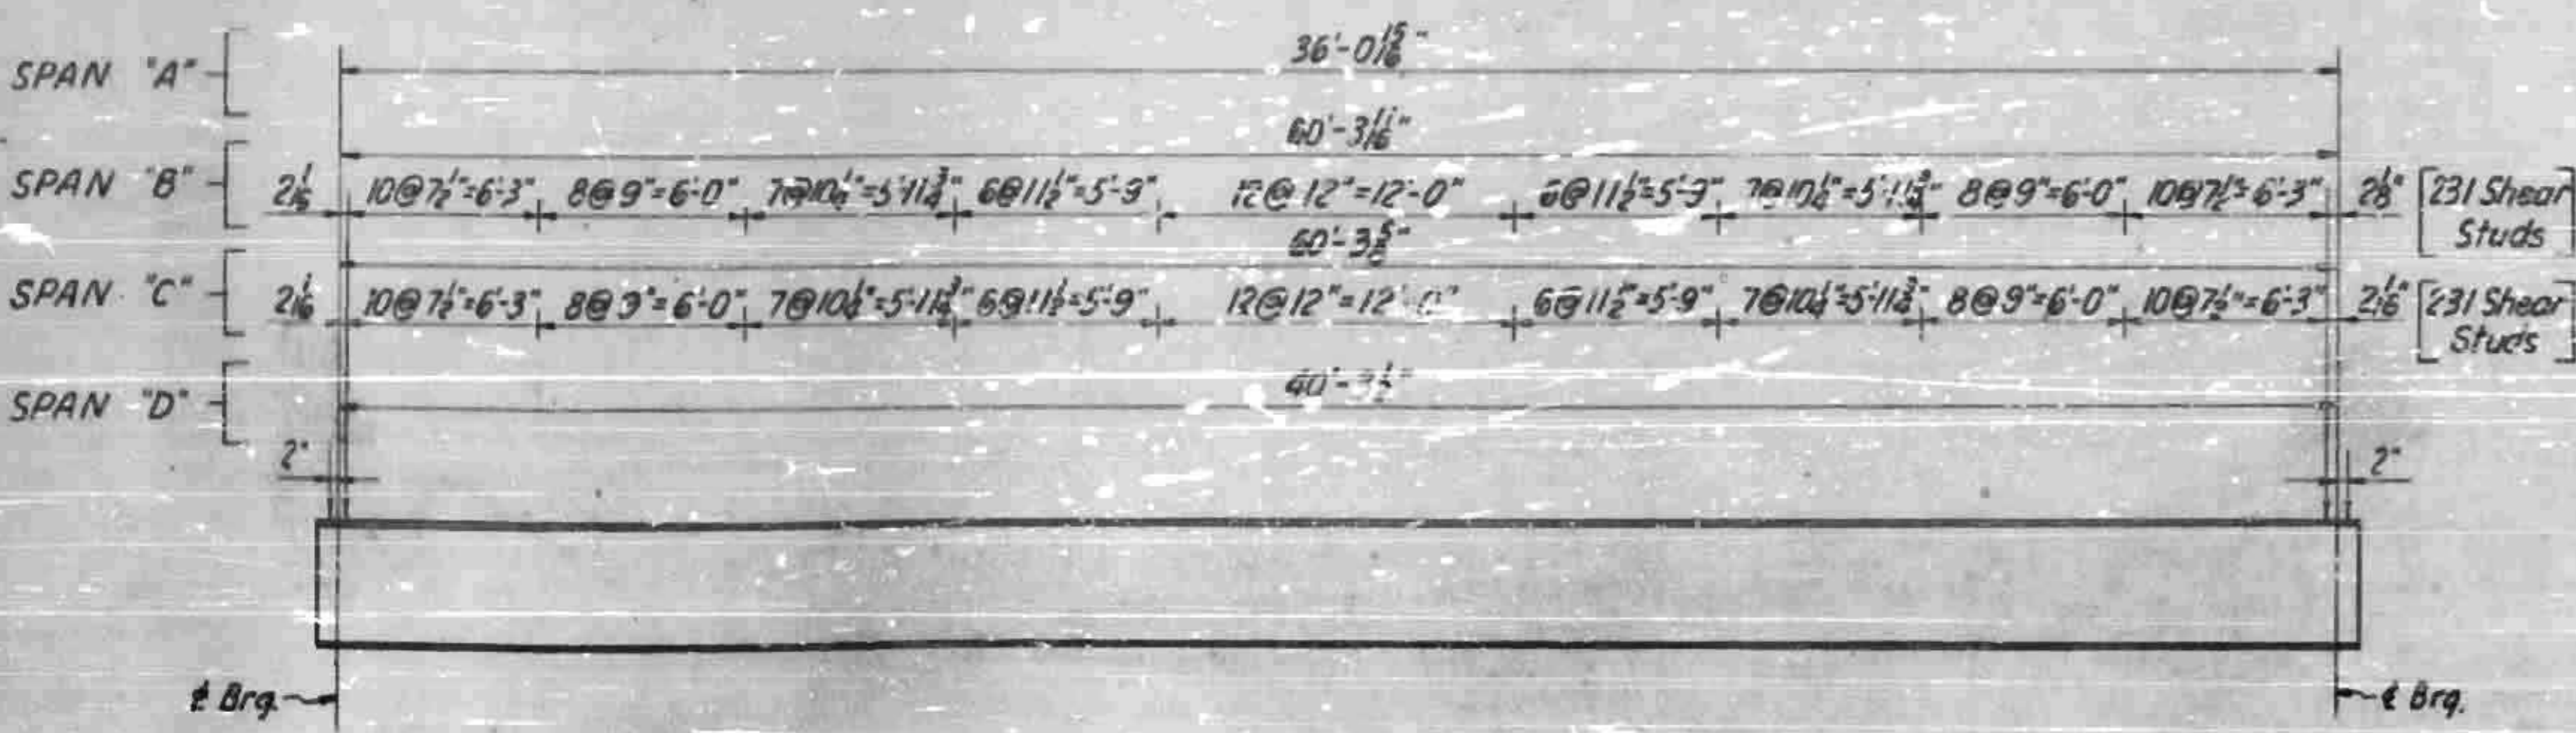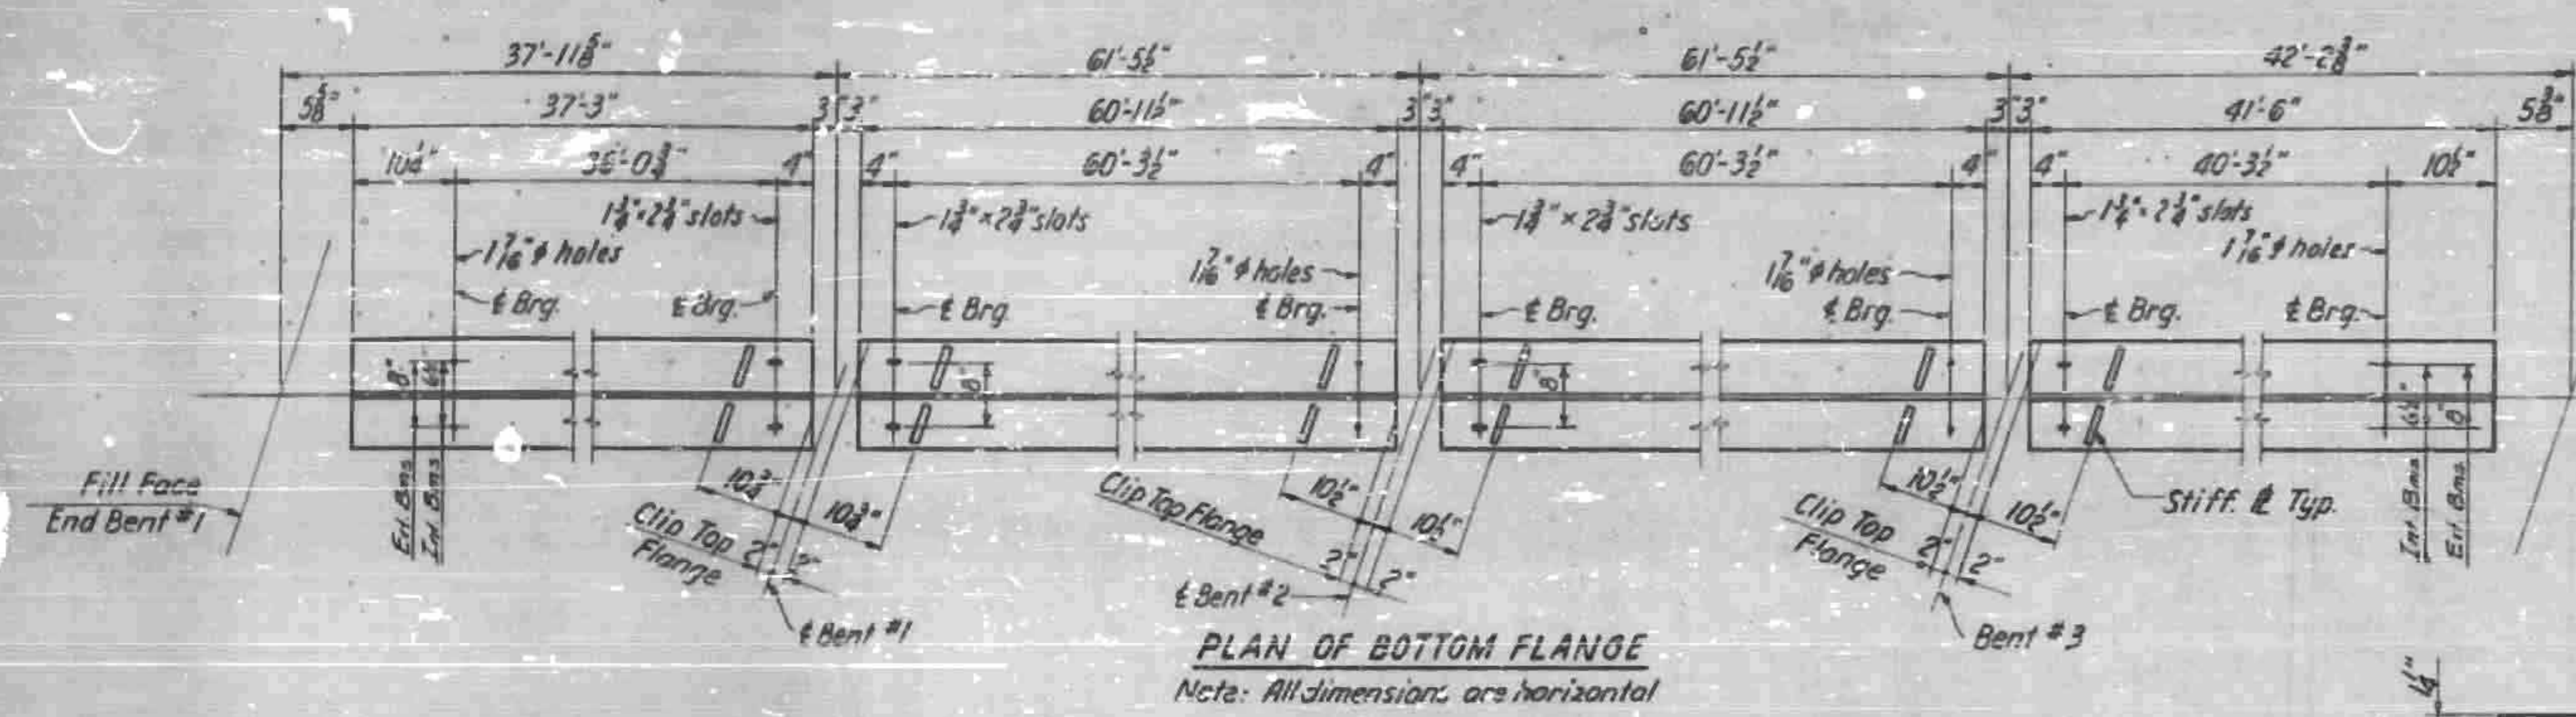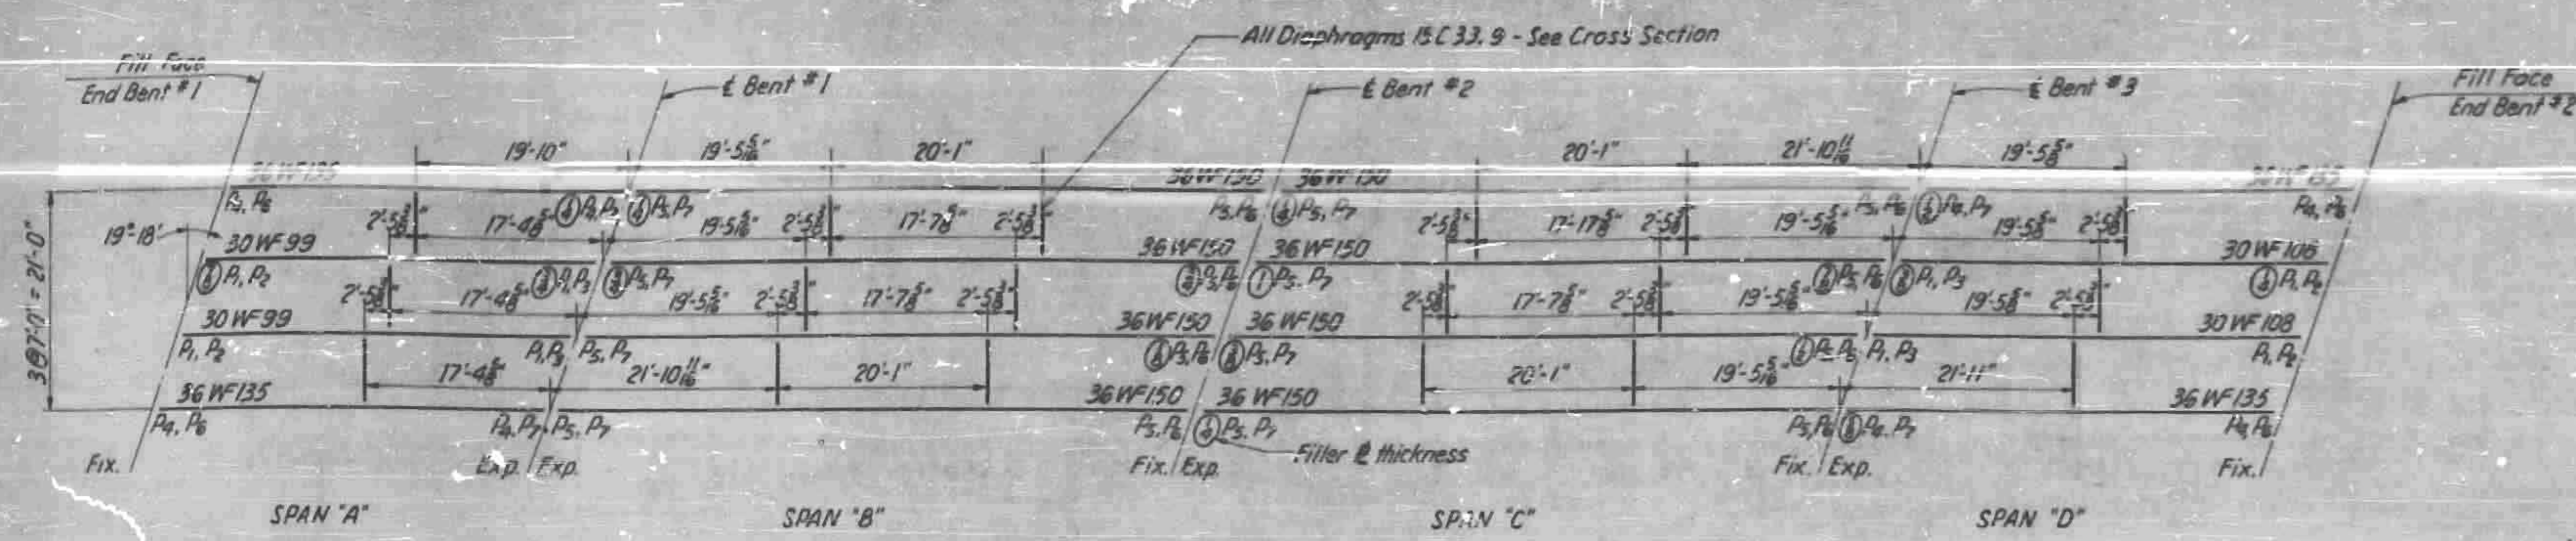

	SPAN "A"		SPAN "B"		SPAN "C"		SPAN "D"	
	Ext. Bm	Int. Bm	Ext. Bm	Int. Bm	Ext. Bm	Int. Bm	Ext. Bm	Int. Bm
Steel	1/16	1/16	1/16	1/16	1/16	1/16	1/16	1/16
Concrete	1/16	1/16	1/16	1/16	1/16	1/16	1/16	1/16
Total DL Defl.	1/8	1/8	1/8	1/8	1/8	1/8	1/8	1/8
Vertical Curve	1/8	1/8	1/8	1/8	1/8	1/8	1/8	1/8
Total Camber	1/8	1/8	1/8	1/8	1/8	1/8	1/8	1/8








NOTE: All beams and channel shear connectors shall be of either ASTM A-36 or A-373 grade structural steel. See Sheet 5-N. Stress in extreme fiber of structural steel = 18,000 lbs. per sq. in.

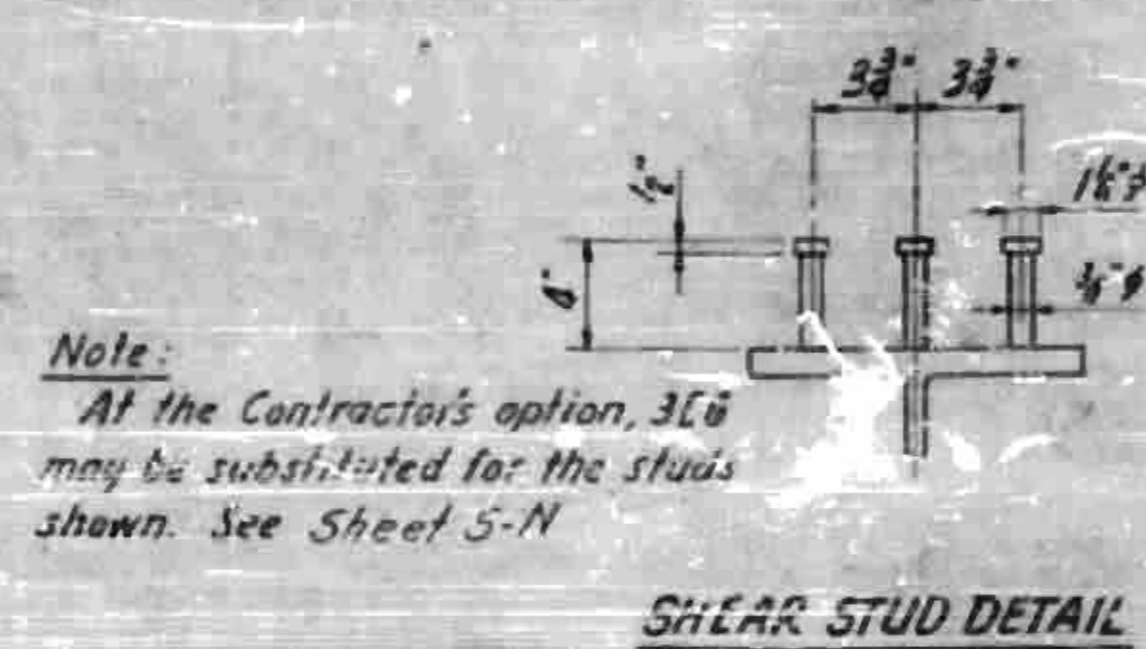

PROJECT NO. 8 18293
 Henderson COUNTY
 STATION 1284 + 06 L
 10 + 00 Y6

STATE OF NORTH CAROLINA
STATE HIGHWAY COMMISSION
HALEIGH
STRUCTURAL STEEL

Revision #1. Revised to add anchor bolt caps for int. bays @ EBs. 8/29/29

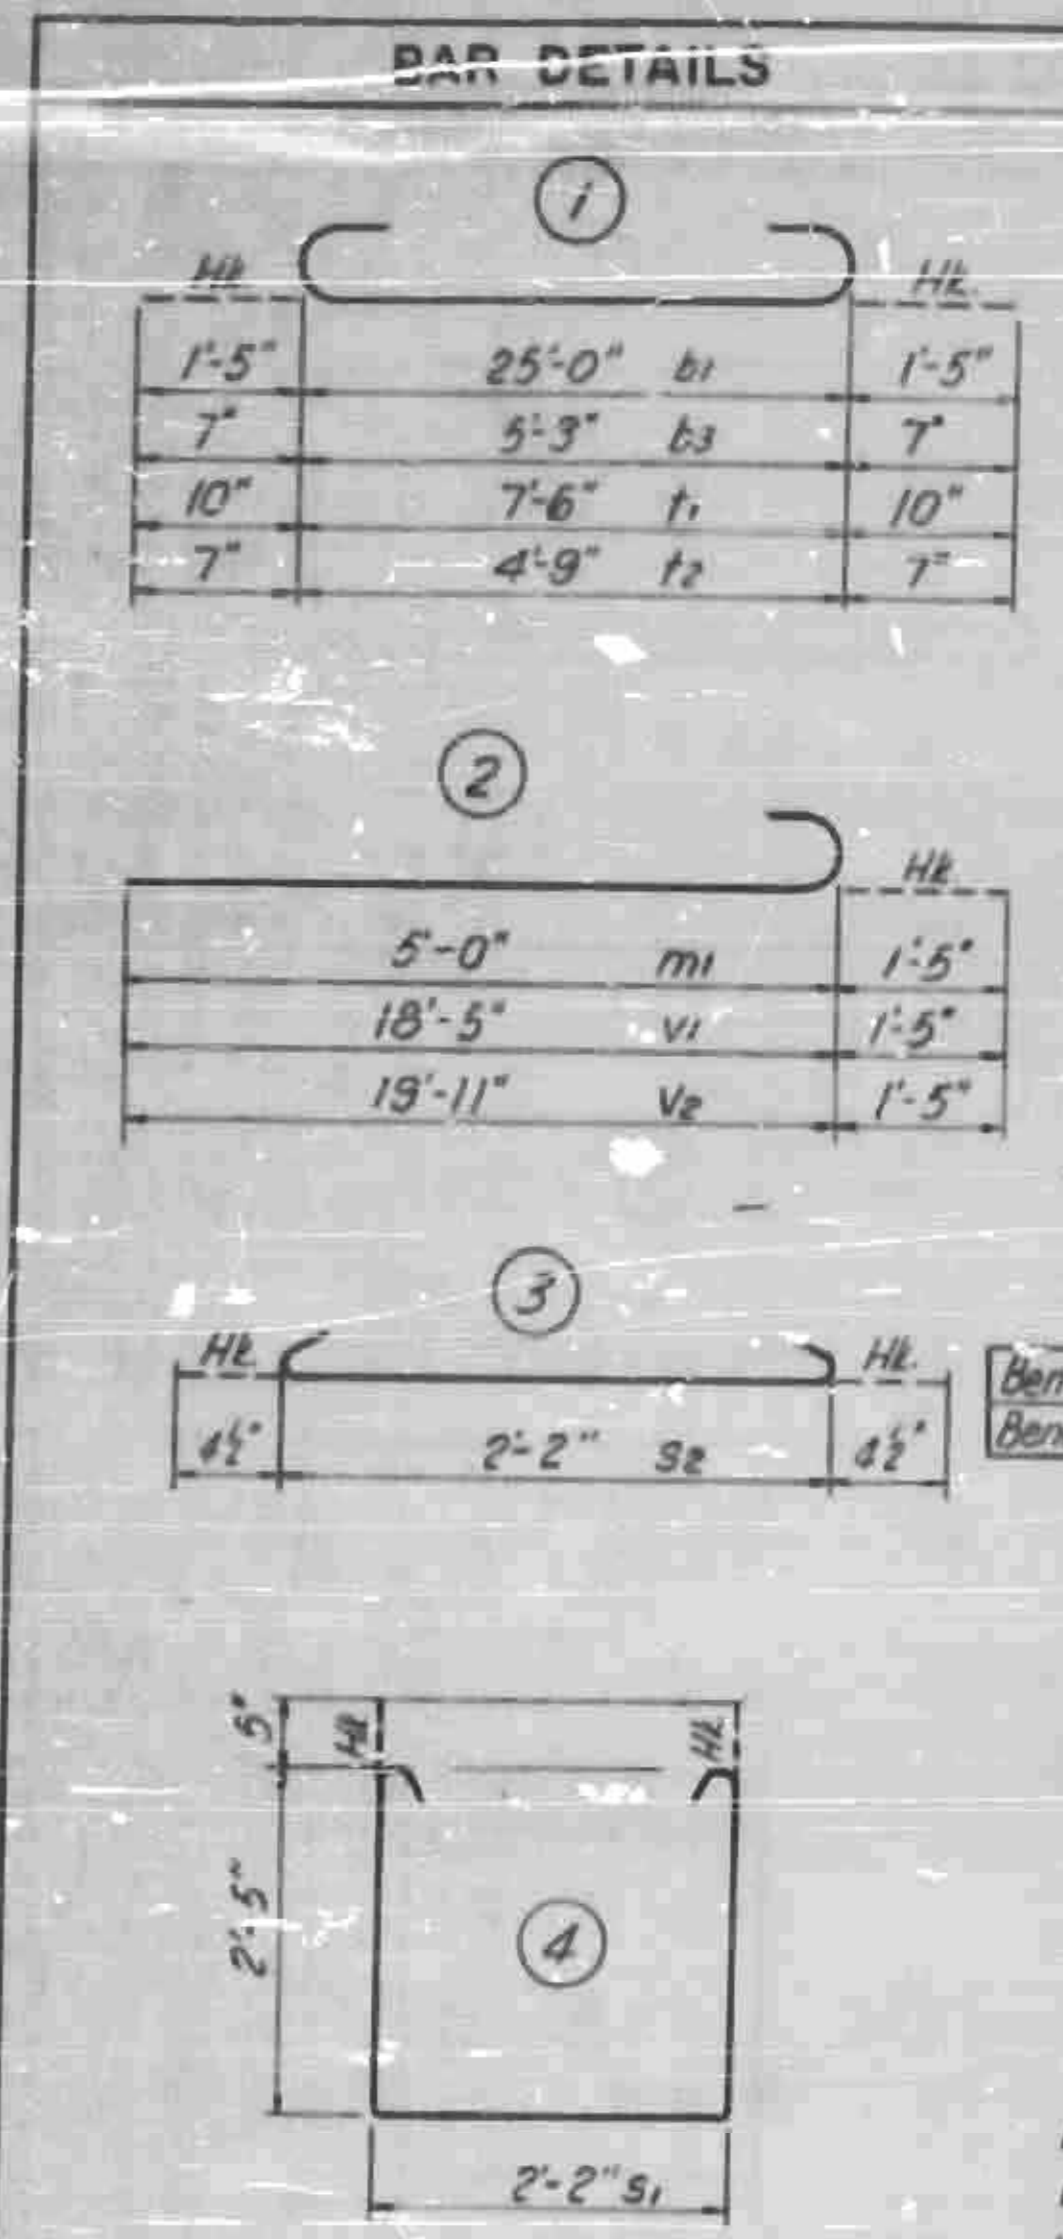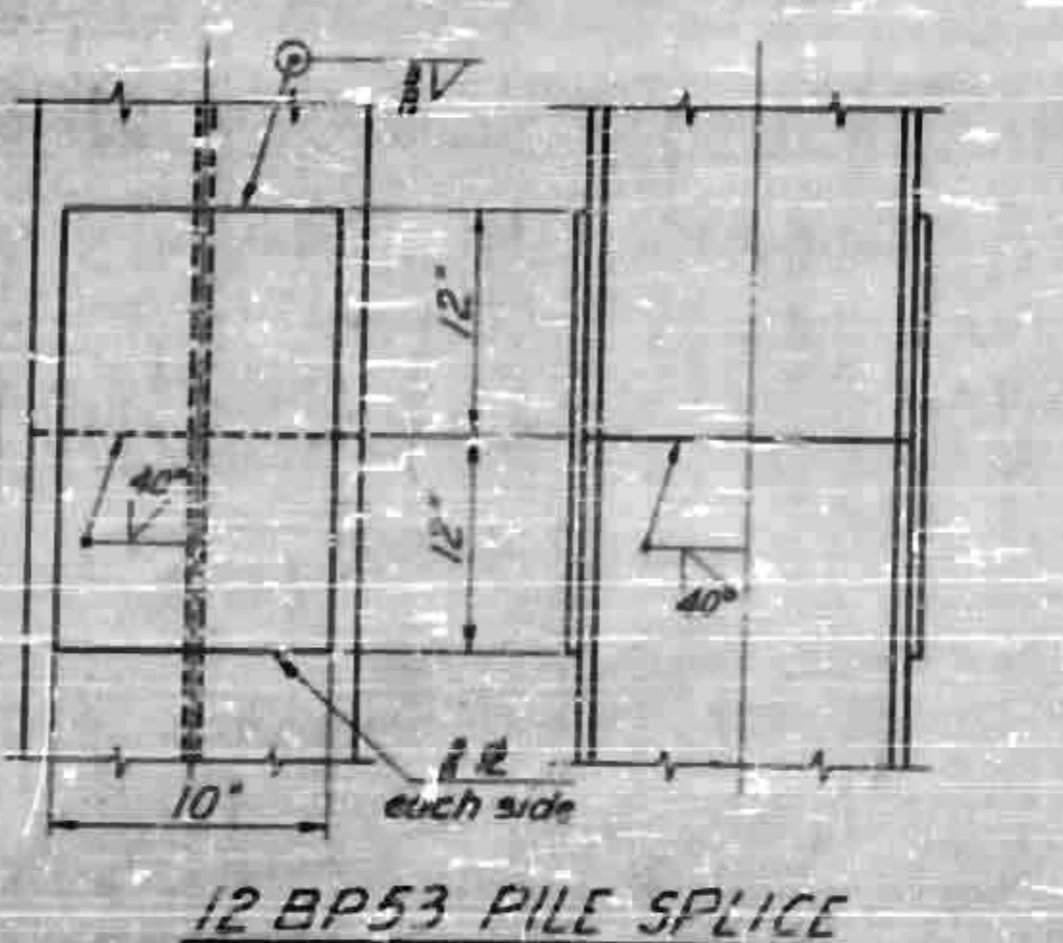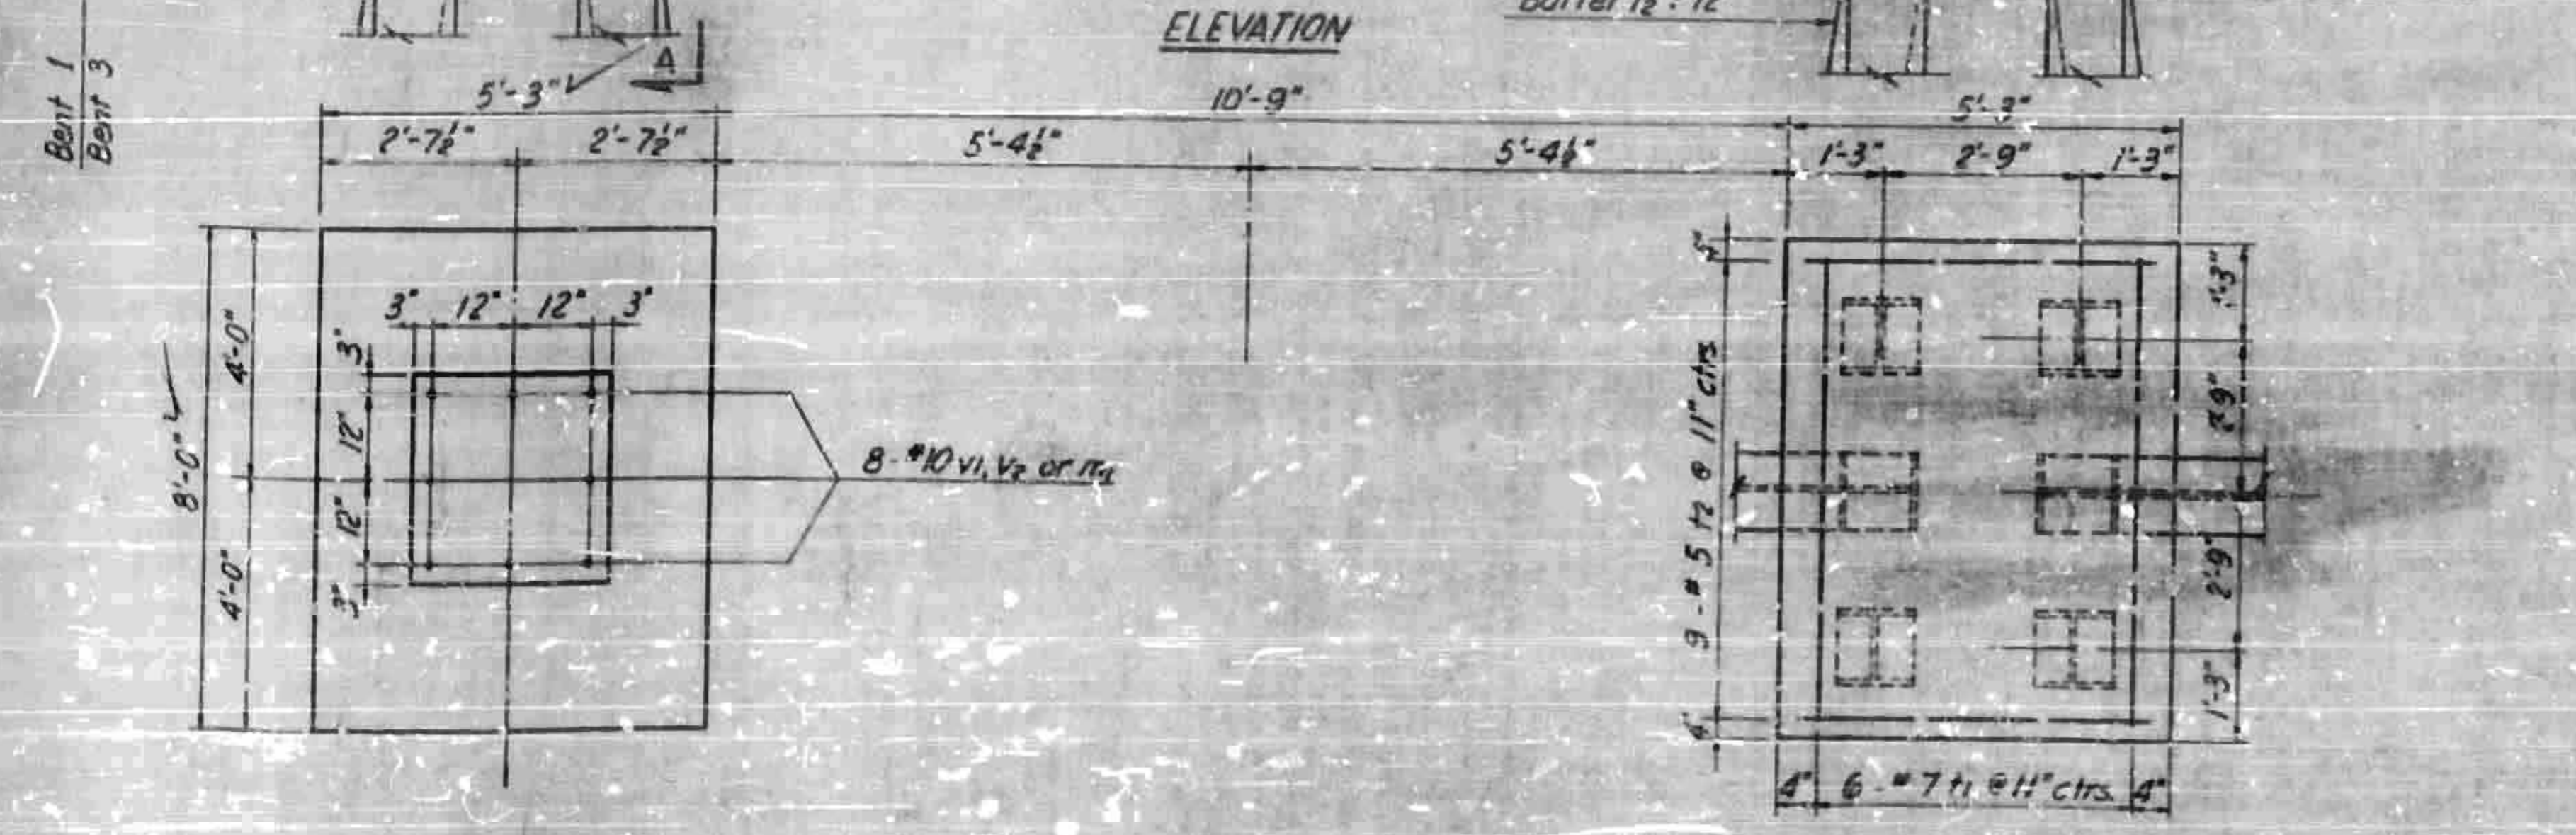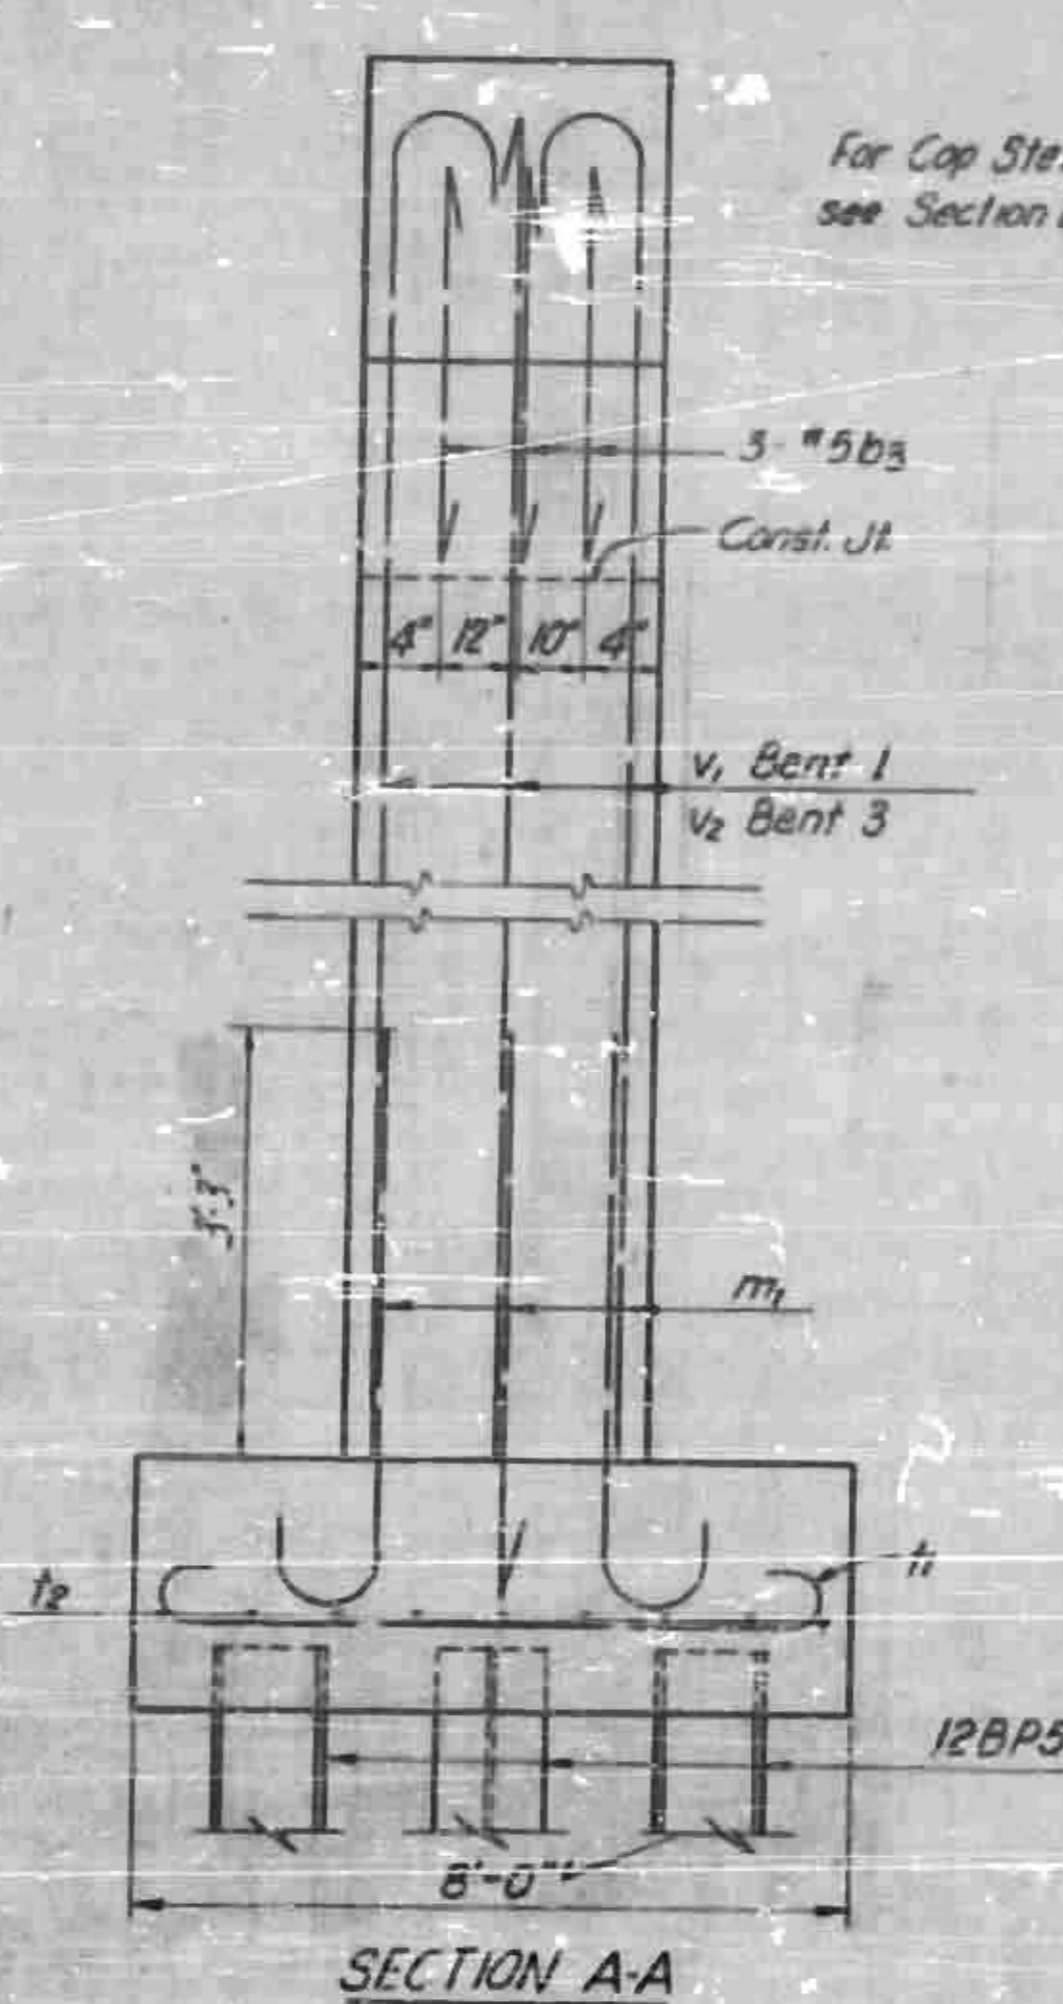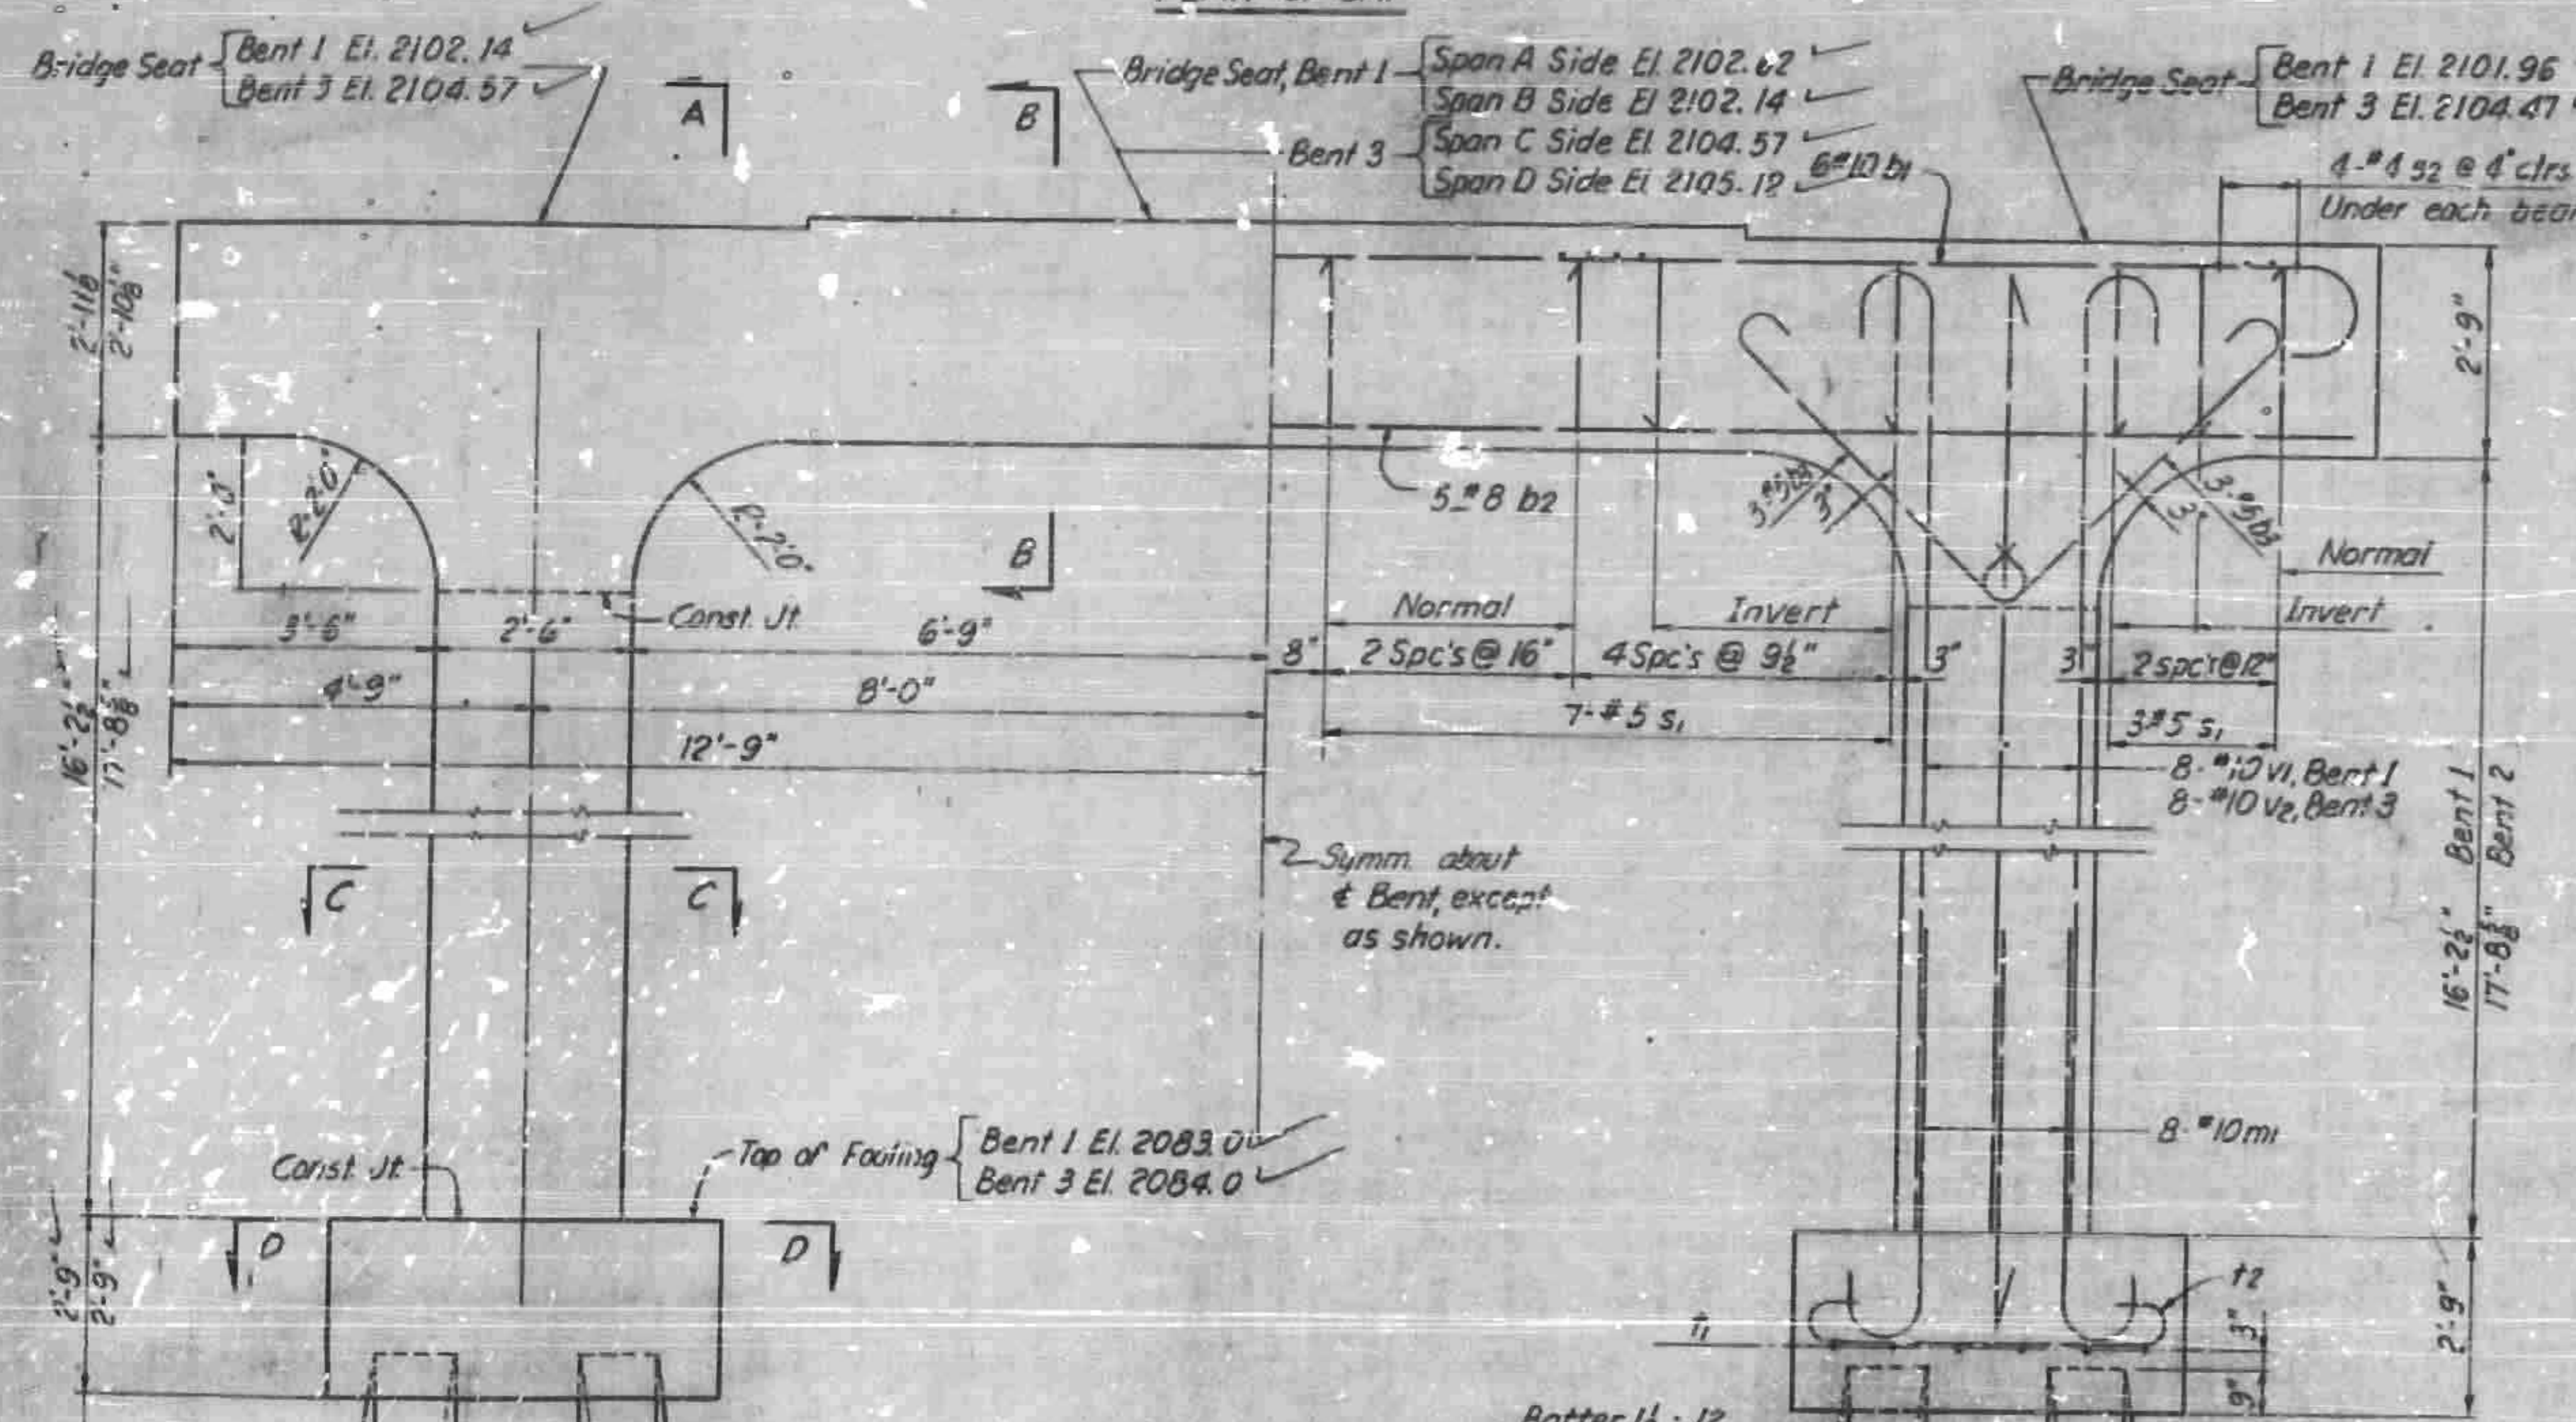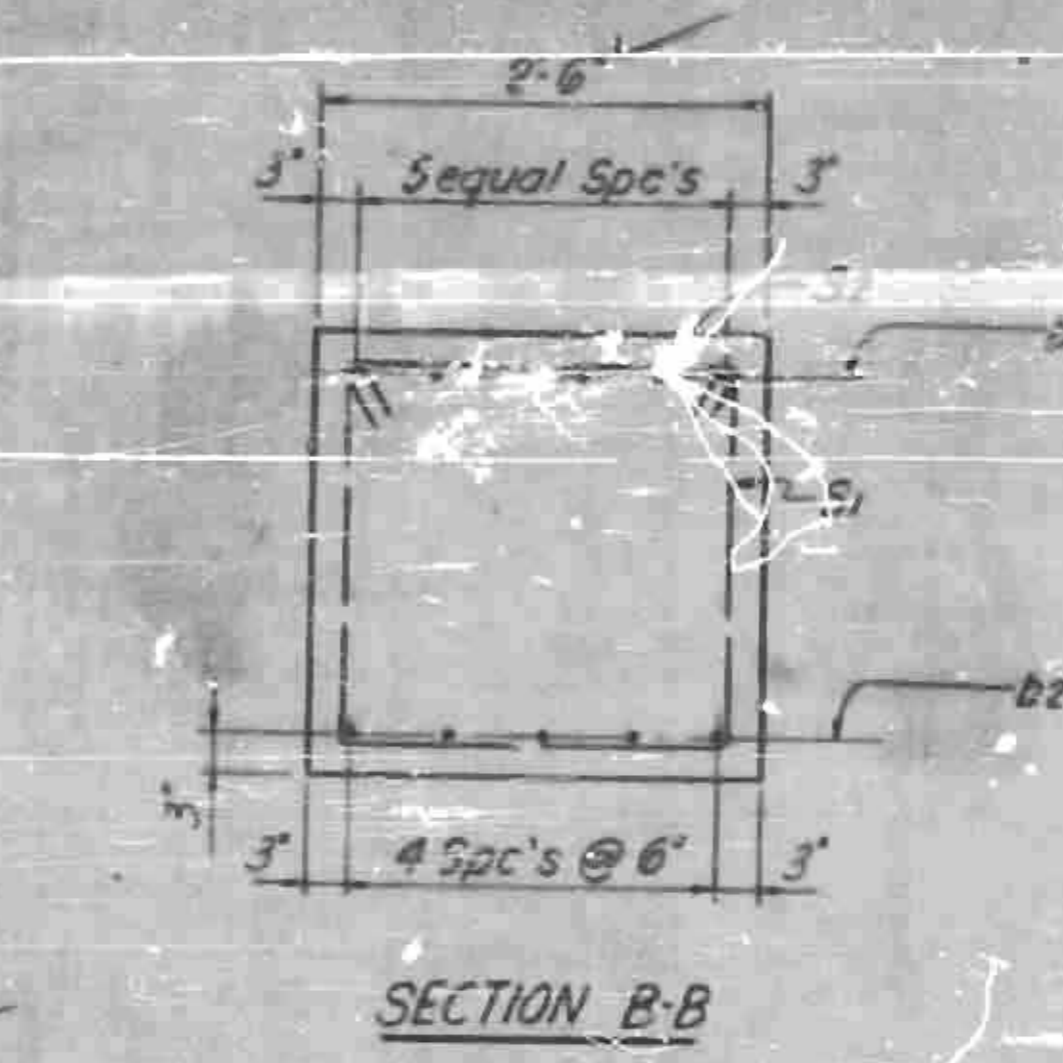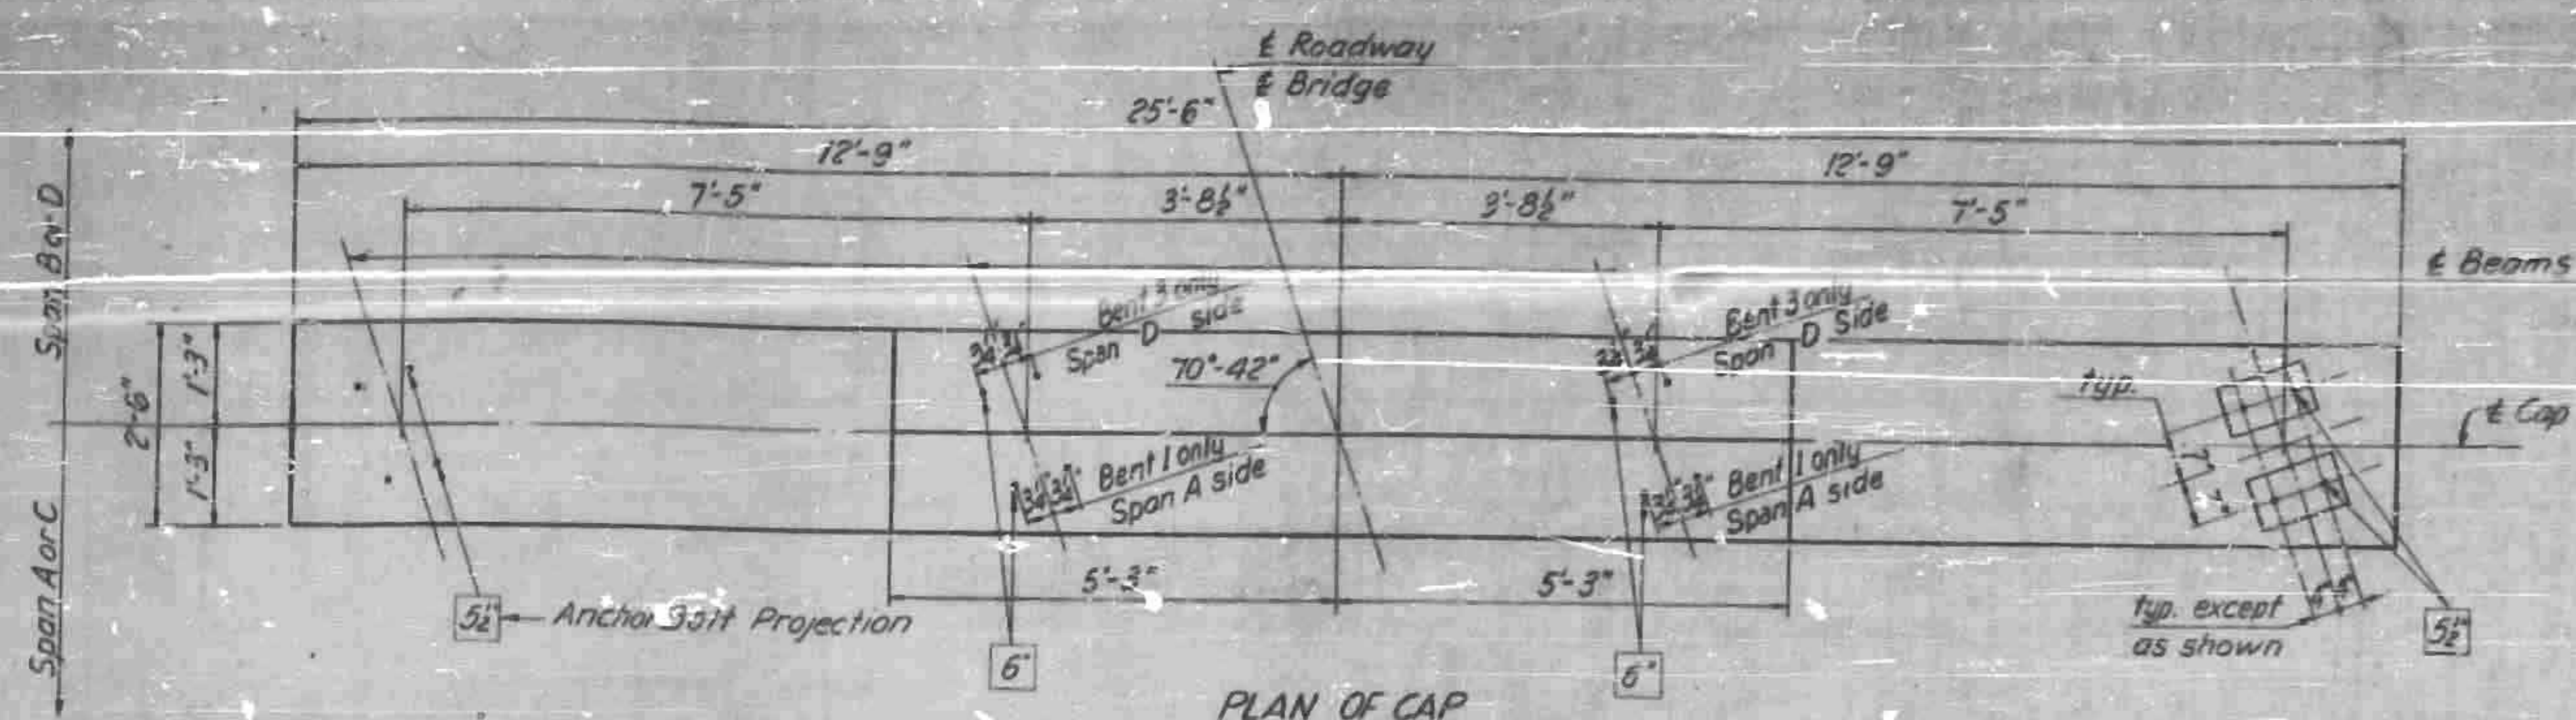

BILL OF MATERIAL					
For 1 Bent - 2 Req'd.					
BAR NO	SIZE	TYPE	LENGTH	WEIGHT	
b1	#6	1	27'-10"	720	
b2	#8	Str.	25'-0"	334	
b3	#5	1	6'-5"	80	
m1	#10	2	6'-5"	444	
s1	#5	4	7'-10"	163	
s2	#4	3	2'-11"	31	
t1	#7	1	3'-2"	225	
t2	#5	1	5'-11"	111	
Bent 1 v1	#10	2	19'-10"	1365	
Bent 3 v2	#10	2	21'-4"	1469	






BENT 1	
Reinf. Steel Lbs.	3473
Class A Concrete Cu. Yds.	23.5
12BP53 Steel Piles No.	12
12BP53 Steel Piles Lin. Ft.	268

BENT 3	
Reinforcing Steel Lbs.	3577
Class A Concrete Cu. Yds.	24.1
12BP53 Steel Piles No.	12
12BP53 Steel Piles Lin. Ft.	277

NOTE: All bar dimensions are out to out.
 Note: Reinforcing in top of Cap may be shifted as necessary to clear Anchor Balls.

PROJECT NO. 8.18293
 HENDERSON COUNTY
 STATION 1284+06 L
 10+00 Y⁶

STATE OF NORTH CAROLINA	
STATE HIGHWAY COMMISSION	
BENTS 1 & 3	

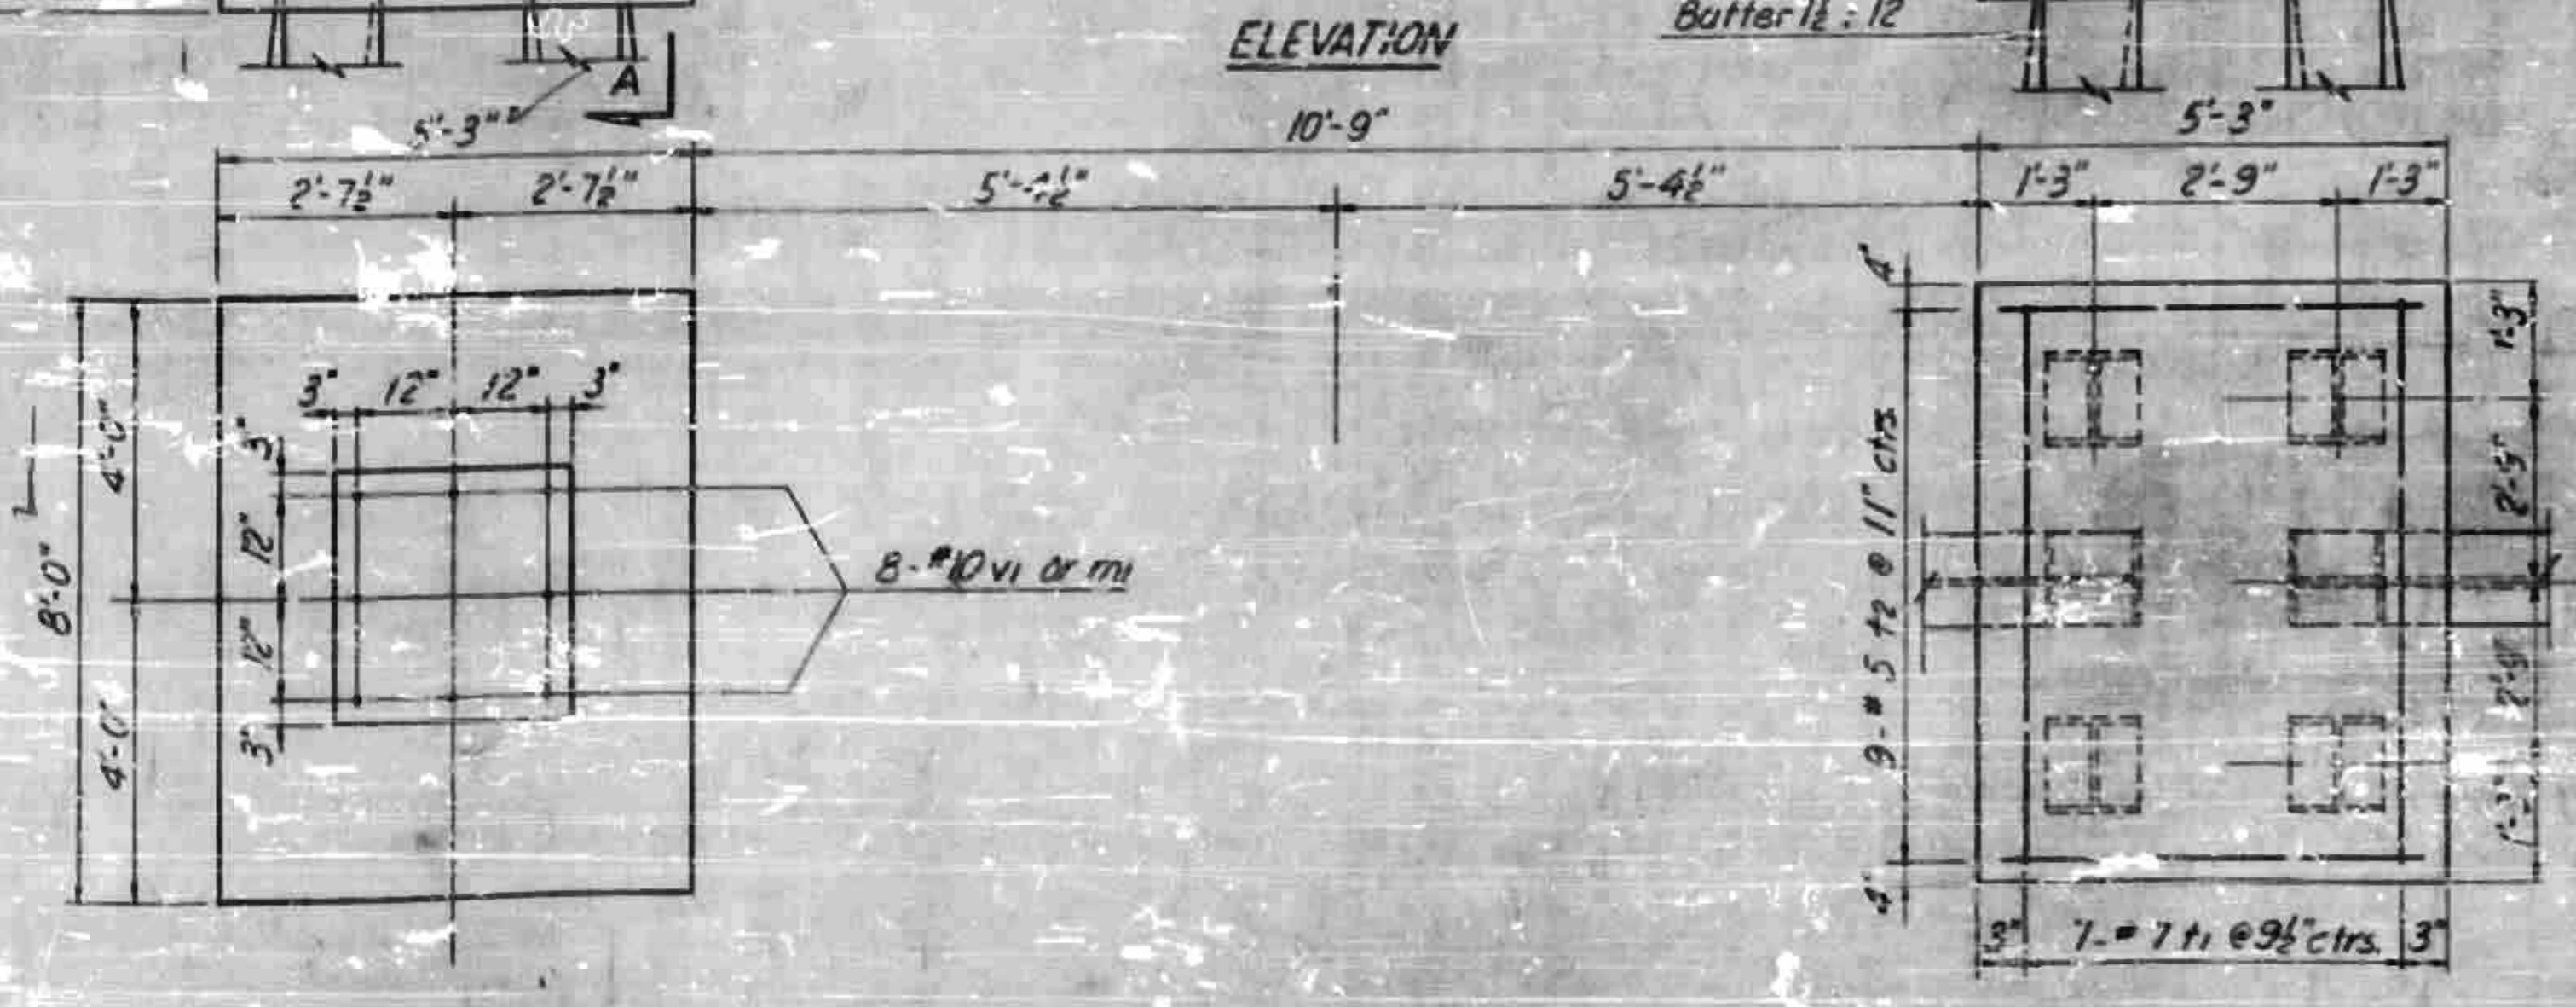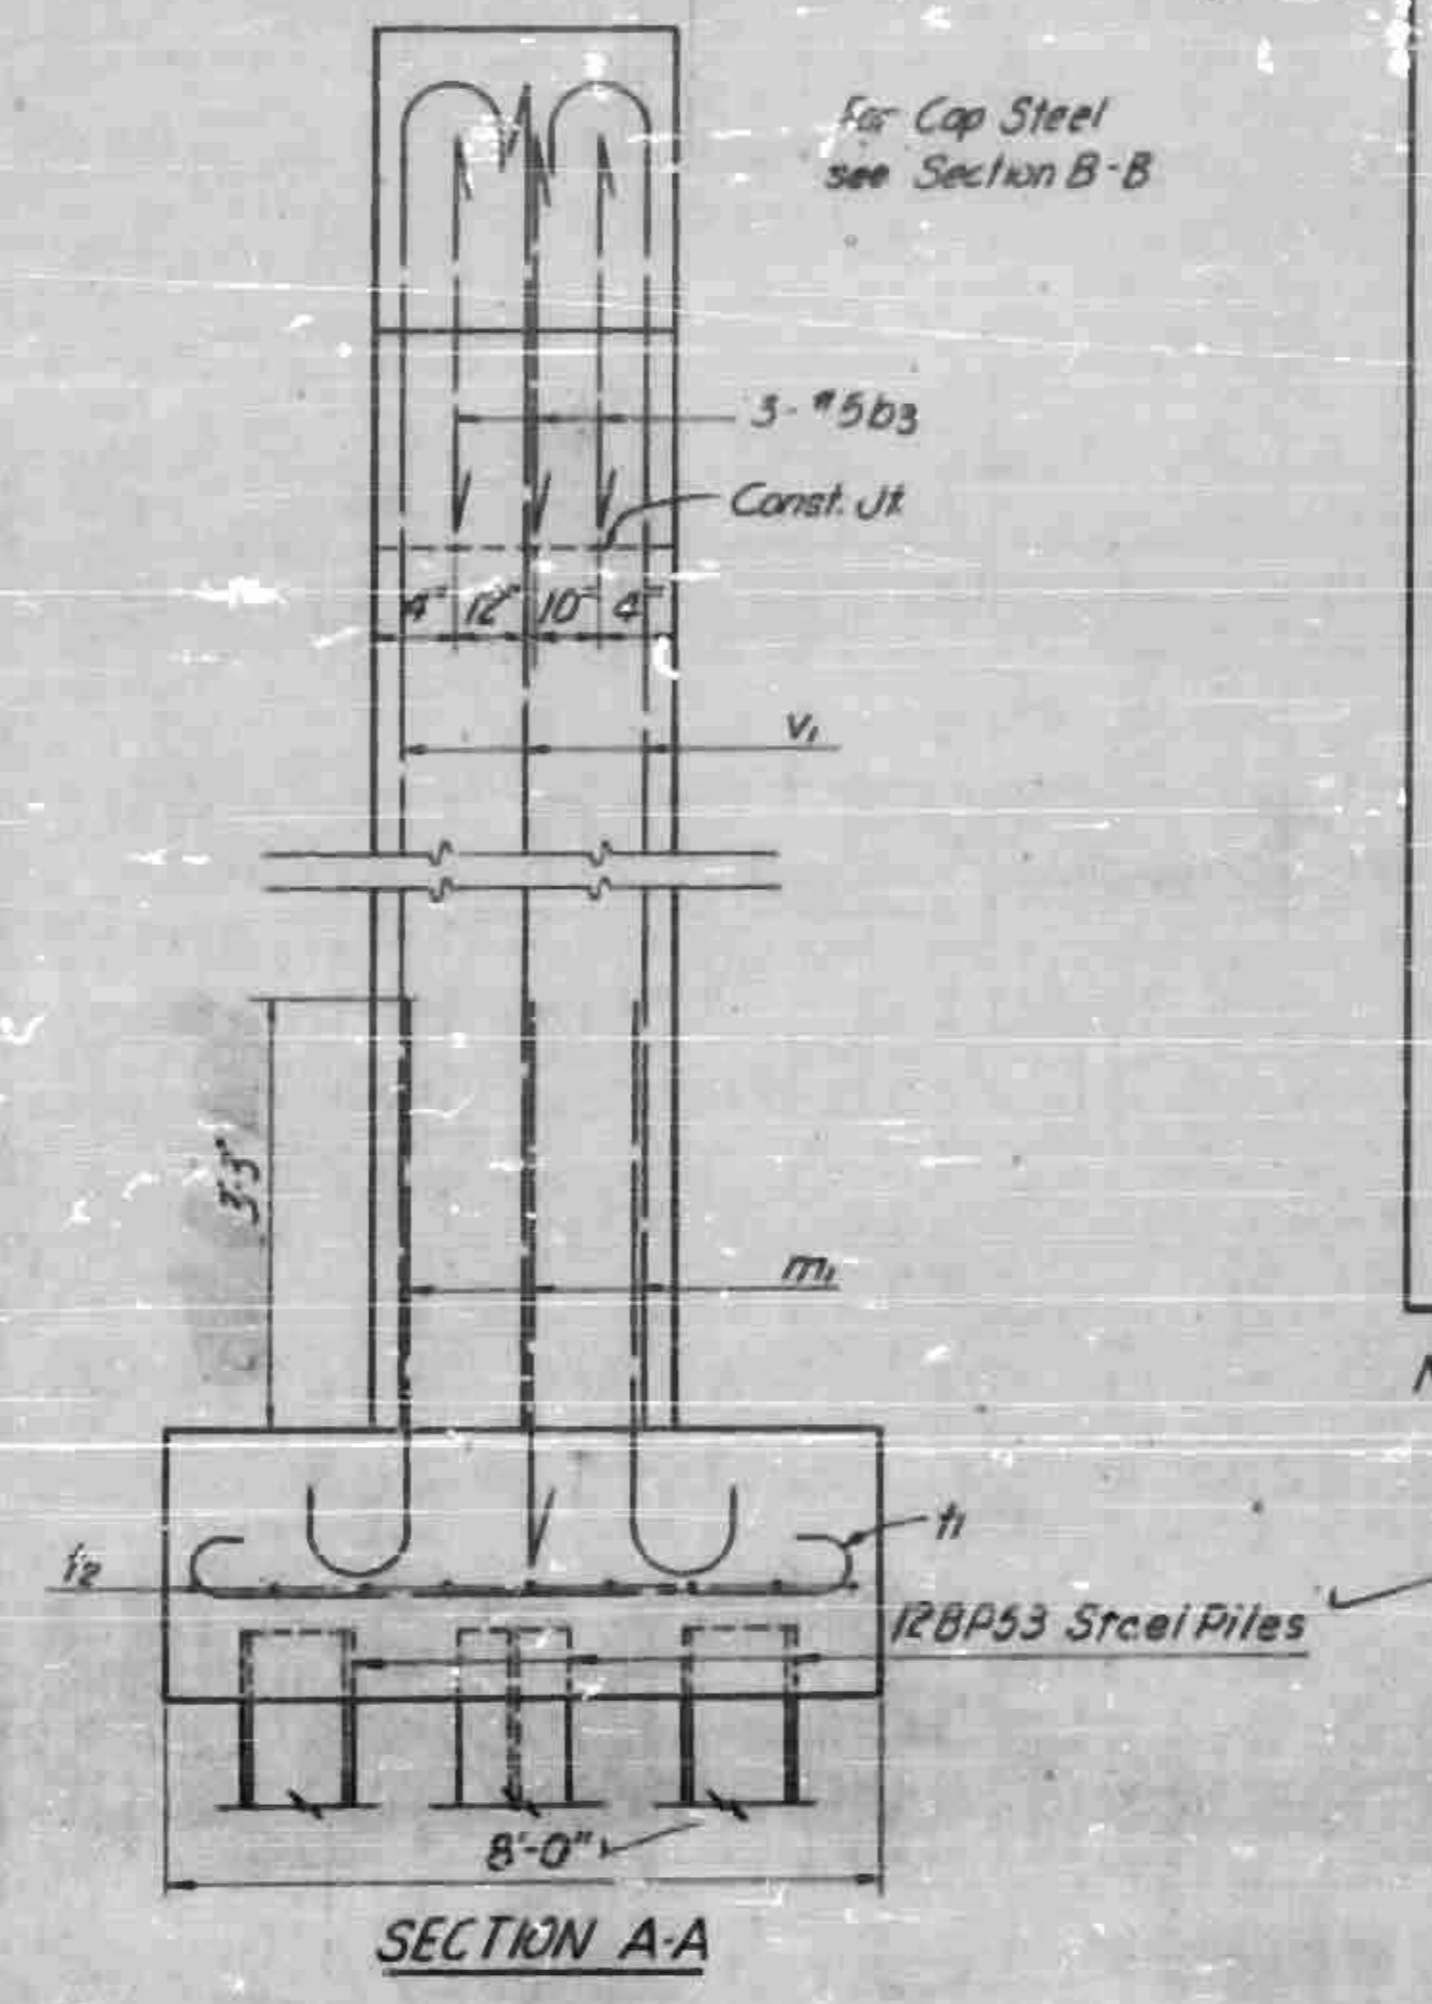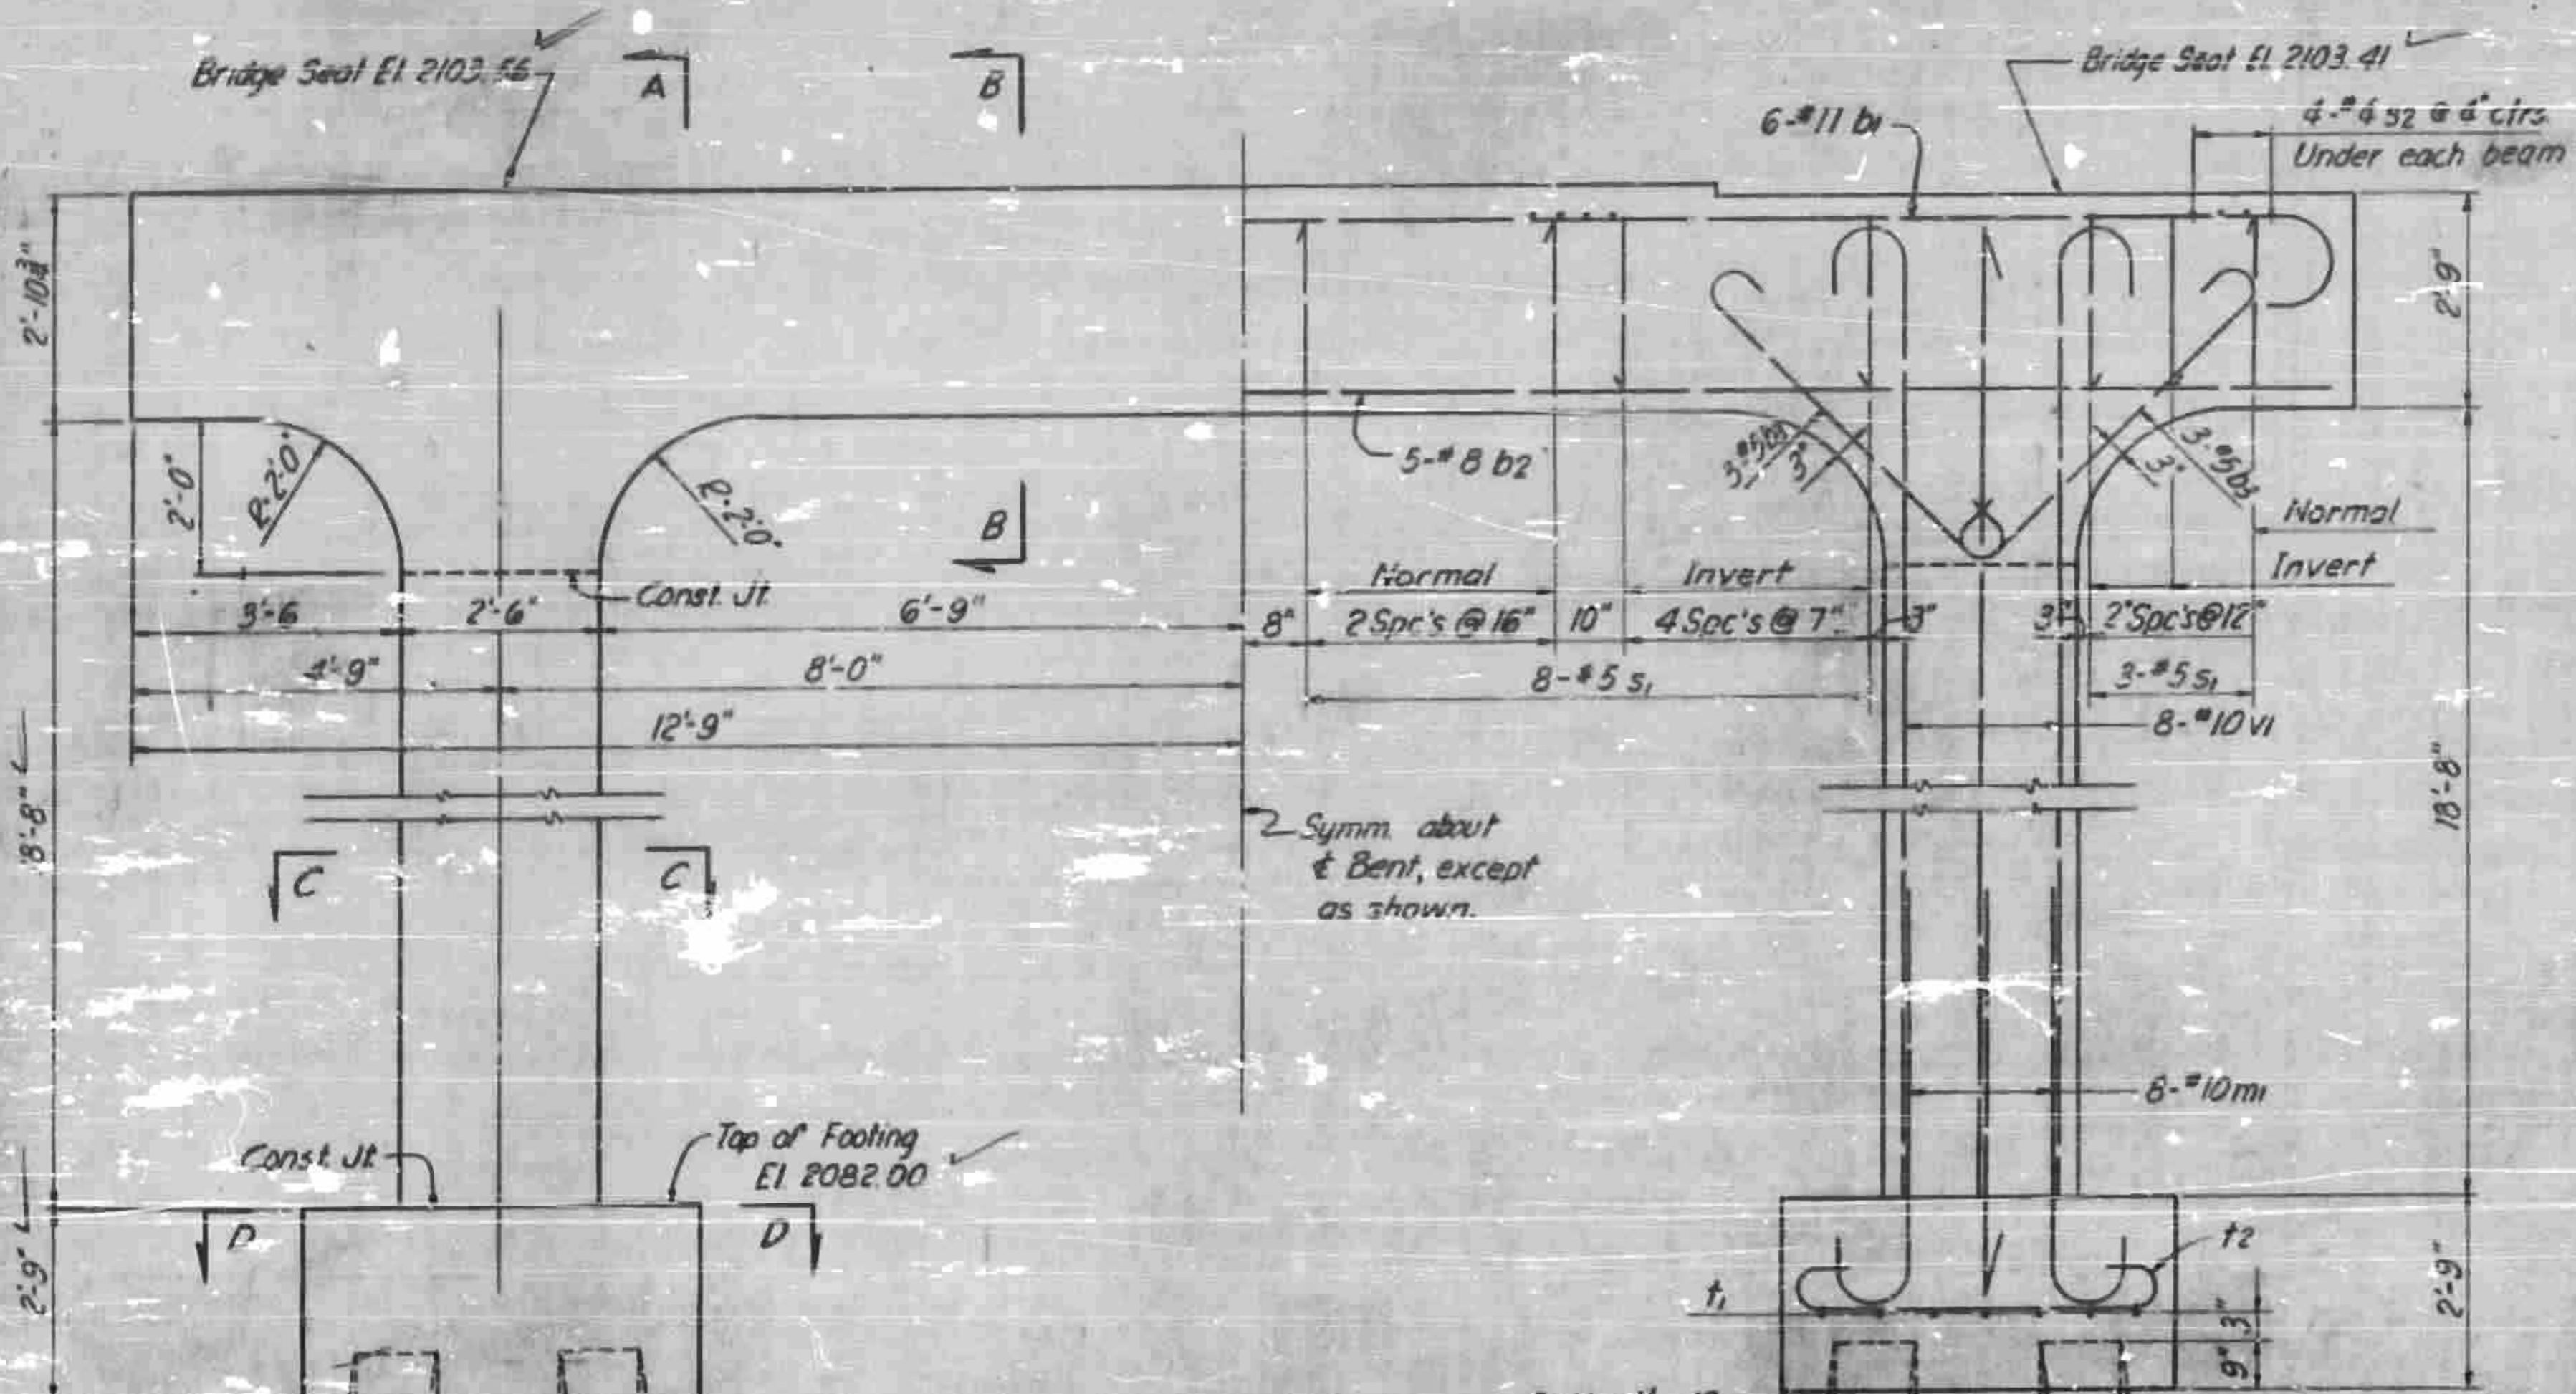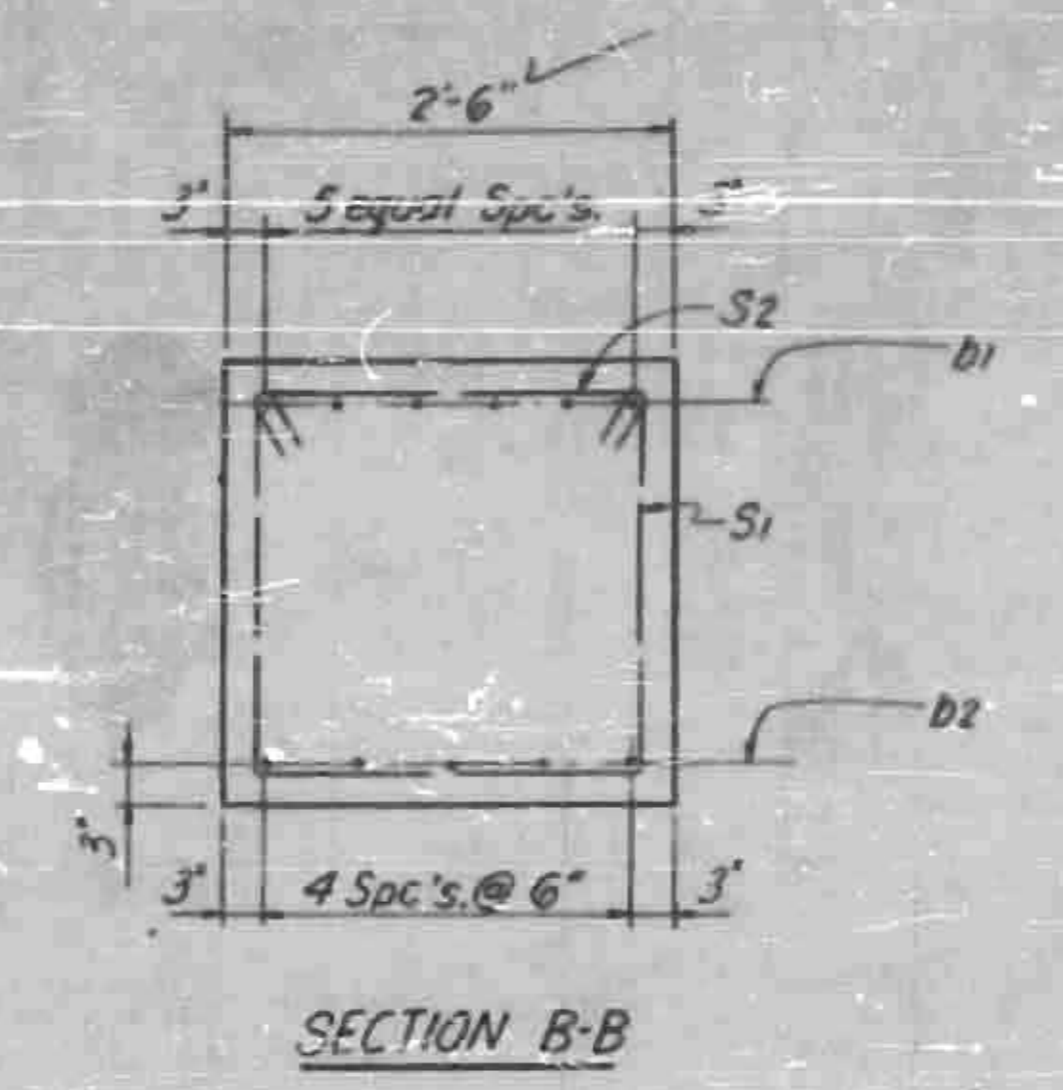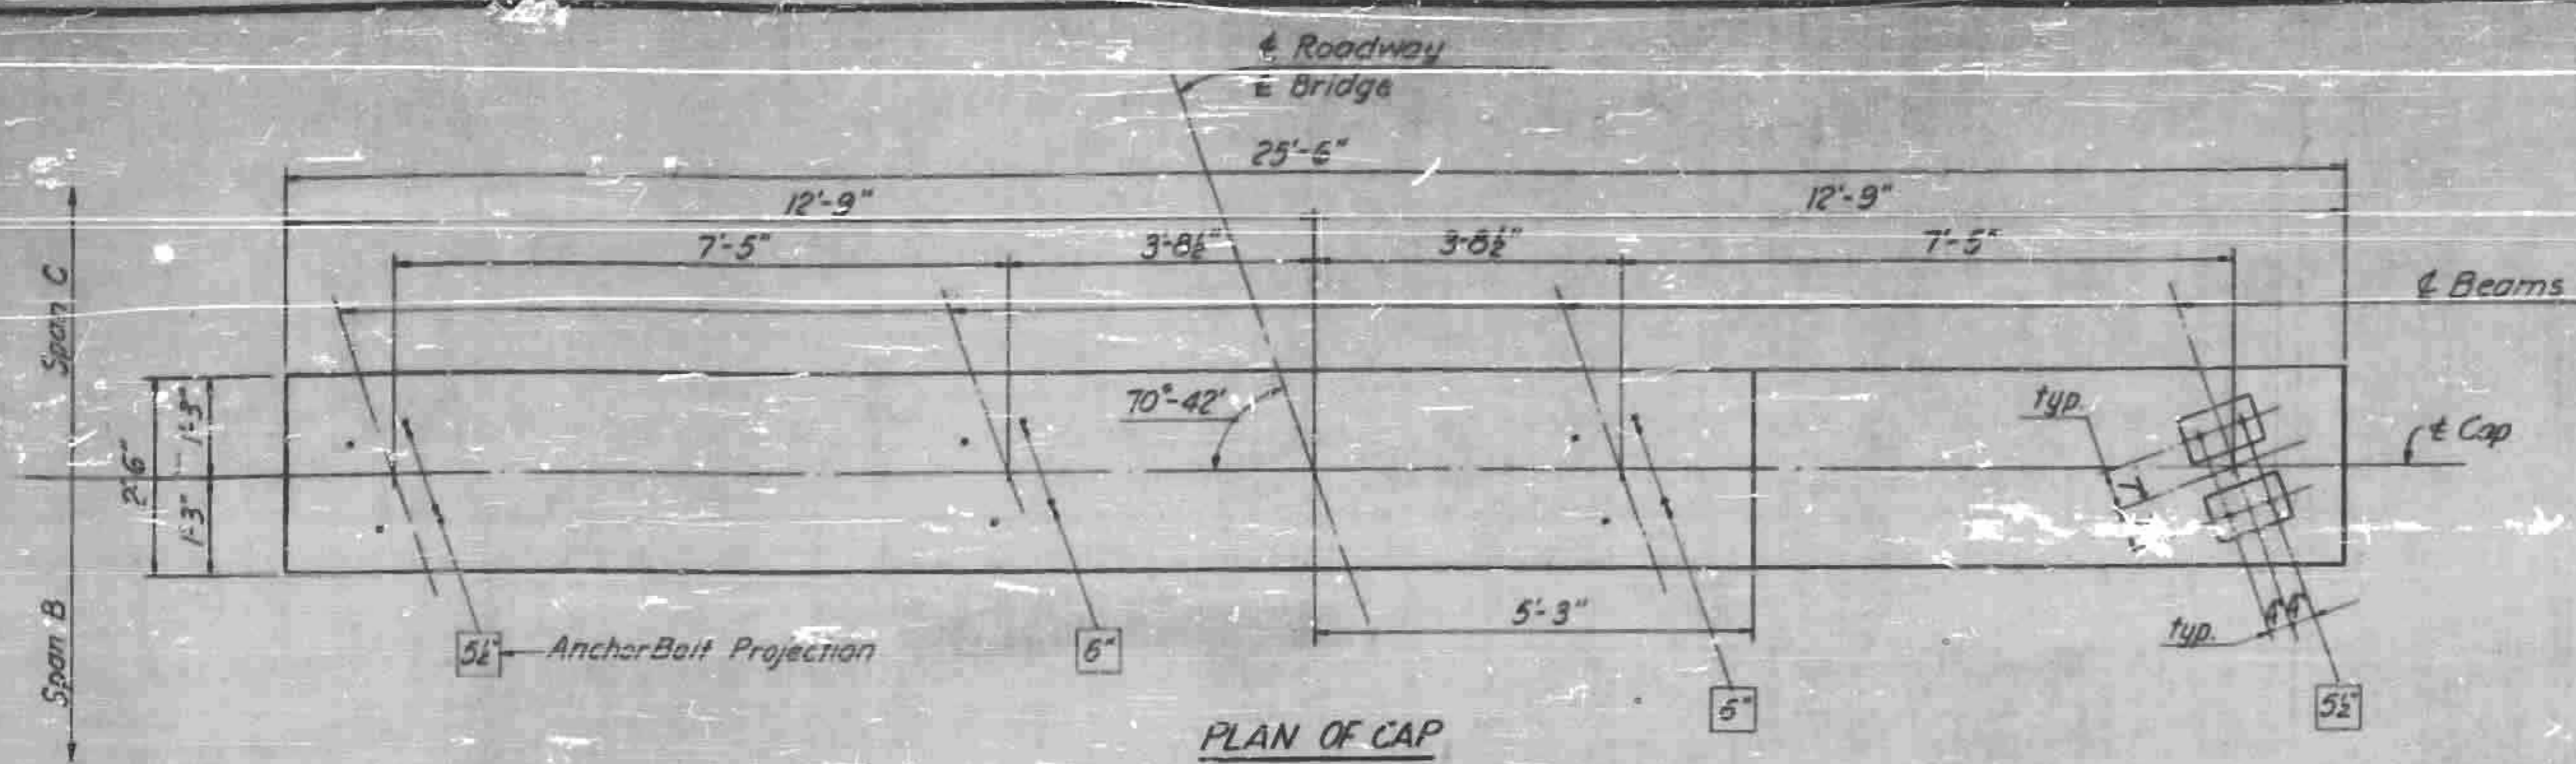

SECTION C-C

PLAN OF FOOTINGS

SECTION D-D

BAR DETAILS			
①			
HL	25'-0"	b1	HL
1'-7"			1'-7"
7"	5'-3"	a1	7"
10"	7'-6"	f1	10"
7"	4'-9"	f2	7"
②			
	5'-0"	m1	HL
	20'-10"	vi	HL
③			
HL	2'-2"	s2	HL
4'-5"			4'-5"
④			
	2'-5"		HL
			HL
	2'-2"	s1	


BILL OF MATERIAL					
For Bent 2					
BAR NO.	SIZE	TYPE	LENGTH	WEIGHT	
b1	#11	1	25'-0"	898	
b2	#8	Str	25'-0"	234	
b3	#5	1	6'-5"	80	
m1	#10	2	6'-5"	444	
s1	#5	4	7'-10"	160	
s2	#4	3	2'-11"	31	
f1	#7	1	9'-2"	22	
f2	#5	1	5'-11"	111	
vi	#10	2	22'-3"	1532	

NOTE: All bar dimensions are out to out
 Note: Reinforcing in top of Cap may be shifted as necessary to clear Anchor Bolts.

Reinforcing Steel Lbs	3,772
Class A Concrete Cu Yds	24.3
12BP53 Steel Piles No.	12
12BP53 Steel Piles Lin Ft.	360
	2,922.4

PROJECT NO. B.18293
 HENDERSON COUNTY
 STATION 1284 + 06 L
 10 + 00 V8


STATE OF NORTH CAROLINA	
STATE HIGHWAY COMMISSION	
RALEIGH	
BENT 2	

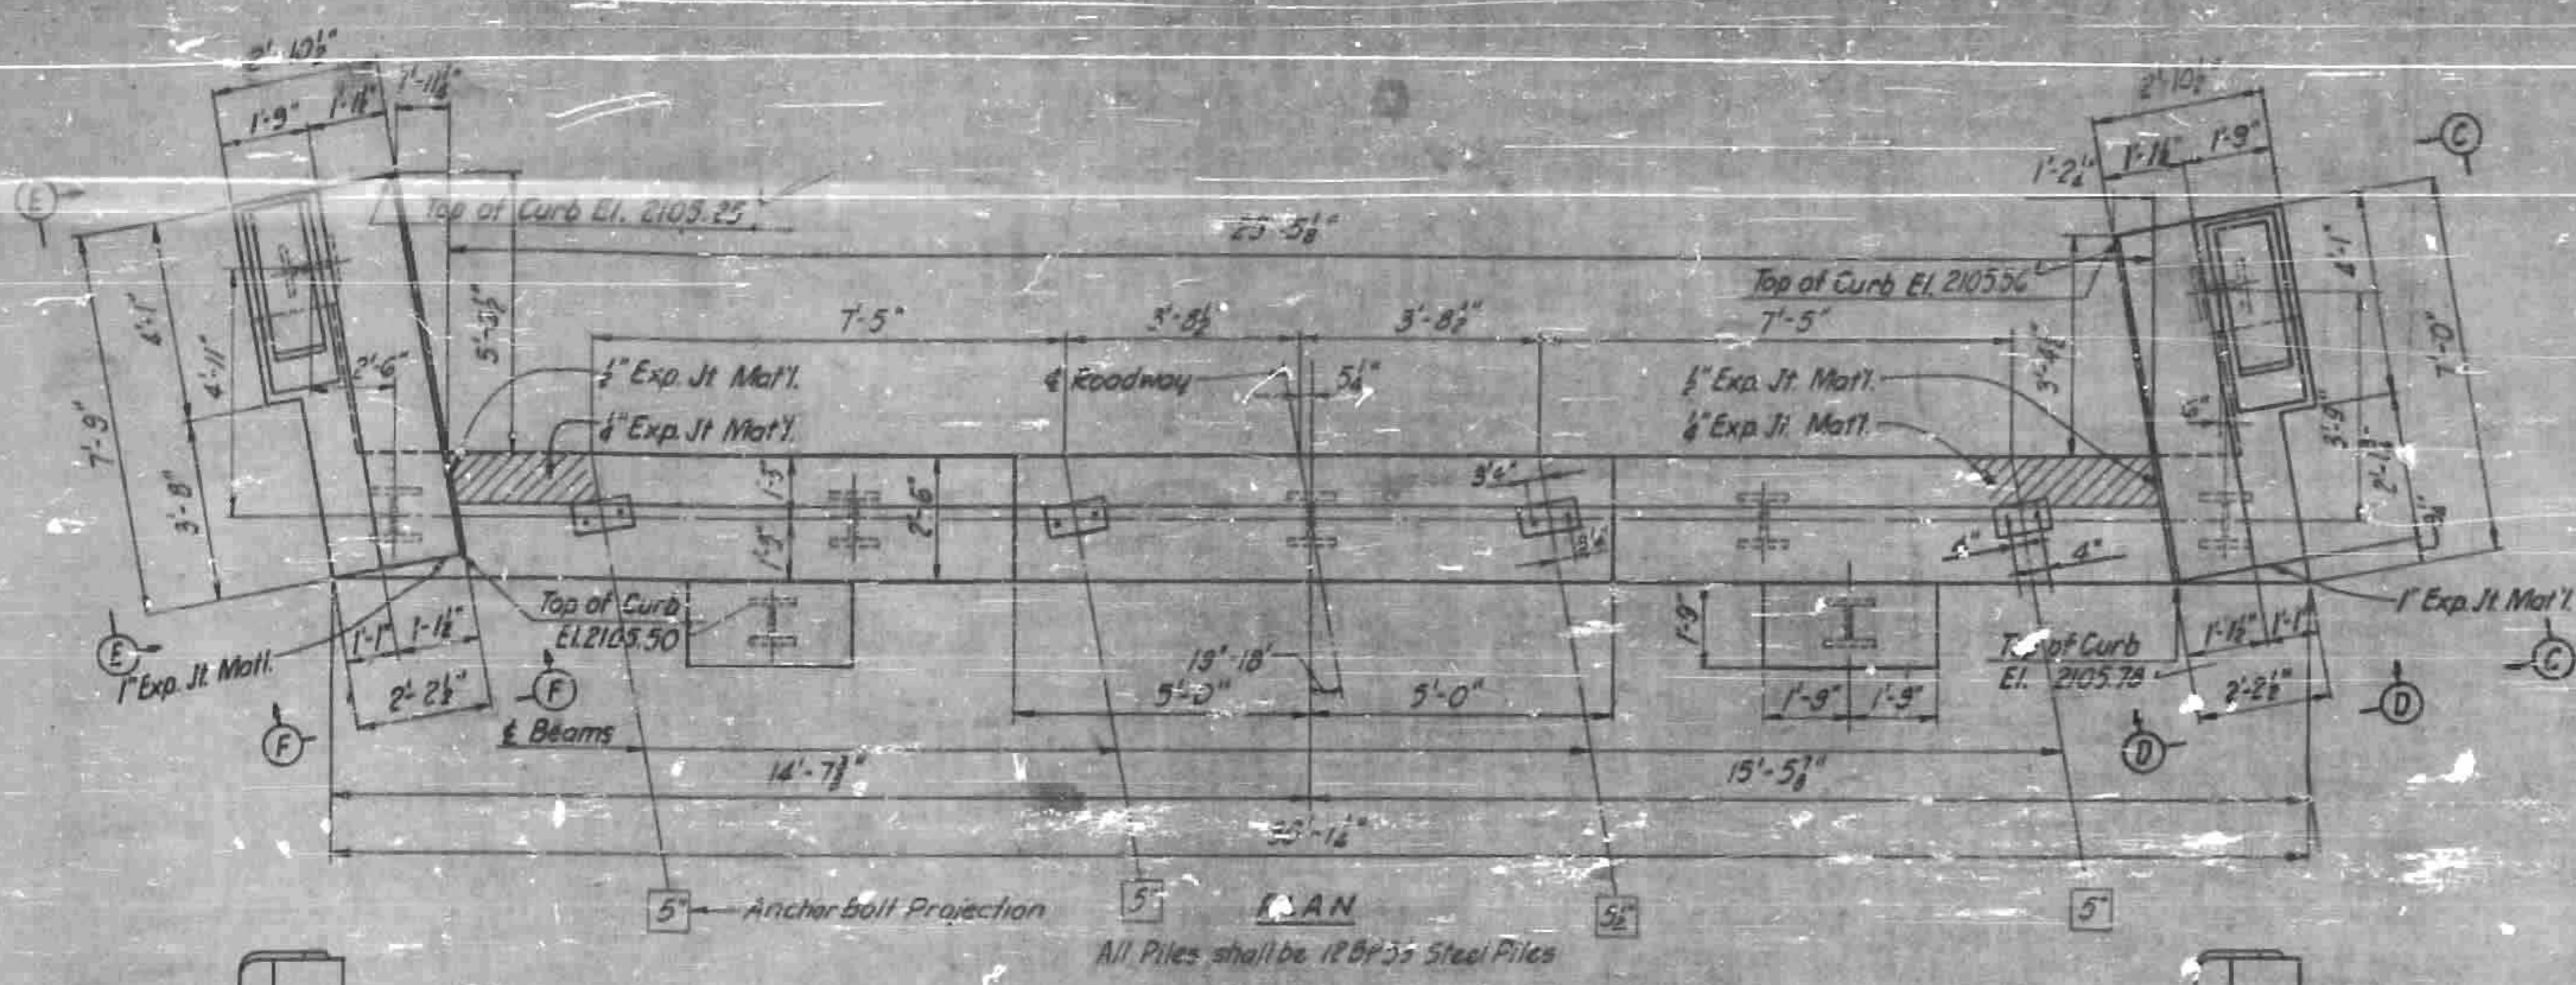


Hk.	1-7	2-0	h1	1-7
	8	3-11	h4	8
	10	6-7	h2	10

PROJECT NO. 483 569
 FEDERAL AID PROJ. 1-60-1-8112


BILL OF MATERIAL					
END BENT #1					
BAR NO.	SIZE	TYPE	LENGTH	WEIGHT	
b1	8	#4	1	96'-8"	1388
b2	4	#4	str.	29'-6"	78
b3	8	#4	str.	2'-2"	12
b4	6	#6	1	5'-3"	47
b5	4	#6	7	11'-9"	71
b6	2	#8	str.	29'-6"	158
a1	4	#4	6	5'-2"	18
h1	4	#4	str.	3'-5"	9
h2	10	#6	str.	5'-11"	89
h3	8	#6	str.	3'-9"	45
h4	10	#6	str.	7'-9"	111
h5	5	#4	str.	8'-0"	12
h6	10	#4	str.	1'-0"	10
h7	5	#4	str.	4'-8"	16
h8	5	#4	str.	4'-10"	16
h9	5	#4	str.	2'-9"	7
s1	22	#4	3	7'-3"	107
s2	22	#4	2	2'-11"	45
s3	6	#4	4	8'-4"	93
s4	6	#4	4	9'-8"	99
s5	8	#4	5	8'-2"	44
v1	14	#4	str.	4'-0"	75
v2	12	#7	1	8'-3"	202
v3	12	#4	str.	2'-3"	18
v4	8	#4	str.	2'-6"	13
v5	8	#4	str.	3'-4"	12
Reinforcing steel				lbs.	2676
Class A Concrete				cu. yds.	19.6
12BP53 Steel Piles				no.	9
12BP53 Steel Piles				lin. ft.	480

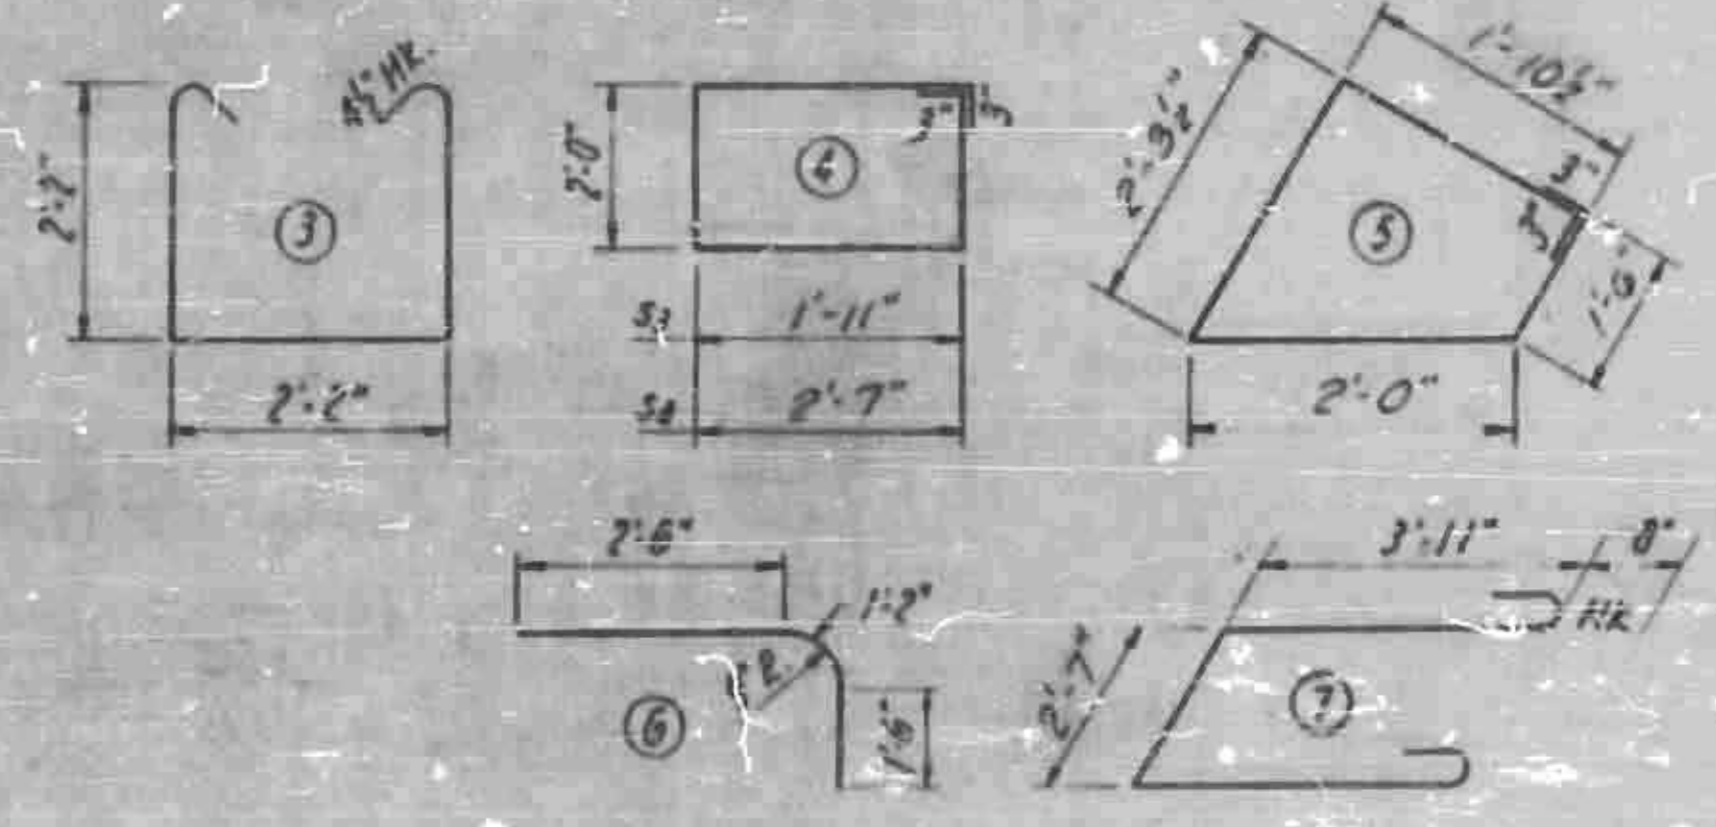


BAR TYPES
 All dimensions are cut to out.

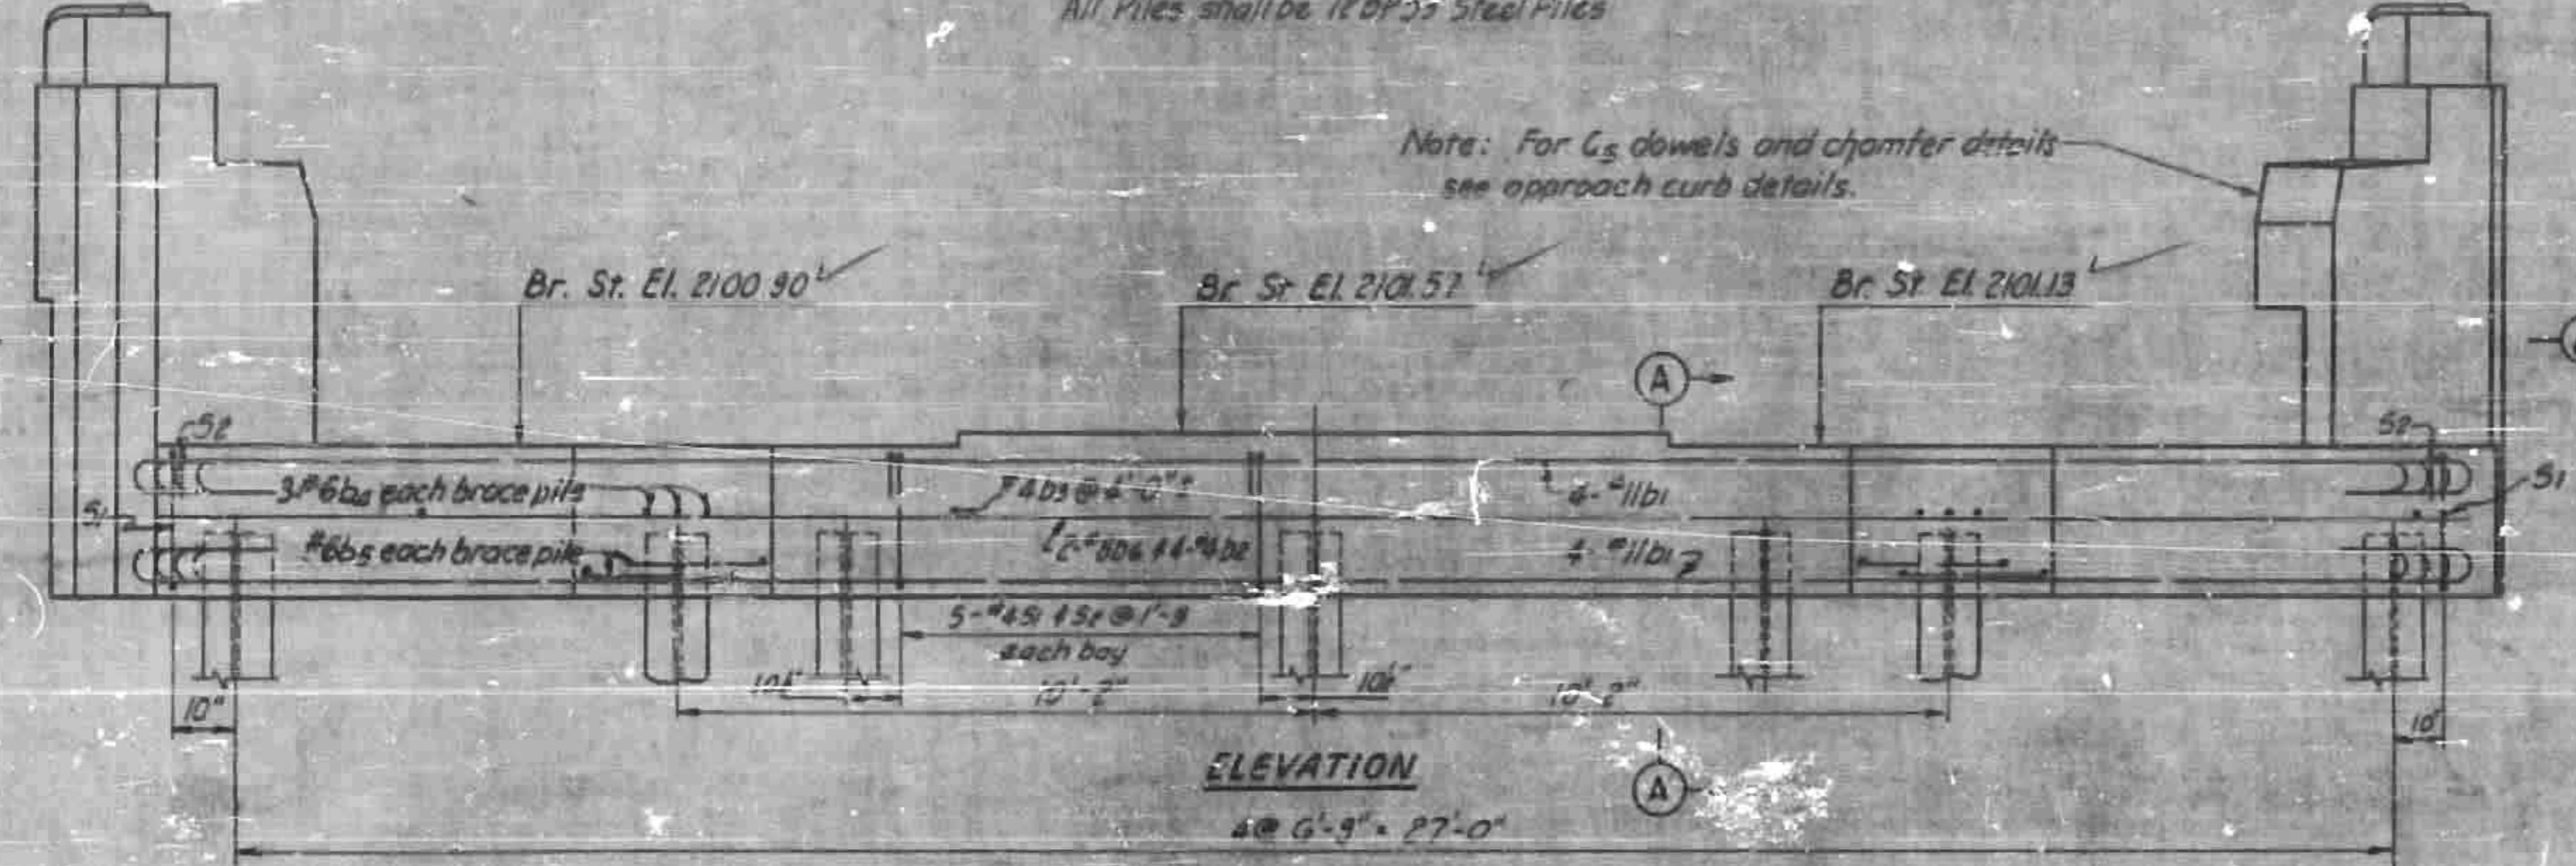


ELEVATION
 @ 6'-9" = 27'-0"

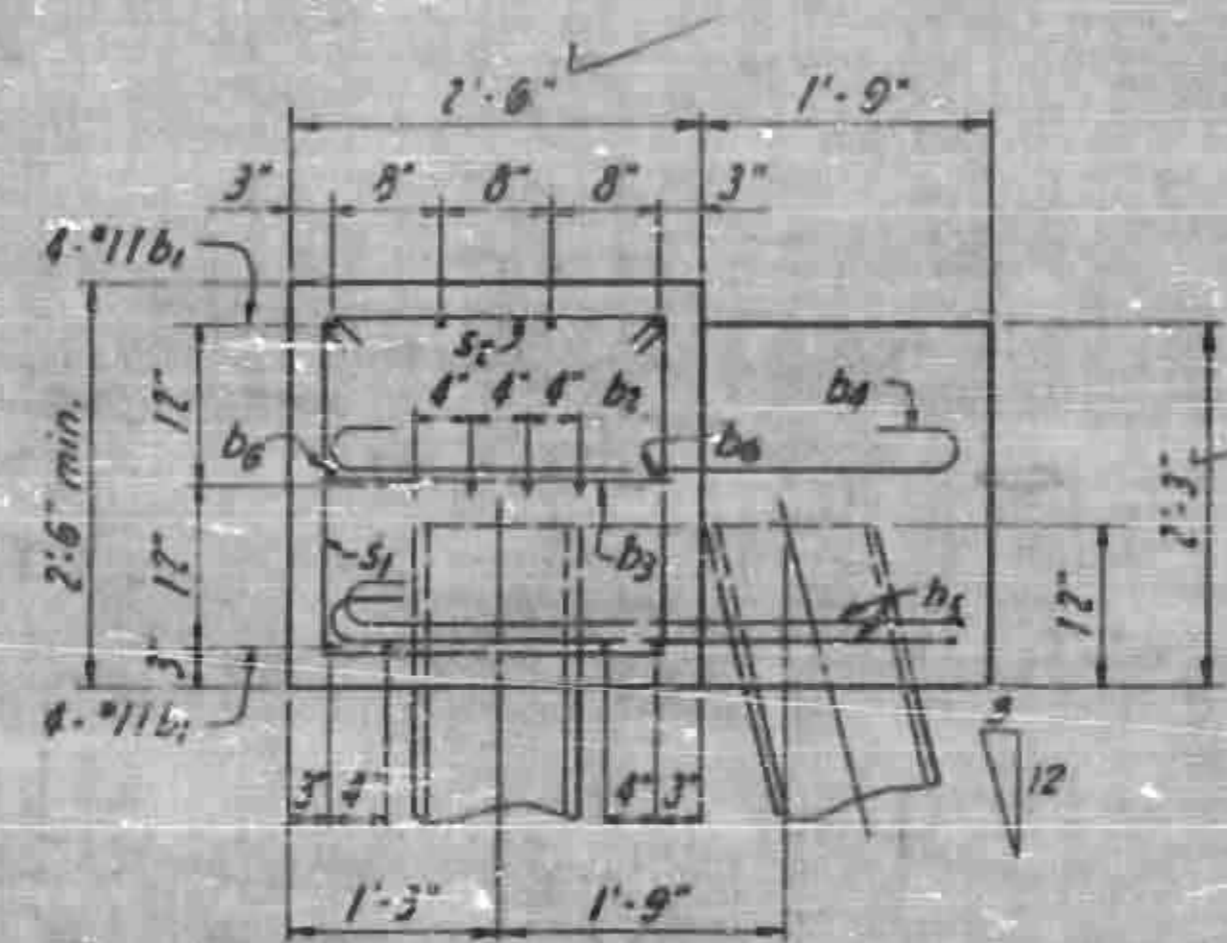


SECTION A-A

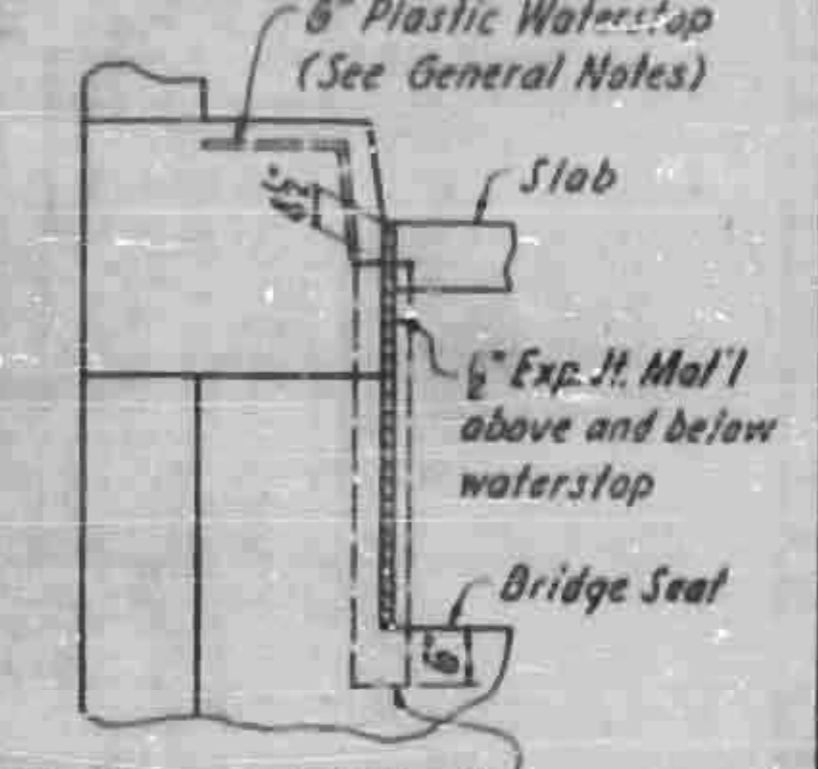


VIEW G-G

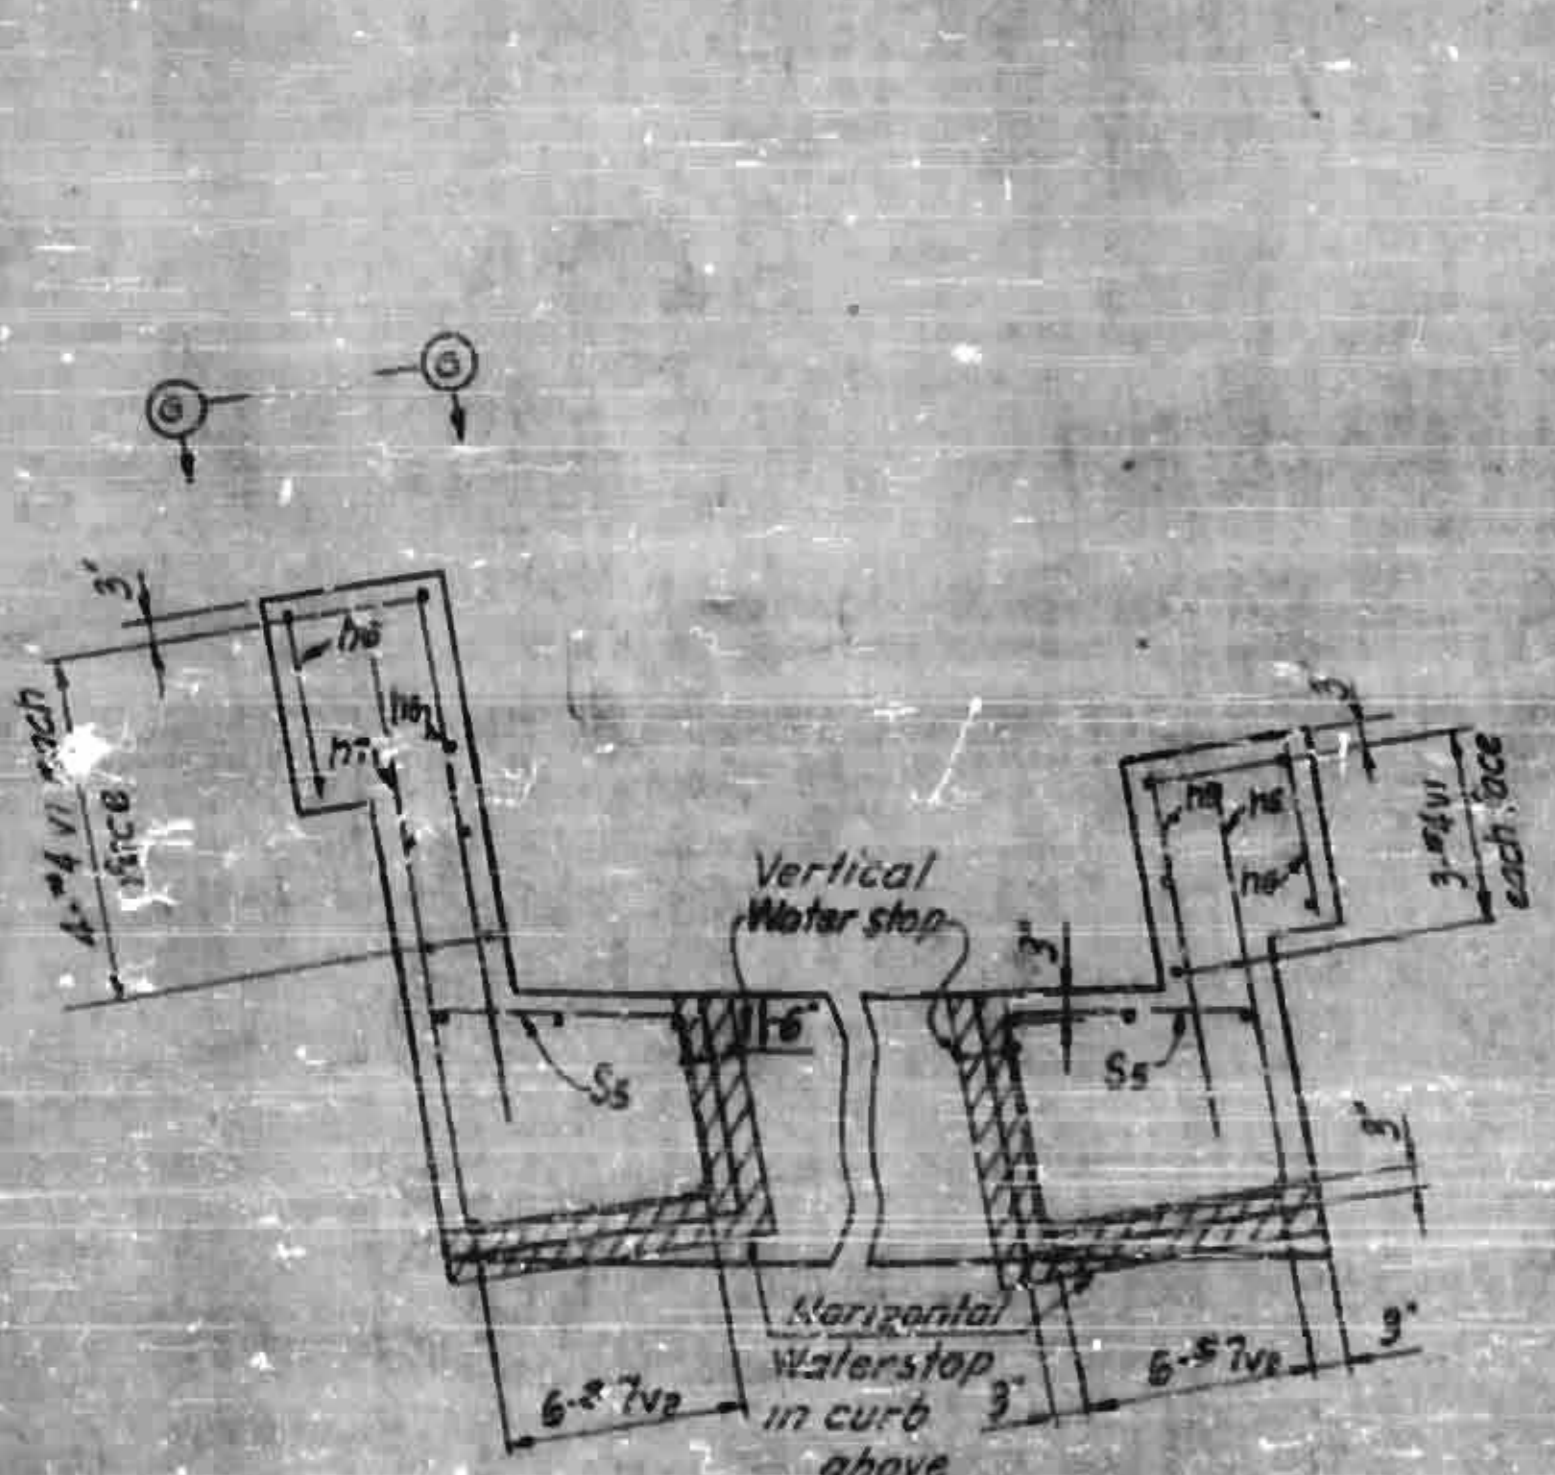

SECTION B-B

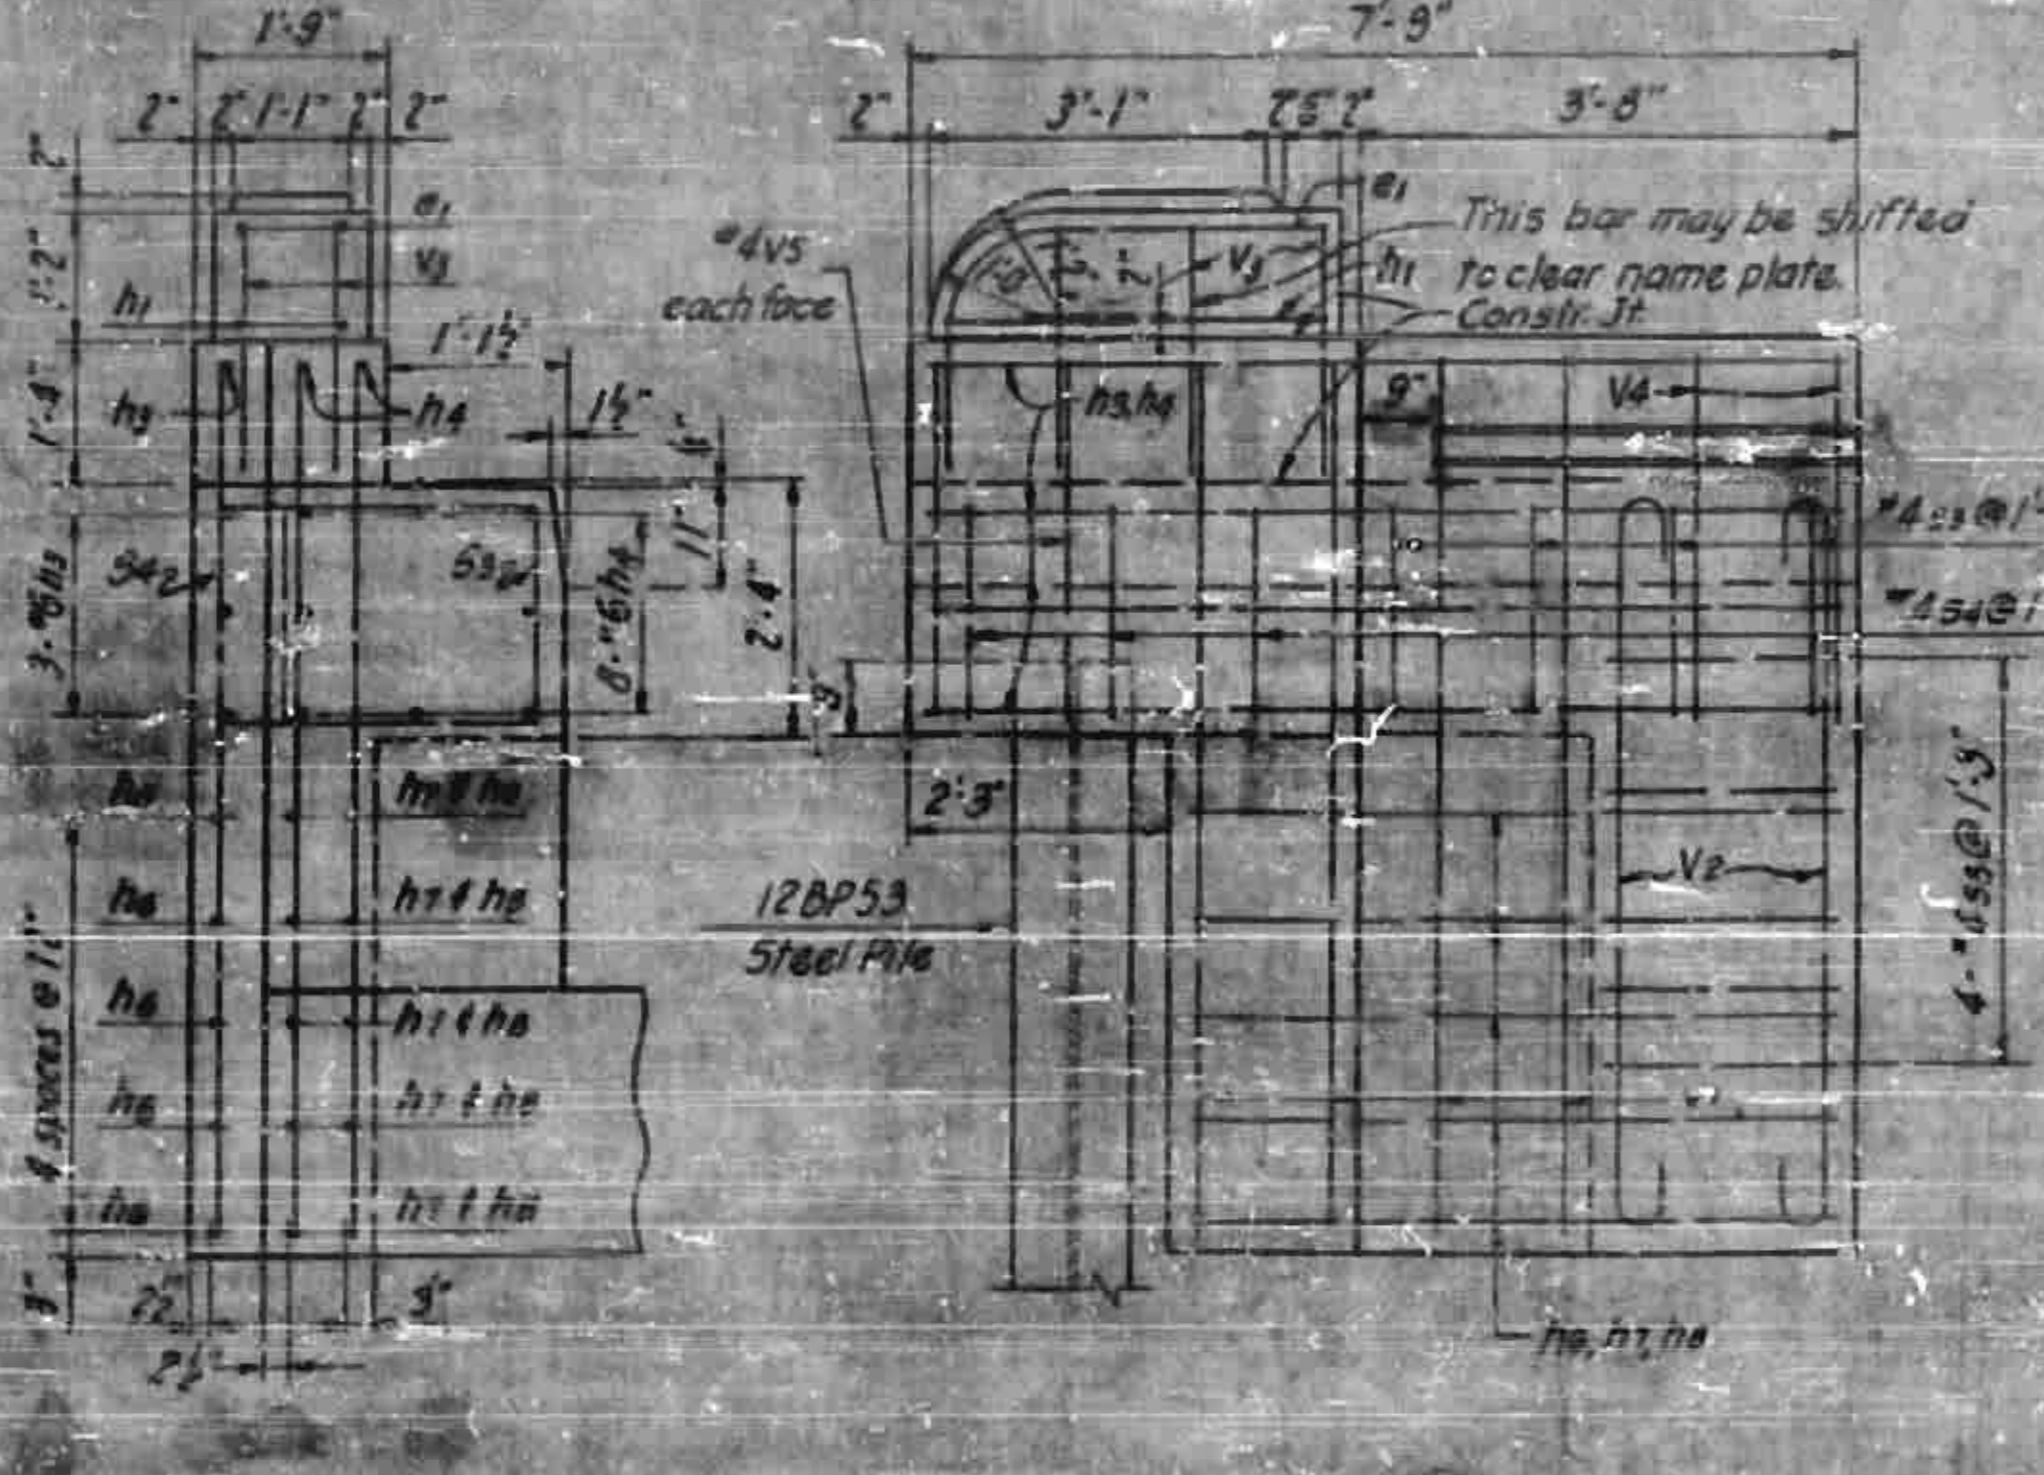


VIEW F-F

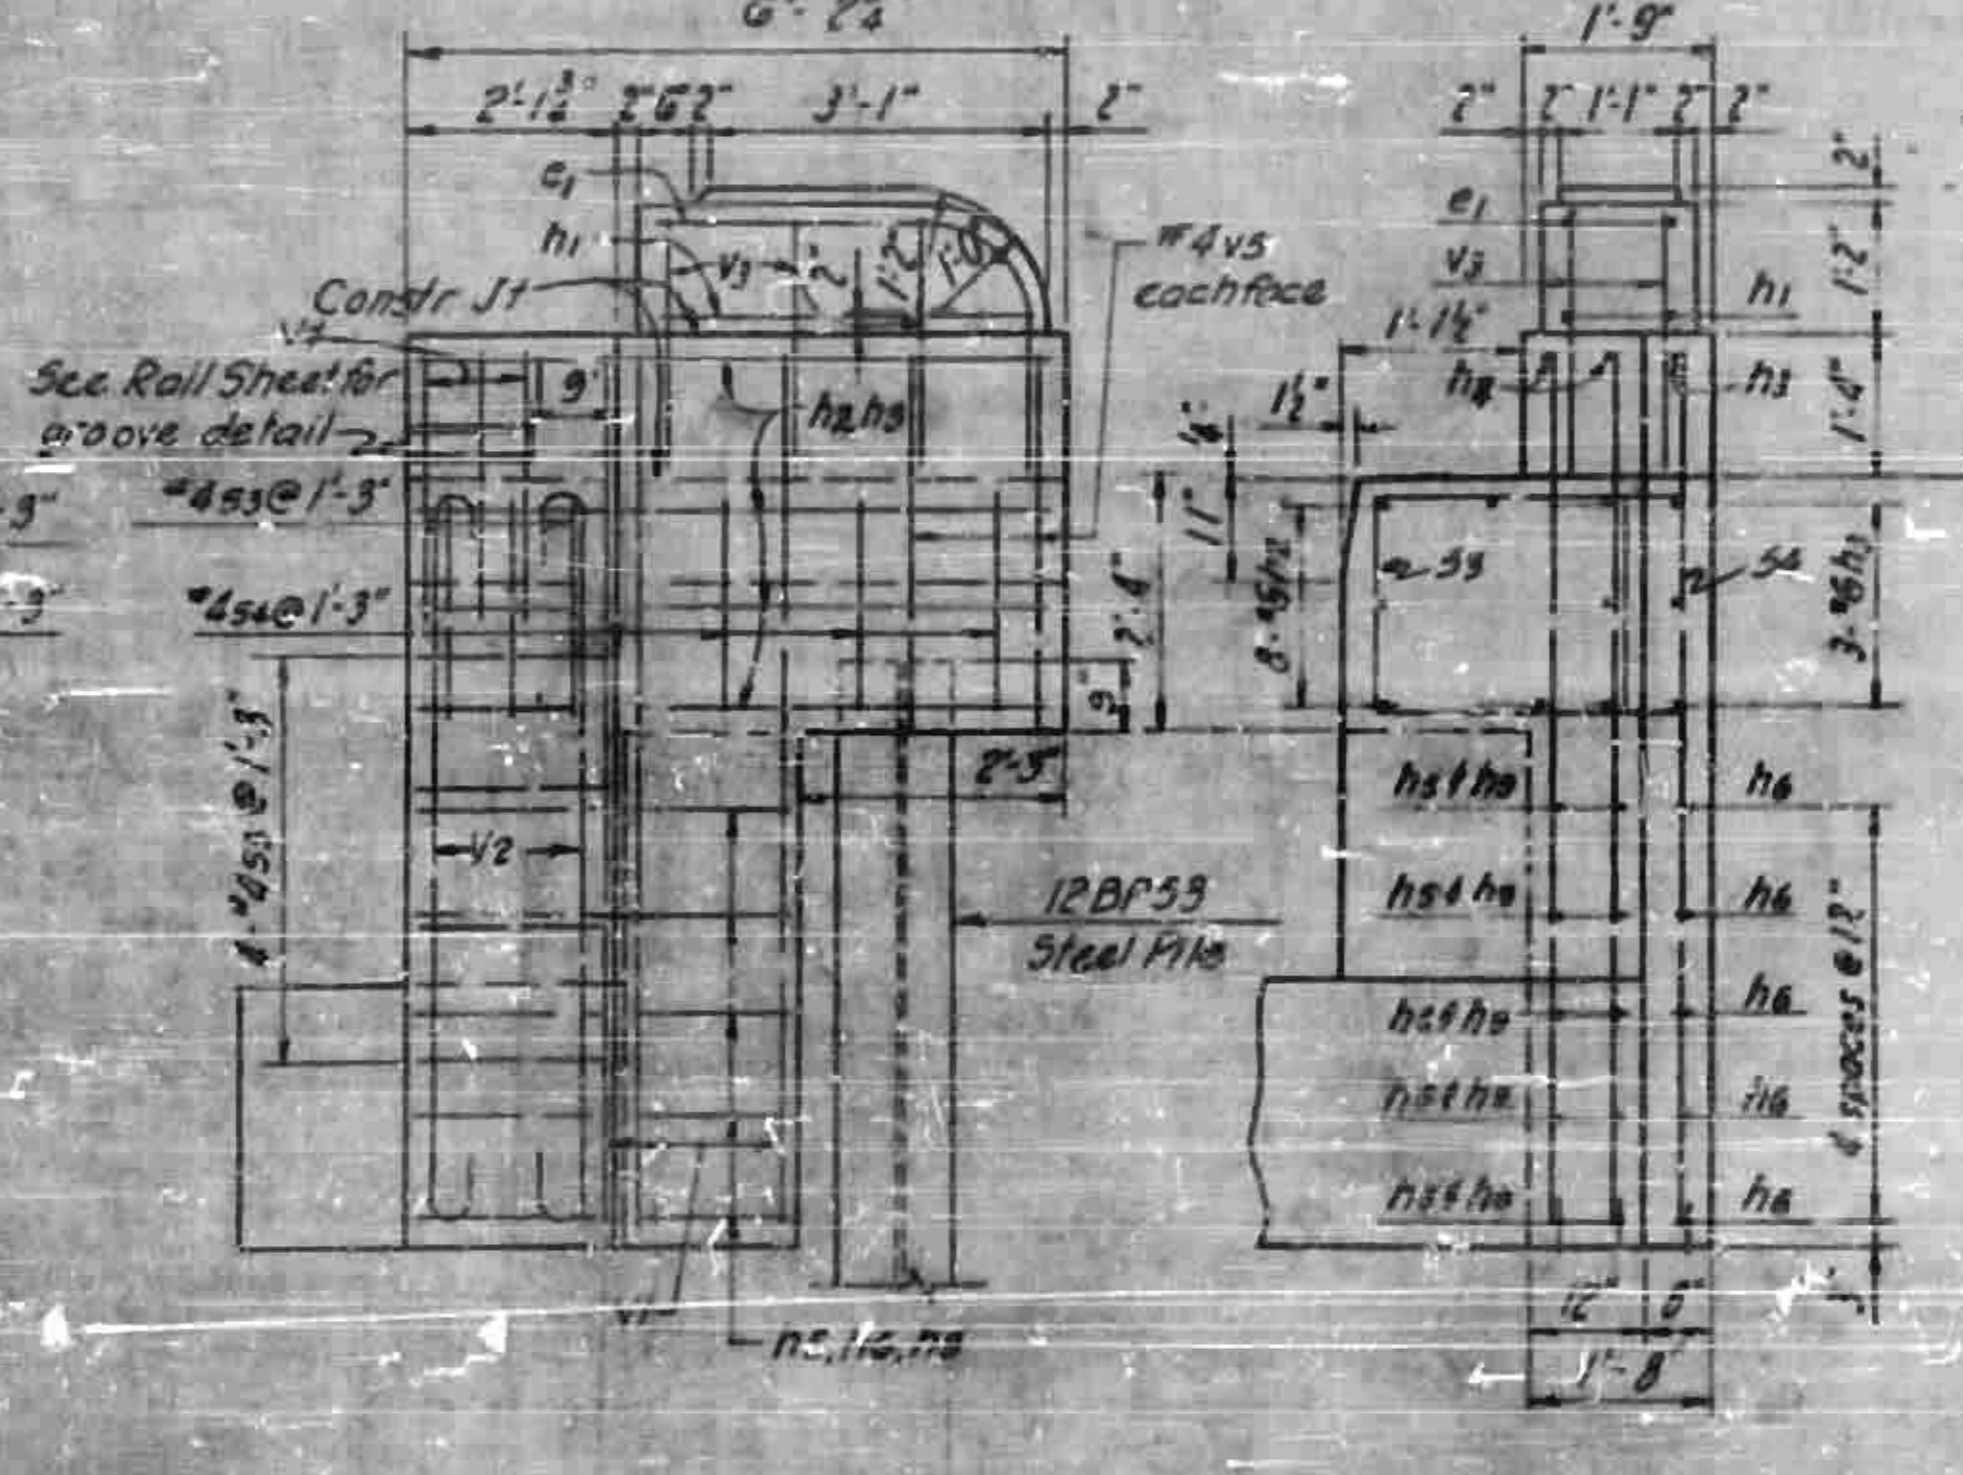

VIEW E-E

VIEW C-C


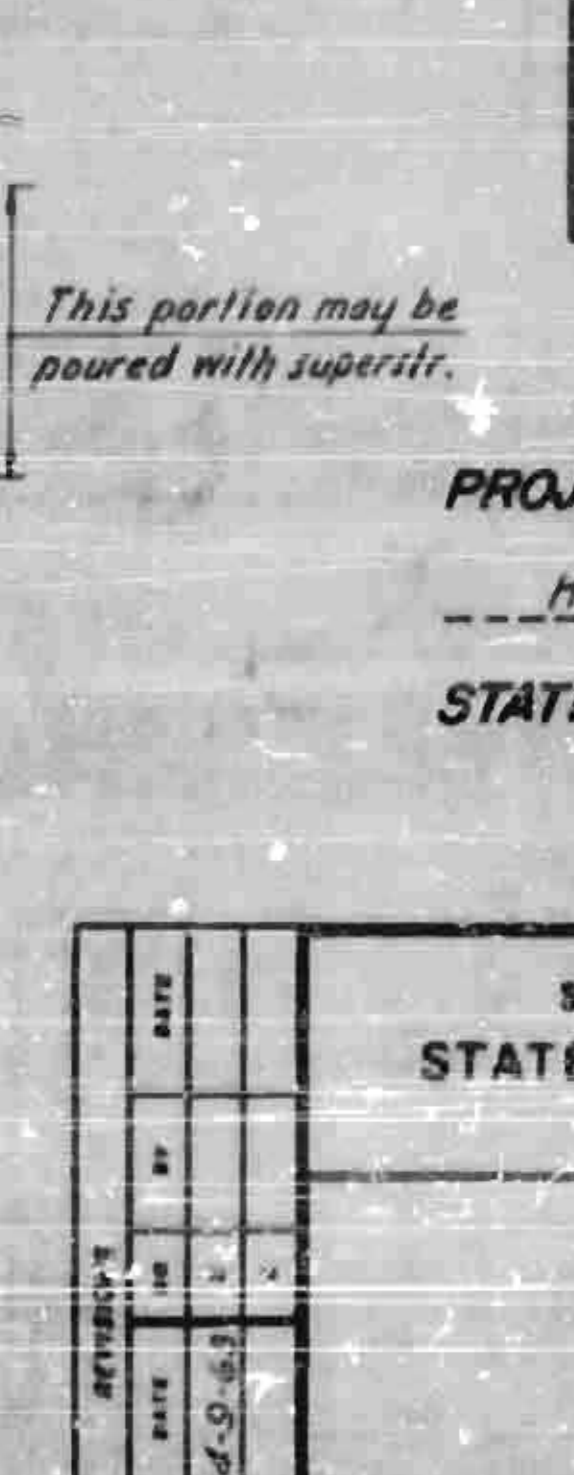


VIEW D-D


PROJECT NO. B. 18233
 HENDERSON COUNTY
 STATION 1284+06L
 10+00Y⁶

STATE OF NORTH CAROLINA	
STATE HIGHWAY COMMISSION	
END BENT I	






Revised 1-2-61 Detail to change anchor ball sp. to 12BP

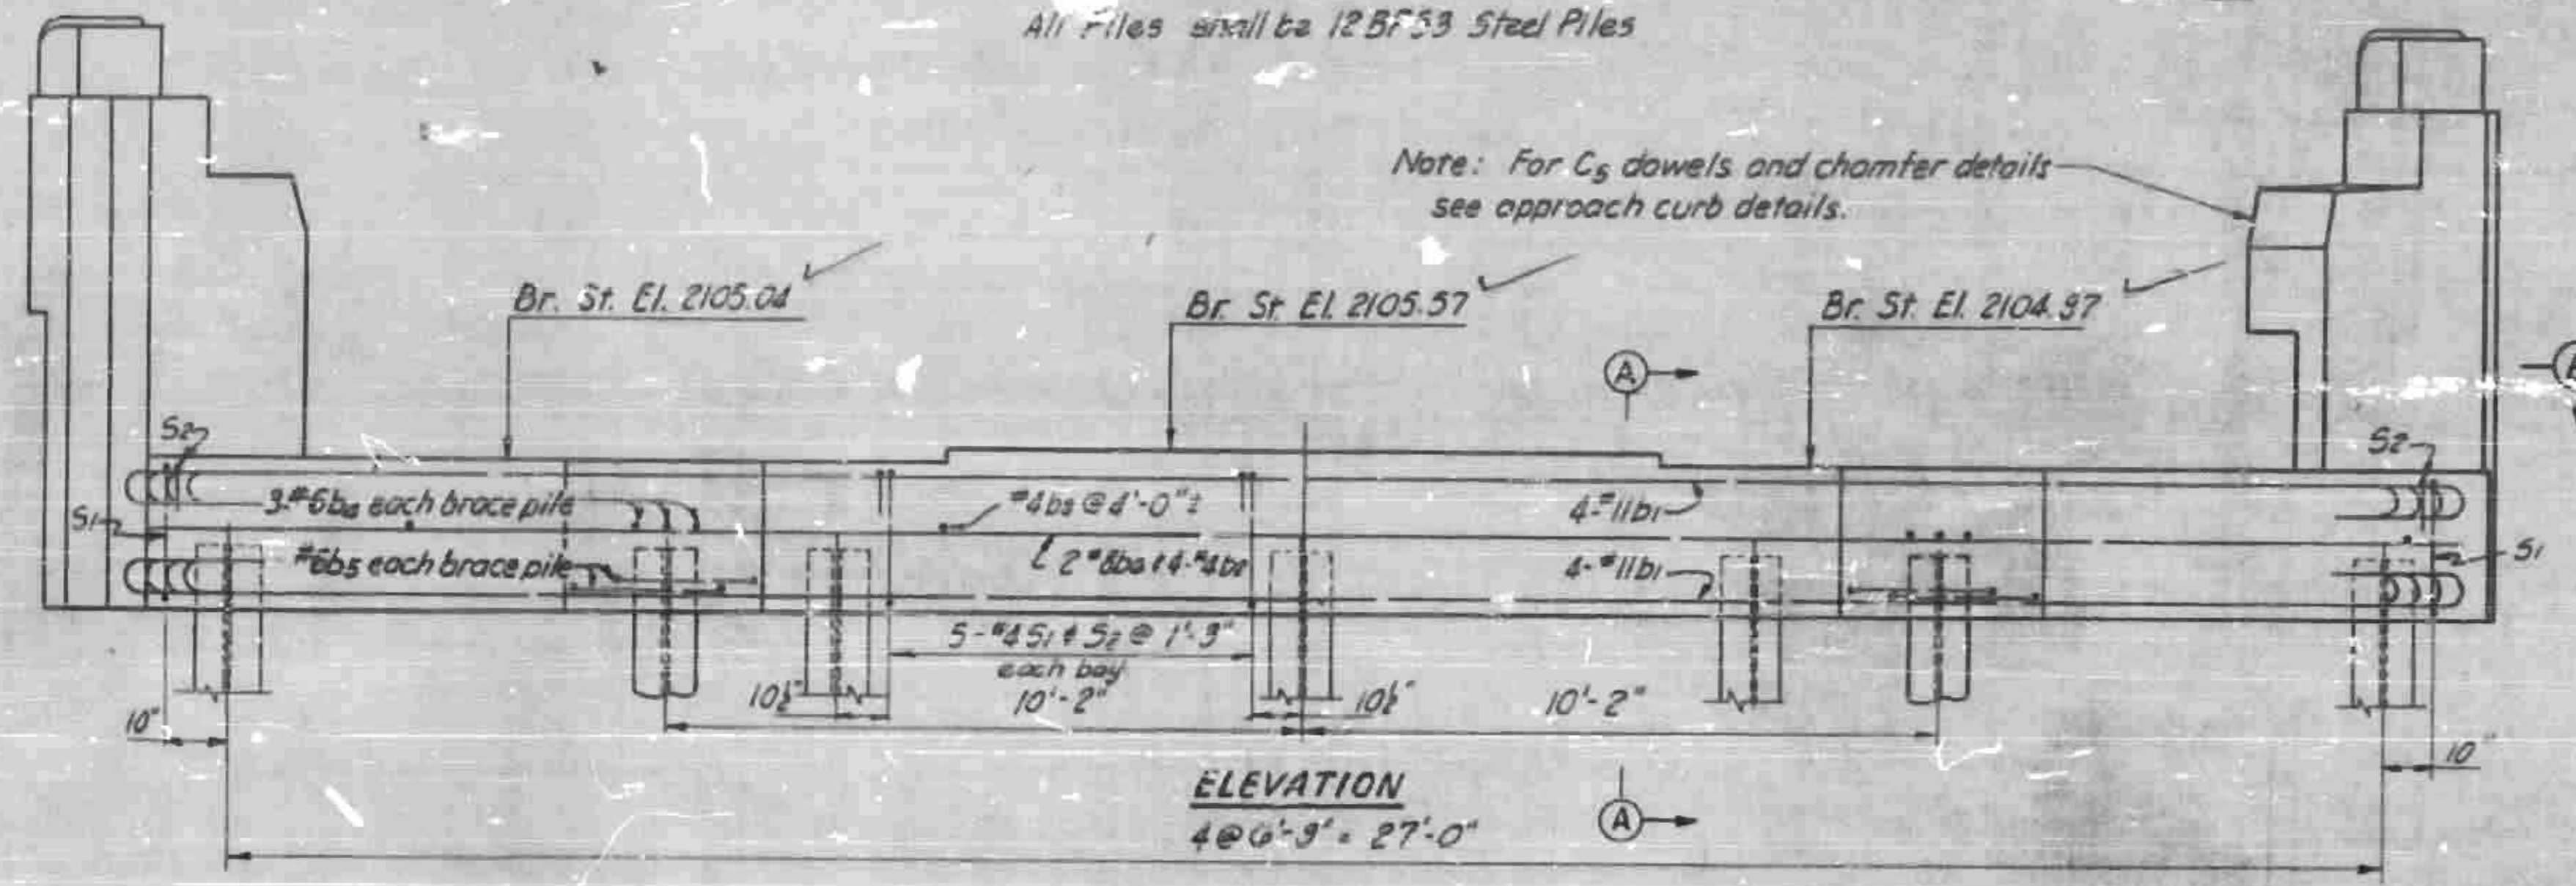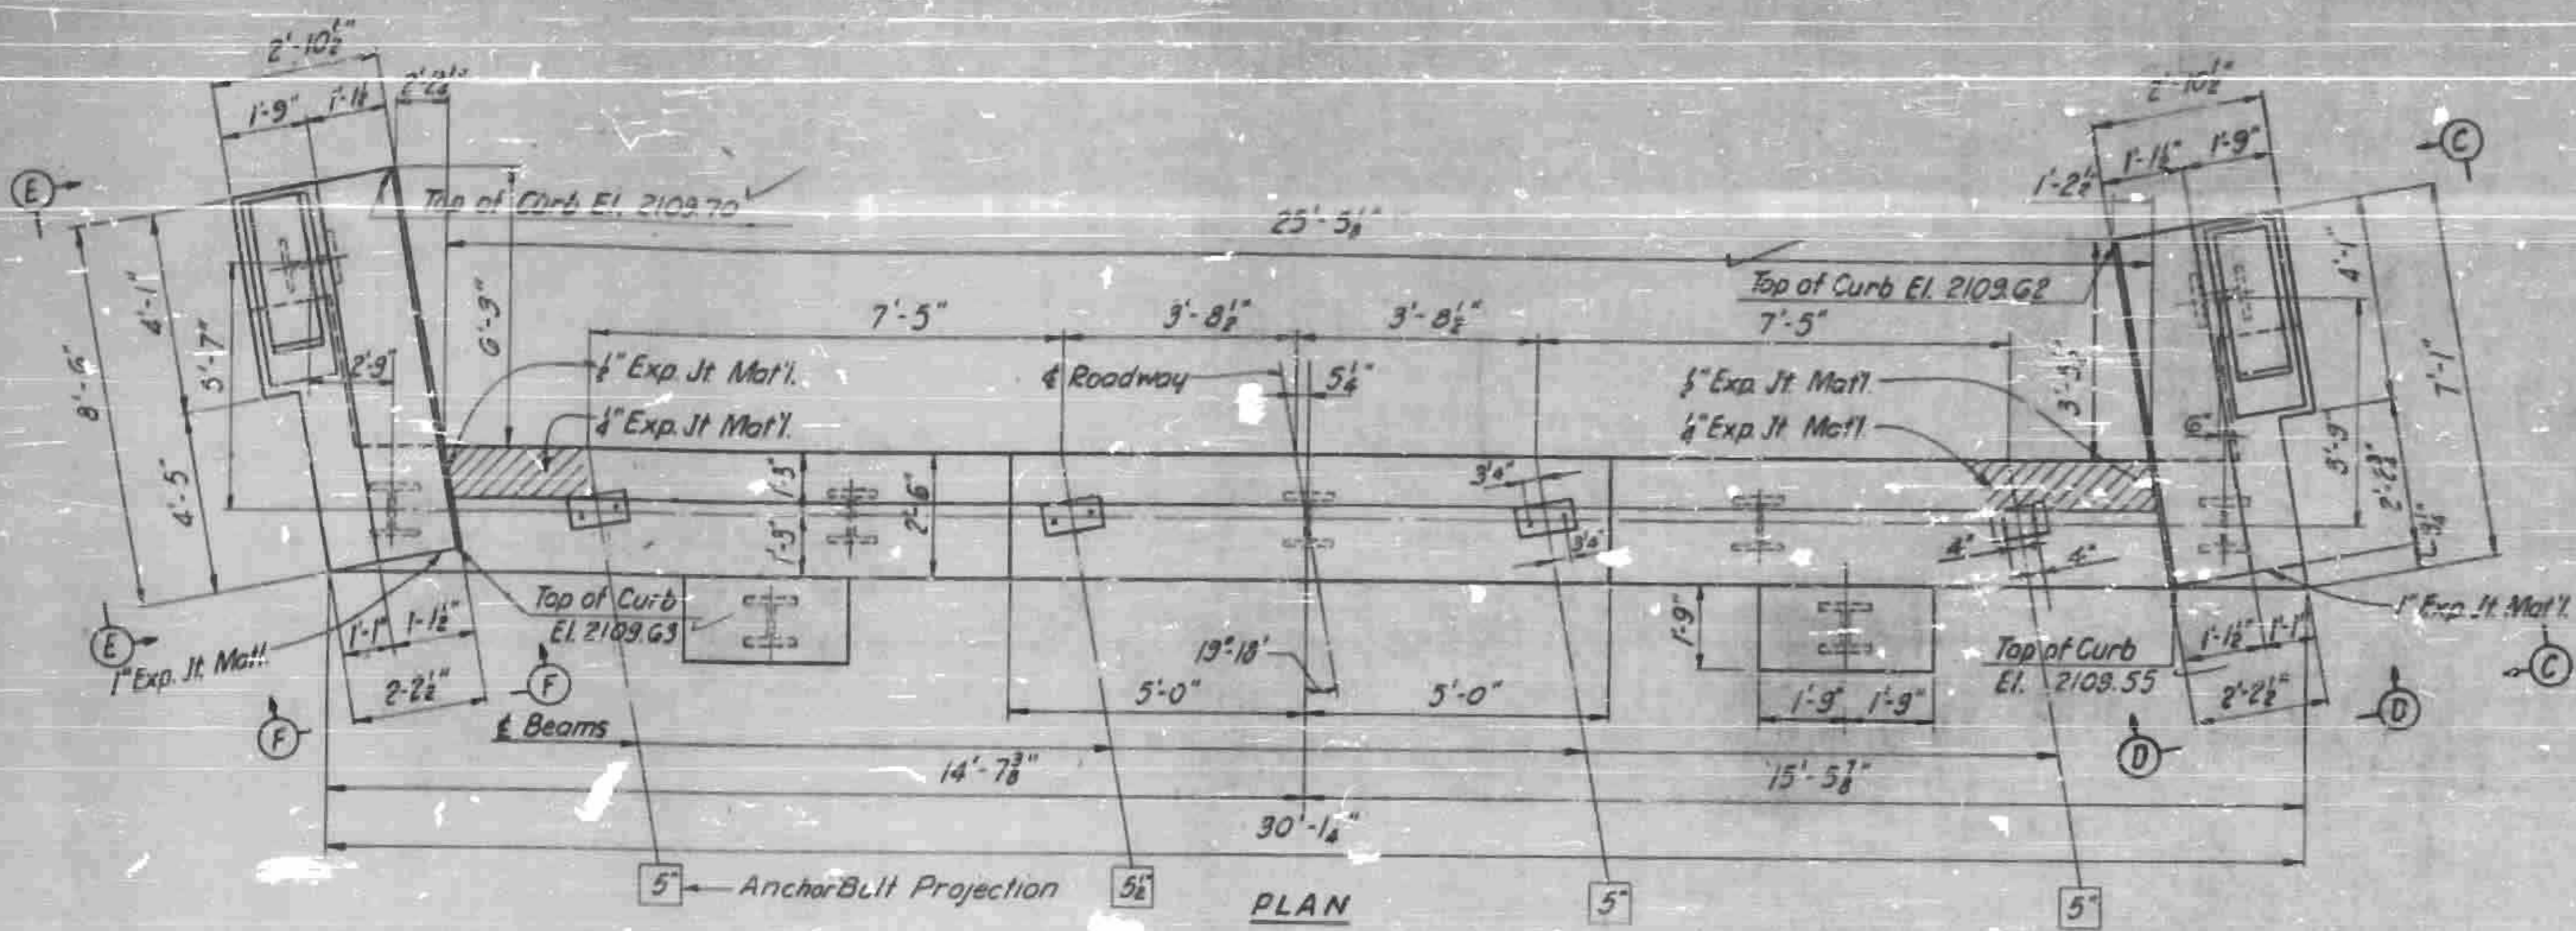

Hk.	29'-6"	11'-9"
1'-7"	29'-6"	11'-9"
8"	3'-2"	8"
10"	6'-3"	10"

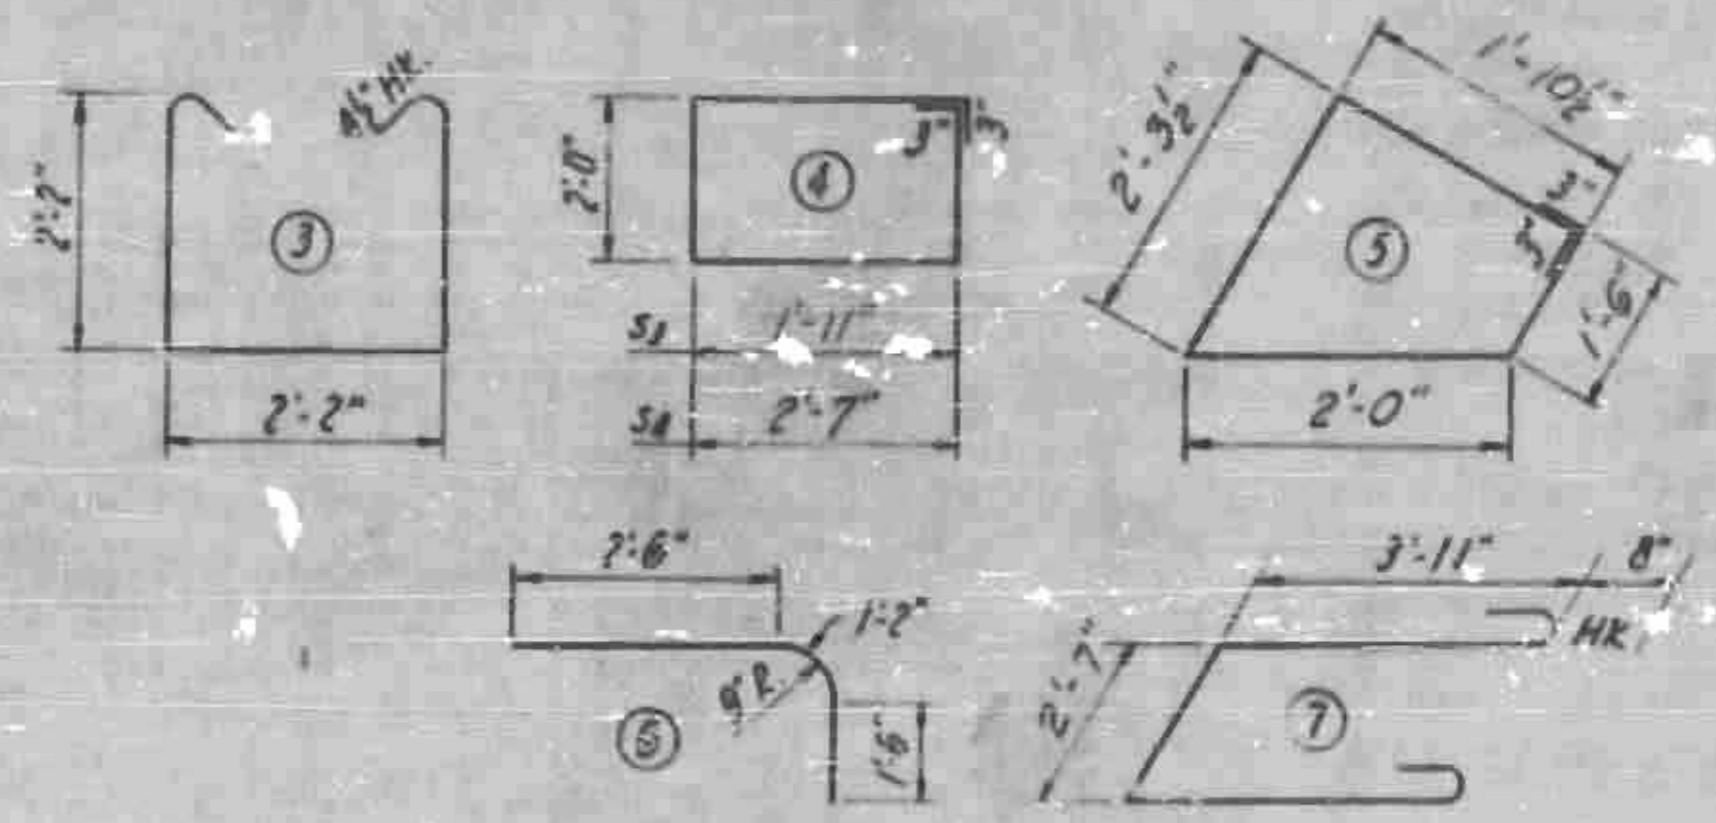

BILL OF MATERIAL					
END BENT #2					
BAR NO.	SIZE	TYPE	LENGTH	WEIGHT	
b ₁	8	#11	7	52'-8"	1,366
b ₂	4	#4	str.	29'-6"	79
b ₃	8	#4	str.	2'-2"	12
b ₄	6	#6	str.	5'-3"	47
b ₅	4	#6	str.	11'-9"	71
b ₆	2	#8	str.	29'-6"	152
e ₁	4	#4	6	5'-2"	14
h ₁	4	#4	str.	3'-5"	9
h ₂	10	#8	str.	0'-0"	30
h ₃	8	#6	str.	3'-8"	45
h ₄	10	#6	str.	8'-2"	123
h ₅	5	#4	str.	3'-0"	15
h ₆	10	#6	str.	1'-6"	10
h ₇	5	#4	str.	5'-0"	18
h ₈	5	#4	str.	5'-8"	18
h ₉	5	#4	str.	2'-10"	9
s ₁	22	#4	3	7'-3"	107
s ₂	22	#4	2	2'-11"	43
s ₃	6	#4	4	8'-4"	33
s ₄	6	#4	4	9'-8"	39
s ₅	5	#4	5	8'-2"	28
v ₁	14	#4	str.	8'-1"	76
v ₂	12	#7	1	8'-9"	206
v ₃	12	#4	str.	2'-3"	18
v ₄	8	#4	str.	2'-6"	17
v ₅	8	#6	str.	3'-4"	16
Reinforcing Steel				lbs	2701
Class A Concrete				cu.yds	15.8
12BP53 Steel Piles				no.	9
12BP53 Steel Piles				lin.ft.	739
					307-0

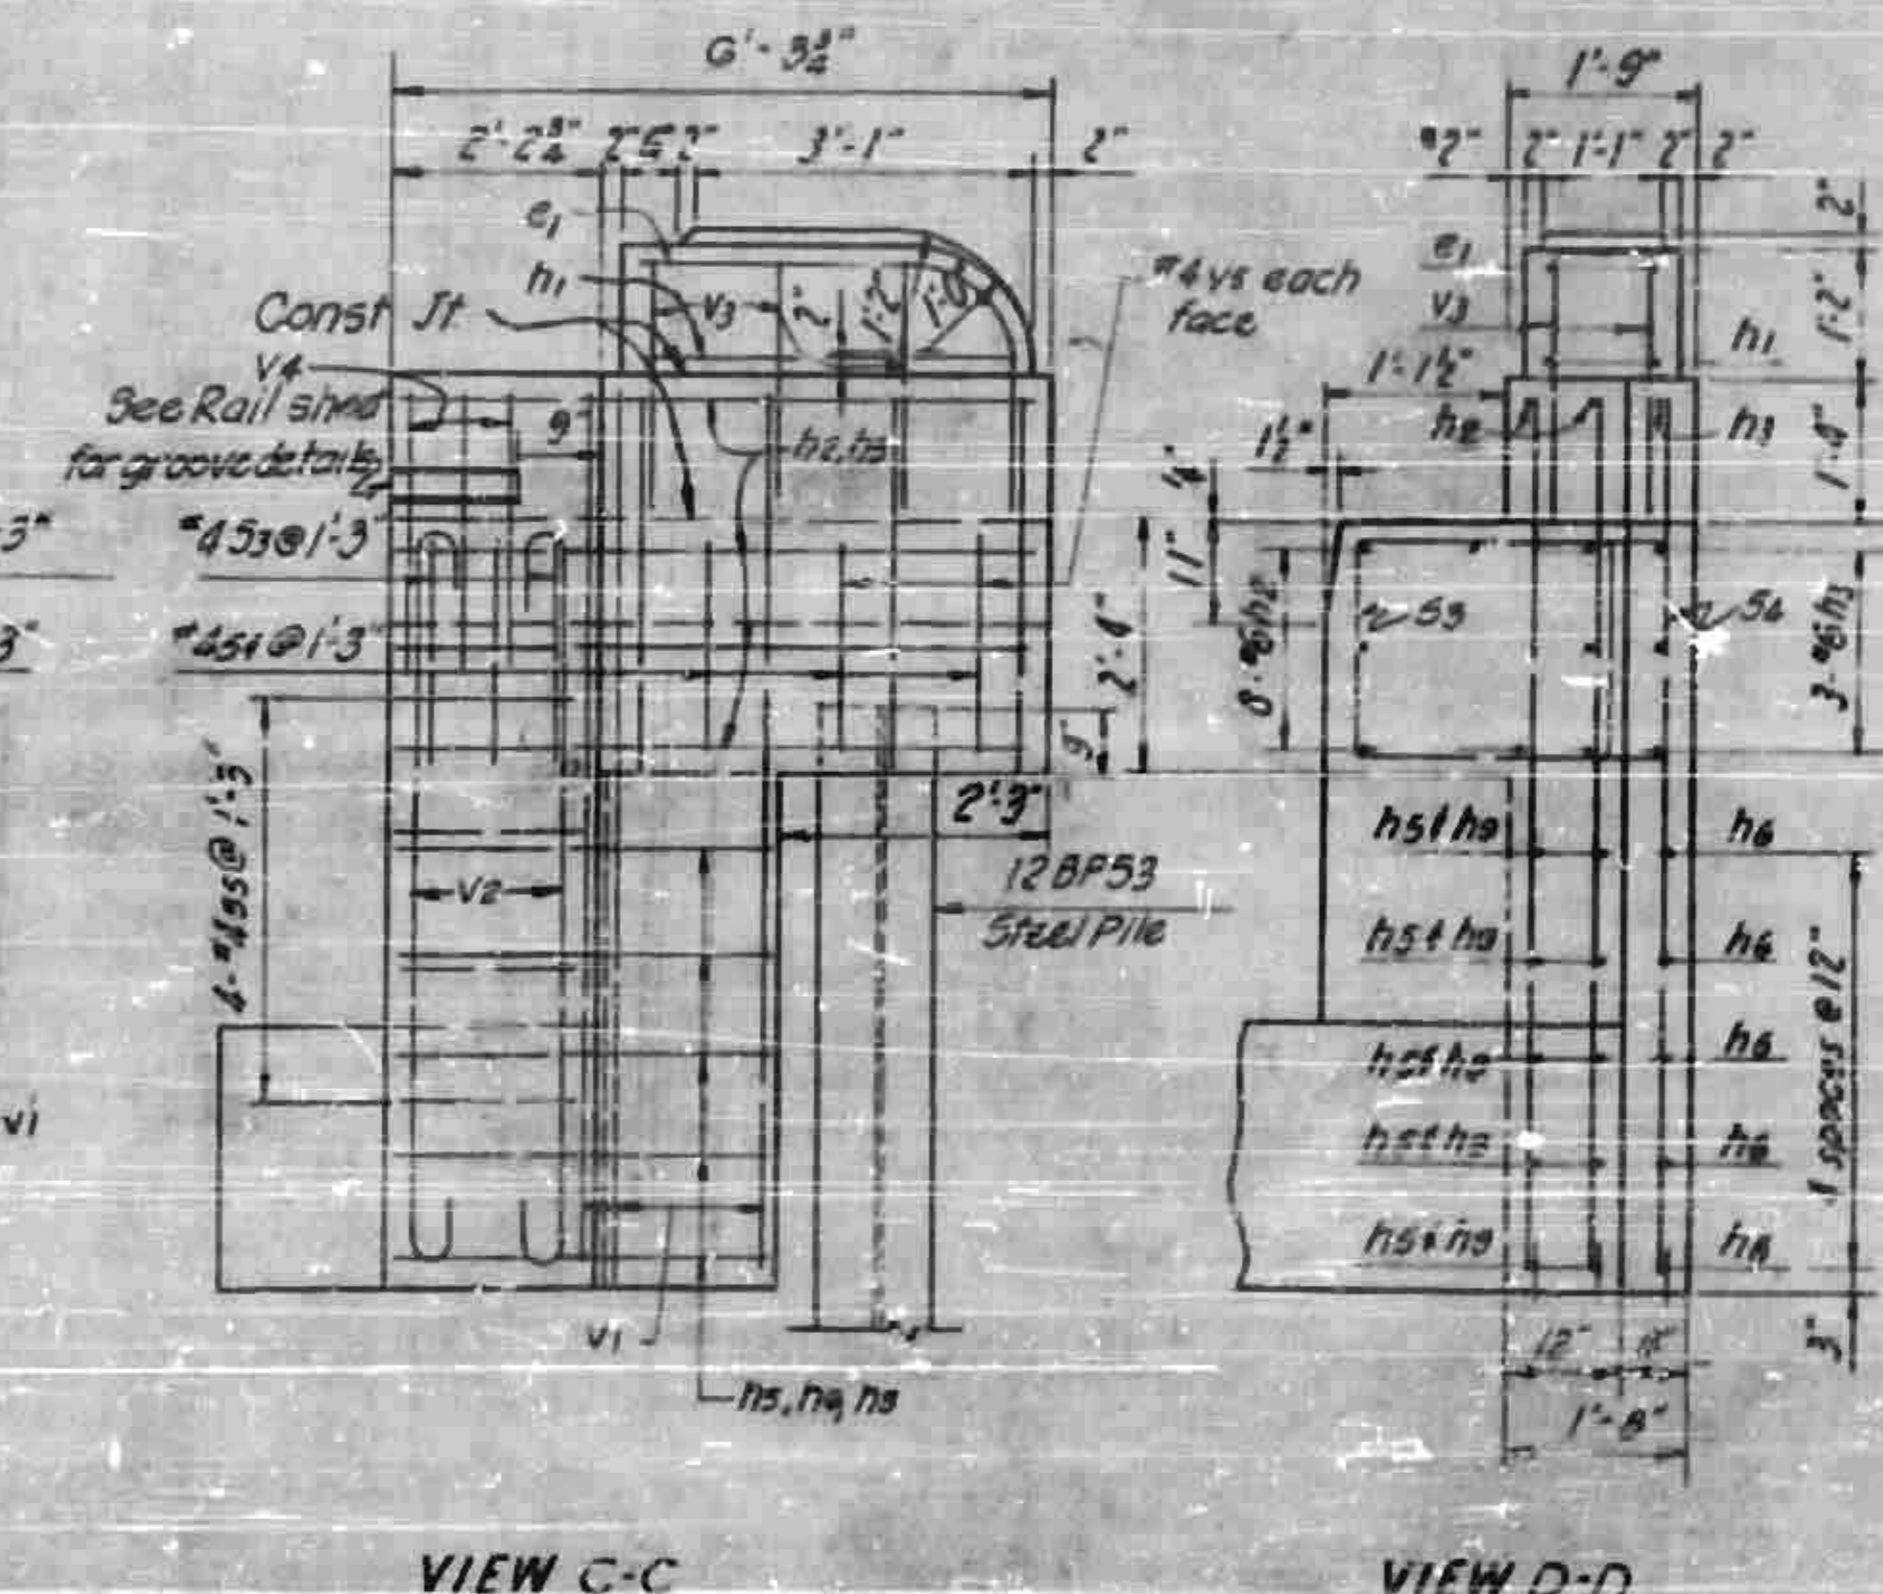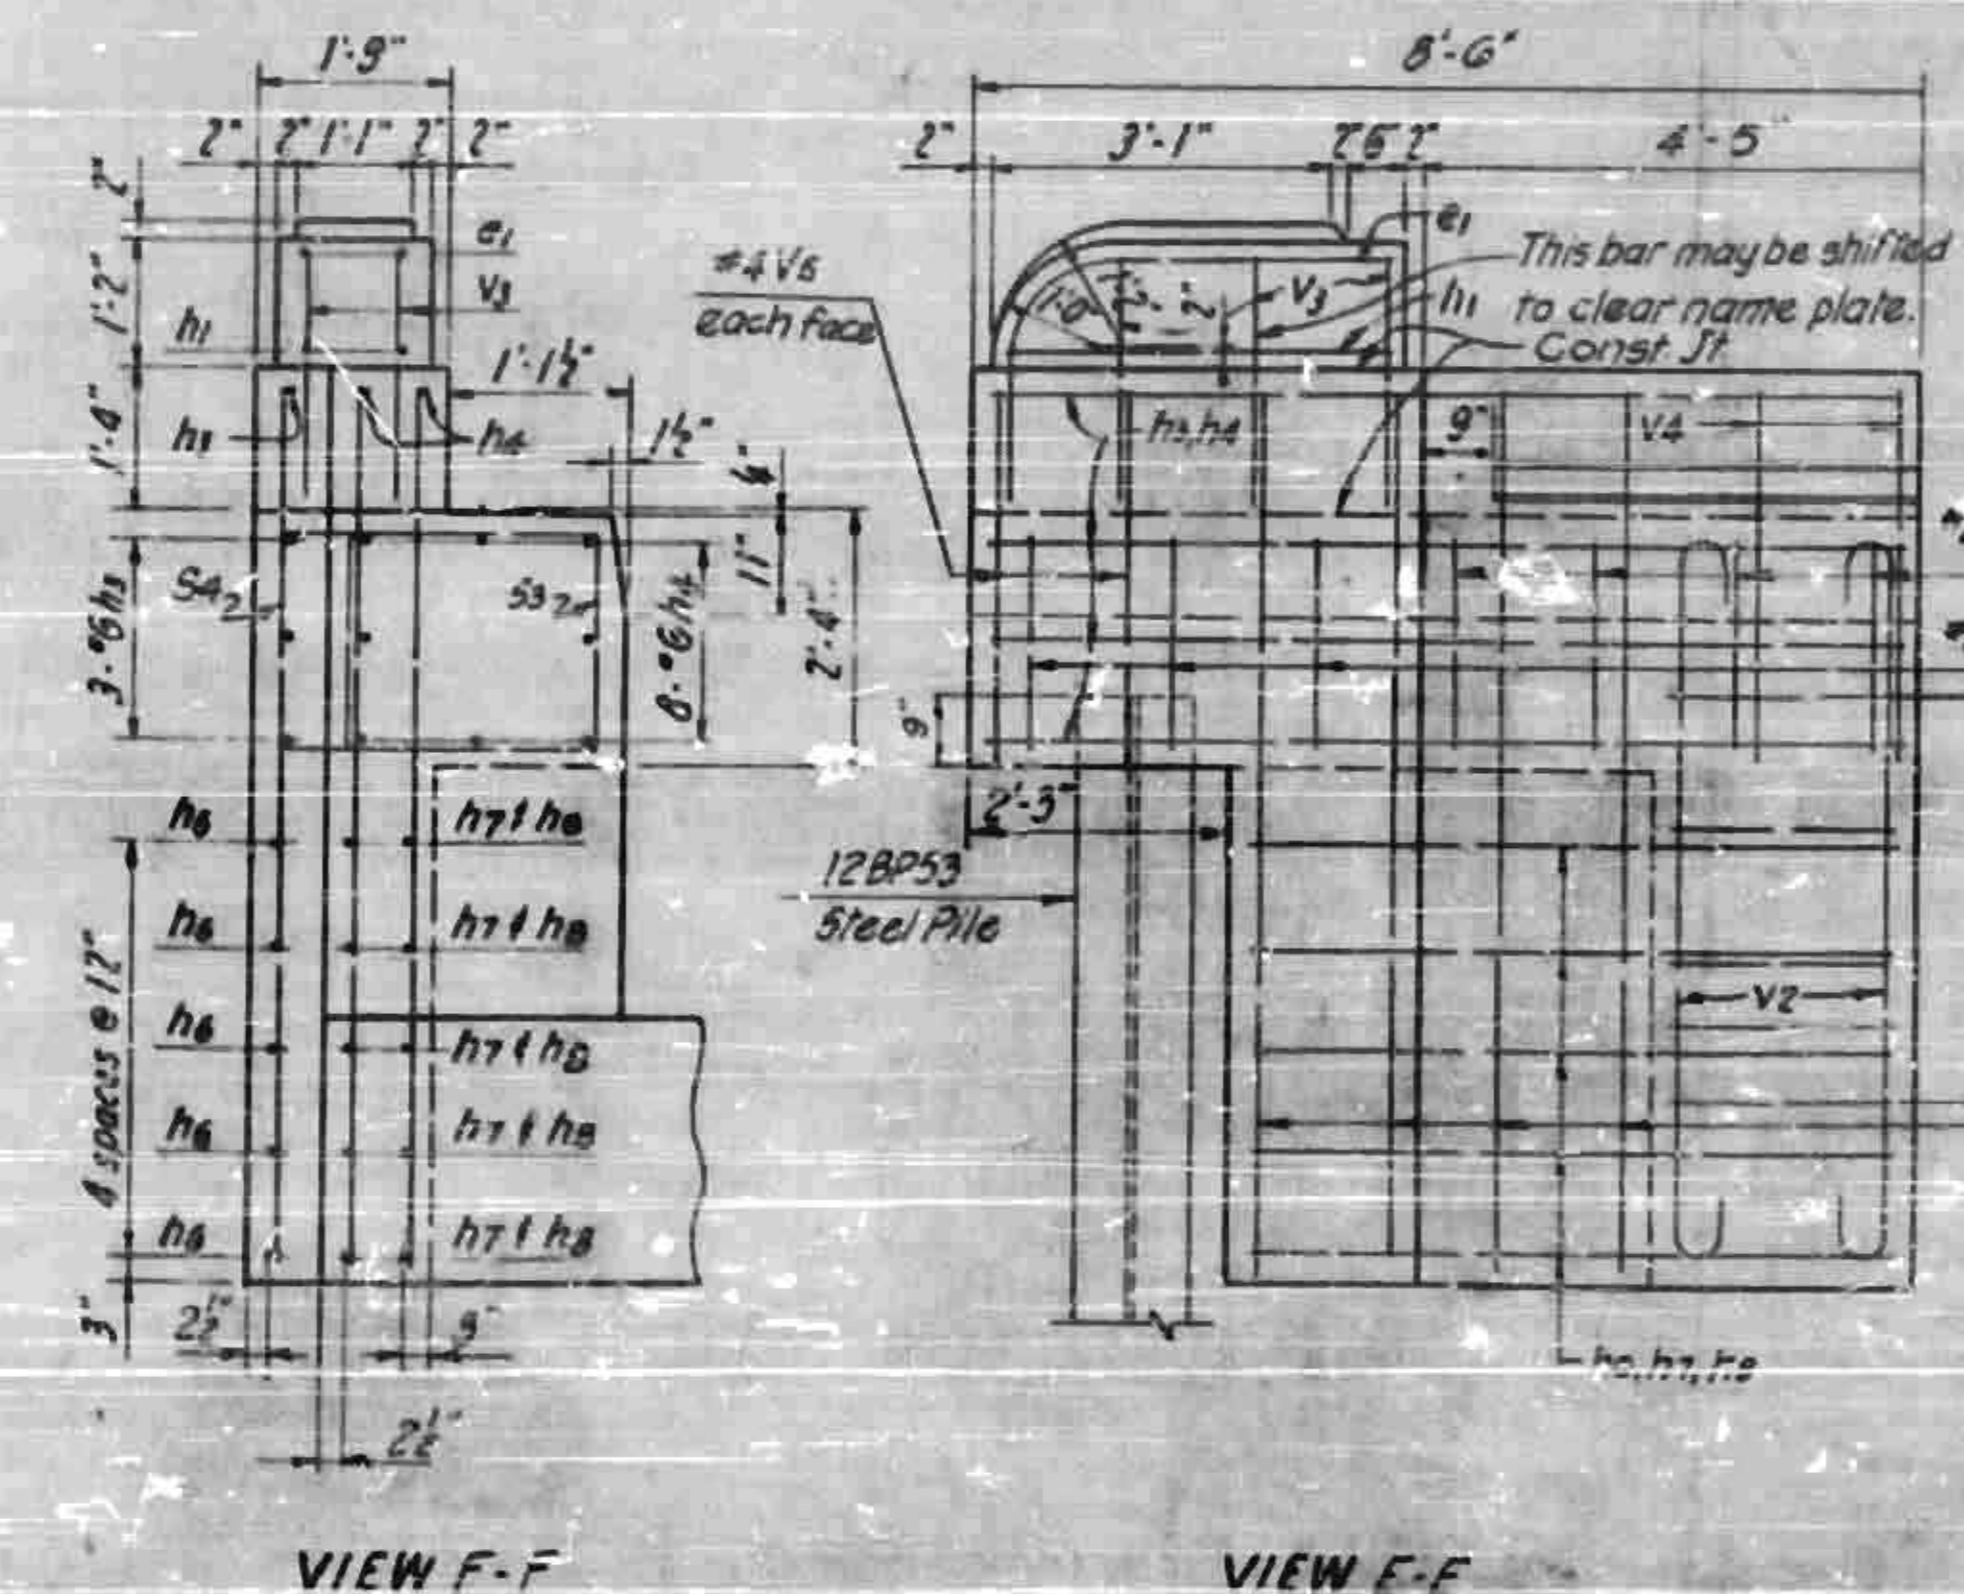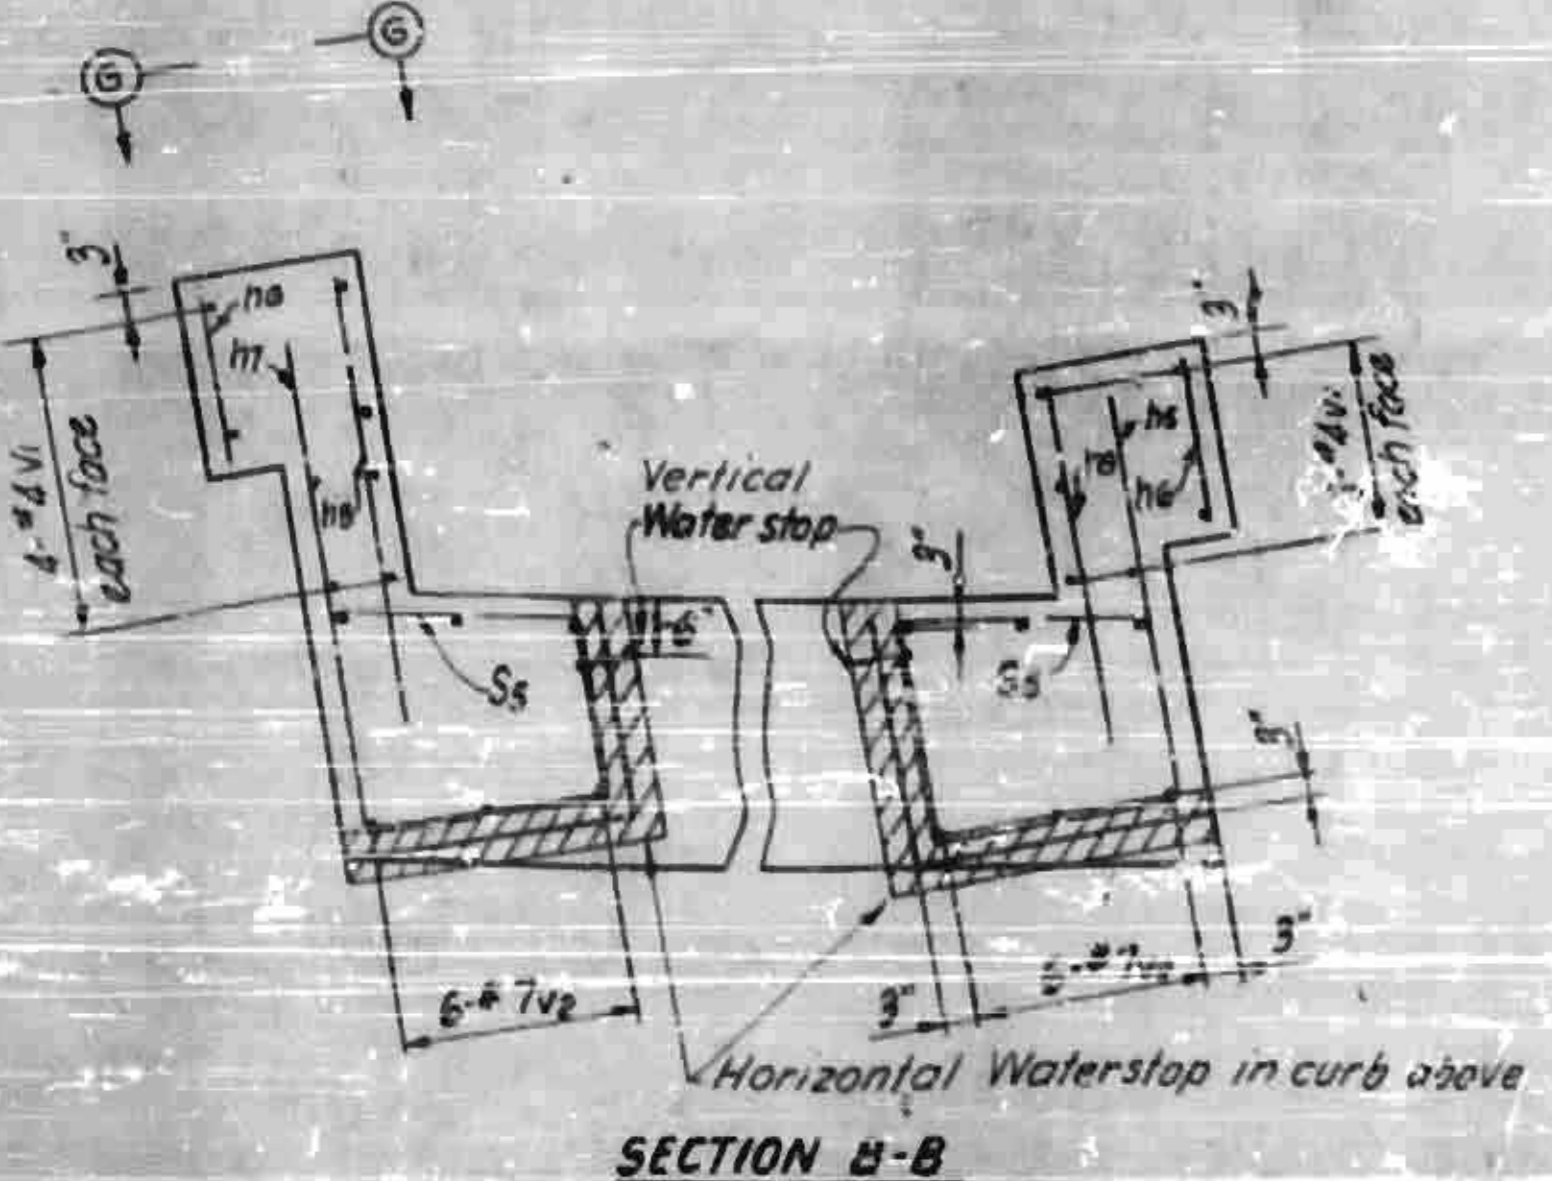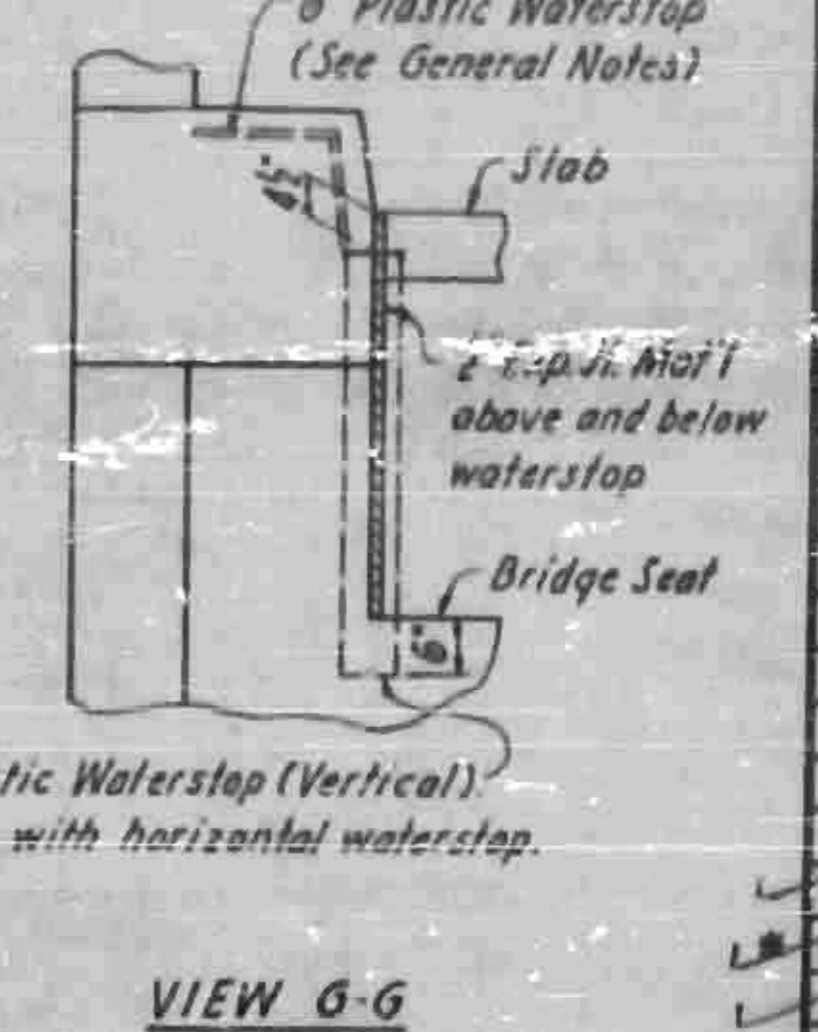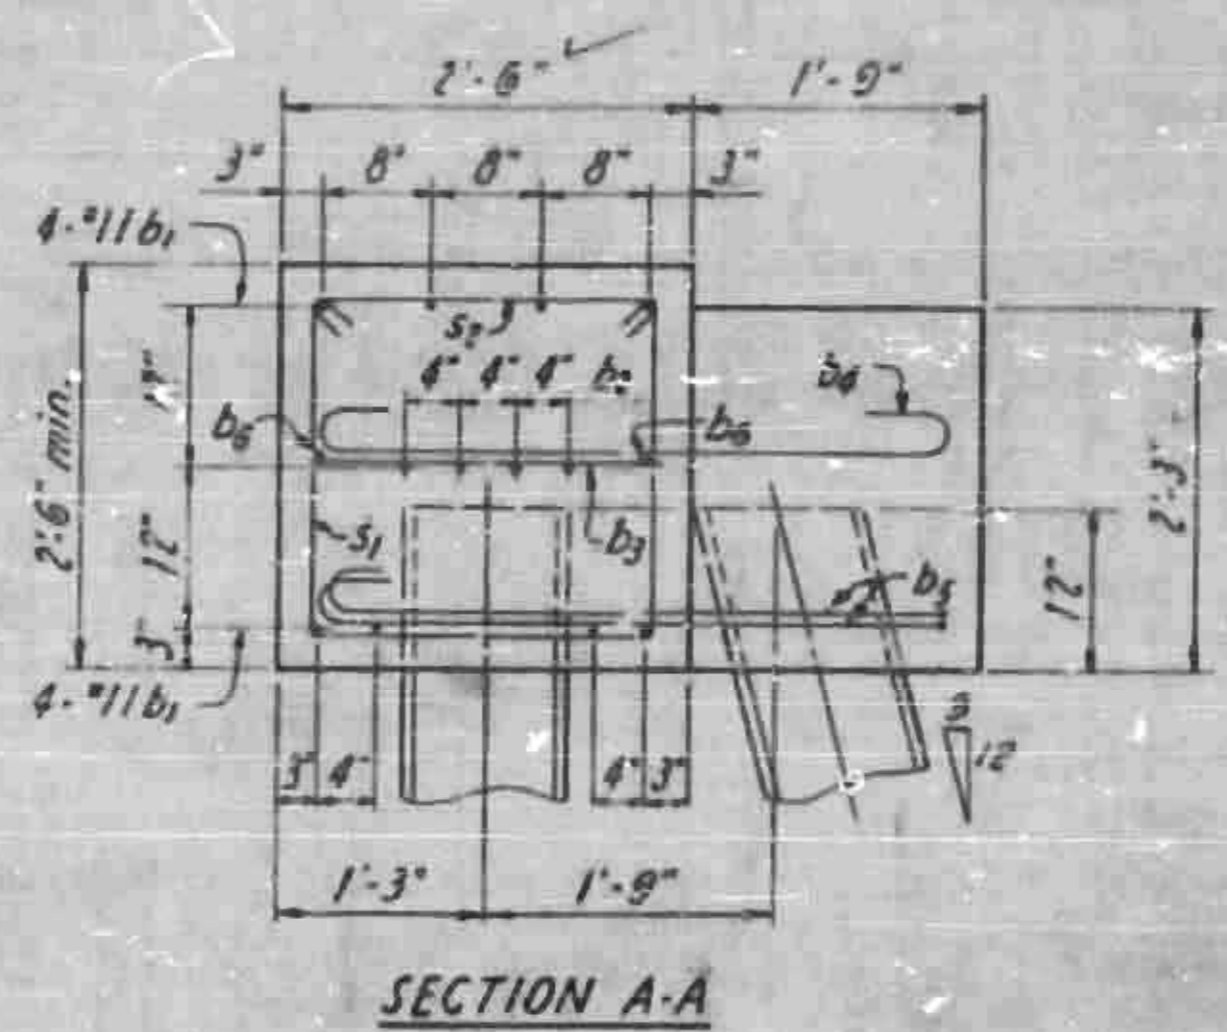


PROJECT NO. **1284 061**
 HENDERSON COUNTY
 STATION **1284+061**
 10+00'

STATE OF NORTH CAROLINA			
STATE HIGHWAY COMMISSION			
END BENT 2			
REVISION	DATE	BY	CHK
1	4-9-59		
2	4-9-59		
3			


Revision 1. Edward to change anchor bolt app. 1-28-59

FED. ROAD DIST. NO.	STATE	PROJECT NO.
7	N.C.	8 18293
FED. AID PROJ. 7-26		1512

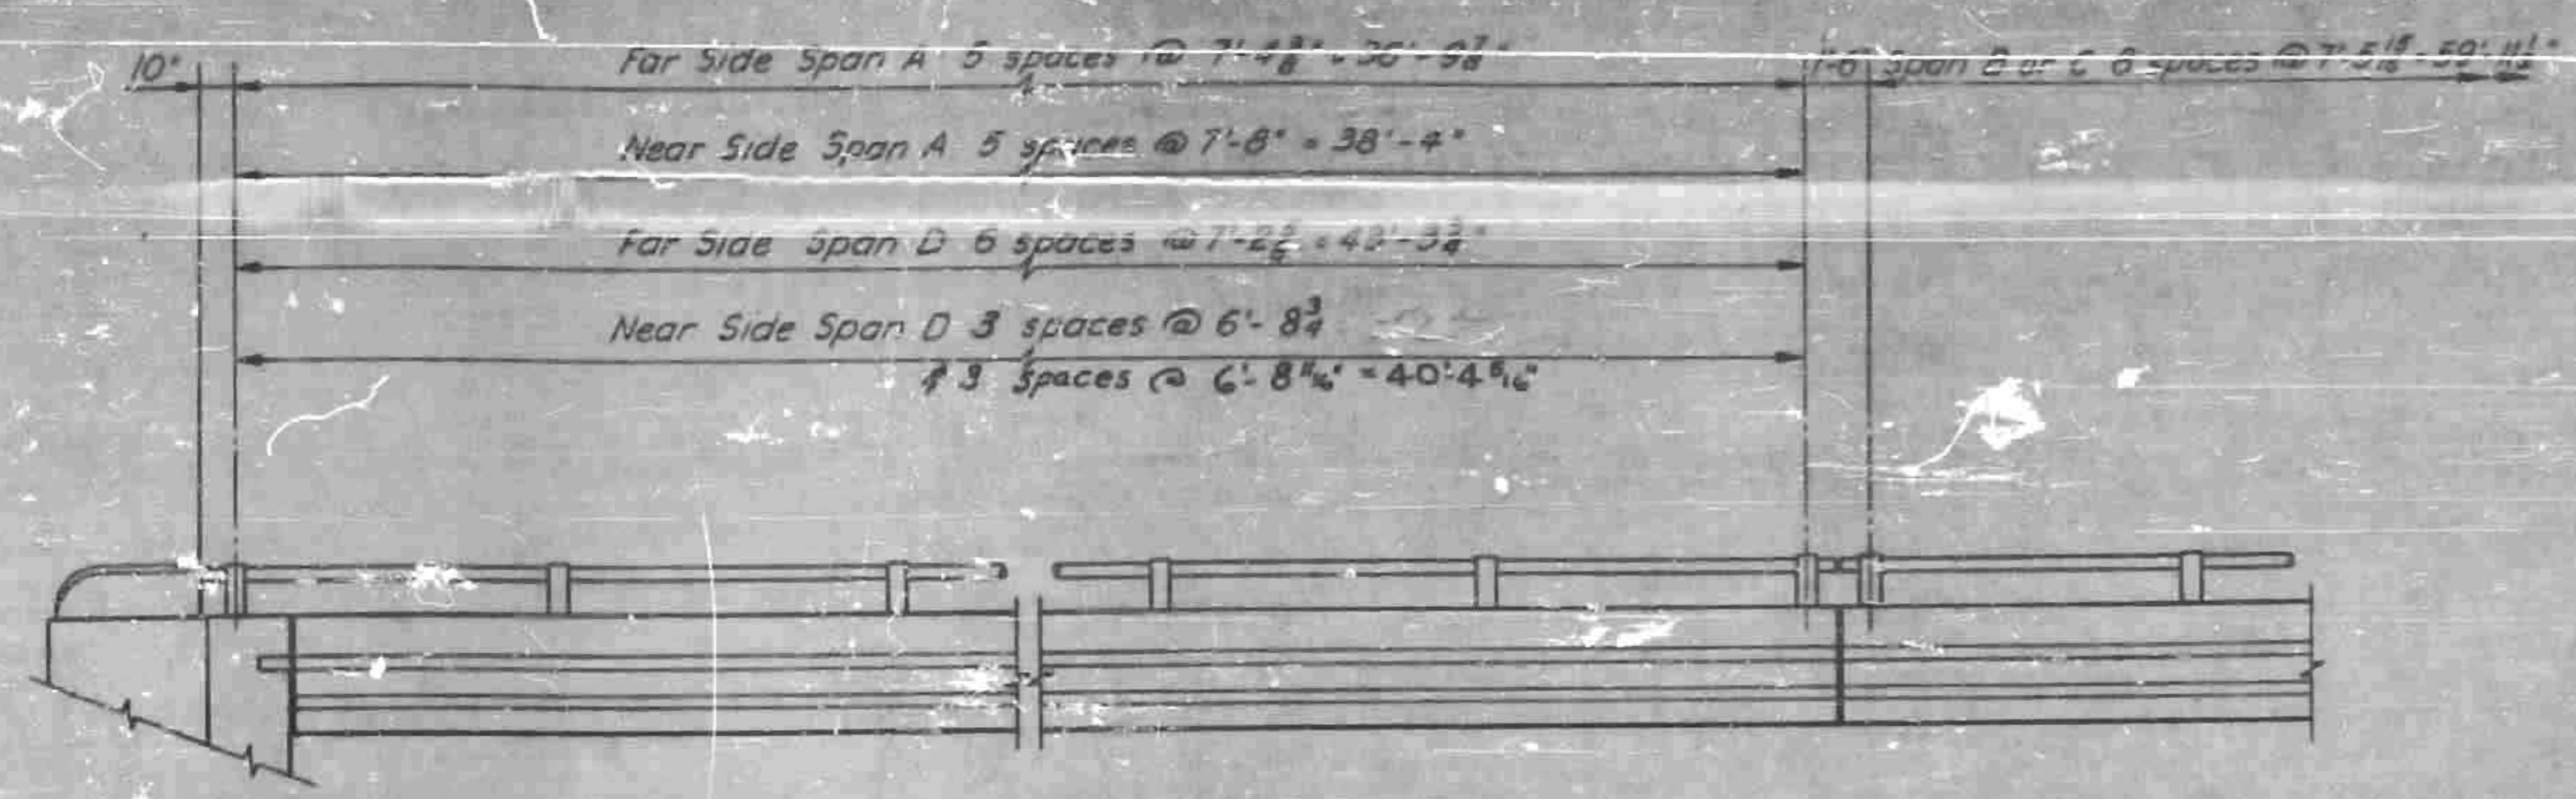


PARAPET AND RAILING ELEVATION

NOTES:
 Unless noted on the plans, maximum length of rail section to be two panels plus 'stick thru'.
 End of rail to clear face of concrete End Post by 1/2".
 For double panel runs of rail, set screws shall be set tight at center post and snug at ends to allow for expansion.
 For single panel runs, set screw to be tight at one end and snug at the other end.
 3/4" Anchor bolts-hex nuts and washers to be steel galvanized in accordance with ASTM A-158 and painted with 2 coats of aluminum paint after erection.
 Cast posts to be as shown or an approved equal.
 Certified Mill reports are required for rails and posts. Shop inspection is not required.
 Metal Rail Posts to be set normal to curb grade.

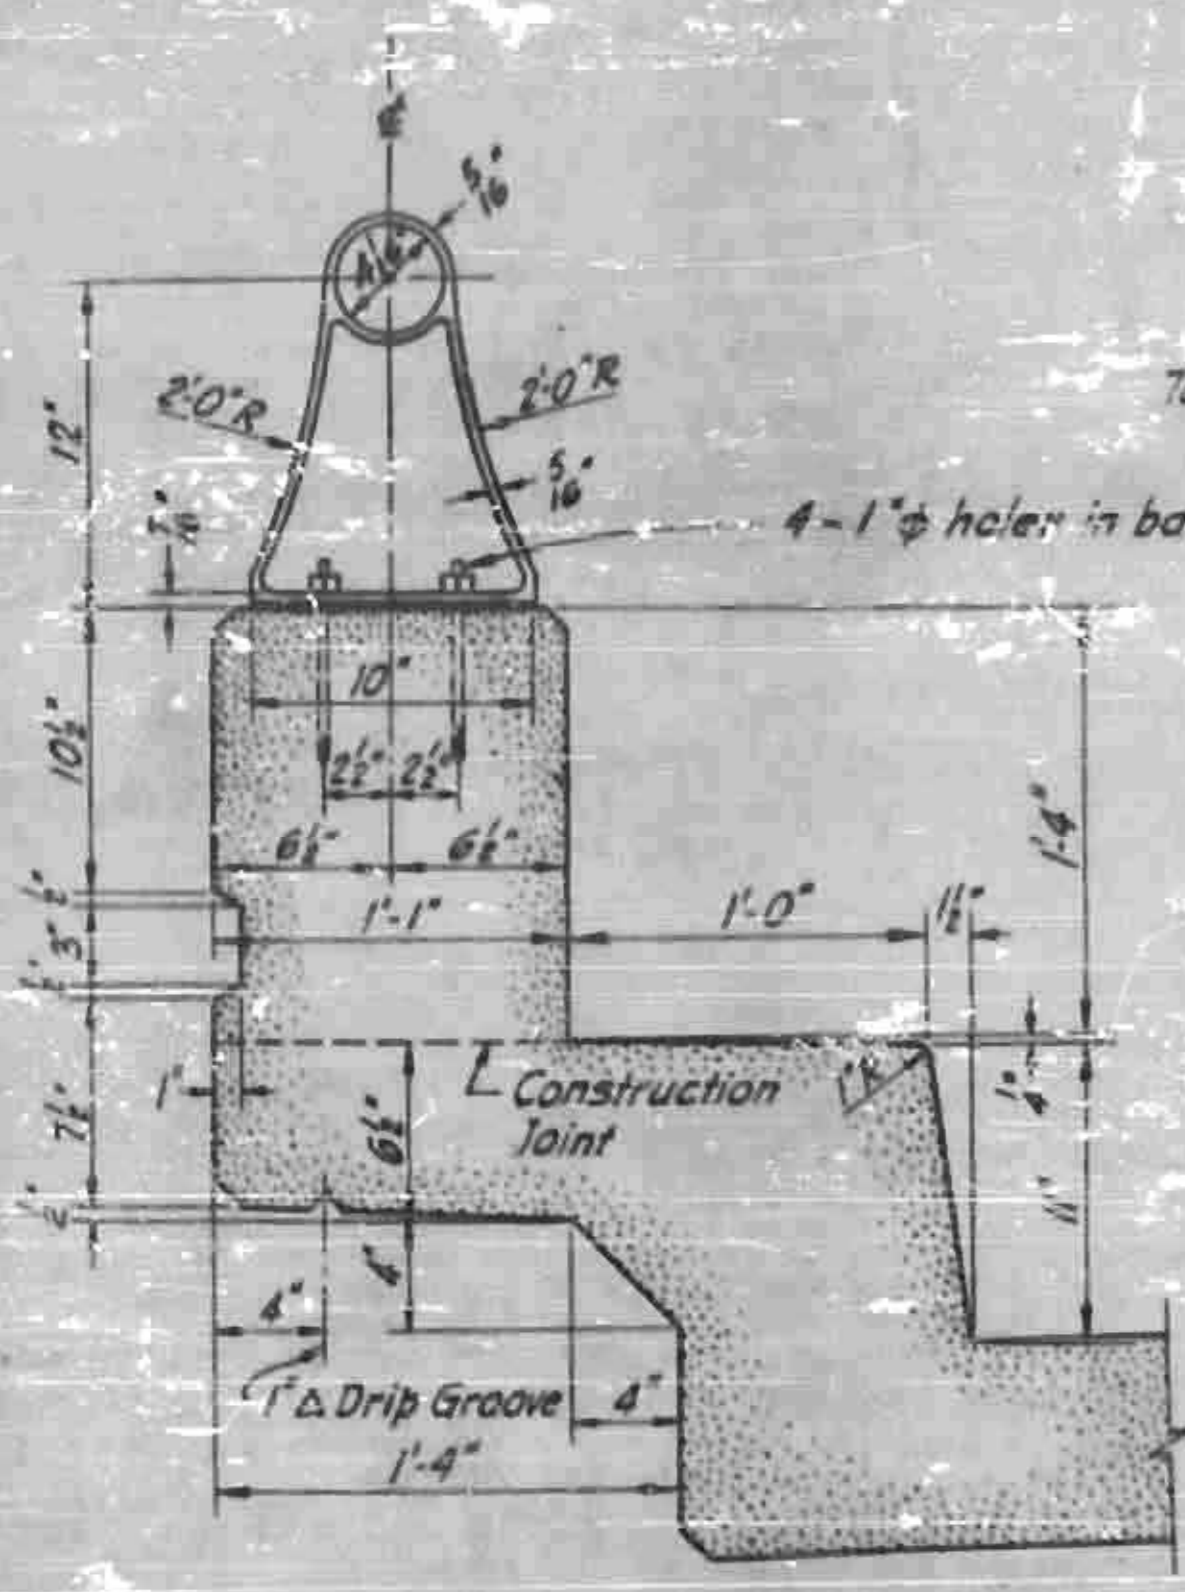

TYPICAL SECTION

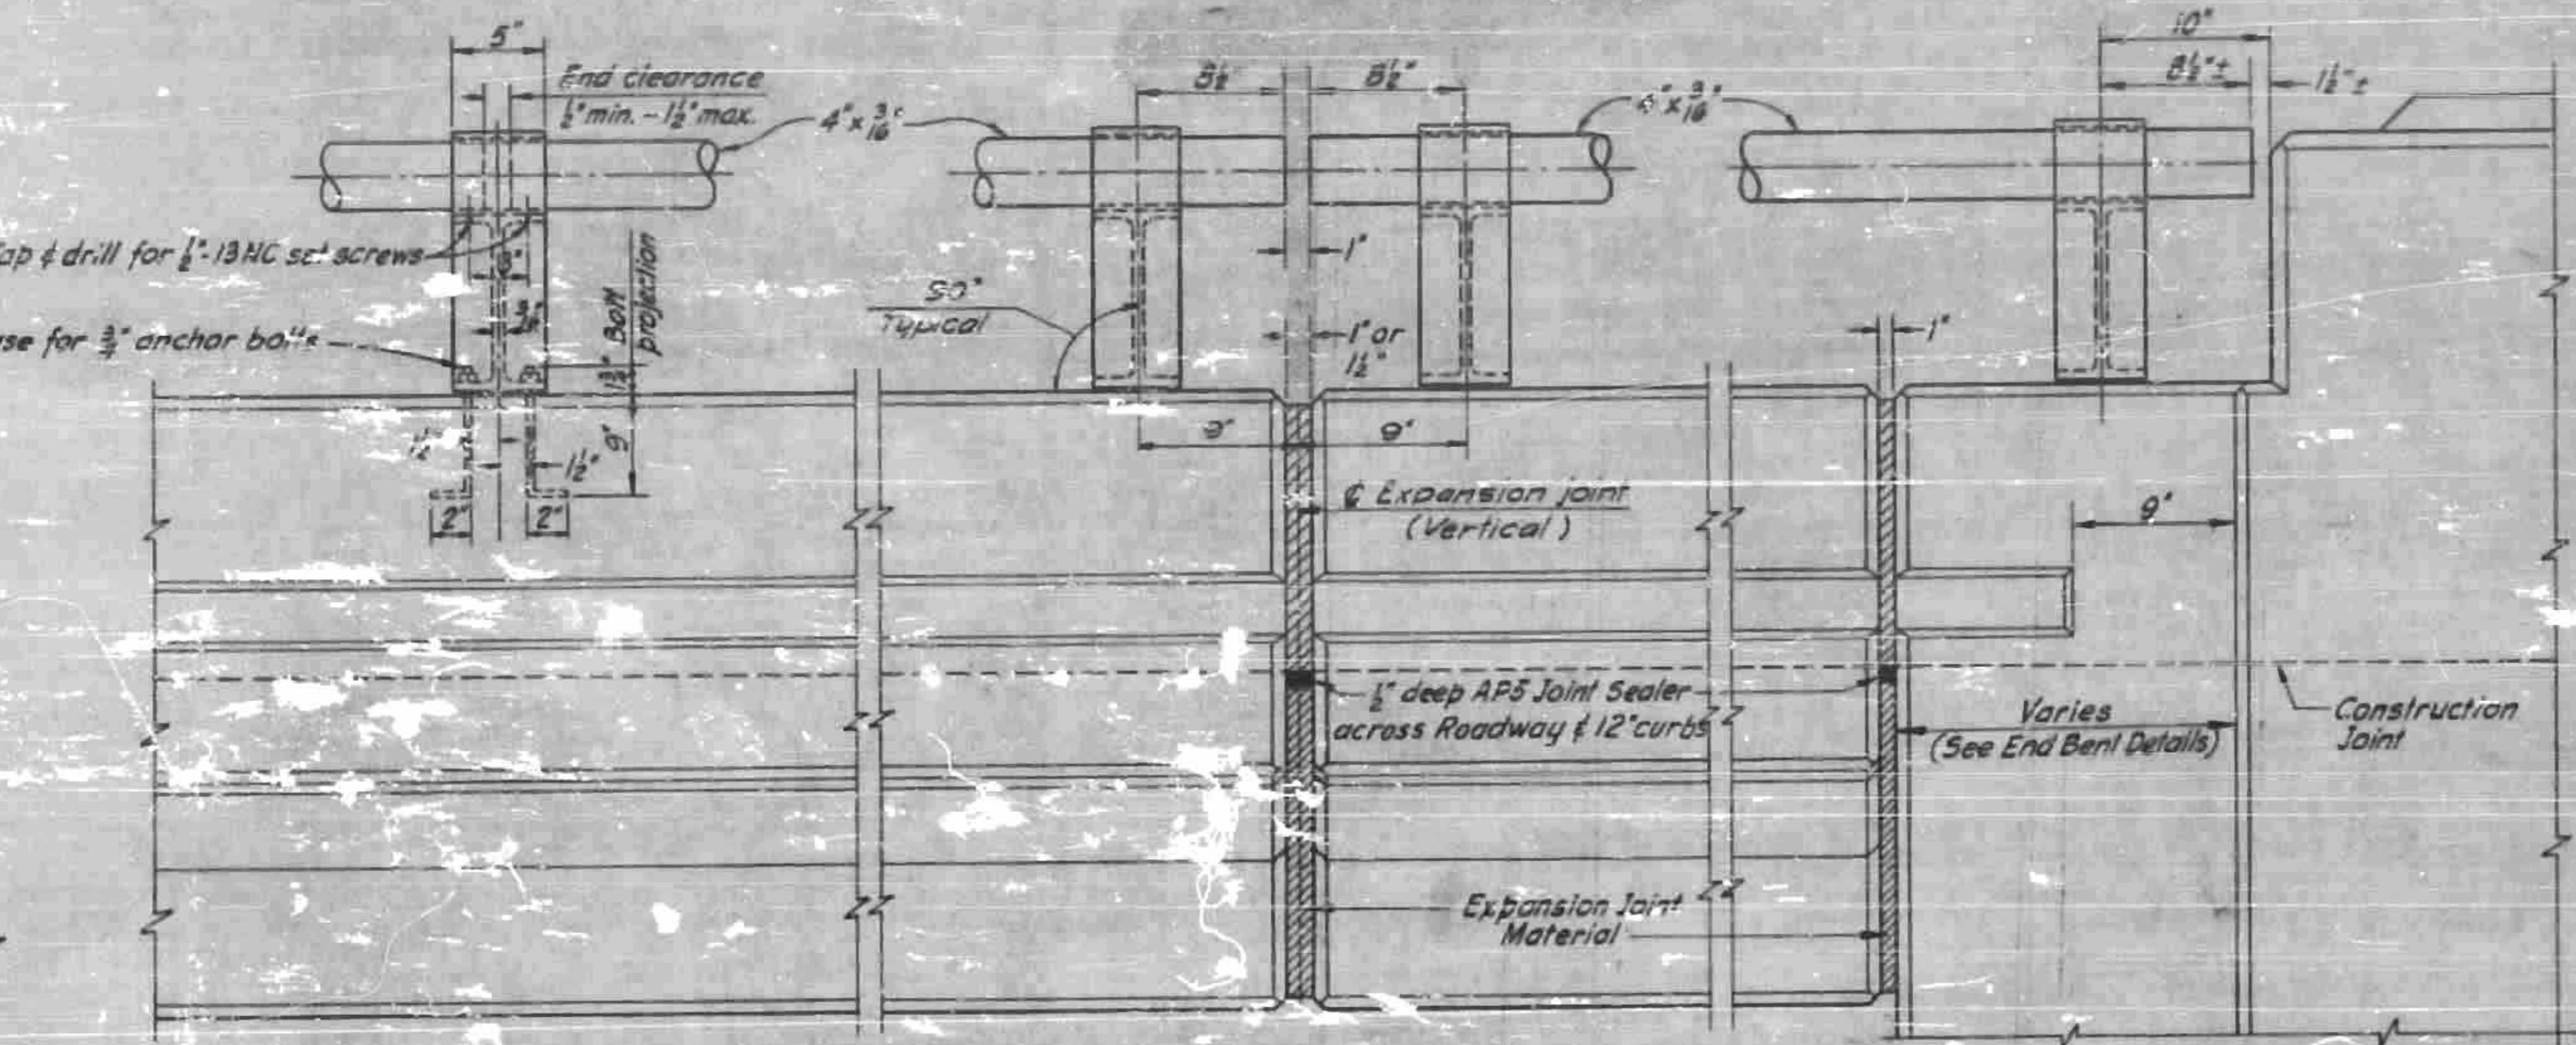


ELEVATION

JOINT DETAILS AT BENTS

JOINT DETAILS AT END BENTS

PARAPET AND RAILING DETAILS

At the Contractor's option metal rail may be either Aluminum or Galvanized Steel in accordance with the requirements of the general notes and the following specifications for the indicated materials; however, the Contractor will be required to use the same rail material on all structures on the project for which metal rail is designated.

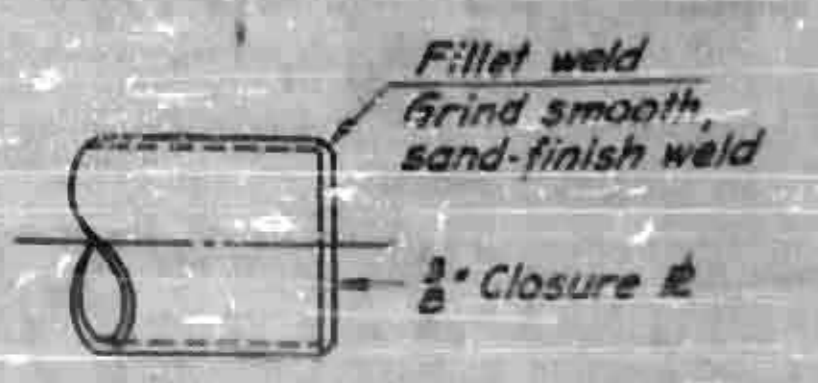

DETAIL END CLOSURE

ALUMINUM RAILS
 Aluminum alloys are to be as follows:
 Cast Rail Posts A75-T6
 Round Tubular Rail 6061-T6 or 6062-T6
 Set Screws 2024-T4
 Closure Plates 6061-T6 or 6062-T6

Round Tubular Rails are to be 4" O.D. with 3/16" minimum wall thickness.
 The base of rail posts, and other aluminum surface in contact with concrete shall be thoroughly coated with an aluminum impregnated caulking compound of approved quality.

GALVANIZED STEEL RAILS
 Material and galvanizing are to conform to the following specifications:
 Cast Rail Post Malleable Cast Iron ASTM A44 Grade 35014 Galvanized to ASTM A429
 or Cast Steel, AASHTO M192-60 Class 70, Galvanized to ASTM A123
 4" O.D. Rail Standard 3 1/2" Steel Pipe, ASTM A53 (Galvanized)
 Closure Plates Steel, ASTM A-246 Grade C, Galvanized to ASTM A-123
 Set Screws Standard Steel Cap Screws, Galvanized to ASTM A-123

The cut ends of galvanized pipe railing, the end closure plate weld after grinding smooth and areas adjacent to the weld where spatter coating has been burned by welding shall be thoroughly cleaned by wire brushing to remove all traces of slag, flux and loose or cracked spatter after which these cleaned areas shall be given two coats of Zinc paint meeting the requirements of Federal Specification MJL-P26915 (USAF) Type 1.

Rev. 11/11 for changed rail spacing for N.S. Span D. V.C.B.P.

PROJECT NO. 8 18293
 Henderson COUNTY
 STATION 1284+06 L
 10+00 Y6

STATE OF NORTH CAROLINA	DATE
STATE HIGHWAY COMMISSION	BY
RAILINGS	DATE
PARAPET AND RAILING DETAILS	DATE