


NOTES

- Loading: AASHTO H-20-S16-44 and BPE Modified Loading for Military Vehicles.
- Future Surfacing: 20 lbs. per sq. ft.
- Roadway Width: 28'-0" curb to curb.
- For other design data and general notes see General Notes Sheet.
- Concrete surfaces shall be given a surface finish in accordance with the Specifications.
- Water Surface Elevation of Flood of Record (July, 1916) controlled by backwater from French Broad River.
- The contractor will be required to drive one 12BP53 steel test pile, 20' long in place at Bent 2. The test pile shall be paid for as linear feet of 12 BP53 Steel Piles. The order lengths for all piles shall be given after the test pile has been driven.
- All piles at End Bents shall be driven through the roadway fill.
- All piles shall be driven to a minimum bearing capacity of 30 tons.
- Soil bearing footing at Bent 1 is designed for a bearing pressure of 3 tons per sq. foot.



PLAN

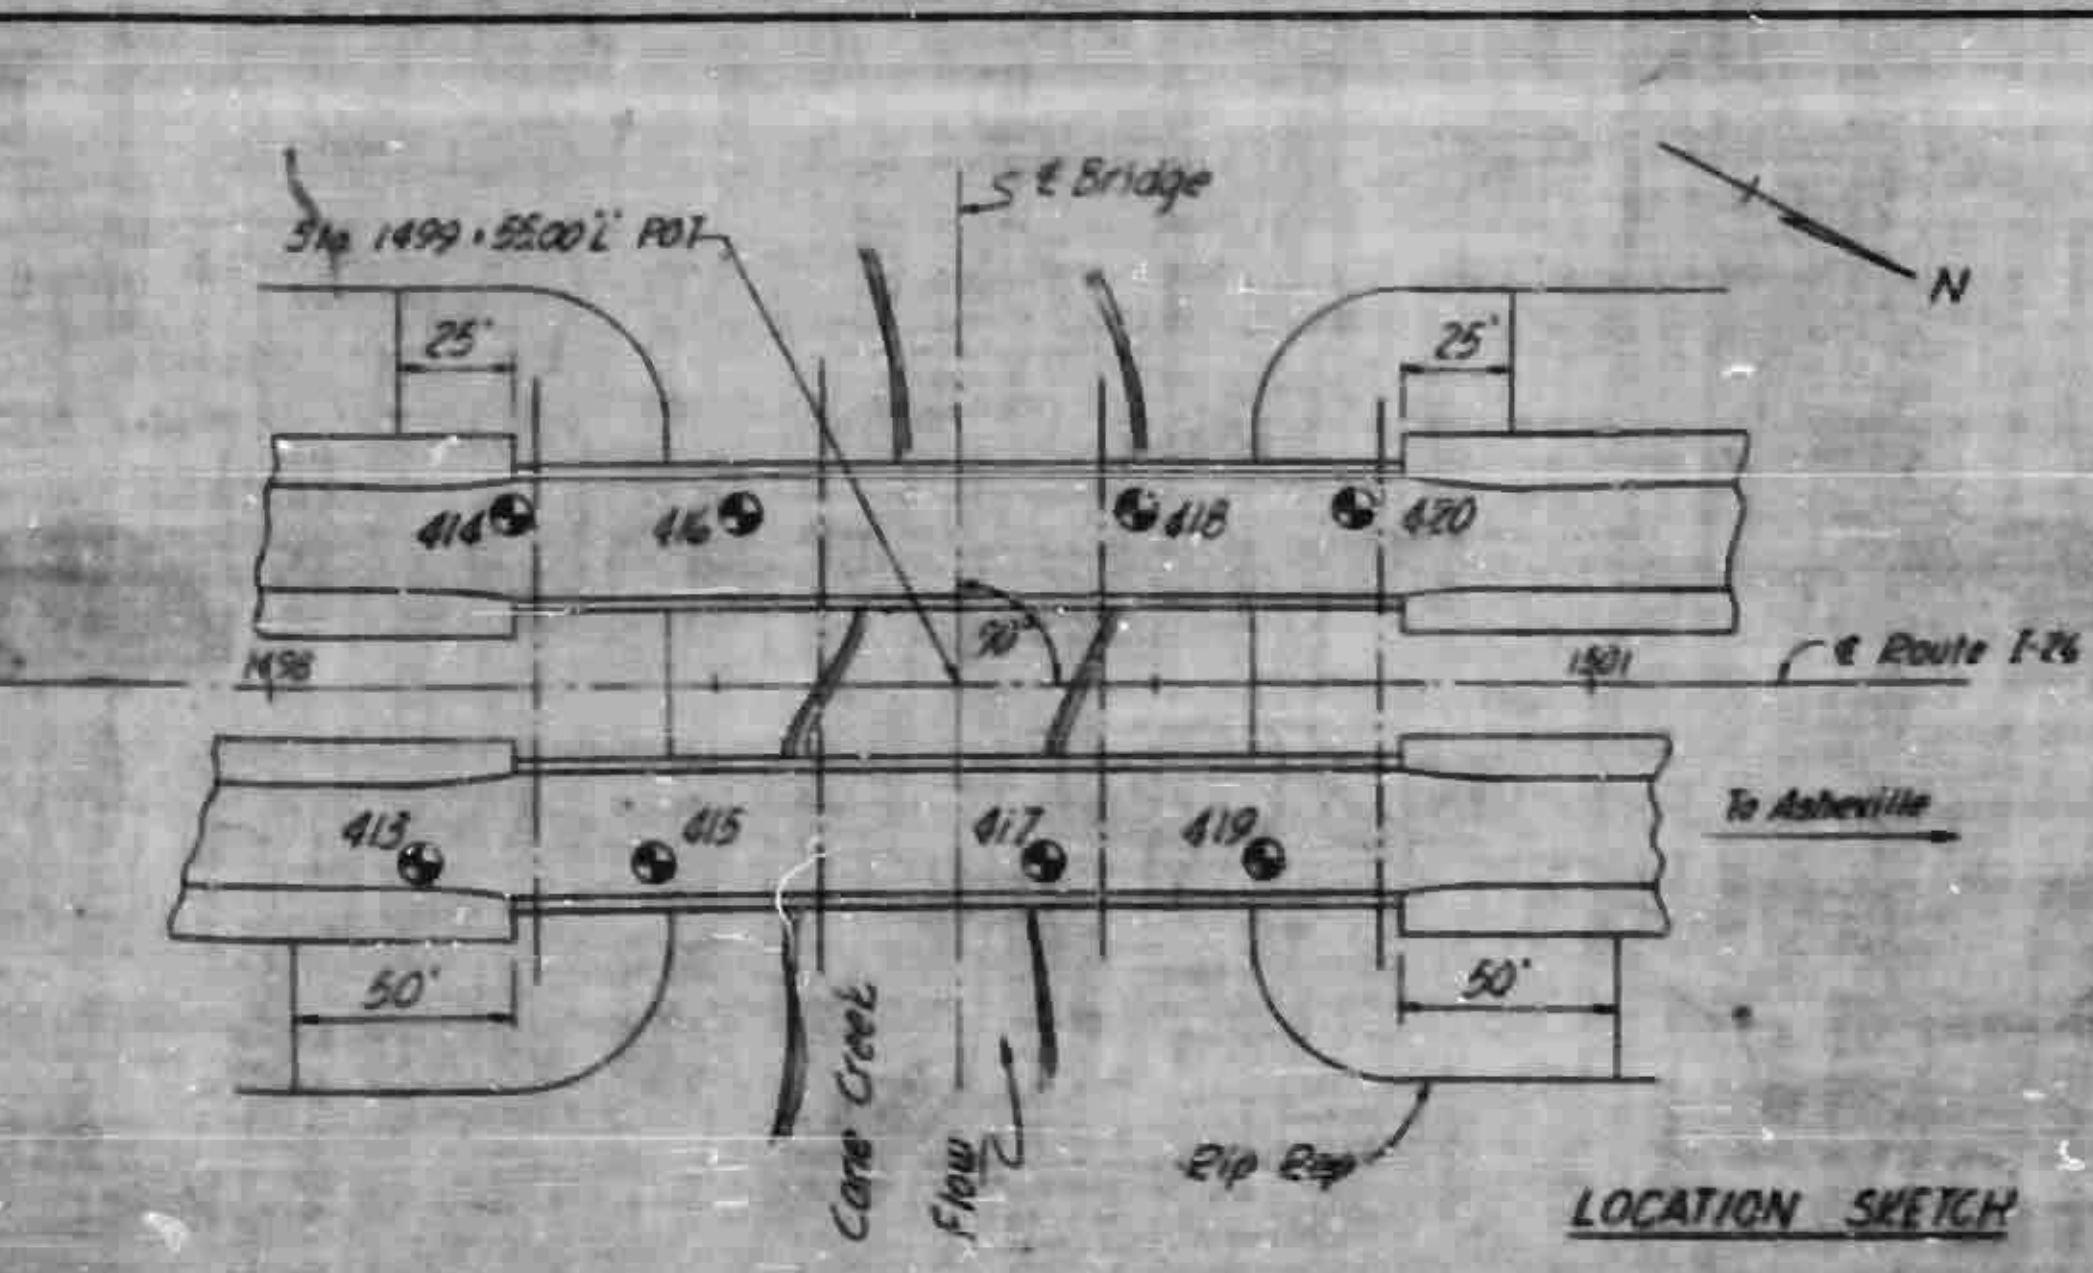




I hereby certify that this structure was built according to REVISED PLANS
 SIGNED: *[Signature]*
 RES. ENGR.

TOTAL BILL OF MATERIAL						
	Class A Concrete Cu. Yds.	Reinf. Steel Lbs.	Structure Steel Approx. Lbs.	12BP 53 Steel Piles No. Lin. Ft.	Excavation Cu. Yds. Wet Dry	Metal Rails Lin. Ft.
Superstructure	196.0	42,388	158,100	21	1,390.83	390.83
End Bent 1	16.0	2,805		9	210.00	229
Bent 1	428.45	5,455.00		14	149.78	
Bent 2	380.75	5,490.00		14	149.78	
End Bent 2	16.0	2,805		9	210.00	229
Approach Curbs	3.2	76				
TOTAL	1,161.4	107,819	158,100	67	2,100.39	847.83

Note: Plan Rip-Rap for S. B. Bridge and N. B. Bridge Masses and computed together (12,656 sq. ft.) See summary sheet on 102.

PROJECT NO. 819002
 HENDERSON-BUNCOMBE COUNTY
 STATION 1499+55 L
 S. B. Bridge

DATE		STATE OF NORTH CAROLINA	
BY		STATE HIGHWAY COMMISSION	
CHECKED		REVISION	
APPROVED		GENERAL DRAWING	
DESIGNED		BRIDGE OVER CANE CREEK	
DRAWN		ON PROPOSED	
SCALE		SOUTHBOUND INTERSTATE ROUTE 26	

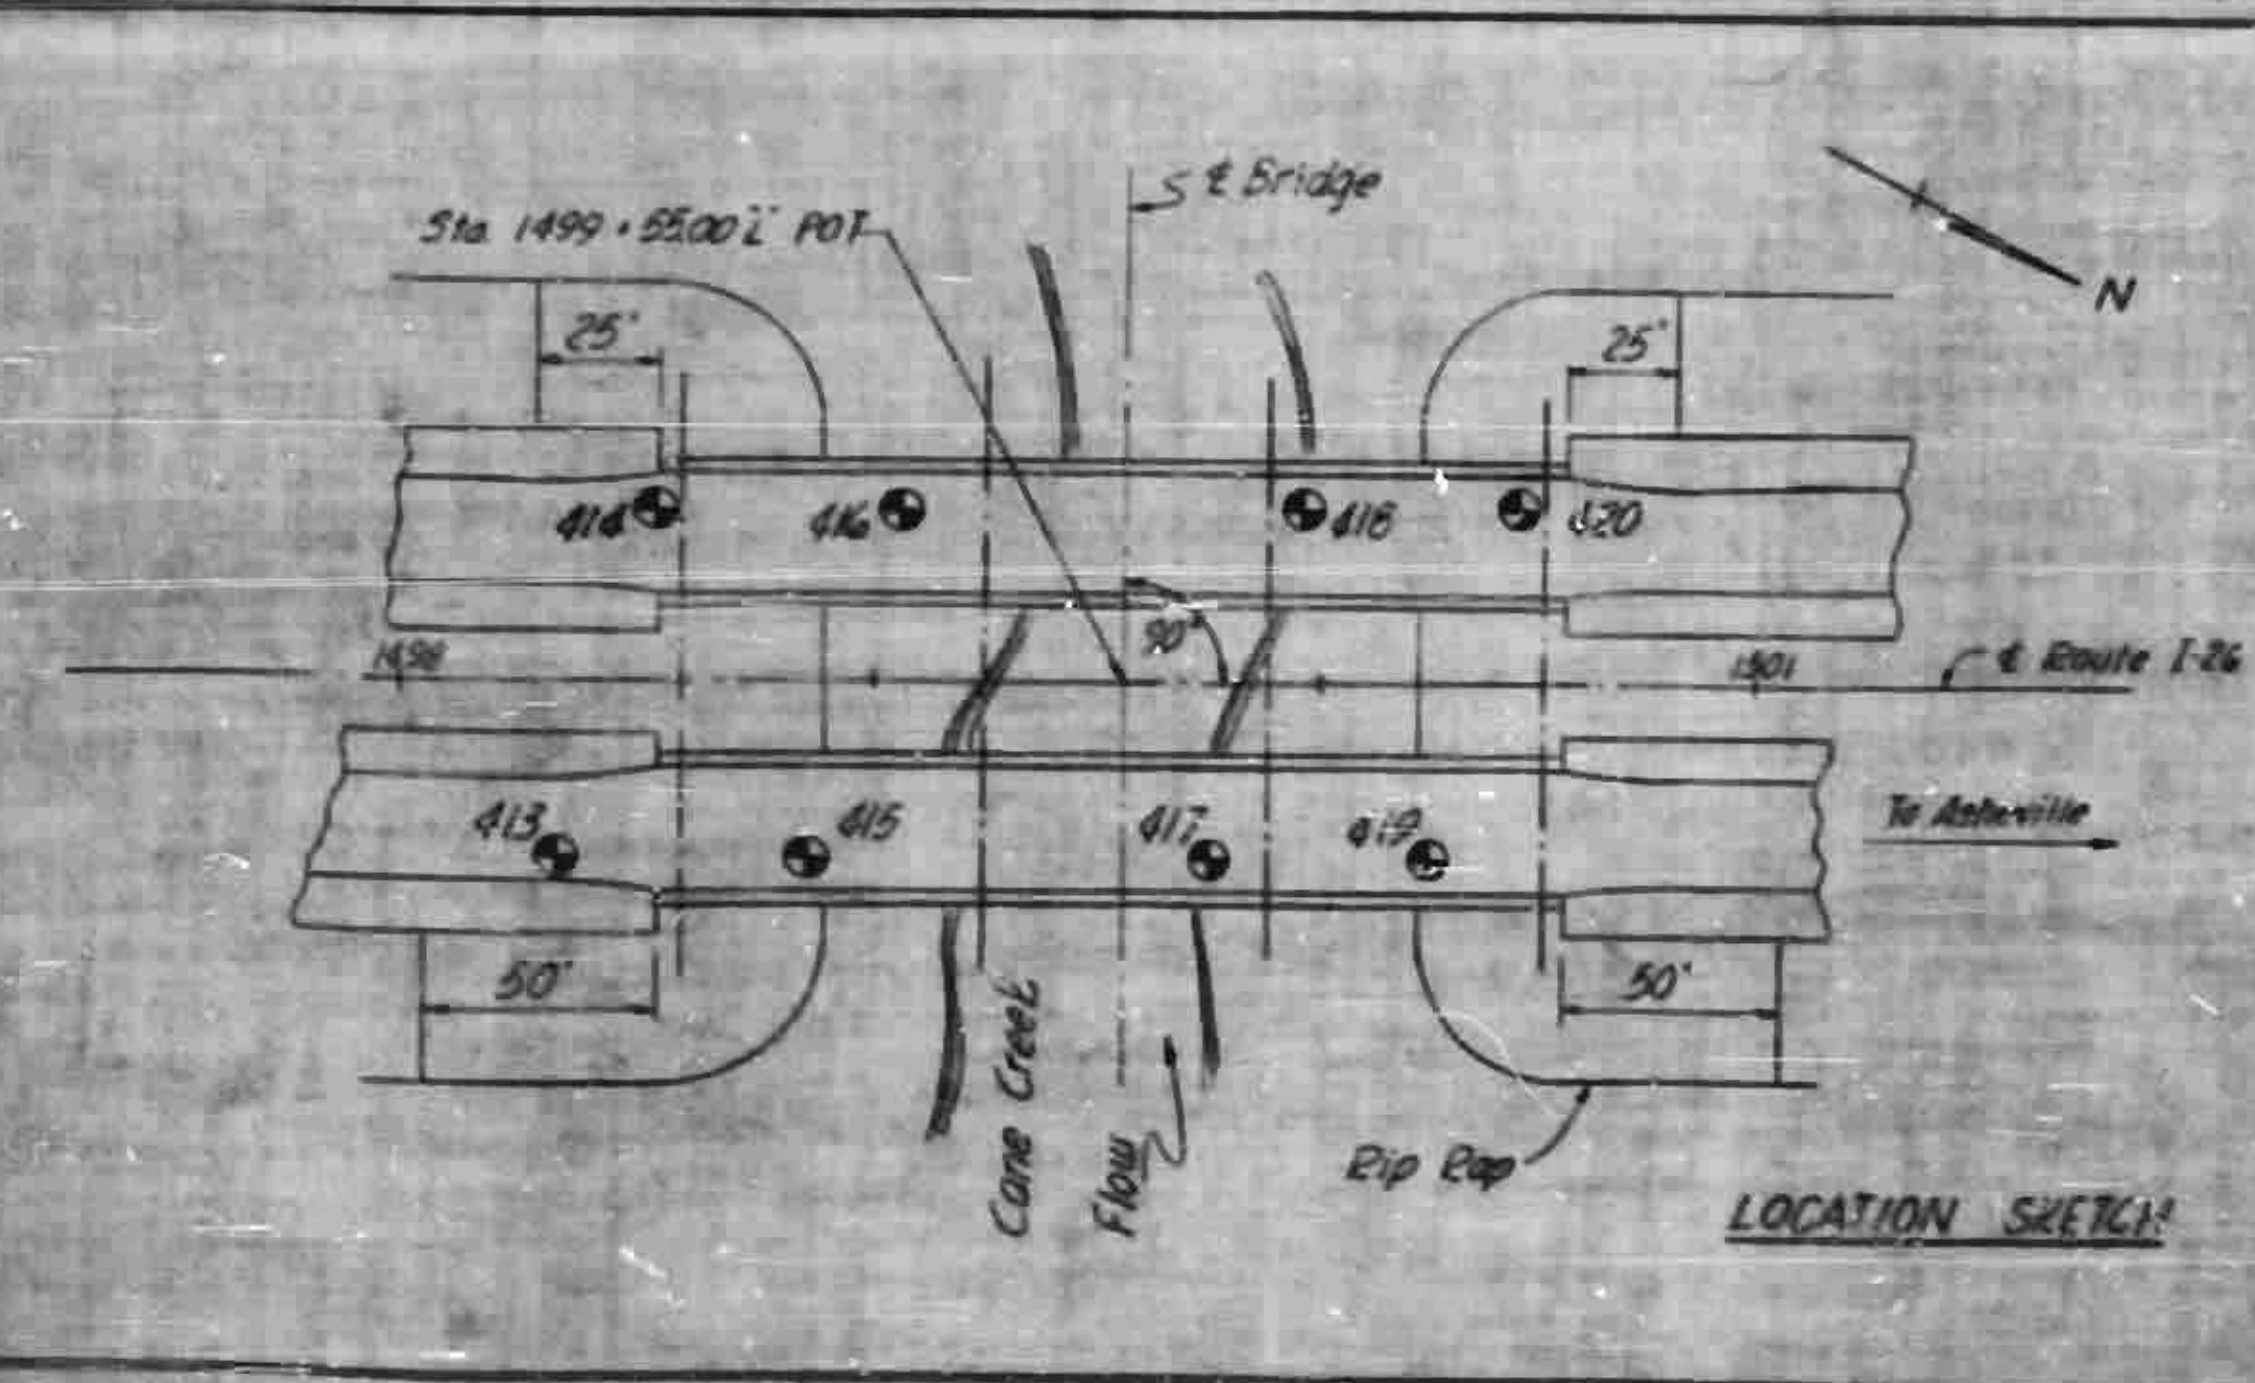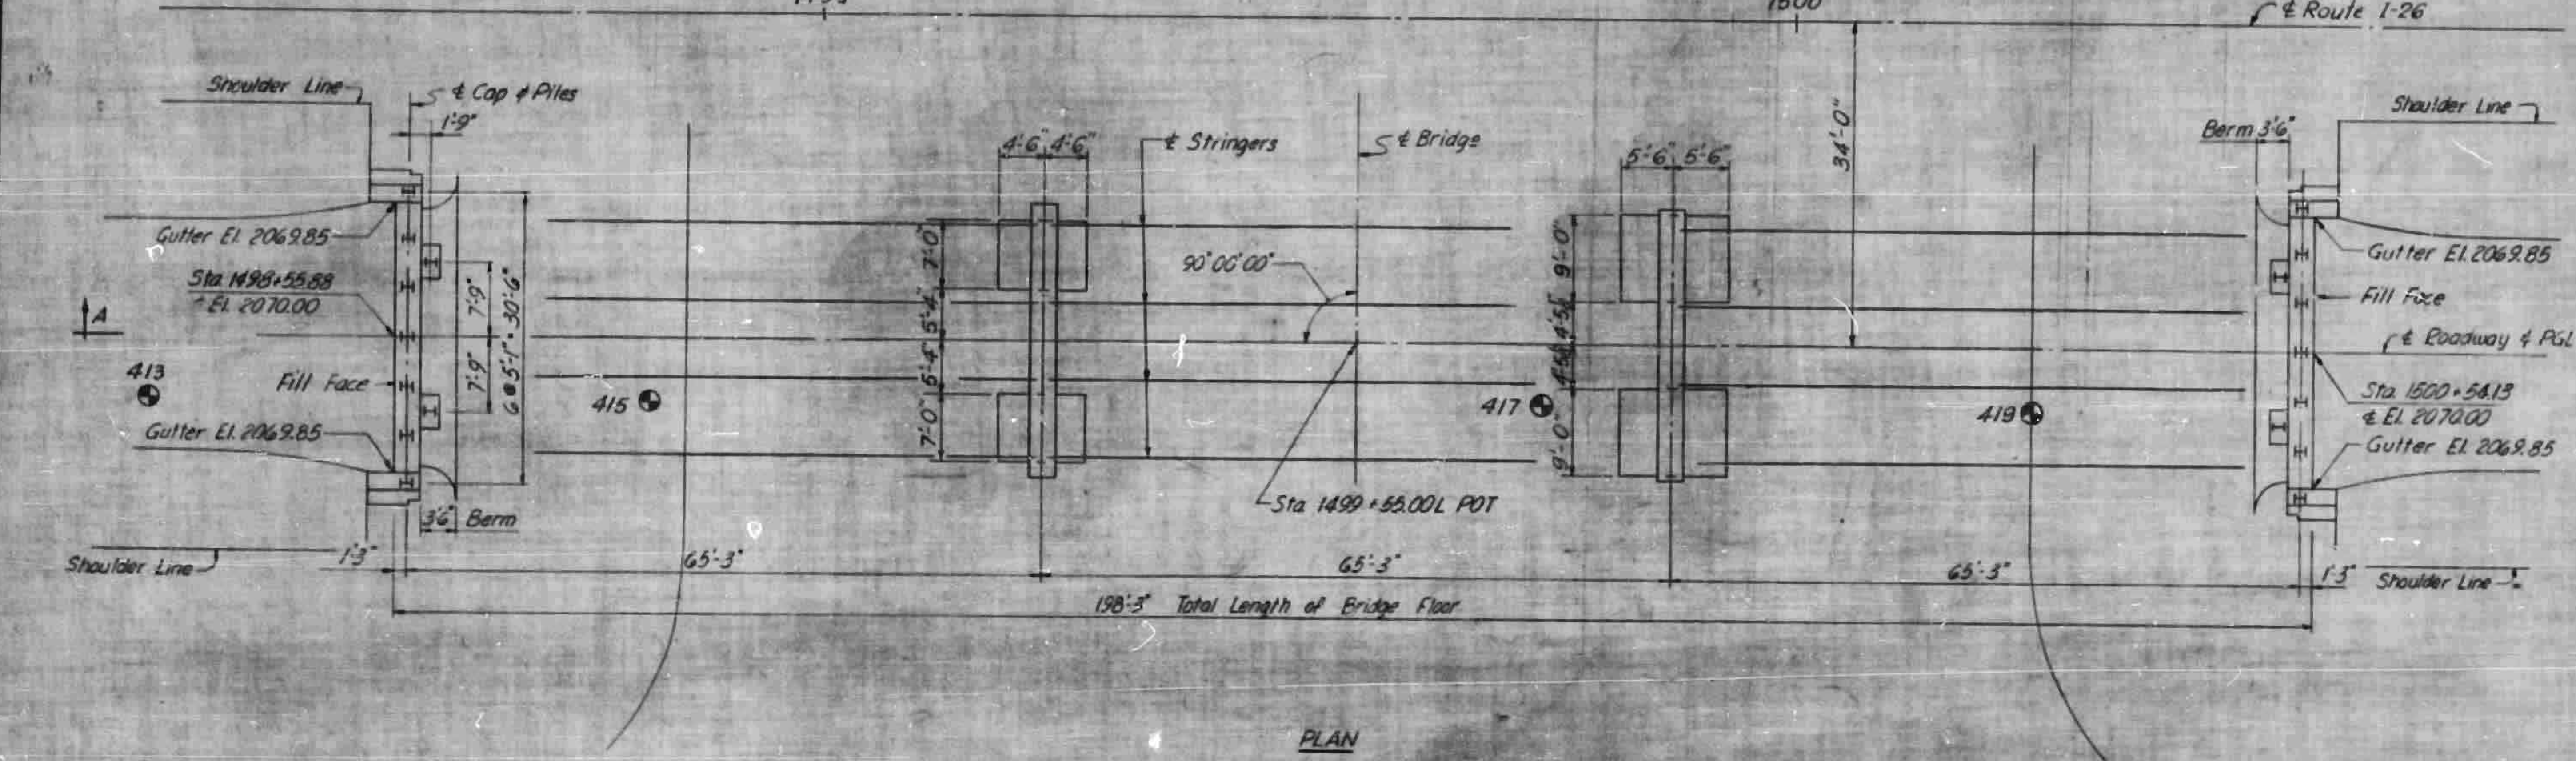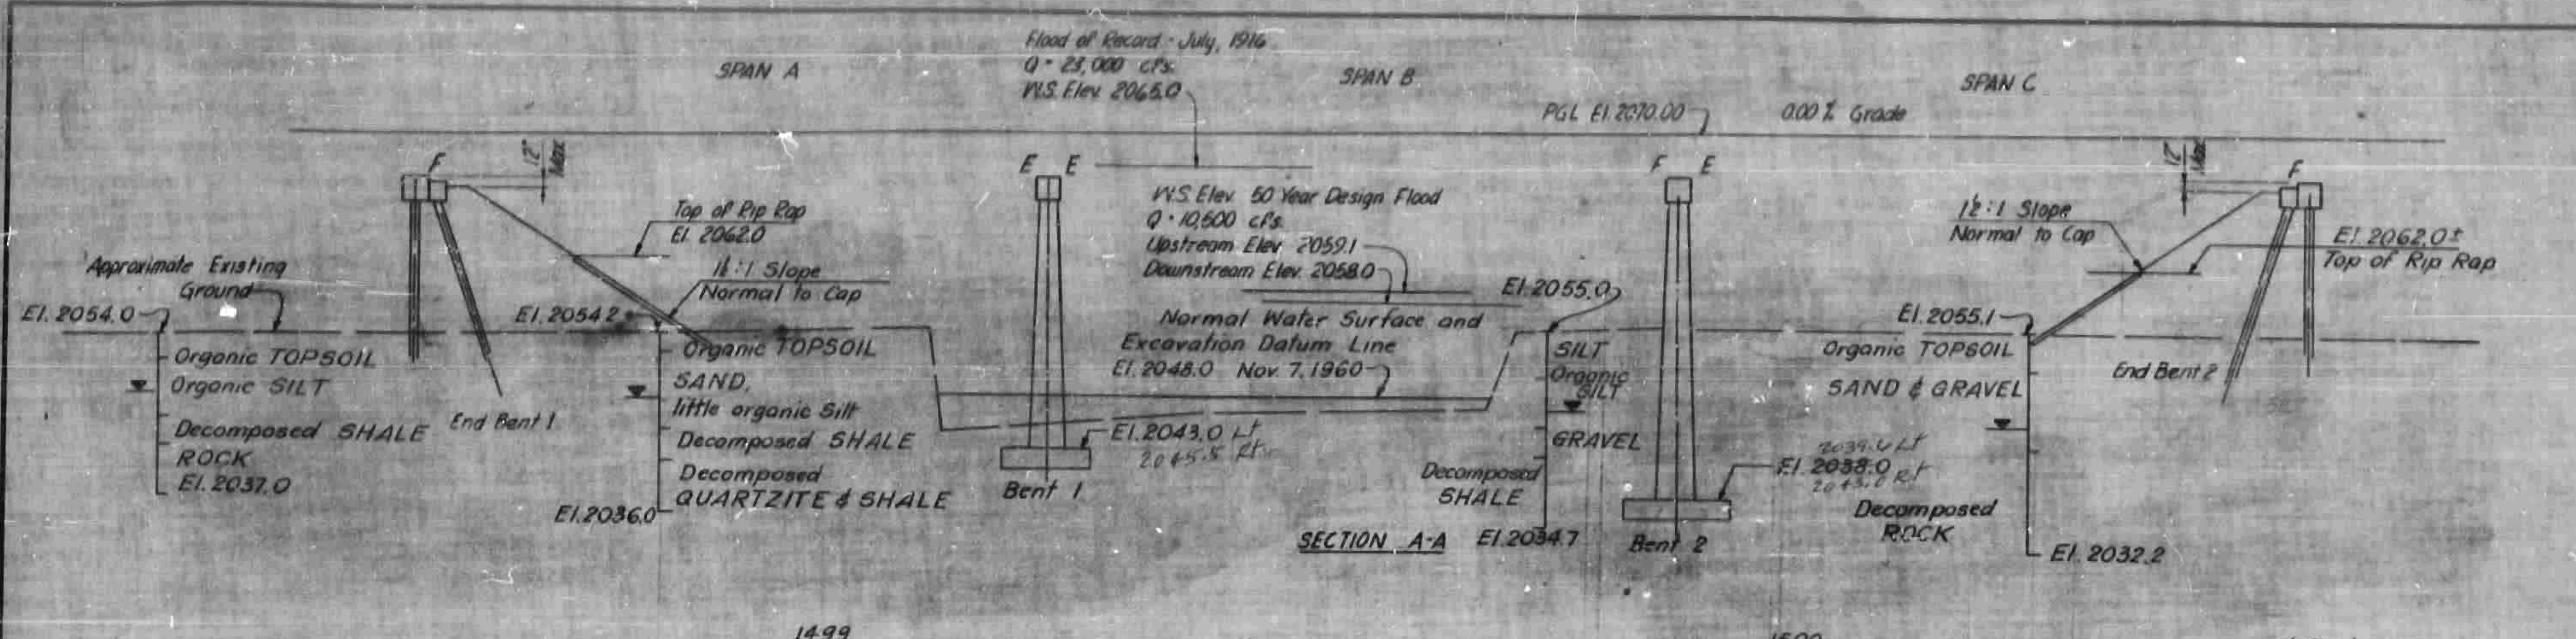

I hereby certify that this structure was built according to REVISED PLANS.

SIGNED: *[Signature]*
RES. ENGR.

TOTAL BILL OF MATERIAL						
	Class 4 Concrete Cu. Yds.	Reinf. Steel Lbs.	Structural Steel Approx. Lbs.	12 SP53 Excavation Steel Piles Cu. Yds.	Metal Rails Lin. Ft.	Plain Rip Rap Sq. Yds.
Superstructure	196.0	42,398	159,100		390.83	
End Bent 1	16.0	2,805		9		351
Bent 1	22.2	6,828				
Bent 2	25.3	8,253				
End Bent 2	16.0	2,805		9		351
Approach Curbs	3.2	76				
TOTAL	319.7	62,372	159,100	18	390.83	668

Notes: Rip Rap for SB Bridge and NB Bridge measured and computed together (1955.40 cu yd).

Pile Splices = 3

NOTES

Loading: AASHO H20-S16-44 and BPE Modified Loading for Military Vehicles.

Future Surfacing: 20 lbs. per sq. ft.

Roadway Width: 28'-0" curb to curb.

For other design data and general notes see General Notes Sheet.

Concrete surfaces shall be given a surface finish in accordance with the Specifications.

Water Surface Elevation of Flood of Record (July, 1916) controlled by backwater from French Broad River.

The contractor will be required to drive one 12BP53 steel test pile, 35' long in place at End Bent 1. The test pile shall be paid for as linear feet of 12 BP53 Steel Piles. The order lengths for all piles shall be given after the test pile has been driven.

All piles at End Bents shall be driven through the roadway fill.

All piles shall be driven to a minimum bearing capacity of 30 tons.

Soil bearing footings at Bents 1&2 are designed for a bearing pressure of 3 tons per sq. foot.

⊕ Indicates 2 1/2" cased hole boring.

⊖ Indicates ground water.

Benchmark: RR Spike in 8" Locust 150' Pt Sta 1499+00 Elevation 2057.09

PROJECT NO. 8,19002

HENDERSON-BUNCOMBE COUNTY

STATION 1499+55 L

N.B. Bridge

STATE OF NORTH CAROLINA	
STATE HIGHWAY COMMISSION	
DESIGN	
GENERAL DRAWING	
BRIDGE OVER CANE CREEK	
ON PROPOSED	
NORTHBOUND INTERSTATE ROUTE 26	




STRUCTURE EXCAVATION - STA 1499+55.3 B

STATE	PROJECT NO.	SHEET NO.	TOTAL SHEETS
N.C.	8.19002	107	208
F.A. PROJ. NO. E-26-1(12)6			

BENT NO. 1
Revised Top Both Flys = 43.00

BENT NO. 2
Revised Top Fly = 41.0

REVISED CONCRETE IN BENTS

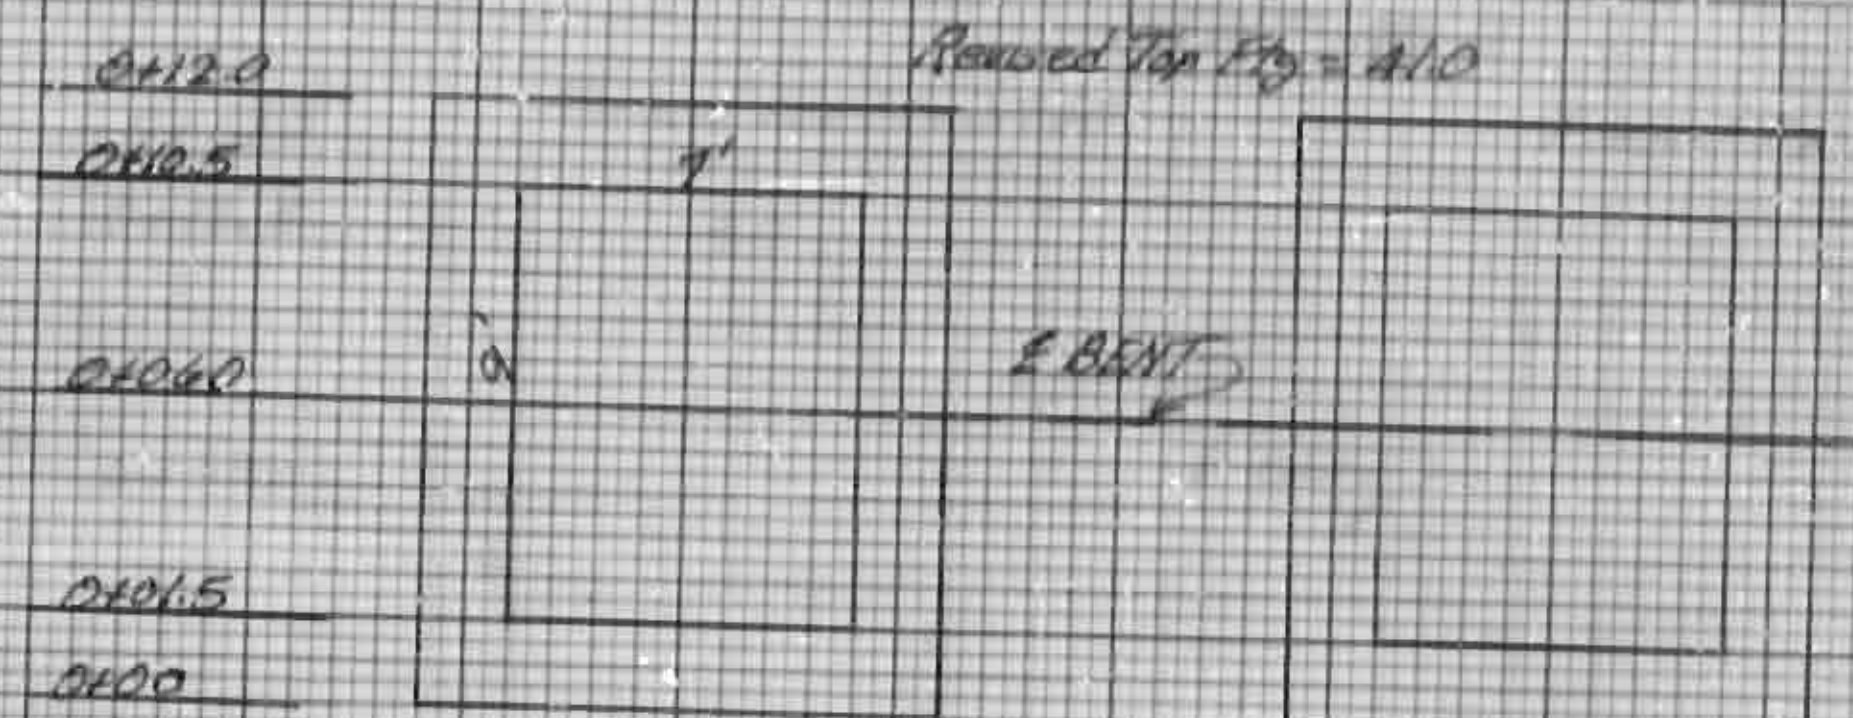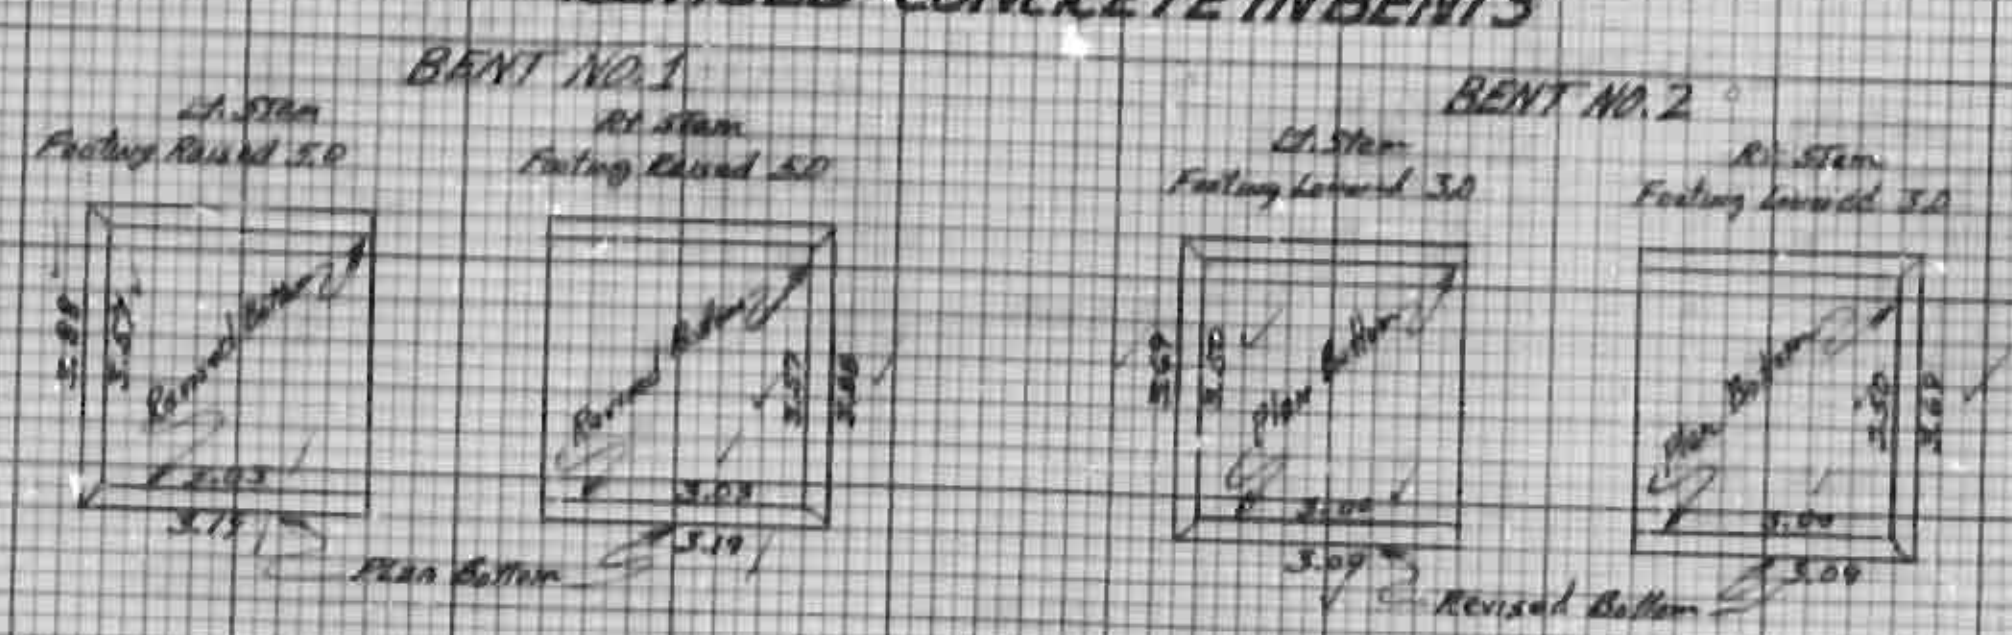
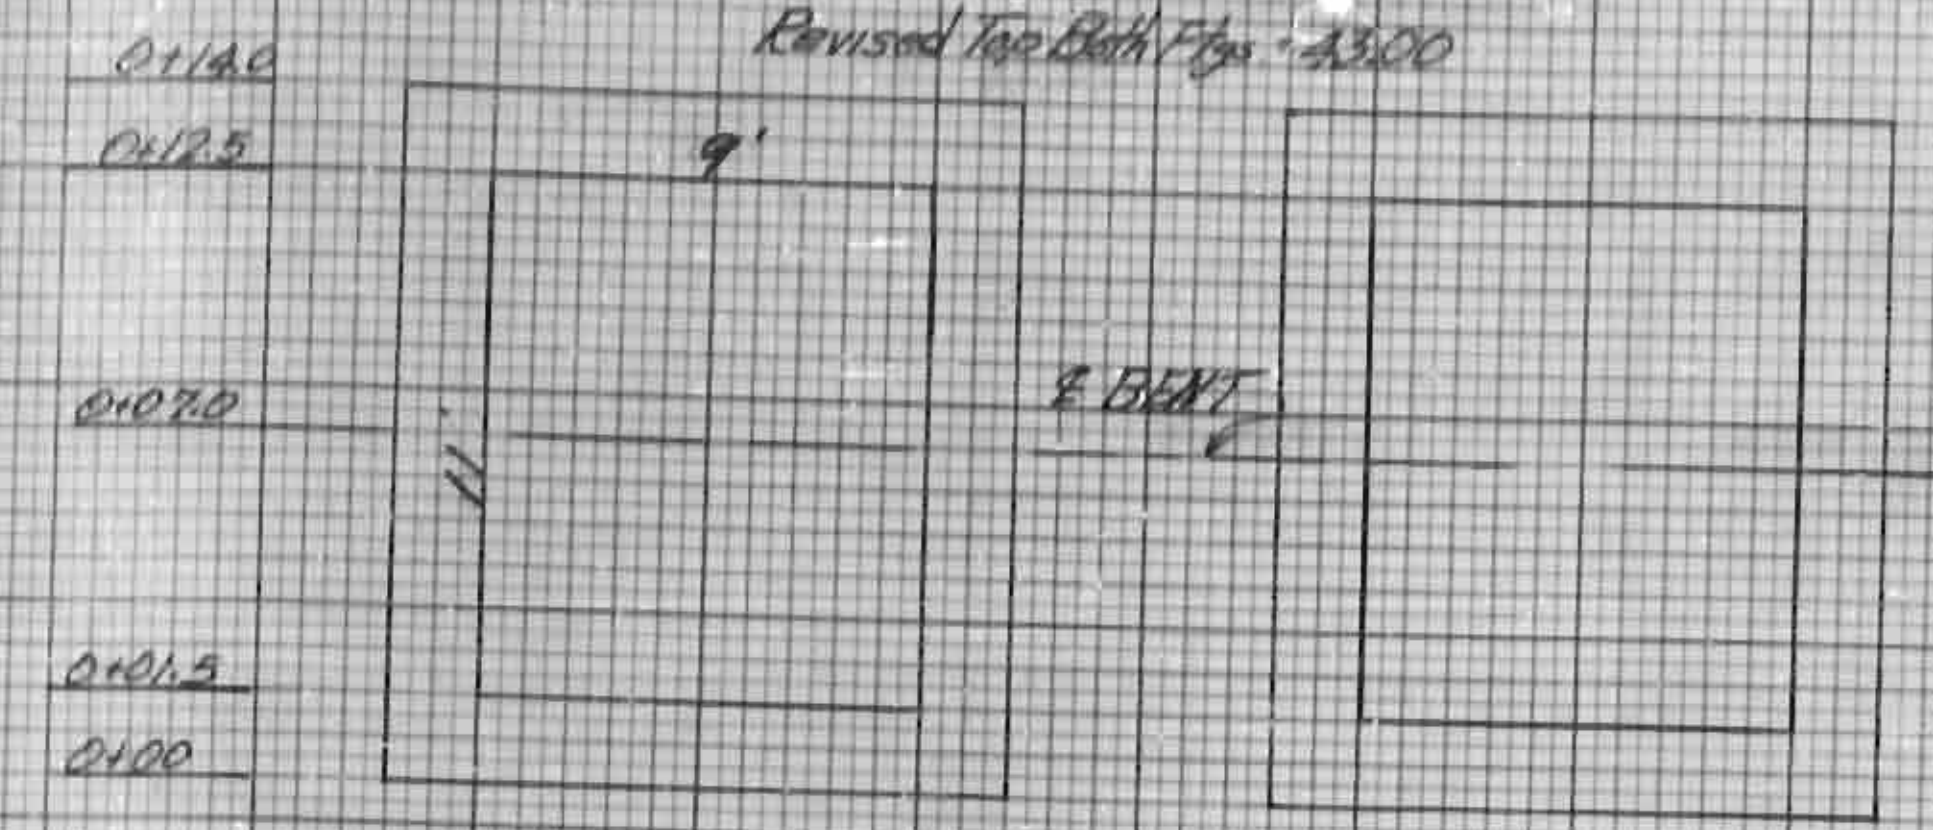


PLAN CONC BENT NO. 1 = 45.30 ✓
 LESS (11.0 x 11.0 x 0.25) 2 = -4.30 ✓
SUB TOTAL = 41.00 ✓
 LESS CONC. PLAN FOOTINGS (11.0 x 11.0 x 2.0) 2 = -14.67 ✓
 PLUS CONC. REVISED FOOTINGS = 16.48 ✓
TOTAL REVISED CONC. BENT NO. 1 = 42.81 ✓

PLAN CONC BENT NO. 2 = 37.60 ✓
 PLUS (11.0 x 11.0 x 0.25) 2 = 2.43 ✓
SUB TOTAL = 42.03 ✓
 LESS CONC. PLAN FOOTINGS (11.0 x 11.0 x 2.0) 2 = -14.22 ✓
 PLUS CONC. REVISED FOOTINGS = 10.28 ✓
TOTAL REVISED CONC. BENT NO. 2 = 38.09 ✓

BENT NO. 2 REVISED REIN. STEEL
 PLAN REINFORCING STEEL = 6,190 lbs ✓
 PLUS 16 # 10M Bars @ 5' 9" = 396 lbs ✓
TOTAL REVISED REIN. STEEL = 6,586 lbs ✓
 See K.L. HATHORN JR. REPORT

BENT NO. 1 REVISED REIN. STEEL
 PLAN REINFORCING STEEL = 8,155 lbs ✓
 LESS 14 # 10 V2 Bars @ 5' = 544 lbs ✓
TOTAL REVISED REIN. STEEL = 7,611 lbs ✓

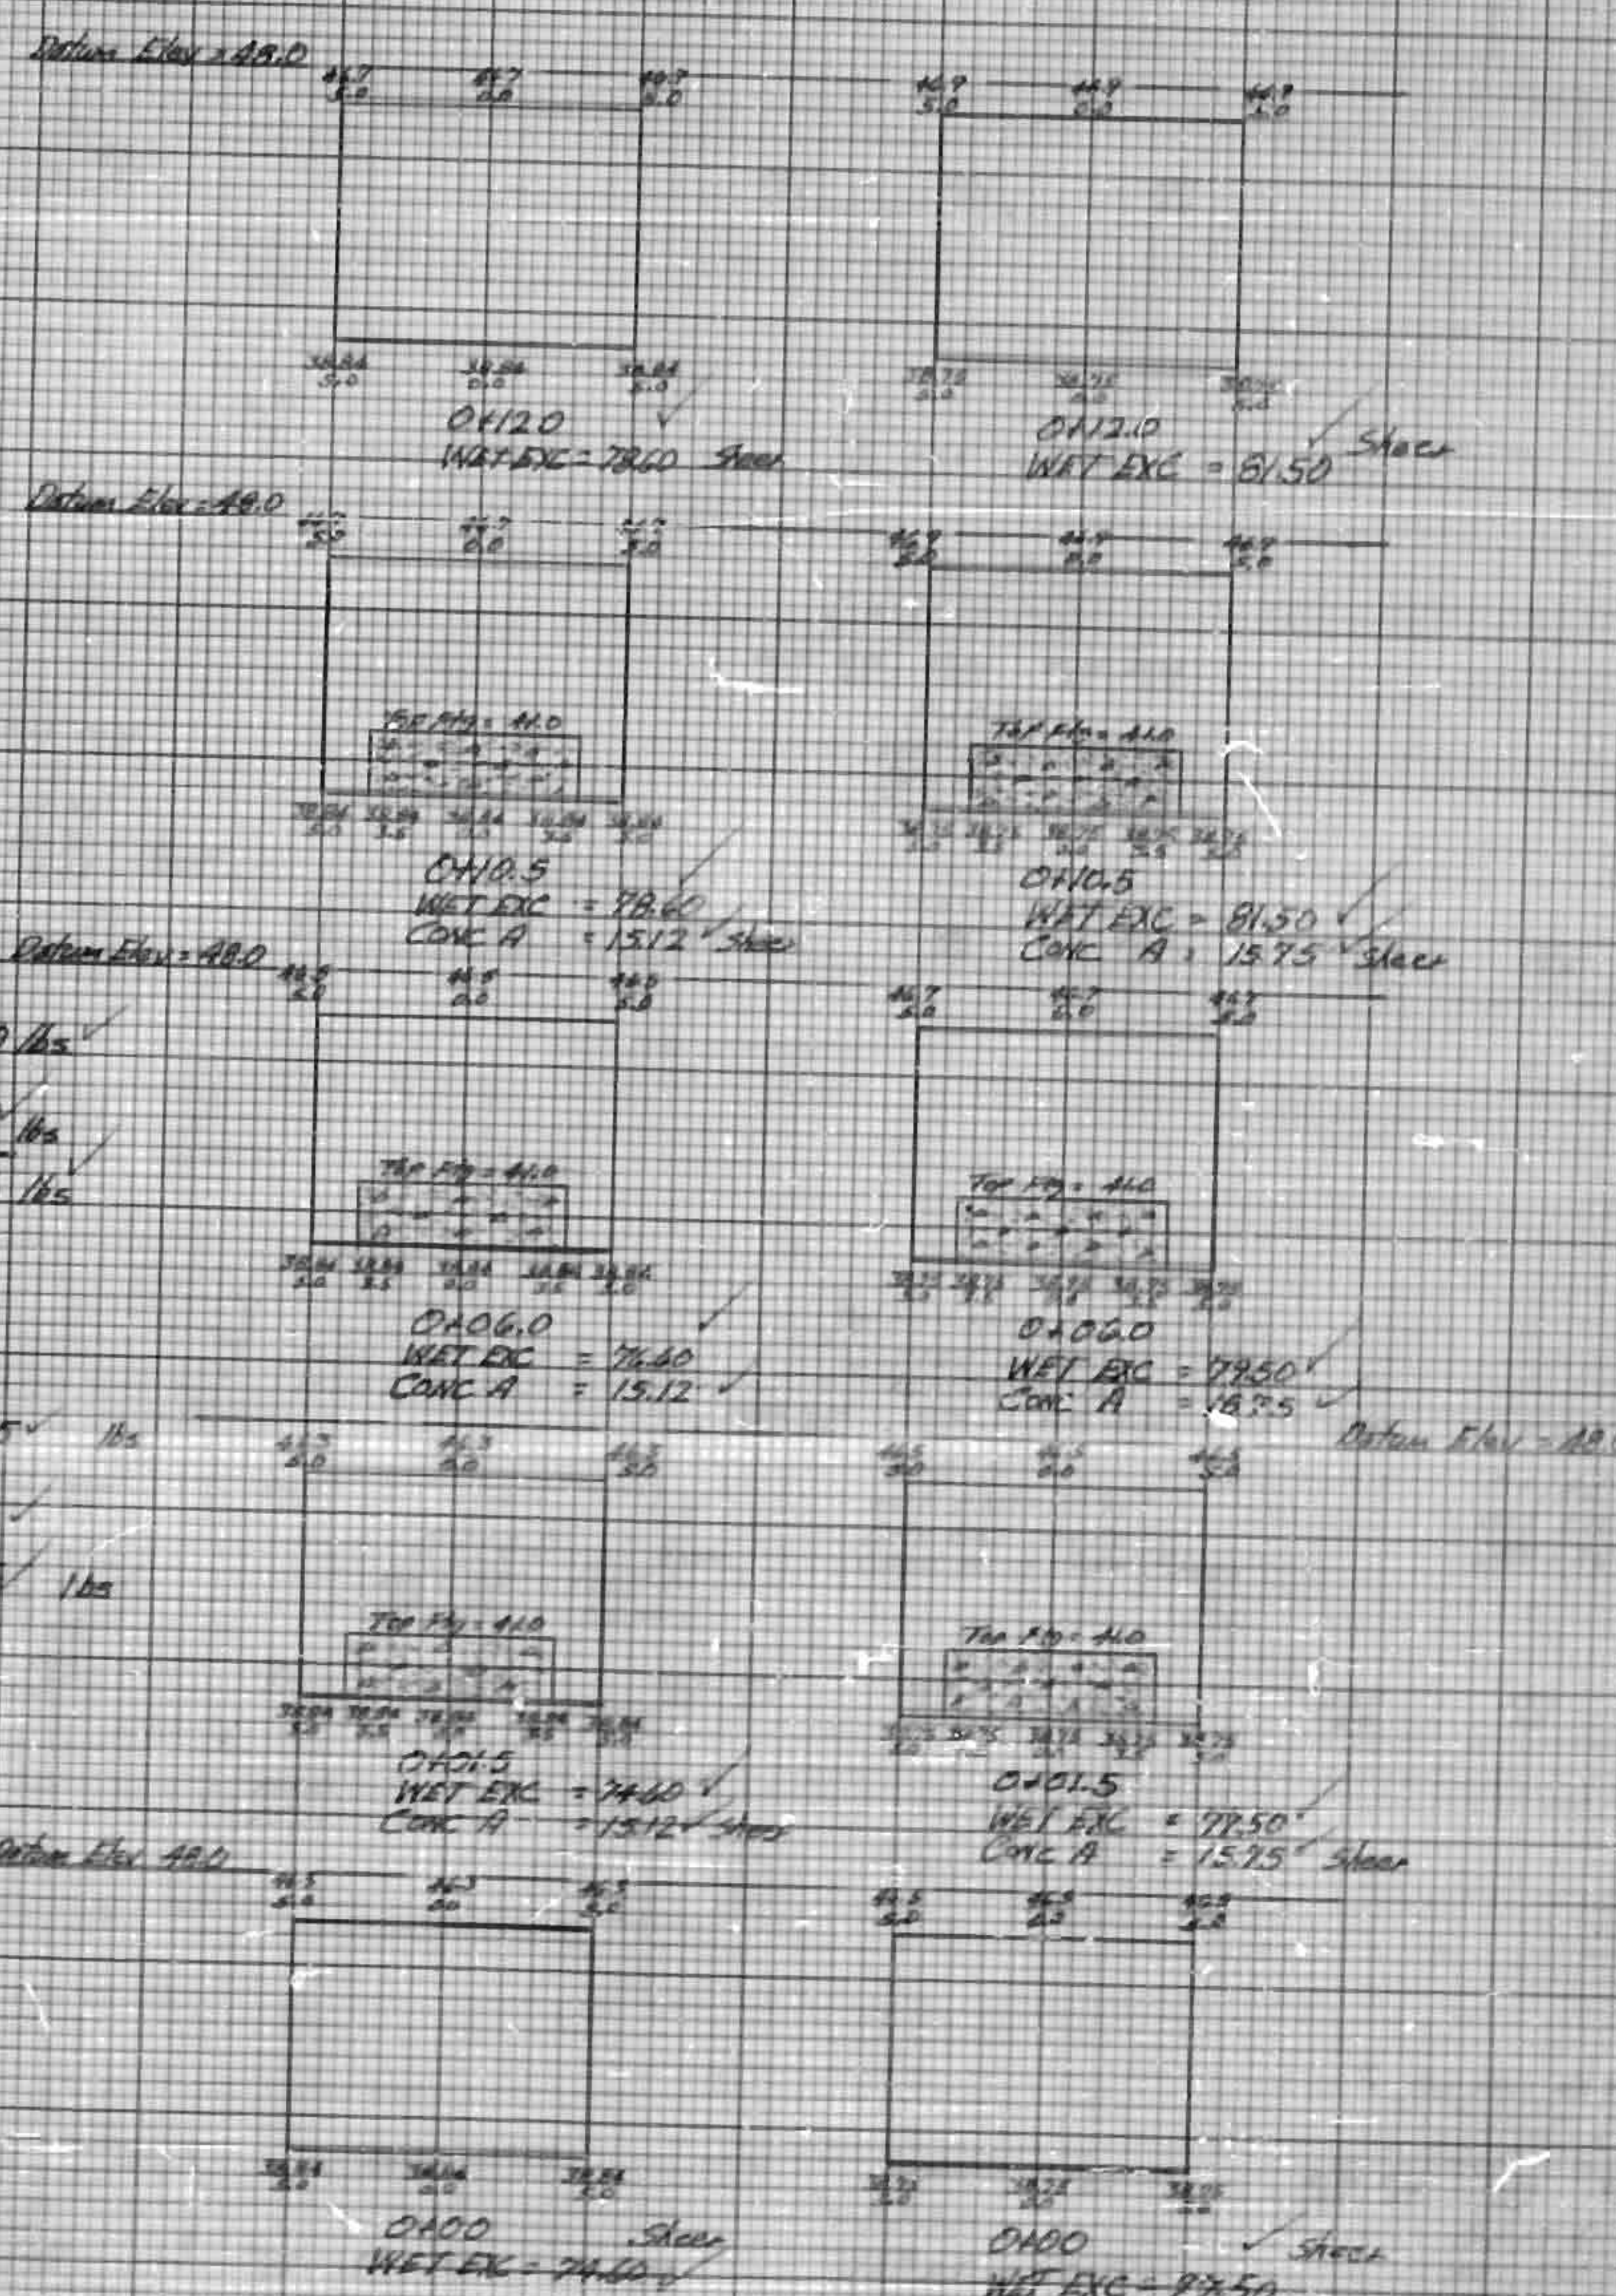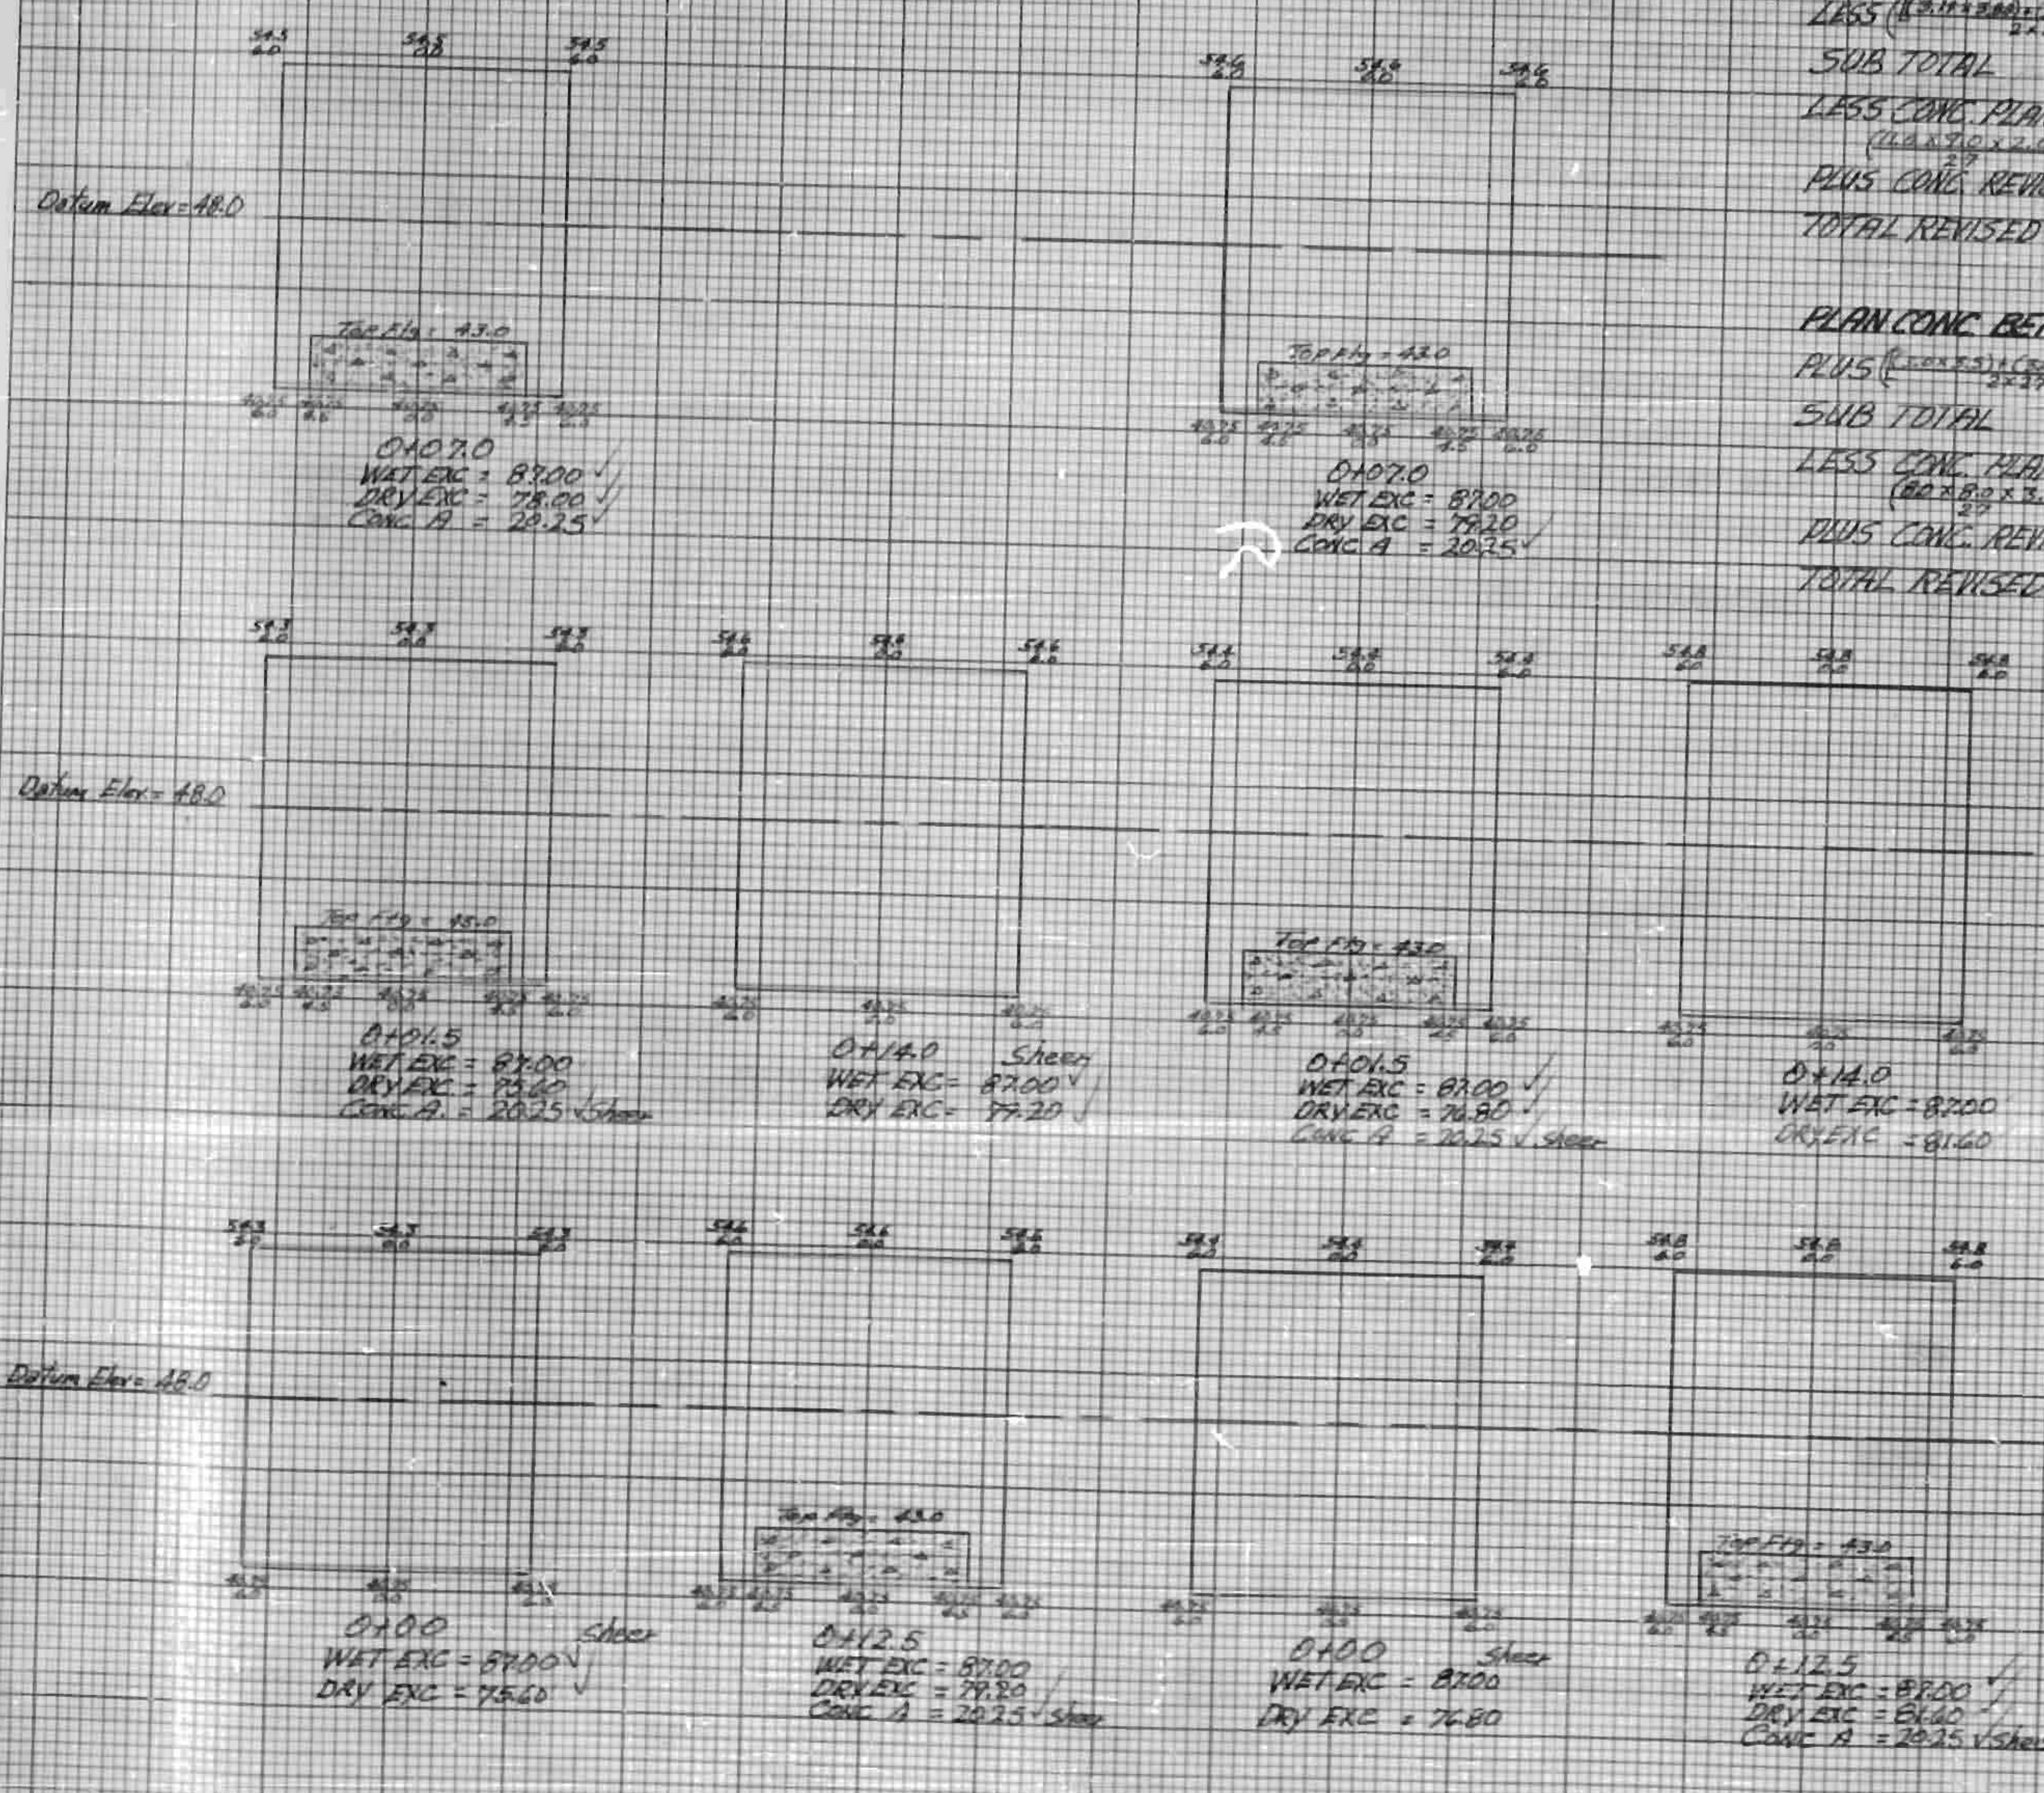


BOOK NO. 34 PAGE NO. 21-29

FOR COMPUTATIONS SEE SHEET NO. 110

STRUCTURE EXCAVATION - STA 1499+55 N.B.

STATE	PROJECT NO.	SHEET NO.	TOTAL SHEETS
N.C.	8,19002	108	200
F.A. PROJ. NO. I-26-1(1)6			

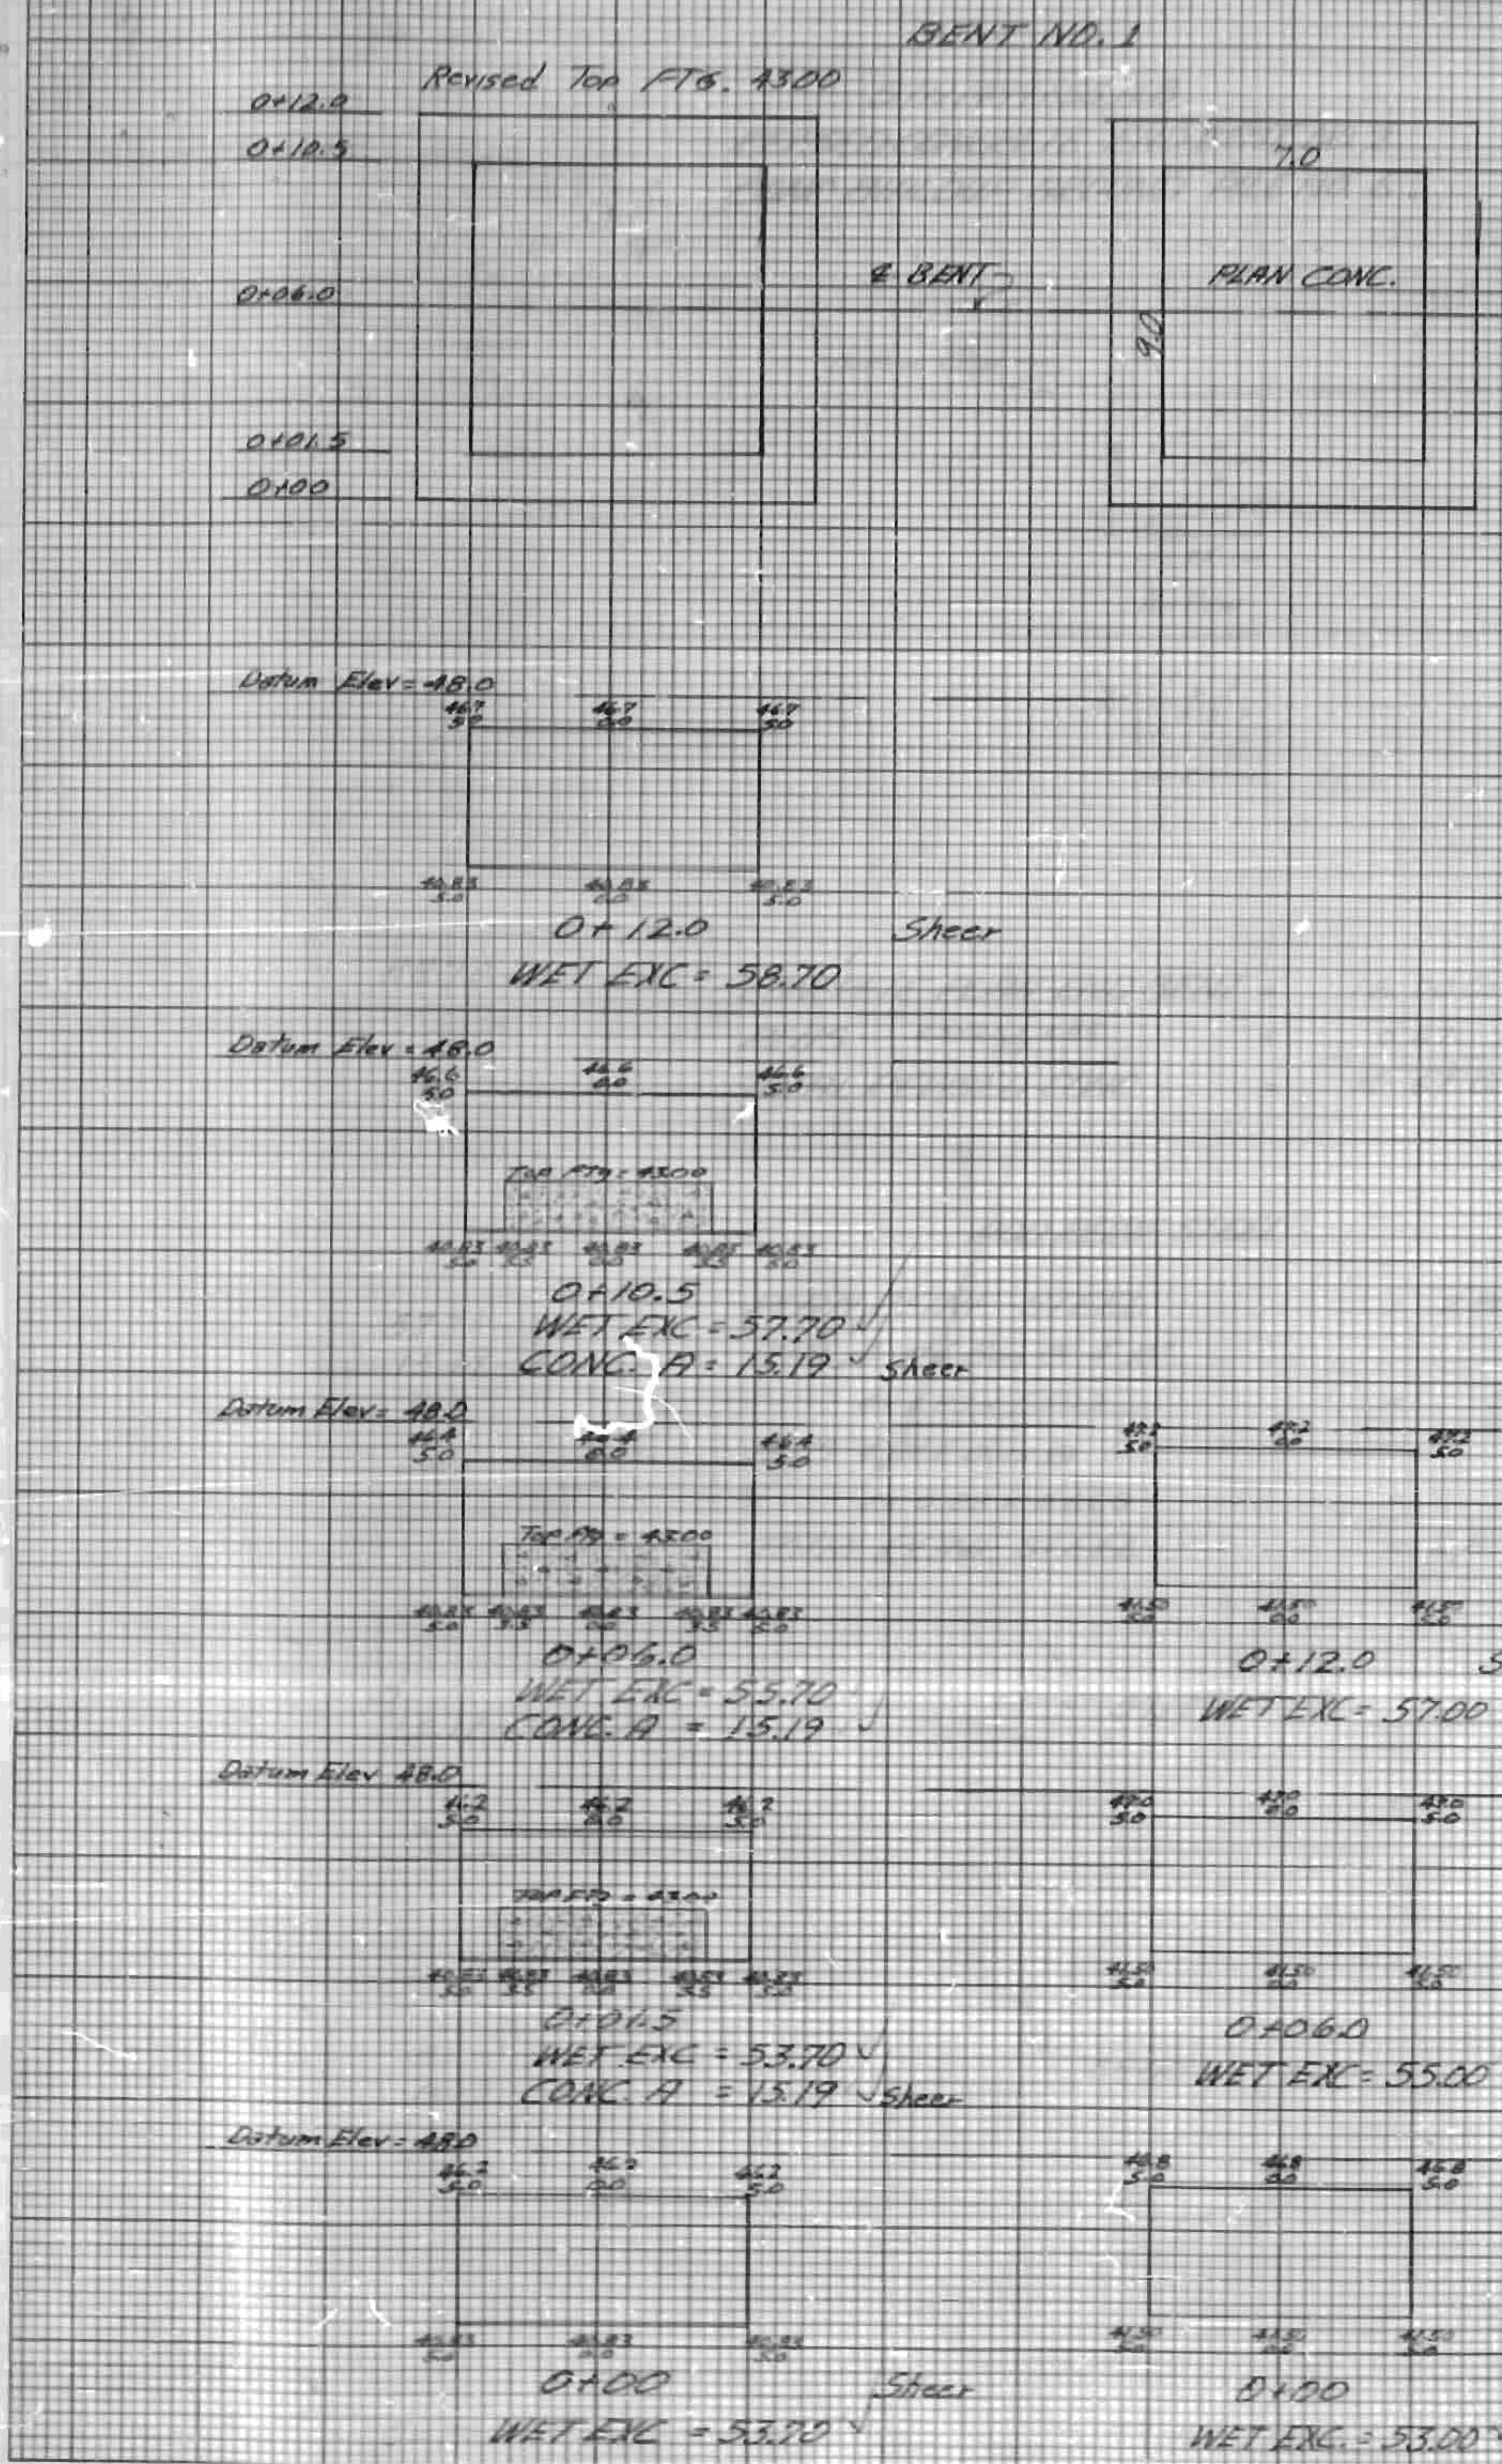

REVISED CONCRETE IN BENTS

BENT NO. 1

PLAN CONC. BENT NO. 1 = 35.50 ✓
 LESS (3.0x3.0x2.0) (2) = 0.20 ✓
 REVISED CONC. BENT NO. 1 = 35.30 ✓
 LESS CONC. PLAN FTG. (10x7.0x2.0) 2 = 4.67 ✓
 PLUS CONC. REVISED FOOTINGS = 5.06 ✓
TOTAL CONC. BENT NO. 1 = 35.69 ✓

BENT NO. 2


PLAN CONC. BENT NO. 2 = 45.30 ✓
 LESS (3.0x3.0x2.0) (2) = 0.20 ✓
 LESS (3.0x3.0x2.0) (2) = 2.15 ✓
 REVISED CONC. BENT NO. 2 = 42.95 ✓
 LESS CONC. PLAN FOOTINGS (10x7.0x2.0) 2 = 4.67 ✓
 PLUS CONC. REVISED FOOTINGS = 15.84 ✓
TOTAL CONC. BENT NO. 2 = 43.60 ✓

BENT NO. 1

Revised Reinf. Steel
 Plain Reinf. Steel = 6,828
 Less 8 # 10 @ 5.0 = 17
Total Revised Reinf. Steel = 6,811

BENT NO. 2

Revised Reinf. Steel
 Plain Reinf. Steel = 8,155 ✓
 Less 8 # 10 @ 5.0 = 17
 Less 8 # 10 @ 5.0 = 17
Total Revised Reinf. Steel = 7,921

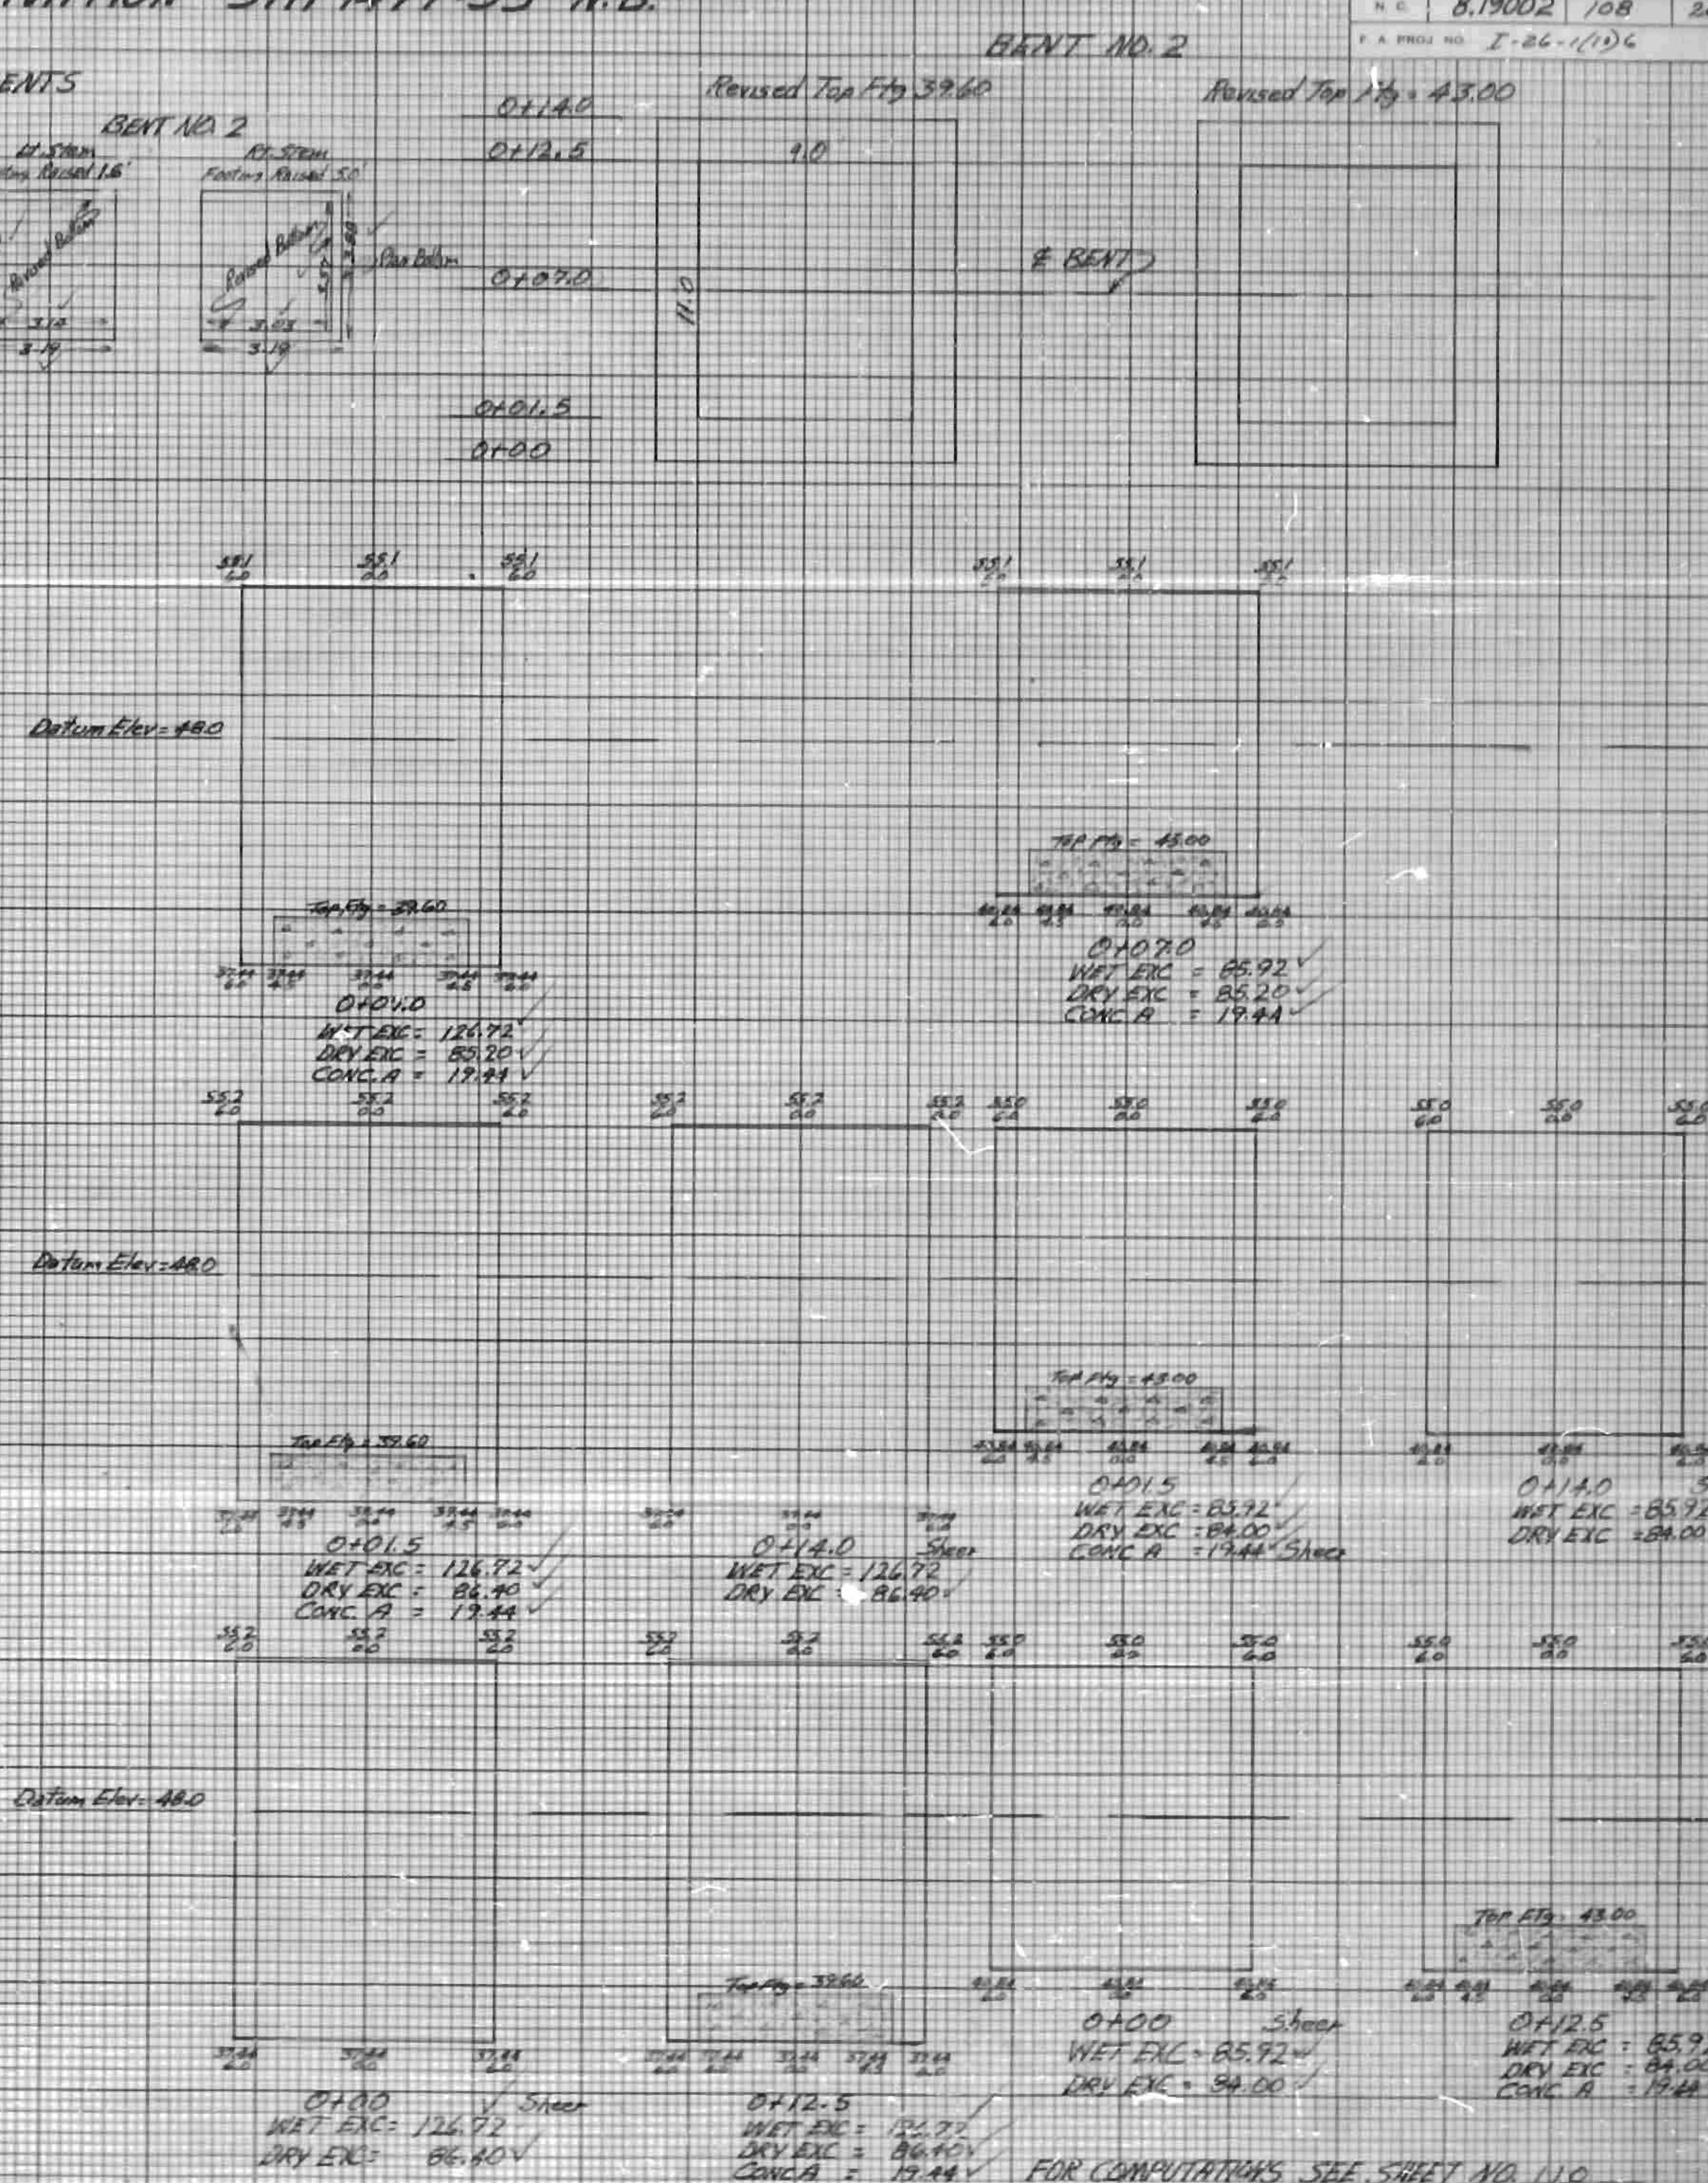

FOR COMPUTATIONS SEE SHEET NO. 110

STR 1499+55 N.B.
 REVISED CONCRETE END BENT NO. 2
 CONC. BUILDUP AROUND PILE NO. 6



CONCRETE PLAN END BENT = 16.00 Cu Yds
 PLUS 25x25x2.00 = 0.67
 TOTAL REVISED CONC. = 16.67 Cu Yds

ADD REIN. STEEL

PLAN REIN. STEEL = 2,805 lbs
 PLUS 4 #6 Bars @ 4' 10" = 29 lbs
 4x 4.83x 1.502
 PLUS 4 #4 Bars @ 10" = 2 lbs
 4x 0.83x 0.668
 TOTAL REIN. STEEL = 2,836 lbs

BOOK NO. 24 PAGE NO. 32

STRUCTURE EXCAVATION - STA 1499+55 S.B.

WET EXC. BENT NO. 1
at Footing

STA DIST AREA AV AREA CUBIC REMARKS

0+00	1.5	87.00	87.00	4.83	Shear
0+01.5	5.5	87.00	87.00	17.72	
0+07.0	5.5	87.00	87.00	17.72	
0+12.5	5.5	87.00	87.00	17.72	
0+18.0	1.5	87.00	87.00	4.83	Shear

at Footing

0+00	1.5	87.00	87.00	4.83	Shear
0+01.5	5.5	87.00	87.00	17.72	
0+07.0	5.5	87.00	87.00	17.72	
0+12.5	5.5	87.00	87.00	17.72	
0+18.0	1.5	87.00	87.00	4.83	Shear
TOTAL				90.20	

WET EXC. BENT NO. 2
at Footing

0+00	1.5	76.60	76.60	4.44	Shear
0+01.5	4.5	76.60	75.60	12.60	
0+06.0	4.5	76.60	77.60	12.93	
0+10.5	1.5	78.60	78.60	4.57	Shear

at Footing

0+00	1.5	77.50	77.50	4.31	Shear
0+01.5	4.5	77.50	78.50	13.08	
0+06.0	4.5	79.50	80.50	13.42	
0+10.5	1.5	81.50	81.50	4.53	Shear
TOTAL				69.38	

DRY EXC. BENT NO. 1
at Footing

0+00	1.5	75.60	75.60	4.20	Shear
0+01.5	5.5	75.60	76.80	15.64	
0+07.0	5.5	78.00	78.60	16.01	
0+12.5	1.5	79.20	79.20	4.40	Shear

at Footing

0+00	1.5	76.80	76.80	4.27	Shear
0+01.5	5.5	76.80	78.00	15.89	
0+07.0	5.5	79.20	80.40	16.38	
0+12.5	1.5	81.60	81.60	4.53	Shear
TOTAL				81.32	

BOOK NO. 24 PAGE NO. 15

CONCRETE - STA 1499+55 S.B.

BENT NO. 1
at Footing

STA DIST AREA AV AREA CUBIC REMARKS

0+01.5	5.5	20.25	20.25	4.12	Shear
0+07.0	5.5	20.25	20.25	4.12	
0+12.5	5.5	20.25	20.25	4.12	Shear

at Footing

0+01.5	5.5	20.25	20.25	4.12	Shear
0+07.0	5.5	20.25	20.25	4.12	
0+12.5	5.5	20.25	20.25	4.12	Shear
TOTAL				16.48	

BENT NO. 2
at Footing

0+01.5	4.5	15.12	15.12	2.52	Shear
0+06.0	4.5	15.12	15.12	2.52	
0+10.5	4.5	15.12	15.12	2.52	Shear

at Footing

0+01.5	4.5	15.75	15.75	2.62	Shear
0+06.0	4.5	15.75	15.75	2.62	
0+10.5	4.5	15.75	15.75	2.62	Shear
TOTAL				10.28	

BOOK NO. 24 PAGE NO. 15

BOOK NO. 24 PAGE NO. 16

BOOK NO. 24 PAGE NO. 16

BOOK NO. 24 PAGE NO. 17

STRUCTURE EXCAVATION - STA 1499+55 N.B.

WET EXC. BENT NO. 1
at Footing

STA DIST AREA AV AREA CUBIC REMARKS

0+00	1.5	53.70	53.70	2.98	Shear
0+01.5	4.5	53.70	54.70	9.12	
0+06.0	4.5	55.70	56.70	9.45	
0+10.5	1.5	57.70	58.20	3.23	Shear

at Footing

0+00	1.5	53.00	53.00	2.88	Shear
0+01.5	4.5	53.00	54.00	12.00	
0+06.0	4.5	55.00	56.00	12.00	
0+10.5	1.5	57.00	58.00	12.00	Shear
TOTAL				49.22	

WET EXC. BENT NO. 2
at Footing

0+00	1.5	126.72	126.72	7.04	Shear
0+01.5	5.5	126.72	126.72	25.81	
0+07.0	5.5	126.72	126.72	25.81	
0+12.5	1.5	126.72	126.72	7.04	Shear

at Footing

0+00	1.5	85.92	85.92	4.77	Shear
0+01.5	4.5	85.92	85.92	17.50	
0+07.0	4.5	85.92	85.92	17.50	
0+12.5	1.5	85.92	85.92	4.77	Shear
TOTAL				110.24	

DRY EXC. BENT NO. 2
at Footing

0+00	1.5	86.40	86.40	4.80	Shear
0+01.5	5.5	86.40	85.50	17.48	
0+07.0	5.5	85.20	85.80	17.48	
0+12.5	1.5	86.40	86.40	4.80	Shear

at Footing

0+00	1.5	84.00	84.00	4.67	Shear
0+01.5	5.5	84.00	84.60	17.23	
0+07.0	5.5	85.20	84.60	17.23	
0+12.5	1.5	84.00	84.00	4.67	Shear
TOTAL				88.36	

BOOK NO. 24 PAGE NO. 17

CONCRETE - STA 1499+55 N.B.

BENT NO. 1
at Footing

STA DIST AREA AV AREA CUBIC REMARKS

0+01.5	4.5	15.19	15.19	2.53	Shear
0+06.0	4.5	15.19	15.19	2.53	
0+10.5	4.5	15.19	15.19	2.53	Shear
TOTAL				5.06	

BENT NO. 2
at Footing

0+01.5	4.5	19.44	19.44	3.96	Shear
0+07.0	5.5	19.44	19.44	3.96	
0+12.5	5.5	19.44	19.44	3.96	Shear
TOTAL				15.84	

BOOK NO. 24 PAGE NO. 18

BOOK NO. 24 PAGE NO. 18



SUMMARY - Wet & Dry EXCAVATION
WET EXCAVATION STA 1499+55 N.B. & S.B.

Bent No. 1 S.B.	90.20 Cu. Yd.
Bent No. 2 S.B.	69.38 "
Bent No. 1 N.B.	49.22 "
Bent No. 2 N.B.	110.24 "
TOTAL	319.04 Cu. Yd.


Dry EXCAVATION STA 1499+55 N.B. & S.B.

Bent No. 1 S.B.	81.32 Cu. Yd.
Bent No. 2 N.B.	88.36 "
TOTAL	169.68 Cu. Yd.

BOOK NO. 24 PAGE NO. 26

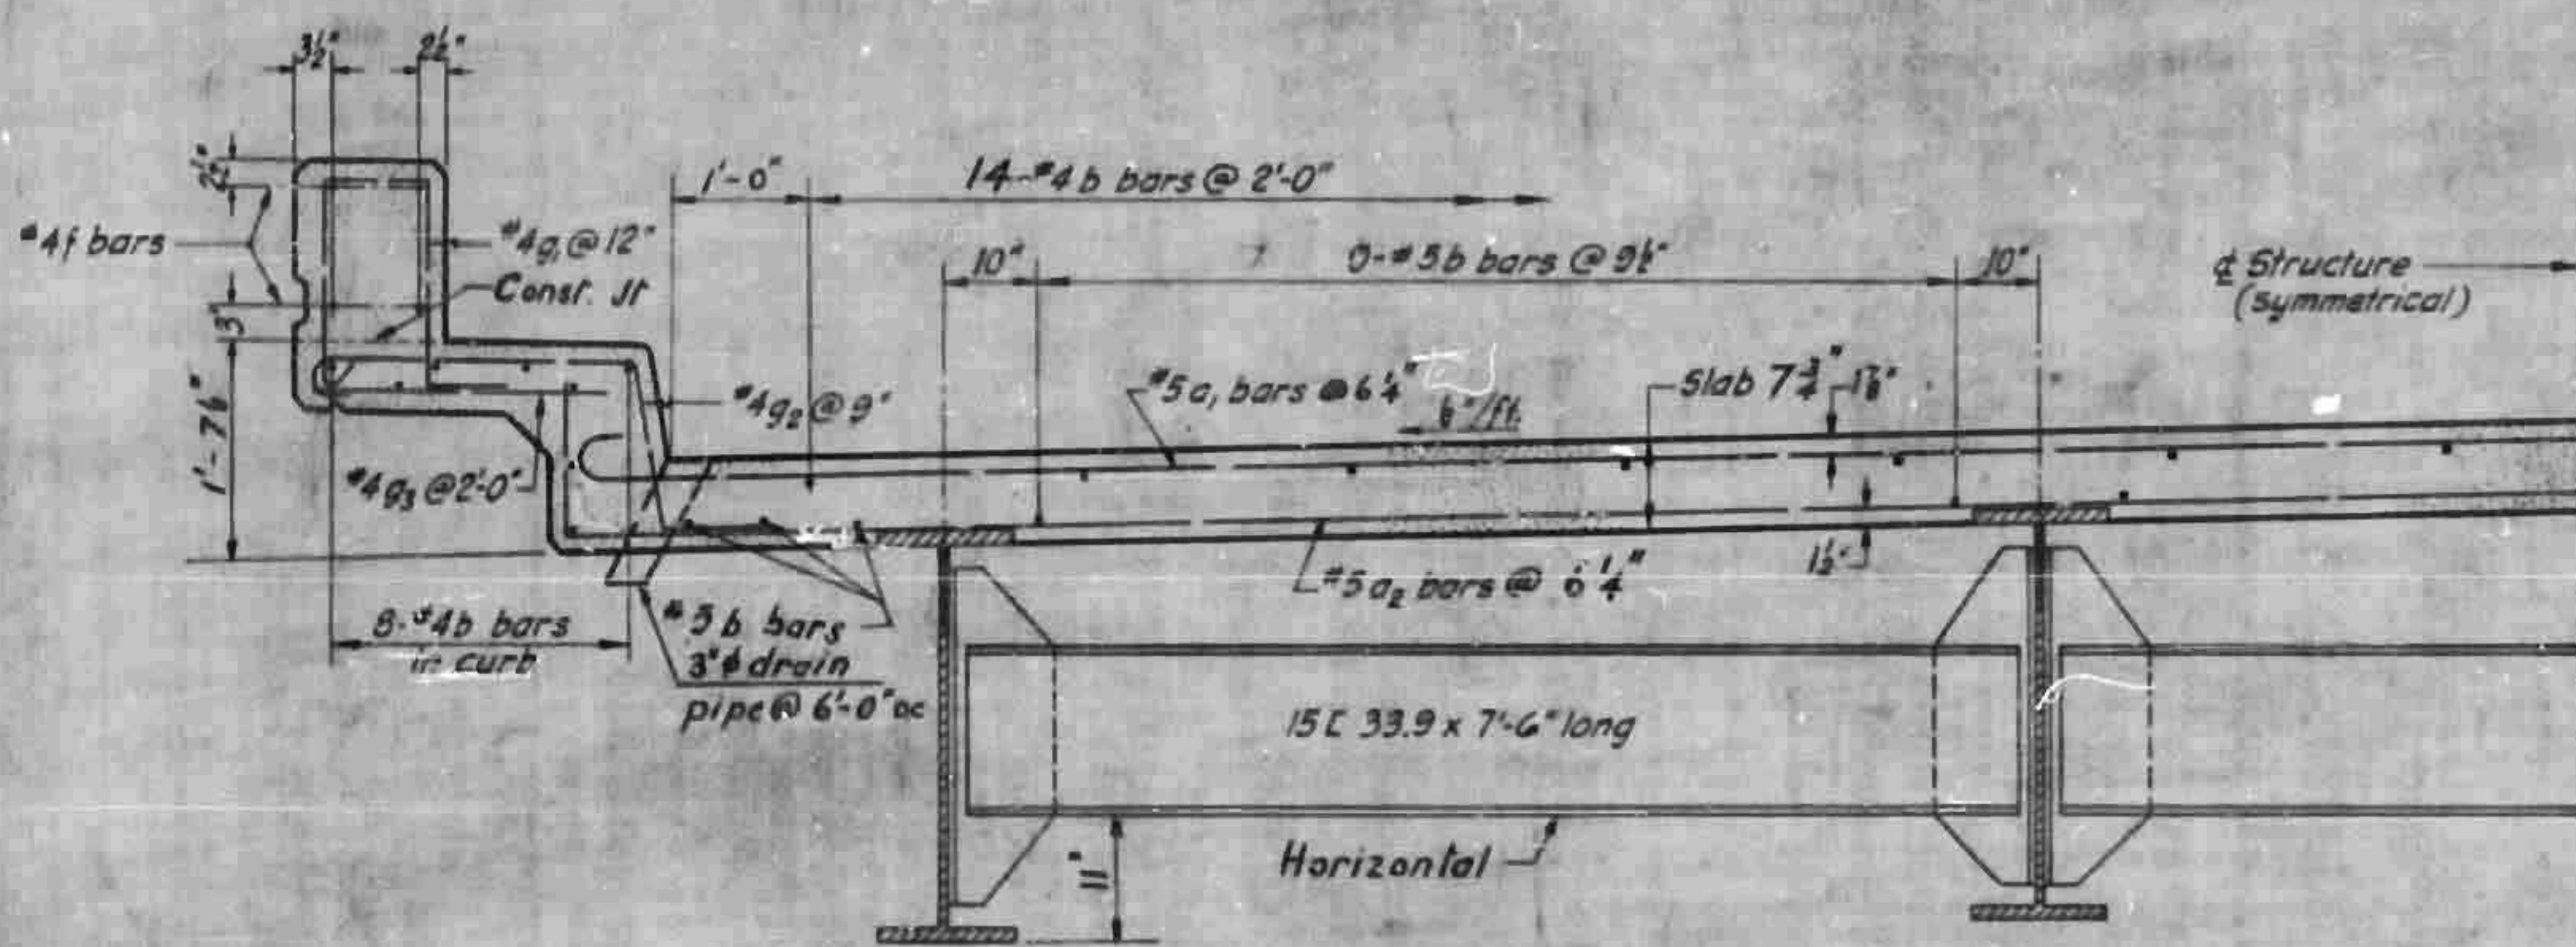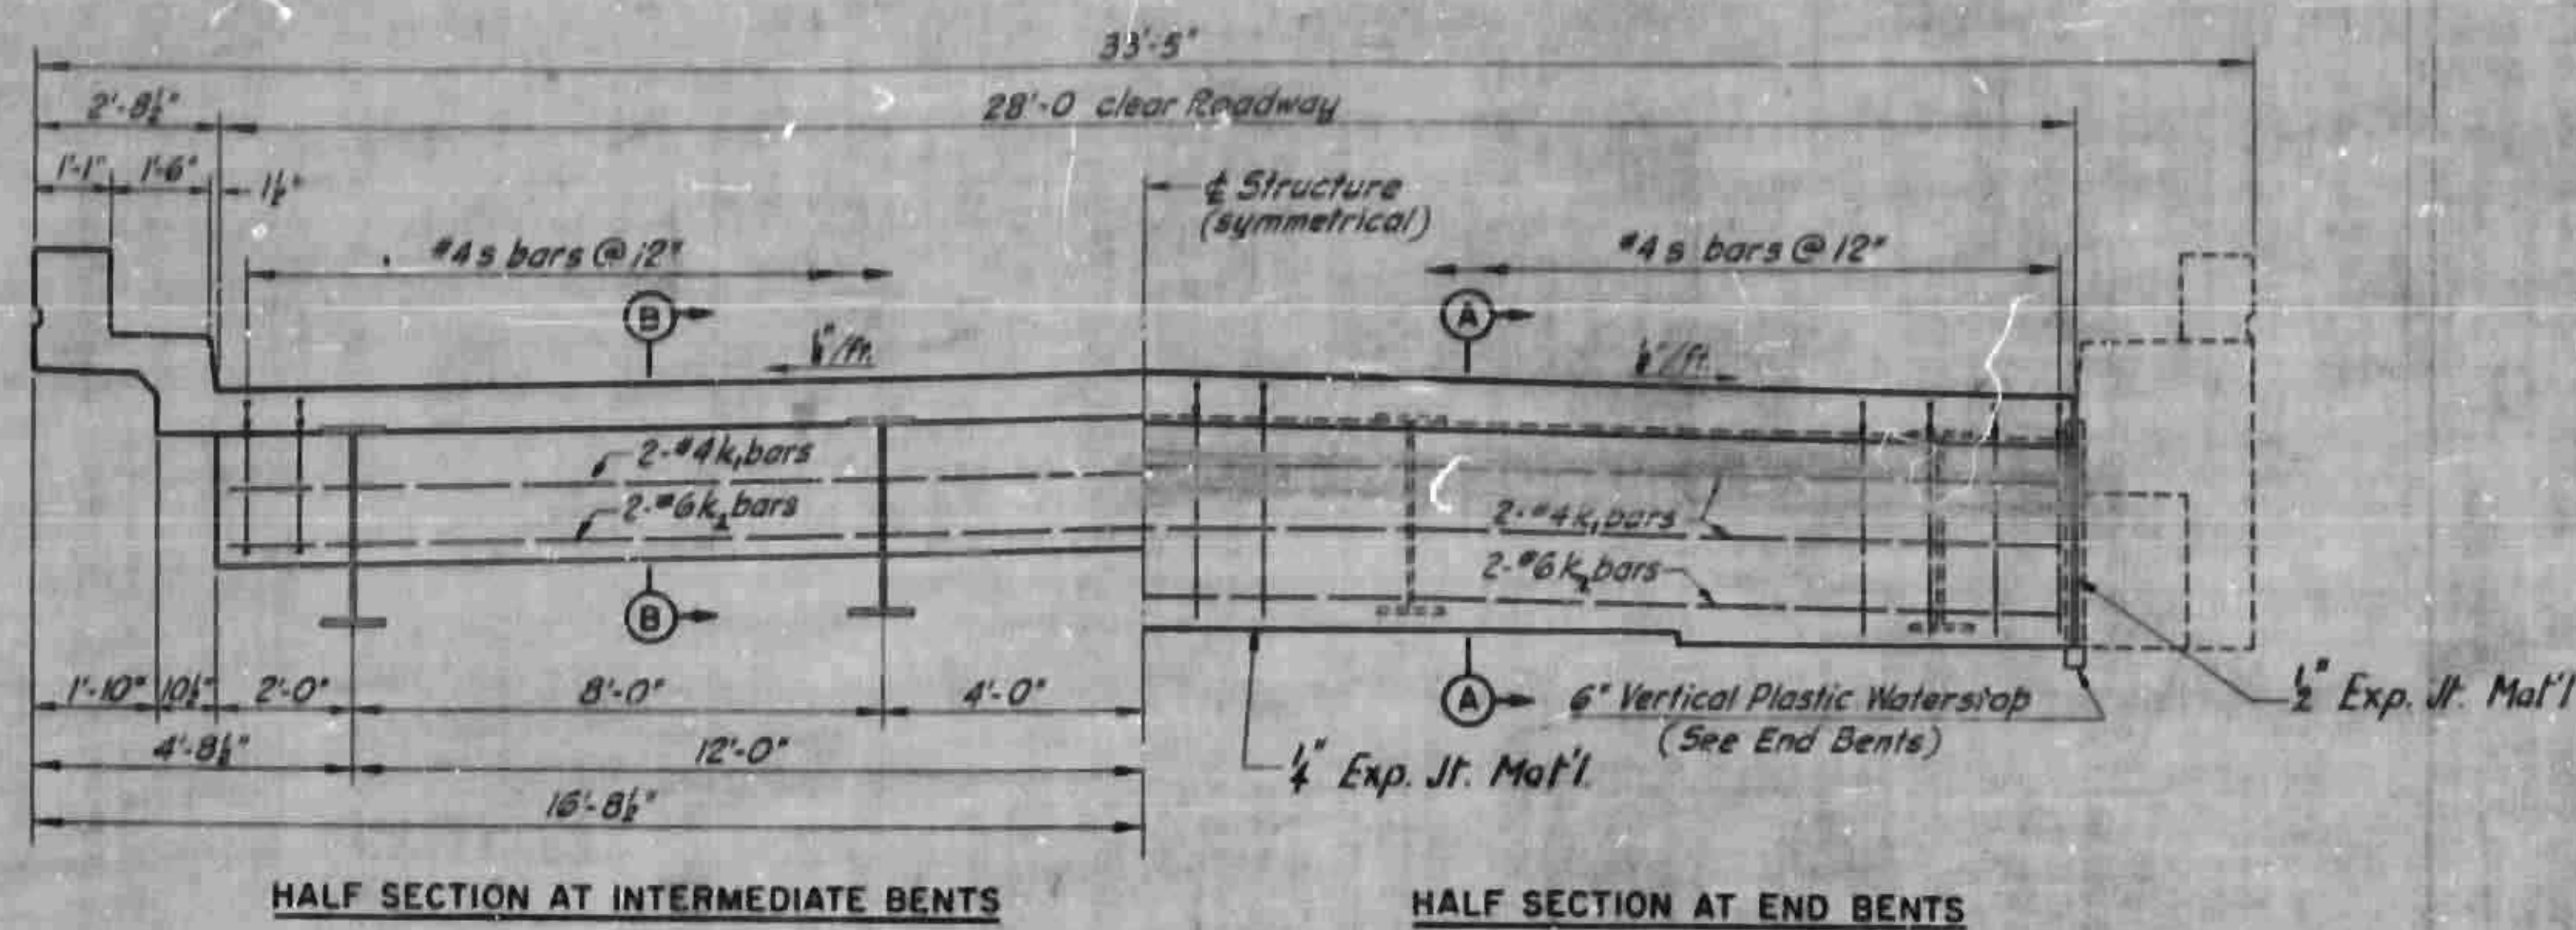


Note: In lieu of the welding procedure for shop and field welds indicated for the intermediate diaphragm connections, the contractor may, at his option, skip weld the connector plates to the beam webs and field weld the channels to the connector plates. Special care in handling the beams must be observed if connector plates are skip welded to the beam webs.

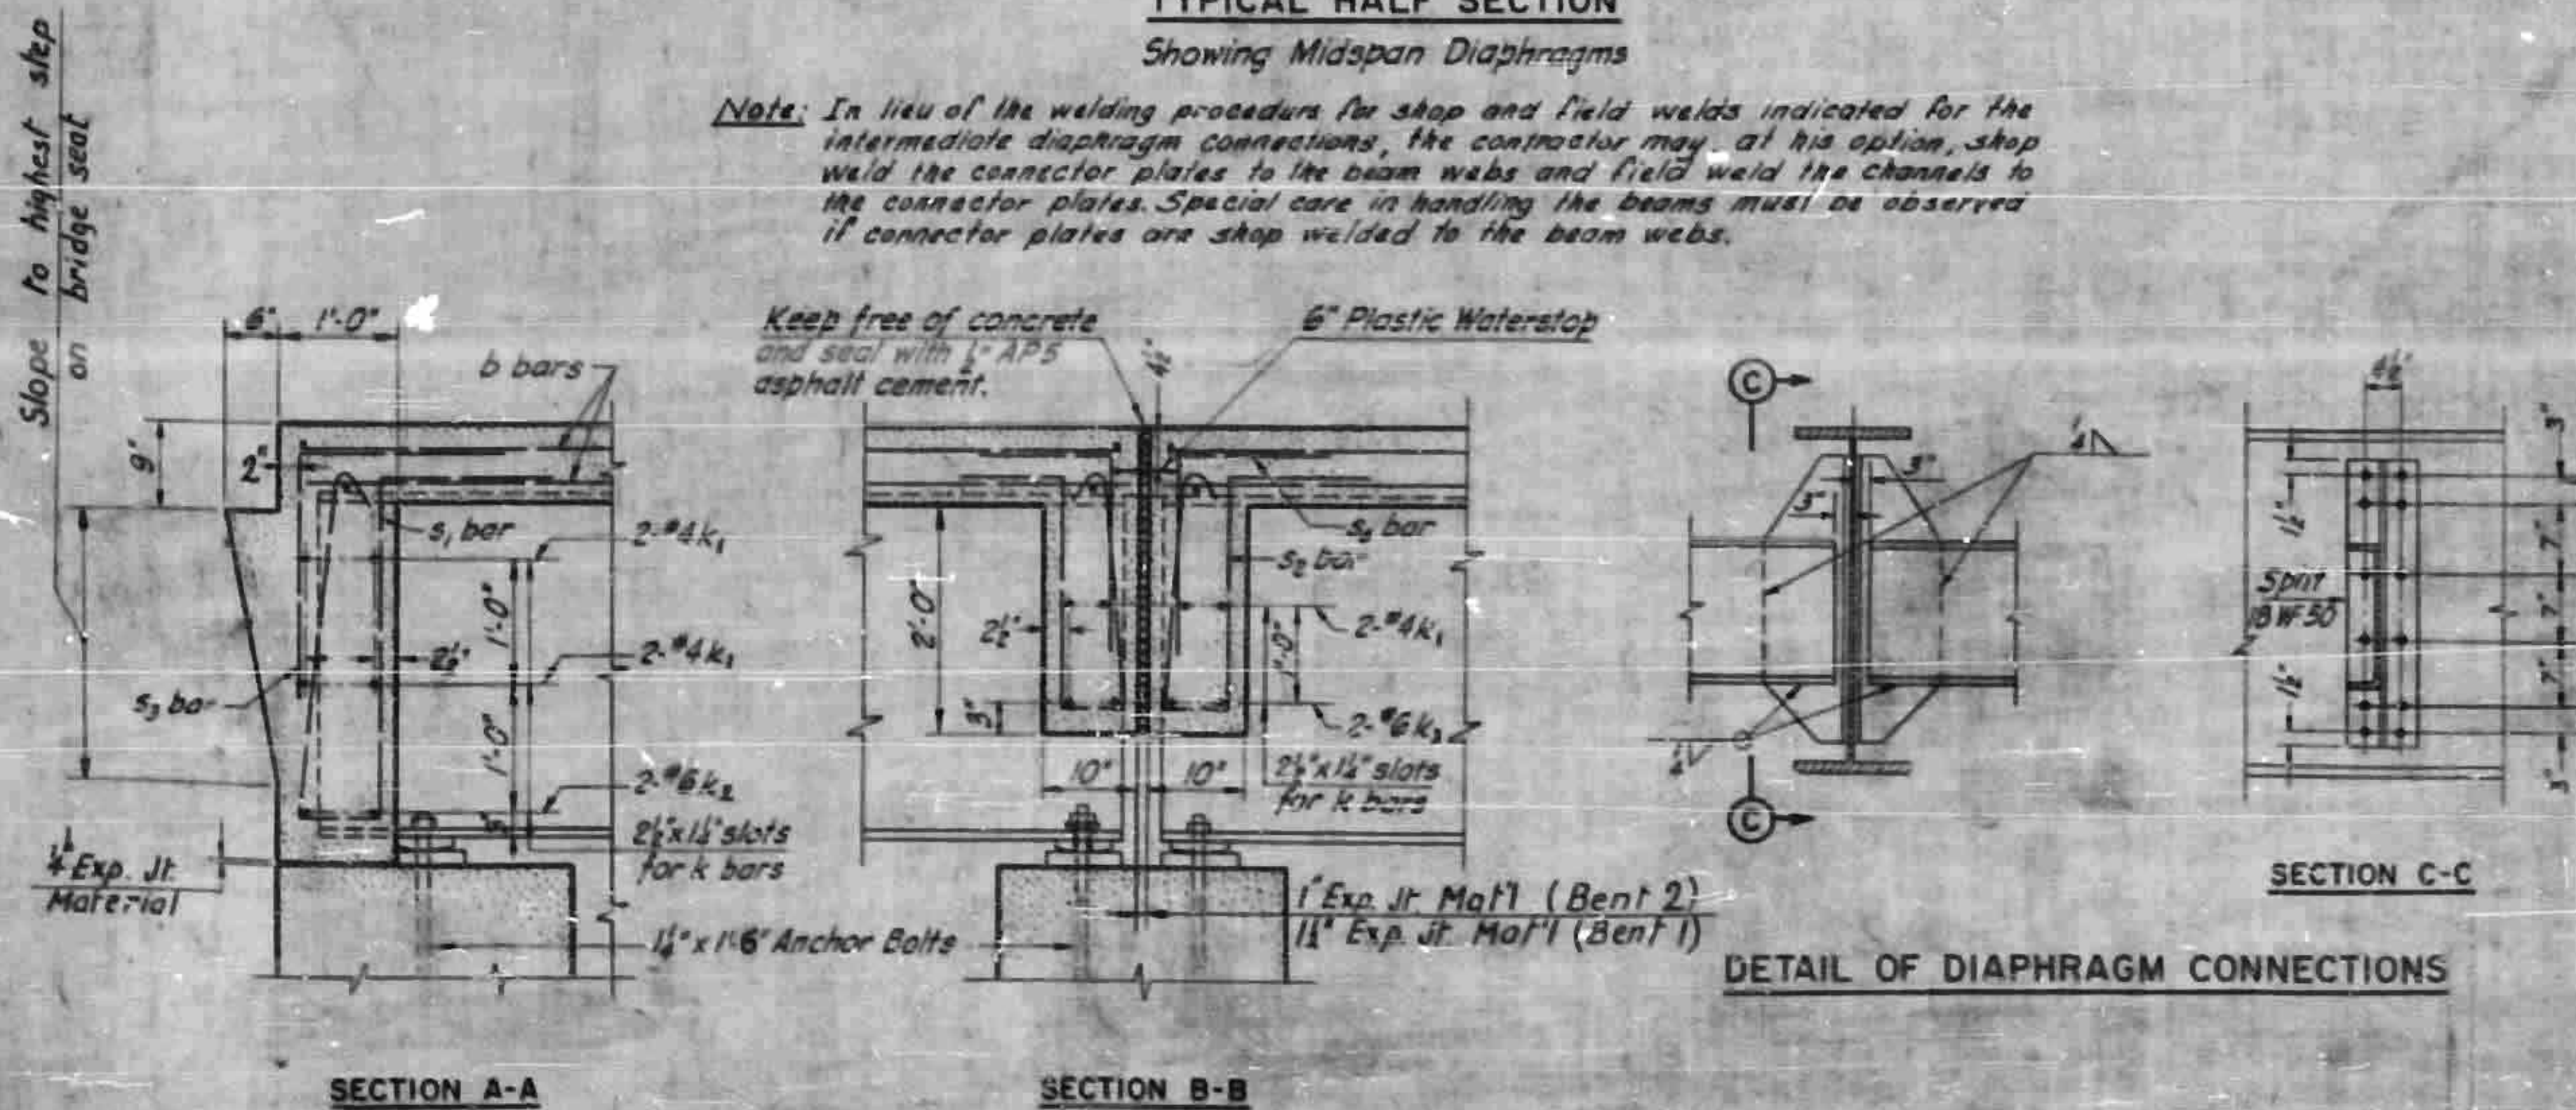

BILL OF MATERIALS — 3 SPANS

BAR	NUMBER OF BARS			TOTAL	SIZE	TYPE	LENGTH	WEIGHT
	SPAN A	SPAN B	SPAN C					
a ₁	124	126	124	374	5	2	30-7	11,930
a ₂	123	125	123	371	5	3	31-9	12,286
a ₃	10	—	10	20	5	str.	27-8	577
b ₁	66	—	66	132	5	str.	34-0	4,680
b ₂	32	—	32	64	4	str.	32-6	1,389
b ₃	—	66	—	66	5	str.	33-4	2,225
b ₄	28	—	28	56	4	str.	29-9	1,253
b ₅	—	60	—	60	4	str.	29-1	1,926
f ₁	16	—	16	32	4	str.	32-6	695
f ₂	—	16	—	16	4	str.	33-1	354
g ₁	130	132	130	392	4	6	5-7	1,461
g ₂	172	176	172	520	4	5	5-5	1,883
g ₃	66	68	66	200	4	str.	2-4	311
k ₁	6	4	6	16	4	str.	27-7	294
k ₂	4	4	4	12	6	str.	27-7	497
s ₁	28	—	28	56	4	6	8-7	318
s ₂	28	56	28	112	4	6	6-5	480
s ₃	28	—	28	56	4	4	3-5	128
s ₄	28	56	28	112	4	4	3-1	231

	Southbound Structure	Northbound Structure
Reinforcing Steel	42,398 lbs	42,398 lbs
Class "A" Concrete	196.0 cu. yds.	196.0 cu. yds.
Structural Steel	158,100 Lbs.	158,100 Lbs.
Metal Rails	390.83 Lin. Ft.	390.83 Lin. Ft.

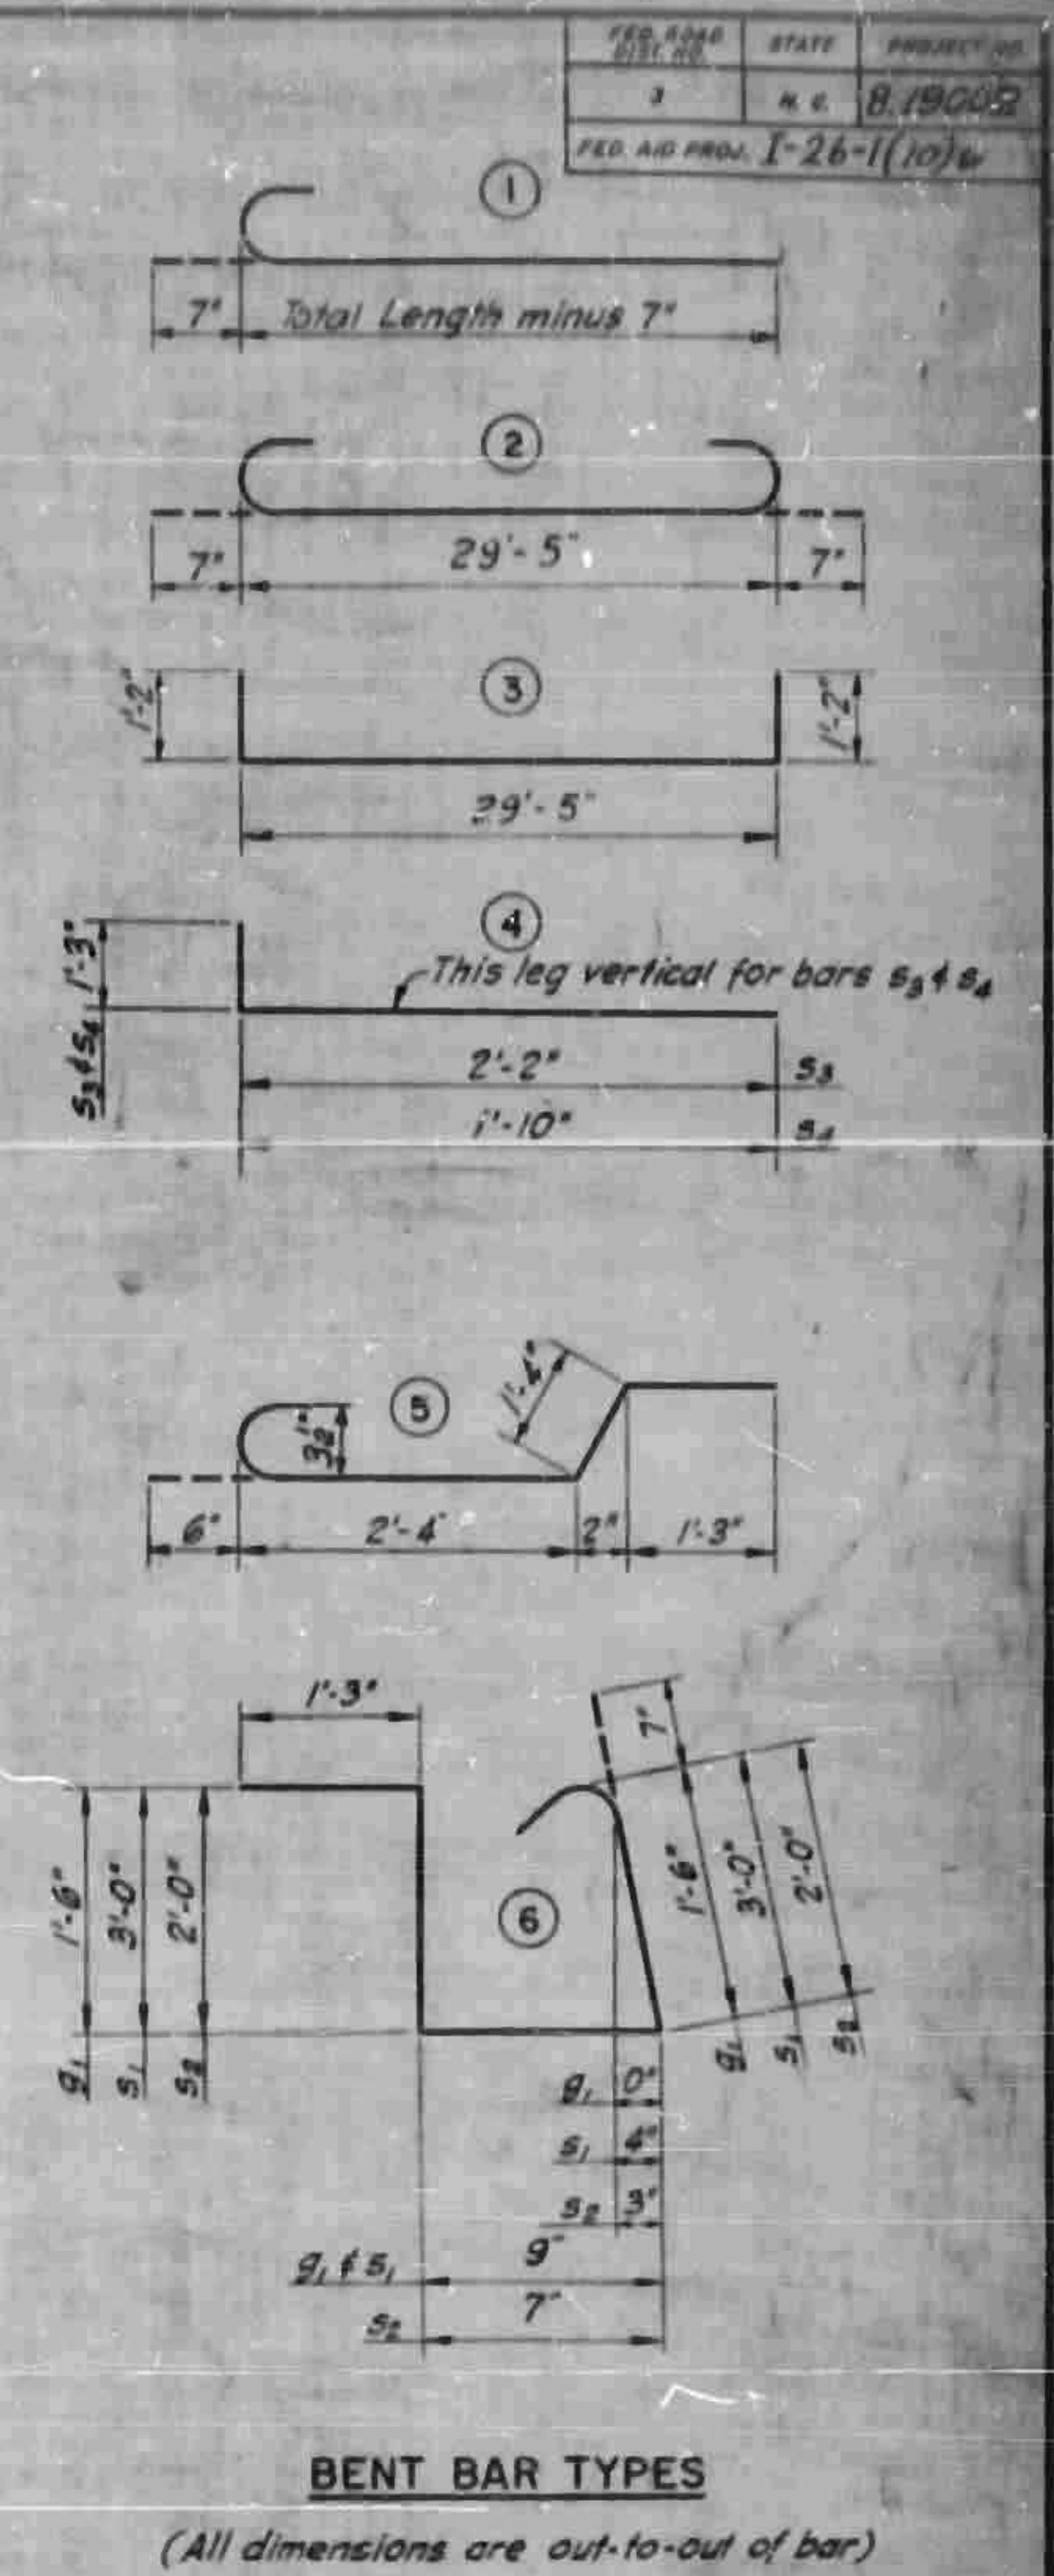


PROJECT NO. 8.19002
Henderson- Buncombe COUNTY
STATION 1499 + 55 L
N.B or S.B. Bridge

STATE OF NORTH CAROLINA
STATE HIGHWAY COMMISSION
RALEIGH

SUPERSTRUCTURE CROSS SECTIONS


Revision No. 1 - Revised to turn back up on G-bars and to show turn back on G-bars 2'-0" @ Bent 1 to 2'

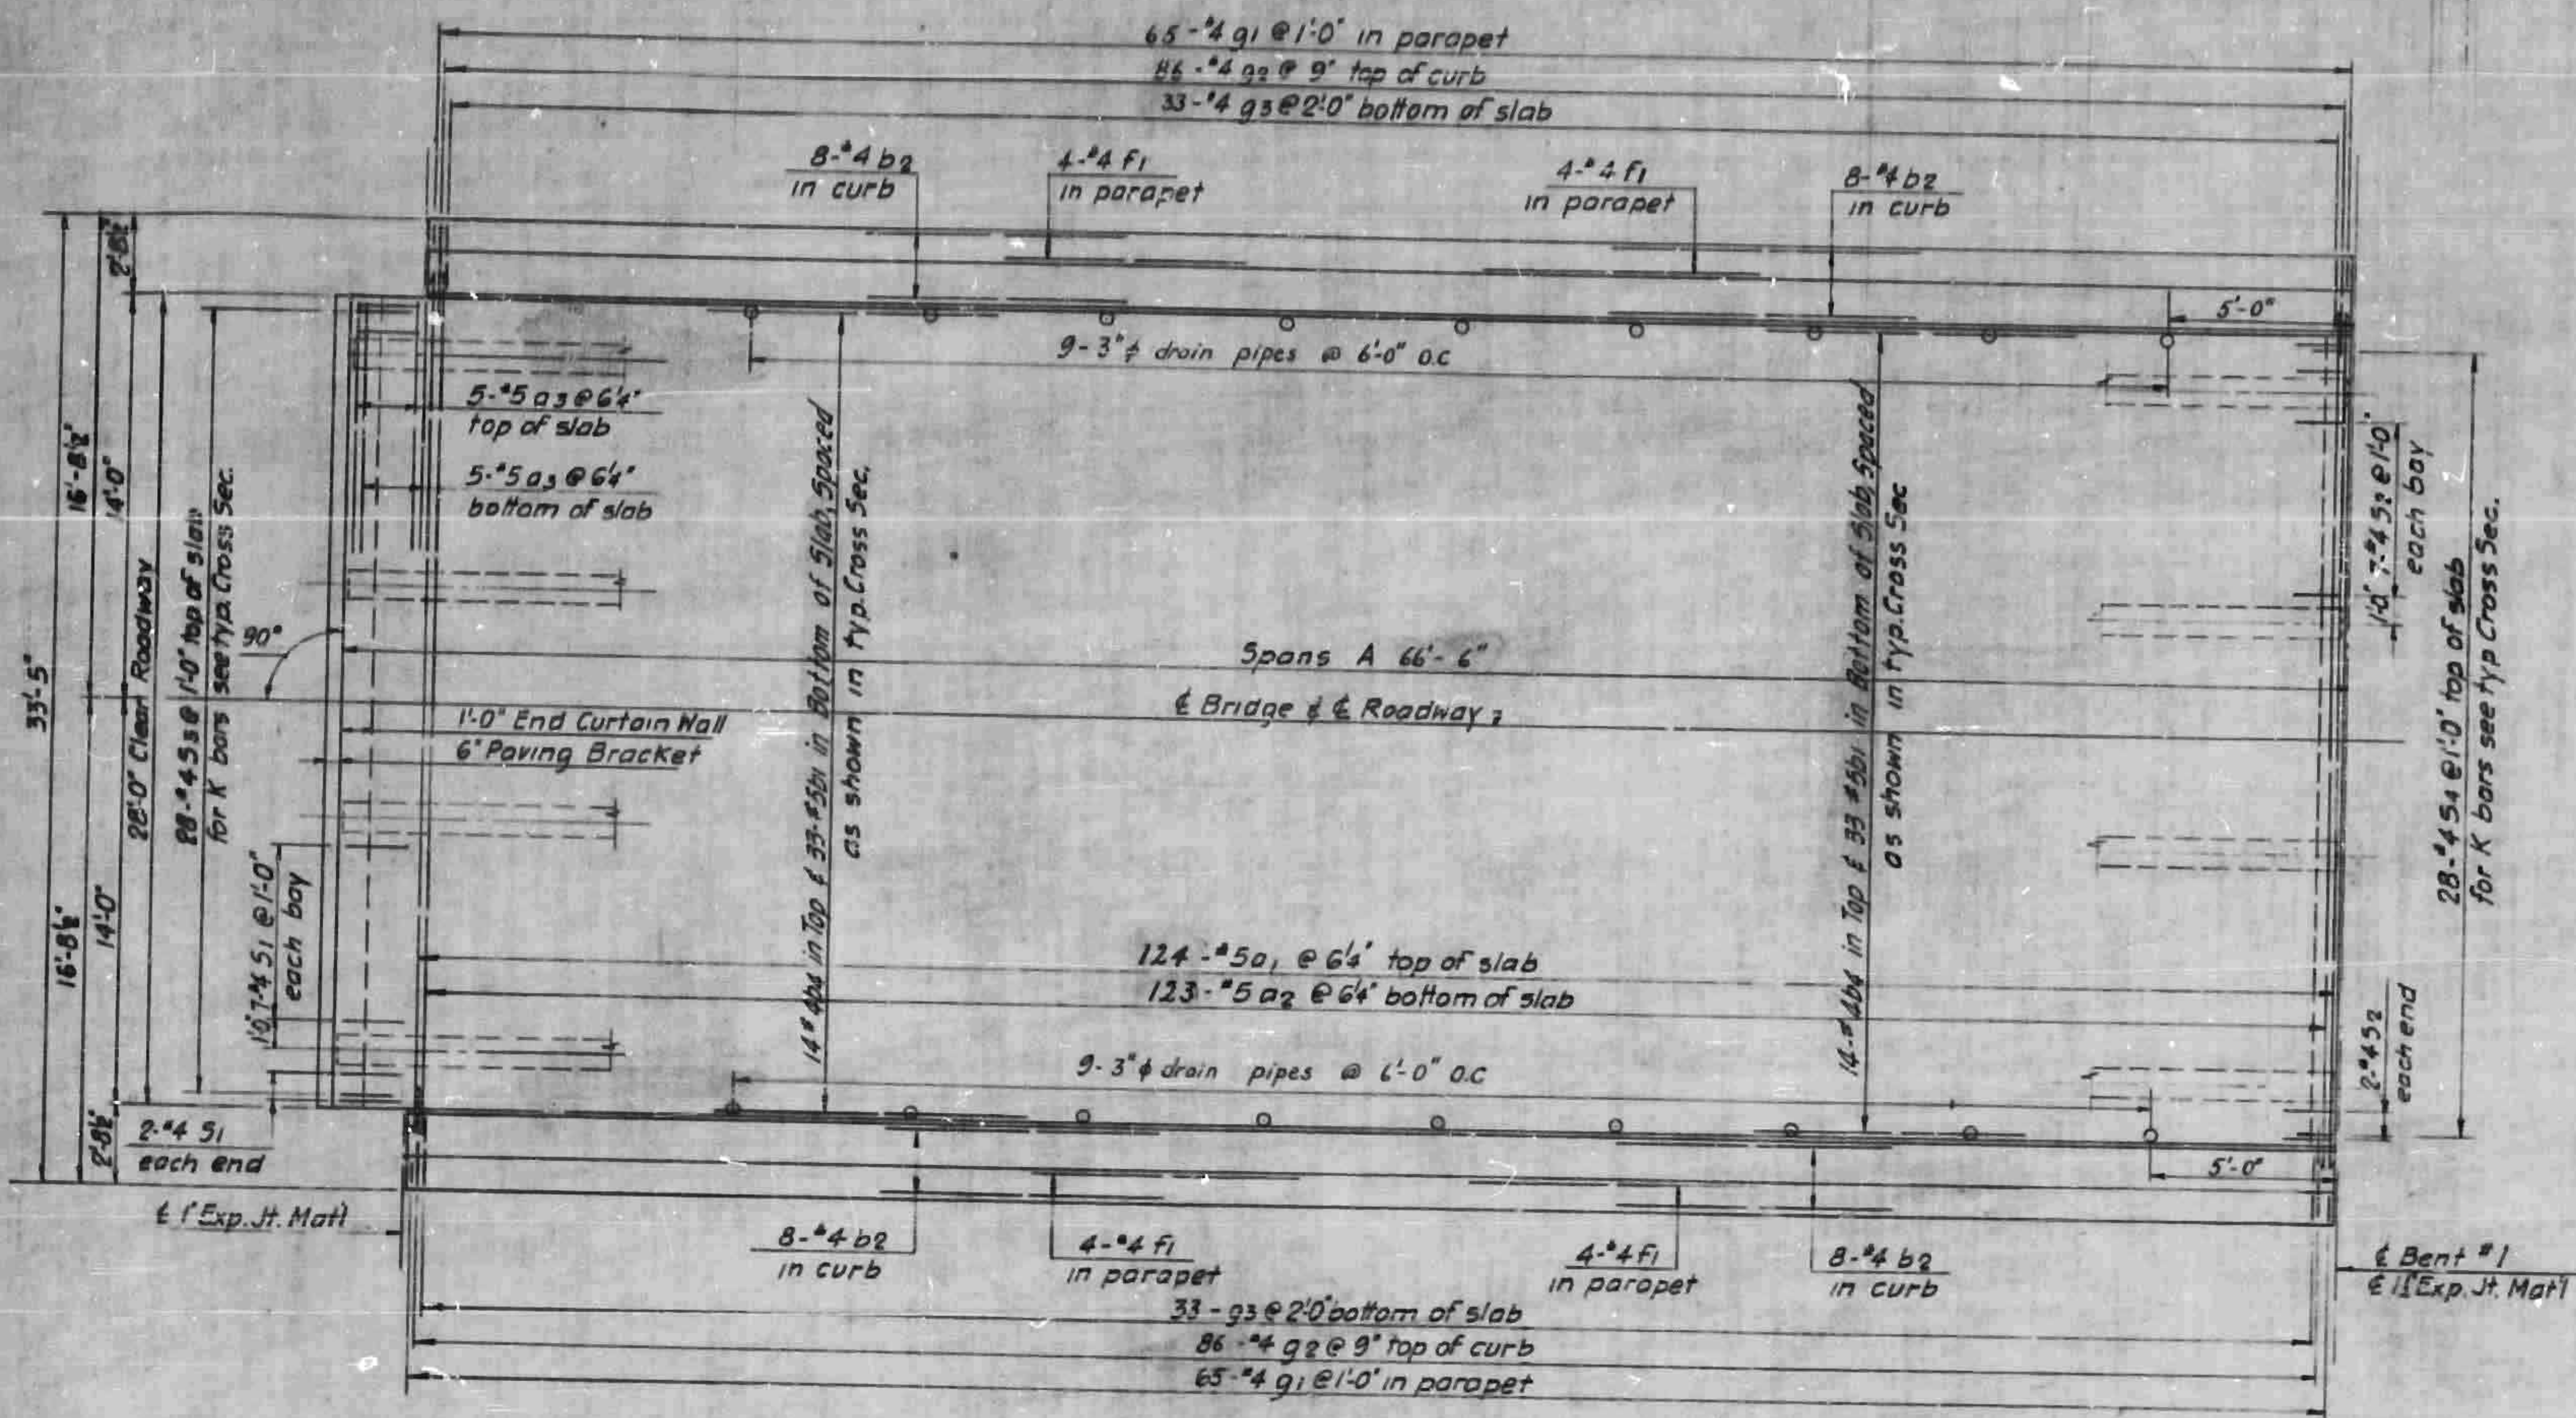

PLAN

PROJECT NO. 819002
 HENDERSON-BUNCOMBE COUNTY
 STATION 1499+55.2
 S.B. or N.B. BRIDGE


STATE OF NORTH CAROLINA STATE HIGHWAY COMMISSION RALEIGH	
SUPERSTRUCTURE SPAN A	
DATE	BY
DATE	BY
DATE	BY
DATE	BY

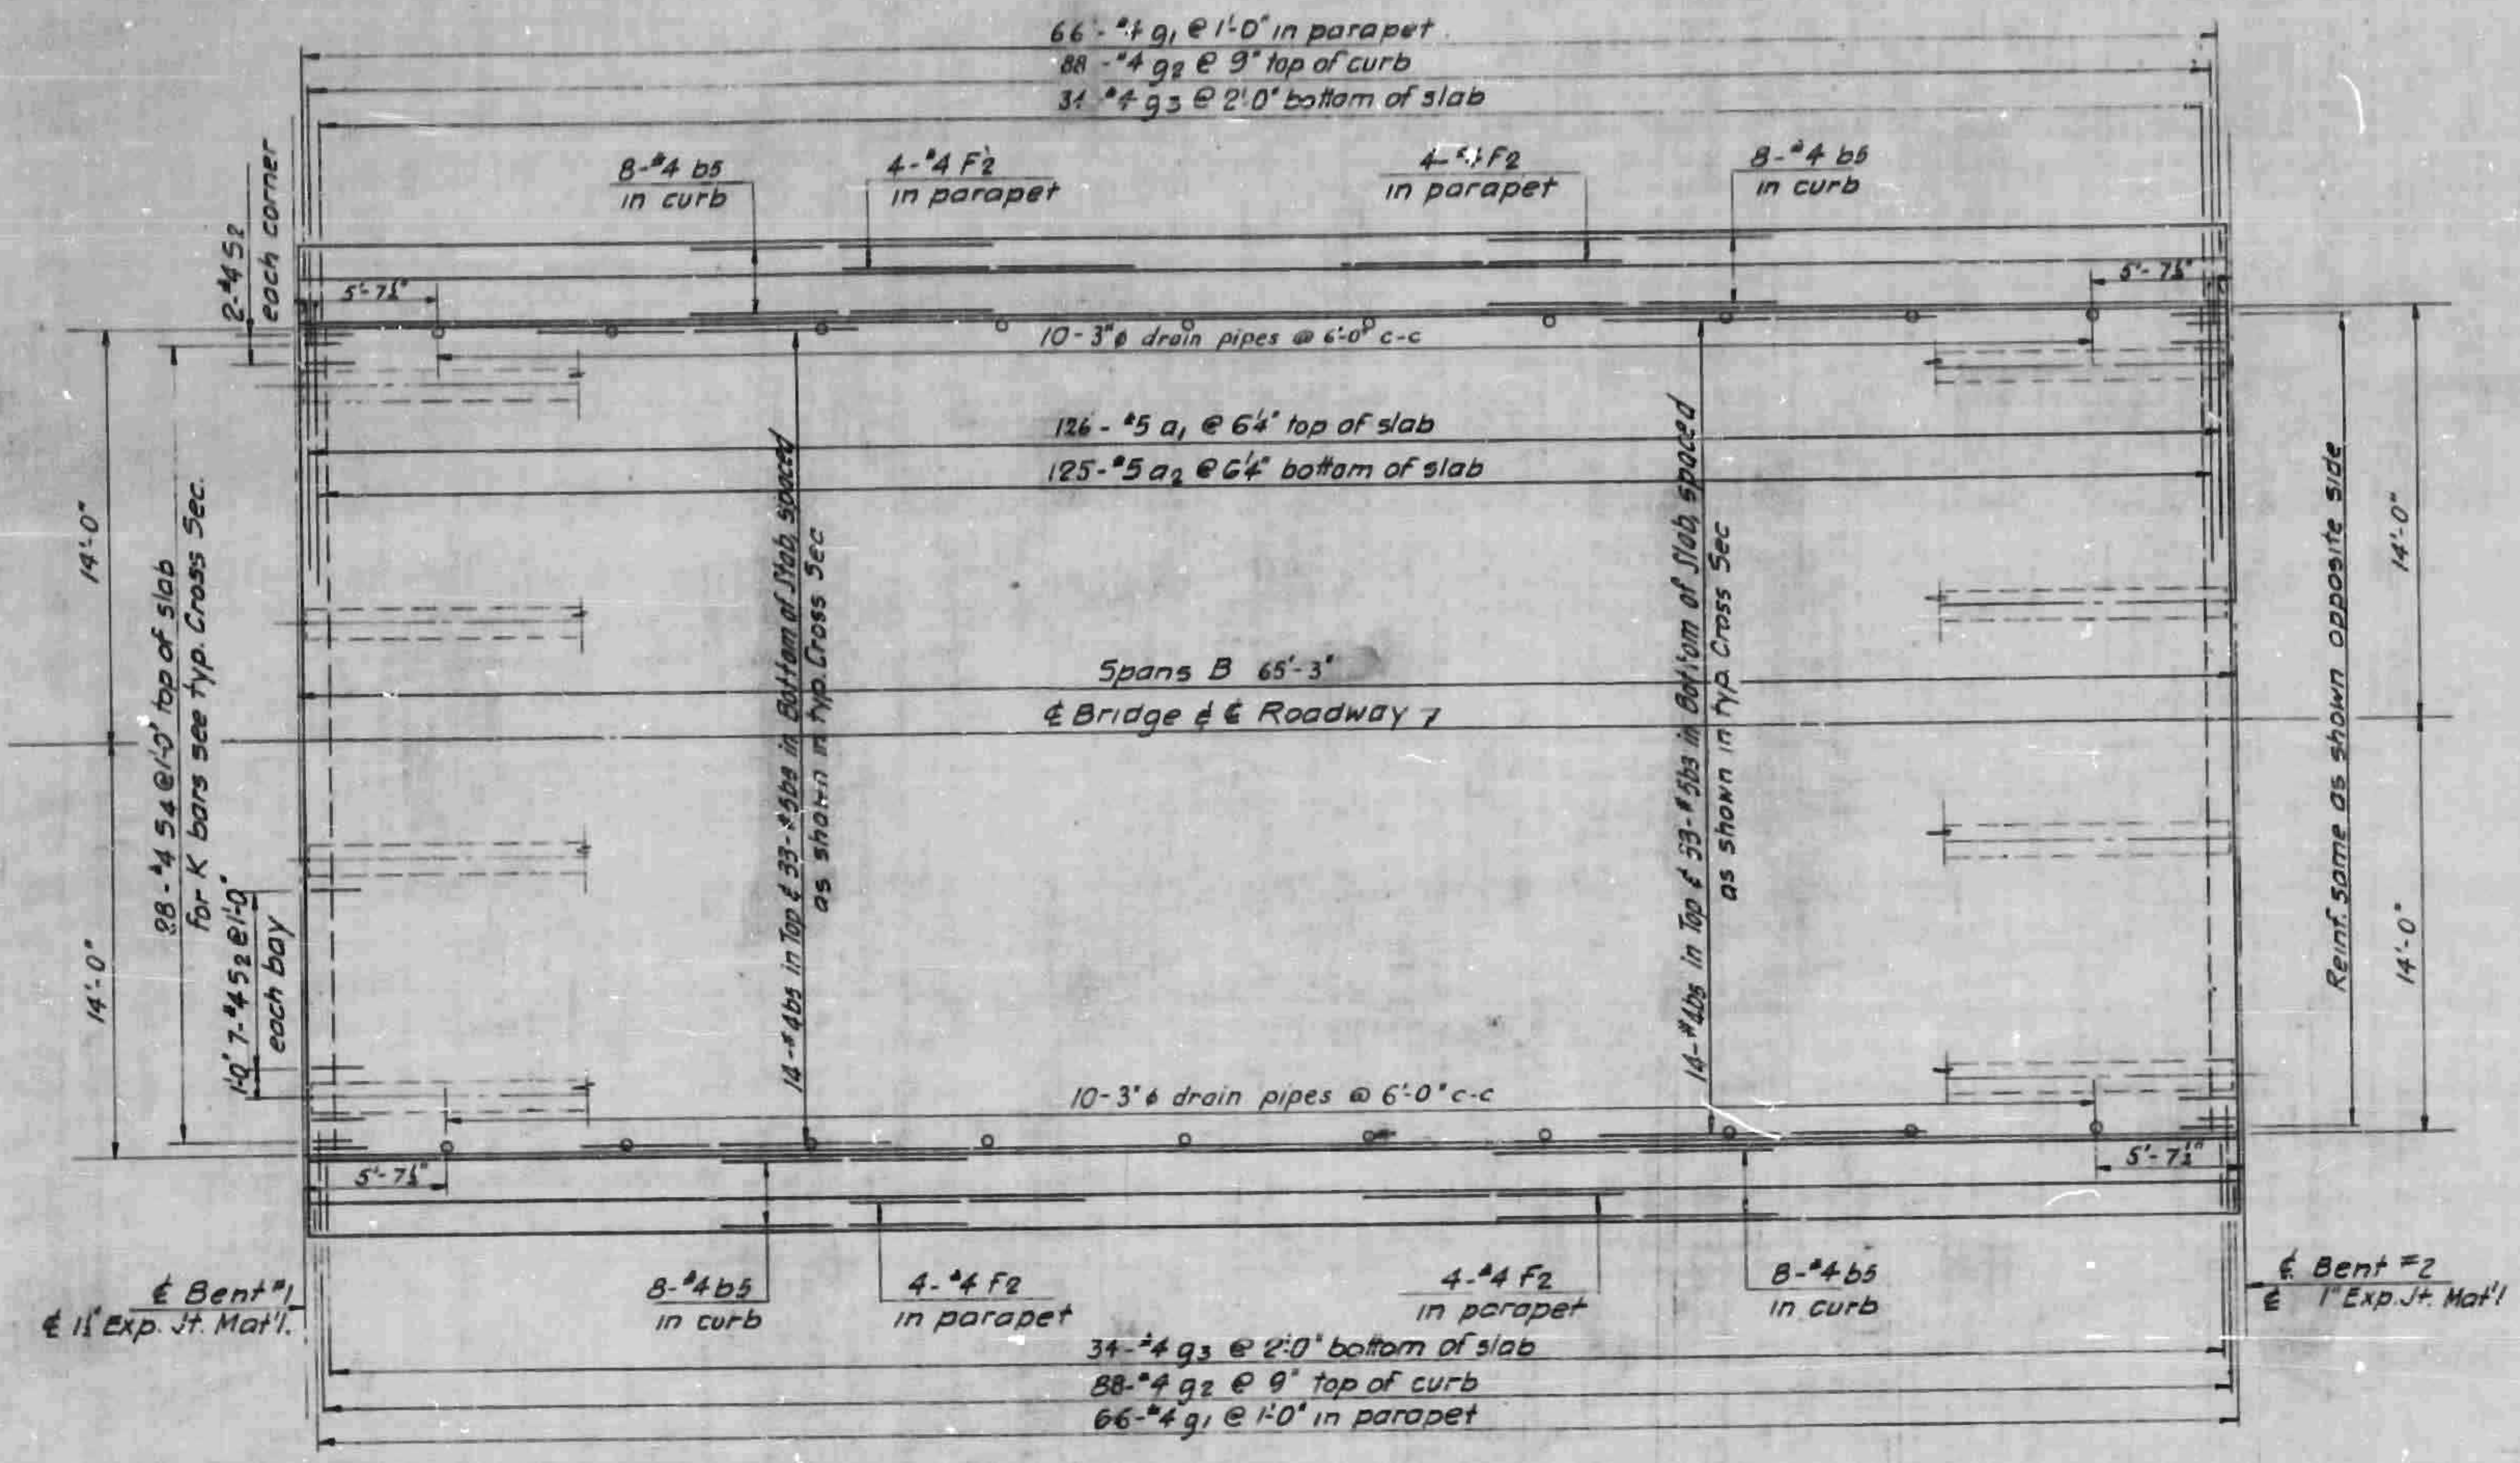

PLAN

PROJECT NO. 812002
 HENDERSON-BUNCOMBE COUNTY
 STATION 1499+55L
 S.B. or N.B. BRIDGE




REVISED	DATE	BY	STATE OF NORTH CAROLINA STATE HIGHWAY COMMISSION RALEIGH
			SUPERSTRUCTURE SPAN 8

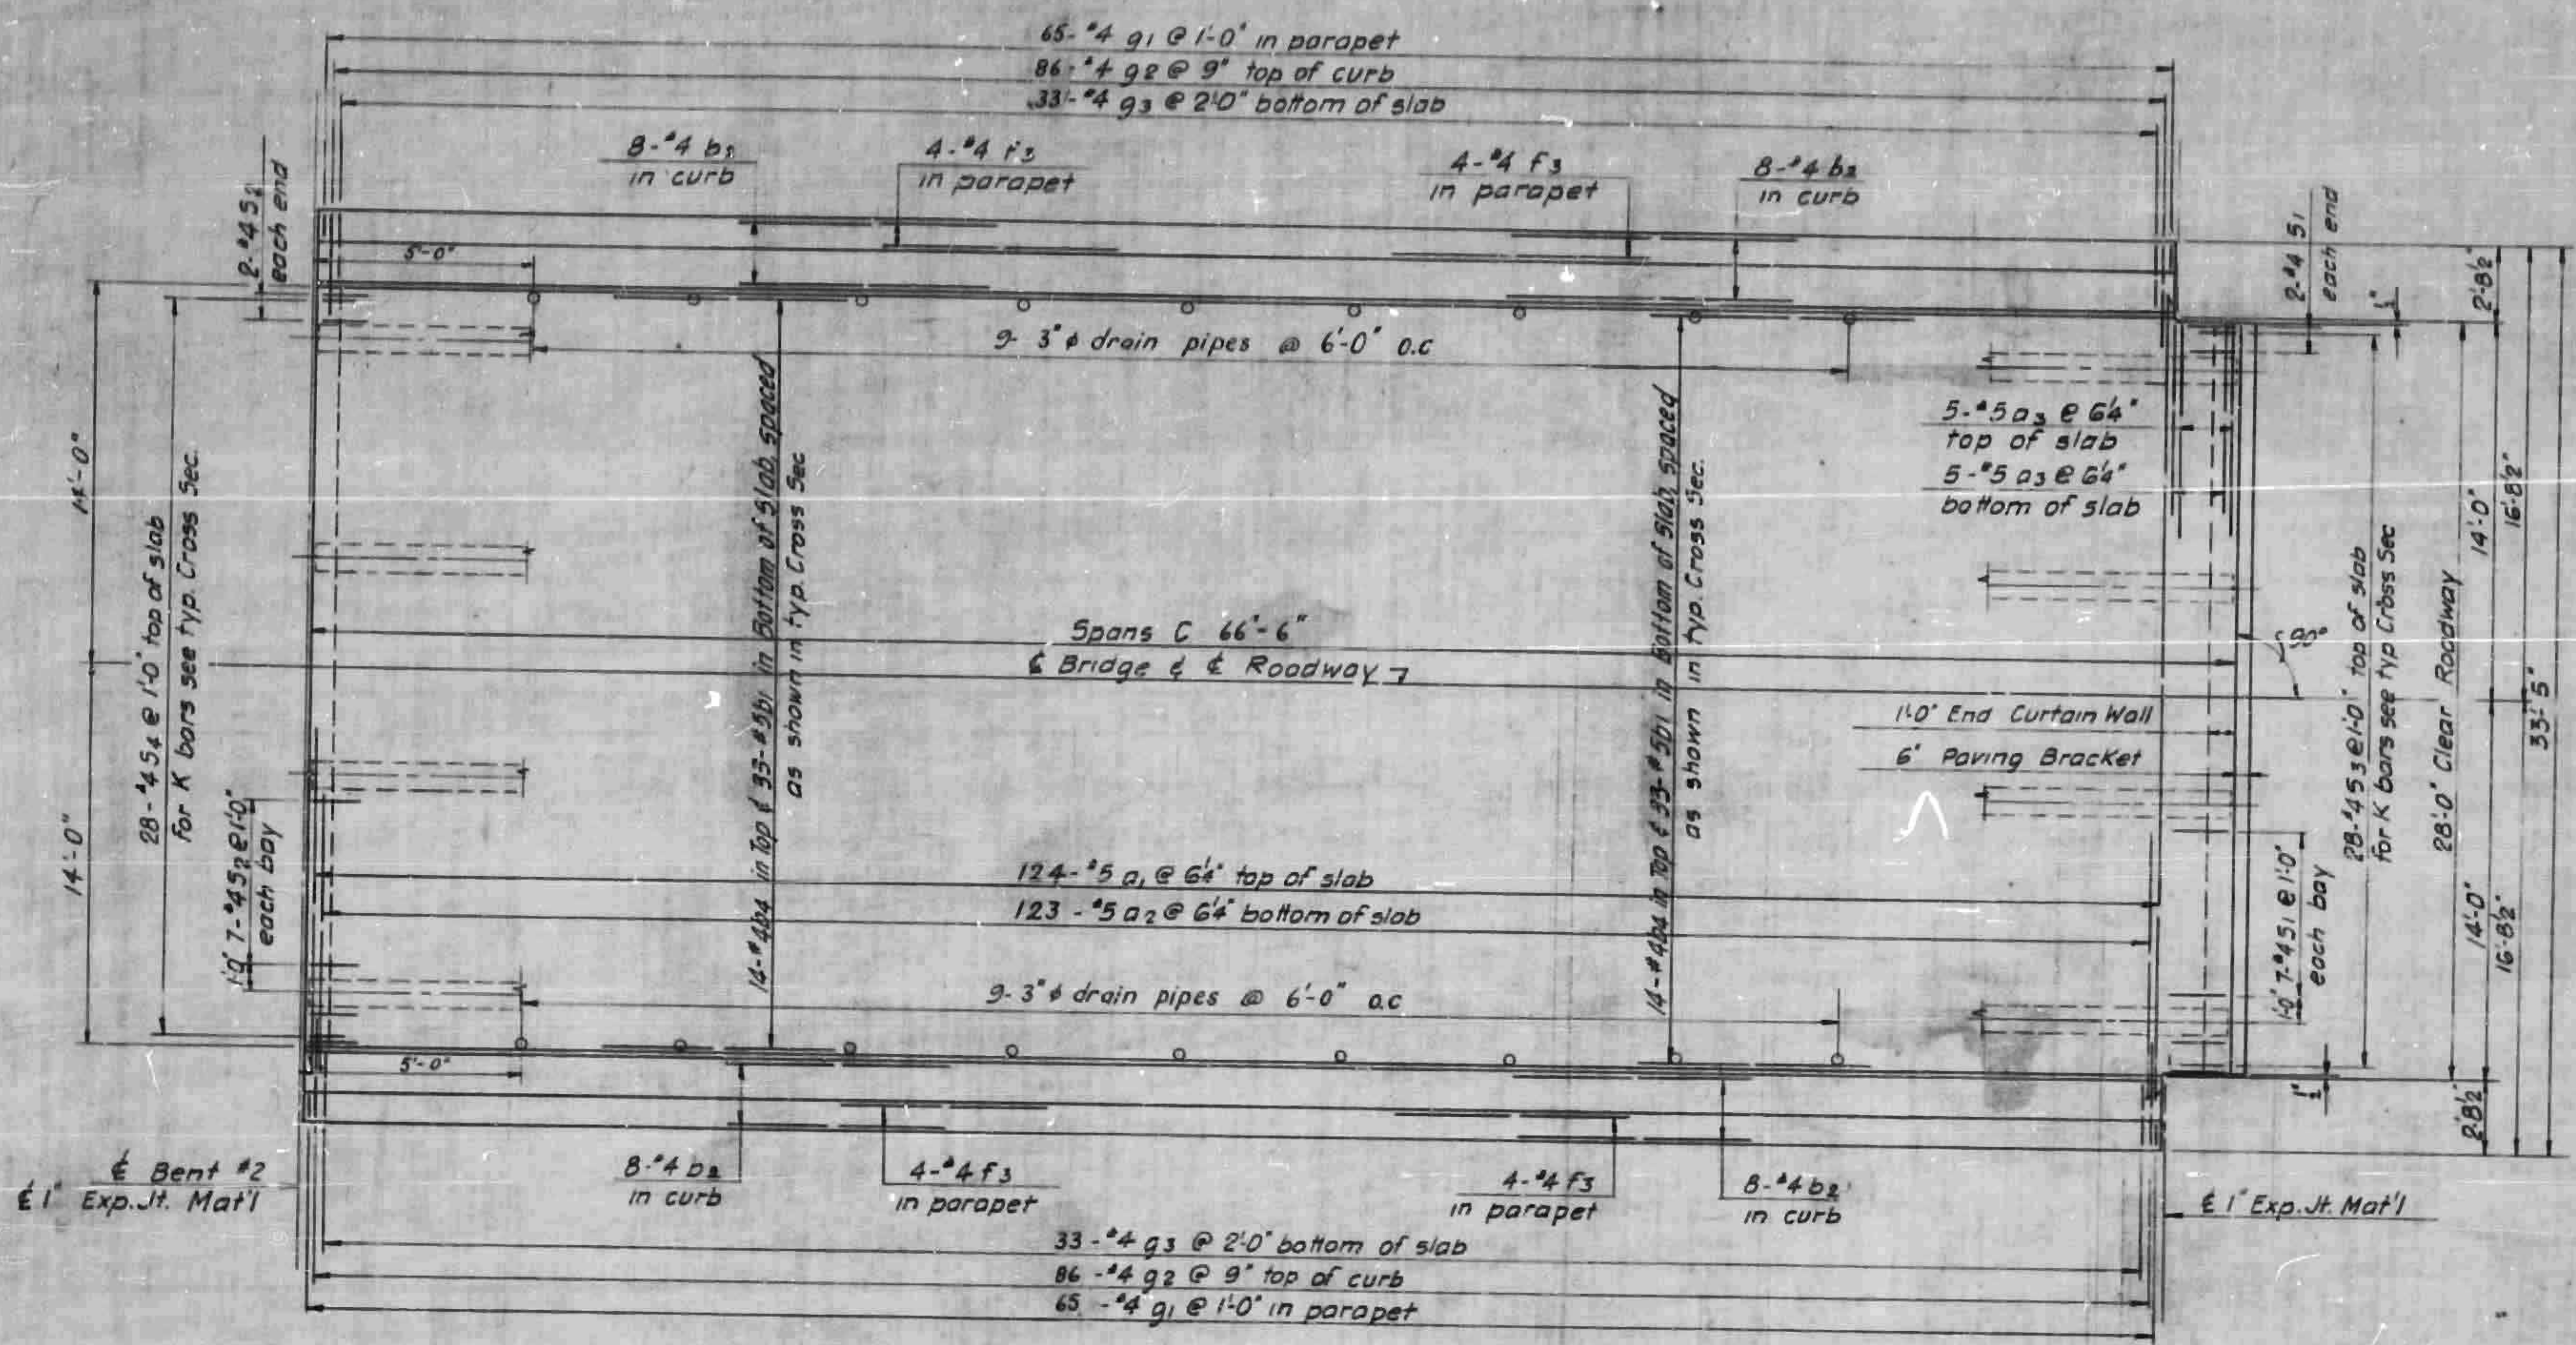




PLAN

PROJECT NO. 819002
 HENDERSON-BUNCOMBE COUNTY
 STATION 1492+55 L
 S.B. or N.B. BRIDGE

DATE		STATE OF NORTH CAROLINA STATE HIGHWAY COMMISSION RALEIGH
BY		
DATE		SUPERSTRUCTURE SPAN C
BY		
DATE		
BY		

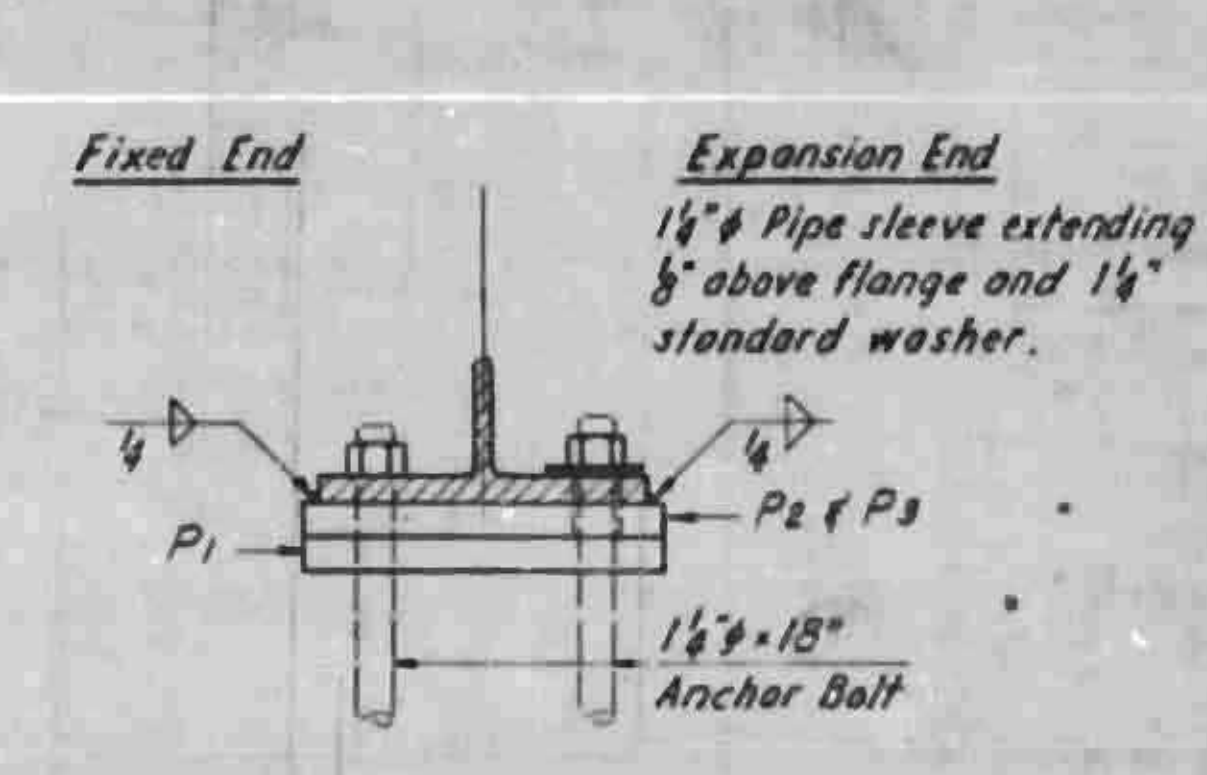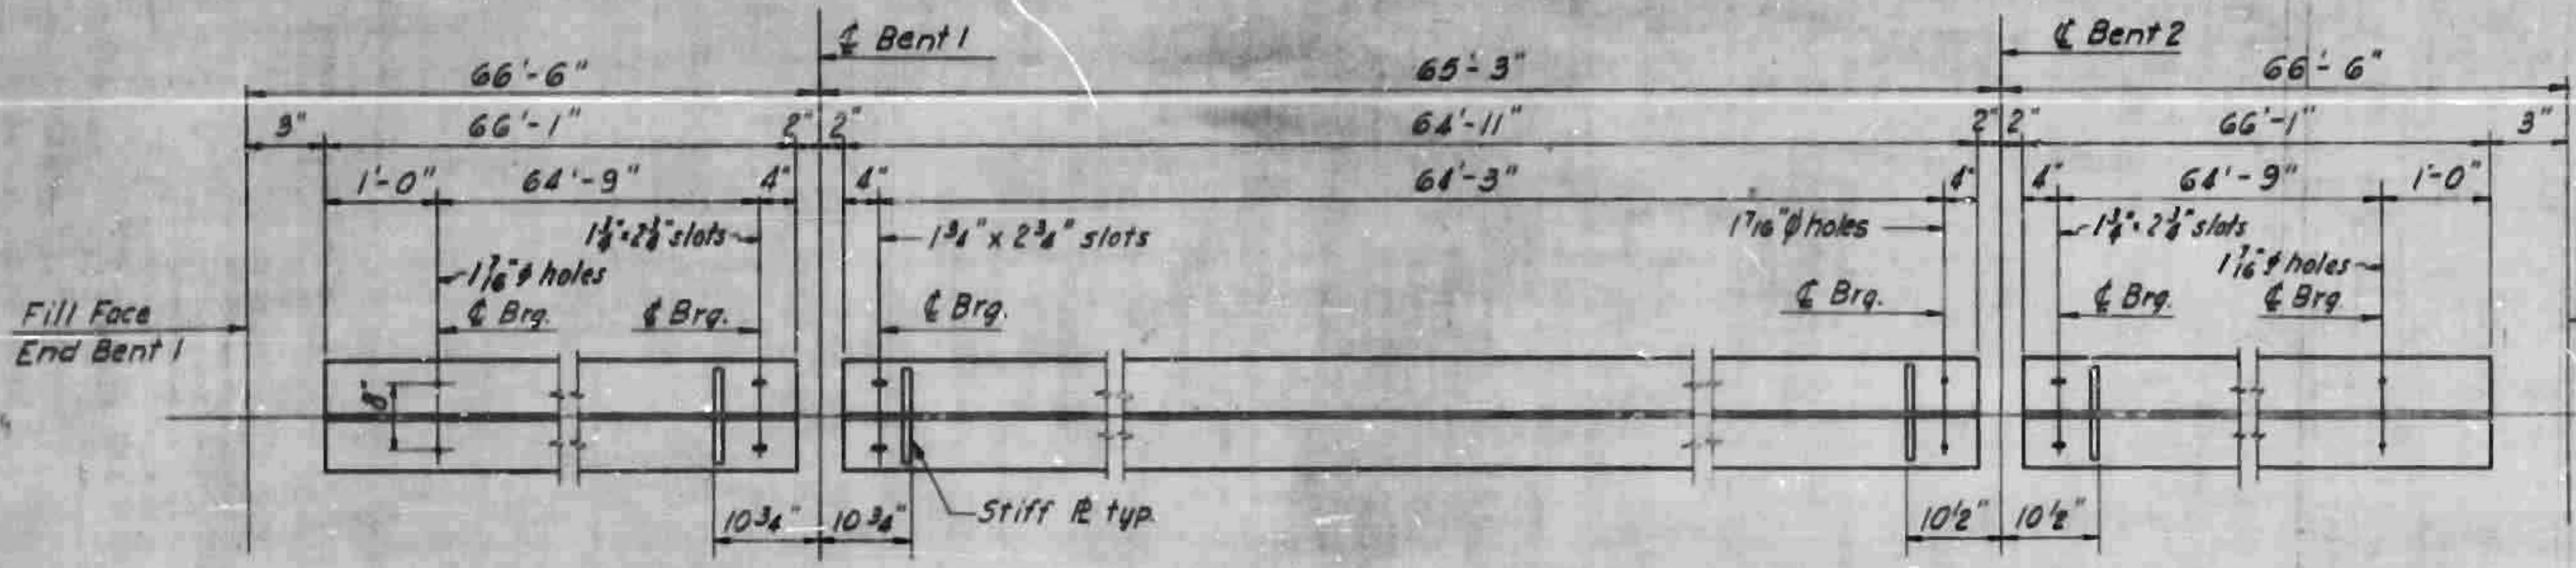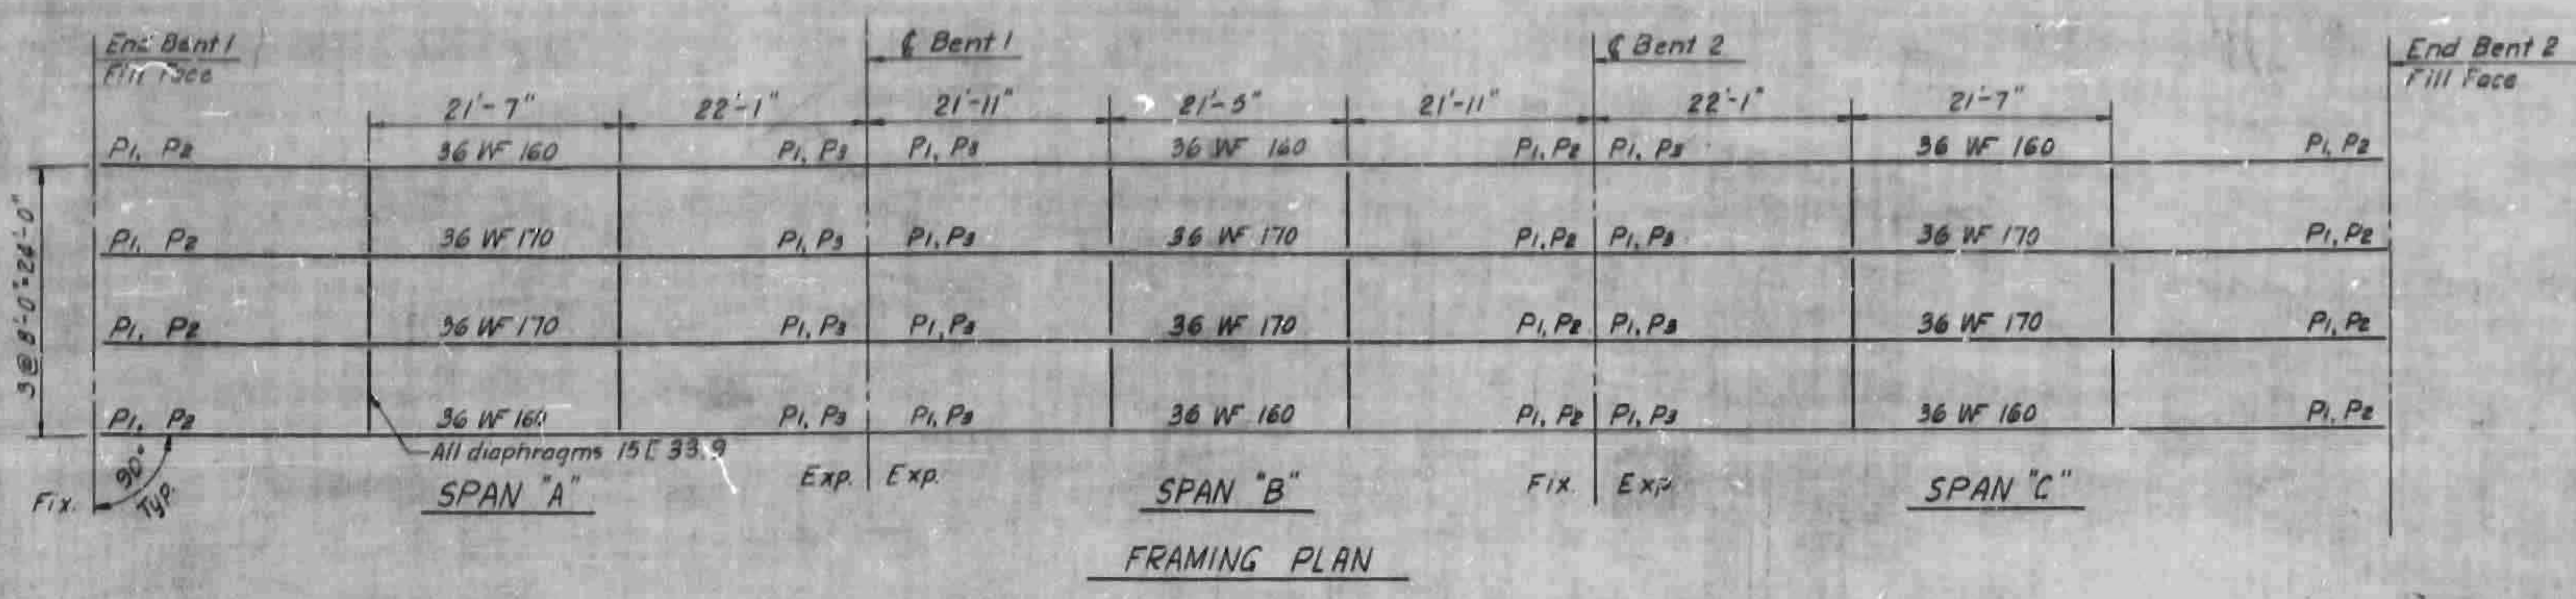


Note: Omit stiffeners on outside of exterior beams at End Bents. Stiffeners are to be normal to beam flanges.

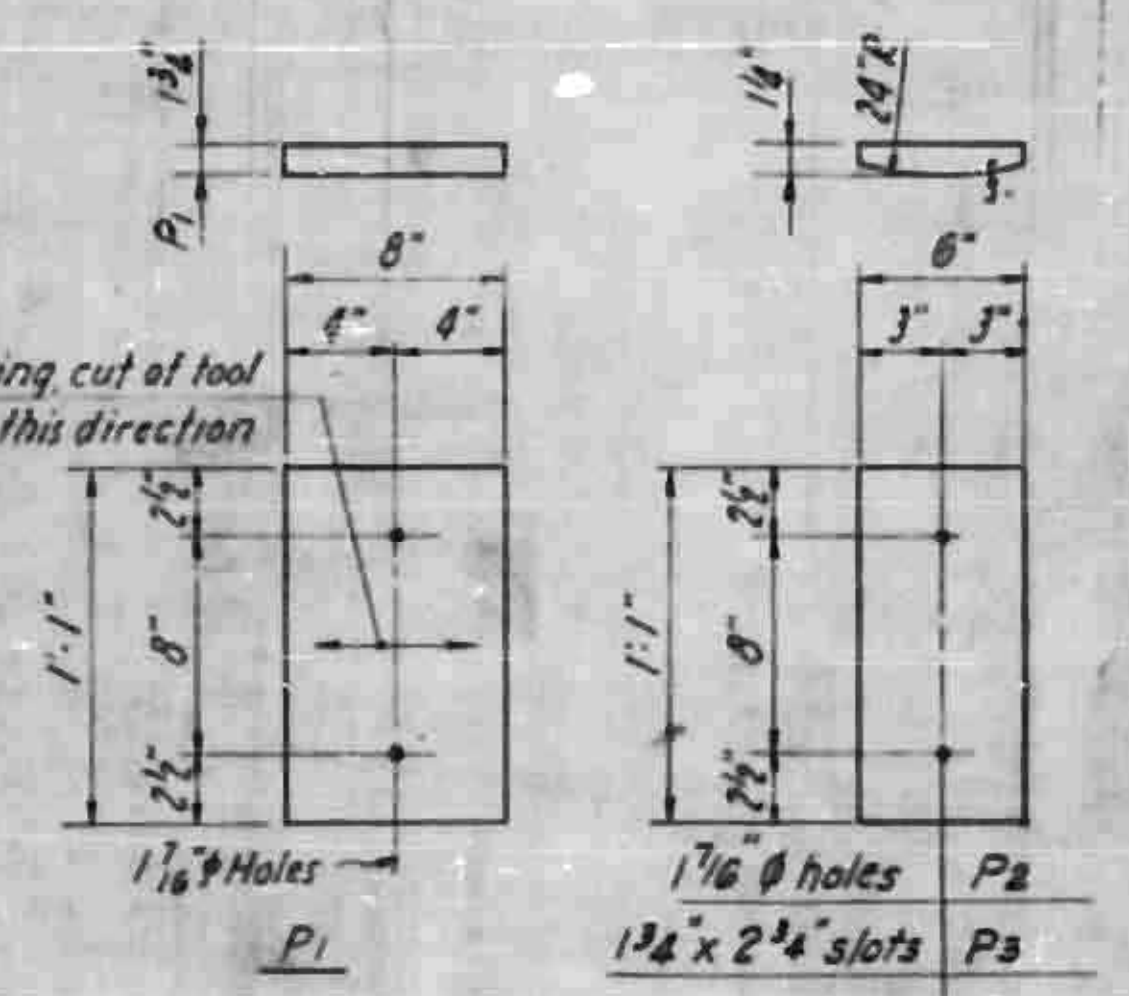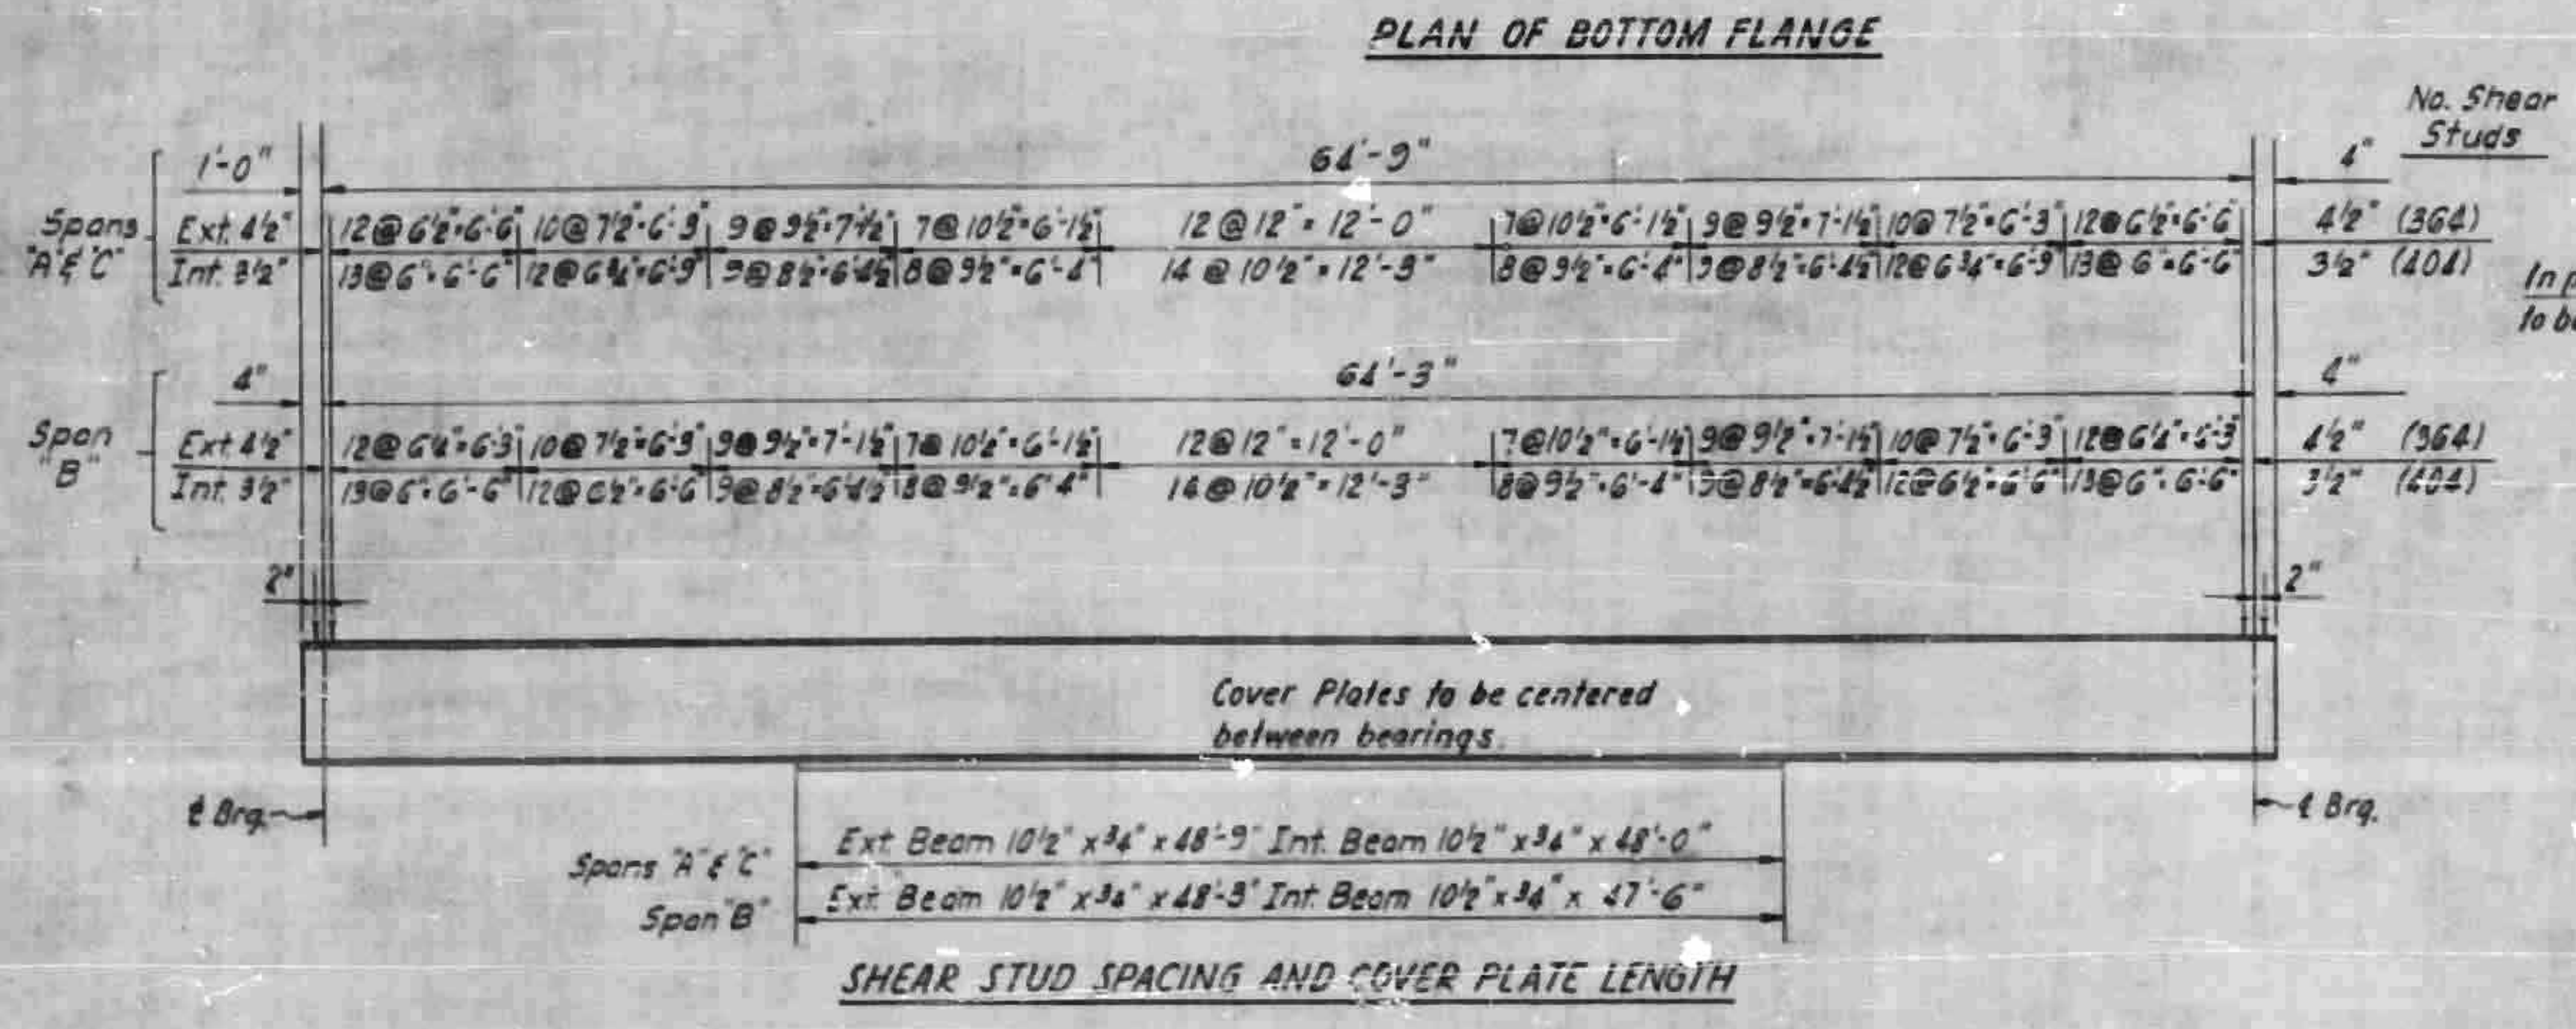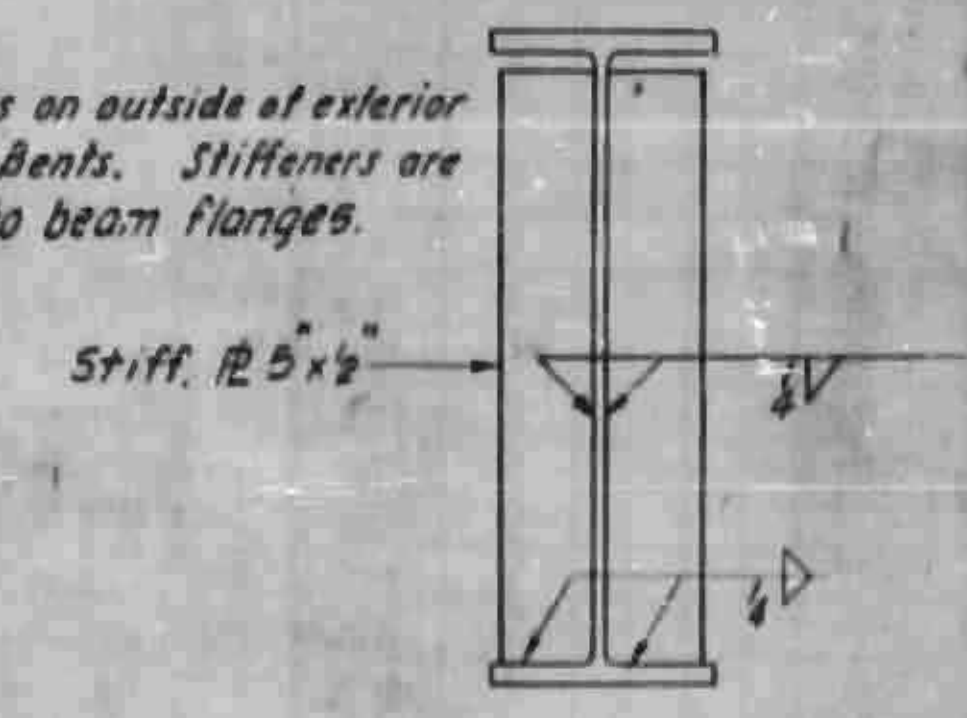



	Ext. Bm	Int. Bm
Steel	1/4"	1/4"
Concrete	1 3/8"	1 1/8"
Total DL Defl	1 1/2"	1 1/4"
Vertical Curve		
Total Camber	1 1/4"	1 1/4"

Note: All beams and cover plates for this structure may be of either A-373 or A-36 steel. Stress in extreme fibers of structural steel = 18,000 p.s.i. See Standard Notes sheet for further requirements.



PROJECT NO. 819002
 HENDERSON-BUNCOMB COUNTY
 STATION 1429+55 L
 N.B. or S.B. Bridge

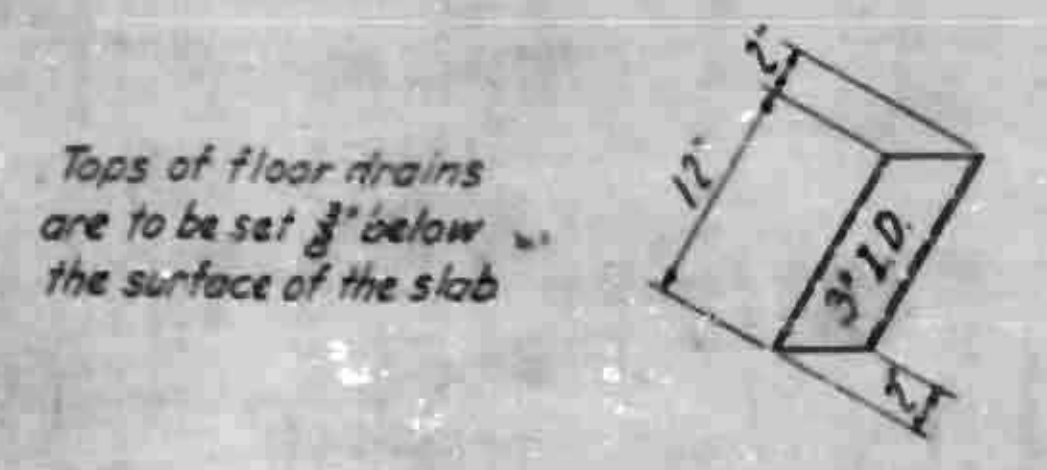




Drains to be set wt. galv. steel pipe. Drains to be painted with two field coats of Aluminum paint.

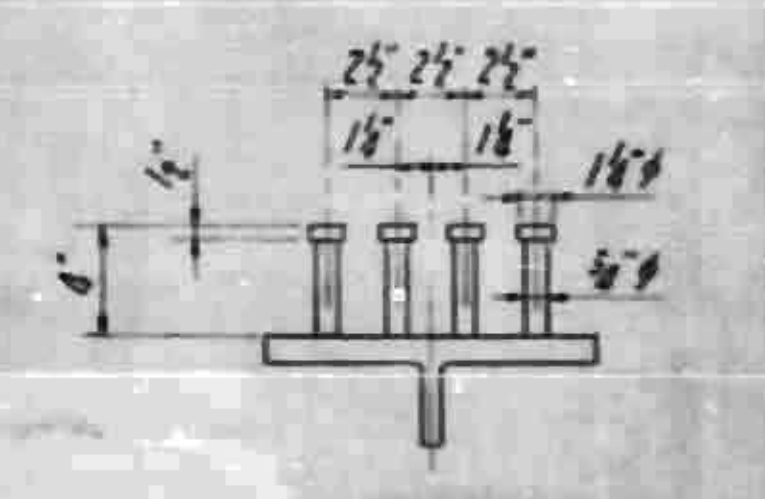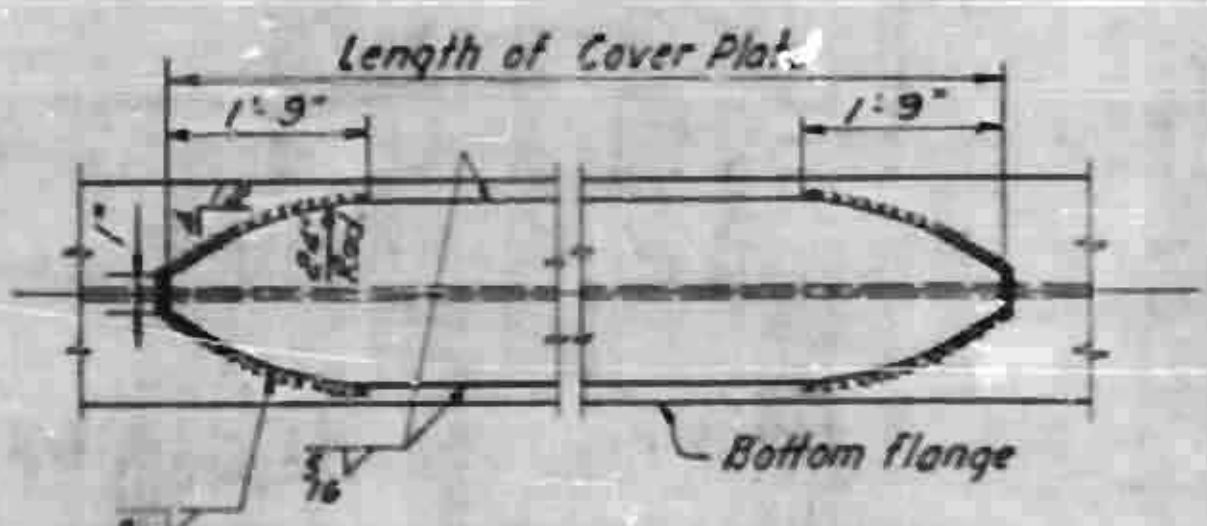

STATE OF NORTH CAROLINA	
STATE HIGHWAY COMMISSION	
HALEIGH	
STRUCTURAL STEEL	
DATE	8/1/02
BY	
DATE	
BY	
DATE	
BY	

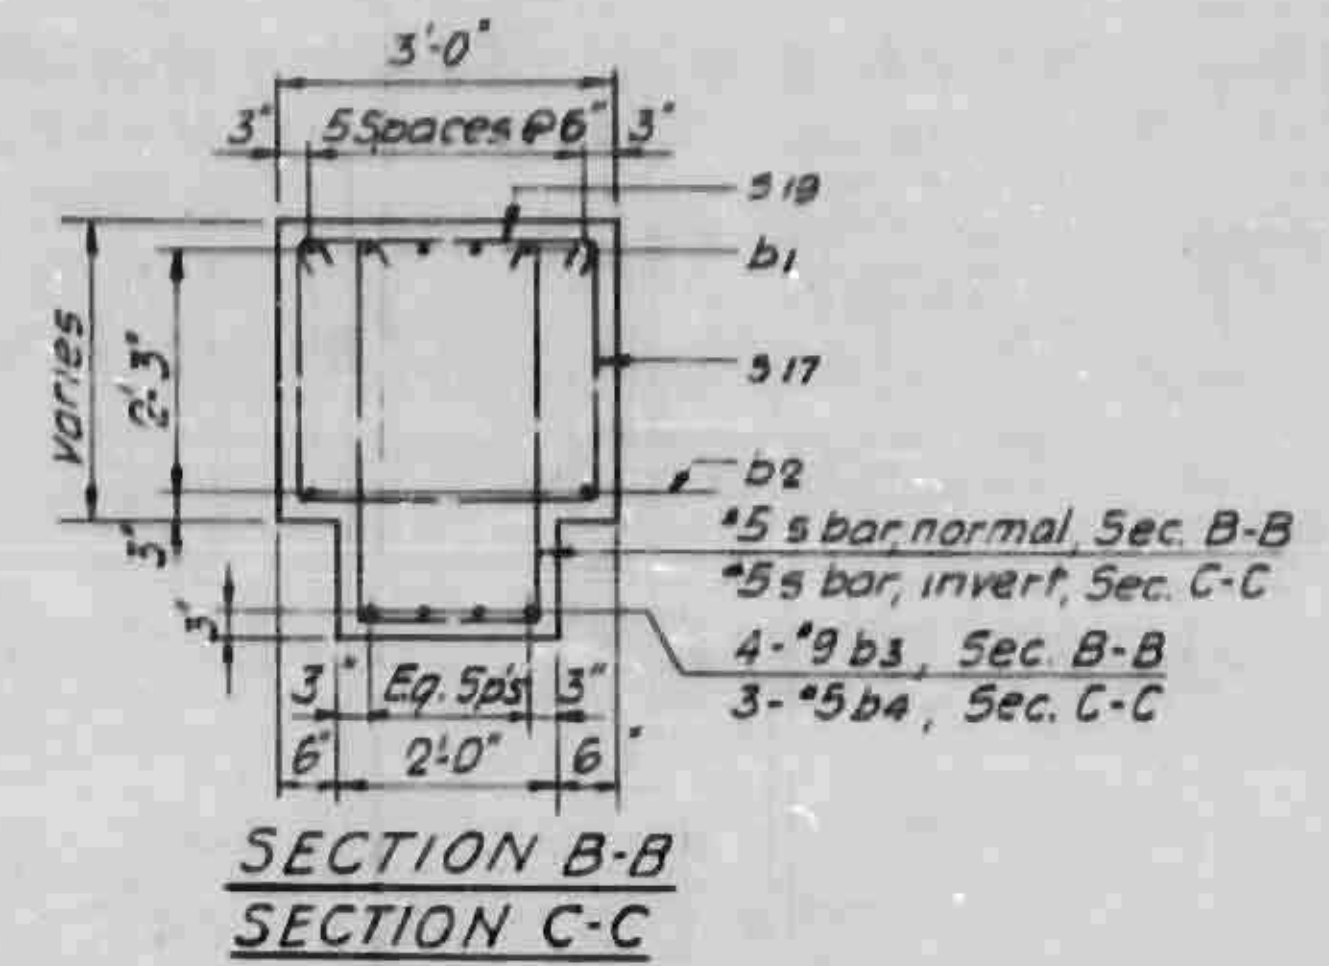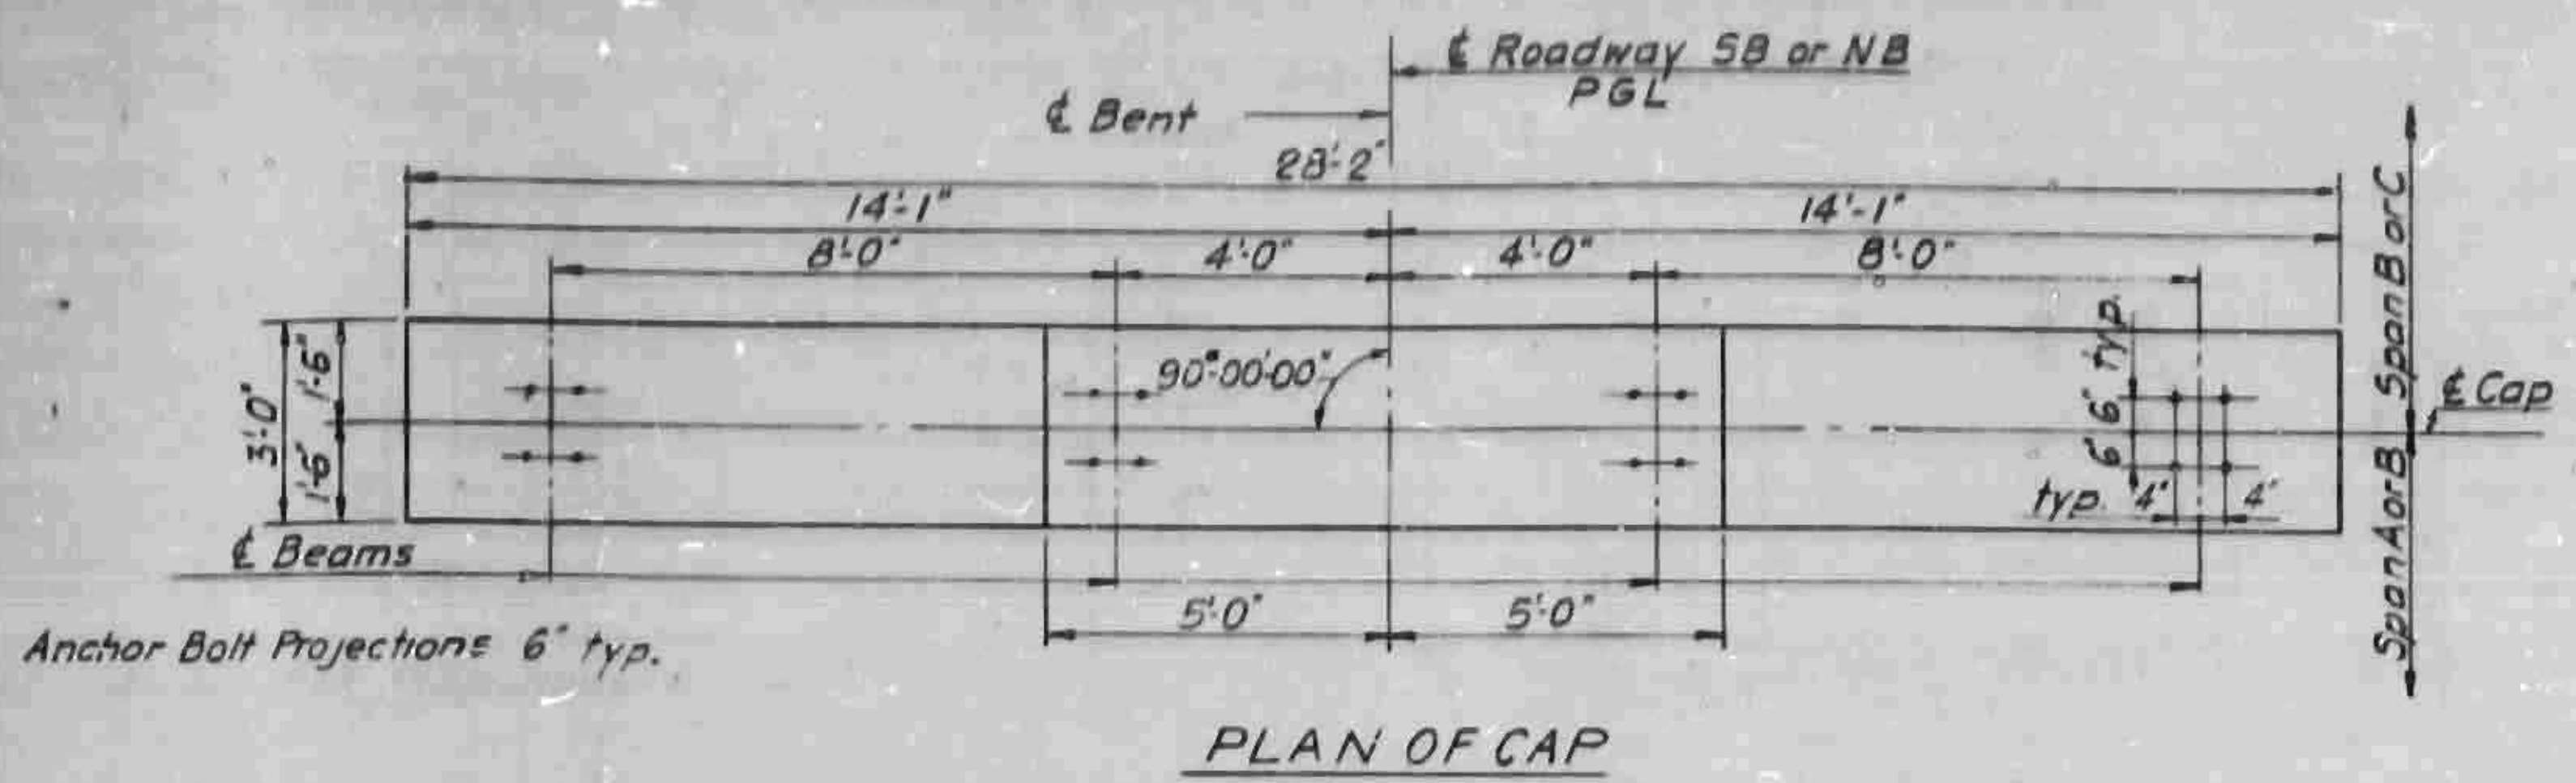





BAR DETAILS				BILL OF MATERIAL	
				for one bent, 2 required	
BAR	NO.	SIZE	TYPE	LENGTH	WEIGHT
b1	6	10	1	30.6	787
b2	2	8	5tr	27.8	148
b3	8	9	2	13.9	374
b4	6	5	3	8.5	53
b5	8	8	1	21.8	463
b6	12	5	1	7.2	90
m1	32	10	2	9.0	1239
s1	1	5	5	8.8	9
s2	2	1	1	9.2	19
s3	2	1	1	9.8	20
s4	2	1	1	10.2	21
s5	2	1	1	10.4	22
s6	2	1	1	10.6	22
s7	2	1	1	10.8	22
s8	2	1	1	10.10	23
s9	2	1	1	11.0	23
s10	2	1	1	11.2	23
s11	2	1	1	9.1	19
s12	2	1	1	9.7	20
s13	2	1	1	10.1	21
s14	2	1	1	10.7	22
s15	2	1	1	11.1	23
s16	2	5	1	11.7	24
s17	14	4	1	8.3	77
s18	12	4	5	6.9	54
s19	16	4	4	3.5	37
t1	22	8	1	12.8	744
t2	30	7	1	10.2	623
v1	16	10	2	28.11	1991
v2	16	10	5tr	16.7	1142

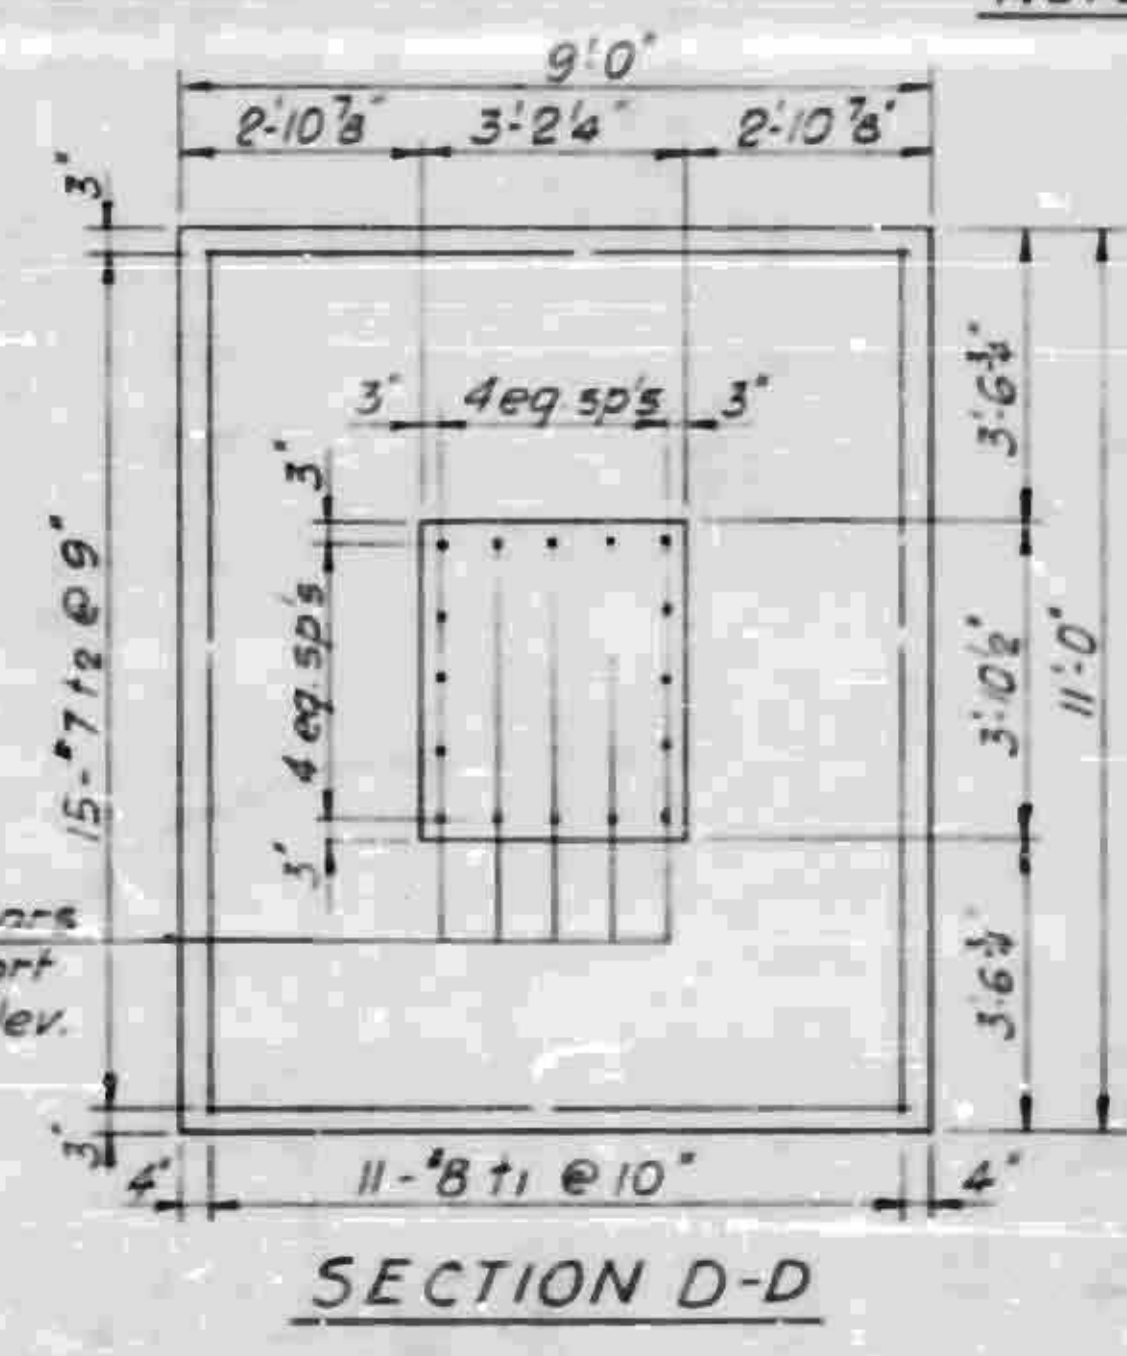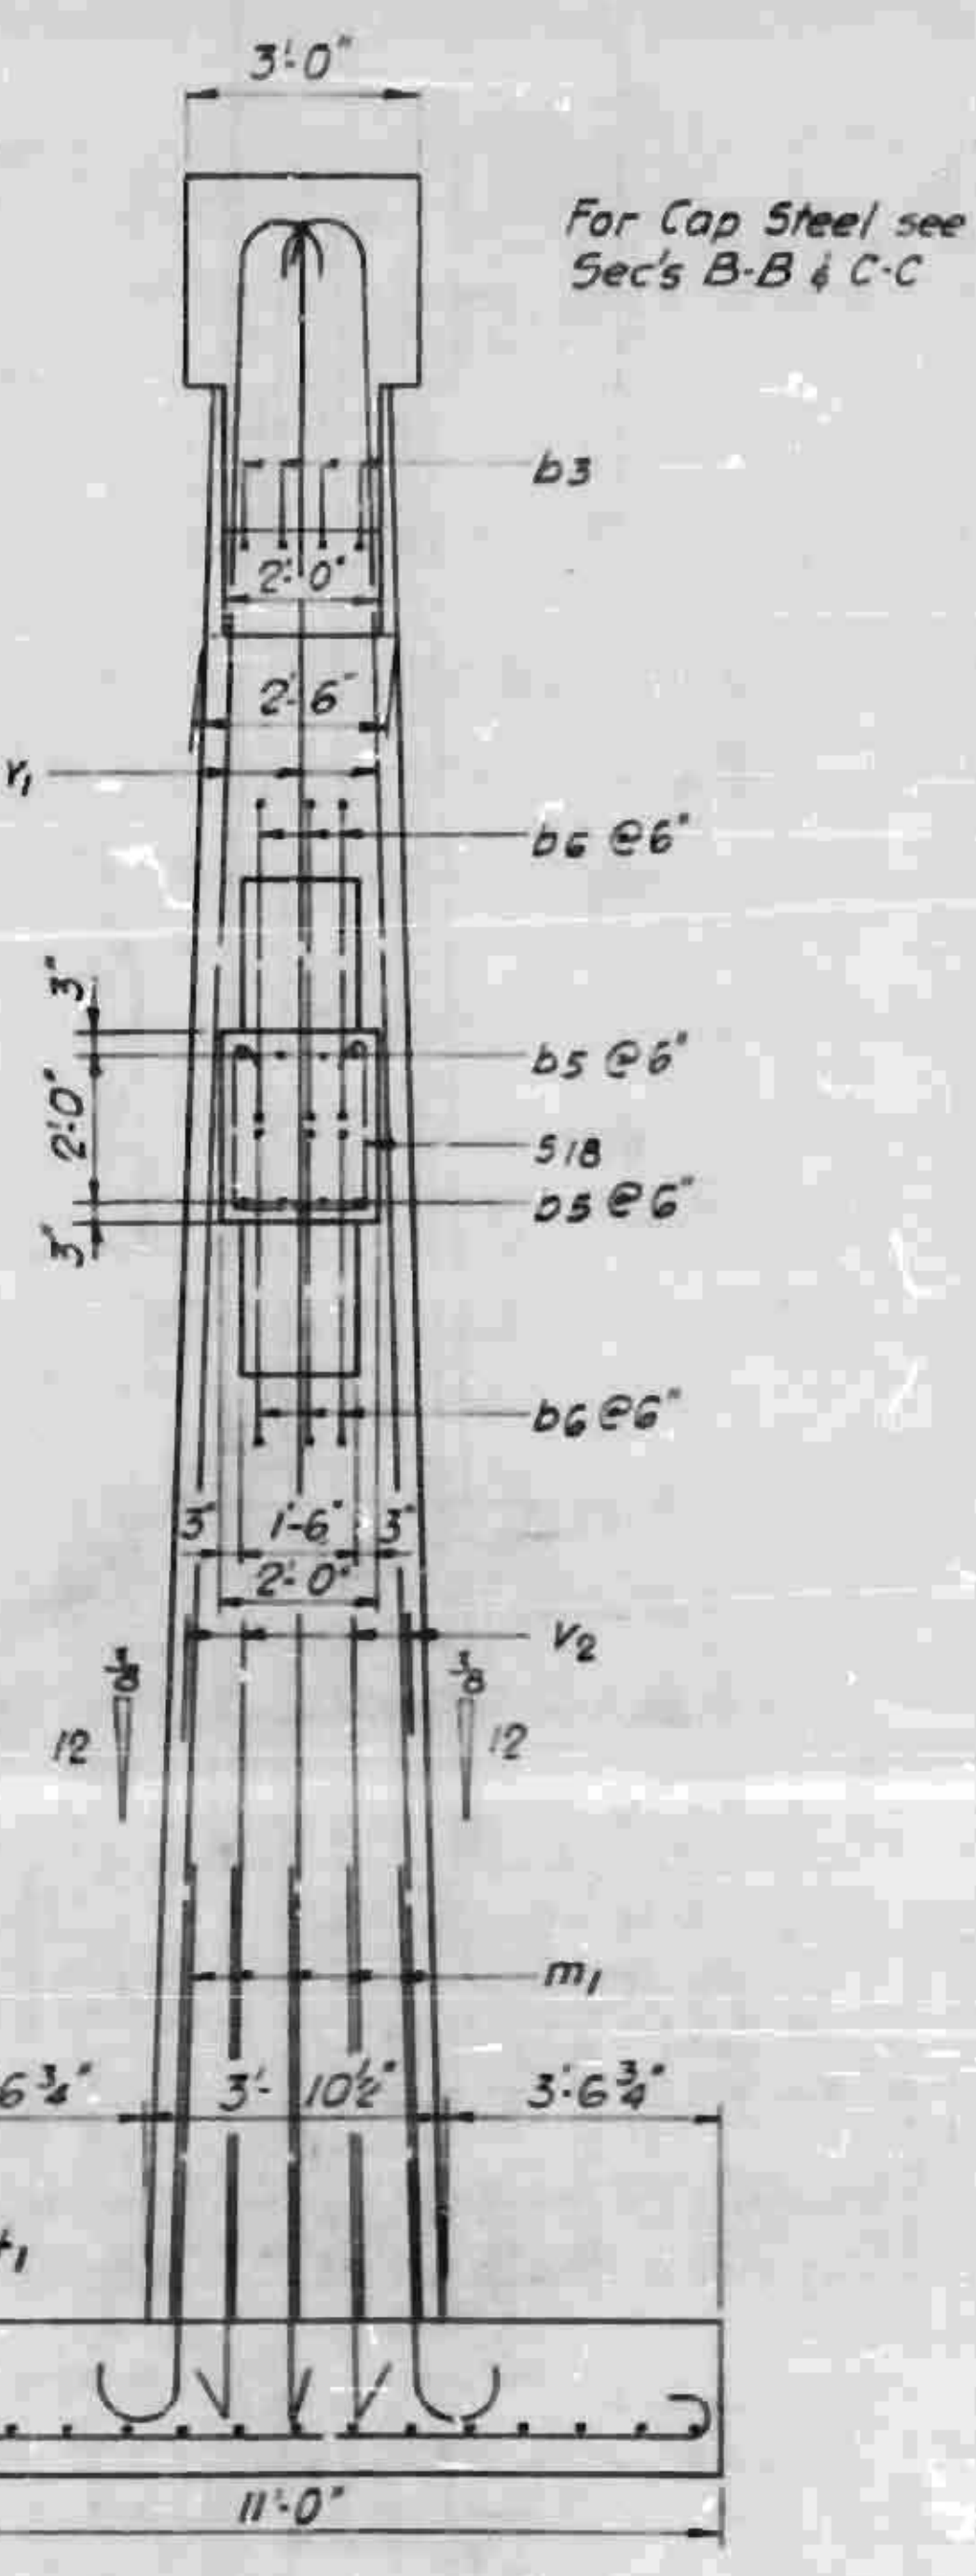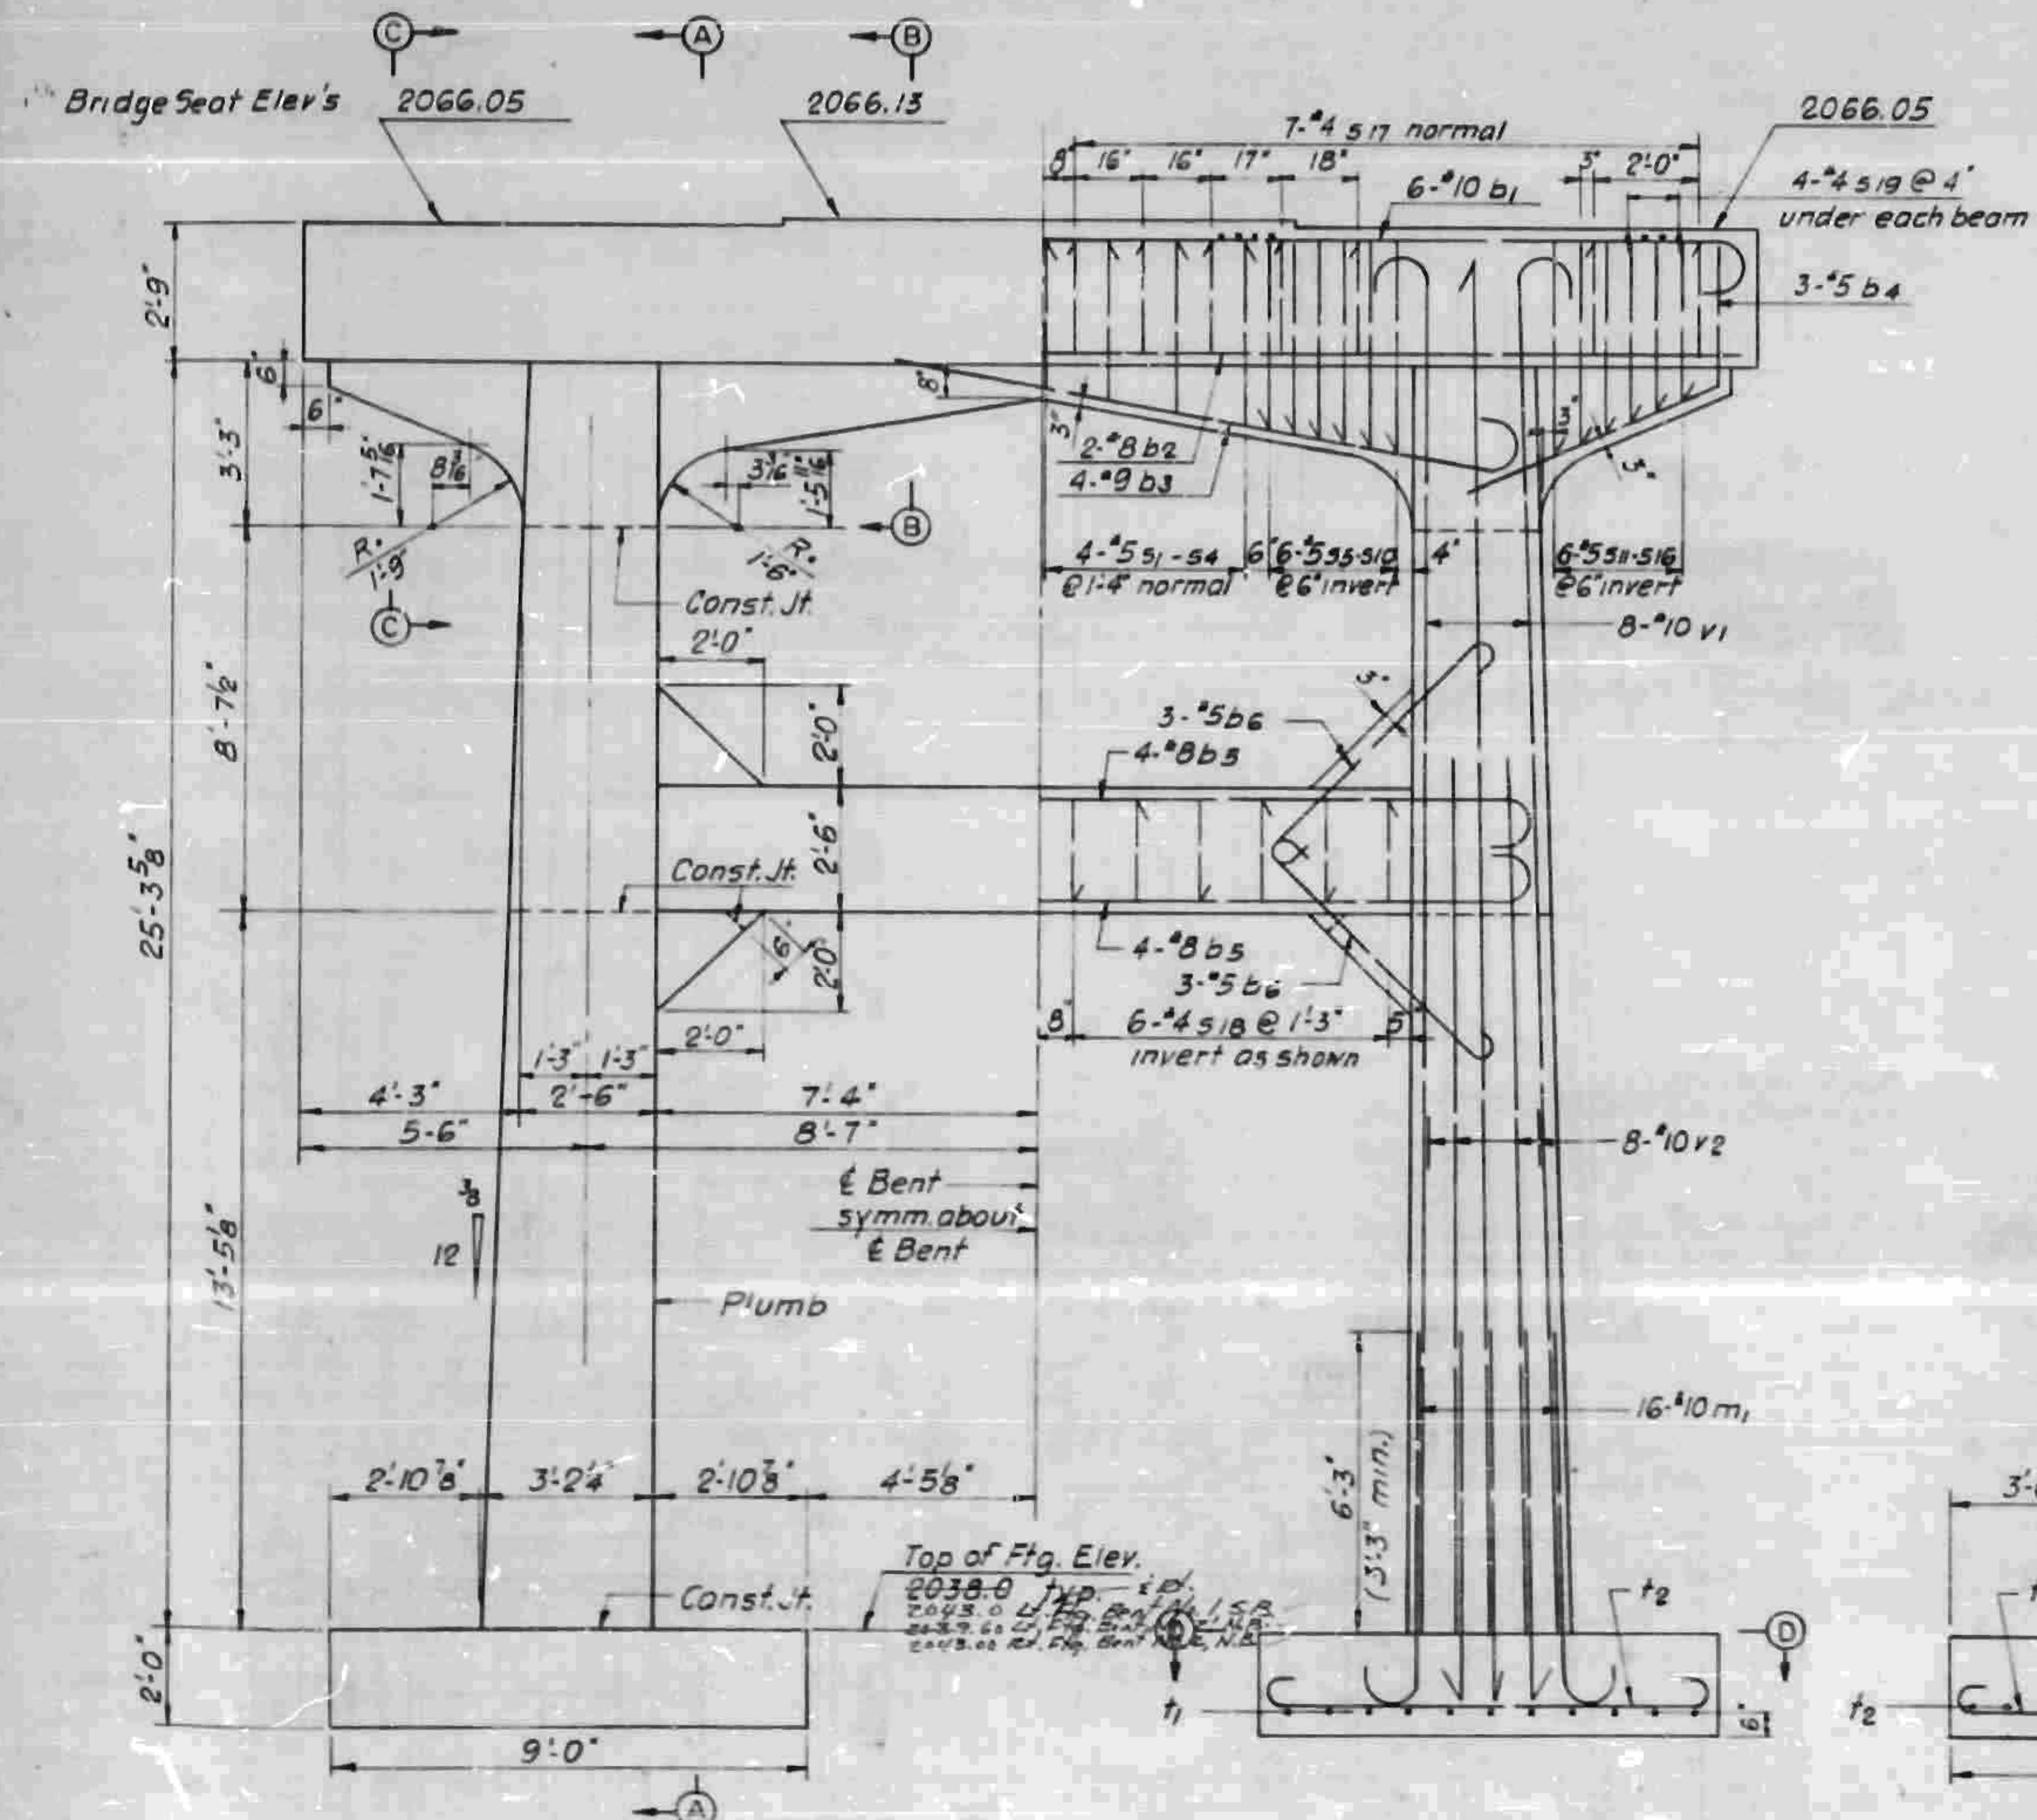

NOTE: All bar dimensions are out to out. Reinforcing in top of cap may be shifted as necessary to clear Anchor Bolts.

PROJECT NO. 819002
 HENDERSON-BUNCOMBE COUNTY
 STATION 1499+55 L

STATE OF NORTH CAROLINA	
STATE HIGHWAY COMMISSION	
BENTS 1 S.B. & 2 N.B.	
DATE	BY
DATE	BY
DATE	BY
DATE	BY

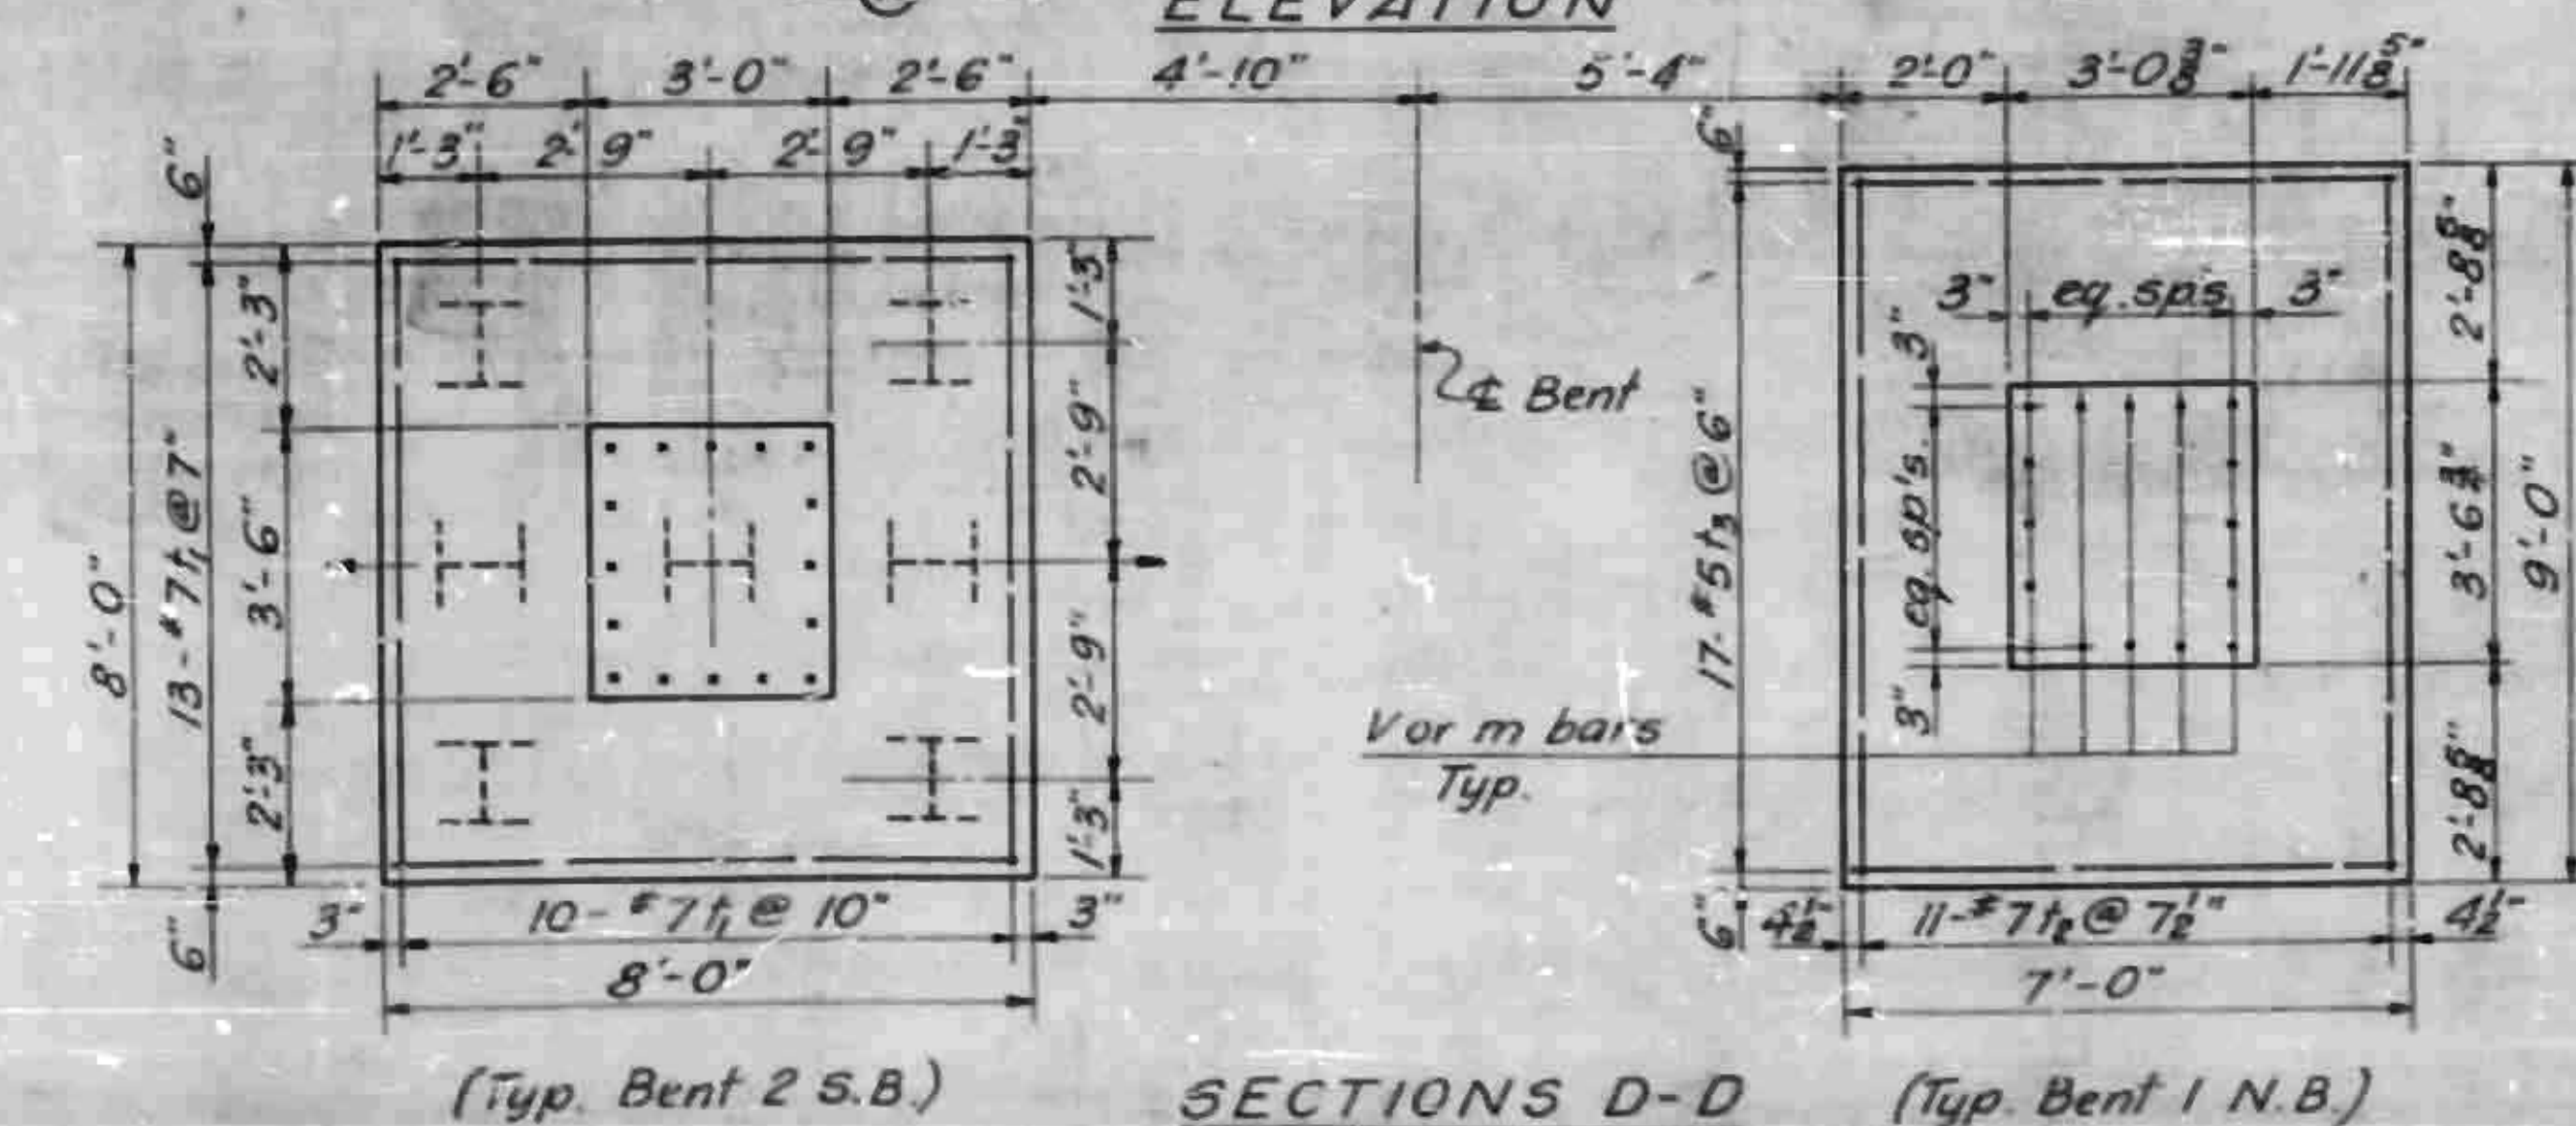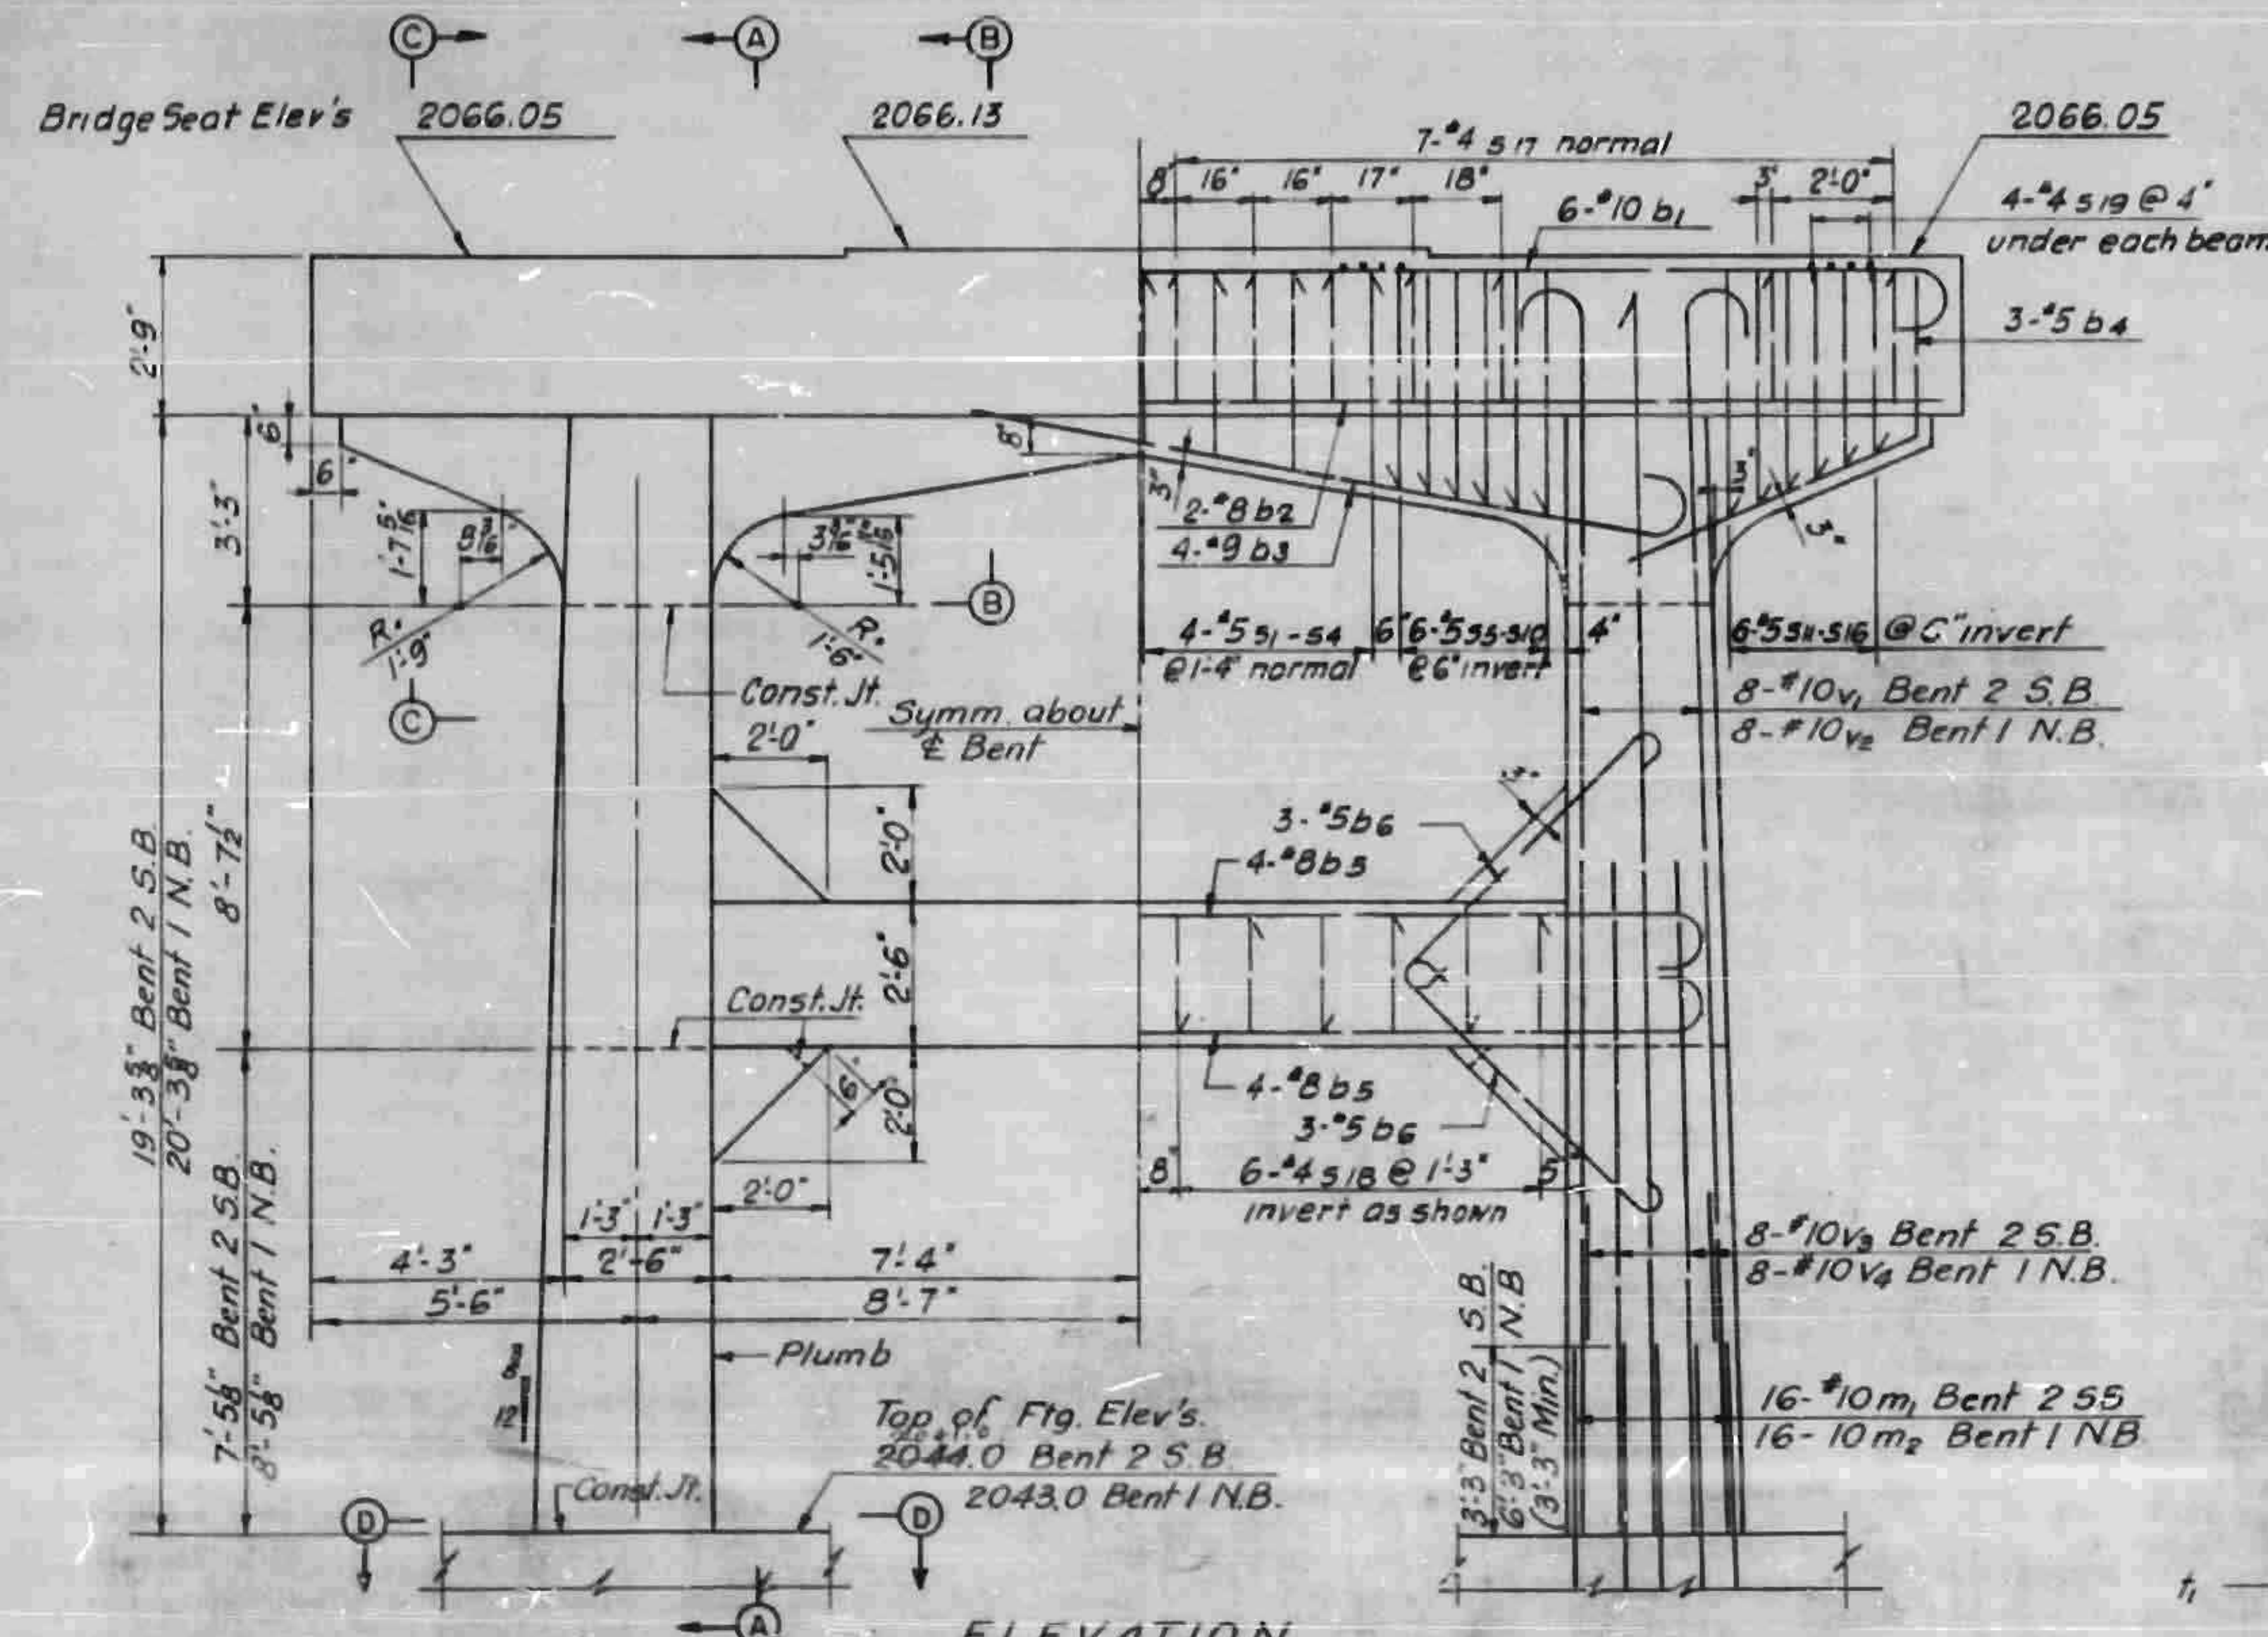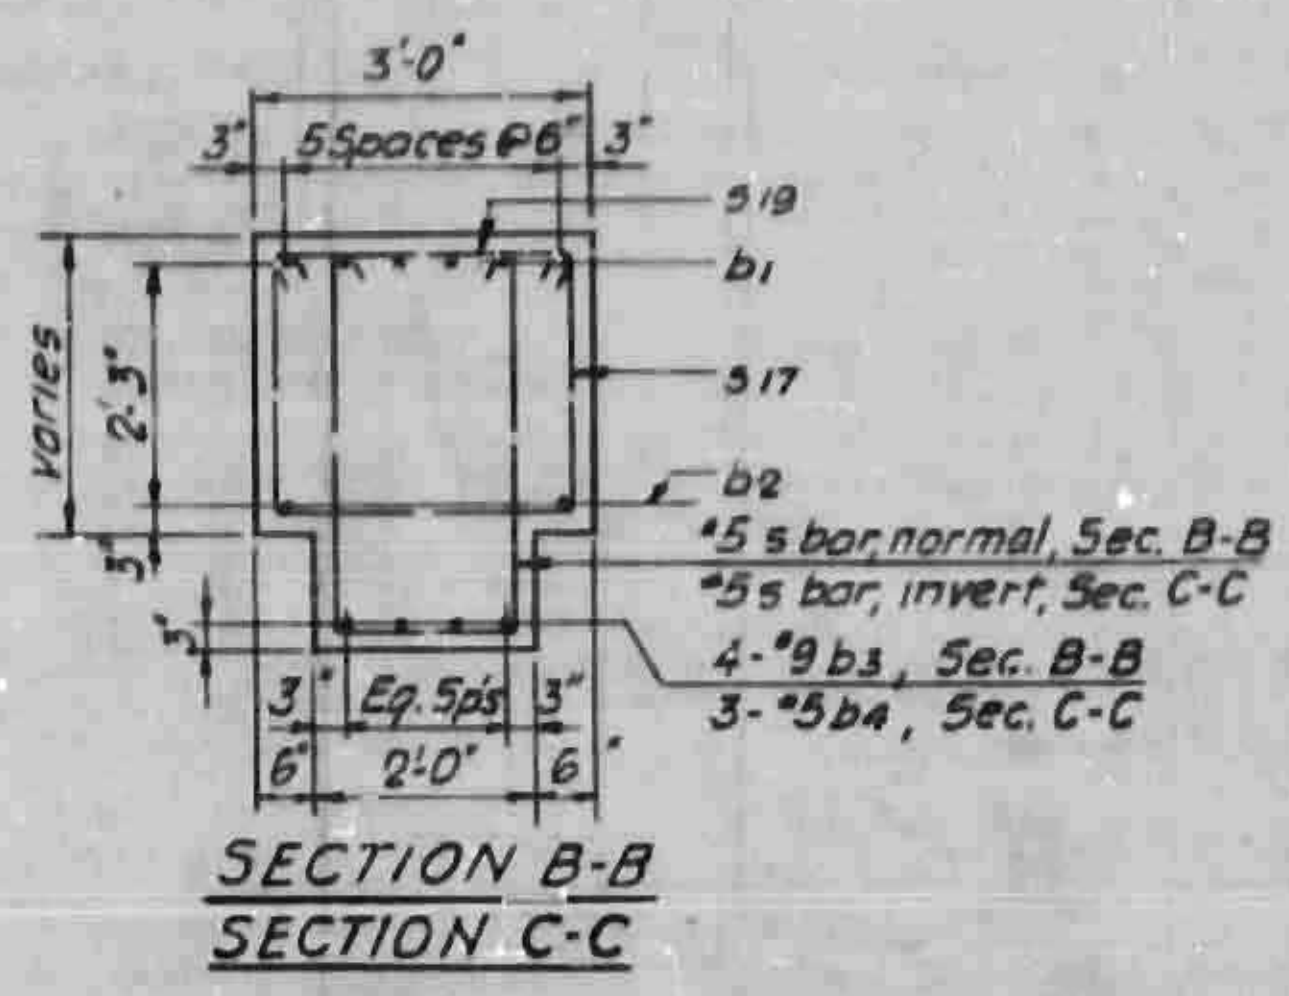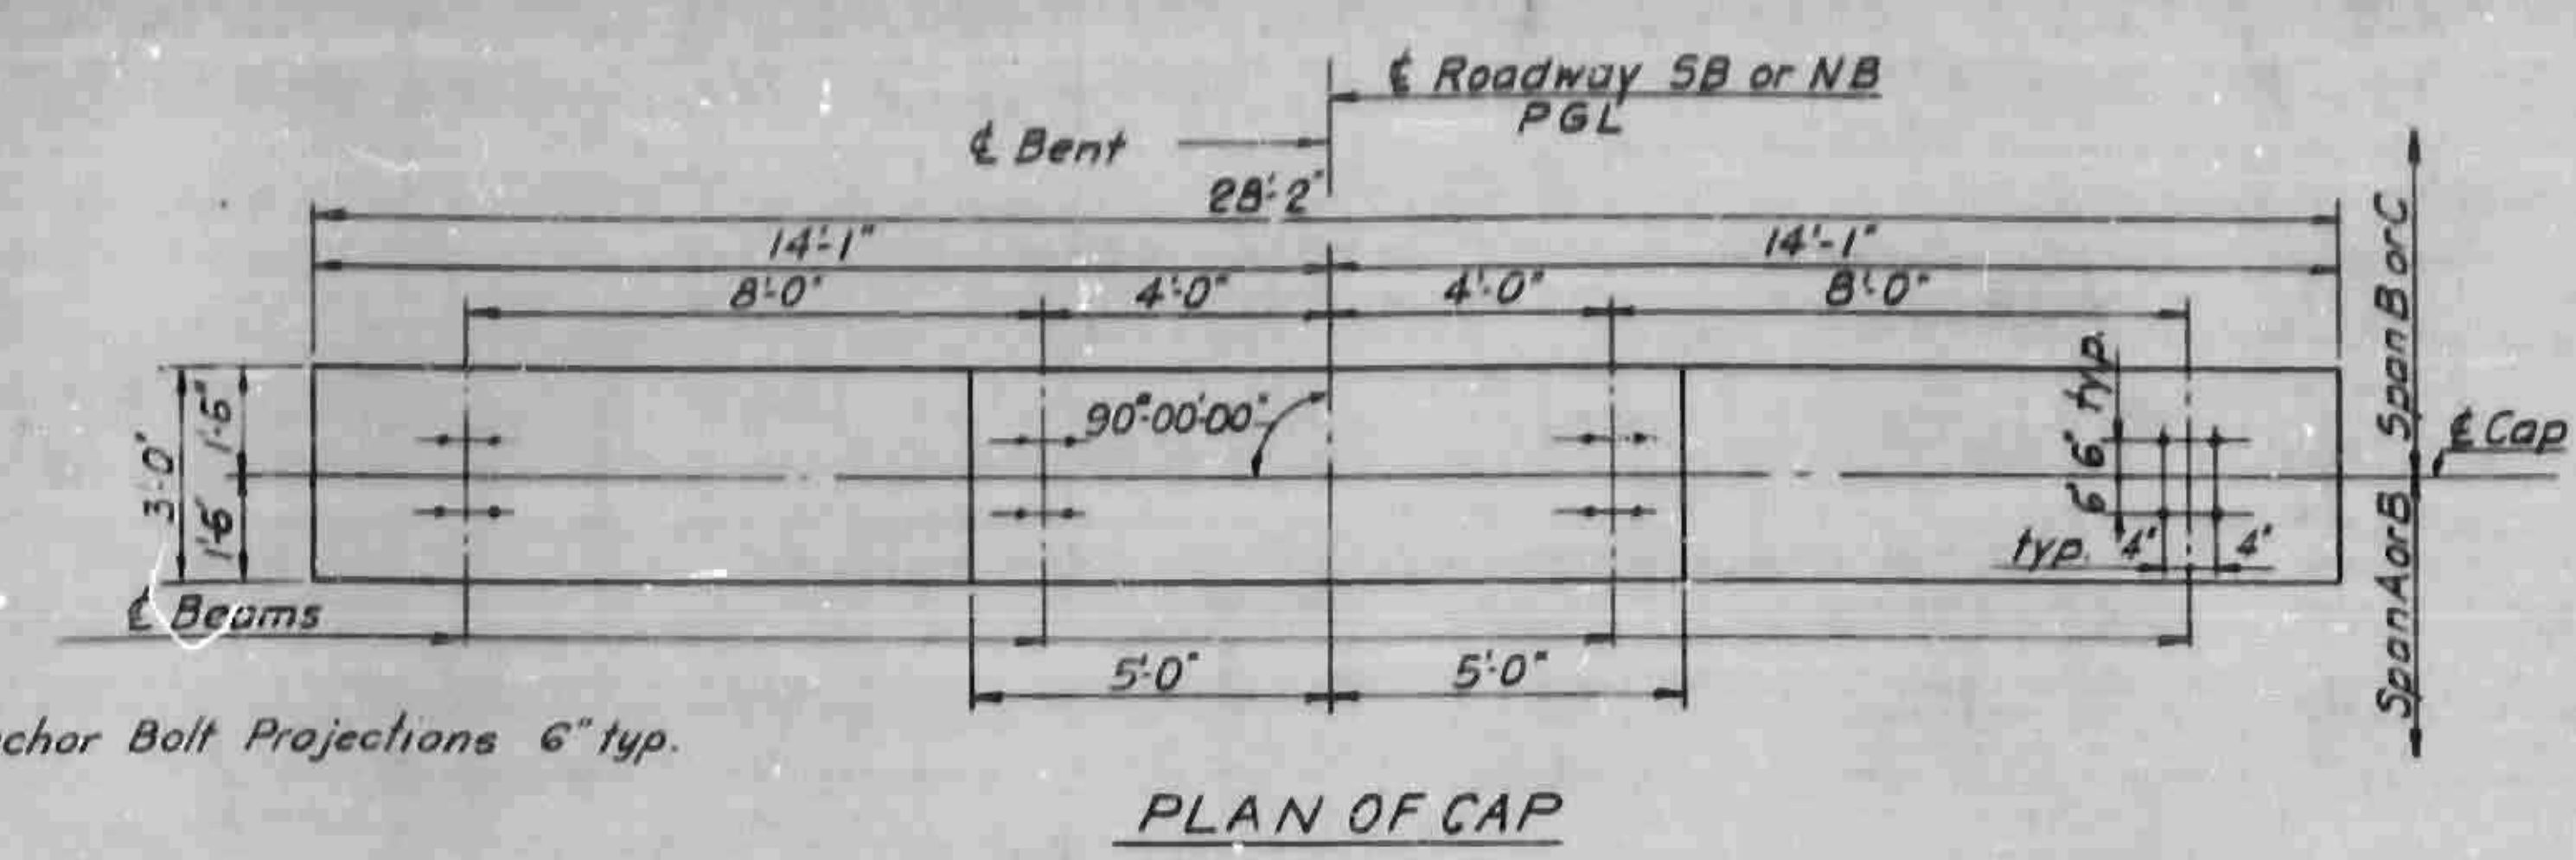

BAR DETAILS				BILL OF MATERIAL						
①				for one bent, 2 required						
HK		HK		BAR NO.	SIZE	TYPE	LENGTH	WEIGHT		
1'-5"	27'-8"	b1	1'-5"	b1	6	10	1	30.6	787	
1'-1"	19'-6"	b5	1'-1"	b2	2	8	5 1/2	27.8	148	
7"	6'-0"	b6	7"	b3	8	9	2	13.9	374	
10"	7'-6"	t1	10"	b4	6	5	3	8.5	53	
10"	8'-6"	t2	10"	b5	8	8	1	21.8	463	
7"	6'-6"	t3	7"	b6	12	5	1	7.2	90	
				Bent 2 S.B.	m1	32	10	2	6.6	895
				Bent 1 N.B.	m2	32	10	2	9.0	1239
				s1	1	5	5	8.8	9	
				s2	2	1	1	9.2	19	
				s3	2	1	1	9.8	20	
				s4	2	1	1	10.2	21	
				s5	2	1	1	10.4	22	
				s6	2	1	1	10.6	22	
				s7	2	1	1	10.8	22	
				s8	2	1	1	10.9	23	
				s9	2	1	1	11.0	23	
				s10	2	1	1	11.2	23	
				s11	2	1	1	9.1	19	
				s12	2	1	1	9.7	20	
				s13	2	1	1	10.1	21	
				s14	2	1	1	10.7	22	
				s15	2	1	1	11.1	23	
				s16	2	5	4	11.7	24	
				s17	14	4	1	8.3	77	
				s18	12	4	5	6.9	54	
				s19	16	4	4	3.5	37	
				Bent 2 S.B.	t1	46	7	1	9.2	862
				" INB	t2	22	7	1	10.2	457
				" INB	t3	34	5	1	7.8	272
				" 2 S.B.	v1	16	10	2	22-11	1578
				Bent 1 N.B.	v2	16	10	2	23-11	1647
				" 2 S.B.	v3	16	10	Str.	10-7	729
				" INB	v4	16	10	Str.	11-7	797
				Bent 2 S.B. 6865						
				Reinforcing Steel Lbs. 6240						
				Class A Concrete Cu.Yds. 352						
				72BP53 Steel Piles No. 14						
				12BP53 Steel Piles Lin. Ft. 166						
				Bent 1 N.B.						
				Reinforcing Steel Lbs. 6828						
				Class A Concrete Cu.Yds. 355						
				35.69						








NOTE: All bar dimensions are out to out. Reinforcing in top of cap may be shifted as necessary to clear Anchor Bolts.

PROJECT NO. 819002
 HENDERSON-BUNCOMBE COUNTY
 STATION 1499 + 55 L

STATE OF NORTH CAROLINA
 STATE HIGHWAY COMMISSION
 Raleigh

BENTS 1 N.B. & 2 S.B.

DATE: _____
 BY: _____
 CHECKED: _____
 DATE: _____

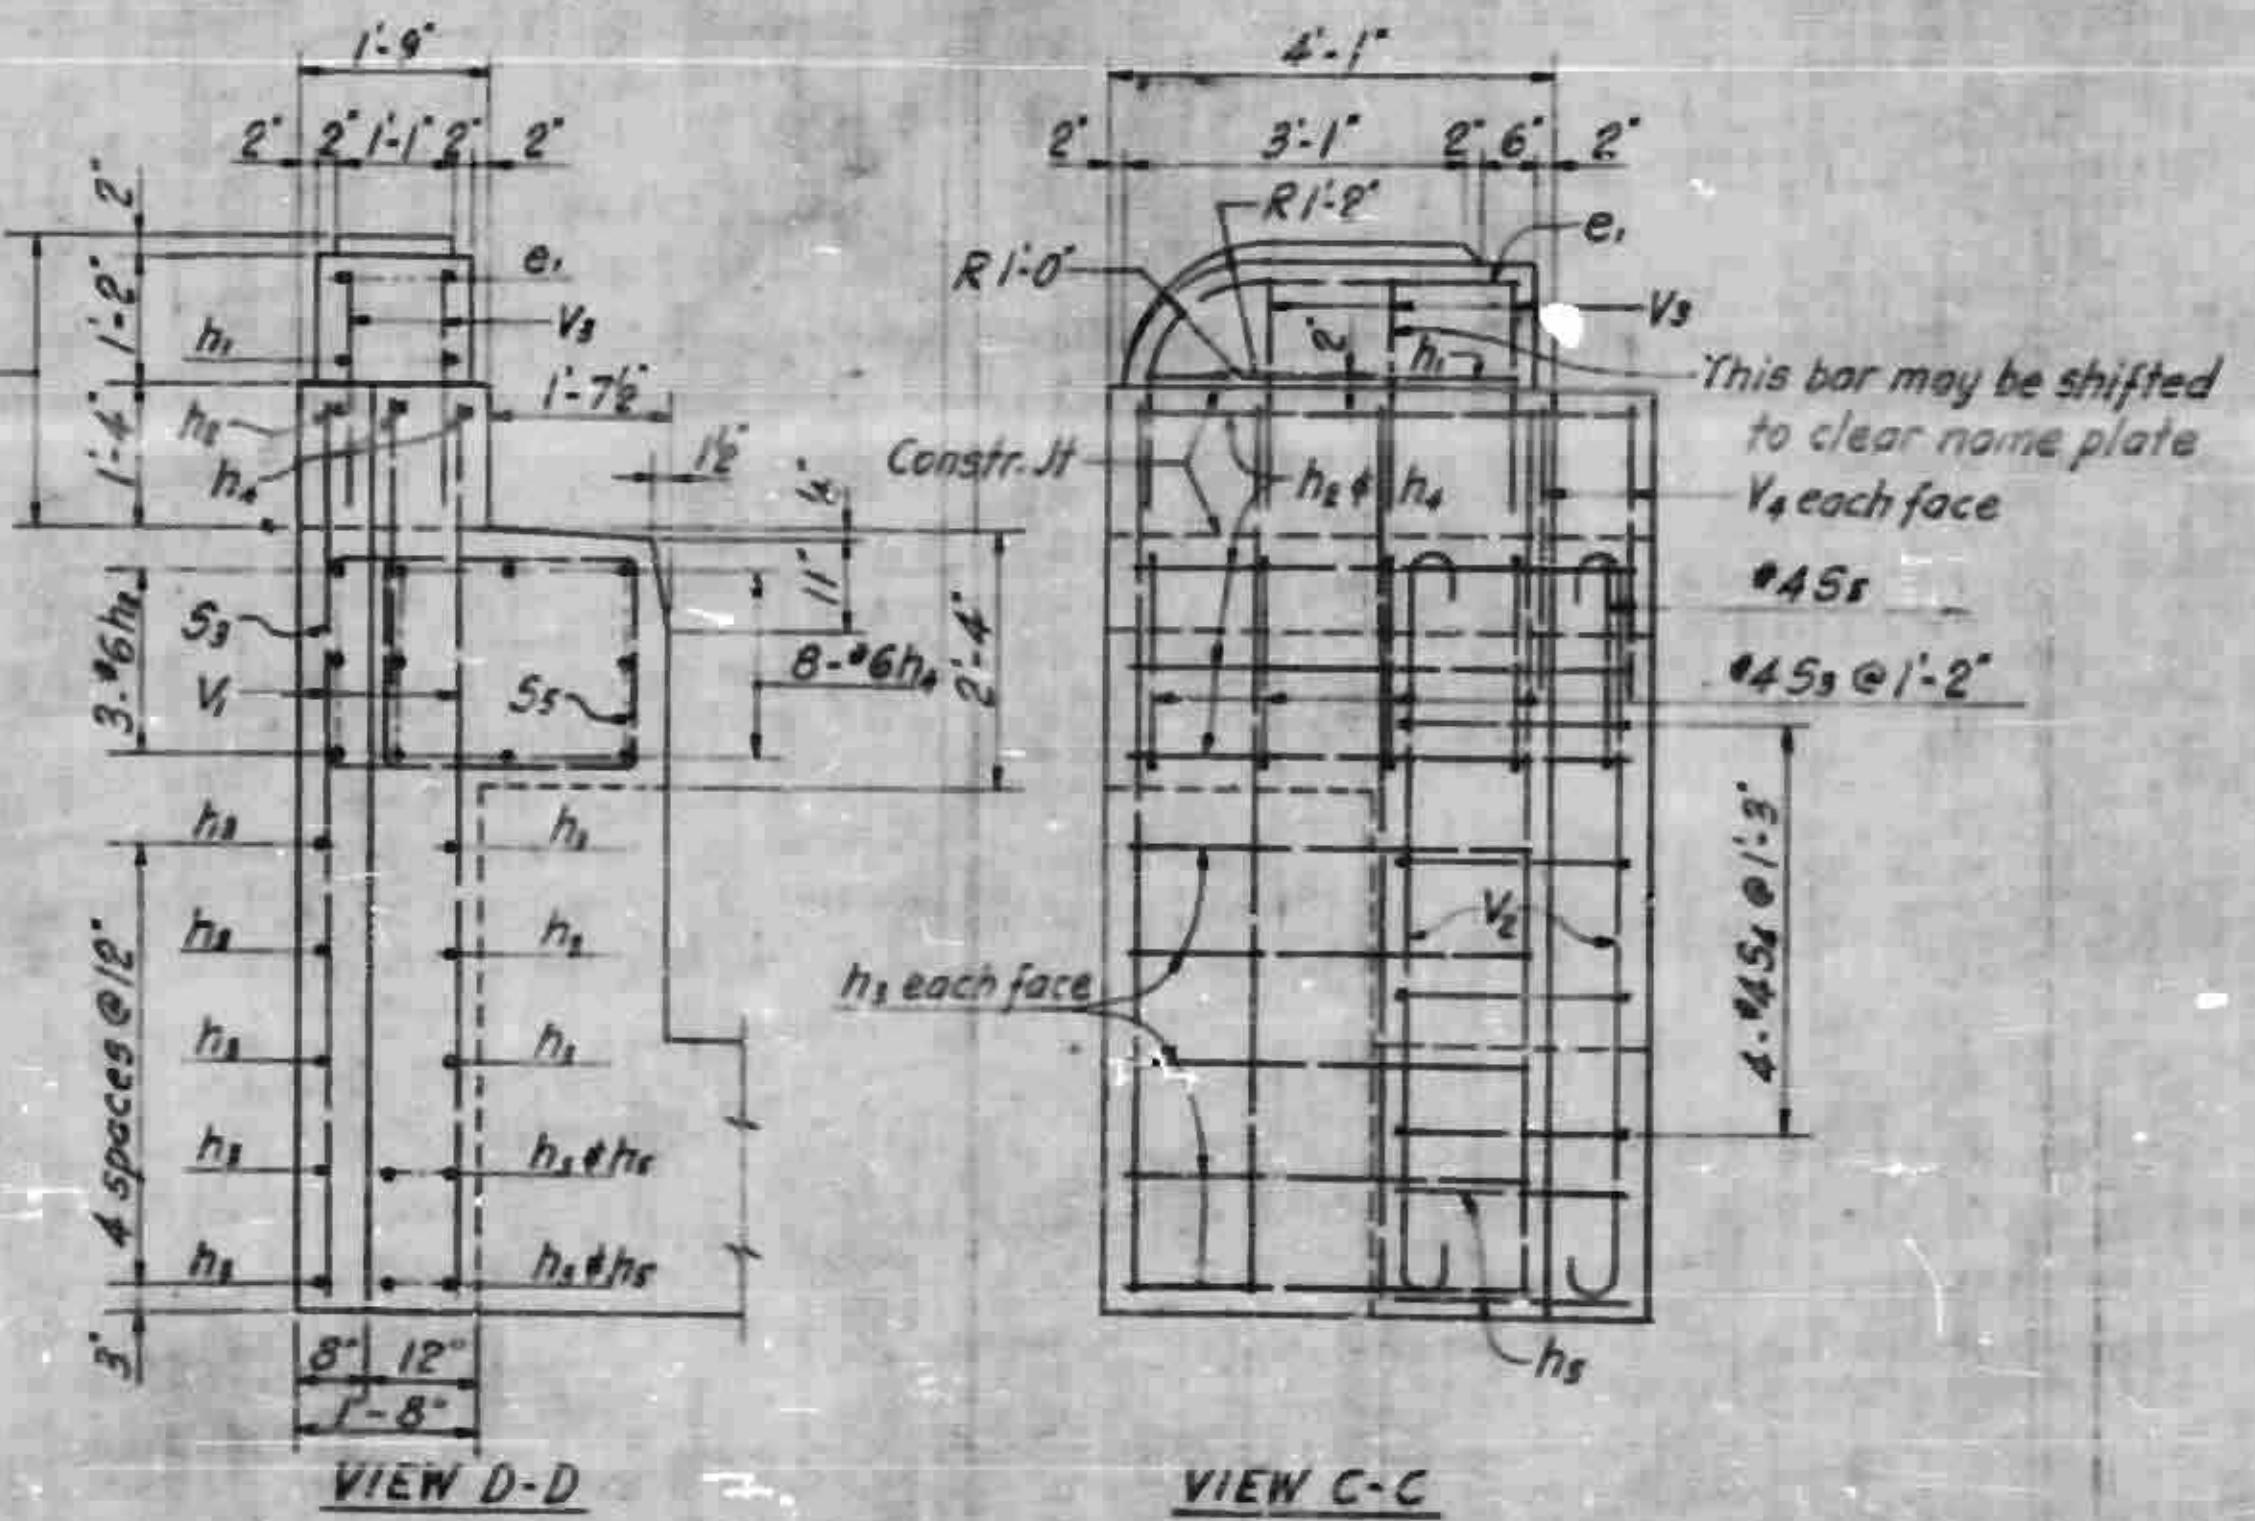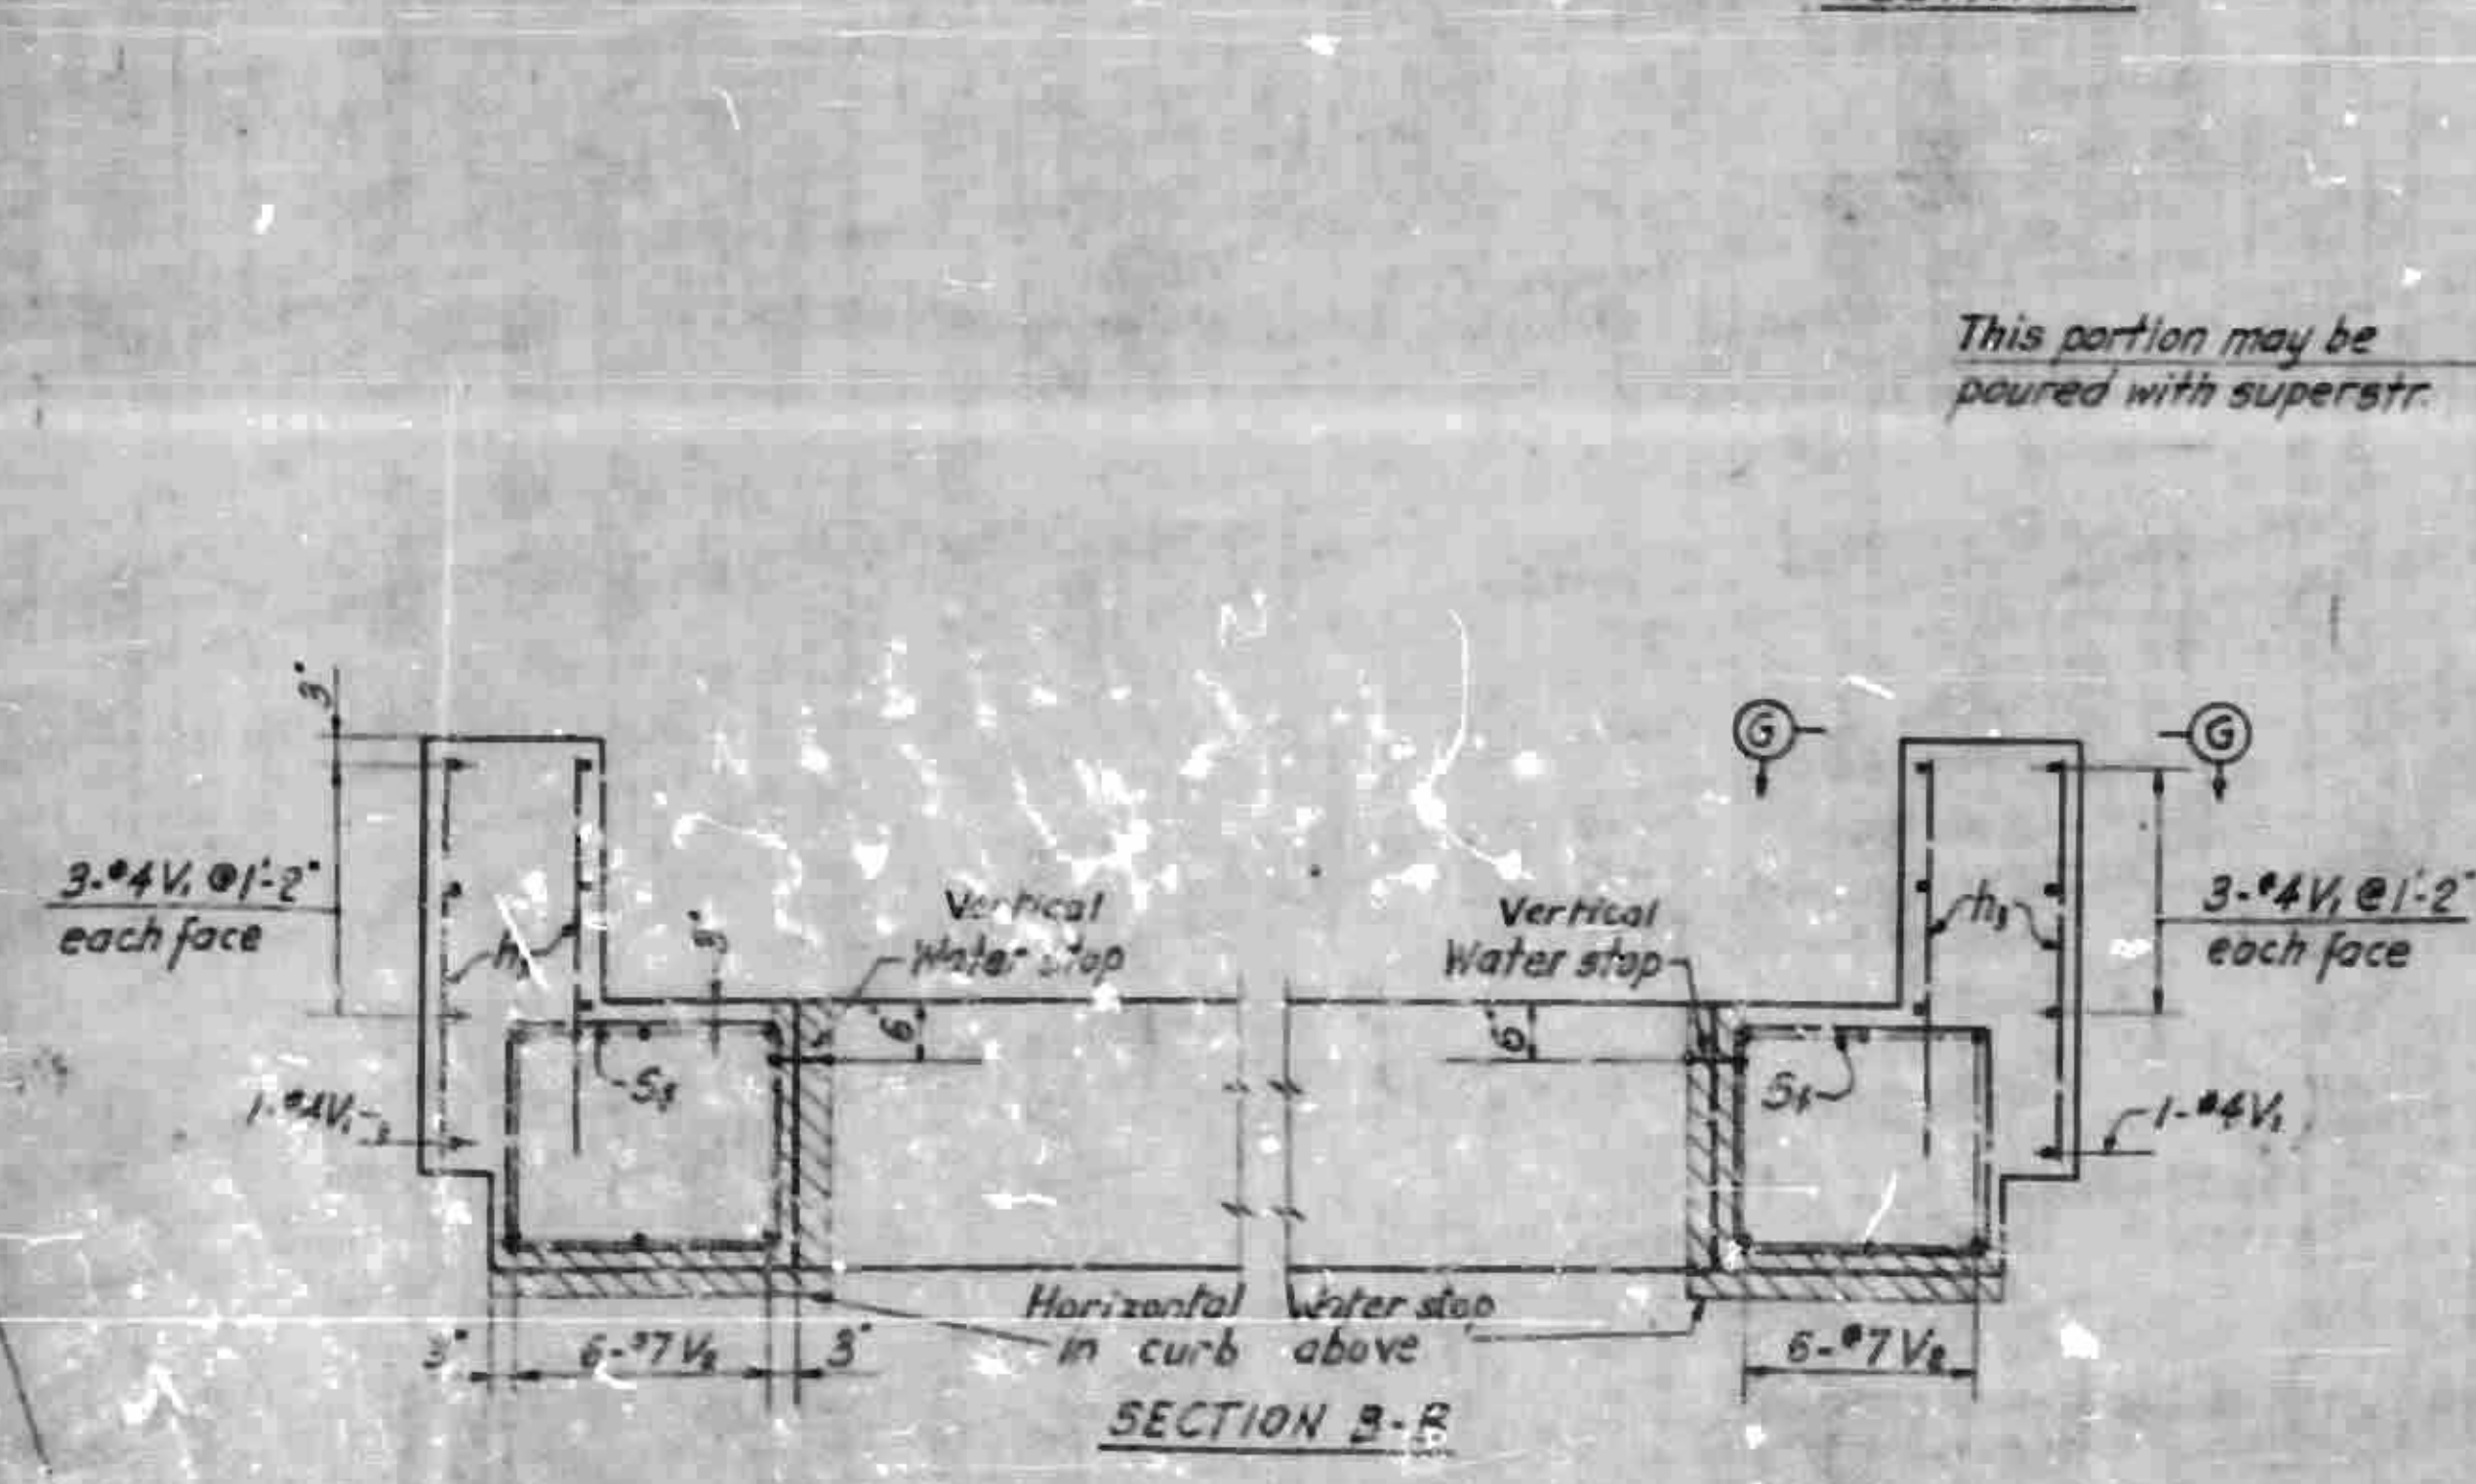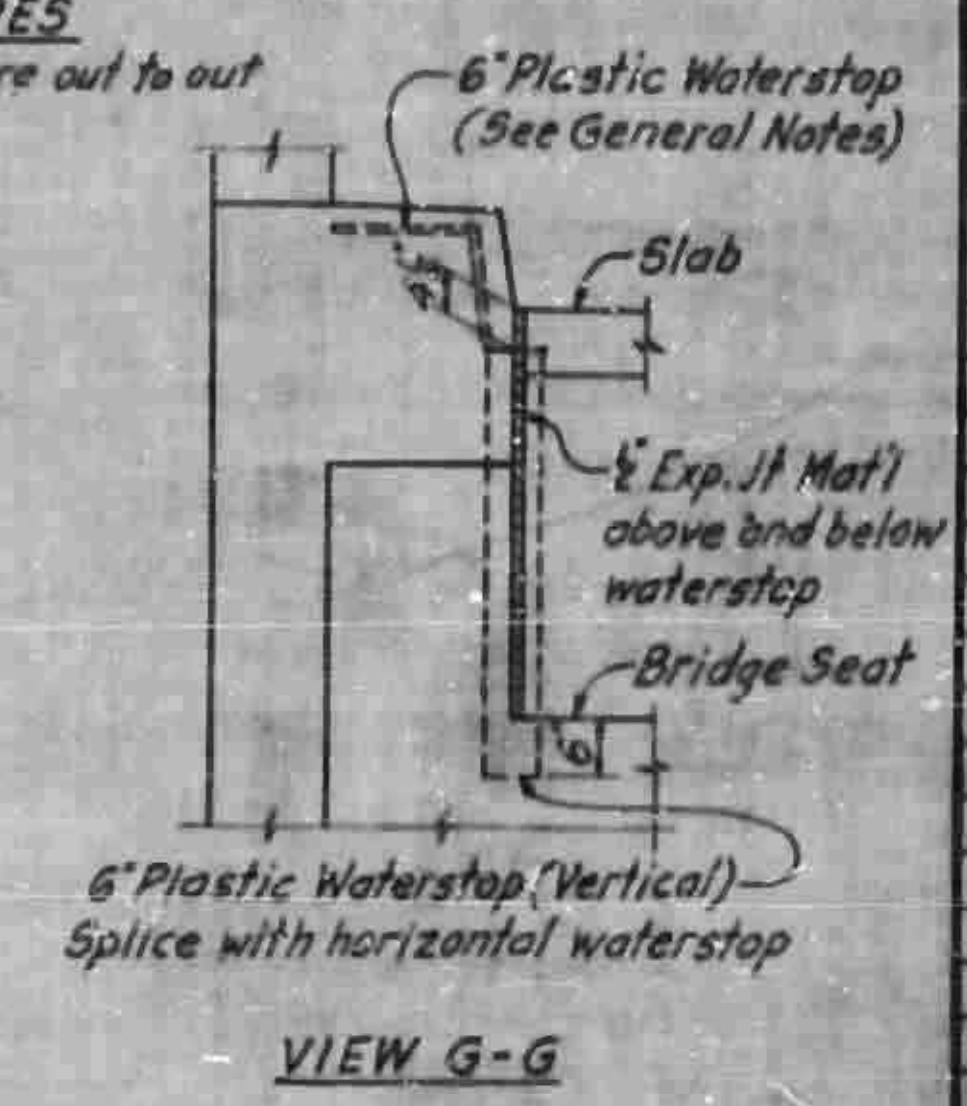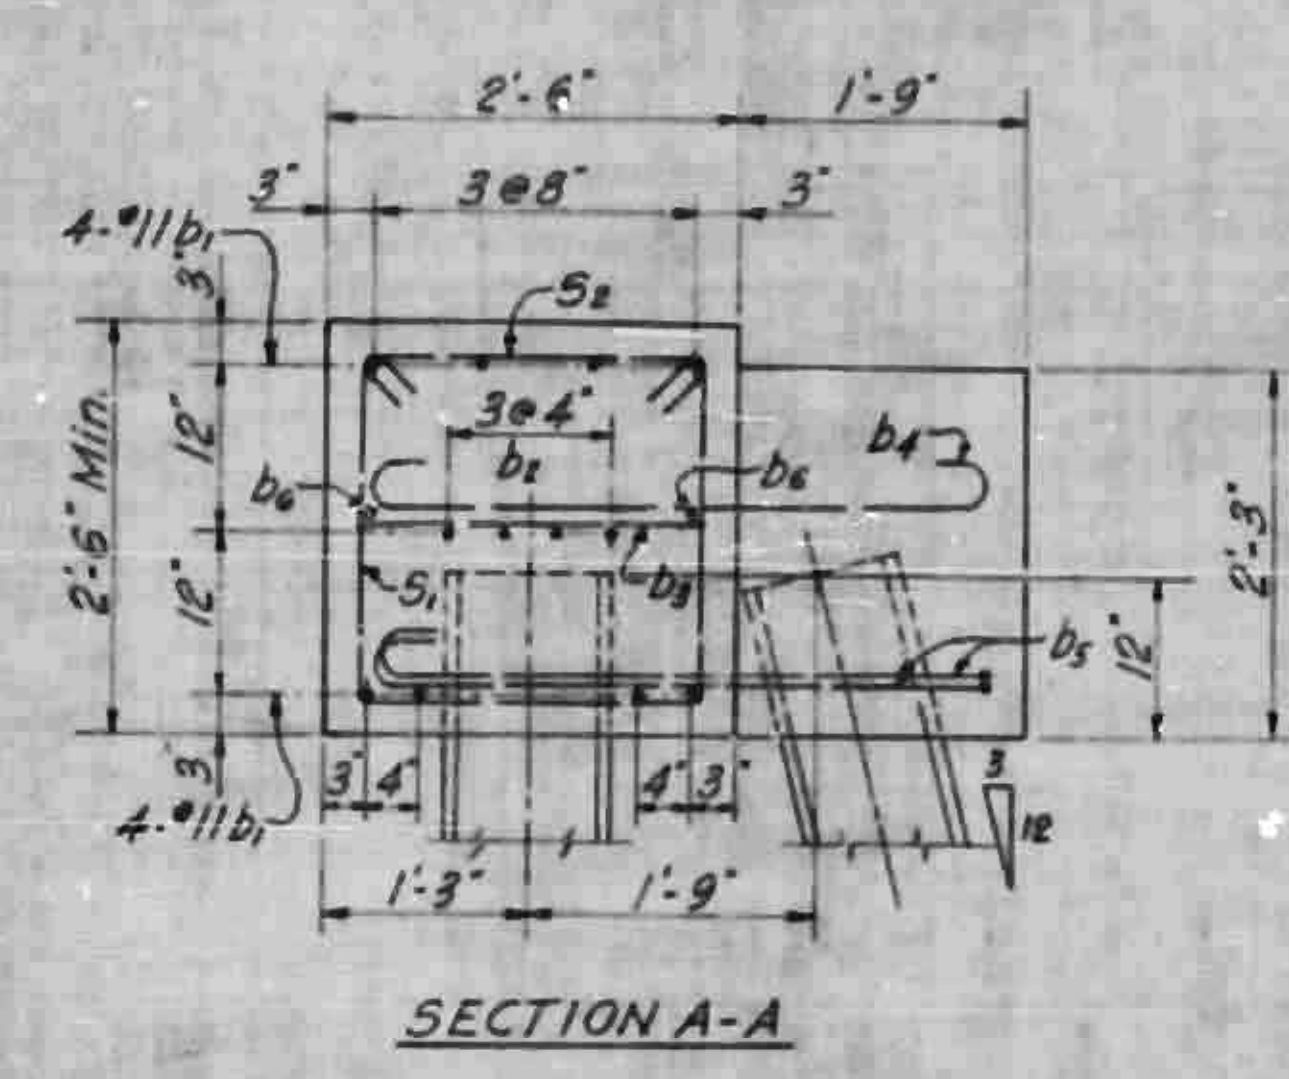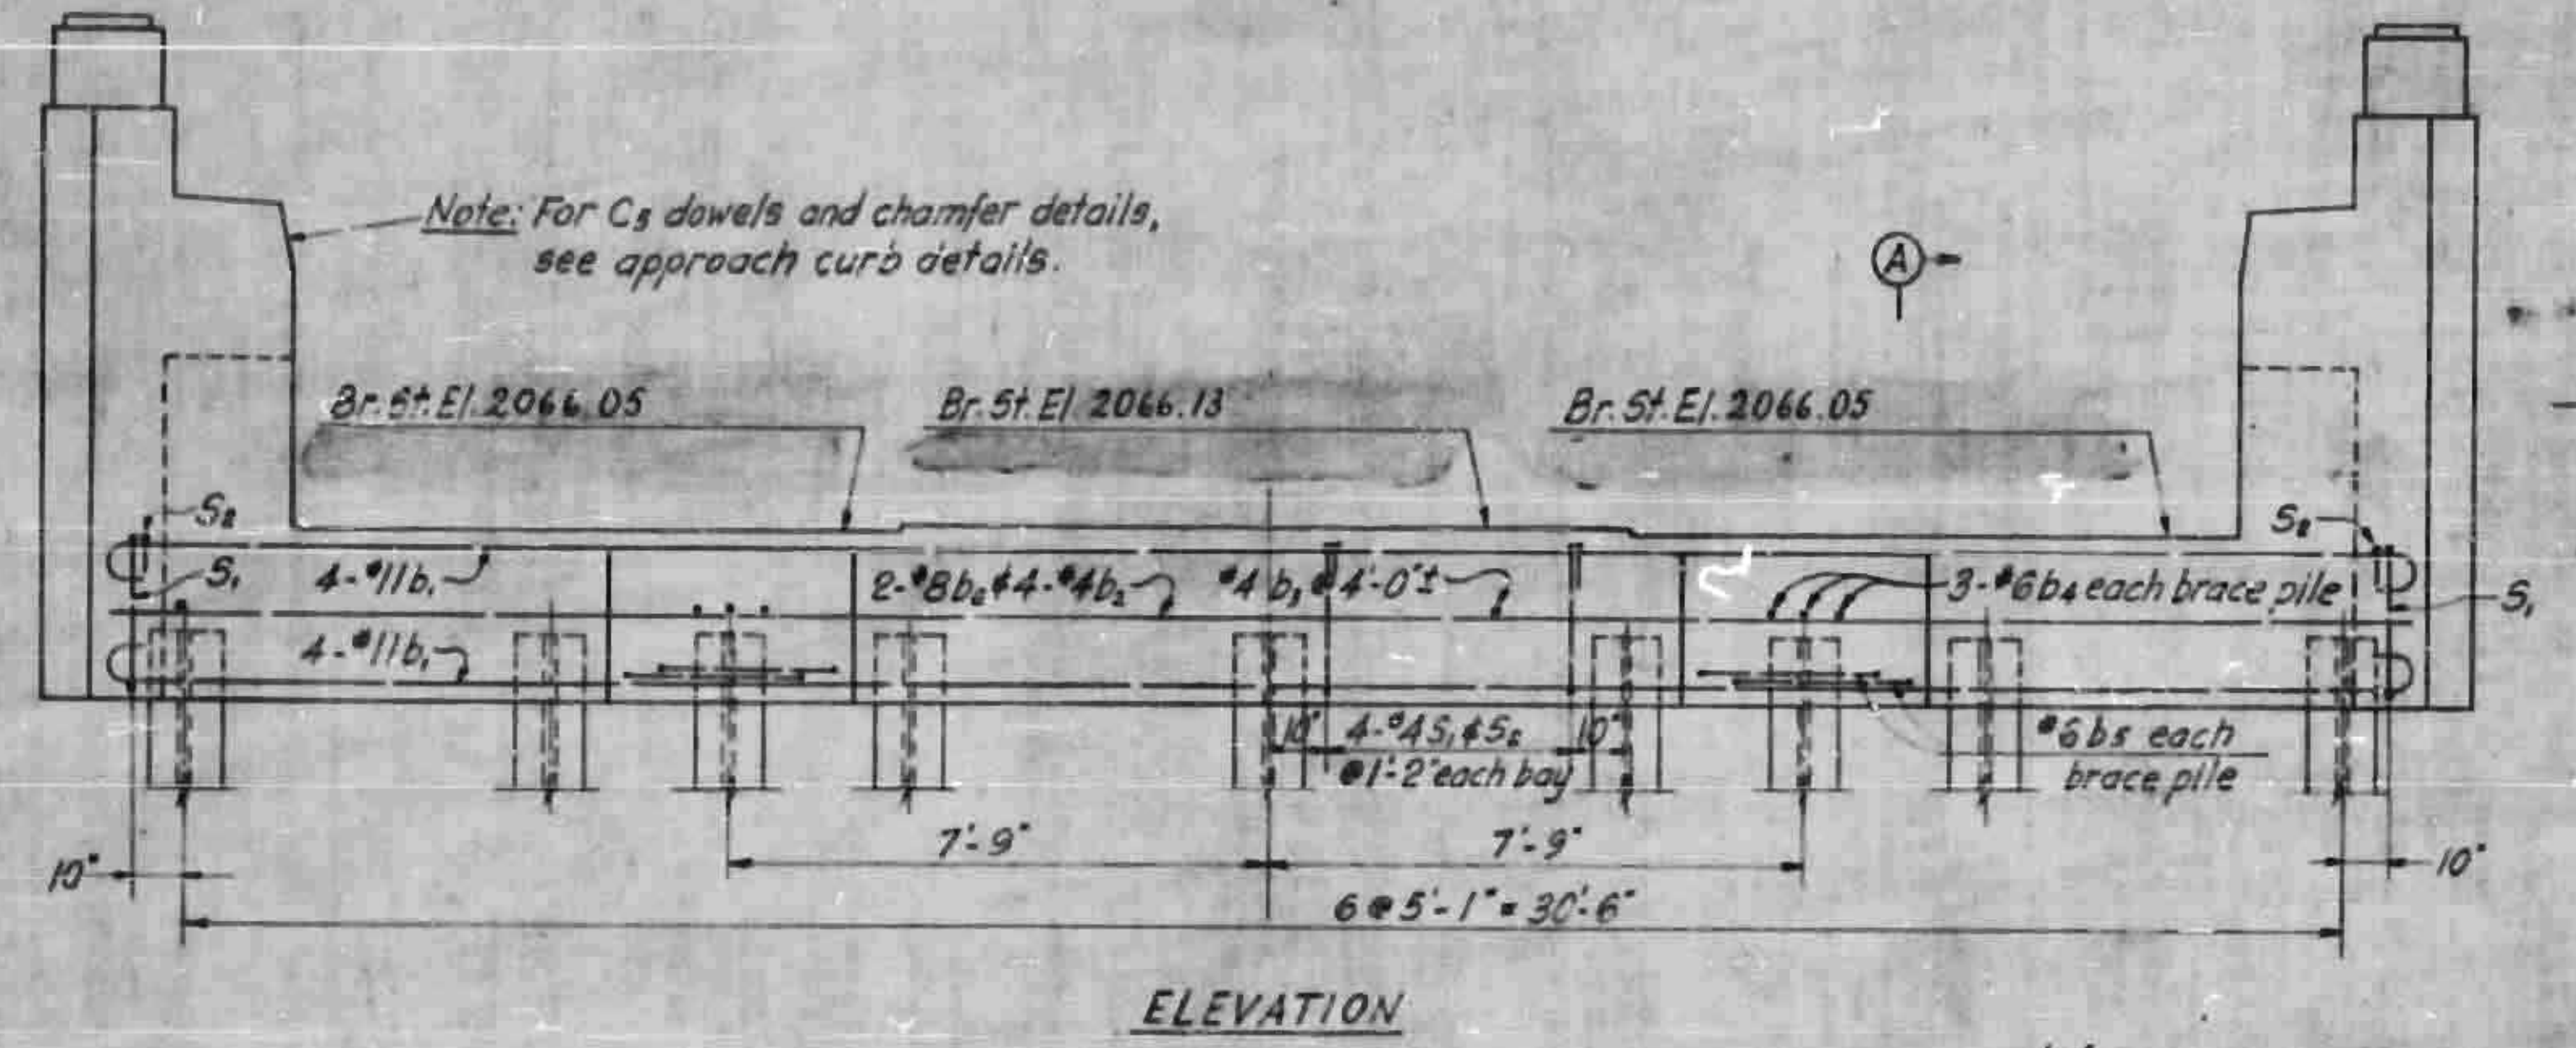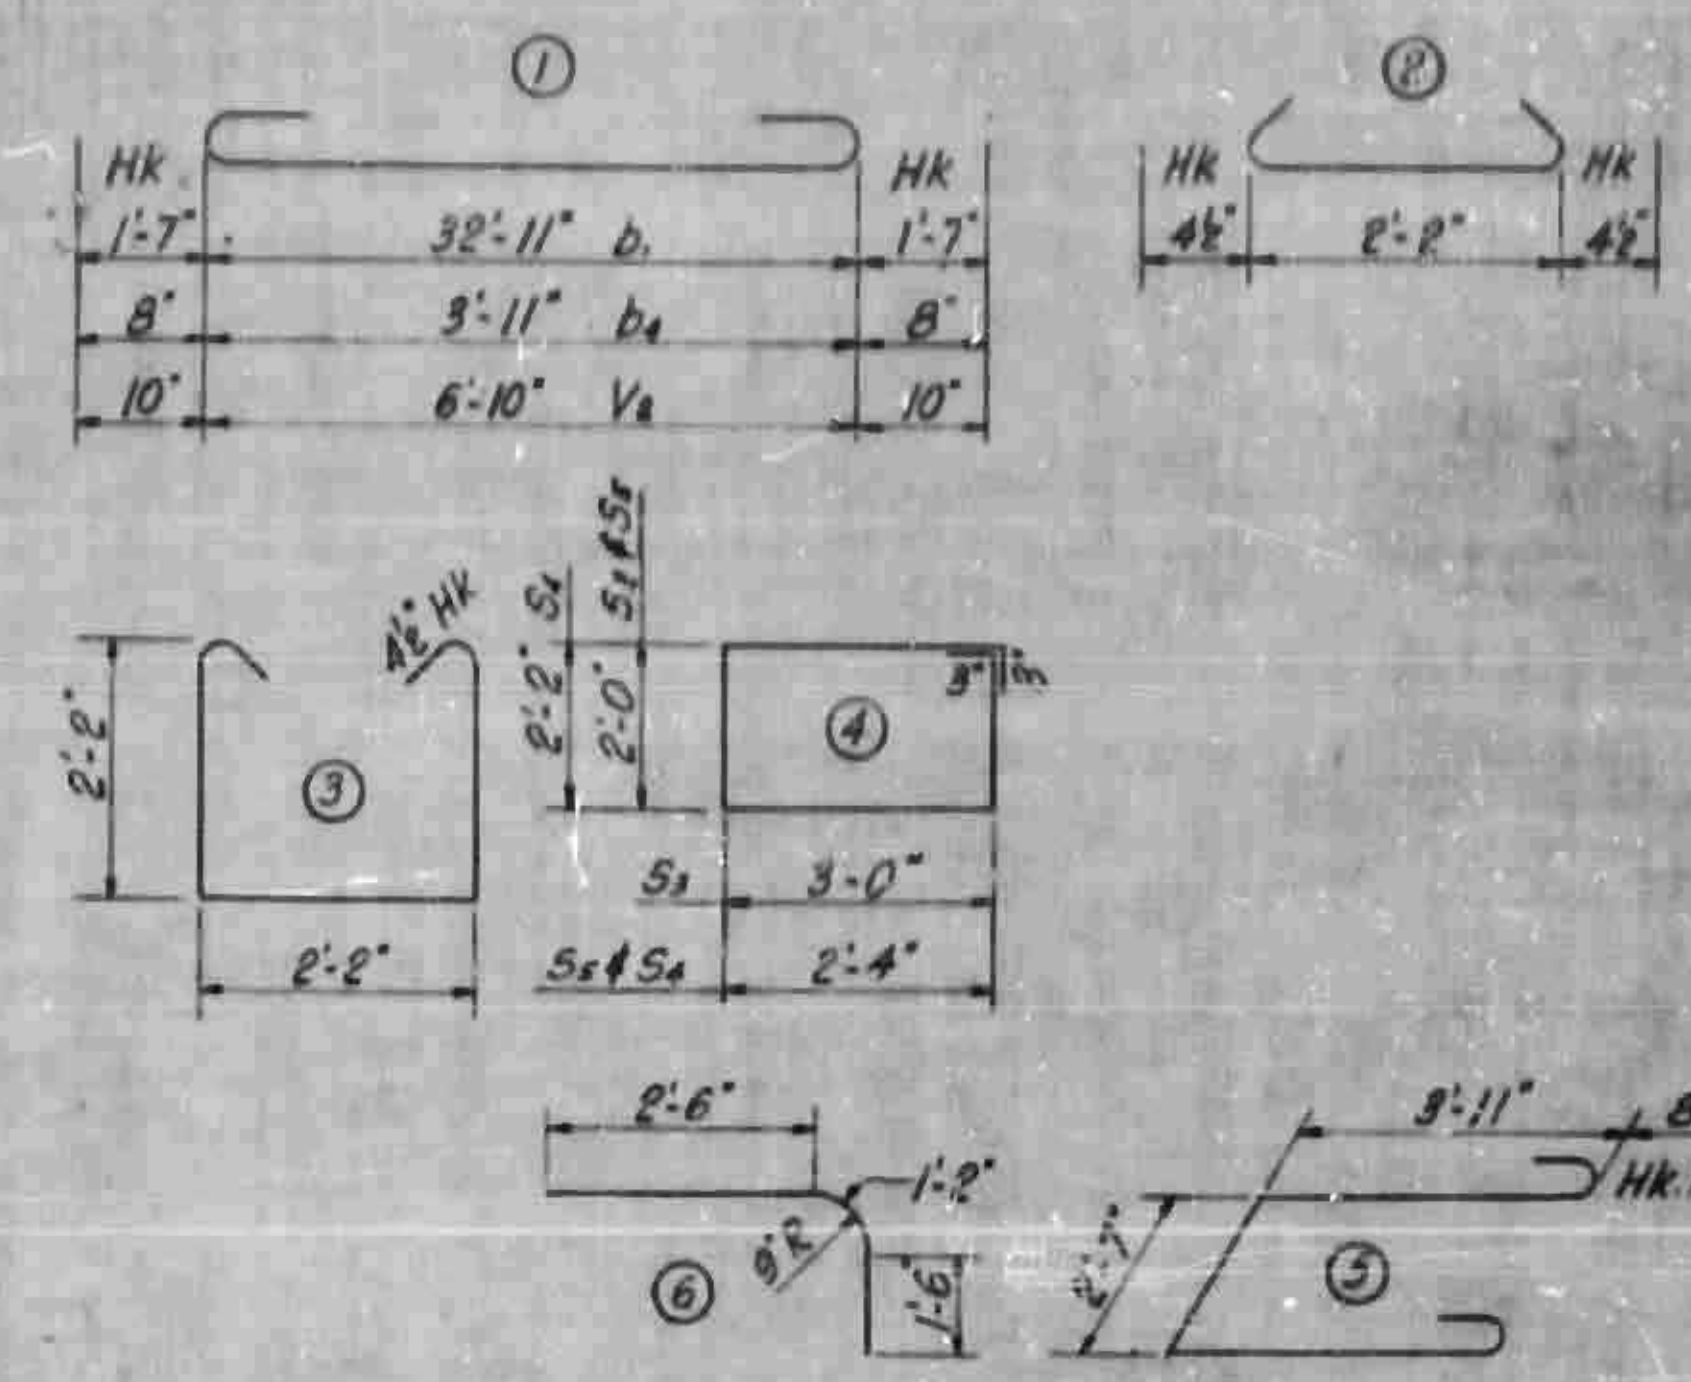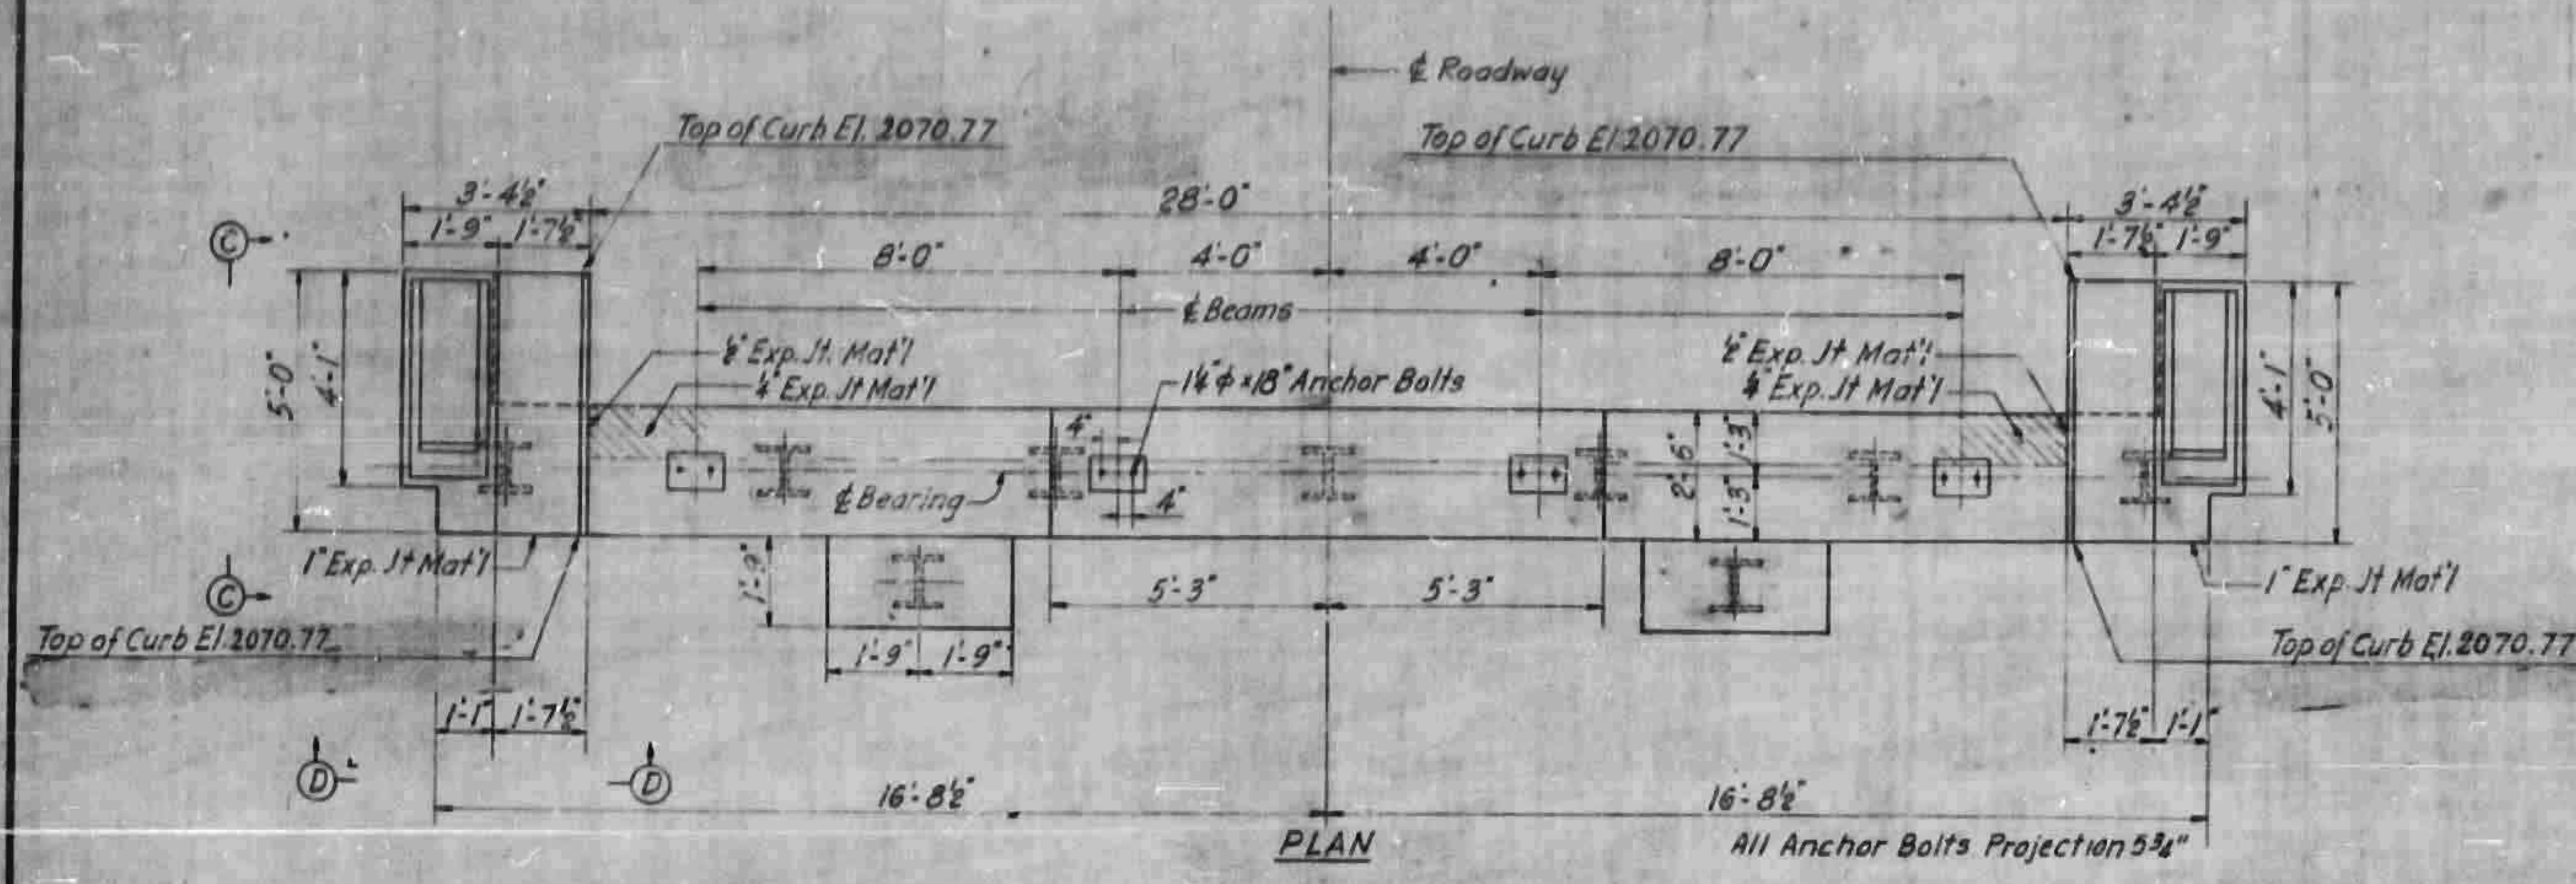

BILL OF MATERIAL FOR ONE END BENT

BAR NO.	SIZE	TYPE	LENGTH	WEIGHT	
b ₁	3	#11	36'-1"	1534	
b ₂	4	#4 Str	32'-11"	88	
b ₃	9	#4 Str	2'-2"	13	
b ₄	6	#6	5'-3"	47	
b ₅	4	#6	11'-9"	71	
b ₆	2	#8 Str	32'-11"	176	
e	4	#4	6	5'-2"	14
h ₁	4	#4 Str	3'-5"	9	
h ₂	3	#6 Str	3'-9"	45	
h ₃	20	#4 Str	3'-9"	50	
h ₄	20	#6 Str	4'-8"	141	
h ₅	4	#4 Str	2'-3"	6	
S ₁	26	#4	3	7'-3"	126
S ₂	26	#6	2	2'-11"	51
S ₃	8	#4	4	10'-6"	56
S ₄	8	#4	4	9'-6"	51
S ₅	2	#4	4	9'-2"	12
V ₁	14	#4 Str	8'-2"	76	
V ₂	12	#7	1	8'-6"	208
V ₃	12	#4 Str	2'-3"	18	
V ₄	8	#4 Str	2'-6"	13	
Total Quantities for one End Bent:					
Reinforcing Steel lbs. 2805					
Class 'A' Concrete cu yds. 16.0					
12 BP 53 Steel Piles no. 0					
12 BP 53 Steel Piles lin. ft. 210					
Total Quantities for 4 End Bents:					
Reinforcing Steel lbs. 11,220					
Class 'A' Concrete cu yds. 64.0					
12 BP 53 Steel Piles no. 36					
12 BP 53 Steel Piles lin. ft. 840					
927.24					


* Concrete displaced by pile heads has been deducted.

PROJECT NO. B-19002
 HENDERSON-BUNCOMBE COUNTY
 STATION 1499+55L
 S.B. or H.B. BRIDGE

STATE OF NORTH CAROLINA
 STATE HIGHWAY COMMISSION
 BALFORD

END BENTS

REV.	DATE	BY	CHK.	APP.

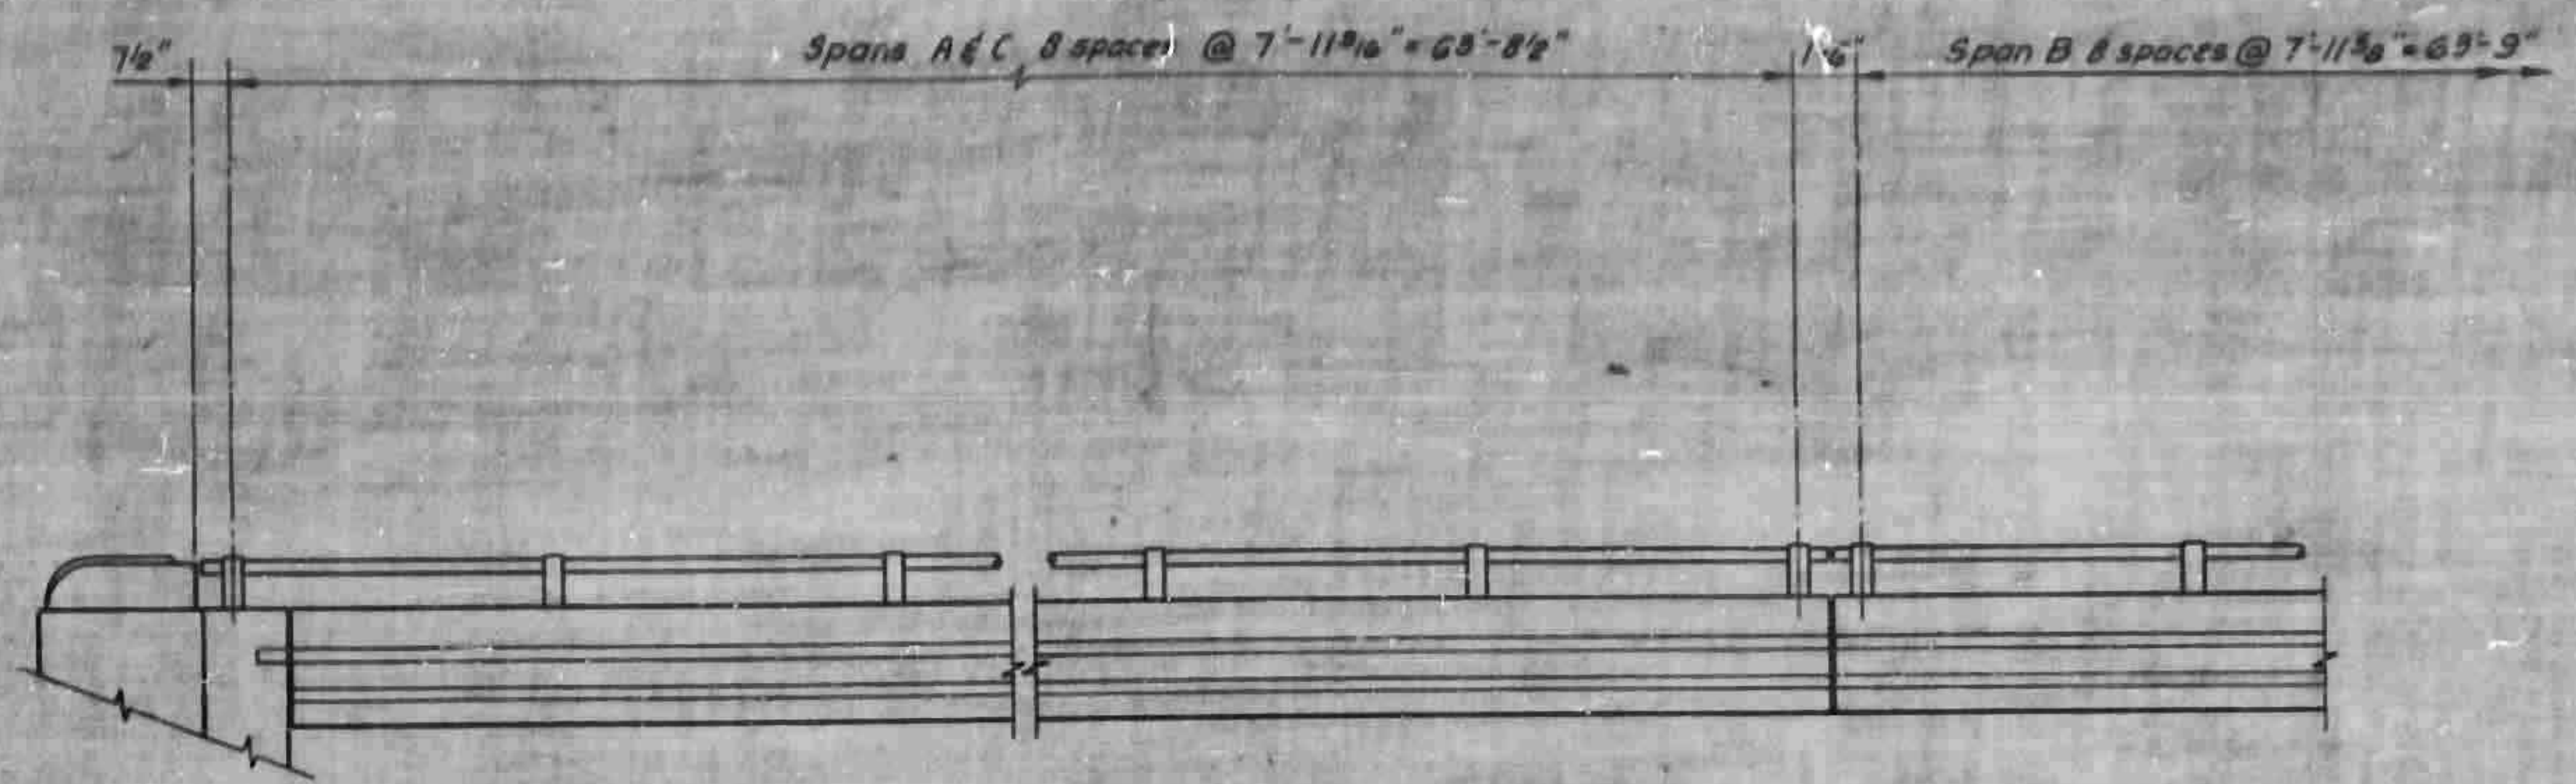

PARAPET AND RAILING ELEVATION

NOTES:

Unless noted on the plans, maximum length section to be two panels plus thick thru.

End of rail to clear face of concrete End Post by 1/2".

For double panel runs of rail, set screws shall be set tight at center post and snug at ends to allow for expansion.

For single panel runs, set screws shall be set tight at one end and snug at the other.


3/4" Anchor Bolts - hex nuts and washers to be steel galvanized in accordance with ASTM A-153 and painted with 2 coats of aluminum paint after erection.

Cast posts to be as shown or an approved equal.

Certified Mill reports are required for rolls and posts. Shop inspection is not required.

Metal Rail Posts to be set normal to curb grade.

Method of measurement for Metal Rails: Unless otherwise stated, the length of Metal rails to be paid for shall be the continuous horizontal length measured from and to end of rail, excepting concrete posts, but without deductions for spaces between rail sections.

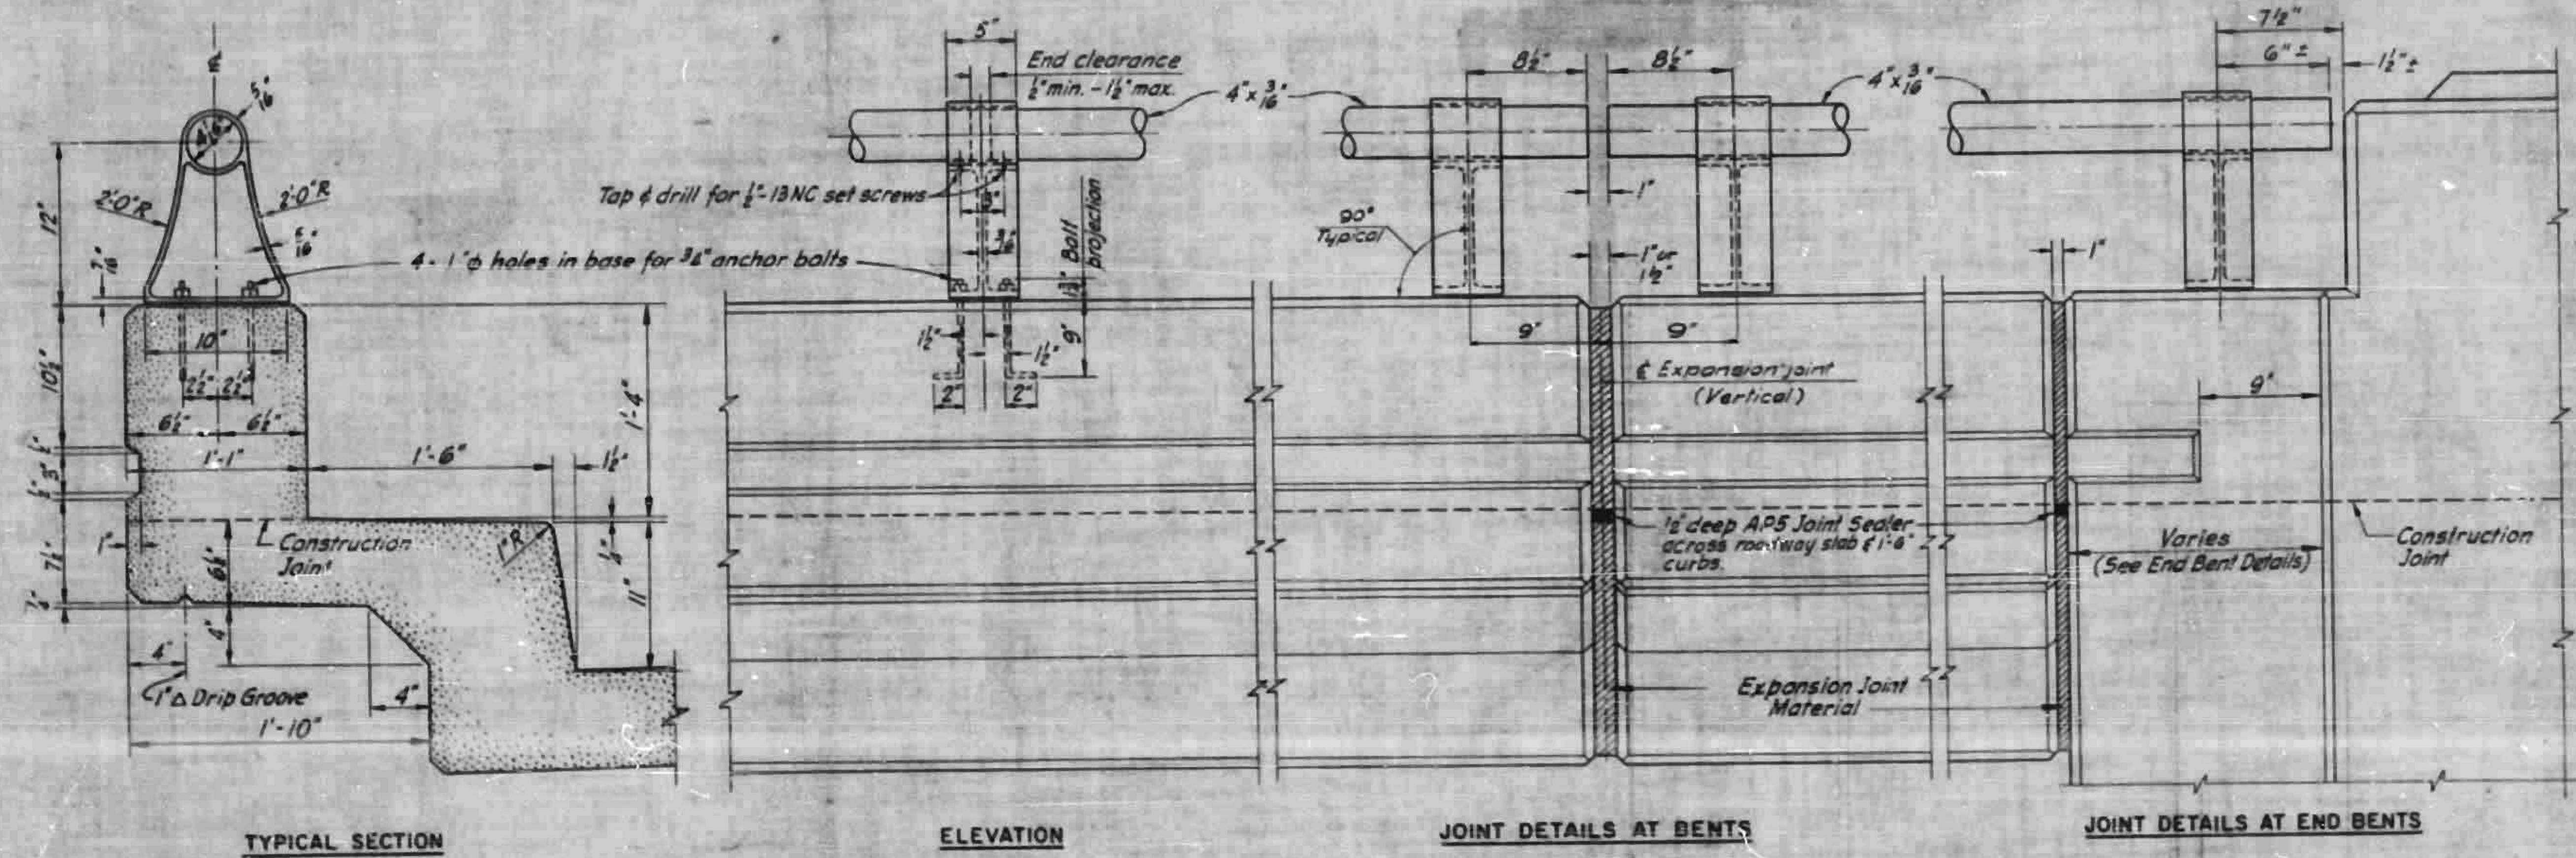

PARAPET AND RAILING DETAILS

At the Contractors option metal rail may be either Aluminum or Galvanized Steel in accordance with the requirements of the general notes and the following specifications for the alternate materials; however, the Contractor will be required to use the same rail material on all structures on the project for which metal rail is designated.

ALUMINUM RAILS

Aluminum alloys are to be as follows:

Cast Rail Posts	A356-T6
Round Tubular Rail	6061-T6 or 6062-T6
Set Screws	2024-T4
Closure Plates	6061-T6 or 6062-T6

Round Tubular Rails are to be of 4" O.D. with a 3/8" minimum wall thickness.


The base of rail posts, or any other aluminum surface in contact with concrete shall be thoroughly coated with an aluminum impregnated caulking compound of approved quality.

GALVANIZED STEEL RAIL

Material and galvanizing are to conform to the following specifications:

Cast Rail Post	Malleable cast iron, ASTM A47 Grade 350B, Galvanized to ASTM A123.
or	Cast Steel, AASHO M198-60 Class 70, Galvanized to ASTM A-123.
4" O.D. Rail	Standard 3 1/2" Galvanized Steel Pipe, ASTM A-153
Closure Plates & Snirns	Steel, ASTM A-245 Grade C, Galvanized to ASTM A-123.
Set Screws	Standard Steel Cap Screws, Galvanized to ASTM A-153

The cut ends of galvanized pipe railing, the end closure plate weld after grinding smooth and areas adjacent to the weld where spelter coating has been burned by welding shall be thoroughly cleaned by wire brushing to remove all traces of welding flux and loose or cracked spelter after which these cleaned areas shall be given two coats of Zinc paint meeting the requirements of Federal Specification MIL-P-26913 (USAF) Type I.


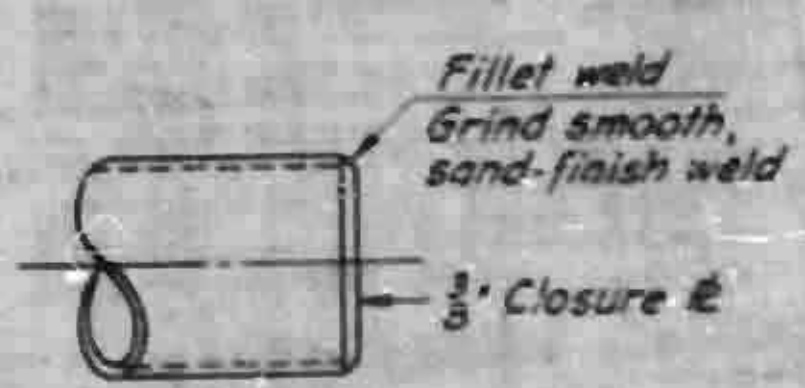


DETAIL END CLOSURE

Note: Aluminum posts are to be furnished with test coupons attached and are to be in accordance with the requirements of AASHO Specification M193-60.

PROJECT NO. 19002
 HENDERSON-BUNCOMBE COUNTY
 STATION 1493+55 L
 NB of 5B BRIDGE

STATE OF NORTH CAROLINA	
STATE HIGHWAY COMMISSION	
BALDWIN	
PARAPET AND RAILING DETAILS	
DATE	BY
DATE	BY
DATE	BY
DATE	BY

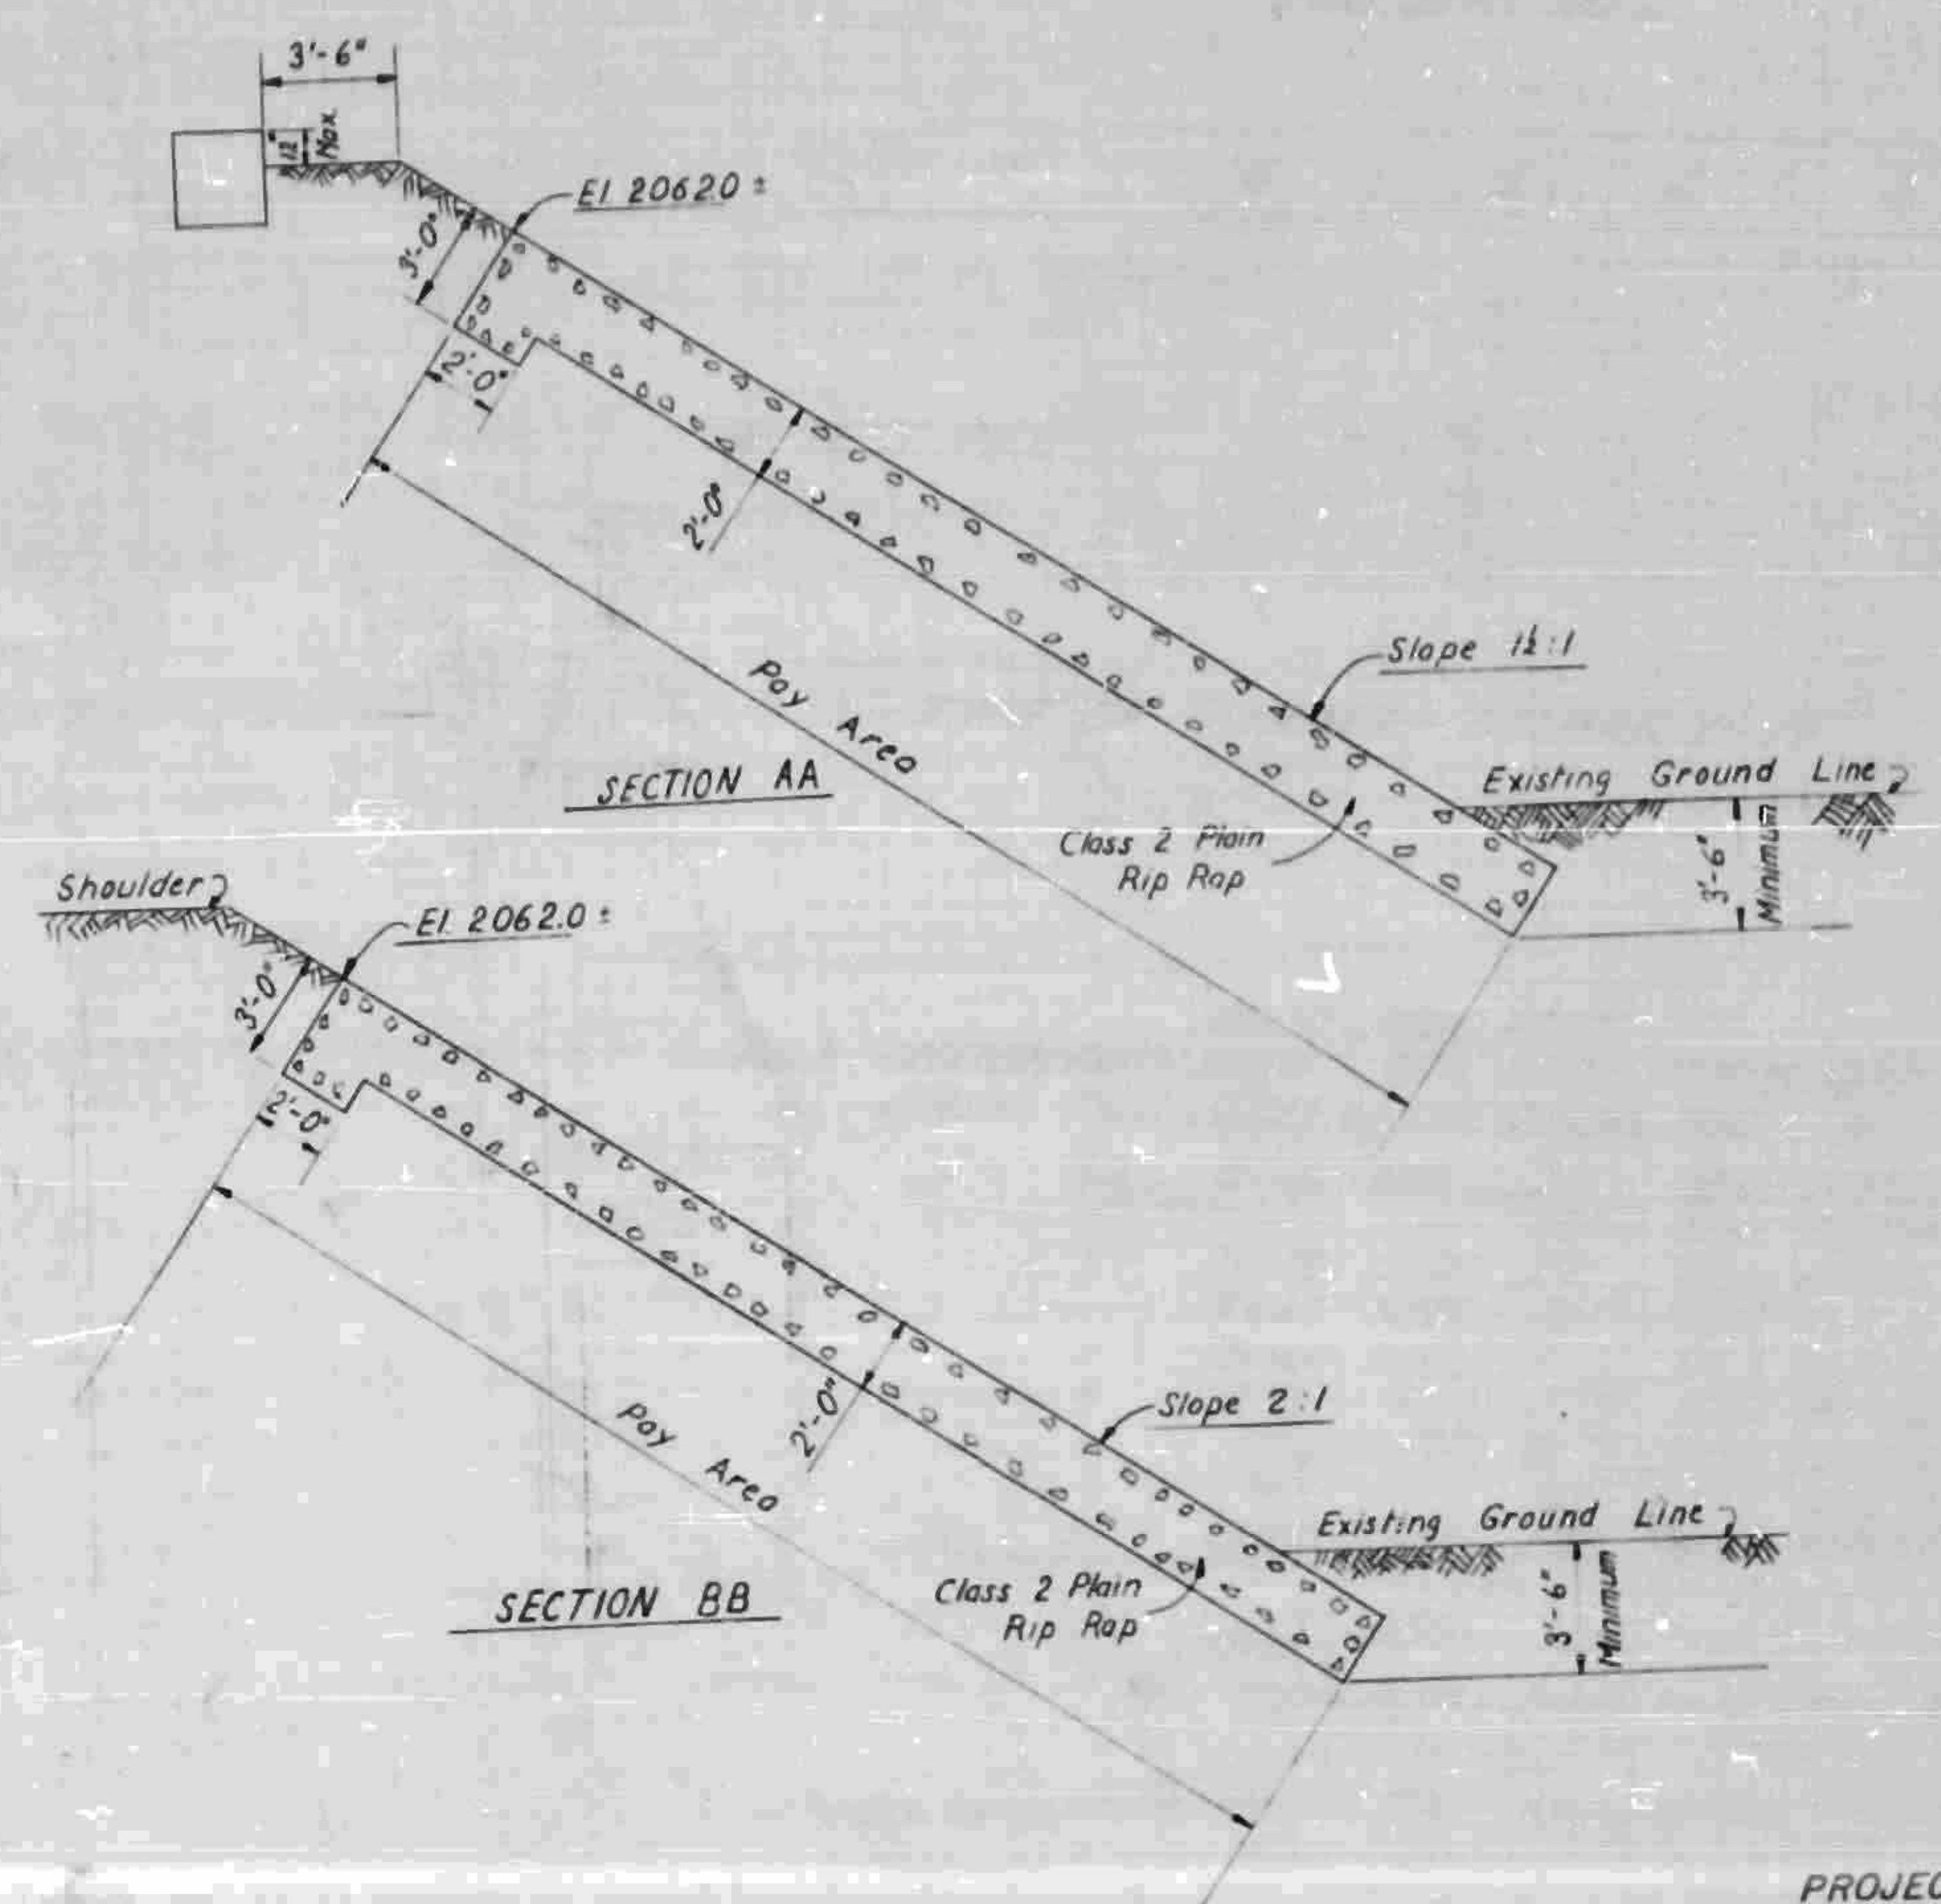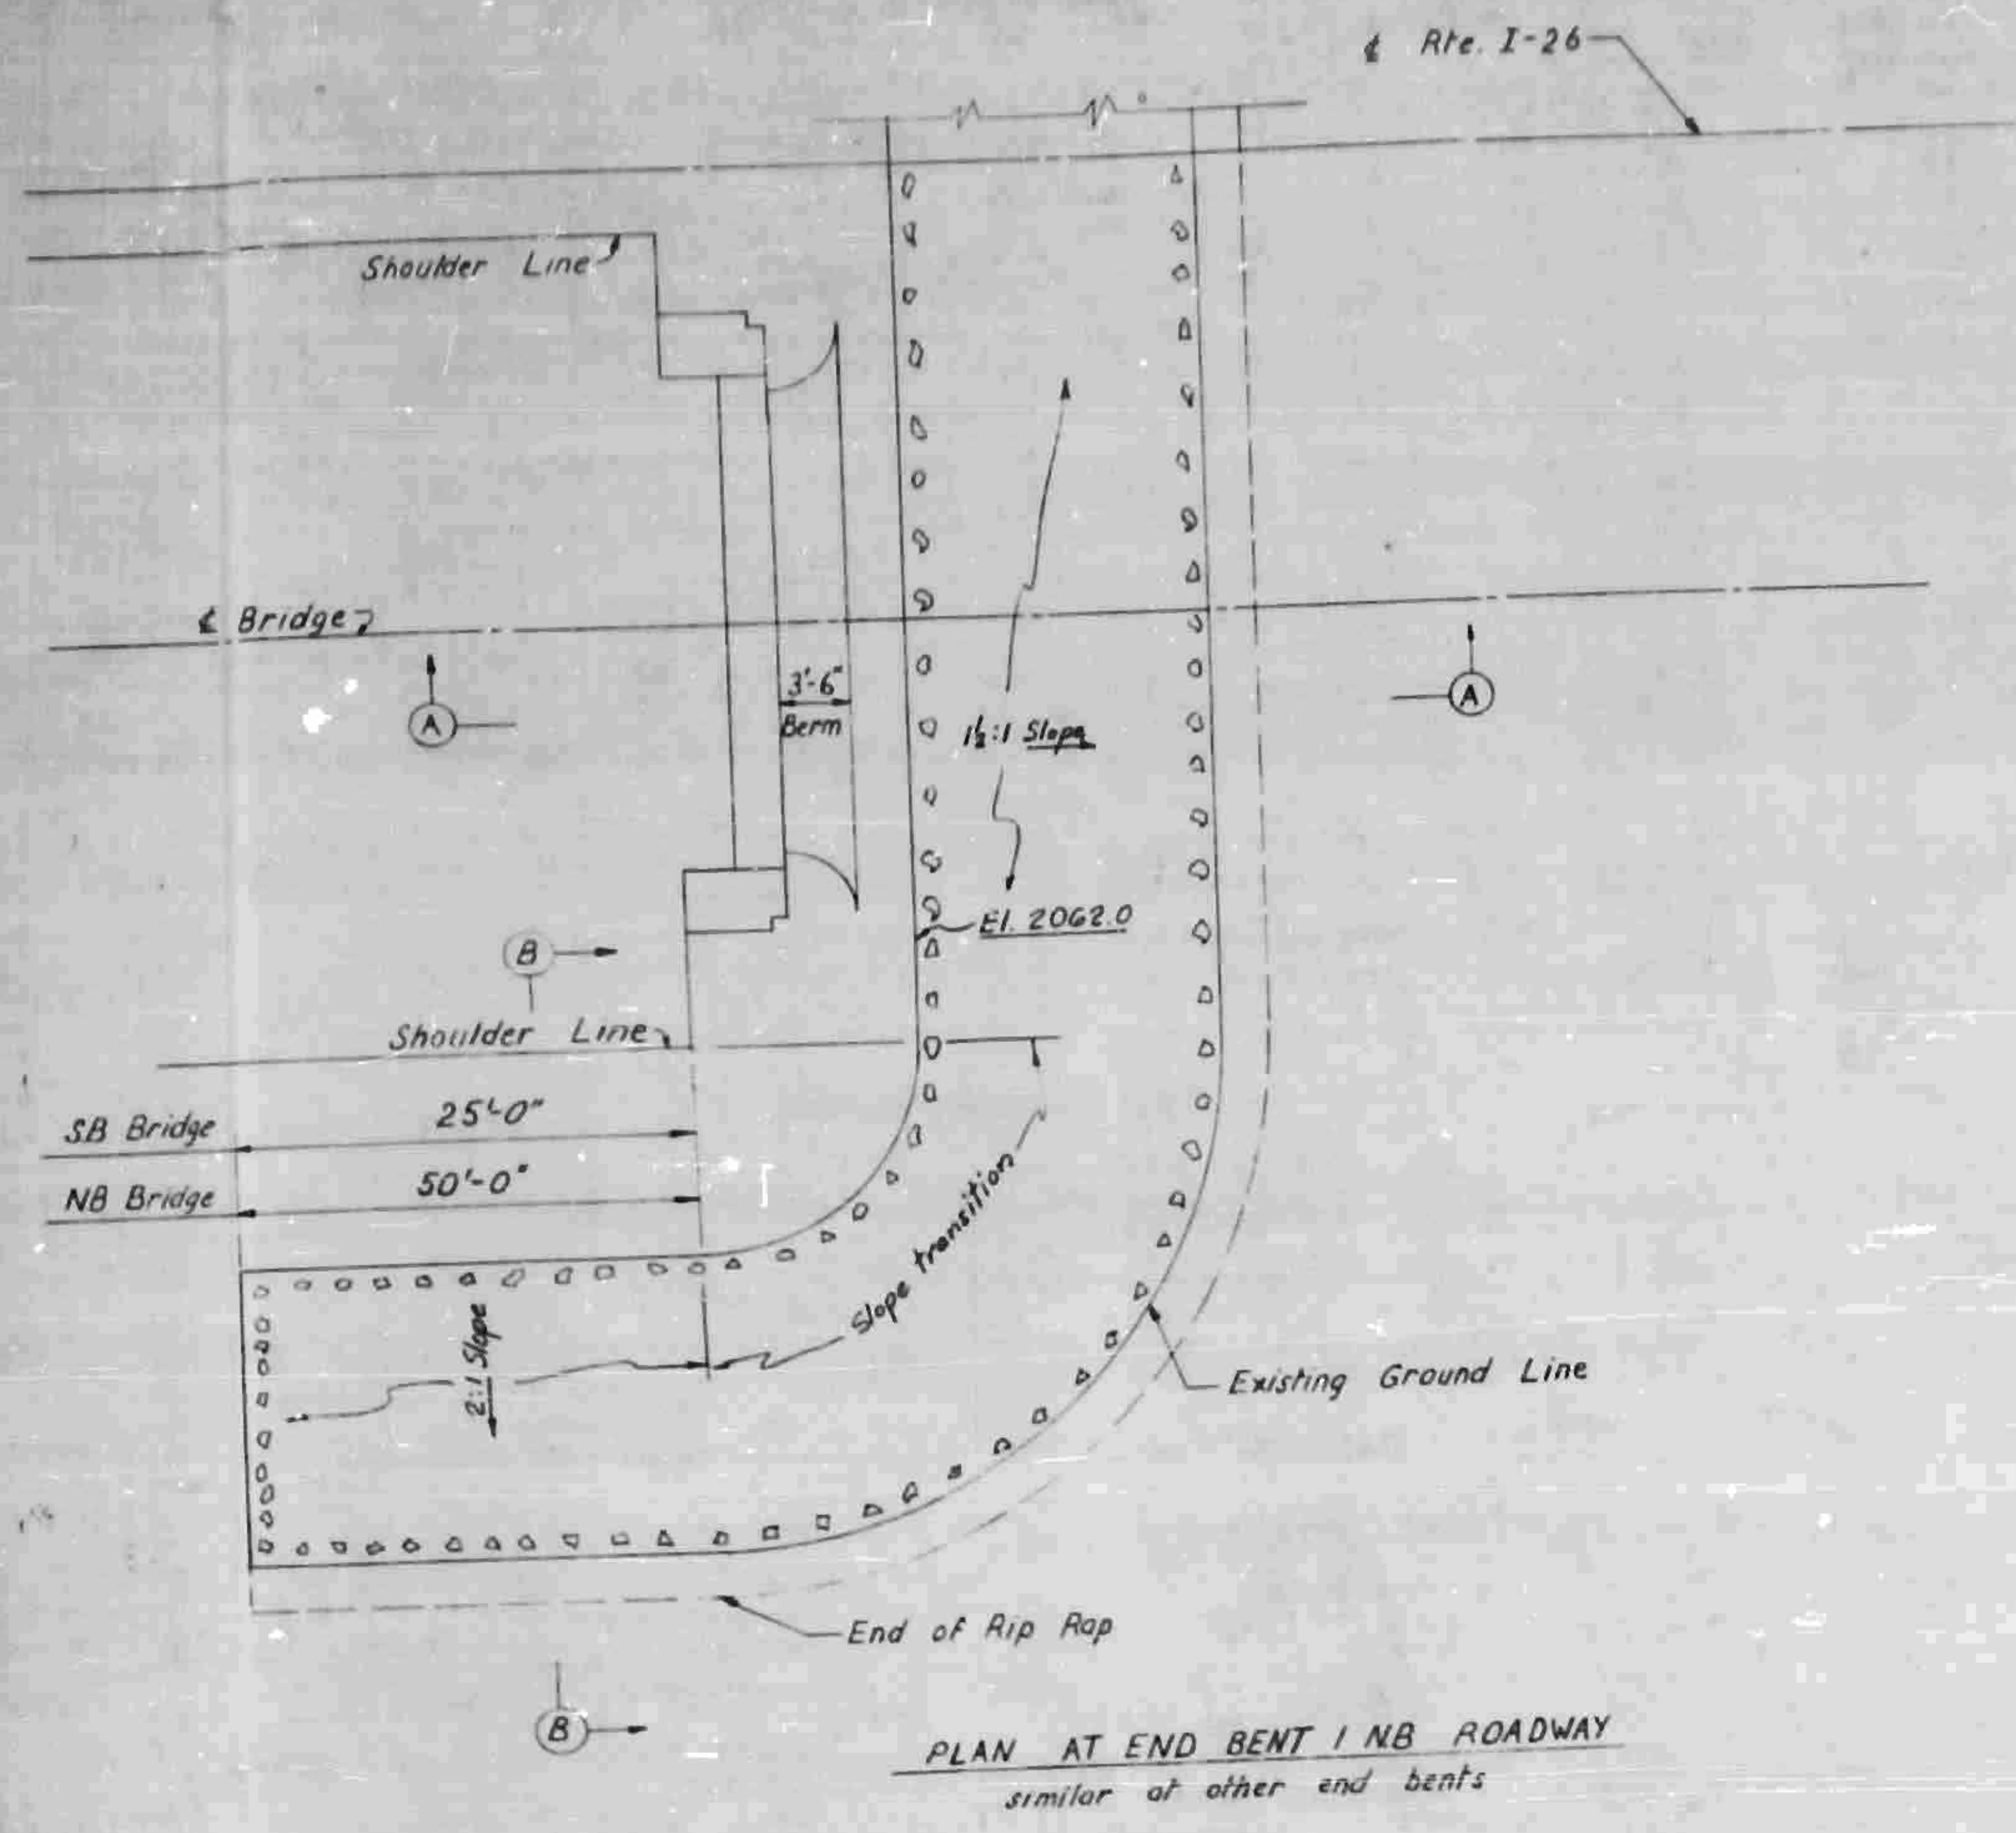

PROJECT NO. 819002
 HENDERSON-BUNCOMB COUNTY
 STATION 1499 + 55 L
 NB & SB Bridge

DATE	BY	REVISION

STATE OF NORTH CAROLINA
 STATE HIGHWAY COMMISSION
 RALEIGH

RIP-RAP DETAILS