

09/08/99

TIP PROJECT: BR-0126

\$\$\$\$\$ SYSTEM \$\$\$\$\$\$
\$\$\$\$\$ DGN \$\$\$\$\$\$
\$\$\$\$\$ USERNAME \$\$\$\$\$\$






STATE OF NORTH CAROLINA
DIVISION OF HIGHWAYS

**UTILITIES BY OTHERS PLANS
WILKES COUNTY**

**LOCATION: BRIDGE NO. 960667 OVER SPARKS
CREEK ON SR 1749
(AUSTIN TRAPHILL ROAD)**
TYPE OF WORK: COMMUNICATIONS

T.I.P. NO.	SHEET NO.
BR-0126	UO-1

NOTE:
ALL UTILITY WORK SHOWN ON THIS SHEET IS DONE BY OTHERS.
NO PAYMENT WILL BE MADE TO THE CONTRACTOR FOR UTILITY WORK SHOWN ON THIS SHEET.

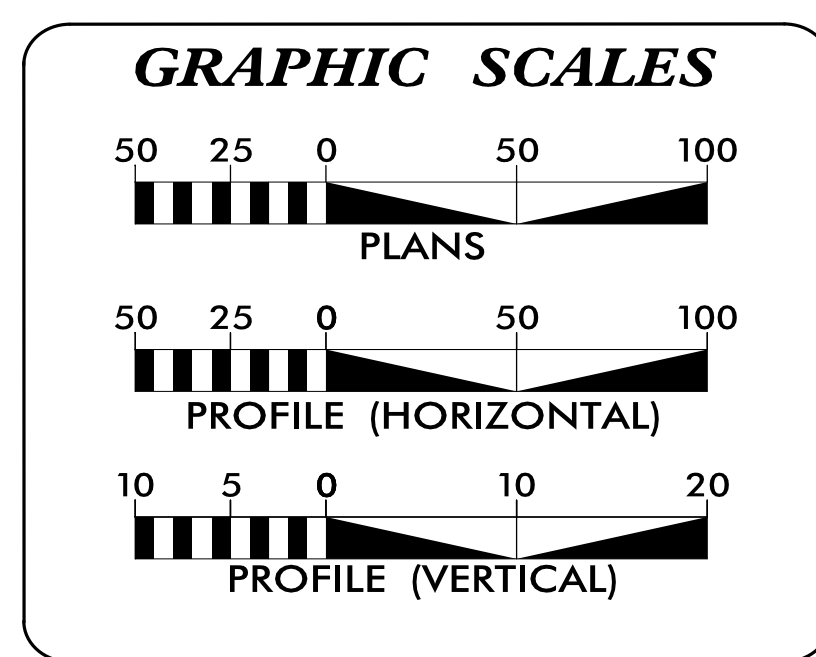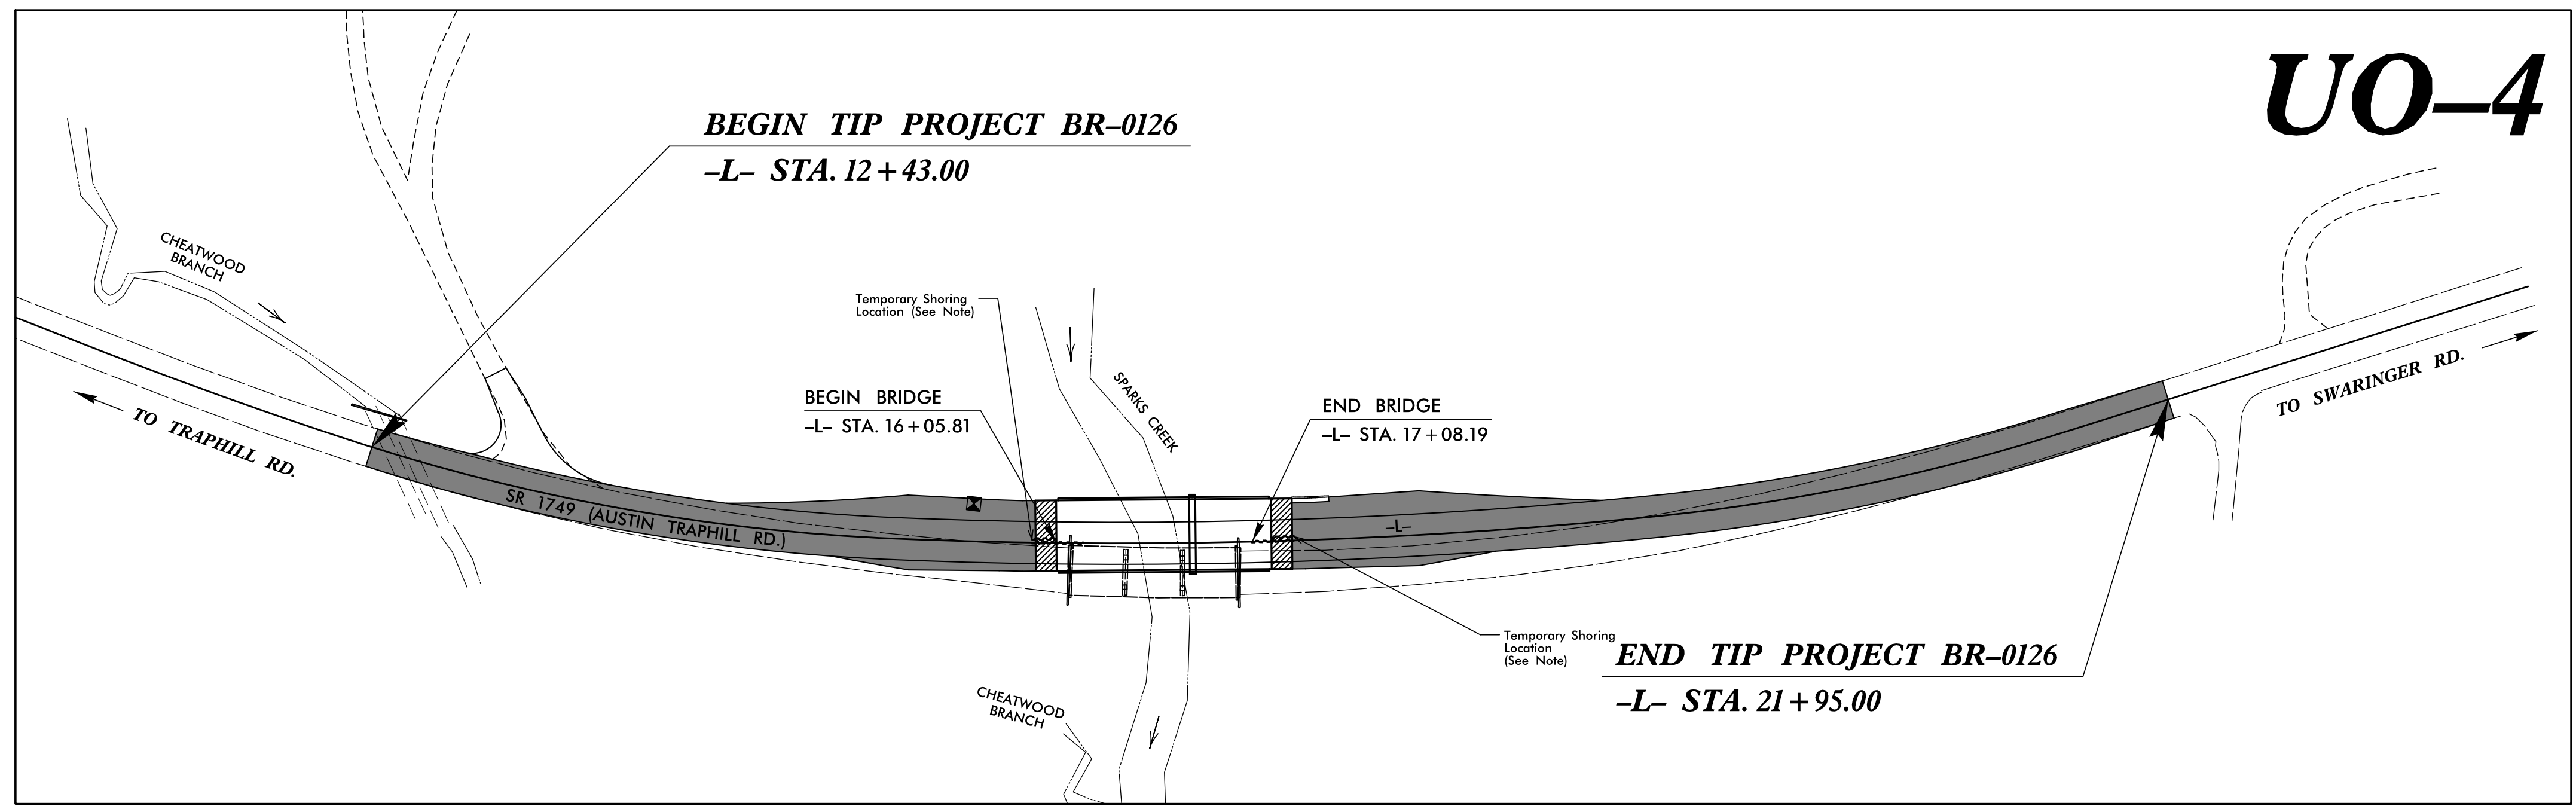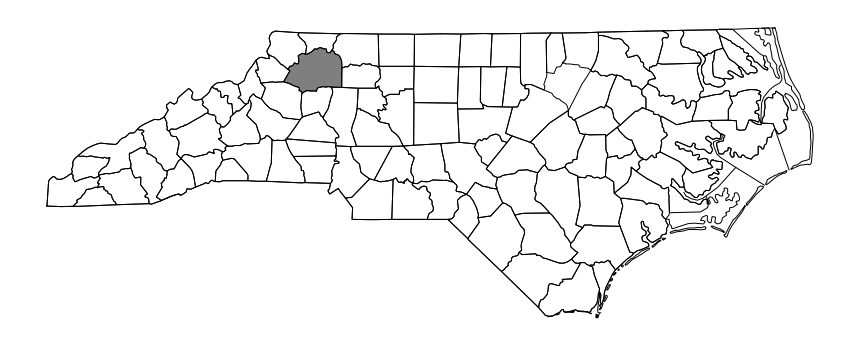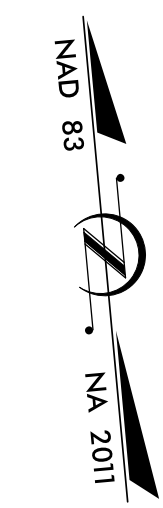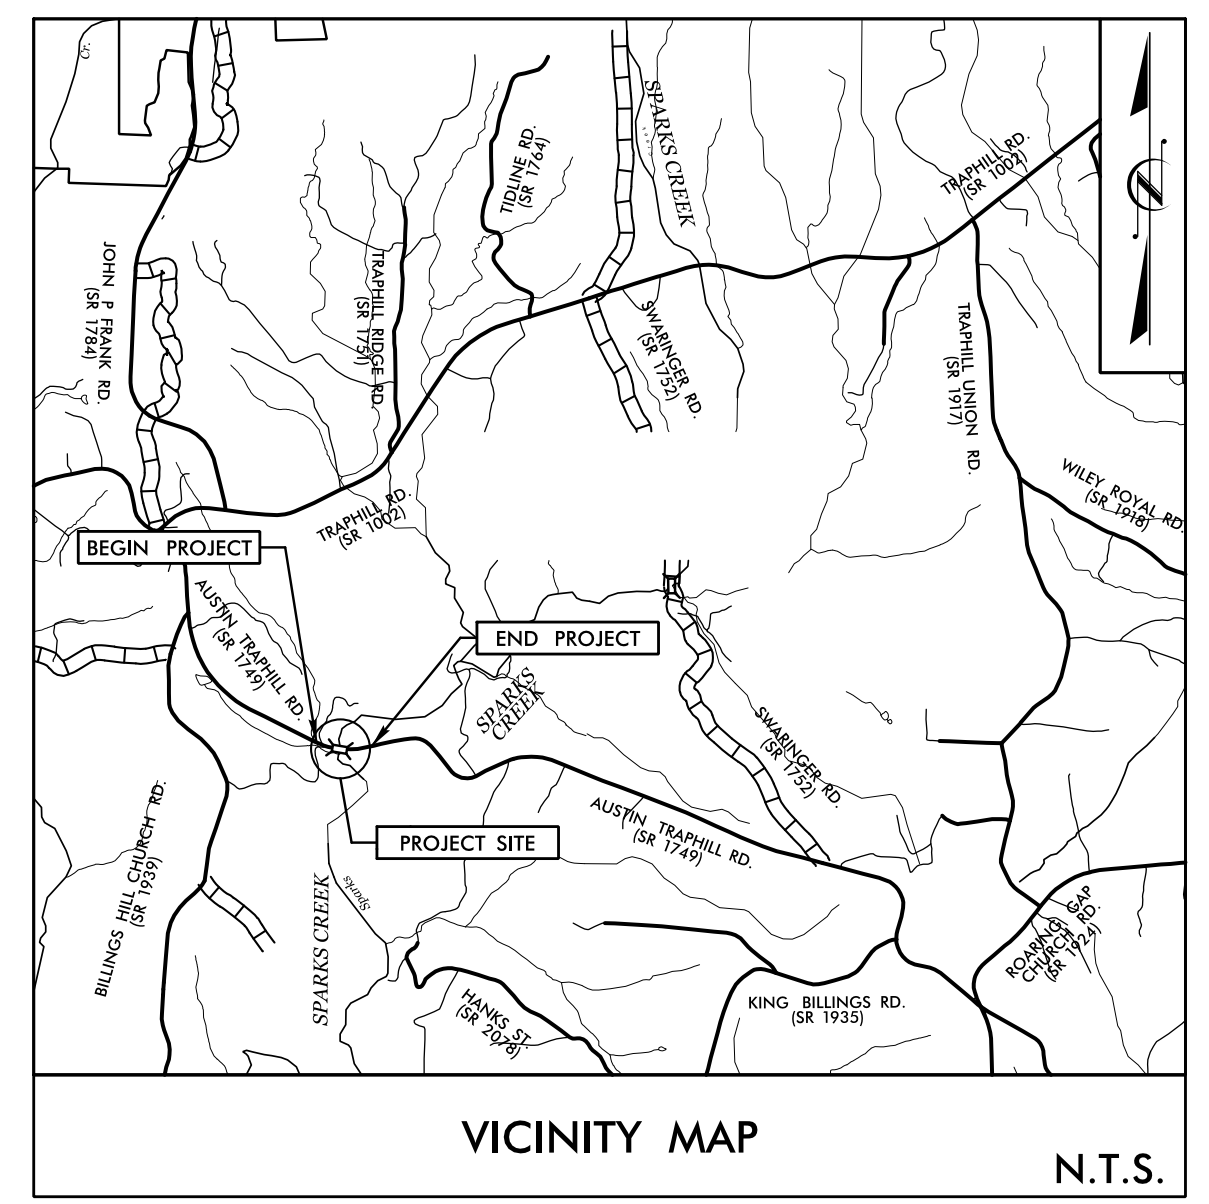

INDEX OF SHEETS

SHEET NO.:	DESCRIPTION:
UO-1	TITLE SHEET
UO-4	UBO PLAN SHEETS

UTILITY OWNERS WITH CONFLICTS

(A) TELEPHONE - WILKES COMMUNICATIONS

PREPARED IN THE OFFICE OF:

STV Engineers, Inc.
800 West Trade St., Suite 715
Charlotte, NC 28202
NC License Number F-0991


Oriana Hernandez	UTILITY PROJECT MANAGER
Laura Braunfeld	PROJECT UTILITY COORDINATOR
Logan Hedrick	PROJECT UTILITY CAD

**DIVISION OF HIGHWAYS
UTILITIES UNIT**
1555 MAIL SERVICES CENTER
RALEIGH, NC 27699-1555
PHONE (919) 707-6690
FAX (919) 250-4151


Michael Bright	UTILITIES REGIONAL ENGINEER
Donald Hampton	UTILITIES ENGINEER
Amy York	UTILITIES AREA COORDINATOR
Sunil Singh	UTILITIES COORDINATOR

UTILITIES BY OTHERS

NOTE:
ALL UTILITY WORK SHOWN ON THIS SHEET WILL BE DONE BY OTHERS. NO PAYMENT WILL BE MADE TO THE CONTRACTOR FOR UTILITY WORK SHOWN ON THIS SHEET.

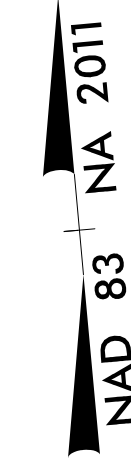

5/14/99
44
45
46
00

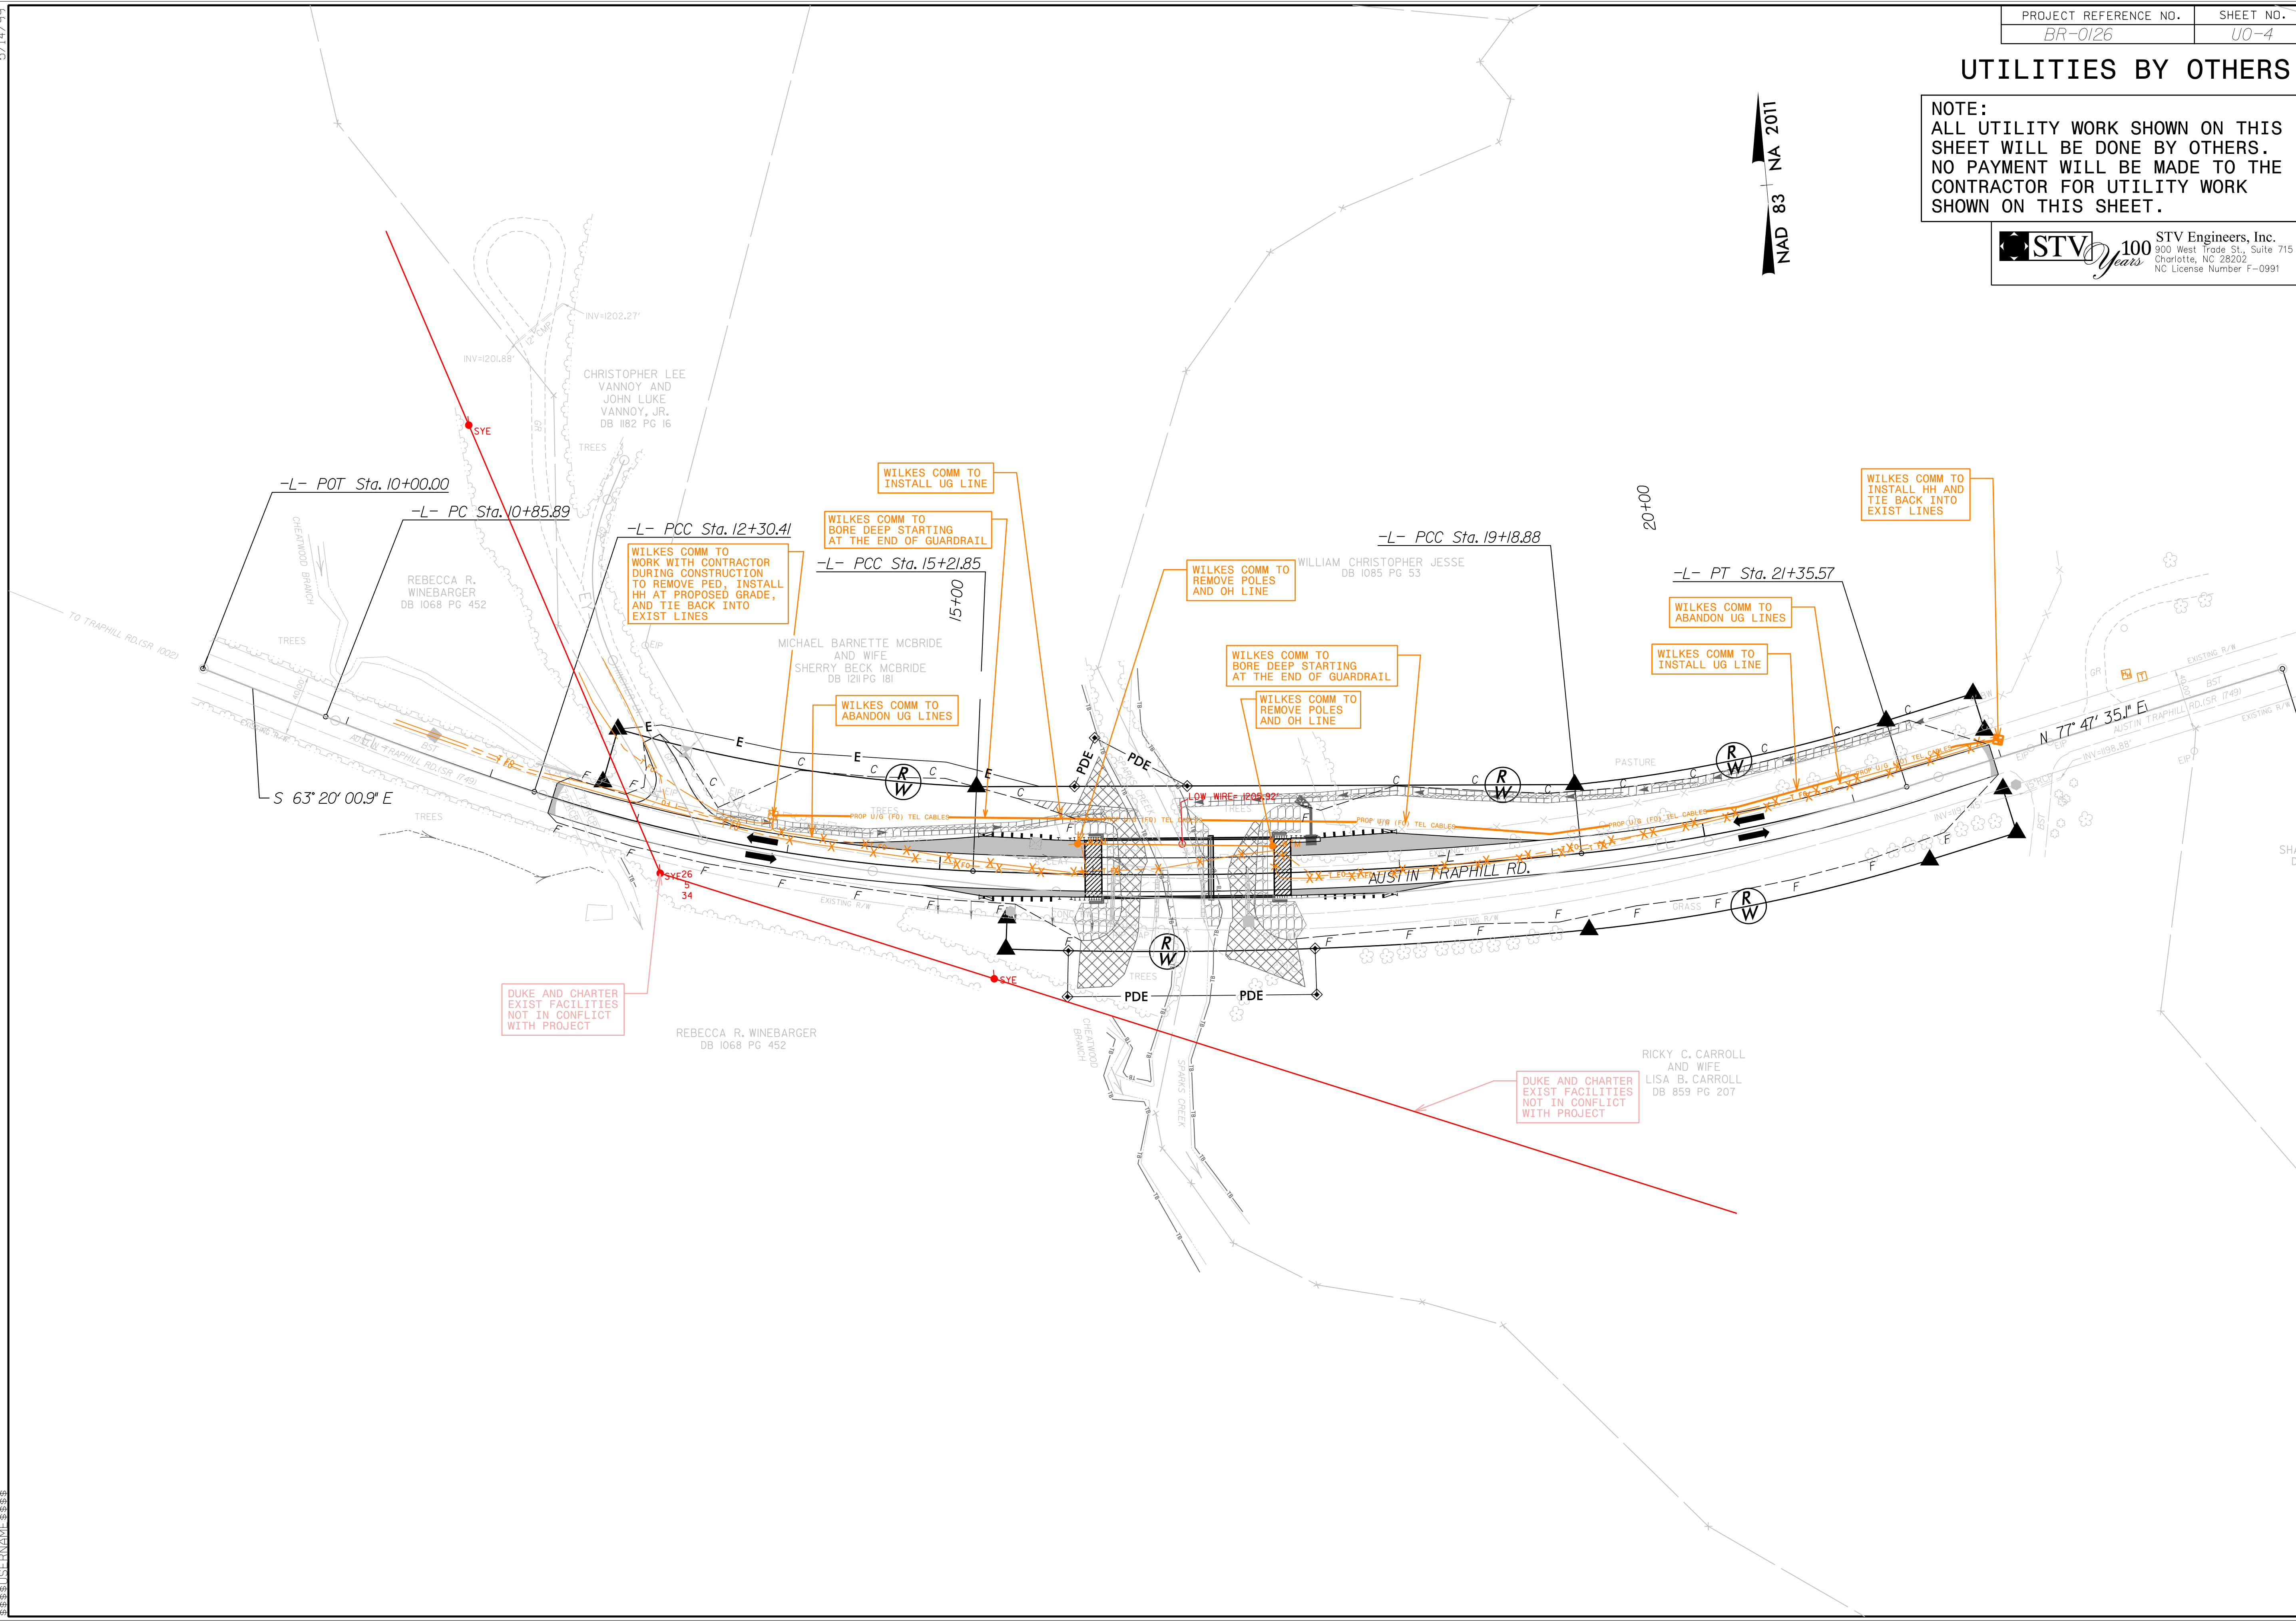


UTILITIES BY OTHERS

NOTE:
ALL UTILITY WORK SHOWN ON THIS SHEET WILL BE DONE BY OTHERS. NO PAYMENT WILL BE MADE TO THE CONTRACTOR FOR UTILITY WORK SHOWN ON THIS SHEET.



NAD 83 NA 2011

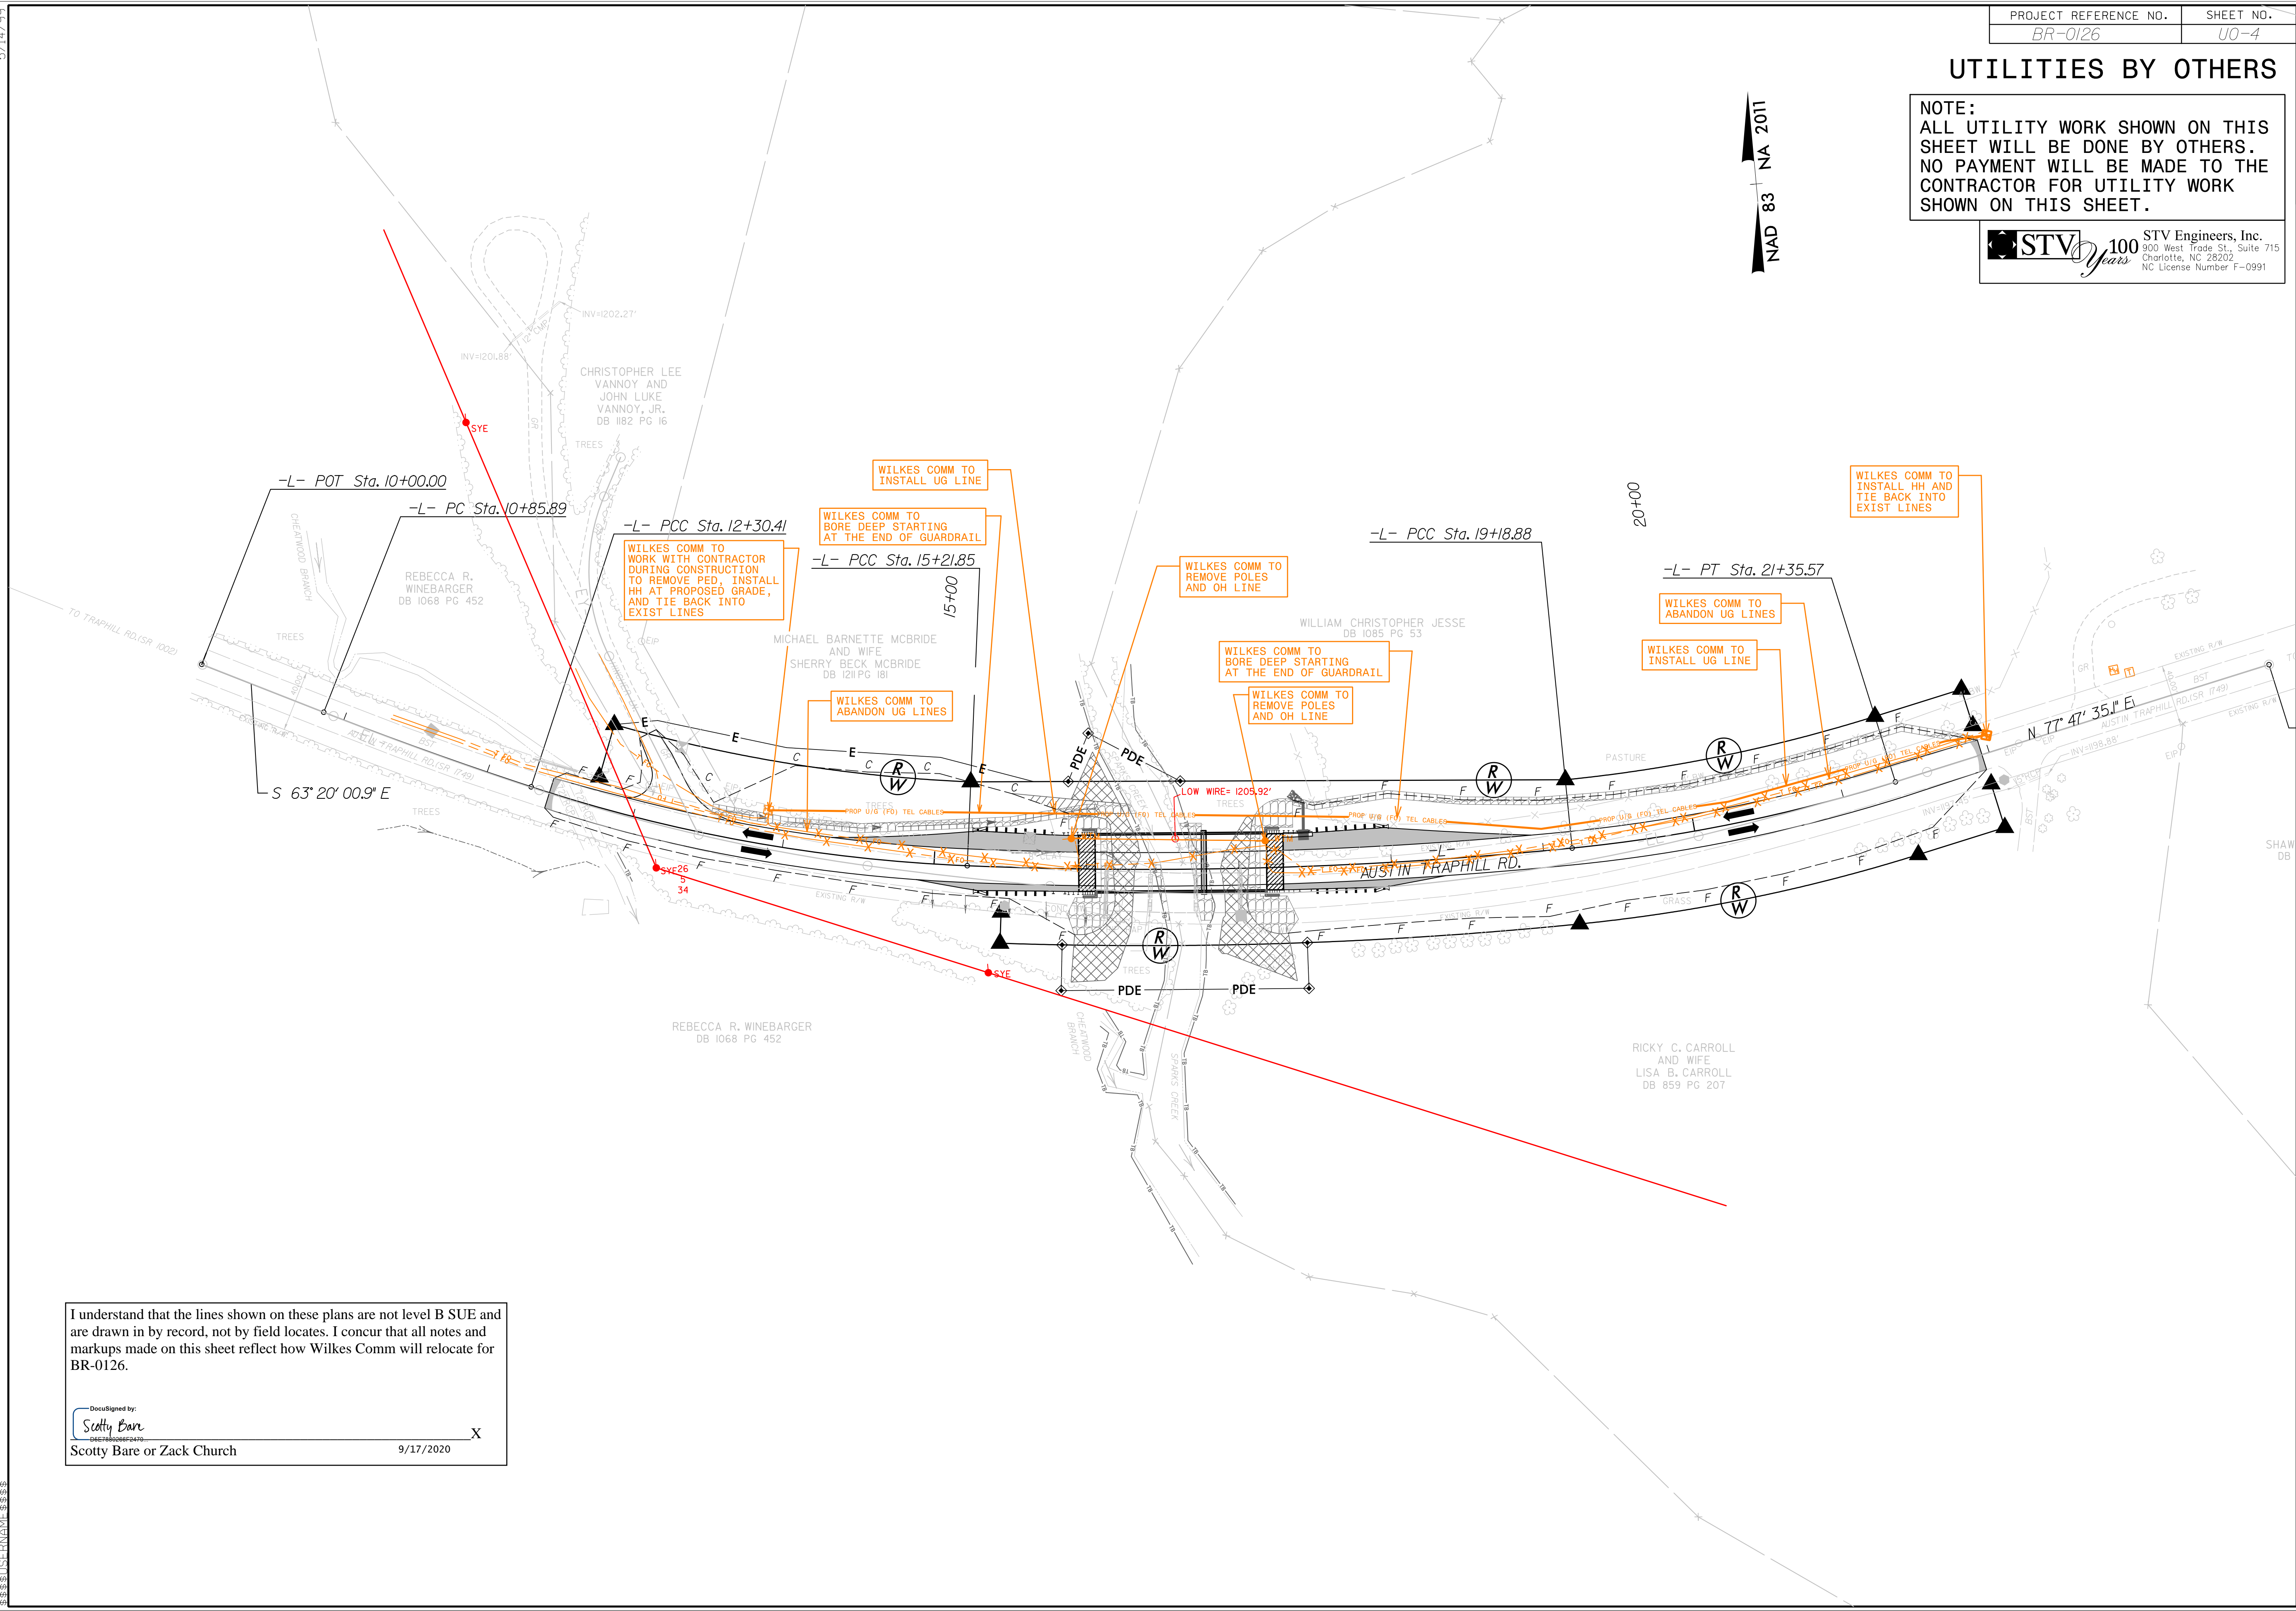

I understand that the lines shown on these plans are not level B SUE and are drawn in by record, not by field locates. I concur that all notes and markups made on this sheet reflect how Wilkes Comm will relocate for BR-0126.

DocuSigned by:
Scotty Bare
0627880882470 X
Scotty Bare or Zack Church 9/17/2020

5/14/2020
45
46
47
100