


09/06/2011

See Sheet 1A For Index of Sheets

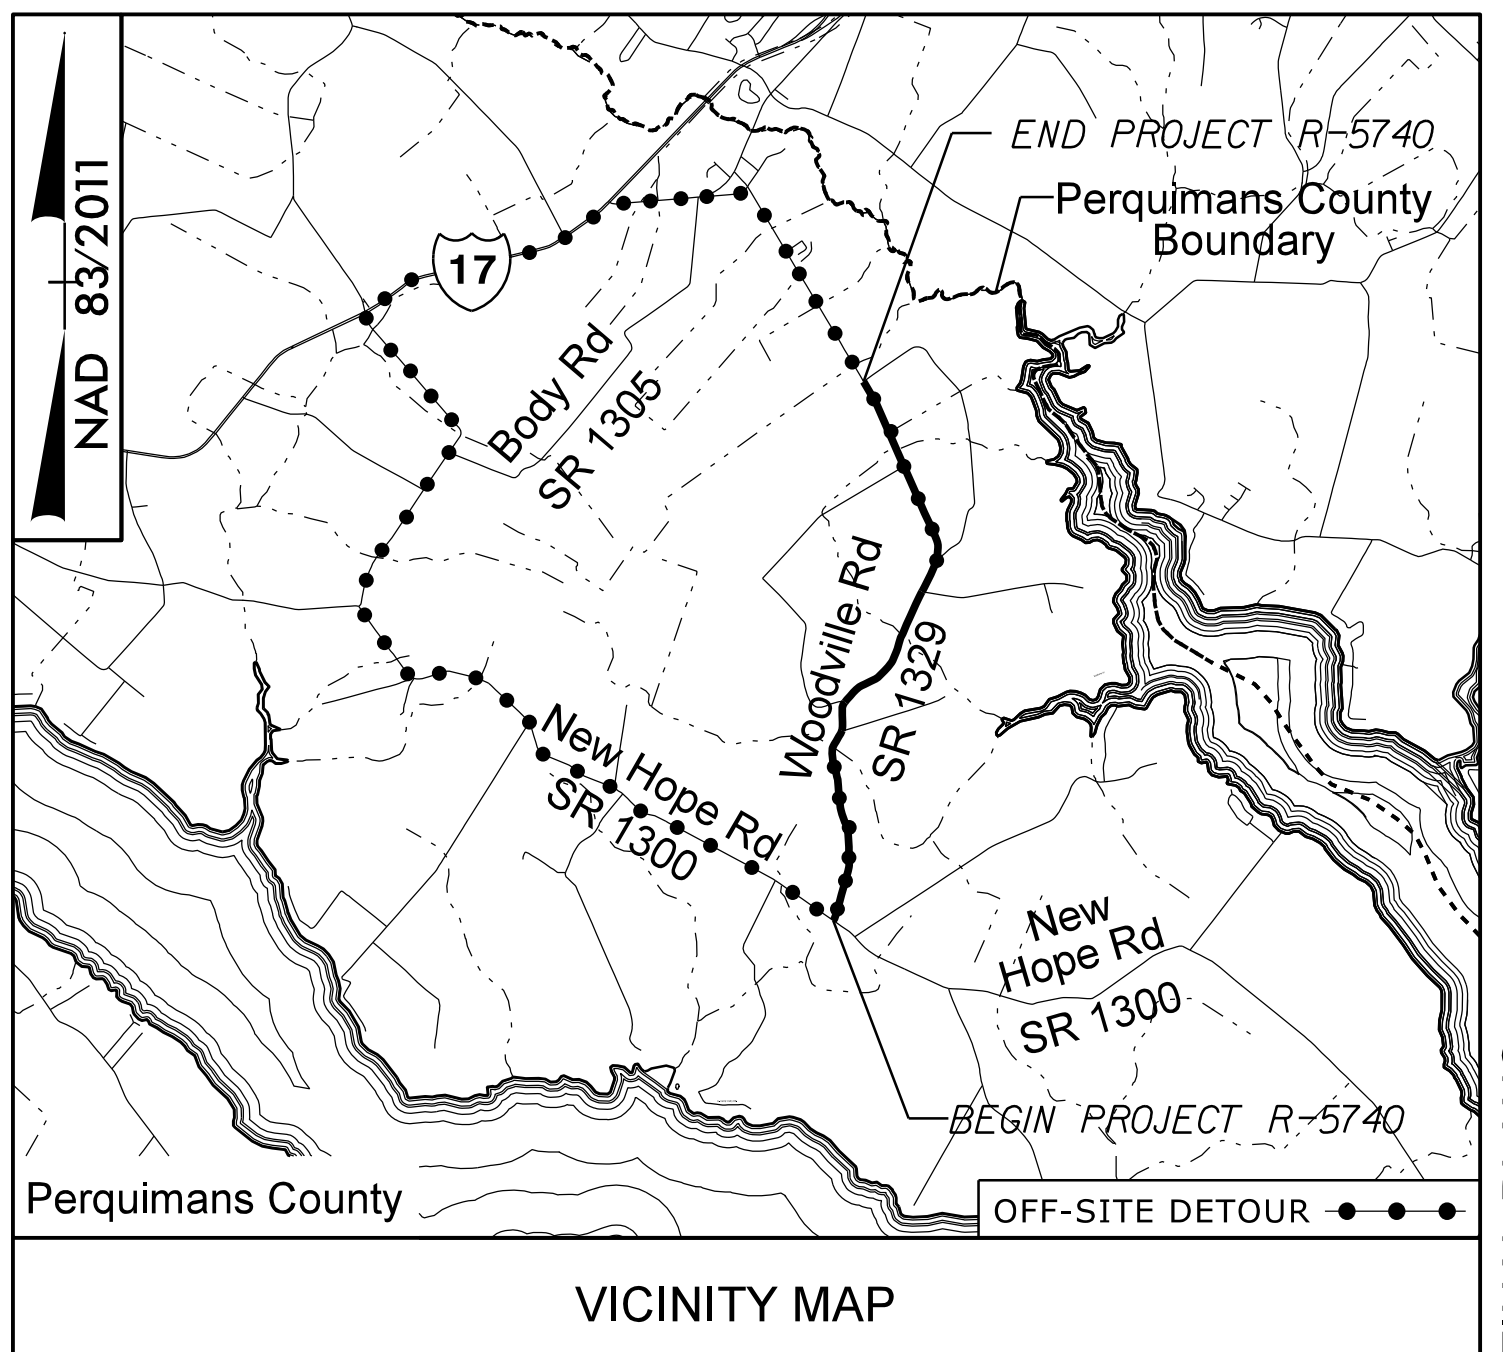


STATE OF NORTH CAROLINA
DIVISION OF HIGHWAYS

PERQUIMANS COUNTY

**LOCATION: SR 1329 (WOODVILLE ROAD) FROM SR 1300 (NEW HOPE ROAD)
TO SR 1331 (RED BANKS ROAD - NORTH END)**


TYPE OF WORK: GRADING, PAVING, DRAINAGE, AND CULVERTS

STATE	STATE PROJECT REFERENCE NO.	SHEET NO.	TOTAL SHEETS
N.C.	R-5740	C-1	
STATE PROJ. NO.	F.A. PROJ. NO.	DESCRIPTION	
50198.1.1		PE	
50198.2.1		RAW	
50198.2.2		UTILITIES	
50198.3.1		CONSTRUCTION	

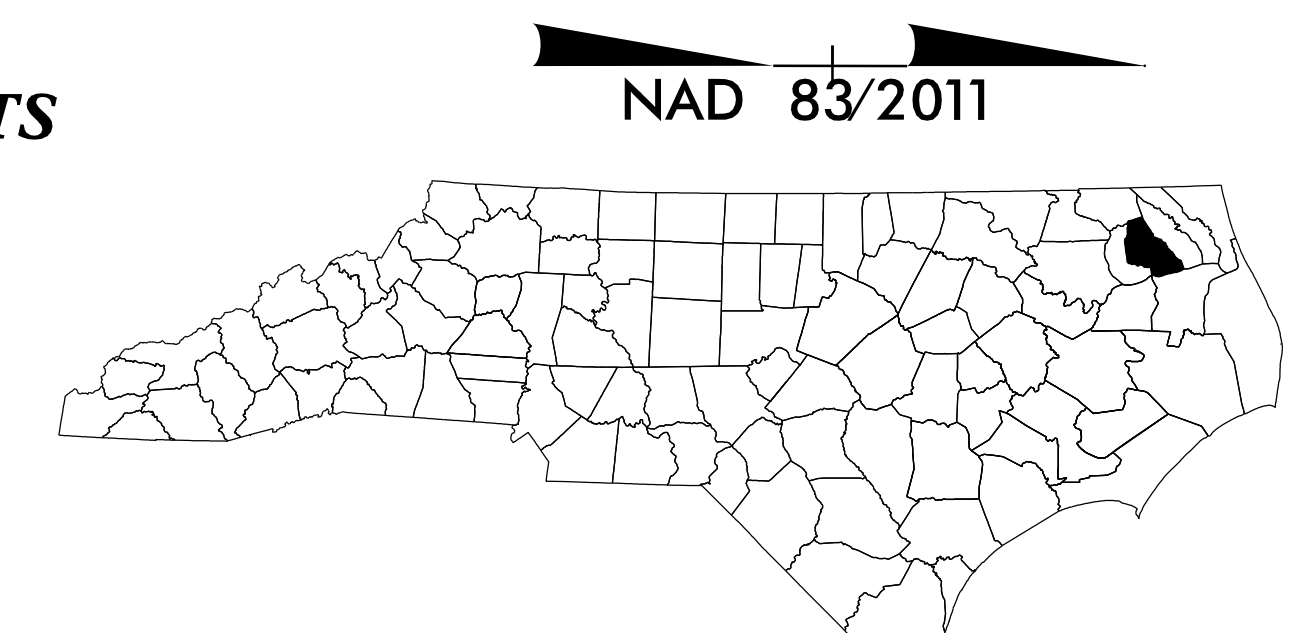


TIP PROJECT: R-5740

CONTRACT: C204593

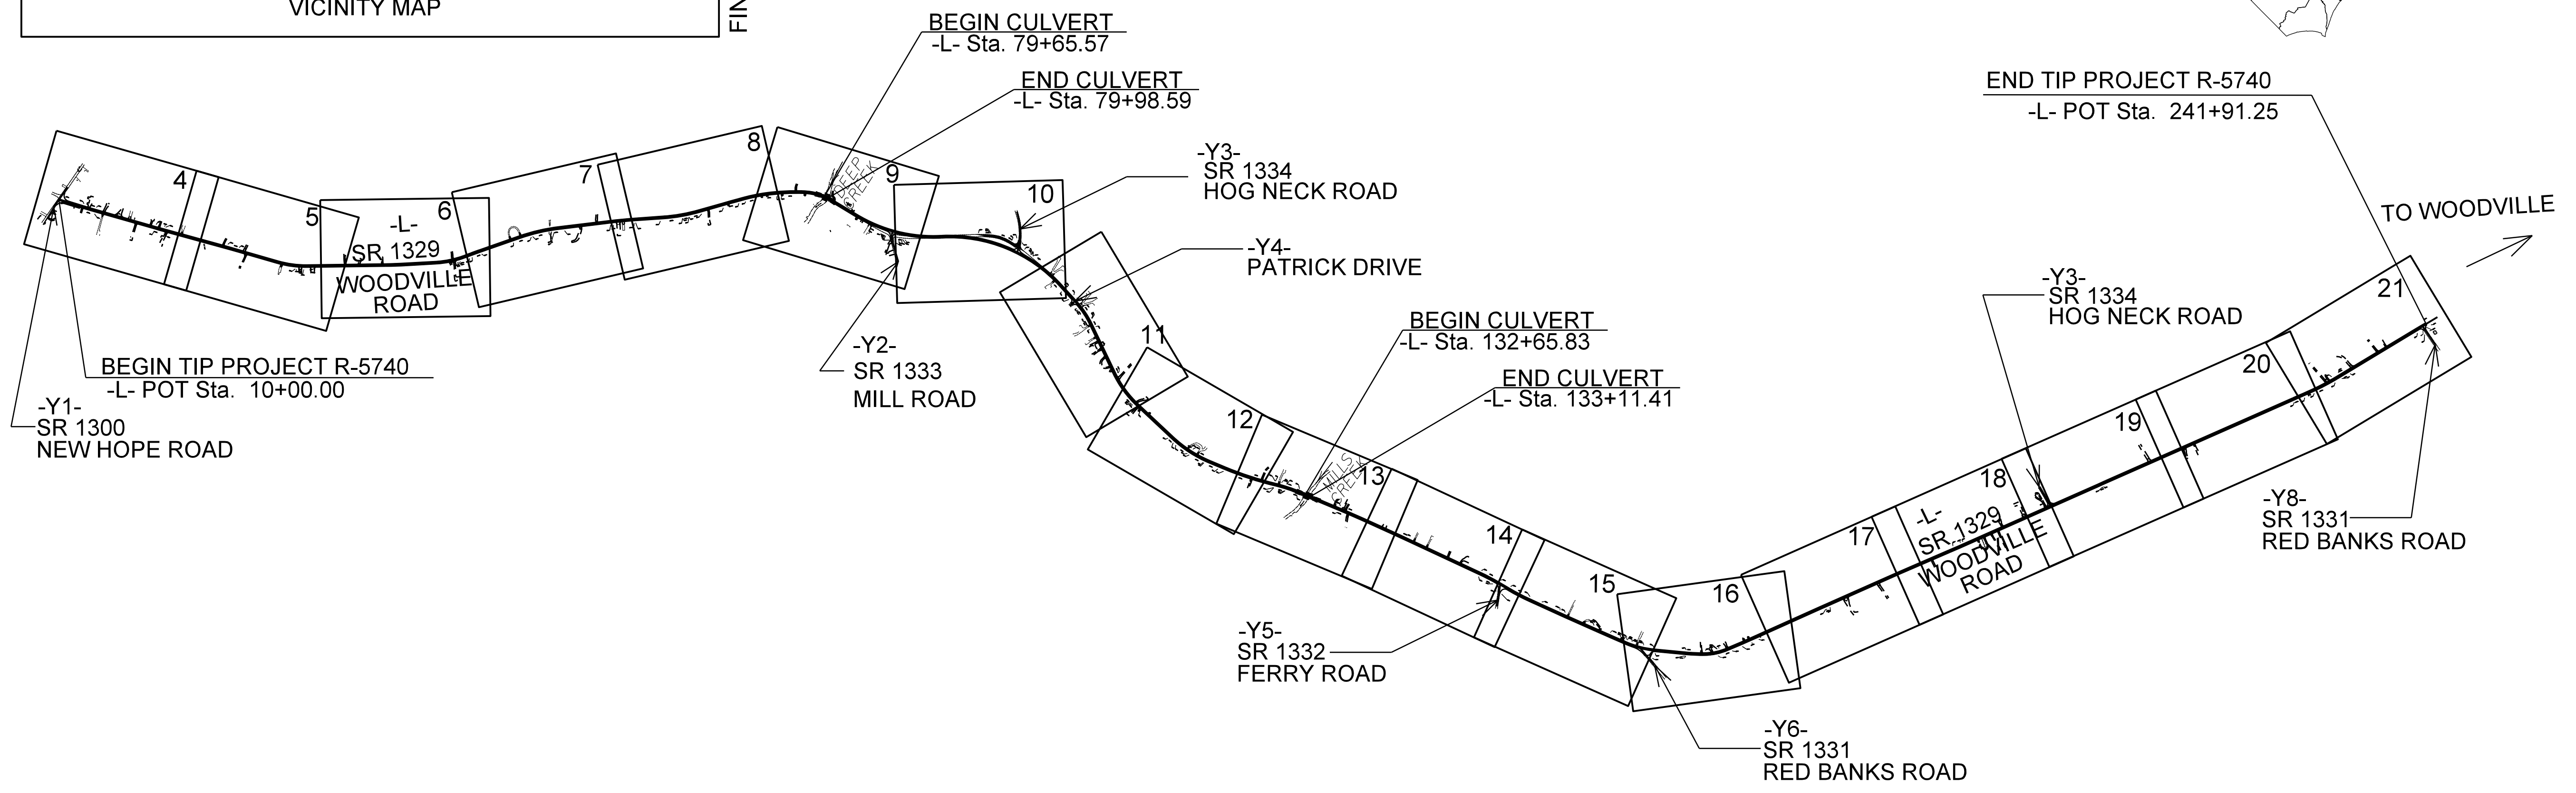

**** HORIZONTAL DESIGN EXCEPTION IS REQUIRED**

**DOCUMENT NOT CONSIDERED FINAL
UNLESS ALL SIGNATURES COMPLETED**

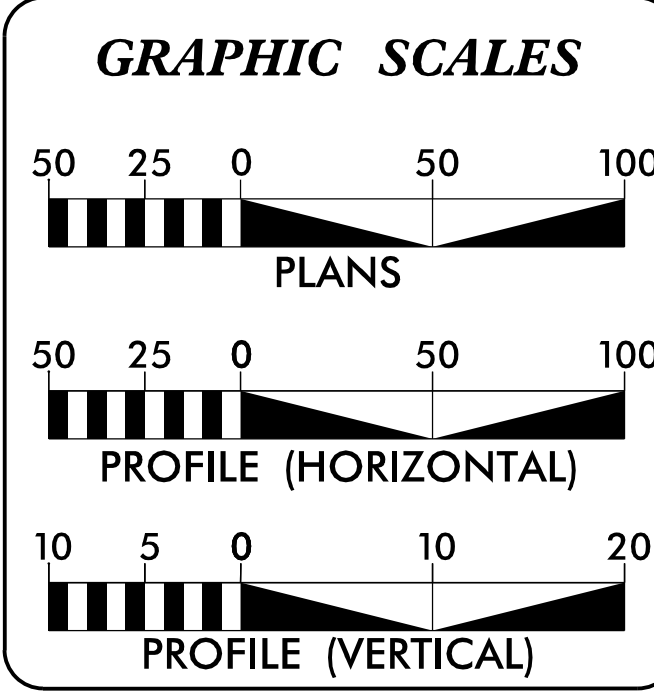

DESIGN DATA
ADT 2016 = 1,400
V = 60 MPH **

PROJECT LENGTH
LENGTH ROADWAY TIP PROJECT R-5740 = 4.377 MILES
LENGTH STRUCTURE TIP PROJECT R-5740 = 0.015 MILES
TOTAL LENGTH TIP PROJECT R-5740 = 4.392 MILES

NCDOT CONTACT: BARRY HOBBS, PE, DIVISION PROJECT MANAGER

Prepared in the Office of:

ATKINS 1616 EAST MILLBROOK ROAD, SUITE 160
RALEIGH, NORTH CAROLINA 27609
(919) 876-6888 NCBEE #F-0326

2018 STANDARD SPECIFICATIONS

RIGHT OF WAY DATE: JULY 2017

LETTING DATE: FEBRUARY 16, 2021

VIRGINIA T. SCHAAR, PE
PROJECT ENGINEER


BRYCE REID, EI
PROJECT DESIGN ENGINEER

HYDRAULICS ENGINEER

Virginia T. Schaar
11/6/2020 P.E.

ROADWAY DESIGN ENGINEER

Virginia T. Schaar
11/5/2020 P.E.

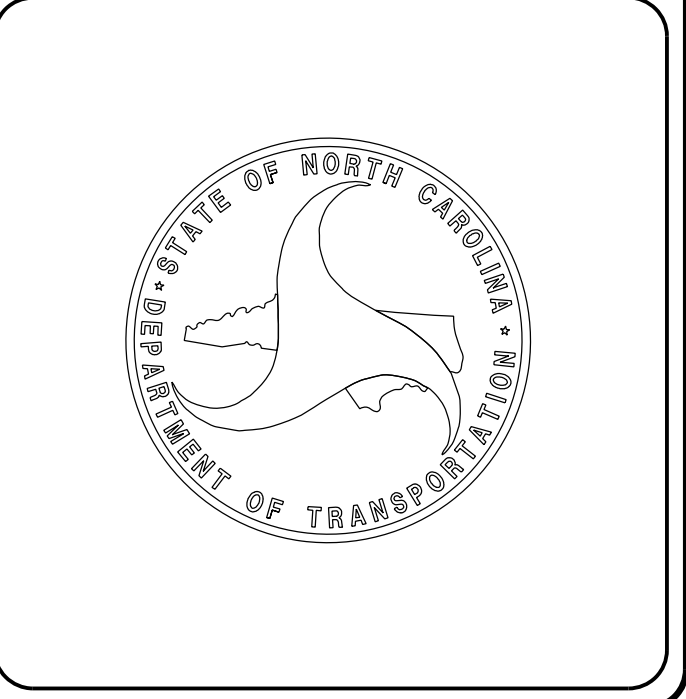

04-NOV-2020 17:28
R:\Roadway\p101\410-R5740_rdy_tsh.dgn
\$\$\$\$\$SERNAME\$\$\$\$\$

BM#3 - NAIL IN 18" OAK
 111' LT. OF STA. 111+69.27 -L-
 ELEV. = 10.75

NOTES

- ASSUMED LIVE LOAD ----- HL-93 OR ALTERNATE LOADING.
- DESIGN FILL ----- MAX. 5.67' ----- MIN. 3.92'
- THE RESIDENT ENGINEER SHALL CHECK THE LENGTH OF CULVERT BEFORE STAKING IT OUT TO MAKE CERTAIN THAT IT WILL PROPERLY TAKE CARE OF THE FILL.
- FOR ALUMINUM BOX CULVERT, SEE SPECIAL PROVISIONS.
- ALL MATERIALS SHALL MEET THE REQUIREMENTS OF THE NCDOT STANDARD SPECIFICATIONS FOR ROADS AND STRUCTURES DATED JANUARY 2018.
- THE DETAILS SHOWN ARE FOR GENERAL LAYOUT ONLY. THE SUPPLIER SHALL PROVIDE DESIGNS AND DETAILS FOR REVIEW AND APPROVAL THAT MEET THE REQUIREMENTS OF AASHTO LFRD BRIDGE DESIGN SPECIFICATIONS, SECTION 12, AND ARE SEALED BY A NORTH CAROLINA REGISTERED PROFESSIONAL ENGINEER.
- UNLESS OTHERWISE INDICATED, THE SUPPLIER SHALL DESIGN, DETAIL AND FURNISH ALL STRUCTURAL ELEMENTS AND HARDWARE.
- THE EXISTING STRUCTURE CONSISTING OF 3 @ 60" CORRUGATED METAL PIPES, 50.4' ALONG C OF PIPE, BURIED 1.0' SHALL BE REMOVED. THE EXISTING STRUCTURE IS PRESENTLY NOT POSTED FOR LOAD LIMIT. SHOULD THE STRUCTURAL INTEGRITY OF THE STRUCTURE DETERIORATE DURING CONSTRUCTION OF THE PROPOSED STRUCTURE, A LOAD LIMIT MAY BE POSTED AND MAY BE REDUCED AS FOUND NECESSARY DURING THE LIFE OF THE PROJECT.
- REMOVAL OF THE EXISTING STRUCTURE SHALL BE PERFORMED SO AS NOT TO ALLOW DEBRIS TO FALL INTO THE WATER. THE CONTRACTOR SHALL REMOVE THE STRUCTURE AND SUBMIT PLANS FOR DEMOLITION IN ACCORDANCE WITH ARTICLE 402-2 OF THE STANDARD SPECIFICATIONS.
- THE EXISTING STRUCTURE INDICATED ON THE PLANS IS FROM THE BEST INFORMATION AVAILABLE. SINCE THIS INFORMATION IS SHOWN FOR THE CONVENIENCE OF THE CONTRACTOR, THE CONTRACTOR SHALL HAVE NO CLAIM WHATSOEVER AGAINST THE DEPARTMENT OF TRANSPORTATION FOR ANY DELAYS OR ADDITIONAL COST INCURRED BASED ON DIFFERENCES BETWEEN THE EXISTING STRUCTURE SHOWN ON THE PLANS AND THE ACTUAL CONDITIONS AT THE PROJECT SITE.
- EXCAVATE ONE FOOT MINIMUM BELOW CULVERT AND REPLACE THE EXCAVATED MATERIAL WITH FOUNDATION CONDITIONING MATERIAL IN ACCORDANCE WITH SECTION 414 OF THE STANDARD SPECIFICATIONS.
- FOR EROSION CONTROL MEASURES, SEE EROSION CONTROL PLANS.
- FOR CRANE SAFETY, SEE SPECIAL PROVISIONS.
- FOR SUBMITTAL OF WORKING DRAWINGS, SEE SPECIAL PROVISIONS.
- FOR FALSEWORK AND FORMWORK, SEE SPECIAL PROVISIONS.
- FOR GROUT FOR STRUCTURES, SEE SPECIAL PROVISIONS.
- FOR OTHER DESIGN DATA AND GENERAL NOTES, SEE SHEET SN.


THIS STRUCTURE SHALL BE DESIGNED IN ACCORDANCE WITH THE AASHTO LFRD BRIDGE DESIGN SPECIFICATIONS.

FOR CULVERT DIVERSION DETAILS AND PAY ITEM, SEE EROSION CONTROL PLANS.

NO PRECAST REINFORCED BOX CULVERT OPTION WILL BE ALLOWED.

BACKFILL SILLS WITH NATIVE MATERIAL.

NATIVE MATERIAL CONSISTS OF MATERIAL THAT IS EXCAVATED FROM THE STREAM AT THE PROJECT SITE DURING CULVERT CONSTRUCTION. NATIVE MATERIAL IS SUBJECT TO APPROVAL BY THE ENGINEER AND MAY BE SUBJECT TO PERMIT CONDITIONS.

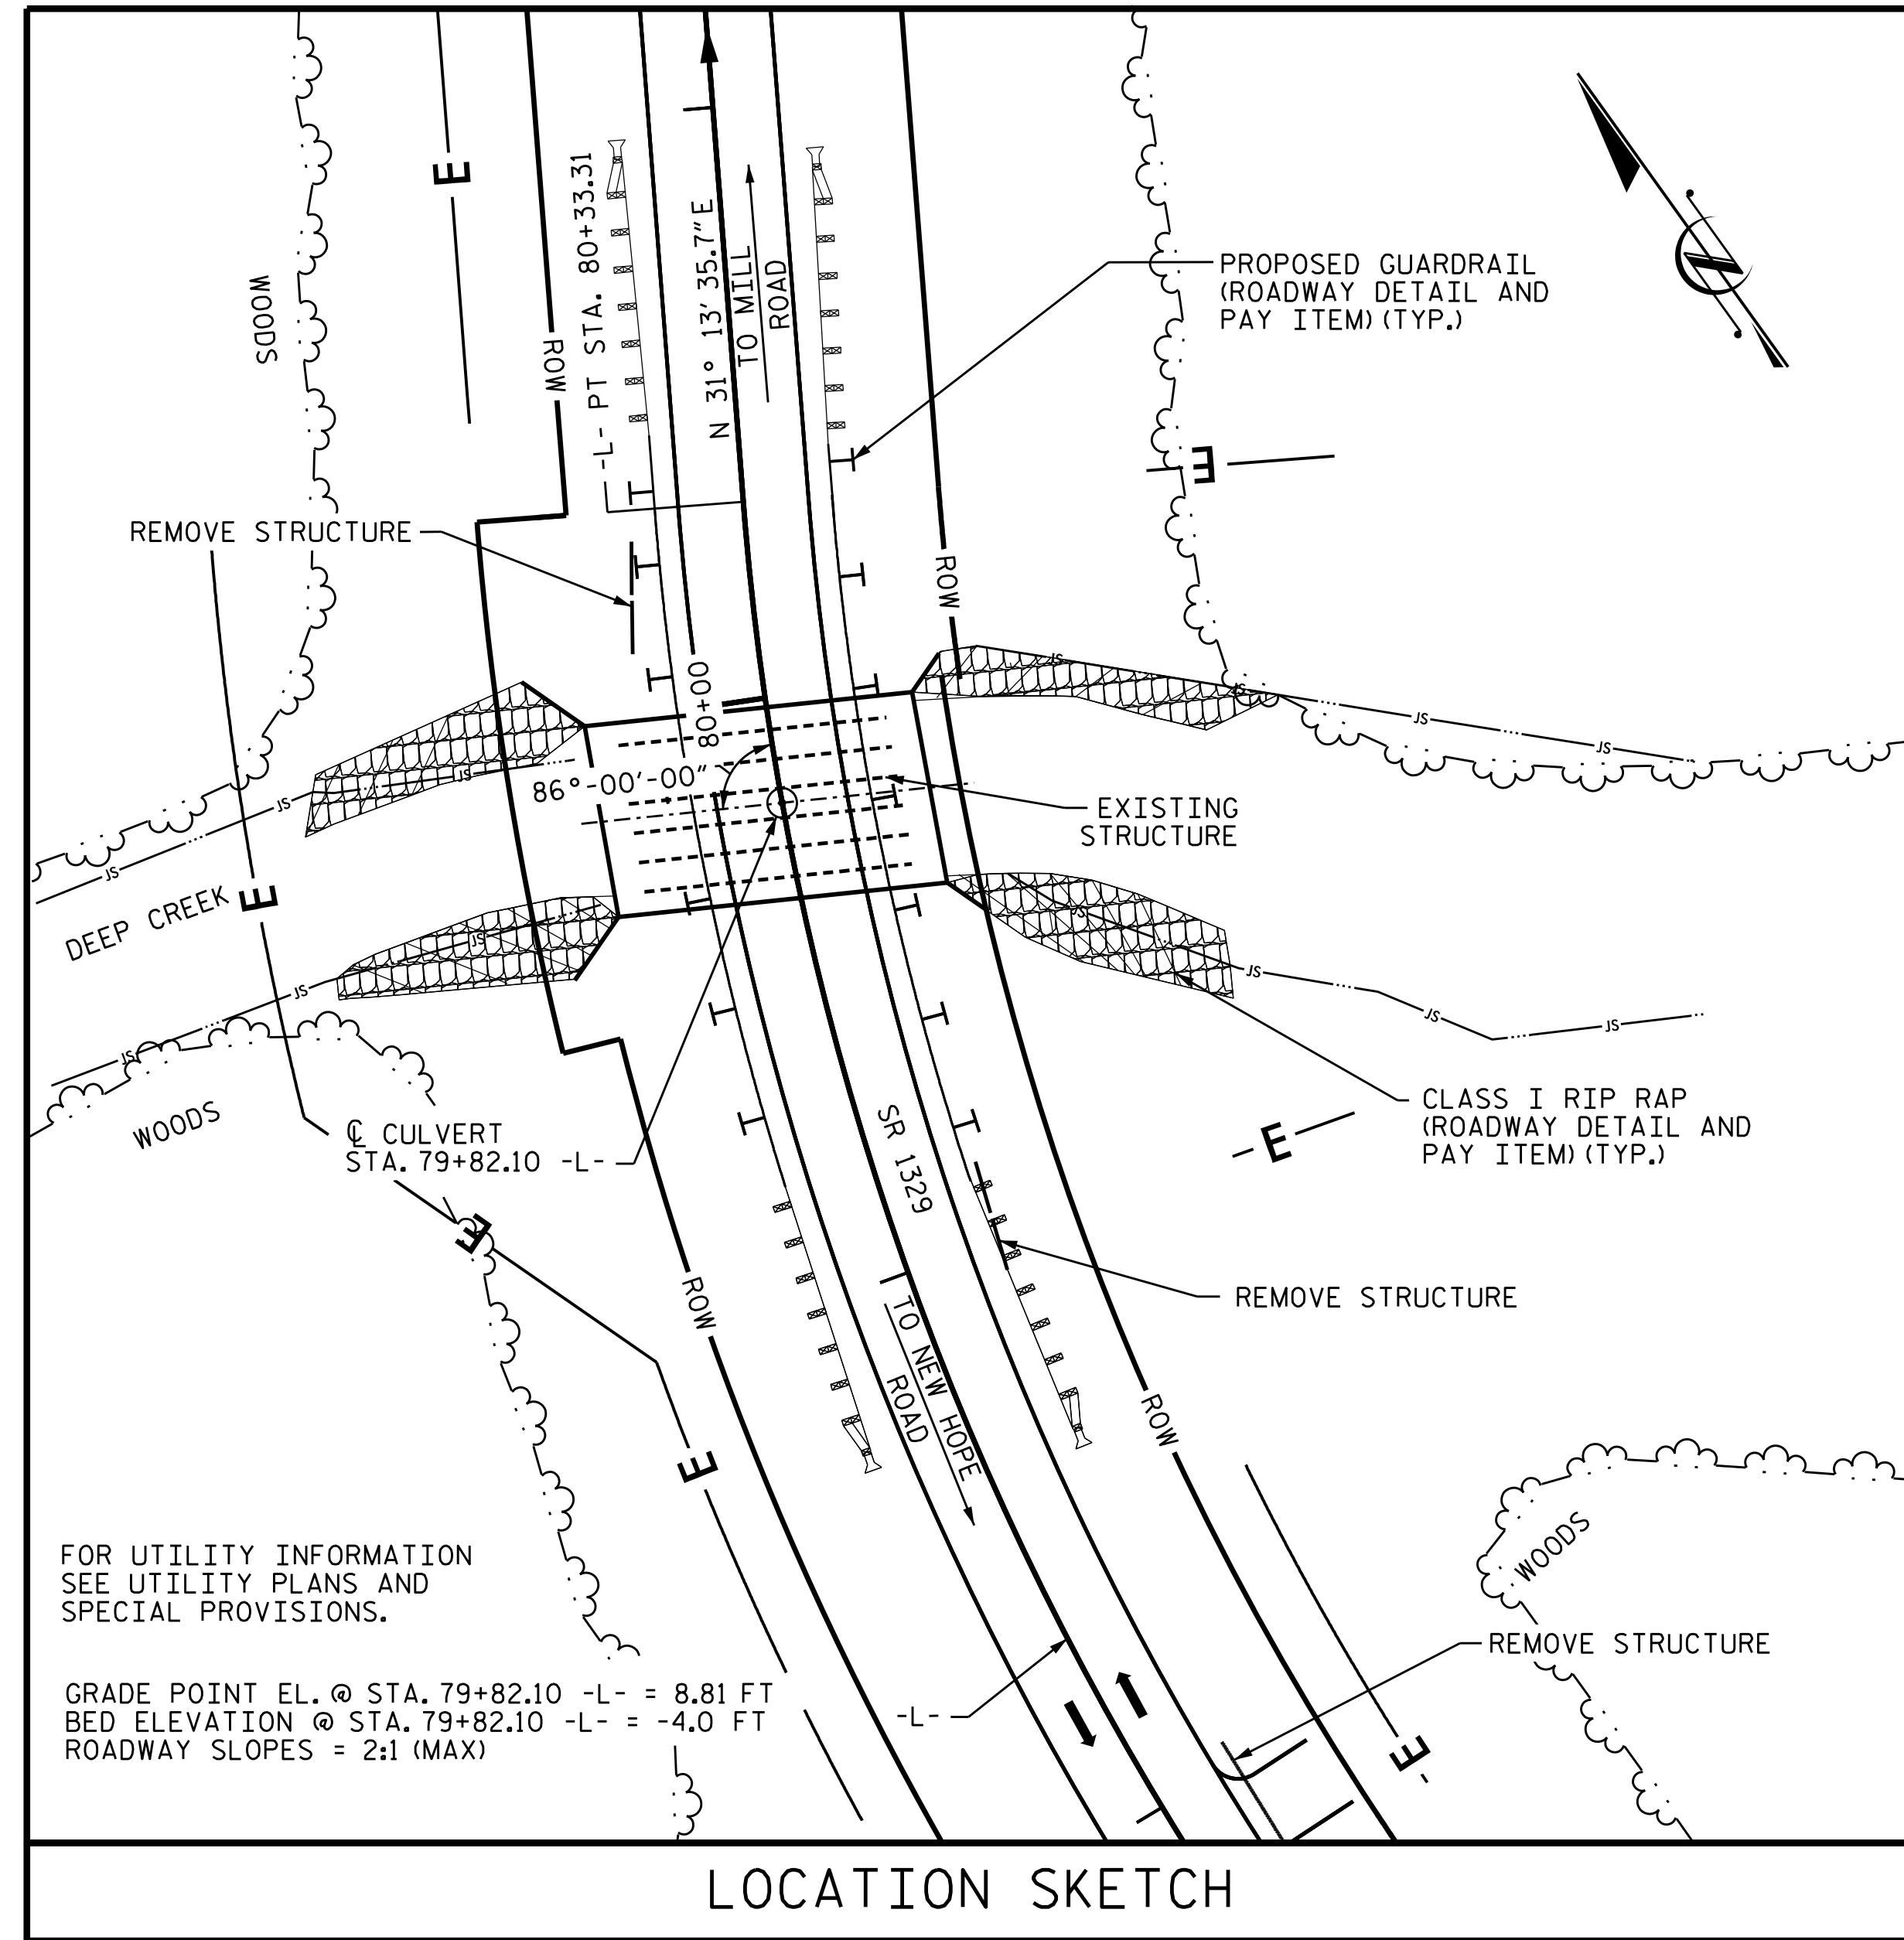

TOTAL STRUCTURE QUANTITIES	
CULVERT EXCAVATION	LUMP SUM
FOUNDATION CONDITIONING MATERIAL	141 TONS
ALUMINUM BOX CULVERT @ STA. 79+82.10 -L-	LUMP SUM
MOMENT SLAB	68.0 LIN. FT.


I HEREBY CERTIFY THESE PLANS ARE THE AS-BUILT PLANS

OVERTOPPING FLOOD DATA

OVERTOPPING DISCHARGE = 1090 CFS
 FREQUENCY OF OVERTOPPING FLOOD = <500 YR.
 OVERTOPPING FLOOD ELEVATION = 6.9 FT.
 OCCURS @ STA. 82+80 -L-


HYDRAULIC DATA

DESIGN DISCHARGE = 563 CFS
 FREQUENCY OF DESIGN FLOOD = 25 YR.
 DESIGN HIGH WATER ELEVATION = 4.2 FT.
 DRAINAGE AREA = 3.41 SQ. MI.
 BASE DISCHARGE (Q₁₀₀) = 909 CFS
 BASE HIGH WATER ELEVATION = 5.2 FT.

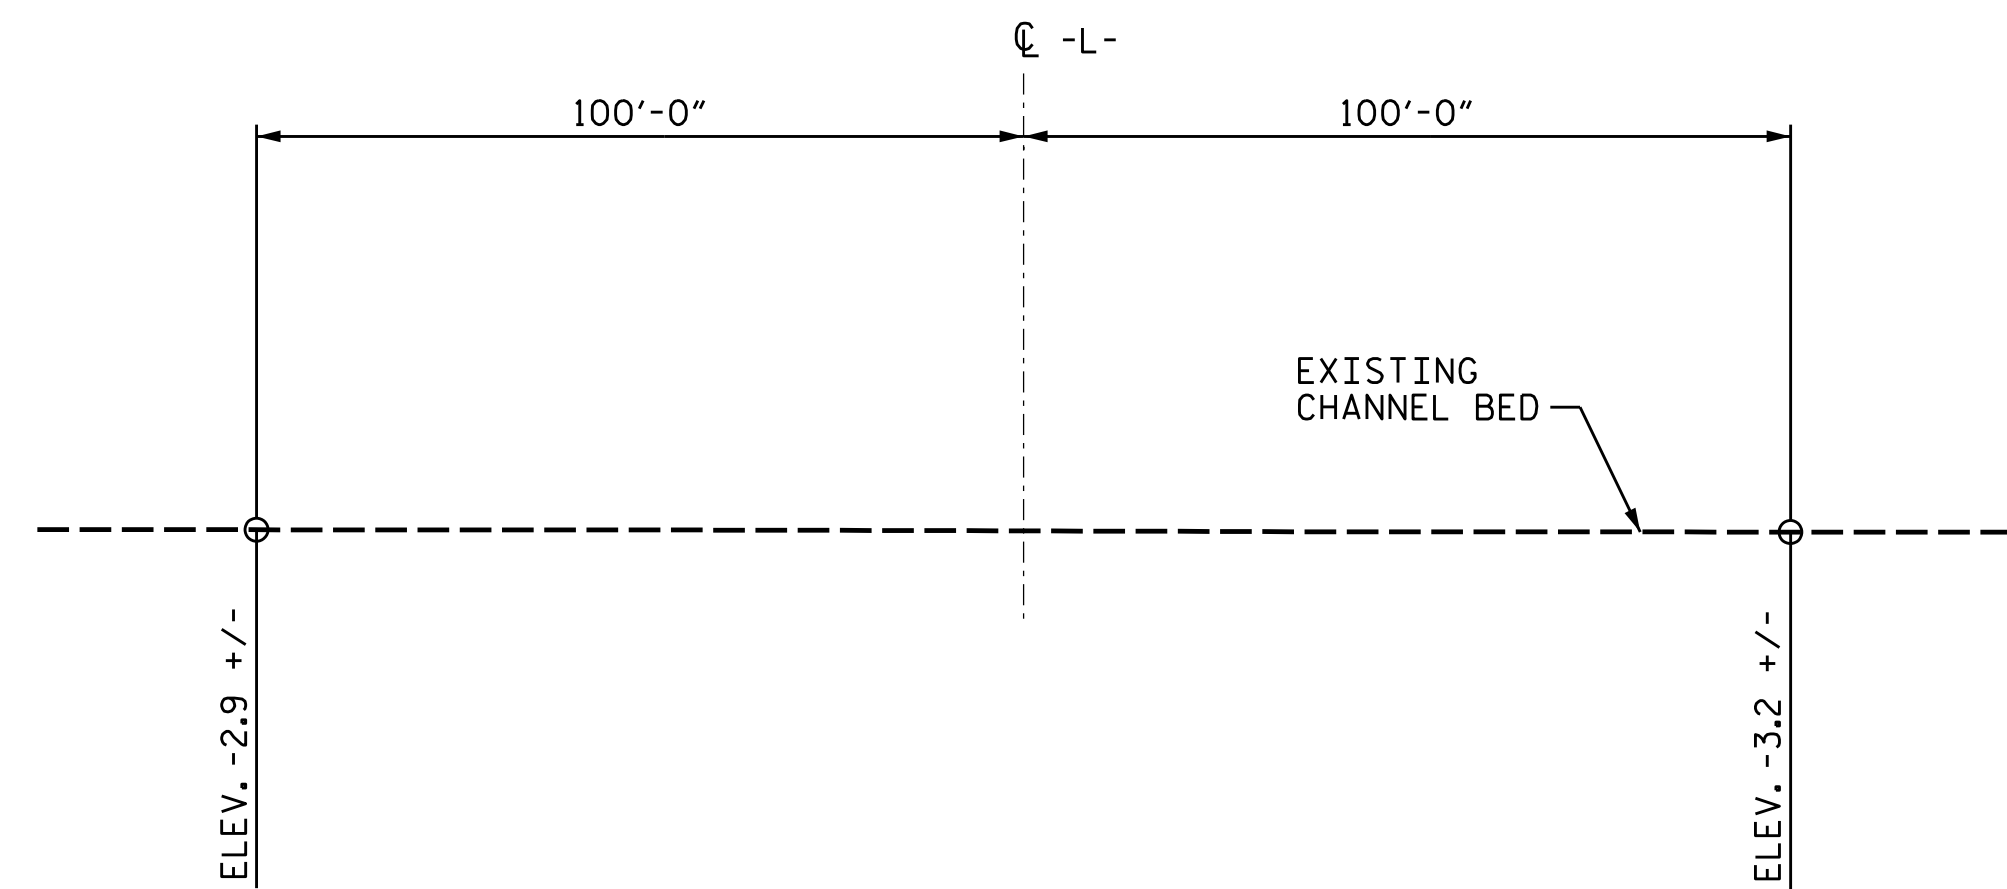

PROJECT NO. R-5740
PERQUIMANS COUNTY
 STATION: 79+82.10 -L-

SHEET 1 OF 3 STRUCTURE NO. 710086

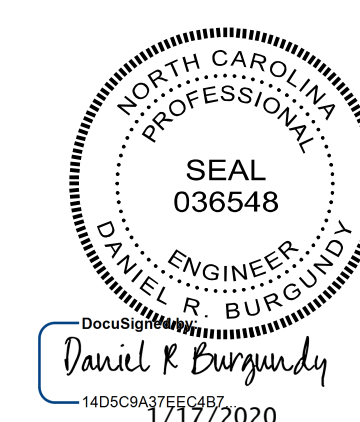


STATE OF NORTH CAROLINA
 DEPARTMENT OF TRANSPORTATION
 RALEIGH

SINGLE
 32'-11" x 9'-4"
 ALUMINUM BOX CULVERT
 94° SKEW


REVISIONS						SHEET NO.
NO.	BY:	DATE:	NO.	BY:	DATE:	C-2
1			3			TOTAL SHEETS
2			4			7

PREPARED IN THE OFFICE OF:
ATKINS
 1616 EAST MILLBROOK ROAD, SUITE 160
 RALEIGH, NORTH CAROLINA 27609
 (919) 876-6888 NCBES #F-0326

DRAWN BY : CAB DATE : 11/19
 CHECKED BY : CYL DATE : 11/19
 DESIGN ENGINEER OF RECORD : DRB DATE : 11/19

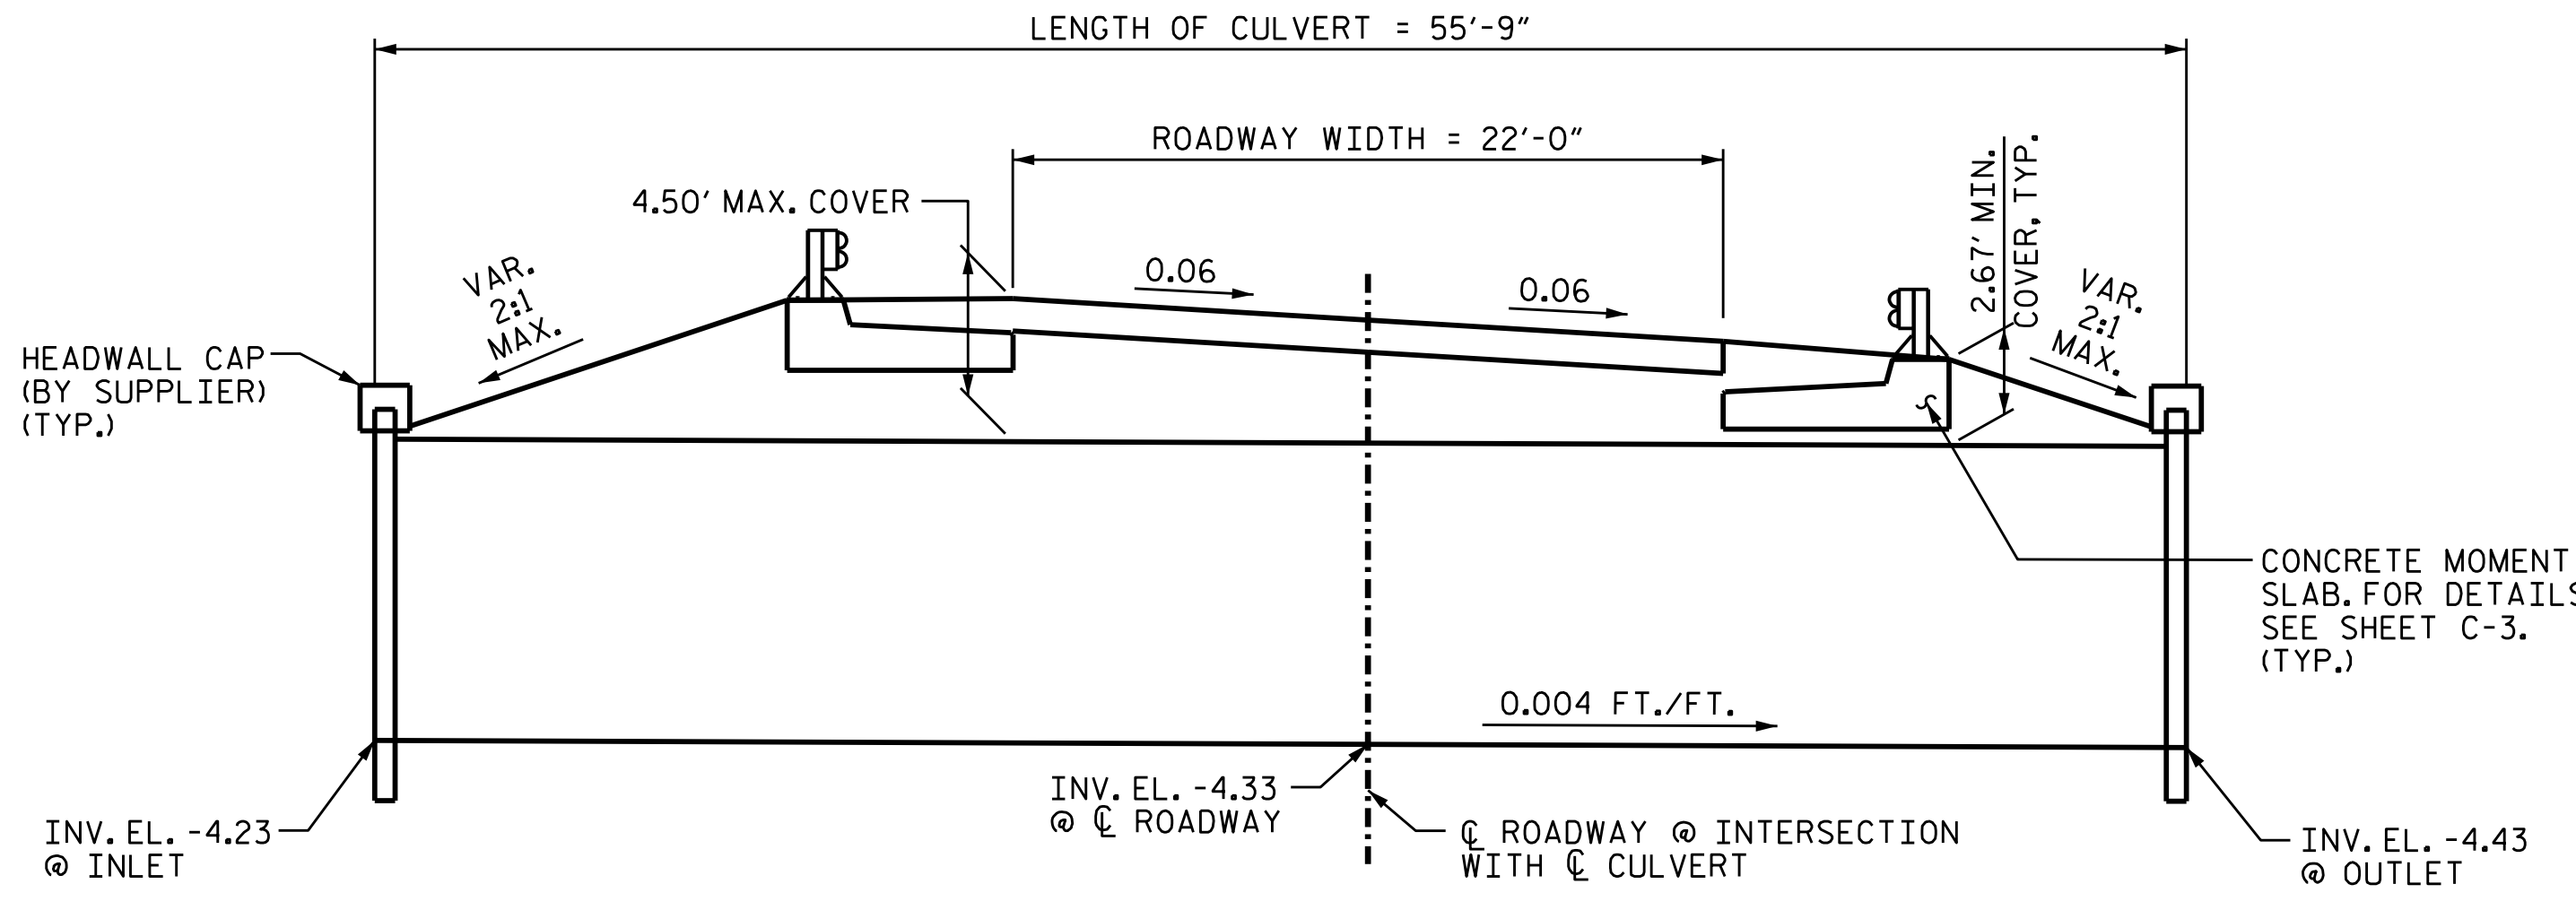


LENGTH FOR ALUMINUM BOX CULVERT

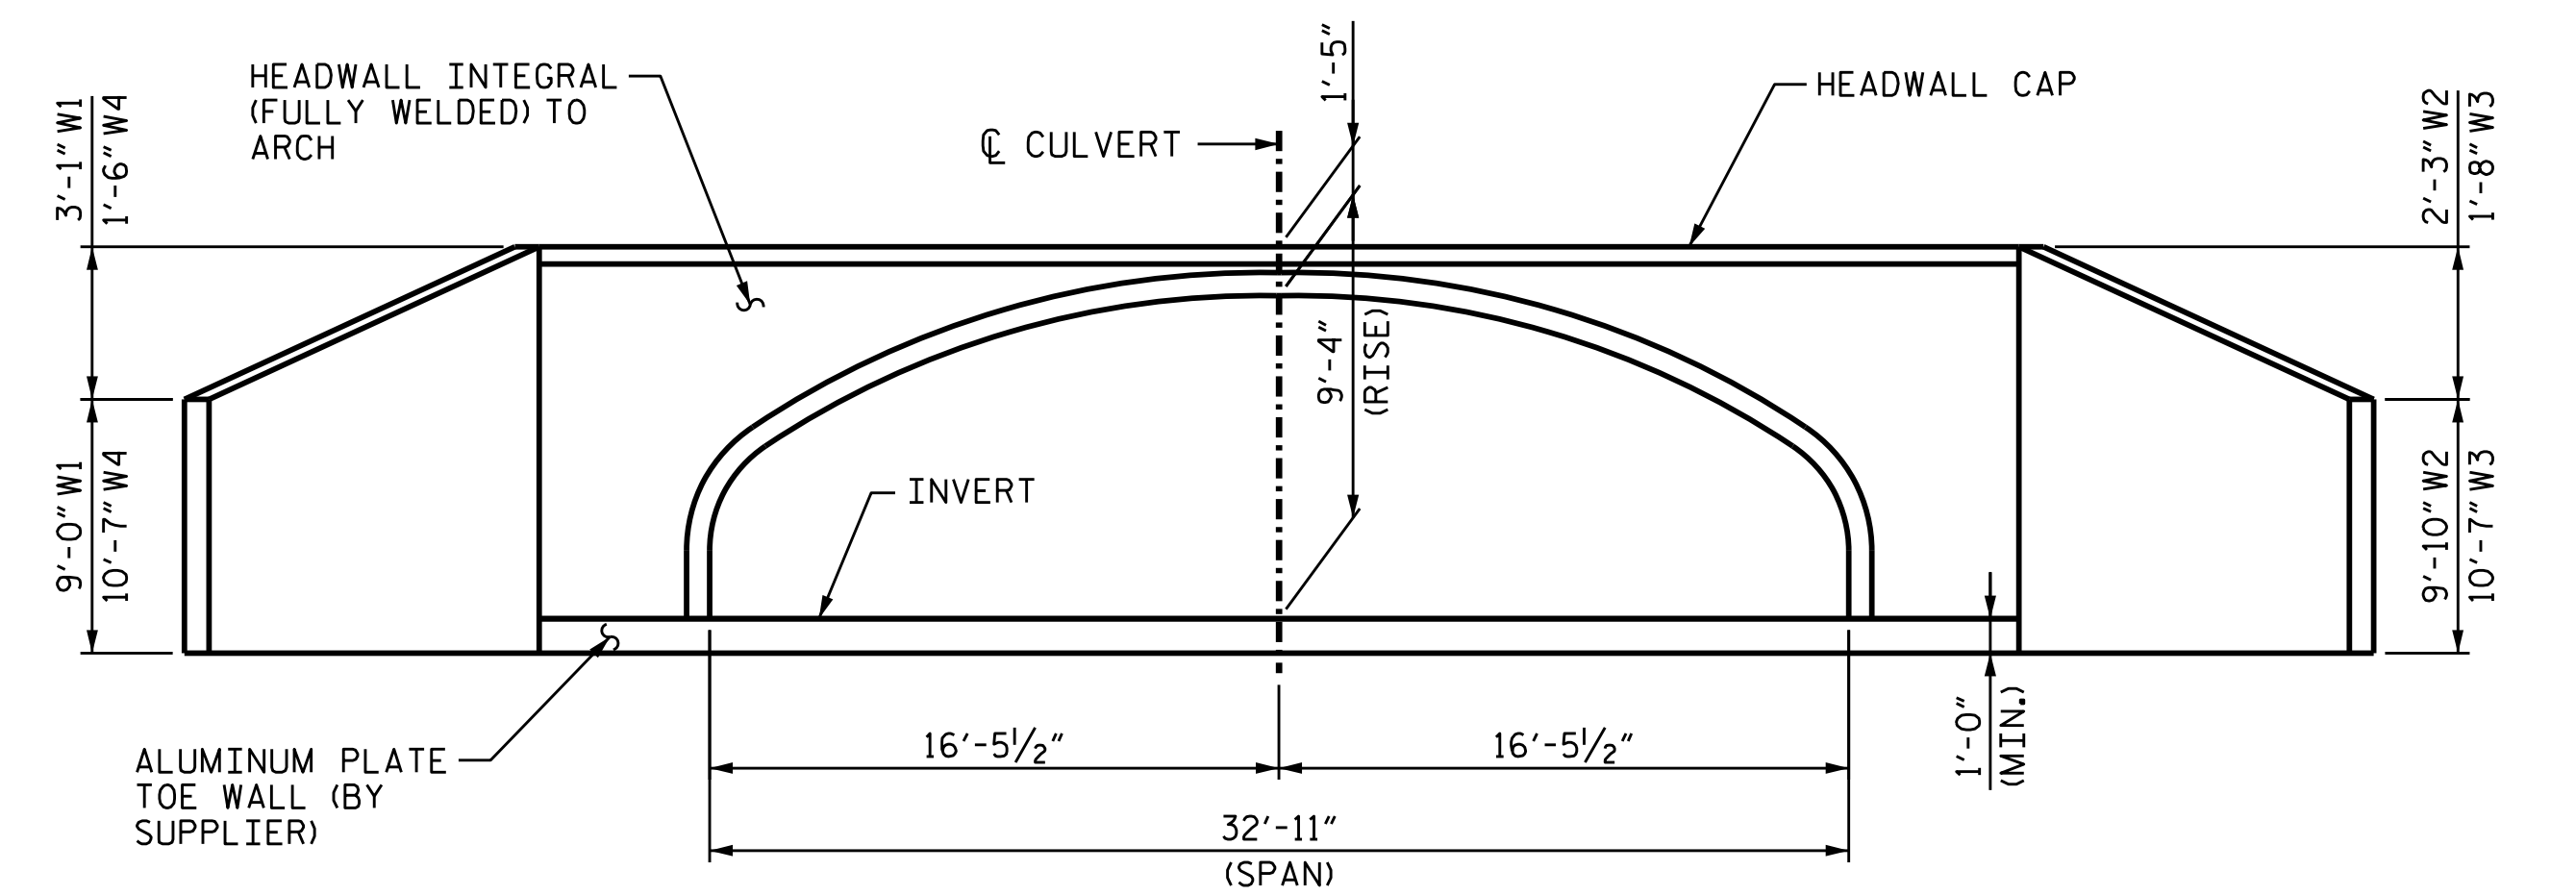

END ELEVATION

INLET SHOWN, OUTLET SIMILAR

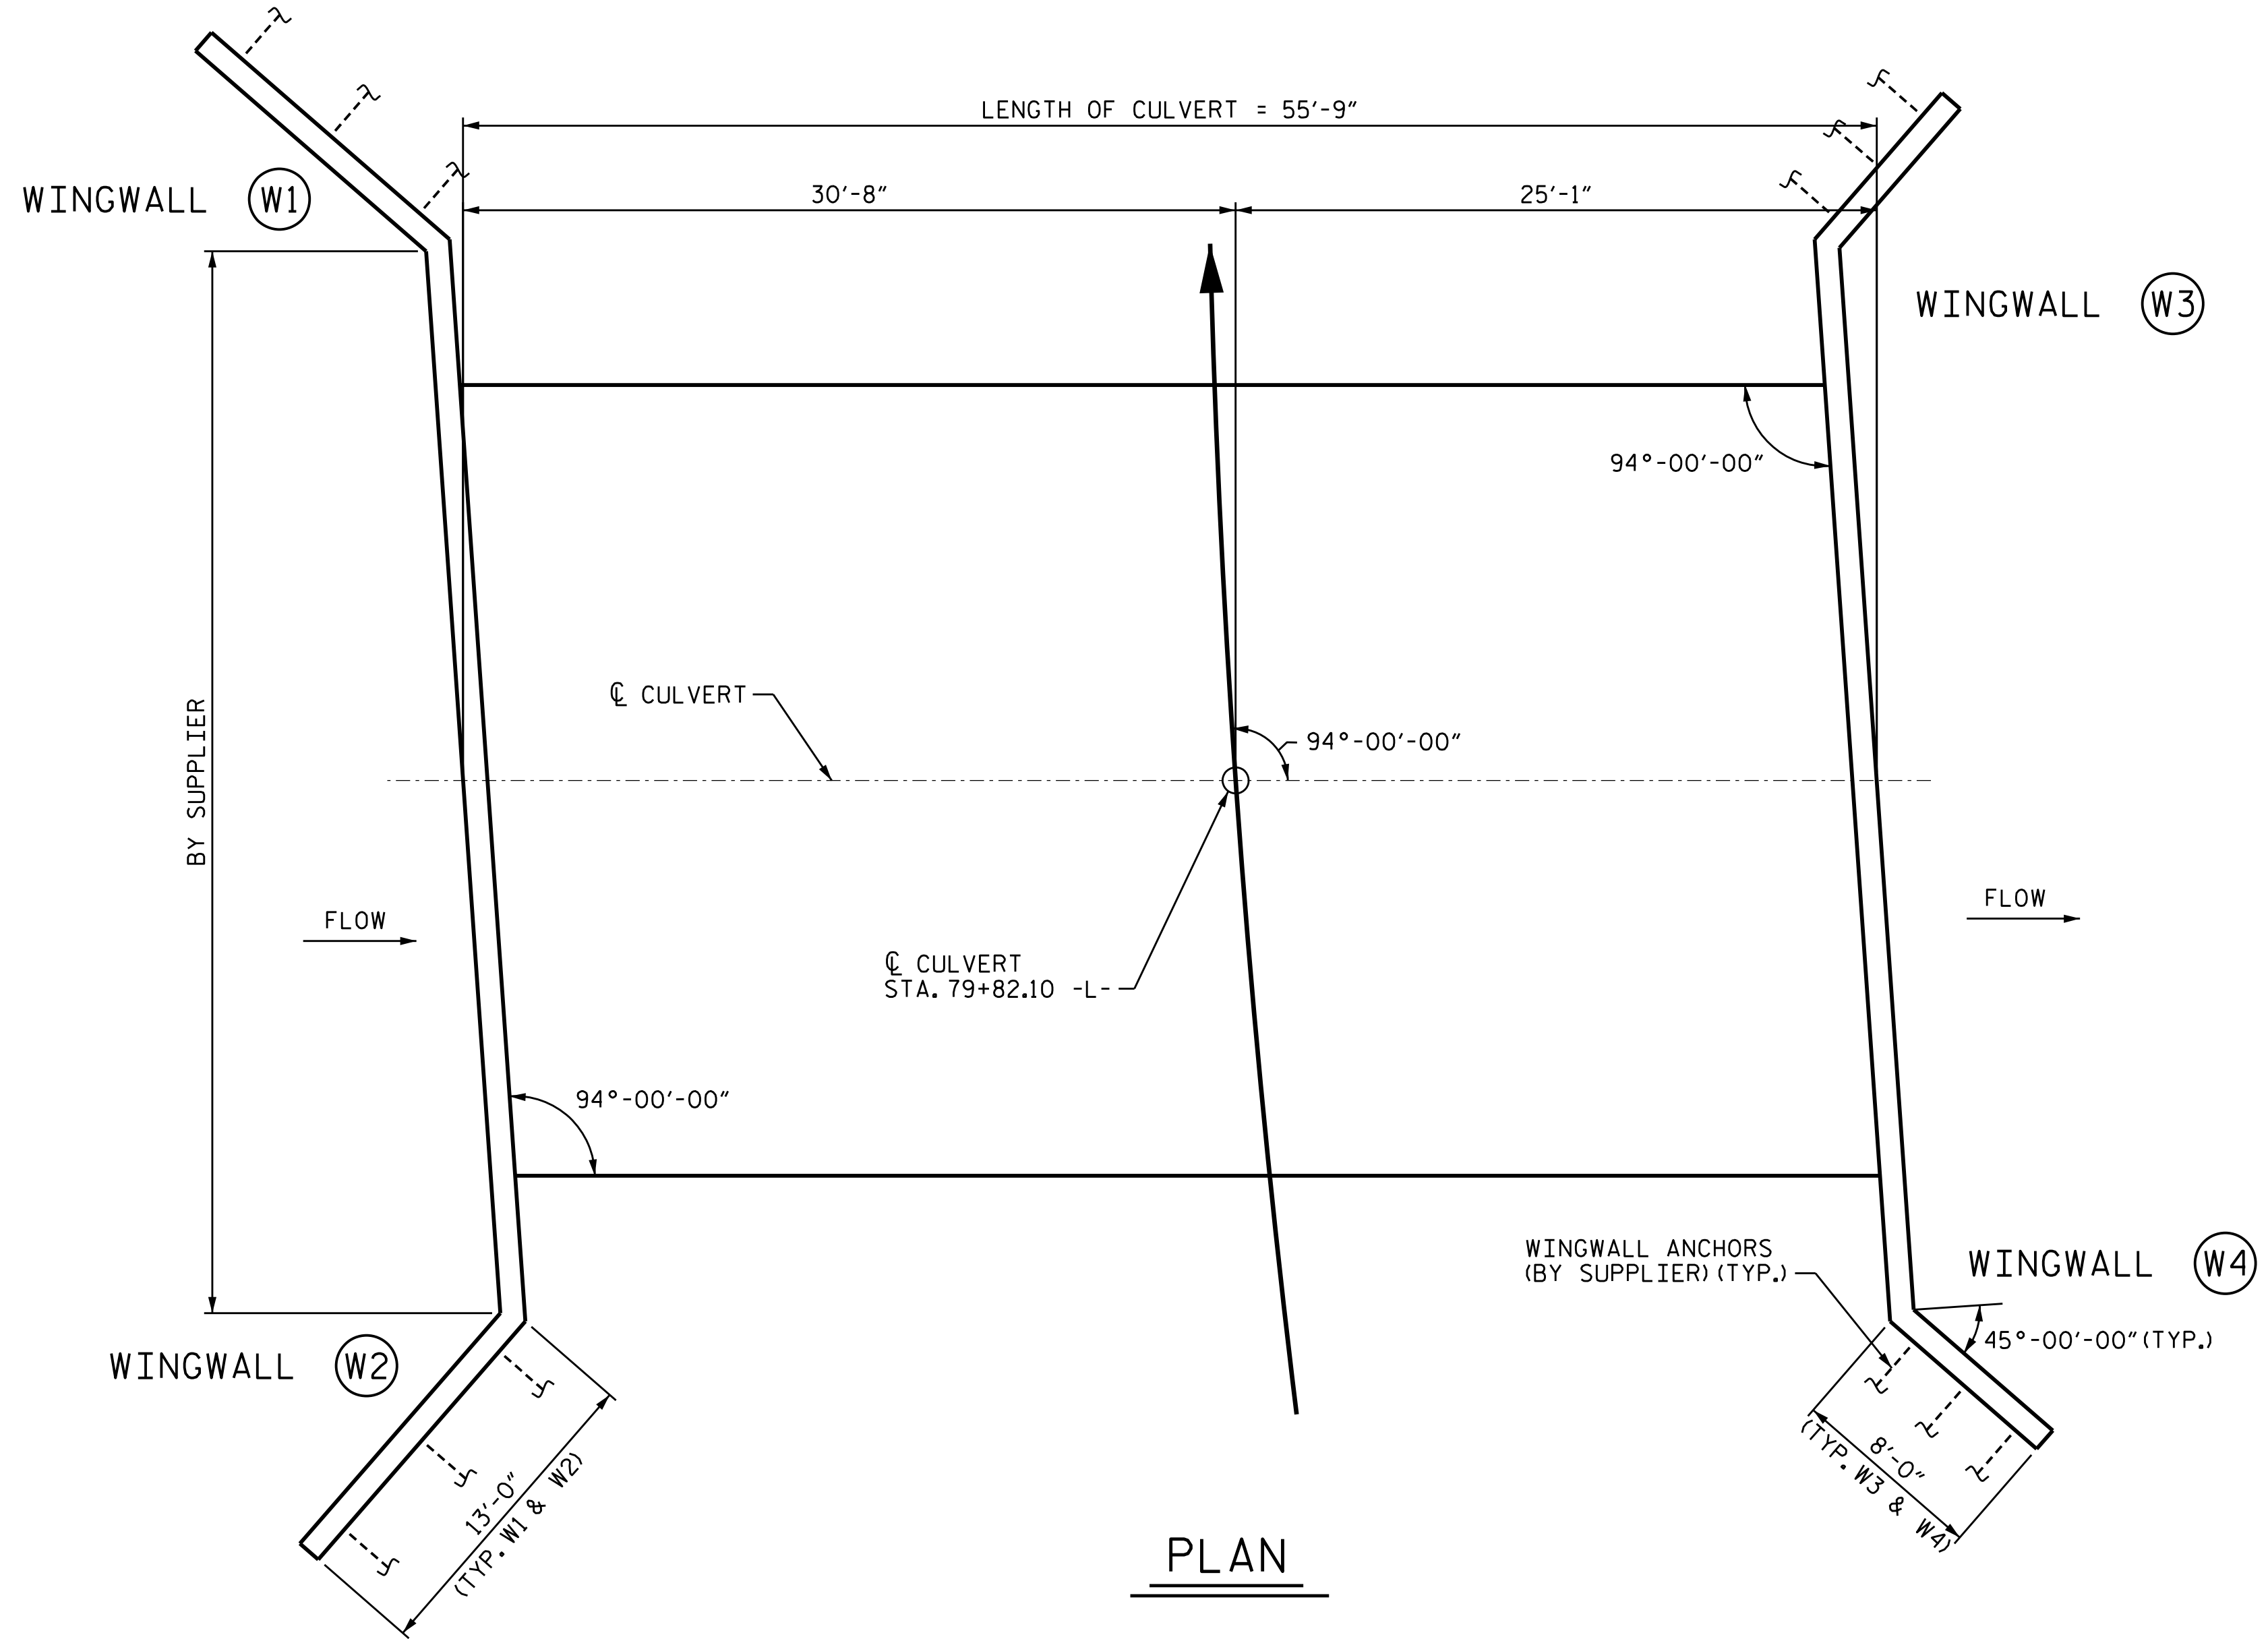

PLAN

I HEREBY CERTIFY THESE PLANS ARE THE AS-BUILT PLANS

PROJECT NO. R-5740
PERQUIMANS COUNTY
 STATION: 79+82.10 -L-

SHEET 2 OF 3

STATE OF NORTH CAROLINA
 DEPARTMENT OF TRANSPORTATION
 RALEIGH


SINGLE
 32'-11" x 9'-4"
 ALUMINUM BOX CULVERT
 94° SKEW

DocuSign by
 Daniel R. Burgundy
 1405619737/2020

PREPARED IN THE OFFICE OF:
ATKINS
 1616 EAST MILLBROOK ROAD, SUITE 160
 RALEIGH, NORTH CAROLINA 27609
 (919) 876-6888 NCBEES #F-0326


DRAWN BY : CAB DATE : 11/19
 CHECKED BY : CYL DATE : 11/19
 DESIGN ENGINEER OF RECORD : DRB DATE : 11/19

REVISIONS						SHEET NO.
NO.	BY:	DATE:	NO.	BY:	DATE:	C-3
1			3			TOTAL SHEETS
2			4			7

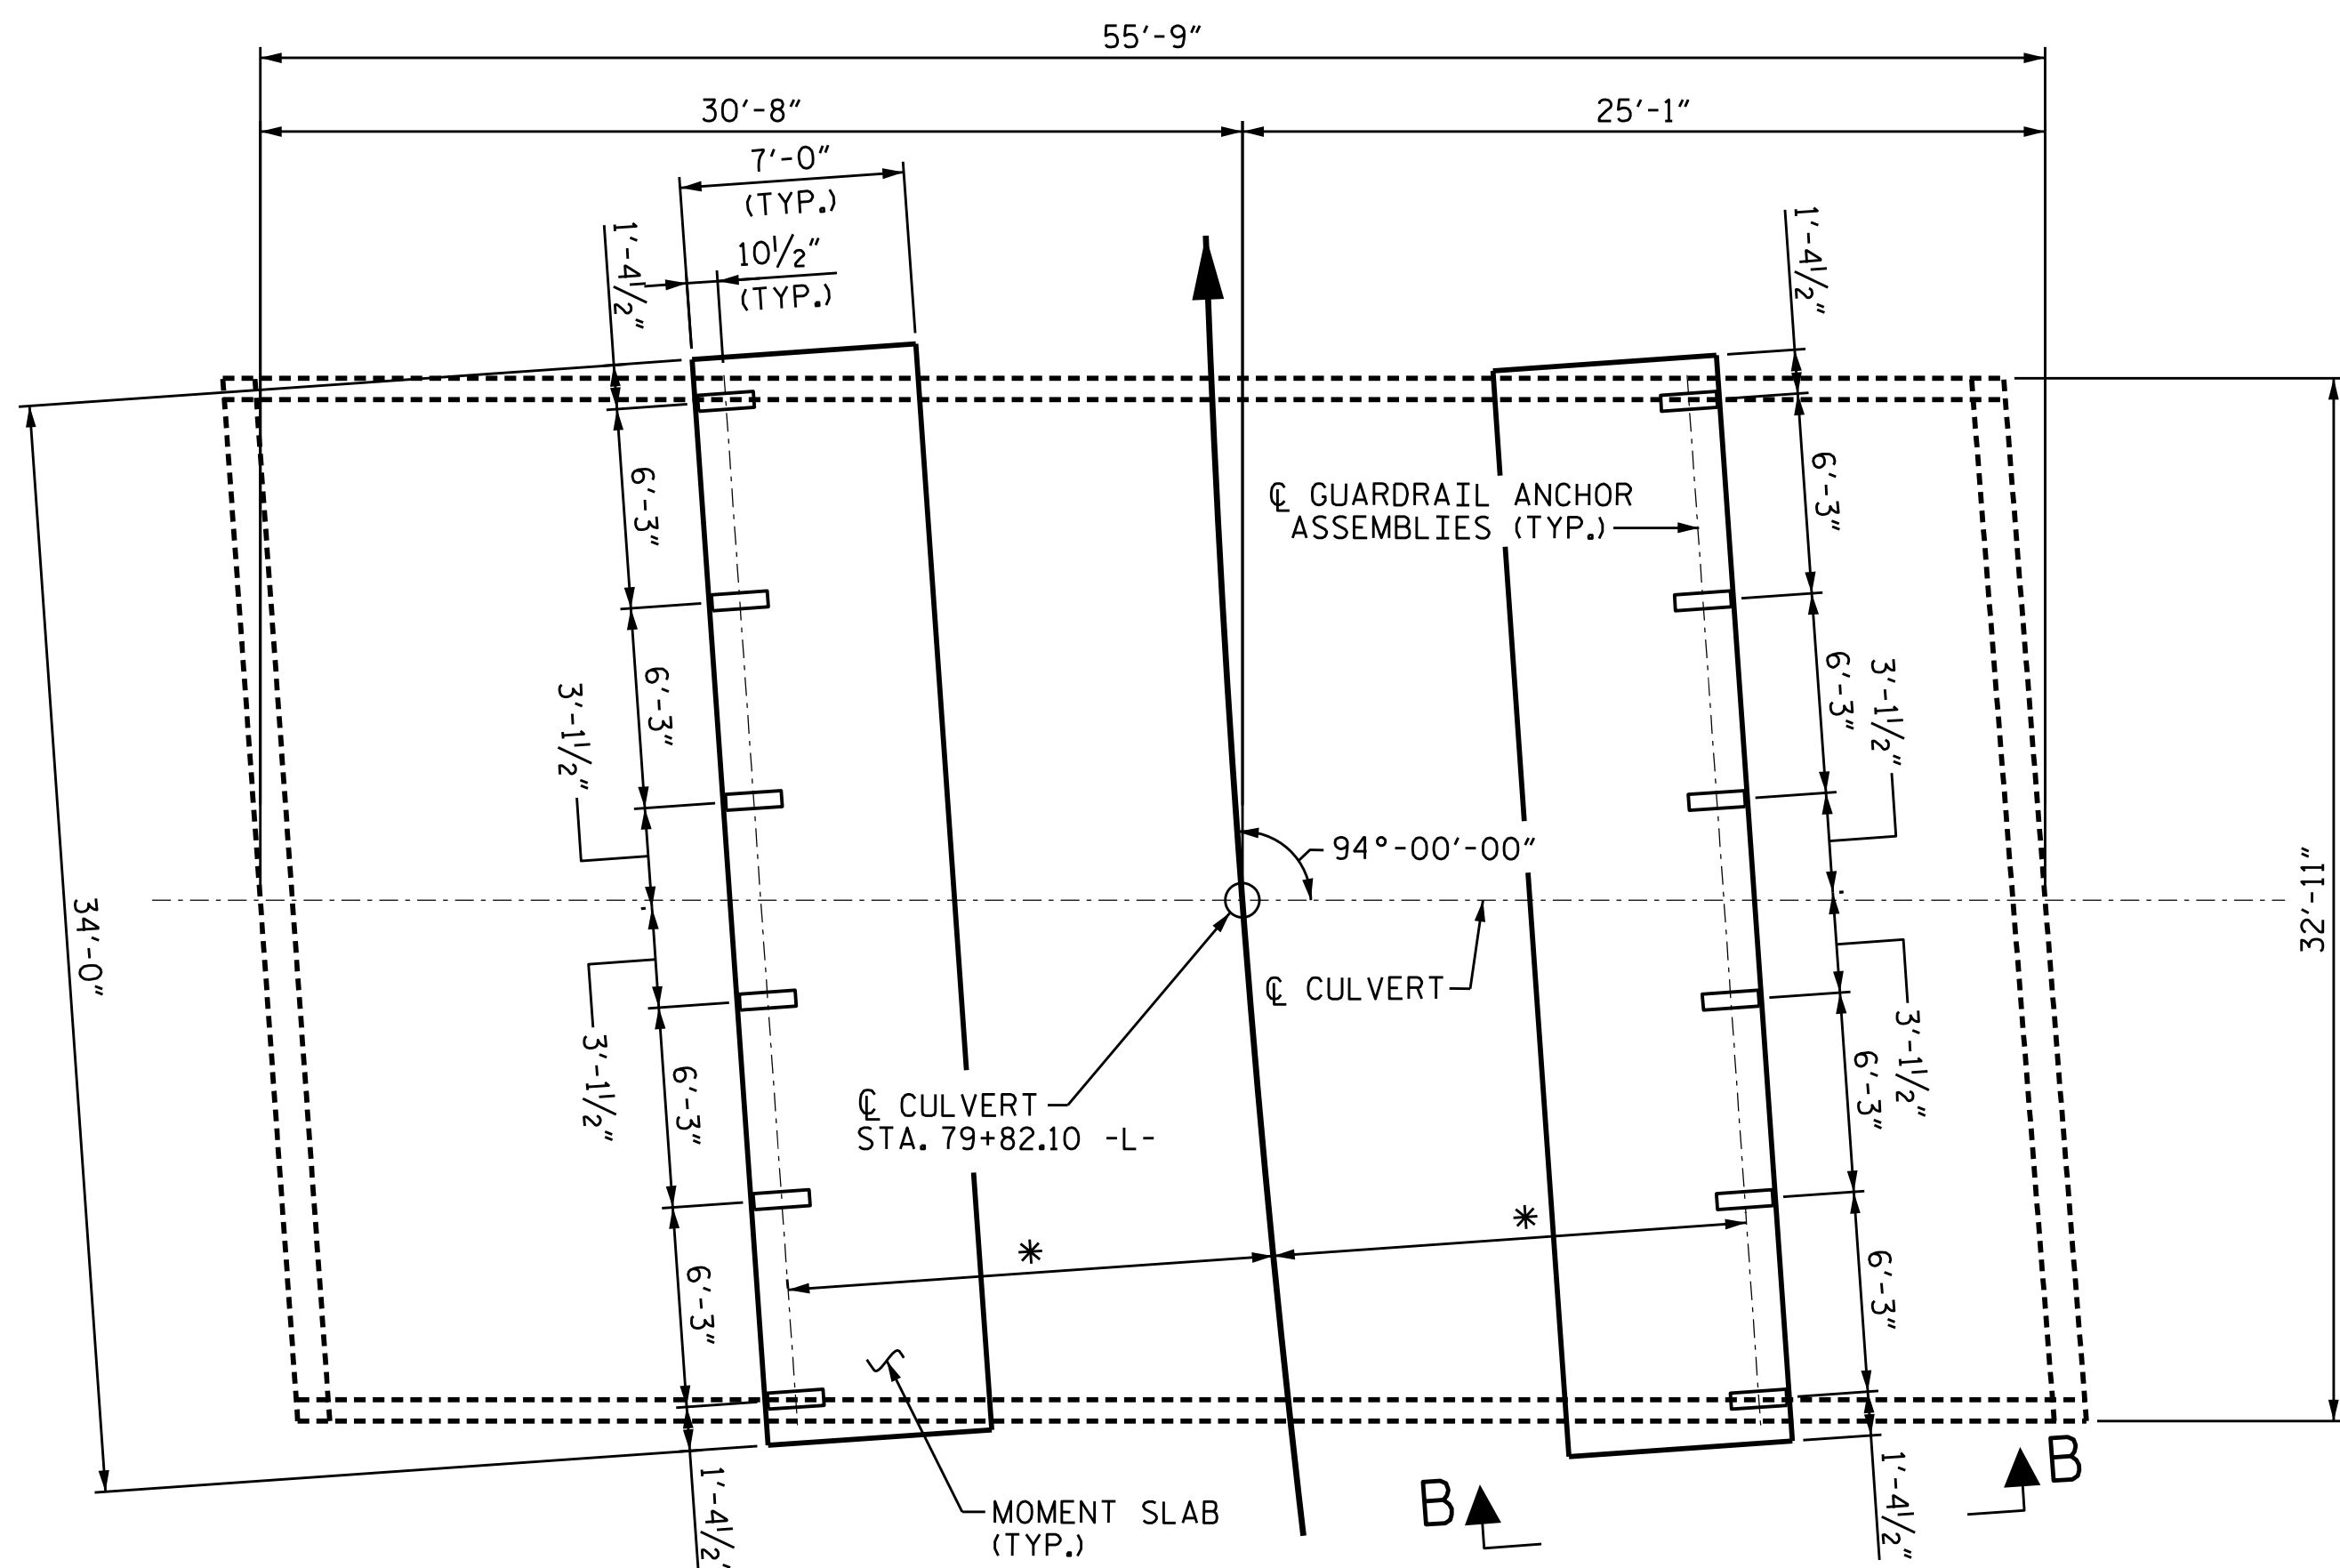

PLAN OF GUARDRAIL POST SPACING & MOMENT SLAB LAYOUT

* THIS DIMENSION TO BE DETERMINED BY THE ENGINEER IN THE FIELD.

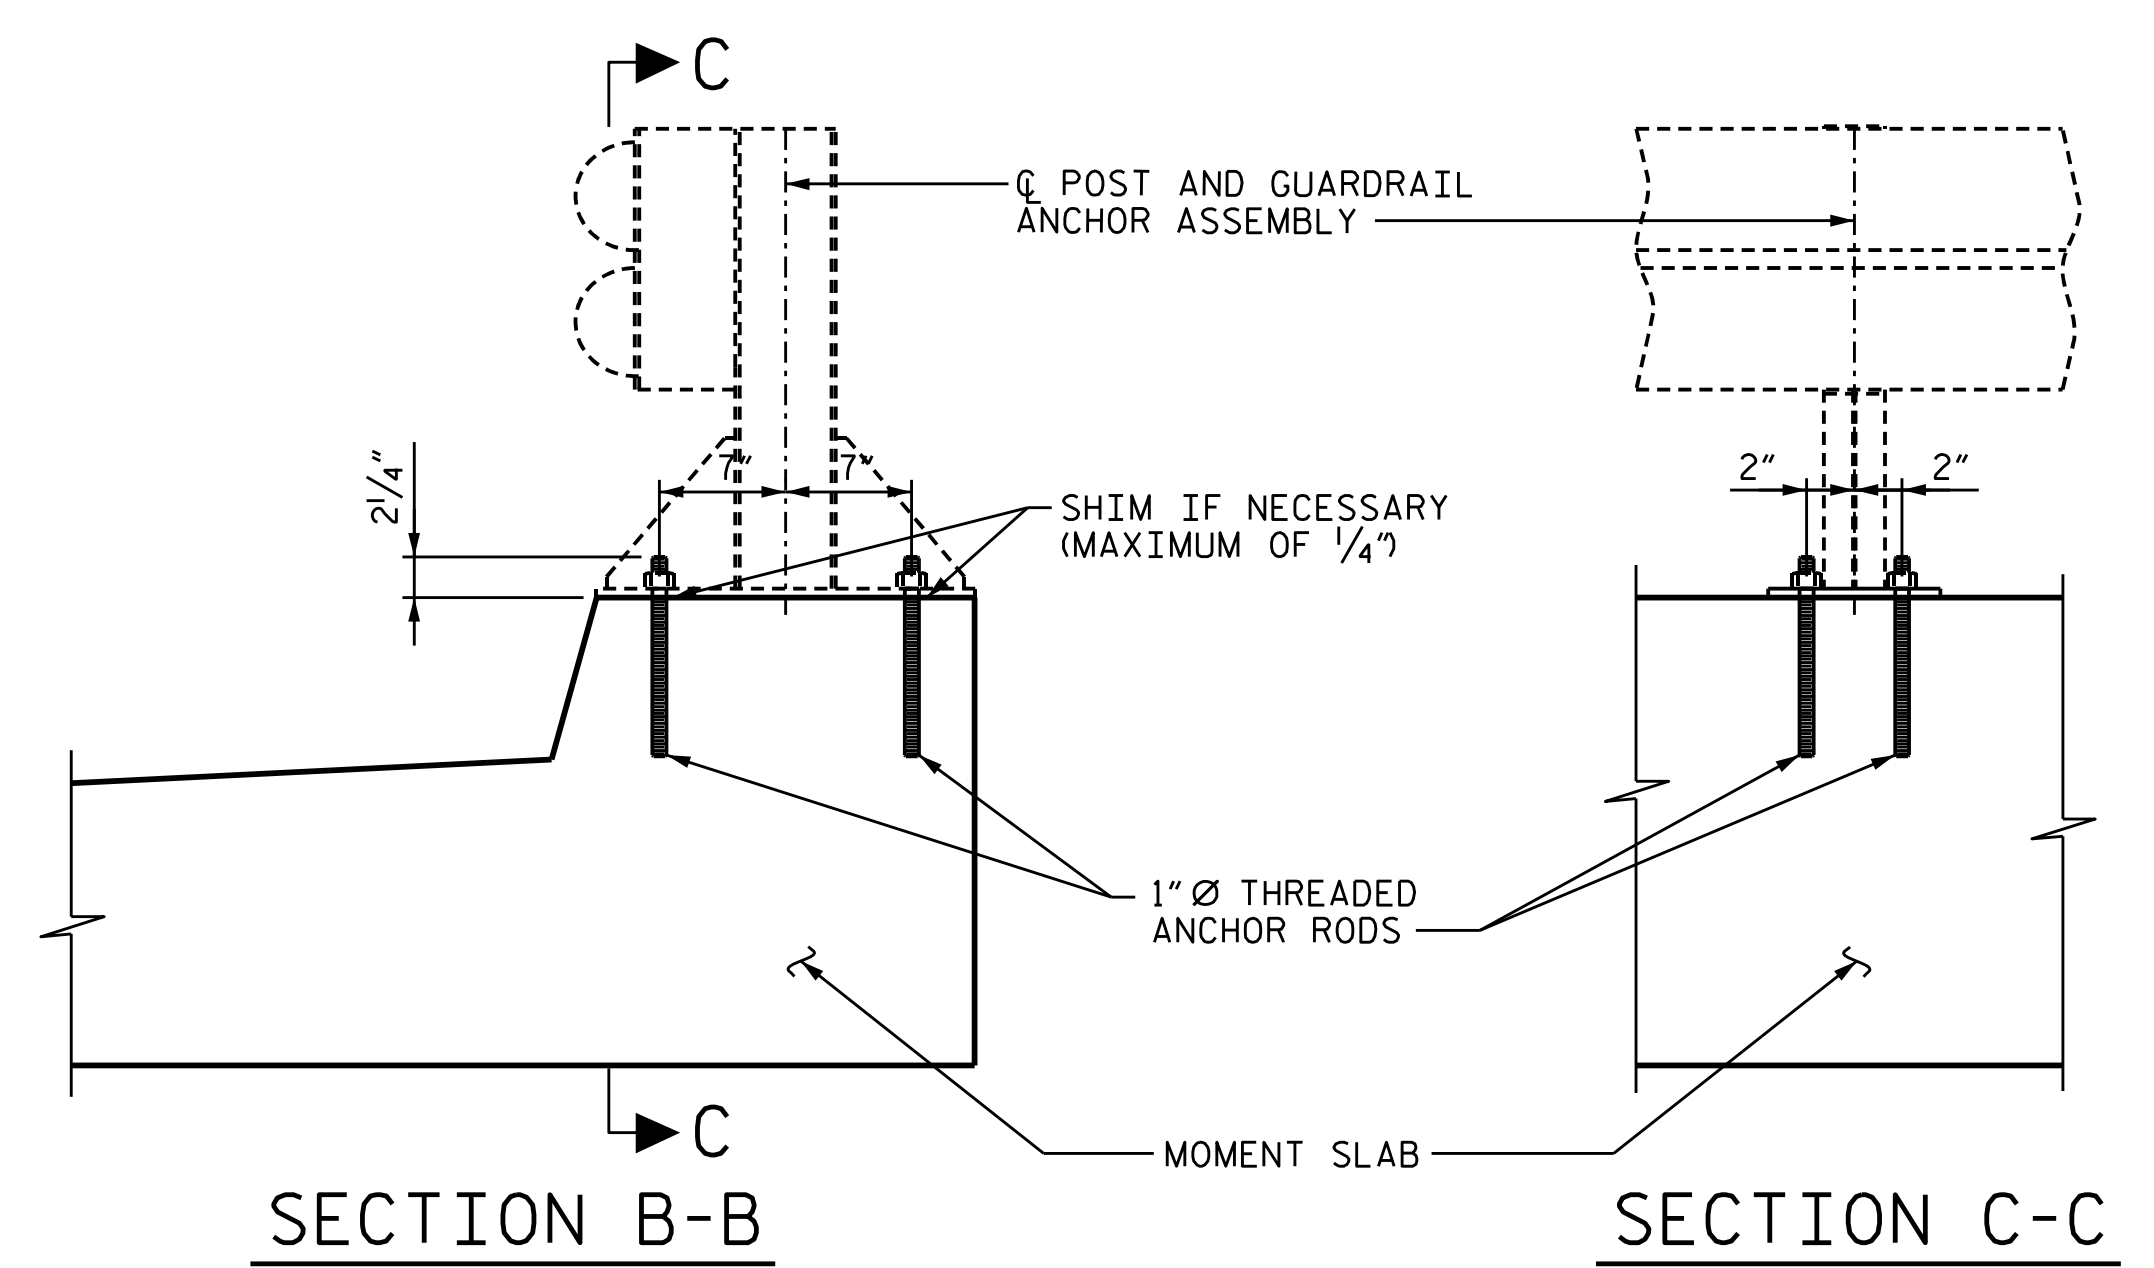

SECTION B-B

SECTION C-C

NOTES

ALL GUARDRAIL ATTACHMENTS SHALL BE MADE USING ADHESIVELY ANCHORED ANCHOR BOLTS. LEVEL TWO FIELD TESTING IS REQUIRED, AND THE YIELD LOAD OF THE 1" Ø BOLT IS 21.8 KIPS. FOR ADHESIVELY ANCHORED ANCHOR BOLTS, SEE THE STANDARD SPECIFICATIONS.

ANCHOR BOLTS, NUTS AND WASHERS SHALL BE 1" Ø AND MEET THE REQUIREMENTS OF ASTM A325. BOLTS, NUTS AND WASHERS SHALL BE GALVANIZED.


PAYMENT FOR GUARDRAIL, POSTS, ADHESIVELY ANCHORED ANCHOR BOLTS AND POST BASE PLATES IS INCLUDED IN ROADWAY PAY ITEMS.

THE GUARDRAIL POSTS SHALL NOT BE ATTACHED UNTIL THE MOMENT SLAB HAS ATTAINED AN AGE OF THREE CURING DAYS, OR A MINIMUM COMPRESSIVE STRENGTH OF 2000 PSI. IN ADDITION, NO FILL MATERIAL, ASPHALT OR CONSTRUCTION EQUIPMENT IS ALLOWED ON THE MOMENT SLAB PRIOR TO SATISFYING THE MINIMUM CONCRETE CURING AND STRENGTH REQUIREMENTS.

ALL REINFORCING STEEL IN THE MOMENT SLAB SHALL BE EPOXY COATED.

THE CONTRACT UNIT PRICE FOR "MOMENT SLAB, LIN. FEET" WILL BE FULL COMPENSATION FOR SUBMITTALS, LABOR, TOOLS, EQUIPMENT, MOMENT SLAB MATERIALS, EXCAVATING, BACKFILLING, HAULING AND REMOVING EXCAVATED MATERIALS, AND SUPPLYING ANY INCIDENTALS NECESSARY TO CONSTRUCT THE CONCRETE MOMENT SLAB. SEE SPECIAL PROVISION.

BAR TYPES					
ALL BAR DIMENSIONS ARE OUT TO OUT					
BILL OF MATERIAL FOR TWO MOMENT SLABS					
FOR CONCRETE MOMENT SLAB ONLY					
BAR	NO.	SIZE	TYPE	LENGTH	WEIGHT
B1	42	#4	STR	33'-8"	945
G1	70	#5	STR	6'-7"	481
G2	70	#4	STR	6'-7"	308
S1	138	#5	①	6'-5"	924
CLASS AA CONCRETE					26.9 CY
EPOXY COATED REINFORCING STEEL					2,658 LBS.
MOMENT SLAB					68.0 LIN. FT.

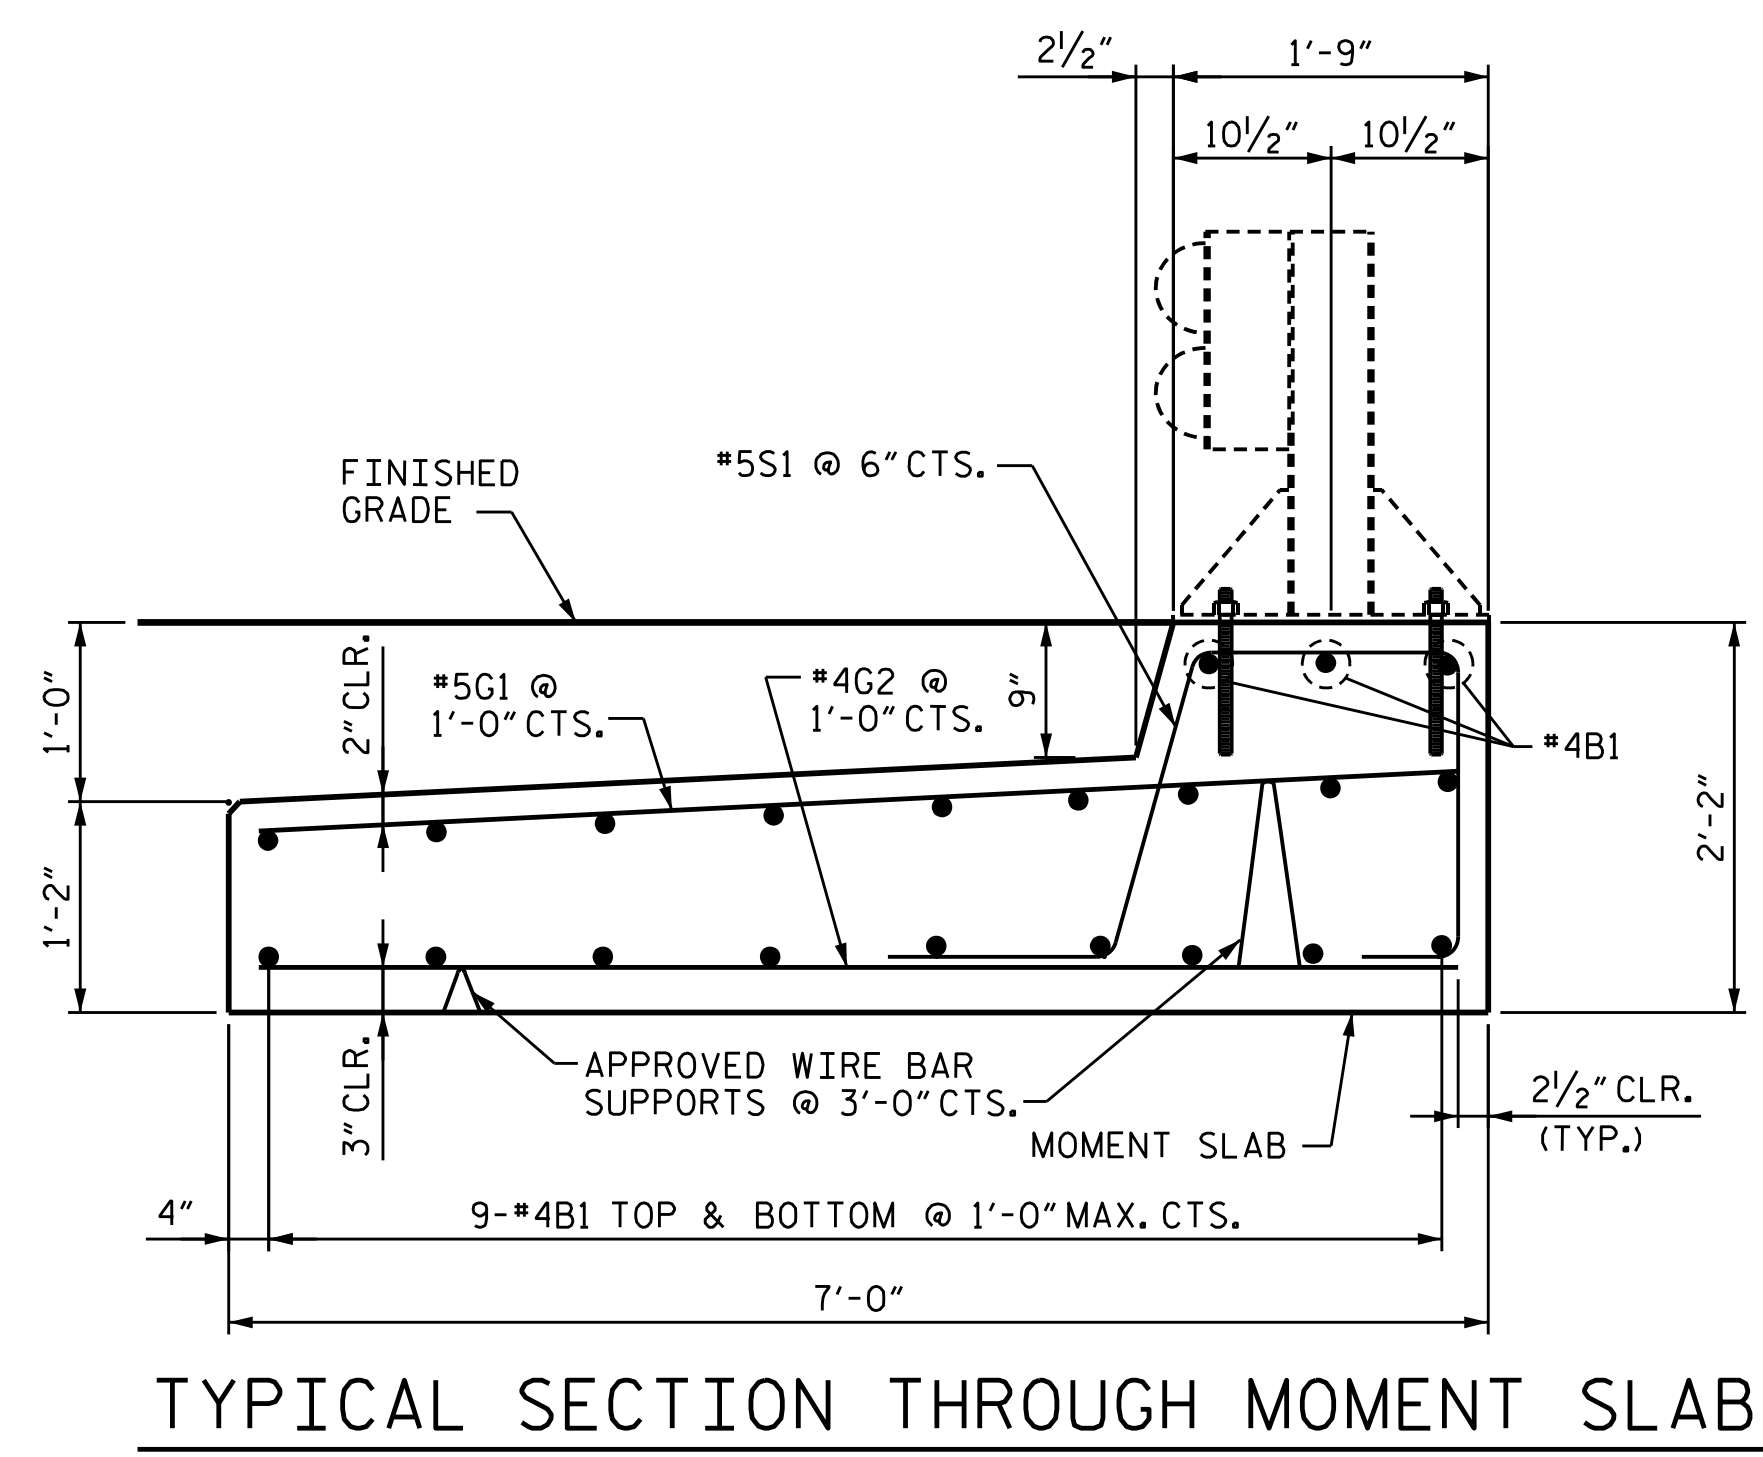

TYPICAL SECTION THROUGH MOMENT SLAB

PROJECT NO. R-5740
 PERQUIMANS COUNTY
 STATION: 79+82.10 -L-

SHEET 3 OF 3



STATE OF NORTH CAROLINA
 DEPARTMENT OF TRANSPORTATION
 RALEIGH
 SINGLE
 32'-11" x 9'-4"
 ALUMINUM BOX CULVERT
 94° SKEW

PREPARED IN THE OFFICE OF:
ATKINS
 1616 EAST MILLBROOK ROAD, SUITE 160
 RALEIGH, NORTH CAROLINA 27609
 (919) 876-6888 NCBES #F-0326

DRAWN BY : CAB DATE : 11/19
 CHECKED BY : CYL DATE : 11/19
 DESIGN ENGINEER OF RECORD : DRB DATE : 11/19

REVISIONS						SHEET NO.
NO.	BY:	DATE:	NO.	BY:	DATE:	C-4
1			3			TOTAL SHEETS
2			4			7

BM#2 - NAIL IN 22" PINE
 46' LT. OF STA. 60+97.81 -L-
 ELEV. = 9.95

NOTES

ASSUMED LIVE LOAD ----- HL-93 OR ALTERNATE LOADING.

DESIGN FILL ----- MAX. 4.83' ----- MIN. 3.83'

THE RESIDENT ENGINEER SHALL CHECK THE LENGTH OF CULVERT BEFORE STAKING IT OUT TO MAKE CERTAIN THAT IT WILL PROPERLY TAKE CARE OF THE FILL.

FOR ALUMINUM BOX CULVERT, SEE SPECIAL PROVISIONS.

ALL MATERIALS SHALL MEET THE REQUIREMENTS OF THE NCDOT STANDARD SPECIFICATIONS FOR ROADS AND STRUCTURES DATED JANUARY 2018.

THE DETAILS SHOWN ARE FOR GENERAL LAYOUT ONLY. THE SUPPLIER SHALL PROVIDE DESIGNS AND DETAILS FOR REVIEW AND APPROVAL THAT MEET THE REQUIREMENTS OF AASHTO LFRD BRIDGE DESIGN SPECIFICATIONS, SECTION 12, AND ARE SEALED BY A NORTH CAROLINA REGISTERED PROFESSIONAL ENGINEER.

UNLESS OTHERWISE INDICATED, THE SUPPLIER SHALL DESIGN, DETAIL AND FURNISH ALL STRUCTURAL ELEMENTS AND HARDWARE.

THE EXISTING STRUCTURE CONSISTING OF 2 @ 95" X 67" ALUMINUM PLATE ARCH CULVERTS, 41.63' LONG WITH HEADWALLS ON BOTH ENDS SHALL BE REMOVED. THE EXISTING STRUCTURE IS PRESENTLY NOT POSTED FOR LOAD LIMIT. SHOULD THE STRUCTURAL INTEGRITY OF THE STRUCTURE DETERIORATE DURING CONSTRUCTION OF THE PROPOSED STRUCTURE, A LOAD LIMIT MAY BE POSTED AND MAY BE REDUCED AS FOUND NECESSARY DURING THE LIFE OF THE PROJECT.

REMOVAL OF THE EXISTING STRUCTURE SHALL BE PERFORMED SO AS NOT TO ALLOW DEBRIS TO FALL INTO THE WATER. THE CONTRACTOR SHALL REMOVE THE STRUCTURE AND SUBMIT PLANS FOR DEMOLITION IN ACCORDANCE WITH ARTICLE 402-2 OF THE STANDARD SPECIFICATIONS.

THE EXISTING STRUCTURE INDICATED ON THE PLANS IS FROM THE BEST INFORMATION AVAILABLE. SINCE THIS INFORMATION IS SHOWN FOR THE CONVENIENCE OF THE CONTRACTOR, THE CONTRACTOR SHALL HAVE NO CLAIM WHATSOEVER AGAINST THE DEPARTMENT OF TRANSPORTATION FOR ANY DELAYS OR ADDITIONAL COST INCURRED BASED ON DIFFERENCES BETWEEN THE EXISTING STRUCTURE SHOWN ON THE PLANS AND THE ACTUAL CONDITIONS AT THE PROJECT SITE.

EXCAVATE ONE FOOT MINIMUM BELOW CULVERT AND REPLACE THE EXCAVATED MATERIAL WITH FOUNDATION CONDITIONING MATERIAL IN ACCORDANCE WITH SECTION 414 OF THE STANDARD SPECIFICATIONS.

FOR EROSION CONTROL MEASURES, SEE EROSION CONTROL PLANS.

FOR CRANE SAFETY, SEE SPECIAL PROVISIONS.

FOR SUBMITTAL OF WORKING DRAWINGS, SEE SPECIAL PROVISIONS.

FOR FALSEWORK AND FORMWORK, SEE SPECIAL PROVISIONS.

FOR GROUT FOR STRUCTURES, SEE SPECIAL PROVISIONS.

FOR OTHER DESIGN DATA AND GENERAL NOTES, SEE SHEET SN.


THIS STRUCTURE SHALL BE DESIGNED IN ACCORDANCE WITH THE AASHTO LFRD BRIDGE DESIGN SPECIFICATIONS.

FOR CULVERT DIVERSION DETAILS AND PAY ITEM, SEE EROSION CONTROL PLANS.

NO PRECAST REINFORCED BOX CULVERT OPTION WILL BE ALLOWED.

BACKFILL SILLS WITH NATIVE MATERIAL.

NATIVE MATERIAL CONSISTS OF MATERIAL THAT IS EXCAVATED FROM THE STREAM AT THE PROJECT SITE DURING CULVERT CONSTRUCTION. NATIVE MATERIAL IS SUBJECT TO APPROVAL BY THE ENGINEER AND MAY BE SUBJECT TO PERMIT CONDITIONS.

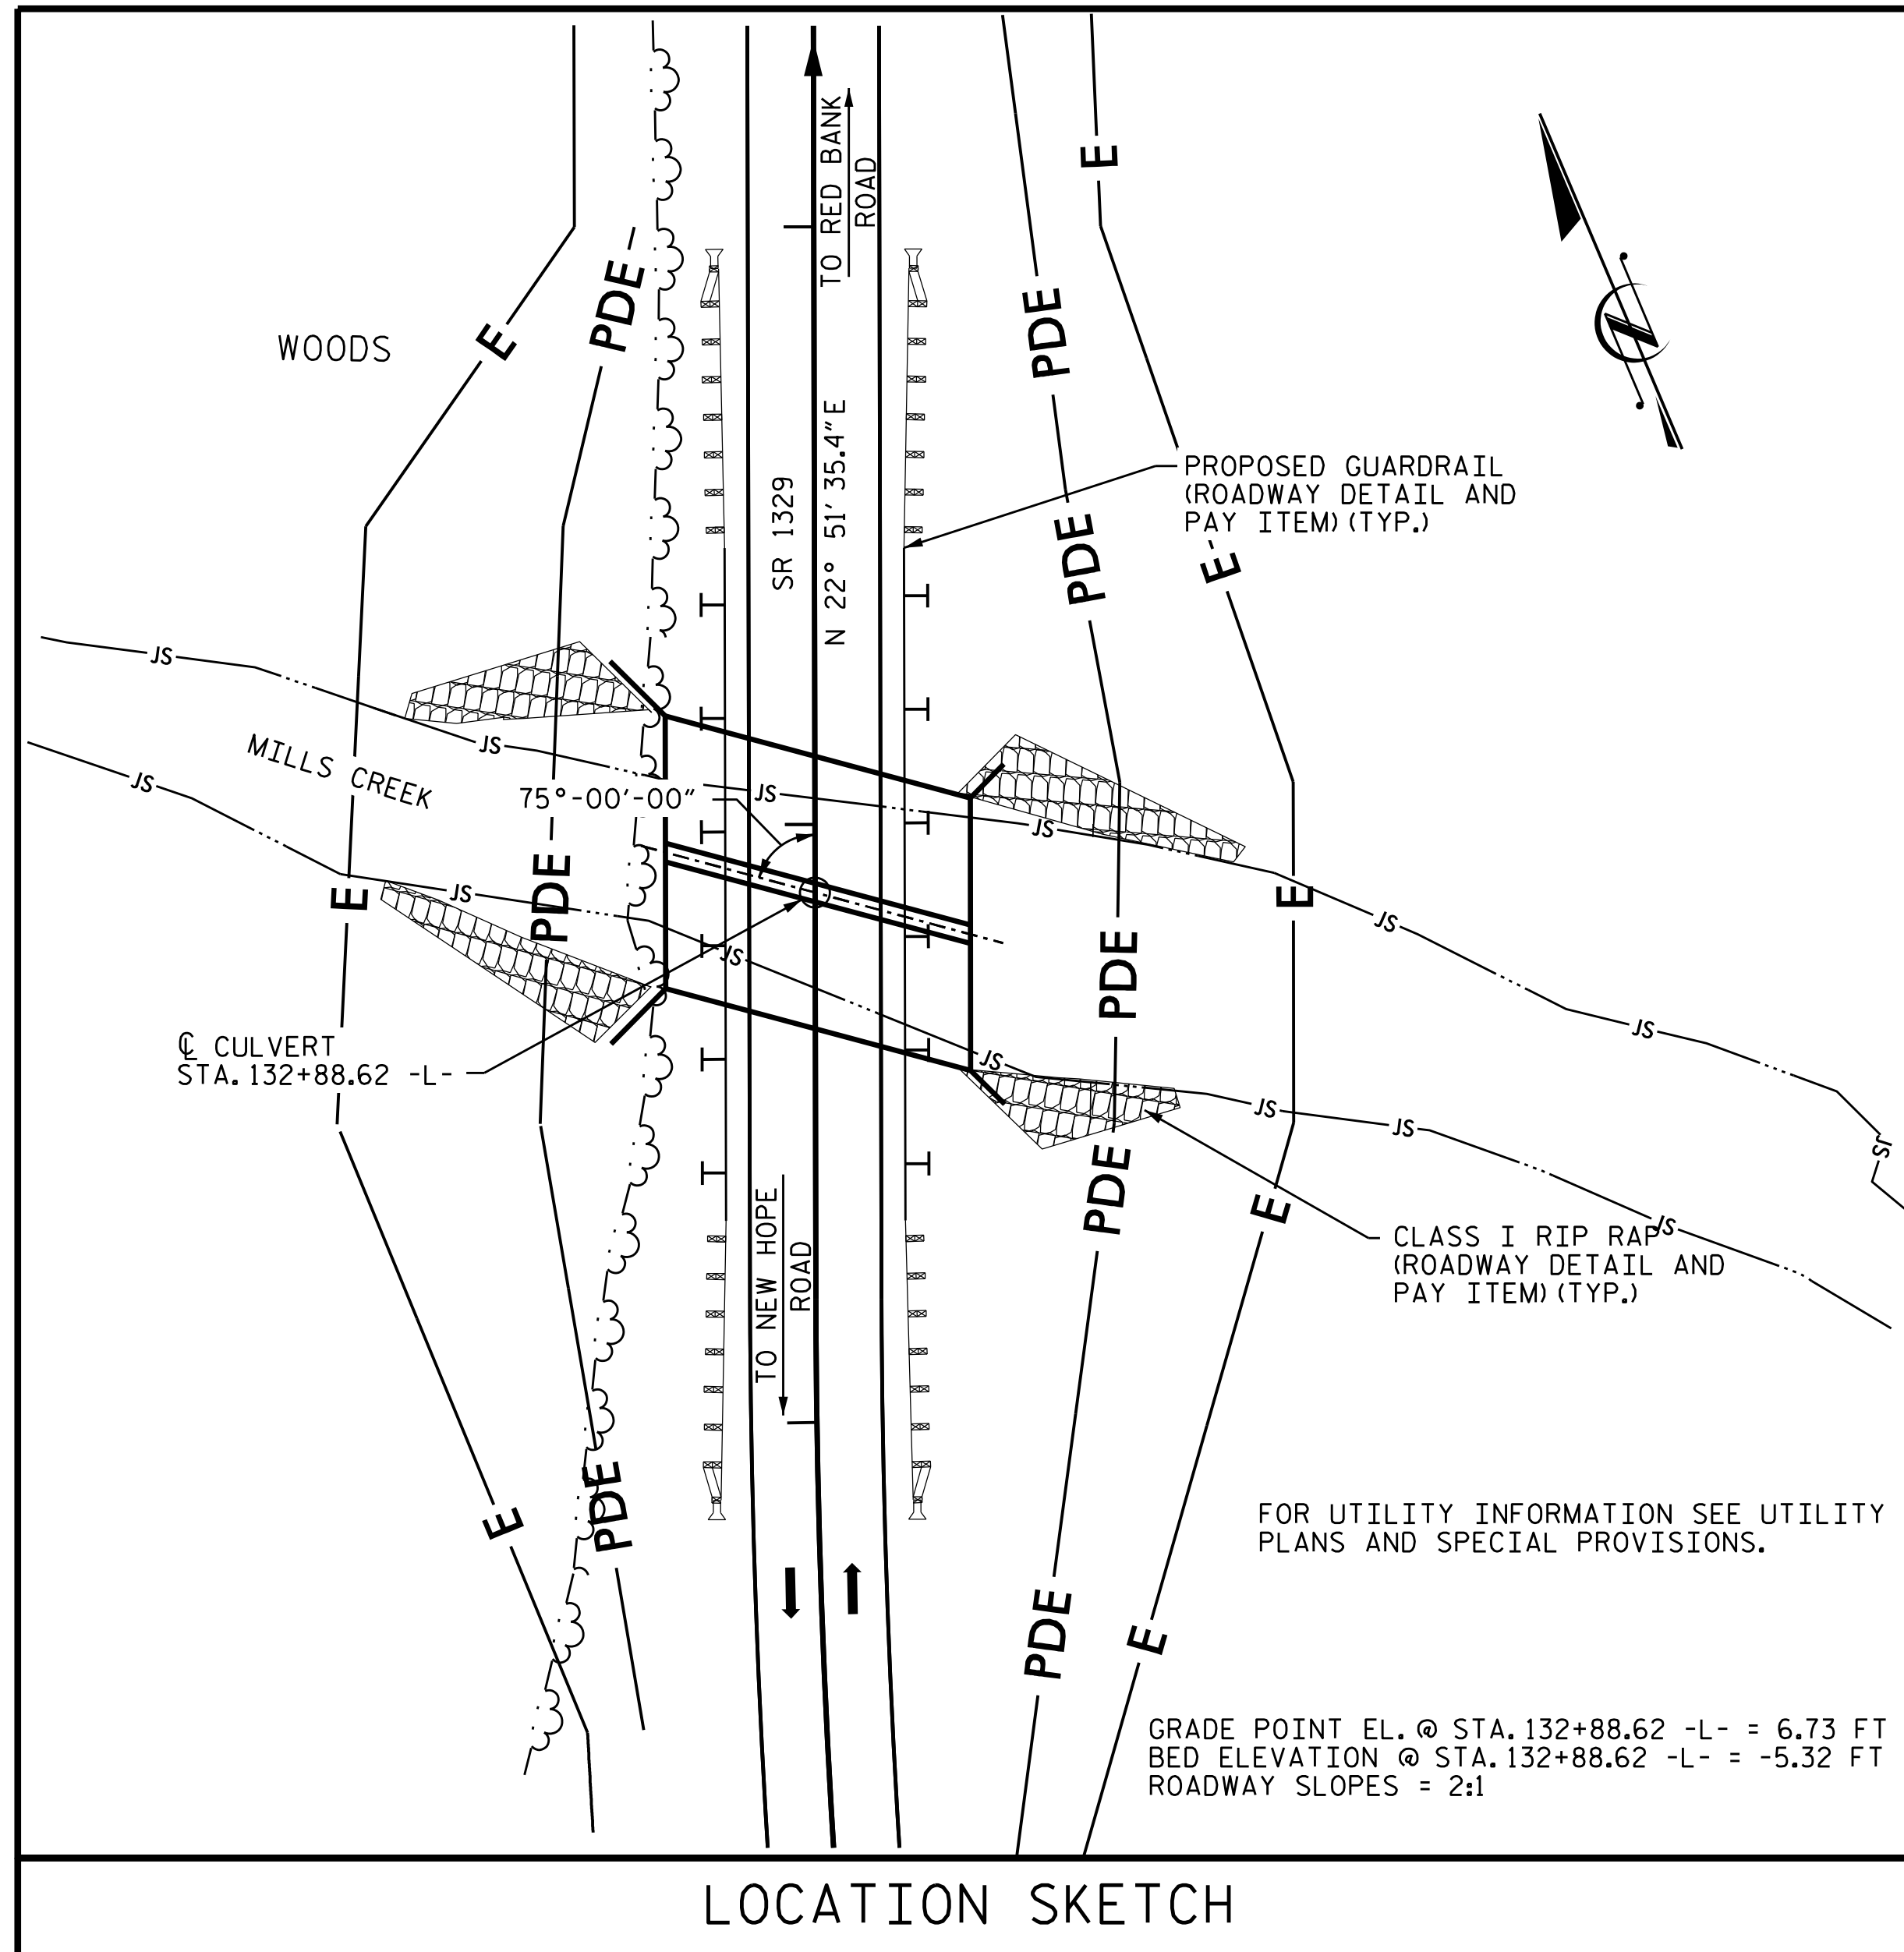


LOCATION SKETCH

OVERTOPPING FLOOD DATA

OVERTOPPING DISCHARGE = 817 CFS
 FREQUENCY OF OVERTOPPING FLOOD = 100 ± YR.
 OVERTOPPING FLOOD ELEVATION = 5.9 FT.
 OCCURS @ STA. 134+65 -L-

HYDRAULIC DATA

DESIGN DISCHARGE = 523 CFS
 FREQUENCY OF DESIGN FLOOD = 25 YR.
 DESIGN HIGH WATER ELEVATION = 4.6 FT.
 DRAINAGE AREA = 2.99 SQ. MI.
 BASE DISCHARGE (Q₁₀₀) = 847 CFS
 BASE HIGH WATER ELEVATION = 5.9 FT.

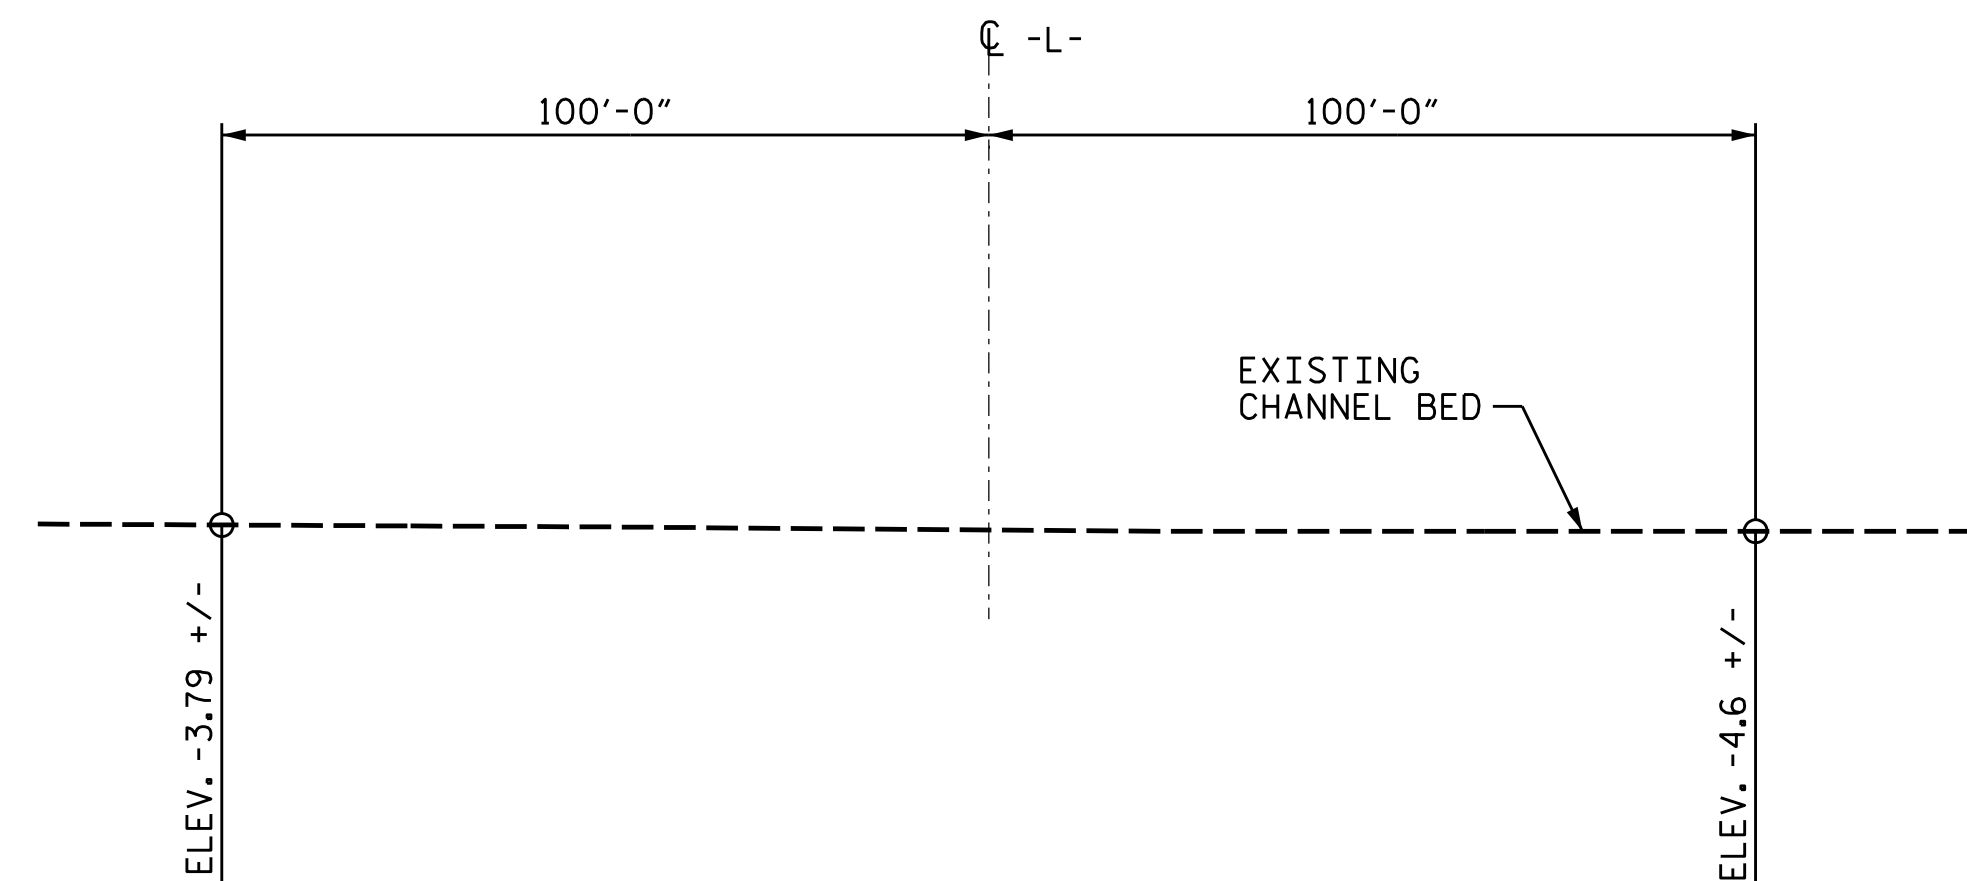

PROFILE ALONG CULVERT

I HEREBY CERTIFY THESE PLANS ARE THE AS-BUILT PLANS

TOTAL STRUCTURE QUANTITIES	
CULVERT EXCAVATION	LUMP SUM
FOUNDATION CONDITIONING MATERIAL	180 TONS
ALUMINUM BOX CULVERT @ STA. 132+88.62 -L-	LUMP SUM
MOMENT SLAB	98.0 LIN. FT.


PREPARED IN THE OFFICE OF:
ATKINS
 1616 EAST MILLBROOK ROAD, SUITE 160
 RALEIGH, NORTH CAROLINA 27609
 (919) 876-6888 NCBES #F-0326

DRAWN BY : CAB DATE : 11/19
 CHECKED BY : CYL DATE : 11/19
 DESIGN ENGINEER OF RECORD : DRB DATE : 11/19


PROJECT NO. R-5740
PERQUIMANS COUNTY
 STATION: 132+88.62 -L-

SHEET 1 OF 3 STRUCTURE NO. 712203


STATE OF NORTH CAROLINA DEPARTMENT OF TRANSPORTATION RALEIGH					
DOUBLE 20'-6" x 7'-3" ALUMINUM BOX CULVERT 105° SKEW					
REVISIONS					SHEET NO.
NO.	BY:	DATE:	NO.	BY:	DATE:
1			3		
2			4		
					C-5
					TOTAL SHEETS 7

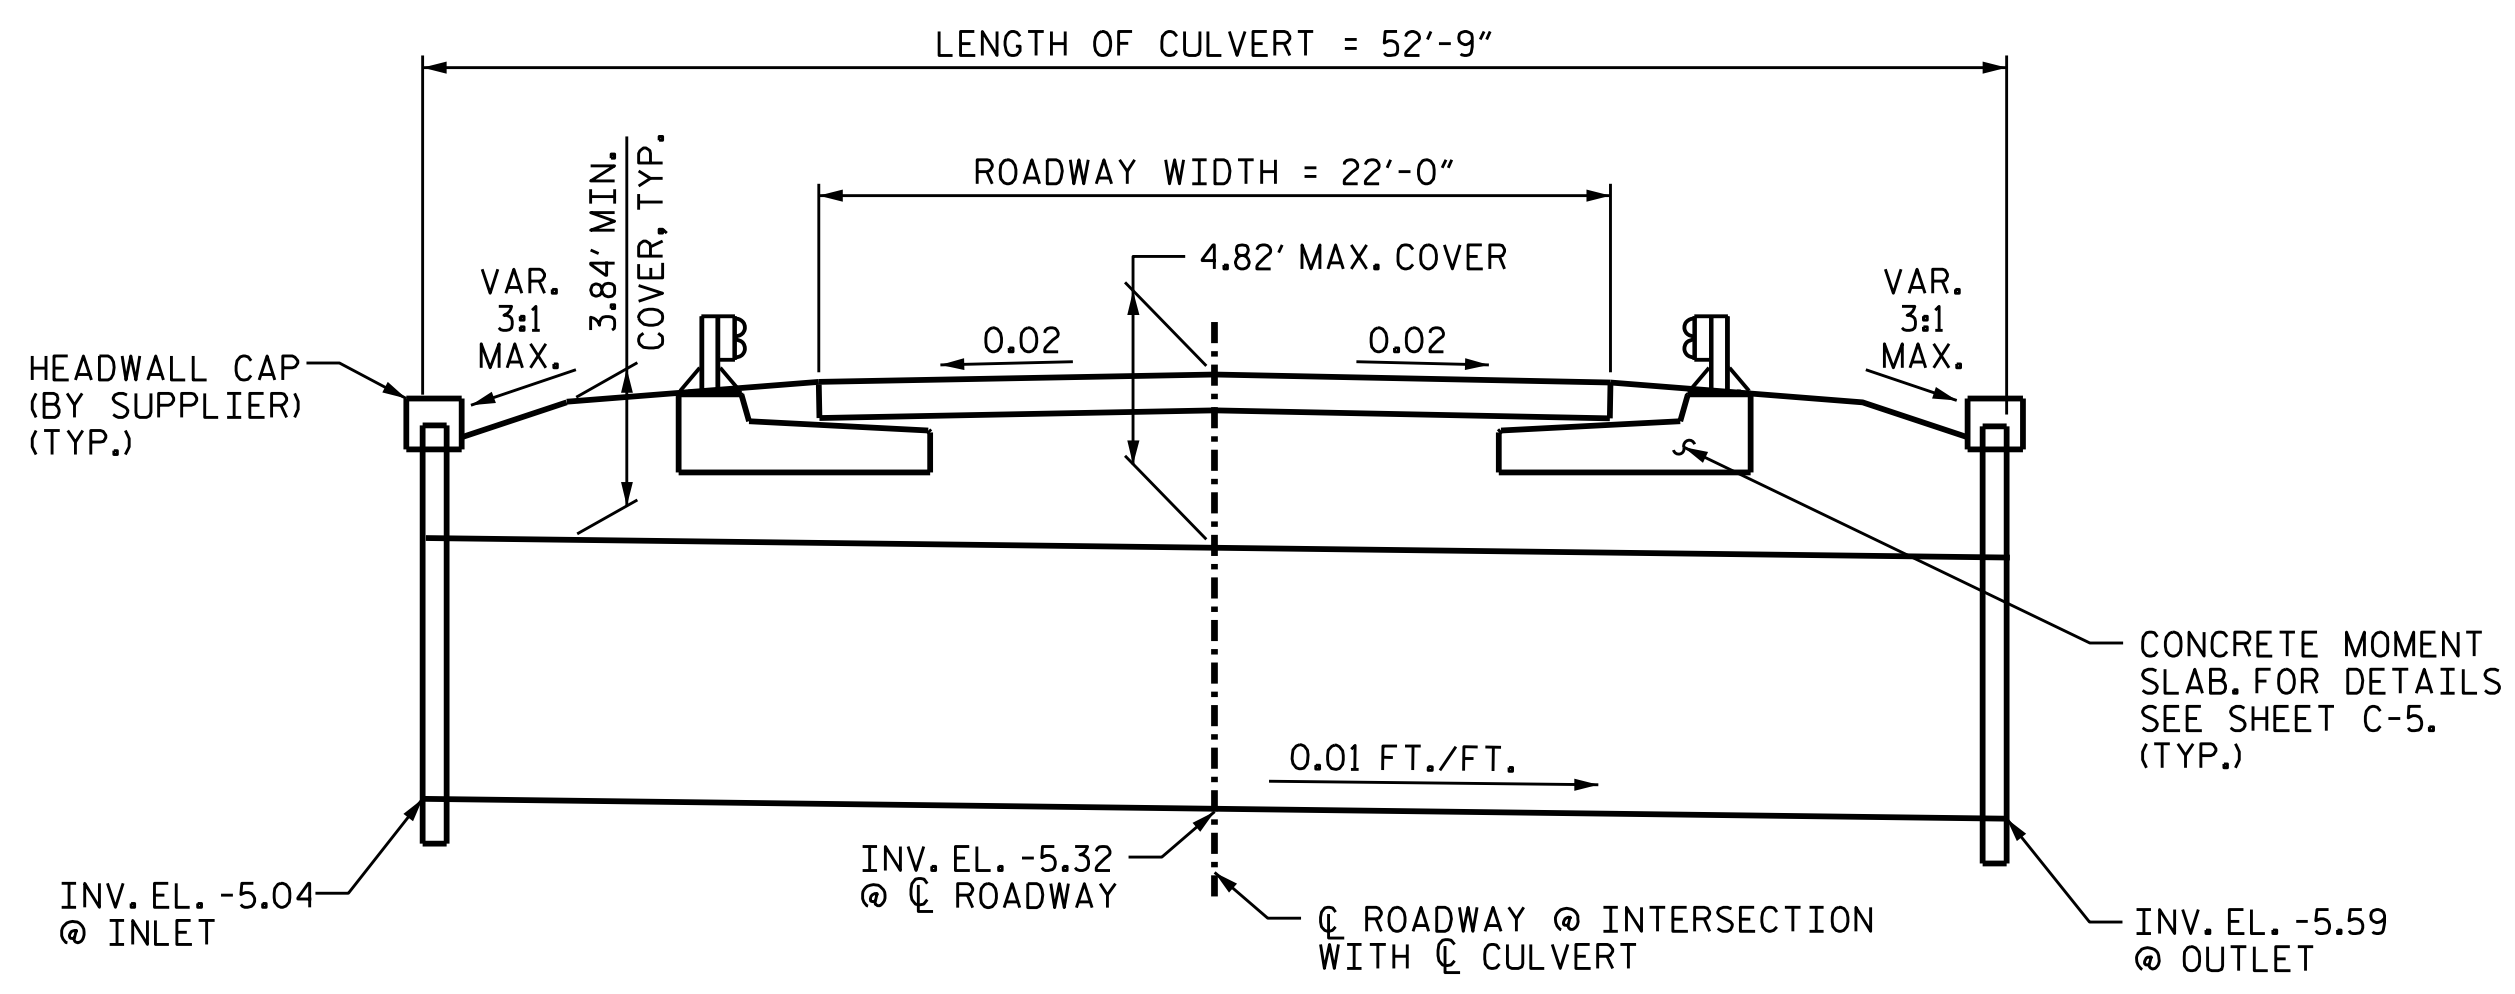

LENGTH FOR ALUMINUM BOX CULVERT

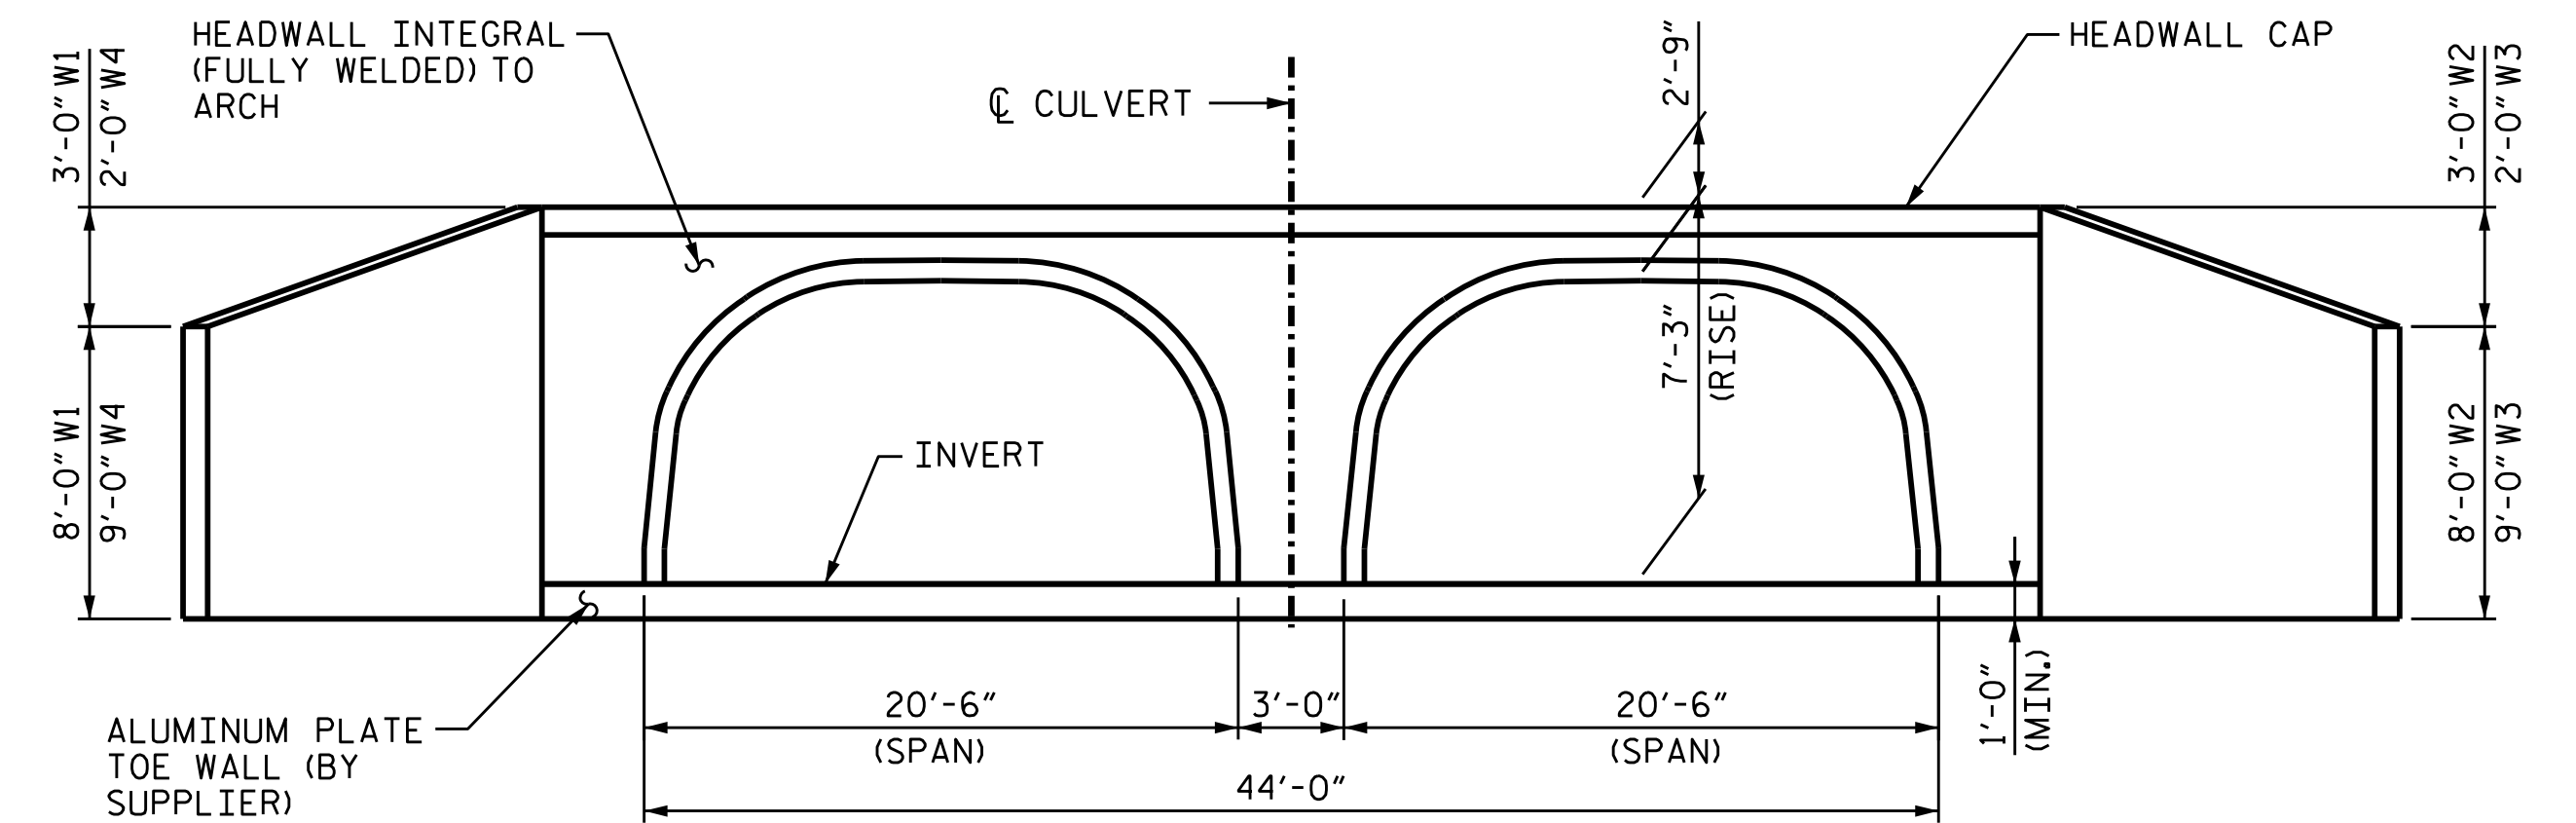

END ELEVATION
INLET SHOWN, OUTLET SIMILAR

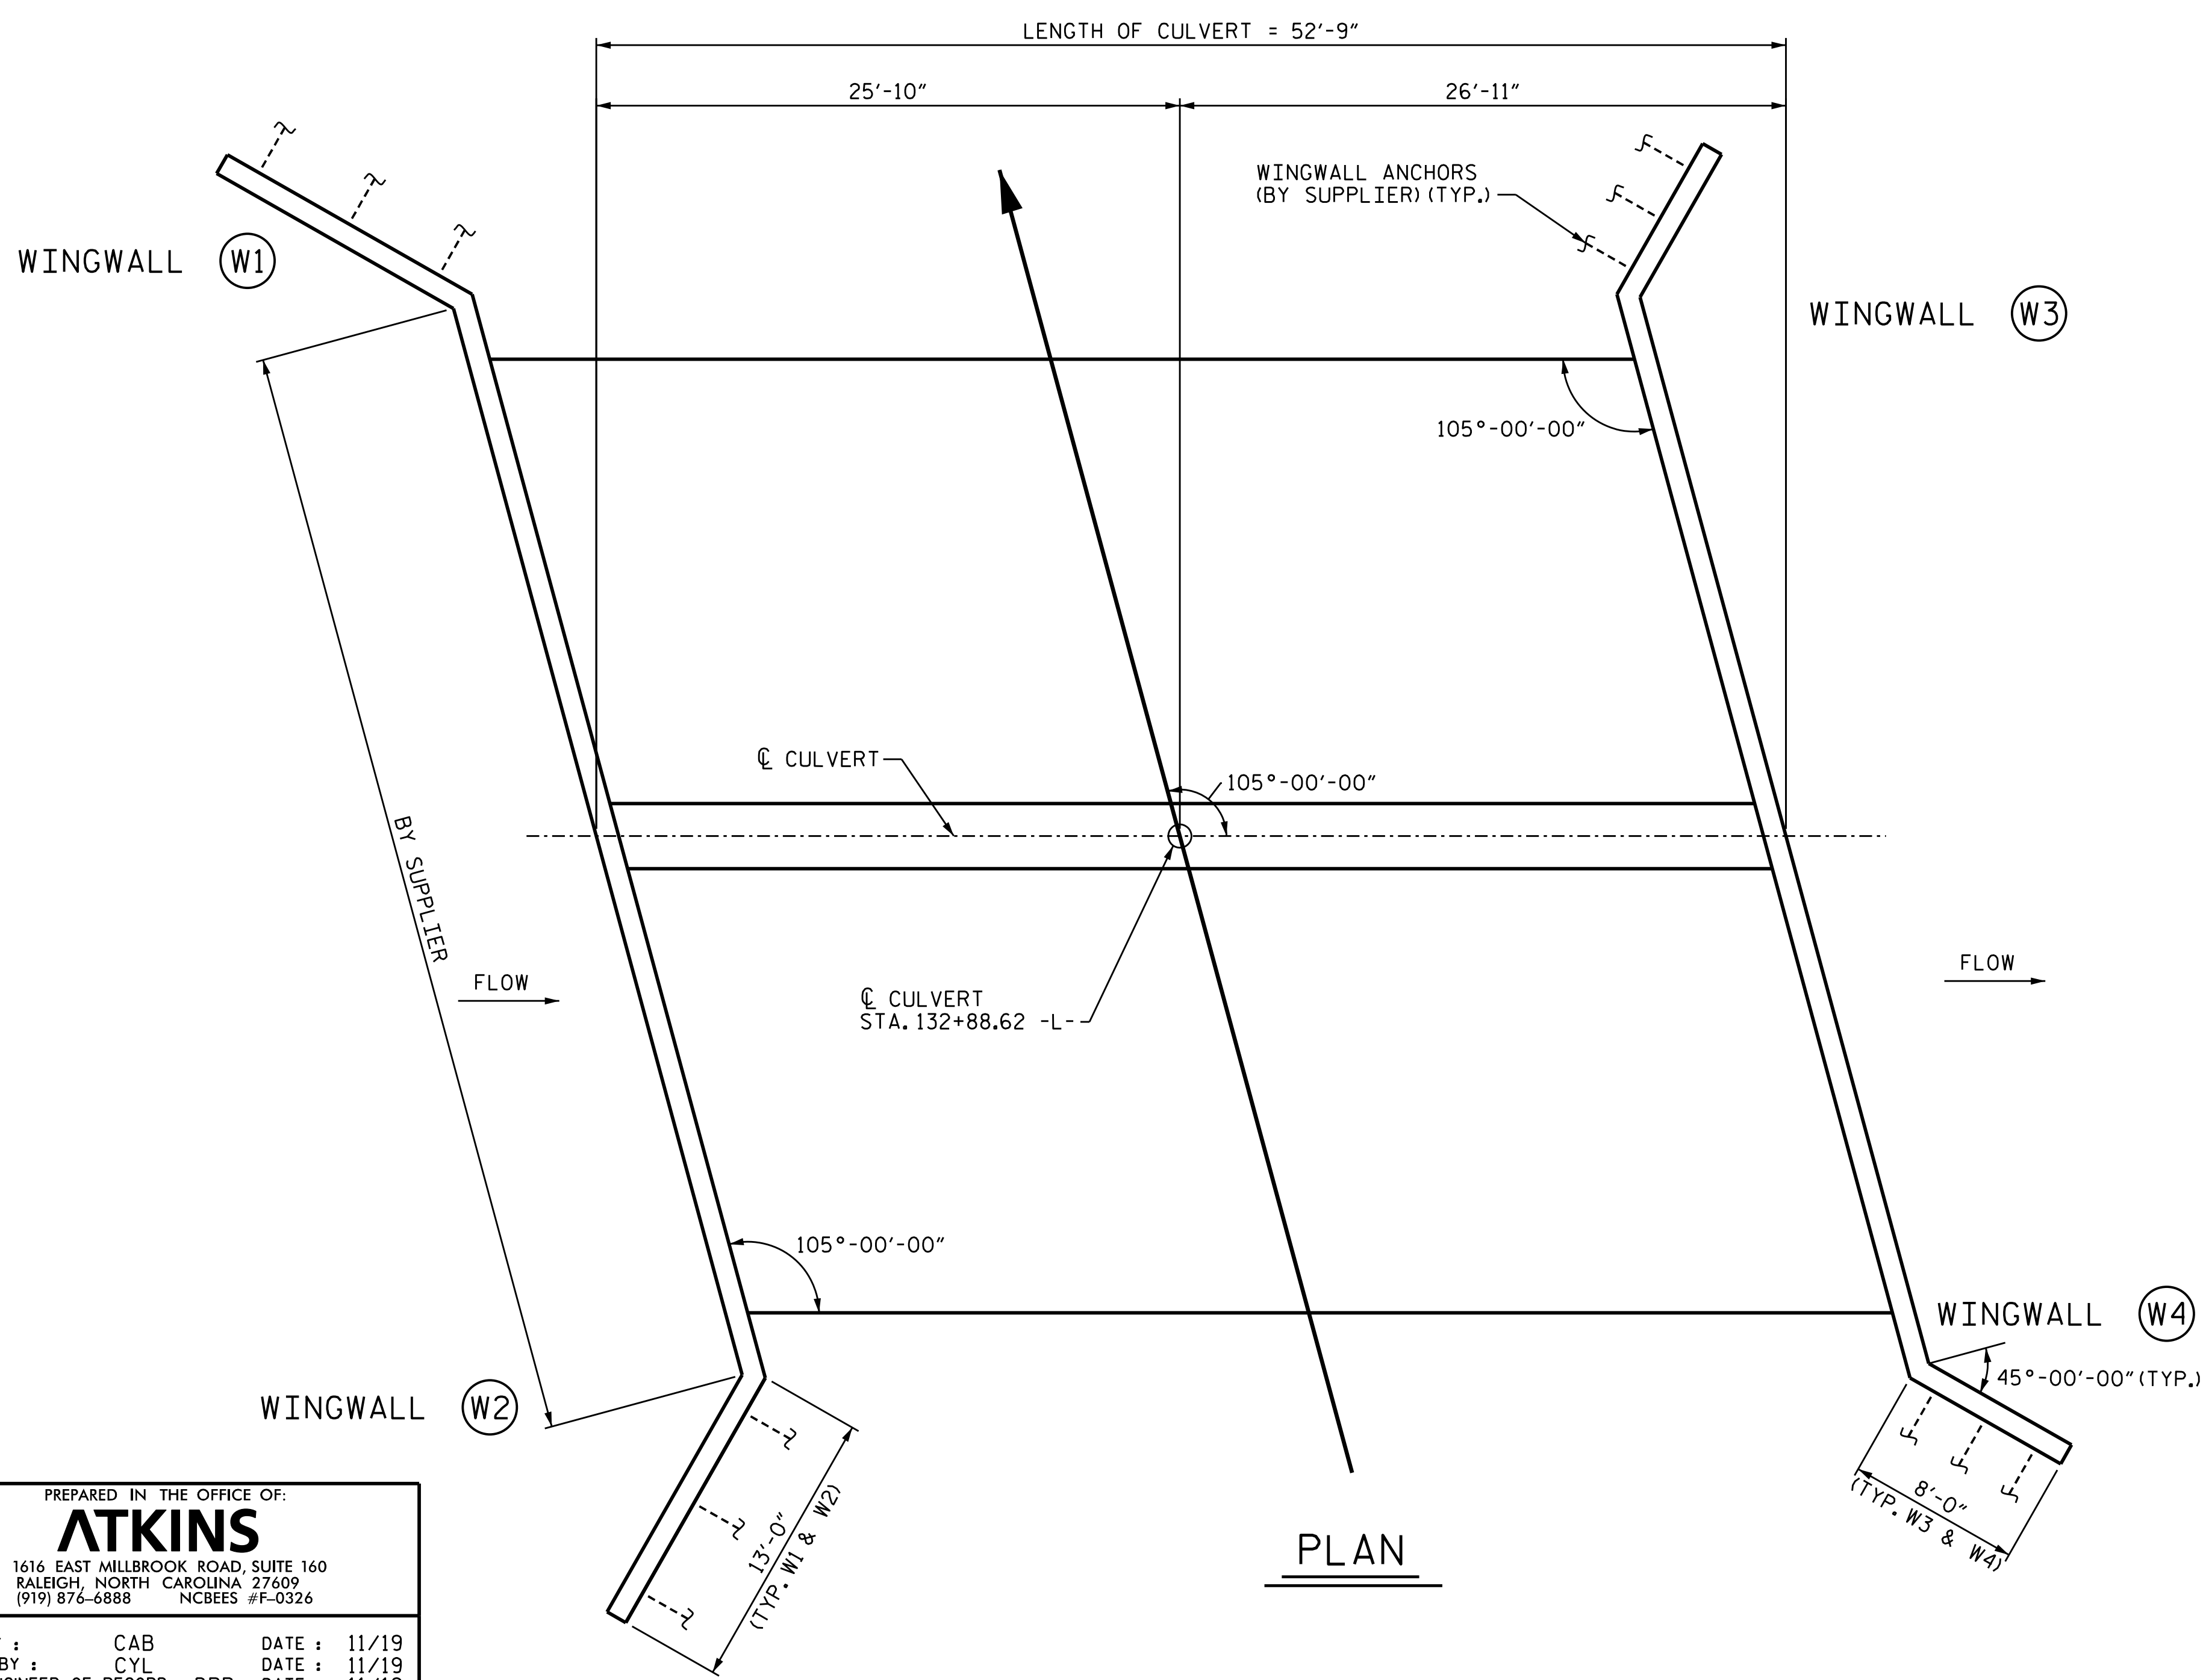

PLAN

I HEREBY CERTIFY THESE PLANS ARE THE AS-BUILT PLANS

PROJECT NO. R-5740
PERQUIMANS COUNTY
 STATION: 132+88.62 -L-

SHEET 2 OF 3



STATE OF NORTH CAROLINA
 DEPARTMENT OF TRANSPORTATION
 RALEIGH

**DOUBLE
 20'-6" x 7'-3"
 ALUMINUM BOX CULVERT
 105° SKEW**

PREPARED IN THE OFFICE OF:
ATKINS
 1616 EAST MILLBROOK ROAD, SUITE 160
 RALEIGH, NORTH CAROLINA 27609
 (919) 876-6888 NCBES #F-0326

DRAWN BY : CAB DATE : 11/19
 CHECKED BY : CYL DATE : 11/19
 DESIGN ENGINEER OF RECORD : DRB DATE : 11/19

REVISIONS						SHEET NO.
NO.	BY:	DATE:	NO.	BY:	DATE:	C-6
1			3			TOTAL SHEETS
2			4			7

NOTES

ALL GUARDRAIL ATTACHMENTS SHALL BE MADE USING ADHESIVELY ANCHORED ANCHOR BOLTS. LEVEL TWO FIELD TESTING IS REQUIRED, AND THE YIELD LOAD OF THE 1" Ø BOLT IS 21.8 KIPS. FOR ADHESIVELY ANCHORED ANCHOR BOLTS, SEE THE STANDARD SPECIFICATIONS.

ANCHOR BOLTS, NUTS AND WASHERS SHALL BE 1" Ø AND MEET THE REQUIREMENTS OF ASTM A325. BOLTS, NUTS AND WASHERS SHALL BE GALVANIZED.


PAYMENT FOR GUARDRAIL, POSTS, ADHESIVELY ANCHORED ANCHOR BOLTS AND POST BASE PLATES IS INCLUDED IN ROADWAY PAY ITEMS.

THE GUARDRAIL POSTS SHALL NOT BE ATTACHED UNTIL THE MOMENT SLAB HAS ATTAINED AN AGE OF THREE CURING DAYS, OR A MINIMUM COMPRESSIVE STRENGTH OF 2000 PSI. IN ADDITION, NO FILL MATERIAL, ASPHALT OR CONSTRUCTION EQUIPMENT IS ALLOWED ON THE MOMENT SLAB PRIOR TO SATISFYING THE MINIMUM CONCRETE CURING AND STRENGTH REQUIREMENTS.

ALL REINFORCING STEEL IN THE MOMENT SLAB SHALL BE EPOXY COATED.

THE CONTRACT UNIT PRICE FOR "MOMENT SLAB, LIN. FEET" WILL BE FULL COMPENSATION FOR SUBMITTALS, LABOR, TOOLS, EQUIPMENT, MOMENT SLAB MATERIALS, EXCAVATING, BACKFILLING, HAULING AND REMOVING EXCAVATED MATERIALS, AND SUPPLYING ANY INCIDENTALS NECESSARY TO CONSTRUCT THE CONCRETE MOMENT SLAB. SEE SPECIAL PROVISION.

BAR TYPES

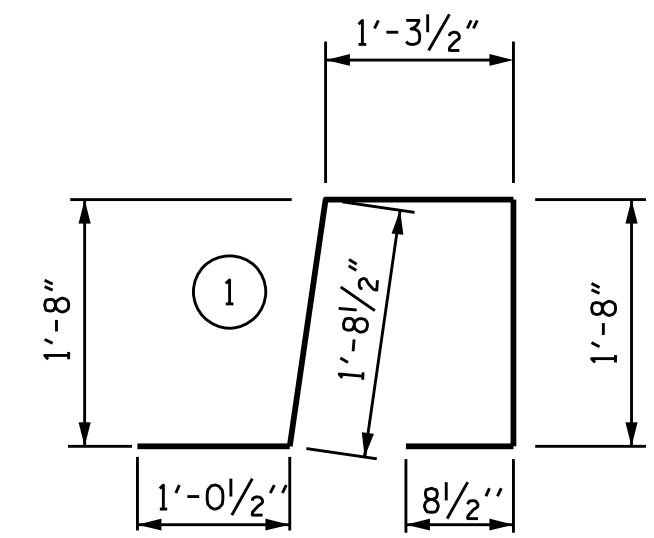


ALL BAR DIMENSIONS ARE OUT TO OUT

BILL OF MATERIAL FOR TWO MOMENT SLABS



FOR CONCRETE MOMENT SLAB ONLY					
BAR	NO.	SIZE	TYPE	LENGTH	WEIGHT
B1	42	#4	STR	48'-8"	1,365
G1	100	#5	STR	6'-7"	687
G2	100	#4	STR	6'-7"	440
S1	198	#5	①	6'-5"	1,325

CLASS AA CONCRETE	38.8 CY
EPOXY COATED REINFORCING STEEL	3,817 LBS.
MOMENT SLAB	98.0 LIN. FT.

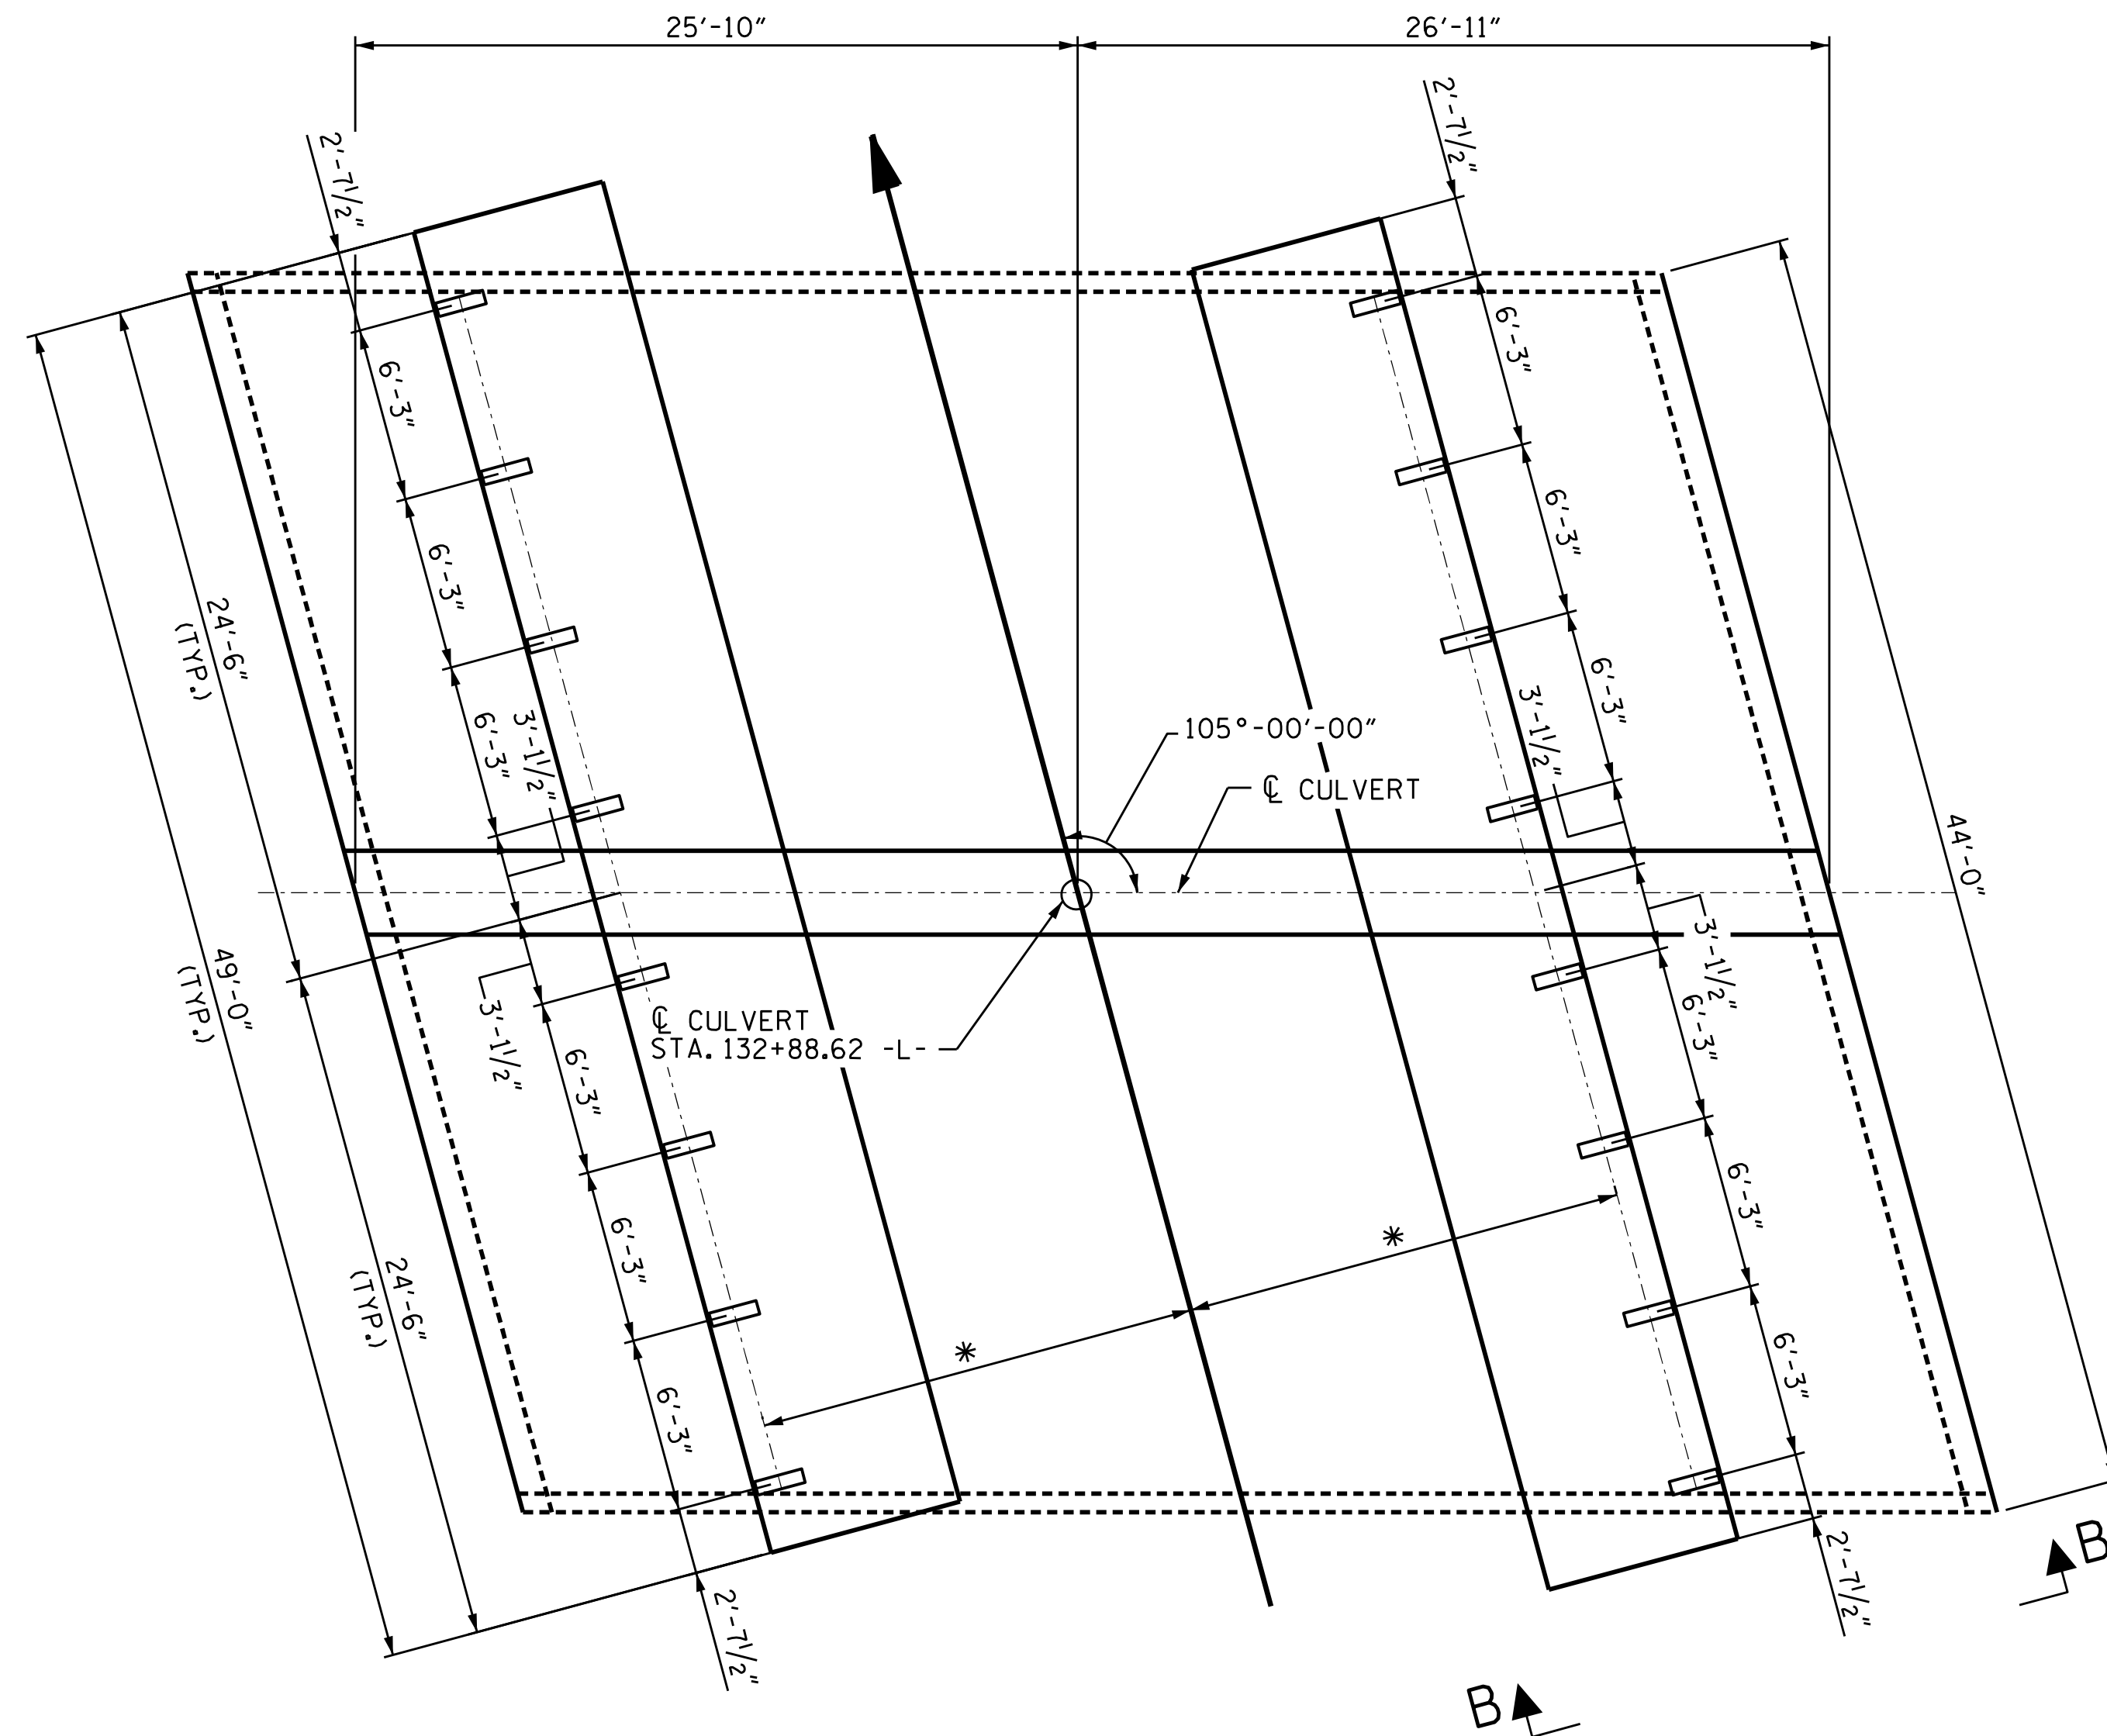

PLAN OF GUARDRAIL POST SPACING & MOMENT SLAB LAYOUT

* THIS DIMENSION TO BE DETERMINED BY THE ENGINEER IN THE FIELD.

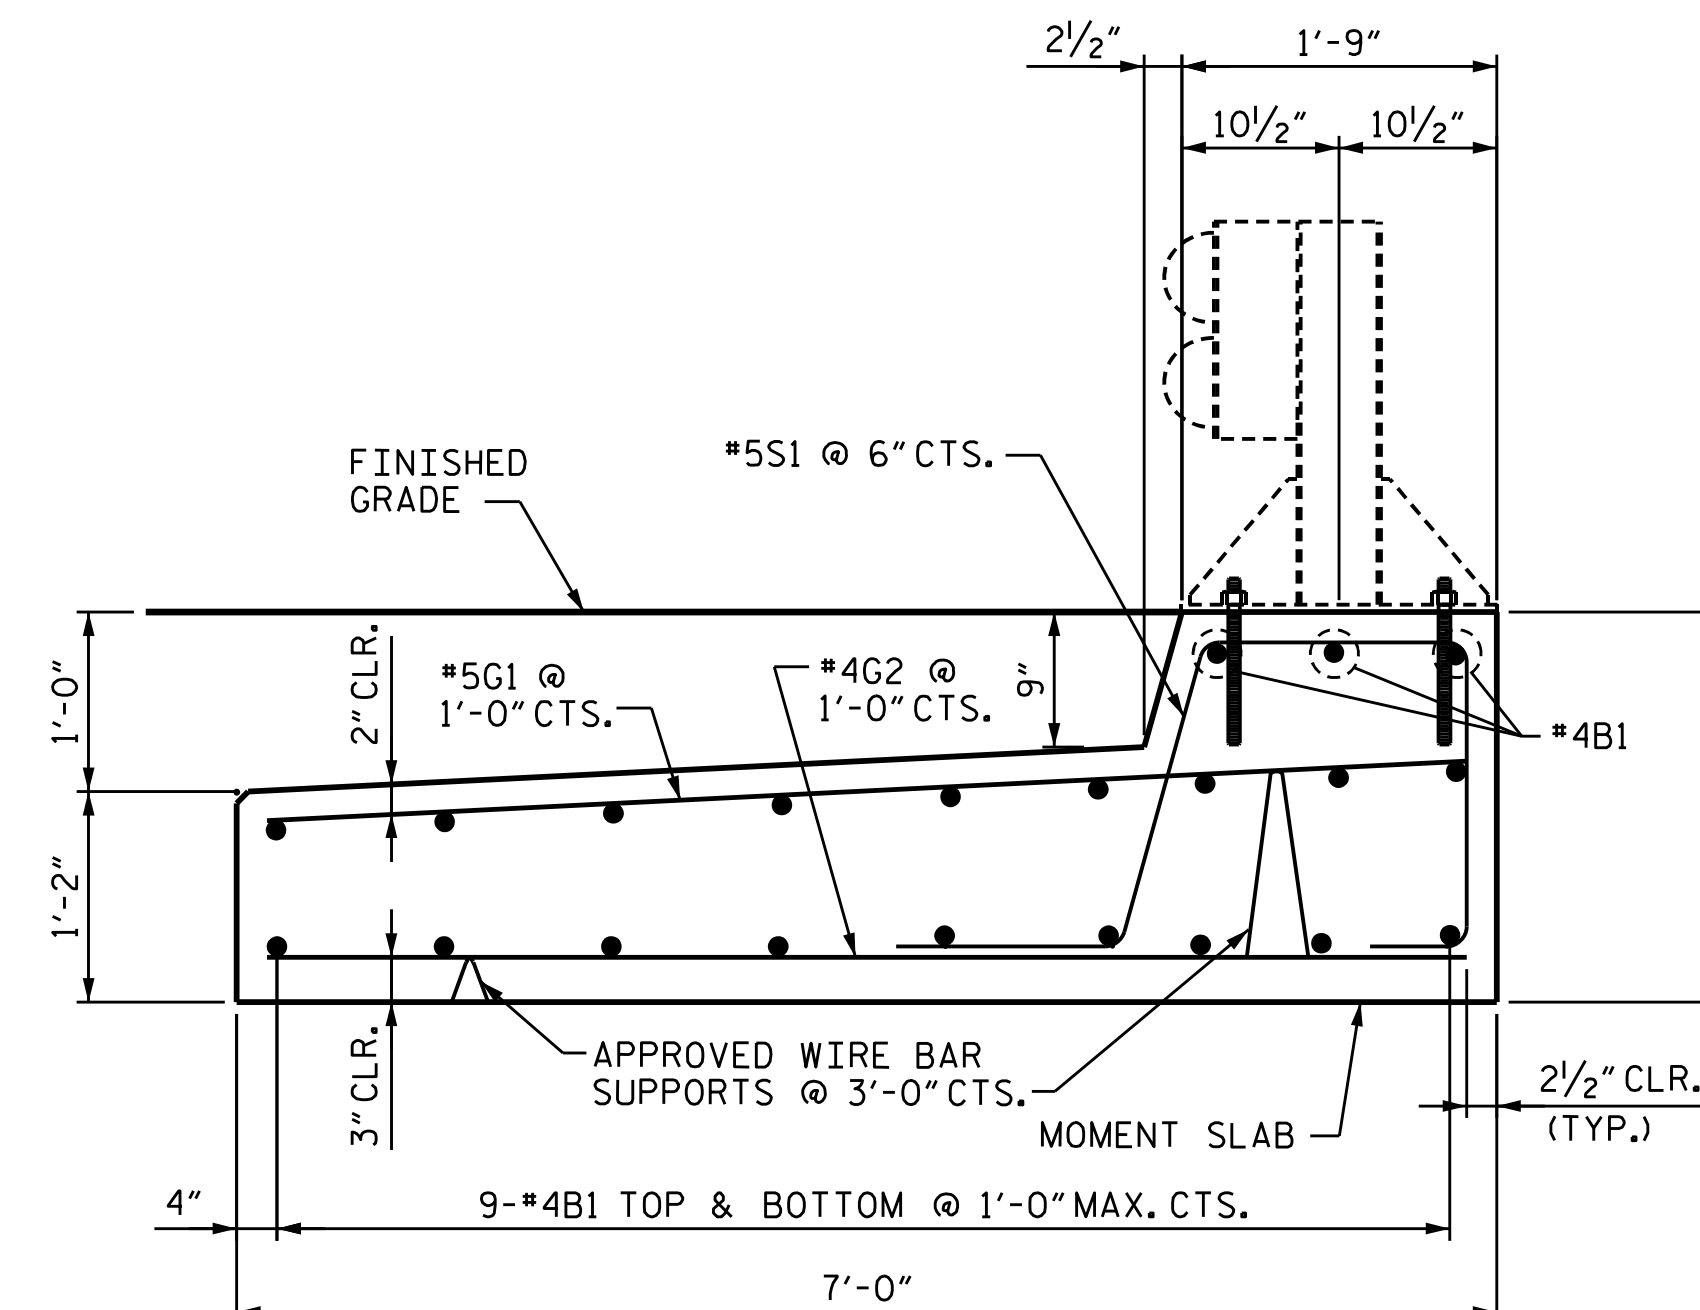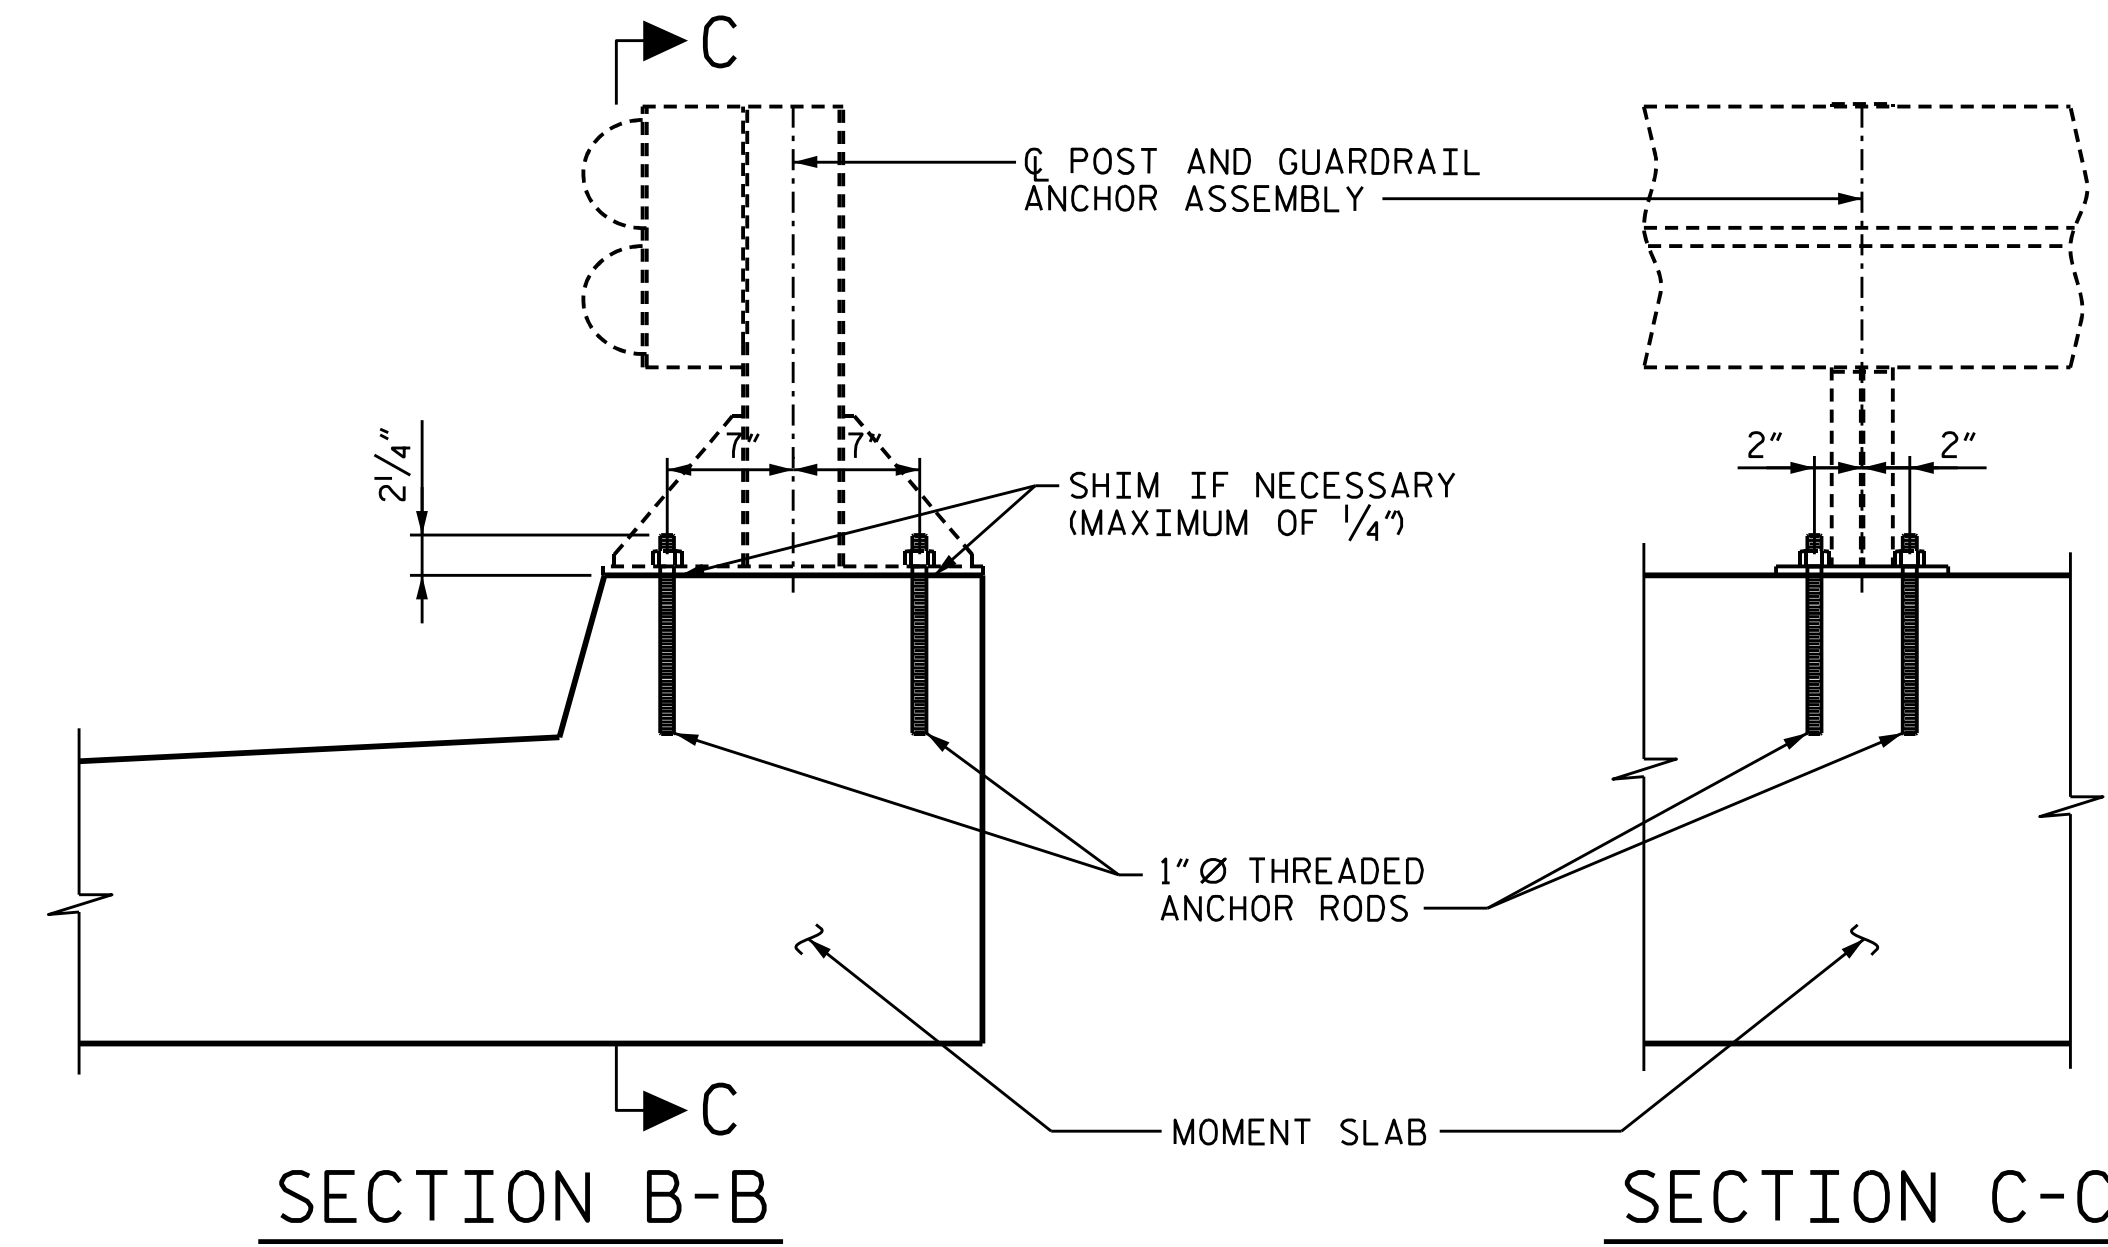

TYPICAL SECTION THROUGH MOMENT SLAB



PROJECT NO. R-5740
 PERQUIMANS COUNTY
 STATION: 132+88.62 -L-

SHEET 3 OF 3

STATE OF NORTH CAROLINA
 DEPARTMENT OF TRANSPORTATION
 RALEIGH

DOUBLE
 20'-6" x 7'-3"
 ALUMINUM BOX CULVERT
 105° SKEW

REVISIONS						TOTAL SHEETS
NO.	BY:	DATE:	NO.	BY:	DATE:	
1			3			7
2			4			

PREPARED IN THE OFFICE OF:
ATKINS
 1616 EAST MILLBROOK ROAD, SUITE 160
 RALEIGH, NORTH CAROLINA 27609
 (919) 876-6888 NCBES #F-0326

DRAWN BY : CAB DATE : 11/19
 CHECKED BY : CYL DATE : 11/19
 DESIGN ENGINEER OF RECORD : DRB DATE : 11/19

STANDARD NOTES

DESIGN DATA:

SPECIFICATIONS	- - - - -	A.A.S.H.T.O. (CURRENT)
LIVE LOAD	- - - - -	SEE PLANS
IMPACT ALLOWANCE	- - - - -	SEE A.A.S.H.T.O.
STRESS IN EXTREME FIBER OF STRUCTURAL STEEL - AASHTO M270 GRADE 36	- -	20,000 LBS. PER SQ. IN.
- AASHTO M270 GRADE 50W	- -	27,000 LBS. PER SQ. IN.
- AASHTO M270 GRADE 50	- -	27,000 LBS. PER SQ. IN.
REINFORCING STEEL IN TENSION - GRADE 60	- - -	24,000 LBS. PER SQ. IN.
CONCRETE IN COMPRESSION	- - - - -	1,200 LBS. PER SQ. IN.
CONCRETE IN SHEAR	- - - - -	SEE A.A.S.H.T.O.
STRUCTURAL TIMBER - TREATED OR UNTREATED EXTREME FIBER STRESS	- - -	1,800 LBS. PER SQ. IN.
COMPRESSION PERPENDICULAR TO GRAIN OF TIMBER	- - - - -	375 LBS. PER SQ. IN.
EQUIVALENT FLUID PRESSURE OF EARTH	- - - - -	30 LBS. PER CU. FT. (MINIMUM)

MATERIAL AND WORKMANSHIP:

EXCEPT AS MAY OTHERWISE BE SPECIFIED ON PLANS OR IN THE SPECIAL PROVISIONS, ALL MATERIAL AND WORKMANSHIP SHALL BE IN ACCORDANCE WITH THE 2018 "STANDARD SPECIFICATIONS FOR ROADS AND STRUCTURES" OF THE N.C. DEPARTMENT OF TRANSPORTATION.

STEEL SHEET PILING FOR PERMANENT OR TEMPORARY APPLICATIONS SHALL BE HOT ROLLED.

CONCRETE:

UNLESS OTHERWISE REQUIRED ON PLANS, CLASS A CONCRETE SHALL BE USED FOR ALL PORTIONS OF ALL STRUCTURES WITH THE EXCEPTION THAT: CLASS AA CONCRETE SHALL BE USED IN BRIDGE SUPERSTRUCTURES, ABUTMENT BACKWALLS, AND APPROACH SLABS; AND CLASS B CONCRETE SHALL BE USED FOR SLOPE PROTECTION AND RIP RAP.

CONCRETE CHAMFERS:

UNLESS OTHERWISE NOTED ON THE PLANS, ALL EXPOSED CORNERS ON STRUCTURES SHALL BE CHAMFERED $\frac{3}{4}$ " WITH THE FOLLOWING EXCEPTIONS: TOP CORNERS OF CURBS MAY BE ROUNDED TO $1\frac{1}{2}$ " RADIUS WHICH IS BUILT INTO CURB FORMS; CORNERS OF TRANSVERSE FLOOR EXPANSION JOINTS SHALL BE ROUNDED WITH A $\frac{1}{4}$ " FINISHING TOOL UNLESS OTHERWISE REQUIRED ON PLANS; AND CORNERS OF EXPANSION JOINTS IN THE ROADWAY FACES AND TOPS OF CURBS AND SIDEWALKS SHALL BE ROUNDED TO A $\frac{1}{4}$ " RADIUS WITH A FINISHING STONE OR TOOL UNLESS OTHERWISE REQUIRED ON PLANS.

DOWELS:

DOWELS WHEN INDICATED ON PLANS AS FOR CULVERT EXTENSIONS, SHALL BE EMBEDDED AT LEAST 12" INTO THE OLD CONCRETE AND GROUTED INTO PLACE WITH 1:2 CEMENT MORTAR.

ALLOWANCE FOR DEAD LOAD DEFLECTION, SETTLEMENT, ETC. IN CASTING SUPERSTRUCTURES:

BRIDGES SHALL BE BUILT ON THE GRADE OR VERTICAL CURVE SHOWN ON PLANS. SLABS, CURBS AND PARAPETS SHALL CONFORM TO THE GRADE OR CURVE.

ALL DIMENSIONS WHICH ARE GIVEN IN SECTION AND ARE AFFECTED BY DEAD LOAD DEFLECTIONS ARE DIMENSIONS AT CENTER LINE OF BEARING UNLESS OTHERWISE NOTED ON PLANS. IN SETTING FORMS FOR STEEL BEAM BRIDGES AND PRESTRESSED CONCRETE GIRDER BRIDGES, ADJUSTMENTS SHALL BE MADE DUE TO THE DEAD LOAD DEFLECTIONS FOR THE ELEVATIONS SHOWN. WHERE BLOCKS ARE SHOWN OVER BEAMS FOR BUILDING UP TO THE SLAB, THE VERTICAL DIMENSIONS OF THE BLOCKS SHALL BE ADJUSTED BETWEEN BEARINGS TO COMPENSATE FOR DEAD LOAD DEFLECTIONS, VERTICAL CURVE ORDINATE, AND ACTUAL BEAM CAMBER. WHERE BOTTOM OF SLAB IS IN LINE WITH BOTTOM OF TOP FLANGES, DEPTH OF SLAB BETWEEN BEARINGS SHALL BE ADJUSTED TO COMPENSATE FOR DEAD LOAD DEFLECTION, VERTICAL CURVE ORDINATE, AND ACTUAL BEAM CAMBER.

IN SETTING FALSEWORK AND FORMS FOR REINFORCED CONCRETE SPANS, AN ALLOWANCE SHALL BE MADE FOR DEAD LOAD DEFLECTIONS, SETTLEMENT OF FALSEWORK, AND PERMANENT CAMBER WHICH SHALL BE PROVIDED FOR IN ADDITION TO THE ELEVATIONS SHOWN. AFTER REMOVAL OF THE FALSEWORK, THE FINISHED STRUCTURES SHALL CONFORM TO THE PROFILE AND ELEVATIONS SHOWN ON THE PLANS AND CONSTRUCTION ELEVATIONS FURNISHED BY THE ENGINEER.

DETAILED DRAWINGS FOR FALSEWORK OR FORMS FOR BRIDGE SUPERSTRUCTURE AND ANY STRUCTURE OR PARTS OF A STRUCTURE AS NOTED ON THE PLANS SHALL BE SUBMITTED TO THE ENGINEER FOR APPROVAL BEFORE CONSTRUCTION OF THE FALSEWORK OR FORMS IS STARTED.

REINFORCING STEEL:

ALL REINFORCING STEEL SHALL BE DEFORMED. DIMENSIONS RELATIVE TO PLACEMENT OF REINFORCING ARE TO CENTERS OF BARS UNLESS OTHERWISE INDICATED IN THE PLANS. DIMENSIONS ON BAR DETAILS ARE TO CENTERS OF BARS OR ARE OUT TO OUT AS INDICATED ON PLANS.

WIRE BAR SUPPORTS SHALL BE PROVIDED FOR REINFORCING STEEL WHERE INDICATED ON THE PLANS. WHEN BAR SUPPORT PIECES ARE PLACED IN CONTINUOUS LINES, THEY SHALL BE SO PLACED THAT THE ENDS OF THE SUPPORTING WIRES SHALL BE LAPPED TO LOCK LEGS ON ADJOINING PIECES.

STRUCTURAL STEEL:

AT THE CONTRACTOR'S OPTION, HE MAY SUBSTITUTE $\frac{7}{8}$ " \emptyset SHEAR STUDS FOR THE $\frac{3}{4}$ " \emptyset STUDS SPECIFIED ON THE PLANS. THIS SUBSTITUTION SHALL BE MADE AT THE RATE OF 3 - $\frac{7}{8}$ " \emptyset STUDS FOR 4 - $\frac{3}{4}$ " \emptyset STUDS, AND STUD SPACING CHANGES SHALL BE MADE AS NECESSARY TO PROVIDE THE SAME EQUIVALENT NUMBER OF $\frac{7}{8}$ " \emptyset STUDS ALONG THE BEAM AS SHOWN FOR $\frac{3}{4}$ " \emptyset STUDS BASED ON THE RATIO OF 3 - $\frac{7}{8}$ " \emptyset STUDS FOR 4 - $\frac{3}{4}$ " \emptyset STUDS. STUDS OF THE LENGTH SPECIFIED ON THE PLANS MUST BE PROVIDED. THE MAXIMUM SPACING SHALL BE 2'-0".

EXCEPT AT THE INTERIOR SUPPORTS OF CONTINUOUS BEAMS WHERE THE COVER PLATE IS IN CONTACT WITH BEARING PLATE, THE CONTRACTOR MAY, AT HIS OPTION, SUBSTITUTE FOR THE COVER PLATES DESIGNATED ON THE PLANS COVER PLATES OF THE EQUIVALENT AREA PROVIDED THESE PLATES ARE AT LEAST $\frac{3}{16}$ " IN THICKNESS AND DO NOT EXCEED A WIDTH EQUAL TO THE FLANGE WIDTH LESS 2" OR A THICKNESS EQUAL TO 2 TIMES THE FLANGE THICKNESS. THE SIZE OF FILLET WELDS SHALL CONFORM TO THE REQUIREMENTS OF THE CURRENT ANSI/AASHTO/AWS "BRIDGE WELDING CODE". ELECTROSLAG WELDING WILL NOT BE PERMITTED.

WITH THE SOLE EXCEPTION OF EDGES AT SURFACES WHICH BEAR ON OTHER SURFACES, ALL SHARP EDGES AND ENDS OF SHAPES AND PLATES SHALL BE SLIGHTLY ROUNDED BY SUITABLE MEANS TO A RADIUS OF APPROXIMATELY $\frac{1}{16}$ " INCH OR EQUIVALENT FLAT SURFACE AT A SUITABLE ANGLE PRIOR TO PAINTING, GALVANIZING, OR METALLIZING.

HANDRAILS AND POSTS:

METAL STANDARDS AND FACES OF THE CONCRETE END POSTS FOR THE METAL RAIL SHALL BE SET NORMAL TO THE GRADE OF THE CURB, UNLESS OTHERWISE SHOWN ON PLANS. THE METAL RAIL AND TOPS OF CONCRETE POSTS USED WITH THE ALUMINUM RAIL SHALL BE BUILT PARALLEL TO THE GRADE OF THE CURB.

METAL HANDRAILS SHALL BE IN ACCORDANCE WITH THE PLANS. RAILS SHALL BE AS MANUFACTURED FOR BRIDGE RAILING. CASTINGS SHALL BE OF A UNIFORM APPEARANCE. FINS AND OTHER DEFORMATIONS RESULTING FROM CASTING OR OTHERWISE SHALL BE REMOVED IN A MANNER SO THAT A UNIFORM COLORING OF THE COMPLETED CASTING SHALL BE OBTAINED. CASTINGS WITH DISCOLORATIONS OR OF NON-UNIFORM COLORING WILL NOT BE ACCEPTED. CERTIFIED MILL REPORTS ARE REQUIRED FOR METAL RAILS AND POSTS.

SPECIAL NOTES:

GENERALLY, IN CASE OF DISCREPANCY, THIS STANDARD SHEET OF NOTES SHALL GOVERN OVER THE SPECIFICATIONS, BUT THE REMAINDER OF THE PLANS SHALL GOVERN OVER NOTES HEREON, AND SPECIAL PROVISIONS SHALL GOVERN OVER ALL. SEE SPECIFICATIONS ARTICLE 105-4.

ENGLISH

JANUARY, 1990

STD. NO. SN