


SEE SHEET 1-A FOR INDEX OF SHEETS

STATE OF NORTH CAROLINA  
BOARD OF TRANSPORTATION  
PLAN AND PROFILE OF PROPOSED  
STATE HIGHWAY  
**CUMBERLAND COUNTY**

LOCATION: I-95 FROM S.R. 2284 NORTHEASTERLY TO 0.68 MI. WEST OF S.R. 2212

TYPE OF WORK: GRADING, DRAINAGE, STRUCTURES, AND PAVING -Y- LINES

STATE	PROJECT REFERENCE NO.	SHEET NO.	TOTAL SHEETS
N.C.	8-1347406	321	19
STATE PROJ. NO.	F.A. PROJ. NO.	DESCRIPTION	
8-1347401	I-95-2(42)40	DE	
8-1347402	I-95-2(42)40	R/W	
8-1347403	I-95-2(42)40	U-1	
8-1347406	I-95-2(42)40	CONST.	

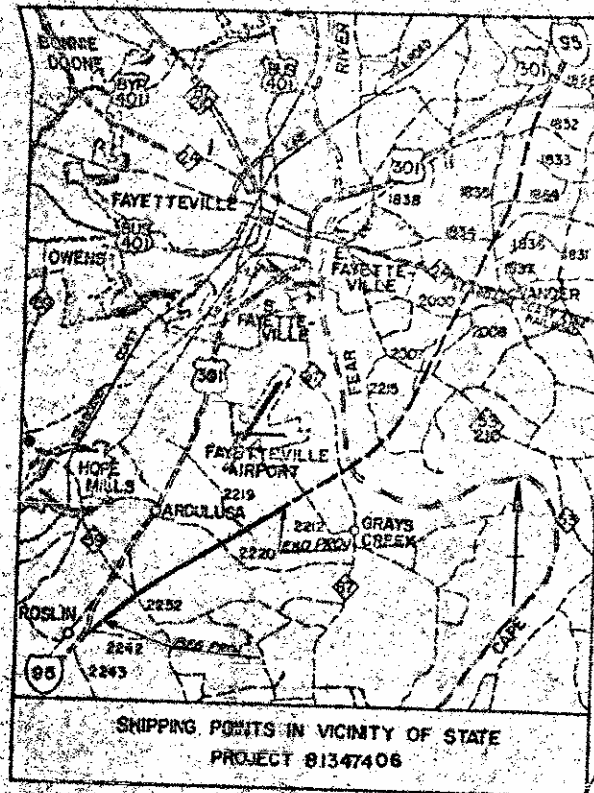


CONVENTIONAL SIGNS

County Line	-----
City or Town Line	-----
Exist. Right of Way Line	-----
Right of Way Line	-----
Survey Line	-----
Property Line	-----
Exist. Fence	-----
Proposed Road	-----
Existing Road	-----
Railroad	-----
Control of Access Line	-----
Slope Stake Line	-----
Bridge	-----
Culvert	-----
Woods	-----
Telephone or Telegraph Pole	-----
Tower Pole and Line	-----
Power Pole	-----
Proposed Right of Way Marker	-----
Existing Right of Way Marker	-----
Guard Rail	-----
Sanitary Sewer Line	-----
Water Line	-----
Gas Line	-----
Proposed Woven Wire Fence	-----
Proposed Chain Link Fence	-----
Permanent Easement	-----
Temporary Construction Easement	-----
Temporary Silt Fence	-----
Silt Basin, Type 'A'	-----
Median Uncleared Woods	-----
BRUSH BARRIER	-----
SPECIAL SILT FENCE	-----

BEG. STATE PROJ. 81347406  
BEG. F.A. PROJ. I-95-2(42)40  
STA. 75+00 MED.

BEG. CONST. - L. MED.  
STA. 72+50


END STATE PROJ. 81347406  
END F.A. PROJ. I-95-2(42)40  
LT. LN. STA. 275+00

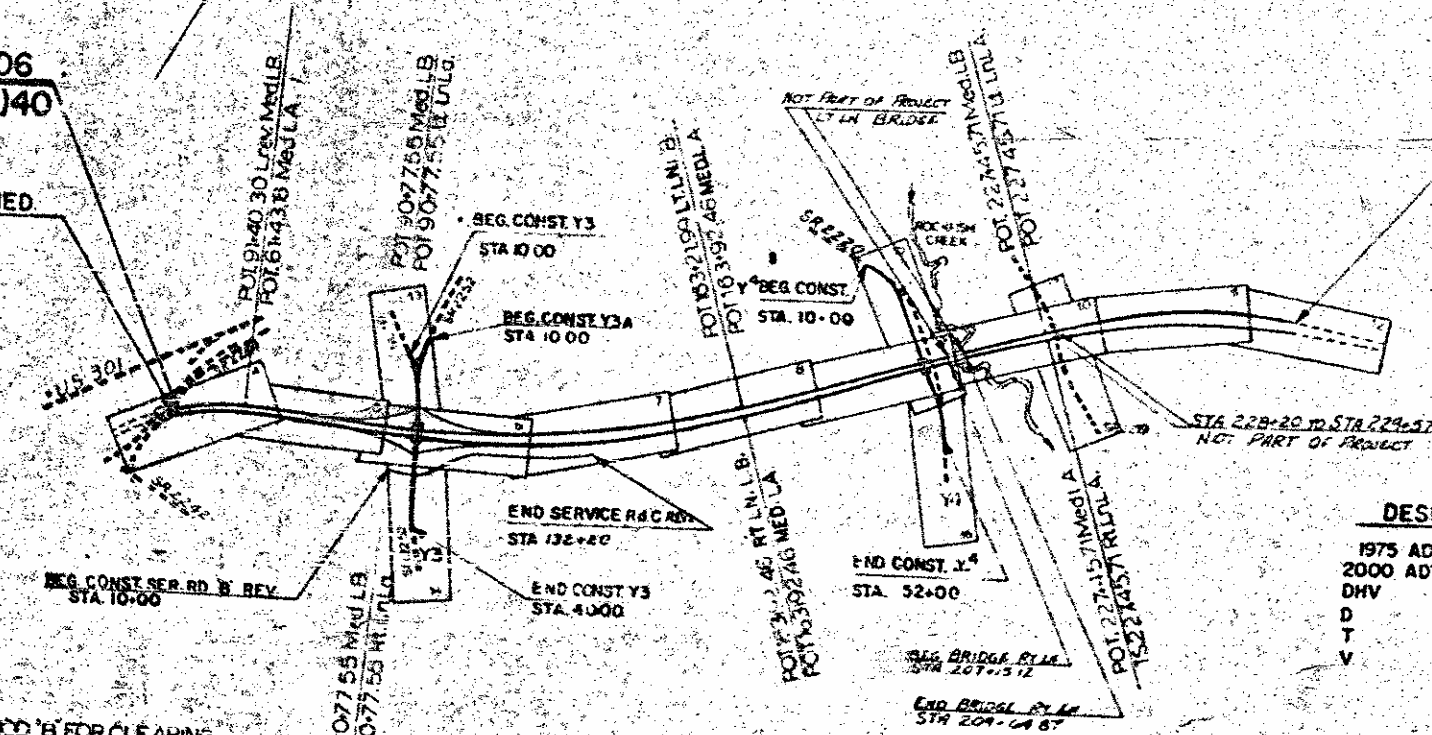

DESIGN DATA

1975 ADT	17,100
2000 ADT	29,300
DHV	12%
D	60%
T	23%
V	70 M.P.H.

GRAPHIC SCALES

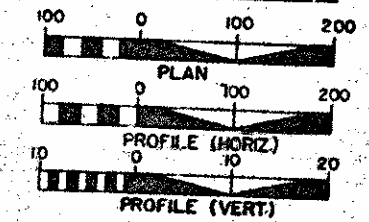

DIVISION OF HIGHWAYS  
STATE OF NORTH CAROLINA

APPROVED: *George E. Wells* P.E.  
MANAGER - HIGHWAY DESIGN BRANCH

APPROVED: *[Signature]*  
CHIEF ENGINEER - OPERATIONS

DEPARTMENT OF TRANSPORTATION  
FEDERAL HIGHWAY ADMINISTRATION

APPROVED: *[Signature]* DATE: \_\_\_\_\_  
DIVISION ADMINISTRATOR

LENGTH OF ROADWAY F.A. PROJ. I-95-2(42)40 = 4.264 MI.  
LENGTH OF STRUCTURES F.A. PROJ. I-95-2(42)40 = 0.047 MI.  
TOTAL LENGTH OF STATE PROJ. 81347406 = 4.316 MI.

THIS PROJECT HAS CONTROLLED ACCESS, SEE PLANS FOR LOCATIONS.  
THE RIGHT OF WAY ON THIS PROJECT IS VARIABLE. SEE PLANS.

PREPARED BY  
DEPARTMENT OF TRANSPORTATION  
AND HIGHWAY SAFETY  
DIVISION OF HIGHWAYS  
RAULPH N. C.

PLANS PREPARED BY  
R.V. BENNETT, PROJECT ENGINEER  
G.M. WHITE, PLANS


LETTING DATE: JUNE 28, 1977

USE METHOD 'B' FOR CLEARING  
STD. 200.01, 200.02

SEE STANDARD SPECIFICATIONS


PROJECT: 81347406 STRUCTURES

FED. ROAD DIST. NO.	STATE	PROJECT NO.
4	N.C.	815479
P.A. PROJECT 95-2(22)4-0		SHEET No. 33
Total Sheets		33

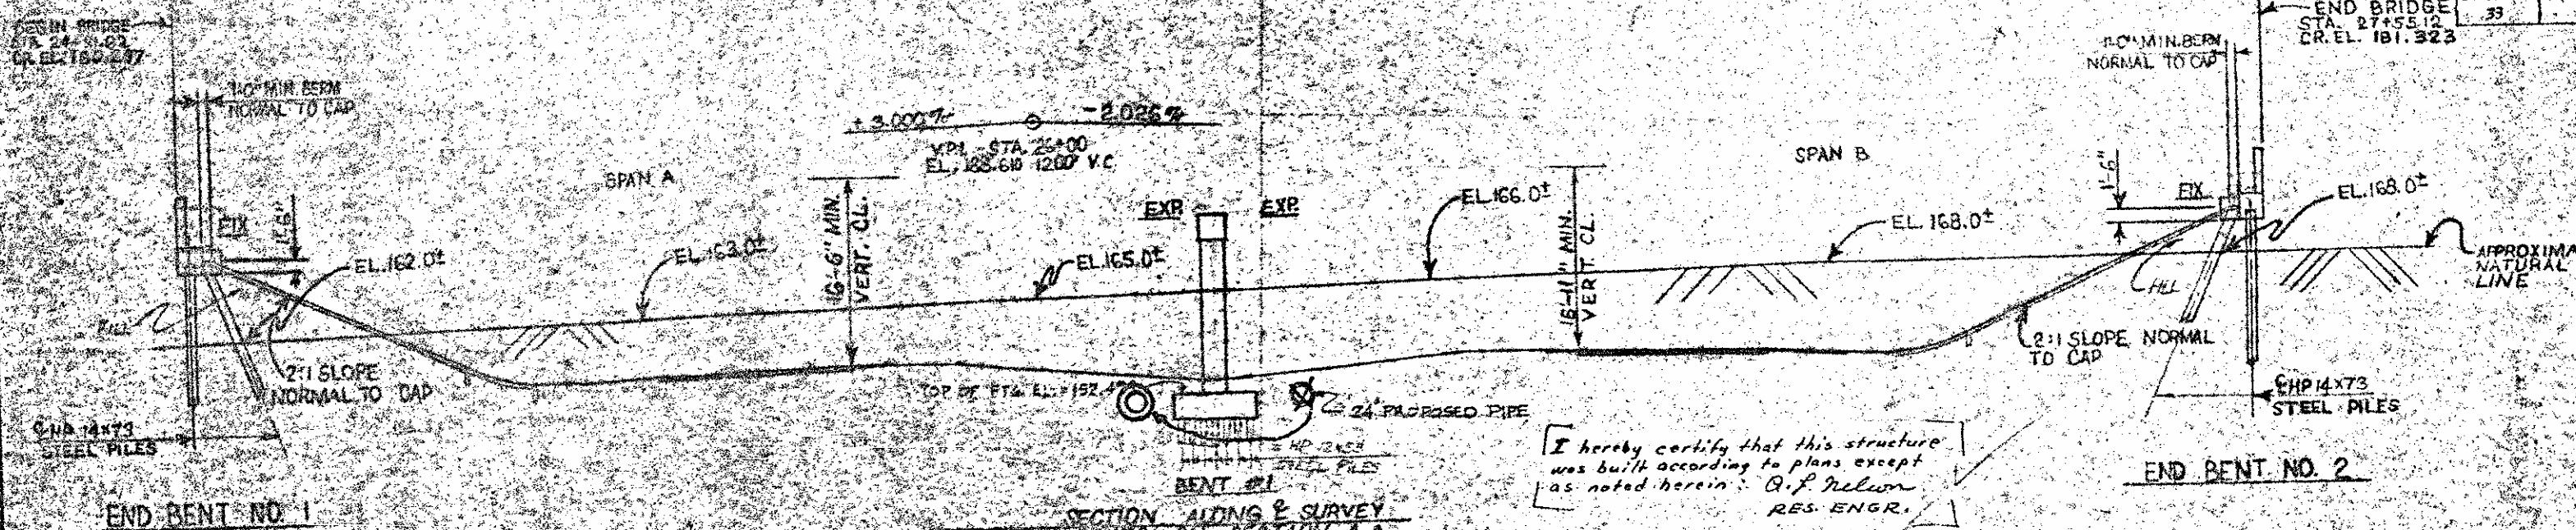

I hereby certify that this structure  
 was built according to plans except  
 as noted herein: Q.P. Nelson  
 RES. ENGR.


SECTION A-A  
 BENT & END BENTS ON SECTION A-A

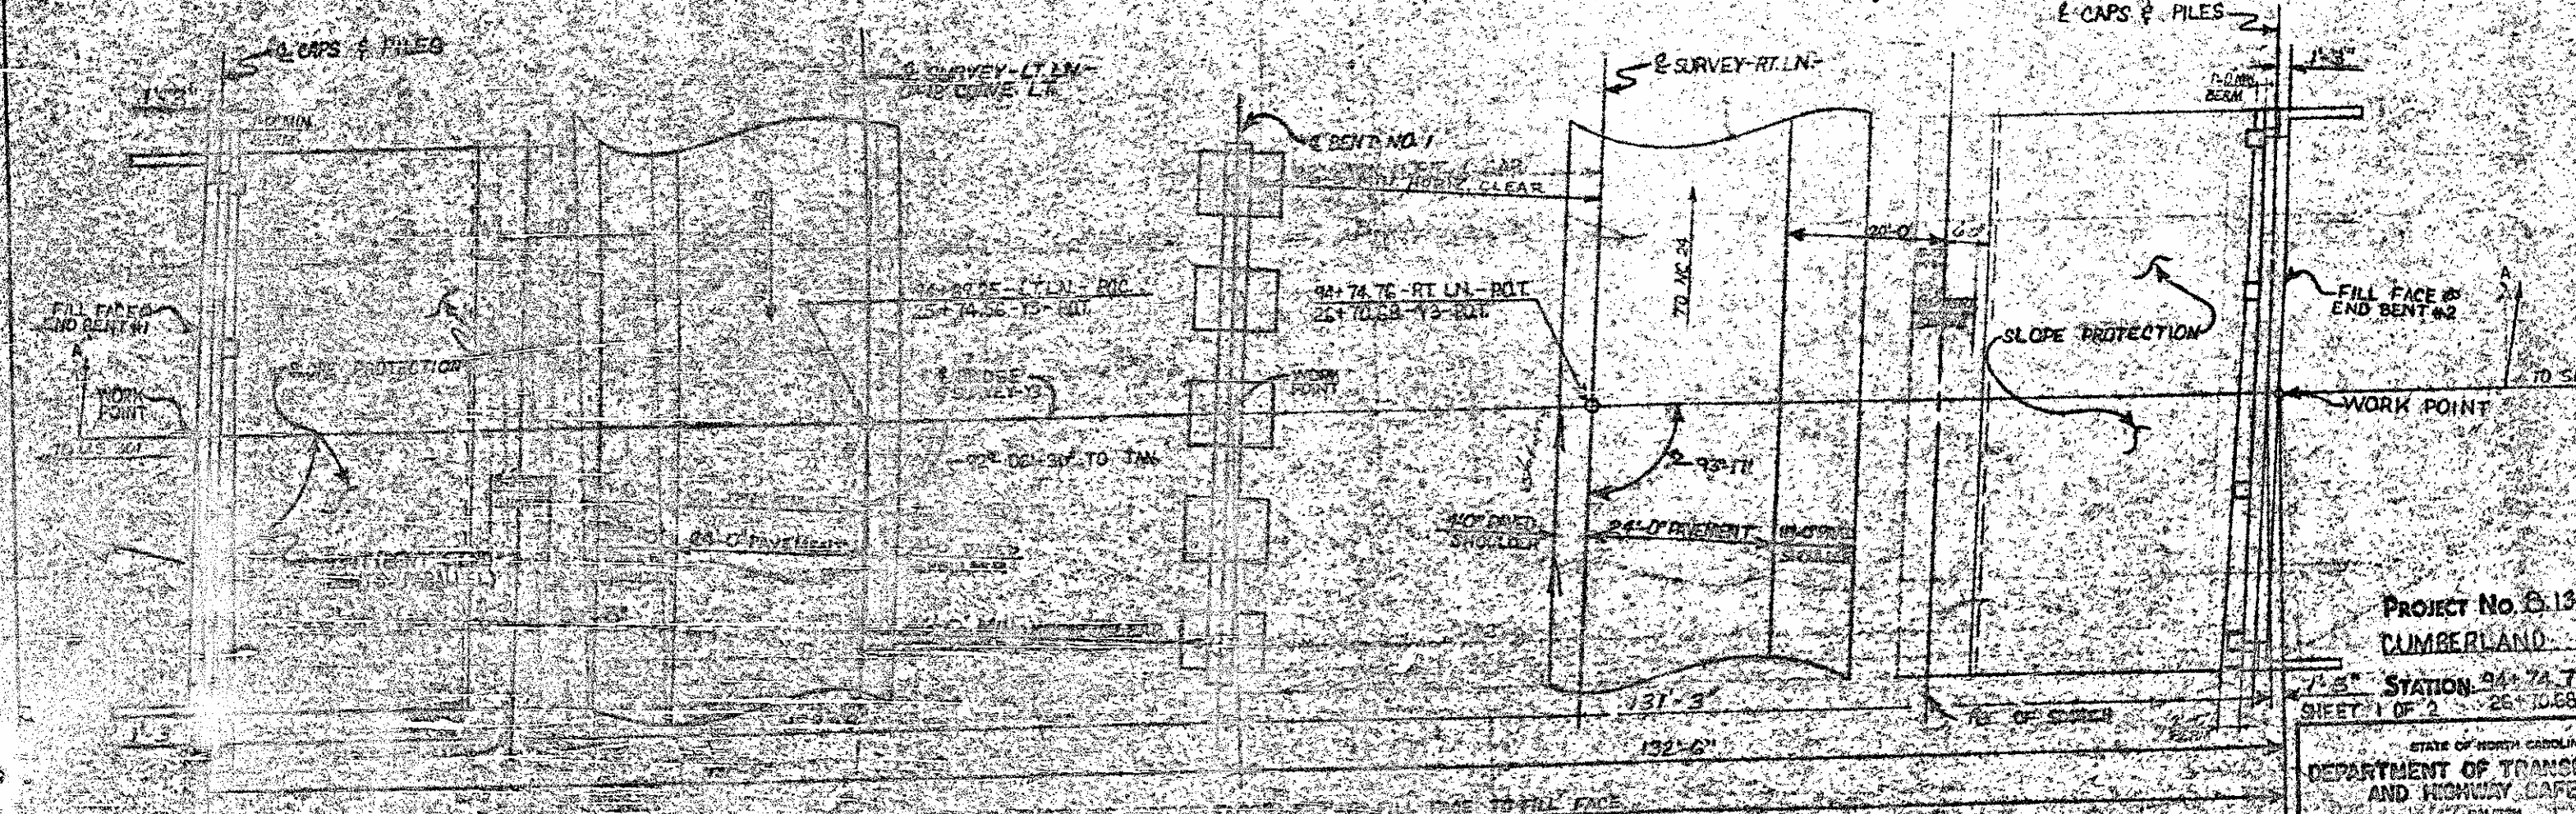

PROJECT No. 813474-06  
 CUMBERLAND COUNTY  
 STATION 94+74.76 - RT. LN. - BOT  
 26+10.68 - 13 - BOT  
 SHEET 1 OF 2  
 STATE OF NORTH CAROLINA  
 DEPARTMENT OF TRANSPORTATION  
 AND HIGHWAY SAFETY  
 GENERAL DRAWING FOR BRIDGE  
 OVER I-85 ON SR 2233 BETWEEN  
 US 301 AND CR 2233

FED. ROAD DIV. NO.	STATE	PROJECT NO.
4	N.C.	1347406
P.A. PROJECT 7-95-2 (42)40		
SHEET NO. 7574C SHEETS		

B.M. IN DITCH IN 2' FROM RT. STA 93+52  
RIGHT LANE (ELEVATION 169.99 M.S.L.)

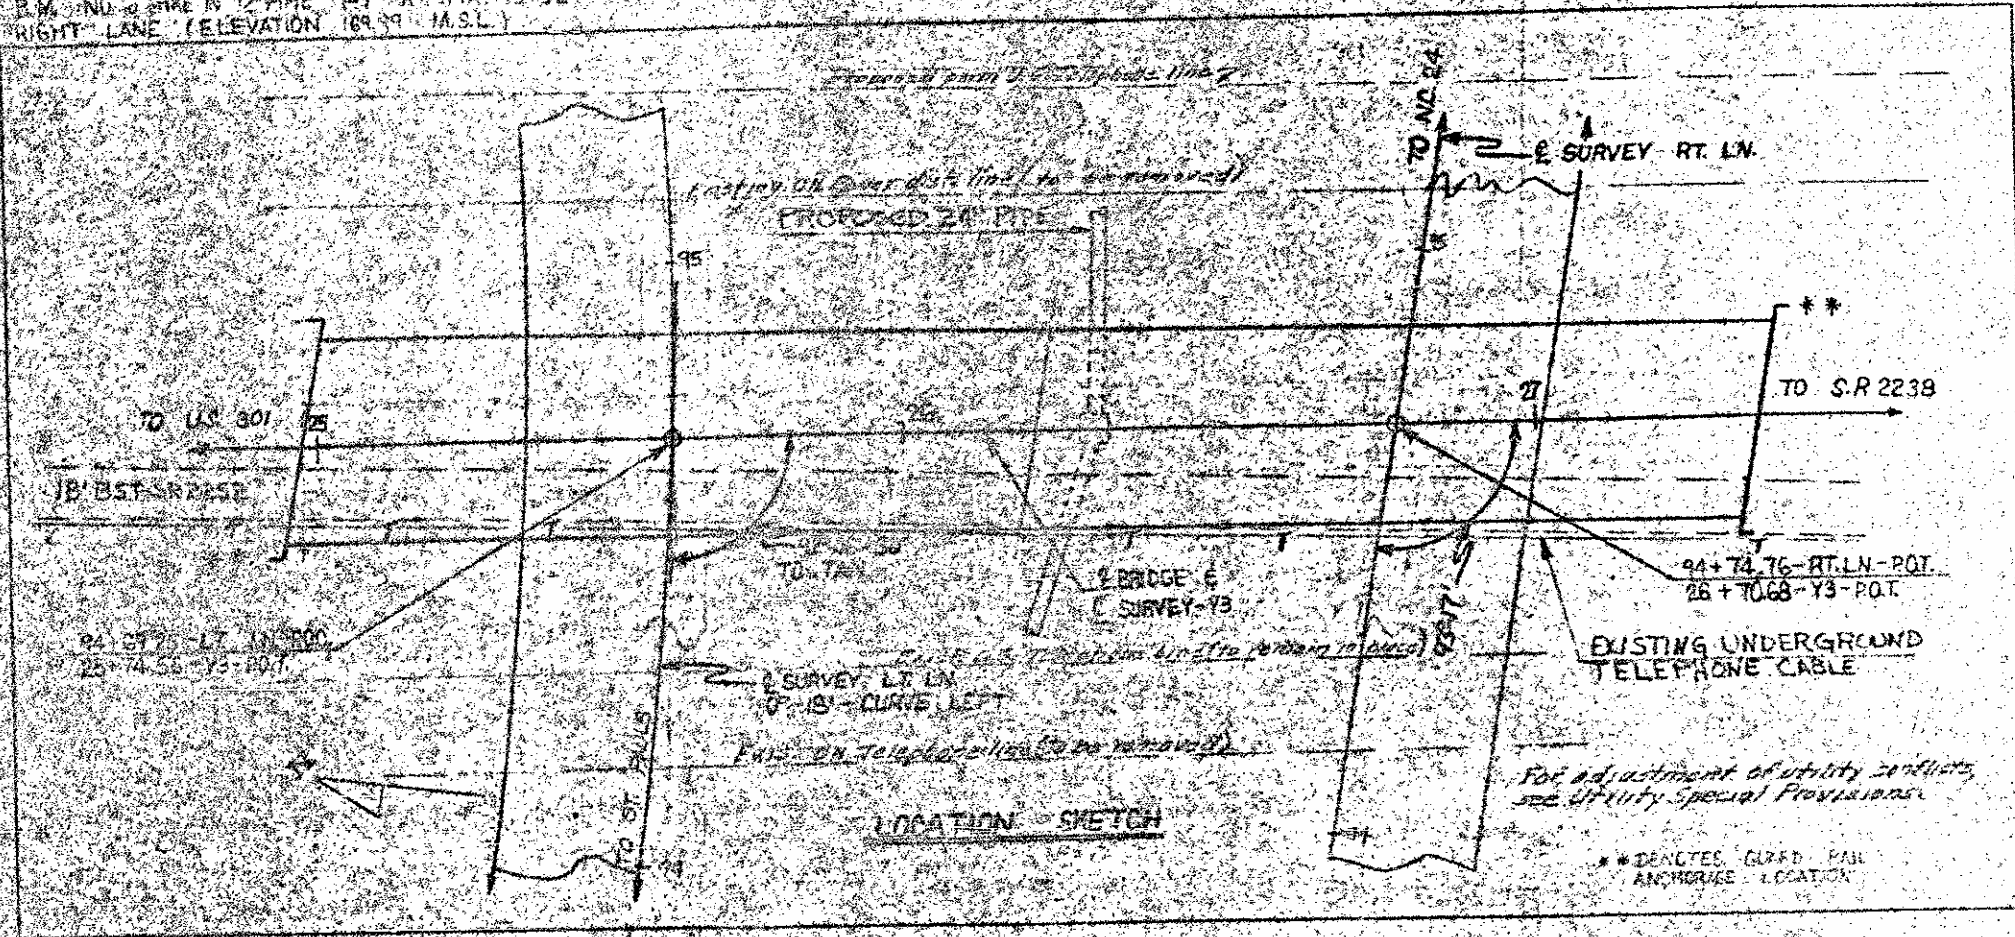

THE ASSUMED LIVE LOAD SHALL BE EQUAL TO THAT CALLED FOR IN THE SPECIAL PROVISIONS.  
 ALL SPACING STEEL TO BE INSTALLED AND LAPPED ENDING BEARING BARS WITH A MINIMUM LAP LENGTH OF 30 DIAM. END SECTIONS, ANCHOR BOLTS, NUTS & WASHERS, WHICH SHALL BE IN ACCORDANCE WITH SPECIFICATIONS. ALL BEARING PLATES EXCEPT SELF-LUBRICATING PLATES SHALL BE GALVANIZED IN ACCORDANCE WITH SPECIFICATIONS.  
 FOR CONTACT PREPARATION AND FINISHING OF EXPOSED STEEL, SEE SPECIAL PROVISIONS.  
 FOR DESIGN REQUIREMENTS FOR BRIDGE DECK, SEE SPECIAL PROVISIONS.  
 WHERE NOT OTHERWISE SPECIFIED ON THE EXTERIOR SURFACE, THE ROADWAY SECTION HAS BEEN ENLARGED BY THE ROADWAY CONTRACTOR UNLESS OTHERWISE PERMITTED BY THE ENGINEER. QUANTITIES ARE BASED ON THE SURFACE OF THE ROADWAY.  
 PILES FOR END BENT NO. 2 TO BE DRIVEN INTO THE SUPPORT PILE.  
 ALL PILES FOR END BENT NO. 2 AND NO. 3 TO BE SET ON A SHELTERED BEARING CAPACITY OF 60 TONS. ALL PILES FOR END BENT NO. 3 AND NO. 4 TO BE SET ON A BEARING CAPACITY OF 150 TONS.  
 THE ROADWAY CONTRACTOR WILL BE REQUIRED TO REMOVE THE EXISTING PAVEMENT AND SCALF THE ROADWAY TO A MINIMUM DEPTH OF 2.0' WITHIN THE AREA OF THE END BENT PILES.  
 FOR PORTLAND CEMENT CONCRETE, SEE SPECIAL PROVISIONS.

REINFORCING STEEL LENGTHS ARE BASED ON THE FOLLOWING MINIMUM SPLICE LENGTHS

BAR SIZE	SPLICE LENGTH
#4	1.00
#5	1.00
#6	1.00
#7	1.00
#8	1.00
#9	1.00
#10	1.00
#11	1.00


DESCRIPTION	TOTAL P.L. OF MATERIAL										
	CONCRETE	CLAS. CONC.	REINFC. STEEL	STRUCT. STEEL	CONCRETE CURB	BRIDGE APPROACH	4" SLOPE PROTECTION	FOUNDATION EXCAVATION	HP 14x79 STEEL PILES	HP 12x59 STEEL PILES	EXPANSION JOINT SEAL
	CU YDS.	CU YDS.	TONS	TONS	LN. FT.	LN. FT.	CU YDS.	CU YDS.	NO. LN.FT.	NO. LN.FT.	LUMP SUM
STRUCTURE	12.00	12.00	12.00	12.00							
END BENT NO. 1	2.00	2.00	2.00	2.00							
END BENT NO. 2	2.00	2.00	2.00	2.00							
CURVED END BENTS	2.00	2.00	2.00	2.00							
TOTAL	18.00	18.00	18.00	18.00							

Project No. 1347406  
 CUMBERLAND COUNTY  
 STATION 94+74.76-RT. LN.  
 25+70.68-Y3

STATE OF NORTH CAROLINA  
 DEPARTMENT OF TRANSPORTATION  
 RALEIGH  
 GENERAL DRAWING  
 FOR BRIDGE OVER U.S. 301  
 BETWEEN U.S. 301 AND S.R. 2238  
 OCTOBER 1974

REVISIONS					
NO.	BY	DATE	NO.	BY	DATE
1			2		
2			3		


FED. ROAD DIST. NO.	STATE	PROJECT NO.
8	N.C.	B.1347406
F. A. PROJECT	95-2 (42) 00	
SHEET NO.	TOTAL SHEETS	
36	36	

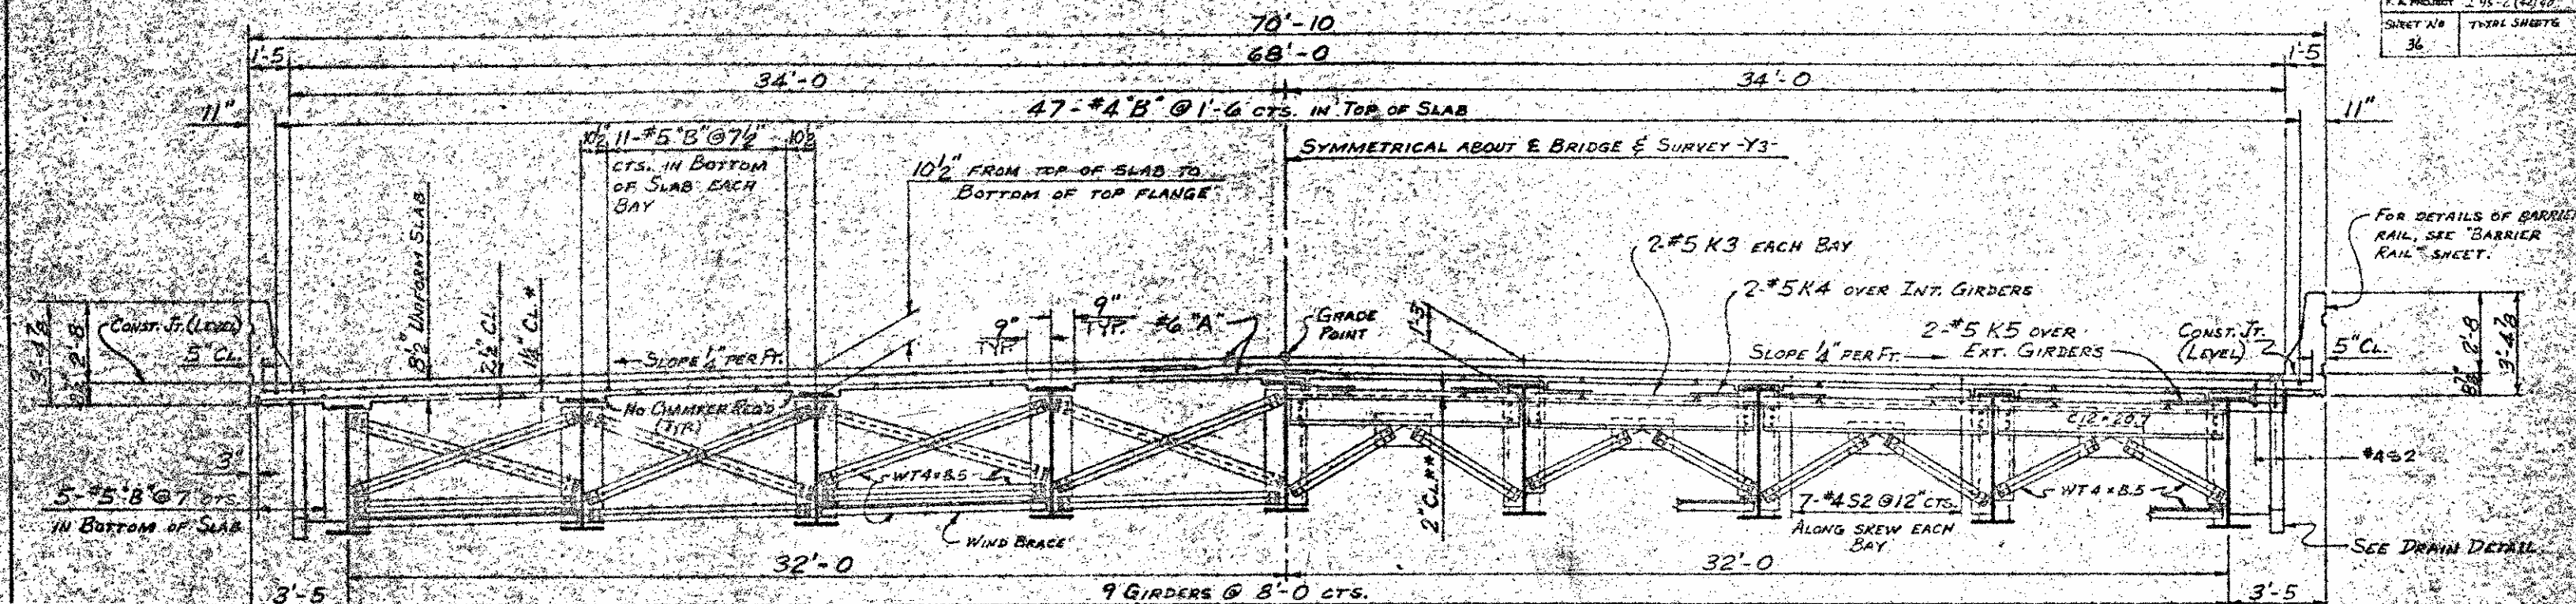

\* PROVIDE 1/2" HIGH B.B. @ 4'-0" CTS. FOR "A" BARS IN BOTTOM OF SLAB. SHOWING INTERMEDIATE DIAPHRAGMS (D2)

\* PROVIDE 2" HIGH B.B. @ 5'-0" CTS. FOR "K" BARS. SHOWING DIAPHRAGMS (D1) @ BENT #1

TYPICAL SECTION


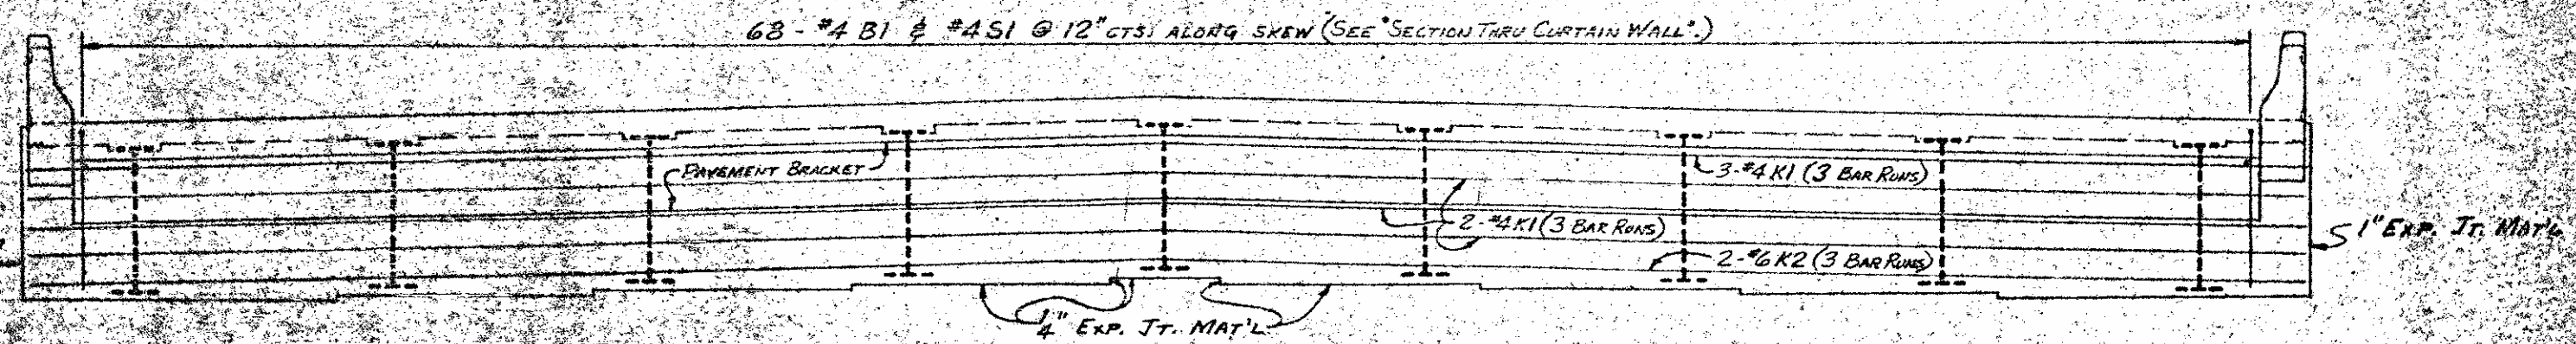


END ELEVATION



PROJECT No. B.1347406  
CUMBERLAND COUNTY  
STATION: 94+74.76  
SHEET 1 OF 2

STATE OF NORTH CAROLINA					
DEPARTMENT OF TRANSPORTATION AND HIGHWAY SAFETY					
RALEIGH					
SUPERSTRUCTURE TYPICAL SECTION					
JUNE 1974					
REVISIONS					
NO.	BY	DATE	NO.	BY	DATE
1			2		
2			3		
					SHEET NO. 54


PROJ. ROAD DIST. NO.	STATE	PROJECT NO.
4	N.C.	8158766L
P.A. PROJECT		I-95-2 (4) 40
SHEET No.		TOTAL SHEETS
37		

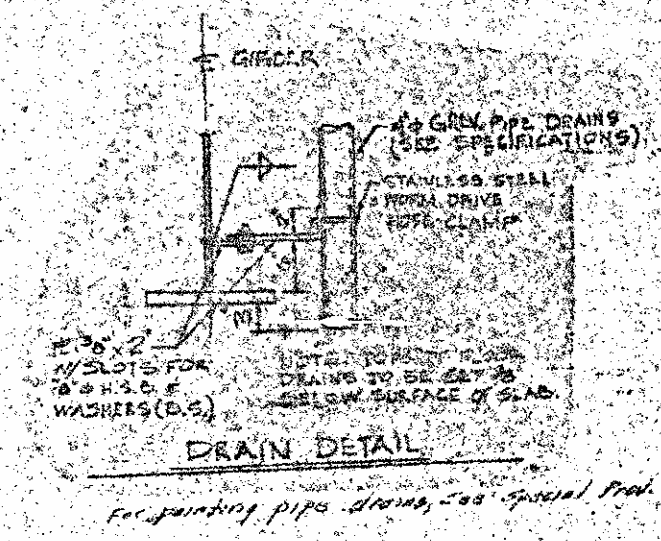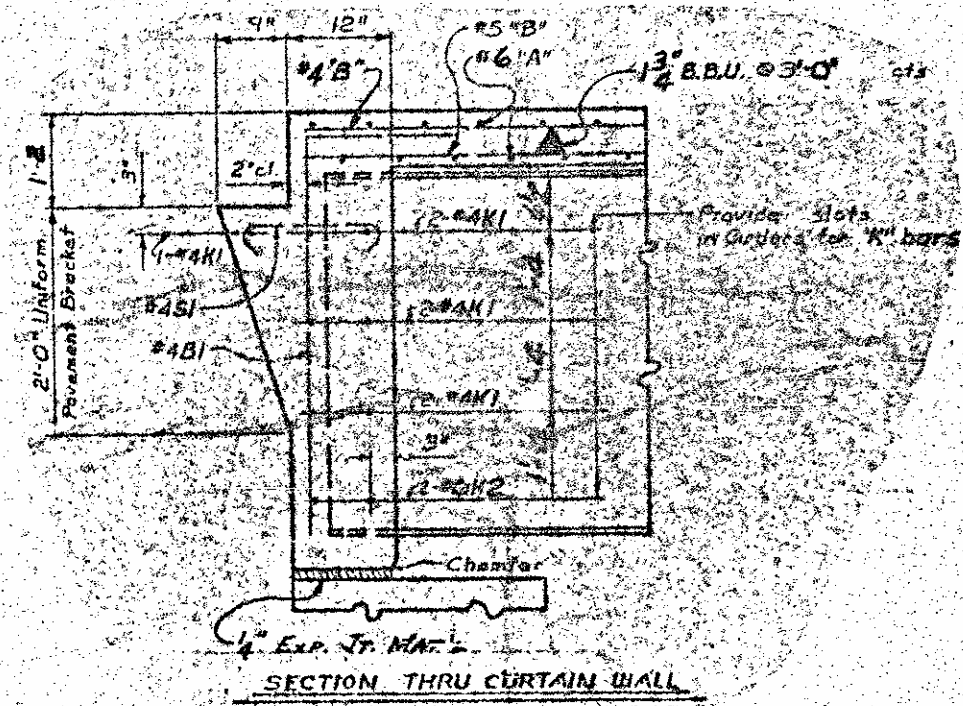

RESIDENT ENGINEER

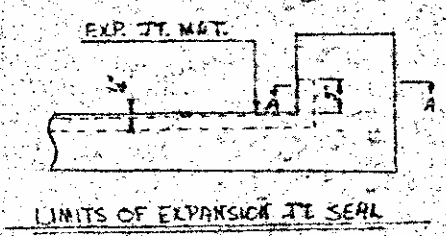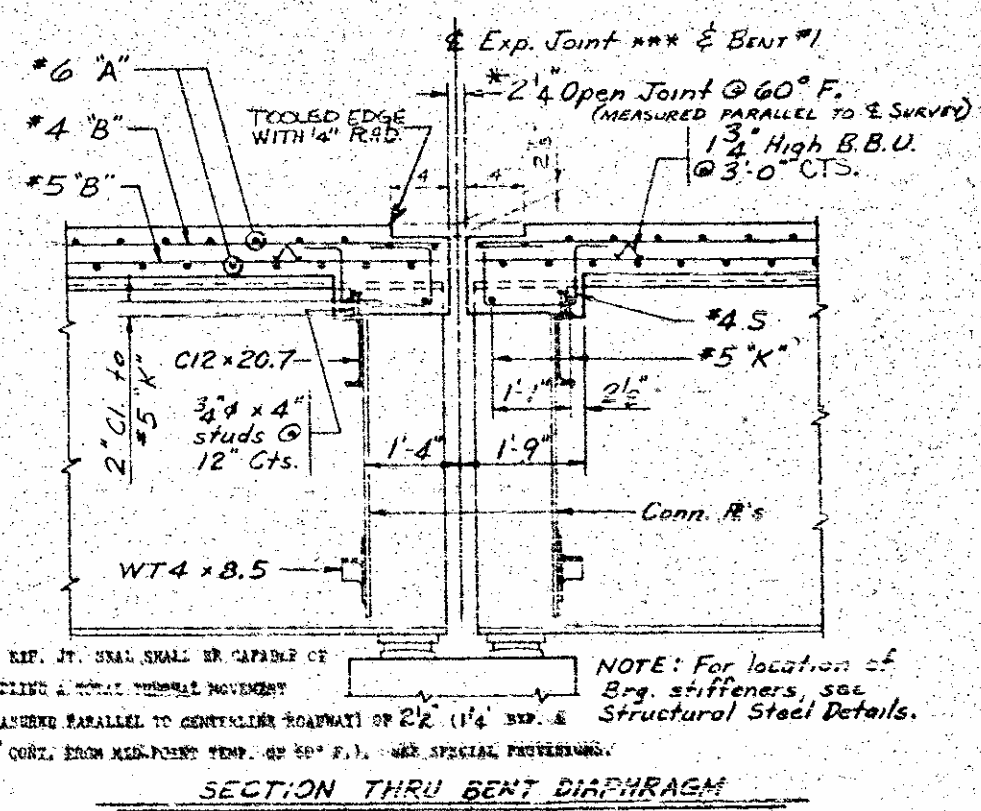

* WIDTH OF OPEN JOINT	
@ 30° F	2 3/4"
@ 60° F	2 1/4"
@ 90° F	1 5/8"

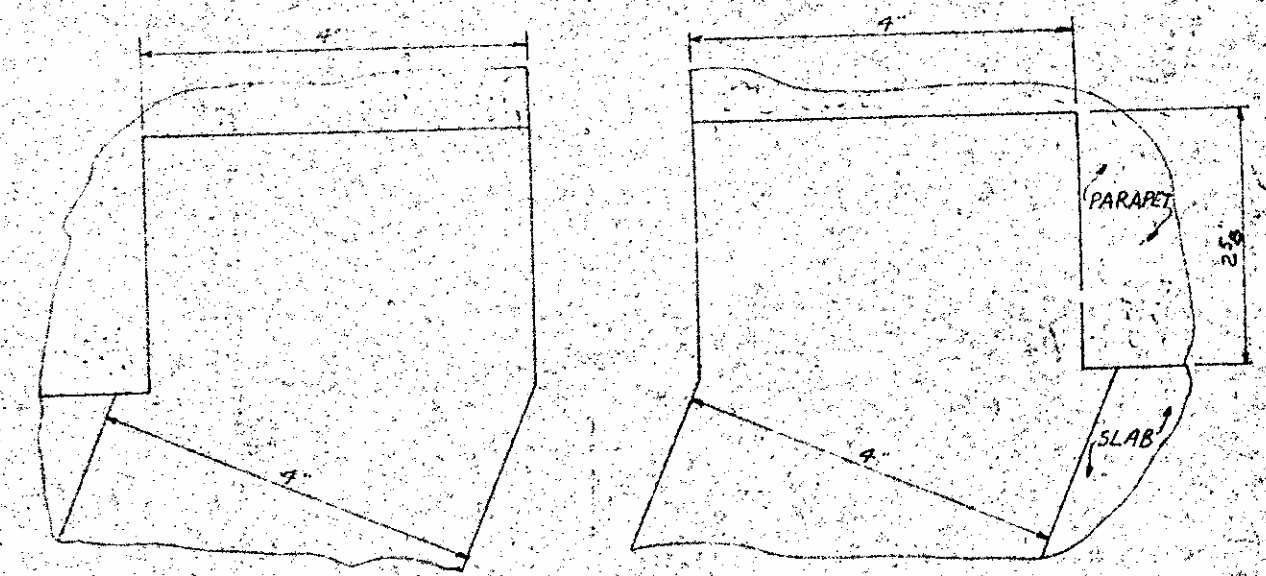

SECTION A-A

PROJECT No. 8.1347406  
 CUMBERLAND COUNTY  
 STATION 94+74.76-1-Rt. 10  
 Sheet 2 of 2


STATE OF NORTH CAROLINA					
DEPARTMENT OF TRANSPORTATION AND HIGHWAY SAFETY					
RALEIGH					
SUPERSTRUCTURE					
TYPICAL SECTION					
JUNE 1974					
REVISIONS					
NO.	BY	DATE	NO.	BY	DATE
1	BT	10/14/77	2		
2			3		
3			4		
SHEET NO. 5-5					

DRAWN BY J. C. CHUCK  
 CHECKED BY T. HARRIS

NOTE: EXPANSION JOINT SEAL SHALL BE SET A MINIMUM OF 1/4" BELOW TOP OF SLAB.

REV #1: Detail Exp. Jt. - C.P.

FED. ROAD DIST. NO.	STATE	PROJECT NO.
4	N.C.	B.1347406
P. A. PROJECT 7-95-2(45)48		
SHEET No	TOTAL SHEETS	
38		

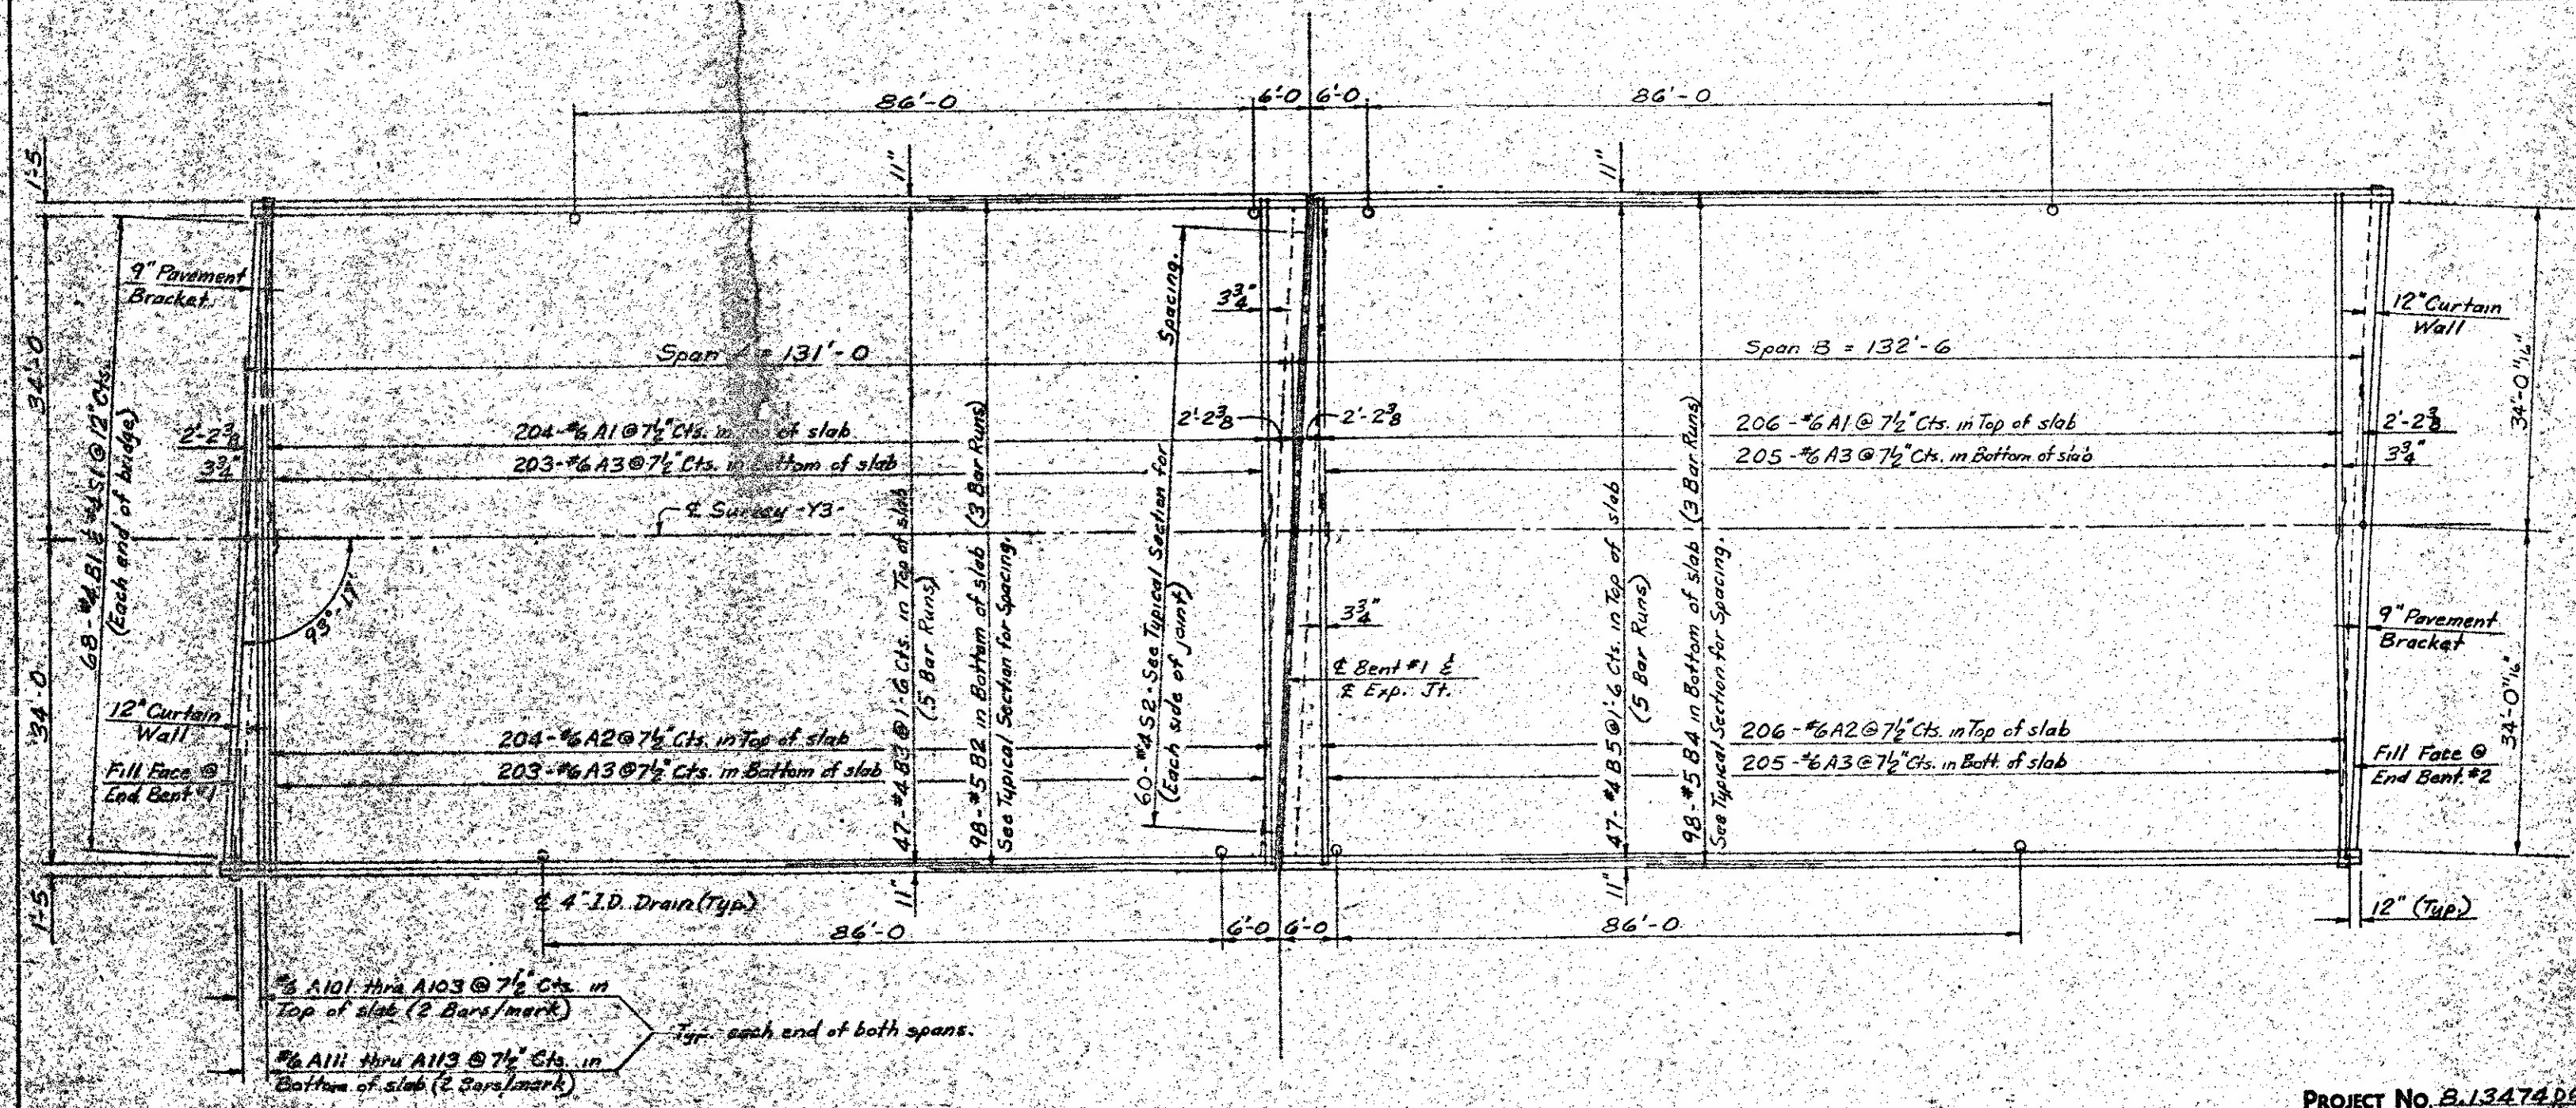

PLAN



LINSEED OIL CONCRETE PROTECTION





PROJECT No. B.1347406  
 CUMBERLAND COUNTY  
 STATION: 94+74.76 L.R.H.Ln.  
 Sheet 1 of 2

STATE OF NORTH CAROLINA  
 DEPARTMENT OF TRANSPORTATION  
 AND HIGHWAY SAFETY  
 BALDWIN  
 SUPERSTRUCTURE  
 SPANS A & B

REVISIONS						DATE
NO.	BY	DATE	NO.	BY	DATE	REVISION
1			1		5-6	
2			2		5-6	
3			3		5-6	

PROJ. ROAD DIST. NO.	STAGE	PROJECT NO.
2	NO. 2	8-75-7700
F.A. PROJECT	7-95-2 (62) 40	
SHEET NO.	TOTAL SHEETS	
38	39	

BILL OF MATERIAL					
FOR BARRIER RAIL ONLY					
BAR	NO.	SIZE	TYPE	LENGTH	WEIGHT
F1	8	#5		10'-3"	86
F2	5	#4		5'-5"	600
F3	16	#5	STR.	4'-0"	67
F4	16	#5	STR.	27'-5"	462
F5	16	#5	STR.	21'-2"	487
F6	128	#5	STR.	25'-8"	3427
REINF. STEEL LBS. # 9,129					
CLASS AA CONG. CYLS 47.8					
BAR TYPE					
ALL DIMENSIONS ARE CUT TO					

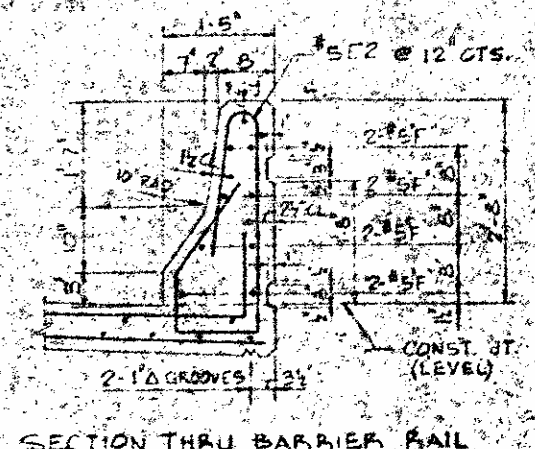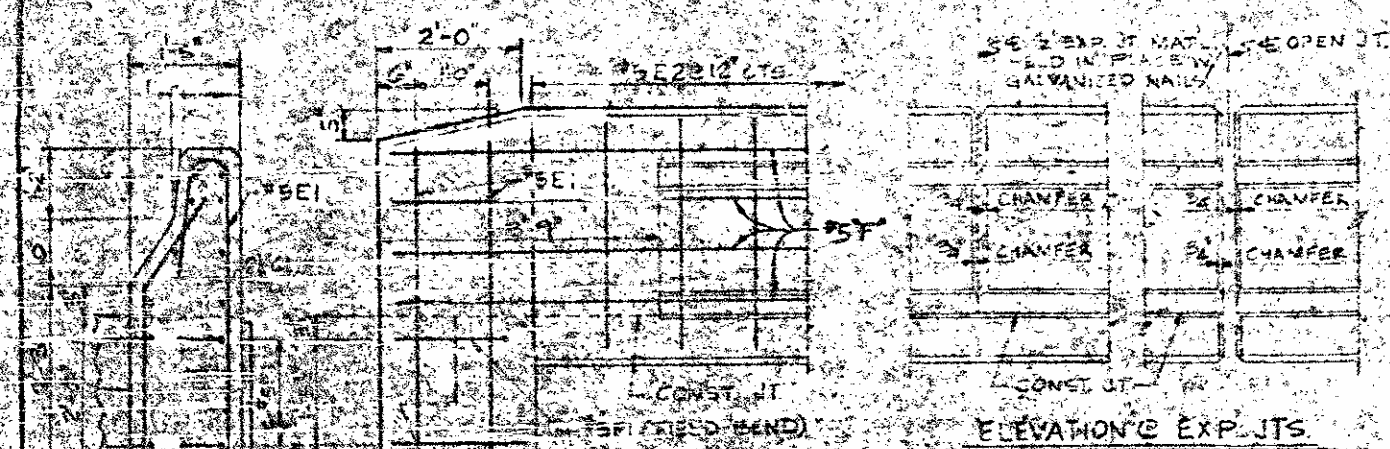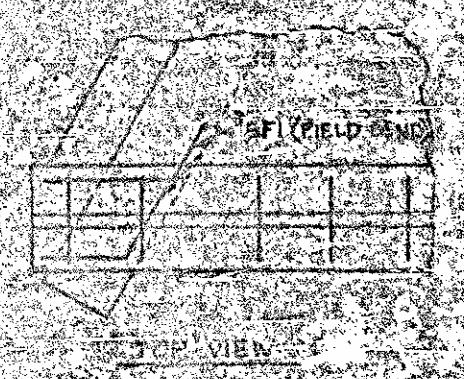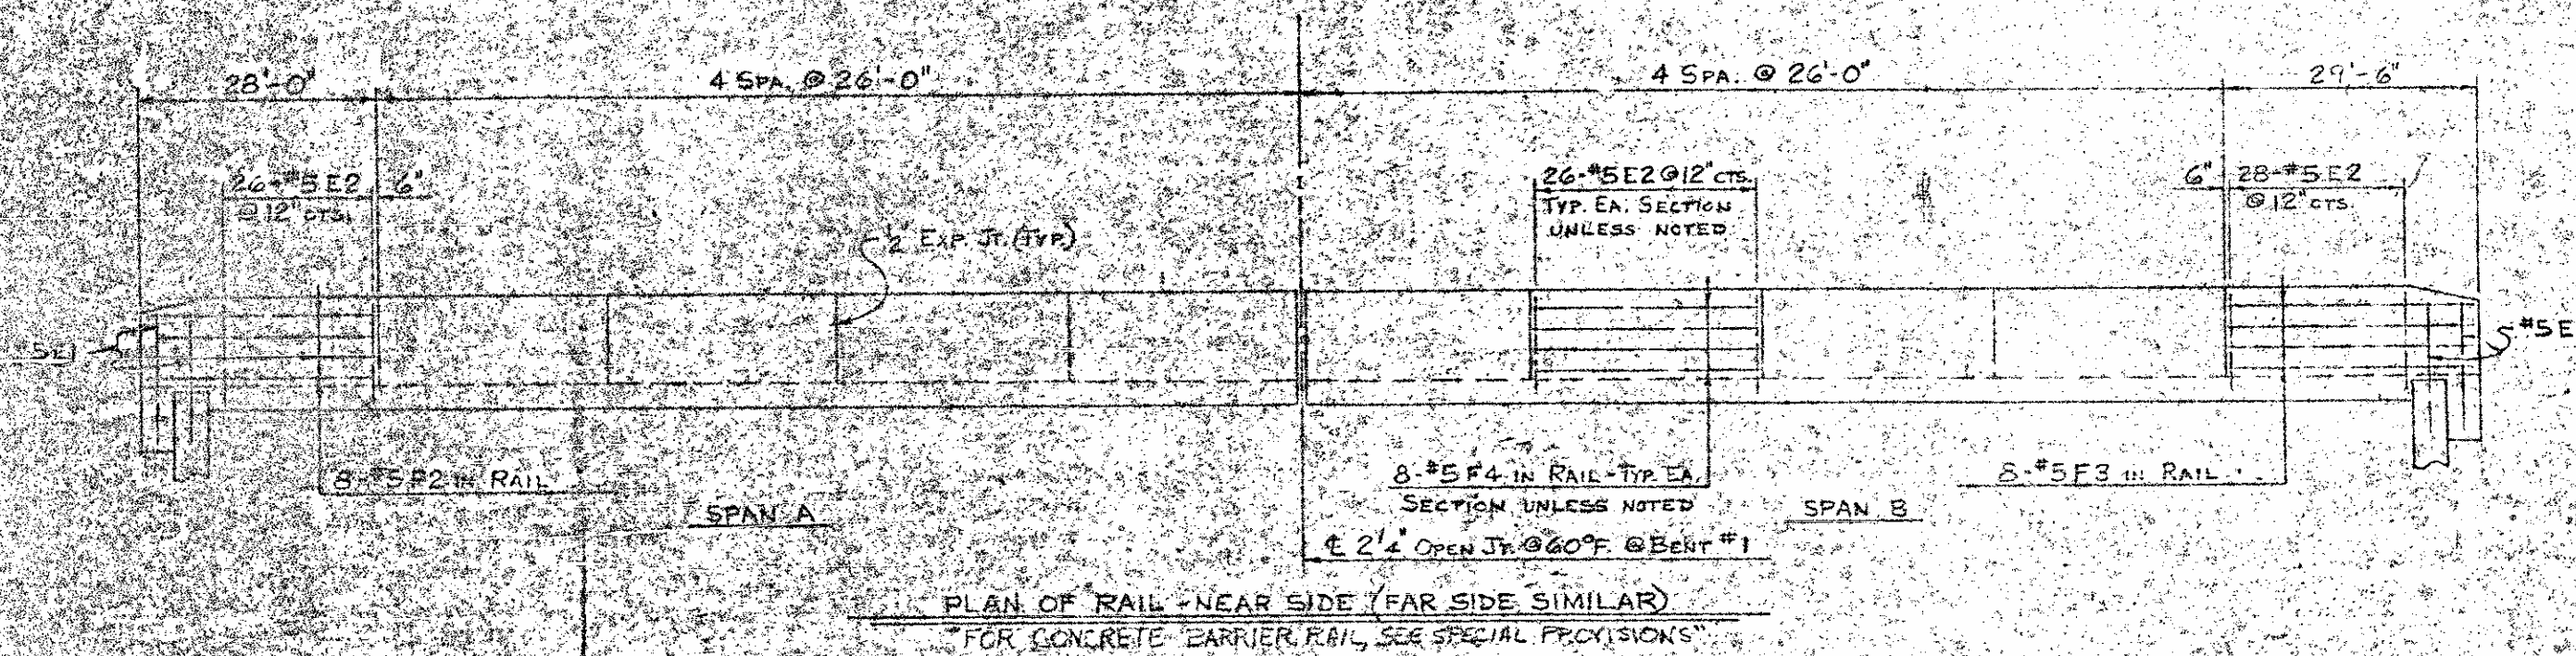

NOTE: SEE STANDARD GUARD RAIL ASSEMBLY SHEET FOR LOCATION OF 1" SLAB FOR CURVED END SIDES AND GUARD RAIL ANCHOR ASSEMBLY.

NOTE: SEE LOCATION SHEET ON GENERAL DRAWING FOR GUARD RAIL ANCHOR LOCATION.

PROJECT No. 8,13474-06  
CUMBERLAND COUNTY  
STATION: 94+76.76-R/L

SHEET 2 OF 2


STATE OF NORTH CAROLINA  
STATE HIGHWAY COMMISSION  
DIVISION

SUBSTRUCTURE  
BARRIER RAIL

JUNE

NO.	BY	DATE	CO.	BY	DATE

FED. ROAD DIST. NO. STATE PROJECT NO.  
 4 N.C. 8.134706  
 P.A. PROJECT J-95-2(62)40  
 SHEET NO. TOTAL SHEETS  
 40 40

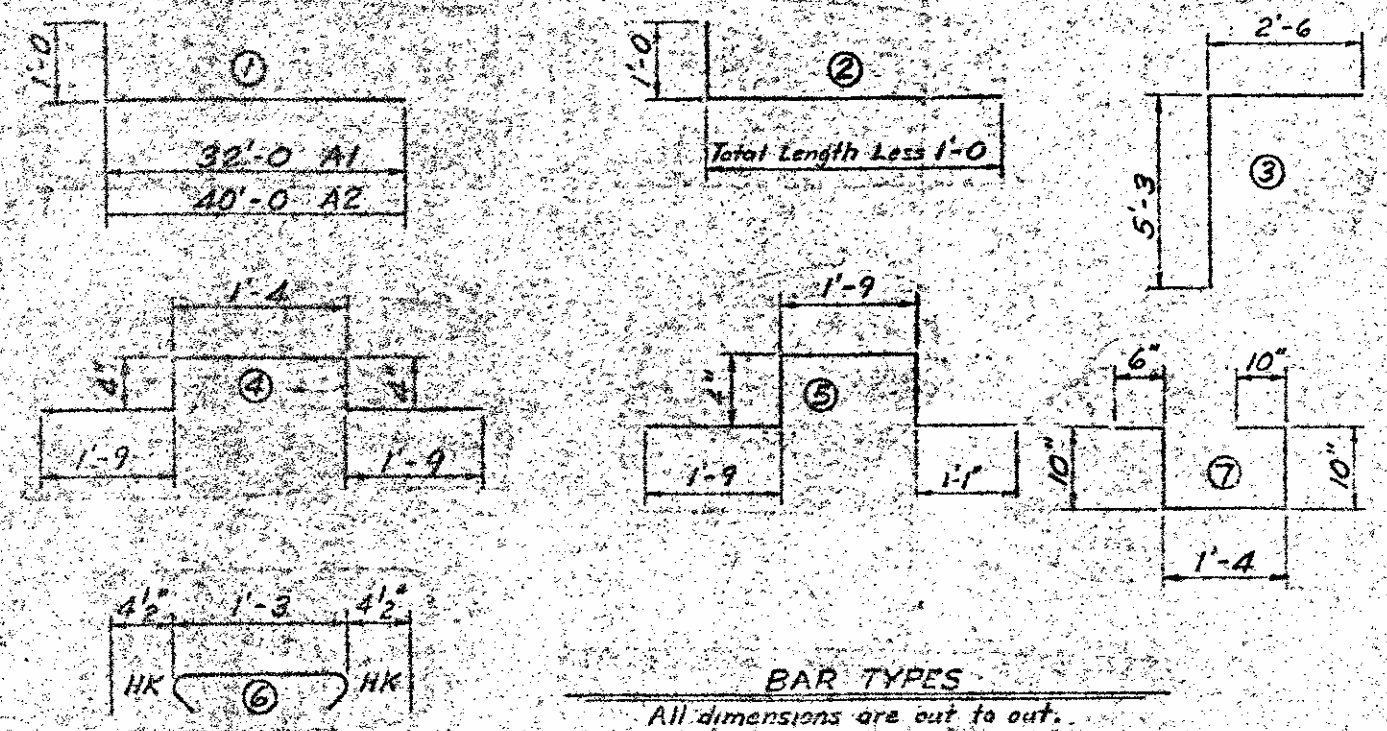

**BAR TYPES**  
 All dimensions are out to out.

REINFORCING SCHEDULE											
SPAN A					SPAN B						
BAR	NO.	SIZE	TYPE	LENGTH	WEIGHT	BAR	NO.	SIZE	TYPE	LENGTH	WEIGHT
A1	204	#6	1	33'-0"	10,111	A1	206	#6	1	33'-0"	10,211
A2	204	#6	1	41'-0"	12,563	A2	206	#6	1	41'-0"	12,684
A3	406	#6	Str.	36'-3"	22,106	A3	410	#6	Str.	36'-3"	22,323
A101	4	#6	2	51'-10"	311	A101	4	#6	2	51'-10"	311
A102	4	#6	2	30'-0"	180	A102	4	#6	2	30'-0"	180
A103	4	#6	2	8'-3"	50	A103	4	#6	2	8'-3"	50
A111	4	#6	Str.	56'-6"	339	A111	4	#6	Str.	56'-6"	339
A112	4	#6	Str.	34'-8"	208	A112	4	#6	Str.	34'-8"	208
A113	4	#6	Str.	12'-11"	78	A113	4	#6	Str.	12'-11"	78
B1	68	#4	3	7'-9"	352	B1	68	#4	3	7'-9"	352
B2	294	#5	Str.	44'-9"	13,722	B2	294	#5	Str.	44'-9"	13,871
B3	235	#4	Str.	27'-2"	4,265	B3	235	#4	Str.	27'-6"	4,311
K1	27	#4	Str.	24'-6"	442	K1	27	#4	Str.	24'-6"	442
K2	6	#6	Str.	25'-0"	225	K2	6	#6	Str.	25'-0"	225
K3	16	#5	Str.	7'-9"	129	K3	16	#5	Str.	7'-9"	129
K4	14	#5	4	5'-6"	80	K4	14	#5	4	5'-6"	80
K5	4	#5	5	5'-3"	22	K5	4	#5	5	5'-3"	22
S1	68	#4	6	2'-0"	91	S1	68	#4	6	2'-0"	91
S2	60	#4	7	4'-4"	174	S2	60	#4	7	4'-4"	174
Total for Span A = 65,448					Total for Span B = 66,011						

CONCRETE BREAKDOWN IN CU. YDS.		
	SPAN A	SPAN B
SLAB	268.6	271.4

BILL OF MATERIAL FOR SUPERSTRUCTURE	
Reinforcing Steel - Lbs.	131,542 ✓
Class AA Concrete - Cu. Yds.	540.0 ✓
Structural Steel - Approx. Lbs.	607,400 ✓
Concrete Barrier Rail - Lin. Ft.	531.00 ✓ 530.45 ✓
Linseed Oil Concrete Protection - Gal.	#5 ✓ 50 ✓
EXPHYSION JOINT SEAL -	LUMP SUM

PROJECT No. 8.134706  
 CUMBERLAND COUNTY  
 STATION 94+74.76-1.01

STATE OF NORTH CAROLINA  
 DEPARTMENT OF TRANSPORTATION  
 AND HIGHWAY SAFETY  
 RALEIGH  
 SUPERSTRUCTURE  
 BILL OF MATERIAL

REVISIONS					
NO.	BY	DATE	NO.	BY	DATE
1			2		
3			4		



ROAD DIST. NO.	STATE	PROJECT NO.
9	N.C.	813A7406
F.A. PROJECT	T-95-2(43)40	
SHEET NO.	TOTAL SHEETS	
21	21	

**NOTES**

FOR LOCATIONS OF HOLES IN BEAMS TO ACCOMMODATE THE BOLTS SEE SUPERSTRUCTURE SECTIONS AND DETAILS.

CAMBERED GIRDER LENGTHS SHALL BE ADJUSTED AND BEARINGS ARE TO BE PLACED ON THE CAMBERED GIBBETS SO AS TO BE ALIGNED WITH THE ANCHORS AFTER THE DEAD LOAD DEFLECTION HAS OCCURRED. SHOP PLANS SHALL BE PREPARED ACCORDINGLY.

CLIP THE CORNERS OF BEARING STIFFENERS 1" AT THE JUNCTIONS OF THE WEB AND FLANGES.

AT ALL FIXED POINTS OF SUPPORT, NUTS FOR ANCHOR BOLTS ARE TO BE WIGHTENED FIRST PART AND THEN RANDED OFF A TURN. THE THREAD OF THE NUT AND BOLT SHALL THEN BE BURRED WITH A SHARP POINTED TOOL.

ALL BEARING ASSEMBLIES SHALL BE GALVANIZED EXCEPT SELF-LUBRICATING PLATES.

ALL BEARING SURFACES THAT ARE NOT REQUIRED TO BE FINISHED SHALL BE SMOOTH AND STATIONARY.

ALL FIELD CONNECTIONS TO BE 7/8" HIGH STRENGTH BOLTS.

ALL SHOP SPLICES IN FLANGE AND WEB PLATES SHALL BE MADE FROM BEARING PLATES OR END PLATES. NO SPLICE OTHER THAN THROUGH BOWTS ON TWO PLATE FIELD BE PERMITTED IN THE FLANGE PLATES. HOWEVER, TWO ADDITIONAL SHOP WEB SPLICES SHALL BE ALLOWED AT APPROXIMATE ONE-THIRD POINTS.

**SHIPPING DETAILS**

SHIPPING DETAILS FOR GIRDERS SHALL BE SUBMITTED FOR APPROVAL, INDICATING THE TOP FLANGE LOCATION, CENTER LINE, AND IN ALL CASES SHOWING THE WEB VERTICAL, THE METHOD OF LIFTING, POSITION ON THE VEHICLE, AND ATTACHMENTS TO THE GIRDERS OF ANY SHIPPING RESTRAINTS SHALL BE CLEARLY DETAILLED.

ALL STRUCTURAL STEEL TO BE UNPAINTED ASTM A-36 (INCLUDING BEARING PLATES) WITH A MINIMUM YIELD STRENGTH OF 50,000 PSI, EXCEPT ANCHOR BOLTS, NUTS & WASHERS WHICH SHALL BE IN ACCORDANCE WITH SPECIFICATIONS. ALL BEARING PLATES EXCEPT SELF-LUBRICATING PLATES SHALL BE GALVANIZED IN ACCORDANCE WITH SPECIFICATIONS.

A CHARPY V-NOTCH TEST IS REQUIRED ON ALL GIRDER WEB AND BOTTOM FLANGE PLATES. SEE SPECIAL PROVISIONS.

THE ATMOSPHERIC CORROSION RESISTANCE AND COLORING CHARACTERISTICS OF ASTM A-36 STEEL IS REQUIRED FOR THE WEB PLATE.

BIGG LENGTH BOLTS, NUTS & WASHERS SHALL MEET THE REQUIREMENTS FOR ASTM A-325 FOR TYPE 3 BOLTS.



IN REGARD TO ELECTRO-SLAG WELDING SEE SPECIAL PROVISIONS.

PROJECT No. 813A7406  
 GUMBERLAND COUNTY  
 STATION: 94+74.76 P.O. 101  
 Sheet 1 of 5

STATE OF NORTH CAROLINA  
 DEPARTMENT OF TRANSPORTATION  
 AND HIGHWAY SAFETY  
 REVISIONS

SUPERSTRUCTURE  
 STRUCTURAL STEEL DETAILS  
 JULY

REVISIONS					
NO.	BY	DATE	NO.	BY	DATE

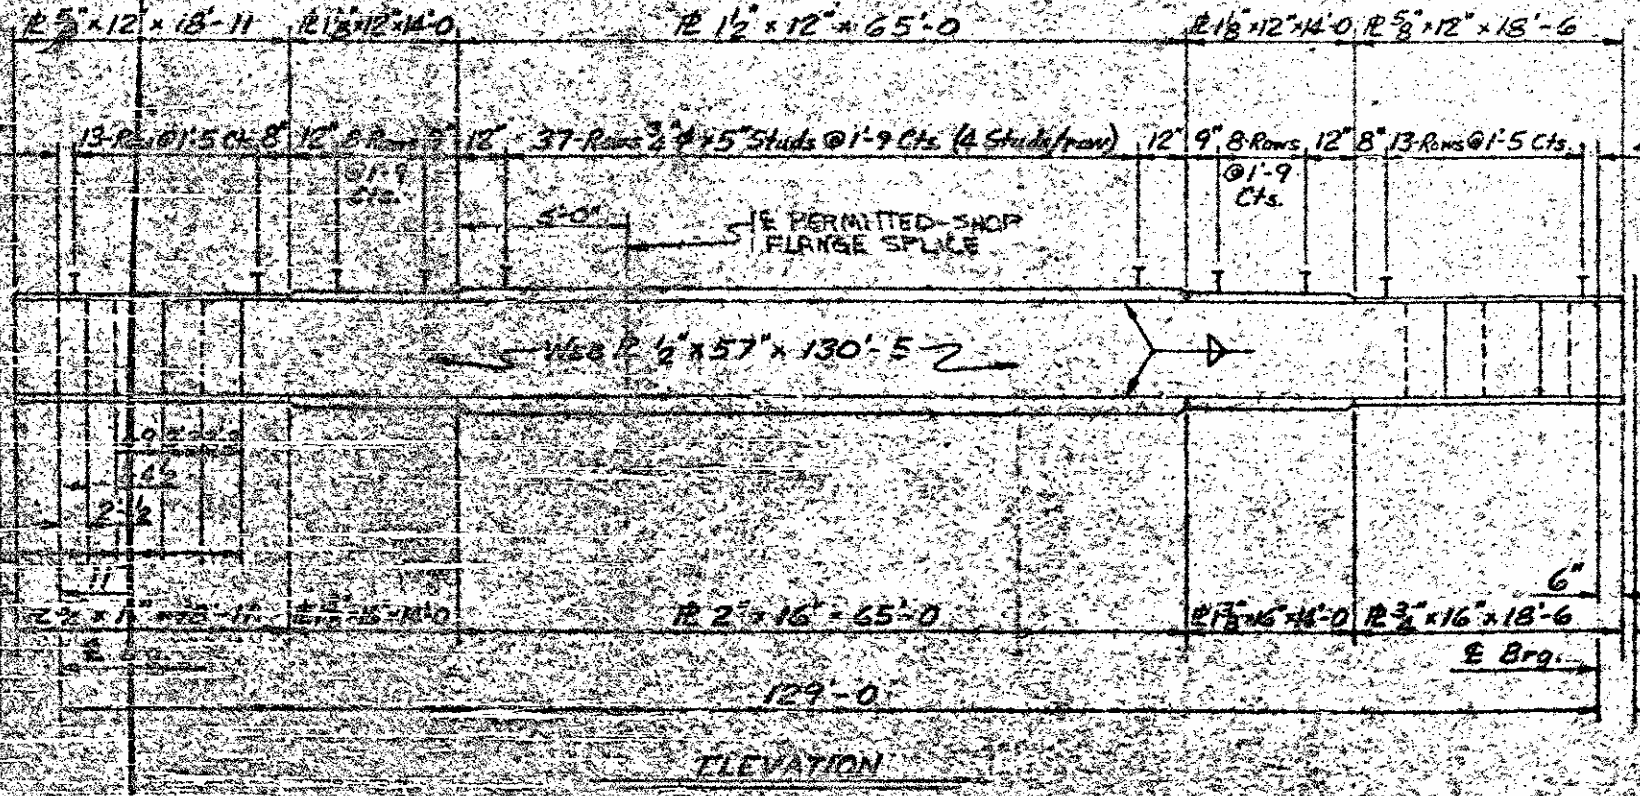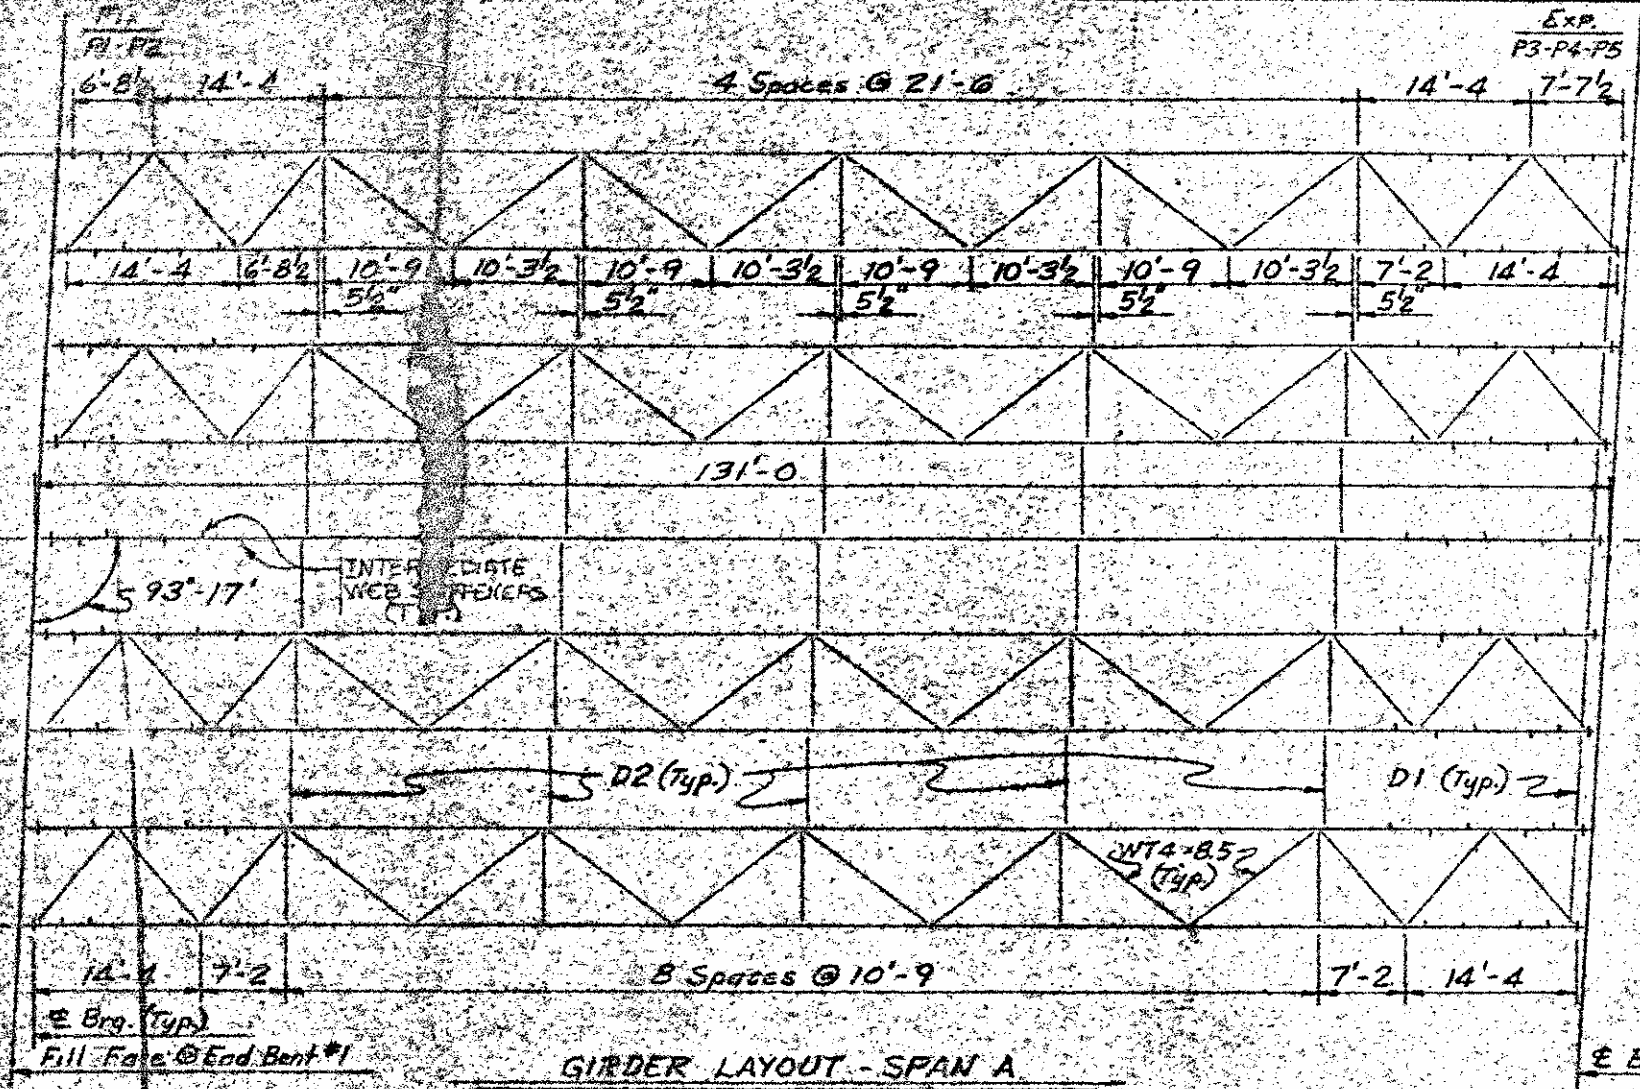

1/2" x 1/2" Intermediate Stiffeners on alternate sides of interior girders & on inside web of exterior members placed as shown. Typ. both ends & detail of Intermediate Stiff.

FED. ROAD DIST. NO.	STATE	PROJECT NO.
6-86	N.C.	813746
K.A. PROJECT		T-05-2(42)46
SHEET NO.		TOTAL SHEETS
21		46

NOTES

FOR LOCATIONS OF HOLES IN BEAMS TO ACCOMMODATE "F" BARS SEE SUPERSTRUCTURE SECTIONS AND DETAILS.

SPACED GIRDER LENGTHS SHALL BE ADJUSTED AND BEARINGS ARE TO BE PLACED ON THE CANTERED GIRDER SO AS TO BE ALIGNED WITH THE ANCHORS AFTER THE DEAD LOAD DEFLECTION HAS OCCURRED. SHOP PLANS SHALL BE PREPARED ACCORDINGLY.

CLIP THE CORNERS OF BEARING STIFFENERS 1" AT THE JUNCTIONS OF THE WEB AND FLANGES.

AT ALL FIXED POINTS OF SUPPORT, NUTS FOR ANCHOR BOLTS ARE TO BE TIGHTENED FINGER-TIGHT AND THEN BACKED OFF 1/4 TURN. THE TREAD OF THE NUT AND BOLT SHALL THEN BE BURIED WITH A SHARP POINTED TOOL.

ALL BEARING ASSEMBLIES SHALL BE GALVANIZED EXCEPT SELF-LUBRICATING PLATES.

ALL BEARING SURFACES THAT ARE NOT GALVANIZED SHALL BE FINISHED SHALTY BE SMOOTH AND STRAIGHT.

ALL FIELD CONNECTIONS TO BE 7/8" Ø HIGH STRENGTH BOLTS.

ALL SHOP SPICES IN FLANGE AND WEB PLATES SHALL BE MADE PRIOR TO BEARING PLATE PLACEMENT. ALL SPICES OTHER THAN THOSE SHOWN ON THE PLANS WILL BE PERMITTED IN THE FLANGE PLATES, HOWEVER, TWO ADDITIONAL SHOP WEB SPICES WILL BE ALLOWED AT APPROPRIATE ONE-THIRD POINTS.

SHIPPED DETAILS

SHIPPING DETAILS FOR GIRDER SHALL BE SUBMITTED FOR APPROVAL, INDICATING THE TOP FLANGE LOCATION, CENTERLINE, AND ALL CASES SHOWING THE VERTICAL POSITION OF BEARING PLATES ON THE VEHICLE AND ATTACHMENTS TO THE GIRDER. ANY SHIPPING REEHLINGS SHALL BE CLEARLY INDICATED.

ALL STRUCTURAL STEEL TO BE UNPAINTED ASTM A 36 (INCLUDING BEARING PLATES) WITH A MINIMUM YIELD STRENGTH OF 50,000 PSI EXCEPT ANCHOR BOLTS, NUTS & WASHERS, WHICH SHALL BE IN ACCORDANCE WITH SPECIFICATIONS. ALL BEARING PLATES EXCEPT SELF-LUBRICATING PLATES SHALL BE GALVANIZED IN ACCORDANCE WITH SPECIFICATIONS.

A CHARPY V-NOTCH TEST IS REQUIRED ON ALL GIRDER WEB AND BOTTOM FLANGE PLATES. SEE SPECIAL PROVISIONS.



THE ATMOSPHERIC CORROSION RESISTANCE AND COLORING CHARACTERISTICS OF ASTM A-369 STEEL IS REQUIRED FOR THE TOP OF GIRDER.

HIGH STRENGTH BOLTS, NUTS & WASHERS SHALL MEET THE REQUIREMENTS FOR ASTM A-325 FOR OVER 3/4" DIAM.

IN REGARD TO ELECTRO-SLAG WELDING, SEE SPECIAL PROVISIONS.



PROJECT No. 813746  
 GUMBERLAND COUNTY  
 STATION 94+74.76 P.C. 101  
 Sheet 1 of 5

STATE OF NORTH CAROLINA				
DEPARTMENT OF TRANSPORTATION AND HIGHWAY SAFETY				
RAILROAD				
SUPERSTRUCTURE				
STRUCTURAL STEEL				
JULY				
REVISIONS				
NO.	BY	DATE	NO.	DATE
1			1	
2			2	

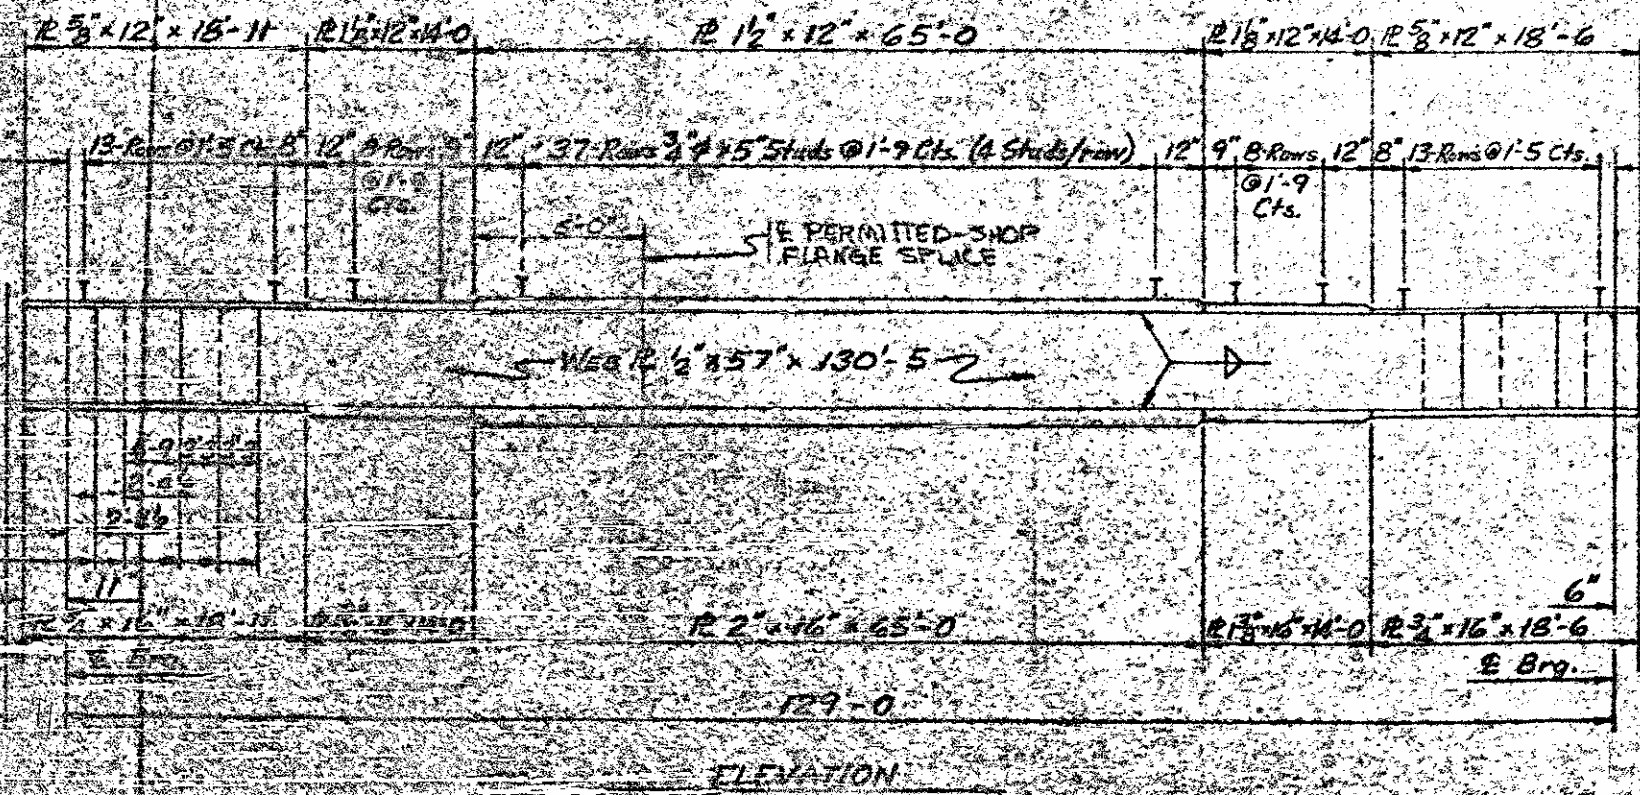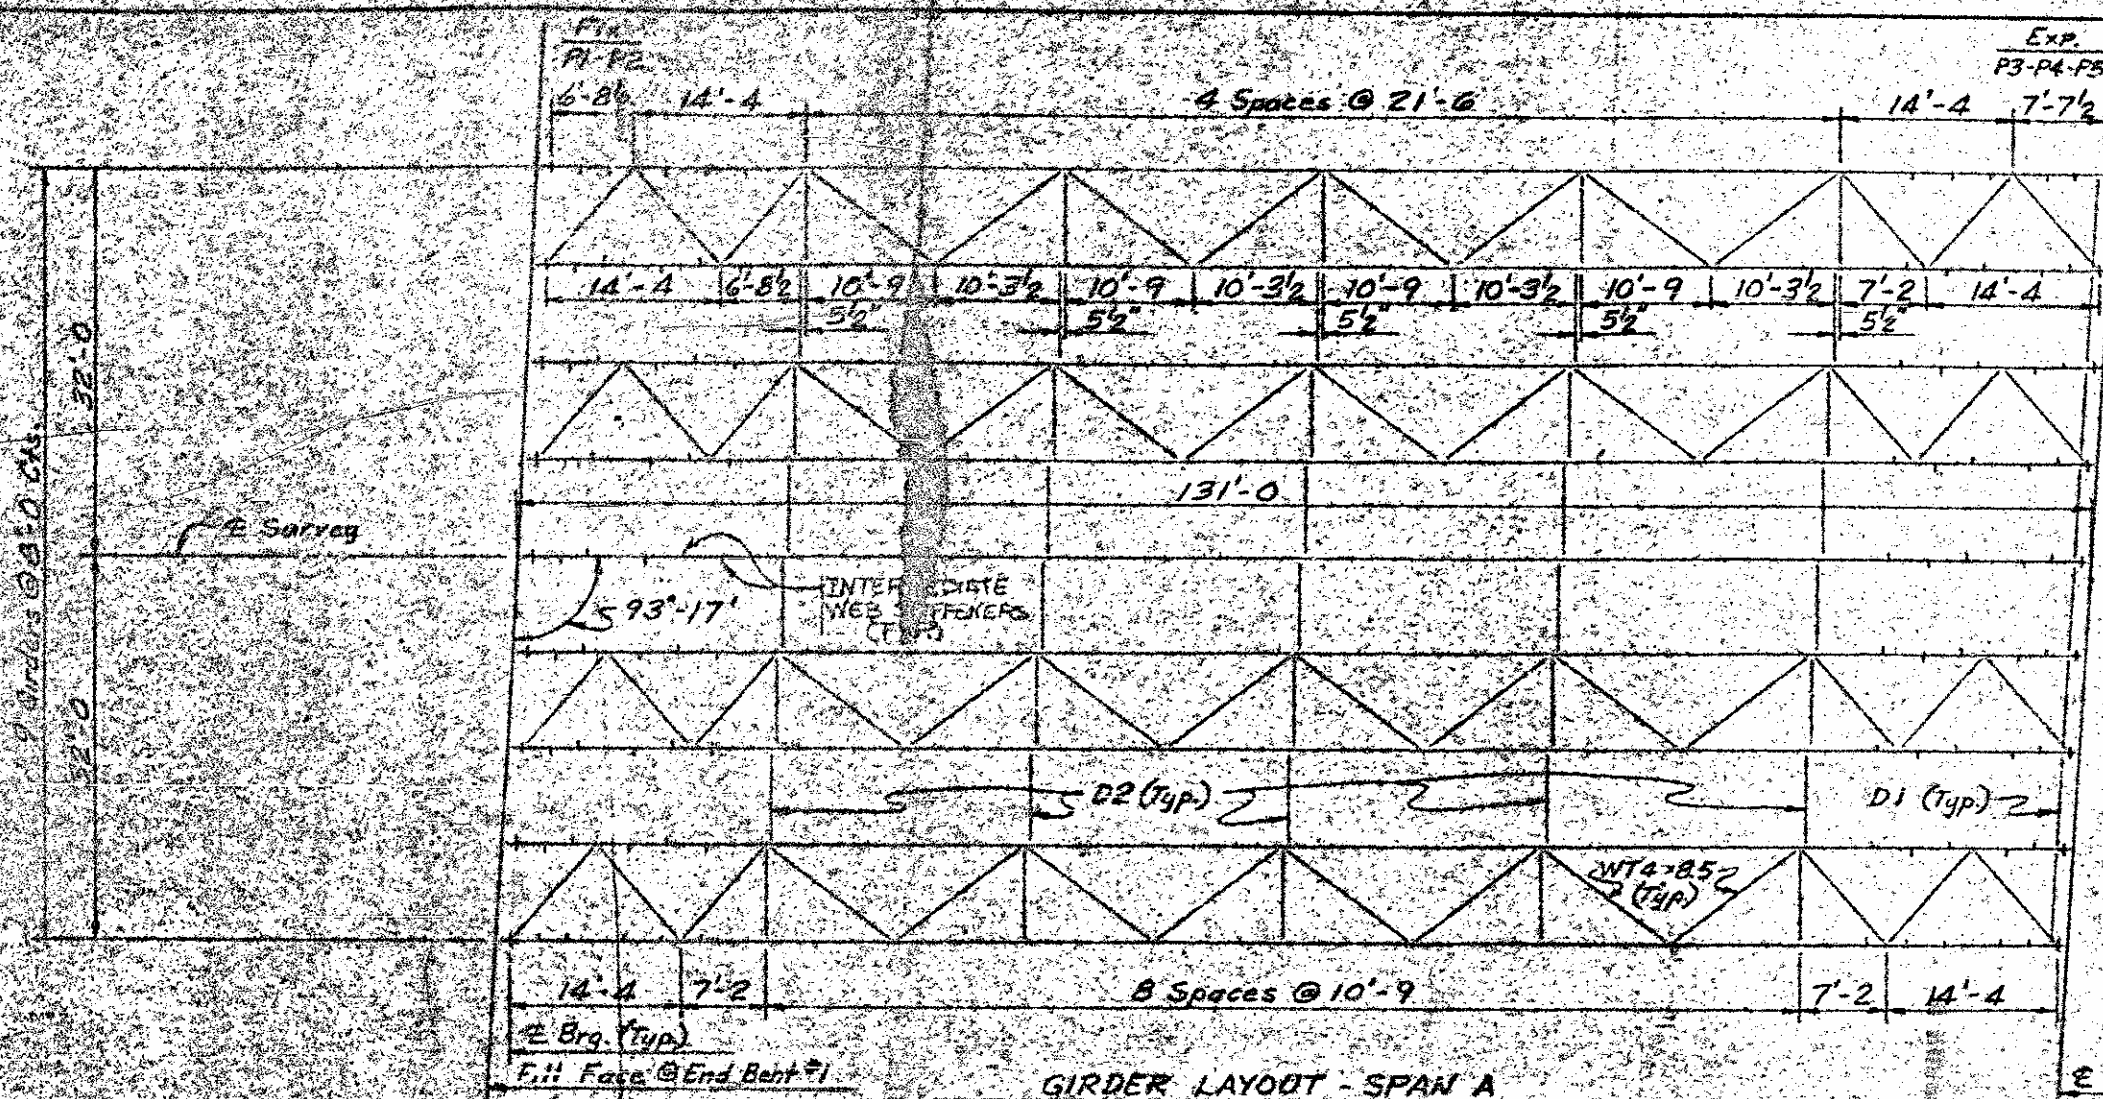

2 1/2" x 4 1/2" Intermediate stiffeners on alternate sides of interior girders & on inside face of web of exterior girders spaced as shown. Top bolts and see Detail of Intermediate stiff.

ELEVATION

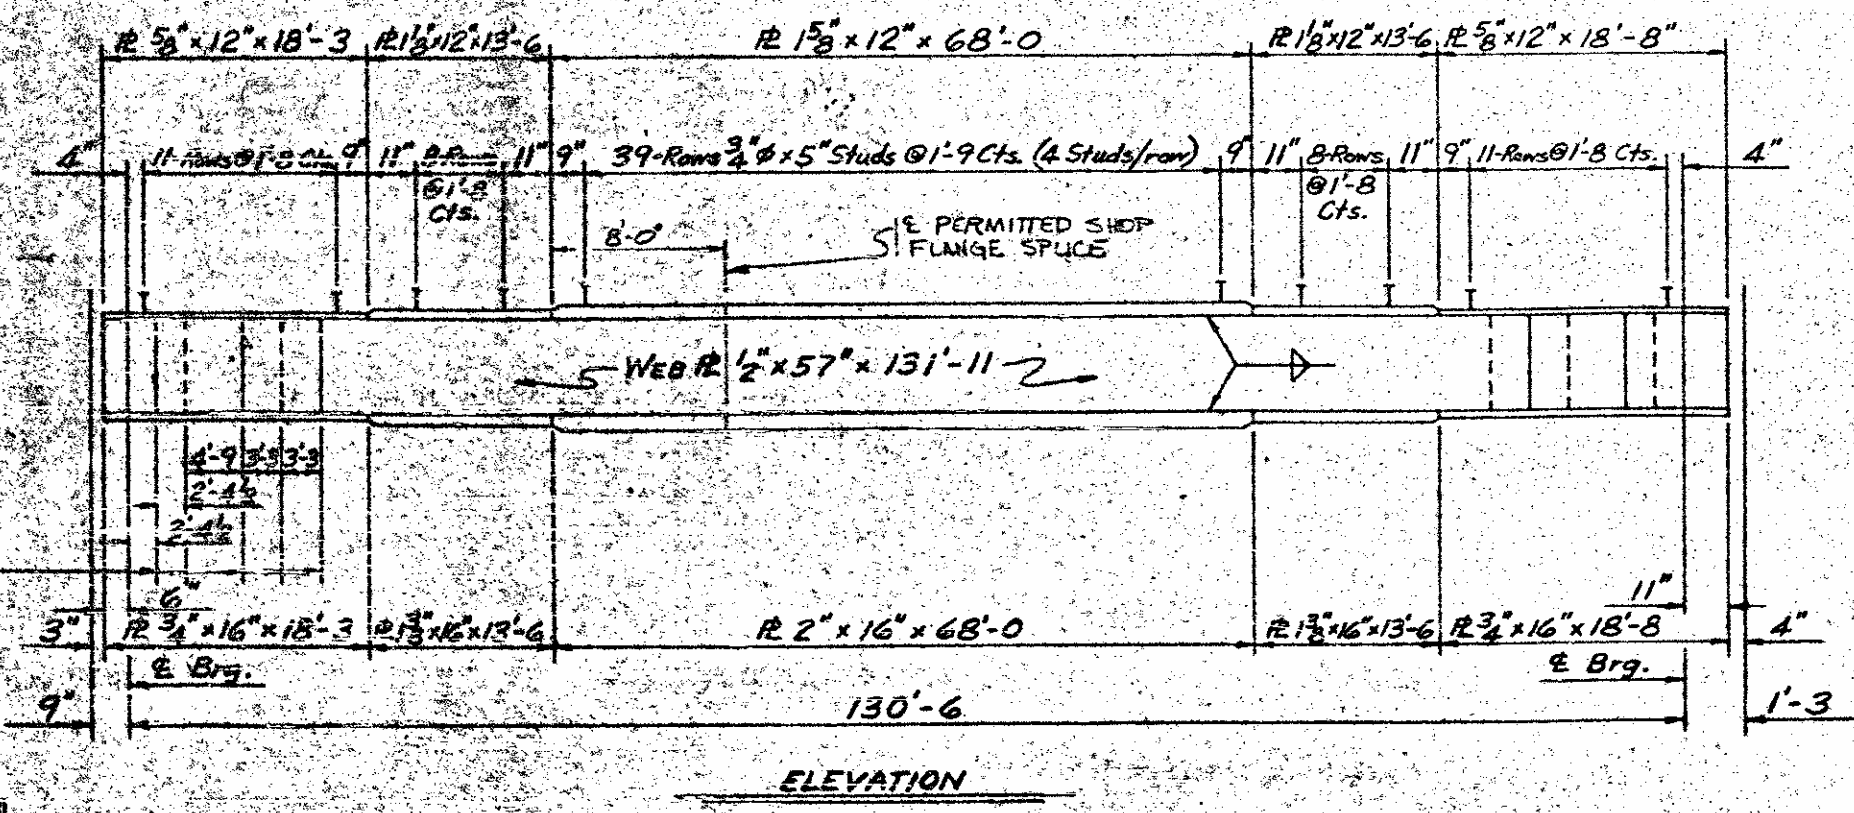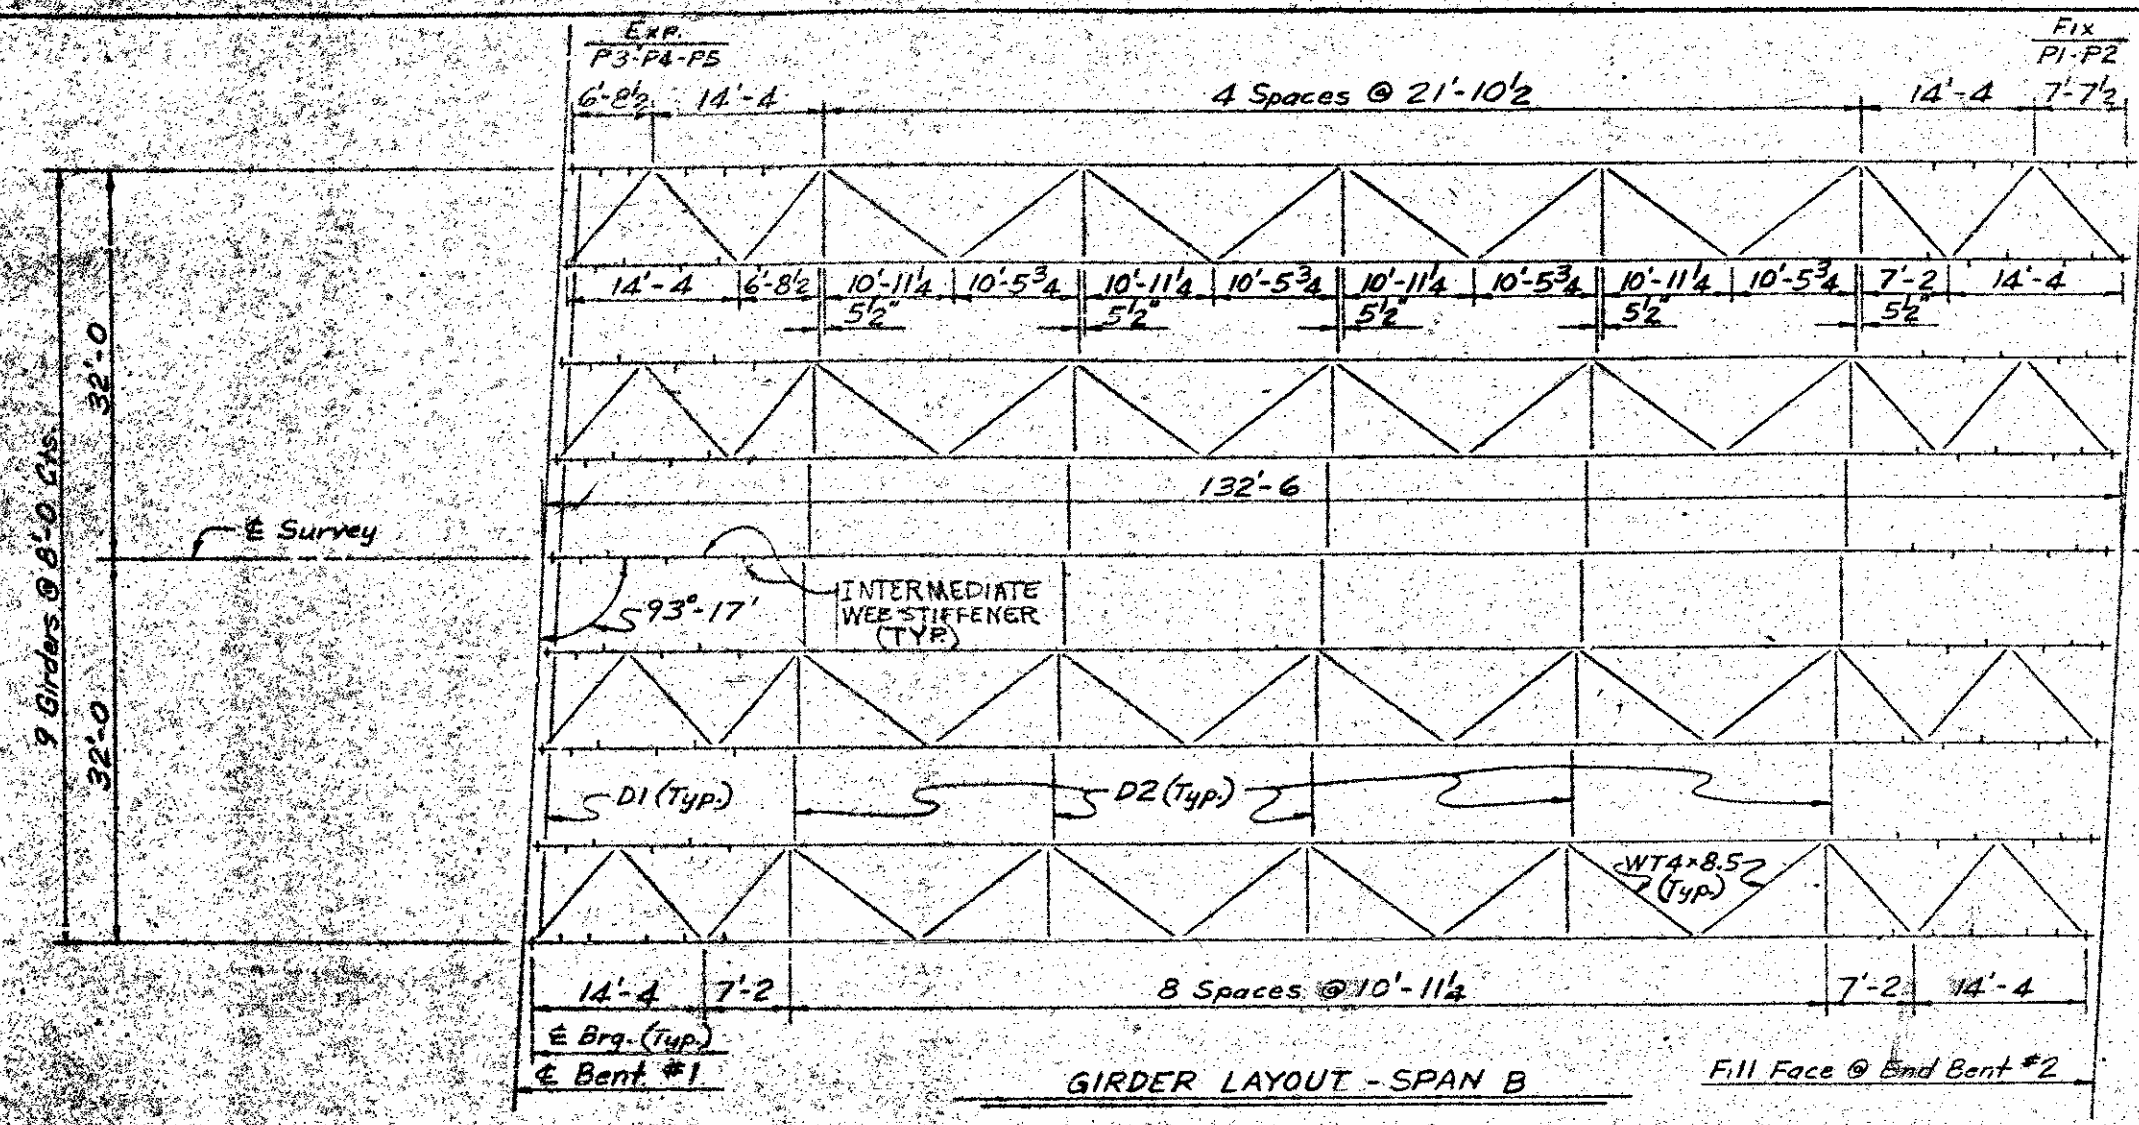



R 5/8 x 4 1/2 Intermediate Stiffeners on alternate sides of interior girders & on inside face of web of exterior girders spaced as shown - Typ. both ends. See Detail of Intermediate Stiff.

PROJECT No. 8.13474.06  
 CUMBERLAND COUNTY  
 STATION 94+74.76 - Rt. Ln.  
 Sheet 2 of 5

STATE OF NORTH CAROLINA  
 DEPARTMENT OF TRANSPORTATION AND HIGHWAY SAFETY  
 RALEIGH  
 SUPERSTRUCTURE  
 STRUCTURAL STEEL DETAILS  
 JULY 1971


REVISIONS						SHEET NO. 5-16
NO.	BY	DATE	NO.	BY	DATE	
1			2			TOTAL SHEETS 54
2			4			

FED. ROAD DIV. NO.	STATE	PROJECT NO.
4	N.C.	8.1347406
F. A. PROJECT	T-95-2 (22) 40	
SHEET NO.	TOTAL SHEETS	
43	43	

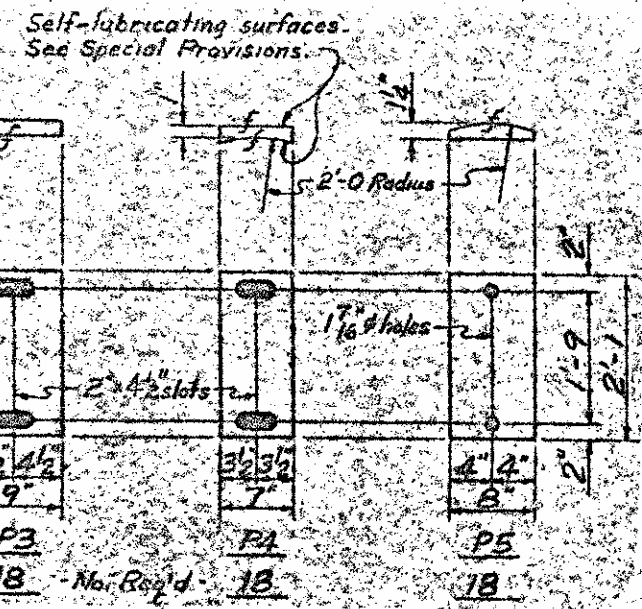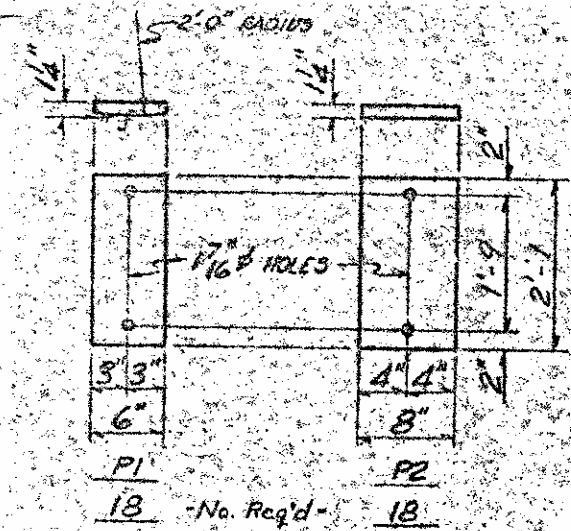


BEARING PLATE DETAILS

SELF-LUBRICATING PLATE SHALL NOT BE GALVANIZED.

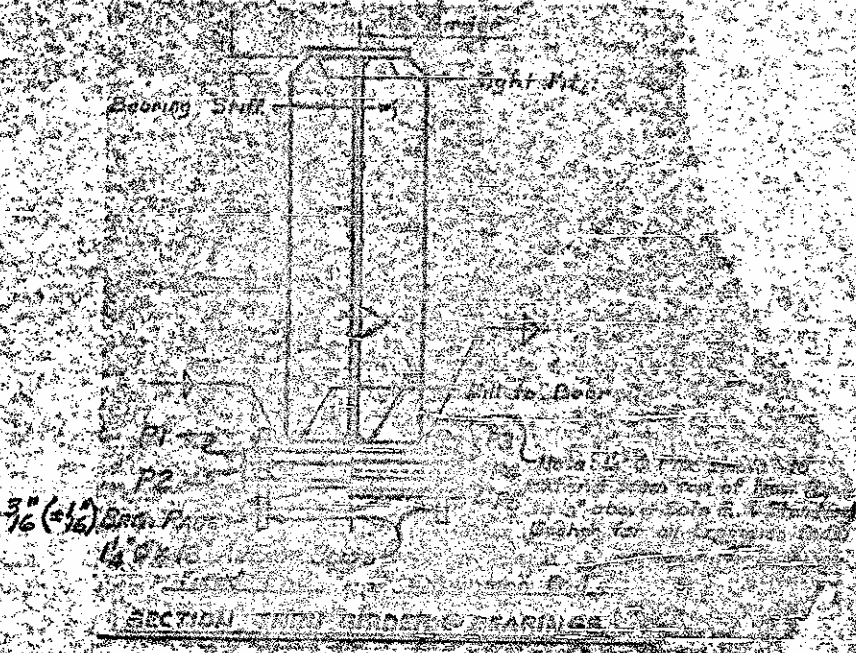


SECTION THRU BEARING STIFFENER

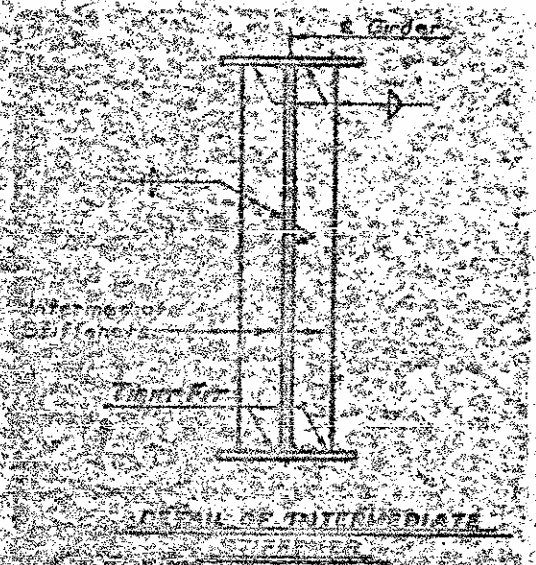


DETAIL OF INTERMEDIATE STIFFENER




FLANGE SPLICE DETAIL

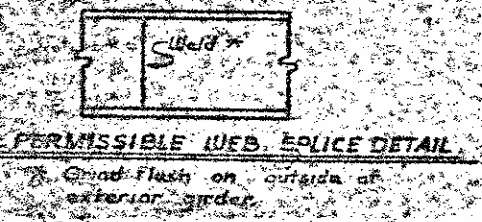


PERMISSIBLE WEB SPLICE DETAIL

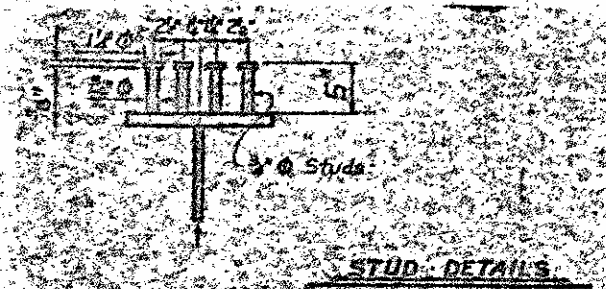

STUD DETAILS

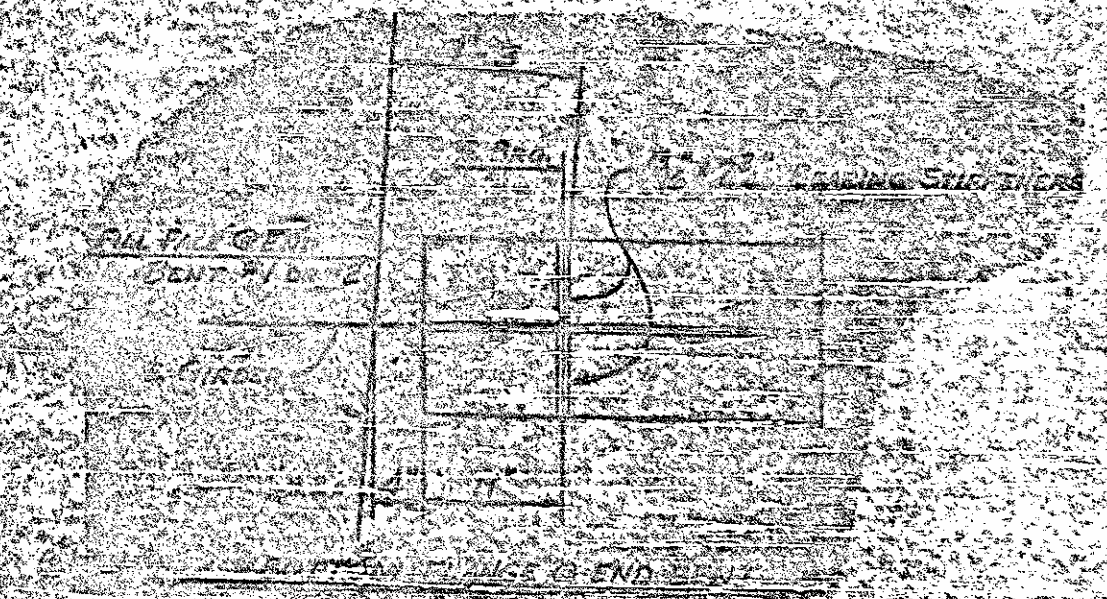

SECTION THRU GIRDER TO END OF BENT

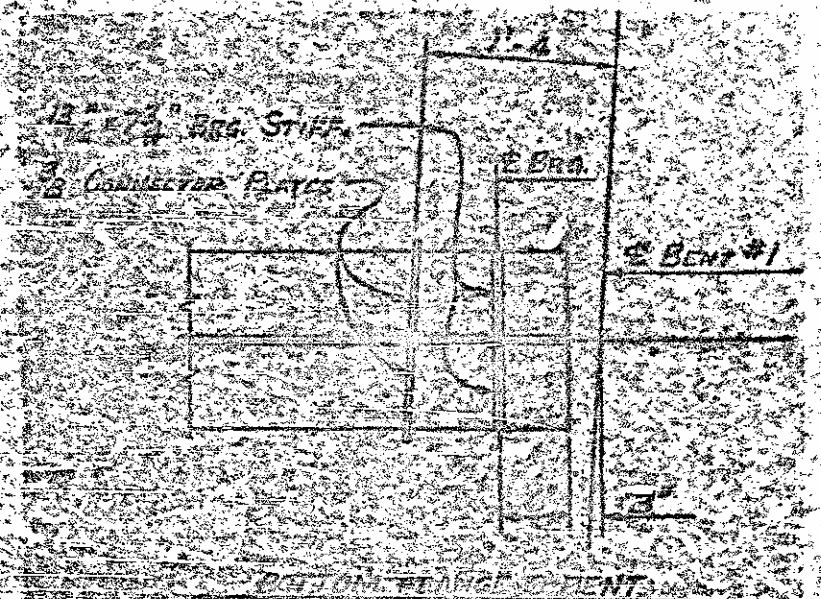


SECTION THRU BENT


PROJECT No. 8.1347406  
 CUMBERLAND COUNTY  
 STATION 94+74.76-RT. LN.  
 Sheet 3 of 5

STATE OF NORTH CAROLINA					
DEPARTMENT OF TRANSPORTATION AND HIGHWAY SAFETY					
RALIGH					
SUPERSTRUCTURE					
STRUCTURAL STEEL DETAILS					
AUGUST 197					
REVISIONS					
NO.	BY	DATE	NO.	BY	DATE
1			2		
3			4		


CONTRACT NO.	STATE	PROJECT NO.
44	N.C.	8.1347406
F.A. PROJECT		I-95-2(41)40
SHEET NO.		TOTAL SHEETS
44		44

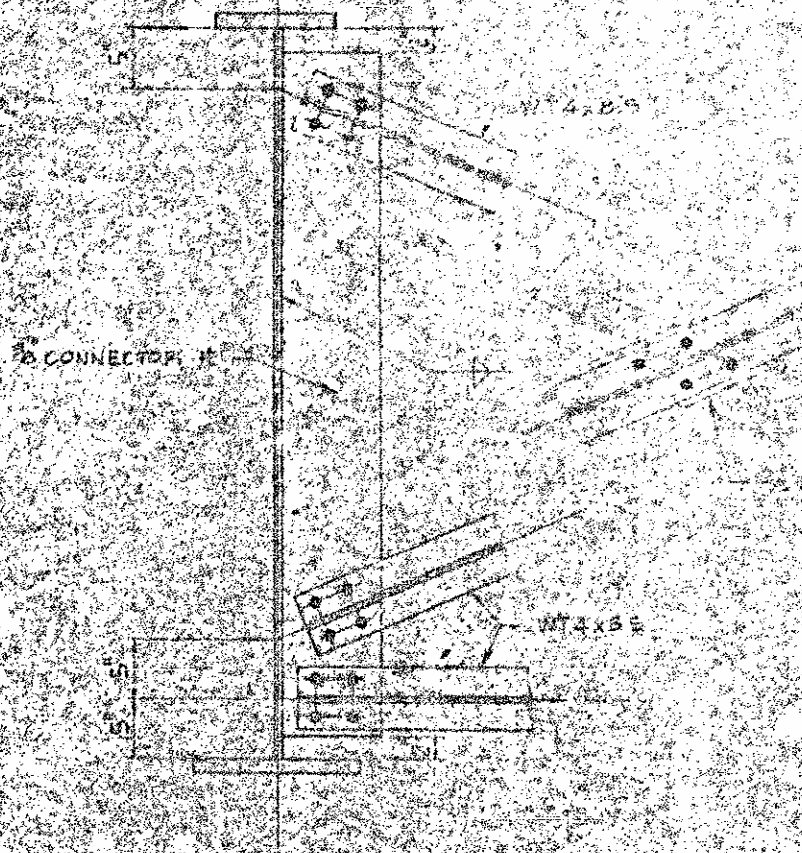


INTERMEDIATE DIAPHRAGM (D2)  
WITHOUT WIND BRACE

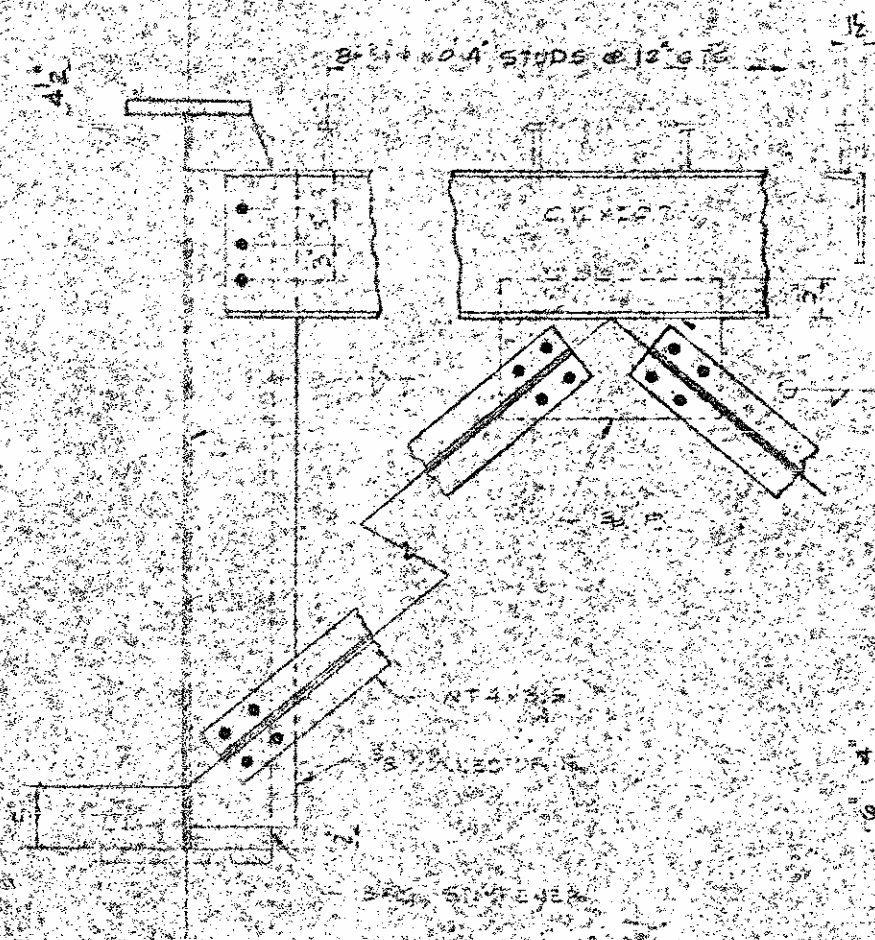


BENT DIAPHRAGM (D1)  
WITHOUT WIND BRACE

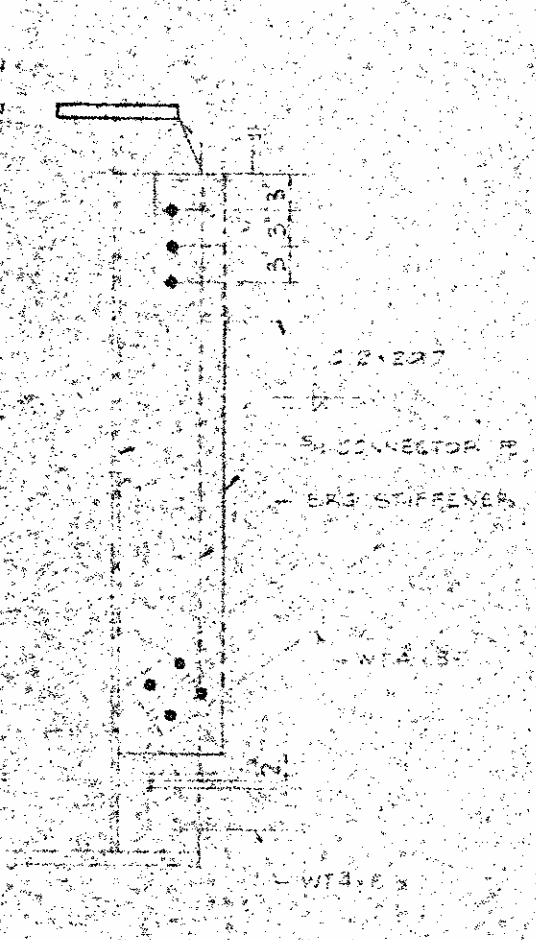


BENT DIAPHRAGM (D1)  
WITH WIND BRACE

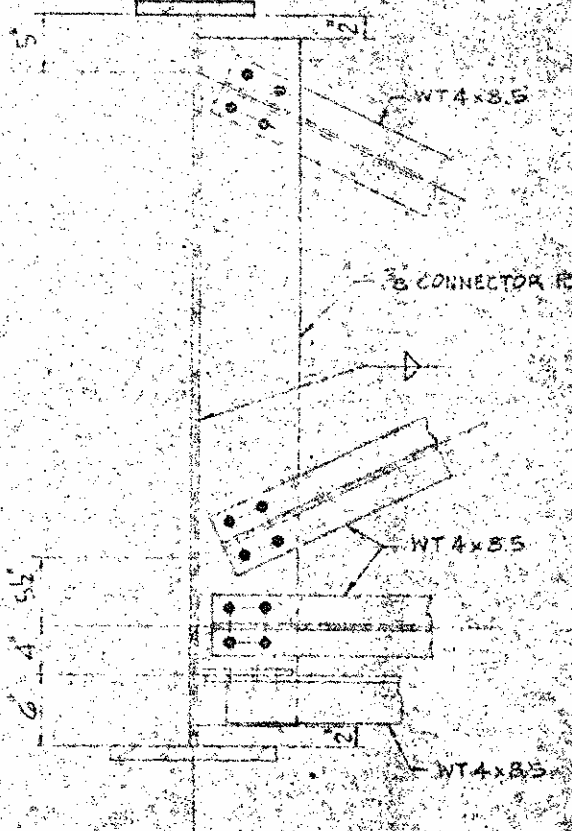


INTERMEDIATE DIAPHRAGM (D2)  
WITH WIND BRACE

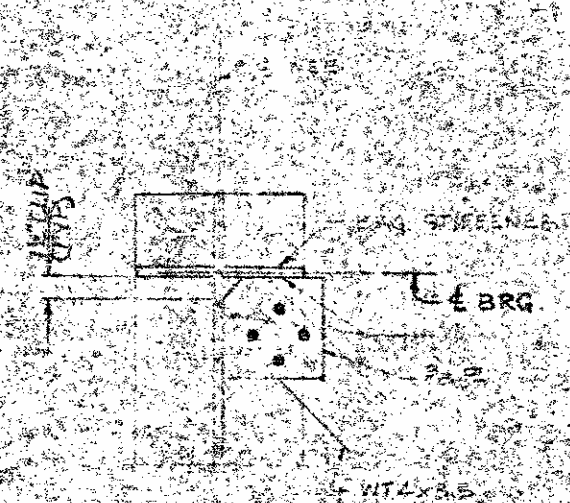

PLAN  
OF BEARING

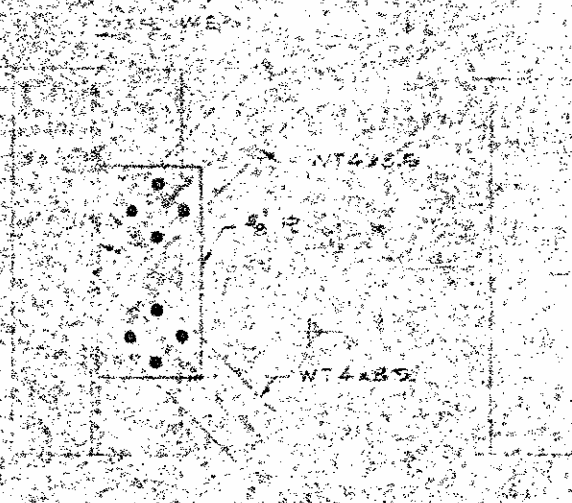

PLAN  
OF INTERMEDIATE CONN.

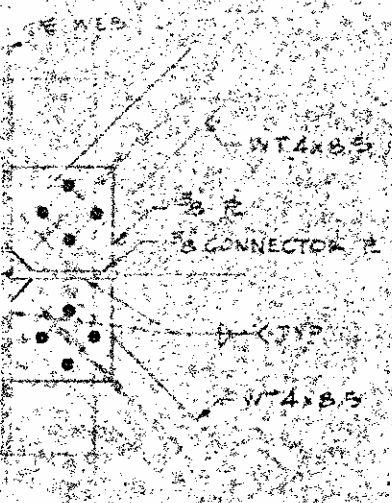

PLAN  
OF DIAPHRAGM (D2)

DETAILS OF WIND-BRACE CONNECTIONS

PROJECT No. 8.1347406  
CUMBERLAND COUNTY  
STATION 94+74.76-R.H.L.  
Sheet 4 of 5

STATE OF NORTH CAROLINA  
DEPARTMENT OF TRANSPORTATION  
AND HIGHWAY SAFETY  
DIVISION  
SUPERSTRUCTURE  
STRUCTURAL STEEL DETAIL

ALLG

NO.	BY	DATE	REVISION

DESIGNED BY: [Name] CHECKED BY: [Name] DATE: [Date]


DEFLECTION DUE TO WEIGHT OF BEAM	SPAN A		SPAN B	
	INT.	EXT.	INT.	EXT.
DEFLECTION DUE TO WEIGHT OF BEAM				
DEFLECTION DUE TO WEIGHT OF CURB				
DEFLECTION DUE TO WEIGHT OF PARAPET WALL, AND FUTURE WEAR SURF				
DEFLECTION DUE TO WEIGHT OF FUTURE ROAD SURF				
DEFLECTION DUE TO WEIGHT OF FUTURE SIDEWALK				
DEFLECTION DUE TO WEIGHT OF FUTURE SIDEWALK				
DEFLECTION DUE TO WEIGHT OF FUTURE SIDEWALK				
DEFLECTION DUE TO WEIGHT OF FUTURE SIDEWALK				

TENTH POINT	SPAN A																		SPAN B																	
	INTERIOR									EXTERIOR									INTERIOR									EXTERIOR								
	1	2	3	4	5	6	7	8	9	1	2	3	4	5	6	7	8	9	1	2	3	4	5	6	7	8	9	1	2	3	4	5	6	7	8	9
DEFLECTION DUE TO WEIGHT OF BEAM	.038	.070	.093	.107	.112	.107	.093	.070	.038	.037	.067	.090	.104	.106	.104	.090	.067	.037	.040	.072	.096	.111	.116	.111	.096	.072	.040	.038	.070	.093	.107	.112	.107	.093	.070	.038
DEFLECTION DUE TO WEIGHT OF CURB	.116	.212	.283	.328	.343	.328	.283	.212	.116	.108	.197	.263	.304	.319	.304	.263	.197	.108	.119	.217	.288	.333	.348	.333	.288	.217	.119	.110	.201	.267	.309	.324	.309	.267	.201	.110
DEFLECTION DUE TO WEIGHT OF BARRIER WALL AND FUTURE WEAR SURF	.021	.039	.053	.061	.064	.061	.053	.039	.021	.022	.040	.054	.063	.066	.063	.054	.040	.022	.022	.041	.055	.064	.067	.064	.055	.041	.022	.023	.042	.056	.065	.068	.065	.056	.042	.023
TOTAL DEAD LOAD DEFLECTION	.175	.321	.429	.496	.519	.496	.429	.321	.175	.167	.304	.407	.471	.493	.471	.407	.304	.167	.181	.330	.439	.508	.531	.508	.439	.330	.181	.171	.313	.416	.481	.504	.481	.416	.313	.171
VERTICAL CURVE CORRECTION (CREST)	.031	.054	.073	.084	.087	.084	.073	.054	.031	.031	.056	.073	.084	.087	.084	.073	.056	.031	.032	.057	.075	.086	.089	.086	.075	.057	.032	.032	.057	.075	.086	.089	.086	.075	.057	.032
DEFLECTION DUE TO SUPPORT SETTLEMENT																																				
ADJUSTED BEAM CURVES	.206	.377	.502	.580	.606	.580	.502	.377	.206	.198	.360	.480	.555	.580	.555	.480	.360	.198	.213	.387	.514	.594	.620	.594	.514	.387	.213	.203	.370	.491	.567	.593	.567	.491	.370	.203


NOTE: DEFLECTIONS ARE GIVEN IN DECIMALS OF A FOOT.

PROJECT 1227  
 CUMBERLAND  
 STATION 24+75.00  
 Sheet 5 of 5  
 SUPERSTRUC  
 STRUCTURAL  
 AUGUST


FED. ROAD DIV. NO.	STATE	PROJECT NO.
4	N.C.	81347406
P.A. PROJECT	7-95-2 (42)40	
SHEET NO.	TOTAL SHEETS	
47	57	

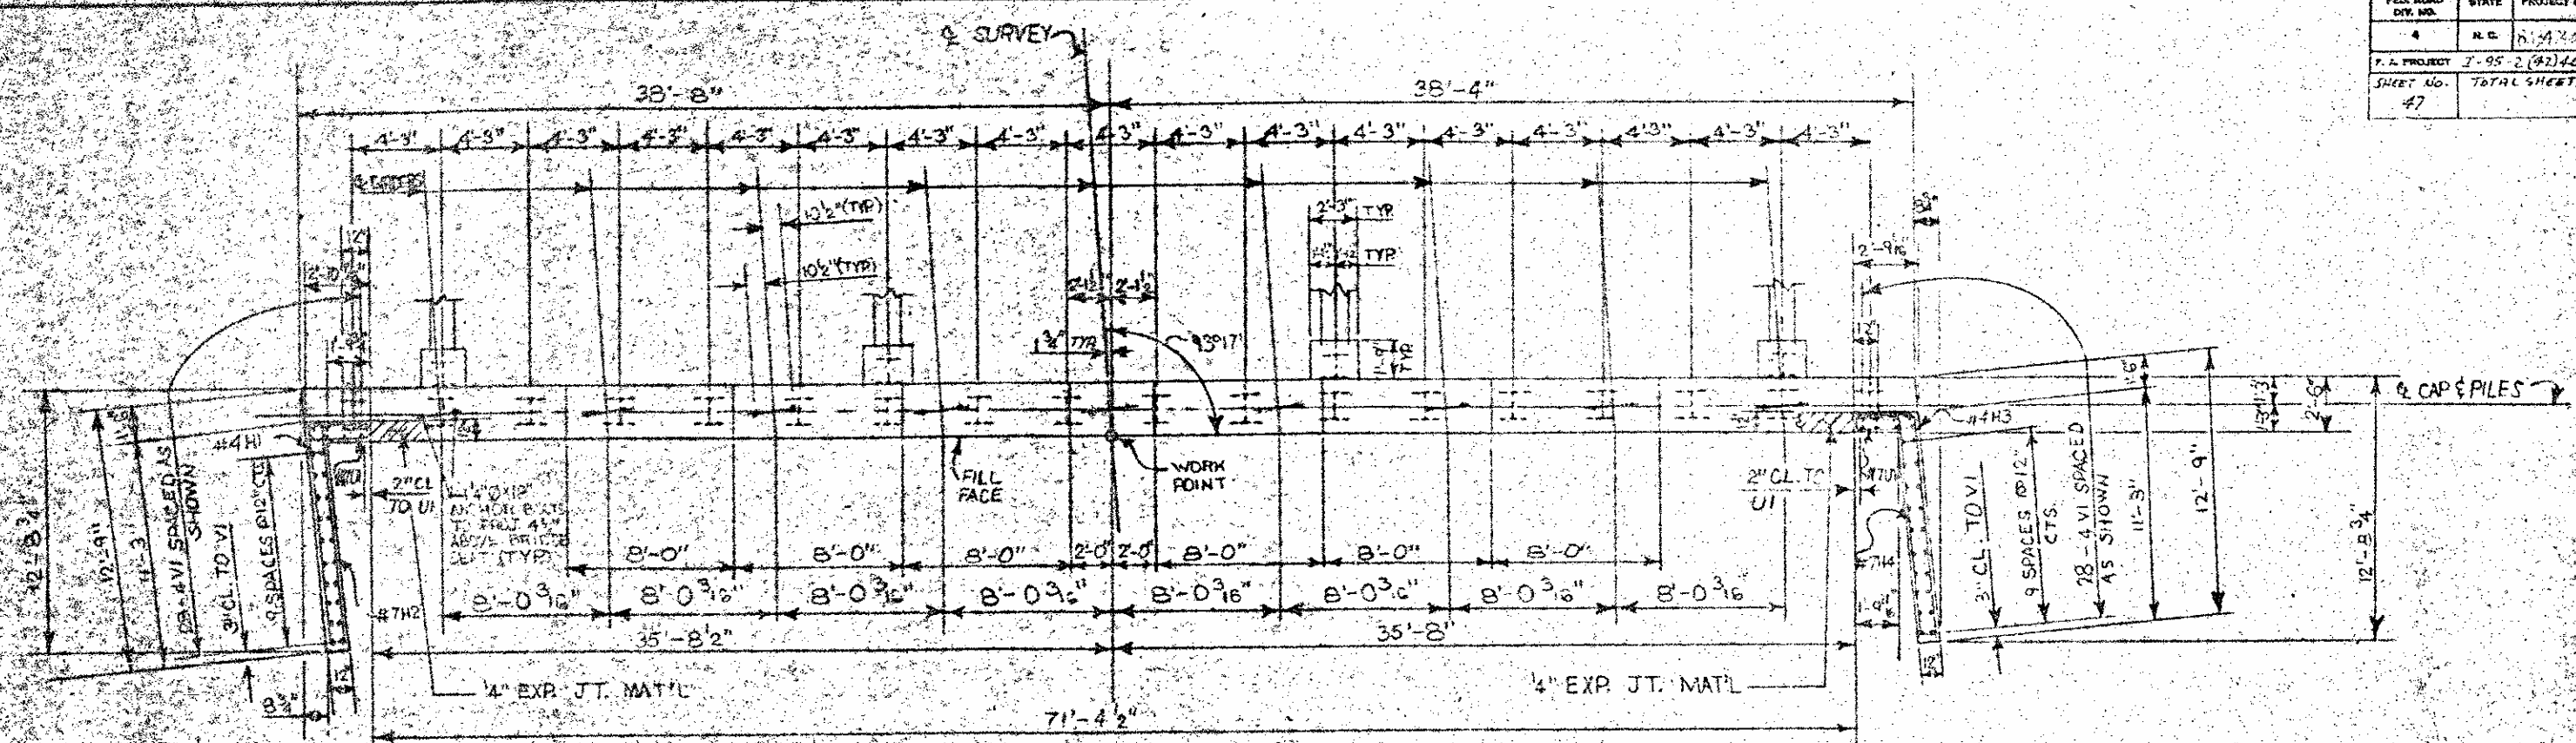

PLAN OF END BENT #1  
(END BENT #2 SIMILAR BY ROTATION)

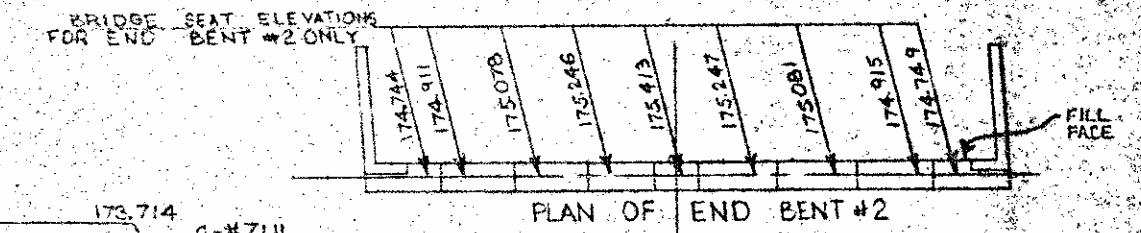

BRIDGE SEAT ELEVATIONS  
END BENT #1 ONLY

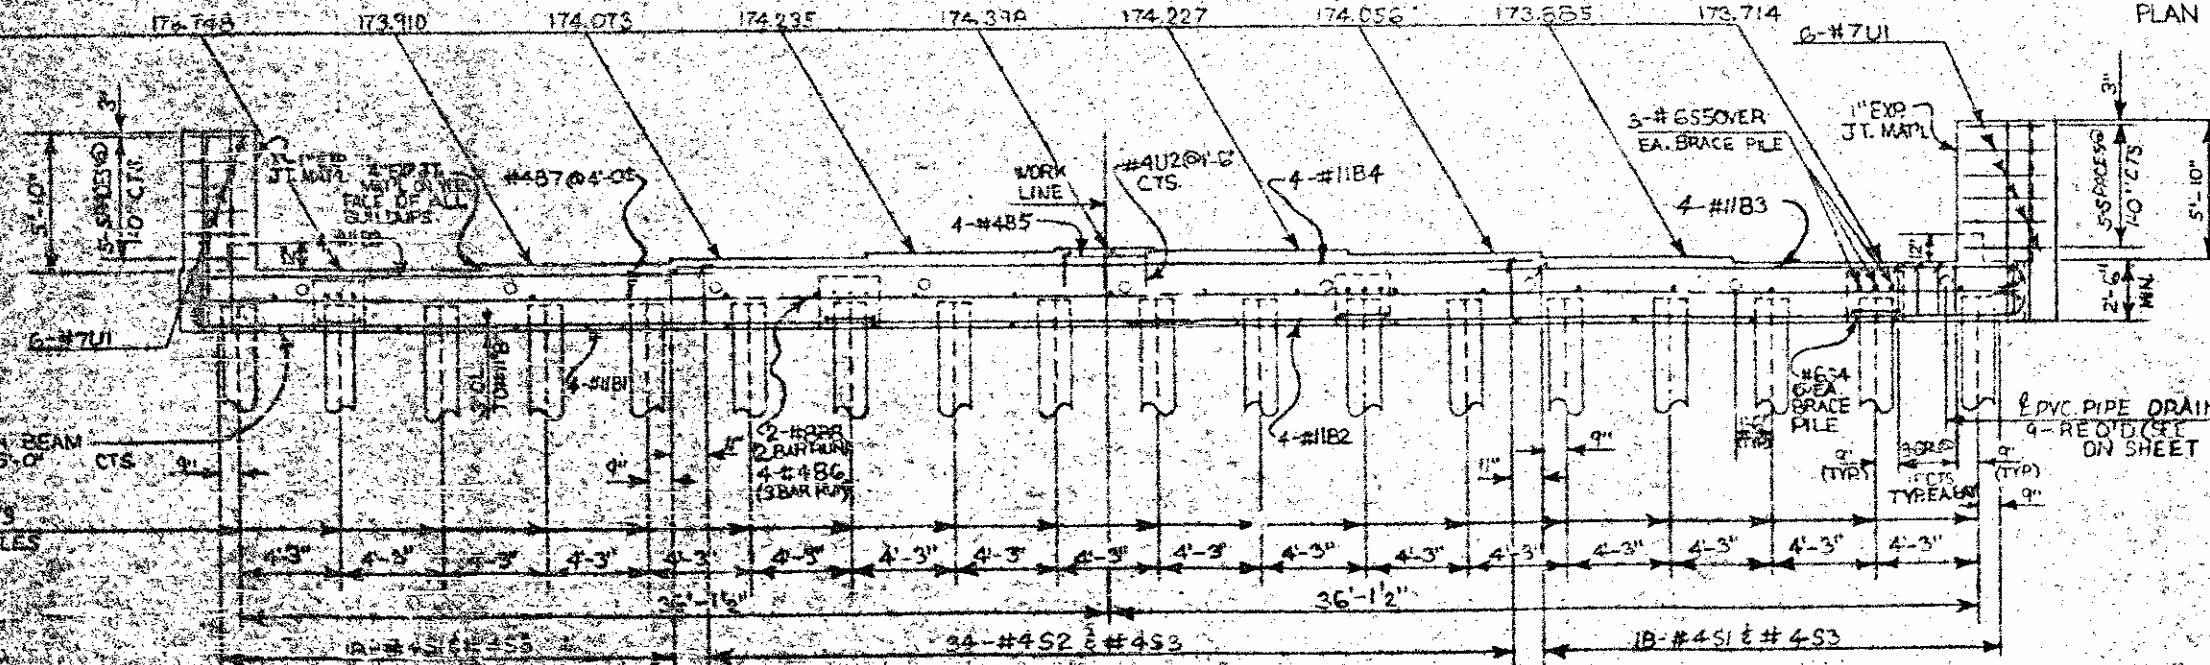

ELEVATION OF END BENT #1

PROJECT No. 81347406  
CUMBERLAND COUNTY  
STATION: 94+74.76-RALN-  
SHEET 1 OF 2

STATE OF NORTH CAROLINA  
DEPARTMENT OF TRANSPORTATION  
AND HIGHWAY SAFETY  
RALEIGH  
SUBSTRUCTURE  
END BENT #1 & 2

REVISIONS						SHEET NO.
NO.	BY	DATE	NO.	BY	DATE	
1			3			57
2			4			57

FED. ROAD DIST. NO.	STATE	PROJECT NO.
4	N.C.	1347406
K.A. PROJECT		F-95-2 (2) 40
SHEET NO.		TOTAL SHEETS
48		

BILL OF MATERIAL					
FOR 1 END BENT - 2 REQ'D					
BAR NO.	NO.	SIZE	TYPE	LENGTH	WEIGHT
31	4	11	6	44'-11"	937
32	4	11	6	33'-7"	641
33	8	11	6	25'-9"	1094
34	4	11	STR	35'-3"	758
35	4	4	STR	8'	10
36	12	4	STR	20'-5"	212
37	20	4	STR	2'-2"	29
38	4	3	STR	39'-7"	423
41	9	4	2	11'-4"	68
42	9	7	2	11'-4"	208
43	9	4	4	11'-5"	69
44	9	7	4	11'-5"	210
51	36	4	5	7'-2"	172
52	34	4	5	7'-10"	178
53	10	4	9	2'-11"	136
54	4	6	8	11'-1"	67
55	12	6	7	5'-3"	95
U1	12	7	1	5'-7"	137
U2	3	4	3	5'-2"	10
YL	56	4	STR	2'-0"	299

PROJECT No. 8.1347406  
 CUMBERLAND COUNTY  
 STATION: 74174.76-RF-111  
 SHEET 2 OF 2

STATE OF NORTH CAROLINA					
DEPARTMENT OF TRANSPORTATION AND HIGHWAY SAFETY					
RALEIGH					
SUBSTRUCTURE SECTIONS					
END BENT #1 & 2					
REVISIONS					
NO.	BY	DATE	NO.	BY	DATE
1			2		
3			4		
SHEET NO. 3-76					TOTAL SHEETS 54


CONCRETE SHALL BE PLACED IN 12" MAXIMUM SIZE OF COARSE AGGREGATE. ANCHOR BARS TO BE PLACED AS SHOWN.




PIPE DRAIN DETAILS

NOTE: PIPE DRAIN MAY BE OBTAINED FROM POSITIONS SHOWN TO CLEAR REINFORCING STEEL AND ANCHOR BARS.  
 NOTE: NO SEPARATE PAYMENT WILL BE MADE FOR FURNISHING AND INSTALLING THE PVC PLASTIC PIPE DRAIN, HANDMADE CLOSURE AND FASTENERS. THE ENTIRE COST OF THIS WORK SHALL BE INCLUDED IN THE UNIT CONTRACT PRICES SET FOR THE GENERAL-PAY ITEMS.


1" PVC PLASTIC PIPE SHALL BE USED. THIS PIPE SHALL MEET THE MINIMUM REQUIREMENTS OF ASTM D 1785.

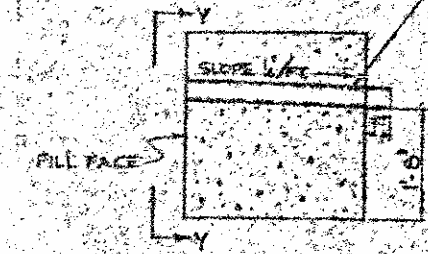


SECTION THRU CAP

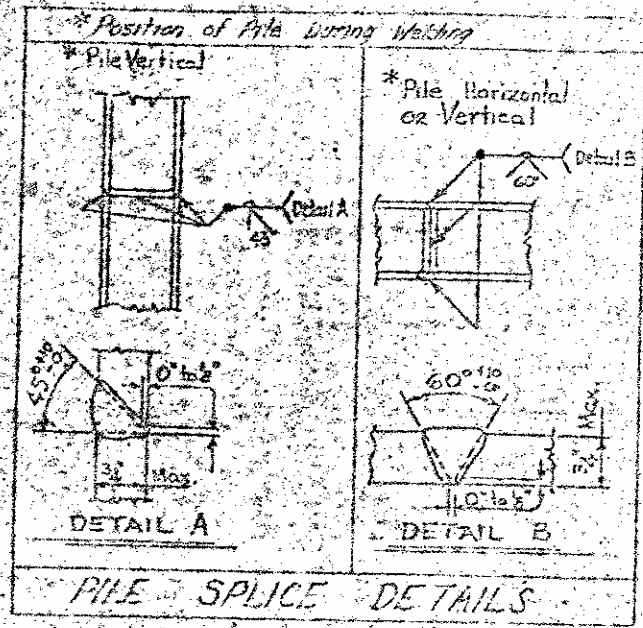


PILE SPLICE DETAILS

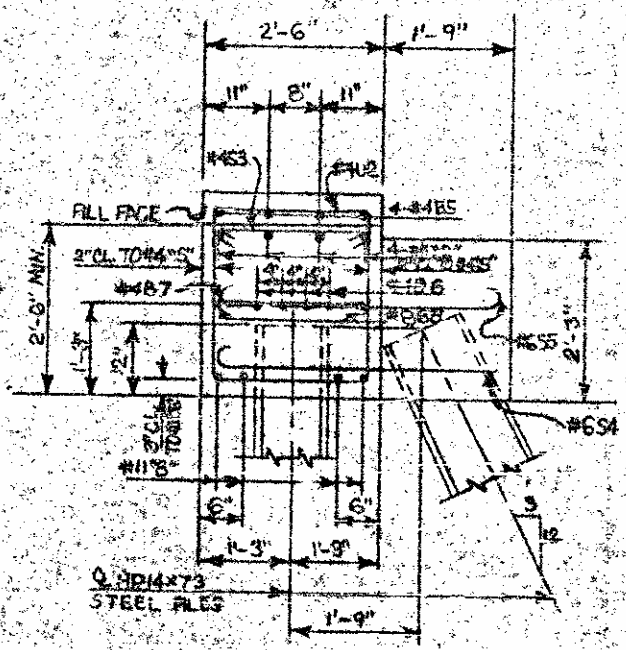


SECTION THRU CAP

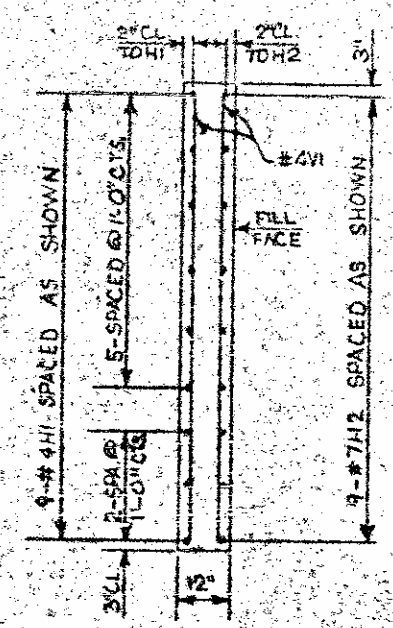

SECTION THRU LEFT WING

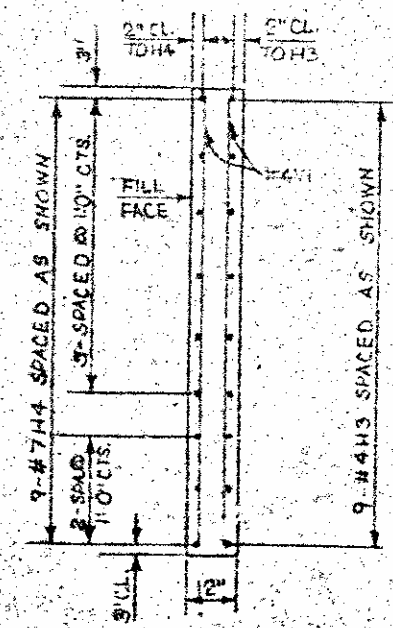

SECTION THRU RIGHT WING


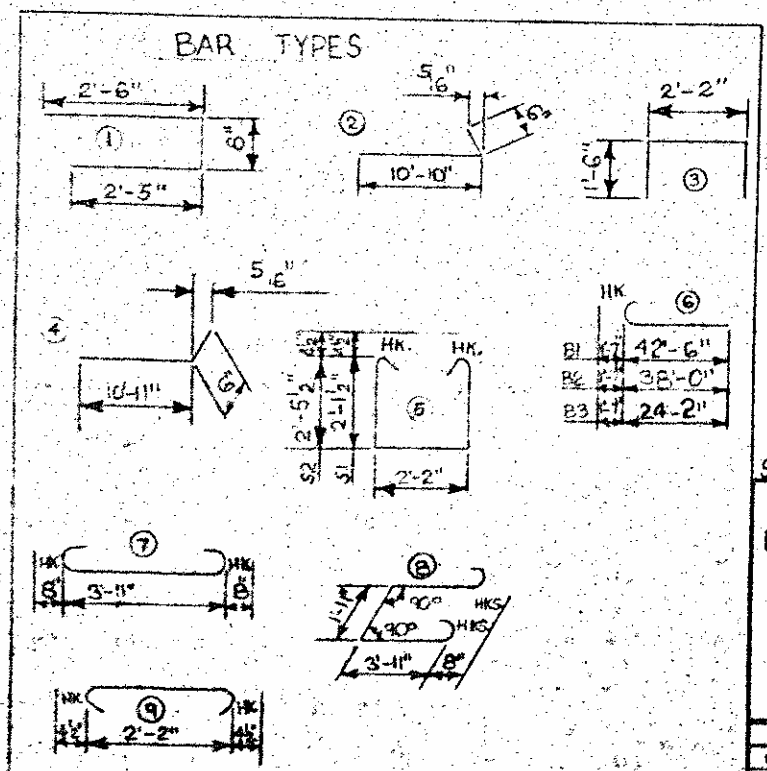


NOTE: ALL BAR DIMENSIONS ARE OUT-TO-OUT

DRAWN BY: LINDY J. EMBERTON DATE: JULY 14, 1995  
 CHECKED BY: J. A. GILES DATE: JULY 14, 1995






FULL ROAD DIV. NO.	STATE	PROJECT NO.
4	N.C.	1347400
F.A. PROJECT	2-95-2(42)40	
SHEET NO.	TOTAL SHEETS	
49	76	

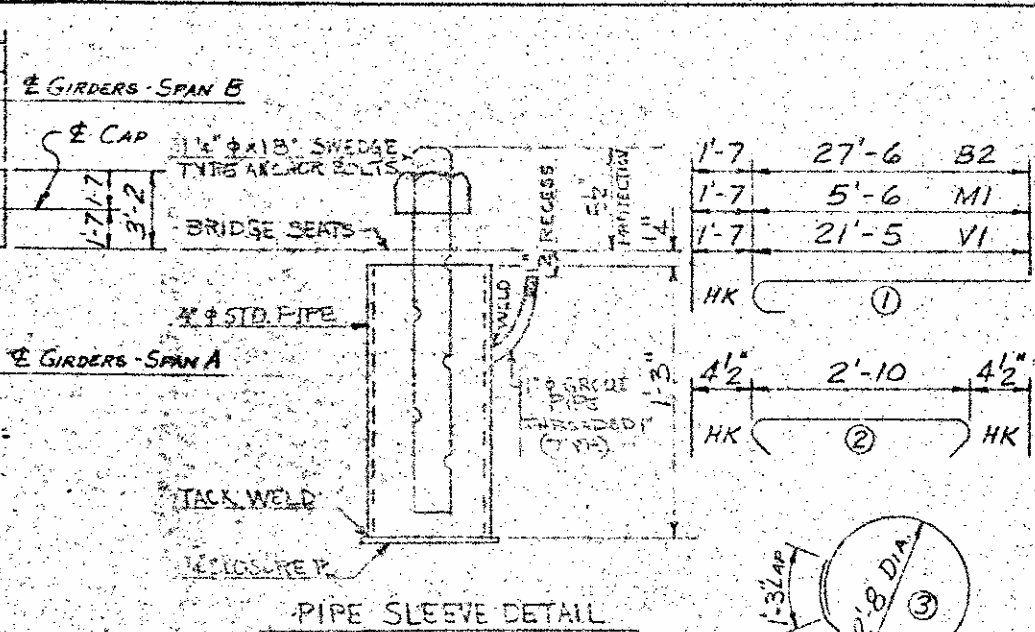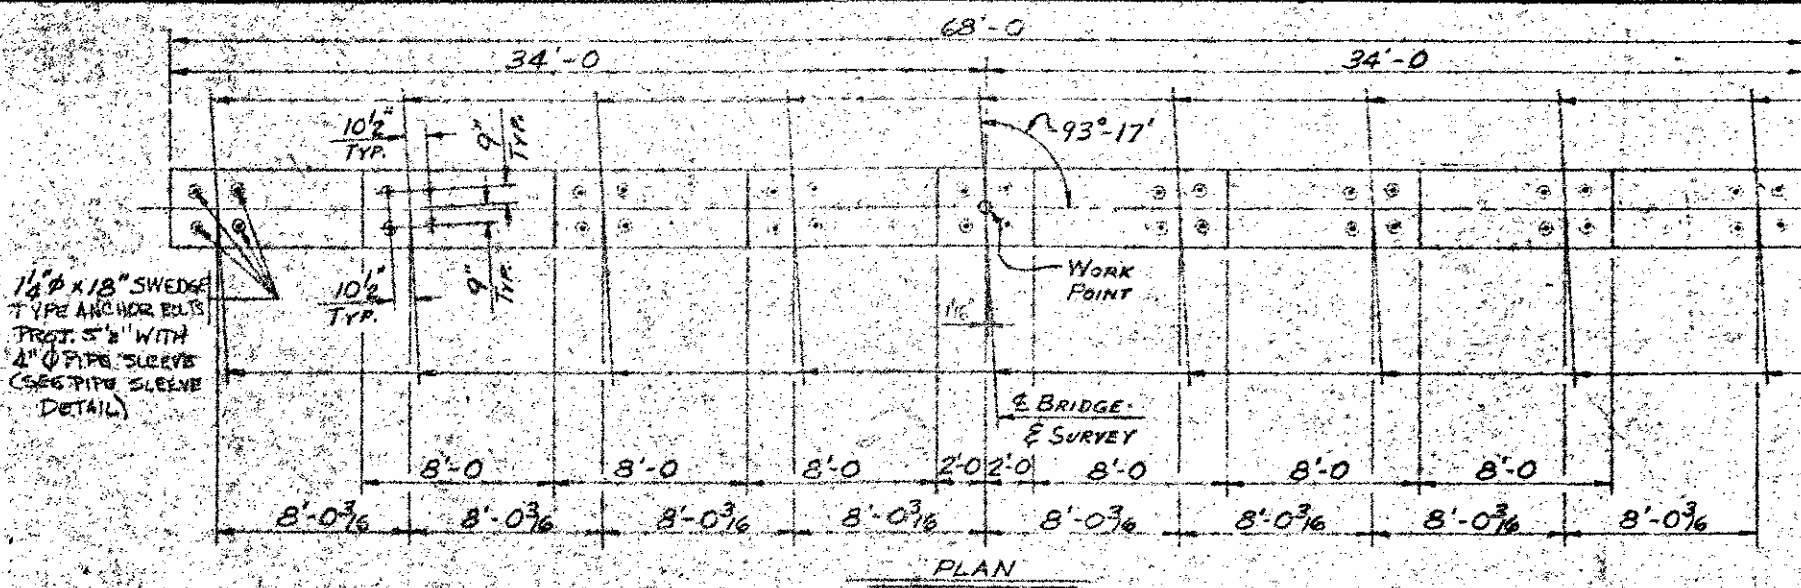

**BILL OF MATERIAL FOR BENT NO. 1**

BAR NO.	NO.	SIZE	TYPE	LENGTH	WEIGHT
B1	16	#11	STR	35'-7"	3025
B2	16	#11	STR	29'-1"	2472
B3	8	#11	STR	19'-8"	836
B4	6	#4	STR	23'-5"	91
M1	40	#11	I	7'-1"	1505
S1	36	#4	2	3'-7"	86
S2	95	#4	3	9'-8"	613
S3	140	#5	4	7'-11"	1156
S4	52	#5	4	2'-11"	299
T1	15	#7	5	8'-4"	1877
T2	60	#3	5	11'-4"	1818
VI	40	#11	I	23'-0"	4888

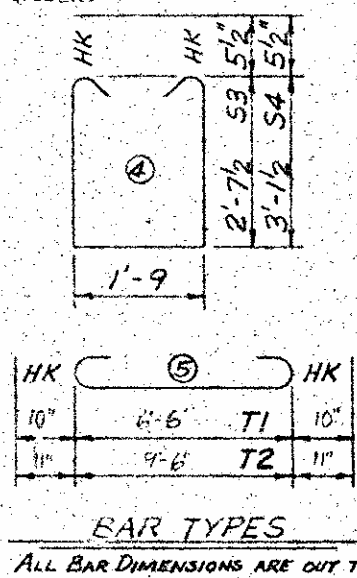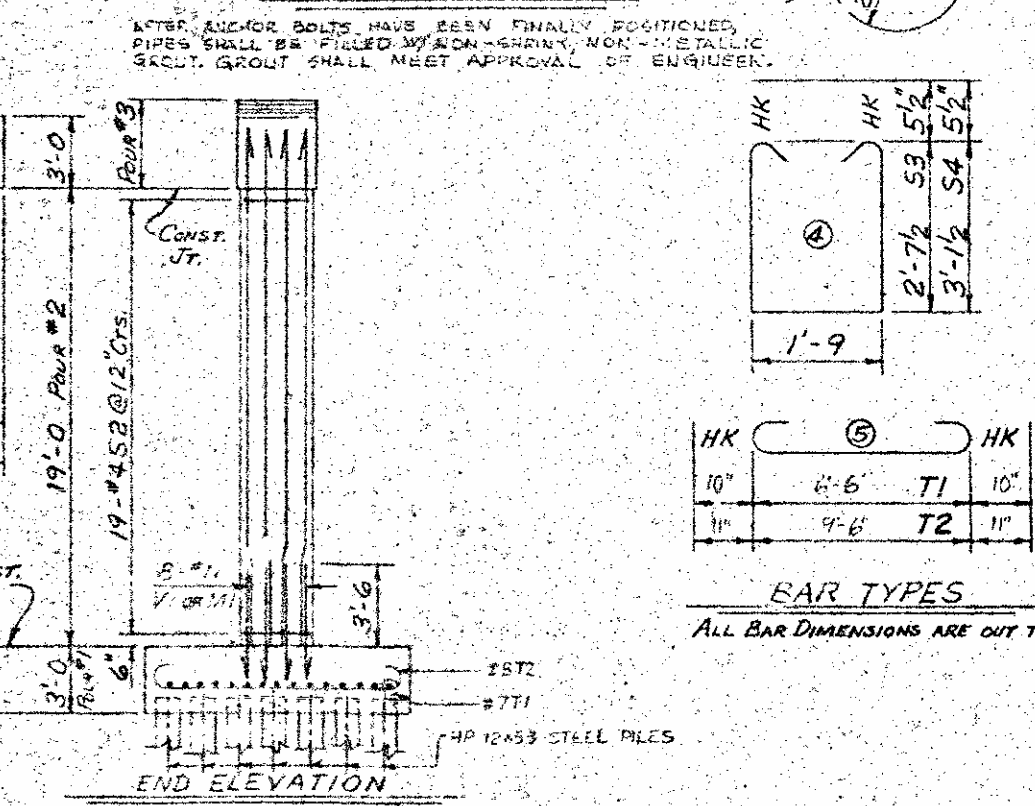
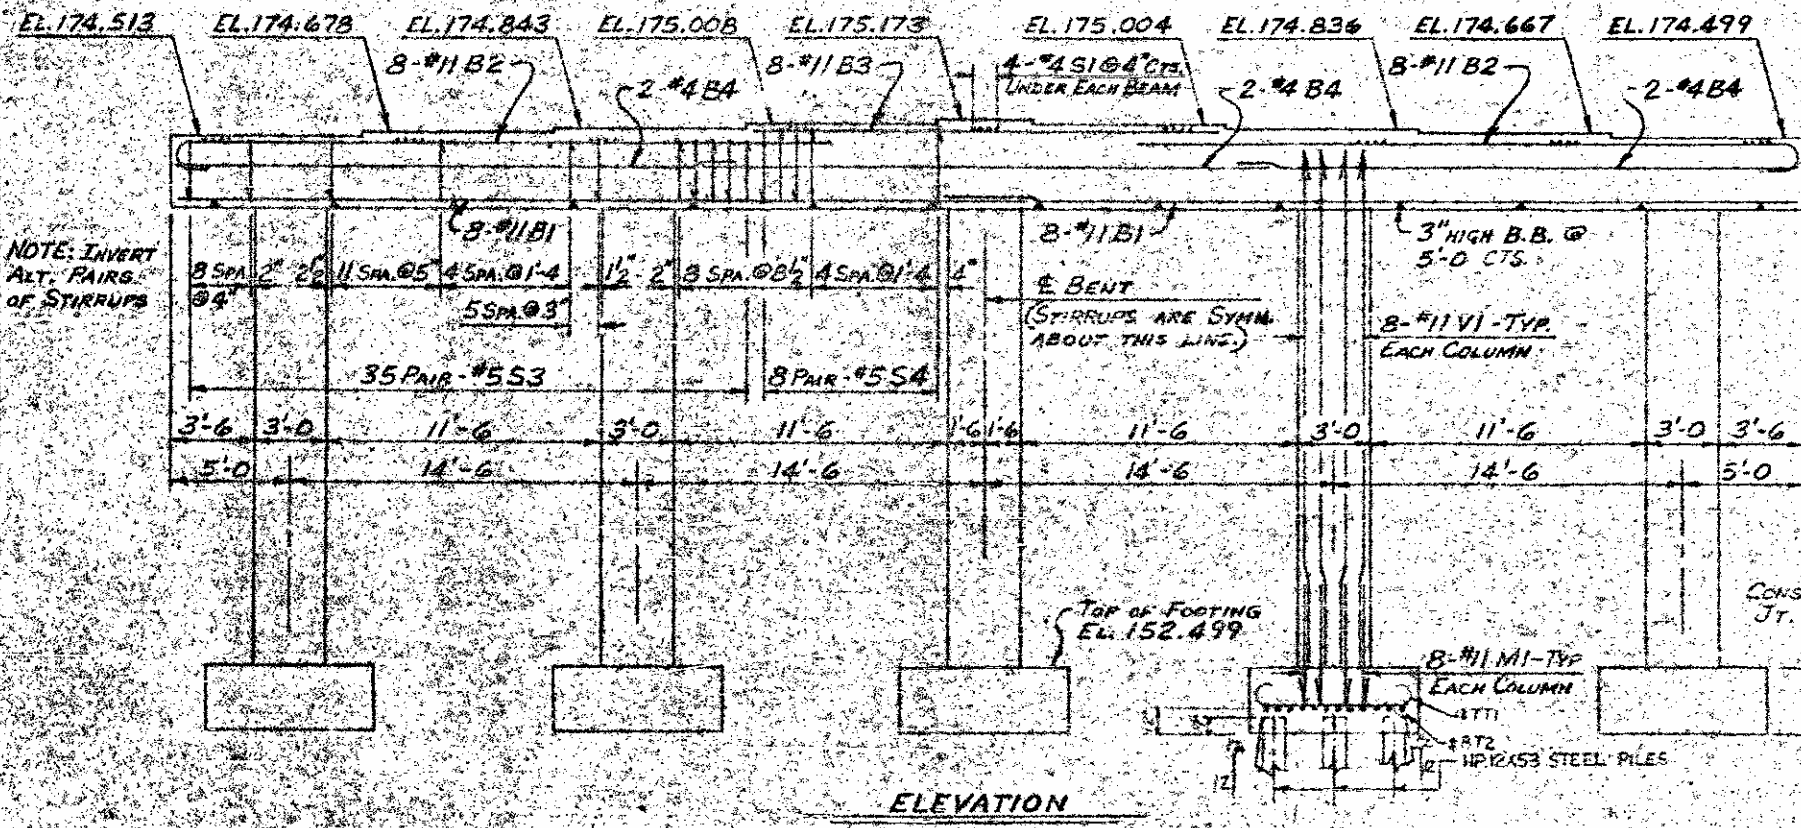


**REINFORCING STEEL - LBS. 18,000**  
**CLASS A CONCRETE - CU. YDS. 92.0**  
**HP 12x53 STEEL PILES - LBS. 3,534.81**  
**L.F. = 3,534.81**

**CONCRETE BREAKDOWN IN CU. YDS.**

POUR #1 (FOOTINGS)	3.5
POUR #2 (COLUMNS)	24.9
POUR #3 (CAP)	26.2
<b>TOTAL</b>	<b>54.6</b>

Found. Excn. = 123.78 C.Y.  
**PROJECT NO. 8-1347400**  
**CUMBERLAND COUNTY**  
**STATION 94+74.76-RT LN.**

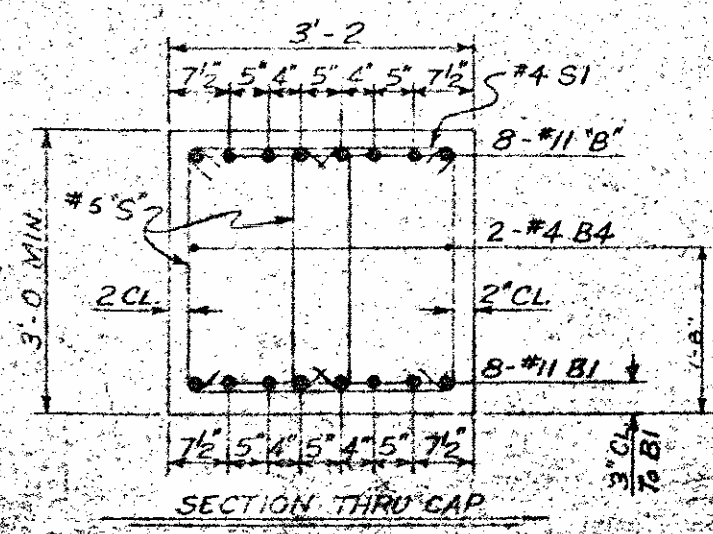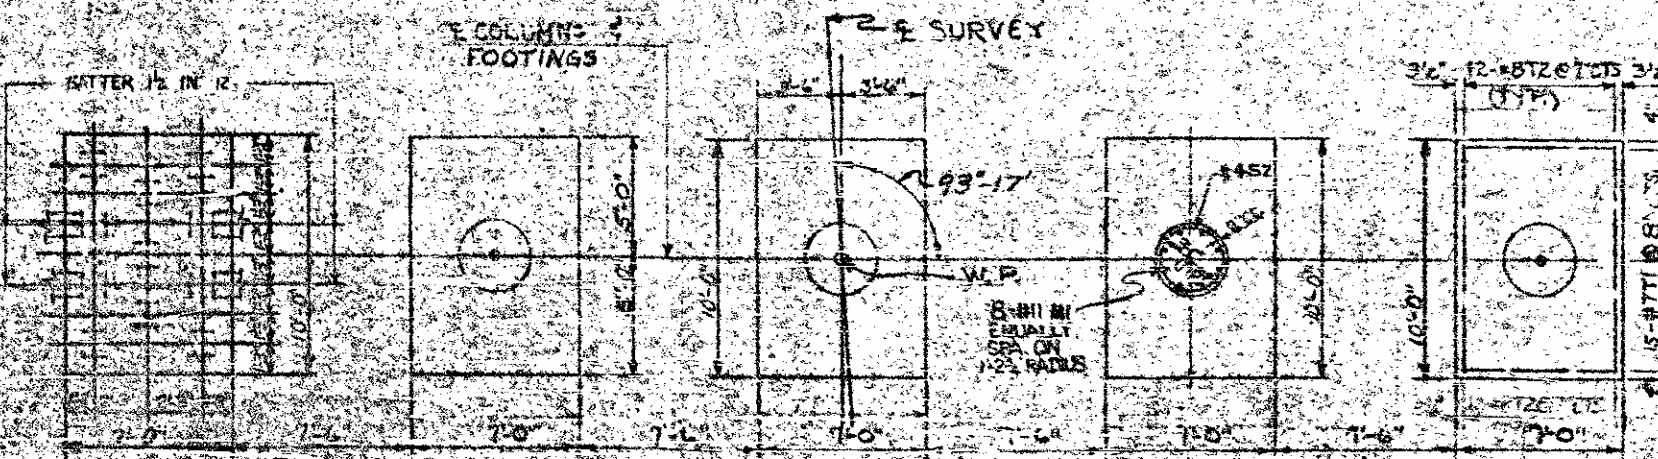


STATE OF NORTH CAROLINA  
**DEPARTMENT OF TRANSPORTATION AND HIGHWAY SAFETY**  
 RALEIGH  
**SUBSTRUCTURE BENT NO. 1**


SEPTEMBER 1974

REVISIONS					
NO.	BY	DATE	NO.	BY	DATE
1			1		
2			2		
3			3		

FED. ROAD DIV. NO.	STATE	PROJECT NO.
NC	NC	81547406
PROJECT		T-95-2 (R) 40
SHEET NO.		TOTAL SHEETS
52		

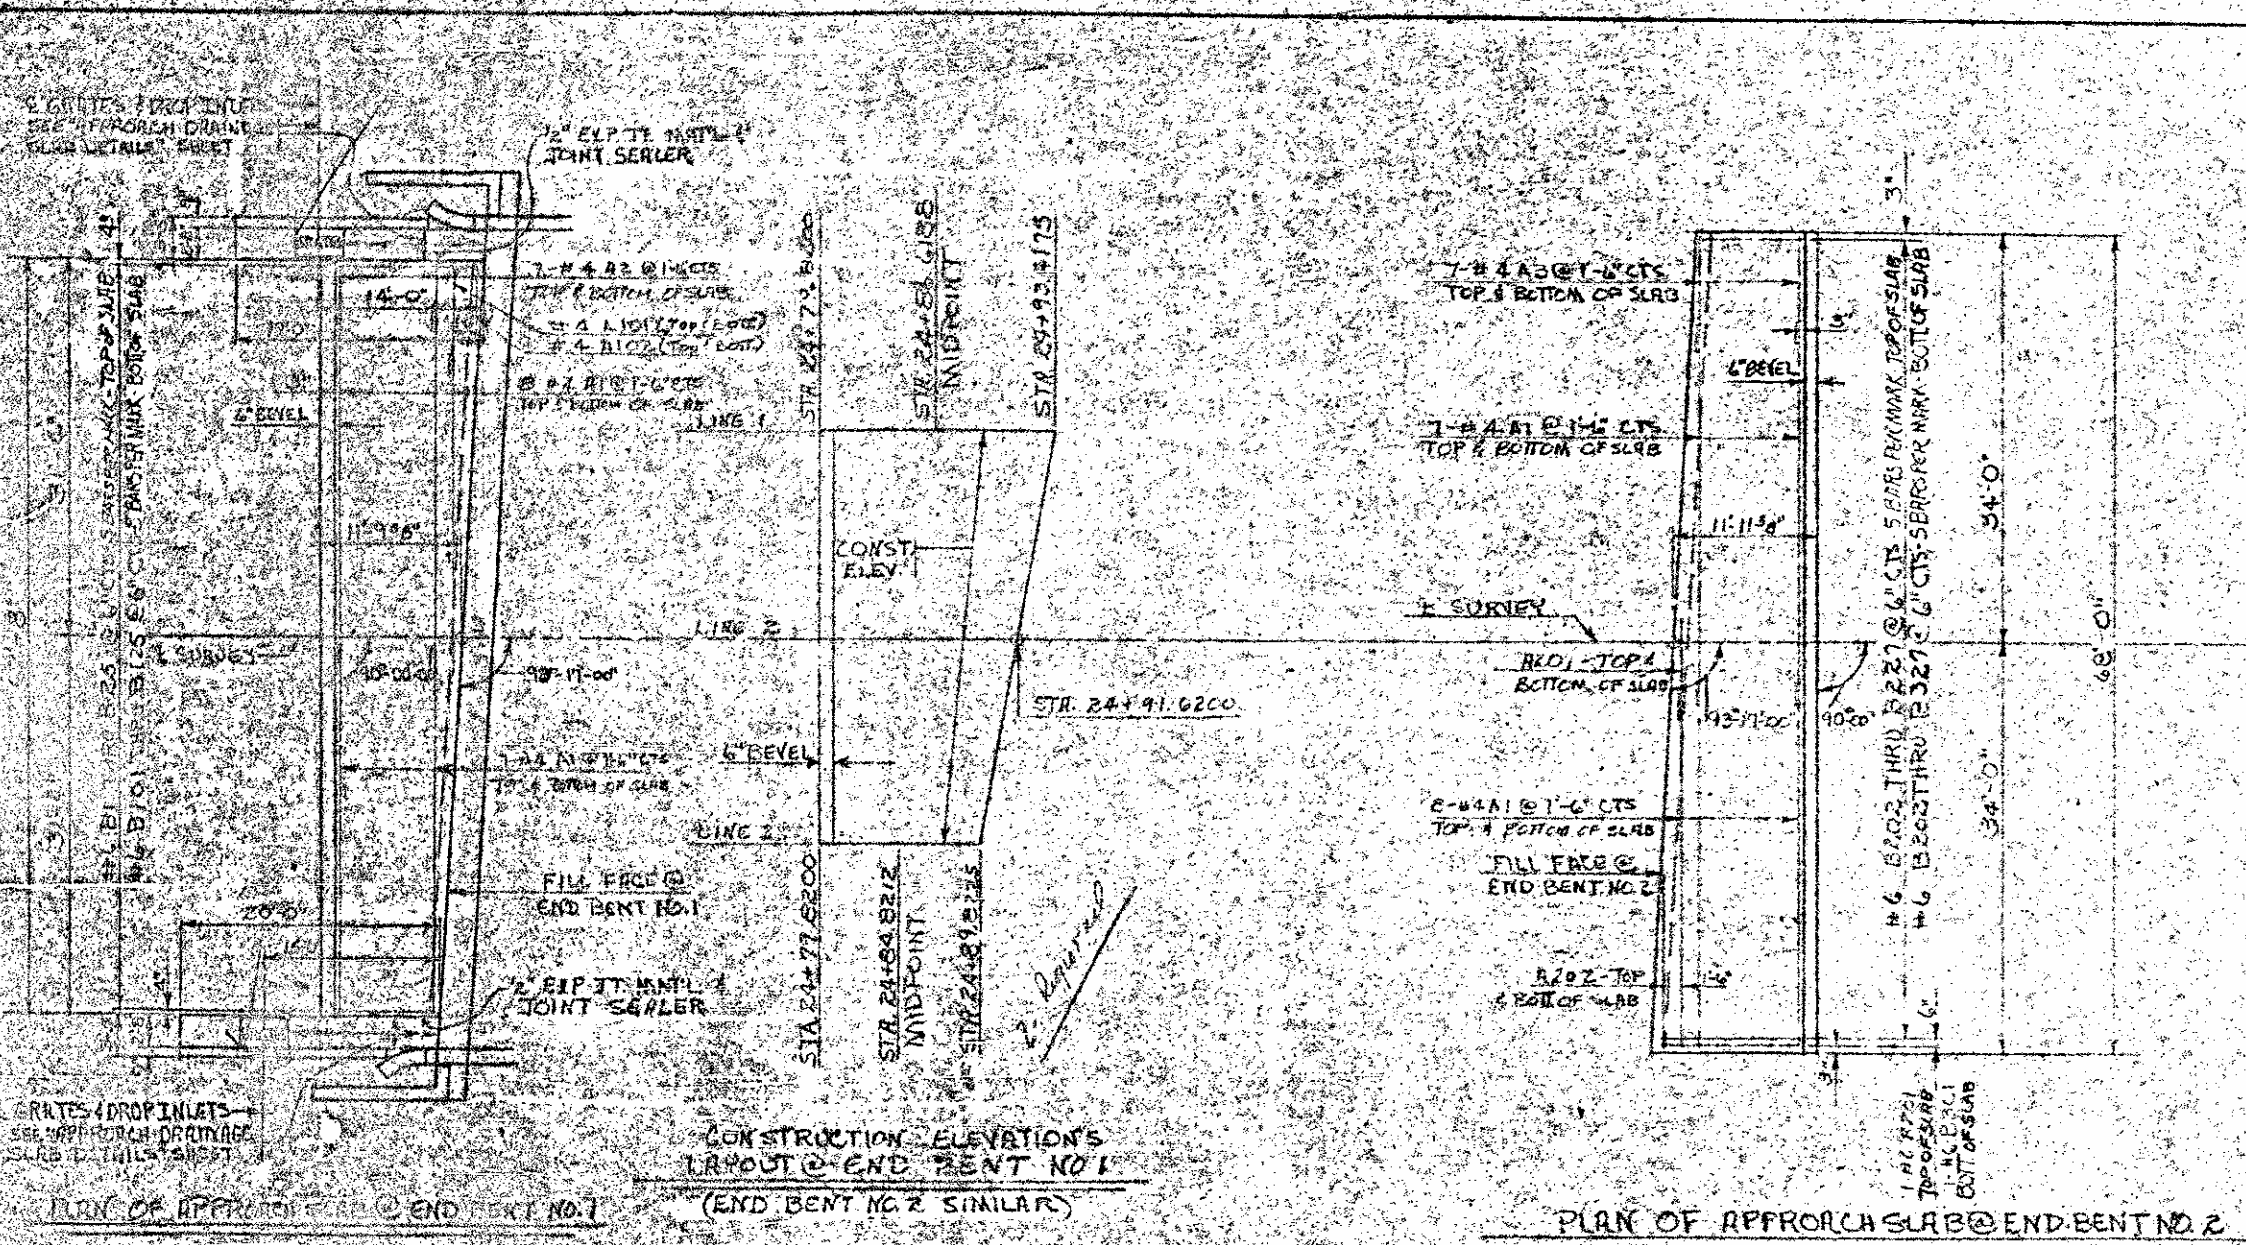

BILL OF MATERIAL APPROACH SLAB NO. 1					BILL OF MATERIAL APPROACH SLAB NO. 2						
BAR	NUMBER	SIZE	TYPE	LENGTH	WEIGHT	BAR	NO.	SIZE	TYPE	LENGTH	WEIGHT
A1	30	3	STR	30-0	801	A1	30	3	STR	30-0	801
A2	14	4	STR	4-10	45	A2	14	4	STR	4-10	45
A101	2	4	STR	7-9	10	A101	2	4	STR	7-9	10
A102	2	4	STR	10-0	13	A102	2	4	STR	10-0	13
B1	5	6	STR	17-7	65	B1	5	6	STR	17-7	65
B2	5	6	STR	12-5	45	B2	5	6	STR	12-5	45
B3	5	6	STR	12-3	42	B3	5	6	STR	12-3	42
B4	5	6	STR	12-1	41	B4	5	6	STR	12-1	41
B5	5	6	STR	12-0	40	B5	5	6	STR	12-0	40
B6	5	6	STR	11-10	39	B6	5	6	STR	11-10	39
B7	5	6	STR	11-8	38	B7	5	6	STR	11-8	38
B8	5	6	STR	11-6	36	B8	5	6	STR	11-6	36
B9	5	6	STR	11-5	36	B9	5	6	STR	11-5	36
B10	5	6	STR	11-3	34	B10	5	6	STR	11-3	34
B11	5	6	STR	11-1	32	B11	5	6	STR	11-1	32
B12	5	6	STR	10-11	31	B12	5	6	STR	10-11	31
B13	5	6	STR	10-10	31	B13	5	6	STR	10-10	31
B14	5	6	STR	10-8	30	B14	5	6	STR	10-8	30
B15	5	6	STR	10-6	29	B15	5	6	STR	10-6	29
B16	5	6	STR	10-4	27	B16	5	6	STR	10-4	27
B17	5	6	STR	10-3	27	B17	5	6	STR	10-3	27
B18	5	6	STR	10-1	26	B18	5	6	STR	10-1	26
B19	5	6	STR	9-11	25	B19	5	6	STR	9-11	25
B20	5	6	STR	9-9	23	B20	5	6	STR	9-9	23
B21	5	6	STR	9-8	23	B21	5	6	STR	9-8	23
B22	5	6	STR	9-6	21	B22	5	6	STR	9-6	21
B23	5	6	STR	9-4	19	B23	5	6	STR	9-4	19
B24	5	6	STR	9-2	18	B24	5	6	STR	9-2	18
B25	5	6	STR	9-1	16	B25	5	6	STR	9-1	16
B101	5	6	STR	13-1	58	B101	5	6	STR	13-1	58
B102	5	6	STR	12-11	47	B102	5	6	STR	12-11	47
B103	5	6	STR	12-9	46	B103	5	6	STR	12-9	46
B104	5	6	STR	12-7	45	B104	5	6	STR	12-7	45
B105	5	6	STR	12-6	44	B105	5	6	STR	12-6	44
B106	5	6	STR	12-4	43	B106	5	6	STR	12-4	43
B107	5	6	STR	12-2	41	B107	5	6	STR	12-2	41
B108	5	6	STR	12-0	40	B108	5	6	STR	12-0	40
B109	5	6	STR	11-11	39	B109	5	6	STR	11-11	39
B110	5	6	STR	11-9	38	B110	5	6	STR	11-9	38
B111	5	6	STR	11-7	37	B111	5	6	STR	11-7	37
B112	5	6	STR	11-5	36	B112	5	6	STR	11-5	36
B113	5	6	STR	11-4	35	B113	5	6	STR	11-4	35
B114	5	6	STR	11-2	34	B114	5	6	STR	11-2	34
B115	5	6	STR	11-0	33	B115	5	6	STR	11-0	33
B116	5	6	STR	10-10	31	B116	5	6	STR	10-10	31
B117	5	6	STR	10-9	31	B117	5	6	STR	10-9	31
B118	5	6	STR	10-7	29	B118	5	6	STR	10-7	29
B119	5	6	STR	10-5	28	B119	5	6	STR	10-5	28
B120	5	6	STR	10-3	27	B120	5	6	STR	10-3	27
B121	5	6	STR	10-2	26	B121	5	6	STR	10-2	26
B122	5	6	STR	10-0	25	B122	5	6	STR	10-0	25
B123	5	6	STR	9-10	24	B123	5	6	STR	9-10	24
B124	5	6	STR	9-8	23	B124	5	6	STR	9-8	23
B125	5	6	STR	9-7	22	B125	5	6	STR	9-7	22
GRAND TOTAL					4819	GRAND TOTAL					5160
REINFC'G STL-TOTAL					4819	REINFC'G STL-TOTAL					5160
CLASS "AA" CONC. CU. YDS. 23.4						CLASS "AA" CONC. CU. YDS. 25.8					
CLASS "A" CONC. FOR APPROACH DRAINAGE SLAB CU. YDS. 8.0						CLASS "A" CONC. FOR APPROACH DRAINAGE SLAB CU. YDS. 8.0					

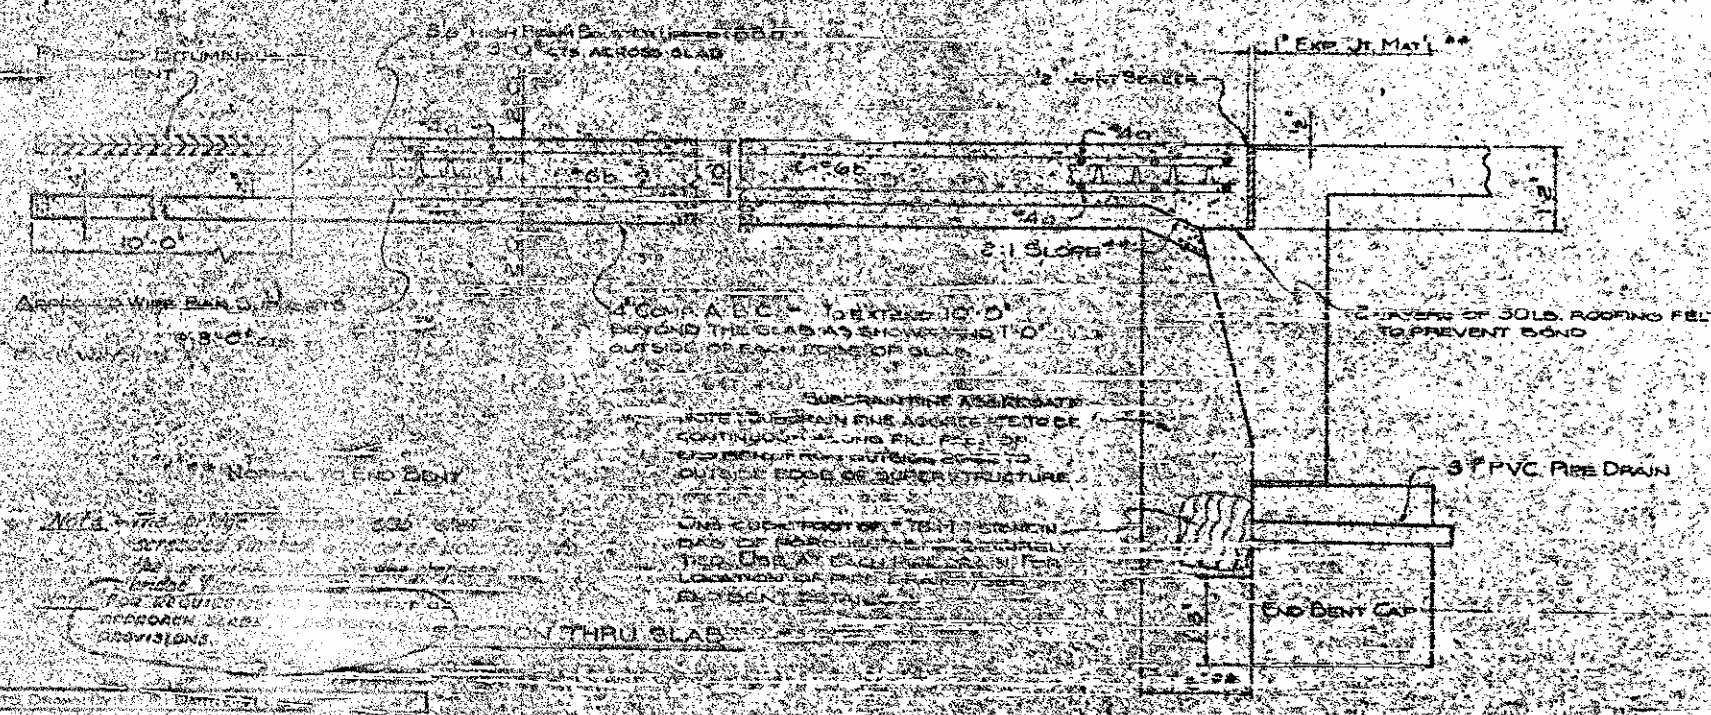

- REV. NO. 10 - TO CHANGE BELT TO FINISHED AND ADD PROPOSED IN FINISH NOTE. BY K.G.P. BY NMS 5-4-76
- REV. NO. 9 - TO REMOVE LOCATION FOR APPROACH SLAB AREA. BY K.G.P. BY 2-21-76
- REV. NO. 8 - TO CHANGE DESIGNATION OF AGGREGATE SIZE AND TO PROVIDE LOCATION FOR APPROACH SLAB AREA. BY K.G.P. BY NMS 1-9-76
- REV. NO. 7 - TO CHANGE DESIGNATION OF AGGREGATE SIZE. BY CCM 1/8 BY W.J.R. 5-17-75
- REV. NO. 6 - TO OMIT MAXIMUM FROM BAS SUPPORT SPACING. BY K.G.P. BY NMS 7-14-75
- REV. NO. 5 - TO CHANGE NOT-FINISHED RUBBER ASPHALT JOINT SEALER TO JOINT SEALER. BY K.G.P. BY 1-15-75
- REV. NO. 4 - TO CHANGE UPPER BEAM BOLSTER TO BEAM BOLSTER LOWER. BY K.G.P. BY NMS 11-20-75
- REV. NO. 3 - NOTE REFERRING TO REQUIREMENTS & PAYMENT OF APPROACH SLABS. BY CCM BY D.W.R. 10/11/75
- REV. NO. 2 - TO CHANGE BAS SUPPORT DESIGNATION. BY K.G.P. BY 12-2-75
- REV. NO. 1 - TO ADD FINISHING REQUIREMENTS. BY J.P. BY D.W. 11-11-75

PROJECT No. 81547406  
 CUMBERLAND COUNTY  
 STATION: 94+74.76 RT. LN.

STATE OF NORTH CAROLINA  
**STATE HIGHWAY COMMISSION**  
 RALEIGH

BRIDGE APPROACH SLABS  
 FOR FLEXIBLE PAVEMENT  
 @ END BENTS NO. 1 & NO. 2

NO.	BY	DATE	NO.	BY	DATE
1			1		
2			2		
3			3		
4			4		
5			5		



PLAN ROAD DIST. NO.	STATE	PROJECT NO.
6	N.C.	8-1347406
P. A. NUMBER T-95-2 (22) 20		
SHEET NO.	TOTAL SHEETS	
53	53	

NOTES








For requirements and payment for Approach Drainage Slab Details, see Special Provisions for Bridge Approach Slabs

2" Expansion joint material shall be used in Approach Drainage Slab to limit the length of pours to a maximum of 35 feet. The location of joints, where required, shall be approved by the Engineer. The expansion joint shall be sealed with joint sealer as shown in Section E-E

The Engineer will be responsible for establishing the elevations for the Approach Drainage Slab

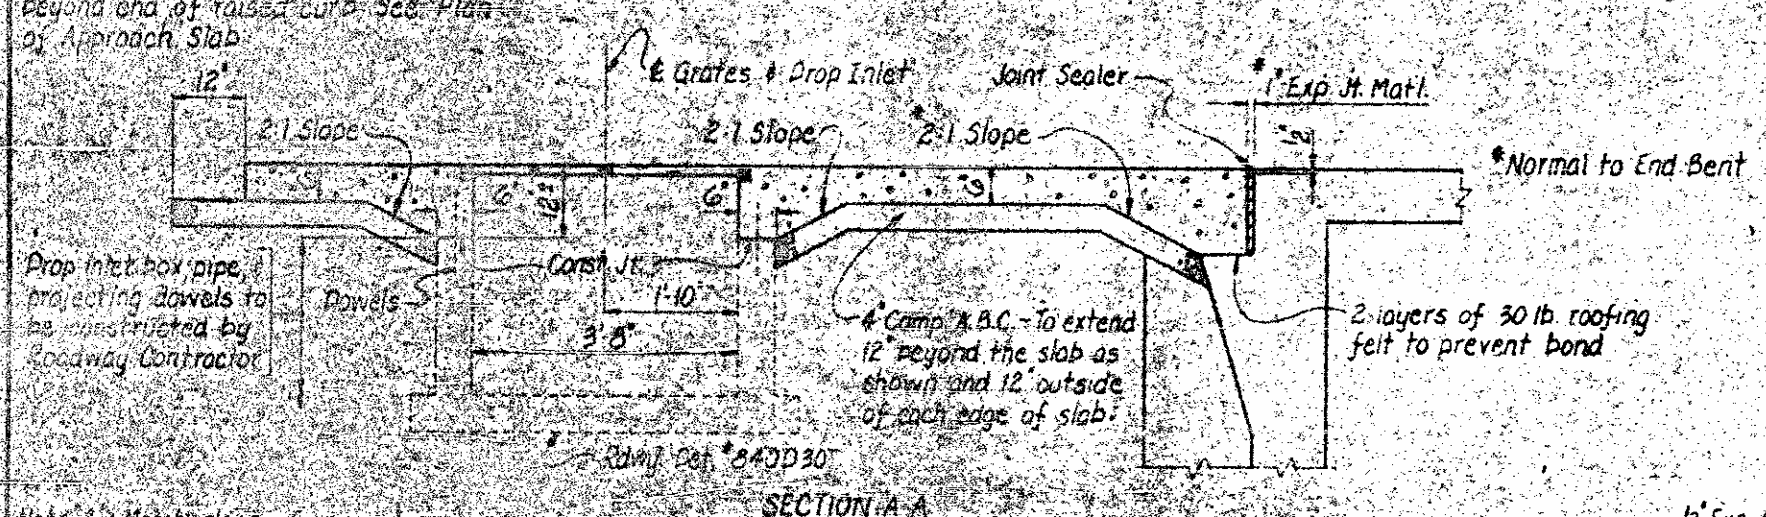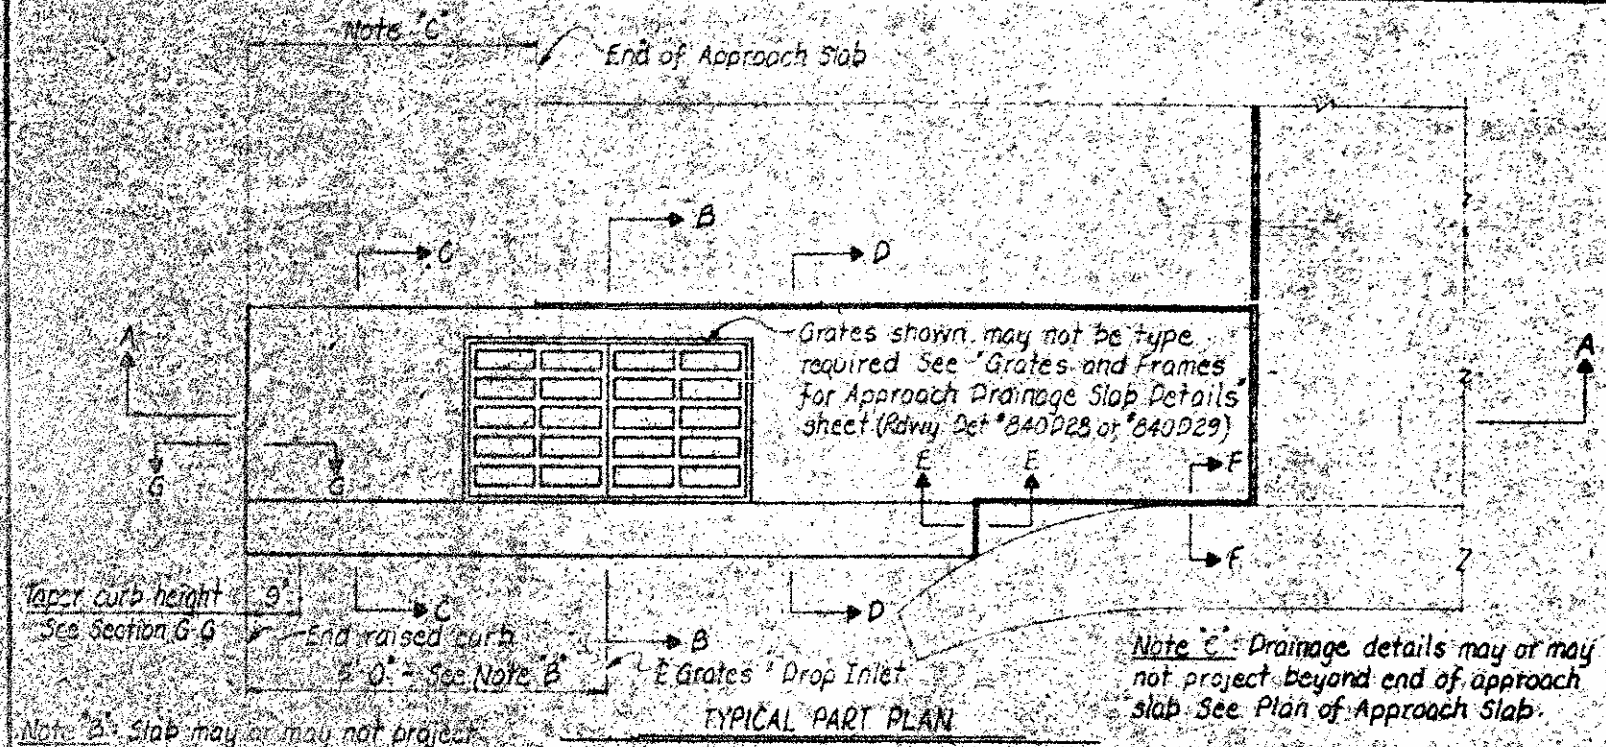

Note A: Match slope of adjacent slab (if present) or slope as directed by the Engineer

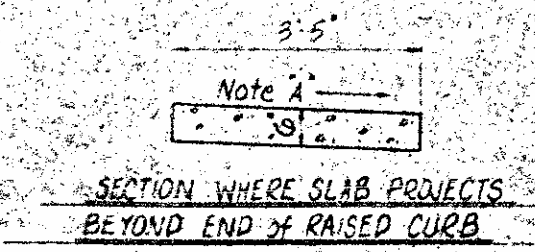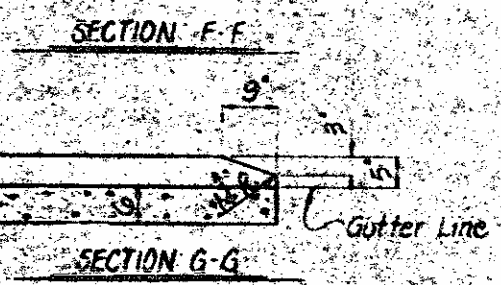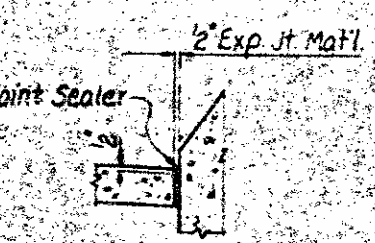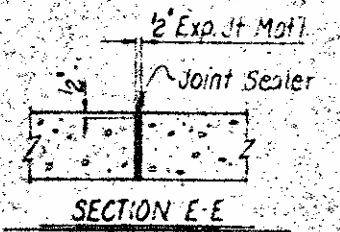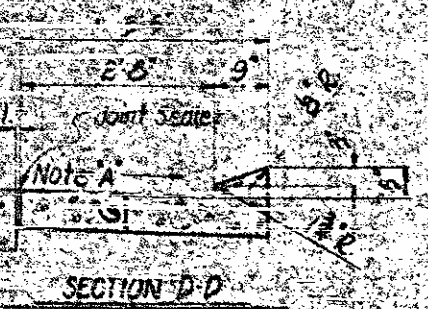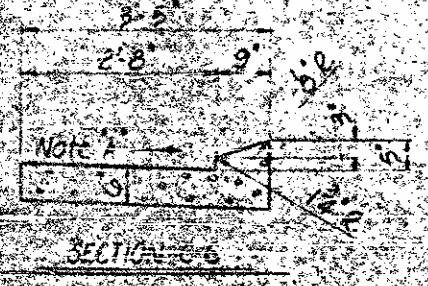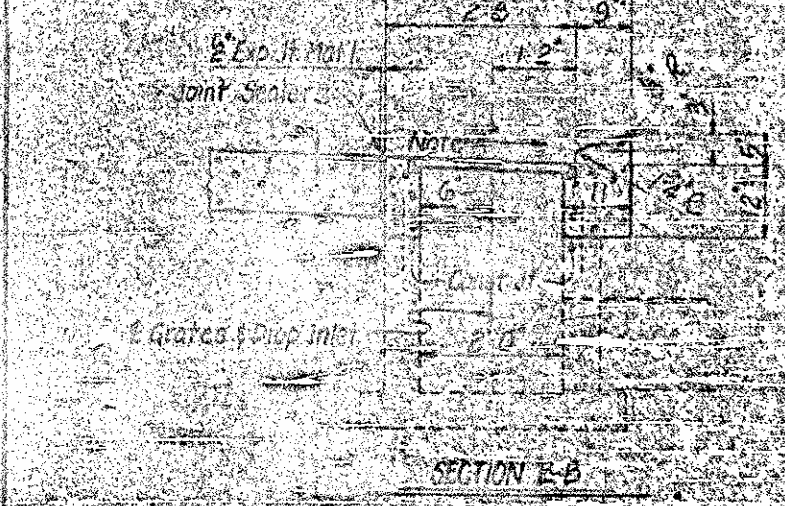

STANDARD DRAWN BY JKT DATE 12-55  
STANDARD CHECKED BY DATE 1-56



Rev #1 Revised to change Rdwy. Det. #840D27 to #840D30 by JRP & B-276 by [unclear]

PROJECT No. 8-1347406  
CUMBERLAND COUNTY  
STATION 94+79.76 R.E.V.

STATE OF NORTH CAROLINA DEPARTMENT OF TRANSPORTATION RALEIGH					
APPROACH DRAINAGE SLAB DETAILS					
REVISIONS					
NO.	BY	DATE	NO.	BY	DATE
1	JCP	8-12-76	2		
2			3		
					5-21
					53

STD. NO. BAS3

FED. ROAD DIST. NO.	STATE	PROJECT NO.
4	N.C.	8.1347406
R.A. PROJECT	I-95-2(4E)40'	
SHEET NO.	70791 SHEETS	
54		

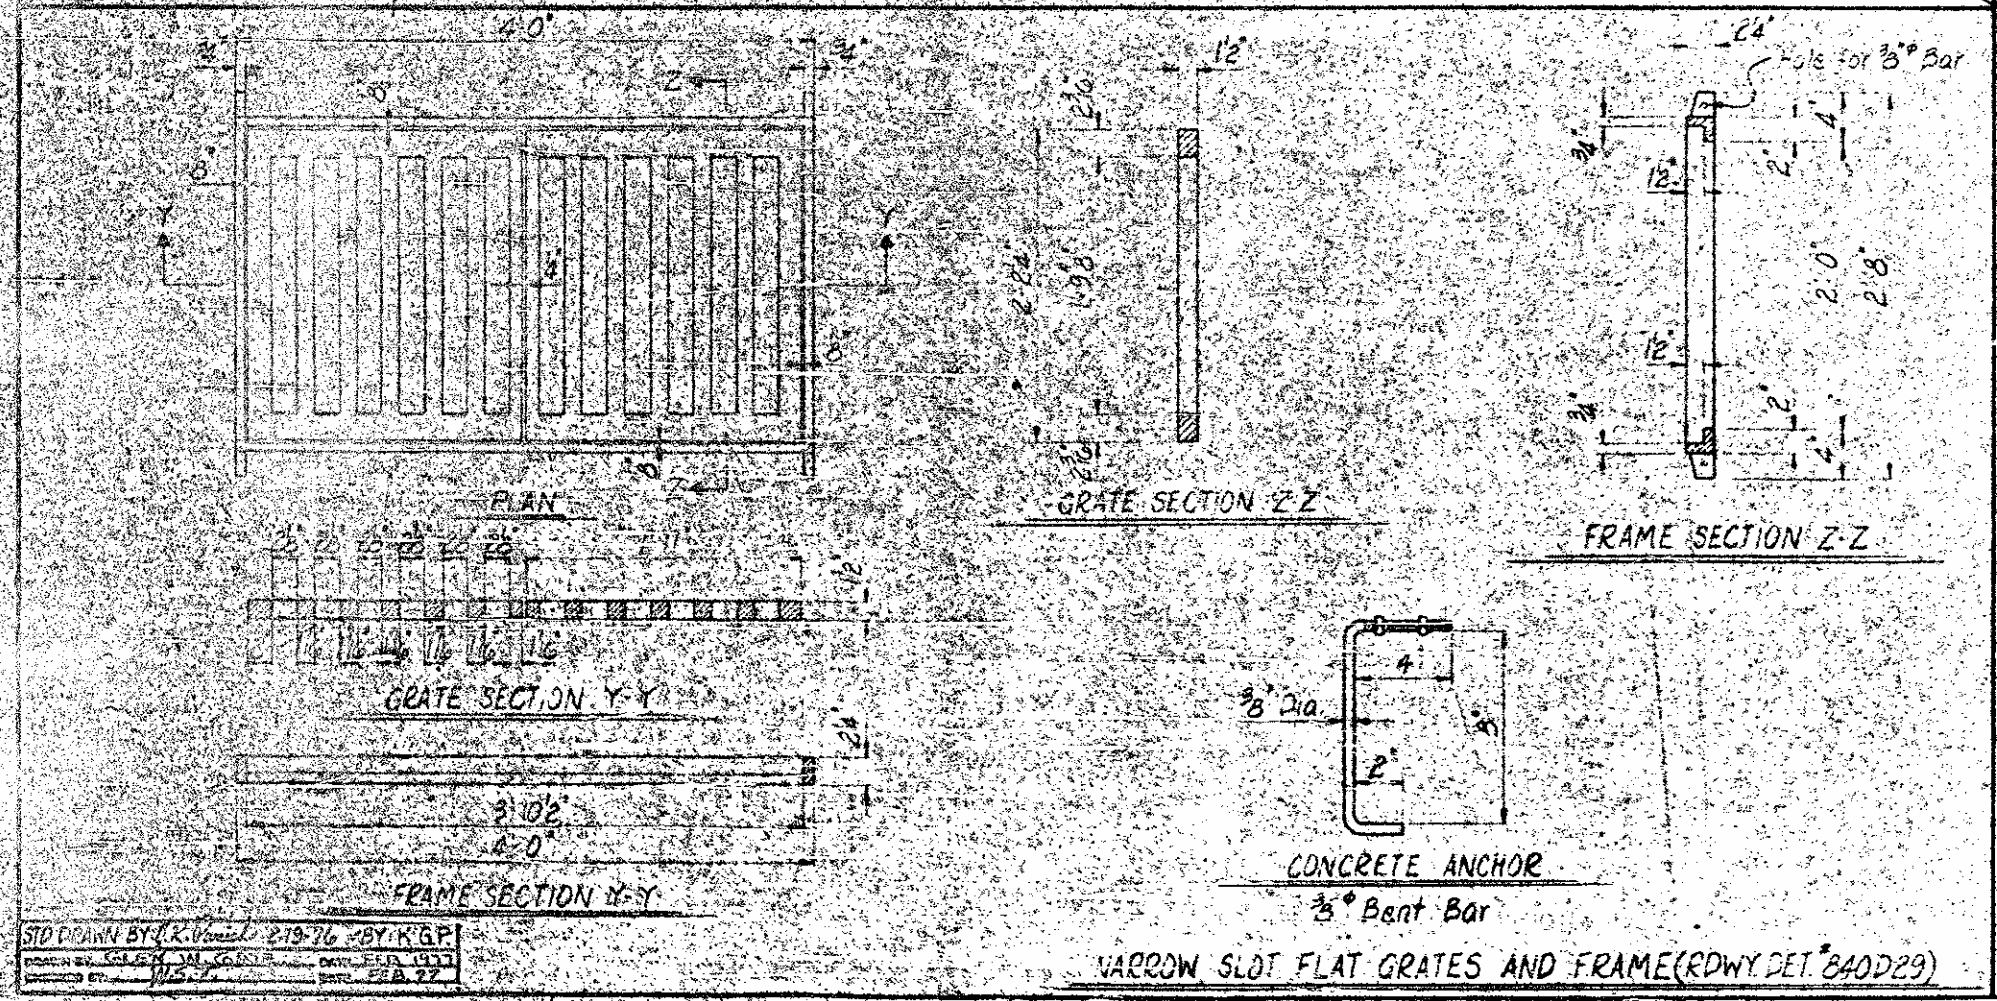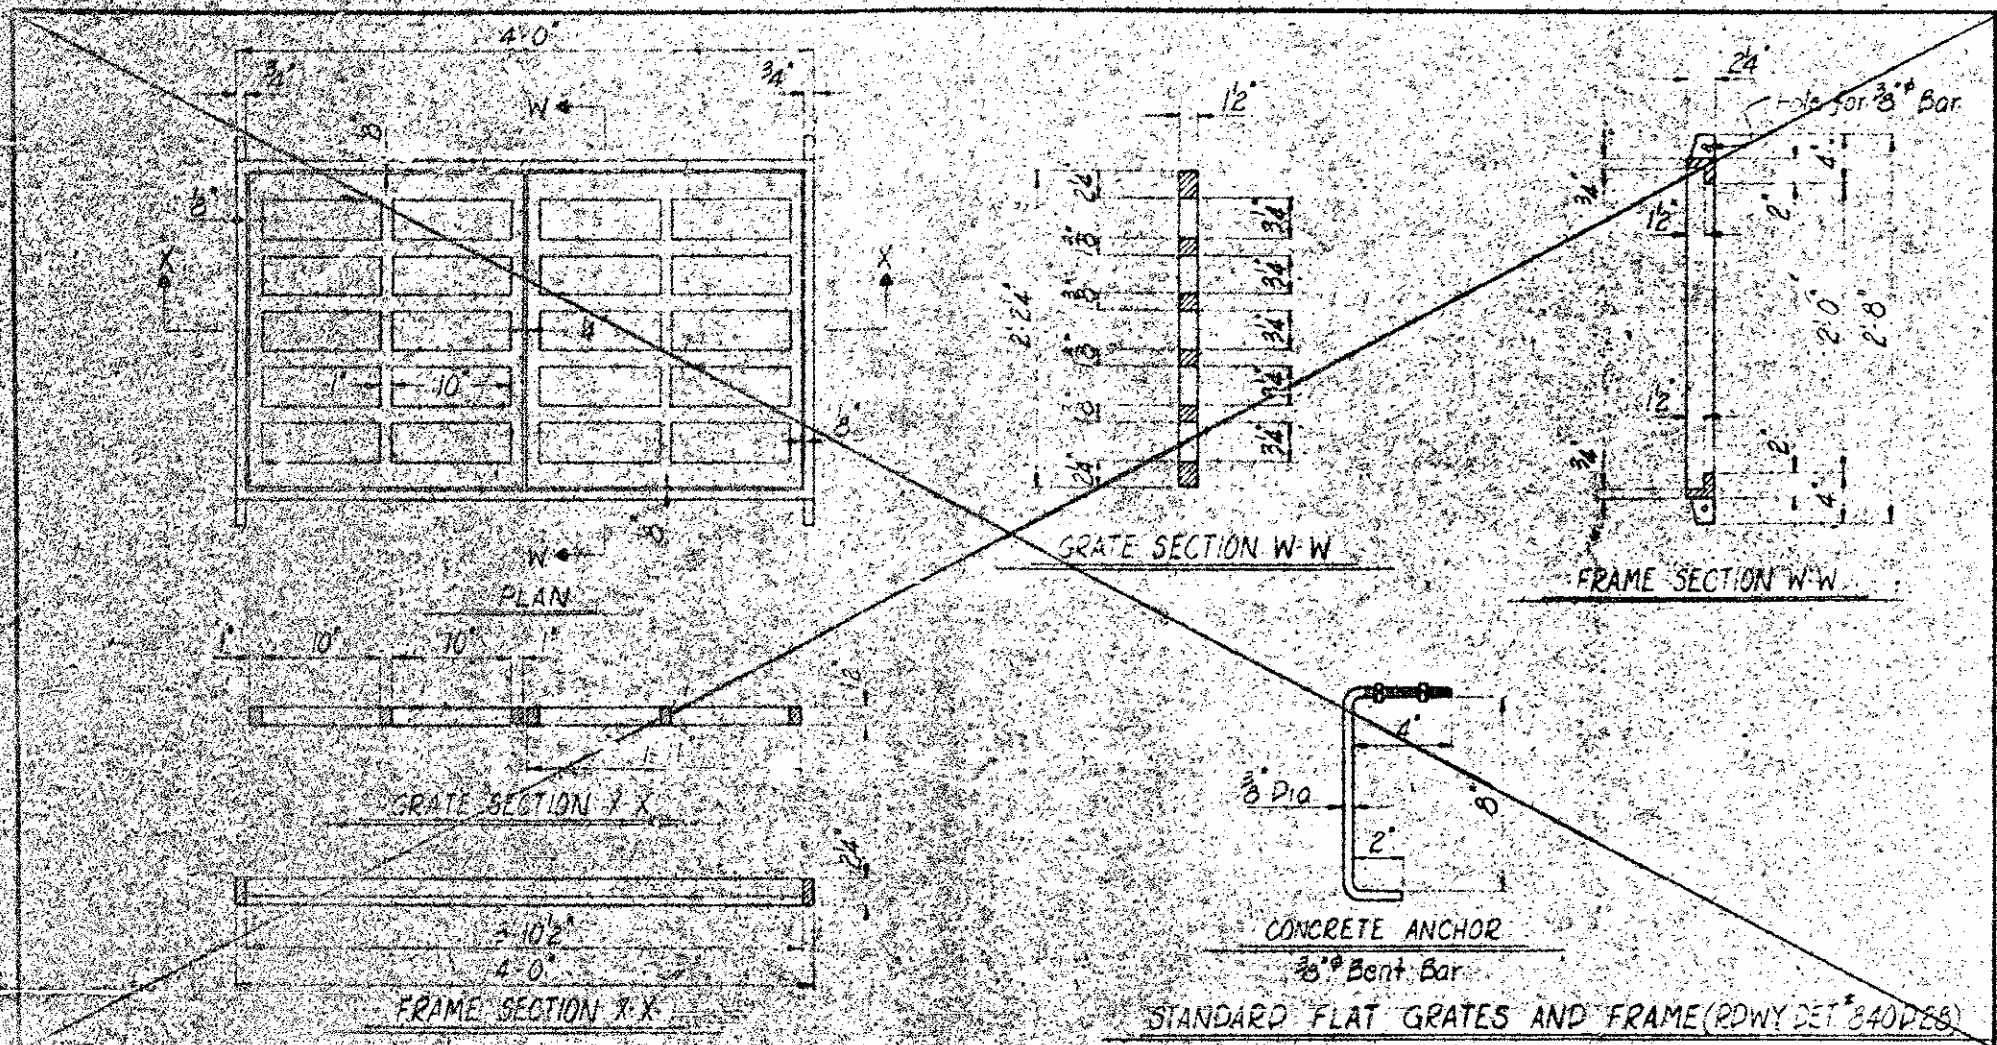

STD DRAWN BY: R. V. ... 2-19-76 BY: KGP  
 DRAWN BY: ... DATE: FEB 1977  
 CHECKED BY: ... DATE: FEB 77

PROJECT No. 8.1347406  
 CUMBERLAND COUNTY  
 STATION 94+74.76 RT-LN

STATE OF NORTH CAROLINA  
 DEPARTMENT OF TRANSPORTATION  
 RALEIGH

GRATES AND FRAMES FOR  
 APPROACH DRAINAGE SLAB

REVISIONS					SHEET
NO.	BY	DATE	NO.	DATE	
1			1		5-22
2			2		54