


**This electronic collection of documents is provided  
for the convenience of the user  
and is Not a Certified Document –**

**The documents contained herein were originally issued  
and sealed by the individuals whose names and license  
numbers appear on each page, on the dates appearing  
with their signature on that page.**

**This file or an individual page  
shall not be considered a certified document.**

BM# 4: -L- STA. 34+22.15 1365.82' LT. N 844967.23, E 1661470.75 EL. 876.61'

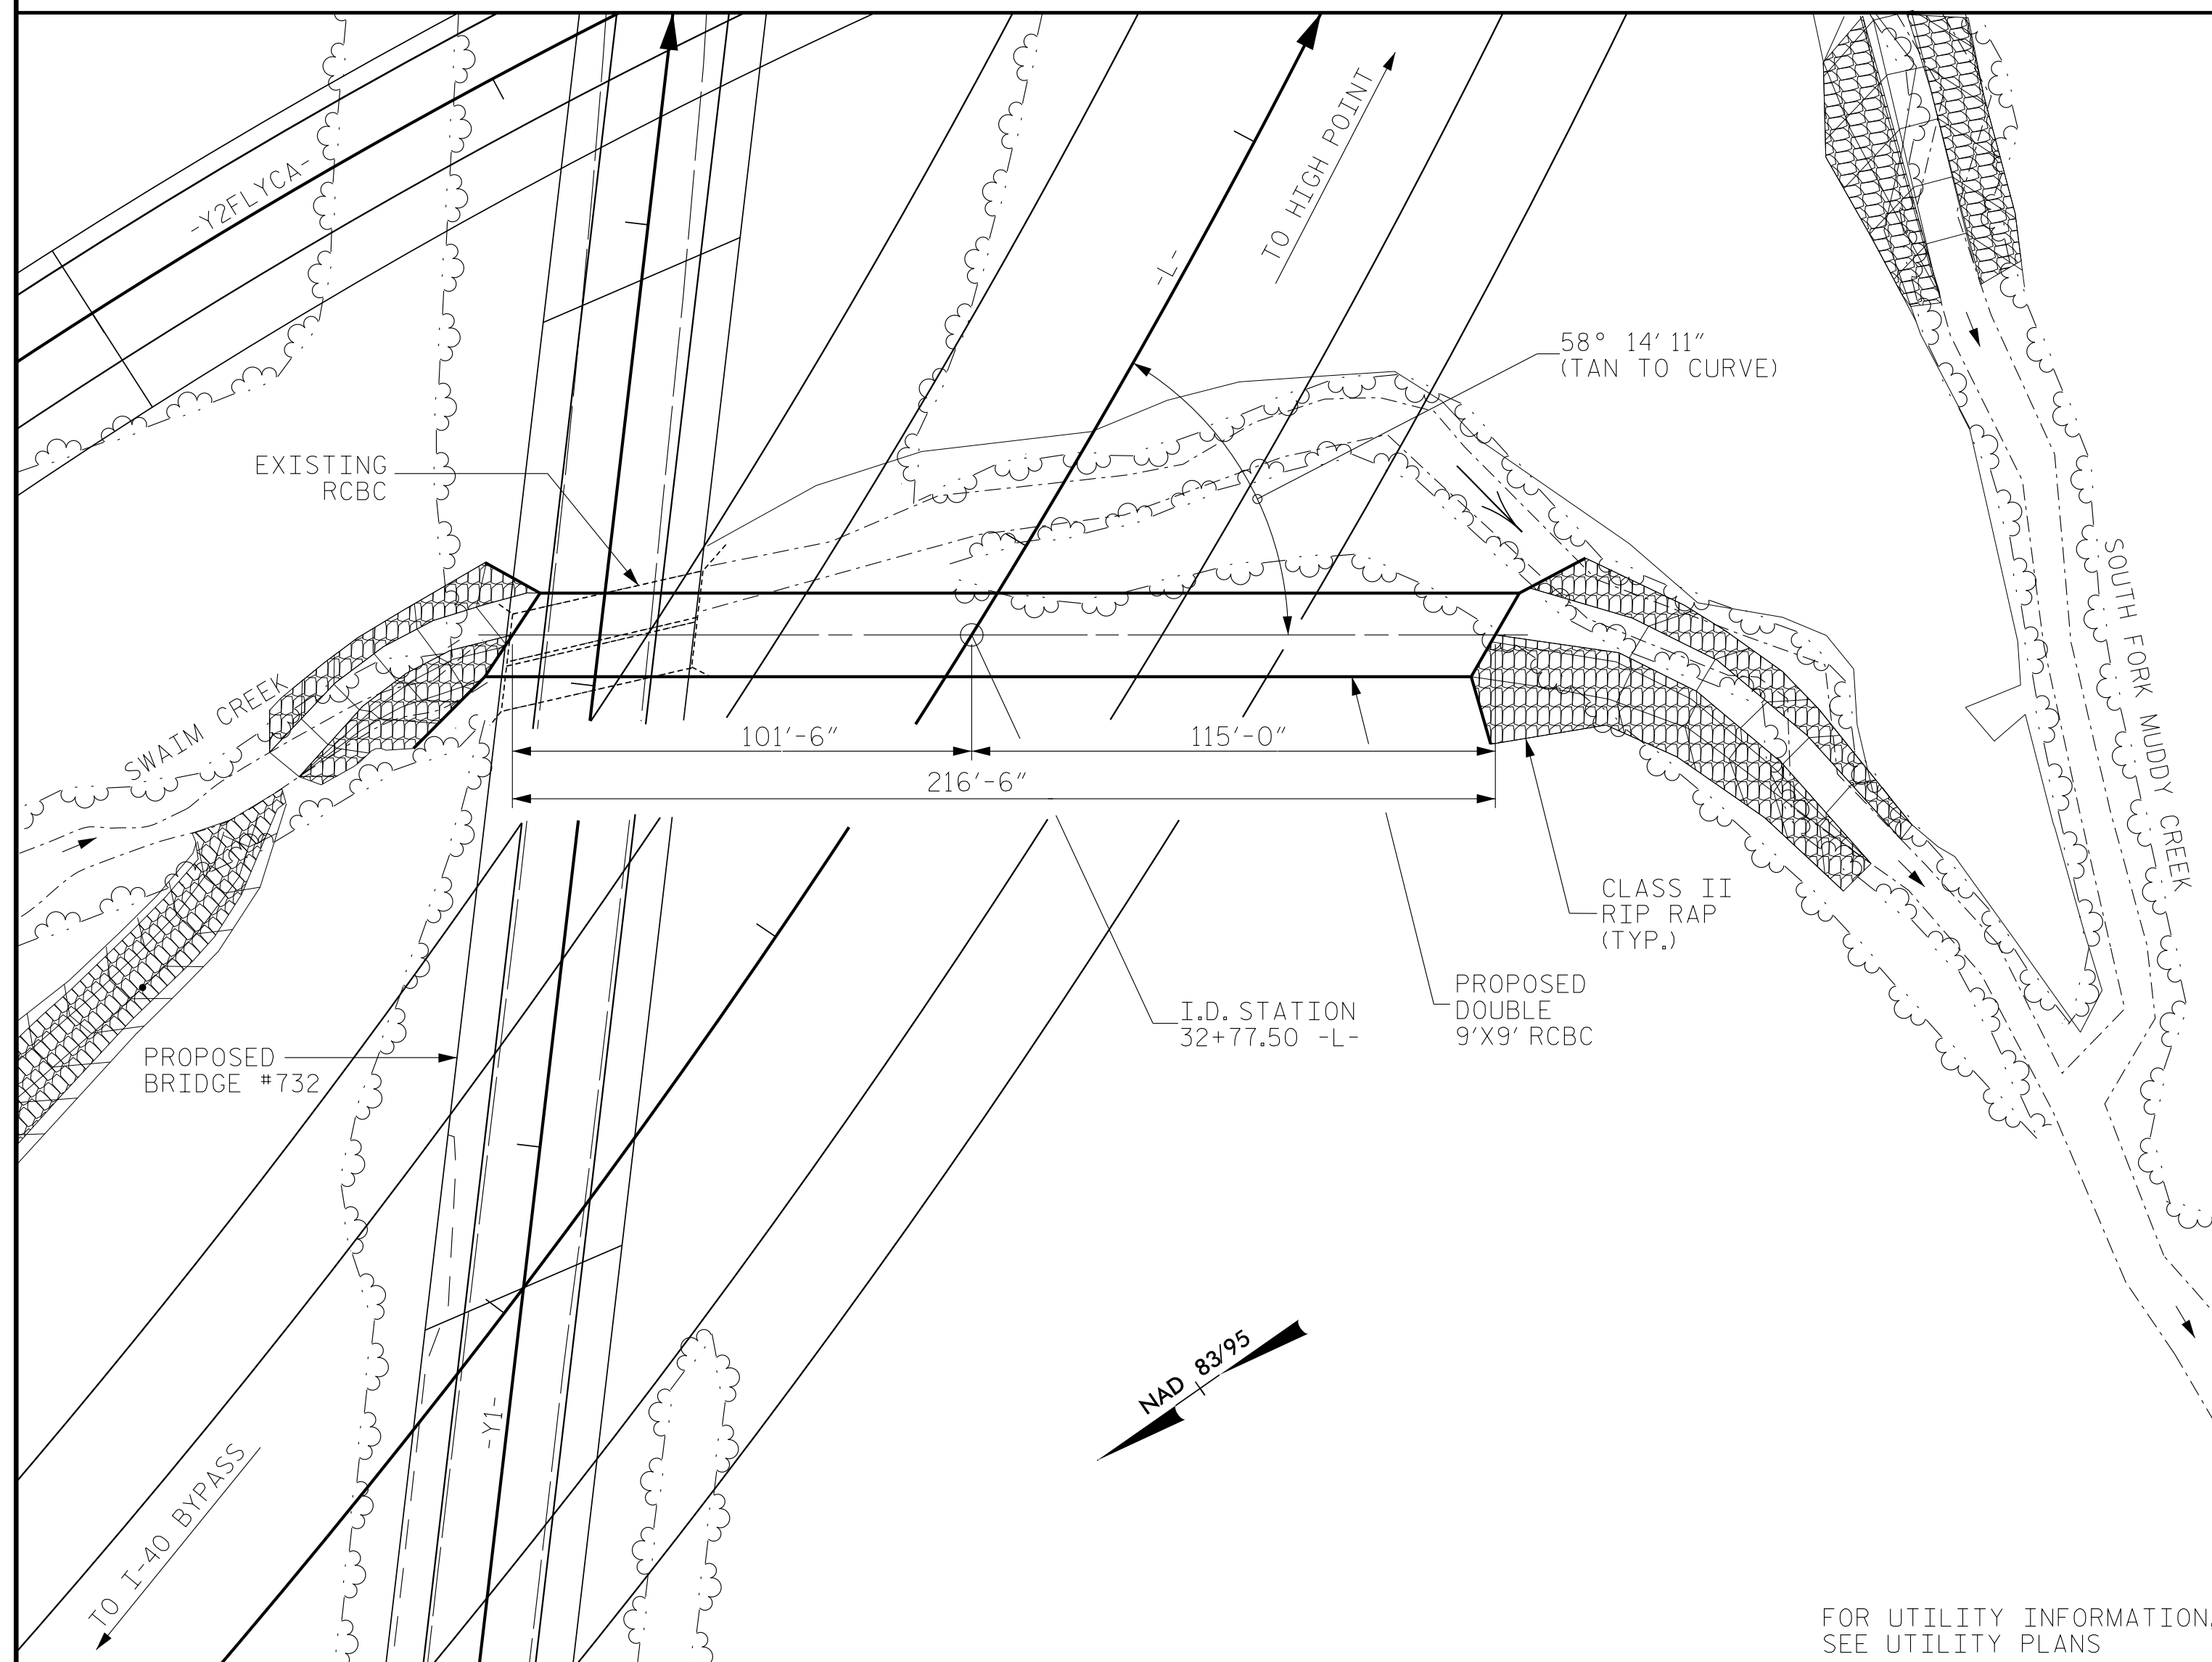

LOCATION SKETCH


GRADE DATA

GRADE POINT ELEV. @ STATION 32+77.50 -L- = 827.37'  
 BED ELEV. @ STATION 32+77.50 -L- = 808.87'  
 ROADWAY SLOPES: 2:1

FOUNDATION NOTES

EXCAVATE 1 FOOT BELOW CULVERT AND FOOTINGS AND REPLACE WITH FOUNDATION CONDITIONING MATERIAL IN ACCORDANCE WITH ARTICLE 414-4 OF THE STANDARD SPECIFICATIONS.

CULVERT EXCAVATION LUMP SUM PAY ITEM SHALL INCLUDE A MINIMUM OF 50 C.Y. OF ROCK EXCAVATION.

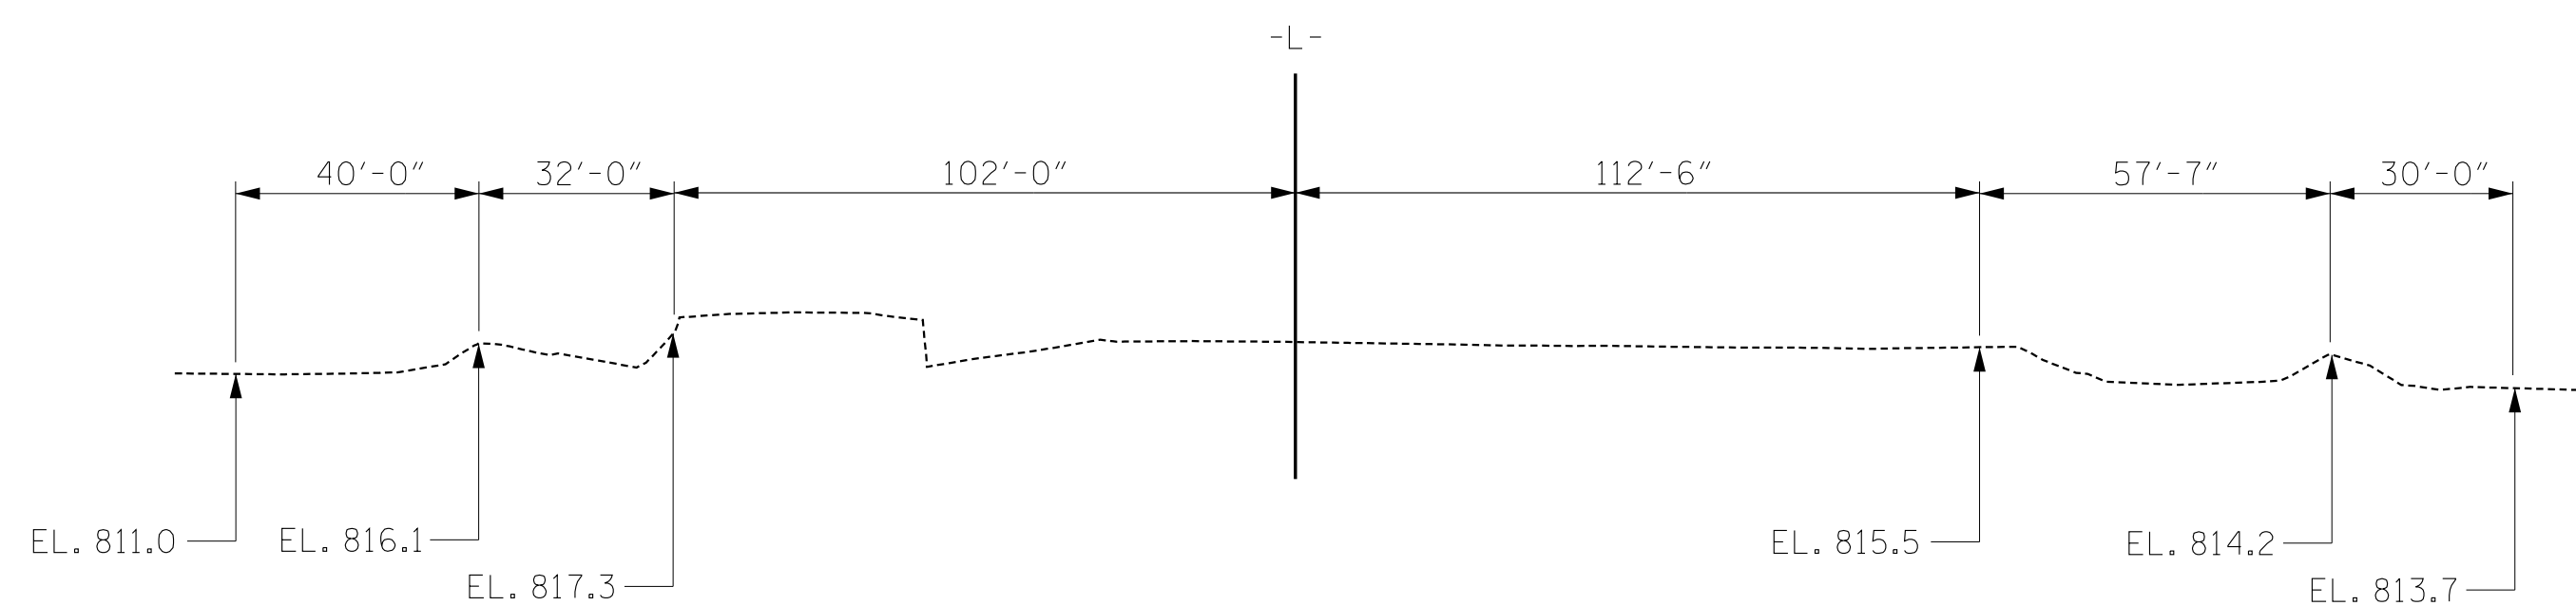

PROFILE ALONG CULVERT

NOTES:

- ASSUMED LIVE LOAD ----- HL-93 OR ALTERNATE LOADING.
- DESIGN FILL ----- MAX.=10.33', MIN.=4.63'
- FOR OTHER DESIGN DATA AND GENERAL NOTES, SEE STANDARD NOTES SHEET SN.
- THE RESIDENT ENGINEER SHALL CHECK THE LENGTH OF CULVERT BEFORE STAKING IT OUT TO MAKE CERTAIN THAT IT WILL PROPERLY TAKE CARE OF THE FILL.
- CONCRETE IN CULVERT SHALL BE POURED IN THE FOLLOWING ORDER:
  1. WINGS FOOTINGS AND FLOOR SLAB INCLUDING 4" OF ALL VERTICAL WALLS.
  2. THE REMAINING PORTIONS OF THE WALLS AND WINGS FULL HEIGHT FOLLOWED BY ROOF SLAB AND HEADWALLS.
- FOR FALSEWORK AND FORMWORK, SEE SPECIAL PROVISIONS.
- FOR SUBMITTAL OF WORKING DRAWINGS, SEE SPECIAL PROVISIONS.
- FOR CRANE SAFETY, SEE SPECIAL PROVISIONS.
- FOR GROUT FOR STRUCTURES, SEE SPECIAL PROVISIONS.
- FOR CULVERT DIVERSION DETAILS AND PAY ITEMS, SEE EROSION CONTROL PLANS.

AT THE CONTRACTOR'S OPTION HE MAY SPLICE THE VERTICAL REINFORCING STEEL IN THE INTERIOR FACE OF THE EXTERIOR WALLS AND BOTH FACES OF THE INTERIOR WALL ABOVE LOWER WALL CONSTRUCTION JOINT. THE SPLICE SHALL BE AS PROVIDED IN THE SPLICE LENGTH CHART SHOWN ON THE PLANS. EXTRA WEIGHT OF STEEL DUE THE SPLICES SHALL BE PAID FOR BY THE CONTRACTOR.

A 3 FOOT STRIP OF FILTER FABRIC SHALL BE ATTACHED TO THE FILL FACE OF THE WING COVERING THE ENTIRE LENGTH OF THE EXPANSION JOINT.

STEEL IN THE BOTTOM SLAB MAY BE SPLICED AT THE PERMITTED, CONSTRUCTION JOINT AT THE CONTRACTOR'S OPTION. EXTRA WEIGHT OF STEEL DUE TO THE SPLICES WILL BE PAID FOR BY THE CONTRACTOR.

DIMENSIONS FOR THE WING LAYOUT AS WELL AS ADDITIONAL REINFORCING STEEL EMBEDDED IN BARREL ARE SHOWN ON WING SHEETS.

3"Ø WEEP HOLES INDICATED SHALL BE IN ACCORDANCE WITH THE STANDARD SPECIFICATIONS.

TRANSVERSE CONSTRUCTION JOINTS SHALL BE USED IN THE BARREL, SPACED TO LIMIT THE POURS TO A MAXIMUM OF 70 FT. LOCATION OF JOINTS SHALL BE SUBJECT TO APPROVAL OF THE ENGINEER.

AT THE CONTRACTOR'S OPTION HE MAY SUBMIT, TO THE ENGINEER FOR APPROVAL, DESIGN AND DETAIL DRAWINGS FOR A PRECAST REINFORCED CONCRETE BOX CULVERT IN LIEU OF THE CAST-IN-PLACE CULVERT SHOWN ON THE PLANS. THE DESIGN SHALL PROVIDE THE SAME SIZE AND NUMBER OF BARRELS AS USED ON THE CAST-IN-PLACE DESIGN. FOR OPTIONAL PRECAST REINFORCED CONCRETE BOX CULVERT, SEE SPECIAL PROVISIONS.

THE CONTRACTOR SHALL PROVIDE INDEPENDENT ASSURANCE SAMPLES OF REINFORCING STEEL AS FOLLOWS: FOR PROJECTS REQUIRING UP TO 400 TONS OF REINFORCING STEEL, ONE 30 INCH SAMPLE OF EACH SIZE BAR USED, AND FOR PROJECTS REQUIRING OVER 400 TONS OF REINFORCING STEEL, TWO 30 INCH SAMPLES OF EACH SIZE BAR USED. THE SAMPLE BARS SHOULD COME FROM STEEL ACTUALLY USED IN THE PROJECT AND THE SAMPLE BARS SHOULD BE REPLACED BY SPLICED BARS AS SPECIFIED IN THE SAMPLE BAR REPLACEMENT CHART. PAYMENT FOR THE SAMPLE BARS AND REPLACEMENT REINFORCING STEEL SHALL BE CONSIDERED INCIDENTAL TO VARIOUS PAY ITEMS.

SAMPLE BAR REPLACEMENT					
SIZE	LENGTH	SIZE	LENGTH	SIZE	LENGTH
#3	6'-2"	#6	9'-8"	#9	13'-2"
#4	7'-4"	#7	10'-10"	#10	14'-6"
#5	8'-6"	#8	12'-0"	#11	15'-10"

NOTE: SAMPLE BAR REPLACEMENT LENGTHS BASED ON 30" (SAMPLE LENGTH) PLUS TWO SPLICE LENGTHS AND  $f_y = 60\text{ksi}$

TOTAL STRUCTURE QUANTITIES	
REMOVAL OF EXISTING STRUCTURE LUMP SUM	
ASBESTOS ASSESSMENT LUMP SUM	
CULVERT EXCAVATION LUMP SUM	
FOUNDATION CONDITIONING MATERIAL	366 TONS
CLASS A CONCRETE	
BARREL @ 2.28 CY/FT	493.6 C.Y.
WINGS, SILLS, ETC.	37.6 C.Y.
TOTAL	531.2 C.Y.
REINFORCING STEEL	
BARREL	68,821 LBS.
WINGS ETC.	2,148 LBS.
TOTAL	70,969 LBS.
CLASS I RIP RAP	334 TONS
GEOTEXTILE FOR DRAINAGE	564 SY

HYDRAULIC DATA

DESIGN DISCHARGE	= 1200	CFS
FREQUENCY OF DESIGN DISCHARGE	= 50	YRS
DESIGN HIGH WATER ELEVATION	= 820.3	FT
DRAINAGE AREA	= 1.6	SQ MI
BASE DISCHARGE (Q100)	= 1300	CFS
BASE HIGH WATER ELEVATION	= 821.2	FT


OVERTOPPING DATA

OVERTOPPING DISCHARGE *	= 1500	CFS
FREQUENCY OF OVERTOPPING	= 500 (+)	YRS
OVERTOPPING ELEVATION	= 825.0	FT

\* AT LOW SIDE SUPER EDGE OF PAVEMENT AT SAG -L- STA. 31+50

PROJECT NO. U-2579AA  
 FORSYTH COUNTY  
 STATION: 32+77.50 -L-

SHEET 1 OF 6 CULVERT #59

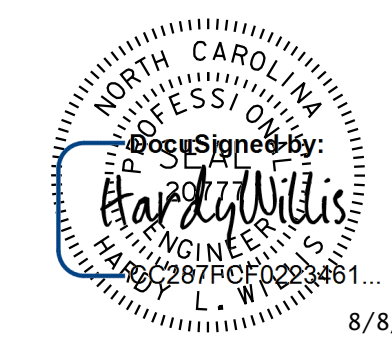


DOCUMENT NOT CONSIDERED FINAL UNLESS ALL SIGNATURES COMPLETED

DSG. ENG. OF RECORD: CMG  
 DWN. BY: WDC DATE: 12/18  
 CHKD. BY: HLW DATE: 12/18

STATE OF NORTH CAROLINA  
 DEPARTMENT OF TRANSPORTATION  
 RALEIGH  
 DOUBLE 9FT. X 9FT.  
 CONCRETE BOX CULVERT  
 60° SKEW  
 ON I-74/US-311 BETWEEN  
 SR 1003 & SR 2643

REVISIONS						SHEET NO.
NO.	BY:	DATE:	NO.	BY:	DATE:	C1-1
1			3			TOTAL SHEETS
2			4			6

I HEREBY CERTIFY THESE PLANS ARE THE AS-BUILT PLANS

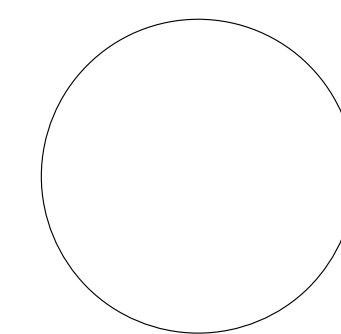

**V&M**  
 Vaughn & Melton  
 Consulting Engineers  
 Asheville, North Carolina  
 828-253-2796

- Boone, NC 828-355-9933
- Tri-Cities, TN 423-467-9400
- Knoxville, TN 865-546-5800
- Spartanburg, SC 864-574-4775
- Charleston, SC 843-974-5660
- Middlesboro, KY 606-248-6600
- Raleigh, NC 919-977-9455
- Charlotte, NC 704-357-0488
- Atlanta, GA 770-621-3590

Copyright © 2006 Vaughn & Melton, Inc. All Rights Reserved.

LOAD AND RESISTANCE FACTOR RATING (LRFR)  
SUMMARY FOR REINFORCED CONCRETE BOX CULVERTS

LEVEL	VEHICLE	WEIGHT (W) (TONS)	CONTROLLING LOAD RATING #	MINIMUM RATING FACTORS (RF)	TONS = W x RF	STRENGTH I LIMIT STATE								COMMENT NUMBER		
						MOMENT				SHEAR						
						LIVE-LOAD FACTORS (γ <sub>LL</sub> )	RATING FACTOR	BOX NO.	ELEMENT TYPE	DISTANCE FROM LEFT END OF ELEMENT (ft)	RATING FACTOR	BOX NO.	ELEMENT TYPE		DISTANCE FROM LEFT END OF ELEMENT (ft)	
DESIGN LOAD RATING	HL-93 (INVENTORY)	N/A	①	1.06	--	1.75	1.40	1	BOTTOM SLAB	9.33'	1.06	1	EXT. WALL	1.56'		
	HL-93 (OPERATING)	N/A		1.37	--	1.35	1.82	1	BOTTOM SLAB	9.33'	1.37	1	EXT. WALL	1.56'		
	HS-20 (INVENTORY)	36.000	②	1.06	38,160	1.75	1.46	1	BOTTOM SLAB	9.33'	1.06	1	EXT. WALL	1.56'		
	HS-20 (OPERATING)	36.000		1.37	49,320	1.35	1.89	1	BOTTOM SLAB	9.33'	1.37	1	EXT. WALL	1.56'		
LEGAL LOAD RATING	SINGLE VEHICLE (SV)	SNSH		1.36	18,360	1.40	3.41	1	BOTTOM SLAB	9.33'	1.36	1	EXT. WALL	1.56'		
		SNGARBS2	20,000		1.35	27,000	1.40	3.19	1	BOTTOM SLAB	9.33'	1.35	1	EXT. WALL	1.56'	
		SNAGRIS2	22,000		1.35	29,700	1.40	3.19	1	BOTTOM SLAB	9.33'	1.35	1	EXT. WALL	1.56'	
		SNCOTTS3	27,250	③	1.32	35,970	1.40	1.81	1	BOTTOM SLAB	9.33'	1.32	1	EXT. WALL	1.56'	
		SNAGGRS4	34,925		1.34	46,800	1.40	2.38	1	BOTTOM SLAB	9.33'	1.34	1	EXT. WALL	1.56'	
		SNS5A	35,550		1.35	47,993	1.40	3.06	1	BOTTOM SLAB	9.33'	1.35	1	EXT. WALL	1.56'	
		SNS6A	39,950		1.35	53,933	1.40	3.05	1	BOTTOM SLAB	9.33'	1.35	1	EXT. WALL	1.56'	
		SNS7B	42,000		1.33	55,860	1.40	2.15	1	BOTTOM SLAB	9.33'	1.33	1	EXT. WALL	1.56'	
	TRUCK TRACTOR SEMI-TRAILER (TTST)	TNAGRIT3	33,000		1.34	44,220	1.40	2.62	1	BOTTOM SLAB	9.33'	1.34	1	EXT. WALL	1.56'	
		TNT4A	33,075		1.33	43,990	1.40	2.15	1	BOTTOM SLAB	9.33'	1.33	1	EXT. WALL	1.56'	
		TNT6A	41,600		1.33	55,328	1.40	2.15	1	BOTTOM SLAB	9.33'	1.33	1	EXT. WALL	1.56'	
		TNT7A	42,000		1.35	56,700	1.40	3.35	1	BOTTOM SLAB	9.33'	1.35	1	EXT. WALL	1.56'	
		TNT7B	42,000		1.33	55,860	1.40	2.15	1	BOTTOM SLAB	9.33'	1.33	1	EXT. WALL	1.56'	
		TNAGRIT4	43,000		1.33	57,190	1.40	2.15	1	BOTTOM SLAB	9.33'	1.33	1	EXT. WALL	1.56'	
TNAGT5A	45,000		1.33	59,850	1.40	2.15	1	BOTTOM SLAB	9.33'	1.33	1	EXT. WALL	1.56'			
TNAGT5B	45,000		1.33	59,850	1.40	2.15	1	BOTTOM SLAB	9.33'	1.33	1	EXT. WALL	1.56'			

LOAD FACTORS:

DESIGN LOAD RATING FACTORS

LOAD TYPE	MAX FACTOR	MIN FACTOR
DC	1.25	0.90
DW	1.50	0.65
EV	1.30	0.90
EH	1.35	0.90
ES	1.35	0.90
LS	1.75	--
WA	1.00	--


NOTE:

RATING FACTORS ARE BASED ON THE STRENGTH I LIMIT STATE.

COMMENTS:

- 
- 
- 
- 

①	CONTROLLING LOAD RATING
①	DESIGN LOAD RATING (HL-93)
②	DESIGN LOAD RATING (HS-20)
③	LEGAL LOAD RATING **
** SEE CHART FOR VEHICLE TYPE	

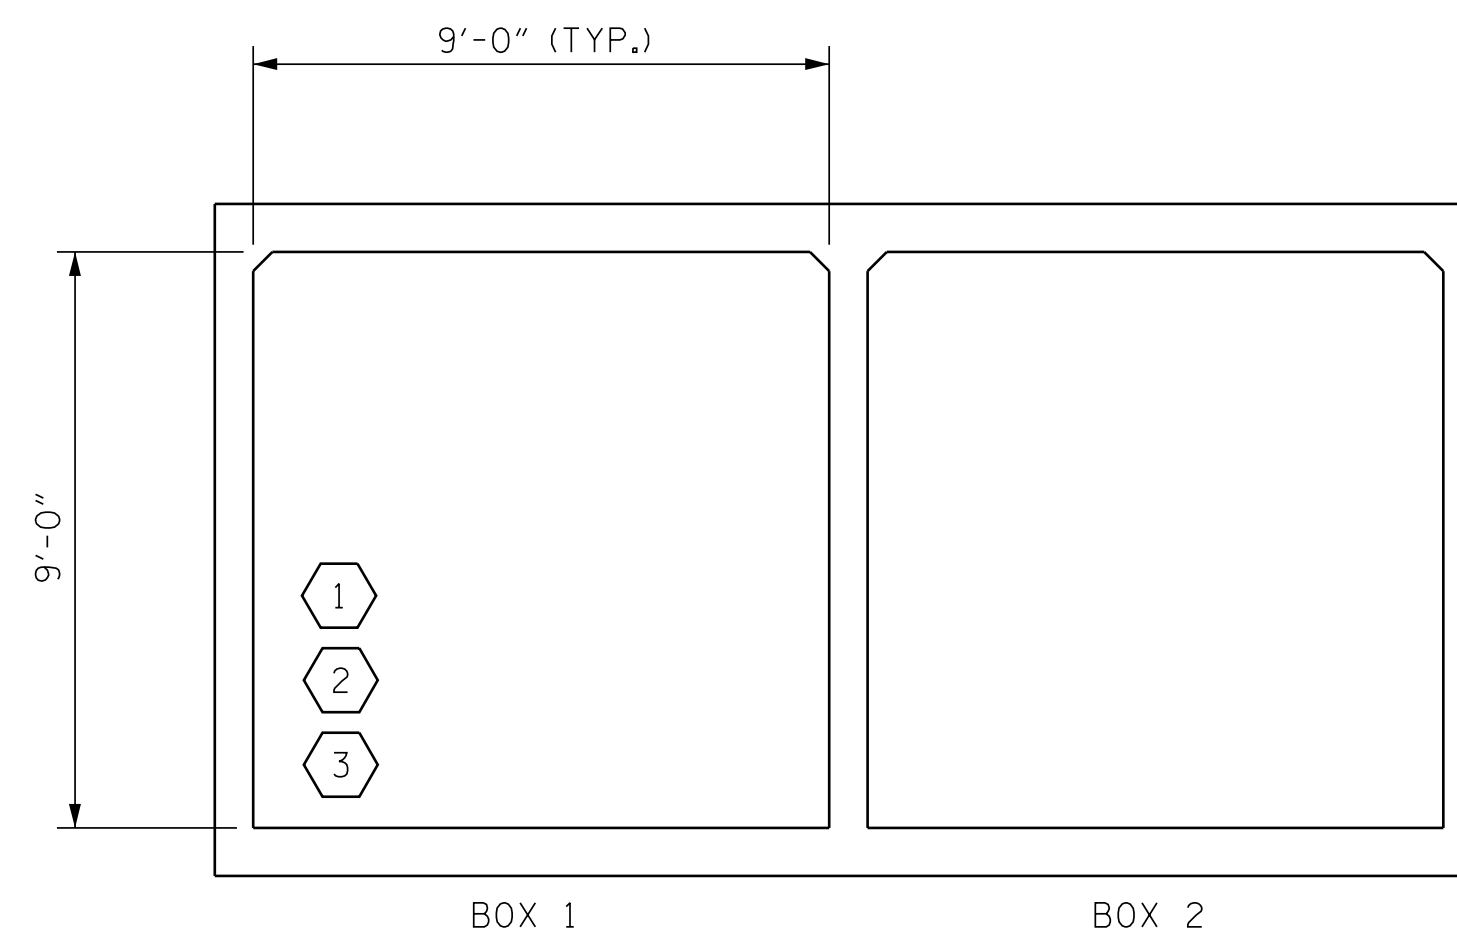

LRFR SUMMARY  
(LOOKING DOWNSTREAM)



7/25/2022

DOCUMENT NOT CONSIDERED  
FINAL UNLESS ALL  
SIGNATURES COMPLETED

PROJECT NO. U-2579AA  
FORSYTH COUNTY  
STATION: 32+77.50 -L-

SHEET 2 OF 6

**V&M**  
Vaughn & Melton  
Consulting Engineers  
Asheville, North Carolina  
828-253-2796

Boone, NC 828-355-9933  
Tri-Cities, TN 423-467-8401  
Knoxville, TN 865-546-5800  
Spartanburg, SC 864-574-4775  
Charleston, SC 843-974-5650  
Middlesboro, KY 606-248-6600  
Raleigh, NC 919-977-9455  
Charlotte, NC 704-357-0488  
Atlanta, GA 770-627-3590


Copyright © 2006 Vaughn & Melton, Inc. All Rights Reserved.

STATE OF NORTH CAROLINA  
DEPARTMENT OF TRANSPORTATION  
RALEIGH  
STANDARD  
LRFR SUMMARY FOR  
REINFORCED CONCRETE  
BOX CULVERTS  
(NON-INTERSTATE TRAFFIC)


DRAWN BY: WMC 7/II  
CHECKED BY: GM 7/II  
REV. 10/1/11 MAA/GM  
REV. 12/17 MAA/THC

DSG. ENG. OF RECORD.: CMG	REVISIONS						SHEET NO.
DWN. BY: WDC	NO.	BY:	DATE:	NO.	BY:	DATE:	C1-2
CHKD. BY: HLW	1			3			TOTAL SHEETS
	2			4			6


STD. NO. LRFR5

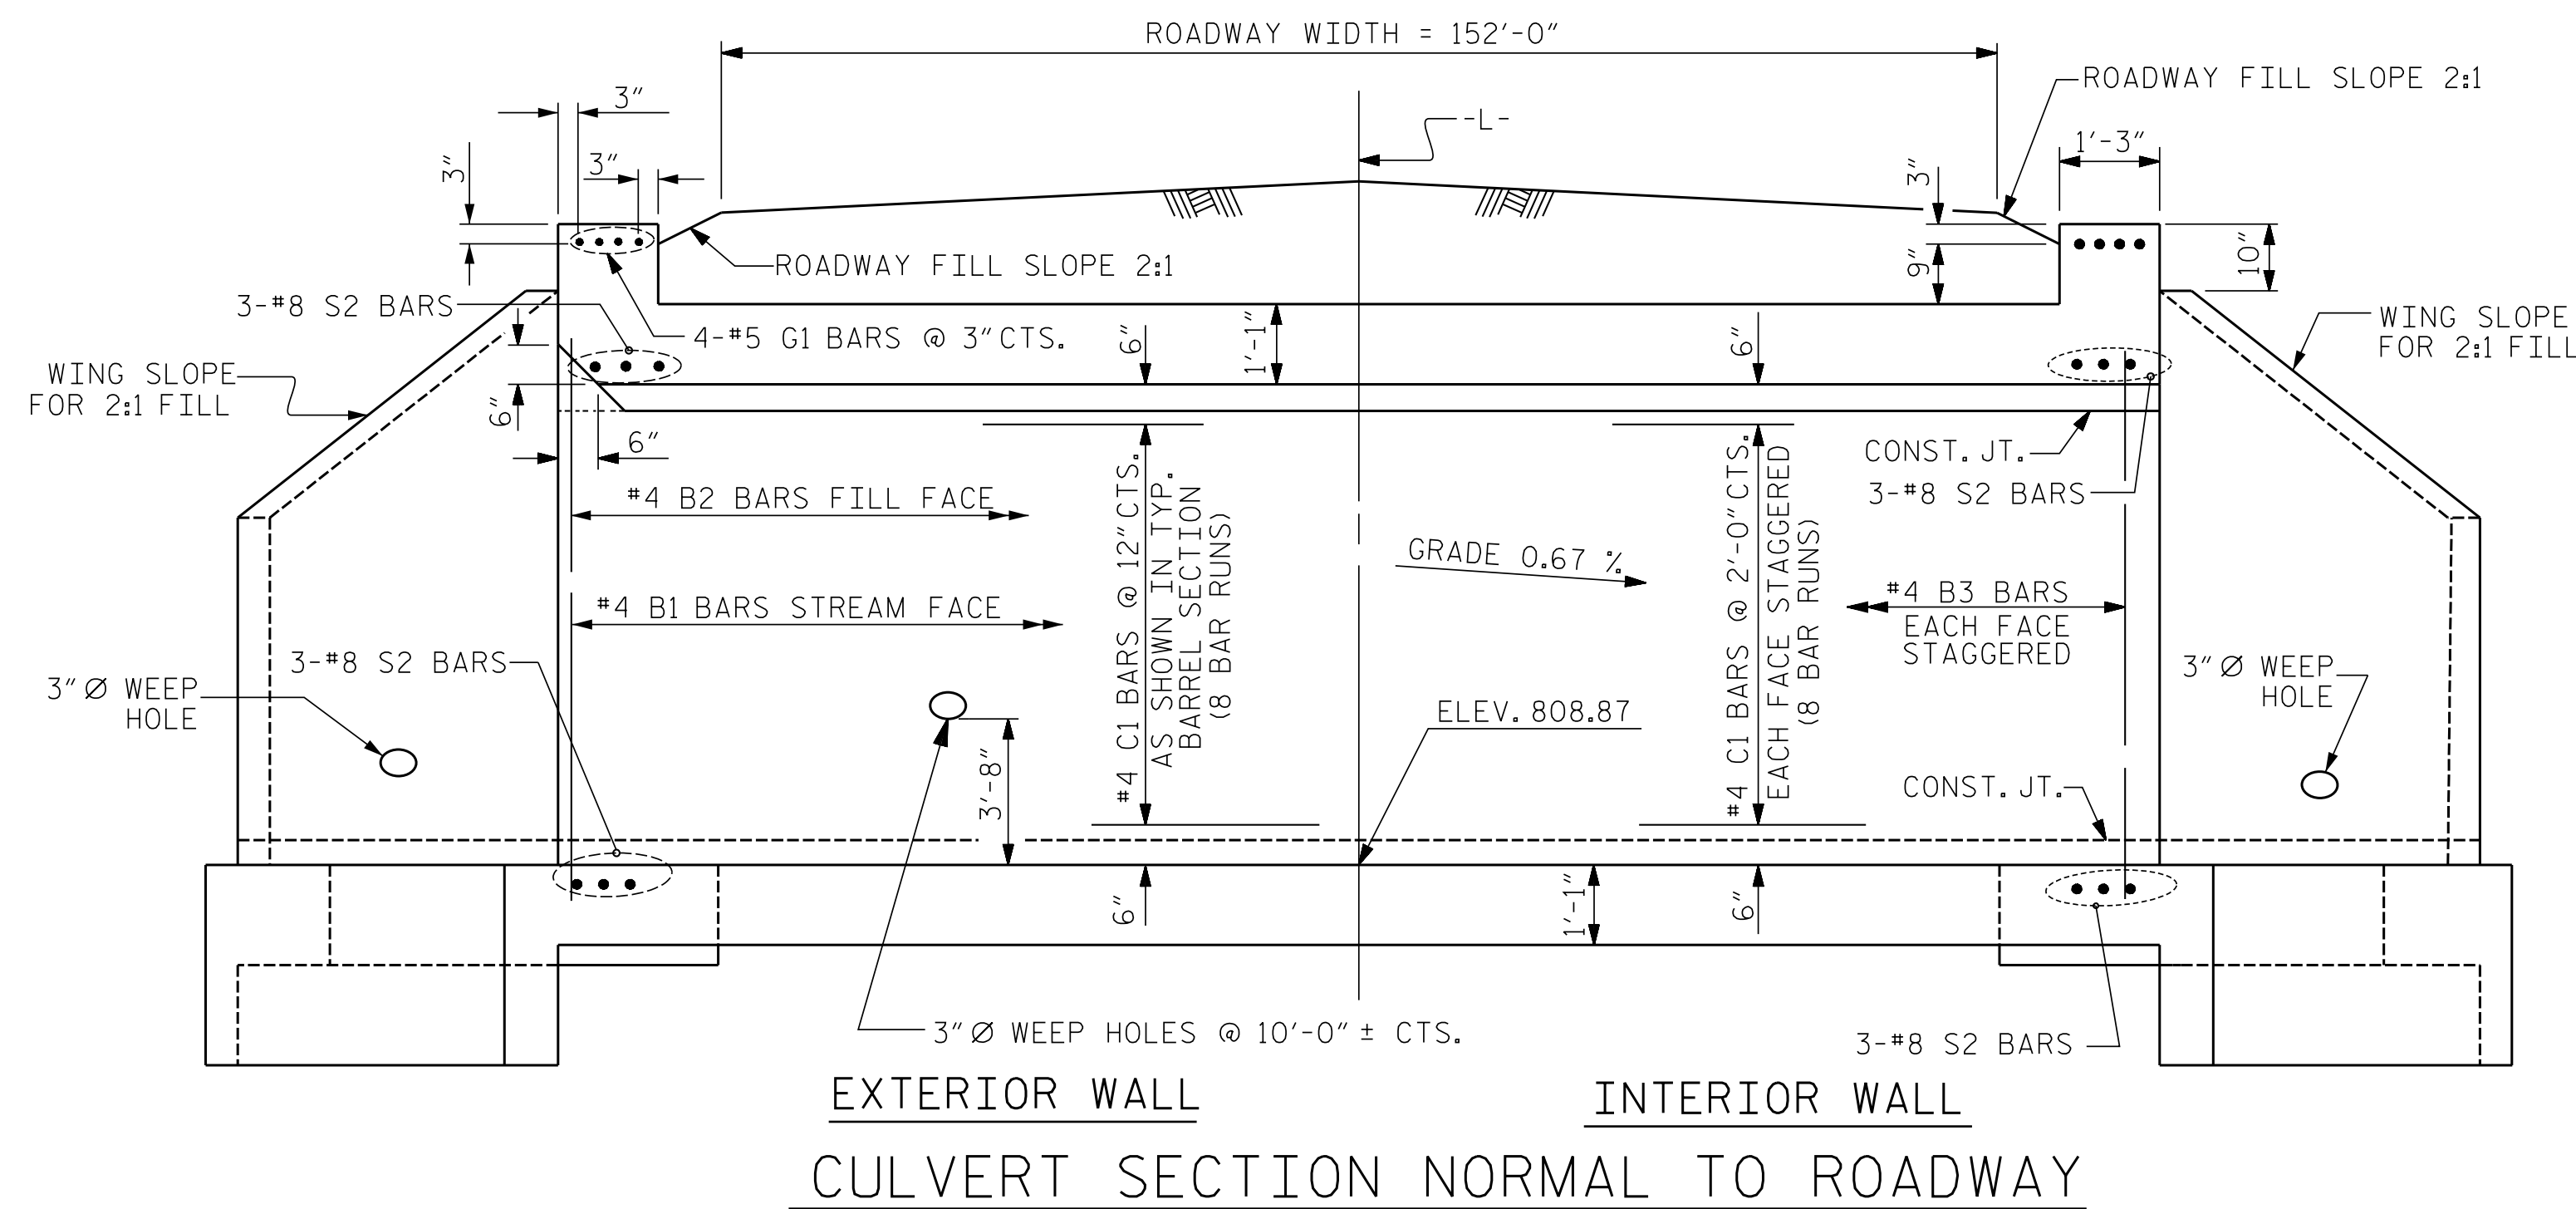

EXTERIOR WALL INTERIOR WALL  
CULVERT SECTION NORMAL TO ROADWAY

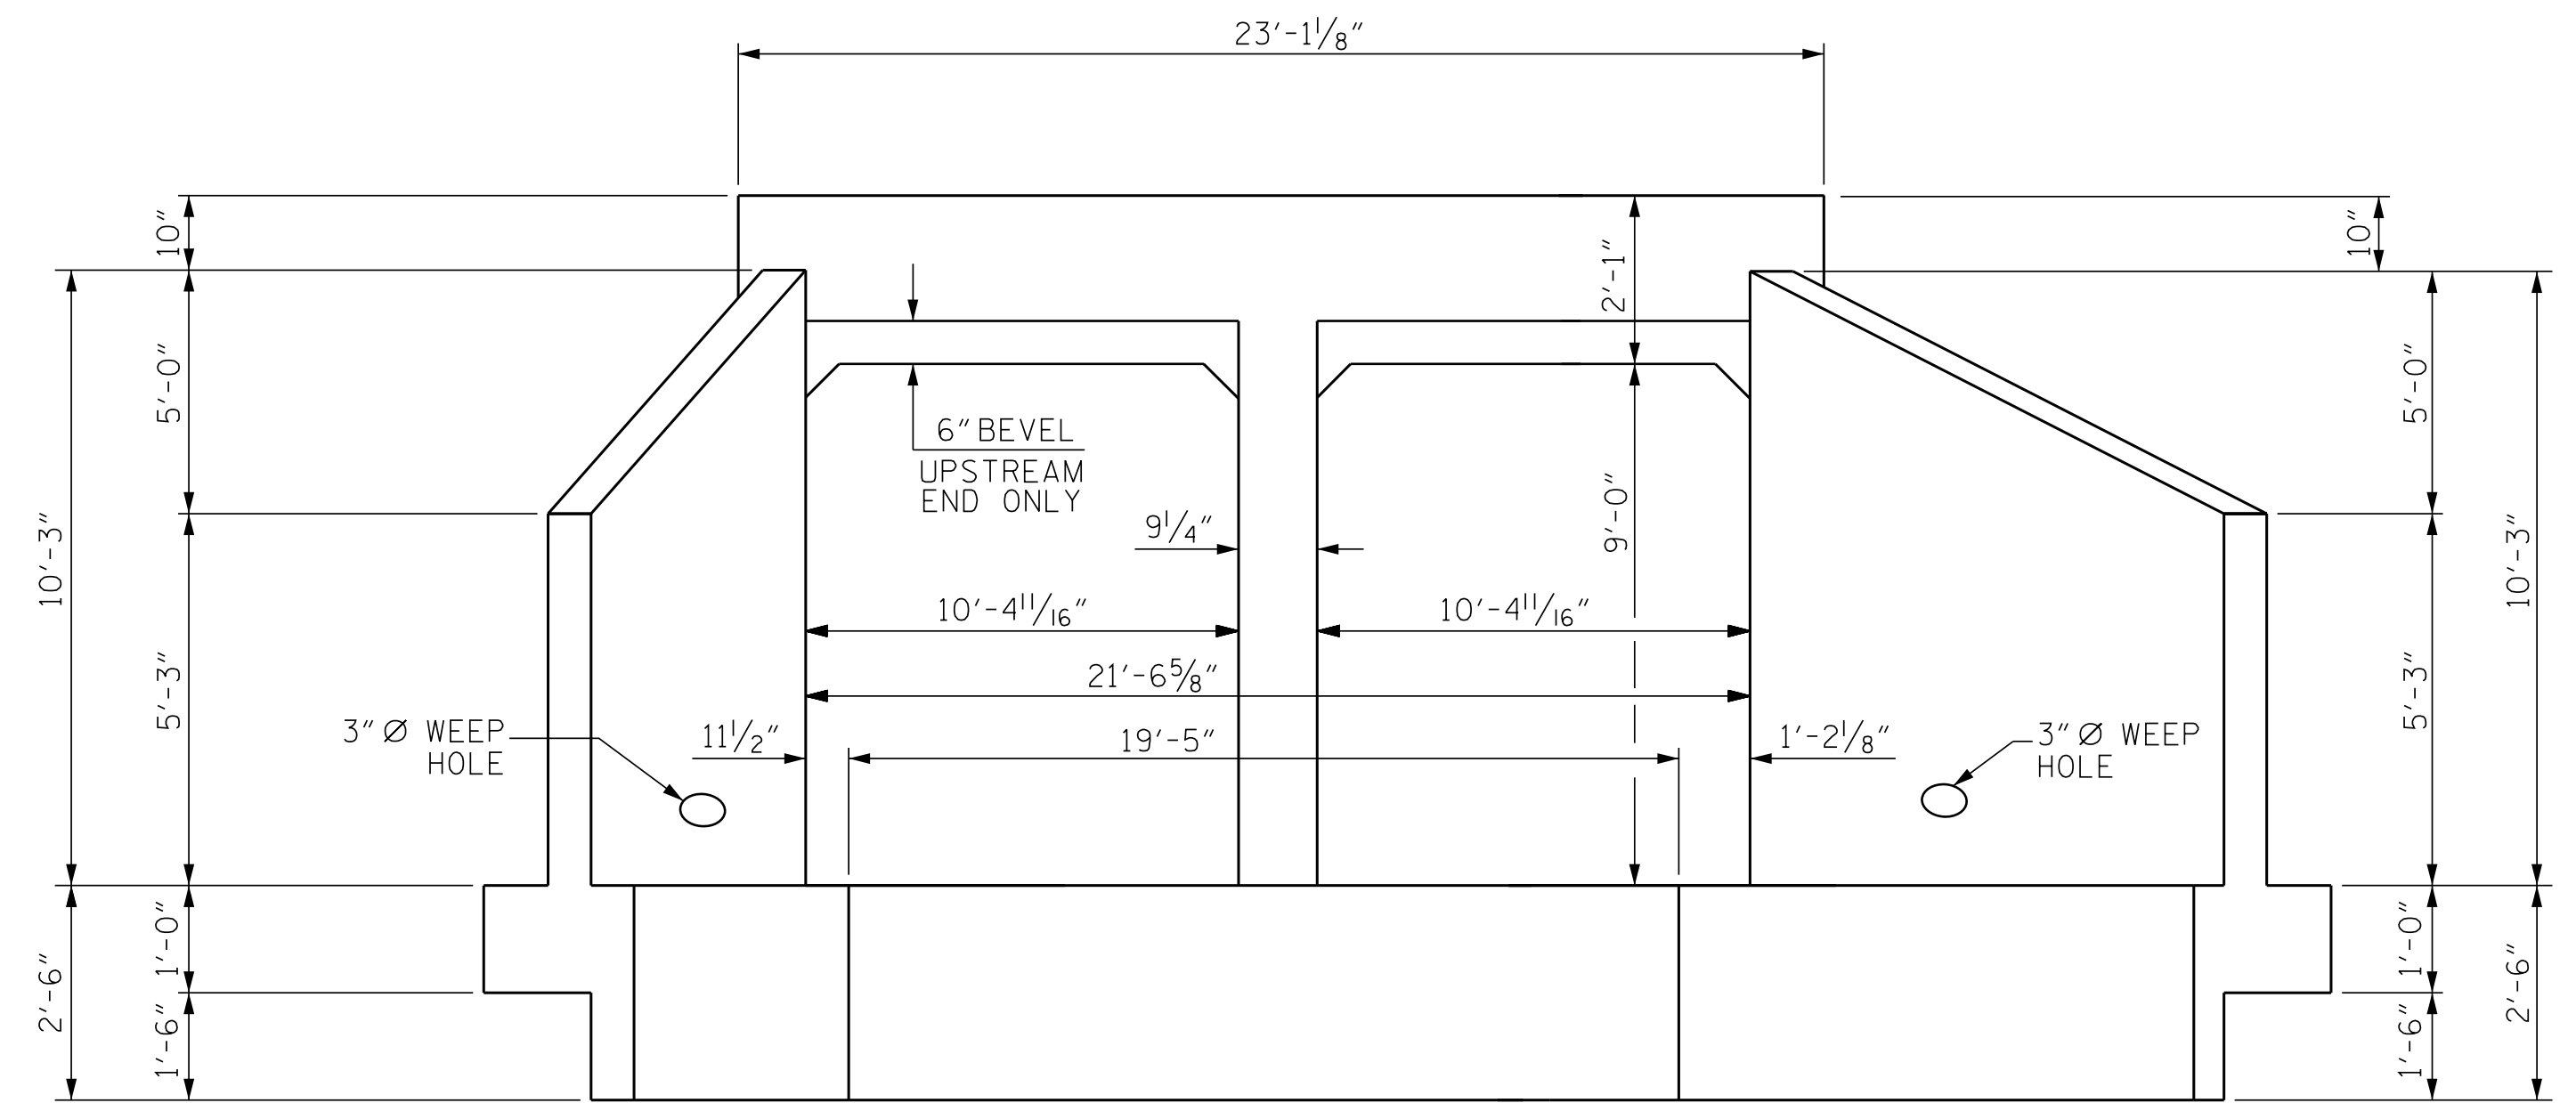



END ELEVATION NORMAL TO SKEW

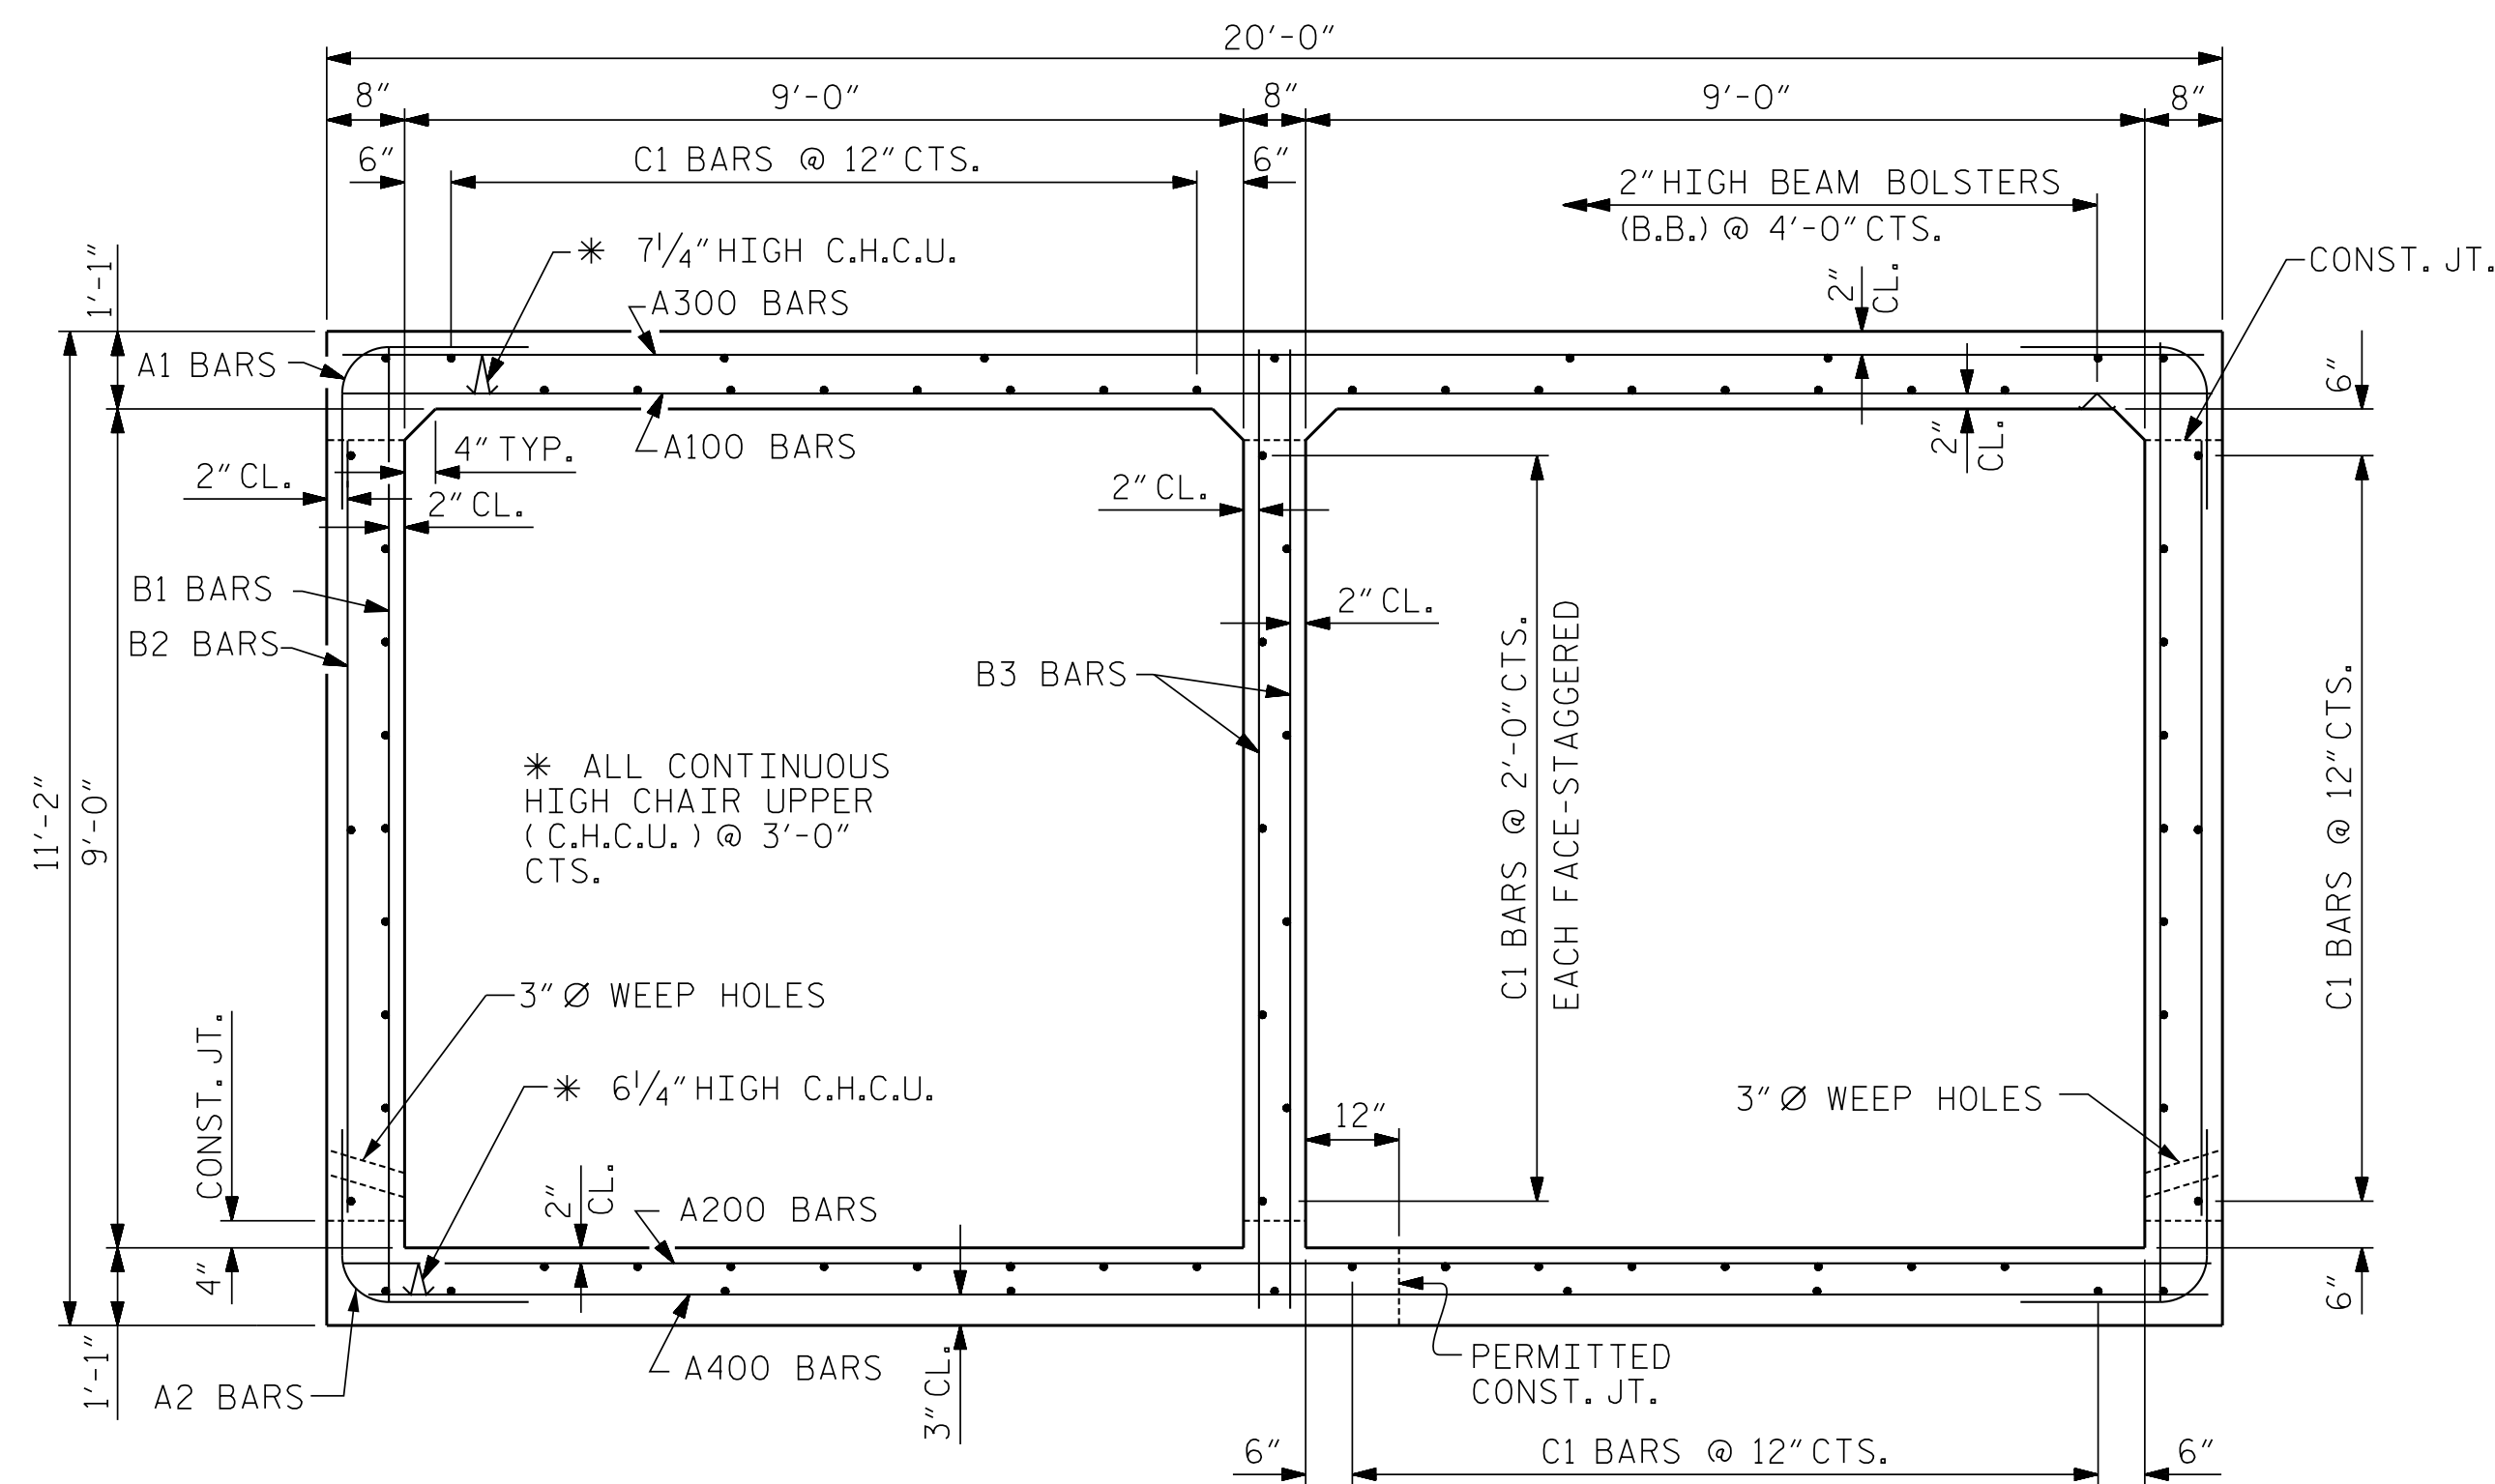


RIGHT ANGLE SECTION OF BARREL

THERE ARE 79 "C" BARS IN SECTION OF BARREL.  
(8 BAR RUNS)

I HEREBY CERTIFY THESE  
PLANS ARE THE AS-BUILT PLANS

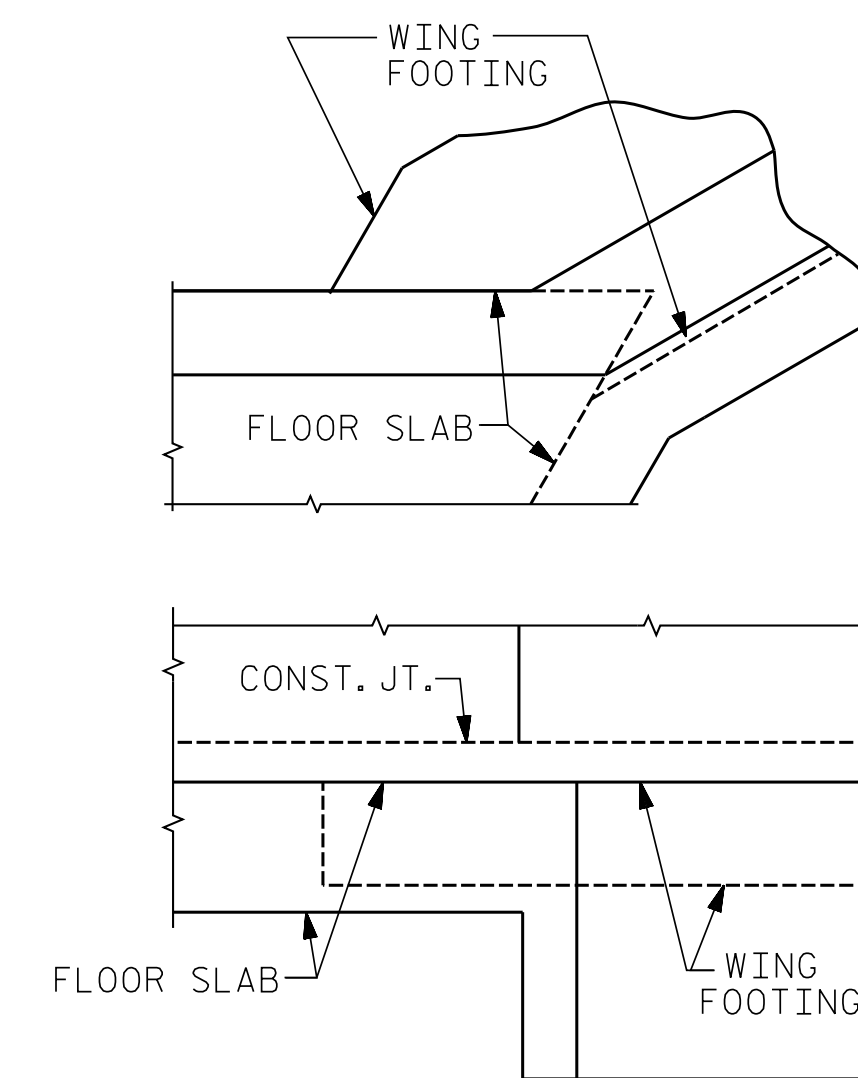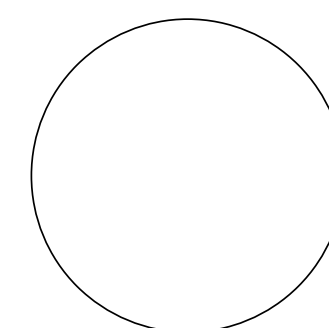

CONNECTION OF WING FOOTING  
AND FLOOR SLAB WHEN SLAB  
IS THICKER THAN FOOTING

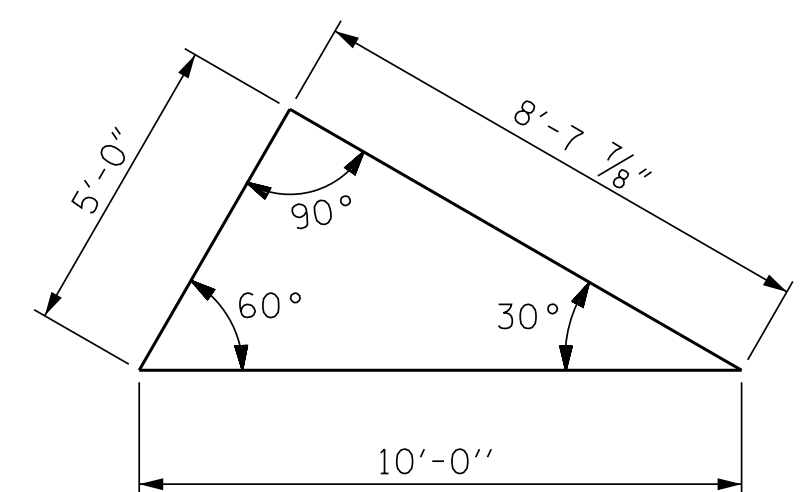

SKEW TRIANGLE


PROJECT NO. U-2579AA

FORSYTH COUNTY

STATION: 32+77.50 -L-

SHEET 3 OF 6

STATE OF NORTH CAROLINA  
DEPARTMENT OF TRANSPORTATION  
RALEIGH  
BARREL STANDARD  
DOUBLE 9FT. X 9FT.  
CONCRETE BOX CULVERT  
60° SKEW

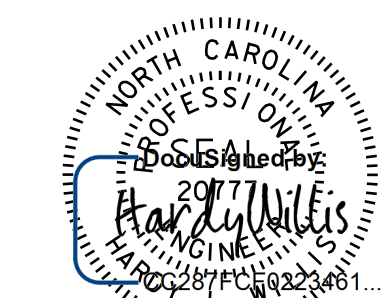

DOCUMENT NOT CONSIDERED  
FINAL UNLESS ALL  
SIGNATURES COMPLETED

**V&M**  
Vaughn & Melton  
Consulting Engineers  
Asheville,  
North Carolina  
828-253-2786

- Boone, NC 828-355-9933
- Tri-Cities, TN 423-467-8401
- Knoxville, TN 865-546-5800
- Spartanburg, SC 864-574-4775
- Charleston, SC 843-974-5650
- Middlesboro, KY 606-248-6500
- Atlanta, GA 770-627-3590
- Raleigh, NC 919-977-9455
- Charlotte, NC 704-357-0488

Copyright © 2006 Vaughn & Melton, Inc. All Rights Reserved

DSG. ENG. OF RECORD.: CMG  
DWN. BY: WDC DATE: 12/18  
CHKD. BY: HLW DATE: 12/18


REVISIONS		SHEET NO.	
NO.	DATE	NO.	DATE
1	3	C1-3	
2	4	TOTAL SHEETS	6

DRAWN BY: B. WYNN/D. DONOVAN DATE: SEPT. 1990  
CHECKED BY: A.R. BISSETTE DATE: OCT. 90

STANDARD

STD. NO. CB32

BAR TYPE

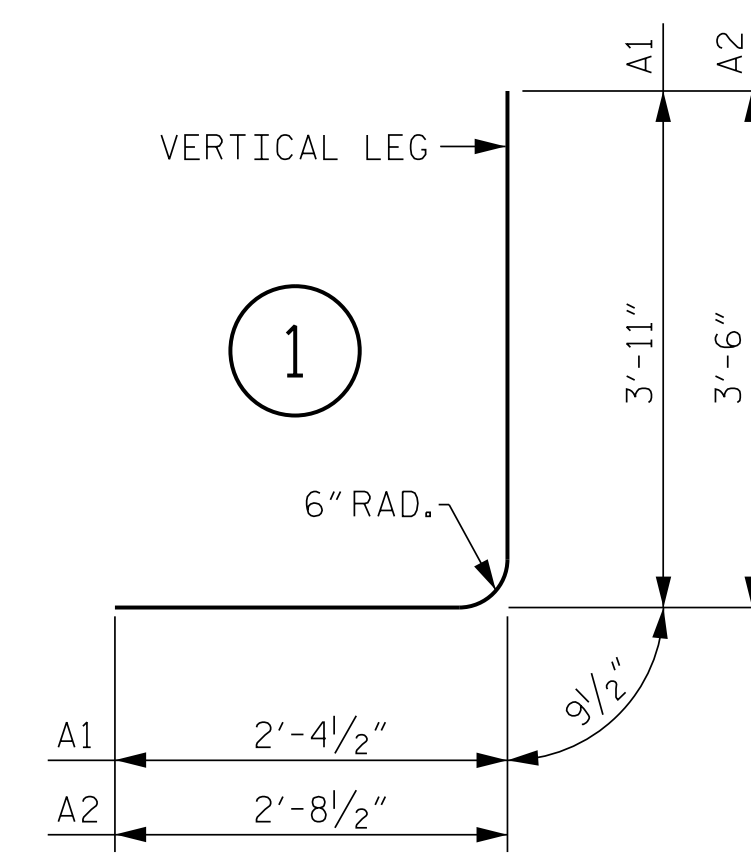


BAR DIMENSIONS ARE OUT TO OUT.

BILL OF MATERIAL

BAR	NO.	SIZE	TYPE	LENGTH	WEIGHT	BAR	NO.	SIZE	TYPE	LENGTH	WEIGHT
A1	574	6	①	7'-1"	6107	A300	273	6	STR.	19'-7"	8030
A2	574	6	①	6'-8"	5748	A301	2	6	STR.	19'-0"	57
						A302	2	6	STR.	17'-8"	53
A100	273	6	STR.	19'-7"	8030	A303	2	6	STR.	16'-5"	49
A101	2	6	STR.	19'-0"	57	A304	2	6	STR.	15'-1"	45
A102	2	6	STR.	17'-8"	53	A305	2	6	STR.	13'-9"	41
A103	2	6	STR.	16'-5"	49	A306	2	6	STR.	12'-6"	38
A104	2	6	STR.	15'-1"	45	A307	2	6	STR.	11'-2"	34
A105	2	6	STR.	13'-9"	41	A308	2	6	STR.	9'-11"	30
A106	2	6	STR.	12'-6"	38	A309	2	6	STR.	8'-7"	26
A107	2	6	STR.	11'-2"	34	A310	2	6	STR.	7'-4"	22
A108	2	6	STR.	9'-11"	30	A311	2	6	STR.	6'-0"	18
A109	2	6	STR.	8'-7"	26	A312	2	6	STR.	4'-8"	14
A110	2	6	STR.	7'-4"	22	A313	2	6	STR.	3'-5"	10
A111	2	6	STR.	6'-0"	18	A314	2	6	STR.	2'-1"	6
A112	2	6	STR.	4'-8"	14						
A113	2	6	STR.	3'-5"	10	A400	273	6	STR.	19'-7"	8030
A114	2	6	STR.	2'-1"	6	A401	2	6	STR.	19'-0"	57
						A402	2	6	STR.	17'-8"	53
A200	273	6	STR.	19'-7"	8030	A403	2	6	STR.	16'-5"	49
A201	2	6	STR.	19'-0"	57	A404	2	6	STR.	15'-1"	45
A202	2	6	STR.	17'-8"	53	A405	2	6	STR.	13'-9"	41
A203	2	6	STR.	16'-5"	49	A406	2	6	STR.	12'-6"	38
A204	2	6	STR.	15'-1"	45	A407	2	6	STR.	11'-2"	34
A205	2	6	STR.	13'-9"	41	A408	2	6	STR.	9'-11"	30
A206	2	6	STR.	12'-6"	38	A409	2	6	STR.	8'-7"	26
A207	2	6	STR.	11'-2"	34	A410	2	6	STR.	7'-4"	22
A208	2	6	STR.	9'-11"	30	A411	2	6	STR.	6'-0"	18
A209	2	6	STR.	8'-7"	26	A412	2	6	STR.	4'-8"	14
A210	2	6	STR.	7'-4"	22	A413	2	6	STR.	3'-5"	10
A211	2	6	STR.	6'-0"	18	A414	2	6	STR.	2'-1"	6
A212	2	6	STR.	4'-8"	14						
A213	2	6	STR.	3'-5"	10	B1	574	4	STR.	9'-6"	3643
A214	2	6	STR.	2'-1"	6	B2	574	4	STR.	8'-8"	3323
						B3	434	4	STR.	10'-8"	3092
						C1	632	4	STR.	28'-7"	12067
						D1	8	6	STR.	2'-6"	30
						G1	8	5	STR.	22'-9"	190
						S2	12	8	STR.	22'-9"	729

SPLICE LENGTH CHART

BAR	SIZE	SPLICE LENGTH
C1	#4	1'-9"
A200 A400	#6	2'-9"

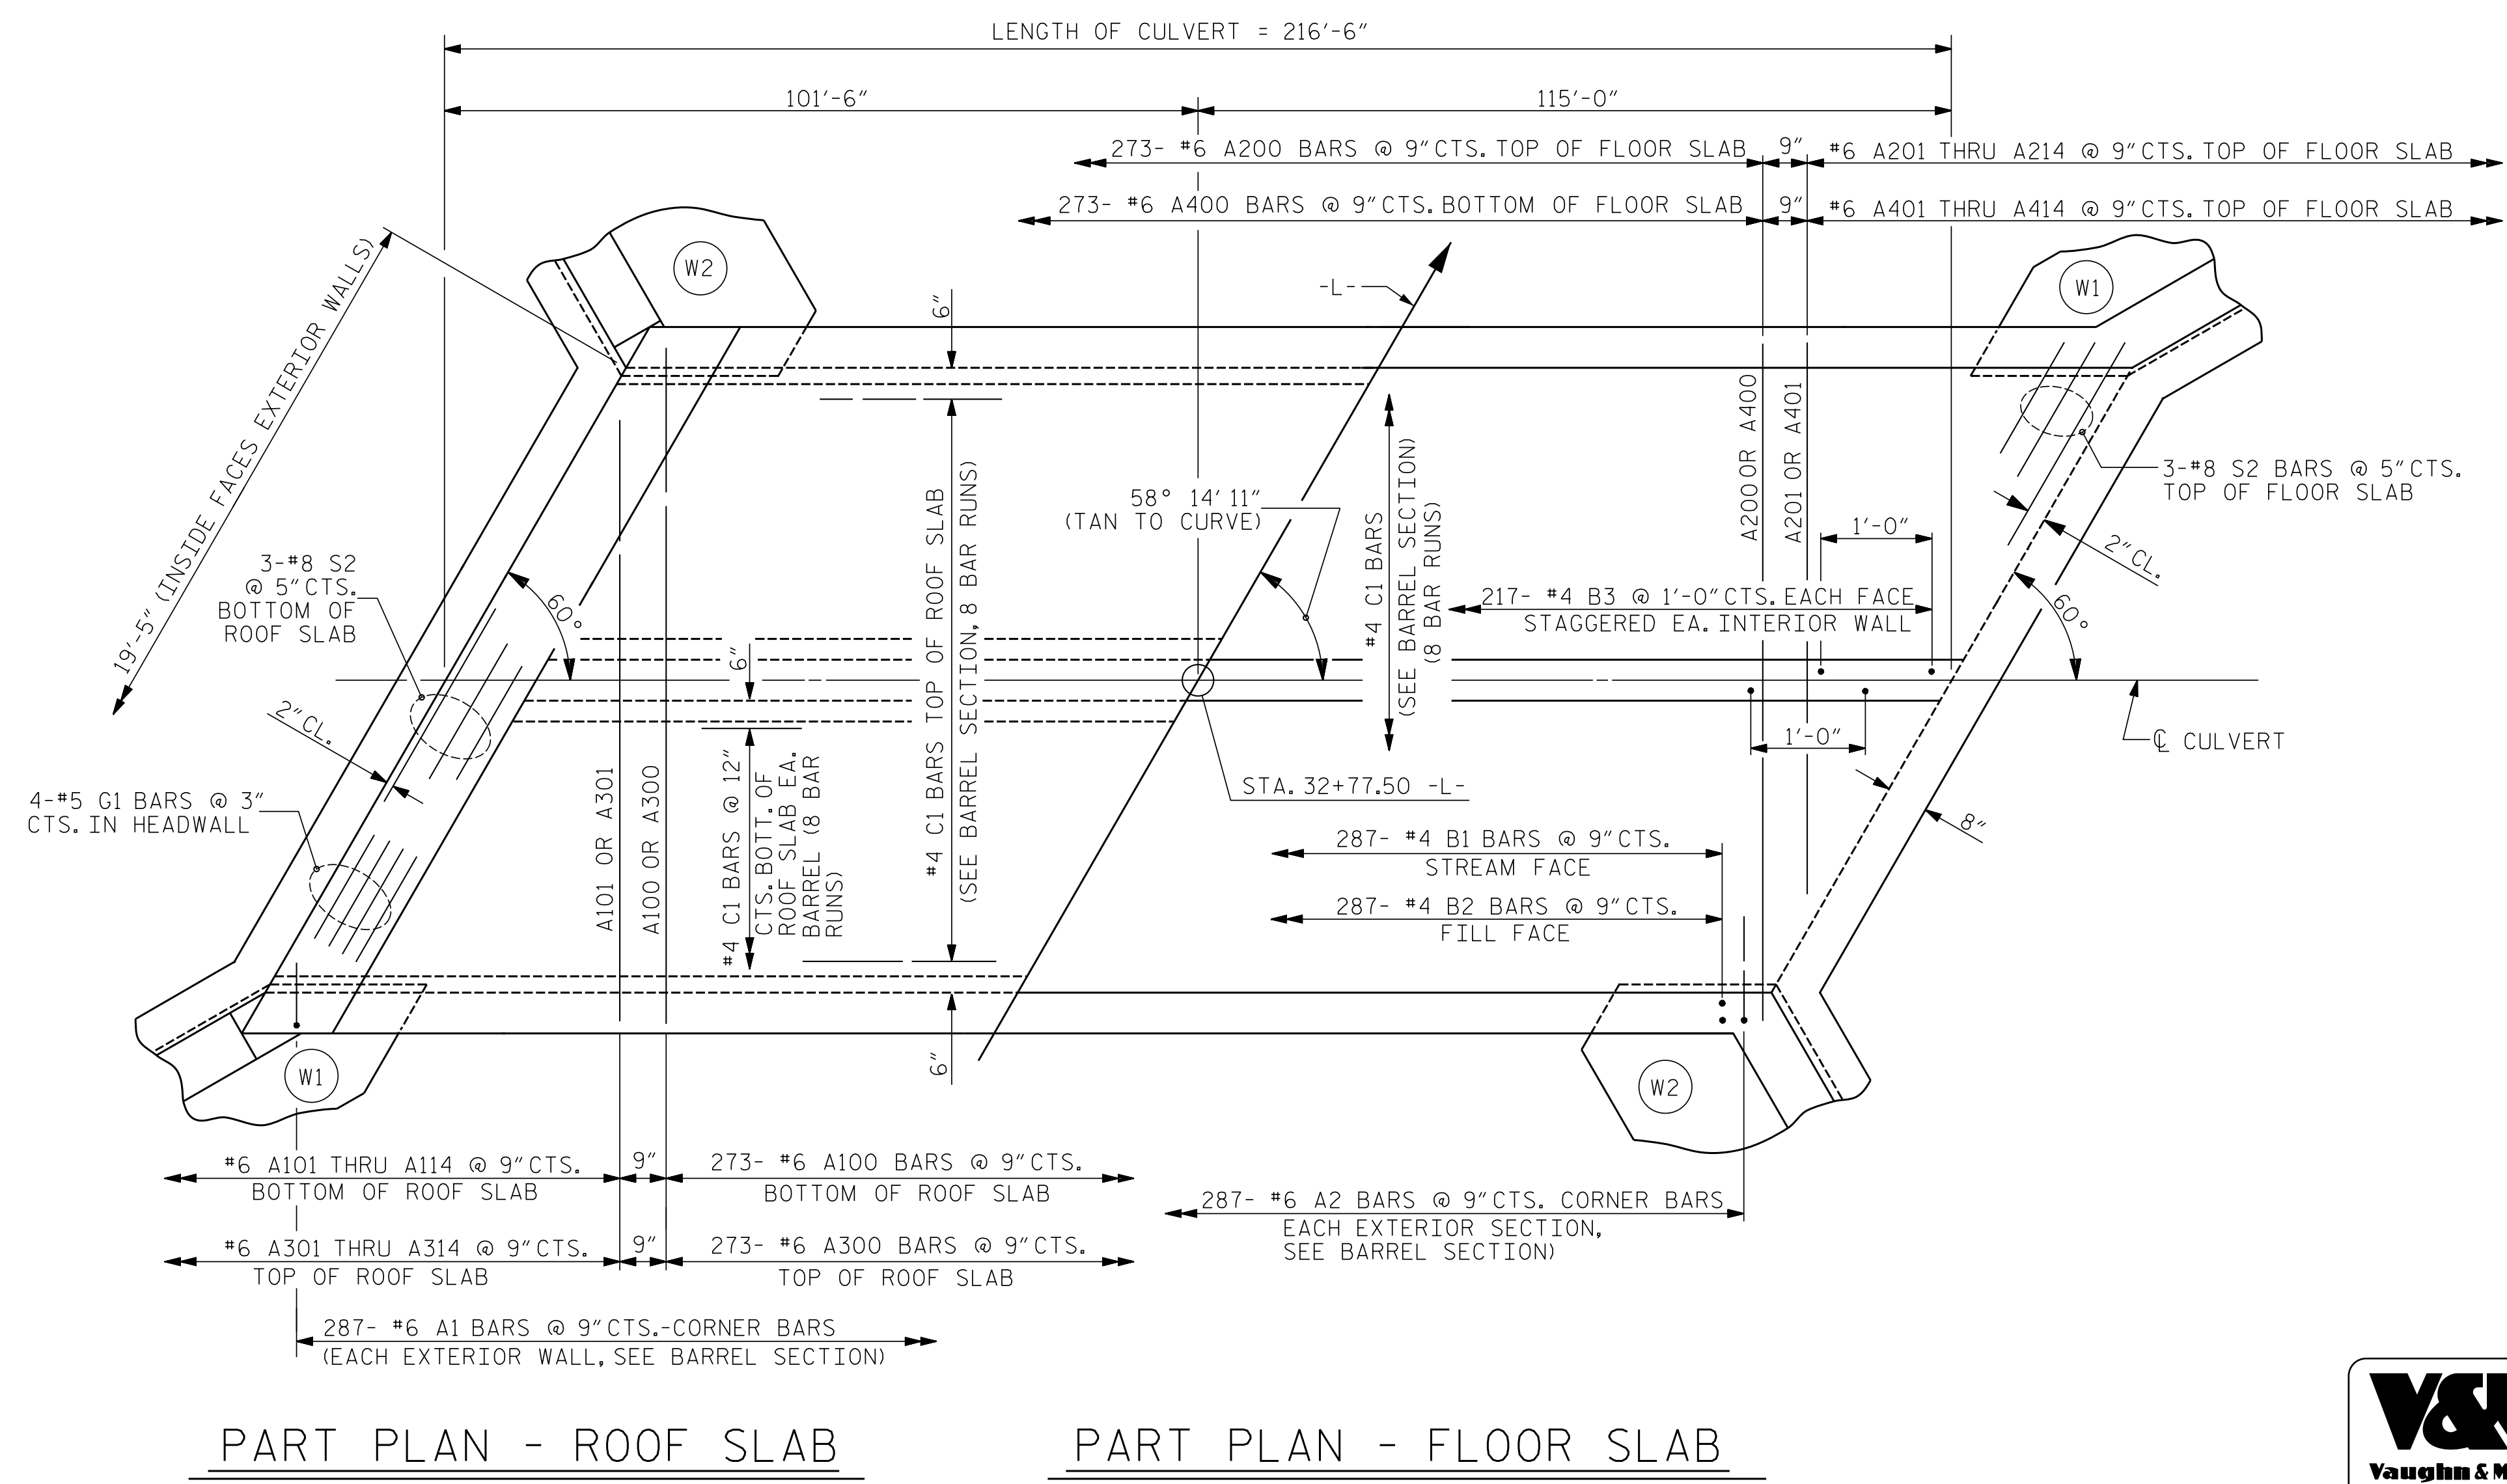

PART PLAN - ROOF SLAB

PART PLAN - FLOOR SLAB

PROJECT NO. U-2579AA  
 FORSYTH COUNTY  
 STATION: 32+77.50 -L-

SHEET 4 OF 6

STATE OF NORTH CAROLINA  
 DEPARTMENT OF TRANSPORTATION  
 RALEIGH  
 BARREL STANDARD  
 DOUBLE 9FT. X 9FT.  
 CONCRETE BOX CULVERT  
 60° SKEW



DOCUMENT NOT CONSIDERED  
 FINAL UNLESS ALL  
 SIGNATURES COMPLETED

**V&M**  
 Vaughn & Melton  
 Consulting Engineers  
 Asheville, North Carolina  
 828-253-2786

- Boone, NC 828-355-9933
- Tri-Cities, TN 423-467-8401
- Knoxville, TN 865-546-5800
- Spartanburg, SC 864-574-4775
- Charleston, SC 843-974-5650
- Middlesboro, KY 606-248-6500
- Atlanta, GA 770-627-3590


Copyright © 2006 Vaughn & Melton, Inc. All Rights Reserved

DSG. ENG. OF RECORD.: CMG  
 DWN. BY: WDC DATE: 12/18  
 CHKD. BY: HLW DATE: 12/18

REVISIONS				SHEET NO.
NO.	BY:	DATE:	NO.	DATE:
1			3	
2			4	

C1-4  
 TOTAL SHEETS: 6


DRAWN BY: B. WYNN/D. DONOVAN DATE: SEPT. 1990  
 CHECKED BY: A.R. BISSETTE DATE: OCT. 90  
 STANDARD

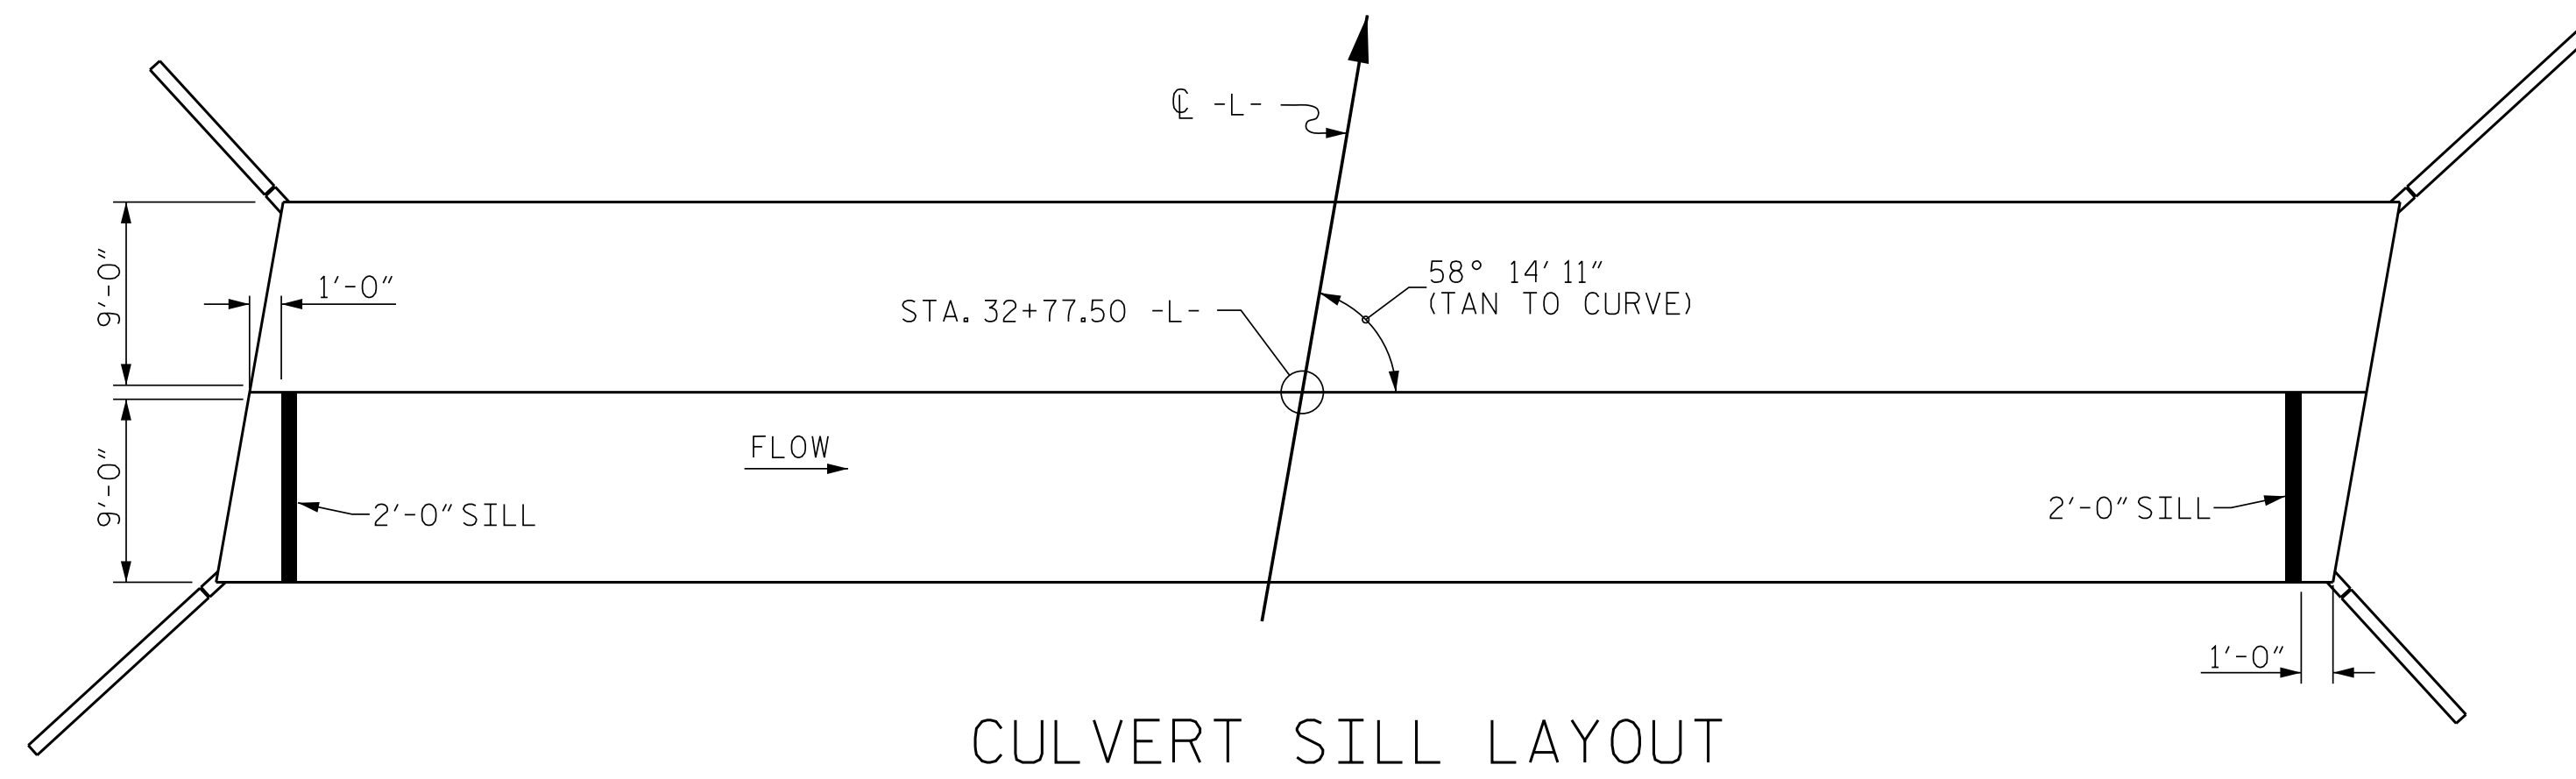

CULVERT SILL LAYOUT


**NOTES:**

- 1) NATIVE MATERIAL BETWEEN SILLS/BAFFLES IN THE CULVERT SHALL PROVIDE A CONTINUOUS LOW FLOW CHANNEL. NATIVE MATERIAL CONSISTS OF MATERIAL THAT IS EXCAVATED FROM THE STREAM OR FLOODPLAIN AT THE PROJECT SITE DURING CONSTRUCTION. ONLY MATERIAL THAT IS EXCAVATED FROM THE STREAM BED MAY BE USED TO LINE THE LOW FLOW CULVERT BARREL. RIP-RAP MAY BE USED TO SUPPLEMENT THE NATIVE MATERIAL IN THE HIGH FLOW CULVERT BARREL. IF RIP-RAP IS USED TO LINE THE HIGH FLOW CULVERT BARREL, NATIVE MATERIAL SHOULD BE PLACED ON TOP TO FILL VOIDS AND PROVIDE A FLAT SURFACE FOR ANIMAL PASSAGE. NATIVE MATERIAL IS SUBJECT TO APPROVAL BY THE ENGINEER AND MAY BE SUBJECT TO PERMIT CONDITIONS.
- 2) SILLS ARE TO BE 1.0 FT. WIDE, CAST SEPARATELY AND ATTACHED BY DOWELS.
- 3) TOP OF LOW FLOW SILLS SHOULD MATCH STREAM BED ELEVATION IN LOW FLOW CHANNEL OF STREAM. (THALWEG)
- 4) DO NOT SET ELEVATION OF HIGH SILLS ABOVE BANK FULL.
- 5) NUMBER OF SILLS DETERMINED BY THE ENGINEER.

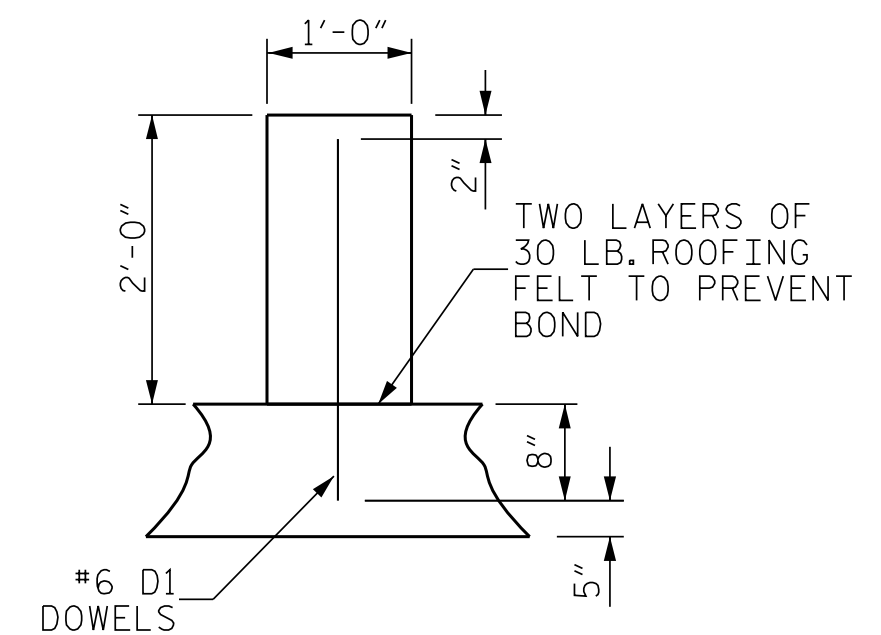

SECTION THROUGH SILL

DOWELS MAY BE PUSHED INTO GREEN CONCRETE AFTER SLAB HAS BEEN FLOATED.

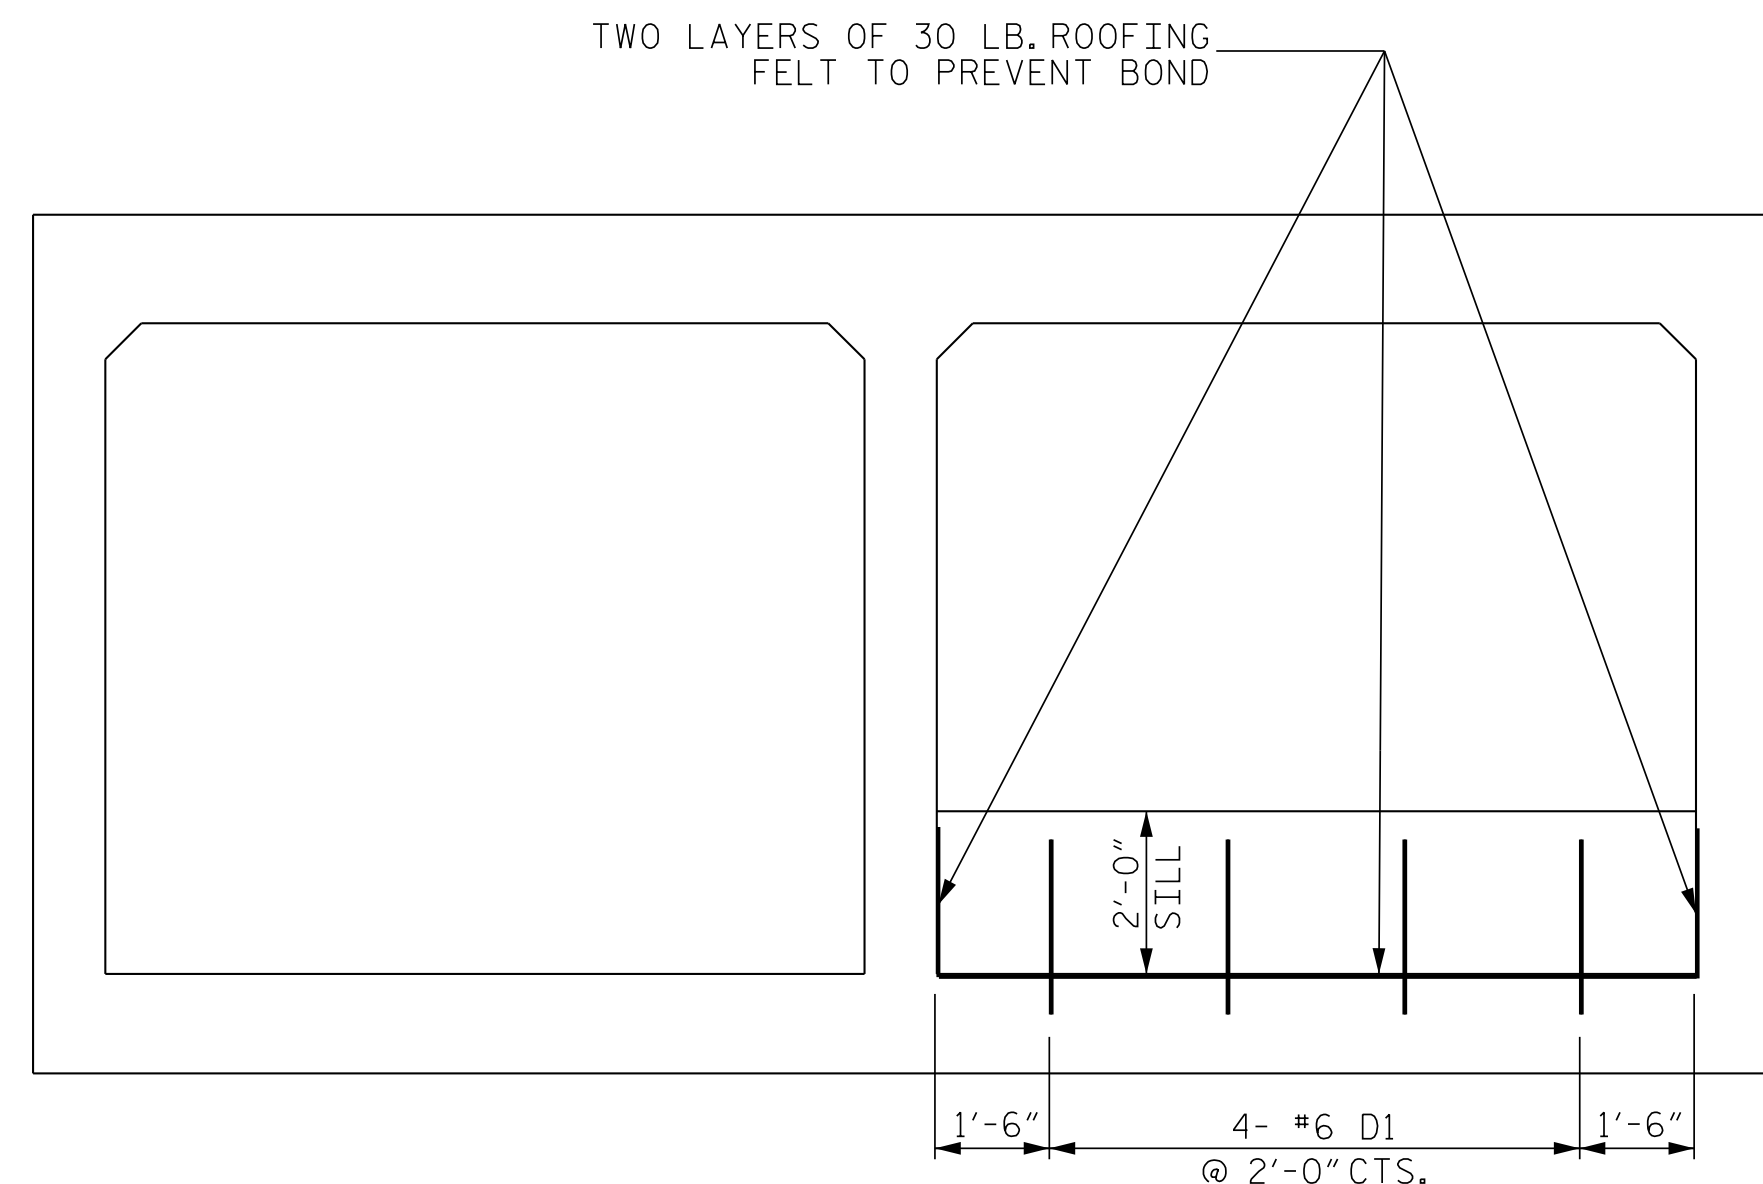

OUTLET END ELEVATION

LOOKING DOWNSTREAM

PROJECT NO. U-2579AA  
FORSYTH COUNTY  
 STATION: 32+77.50 -L-

SHEET 5 OF 6

STATE OF NORTH CAROLINA  
 DEPARTMENT OF TRANSPORTATION  
 RALEIGH

DOUBLE 9FT. X 9FT.  
 CONCRETE BOX CULVERT  
 60° SKEW



DOCUMENT NOT CONSIDERED FINAL UNLESS ALL SIGNATURES COMPLETED


**V&M**  
 Consulting Engineers  
 Asheville, North Carolina  
 828-253-2796

- Boone, NC 828-355-9933
- Tri-Cities, TN 423-467-8401
- Knoxville, TN 865-546-5800
- Spartanburg, SC 864-574-4775
- Charleston, SC 843-974-5650
- Middleboro, KY 506-248-6500
- Raleigh, NC 919-977-9495
- Charlotte, NC 704-357-0488
- Atlanta, GA 770-627-3590


Copyright © 2006 Vaughn & Melton, Inc. All Rights Reserved

DSG. ENG. OF RECORD.: CMG  
 DWN. BY: WDC DATE: 12/18  
 CHKD. BY: HLW DATE: 12/18


REVISIONS						SHEET NO.
NO.	BY:	DATE:	NO.	BY:	DATE:	C1-5
1			3			TOTAL SHEETS
2			4			6

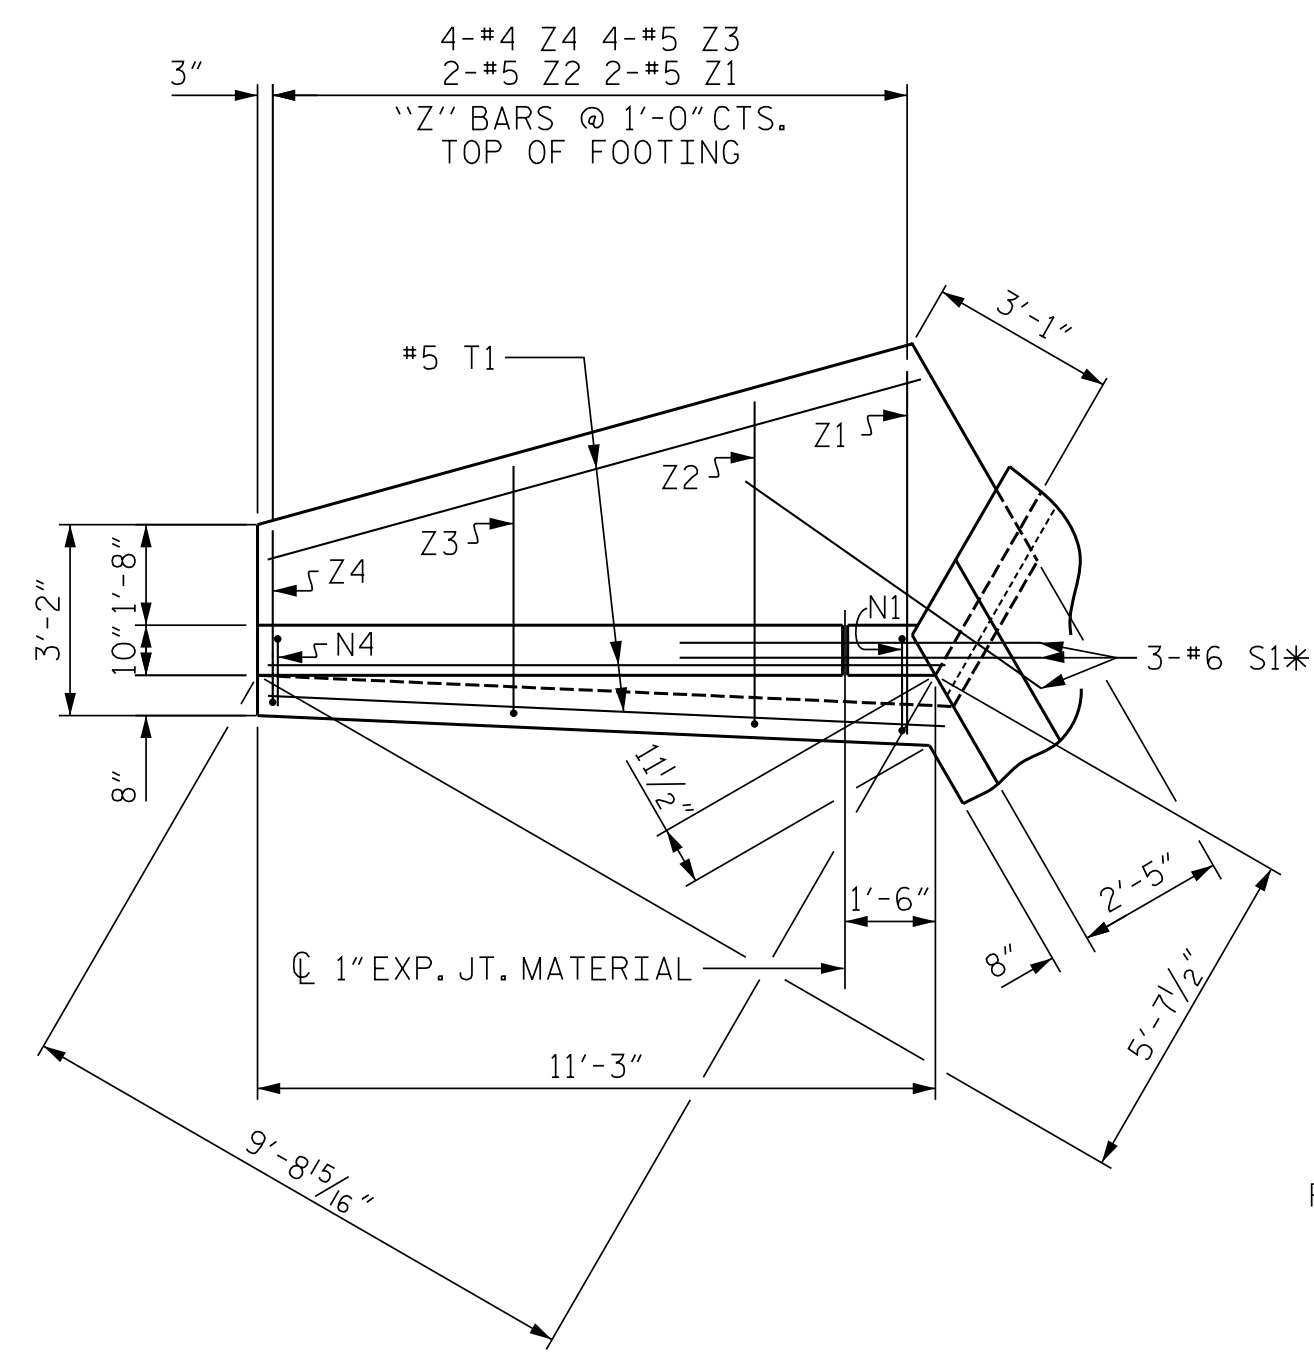


PLAN W2

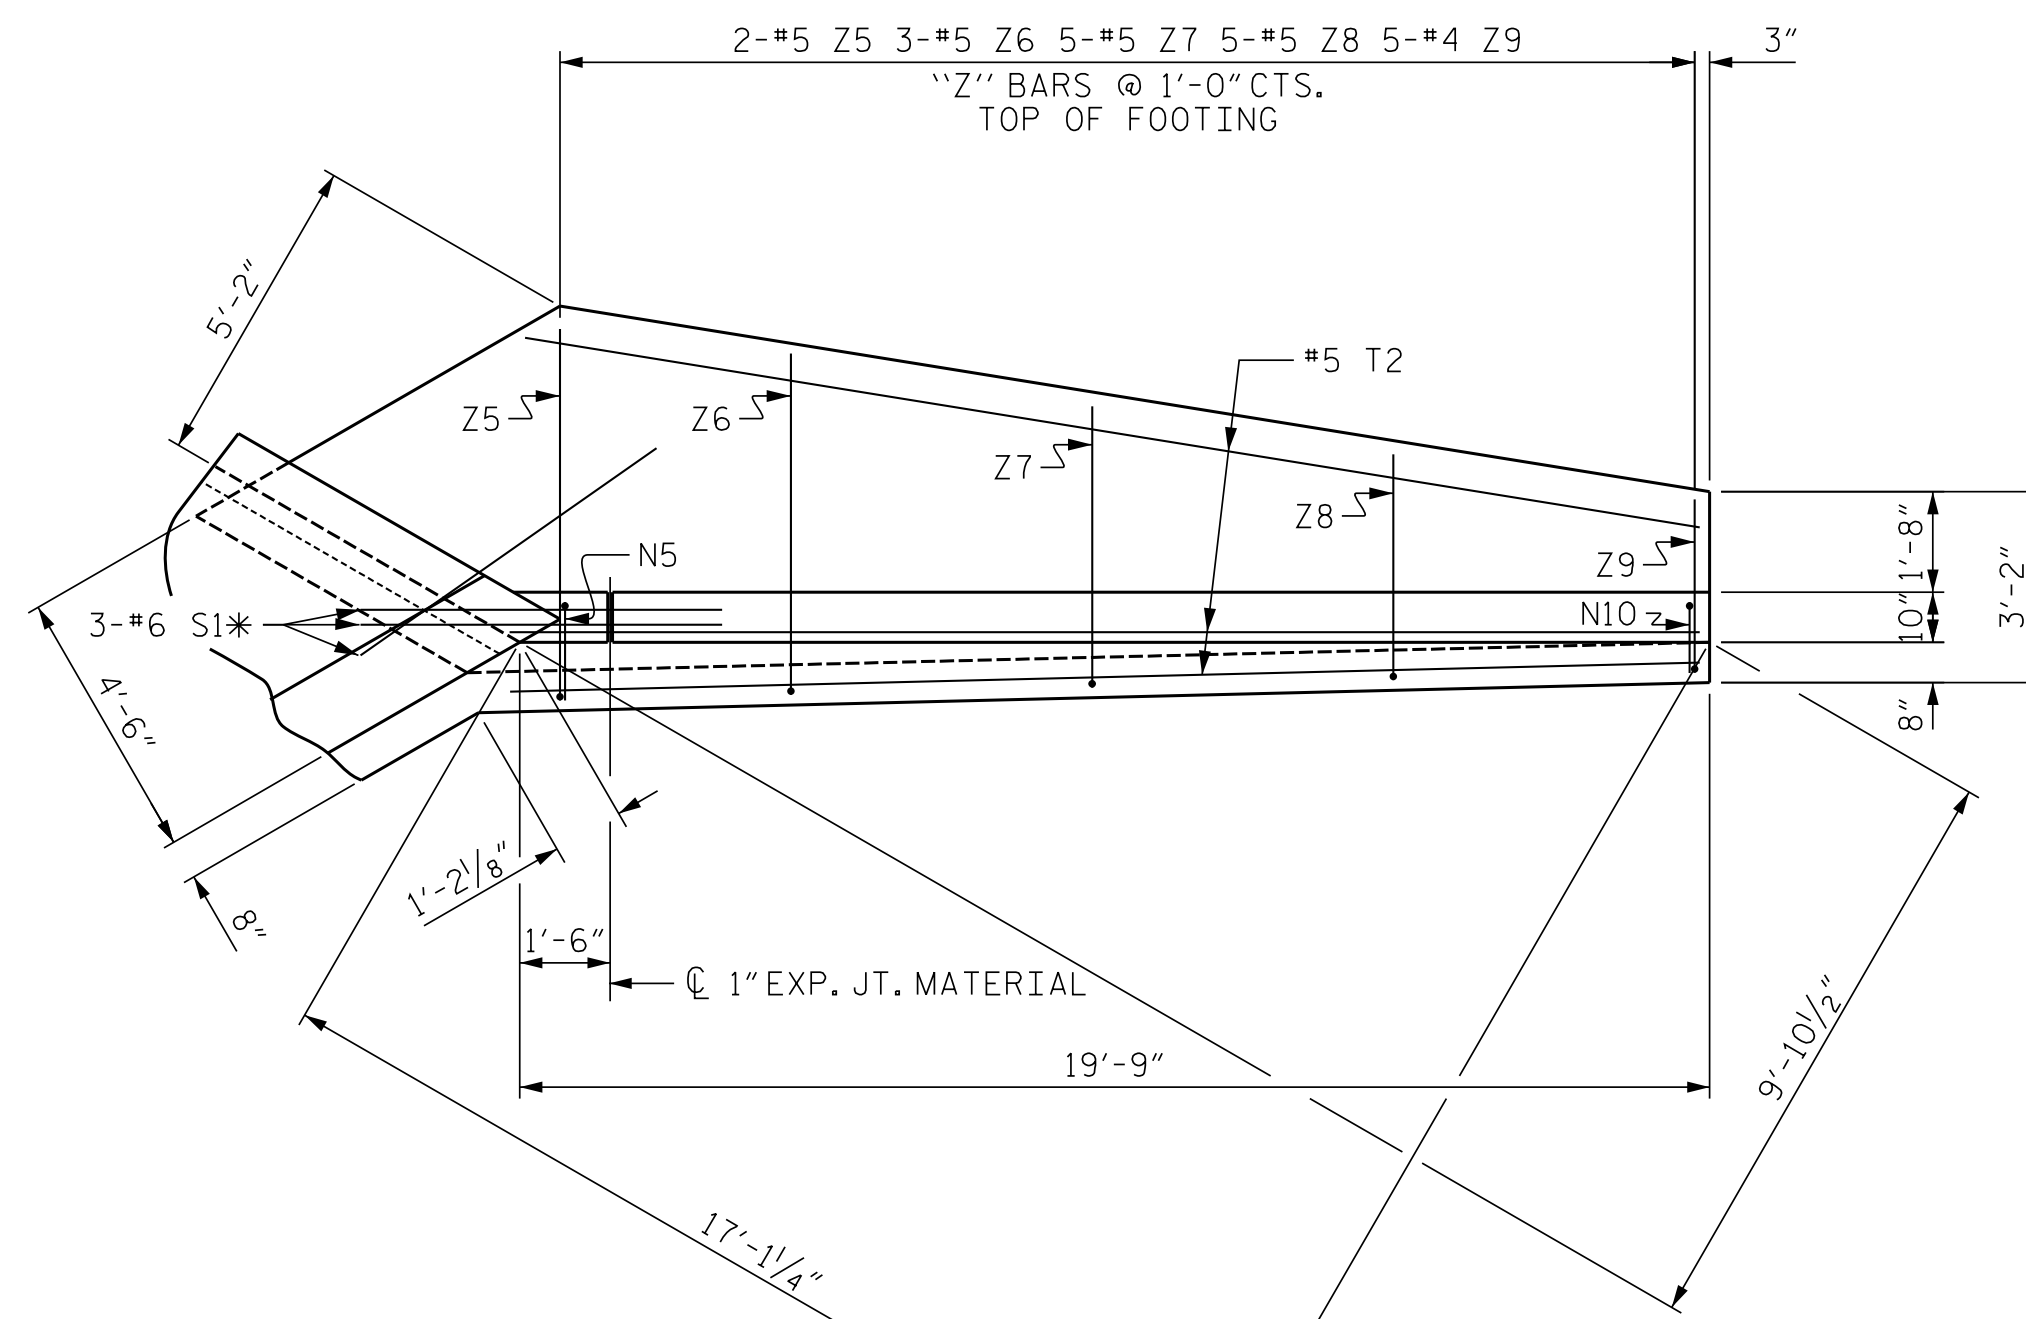


PLAN W1

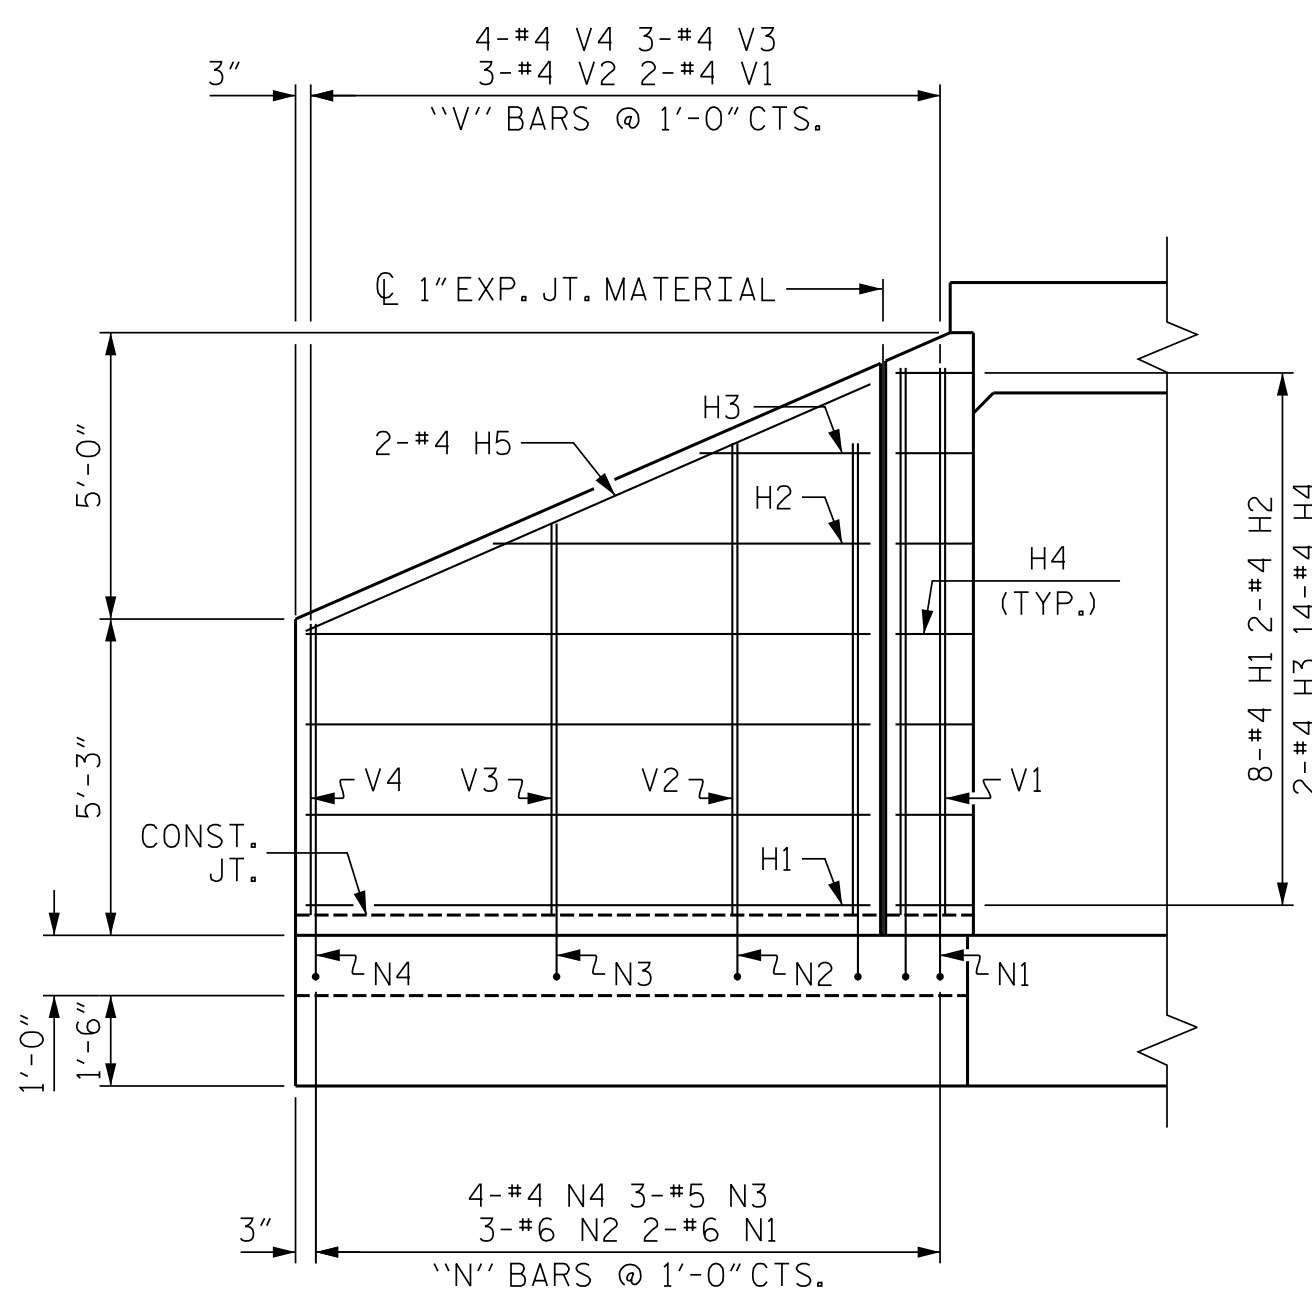

ELEVATION W2

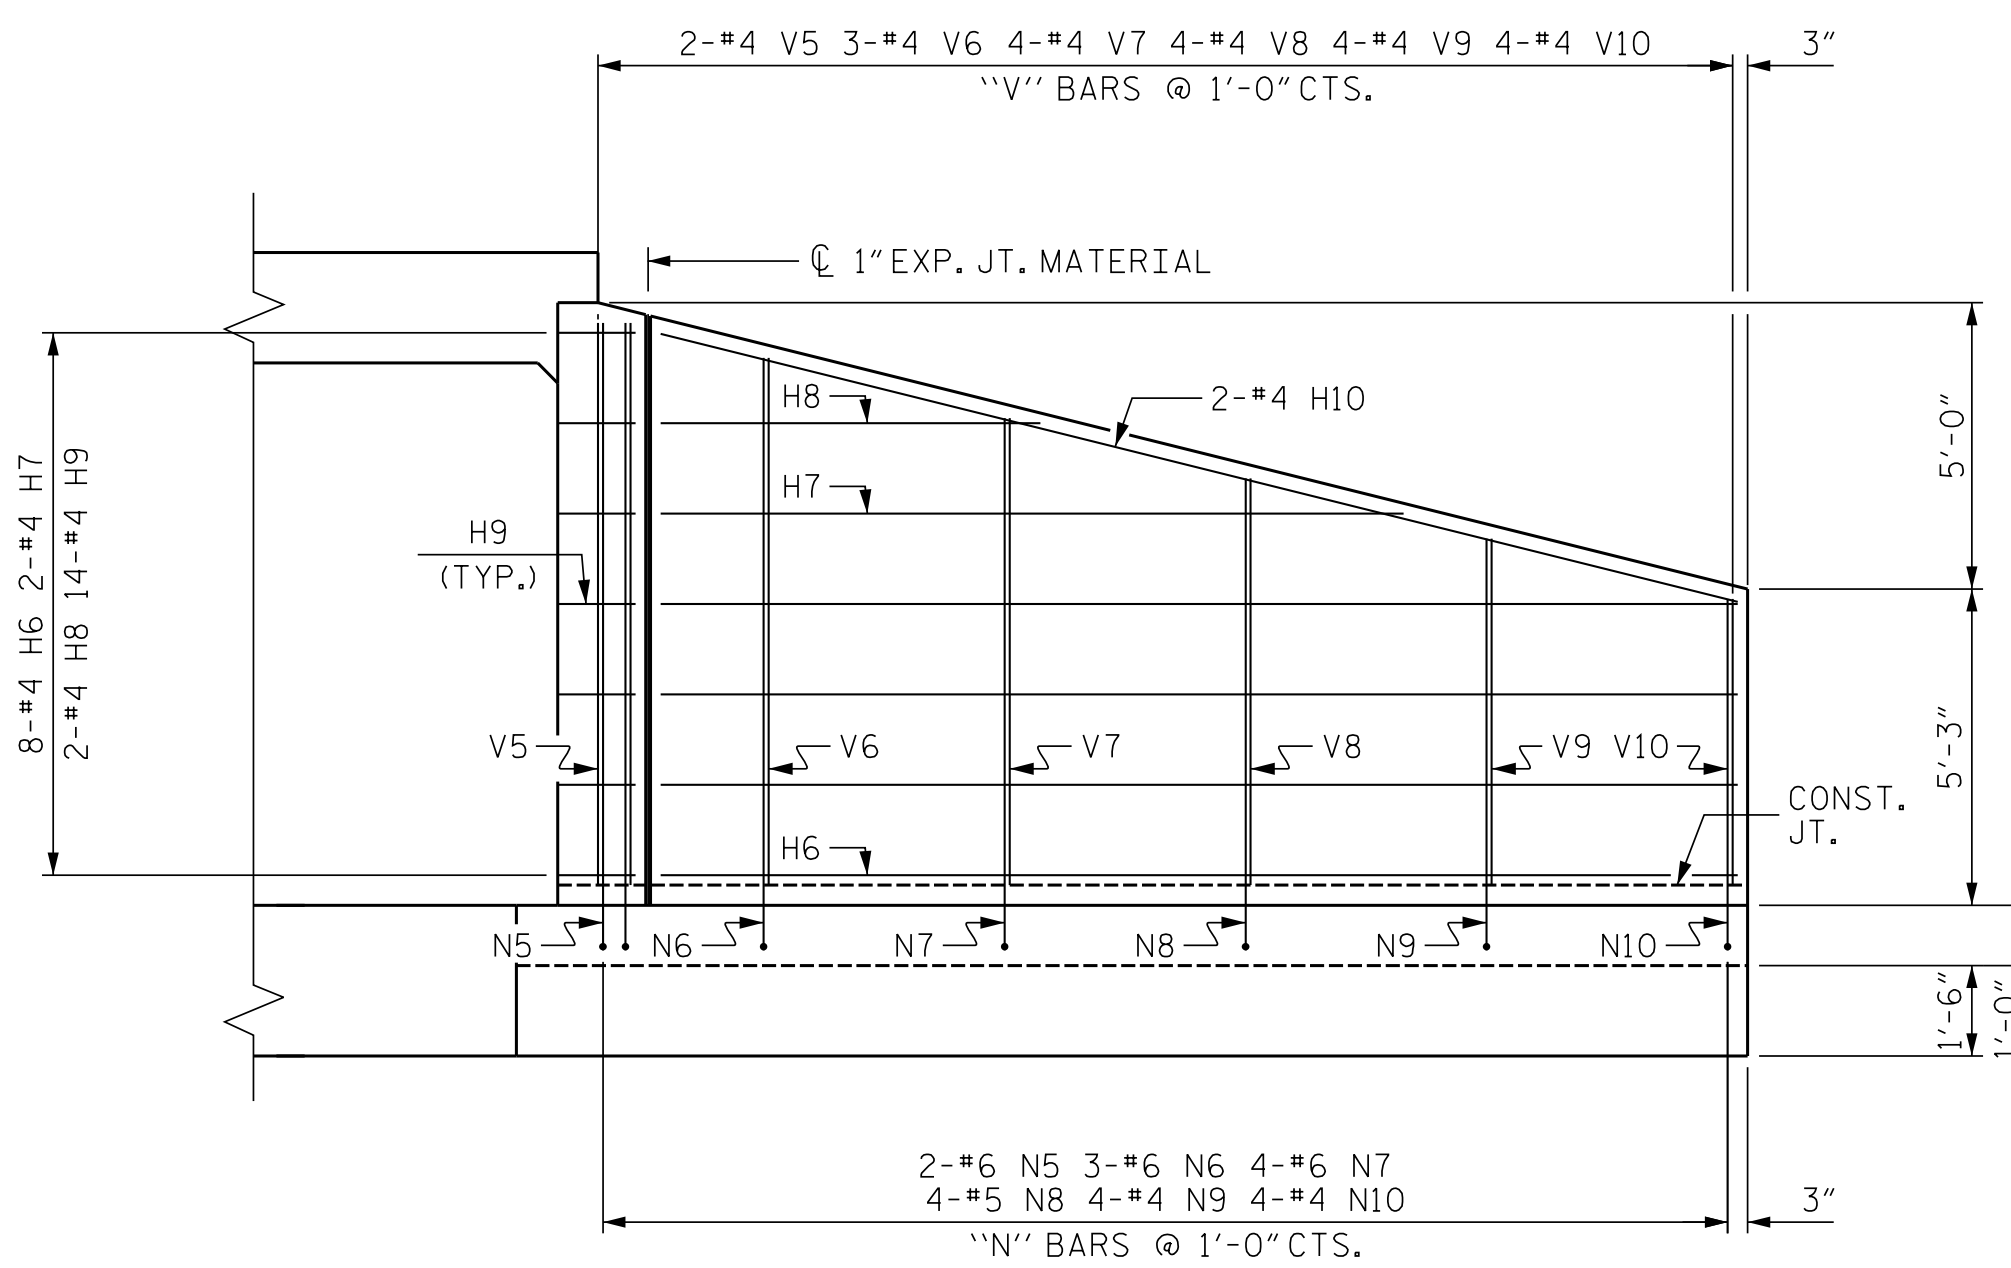


ELEVATION W1

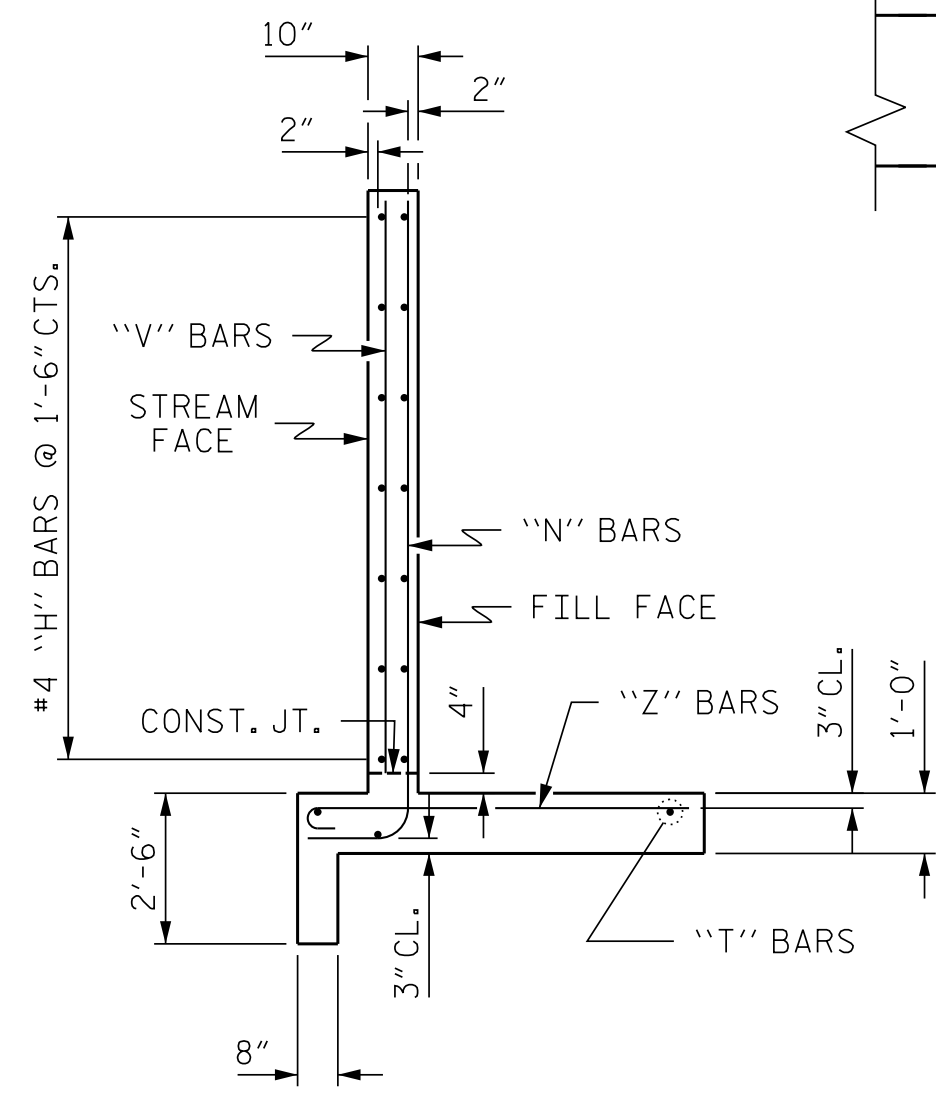

TYPICAL WING SECTION

BAR TYPES

ALL BAR DIMENSIONS ARE OUT TO OUT.

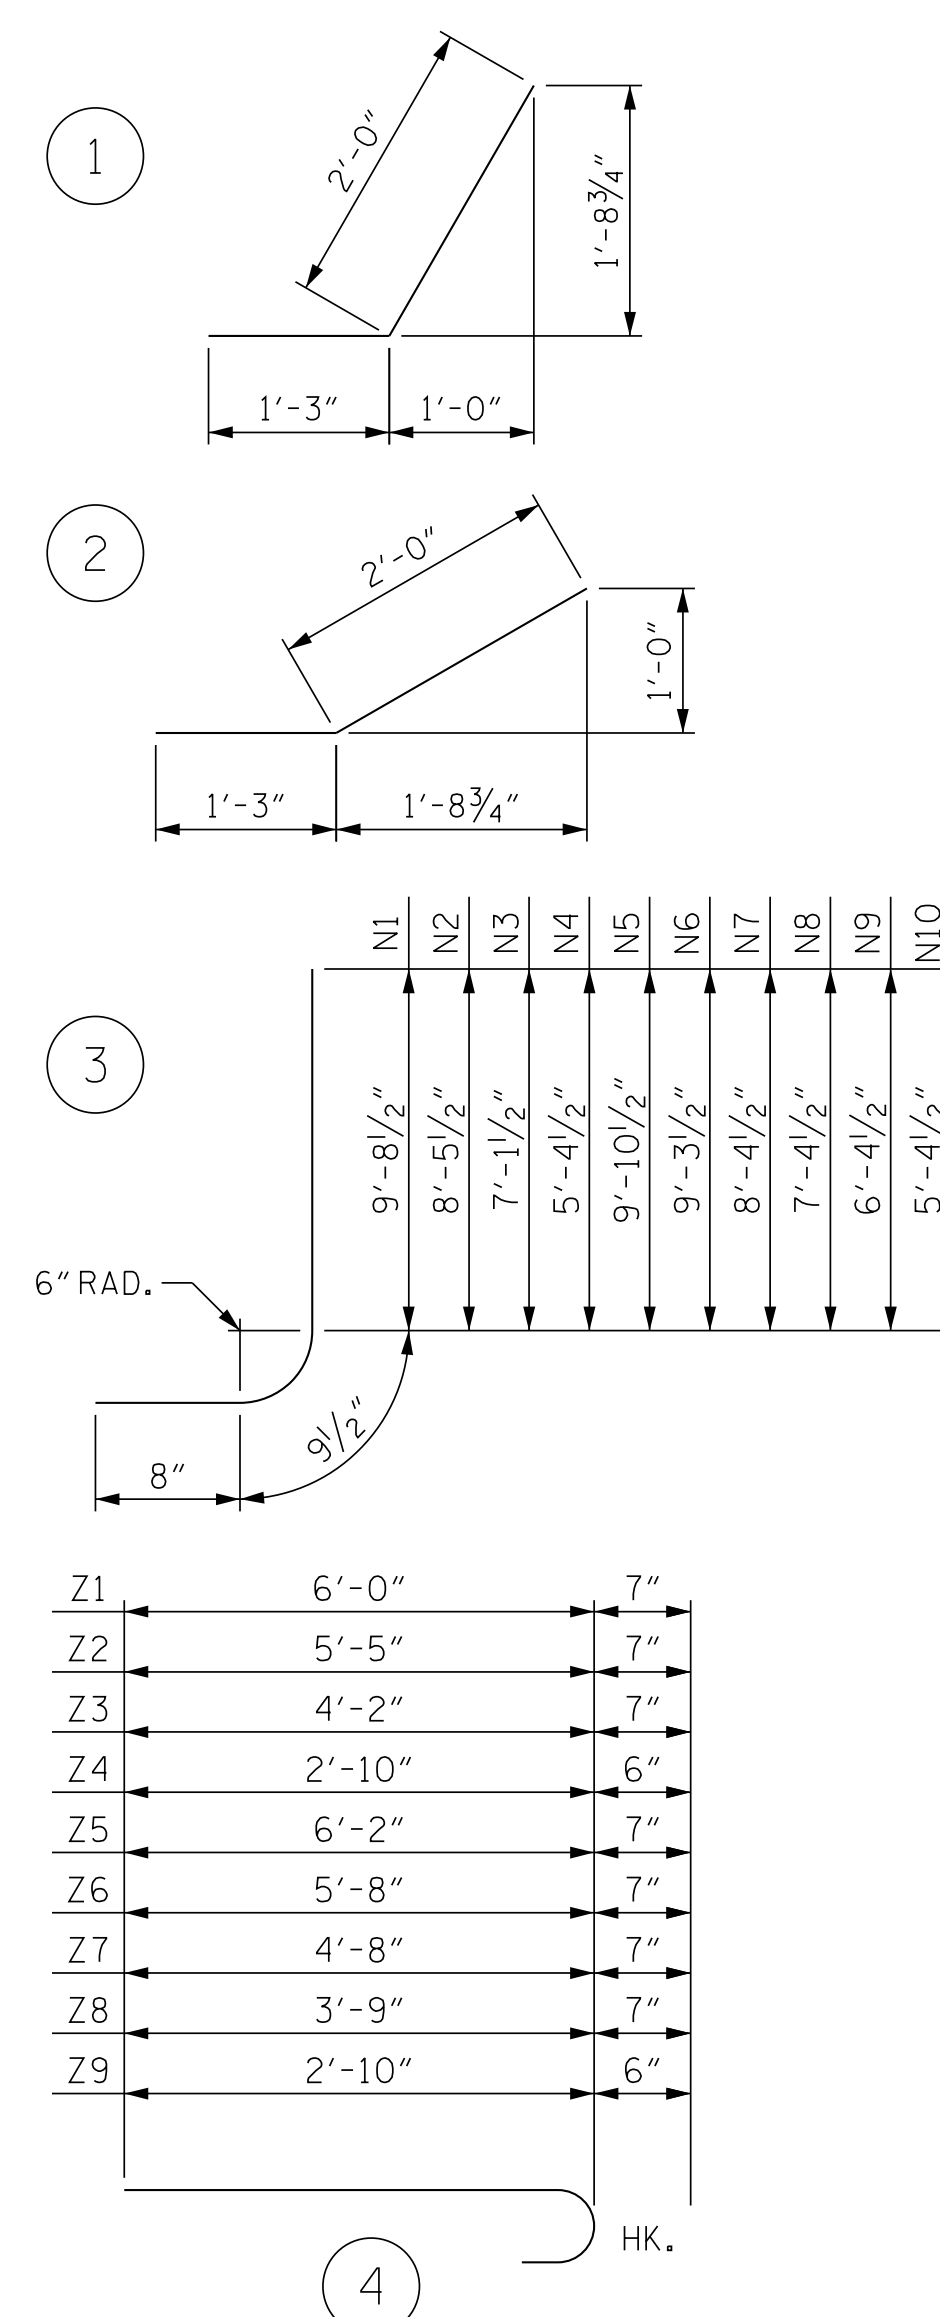

Z1	6'-0"	7"
Z2	5'-5"	7"
Z3	4'-2"	7"
Z4	2'-10"	6"
Z5	6'-2"	7"
Z6	5'-8"	7"
Z7	4'-8"	7"
Z8	3'-9"	7"
Z9	2'-10"	6"

BILL OF MATERIAL


BAR	NO.	SIZE	TYPE	LENGTH	WEIGHT
H1	16	#4	STR	9'-4"	100
H2	4	#4	STR	6'-3"	17
H3	4	#4	STR	2'-10"	8
H4	28	#4	1	3'-3"	61
H5	4	#4	STR	10'-2"	27
H6	16	#4	STR	17'-10"	191
H7	4	#4	STR	12'-4"	33
H8	4	#4	STR	6'-3"	17
H9	28	#4	2	3'-3"	61
H10	4	#4	STR	18'-5"	49
N1	4	#6	3	11'-2"	67
N2	6	#6	3	9'-11"	89
N3	6	#5	3	8'-7"	54
N4	8	#4	3	6'-10"	37
N5	4	#6	3	11'-4"	68
N6	6	#6	3	10'-9"	97
N7	8	#6	3	9'-10"	118
N8	8	#5	3	8'-10"	74
N9	8	#4	3	7'-10"	42
N10	8	#4	3	6'-10"	37
S1	12	#6	STR	6'-0"	108
T1	6	#5	STR	11'-3"	70
T2	6	#5	STR	19'-9"	124
V1	4	#4	STR	9'-1"	24
V2	6	#4	STR	7'-10"	31
V3	6	#4	STR	6'-6"	26
V4	8	#4	STR	4'-10"	26
V5	4	#4	STR	9'-4"	25
V6	6	#4	STR	8'-9"	35
V7	8	#4	STR	7'-9"	41
V8	8	#4	STR	6'-9"	36
V9	8	#4	STR	5'-9"	31
V10	8	#4	STR	4'-9"	25
Z1	4	#5	4	6'-7"	27
Z2	4	#5	4	6'-0"	25
Z3	8	#5	4	4'-9"	40
Z4	8	#4	4	3'-4"	18
Z5	4	#5	4	6'-9"	28
Z6	6	#5	4	6'-3"	39
Z7	10	#5	4	5'-3"	55
Z8	10	#5	4	4'-4"	45
Z9	10	#4	4	3'-4"	22
REINFORCING STEEL					2148 LBS
FOR 4 WINGS					
CLASS A CONCRETE					
4 WINGS					30.2 CY
2 HEADWALLS					2.1 CY
2 END CURTAIN WALLS					4.0 CY
2 SILLS					1.3 CY
TOTAL					37.6 CY

DRAWN BY : CCJ 12/99  
CHECKED BY : RWW 03/00

**V&M**  
Vaughn & Melton  
Consulting Engineers  
Asheville, NC  
919-977-9455

Boone, NC 828-355-9933  
Tri-Cities, TN 423-467-8401  
Knoxville, TN 865-546-5800  
Spartanburg, SC 864-574-4775  
Charleston, SC 843-974-5650  
Middleboro, KY 506-248-6600  
Atlanta, GA 770-627-3590

Copyright © 2006 Vaughn & Melton, Inc. All Rights Reserved

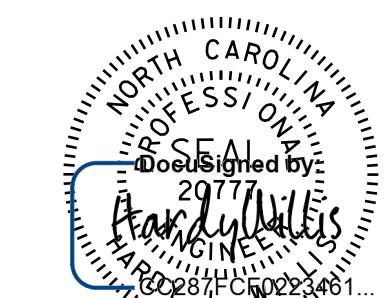

DOCUMENT NOT CONSIDERED FINAL UNLESS ALL SIGNATURES COMPLETED

DSG. ENG. OF RECORD.: CMG  
DWN. BY: MAF DATE: 07/18  
CHKD. BY: HLW DATE: 07/18

PROJECT NO. U-2579AA  
FORSYTH COUNTY  
STATION: 32+77.50 -L-

STATE OF NORTH CAROLINA  
DEPARTMENT OF TRANSPORTATION  
RALEIGH

STANDARD WINGS  
FOR  
CONCRETE BOX CULVERT  
H = 9'-0" SLOPE = 2:1  
60° OR 120° SKEW

SHEET 6 OF 6

NO.	BY:	DATE:	NO.	BY:	DATE:
1			3		
2			4		

REVISIONS

SHEET NO. C1-6  
TOTAL SHEETS 6

STD. NO. CW6009

## STANDARD NOTES

### DESIGN DATA:

SPECIFICATIONS - - - - -	A.A.S.H.T.O. (CURRENT)
LIVE LOAD - - - - -	SEE PLANS
IMPACT ALLOWANCE - - - - -	SEE A.A.S.H.T.O.
STRESS IN EXTREME FIBER OF STRUCTURAL STEEL - AASHTO M270 GRADE 36 - -	20,000 LBS. PER SQ. IN.
- AASHTO M270 GRADE 50W - -	27,000 LBS. PER SQ. IN.
- AASHTO M270 GRADE 50 - -	27,000 LBS. PER SQ. IN.
REINFORCING STEEL IN TENSION - GRADE 60 - - -	24,000 LBS. PER SQ. IN.
CONCRETE IN COMPRESSION - - - - -	1,200 LBS. PER SQ. IN.
CONCRETE IN SHEAR - - - - -	SEE A.A.S.H.T.O.
STRUCTURAL TIMBER - TREATED OR UNTREATED EXTREME FIBER STRESS - - -	1,800 LBS. PER SQ. IN.
COMPRESSION PERPENDICULAR TO GRAIN OF TIMBER - - - - -	375 LBS. PER SQ. IN.
EQUIVALENT FLUID PRESSURE OF EARTH - - - - -	30 LBS. PER CU. FT. (MINIMUM)

### MATERIAL AND WORKMANSHIP:

EXCEPT AS MAY OTHERWISE BE SPECIFIED ON PLANS OR IN THE SPECIAL PROVISIONS, ALL MATERIAL AND WORKMANSHIP SHALL BE IN ACCORDANCE WITH THE 2018 "STANDARD SPECIFICATIONS FOR ROADS AND STRUCTURES" OF THE N.C. DEPARTMENT OF TRANSPORTATION.

STEEL SHEET PILING FOR PERMANENT OR TEMPORARY APPLICATIONS SHALL BE HOT ROLLED.

### CONCRETE:

UNLESS OTHERWISE REQUIRED ON PLANS, CLASS A CONCRETE SHALL BE USED FOR ALL PORTIONS OF ALL STRUCTURES WITH THE EXCEPTION THAT: CLASS AA CONCRETE SHALL BE USED IN BRIDGE SUPERSTRUCTURES, ABUTMENT BACKWALLS, AND APPROACH SLABS; AND CLASS B CONCRETE SHALL BE USED FOR SLOPE PROTECTION AND RIP RAP.

### CONCRETE CHAMFERS:

UNLESS OTHERWISE NOTED ON THE PLANS, ALL EXPOSED CORNERS ON STRUCTURES SHALL BE CHAMFERED  $\frac{3}{4}$ " WITH THE FOLLOWING EXCEPTIONS: TOP CORNERS OF CURBS MAY BE ROUNDED TO  $1\frac{1}{2}$ " RADIUS WHICH IS BUILT INTO CURB FORMS; CORNERS OF TRANSVERSE FLOOR EXPANSION JOINTS SHALL BE ROUNDED WITH A  $\frac{1}{4}$ " FINISHING TOOL UNLESS OTHERWISE REQUIRED ON PLANS; AND CORNERS OF EXPANSION JOINTS IN THE ROADWAY FACES AND TOPS OF CURBS AND SIDEWALKS SHALL BE ROUNDED TO A  $\frac{1}{4}$ " RADIUS WITH A FINISHING STONE OR TOOL UNLESS OTHERWISE REQUIRED ON PLANS.

### DOWELS:

DOWELS WHEN INDICATED ON PLANS AS FOR CULVERT EXTENSIONS, SHALL BE EMBEDDED AT LEAST 12" INTO THE OLD CONCRETE AND GROUTED INTO PLACE WITH 1:2 CEMENT MORTAR.

### ALLOWANCE FOR DEAD LOAD DEFLECTION, SETTLEMENT, ETC. IN CASTING SUPERSTRUCTURES:

BRIDGES SHALL BE BUILT ON THE GRADE OR VERTICAL CURVE SHOWN ON PLANS. SLABS, CURBS AND PARAPETS SHALL CONFORM TO THE GRADE OR CURVE.

ALL DIMENSIONS WHICH ARE GIVEN IN SECTION AND ARE AFFECTED BY DEAD LOAD DEFLECTIONS ARE DIMENSIONS AT CENTER LINE OF BEARING UNLESS OTHERWISE NOTED ON PLANS. IN SETTING FORMS FOR STEEL BEAM BRIDGES AND PRESTRESSED CONCRETE GIRDER BRIDGES, ADJUSTMENTS SHALL BE MADE DUE TO THE DEAD LOAD DEFLECTIONS FOR THE ELEVATIONS SHOWN. WHERE BLOCKS ARE SHOWN OVER BEAMS FOR BUILDING UP TO THE SLAB, THE VERTICAL DIMENSIONS OF THE BLOCKS SHALL BE ADJUSTED BETWEEN BEARINGS TO COMPENSATE FOR DEAD LOAD DEFLECTIONS, VERTICAL CURVE ORDINATE, AND ACTUAL BEAM CAMBER. WHERE BOTTOM OF SLAB IS IN LINE WITH BOTTOM OF TOP FLANGES, DEPTH OF SLAB BETWEEN BEARINGS SHALL BE ADJUSTED TO COMPENSATE FOR DEAD LOAD DEFLECTION, VERTICAL CURVE ORDINATE, AND ACTUAL BEAM CAMBER.

IN SETTING FALSEWORK AND FORMS FOR REINFORCED CONCRETE SPANS, AN ALLOWANCE SHALL BE MADE FOR DEAD LOAD DEFLECTIONS, SETTLEMENT OF FALSEWORK, AND PERMANENT CAMBER WHICH SHALL BE PROVIDED FOR IN ADDITION TO THE ELEVATIONS SHOWN. AFTER REMOVAL OF THE FALSEWORK, THE FINISHED STRUCTURES SHALL CONFORM TO THE PROFILE AND ELEVATIONS SHOWN ON THE PLANS AND CONSTRUCTION ELEVATIONS FURNISHED BY THE ENGINEER.

DETAILED DRAWINGS FOR FALSEWORK OR FORMS FOR BRIDGE SUPERSTRUCTURE AND ANY STRUCTURE OR PARTS OF A STRUCTURE AS NOTED ON THE PLANS SHALL BE SUBMITTED TO THE ENGINEER FOR APPROVAL BEFORE CONSTRUCTION OF THE FALSEWORK OR FORMS IS STARTED.

### REINFORCING STEEL:

ALL REINFORCING STEEL SHALL BE DEFORMED. DIMENSIONS RELATIVE TO PLACEMENT OF REINFORCING ARE TO CENTERS OF BARS UNLESS OTHERWISE INDICATED IN THE PLANS. DIMENSIONS ON BAR DETAILS ARE TO CENTERS OF BARS OR ARE OUT TO OUT AS INDICATED ON PLANS.

WIRE BAR SUPPORTS SHALL BE PROVIDED FOR REINFORCING STEEL WHERE INDICATED ON THE PLANS. WHEN BAR SUPPORT PIECES ARE PLACED IN CONTINUOUS LINES, THEY SHALL BE SO PLACED THAT THE ENDS OF THE SUPPORTING WIRES SHALL BE LAPPED TO LOCK LEGS ON ADJOINING PIECES.

### STRUCTURAL STEEL:

AT THE CONTRACTOR'S OPTION, HE MAY SUBSTITUTE  $\frac{7}{8}$ "  $\emptyset$  SHEAR STUDS FOR THE  $\frac{3}{4}$ "  $\emptyset$  STUDS SPECIFIED ON THE PLANS. THIS SUBSTITUTION SHALL BE MADE AT THE RATE OF 3 -  $\frac{7}{8}$ "  $\emptyset$  STUDS FOR 4 -  $\frac{3}{4}$ "  $\emptyset$  STUDS, AND STUD SPACING CHANGES SHALL BE MADE AS NECESSARY TO PROVIDE THE SAME EQUIVALENT NUMBER OF  $\frac{7}{8}$ "  $\emptyset$  STUDS ALONG THE BEAM AS SHOWN FOR  $\frac{3}{4}$ "  $\emptyset$  STUDS BASED ON THE RATIO OF 3 -  $\frac{7}{8}$ "  $\emptyset$  STUDS FOR 4 -  $\frac{3}{4}$ "  $\emptyset$  STUDS. STUDS OF THE LENGTH SPECIFIED ON THE PLANS MUST BE PROVIDED. THE MAXIMUM SPACING SHALL BE 2'-0".

EXCEPT AT THE INTERIOR SUPPORTS OF CONTINUOUS BEAMS WHERE THE COVER PLATE IS IN CONTACT WITH BEARING PLATE, THE CONTRACTOR MAY, AT HIS OPTION, SUBSTITUTE FOR THE COVER PLATES DESIGNATED ON THE PLANS COVER PLATES OF THE EQUIVALENT AREA PROVIDED THESE PLATES ARE AT LEAST  $\frac{3}{16}$ " IN THICKNESS AND DO NOT EXCEED A WIDTH EQUAL TO THE FLANGE WIDTH LESS 2" OR A THICKNESS EQUAL TO 2 TIMES THE FLANGE THICKNESS. THE SIZE OF FILLET WELDS SHALL CONFORM TO THE REQUIREMENTS OF THE CURRENT ANSI/AASHTO/AWS "BRIDGE WELDING CODE". ELECTROSLAG WELDING WILL NOT BE PERMITTED.

WITH THE SOLE EXCEPTION OF EDGES AT SURFACES WHICH BEAR ON OTHER SURFACES, ALL SHARP EDGES AND ENDS OF SHAPES AND PLATES SHALL BE SLIGHTLY ROUNDED BY SUITABLE MEANS TO A RADIUS OF APPROXIMATELY  $\frac{1}{16}$ " INCH OR EQUIVALENT FLAT SURFACE AT A SUITABLE ANGLE PRIOR TO PAINTING, GALVANIZING, OR METALLIZING.

### HANDRAILS AND POSTS:

METAL STANDARDS AND FACES OF THE CONCRETE END POSTS FOR THE METAL RAIL SHALL BE SET NORMAL TO THE GRADE OF THE CURB, UNLESS OTHERWISE SHOWN ON PLANS. THE METAL RAIL AND TOPS OF CONCRETE POSTS USED WITH THE ALUMINUM RAIL SHALL BE BUILT PARALLEL TO THE GRADE OF THE CURB.

METAL HANDRAILS SHALL BE IN ACCORDANCE WITH THE PLANS. RAILS SHALL BE AS MANUFACTURED FOR BRIDGE RAILING. CASTINGS SHALL BE OF A UNIFORM APPEARANCE. FINS AND OTHER DEFORMATIONS RESULTING FROM CASTING OR OTHERWISE SHALL BE REMOVED IN A MANNER SO THAT A UNIFORM COLORING OF THE COMPLETED CASTING SHALL BE OBTAINED. CASTINGS WITH DISCOLORATIONS OR OF NON-UNIFORM COLORING WILL NOT BE ACCEPTED. CERTIFIED MILL REPORTS ARE REQUIRED FOR METAL RAILS AND POSTS.

### SPECIAL NOTES:

GENERALLY, IN CASE OF DISCREPANCY, THIS STANDARD SHEET OF NOTES SHALL GOVERN OVER THE SPECIFICATIONS, BUT THE REMAINDER OF THE PLANS SHALL GOVERN OVER NOTES HEREON, AND SPECIAL PROVISIONS SHALL GOVERN OVER ALL. SEE SPECIFICATIONS ARTICLE 105-4.


ENGLISH

JANUARY, 1990

STD. NO. SN



BM# 4 : -BL- STA. 34+22.15 1365.82' LT  
N 844967.23 E 1661470.75 EL. 876.61'

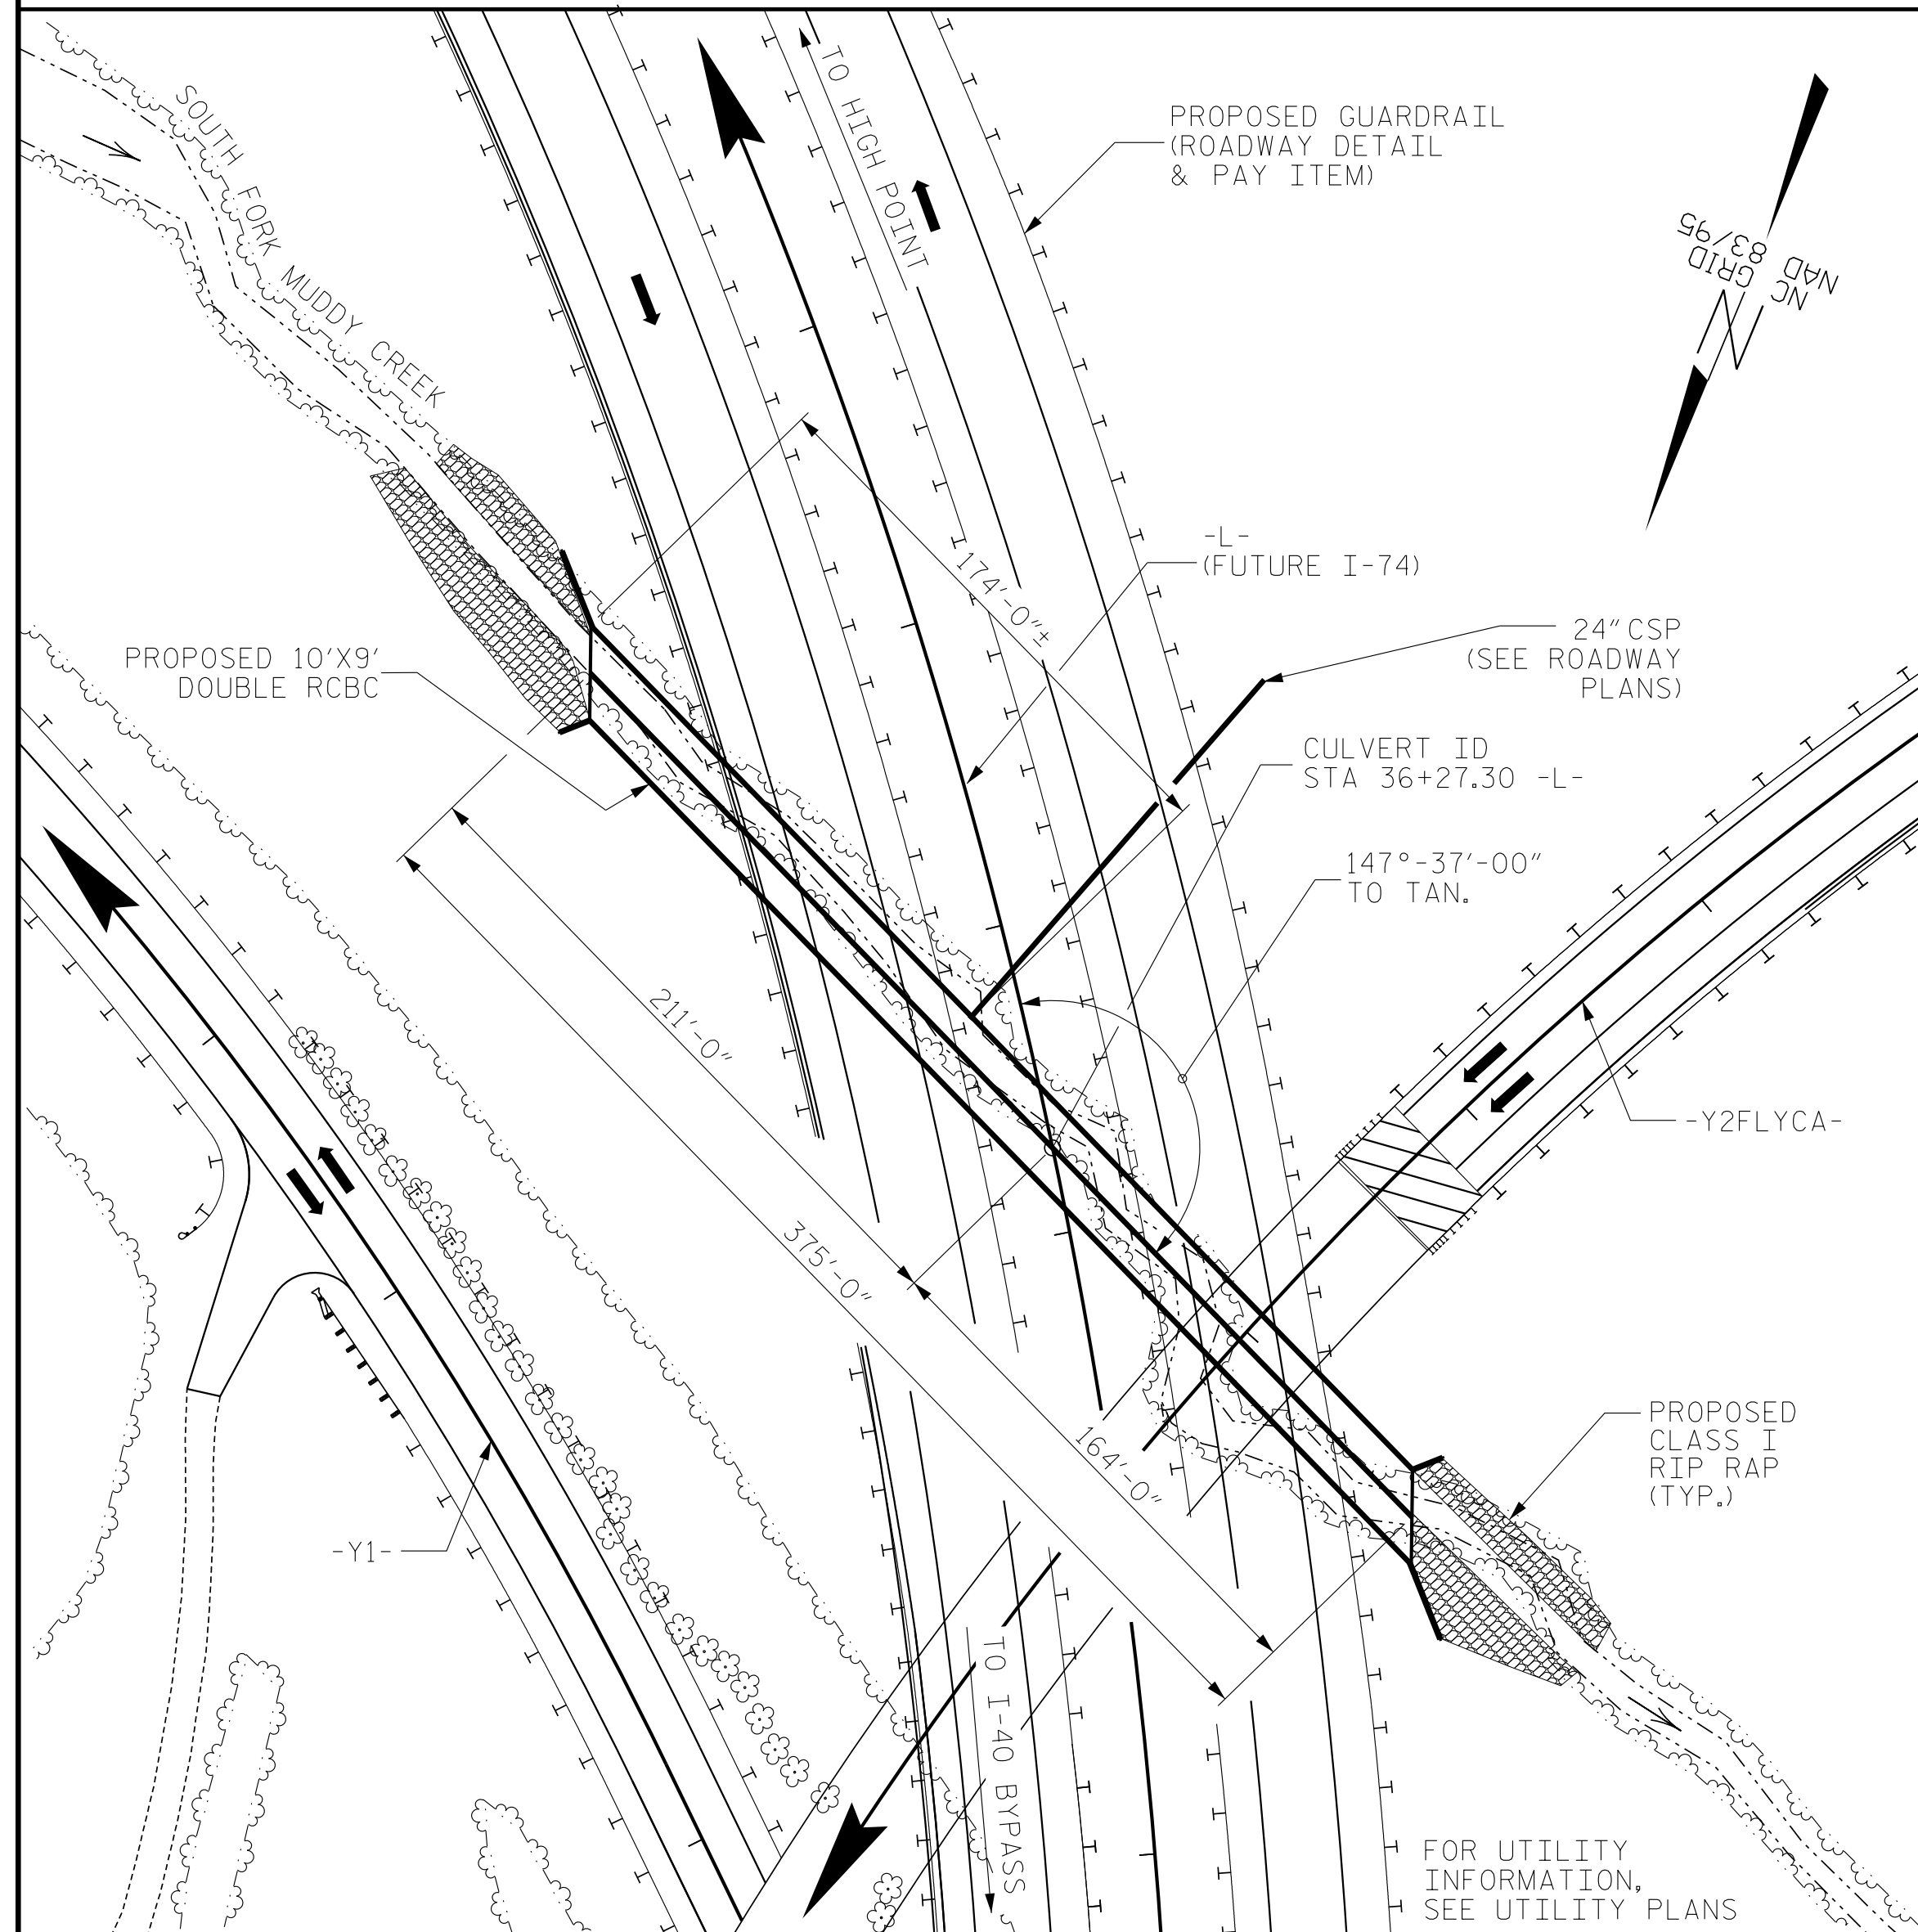


LOCATION SKETCH

GRADE DATA

GRADE POINT ELEV. @ STATION 36+27.30 -L- = 832.25' ±

BED ELEV. @ STATION 36+27.30 -L- = 809.2' ±

ROADWAY SLOPES: 3:1

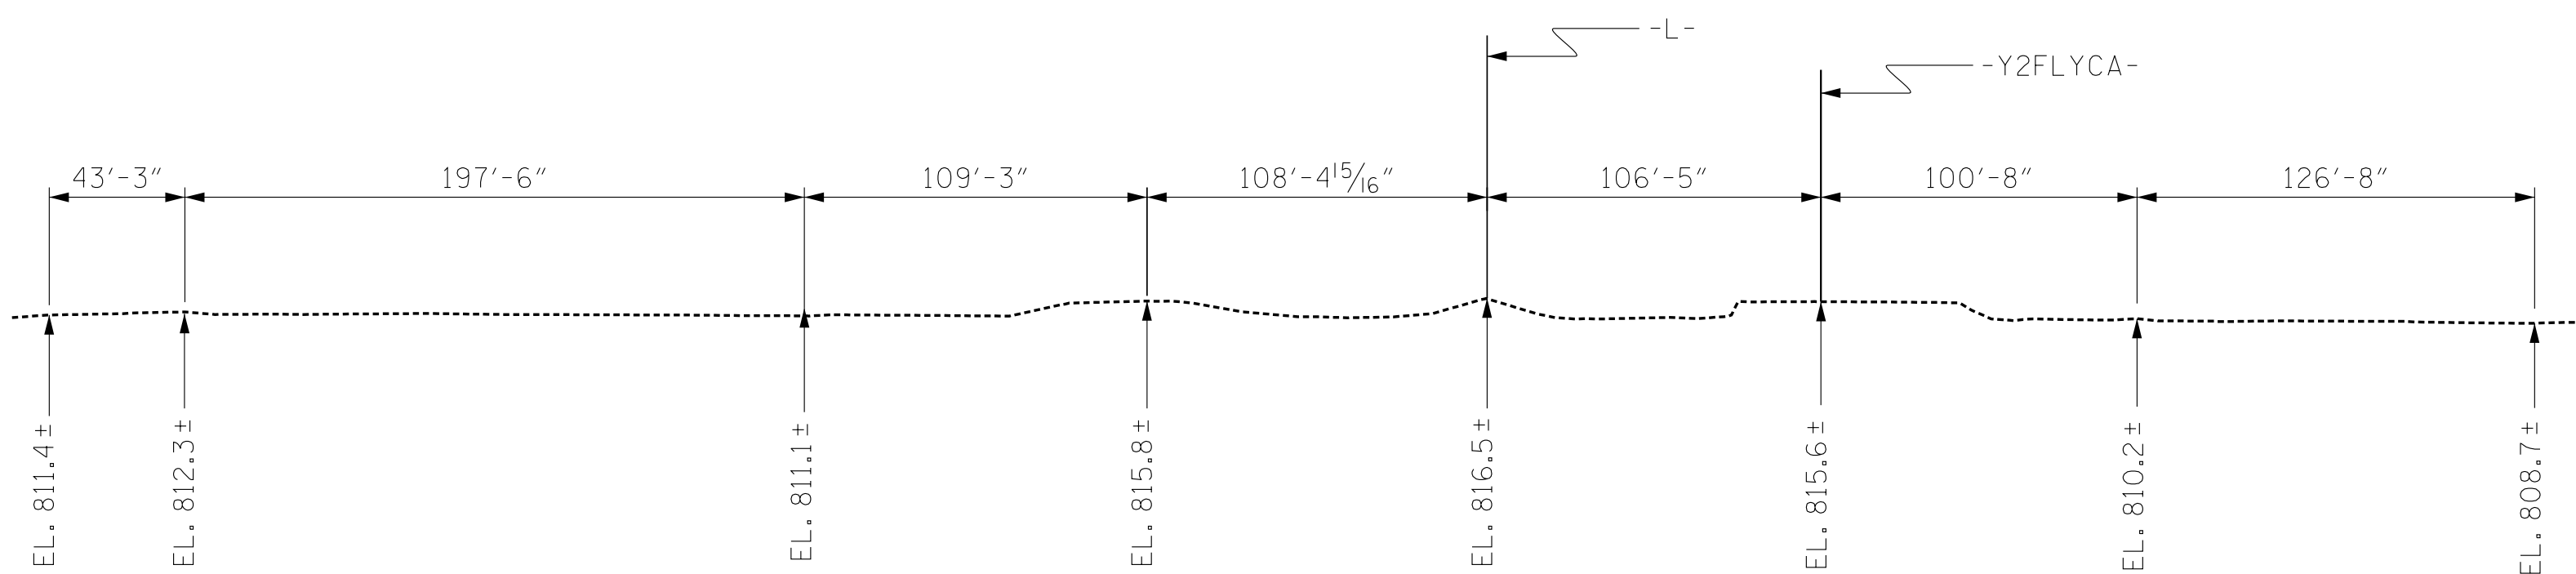

PROFILE ALONG CULVERT

NOTES:

ASSUMED LIVE LOAD ----- HL-93 OR ALTERNATE LOADING.  
DESIGN FILL-----MIN. = 8.84' MAX. = 14.42'  
FOR OTHER DESIGN DATA AND NOTES SEE STANDARD NOTE SHEET.  
3" Ø WEEP HOLES INDICATED TO BE IN ACCORDANCE WITH THE SPECIFICATIONS.  
CONCRETE IN CULVERTS TO BE POURED IN THE FOLLOWING ORDER:

1. WING FOOTINGS AND FLOOR SLAB INCLUDING 4" OF ALL VERTICAL WALLS.
2. THE REMAINING PORTIONS OF THE WALLS AND WINGS FULL HEIGHT FOLLOWED BY ROOF SLAB AND HEADWALLS.

THE RESIDENT ENGINEER SHALL CHECK THE LENGTH OF CULVERT BEFORE STAKING IT OUT TO MAKE CERTAIN THAT IT WILL PROPERLY TAKE CARE OF THE FILL.

DIMENSIONS FOR WING LAYOUT AS WELL AS ADDITIONAL REINFORCING STEEL EMBEDDED IN BARREL ARE SHOWN ON WING SHEET.

STEEL IN THE BOTTOM SLAB MAY BE SPLICED AT THE PERMITTED CONSTRUCTION JOINT AT THE CONTRACTOR'S OPTION. EXTRA WEIGHT OF STEEL DUE TO THE SPLICES SHALL BE PAID FOR BY THE CONTRACTOR.

AT THE CONTRACTOR'S OPTION, HE MAY SPLICE THE VERTICAL REINFORCING STEEL IN THE INTERIOR FACE OF EXTERIOR WALL AND BOTH FACES OF INTERIOR WALLS ABOVE LOWER WALL CONSTRUCTION JOINT. THE SPLICE LENGTH SHALL BE AS PROVIDED IN THE SPLICE LENGTH CHART SHOWN ON THE PLANS. EXTRA WEIGHT OF STEEL DUE TO THE SPLICES SHALL BE PAID FOR BY THE CONTRACTOR.

TRANSVERSE CONSTRUCTION JOINTS SHALL BE USED IN THE BARREL, SPACED TO LIMIT THE POURS TO A MAXIMUM OF 70 FT. LOCATION OF JOINTS SHALL BE SUBJECT TO APPROVAL OF THE ENGINEER.

FOR CULVERT DIVERSION DETAILS AND PAY ITEM, SEE EROSION CONTROL PLANS.

A 3'-0" STRIP OF FILTER FABRIC SHALL BE ATTACHED TO THE FILL FACE OF THE WING COVERING THE ENTIRE LENGTH OF THE EXPANSION JOINT.

FOR SUBMITTAL OF WORKING DRAWINGS, SEE SPECIAL PROVISIONS.

FOR FALSEWORK AND FORMWORK, SEE SPECIAL PROVISIONS.

FOR GROUT FOR STRUCTURES, SEE SPECIAL PROVISIONS.

FOR CRANE SAFETY, SEE SPECIAL PROVISIONS.

AT THE CONTRACTOR'S OPTION HE MAY SUBMIT, TO THE ENGINEER FOR APPROVAL, DESIGN AND DETAIL DRAWINGS FOR A PRECAST REINFORCED CONCRETE BOX CULVERT IN LIEU OF THE CAST-IN-PLACE CULVERT SHOWN ON THE PLANS. THE DESIGN SHALL PROVIDE THE SAME SIZE AND NUMBER OF BARRELS AS USED ON THE CAST-IN-PLACE DESIGN. FOR OPTIONAL PRECAST REINFORCED CONCRETE BOX CULVERT, SEE SPECIAL PROVISIONS.

THE CONTRACTOR SHALL PROVIDE INDEPENDENT ASSURANCE SAMPLES OF REINFORCING STEEL AS FOLLOWS: FOR PROJECTS REQUIRING UP TO 400 TONS OF REINFORCING STEEL, ONE 30 INCH SAMPLE OF EACH SIZE BAR USED, AND FOR PROJECTS REQUIRING OVER 400 TONS OF REINFORCING STEEL, TWO 30 INCH SAMPLES OF EACH SIZE BAR USED. THE SAMPLE BARS SHOULD COME FROM STEEL ACTUALLY USED IN THE PROJECT AND THE SAMPLE BARS SHOULD BE REPLACED BY SPLICED BARS AS SPECIFIED IN THE SAMPLE BAR REPLACEMENT CHART. PAYMENT FOR THE SAMPLE BARS AND REPLACEMENT REINFORCING STEEL SHALL BE CONSIDERED INCIDENTAL TO VARIOUS PAY ITEMS.

SAMPLE BAR REPLACEMENT					
SIZE	LENGTH	SIZE	LENGTH	SIZE	LENGTH
#3	6'-2"	#6	9'-8"	#9	13'-2"
#4	7'-4"	#7	10'-10"	#10	14'-6"
#5	8'-6"	#8	12'-0"	#11	15'-10"

NOTE: SAMPLE BAR REPLACEMENT LENGTHS BASED ON 30" (SAMPLE LENGTH) PLUS TWO SPLICE LENGTHS AND  $f_y = 60\text{ksi}$

FOUNDATION NOTES

EXCAVATE 1 FOOT BELOW THE CULVERT AND REPLACE WITH FOUNDATION CONDITIONING MATERIAL IN ACCORDANCE WITH ARTICLE 414 OF THE STANDARD SPECIFICATIONS.

UNDERCUT SOFT OR LOOSE SOILS TO A MINIMUM DEPTH OF 3 FEET BELOW THE BOTTOM OF THE FOUNDATION CONDITIONING MATERIAL AND BACKFILL WITH FOUNDATION CONDITIONING MATERIAL AS DIRECTED BY THE ENGINEER.

HYDRAULIC DATA

DESIGN DISCHARGE = 1100 CFS  
FREQUENCY OF DESIGN DISCHARGE = 50 YRS  
DESIGN HIGH WATER ELEVATION = 820.5 FT  
DRAINAGE AREA = 1.3 SQ MI  
BASE DISCHARGE (Q100) = 1100 CFS  
BASE HIGH WATER ELEVATION = 820.8 FT

OVERTOPPING DATA



OVERTOPPING DISCHARGE \* = 1200 CFS  
FREQUENCY OF OVERTOPPING = 200 (+) YRS  
OVERTOPPING ELEVATION = 821.8 FT

\* OVERTOPPING OCCURS AT BERM BETWEEN WALL & -L- FILL -Y1- 33+50 RT.

TOTAL STRUCTURE QUANTITIES

CULVERT EXCAVATION	LUMP SUM
FOUNDATION CONDITIONING MATERIAL	696 TONS
CLASS A CONCRETE	
BARREL @ 2.92 CY/FT	= 1096.1 C.Y.
WINGS, SILLS, ETC.	42.5 C.Y.
TOTAL	1138.6 C.Y.
REINFORCING STEEL	
BARREL	145,628 LBS.
WINGS ETC.	2,516 LBS.
TOTAL	148,144 LBS.
CLASS I RIP RAP	311 TONS
GEOTEXTILE FOR DRAINAGE	523 SY

I HEREBY CERTIFY THAT THESE PLANS ARE THE AS-BUILT PLANS.

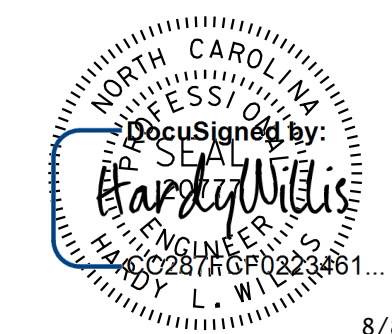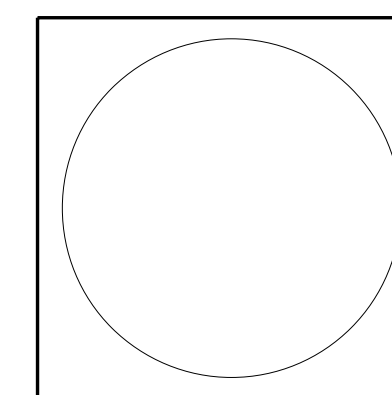

8/8/2022

PROJECT NO. U-2579AA

FORSYTH COUNTY

STATION: 36+27.30 -L-

SHEET 1 OF 6 CULVERT #813

STATE OF NORTH CAROLINA  
DEPARTMENT OF TRANSPORTATION  
RALEIGH

DOUBLE BARREL  
10'X9' RCBC  
SKEW 147°37'

ON FUTURE I-74 BETWEEN  
SR 1003 & SR 2643

DOCUMENT NOT CONSIDERED FINAL UNLESS ALL SIGNATURES COMPLETED

**V&M**  
Vaughn & Melton  
Consulting Engineers  
Asheville, North Carolina  
828-253-2796

- Boone, NC 828-355-9933
- Tri-Cities, TN 423-467-8401
- Knoxville, TN 865-546-5800
- Spartanburg, SC 864-574-4775
- Charleston, SC 843-974-5650
- Middlesboro, KY 606-248-6600
- Raleigh, NC 919-977-9455
- Charlotte, NC 704-357-0488
- Atlanta, GA 770-627-3590

Copyright © 2006 Vaughn & Melton, Inc. All Rights Reserved

DSG. ENG. OF RECORD: CMG  
DWN. BY: WDC DATE: 12/18  
CHKD. BY: HLW DATE: 12/18

REVISIONS						SHEET NO. C2-1 TOTAL SHEETS 6
NO.	BY:	DATE:	NO.	BY:	DATE:	
1			3			
2			4			

LOAD FACTORS:

DESIGN LOAD RATING FACTORS

LOAD TYPE	MAX FACTOR	MIN FACTOR
DC	1.25	0.90
DW	1.50	0.65
EV	1.30	0.90
EH	1.35	0.90
ES	1.35	0.90
LS	1.75	--
WA	1.00	--

NOTE:


RATING FACTORS ARE BASED ON THE STRENGTH I LIMIT STATE.

COMMENTS:


- 1.
- 2.
- 3.
- 4.

#	CONTROLLING LOAD RATING
1	DESIGN LOAD RATING (HL-93)
2	DESIGN LOAD RATING (HS-20)
3	LEGAL LOAD RATING **
** SEE CHART FOR VEHICLE TYPE	

LOAD AND RESISTANCE FACTOR RATING (LRFR) SUMMARY FOR REINFORCED CONCRETE BOX CULVERTS															
LEVEL	VEHICLE	WEIGHT (W) (TONS)	CONTROLLING LOAD RATING #	MINIMUM RATING FACTORS (RF)	TONS = W x RF	STRENGTH I LIMIT STATE								COMMENT NUMBER	
						LIVE-LOAD FACTORS (γ <sub>LL</sub> )	MOMENT				SHEAR				
							RATING FACTOR	BOX NO.	ELEMENT TYPE	DISTANCE FROM LEFT END OF ELEMENT (ft)	RATING FACTOR	BOX NO.	ELEMENT TYPE		DISTANCE FROM LEFT END OF ELEMENT (ft)
DESIGN LOAD RATING	HL-93 (INVENTORY)	N/A	1	1.76	--	1.75	2.03	1	TOP SLAB	10.83'	1.76	1	TOP SLAB	9.90'	
	HL-93 (OPERATING)	N/A		2.28	--	1.35	2.63	1	TOP SLAB	10.83'	2.28	1	TOP SLAB	9.90'	
	HS-20 (INVENTORY)	36.00	2	1.76	63.360	1.75	2.12	1	TOP SLAB	10.83'	1.76	1	TOP SLAB	9.90'	
	HS-20 (OPERATING)	36.00		2.28	82.080	1.35	2.74	1	TOP SLAB	10.83'	2.28	1	TOP SLAB	9.90'	
LEGAL LOAD RATING	SINGLE VEHICLE (SV)	SNSH		2.27	30.645	1.40	5.98	1	EXT. WALL	5.81'	2.27	1	EXT. WALL	1.93'	
		SNGARBS2	20.00		2.27	45.400	1.40	4.61	1	TOP SLAB	10.83'	2.27	1	EXT. WALL	1.93'
		SNAGRIS2	22.00		2.27	49.940	1.40	4.19	1	TOP SLAB	10.83'	2.27	1	EXT. WALL	1.93'
		SNCOTTS3	27.25		2.18	59.405	1.40	2.43	1	TOP SLAB	10.83'	2.18	1	TOP SLAB	9.90'
		SNAGGRS4	34.925		1.89	66.008	1.40	2.19	1	TOP SLAB	10.83'	1.89	1	TOP SLAB	9.90'
		SNS5A	35.55		1.94	68.967	1.40	2.27	1	TOP SLAB	10.83'	1.94	1	TOP SLAB	9.90'
		SNS6A	39.95		1.66	66.317	1.40	2.09	1	TOP SLAB	10.83'	1.66	1	TOP SLAB	9.90'
		SNS7B	42.00		1.62	68.040	1.40	1.97	1	TOP SLAB	10.83'	1.62	1	TOP SLAB	9.90'
	TRUCK TRACTOR SEMI-TRAILER (TTST)	TNAGRIT3	33.00		1.99	65.670	1.40	2.61	1	TOP SLAB	10.83'	1.99	1	TOP SLAB	9.90'
		TNT4A	33.075		1.95	64.496	1.40	2.39	1	TOP SLAB	10.83'	1.95	1	TOP SLAB	9.90'
		TNT6A	41.60		1.74	72.384	1.40	2.04	1	TOP SLAB	10.83'	1.74	1	TOP SLAB	9.90'
		TNT7A	42.00		1.72	72.240	1.40	2.11	1	TOP SLAB	10.83'	1.72	1	TOP SLAB	9.90'
		TNT7B	42.00		1.91	80.220	1.40	2.26	1	TOP SLAB	10.83'	1.91	1	TOP SLAB	9.90'
		TNAGRIT4	43.00		1.57	67.510	1.40	2.03	1	TOP SLAB	10.83'	1.57	1	TOP SLAB	9.90'
TNAGT5A	45.00		1.70	76.500	1.40	1.91	1	TOP SLAB	10.83'	1.70	1	TOP SLAB	9.90'		
TNAGT5B	45.00		3	1.45	65.250	1.40	1.85	1	TOP SLAB	10.83'	1.45	1	TOP SLAB	9.90'	

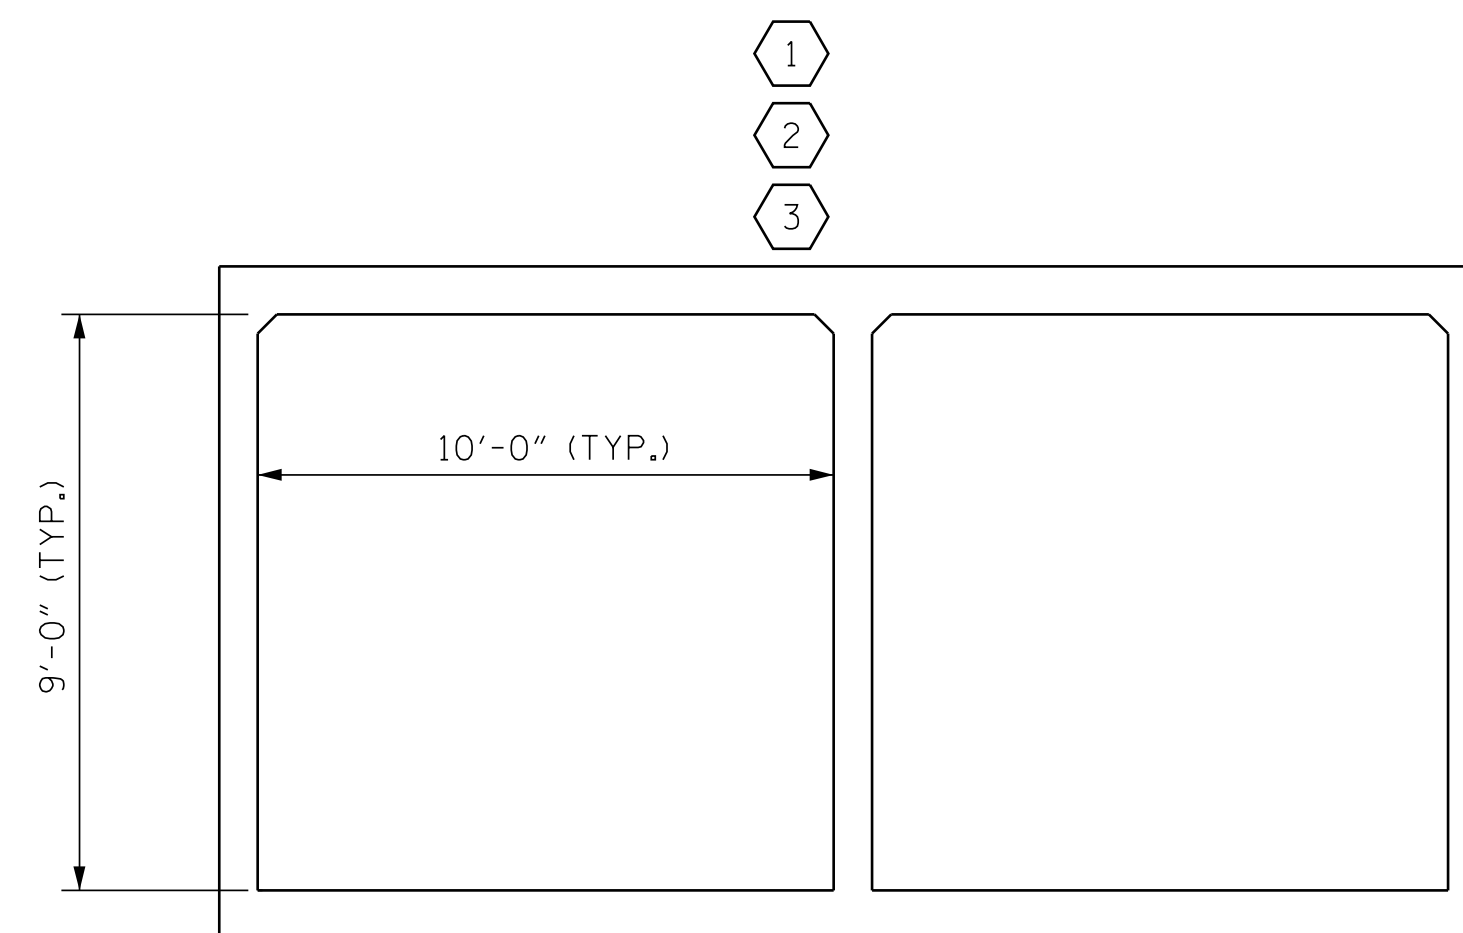

LRFR SUMMARY  
(LOOKING DOWNSTREAM)

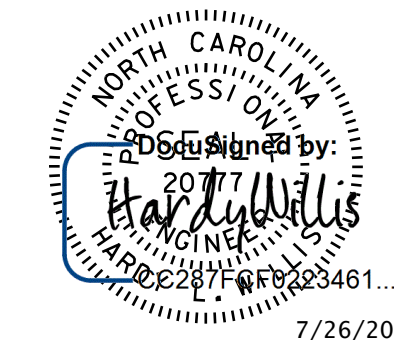

DOCUMENT NOT CONSIDERED FINAL UNLESS ALL SIGNATURES COMPLETED

**V&M**  
Vaughn & Melton  
Consulting Engineers  
Asheville, North Carolina  
828-253-2796

Boone, NC 828-355-9933  
Tri-Cities, TN 423-467-8401  
Knoxville, TN 865-546-5800  
Spartanburg, SC 864-574-4775  
Charleston, SC 843-974-5650  
Middlesboro, KY 606-248-6600  
Raleigh, NC 919-977-9455  
Charlotte, NC 704-357-0488  
Atlanta, GA 770-627-3590

Copyright © 2006 Vaughn & Melton, Inc. All Rights Reserved.


PROJECT NO. U-2579AA  
FORSYTH COUNTY  
STATION: 36+27.30 -L-

STATE OF NORTH CAROLINA  
DEPARTMENT OF TRANSPORTATION  
RALEIGH  
STANDARD  
LRFR SUMMARY FOR  
REINFORCED CONCRETE  
BOX CULVERTS  
(INTERSTATE TRAFFIC)


DRAWN BY: WMC 7/II  
CHECKED BY: GM 7/II  
REV. 10/1/11 MAA/GM  
REV. 12/17 MAA/THC

DSG. ENG. OF RECORD.: CMG	REVISIONS						SHEET NO. C2-2
DWN. BY: WDC DATE: 12/18	NO.	BY:	DATE:	NO.	BY:	DATE:	TOTAL SHEETS 6
CHKD. BY: HLW DATE: 12/18	1			3			
	2			4			


STD. NO. LRFR6

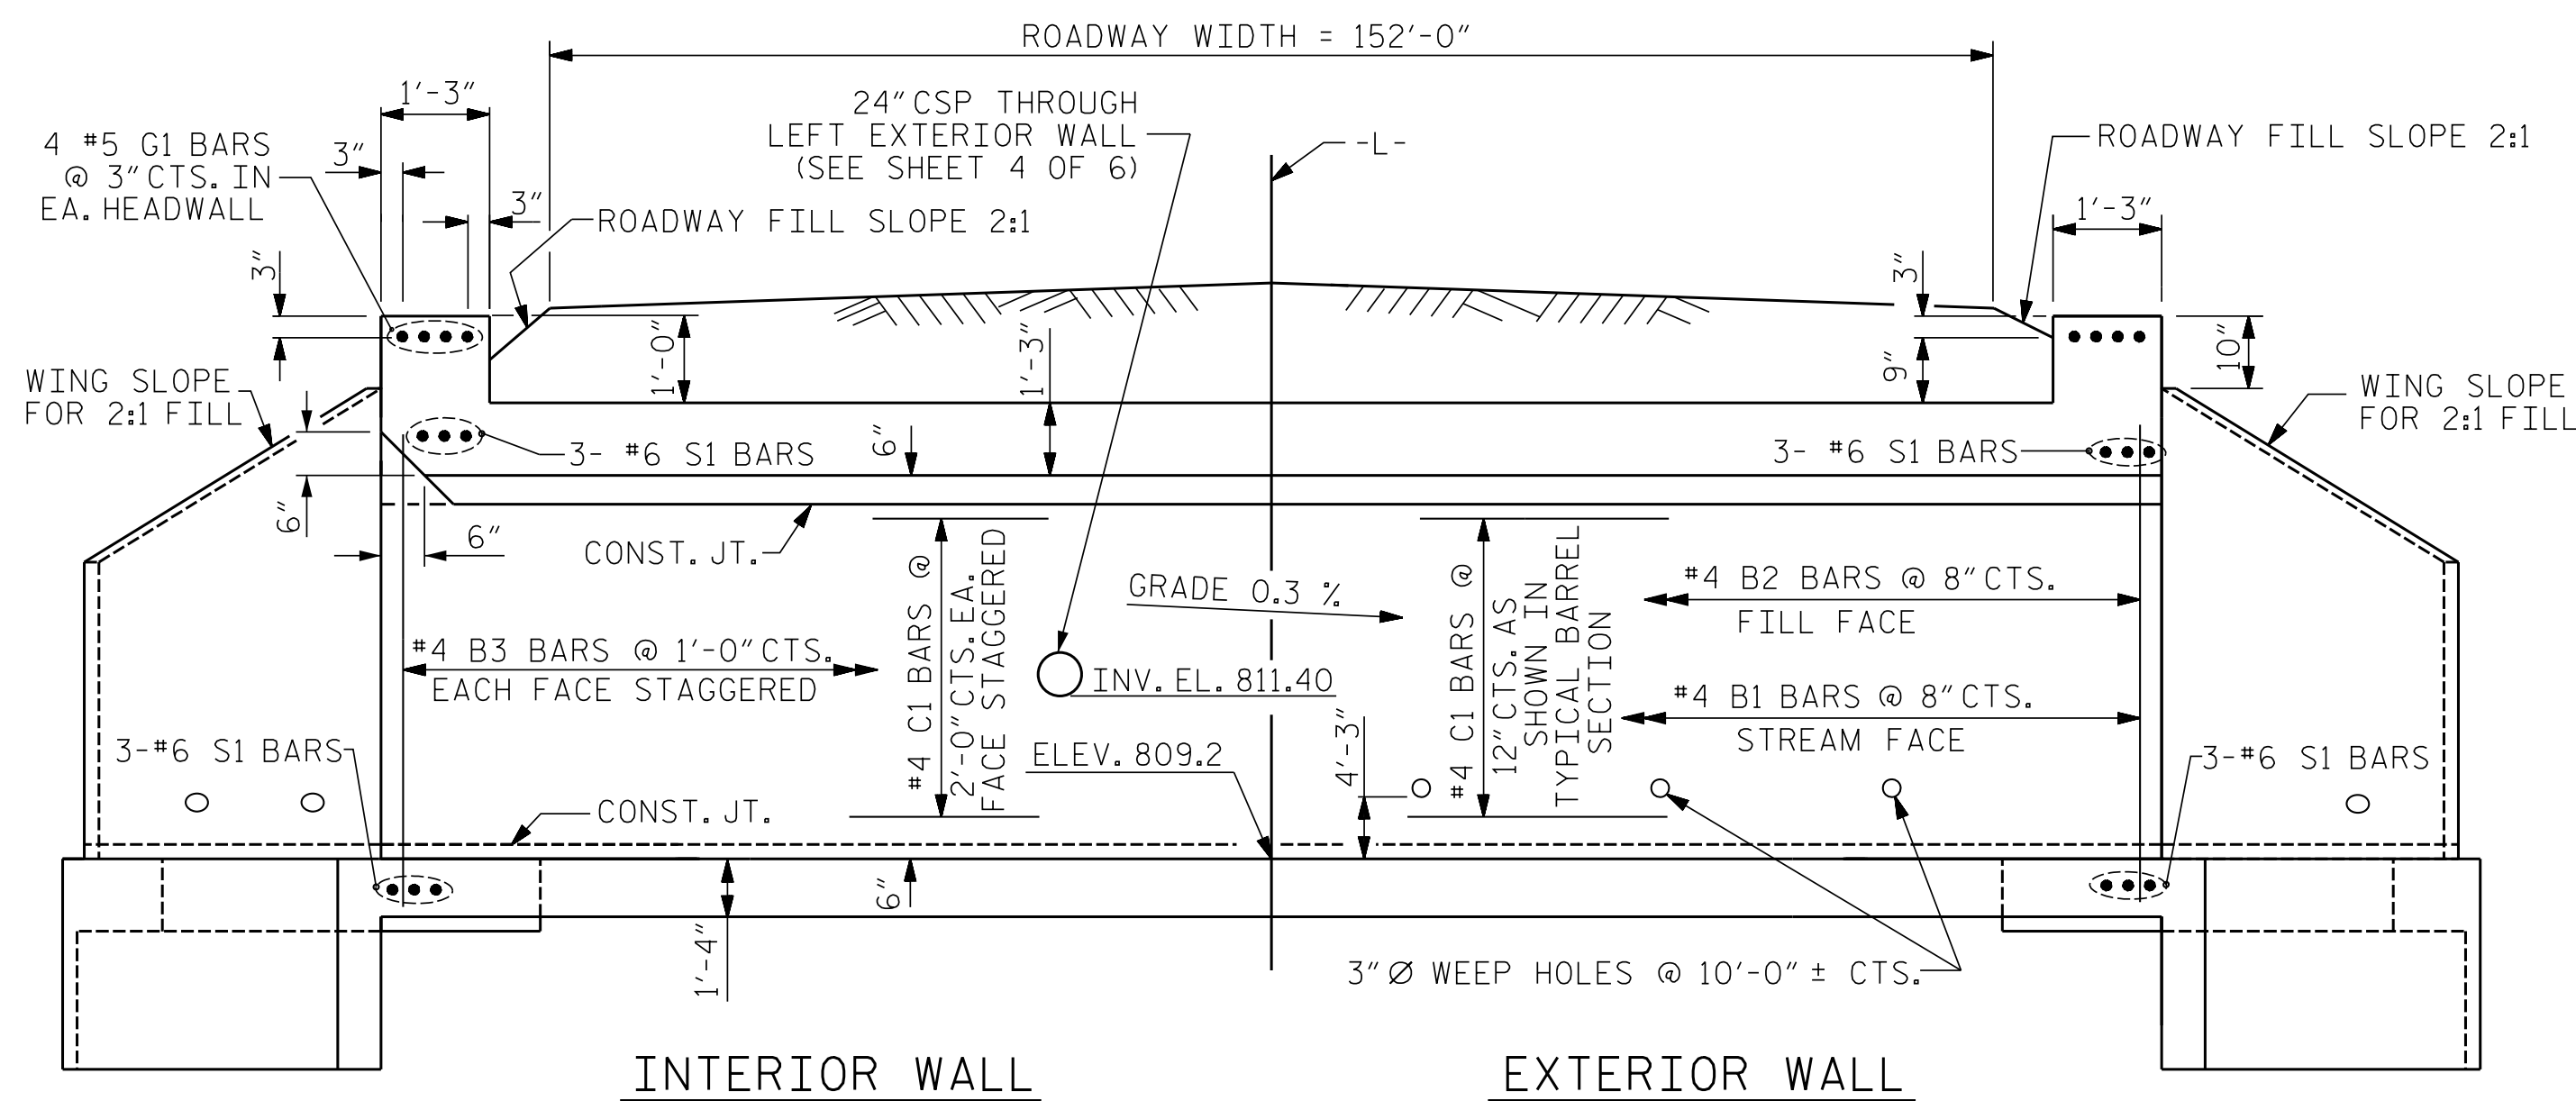

CULVERT SECTION NORMAL TO ROADWAY

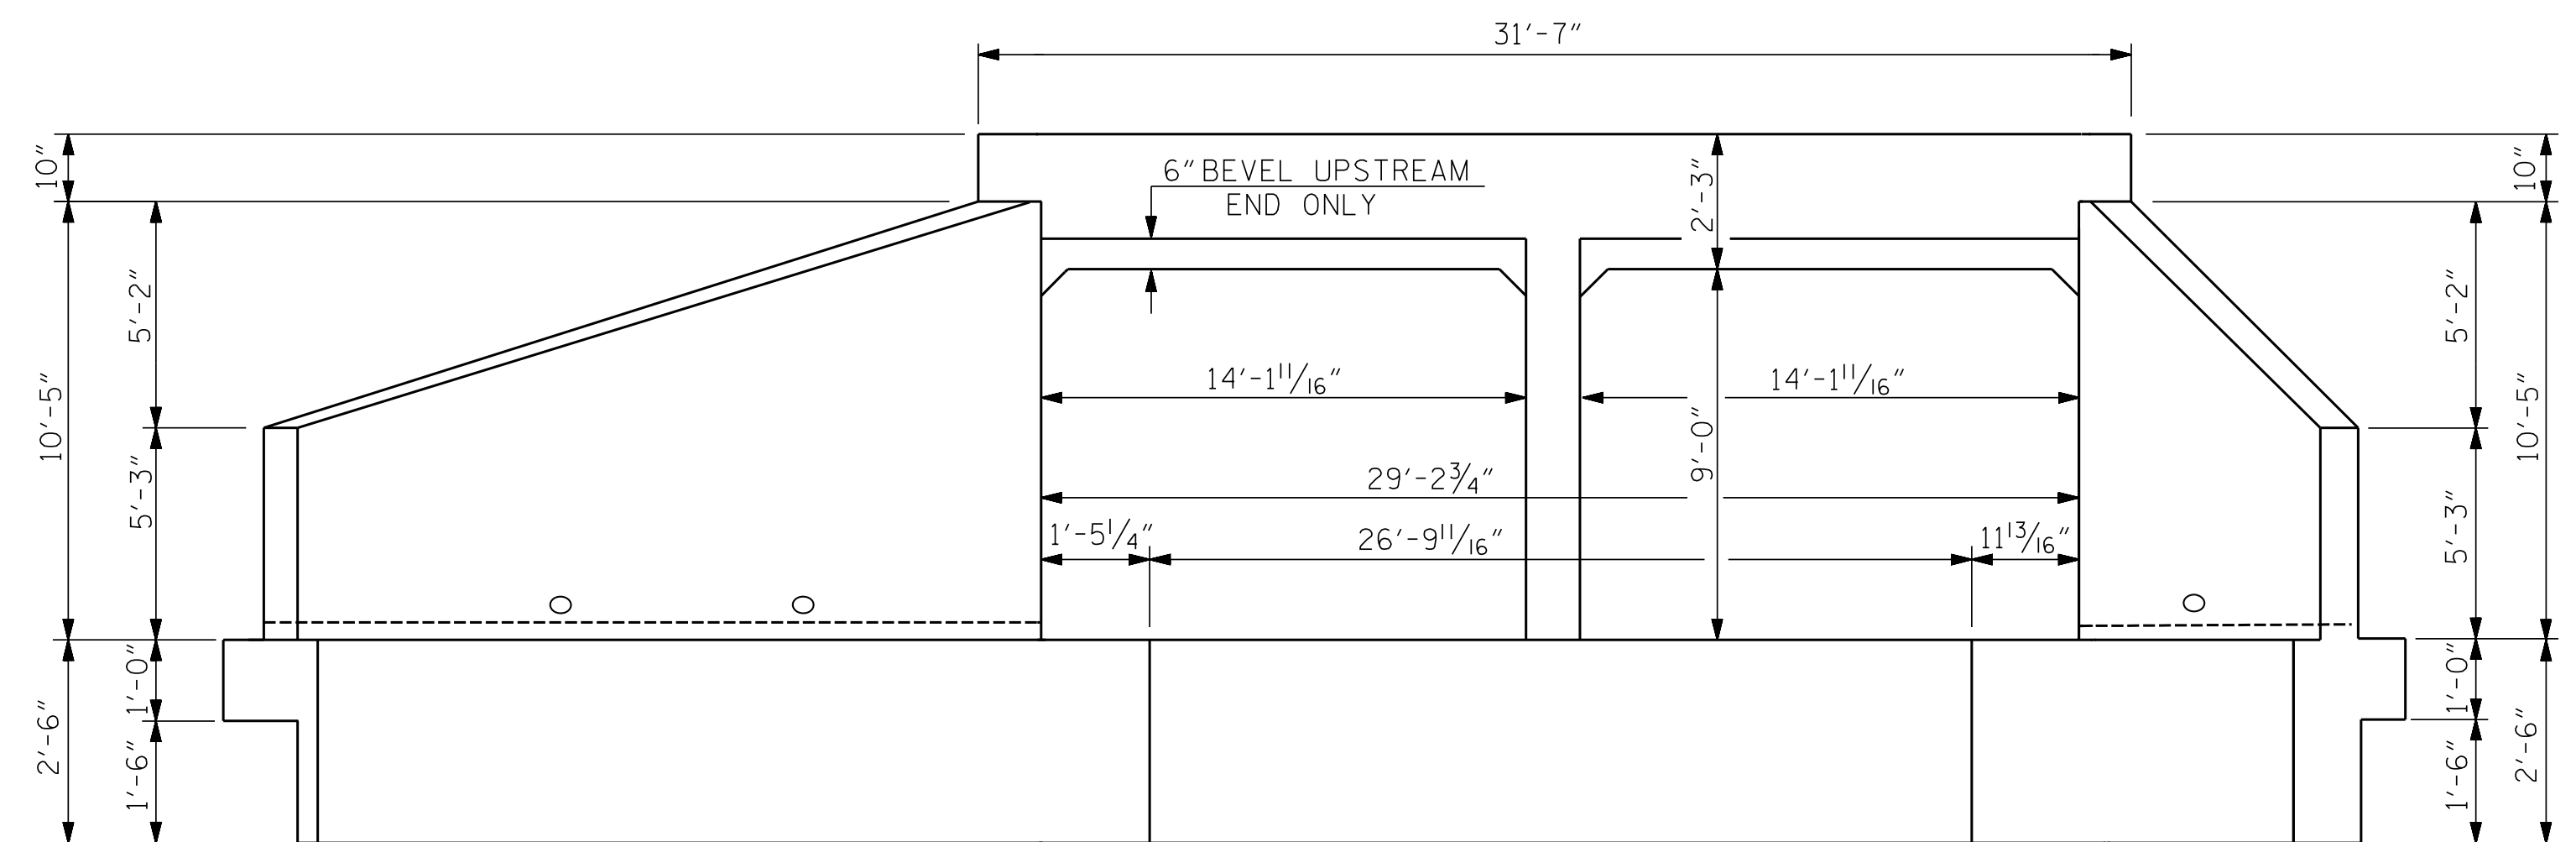


END ELEVATION NORMAL TO SKEW

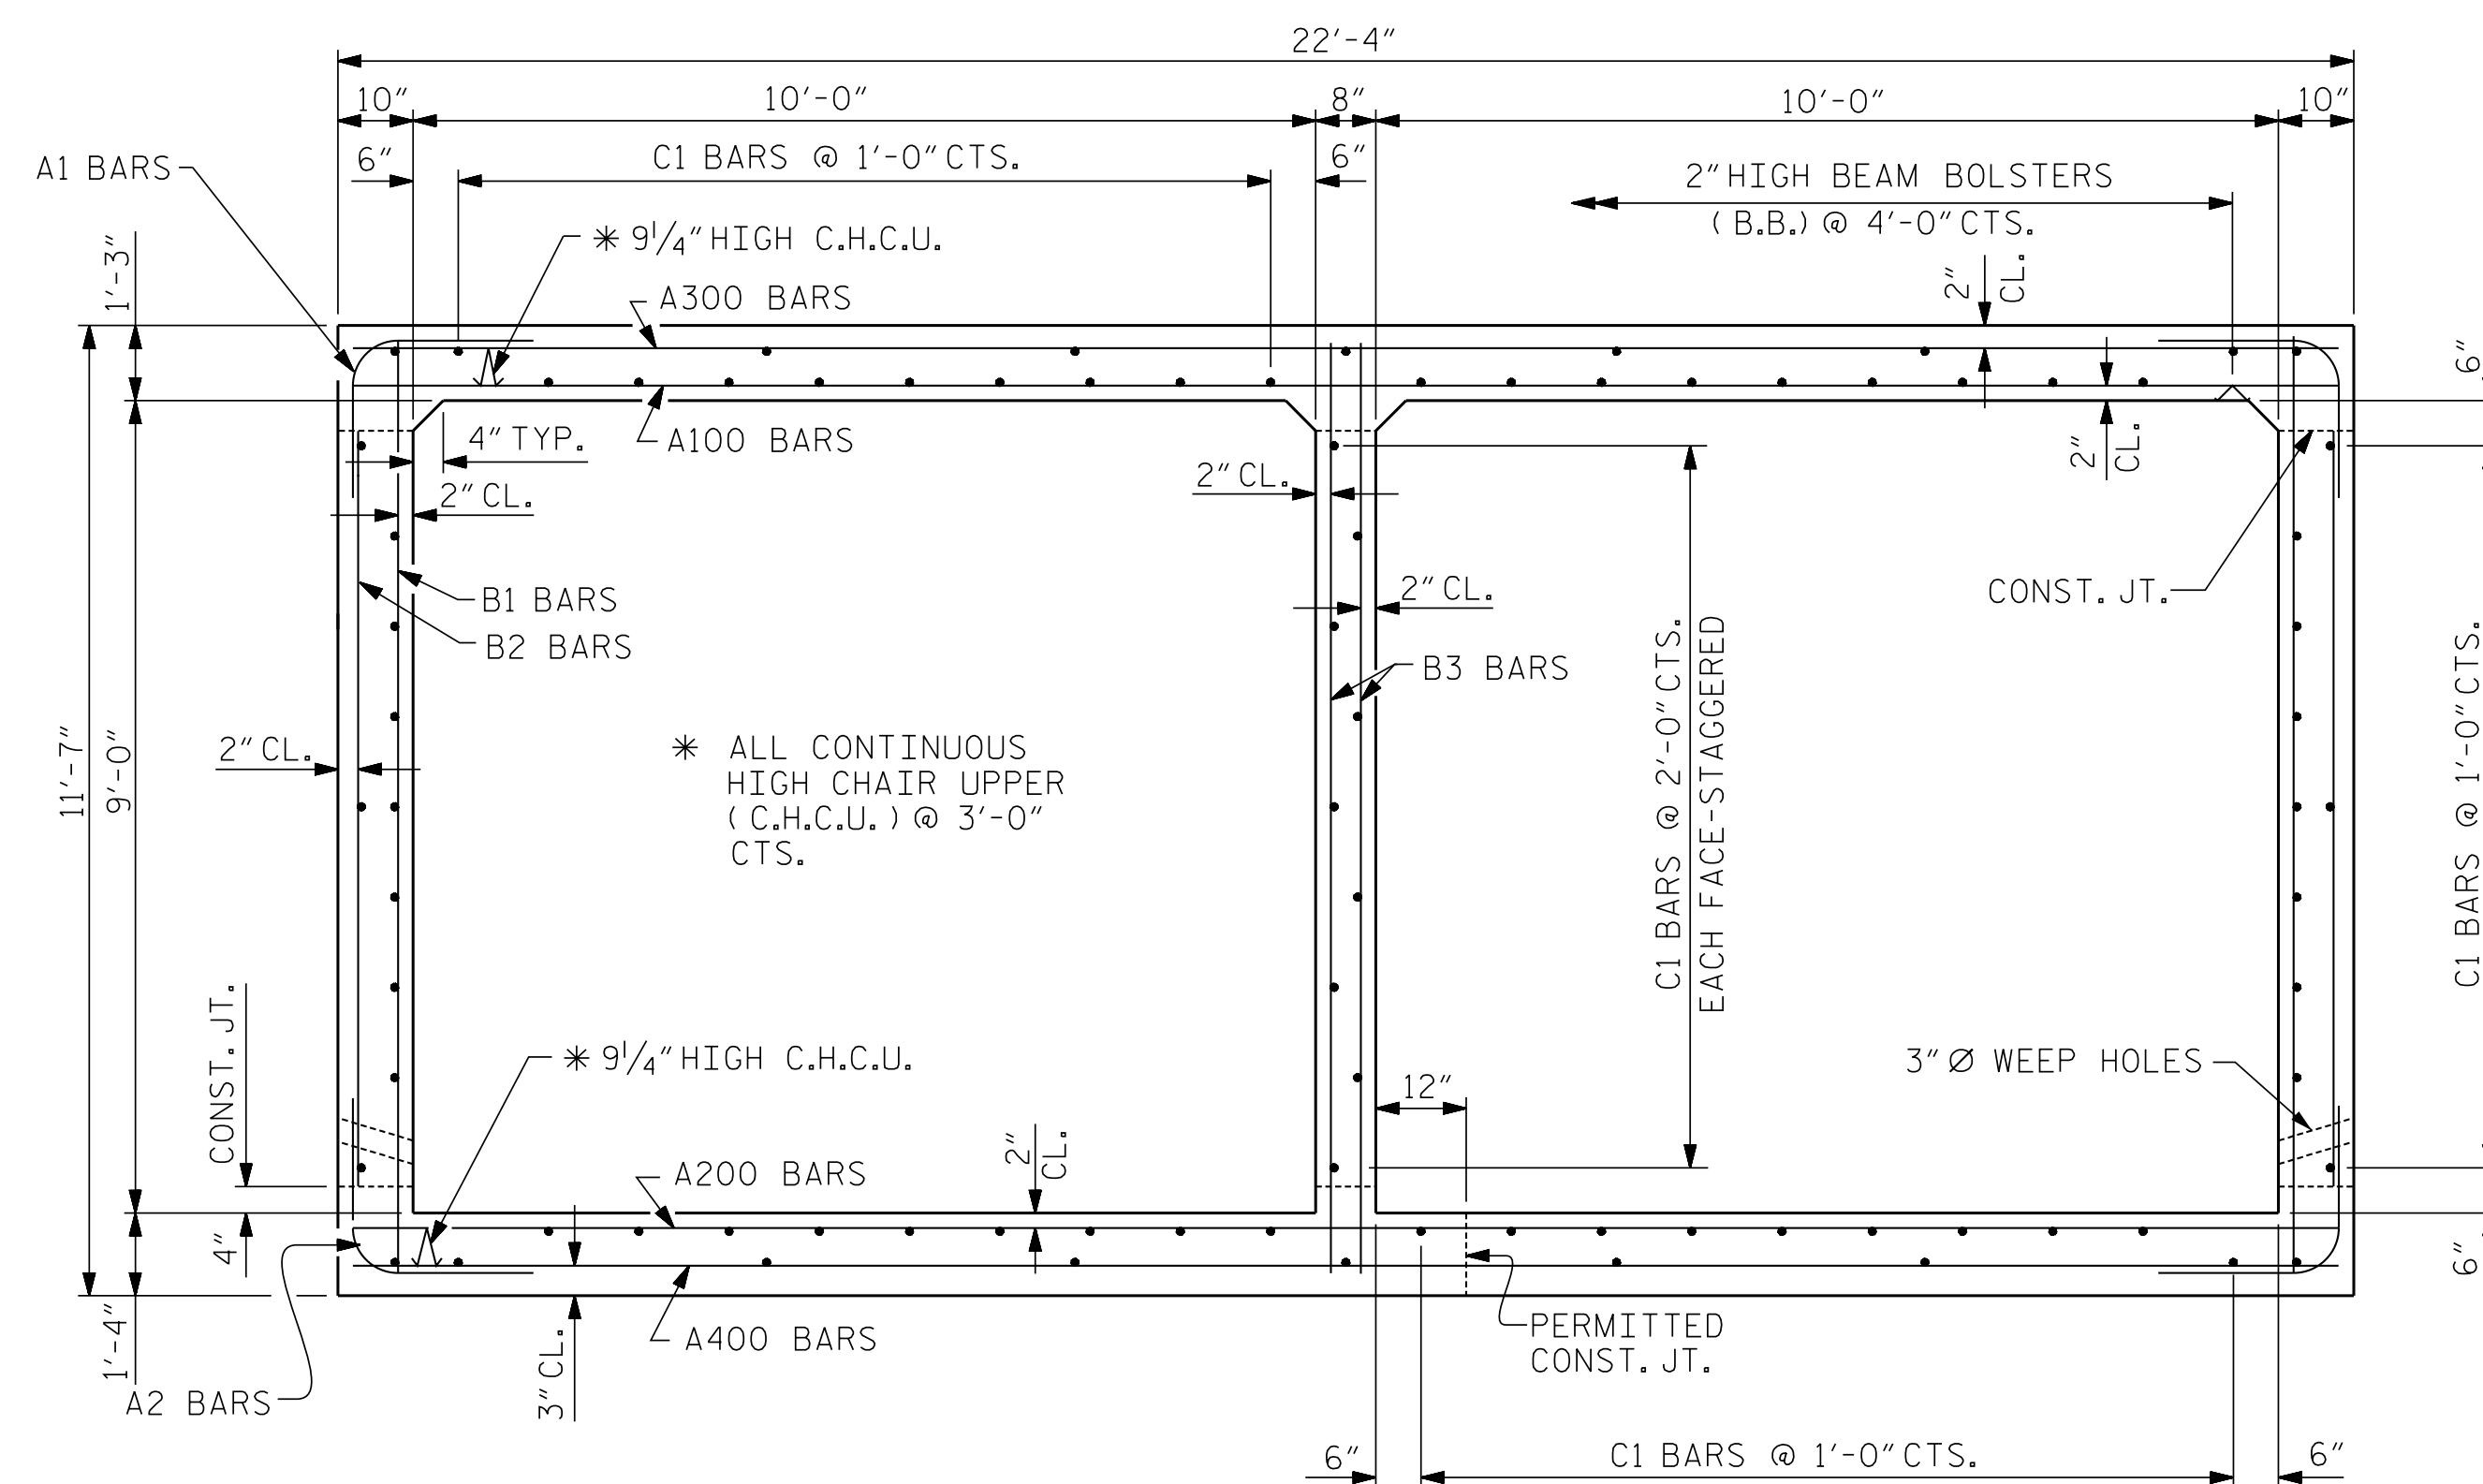


RIGHT ANGLE SECTION OF BARREL

THERE ARE 83 "C" BARS IN SECTION OF BARREL.

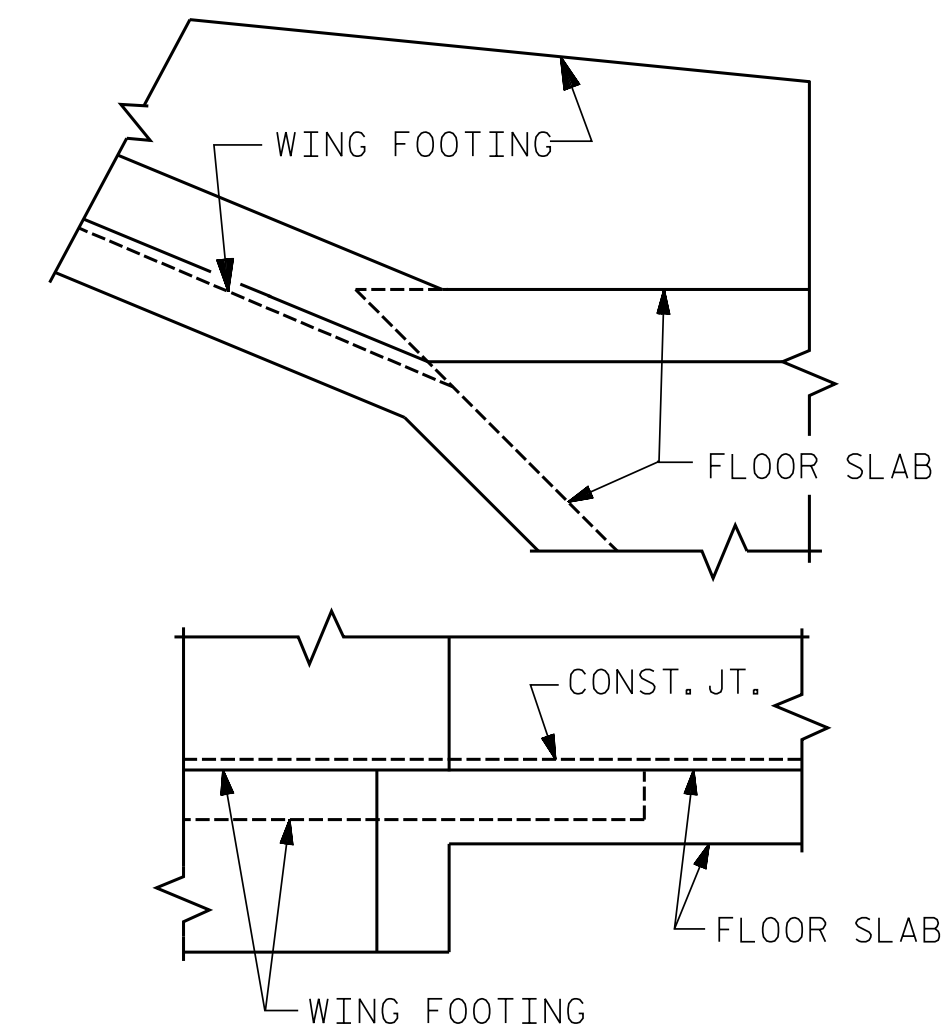

CONNECTION OF WING FOOTING AND FLOOR SLAB WHEN SLAB IS THICKER THAN FOOTING

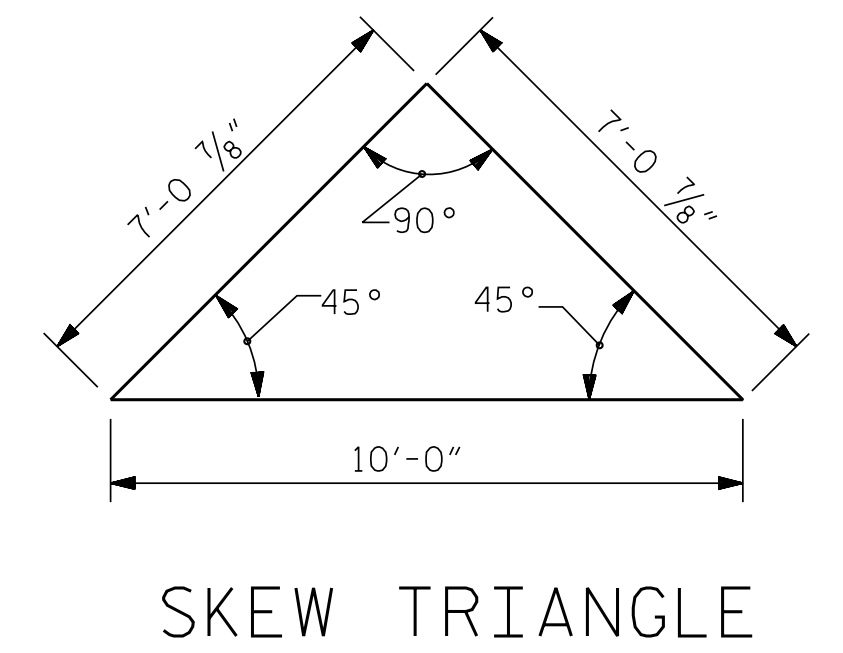

SKEW TRIANGLE

PROJECT NO. U-2579AA  
 FORSYTH COUNTY  
 STATION: 36+27.30 -L-

SHEET 3 OF 6



STATE OF NORTH CAROLINA  
 DEPARTMENT OF TRANSPORTATION  
 RALEIGH  
 BARREL STANDARD  
 DOUBLE 10 FT. X 9 FT.  
 CONCRETE BOX CULVERT WITH  
 VERTICAL CLEARANCE OF  
 8 FT. OR MORE  
 135° SKEW

REVISED 11-19-99 BY M.M. CHECKED BY R.W.W.  
 REDRAWN BY: COC 11/90 CHECKED BY: ELR 10/90

DRAWN BY: RALPH D. UNDERWOOD DATE: APR. 1972  
 CHECKED BY: HASON A. JUDEH DATE: 5-23-1972

STANDARD

I HEREBY CERTIFY  
 THAT THESE PLANS  
 ARE THE  
 AS-BUILT PLANS.

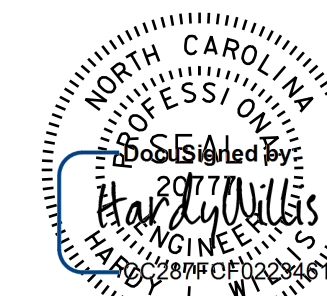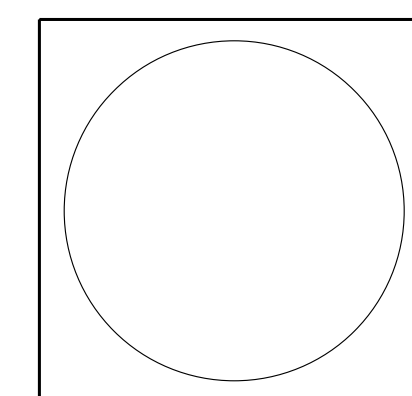

7/26/2022

DOCUMENT NOT CONSIDERED  
 FINAL UNLESS ALL  
 SIGNATURES COMPLETED

**V&M**  
 Vaughn & Melton  
 Consulting Engineers  
 Asheville, North Carolina  
 828-253-2796  
 Raleigh, NC 919-977-9455  
 Charlotte, NC 704-357-0488  
 Knoxville, TN 865-546-5800  
 Sparta, TN 865-546-5800  
 Charleston, SC 843-974-5650  
 Middlesboro, KY 606-248-6600  
 Atlanta, GA 770-627-3590  
 Copyright © 2006 Vaughn & Melton, Inc. All Rights Reserved

DSG. ENG. OF RECORD.: CMG  
 DWN. BY: WDC DATE: 12/18  
 CHKD. BY: HLW DATE: 12/18



REVISIONS						SHEET NO.
NO.	BY:	DATE:	NO.	BY:	DATE:	C2-3
1			3			TOTAL SHEETS
2			4			6

STD. NO. CB552




**NOTES:**

- 1) NATIVE MATERIAL BETWEEN SILLS/BAFFLES IN THE CULVERT SHALL PROVIDE A CONTINUOUS LOW FLOW CHANNEL. NATIVE MATERIAL CONSISTS OF MATERIAL THAT IS EXCAVATED FROM THE STREAM OR FLOODPLAIN AT THE PROJECT SITE DURING CONSTRUCTION. ONLY MATERIAL THAT IS EXCAVATED FROM THE STREAM BED MAY BE USED TO LINE THE LOW FLOW CULVERT BARREL. RIP-RAP MAY BE USED TO SUPPLEMENT THE NATIVE MATERIAL IN THE HIGH FLOW CULVERT BARREL. IF RIP-RAP IS USED TO LINE THE HIGH FLOW CULVERT BARREL, NATIVE MATERIAL SHOULD BE PLACED ON TOP TO FILL VOIDS AND PROVIDE A FLAT SURFACE FOR ANIMAL PASSAGE. NATIVE MATERIAL IS SUBJECT TO APPROVAL BY THE ENGINEER AND MAY BE SUBJECT TO PERMIT CONDITIONS.
- 2) SILLS ARE TO BE 1.0 FT/ WIDE, CAST SEPARATELY AND ATTACHED BY DOWELS.
- 3) TOP OF LOW FLOW SILLS SHOULD MATCH STREAM BED ELEVATION IN LOW FLOW CHANNEL OF STREAM. (THALWEG)
- 4) DO NOT SET ELEVATION OF HIGH SILLS ABOVE BANK FULL.
- 5) NUMBER OF SILLS DETERMINED BY THE ENGINEER.

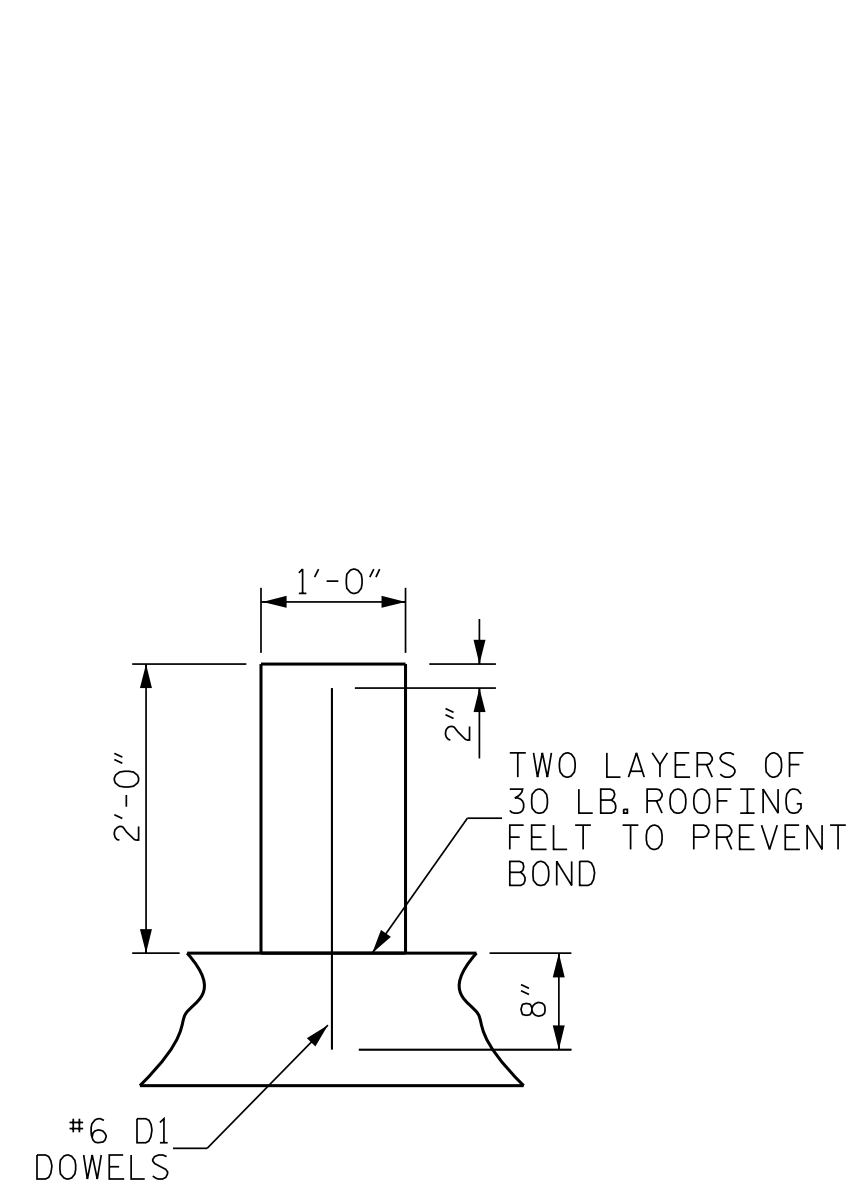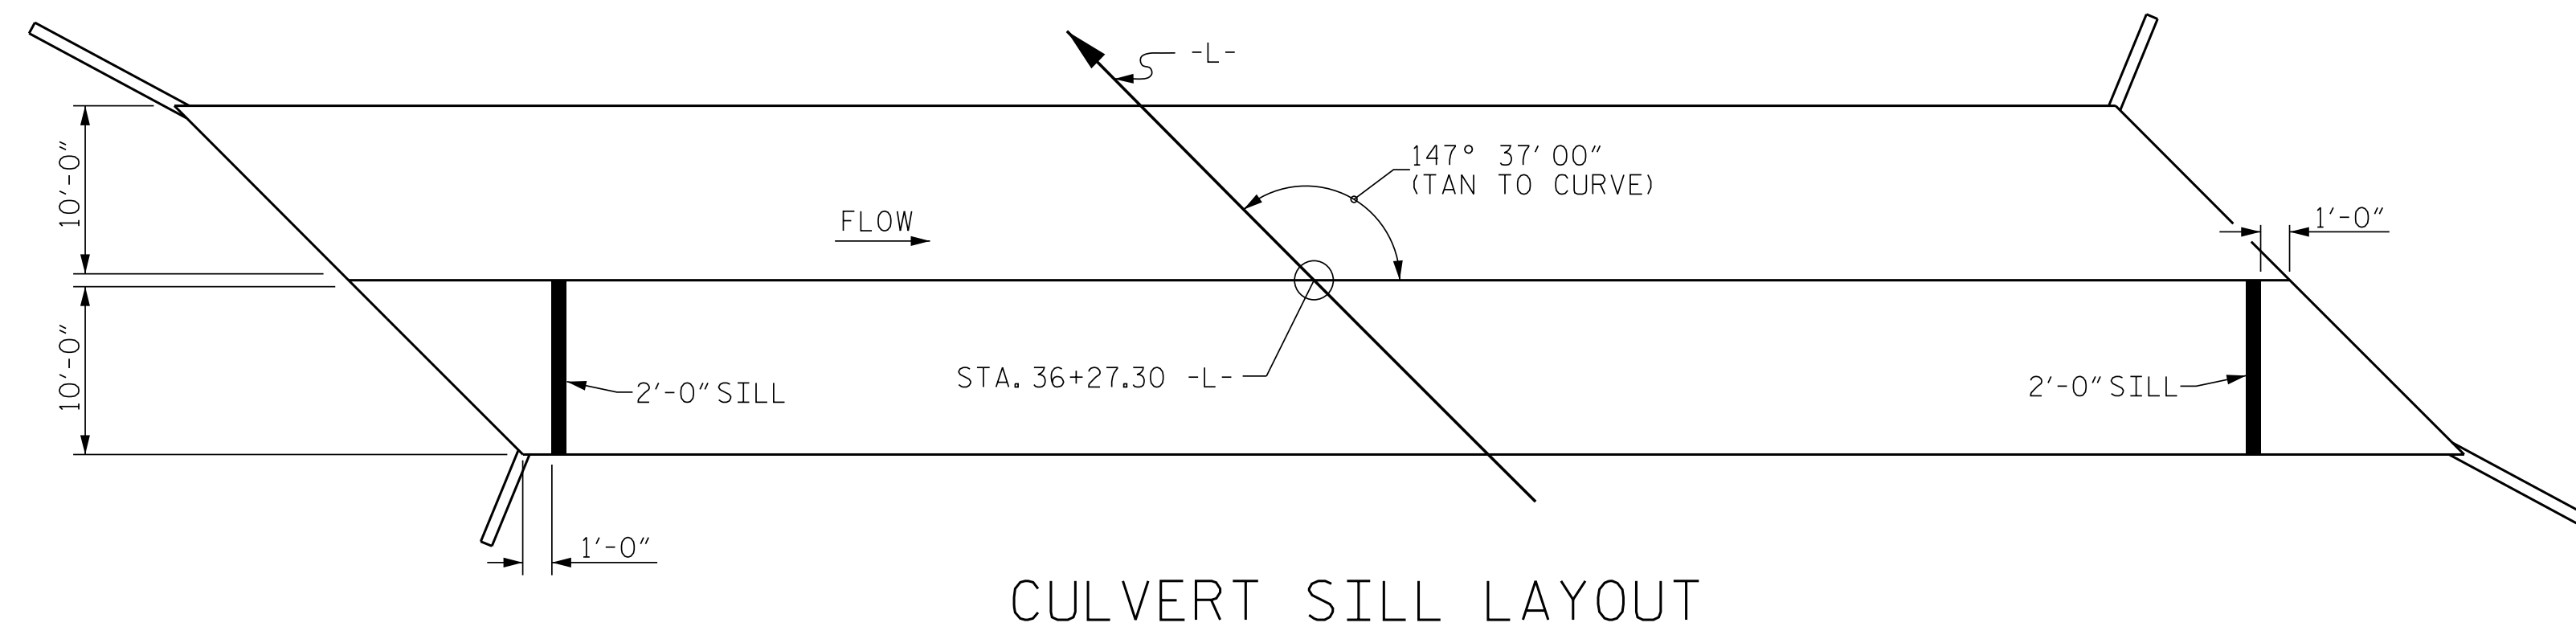

**SECTION THROUGH SILL**

DOWELS MAY BE PUSHED INTO GREEN CONCRETE AFTER SLAB HAS BEEN FLOATED.

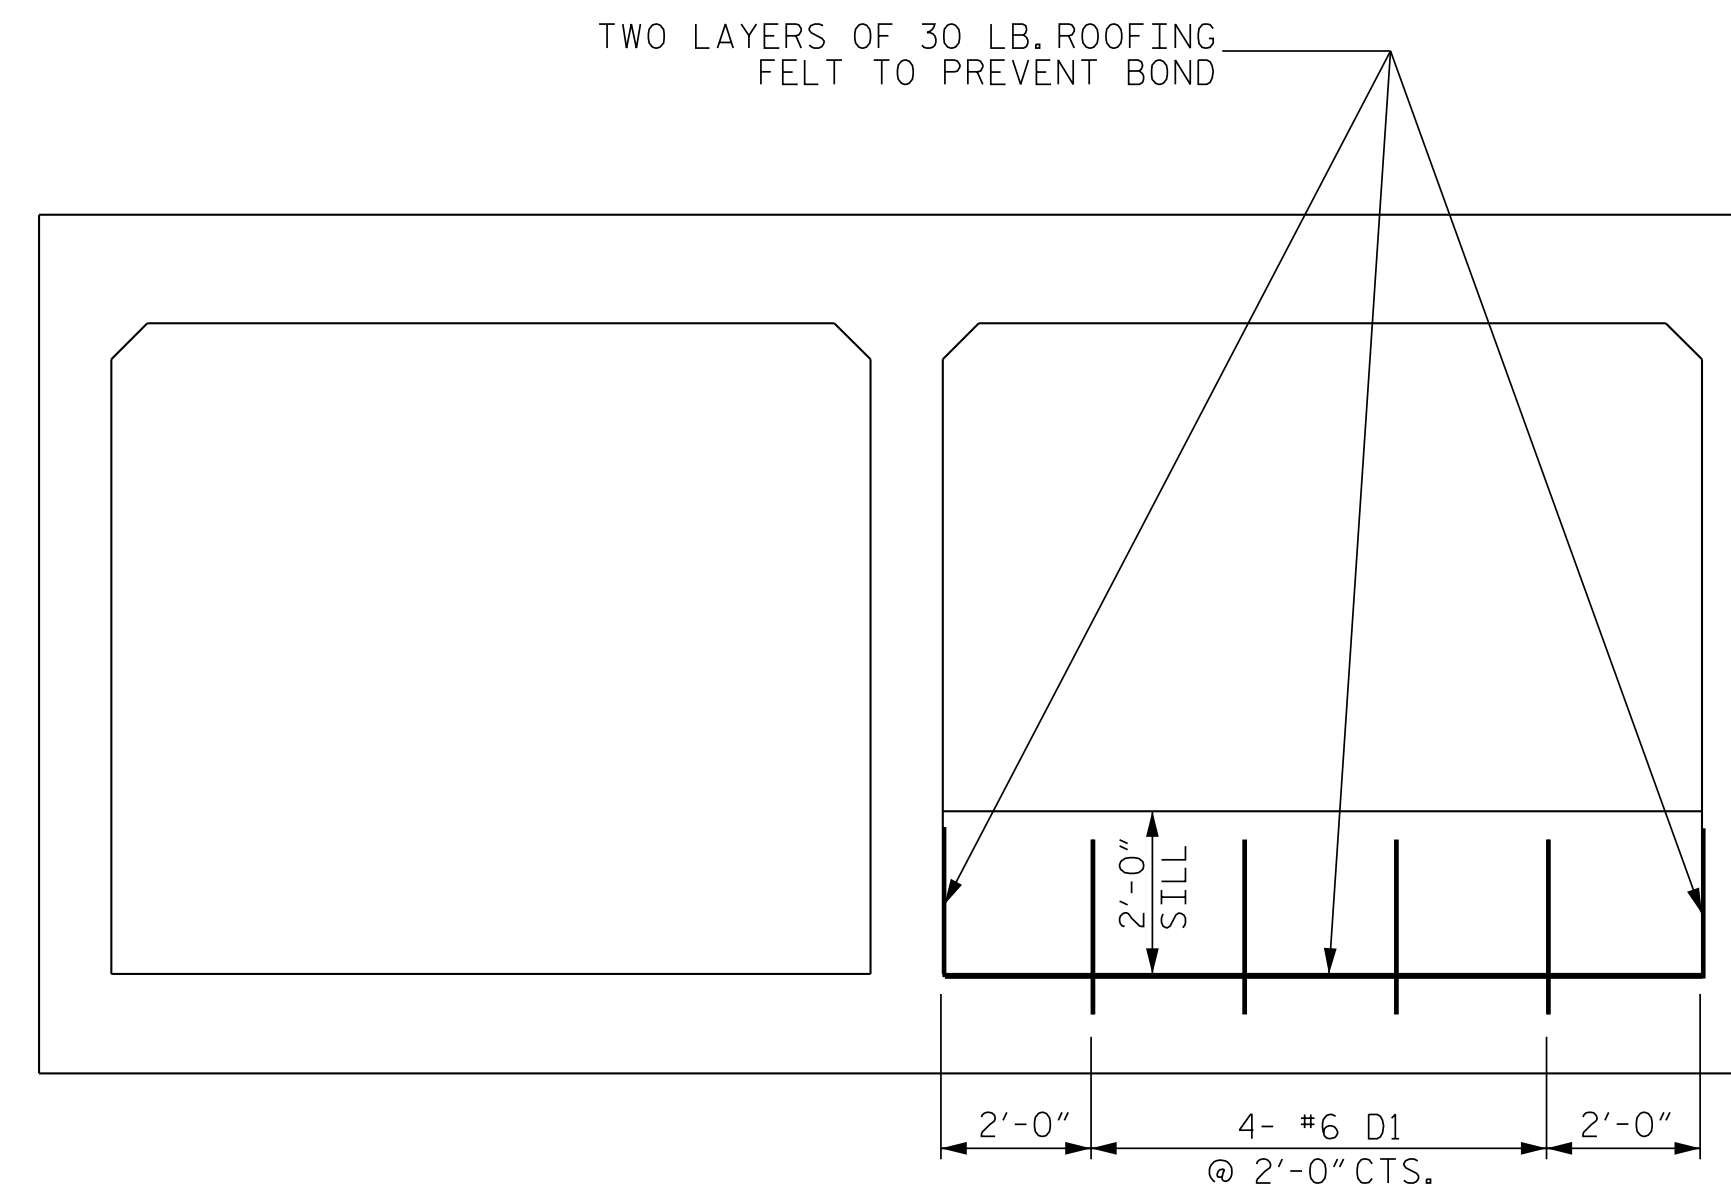


PROJECT NO. U-2579AA  
FORSYTH COUNTY  
 STATION: 36+27.30 -L-

SHEET 5 OF 6

STATE OF NORTH CAROLINA  
 DEPARTMENT OF TRANSPORTATION  
 RALEIGH

**DOUBLE BARREL**  
 10'X9' RCBC  
 SKEW 147°37'

ON FUTURE I-74 BETWEEN  
 SR 1003 & SR 2643

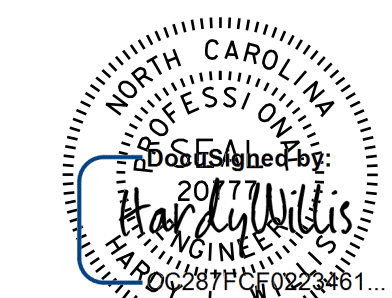

DOCUMENT NOT CONSIDERED  
 FINAL UNLESS ALL  
 SIGNATURES COMPLETED

**V&M**  
**Vaughn & Melton**  
 Consulting Engineers


Asheville, North Carolina  
 828-253-2786

Boone, NC 828-355-9933  
 Tri-Cities, TN 423-467-8401  
 Knoxville, TN 865-546-5800  
 Spartanburg, SC 864-574-4775  
 Charleston, SC 843-974-5650  
 Middleboro, KY 506-248-6500  
 Atlanta, GA 770-627-3590


Copyright © 2006 Vaughn & Melton, Inc. All Rights Reserved

DSG. ENG. OF RECORD.: CMG  
 DWN. BY: WDC DATE: 12/18  
 CHKD. BY: HLW DATE: 12/18


REVISIONS						SHEET NO.
NO.	BY:	DATE:	NO.	BY:	DATE:	C2-5
1			3			TOTAL SHEETS
2			4			6

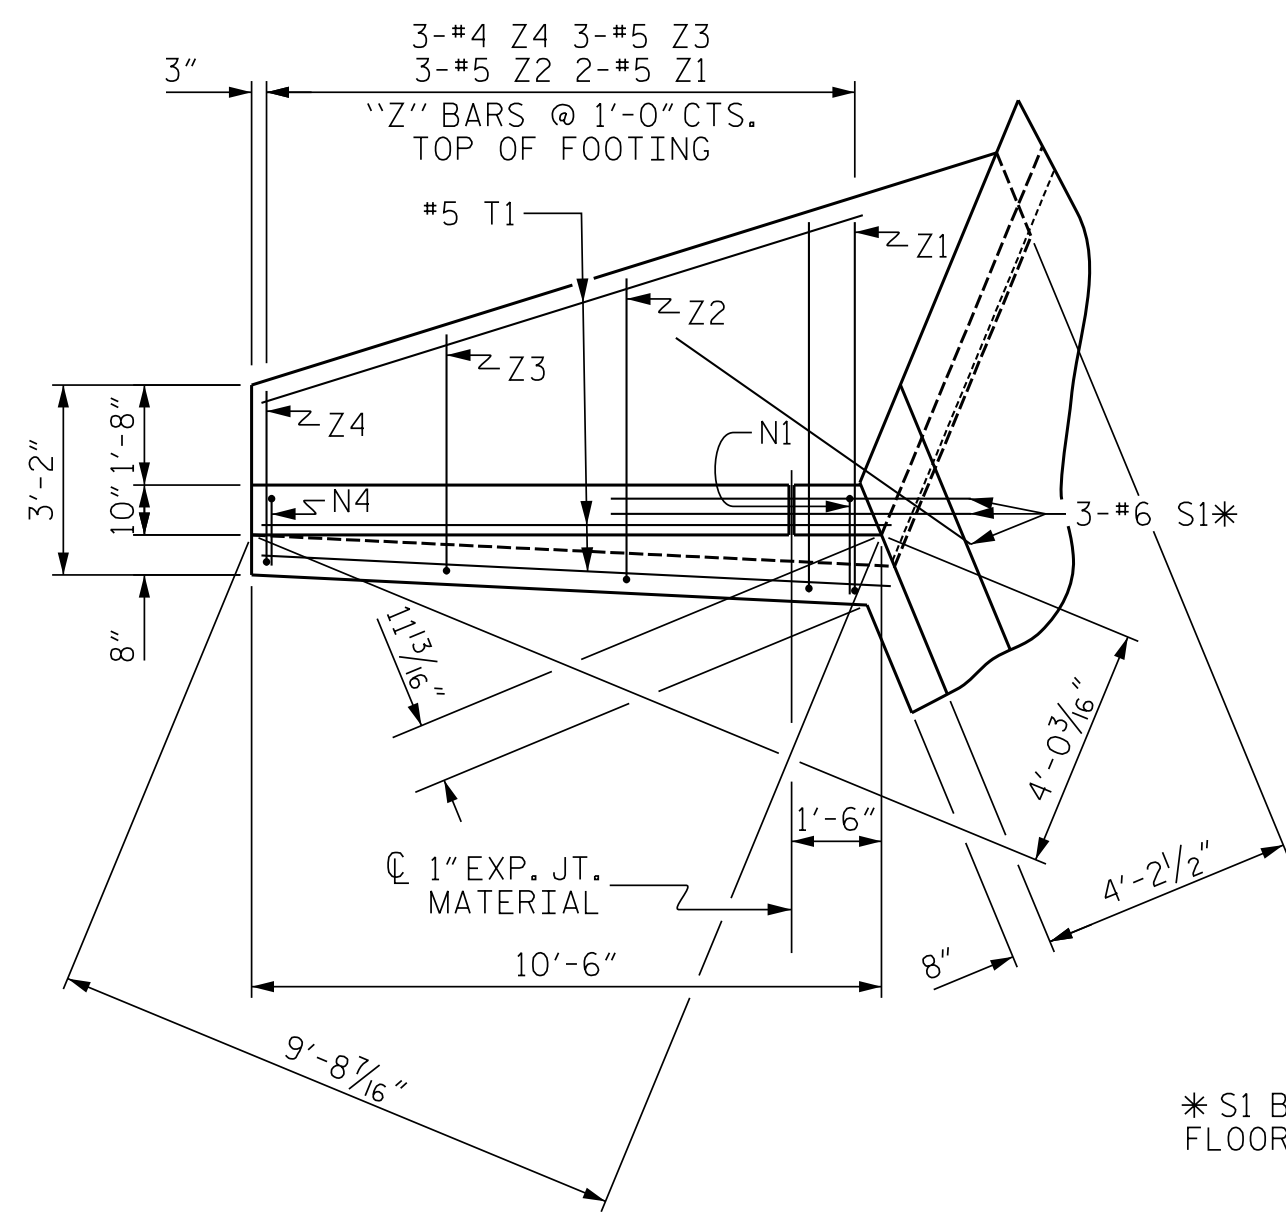


PLAN W2

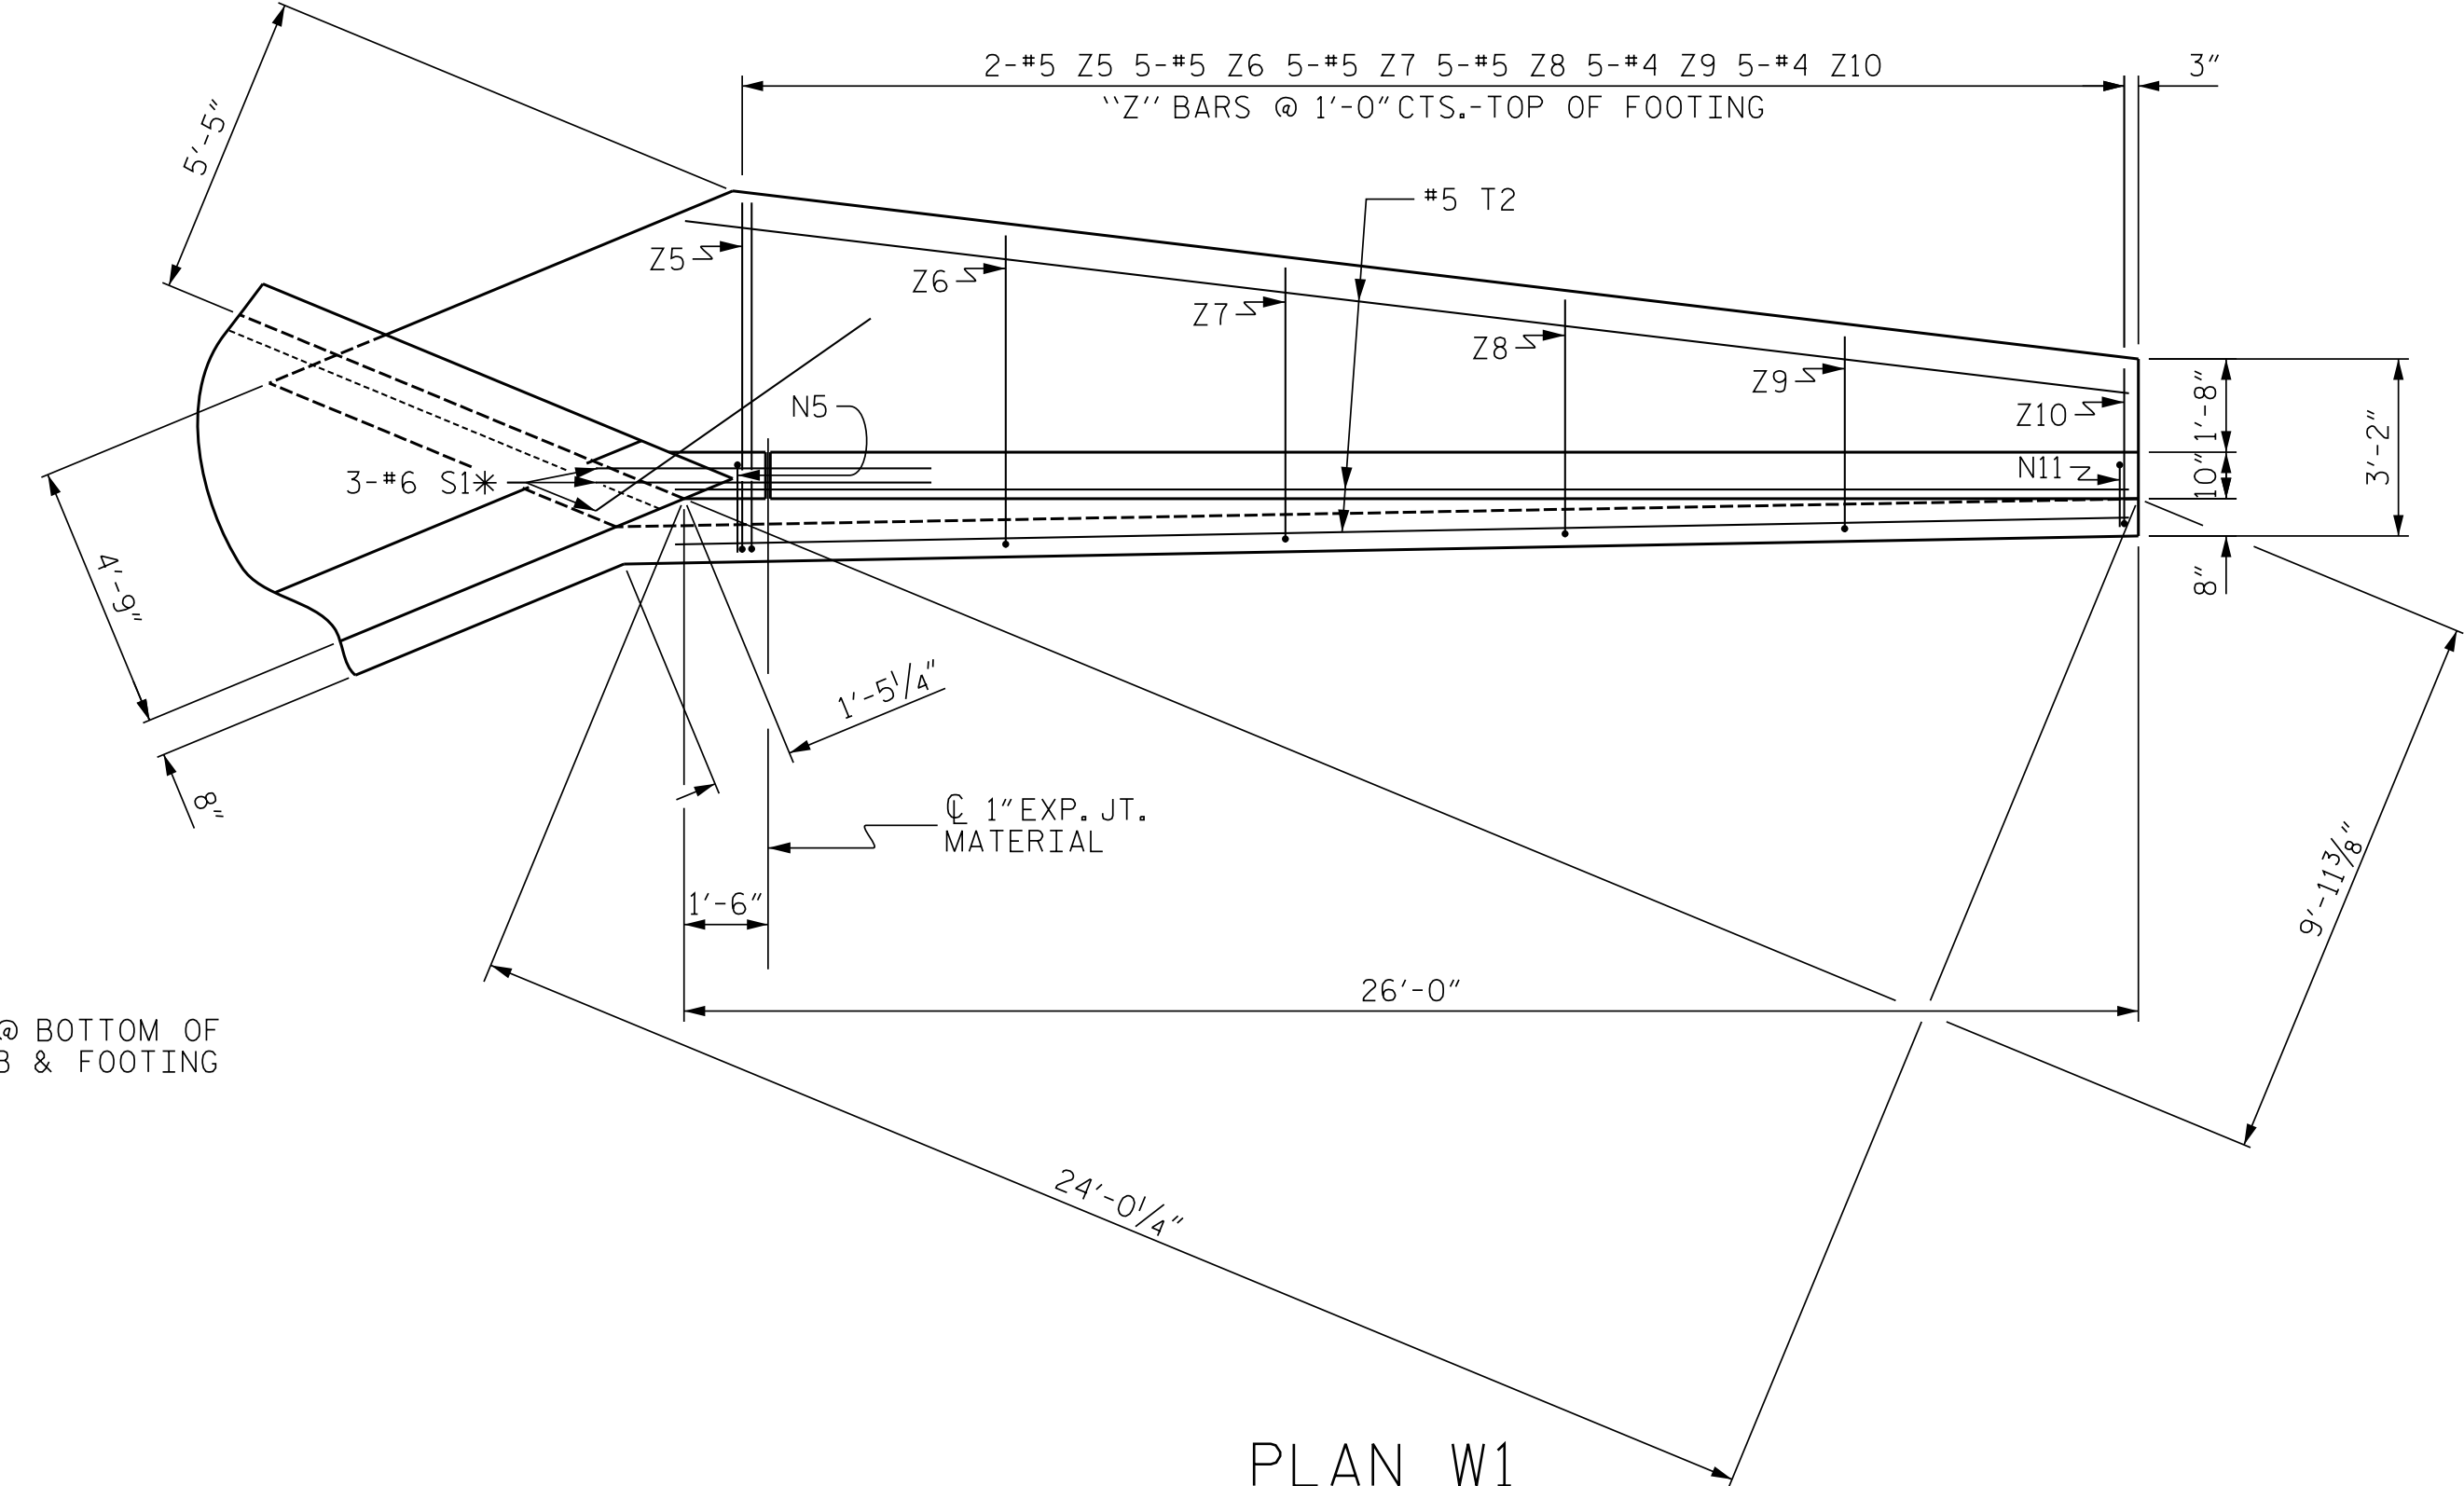


PLAN W1

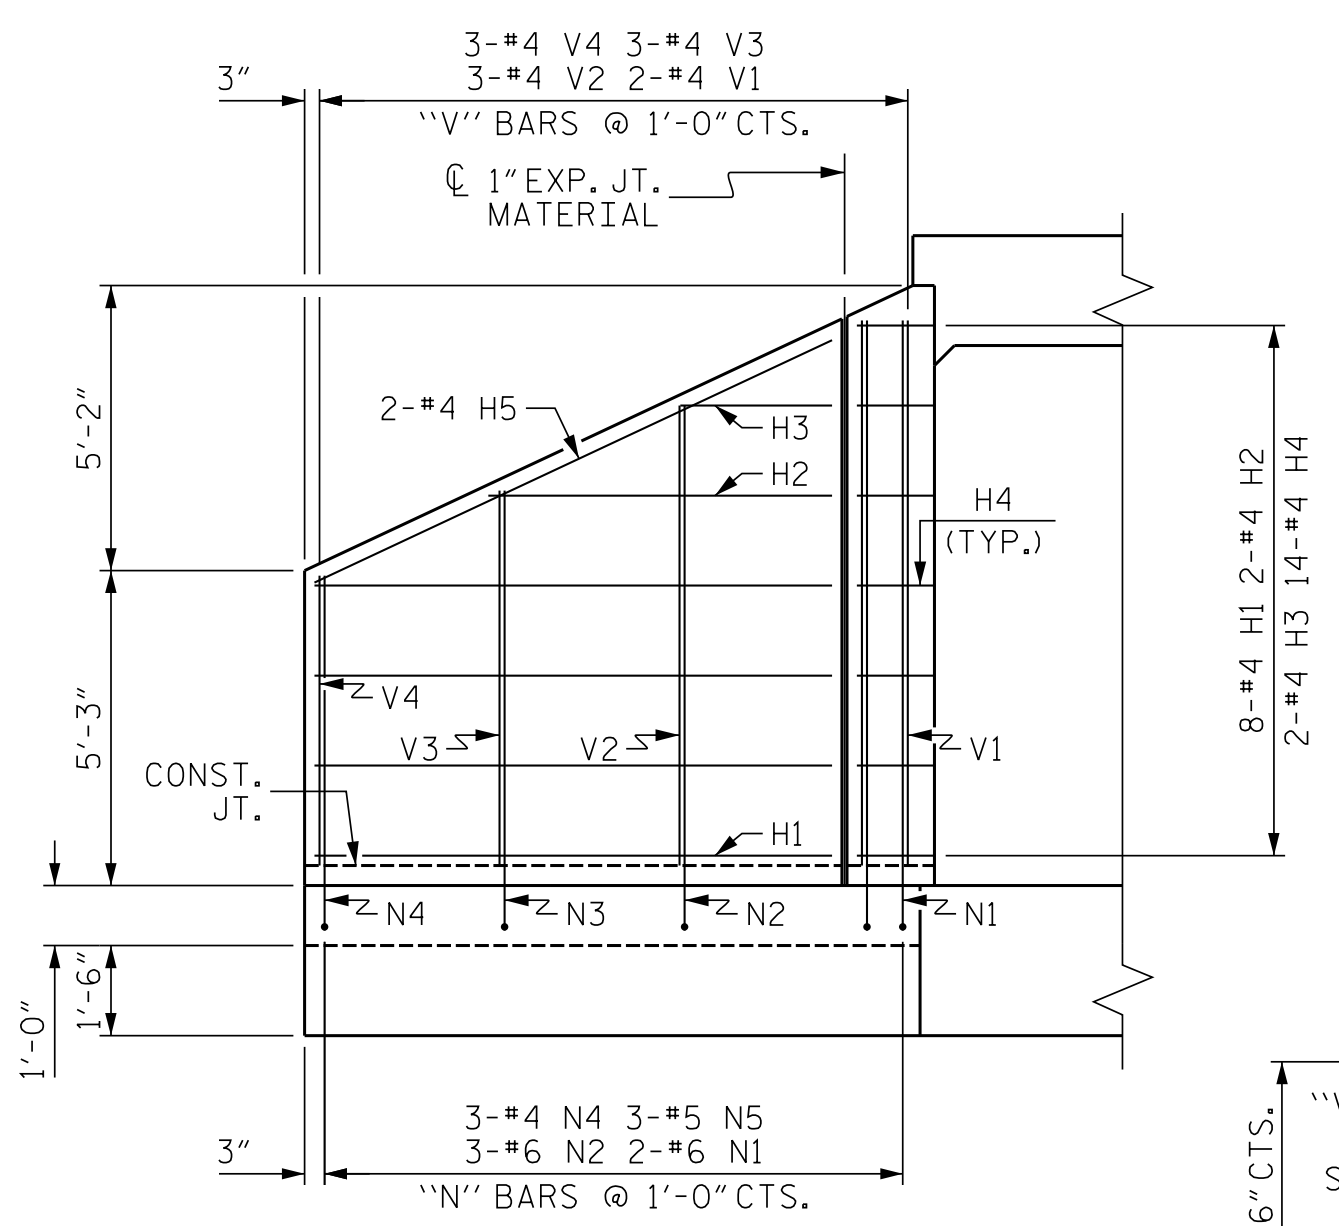

ELEVATION W2

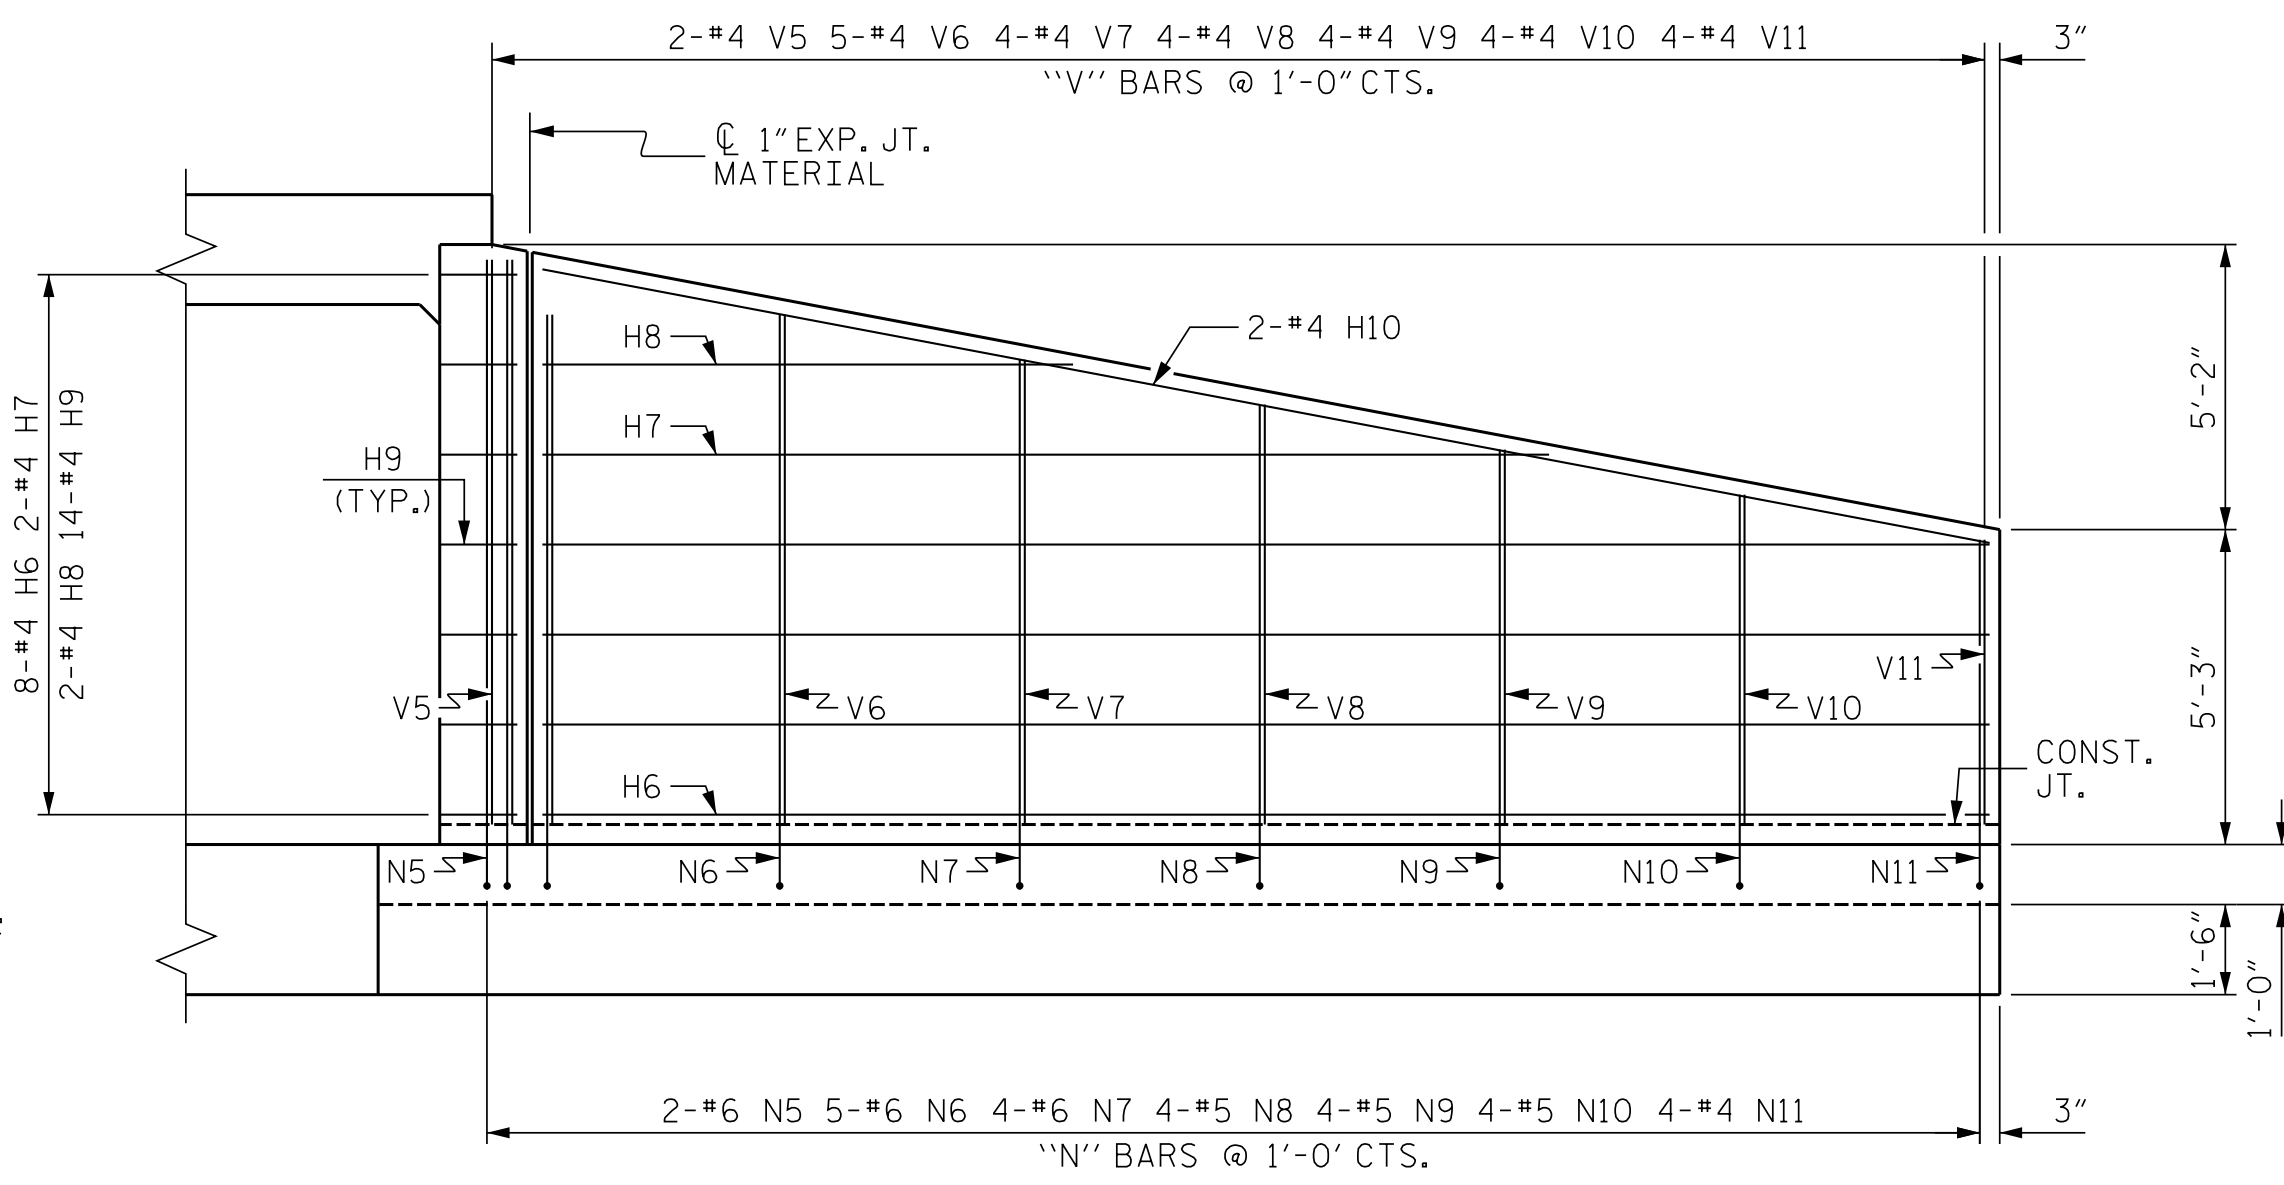

ELEVATION W1

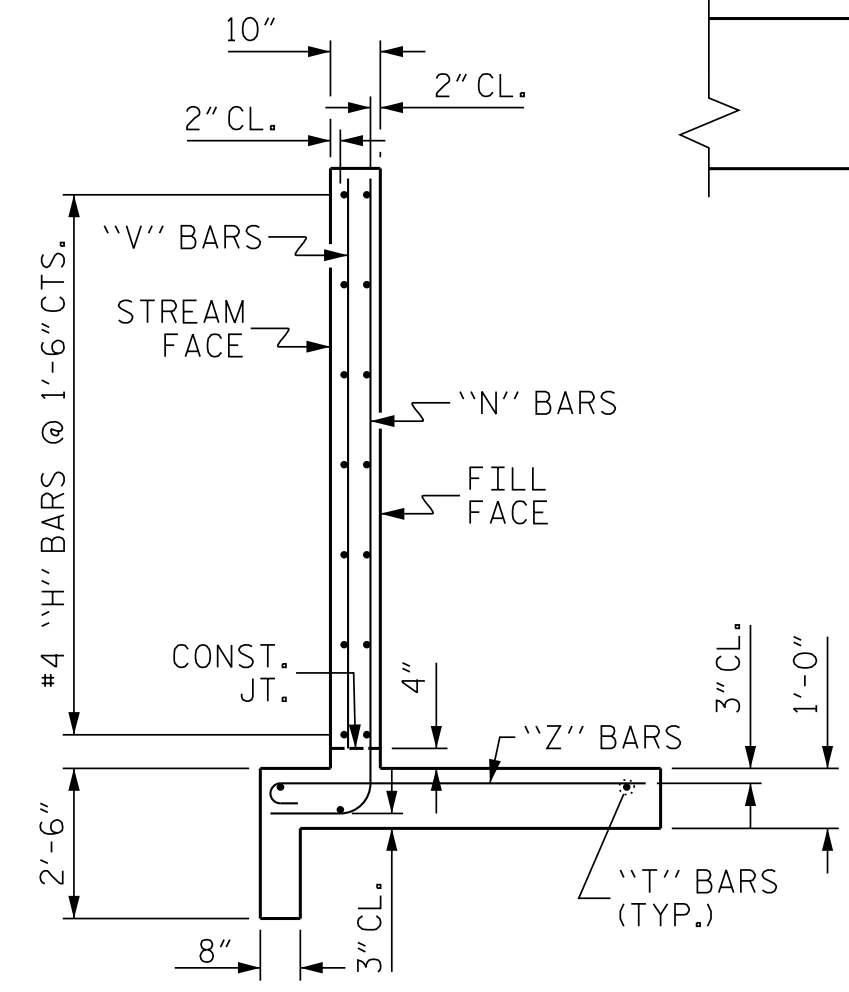

TYPICAL WING SECTION

DRAWN BY : CCJ 01/00  
 CHECKED BY : RWW 03/00


**BAR TYPES**  
 ALL BAR DIMENSIONS ARE OUT TO OUT.

Z1	6'-2"	7"
Z2	5'-1"	7"
Z3	4'-0"	7"
Z4	2'-11"	6"
Z5	6'-3"	7"
Z6	5'-7"	7"
Z7	4'-11"	7"
Z8	4'-3"	7"
Z9	3'-6"	6"
Z10	2'-10"	6"

**BILL OF MATERIAL**

BAR NO.	SIZE	TYPE	LENGTH	WEIGHT
H1	#4	STR	8'-7"	92
H2	#4	STR	5'-8"	15
H3	#4	STR	2'-6"	7
H4	#4	STR	3'-3"	61
H5	#4	STR	9'-6"	25
H6	#4	STR	24'-1"	257
H7	#4	STR	16'-9"	45
H8	#4	STR	8'-10"	24
H9	#4	STR	3'-3"	61
H10	#4	STR	24'-6"	65
N1	#6	3	11'-1"	67
N2	#6	3	9'-8"	87
N3	#5	3	8'-3"	52
N4	#4	3	6'-11"	28
N5	#4	3	11'-5"	69
N6	#6	3	10'-7"	159
N7	#6	3	9'-10"	118
N8	#5	3	9'-1"	76
N9	#5	3	8'-4"	70
N10	#5	3	7'-7"	63
N11	#4	3	6'-10"	37
S1	#6	STR	6'-0"	108
T1	#5	STR	10'-6"	66
T2	#5	STR	26'-0"	163
V1	#4	STR	9'-1"	24
V2	#4	STR	7'-8"	31
V3	#4	STR	6'-3"	25
V4	#4	STR	4'-10"	19
V5	#4	STR	9'-5"	25
V6	#4	STR	8'-6"	57
V7	#4	STR	7'-9"	41
V8	#4	STR	7'-0"	37
V9	#4	STR	6'-3"	33
V10	#4	STR	5'-6"	29
V11	#4	STR	4'-9"	25
Z1	#5	4	6'-9"	28
Z2	#5	4	5'-8"	35
Z3	#5	4	4'-7"	29
Z4	#4	4	3'-5"	14
Z5	#5	4	6'-10"	29
Z6	#5	4	6'-2"	64
Z7	#5	4	5'-6"	57
Z8	#5	4	4'-10"	50
Z9	#4	4	4'-0"	27
Z10	#4	4	3'-4"	22

REINFORCING STEEL 2,516 LBS  
 FOR 4 WINGS  
 CLASS A CONCRETE  
 4 WINGS 36.1 CY  
 2 HEADWALLS 2.9 CY  
 2 END CURTAIN WALLS 2.0 CY  
 2 SILLS 1.5 CY  
**TOTAL 42.5 CY**

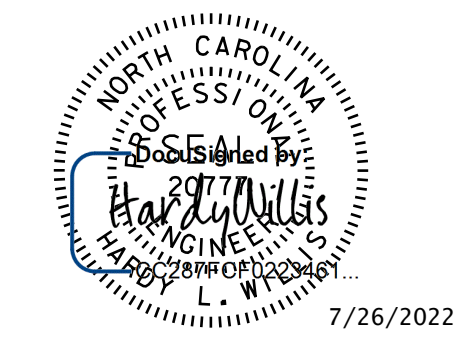

DOCUMENT NOT CONSIDERED FINAL UNLESS ALL SIGNATURES COMPLETED

**V&M**  
 Vaughn & Melton  
 Consulting Engineers  
 Asheville, North Carolina  
 828-253-2796

Boone, NC 828-355-9933  
 Tri-Cities, TN 423-467-8401  
 Knoxville, TN 865-546-5800  
 Spartanburg, SC 864-574-4775  
 Charleston, SC 843-974-5650  
 Middlesboro, KY 606-248-6600  
 Raleigh, NC 919-977-9455  
 Charlotte, NC 704-357-0488  
 Atlanta, GA 770-627-3590

Copyright © 2006 Vaughn & Melton, Inc. All Rights Reserved.

PROJECT NO. U-2579AA  
FORSYTH COUNTY  
 STATION: 36+27.30 -L-  
 SHEET 6 OF 6

STATE OF NORTH CAROLINA  
 DEPARTMENT OF TRANSPORTATION  
 RALEIGH

**STANDARD WINGS FOR CONCRETE BOX CULVERT**  
 H = 9'-0" SLOPE = 2:1  
 45° OR 135° SKEW


DSG. ENG. OF RECORD: CMG		REVISIONS			SHEET NO.
NO.	BY:	DATE:	NO.	BY:	DATE:
1	WDC	12/18	3	HLW	12/18
2	HLW	12/18	4		

TOTAL SHEETS 6

STD. NO. CW4509





BM#8 : -BY13- STA. 26+90.31 122.24' LT N 840060.12 E 1659637.42 ELEV. 864.85

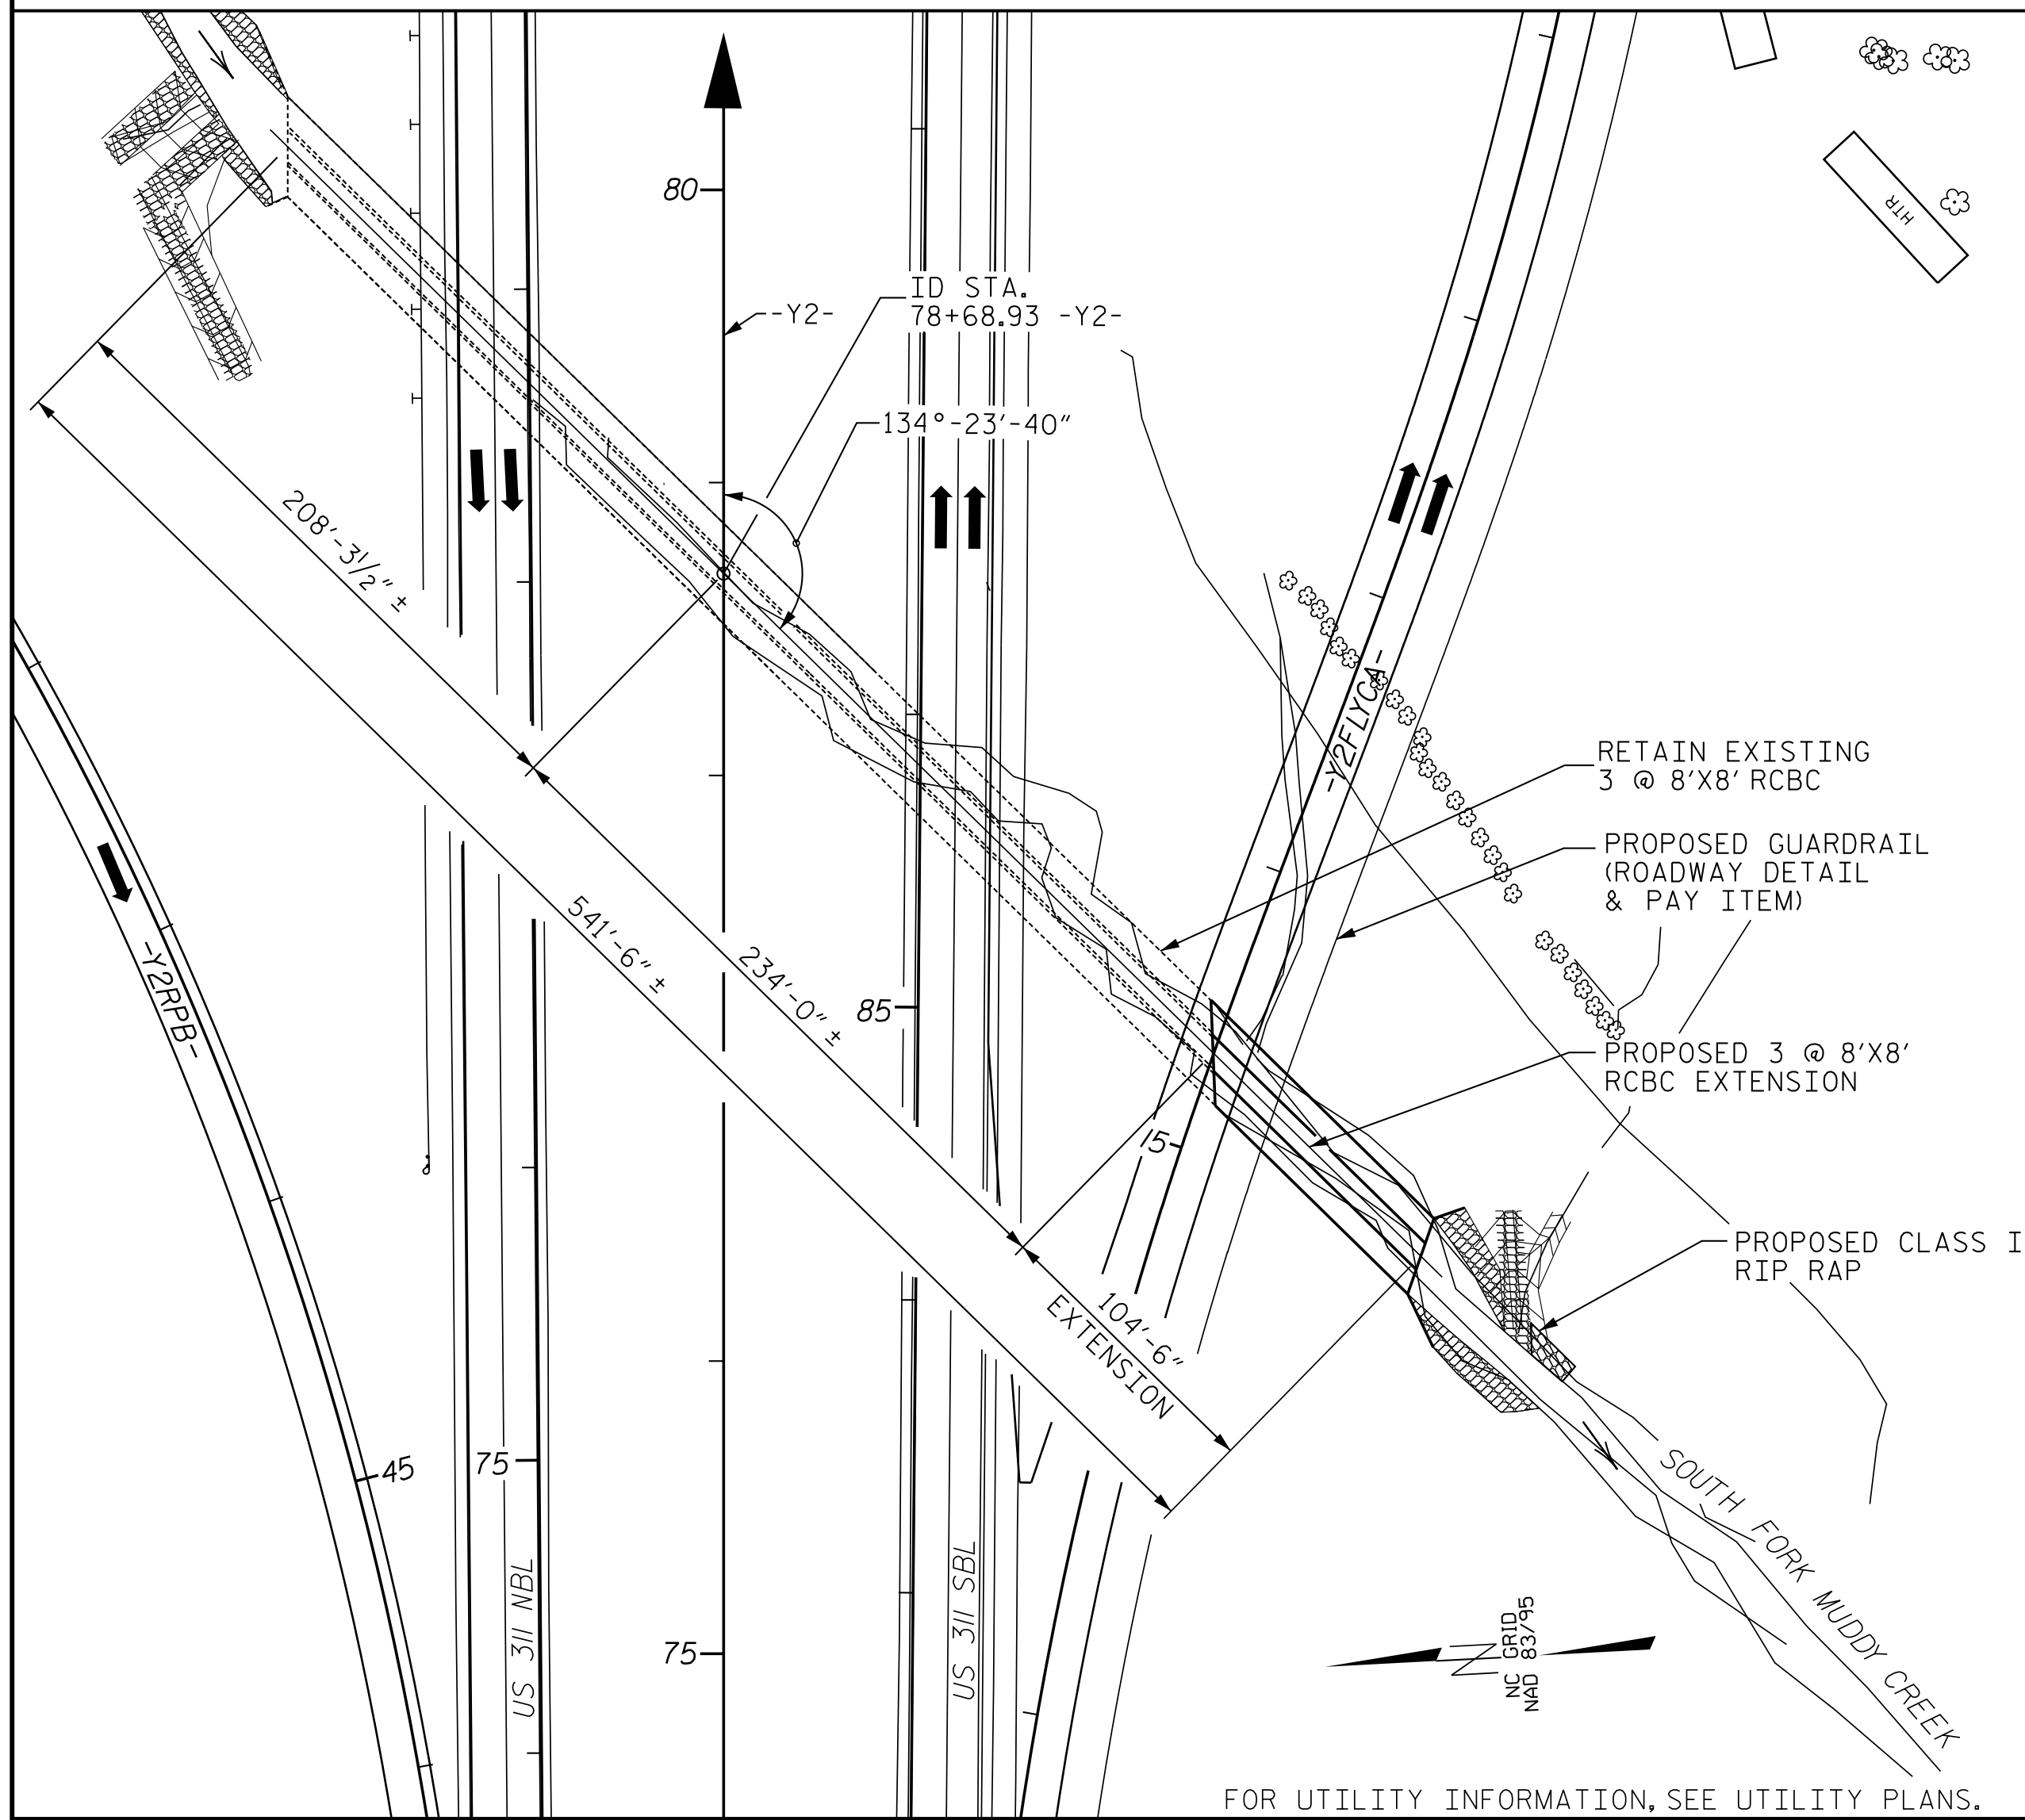

**GRADE DATA**

GRADE POINT ELEV. @ STATION STA. 15+34.67 -Y2FLYCA- = 842.7  
 BED ELEVATION @ STATION STA. 15+34.67 -Y2FLYCA- = 801.6  
 ROADWAY SLOPES: 2:1 AT EXTENSION

I HEREBY CERTIFY THESE PLANS ARE THE AS-BUILT PLANS

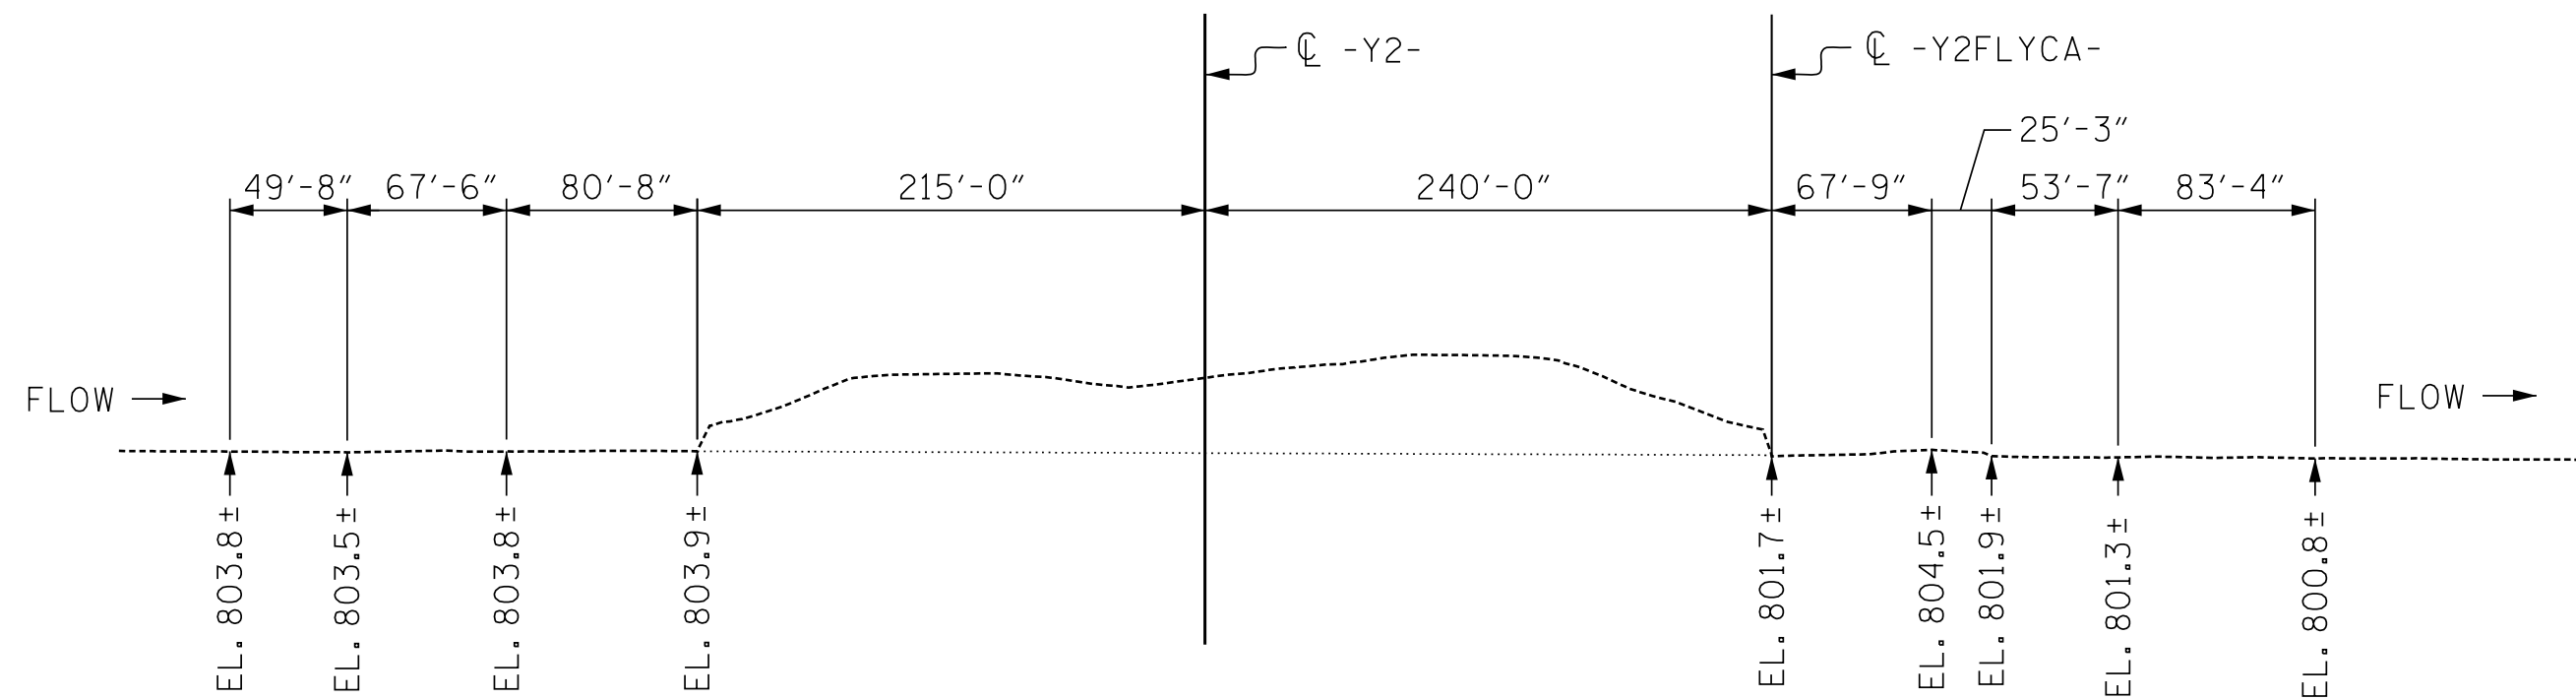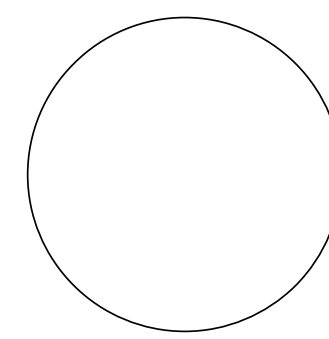

**NOTES:**

ASSUMED LIVE LOAD ----- HL-93 OR ALTERNATE LOADING.  
 DESIGN FILL-----MIN. = 30.81' MAX. = 31.65'  
 FOR OTHER DESIGN DATA AND NOTES SEE STANDARD NOTE SHEET.  
 3" Ø WEEP HOLES INDICATED TO BE IN ACCORDANCE WITH THE SPECIFICATIONS.  
 CONCRETE IN CULVERTS TO BE POURED IN THE FOLLOWING ORDER:

1. WING FOOTINGS AND FLOOR SLAB INCLUDING 4" OF ALL VERTICAL WALLS.
2. THE REMAINING PORTIONS OF THE WALLS AND WINGS FULL HEIGHT FOLLOWED BY ROOF SLAB AND HEADWALLS.

THE RESIDENT ENGINEER SHALL CHECK THE LENGTH OF CULVERT BEFORE STAKING IT OUT TO MAKE CERTAIN THAT IT WILL PROPERLY TAKE CARE OF THE FILL.

DIMENSIONS FOR WING LAYOUT AS WELL AS ADDITIONAL REINFORCING STEEL EMBEDDED IN BARREL ARE SHOWN ON WING SHEET.

STEEL IN THE BOTTOM SLAB MAY BE SPLICED AT THE PERMITTED CONSTRUCTION JOINT AT THE CONTRACTOR'S OPTION, EXTRA WEIGHT OF STEEL DUE TO THE SPLICES SHALL BE PAID FOR BY THE CONTRACTOR.

AT THE CONTRACTOR'S OPTION, HE MAY SPLICE THE VERTICAL REINFORCING STEEL IN THE INTERIOR FACE OF EXTERIOR WALL AND BOTH FACES OF INTERIOR WALLS ABOVE LOWER WALL CONSTRUCTION JOINT. THE SPLICE LENGTH SHALL BE AS PROVIDED IN THE SPLICE LENGTH CHART SHOWN ON THE PLANS, EXTRA WEIGHT OF STEEL DUE TO THE SPLICES SHALL BE PAID FOR BY THE CONTRACTOR.

NO PRECAST REINFORCED BOX CULVERT OPTION WILL BE ALLOWED.

FOR EROSION CONTROL, SEE ROADWAY PLANS.

TRANSVERSE CONSTRUCTION JOINTS SHALL BE USED IN THE BARREL, SPACED TO LIMIT THE POURS TO A MAXIMUM OF 70 FT. LOCATION OF JOINTS SHALL BE SUBJECT TO APPROVAL OF THE ENGINEER.

DETAILED DRAWINGS FOR FALSEWORK AND FORMS FOR THIS CULVERT SHALL BE SUBMITTED. SEE SHEET SN.

FOR CULVERT DIVERSION DETAILS AND PAY ITEMS, SEE EROSION CONTROL PLANS.

A 3'-0" STRIP OF FILTER FABRIC SHALL BE ATTACHED TO THE FILL FACE OF THE WING COVERING THE ENTIRE LENGTH OF THE EXPANSION JOINT.

DOWELS SHALL BE USED TO CONNECT THE CULVERT EXTENSION TO THE EXISTING CULVERT AS SHOWN. FOR NOTE REGARDING SETTING DOWELS, SEE SHEET SN.

SAWCUT AND REMOVE EXISTING WINGS AT EXTENSION ENDS.

IF APPROVED BY THE ENGINEER, THE CONTRACTOR MAY USE THE EXISTING WINGS AS TEMPORARY SHORING FOR THE CONSTRUCTION OF THE CULVERT EXTENSION. IN THIS CASE, THE FOOTINGS OF THE EXTENSION SHALL BE POURED AT LEAST 72 HOURS PRIOR TO CUTTING THE WINGS. THE WINGS MAY BE CUT EARLIER PROVIDED THE FOOTING CONCRETE HAS REACHED A MINIMUM COMPRESSIVE STRENGTH OF 1500 PSI.

FOR SUBMITTAL OF WORKING DRAWINGS, SEE SPECIAL PROVISIONS.

FOR MAINTENANCE OF TRAFFIC, SEE TRAFFIC CONTROL PLANS.

FOR FALSEWORK AND FORMWORK, SEE SPECIAL PROVISIONS.

FOR GROUT FOR STRUCTURES, SEE SPECIAL PROVISIONS.

FOR CRANE SAFETY, SEE SPECIAL PROVISIONS.

THE CONTRACTOR SHALL PROVIDE INDEPENDENT ASSURANCE SAMPLES OF REINFORCING STEEL AS FOLLOWS: FOR PROJECTS REQUIRING UP TO 400 TONS OF REINFORCING STEEL, ONE 30 INCH SAMPLE OF EACH SIZE BAR USED, AND FOR PROJECTS REQUIRING OVER 400 TONS OF REINFORCING STEEL, TWO 30 INCH SAMPLES OF EACH SIZE BAR USED. THE SAMPLE BARS SHOULD COME FROM STEEL ACTUALLY USED IN THE PROJECT AND THE SAMPLE BARS SHOULD BE REPLACED BY SPLICED BARS AS SPECIFIED IN THE SAMPLE BAR REPLACEMENT CHART, PAYMENT FOR THE SAMPLE BARS AND REPLACEMENT REINFORCING STEEL SHALL BE CONSIDERED INCIDENTAL TO VARIOUS PAY ITEMS.

SAMPLE BAR REPLACEMENT					
SIZE	LENGTH	SIZE	LENGTH	SIZE	LENGTH
#3	6'-2"	#6	9'-8"	#9	13'-2"
#4	7'-4"	#7	10'-10"	#10	14'-6"
#5	8'-6"	#8	12'-0"	#11	15'-10"

NOTE: SAMPLE BAR REPLACEMENT LENGTHS BASED ON 30" (SAMPLE LENGTH) PLUS TWO SPLICE LENGTHS AND  $f_y = 60\text{ksi}$

**FOUNDATION NOTES**

EXCAVATE 1 FOOT BELOW THE CULVERT AND REPLACE WITH FOUNDATION CONDITIONING MATERIAL IN ACCORDANCE WITH ARTICLE 414 OF THE STANDARD SPECIFICATIONS.

UNDERCUT SOFT OR LOOSE SOILS TO A MINIMUM DEPTH OF 3 FEET BELOW THE BOTTOM OF THE FOUNDATION CONDITIONING MATERIAL AND BACKFILL WITH FOUNDATION CONDITIONING MATERIAL AS DIRECTED BY THE ENGINEER.

**HYDRAULIC DATA**

DESIGN DISCHARGE	= 1900	CFS
FREQUENCY OF DESIGN DISCHARGE	= 50	YRS
DESIGN HIGH WATER ELEVATION	= 812.4	FT
DRAINAGE AREA	= 3.2	SQ MI
BASE DISCHARGE (Q100)	= 2100	CFS
BASE HIGH WATER ELEVATION	= 813.9	FT

**OVERTOPPING DATA**

OVERTOPPING DISCHARGE	= 2600 (+)	CFS
FREQUENCY OF OVERTOPPING	= 500 (+)	YRS
OVERTOPPING ELEVATION	= 826.2	FT

**TOTAL STRUCTURE QUANTITIES**

CLASS A CONCRETE	
STAGE I BARREL @ 1.856 CY/FT	194.0 C.Y.
STAGE II BARREL @ 2.519 CY/FT	263.3 C.Y.
WINGS, ETC.	16.9 C.Y.
TOTAL	474.2 C.Y.

REINFORCING STEEL	
STAGE I BARREL	19,334 LBS.
STAGE II BARREL	22,768 LBS.
WINGS ETC.	838 LBS.
TOTAL	42,940 LBS.

CULVERT EXCAVATION	LUMP SUM
FOUNDATION CONDITIONING MATERIAL	231 TONS
RIP RAP, CLASS I	77 TONS
GEOTEXTILE FOR DRAINAGE	108 SY



DOCUMENT NOT CONSIDERED FINAL UNLESS ALL SIGNATURES COMPLETED

PROJECT NO. U-2579AA

FORSYTH COUNTY

STATION: 78+68.93 -Y2-

SHEET 1 OF 7 CULVERT #393

**V&M**  
 Vaughn & Melton  
 Consulting Engineers  
 Asheville, North Carolina  
 828-253-2796

Boone, NC 828-355-9933  
 Tri-Cities, TN 423-467-9400  
 Knoxville, TN 865-546-5800  
 Spartanburg, SC 864-574-4775  
 Asheville, NC 843-974-5650  
 Middleboro, KY 606-248-6600  
 Raleigh, NC 919-977-9455  
 Charlotte, NC 704-357-0488  
 Atlanta, GA 770-627-3590

Copyright © 2006 Vaughn & Melton, Inc. All Rights Reserved

STATE OF NORTH CAROLINA  
 DEPARTMENT OF TRANSPORTATION  
 RALEIGH

TRIPLE 8'X8' RCBC  
 EXTENSION (OUTLET END)

ON I-74/US-311 BETWEEN  
 SR 2698 & SR 2643

REVISIONS						SHEET NO.
NO.	BY:	DATE:	NO.	BY:	DATE:	C3-1
1			3			TOTAL SHEETS
2			4			7



LOAD FACTORS:

LOAD TYPE	MAX FACTOR	MIN FACTOR
DC	1.25	0.90
DW	1.50	0.65
EV	1.30	0.90
EH	1.35	0.90
ES	1.35	0.90
WA	1.00	--


LOAD AND RESISTANCE FACTOR RATING (LRFR) SUMMARY FOR REINFORCED CONCRETE BOX CULVERTS										
	CONTROLLING LOAD RATING	MINIMUM RATING FACTOR (RF)	STRENGTH I LIMIT STATE							
			MOMENT				SHEAR			
			RATING FACTOR	BOX NO.	ELEMENT TYPE	DISTANCE FROM LEFT END OF ELEMENT (ft)	RATING FACTOR	BOX NO.	ELEMENT TYPE	DISTANCE FROM LEFT END OF ELEMENT (ft)
PERMANENT LOAD RATING	①	1.01	1.09	2	BOTTOM SLAB	0.33	1.01	2	BOTTOM SLAB	1.57

NOTES:

RATING FACTORS ARE BASED ON THE STRENGTH I LIMIT STATE.

THE EFFECTS OF LIVE LOAD ON DESIGN AND LOAD RATING MAY BE NEGLECTED FOR CULVERTS WITH CERTAIN FILL DEPTHS DESCRIBED IN THE AASHTO LRFD BRIDGE DESIGN SPECIFICATIONS.


CULVERTS WITH NEGLIGIBLE LIVE LOAD SHOULD BE LOAD RATED FOR PERMANENT LOADS ONLY IN ACCORDANCE WITH THE AASHTO MANUAL FOR BRIDGE EVALUATION.

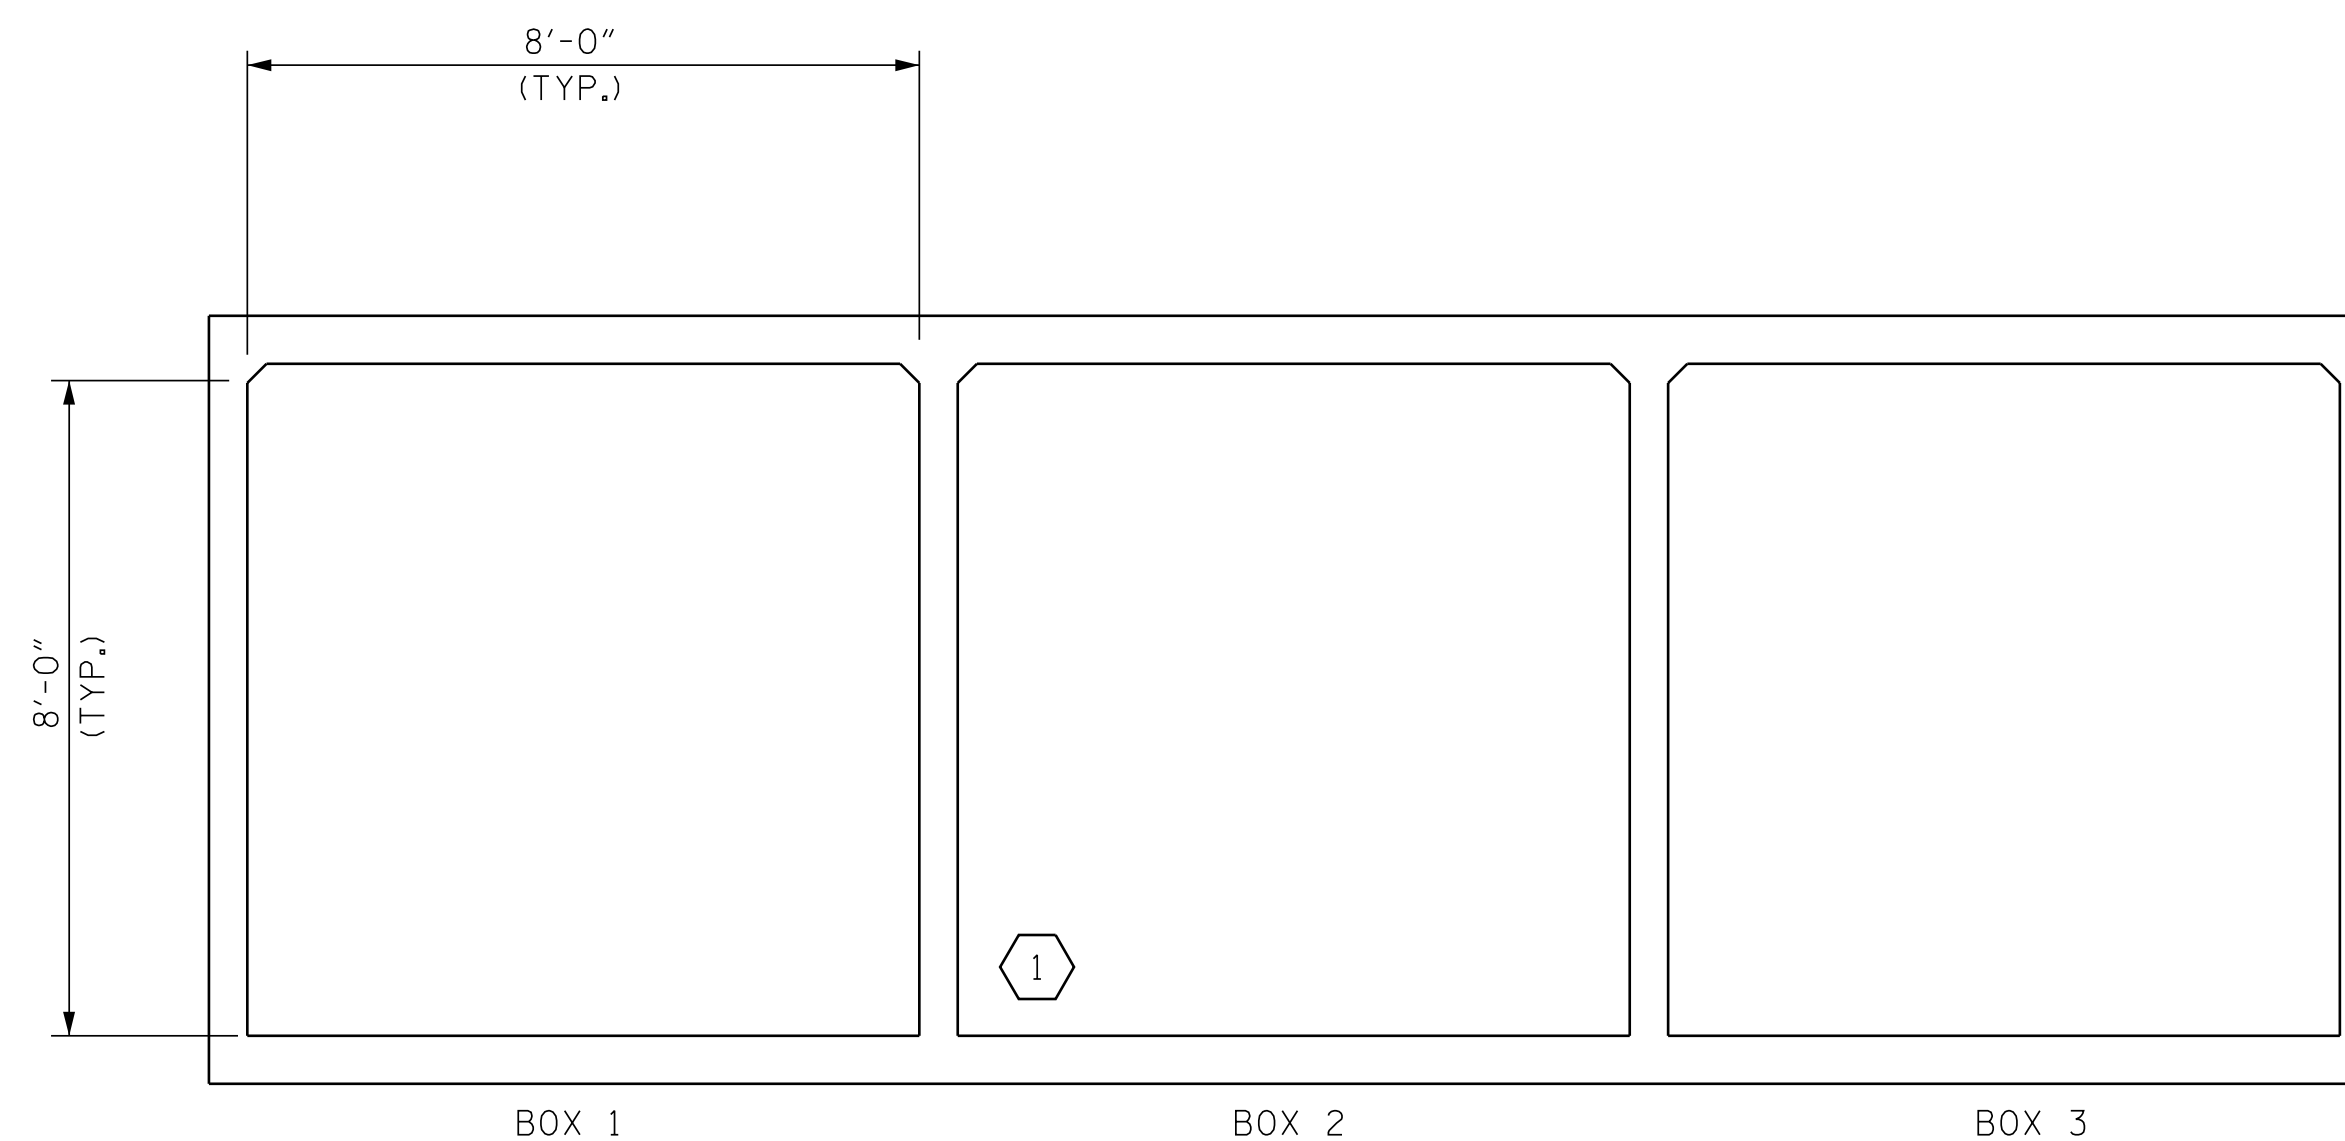

LRFR SUMMARY  
(LOOKING DOWNSTREAM)

PROJECT NO. U-2579AA  
FORSYTH COUNTY  
 STATION: 78+68.93 -Y2-

SHEET 2 OF 7

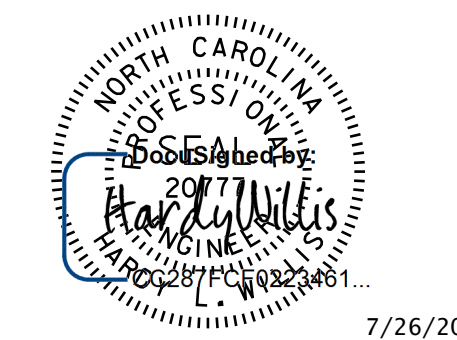

DOCUMENT NOT CONSIDERED  
FINAL UNLESS ALL  
SIGNATURES COMPLETED

STATE OF NORTH CAROLINA  
 DEPARTMENT OF TRANSPORTATION  
 RALEIGH  
 STANDARD  
 LRFR SUMMARY FOR  
 REINFORCED CONCRETE  
 BOX CULVERTS  
 (DEEP FILLS)

**V&M**  
**Vaughn & Melton**  
 Consulting Engineers

Asheville, North Carolina  
 828-253-2796

Boone, NC 828-355-9933  
 Tri-Cities, TN 423-467-9400  
 Knoxville, TN 865-546-5800  
 Spartanburg, SC 864-574-4775  
 Charleston, SC 843-974-5660  
 Middlesboro, KY 606-248-6600  
 Raleigh, NC 919-977-9455  
 Charlotte, NC 704-357-0488  
 Atlanta, GA 770-621-3590


Copyright © 2006 Vaughn & Melton, Inc. All Rights Reserved.

DSG. ENG. OF RECORD.: AML  
 DWN. BY: WDC DATE: 2/19  
 CHKD. BY: HLW DATE: 2/19


REVISIONS						SHEET NO.
NO.	BY:	DATE:	NO.	BY:	DATE:	C3-2
1			3			TOTAL SHEETS
2			4			7

V & M PROJECT NO.: 31748-44


DRAWN BY : WMC	7/11	REV. 10/1/11	MAA/GM
CHECKED BY : GM	7/11		

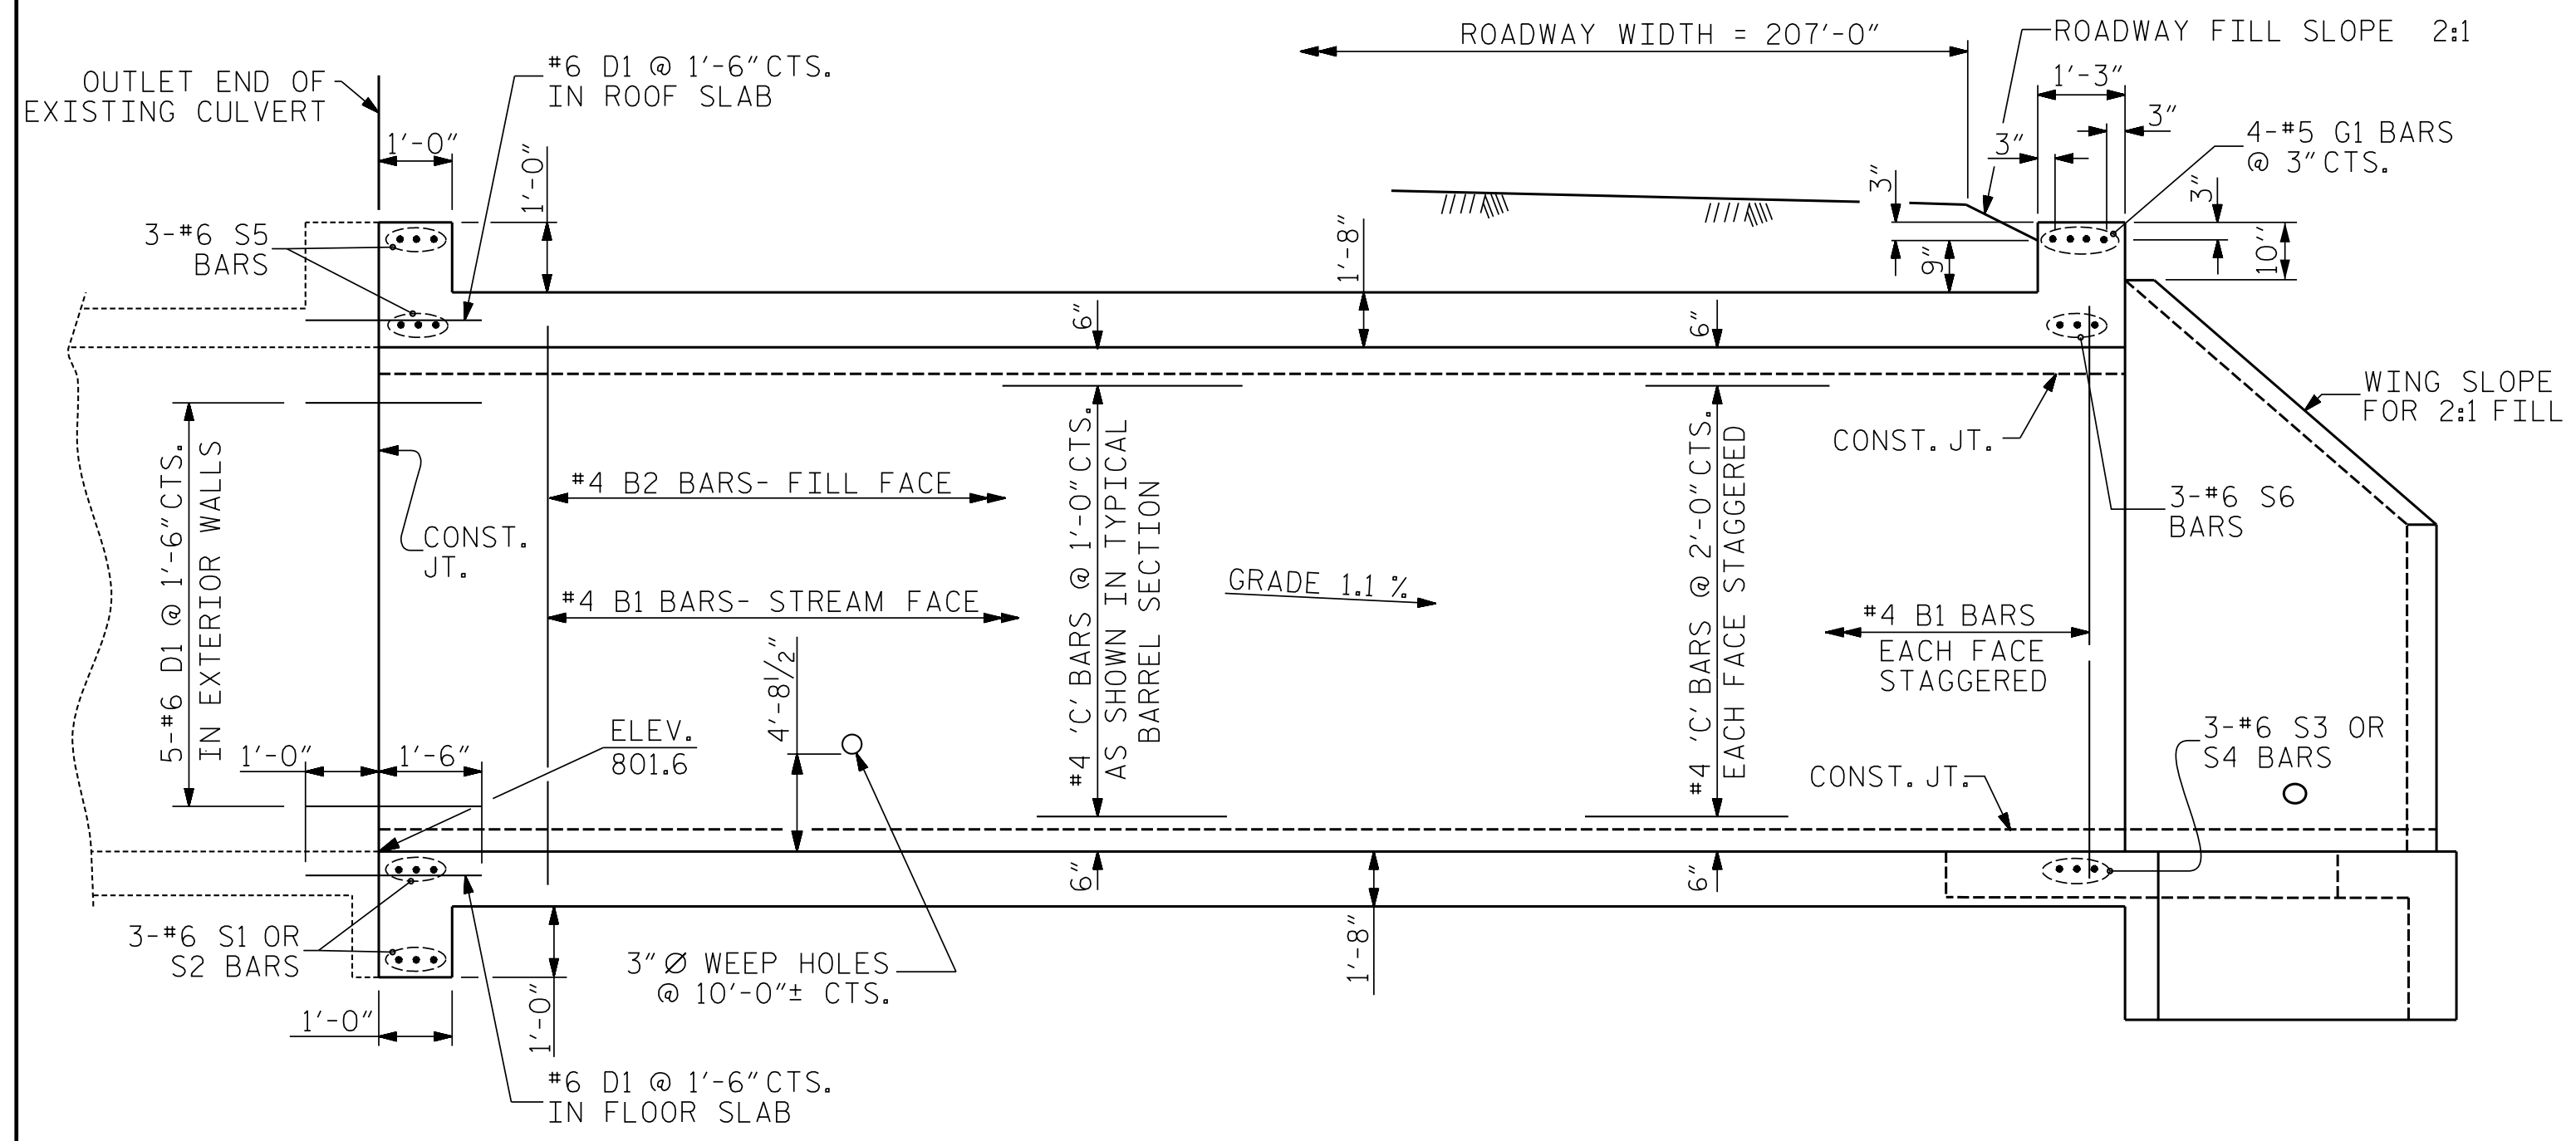


EXTERIOR WALL INTERIOR WALL  
CULVERT SECTION NORMAL TO ROADWAY

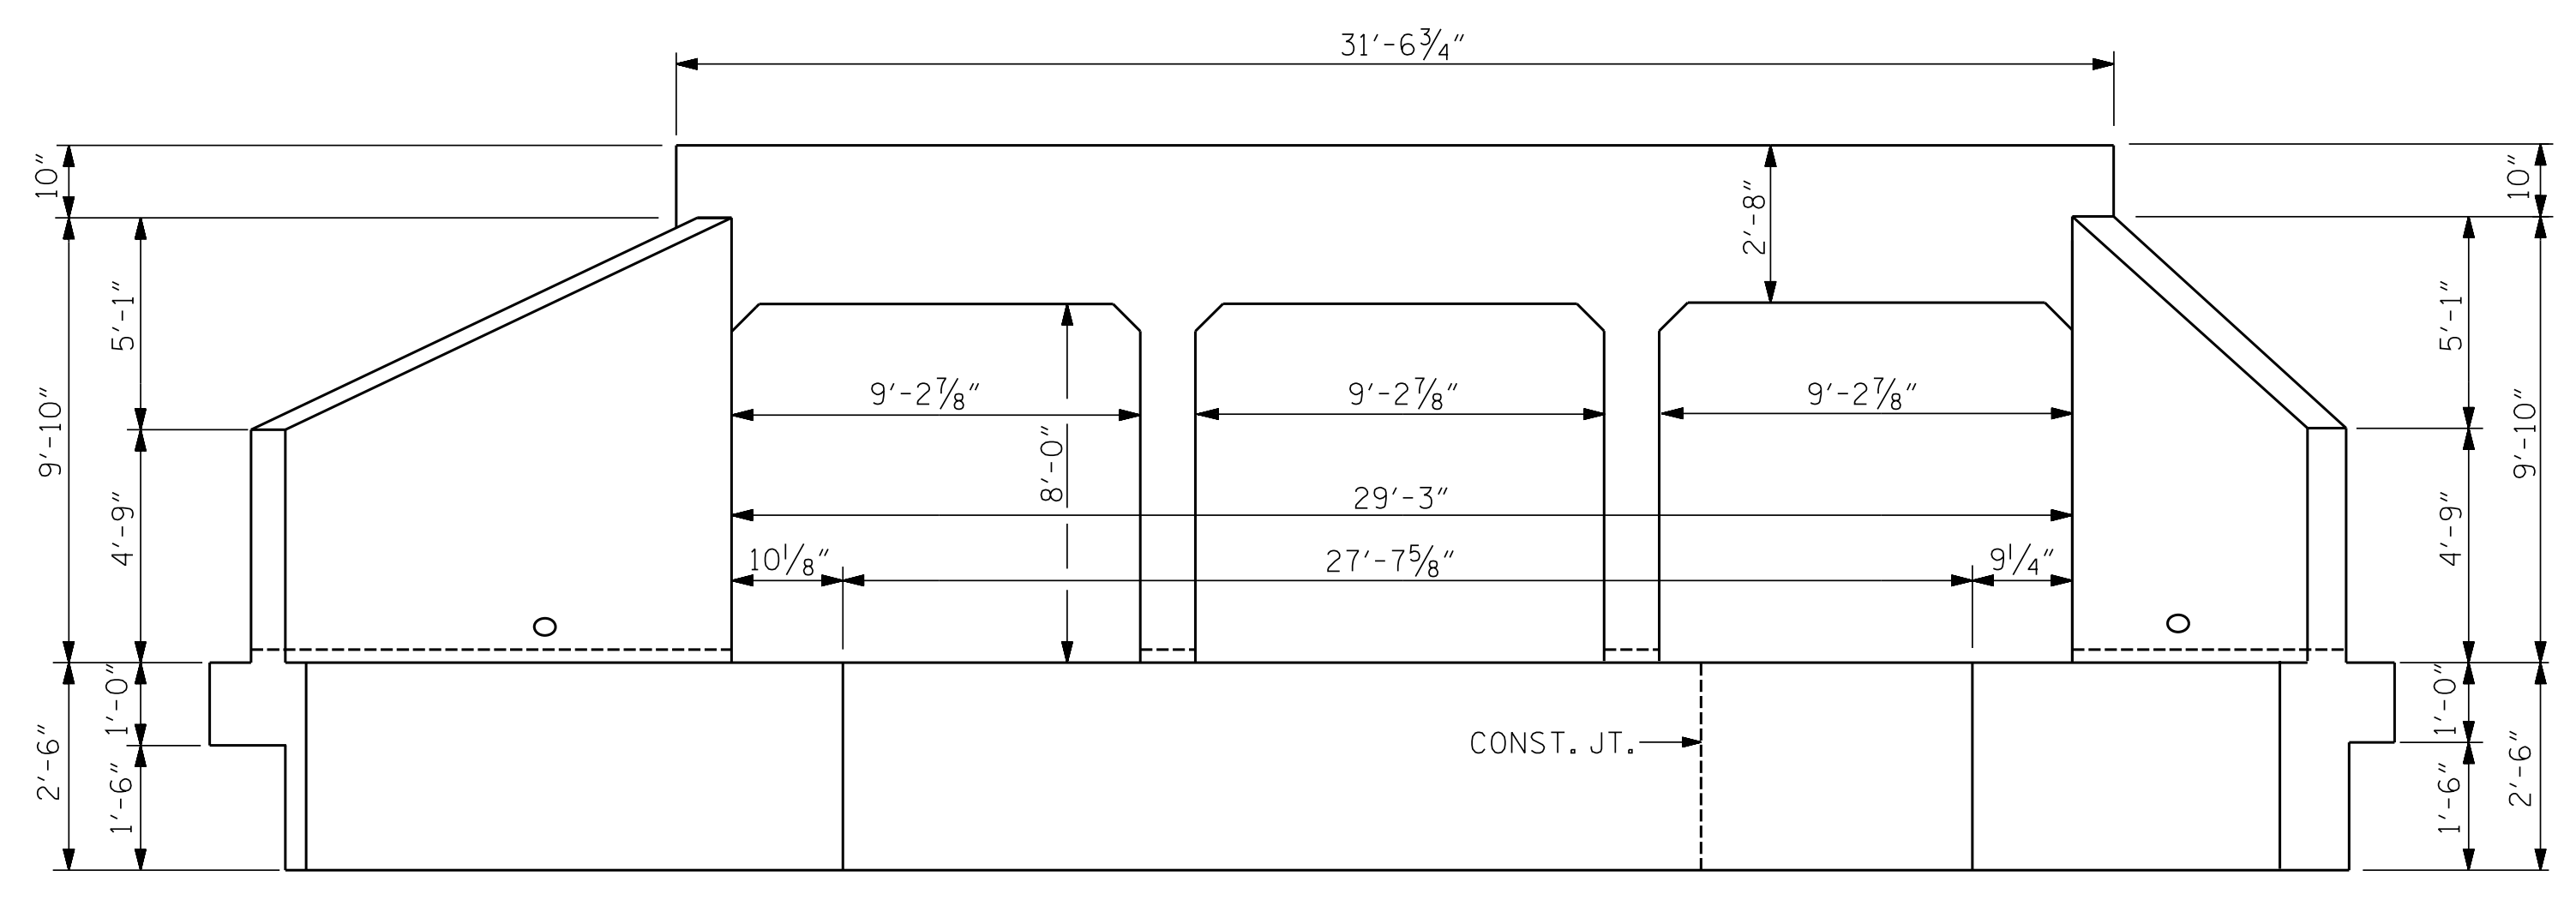


END ELEVATION NORMAL TO SKEW  
LOOKING UPSTREAM

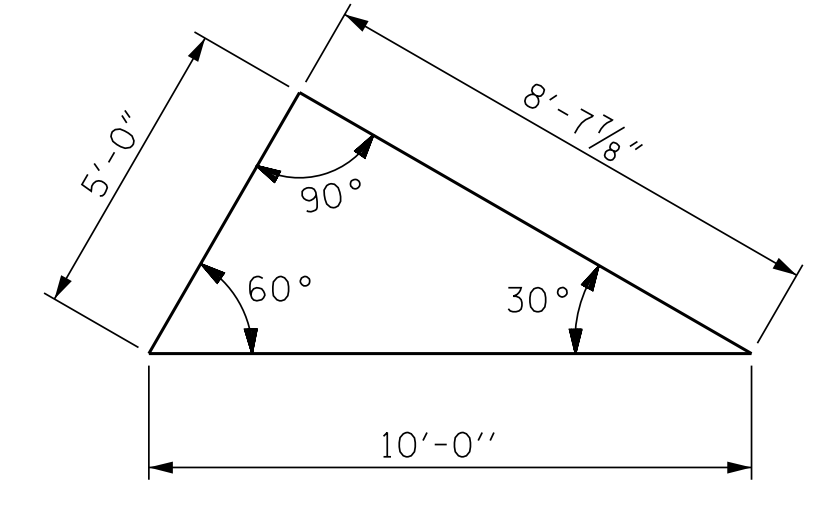

SKEW TRIANGLE

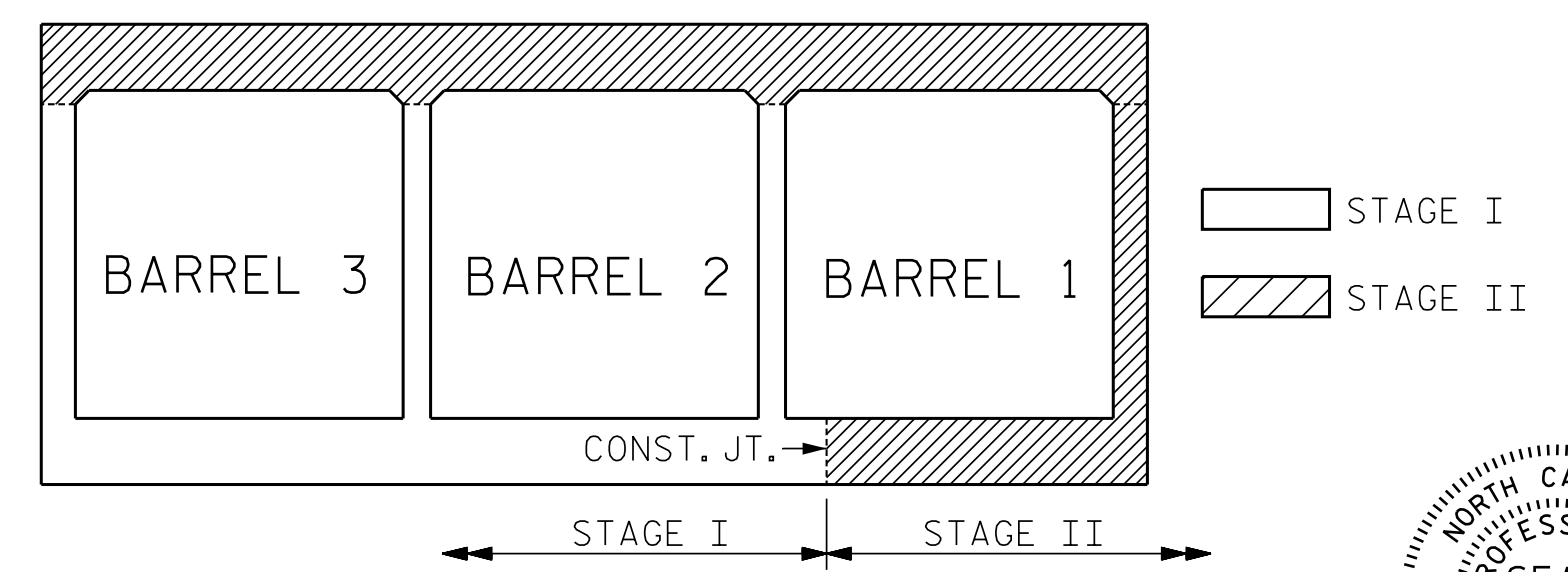


STAGING DIAGRAM  
LOOKING UPSTREAM

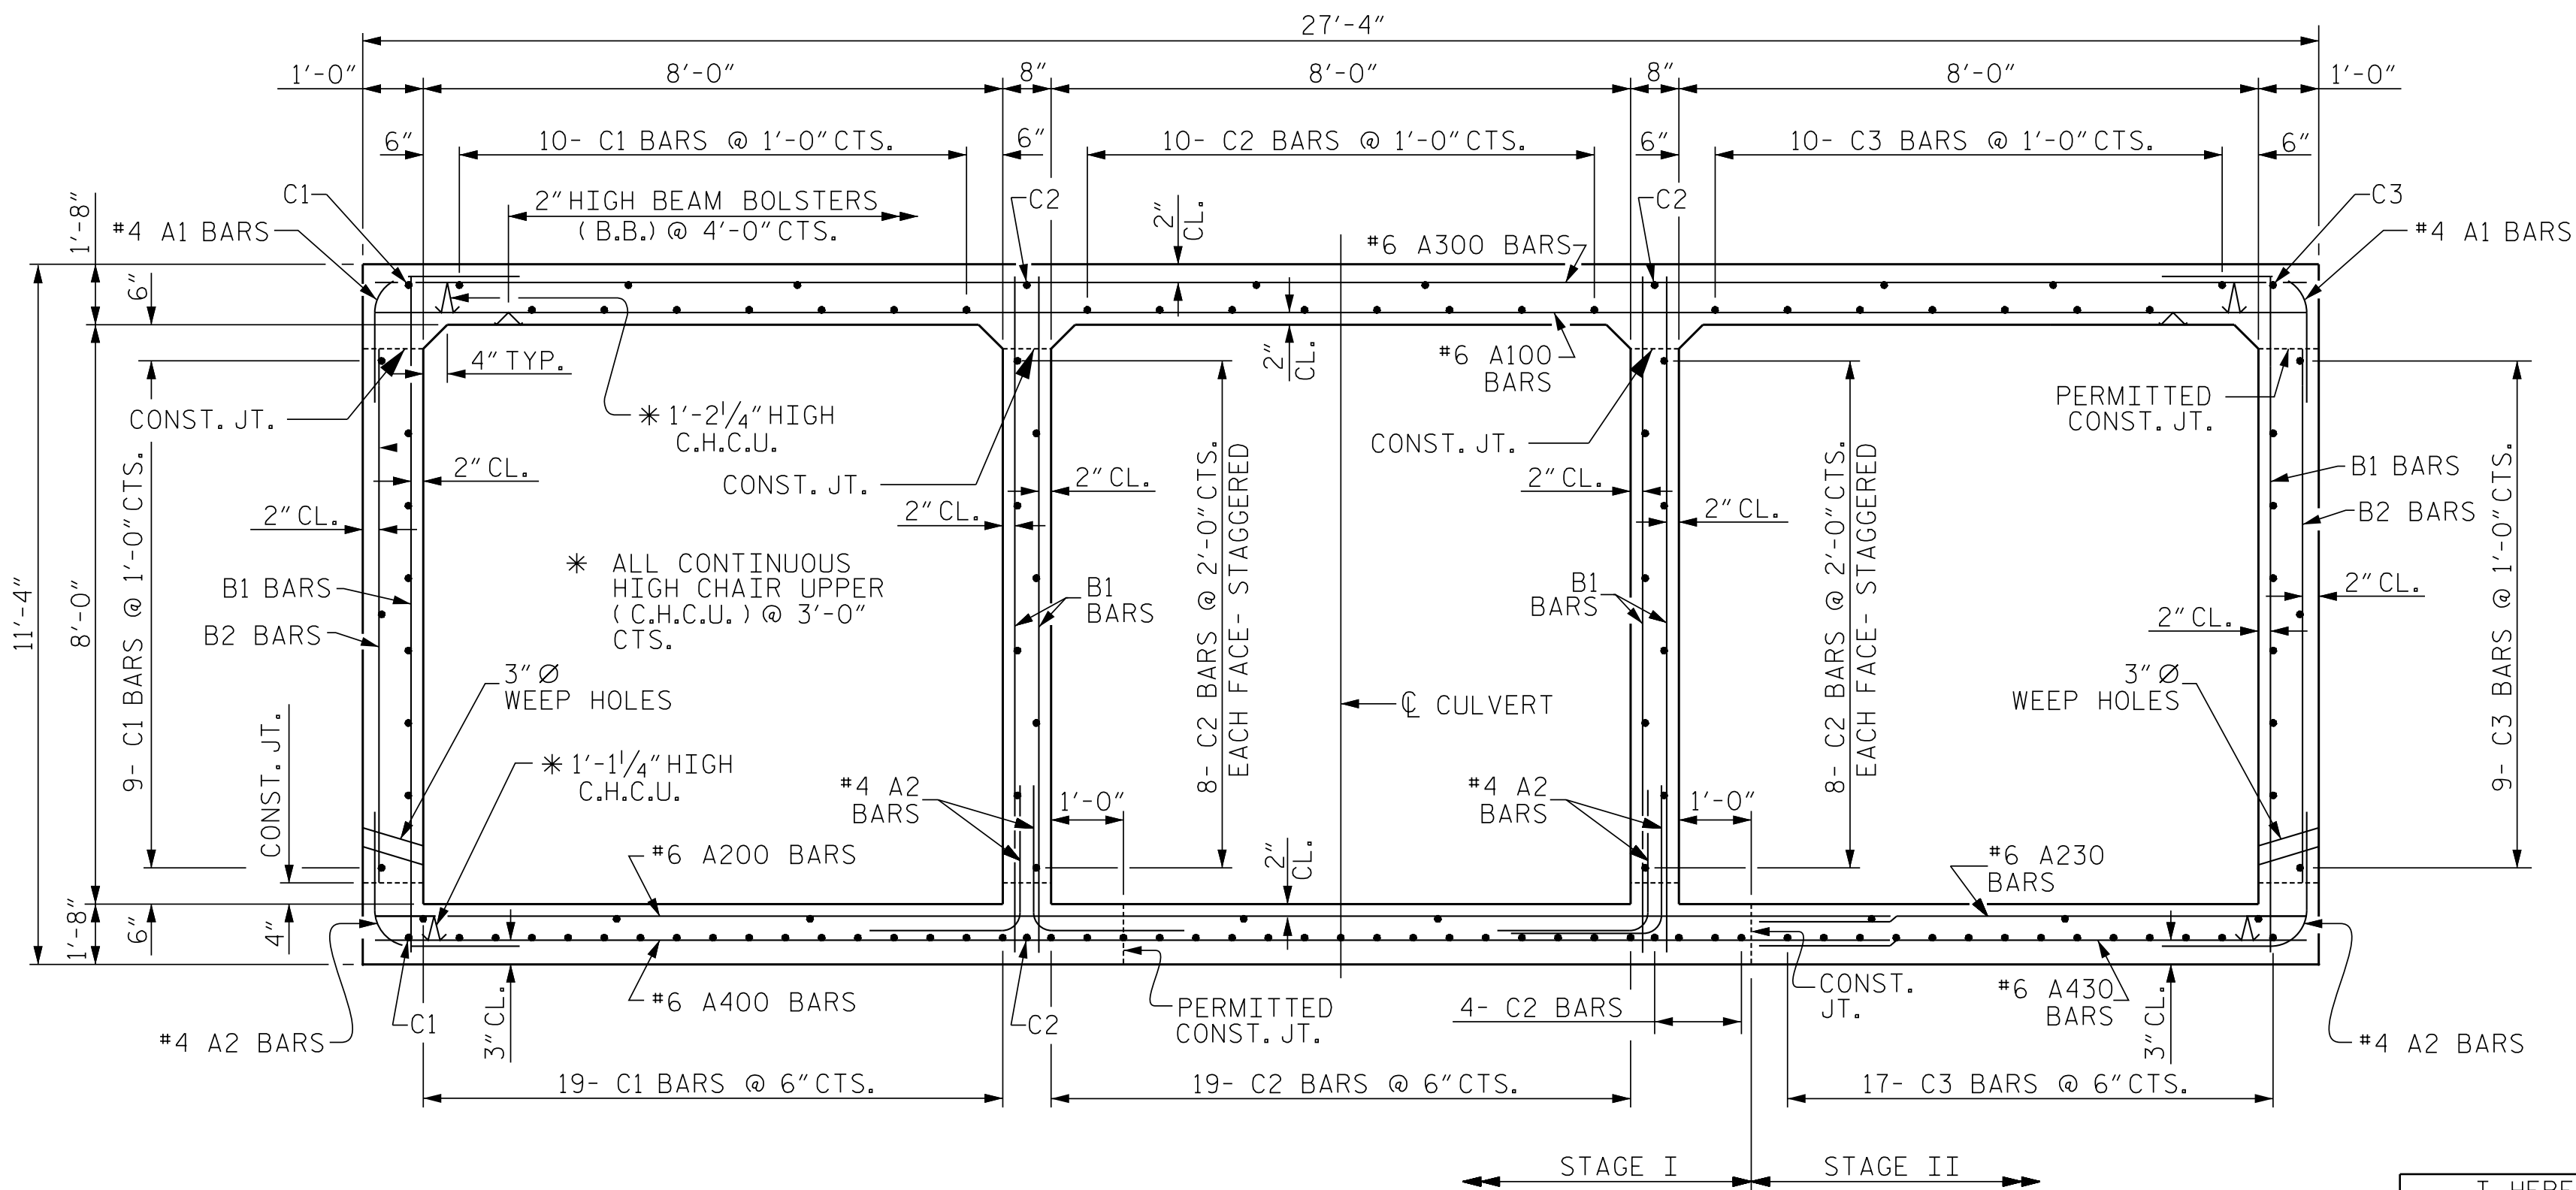

RIGHT ANGLE SECTION OF BARREL

THERE ARE 129 'C' BARS IN SECTION OF BARREL.  
LOOKING UPSTREAM  
THERE ARE 69 'C' BARS IN STAGE I SECTION OF BARREL.  
THERE ARE 60 'C' BARS IN STAGE II SECTION OF BARREL.

I HEREBY CERTIFY THESE  
PLANS ARE THE AS-BUILT PLANS

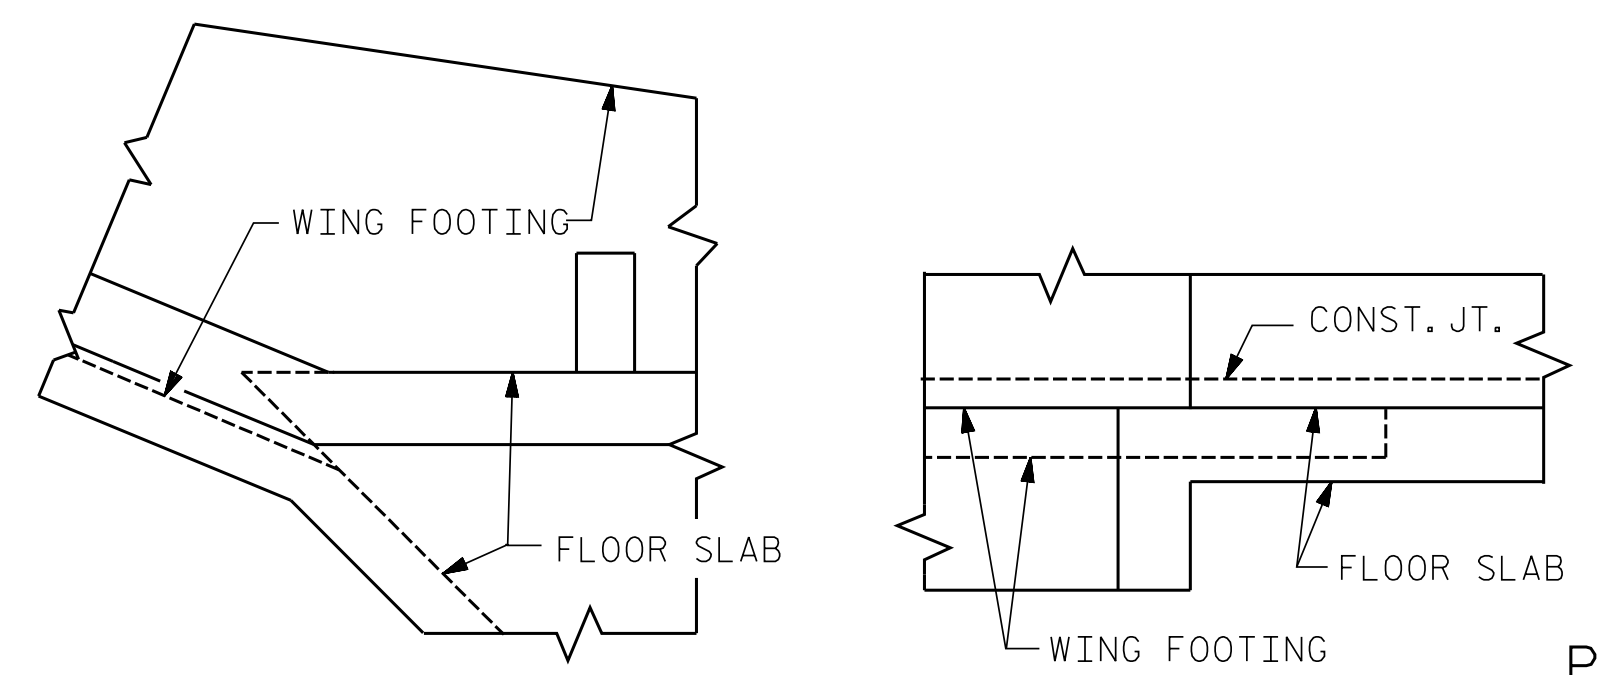

CONNECTION OF WING  
FOOTING AND FLOOR  
SLAB WHEN SLAB IS  
THICKER THAN FOOTING



7/26/2022

DOCUMENT NOT CONSIDERED  
FINAL UNLESS ALL  
SIGNATURES COMPLETED

**V&M**  
Vaughn & Melton  
Consulting Engineers  
Asheville, North Carolina  
828-253-2796

- Boone, NC 828-355-9933
- Tri-Cities, TN 423-467-8401
- Knoxville, TN 865-546-5800
- Spartanburg, SC 864-574-4775
- Charleston, SC 843-974-5650
- Middlesboro, KY 606-248-6600
- Raleigh, NC 919-977-9455
- Charlotte, NC 704-357-0488
- Atlanta, GA 770-627-3590

Copyright © 2006 Vaughn & Melton, Inc. All Rights Reserved

PROJECT NO. U-2579AA  
FORSYTH COUNTY  
STATION: 78+68.93 -Y2-


SHEET 3 OF 7

STATE OF NORTH CAROLINA  
DEPARTMENT OF TRANSPORTATION  
RALEIGH


TRIPLE 8'X8' RCBC  
EXTENSION (OUTLET END)  
ON I-74/US-31 BETWEEN  
SR 2698 & SR 2643

DSG. ENG. OF RECORD.: AML		REVISIONS				SHEET NO.
DWN. BY: WDC	DATE: 2/19	NO.	BY:	DATE:		C3-3
CHKD. BY: HLW	DATE: 2/19	1				TOTAL SHEETS
		2				7



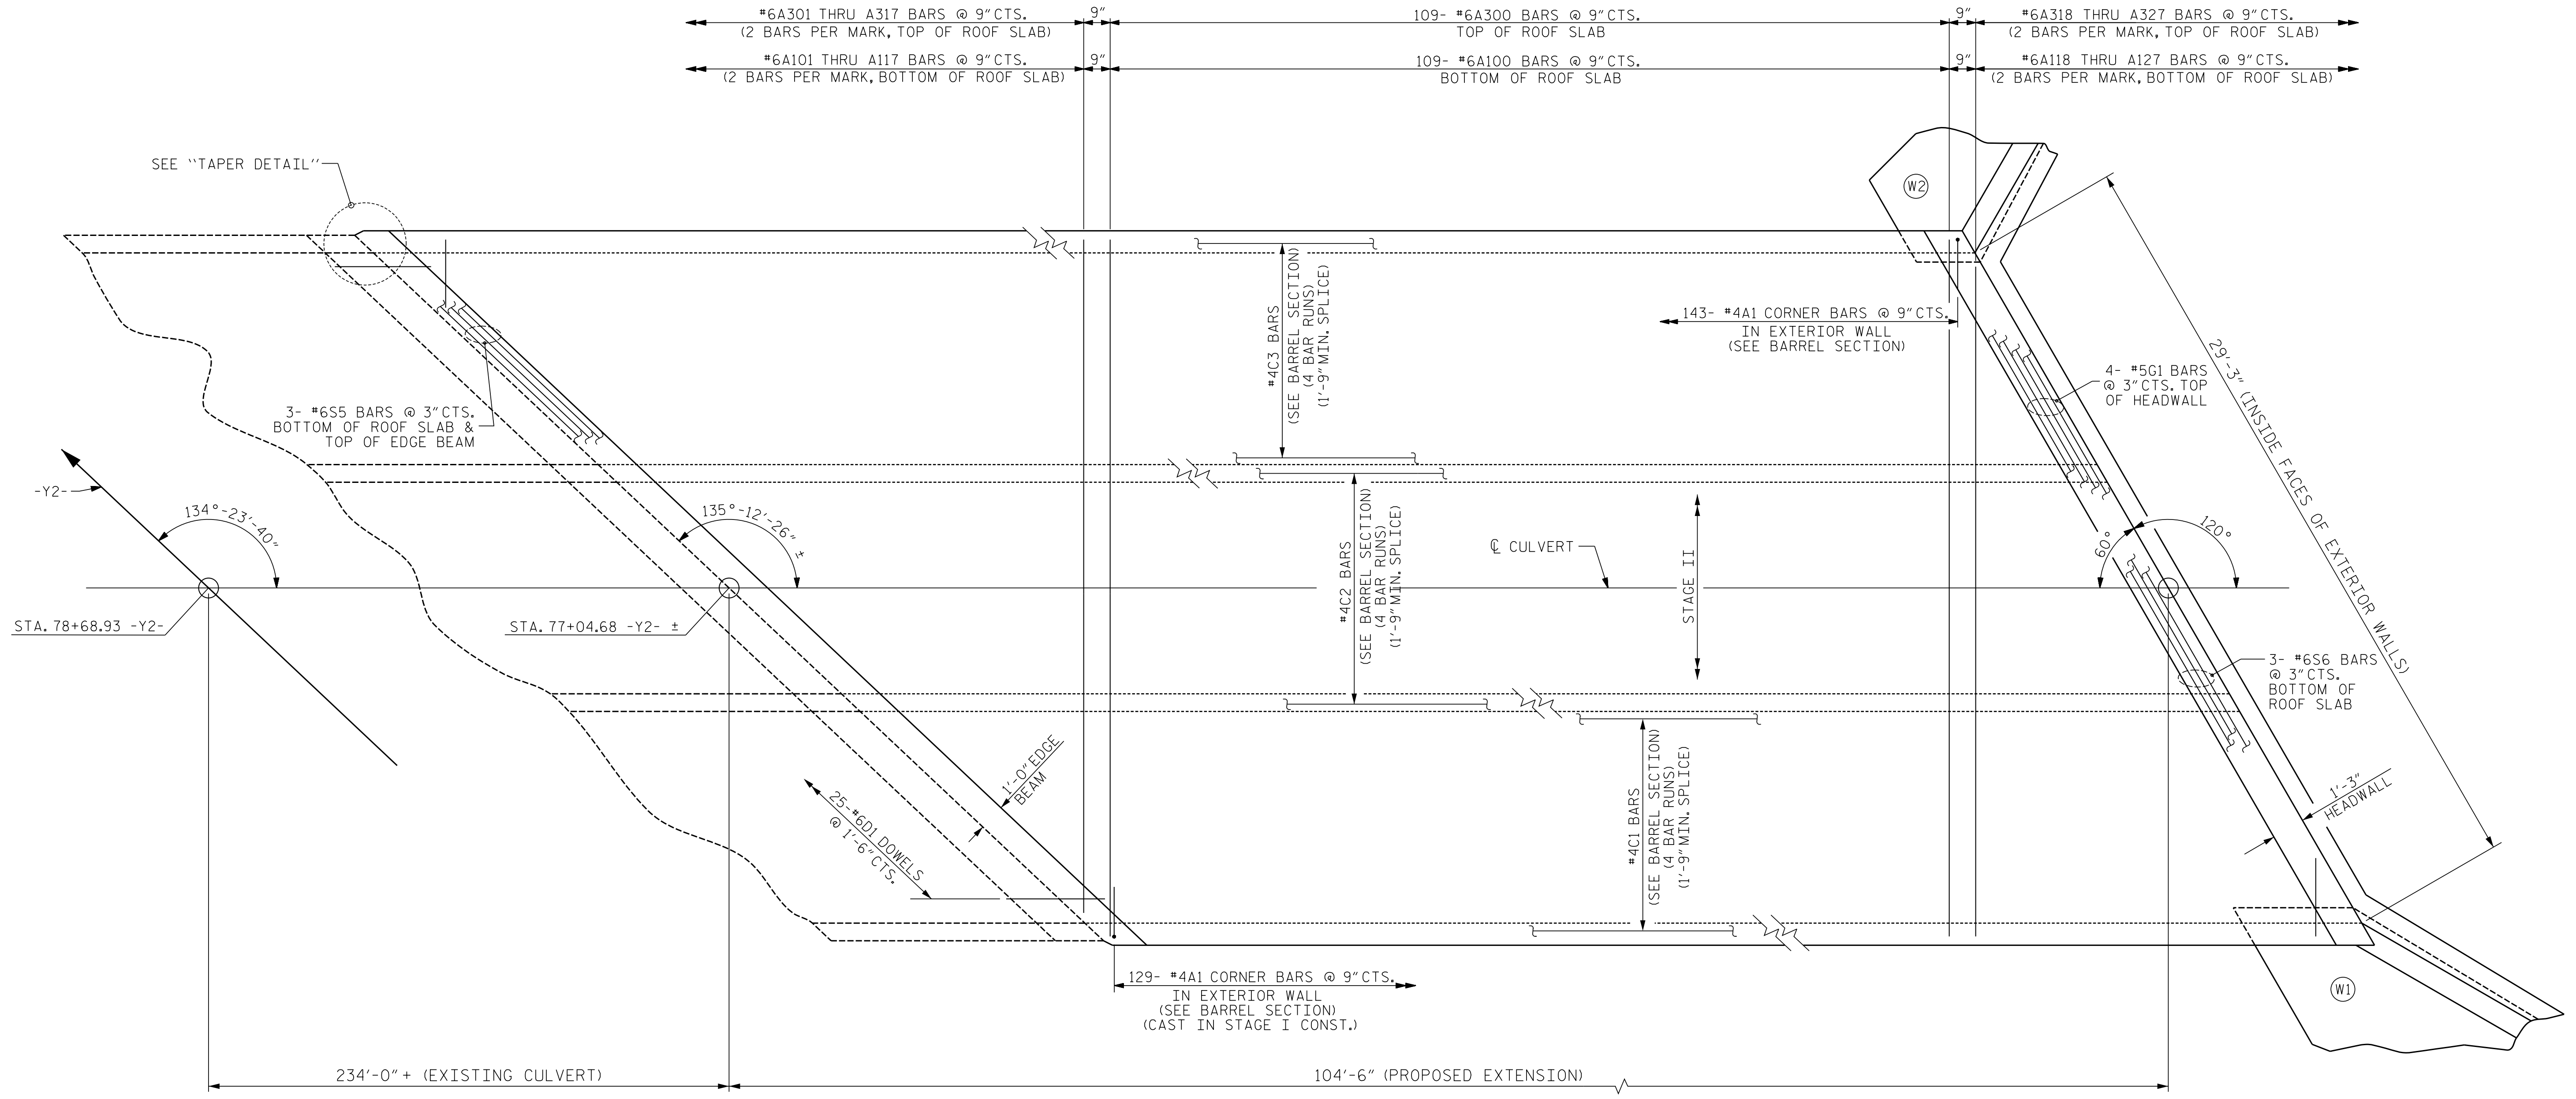

**ROOF PLAN**  
(STAGE II)

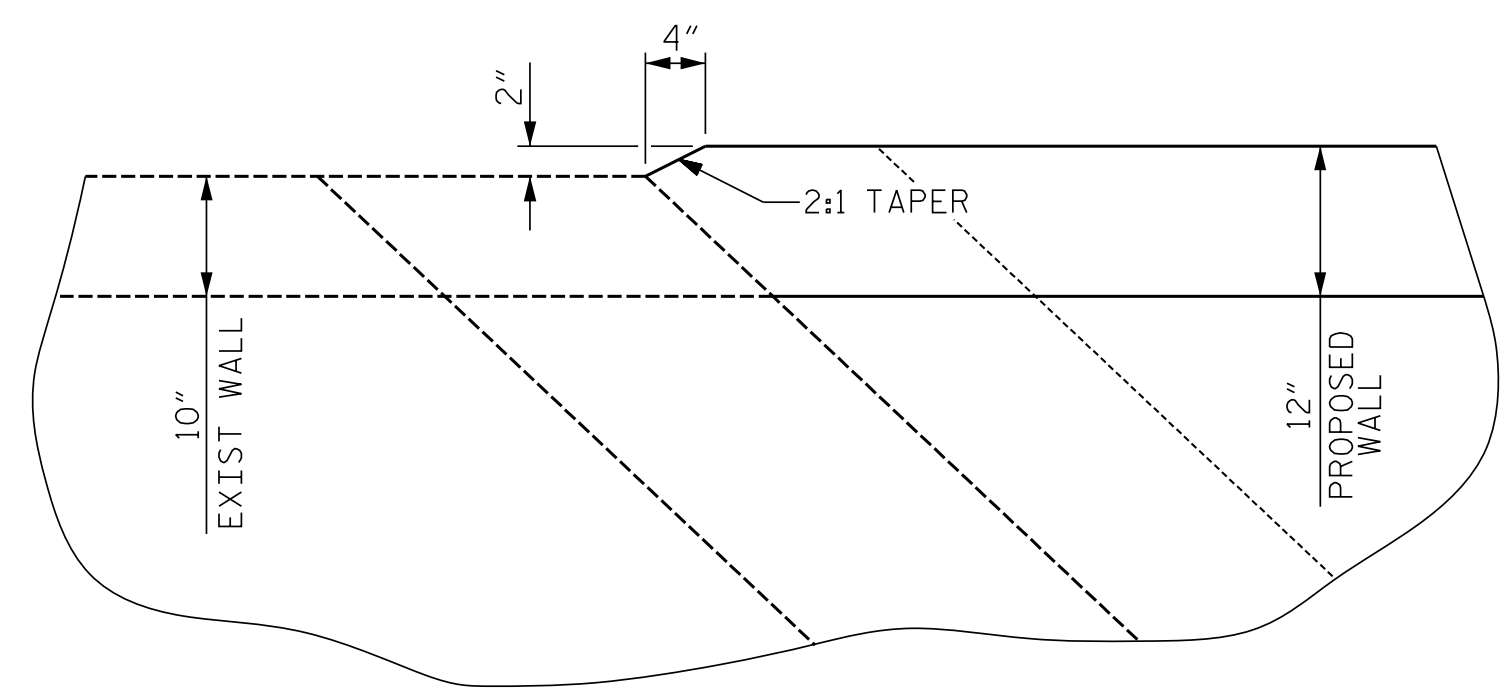

**TAPER DETAIL**  
(TYP. EACH EXT. WALL)  
(ANY REINFORCING STEEL IN THE AREA OF THE TAPER SHALL BE ADJUSTED OR FIELD BENT TO MAINTAIN 2" CL. FROM THE OUTSIDE FACE OF THE WALL)

PROJECT NO. U-2579AA  
 FORSYTH COUNTY  
 STATION: 78+68.93 -Y2-  
 SHEET 5 OF 7



DOCUMENT NOT CONSIDERED FINAL UNLESS ALL SIGNATURES COMPLETED

**V&M**  
**Vaughn & Melton**  
 Consulting Engineers  
 Asheville, North Carolina  
 828-253-2796  
 2006 Vaughn & Melton, Inc. All Rights Reserved

- Boone, NC 828-355-9933
- Tri-Cities, TN 423-467-8401
- Knoxville, TN 865-546-5800
- Spartanburg, SC 864-574-4775
- Charleston, SC 843-314-5650
- Middletown, KY 606-249-6600
- Raleigh, NC 919-977-9455
- Charlotte, NC 704-357-0488
- Atlanta, GA 770-627-3590


STATE OF NORTH CAROLINA  
 DEPARTMENT OF TRANSPORTATION  
 RALEIGH  
 TRIPLE 8'X8' RCBC  
 EXTENSION (OUTLET END)  
 ON I-74/US-311 BETWEEN  
 SR 2698 & SR 2643

DSC. ENG. OF RECORD: AML		REVISIONS		SHEET NO.	
DWN. BY: MAF	DATE: 2/19	NO. 1	BY:	DATE:	C3-5
CHKD. BY: HLW	DATE: 2/19	NO. 2	BY:	DATE:	TOTAL SHEETS
		NO. 3	BY:	DATE:	7
		NO. 4	BY:	DATE:	

## BILL OF MATERIAL

STAGE I						STAGE II											
BAR	NO.	SIZE	TYPE	LENGTH	WEIGHT	BAR	NO.	SIZE	TYPE	LENGTH	WEIGHT	BAR	NO.	SIZE	TYPE	LENGTH	WEIGHT
A200	114	6	STR.	21'-11"	3753	A100	109	6	STR.	27'-0"	4420	A230	136	6	STR.	7'-10"	1600
A201	2	6	STR.	20'-8"	62	A101	2	6	STR.	26'-5"	79	A231	2	6	STR.	7'-1"	21
A202	2	6	STR.	19'-1"	57	A102	2	6	STR.	24'-11"	75	A232	2	6	STR.	5'-7"	17
A203	2	6	STR.	17'-8"	53	A103	2	6	STR.	23'-5"	70	A233	2	6	STR.	4'-1"	12
A204	2	6	STR.	16'-2"	49	A104	2	6	STR.	21'-11"	66	A234	2	6	STR.	2'-7"	8
A205	2	6	STR.	14'-8"	44	A105	2	6	STR.	20'-5"	61	A235	2	6	STR.	5'-2"	16
A206	2	6	STR.	13'-2"	40	A106	2	6	STR.	18'-11"	57	A236	2	6	STR.	2'-7"	8
A207	2	6	STR.	11'-8"	35	A107	2	6	STR.	17'-6"	53						
A208	2	6	STR.	10'-3"	31	A108	2	6	STR.	16'-0"	48	A430	136	6	STR.	7'-10"	1600
A209	2	6	STR.	8'-9"	26	A109	2	6	STR.	14'-6"	44	A431	2	6	STR.	7'-1"	21
A210	2	6	STR.	7'-3"	22	A110	2	6	STR.	13'-0"	39	A432	2	6	STR.	5'-7"	17
A211	2	6	STR.	5'-9"	17	A111	2	6	STR.	11'-6"	35	A433	2	6	STR.	4'-1"	12
A212	2	6	STR.	4'-3"	13	A112	2	6	STR.	10'-0"	30	A434	2	6	STR.	2'-7"	8
A213	2	6	STR.	20'-6"	62	A113	2	6	STR.	8'-6"	26	A435	2	6	STR.	5'-2"	16
A214	2	6	STR.	17'-11"	54	A114	2	6	STR.	7'-0"	21	A436	2	6	STR.	2'-7"	8
A215	2	6	STR.	15'-3"	46	A115	2	6	STR.	5'-7"	17						
A216	2	6	STR.	12'-8"	38	A116	2	6	STR.	4'-1"	12	A1	143	4	①	6'-9"	645
A217	2	6	STR.	10'-1"	30	A117	2	6	STR.	2'-7"	8	A2	144	4	①	5'-9"	553
A218	2	6	STR.	7'-6"	23	A118	2	6	STR.	25'-8"	77						
A219	2	6	STR.	4'-11"	15	A119	2	6	STR.	23'-1"	69	B1	147	4	STR.	10'-11"	1072
A220	2	6	STR.	2'-3"	7	A120	2	6	STR.	20'-6"	62	B2	111	4	STR.	7'-4"	544
A400	114	6	STR.	21'-11"	3753	A121	2	6	STR.	17'-10"	54						
A401	2	6	STR.	20'-8"	62	A122	2	6	STR.	15'-3"	46	C1	44	4	STR.	26'-10"	789
A402	2	6	STR.	19'-1"	57	A123	2	6	STR.	12'-8"	38	C2	48	4	STR.	28'-0"	898
A403	2	6	STR.	17'-8"	53	A124	2	6	STR.	10'-1"	30	C3	148	4	STR.	28'-10"	2851
A404	2	6	STR.	16'-2"	49	A125	2	6	STR.	7'-6"	23						
A405	2	6	STR.	14'-8"	44	A126	2	6	STR.	4'-11"	15	D1	37	6	STR.	2'-6"	139
A406	2	6	STR.	13'-2"	40	A127	2	6	STR.	2'-3"	7						
A407	2	6	STR.	11'-8"	35							G1	4	5	STR.	31'-2"	130
A408	2	6	STR.	10'-3"	31	A300	109	6	STR.	27'-0"	4420						
A409	2	6	STR.	8'-9"	26	A301	2	6	STR.	26'-5"	79	S2	6	6	STR.	11'-1"	100
A410	2	6	STR.	7'-3"	22	A302	2	6	STR.	24'-11"	75	S4	3	6	STR.	9'-0"	41
A411	2	6	STR.	5'-9"	17	A303	2	6	STR.	23'-5"	70	S5	6	6	STR.	38'-3"	345
A412	2	6	STR.	4'-3"	13	A304	2	6	STR.	21'-11"	66	S6	3	6	STR.	31'-2"	140
A413	2	6	STR.	20'-6"	62	A305	2	6	STR.	20'-5"	61						
A414	2	6	STR.	17'-11"	54	A306	2	6	STR.	18'-11"	57	REINFORCING STEEL 22,768 LBS.					
A415	2	6	STR.	15'-3"	46	A307	2	6	STR.	17'-6"	53						
A416	2	6	STR.	12'-8"	38	A308	2	6	STR.	16'-0"	48						
A417	2	6	STR.	10'-1"	30	A309	2	6	STR.	14'-6"	44						
A418	2	6	STR.	7'-6"	23	A310	2	6	STR.	13'-0"	39						
A419	2	6	STR.	4'-11"	15	A311	2	6	STR.	11'-6"	35						
A420	2	6	STR.	2'-3"	7	A312	2	6	STR.	10'-0"	30						
A1	129	4	①	6'-9"	582	A313	2	6	STR.	8'-6"	26						
A2	334	4	①	5'-9"	1283	A314	2	6	STR.	7'-0"	21						
B1	342	4	STR.	10'-11"	2494	A315	2	6	STR.	5'-7"	17						
B2	99	4	STR.	7'-4"	485	A316	2	6	STR.	4'-1"	12						
C1	116	4	STR.	26'-10"	2079	A317	2	6	STR.	2'-7"	8						
C2	160	4	STR.	28'-0"	2993	A318	2	6	STR.	25'-8"	77						
D1	23	6	STR.	2'-6"	86	A319	2	6	STR.	23'-1"	69						
S1	6	6	STR.	30'-0"	270	A320	2	6	STR.	20'-6"	62						
S3	3	6	STR.	24'-11"	112	A321	2	6	STR.	17'-10"	54						
REINFORCING STEEL 19,334 LBS.						A322	2	6	STR.	15'-3"	46						
						A323	2	6	STR.	12'-8"	38						
						A324	2	6	STR.	10'-1"	30						
						A325	2	6	STR.	7'-6"	23						
						A326	2	6	STR.	4'-11"	15						
						A327	2	6	STR.	2'-3"	7						

### BAR TYPE

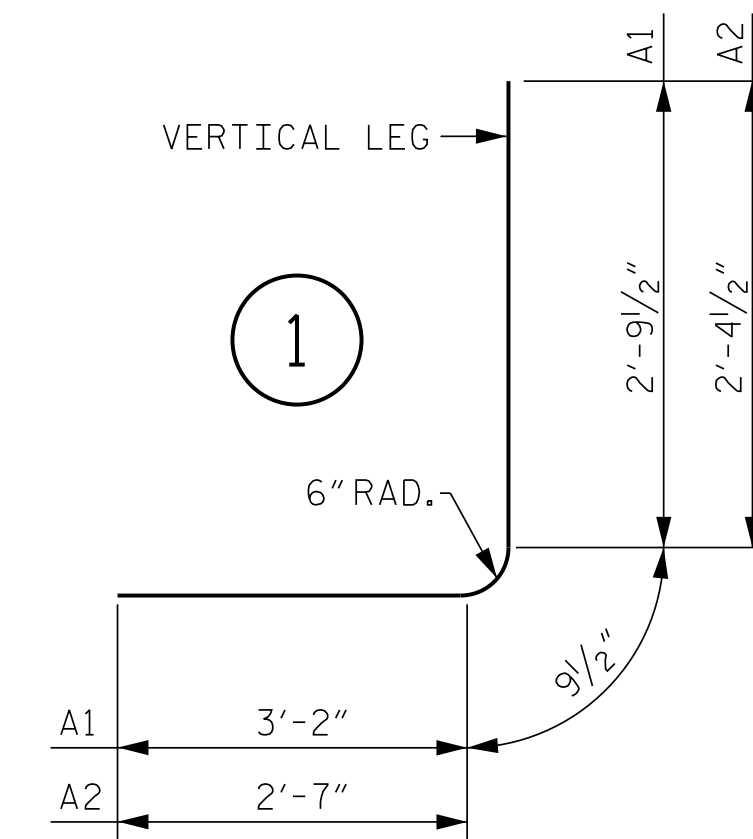

BAR DIMENSIONS ARE OUT TO OUT.

### SPLICE LENGTH CHART

BAR	SIZE	SPLICE LENGTH
"C"	#4	1'-9"
A100, A200, A300, A400	#6	2'-9"

PROJECT NO. U-2579AA

FORSYTH COUNTY


STATION: 78+68.93 -Y2-

SHEET 6 OF 7

STATE OF NORTH CAROLINA  
DEPARTMENT OF TRANSPORTATION  
RALEIGH

TRIPLE 8'X8' RCBC  
EXTENSION (OUTLET END)

ON I-74/US-311 BETWEEN  
SR 2698 & SR 2643

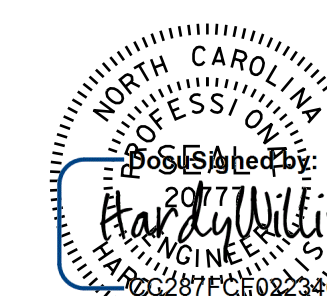

7/26/2022

DOCUMENT NOT CONSIDERED  
FINAL UNLESS ALL  
SIGNATURES COMPLETED

Boone, NC 828-355-9933

Tri-Cities, TN 423-467-8401

Knoxville, TN 865-546-5800

Spartanburg, SC 864-574-4775

Charleston, SC 843-374-5650

Midway, KY 606-248-6600


Raleigh, NC 919-977-9455

Charlotte, NC 704-357-0488


Atlanta, GA 770-627-3590

Copyright © 2006 Vaughn & Mellon, Inc. All Rights Reserved


DSG. ENG. OF RECORD: AML		REVISIONS						SHEET NO.
NO.	BY:	DATE:	NO.	BY:	DATE:	TOTAL SHEETS		
1	MAF	2/19	3			C3-6		
2	HLW	2/19	4			7		

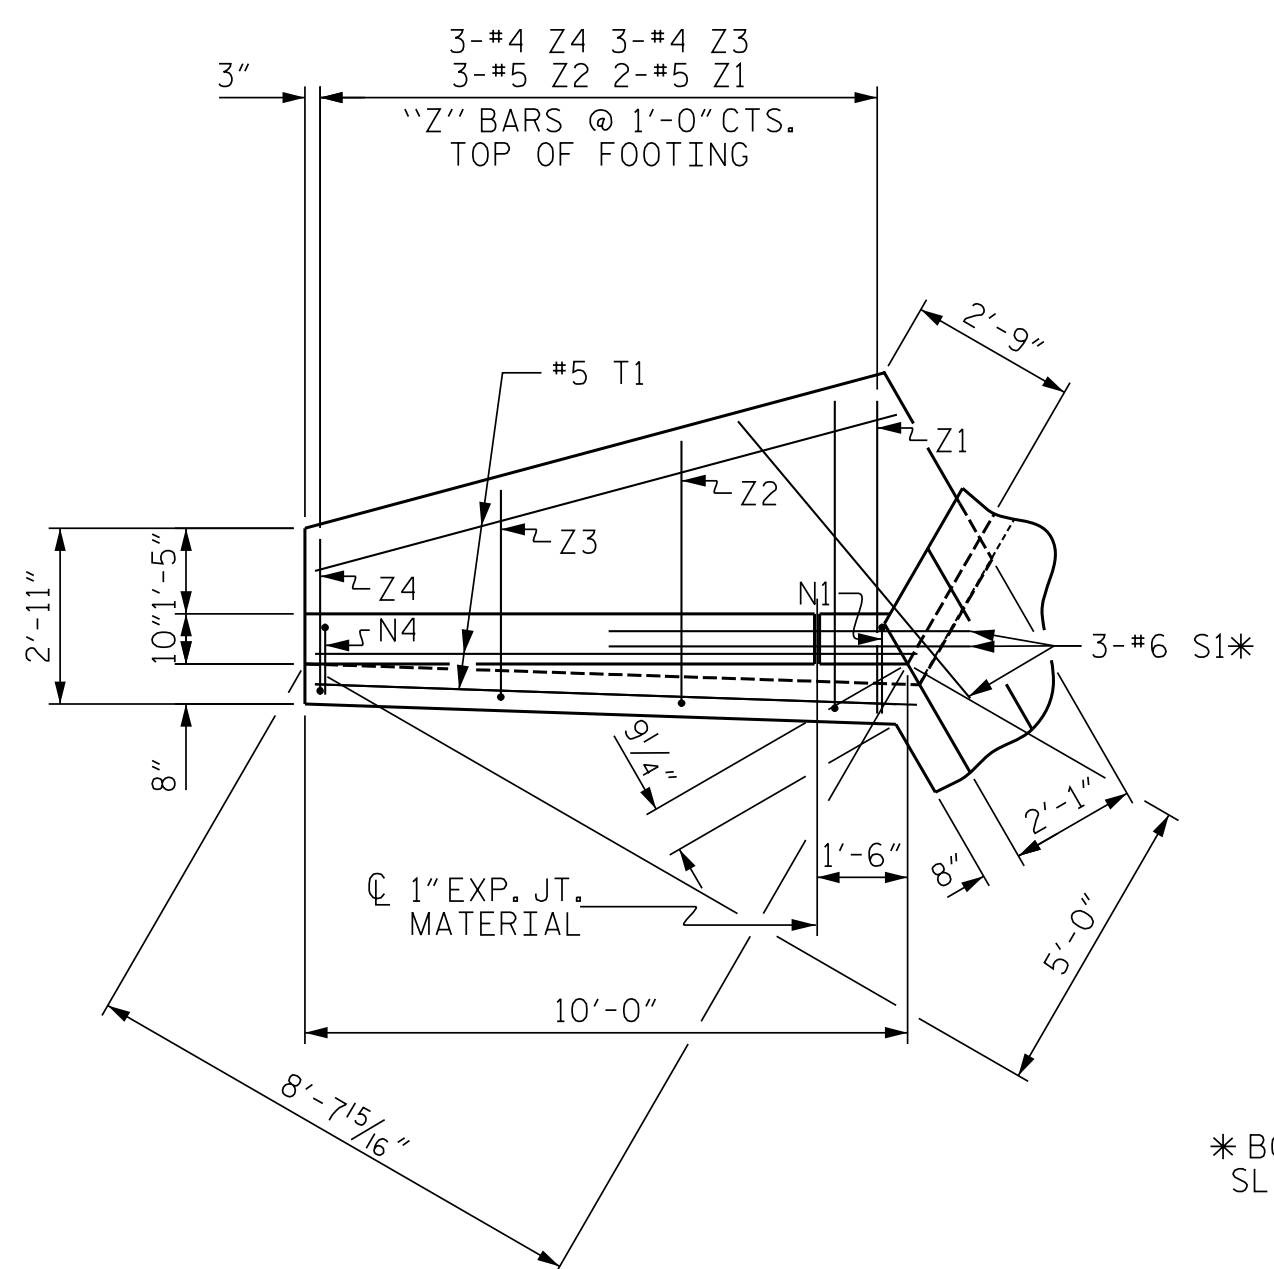


PLAN W2

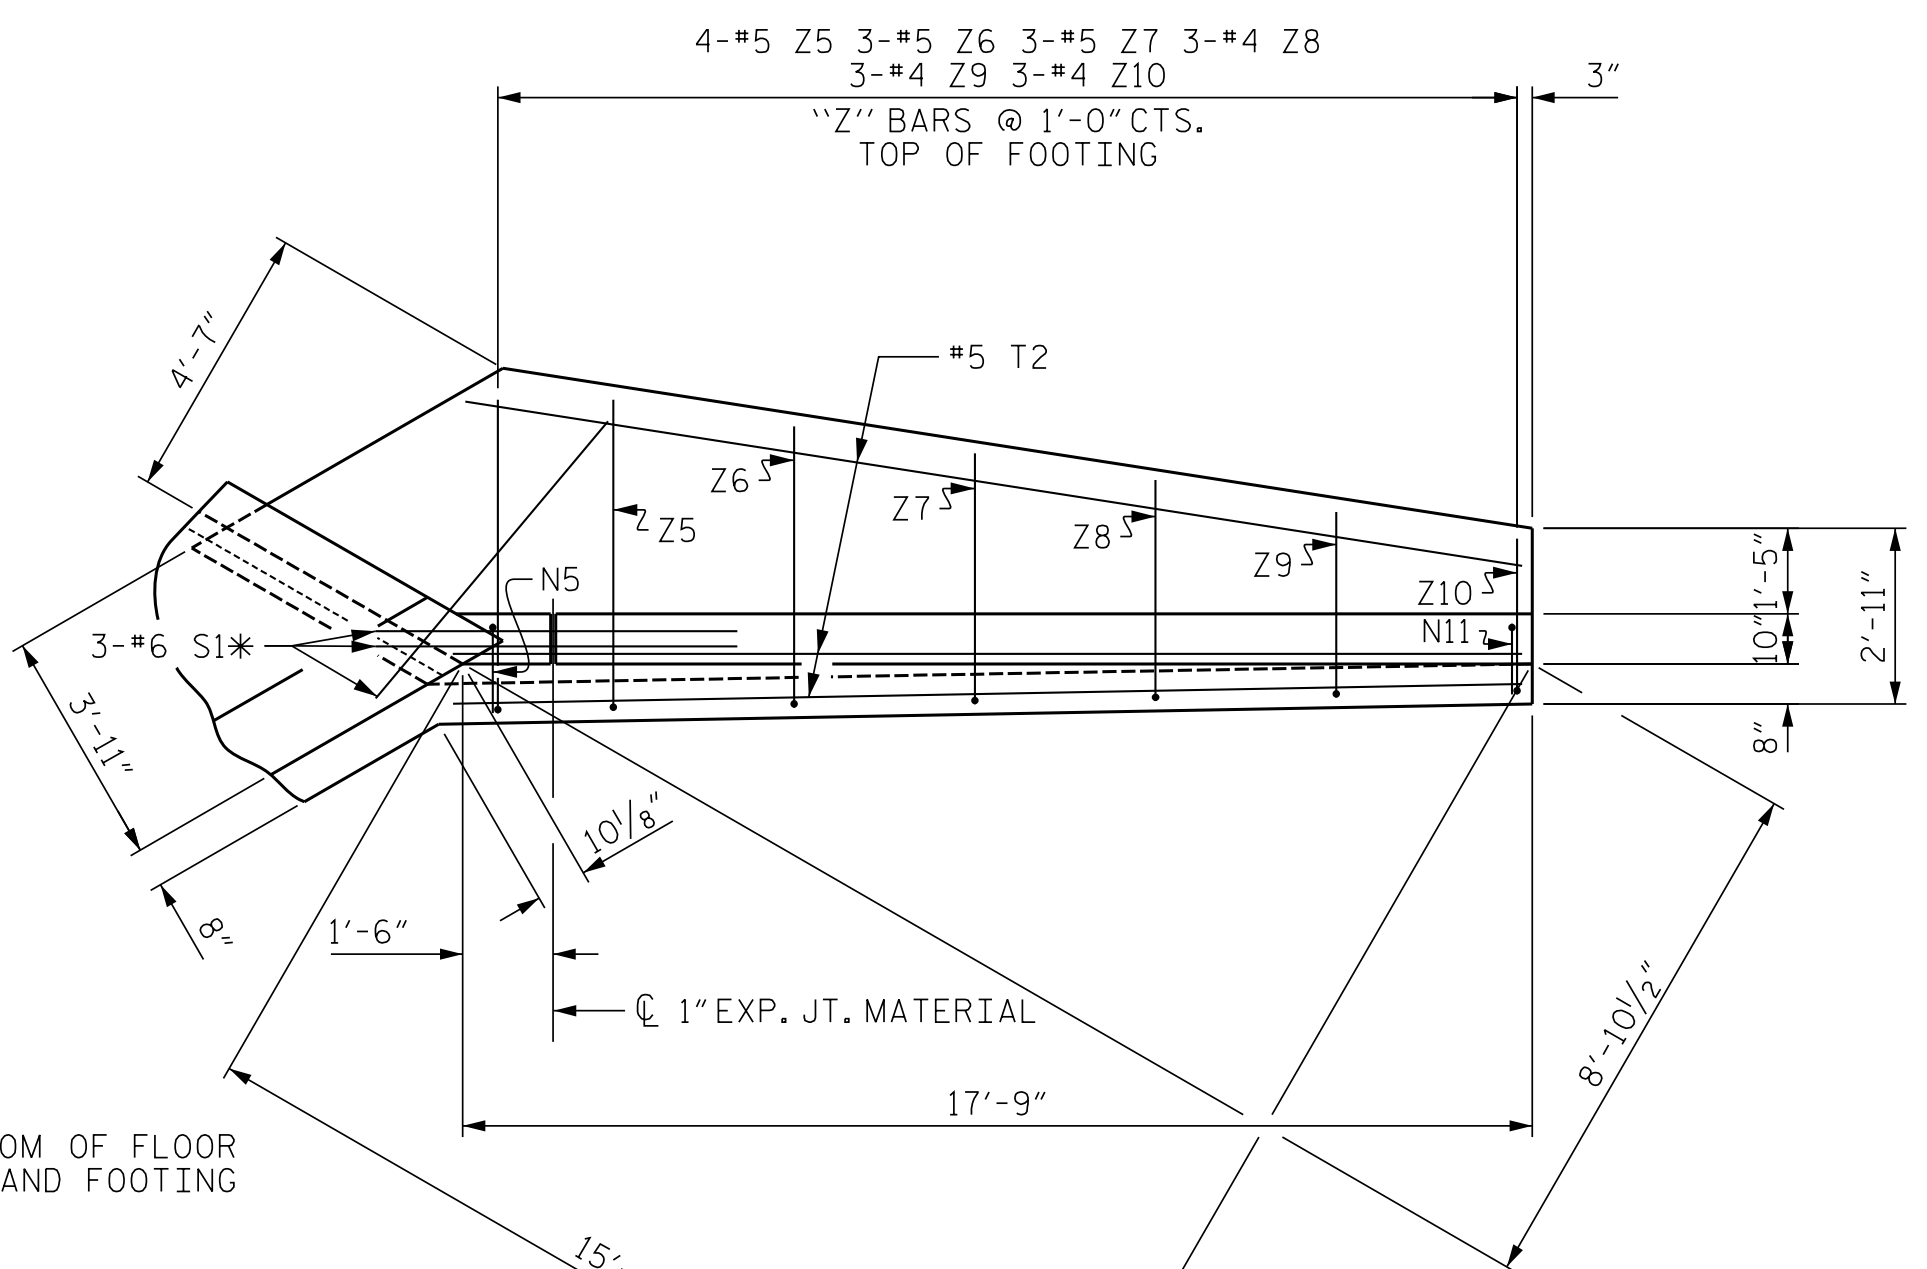


PLAN W1

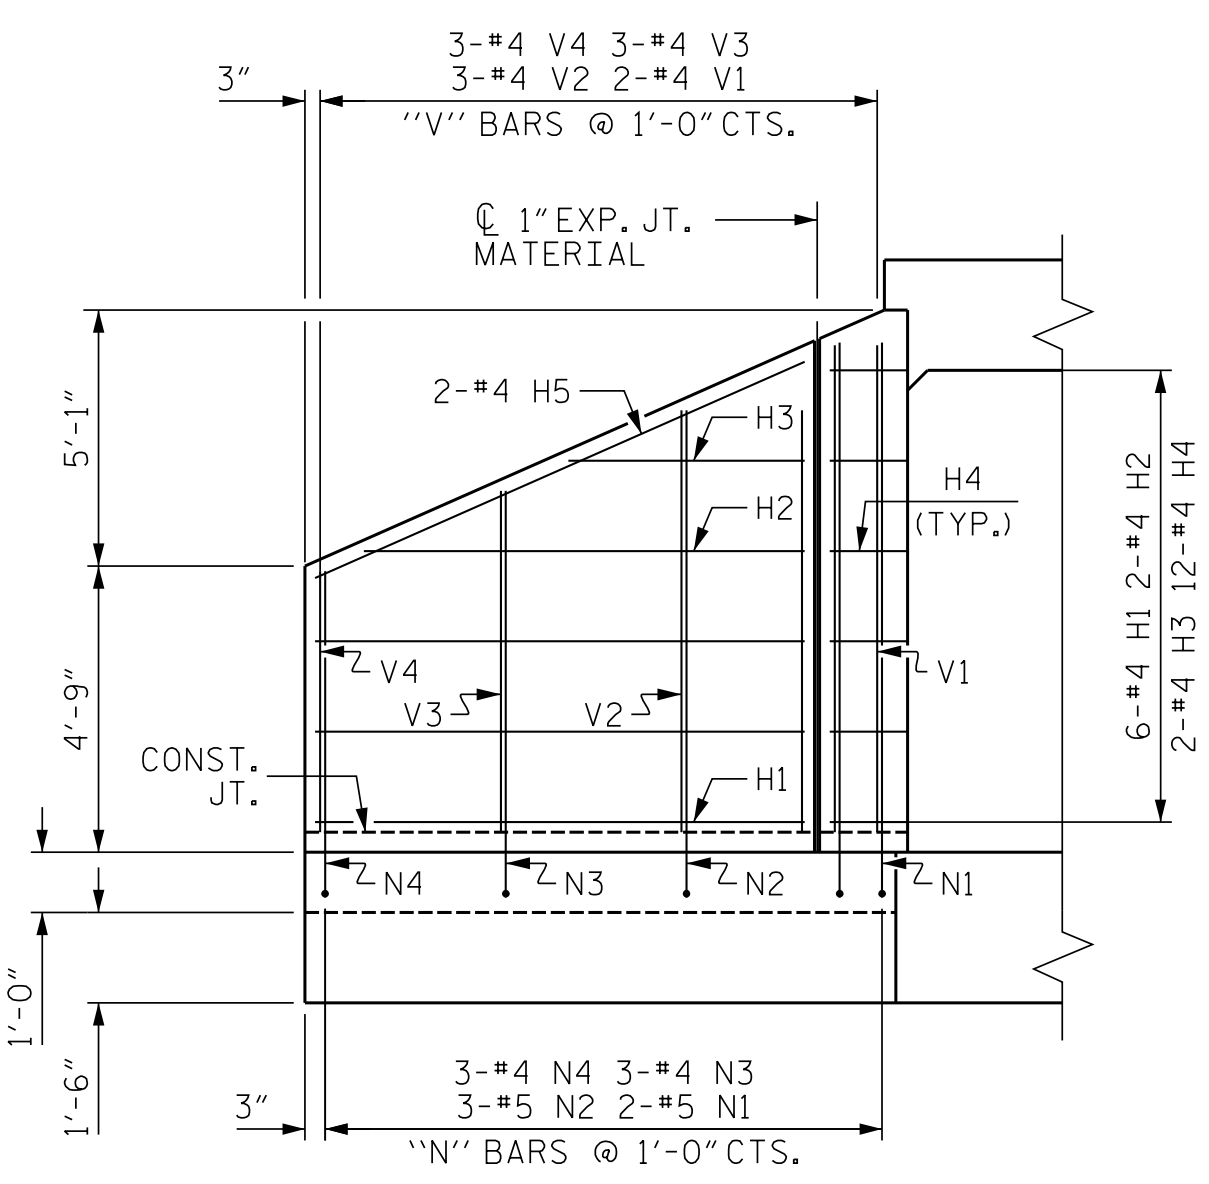

ELEVATION W2

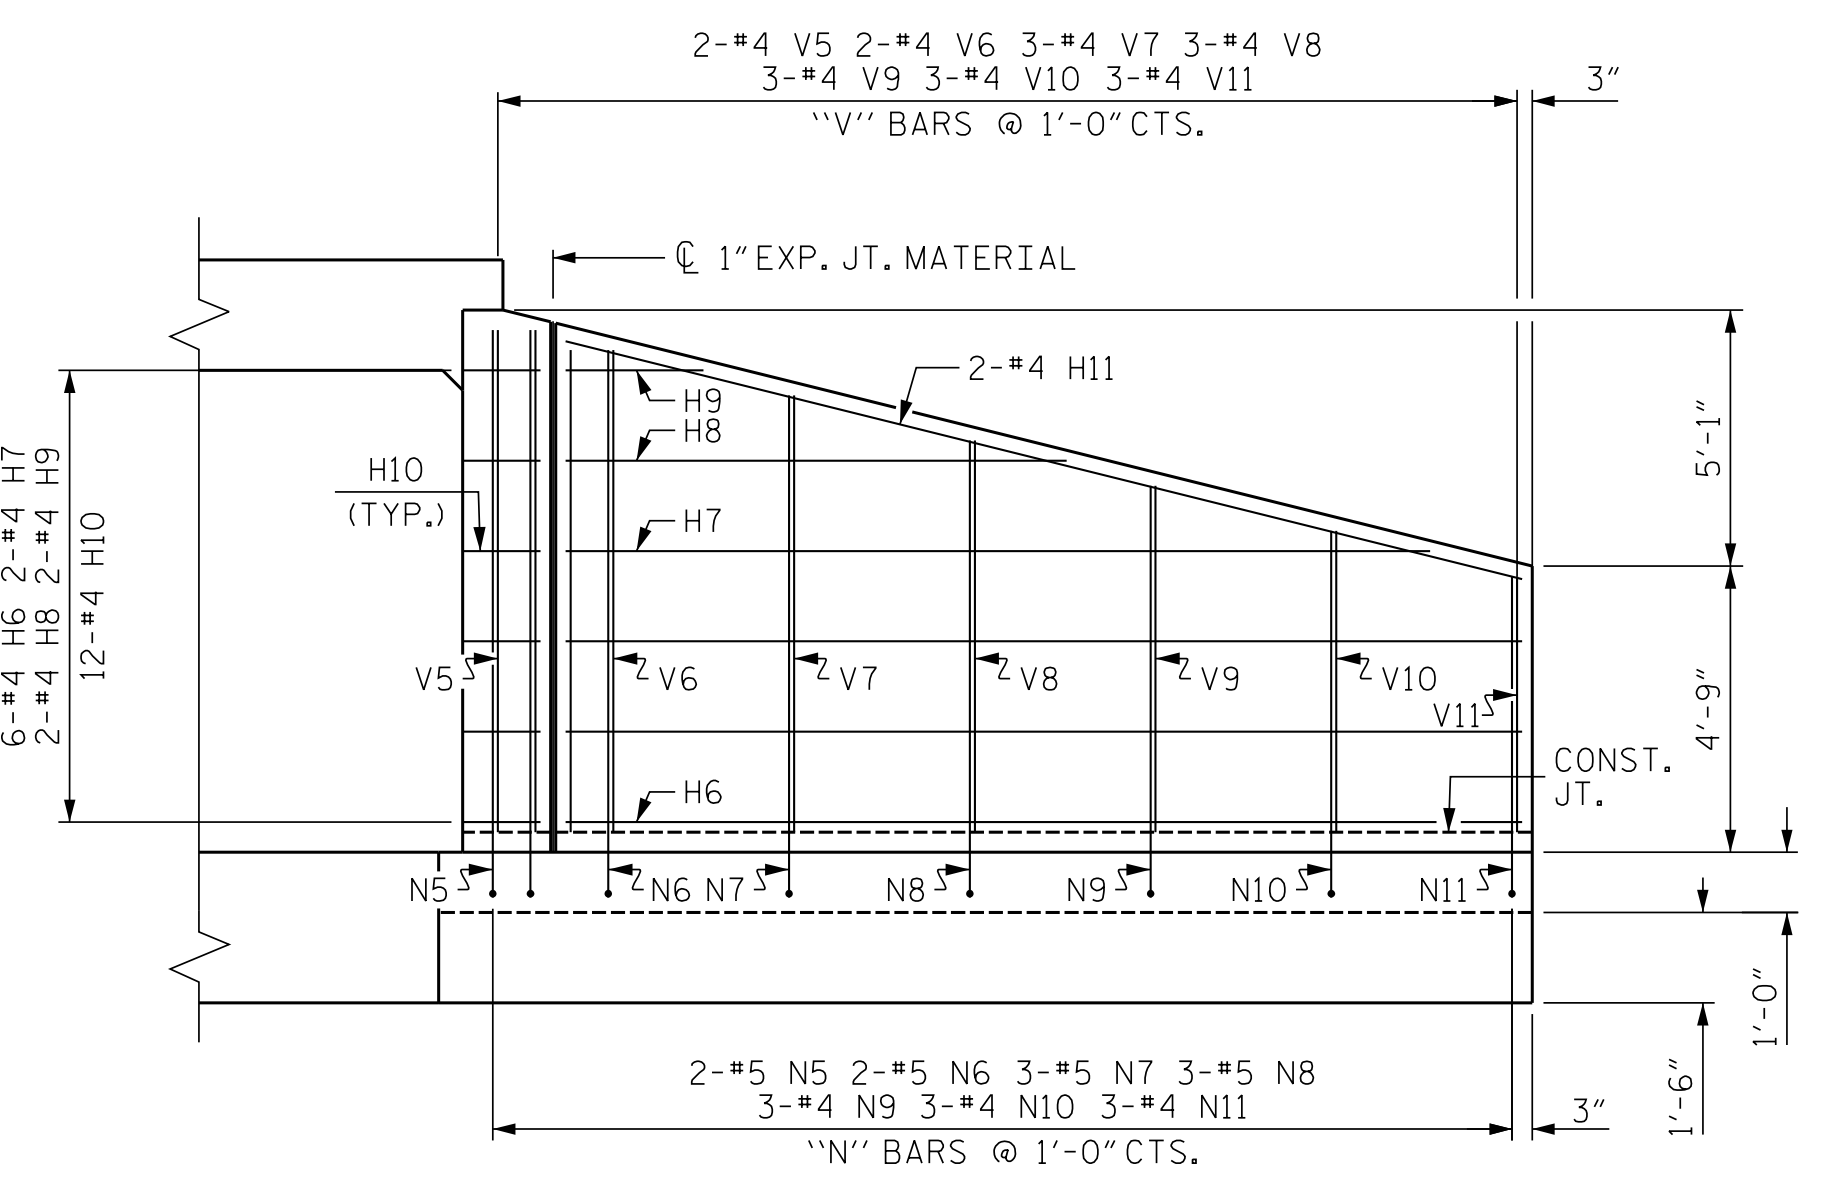


ELEVATION W1

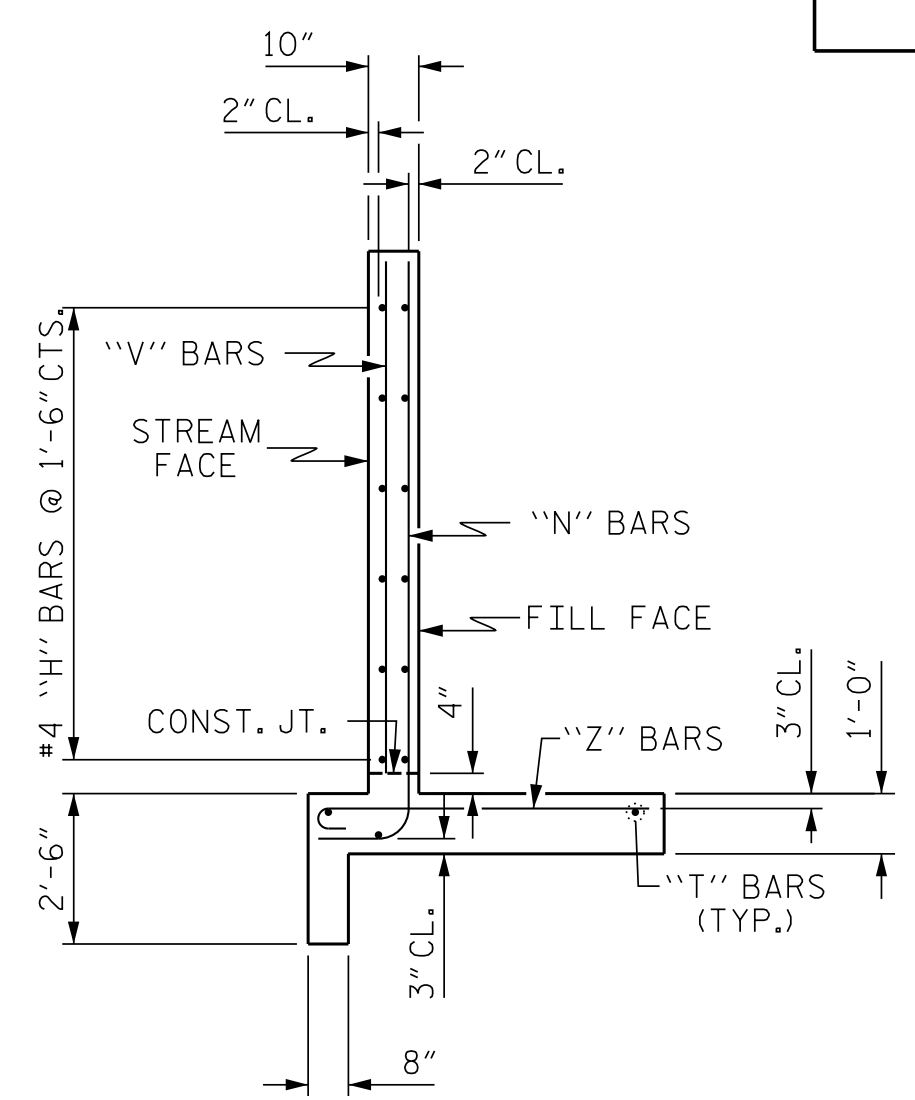

TYPICAL WING SECTION

BAR TYPES

ALL BAR DIMENSIONS ARE OUT TO OUT.

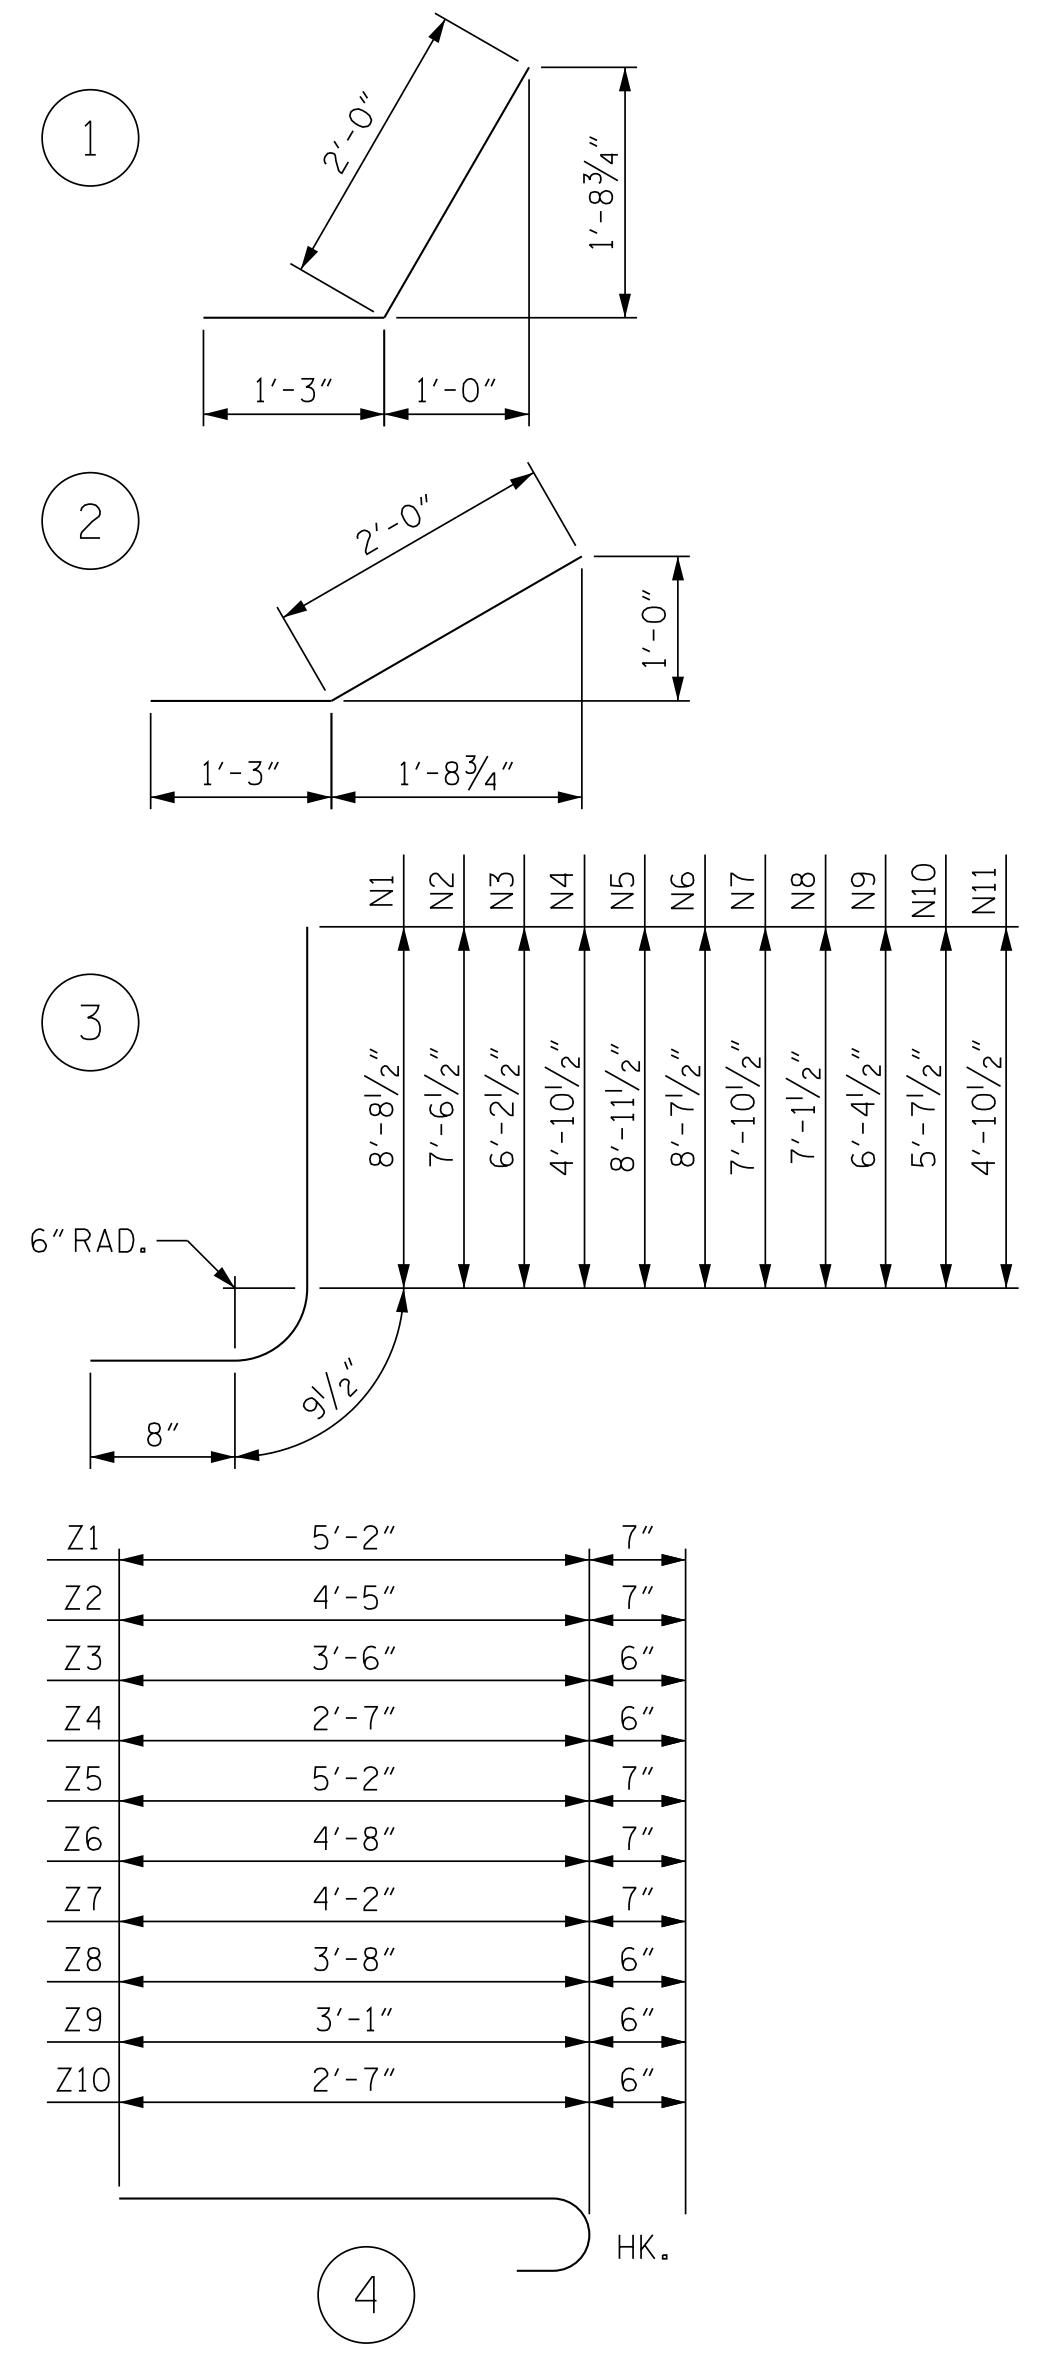

BILL OF MATERIAL

BAR NO.	SIZE	TYPE	LENGTH	WEIGHT
H1	#4	STR	8'-1"	32
H2	#4	STR	7'-3"	15
H3	#4	STR	3'-11"	5
H4	#4	1	3'-3"	26
H5	#4	STR	8'-10"	12
H6	#4	STR	15'-10"	63
H7	#4	STR	14'-4"	19
H8	#4	STR	8'-3"	11
H9	#4	STR	2'-3"	3
H10	#4	2	3'-3"	26
H11	#4	STR	16'-4"	22
N1	#5	3	10'-2"	21
N2	#5	3	9'-0"	28
N3	#4	3	7'-8"	15
N4	#4	3	6'-4"	13
N5	#5	3	10'-5"	22
N6	#5	3	10'-1"	21
N7	#5	3	9'-4"	29
N8	#5	3	8'-7"	27
N9	#4	3	7'-10"	16
N10	#4	3	7'-1"	14
N11	#4	3	6'-4"	13
S1	#6	STR	6'-0"	54
T1	#5	STR	10'-0"	31
T2	#5	STR	17'-9"	56
V1	#4	STR	8'-1"	11
V2	#4	STR	7'-0"	14
V3	#4	STR	5'-8"	11
V4	#4	STR	4'-4"	9
V5	#4	STR	8'-4"	11
V6	#4	STR	8'-0"	11
V7	#4	STR	7'-3"	15
V8	#4	STR	6'-6"	13
V9	#4	STR	5'-9"	12
V10	#4	STR	5'-0"	10
V11	#4	STR	4'-3"	9
Z1	#5	4	5'-9"	12
Z2	#5	4	5'-0"	16
Z3	#4	4	4'-0"	8
Z4	#4	4	3'-1"	6
Z5	#5	4	5'-9"	24
Z6	#5	4	5'-3"	16
Z7	#5	4	4'-9"	15
Z8	#4	4	4'-2"	8
Z9	#4	4	3'-7"	7
Z10	#4	4	3'-1"	6
REINFORCING STEEL FOR 2 WINGS				838 LBS
CLASS A CONCRETE				
2 WINGS				12.2 CY
1 HEADWALL				1.5 CY
1 END CURTAIN WALL				0.9 CY
2 EDGE BEAMS				2.3 CY
TOTAL				16.9 CY



DOCUMENT NOT CONSIDERED FINAL UNLESS ALL SIGNATURES COMPLETED

**V&M**  
**Vaughn & Melton**  
 Consulting Engineers  
 Asheville, North Carolina  
 828-253-2796  
 Raleigh, NC 919-977-9455 | Charlotte, NC 704-357-0488 | Atlanta, GA 770-627-3590  
 Copyright © 2006 Vaughn & Melton, Inc. All Rights Reserved

PROJECT NO. U-2579AA  
 FORSYTH COUNTY  
 STATION: 78+68.93 -Y2-

SHEET 7 OF 7  
 STATE OF NORTH CAROLINA  
 DEPARTMENT OF TRANSPORTATION  
 RALEIGH  
**STANDARD WINGS FOR CONCRETE BOX CULVERT**  
 H = 8'-0" SLOPE = 2:1  
 60° OR 120° SKEW

DSG. ENG. OF RECORD.: AML  
 DWN. BY: WDC DATE: 2/19  
 CHKD. BY: HLW DATE: 2/19

REVISIONS					SHEET NO.	
NO.	BY:	DATE:	NO.	BY:	DATE:	C3-7
1			3			TOTAL SHEETS
2			4			7

DRAWN BY: CCJ 11/99  
 CHECKED BY: RWW 03/00

