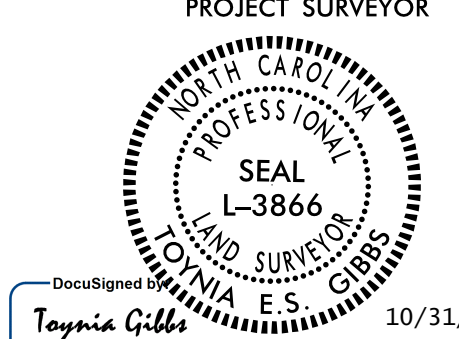



PROJECT REFERENCE NO. U-5826	SHEET NO. RW09
<b>Location and Surveys</b>	
ESP ASSOCIATES, INC. 2200 GATEWAY CENTRE BLVD, SUITE 216 MORRISVILLE, NC 27560	
PROJECT SURVEYOR  10/31/2019	
DOCUMENT NOT CONSIDERED FINAL UNLESS ALL SIGNATURES COMPLETED	

I, Toynia E.S. Gibbs, a Professional Land Surveyor in the state of North Carolina hereby certify to the best of my knowledge and belief that the following work item(s) (R/W Staking) performed under my responsible charge meet NCDOT Survey Standards as directed in the NCDOT Location & Surveys guidelines and procedures.

I further certify that the right of way and permanent easement points shown herein and outlined in the tables shown hereon (localized coordinates, station/offset) have been checked and are accurate representations of the right of way and permanent easement points depicted on the corresponding highway plans. I also certify that the right of way and permanent easement points shown herein have been field monumented under my supervision from existing survey control provided by others; that the depicted property data shown herein were surveyed by others; and these monuments denote the right of way and easement boundaries at the time of staking which may be subject to change due to right of way revisions (See deeds for final determination).


Witness my original signature, registration number and seal this date 10/31/2019

DocuSigned by:  
*Toynia Gibbs* L-3866  
Professional Land Surveyor PLS # Seal

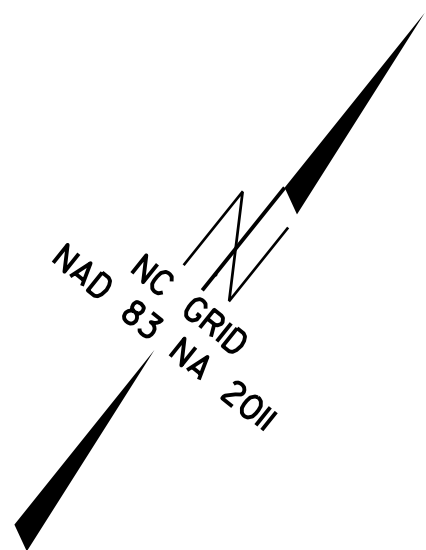

REVISIONS

3:\01-2019\0957\Projects\5826\HM01\037\001\_U5826.con.est#6\_RoFW\_Re-Staking\Submitt\10-31-19\_Project\_Redlines\U5826.ls\_rw03e-9\_191031.dgn  
 3:\01-2019\0957\Projects\5826\HM01\037\001\_U5826.con.est#6\_RoFW\_Re-Staking\Submitt\10-31-19\_Project\_Redlines\U5826.ls\_rw03e-9\_191031.dgn  
 3:\01-2019\0957\Projects\5826\HM01\037\001\_U5826.con.est#6\_RoFW\_Re-Staking\Submitt\10-31-19\_Project\_Redlines\U5826.ls\_rw03e-9\_191031.dgn

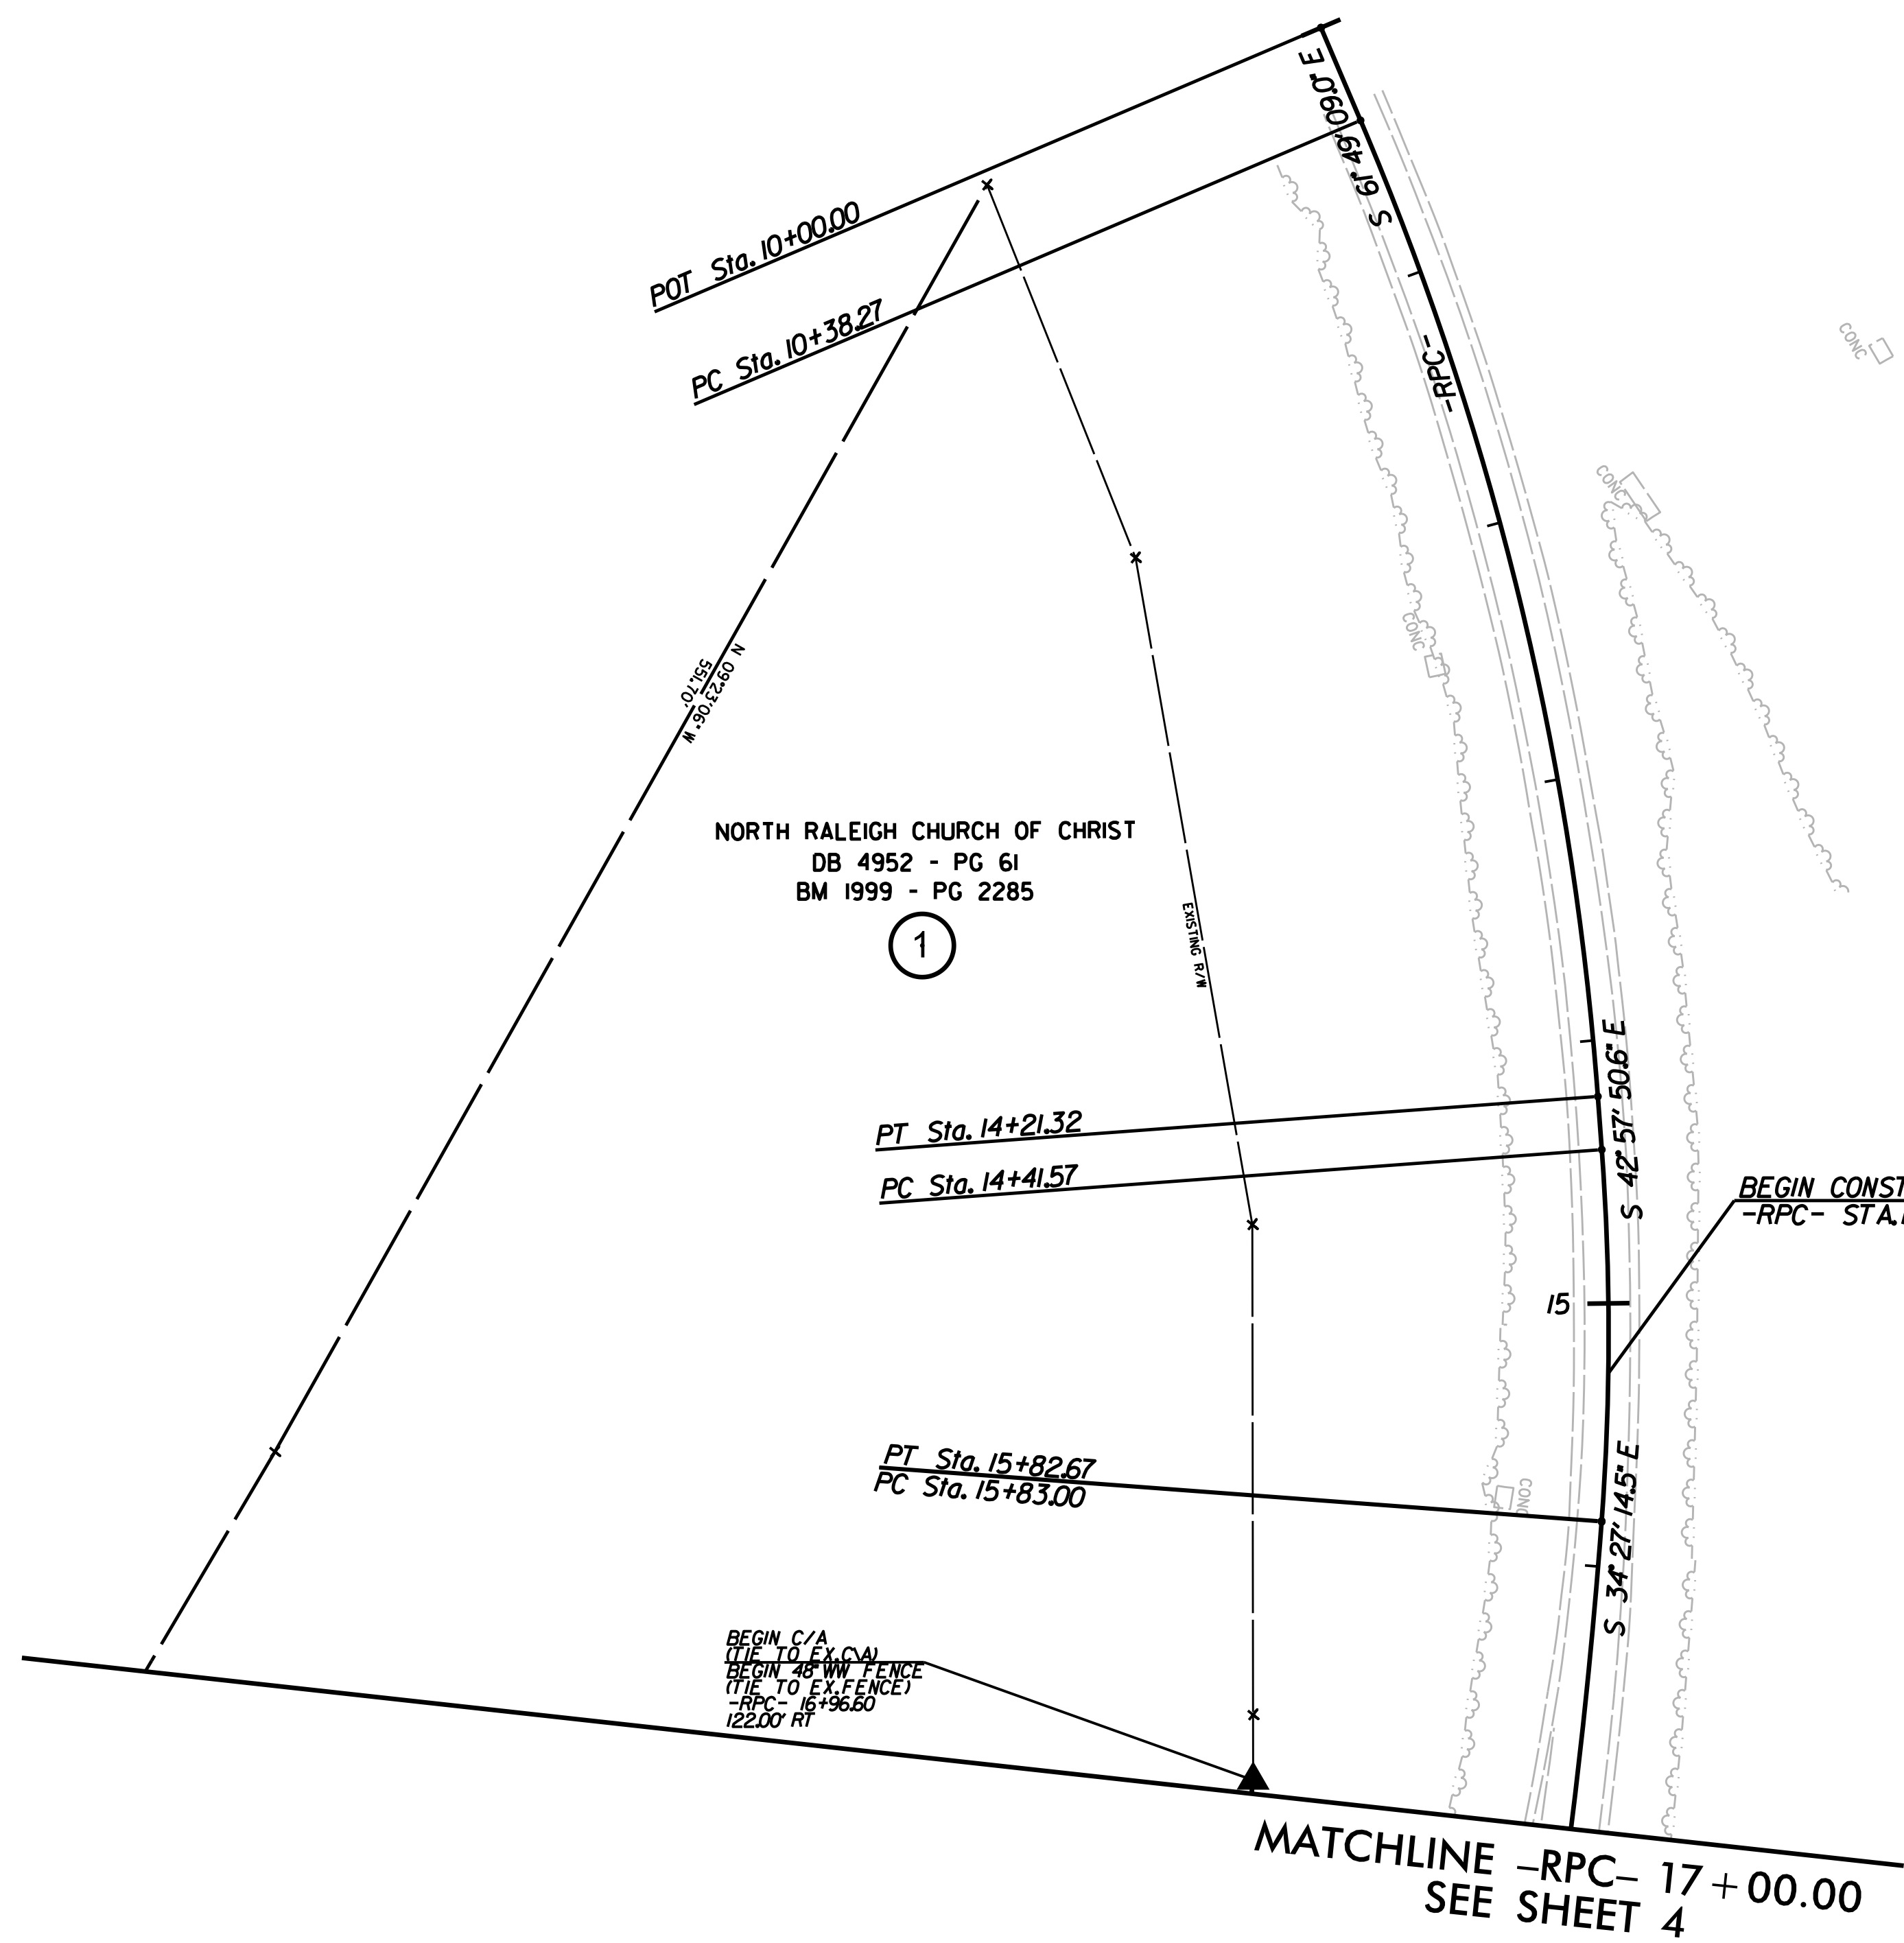

-RPC-

PI Sta 12+31.54  
 $\Delta = 18^{\circ} 51' 18.3'' (RT)$   
 $D = 4' 55' 20.0''$   
 $L = 383.05'$   
 $T = 193.27'$   
 $R = 1,164.00'$

-RPC-

PI Sta 15+12.25  
 $\Delta = 8^{\circ} 30' 36.2'' (RT)$   
 $D = 6' 01' 52.1''$   
 $L = 141.0'$   
 $T = 70.68'$   
 $R = 950.00'$

-RPC-

PI Sta 17+04.93  
 $\Delta = 5^{\circ} 56' 24.0'' (RT)$   
 $D = 2' 26' 17.2''$   
 $L = 243.63'$   
 $T = 121.92'$   
 $R = 2,350.00'$

**NOTES:**

1. IF FURTHER INFORMATION REGARDING PROJECT CONTROL IS NEEDED, PLEASE CONTACT THE LOCATION AND SURVEYS UNIT.
2. PROJECT CONTROL WAS ESTABLISHED USING GNSS, THE GLOBAL NAVIGATION SATELLITE SYSTEM.