
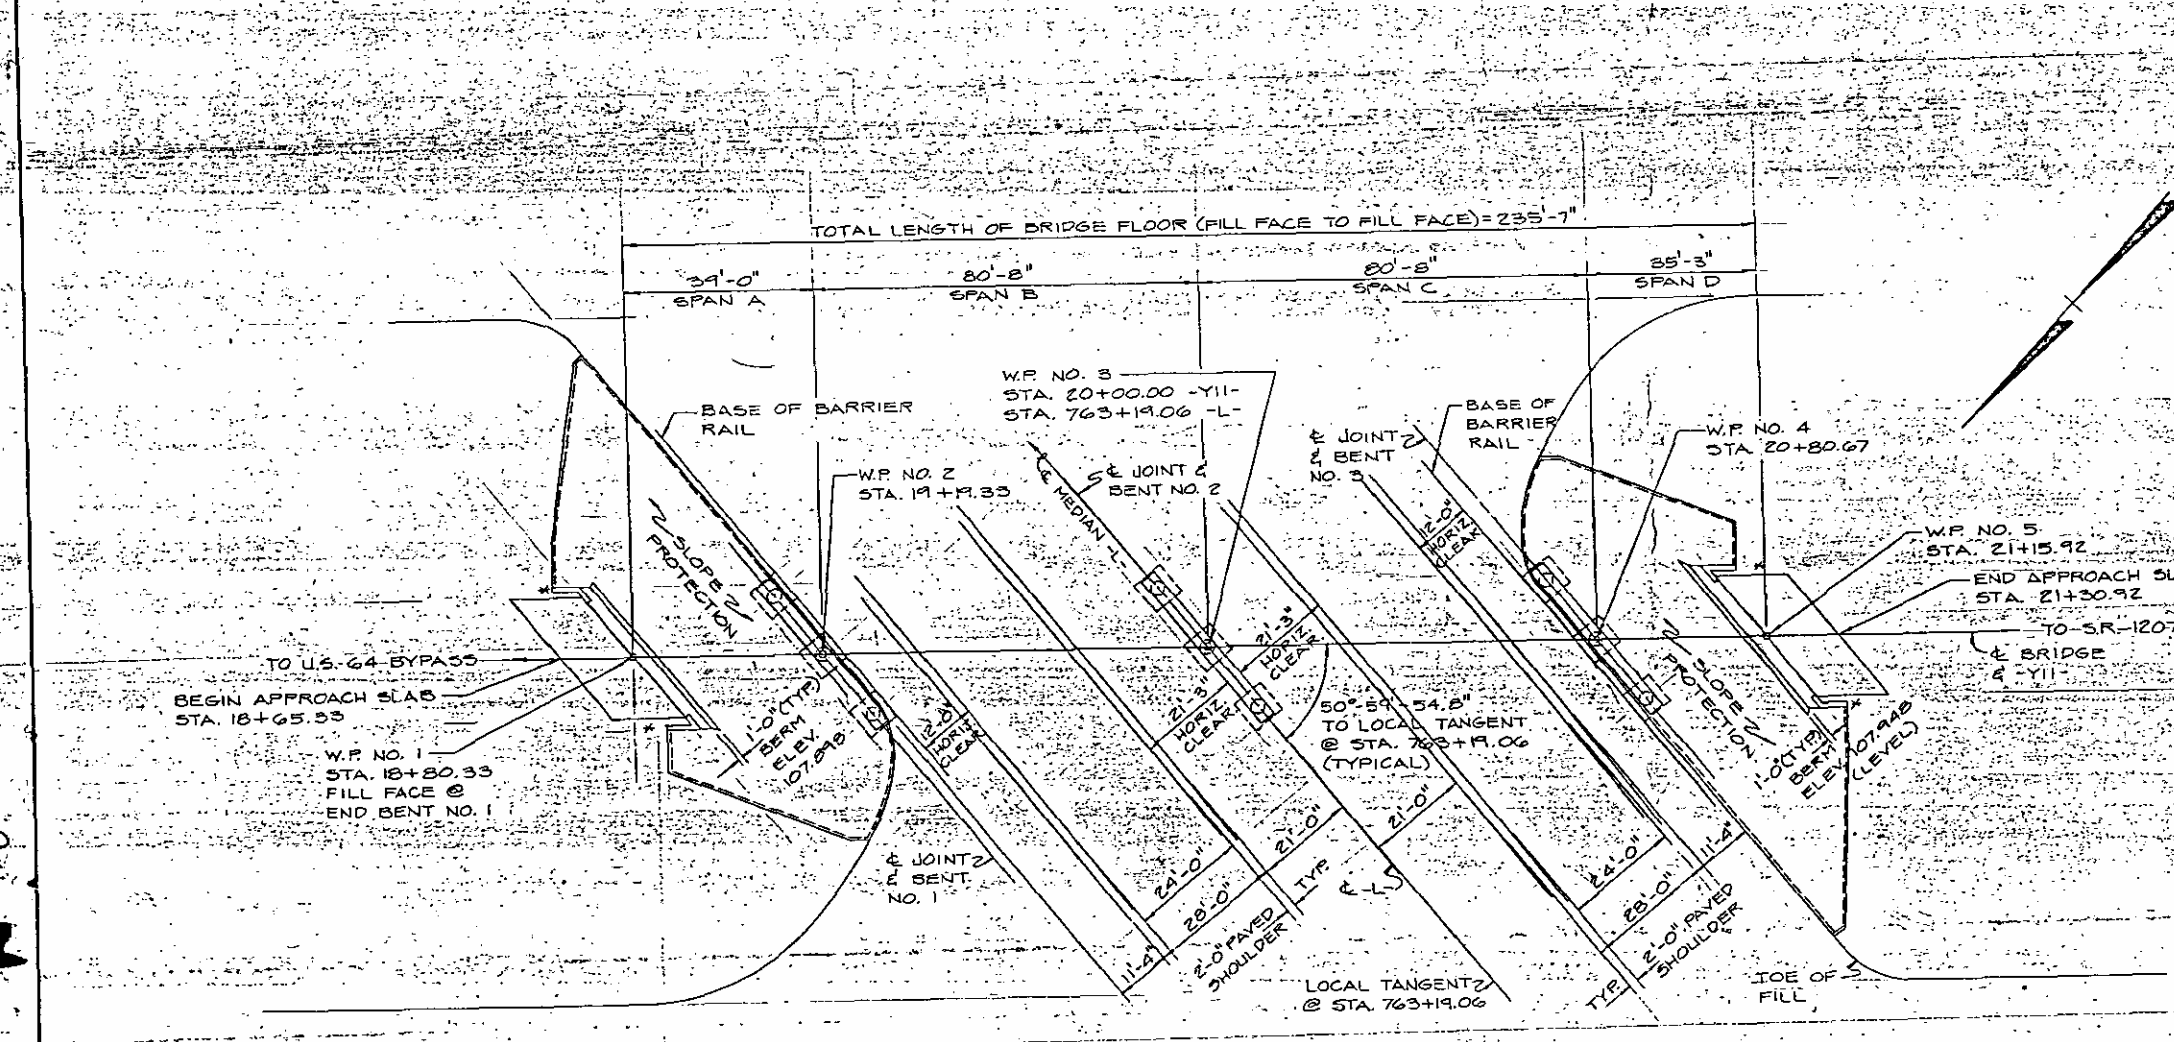


BR 152 #

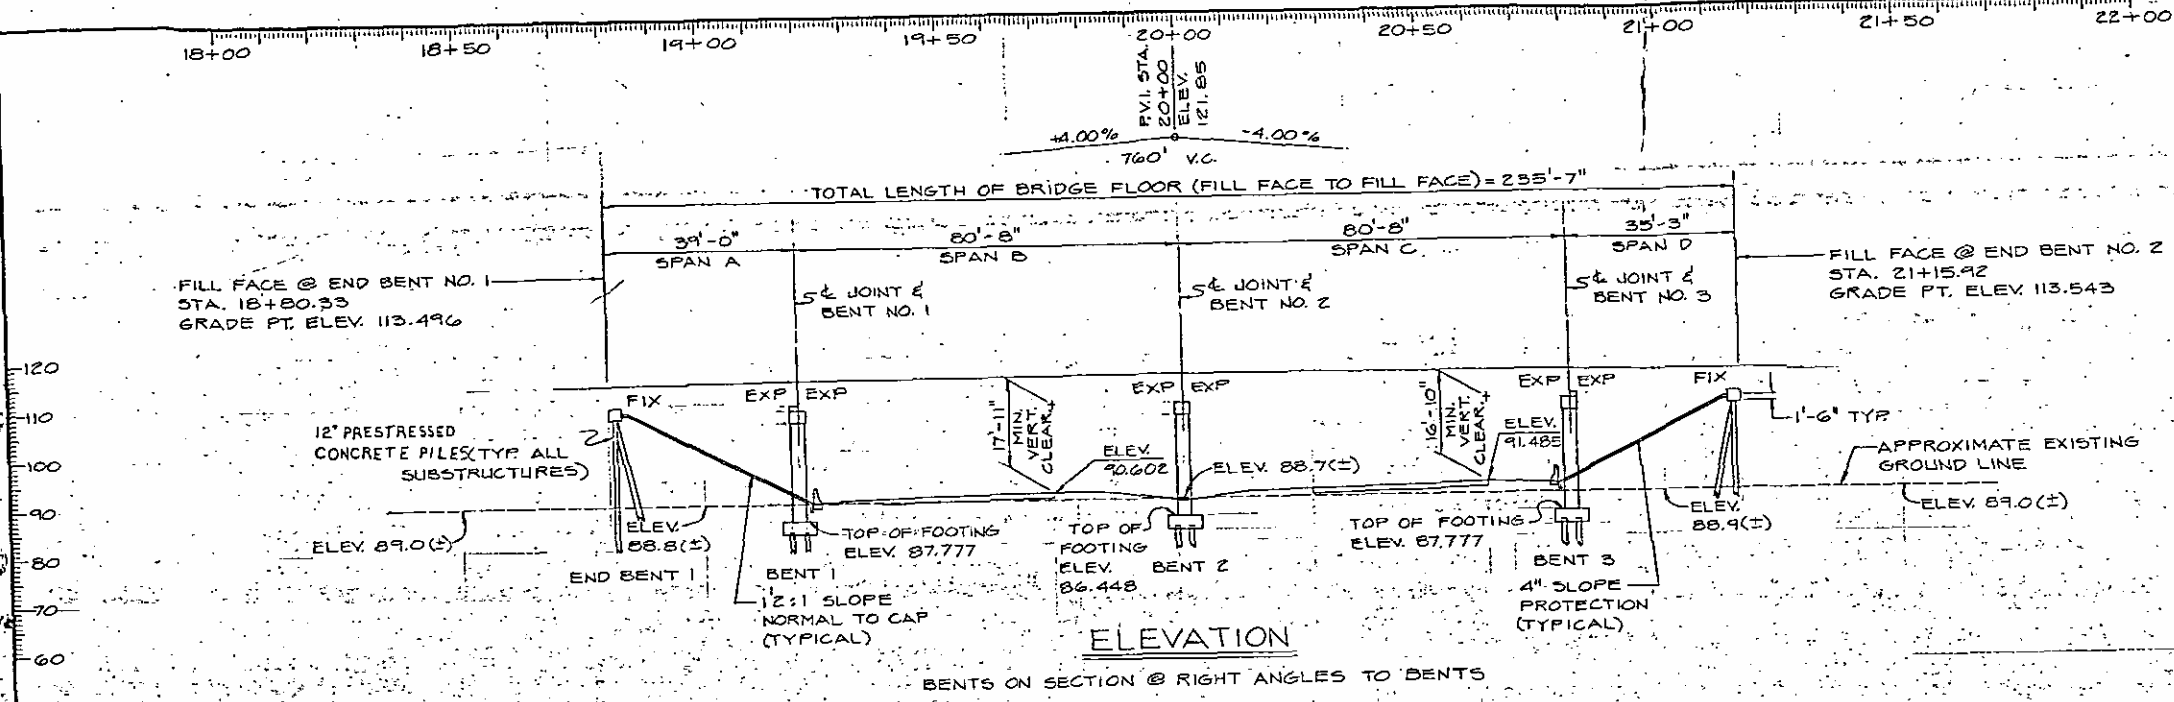

**CURVE DATA LINE -L-**

PI. STA. = 781+42.44
Δ = 30°-44'-37.7" LT.
D = 0°-45'-00"
Ls = 200.00'
Lt = 0°-45'-00"
Ts = 2200.28'
Lc = 3899.18'
R = 7639.437'
LT = 133.33'
ST = 66.67'
SE = .03 1/2

- NOTES**
- ASSUMED LIVE LOAD = HS-20-44 OR ALTERNATE LOADING.
  - FOR OTHER DESIGN DATA AND GENERAL NOTES, SEE SHEET S-II.
  - ALL REINFORCING STEEL SHALL CONFORM TO THE REQUIREMENTS OF ASTM A 615 FOR GRADE 60.
  - TRAFFIC IS TO BE DETOURED.
  - FOR REINFORCED CONCRETE DECK SLABS, SEE SPECIAL PROVISIONS.
  - FOR CURING BRIDGE DECK SLABS, SEE SPECIAL PROVISIONS.
  - FOR METAL STAY-IN-PLACE FORMS, SEE SPECIAL PROVISIONS.
  - FOR PRESTRESSED CONCRETE PANELS, SEE SPECIAL PROVISIONS.
  - THE EXISTING PAVEMENT WITHIN THE AREA OF THE END BENT PILES SHALL BE REMOVED, AND THE ROADBED SCARIFIED TO A MINIMUM DEPTH OF 2'-0".
  - FOUNDATION EXCAVATION TO BE MEASURED FROM THE GRADED ROADWAY SECTION.
  - FOR EPOXY PROTECTIVE COATING SEE SPECIAL PROVISIONS.
  - NO WORK TO BE DONE ON BOTH END BENTS UNTIL SIX MONTHS AFTER THE FILL HAS BEEN PLACED TO GRADE.
  - AUGERING THRU FILL REQUIRED FOR PILE AT END BENTS 1 AND 2.
  - ALL PILES SHALL HAVE A MINIMUM TIP ELEVATION OF -50, AND A MINIMUM BEARING CAPACITY OF 40 TONS EACH.

PROJECT No. 81125805  
EDGEcombe COUNTY

STATION: 20+00.00 -YII-  
763+19.06 -L-

STATE OF NORTH CAROLINA  
DEPARTMENT OF TRANSPORTATION  
RALEIGH


GENERAL DRAWING  
BRIDGE OVER U.S. 64 ON S.R. 1205  
BETWEEN U.S. 64 BYPASS & S.R. 1207

REVISIONS

NO.	BY	DATE	NO.	BY	DATE
1			2		
3			4		

SHEET NO. 149  
TOTAL SHEETS



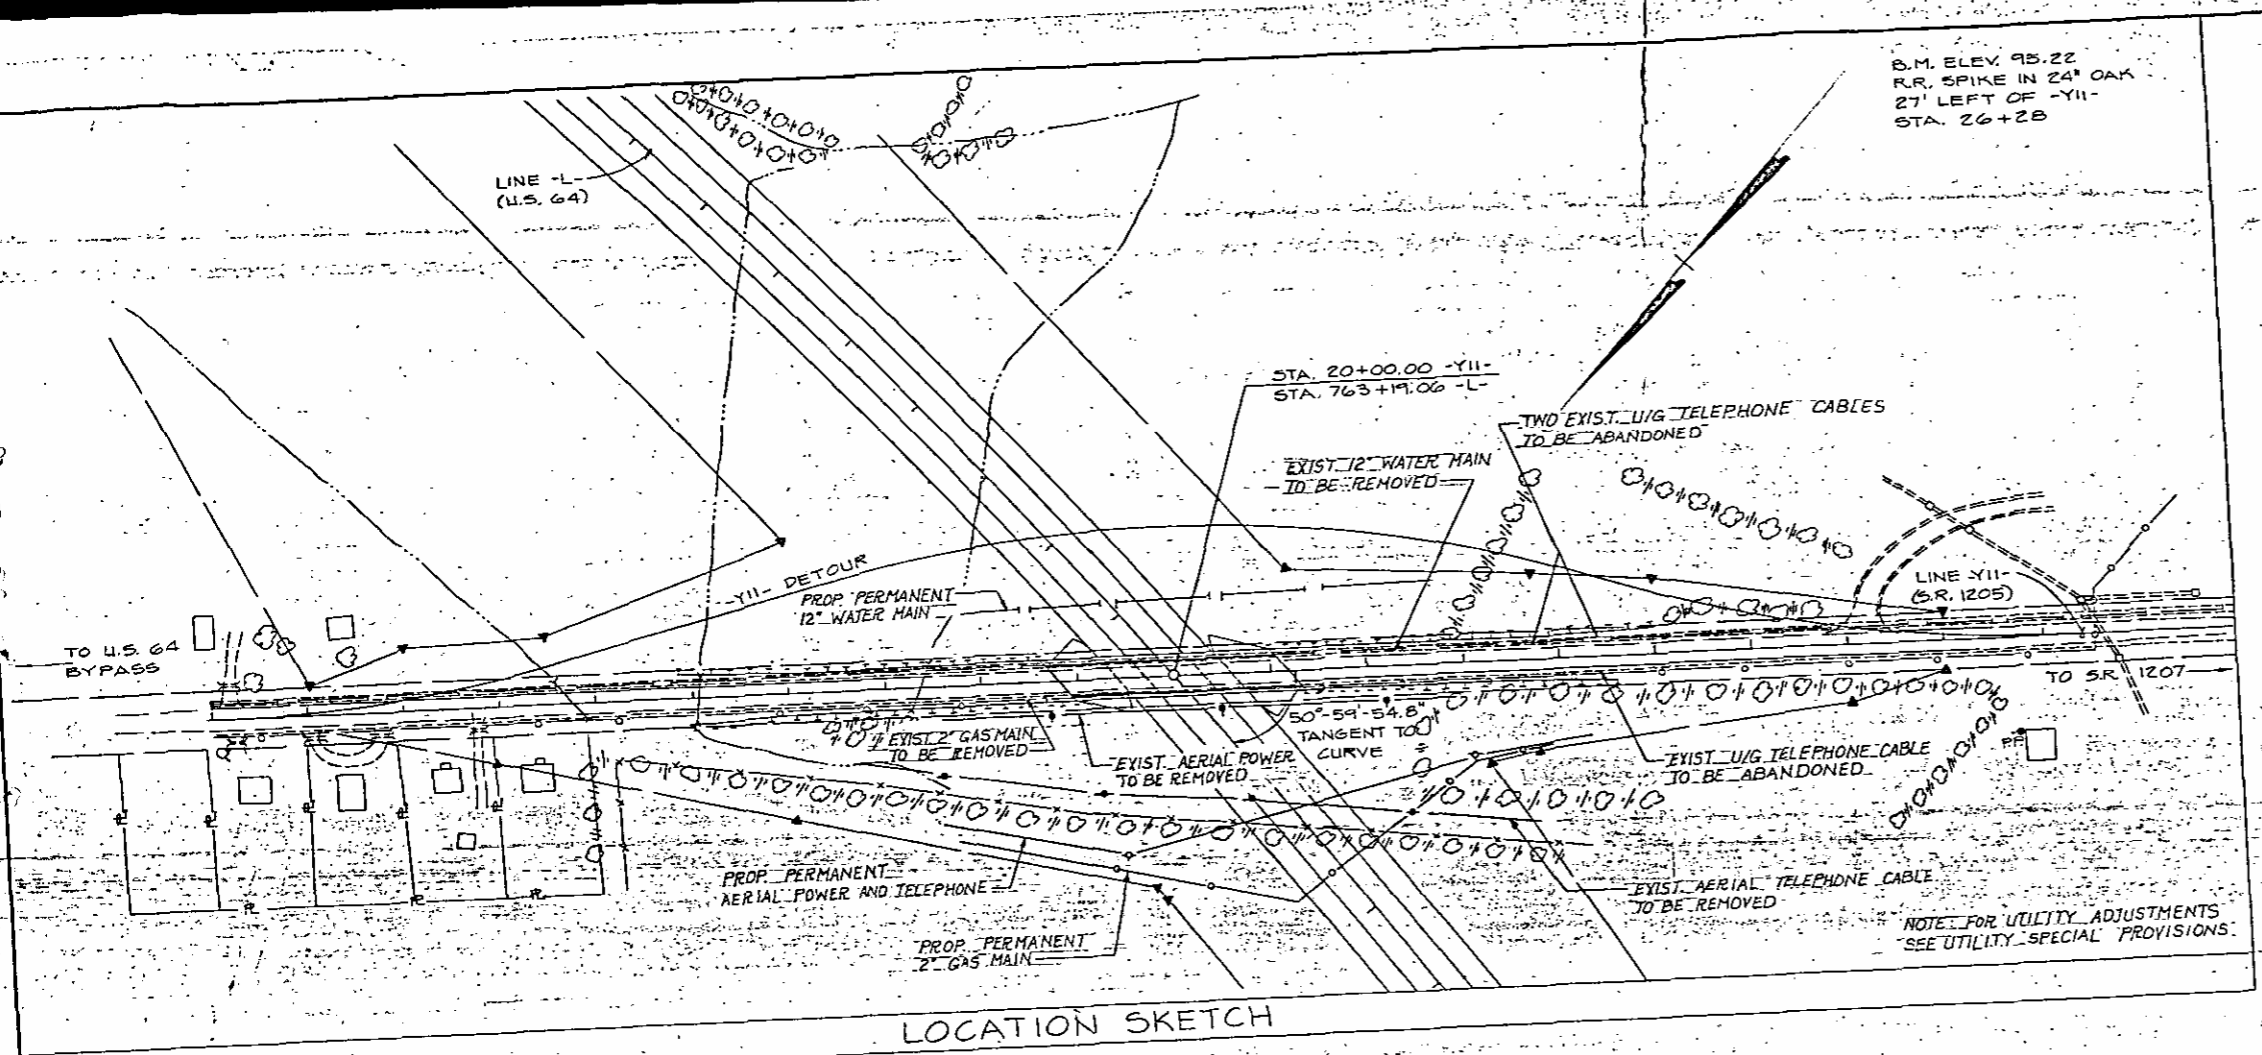

LOCATION SKETCH

I hereby certify that this structure was built according to Plans except as noted herein.  
 J. Manning  
 Resident Engineer  
 Date: June 26, 1987  
 BJA

**TOTAL BILL OF MATERIAL**

	FOUNDATION EXCAVATION	REINFORCED CONCRETE DECK SLAB	CLASS A CONCRETE	REINFORCING STEEL	SPIRAL COLUMN REINFORCING STEEL	36" PRESTRESSED CONCRETE GIRDER	54" PRESTRESSED CONCRETE GIRDER	12" PRESTRESSED CONCRETE PILES	CONCRETE BARRIER RAIL	LINSEED OIL CONCRETE PROTECTION	BRIDGE APPROACH SLAB STA. 20+00	ELASTOMERIC BEARINGS	4" SLOPE PROTECTION	PREFORMED COMPRESSION JOINT SEAL
	CU. YDS.	SQ. FT.	CU. YDS.	LBS.	LBS.	NO. LIN. FT.	NO. LIN. FT.	NO. LIN. FT.	LIN. FT.	GALS.	LUMP SUM	LUMP SUM	SQ. YDS.	LUMP SUM
SUPERSTRUCTURE		7,735.0							476.84	19	LUMP SUM	LUMP SUM	415.39	LUMP SUM
END BENT 1			17.3	2,860	1,439			7	434.0					
BENT 1	85.2		45.7	6,309	1,439			15	718.0					
BENT 2	67.8		49.6	7,188	1,578			15	672.0					
BENT 3	69.3		45.7	6,309	1,439			7	434.0		LUMP SUM		344.90	LUMP SUM
END BENT 2			17.3	2,860										
CURVED END BLOCKS			2.9	600										
TOTAL	222.3	7,735.0	178.5	26,126	4,456	8	287.50	59	2878.7	19	LUMP SUM	LUMP SUM	760.29	LUMP SUM

PROJECT No. B.1125805  
 EDGECOMBE COUNTY

STATION: 20+00.00 -YII-  
 763+19.06 -L-  
 SHEET 2 OF 2


STATE OF NORTH CAROLINA  
 DEPARTMENT OF TRANSPORTATION  
 RALEIGH

GENERAL DRAWING  
 BRIDGE OVER U.S. 64 ON S.R. 1205  
 BETWEEN U.S. 64 BYPASS & S.R. 1207

FEBRUARY 1984

NO.	BY	DATE	NO.	BY	DATE	SHEET NO. / 50
1			2			TOTAL SHEETS
2			4			

DWG. 5-2

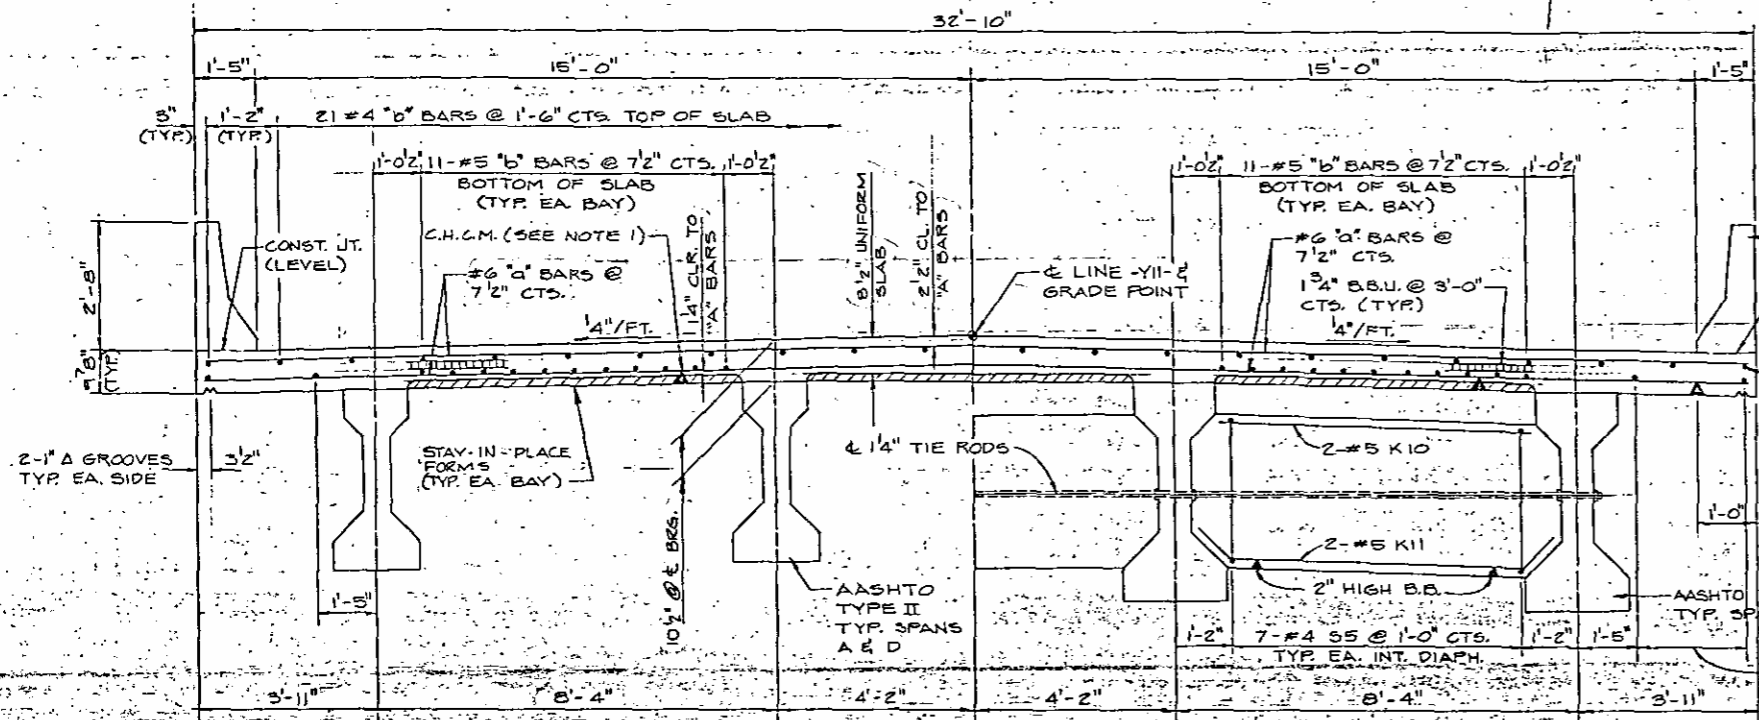


HALF SECTION SPANS A & D

TYPICAL SECTION

HALF SECTION SHOWING INTER. DIAPH. IN SPANS B & C

NOTE: ALL SPANS ARE SIMPLE, COMPOSITE, PRESTRESSED CONCRETE GIRDERS.

NOTE: FOR SECTIONS THRU BENT DIAPHRAGM & INTERMEDIATE DIAPHRAGM SEE DRAWING 5-5.

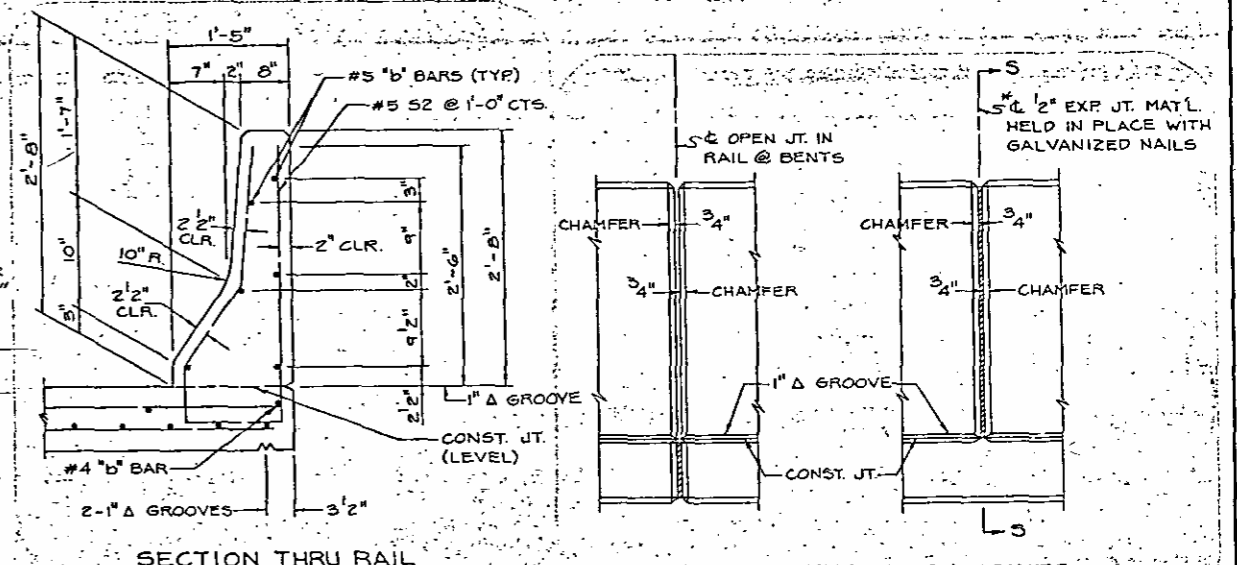


SECTION THRU RAIL

ELEVATION AT EXPANSION JOINTS


NOTE: 1" Δ GROOVE AT CONSTRUCTION JOINT MAY BE OMITTED

\*OMIT EXP. JT. MAT'L WHEN SLIP FORM IS USED.

BARRIER RAIL DETAILS

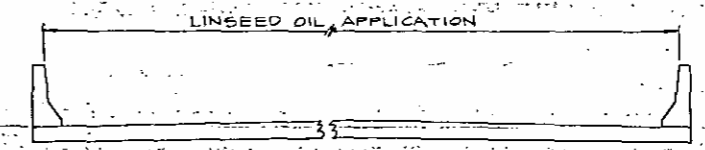


LINSEED OIL CONCRETE PROTECTION

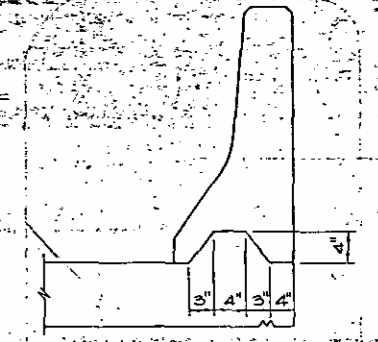

SECTION S-S

AT DAM IN OPEN JOINT (THIS IS TO BE USED ONLY WHEN SLIP FORM IS USED)

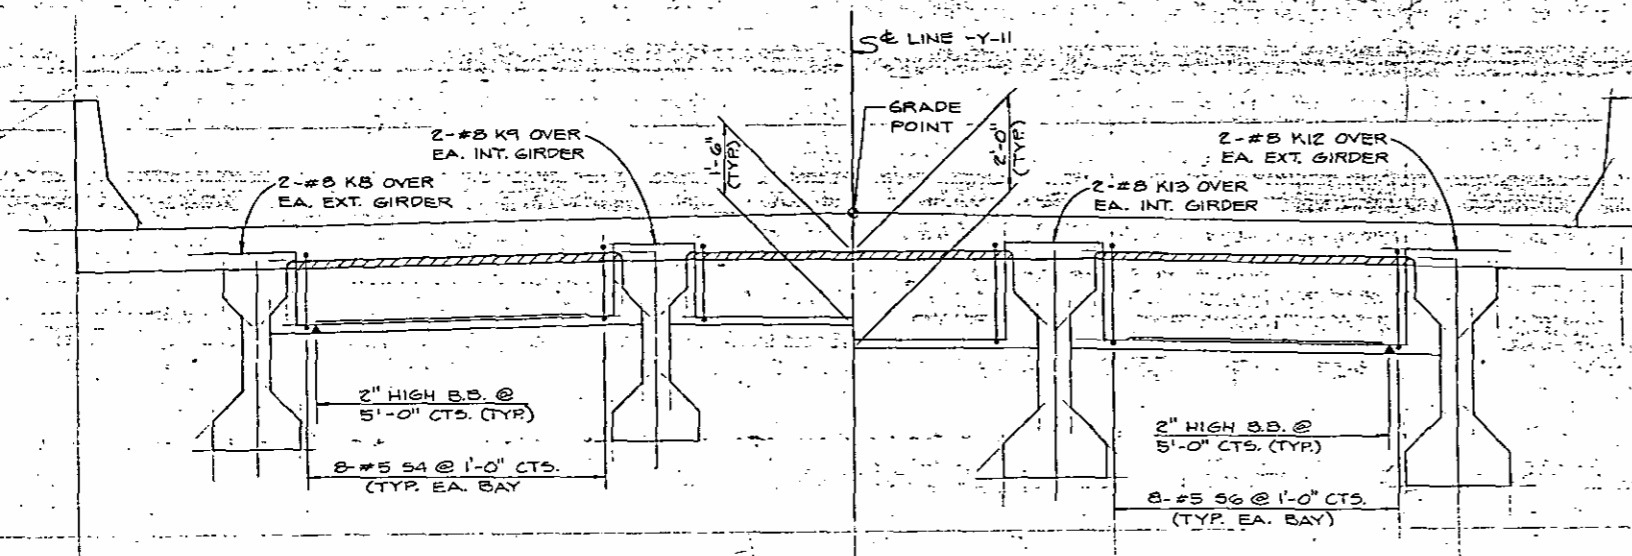

HALF SECTION SHOWING BENT DIAPH. @ BENT 1 NEAR SIDE & BENT 3 FAR SIDE

HALF SECTION SHOWING BENT DIAPH. @ BENT 1 FAR SIDE, BENT 2 NEAR & FAR SIDE AND BENT 3 NEAR SIDE

TYPICAL DIAPHRAGM SECTIONS @ BENTS

SUPERSTRUCTURE NOTES

- 1- PROVIDE CONTINUOUS HIGH CHAIR FOR METAL DECK (C.H.C.M.) @ 4'-0" CENTERS WITH LEG SPACING TO MATCH THE PITCH OF THE FORM AND WITH A HEIGHT TO SUPPORT THE BOTTOM LAYER OF SLAB REINFORCEMENT A CLEAR DISTANCE OF 1 1/4" ABOVE THE TOP OF THE STAY-IN-PLACE FORM.
- 2- FOR CONCRETE BARRIER RAILS, SEE SPECIAL PROVISIONS.
- 3- FOR ELASTOMERIC BEARINGS, SEE SPECIAL PROVISIONS.
- 4- BARRIER RAIL IN EACH SPAN SHALL NOT BE CAST UNTIL ALL SLAB CONCRETE IN THAT SPAN HAS BEEN CAST AND HAS REACHED A MINIMUM COMPRESSIVE STRENGTH OF 3,000 PSI.
- 5- A 1 1/2" EXTENSION OF THE CONCRETE SLAB BEYOND THE OUTSIDE FACE OF THE BARRIER RAIL WILL BE PERMITTED IF THE CONTRACTOR ELECTS TO SLIP FORM THE BARRIER RAILS. NO ADDITIONAL REINFORCING STEEL IS REQUIRED AND THE PAYMENT FOR REINFORCED CONCRETE DECK SLAB WILL BE FOR THE QUANTITY SHOWN ON THE PLANS.
- 6- TEMPORARY STRUTS SHALL BE PLACED BETWEEN PRESTRESSED GIRDERS ADJACENT TO THE DIAPHRAGMS AND THE NUTS ON THE 1 1/4" DIA. TIE RODS SHALL BE FULLY TIGHTENED BEFORE THE DIAPHRAGMS ARE CAST. STRUTS SHALL REMAIN IN PLACE THREE (3) DAYS AFTER CONCRETE IS PLACED. THE TIE RODS SHALL BE RETIGHTENED AFTER THE STRUTS HAVE BEEN REMOVED.
- 7- CONCRETE IN INTERMEDIATE DIAPHRAGMS MAY BE CLASS A IN LIEU OF CLASS AA. PAYMENT SHALL BE MADE UNDER THE UNIT CONTRACT PRICE BID FOR REINFORCED CONCRETE DECK SLAB.

PROJECT No. 8.1125805

EDGEcombe COUNTY


STATION: 20+00.00 -Y11-

SHEET 1 OF 3 = 763+19.06 -L-

STATE OF NORTH CAROLINA  
DEPARTMENT OF TRANSPORTATION  
RALEIGH


SUPERSTRUCTURE  
TYPICAL SECTIONS

FEBRUARY				REVISIONS				1984	
NO.	BY	DATE	NO.	BY	DATE	SHEET NO.	TOTAL SHEETS		
1			3			151			
2			4						

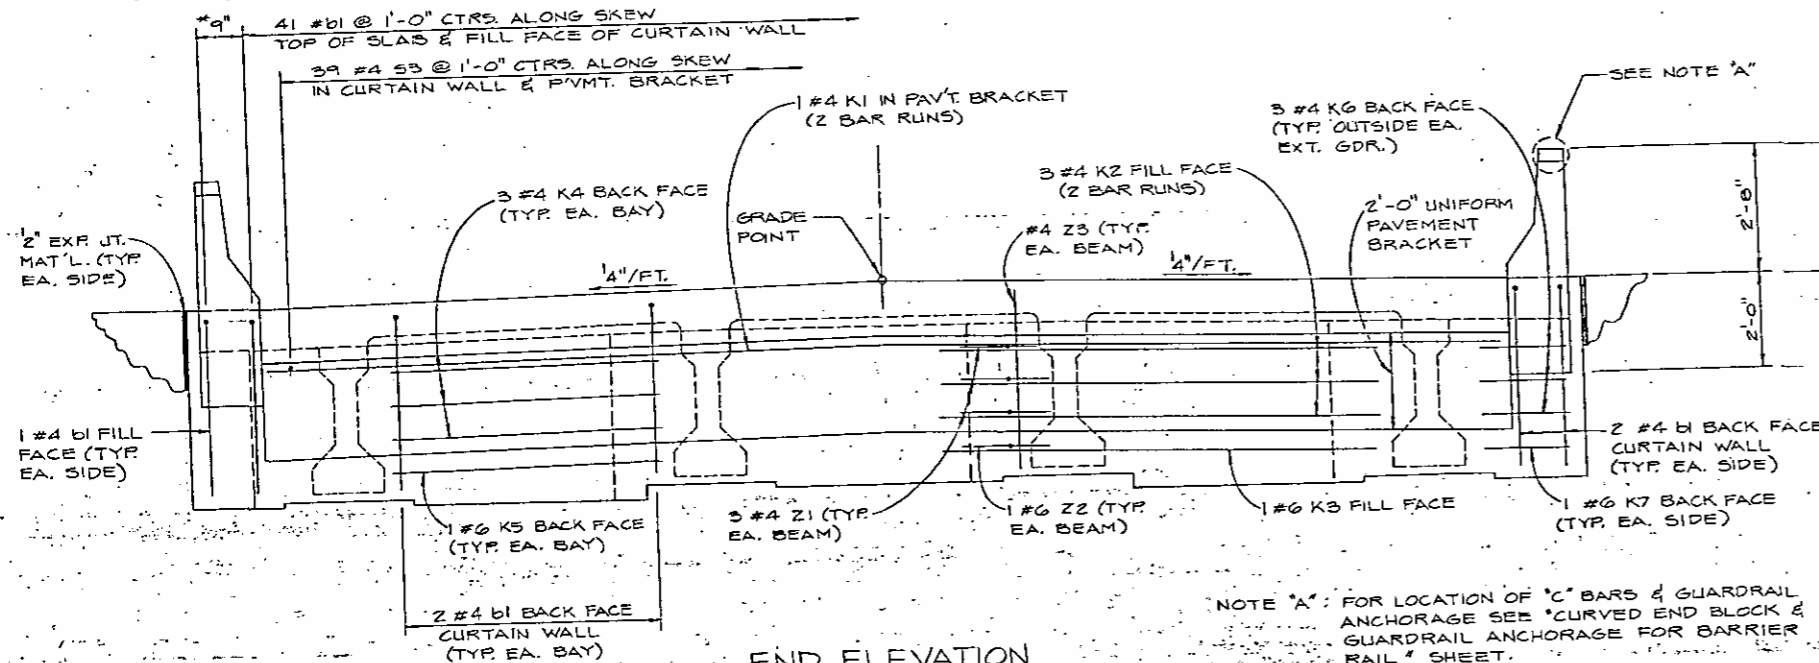


**END ELEVATION**


LOOKING FORWARD ON SURVEY @ END BENT 1  
LOOKING BACK ON SURVEY @ END BENT 2

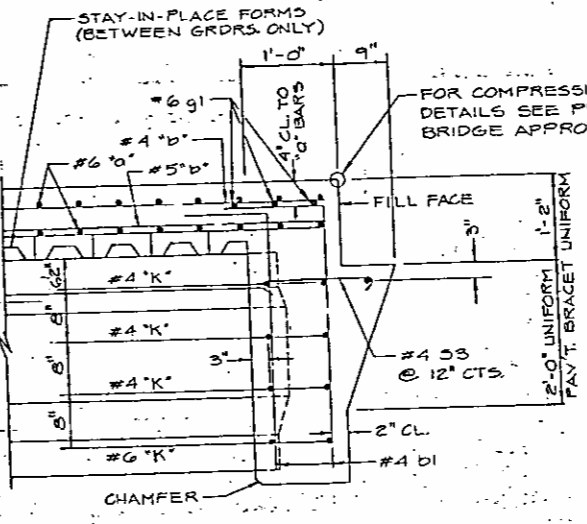

**SECTION THRU CURTAIN WALL**

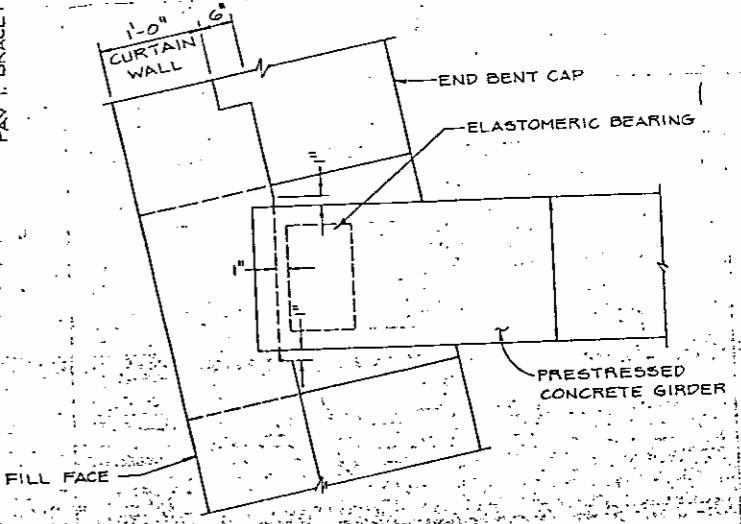


**SECTION C-C**

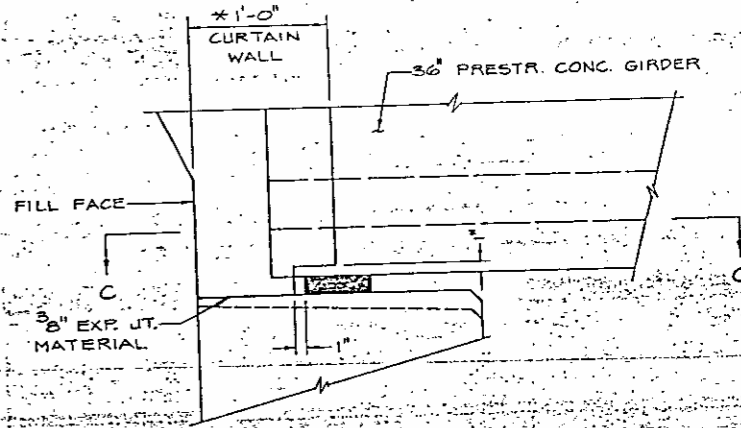


**CURTAIN WALL BLOCKOUT @ END BENT**


\* SEE DETAIL 'A' ON S-6

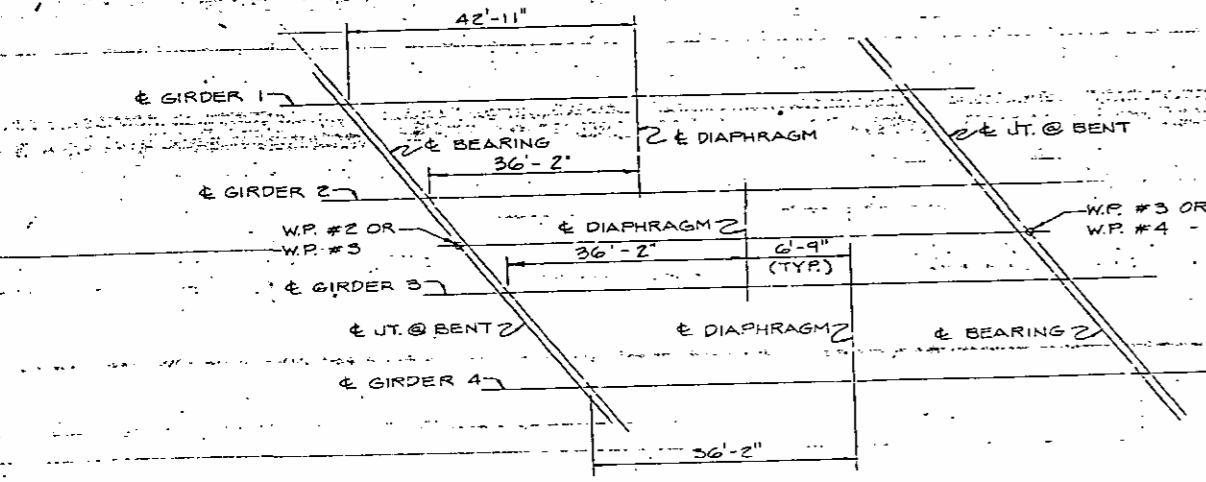

**INTERMEDIATE DIAPHRAGM LAYOUT**

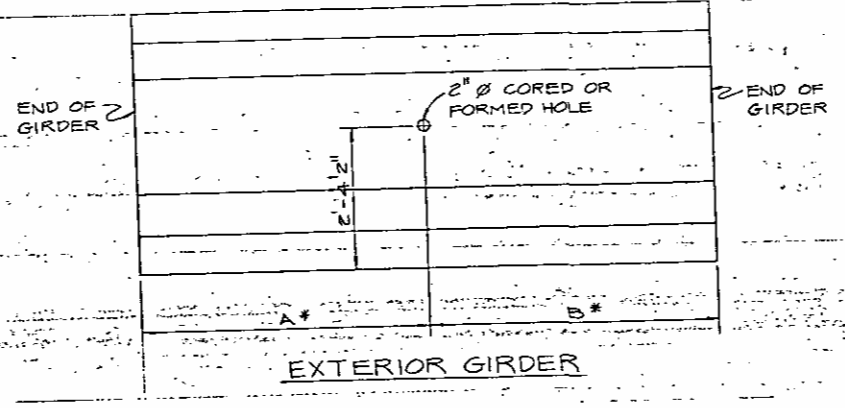

**EXTERIOR GIRDER**

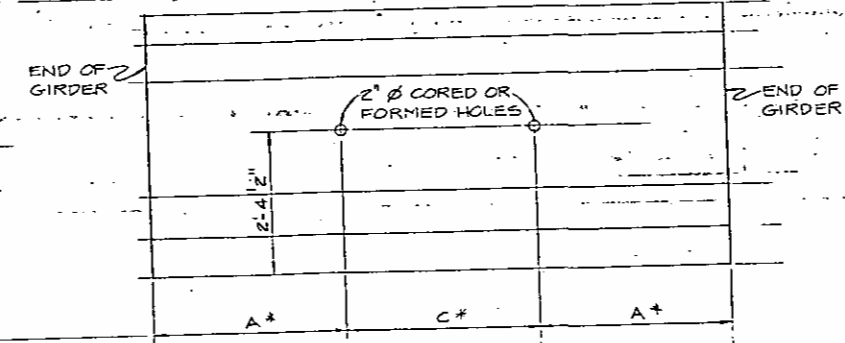

**INTERIOR GIRDER**

**GIRDER ELEVATIONS**

\* SEE TABLE 1 FOR DIMENSIONS

TABLE 1 LOCATION OF HOLES FOR TIE RODS			
GIRDER	SPAN 'B' OR 'C'		
	A	B	C
1	43'-7 1/2"	36'-10 1/2"	—
2 & 3	36'-10 1/2"	—	6'-9"
4	36'-10 1/2"	43'-7 1/2"	—

**PROJECT No. 8.1125805**

**EDGEcombe COUNTY**

**STATION: 20+00.00 -Y11-  
763+19.06 -L-**

SHEET 2 OF 3




STATE OF NORTH CAROLINA  
**DEPARTMENT OF TRANSPORTATION**  
RALEIGH

**SUPERSTRUCTURE  
TYPICAL SECTIONS**




FEBRUARY 1984

REVISIONS						SHEET NO. 152	TOTAL SHEETS
NO.	BY	DATE	NO.	BY	DATE		
1			3			152	TOTAL SHEETS
2			4				

DWG. S-4

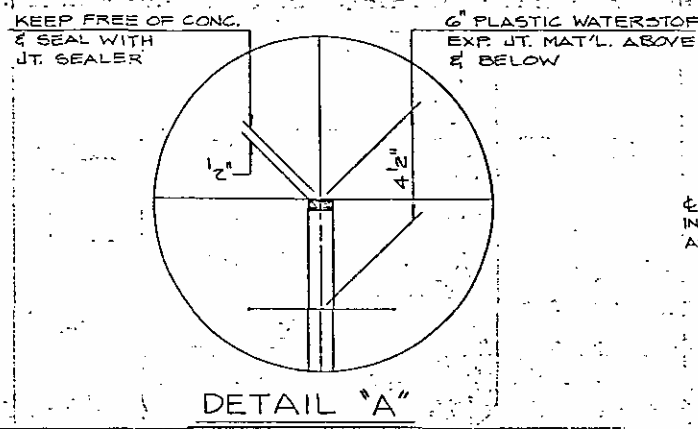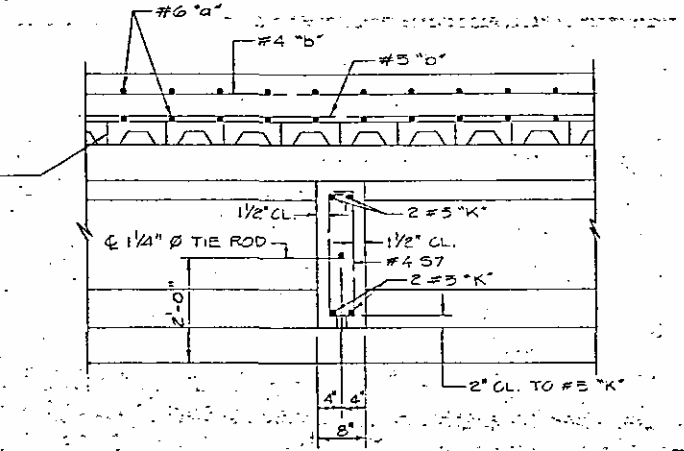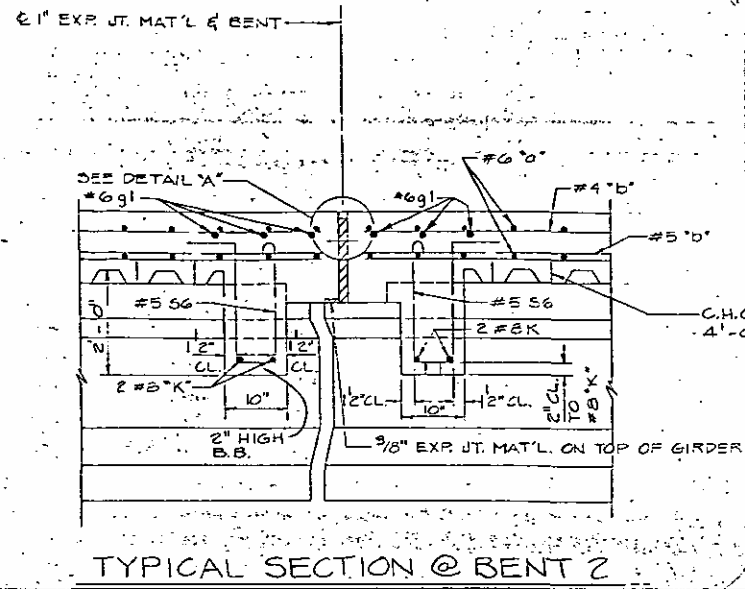


NOTE: SEE 'STANDARD CURVED END BLOCK, GUARDRAIL ANCHORAGE AND CURB BLOCK' SHEET FOR LOCATION OF 'C' BARS FOR CURVED END BLOCKS AND GUARDRAIL ANCHORAGE ASSEMBLY.

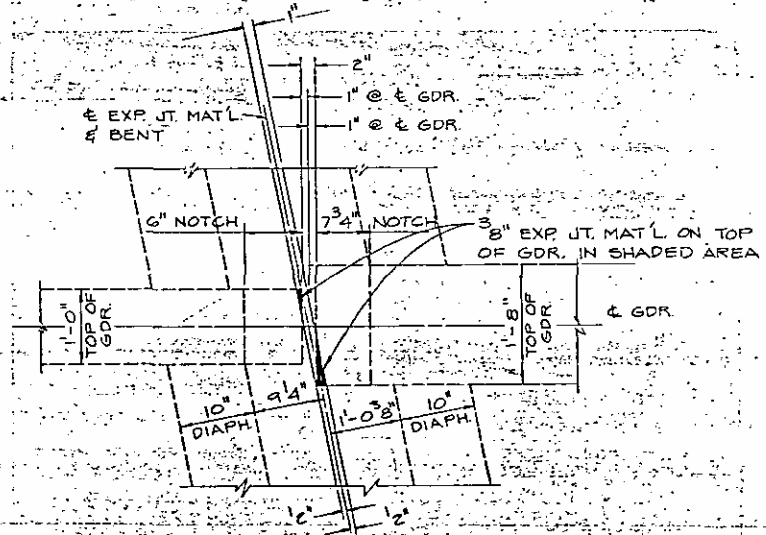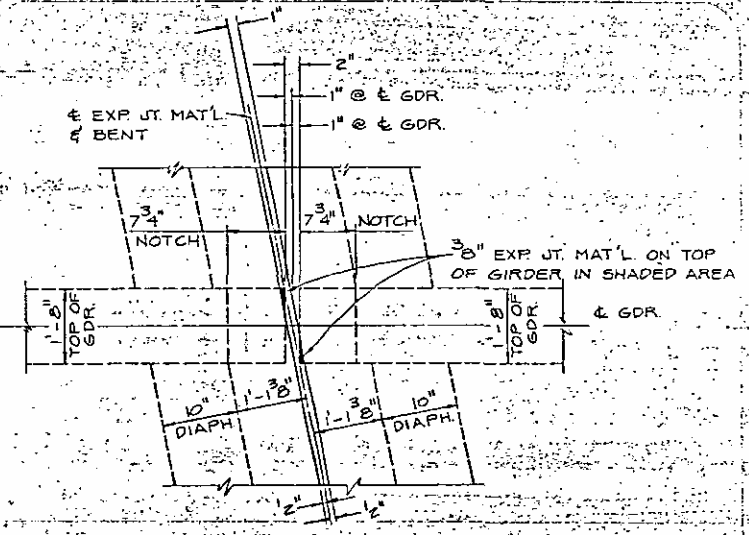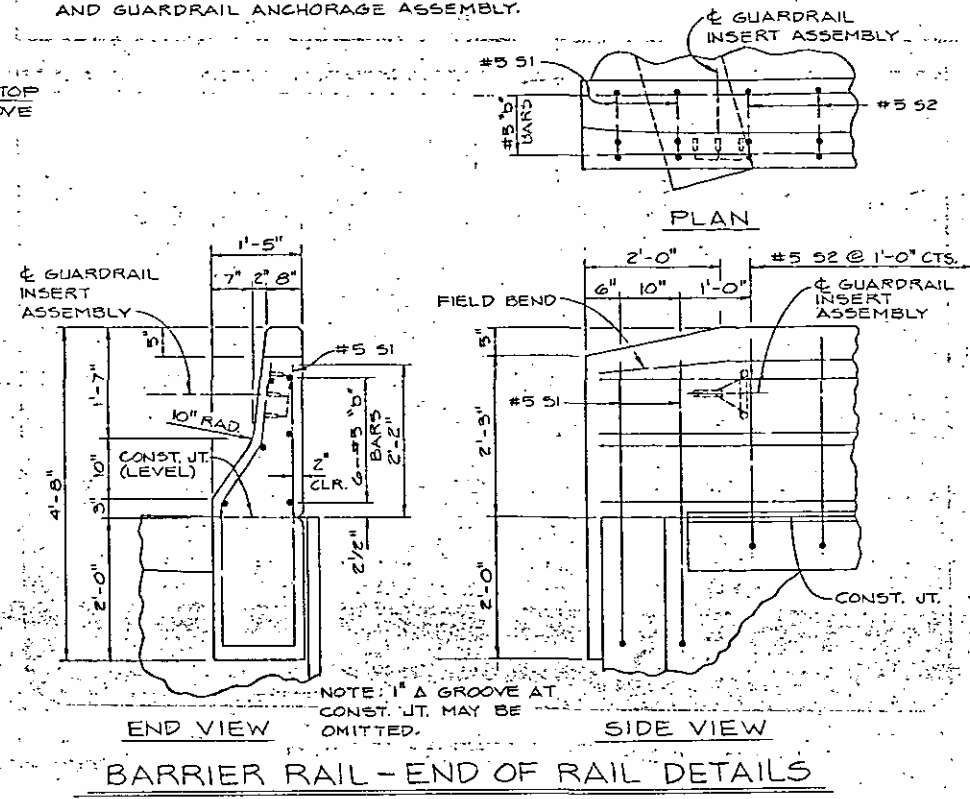

END OF GIRDER DETAILS AT JOINT BENT 2


END OF GIRDER DETAILS AT JOINT BENT 1 OR 3

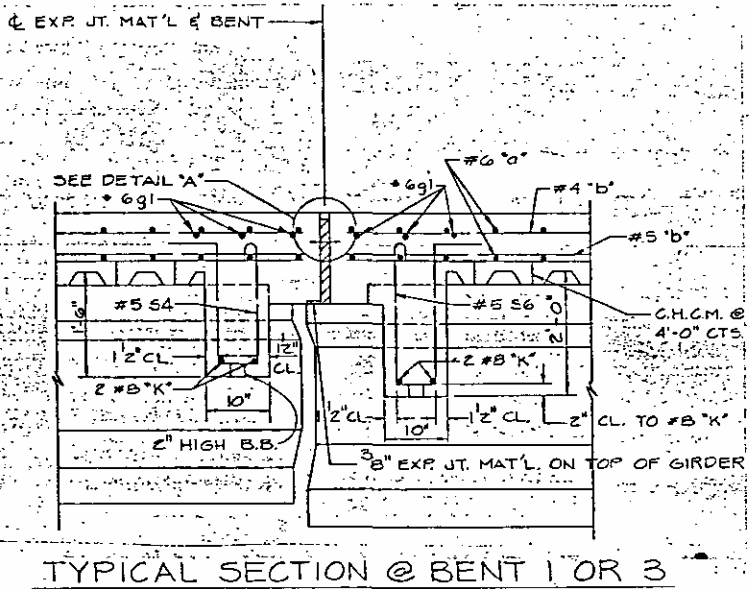

TYPICAL SECTION @ BENT 1 OR 3

PROJECT No. 8.1125805  
 EDGECOMBE COUNTY  
 STATION: 20+00.00 -Y11-  
 SHEET 3 OF 3 763+19.06 -L-

STATE OF NORTH CAROLINA DEPARTMENT OF TRANSPORTATION RALEIGH						
SUPERSTRUCTURE SECTIONS AND DETAILS						
FEBRUARY						1984
REVISIONS						
NO.	BY	DATE	NO.	BY	DATE	SHEET NO.
1			3			153
2			4			TOTAL SHEETS

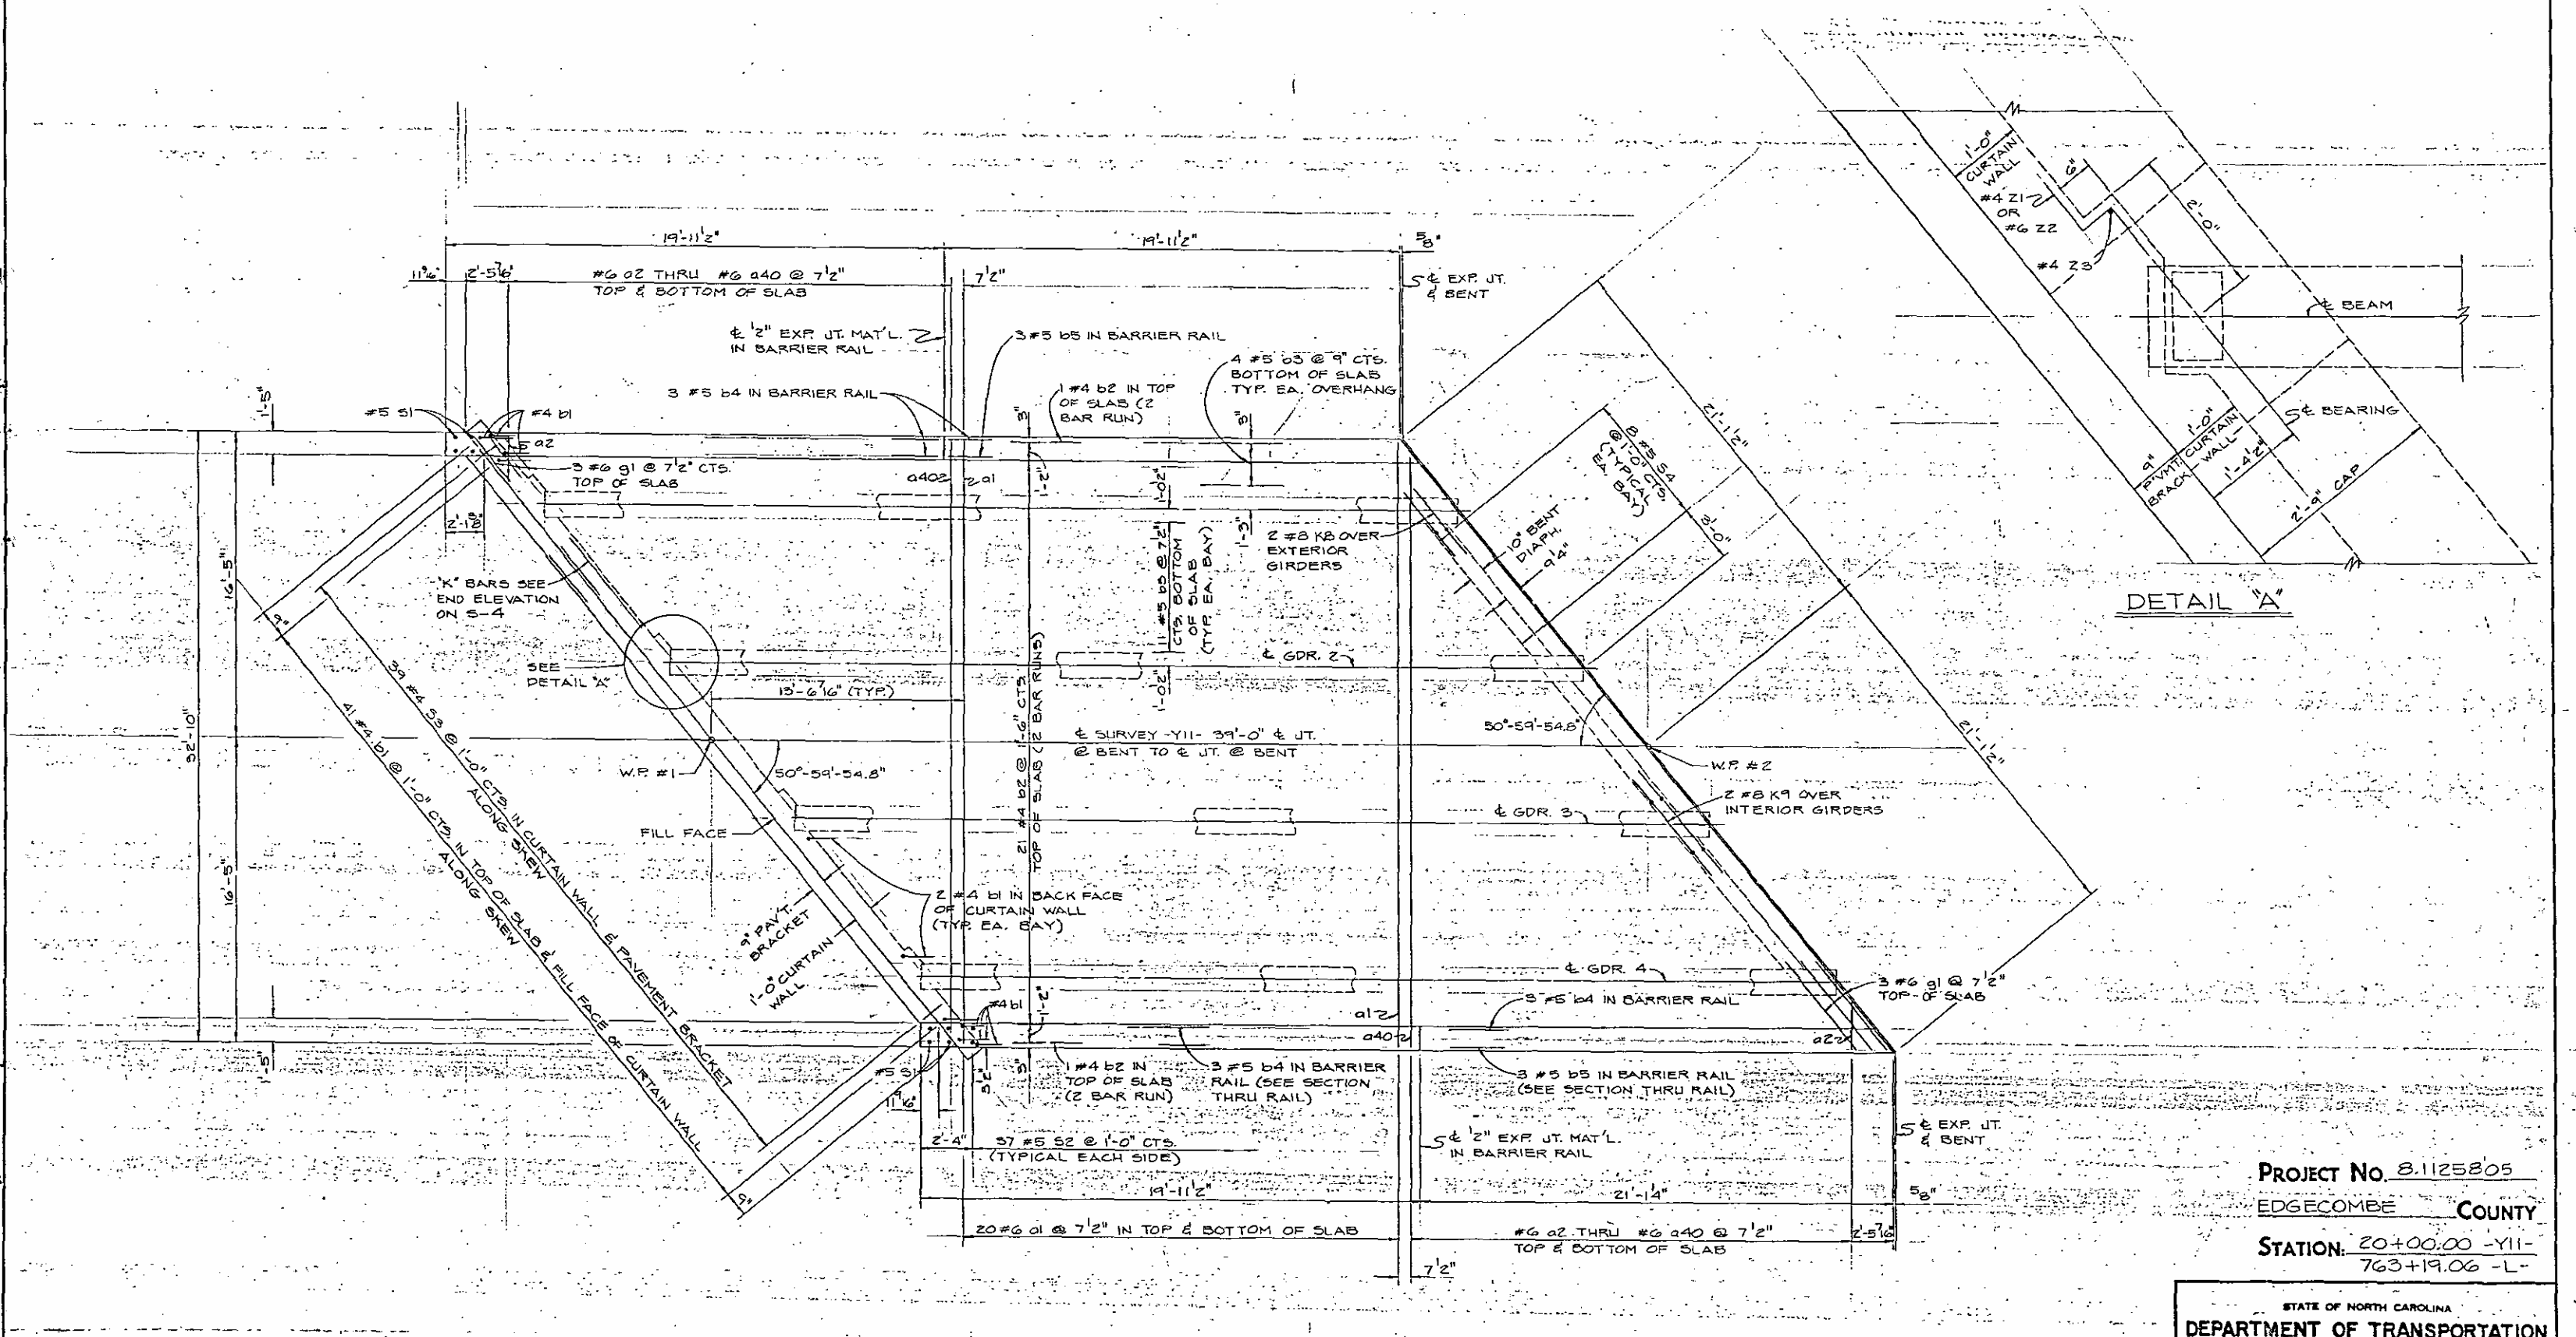

DETAIL "A"


PLAN OF SPAN "A"

PROJECT No. 8.1125805  
 EDGECOMBE COUNTY  
 STATION: 20+00.00 -Y11-  
 763+19.06 -L-

STATE OF NORTH CAROLINA					
DEPARTMENT OF TRANSPORTATION					
RALEIGH					
SUPERSTRUCTURE					
PLAN-SPAN "A"					
FEBRUARY 1984					
REVISIONS					
NO.	BY	DATE	NO.	BY	DATE
1			3		
2			4		
					SHEET NO. 154
					TOTAL SHEETS

DRAWN BY: J.W. ROBINSON DATE: FEB. 1984  
 CHECKED BY: JOSE PANON DATE: FEB. 1984

DWG. S-6

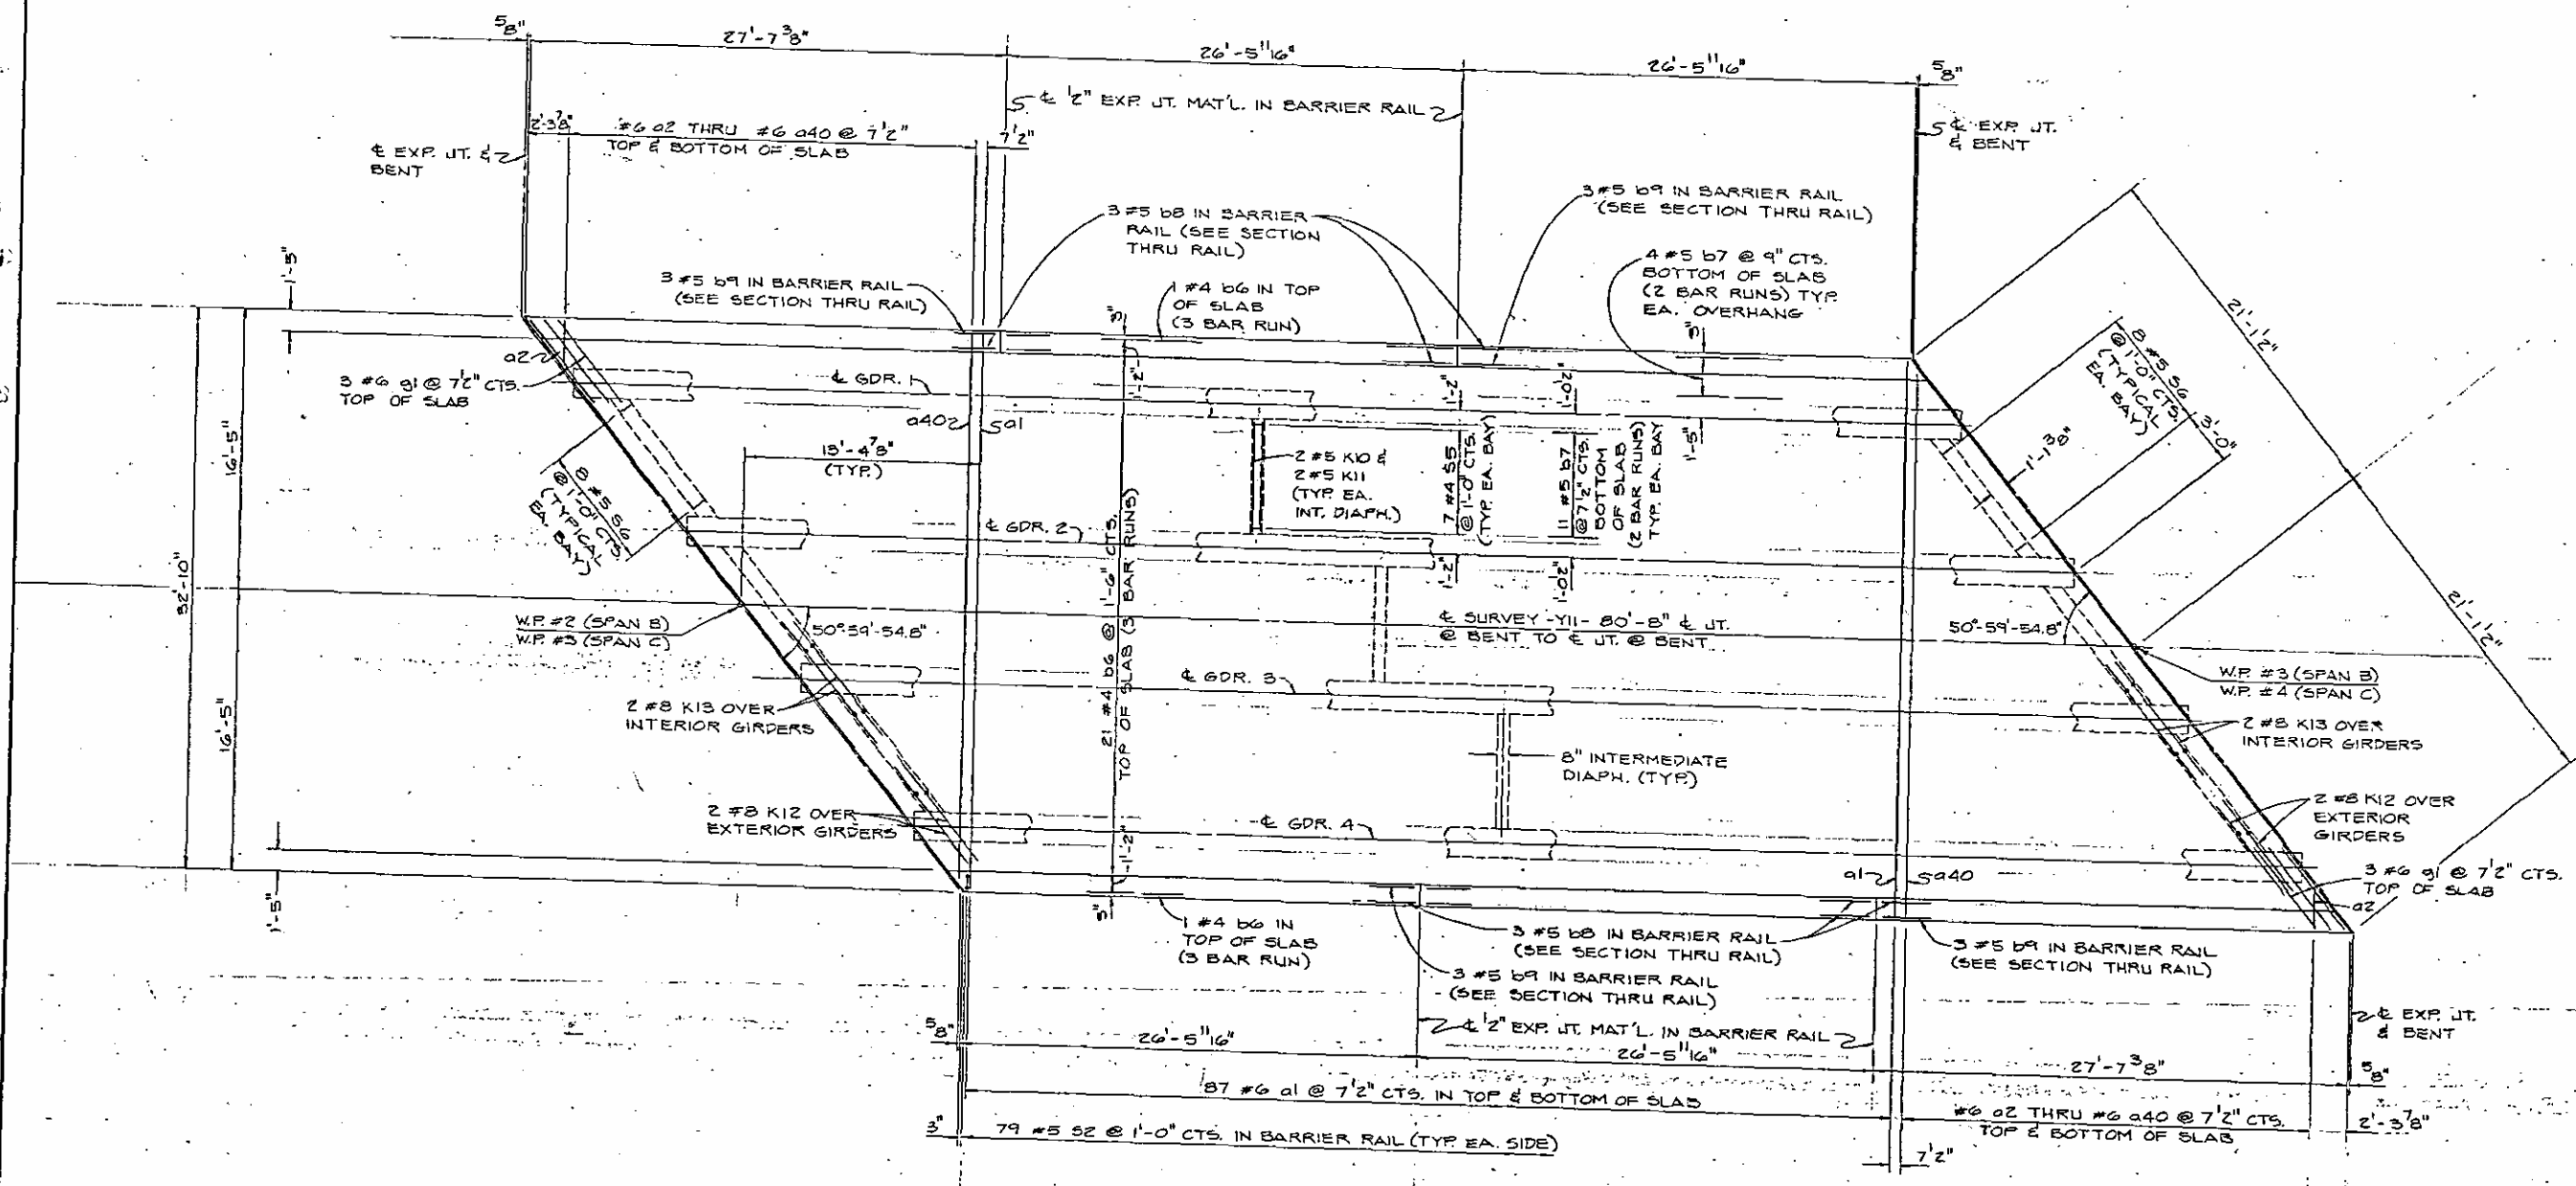

PLAN OF SPANS "B" OR "C"

PROJECT No. 8.1125805  
 EDGECOMBE COUNTY  
 STATION: 20+00.00 -YII-  
 763+19.06 -L-

STATE OF NORTH CAROLINA  
 DEPARTMENT OF TRANSPORTATION  
 RALEIGH  
 SUPERSTRUCTURE  
 PLAN-SPAN "B" OR "C"

FEBRUARY 1964


REVISIONS					
NO.	BY	DATE	NO.	BY	DATE
1			2		
2			3		
			4		

SHEET NO. 155

TOTAL SHEETS

DRAWN BY J.W. ROBINSON DATE FEB. 1964  
 CHECKED BY A.M. SMITH DATE FEB. 1964

DWG. 5-7

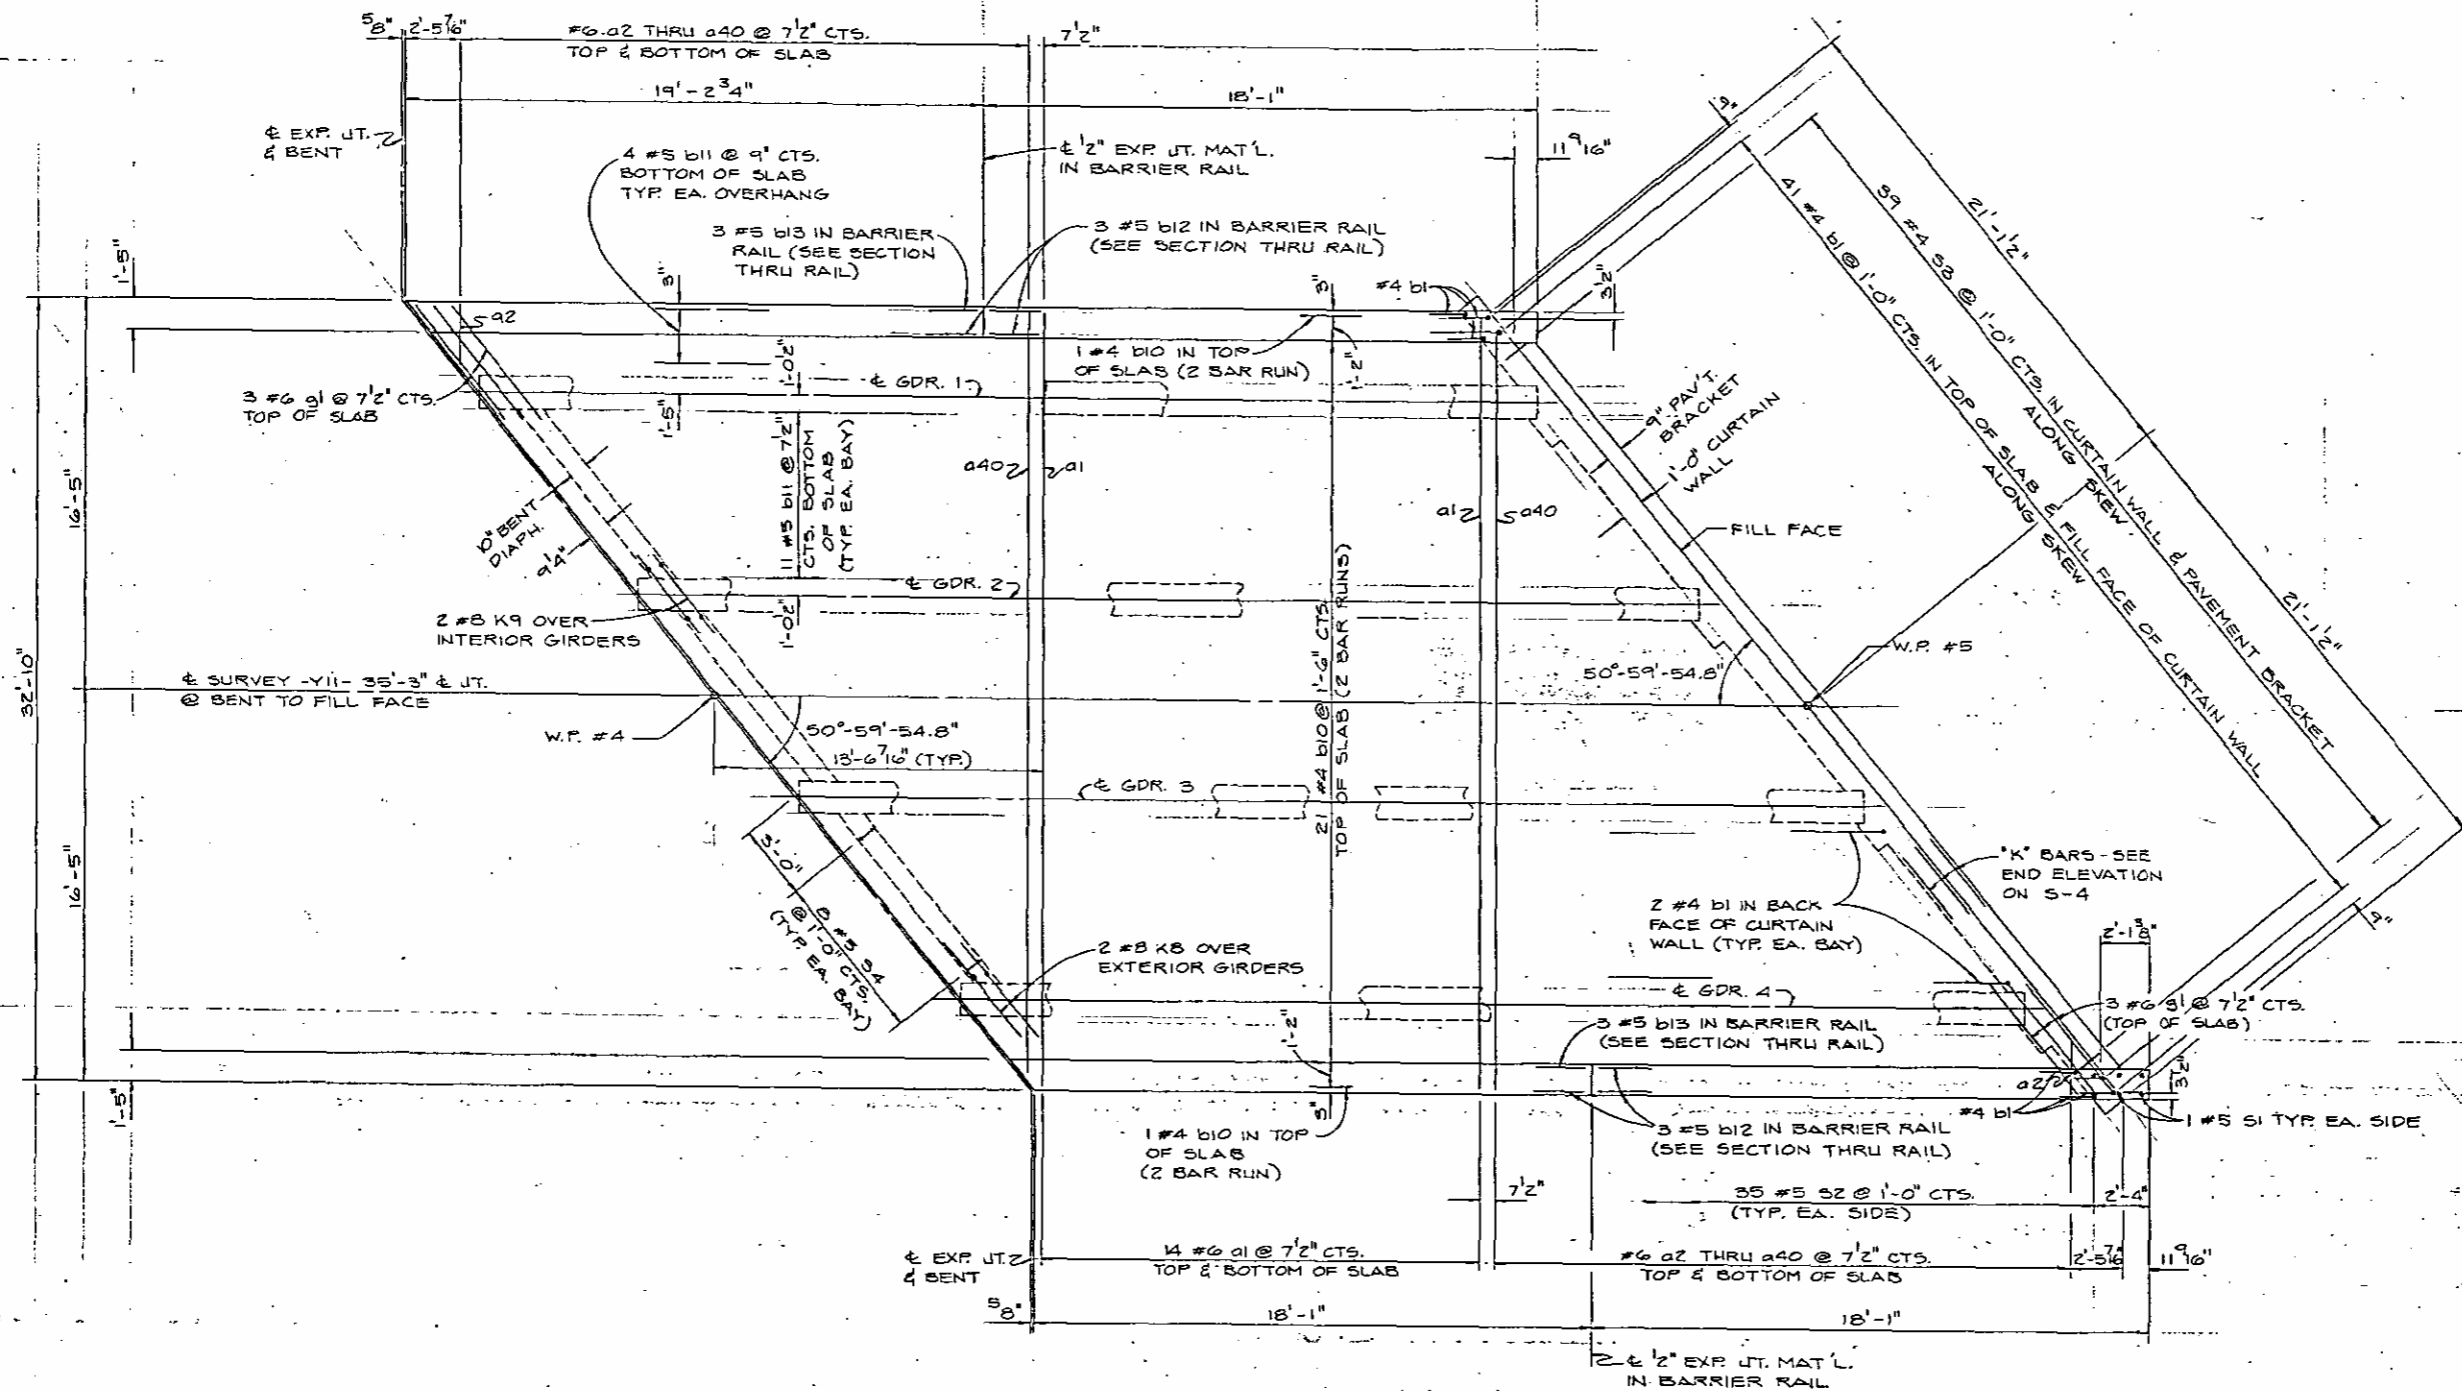

**PLAN OF SPAN "D"**

NOTE: SEE DETAIL "A" ON S-6 FOR CURTAIN WALL DETAILS NEAR BEAM.

PROJECT No. 8.1125805  
 EDGECOMBE COUNTY  
 STATION: 20+00.00 -Y11-  
 763+19.06 -L-













STATE OF NORTH CAROLINA  
 DEPARTMENT OF TRANSPORTATION  
 RALEIGH  
 SUPERSTRUCTURE  
 PLAN-SPAN "D"

REVISIONS						SHEET NO.	
NO.	BY	DATE	NO.	BY	DATE	TOTAL SHEETS	
1			3			156	
2			4				

DRAWN BY J.W. ROBINSON DATE FEB. 1984  
 CHECKED BY JOSE DANON DATE FEB. 1984

DWG. S-8




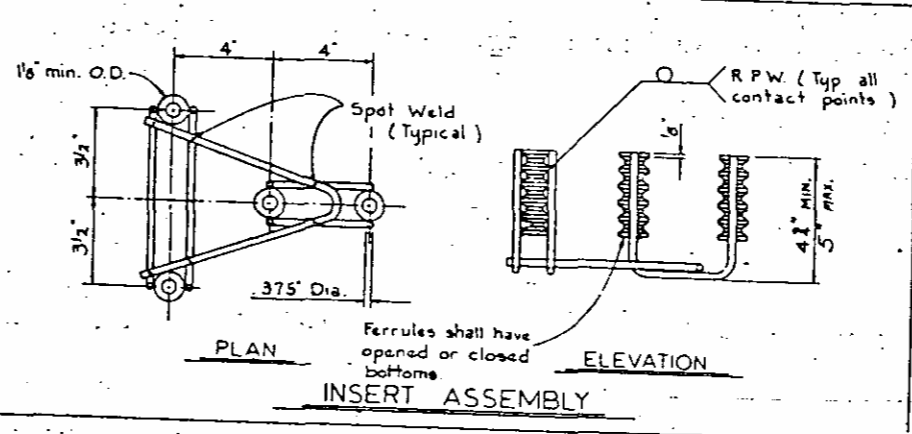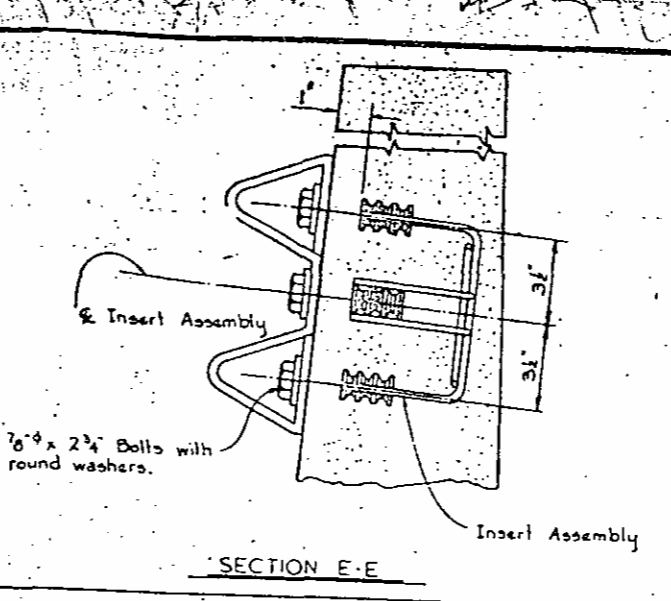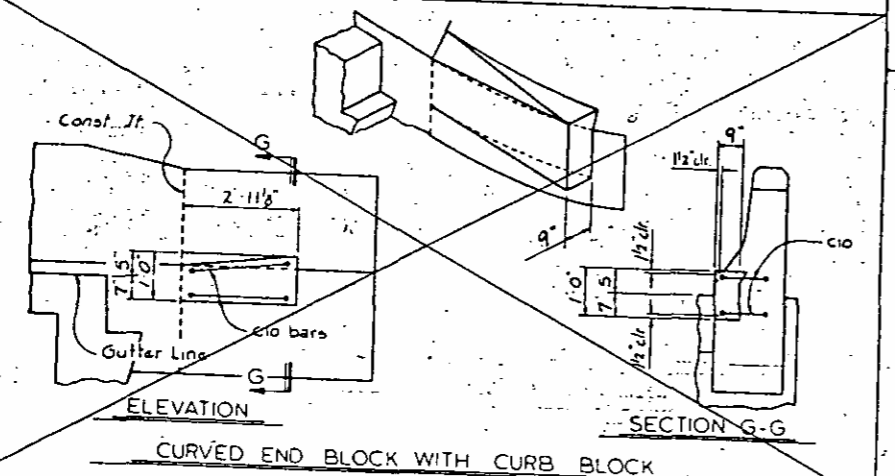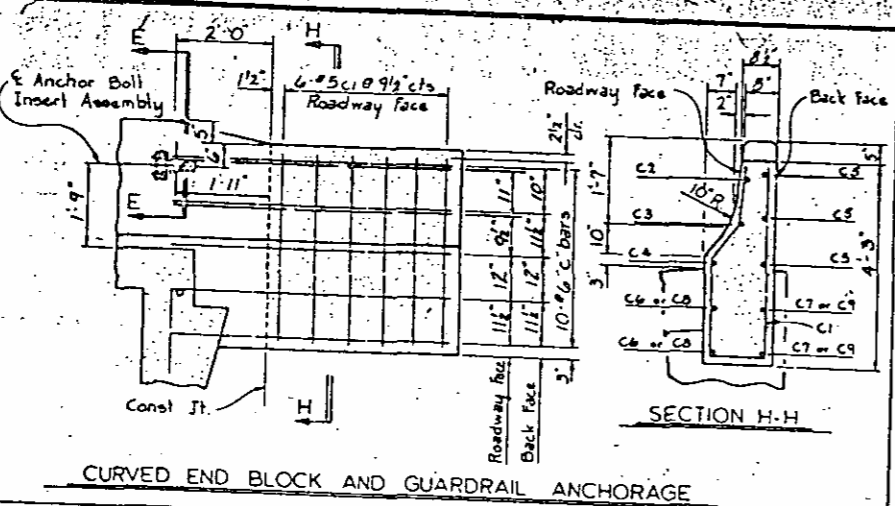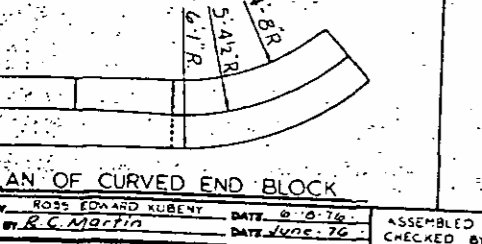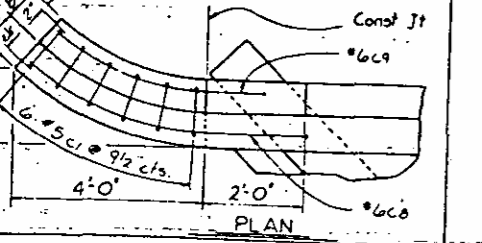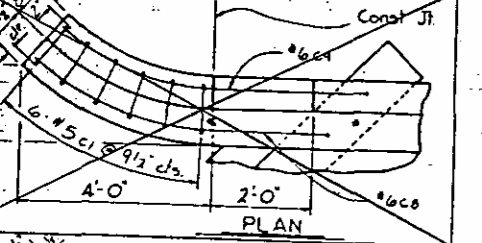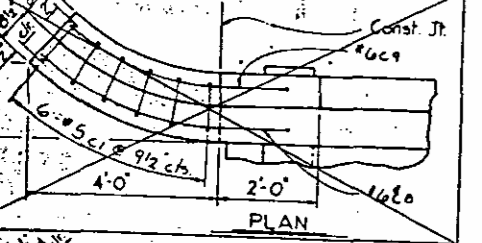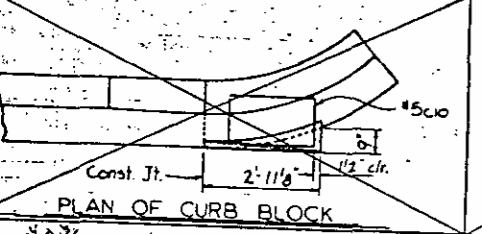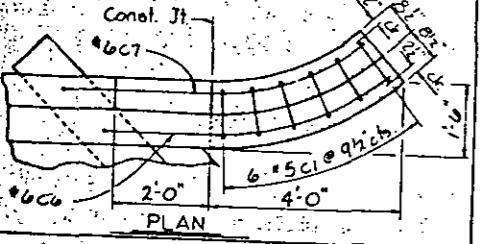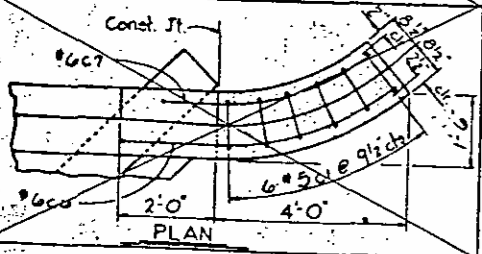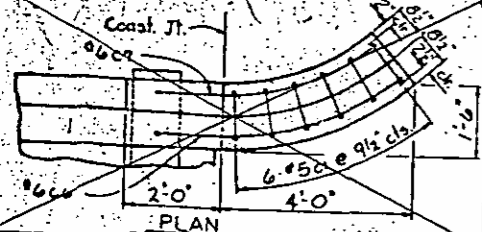


**BILL OF MATERIAL FOR FOUR CURVED END BLOCKS**

BAR	NO.	SIZE	TYPE	LENGTH	WEIGHT
C1	24	#5	3	4'-3"	232
C2	4	#6	4	5'-6"	33
C3	4	#6	4	5'-7"	34
C4	4	#6	4	4'-0"	36
C5	12	#6	4	5'-5"	98
C6	4	#6	1	6'-7"	40
C7	4	#6	1	7'-0"	42
C8	4	#6	2	7'-10"	47
C9	4	#6	2	6'-3"	38

Reinforcing Steel lbs. 600  
Class "A" Concrete Cu. Yds. 2.9

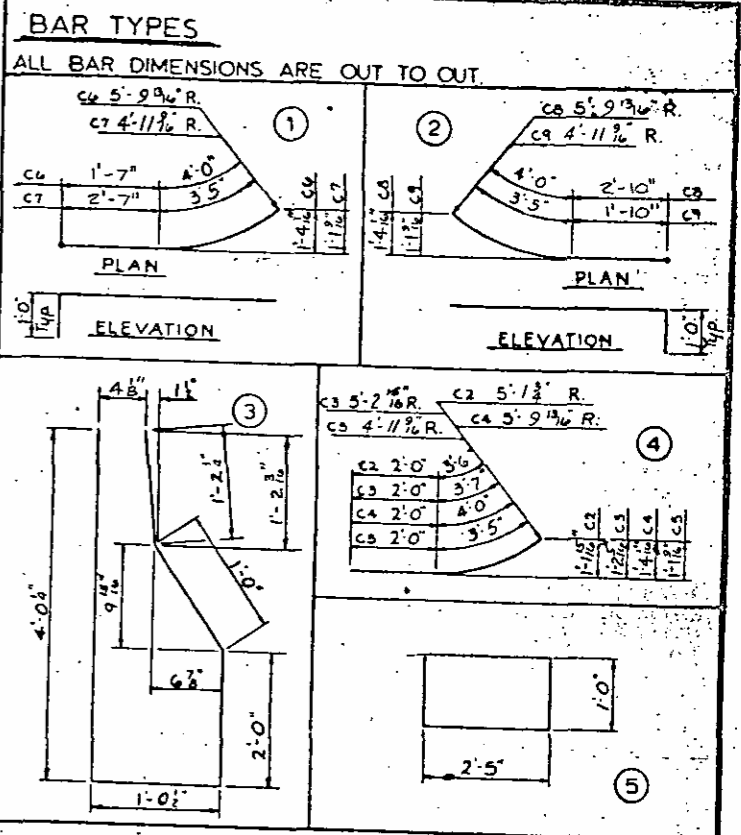

- THE 4-BOLT INSERT ASSEMBLY UNIT SHALL CONSIST OF THE FOLLOWING COMPONENTS:
  - FERRULES SHALL BE MADE FROM STEEL MEETING THE REQUIREMENTS OF ASTM A108, GRADE 12L14 AND SHALL HAVE A MINIMUM LENGTH OF THREADS OF 1 1/2".
  - 4 - 7/8" Ø x 2 3/4" BOLTS WITH WASHERS. BOLTS SHALL CONFORM TO THE REQUIREMENTS OF ASTM A307. BOLTS AND WASHERS SHALL BE GALVANIZED. (AT THE CONTRACTOR'S OPTION, STAINLESS STEEL BOLTS AND WASHERS MAY BE USED AS AN ALTERNATE FOR THE MECHANICAL REQUIREMENTS OF ASTM A307. THE USE OF THIS ALTERNATE SHALL BE APPROVED BY THE ENGINEER.)
  - WIRE STRUTS SHOWN IN THE INSERT ASSEMBLY DETAIL ARE MINIMUM ALLOWABLE SIZE AND SHALL HAVE A MINIMUM TENSILE STRENGTH OF 100,000 P.S.I.
- THE INSERT ASSEMBLY WITH BOLTS SHALL BE ASSEMBLED IN THE SHOP. BOLT THREADS MAY BE RECUT AS NECESSARY TO INSURE FIT.
- THE COST OF THE 4-BOLT INSERT ASSEMBLY UNIT COMPLETE IN PLACE, SHALL BE INCLUDED IN THE UNIT CONTRACT PRICE BID FOR CONCRETE BARRIER RAIL.
- THE 4-BOLT INSERT ASSEMBLY UNIT IS REQUIRED AT ALL POINTS WHERE APPROACH GUARDRAIL IS TO BE ATTACHED TO THE END POSTS. FOR POINTS OF ATTACHMENT, SEE PLANS.
- CURVED END BLOCKS ARE REQUIRED AT ALL END POSTS.
- THE COST OF THE EXCAVATION AND BACKFILL FOR THE CURVED END BLOCKS SHALL BE INCLUDED IN THE UNIT CONTRACT PRICE BID FOR CLASS "A" CONCRETE.

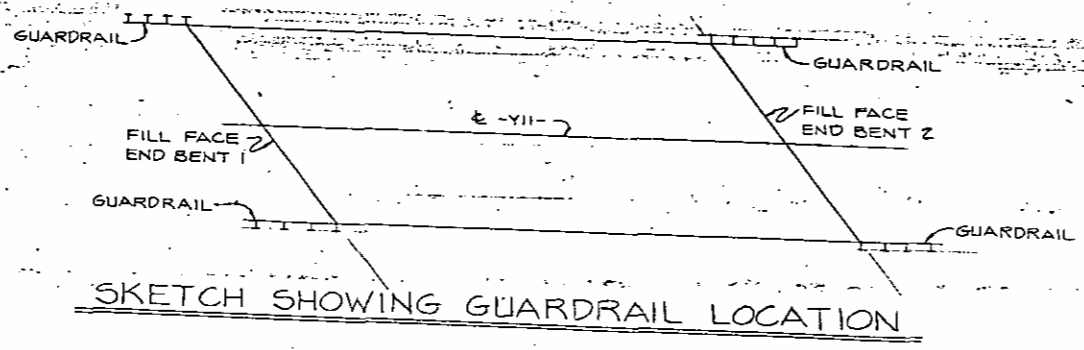

**BILL OF MATERIAL FOR CURB BLOCK**

Block	BAR NO.	SIZE	TYPE	LENGTH	Reinforcing Steel - lbs.	
					WEIGHT	
1 Block	c10	2	#5	5	6'-10"	14
2 Blocks	c10	4	#5	5	6'-10"	29
3 Blocks	c10	6	#5	5	6'-10"	43
4 Blocks	c10	8	#5	5	6'-10"	57

**TOTAL BILL OF MATERIAL**  
Reinforcing Steel - lbs. - 600  
Class "A" Concrete - Cu. Yds. - 2.9

PROJECT No. 8.1125805  
EDGEcombe COUNTY  
STATION: 20+00.00 -Y11-  
= 763+19.06 -L-

STATE OF NORTH CAROLINA  
DEPARTMENT OF TRANSPORTATION  
RALEIGH

STANDARD  
CURVED END BLOCK, GUARDRAIL ANCHORAGE, AND CURB BLOCK  
JULY FOR BARRIER RAIL 1978



REVISIONS					SHEET NO. 157
NO.	BY	DATE	NO.	BY	
1			2		TOTAL SHEETS
2			4		

DWG. S-9

Revised 10-24-03 By: R.L. ...  
 Revised 02-22-02 By: E.R.L. ...  
 Revised 09-15-02 By: E.D.U. ...  
 Revised 1-19-02 By: E.R.L. ...  
 Revised 13-22-02 By: R.K. ...  
 Revised 4-10-99 By: K. ...  
 Revised 10-14-97 By: K. ...  
 D.M.I.  
 E.D.U.  
 R.C.M.

DRAWN BY: ROSS EDWARD KUBENY DATE: 6-8-76  
 CHECKED BY: R.C. MARTIN DATE: June-76  
 ASSEMBLED BY: J.W. ROBINSON DATE: FEB. 1984  
 CHECKED BY: A.M. SMITH DATE: FEB. 1984



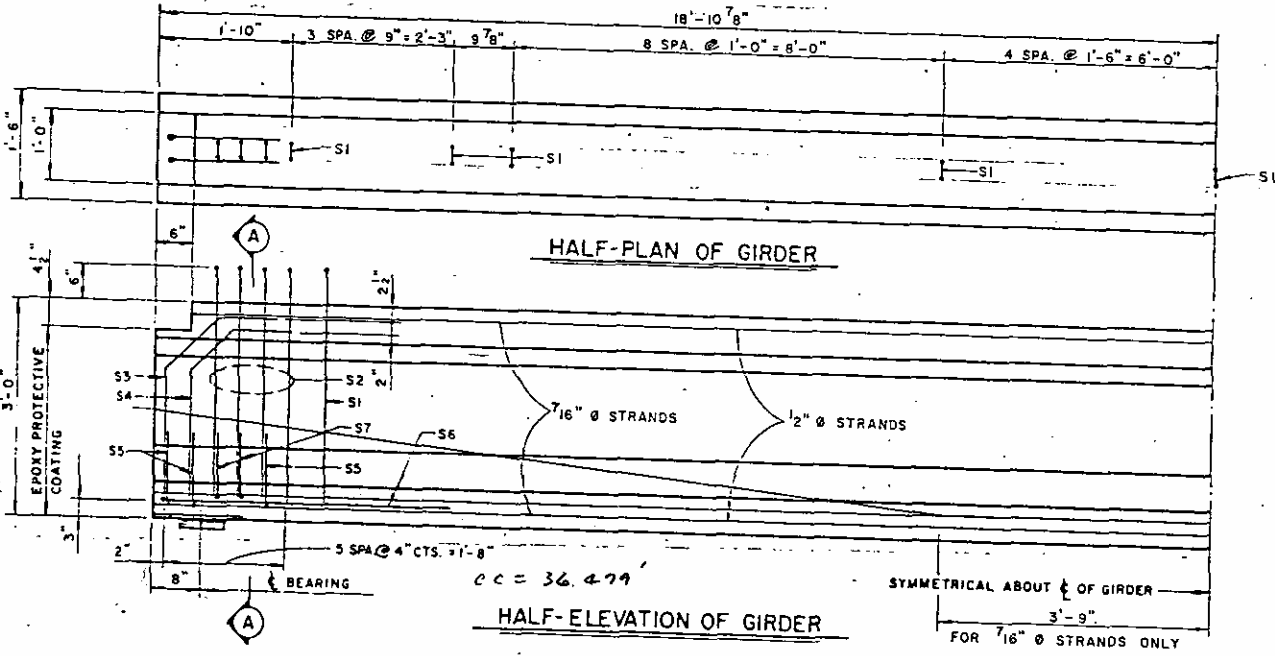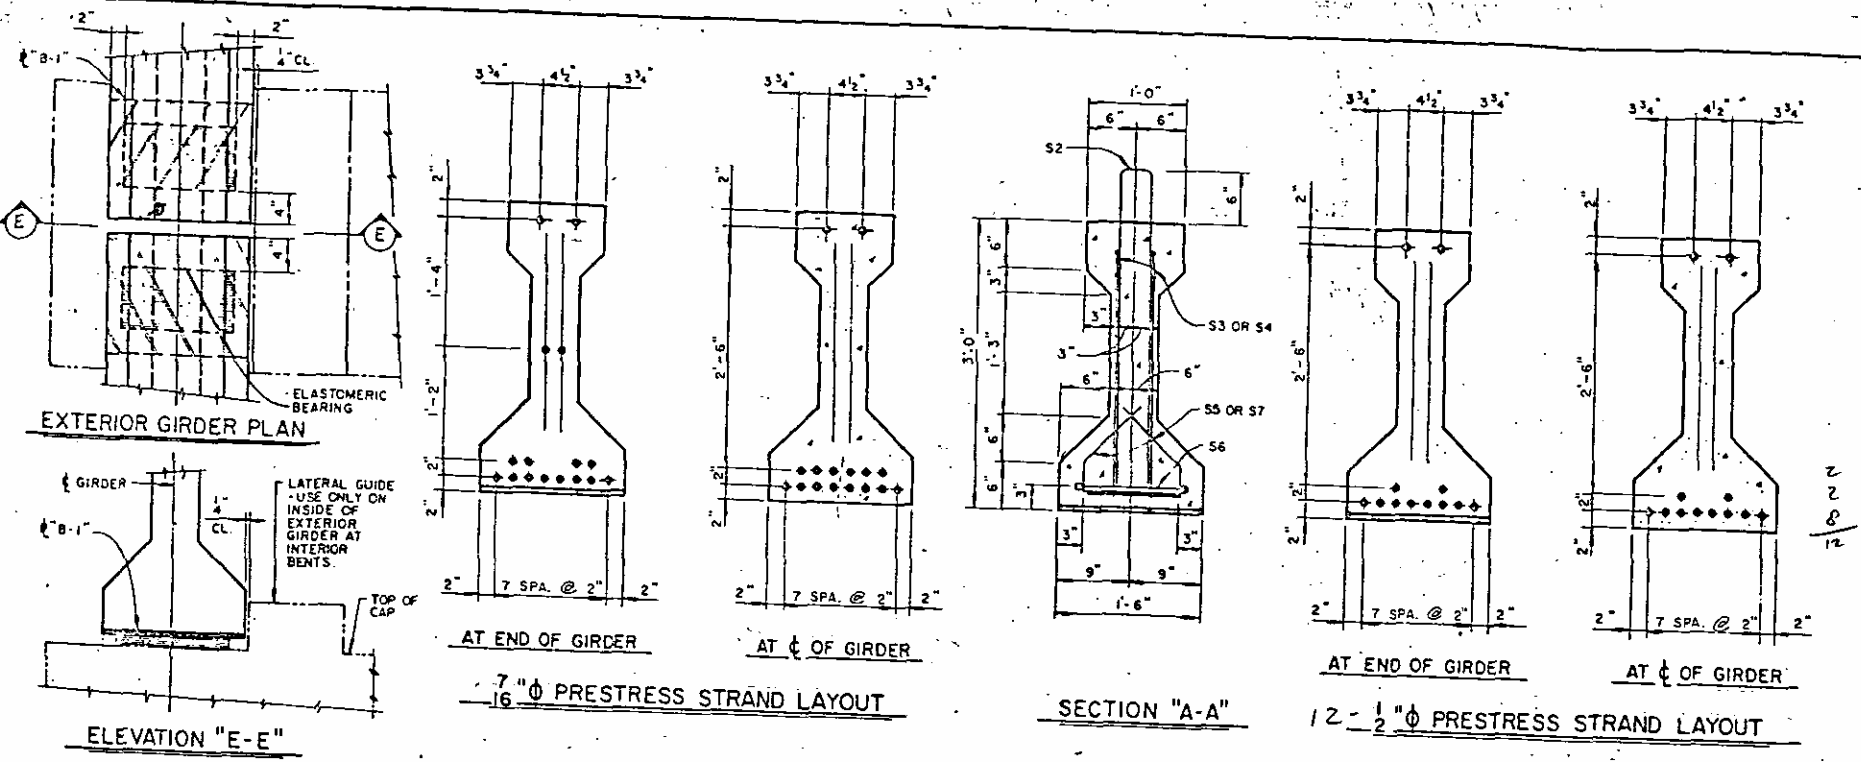




**DEFLECTION TABLE FOR SPAN "A"**

GIRDER	CAMBER (GIRDER ALONE IN PLACE)	USING 7" $\phi$ STRANDS	
		DEFLECTION DUE TO SUPERIMPOSED DEAD LOAD *	FINAL DEFLECTION
INTERIOR	9/16"	1/4"	5/16"
EXTERIOR	9/16"	1/4"	5/16"
USING 7/16" $\phi$ STRANDS			
INTERIOR	5/8"	1/4"	3/8"
EXTERIOR	5/8"	1/4"	3/8"

\* INCLUDES FUTURE WEARING SURFACE IN SUPERIMPOSED DEAD LOAD.

ASSEMBLED BY J.W. ROBINSON DATE FEB. 1984  
 CHECKED BY A.M. SMITH DATE FEB. 1984  
 DRAWN BY C.C. MITCHNER DATE SEPT. 1980  
 CHECKED BY R.D. UNDERWOOD DATE SEPT. 10, 1980

SPECIAL  
STANDARD

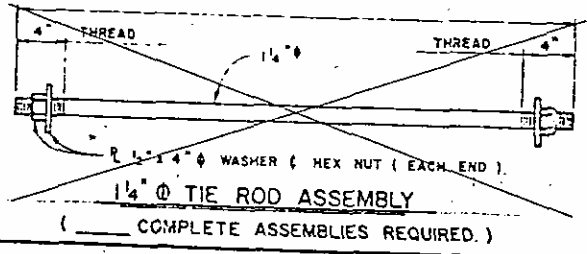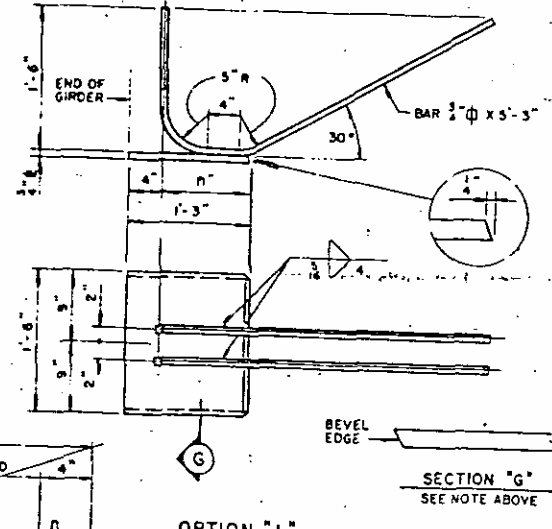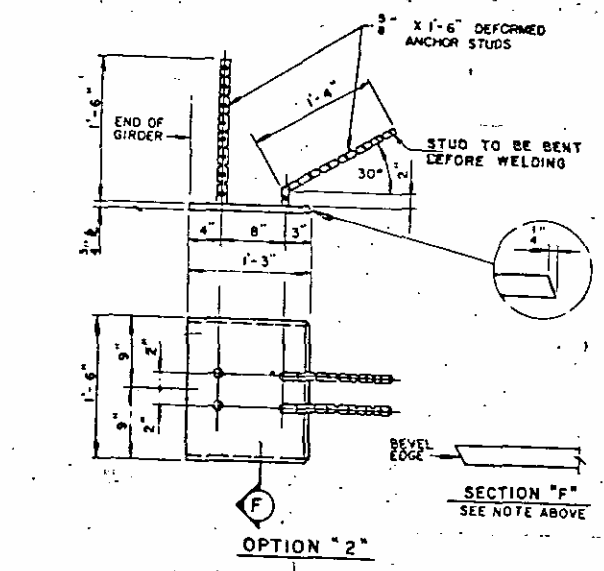

**EMBEDDED PLATE "B-1" DETAILS**

Rev. #1: Revised to change Deflection in Table. By: JEC / By: TVK Date: 9/11/85

**NOTES**

THE CONTRACTOR MAY USE EITHER 7/16"  $\phi$  OR 1/2"  $\phi$  STRESS RELIEVED STRANDS ACCORDING TO LAYOUTS SHOWN ON THIS SHEET.

THE CONTRACTOR, AT HIS OPTION, MAY USE LOW-RELAXATION STRANDS IN LIEU OF STRESS RELIEVED STRANDS. DESIGN AND STRAND PATTERN MUST PROVIDE AT LEAST THE SAME NET COMPRESSIVE STRESS AFTER THE LOSSES. THE ULTIMATE STRENGTH OF THE GIRDER MUST MEET THE REQUIREMENTS OF THE APPLICABLE AASHTO SPECIFICATIONS. LOW-RELAXATION STRANDS SHALL BE TENSIONED AND ANCHORED AT A LOAD EQUAL TO 75% OF ITS ULTIMATE STRENGTH. THIS APPLIED PRESTRESSING FORCE SHALL BE SHOWN ON THE PLANS. SIZE OF LOW-RELAXATION STRANDS SHALL NOT BE LARGER THAN THOSE SHOWN FOR STRESS RELIEVED STRANDS. DESIGN AND DETAIL PLANS USING LOW-RELAXATION STRANDS MUST BE SUBMITTED TO THE HEAD OF STRUCTURE DESIGN UNIT FOR APPROVAL. ANY ADDITIONAL COST DUE TO THE USE OF LOW-RELAXATION STRANDS WILL BE PAID FOR BY THE CONTRACTOR.

THE SAME TYPE AND SAME SIZE STRANDS SHALL BE USED FOR ALL GIRDERS IN THE STRUCTURE.

ALL PRESTRESSING STRANDS SHALL BE 7-WIRE STRESS RELIEVED OR LOW-RELAXATION GRADE 270 STRANDS AND SHALL CONFORM TO ASTM A-416 EXCEPT FOR SAMPLING REQUIREMENTS WHICH SHALL BE IN ACCORDANCE WITH THE STANDARD SPECIFICATIONS.

WHEN USED ON 90° SKEN, NOTCH IN TOP FLANGE OF GIRDER MAY BE OMITTED.

ALL REINFORCING STEEL SHALL BE GRADE 60.

APPLY EPOXY PROTECTIVE COATING TO END OF GIRDER SURFACES. FOR EPOXY PROTECTIVE COATING, SEE SPECIAL PROVISIONS.

ELASTOMER IN ALL BEARINGS SHALL HAVE A GRADE 50 DUREMETER HARDNESS. SEE SPECIAL PROVISIONS.

STEEL PLATES IN LAMINATED BEARINGS SHALL CONFORM TO ASTM A-36.



EMBEDDED PLATE "B-1" SHALL BE GALVANIZED.

THE CONTRACTOR MAY SELECT OPTION "1" OR OPTION "2" FOR EMBEDDED PLATE "B-1".

BEVEL EDGES OF PLATE "B-1" TO GIVE CLOSE FIT BUT NOT TIGHT FIT TO STEEL CASTING FORM.

DEFORMED ANCHOR STUDS SHALL CONFORM TO ASTM A-496. WELDING PROCEDURE QUALIFICATION TEST FOR DEFORMED ANCHOR STUDS MAY BE REQUIRED.

ENDS OF ALL PRESTRESSED STRANDS SHALL BE RECESSED AND GROUDED. SEE DETAIL BELOW. GROUT TO BE NON-METALLIC, NON-SHRINK AND SHALL BE APPROVED BY THE ENGINEER. SEE SPECIAL PROVISIONS.

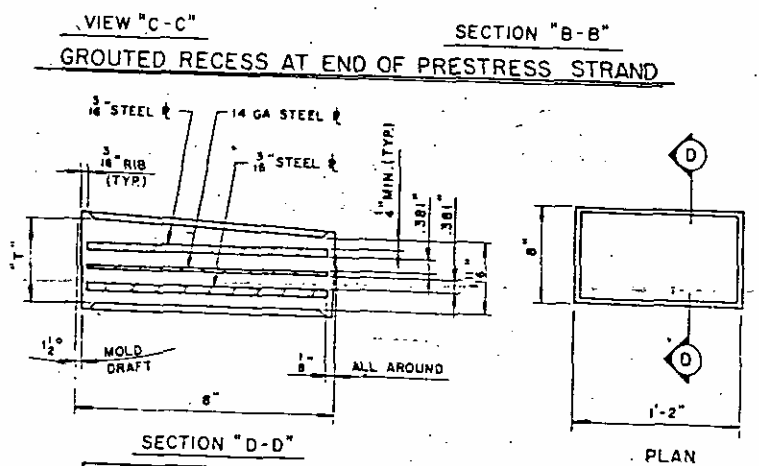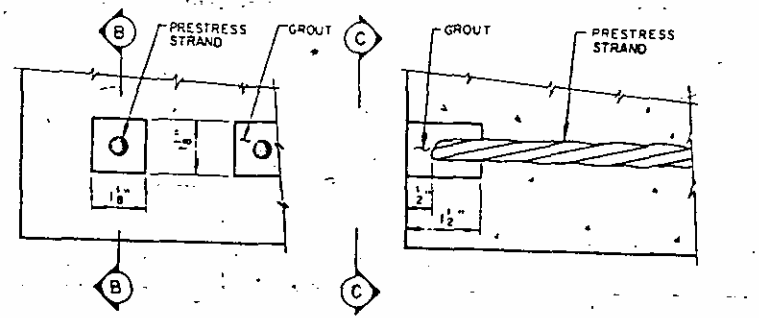

BEARING TYPE	THICKNESS (")	GIRDER GRADE (%)	NUMBER REQUIRED
P1	1 1/2"	0.00 - 1.00	2
P2	1 1/2"	1.00 - 2.25	2
P3	1 1/2"	2.25 - 3.50	2
P4	2 1/4"	3.50 - 5.50	2


**ELASTOMERIC BEARING DETAILS**

**GRADE 270 S. R. STRANDS**

	7" $\phi$	1/2" $\phi$
AREA (SQUARE INCHES)	0.115	0.153
ULTIMATE STRENGTH (LBS. PER STRAND)	31,000	41,300
APPLIED PRESTRESS (LBS. PER STRAND)	21,700	28,900

**REINFORCING STEEL FOR ONE GIRDER**

BAR	NUMBER	SIZE	TYPE	LENGTH	WEIGHT
S1	31	#4	1	6'-10"	142
S2	8	#5	1	6'-10"	57
S3	4	#6	2	3'-8"	22
S4	4	#6	2	3'-5"	21
S5	12	#4	3	2'-4"	19
S6	2	#6	4	9'-2"	28
S7	8	#4	3	2'-1"	11

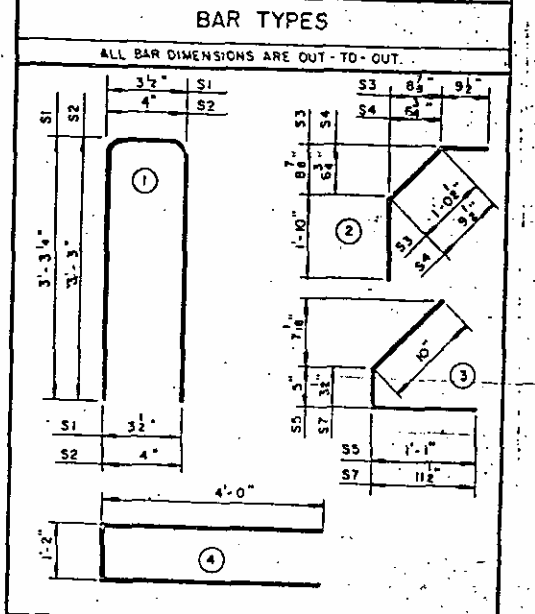

**QUANTITIES FOR ONE GIRDER**

REINFORCING STEEL	3,000 PSI CONCRETE	7" $\phi$ S.R. STRANDS	1/2" $\phi$ S.R. STRANDS
LB	CY	N <sup>o</sup>	N <sup>o</sup>
300	3.6	16	12

**GIRDERS REQUIRED**

NUMBER	LENGTH	TOTAL LENGTH
4	37'-9 3/4"	151'-3"

**PROJECT No. 8.1125805**

**EDGEcombe COUNTY**

**STATION: 20+00.00 -YII-**


**763+19.06 -L-**

STATE OF NORTH CAROLINA  
**DEPARTMENT OF TRANSPORTATION**  
 RALPH H. HARRIS  
 STANDARD  
**36" PRESTRESSED CONCRETE GIRDER**  
 SPAN "A"


SEPT. 1980

NO.	BY	DATE	NO.	BY	DATE
1	JEC	9-18-85	3		

SHEET NO. 159

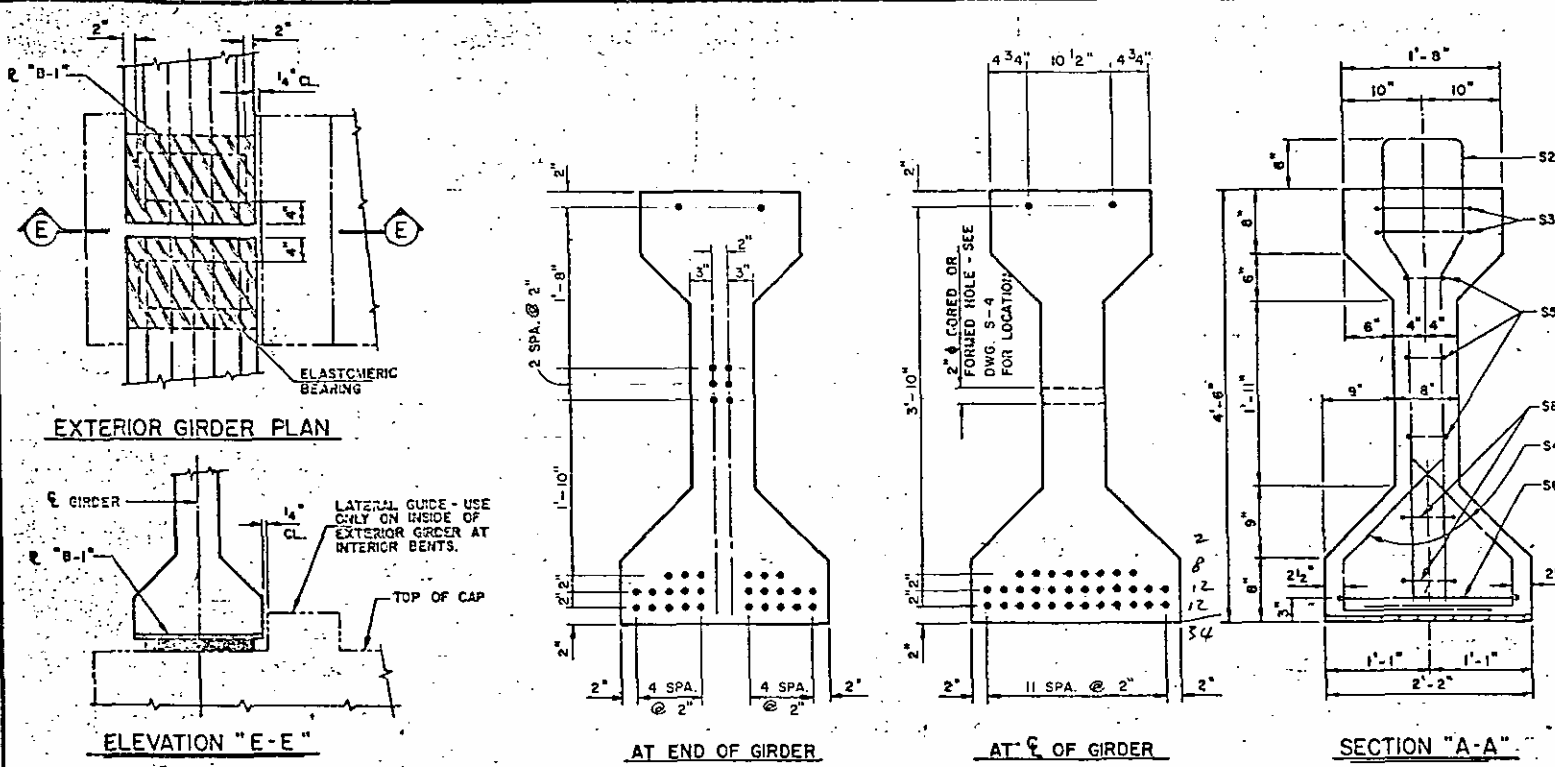

34-1/2" Ø PRESTRESS STRAND LAYOUT

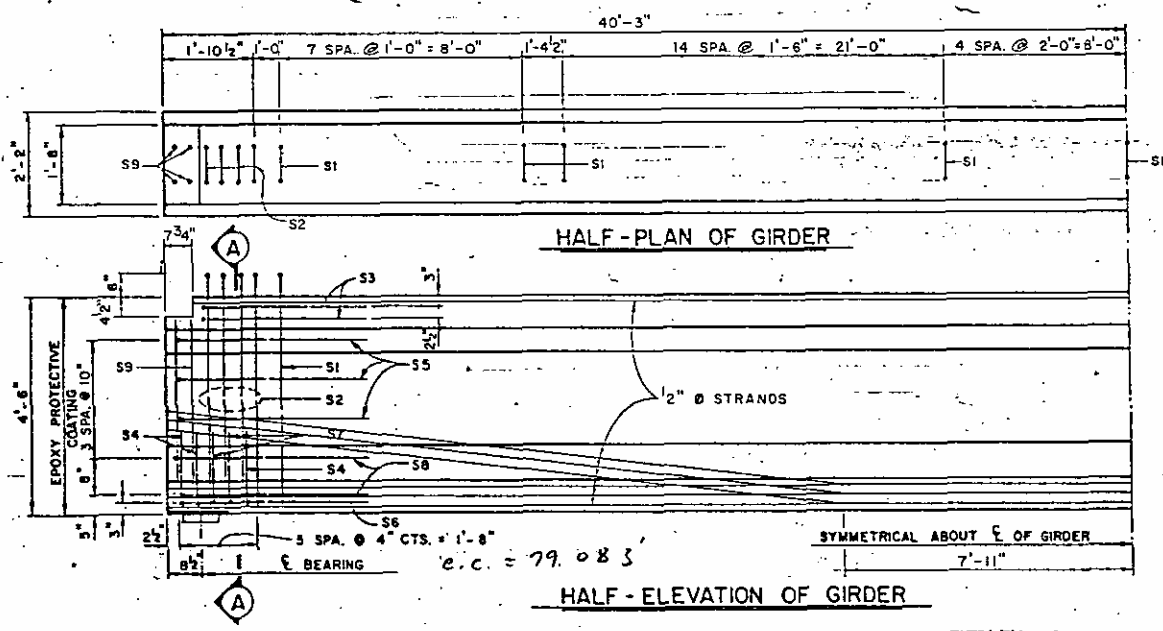

DEFLECTION TABLE FOR SPANS "B" AND "C"

GIRDER	USING 1/2" Ø STRANDS		
	CAMBER (GIRDER ALONE IN PLACE)	DEFLECTION DUE TO SUPERIMPOSED DEAD LOAD *	FINAL DEFLECTION
INTERIOR	2 3/8"	1 1/8"	1 5/8"
EXTERIOR	2 3/8"	1 1/8"	1 5/8"

\* INCLUDES FUTURE WEARING SURFACE IN SUPERIMPOSED DEAD LOAD.

ASSEMBLED BY J.W. ROBINSON	DATE FEB. 1984	SPECIAL
CHECKED BY JOSE DANON	DATE FEB. 1984	
DRAWN BY ROSS EDWARD KLOSZY	DATE JUNE 1982	STANDARD
CHECKED BY E. RUSSELL LURWICK, JR.	DATE JUNE 1982	

NOTES

THIS STANDARD SHOWS DESIGN, DETAIL AND PROPERTIES OF STRANDS BASED ON STRESS RELIEVED STRANDS. HOWEVER, THE CONTRACTOR, AT HIS OPTION, MAY USE LOW-RELAXATION STRANDS IN LIEU OF STRESS RELIEVED STRANDS. DESIGN AND STRAND PATTERN MUST PROVIDE AT LEAST THE SAME NET COMPRESSIVE STRESS AFTER THE LOSSES. THE ULTIMATE STRENGTH OF THE GIRDER MUST MEET THE REQUIREMENTS OF THE APPLICABLE AASHTO SPECIFICATIONS. LOW RELAXATION STRANDS SHALL BE TENSIONED AND ANCHORED AT A LOAD EQUAL TO 75% OF ITS ULTIMATE STRENGTH. THIS APPLIED PRESTRESSED FORCE SHALL BE SHOWN ON THE PLANS. SIZE OF LOW-RELAXATION STRANDS SHALL NOT BE LARGER THAN THOSE SHOWN FOR STRESS RELIEVED STRANDS. DESIGN AND DETAIL PLANS USING LOW-RELAXATION STRANDS MUST BE SUBMITTED TO THE HEAD OF STRUCTURE DESIGN UNIT FOR APPROVAL. ANY ADDITIONAL COST DUE TO THE USE OF LOW RELAXATION STRANDS WILL BE PAID FOR BY THE CONTRACTOR.

ALL PRESTRESSING STRANDS SHALL BE 7-WIRE STRESS RELIEVED OR LOW-RELAXATION GRADE 270 STRANDS AND SHALL CONFORM TO ASTM A-416 EXCEPT FOR SAMPLING REQUIREMENTS WHICH SHALL BE IN ACCORDANCE WITH THE STANDARD SPECIFICATIONS.

THE SAME TYPE STRANDS SHALL BE USED FOR ALL GIRDERS IN THE STRUCTURE.

TIE ROD ASSEMBLY SHALL BE ASTM A-36 GRADE STRUCTURAL STEEL.

ALL REINFORCING STEEL SHALL BE GRADE 60.

APPLY EPOXY PROTECTIVE COATING TO END OF GIRDER SURFACES.

FOR EPOXY PROTECTIVE COATING, SEE SPECIAL PROVISIONS.

FOR ELASTOMERIC BEARINGS, SEE SPECIAL PROVISIONS.


EMBEDDED PLATE "B-1" SHALL BE GALVANIZED.

THE CONTRACTOR MAY SELECT OPTION "1" OR OPTION "2" FOR EMBEDDED PLATE "B-1".

BEVEL EDGES OF PLATE "B-1" TO GIVE CLOSE FIT BUT NOT TIGHT FIT TO STEEL CASTING FORM.

DEFORMED ANCHOR STUDS SHALL CONFORM TO ASTM A-496. WELDING PROCEDURE QUALIFICATION TEST FOR DEFORMED ANCHOR STUDS MAY BE REQUIRED.

ENDS OF ALL PRESTRESSED STRANDS SHALL BE RECESSED AND GROUTED. SEE DETAIL BELOW. GROUT TO BE NON-METALLIC, NON-SHRINK AND SHALL BE APPROVED BY THE ENGINEER. SEE SPECIAL PROVISIONS.

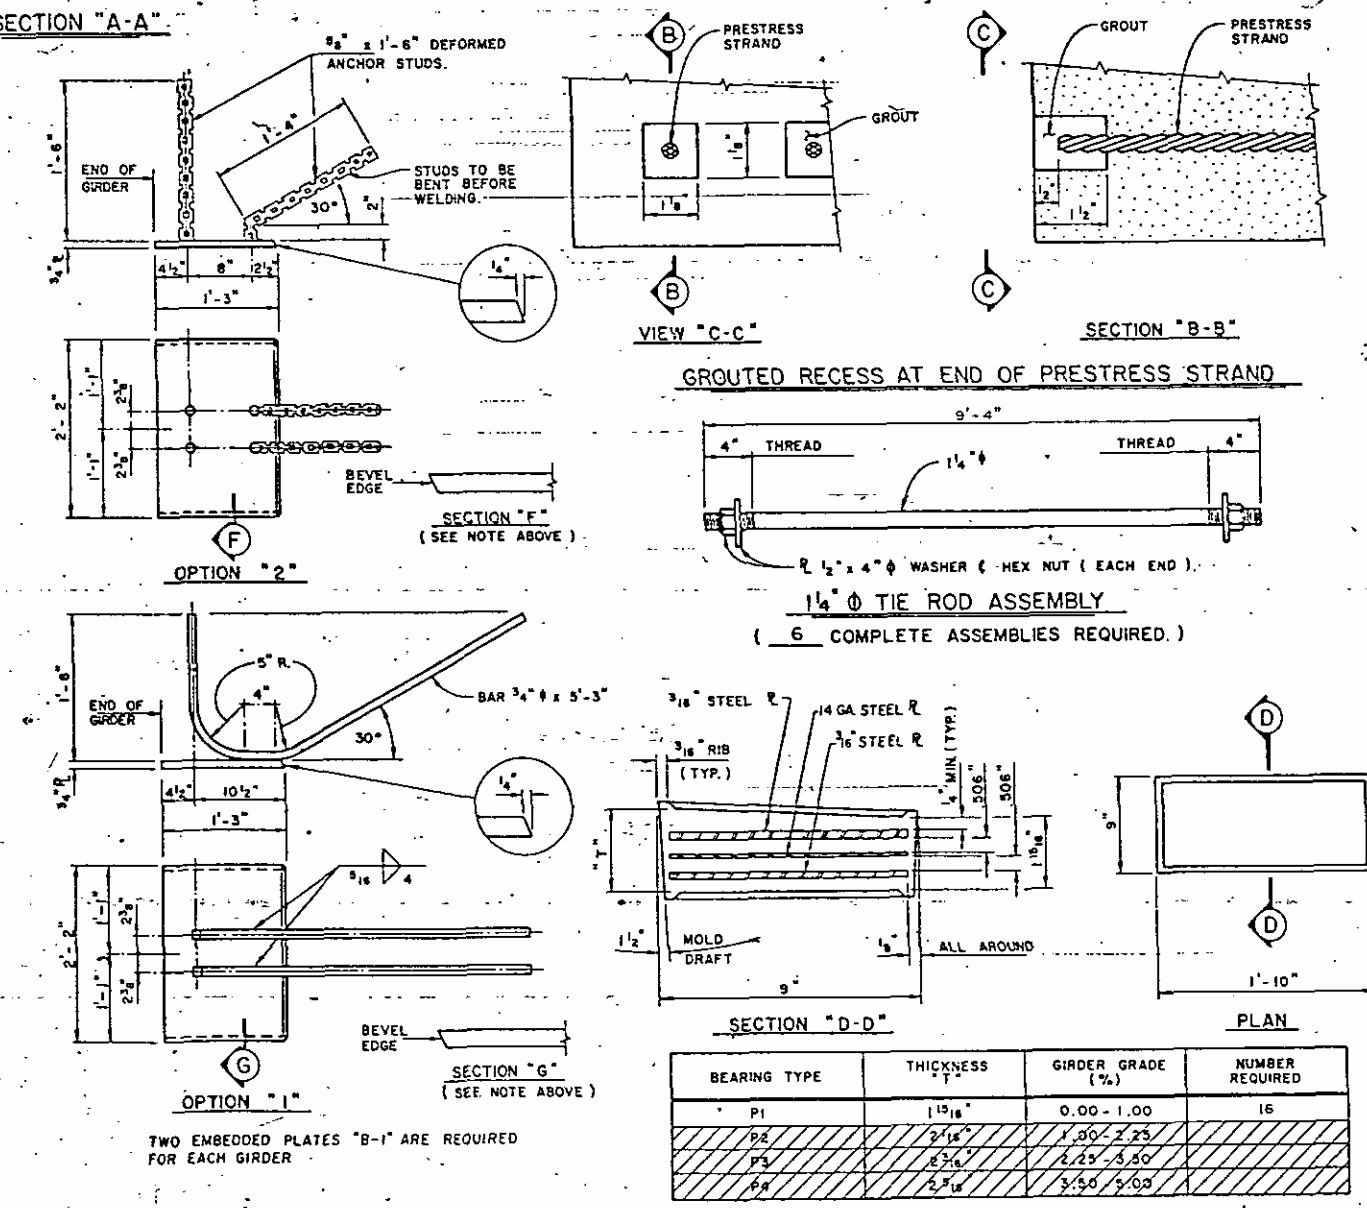

EMBEDDED PLATE "B-1" DETAILS

ELASTOMERIC BEARING DETAILS

BEARING TYPE	THICKNESS T	GIRDER GRADE (%)	NUMBER REQUIRED
P1	1 1/8"	0.00 - 1.00	16
P2	2 1/8"	1.00 - 2.25	
P3	2 3/8"	2.25 - 3.50	
P4	2 7/8"	3.50 - 5.00	

GRADE 270 S. R. STRANDS


AREA SQUARE INCHES	0.153
ULTIMATE STRENGTH (LBS. PER STRAND)	41,300
APPLIED PRESTRESS (LBS. PER STRAND)	28,900

REINFORCING STEEL FOR ONE GIRDER

BAR	NUMBER	SIZE	TYPE	LENGTH	WEIGHT
S1	53	#4	1	10'-8"	378
S2	8	#6	1	10'-8"	128
S3	4	#4	2	9'-1"	24
S4	12	#4	3	3'-5"	27
S5	6	#4	2	8'-5"	34
S6	2	#6	2	9'-11"	30
S7	8	#4	3	3'-3"	17
S8	4	#4	2	8'-7"	23
S9	8	#6	STR.	3'-11"	47

BAR TYPES

ALL BAR DIMENSIONS ARE OUT-TO-OUT

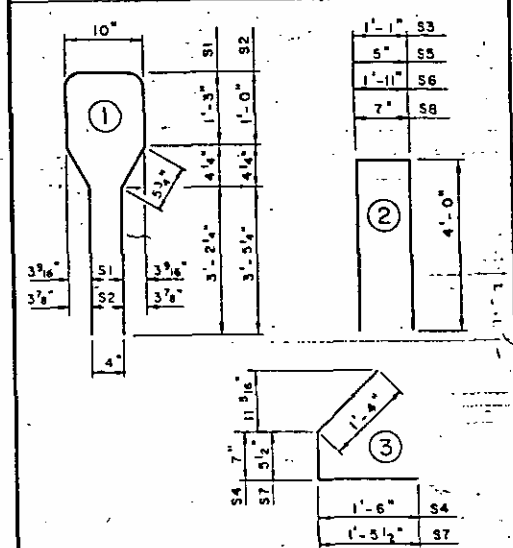

QUANTITIES FOR ONE GIRDER

REINFORCING STEEL	5,000 P.S.I. CONCRETE	1/2" Ø S. R. STRANDS
LBS.	CY	NO.
708	16.3	34

GIRDERS REQUIRED

NUMBER	LENGTH	TOTAL LENGTH
8	80'-6"	644'-0"

PROJECT No. 8.1125805

EDGECOMBE COUNTY

STATION: 20+00.00 -YII-  
763+19.06 -L-



STATE OF NORTH CAROLINA  
DEPARTMENT OF TRANSPORTATION  
RALEIGH  
STANDARD  
54" PRESTRESSED  
CONCRETE GIRDER  
SPANS "B" AND "C"

JUNE	1982				
REVISIONS					
NO.	BY	DATE	NO.	BY	DATE
1	JEC	9-18-85	2		
2			4		

STD. NO. PCG3

REVISED 5-23-83 BY: ERL  
7-15-86 BY: J.K.K.  
REVISION 6-18-82 BY: ERL




Rev. #1: Revised to change Deflection in Table. By: JEC/VB/TVK Date: 9/18/85 DWG. 5-12

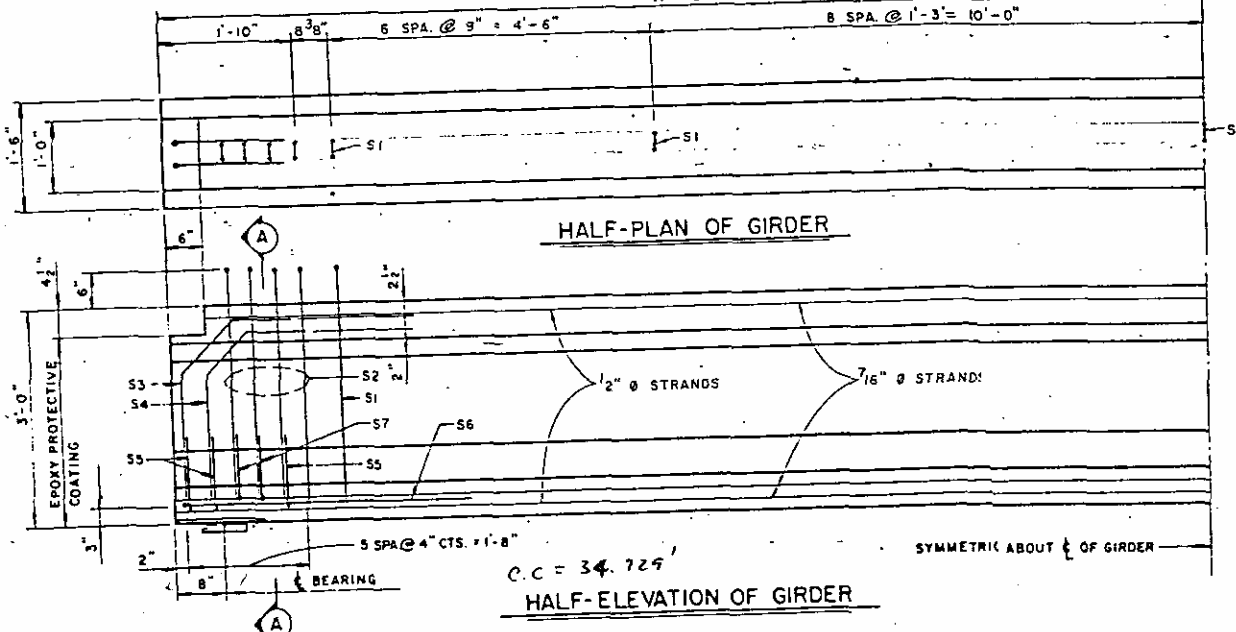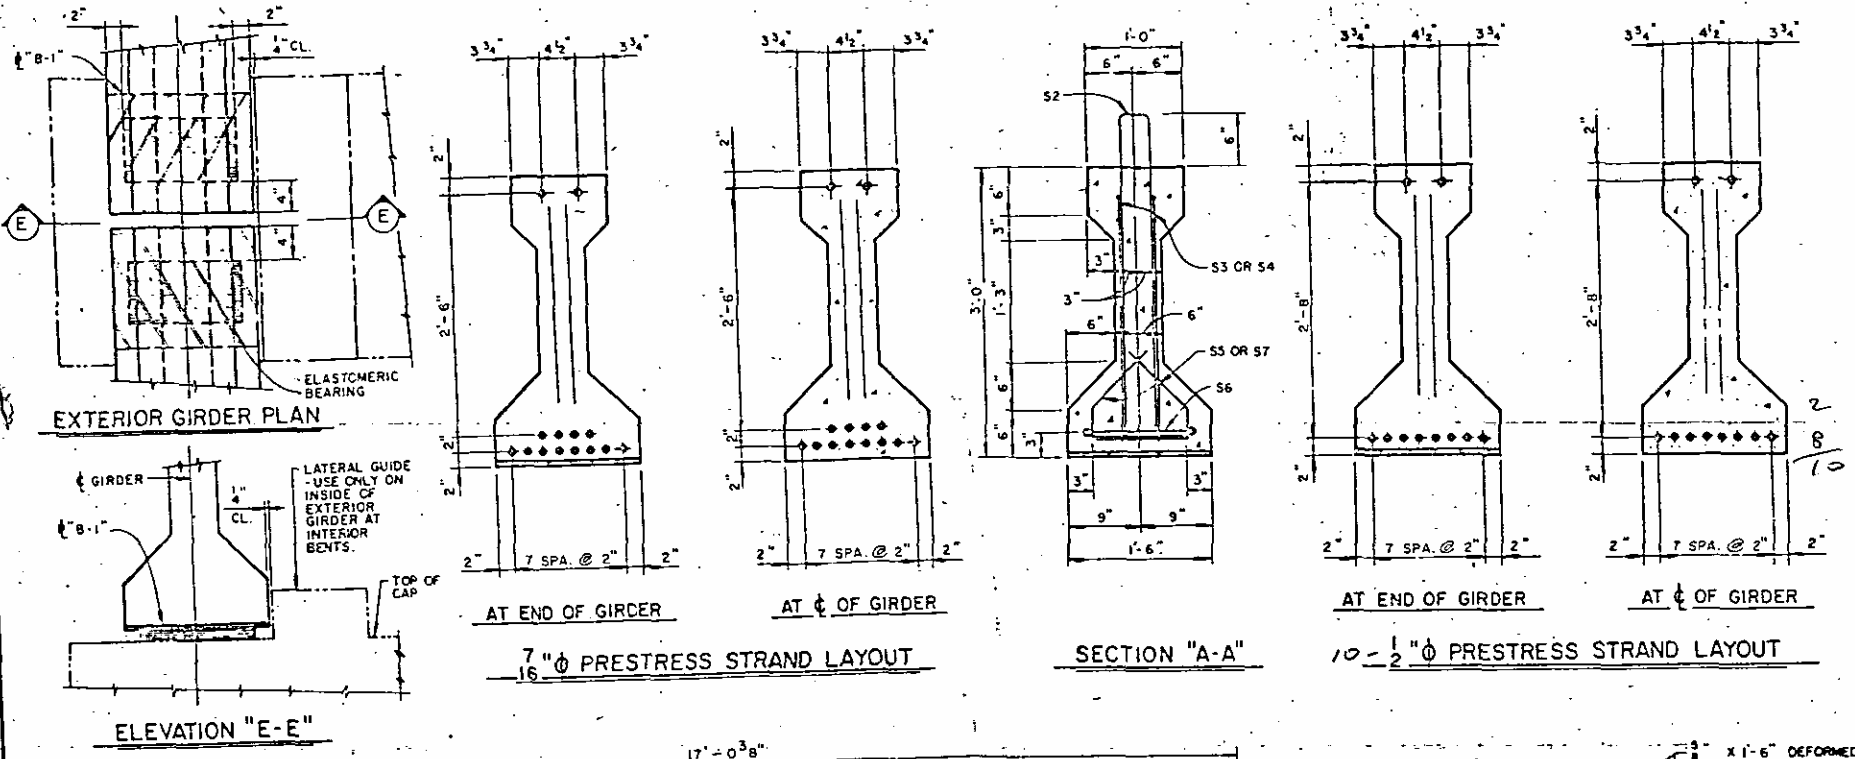

**DEFLECTION TABLE FOR SPAN "D"**

GIRDER	USING 7/16" $\phi$ STRANDS		FINAL DEFLECTION
	CAMBER (GIRDER ALONE IN PLACE)	DEFLECTION DUE TO SUPERIMPOSED DEAD LOAD *	
INTERIOR	3/8"	5/8"	1/4"
EXTERIOR	3/8"	5/8"	1/4"
USING 7/16" $\phi$ STRANDS			
INTERIOR	7/16"	5/8"	5/16"
EXTERIOR	7/16"	5/8"	5/16"

\* INCLUDES FUTURE WEARING SURFACE IN SUPERIMPOSED DEAD LOAD.

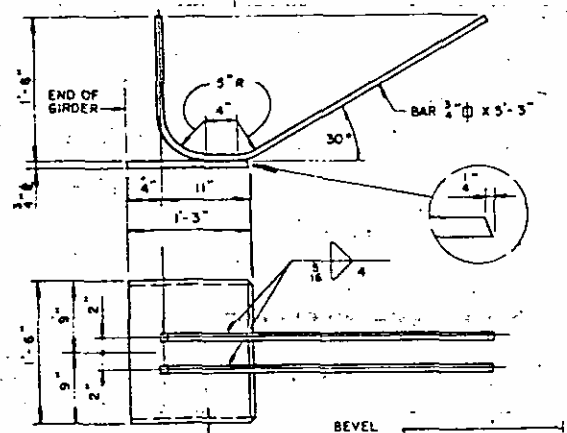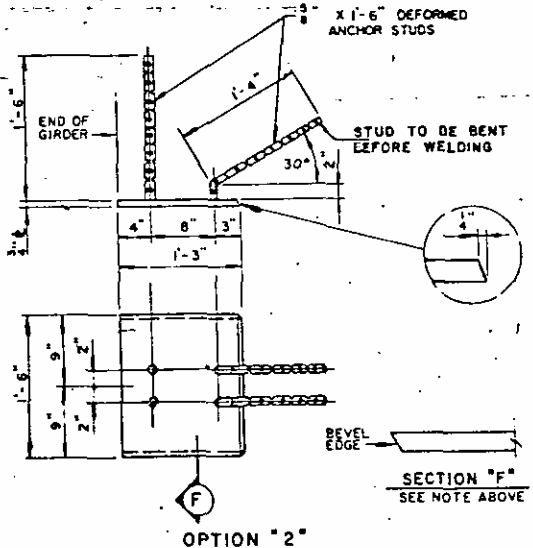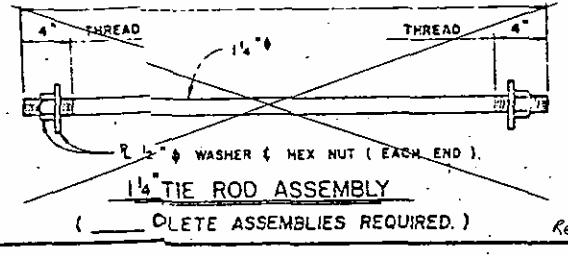

**EMBEDDED PLATE "B-1" DETAILS**

**NOTES**

THE CONTRACTOR MAY USE EITHER 7/16"  $\phi$  OR 1/2"  $\phi$  STRESS RELIEVED STRANDS ACCORDING TO LAYOUTS SHOWN ON THIS SHEET.

THE CONTRACTOR, AT HIS OPTION, MAY USE LOW-RELAXATION STRANDS IN LIEU OF STRESS RELIEVED STRANDS. DESIGN AND STRAND PATTERN MUST PROVIDE AT LEAST THE SAME NET COMPRESSIVE STRESS AFTER THE LOSSES. THE ULTIMATE STRENGTH OF THE GIRDER MUST MEET THE REQUIREMENTS OF THE APPLICABLE AASHTO SPECIFICATIONS. LOW-RELAXATION STRANDS SHALL BE TENSIONED AND ANCHORED AT A LOAD EQUAL TO 75% OF ITS ULTIMATE STRENGTH. THIS APPLIED PRESTRESSING FORCE SHALL BE SHOWN ON THE PLANS. SIZE OF LOW-RELAXATION STRANDS SHALL NOT BE LARGER THAN THOSE SHOWN FOR STRESS RELIEVED STRANDS. DESIGN AND DETAIL PLANS USING LOW-RELAXATION STRANDS MUST BE SUBMITTED TO THE HEAD OF STRUCTURE DESIGN UNIT FOR APPROVAL. ANY ADDITIONAL COST DUE TO THE USE OF LOW-RELAXATION STRANDS WILL BE PAID FOR BY THE CONTRACTOR.

THE SAME TYPE AND SAME SIZE STRANDS SHALL BE USED FOR ALL GIRDERS IN THE STRUCTURE.

ALL PRESTRESSING STRANDS SHALL BE 7-WIRE STRESS RELIEVED OR LOW-RELAXATION GRADE 270 STRANDS AND SHALL CONFORM TO ASTM A-416 EXCEPT FOR SAMPLING REQUIREMENTS WHICH SHALL BE IN ACCORDANCE WITH THE STANDARD SPECIFICATIONS.

WHEN USED ON 90° SKEW, NOTCH IN TOP FLANGE OF GIRDER MAY BE OMITTED.

ALL REINFORCING STEEL SHALL BE GRADE 60.

APPLY EPOXY PROTECTIVE COATING TO END OF GIRDER SURFACES. FOR EPOXY PROTECTIVE COATING, SEE SPECIAL PROVISIONS.

ELASTOMER IN ALL BEARINGS SHALL HAVE A GRADE 50 DUROMETER HARDNESS. SEE SPECIAL PROVISIONS.

STEEL PLATES IN LAMINATED BEARINGS SHALL CONFORM TO ASTM A-36.



EMBEDDED PLATE "B-1" SHALL BE GALVANIZED.

THE CONTRACTOR MAY SELECT OPTION "1" OR OPTION "2" FOR EMBEDDED PLATE "B-1".

BEVEL EDGES OF PLATE "B-1" TO GIVE CLOSE FIT BUT NOT TIGHT FIT TO STEEL CASTING FORM.

DEFORMED ANCHOR STUDS SHALL CONFORM TO ASTM A-496. WELDING PROCEDURE QUALIFICATION TEST FOR DEFORMED ANCHOR STUDS MAY BE REQUIRED.

ENDS OF ALL PRESTRESSED STRANDS SHALL BE RECESSED AND GROUTED. SEE DETAIL BELOW. GROUT TO BE NON-METALLIC, NON-SHRINK AND SHALL BE APPROVED BY THE ENGINEER. SEE SPECIAL PROVISIONS.

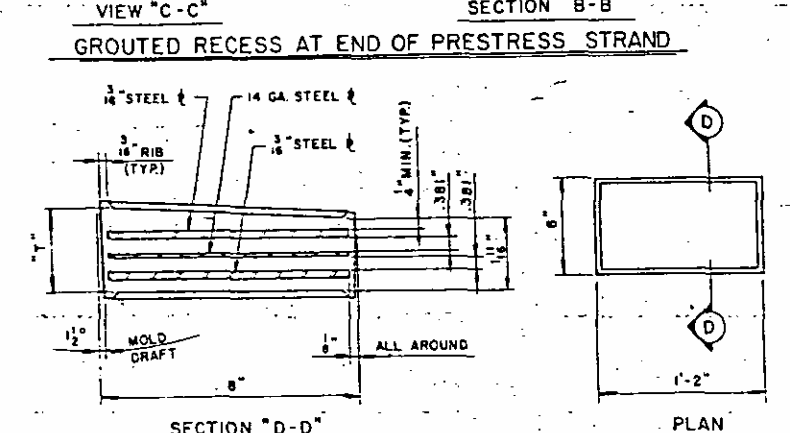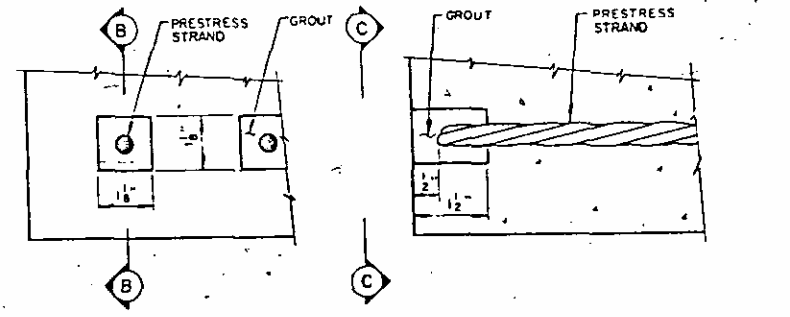

BEARING TYPE	THICKNESS "T"	GIRDER GRADE (%)	NUMBER REQUIRED
P1	1 1/2"	0.00 - 1.00	8
P2	1 1/2"	1.00 - 2.25	8
P3	1 1/2"	2.25 - 3.50	8
P4	2 1/4"	3.50 - 5.50	8


**ELASTOMERIC BEARING DETAILS**

**GRADE 270 S. R. STRANDS**

	7/16" $\phi$	1/2" $\phi$
AREA (SQUARE INCHES)	0.115	0.153
ULTIMATE STRENGTH (LBS. PER STRAND)	31,000	41,300
APPLIED PRESTRESS (LBS. PER STRAND)	21,700	28,900

**REINFORCING STEEL FOR ONE GIRDER**

BAR	NUMBER	SIZE	TYPE	LENGTH	WEIGHT
S1	29	#4	1	6'-10"	133
S2	8	#5	1	6'-10"	57
S3	4	#6	2	3'-8"	22
S4	4	#6	2	3'-5"	21
S5	12	#4	3	2'-4"	19
S6	2	#6	4	9'-2"	28
S7	8	#4	3	2'-1"	11

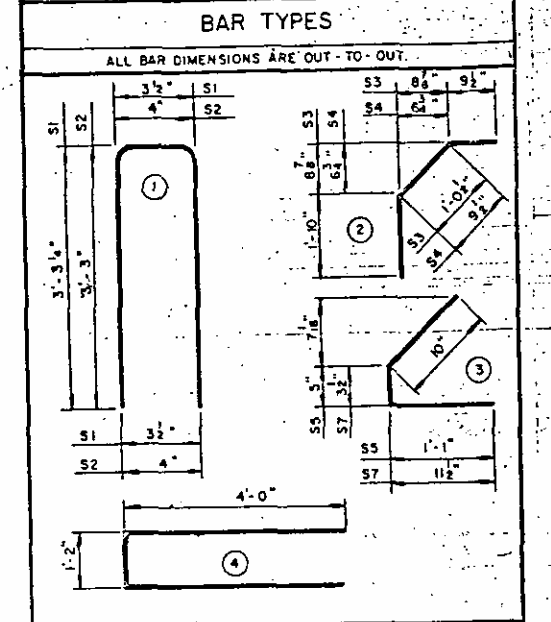

**QUANTITIES FOR ONE GIRDER**

REINFORCING STEEL	5,000 PSI CONCRETE	7" $\phi$ S.R. STRANDS	1/2" $\phi$ S.R. STRANDS	
			LB	CY
291	3.2	14	10	

**GIRDERS REQUIRED**

NUMBER	LENGTH	TOTAL LENGTH
4	34'-0 3/4"	136'-3"

**PROJECT No. 8.1125805**

**EDGEcombe COUNTY**

**STATION: 20+00.00 -YII-763+19.06 -L-**

STATE OF NORTH CAROLINA  
**DEPARTMENT OF TRANSPORTATION**  
 RALEIGH

**STANDARD**  
**36" PRESTRESSED CONCRETE GIRDER**  
**SPAN "D"**

SEPT. 1980

**REVISIONS**

NO.	BY	DATE	NO.	BY	DATE
1	JEC	9-18-85	3		

**SHEET 16**

**TOTAL SHEETS**

REVISIONS: 9-11-81 BY: ERL; 7-9-81 BY: REK; 4-16-80 BY: CCM; 3-10-80 BY: RDU; 1-19-82 BY: ERL; 6-16-82 BY: ERL; 7-14-82 BY: ERL; 8-20-82 BY: R.G.G.; 1-19-82 BY: RDU.

ASSEMBLED BY: J.W. ROBINSON DATE: FEB. 1984 SPECIAL

CHECKED BY: A.M. SMITH DATE: FEB. 1984

DRAWN BY: C.C. MITCHNER DATE: SEPT 1980 STANDARD

CHECKED BY: R.D. UNDERWOOD DATE: SEP 10, 1980

Rev. #1: Revised to change Deflection in table. By: SEC ✓ By: TVR date: 9/18/85


DWG. 5-13

STD. NO. PCGI

REV. NO.	DESCRIPTION	DATE
1	REVISED BEAM SEAT DIMENSIONS	2-20-86
2	REVISIONS	BY: SKC


**NOTES**

1. PIPE DRAINS MAY BE SHIFTED SLIGHTLY AS NECESSARY TO CLEAR REINFORCING STEEL.
2. THE TOP SURFACE AREA OF THE END BENT CAPS SHALL BE CURED IN ACCORDANCE WITH THE STANDARD SPECIFICATIONS EXCEPT THAT THE MEMBRANE CURING COMPOUND METHOD SHALL NOT BE USED.
3. FOR EPOXY PROTECTIVE COATING, SEE SPECIAL PROVISIONS.
4. FOR DETAILS OF P.V.C. PLASTIC PIPE DRAINS, SEE S-15.

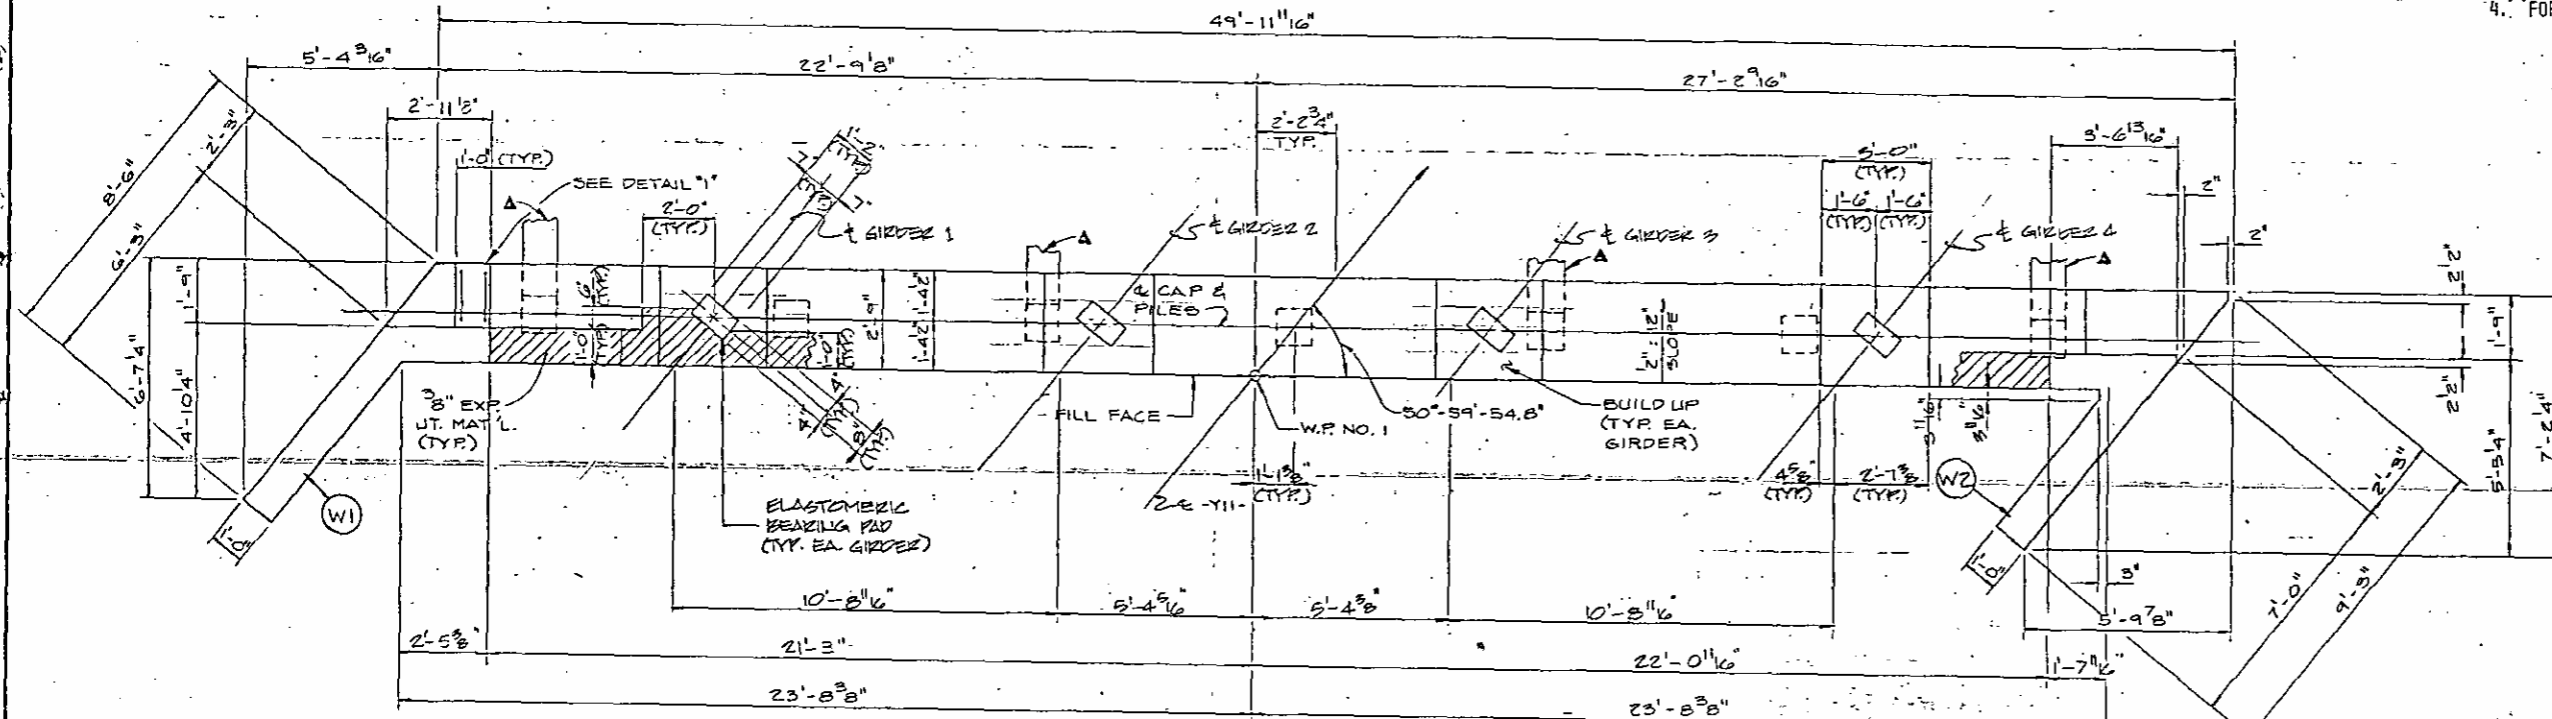


**PLAN END BENT 1**

▲ DENOTES BRACE PILE BATTERED AT 3:12 SLOPE

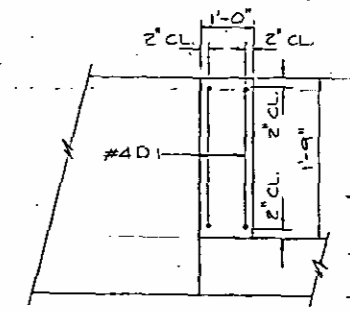


**DETAIL 1**

(RETAINING BLOCK - TYPICAL EACH SIDE)

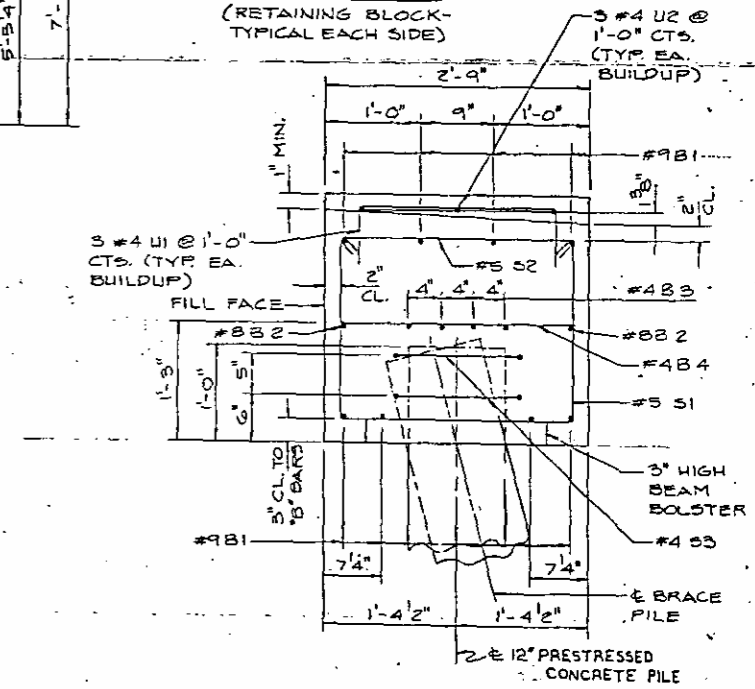

**SECTION A-A**

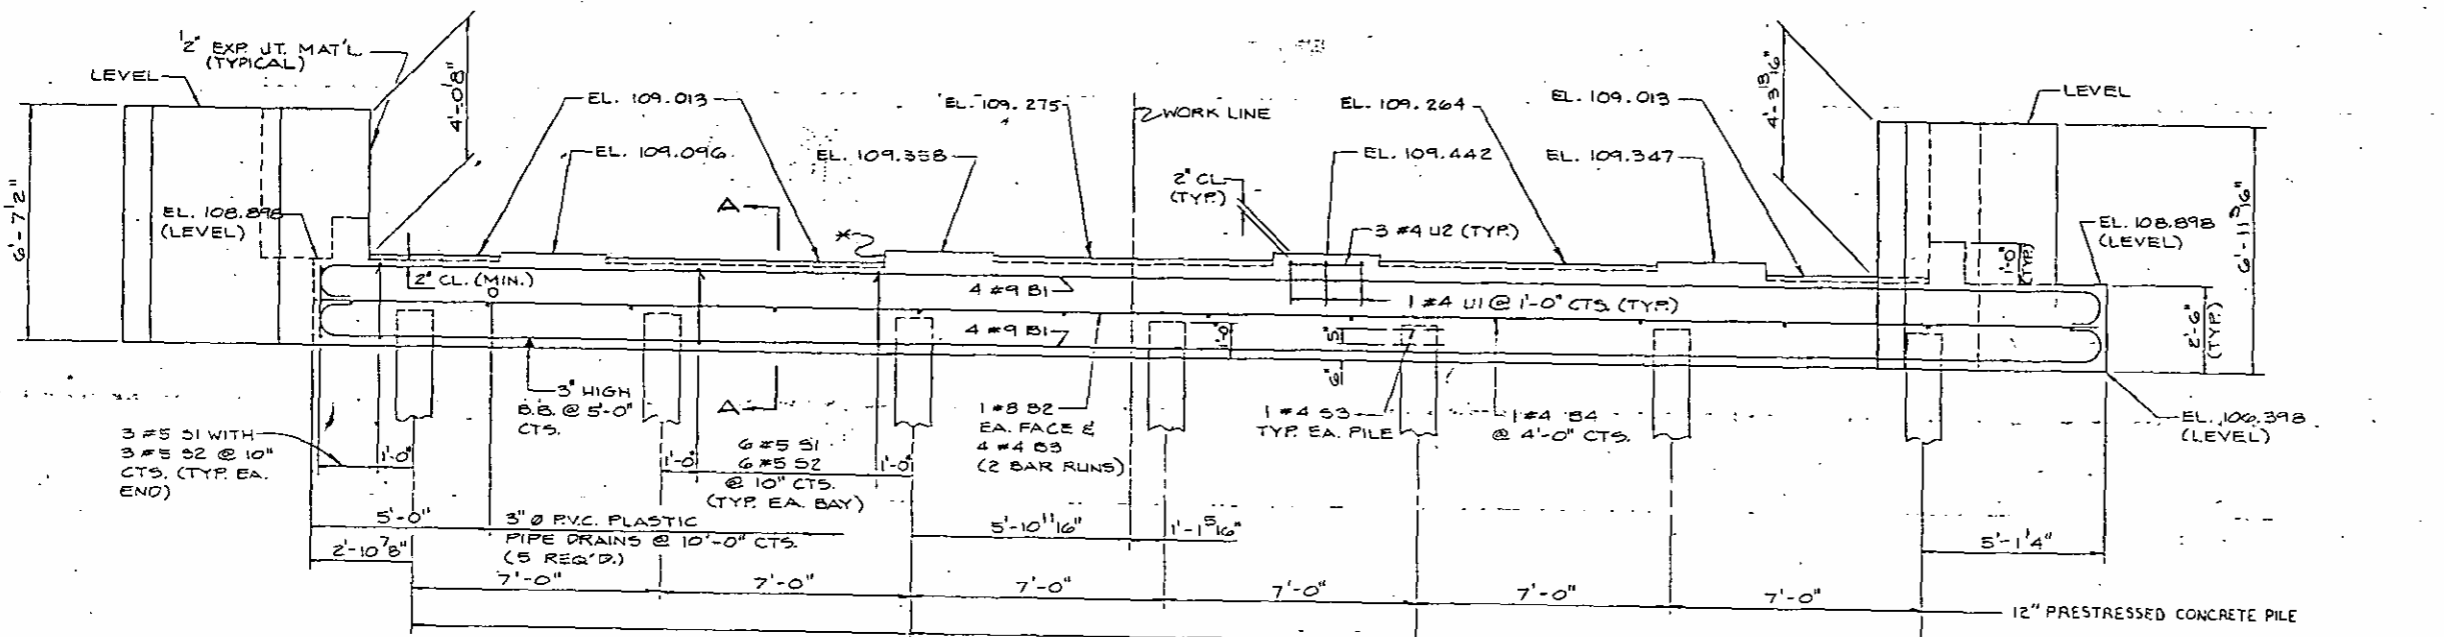

**ELEVATION**

\* 3\"/>

PROJECT No. 8.1125805

EDGEcombe COUNTY

STATION: 20+00.00 - 11-

763+19.06 - L-


SHEET 1 OF 2

STATE OF NORTH CAROLINA					
DEPARTMENT OF TRANSPORTATION					
RALEIGH					
SUBSTRUCTURE					
END BENT 1					
FEBRUARY 1984					
REVISIONS					
NO.	BY	DATE	NO.	BY	DATE
1	AMS	2-20-86	3		
2			4		


DRAWN BY: J.W. ROBINSON DATE: FEB. 1984  
 CHECKED BY: KOSZ DANCAN DATE: FEB. 1984

REVISED BEAM SEAT DIMENSIONS BY: AMS ✓ BY: SKC DATE: 2-26-86


DWG. S-14

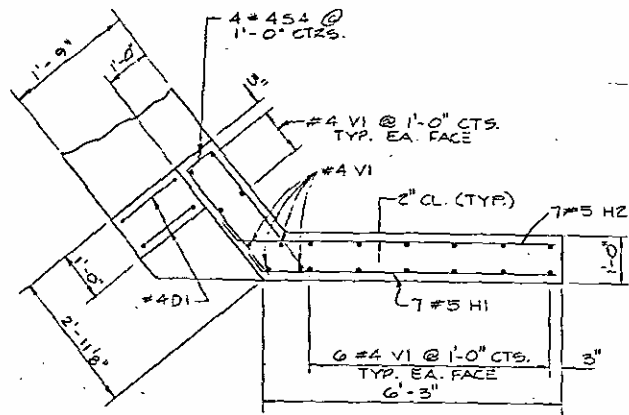


PLAN LEFT WING W1

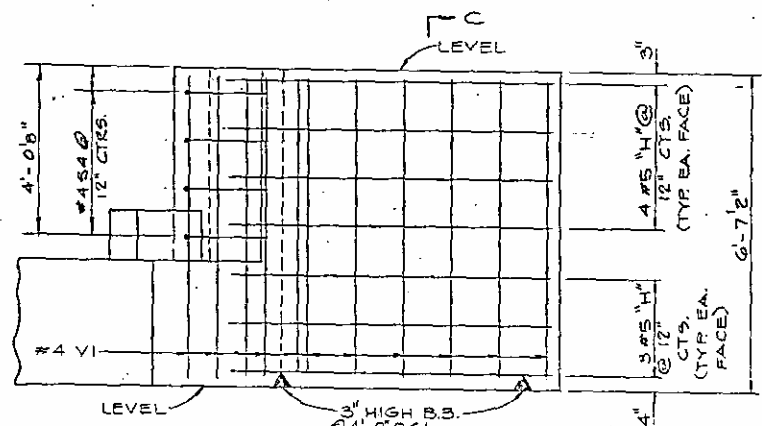


ELEVATION LEFT WING W1

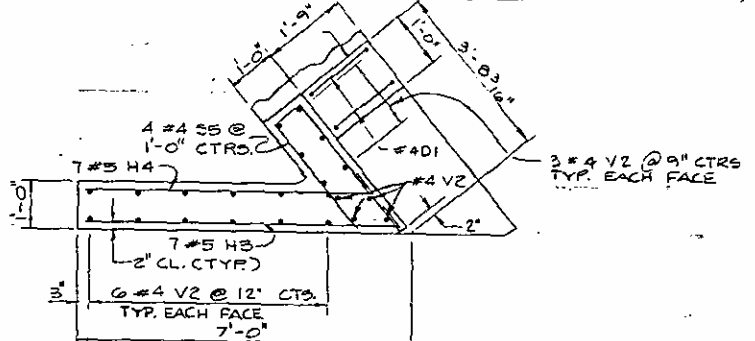


PLAN RIGHT WING W2

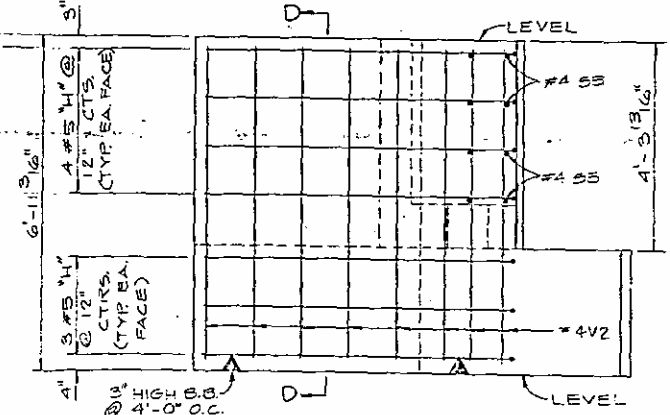

ELEVATION RIGHT WING W2

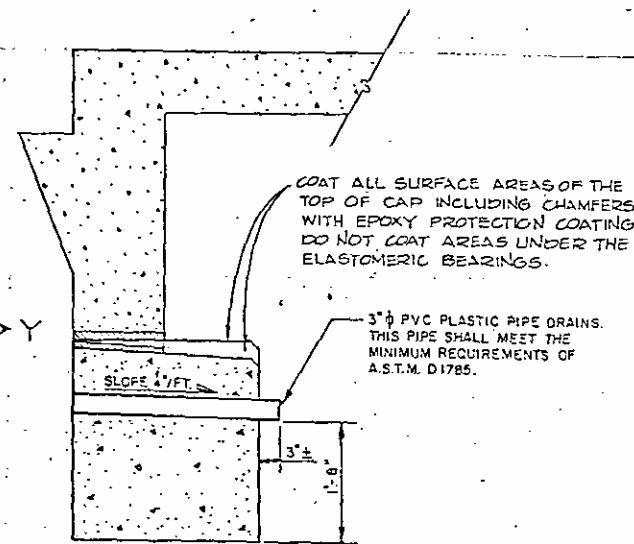


SECTION THRU CAP

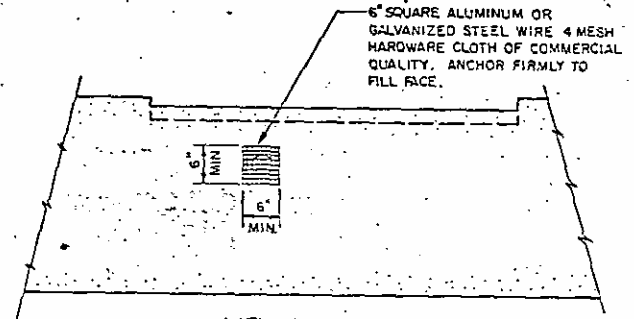


VIEW Y-Y

NOTE: NO SEPARATE PAYMENT WILL BE MADE FOR FURNISHING AND INSTALLING THE PVC PLASTIC PIPE DRAINS, HARDWARE CLOTH AND FASTENERS. THE ENTIRE COST OF THIS WORK SHALL BE INCLUDED IN THE UNIT CONTRACT PRICE BID FOR THE SEVERAL PAY ITEMS.


PIPE DRAIN DETAILS

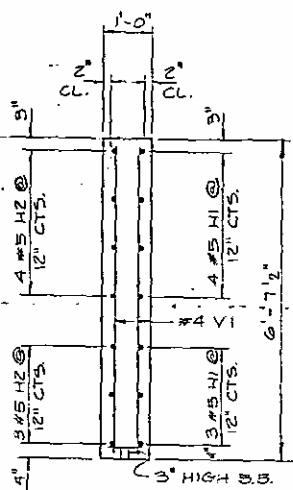

SECTION C-C

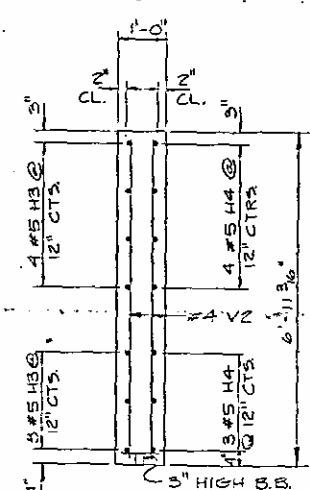

SECTION D-D

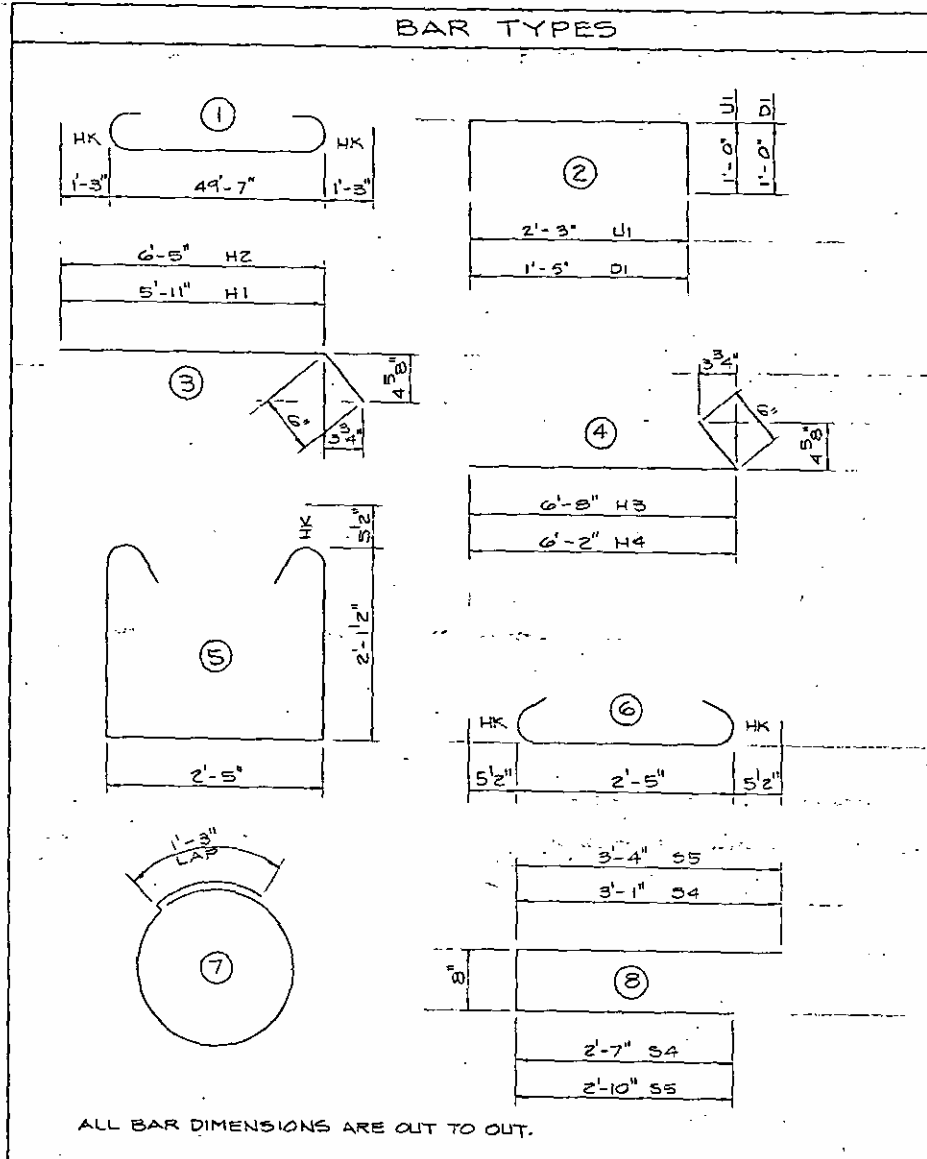

ALL BAR DIMENSIONS ARE OUT TO OUT.

BILL OF MATERIAL					
END BENT 1					
BAR NO.	SIZE	TYPE	LENGTH	WEIGHT	
B1	8	9	1	52'-1"	1417
B2	2	8	STR.	49'-7"	269
B3	8	4	STR.	25'-5"	136
B4	12	4	STR.	2'-5"	20
D1	4	4	2	5'-1"	14
H1	7	5	3	6'-5"	47
H2	7	5	3	6'-11"	51
H3	7	5	4	7'-2"	53
H4	7	5	4	6'-8"	49
S1	42	5	5	7'-7"	333
S2	42	5	6	3'-4"	147
S3	14	4	7	6'-0"	57
S4	4	4	8	6'-4"	17
S5	4	4	8	6'-10"	19
U1	12	4	2	4'-3"	35
U2	12	4	STR.	2'-8"	22
V1	20	4	STR.	6'-2"	83
V2	22	4	STR.	6'-5"	95
TOTAL LBS.				=	2,860
REINFORCING STEEL LBS. = 2,860					
CLASS "A" CONCRETE CU. YDS. = 17.3					
12" PRESTRESSED CONCRETE PILE					
NO. = 7 LIN. FT. = 75.0' @ 434.0'					
CONCRETE DISPLACED BY PILE HEADS HAS BEEN DEDUCTED					


PROJECT NO. 8.1125805  
 EDGEcombe COUNTY  
 STATION: 20+00.00-Y11  
 SHEET 2 OF 2 763+19.06-L-

STATE OF NORTH CAROLINA DEPARTMENT OF TRANSPORTATION RALEIGH					
SUBSTRUCTURE END BENT 1					
FEBRUARY 1964					
REVISIONS					
NO.	BY	DATE	NO.	BY	DATE
1			3		
2			4		

SHEET NO. 163  
TOTAL SHEETS

DRAWN BY J.W. ROBINSON DATE FEB. 1964  
 CHECKED BY A.M. SMITH DATE FEB. 1964


DWG. 5-15

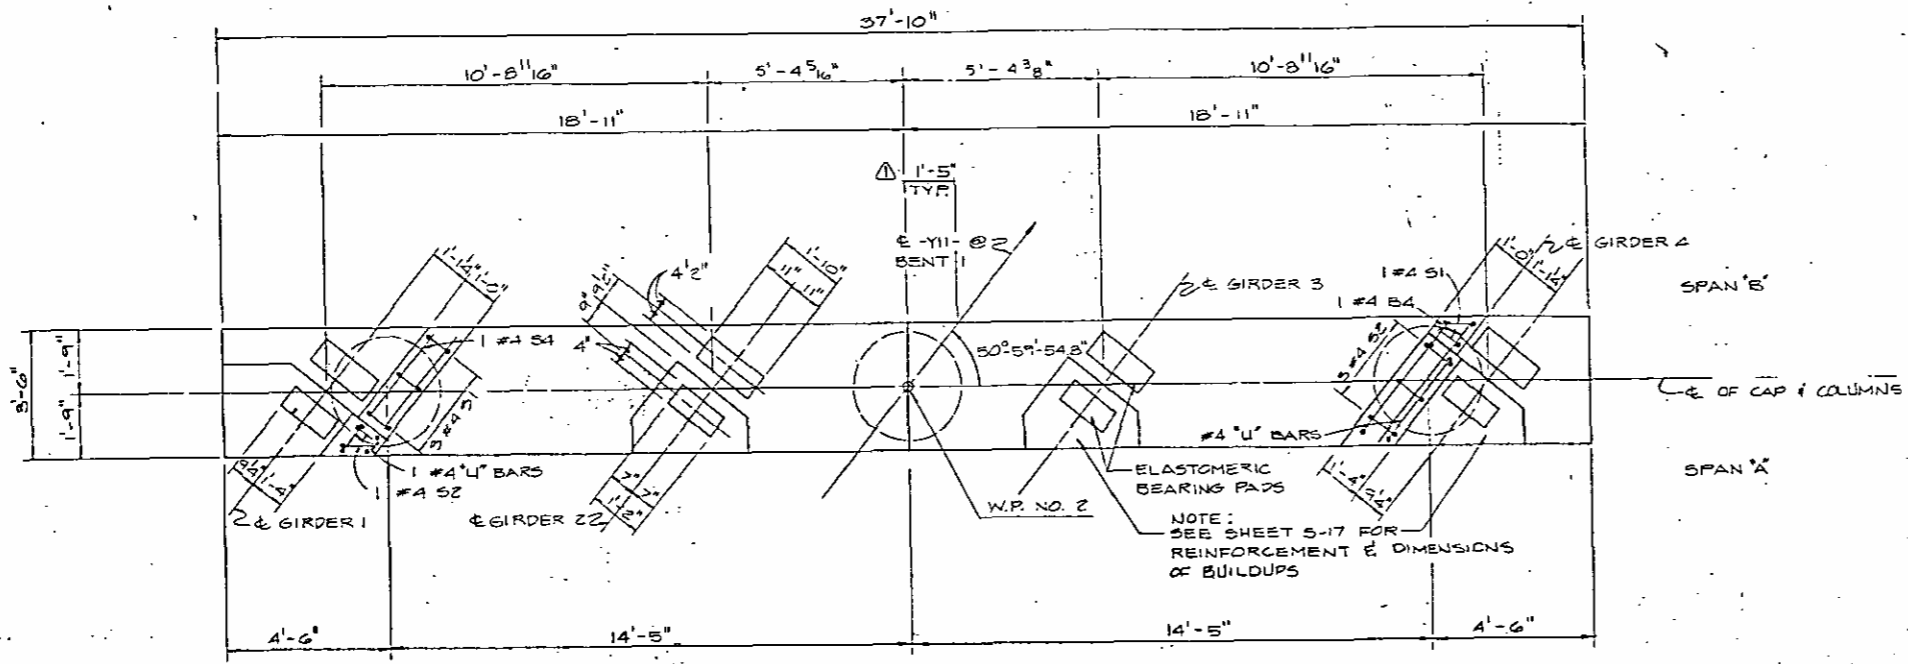

PLAN

BENT 1 (LOOKING AHEAD ON SURVEY)

NOTE A: CONSTRUCTION JOINT PERMITTED AT TOP OF CAP

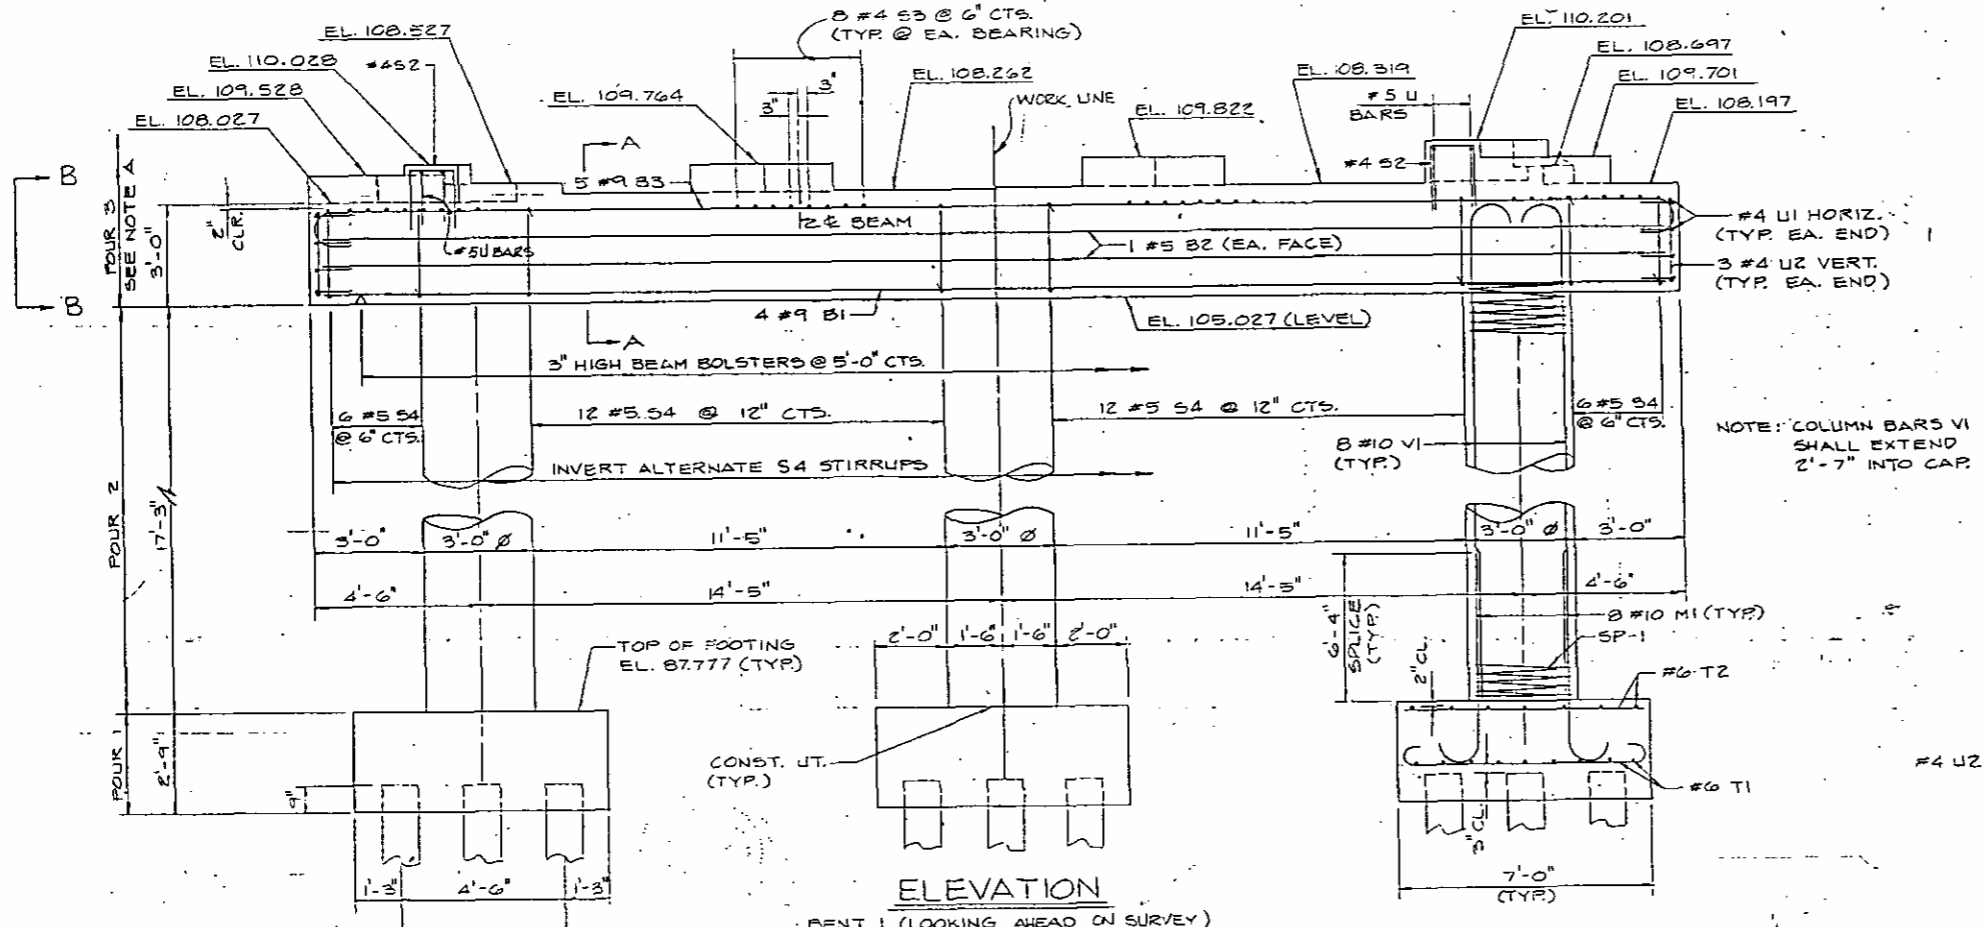

ELEVATION

BENT 1 (LOOKING AHEAD ON SURVEY)

NOTES


HOOKS ON "V" BARS MAY BE TURNED AS NECESSARY FOR PLACING REINFORCING STEEL. THE TOP SURFACE AREA OF THE BENT CAP SHALL BE CURED IN ACCORDANCE WITH THE STANDARD SPECIFICATIONS EXCEPT THE MEMBRANE CURING COMPOUND METHOD SHALL NOT BE USED.

FOR EPOXY PROTECTIVE COATING FOR CONCRETE, SEE SPECIAL PROVISIONS.


COAT ALL SURFACE AREAS OF TOP OF CAP INCLUDING LATERAL GUIDES & CHAMBERS WITH EPOXY PROTECTIVE COATING. DO NOT COAT AREA UNDER ELASTOMERIC BEARINGS.

FOR SPIRAL COLUMN REINFORCING, SEE SPECIAL PROVISIONS.

REV. NO.	DESCRIPTION	DATE
1	REVISED DIMENSION AS NOTED	2-20-83
REVISIONS		

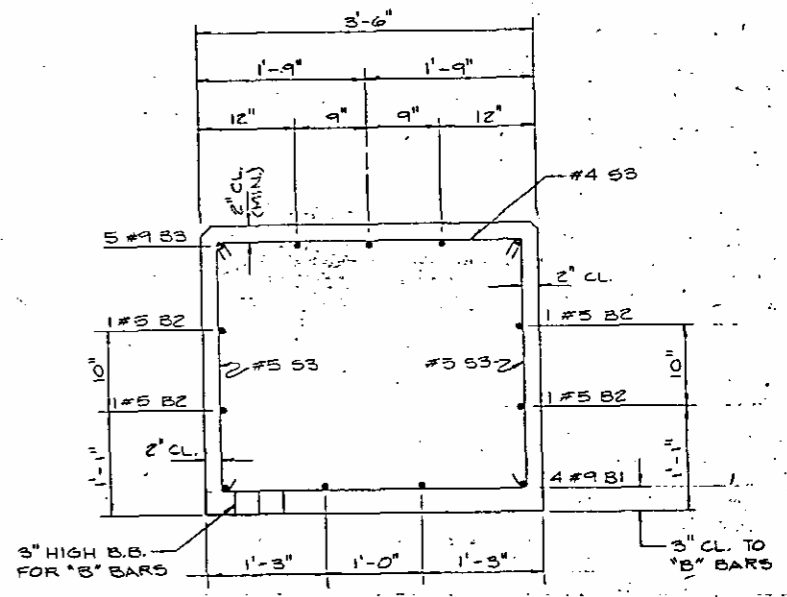

SECTION A-A

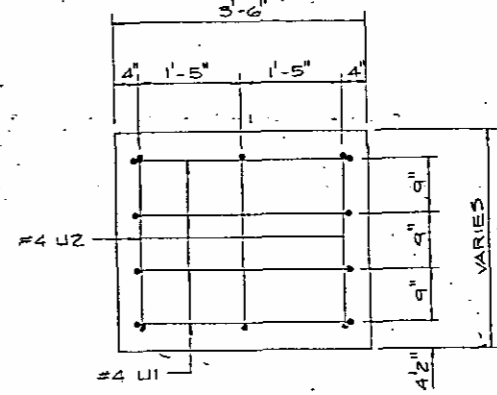

VIEW B-B

PROJECT No. 8.1125805  
 EDGECOMBE COUNTY  
 STATION: 20+00.00 -Y11-  
 763+19.06 -L-

SHEET 1 OF 2


STATE OF NORTH CAROLINA					
DEPARTMENT OF TRANSPORTATION					
RALEIGH					
SUBSTRUCTURE					
BENT 1					
FEBRUARY 1984					
REVISIONS			SHEET NO.		
NO.	BY	DATE	NO.	BY	DATE
1	AMS	2-20-83	3		
2			4		
					TOTAL SHEETS
					164

DWG. 5-16

DRAWN BY J.W. ROBINSON DATE FEB. 1984  
 CHECKED BY JOSE DANCAN DATE FEB. 1984

REV A REVISED DIMENSION AS NOTED BY AMS ✓ BY: SKC DATE: 2-26-86







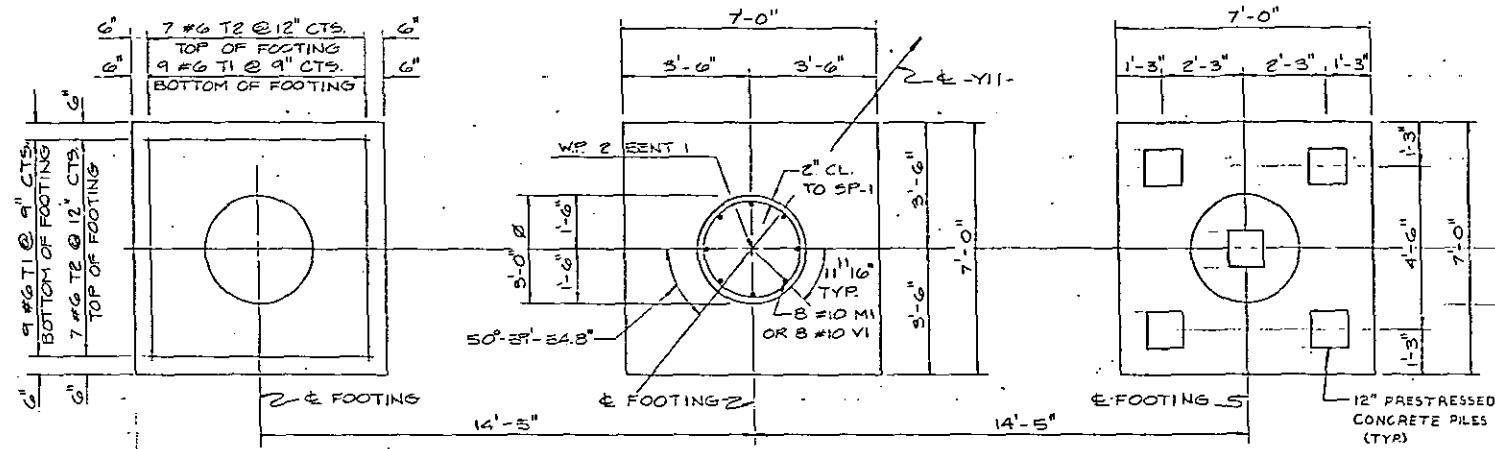

**PLAN OF FOOTINGS**  
DATA SHOWN TYPICAL FOR EACH FOOTING

NOTE: BUILDUPS NOT SHOWN FOR CLARITY.

**BAR TYPES**

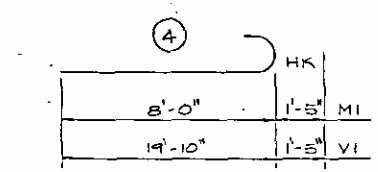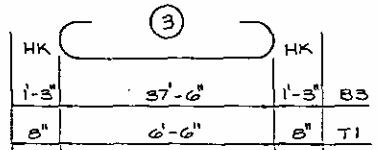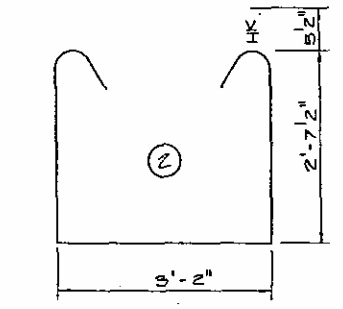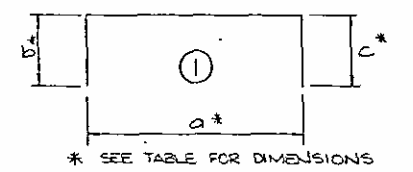


TYPE (1) BAR			
BAR	a	b	c
S1	8"	1'-6"	1'-6"
S2	1'-0"	2'-10"	2'-10"
U1	3'-2"	6"	6"
U2	2'-8"	6"	6"
U4	1'-10"	2'-8"	2'-8"
U5	2'-11"	2'-8"	2'-8"
U6	1'-6"	2'-8"	2'-8"
U7	11"	2'-8"	2'-8"
U9	3'-3"	3'-1"	3'-1"
U10	2'-7"	3'-1"	3'-1"
U13	1'-3"	2'-8"	2'-8"
U14	2'-7"	2'-8"	2'-8"
U15	11"	3'-1"	3'-1"
U16	5"	3'-1"	3'-1"
U17	2'-0"	3'-9"	1'-7"
S3	3'-2"	4'-2"	4'-2"
U8	2'-9"	8"	8"

**BILL OF MATERIAL**


BENT 1						
BAR	NO.	SIZE	TYPE	LENGTH	WEIGHT	
B1	4	9	STR.	37'-6"	510	
B2	4	8	STR.	37'-6"	157	
B3	5	9	3	40'-0"	680	
B4	4	4	STR.	3'-6"	10	
M1	24	10	4	9'-5"	973	
S1	5	4	1	3'-8"	13	
S2	5	4	1	6'-8"	23	
S3	32	4	1	3'-11"	84	
S4	36	5	2	9'-4"	551	
T1	54	6	3	7'-10"	636	
T2	42	6	STR.	6'-6"	411	
U1	8	4	1	4'-2"	23	
U2	6	4	1	3'-8"	15	
U3	4	5	5	3'-10"	16	
U4	2	5	1	7'-2"	15	
U5	4	5	1	7'-5"	31	
U6	4	5	1	6'-10"	29	
U7	3	5	1	6'-3"	20	
U8	4	5	1	4'-1"	18	
U9	1	5	1	9'-5"	10	
U10	1	5	1	8'-9"	10	
U11	2	5	5	6'-3"	14	
U12	2	5	5	5'-3"	11	
U13	1	5	1	6'-7"	7	
U14	1	5	1	7'-11"	9	
U15	1	5	1	7'-1"	8	
U16	1	5	1	6'-7"	7	
U17	2	5	1	7'-4"	16	
U18	2	5	5	3'-3"	7	
VI	24	10	4	21'-3"	2,195	
TOTAL					6,309	
SP-1	3	6		717'-5"	1,439	
REINFORCING STEEL LBS. = 6,309						
SPIRAL COLUMN REIN. STEEL LBS. = 1,439						
* CLASS "A" CONCRETE CU. YDS = 45.7						
EXCAVATION (BENT 1) CU. YDS = 67						
12" PRESTRESSED CONCRETE PILE 718.0						
BENT 1 NO. 15 UN. FT. = 675						
DIVISION OF CONCRETE						
FOUR NUMBER				CU. YDS		
1				14.6		
2				13.6		
3				17.5		
TOTAL				45.7		

\* CONCRETE DISPLACED BY PILE HEADS HAS BEEN DEDUCTED.

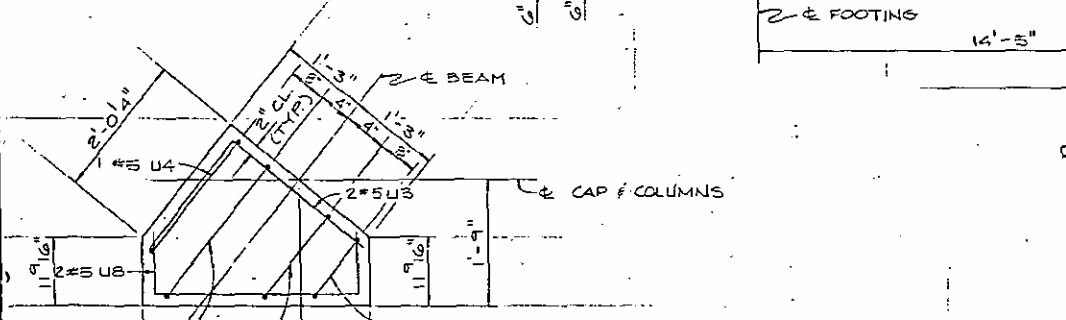


**BUILDUP FOR GIRDER 2 & 3**

**BUILDUP FOR GIRDER 4**

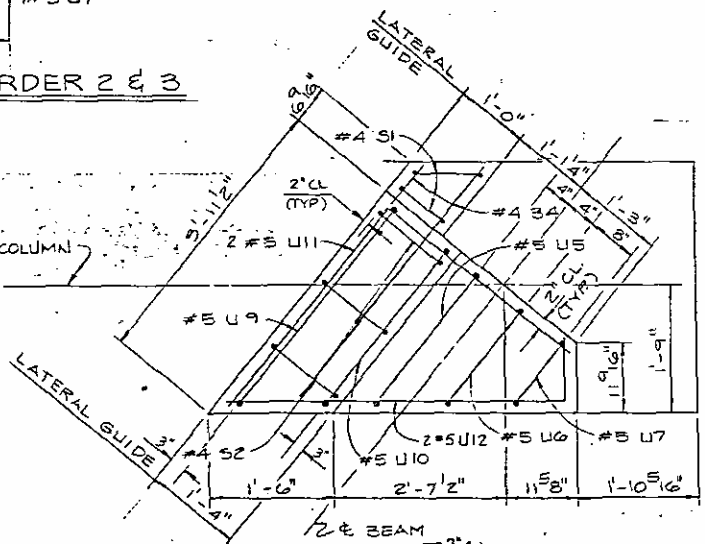


\* TYP. ALL BUILDUPS

**ELEVATION OF BUILDUP FOR GIRDER 4**  
(OTHER BUILDUPS SIMILAR)

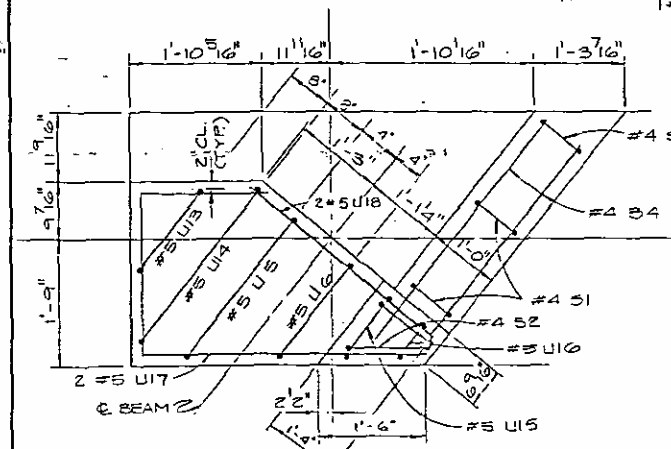


**BUILDUP FOR GIRDER 1**

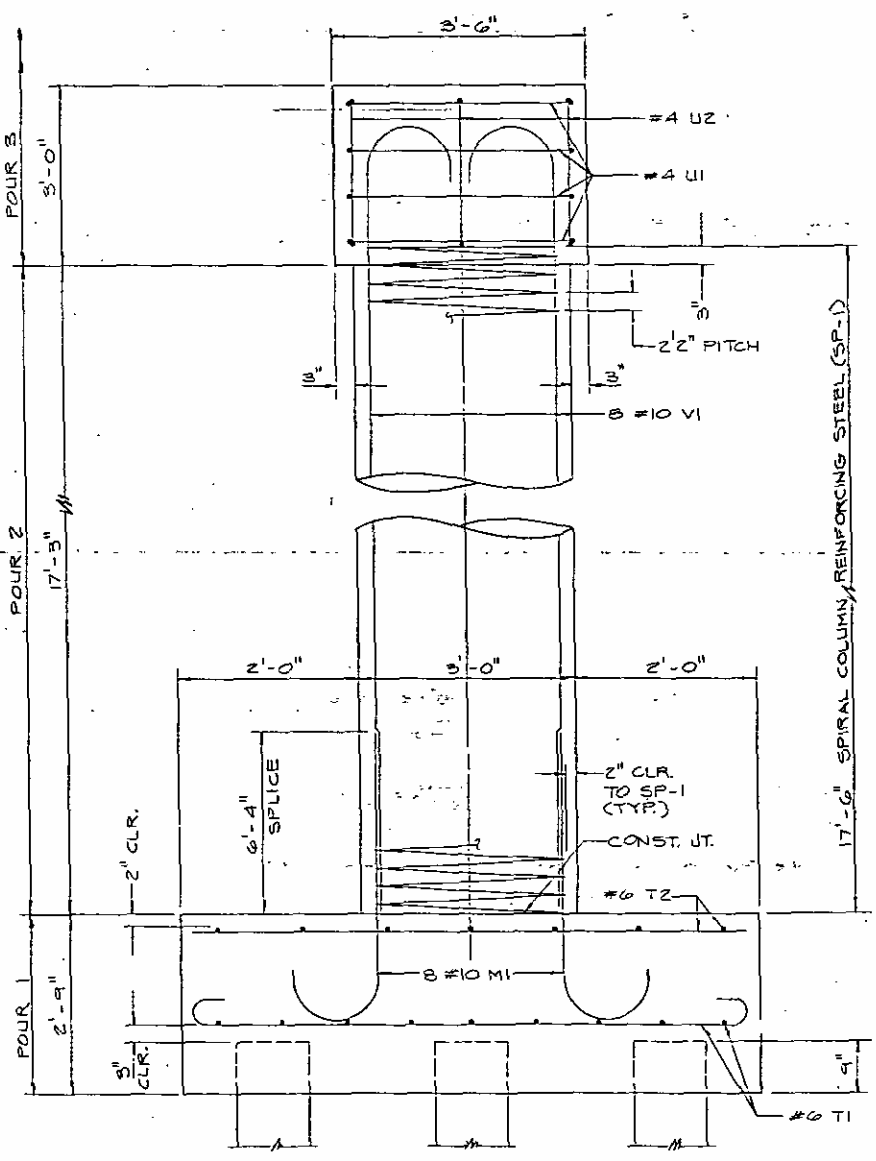

**END ELEVATION**

ALL BAR DIMENSIONS ARE OUT TO OUT.

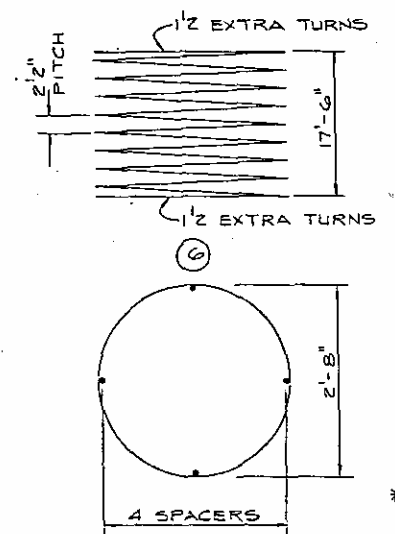

PROJECT No. 8.1125805  
EDGEcombe COUNTY  
STATION: 20+00.00 -Y11-  
763+19.06 -L-

STATE OF NORTH CAROLINA  
DEPARTMENT OF TRANSPORTATION  
RALEIGH  
SUBSTRUCTURE  
BENT 1

REVISIONS					
NO.	BY	DATE	NO.	BY	DATE
1			3		
2			4		

FEBRUARY 1984  
SHEET NO. 165  
TOTAL SHEETS

NOTES


HOOKS ON "V" BARS MAY BE TURNED AS NECESSARY FOR PLACING REINFORCING STEEL. THE TOP SURFACE AREA OF THE BENT CAP SHALL BE CURED IN ACCORDANCE WITH THE STANDARD SPECIFICATIONS EXCEPT THE MEMBRANE CURING COMPOUND METHOD SHALL NOT BE USED.

FOR EPOXY PROTECTIVE COATING FOR CONCRETE, SEE SPECIAL PROVISIONS.

COAT ALL SURFACE AREAS OF TOP OF CAP INCLUDING LATERAL GUIDES & CHAMFERS WITH EPOXY PROTECTIVE COATING. DO NOT COAT AREA UNDER ELASTOMERIC BEARINGS.


FOR SPIRAL COLUMN REINFORCING, SEE SPECIAL PROVISIONS.

REV. NO.	DESCRIPTION	DATE
1	REVISED DIMENSION AS NOTED	2-20-86
REVISIONS		

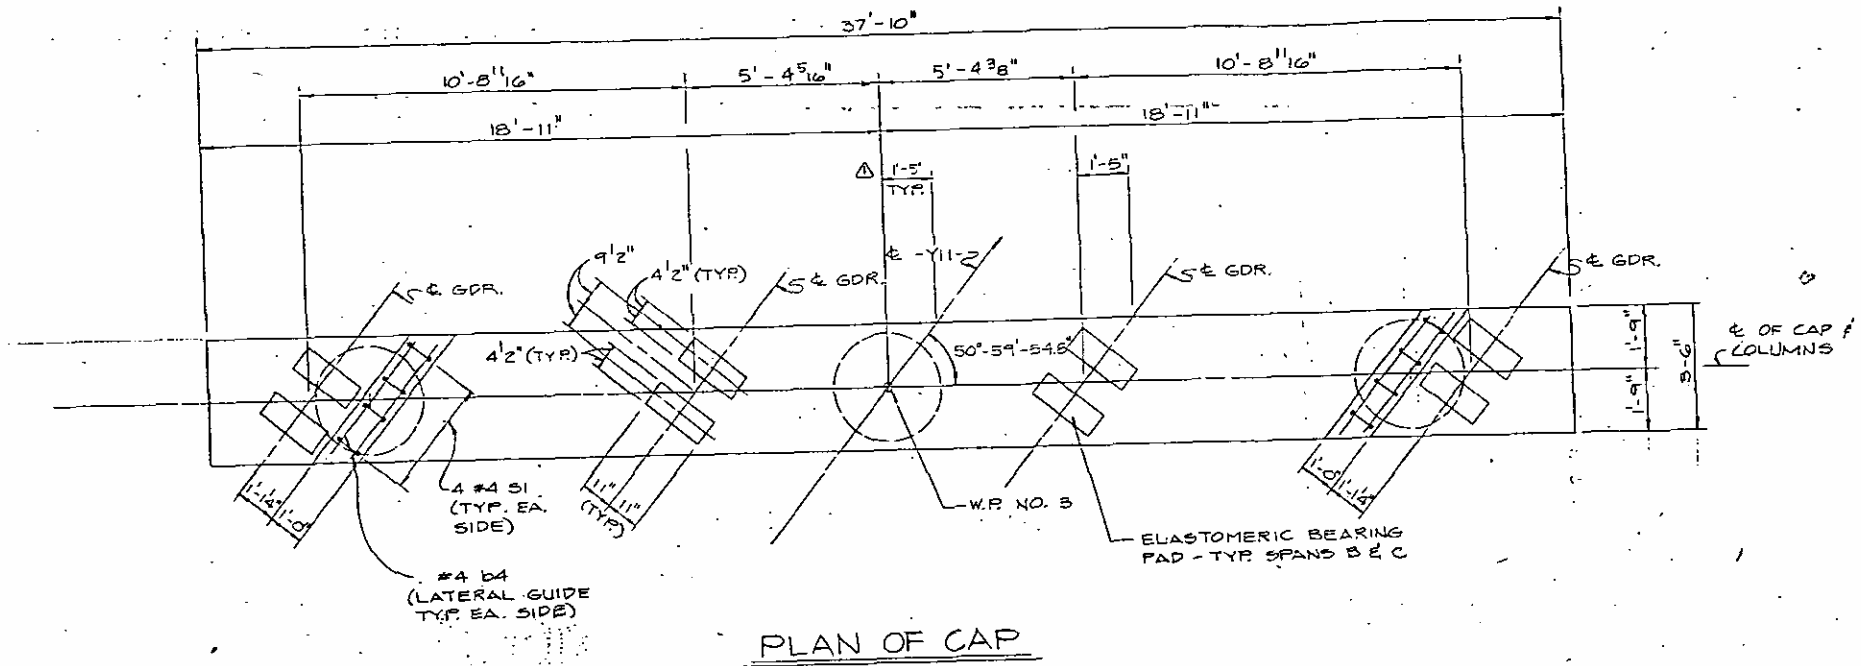


PLAN OF CAP

NOTE A: CONSTRUCTION JOINT PERMITTED AT TOP OF CAP.

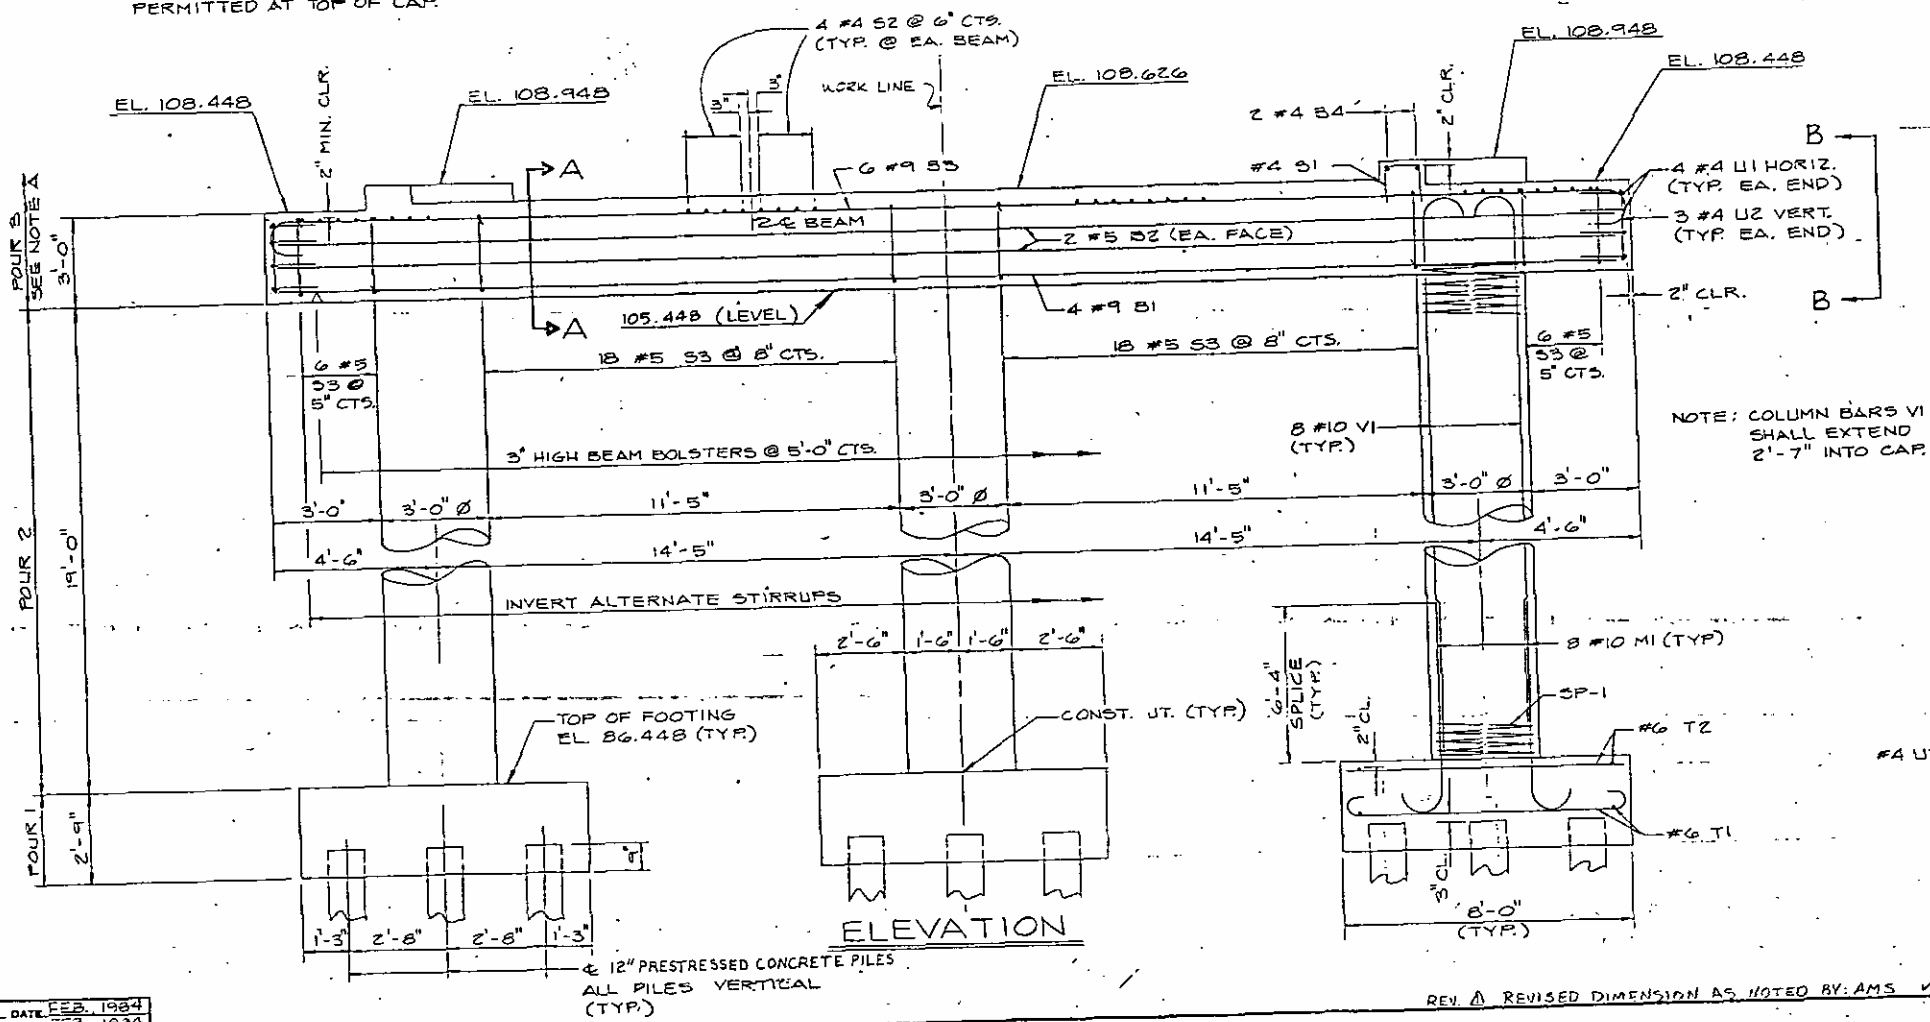

ELEVATION

NOTE: COLUMN BARS V1 SHALL EXTEND 2'-7" INTO CAP.

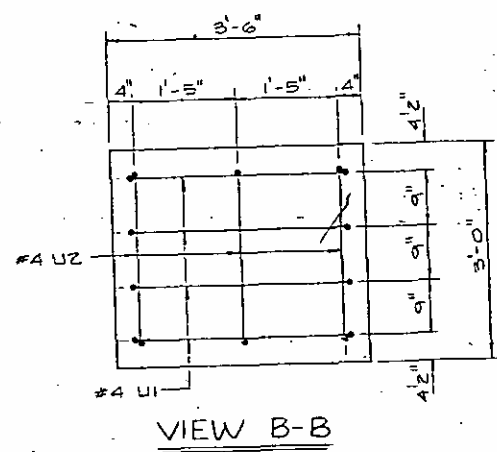

VIEW B-B

PROJECT No. 8.1125805  
 EDGECOMBE COUNTY  
 STATION: 20+00.00 -Y11-  
 =763+19.06 -L-

SHEET 1 OF 2

STATE OF NORTH CAROLINA  
 DEPARTMENT OF TRANSPORTATION  
 RALEIGH

SUBSTRUCTURE  
 BENT 2


FEBRUARY 1984

REVISIONS					
NO.	BY	DATE	NO.	BY	DATE
1	AMS	2-20-86	2		
3			4		


DWG 5-18

NOTE: BUILDUP NOT SHOWN FOR CLARITY.


NOTE: COLUMN BARS VI SHALL EXTEND 2'-7" INTO CAP.

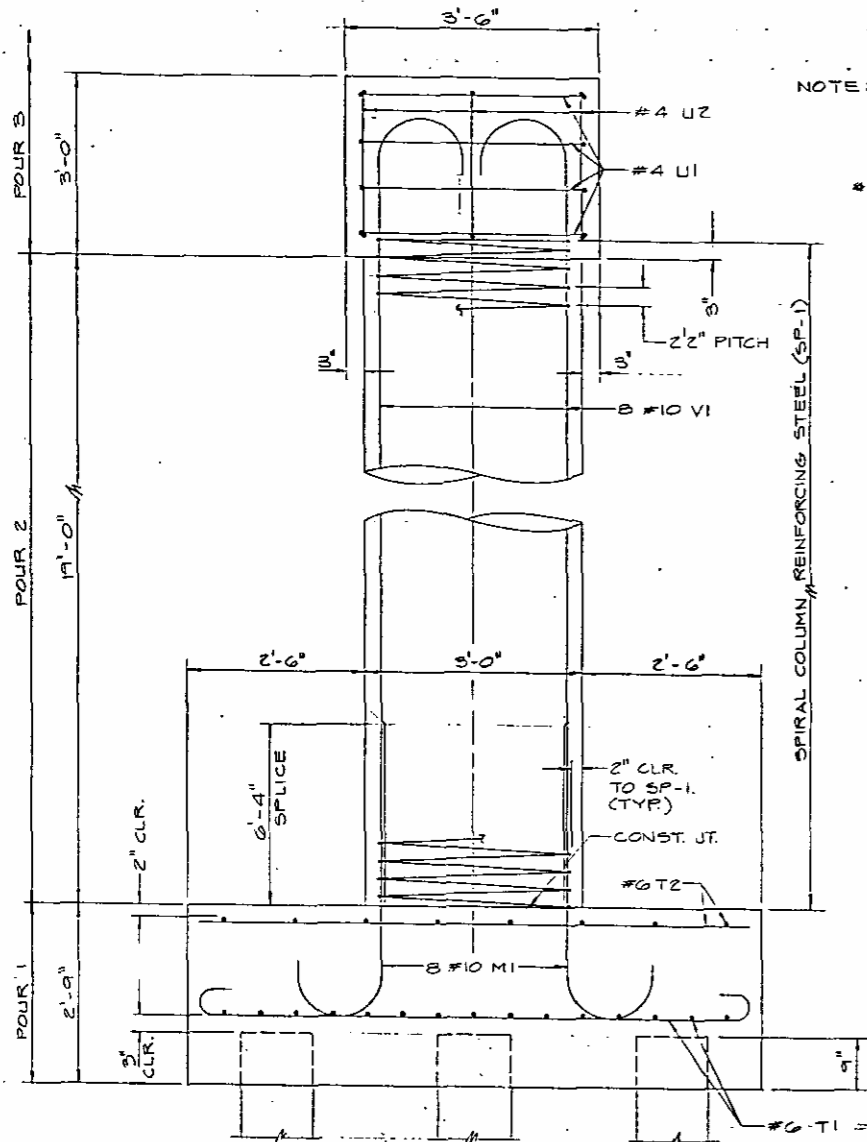




END ELEVATION

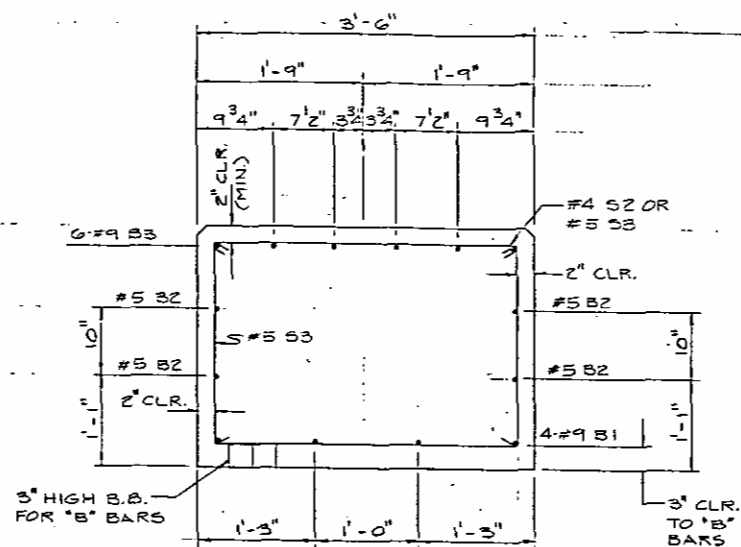

SECTION A-A

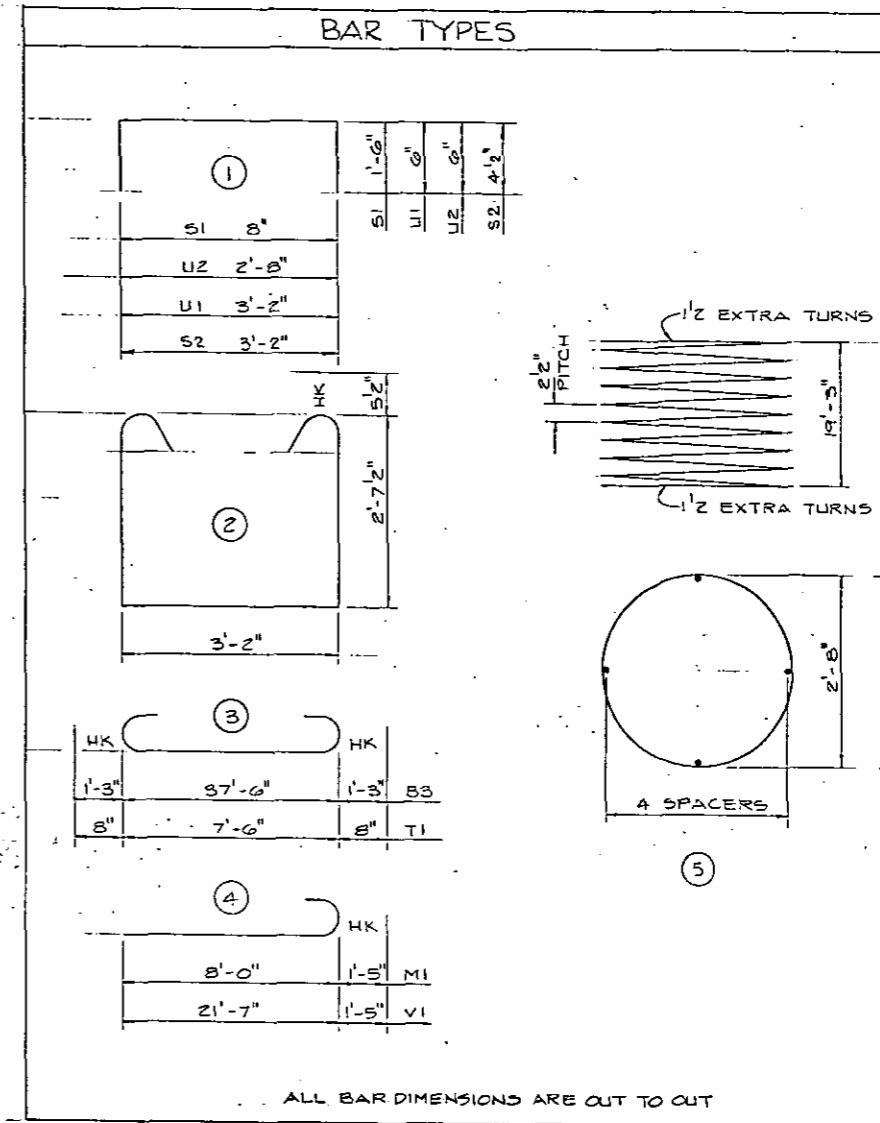

ALL BAR DIMENSIONS ARE OUT TO OUT

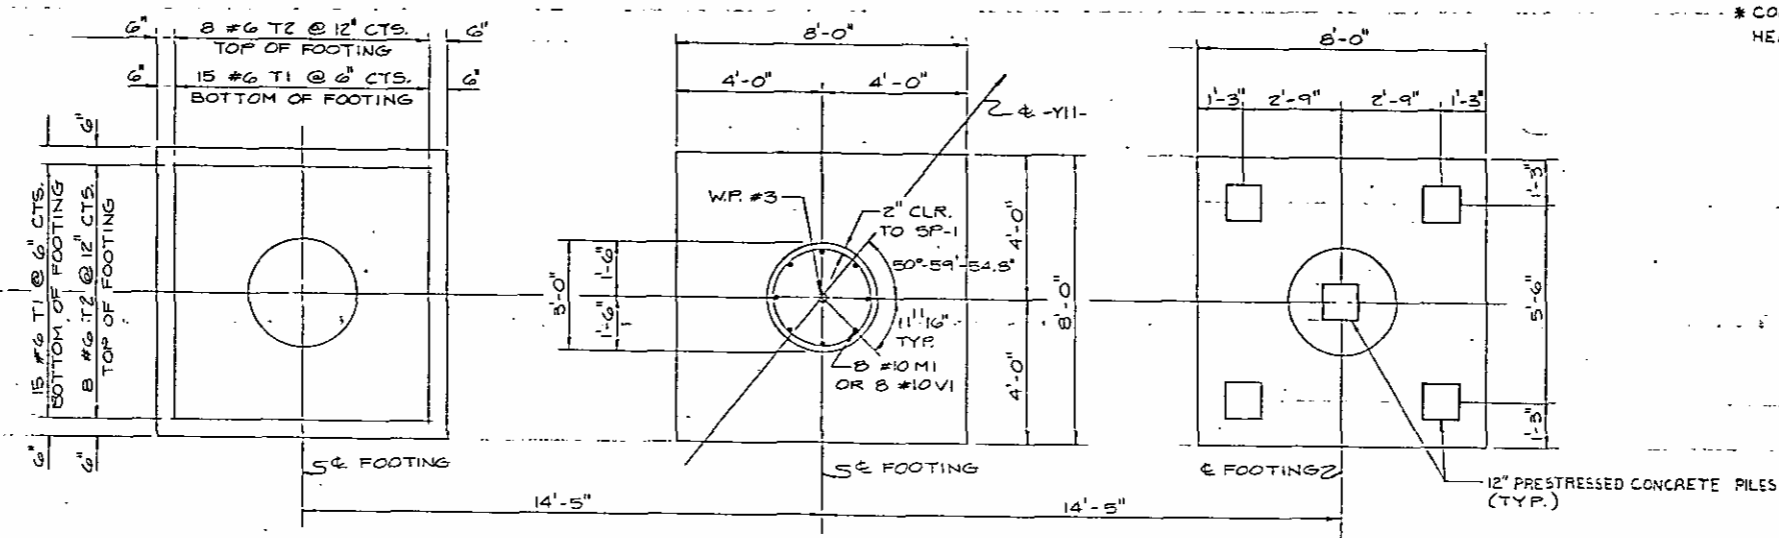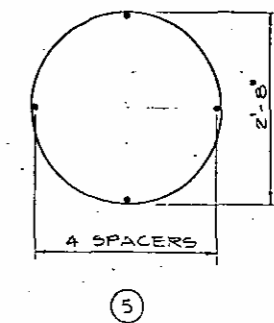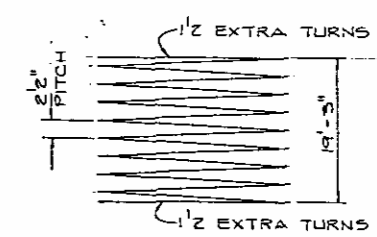

PLAN OF FOOTINGS  
DATA SHOWN TYPICAL FOR EACH FOOTING

BILL OF MATERIAL					
BENT 2					
BAR	NO.	SIZE	TYPE	LENGTH	WEIGHT
B1	4	#9	STR.	37'-6"	510
B2	4	#5	STR.	37'-6"	157
B3	6	#9	S	40'-0"	816
B4	4	#4	STR.	3'-6"	10
M1	24	#10	S	9'-5"	973
S1	8	#4	S	3'-5"	20
S2	32	#4	S	3'-11"	84
S3	48	#3	S	9'-2"	468
T1	90	#6	S	8'-10"	1,195
T2	48	#6	STR.	7'-6"	541
U1	8	#4	S	4'-2"	23
U2	6	#4	S	3'-3"	15
VI	24	#10	S	23'-0"	2,376
TOTAL					7,188
SP-1	3		5	787'-0"	1,578
12" PRESTRESSED CONCRETE PILES					
NO. = 15 LIN. FT. = 275-672.0					
REINFORCING STEEL LBS. = 7,128					
SPIRAL COLUMN REIN. STEEL					
LBS. = 1,578					
* CLASS 'A' CONCRETE CU. YDS. = 49.6					
EXCAVATION CU. YDS. = 76.67					
DIVISION OF CONCRETE					
POUR NUMBER	CUBIC YARDS				
1	19.1				
2	14.9				
3	15.6				
TOTAL	49.6				

PROJECT No. 8.1125805  
EDGEcombe COUNTY  
STATION: 20+00.00 -Y11-  
SHEET 2 OF 2 763+19.06 -L-

STATE OF NORTH CAROLINA  
DEPARTMENT OF TRANSPORTATION  
RALEIGH  
SUBSTRUCTURE  
BENT 2

REVISIONS					
NO.	BY	DATE	NO.	BY	DATE
1			3		
2			4		

FEBRUARY 1984  
SHEET NO. 167  
TOTAL SHEETS


DRAWN BY J.W. ROBINSON DATE FEB. 1984  
CHECKED BY A.M. SMITH DATE FEB. 1984

DWG. 5-19




**NOTES**

HOOKS ON "V" BARS MAY BE TURNED AS NECESSARY FOR PLACING REINFORCING STEEL.  
 THE TOP SURFACE AREA OF THE BENT CAP SHALL BE CURED IN ACCORDANCE WITH THE STANDARD SPECIFICATIONS, EXCEPT THE MEMBRANE CURING COMPOUND METHOD SHALL NOT BE USED.  
 FOR EPOXY PROTECTIVE COATING FOR CONCRETE, SEE SPECIAL PROVISIONS.  
 COAT ALL SURFACE AREAS OF TOP OF CAP INCLUDING LATERAL GUIDES & CHAMBERS WITH EPOXY PROTECTIVE COATING. DO NOT COAT AREA UNDER ELASTOMERIC BEARINGS.  
 FOR SPIRAL COLUMN REINFORCING, SEE SPECIAL PROVISIONS.

REV. NO.	DESCRIPTION	DATE
1	REVISED DIMENSION AS NOTED	2-20-86
REVISIONS		

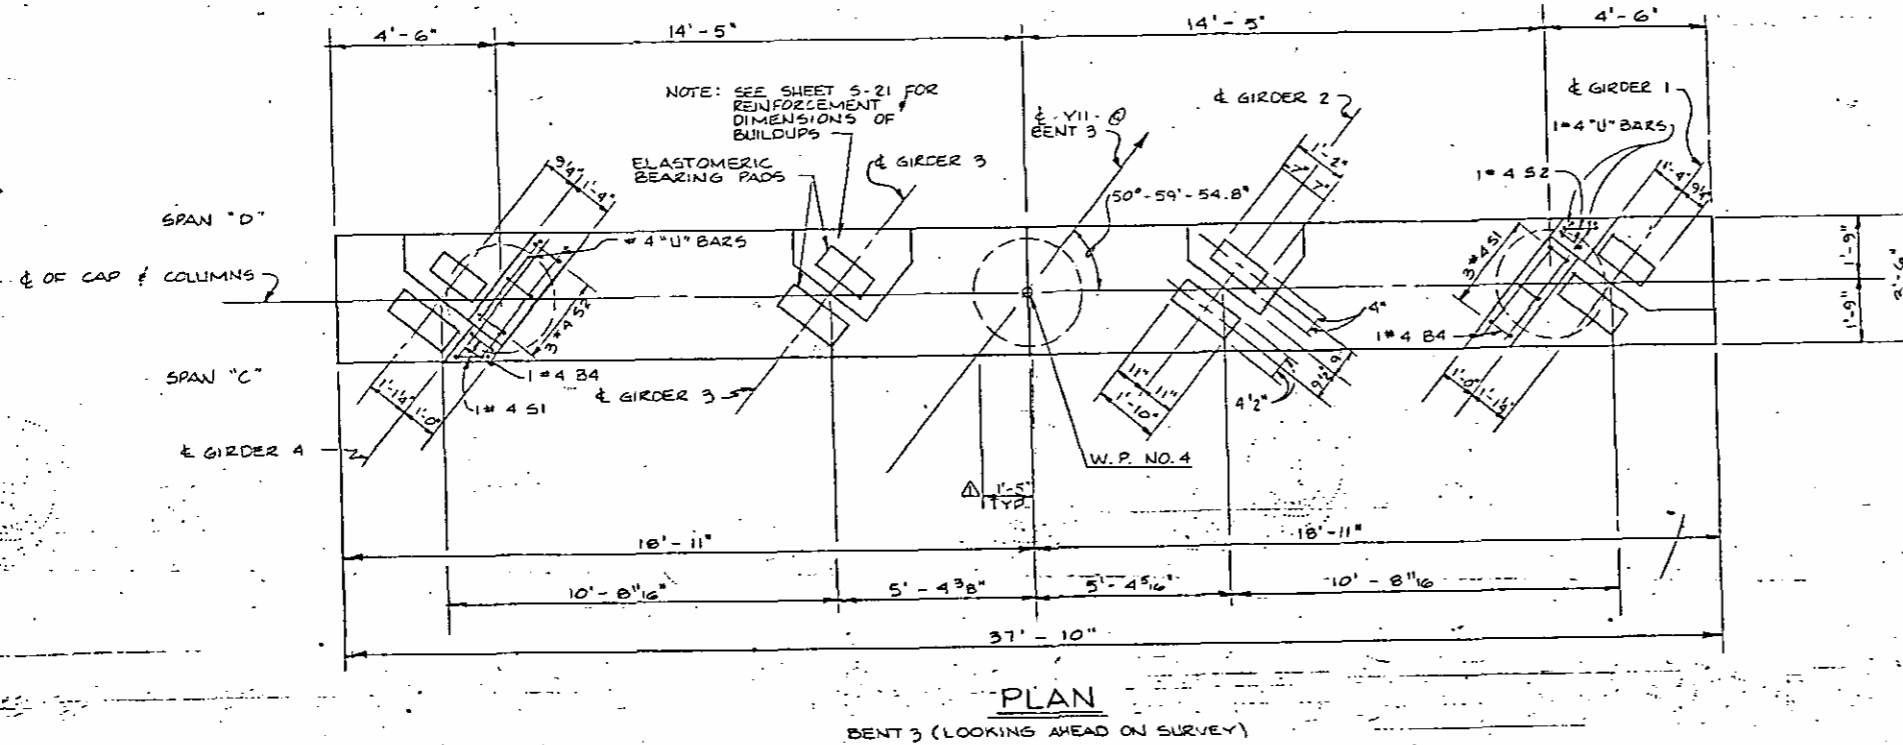


NOTE A: CONSTRUCTION JOINT PERMITTED AT TOP OF CAP

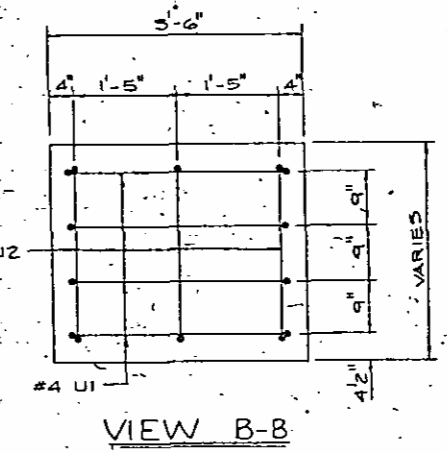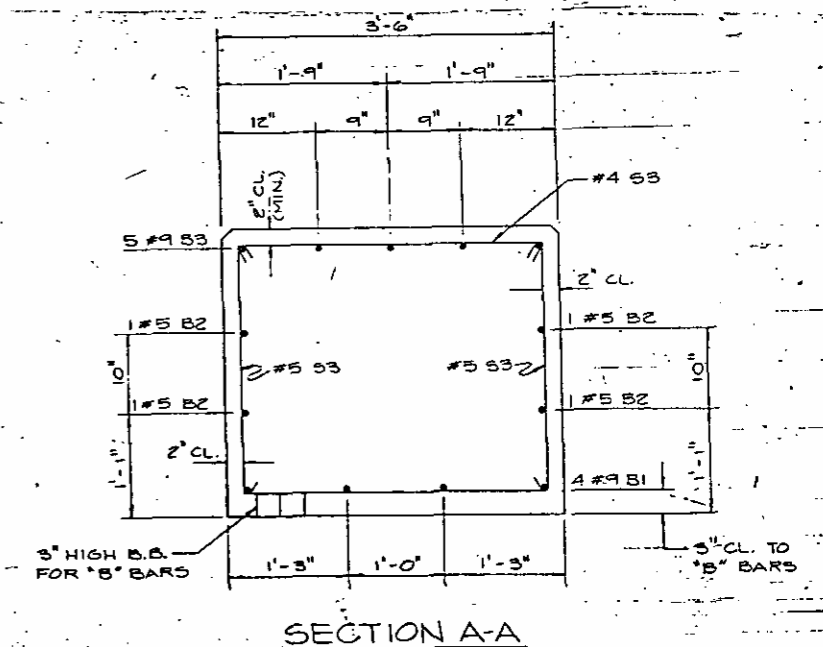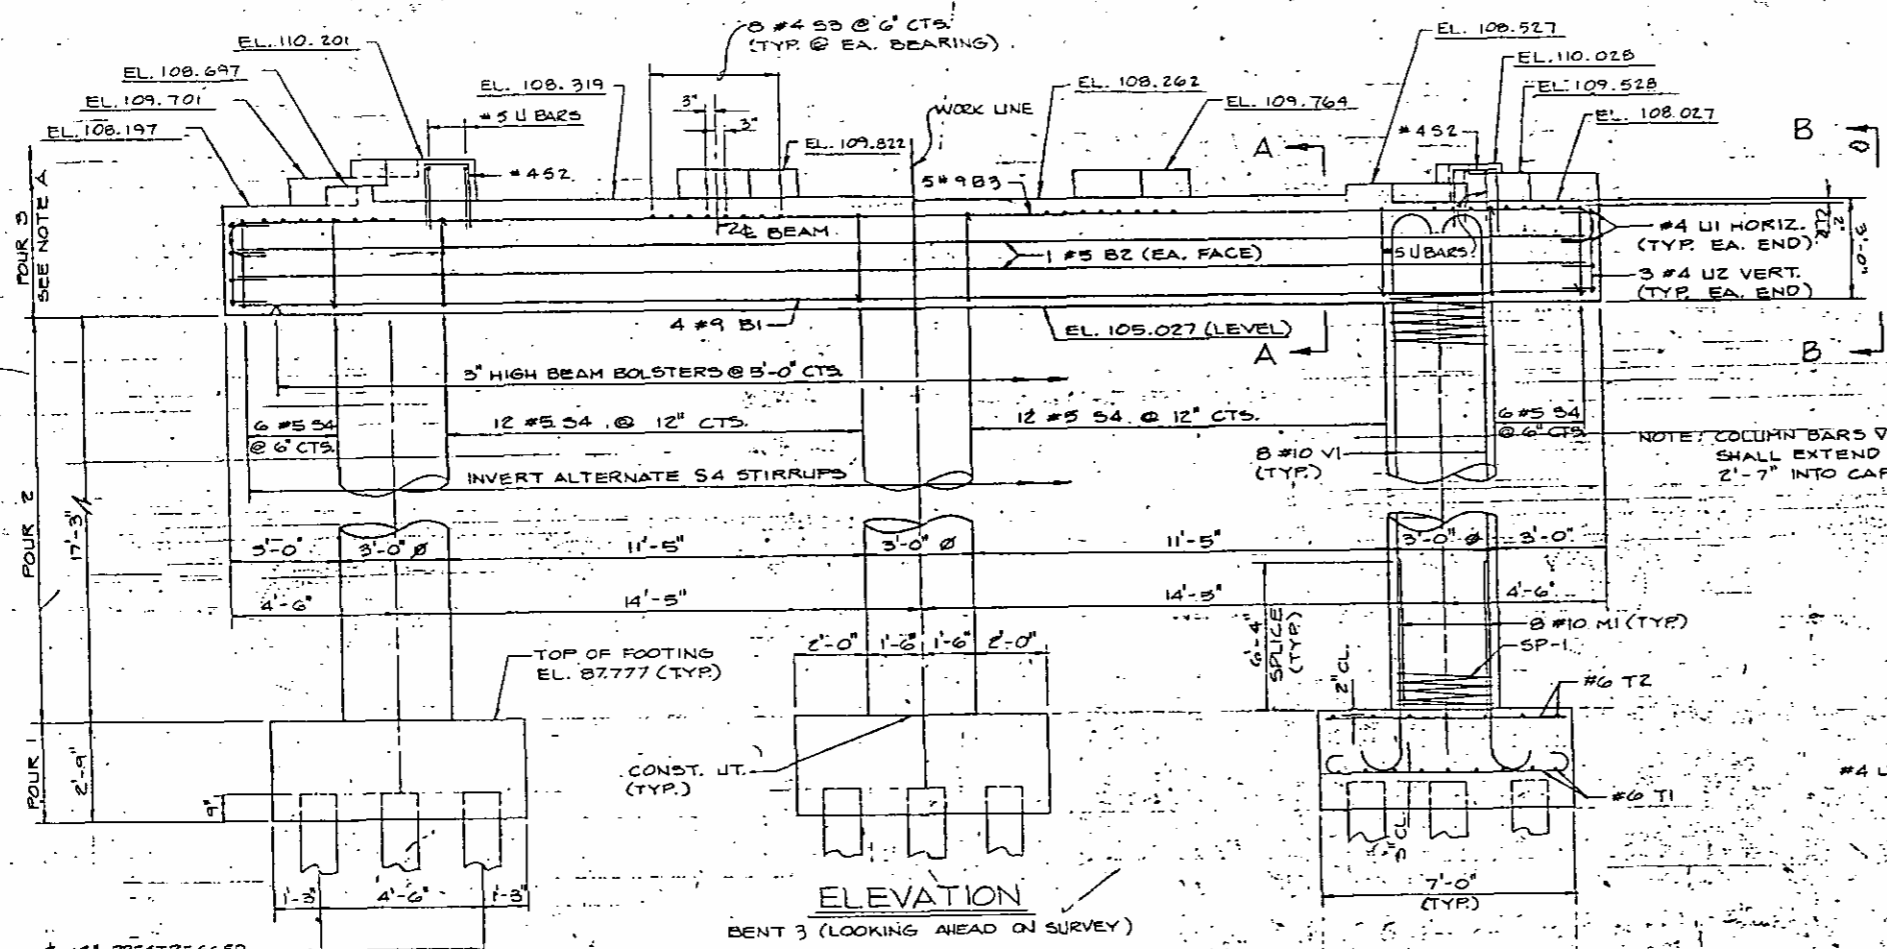





PROJECT No. **S-H25805**  
 EDGEcombe COUNTY  
 STATION: **20+00.00 -111-**  
**763+19.06 -L-**

STATE OF NORTH CAROLINA DEPARTMENT OF TRANSPORTATION RALEIGH					
SUBSTRUCTURE BENT 3					
FEBRUARY 1984					
REVISIONS					
NO.	BY	DATE	NO.	BY	DATE
1	AMS	2-20-86	3		
2			4		
					SHEET NO. 168
					TOTAL SHEETS

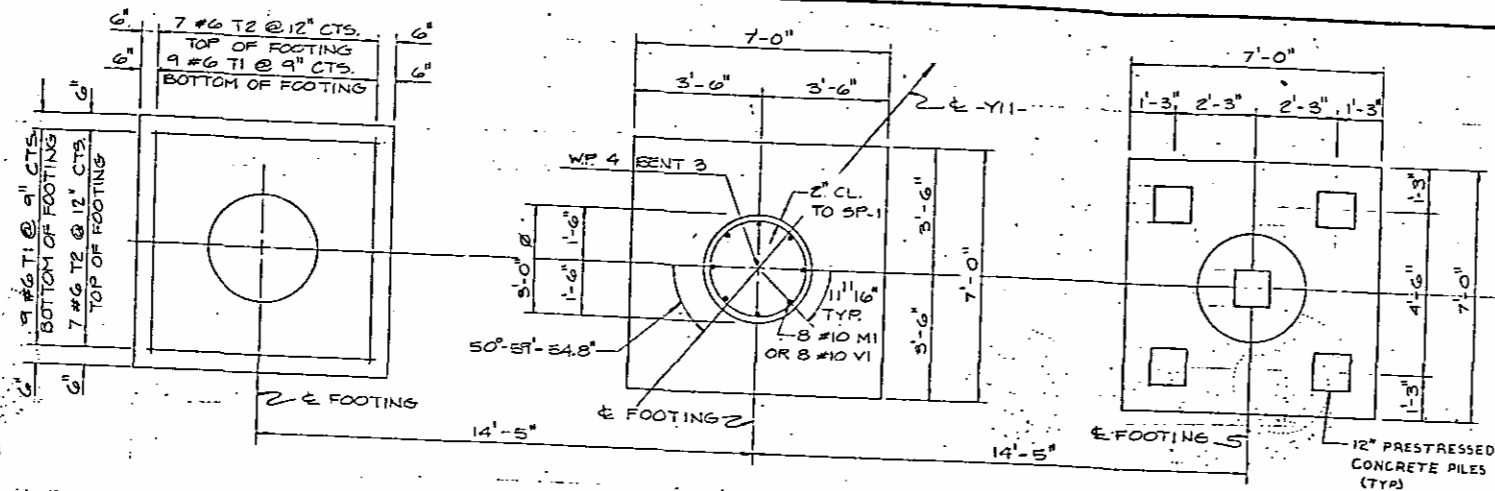

**PLAN OF FOOTINGS**  
DATA SHOWN TYPICAL FOR EACH FOOTING


**BAR TYPES**

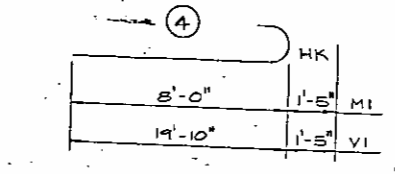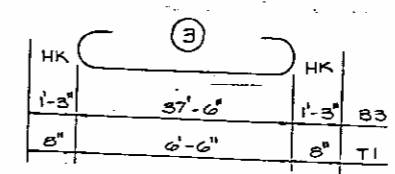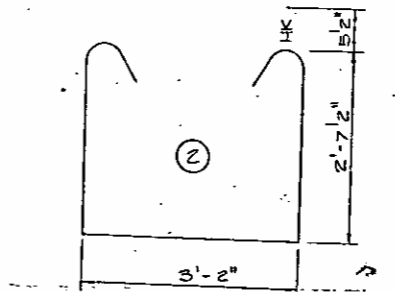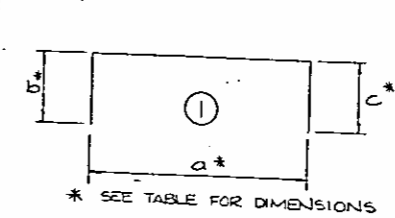

TYPE (1) BAR		a	b	c
S1	8"	1'-6"	1'-6"	1'-6"
S2	1'-0"	2'-0"	2'-10"	
U1	3'-2"	6"	6"	
U2	2'-8"	6"	6"	
U4	1'-10"	2'-8"	2'-8"	
U5	2'-1"	2'-8"	2'-8"	
U6	1'-6"	2'-8"	2'-8"	
U7	11"	2'-8"	2'-8"	
U9	3'-3"	3'-1"	3'-1"	
U10	2'-7"	3'-1"	3'-1"	
U13	1'-3"	2'-8"	2'-8"	
U14	2'-7"	2'-8"	2'-8"	
U15	11"	3'-1"	3'-1"	
U16	5"	3'-1"	3'-1"	
U17	2'-0"	3'-9"	1'-7"	
S3	3'-2"	4'-2"	4'-2"	
U8	2'-9"	8"	8"	

**BILL OF MATERIAL**

BENT 3				
BAR NO.	SIZE	TYPE	LENGTH	WEIGHT
B1	4	9	37'-6"	510
B2	4	5	37'-6"	157
B3	5	9	40'-0"	680
B4	4	4	3'-6"	10
M1	24	10	4	97.3
S1	5	4	3'-2"	13
S2	5	4	6'-8"	23
S3	32	4	3'-11"	84
S4	36	5	2	351
T1	54	6	3	636
T2	42	6	STR.	411
U1	8	4	4'-2"	23
U2	6	4	3'-8"	15
U3	4	5	5	16
U4	2	5	1	15
U5	4	5	1	31
U6	4	5	1	29
U7	3	5	1	20
U8	4	5	1	18
U9	1	5	1	10
U10	1	5	1	10
U11	2	5	5	14
U12	2	5	5	11
U13	1	5	1	7
U14	1	5	1	9
U15	1	5	1	8
U16	1	5	1	7
U17	2	5	1	16
U18	2	5	5	7
VI	24	10	4	2,195
TOTAL				6,309
SP-1	3	6	717'-8"	1439
REINFORCING STEEL LBS. = 6,309				
SPIRAL COLUMN REIN. STEEL LBS. = 1,439				
CLASS 'A' CONCRETE CU. YDS. = 457.7				
EXCAVATION (BENT 3) CU. YDS. = 67.3				
12" PRESTRESSED CONCRETE PILE 220.7				
BENT 3 NO. 15 LIN. FT. = 600'				
DIVISION OF CONCRETE				
FOUR NUMBER				CU. YDS.
1				14.6
2				13.6
3				17.5
TOTAL				45.7

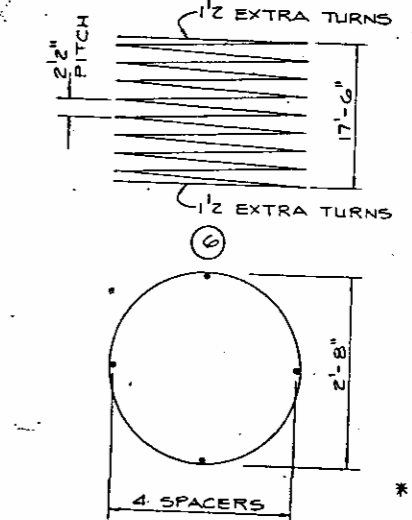


BAR NO.	SIZE	TYPE	LENGTH	WEIGHT
U3	2'-2"			
U12	4'-6"			
U11	3'-4"			
U10	3'-0"			
U3	1'-8"	U3		
	0'-9"	U12		
	2'-11"	U11		
	0'-3"	U18		


ALL BAR DIMENSIONS ARE OUT TO OUT.

\* CONCRETE DISPLACED BY PILE HEADS HAS BEEN DEDUCTED.

**BUILDUP FOR GIRDER 2 & 3**

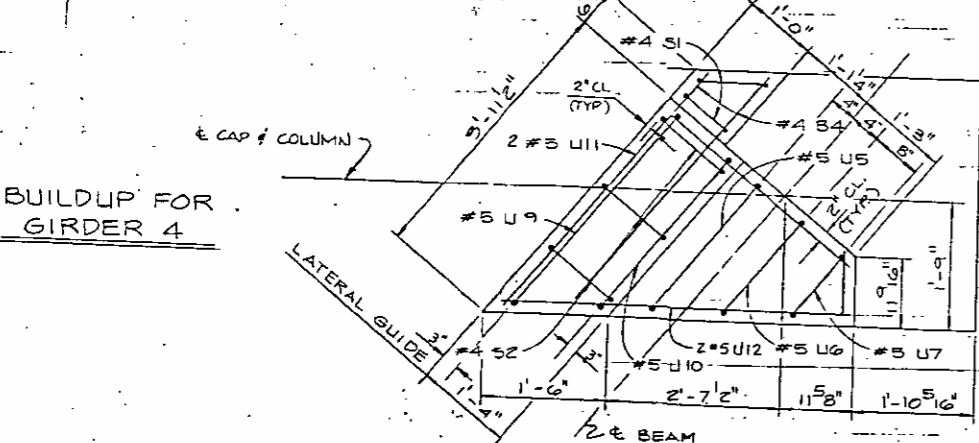


**BUILDUP FOR GIRDER 4**

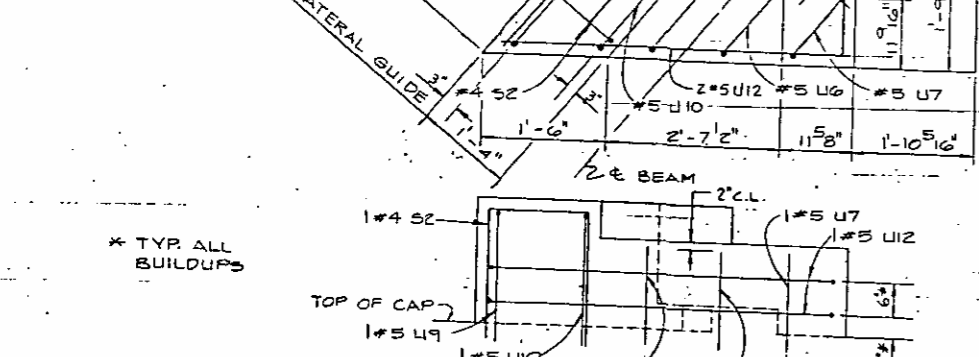


\* TYP ALL BUILDUPS

**ELEVATION OF BUILDUP FOR GIRDER 4**  
(OTHER BUILDUPS SIMILAR)

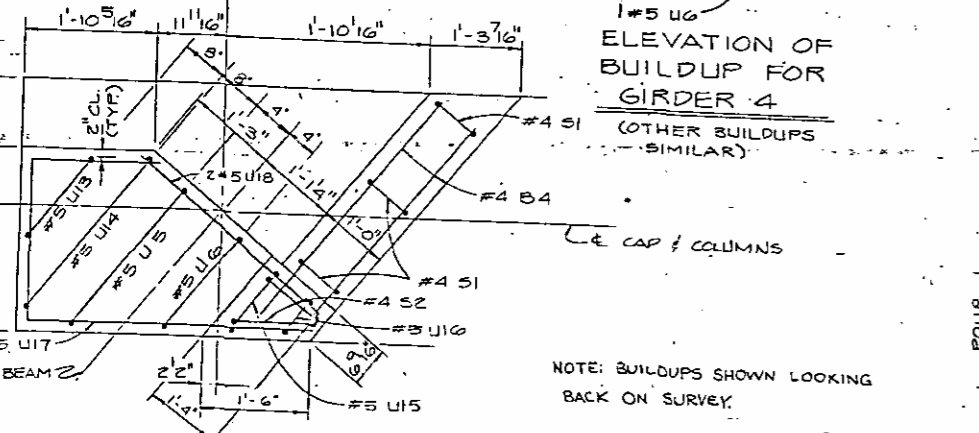


NOTE: BUILDUPS SHOWN LOOKING BACK ON SURVEY.

**BUILDUP FOR GIRDER 1**

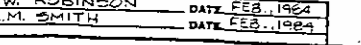

DRAWN BY J.W. ROBINSON DATE FEB. 1982  
CHECKED BY A.M. SMITH DATE FEB. 1984

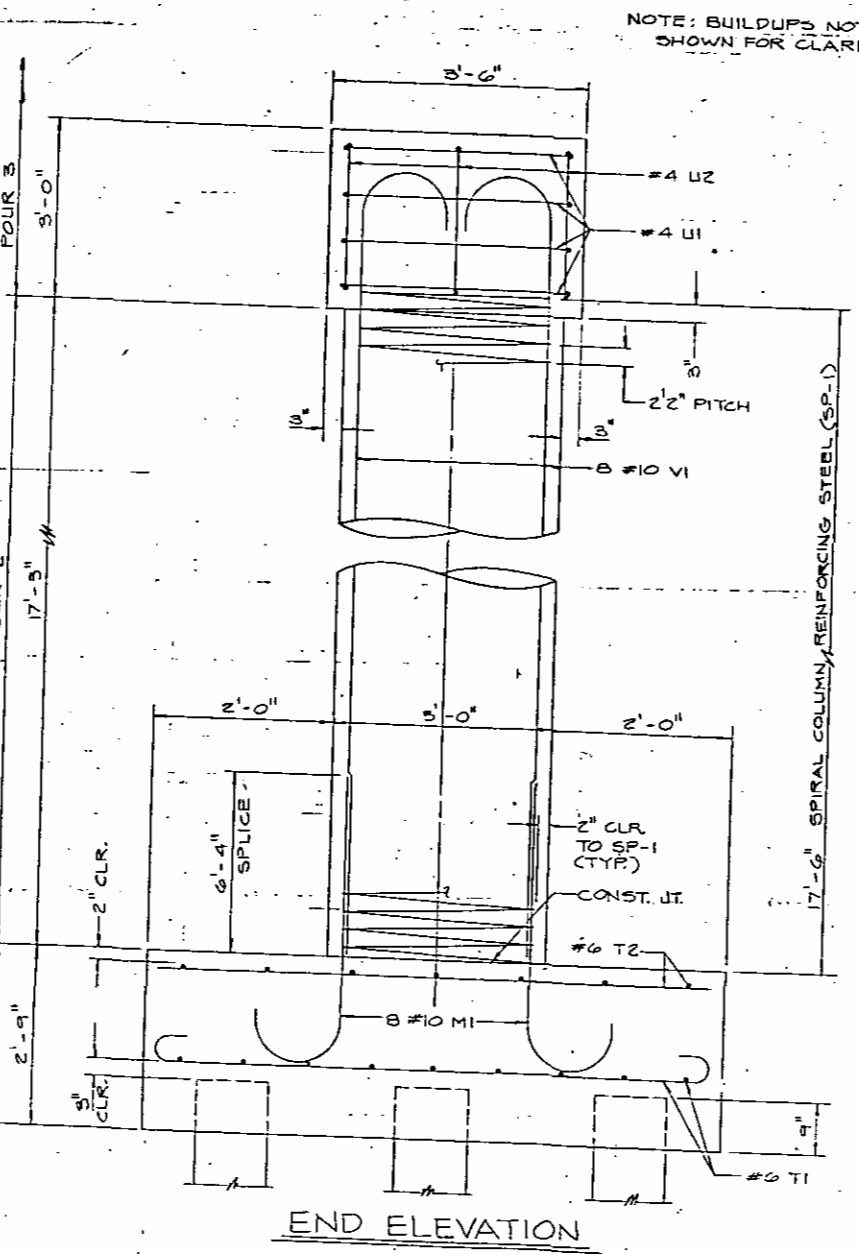

**END ELEVATION**

PROJECT NO. B.1125805  
EDGEcombe COUNTY  
STATION: 20+00.00 -Y11-  
763+19.06 -L-

SHEET 2 OF 2

STATE OF NORTH CAROLINA  
DEPARTMENT OF TRANSPORTATION  
RALEIGH

SUBSTRUCTURE  
BENT 3

FEBRUARY 1984

REVISIONS			
NO.	BY	DATE	NO.
1			3
2			4


DWG. 5-21

SHEET NO. 169  
TOTAL SHEETS

REV. NO.	DESCRIPTION	DATE
1	REVISED BEAM SEAT DIMENSIONS	2-20-84
REVISIONS		


**NOTES**

1. PIPE DRAINS MAY BE SHIFTED SLIGHTLY AS NECESSARY TO CLEAR REINFORCING STEEL.
2. THE TOP SURFACE AREA OF THE END BENT CAPS SHALL BE CURED IN ACCORDANCE WITH THE STANDARD SPECIFICATIONS EXCEPT THAT THE MEMBRANE CURING COMPOUND METHOD SHALL NOT BE USED.
3. FOR EPOXY PROTECTIVE COATING, SEE SPECIAL PROVISIONS.
4. FOR DETAILS OF P.V.C. PLASTIC PIPE DRAINS, SEE S-15.

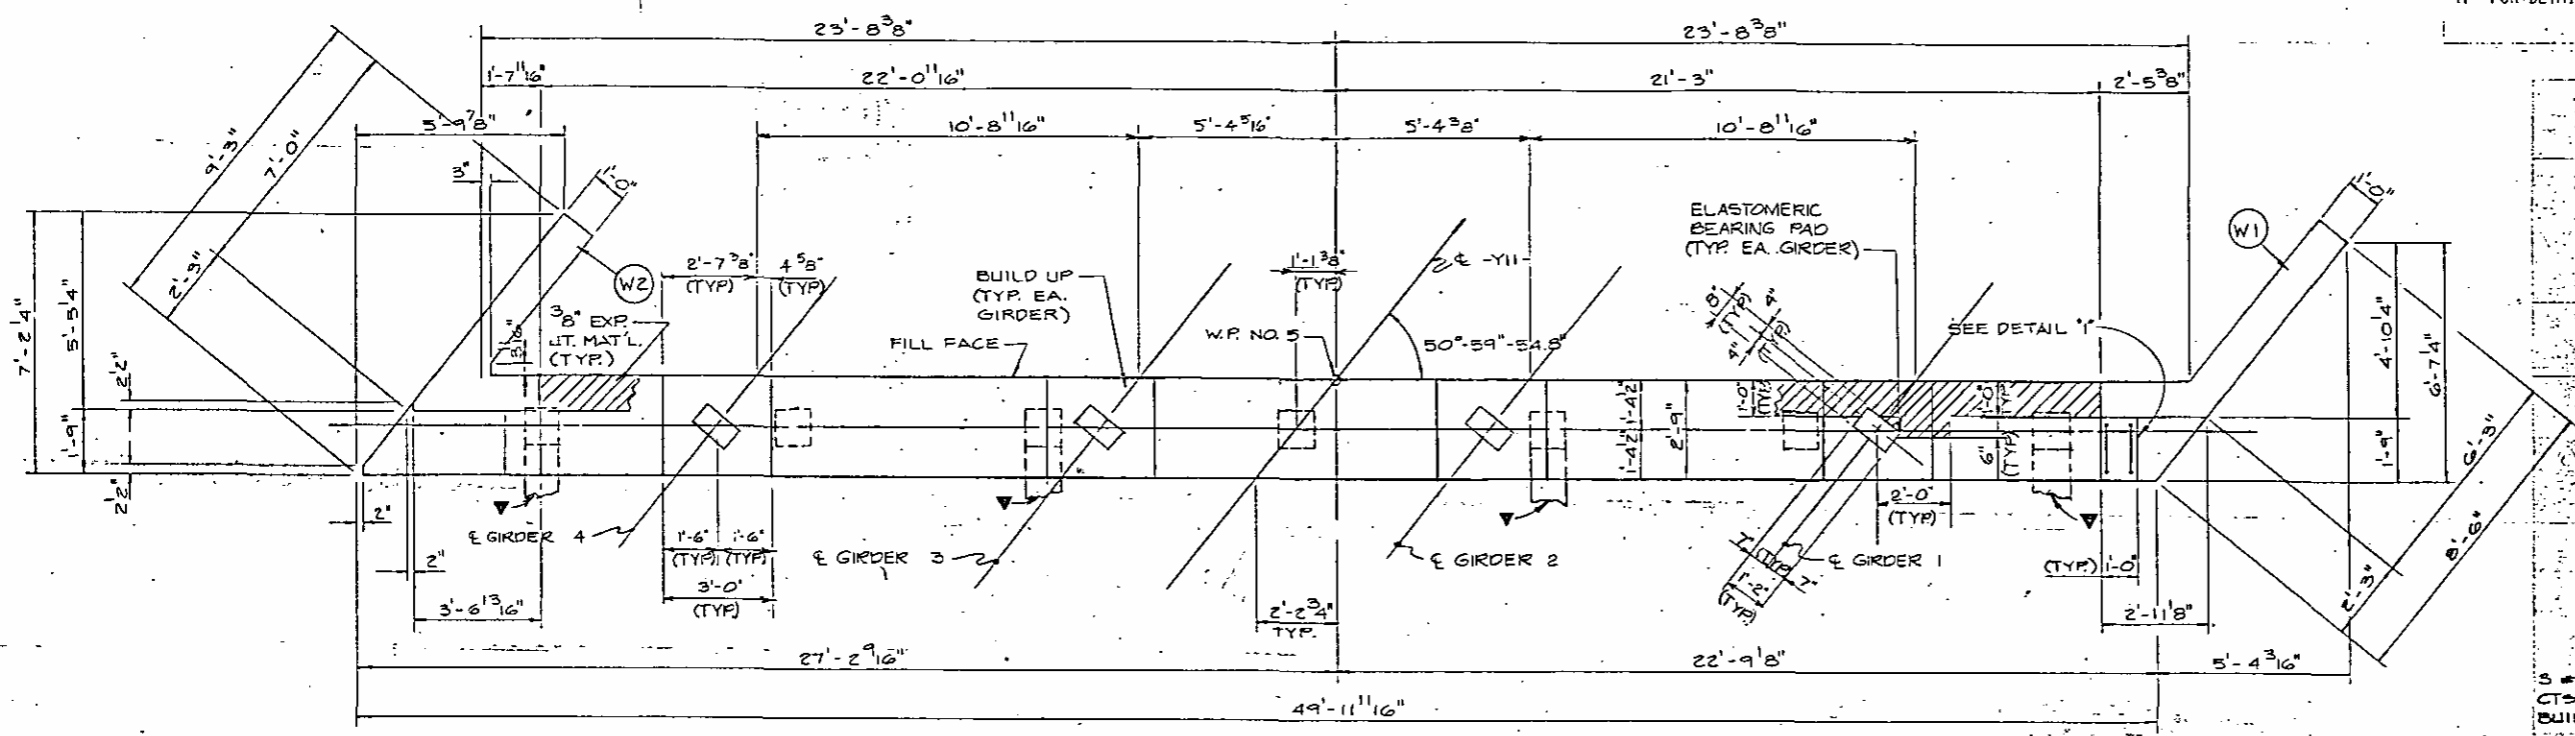


**PLAN END BENT 2**

▽ DENOTES BRACE PILE BATTERED AT 3:12 SLOPE

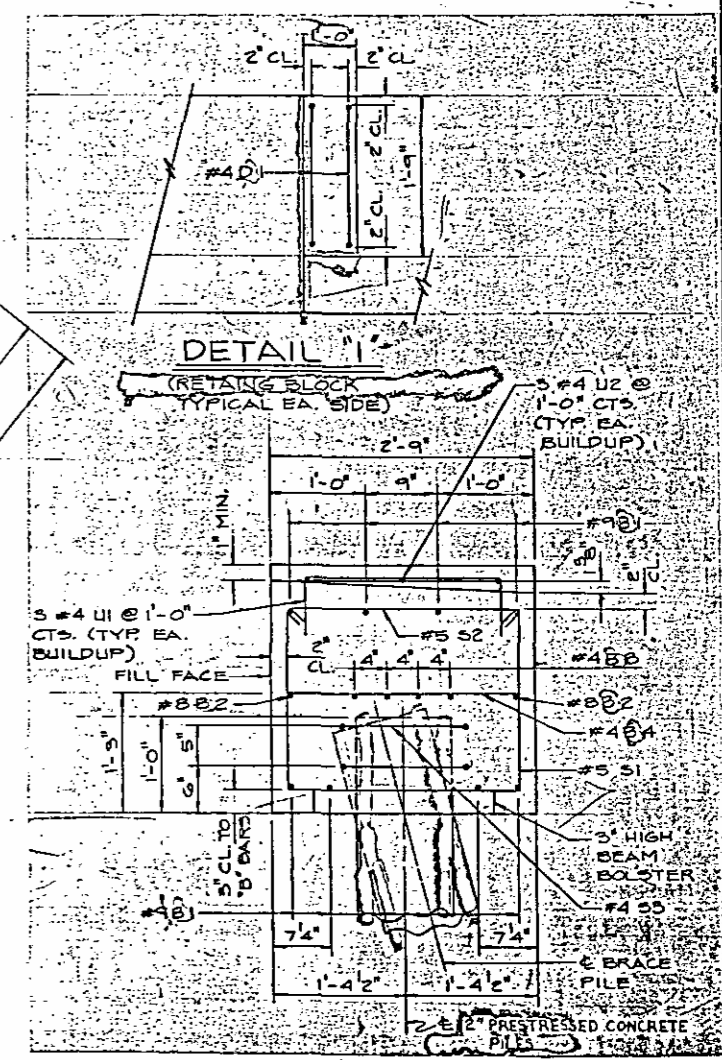

**SECTION 'A-A'**

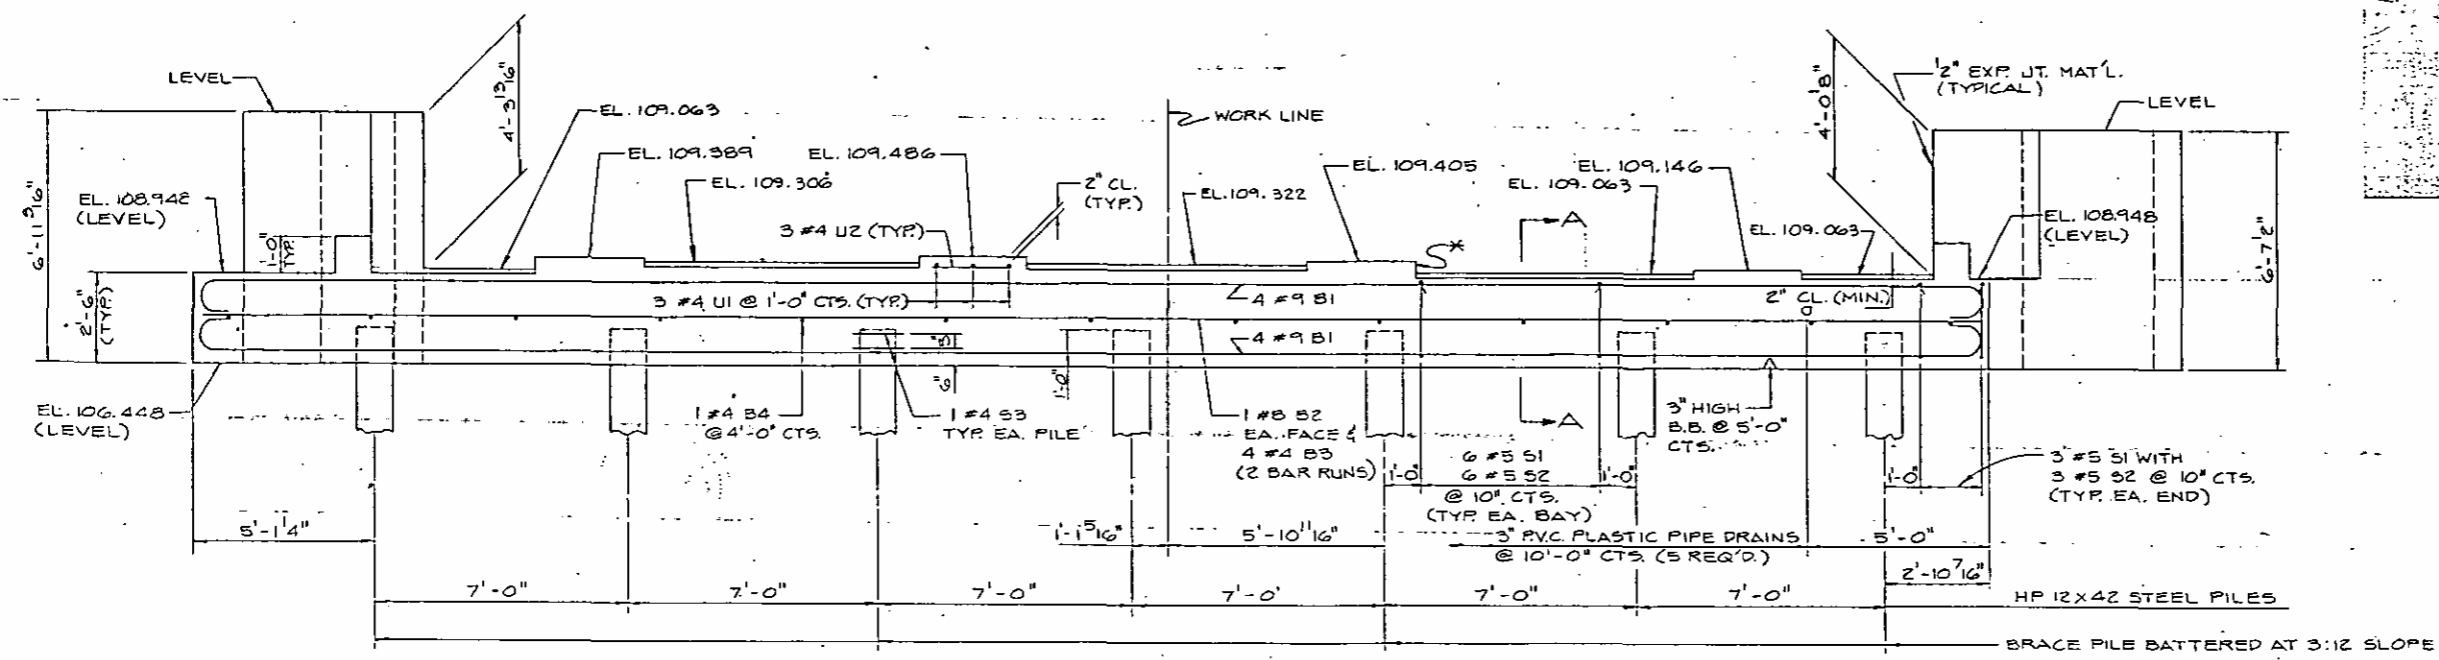

**ELEVATION**

\* 3" EXP. JT. MAT'L. ON VERTICAL FACE OF EACH BUILD-UP

**PROJECT No. 8.1125805**  
**EDGEcombe COUNTY**  
**STATION 20+00.00 -Y11-**  
**763+19.06 -L-**

STATE OF NORTH CAROLINA  
**DEPARTMENT OF TRANSPORTATION**  
 RALEIGH








**SUBSTRUCTURE**  
**END BENT 2**

REVISIONS						SHEET NO. 170	TOTAL SHEETS
NO.	BY	DATE	NO.	BY	DATE		
1	AMS	2-20-84	3				
2			4				

DRAWN BY: U.W. ROBINSON DATE: FEB. 1984  
 CHECKED BY: JOSE PANON DATE: FEB. 1984

REV A REVISED BEAM SEAT DIMENSIONS BY: AMS / BY: SKC DATE: 2-21-84

DWG. 3-22

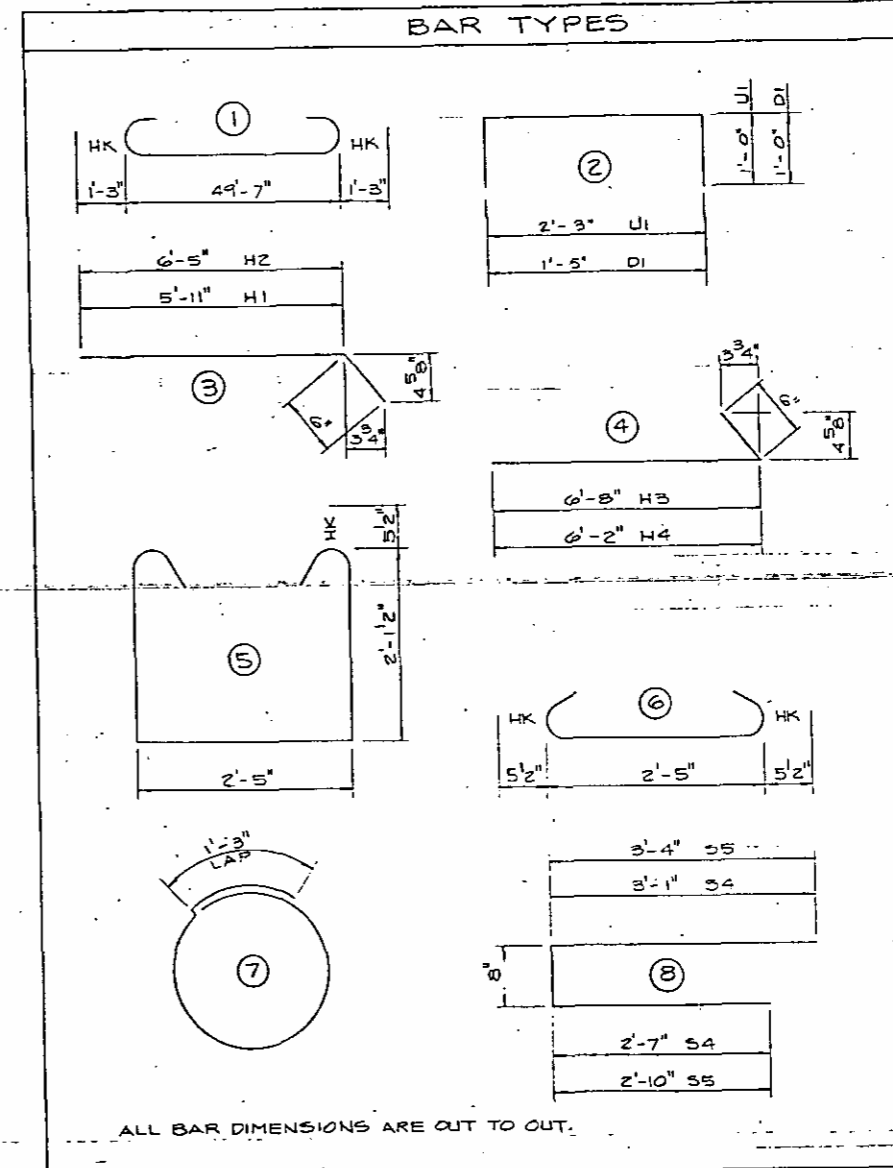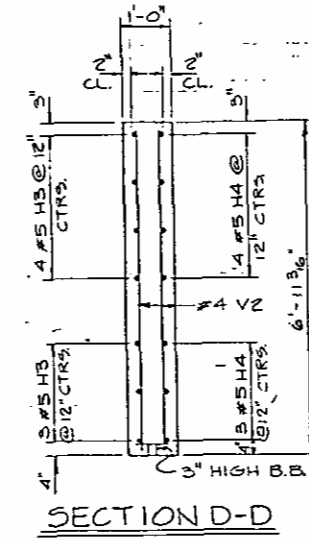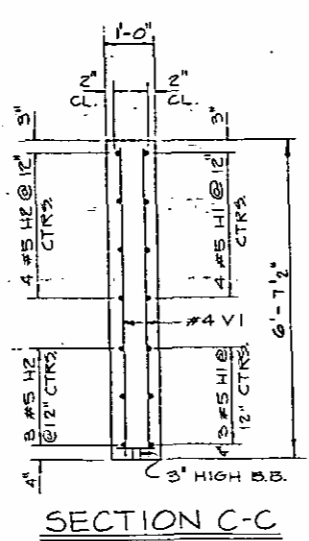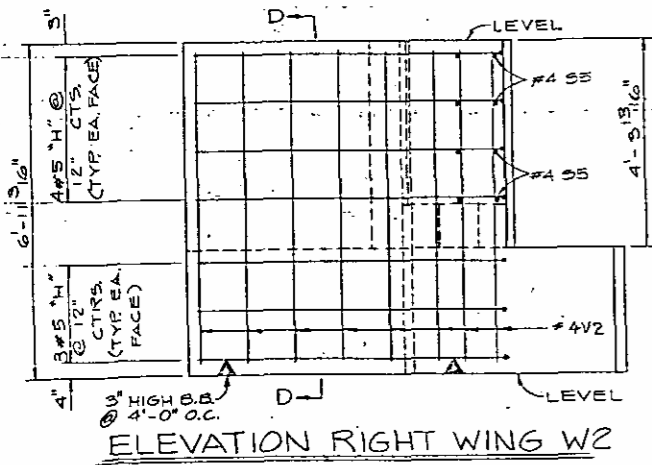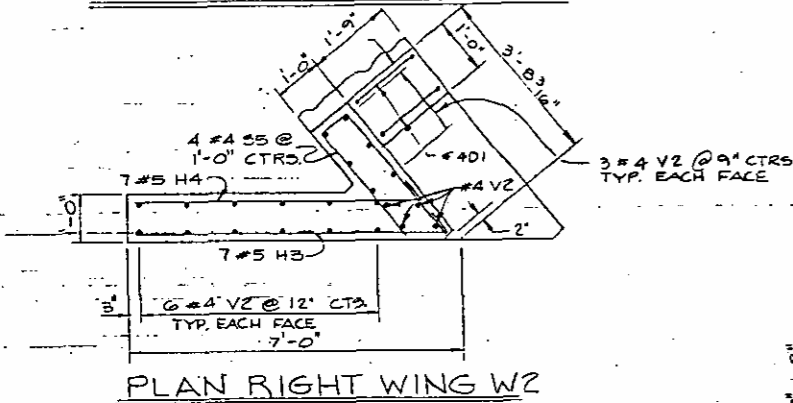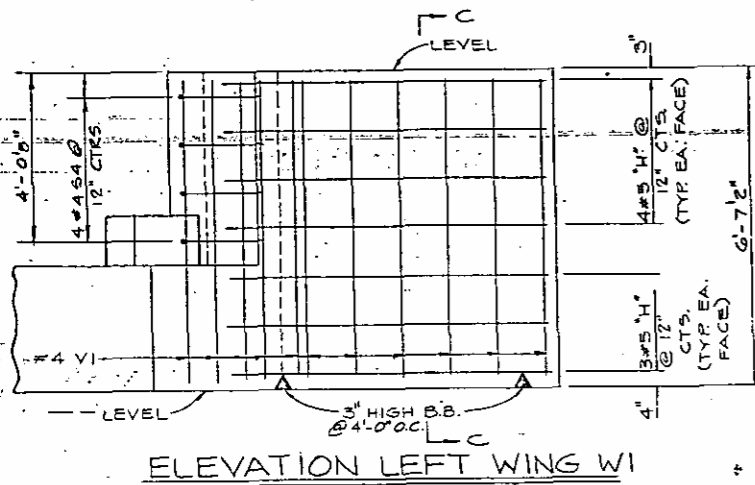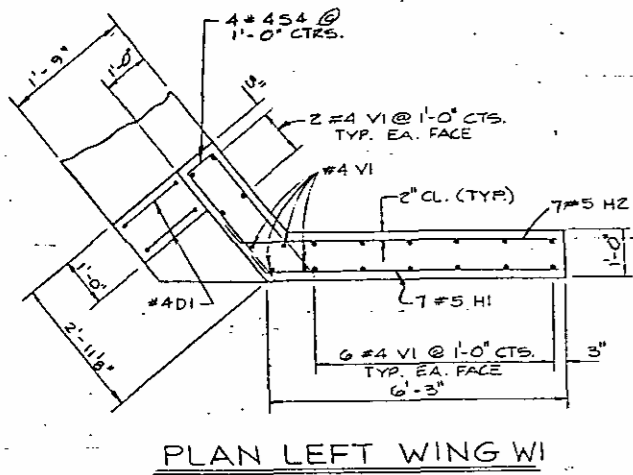

BILL OF MATERIAL					
END BENT 2					
BAR	NO.	SIZE	TYPE	LENGTH	WEIGHT
B1	8	9	1	52'-1"	1,417
B2	2	8	STR.	49'-7"	265
B3	8	4	STR.	25'-5"	136
B4	12	4	STR.	2'-5"	20
D1	4	4	2	5'-1"	14
H1	7	5	3	6'-5"	47
H2	7	5	3	6'-11"	51
H3	7	5	4	7'-2"	53
H4	7	5	4	6'-8"	49
S1	42	5	5	7'-7"	333
S2	42	5	6	3'-4"	147
S3	14	4	7	6'-0"	57
S4	4	4	8	6'-4"	17
S5	4	4	8	6'-10"	19
U1	12	4	2	4'-3"	35
U2	12	4	STR.	2'-8"	22
V1	20	4	STR.	6'-2"	83
V2	22	4	STR.	6'-5"	95
TOTAL LBS.					2,860
REINFORCING STEEL LBS. = 2,860					
* CLASS "A" CONCRETE CU. YDS. = 17.3					
12" PRESTRESSED CONCRETE PILES 434.0					
NO. = 7 LIN. FT. = 120' IN.					
* CONCRETE DISPLACED BY PILE HEADS BEEN DEDUCTED					

ALL BAR DIMENSIONS ARE OUT TO OUT.

PROJECT NO. 8.1125805  
 EDGEcombe COUNTY  
 STATION: 20+00.00-Y11  
 763+19.06-L-

SHEET 2 OF 2


STATE OF NORTH CAROLINA  
 DEPARTMENT OF TRANSPORTATION  
 RALEIGH

SUBSTRUCTURE  
 END BENT 2

FEBRUARY 1984

REVISIONS					
NO.	BY	DATE	NO.	BY	DATE
1			3		
2			4		

SHEET NO. 171  
 TOTAL SHEETS

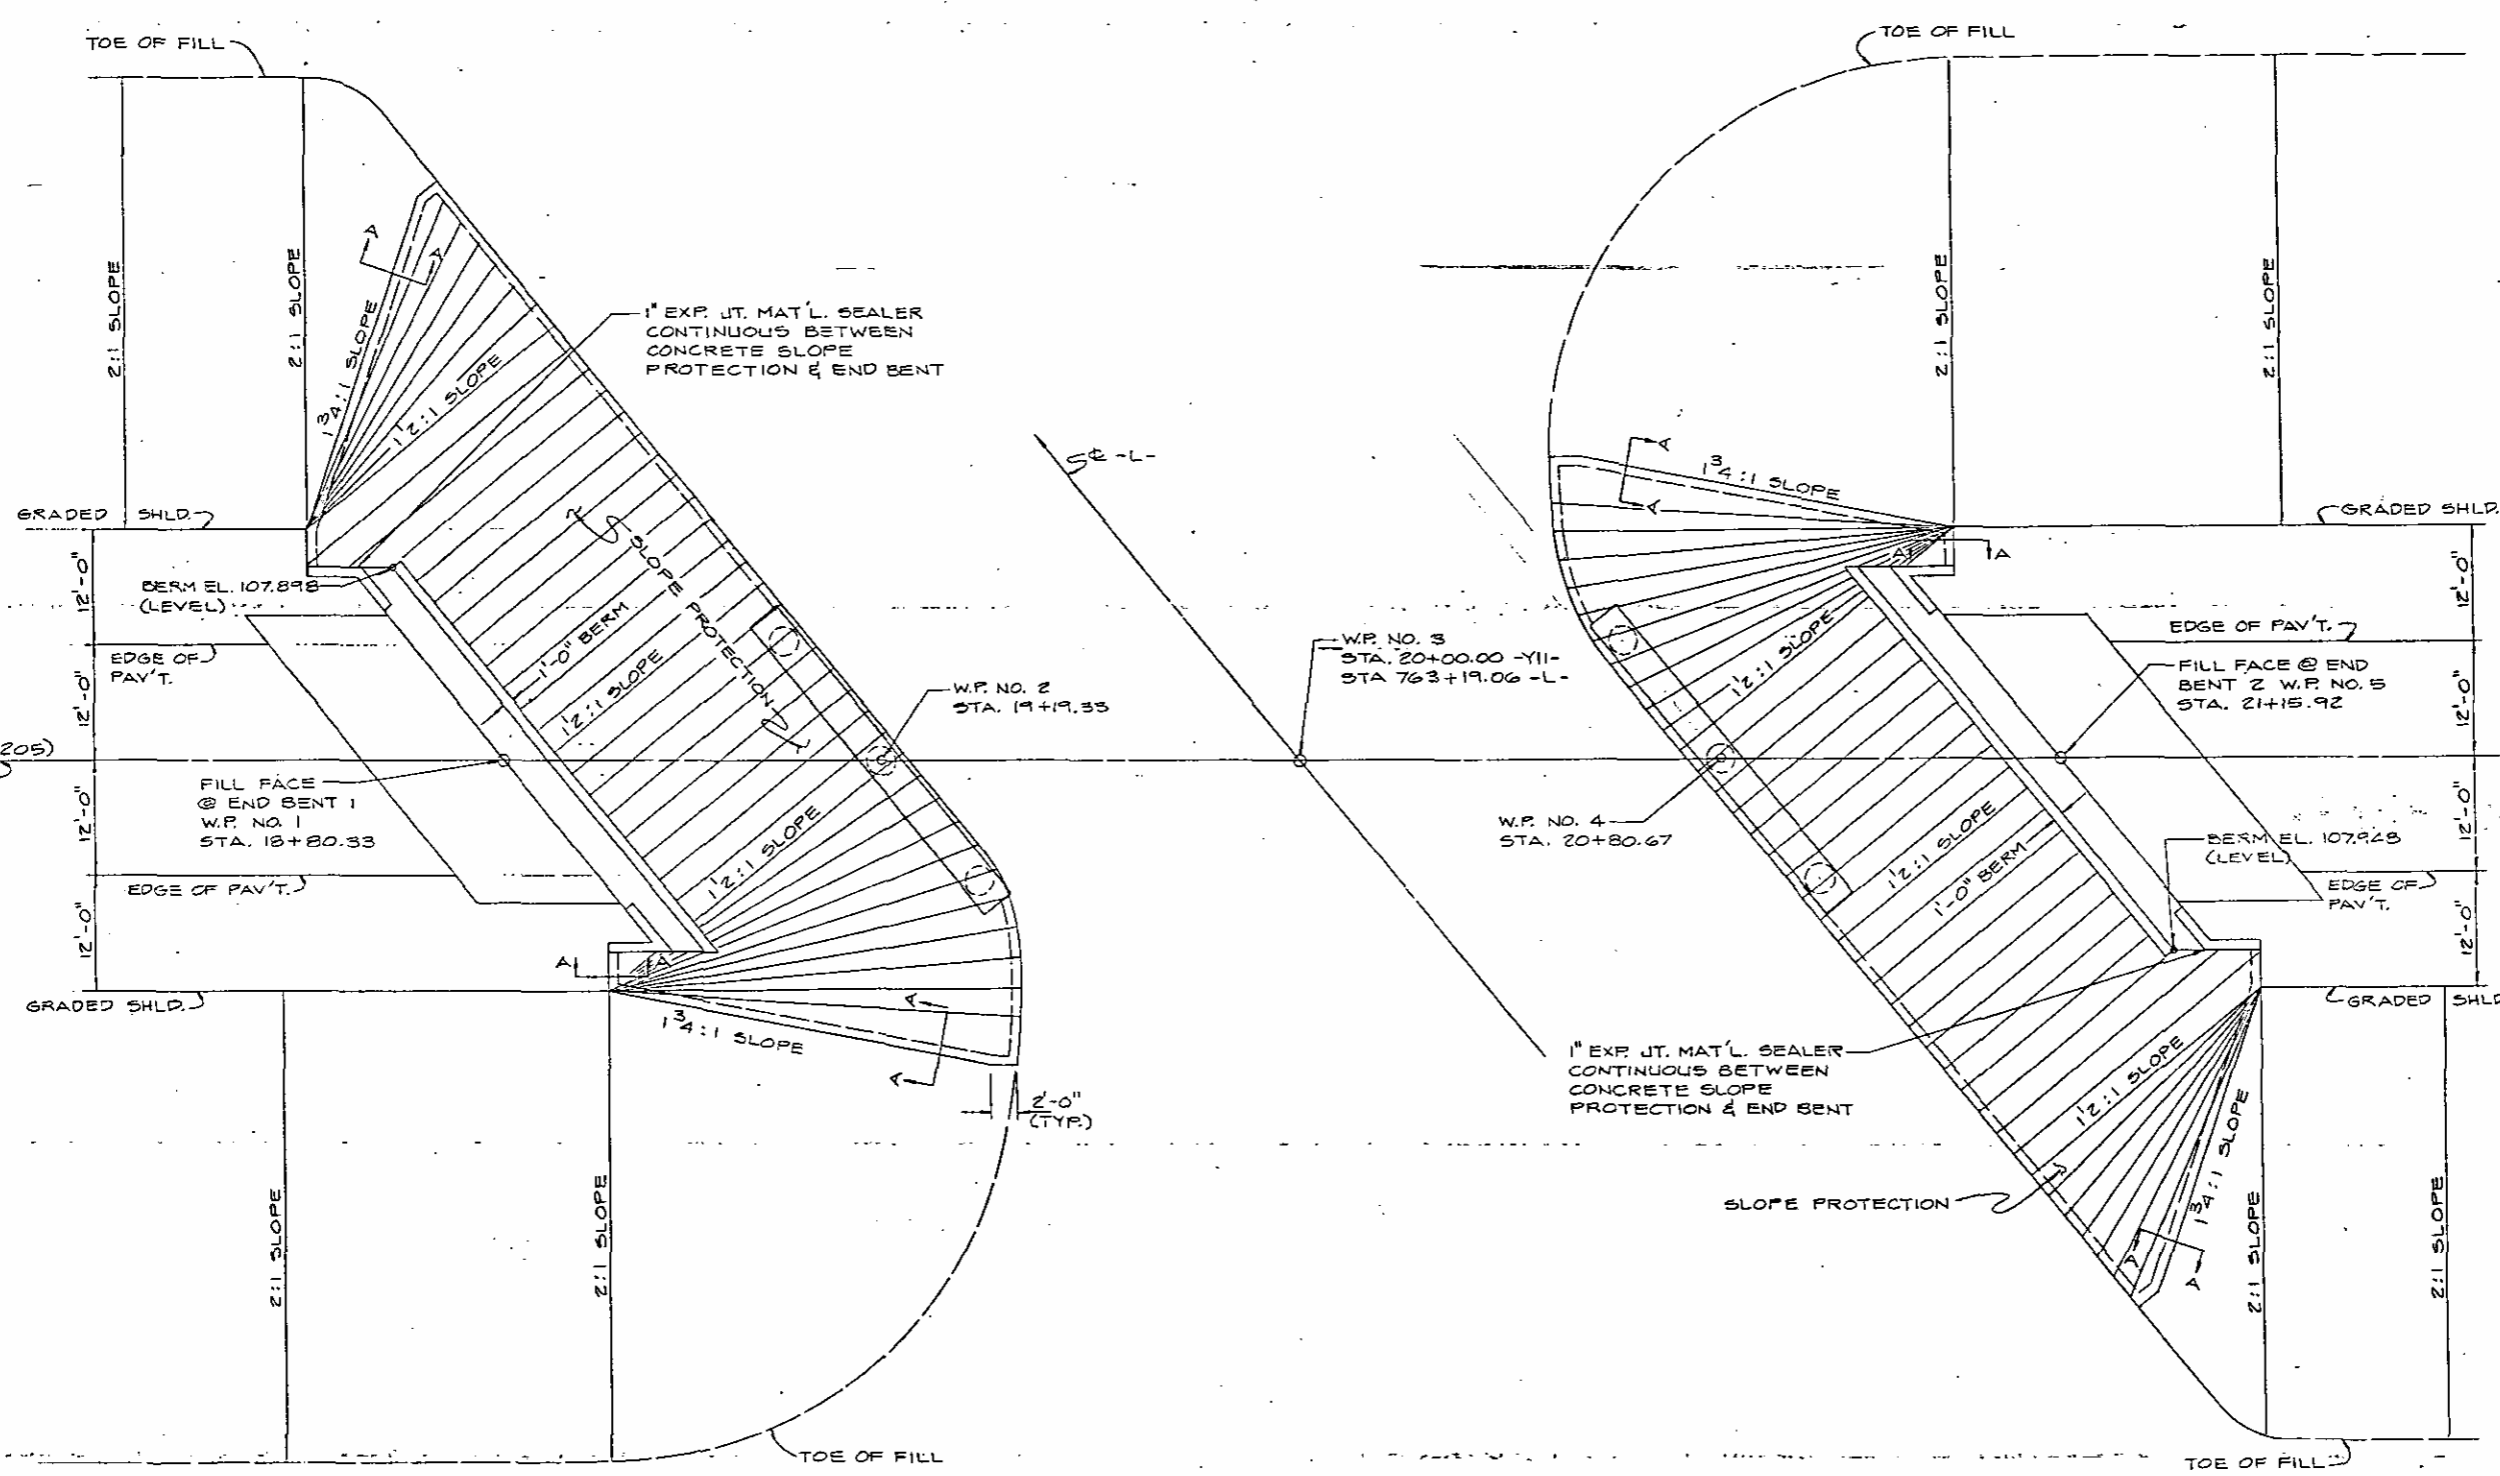

PLAN OF SLOPE PROTECTION

PROJECT No. 8.1125805

EDGECOMBE COUNTY

STATION: 20+00.00 -YII-  
763+19.06 -L-

SHEET 1 OF 2


STATE OF NORTH CAROLINA  
DEPARTMENT OF TRANSPORTATION  
RALEIGH  
SLOPE PROTECTION  
DETAILS

REVISIONS						SHEET NO. 172	TOTAL SHEETS
NO.	BY	DATE	NO.	BY	DATE		
1			3				
2			4				

DRAWN BY: U.W. ROBINSON DATE: FEB. 1984  
CHECKED BY: JOSE DANON DATE: FEB. 1984


DWG. 5-24



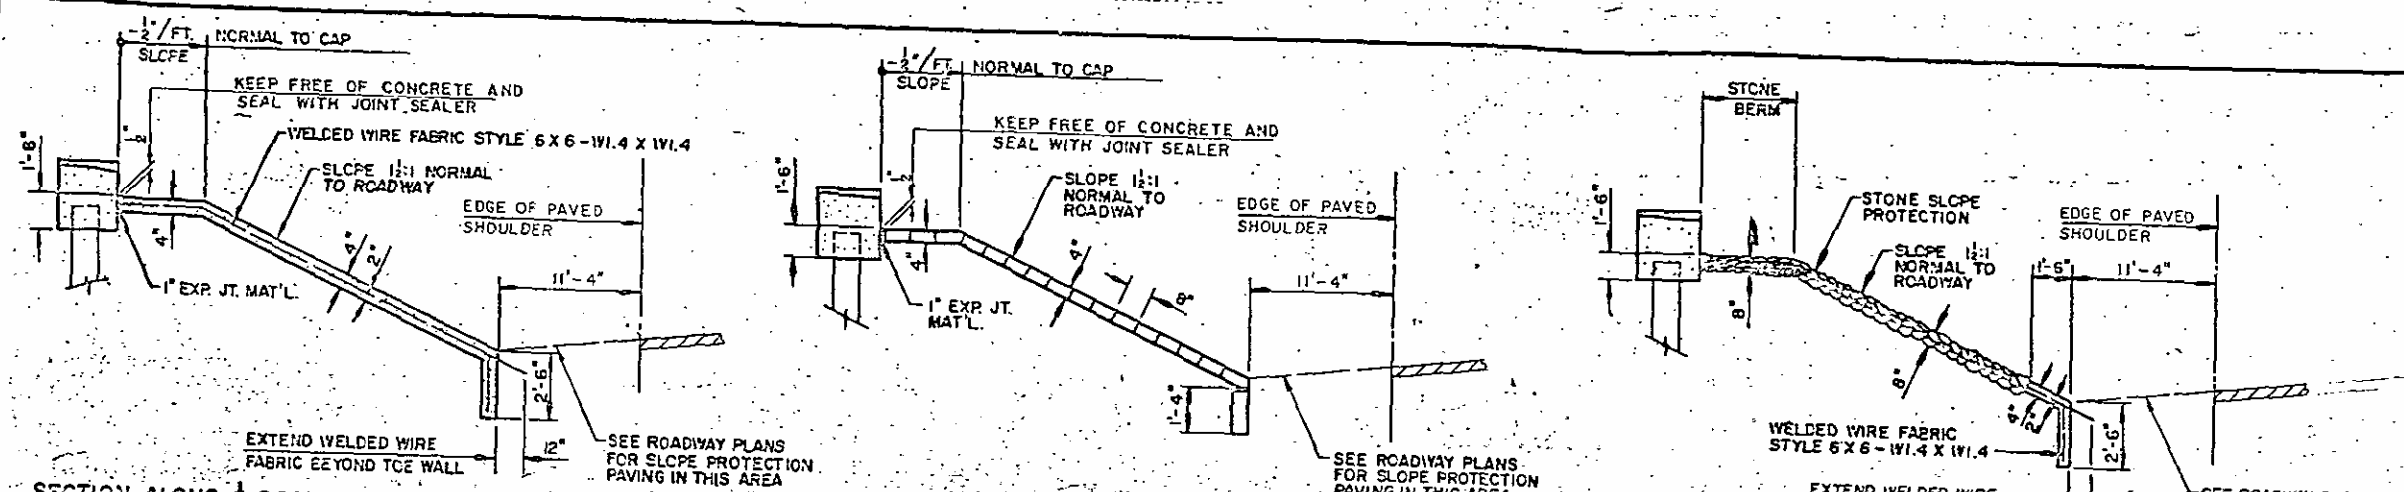


**GENERAL NOTES**

4 INCH SLOPE PROTECTION SHALL BE PLACED UNDER THE ENDS OF THE BRIDGE. LIMITS OF THE PROTECTION SHALL BE AS SHOWN IN THE DETAILS. THE CONTRACTOR, AT HIS OPTION, MAY PLACE EITHER TYPE, ALTERNATES "A", "B" OR "C", AS DESCRIBED BELOW. STRAIGHT EDGING WILL NOT BE REQUIRED UNLESS, IN THE OPINION OF THE ENGINEER, VISUAL INSPECTION INDICATES A NEED FOR IT. METHOD OF MEASUREMENT AND BASIS OF PAYMENT SHALL BE AS PRESCRIBED IN SECTION 870 OF THE STANDARD SPECIFICATIONS. THE SAME TYPE OF SLOPE PROTECTION SHALL BE USED UNDER BOTH ENDS OF ANY ONE BRIDGE. FOR BERM WIDTH, SEE GENERAL DRAWING.

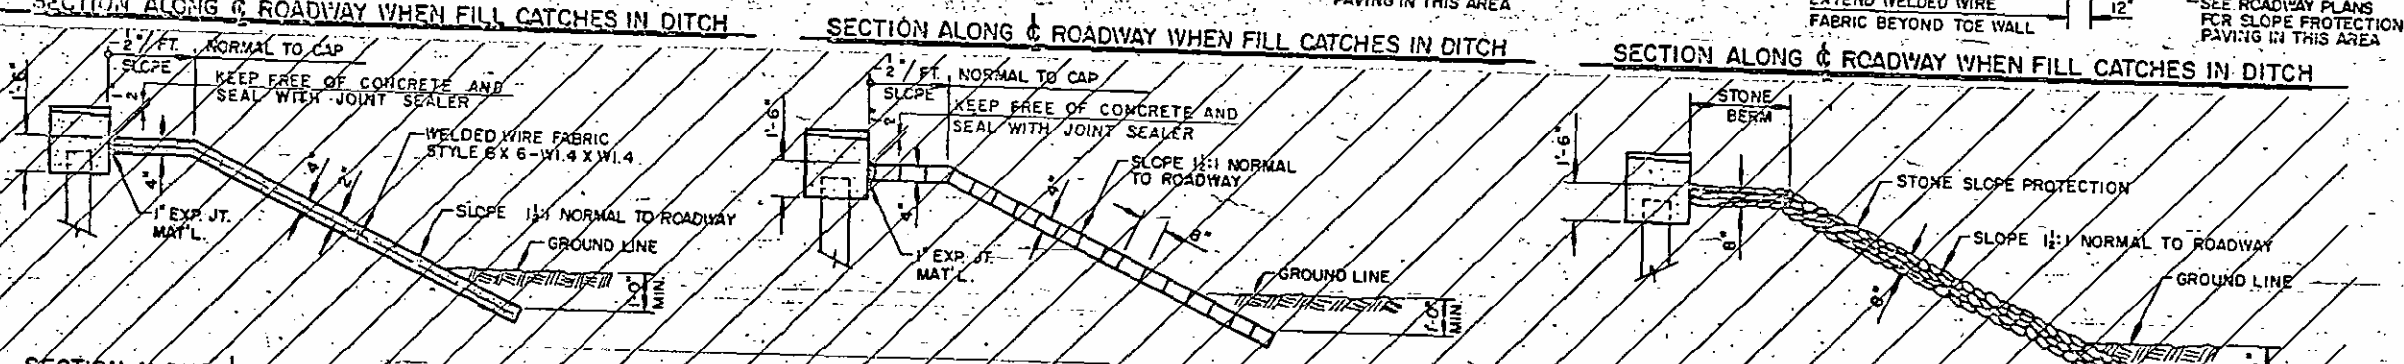


**ALTERNATE "A"**

ALTERNATE "A" SHALL CONSIST OF FOUR INCH POURED-IN-PLACE CONCRETE PAVING AS SHOWN IN THE DETAILS ON THIS SHEET. CONCRETE SHALL BE CLASS B. THE CONCRETE SURFACE SHALL BE FLOATED WITH A WOODEN FLOAT AND FINISHED. ALTERNATE "A" WELDED WIRE FABRIC REINFORCING SHALL BE STYLE 6 X 6 - W1.4 X W1.4, 60 INCHES WIDE. ADJACENT RUNS OF WELDED WIRE FABRIC SHALL LAP AT LEAST SIX INCHES. SLOPE PROTECTION SHALL BE POURED IN ALTERNATE FOUR FT. AND FIVE FT. STRIPS AS SHOWN IN POURING DETAIL. THE COST OF THE WELDED WIRE FABRIC SHALL BE INCLUDED IN THE CONTRACT UNIT PRICE BID PER SQUARE YARD FOR 4 INCH SLOPE PROTECTION.

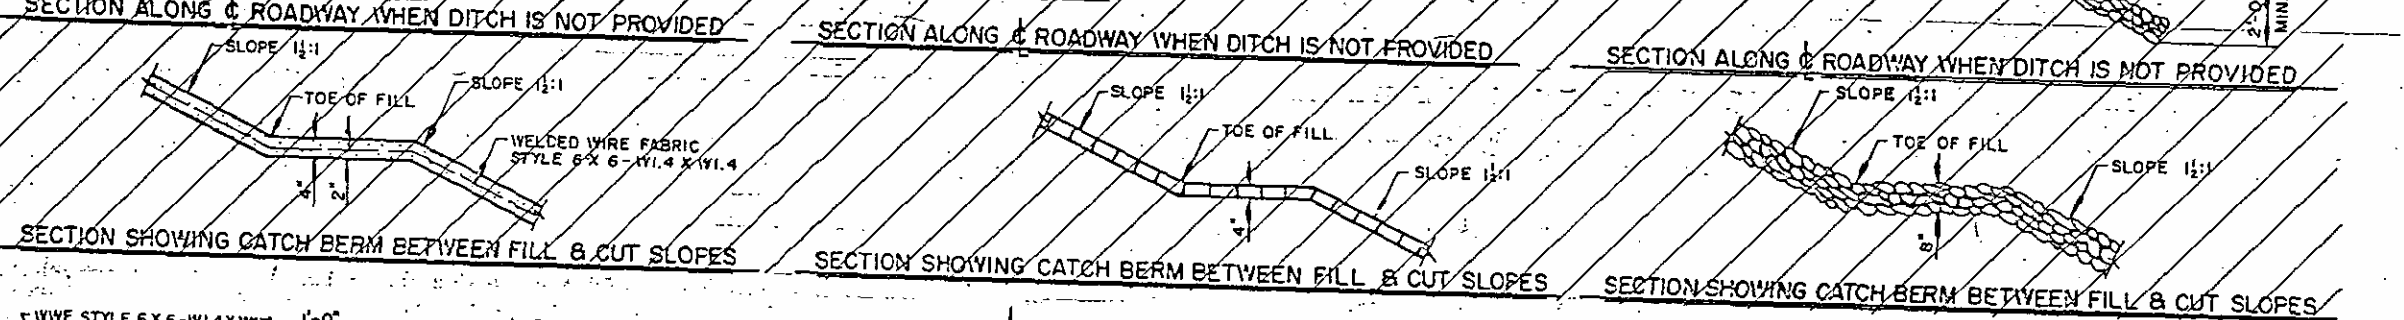

**ALTERNATE "B"**


ALTERNATE "B" SHALL CONSIST OF SOLID CONCRETE BLOCKS 4" X 8" X 16" LAID IN HORIZONTAL COURSES SUCH THAT THOSE IN SUCCESSIVE COURSES WILL BREAK JOINTS WITH UNITS IN THE PRECEDING ONE. BLOCKS SHALL BE LAID WITH THEIR LONG AXIS PARALLEL TO THE END BENT CAP WITH GROUTED JOINTS PREFERABLY 1/2" BUT NOT LESS THAN 1/4" NOR MORE THAN 3/4" WIDE BETWEEN SUCCESSIVE COURSES AND ENDS OF BLOCKS. JOINTS SHALL BE GROUTED BY POURING A MIXTURE OF ONE PART PORTLAND CEMENT TO THREE PARTS SAND MIXED WITH SUFFICIENT WATER TO ENABLE THE MIXTURE TO BE POURED THROUGH A SPOUT. THE CONCRETE BLOCKS SHALL BE CAST TO ACCURATE DIMENSIONS, SHALL HAVE UNIFORM SURFACE COLOR AND TEXTURE AND SHALL BE MANUFACTURED OF MATERIALS TO PRODUCE A COMPRESSIVE STRENGTH OF NOT LESS THAN 3,000 PSI AT AGE OF 28 DAYS. NO BROKEN BLOCKS SHALL BE USED EXCEPT IN CONSTRUCTING A STRAIGHT LINE ALONG EACH SIDE OF THE PAVING DOWN THE SLOPE. CARE SHALL BE TAKEN TO BREAK THE BLOCKS SO AS TO GIVE A UNIFORM WORKMANLIKE JOINT AND SURFACE.

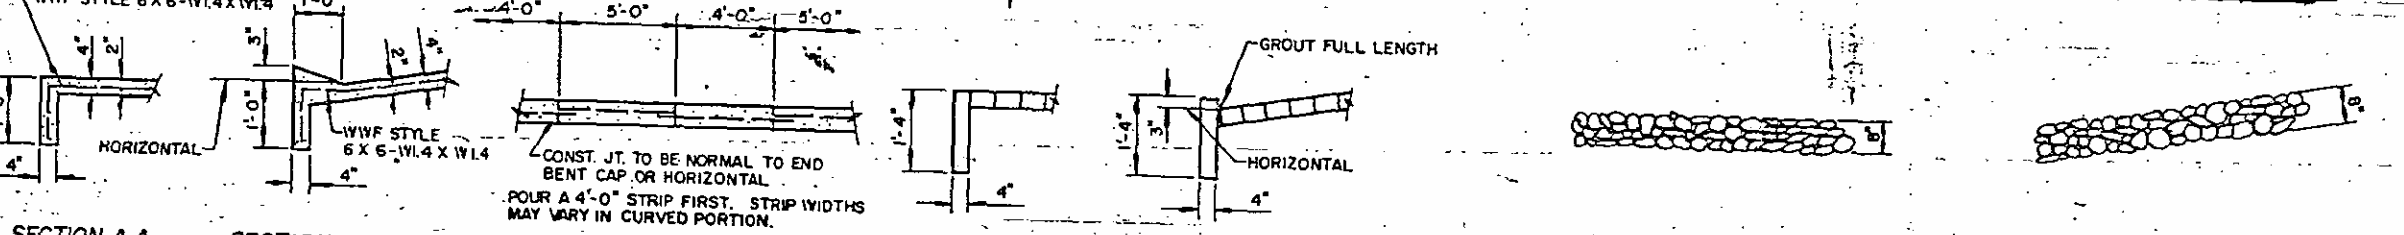

**ALTERNATE "C"**

ALTERNATE "C" SHALL BE CONSIDERED FOR HIGHWAY OVER HIGHWAY GRADE SEPARATIONS ONLY. ALTERNATE "C" SHALL CONSIST OF A COMBINATION CONCRETE SLAB AND STONE SLOPE PROTECTION. THE CONCRETE PORTIONS SHALL CONSIST OF PAVED STRIPS ALONG THE DITCH AS SHOWN IN THE DETAILS. 8 INCHES OF STONE SHALL BE PLACED OVER THE REMAINING AREA SHOWN ON THE PLANS TO BE COVERED WITH SLOPE PROTECTION. CONCRETE SHALL BE CLASS B. THE COST OF THE CONCRETE, STONE AND WELDED WIRE FABRIC STYLE 6 X 6 - W1.4 X W1.4 SHALL BE INCLUDED IN THE CONTRACT UNIT PRICE BID PER SQUARE YARD FOR 4 INCH SLOPE PROTECTION. FOR REQUIREMENTS ON SUBGRADING, STONE TYPE, STONE SIZING AND HERBICIDE PROTECTION, SEE SPECIAL PROVISIONS FOR SLOPE PROTECTION.

BRIDGE @ STA. 20+00.00 -YII-	4 INCH SLOPE PROTECTION SQUARE YARDS		WELDED WIRE FABRIC, 60" WIDE APPROX. L.F.
	END BENT 1	END BENT 2	
	378.39	360.00	1,450
	415.39	344.90	

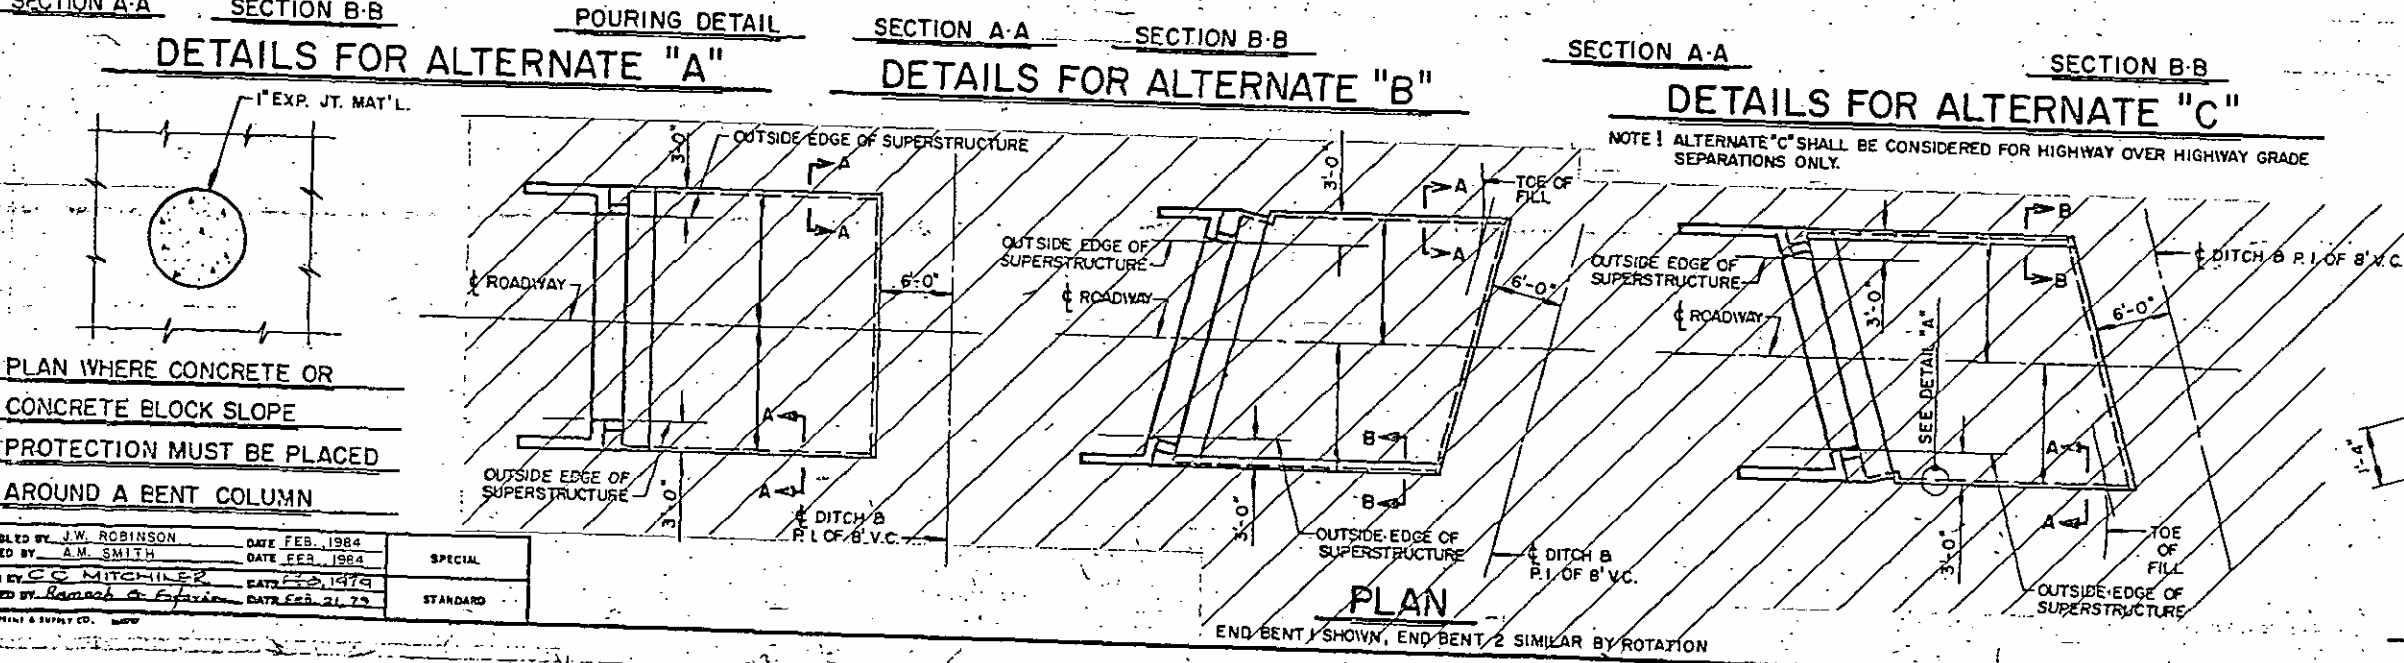

PROJECT No. 8.1125805

EDGEcombe COUNTY

STATION: 20+00.00 -YII- = 763+19.06 -L-

SHEET 2 OF 2

STATE OF NORTH CAROLINA  
DEPARTMENT OF TRANSPORTATION  
RALEIGH

STANDARD SLOPE PROTECTION DETAILS


FEBRUARY 1979

REVISIONS

NO.	BY	DATE	NO.	BY	DATE
1			2		
3			4		

DWG. S-25

REVISED 3-25-82 BY: R.D.U. V.B.Y.R.G.F.  
 REVISED 2/9/82 BY: E.R.L. V.B.Y.R.D.U.  
 REDRAWN AND ADOPTED APRIL 1, 1979  
 CHECKED BY: A.M. SMITH  
 DATE FEB. 1984  
 DRAWN BY: G. MITCHELL  
 DATE FEB. 1979  
 CHECKED BY: R. S. S. V.B.Y.R.G.F.  
 DATE FEB. 21, 79  
 SPECIAL STANDARD  
 CASE ILLUMINATING & SUPPLY CO.

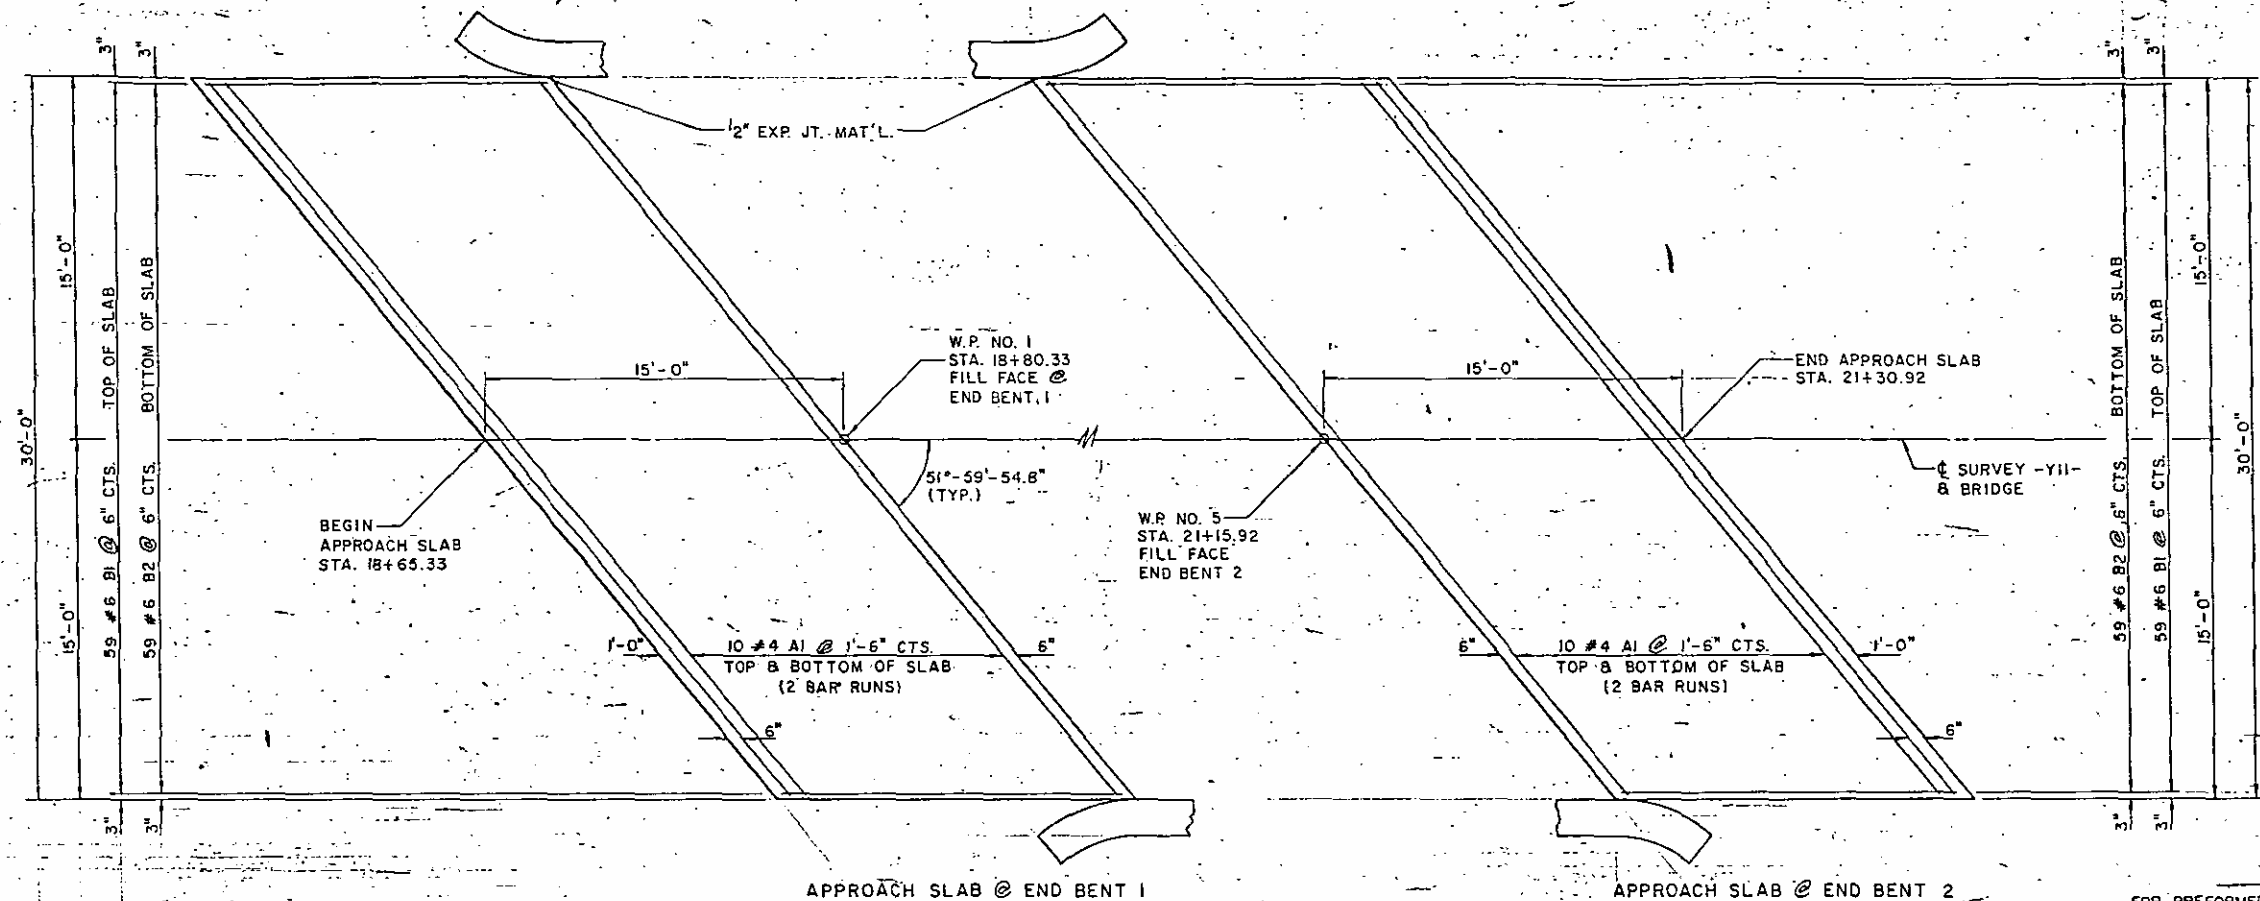

**BILL OF MATERIAL**

**APPROACH SLAB @ END BENT 1**

BAR	NO.	SIZE	TYPE	LENGTH	WEIGHT
* A1	40	4	STR.	19'-9"	528
B1	59	6	STR.	14'-2"	1,256
B2	59	6	STR.	14'-8"	1,300
REINFORCING STEEL LBS. =					3,084
CLASS AA CONCRETE CU. YDS. =					14.2

**APPROACH SLAB @ END BENT 2**

BAR	NO.	SIZE	TYPE	LENGTH	WEIGHT
* A1	40	4	STR.	19'-9"	528
B1	59	6	STR.	14'-2"	1,256
B2	59	6	STR.	14'-8"	1,300
REINFORCING STEEL LBS. =					3,084
CLASS AA CONCRETE CU. YDS. =					14.2

\* BAR LENGTH BASED ON SPLICE LENGTH OF 1'-2"

**NOTES**

FOR PREFORMED COMPRESSION JOINT SEAL, SEE SPECIAL PROVISIONS.

PREFORMED COMPRESSION JOINT SEAL SHALL BE PAID FOR AT THE CONTRACT LUMP SUM PRICE BID. SEE GENERAL DRAWING.




OPENING SHOWN IS BASED ON A NOMINAL UNCOMPRESSED SEAL WIDTH OF 2"

THE INSTALLED COMPRESSION SEAL SHALL BE WATERTIGHT.

PROVIDE WATERTIGHT SEAL AT END OF COMPRESSION SEAL AS RECOMMENDED BY MANUFACTURER.

COMPRESSION SEAL EXTENDS FROM GUTTER TO GUTTER ALONG BRIDGE DECK NOTCH.

THE CONTRACTOR, AT HIS OPTION, MAY USE 4" BITUMINOUS CONCRETE BASE COURSE, TYPE HB IN LIEU OF 6" A.B.C. ANY ADDITIONAL COST DUE TO USE OF THIS OPTION WILL BE PAID FOR BY THE CONTRACTOR.

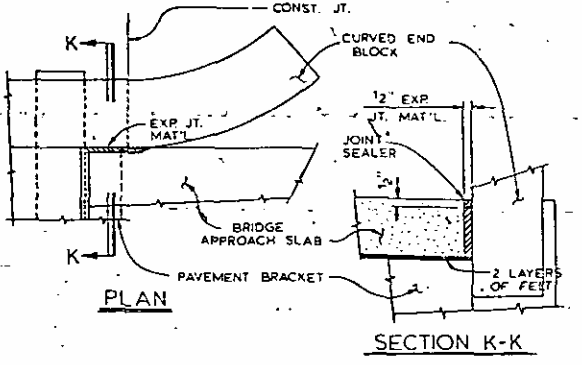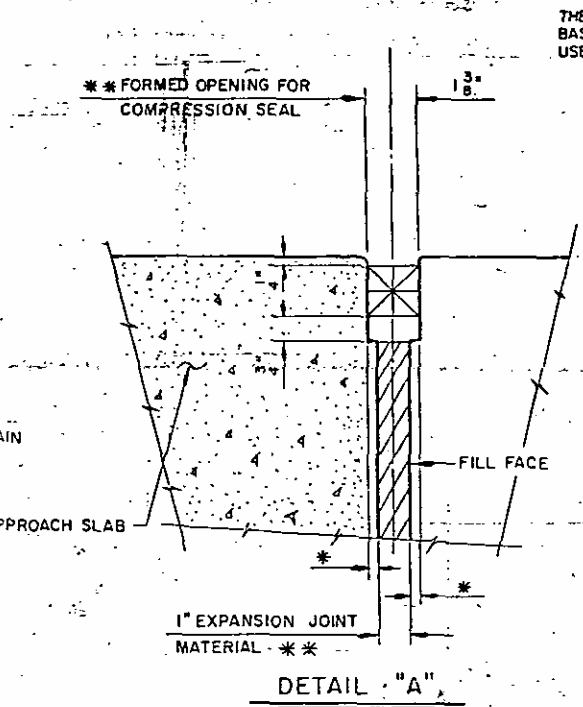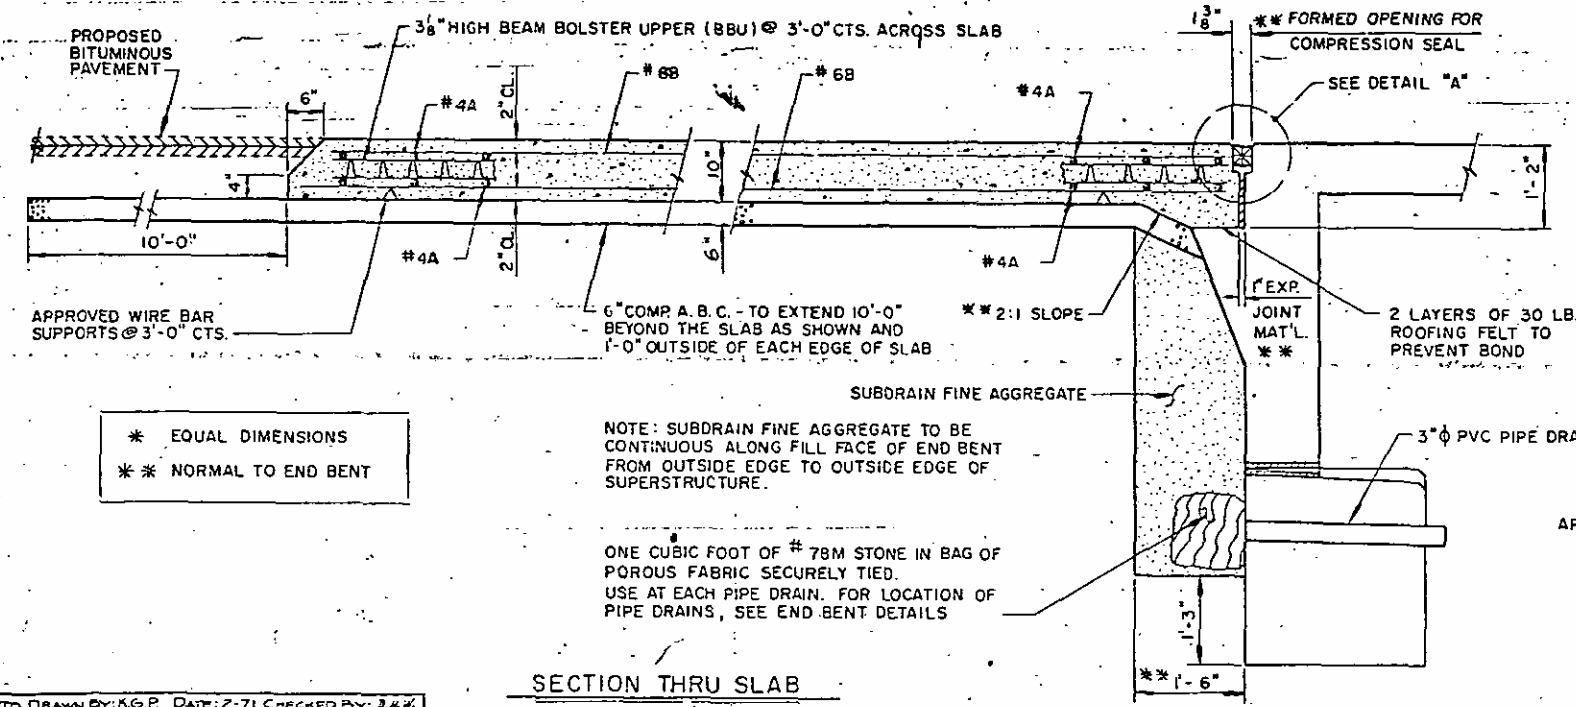

**DETAIL OF EXP. JT. MAT'L. BETWEEN APPROACH SLAB AND CURV. END BLK**

PROJECT No. 8.1125805  
 EDGECOMBE COUNTY  
 STATION: 20+00.00 -YII-  
 = 763+19.06 -L-

STATE OF NORTH CAROLINA  
 DEPARTMENT OF TRANSPORTATION  
 RALEIGH

BRIDGE APPROACH SLAB FOR FLEXIBLE PAVEMENT

NO.	BY	DATE	NO.	BY	DATE
1			2		
2			3		

JULY 1978

SHEET NO. 174  
 TOTAL SHEETS





9-1-81 BY: E.R.L. CHECKED BY: R.D.U.  
 8-26-81 BY: R.E.K. CHECKED BY: R.D.U.  
 4-1-79 BY: C.C.M. CHECKED BY: R.D.U.  
 7-31-78 BY: R.E.K. CHECKED BY: R.D.U.

Revised 2-2-82 By: E.R.L. Checked By: R.D.U.

STD. DRAWN BY: A.G.P. DATE: 2-71 CHECKED BY: J.A.W.  
 DRAWN BY: J.W. ROBINSON DATE FEB. 1984  
 CHECKED BY: JOSE DANON DATE FEB. 1984



DWG. S-26

STD. NO. BAS2

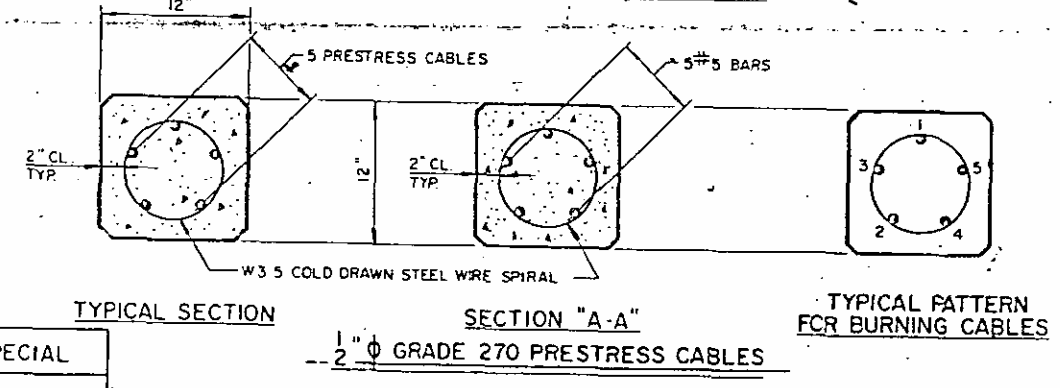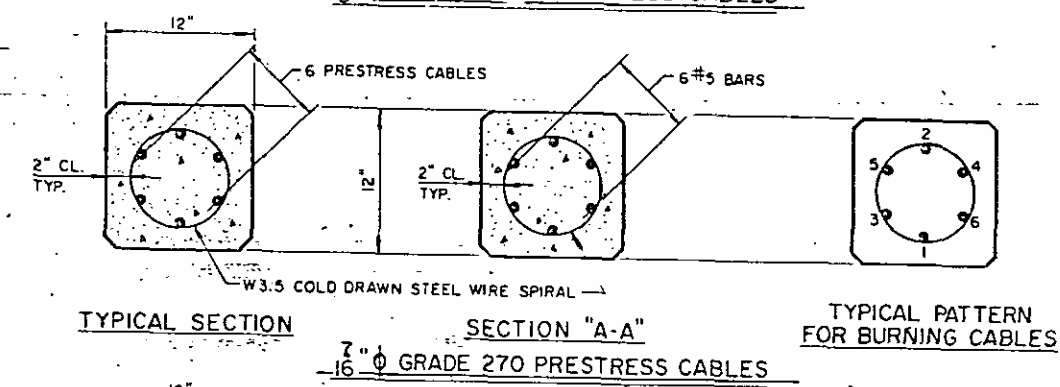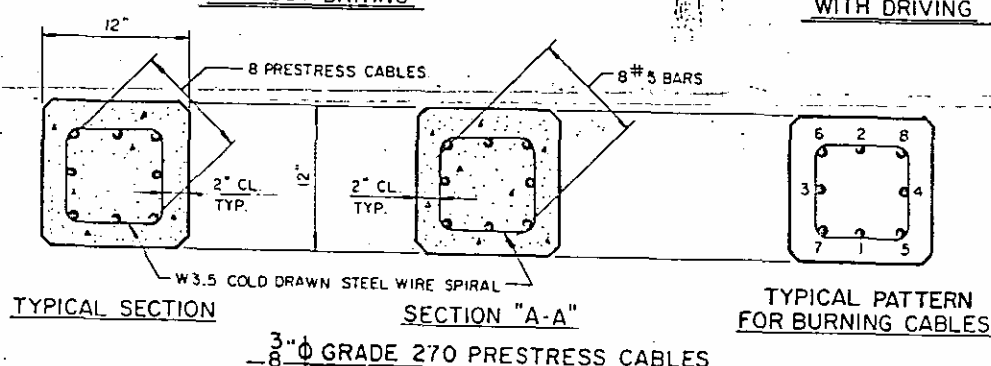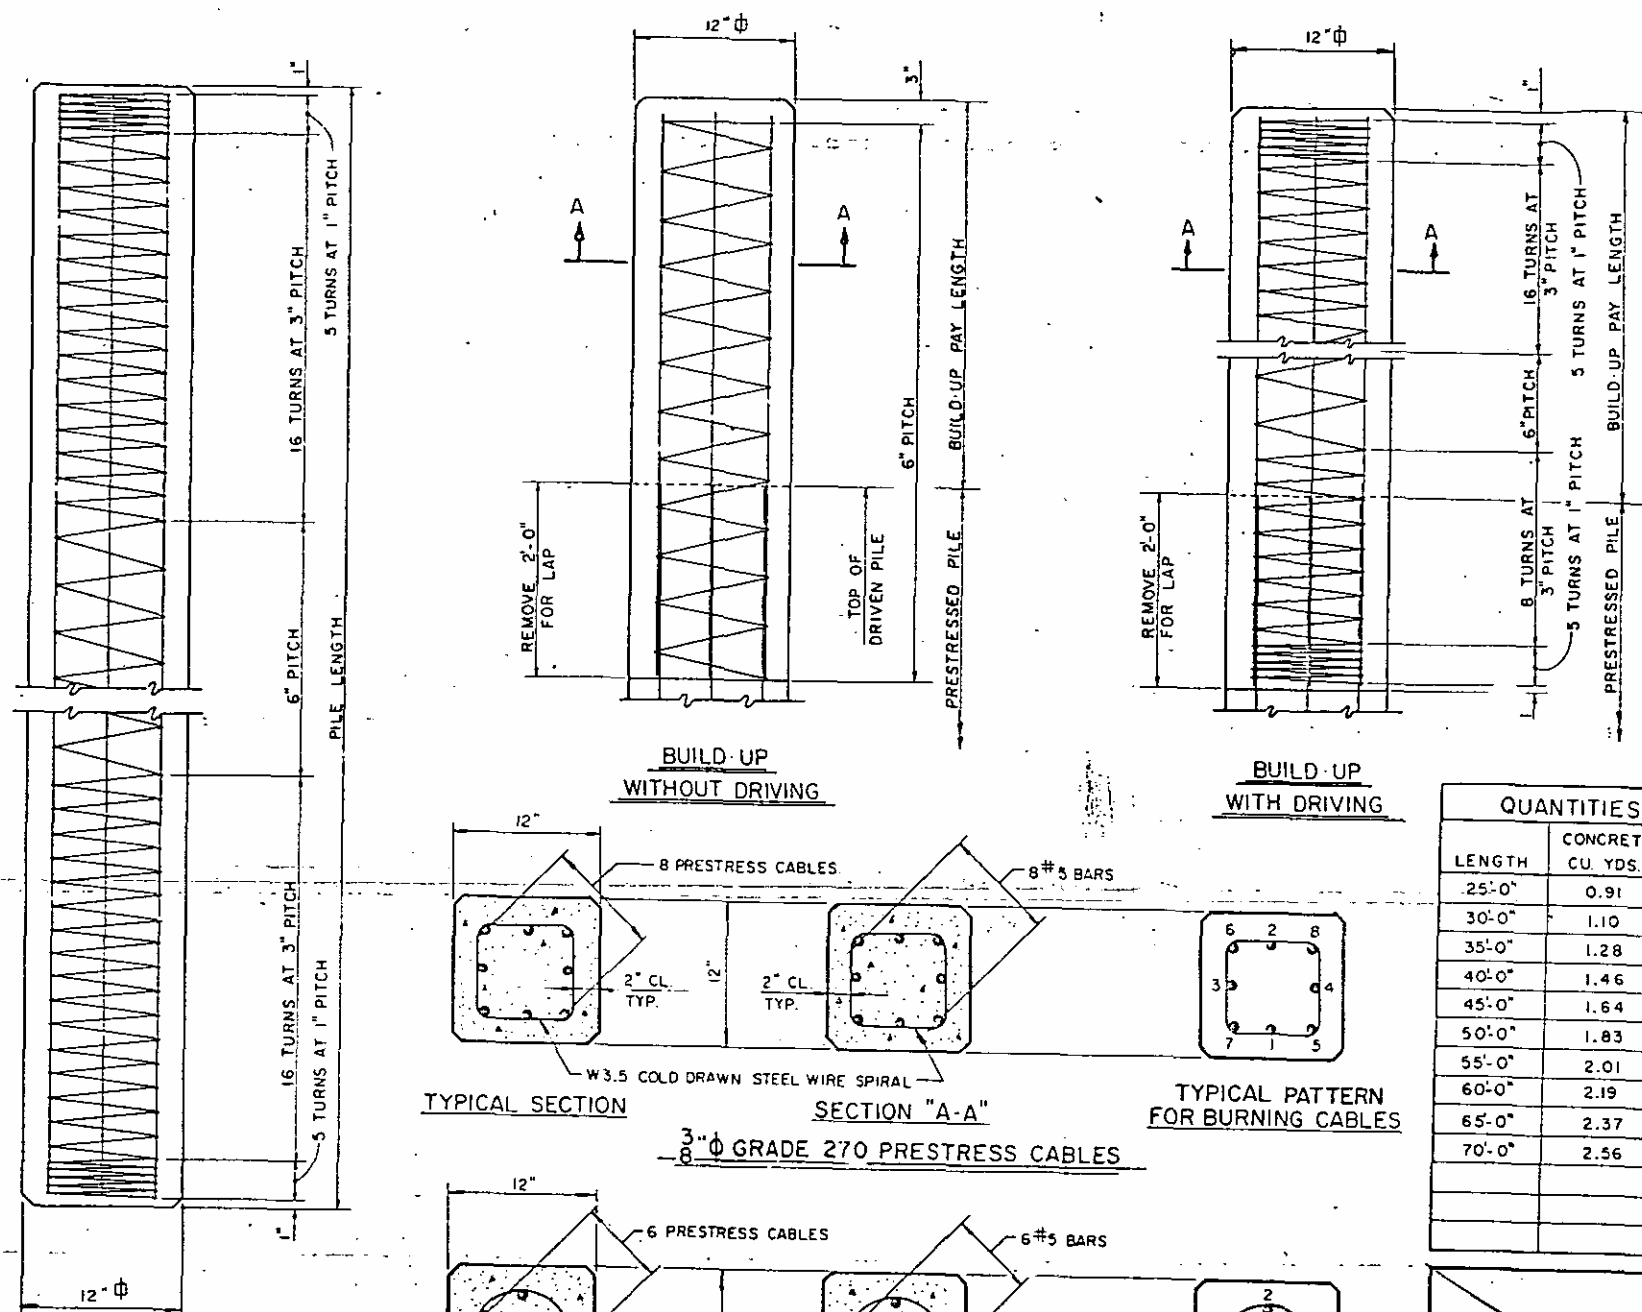

QUANTITIES FOR ONE 12" PRESTRESSED PILE

LENGTH	CONCRETE CU. YDS.	PILE WT. TONS	ONE PICK-UP POINT		TWO PICK-UP POINT	
			0.300L	0.700L	0.207L	0.586L
25'-0"	0.91	1.85	7'-6"	17'-6"		
30'-0"	1.10	2.22	9'-0"	21'-0"		
35'-0"	1.28	2.59	10'-6"	24'-6"		
40'-0"	1.46	2.96	12'-0"	28'-0"		
45'-0"	1.64	3.33	13'-6"	31'-6"		
50'-0"	1.83	3.70	15'-0"	35'-0"		
55'-0"	2.01	4.07			11'-4 1/2"	32'-3"
60'-0"	2.19	4.44			12'-5"	35'-2"
65'-0"	2.37	4.81			13'-5 1/2"	38'-1"
70'-0"	2.56	5.18			14'-6"	41'-0"

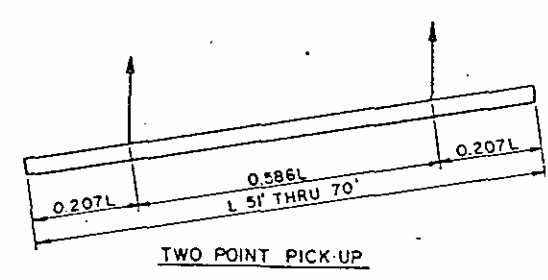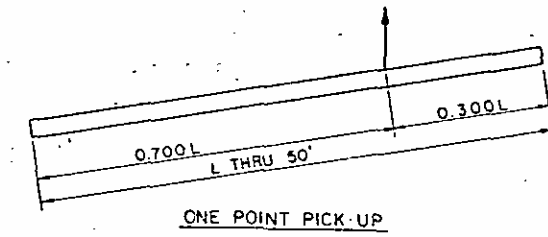

PICK-UP POINTS

**NOTES**

CONCRETE DESIGN DATA:  $f'_c = 5,000 \text{ PSI}$ ;  $f_t = 2,000 \text{ PSI}$

IMPACT IN HANDLING = 50%

IN DRIVING PILES, A METHOD APPROVED BY THE ENGINEER SHALL BE USED, WHEREBY THE HEAD OF THE PILE IS NOT DAMAGED.

DEVICES FOR LIFTING THE PILES SHALL BE APPROVED BY THE ENGINEER. LOOPS OF CABLE CAST IN THE PILES WILL NOT BE PERMITTED. INSERTS, CAST IN THE PILES TO RECEIVE THREADED EYE-BOLTS OR SIMILAR APPROVED DEVICES, MAY BE USED; OR WHERE IT IS PRACTICABLE, SATISFACTORY CLAMPS OR SLINGS MAY BE USED. WHERE PILES WILL BE EXPOSED TO VIEW IN THE STRUCTURE AND INSERTS ARE CAST IN THE PILES, THE OPENINGS SHALL BE REPAIRED AFTER THE EYE-BOLTS OR OTHER ATTACHMENTS HAVE BEEN REMOVED. THE OPENINGS SHALL BE REPAIRED IN A SATISFACTORY MANNER IN ORDER TO OBTAIN A UNIFORM APPEARANCE.

ALL PRESTRESSING STRANDS SHALL BE 7-WIRE CABLES AS PRESCRIBED IN THE SPECIFICATIONS. THE CONTRACTOR MAY, AT HIS OPTION, USE EITHER OF THE THREE TYPES OF CABLES LISTED BELOW. HOWEVER, ALL CABLES IN A PILE SHALL BE OF THE SAME TYPE.


SIZE	GRADE	NUMBER OF CABLES	AREA	ULTIMATE STRENGTH	APPLIED PRESTRESS FORCE
3/8"	270	8	0.085"	23,000 # PER CABLE	16,100 # PER CABLE
7/16"	270	6	0.115"	31,000 # PER CABLE	21,700 # PER CABLE
1"	270	5	0.153"	41,300 # PER CABLE	28,900 # PER CABLE

IF CABLE STRESS IS RELIEVED BY BURNING, THE CABLES SHALL BE BURNED IN PAIRS, EXCEPT WHERE 5 CABLES ARE USED THE LAST CABLE MAY BE BURNED SINGLY, ACCORDING TO BURNING PATTERNS SHOWN. NOT MORE THAN 4 CABLES MAY BE BURNED AT ANY ONE SECTION BEFORE THE SAME CABLES ARE BURNED AT BOTH ENDS OF THE BED AND BETWEEN EACH PAIR OF PILES IN THE BED.

BUILD-UPS SHALL BE CLASS "A" CONCRETE W/20% ADDITIONAL CEMENT. NO DRIVING OF THE BUILT-UP PILE WILL BE PERMITTED UNTIL THE CONCRETE HAS REACHED A COMPRESSIVE STRENGTH OF 3,000 PSI AND UNTIL A PERIOD OF SEVEN DAYS HAS ELAPSED SINCE CASTING OF THE BUILD-UP.

ALL CORNERS TO BE CHAMFERED 3/4".

WHERE CAST-IN-PLACE LIFTING DEVICES ARE NOT USED, PICK-UP POINTS TO BE INDICATED WITH A BLACK MARK 2" WIDE.

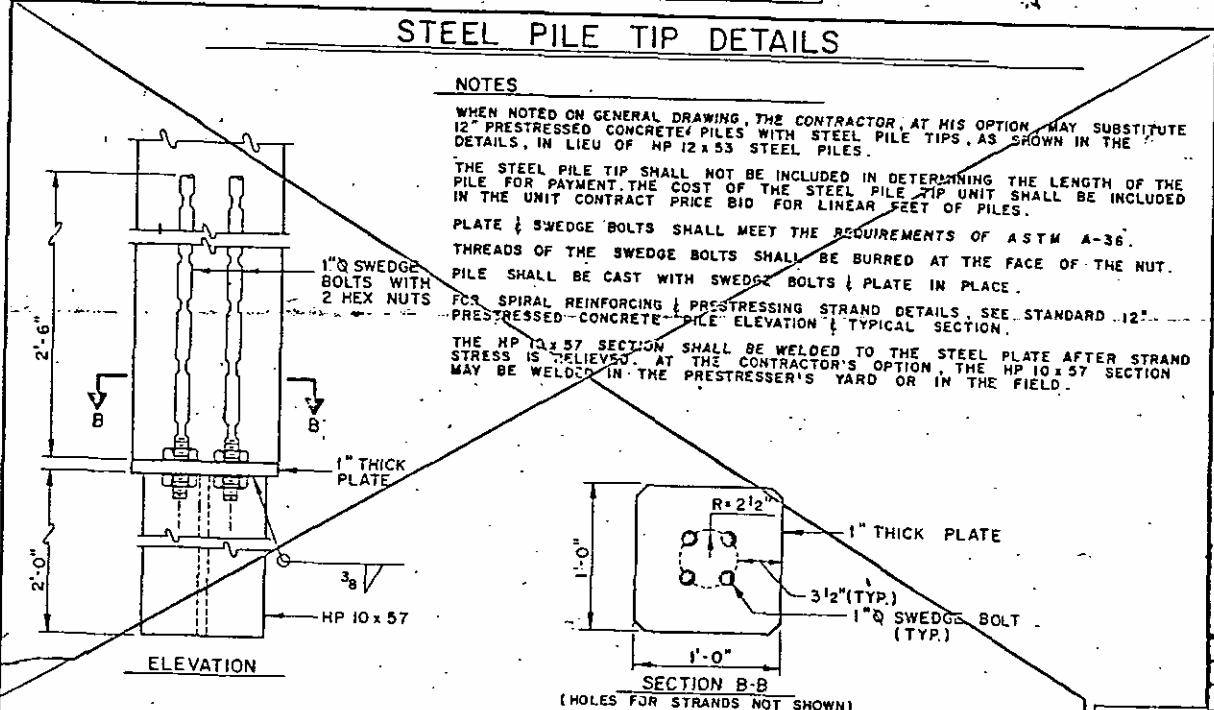

PROJECT No. 8.1125805  
EDGEcombe COUNTY  
STATION: 20+00.00-Y11-763+19.06-L

STATE OF NORTH CAROLINA  
DEPARTMENT OF TRANSPORTATION  
RALEIGH

STANDARD 12" PRESTRESSED CONCRETE PILE

REVISIONS					
NO.	BY	DATE	NO.	BY	DATE
1			2		
2			3		
3			4		

SHEET NO. 175  
TOTAL SHEETS

STD. NO. PCP1

REVISED 11-12-82 BY JMB /BY RDU  
REVISED 12-22-80 BY CCM /BY RDU  
REVISED 7-31-78 BY REK /BY RDU  
REVISED 2-3-83 BY JMB /BY RDU

ASSEMBLED BY AL SMITH	DATE MAY 1984	SPECIAL
CHECKED BY J. DANON	DATE MAY 1984	
DRAWN BY R. BRIGHTON	DATE Oct 14 1977	STANDARD
CHECKED BY Ramesh A. Entine	DATE Nov 7 1977	

DWG. S-27