


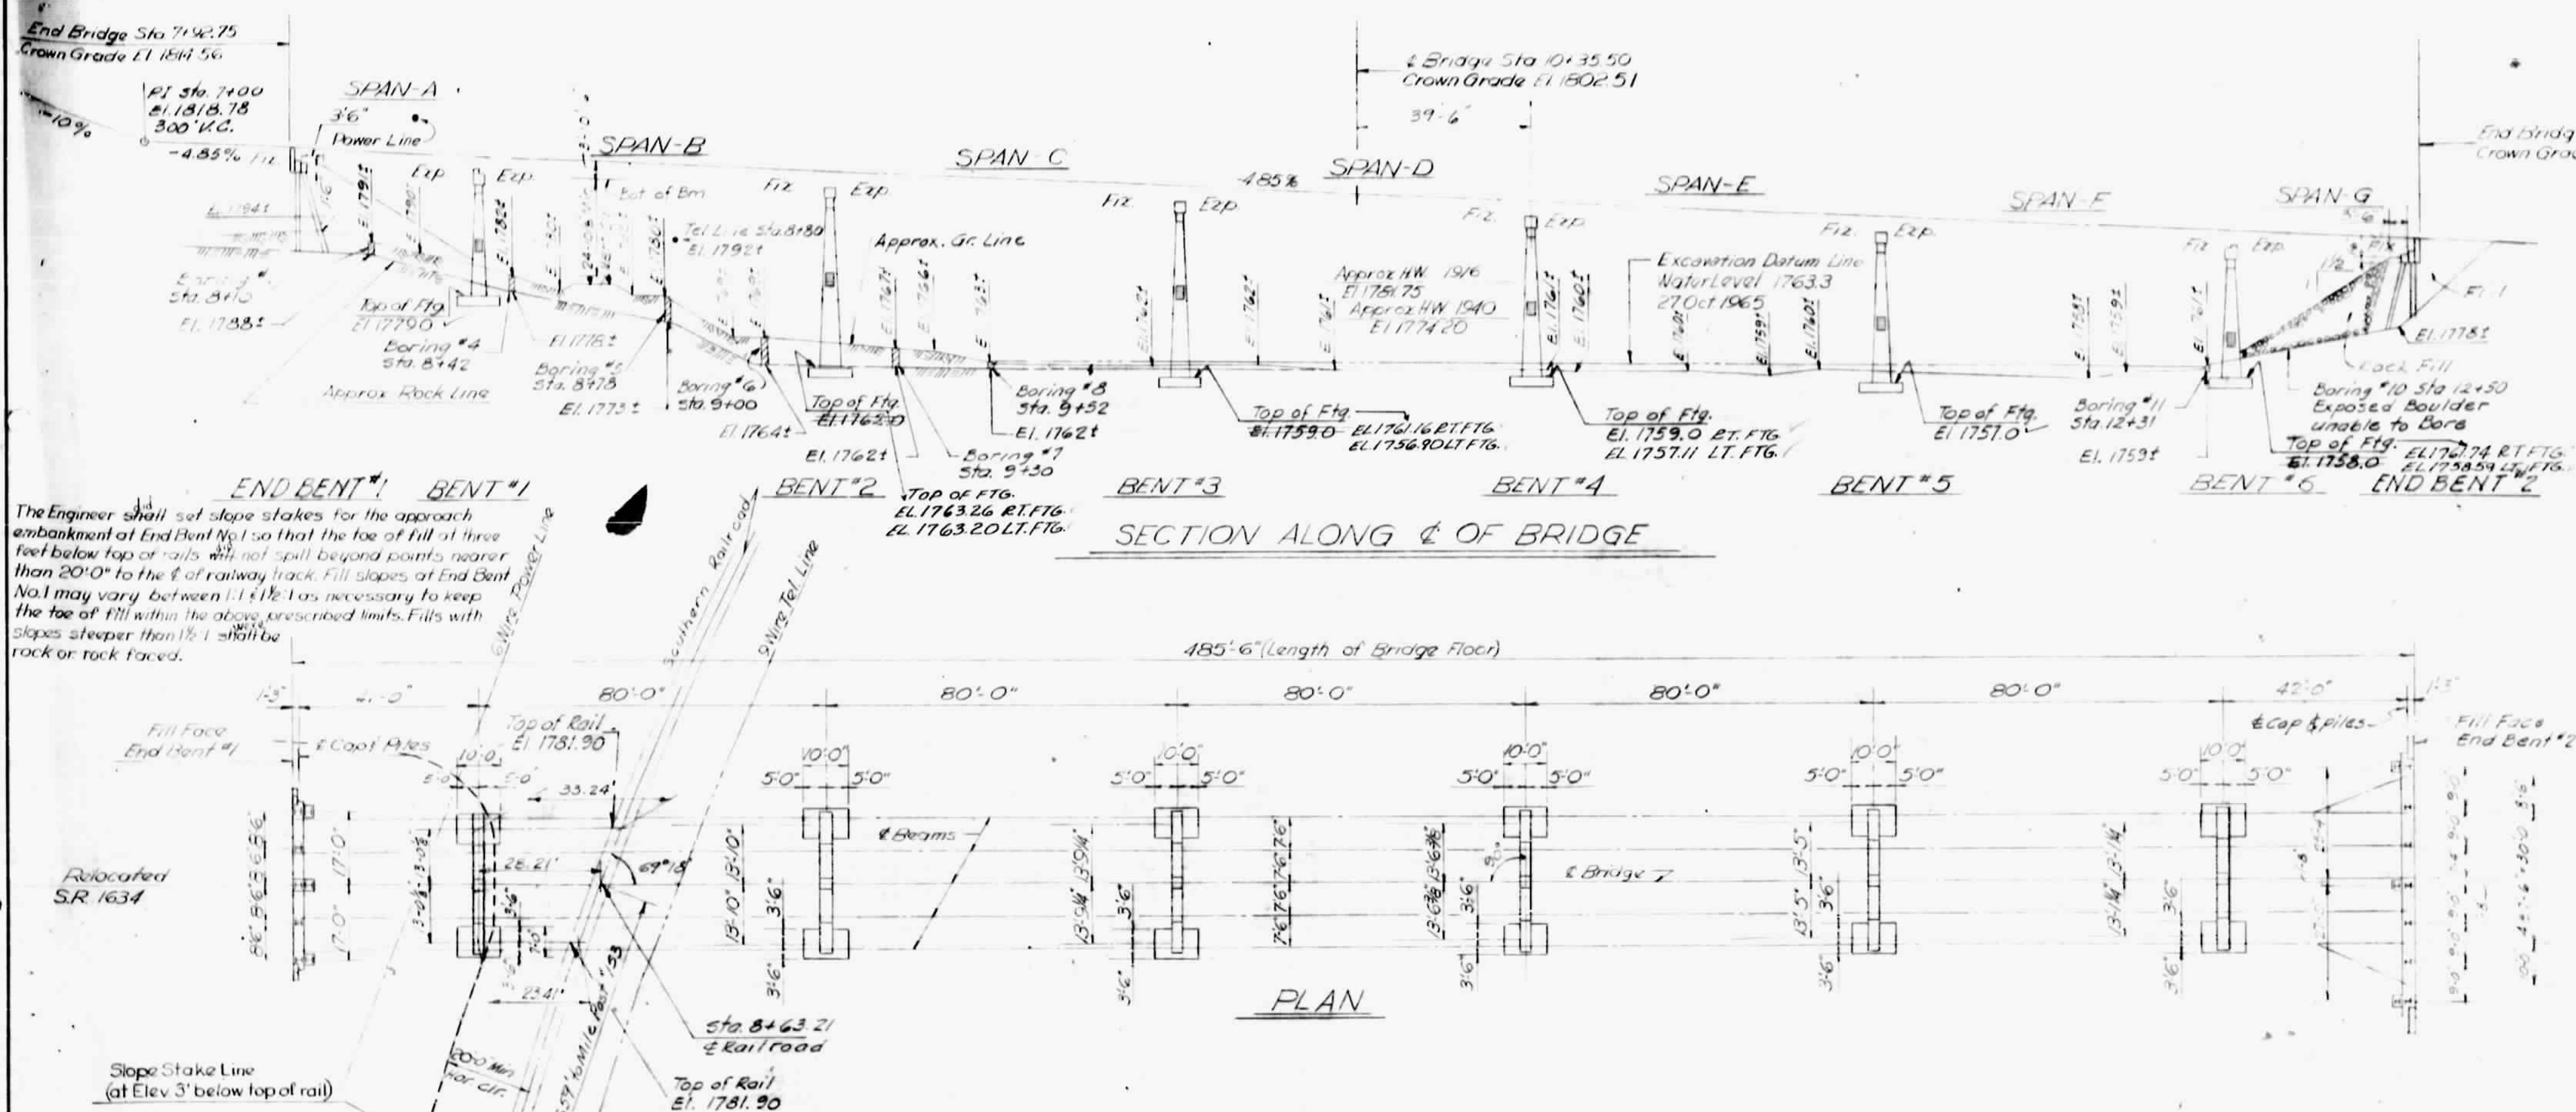

NOTES

Assumed Live Load: H-15-44

For other Design Data and General Note, see Sheet S-N.

Computed foundation load for Bents #1, #2, #3, #4, #5, #6 equals 46 tons per sq ft.

Footings for Bents #1, #2, #3, #4, #5, #6 to be carried at least 12" into rock with thickness as shown on plans.

Piles in End Bent #1 & #2 are designed for bearing capacity of 36 tons per pile. These piles shall be driven to rock or to practical refusal.

Fill for End Bent #2 shall be rock with an earth core through which End Bent #2 piles are to be driven. Before placement of fill for End Bent #2, the Contractor shall remove existing broken rock and boulders from the pile locations to assure piles are driven to solid rock.

The Contractor shall be responsible for determining the correct length of piles. See Special Provisions.

Existing 6 Wire Power Line will be relocated by others to clear Const.

MAINTENANCE AND REMOVAL OF EXISTING STRUCTURE:


After serving as a temporary crossing, the existing structure, consisting of 3@115' steel thru truss spans, crea. tim. floor, rubble masonry abutments, concrete piers, 15' cl. roadway, and located 0.5 miles upstream from proposed structure, shall be removed as follows: Superstructure completely. Substructure in accordance with the Specifications (See Specifications and Special Provisions)

I hereby certify that this structure was built according to plan except as noted herein.

Signed: *[Signature]* Date: 7-23-70
Resident Engineer

**See Special Provisions for method of curing bridge deck and mixing and applying the linseed oil solution.

PROJECT No. 82016601
BUNCOMBE COUNTY
STATION: 10+35.50
M.P. Sta. 153.1


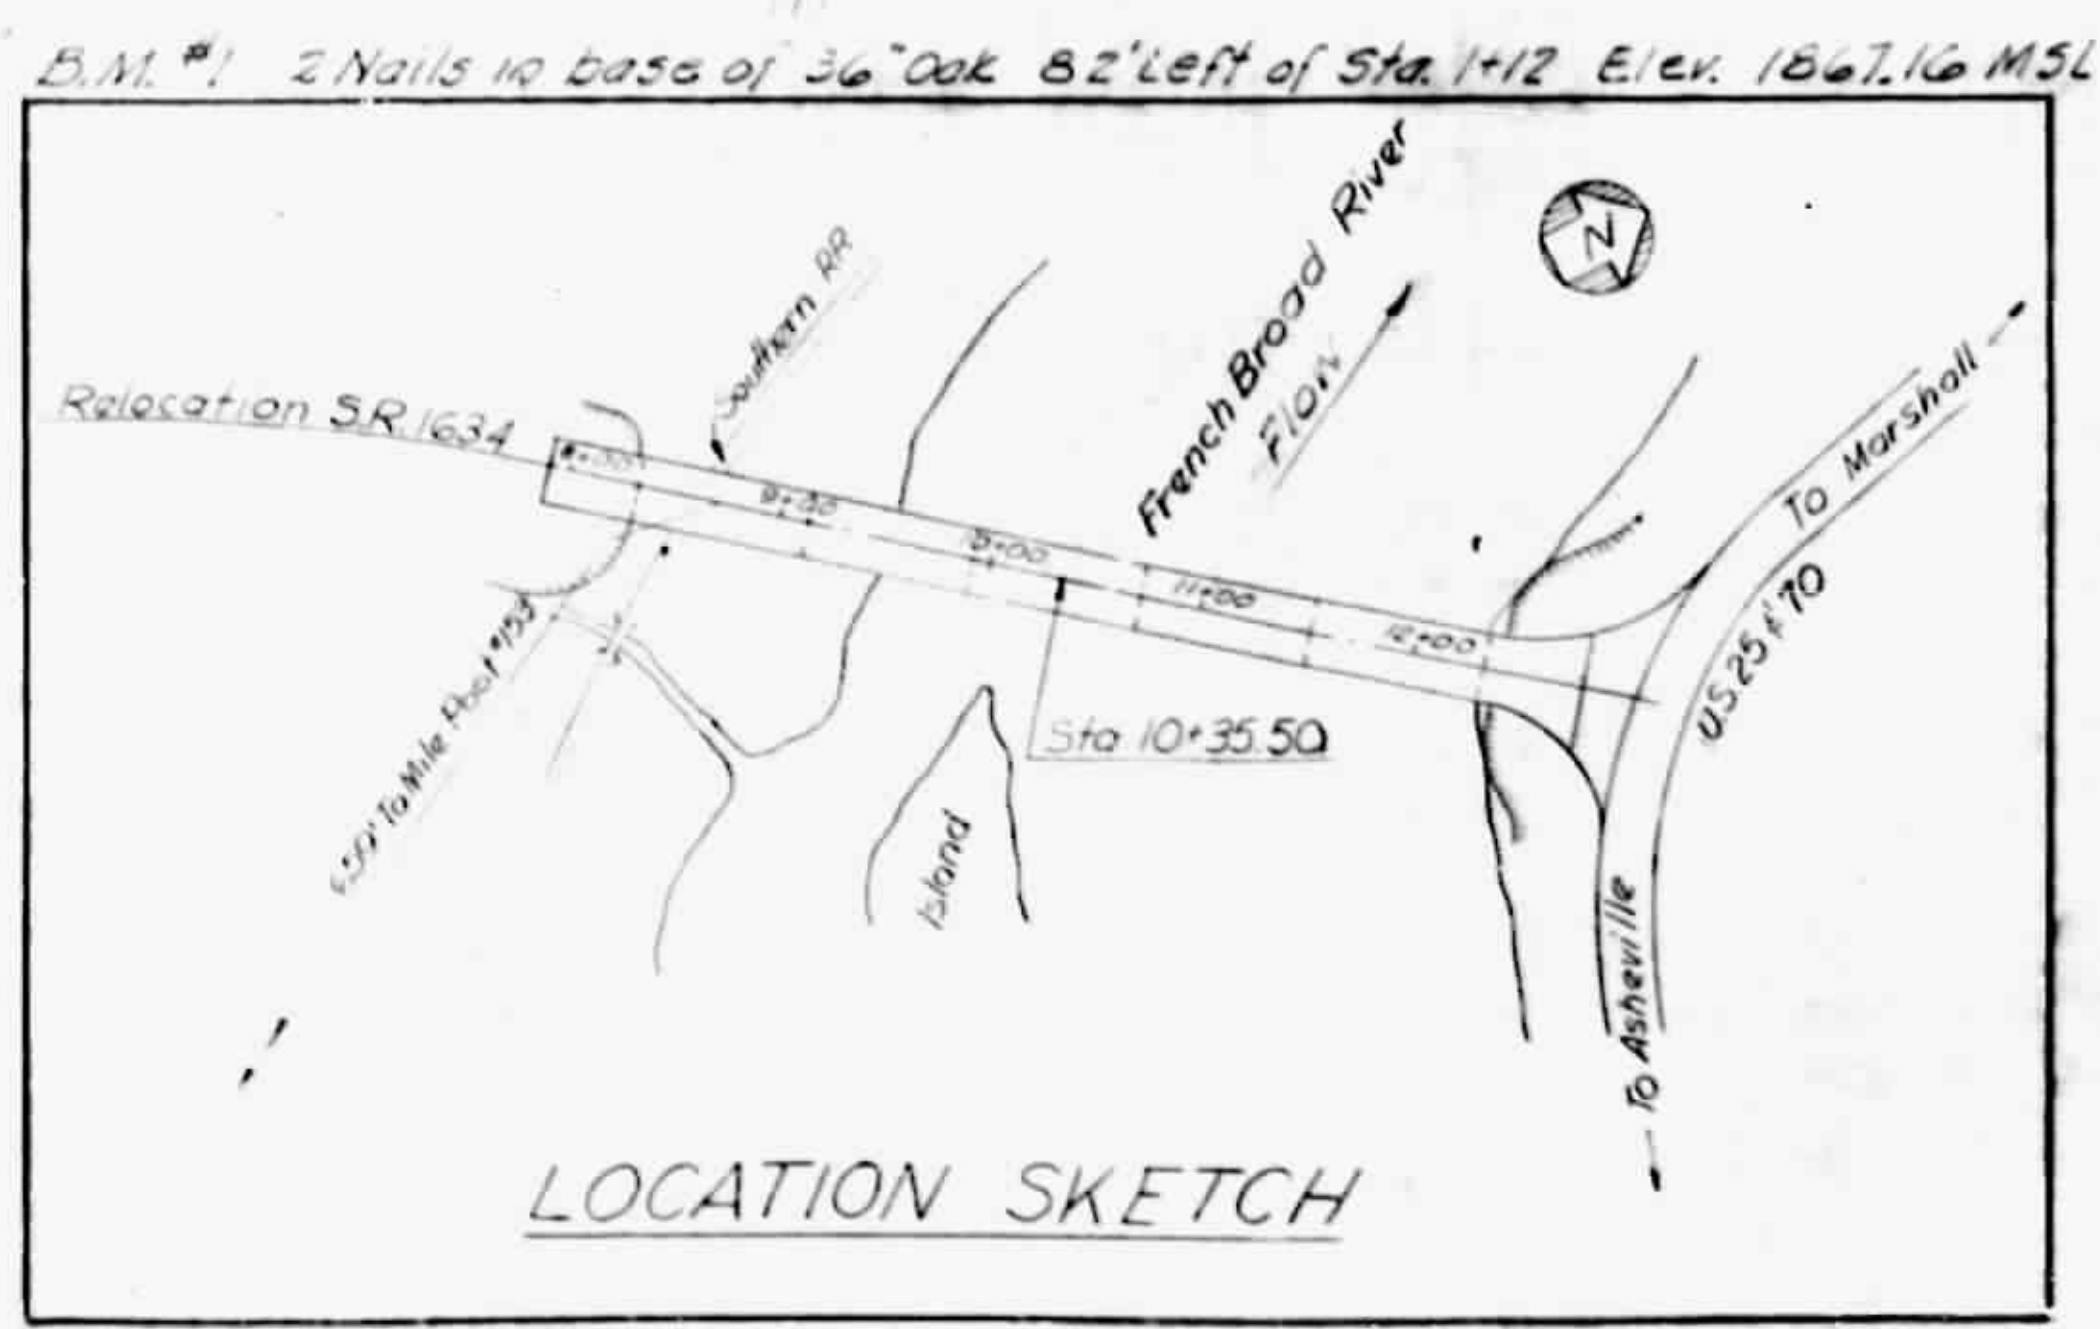


*INCLUDES QUANTITIES IN CURVED END BLOCK


TOTAL BILL OF MATERIAL										
	Reinf Steel 110,133 Pounds	Class "A" Conc Cu Yds.	Struct Steel Approx Pounds	12 H. 53" Steel Piles No. Lin. Ft.	Excavation WET DRY Cu Yds. Cu Yds.	CONC. HAND-RAIL LIN. FT.	Licensed Oil Conc. Protect. Gal.	Maint./Remove of Exst. Struct. Lump Sum	Class "A" CONC. Cu Yds.	
Superstructure	46,156		466,300							
End Bent #1	2,236	41.7	10,700	8	172					
Bent #1	9,508	41.7	43,730							
Bent #2	10,863	50.5	52,050							
Bent #3	10,853	49.7	43,000							
Bent #4	10,311	46.6	49,505							
Bent #5	10,291	45.2	44,950							
Bent #6	9,650	41.9	43,351							
End Bent #2	3,599	18.3		10	203					
Totals	167,176	305.9	466,300	18	377	240	112	8565	41	Lump Sum 4,312
TOTALS	177,441	310.08								

STATE OF NORTH CAROLINA STATE HIGHWAY COMMISSION					
GENERAL DRAWING FOR BRIDGE OVER FRENCH BROAD RIVER ON SR 1634 RELOCATION NOV. 1966					
REVISIONS					
NO.	BY	DATE	NO.	BY	DATE
1			1		
2					

DESIGNED BY: R. Turner
DRAWN BY: R. Blair
CHECKED BY: R. Self
DATE: NOV 66
DATE: NOV 66
DATE: NOV 66

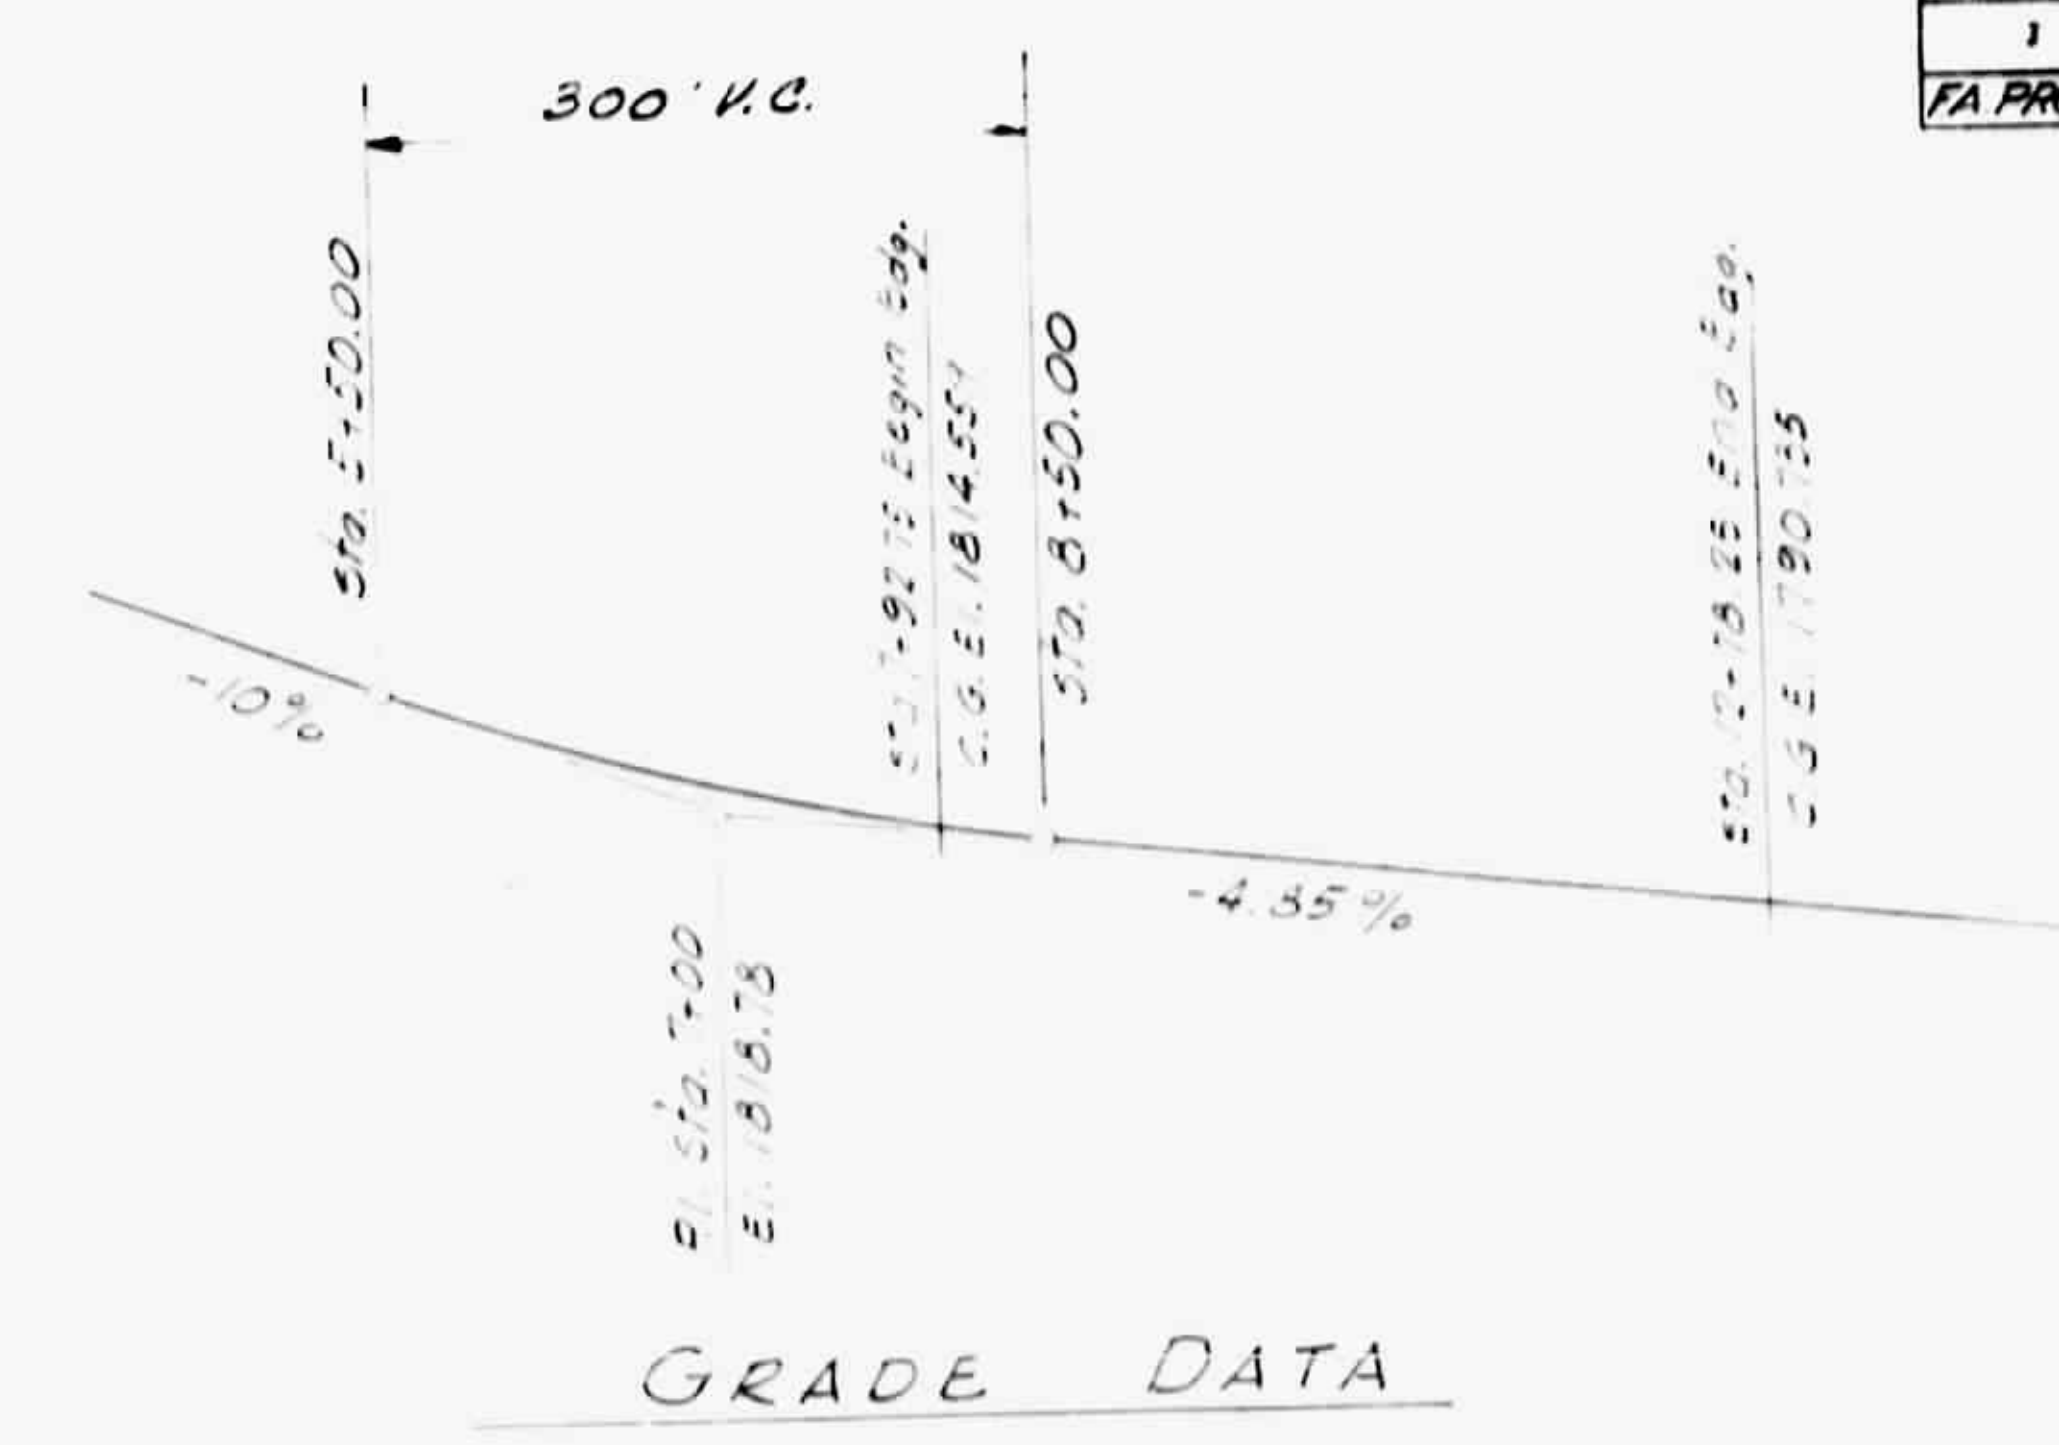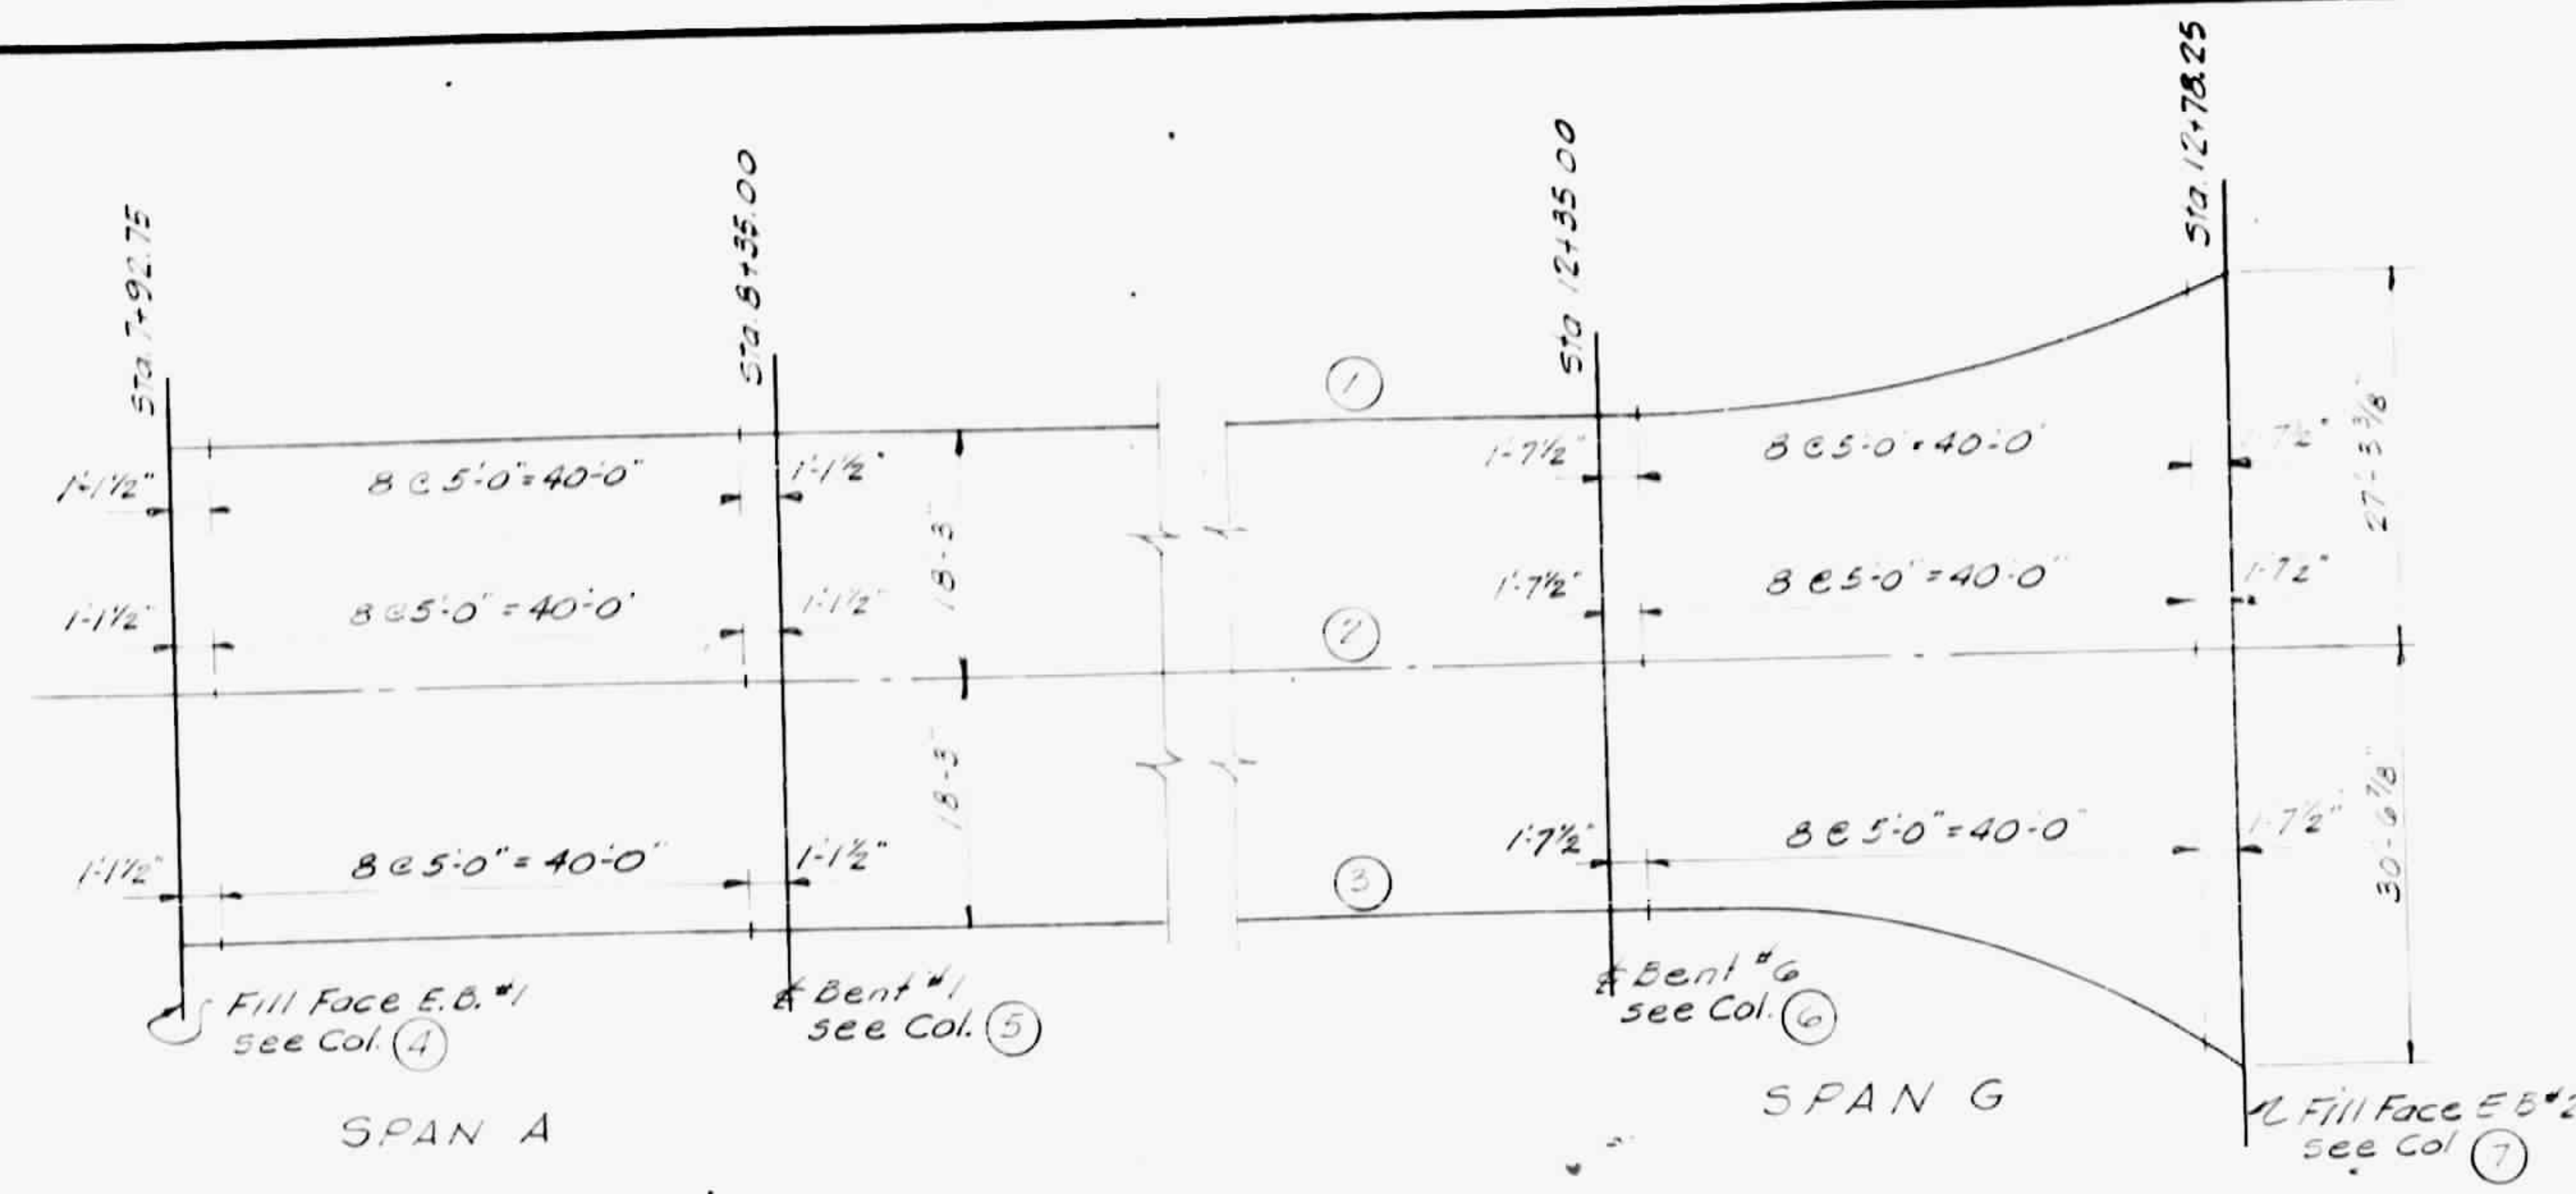


PLAN

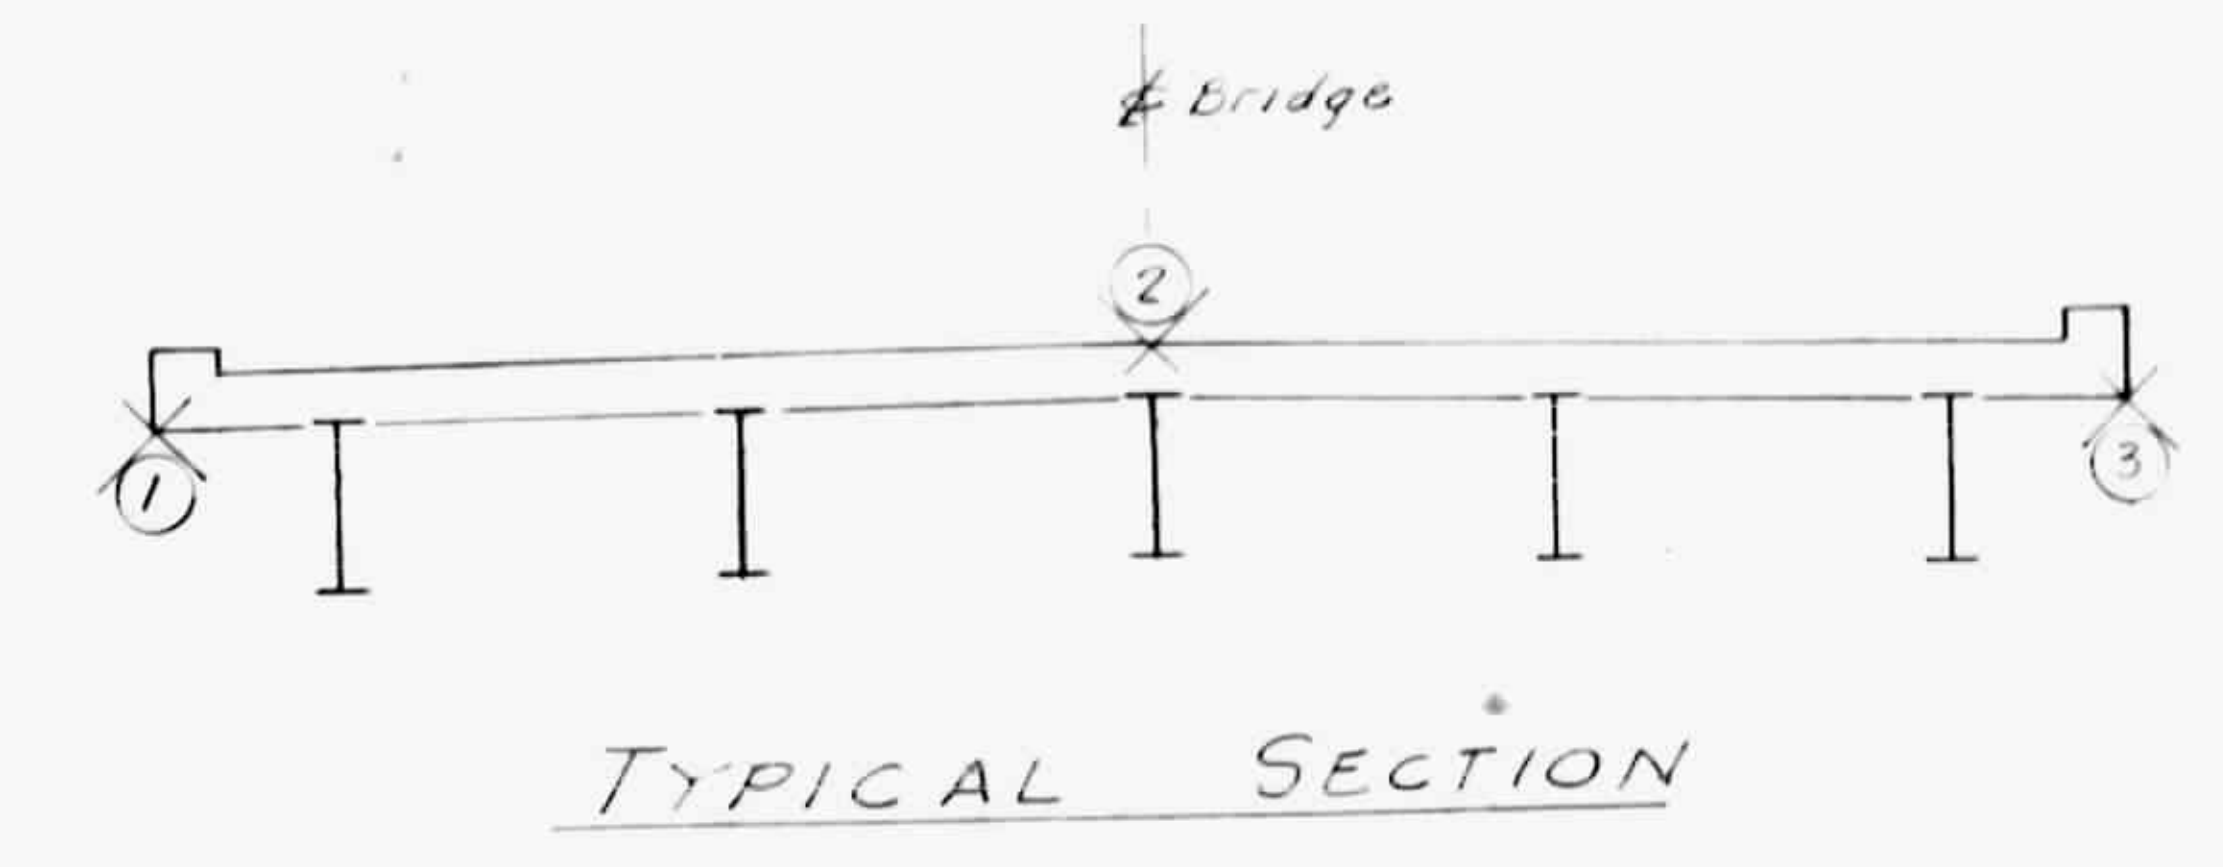


Dist.	Location	Col. (1) Elevation Bottom of Overhang	Col. (2) Elevation Bottom of Roadway	Col. (3) Elevation Bottom of Overhang	
SPAN A					
	Fill Face	1813.606	1814.559	1813.606	
1'-1/2"	7+93.88	1813.540	1814.493	1813.540	
8 5'-0" = 40'-0"		1813.252	1814.205	1813.252	
		1812.967	1813.920	1812.967	
		1812.657	1813.640	1812.657	
		1812.412	1813.365	1812.412	
		1812.140	1813.093	1812.140	
		1811.873	1812.826	1811.873	
		1811.611	1812.564	1811.611	
	8+33.88	1811.351	1812.304	1811.351	
1'-1/2"	8+57.41	1811.296	1812.249	1811.296	
SPAN B					
	4 Bent #6	1791.879	1792.832	1791.879	
1'-7/2"	12+36.63	1791.800	1792.753	1791.800	
8 5'-0" = 40'-0"		1791.553	1792.511	1791.553	
		1791.302	1792.268	1791.302	
		1791.047	1792.026	1791.051	
		1790.787	1791.783	1790.786	
		1790.524	1791.541	1790.515	
		1790.255	1791.298	1790.235	
		1789.983	1791.056	1789.974	
		1789.705	1790.813	1789.688	
	1'-7/2"	Fill Face	1789.615	1790.735	1789.549

TYPICAL SECTION
(showing diaphragms - rib bands)

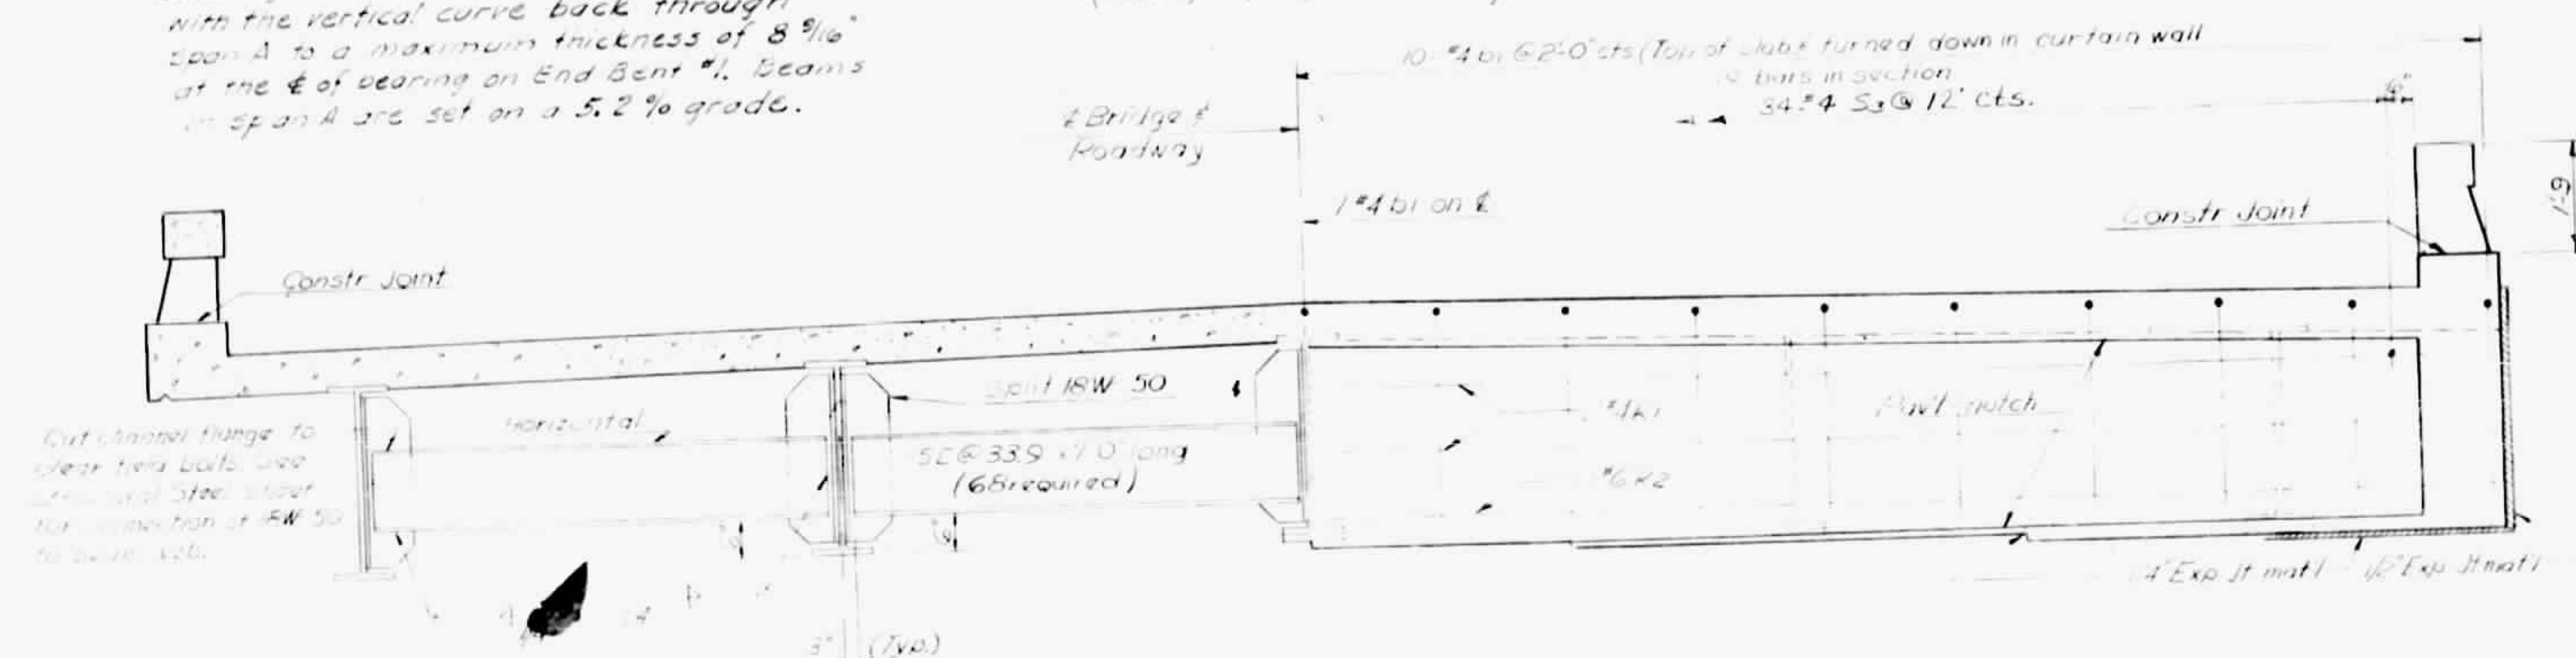

TYPICAL HALF SECTION

(Showing 130 days to midspan)

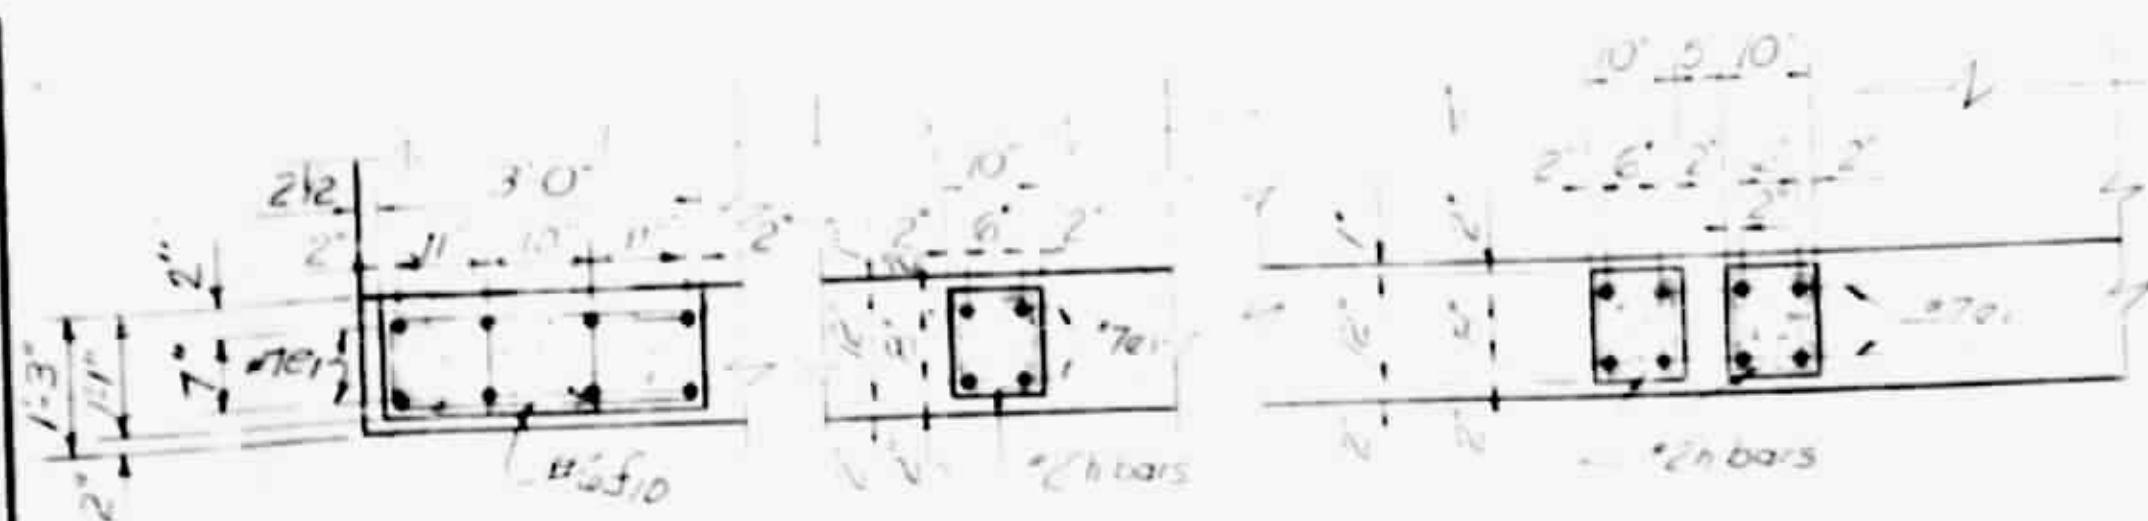


NOTE:
Vertical bars may be shifted to clear name plate / road guard rail.


POST DETAILS
(Taken at base of posts)




(1) $\alpha = 1$ and $\beta = 1$ are the only solutions.

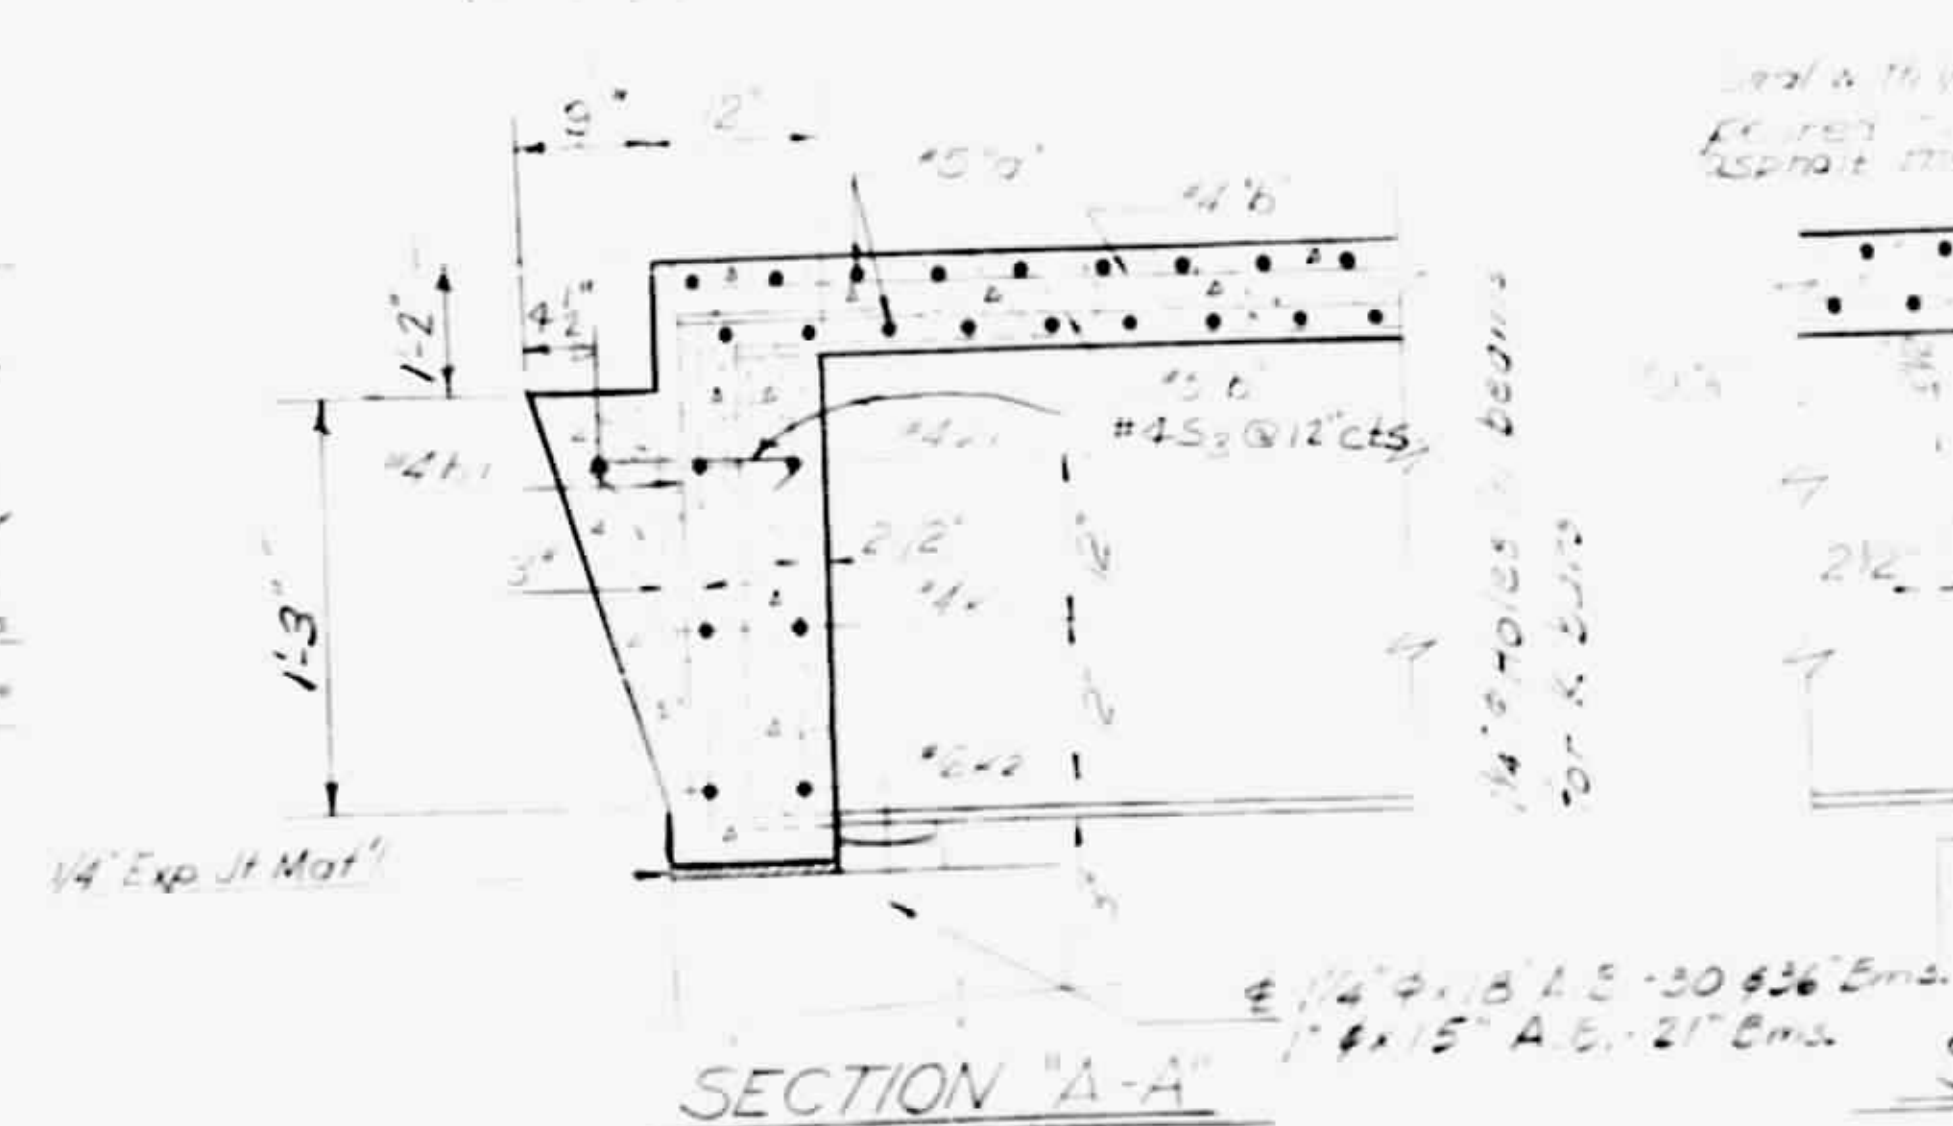

SECTION "A-A"

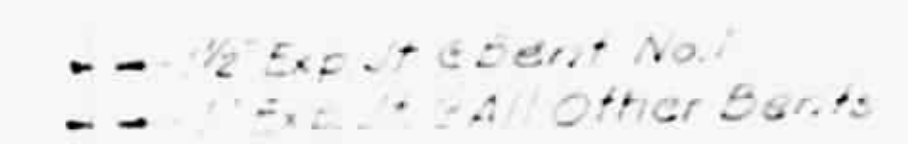


Seal with 1/2" red
polymer fiber
asphalt material

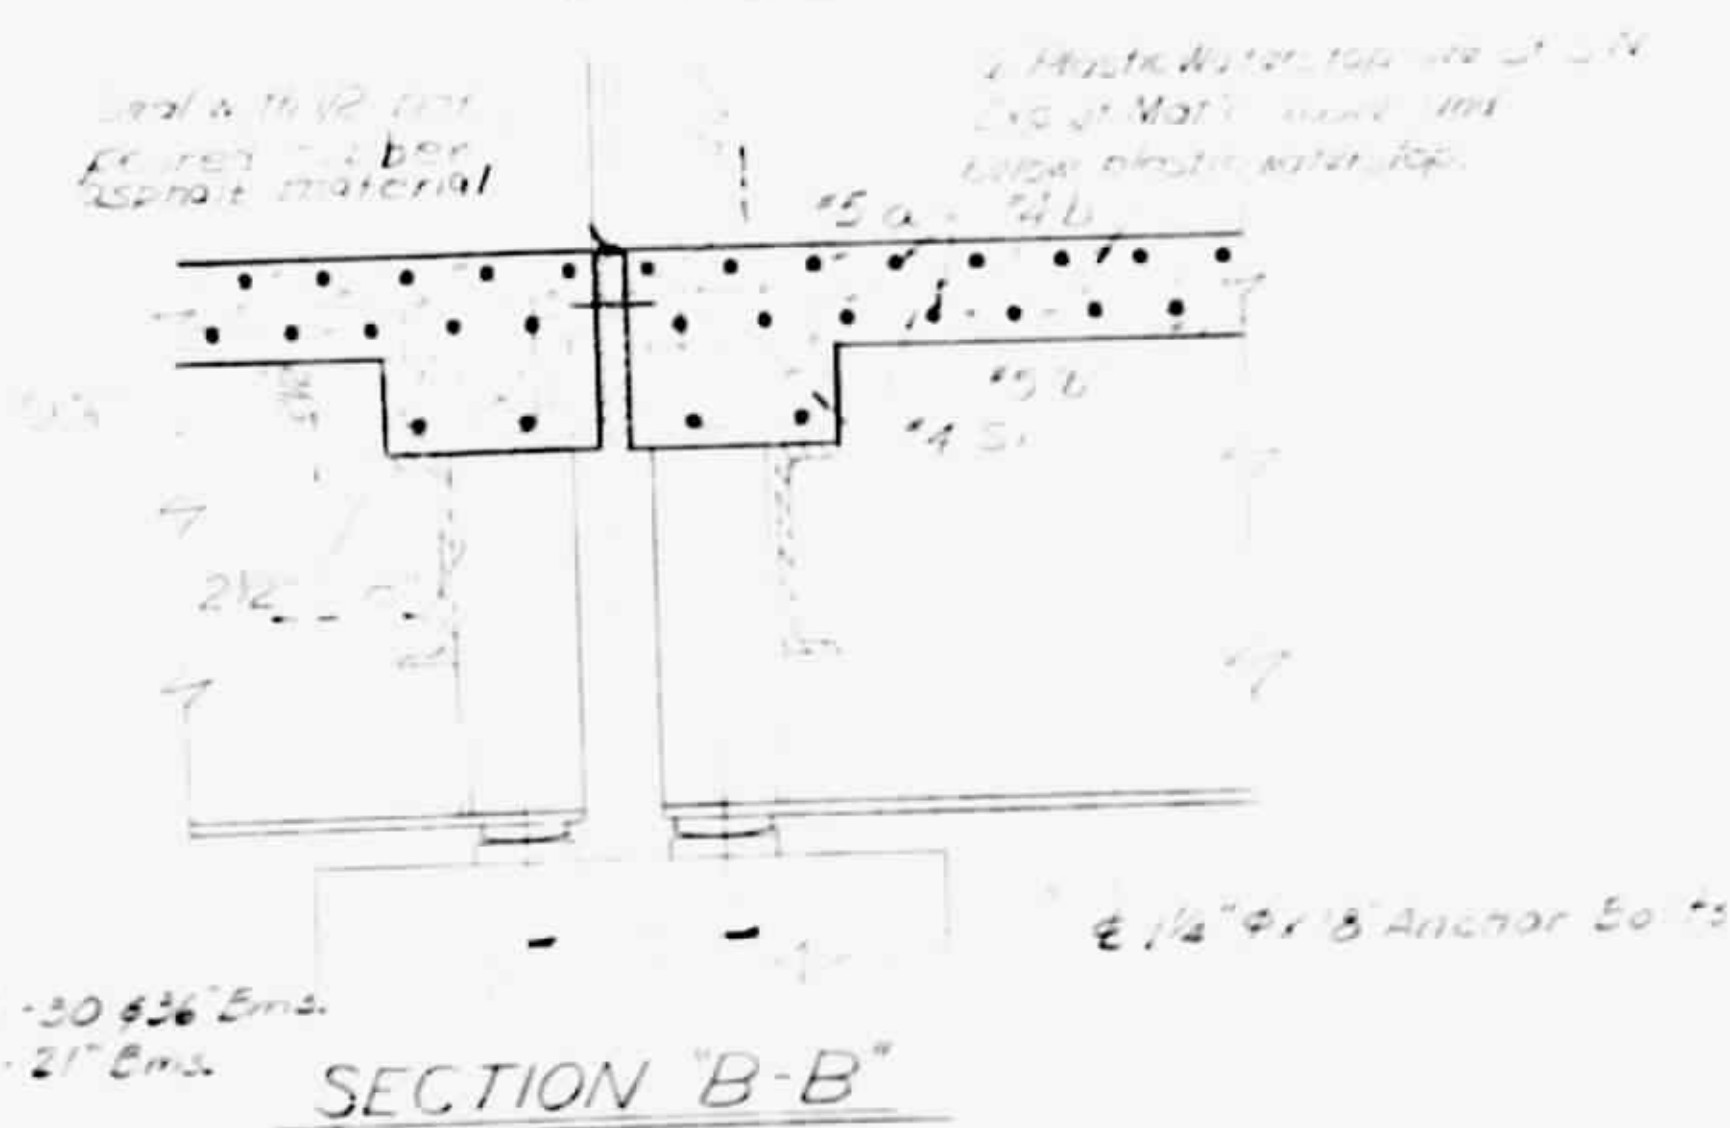

SECTION "B-B"

SECTION THRU CURB

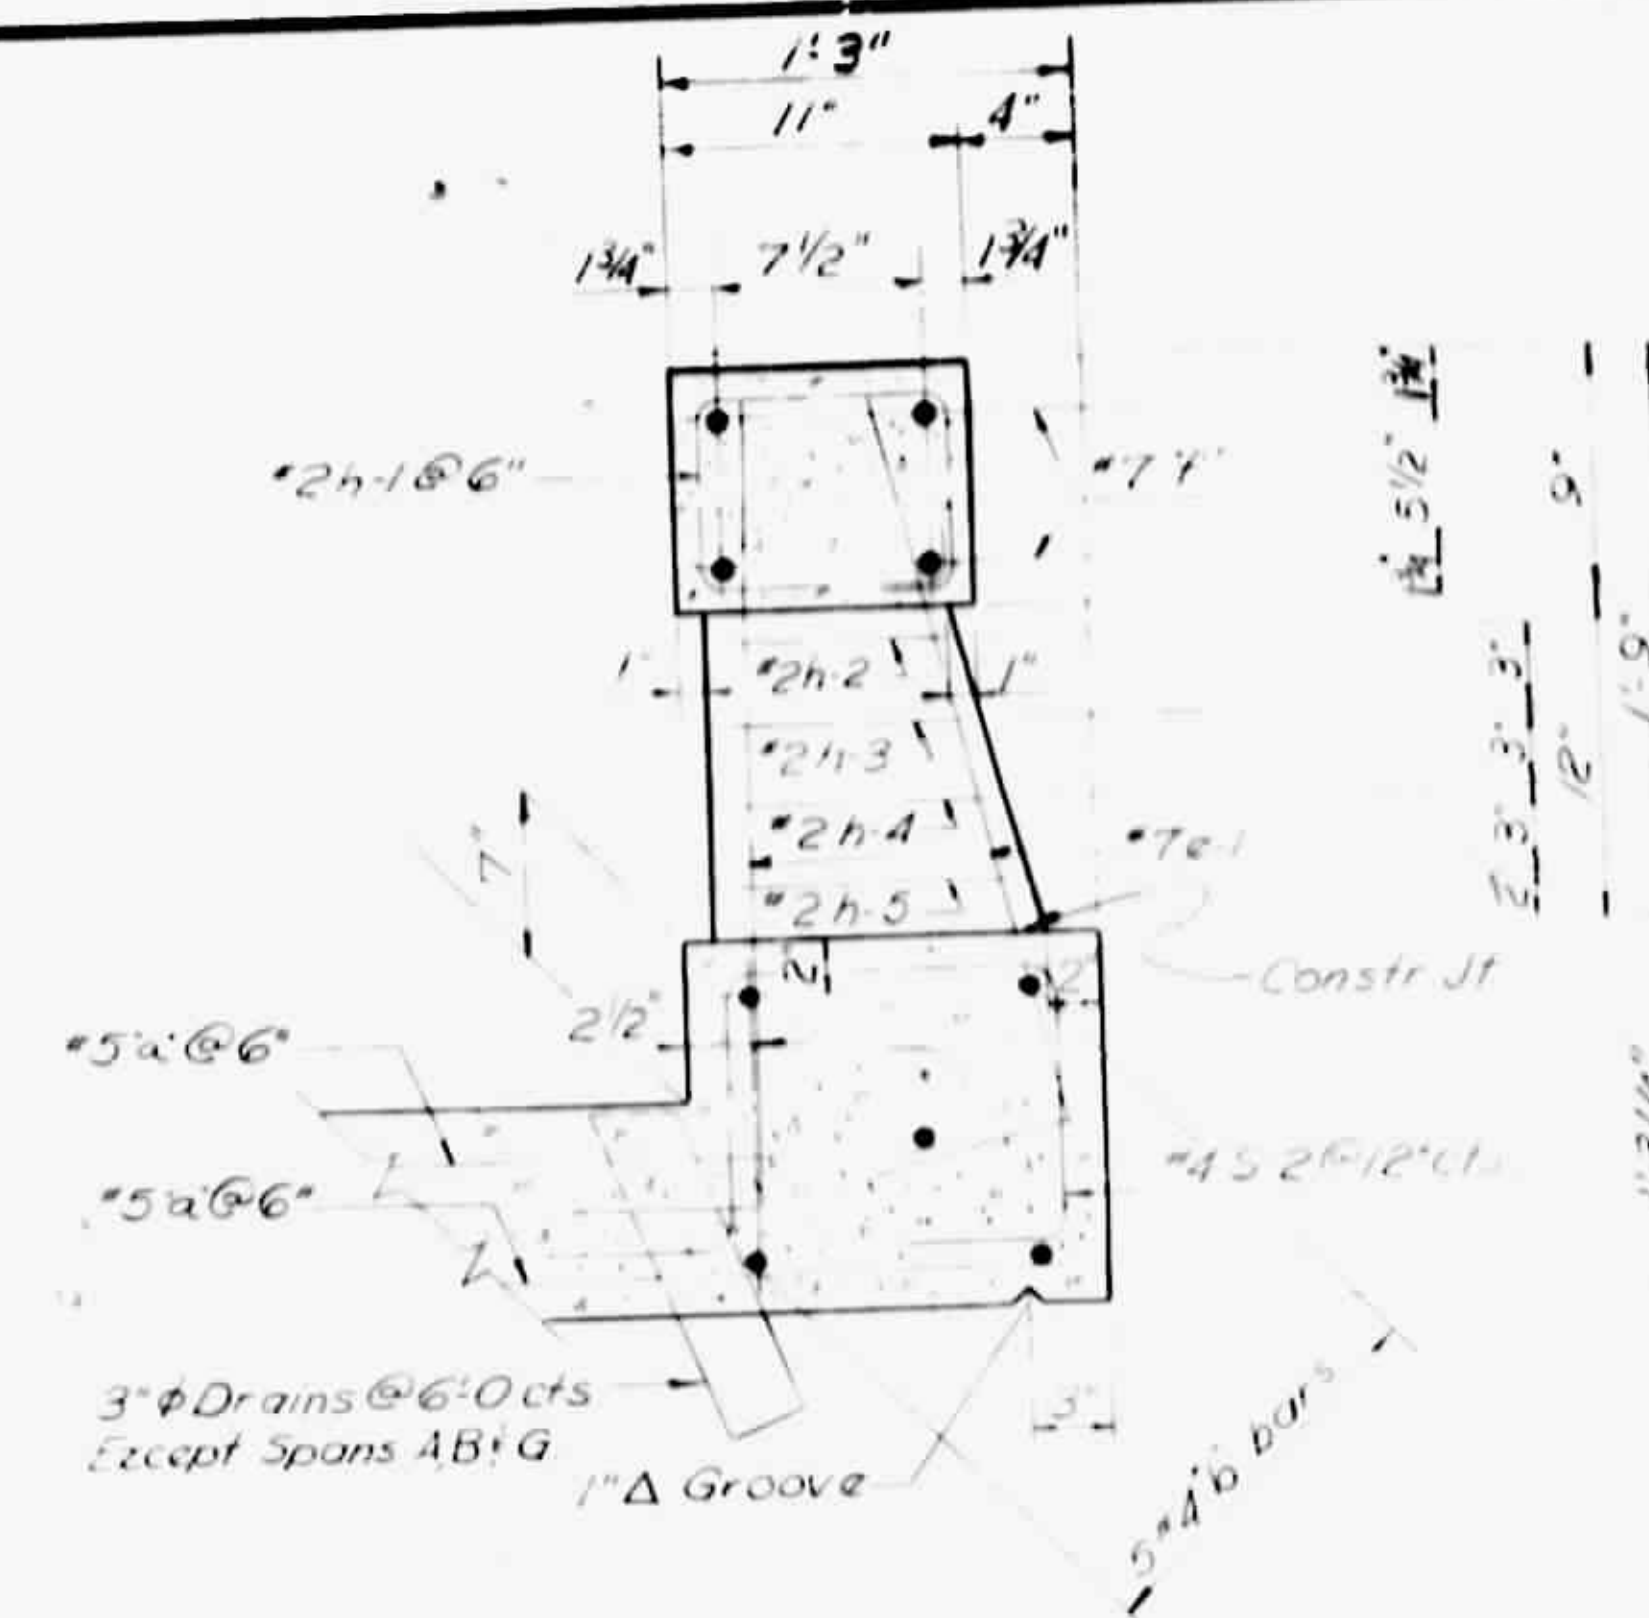

SECTION THRU CURB

[illegible]

of PVC Plastic pipe
must meet requirements of
See Sheet S-N

PROJECT NO. 8.20/6601

BUNCOMBE COUNTY

STATION: 10+35.50

MP Sta 153.1

STATE OF NORTH CAROLINA
STATE HIGHWAY COMMISSION

MAILED 10/11
SUPERSTRUCTURE
SECTIONS & DETAILS
FOR SPANS A THROUGH F

NOV 1966

REVISIONS						SHEET NO.
NO.	BY	DATE	NO.	BY	DATE	TOTAL SHEETS
1			2			15
2			4			

SPECIAL	DESIGNED BY	R. Turner	DATE	Nov 66
	DRAWN BY	R. Blair	DATE	Nov 66
	TRACED BY		DATE	
	CHECKED BY	R. Self	DATE	Nov 66

Reinforcing Steel, Lbs. 9,620
Class "A" Concrete Cu. Yds. 45.2
Structural Steel (Approx) Lbs. 27,3



Bar	No	Size	Type	Length	Wt.
#1	12	#7	S	3'-5"	50
#1	8	#7	Str.	10'-3"	75
#2	16	#7	Str.	15'-4"	54
#3	4	#6	S	3'-5"	3
#4	130	#6	S	3'-3"	7
#5	4	#2	S	2'-11"	
#6	14	#2	S	3'-1"	
#7	14	#2	S	3'-2"	
#8	14	#2	S	3'-2"	

PROJECT NO. 8.2016601
BUNCOMBE COUNTY
STATION: 10+35.50

STATE OF NORTH CAROLINA
STATE HIGHWAY COMMISSION


NOV. 1966

SPECIAL	DESIGNED BY	R Turner	DATE	Nov. 66
	DRAWN BY	R Blair	DATE	Nov. 66
	TRACED BY		DATE	
	CHECKED BY	R Self	DATE	Nov. 66

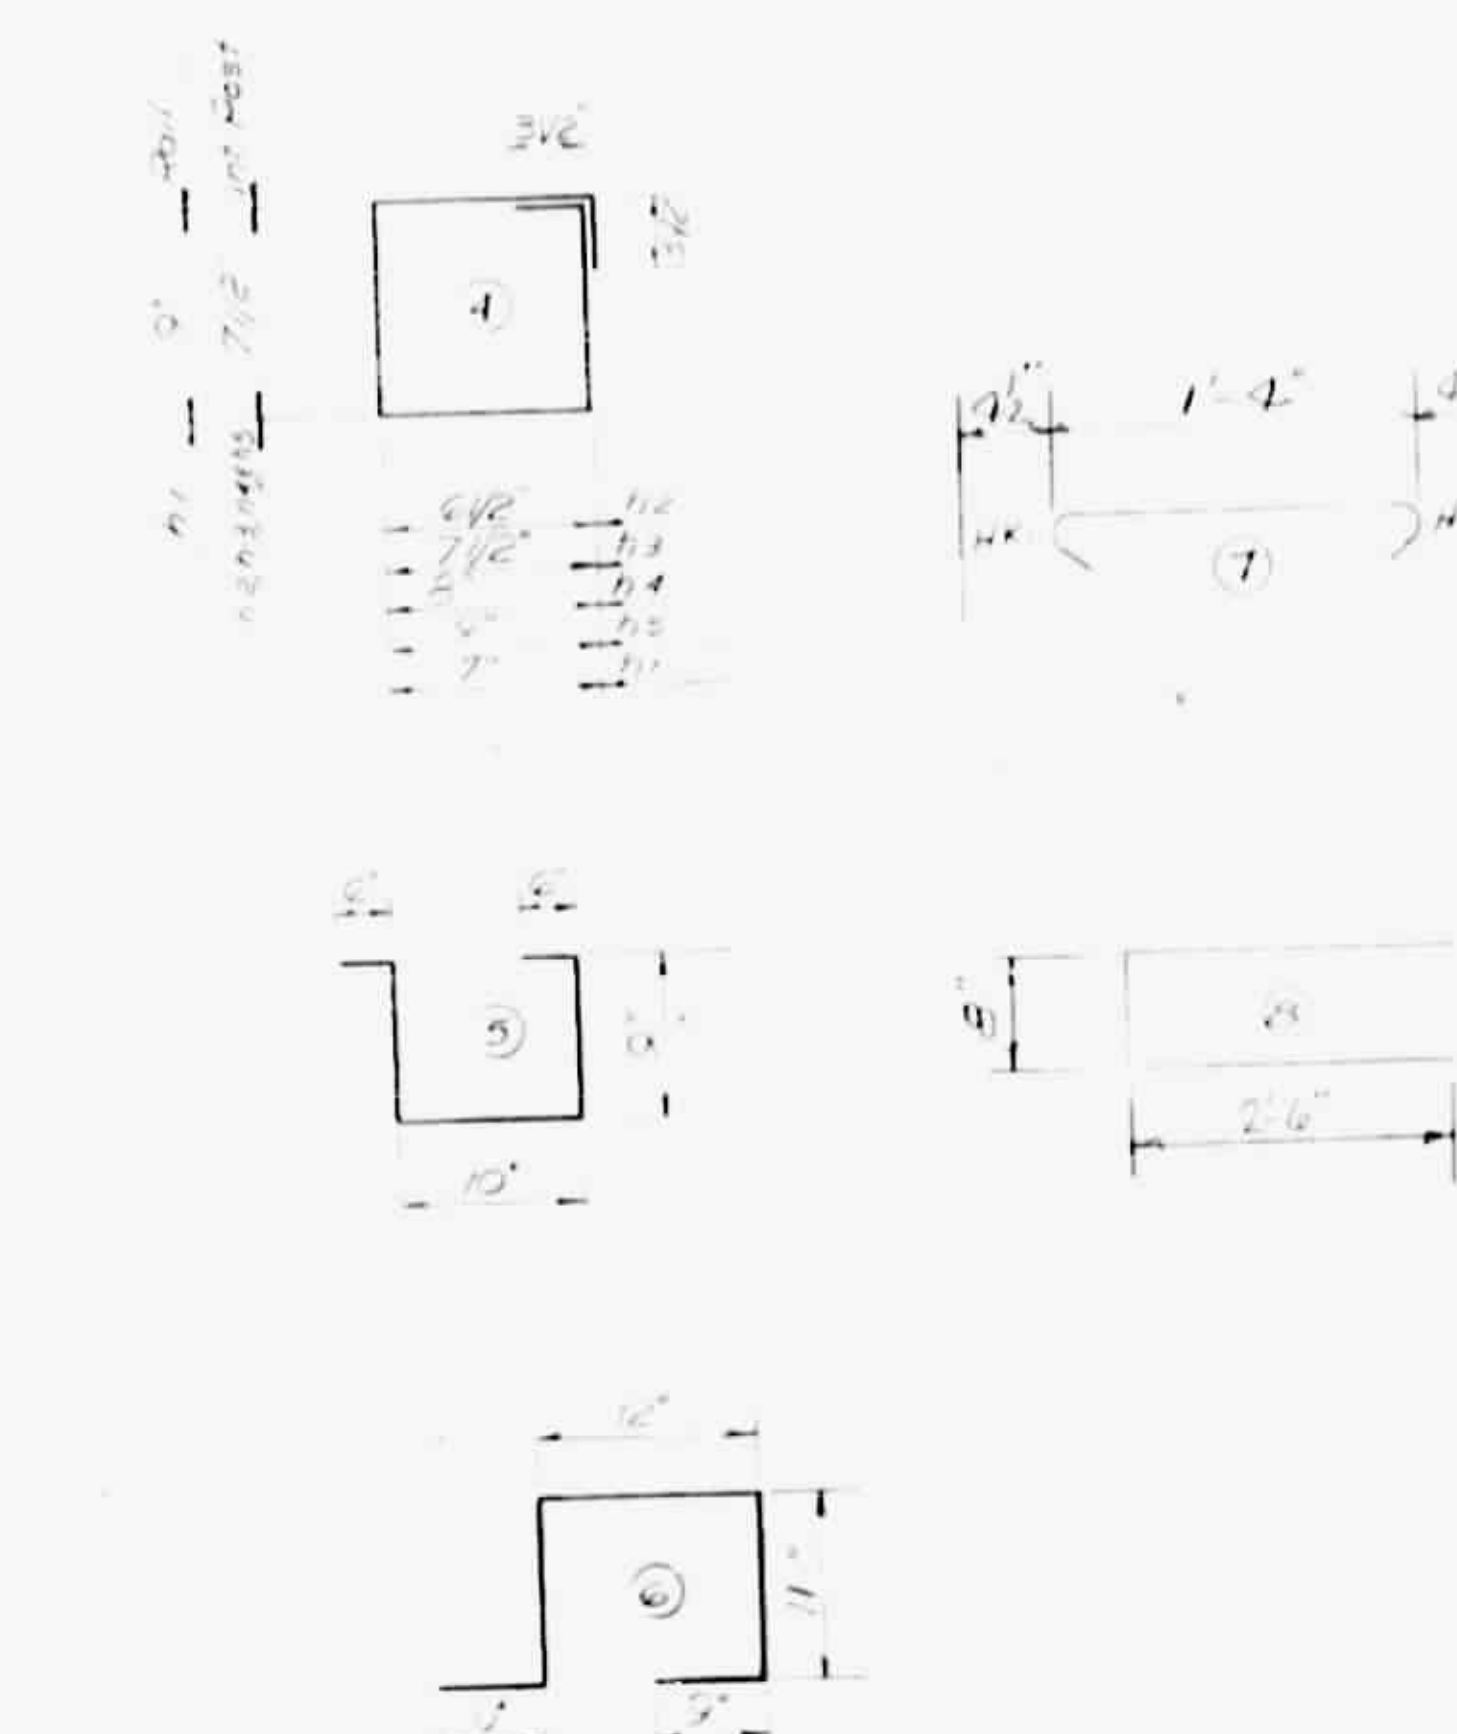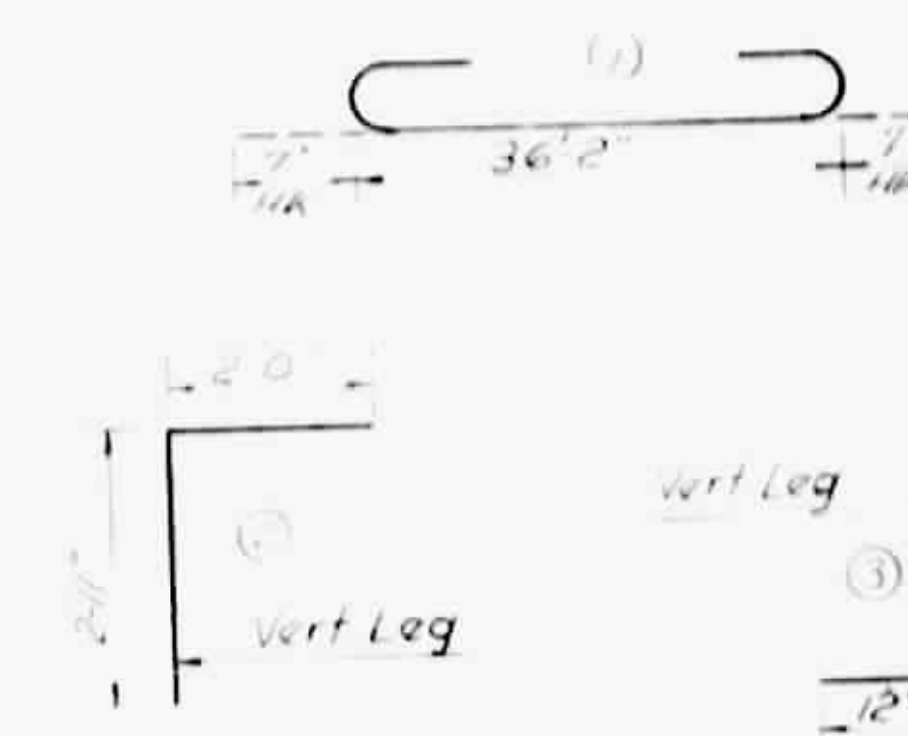


NOTE: All dimensions in "Base Details" are out to out of base

Note: SEE SCORES E, C, D, E, & F
for % of Total Quantities

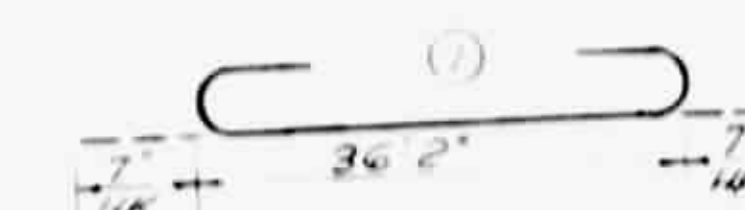

RAIL ELEVATION

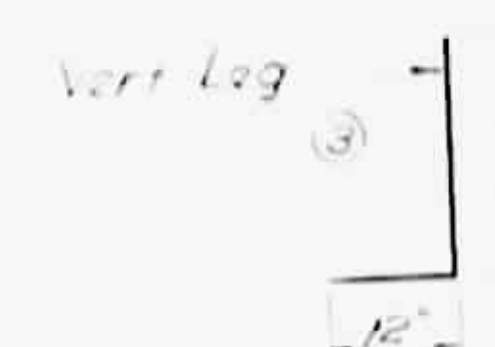



Star	No.	Size	Type	Length	Weight
2	10	#3	1	27" 4"	140
3	12.5	#5	3fr.	36" 0"	250
4	8	#3	3fr.	27" 0"	140
5	80	#3	3fr.	40" 0"	350
6	16	#5	3fr.	72" 0"	120
7	20	#5	3fr.	4" 0"	8
8	64	#4	3fr.	3' 4"	140
9	60	#4	3fr.	4' 4"	40

Reinforcing Steel, Lbs.	178
Class "A" Concrete Cu. Yds.	7
Structural Steel (Approx.) Lbs.	31

Bar	No.	Size	Type	Length	Weight
#1	120	#7	3	3'-5"	8
#3	40	#7	Str.	15'-6"	12
#1	360	#2	4	3'-3"	1
#2	30	#2	4	2'-11"	1
#3	30	#2	4	3'-1"	1
#4	30	#2	4	3'-2"	1
#5	30	#2	4	3'-4"	1

Reinforcing Steel Lbs. 23
1435 "A" concrete Cu. Yds. 4

NOTE:
For measurement and
payment of Concrete
Handrails see Special
Provisions.

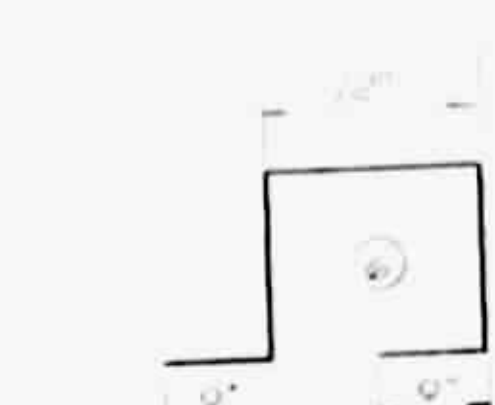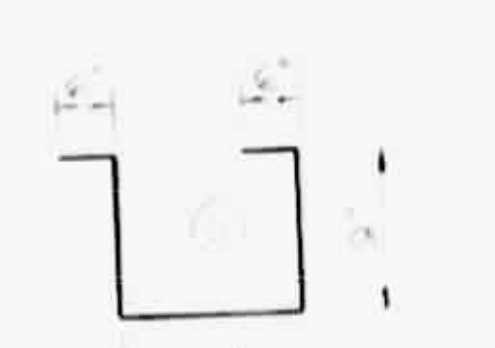

PLAN OF SPAN "B", "C", "D", "E", "F"

* Includes quantity in ⁴ curved end blocks

TOTAL QUANTITIES FOR SPANS A, B, C, D, E, F, & G
 Grade 60 Steel lbs 110,133 + 116,156 = 226,289
 Grade 60 Reinforcing Curbs 43,320
 Structural Steel (Approx) lbs 466,320

PROJECT NO. 8.201660

BUNCOMBE COUNTY

STATION: 10+35.50

MP Sta. 153.1

STATE OF NORTH CAROLINA
STATE HIGHWAY COMMISSION


MALEISH

SUPERSTRUCTURE
SPANS B,C,D,E, & F

NOV 1968

REVISIONS						SHEET NO.
NO.	BY	DATE	NO.	BY	DATE	TOTAL SHEETS
1			2			55
2			4			19


SPECIAL	DESIGNED BY	R. Turner	DATE	Nov 66
	DRAWN BY	R. Blair	DATE	Nov 66
	TRACED BY		DATE	
	CHECKED BY	R. Self	DATE	Nov 66

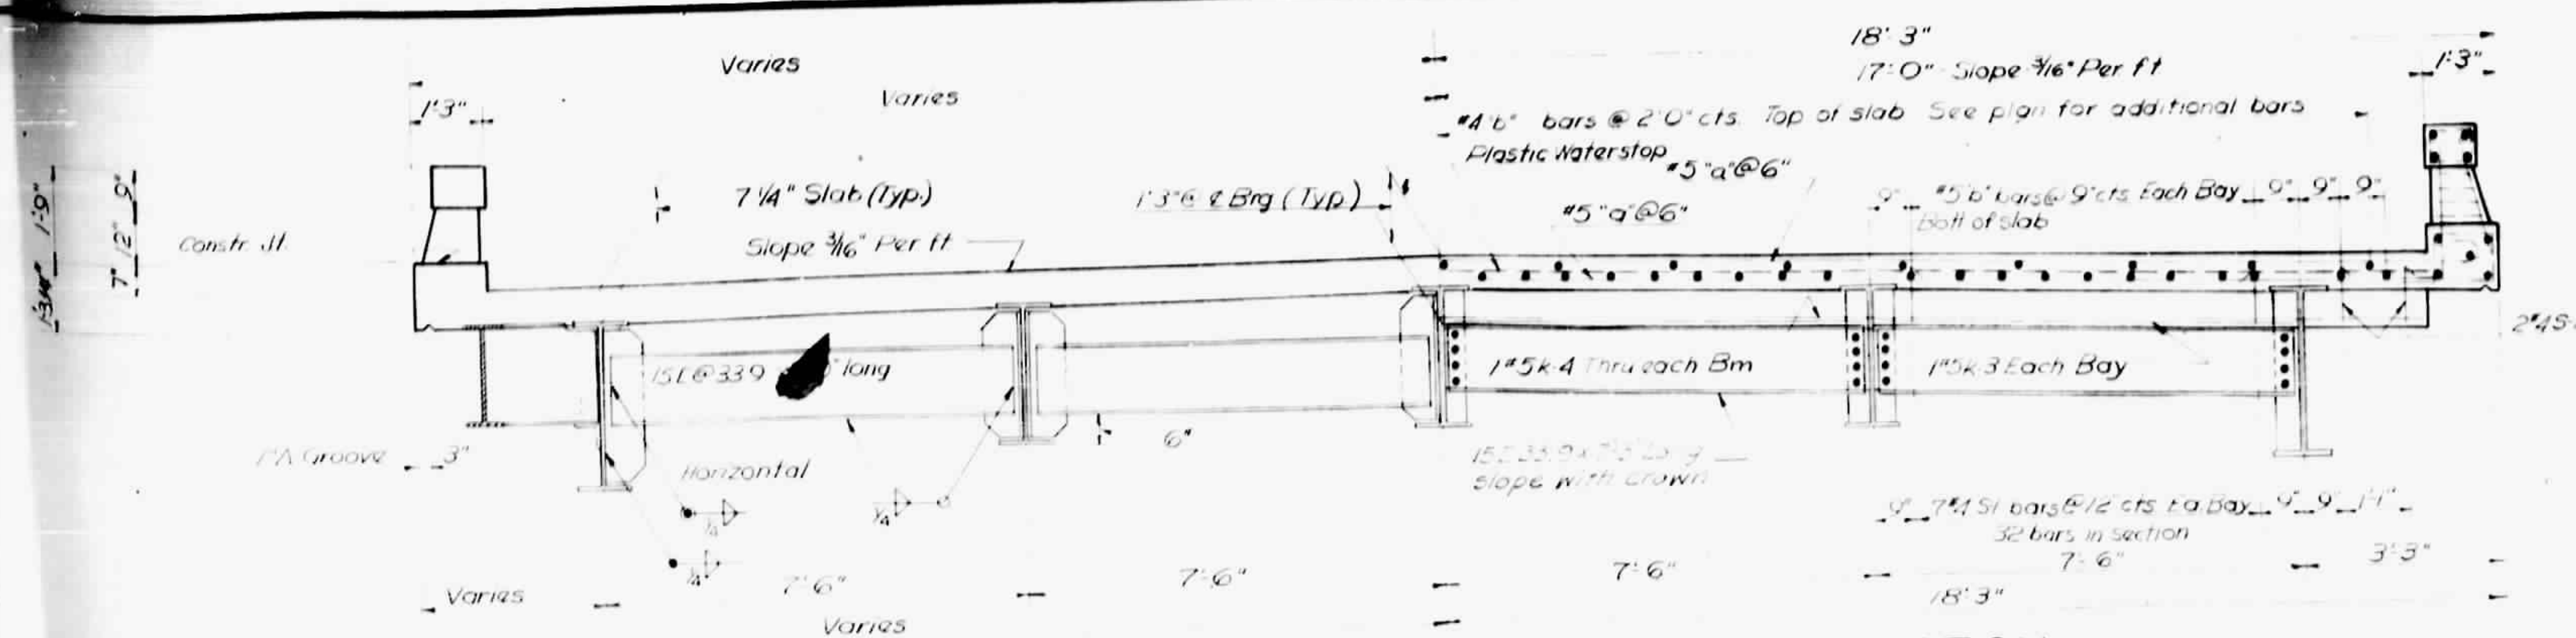


TYPICAL HALF SECTION
(Showing diaphragm @ midspan)

TYPICAL HALF SECTION
(Showing diaphragm @ int. bent)


NOTE:
For bars indicated and no bar marks shown, see concrete plan Superstructure Span G.
For Section Thru Curb, Rail Post Details, Section A-A and Section B-B see Superstructure Sections and Details for Spans A Through F.

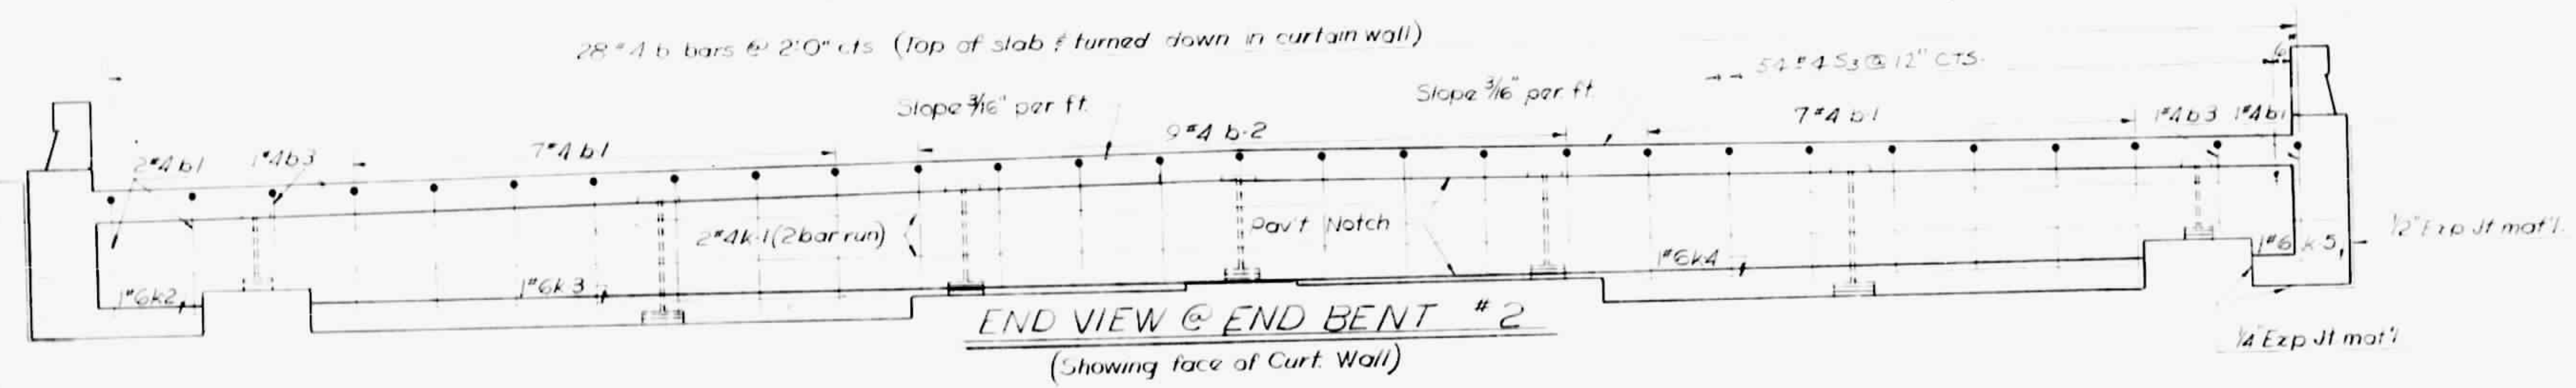

END VIEW @ END BENT #2
(Showing face of Curb Wall)

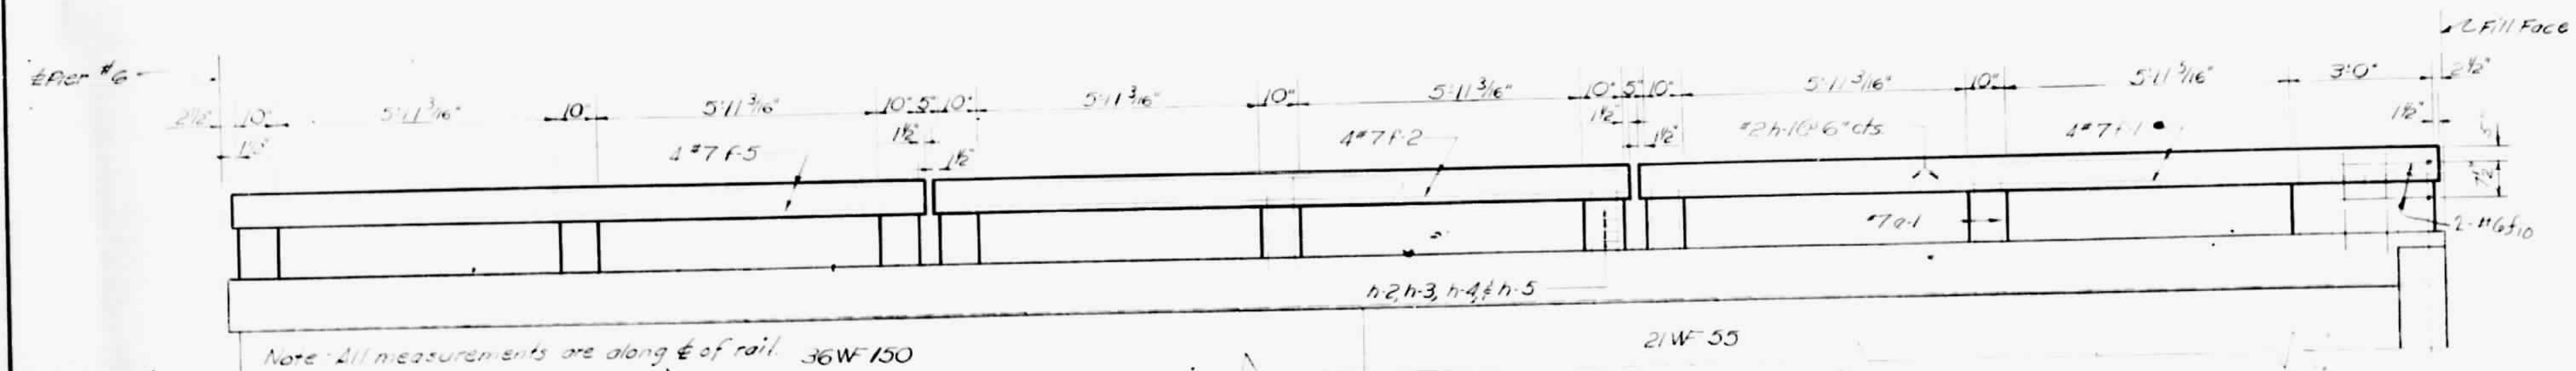

ELEVATION — GUARD RAIL ON 60' RADIUS
(Expanded View)

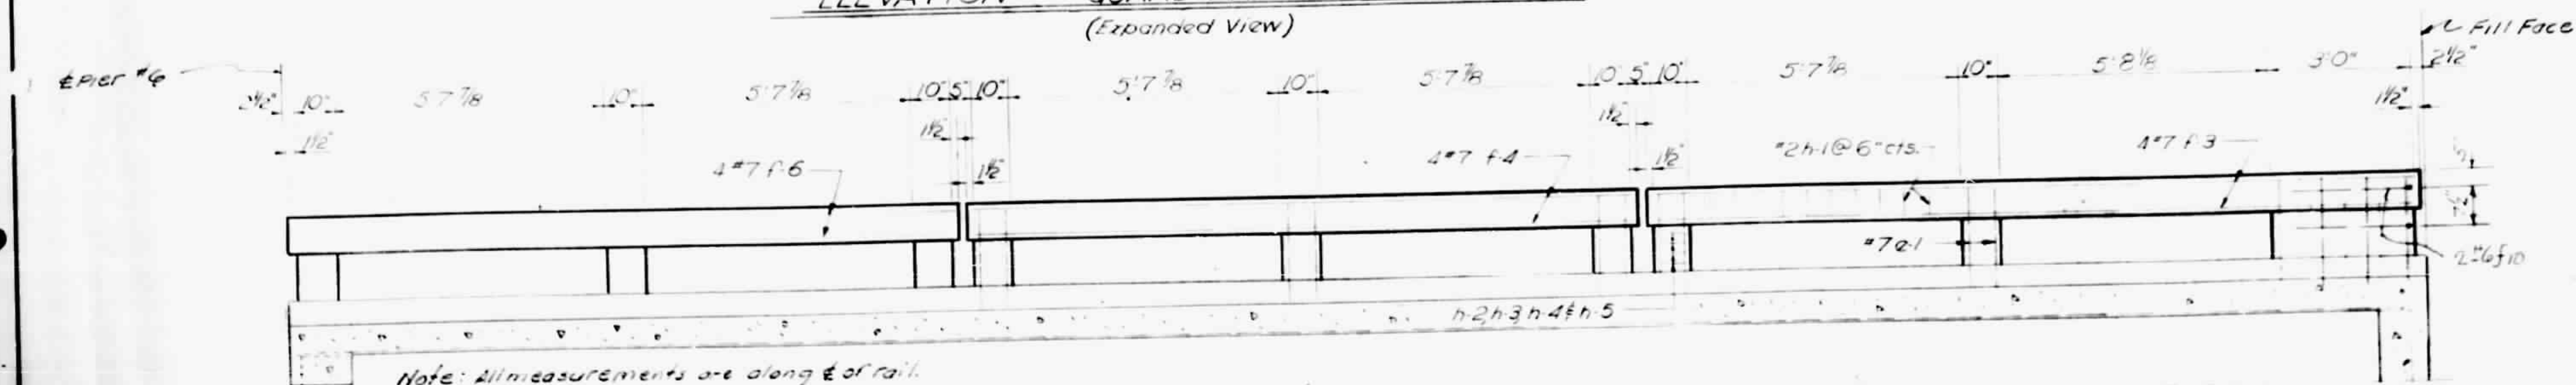


ELEVATION — GUARD RAIL ON 100' RADIUS
(Expanded View)

PROJECT No. 82016601
BUNCOMBE COUNTY
STATION: 10+35.50
M.P. Sta 1531
STATE OF NORTH CAROLINA
STATE HIGHWAY COMMISSION
SUPERSTRUCTURE
SECTIONS, DETAILS & ELEV.
FOR SPAN G
NOV 1966

REVISIONS					
NO.	BY	DATE	NO.	BY	DATE
1			1		
2			2		


SPECIAL
DESIGNED BY: R. Turner
DRAWN BY: R. Blair
CHECKED BY: R. Self
DATE: NOV. 66
DATE: NOV. 66
DATE: NOV. 66

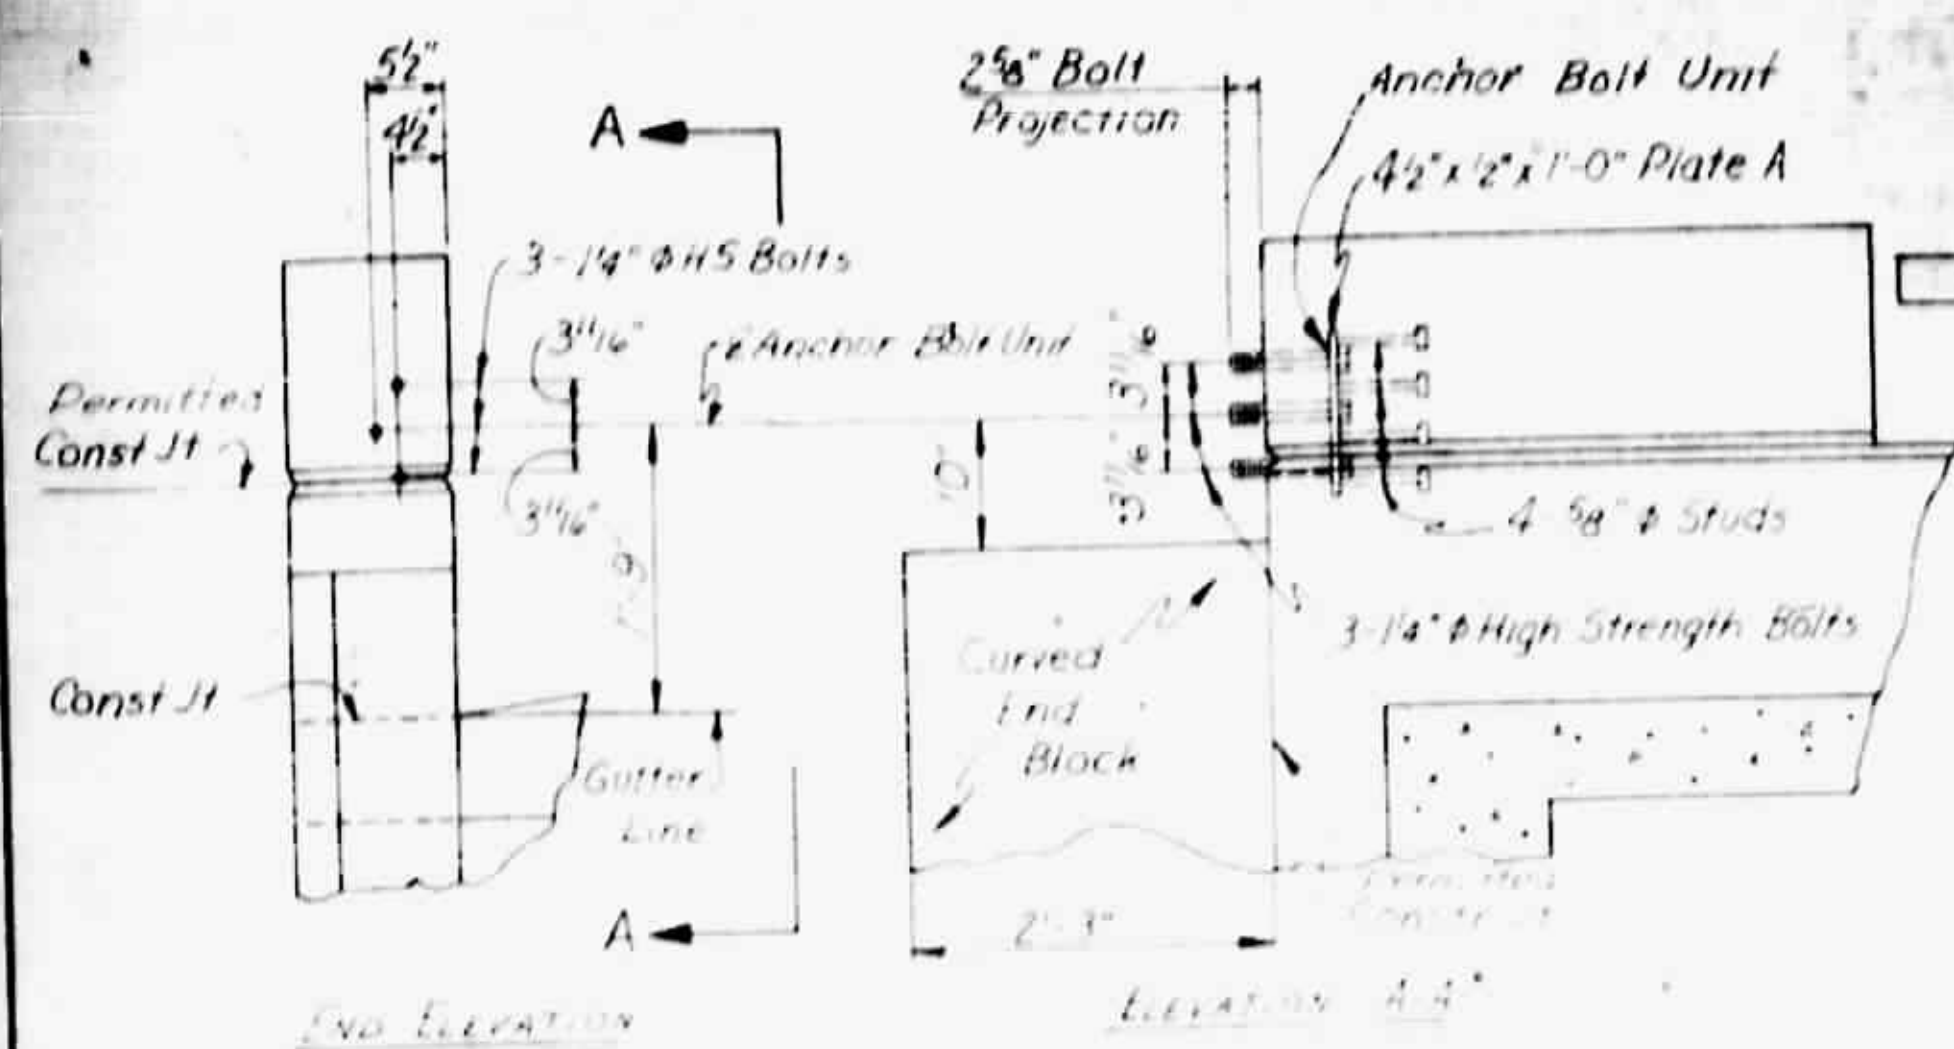


GUARD RAIL ANCHORAGE TYPE 1




GUARD RAIL ANCHORAGE TYPE 2

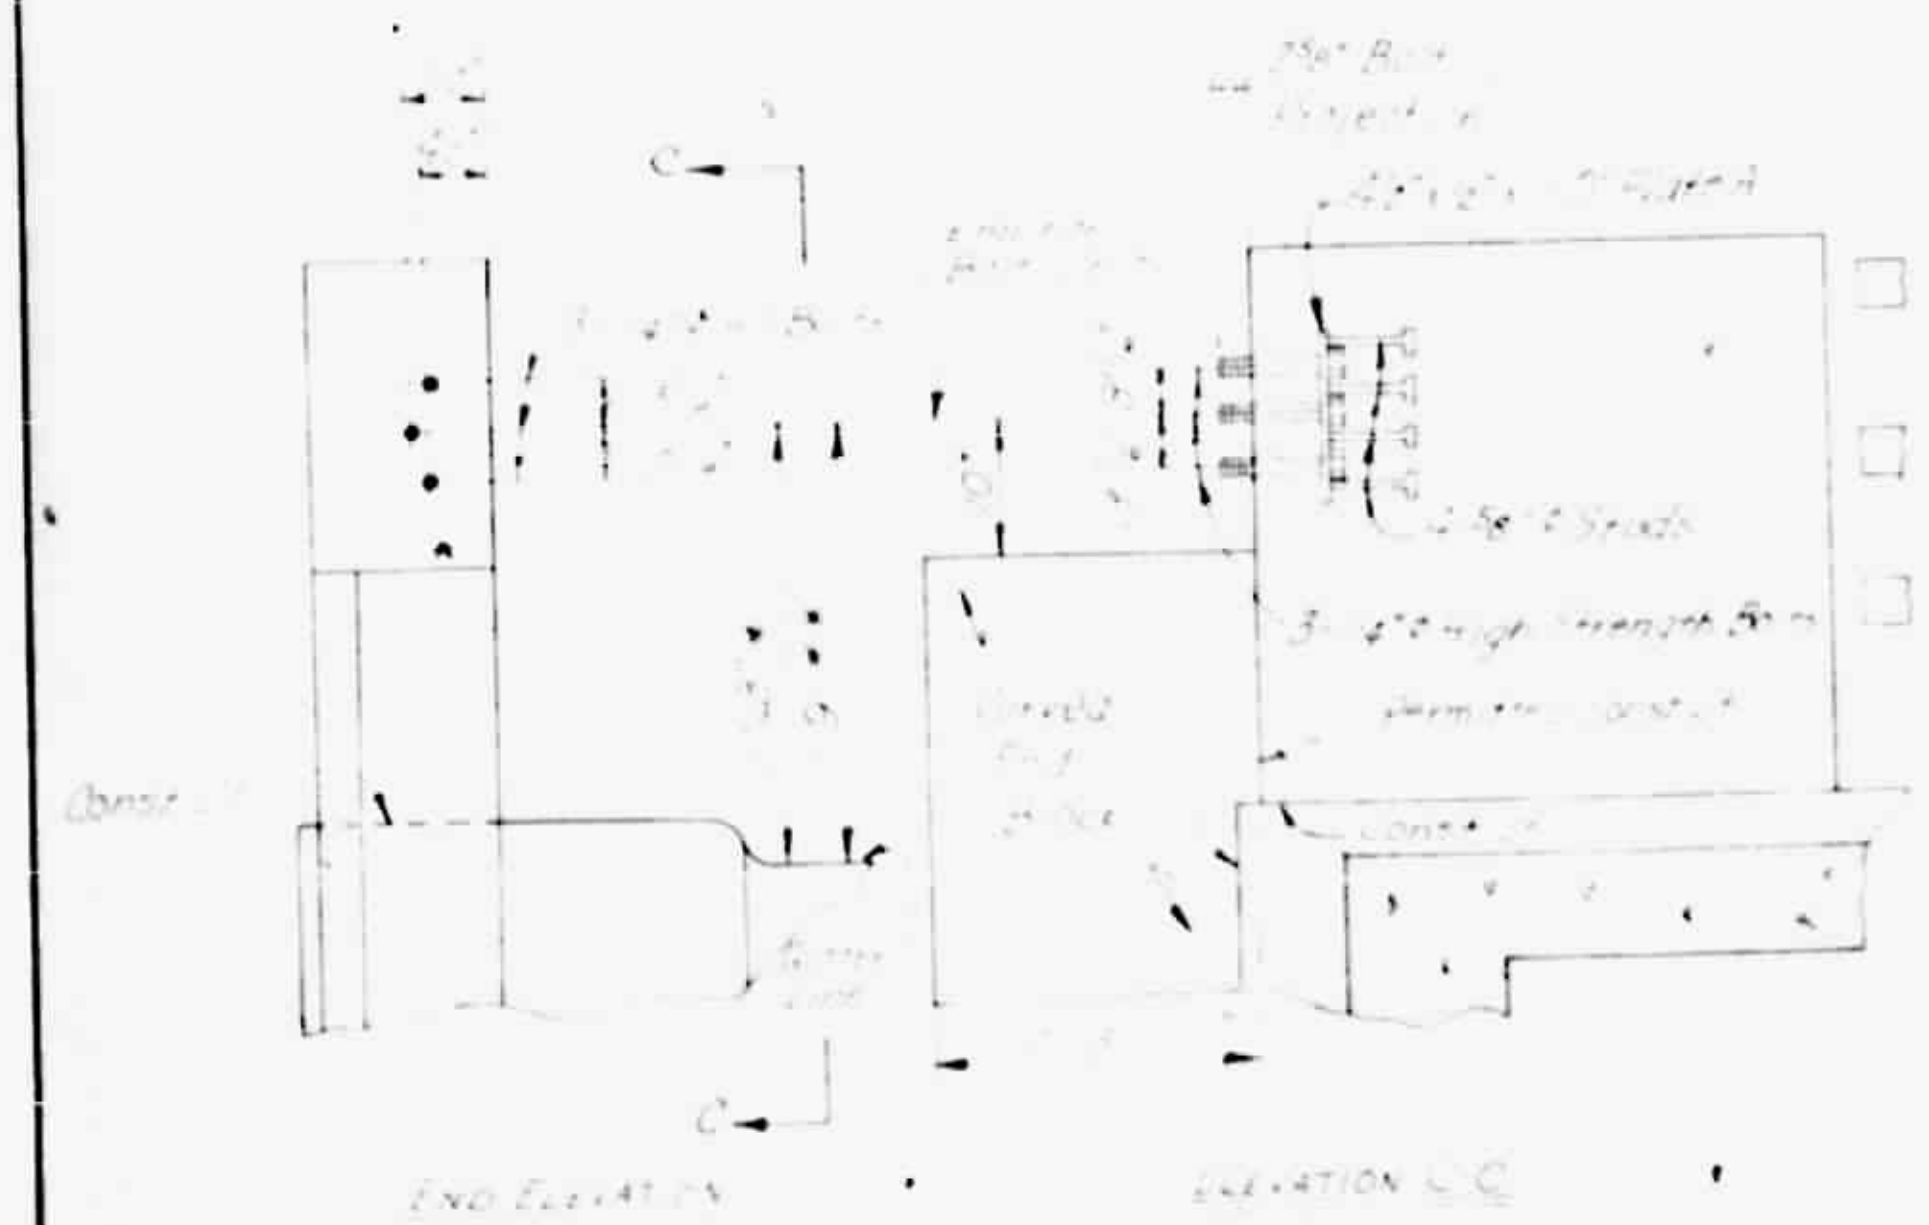

GUARD RAIL ANCHORAGE TYPE 3

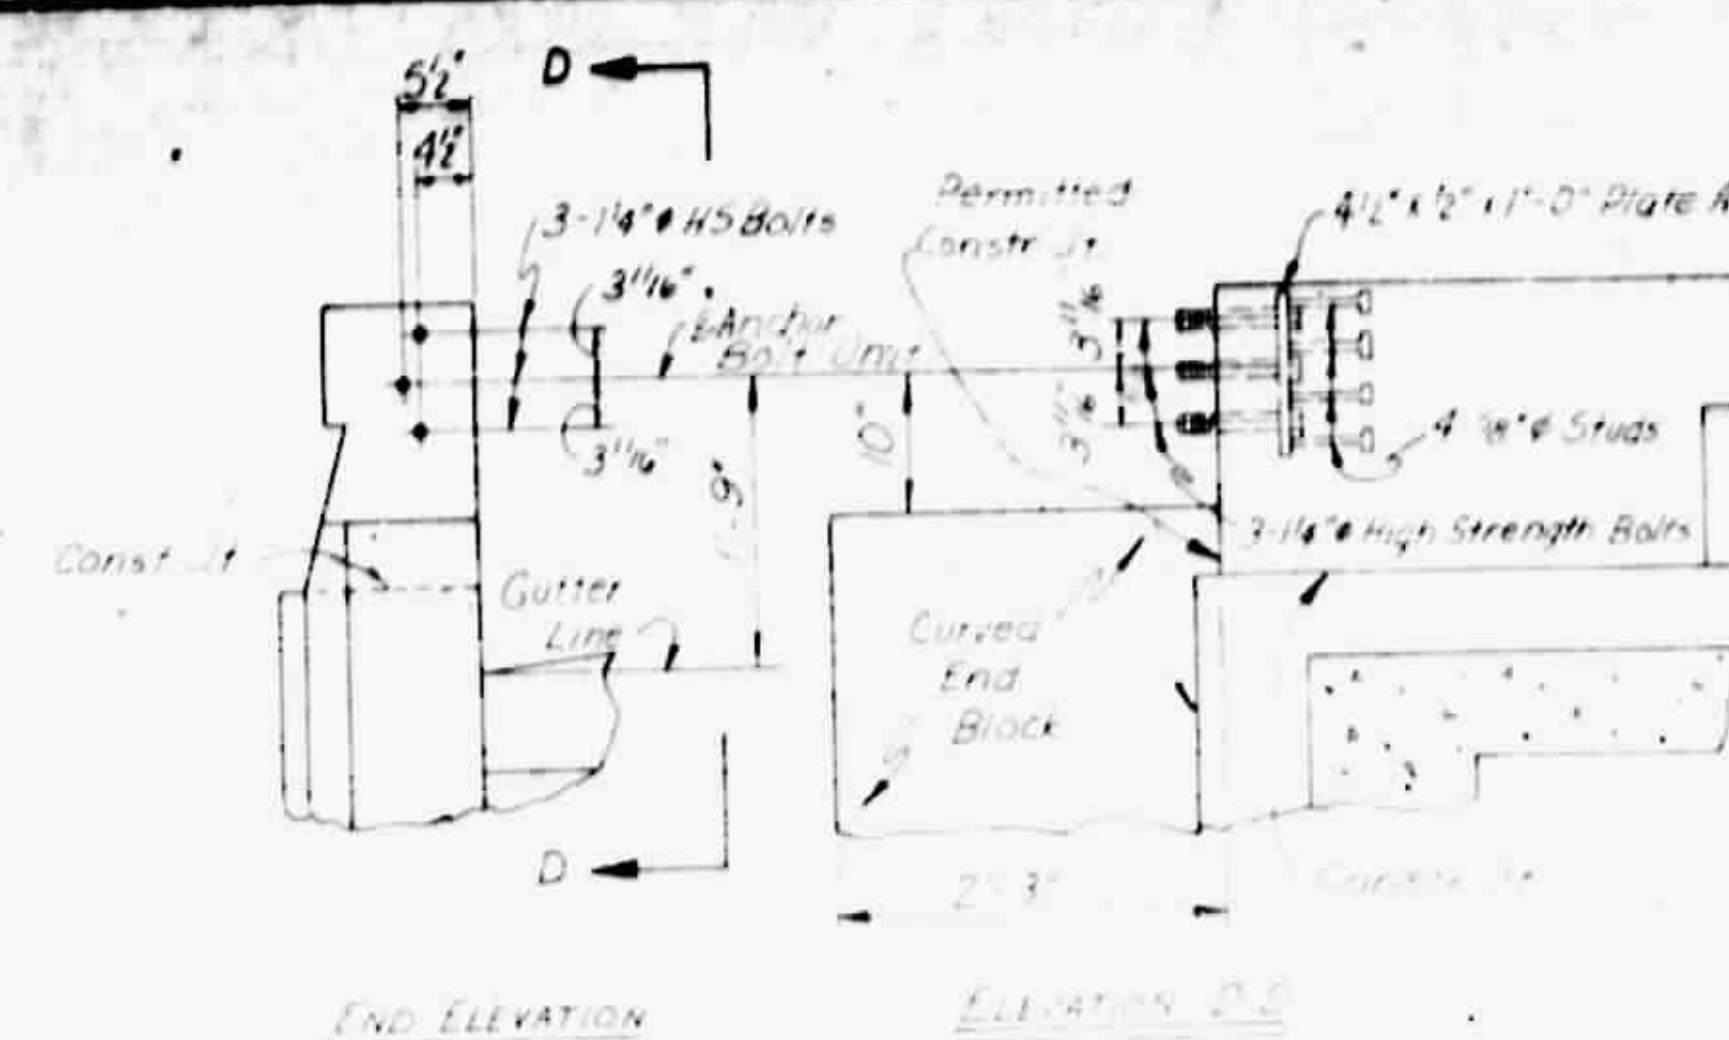


GUARD RAIL ANCHORAGE TYPE 4

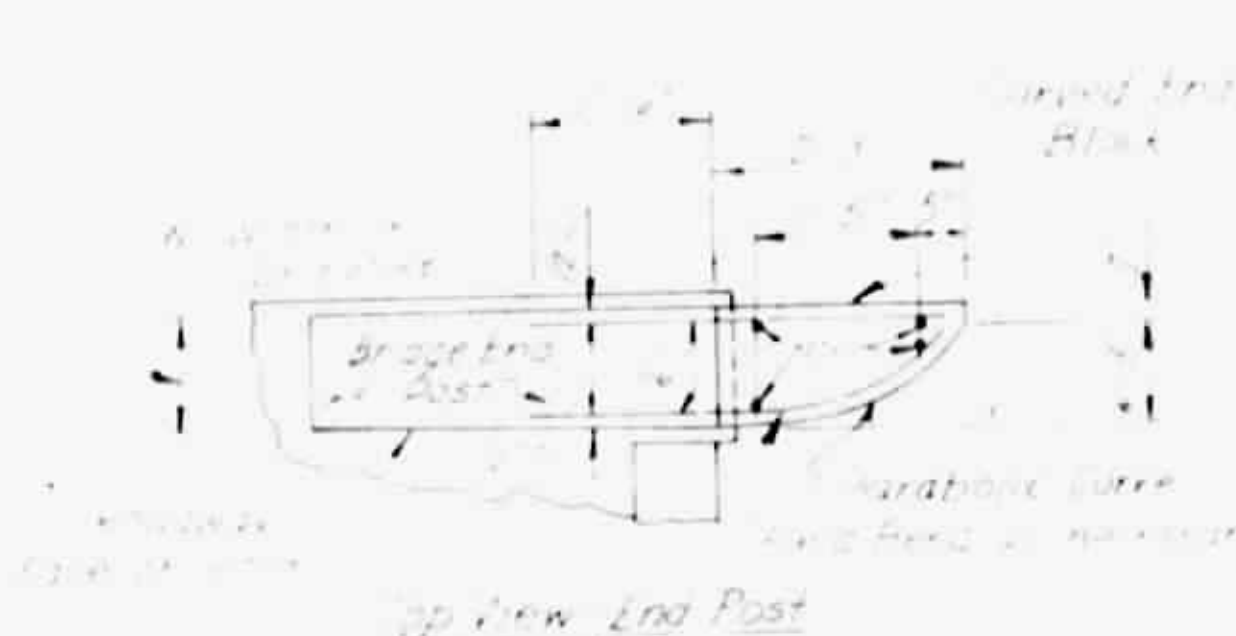


Top View End Post




Detail 1/4 x 5/8 HS Bolt Hexagonal Head

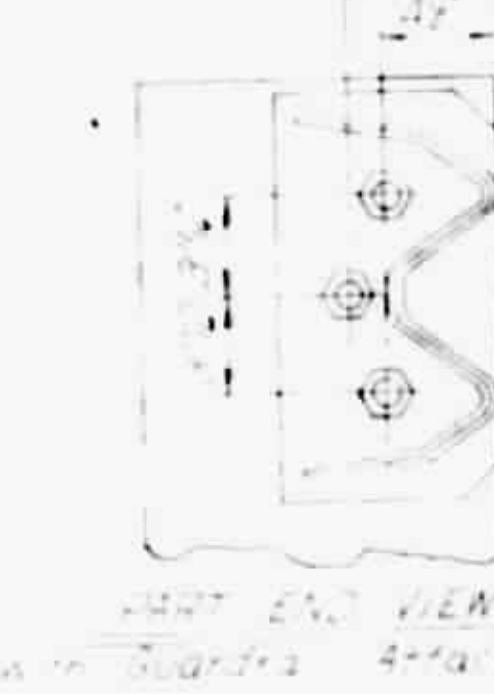


Front End View with Guards Attached

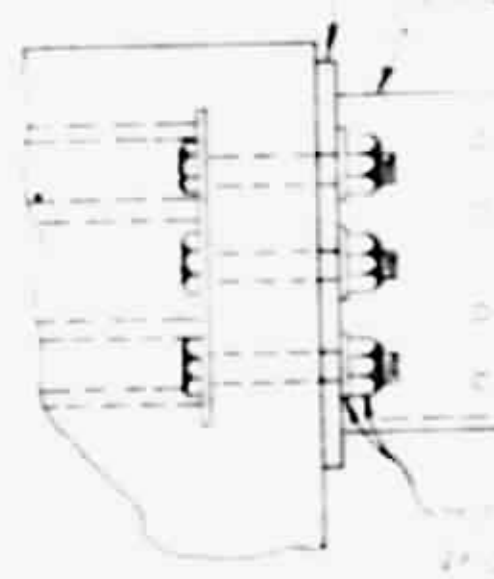

Side View End Post

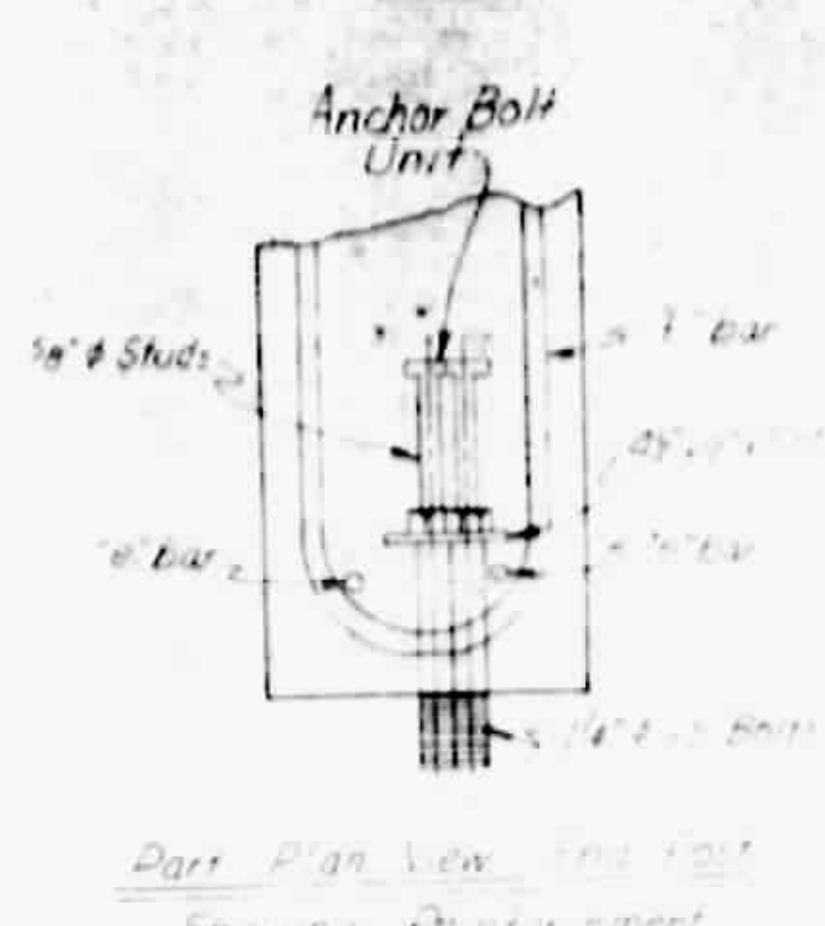

Part Plan View End Post Showing Orientation

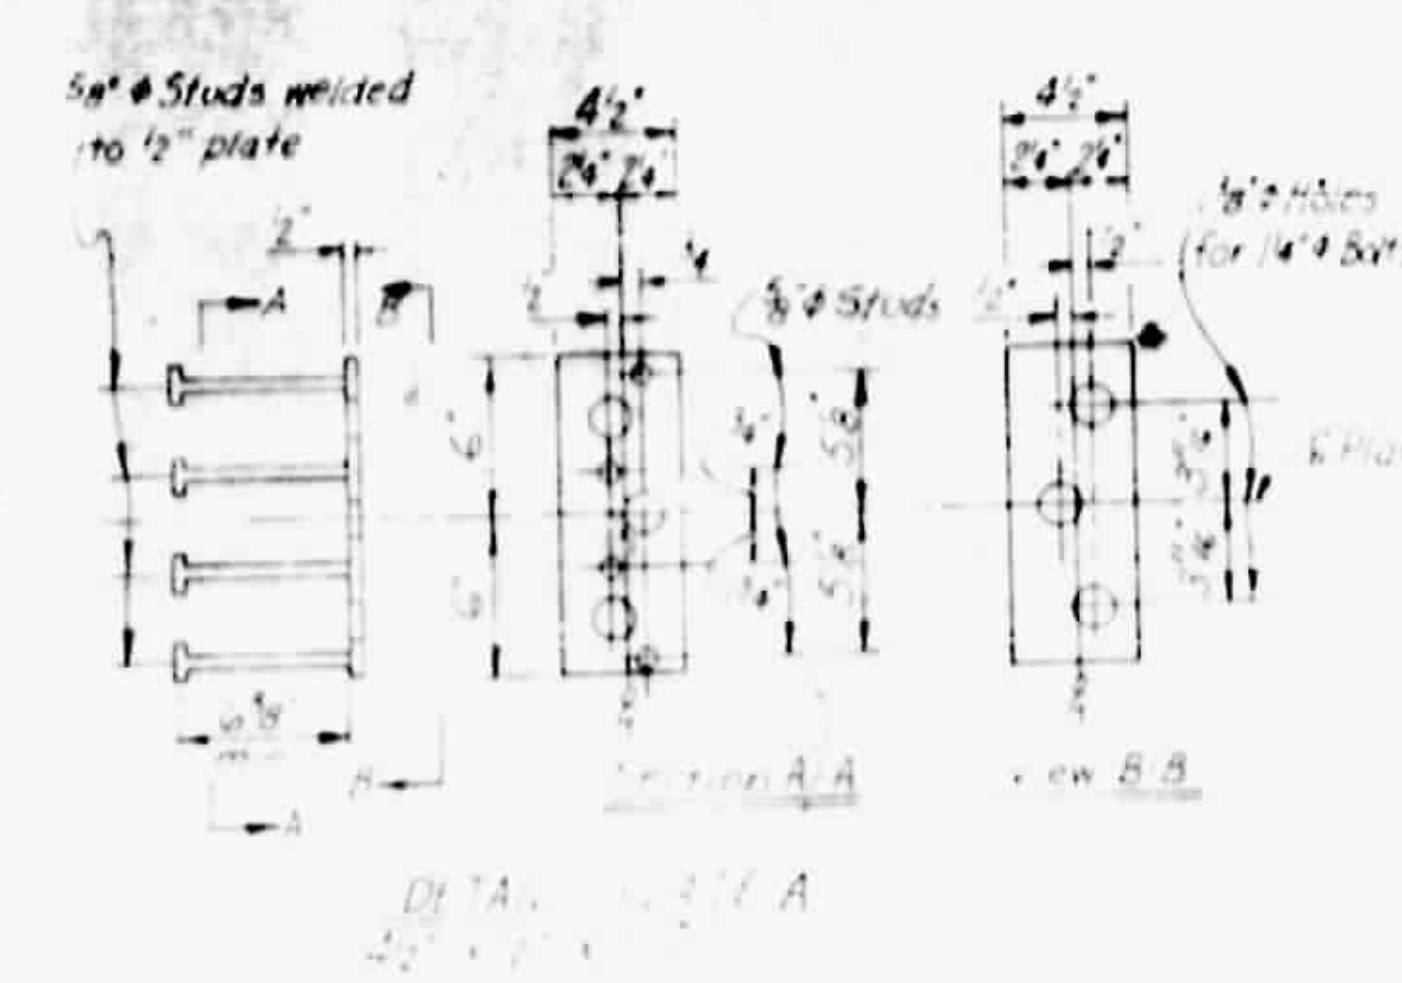


Detail A-A of Stud

See General Notes for Stud Alternate

ITEM	QUANTITY	UNIT	REMARKS
Anchor Bolt Unit	1	each	
4 1/2 x 2 x 1/8 Plate A	1	each	
3-1/4 High Strength Bolts	3	each	
4 5/8 Stud	4	each	
2 5/8 Bolt Projection	2	each	

NOTE: THESE QUANTITIES ARE INCLUDED IN TOTAL QUANTITIES FOR SUPERSTRUCTURE.

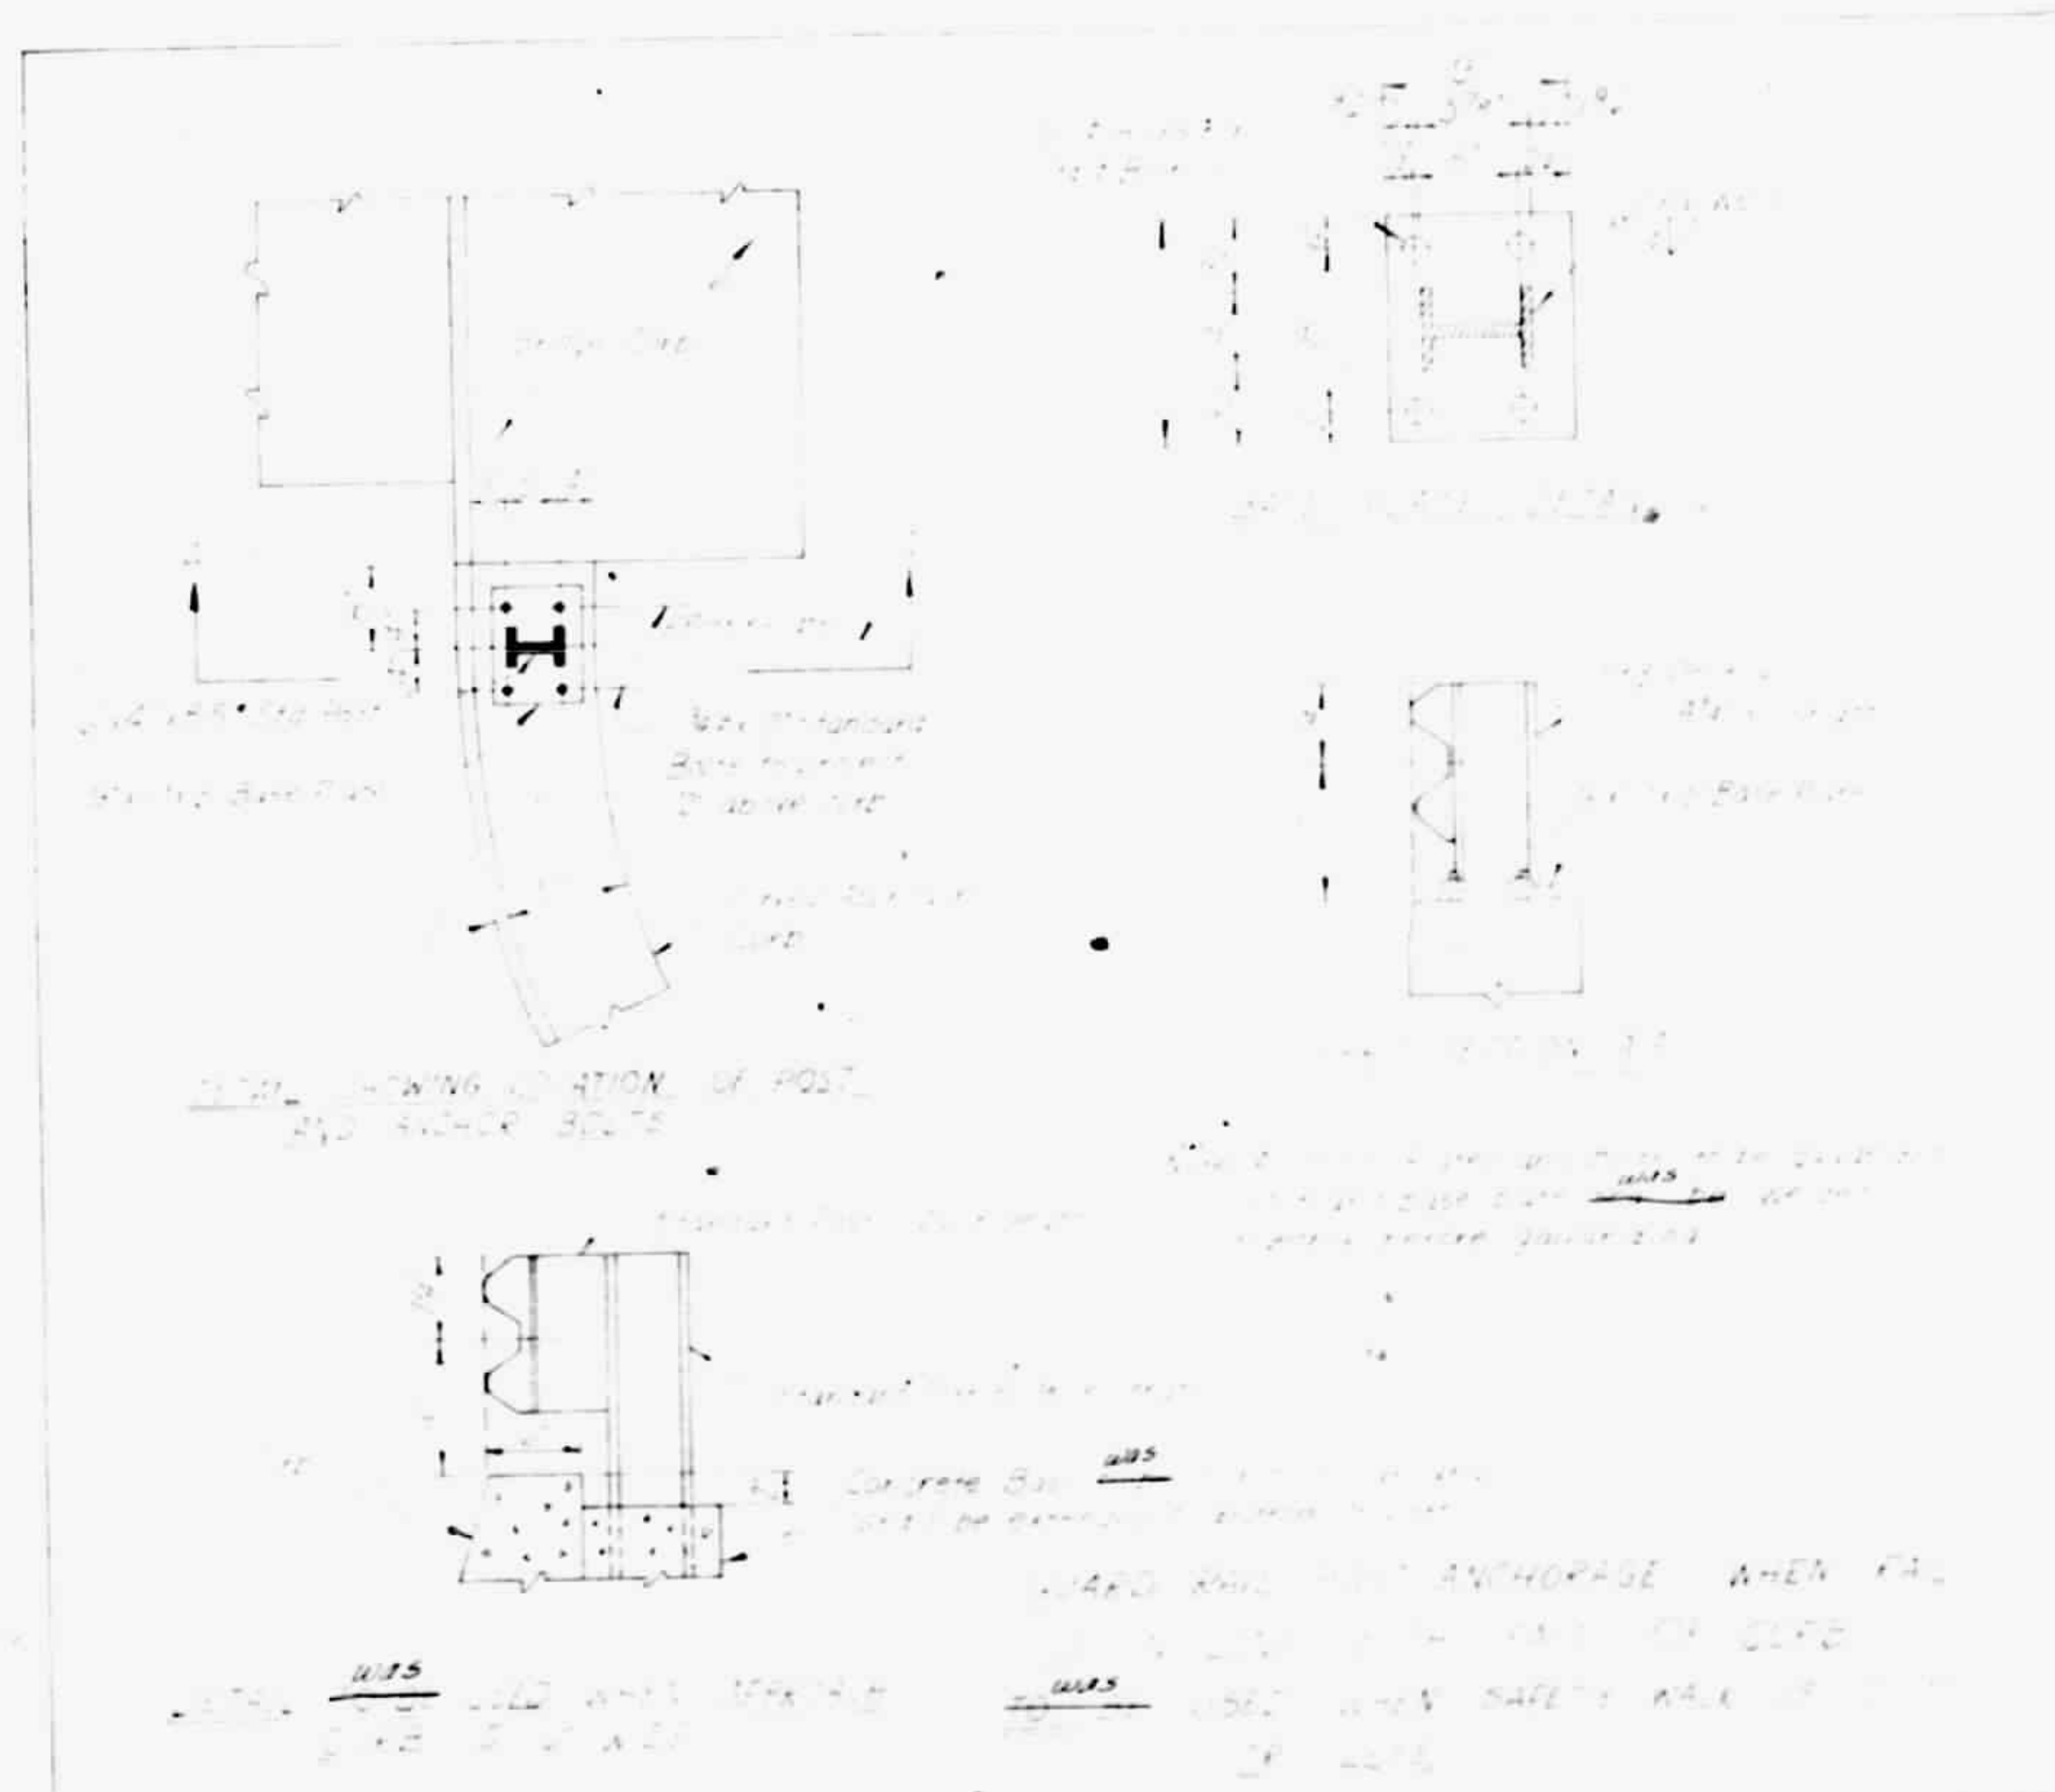


PROJECT NO S-2016601
 BUNCOMBE COUNTY
 STATION 10+35.50
 MP 153.1


STATE OF NORTH CAROLINA
STATE HIGHWAY COMMISSION
 RALEIGH
 STANDARD
 GUARD RAIL ANCHORAGE

REVISIONS	DATE	BY	DATE
1	5-3-68	GT. PHILIPS	

SPEC. A
 DRAWN BY GT. PHILIPS
 CHECKED BY
 DATE 5-3-68
 STANDARD
 DATE 5-3-68

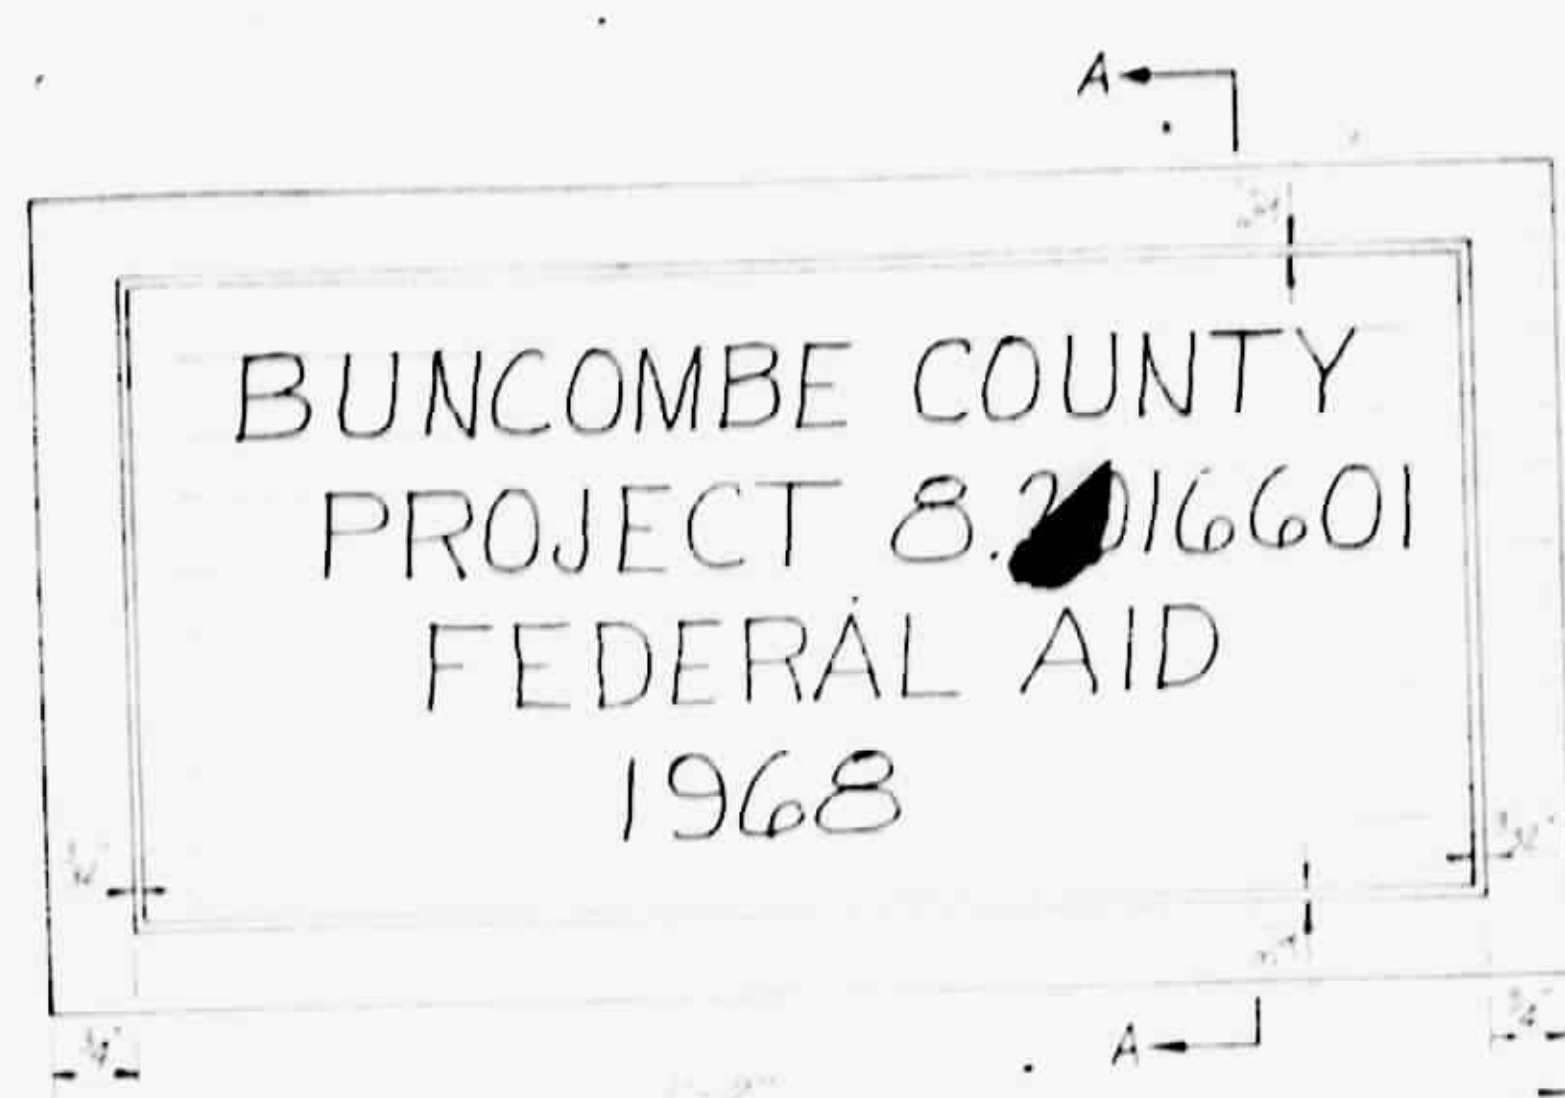

ELEVATION SHOWING CORRECT WORDING
NAME PLATE USING FOUR LINES

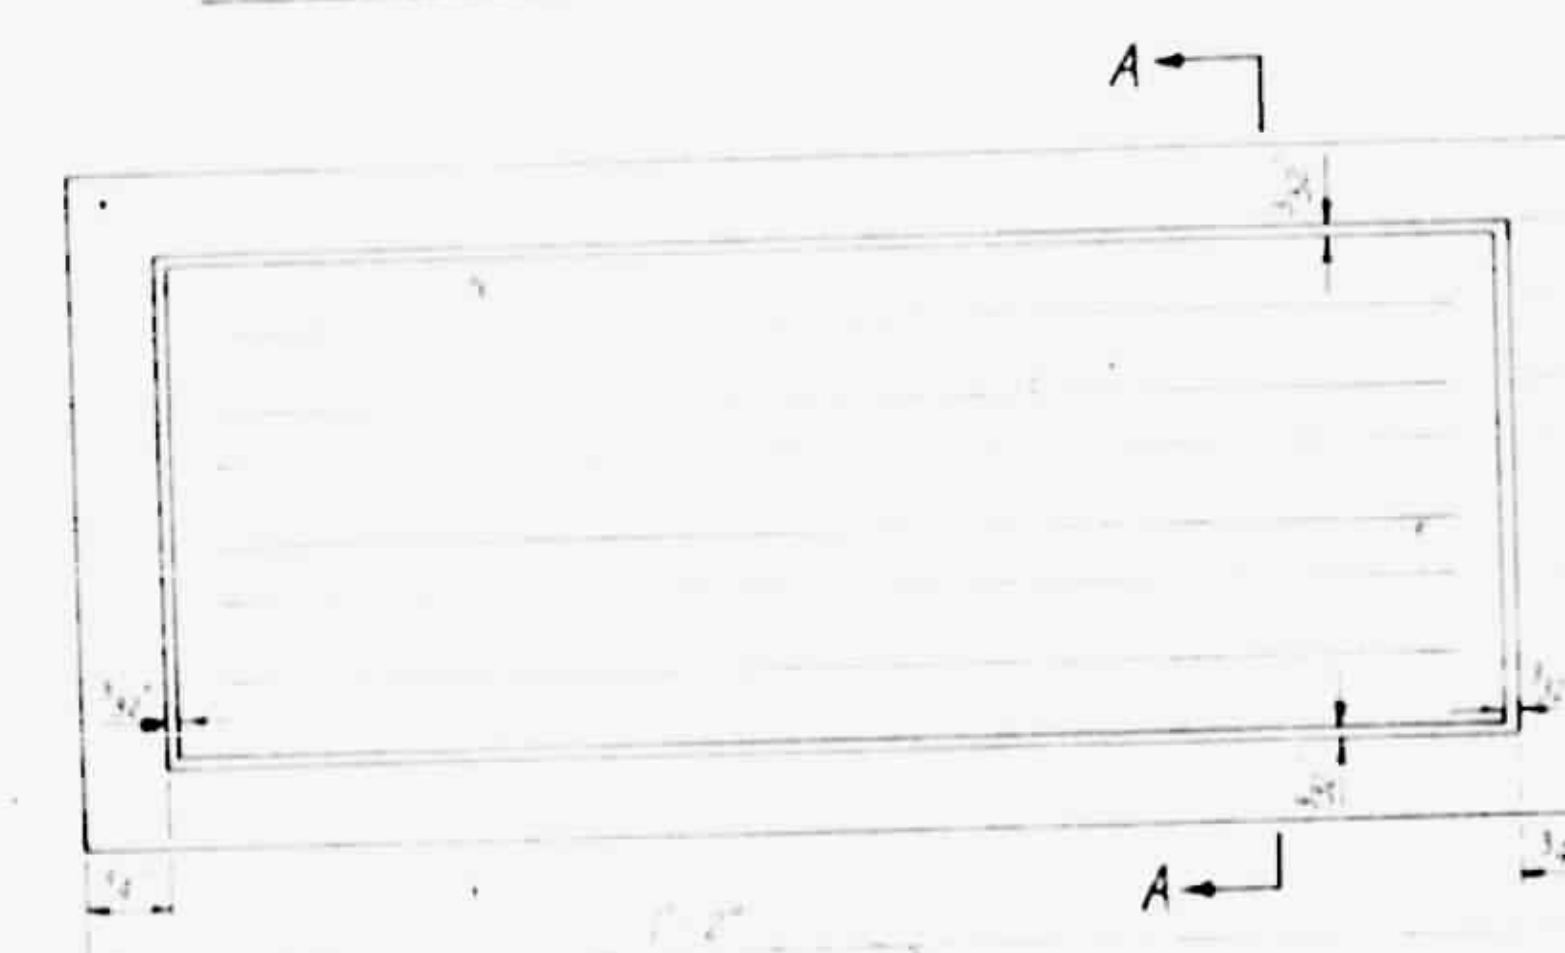

ELEVATION SHOWING CORRECT WORDING
NAME PLATE USING THREE LINES


GENERAL NOTES

For bridges on which there is two way traffic, two name plates are required for each bridge. For bridges on which there will be one way traffic, one name plate is required for each bridge. Name plate to be placed at the right hand end of approach to the bridge, as shown in end view.


The name plates were made of granite, granite was light gray, fine or medium grained, sound in quality and free from defects that would mar its appearance. Exposed face of plates to have a fine rubbed finish.

Lettering was sandblast sunk 1/8 inch, vertical, Modern Roman style. The wording shall be as shown in the ELEVATION SHOWING CORRECT WORDING.


The entire cost of the name plates, complete in place included in the contract price bid for Class 44" Concrete.

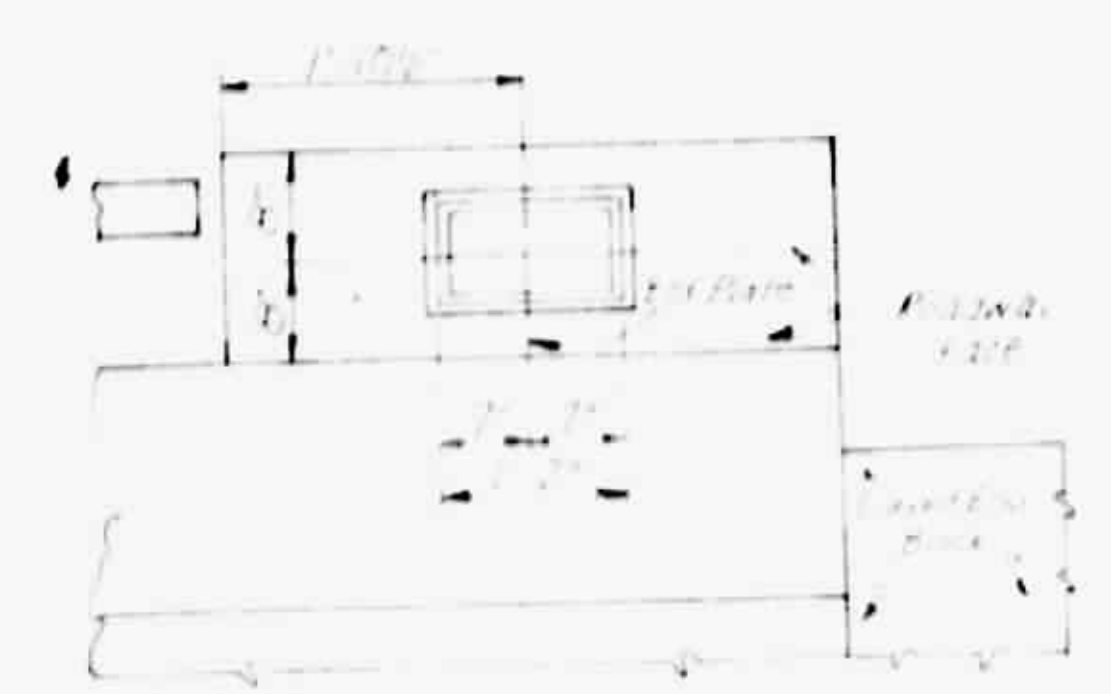


FOR ONE BAR METAL RAIL

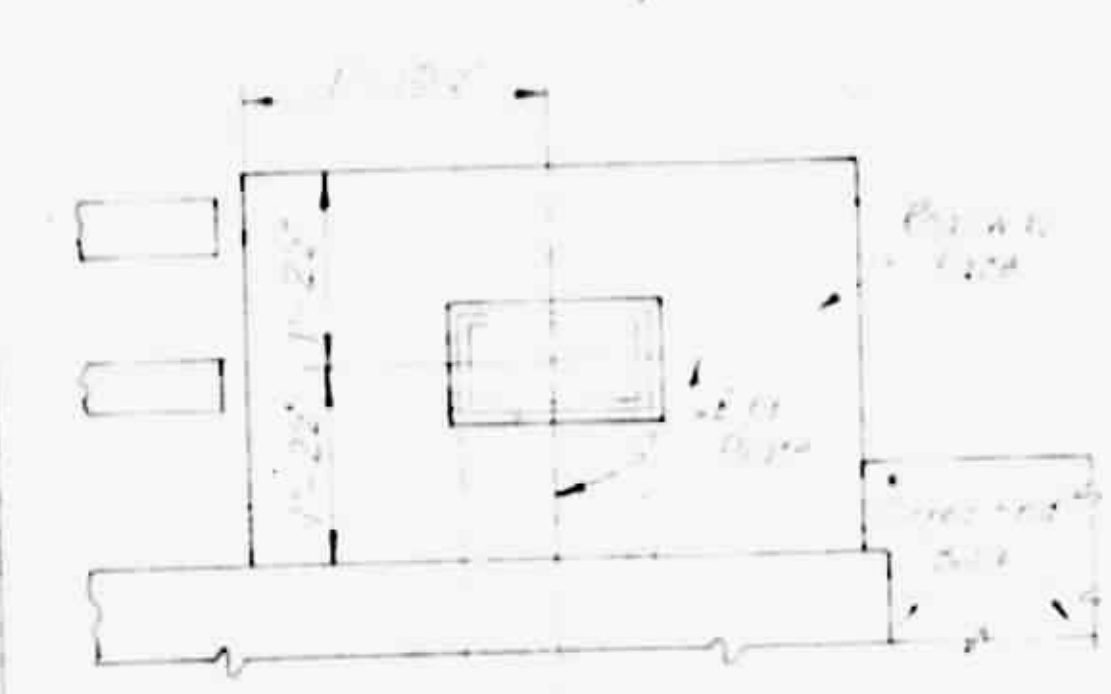

FOR TWO BAR METAL RAIL

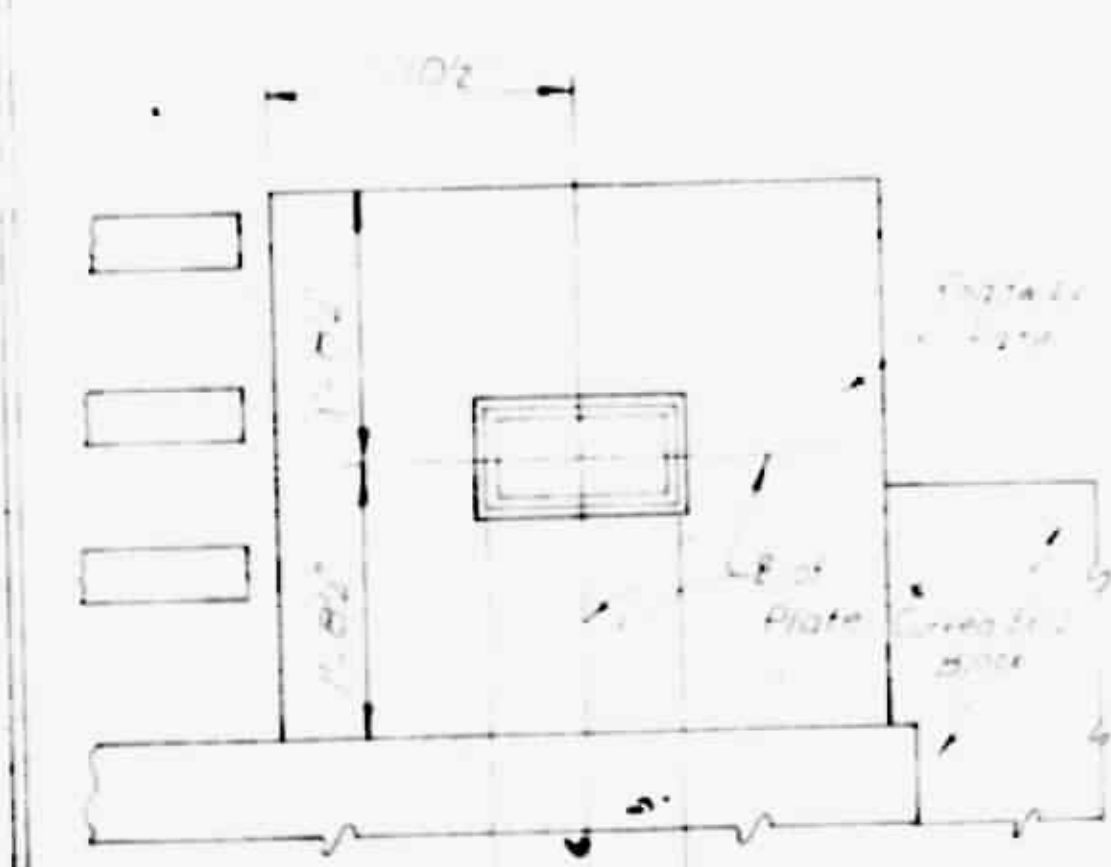

FOR THREE BAR METAL RAIL

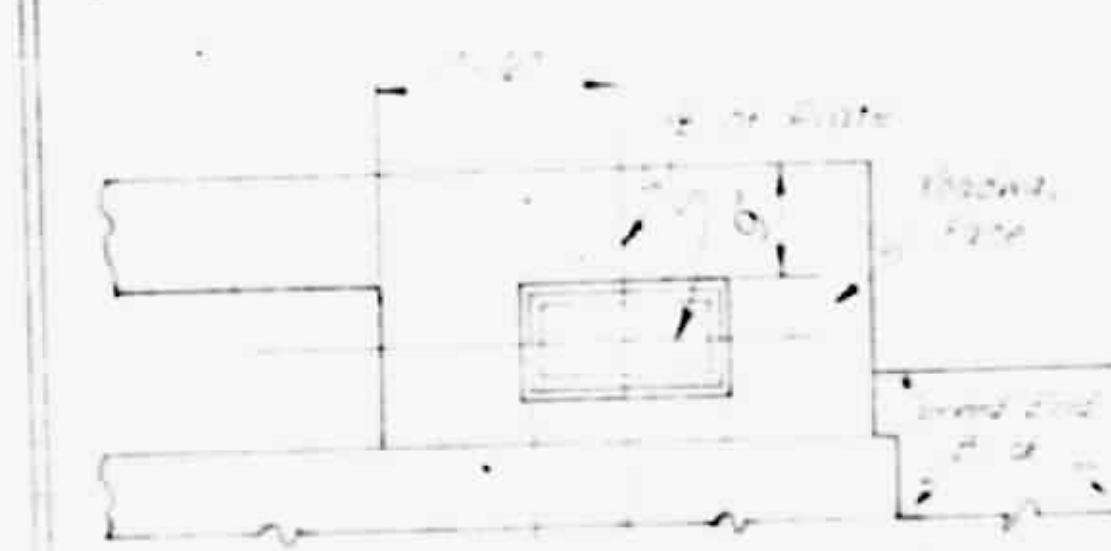

FOR CONCRETE BAR TIE RAIL

NAME PLATE
LOCATION

SPECIAL	
ASSEMBLED BY	GEORGE PHILLIPS
CHECKED BY	DATE 5-3-68
STANDARD	
DRAWN BY	M. COLEMAN
CHECKED BY	DATE 5-3-68

PROJECT No. B.2016601
BUNCOMBE COUNTY
STATION 10+35.50
M.P. Sta 1531

STATE OF NORTH CAROLINA
STATE HIGHWAY COMMISSION
RALEIGH



STANDARD
NAME PLATES

FEB 1968








NO.	BY	DATE	NO.	BY	DATE
1	BY	4-2-68	2	BY	

SHEET 50
TOTAL SHEETS 10

* Required only when general is attached

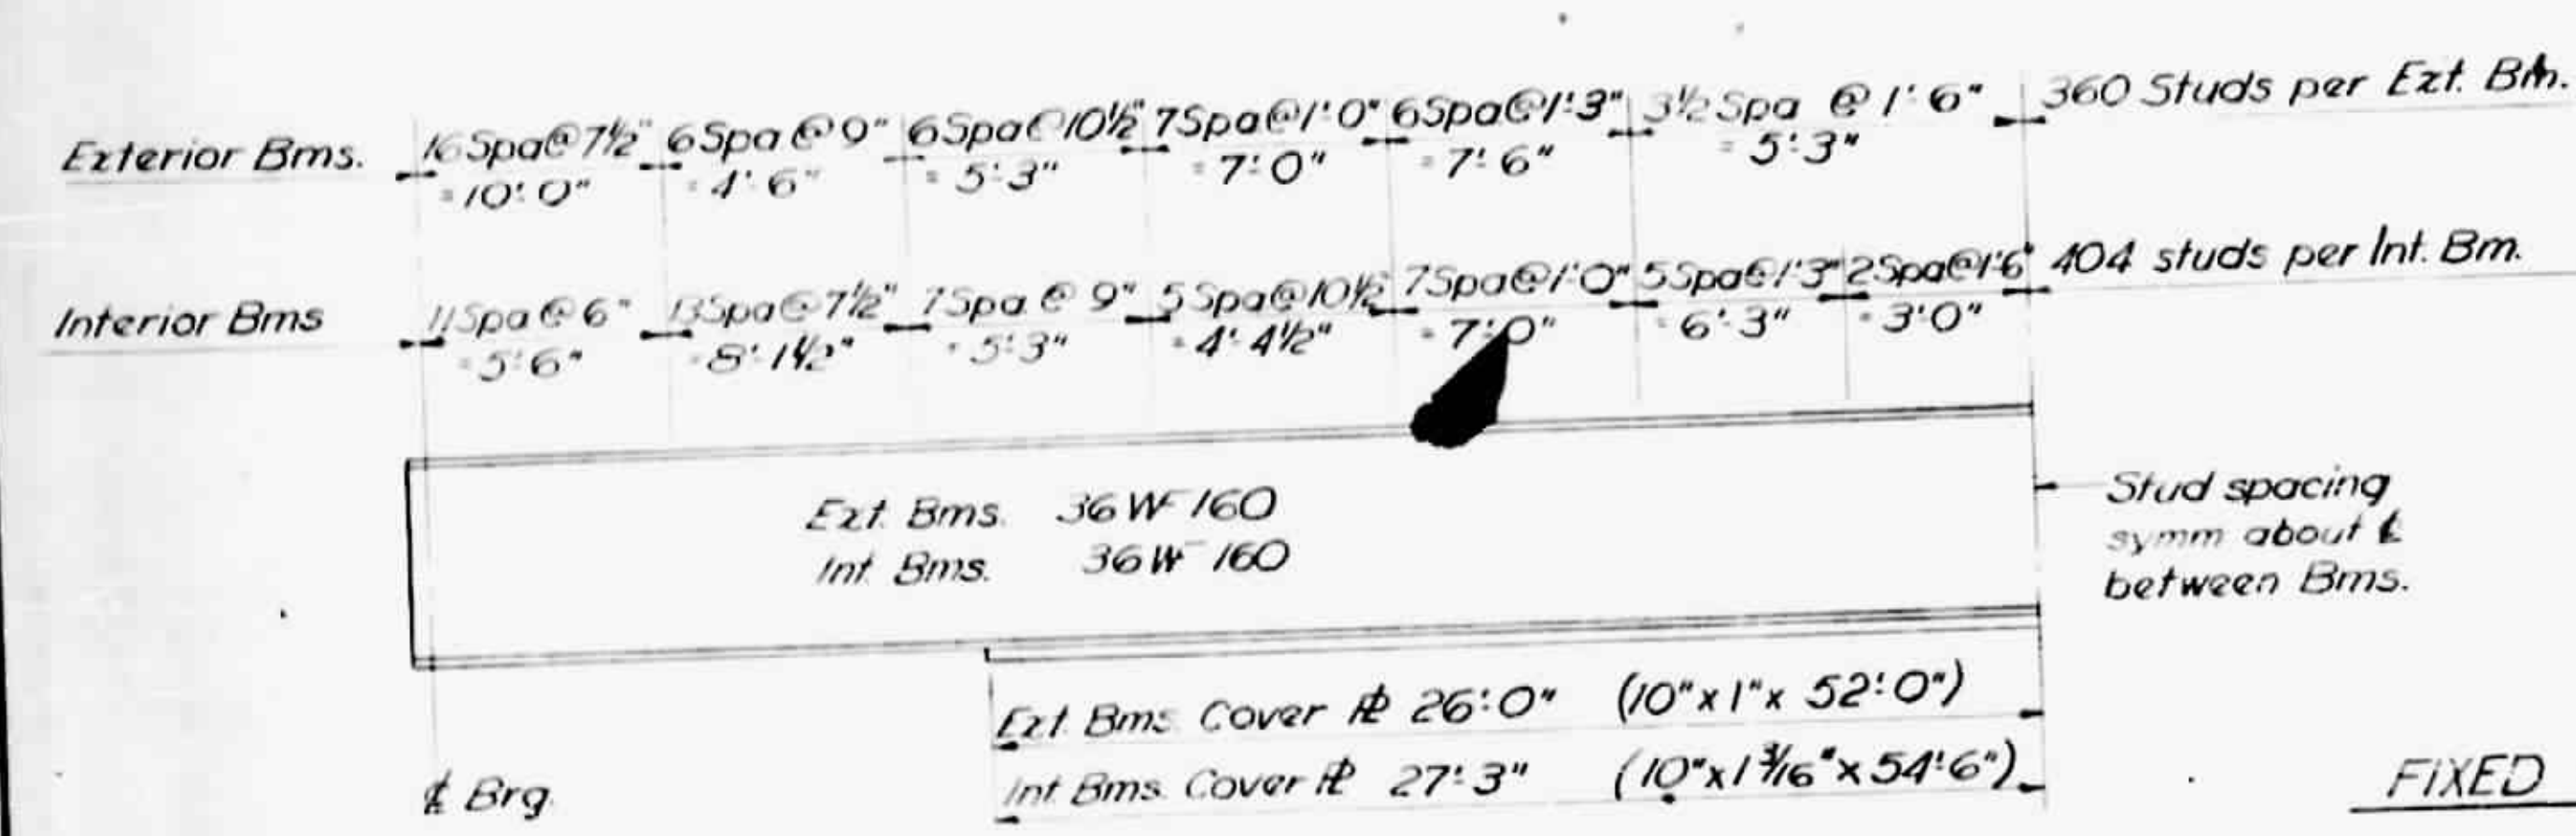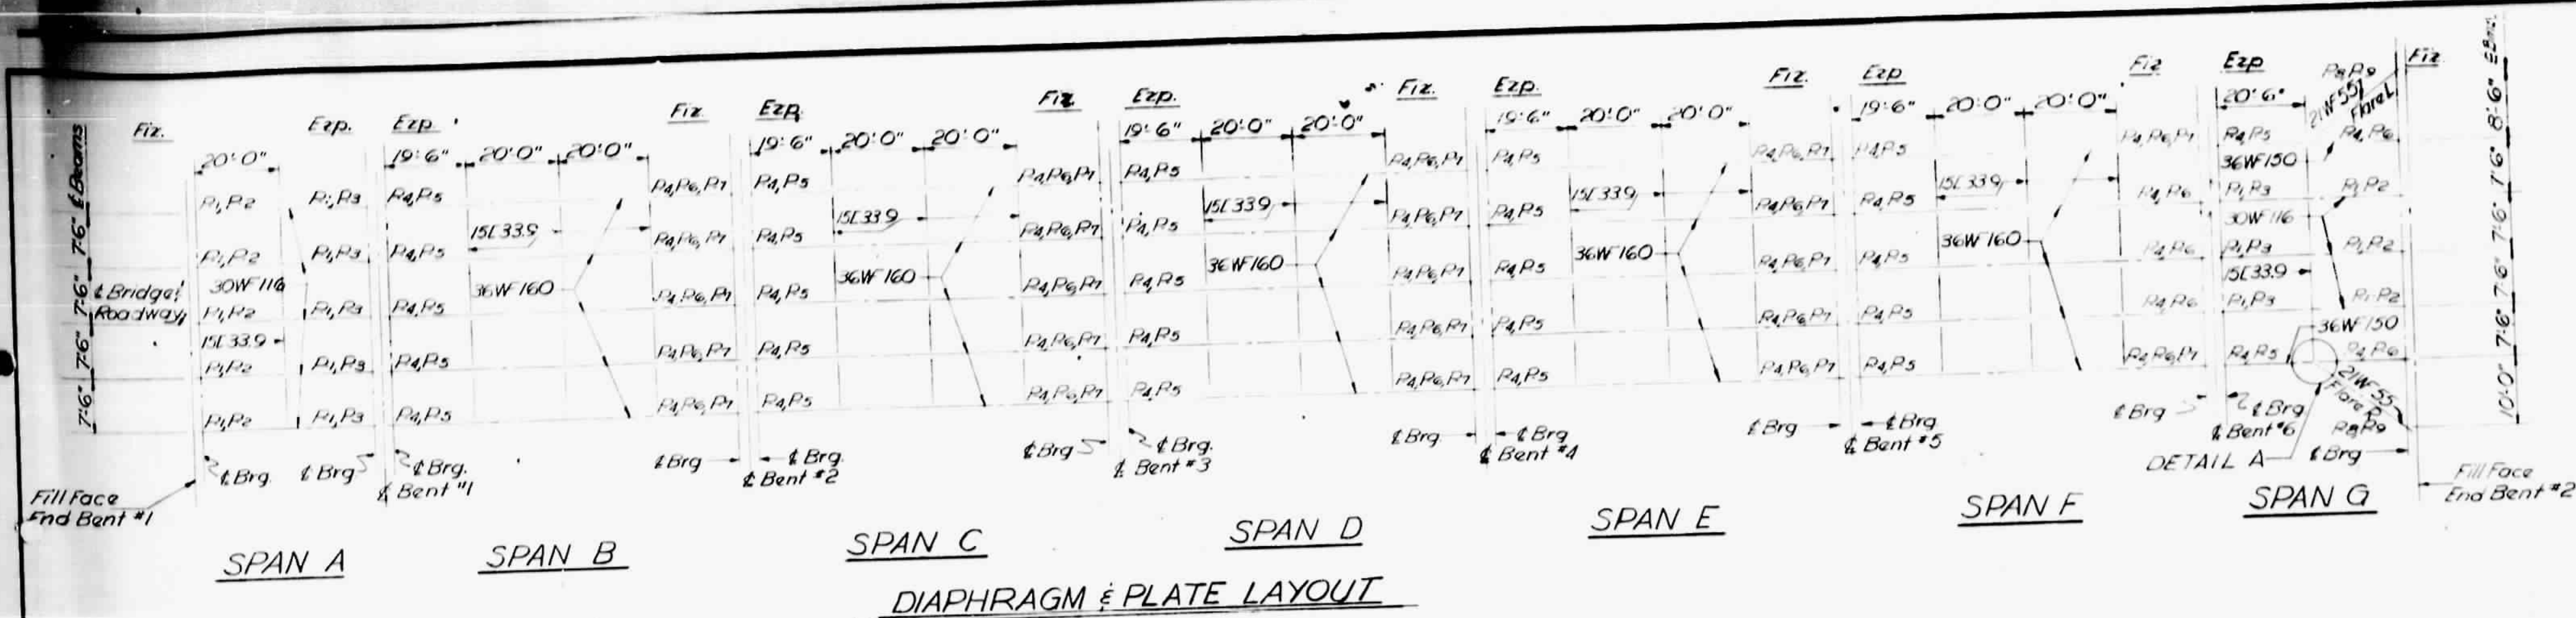

At the contractor's option, he may substitute for the cover plates designated on the plans cover plates of equivalent area provided these plates are at least 5/16" in thickness, and do not exceed a width equal to the flange width less 2" or a thickness equal to the flange thickness plus 1/8". The size of the weld for attaching these cover plates shall be in accordance with the AWS Specifications.

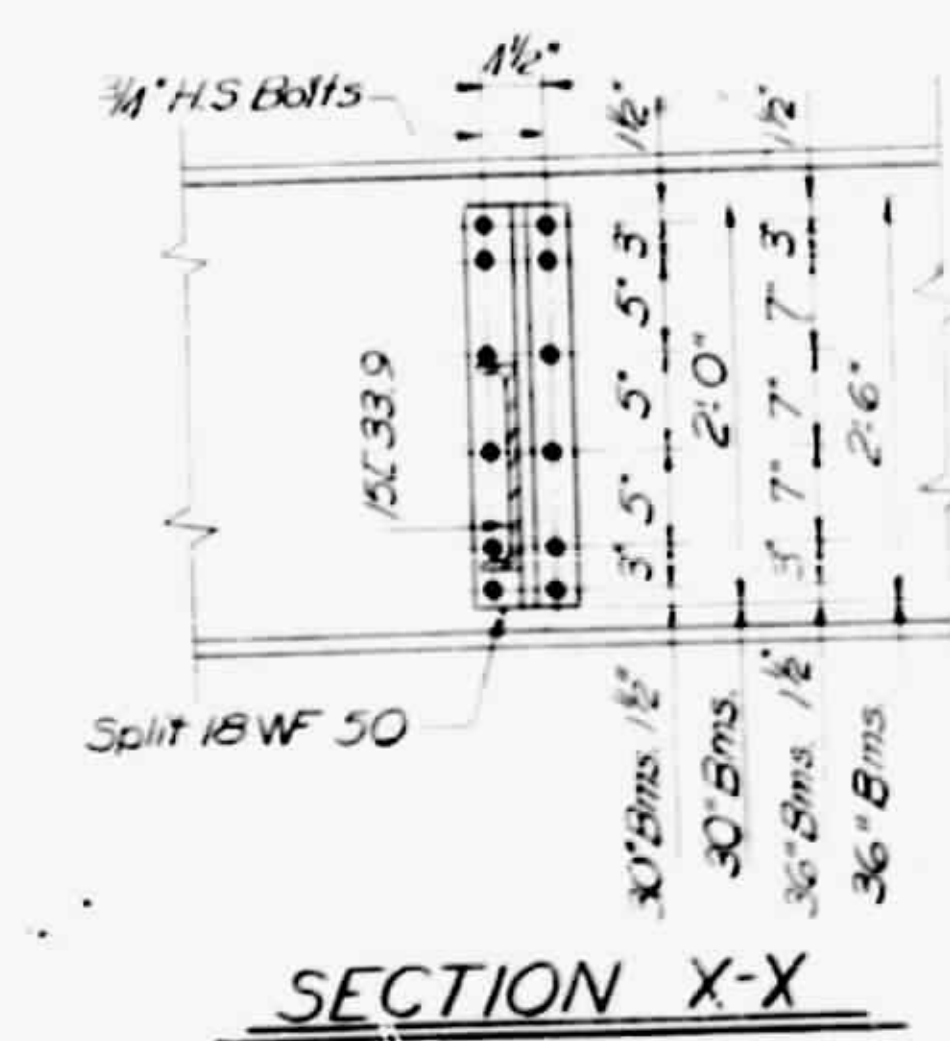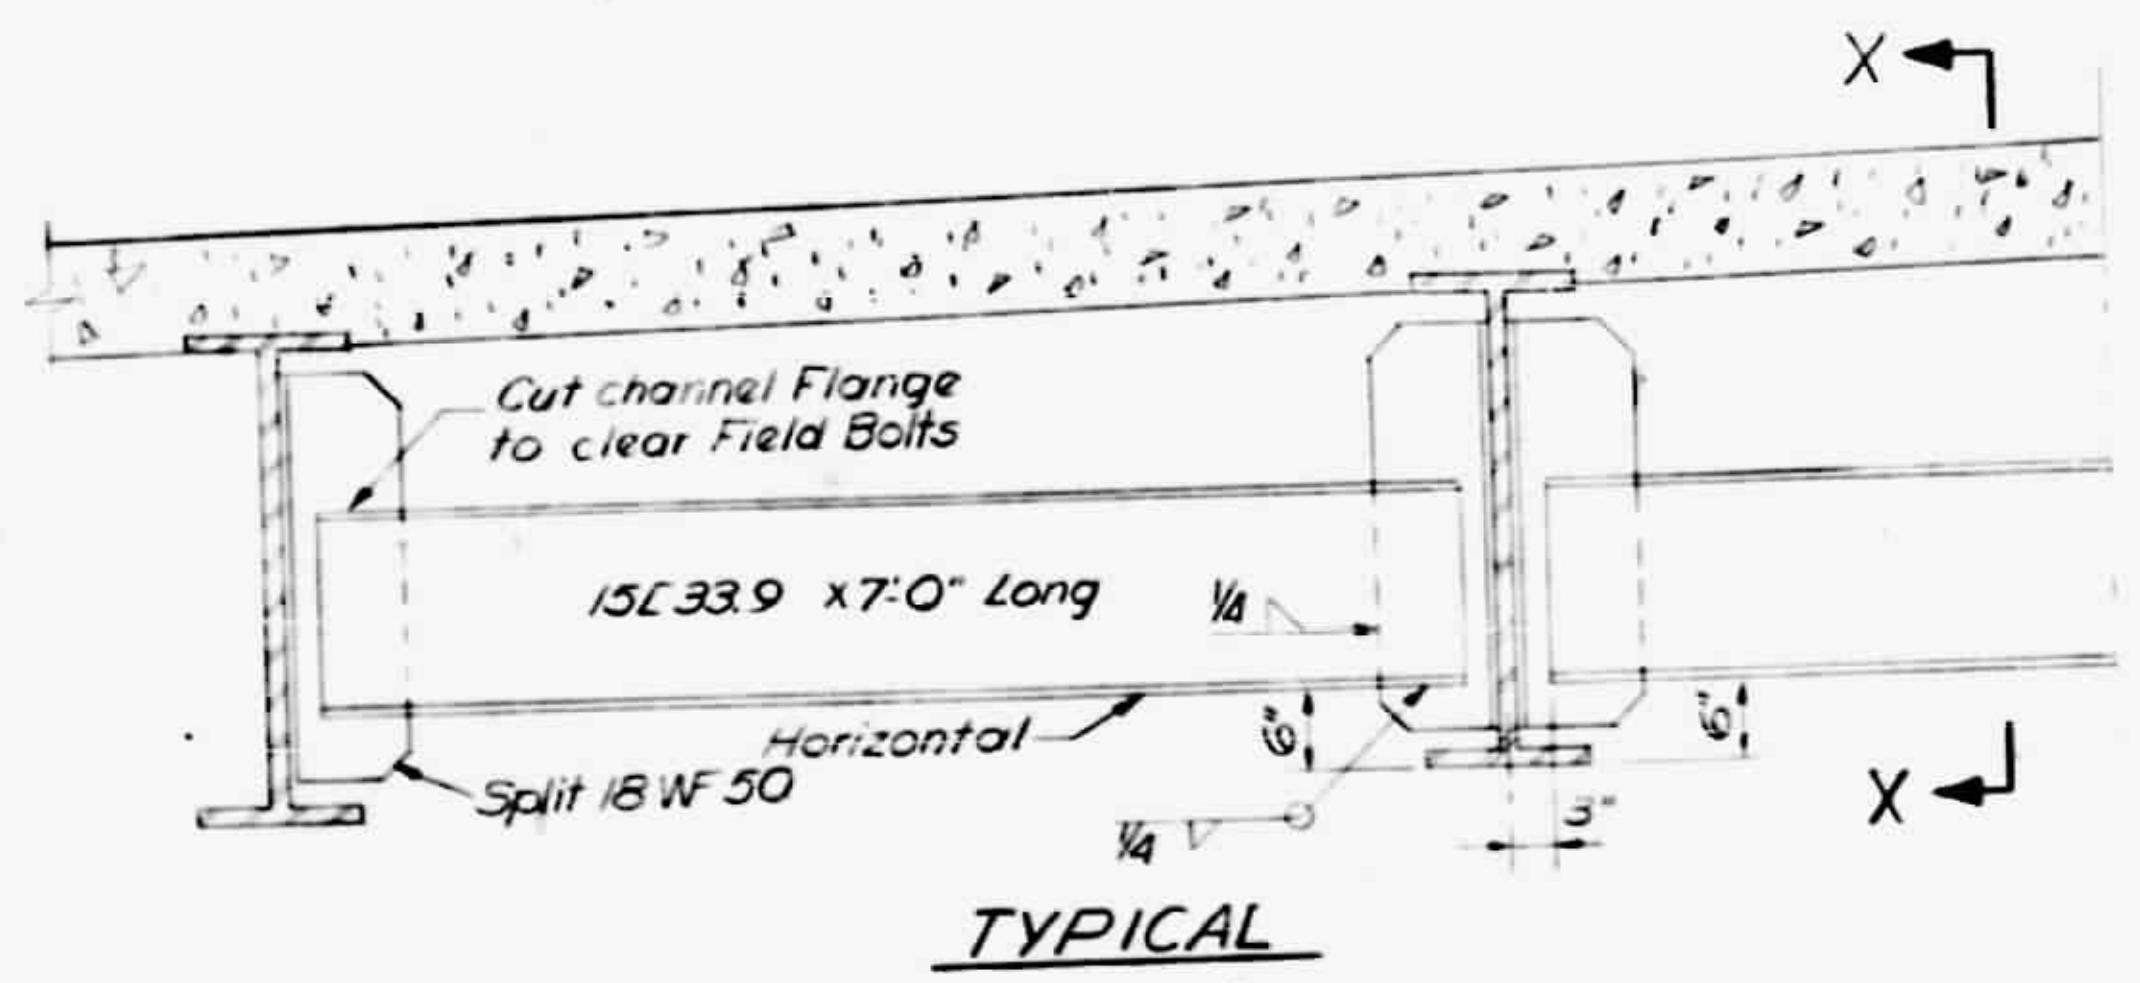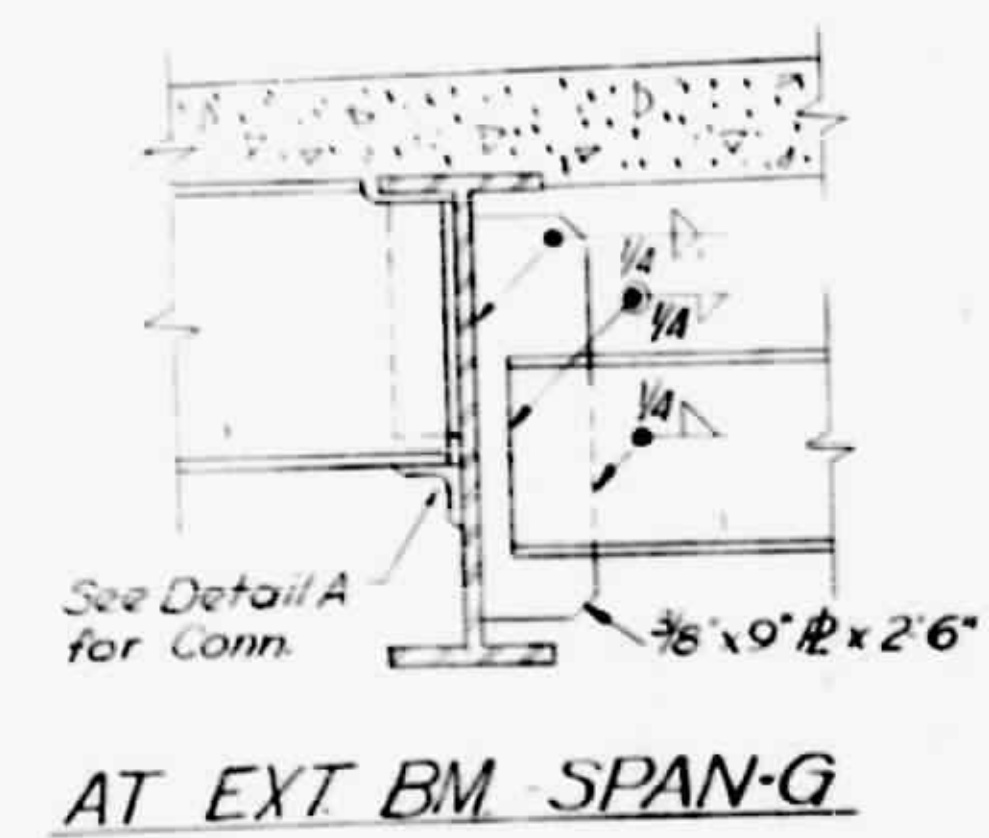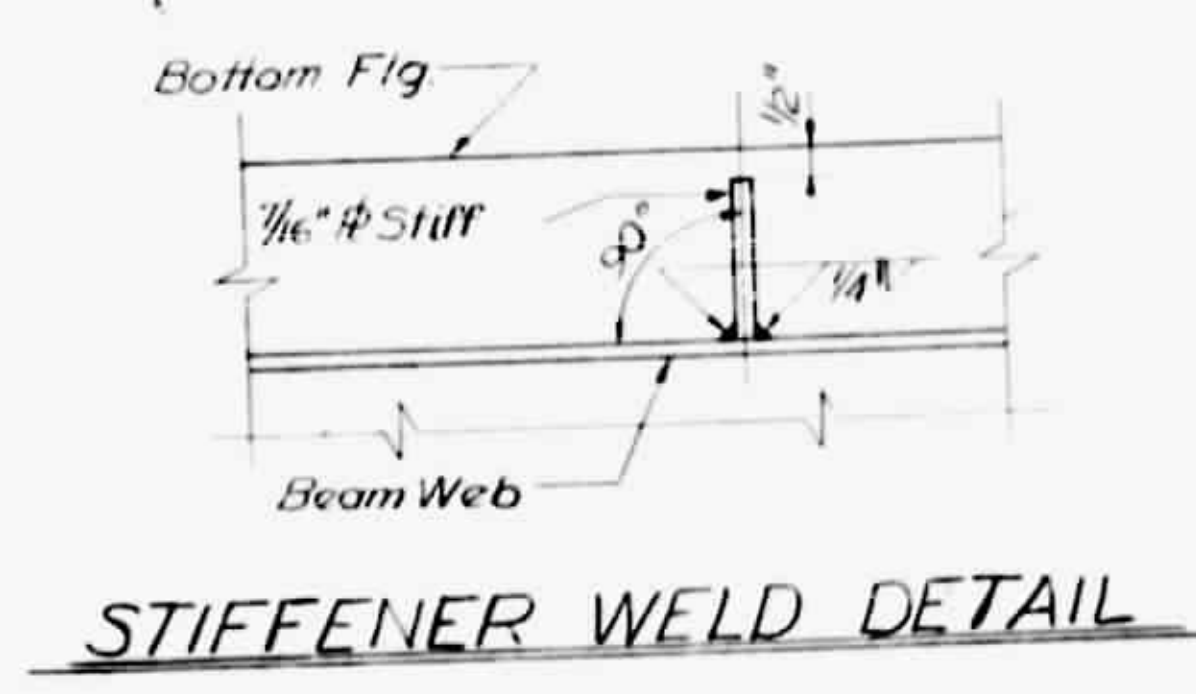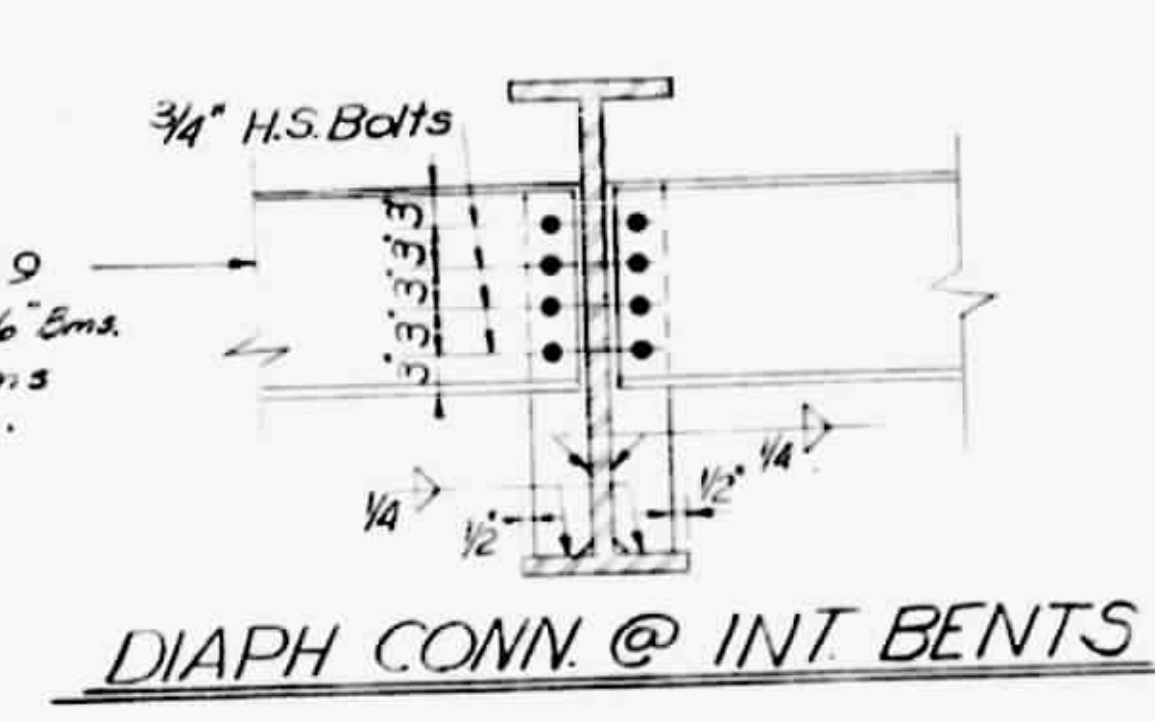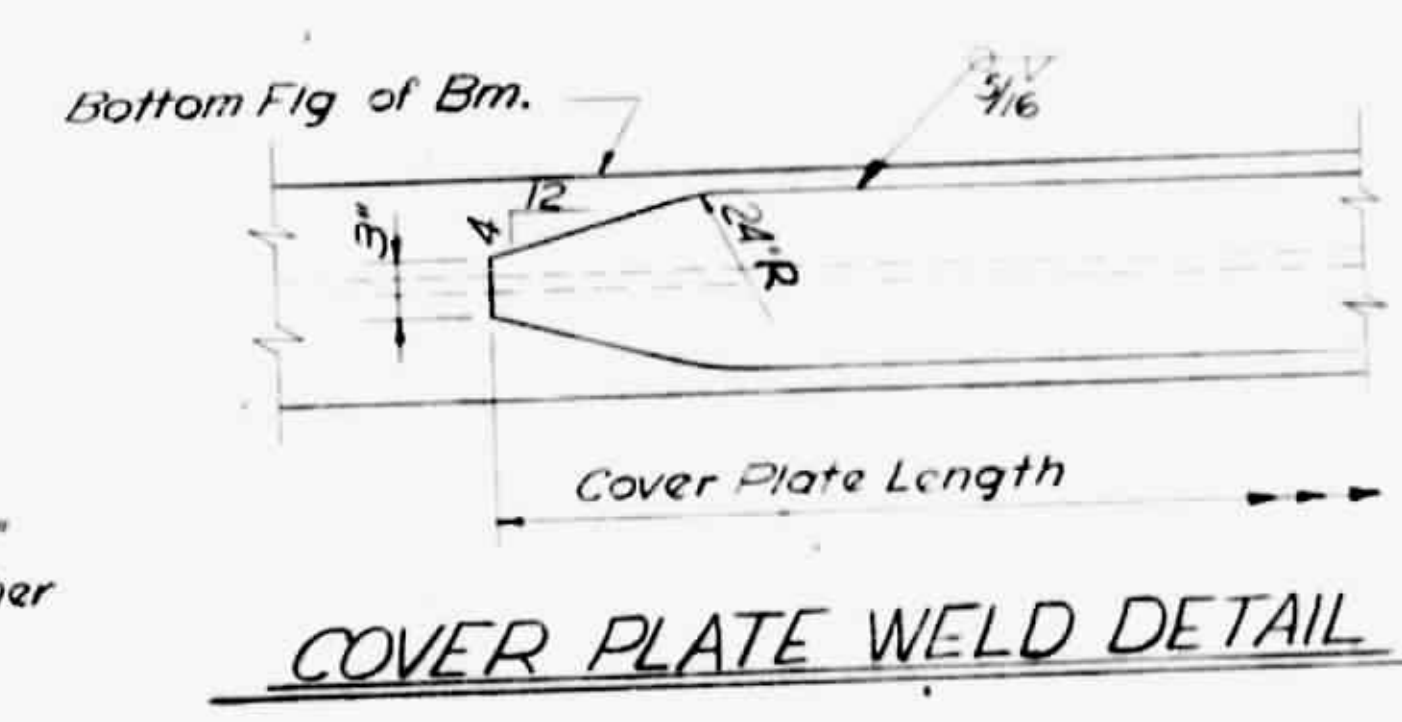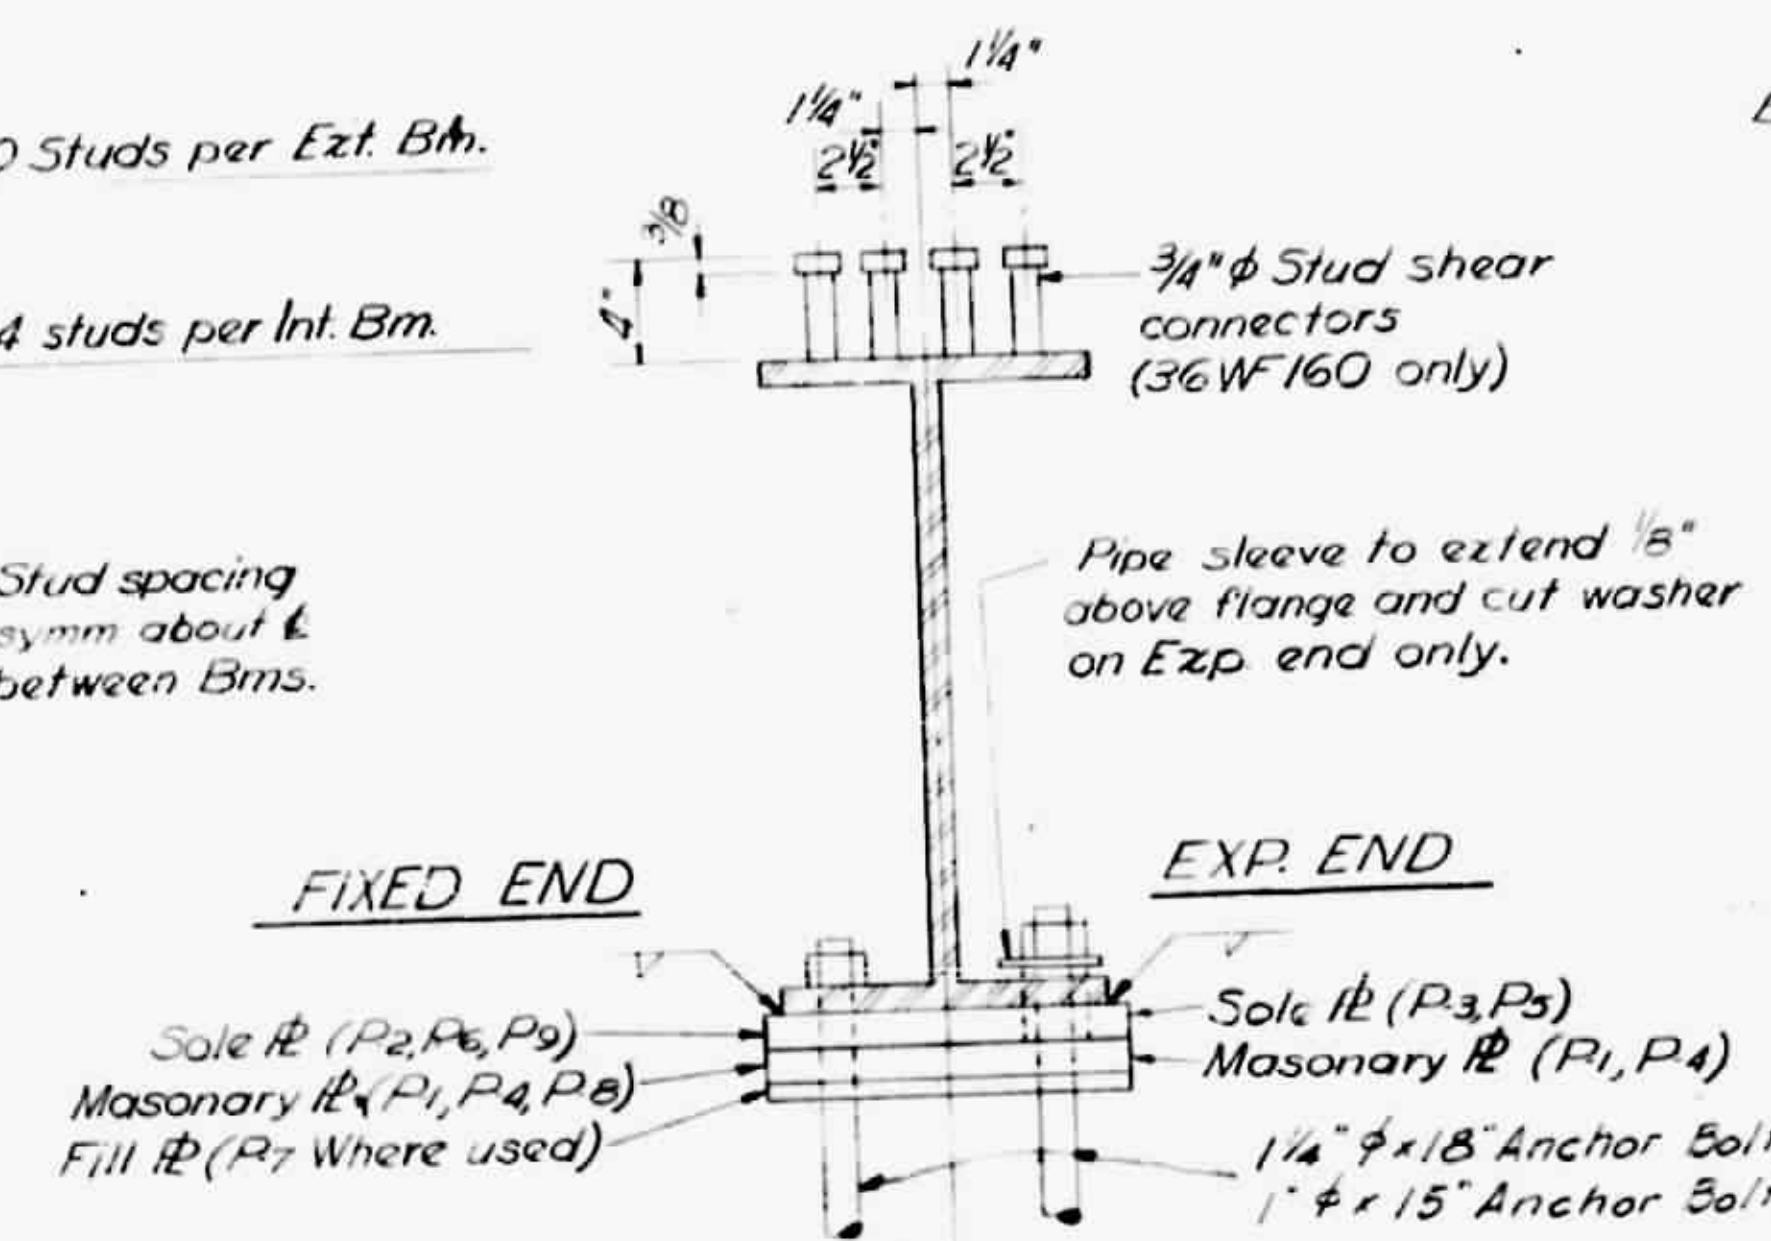

PROJECT NO. 82016601
 BUNCOMBE COUNTY
 STATION: 10+35.50
 MP Sta 1531

STATE OF NORTH CAROLINA
 STATE HIGHWAY COMMISSION

STRUCTURAL STEEL
 DETAILS

NOV. 1966

NO.	BY	DATE	NO.	BY	DATE
1			2		
2			3		

REVISIONS

NO. 10

SPECIAL

DESIGNED BY R.L. Turner
 DRAWN BY R.E. Blair
 CHECKED BY R.E. Turner

DATE NOV. 66
 DATE NOV. 66
 DATE NOV. 66

NOTES

All beams and cover plates shall be of A.S.T.M. A-36 grade structural steel. See S-N Sheet.

Field connections of diaphragms to beams shall be bolted using $\frac{3}{4}$ " ϕ high strength bolts in accordance with the Specifications.


Tops of floor drains to be set $\frac{3}{8}$ " below surface of slab.

No web stiffeners are required on outside of exterior beams or at End Bents. Stiffeners are to be parallel to ends of beams.


STRUCTURAL STEEL

APPROX. LBS.

SPAN	APPROX. LBS.
A	27,300
B	8,100
C	8,100
D	8,100
E	8,100
F	8,100
G	33,500
Total	466,300

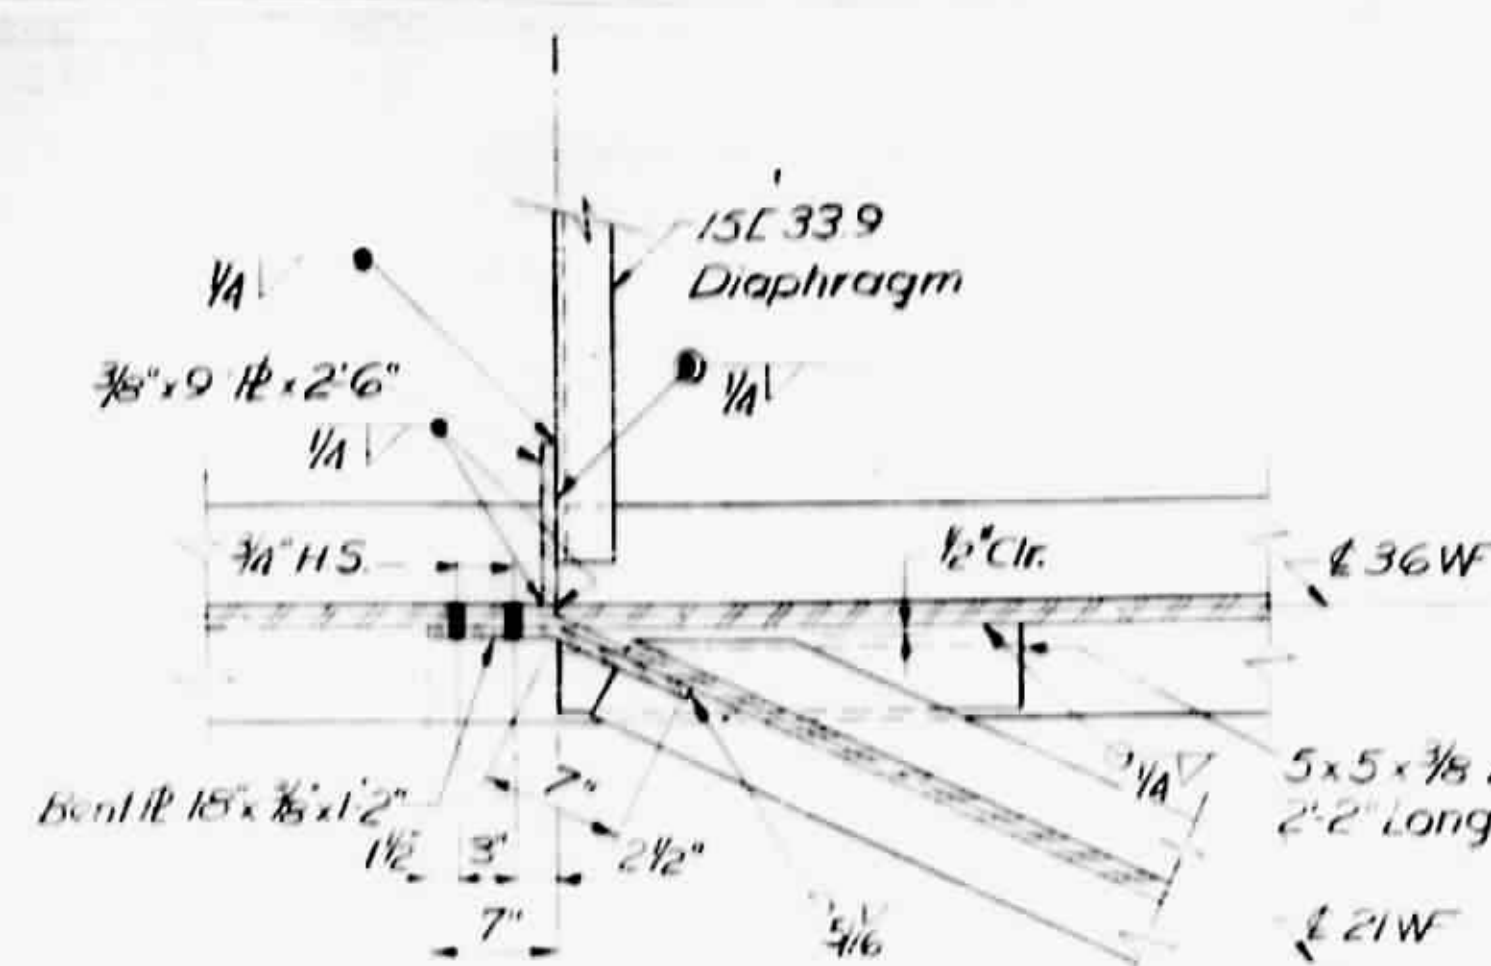


PLAN

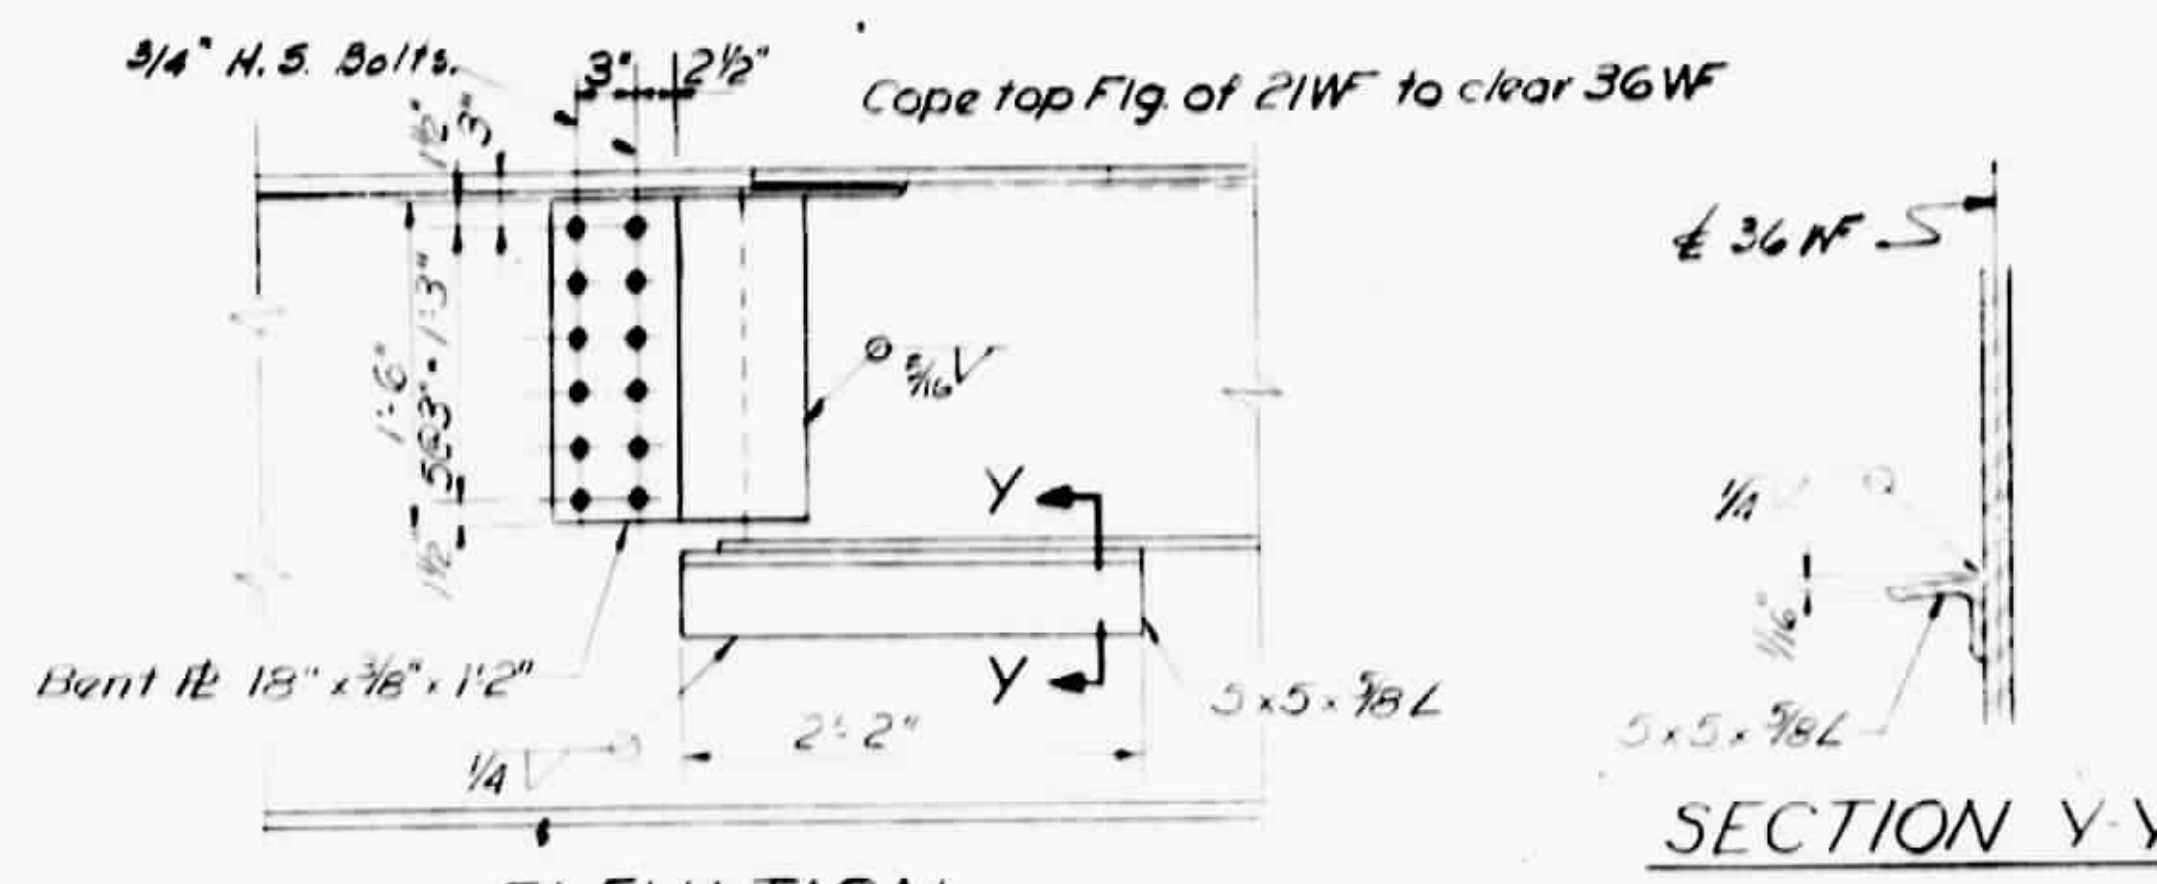

ELEVATION




SECTION Y-Y

DETAIL "A"

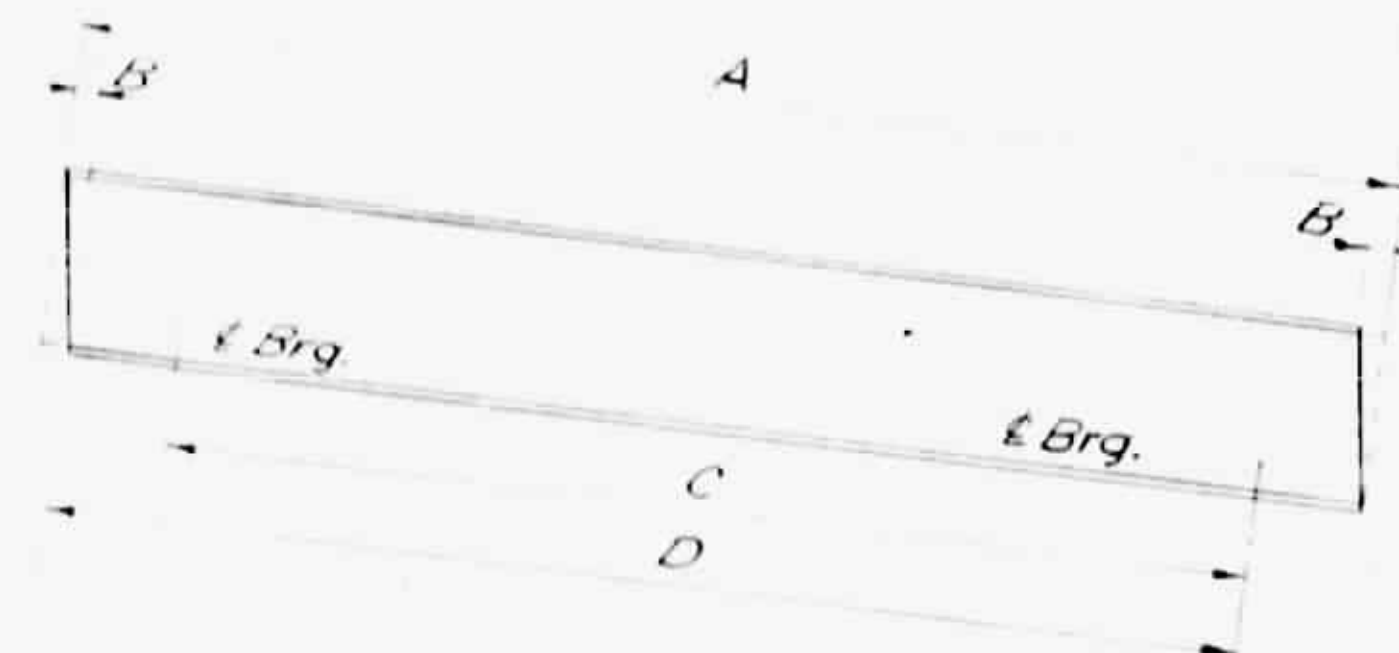

SPAN	BM.	A	B	C	D
A	All	41' 11 1/4"	1 3/4"	40' 6 1/4"	—
B, C, D, E, F	All	79' 10 7/8"	1 3/4"	79' 11 1/8"	—
G	Int.	42' 11"	1 1/4"	41' 6 3/4"	—
G	Ext.	42' 11 5/8"	1 3/4"	41' 6 3/4"	—
G	Flare L	23' 6 3/8"	1 1/4"	—	22' 5 3/8"
G	Flare R	24' 2 1/2"	1 1/4"	—	23' 1 1/4"

BEAM BEVEL DETAIL

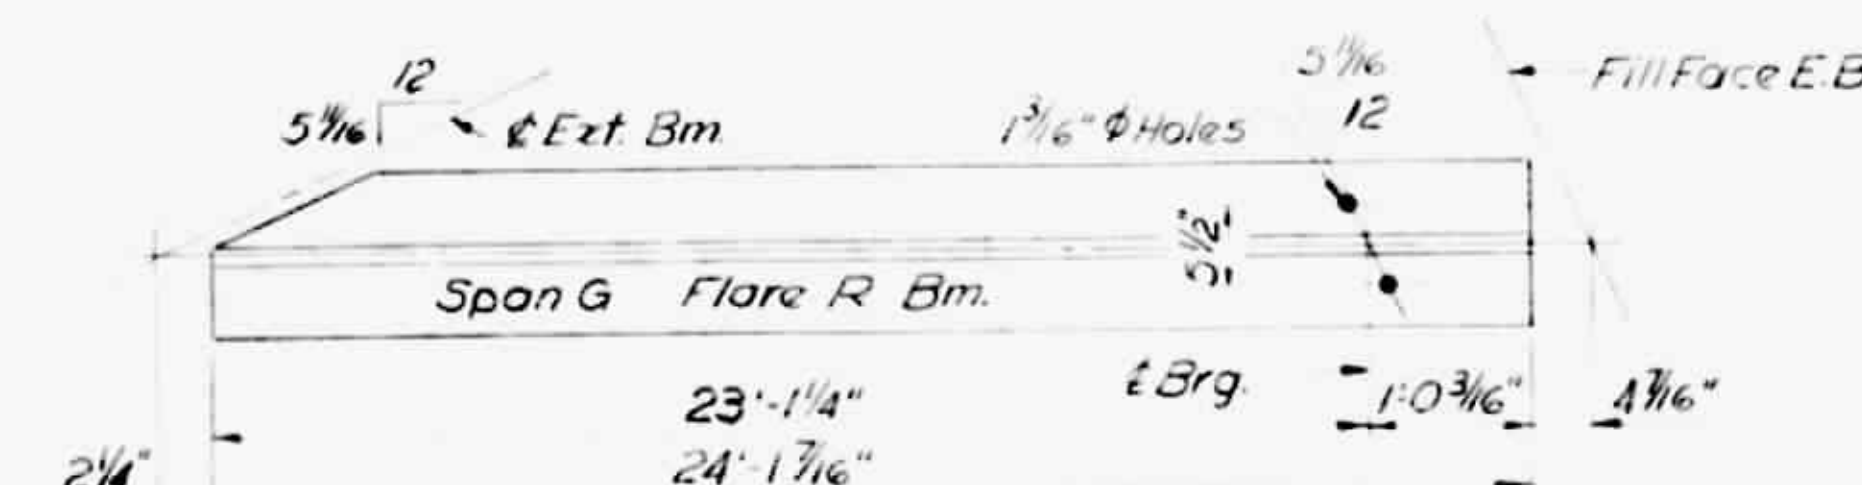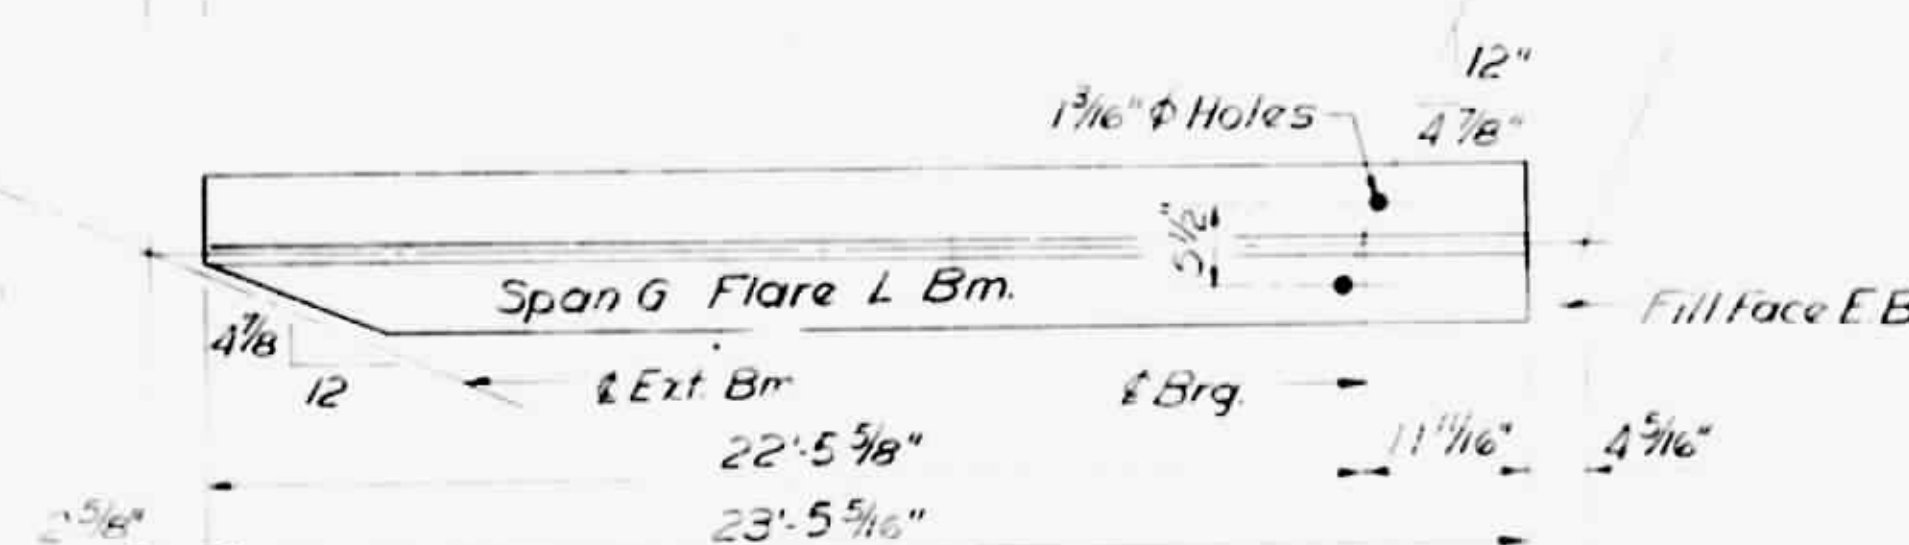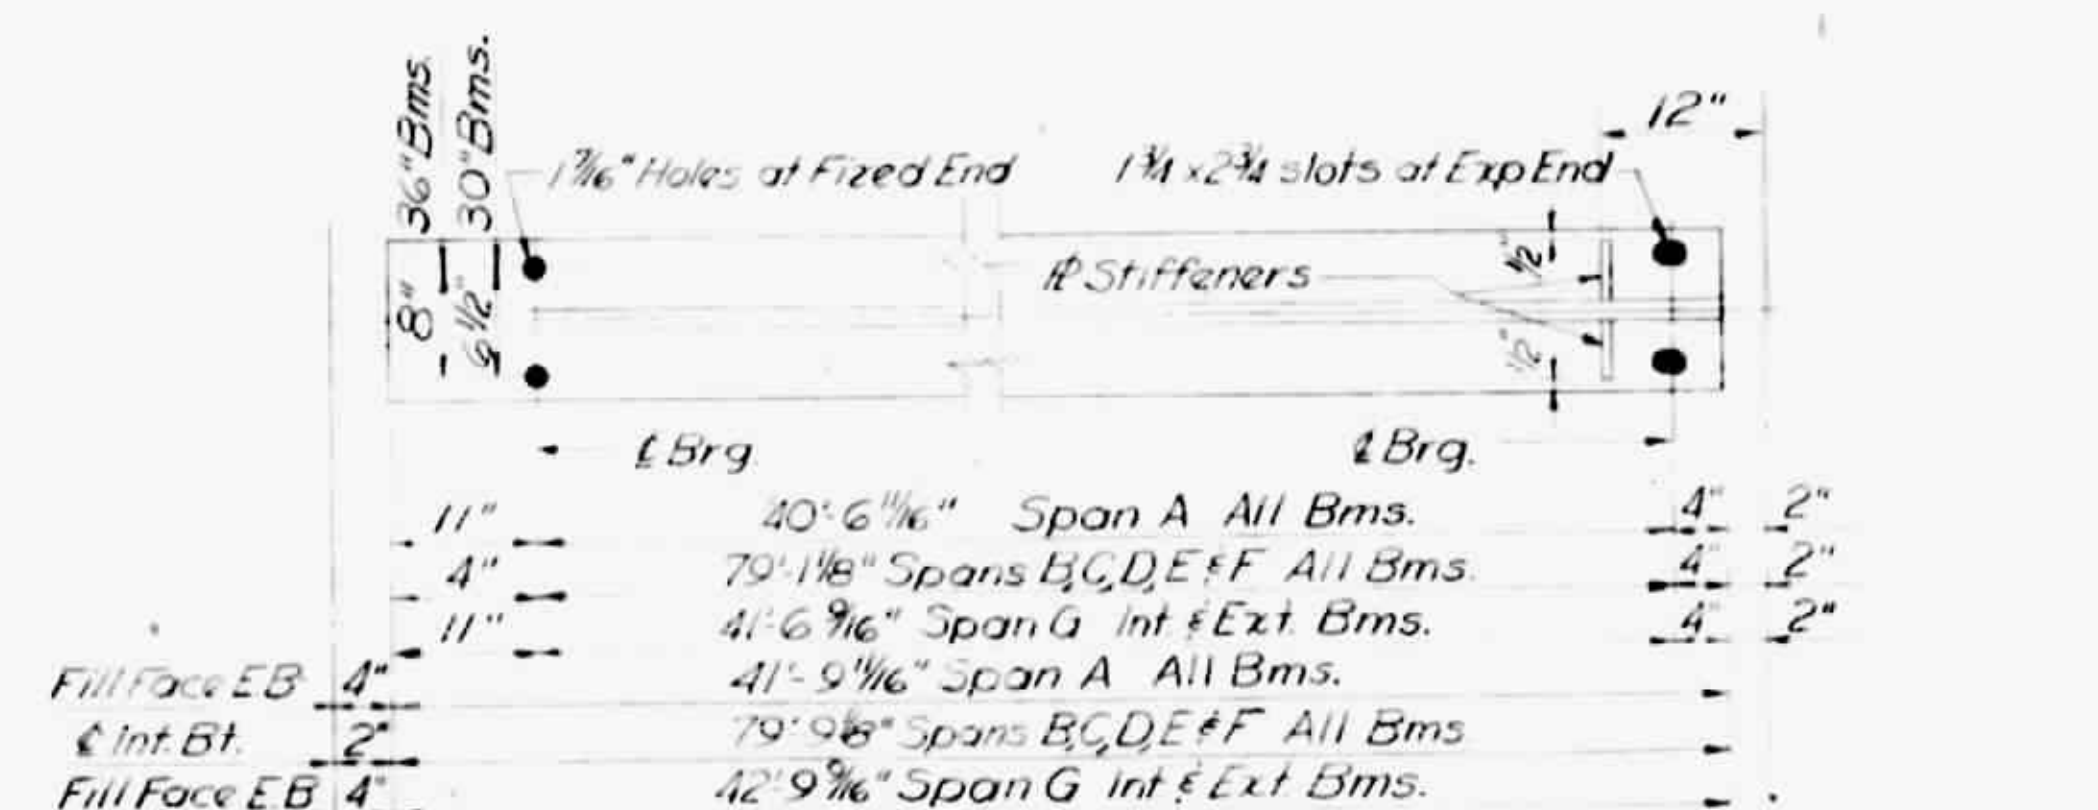


BOTTOM FLANGE DETAILS

DEFLECTION TABLES

	SPAN A		SPAN B, C, D, E, F		SPAN G	
	Int Bm	Ext Bm	Int Bm	Ext Bm	Int Bm	Ext Bm
Deflection due to Beam Weight	1/16"	1/16"	1/2"	1/2"	1/16"	1/16"
Deflection due to superimposed dead load	7/16"	7/16"	1 7/16"	2 1/8"	7/16"	3/8"
TOTAL DEFLECTION	1/2"	1/2"	2 7/16"	2 7/8"	1/2"	7/16"
CAMBER BEAMS	*	*	2 1/16"	2 7/8"	*	*

* No camber other than natural mill camber required.

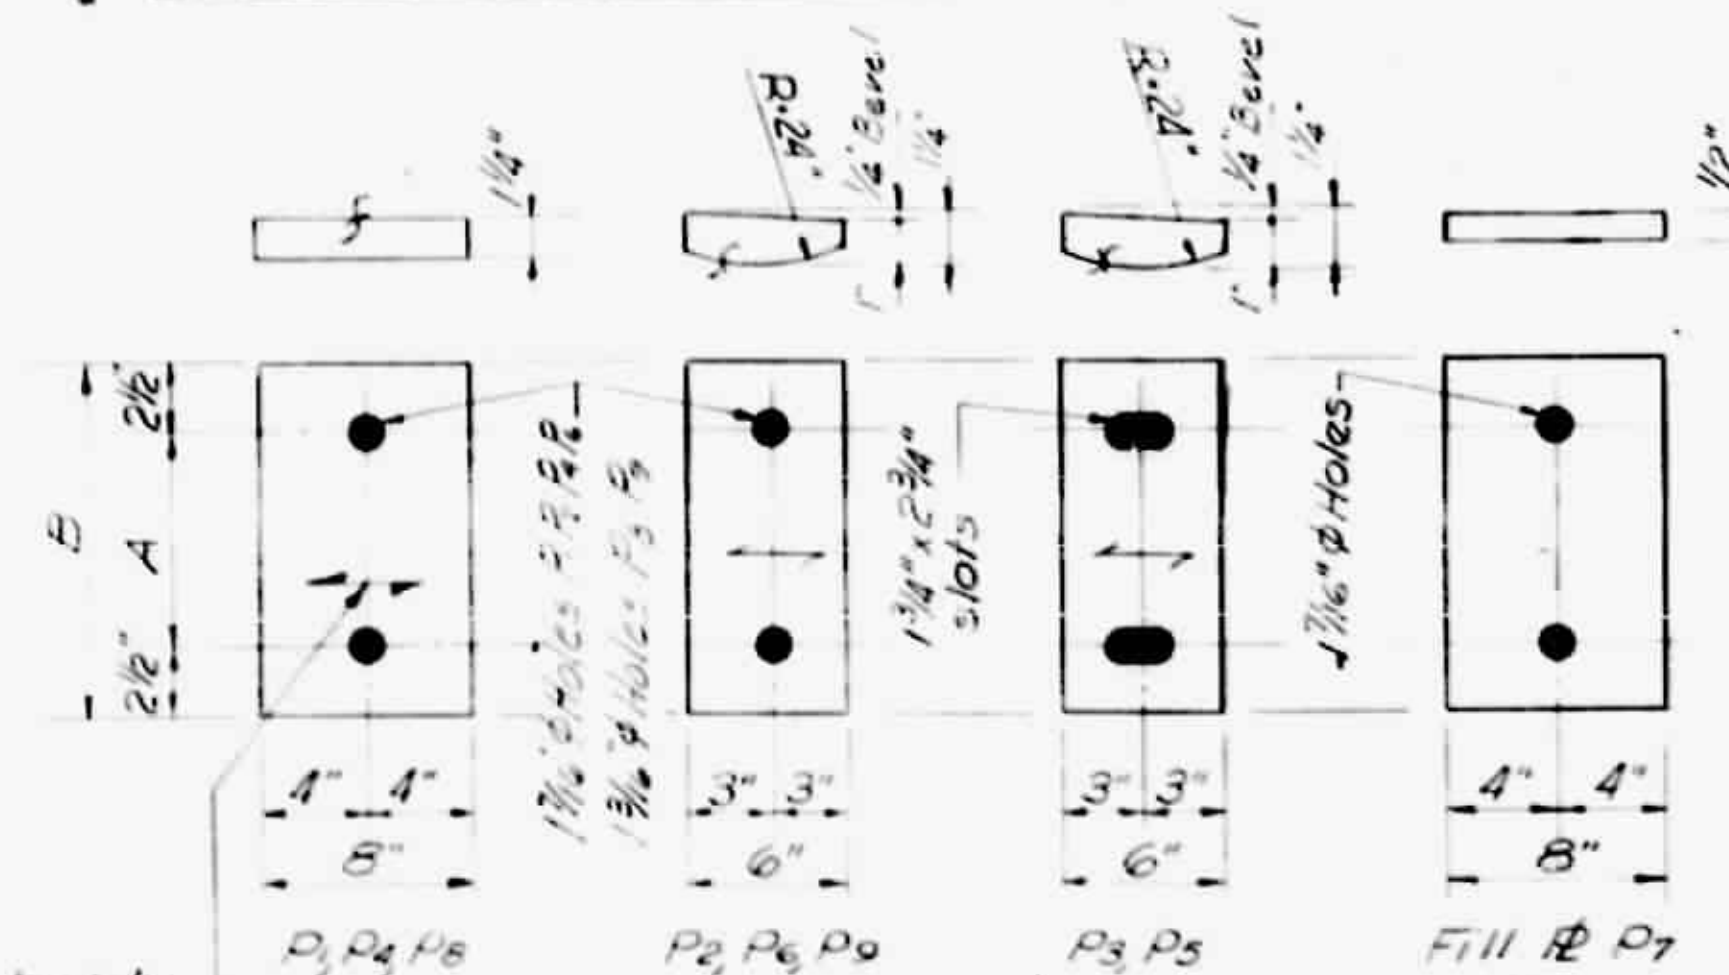

No. Req'd	16	8	8	54	27	27	22	2	2
	P1	P2	P3	P4	P5	P6	P7	P8	P9
A	6 1/2	6 1/2	6 1/2	8	8	8	8	5 1/2	5 1/2
B	11 1/2	11 1/2	11 1/2	1-1	1-1	1-1	1-1	10 1/2	10 1/2


BEARING PLATE DETAILS

In planing cut of tool to be in this direction

SPECIAL
DESIGNED BY: R. E. Turner
DRAWN BY: R. E. Blair
CHECKED BY: R. E. Turner
DATE: NOV. 66
DATE: NOV. 66
DATE: NOV. 66
DATE: NOV. 66

PROJECT NO. 82016601
BUNCOMBE COUNTY
STATION: 10+35.50
M.P. Sta 1531

STATE OF NORTH CAROLINA STATE HIGHWAY COMMISSION					
STRUCTURAL STEEL DETAILS					
NOV. 1966					
REVISIONS					
NO.	BY	DATE	NO.	BY	DATE
1			2		
2			3		

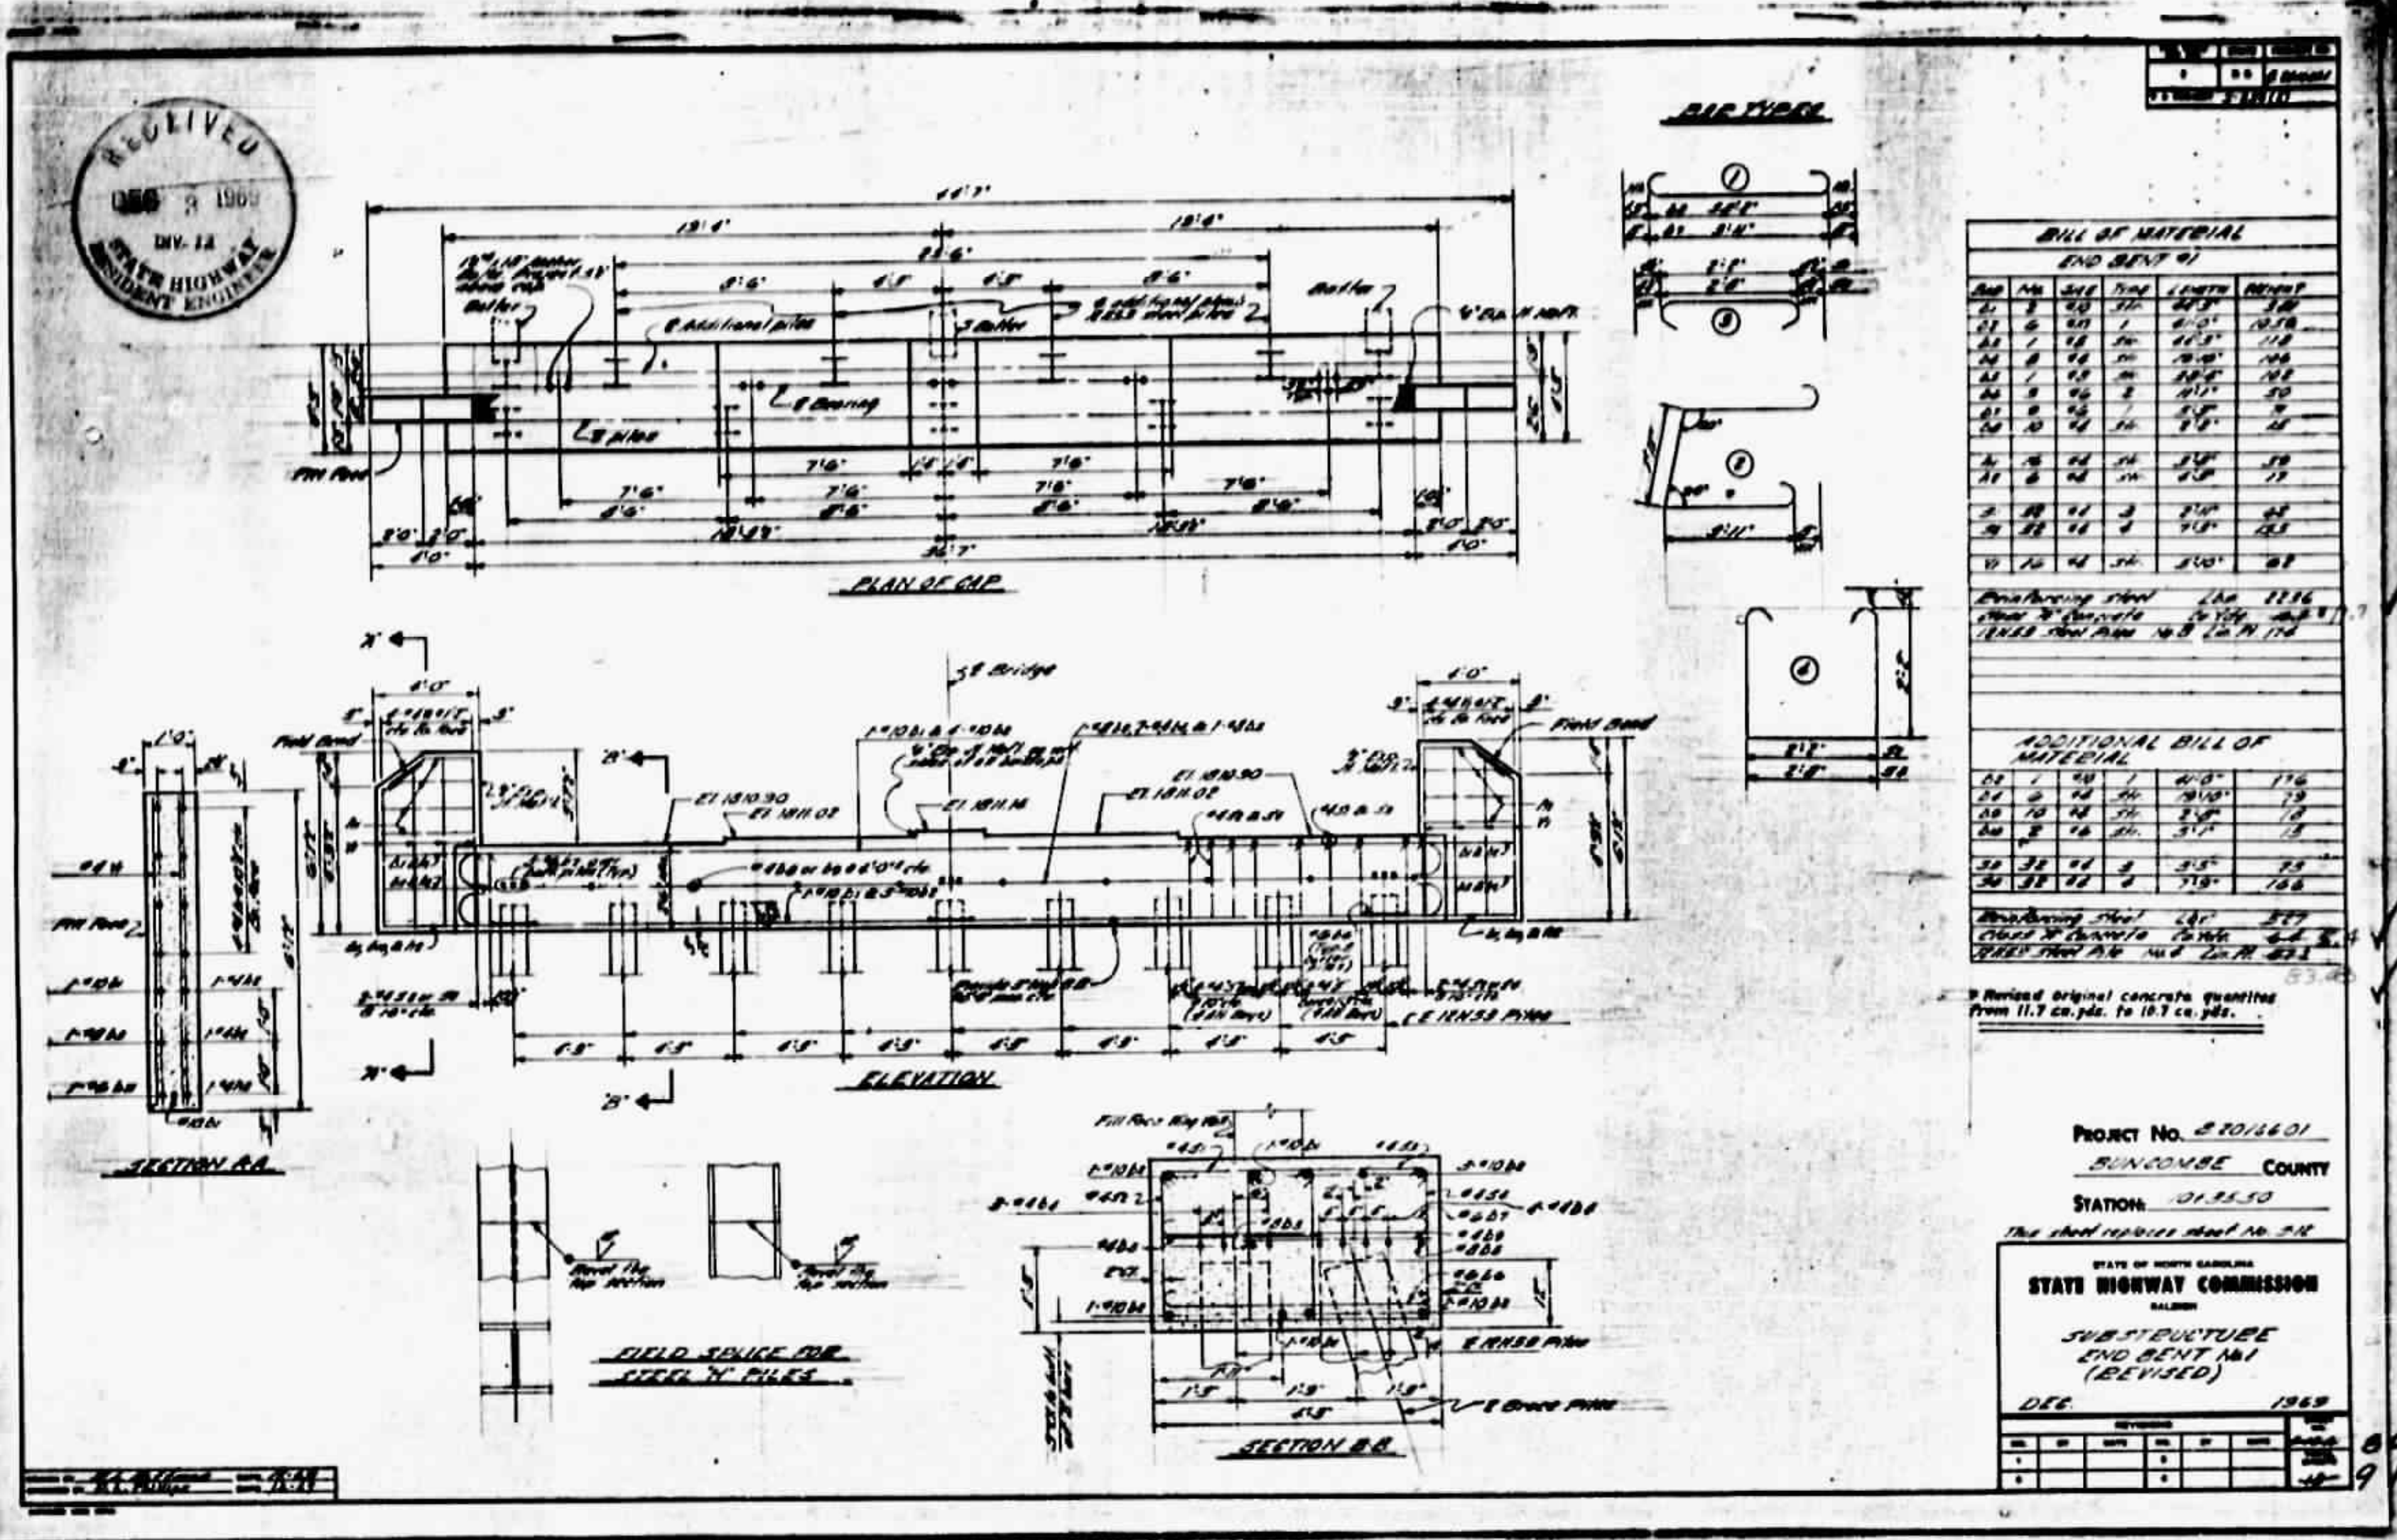

BILL OF MATERIAL


NO.	QTY.	SIZE	TYPE	LENGTH	WEIGHT
1	1	10"	PIPE	10.0'	1058
2	1	10"	PIPE	10.0'	1058
3	1	10"	PIPE	10.0'	1058
4	1	10"	PIPE	10.0'	1058
5	1	10"	PIPE	10.0'	1058
6	1	10"	PIPE	10.0'	1058
7	1	10"	PIPE	10.0'	1058
8	1	10"	PIPE	10.0'	1058
9	1	10"	PIPE	10.0'	1058
10	1	10"	PIPE	10.0'	1058

ADDITIONAL BILL OF MATERIAL

NO.	QTY.	SIZE	TYPE	LENGTH	WEIGHT
11	1	10"	PIPE	10.0'	1058
12	1	10"	PIPE	10.0'	1058
13	1	10"	PIPE	10.0'	1058
14	1	10"	PIPE	10.0'	1058
15	1	10"	PIPE	10.0'	1058



PROJECT NO. 8.2016601
BUNCOMBE COUNTY
STATION: 10+35.50
SUBSTRUCTURE
END BENT NO. 1
(REVISED)

Additional material at contractor's expense due to error, not included in final pay quantities.

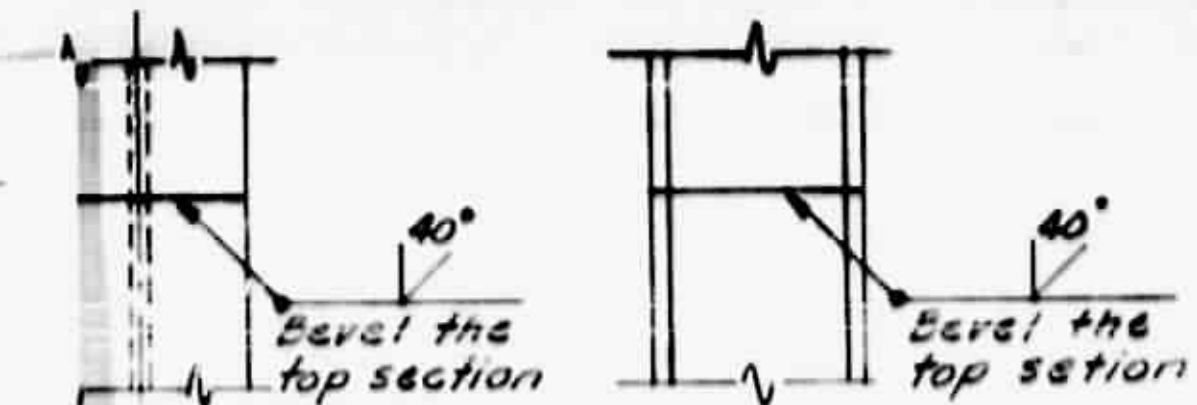

FIELD SPICE FOR
STEEL H PILES

BAR DETAILS

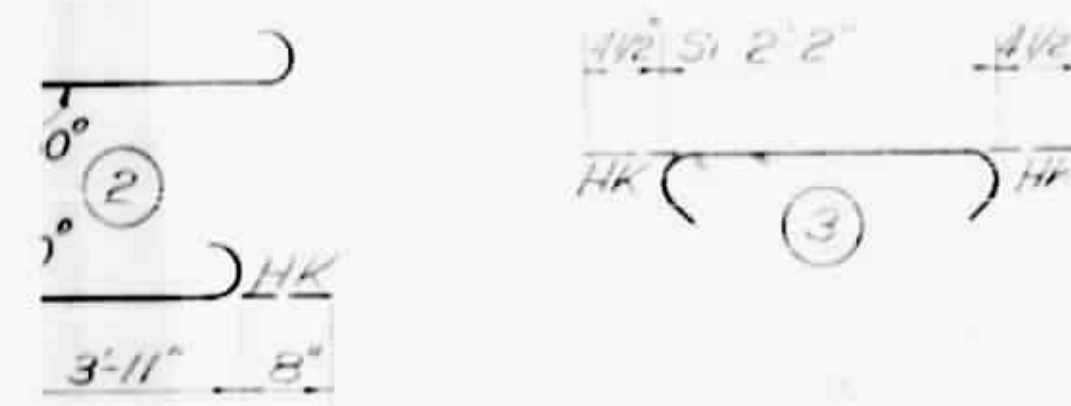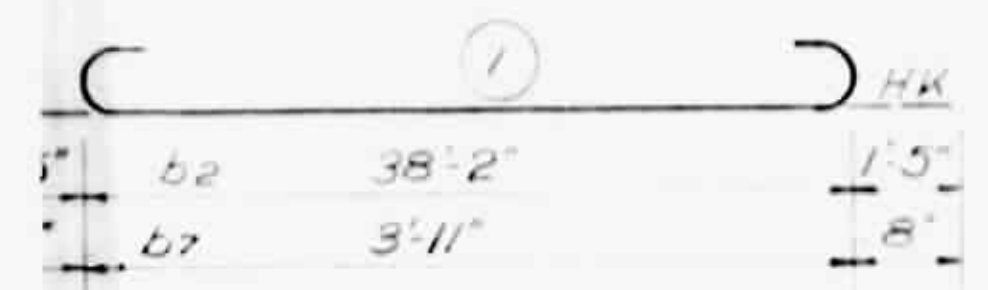


NOTE: All dimensions in Bar Details are out to out of bar.


BILL OF MATERIAL

NO.	QTY.	SIZE	TYPE	LENGTH	WEIGHT
1	1	10"	PIPE	10.0'	1058
2	1	10"	PIPE	10.0'	1058
3	1	10"	PIPE	10.0'	1058
4	1	10"	PIPE	10.0'	1058
5	1	10"	PIPE	10.0'	1058
6	1	10"	PIPE	10.0'	1058
7	1	10"	PIPE	10.0'	1058
8	1	10"	PIPE	10.0'	1058
9	1	10"	PIPE	10.0'	1058
10	1	10"	PIPE	10.0'	1058


See note revised sheet

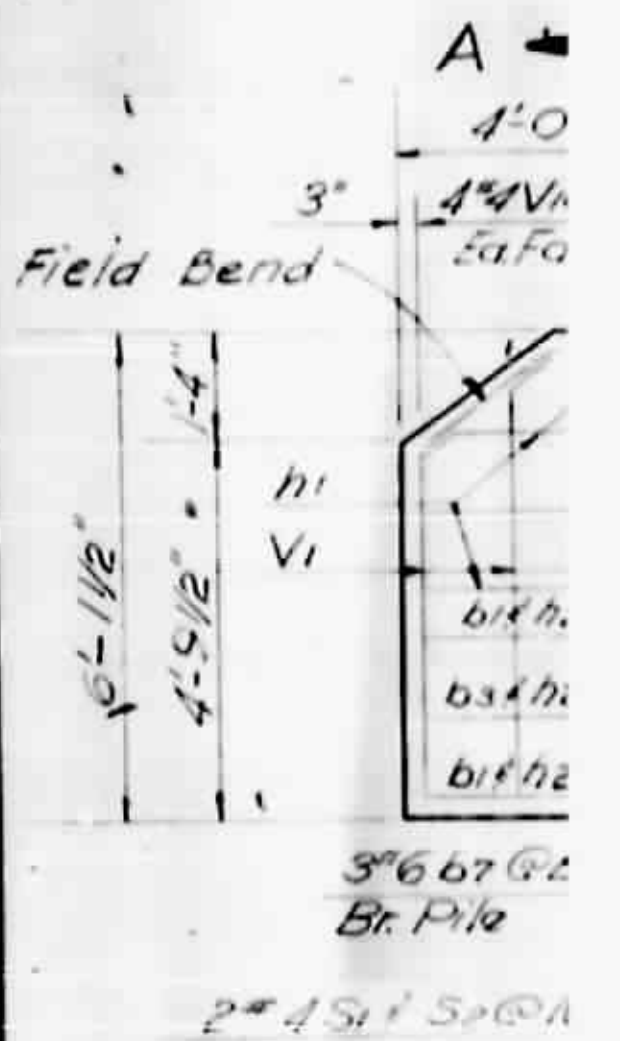

ELEVATION

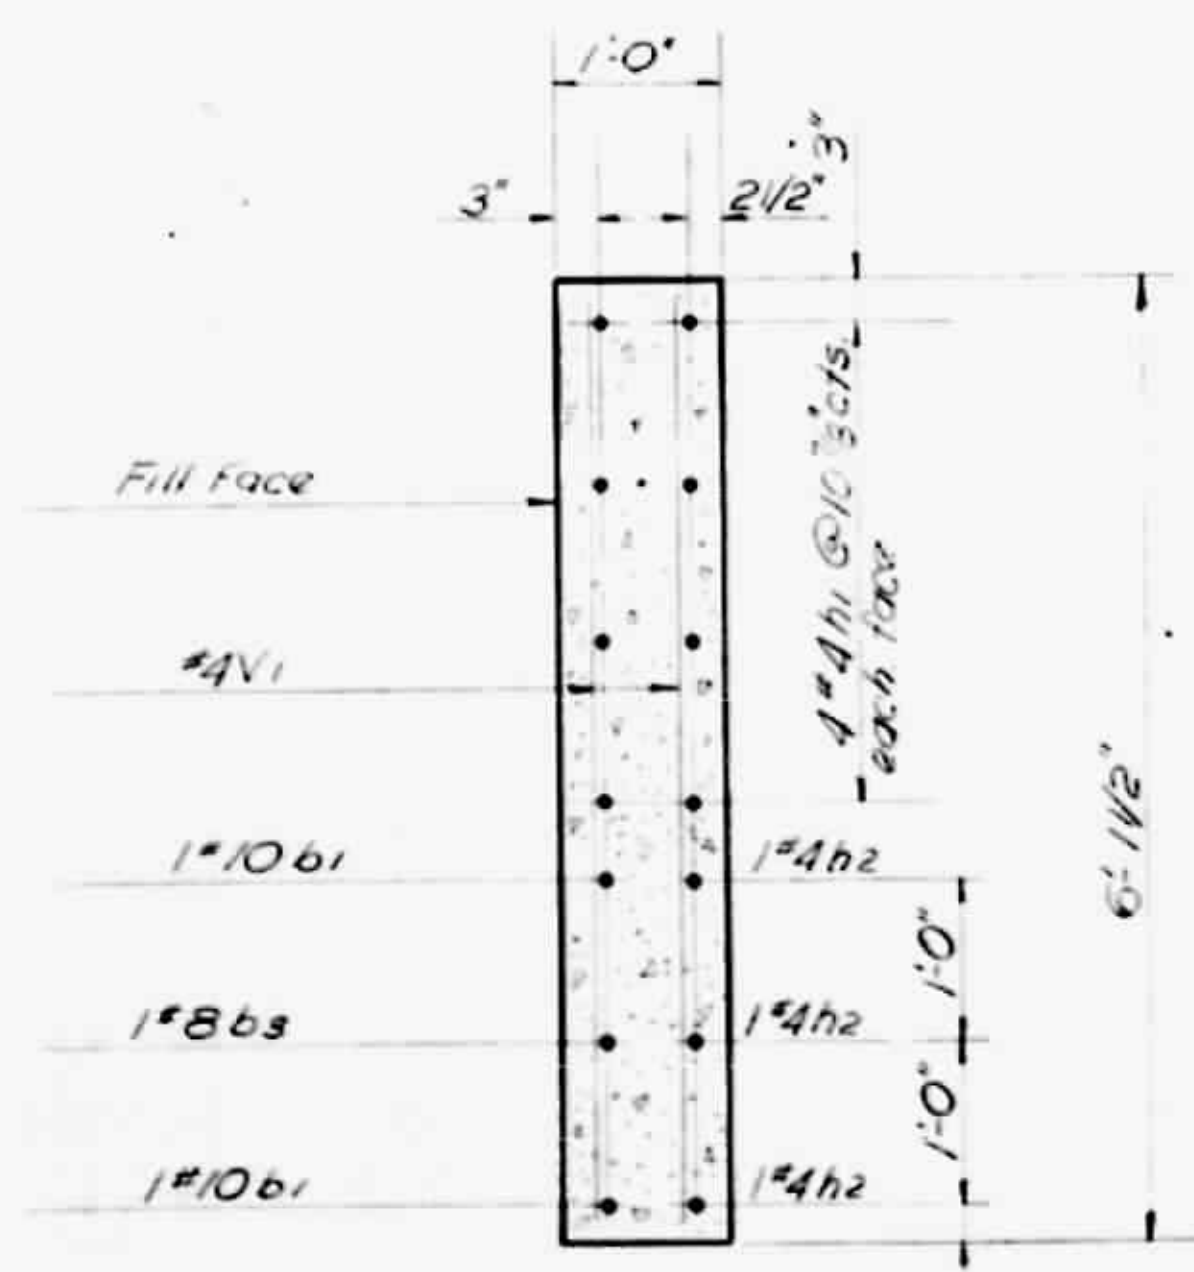

SECTION A-A

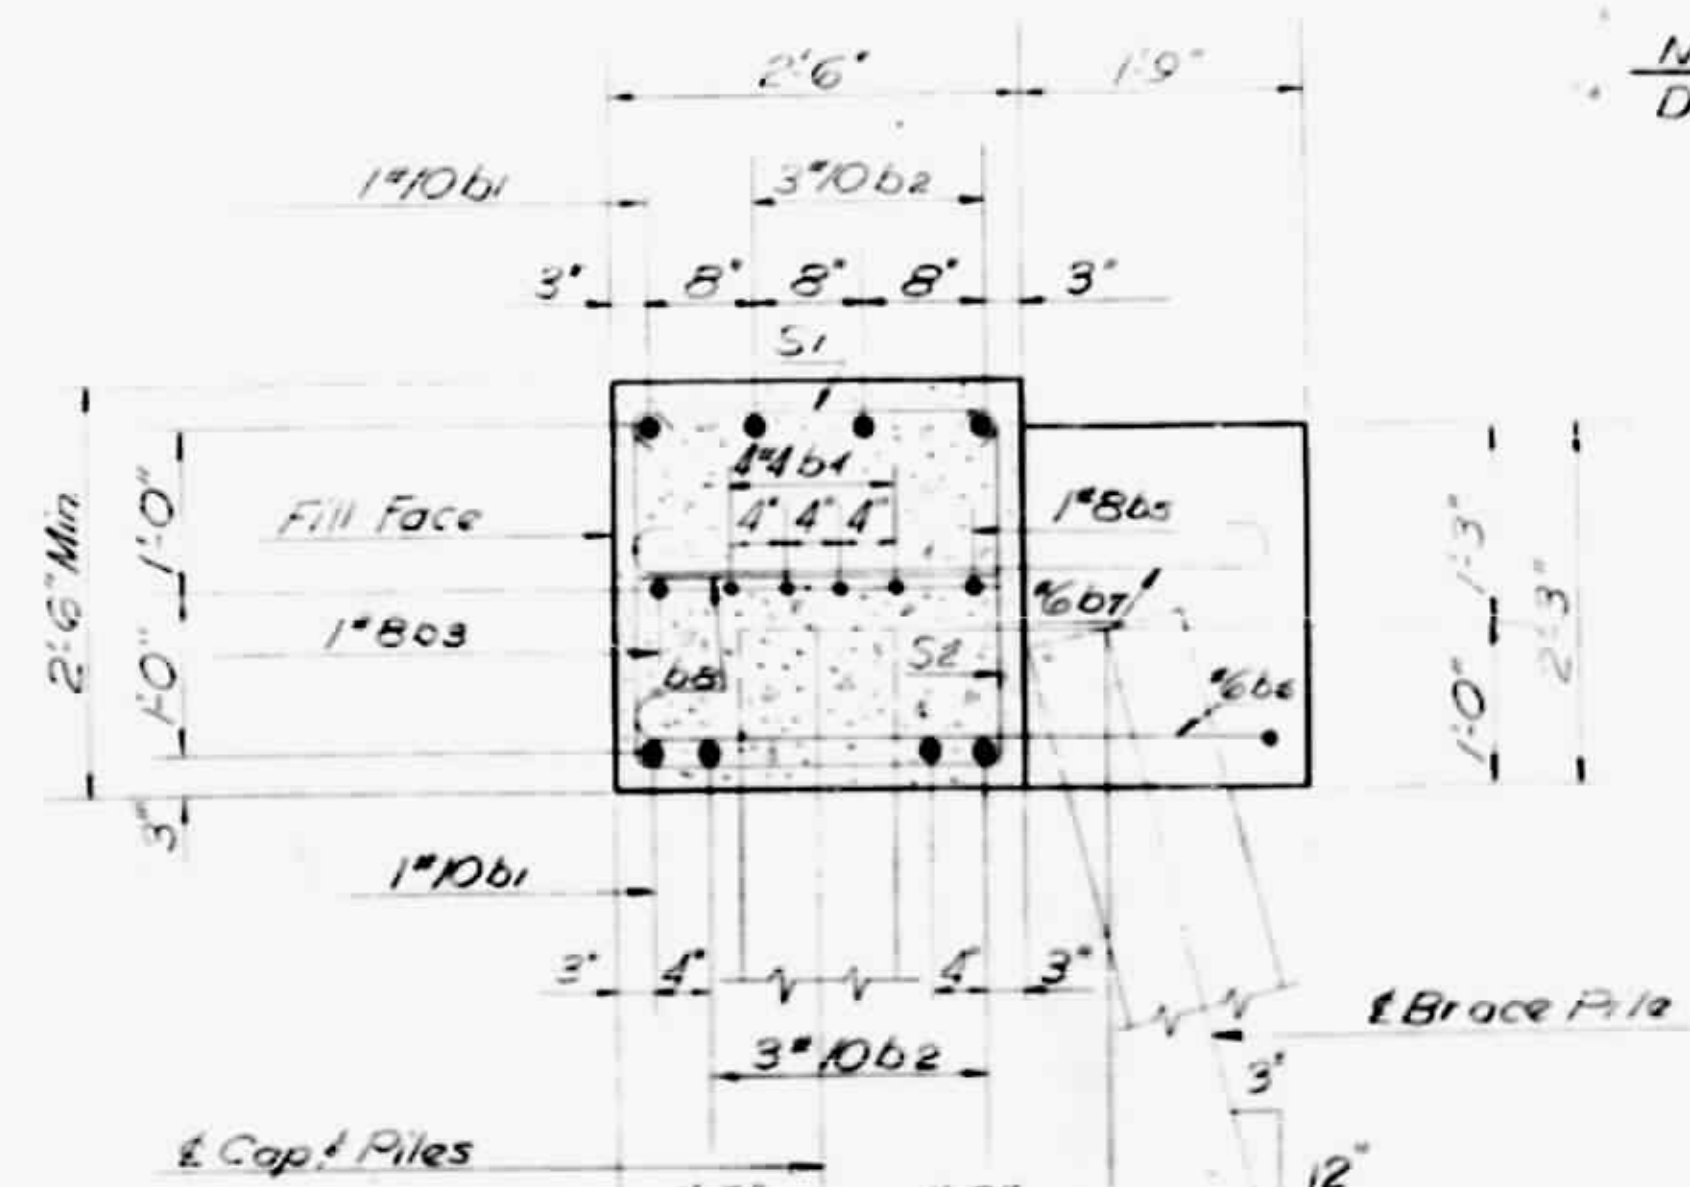

SECTION B-B

PROJECT NO. 8.2016601
BUNCOMBE COUNTY
STATION: 10+35.50
MP 153.1



STATE OF NORTH CAROLINA
STATE HIGHWAY COMMISSION
SUBSTRUCTURE
END BENT NO. 1

NOV 1966

REVISIONS


NO.	BY	DATE	NO.	BY	DATE
1			1		
2			2		

SPECIAL
DESIGNED BY: R. Turner
DRAWN BY: R. Blair
CHECKED BY: R. Self
DATE: NOV. 66
DATE: NOV. 66
DATE: NOV. 66

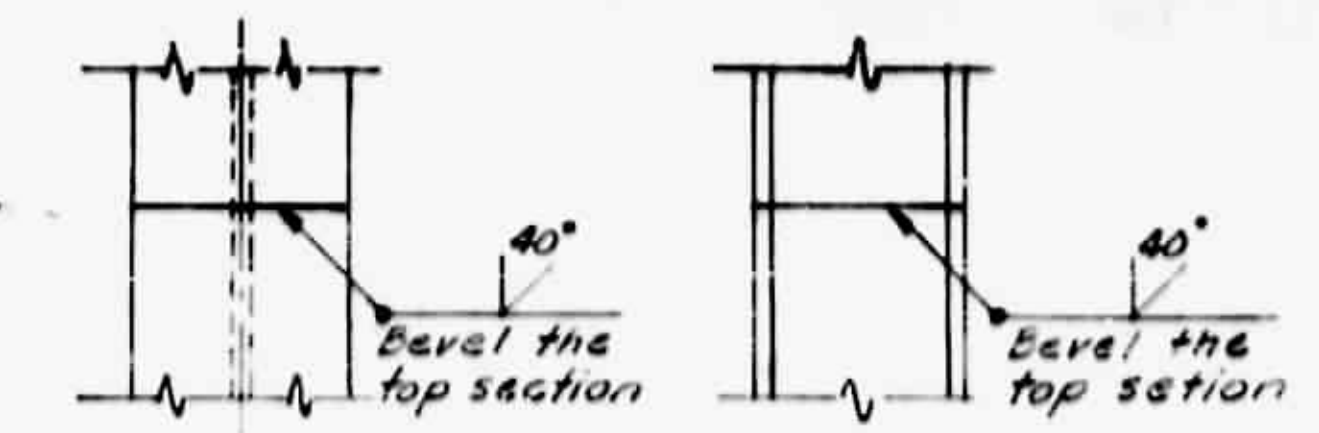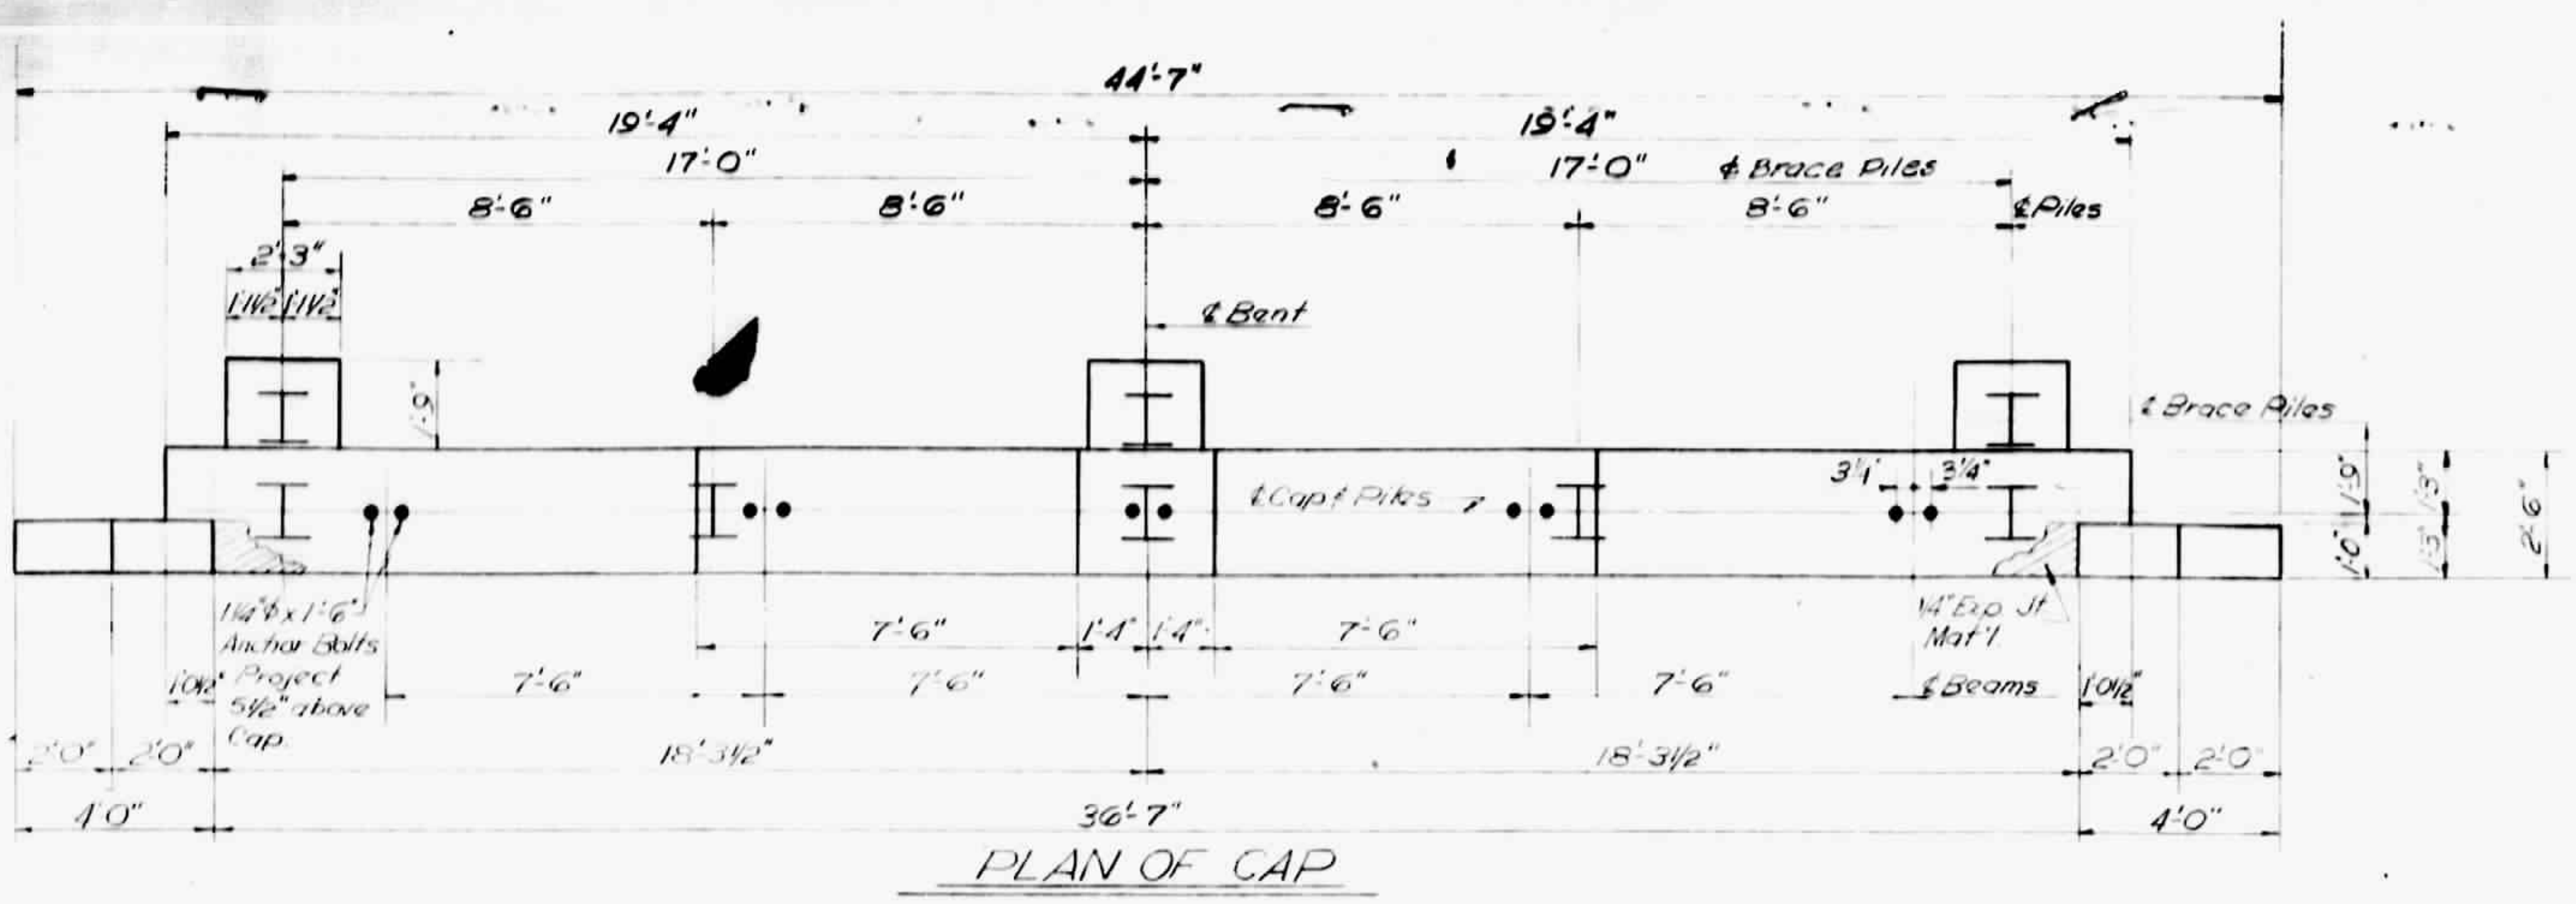

FIELD SPLICE FOR STEEL H PILES

BAR DETAILS




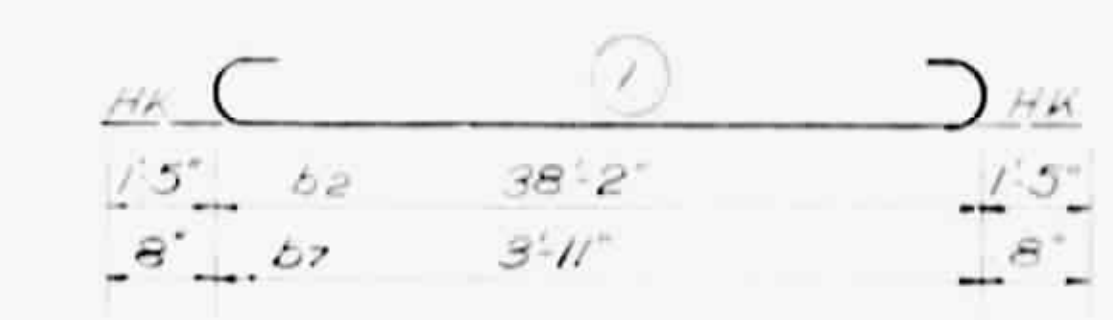


BILL OF MATERIAL

NO.	QTY	SIZE	TYPE	LENGTH	WEIGHT
1	2	#10	Str	41'-0"	387
2	2	#10	Str	41'-0"	387
Reinforcing Steel 100 2236 11.7
100# Steel Piles 172 11.7
172# Steel Piles 172 11.7

See note revised sheet

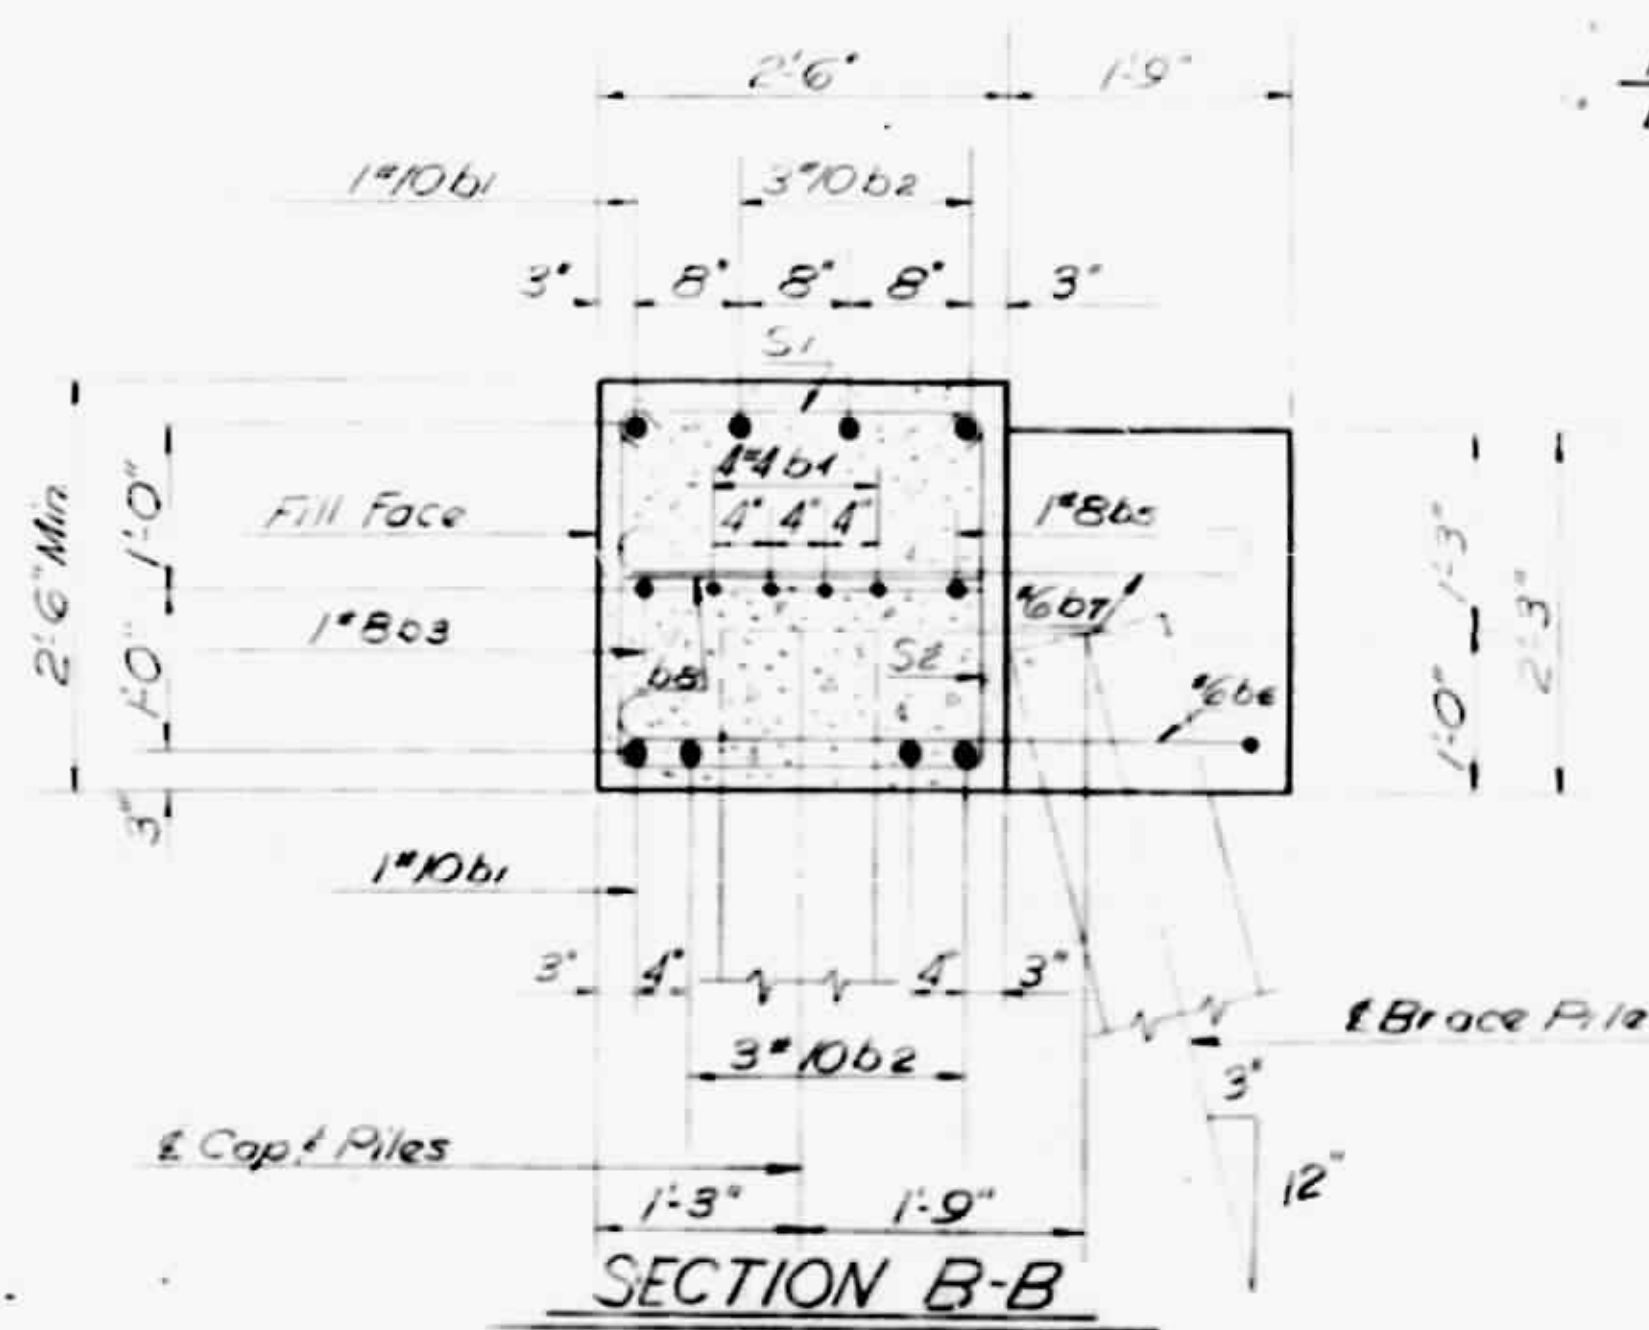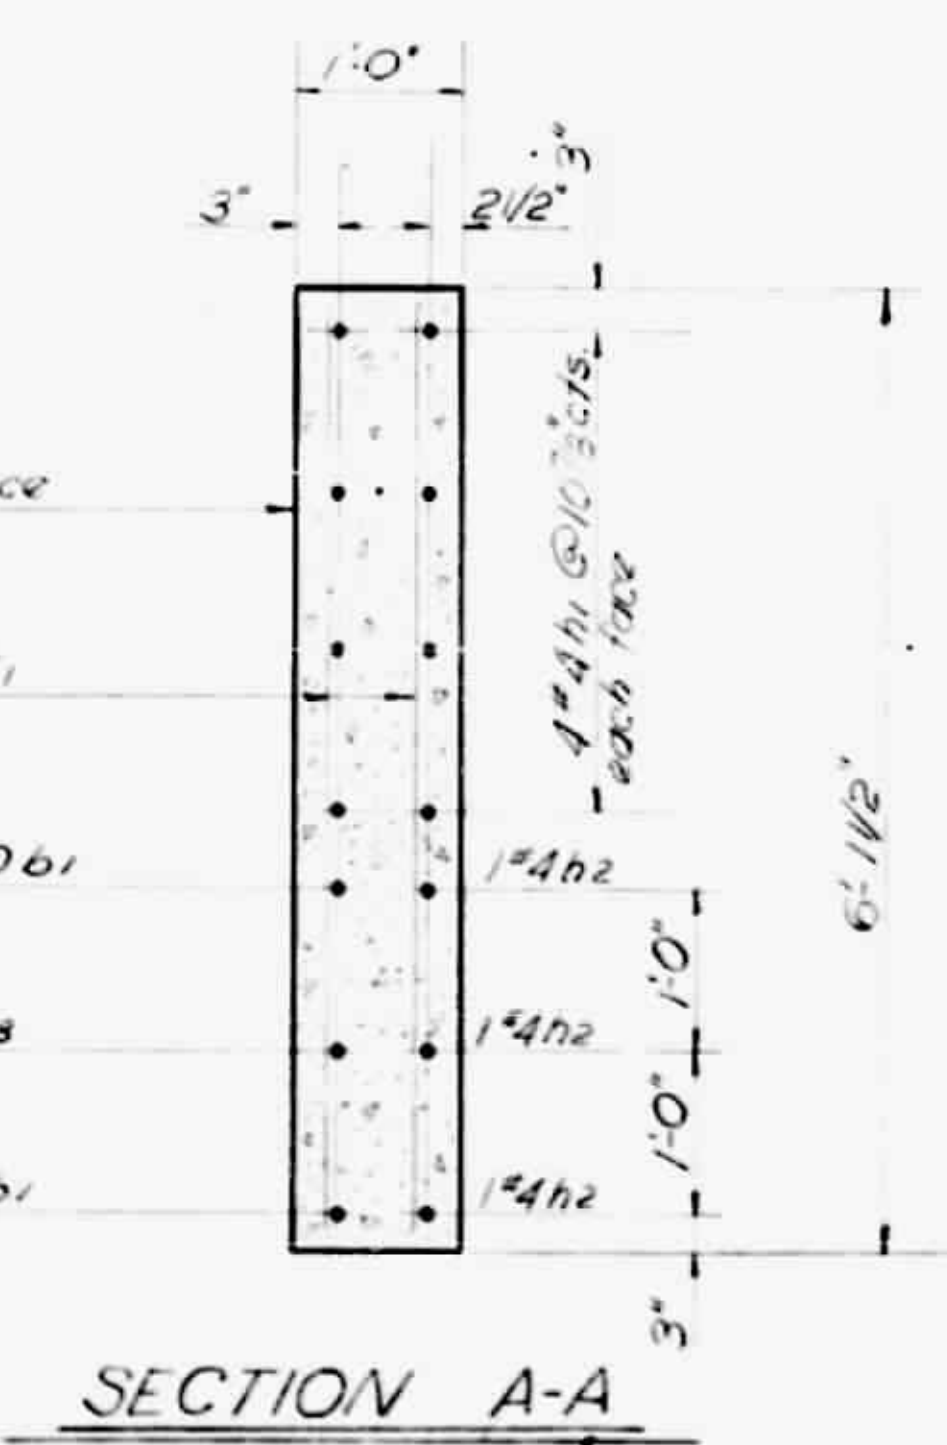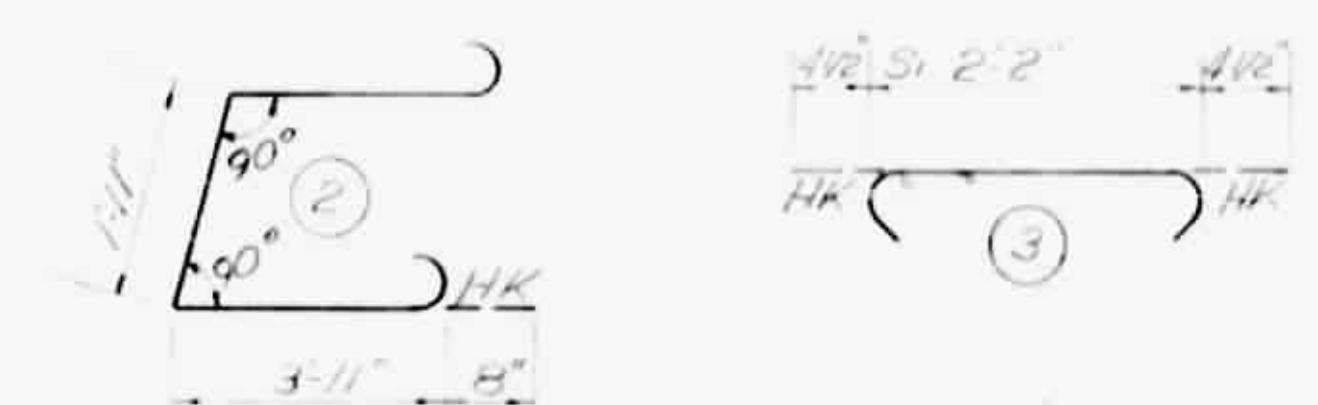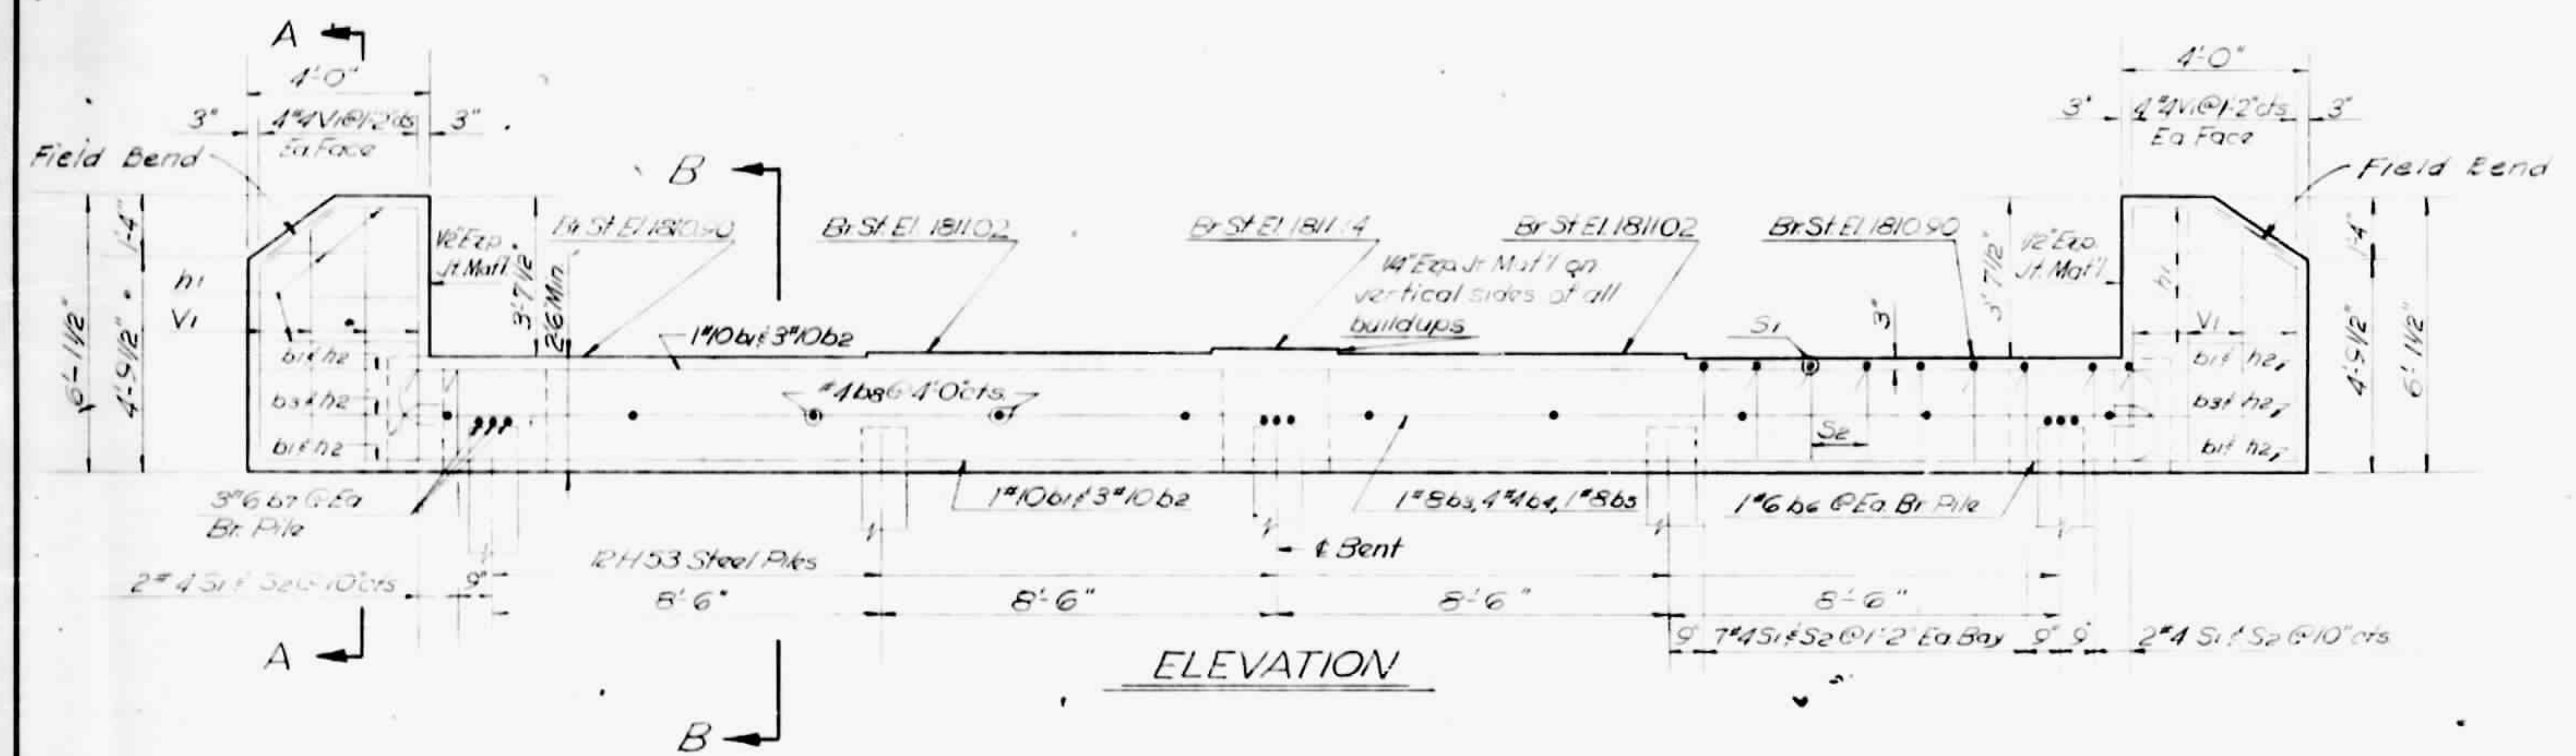


NOTE: All dimensions in "Bar Details" are cut to out of bar.


PROJECT NO. 8.2016601
BUNCOMBE COUNTY
STATION: 10+35.50
MP 153.1

STATE OF NORTH CAROLINA STATE HIGHWAY COMMISSION					
SUBSTRUCTURE END BENT NO. 1					
NOV. 1966					
REVISIONS					
NO.	BY	DATE	NO.	BY	DATE
1			1		
2			2		

SPECIAL
DESIGNED BY: R. Turner
DRAWN BY: R. Blair
CHECKED BY: R. Blair
DATE: NOV. 66
DATE: NOV. 66
DATE: NOV. 66

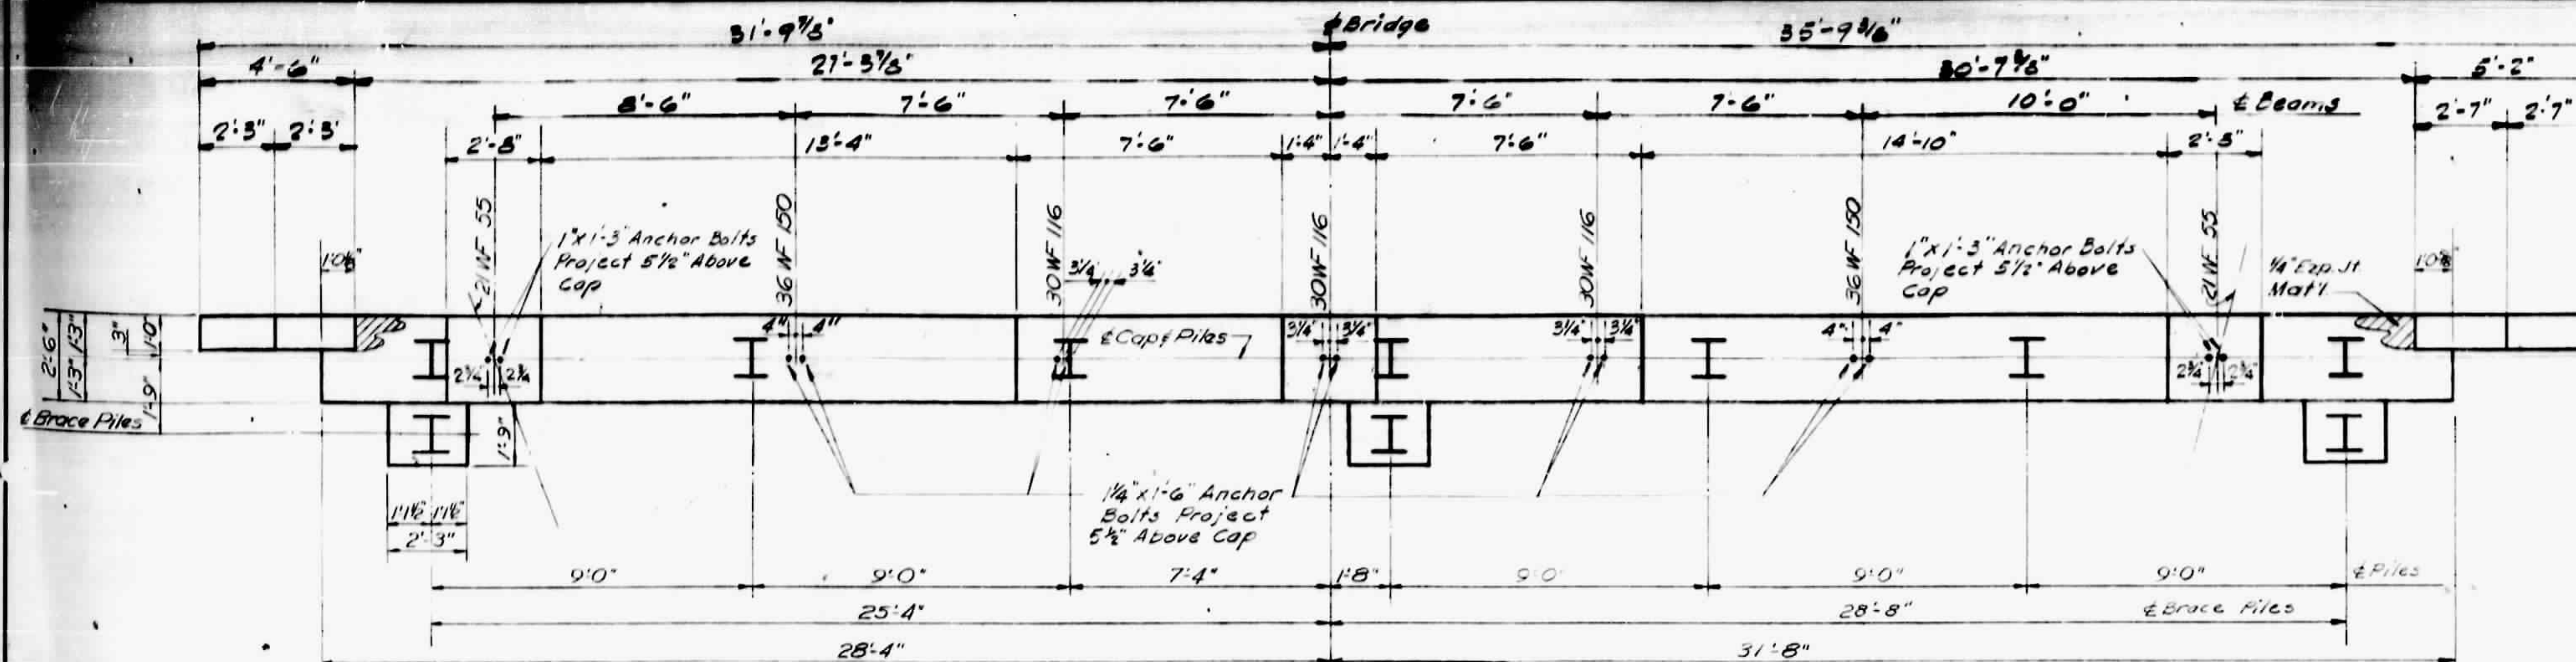


PLAN OF CAP

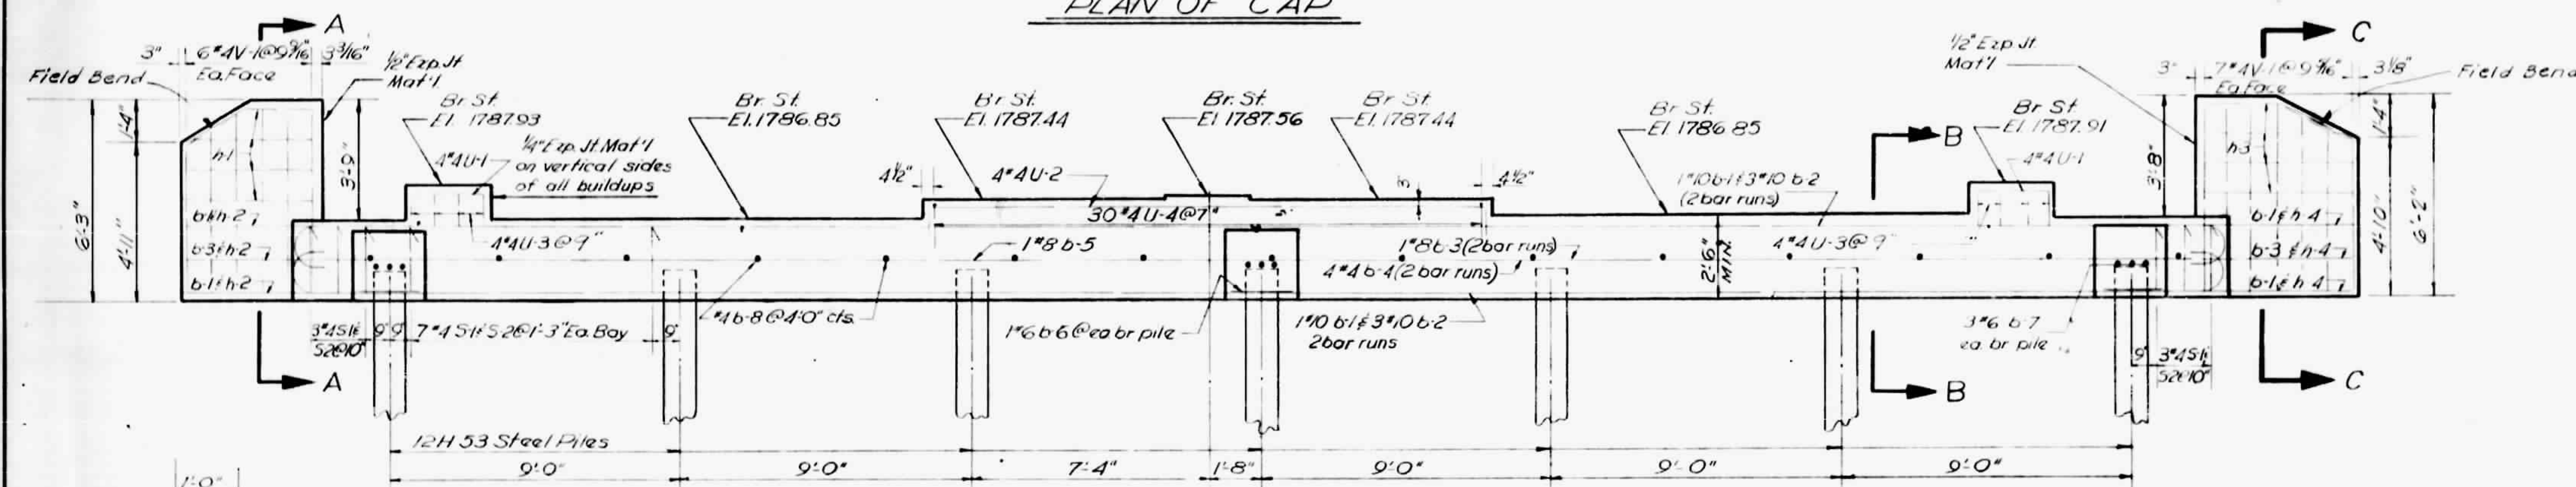


ELEVATION


BAR DETAILS

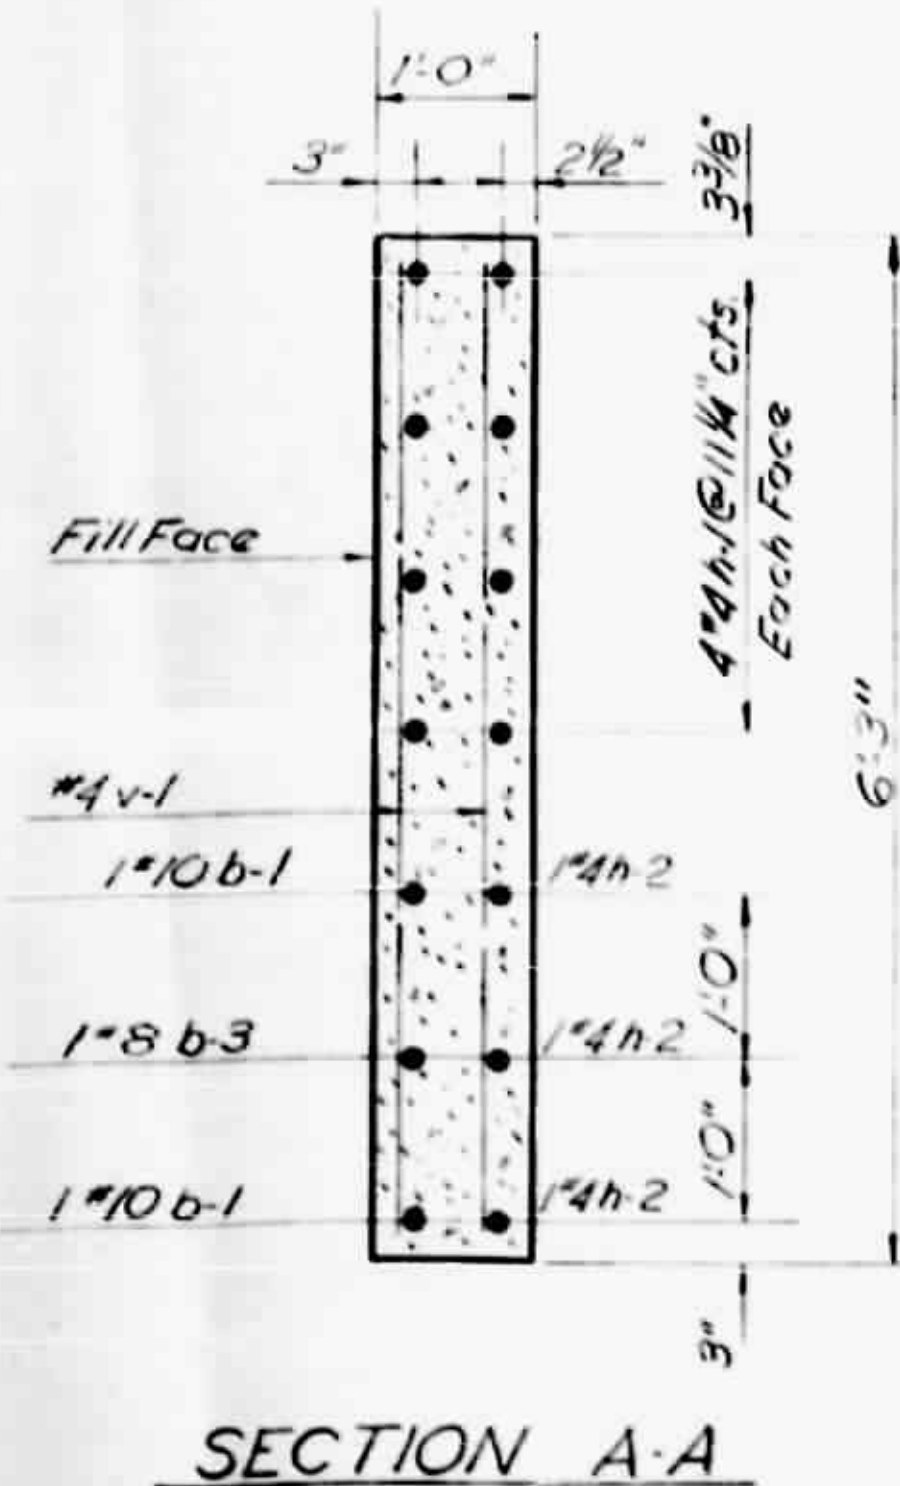


SECTION A-A

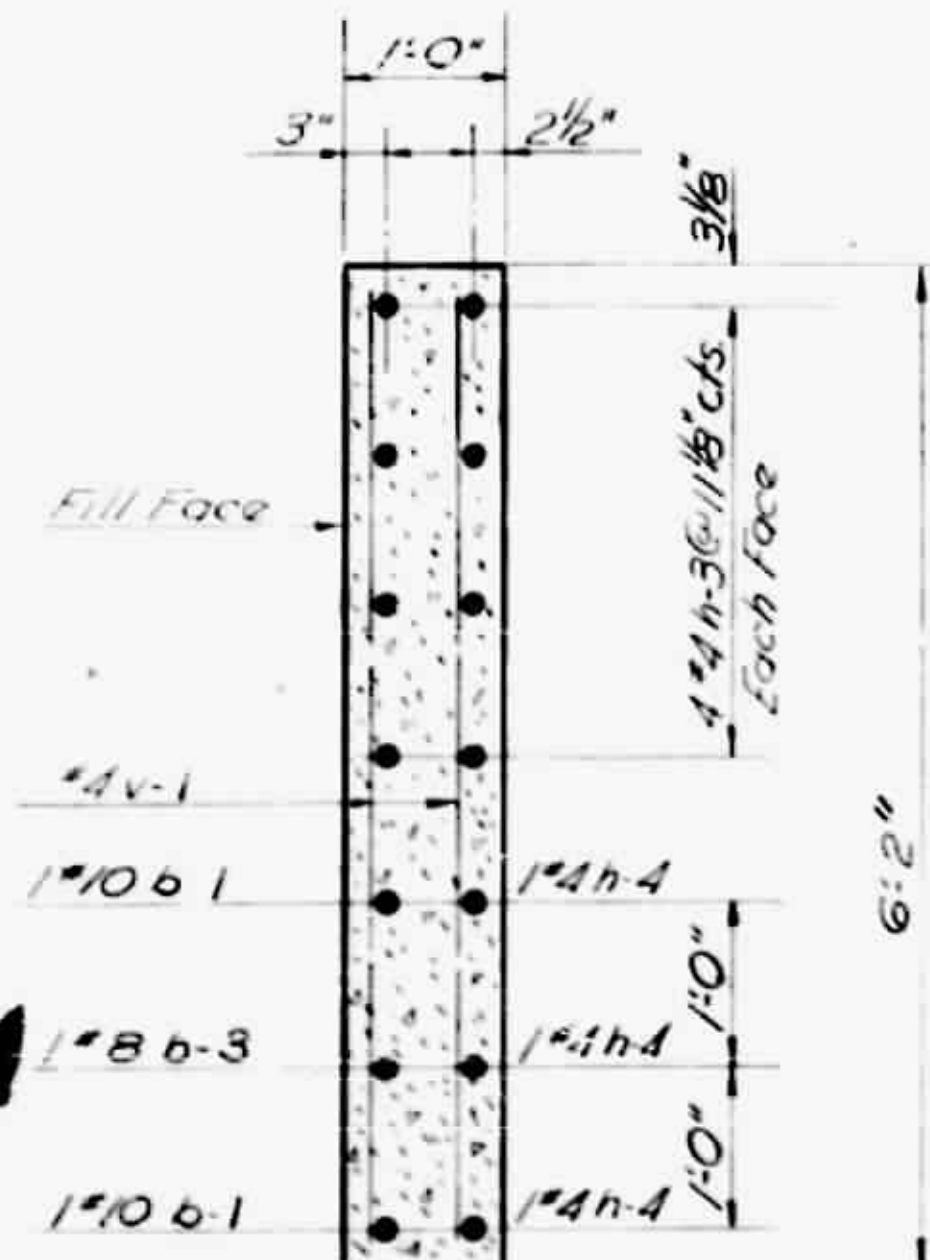

SECTION C-C

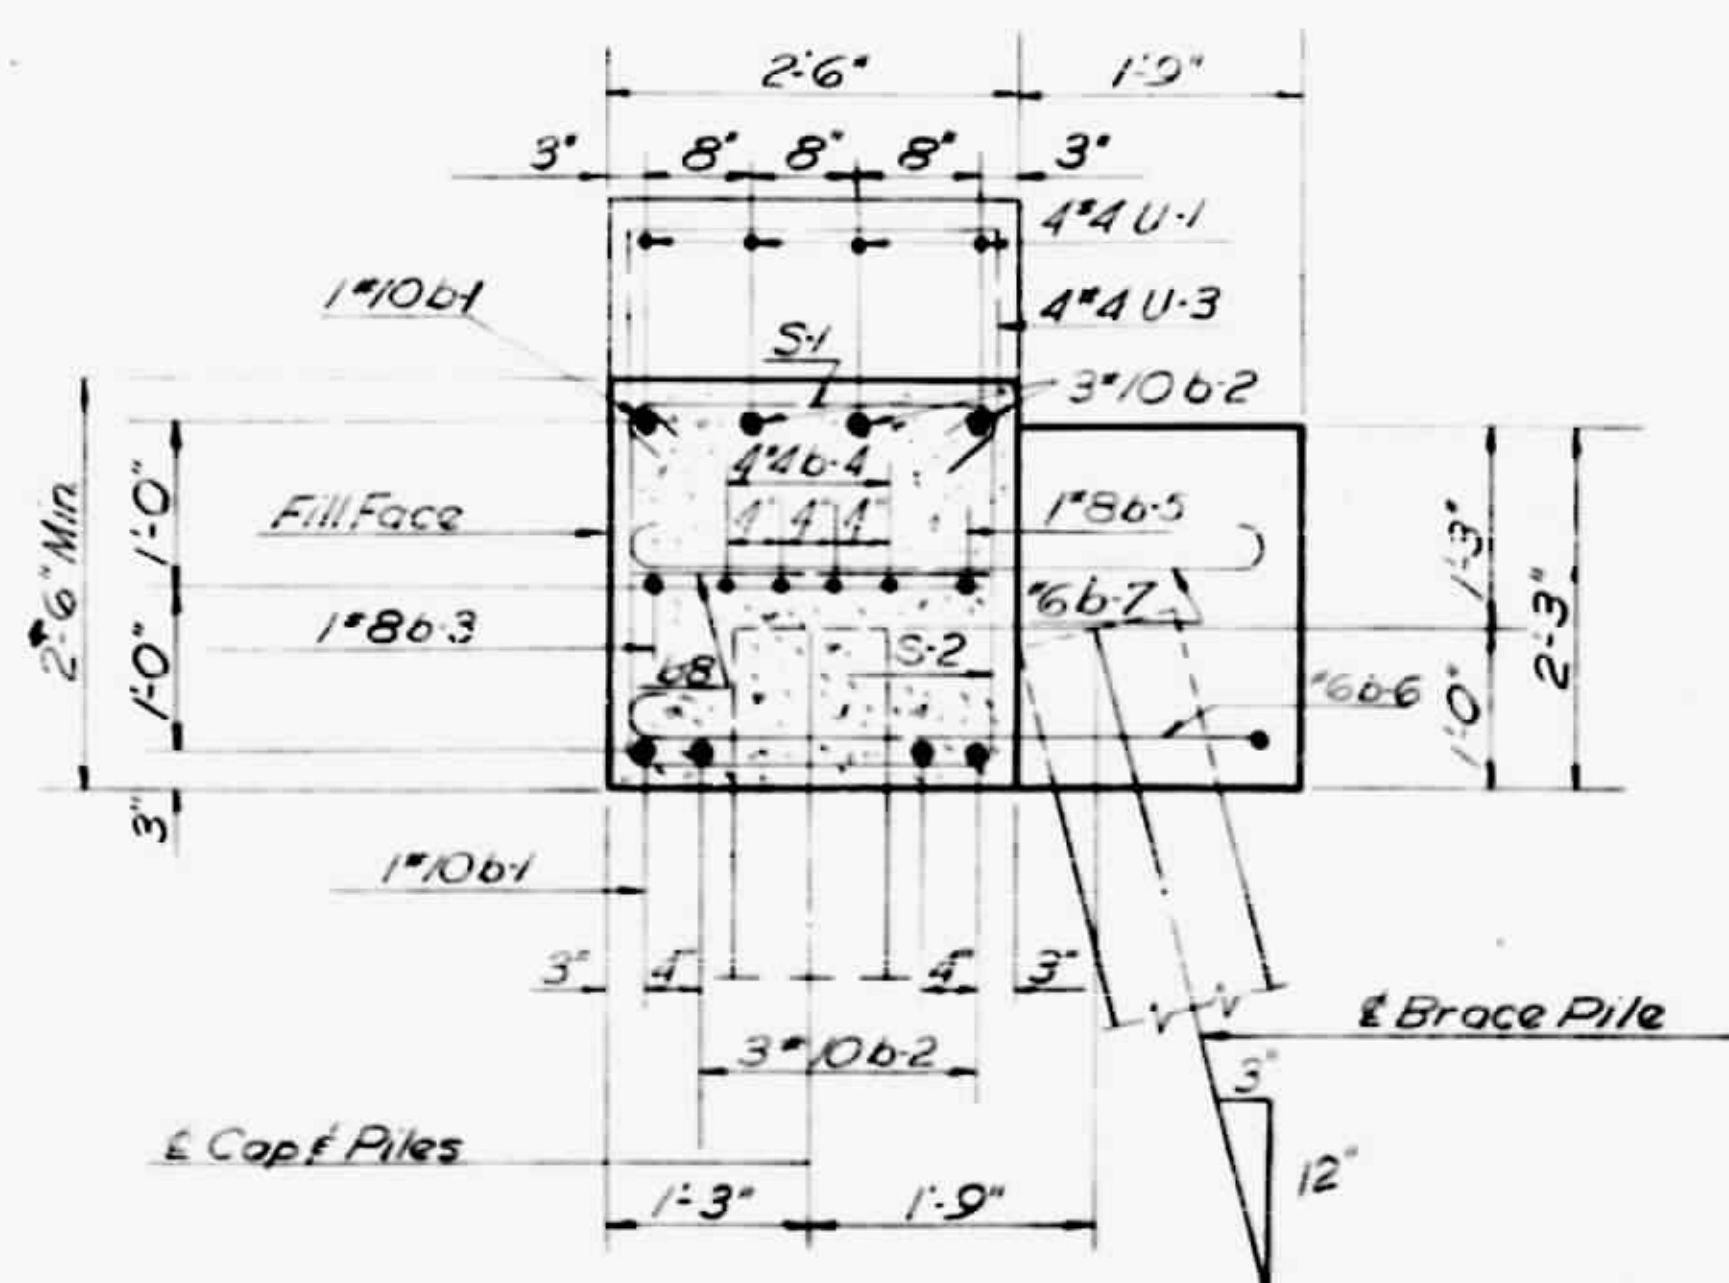

SECTION B-B

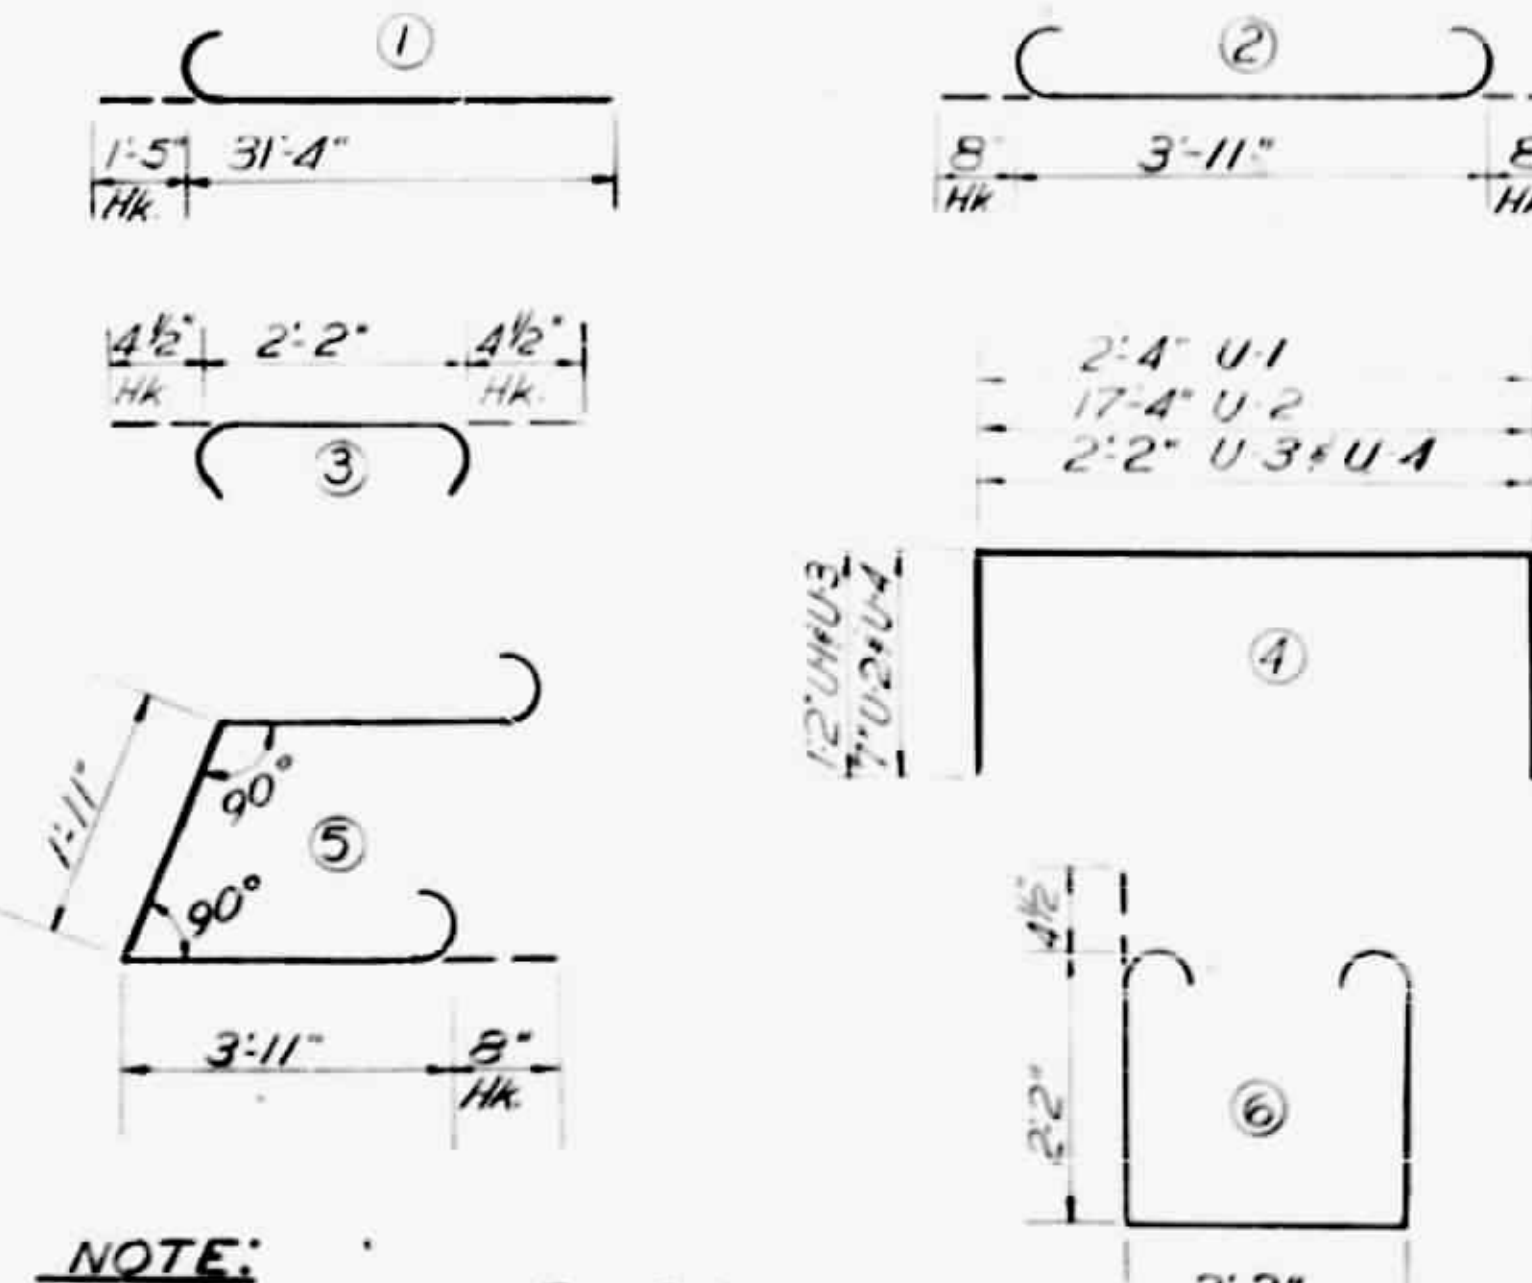

NOTE:
All dimensions in "Bar Details" are out to out of bar.

BILL OF MATERIAL
FOR END BENT NO. 2

Bar	No	Size	Type	Length	Weight
b1	4	10	str	35'-2"	605
b2	12	10	str	35'-2"	1881
b3	2	8	str	34'-10"	186
b4	8	8	str	34'-10"	186
b5	1	8	str	30'-0"	139
b6	3	8	str	30'-0"	139
b7	9	8	str	30'-0"	139
b8	15	8	str	30'-0"	22
b9	4	8	str	1'-0"	21
b10	4	8	str	4'-8"	25
b11	4	8	str	5'-3"	11
b12	48	4	3	2'-11"	94
b13	48	4	6	7'-3"	232
b14	8	4	1	4'-8"	25
b15	4	4	1	15'-6"	40
b16	8	4	1	4'-6"	24
b17	30	4	1	3'-4"	67
b18	26	4	str	5'-8"	98

PROJECT NO. 82016601
BUNCOMBE COUNTY
STATION: 10+35.50

MP1531

STATE OF NORTH CAROLINA
STATE HIGHWAY COMMISSION
SUBSTRUCTURE
END BENT NO 2

NOV 1966

NO.	BY	DATE	NO.	BY	DATE
1			2		
3			4		

SPECIAL
DESIGNED BY
DRAWN BY
CHECKED BY
DATE NOV. 66
DATE NOV. 66
DATE NOV. 66

REINFORCING BAR SCHEDULE

BAR	SIZE	TYPE	LENGTH	NO.	WEIGHT
b1	10	4	35'-2"	7	1,059
b2	11	Str.	32'-4"	2	344
b3	11	Str.	25'-4"	2	269
b4	11	3	29'-10"	5	793
b5	9	4	28'-4"	8	771
b6	4	Str.	17'-4"	2	23
b7	4	Str.	8'-6"	4	23
m	11	5	9'-7"	20	1,018
u	5	2	7'-4"	31	237
u2	5	2	8'-6"	2	18
u3	5	2	9'-10"	2	21
u4	5	2	10'-8"	30	334
u5	4	2	7'-9"	16	93
u6	4	1	1'-7"	40	42
PI-PI	3	6	0.2292' x 2#0	200	
ti	7	4	11'-2"	26	593
ti2	6	4	7'-10"	38	447
u	4	7	3'-0"	22	44
vi	11	5	14'-7"	16	1,089
ve	11	Str.	14'-3"	20	1,514

CONCRETE VOLUMES BY POURS

POUR NO.	LOCATION	CU. YDS.
4	Cap	12.5
3	Stems & Struts	11.5
2	Stems	6.7
1	Footings	10.41529

BILL OF MATERIAL

LOCATION	CLASS A CONCRETE CU. YDS.	REINFORCING STEEL LBS.
Bent No. 1	41.7	9,508
	43.930	


PROJECT NO. 8-2016601
BUNCOMBE COUNTY
STATION: 10+35.50
MPI531

STATE OF NORTH CAROLINA
STATE HIGHWAY COMMISSION



SUBSTRUCTURE BENT NO. 1

NOV. 1966

NO.	BY	DATE	NO.	BY	DATE
1			2		
2			3		

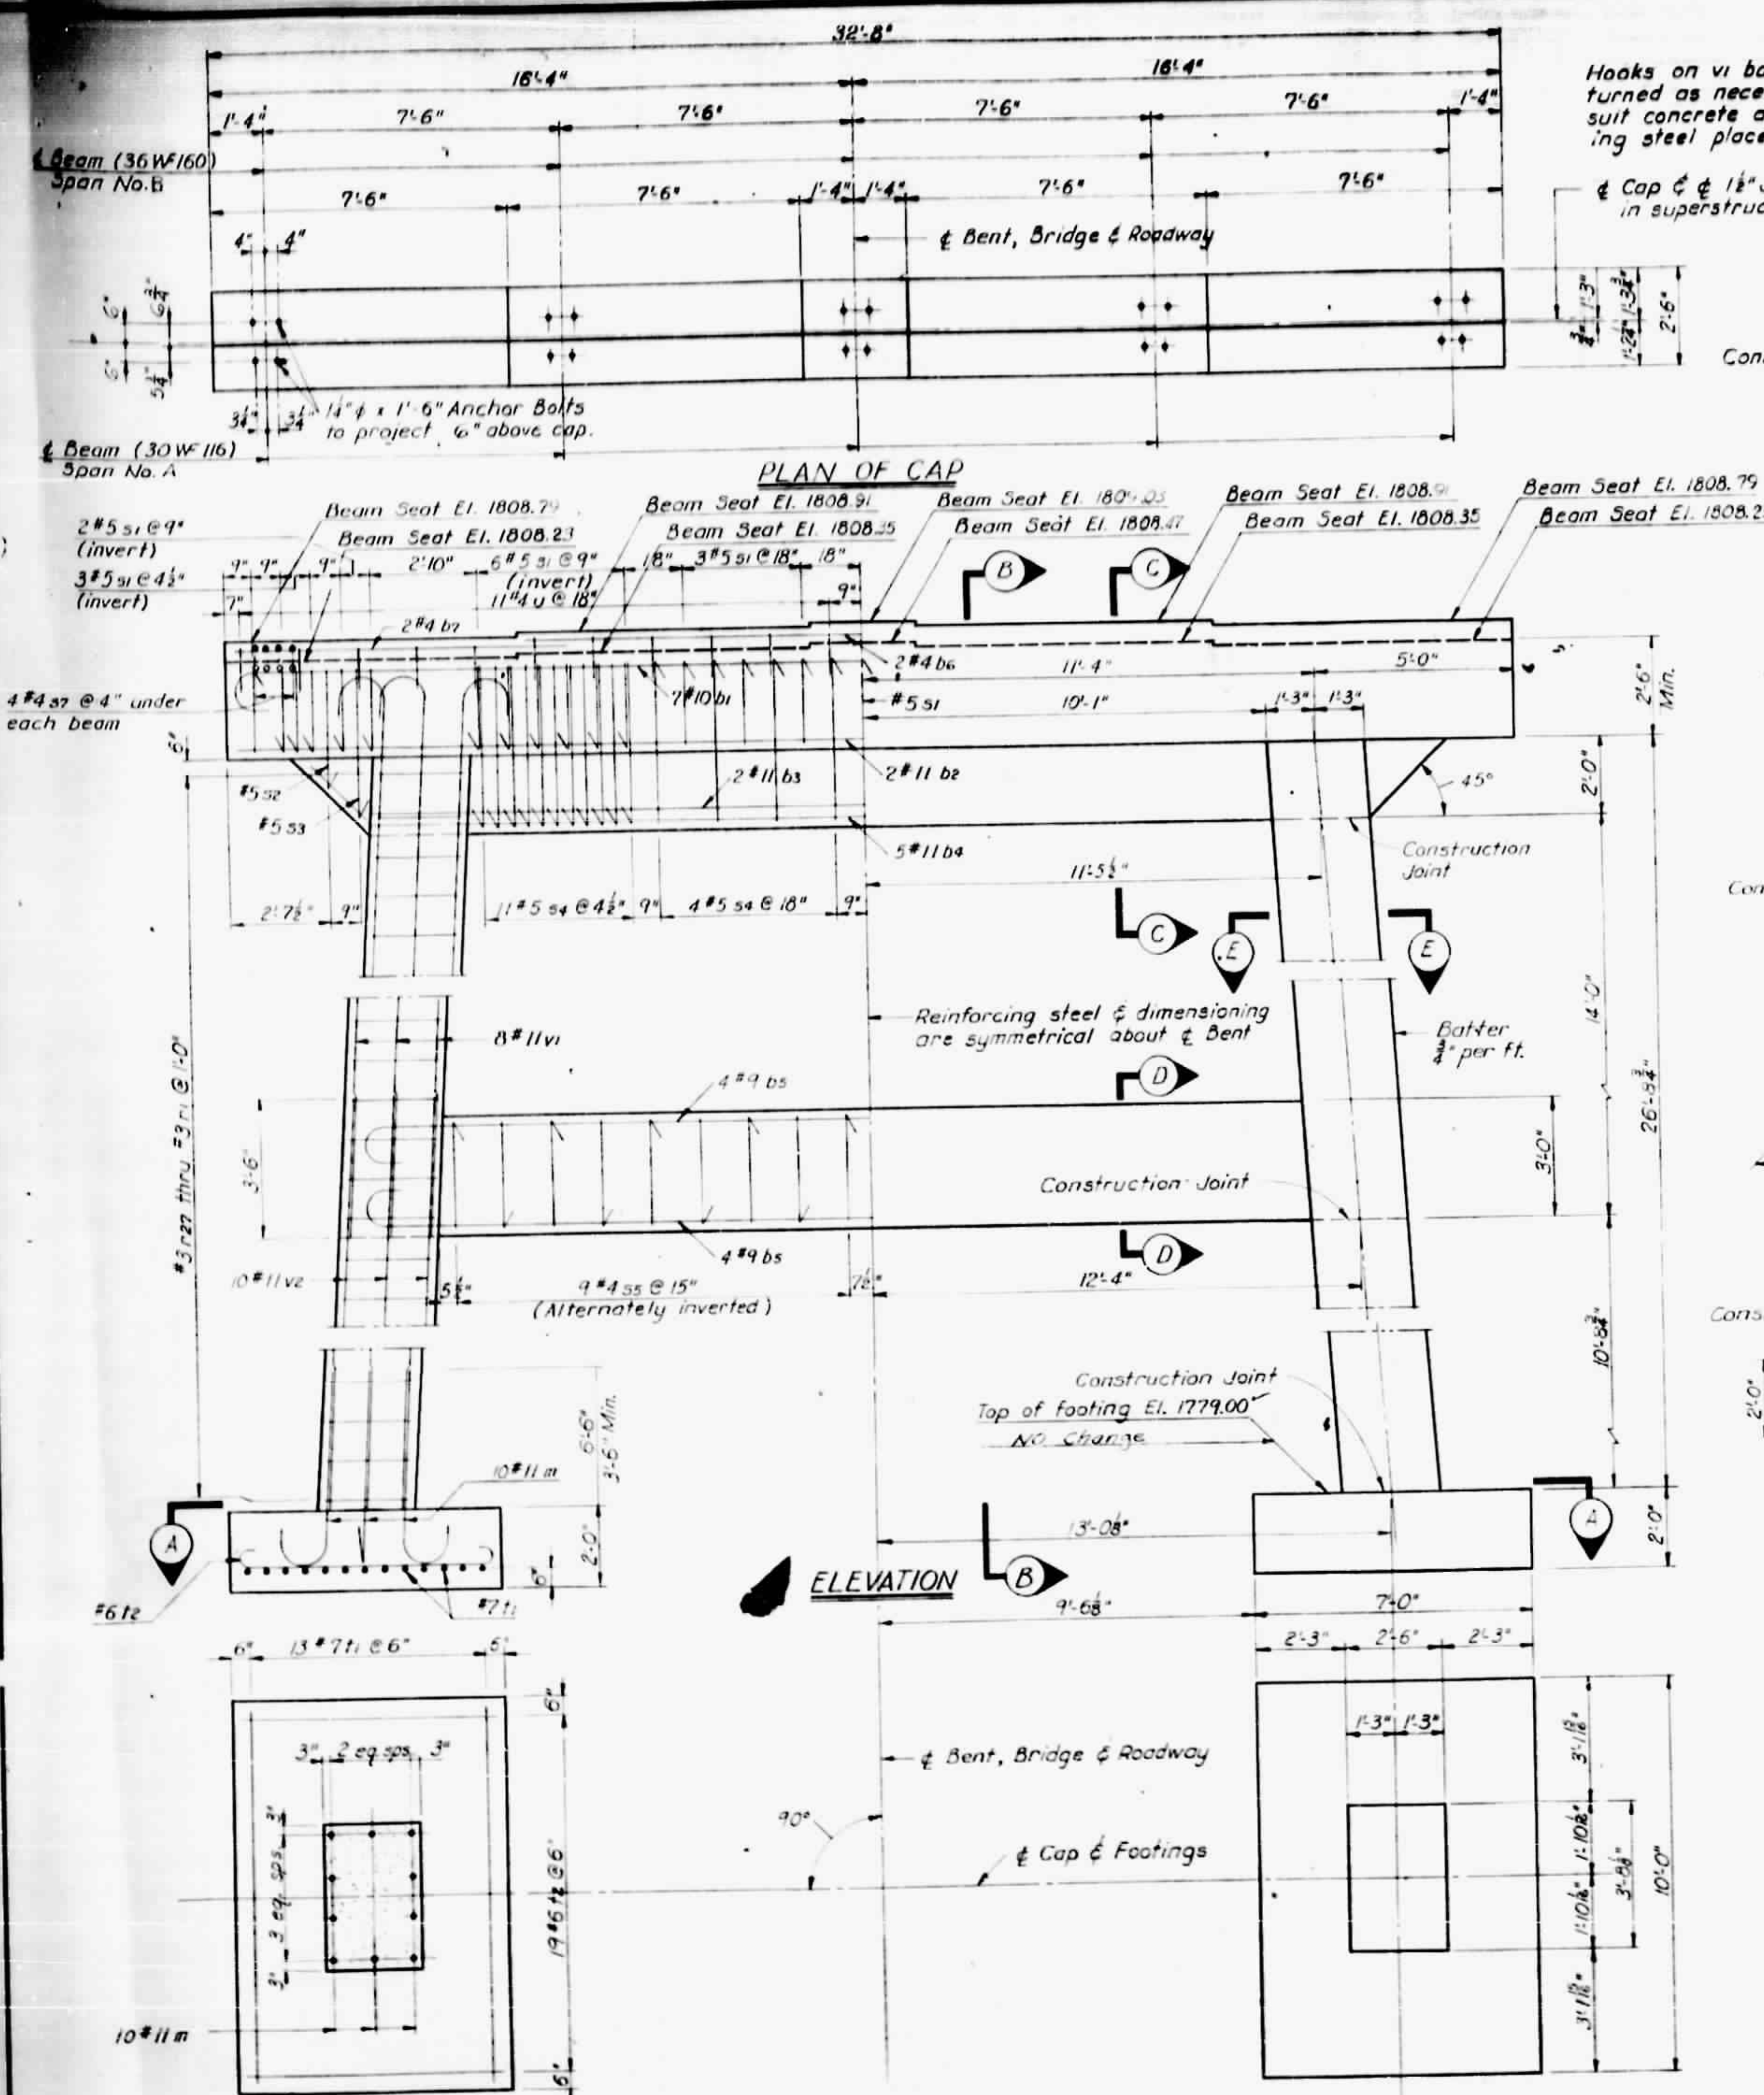

DESIGNED BY: Eduardo J. Morales DATE: 8-66
DRAWN BY: Leola B. Pierce DATE: 8-66
CHECKED BY: R. Self DATE: 8-66

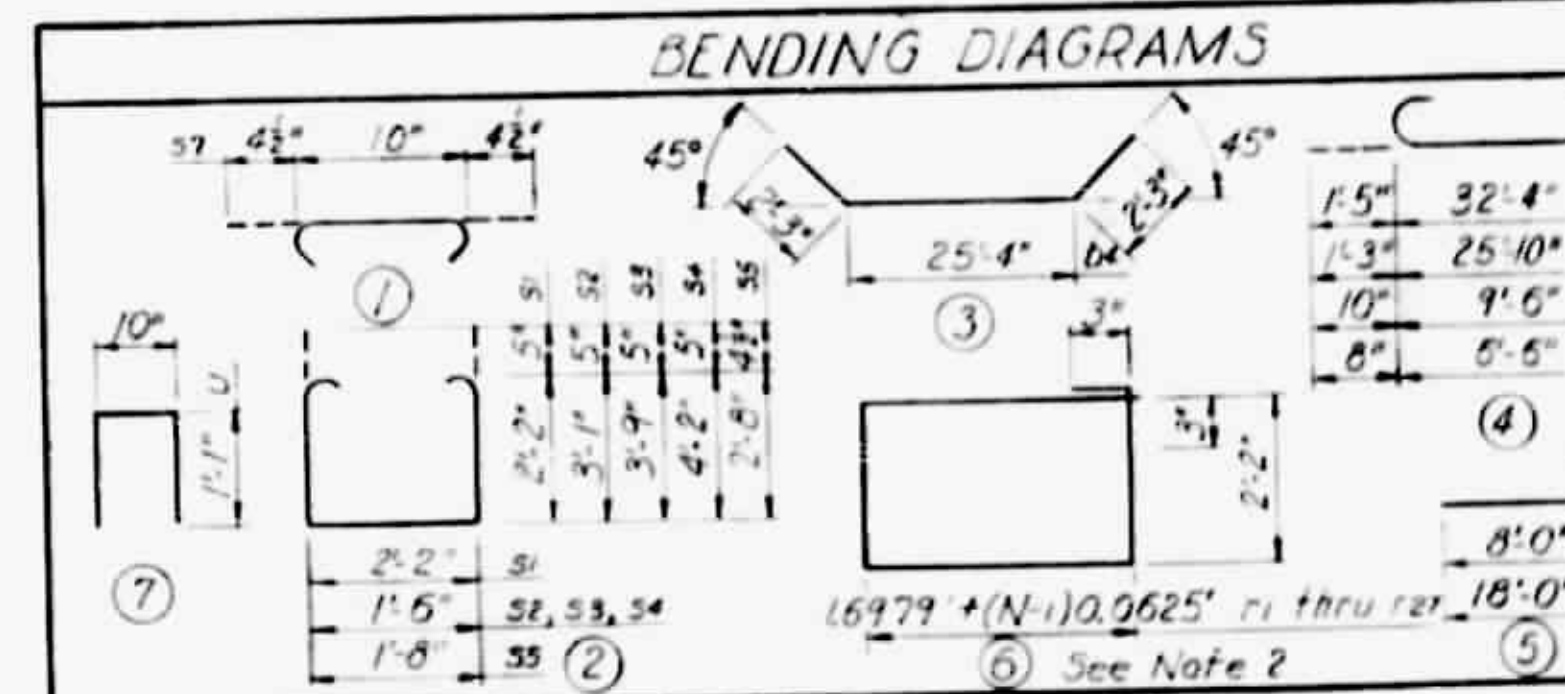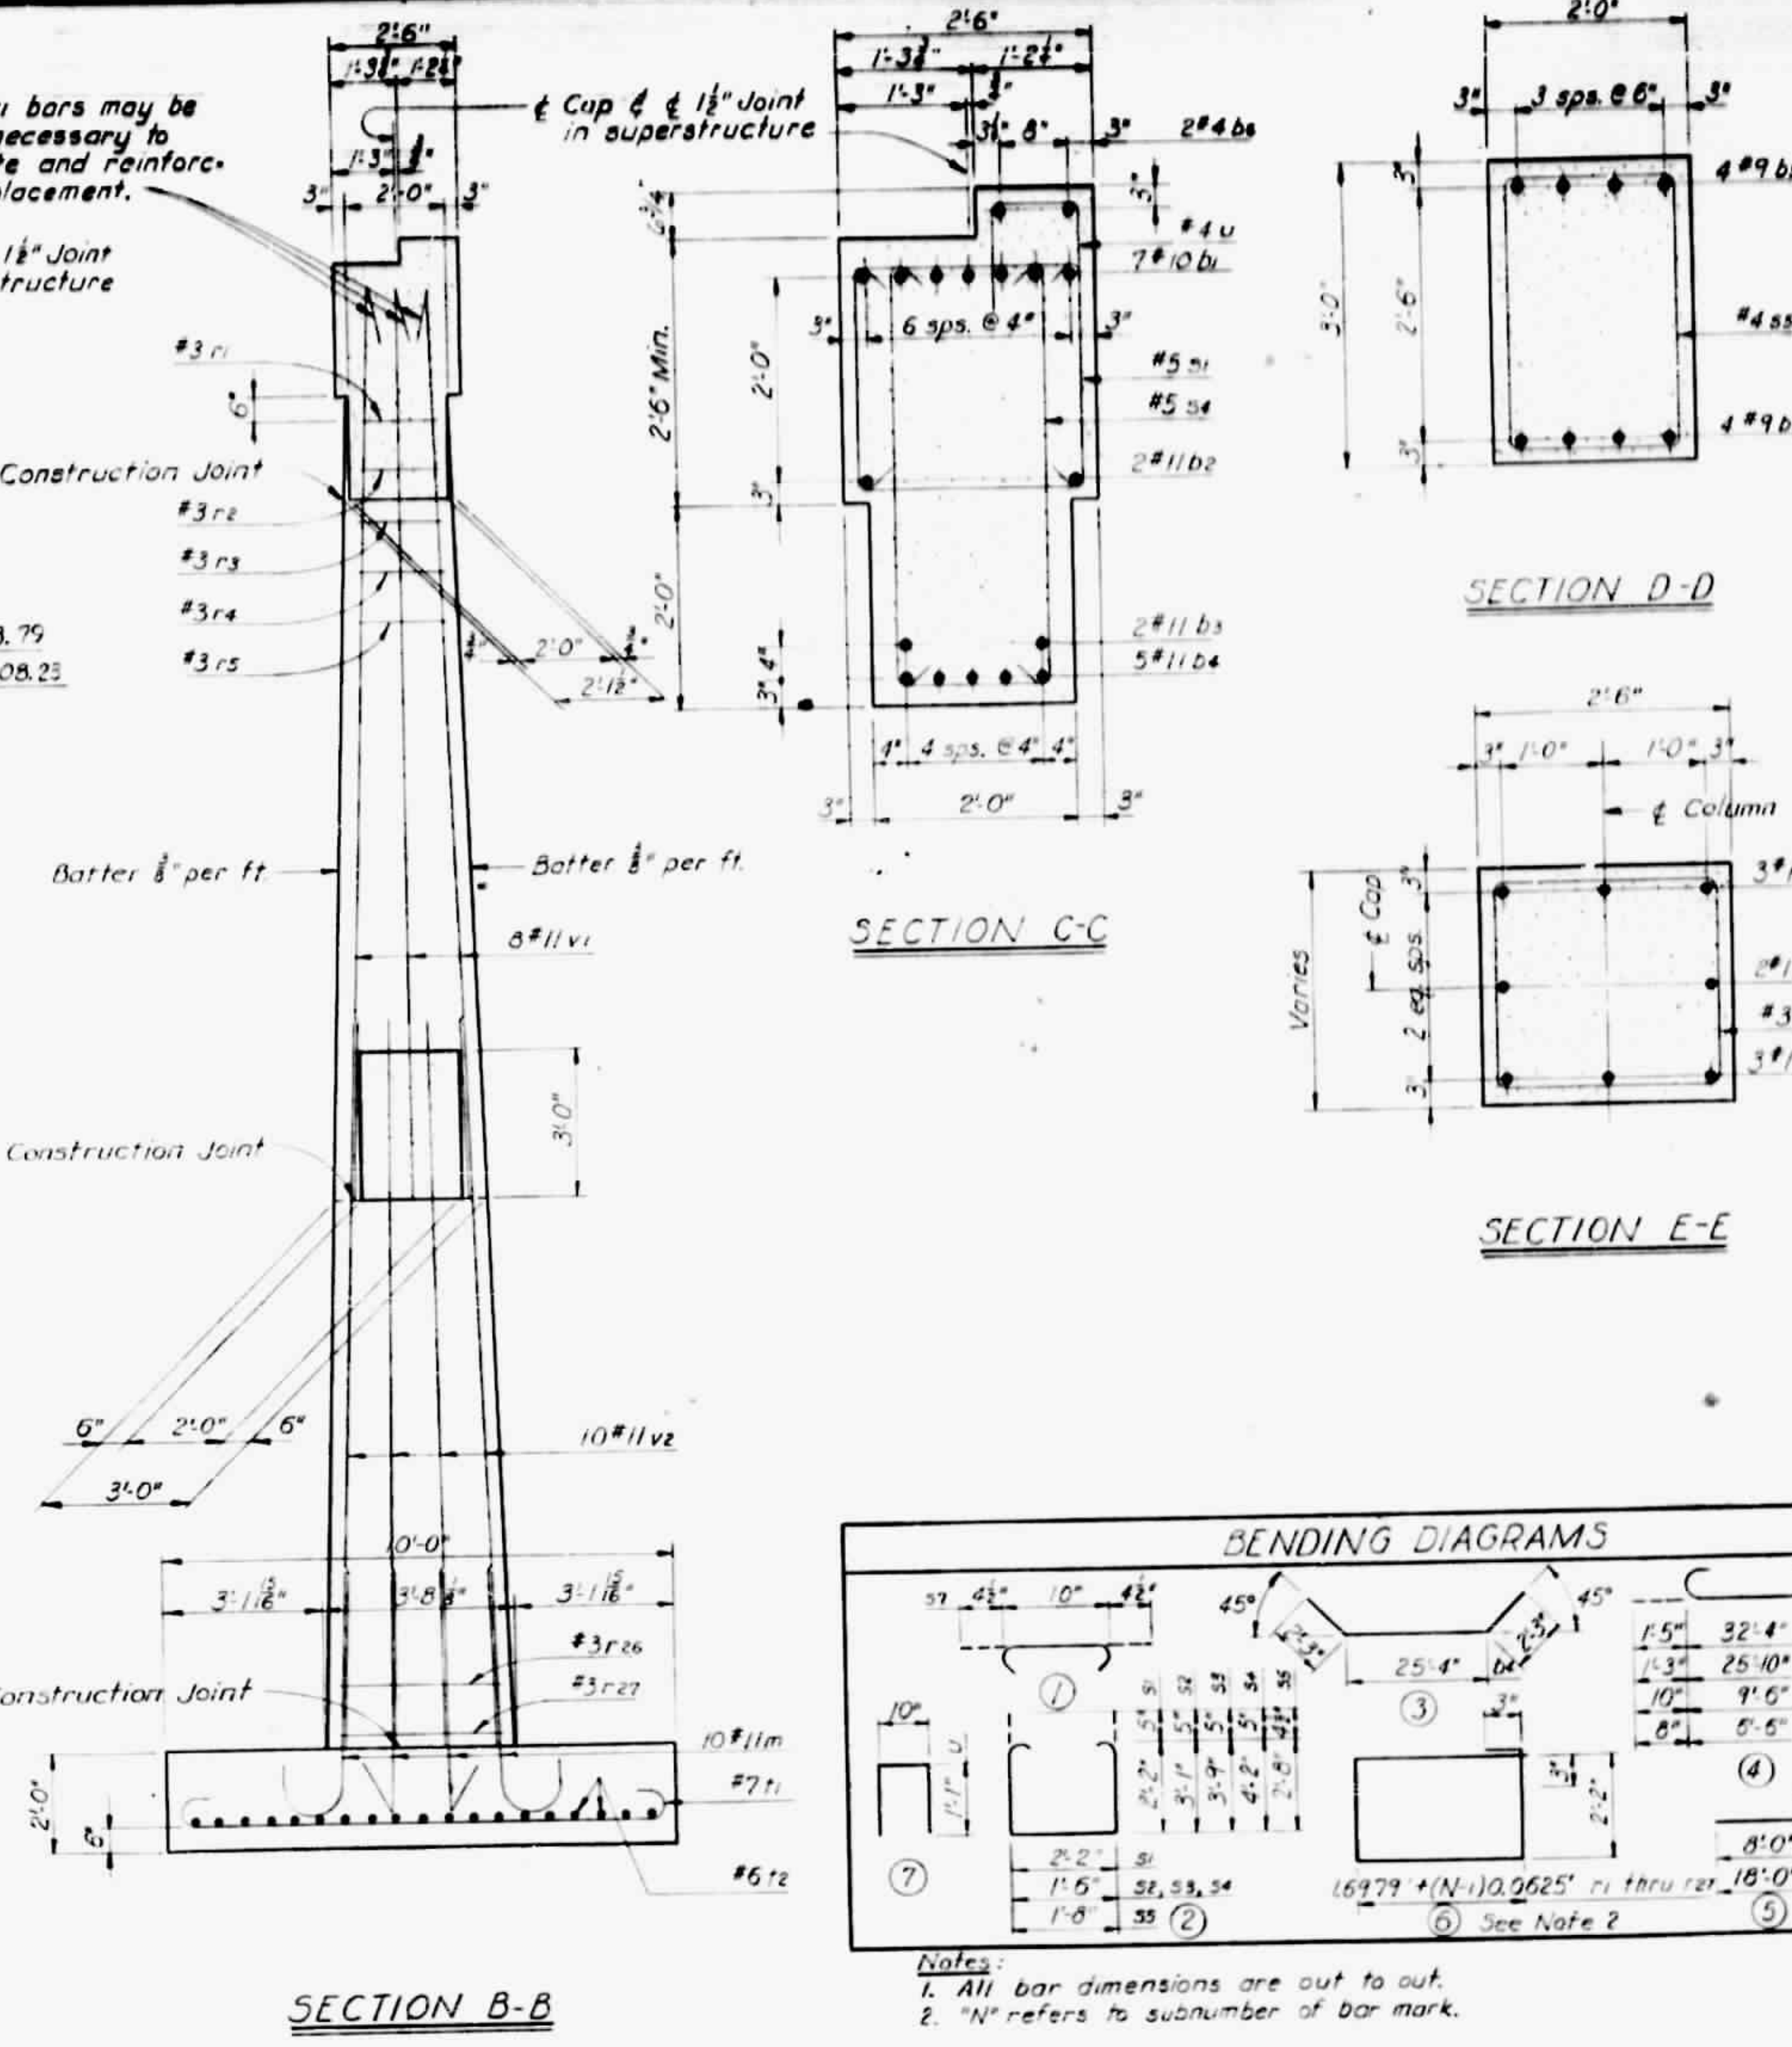


PLAN OF FOOTINGS

SECTION A-A


REINFORCING BAR SCHEDULE FOR ONE BENT

BAR	SIZE	TYPE	LENGTH	NO.	WEIGHT
b1	10	4	35'-2"	7	1,059
b2	11	5fr.	32'-4"	2	344
b3	11	5fr.	25'-4"	2	269
b4	11	3	29'-10"	5	793
b5	9	4	28'-10"	6	784
m	11	5	9'-7"	20	1,018
s1	5	2	7'-4"	31	237
s2	5	2	8'-6"	2	18
s3	5	2	9'-10"	2	21
s4	5	2	10'-8"	30	334
s5	4	2	7'-9"	18	93
s6	4	1	2'-11"	20	39
ci-r40	3	6	6'-2 1/2" + (N-1) 0.1250'	2 ea.	321
f1	7	4	11'-2"	26	593
f2	6	4	7'-10"	38	447
vi	11	5	23'-7"	16	2,005
vr	11	5fr.	23'-5"	20	2,488


SECTION D-D

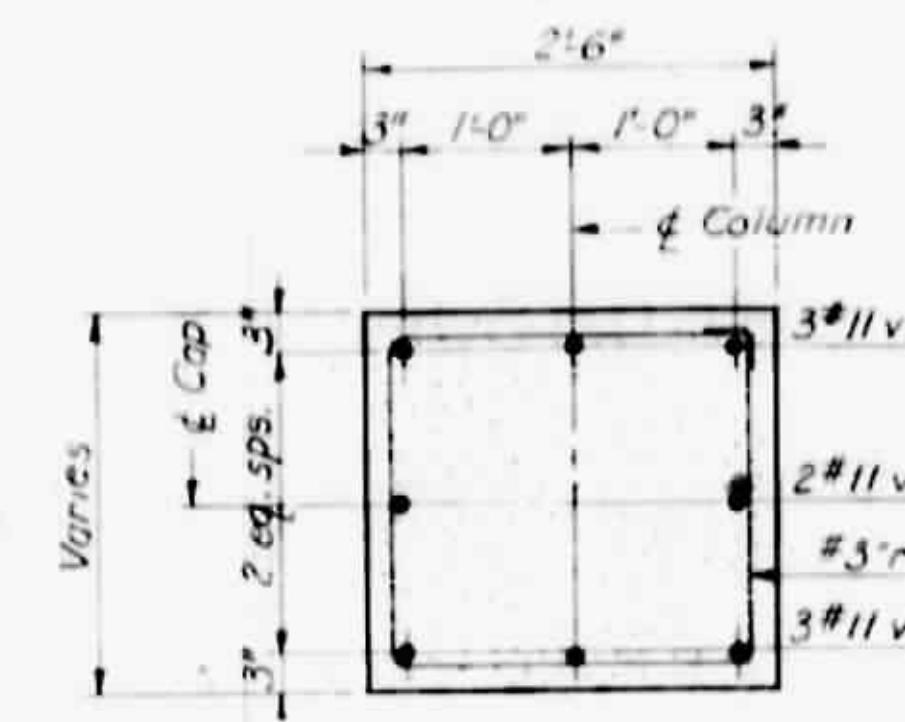


SECTION E-E

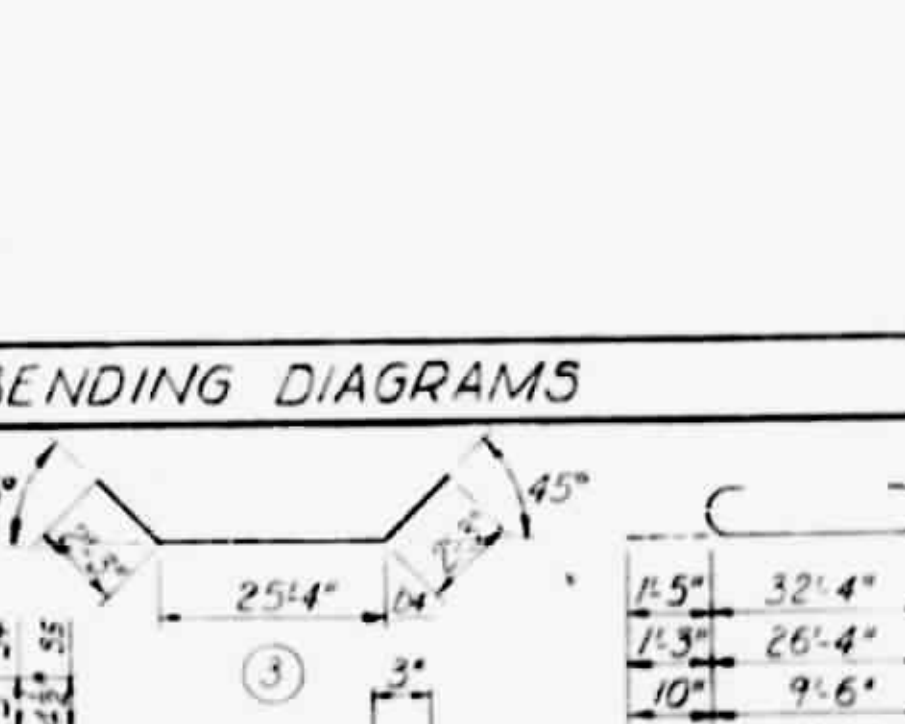


SECTION C-C

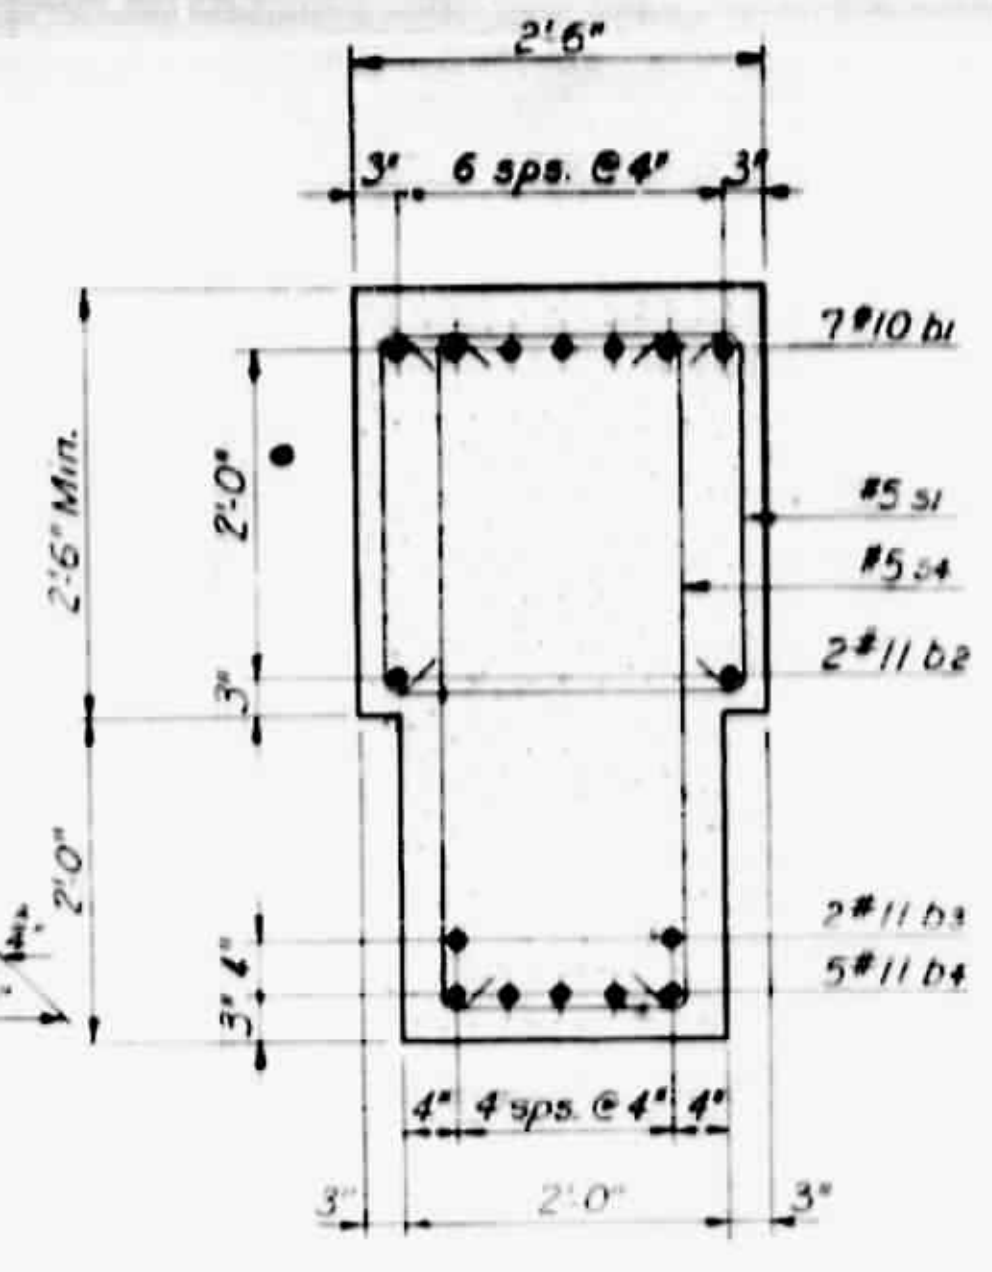

SECTION B-B

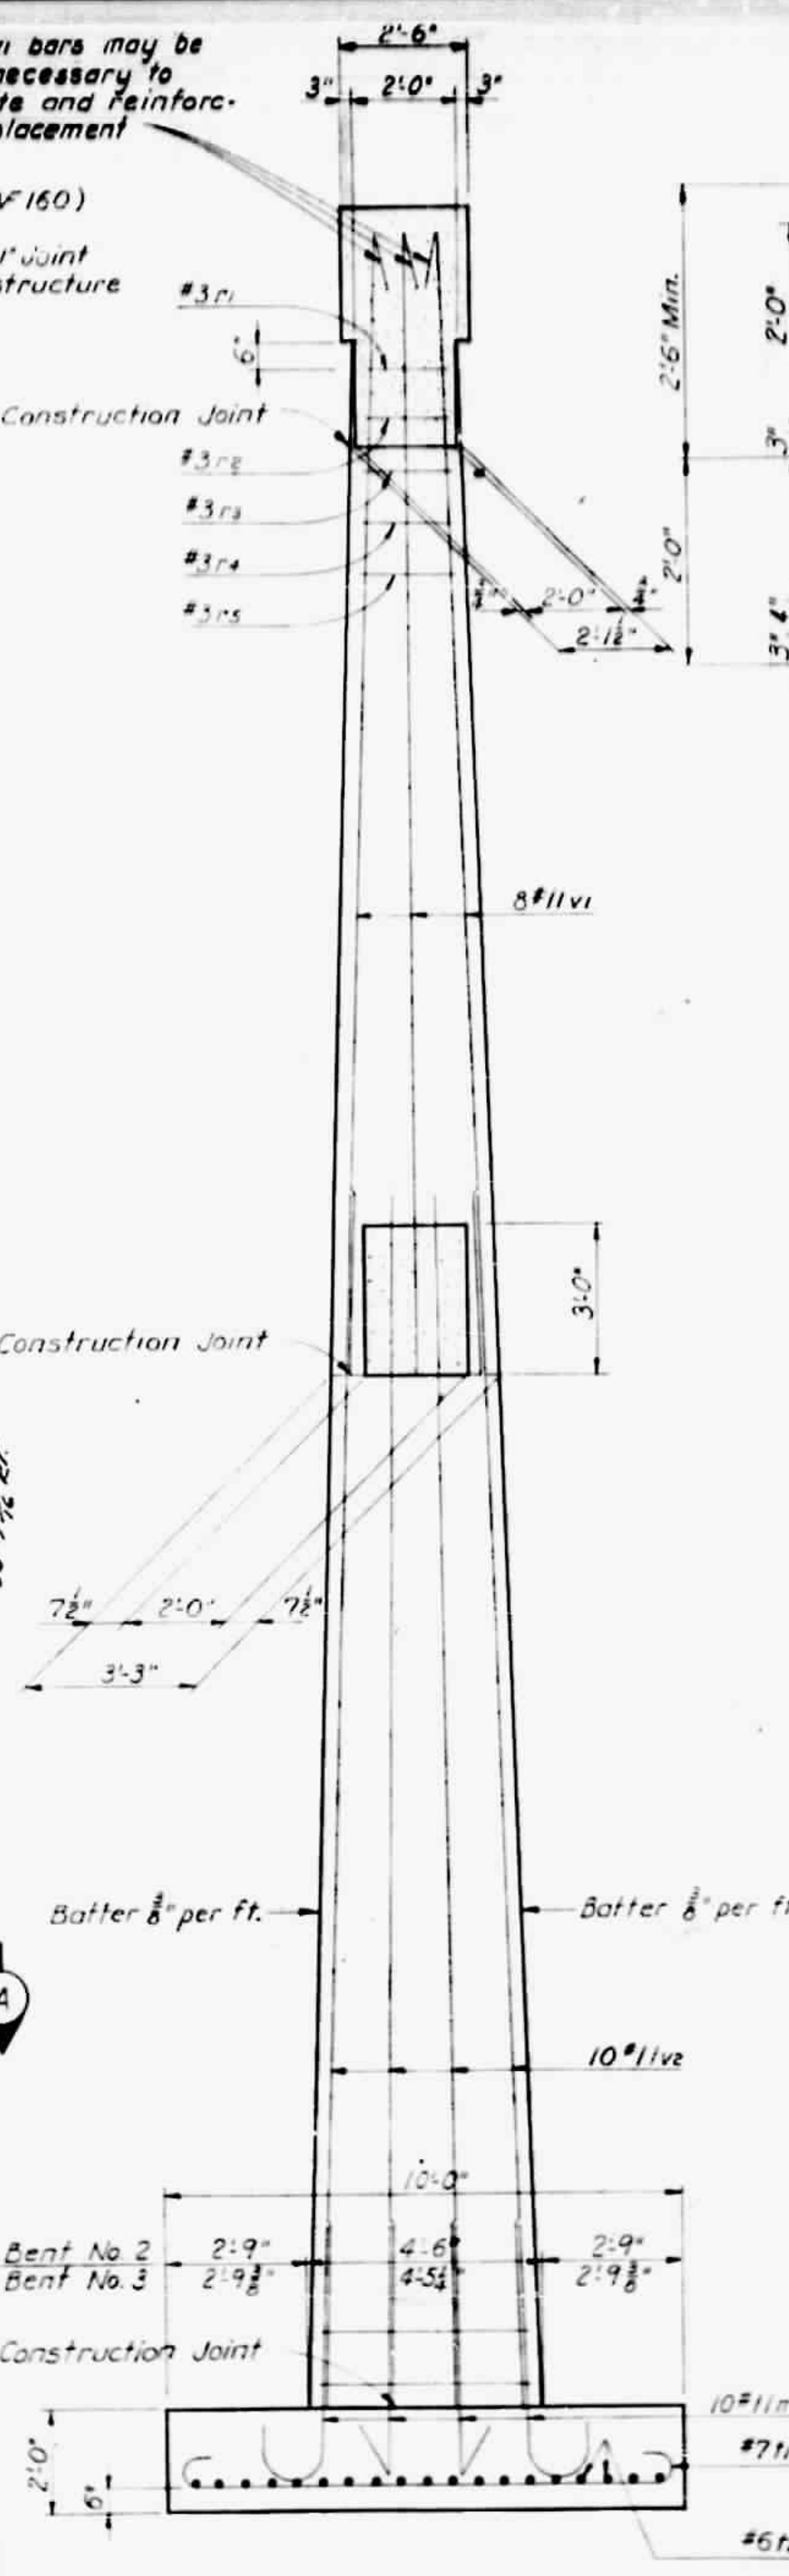

BENDING DIAGRAMS

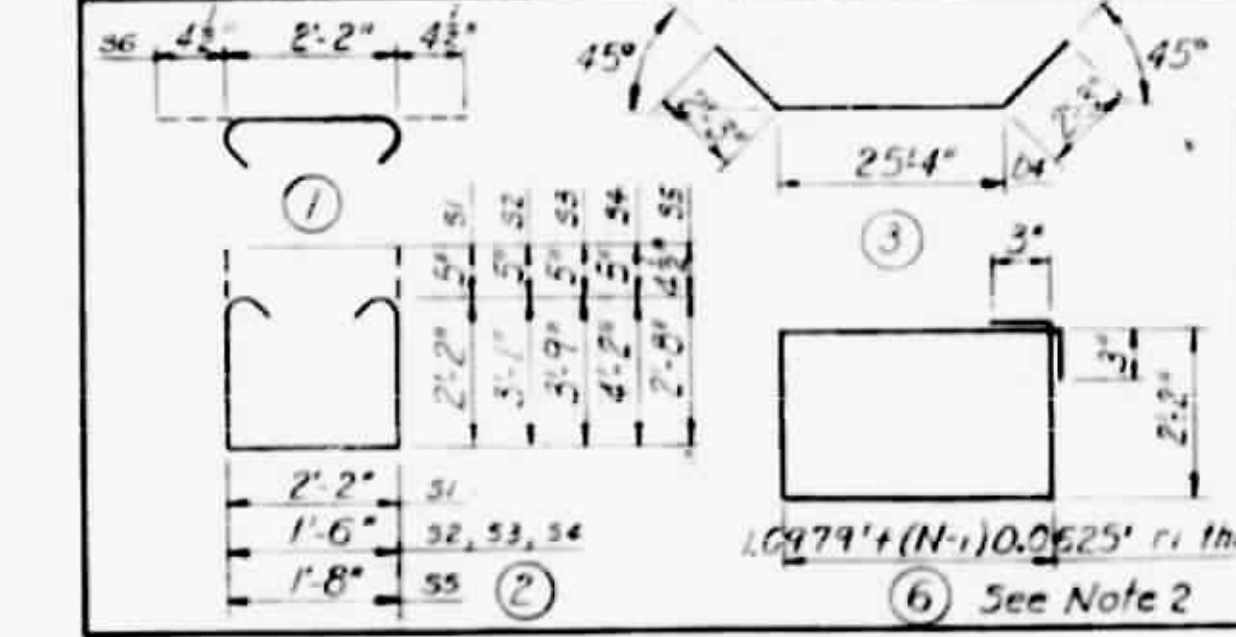

Notes:
1. All bar dimensions are out to out.
2. "N" refers to subnumber of bar mark.
* Omit bar #40 in Bent No. 3.

ELEVATIONS OF FOOTINGS (BUILT)

MARK	BENT NO. 2	BENT NO. 3
A	1763.20 FT.	1756.70 FT.
B	1763.26 FT.	1761.16 FT.

SCHEDULE OF ELEVATIONS

MARK	BENT NO. 2	BENT NO. 3
A	1762.00	1759.00
B	1804.36	1800.45
C	1804.28	1800.60
D	1804.50	1800.72

CONCRETE VOLUMES BY POURS

POUR NO.	LOCATION	CU. YDS.
4	Cap	11.8
3	Stems & Strut	14.0
2	Stems	13.5
1	Footings	10.4

BILL OF MATERIAL


LOCATION	CLASS A CONCRETE CU. YDS.	REINFORCING STEEL LBS.
Bent No. 2	50.55	12,863
Bent No. 3	49.76	10,853

PROJECT NO. 2016601
BUNCOMBE COUNTY
STATION: 10+35.50
M.P. 153.1

STATE OF NORTH CAROLINA
STATE HIGHWAY COMMISSION
SUBSTRUCTURE
BENT NO. 2 & 3
NOV 1966

REVISIONS

NO.	BY	DATE	NO.	BY	DATE
1			2		
3			4		

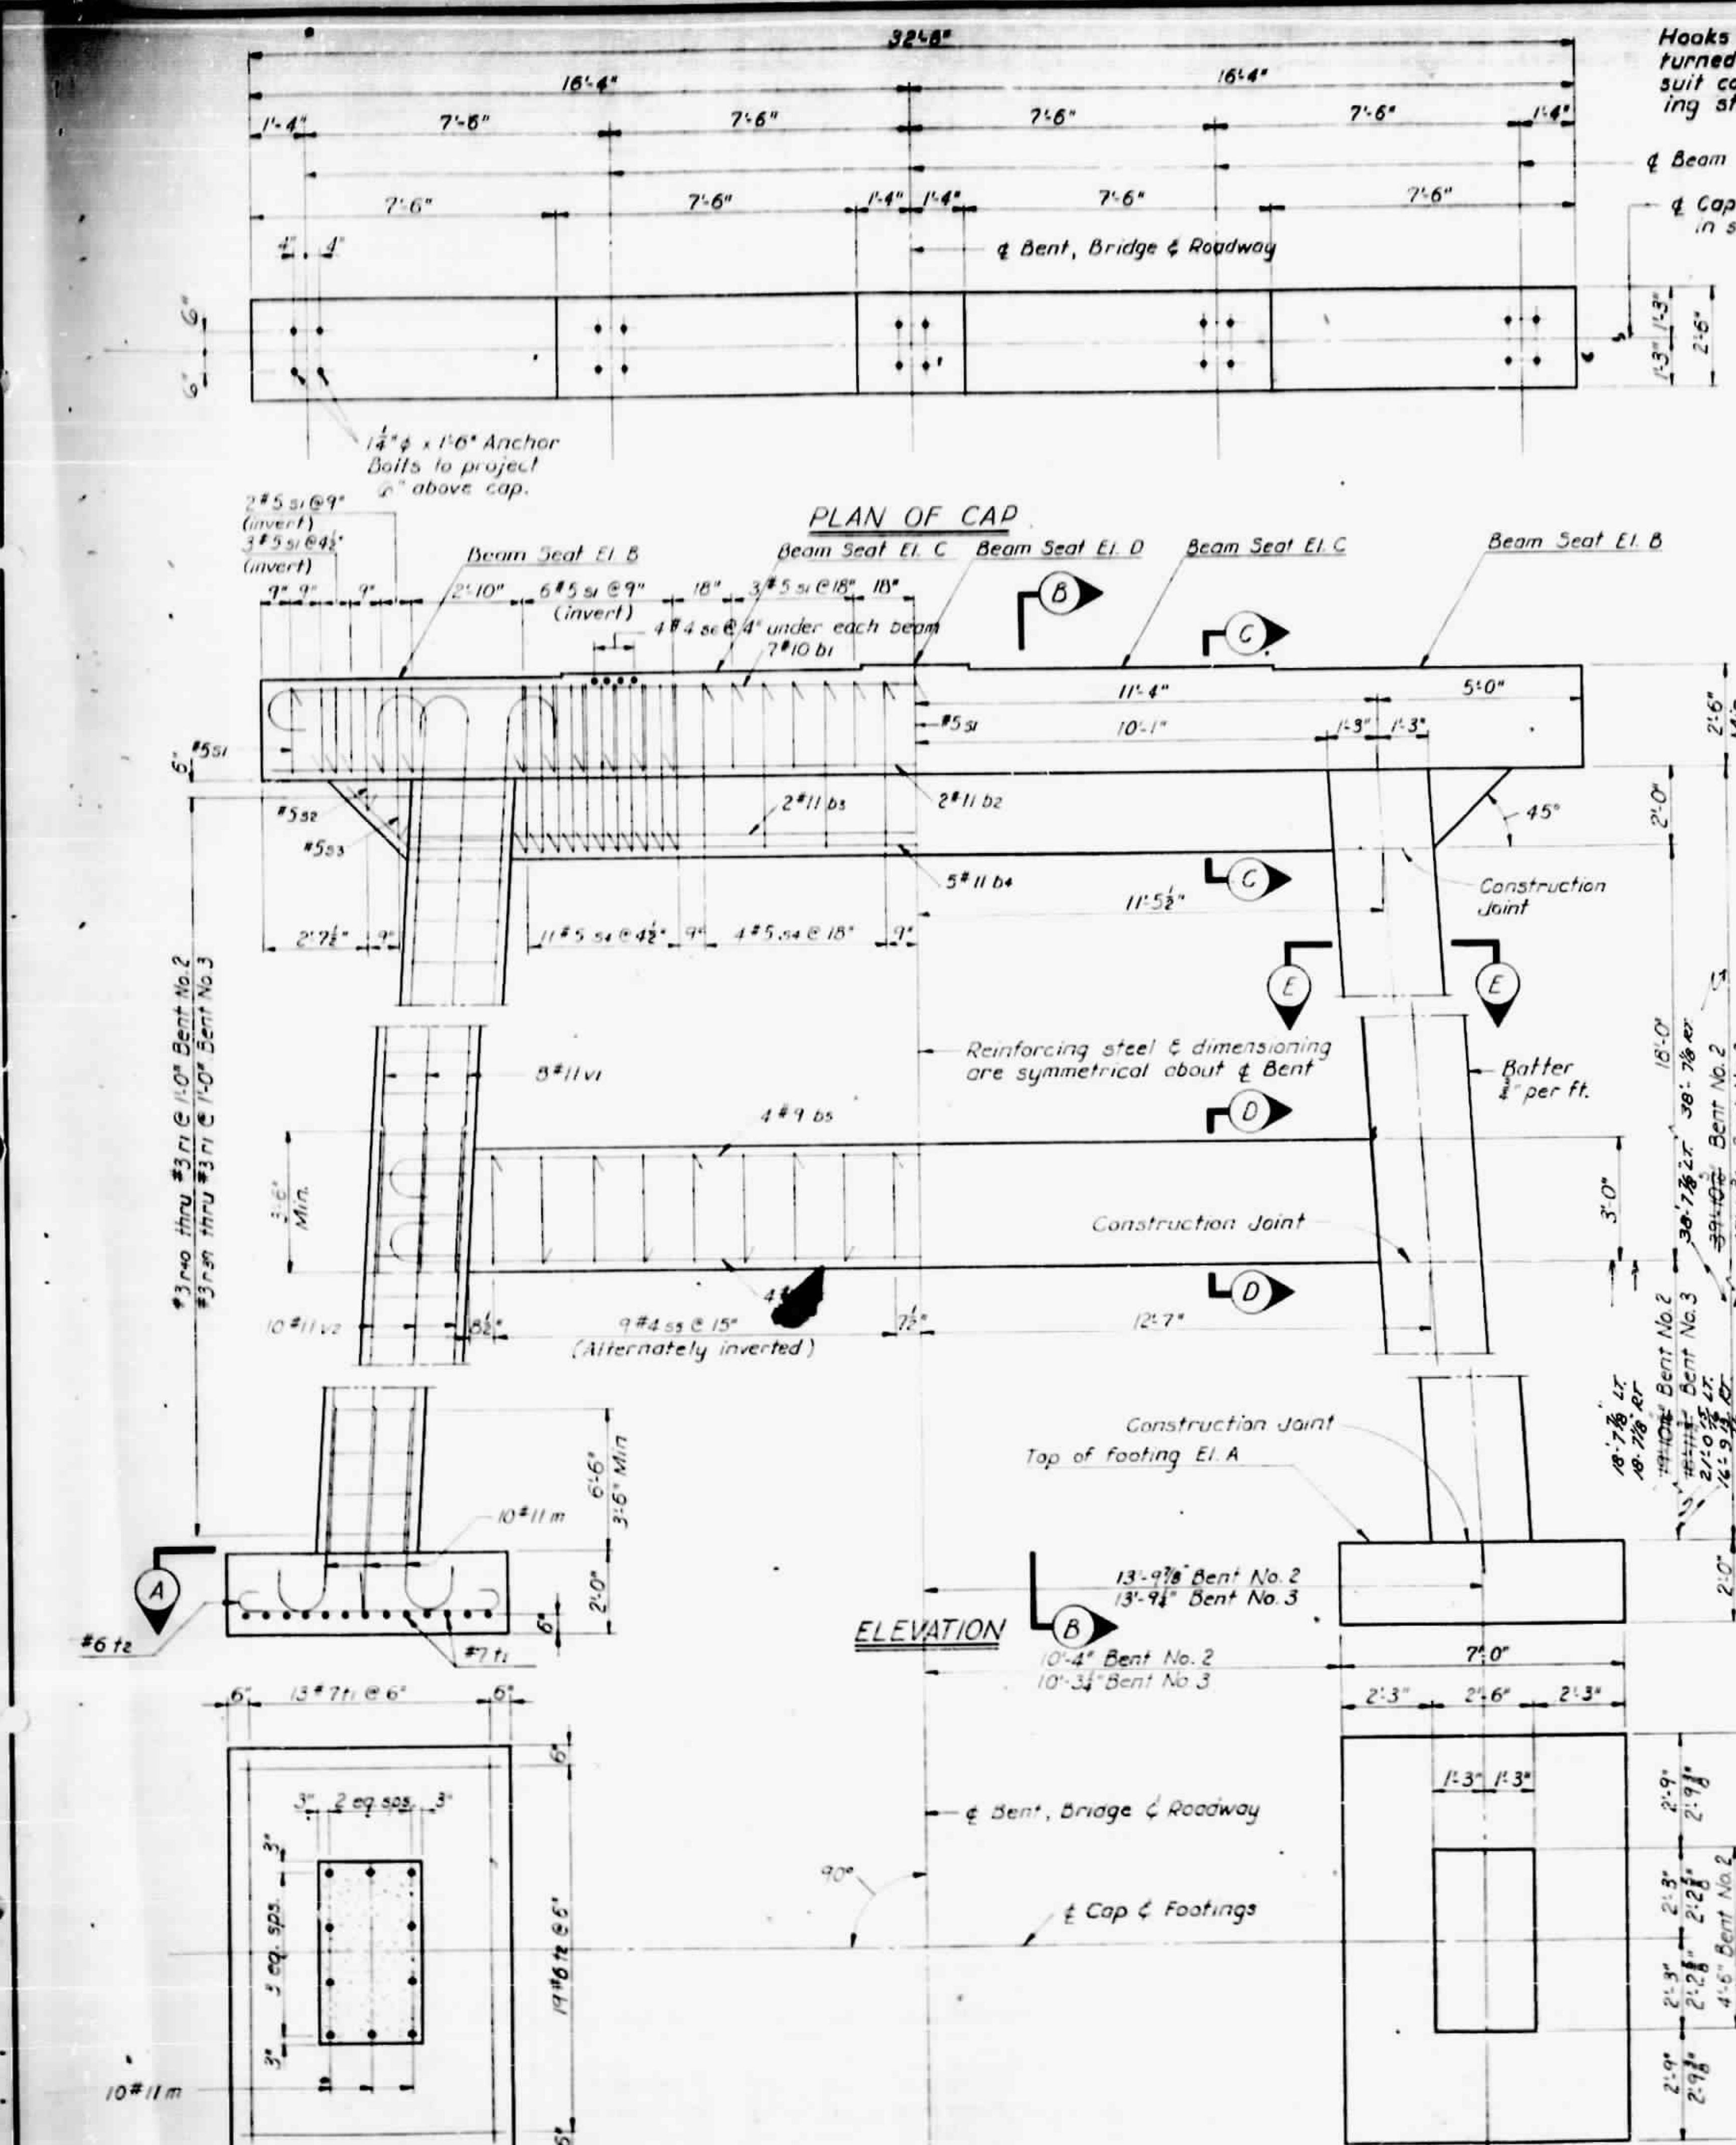

PLAN OF FOOTINGS SECTION A-A

SPECIAL
DESIGNED BY: Eduardo J. Morales
DRAWN BY: Leola B. Pierce
CHECKED BY: R. Self
DATE: 10-66

REINFORCING BAR SCHEDULE FOR ONE BENT

BAR	SIZE	TYPE	LENGTH	NO.	WEIGHT
b1	10	4	35'-2"	7	1,089
b2	11	5	32'-4"	2	344
b3	11	5	25'-4"	2	268
b4	11	3	29'-10"	5	793
b5	9	4	28'-10"	8	784
m	11	5	31'-7"	20	1,018
s1	5	2	7'-4"	31	137
s2	5	2	8'-6"	2	18
s3	5	2	9'-0"	2	21
s4	5	2	10'-8"	30	334
s5	4	2	7'-9"	18	93
s6	4	1	2'-11"	20	39
n1	3	6	8'-22 1/2"	2	273
n2	3	6	10'-10 1/2"	2	273
v1	11	5	23'-7"	16	2,005
v2	11	5	18'-8"	20	1,964

CONCRETE VOLUME BY POURS

POUR NO.	LOCATION	CUL. YDS.	MIN. 4	BENT 5
4	Cup	11.8		
3	Stems & Struts	14.0	14.0	
2	Stems & Struts	10.4	9.0	
1	Footings	10.4	10.4	

BILL OF MATERIAL

LOCATION	CLASS A CONCRETE CU YDS.	REINFORCING STEEL LBS.
Bent No. 4	46.2	10,311
Bent No. 5	45.2	10,291

Notes:
1. All bar dimensions are cut to out.
2. "N" refers to subnumber of bar mark.
* Omit bars #34 & #35 in Bent No. 4.

PROJECT NO. 8.2016601
BUNCOMBE COUNTY
STATION: 10+35.50

MP Sta. 1531

STATE OF NORTH CAROLINA
STATE HIGHWAY COMMISSION



SUBSTRUCTURE
BENT NO. 4 & 5

NOV 1966

REVISIONS

NO.	BY	DATE	NO.	BY	DATE
1			2		

TOTAL SHEETS 5-16 84

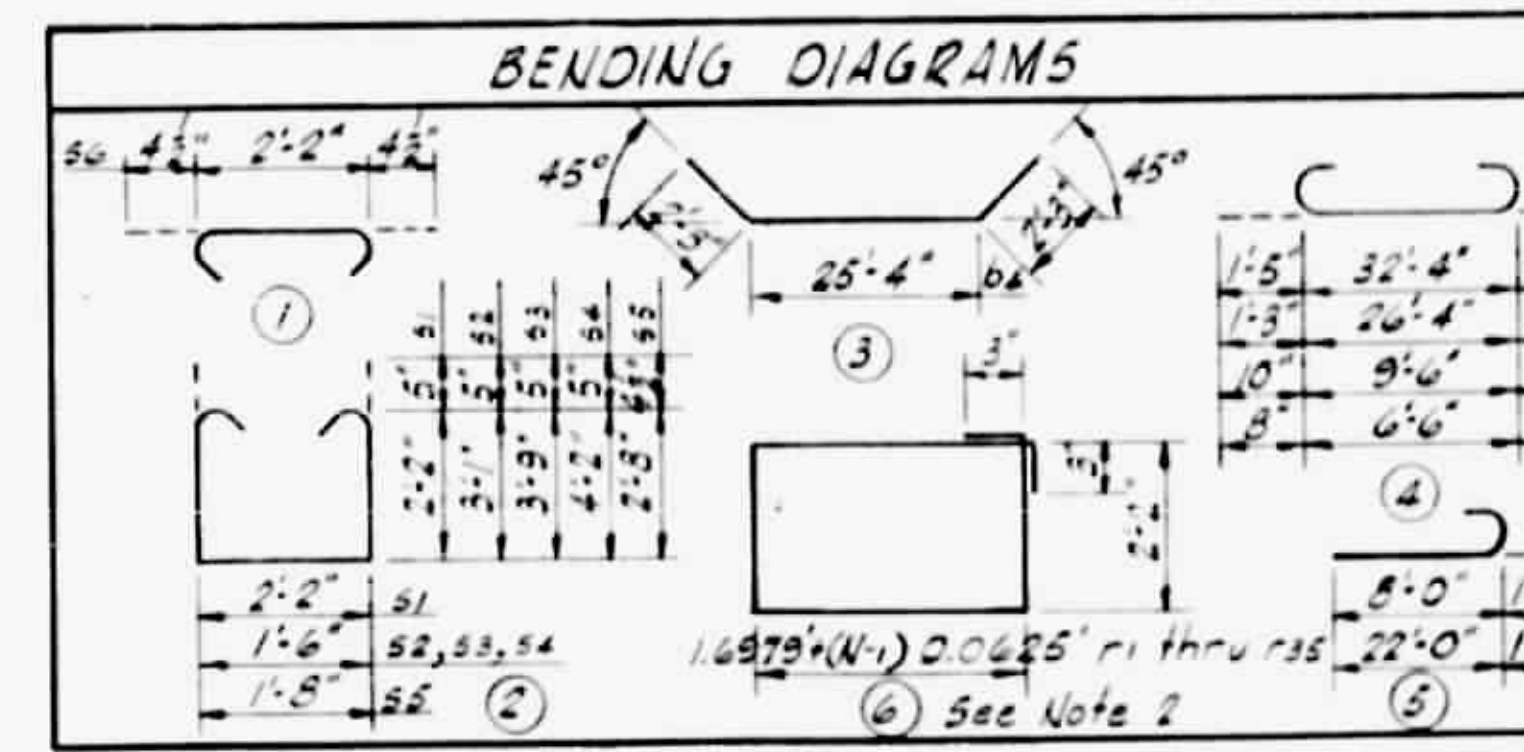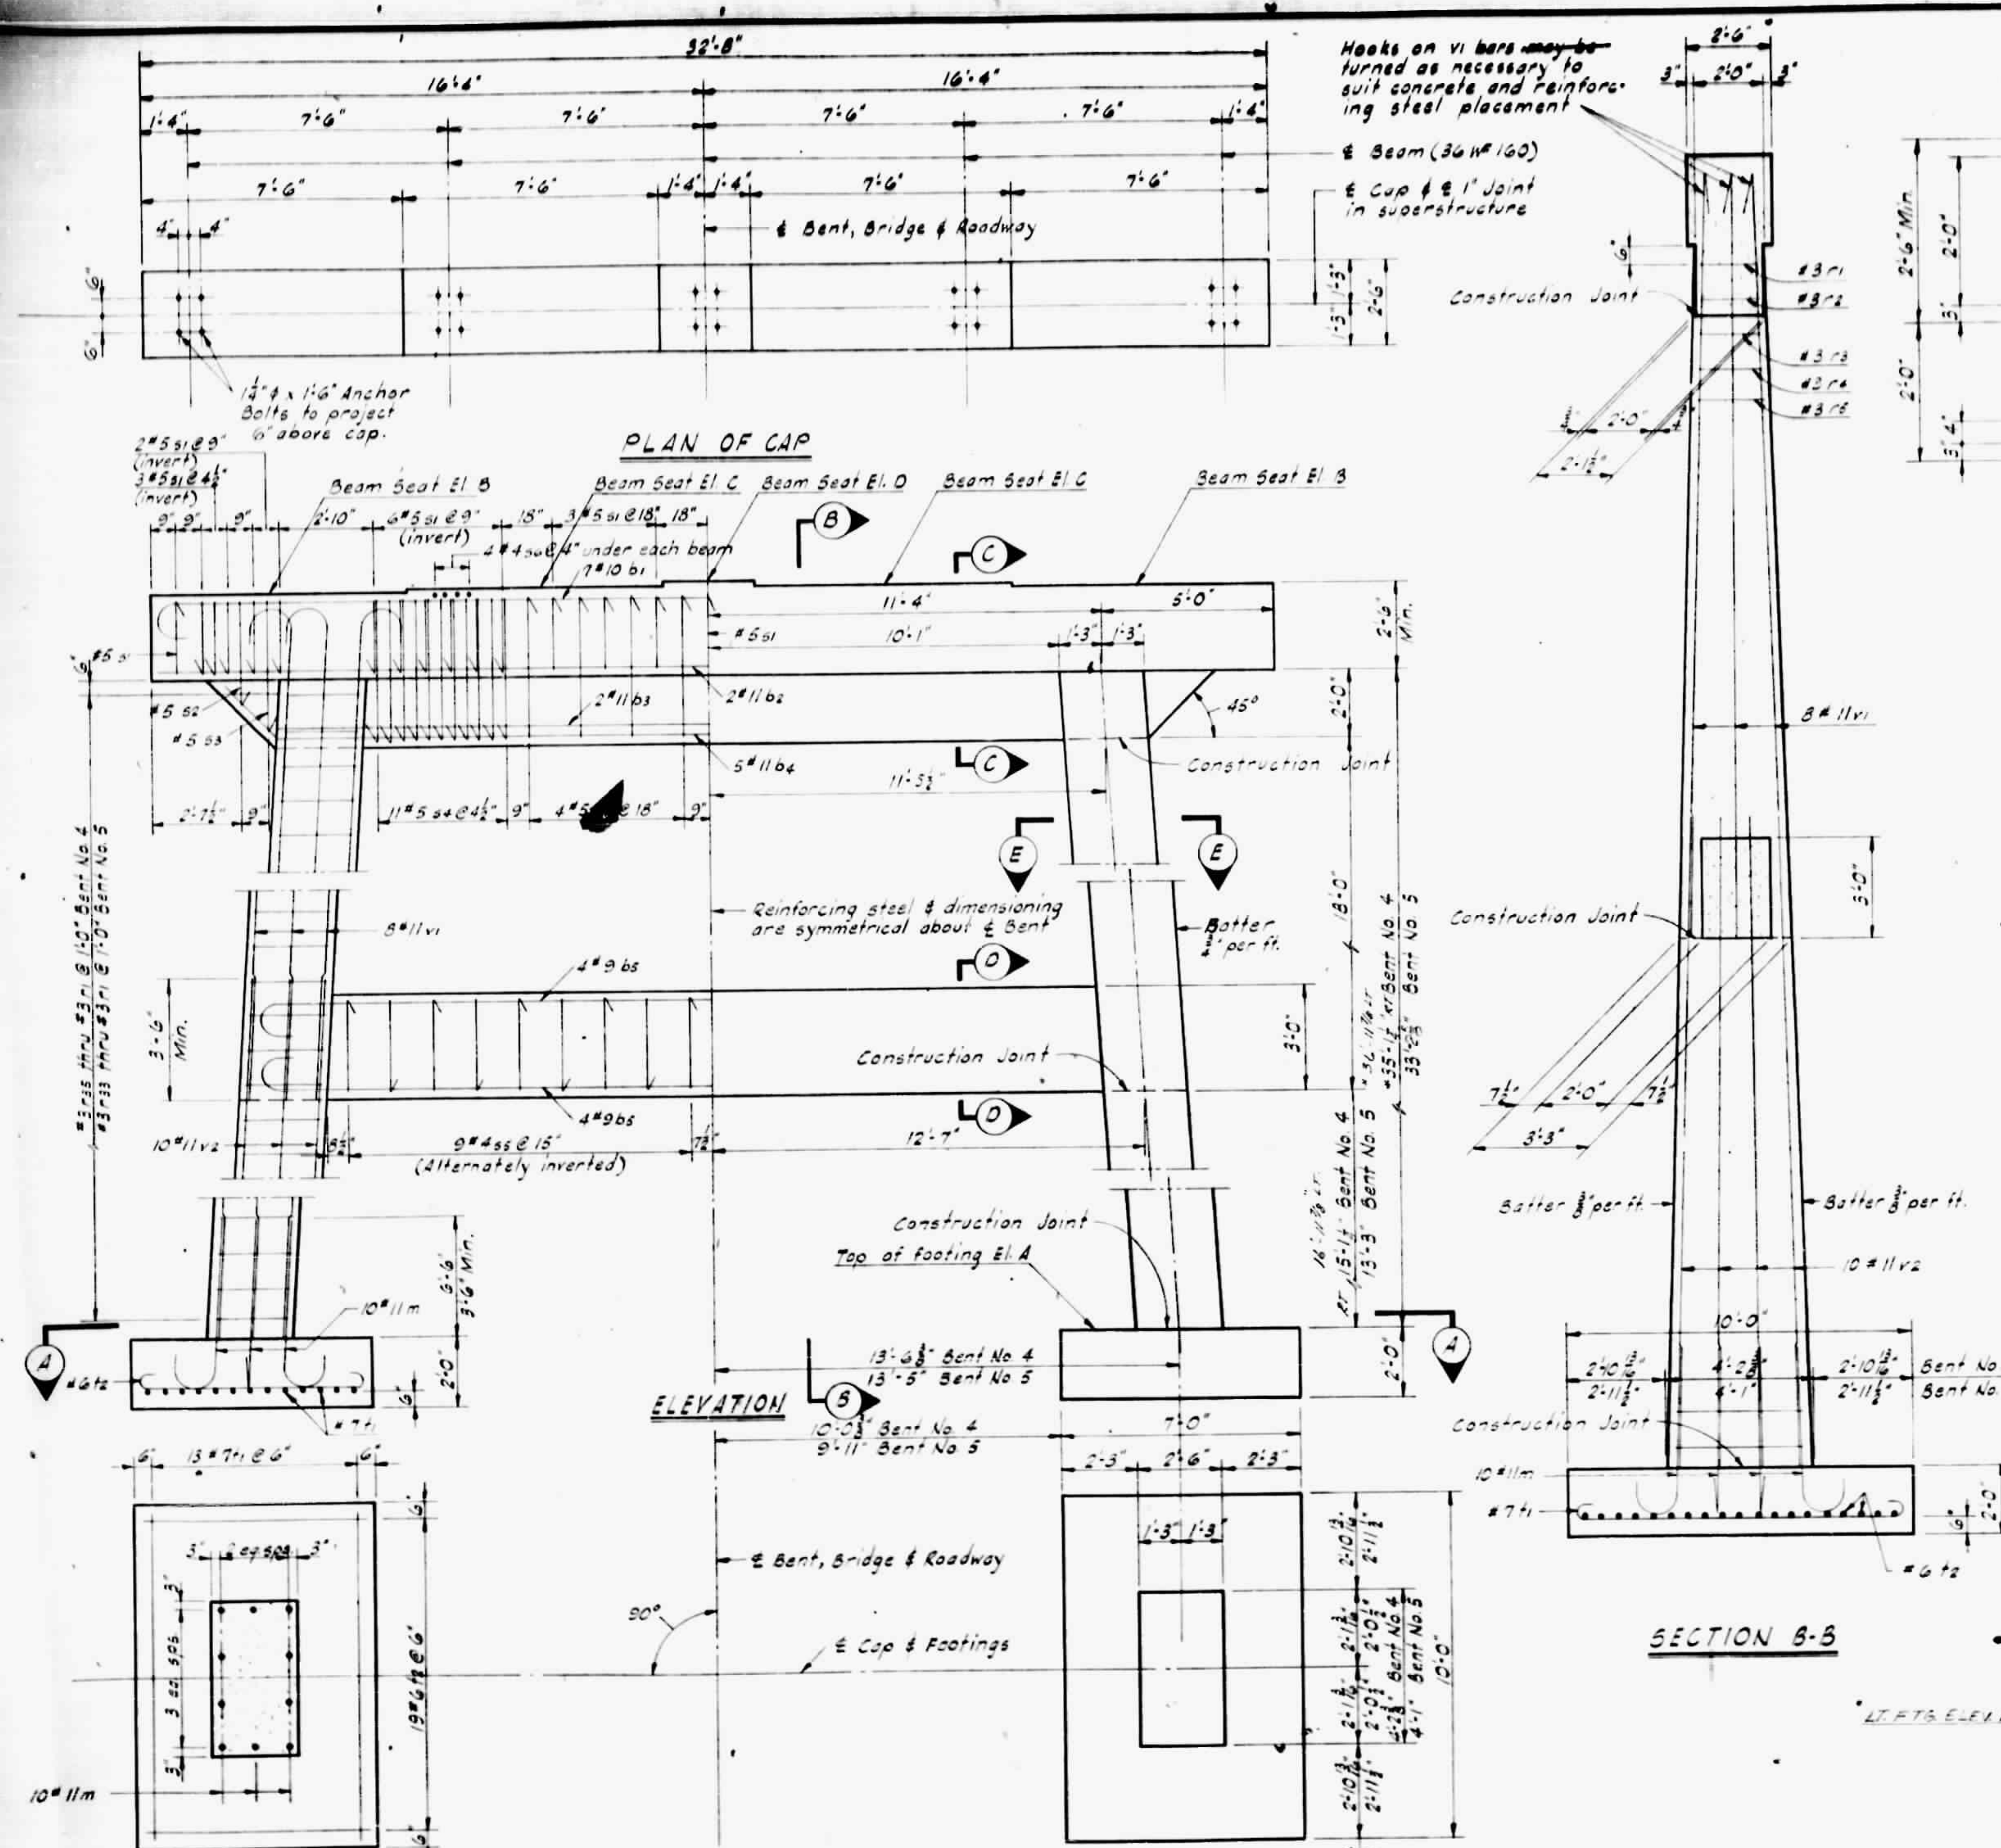

Notes:
1. All bar dimensions are cut to out.
2. "N" refers to subnumber of bar mark.
* Omit bars #34 & #35 in Bent No. 4.

SCHEDULE OF ELEVATIONS


MARK	BENT NO. 4	BENT NO. 5
A	1759.00	1757.00
B	1796.40	1792.72
C	1796.72	1792.84
D	1796.84	1792.96


SPECIAL
DESIGNED BY: Eduardo J. Morales
DRAWN BY: Joe K. Thigpen
CHECKED BY: R. Self
DATE: 10-66

PLAN OF FOOTINGS
SECTION A-A

BRIDGE STA 101+35.50


DRY AND WET EXCAVATION PLAN ALSO EXTRA DEPTH
CONCRETE IN FOOTINGS

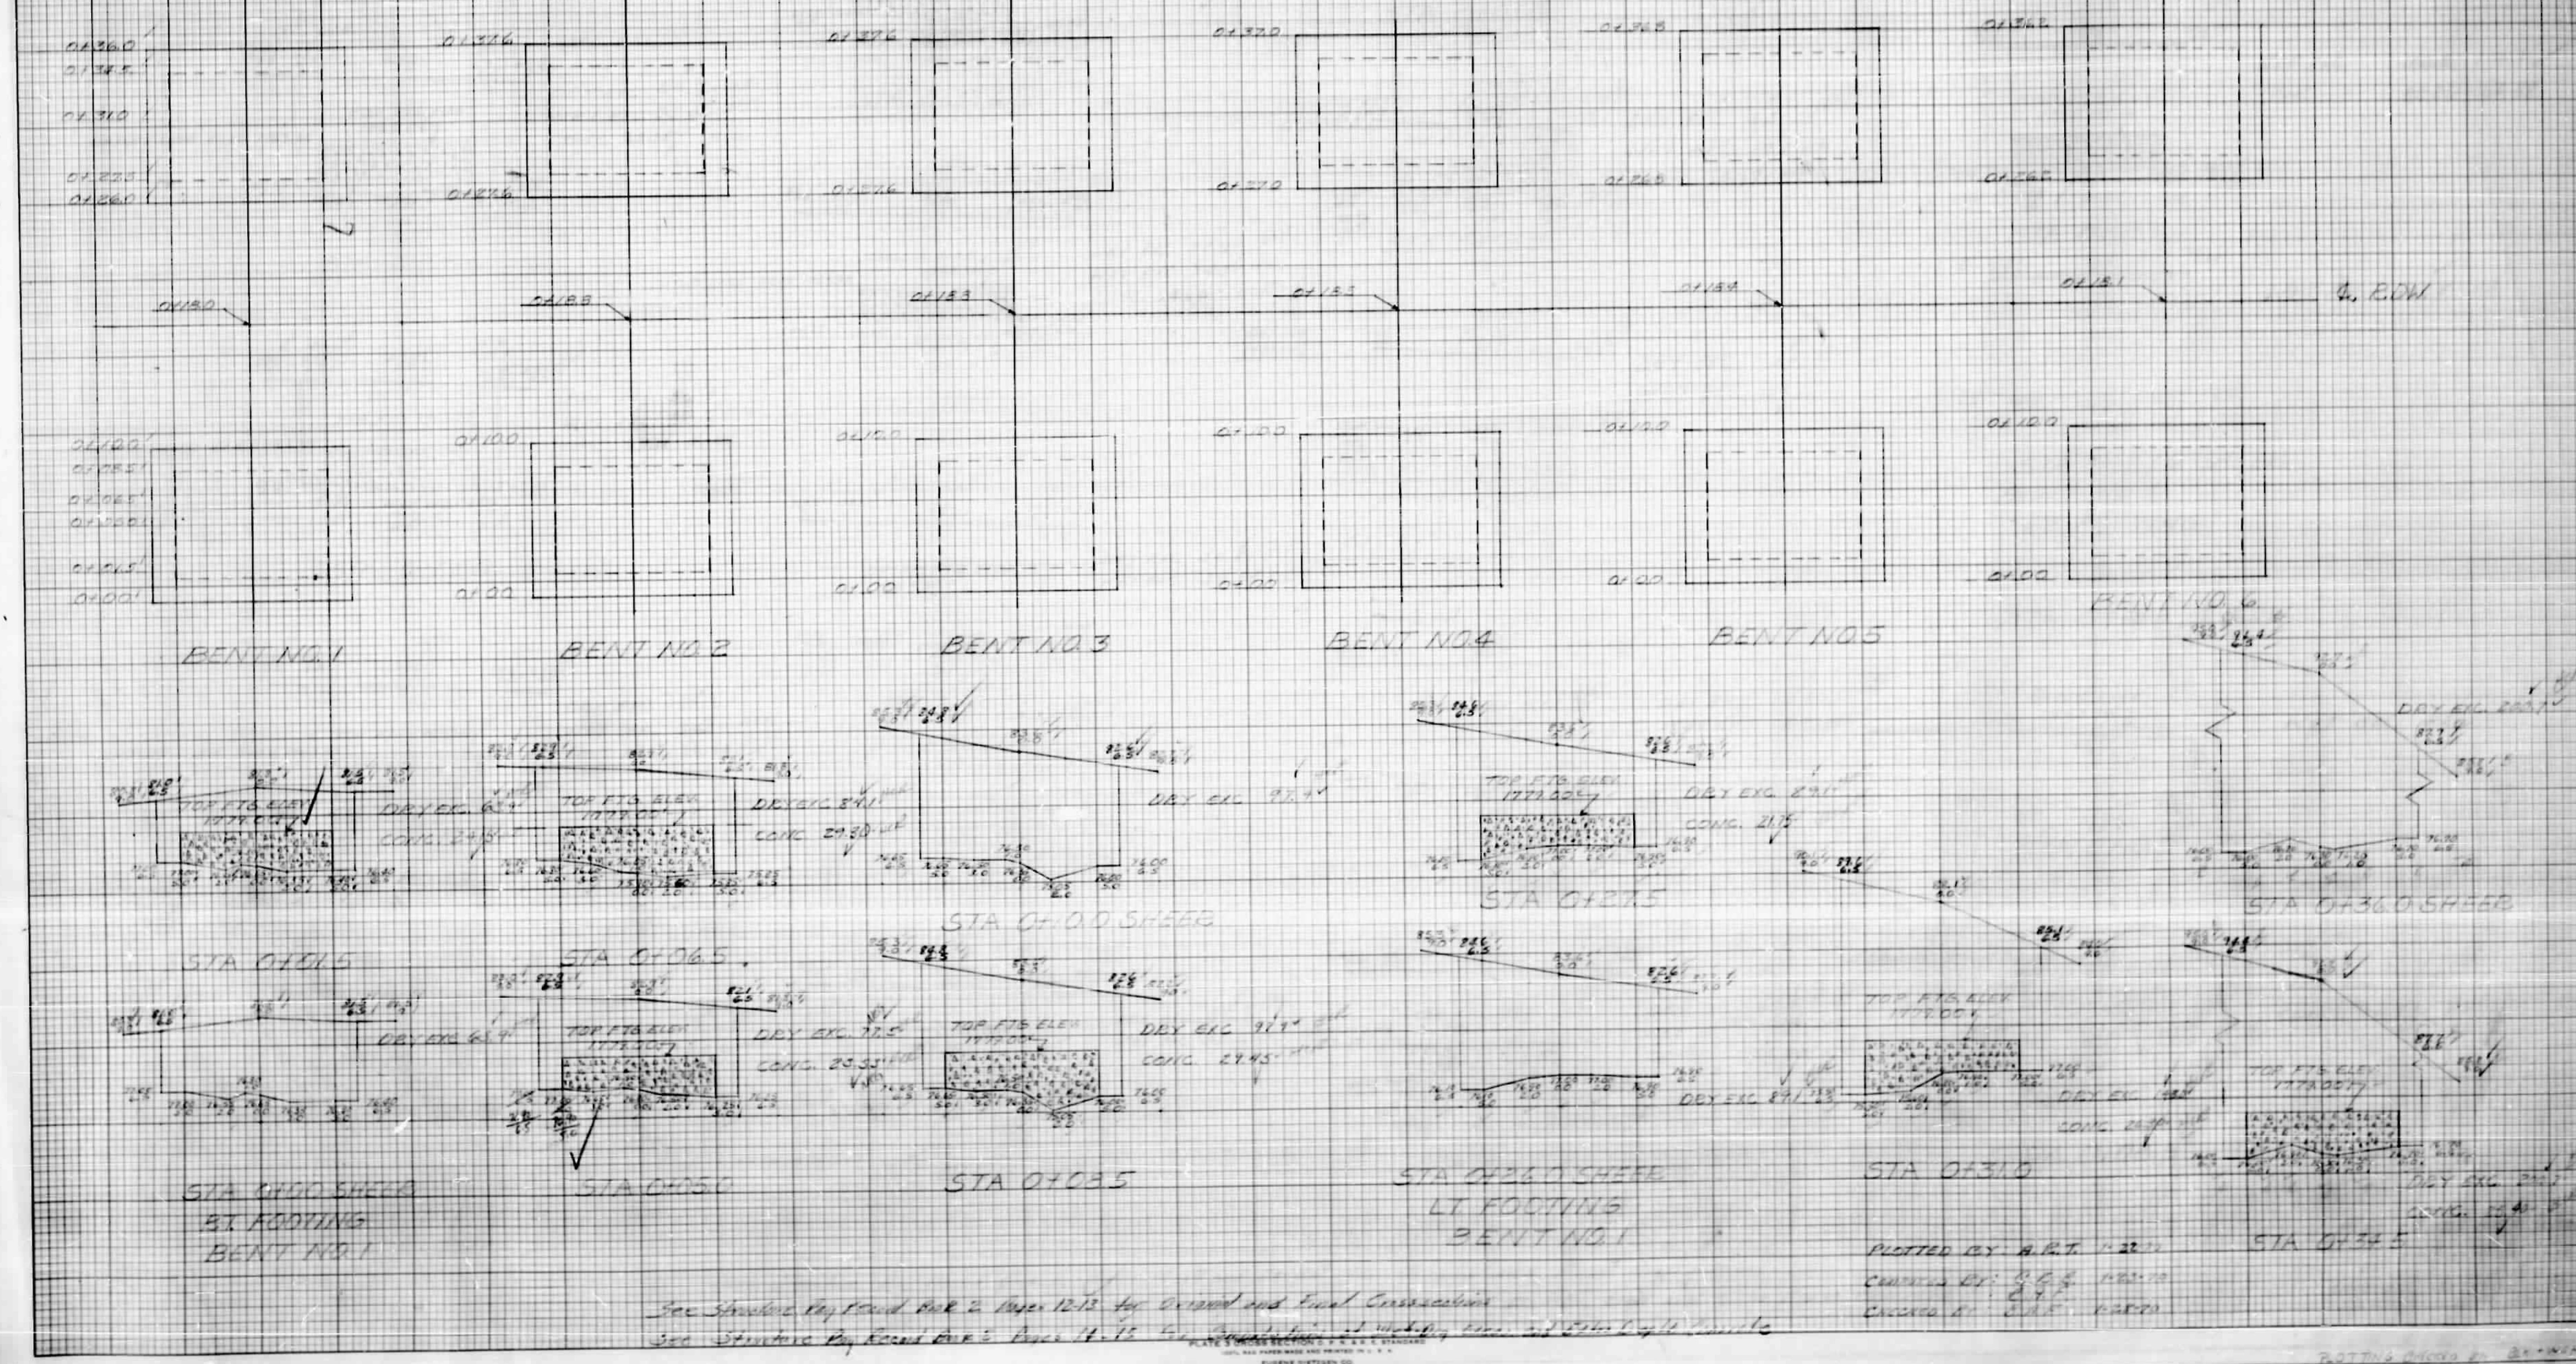

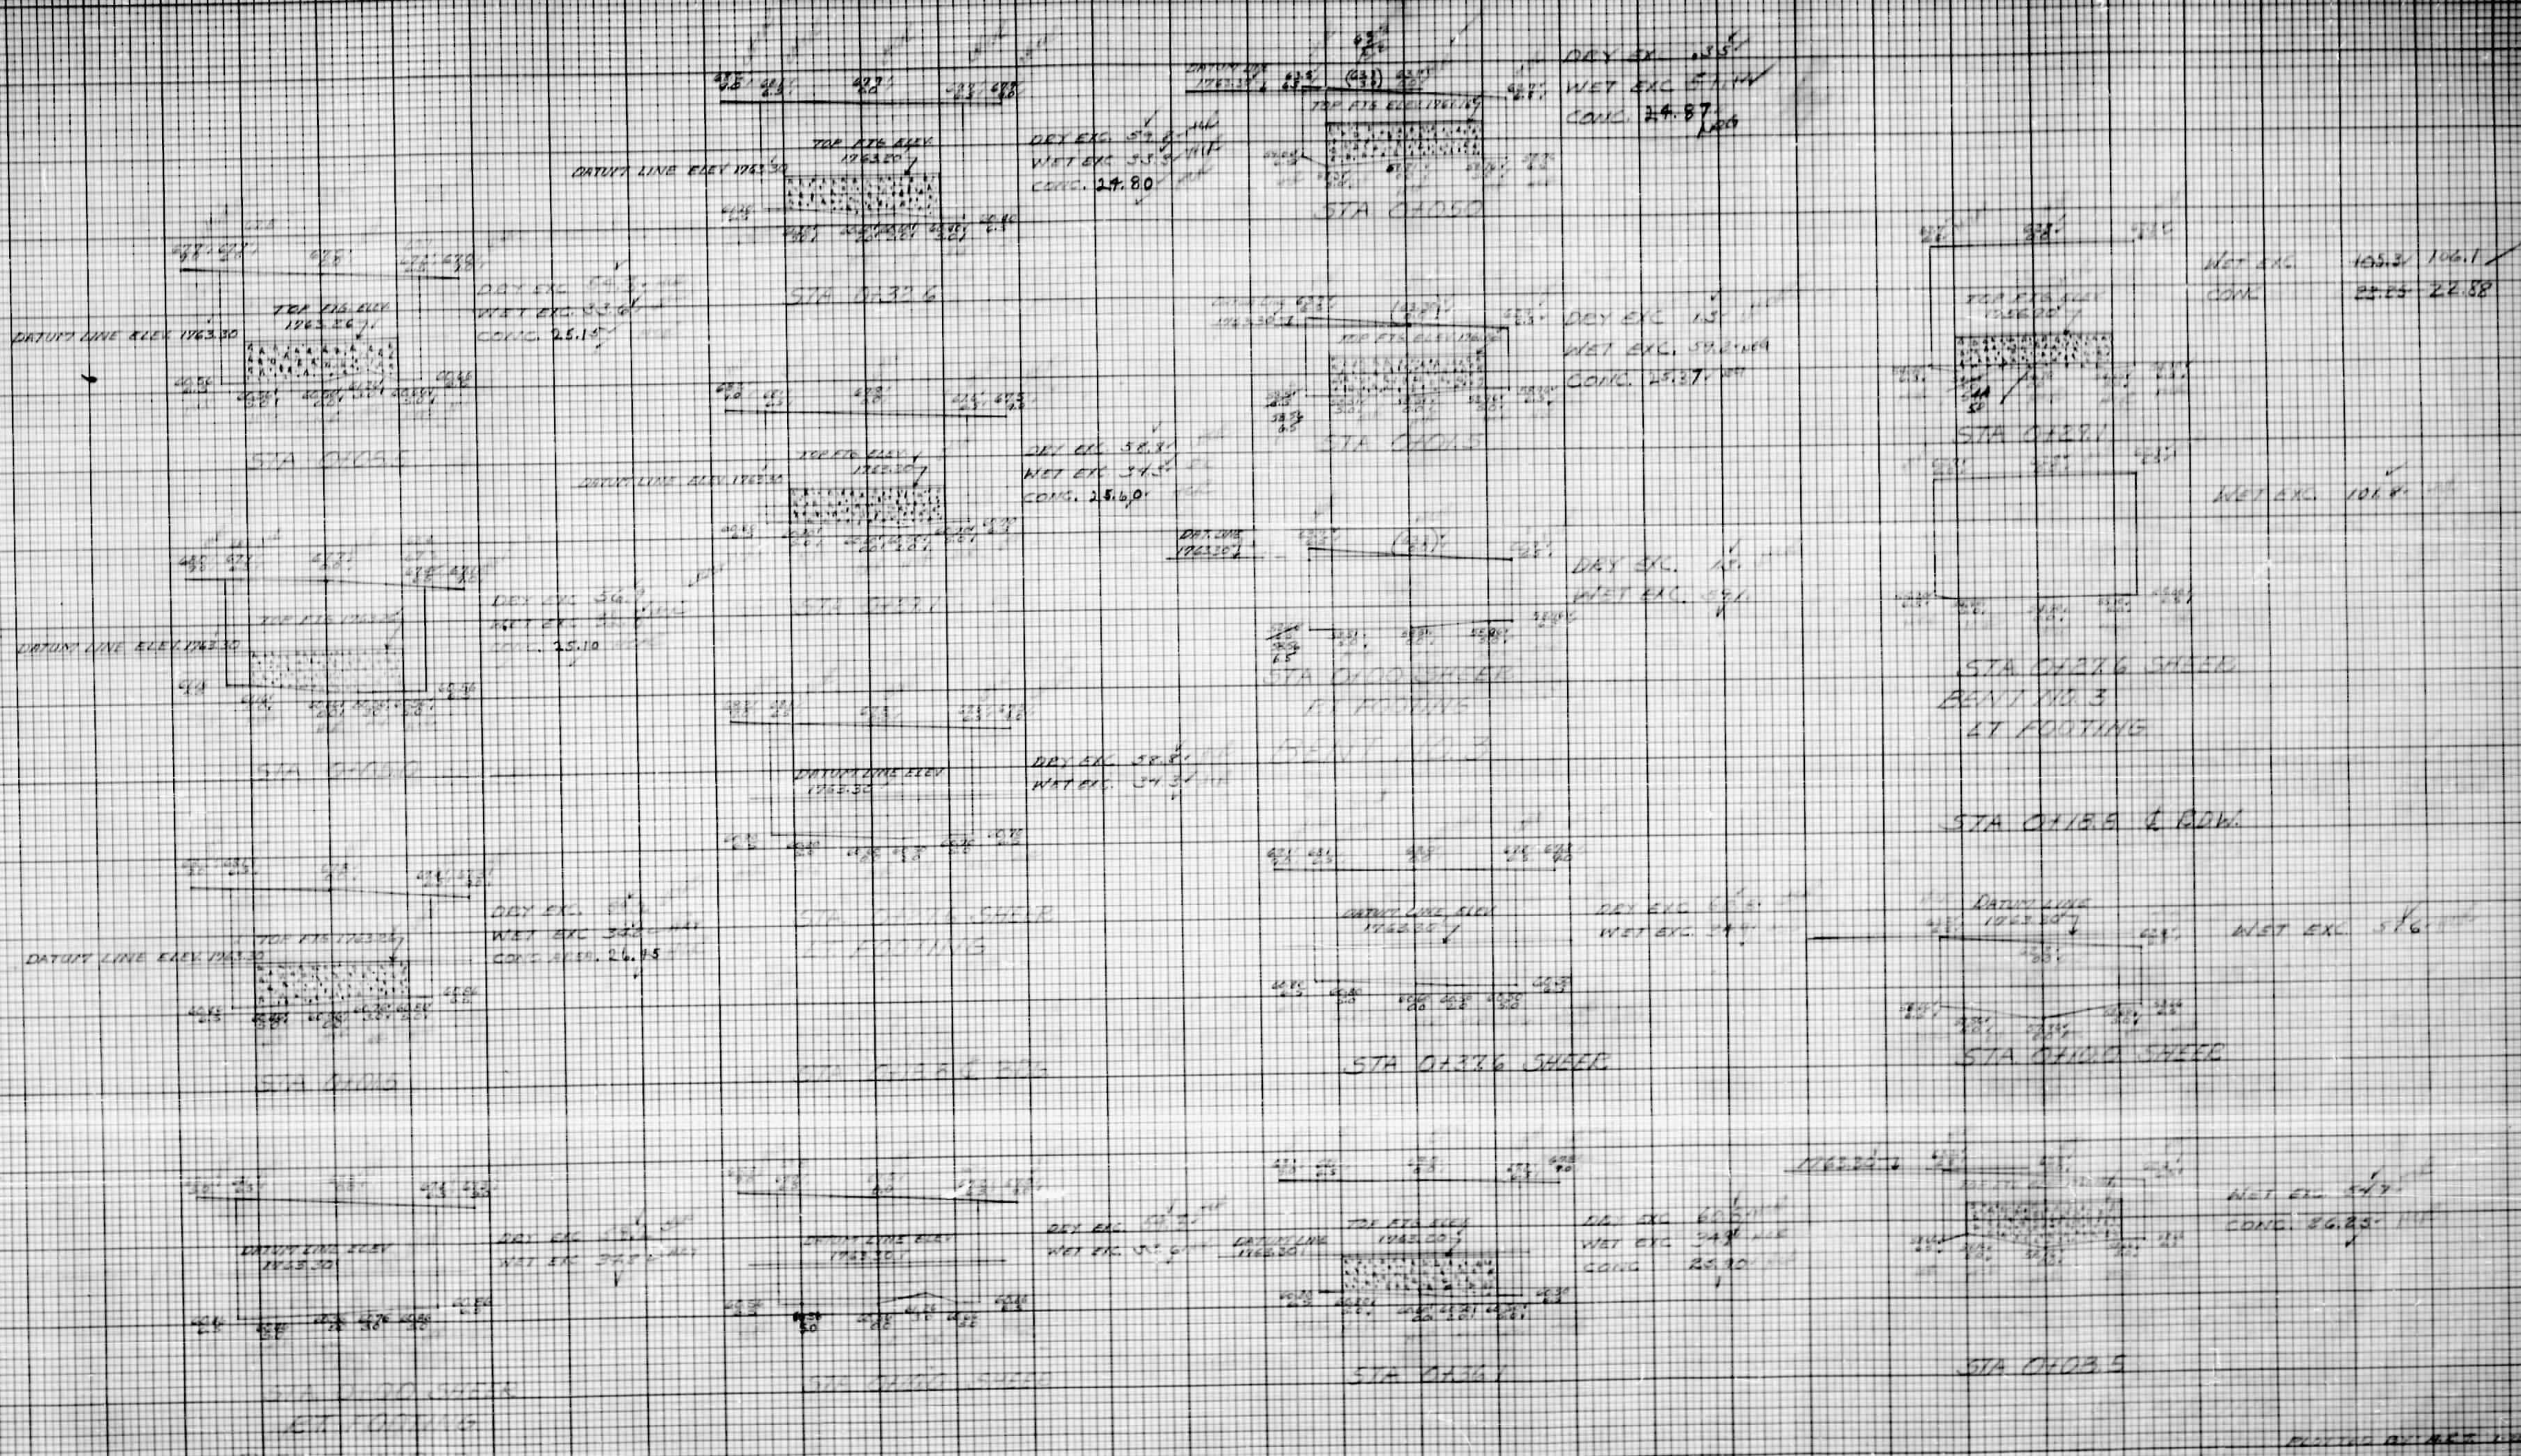


See Stationing Key Sheet Box C Pages 18-19 and 24-25 for Original and Final Construction
 See Stationing Key Sheet Box C Pages 20-21, 24-25 for Computations of Wet-Dry ECU and Soil Dry & Comp. etc.

REVISION BY: R.C.T. 1/2/81
 CHECKED BY: R.C.T. 1/2/81
 DESIGNED BY: R.C.T. 1/2/81

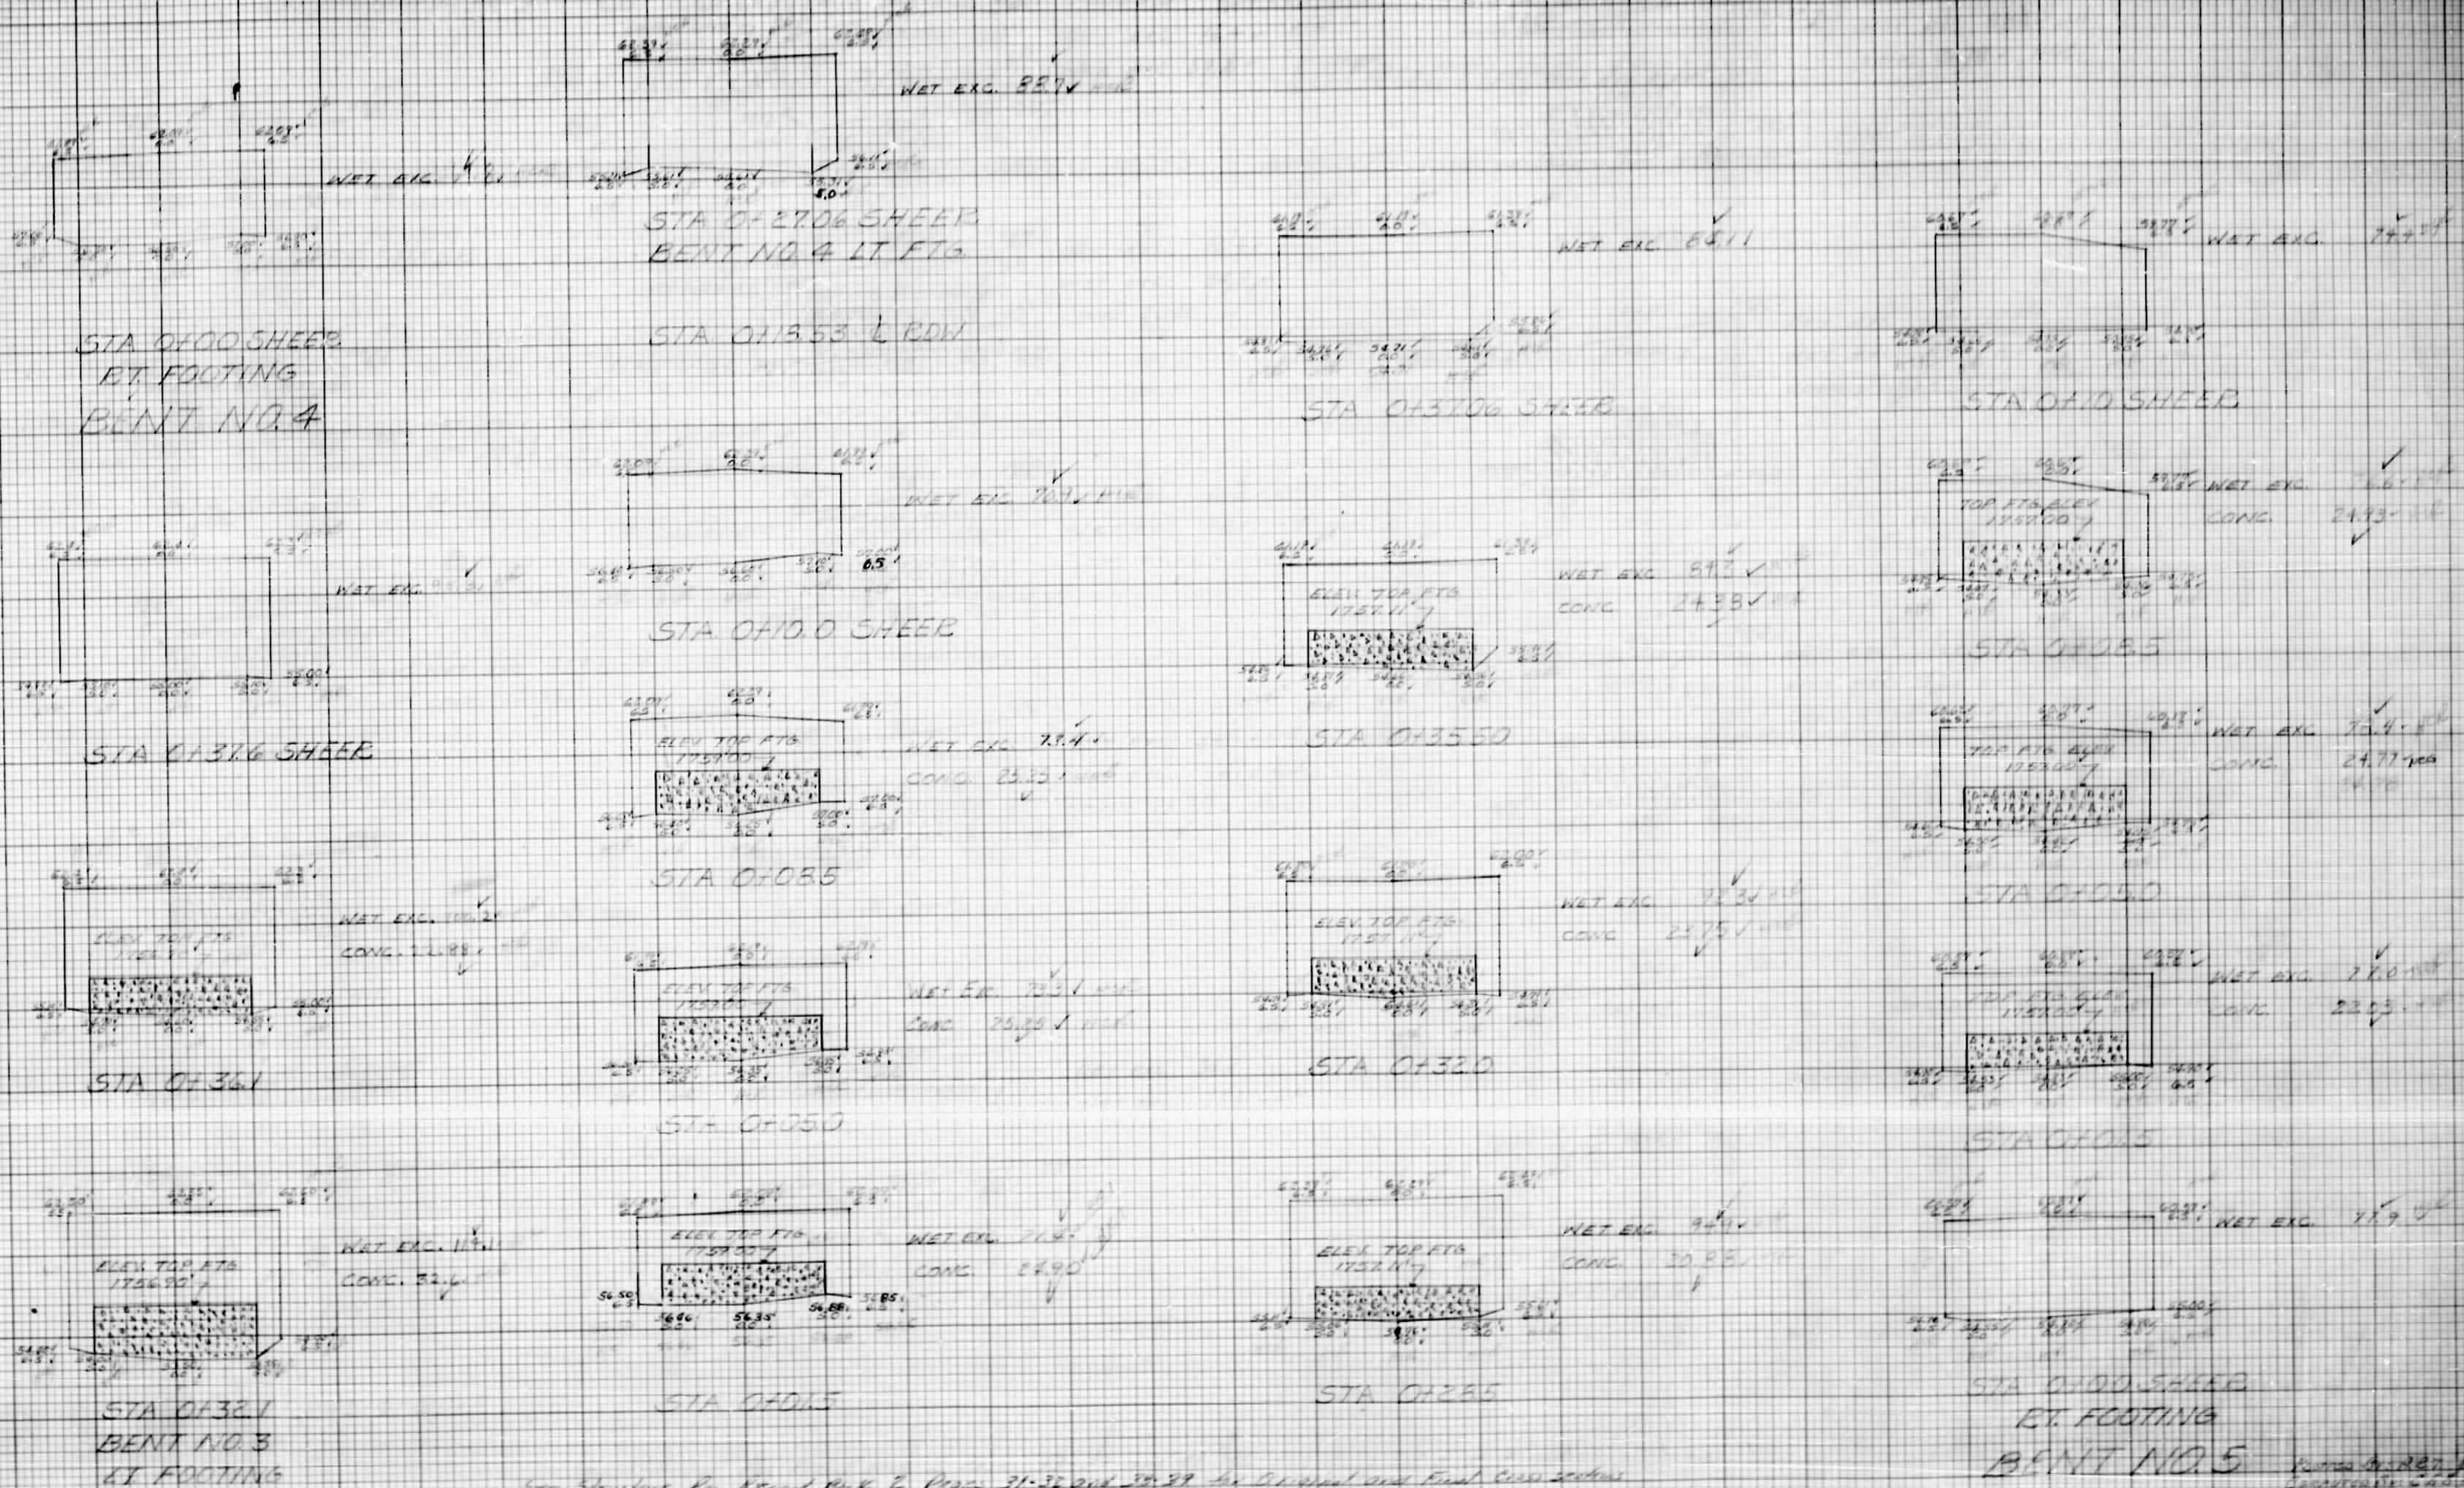

See Structure Pay Record Book 2, Pages 31-32 and 38-39 for Original and Final Cross Sections
See Structure Pay Record Book 2, Pages 26, 29, 35, 39, 41 for Computations at Wet-Dry Stage and Extra Depth Concrete

SUMMARY OF QUANTITIES AND CROSS SECTIONS

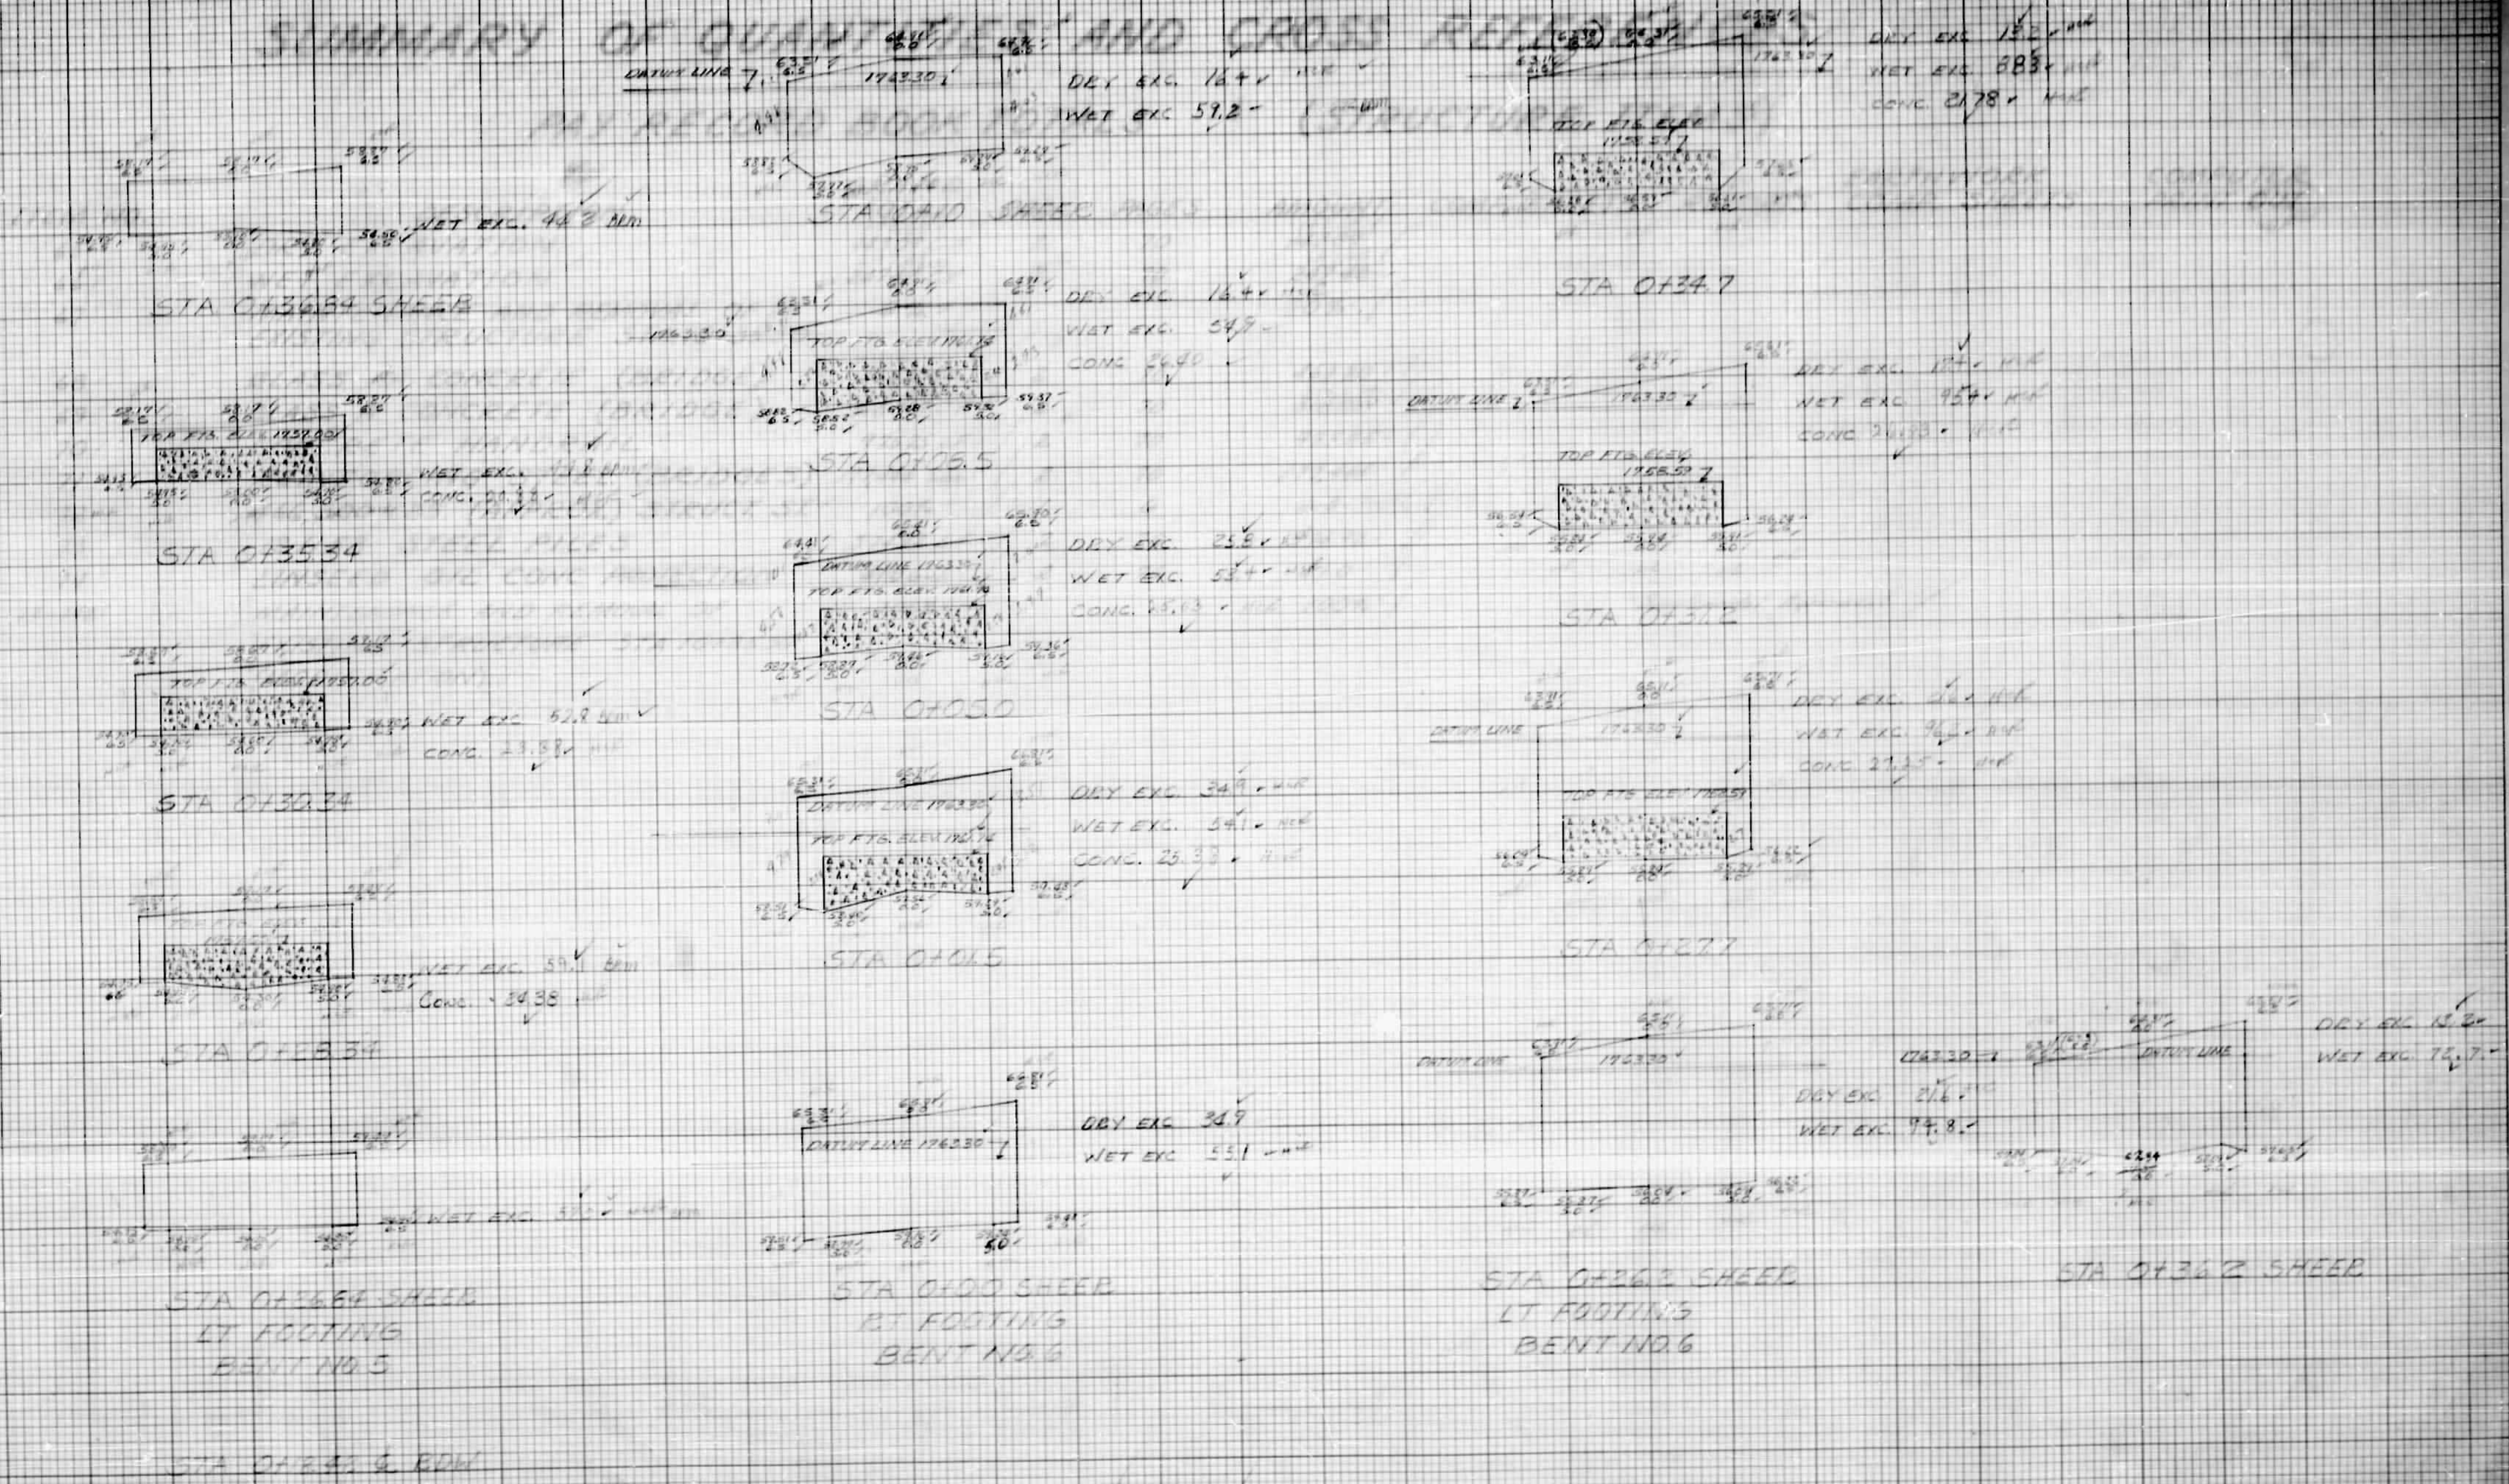

See Structure Key Record Book 2 Pages 38-39 and 45-46 for Original and Final Computations
 See Structure Key Record Book 2 Pages 40, 41, 42, 43 for Computations of Unit Dry Sum and Extra Depth Concrete

PLotted by ART. 10/20/61
 Checked by J. C. 10/20/61
 Approved by J. C. 10/20/61

SUMMARY OF QUANTITIES AND CROSS REFERENCES

PAY RECORD BOOK TOTALS

(STRUCTURE ITEMS)

ITEM NO.	DESCRIPTION	GRAND TOTAL	BOOK	PAGES	AMOUNT	COMP. SHEETS	REPORTS	EARTHWORK COMP. SHEETS	COMPUTER PRINT OUT
65	DRY EXCAVATION	143.09 C.Y.	2	70	143.09				
66	WET EXCAVATION	247.42 C.Y.	2	70	247.42				
67	MAINTENANCE AND REMOVAL OF EXISTING STRUCTURE STA. 10+35.50	0%			0%				
68	CLASS AA CONCRETE (BRIDGE)	463.20 C.Y.	2	70	463.20				
69	CLASS A CONCRETE (BRIDGE)	318.039 C.Y.	2	70	318.039				
70	CONCRETE HANDRAIL	975.25 L.F.	2	70	975.25				
71	REINFORCING STEEL (BRIDGES)	177,444 Lbs.	2	70	177,444				
72	466,300/LBS. (APPROX.) STRUCT. ST.	100%	1	6	4.5-100%				
73	12 H53 STEEL PILES	374.92 L.F.	2	70	374.92				
74	LINSEED OIL CONC. PROTECTION	41.06 gal.	2	74	41.0				
13-192	MAINTENANCE AND REMOVAL OF EXISTING STRUCTURE STA 10+35.50 (MODIFICATION)	100%			100%				Supplemental Agreement

THE FINAL ESTIMATE
N.C. PROJECT NO 8.2016601
F.A. PROJECT NO S-254(2)

(STRUCTURE ITEMS AND PROJECT
TOTALS CONTINUED FROM SHEET 67)

ITEM NO.	ITEM
65	DRY EXCAVATION
66	WET EXCAVATION
67	MAINTENANCE AND REMOVAL OF EXISTING STRUCTURE @ STA. 10+35.50
68	CLASS AA CONCRETE (BRIDGE)
69	CLASS A CONCRETE (BRIDGE)
70	CONCRETE HANDRAIL
71	REINFORCING STEEL (BRIDGE)
72	466,300 LBS. (APPROX.) STRUCTURAL STEEL
73	12 H 53 STEEL PILES
74	LINSEED OIL CONCRETE PROTECTION
13-192	MAINTENANCE AND REMOVAL OF EXISTING STRUCTURE @ STA 10+35.50 (MODIFICATION)

UNIT	QUANTITY	CONTRACT PRICE	AMOUNT
CU. YD.	143.00	10.00	1,430.00
CU. YD.	244.42	60.00	14,665.20
LUMP SUM	0%	8,500.00	0.00
CU. YD.	463.20	110.00	50,952.00
CU. YD.	318.032	110.00	34,983.52
LIN. FT.	915.25	16.00	14,644.00
LBS.	177,444	.14	24,842.16
LUMP SUM	100%	75,000.00	75,000.00
LIN. FT.	374.92	12.00	4,499.04
GAL.	41.0	15.00	615.00
LUMP SUM	100%	8,300.00	8,300.00

TOTAL STRUCTURE ITEMS: 231,072.59

ROADWAY ITEMS (Carried Forward) : 227,590.41 229,469.82

TOTAL CONTRACT: 458,663.00 460,542.41

LESS PREVIOUS PAYMENTS: 427,047.04

(1-19)
33

BALANCE DUE

\$ 14,911.84
\$ 28,507.75
\$ 31,715.96
\$ 33,495.37

I hereby certify that this
structure was built according
to plan except as noted herein.

Signed [Signature] Date 7-23-70
Resident Engineer

I hereby certify that I have
checked this estimate and that
it is true and correct according
to my best knowledge and belief.

Signed [Signature] Date 7-23-70
Resident Engineer

I hereby certify that I have
examined this estimate in detail
and that it is true and correct
according to my best knowledge
and belief.

Signed [Signature] Date 8-24-70
Division Engineer

