



STATE OF NORTH CAROLINA
DEPARTMENT OF TRANSPORTATION

ROY COOPER
GOVERNOR

J. ERIC BOYETTE
SECRETARY

DATE: February 5, 2021
TO: Mr. Mark Stafford, PE
 Division Engineer
 Division 12
FROM: Vacant
 Manager
 Geographic Information Systems Unit
SUBJECT: 2021 District 1 Road System Changes

The GIS Unit's Spatial Data Operations Group has been authorized to make the changes indicated below to the state road system. We request that you update the related maps and files in your offices and install appropriate road number signs, if necessary. If our system changes do not conform to the actual conditions in the field, please return this memorandum with recommendations.

Document Number	County	Approval Date
LRS_8741_02-21	CLEVELAND	10/09/2006

Questions or comments about changes should be referred to the GIS Help Desk at GISHelp@ncdot.gov.

Thank you for your assistance.

EAL

cc: BSIP
 Bridge Maintenance
 Division Right of Way
 IMG
 Pavement Management
 Permit Unit
 State Road Maintenance
 Traffic Engineering
 Traffic Surveys

MAILING ADDRESS:
 NC DEPARTMENT OF TRANSPORTATION
 GEOGRAPHIC INFORMATION SYSTEMS UNIT
 1521 MAIL SERVICE CENTER
 RALEIGH, NC 27699-1521

Telephone: (919) 707-2165
 FAX: 919-707-2210
 Customer Service: 1-877-368-4968
 Website: www.ncdot.gov

LOCATION:
 4101 CAPITAL BLVD.
 RALEIGH, NC 27604

2021 Road System Changes

Project Name: LRS_8741_02-21
Date: 10/09/2006
County: CLEVELAND

Additions


Route	Street Name	Mileage	Map
SR 1919		0.04	

Deletions

Route	Street Name	Mileage	Map
SR 1919		0.12	

Reassignments

Existing Route	New Route	Street Name	Mileage	Map
None				

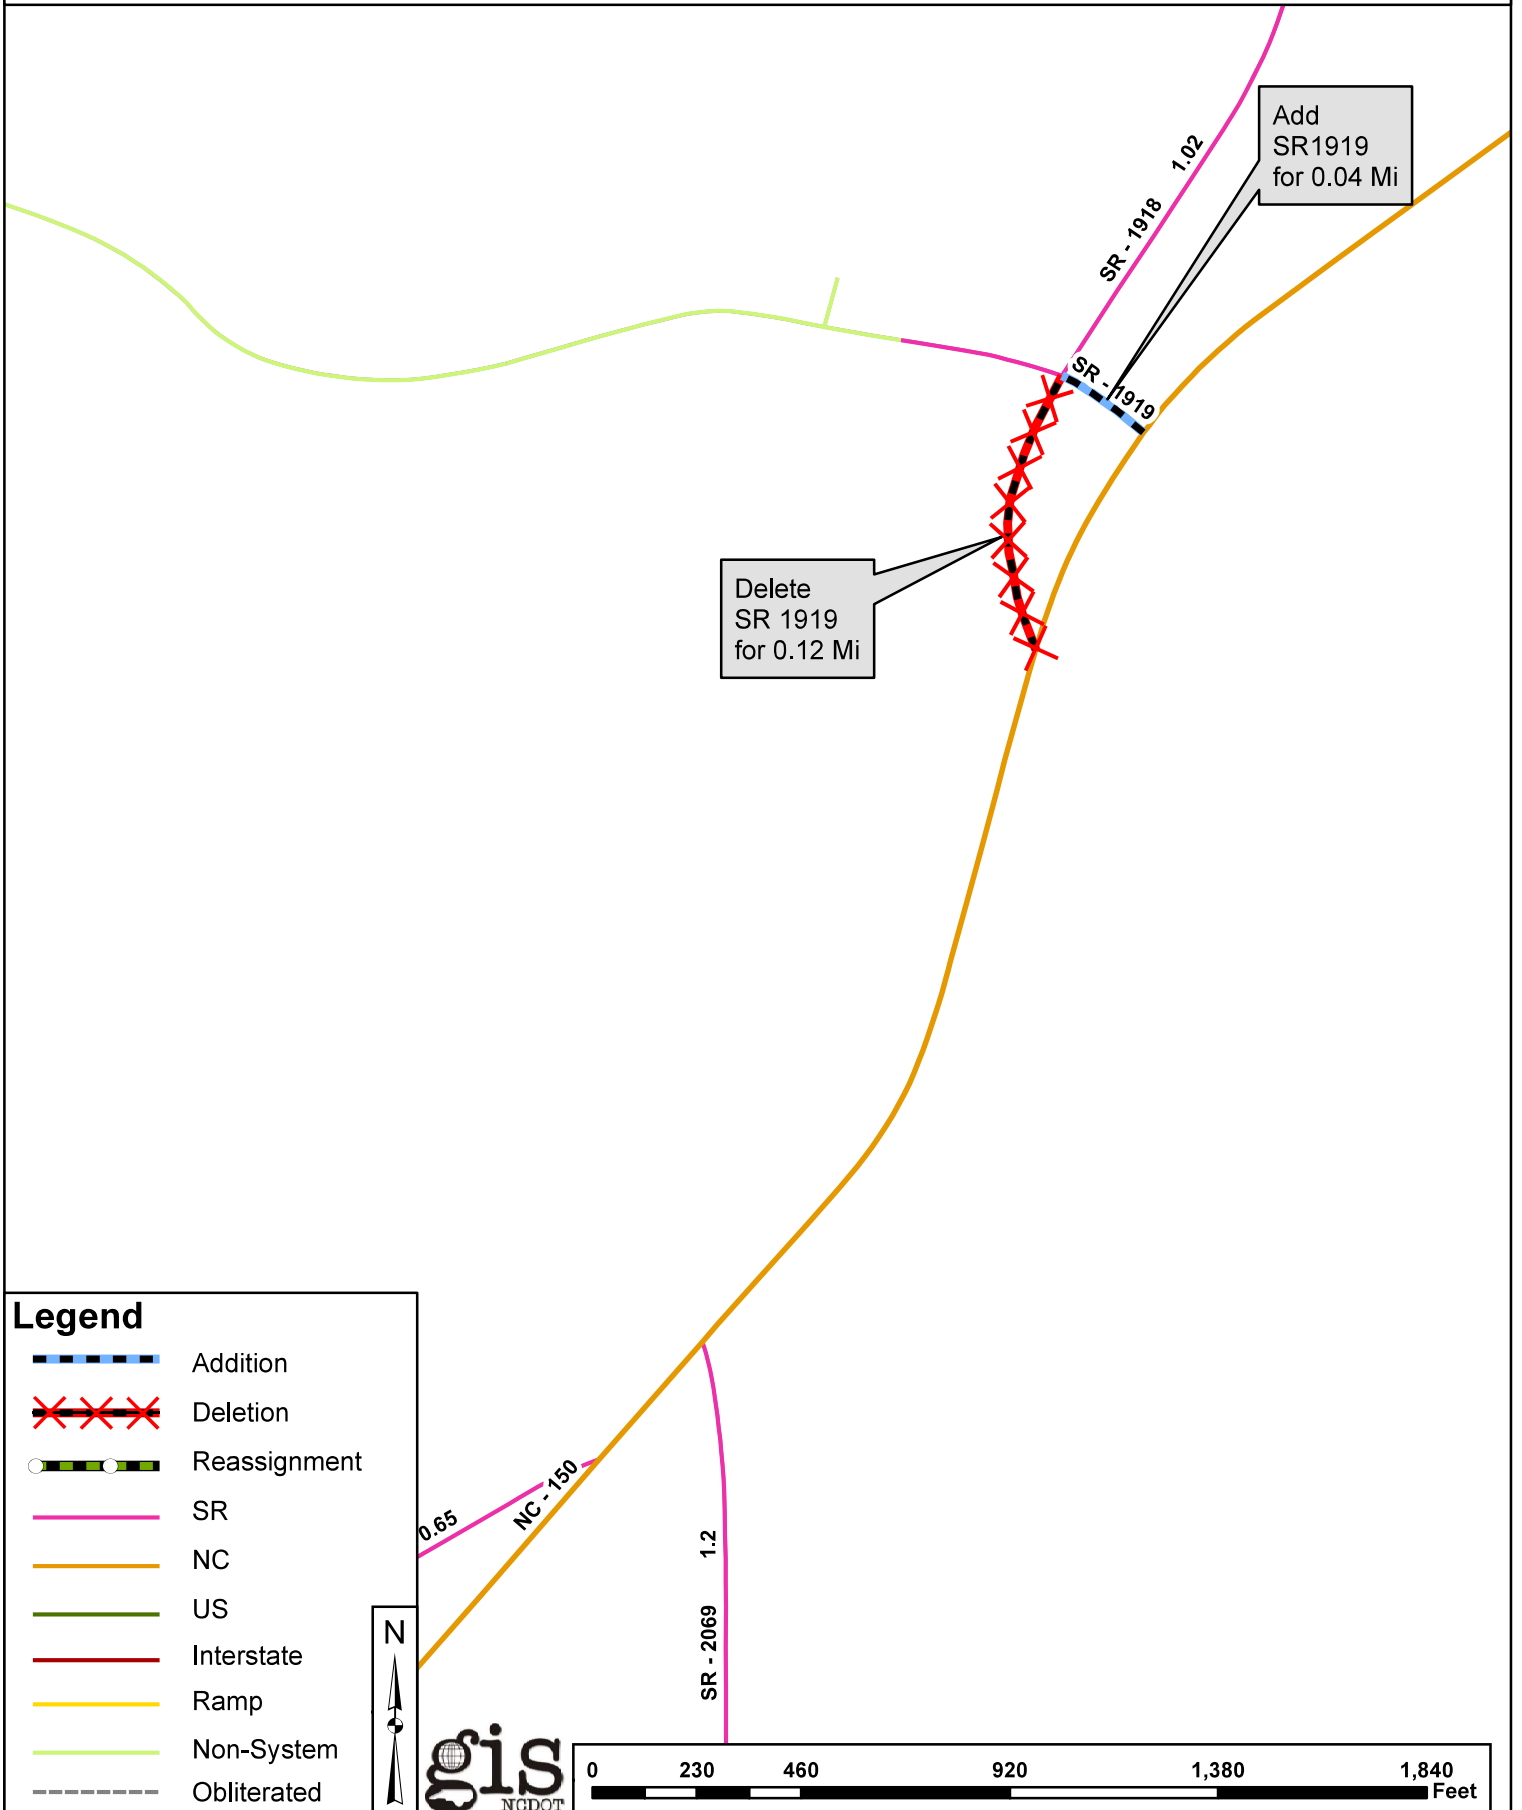

Add
SR1919
for 0.04 Mi

Delete
SR 1919
for 0.12 Mi

Legend

- Blue dashed line: Addition
- Red dashed line with X: Deletion
- Green dashed line with circle: Reassignment
- Pink line: SR
- Yellow line: NC
- Green line: US
- Red line: Interstate
- Yellow line: Ramp
- Light green line: Non-System
- Grey dashed line: Obliterated

gis
NGDOT

