



STATE OF NORTH CAROLINA
DEPARTMENT OF TRANSPORTATION

PATRICK MCCRORY
GOVERNOR

Tuesday, October 13, 2015

NICHOLAS J. TENNYSON
SECRETARY

MEMORANDUM TO: Mr. J. B. (Joel) Setzer, P.E.
Division Engineer
Division 14

FROM: John C. Farley, Manager
Geographic Information Systems Unit

SUBJECT: 2015 District 1 Road System Changes

The Data Conversion Group has been authorized to make the following changes to the state road system as indicated below. We request that you make similar changes to the related maps and files in your Division and District offices, and install appropriate road number signs if necessary. We have updated our records accordingly. If our system changes do not conform to the actual conditions in the field, please return this memorandum with recommendations.

PETITION	County	Approval Date
HENDERSON_2015_10_50909	HENDERSON	10/8/2015

Inquiries about changes should be referred to the GIS Help Desk at GISHelp@ncdot.gov. Thank you for your assistance.

JCF


- cc: BSIP
- Bridge Maintenance
- Division Right of Way
- IMG
- Pavement Management
- Permit Unit
- State Road Maintenance
- Traffic Engineering
- Traffic Surveys



2015 ROAD SYSTEM CHANGES

PETITION	COUNTY	APPROVAL DATE	ROUTE NUMBER	PORTION REASSIGNED TO	STREET NAME	LENGTH (miles)	TYPE OF CHANGE	REMARKS (See Attached Map)
HENDERSON_2015_10_509 09	HENDERSON	10/8/2015	SR 2421		SUMMERWIND RD	0.27	SYSTEM ADDITION VIA PETITION	

Add
SR 2421
Summerwind Rd
for 0.27 Mi

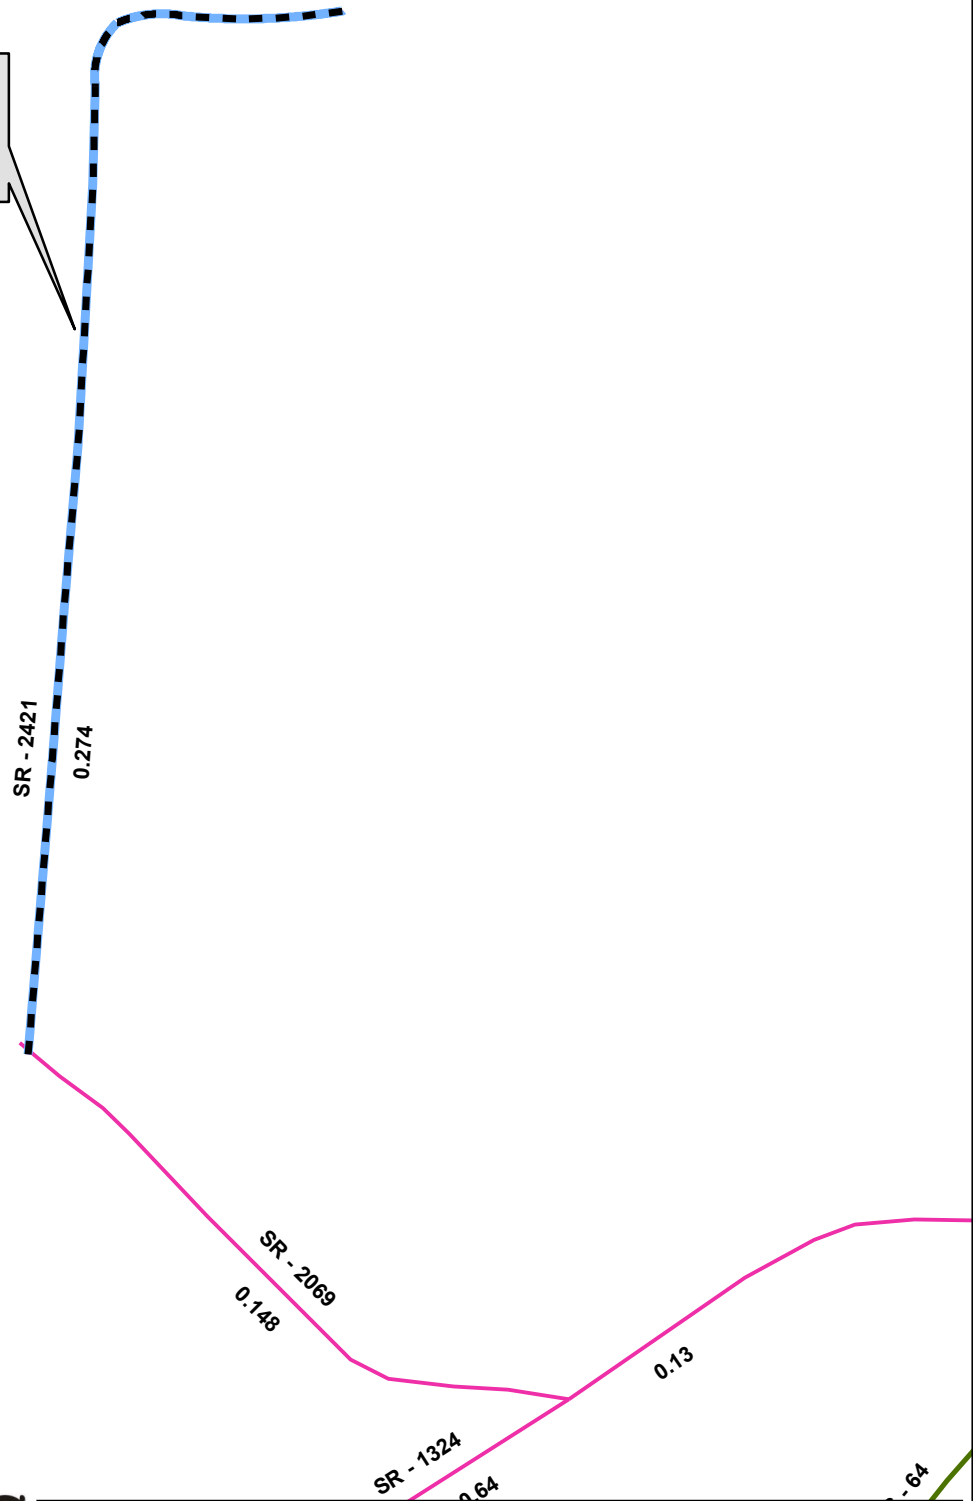

Legend

- Blue dashed line: Addition
- Red line with X's: Deletion
- Green dashed line with circles: Reassignment
- Pink line: SR
- Yellow line: NC
- Green line: US
- Red line: Interstate
- Yellow line: Ramp
- Light blue line: Non-System
- Grey dashed line: Obliterated

N

