



STATE OF NORTH CAROLINA  
DEPARTMENT OF TRANSPORTATION

PATRICK MCCRORY  
GOVERNOR

July 12, 2016

NICHOLAS J. TENNYSON  
SECRETARY

**MEMORANDUM TO:** Mr. Joseph R. Hopkins, PE  
Division Engineer  
Division 5

**FROM:** Mr. John C. Farley, GISP, CPM  
Manager  
Geographic Information Systems Unit

**SUBJECT:** 2016 District 1 Road System Changes

The GIS Unit's Data Conversion Group has been authorized to make the changes indicated below to the state road system. We request that you update the related maps and files in your offices and install appropriate road number signs, if necessary. If our system changes do not conform to the actual conditions in the field, please return this memorandum with recommendations.

Petition	County	Approval Date
WAKE_2016_06_51126	WAKE	6/30/2016

Questions or comments about changes should be referred to the GIS Help Desk at [GISHelp@ncdot.gov](mailto:GISHelp@ncdot.gov).  
Thank you for your assistance.

JCF

cc: BSIP  
Bridge Maintenance  
Division Right of Way  
IMG  
Pavement Management  
Permit Unit  
State Road Maintenance  
Traffic Engineering  
Traffic Surveys


---

# 2016 ROAD SYSTEM CHANGES

---

<b>PETITION</b>	<b>COUNTY</b>	<b>APPROVAL DATE</b>	<b>ROUTE NUMBER</b>	<b>PORTION REASSIGNED TO</b>	<b>STREET NAME</b>	<b>LENGTH (miles)</b>	<b>TYPE OF CHANGE</b>	<b>REMARKS (See Attached I</b>
WAKE_2016_06_51126	WAKE	6/30/2016	SR 1146		MT. ZION CHURCH RD	.08	SYSTEM DELETION VIA PETITION	

Delete  
SR 1146  
Mt. Zion Church Rd  
for 0.08 Mi

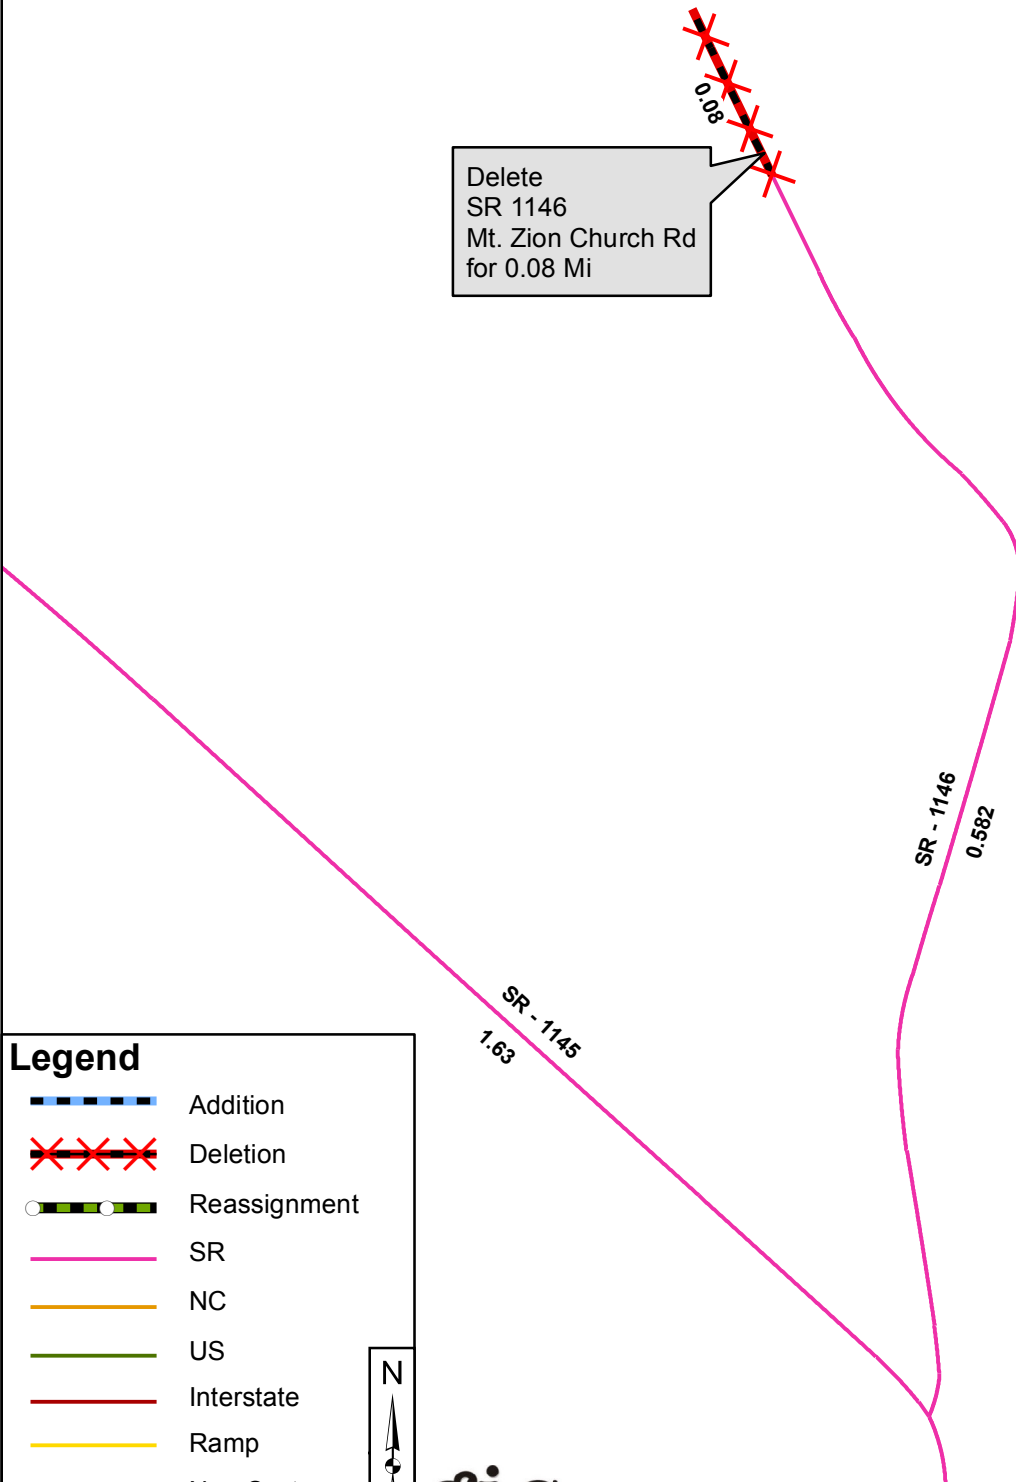

**Legend**

- Blue dashed line: Addition
- Red 'X' line: Deletion
- Black and white dashed line: Reassignment
- Pink line: SR
- Orange line: NC
- Green line: US
- Red line: Interstate
- Yellow line: Ramp
- Light brown line: Non-System
- Grey dashed line: Obliterated

N

gis NCDOT

0 245 490 980 1,470 1,960 Feet