



STATE OF NORTH CAROLINA
DEPARTMENT OF TRANSPORTATION

ROY COOPER
GOVERNOR

JAMES H. TROGDON, III
SECRETARY

DATE: November 28, 2018
TO: Mr. Michael A. Pettyjohn, PE
Division Engineer
Division 11
FROM: John C. Farley
Manager
Geographic Information Systems Unit
SUBJECT: 2018 District 3 Road System Changes

The GIS Unit's Data Conversion Group has been authorized to make the changes indicated below to the state road system. We request that you update the related maps and files in your offices and install appropriate road number signs, if necessary. If our system changes do not conform to the actual conditions in the field, please return this memorandum with recommendations.

Document Number	County	Approval Date
LRS 12149 11-18	WILKES	10/02/2018

Questions or comments about changes should be referred to the GIS Help Desk at GISHelp@ncdot.gov.

Thank you for your assistance.

JCF

cc: BSIP
Bridge Maintenance
Division Right of Way
IMG
Pavement Management
Permit Unit
State Road Maintenance
Traffic Engineering
Traffic Surveys

MAILING ADDRESS:
NC DEPARTMENT OF TRANSPORTATION
GEOGRAPHIC INFORMATION SYSTEMS UNIT
1521 MAIL SERVICE CENTER
RALEIGH, NC 27699-1521

Telephone: (919) 707-2165
FAX: 919-707-2210
Customer Service: 1-877-368-4968
Website: www.ncdot.gov

LOCATION:
4101 CAPITAL BLVD.
RALEIGH, NC 27604

2018 Road System Changes

Petition Name: LRS_12149_11-18
Date: 10/02/2018
County: WILKES

Additions


Route	Street Name	Mileage	Map
None			

Deletions

Route	Street Name	Mileage	Map
SR 2471	GOLD MEDAL ORCHARD RD	0.18	

Reassignments

Existing Route	New Route	Street Name	Mileage	Map
None				

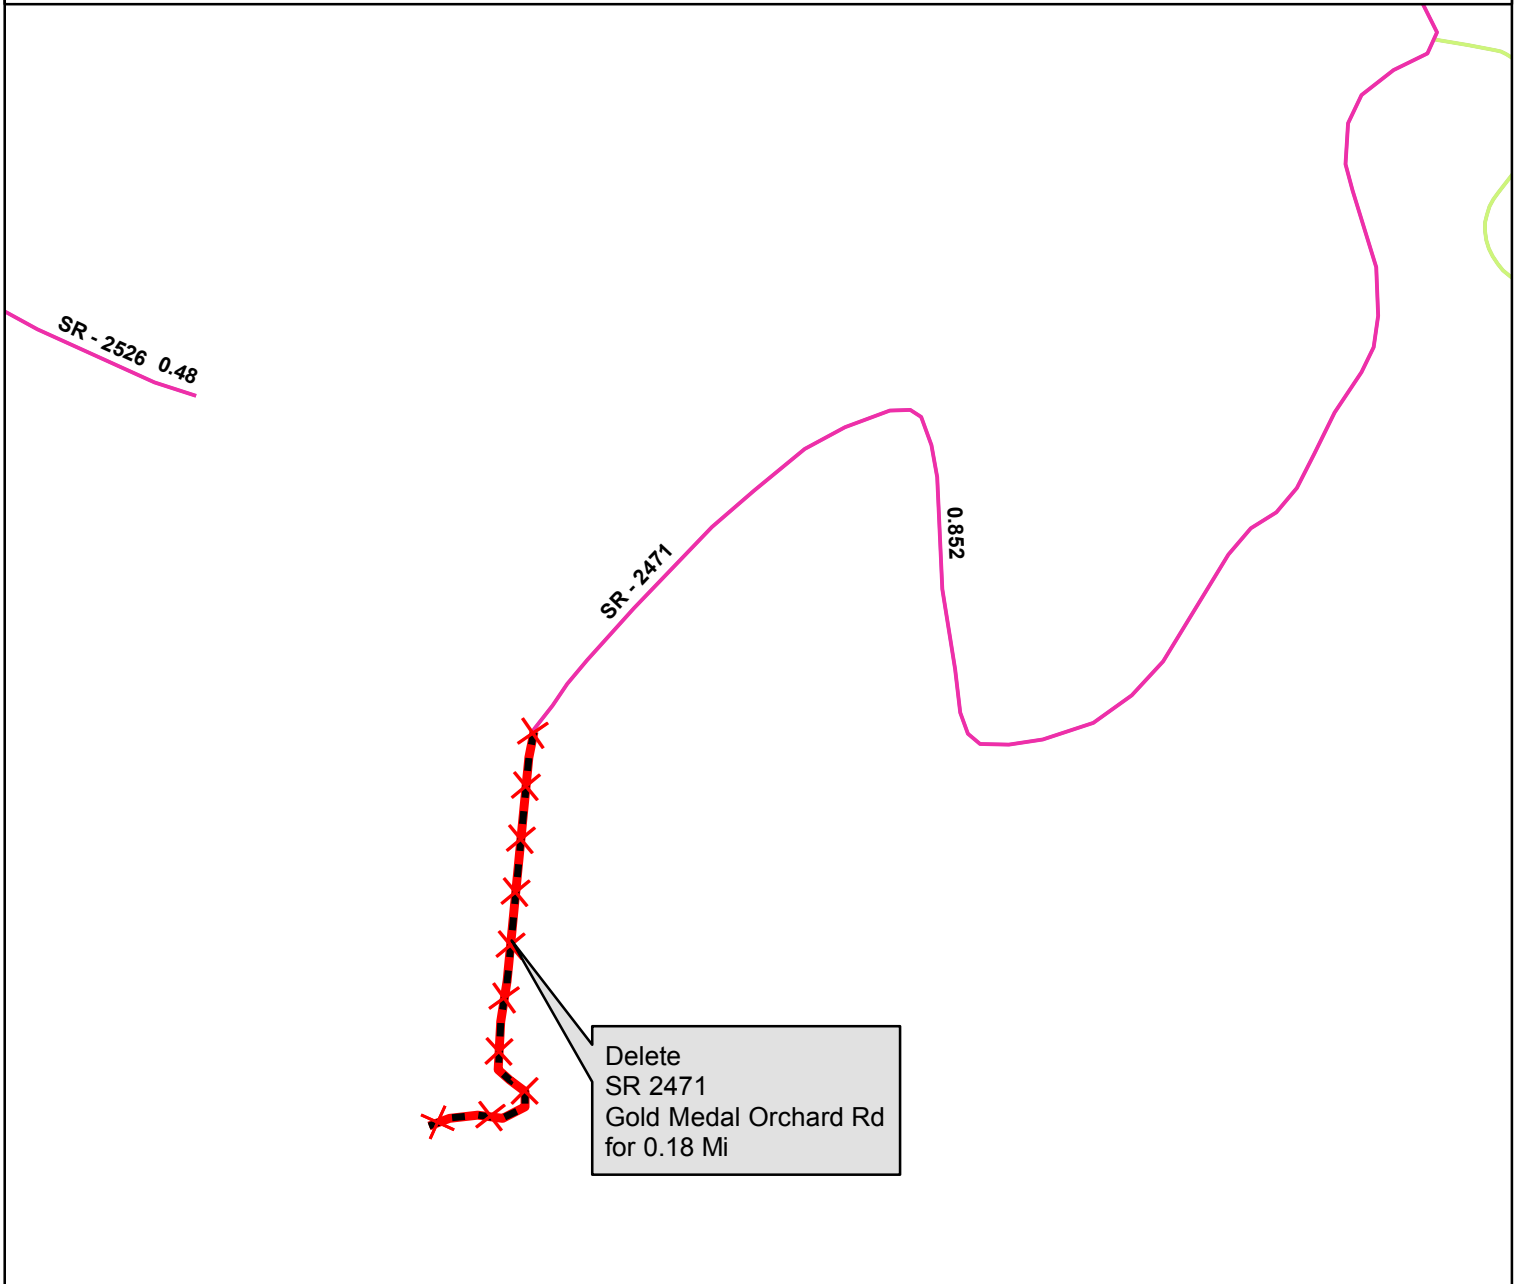

Legend

- Blue dashed line: Addition
- Red 'X' line: Deletion
- Black and white dashed line: Reassignment
- Pink line: SR
- Orange line: NC
- Green line: US
- Red line: Interstate
- Yellow line: Ramp
- Light green line: Non-System
- Grey dashed line: Obliterated

N

