



STATE OF NORTH CAROLINA  
DEPARTMENT OF TRANSPORTATION

JOSH STEIN  
GOVERNOR

DANIEL H. JOHNSON  
SECRETARY

**DATE:** June 10, 2026

**TO:** Rebecca J Gallas, PE  
Division Engineer  
Division 5

**FROM:** Erin Lesh, GISP  
Supervisor, Spatial Data Operations Group  
Geographic Information Systems Unit

**SUBJECT:** 2026 District 3 Road System Changes

The GIS Unit's Spatial Data Operations Group has been authorized to make the changes indicated below to the state road system. We request that you update the related maps and files in your offices and install appropriate road number signs, if necessary. If our system changes do not conform to the actual conditions in the field, please return this memorandum with recommendations.

Document Number	County	Approval Date
Franklin_2026_06_53383	FRANKLIN	06/04/2026

Questions or comments about changes should be referred to the GIS Help Desk at GISHelp@ncdot.gov.

Thank you for your assistance.

EAL

- cc: BSIP  
Bridge Maintenance  
Division Right of Way  
IMG  
Pavement Management  
Permit Unit  
Rail Coordination & Safety  
State Road Maintenance  
Traffic Engineering  
Traffic Surveys

**MAILING ADDRESS:**

NC DEPARTMENT OF TRANSPORTATION  
GEOGRAPHIC INFORMATION SYSTEMS UNIT  
1521 MAIL SERVICE CENTER  
RALEIGH, NC 27699-1521

Telephone: (919) 707-2165  
FAX: 919-707-2210  
Customer Service: 1-877-368-4968  
Website: www.ncdot.gov

**LOCATION:**

1020 BIRCH RIDGE DR  
RALEIGH, NC 27610

# 2026 Road System Changes

---

**Petition Name:** Franklin\_2026\_06\_53383

**Date:** 06/04/2026

**County:** FRANKLIN

## Additions

<b>Route</b>	<b>Street Name</b>	<b>Mileage</b>	<b>Map</b>
SR 2188	NEW LIBERTY DR	0.12	
SR 2189	GUARDIAN ST	0.32	
SR 2190	ACCORD DR	0.16	
SR 2191	BOLD DR	0.28	

## Deletions

### Route

---

None

---


## Reassignments

### Route

---

None

---

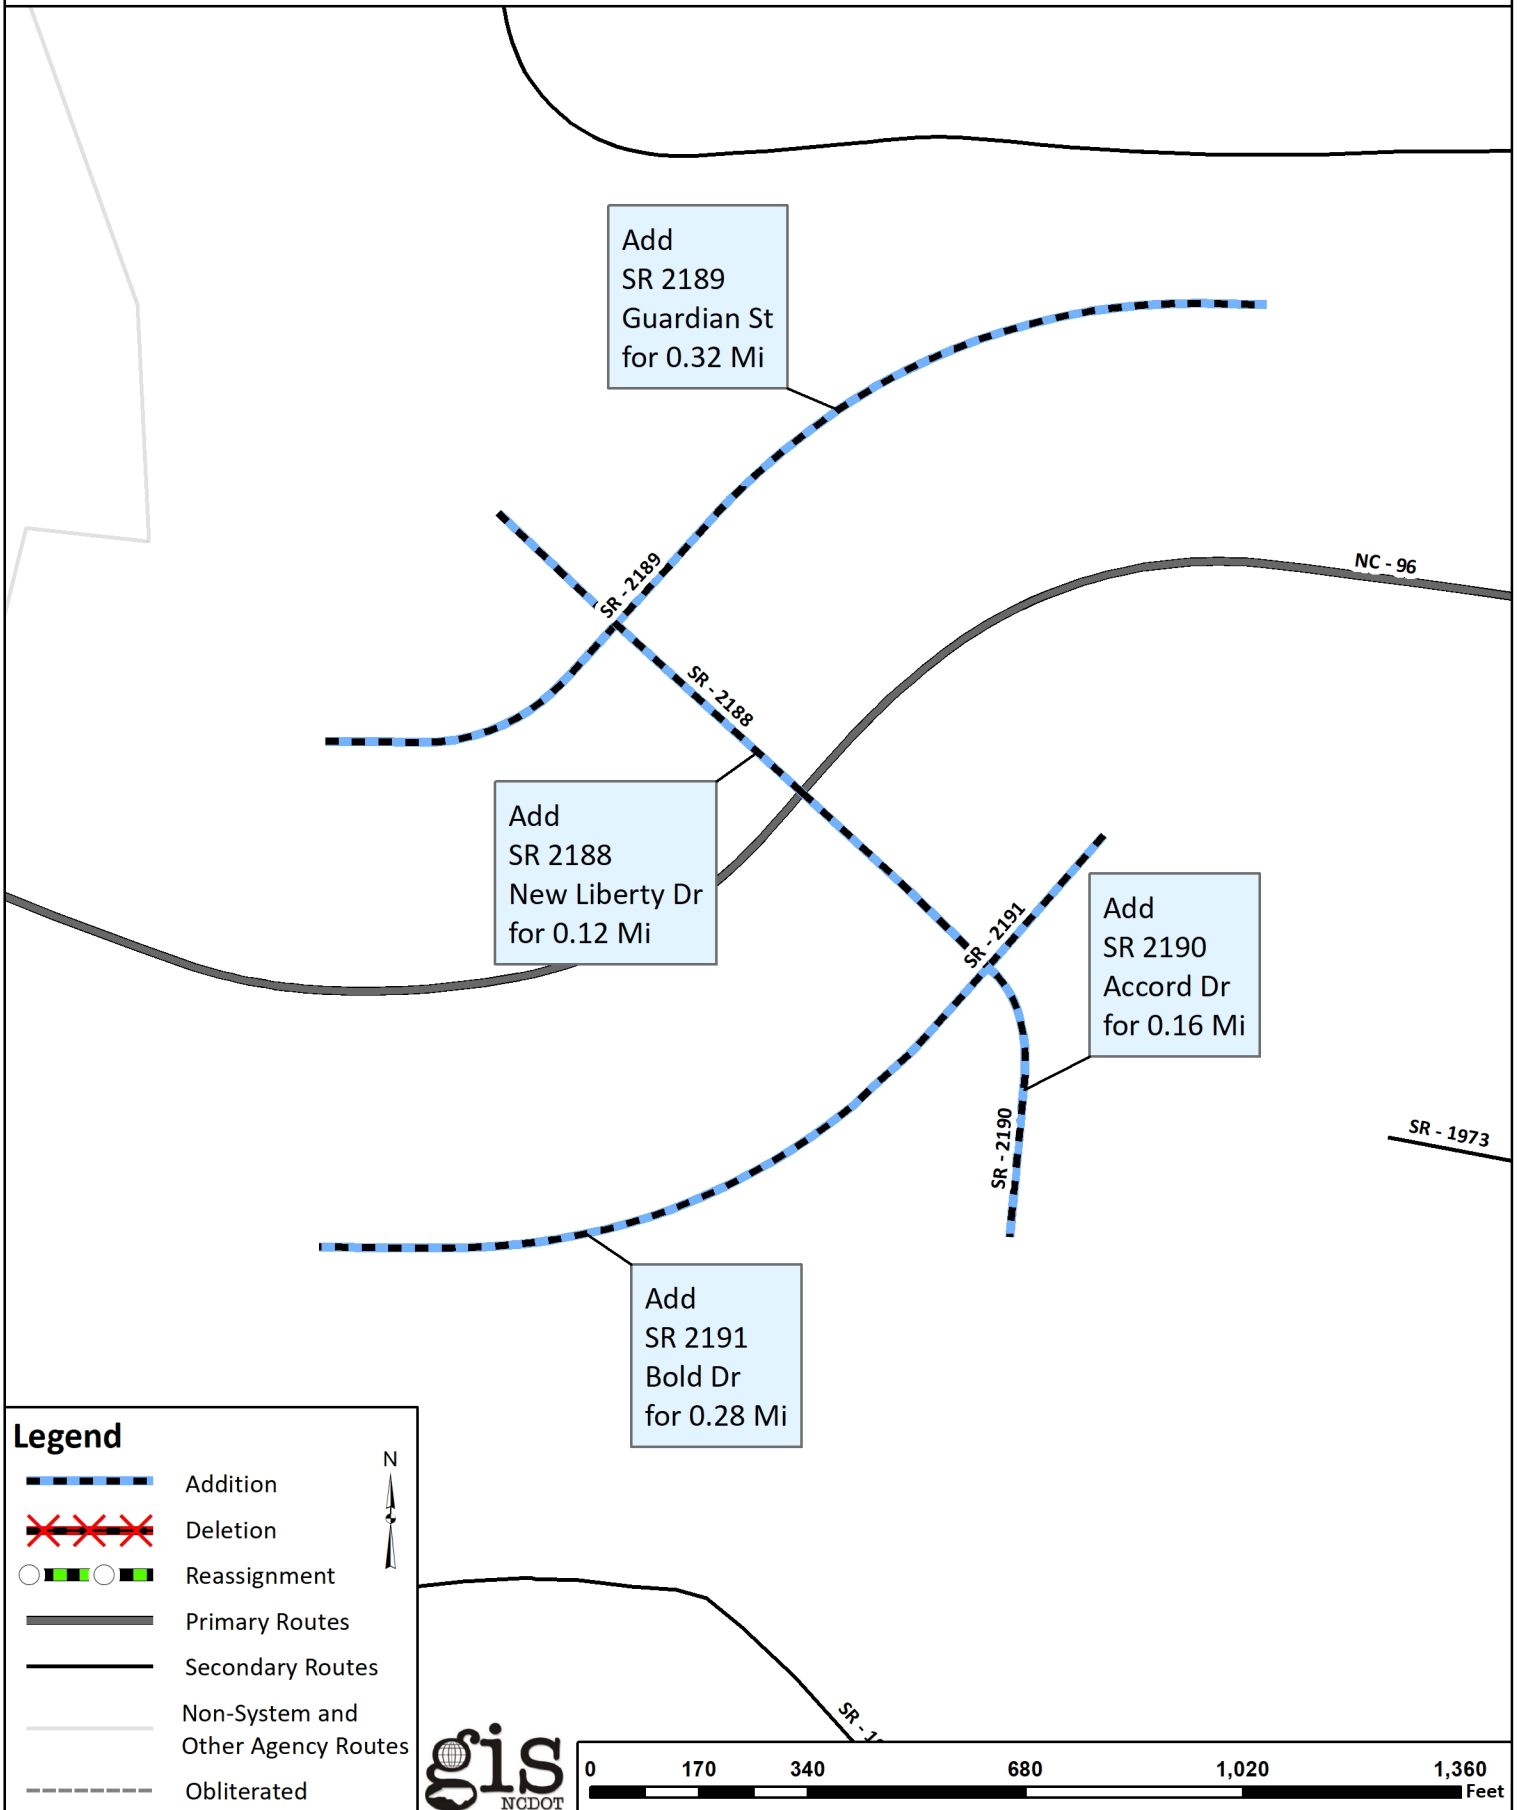

Add  
SR 2189  
Guardian St  
for 0.32 Mi

Add  
SR 2188  
New Liberty Dr  
for 0.12 Mi

Add  
SR 2190  
Accord Dr  
for 0.16 Mi

Add  
SR 2191  
Bold Dr  
for 0.28 Mi

**Legend**

- Blue dashed line: Addition
- Red line with X's: Deletion
- Green dashed line: Reassignment
- Thick black line: Primary Routes
- Thin black line: Secondary Routes
- Thin grey line: Non-System and Other Agency Routes
- Grey dashed line: Obliterated

gis  
NCDOT

