

Rivenbark, Chris

From: Ward, Garcy
Sent: Wednesday, August 21, 2013 4:32 PM
To: Wheeler, Tracey L SAW; Rivenbark, Chris; Willis, Thomas C
Cc: Biddlecome, William J SAW; Williams, Paul C; Ward, Garcy
Subject: RE: B-4599 Knobb's Creek, Pasquotank County (UNCLASSIFIED)

Chris,

This e-mail serves as authorization from DWR to remove the identified 'danger trees' in accordance with the conditions stated in your e-mail dated June 25, 2013 and per the Corps e-mail below.

Thanks,

Garcy Ward
Environmental Senior Specialist
North Carolina Division of Water Resources Washington Regional Office

-----Original Message-----

From: Wheeler, Tracey L SAW [<mailto:Tracey.L.Wheeler@usace.army.mil>]
Sent: Friday, August 16, 2013 12:13 PM
To: Rivenbark, Chris; Willis, Thomas C
Cc: Biddlecome, William J SAW; Ward, Garcy; Williams, Paul C
Subject: RE: B-4599 Knobb's Creek, Pasquotank County (UNCLASSIFIED)

Classification: UNCLASSIFIED

Caveats: NONE

Chris,

Per your June 25, 2013 request, DoD permit SAW-2009-01088 has been revised to allow hand clearing of approximately 70 trees in jurisdictional wetlands. The trees are being removed to protect power lines. This authorization is only for the removal of mature trees and does not permit clear cutting in the area. Please feel free to contact me if you have additional questions.

Tracey L. Wheeler
Regulatory Project Manager
U.S. Army Corps of Engineers
Washington Regulatory Field Office
2407 West 5th Street
Washington, North Carolina 27889
(910) 251-4627

The Wilmington District is committed to providing the highest level of support to the public. To help us ensure we continue to do so, please complete the Customer Satisfaction Survey located at our website at <http://regulatory.usacesurvey.com/> to complete the survey online.

From: Rivenbark, Chris

Rivenbark, Chris

From: Williams, Paul C
Sent: Wednesday, August 14, 2013 10:13 AM
To: Rivenbark, Chris; william.j.biddlecome@usace.army.mil; Ward, Garcy
Cc: Brittingham, Cathy; Manley, Chris
Subject: RE: B-4599 Knobb's Creek, Pasquotank County

DCM approves of the hand clearing of the "danger trees" in wetlands as described in your message. This email serves as authorization for this modification to your project.

Please contact me if you have any questions or revisions on the plan.

Thanks,

Paul C. Williams, Jr.

DOT Project Field Representative
N.C. Dept. of Environment & Natural Resources
Division of Coastal Management
1367 U.S. 17 South
Elizabeth City, NC 27909
Office: (252)264-3901
Mobile: (252)506-5494
Fax: (252)264-3723
paul.williams@ncdenr.gov

E-mail correspondence to and from this address may be subject to the North Carolina Public Records Law and may be disclosed to third parties.

Please complete the DENR Customer Service Survey by May 31 to give us feedback on how we are doing and how we can improve: <https://www.surveymonkey.com/s/2013DENRCustomerService>


Please contact eac@ncdenr.gov if you have problems accessing the survey.

From: Rivenbark, Chris
Sent: Tuesday, June 25, 2013 1:43 PM
To: william.j.biddlecome@usace.army.mil; Williams, Paul C; Ward, Garcy
Cc: Brittingham, Cathy; Manley, Chris
Subject: B-4599 Knobb's Creek, Pasquotank County

Several "danger trees" in wetlands will need to be removed as a result of utility relocations. All trees will be hand cleared above ground surface, no grubbing or grinding of stumps will take place. The contractor will mat access into the trees to cut as well. This is similar to the clearing that was needed on the R-2583 project.

The attached DangerTrees.pdf shows the proposed clearing of approximately 104 trees (60 pg1, 44 pg2) selected for clearing. At this time, an accurate count is not available for the area shown danger trees str6.pdf however approximately 70 trees will be cleared in the area shown between the yellow line and the nearest red line.

There are approximately 76 danger trees to cut. Less than 40% canopy reduction.

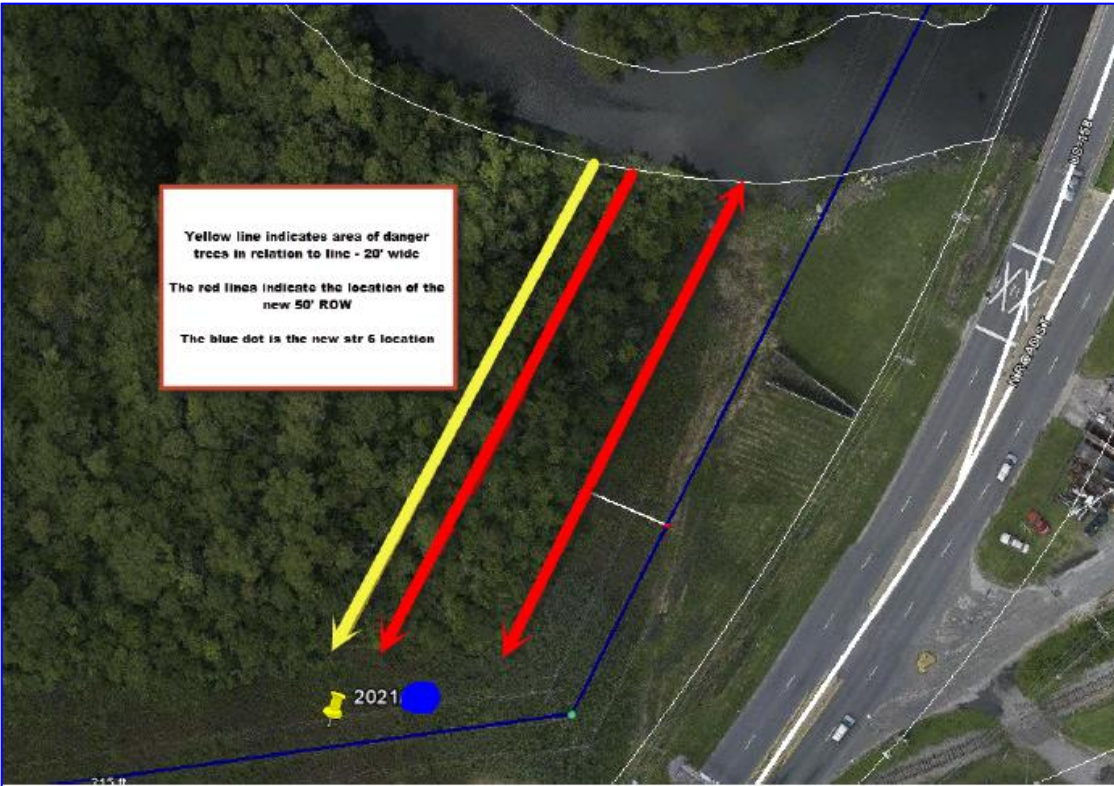



MARKED DANGER TREES AS LOCATED 12/13/12

NEW NCDOT P.U.E.

NEW CENTERLINE - TL-2021

EXISTING CENTERLINE - TL-2021

NEW NCDOT R/W MARGIN

EXISTING TL-2021 R/W MARGIN


NORTH ROAD ST. (US 17 BUS.)

EXIST. TL-2021 R/W MARGIN

60'

DOMINION NC POWER RICHMOND, VIRGINIA			
TL-2021 -- KNOBBS CREEK REROUTE DANGER TREE LOCATION			
Booth&Associates Inc. 5811 Glenwood Avenue Raleigh, NC 27612 CONSULTING ENGINEERS NC F-0221			
DWN.	MEC	DATE:	12/17/12
CKD.	DSH	APPD.	
SCALE:	1" = 50'	12-7339	
DATE	REVISION	DATE	REVISION

DWG. NO.
1 OF 2

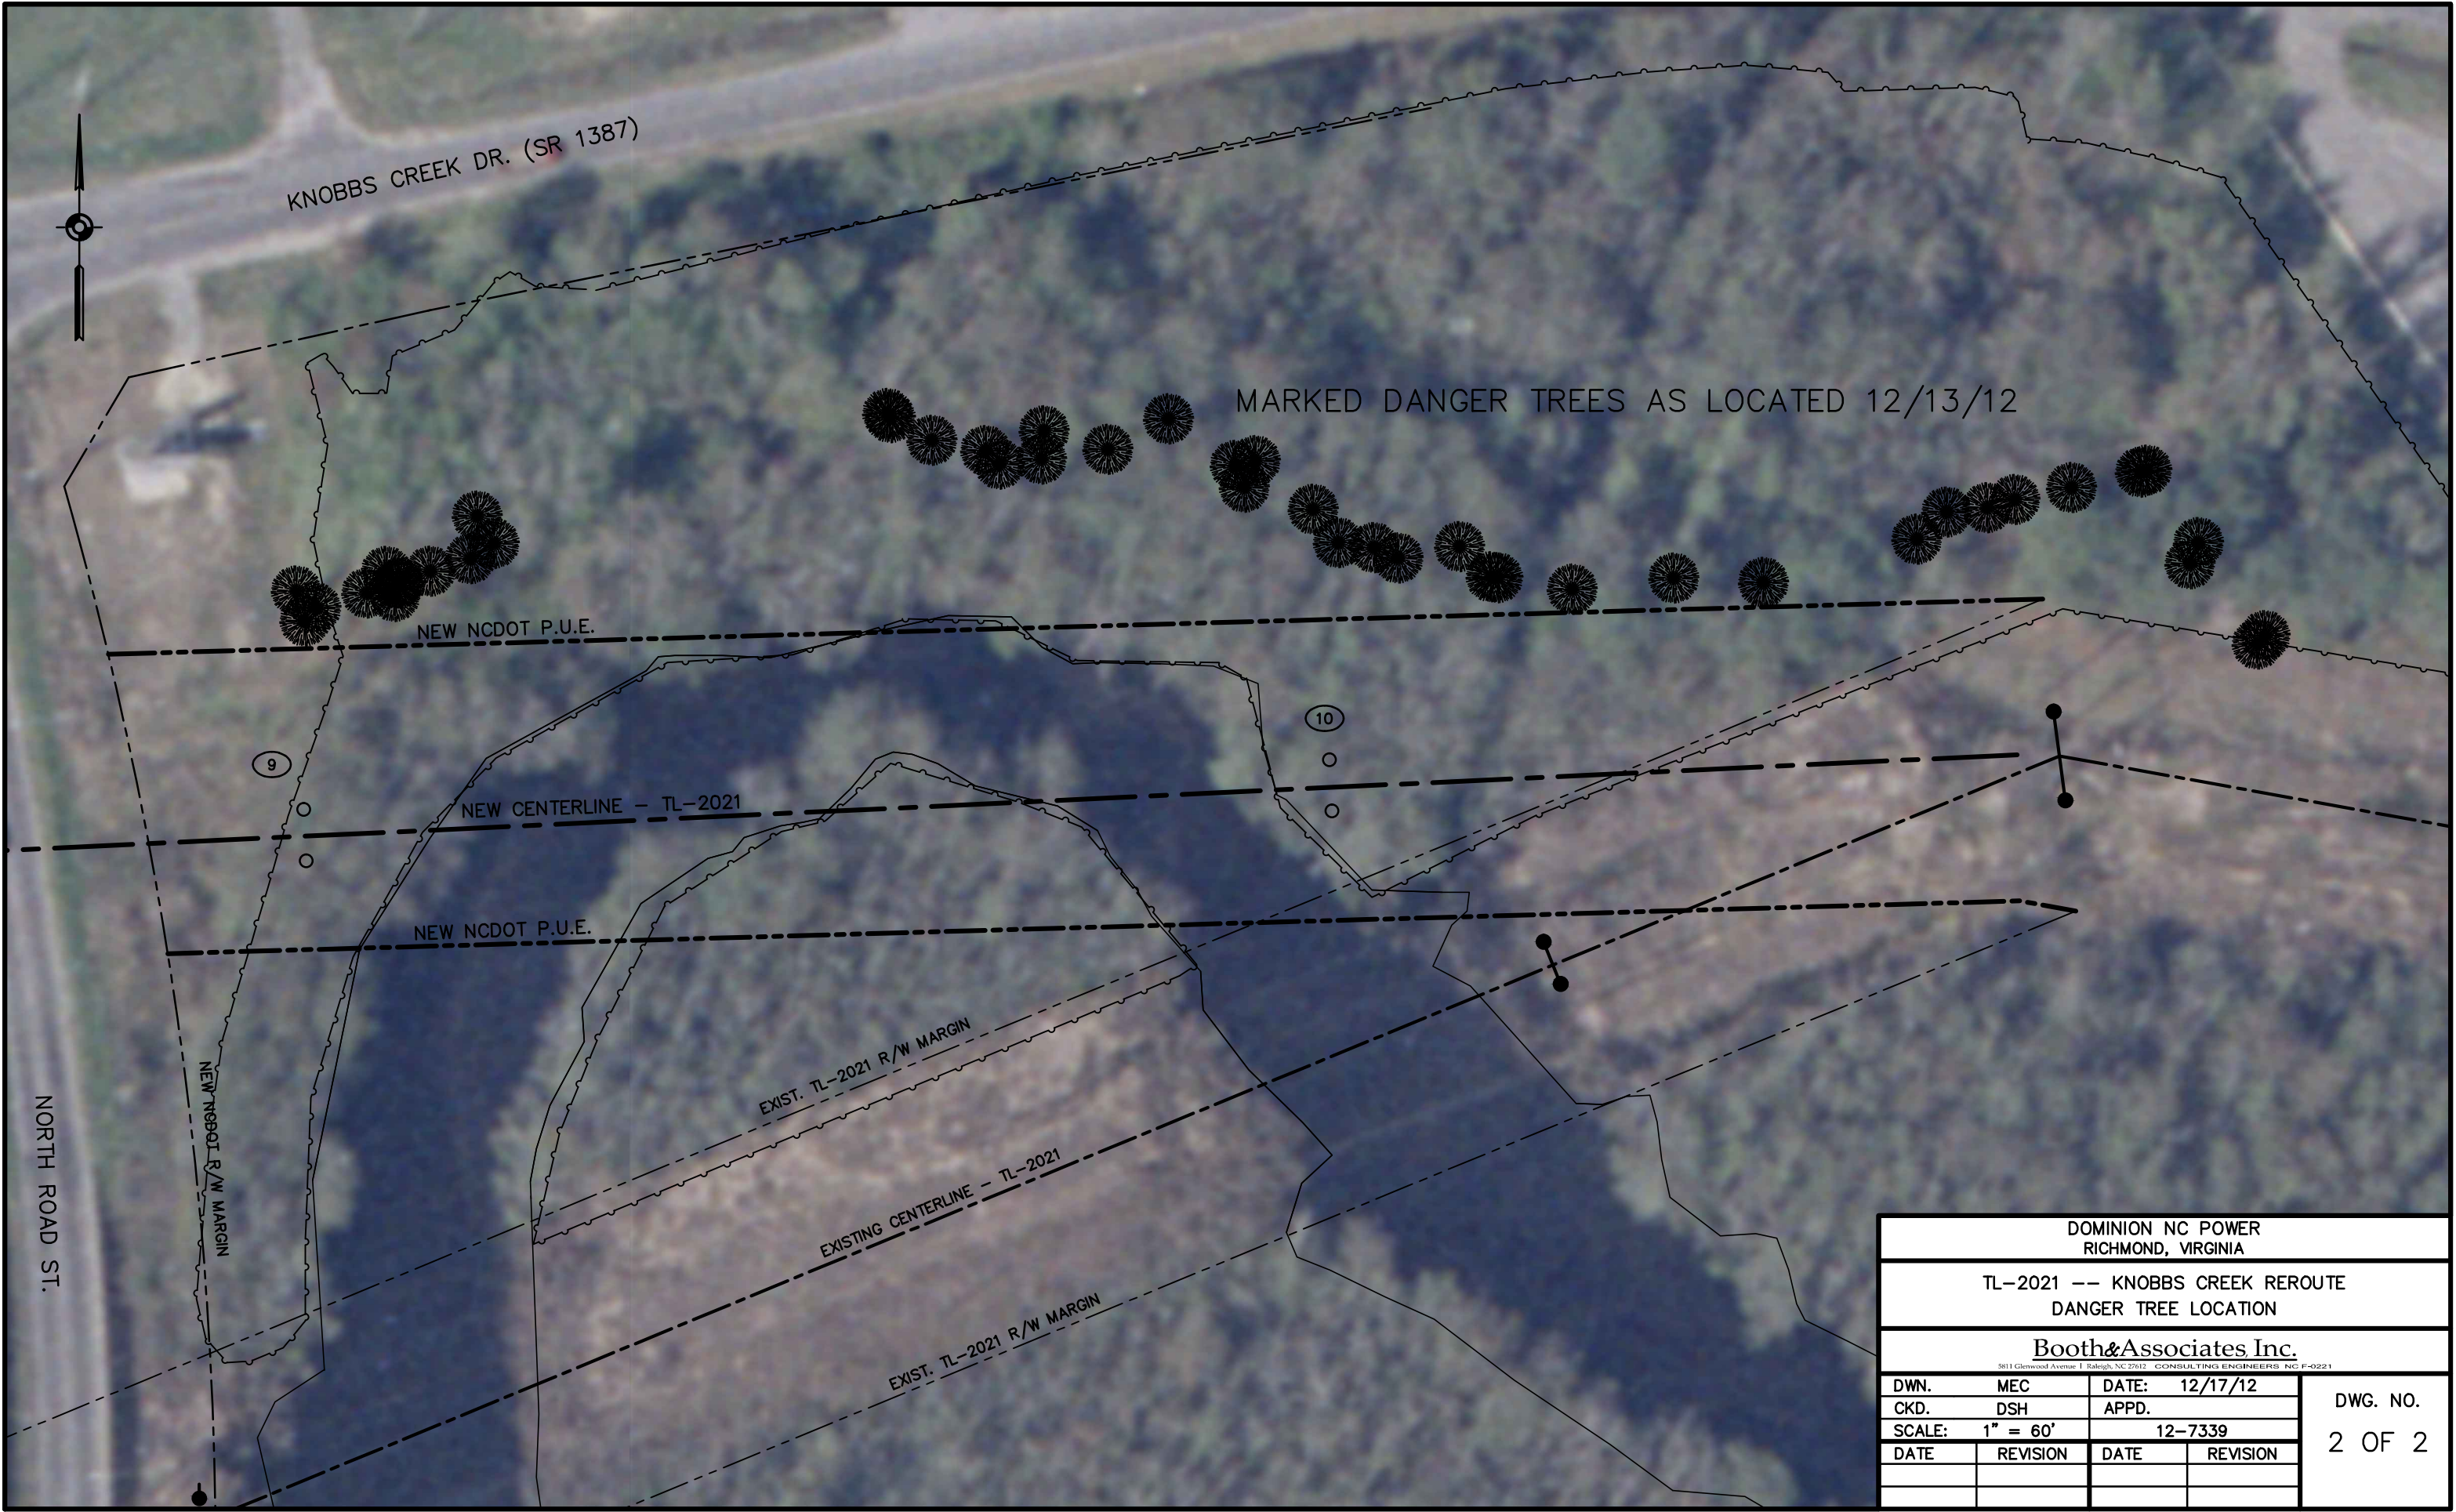

DOMINION NC POWER RICHMOND, VIRGINIA			
TL-2021 -- KNOBBS CREEK REROUTE DANGER TREE LOCATION			
Booth&Associates Inc. 5811 Glenwood Avenue Raleigh, NC 27612 CONSULTING ENGINEERS NC F-0221			
DWN.	MEC	DATE:	12/17/12
CKD.	DSH	APPD.	
SCALE:	1" = 60'	12-7339	
DATE	REVISION	DATE	REVISION
DWG. NO. 2 OF 2			