



STATE OF NORTH CAROLINA
DEPARTMENT OF TRANSPORTATION

PAT L. MCCRORY
GOVERNOR

ANTHONY J. TATA
SECRETARY

May 8, 2013

Charles Waklid
NC Division of Water Quality
Transportation and Permitting Unit
1650 Mail Service Center
Raleigh, NC 27699-1617

Subject: **Response to On Hold Letter** for request for Section 401 Water Quality Certification Modification, Wilmington Bypass from north of US 74/76 in Brunswick County to US 421 in New Hanover County. DWQ Project No. 10-0867v.4. TIP R-2633B.

Reference: NCDOT Modification Request, dated April 3, 2013
NCDWQ On Hold Letter, dated April 19, 2013, received April 26, 2013

Dear Sir:

Per the above-referenced On-Hold letter, the N.C. Department of Transportation (NCDOT) has reviewed your comments and addressed the issues identified. A copy of the letter is included for your convenience. We respectfully provide the following responses:

1. *Sites 3 & 5 – the cross section station numbers do not match the station numbers on the plan sheet. Also, the match line station numbers do not match the stations on the plan sheet. The station numbers in the impact summary and on the plan sheets run from 40+57 to 75+00 but the cross section numbers are listed as 345+00 to 375+00. Please change the cross section station and match line stations to coincide with the stations along the –L– line on the plan sheets.*

The station numbers on the impact summary sheet have been revised for sites 3 & 5. A slight change in the design for R-2633A resulted in the need for a geometric alignment shift for R-2633 BA (LREV) to tie the two sections together. Both sets of stations are correctly shown on the Permit Drawing Sheets 2, 3, 9 & 10 and an equality point is provided on Permit Drawing Sheets 9 & 10.

2. *Site 6 – no cross sections were provided for the wetland impacts between Sta. 109+28 to 118+00 and 123+00 to 135+00. Please provide these cross sections.*

Representative cross sections were provided in the application. Nevertheless, additional cross sections are enclosed, providing a larger sampling of cross sections in jurisdictional areas.

3. *Your application states in the Avoidance and Minimization section that 3:1 slopes will be used in wetland areas to minimize wetland impacts. Upon review of the application there are several cross sections that show greater than 3:1 slopes. Please correct.*

Sites 3, 5 & 6 permit drawings, cross sections, and impact summary sheet have been revised and are enclosed. As a result, proposed permanent fill has decreased at these sites by 1.42 acres. Additionally, we will submit a revised request to EEP for an updated acceptance letter.

4. *Site 7 (permit drawings 27/28), a wetland boundary limit is shown on the cross sections beyond the clearing limits however the plan sheets show that the entire right of way is within the wetland. Please clarify.*

The wetland boundary limits are outside of the fill slopes. A note has been added to the cross sections. Revised sheets for Site 7 (Permit drawings 27 and 28) are enclosed.

5. *Site 15 (permit drawing 43/44), please confirm that the impacts for the base ditch on the north side of the bridge are include in the Site 15 impacts listed in the impact summary sheet.*

The ditch impacts were included in the Site 15 impacts on the previously submitted wetland summary sheet.


6. *Has DOT received confirmation from USFWS that suitable habitat for Carex lutea does not exist within the project limits? Please provide a copy of correspondence to this affect.*

NCDOT conducted surveys on January 8, 2013, verifying that there is no suitable habitat for *Carex lutea*. As a result, NCDOT has issued a No Effect call. The NCDOT has a programmatic agreement with the USFWS, which precludes the need for project-specific Section 7 concurrence with No Effect calls. Therefore, the requirements of the federal Endangered Species Act have been met.

We believe that this new information addresses your concerns regarding the project and request that you to proceed with processing the permit application. A copy of this On-Hold response packet will be posted on the NCDOT Website <https://connect.ncdot.gov/resources/Environmental/Pages/>

If you have any questions or need additional information, please contact Rachelle Beauregard at rbeauregard@ncdot.gov or (919) 707-6105.

Sincerely,

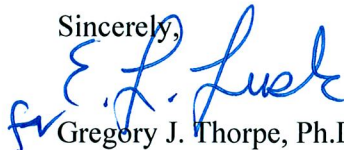

Gregory J. Thorpe, Ph.D., Manager
Project Development and Environmental Analysis Unit

cc:

Brad Shaver, USACE
Mason Herndon, NCDWQ
Stoney Mathis, Division 3 Environmental Officer
Travis Wilson, NC Wildlife Resources Commission
Chris Militscher, Environmental Protection Agency
Steve Sollod, NC Division of Coastal Management
Gary Jordan, US Fish and Wildlife Service
Sonia Carrillo, NCDWQ Central Office



North Carolina Department of Environment and Natural Resources

Pat McCrory
Governor


Division of Water Quality
Charles Wakild, P. E.
Director

John E. Skvarla, III
Secretary

April 19, 2013

CERTIFIED MAIL - RETURN RECEIPT REQUESTED

Dr. Greg Thorpe, PhD., Manager
Project Development and Environmental Analysis
North Carolina Department of Transportation
1598 Mail Service Center
Raleigh, North Carolina, 27699-1598

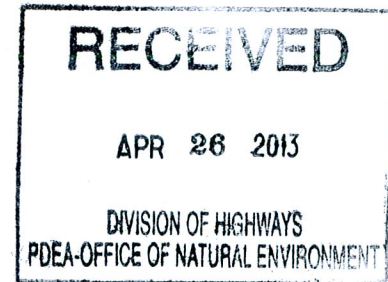

Subject: Request for Modification to Individual Section 404 and Section 401 Water Quality Certification for the Wilmington Bypass from north of US 74/76 in Brunswick County to US 421 in New Hanover County. Federal Aid Project Nos. NHF-0017 (96) and STM-0017(97), WBS No. 34491.2.3, TIP No. R-2633B, DWQ Project No. 10-0867v.4

Dear Dr. Thorpe:

The Division of Water Quality has reviewed your submittal for a 401 Water Quality Certification modification for the aforementioned project. Review of your application revealed it lacking necessary information required for making an informed permit decision. The permit application was deficient in the following areas:

1. Sites 3 & 5 – the cross section station numbers do not match the station numbers on the plan sheet. Also, the match line station numbers do not coincide with the stations on the plan sheet. The station numbers in the impact summary and plan sheets run from Sta. 40+57 to 75+00 but the cross section numbers are listed as Sta. 345+00 to 375+00. Please change the cross section stations and match line stations to coincide with the stations along the -L- line on the plan sheets.
2. Site 6 – no cross sections were provided for the wetland impacts between Sta. 109+28 to 118+00 and 123+00 to 135+00. Please provide these cross sections.
3. Your application states in the "Avoidance and Minimization" section that 3:1 slopes will be used in wetland areas to minimize wetland impacts. Upon review of the application there are several cross sections that show greater than 3:1 slopes. Please correct.
4. Site 7 (permit drawings 27 /28), a wetland boundary limit is shown on the cross sections beyond the clearing limits however the plan sheets show that the entire right of way is within the wetland. Please clarify.
5. Site 15 (permit drawing 43/44), please confirm that the impacts for the base ditch on the north side of the bridge are include in the Site 15 impacts listed in the impact summary sheet.
6. The "Protected Species" section of the application states that Golden Sedge (*Carex Lutea*) was added to the USFWS list for New Hanover County just prior to the submittal of the original application and therefore was not included in the FEIS. Has NCDOT received correspondence from USFWS that concurs with NCDOT's recommendation that there is no suitable habitat for *Carex lutea* within the project limits and therefore the project will have "No Effect" on Golden Sedge? Please provide a copy of correspondence to this affect.

Therefore, pursuant to 15A NCAC 2H .0507(a) (5), we will have to place the permit application on hold until we are supplied the necessary information. You have 21 days to respond in writing with the requested information or notification to this office that the information is forthcoming. If, at the end of the 21 days, this office has not

Transportation and Permitting Unit
1650 Mail Service Center, Raleigh, North Carolina 27699-1617
Location: 512 N. Salisbury St. Raleigh, North Carolina 27604
Phone: 919-807-6300 \ FAX: 919-807-6492
Internet: www.ncwaterquality.org


An Equal Opportunity \ Affirmative Action Employer

One
North Carolina
Naturally

received this information in writing, we will assume you are withdrawing your application and it will be returned. Furthermore, until the information is received by the NC Division of Water Quality, we request (by copy of this letter) that the US Army Corps of Engineers place the permit application on hold.

If you have any questions or require additional information, please contact Mason Herndon at (910) 308-4021 or mason.herndon@ncdenr.gov.

Sincerely,

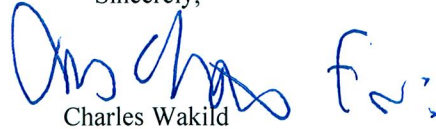

Charles Wakild
Director

cc: Brad Shaver, US Army Corps of Engineers, Wilmington Field Office
Stoney Mathis, Division 3 Environmental Officer
Travis Wilson, NC Wildlife Resources Commission
Chris Militscher, Environmental Protection Agency
Steve Sollod, NC Coastal Management
Gary Jordon, US Fish and Wildlife Service
Sonia Carrillo, DWQ Central Regional Office
File Copy


8/17/09

LOCHNER

H. W. LOCHNER, INC.
2840 PLAZA PLACE, SUITE 202
RALEIGH, NC 27612

PROJECT REFERENCE NO. R-2633B	SHEET NO. 06
RAW SHEET NO.	
ROADWAY DESIGN ENGINEER	HYDRAULICS ENGINEER
PRELIMINARY PLANS DO NOT USE FOR CONSTRUCTION	


INFORMATION PROVIDED ON
THIS PLAN SHEET IS FROM
INTERCHANGE PLAN SHEET 6

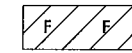

DENOTES FILL IN
WETLAND



DENOTES HAND
CLEARING

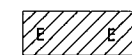

DENOTES EXCAVATION
IN WETLAND

Permit Drawing
Sheet 2 of 73
revised 5/2/13

Q10 = 42 cfs
V10 = 1.46 fps

Q10 = 2.3 cfs
V10 = 0.76 fps

BEGIN STATE PROJECT R-2633B
BEGIN PAVING
-LREV- POC STA. 339+13.00

SPECIAL 2" CUT DITCH
SEE DETAIL C

CPAL EASEMENT

POOR 100' R/W

CHORD

MATCH TO SHEET 7 -LREV- STA. 352+70.00

REVISIONS

8/17/09
H. W. LOCHNER, INC.
2840 PLAZA PLACE, SUITE 202
RALEIGH, NC 27612

H. W. LOCHNER, INC.
2840 PLAZA PLACE, SUITE 202
RALEIGH, NC 27612

RAW SHEET NO.

ROADWAY DESIGN ENGINEER	HYDRAULICS ENGINEER
----------------------------	------------------------

PRELIMINARY PLANS
DO NOT USE FOR CONSTRUCTION

INFORMATION PROVIDED ON
THIS PLAN SHEET IS FROM
INTERCHANGE PLAN SHEET 6


 DENOTES FILL IN WETLAND
 DENOTES HAND CLEARING
 DENOTES EXCAVATION IN WETLAND

Permit Drawing
Sheet 3 of 73
rev. 5/2/13

BEGIN STATE PROJECT R-2633B
BEGIN PAVING
-LREV- POC Std. 339+13.00



Q10 = 42 cfs
V10 = 1.46 fps

Q10 = 2.3 cfs
Y10 = 0.76 fps

LOCHNER

H. W. LOCHNER, INC.
2840 PLAZA PLACE, SUITE 202
RALEIGH, NC 27612

PROJECT REFERENCE NO.	SHEET NO.
R-2633B	07
RAW SHEET NO.	
ROADWAY DESIGN ENGINEER	HYDRAULICS ENGINEER
PRELIMINARY PLANS DO NOT USE FOR CONSTRUCTION	

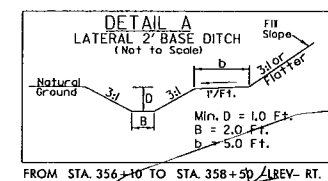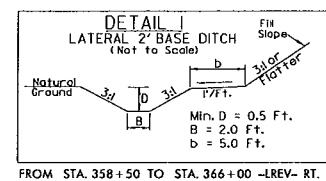

EQUALIZER PIPE INVERTS WILL NOT BE BURIED

NAD 83/95

revised 5/2/13
Permit Drawing
Sheet 4 of 73

MATCH TO SHEET 6 -LREV- STA. 353+00.00


MATCH TO SHEET 8 -LREV- STA. 367+00.00

Q10 = 4.84 cfs
V10 = 1.01 fps

Q10 = 11.9 cfs
V10 = 1.6 fps

F F DENOTES FILL IN WETLAND

HC HC DENOTES HAND CLEARING

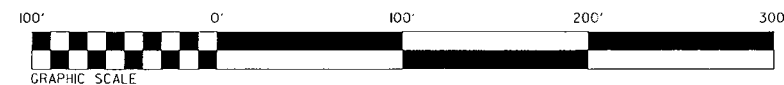

V. A. CREECH, JR.

= 7.0%




SEE SHEET 43 FOR -LREV- PROFILE

REVISIONS
R/W REVISION 10/ /09 - NAME AND DEED CHANGE PARCEL 10. PROPERTY OWNER NAME CHANGE FROM WCM ENTERPRISES, LLC TO CMC, LLC
R/W REVISION 1/ /09 - ADJUSTED MONUMENT ON PARCEL 10A. MOVED PROPERTY OWNER NAME ON PARCEL 11.

9/17/99

REVISIONS
R/W REVISION: 07 / 09 - NAME AND DEED CHANGE PARCEL 10, PROPERTY OWNER NAME CHANGE FROM WCM ENTERPRISES, LLC TO CKC, LLC
R/W REVISION: 17 / 09 - ADJUSTED MONUMENT ON PARCEL 10A MOVED PROPERTY OWNER NAME ON PARCEL 11.

5/14/2016
H:\Projects\2016\Permit\353\353.dgn
353.dgn

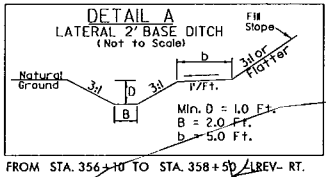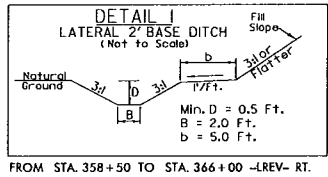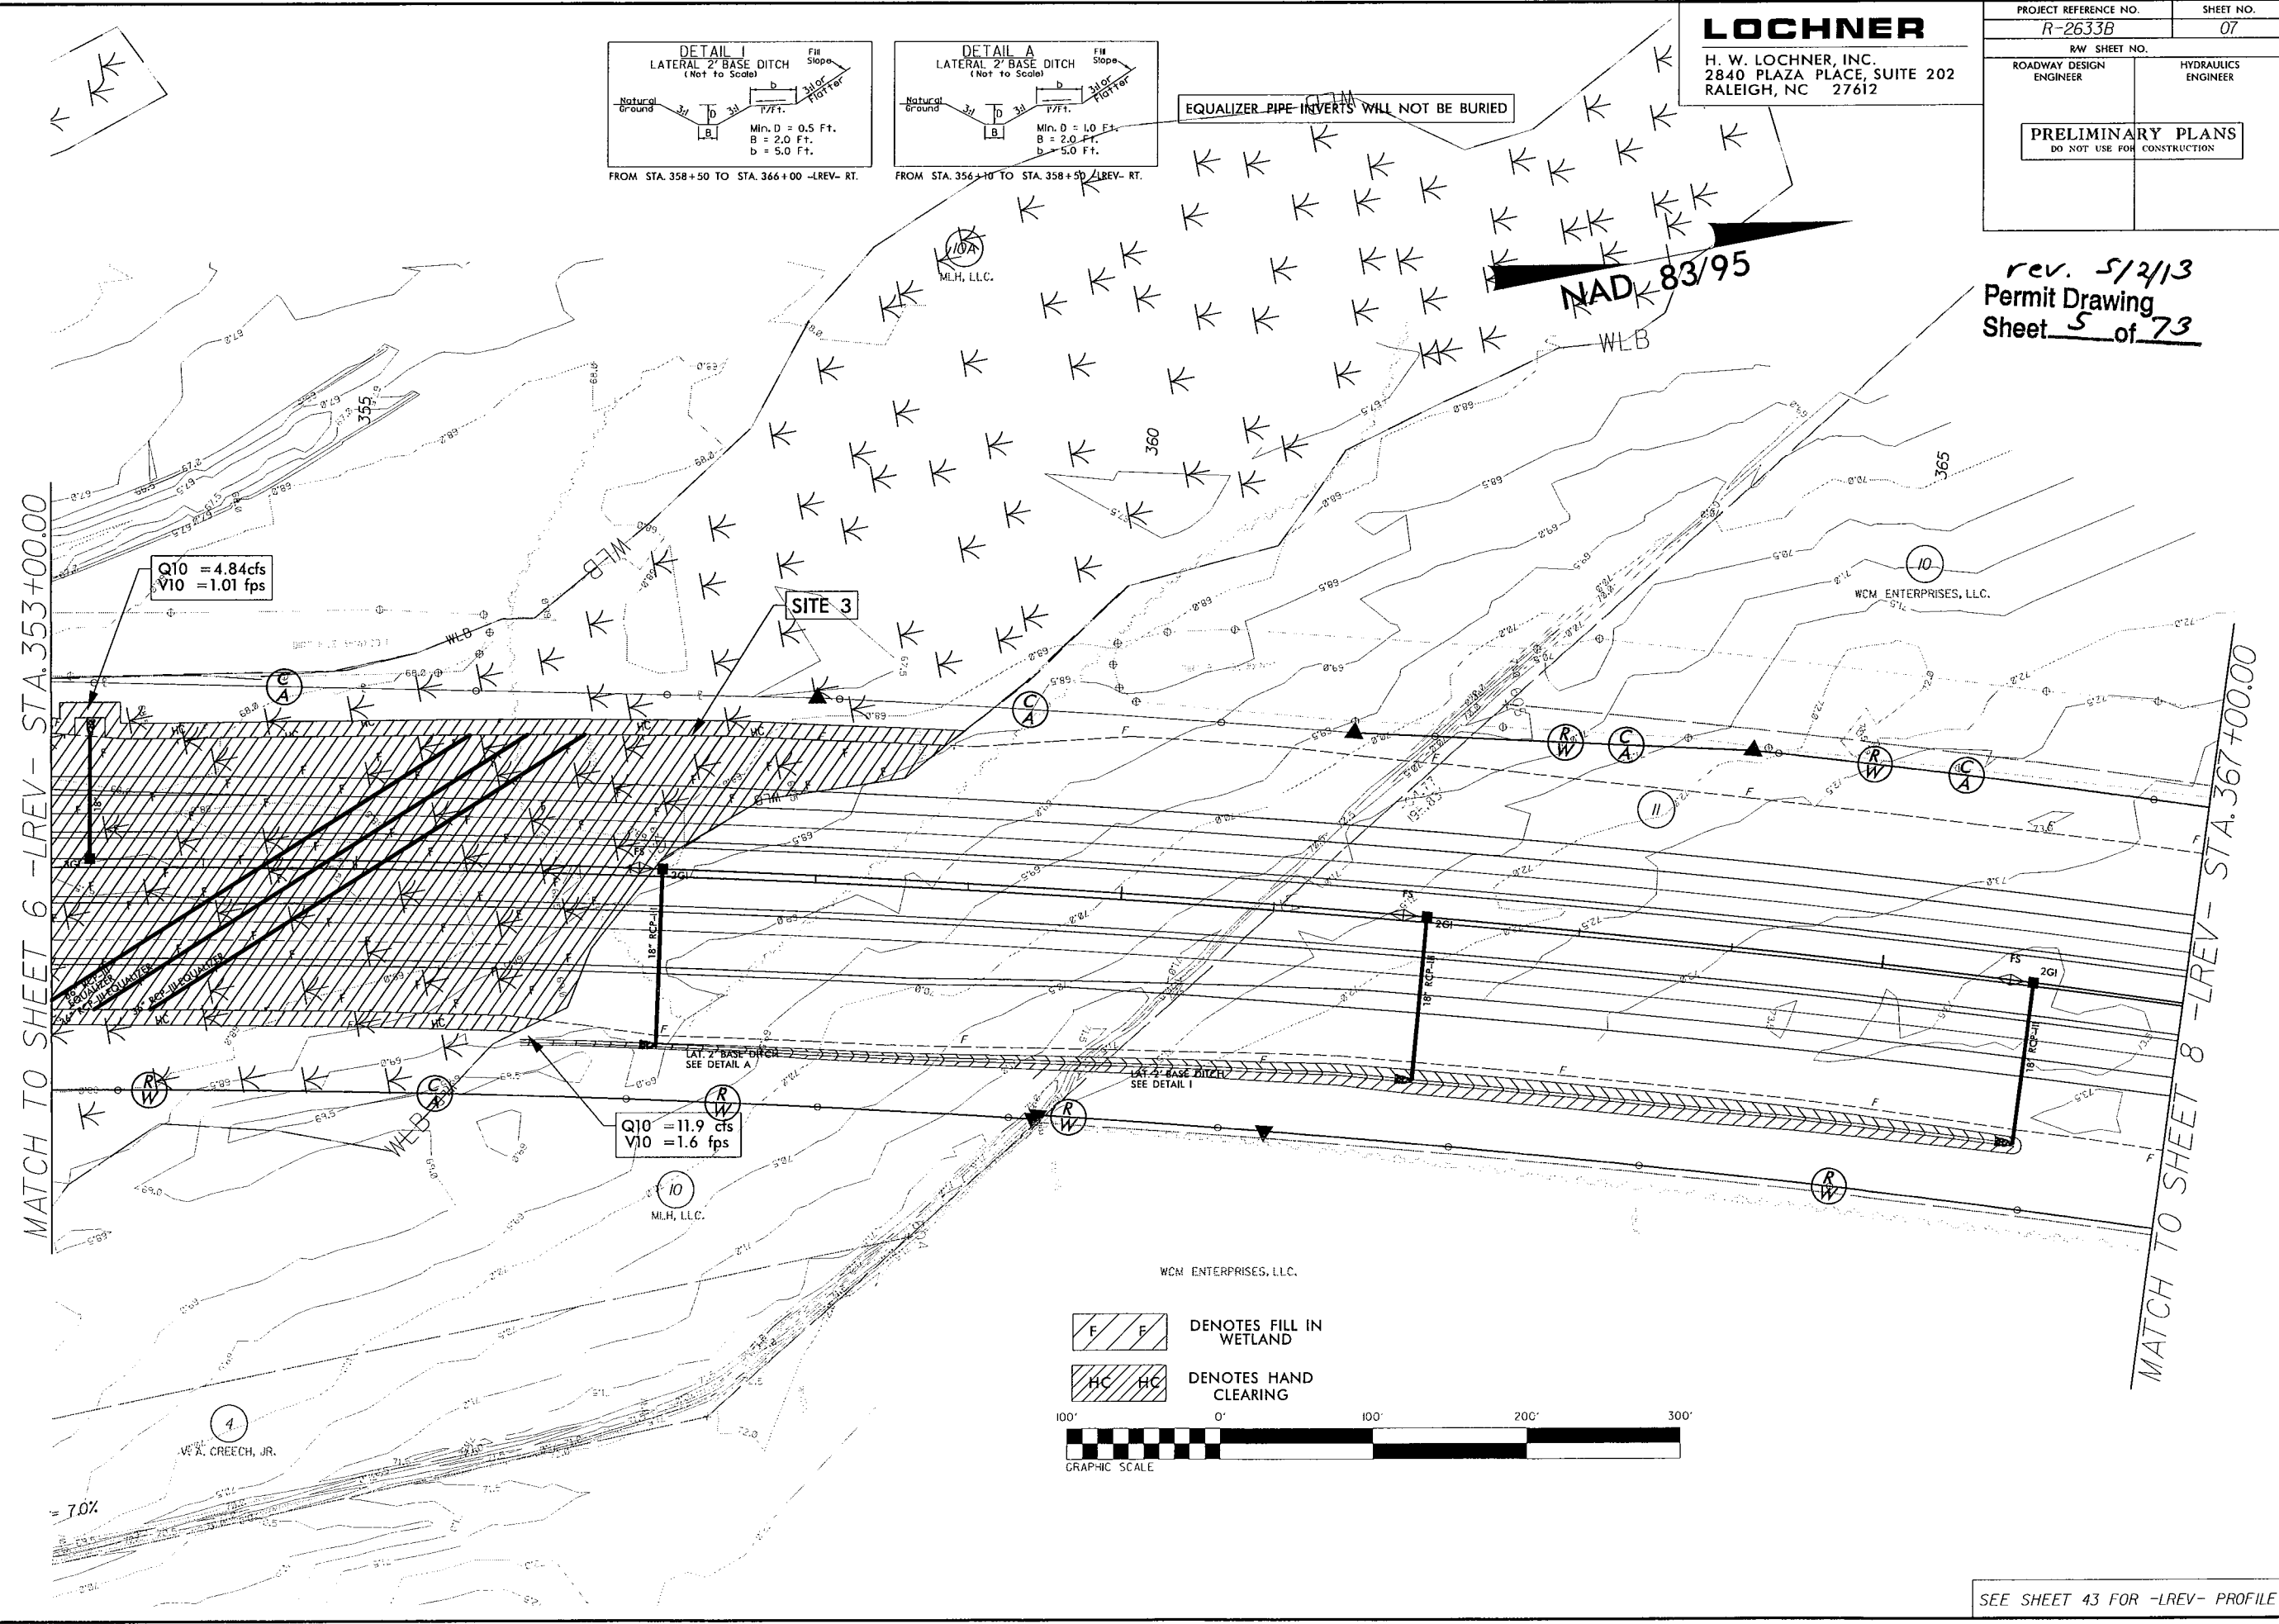

EQUALIZER PIPE INVERTS WILL NOT BE BURIED

LOCHNER
H. W. LOCHNER, INC.
2840 PLAZA PLACE, SUITE 202
RALEIGH, NC 27612

PROJECT REFERENCE NO. R-2633B	SHEET NO. 07
R/W SHEET NO.	
ROADWAY DESIGN ENGINEER	HYDRAULICS ENGINEER
PRELIMINARY PLANS DO NOT USE FOR CONSTRUCTION	


rev. 5/2/13
Permit Drawing
Sheet 5 of 73

Q10 = 4.84 cfs
V10 = 1.01 fps

Q10 = 11.9 cfs
V10 = 1.6 fps




DENOTES FILL IN WETLAND

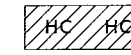

DENOTES HAND CLEARING



SEE SHEET 43 FOR -LREV- PROFILE

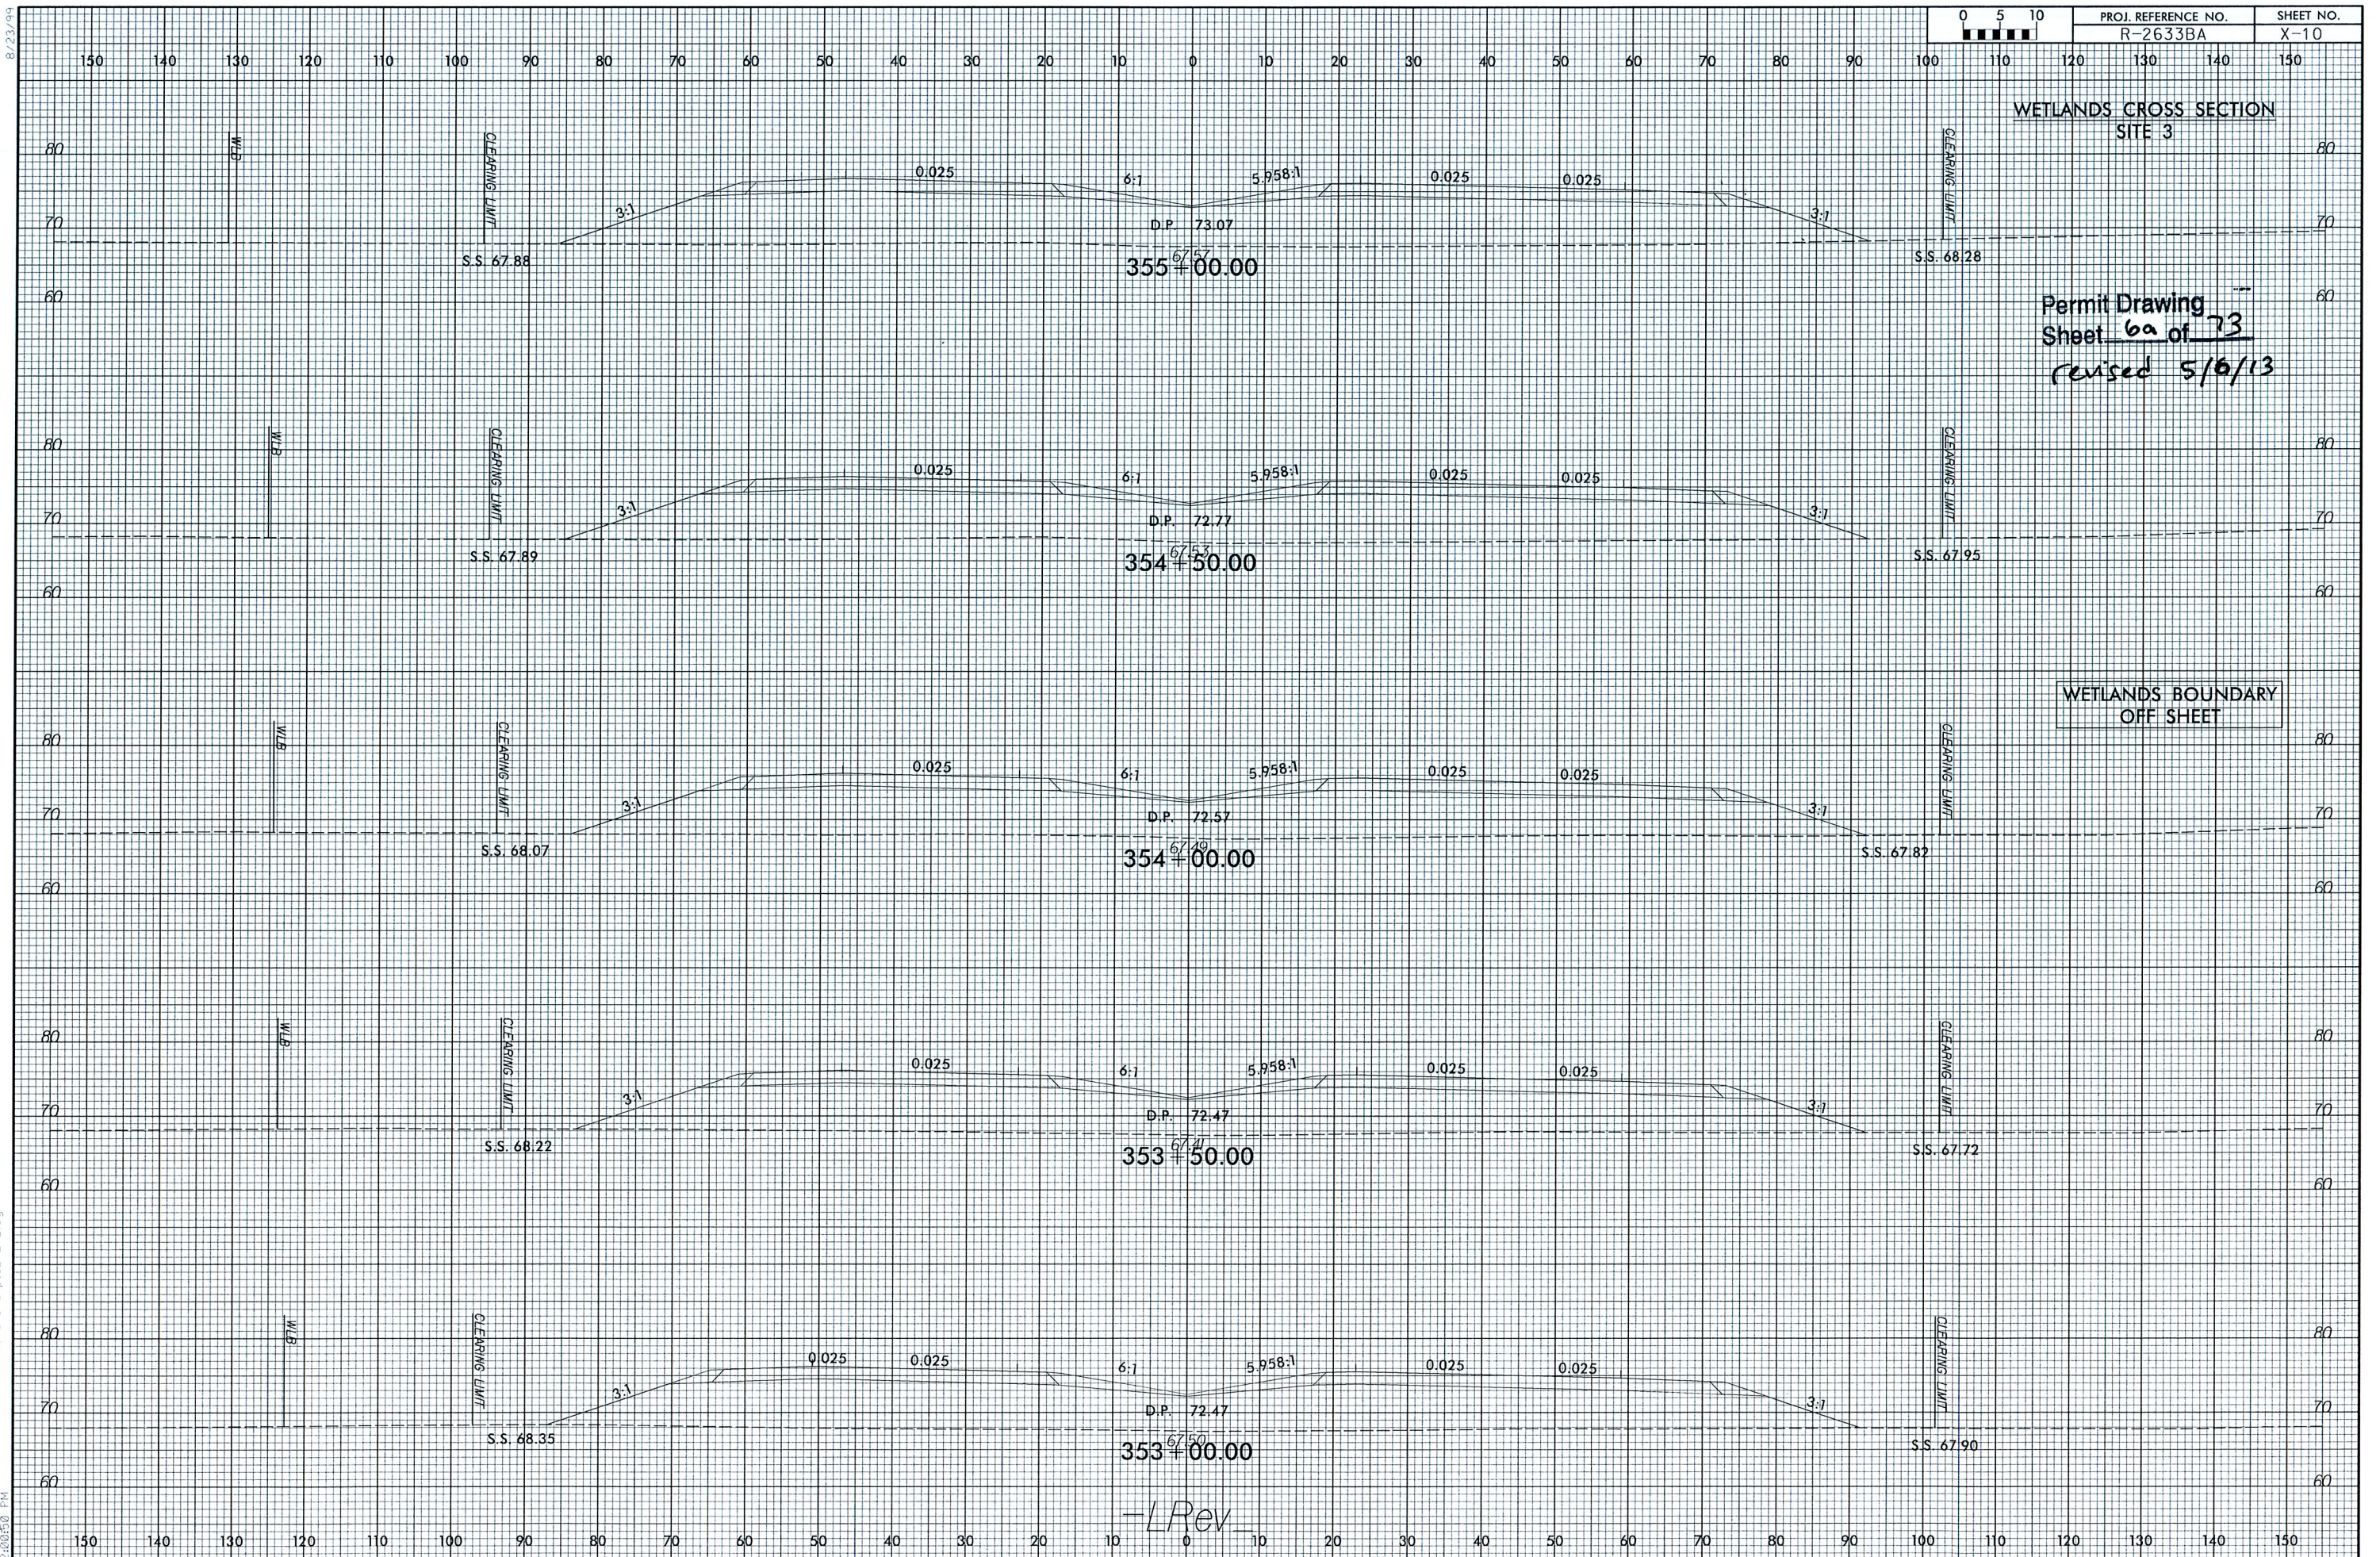


8/17/99

LOCHNER


H. W. LOCHNER, INC.
2840 PLAZA PLACE, SUITE 202
RALEIGH, NC 27612

PROJECT REFERENCE NO. R-2633B	SHEET NO. 08
R/W SHEET NO.	
ROADWAY DESIGN ENGINEER	HYDRAULICS ENGINEER
PRELIMINARY PLANS DO NOT USE FOR CONSTRUCTION	

EQUALIZER PIPE INVERTS WILL NOT BE BURIED

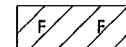

DENOTES FILL IN
WETLAND

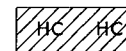

DENOTES HAND
CLEARING

NAD 83/95

rev. 5/2/13
Permit Drawing
Sheet 9 of 73

370

10

WCM ENTERPRISES, LLC.

375

85

REVISIONS

R/W REVISION: 10/ /09 - NAME AND DEED CHANGE PARCEL 10.
R/W REVISION: 1/ /11 - MOVED OWNERS NAME ON PARCEL 11.

8/2/2015
C:\Users\jlochner\Documents\Projects\2633B\2633B.dgn
WCM Enterprises, LLC. WCM Enterprises, LLC. WCM Enterprises, LLC.

MATCH TO SHEET 7 -LREV- STA. 367+00.00

PCC Sta. 368+3.22

11

TOE PROTECTION
SEE DETAIL J

CLASS B RIP RAP
EST. 10 SY FF

TOE PROTECTION
SEE DETAIL J

SITE 5

-LREV- PT Sta. 375+54.20 BK =
-L- CSSSta. 83+54.50 AH

SCSSta. 86+04.50

MATCH TO SHEET 9 -L- STA. 87+00.00

WCM ENTERPRISES, LLC.

SEE SHEET 44 FOR -LREV- PROFILE

8/17/99
5/2/2013
R:\Hydro\Hydro\Permit\Stream & Wetland\H-2633B hyd.prm.wet.pst\08.dgn

REVISIONS


R/W REVISION 10/ /09 - NAME AND DEED CHANGE PARCEL 10.
R/W REVISION 1/ /11 - MOVED OWNERS NAME ON PARCEL 11.

LOCHNER

H. W. LOCHNER, INC.
2840 PLAZA PLACE, SUITE 202
RALEIGH, NC 27612

PROJECT REFERENCE NO.	SHEET NO.
R-2633B	08
RAW SHEET NO.	
ROADWAY DESIGN ENGINEER	HYDRAULICS ENGINEER
PRELIMINARY PLANS DO NOT USE FOR CONSTRUCTION	

EQUALIZER PIPE INVERTS WILL NOT BE BURIED

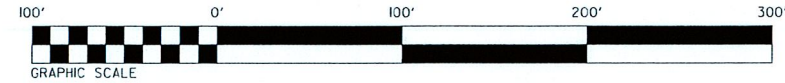


DENOTES FILL IN WETLAND



DENOTES HAND CLEARING




rev. 5/2/13
Permit Drawing
Sheet 10 of 73

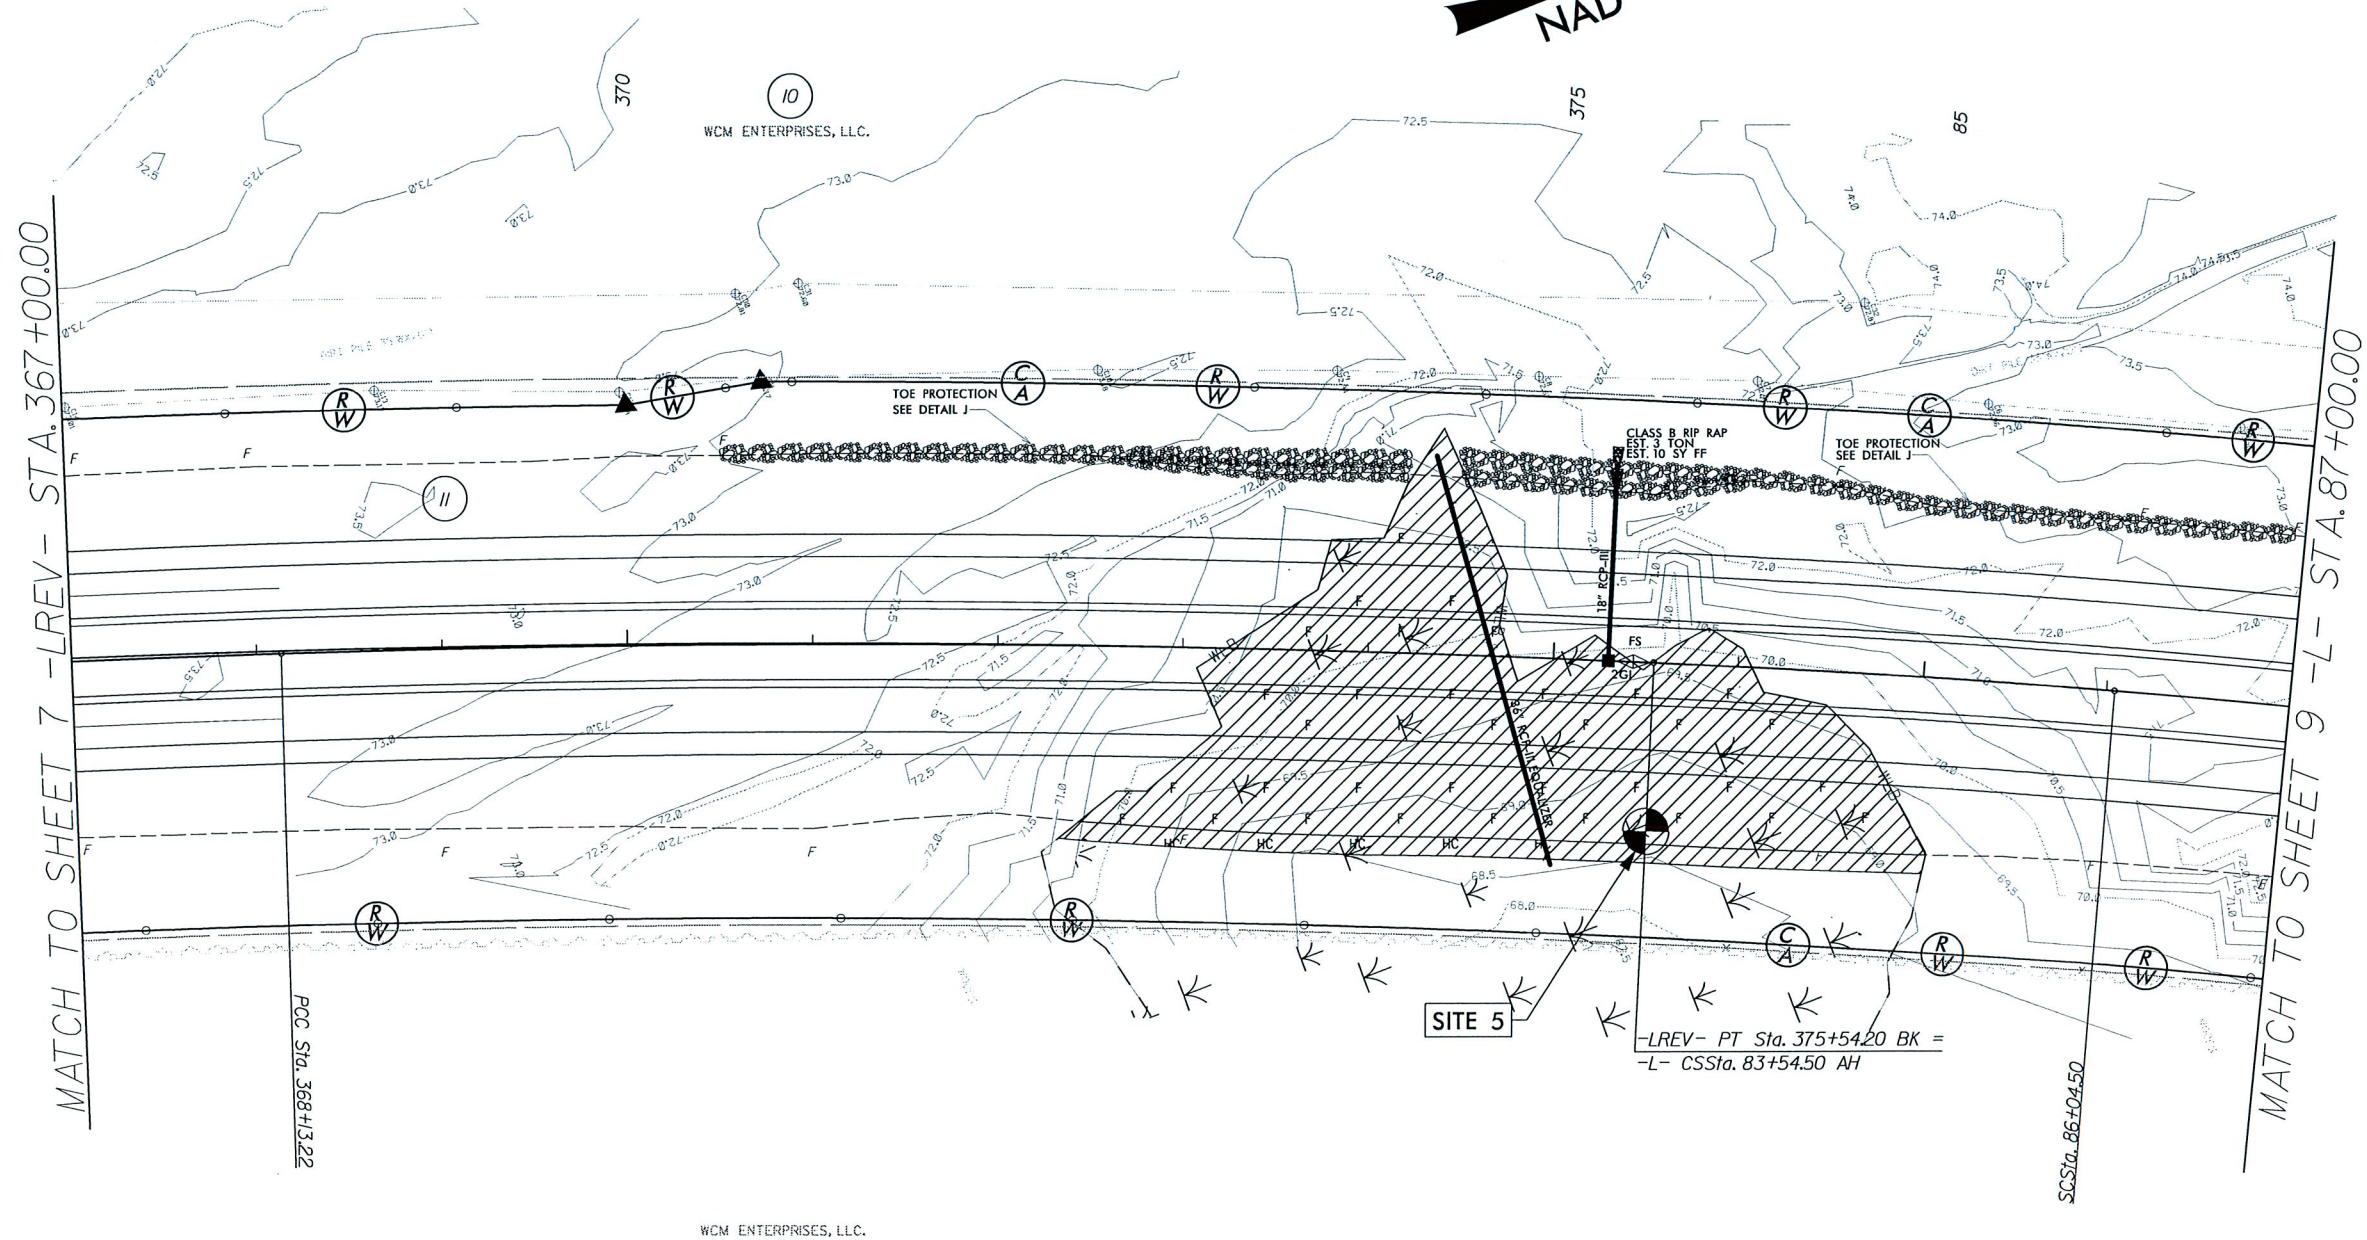

SEE SHEET 44 FOR -LREV- PROFILE


8/23/99

5/6/2013
R:\hydro\projects\Permit\X-19\2633BA.RD\X-19.LREV2.dgn
11:54:11 PM

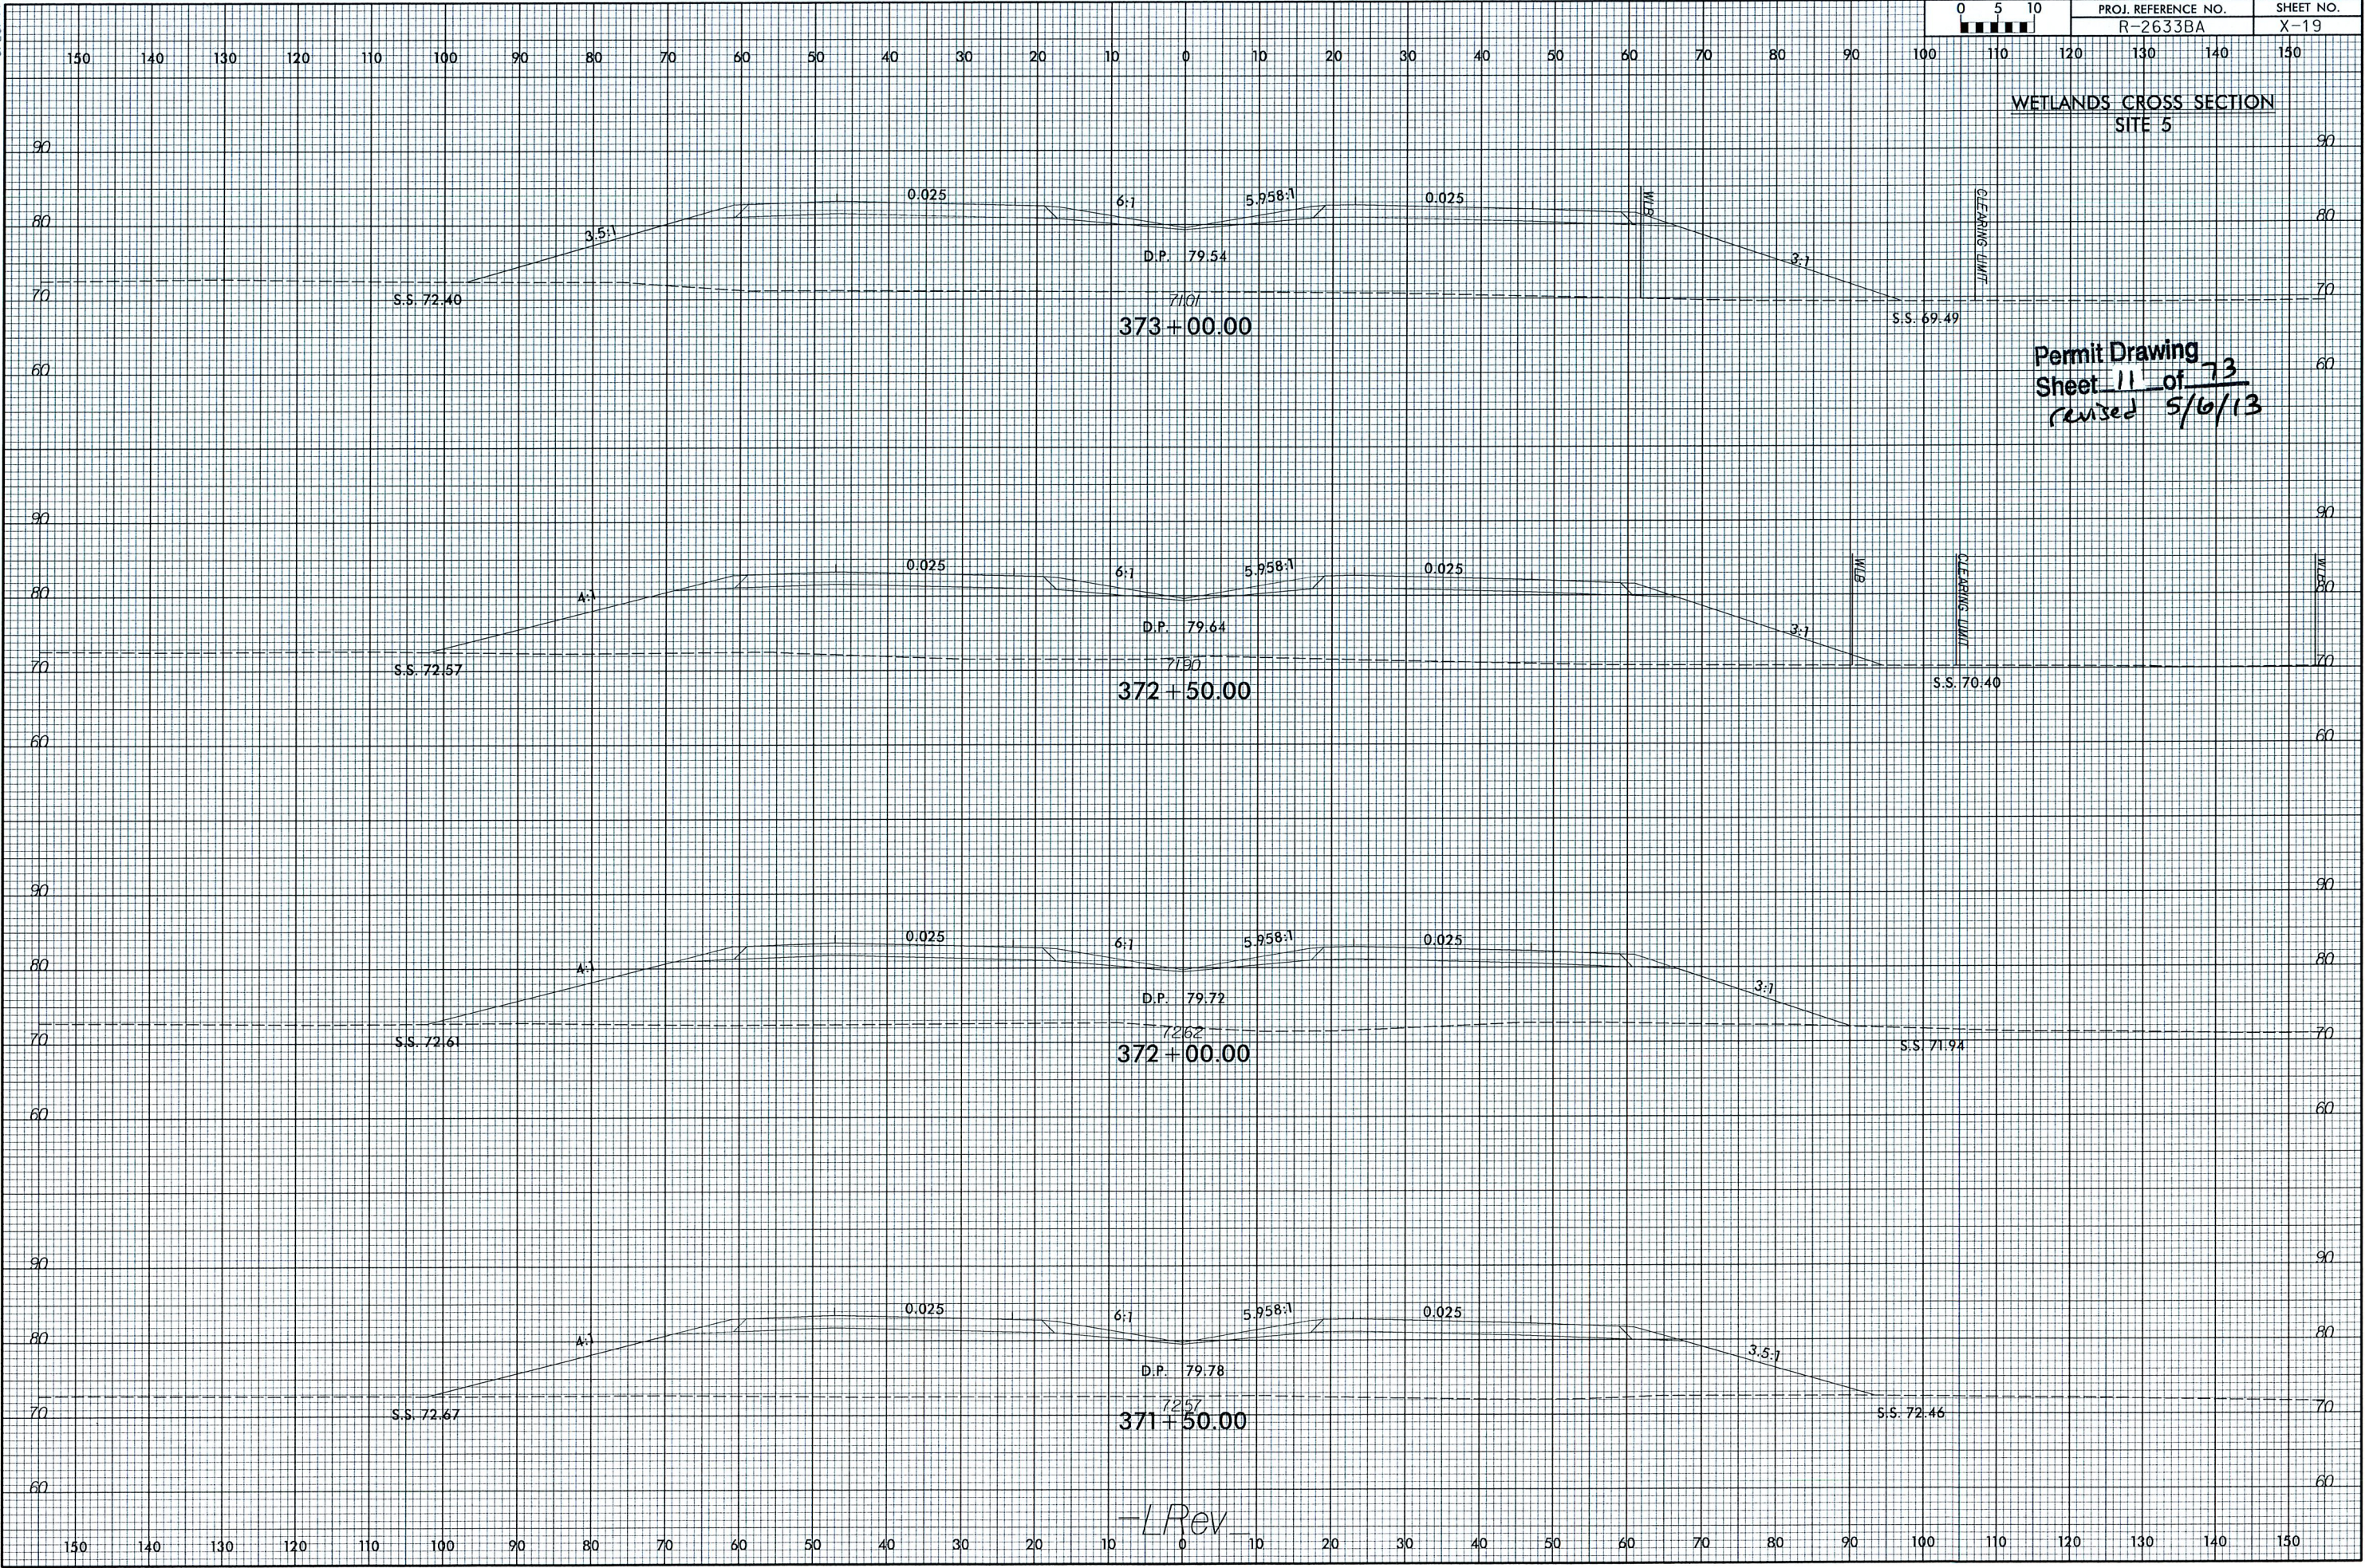

8/23/99

5/6/2013
R:\Highways\Permit\ssc\R-2633BA.RDY_xpl.LREV2.dgn
1:55:23 PM

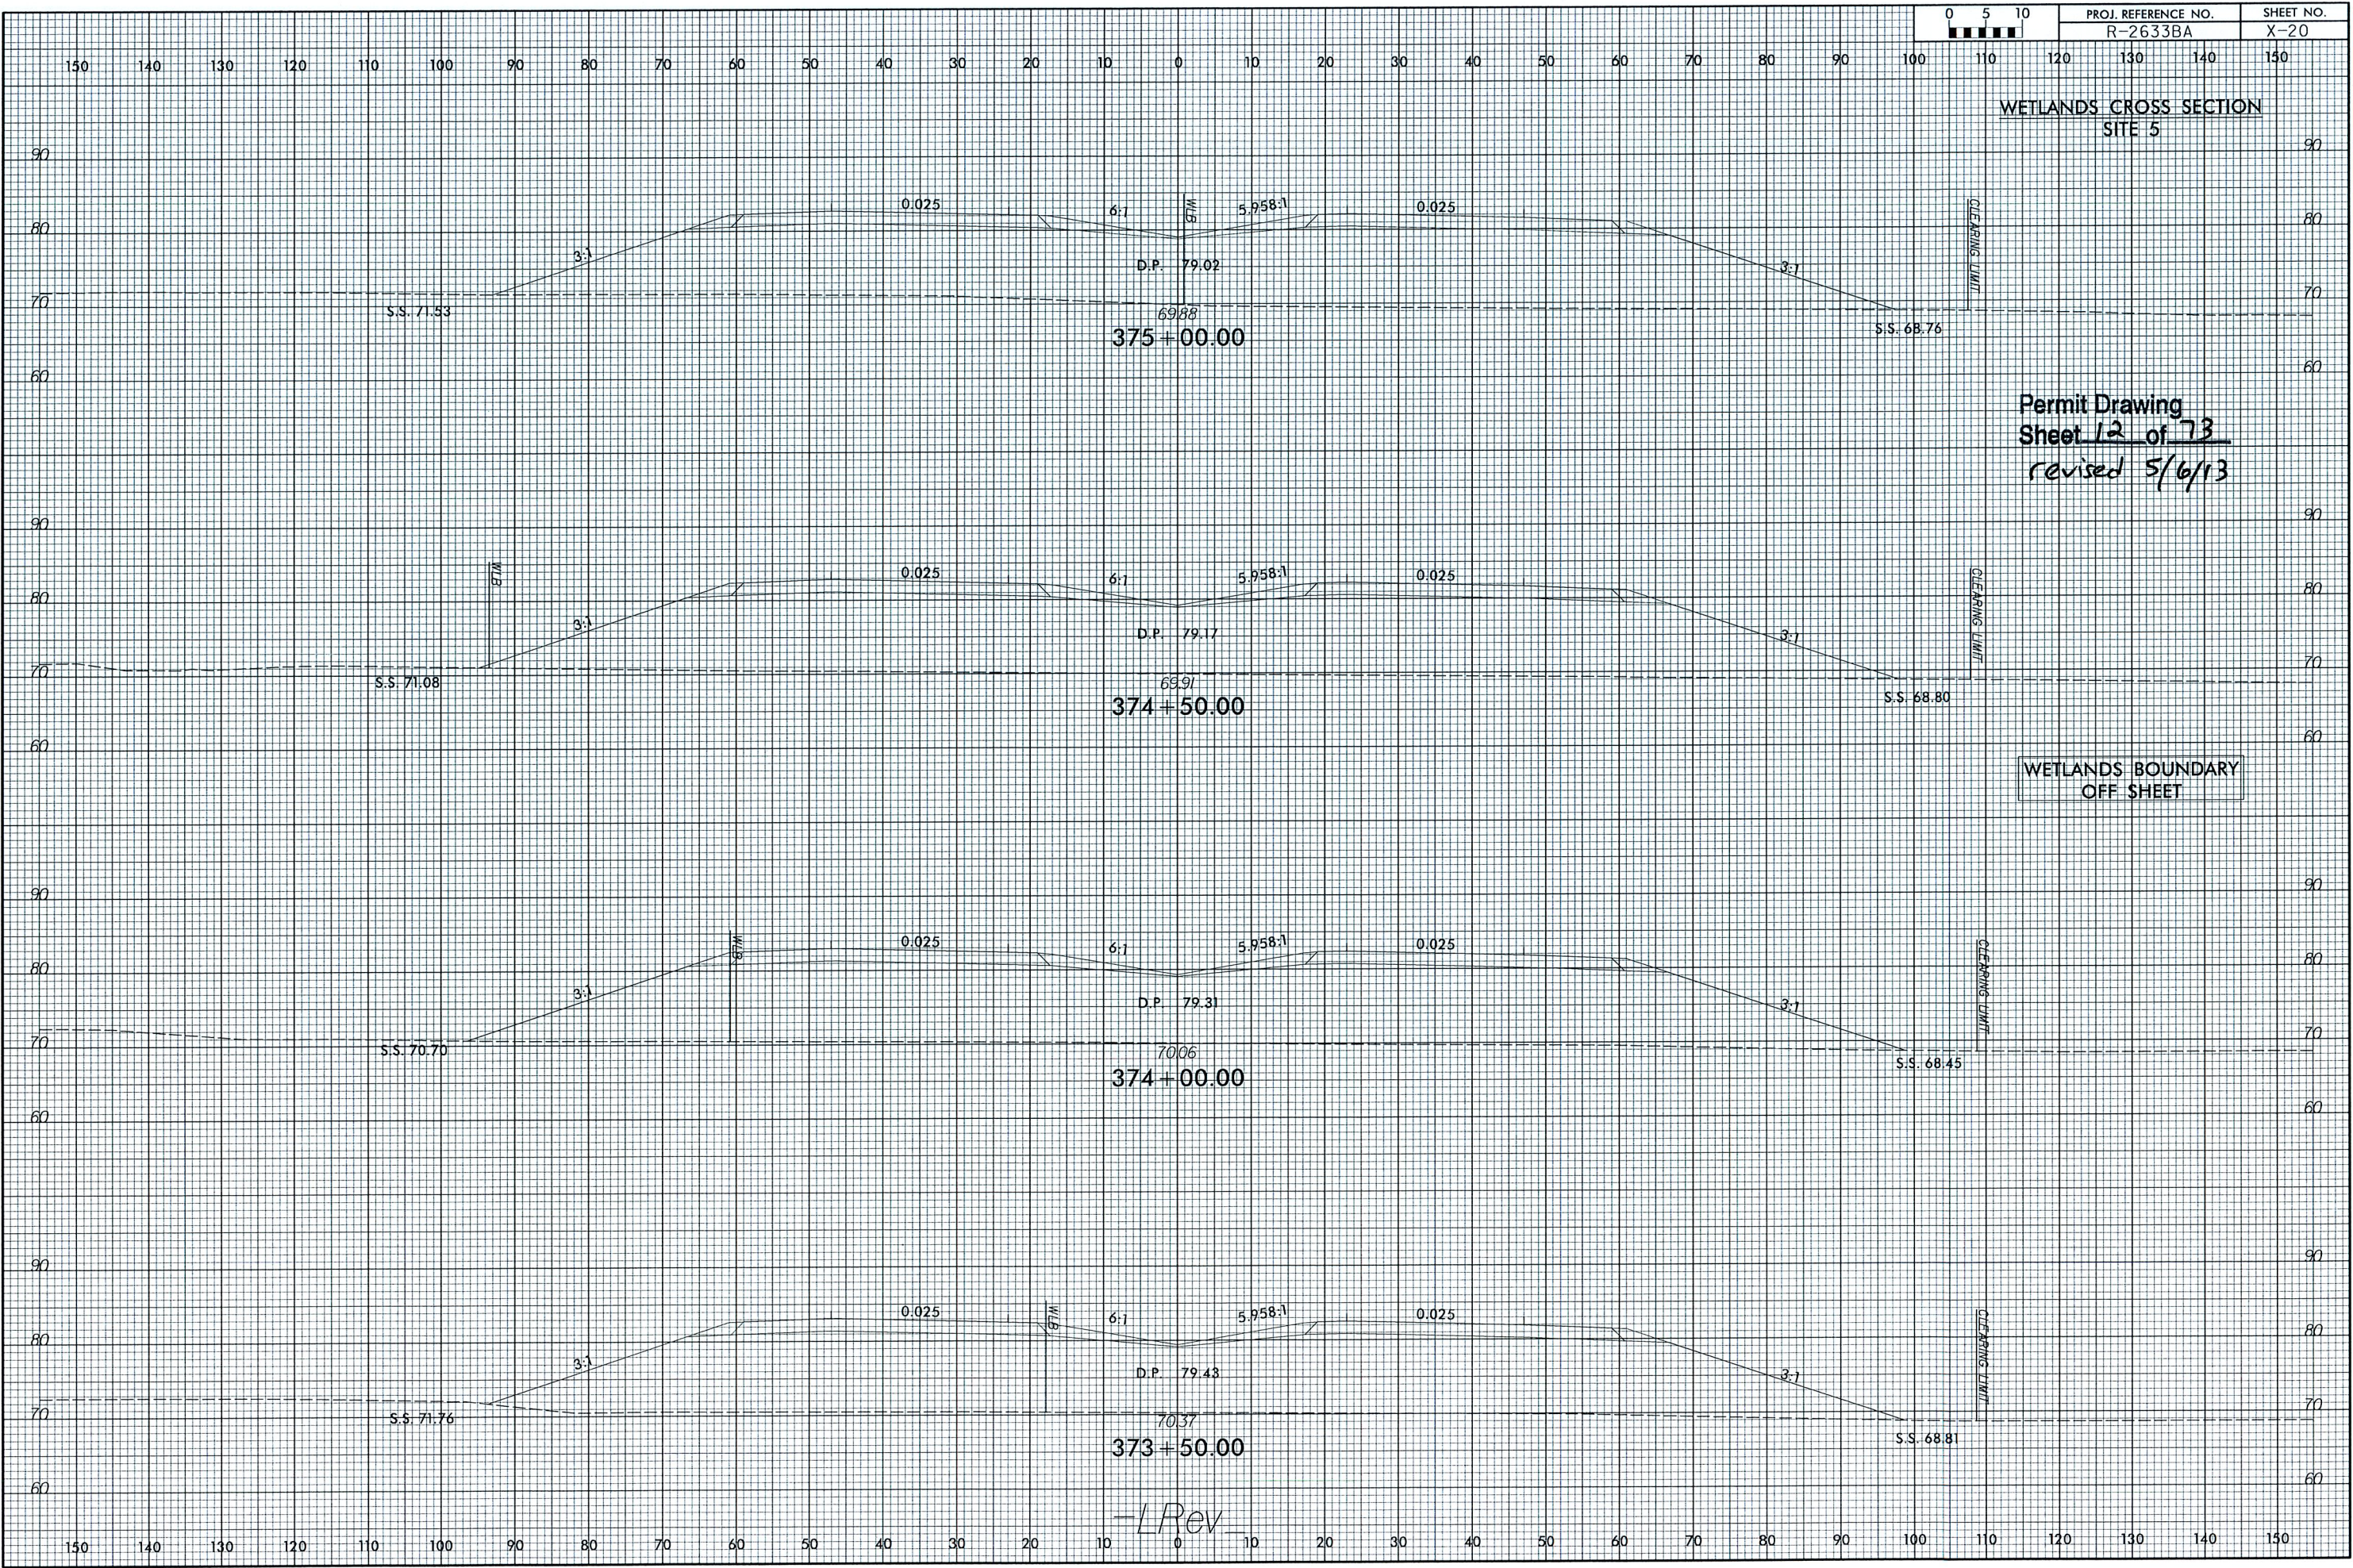




8/17/98

LOCHNER

H. W. LOCHNER, INC.
2840 PLAZA PLACE, SUITE 202
RALEIGH, NC 27612

PROJECT REFERENCE NO.	SHEET NO.
R-2633B	10
RAW SHEET NO.	
ROADWAY DESIGN ENGINEER	HYDRAULICS ENGINEER
PRELIMINARY PLANS DO NOT USE FOR CONSTRUCTION	

EQUALIZER PIPE INVERTS WILL NOT BE BURIED

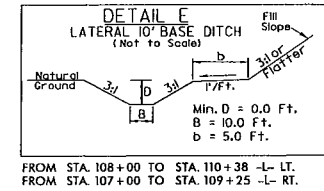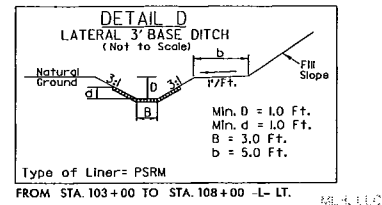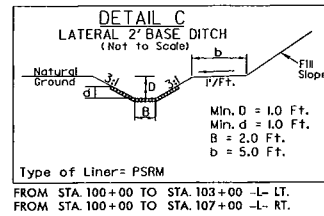


NAD 83/95

rev. 5/2/13
Permit Drawing
Sheet 13 of 23

REVISIONS

8/17/98
H. W. LOCHNER, INC.
2840 PLAZA PLACE, SUITE 202
RALEIGH, NC 27612

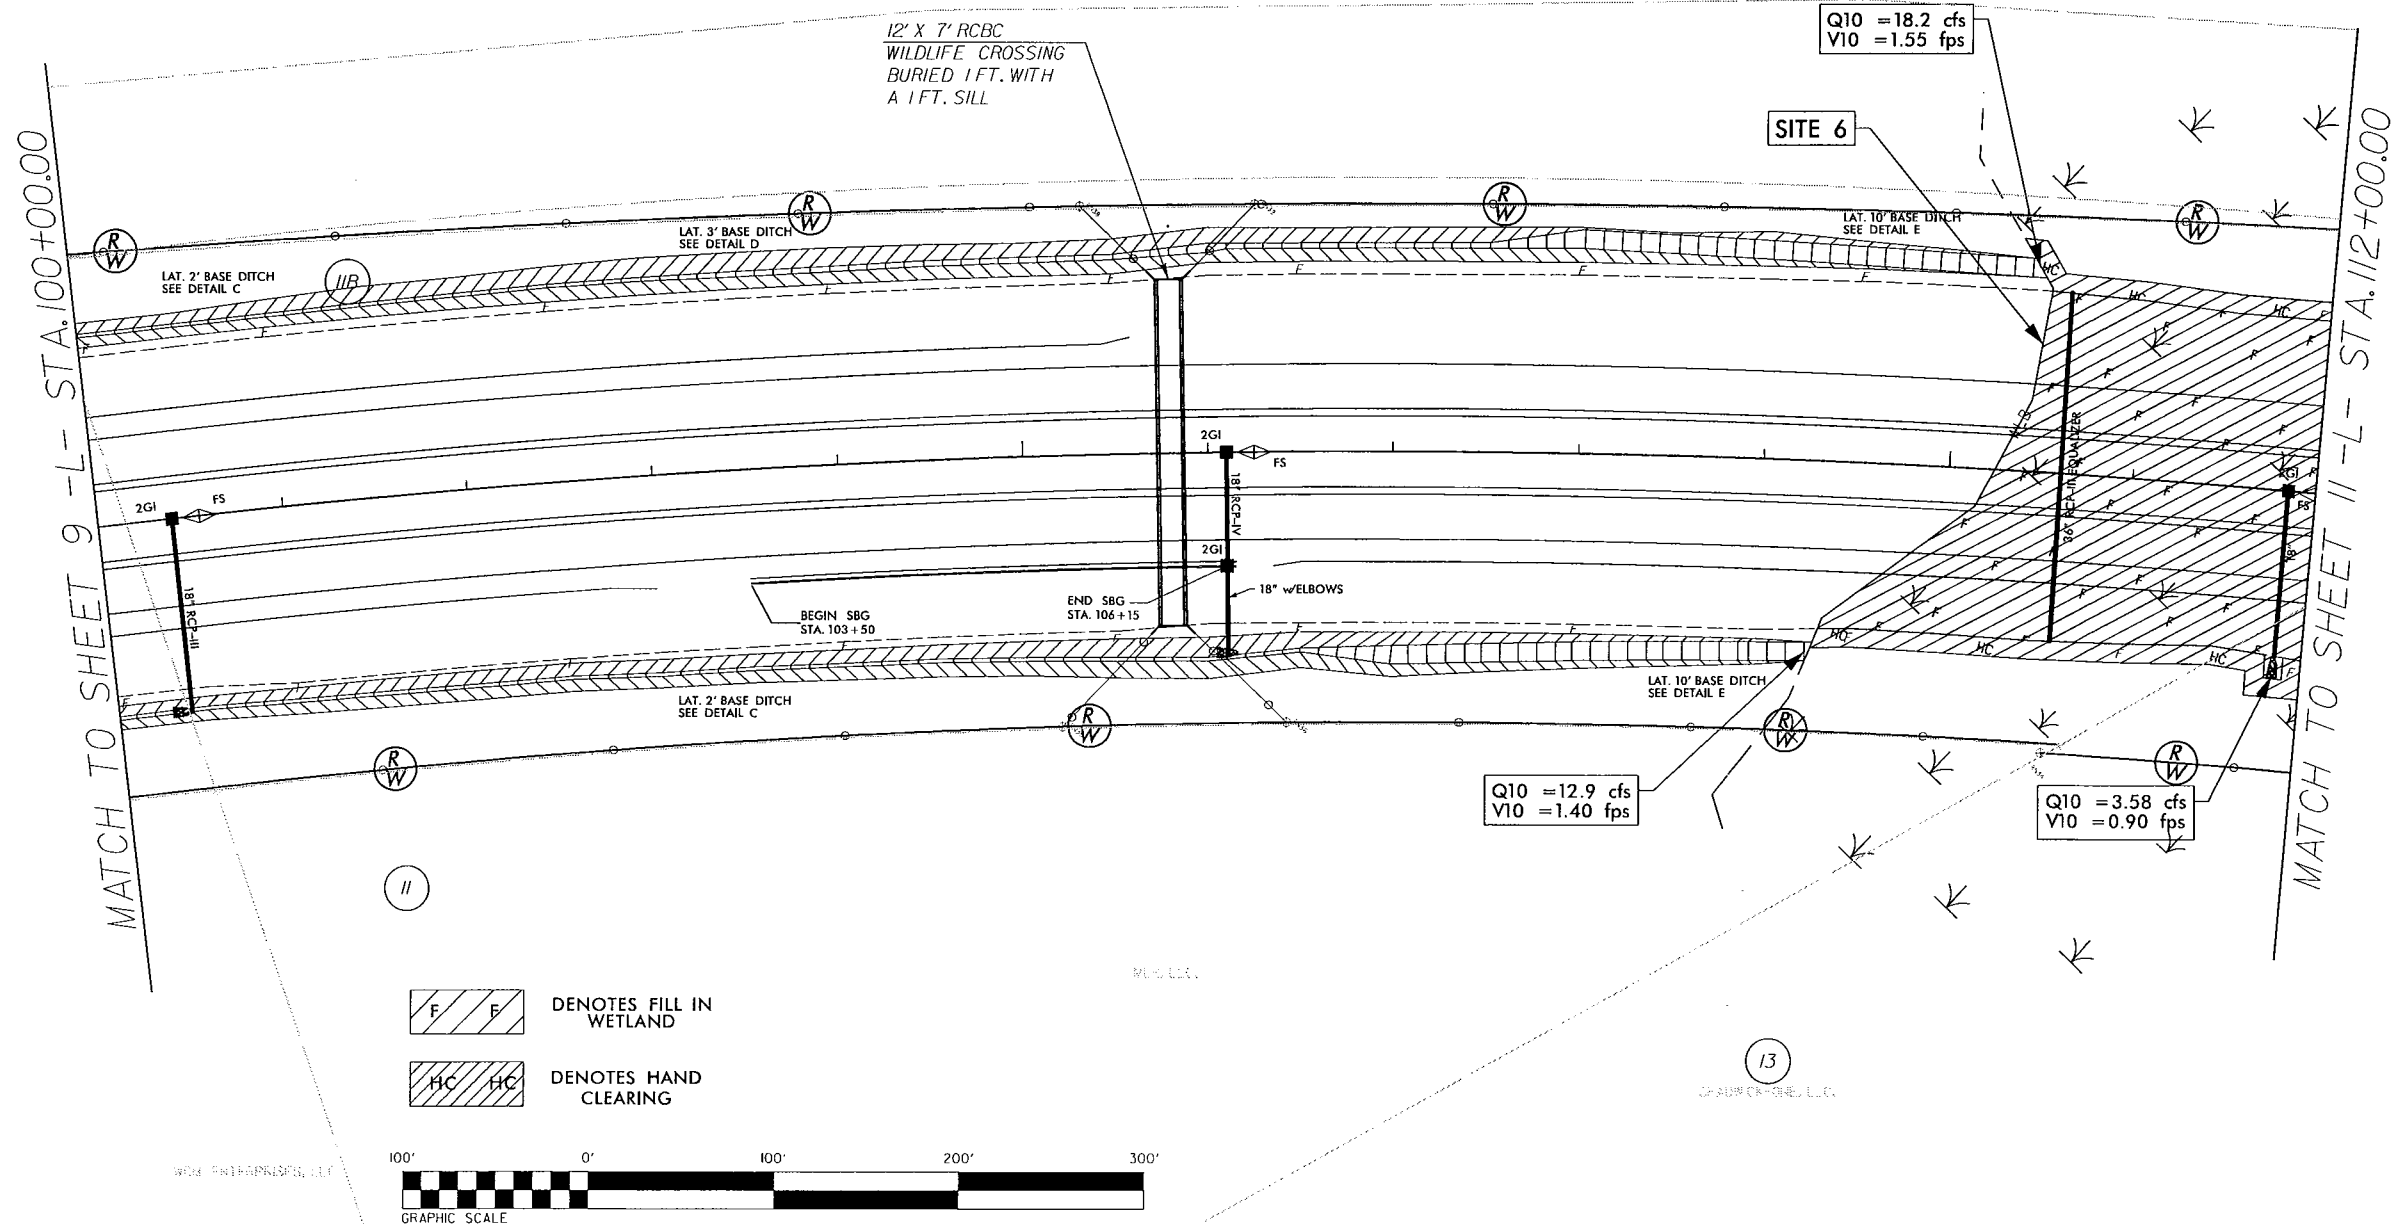

SEE SHEET 45 FOR -L- PROFILE




8/17/94

LOCHNER

H. W. LOCHNER, INC.
2840 PLAZA PLACE, SUITE 202
RALEIGH, NC 27612

PROJECT REFERENCE NO. R-2633B	SHEET NO. 10
R/W SHEET NO.	
ROADWAY DESIGN ENGINEER	HYDRAULICS ENGINEER
PRELIMINARY PLANS DO NOT USE FOR CONSTRUCTION	

EQUALIZER PIPE INVERTS WILL NOT BE BURIED

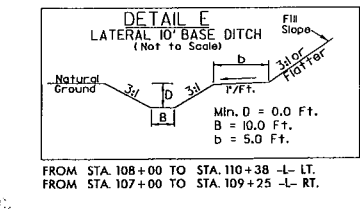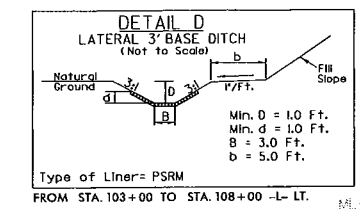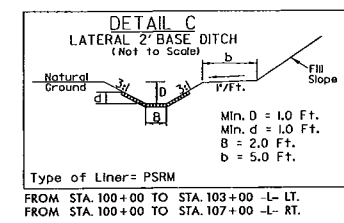


NAD 83/95

rev. 5/2/13
Permit Drawing
Sheet 14 of 73


REVISIONS

5/2/2013
H:\Projects\Permitting\2633B\8. Weiland\H-2633B.hgd.prm.wat.psd\10.dgn

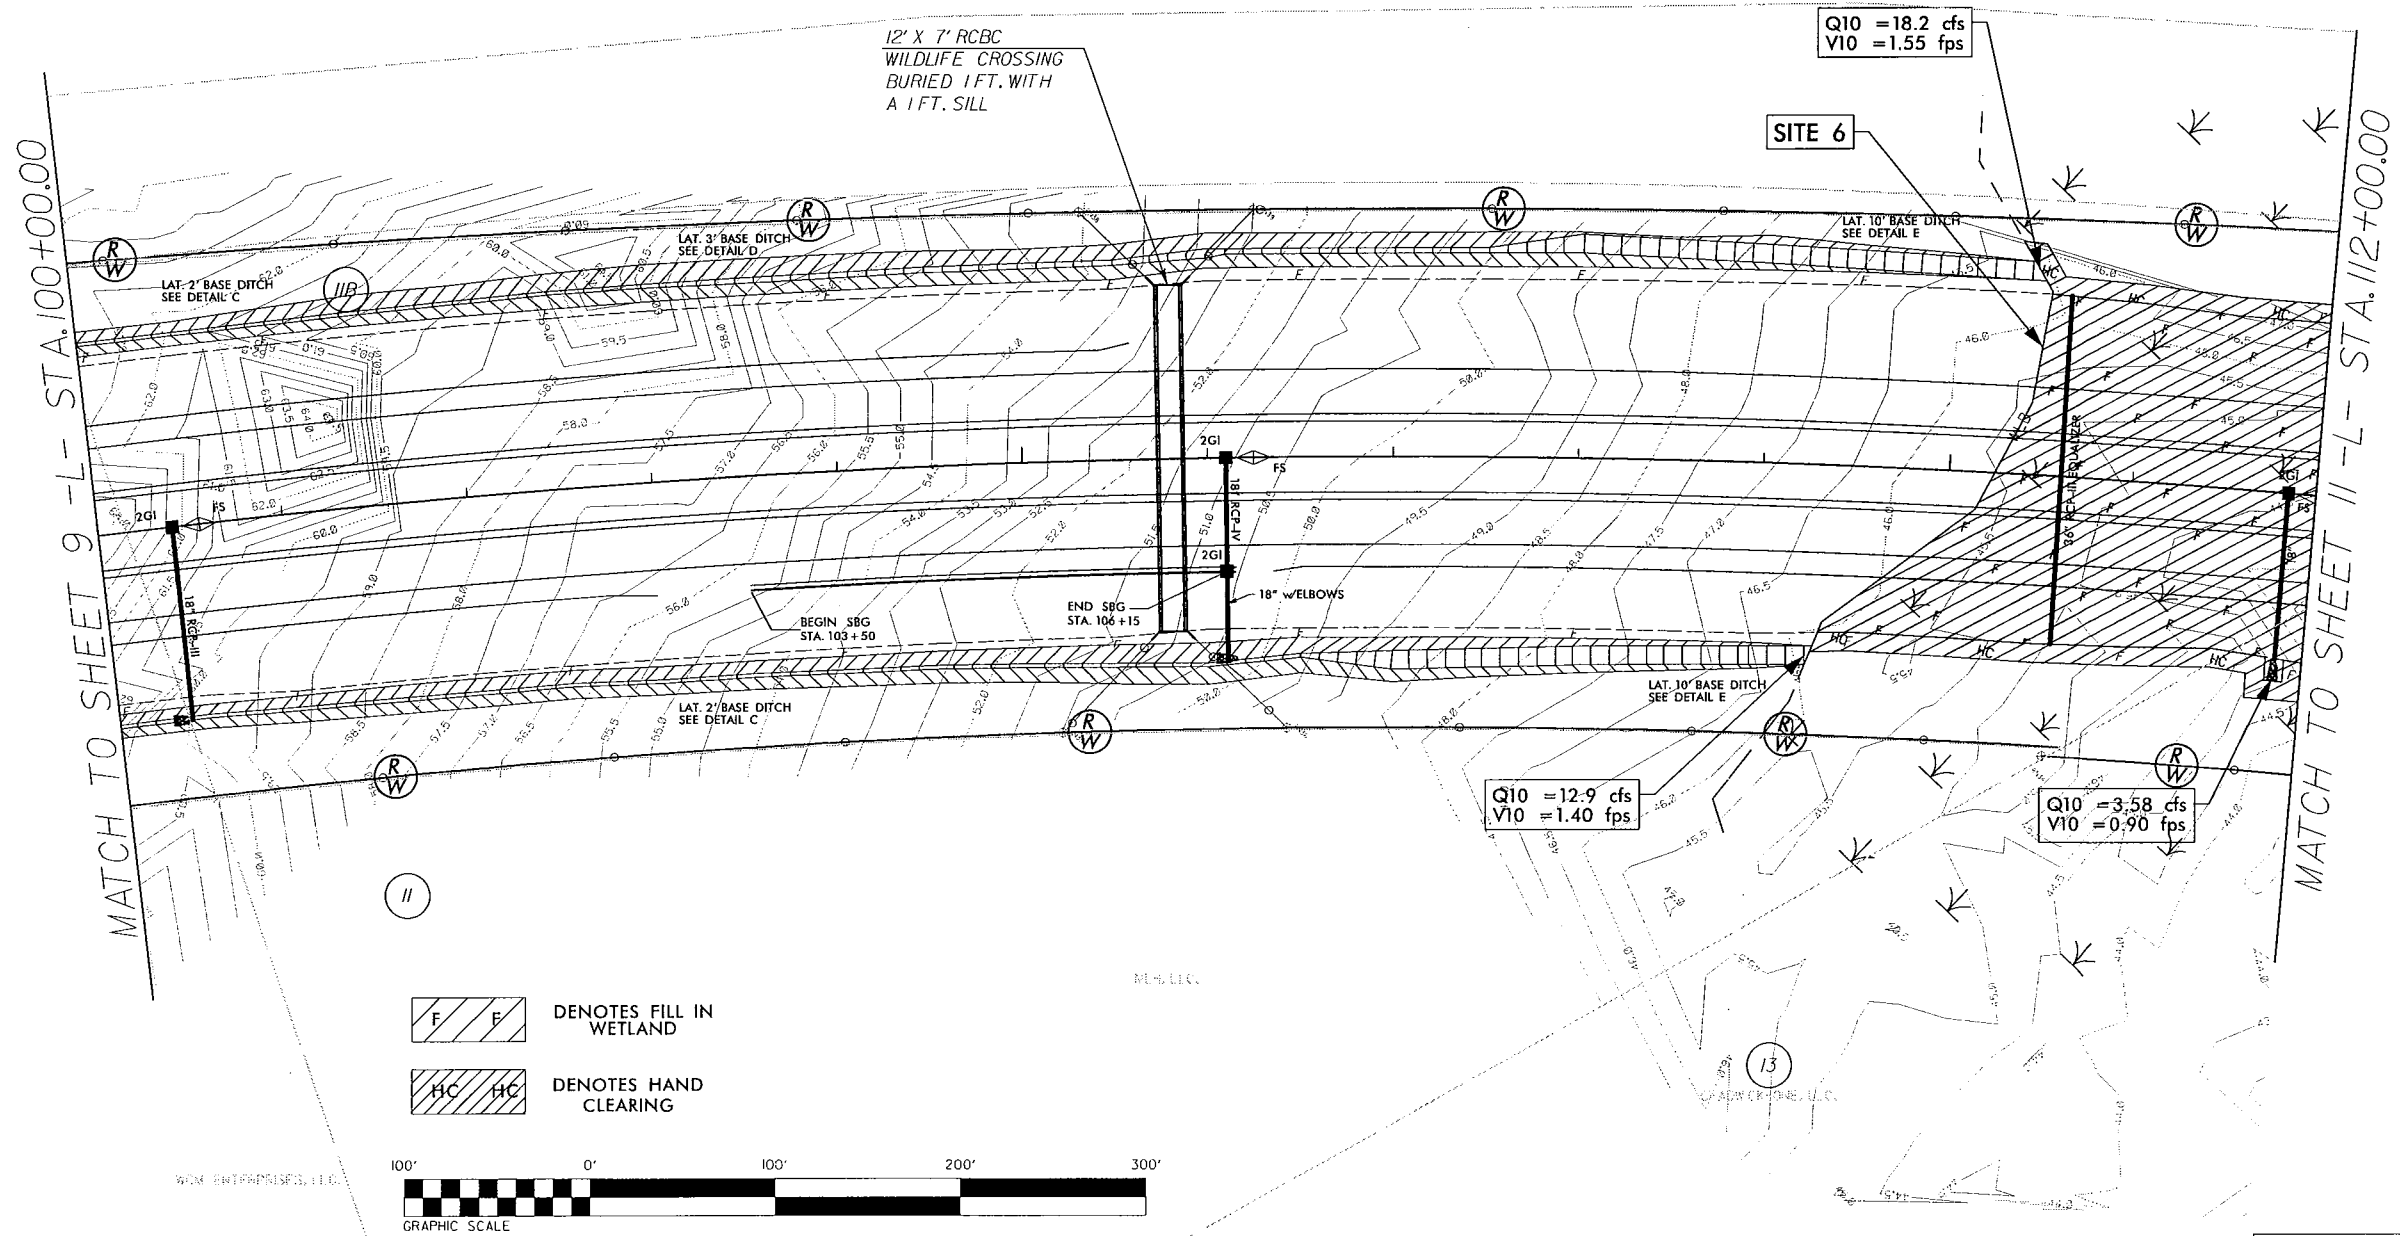

DENOTES FILL IN
WETLAND

DENOTES HAND
CLEARING

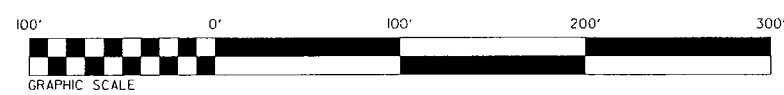


SEE SHEET 45 FOR -L- PROFILE

EQUALIZER PIPE INVERTS WILL NOT BE BURIED

NAD 83/95

rev. 5/2/13
Permit Drawing
Sheet 15 of 23

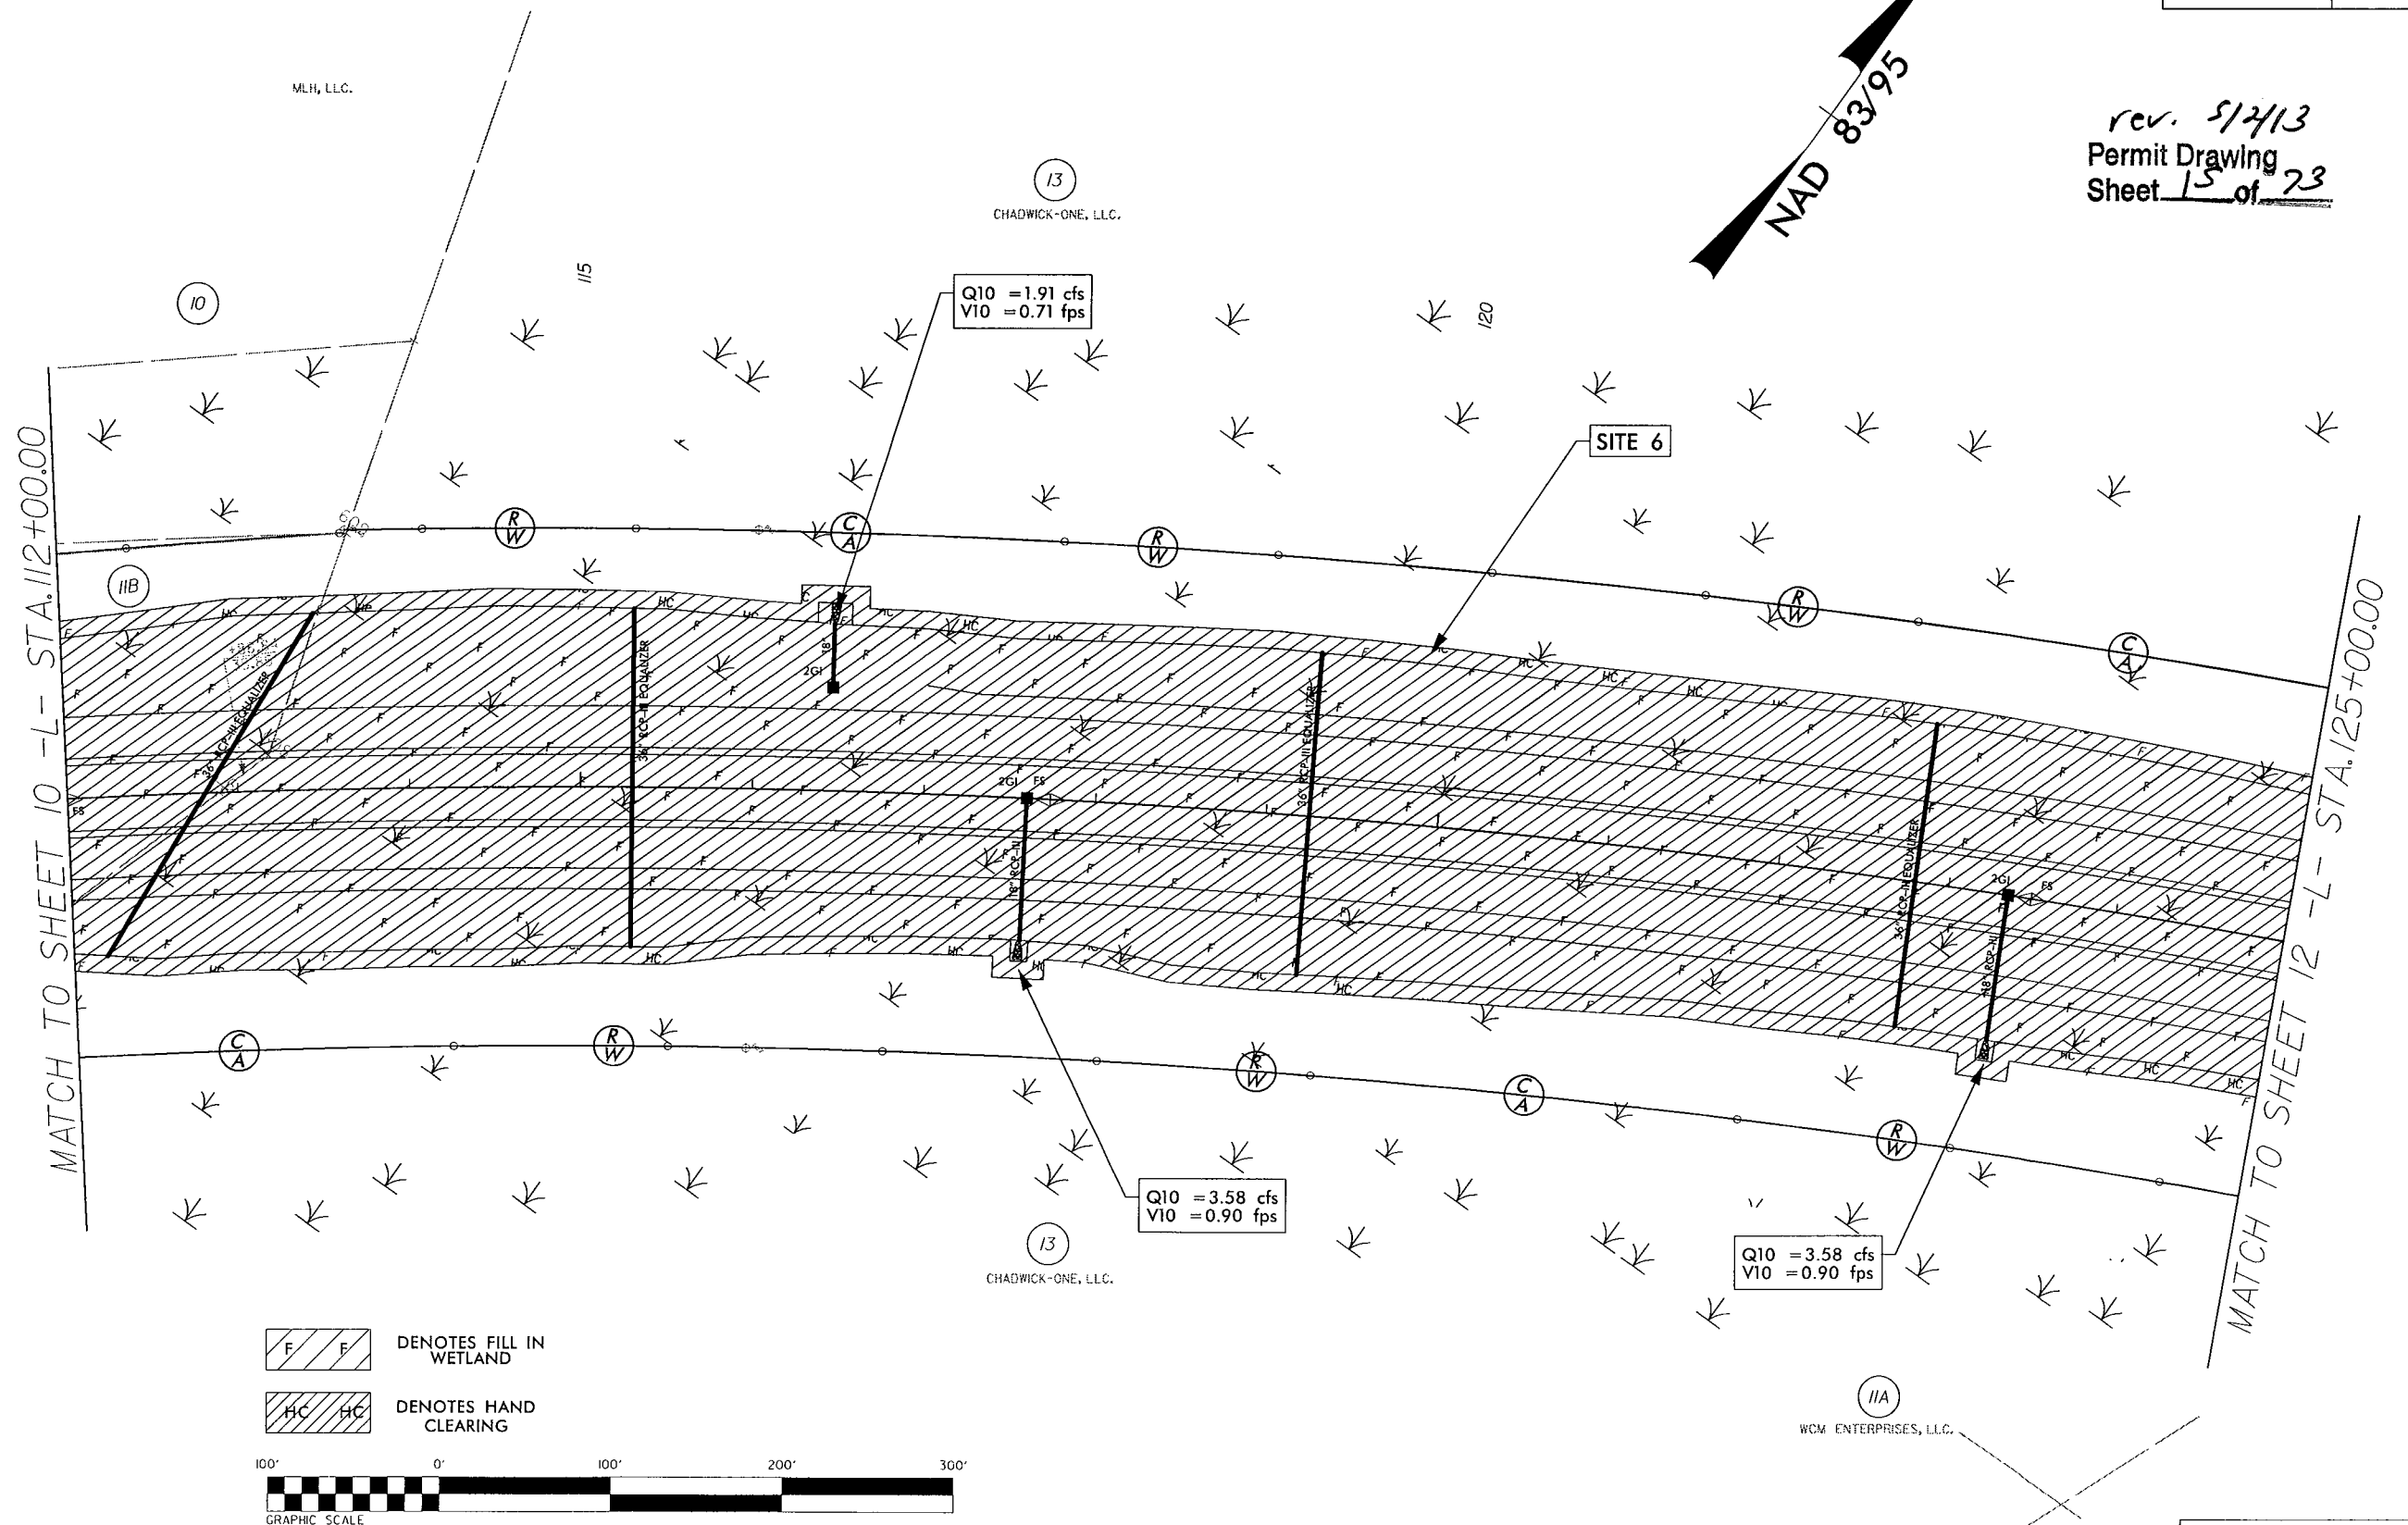

SEE SHEET 45 FOR -L- PROFILE

8/17/94

LOCHNER

H. W. LOCHNER, INC.
2840 PLAZA PLACE, SUITE 202
RALEIGH, NC 27612

PROJECT REFERENCE NO. R-2633B	SHEET NO. 11
RAW SHEET NO.	
ROADWAY DESIGN ENGINEER	HYDRAULICS ENGINEER
PRELIMINARY PLANS DO NOT USE FOR CONSTRUCTION	

EQUALIZER PIPE INVERTS WILL NOT BE BURIED

NAD 83/95


rev. 5/2/13
Permit Drawing
Sheet 16 of 73

REVISIONS


8/17/94
H. W. LOCHNER, INC.
2840 PLAZA PLACE, SUITE 202
RALEIGH, NC 27612

MATCH TO SHEET 10 -L- STA.112+00.00


MATCH TO SHEET 12 -L- STA.125+00.00

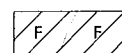

DENOTES FILL IN
WETLAND

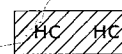

DENOTES HAND
CLEARING

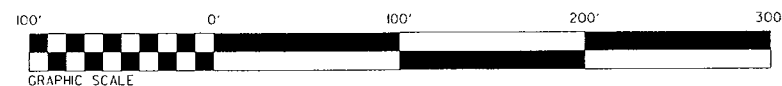


Q10 = 1.91 cfs
V10 = 0.71 fps

Q10 = 3.58 cfs
V10 = 0.90 fps

Q10 = 3.58 cfs
V10 = 0.90 fps

SEE SHEET 45 FOR -L- PROFILE

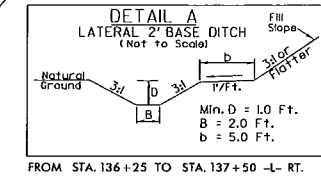



NAD 83/95




H. W. LOCHNER, INC.
2840 PLAZA PLACE, SUITE 202
RALEIGH, NC 27612

PROJECT REFERENCE NO.	SHEET NO.
R-2633B	12
RW. SHEET NO.	
ROADWAY DESIGN ENGINEER	HYDRAULICS ENGINEER
PRELIMINARY PLANS DO NOT USE FOR CONSTRUCTION	


rev. 5/2/13
Permit Drawing
Sheet 18 of 23

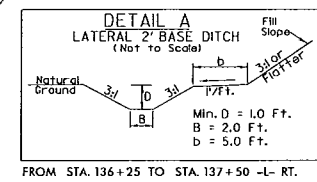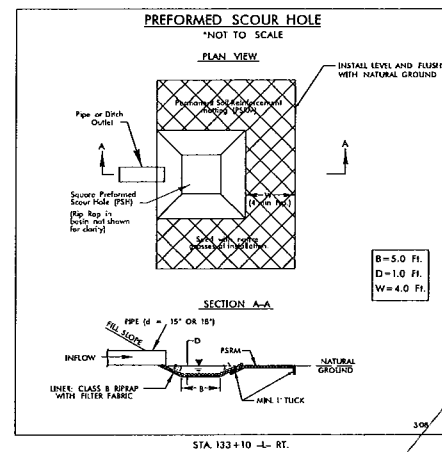


EQUALIZER PIPE INVERTS WILL NOT BE BURIED

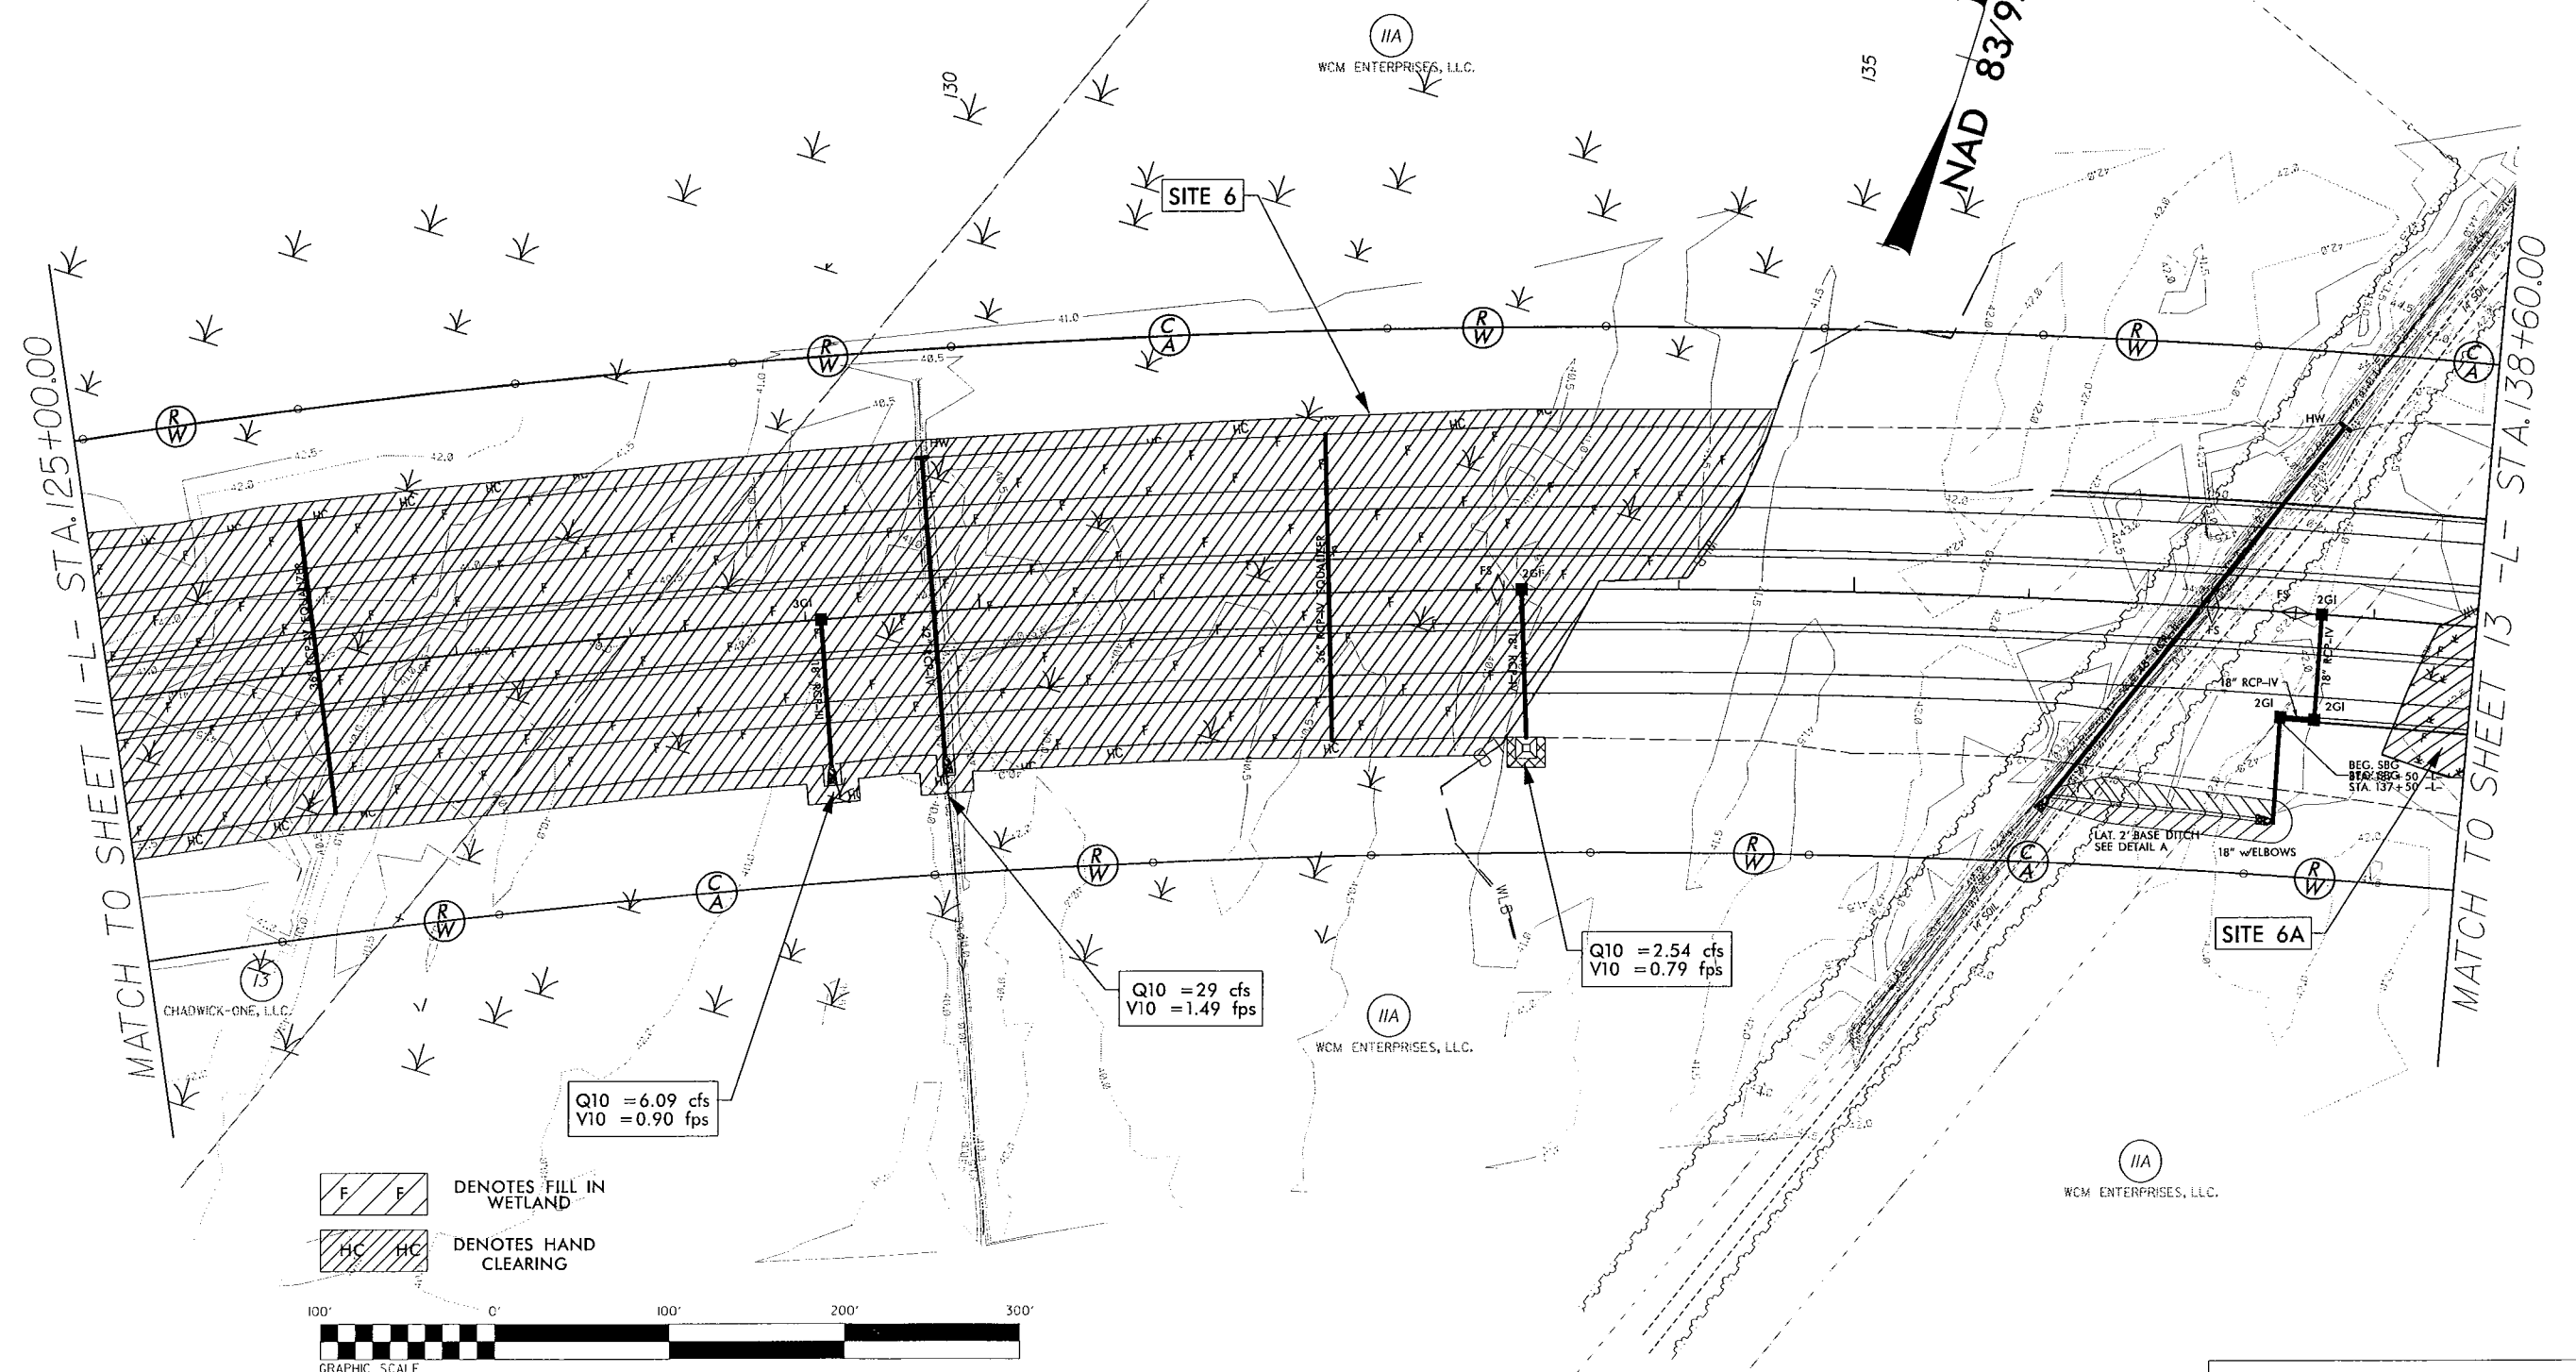

SEE SHEET 46 FOR -L- PROFILE

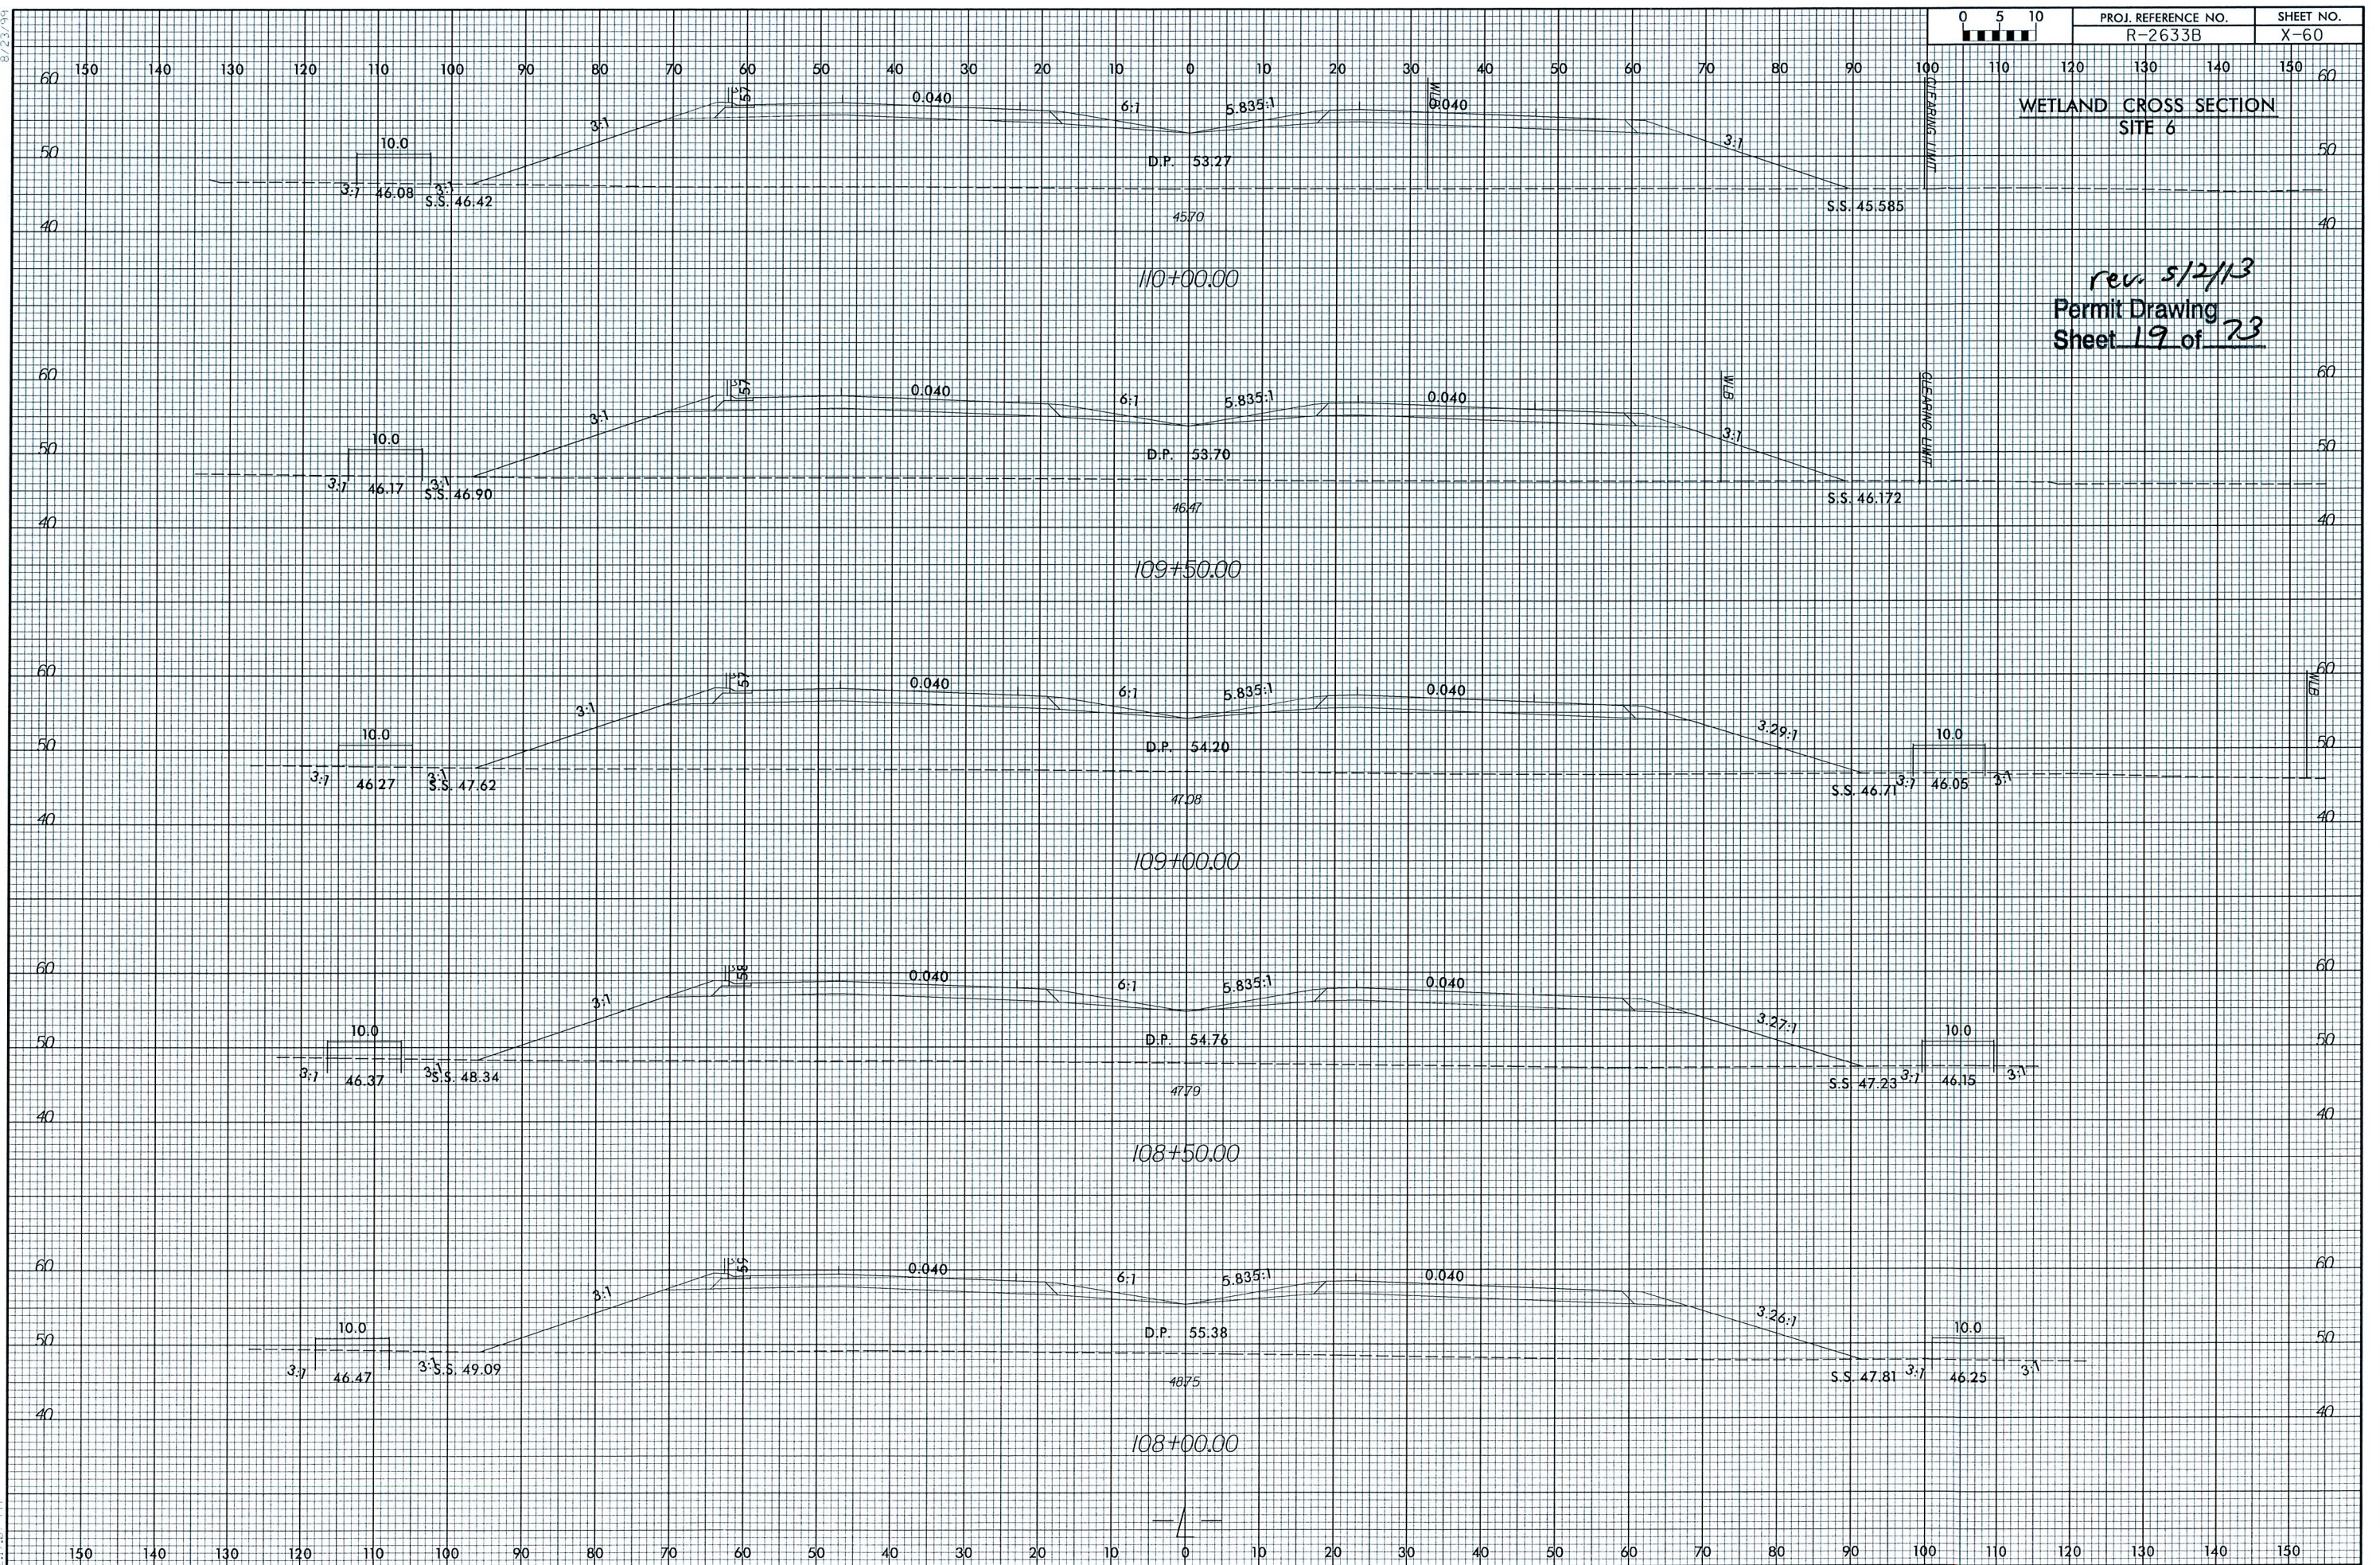

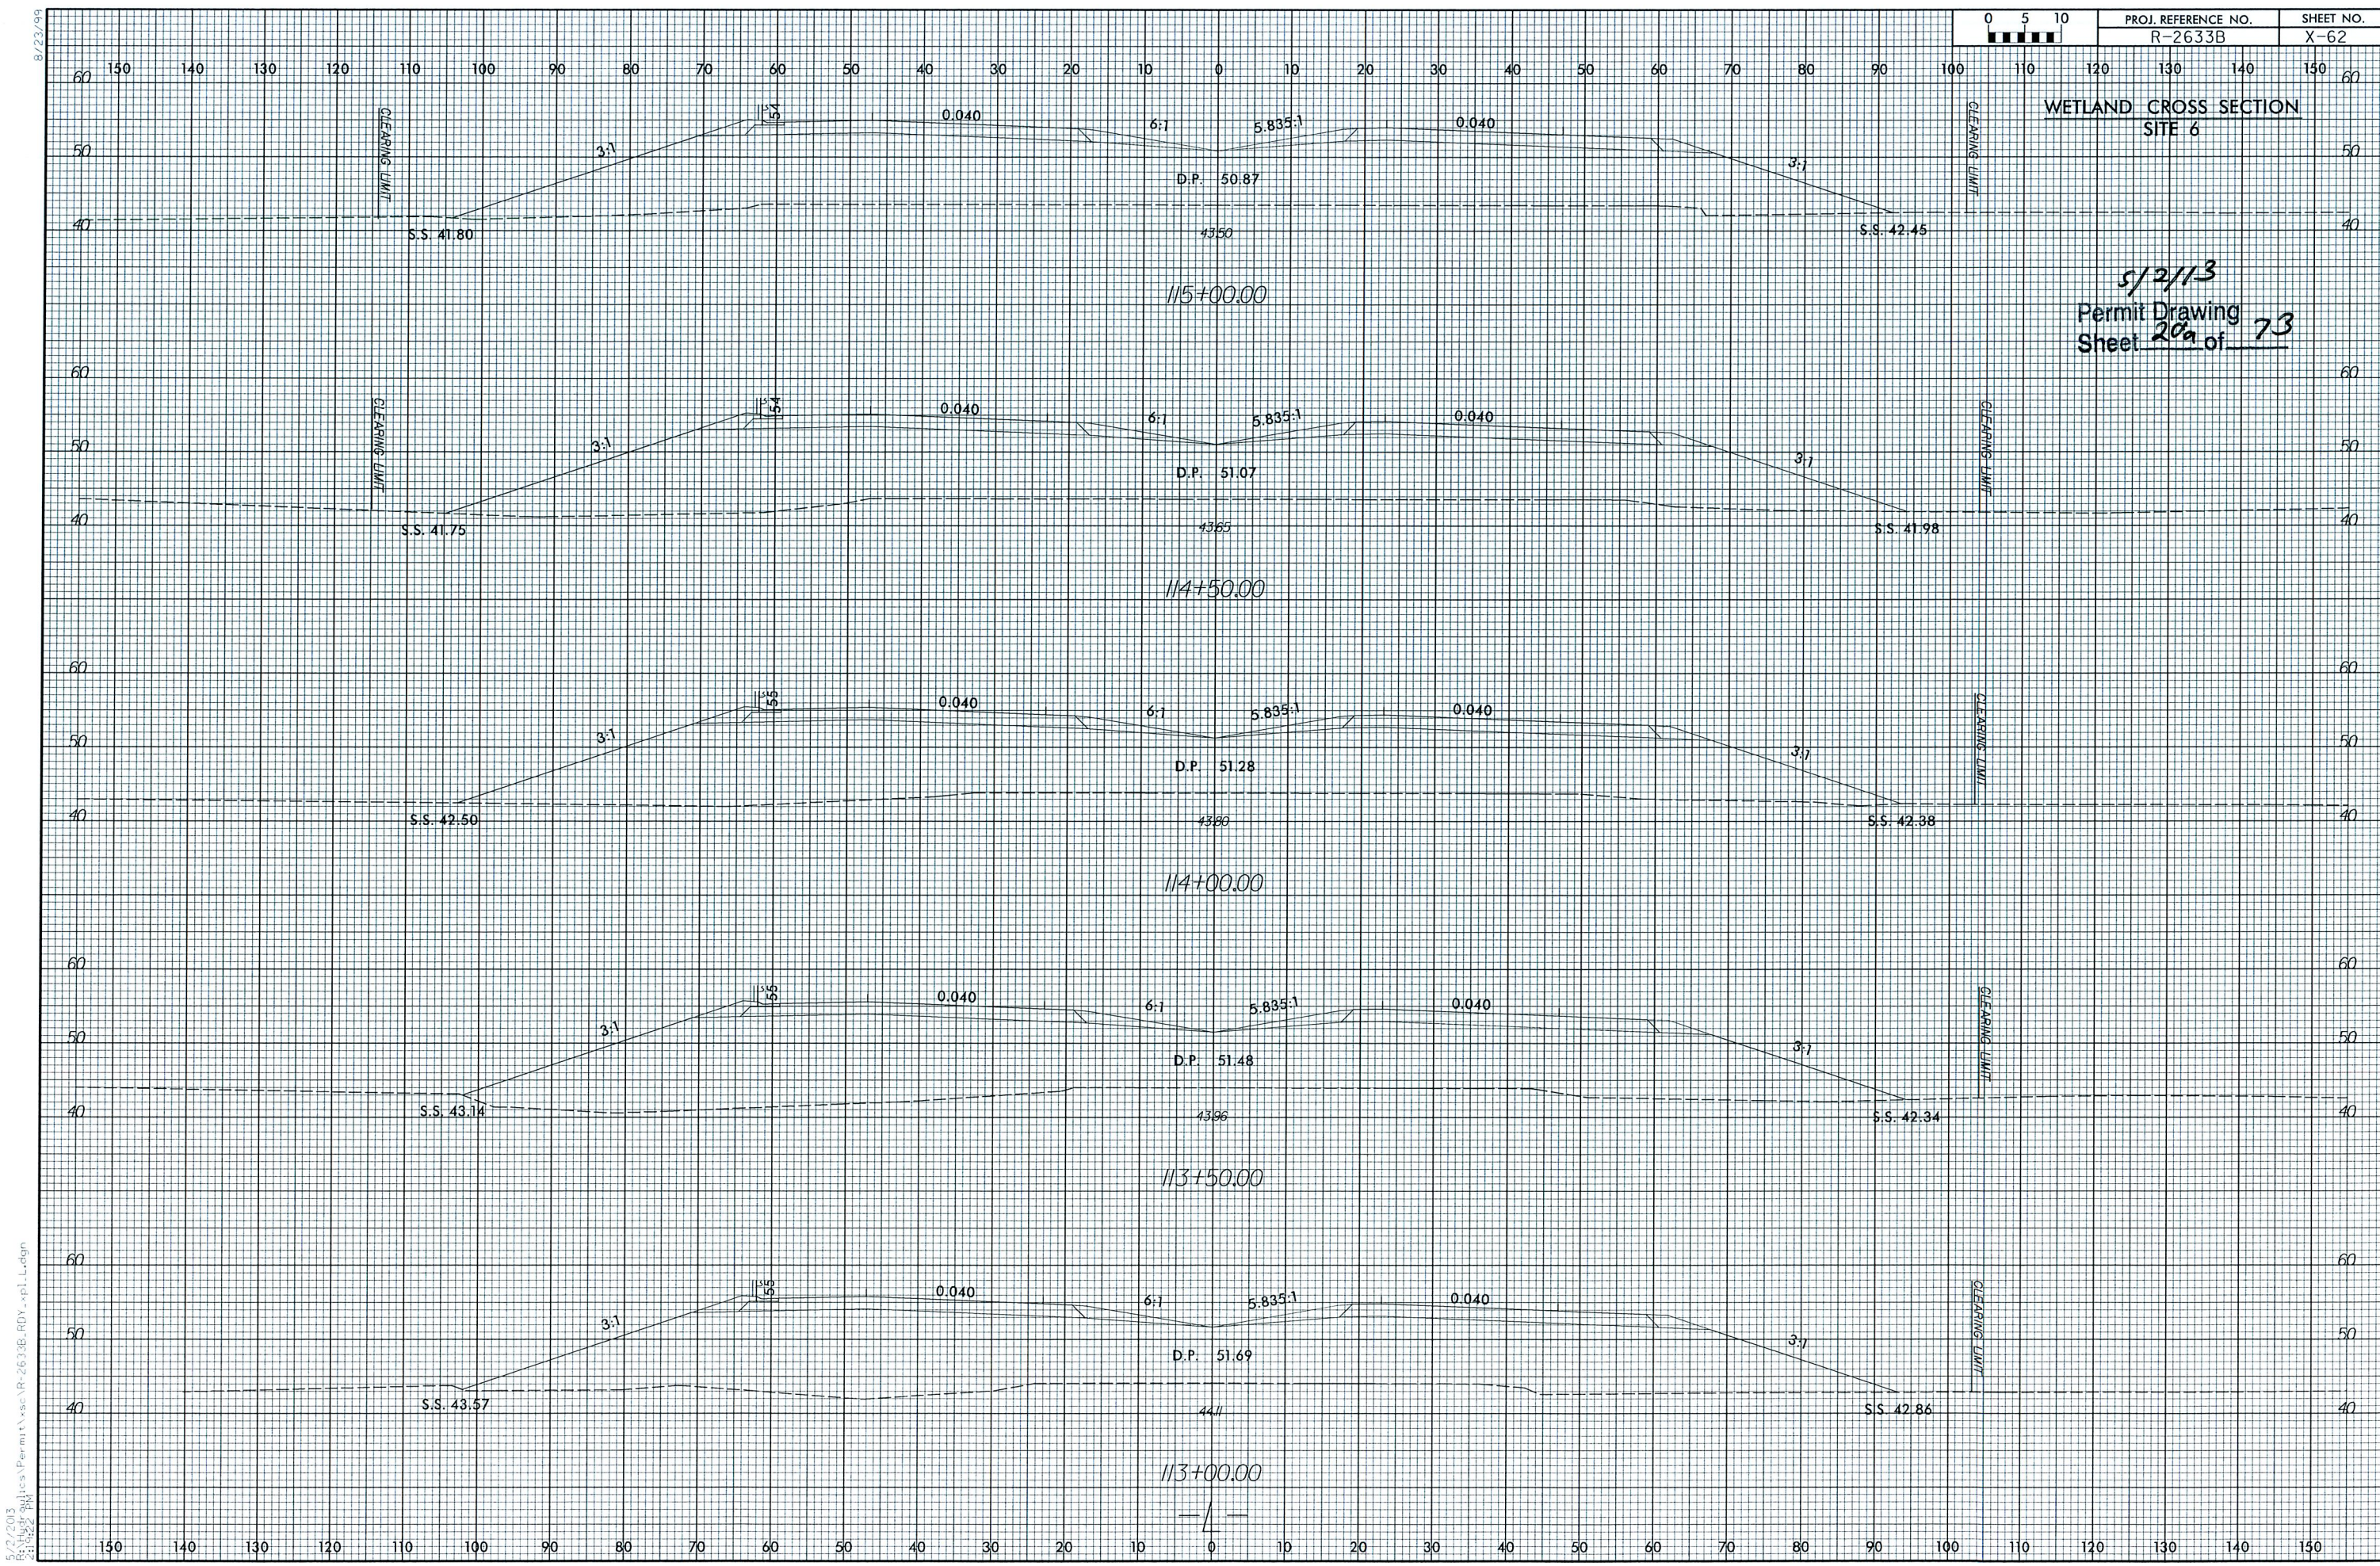

WETLAND CROSS SECTION
SITE 6


5/2/13
Permit Drawing
Sheet 20a of 73

0	5	10


PROJ. REFERENCE NO.	SHEET NO.
R-2633B	X-62

8/23/99

5/2/2013
R:\Hydro\Utilities\Permit\ssc\R-2633B.RDY.xpl.dgn
2:22:50 PM

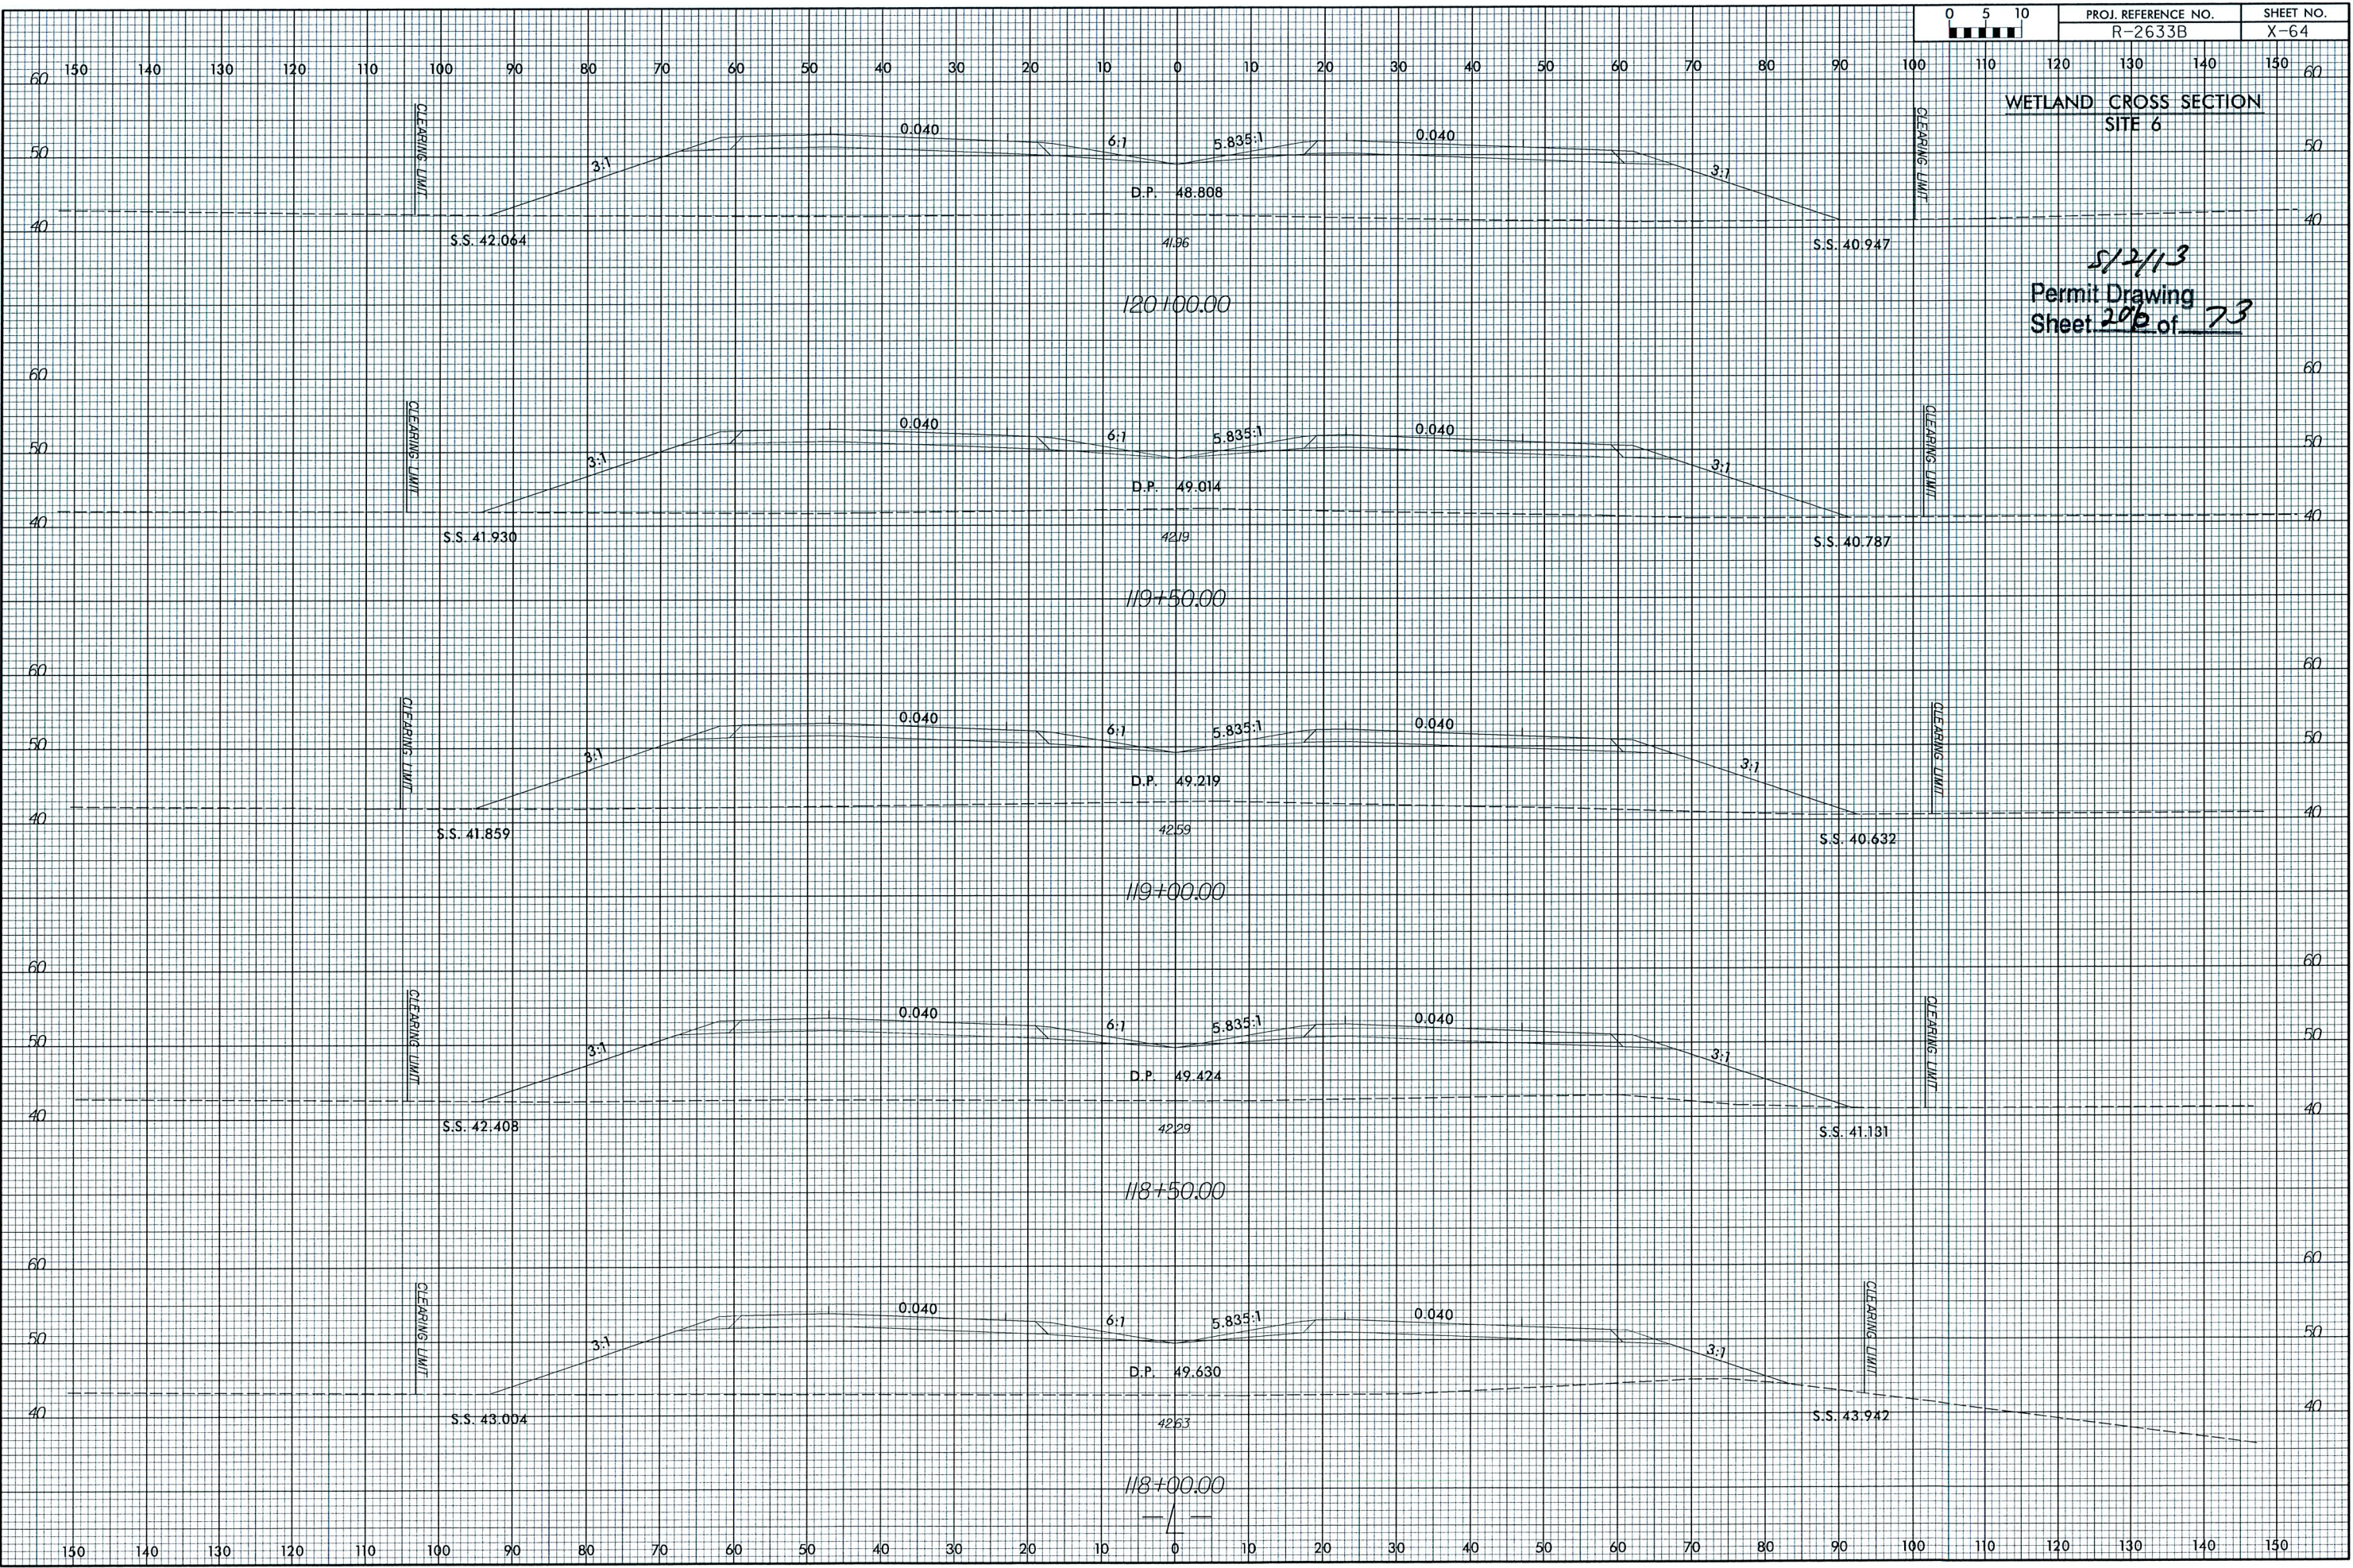


8/23/99
5/2/2013
R:\Hydro\pfiles\Permit\ssc\R-2633B.RDY_xpl.dgn

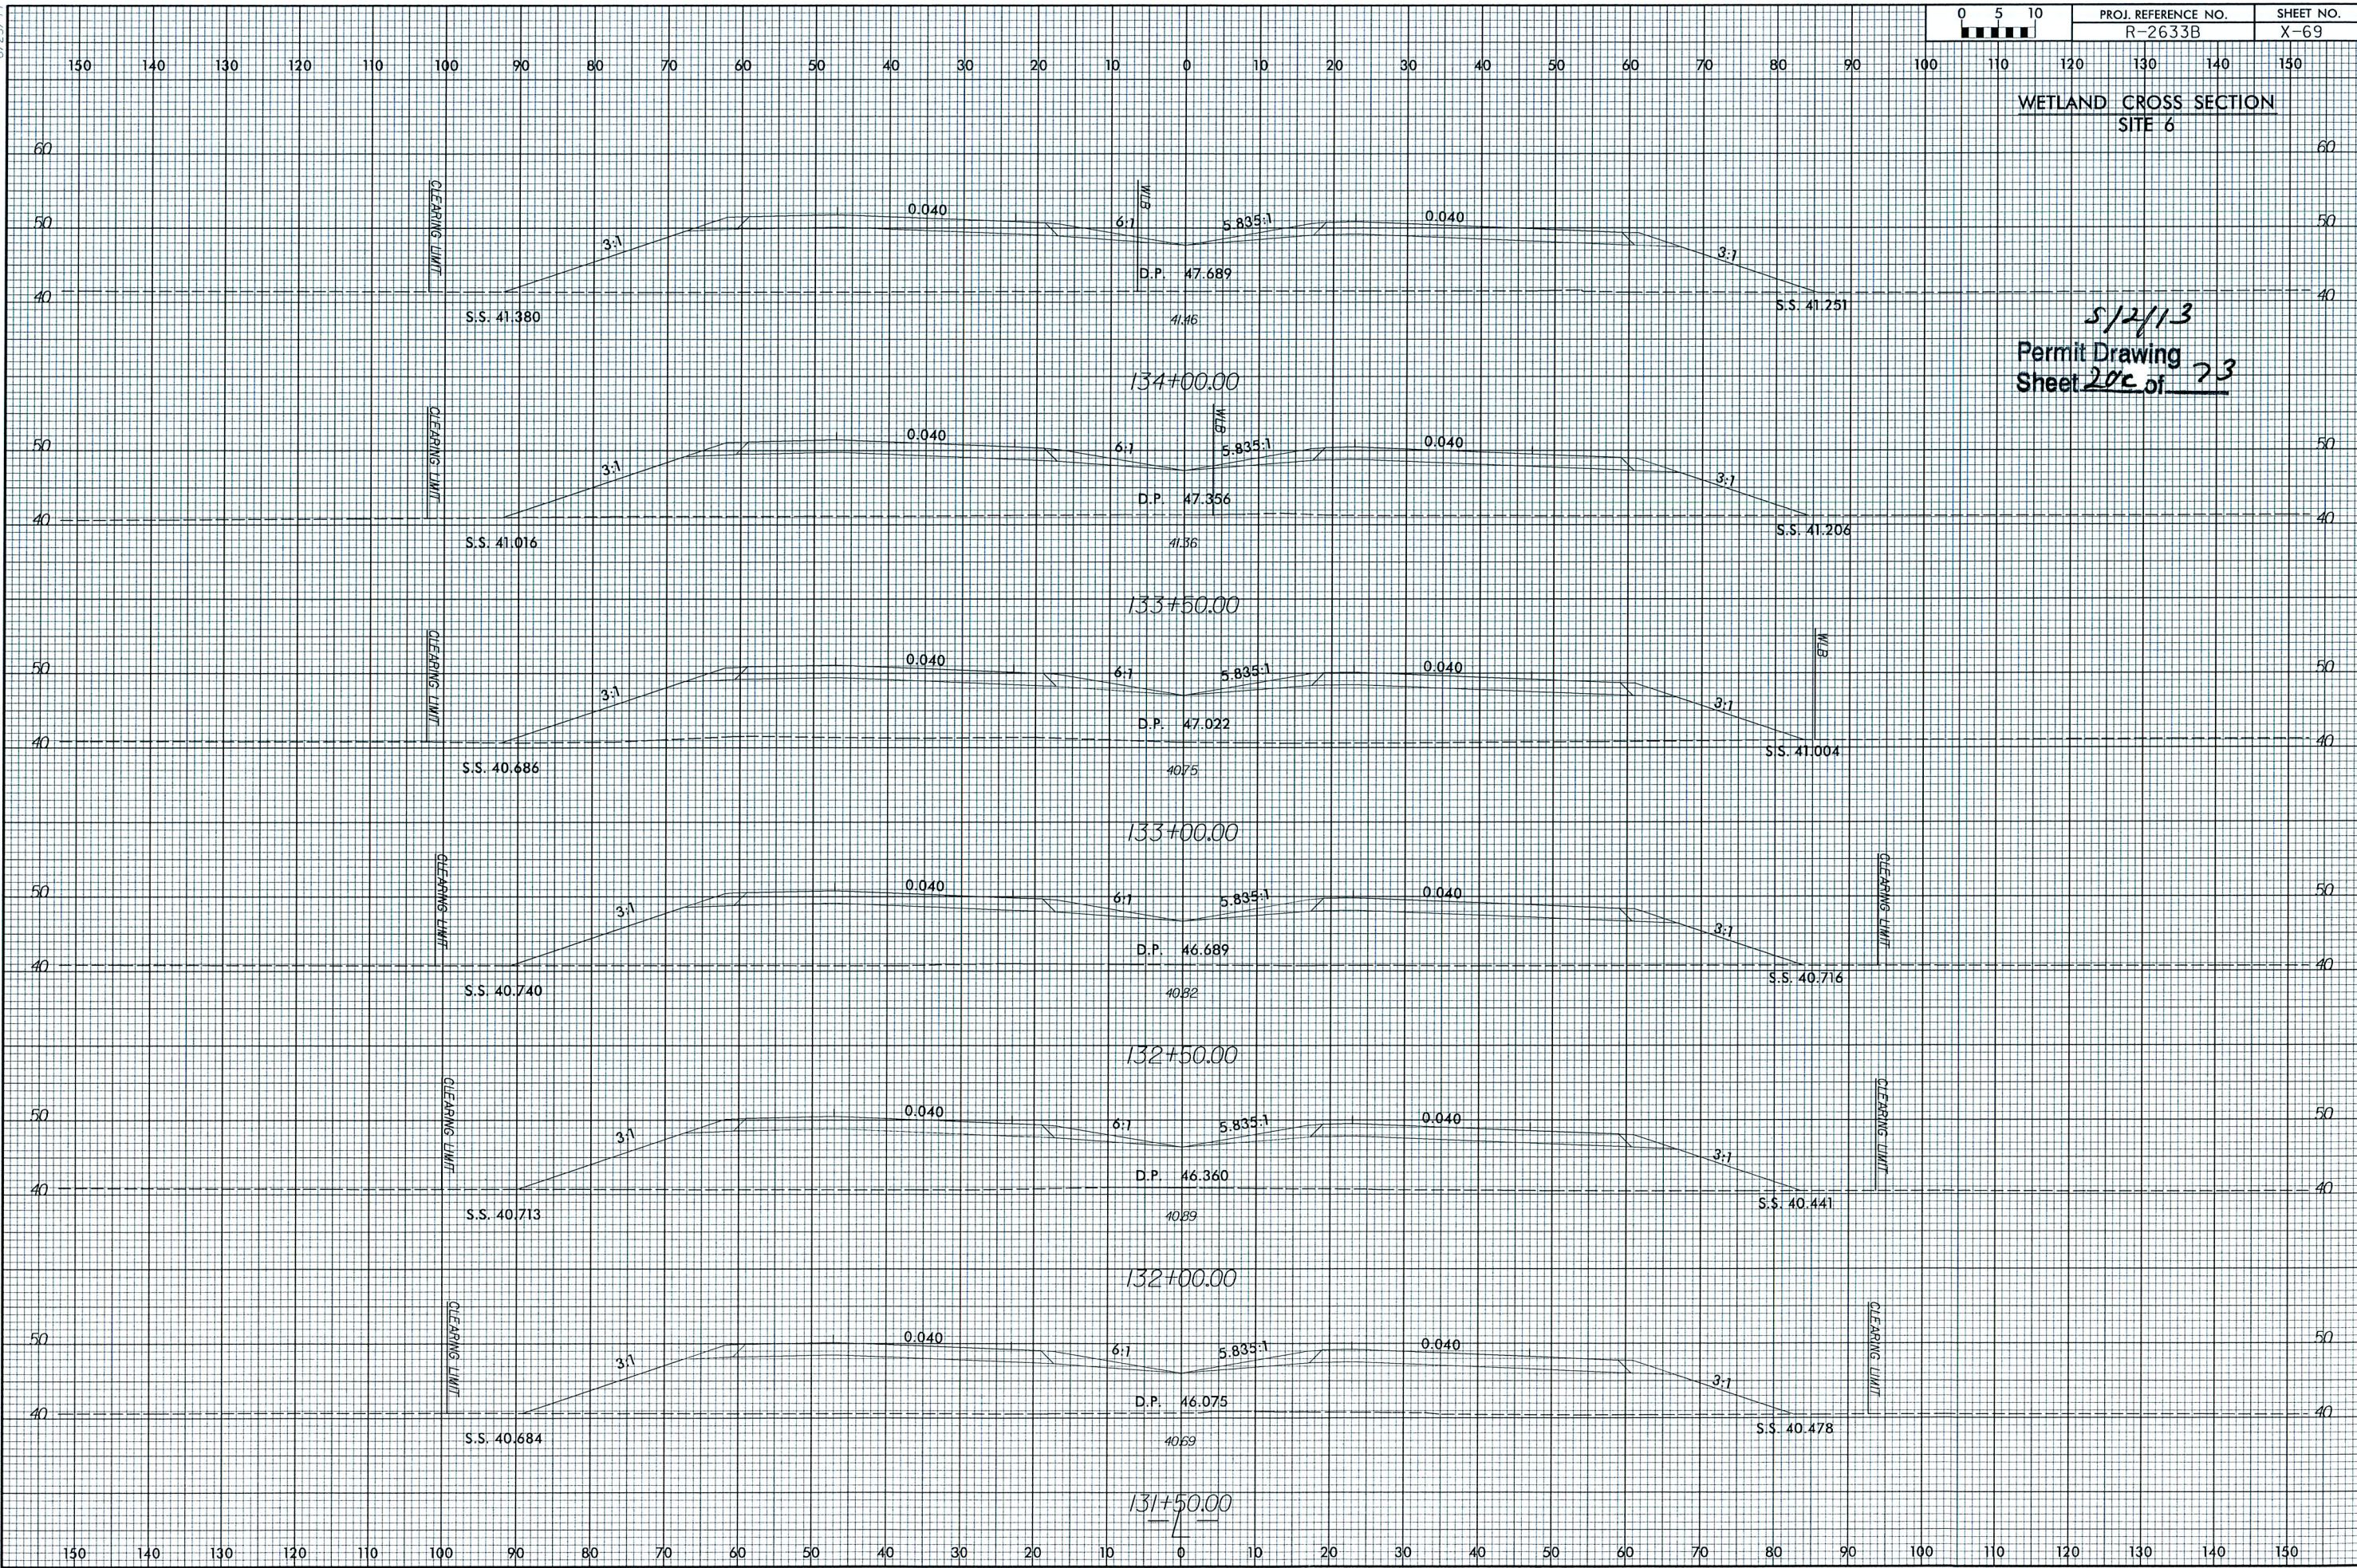

8/23/99
5/2/2013
R:\projects\Permit\1\sc\R-2633B.RD\1.L.dgn
2:58:02 PM

WETLAND CROSS SECTION
SITE 6

5/2/13
Permit Drawing
Sheet 2633B-73

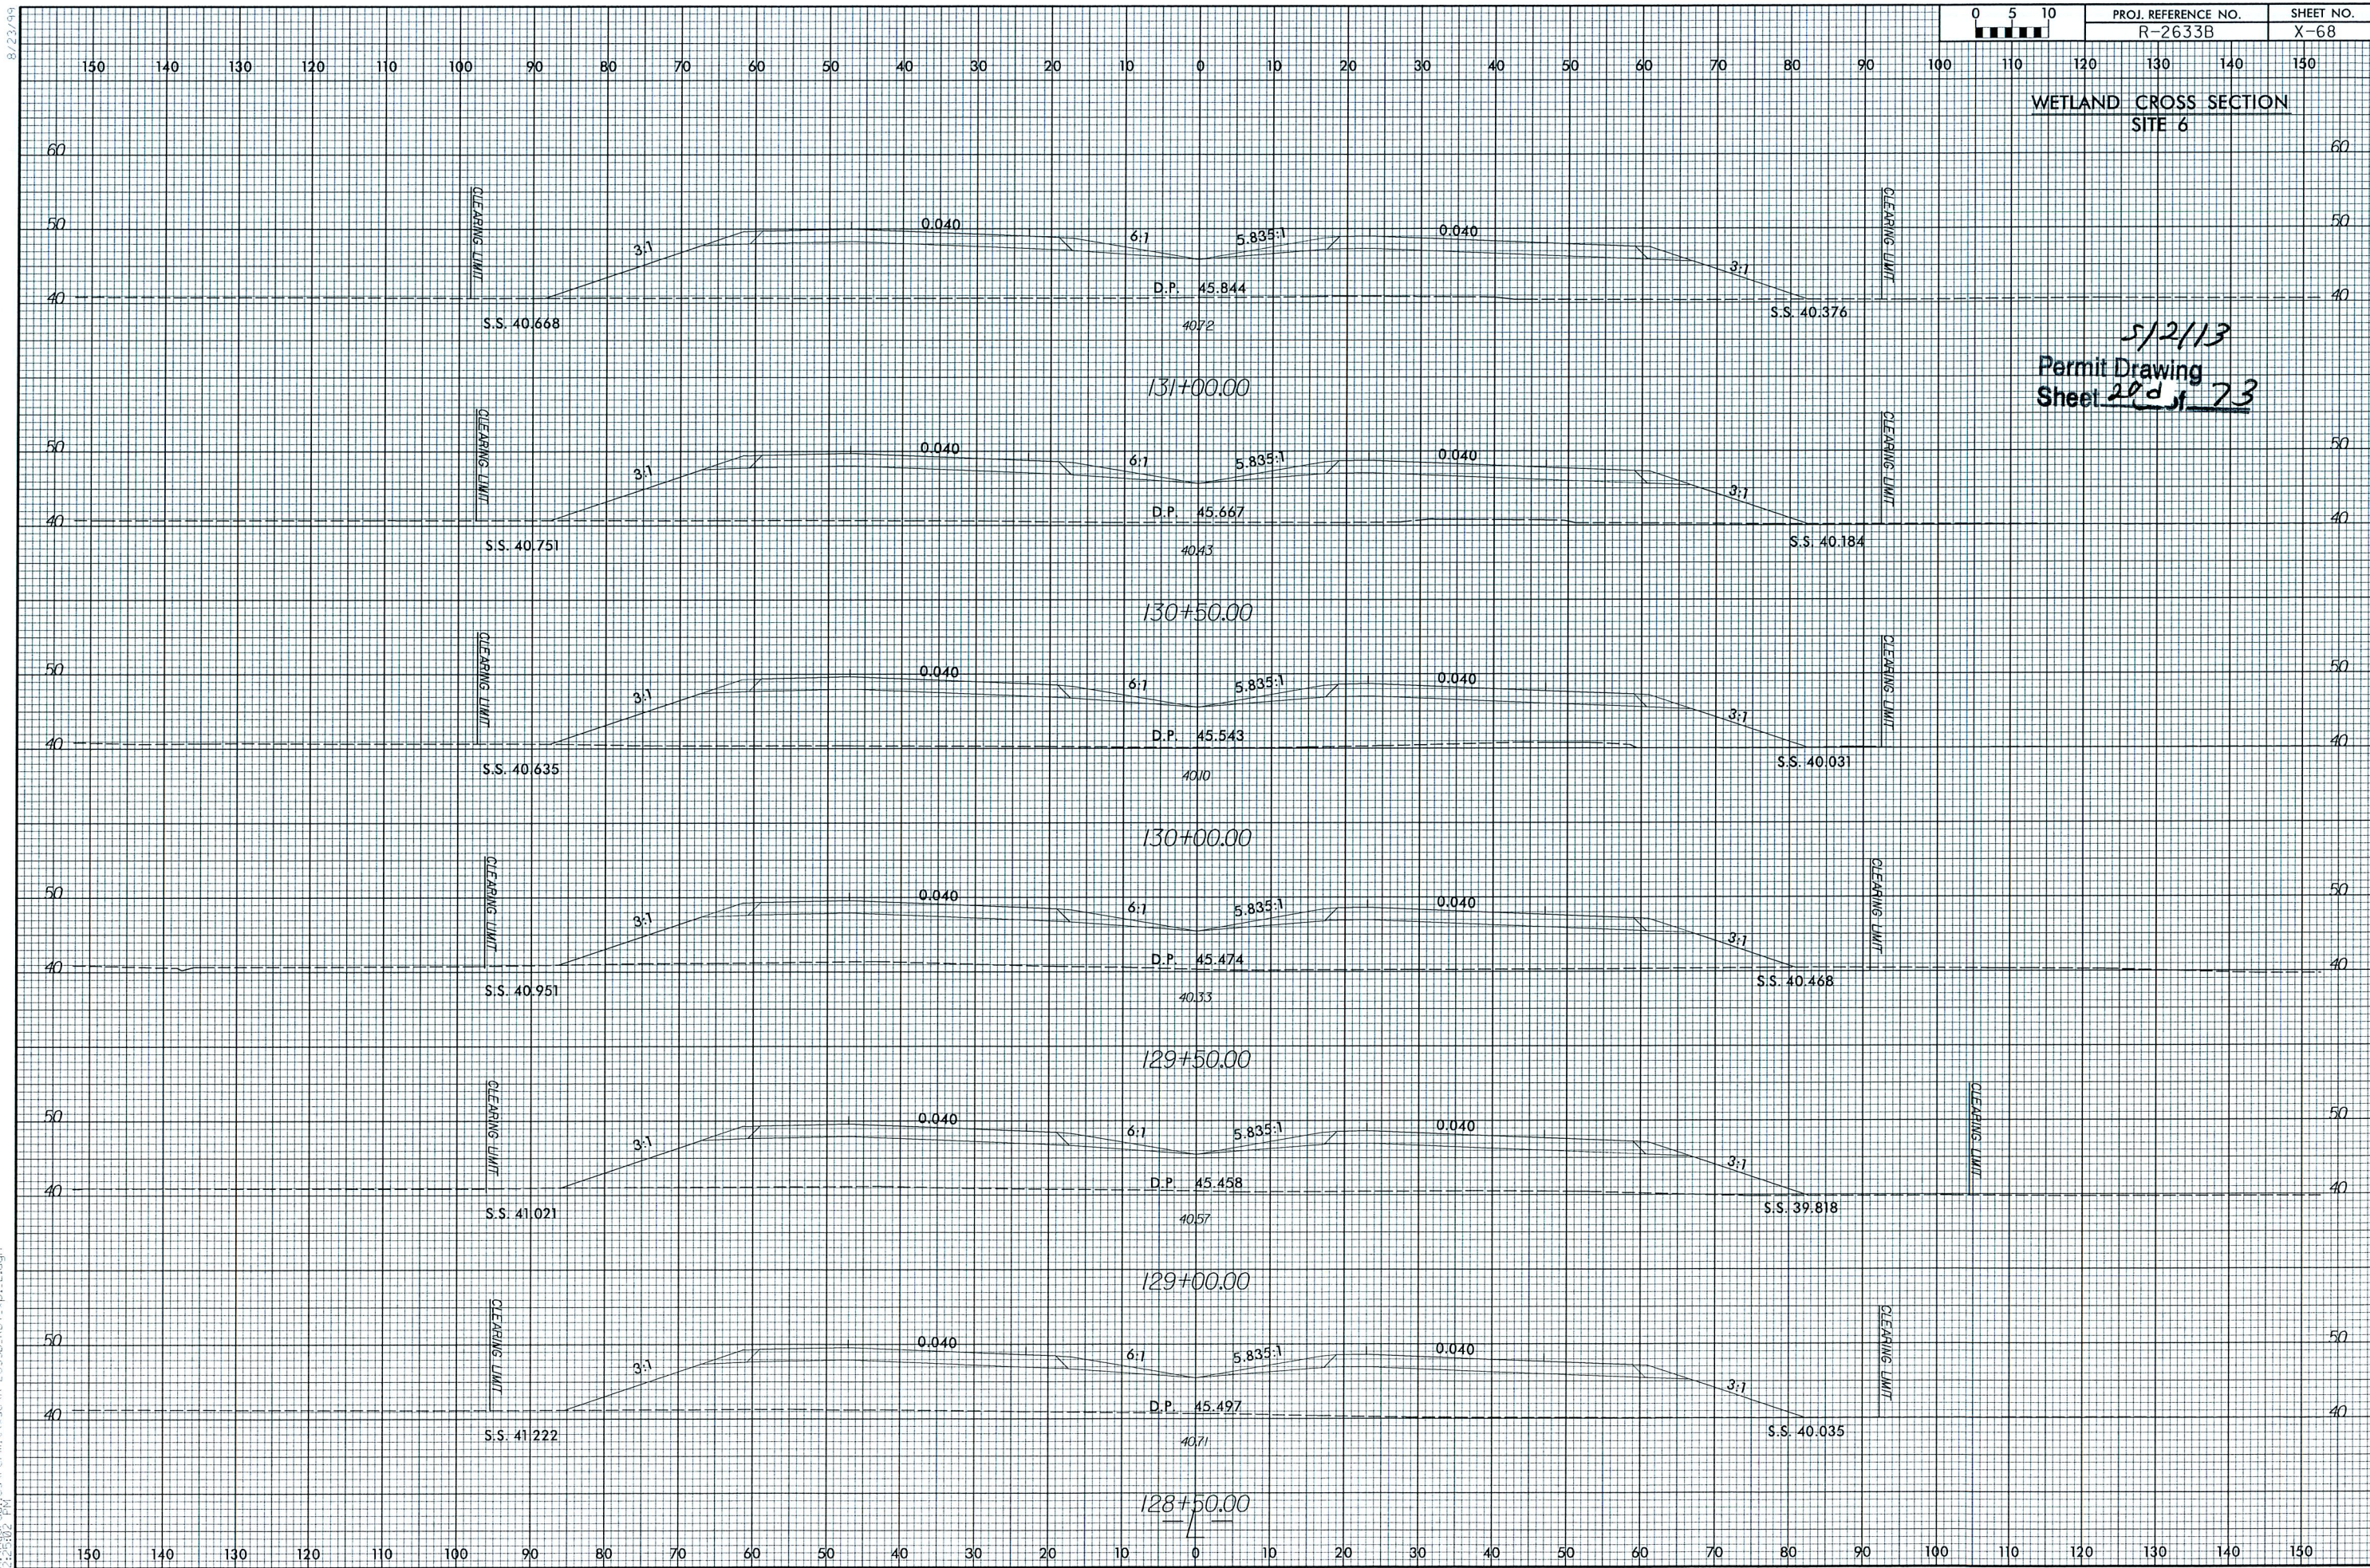



LOCHNER

H. W. LOCHNER, INC.
2840 PLAZA PLACE, SUITE 202
RALEIGH, NC 27612

PROJECT REFERENCE NO. SHEET NO.

R-2633B 13

RAW SHEET NO.

ROADWAY DESIGN ENGINEER HYDRAULICS ENGINEER

PRELIMINARY PLANS
DO NOT USE FOR CONSTRUCTION

Permit Drawing
Sheet 21 of 23
rev. 9/2/13



Q10 = 2.03 cfs
V10 = 1.02 fps

NOTE: A RAILROAD CROSSING AGREEMENT WILL BE
NEEDED AT THIS LOCATION (-L- Sta.147+38.89).

EQUALIZER PIPE INVERTS WILL NOT BE BURIED

BARNEY L. PADGETT ET UX

REVISIONS
10/ /09 - CHANGED PARCEL #1 TO IIA COMBINED PARCEL 13 AND 14 AND ELIMINATED 14. CORRECTED PROPERTY LINES AND RAILROAD R/W LINE ON PARCEL 15.
11/ /11 - CHANGED PARCEL #13 TO 13A. ADDED CA AND FENCE TO RAILROAD R/W. CHANGED STATION ON MONUMENT TO 142+318.17.

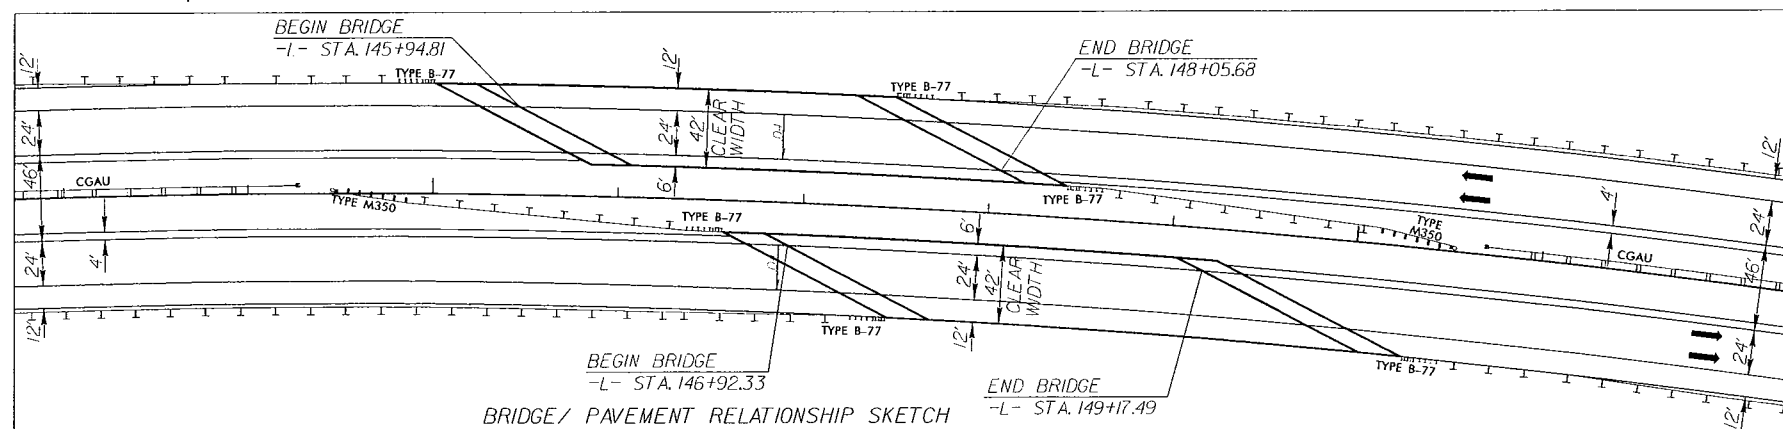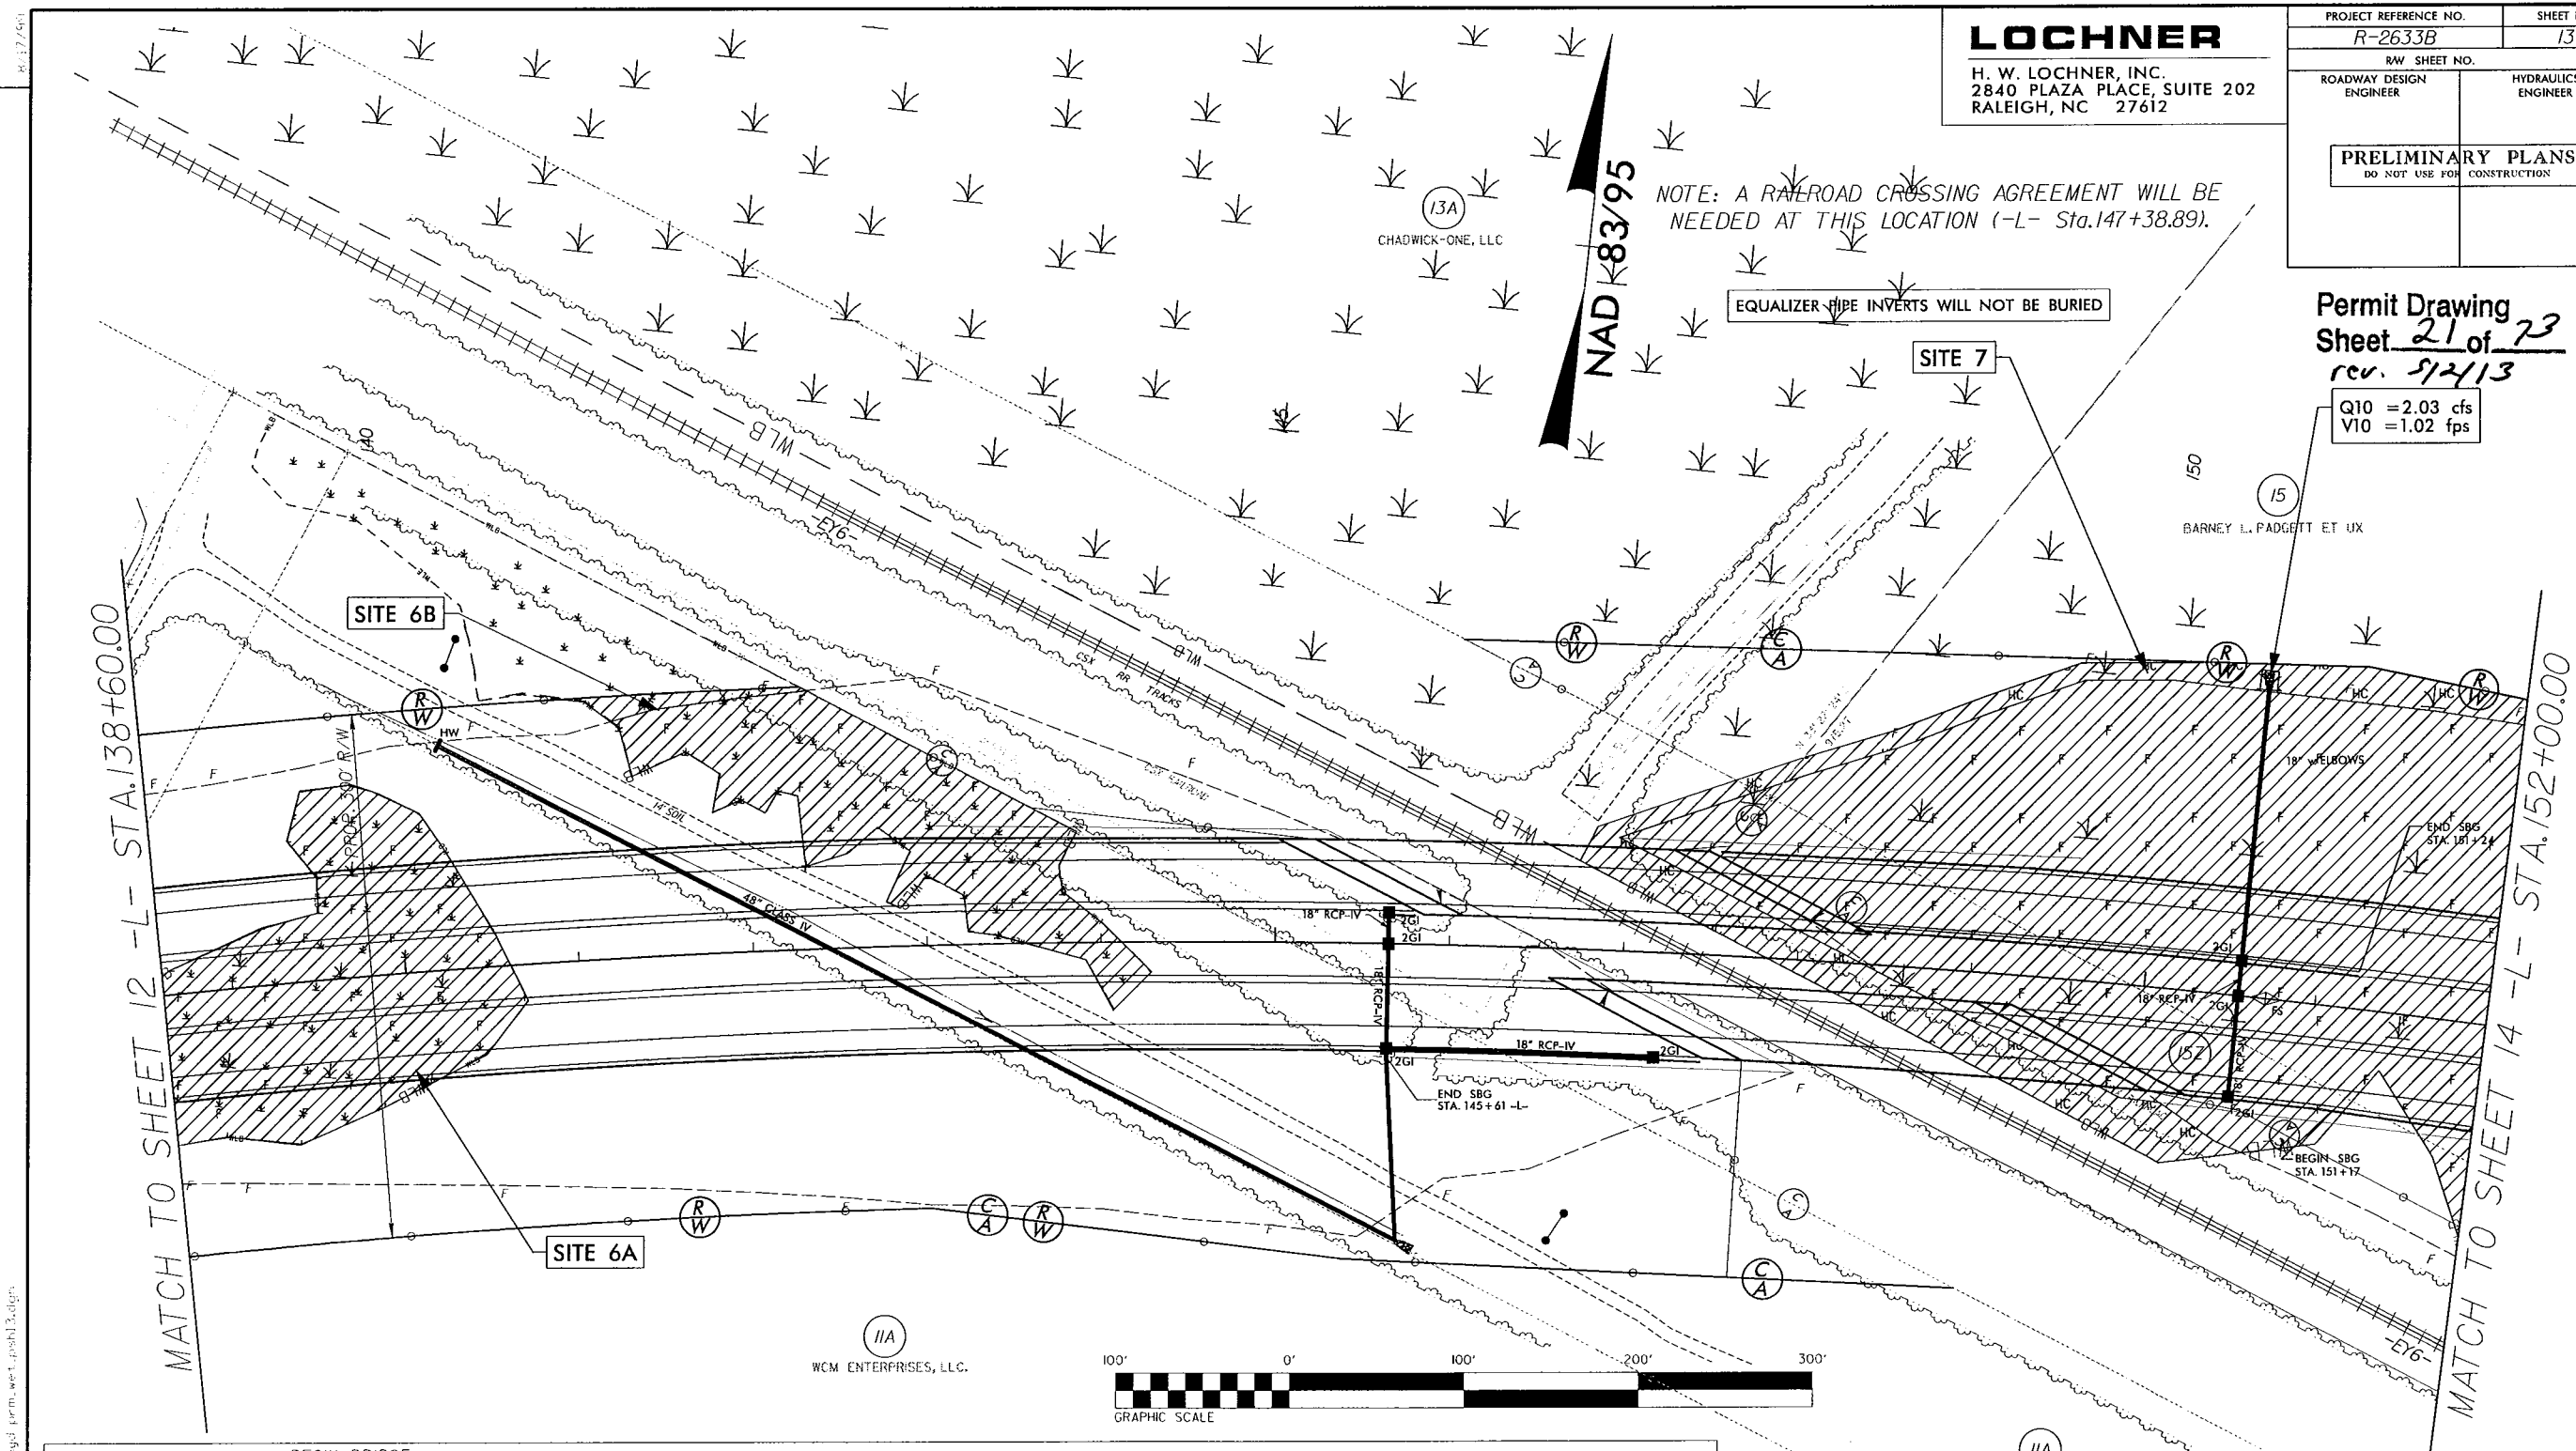

F F DENOTES FILL IN WETLAND
HC HC DENOTES HAND CLEARING

SEE SHEET 46 FOR -L- PROFILE

8/17/99

REVISIONS

10/ /08 - CHANGED PARCEL #1 TO 11A. CORRECTED PROPERTY LINES AND RAILROAD R/W LINE ON PARCEL 15.
11/ /11 - CHANGED PARCEL #13 TO 13A. ADDED CA AND FENCE TO RAILROAD R/W. CHANGED STATION ON MONUMENT TO 142+319.17.

8/2/2013
R:\Projects\Permit\Stream & Wetland\263333.hyd.prm.wet.psh13.dgn

LOCHNER

H. W. LOCHNER, INC.
2840 PLAZA PLACE, SUITE 202
RALEIGH, NC 27612



PROJECT REFERENCE NO. R-2633B	SHEET NO. 13
R/W SHEET NO.	
ROADWAY DESIGN ENGINEER	HYDRAULICS ENGINEER
PRELIMINARY PLANS DO NOT USE FOR CONSTRUCTION	

Permit Drawing
Sheet 22 of 73
rev. 5/2/13

Q10 = 2.03 cfs
V10 = 1.02 fps


NOTE: A RAILROAD CROSSING AGREEMENT WILL BE NEEDED AT THIS LOCATION (-L- Sta.147+38.89).

EQUALIZER PIPE INVERTS WILL NOT BE BURIED

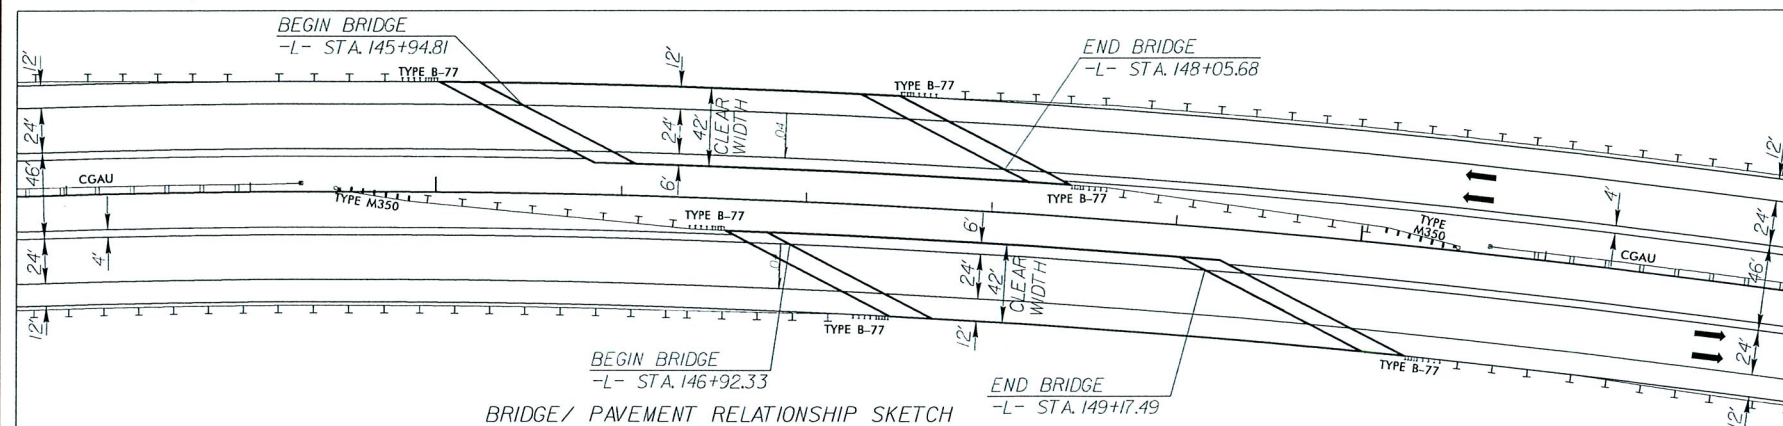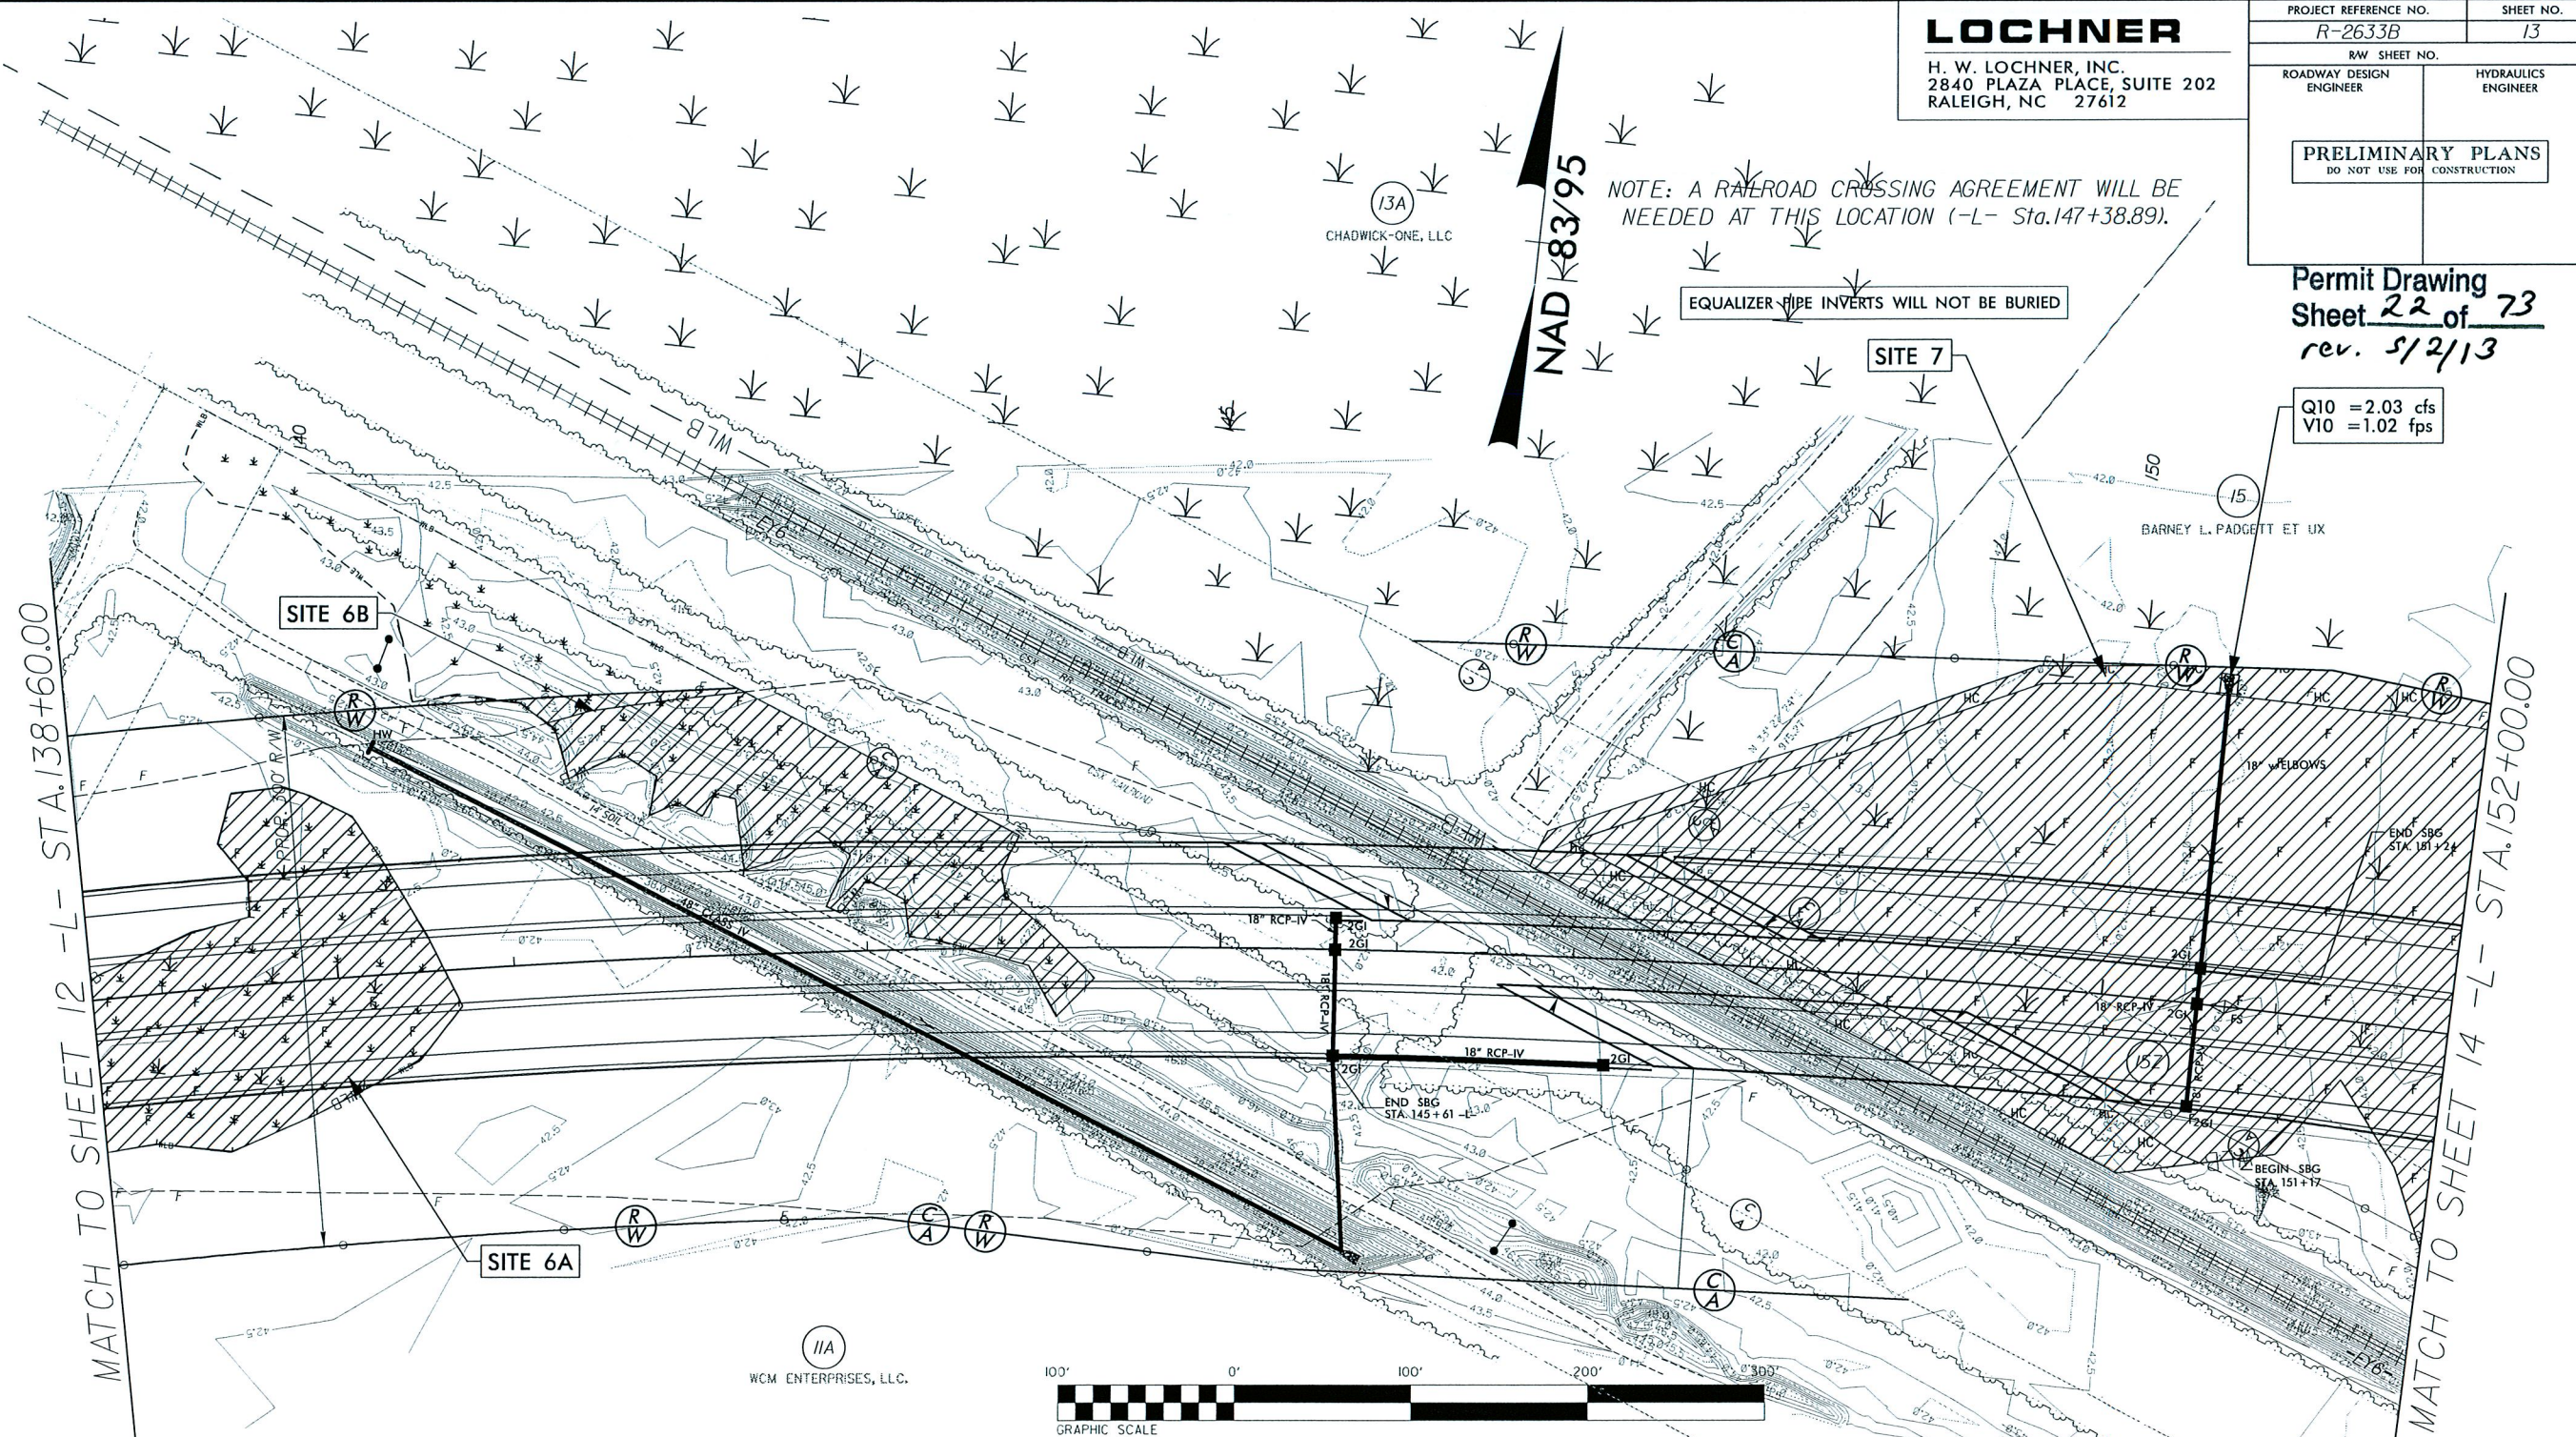

F F DENOTES FILL IN WETLAND
HC HC DENOTES HAND CLEARING

SEE SHEET 46 FOR -L- PROFILE

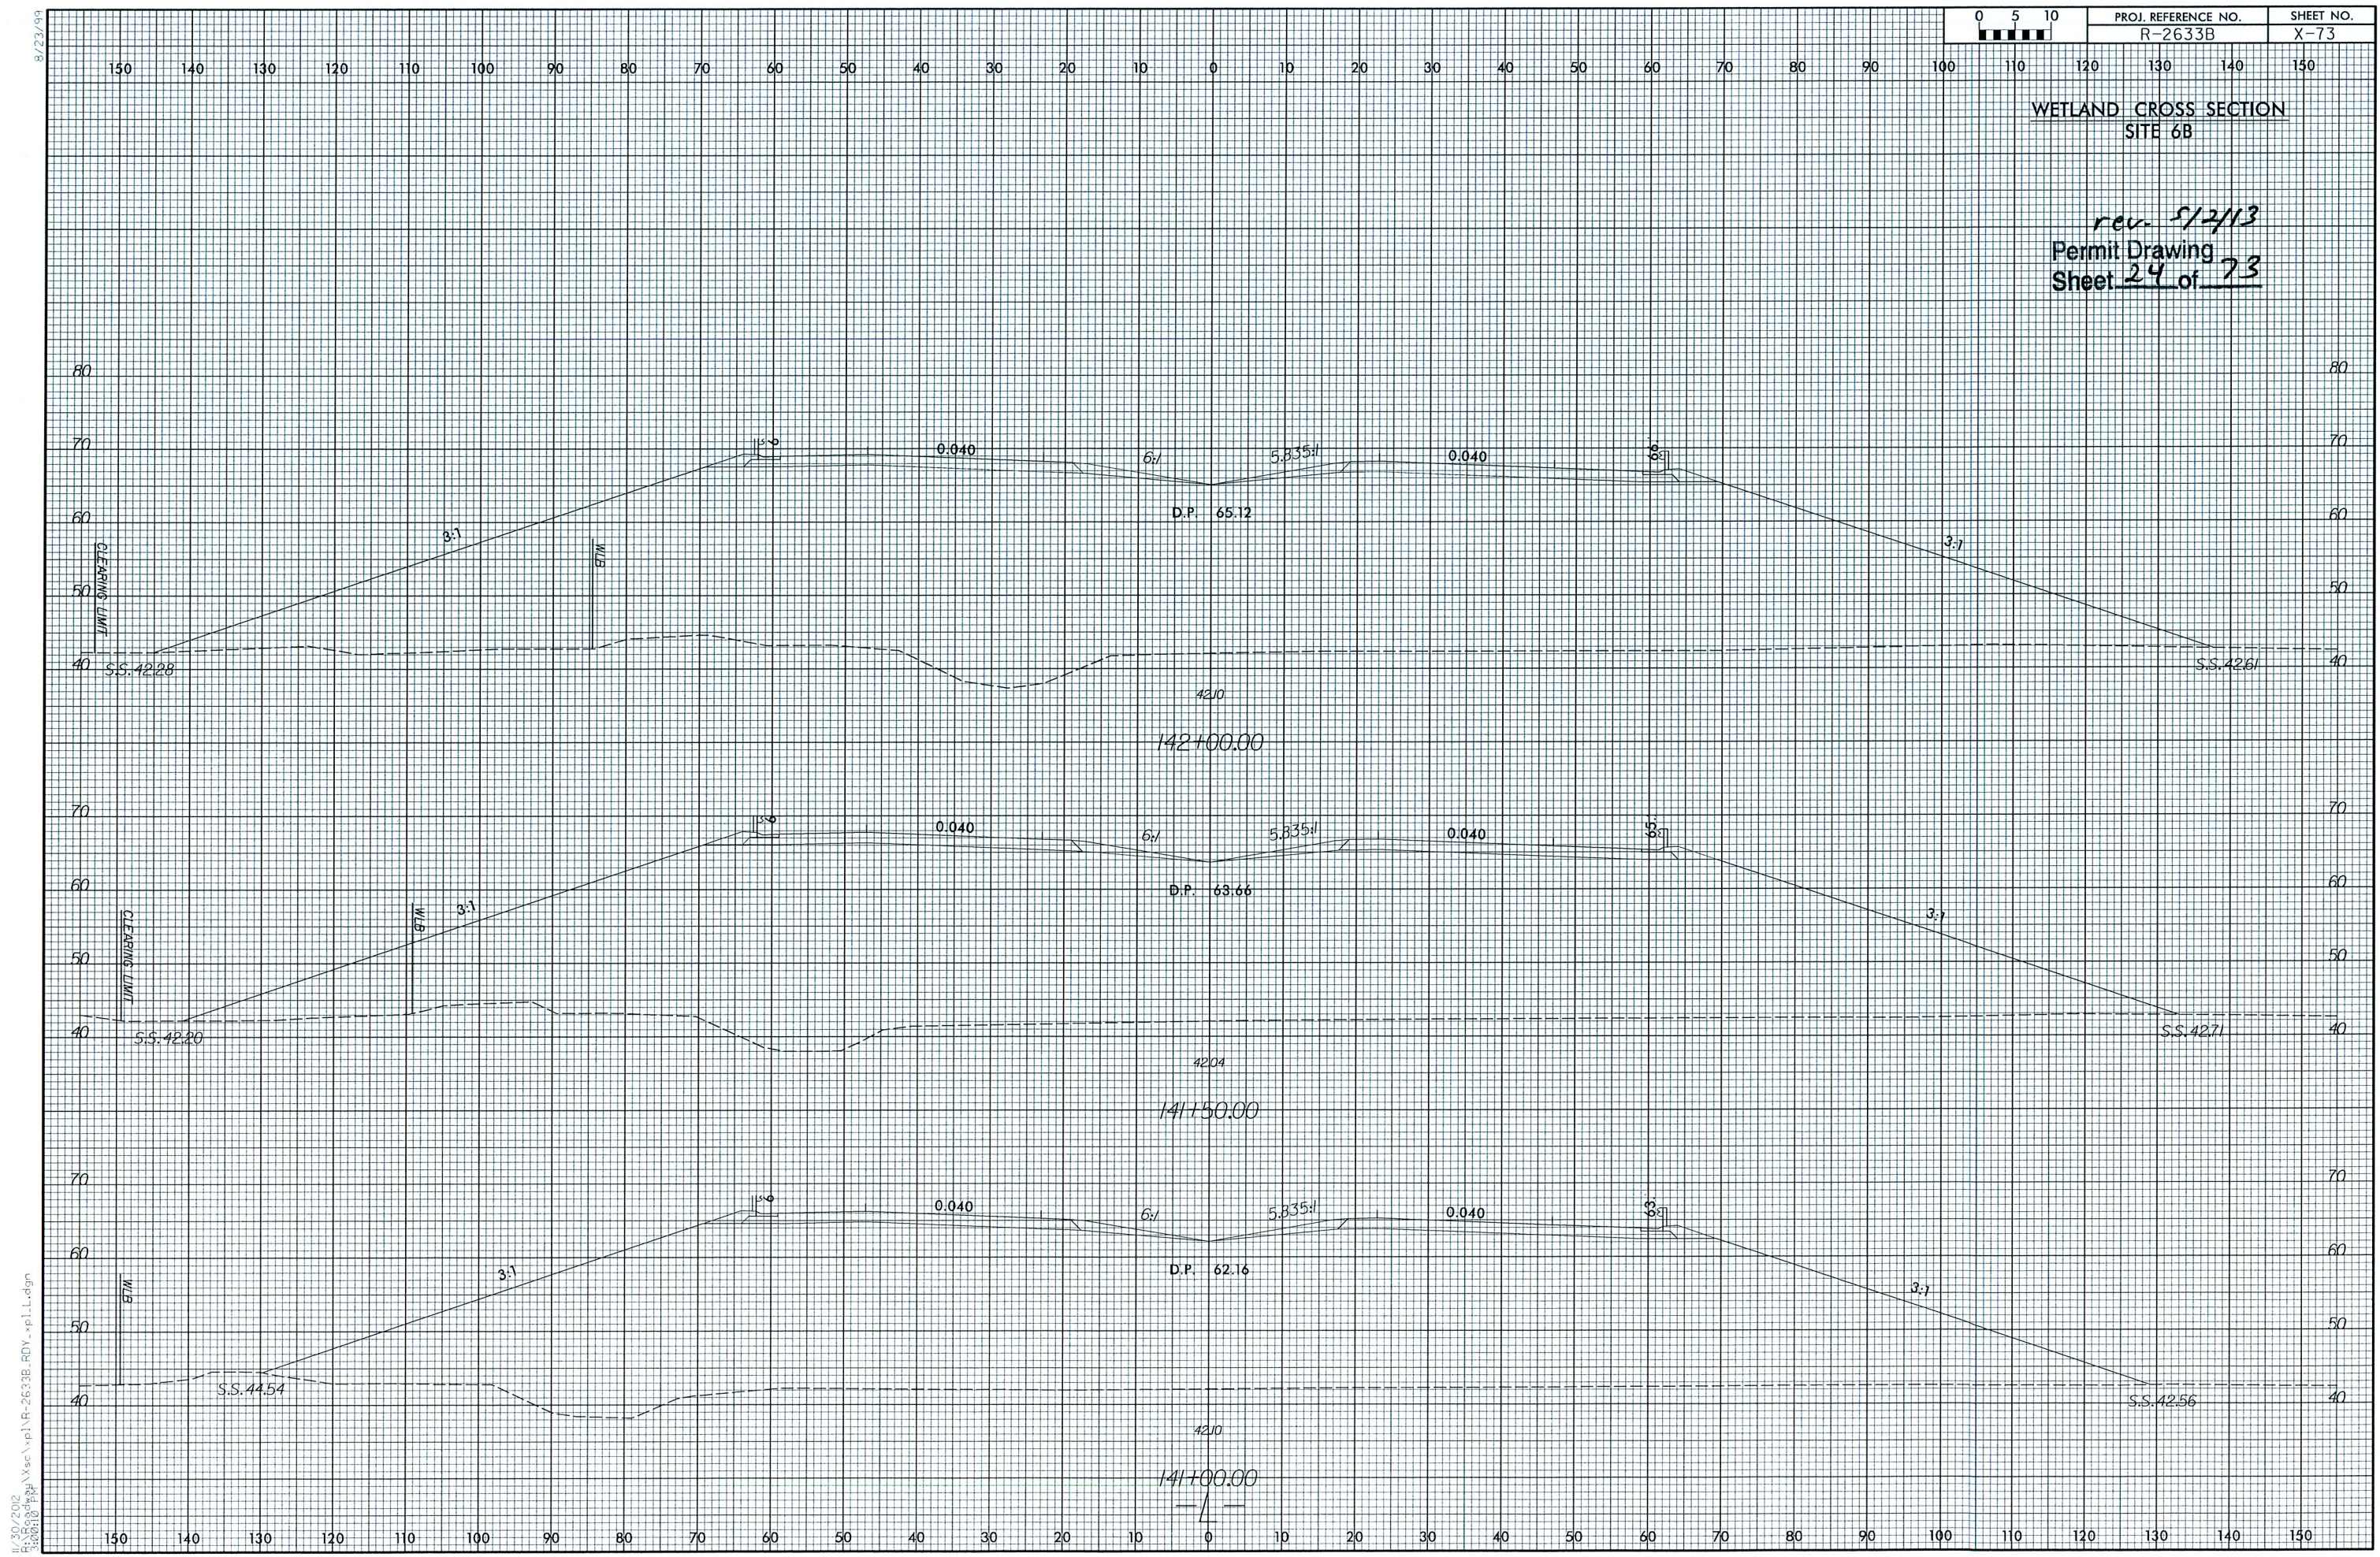

WETLAND CROSS SECTION
SITE 6B

rev. 5/2/13
Permit Drawing
Sheet 24 of 73

8/23/99
11/30/2012
R:\Roadway\Xsec\p1\R-2633B.RDY_xp1.L.dgn
3:08:10 PM



PRELIMINARY PLANS
DO NOT USE FOR CONSTRUCTION

rev. 5/2/13
Permit Drawing
Sheet 25 of 73



8/17/99



F F DENOTES FILL IN WETLAND
HC HC DENOTES HAND CLEARING


EQUALIZER PIPE INVERTS WILL NOT BE BURIED

LOCHNER
H. W. LOCHNER, INC.
2840 PLAZA PLACE, SUITE 202
RALEIGH, NC 27612

PROJECT REFERENCE NO. <i>R-2633B</i>	SHEET NO. <i>14</i>
RW SHEET NO.	
ROADWAY DESIGN ENGINEER	HYDRAULICS ENGINEER
PRELIMINARY PLANS DO NOT USE FOR CONSTRUCTION	

rev. 5/2/13
Permit Drawing
Sheet 26 of 73

NAD 83/95

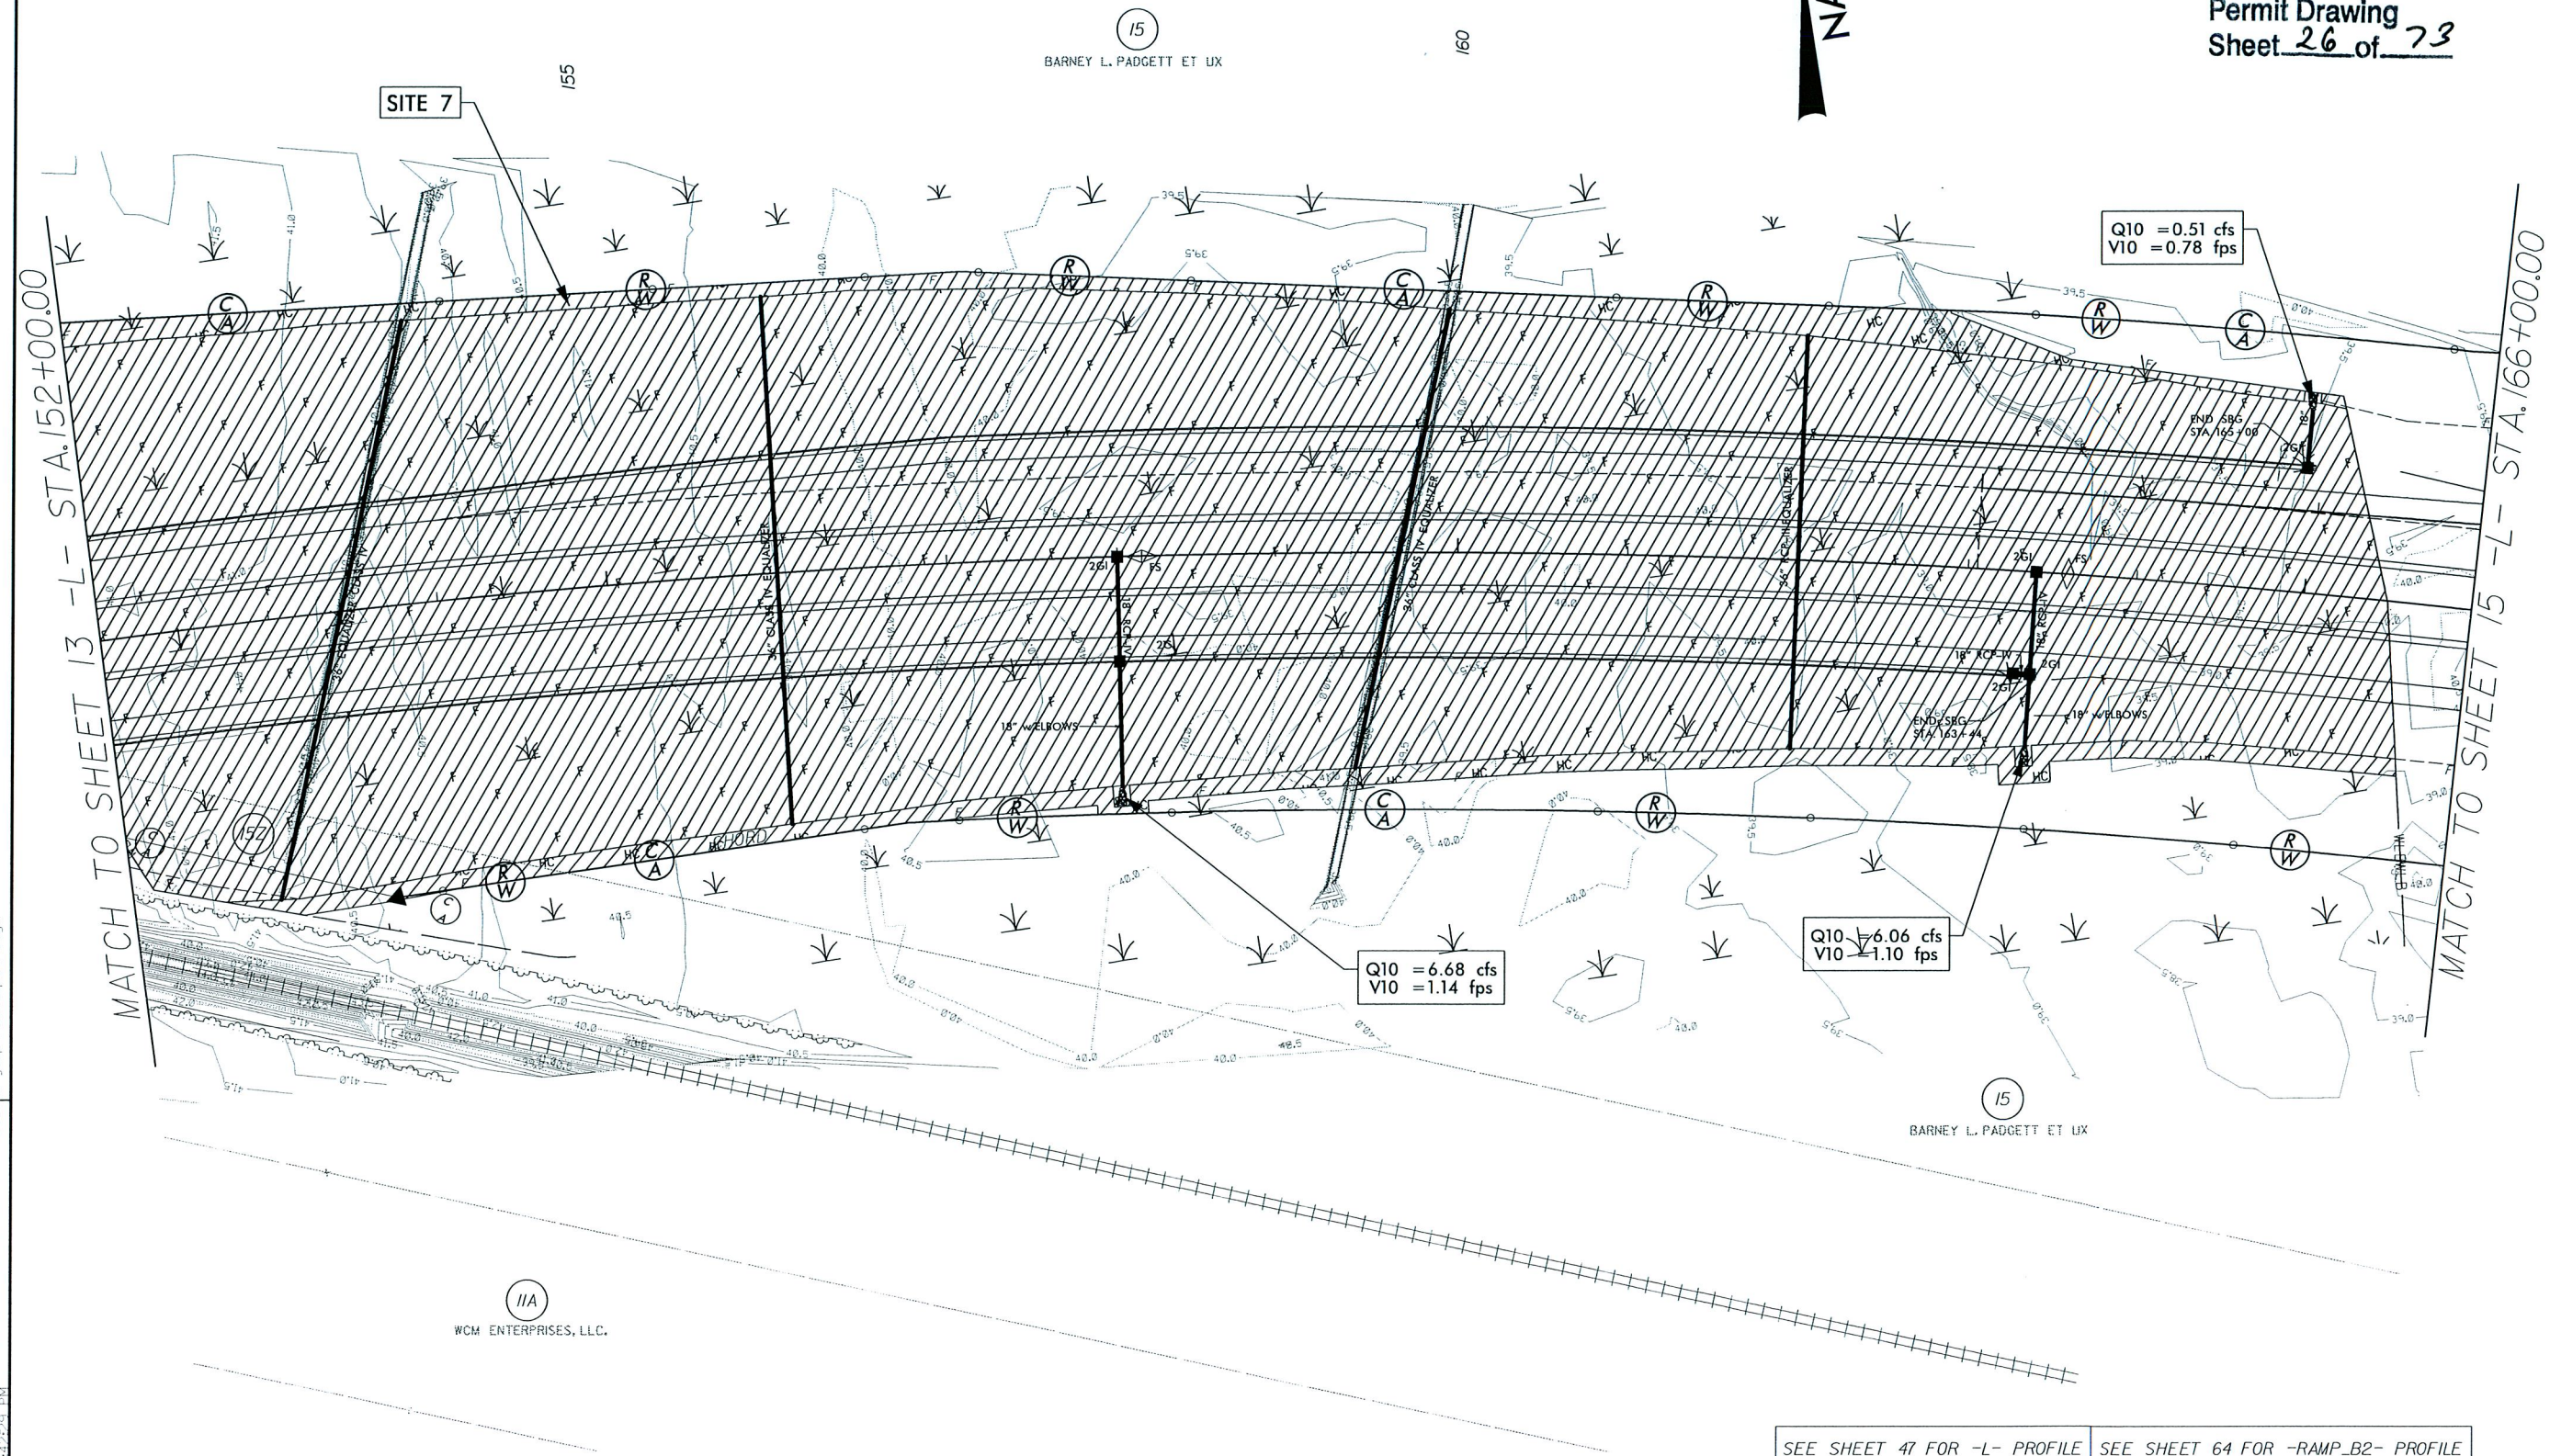

REVISIONS

5/2/2013
R:\Projects\Permit\Stream & Wetland\2633B_hyd_perm_wet_csh14.dgn
2633B.dgn

SEE SHEET 47 FOR -L- PROFILE SEE SHEET 64 FOR -RAMP_B2- PROFILE

8/23/99
4/29/2013
R:\Hugr\outlets\Permit\ssc\F-2633B.RD\X-83.L.dgn
2:55:24 PM

WETLAND CROSS SECTION
SITE 7
rev. 5/2/13
Permit Drawing
Sheet 22 of 73

WETLAND BOUNDARIES
OFF SHEET

CLEARING LIMIT

CLEARING LIMIT

S.S. 40395

S.S. 40570

S.S. 40788

3s

3s

3s

B

B

B

4062

156+00.00

D.P. 65275

4078


155+50.00

D.P. 66861

4070

155+00.00

D.P. 67948

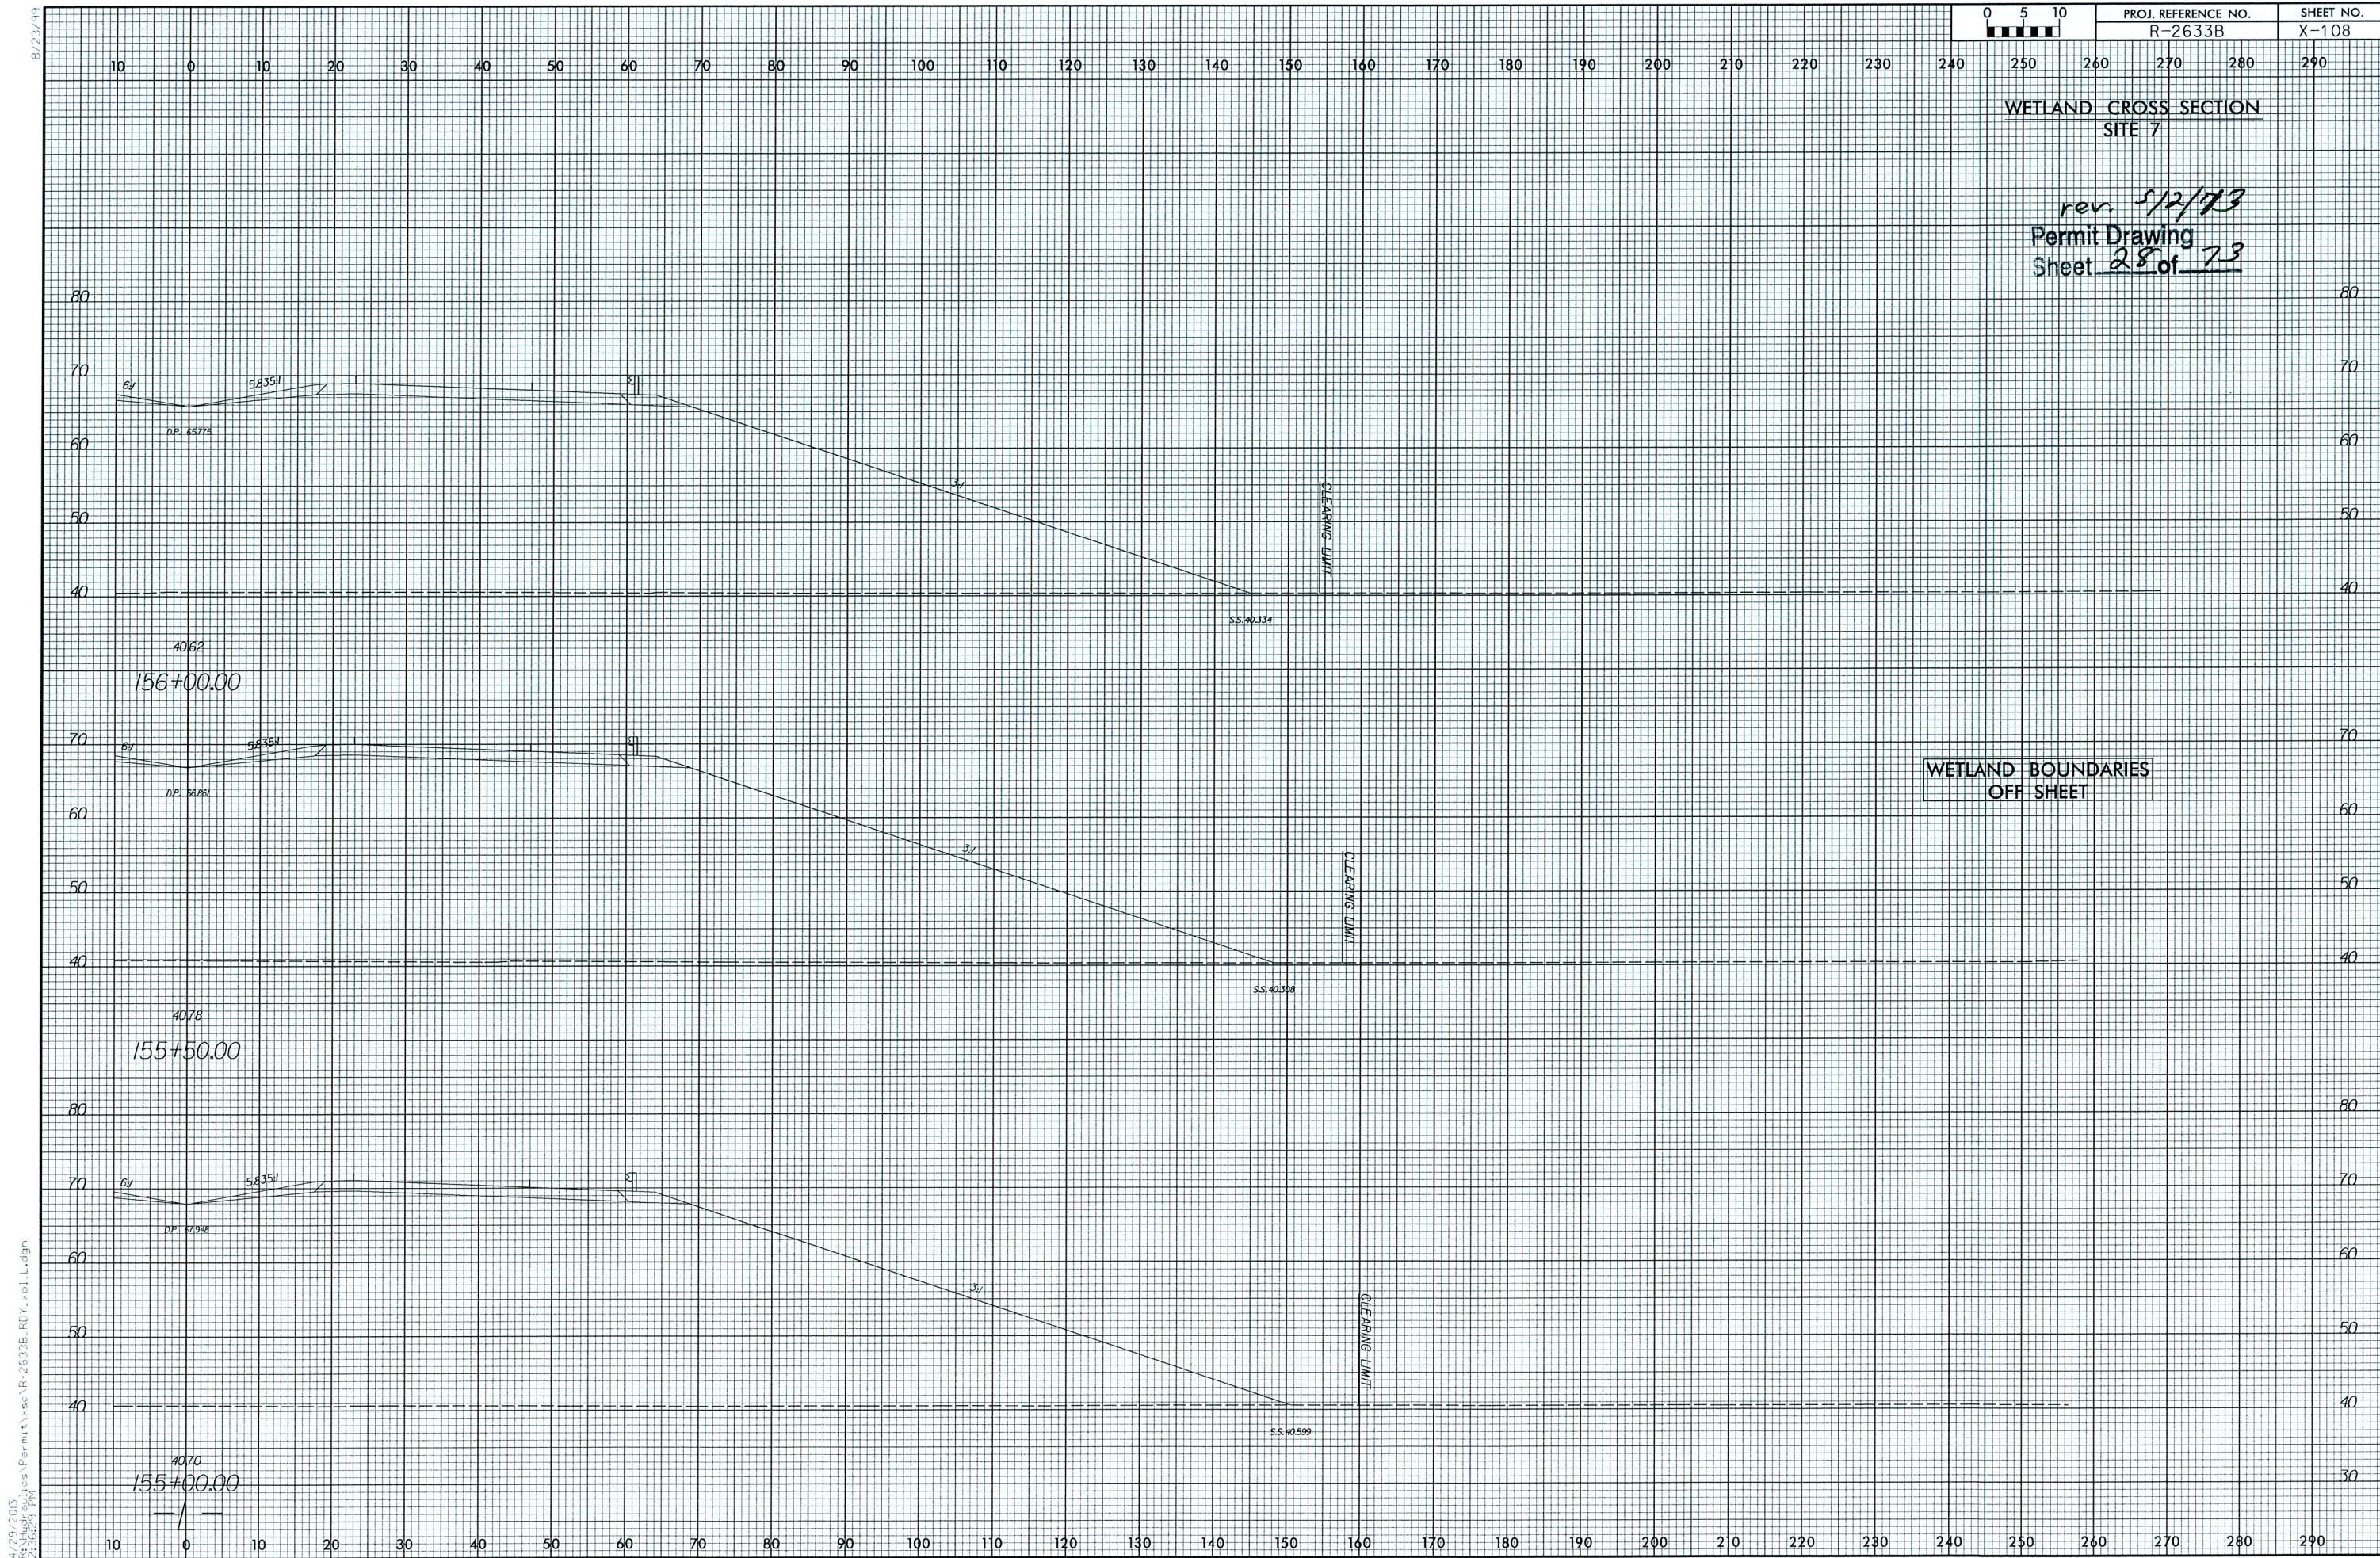

WETLAND CROSS SECTION
SITE 7

rev. 5/2/73
Permit Drawing
Sheet 28 of 73

WETLAND PERMIT IMPACT SUMMARY														
Site No.	Station (From/To)	Structure Size / Type	WETLAND IMPACTS						SURFACE WATER IMPACTS					
			404 Permanent Fill In Wetlands (ac)	CAMA Permanent Fill In Wetlands (ac)	Temp. Fill In Wetlands (ac)	Excavation in Wetlands (ac)	Mechanized Clearing in Wetlands (ac)	404 Hand Clearing in Wetlands (ac)	CAMA Hand Clearing in Wetlands (ac)	Permanent SW impacts (ac)	Temp. SW impacts (ac)	Existing Channel Impacts Permanent (ft)	Existing Channel Impacts Temp. (ft)	Natural Stream Design (ft)
1***	-L- 24+75 Lt.	Roadway Fill												
2***	-L- 37+96 Rt.	Bridge												
3****	-LREV- 339+73 to 358+92	Roadway Fill	7.45			0.03		0.58						
4	-RP D1- 22+60	Deleted due to new JS delineation												
5*	-LREV- 372+74 to -L-85+08	Roadway Fill	1.04					0.12						
6*	-L- 109+28 to 134+54	Roadway Fill	9.72					1.13						
6A**	-L- 138+11 to 140+70	Roadway Fill	0.68											
6B**	-L- 141+20 to 144+29	Roadway Fill	0.41					0.02						
7*	-L- 146+78 to 165+66	Roadway Fill	10.55					0.98						
8	-L 166+60	Deleted due to new JS delineation												
9*	-L- 186+97 to 191+88	Roadway Fill	1.04					0.09						
10	-RP D2- 19+20 Lt.	Deleted due to new JS delineation												
11*	-L- 194+75 to 216+13	Roadway Fill; 3@42"	8.72					0.93		0.07	<0.01	205	20	
12	-L- 230+39 to 242+11	Deleted due to new JS delineation												
13	-L- 256+36 to 265+87	Deleted due to new JS delineation												
14*	-L- 264+32 to 266+94	Bridge					0.03	0.20		<0.01				
		Temp. Work Bridge						0.10						
15*	319+46 to 387+92	Bridge	0.05				1.17	10.06	8.20	0.13	0.03			
		Temp. Work Bridge						6.43	4.70					
16*	-L- 399+43 to 400+51	Roadway Fill	0.22											
17***	-Y6-16+25 Rt.	48" RCP												
18***	-Y6-16+25 Lt.	48" RCP												
19*	-Y7- 52+09	Culvert								<0.01	<0.01	5	39	
	-Y7 DET- 16+45	Detour Culvert			0.06			0.03			0.61		90	
20*	-Y8- 47+74 to 49+88	Bridge	<0.01				0.04	0.17						
	-Y8- 48+78 to 49+95	Temp. Work Bridge						0.14						
TOTALS:			39.88		0.06	0.03	1.24	20.98	12.90	0.20	0.63	210	149	0.00

Site 14 See Structures sheet for Bridge Impacts on Cartwheel Branch
Site 15 Impacts for Permanent Dual Bridges CAMA=0.07 Ac, 404=0.07 Ac, Surface Water=0.0 1Ac; Total=0.15 Ac.

Site 15 Impacts for Temporary Work Bridge CAMA=0.16 Ac, 404=0.21 Ac, Surface Water=0.0 1 Ac; Total=0.38 Ac.

* Revised due to new JS Delineation

** New Site due to new JS Delineation

*** Sites 1, 2, 17, and 18 are now permitted with R-2633AA & AB and the impacts are included with that project.

**** A portion of Site 3 is now permitted with R-2633AA & AB and the impacts are included with that project.

0.75 acres of Temp. Fill in 404 Wetlands in the Hand Clearing areas for Erosion Control Measures

NC DEPARTMENT OF TRANSPORTATION

DIVISION OF HIGHWAYS

BRUNSWICK AND NEW HANOVER COUNTIES

WBS - 34491.1.2 (R-2633B)

SHEET

73 of 73
rev. 5/2/13