



STATE OF NORTH CAROLINA
DEPARTMENT OF TRANSPORTATION

ROY COOPER
GOVERNOR

JAMES H. TROGDON, III
SECRETARY

July 18, 2019

US Army Corps of Engineers
Regulatory Field Office
3331 Heritage Trade Drive, Suite 105
Wake Forest, North Carolina 27587

ATTN: Mr. Andy Williams
NCDOT Coordinator

Dear Sir:

Subject: Request for Modification to Individual Section 404 and Section 401 Water Quality Certification for widening and new lane construction from US 74 Rockingham/Hamlet Bypass to US 220 Ellerbe Bypass in Richmond County. Federal Aid Project No. NHF-0220(4), State Project No. 8.1580802, Division 8, TIP Nos. R-3421A and B.

References: Section 404 Individual Permit issued August 7, 2012(SAW-1996- 03023)
Section 401 Water Quality Certification issued May 10, 2012 (3916)
Modification of Section 404 Individual Permit issued October 17, 2012
Modification of Section 401 Water Quality Certification issued August 28, 2012

The purpose of this letter is to submit final drawings for modification of the Clean Water Act (CWA) Section 404 Individual Permit (IP) and Section 401 Water Quality Certification for R-3421A and B. Preliminary drawings for these sections were submitted with the original phased permit application.

Included in this application package are the following: (1) this cover letter, (2) Division of Mitigation Services (DMS) confirmation letter, (3) Hydraulic Design and Permit Drawing Review Meetings (CP 4B & 4C) minutes for Sections A and B, (4) Stormwater Management Plan, (5) permit drawings, (6) utility permit drawings for Section B.

Since issuance of the original Individual Permit for R-3421, Sections A and B were re-delineated in December 2014. A field verification with Sarah Hair (USACE) was conducted in January 2015, with a Preliminary Jurisdictional Determination issued on February 27, 2015.

Information in the following tables present impact comparisons between the preliminary drawings presented in the original permit application and the current design for the project. Site numbers have remained the same between preliminary and final design, however some sites have been broken into sub-sites. These sites are denoted in **bold** in the tables under the Permit Site No. column.

This project is scheduled to Let on October 15, 2019, with a review date of July 30, 2019.

Jurisdictional Impacts

Table 1. R-3421A Riparian Wetland Impacts

Permit Site No.	Wetland ID in FONSI	JD package ID	Preliminary Impacts (ac)	Final Permanent Impact (ac)
2	NA	WG	0.76	0.48
6	3	WC	0.25	<0.01
7 (7S)	1	WI	0.15	0.17
8	NA	WA	0.09	0.02
Section A Total			1.25	0.68*

*Total impacts due to rounding.

Table 2. R-3421B Riparian Wetland Impacts

Permit Site No.	Wetland ID in FONSI	JD package ID	Preliminary Impacts (ac)	Final Permanent Impact (ac)
1	4,5	WD,WE,WJ	0.25	0.24
3	NA	WAA	0.03	0.03
4	NA	WBB	0.09	0.07
5	NA	Site Removed	0.02	0.00
6	5A	WK	0.58	0.09
8	5B	Site Removed	0.20	0.00
9	10	WM,WL	0.42	0.12
10	7,9	WCC,WEE,WFF	1.11	0.87
11	8	Site Removed	<0.01	0.00
12	11	WN	1.92	2.38
Section B Total			4.62*	3.80

*Total impacts due to rounding.

Table 3. R-3421A Streams Impacted

Permit Site No.	Stream ID in FONSI	JD Package ID	Stream Name	Intermittent/ Perennial	Preliminary Stream Impacts (ft) Perm/Temp	Final Stream Impacts (ft) Perm/Temp
1	2	SG	UT to PeeDee River	Perennial	364 / 0	411/10
2	3,4	SH	UT to PeeDee River	Perennial	1,097 / 0	1,011/50
3 (3A/3B)	5,6	SH	UT to PeeDee River	Perennial	676 / 0	617/116
4	10	SO	UT to PeeDee River	Intermittent	511 / 0	205/12
5 (5/5A)	8,9	SI,SM	UT to PeeDee River	Intermittent(SI) Perennial(SM)	435 / 0	445/35
7 (7/7S/7N)	7	SH,SK	UT to PeeDee River	Perennial (SH) Intermittent (SK)	1,247 / 100	1,130/32
8 (8/8A)	11	SA	UT to PeeDee River	Intermittent	187 / 0	147/0
Section A Total					4,517 / 100	3,966/255

Table 4. R-3421B Streams Impacted

Permit Site No.	Stream ID in FONSI	JD Package ID	Stream Name	Intermittent/ Perennial	Preliminary Stream Impacts (ft) Perm/Temp	Final Stream Impacts (ft) Perm/Temp
1	No #	SQ	UT to Seaburn Branch	Intermittent	24 / 15	33/10
2	13	SAA	Seaburn Branch	Perennial	28 / 40	201/20
2A*	No #	SAA/SCC	Seaburn Branch and UT	Perennial	0/0	0/36
3	13	SAA	UT to Seaburn Branch	Perennial	759 / 37	578/21
4	No #	SW	UT to Seaburn Branch	Perennial	352 / 26	397/22
5	14	SR	UT to Cartledge Creek	Perennial	645 / 20	669/23
7	15	ST	UT to Cartledge Creek	Intermittent	610 / 20	610/34
8	16	SU	UT to Cartledge Creek	Perennial	832 / 90	703/161
10**	19,21	SV	UT to Cartledge Creek	Perennial	0/0	339/11
11	No #	SDD	UT to Cartledge Creek	Intermittent	47 / 10	81/21
Section B Total					3,297 / 258	3,611/359

*Impacts for this site were originally attributed to Site 2.

**Previously identified as linear wetland

Explanation of Impact Changes

Impacts changed for most sites from the preliminary development to final design. In many cases impact numbers were reduced from their preliminary projection, while other sites increased slightly. These minor changes can be attributed to the refinement of the impacts once the design of the roadway was finalized.

The re-delineation of the project in December 2014 resulted in the following changes:

Section A:

- Removal of a significant portion of Site 2 due from being a previously inundated area due to beaver activity. The beavers had been removed by the time of the 2014 re-delineation.

Section B:

- Removal of Sites 5, 8 and 11, due to previously identified wetlands not exhibiting wetland function during re-delineation.
- A linear wetland at Site 10 was changed to a jurisdictional stream during the 2014 re-delineation.
- The wetland at Site 12 increased in size during the re-delineation increasing impacts.

Other notable change resulting in an increase:

Section B:

- Site 2- In the final impact drawings, Site 2 was split, adding a Site 2A. Also, it appears that

preliminary calculations of impacts along the -Y- line were incorrect and did not fully account for the true impact.

Utilities

Section A: There will be no impacts to jurisdictional resources due to relocation of utilities.

Section B: Relocation of overhead aerial lines along the intersections with -Y- lines will result in 0.48 ac. of hand clearing in wetlands.

Protected Species

As of April 2019, Schweinitz's sunflower has been added to the list of federally protected species for Richmond County. Surveys for the species have not been completed, due to the survey window not opening until late August. Once the survey window opens, the surveys will be completed. A review of the NCNHP database shows two known occurrences of the species in the county, both in the same general area, approximately nine miles from the project.

Surveys for red-cockaded woodpecker, Michaux's sumac and rough-leaved loosestrife were updated on May 16, 2019. The biological conclusions for these species remain No Effect.

Regulatory Approvals

Section 404: We are hereby requesting the modification of the USACE Individual 404 Permit signed August 7, 2012 (SAW 1992-03237) and modified on October 17, 2012, for the above-described activities. NCDOT also requests that the current permit for the project to be extended for a period of five (5) years.

Section 401: We are hereby requesting a modification to the 401 Water Quality Certification from the NCDWR issued May 10, 2012 (DWQ No. 20120240) and modified on August 28, 2012. In compliance with Section 143-215.3D(e) of the NCAC, we will provide \$570.00 to act as payment for processing the Section 401 permit modification.

A copy of this permit modification request will be posted on the NCDOT Website at <https://xfer.services.ncdot.gov/pdea/PermApps/>

Thank you for your assistance with this project. If you have any questions or need additional information, please contact Jason Dilday at 919-707-6111 or jldilday@ncdot.gov.

Sincerely,



for Philip S. Harris III, P.E., C.P.M.
Environmental Analysis Unit Head

cc:

NCDOT Permit Application Standard Distribution List

Minutes for Hydraulic Design Review Meeting R-23421A

State Project 34542.1.1

**US 220 BYPASS FROM US 74 BYPASS WEST OF ROCKINGHAM
AT SR 1109 (ZION CHURCH ROAD) INTERCHANGE TO 0.3
MILES SOUTH OF SR 1140 (OLD CHARLOTTE HIGHWAY),
RICHMOND COUNTY, DIVISION 8**

A Hydraulic Design Review Meeting was held on Wednesday, March 16, 2005 in the Location and Surveys conference room at the NCDOT Century Center Complex, Raleigh.

Team Members: Andrew Nottingham-NCDOT Hydraulics (Present)
Richard Spencer-USACOE (Present)
Brian Wrenn- NCDWQ (Present)
Travis Wilson-NCWRC (Absent, will provide comments)
Gary Jordan-USFWS (Absent)
Chris Militscher-EPA (Present)
Cathy Houser- NCDOT Roadway Design (Absent)
Elizabeth Lusk-PDEA (Present)
Rob Ayers-FHWA (Absent)
John Olinger-Division 8 (Present)

Participants: Stephen Morgan-NCDOT Hydraulics
Virginia Mabry-NCDOT Roadway Design
Michael Penney-PDEA
Carla Dagnino-PDEA
Lonnie Brooks-Structure Design
Karen Gullledge-Hydraulics

The meeting began at 9:15 a.m. with NCDOT Hydraulics giving a brief description and history of the project. The team then reviewed the plans sheet by sheet. The following items of importance were discussed.

Sheet Nos. 6, 7 and 8

- Division 8 noted that the existing roadway cut slopes along US 74 from +/- sta. 60+00 to +/- sta. 80+00 are experiencing problems with ground water seepage. Rip rap has been used to stabilize the slopes but this continues to be a maintenance problem. Division 8 noted that this problem needs to be addressed since the proposed

project will be increasing the cut slopes in these areas. USACOE noted that they wanted to make a site visit to review this area.

Sheet No. 8

- The stream right of sta. 87+00 I-73 will be piped to the culvert located on sheet no. 8 under loop B.

Sheet No. 9

- Due to the proposed new interchange the culvert under the existing US 74 ramp will be extended up and downstream and connected on the downstream extension to the existing culvert under existing US 74. The total length of the new culvert created by the extensions and connections will be +/- 1350 feet. Low flow sills will be used at the entrance of the culvert to divert flow into the middle barrel. Baffles are proposed on the new extension portions of the culvert to help retain the bed material in the culvert. DWQ asked if some of the culvert under the existing US 74 ramp could be removed. NCDOT noted that some of the culvert could possibly be remove but that it would leave only a small portion of the channel open (+/- 100 feet) and it was felt that it would be less disturbance to the stream to leave it in place.
- NCDOT noted that the rip rap at the outlet of the culvert under loop C is needed for erosion control and it is shown on the stream banks only and not in the channel. Low flow sills and baffles will be used on the culvert under loop C.

Sheet No. 11

- Low flow sills and baffles will be used on the culvert under ramp C. USACOE noted they require new stream channels to vegetate through one growing season prior to diverting flow into the channel. If temporary stream diversions required to construct the stream relocation and culvert fall outside the roadway footprint their impacts will need to be accounted for in the plans and permit. NCDOT will investigate connecting the tributary that enters the stream relocation from the east at a better angle.

Sheet 12

- The culvert under existing US 74 will be extended up and downstream and low flow sill will be used. USACOE noted that they would like to review the pond site upstream of the culvert that is proposed to be drained.

Sheet 16

- NCDOT will show channel relocation on right side from sta. +/- 134+00 to sta. +/- 135+50 due to proposed fill slope filling in the existing channel.

Sheet 10

- NCDOT will investigate shifting the junction box or possibly eliminating it on the 48" cross pipe.
- NCDOT noted that the rip rap at the outlet of the 60" cross pipes under ramp D is needed for erosion control and it is shown on the stream banks only and not in the channel.

**Draft Minutes for 4C Permit Drawing Review Meeting
R3421A**

State Project 34542.1.1

US 220 Bypass From US 74 Bypass West of Rockingham at SR 1109 (Zion Church Road) Interchange to
0.3 miles South of SR 1140 (Old Charlotte Highway), Richmond County, Div. 8

Purpose: The purpose of this meeting was to review the 4C Permit Drawings and resulting environmental impacts. The Drawings were reviewed, addressing each impact site sequentially. These minutes represent a summary of the items discussed during the meeting.

1. Stephen Morgan began the meeting by reviewing a timeline of the project – different sections of the project (A, B, C), project documents, Merger history, field investigation verifications, and permitting. A summary of preliminary impacts (2005) vs current impacts was also reviewed.
2. General – note areas of proposed utility activity near any JS or wetland, even if no impacts occur. Include cross sections (and details) at inlet/outlet of culverts, relocated stream.
3. Permits – a Phased Individual Permit was issued in 2012 and expires December 2017.
4. Site 1
 - Note existing rip rap at outlet of 36" pipe.
 - Show Temporary Impacts at outlet of 36" pipe.
5. Site 2
 - Show stream as a total take between proposed culvert and culvert that will have a portion removed.
6. Site 3
 - Show Bank Stabilization at outlet of culvert at Loop C.
 - Show Diversion Channel used for construction of culvert.
 - Include more Temporary Impacts for Diversion Channel.
7. Site 3A/3B
 - No Comments
8. Site 4
 - Stream has been impacted since preliminary impacts were shown by logging operations. Permanent impacts will be shown as they were in preliminary drawings until further determination. NCDOT will coordinate with DWQ and USACE for mitigation.
9. Site 5/5A
 - A smaller size Energy Dissipater Basin will be shown, decreasing the Permanent and Temporary impacts to the stream.
10. Site 7 (North & South)
 - For clarification, label stream location between the culverts.
 - Show stream cross section and detail.
11. Site 8/8A
 - Add notation for beginning of JS.
 - Note that pond has been drained.

This concluded review of R3421A permit drawings.

Subject: Draft Minutes of the Interagency Permit Drawings Review (4b)
Meeting on March 16, 2005 for R-3421B, Richmond County

Participants: Team Members:

Randy Henegar, NCDOT, Hydraulics (present)
Richard Spencer, USACE (present)
Beth Barnes, NCDWQ (not present)
Michael Penney, NCDOT, PD&EA (present)
Travis Wilson, NCWRC (not present)
Gary Jordan, USFWS (not present)
Chris Militscher, USEPA (present)
Cathy Houser, NCDOT, Roadway (not present)
Rob Ayers, FHWA (not present)
Elizabeth Lusk, ONE (present)
John Olinger, NCDOT, Division 8 (present)

Other Attendees:

Carla Dagnino, NCDOT, ONE
Virginia Mabry, NCDOT, Roadway
Paul Fisher, NCDOT, Hydraulics
Joe Dunnehoo, NCDOT, Hydraulics
Brian Wrenn, NCDWQ
Lonnie Brooks, NCDOT, Structures

This meeting commenced at approximately 11:00 A.M. Randy Henegar led the attendees in reviewing the plan sheets (sheet by sheet). Comments were as follows:

Plan Sheet 4: No comments.

Action taken: N/A

Plan Sheet 5: No comments.

Action taken: N/A

Plan Sheet 6: No comments.

Action taken: N/A

Plan Sheet 7: No comments.

Action taken: N/A

Plan Sheet 8: No comments.

Action taken: N/A

Plan Sheet 9: No comments.

Action taken: N/A

Plan Sheet 10: No comments.

Action taken: N/A

Plan Sheet 11: USACE will go to the field to look at wetlands @ -L- Sta. 226+00 +/-.

Action taken: Carla Dagnino will coordinate field visit with USACE.

Plan Sheet 12: No comments.

Action taken: N/A

Plan sheet 13: No comments.

Action taken: N/A

Plan Sheet 14: No comments

Action taken: N/A

Plan Sheet 15: No comments.

Action taken: N/A

Plan Sheet 16: Richard Spencer wanted to put diversion ditch (-L- Sta. 304+00 +/-) under roadway fill and work in dry season.

Action taken: O.N.E. will include note to this effect in the Permit write-up.

Plan Sheet 17: No comments

Action taken: N/A

Plan Sheet 18: No comments

Action taken: N/A

Plan Sheet 19: All upland wetlands should be counted as impacted wetlands. Check for 2:1 side slopes in wetland areas. USACE to look in field to see if proposed road cuts off groundwater from crossing roadway.

Action taken: Joe Dunnehoo will check plans for 2:1 side slopes. Carla Dagnino will coordinate the site visit with USACE.

Plan Sheet 20: No comments

Action taken: N/A

Plan Sheet 21: USACE was concerned about the amount of stream relocation near –Y4- & -SR 1- intersection.

Action taken: Engineering Coordination will look at design changes that could reduce the amount of stream relocation.

Plan Sheet 22: No comments

Action taken: N/A

Plan Sheet 23: Remove rip rap from pipe outlet at –Y5- Sta. 39+00 +/-.

Action taken: Done.

No further comments were recorded, and the meeting adjourned at approximately 12:30 P.M.

4C Meeting Minutes for R-3421B

**PROJECT: R-3421B
34542.1.FR3**

**DESCRIPTION: I-73/74 Bypass from South of SR 1140 (Old Charlotte Hwy)
To Southwest of SR 1304 (Harrington Rd)**

COUNTY: Richmond - Division 8

***NOTE: On 9/1/2015 we were notified this project was removed from the “Bond List” and that work should cease at an appropriate point and to not resume until funding becomes available. The 4C permit will be revised per comments below and then work will cease until notification is sent to the Hydraulics Unit to proceed with Draft and Final permit submittals.**

Team Members:

Andy Williams-USACE (Present, conference call)
David Wanucha- NCDWQ (Present, conference call)
Travis Wilson-NCWRC (Absent)
Gary Jordan-USFWS (Absent)
Dr. Cynthia Van Der Wiele-USEPA (Absent)
David Harris- REU(Absent)
Felix Davila-FHWA (Present)

Participants:

Galen Cail-NCDOT Hydraulics (Present)
Joe Dunneho-NCDOT Hydraulics (Present)
Chris Rivenbark-NES (Present)
Jason Dilday-NES (Present)
Lisa Feller-PDEA (Present)
John Olinger-Division 8 (Present)
Rekha Patel- NCDOT Roadway Design (Present)
Chris Adam-NCDOT Roadway Design (Present)
Mark Staley-Roadside (Present)
Mack Bailey-Structures (Present)
Don Proper-Utilities (Present)
Kyle Pleasant-Utilities (Present)

The 4C Meeting was held on Wednesday, August 19, 2015 in the Hydraulics Unit Conference room at the NCDOT Century Center Complex, Raleigh. Galen Cail reviewed the plan sheets with the attendees. Comments are as follows:

General Comments:

- Andy Williams noted that Bank Stabilization impacts (permanent) should be separate from the fill in stream impacts (permanent) on the Impacts Summary. This will be reviewed and verified.
- Andy Williams and Davis Wanucha requested a copy of the Impact Comparison Table. Will be attached with 4C minutes.

Site # 1 (Plan Sheet 5 & 6):

- No comments.

Site # 2 (Plan Sheet 21):

- The 66" pipe and impacts located at sta. 12+90-Y4- will be shown as Site 2A.

Site #3 (Plan Sheet 7):

- Review alignment of outlet pipes relative to downstream outfall channel.

Site #4 (Plan Sheet 8):

- Review alignment of outlet pipes relative to downstream outfall channel.

Site #5 (Plan Sheet 10):

- No comments.

Site #6 (Plan Sheet 11):

- It was discussed to continue the wetland boundary outside of proposed R/W for clarity. After the 4C meeting it was determined the wetland boundary should close just outside of proposed R/W. Therefore, this wetland will be accounted for as a total take.

Site #7 (Plan Sheet 11):

- No comments.

Site #8 (Plan Sheet 12):

- Add inlet and outlet channel detail for the culvert to the plan sheet and permit drawing.

Site #9 (Plan Sheets 16 & 22):

- No comments.

Site #10 (Plan Sheet 16):

- It was verified the JS stream does stop in the wetlands at sta. 304+60±-L- (Lt.)
- The wetlands at sta. 35+35±-Y5-(Lt.) within the ramp and mainline quadrant will be shown and accounted for as a total take as both mechanized clearing and excavation in wetlands impacts.

Site #11 (Plan Sheet 23):

- No comments.

Site #12 (Plan Sheet 19):

- The wetlands between Sta. 351+00± to sta. 354+75±-L-(Rt.) will not be shown as a total take. Also, portions of this wetland impact were accounted for on the original R-3421C permit. These impacts will be accounted for/subtracted from the final impacts in the R-3421B permit.

Surface Water Impacts Comparison Table:

- Under the “Existing Channel Impacts Permanent (ft.)” for Site No. 2, the quantity is shown as 28. This was determined to be a type-o. The correct number should have been 203 ft. This will be changed on the form.

Wetland Impacts Comparison Table:

- It was asked why there was a big difference between the Current and Preliminary Impacts at Site #10. The difference was because the wetlands were redelineated and the area was reduced.



NORTH CAROLINA
Environmental Quality

ROY COOPER
Governor

MICHAEL S. REGAN
Secretary

TIM BAUMGARTNER
Director

July 12, 2019

Mr. Philip S. Harris, III, P.E.
Environmental Analysis Unit
North Carolina Department of Transportation
1598 Mail Service Center
Raleigh, North Carolina 27699-1598

Dear Mr. Harris:

Subject: Mitigation Acceptance Letter:

R-3421A, US 220 Bypass from US 74 Bypass West of Rockingham at SR 1109 (Zion Church Road) Interchange to South of SR 1140 (Old Charlotte Highway), Richmond County

The purpose of this letter is to notify you that the Division of Mitigation Services (DMS) will provide the compensatory stream and wetland mitigation for the subject project. Based on the information supplied by you on July 12, 2019, the impacts are located in CU 03040201 of the Yadkin River basin in the Southern Piedmont (SP) Eco-Region, and are as follows:

Yadkin 03040201 SP	Stream			Wetlands			Buffer (Sq. Ft.)	
	Cold	Cool	Warm	Riparian	Non-Riparian	Coastal Marsh	Zone 1	Zone 2
Impacts (feet/acres)	0	0	3,966.0	0.68	0	0	0	0

*Some of the stream and/or wetland impacts may be proposed to be mitigated at a 1:1 mitigation ratio. See permit application for details.

DMS commits to implementing sufficient compensatory stream and wetland mitigation credits to offset the impacts associated with this project as determined by the regulatory agencies in accordance with the In-Lieu Fee Instrument dated July 28, 2010. If the above referenced impact amounts are revised, then this mitigation acceptance letter will no longer be valid and a new mitigation acceptance letter will be required from DMS.

If you have any questions or need additional information, please contact Beth Harmon at 919-707-8420.

Sincerely,


James B. Stanfill
DMS Asset Management Supervisor

cc: Mr. Monte Matthews, USACE – Raleigh Regulatory Field Office
Ms. Amy Chapman, NCDWR
File: R-3421A





NORTH CAROLINA
Environmental Quality

ROY COOPER
Governor

MICHAEL S. REGAN
Secretary

TIM BAUMGARTNER
Director

August 2, 2019

Mr. Philip S. Harris, III, P.E.
Environmental Analysis Unit
North Carolina Department of Transportation
1598 Mail Service Center
Raleigh, North Carolina 27699-1598

Dear Mr. Harris:

Subject: Mitigation Acceptance Letter:

R-3421B, US 220 Bypass, Richmond County

The purpose of this letter is to notify you that the Division of Mitigation Services (DMS) will provide the compensatory stream and wetland mitigation for the subject project. Based on the information supplied by you on July 30, 2019, the impacts are located in CU 03040201 of the Yadkin River basin in the Southern Piedmont (SP) Eco-Region, and are as follows:


Yadkin 03040201 SP	Stream			Wetlands			Buffer (Sq. Ft.)	
	Cold	Cool	Warm	Riparian	Non-Riparian	Coastal Marsh	Zone 1	Zone 2
Impacts (feet/acres)	0	0	3,611.0	3.80	0	0	0	0

*Some of the stream and/or wetland impacts may be proposed to be mitigated at a 1:1 mitigation ratio. See permit application for details.

DMS commits to implementing sufficient compensatory stream and wetland mitigation credits to offset the impacts associated with this project as determined by the regulatory agencies in accordance with the In-Lieu Fee Instrument dated July 28, 2010. If the above referenced impact amounts are revised, then this mitigation acceptance letter will no longer be valid and a new mitigation acceptance letter will be required from DMS.

If you have any questions or need additional information, please contact Beth Harmon at 919-707-8420.

Sincerely,

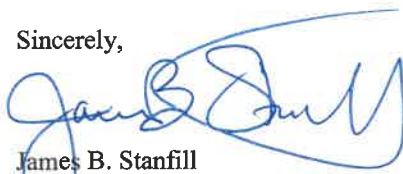
James B. Stanfill
DMS Asset Management Supervisor

cc: Mr. Monte Matthews, USACE – Raleigh Regulatory Field Office
Ms. Amy Chapman, NCDWR
File: R-3421B



		North Carolina Department of Transportation Highway Stormwater Program STORMWATER MANAGEMENT PLAN FOR NCDOT PROJECTS					
(Version 2.08; Released April 2018)							
WBS Element: 34542.1.FR4		TIP No.: R-3421A		County(ies): Richmond		Page 1 of 3	
General Project Information							
WBS Element:		34542.1.FR4		TIP Number: R-3421A		Project Type: New Location	
NCDOT Contact:		Mr. Stephen R. Morgan, PE		Contractor / Designer:		Date: 7/30/2019	
Address:		1000 Birch Ridge Drive Raleigh, NC		Address:			
Phone:		919-707-6739		Phone:			
Email:		smorgan@ncdot.gov		Email:			
City/Town:				County(ies):		Richmond	
River Basin(s):		Yadkin-Pee Dee		CAMA County?		No	
Wetlands within Project Limits?		Yes					
Project Description							
Project Length (lin. miles or feet):		1.78		Surrounding Land Use:		Agricultural, Rural, Residential	
		Proposed Project		Existing Site			
Project Built-Up Area (ac.):		54.4 ac.		ac.			
Typical Cross Section Description:		46' Grass median, 2@12' paved inside shoulders, 2@12' lanes each direction, 12' paved outside shoulder, grass roadway ditches.					
Annual Avg Daily Traffic (veh/hr/day):		Design/Future: Year:		Existing:		Year: 2019	
General Project Narrative: (Description of Minimization of Water Quality Impacts)		CSR 1 & 2 on Loop B & I73; CSR 3 Loop C; CSR 4 Ramp C; CSR 5 on L2/L2Rev (extension). R-3421A is an interchange and bypass project (US220 Bypass From US74 Bypass West Of Rockingham at SR1109 Interchange) which will include a 46' grass median with 2@12' travel lanes in each direction. The project also includes grass lined roadway ditches. The proposed project includes 4 major drainage structures (3Culverts & extension of 2 culverts) located in the interchange, which will convey Un-named Tribs to the Pee Dee River. The culverts will include sills and utilize Low Flow Benches as well as a stream relocation between 2 culverts to maintain the low flow in one barrel of the culvert. A Rip Rapped Energy Dissipator will be utilized at the outlet of 2 60" pipes to dissipate the energy and prevent erosion to the receiving stream. There are some minor channel improvements at the inlet and outlet of a few of the culverts. Direct discharges into jurisdictional features were avoided to the maximum extent practicable. Where possible, drainage systems were released away from jurisdictional features. However, in some locations direct discharge was unavoidable due to extreme topographic constraints as well as proposed roadway profiles. In these locations no practical alternatives were present.					
Waterbody Information							
Surface Water Body (1):		Un-named Trib to Pee Dee River		NCDWR Stream Index No.:		UT to 13 - (34)	
NCDWR Surface Water Classification for Water Body		Primary Classification:		Class C			
		Supplemental Classification:					
Other Stream Classification:		None					
Impairments:		None					
Aquatic T&E Species?		No		Comments:			
NRTR Stream ID:				Buffer Rules in Effect:		N/A	
Project Includes Bridge Spanning Water Body?		No		Deck Drains Discharge Over Buffer?		N/A	
Deck Drains Discharge Over Water Body?		N/A		(If yes, provide justification in the General Project Narrative)		(If yes, describe in the General Project Narrative; if no, justify in the General Project Narrative)	
(If yes, provide justification in the General Project Narrative)							



FOR NCDOT PROJECTS

Page 2 of 3

[illegible]

The design for R-3421A includes typical grassed cut ditches within the roadway footprint. These ditches are collecting runoff from the impervious roadway surfaces and transporting the runoff to inlets and pipes. The geometry of the typical cut ditches contain side slopes ranging from 4:1 to 8:1 and having mostly mild longitudinal slopes. However, no grassed swale treatment was claimed nor required for this portion of the project even though many aspects of the grassed swale criteria was incorporated into the design.

Revised 7/30/19



Page 3 of 3

Additional Comments

Revised 7/25/2019


l:45:45 PM
R:\Hydraulics\PERMITS_Environmental\Drawings\R3421A\R3421a_Hyd_tsh_20150423.dgn

09/08/99

CONTRACT:

TIP PROJECT: R-3421A

See Sheet 1-A For Index of Sheets
See Sheet 1-B For Conventional Symbols

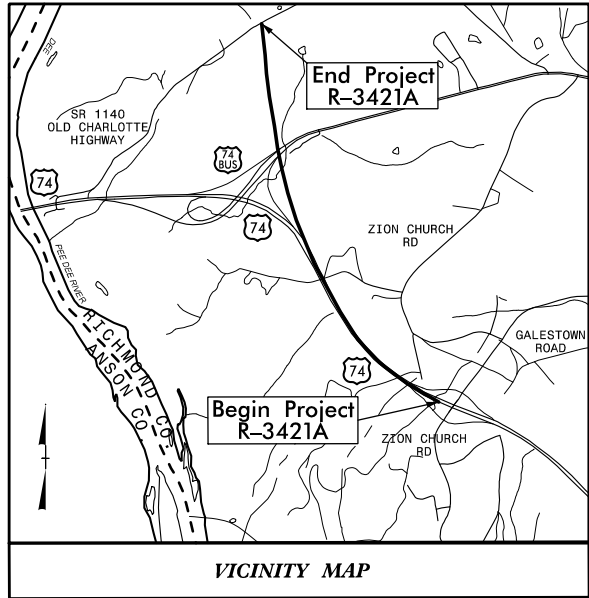

PLFI PLAN REVIEW

STATE OF NORTH CAROLINA
DIVISION OF HIGHWAYS

RICHMOND COUNTY

**LOCATION: I-73/74 FROM US 74 BYPASS WEST
OF ROCKINGHAM AT SR 1109 (ZION CHURCH RD.)
INTERCHANGE TO 0.3 MILES SOUTH OF SR 1140
(OLD CHARLOTTE HWY.)**

**TYPE OF WORK: GRADING, DRAINAGE, PAVING,
SIGNING, STRUCTURES, CULVERT, & RETAINING WALLS**


WETLAND AND SURFACE WATER IMPACTS PERMIT

STATE	STATE PROJECT REFERENCE NO.	SHEET NO.	TOTAL SHEETS
N.C.	R-3421A	1	
STATE PROJ. NO.	F.A. PROJ. NO.	DESCRIPTION	
34542.1.FR4	HPPF-0220(75)	P.E.	
34542.2.4	HPPF-0220(30)	R/W, UTIL.	
34542.3.FS4	HPPF-0220(30)	P.E.	

-US 74- POT 147+38.68
END CONSTRUCTION

**PERMIT DRAWING
SHEET 1 OF 37**


SITES 8 & 8A

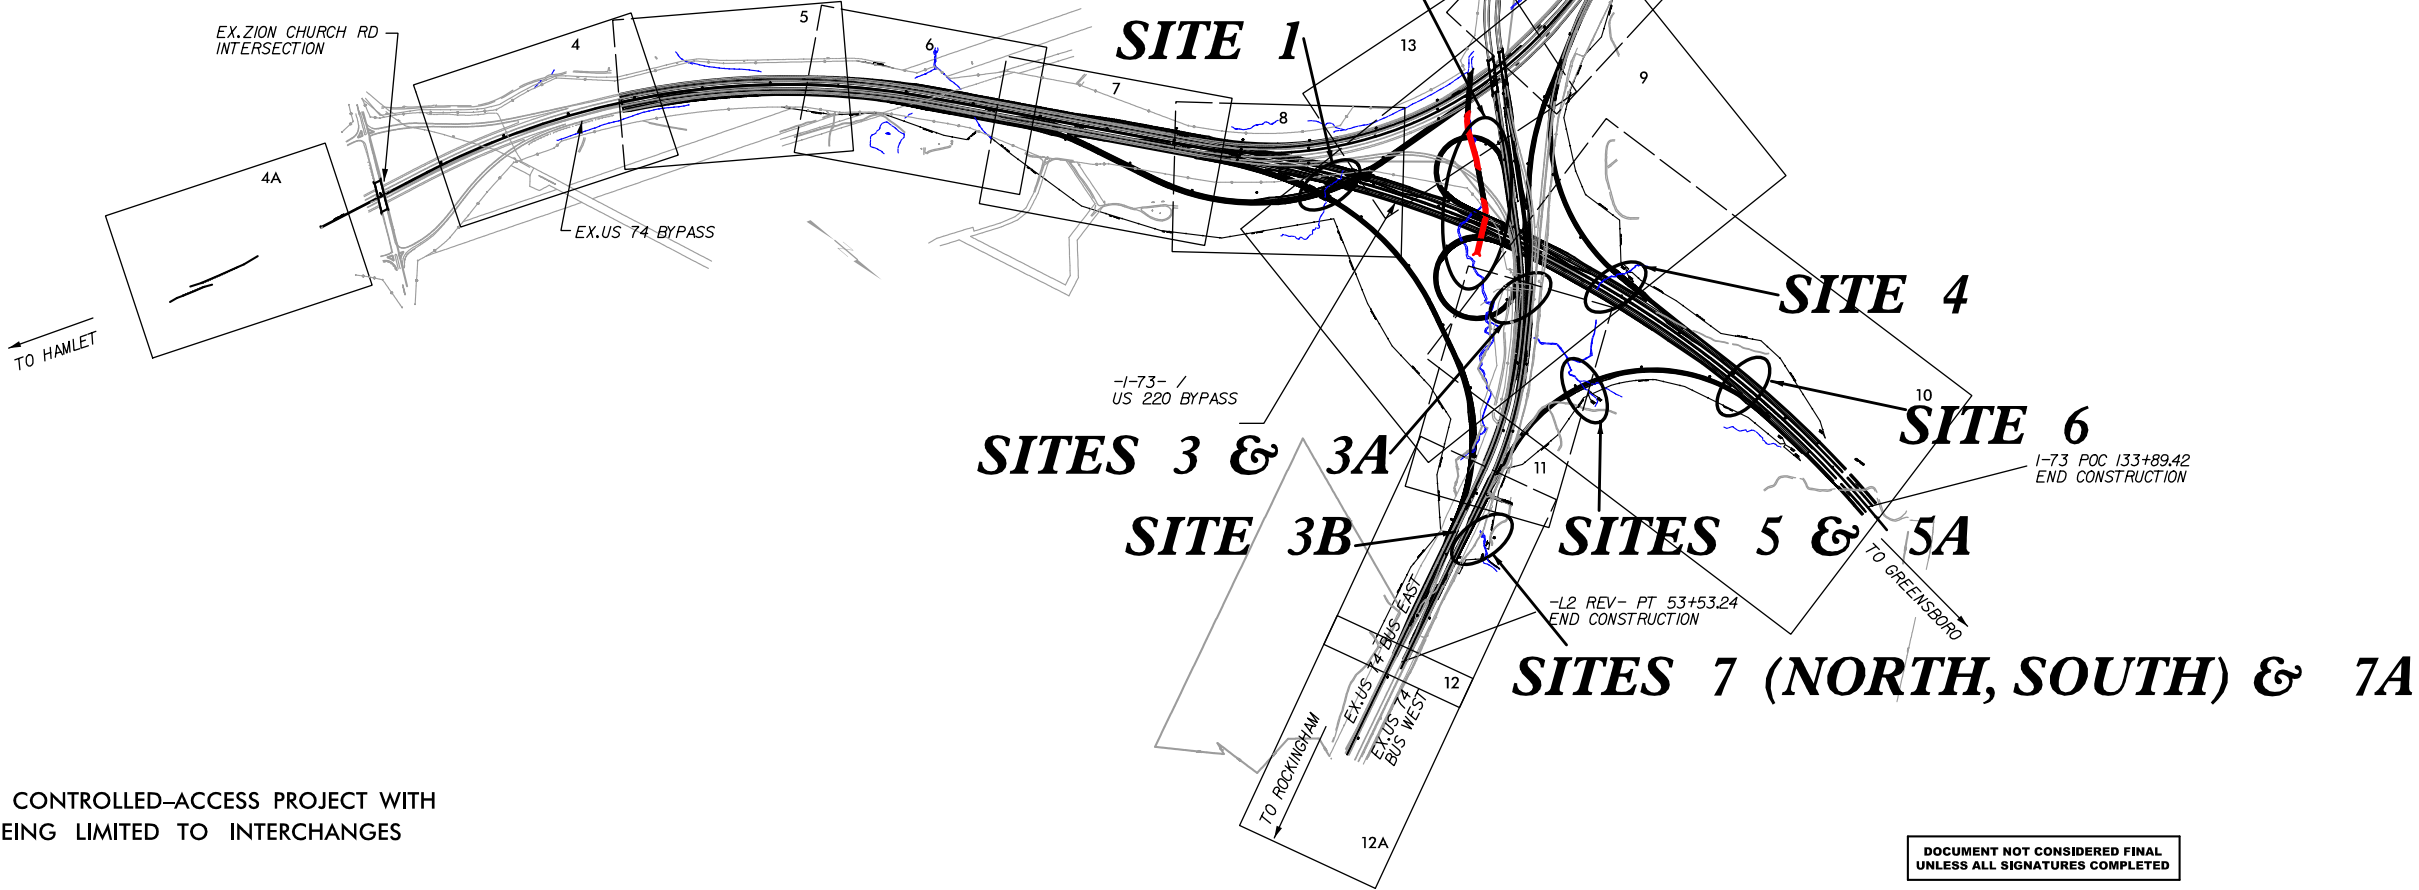

THIS IS A CONTROLLED-ACCESS PROJECT WITH
ACCESS BEING LIMITED TO INTERCHANGES

DOCUMENT NOT CONSIDERED FINAL
UNLESS ALL SIGNATURES COMPLETED

GRAPHIC SCALES

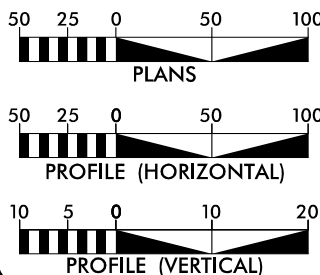

DESIGN DATA

ADT (2016) = 9,330-12,800
ADT (2036) = 19,900-23,800
K = 10%
D = 60%
T = 26% *
V = 70 mph
FUNC. CLASS. = INTERSTATE
* (TTST 9% + DUAL 17%)

PROJECT LENGTH

LENGTH ROADWAY TIP PROJECT R-3421A = 1.707 miles
LENGTH STRUCTURES TIP PROJECT R-3421A = 0.073 miles
TOTAL LENGTH OF TIP PROJECT R-3421A = 1.782 miles
(SB LANES WERE USED FOR LENGTH OF PROJECT)

Prepared In the Office of:
RK&K
FOR NORTH CAROLINA
DEPARTMENT OF TRANSPORTATION

2012 STANDARD SPECIFICATIONS

RIGHT OF WAY DATE:
JUNE 20, 2008

LETTING DATE:
OCTOBER, 2019


NCDOT CONTACT:

MICHAEL T. MERRITT, PE
PROJECT ENGINEER
RK&K, LLP
SCOTT BLEVINS, P.E.
PROJECT DESIGN ENGINEER
RK&K, LLP

GREGORY S. DAVIS, P.E.
DIVISION 8 PROJECT ENGINEER

HYDRAULICS ENGINEER

SIGNATURE: _____ P.E.
**ROADWAY
DESIGN
ENGINEER**
SIGNATURE: _____ P.E.

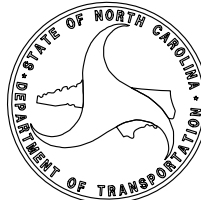

**DIVISION OF HIGHWAYS
STATE OF NORTH CAROLINA**

5/09/99





REVISIONS

7/19/2019
R:\Roadway\p\proj\3421a-rdy-pah02D-1.dgn
Default

STREAM RELOCATION DETAILS

PERMIT DRAWING
SHEET 1A OF 37











PROJECT REFERENCE NO.		SHEET NO.
R-3421A		2D-1
ROADWAY DESIGN ENGINEER	HYDRAULICS ENGINEER	

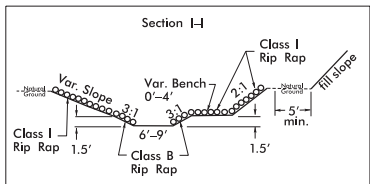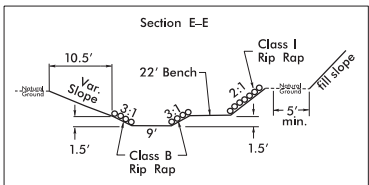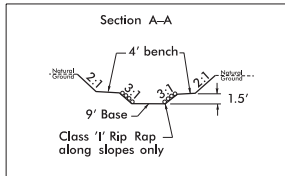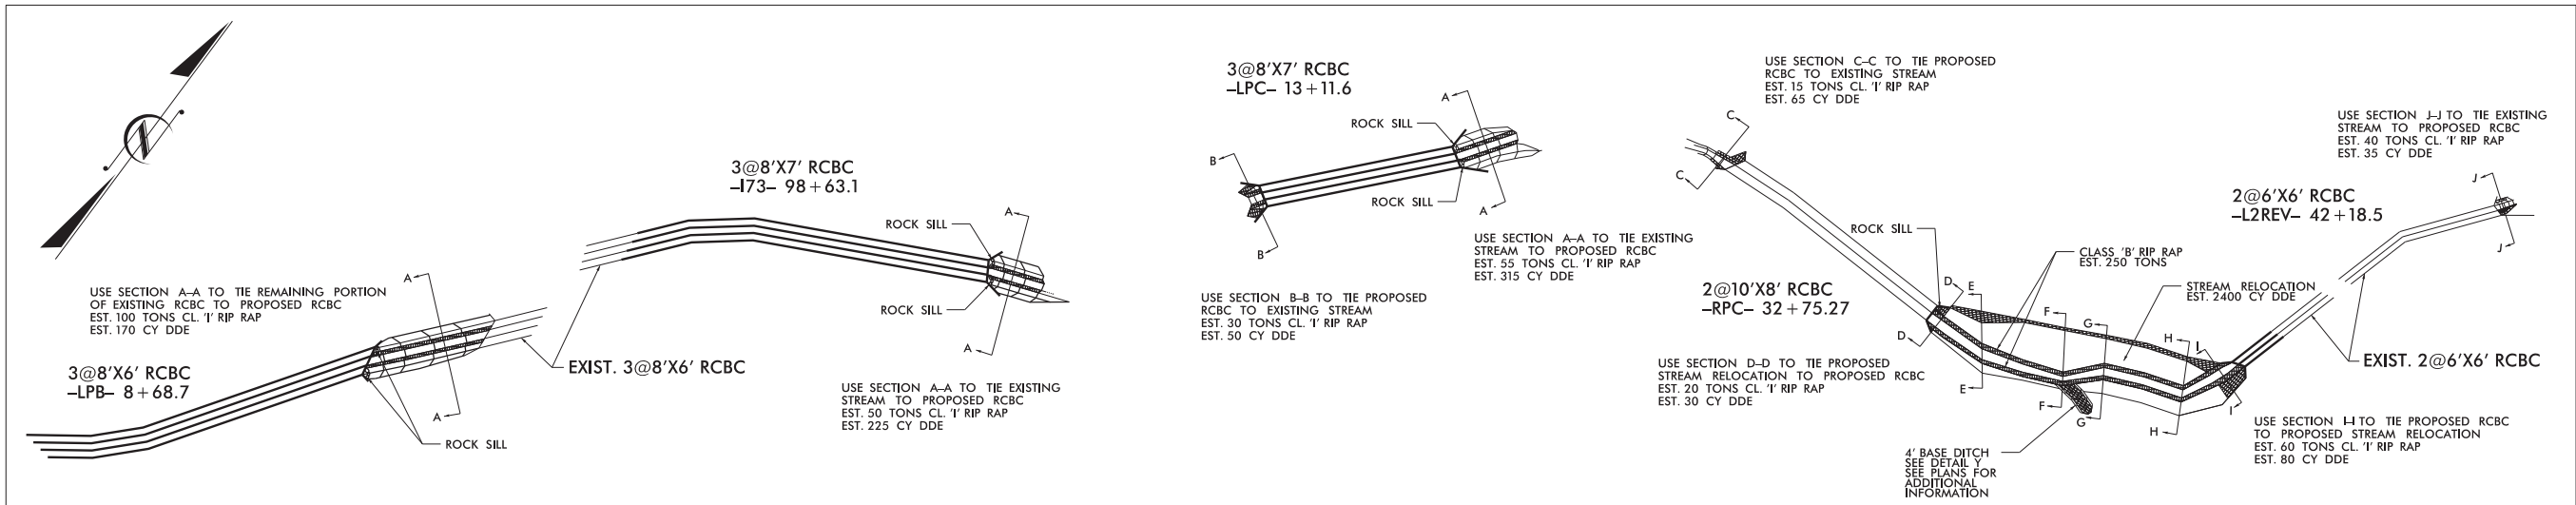

Section Distances And Elevations
Along CL Stream Relocation From
Outlet Of 2@6'x6' RCBC

Section	Distance From Outlet	Centerline Elevation
H-H	69' +/-	215.4' +/-
G-G	158' +/-	214.5' +/-
F-F	204' +/-	214.3' +/-
E-E	297' +/-	213.3' +/-

All distances and elevations listed are approximate.

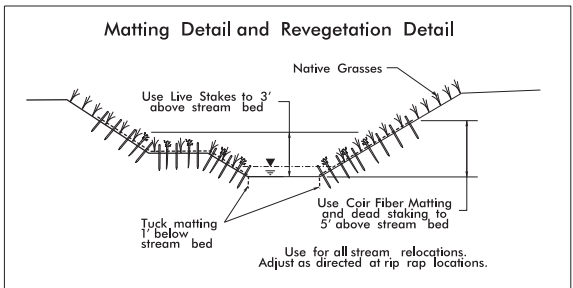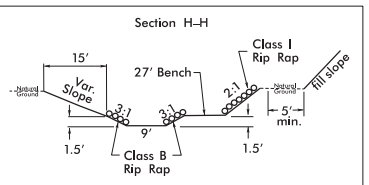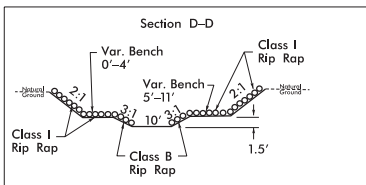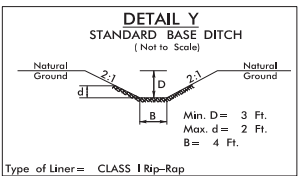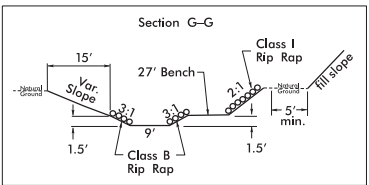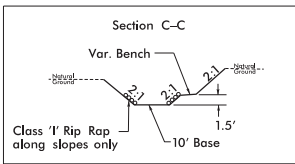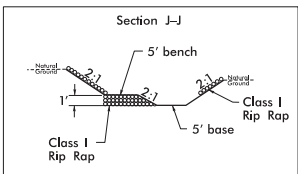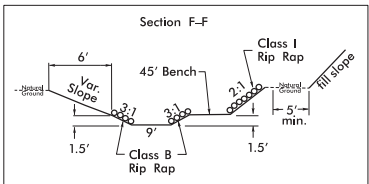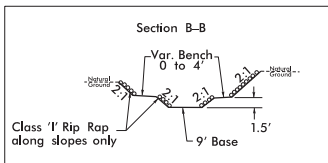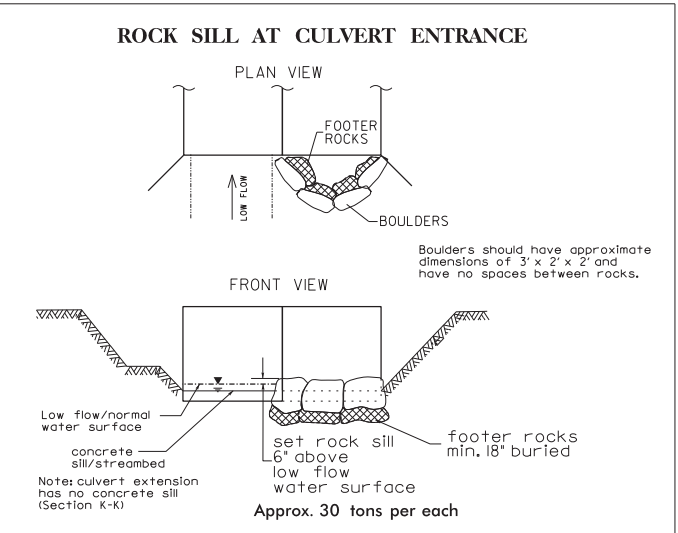


NOTES:
THE TYPICAL BANKFULL DEPTH FOR THE RELOCATED STREAM IS 1.5'.
BENCH WIDTHS MAY VARY FROM DIMENSIONS SHOWN DEPENDING ON FIELD CONDITIONS, THE INTENT IS TO PROVIDE FLOODPLAIN TO THE MAXIMUM EXTENT POSSIBLE BETWEEN SECTIONS D-D AND I-I.
OTHER DIMENSIONS, ELEVATIONS AND GEOMETRY MAY VARY DEPENDING ON FIELD CONDITIONS AND WITH THE ENGINEER'S APPROVAL.
ADDITIONAL INFORMATION MAY BE SHOWN ON THE PLAN SHEETS.

Revised 7/25/2019

8/17/99

PERMIT DRAWING
SHEET 2 OF 37

PROJECT REFERENCE NO.		SHEET NO.	
R-342A		8	
RW SHEET NO.			
ROADWAY DESIGN ENGINEER		HYDRAULICS ENGINEER	
INCOMPLETE PLANS DO NOT USE FOR R/W ACQUISITION PRELIMINARY PLANS DO NOT USE FOR CONSTRUCTION			

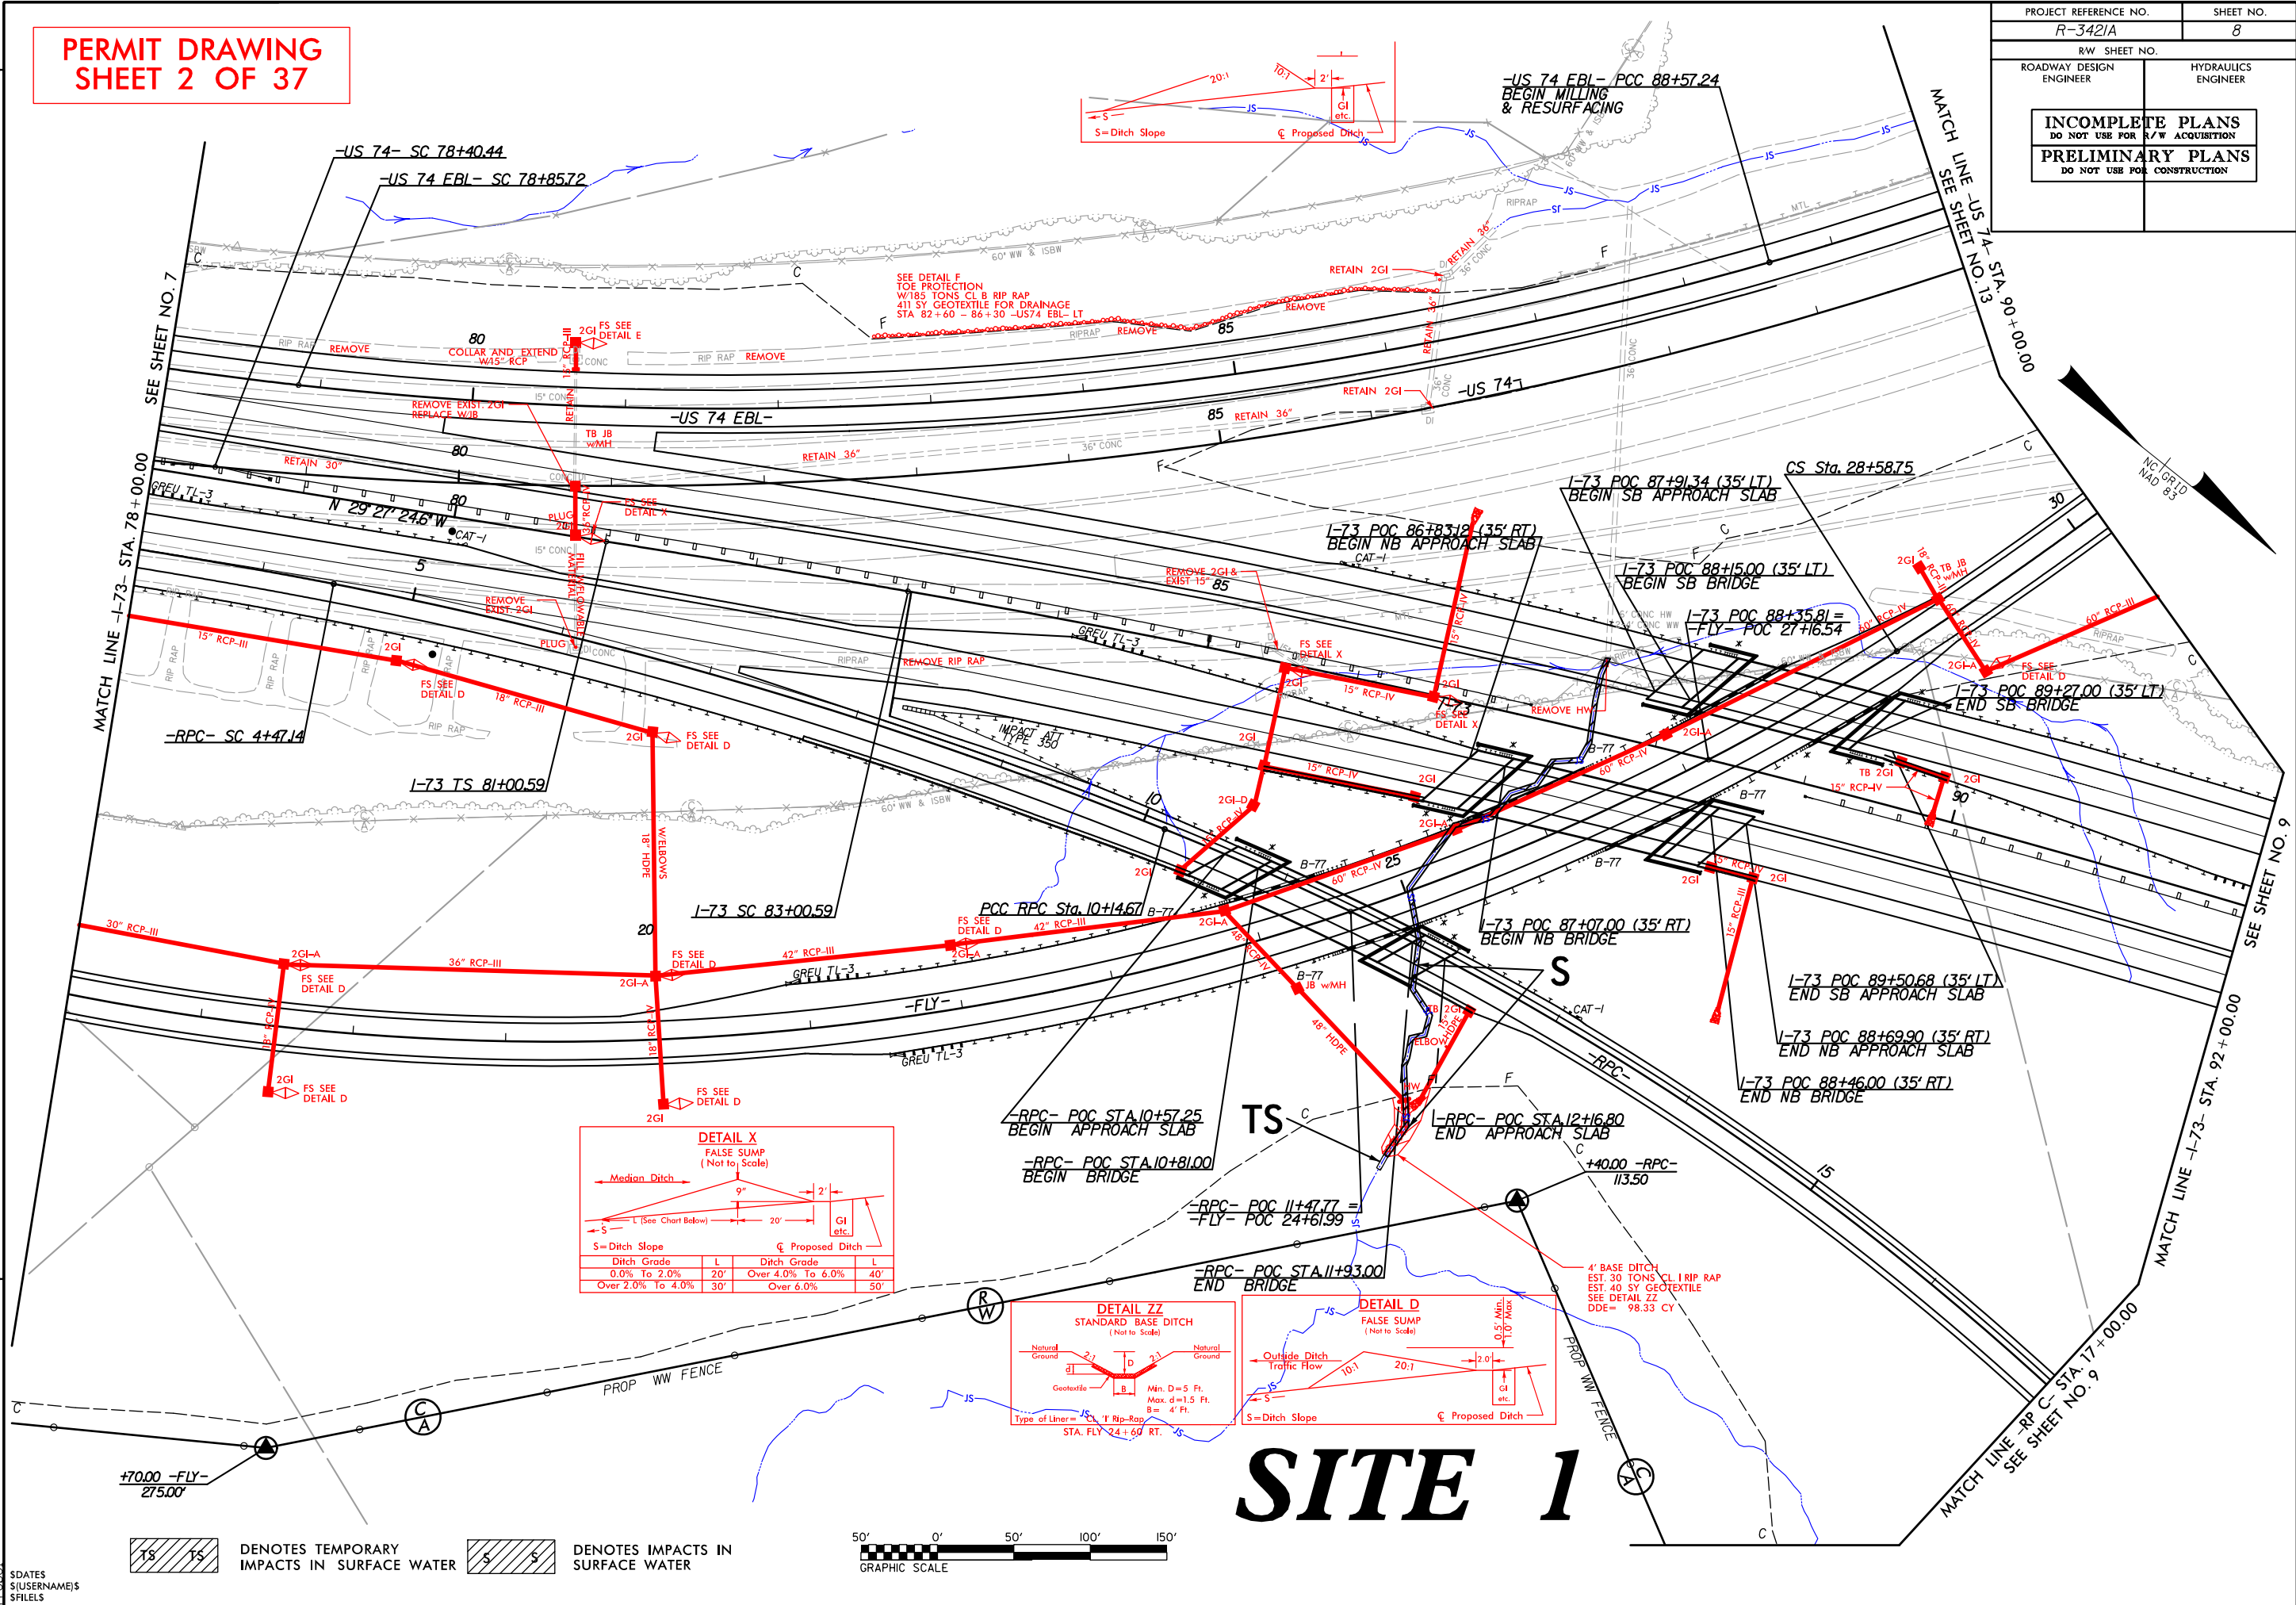

SITE 1


1:46:20 PM
R:\Hydraulics\PERMITS-Environmental\Drawings\R3421A\R3421a-hyd-prm-psb08_20150129.dgn

```
SDATES$
S(USERNAME)$
SFILES$
```


8/17/99

PERMIT DRAWING
SHEET 3 OF 37

PROJECT REFERENCE NO. R-3421A		SHEET NO. 8	
RW SHEET NO.		HYDRAULICS ENGINEER	
ROADWAY DESIGN ENGINEER		DO NOT USE FOR CONSTRUCTION	
INCOMPLETE PLANS DO NOT USE FOR ACQUISITION		PRELIMINARY PLANS DO NOT USE FOR CONSTRUCTION	

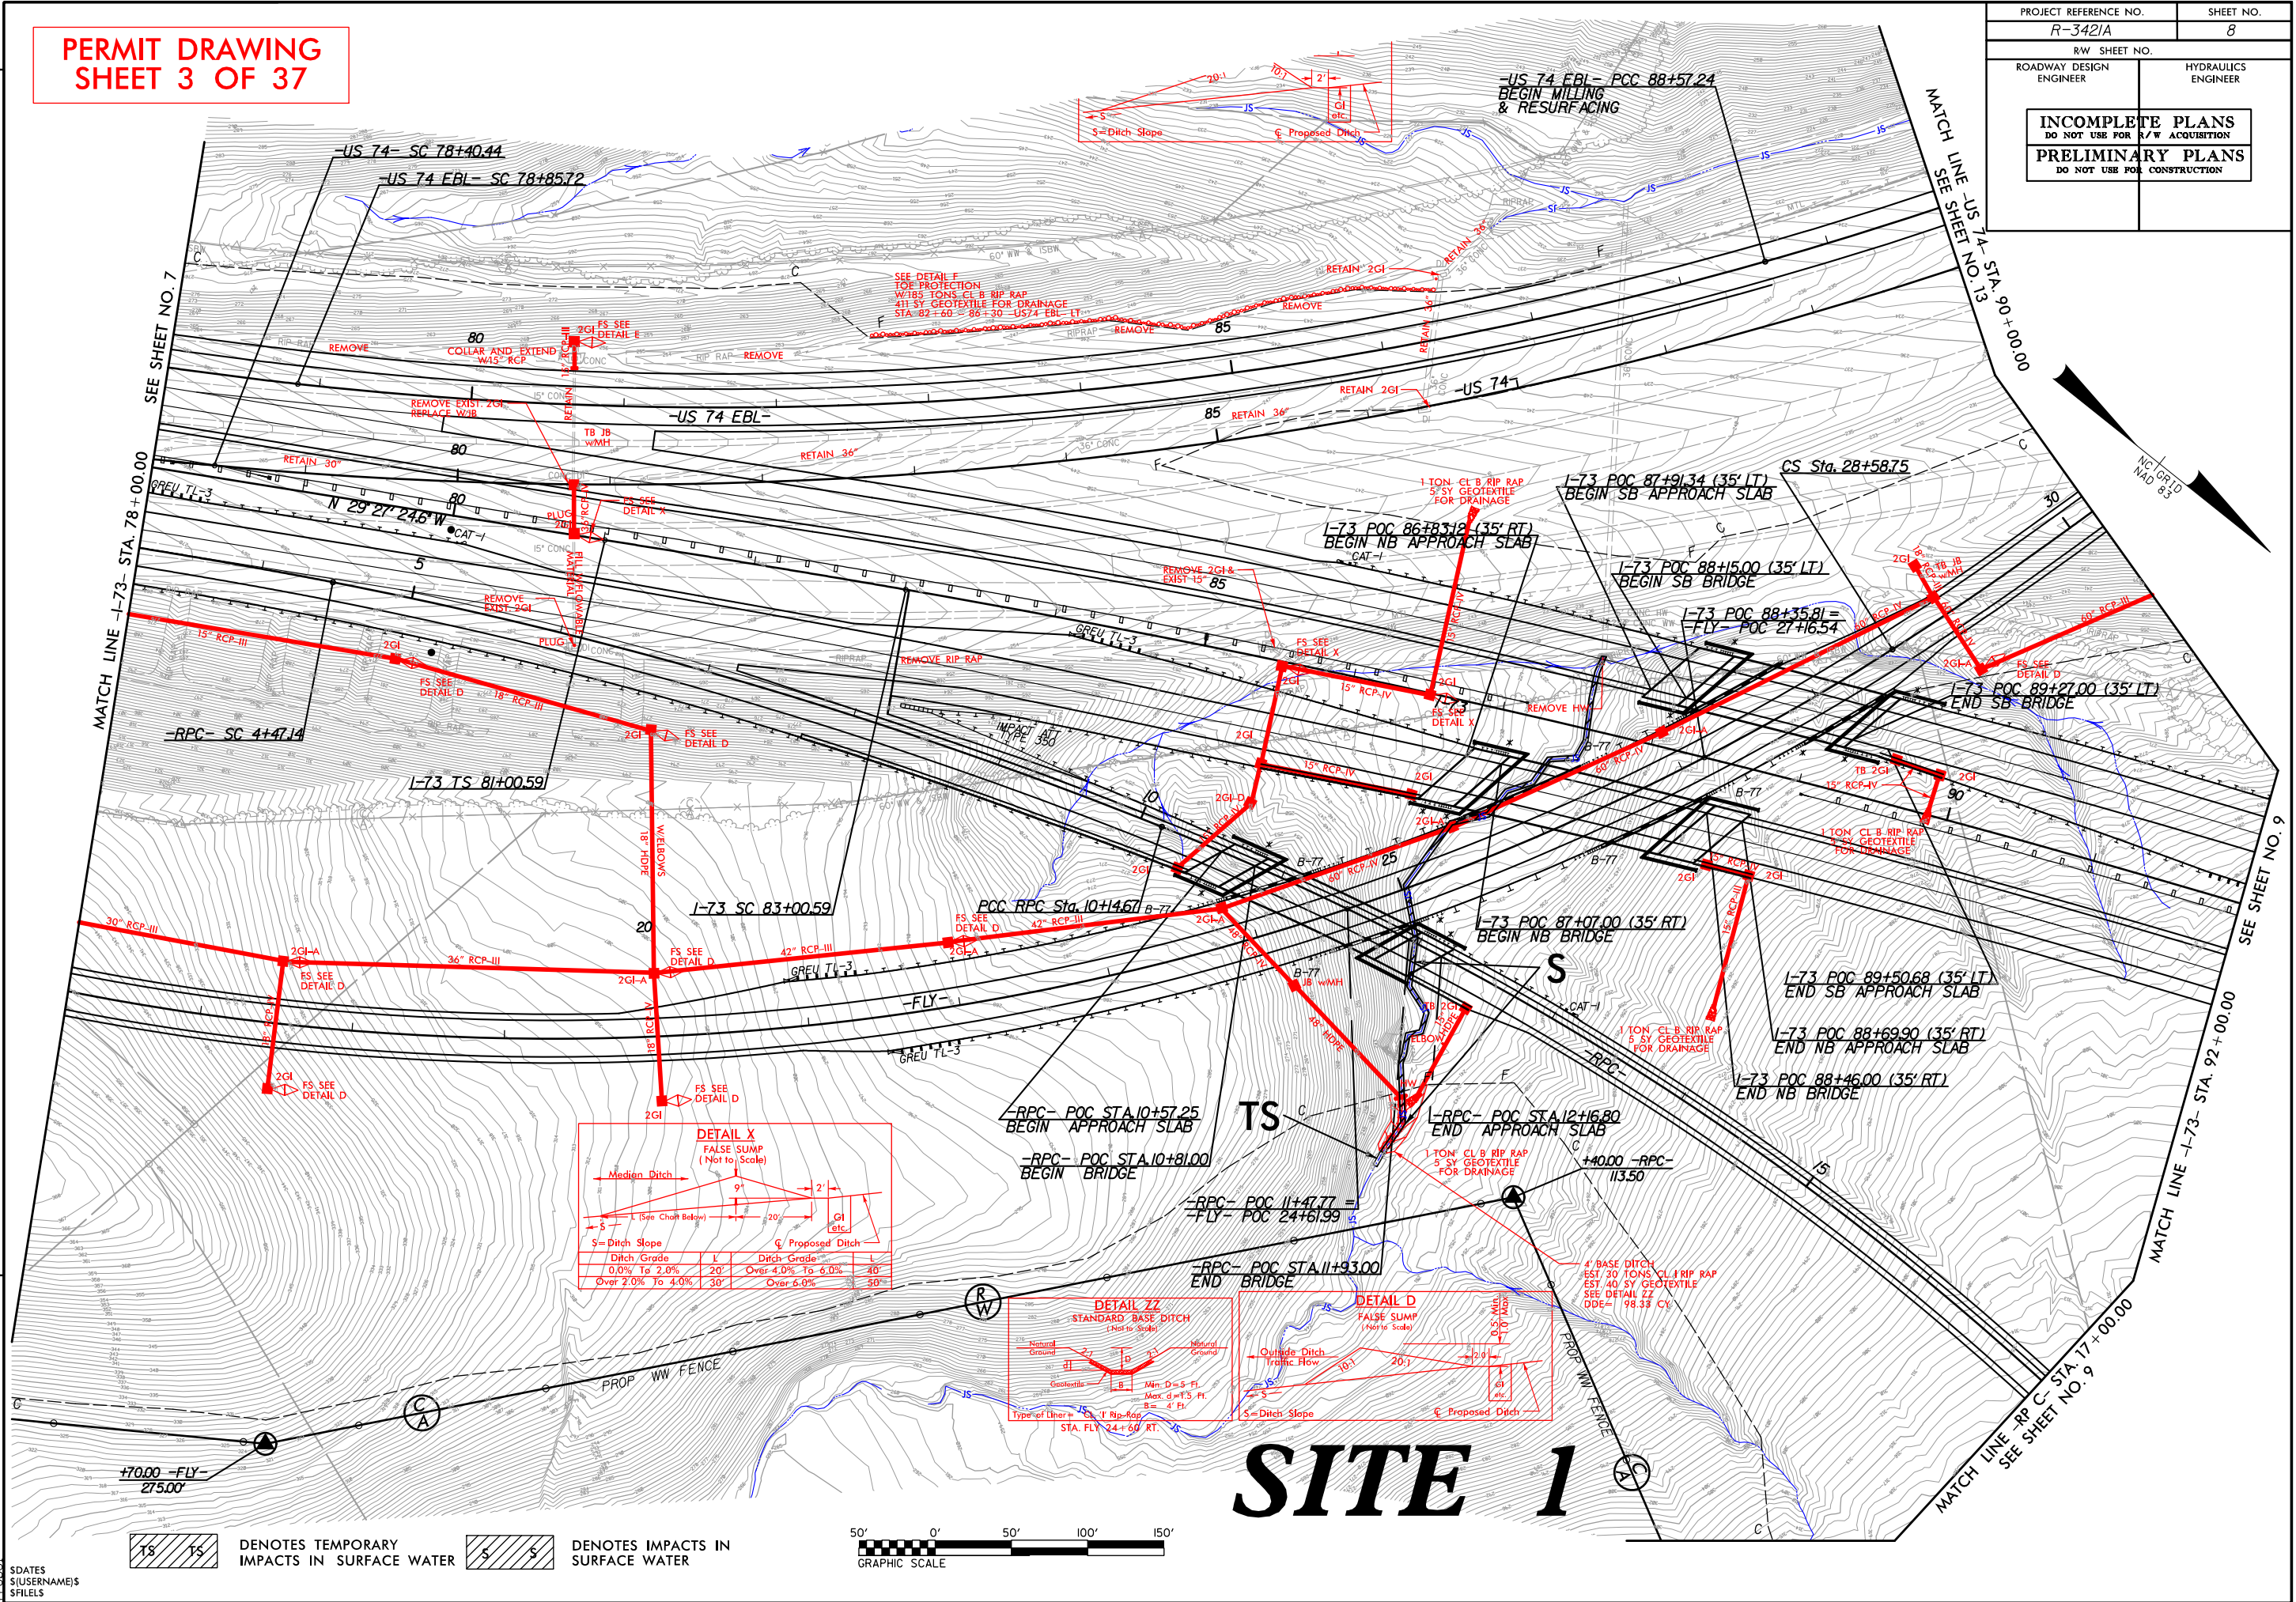


SITE 1

Revised 7/25/2019

8/17/99



\\h47423\PM\PERMITS\Environmental\Drawings\R3421A\Hyd\hyd-prm-psh08_enlarge_site1_20150129.dgn

SITE 1 ENLARGEMENT

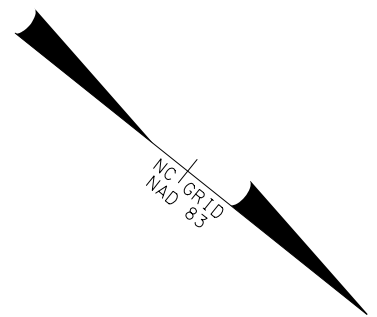

PROJECT REFERENCE NO.	SHEET NO.
R-3421A	8
R/W SHEET NO.	
ROADWAY DESIGN ENGINEER	HYDRAULICS ENGINEER
INCOMPLETE PLANS DO NOT USE FOR R/W ACQUISITION	
PRELIMINARY PLANS DO NOT USE FOR CONSTRUCTION	

PERMIT DRAWING
SHEET 4 OF 37

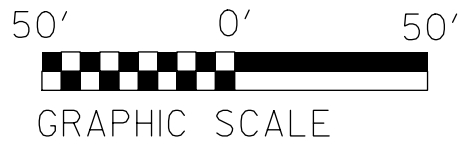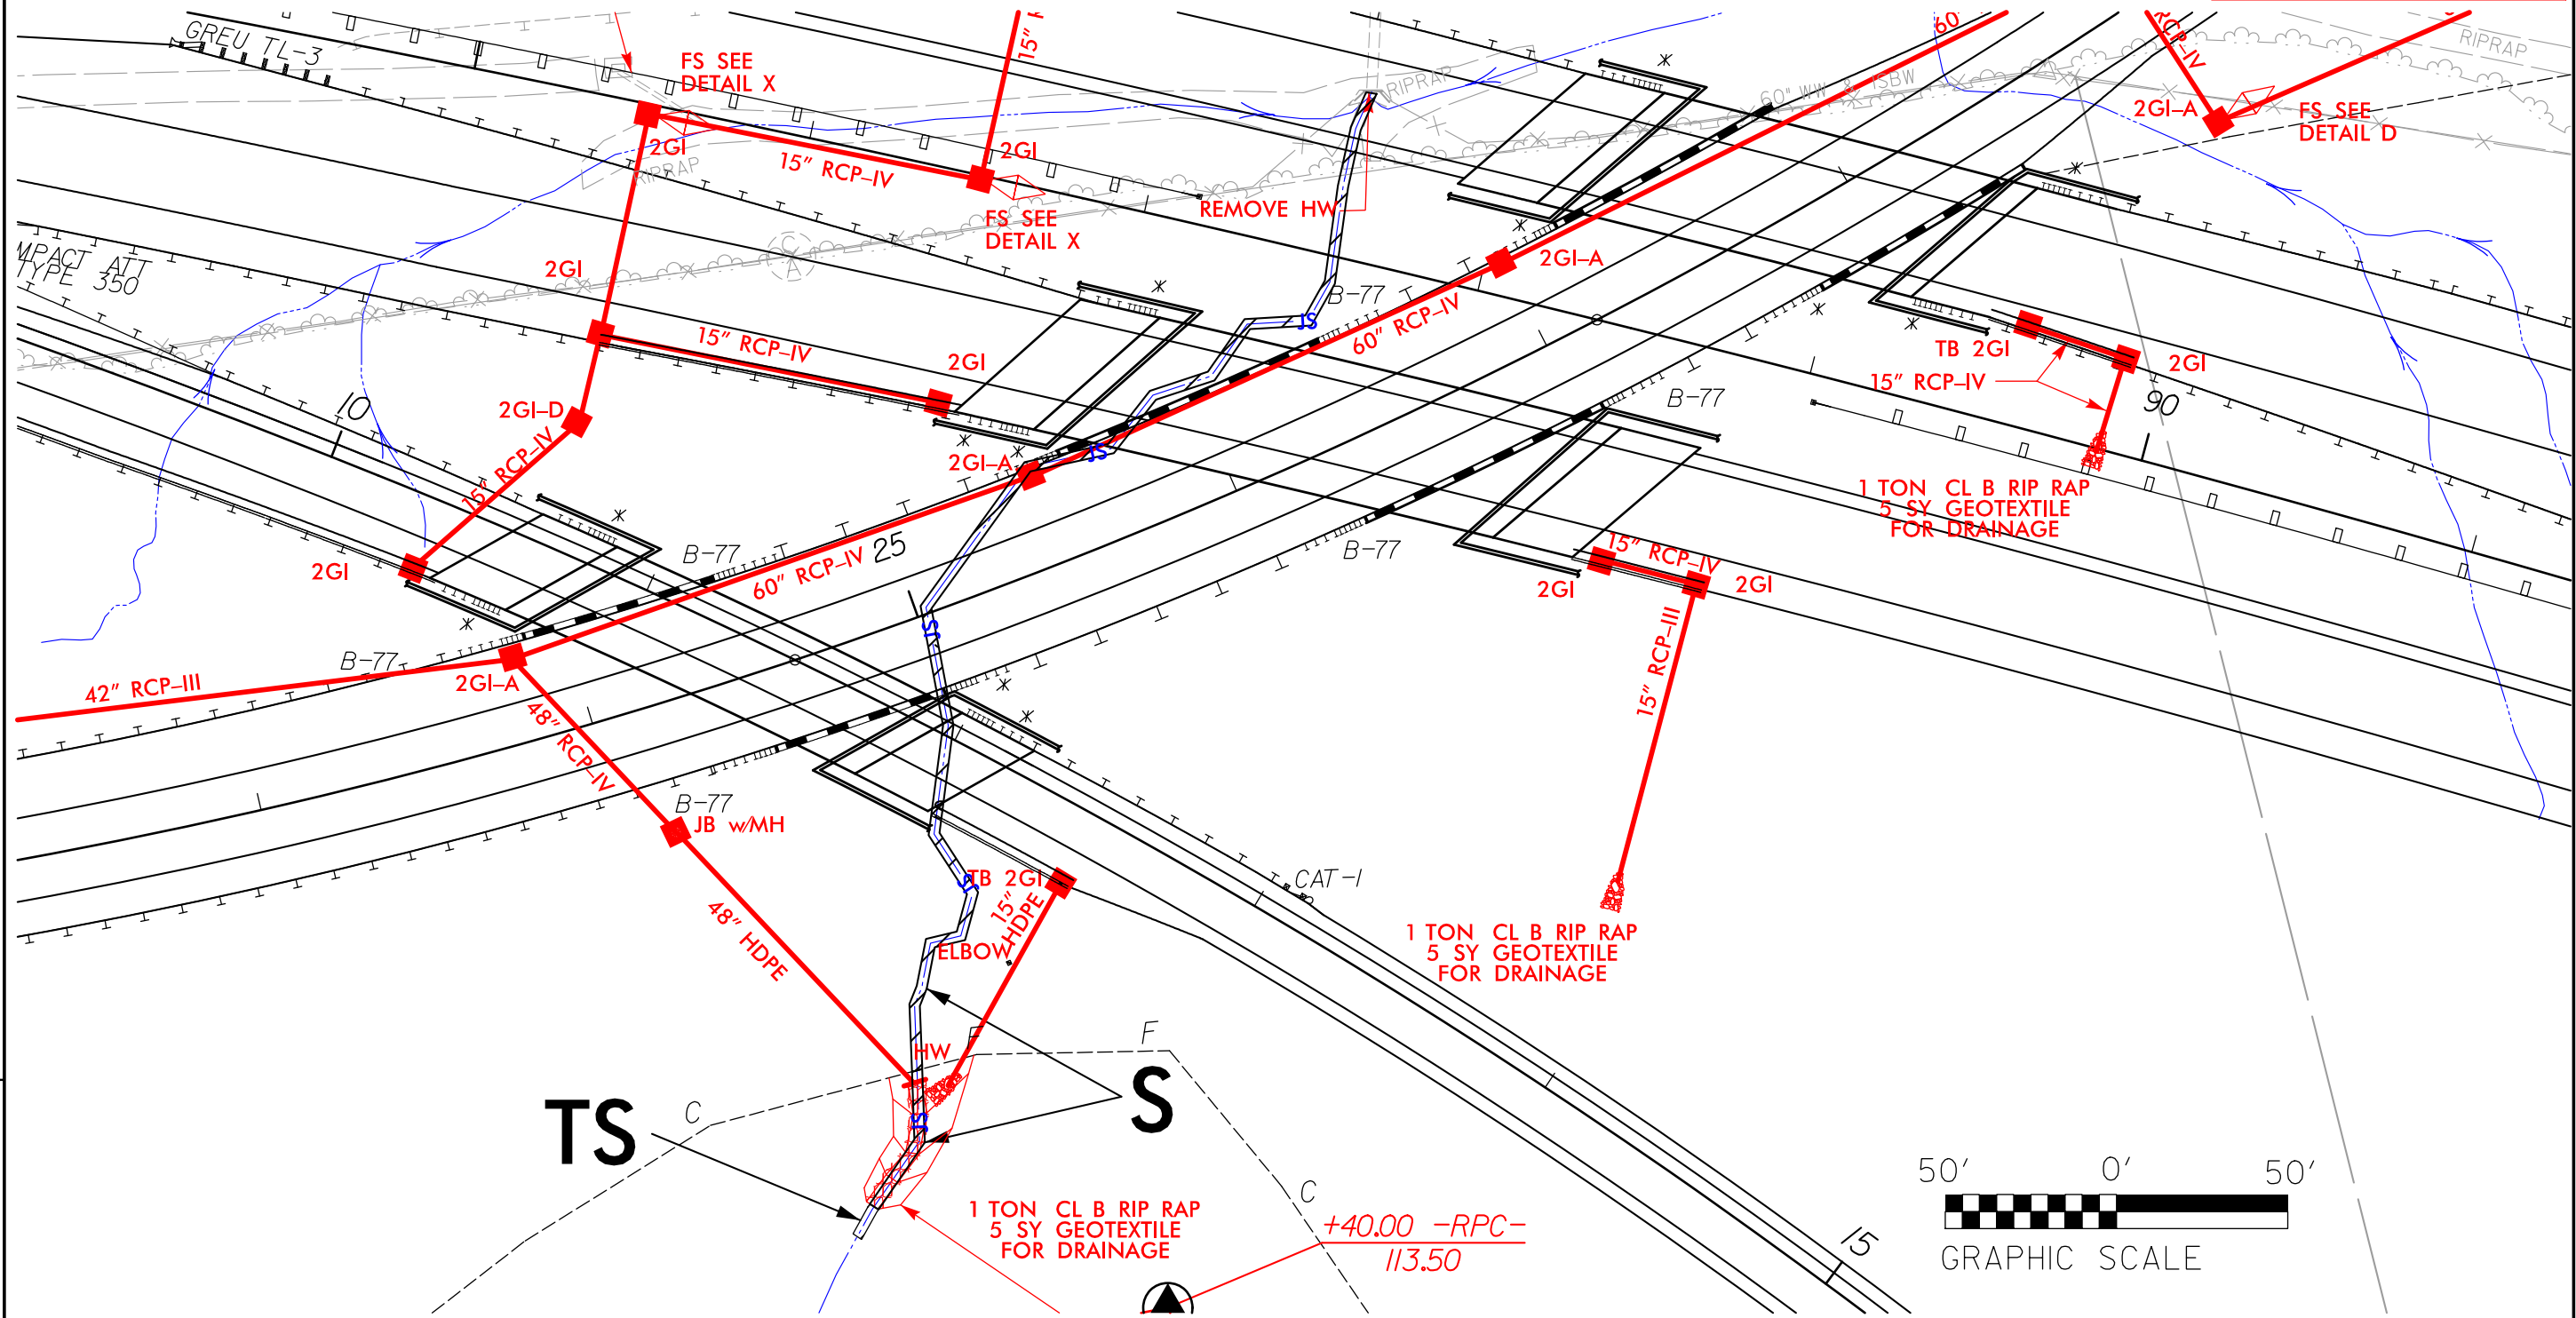

DENOTES IMPACTS IN
SURFACE WATER



DENOTES TEMPORARY
IMPACTS IN SURFACE WATER


Revised 7/25/2019

8/17/99

\\4728 PM
R:\Hydraulics\PERMITS\Environmental\Drawings\R3421A\3421a_hyd_prm_psh08_enlarge_site1_20150129_con.dgn


REVISIONS

SITE 1 ENLARGEMENT

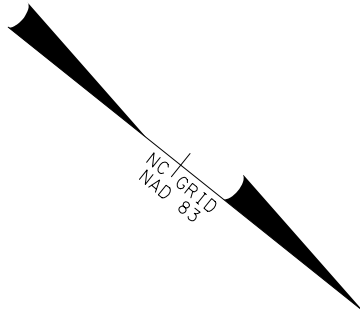

PROJECT REFERENCE NO.	SHEET NO.
R-3421A	8
RW SHEET NO.	
ROADWAY DESIGN ENGINEER	HYDRAULICS ENGINEER
INCOMPLETE PLANS DO NOT USE FOR R/W ACQUISITION	
PRELIMINARY PLANS DO NOT USE FOR CONSTRUCTION	

PERMIT DRAWING
SHEET 5 OF 37

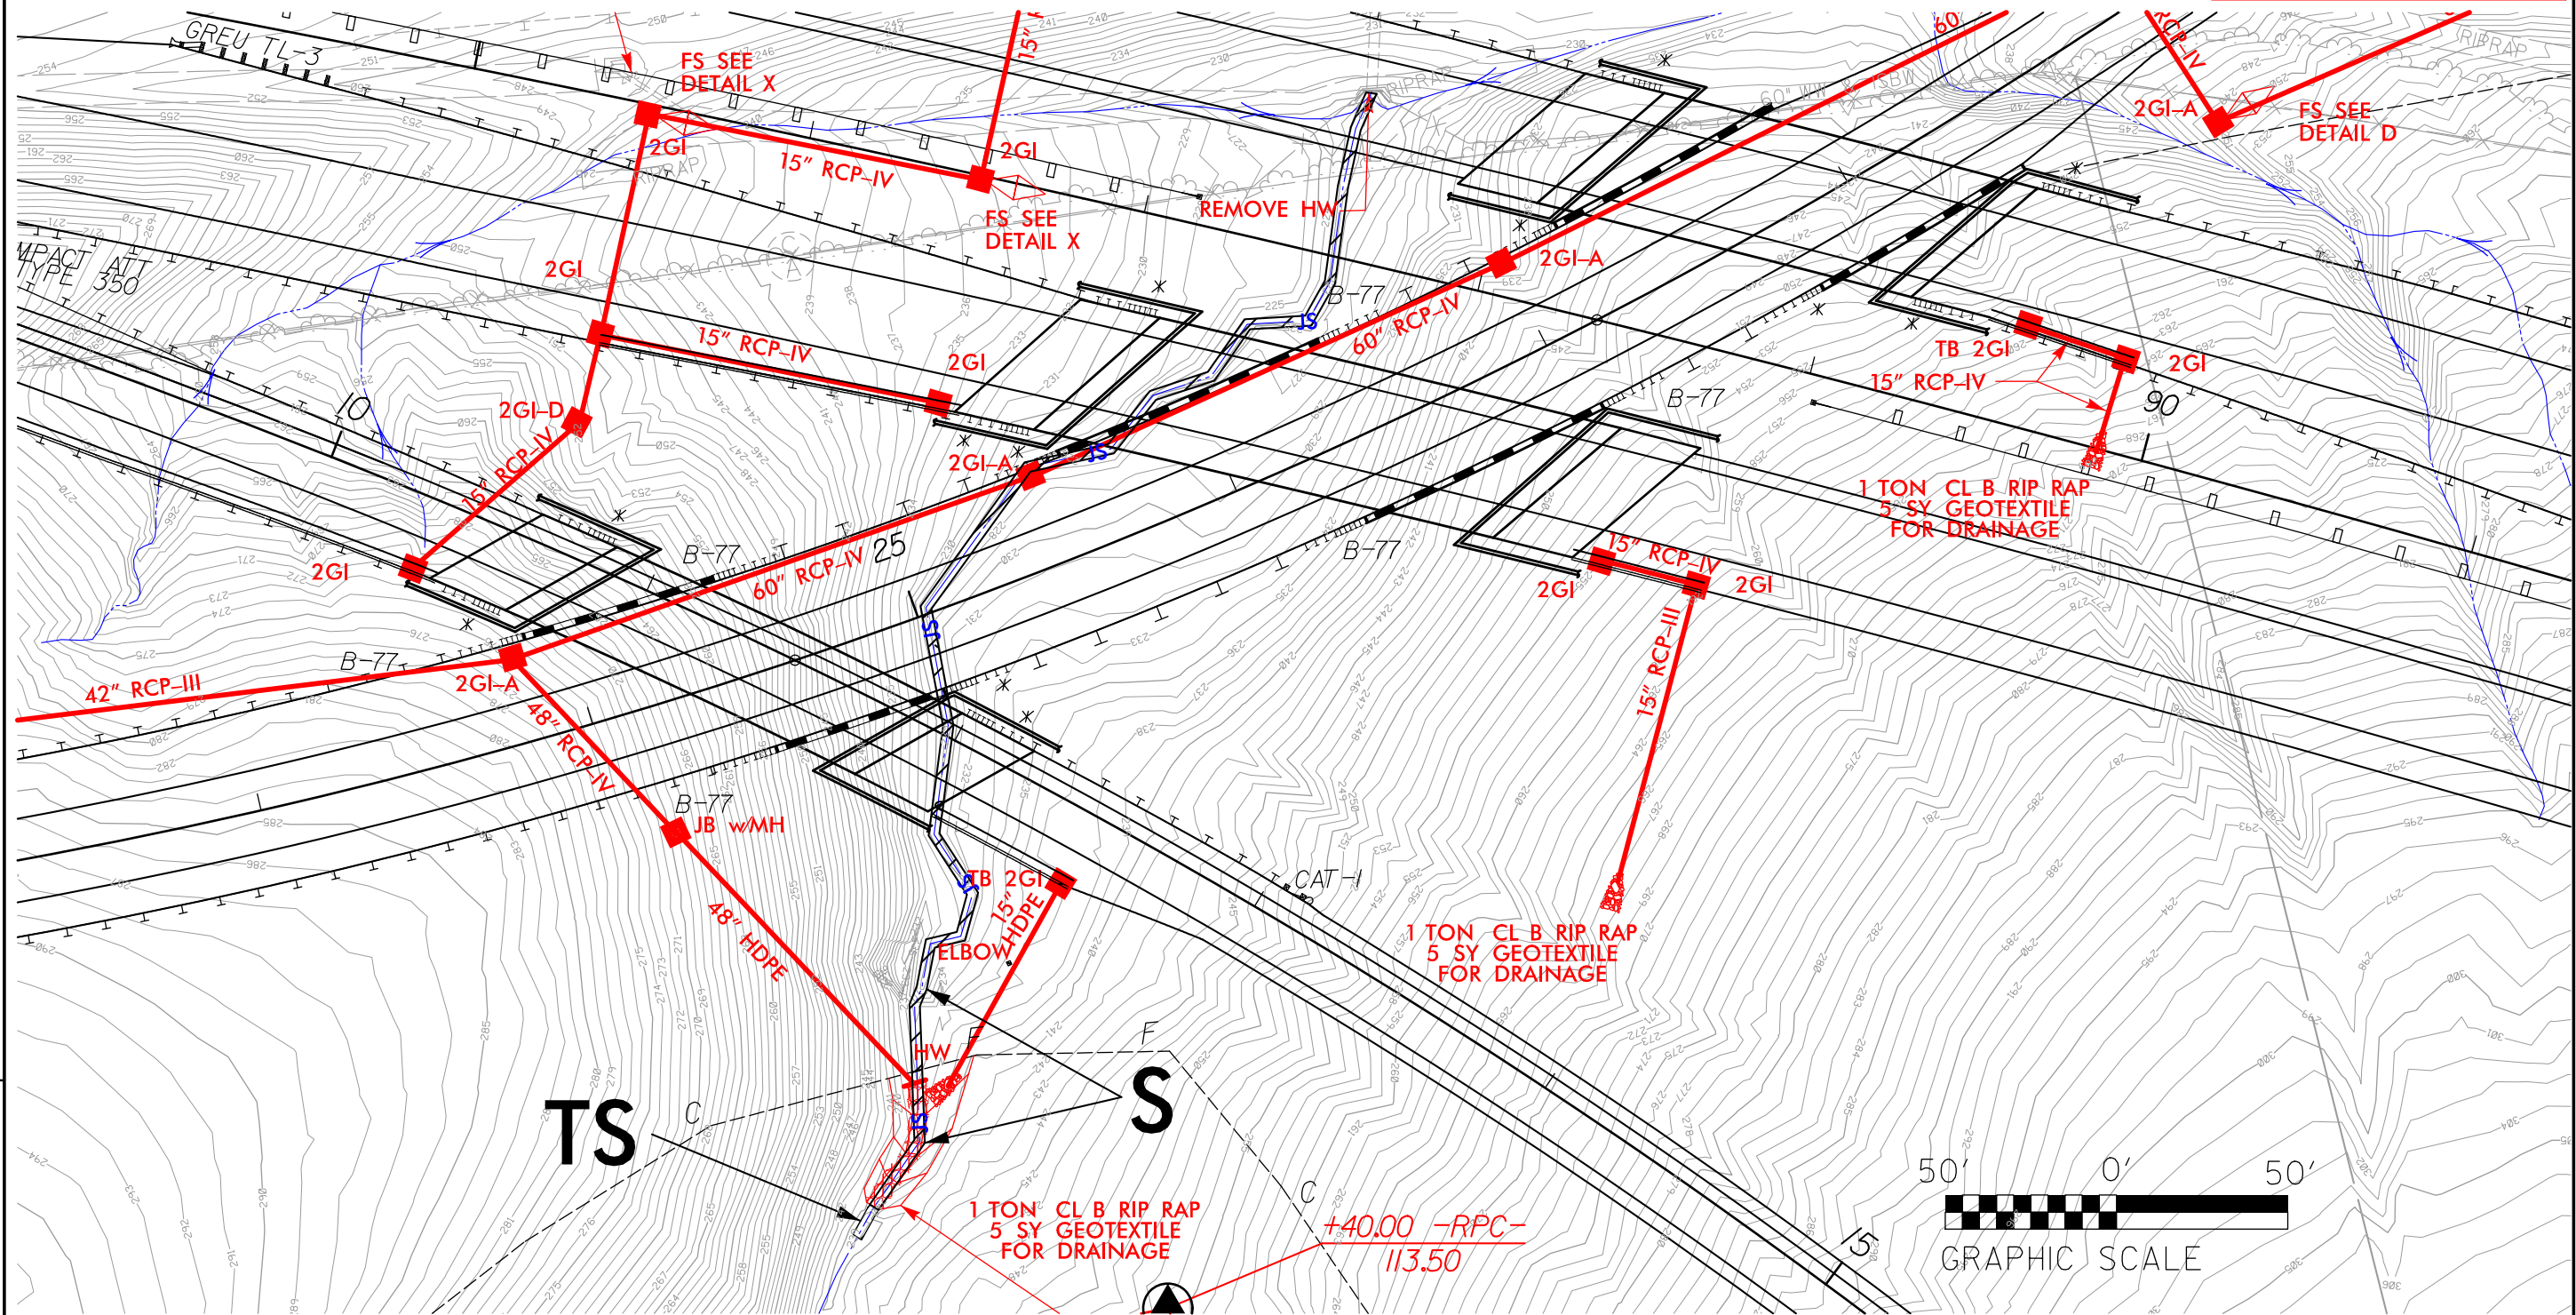

\$DATES
\$(USERAME)\$
\$FILEL\$



DENOTES IMPACTS IN
SURFACE WATER



DENOTES TEMPORARY
IMPACTS IN SURFACE WATER

Revised 7/25/2019

8/17/99


REVISIONS

147:32 PM
R:\Hydraulics\PERMITS\Environmental\Drawings\R3421A\hyd_prm_psh05_20150203.dgn

\$DATES
\$(USERAME)\$
\$FILE\$

PROJECT REFERENCE NO.		SHEET NO.
R-3421A		9
R/W SHEET NO.		
ROADWAY DESIGN ENGINEER		HYDRAULICS ENGINEER
INCOMPLETE PLANS DO NOT USE FOR R/W ACQUISITION		
PRELIMINARY PLANS DO NOT USE FOR CONSTRUCTION		

PERMIT DRAWING
SHEET 6 OF 37

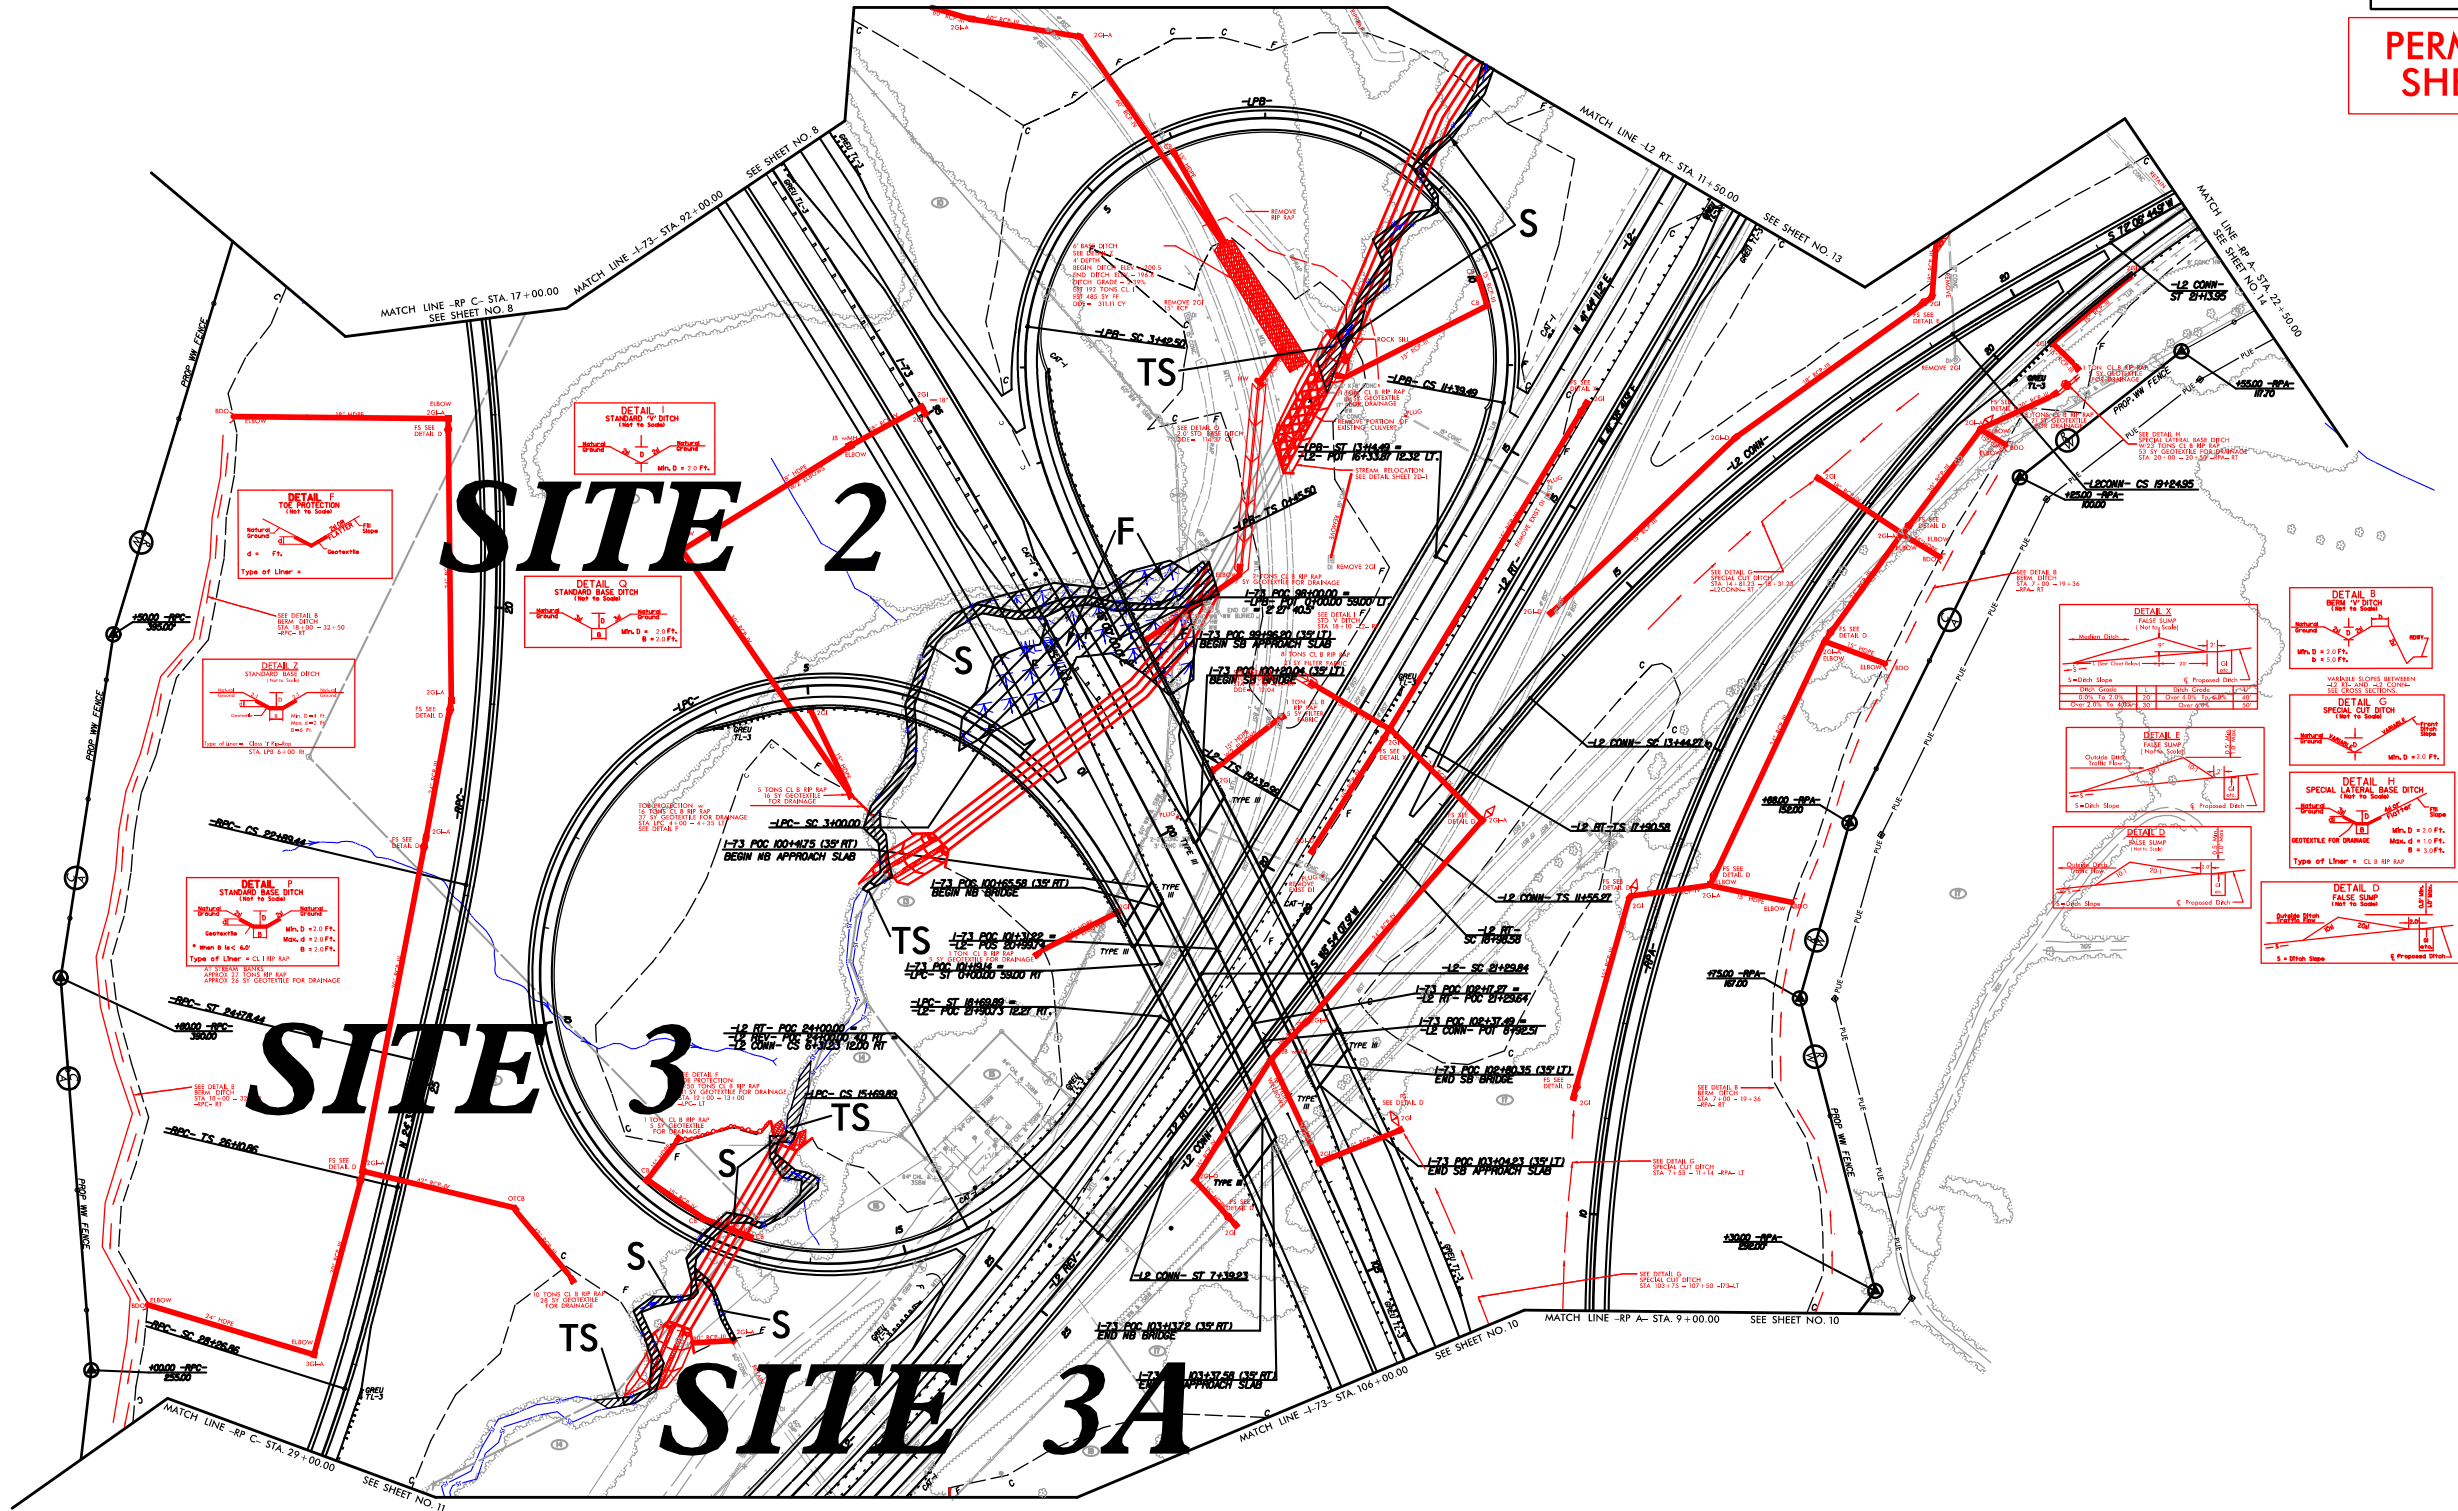

DENOTES IMPACTS IN
SURFACE WATER

DENOTES TEMPORARY
IMPACTS IN SURFACE WATER

DENOTES FILL IN
WETLAND

Revised 7/25/2019

8/17/99


REVISIONS

\\47:37 PM \$D:\Hydraulics\PERMITS\Environmental\Drawings\3421A\3421a-hyd-prm-psd05-20150203.com.dgn

\$D:\Hydraulics\PERMITS\Environmental\Drawings\3421A\3421a-hyd-prm-psd05-20150203.com.dgn

PROJECT REFERENCE NO.	SHEET NO.
R-3421A	9
R/W SHEET NO.	
ROADWAY DESIGN ENGINEER	HYDRAULICS ENGINEER
INCOMPLETE PLANS DO NOT USE FOR R/W ACQUISITION	
PRELIMINARY PLANS DO NOT USE FOR CONSTRUCTION	

PERMIT DRAWING
SHEET 7 OF 37

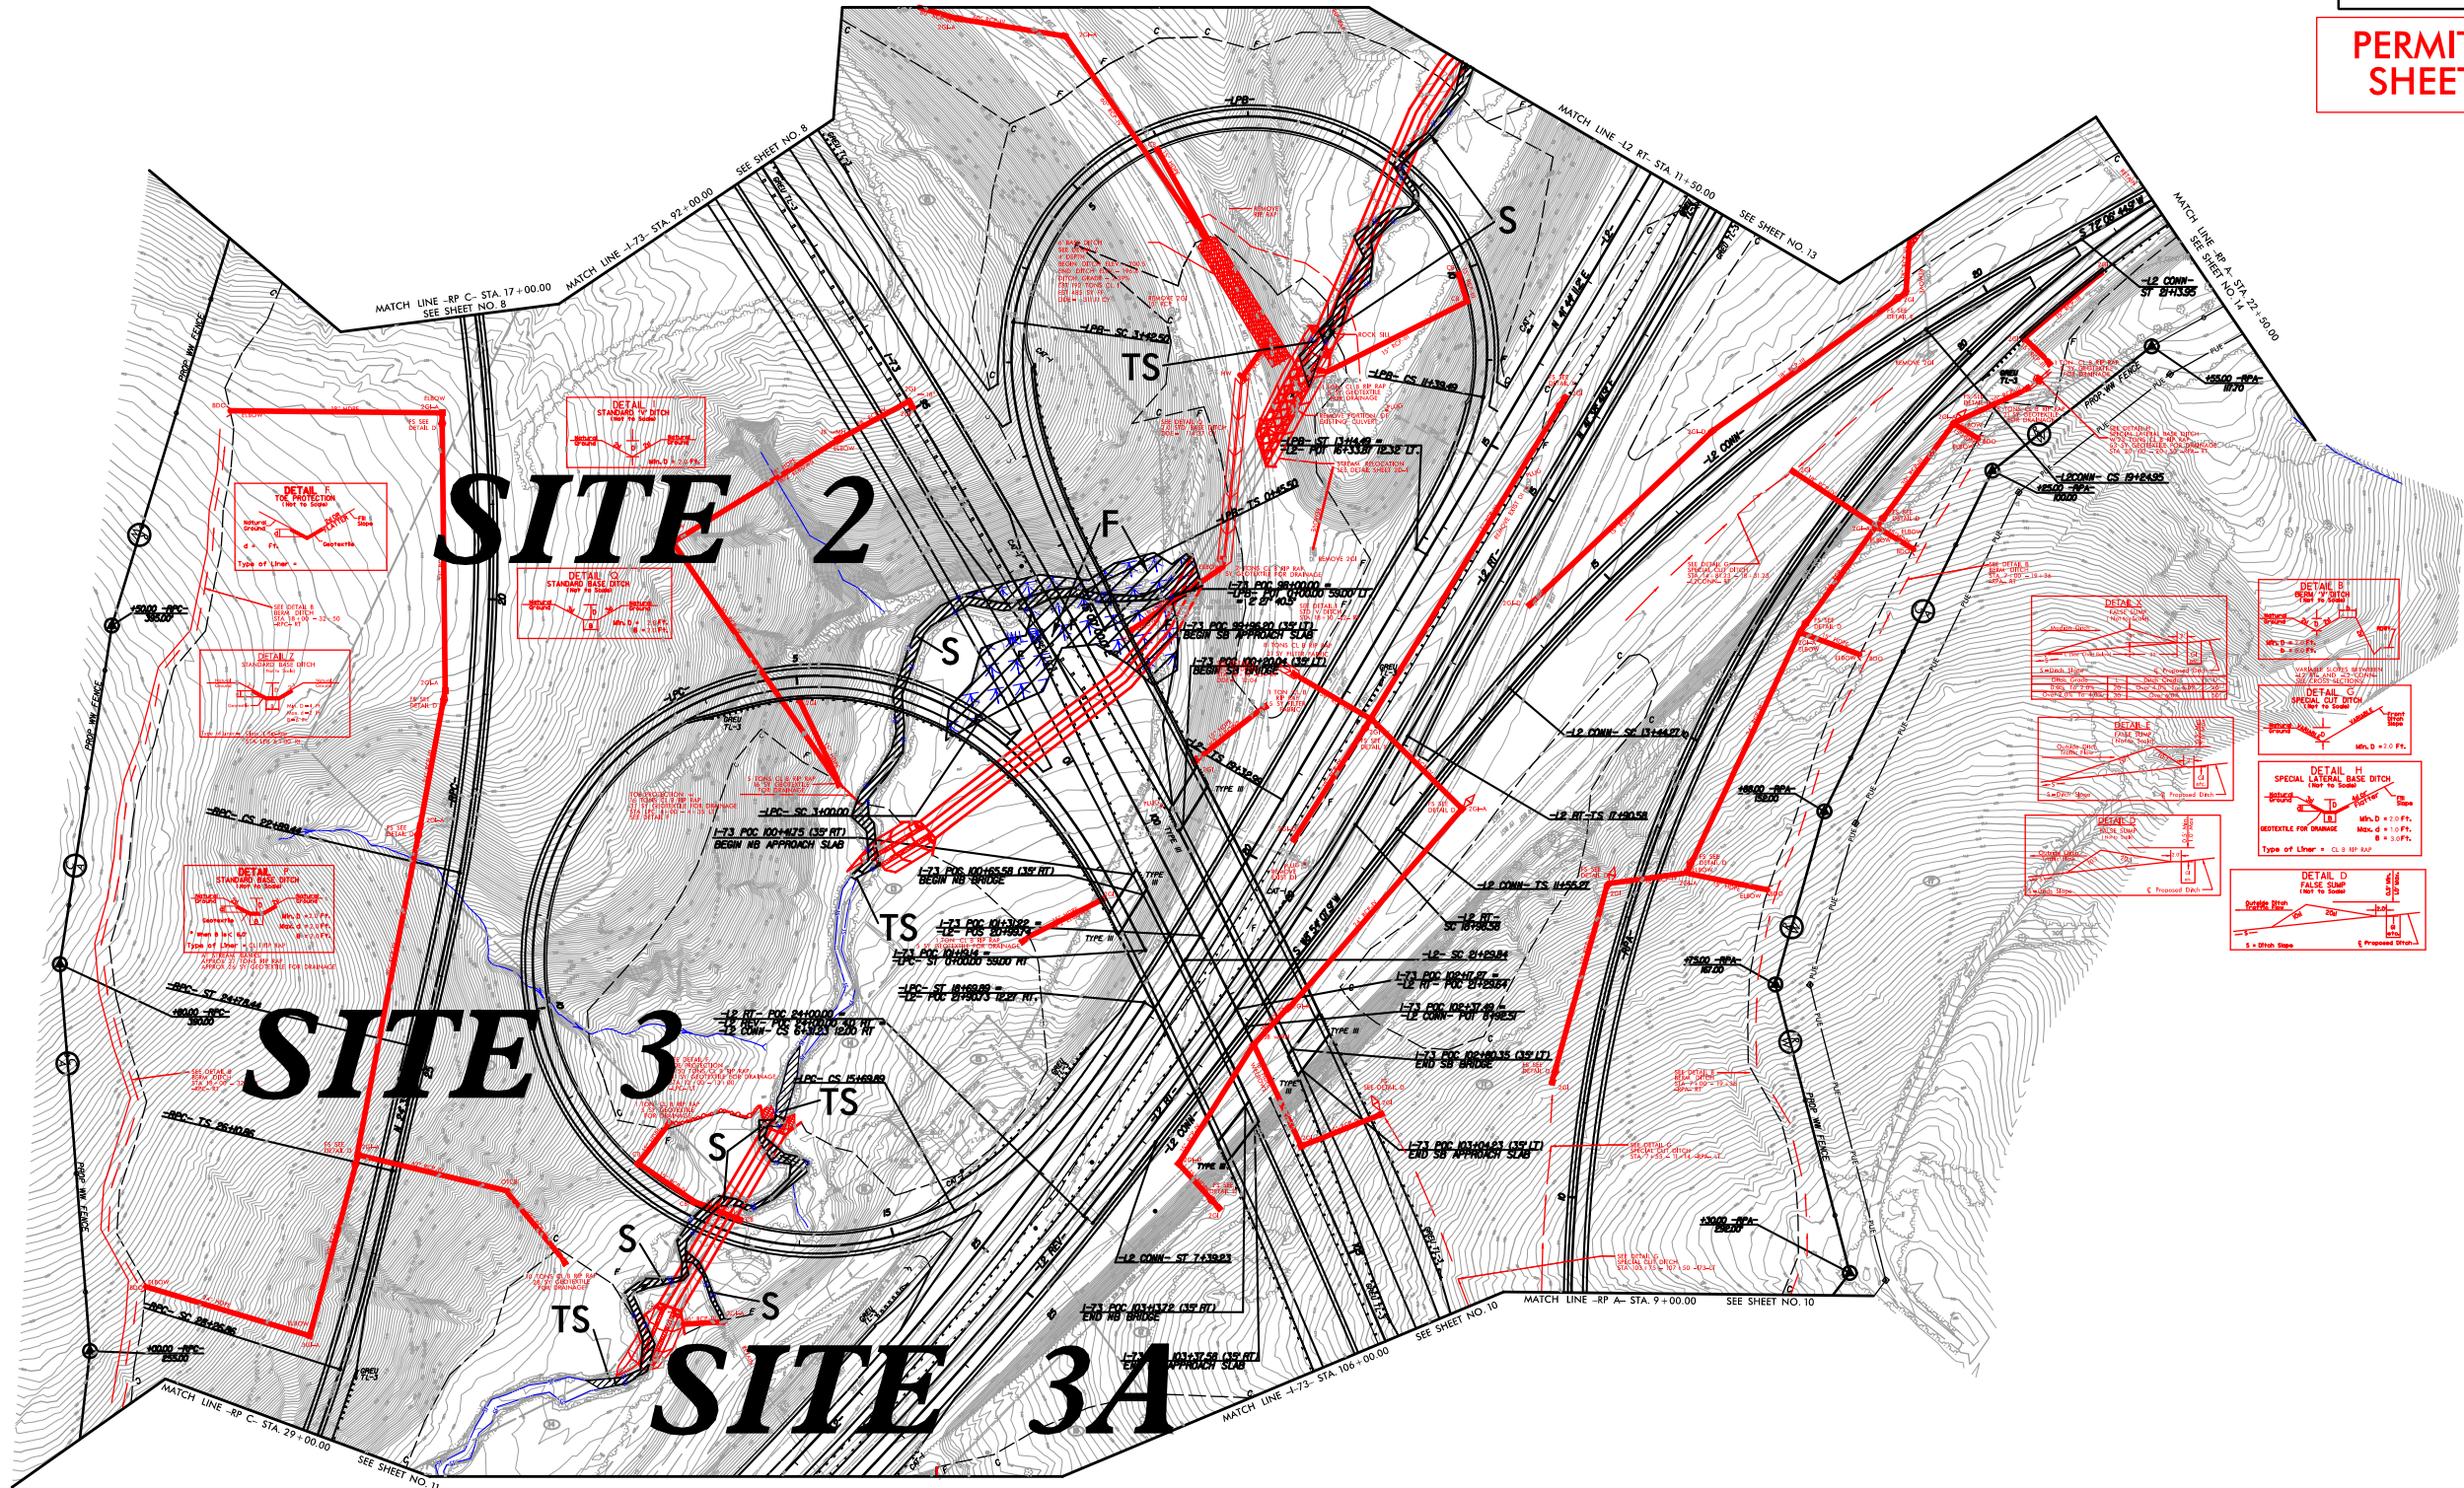


Denotes Impacts in Surface Water

Denotes Temporary Impacts in Surface Water

Denotes Fill in Wetland

REVISIONS

\\h47433.PM\Hydraulics\PERMITS\Environmental\Drawings\R3421A\Hyd\prj\psh09-enlargege site2-20150203.dgn

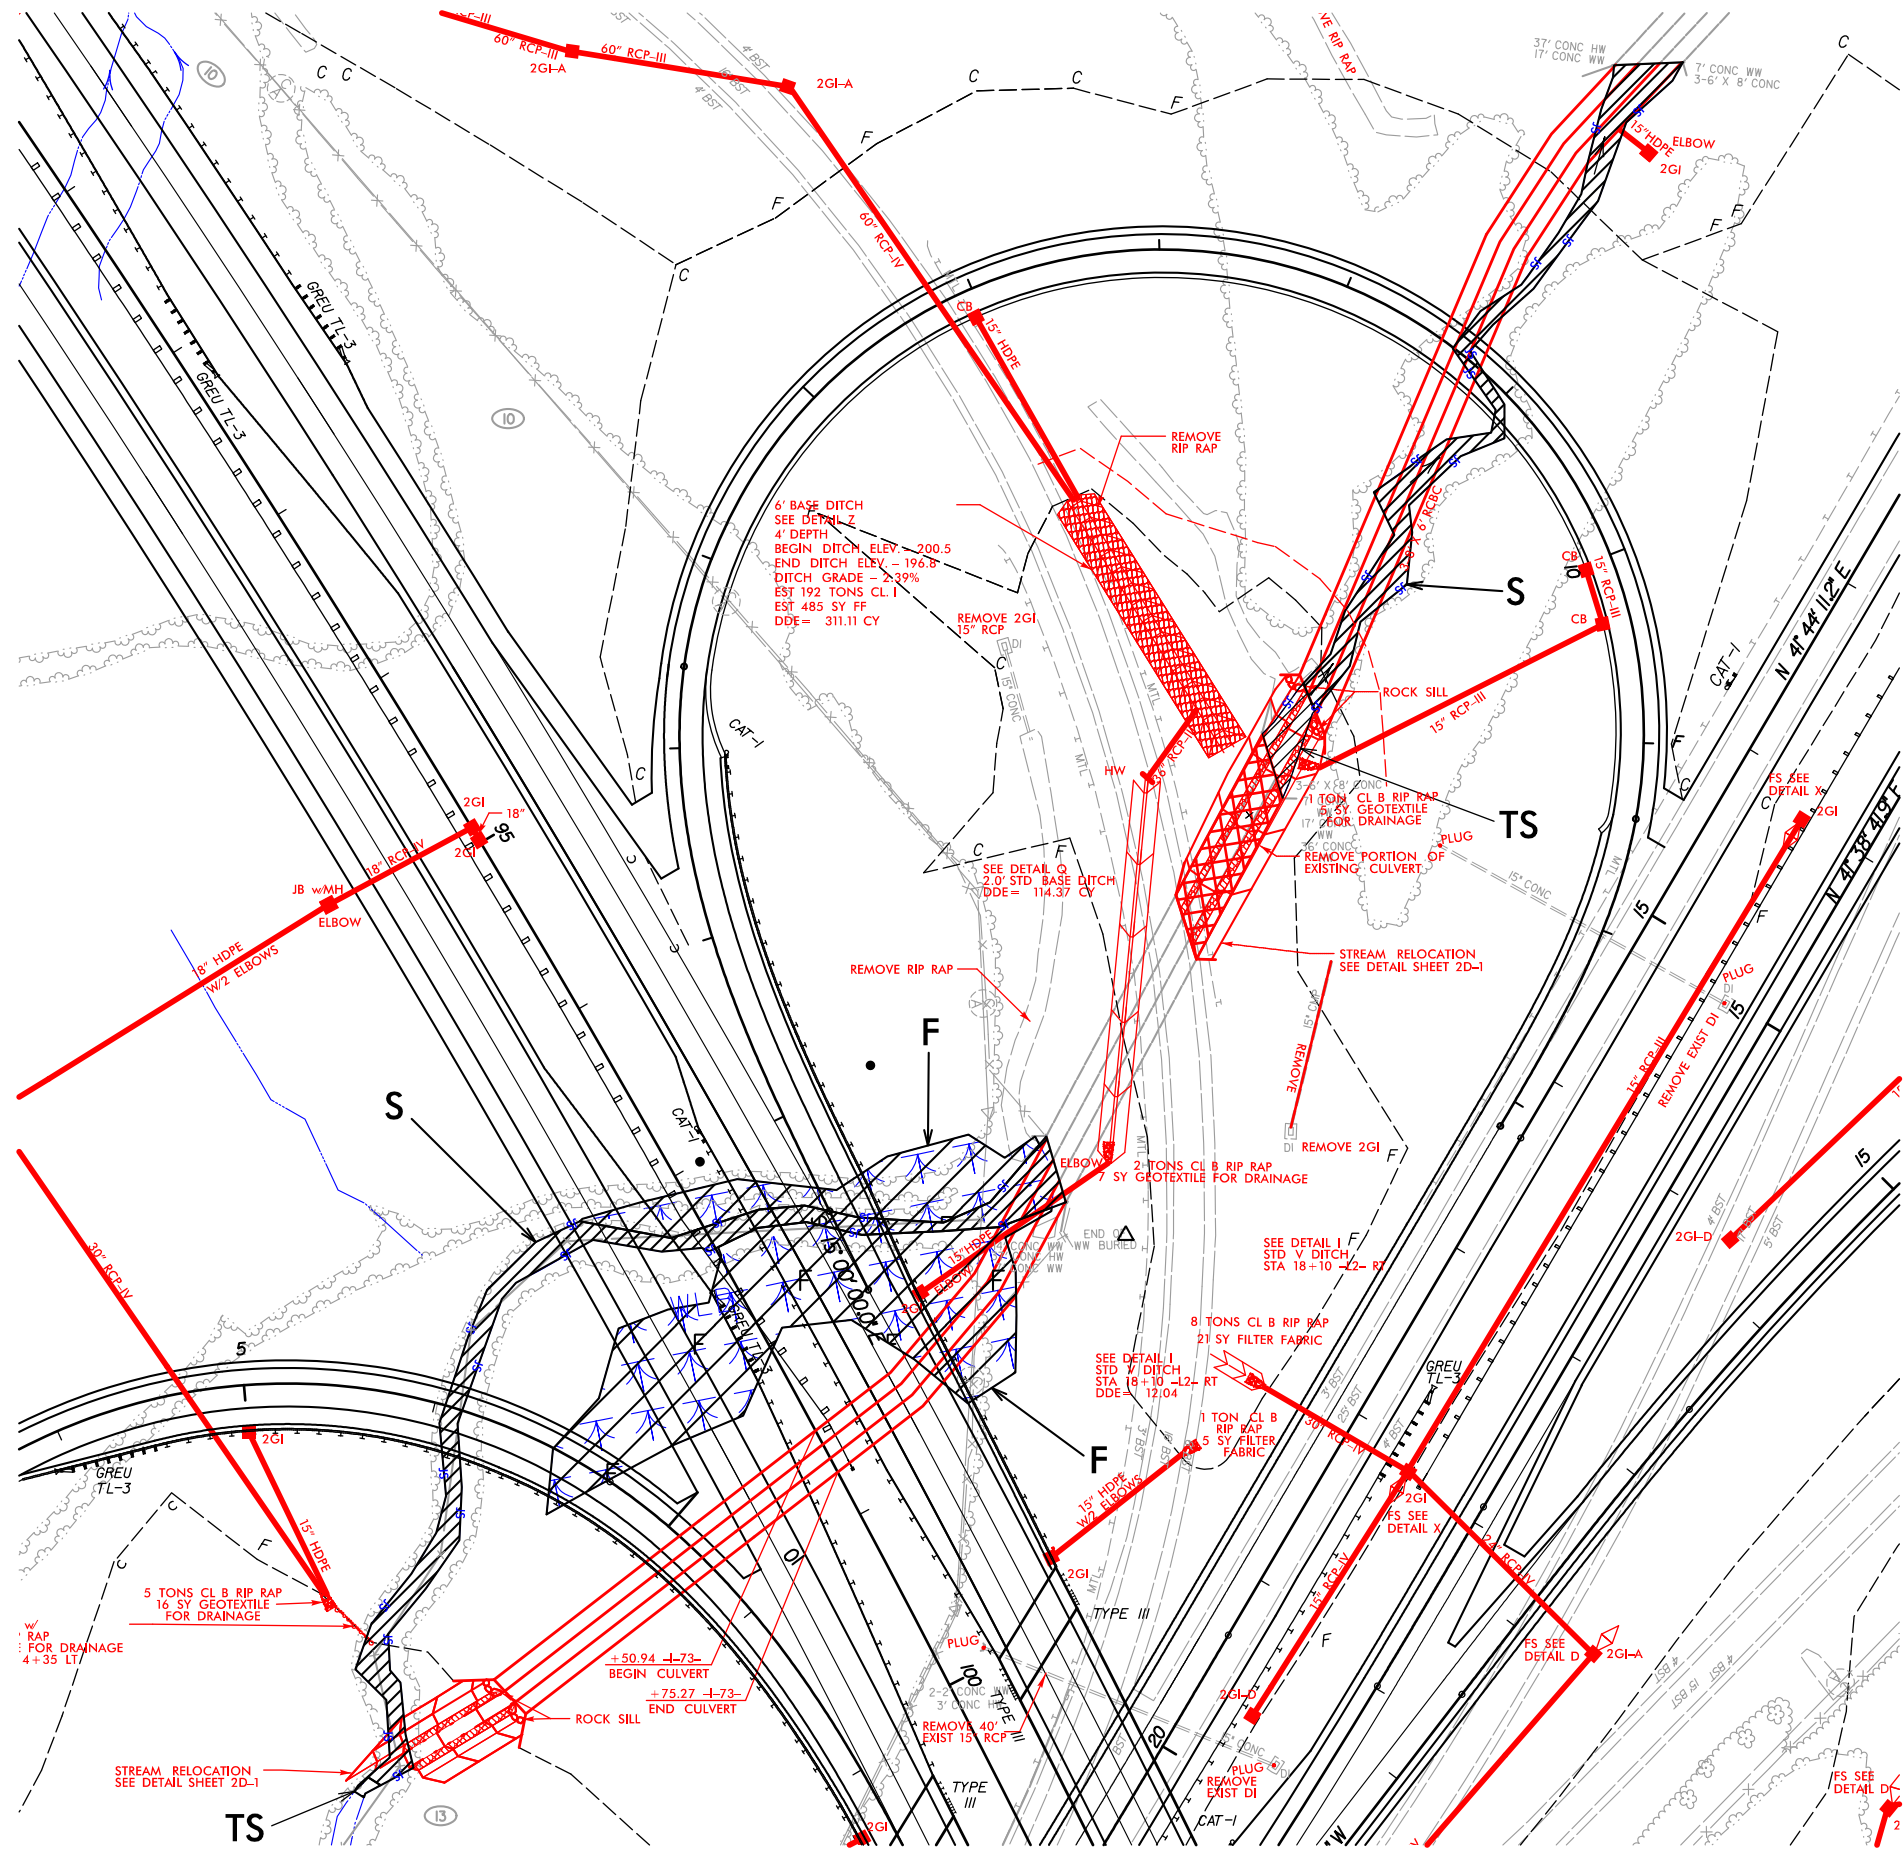

PROJECT REFERENCE NO.	SHEET NO.
R-3421A	9
R/W SHEET NO.	
ROADWAY DESIGN ENGINEER	HYDRAULICS ENGINEER
INCOMPLETE PLANS DO NOT USE FOR R/W ACQUISITION	
PRELIMINARY PLANS DO NOT USE FOR CONSTRUCTION	

PERMIT DRAWING
SHEET 8 OF 37



SITE 2 ENLARGEMENT



- DENOTES IMPACTS IN SURFACE WATER
- DENOTES TEMPORARY IMPACTS IN SURFACE WATER
- DENOTES FILL IN WETLAND

\$DATES\$
\$(USERNAME)\$
\$FILES\$


R:\Hydraulics\PERMITS_Environmental\Drawings\R3421A\R3421a_hyd_prm_psh09-enlarge site2-20150203_con.dgn

PROJECT REFERENCE NO.		SHEET NO.	
R-3421A		9	
R/W SHEET NO.			
ROADWAY DESIGN ENGINEER		HYDRAULICS ENGINEER	
INCOMPLETE PLANS DO NOT USE FOR R/W ACQUISITION PRELIMINARY PLANS DO NOT USE FOR CONSTRUCTION			

PERMIT DRAWING
SHEET 9 OF 37




SITE 2 ENLARGEMENT

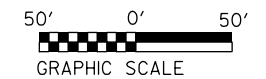

	DENOTES IMPACTS IN SURFACE WATER
	DENOTES TEMPORARY IMPACTS IN SURFACE WATER
	DENOTES FILL IN WETLAND

Revised 7/25/2019

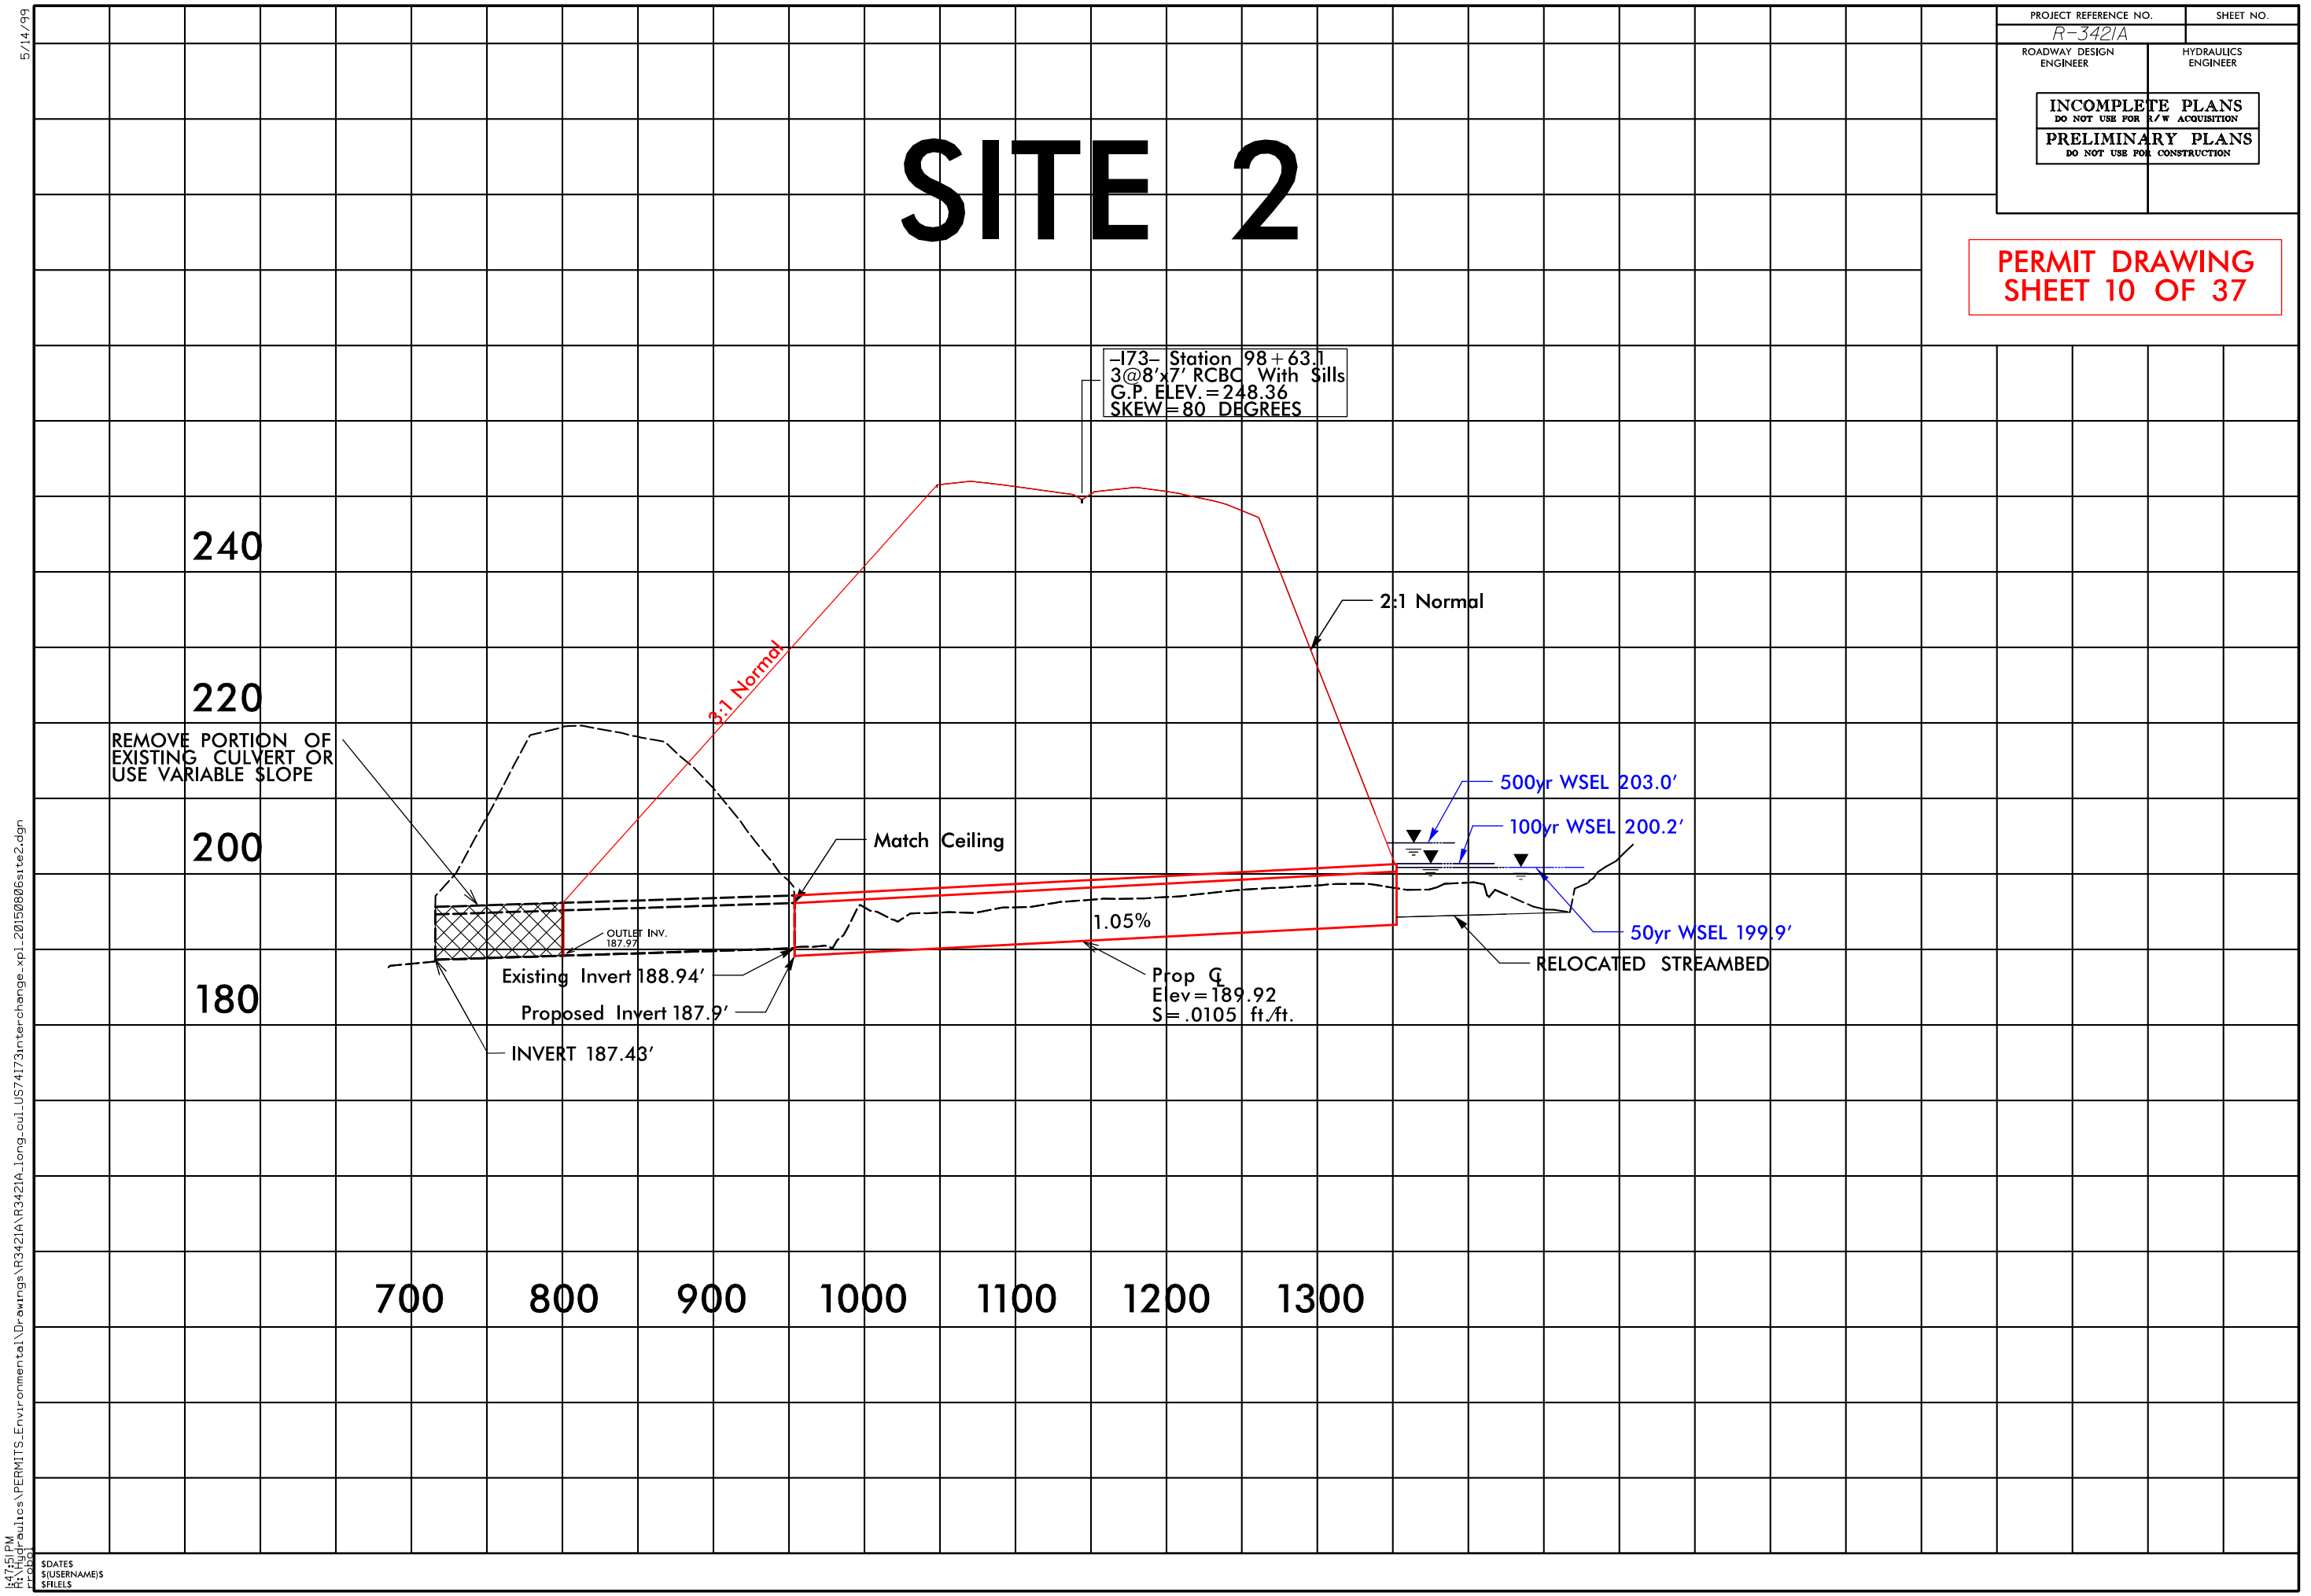

SHEET NO.

HYDRAULICS
ENGINEER

INCOMPLETE PLANS DO NOT USE FOR R/W ACQUISITION	
PRELIMINARY PLANS DO NOT USE FOR CONSTRUCTION	

**PERMIT DRAWING
SHEET 11 OF 37**

SITE 2

0	100	200	300	400	500	600	700
---	-----	-----	-----	-----	-----	-----	-----

240

220

200

180

-LPB-	8 + 68.7	
3@8'x7' RCBC	with Sills	
G.P. ELEV. =	232.32	
SKEW=74 Deg.		



100 YR WS
ELEV-193.5'

50 YR WS
ELEV-192.9'

-US 74 BYP-

15" RCP
INV. 184.0

~~1.27%~~

Proposed G
Elev. = 183.01
S = .0127 FT/FT.

Exist. 3	@8'x6'	RCBC
----------	--------	------

Existing	
Invert 181.70	

Invert 180.27'

```
$DATES
$(USERNAME)$
$FILELS
```

5/14/99

4:47:53 PM
R:\Hobart\Engineering\PERMITS-Environmental\Drawings\R3421A\R3421A-long.cul-ipbus74-xpl-20150806site2.dgn

Revised 7/25/2019

Revised 7/25/2019


8/17/99

REVISIONS

148:00 PM
R:\Hydraulics\PERMITS\Environmental\Drawings\R3421A\Hyd-prm-psh09_enlarge site3.20150203.dgn


\$DATES
\$(USERNAME)\$
\$FILEL\$

SITE 3 ENLARGEMENT

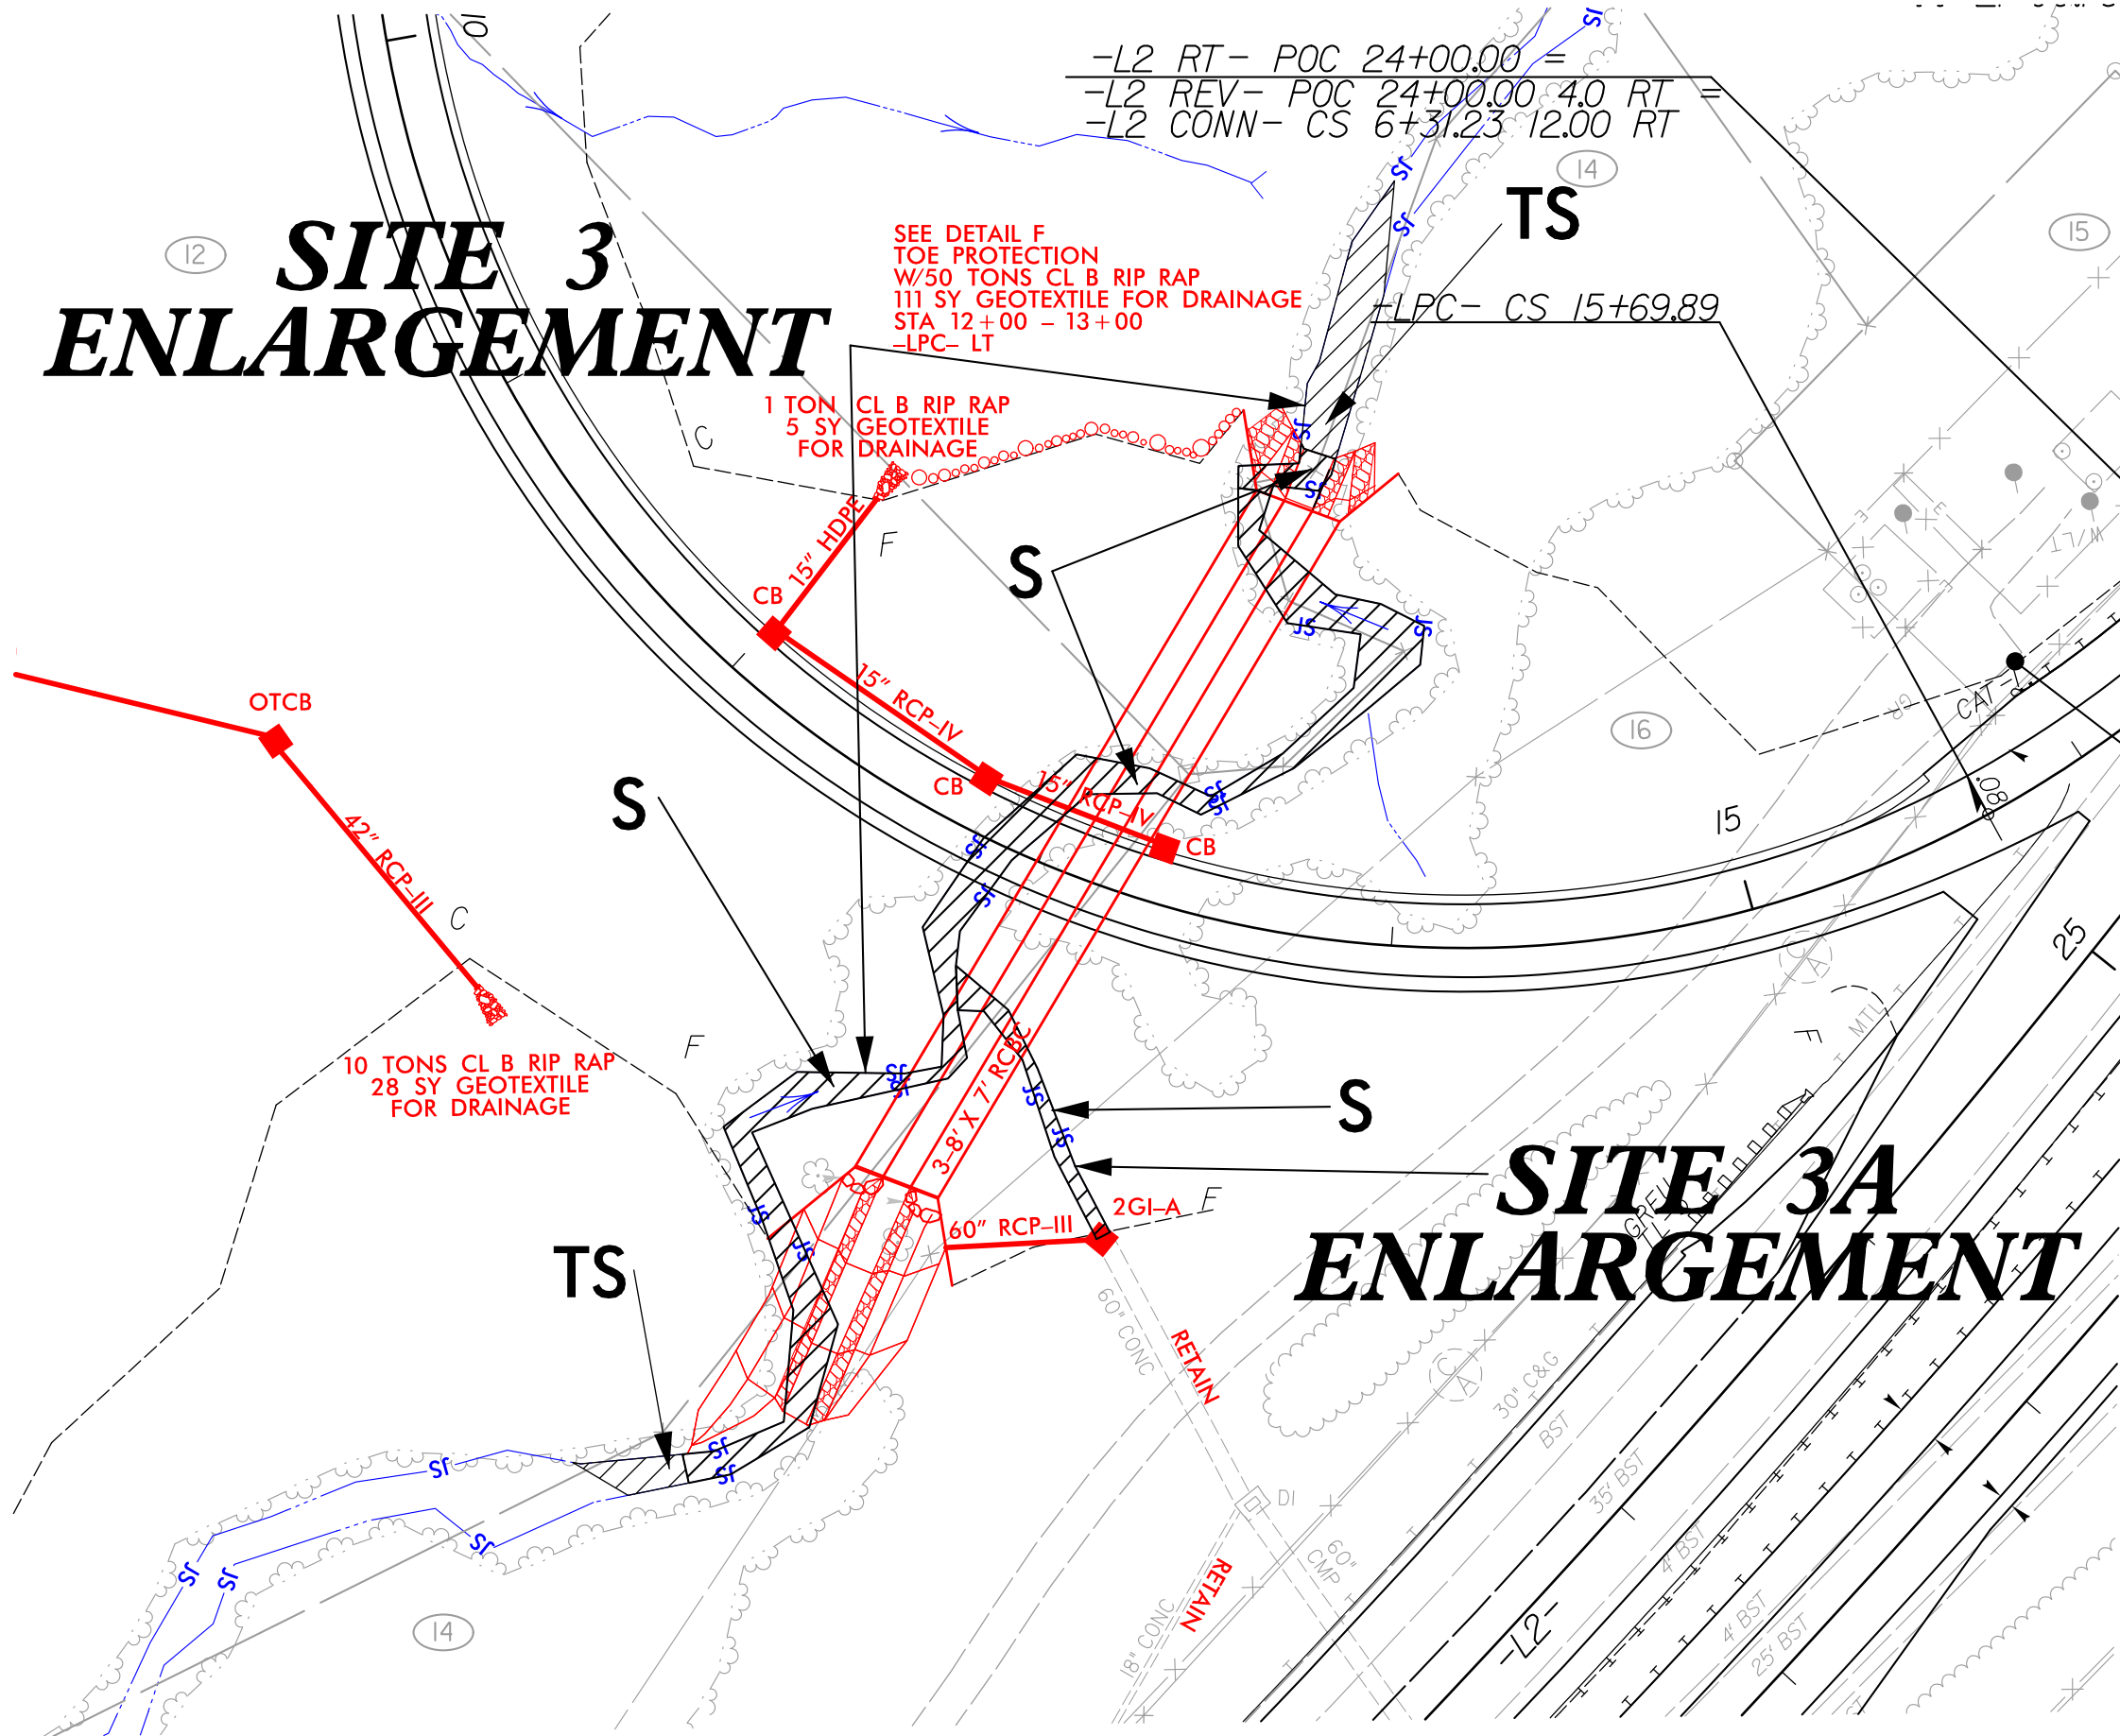

PROJECT REFERENCE NO.	SHEET NO.
R-3421A	9
R/W SHEET NO.	
ROADWAY DESIGN ENGINEER	HYDRAULICS ENGINEER
INCOMPLETE PLANS DO NOT USE FOR R/W ACQUISITION	
PRELIMINARY PLANS DO NOT USE FOR CONSTRUCTION	

PERMIT DRAWING
SHEET 12 OF 37

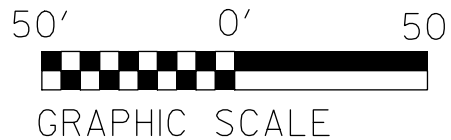

DENOTES IMPACTS IN
SURFACE WATER



DENOTES TEMPORARY
IMPACTS IN SURFACE WATER


Revised 7/25/2019

8/17/99

REVISIONS

I:\4804 PM
R:\Hyd-aulics\PERMITS\Environmental\Drawings\R3421A\3421a-hyd-prm-psh09_enlarge site3.20150203_con.dgn

\$DATES
\$(USERNAME)\$
\$FILEL\$

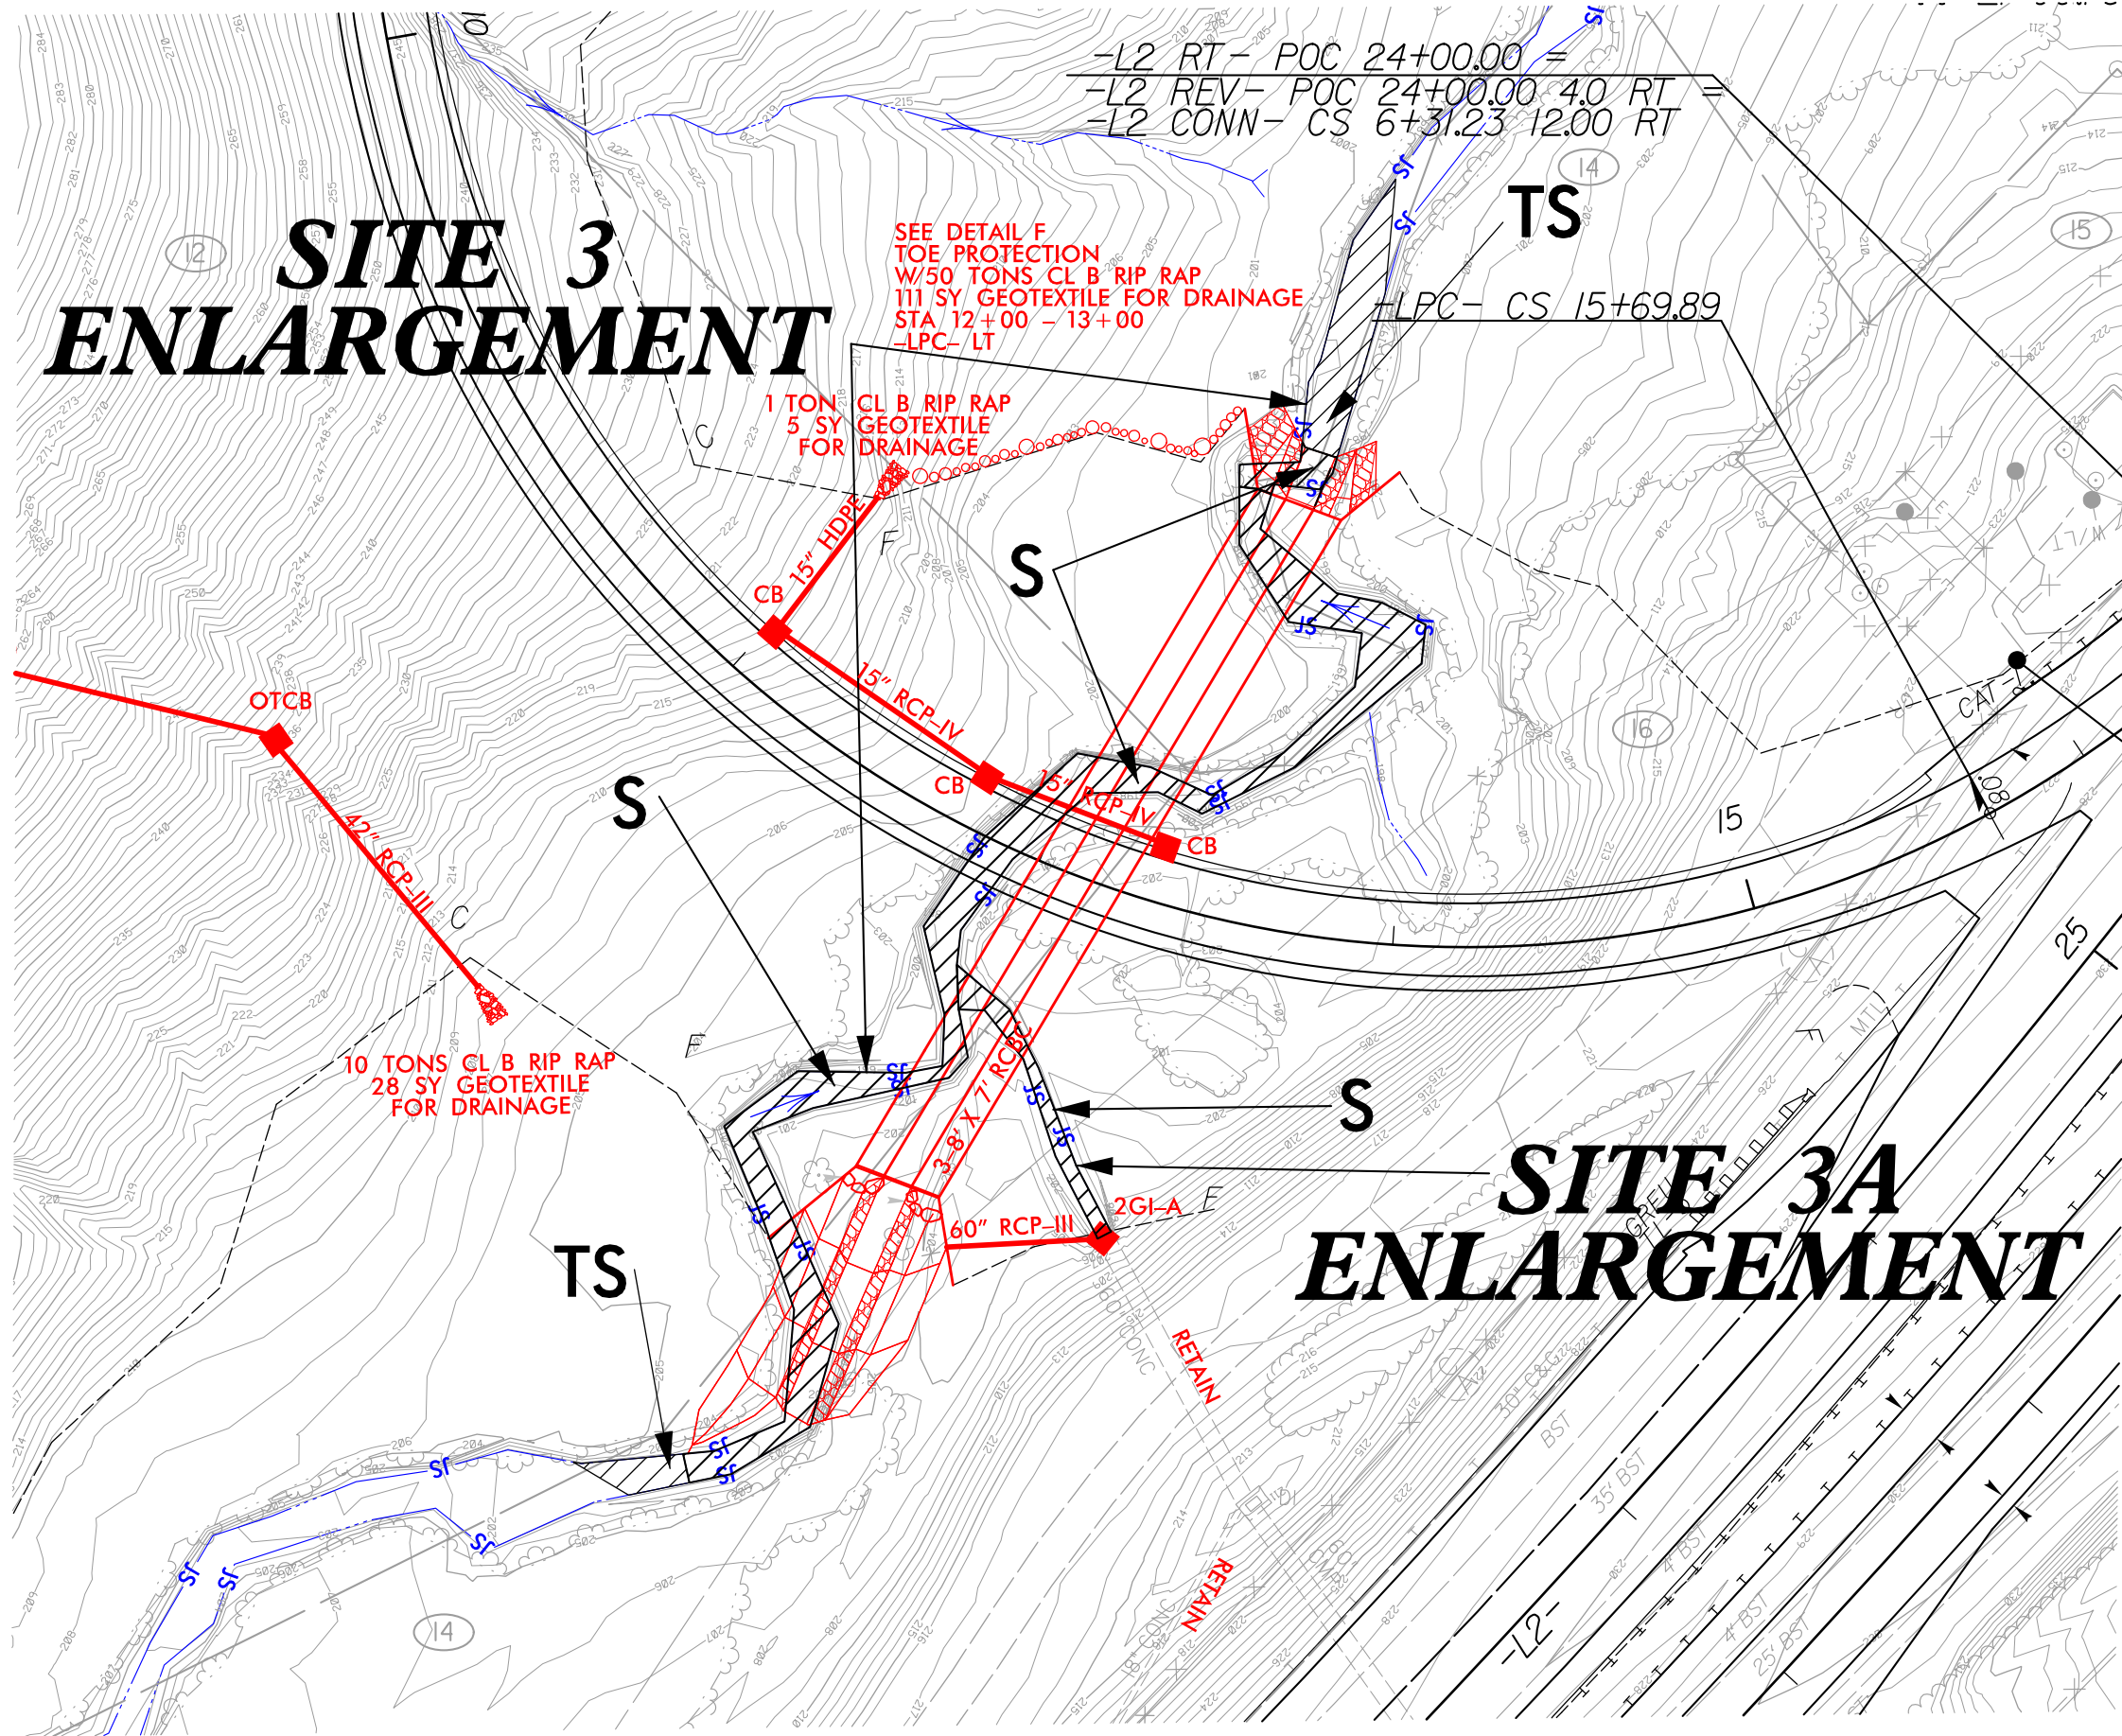

PROJECT REFERENCE NO.	SHEET NO.
R-3421A	9
R/W SHEET NO.	
ROADWAY DESIGN ENGINEER	HYDRAULICS ENGINEER
INCOMPLETE PLANS DO NOT USE FOR R/W ACQUISITION	
PRELIMINARY PLANS DO NOT USE FOR CONSTRUCTION	

PERMIT DRAWING
SHEET 13 OF 37



DENOTES IMPACTS IN
SURFACE WATER




DENOTES TEMPORARY
IMPACTS IN SURFACE WATER

Revised 7/25/2019

5/14/99
H:\Hydro\Drawings\PERMITS\Environmental\Drawings\3421A\3421A-LoopC-cul_xpl_20150806site3.dgn
14807 PM
R. J. H. P.


SITE 3

PROJECT REFERENCE NO. <i>R-3421A</i>		SHEET NO.	
ROADWAY DESIGN ENGINEER		HYDRAULICS ENGINEER	
INCOMPLETE PLANS DO NOT USE FOR R/W ACQUISITION PRELIMINARY PLANS DO NOT USE FOR CONSTRUCTION			
PERMIT DRAWING SHEET 14 OF 37			

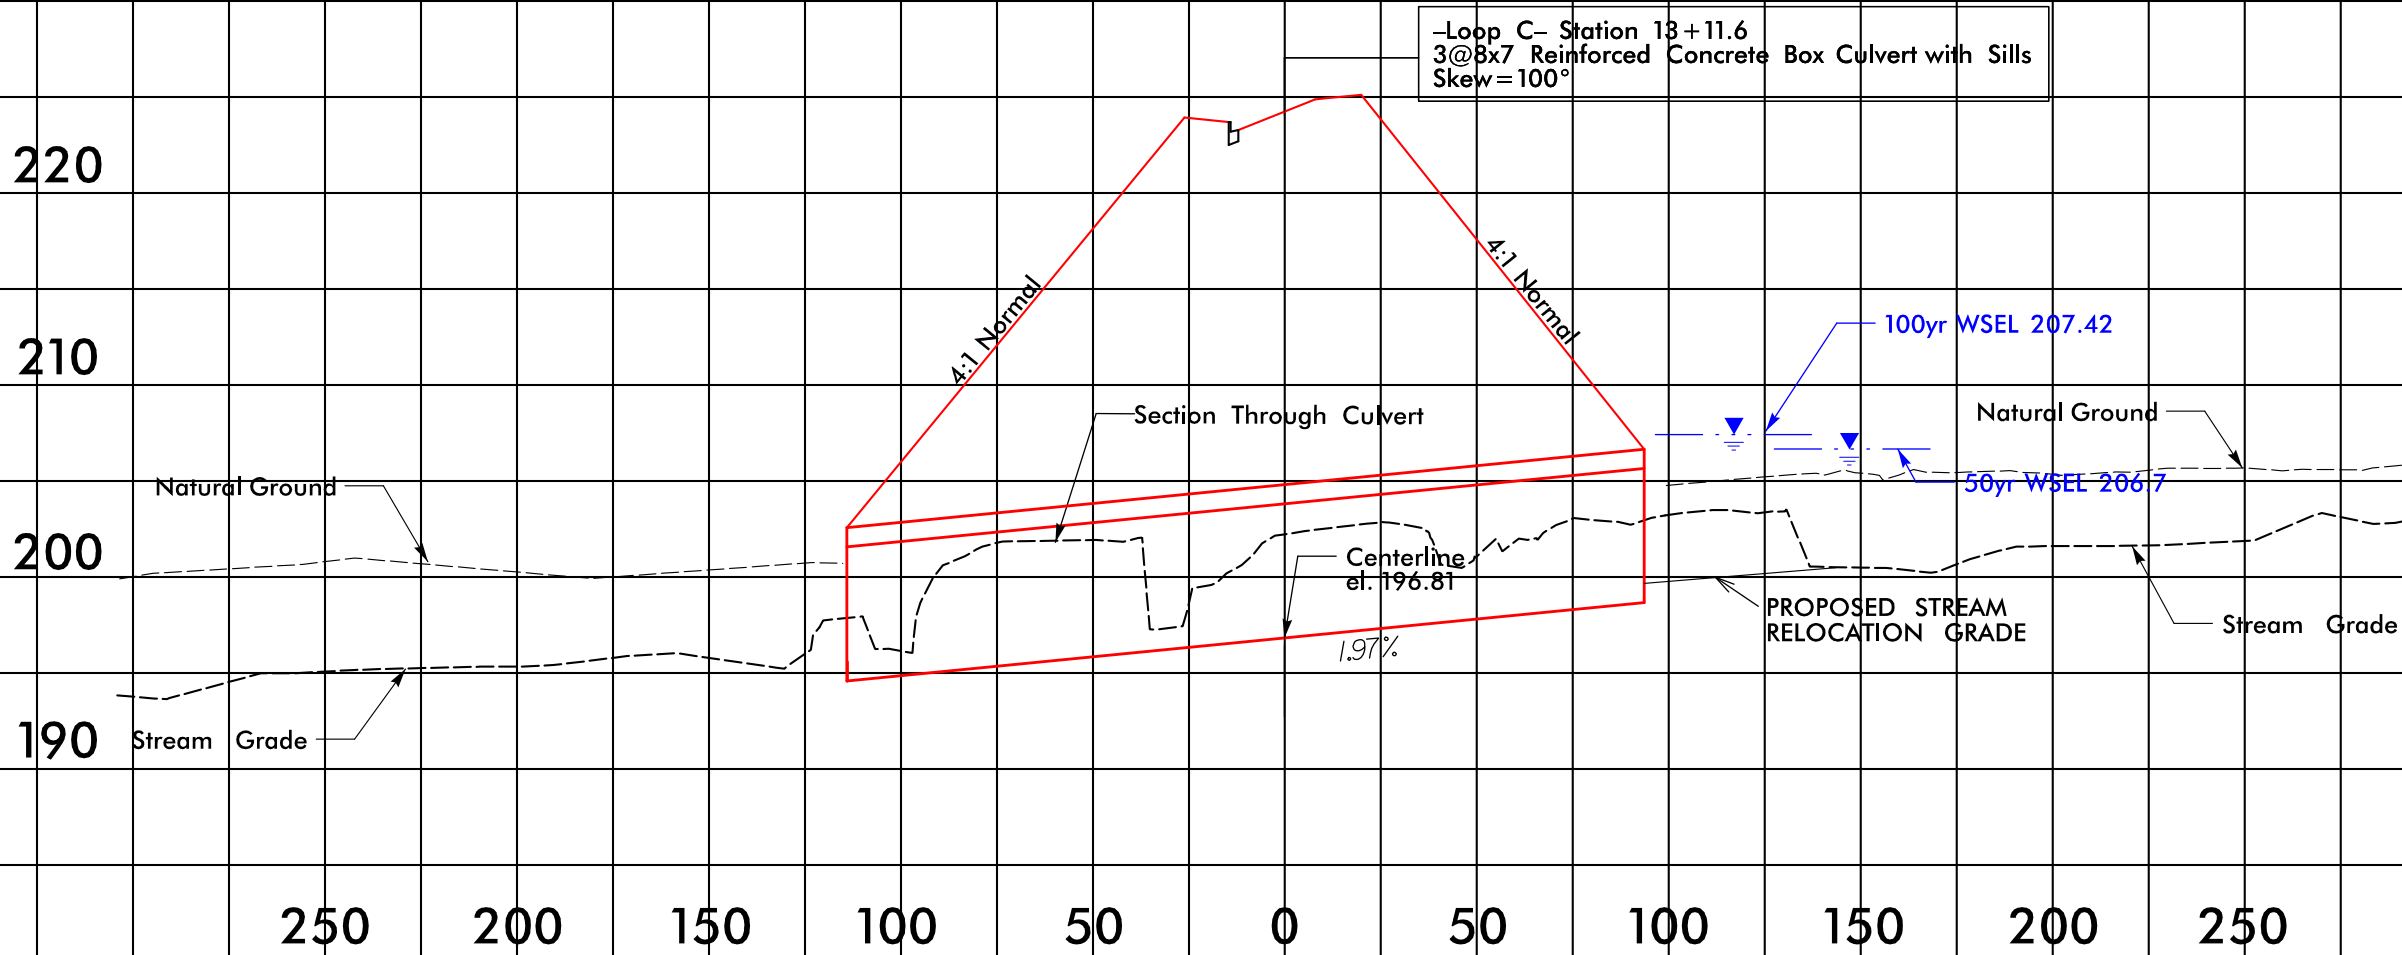

R:\Hydraulics\PERMITS_Environmental\Drawings\R3421A\r3421a_hyd-prm_psh10_20150203.dgn

PERMIT DRAWING
SHEET 15 OF 37

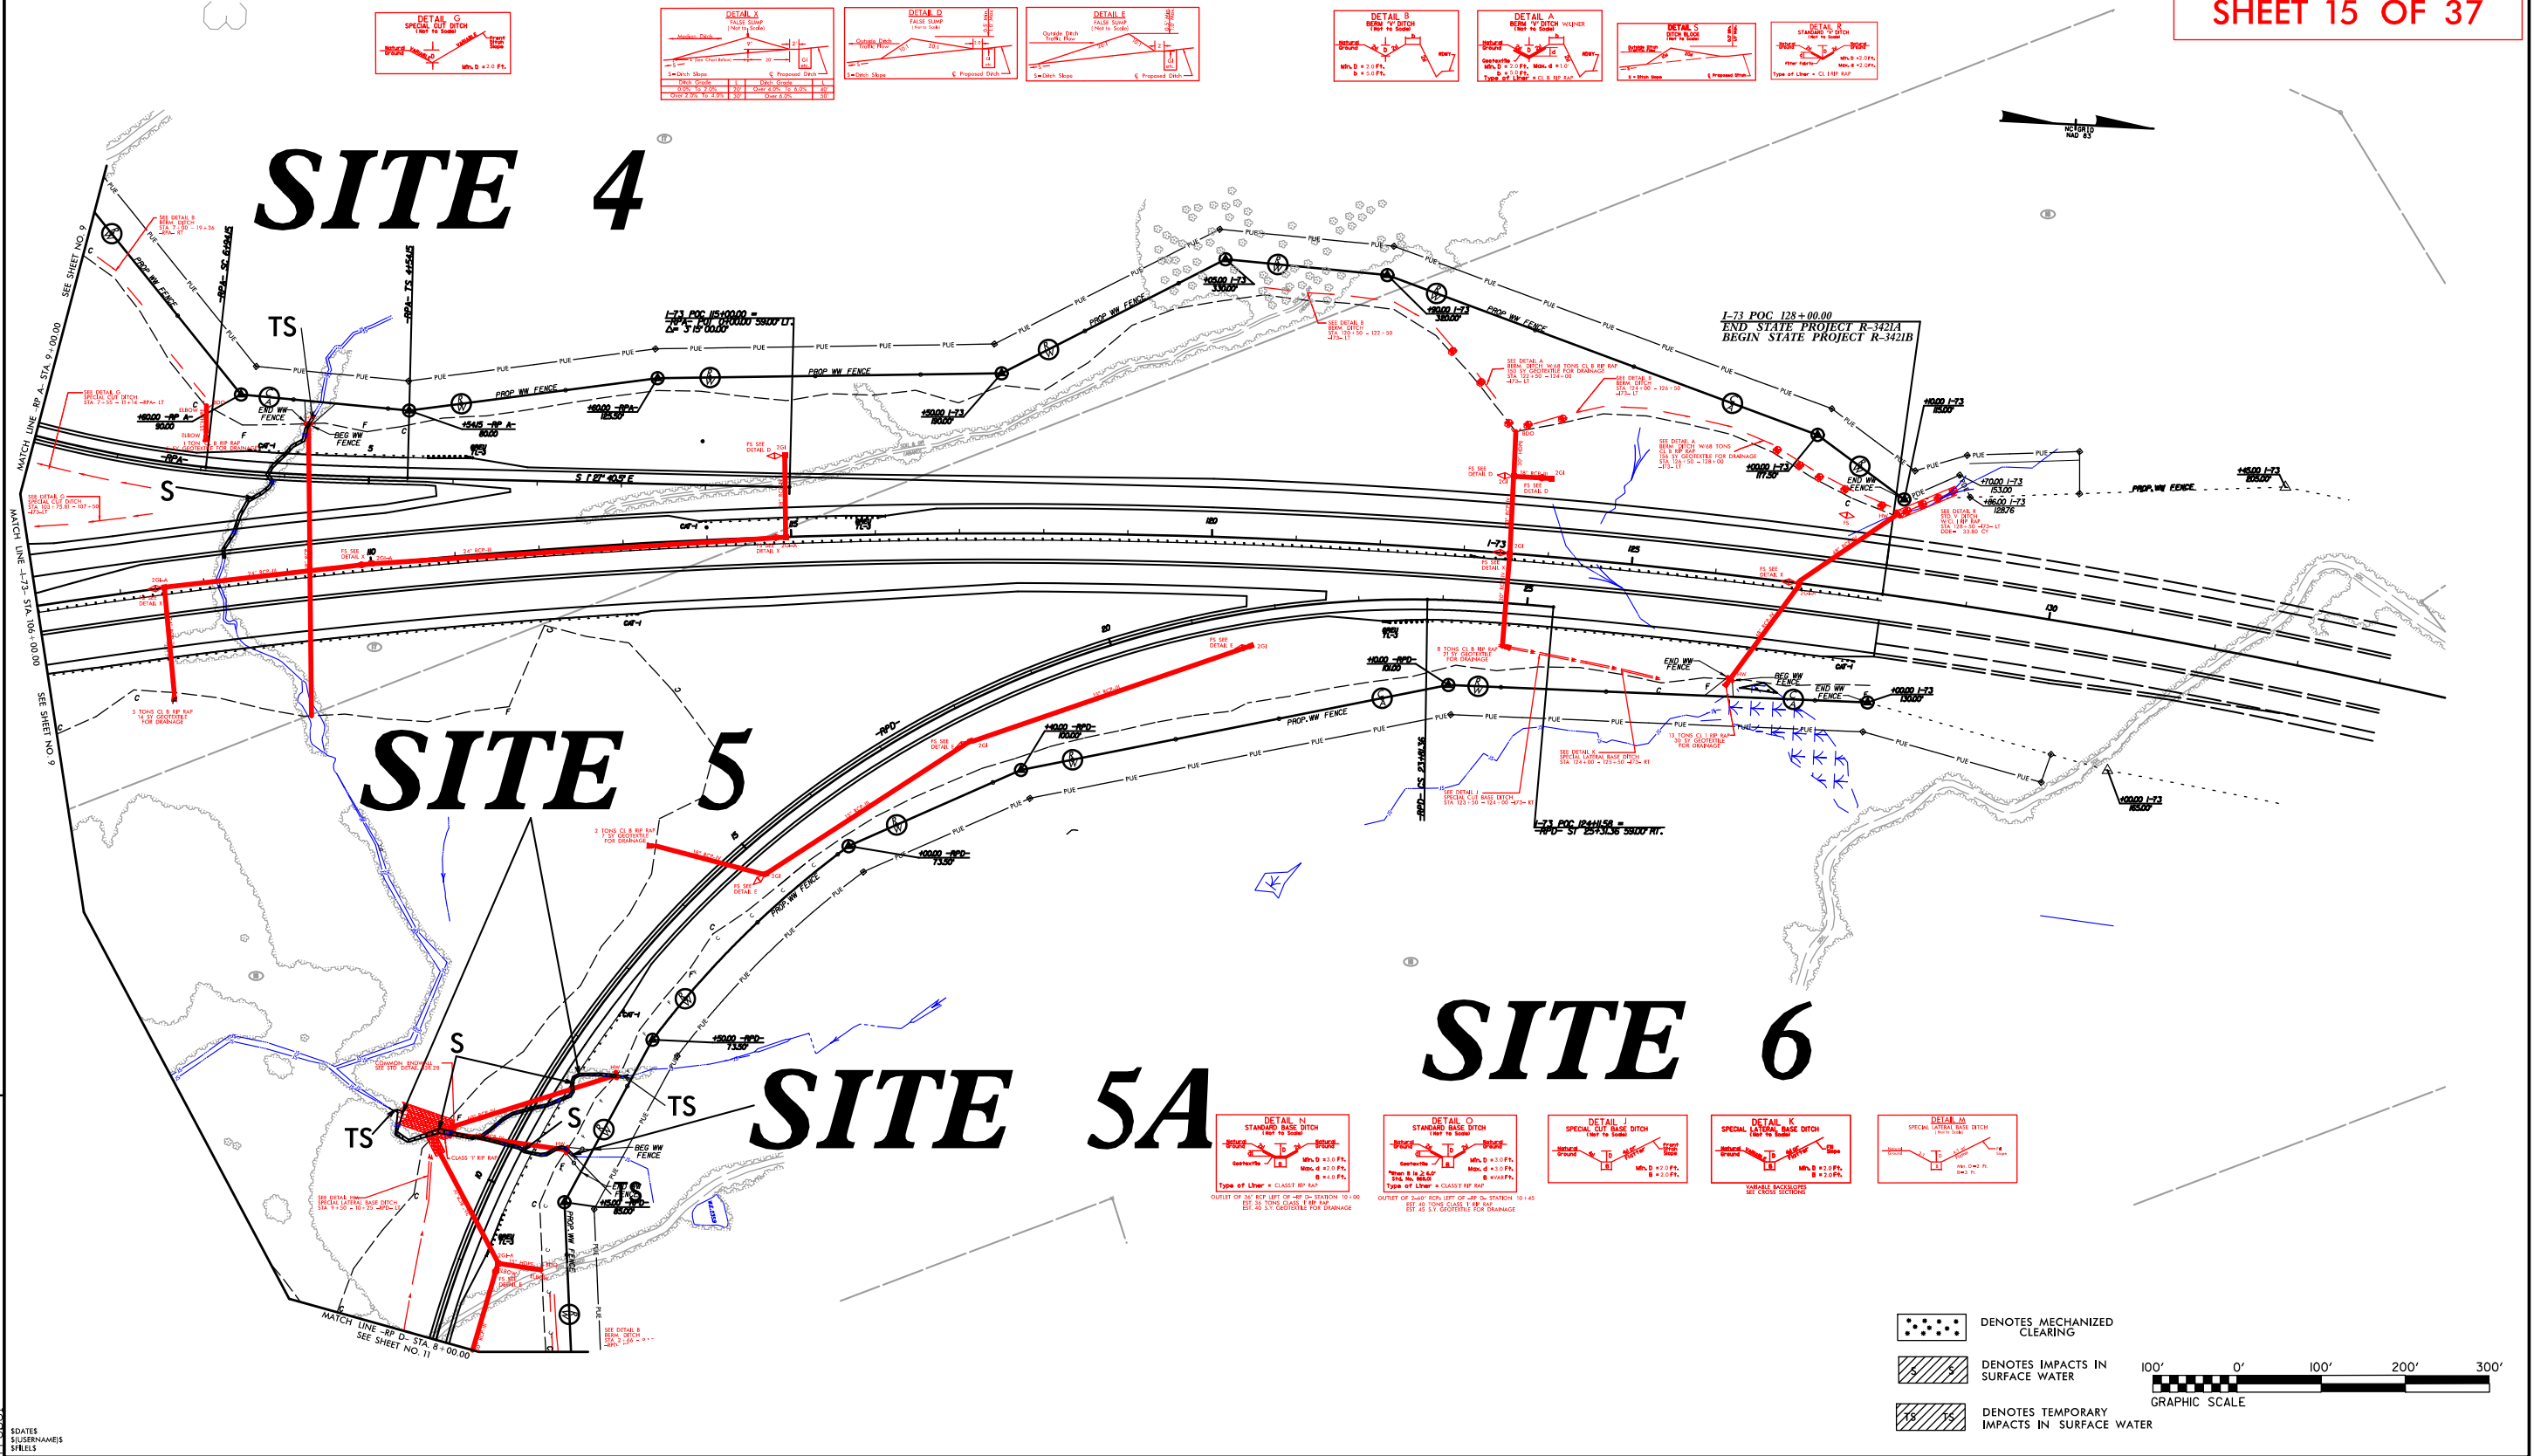

Revised 7/25/2019

8/17/99


REVISIONS

148:19 PM R:\Hydraulics\PERMITS\Environmental\Drawings\R3421A\hyd_prm_psh10_20150203_con.dgn

SDATES
SUSSENAEIS
SUSSENAEIS

PROJECT REFERENCE NO.	SHEET NO.
R-3421A	10
R/W SHEET NO.	
ROADWAY DESIGN ENGINEER	HYDRAULICS ENGINEER
INCOMPLETE PLANS DO NOT USE FOR R/W ACQUISITION	
PRELIMINARY PLANS DO NOT USE FOR CONSTRUCTION	

PERMIT DRAWING
SHEET 16 OF 37

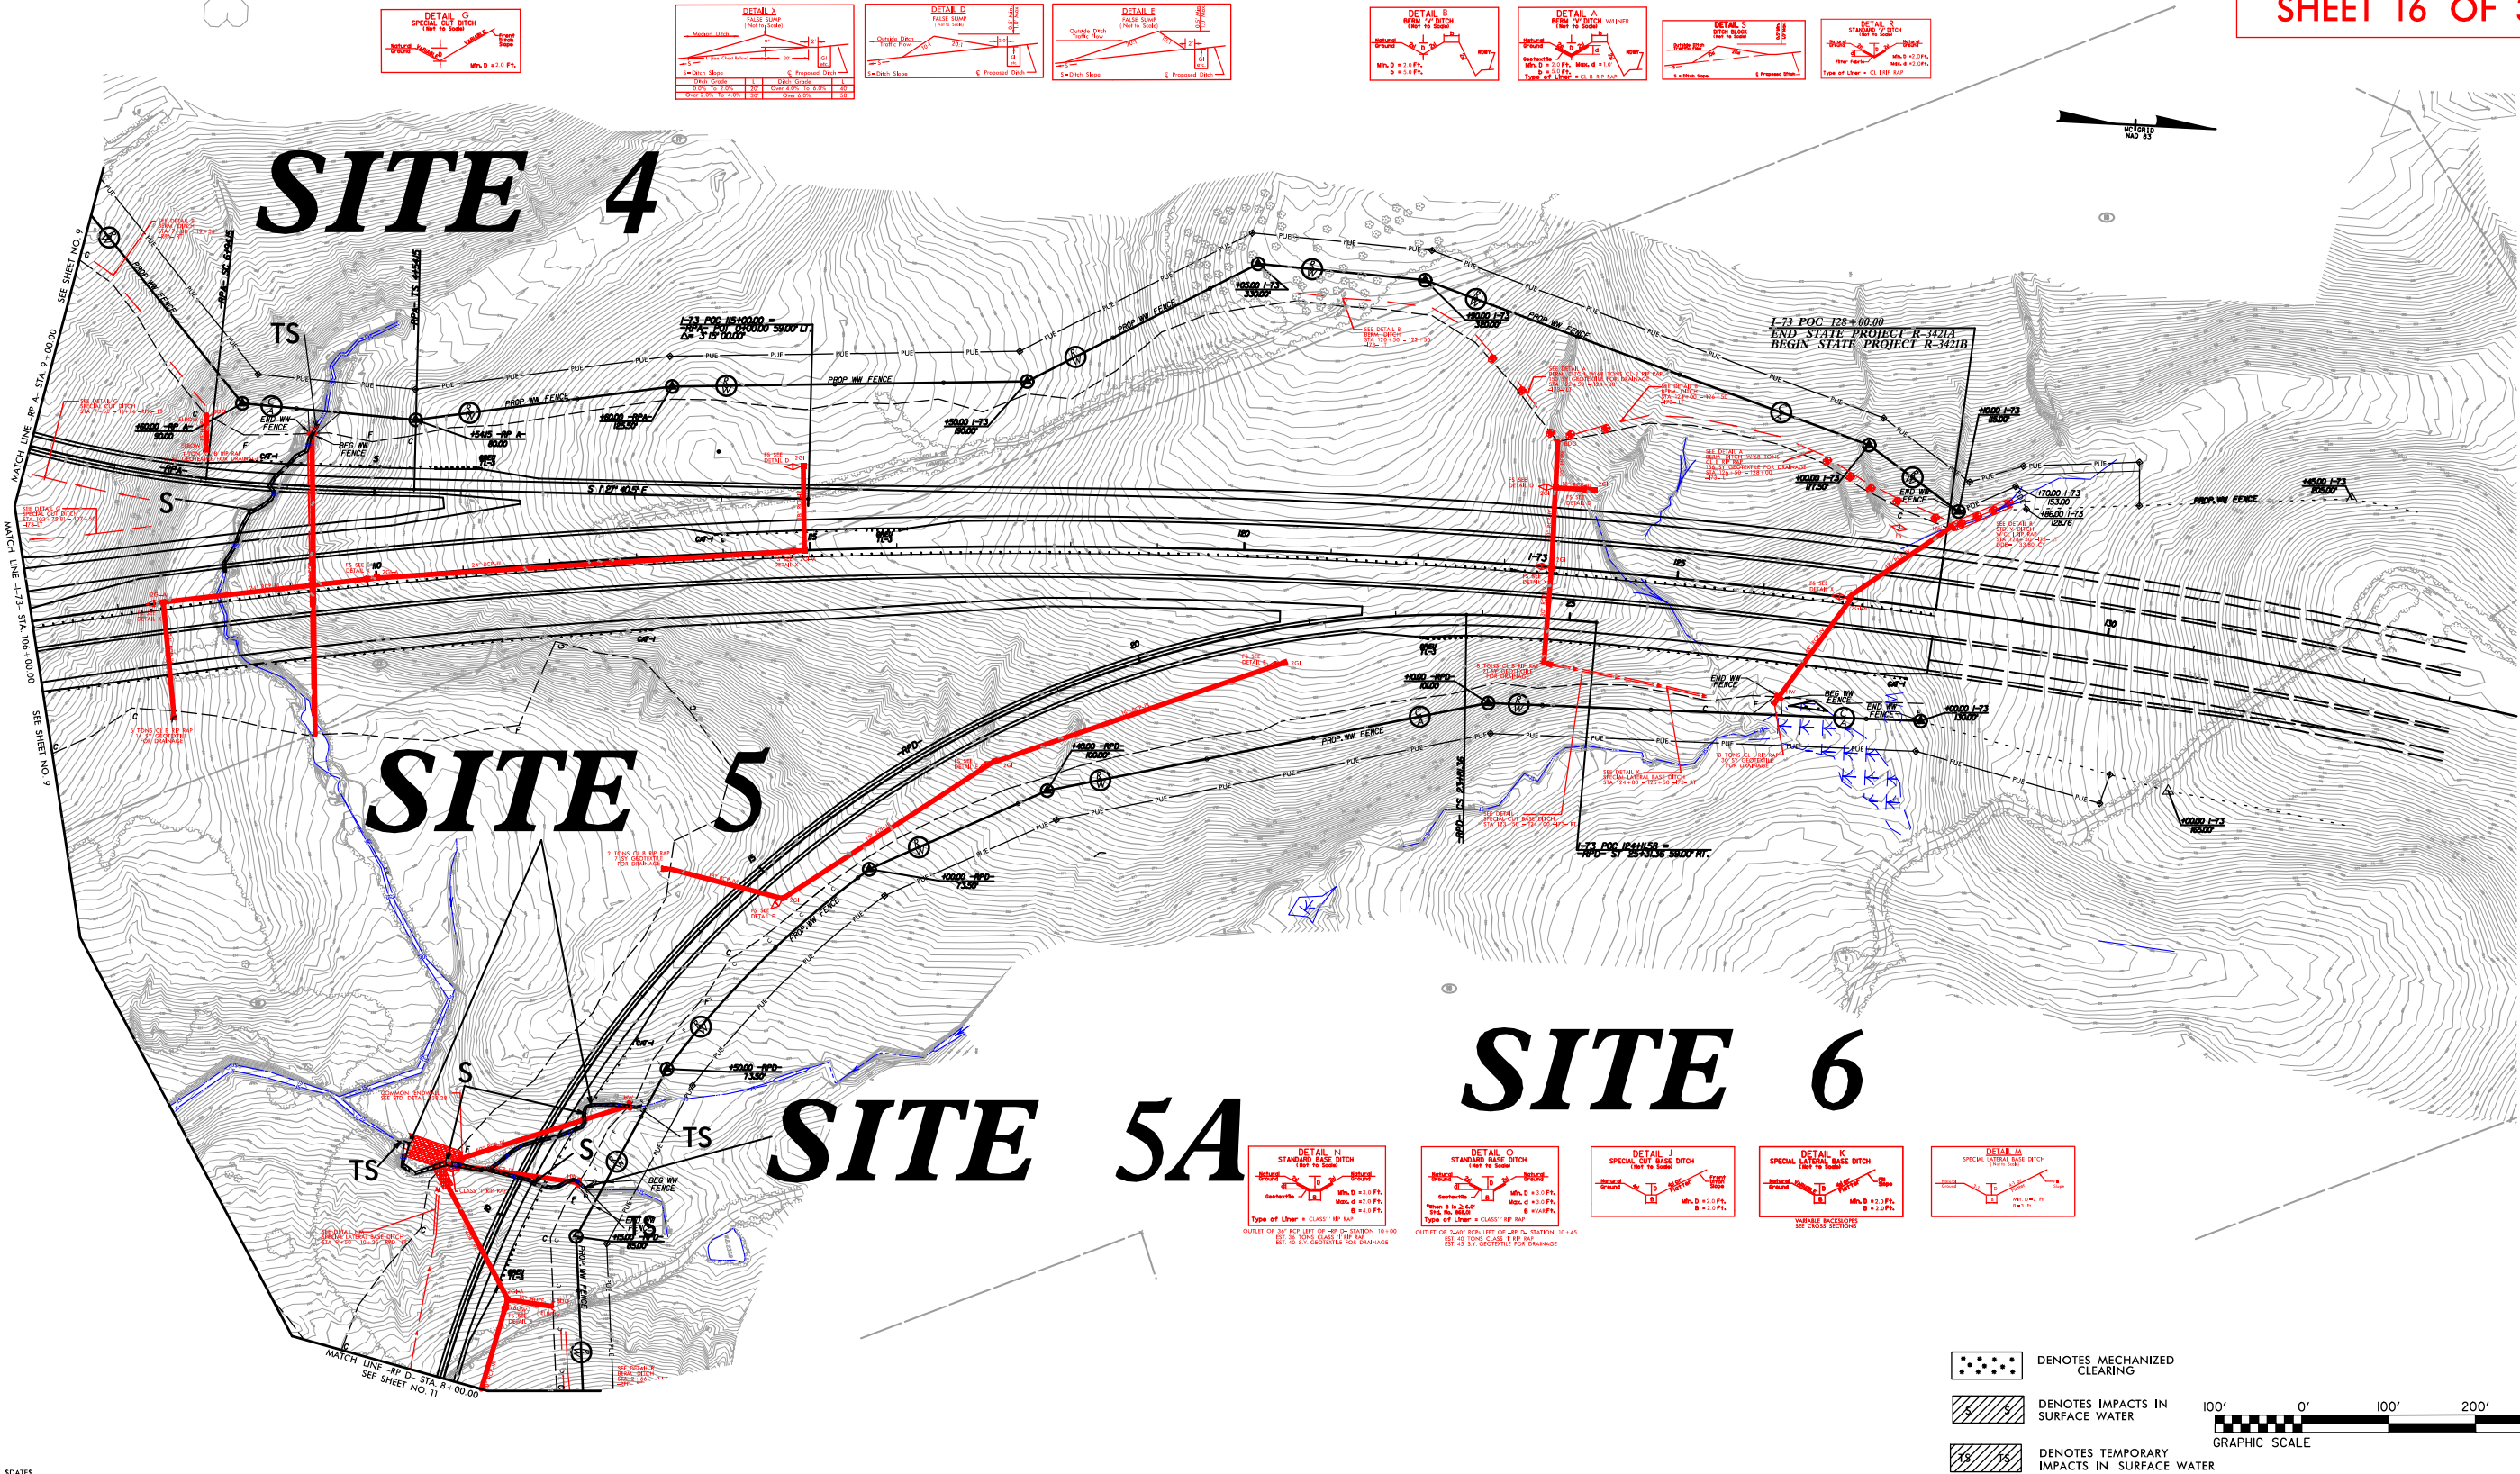

PERMIT DRAWING
SHEET 17 OF 37

NC GRID
NAD 83

A rectangular region with diagonal hatching (lines from top-left to bottom-right). Inside the rectangle, there are two 'S' labels, one on the left and one on the right.

TS TS

DENOTES TEMPORARY
IMPACTS IN SURFACE WATER

5 TONS CL B RIP RAP
14 SY GEOTEXTILE
FOR DRAINAGE

```
$DATE$
$(USERNAME)$
$FILE$
```

48:23 PM
C:\PERMITS\Environmental Drawings\R342\A\~342\o_hyd_prm_pshl0_elarge_ssta4_20150624.dgn

REVISIONS

8/17/99


Revised 7/25/2019

Revised 7/25/2019

8/17/99

REVISIONS

I:\4827 PM
R:\Hydra\lics\PERMITS\Environmental\Drawings\R3421A\Hyd\prj\psh10_elarge_site4_20150624_con.dgn


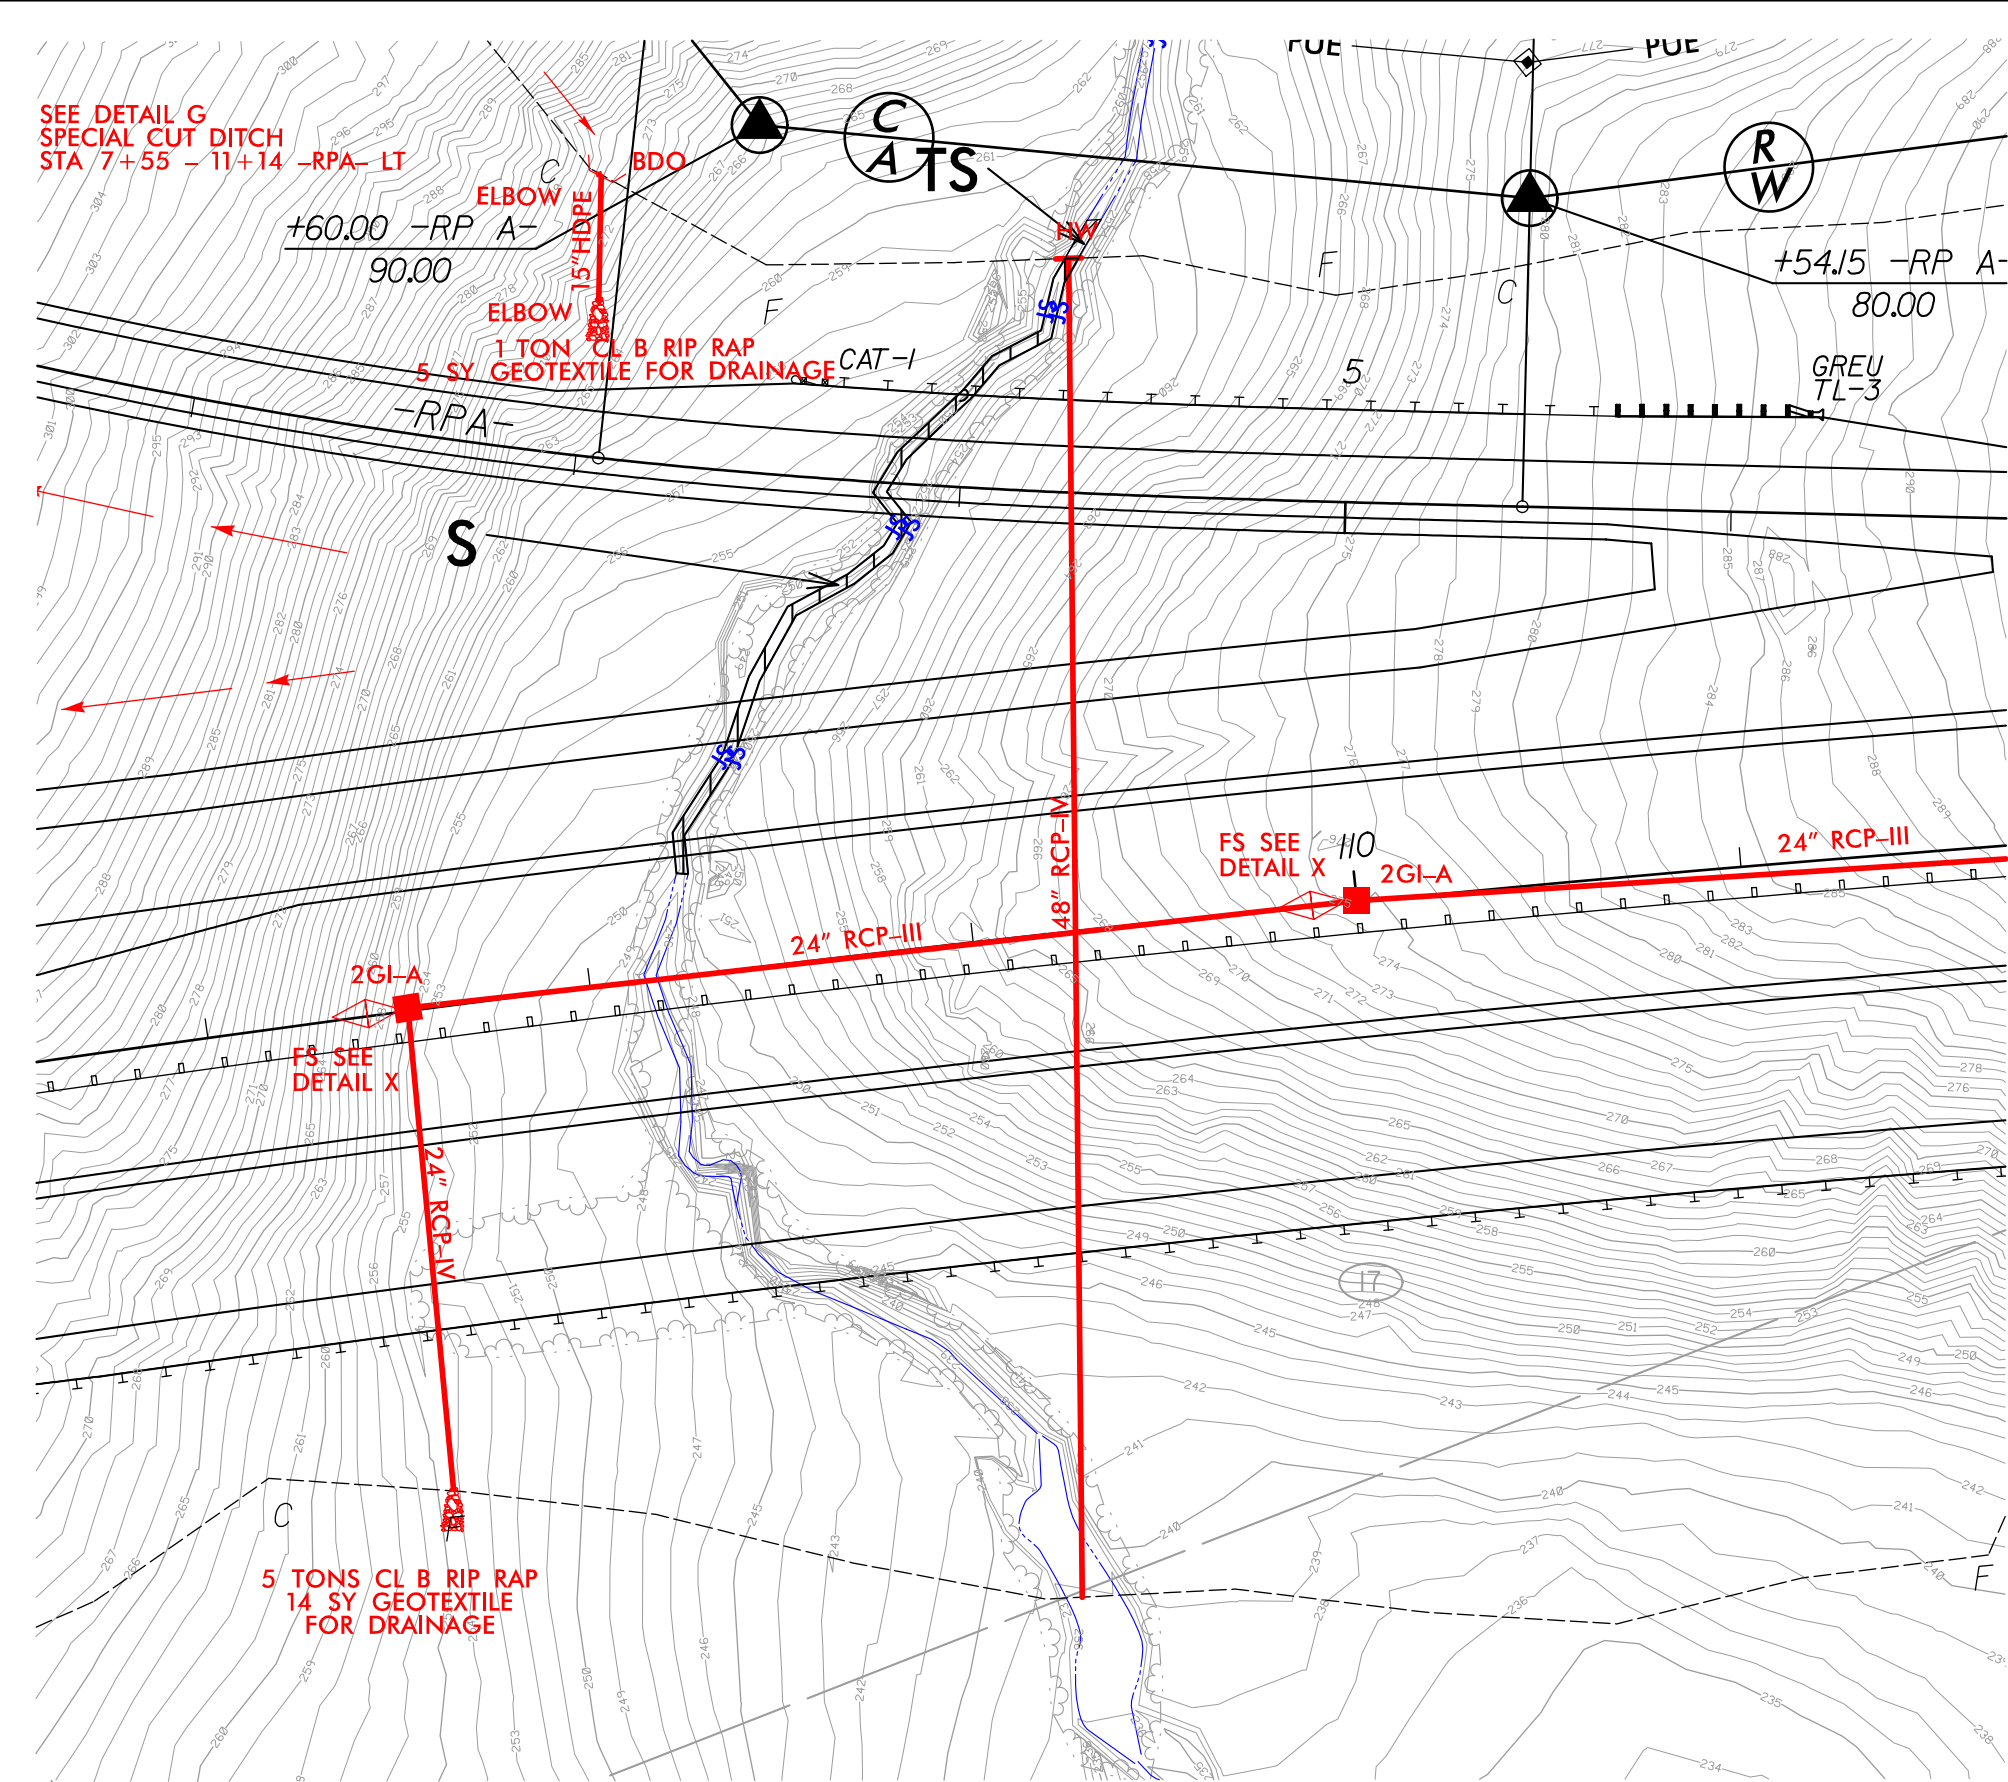


PROJECT REFERENCE NO.	SHEET NO.
R-3421A	10
RW SHEET NO.	
ROADWAY DESIGN ENGINEER	HYDRAULICS ENGINEER
INCOMPLETE PLANS DO NOT USE FOR R/W ACQUISITION	
PRELIMINARY PLANS DO NOT USE FOR CONSTRUCTION	


PERMIT DRAWING
SHEET 18 OF 37



SITE 4 ENLARGEMENT

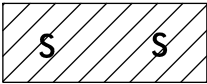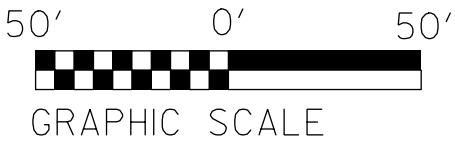

DENOTES IMPACTS IN
SURFACE WATER

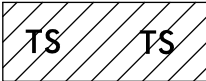

DENOTES TEMPORARY
IMPACTS IN SURFACE WATER


\$DATE\$
\$(USERNAME)\$
\$FILE\$

Revised 7/25/2019

8/17/99


REVISIONS

I:\483\PM
R:\Hydraulics\PERMITS-Environmental\Drawings\R3421A\3421a-hyd-prm-psh10-enlarge site5-20150624.dgn

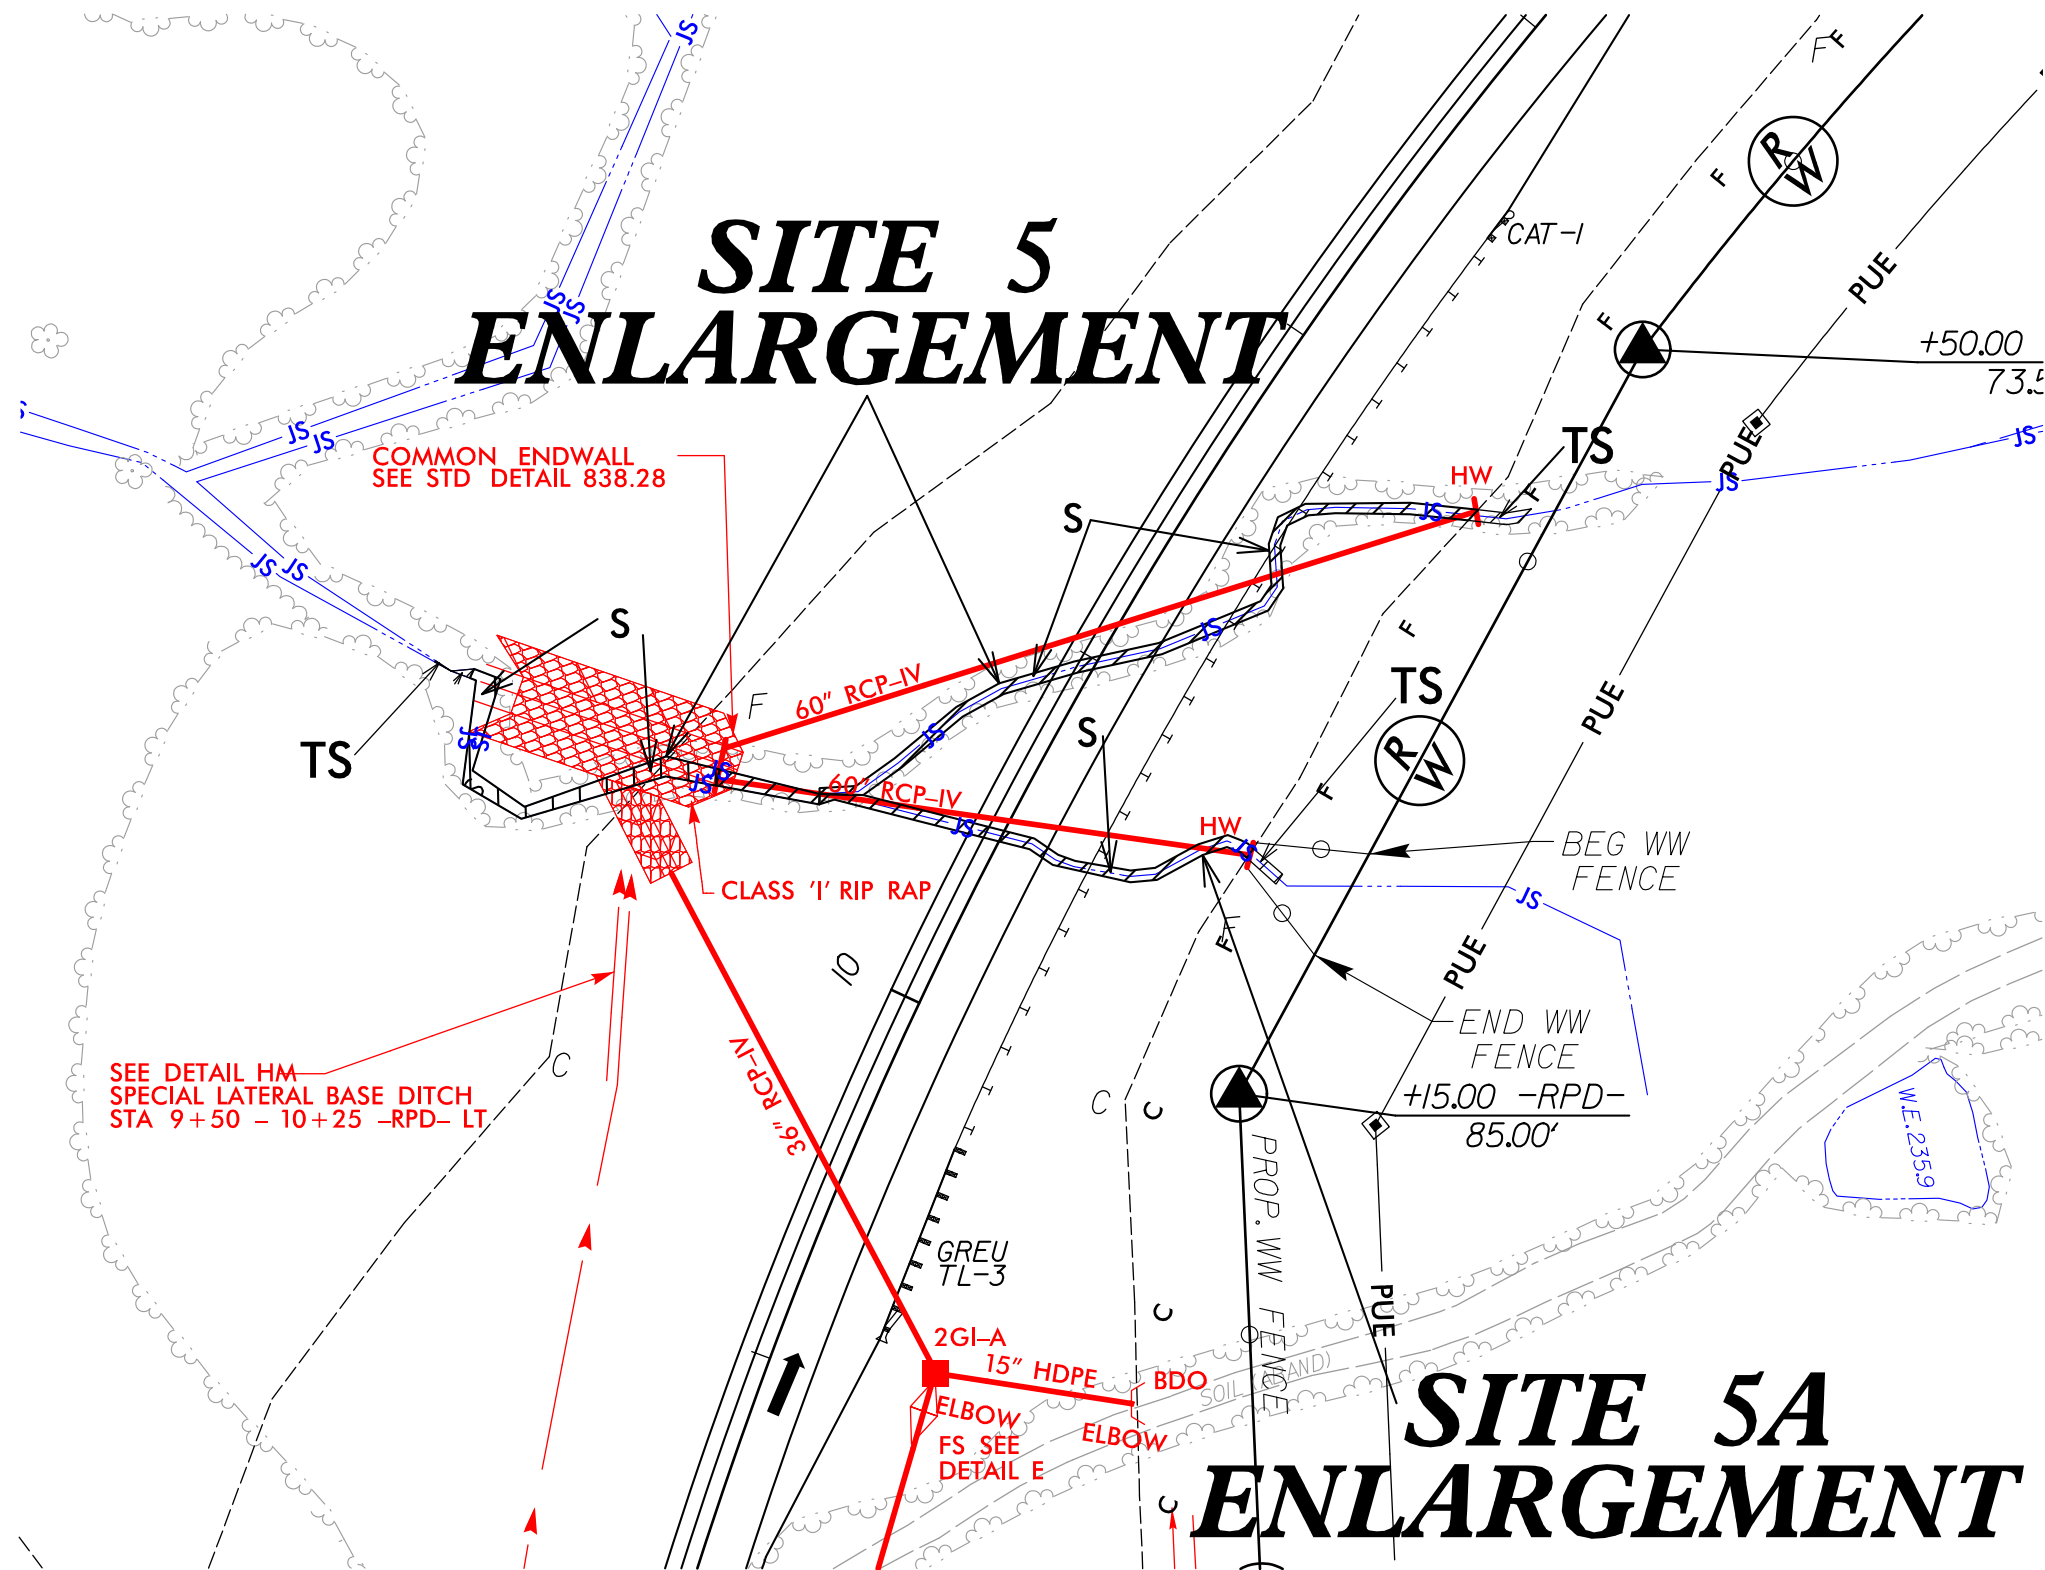


PROJECT REFERENCE NO.		SHEET NO.	
R-3421A		10	
RW SHEET NO.			
ROADWAY DESIGN ENGINEER		HYDRAULICS ENGINEER	
INCOMPLETE PLANS DO NOT USE FOR R/W ACQUISITION PRELIMINARY PLANS DO NOT USE FOR CONSTRUCTION			

PERMIT DRAWING
SHEET 19 OF 37

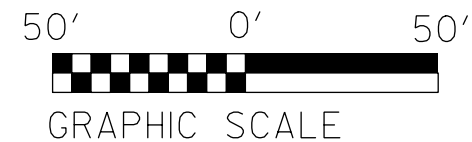

DENOTES IMPACTS IN
SURFACE WATER

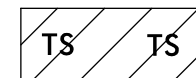

DENOTES TEMPORARY
IMPACTS IN SURFACE WATER


\$DATES
\$(USERNAME)\$
\$FILEL\$

Revised 7/25/2019

8/17/99


REVISIONS

I:\48\44 PM R:\Hydraulics\PERMITS\Environmental\Drawings\R3421A\3421a-hyd-prm-psh10-enlarge site5.20150624_con.dgn

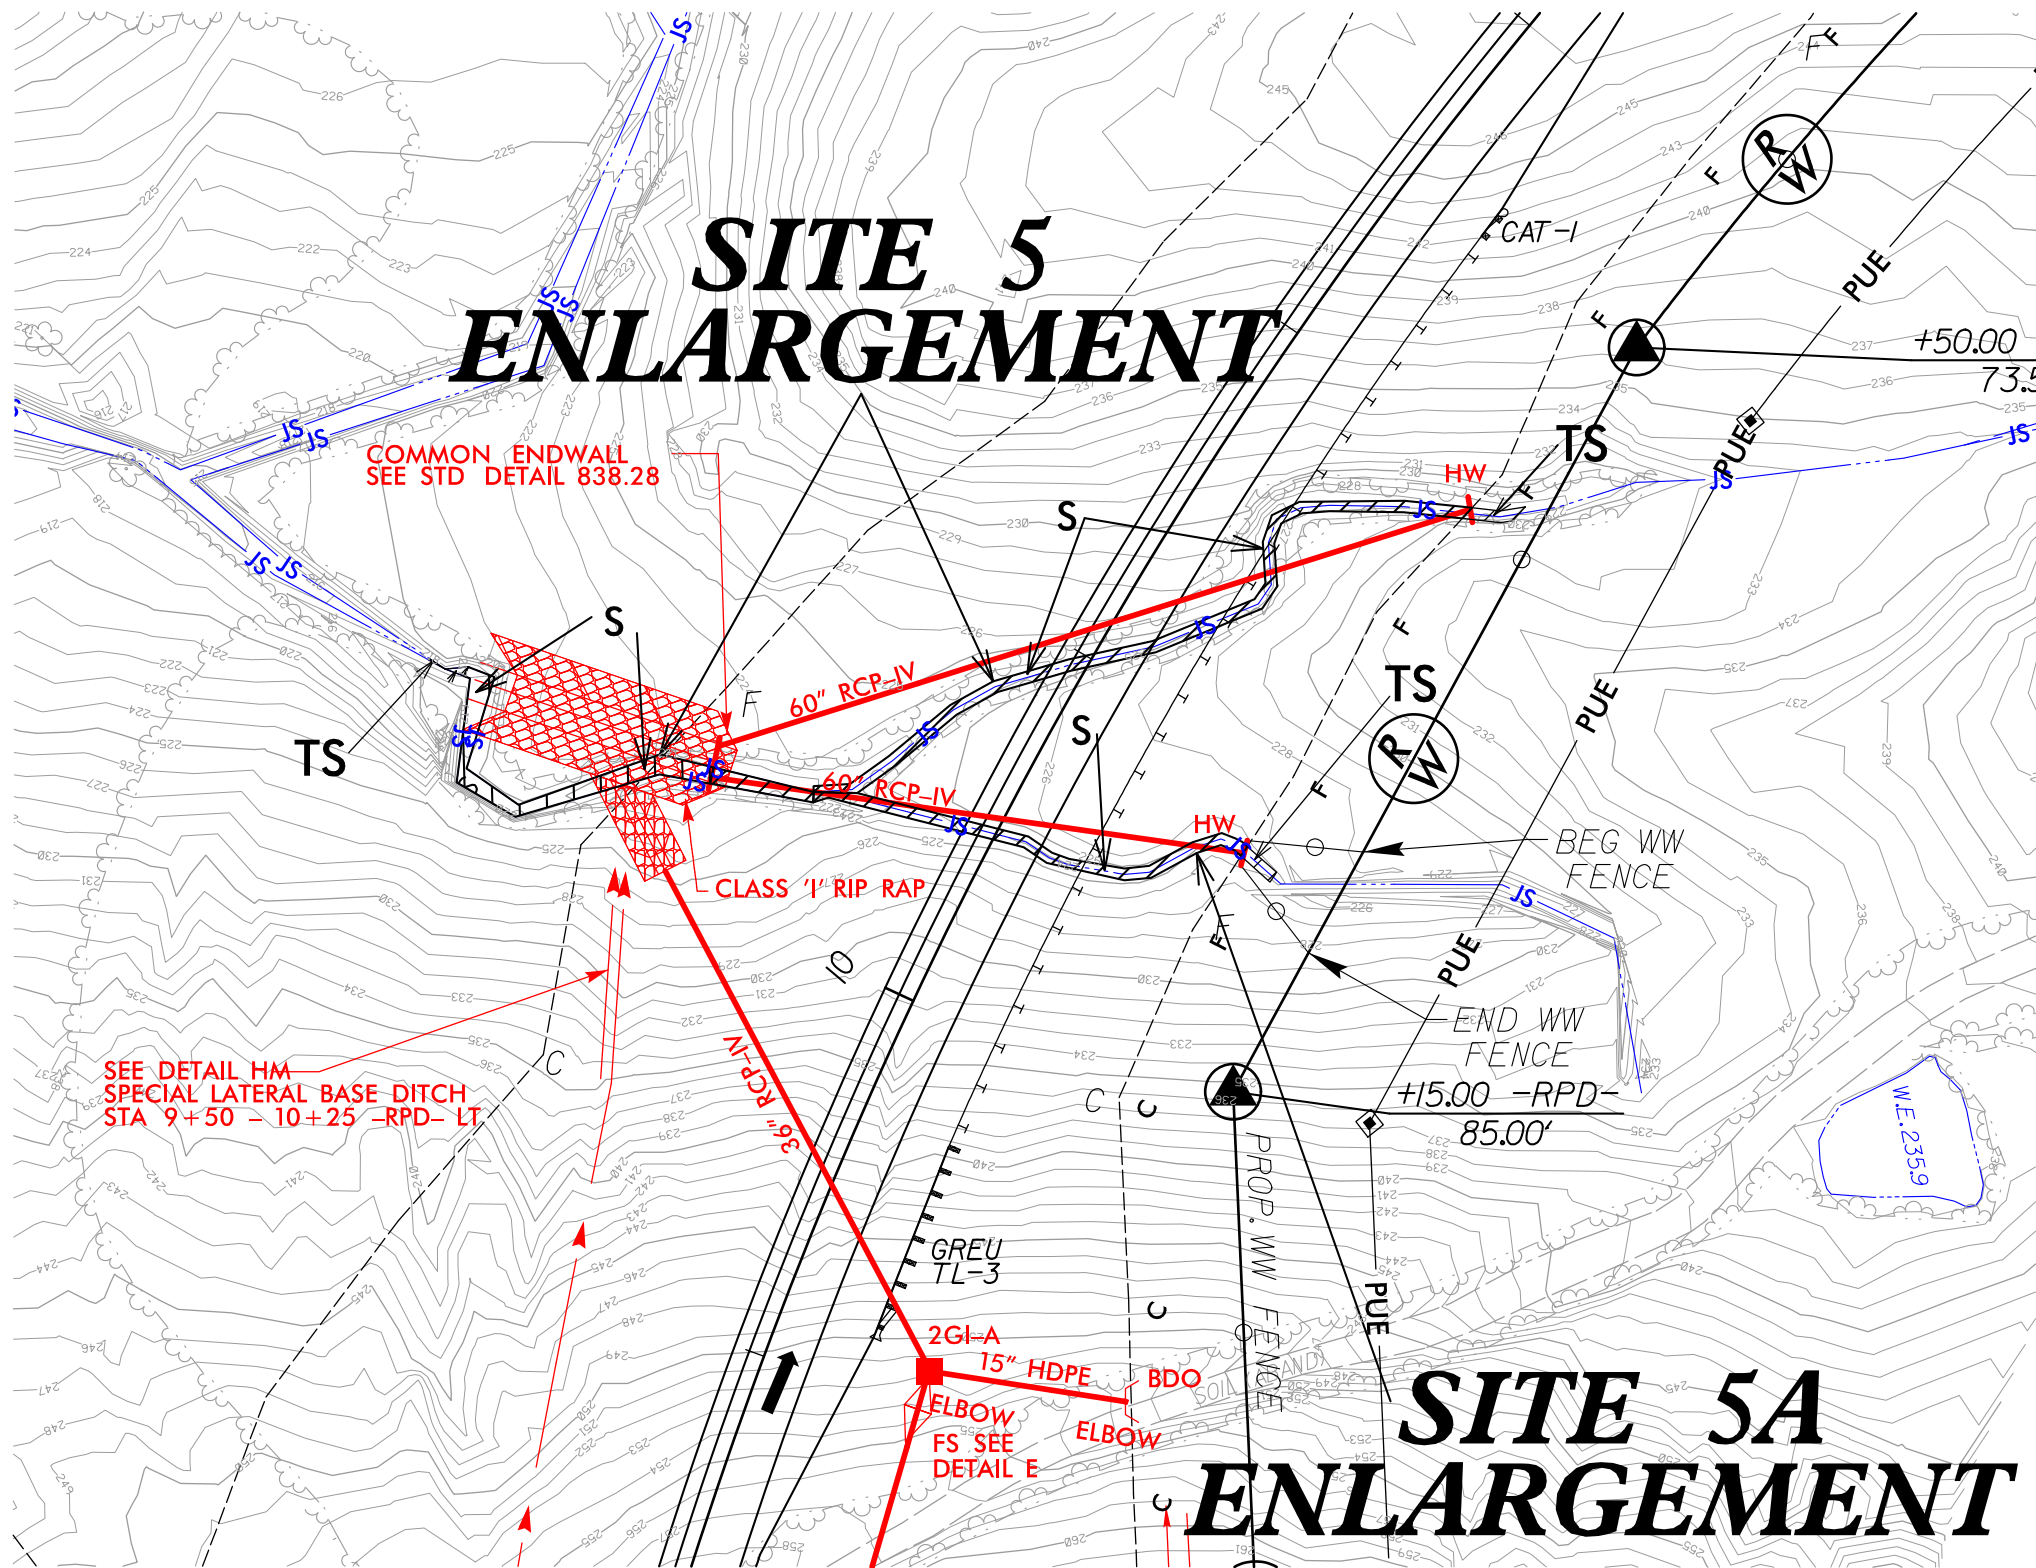

PROJECT REFERENCE NO.		SHEET NO.	
R-3421A		10	
R/W SHEET NO.			
ROADWAY DESIGN ENGINEER		HYDRAULICS ENGINEER	
INCOMPLETE PLANS DO NOT USE FOR R/W ACQUISITION			
PRELIMINARY PLANS DO NOT USE FOR CONSTRUCTION			


PERMIT DRAWING
SHEET 20 OF 37

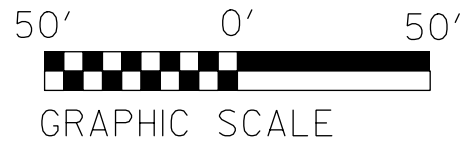

\$DATES
\$(USERNAME)\$
\$FILE\$



DENOTES IMPACTS IN
SURFACE WATER







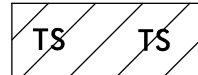


DENOTES TEMPORARY
IMPACTS IN SURFACE WATER

REVISIONS


1:48:48 PM
R:\Hydraulics\PERMITS.Environmental\Drawings\R3421A\R3421a_hyd.prm.psh1.20150204.dgn

```
$DATES
$(USERNAME)$
$FILE$
```

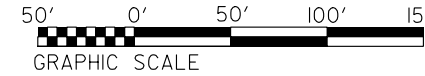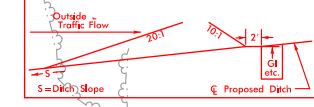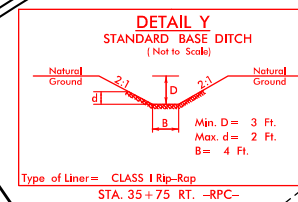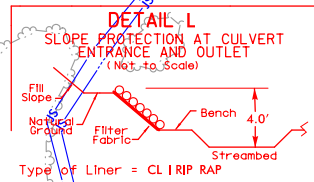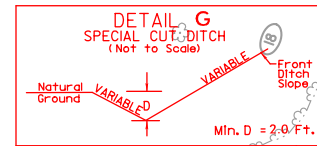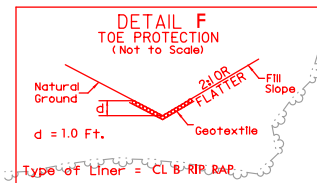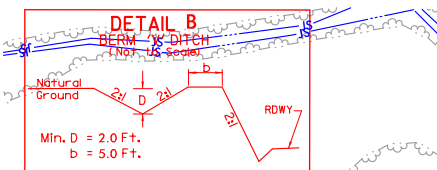

PERMIT DRAWING
SHEET 21 OF 37


PROJECT REFERENCE NO.	SHEET NO.
R-3421A	11
RW SHEET NO.	
ROADWAY DESIGN ENGINEER	HYDRAULICS ENGINEER
INCOMPLETE PLANS DO NOT USE FOR R/W ACQUISITION	
PRELIMINARY PLANS DO NOT USE FOR CONSTRUCTION	
DOCUMENT NOT CONSIDERED FINAL UNLESS ALL SIGNATURES COMPLETED	

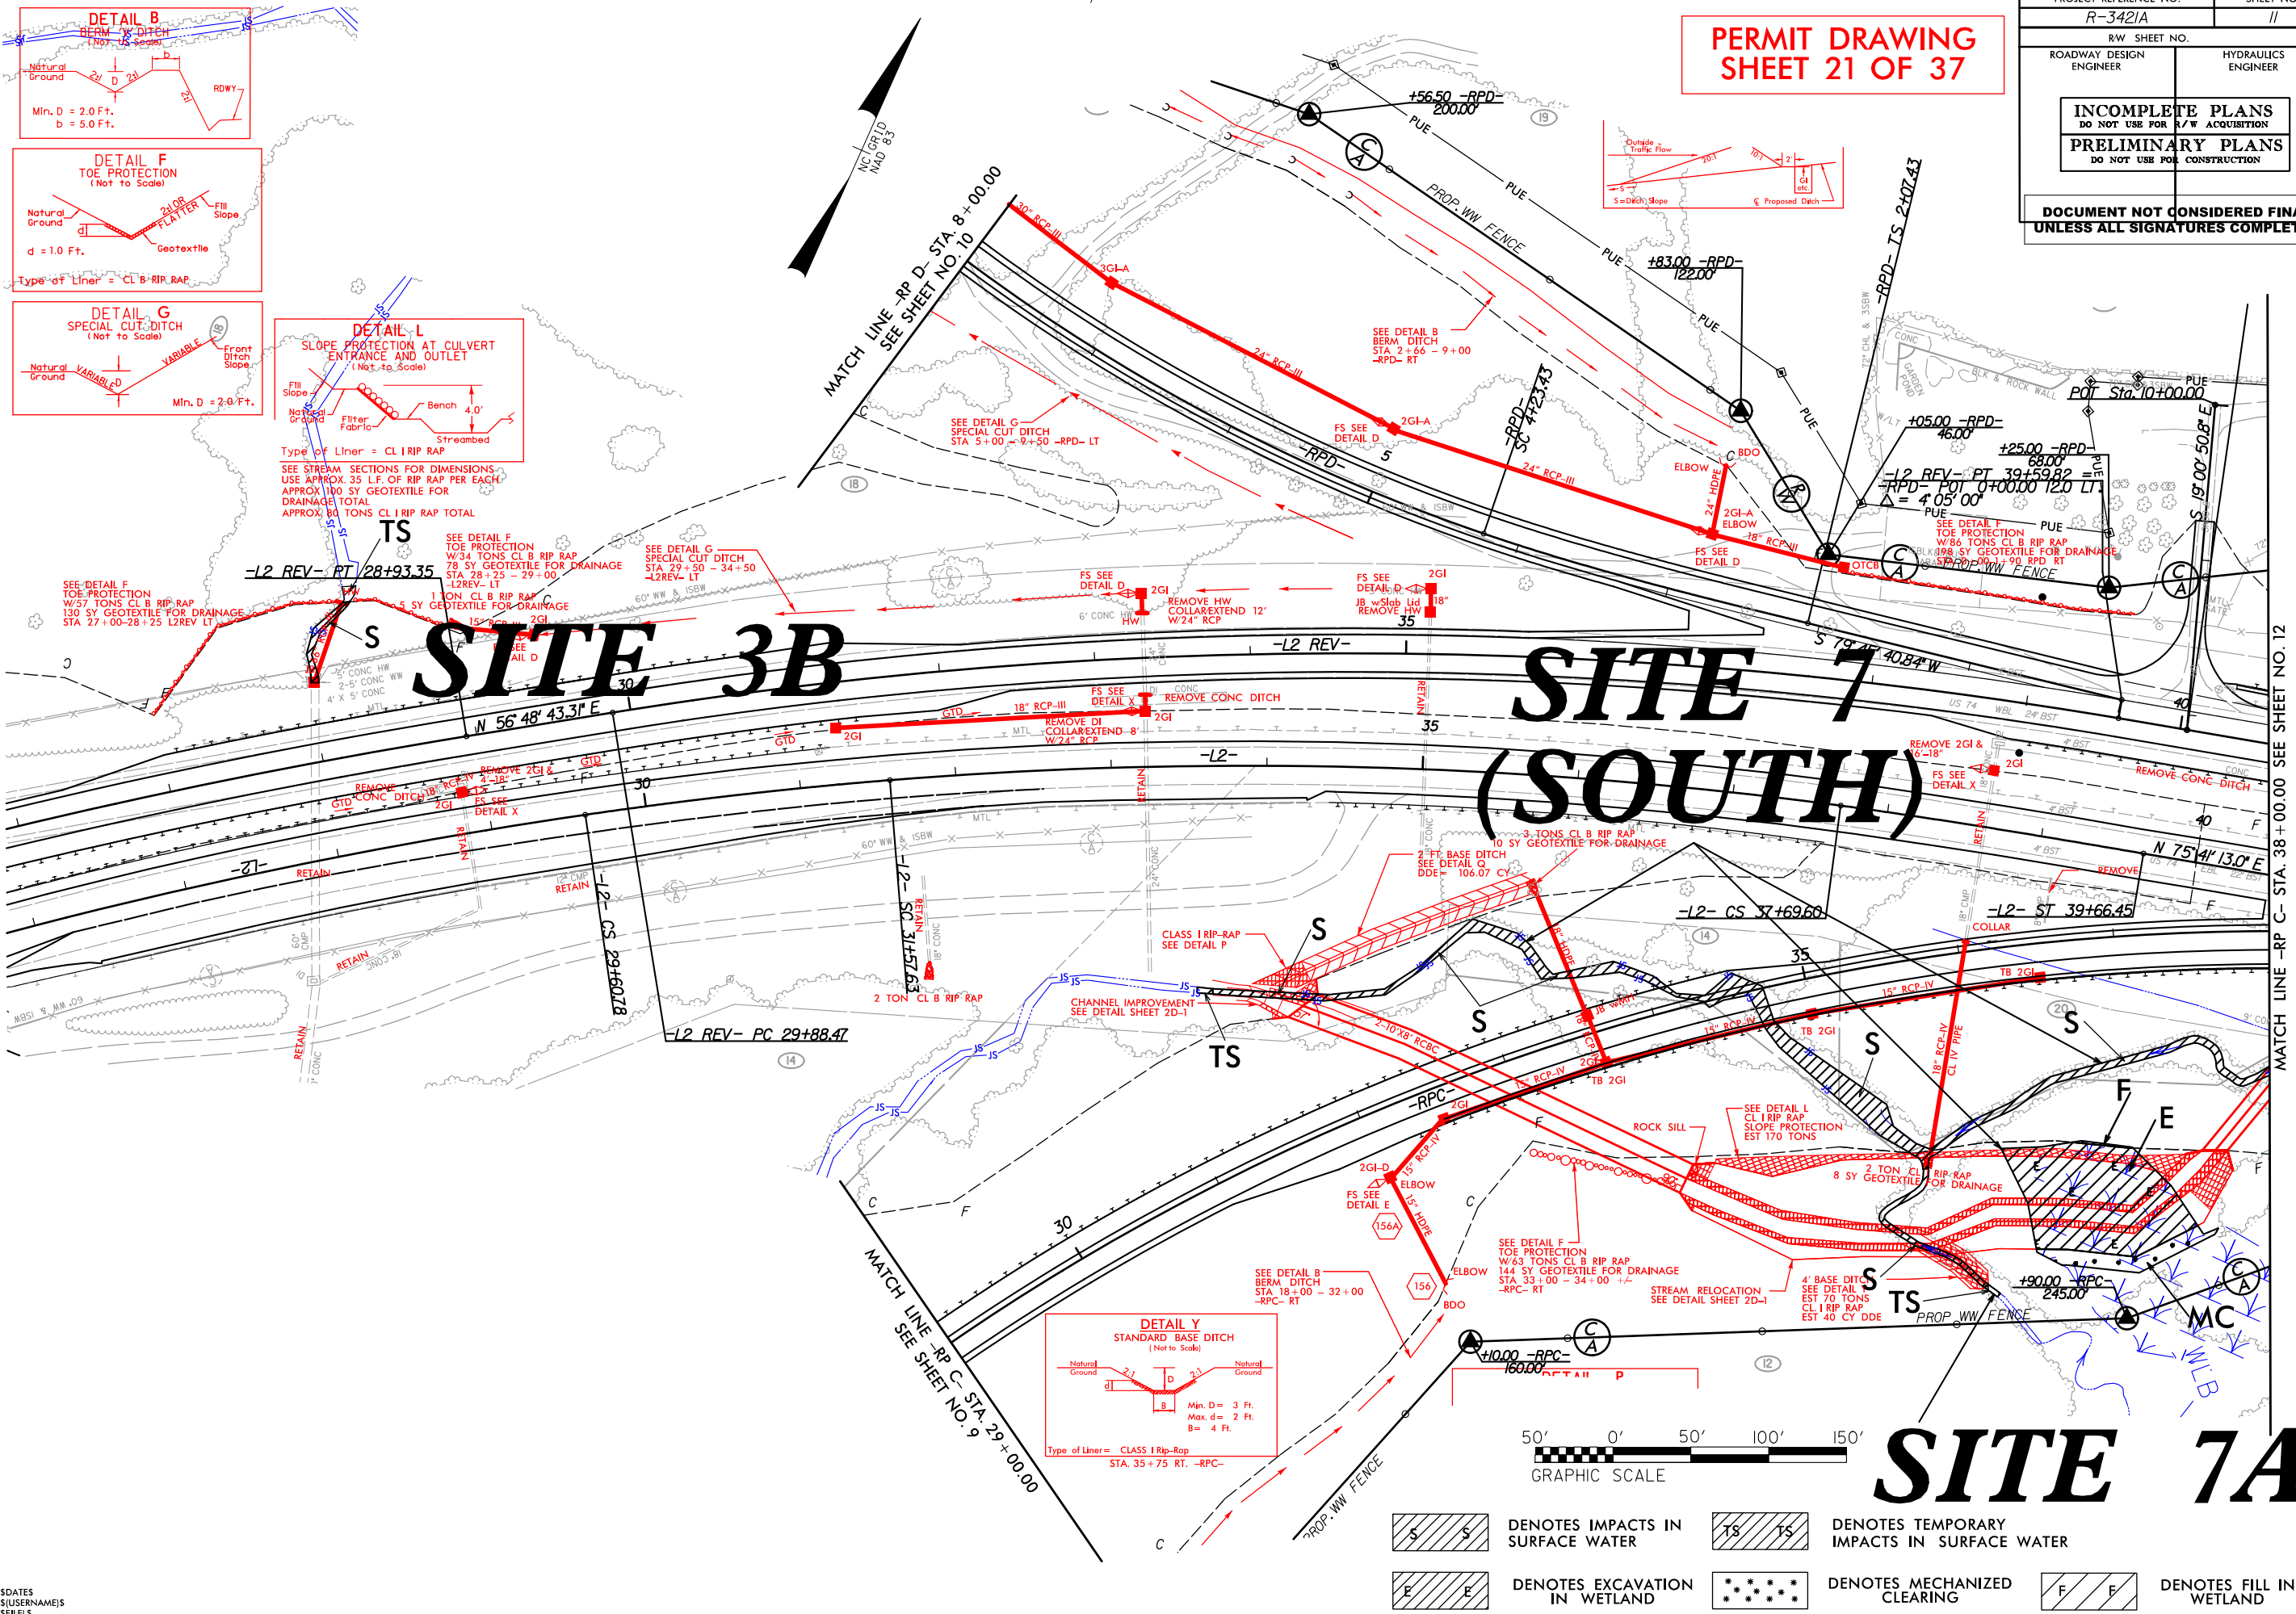

SITE 7A

 DENOTES IMPACTS IN SURFACE WATER
  DENOTES TEMPORARY IMPACTS IN SURFACE WATER

 DENOTES EXCAVATION IN WETLAND
  DENOTES MECHANIZED CLEARING
  DENOTES FILL IN WETLAND

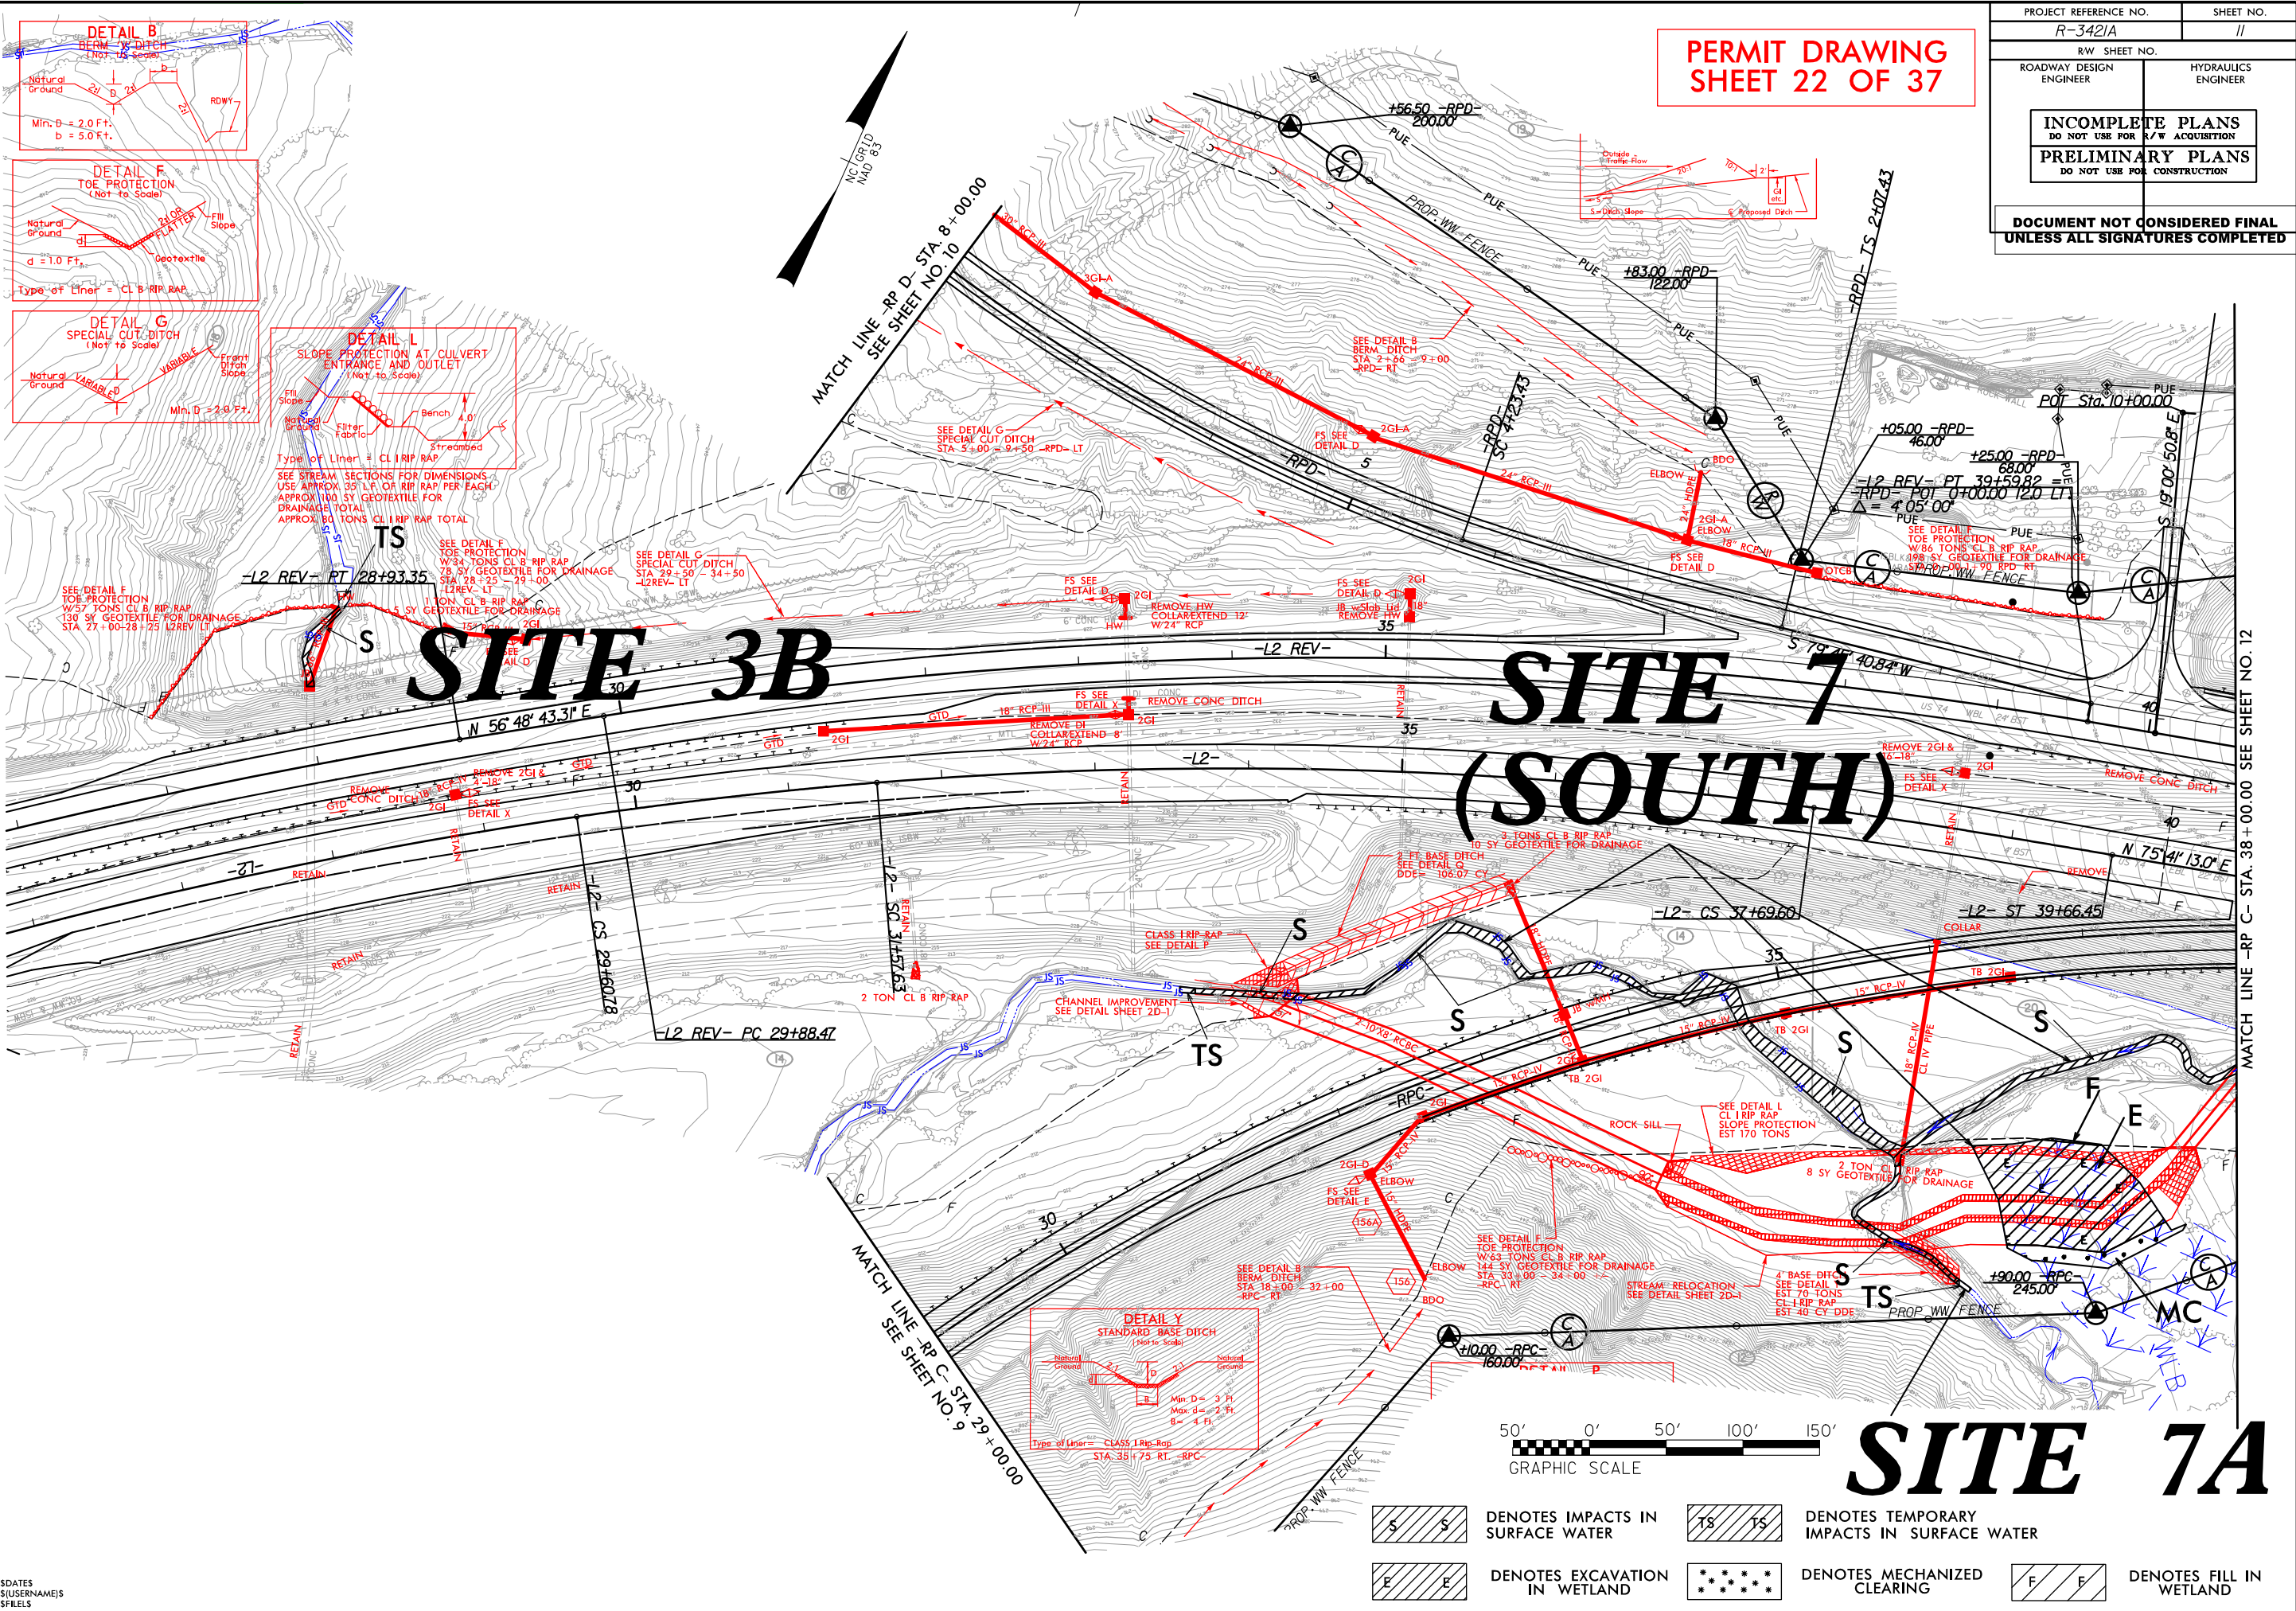

Revised 7/25/2019

8/17/99


REVISIONS

I:\48558 PM R:\Hydraulics\PERMITS-Environmental\Drawings\R3421A\Hyd-prm-psih1-enlarge site3.20150624.dgn


SITE 3B ENLARGEMENT

PROJECT REFERENCE NO.	SHEET NO.
R-3421A	11
R/W SHEET NO.	
ROADWAY DESIGN ENGINEER	HYDRAULICS ENGINEER
INCOMPLETE PLANS DO NOT USE FOR R/W ACQUISITION	
PRELIMINARY PLANS DO NOT USE FOR CONSTRUCTION	

PERMIT DRAWING
SHEET 23 OF 37

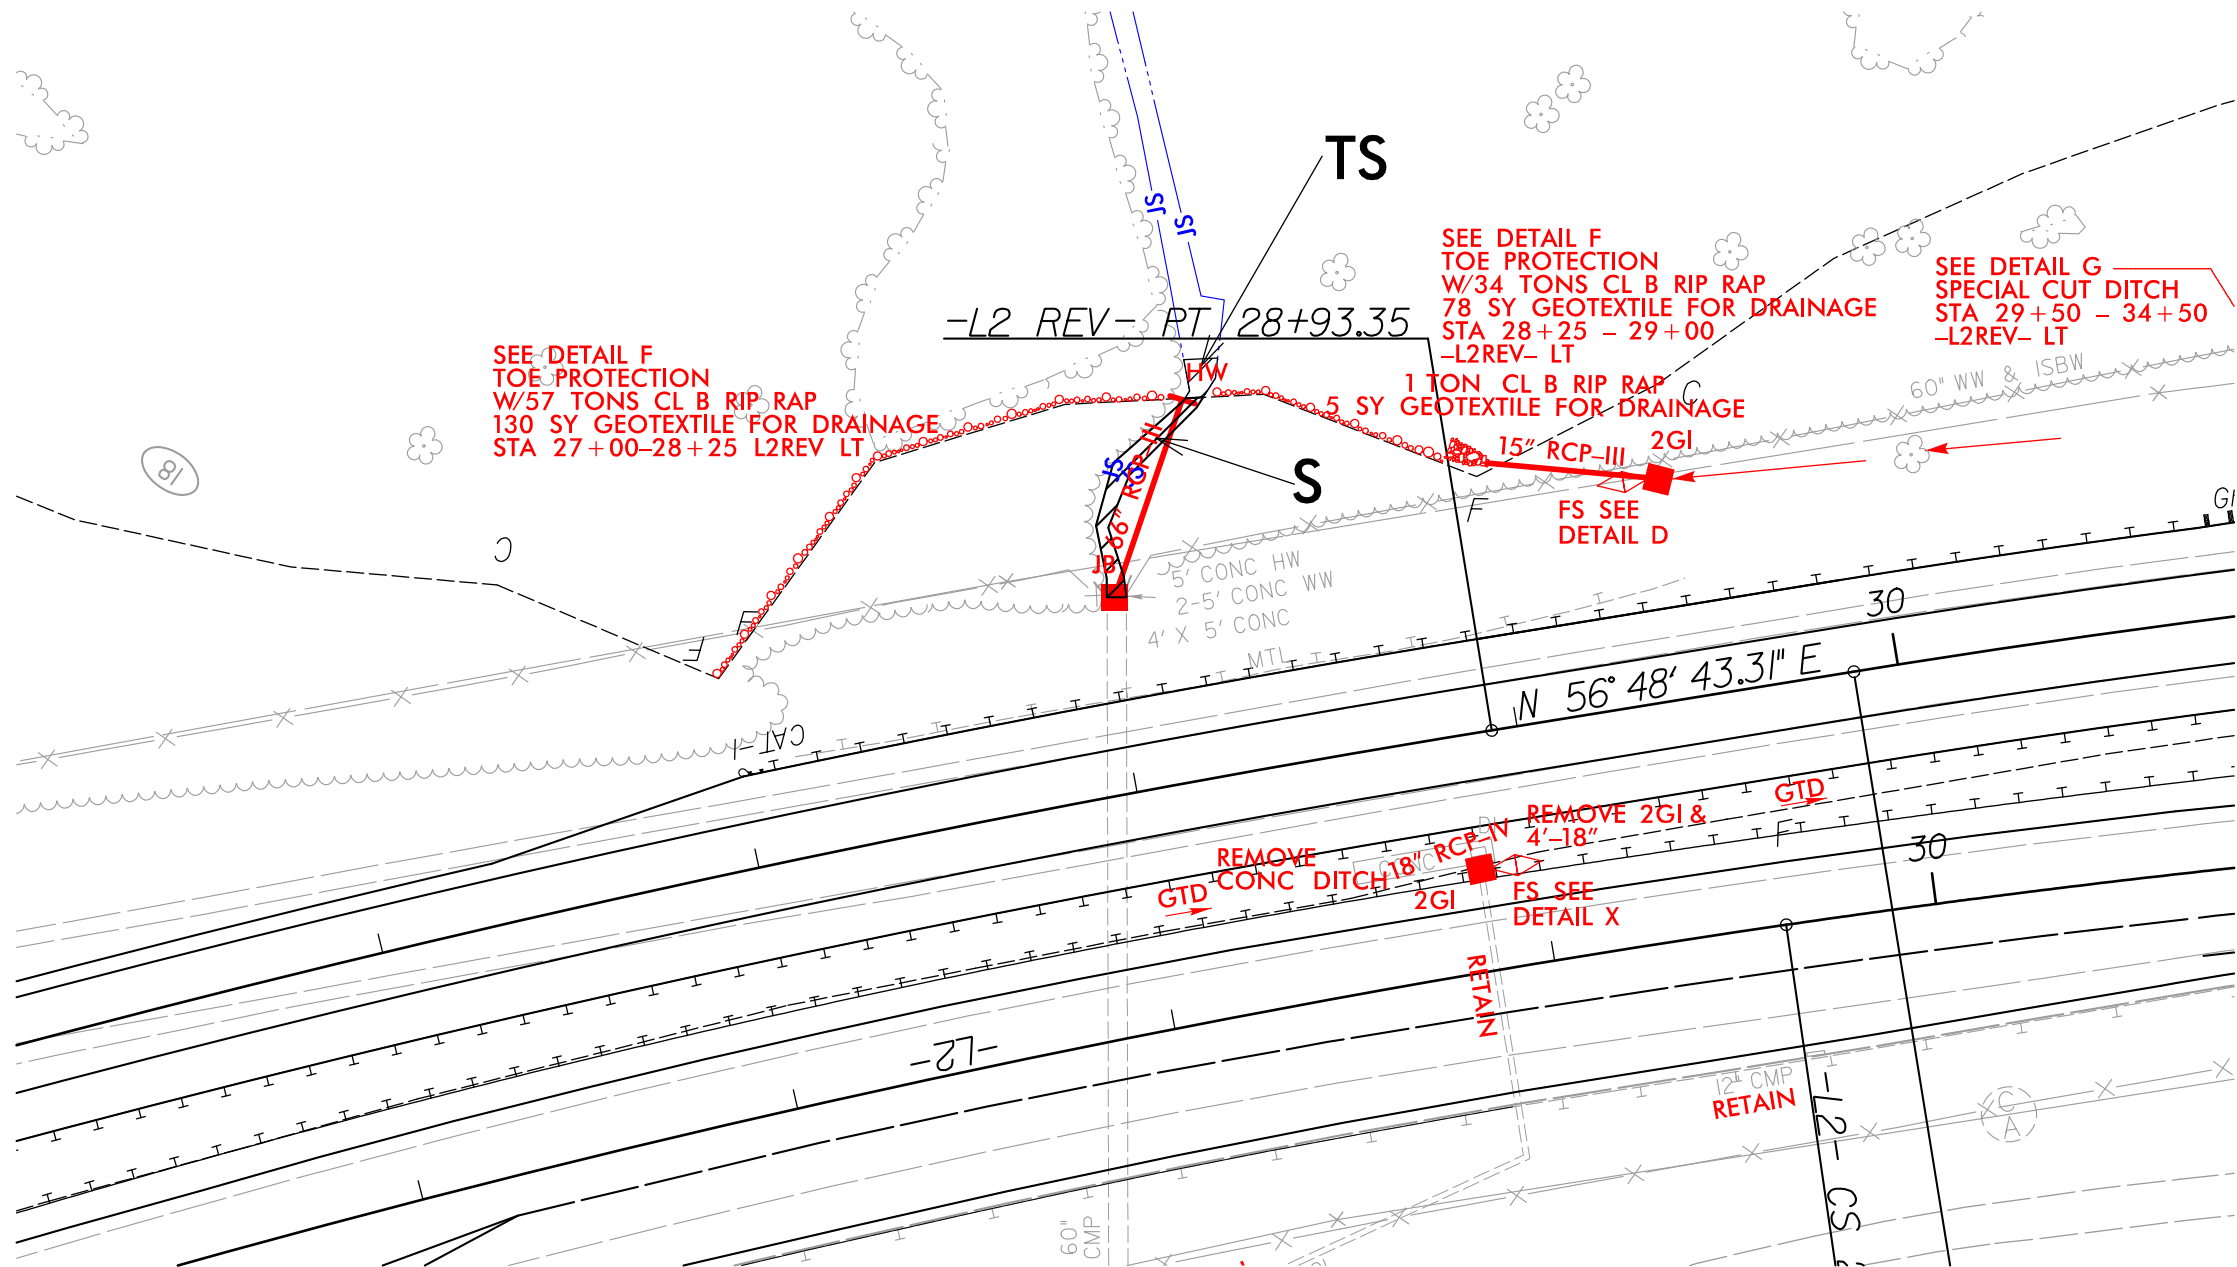

GRAPHIC SCALE

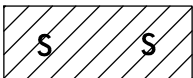

DENOTES IMPACTS IN
SURFACE WATER



DENOTES TEMPORARY
IMPACTS IN SURFACE WATER

\$DATE\$
\$(USERNAME)\$
\$FILEL\$

PERMIT DRAWING
SHEET 24 OF 37



A rectangular block with diagonal hatching (lines from top-left to bottom-right). Inside the block, there are two 'S' symbols, one on the left and one on the right.

A rectangular block with diagonal hatching. Inside the block, the letters 'TS' are written twice, separated by a space.

DENOTES TEMPORARY
IMPACTS IN SURFACE WATER

```
$DATE$
$(USERNAME)$
$FILE$
```

4:49:02 PM
C:\Users\Hydraulics\Documents\PERMITS.Environmental\Drawings\R3421A\3421a_hyd_prm_psh11_enlarge_site3_20150624_con.dgn
[unclear]

REVISIONS

1:49:02 PM
R:\Hydraul

Revised 7/25/2019

Revised 7/25/2019


8/17/99

\\h4906\PM\PERMITS\Environmental\Drawings\R3421A\Hyd\prj\psh1\enlarge site7_20150624.dgn

SITE 7 (SOUTH) ENLARGEMENT

PROJECT REFERENCE NO.	SHEET NO.
R-3421A	II
R/W SHEET NO.	
ROADWAY DESIGN ENGINEER	HYDRAULICS ENGINEER
INCOMPLETE PLANS DO NOT USE FOR R/W ACQUISITION	
PRELIMINARY PLANS DO NOT USE FOR CONSTRUCTION	

PERMIT DRAWING
SHEET 25 OF 37

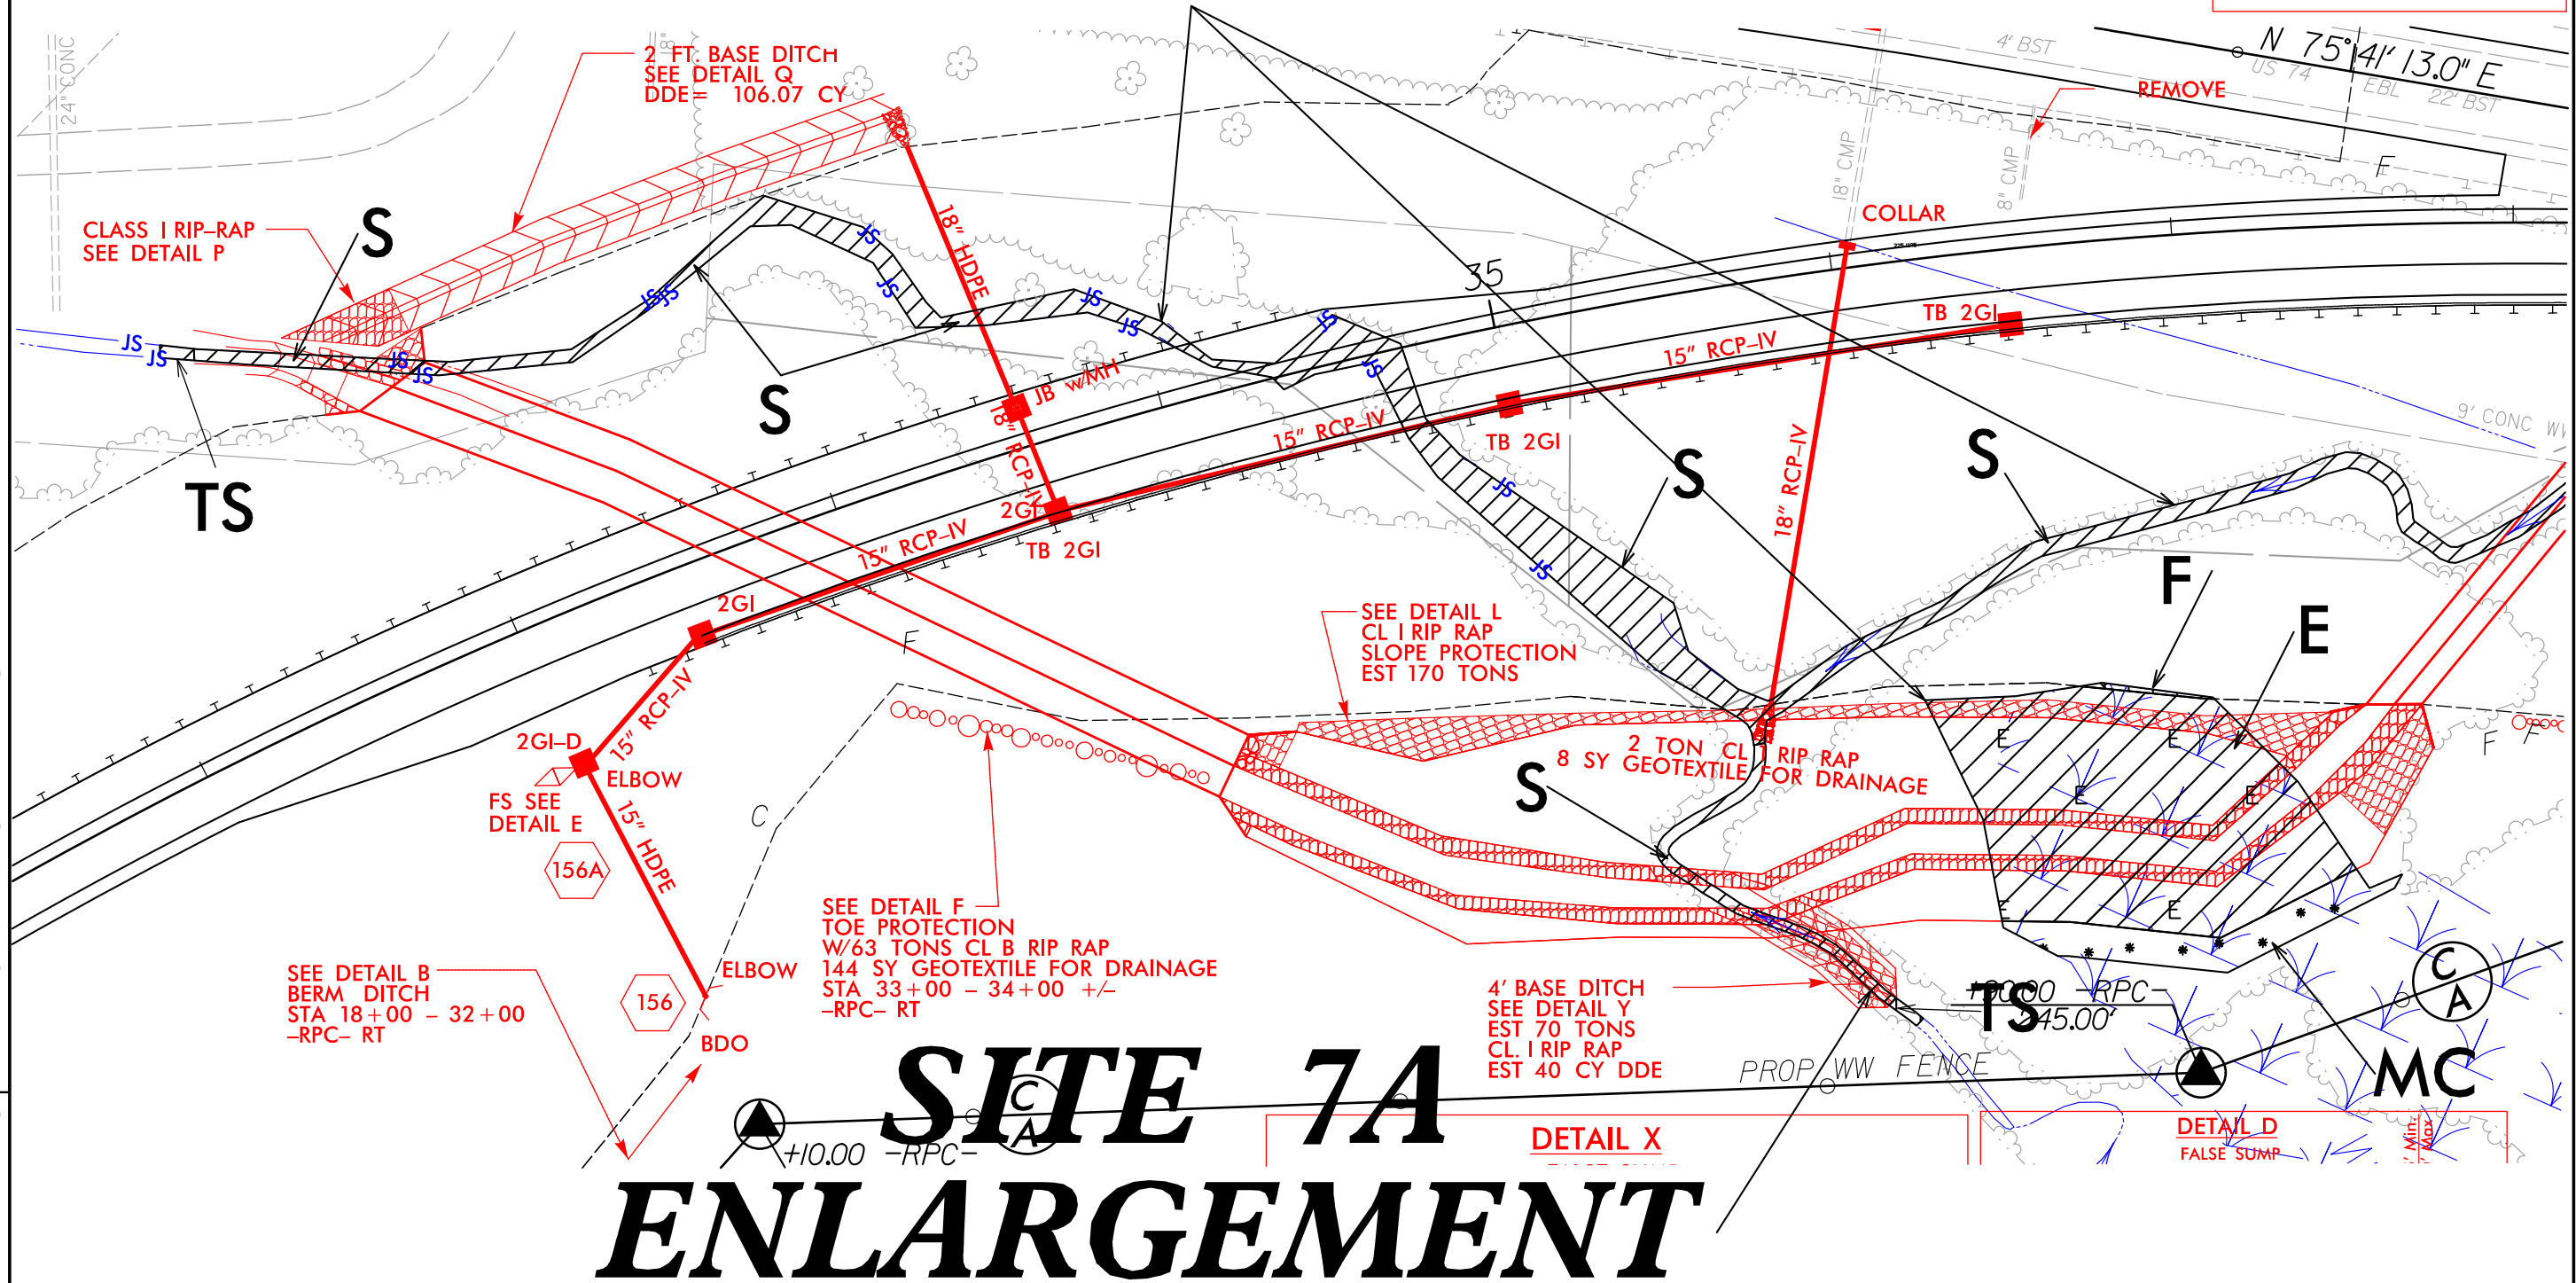

SITE 7A ENLARGEMENT

F

F

Denotes Fill in Wetland

S

S

Denotes Impacts in Surface Water

TS

TS

Denotes Temporary Impacts in Surface Water

E

E

Denotes Excavation in Wetland

*

*

Denotes Mechanized Clearing

50'

0'

50'

GRAPHIC SCALE

\$DATES
\$(USERNAME)\$
\$FILELS

PROJECT REFERENCE NO.	SHEET NO.
R-342/A	II
R/W SHEET NO.	
ROADWAY DESIGN ENGINEER	HYDRAULICS ENGINEER
INCOMPLETE PLANS DO NOT USE FOR R/W ACQUISITION PRELIMINARY PLANS DO NOT USE FOR CONSTRUCTION	



GRAPHIC SCALE

Revised 7/25/2019

Revised 7/25/2019

5/14/99
1:49:14 PM
H:\Hydro\Projects\PERMITS\Environmental\Drawings\R342\A\R342\A_rampC_cul_Revise7.dgn
R342

SITE 7

PROJECT REFERENCE NO. <i>R-342/A</i>		SHEET NO.	
ROADWAY DESIGN ENGINEER		HYDRAULICS ENGINEER	
INCOMPLETE PLANS DO NOT USE FOR R/W ACQUISITION		PRELIMINARY PLANS DO NOT USE FOR CONSTRUCTION	

PERMIT DRAWING
SHEET 27 OF 37


240


230

220


210

200

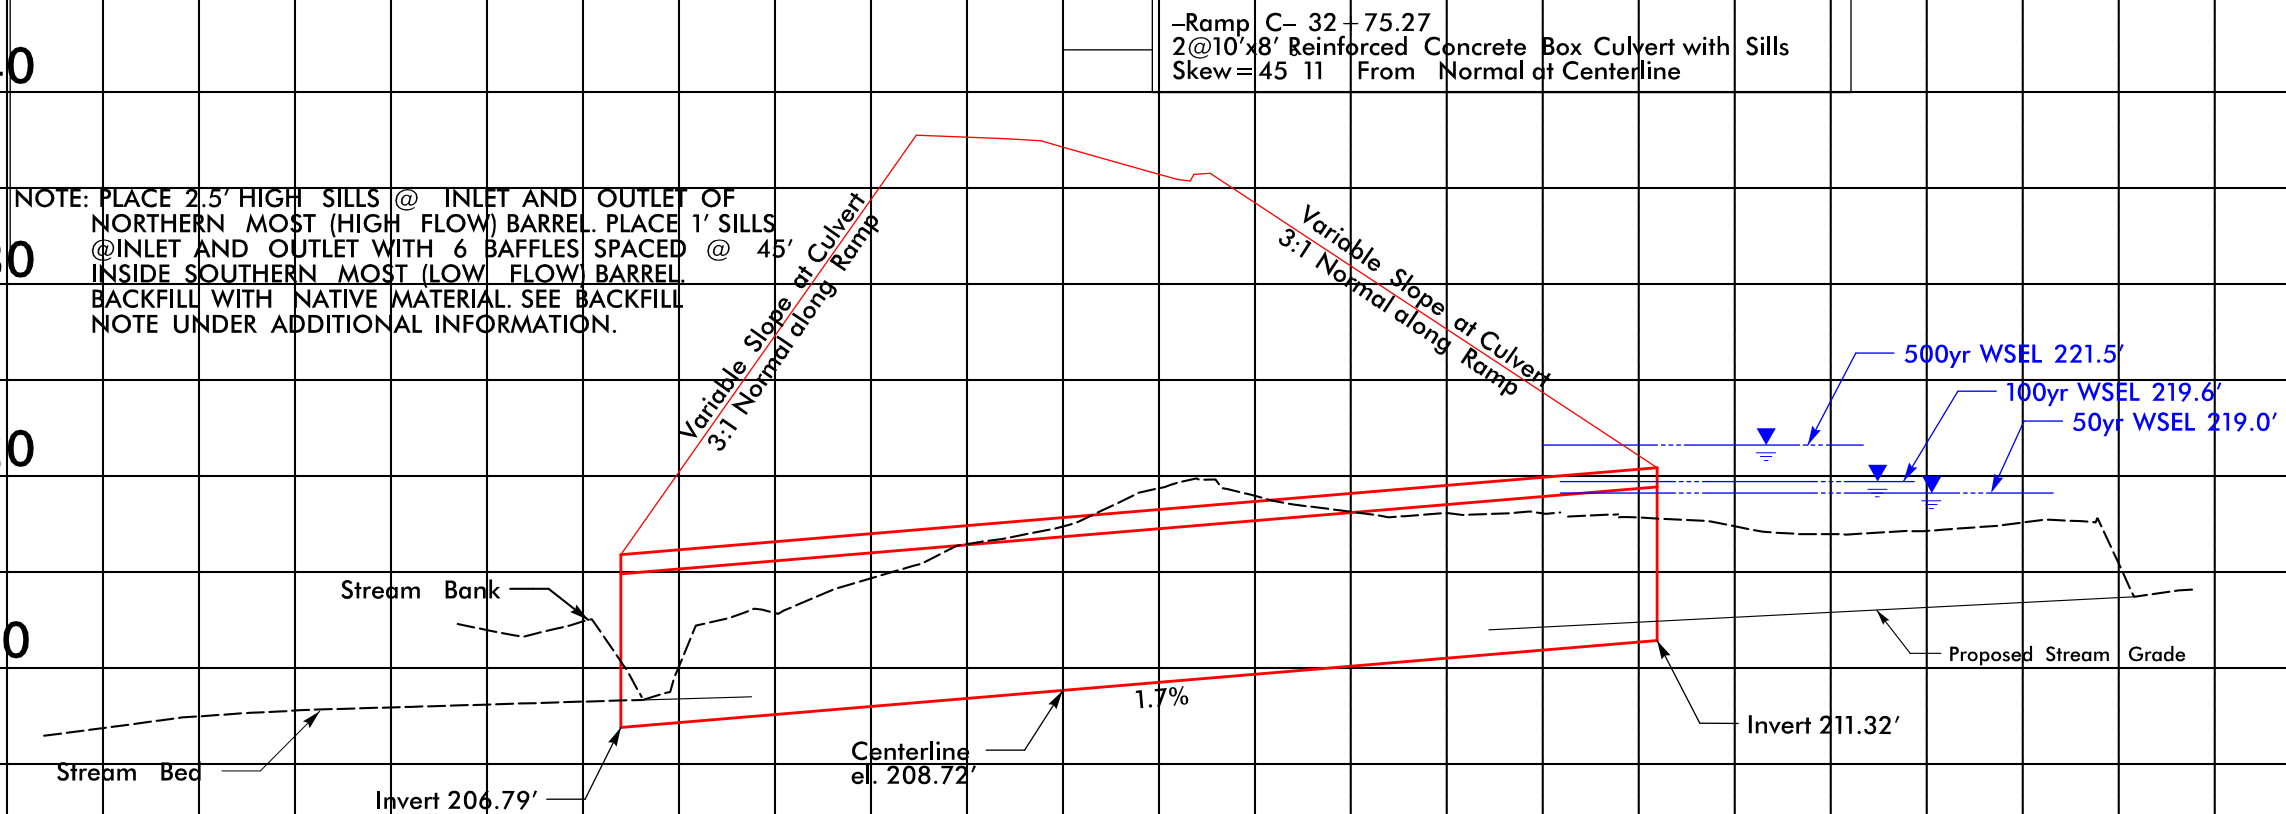

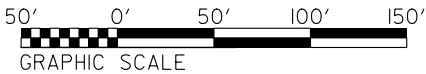

```
$DATES
$(USERNAME)$
$FILE$
```
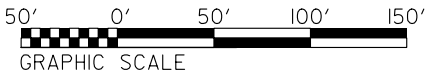
```
$DATES
$(USERNAME)$
$FILE$
```



Revised 7/25/2019

8/17/99

REVISIONS



I:\49:30 PM R:\Hydraulics\PERMITS\Environmental\Drawings\R3421A\Hyd\prj\psh12_enlarge site7N.20150624.dgn

SITE 7 (NORTH) ENLARGEMENT

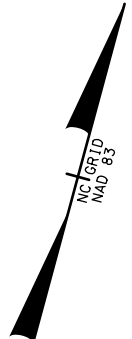


PROJECT REFERENCE NO. <i>R-3421A</i>		SHEET NO. <i>12</i>	
R/W SHEET NO.			
ROADWAY DESIGN ENGINEER		HYDRAULICS ENGINEER	
INCOMPLETE PLANS DO NOT USE FOR R/W ACQUISITION PRELIMINARY PLANS DO NOT USE FOR CONSTRUCTION			

PERMIT DRAWING
SHEET 30 OF 37

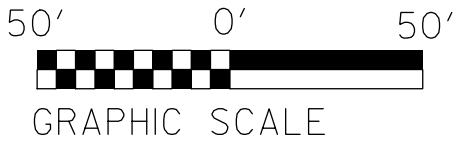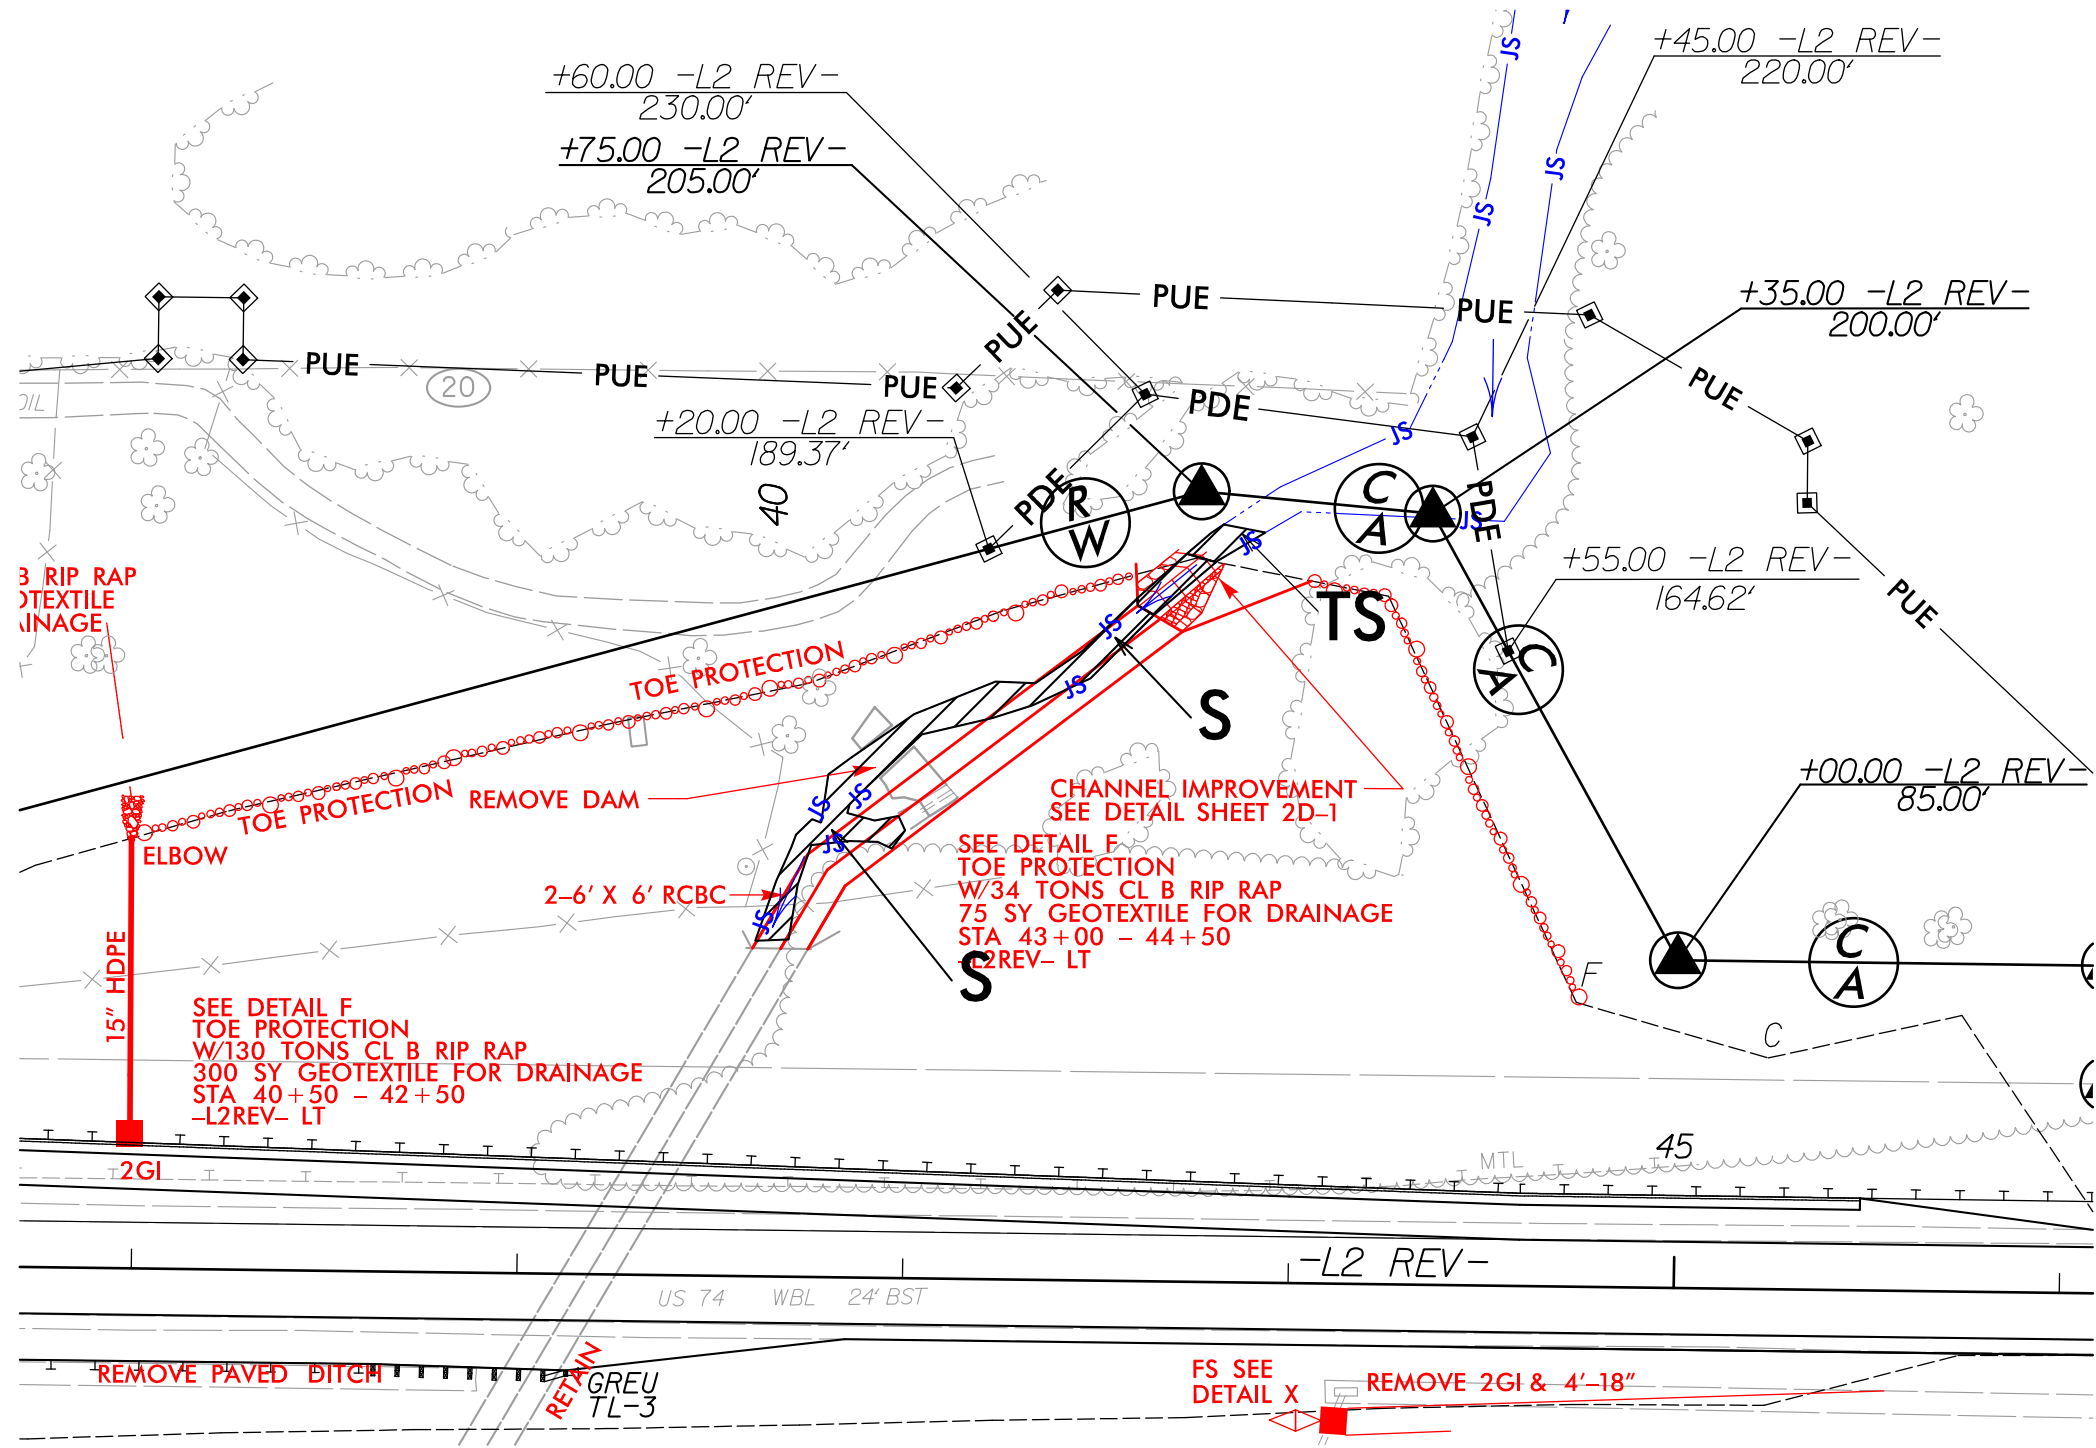

\$DATE\$
\$(USERNAME)\$
\$FILEL\$

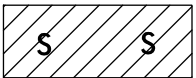

DENOTES IMPACTS IN
SURFACE WATER



DENOTES TEMPORARY
IMPACTS IN SURFACE WATER


Revised 7/25/2019

8/17/99

REVISIONS



\\49:34 PM R:\Hydraulics\PERMITS\Environmental\Drawings\R3421A\Hyd\prj\psh12_enlarge site7\N20150624.com.dgn

SITE 7 (NORTH) ENLARGEMENT

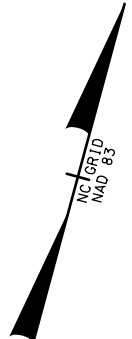


PROJECT REFERENCE NO. R-3421A		SHEET NO. 12	
R/W SHEET NO.			
ROADWAY DESIGN ENGINEER		HYDRAULICS ENGINEER	
INCOMPLETE PLANS DO NOT USE FOR R/W ACQUISITION PRELIMINARY PLANS DO NOT USE FOR CONSTRUCTION			

PERMIT DRAWING
SHEET 31 OF 37

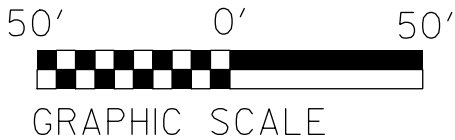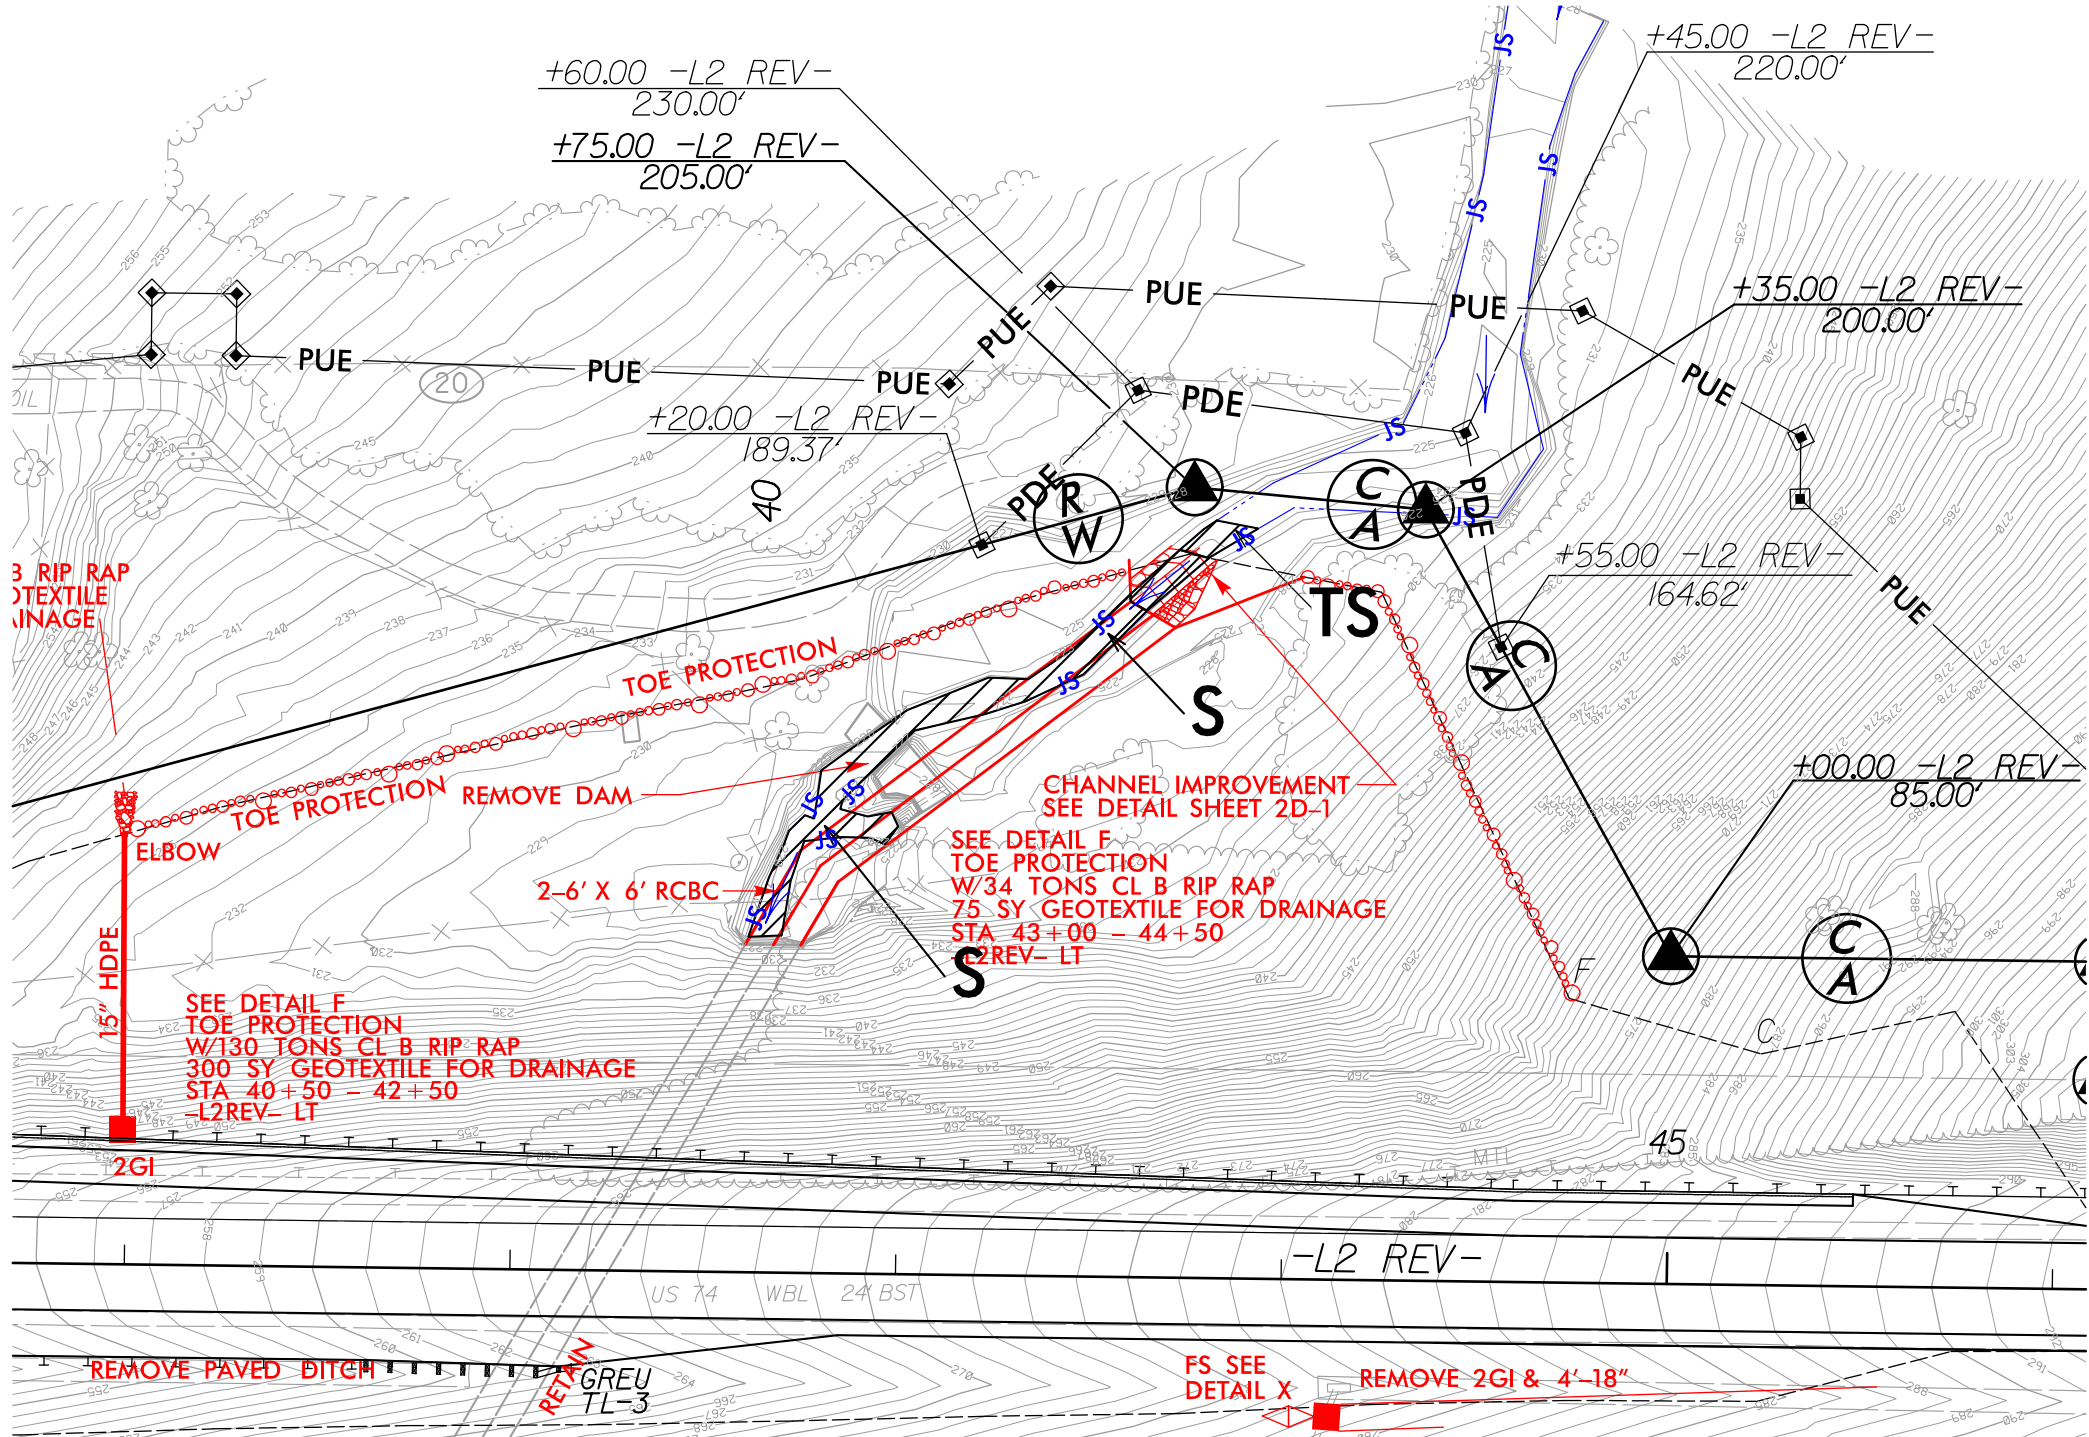

\$DATE\$
\$(USERNAME)\$
\$FILEL\$

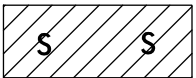


DENOTES IMPACTS IN
SURFACE WATER



DENOTES TEMPORARY
IMPACTS IN SURFACE WATER

Revised 7/25/2019

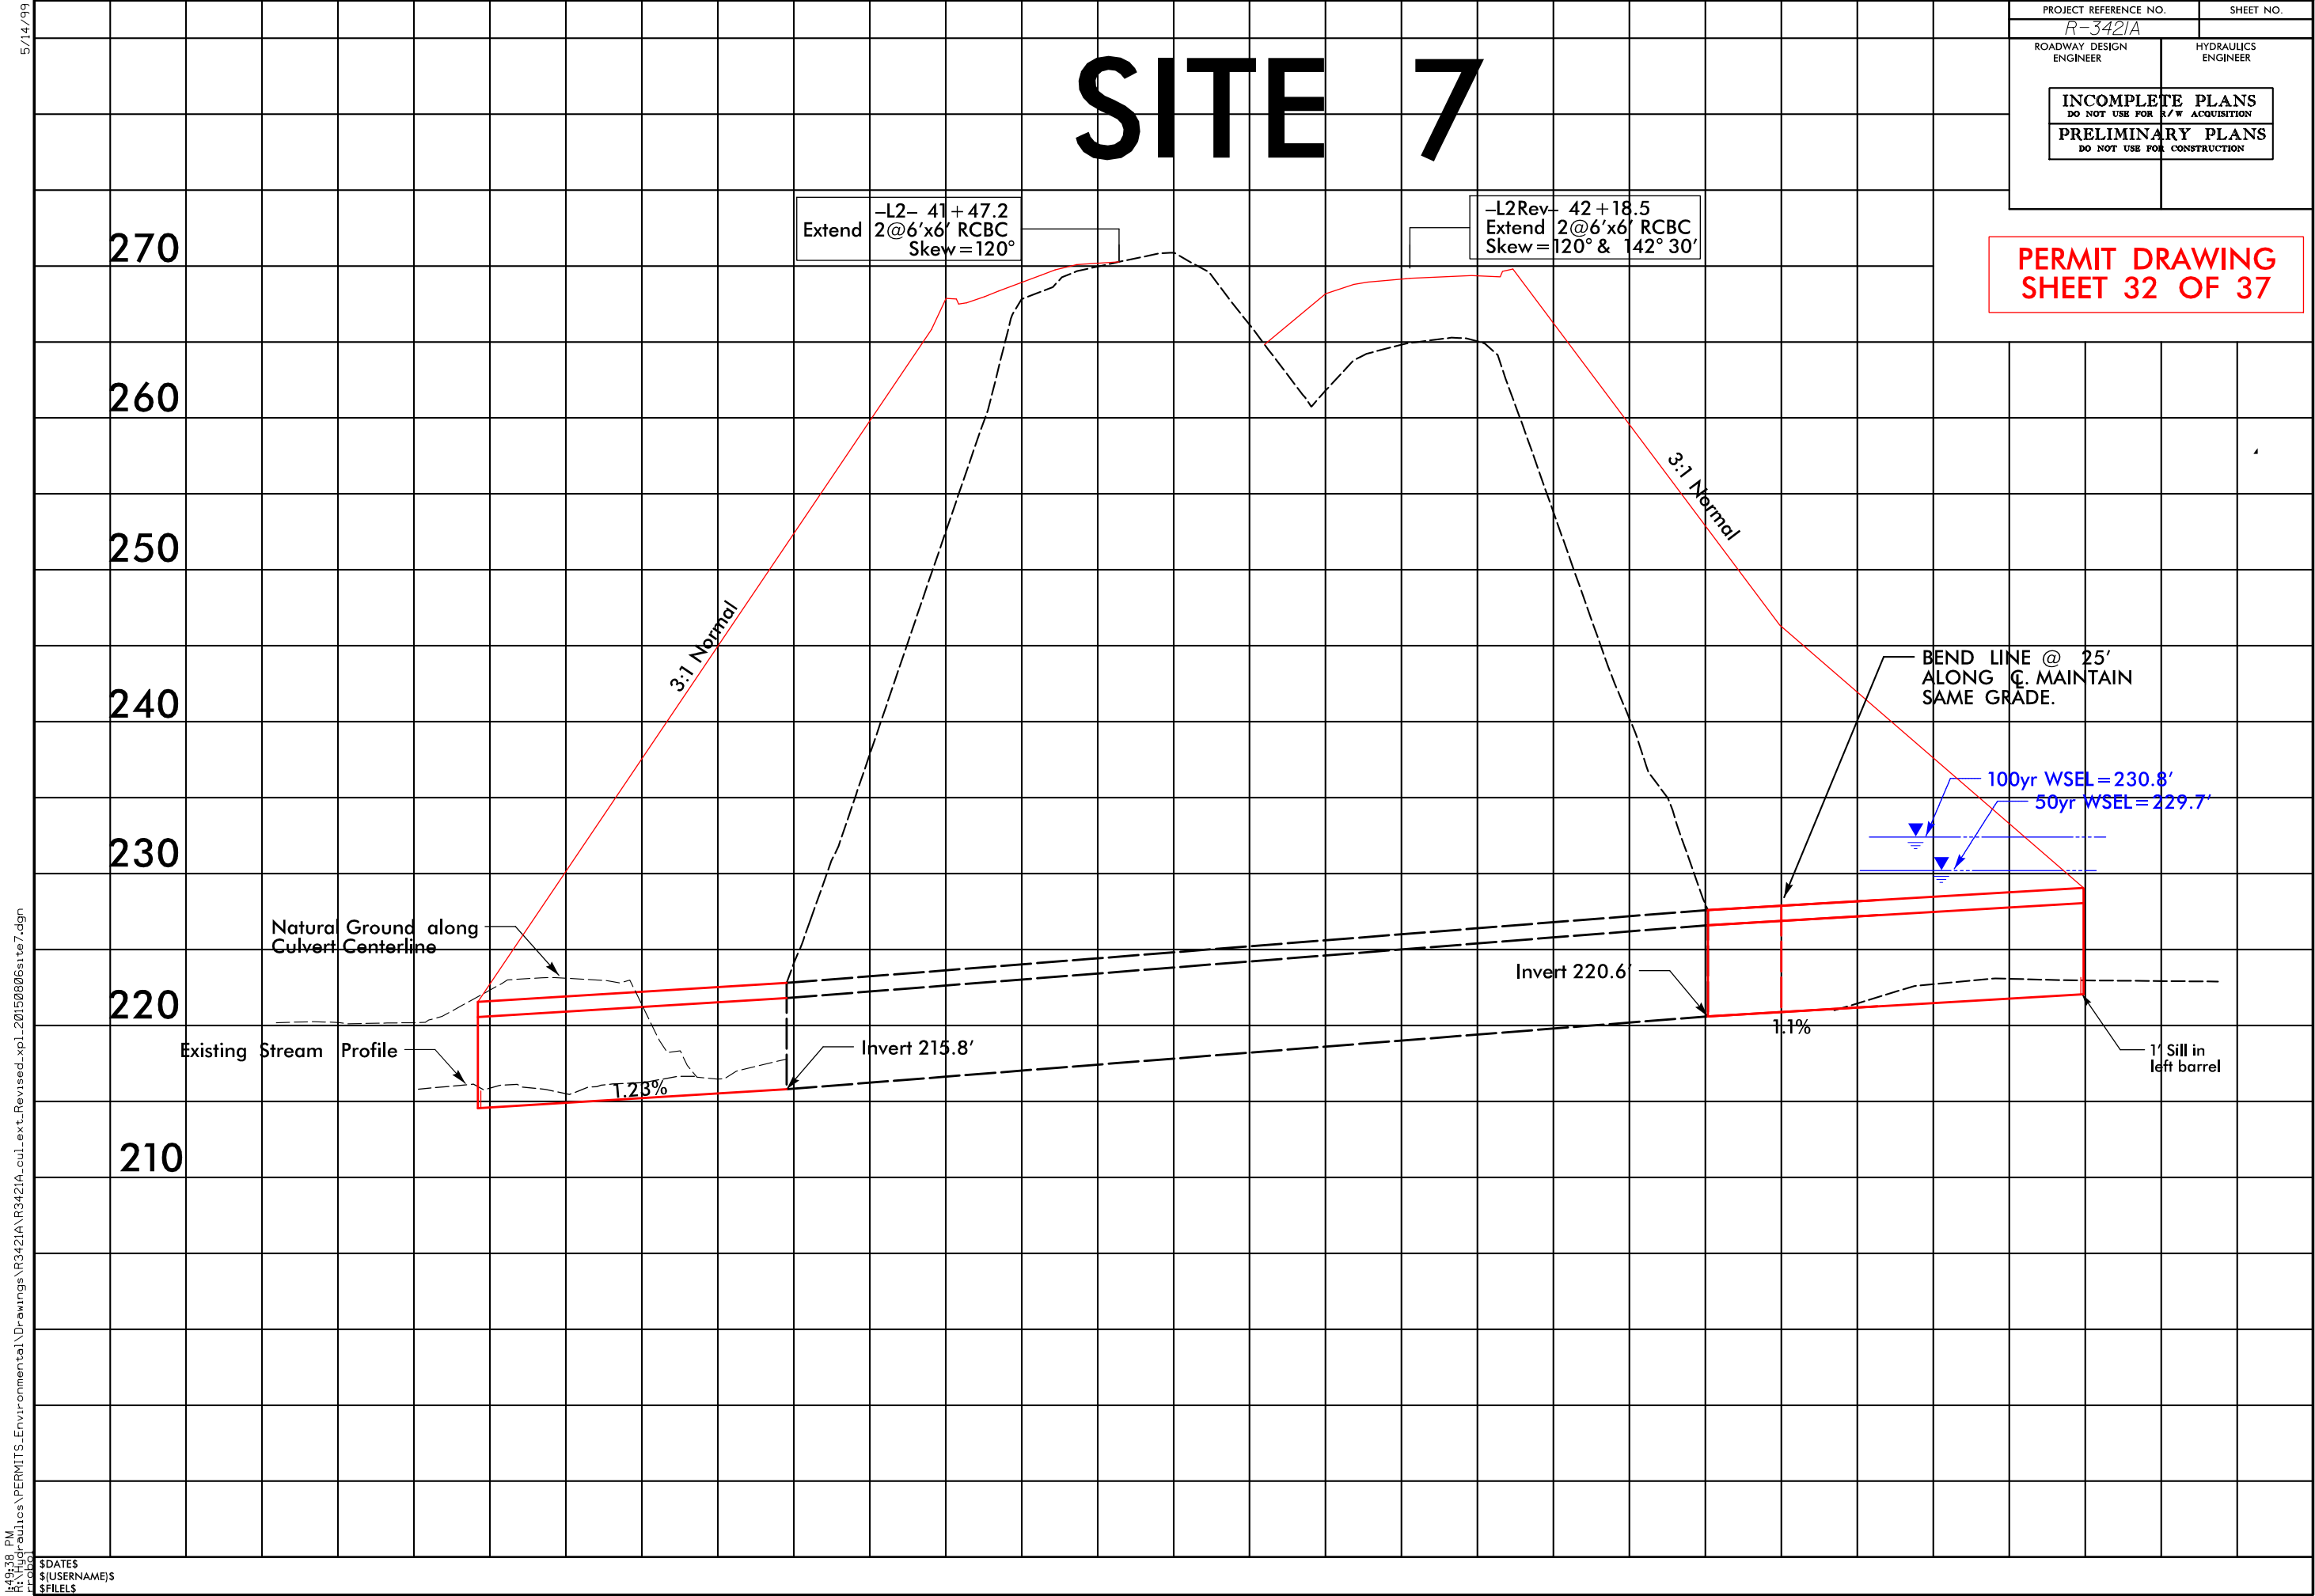

Revised 7/25/2019

8/17/99


149:44 PM
R:\Hydraulics\PERMITS\Environmental\Drawings\R3421A\3421a_hyd_prm_psh16_20150209.dgn

SDATES
S(USERNAME)S
SFILELS



REVISIONS

PROJECT REFERENCE NO. R-3421A		SHEET NO. 16	
R/W SHEET NO.			
ROADWAY DESIGN ENGINEER		HYDRAULICS ENGINEER	
INCOMPLETE PLANS DO NOT USE FOR R/W ACQUISITION		PRELIMINARY PLANS DO NOT USE FOR CONSTRUCTION	

PERMIT DRAWING
SHEET 33 OF 37

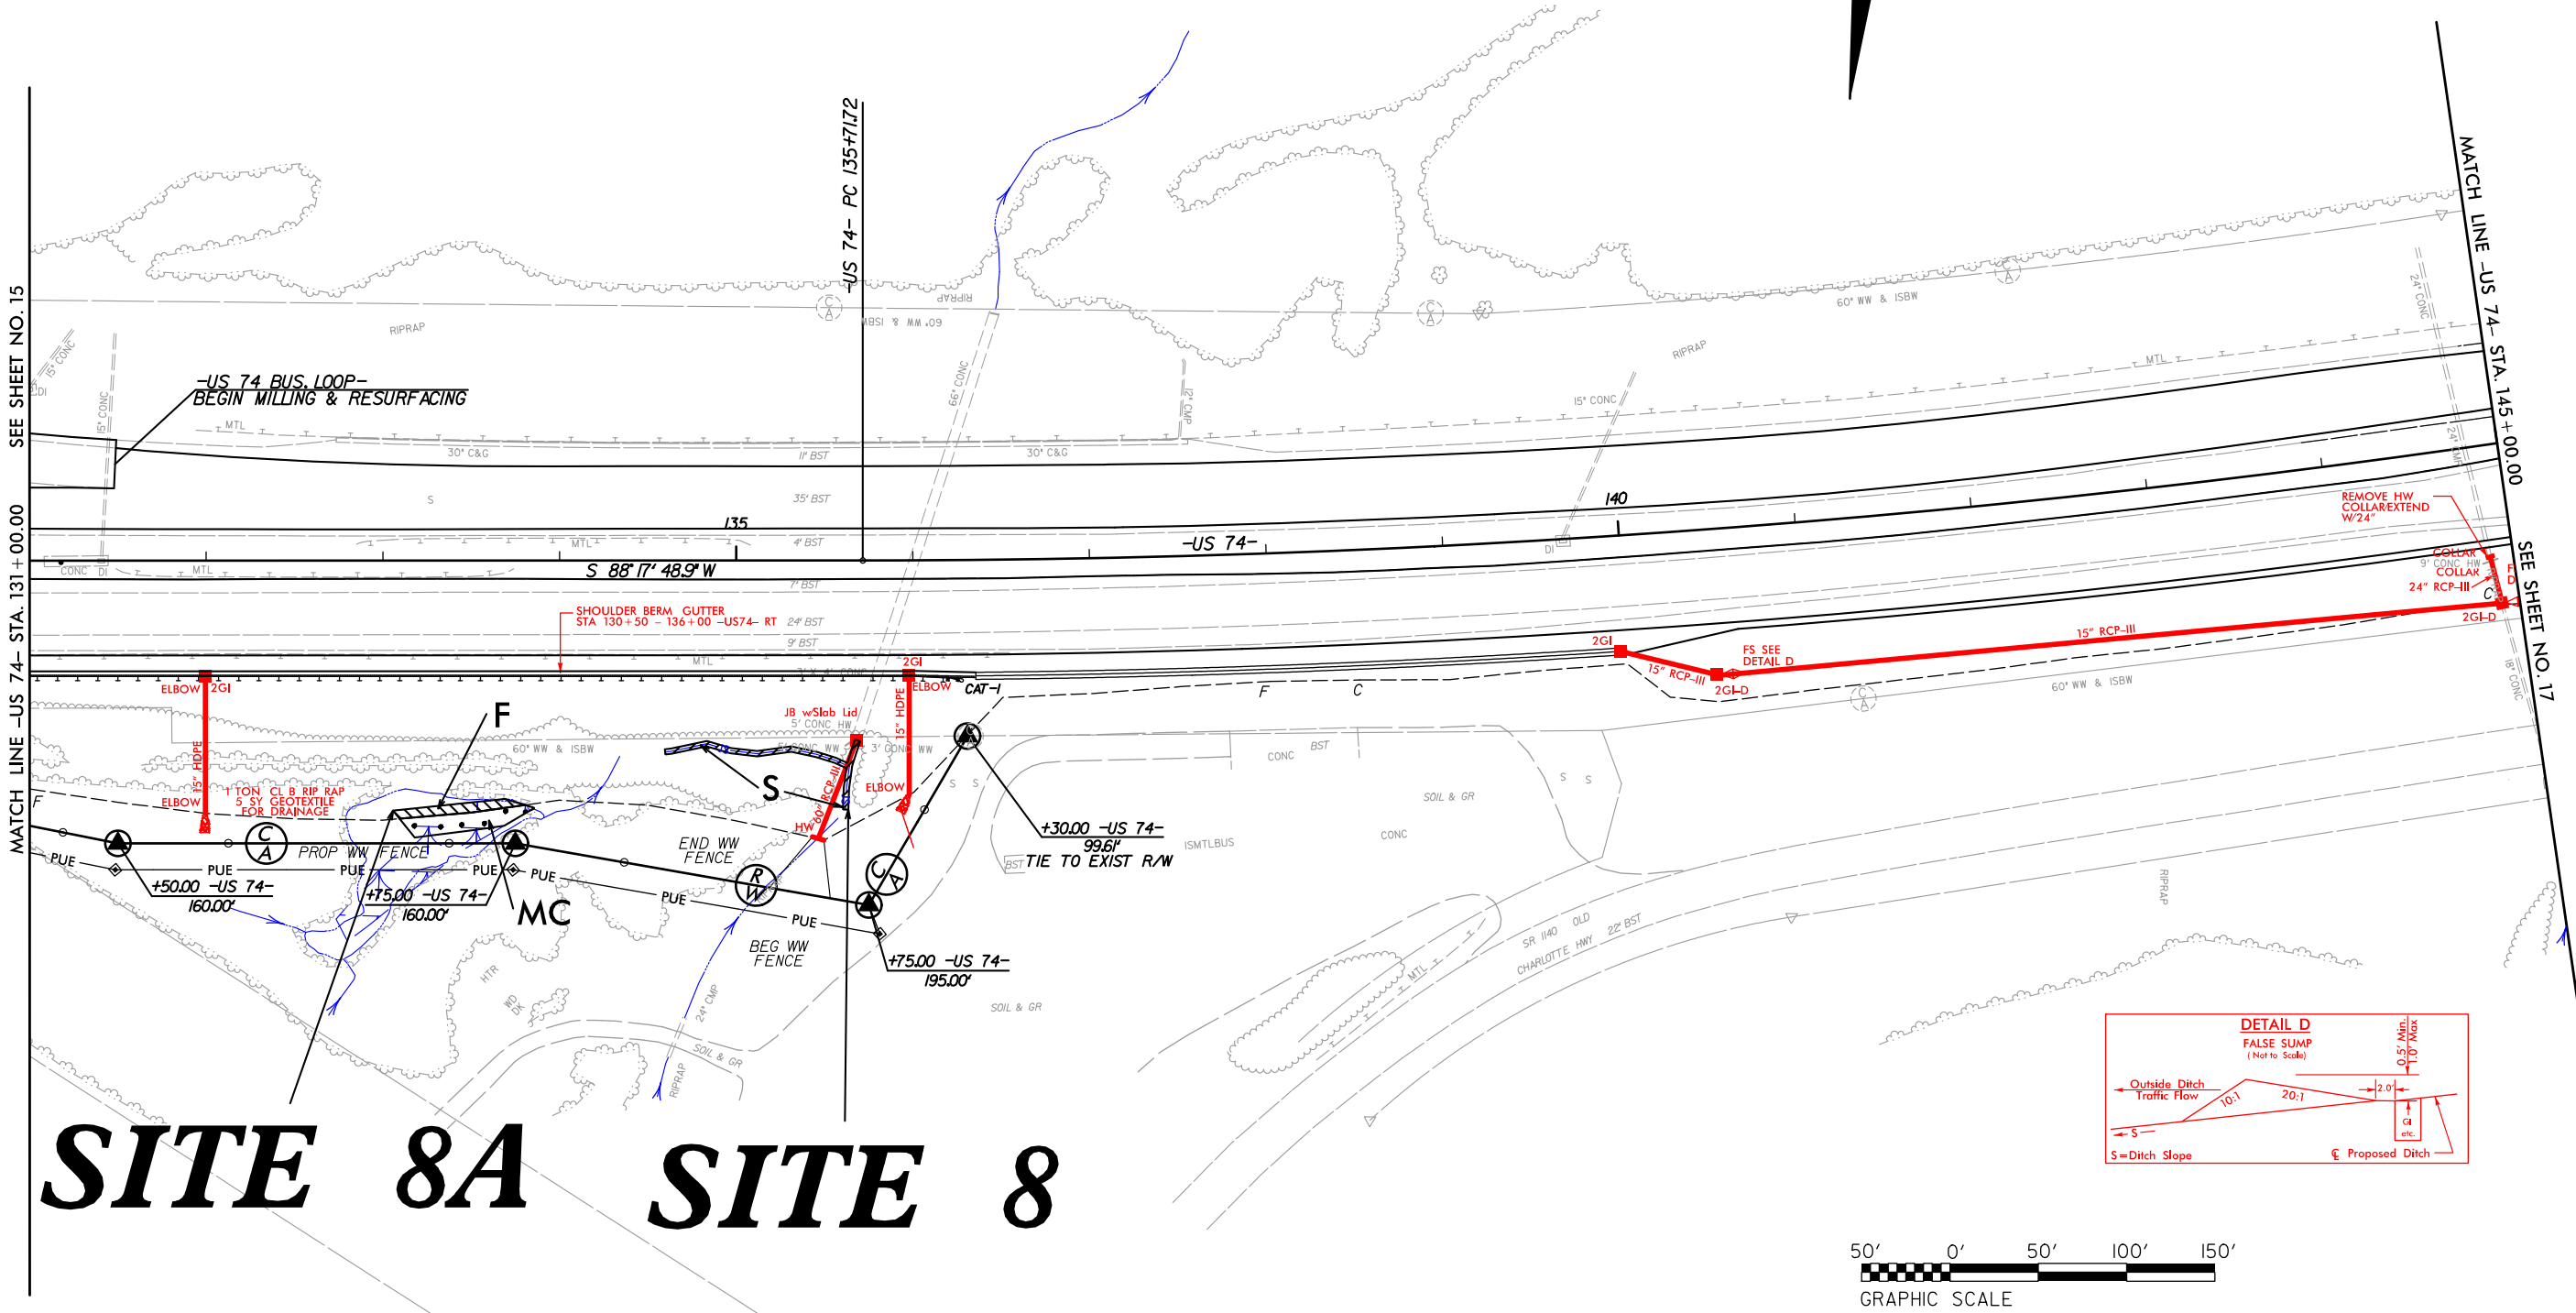

SITE 8A SITE 8

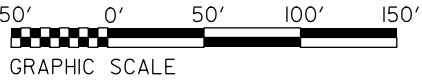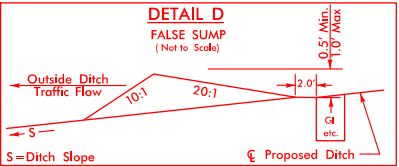

- DENOTES IMPACTS IN SURFACE WATER
- DENOTES FILL IN WETLAND
- DENOTES MECHANIZED CLEARING

R:\Hydraulics\PERMITS_Environmental\Drawings\R3421A\r3421a_hyd-prm_psh16-20150209_con.dgn

PERMIT DRAWING
SHEET 34 OF 37



 DENOTES MECHANIZED CLEARING

Revised 7/25/2019

8/17/99


REVISIONS

\\Fs4954.PM
R:\Hydraulics\PERMITS\Environmental\Drawings\R3421A\Hyd\prj\psh16_enlarge_site8_20150624.dgn

\$DATES
\$(USERNAME)\$
\$FILE\$

PROJECT REFERENCE NO.	SHEET NO.
R-3421A	16
R/W SHEET NO.	
ROADWAY DESIGN ENGINEER	HYDRAULICS ENGINEER
PRELIMINARY PLANS DO NOT USE FOR CONSTRUCTION	


PERMIT DRAWING
SHEET 35 OF 37

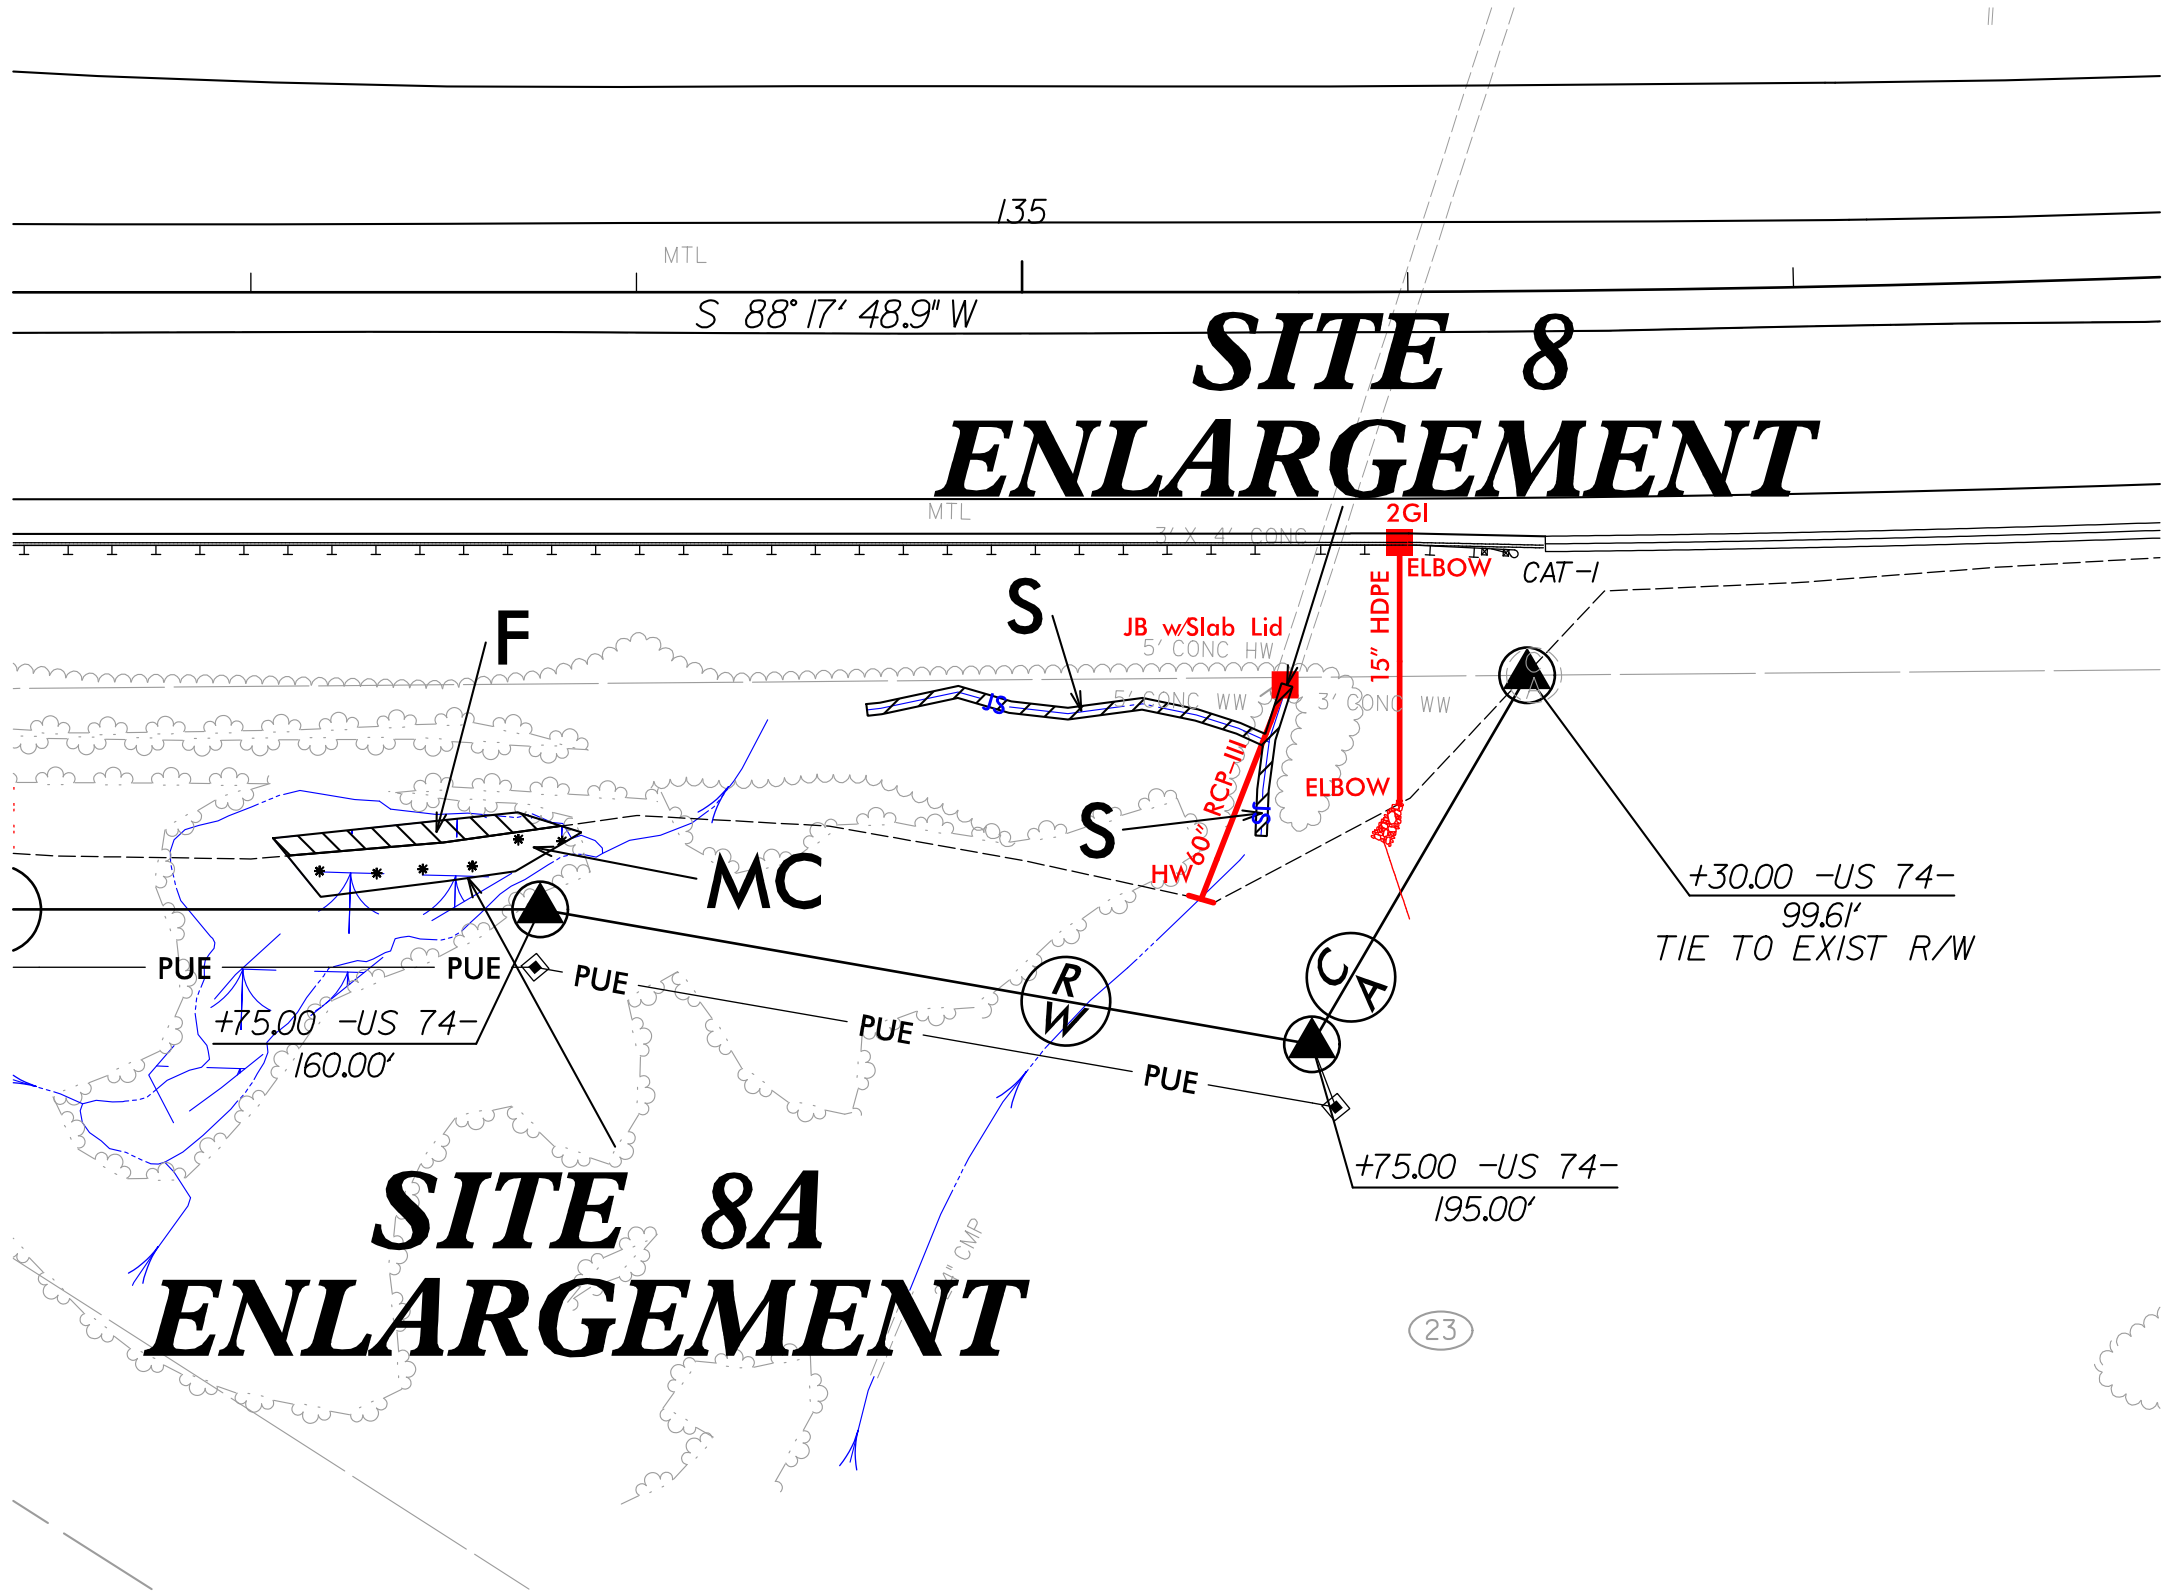

DENOTES IMPACTS IN
SURFACE WATER



DENOTES FILL IN
WETLAND

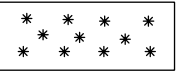

DENOTES MECHANIZED
CLEARING

**PERMIT DRAWING
SHEET 36 OF 37**

50' 0' 50'



GRAPHIC SCALE

DENOTES IMPACTS IN
SURFACE WATER

DENOTES FILL IN WETLAND


**DENOTES MECHANIZED
CLEARING**

8/17/99

REVISIONS

R:\Hydraulics\PERMITS_Environmental\Drawings\R3421A\psh16-enlarge site8-20150624_con.dgn

```
$DATE$
$(USERNAME)$
$FILE$
```

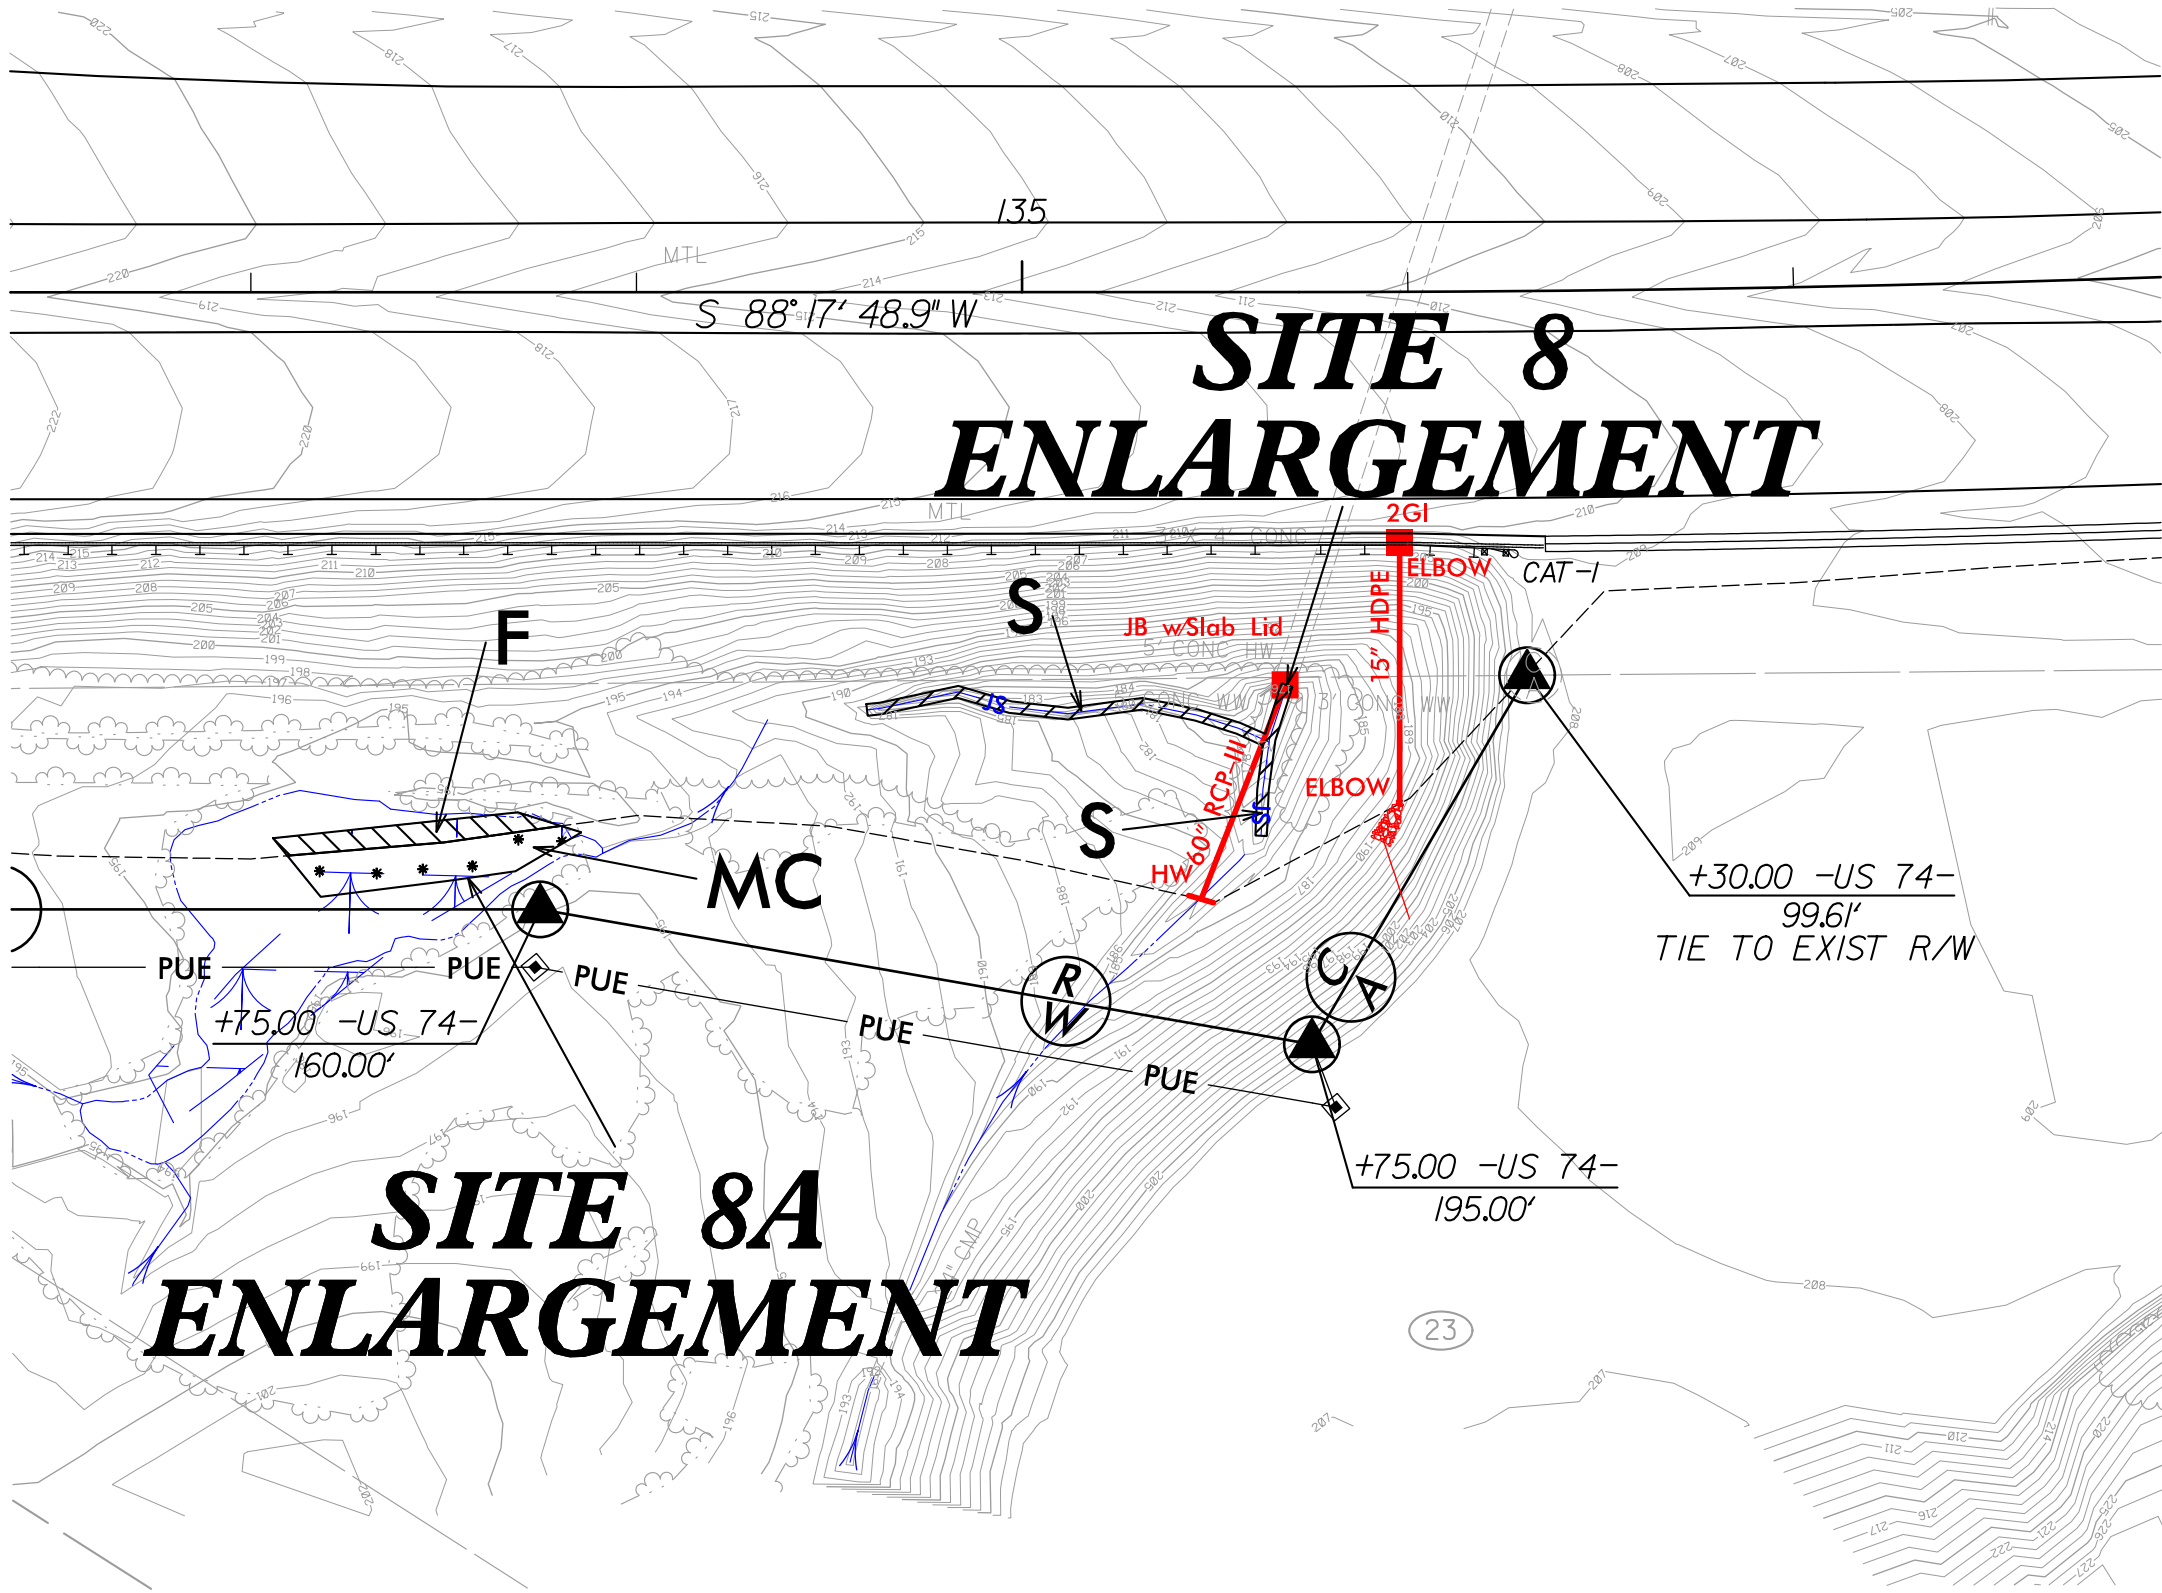

WETLAND PERMIT IMPACT SUMMARY												
Site No.	Station (From/To)	Structure Size / Type	WETLAND IMPACTS					SURFACE WATER IMPACTS				
			Permanent Fill In Wetlands (ac)	Temp. Fill In Wetlands (ac)	Excavation in Wetlands (ac)	Mechanized Clearing in Wetlands (ac)	Hand Clearing in Wetlands (ac)	Permanent SW impacts (ac)	Temp. SW impacts (ac)	Existing Channel Impacts Permanent (ft)	Existing Channel Impacts Temp. (ft)	Natural Stream Design (ft)
1	24+53 / 26+88 -FLY-	PROP PIPE SYSTEM						0.03	< 0.01	411	10	
2	94+76 / 98+53 -I-73-	TRIPLE BARREL	0.48					0.25	0.02	1011	50	
		CULVERT EXTENSIONS										
3	12+62 / 14+03 -LPC-	PROP 3-BARREL CULVERTS						0.09	0.02	475	106	
3A	12+90 / 13+44 -LPC-RT	60" RCP EXTENSION						< 0.01		81		
		PROP 3-BARREL CULVERTS										
3B	28+02 / 28+38 -L2REV-	PROP 66" RCP						< 0.01	< 0.01	61	10	
4	108+56 / 109+94 -I-73-	PROP 48" RCP						0.01	< 0.01	205	12	
5	10+00 / 11+96 -RPD-	PROP 60" RCP						0.02	< 0.01	327	25	
5A	10+34 / 10+71 -RPD-	PROP 60" RCP						< 0.01	< 0.01	118	10	
6	126+44 / 126+91 -I-73-	CLEARING FOR ROADWAY FILL				< 0.01						
7A	35+17 / 35+87 -RPC-	PROP CULVERTS						< 0.01	< 0.01	127	10	
7 SOUTH	31+62 / 38+32 -RPC-	PROP CULVERTS, 18"RCP, STREAM REALIGN			0.15	0.02		0.11	< 0.01	828	10	
7 NORTH	42+60 / 43+90 -L2REV-	CULVERTS EXTENSIONS, PROP CULVERT &						0.03	< 0.01	175	12	
8	134+60 / 135+70 -US 74-	60" RCP EXTENSION						0.01		147		
8A	133+06 / 133+86 -US 74-	ROADWAY FILL	< 0.01			0.02						
TOTALS*:			0.48		0.15	0.05		0.58	0.05	3966	255	0

*Rounded totals are sum of actual impacts

NOTES:

NC DEPARTMENT OF TRANSPORTATION
DIVISION OF HIGHWAYS
5/28/2019
RICHMOND COUNTY
R-3421A
WBS 34542.1.1

		North Carolina Department of Transportation Highway Stormwater Program STORMWATER MANAGEMENT PLAN FOR NCDOT PROJECTS					
(Version 2.08; Released April 2018)							
WBS Element: 34542.1.FR3		TIP No.: R-3421B		County(ies): Richmond		Page 1 of 3	
General Project Information							
WBS Element:		34542.1.FR3		TIP Number: R-3421B		Project Type: New Location	
NCDOT Contact:		Mr. Galen Cail, PE		Contractor / Designer:		Date: 7/30/2019	
Address:		1000 Birch Ridge Drive Raleigh, NC		Address:			
Phone:		919-707-6711		Phone:			
Email:		gcail@ncdot.gov		Email:			
City/Town:				County(ies):		Richmond	
River Basin(s):		Yadkin-Pee Dee		CAMA County?		No	
Wetlands within Project Limits?		Yes					
Project Description							
Project Length (lin. miles or feet):		4.30		Surrounding Land Use:		Agricultural, Rural, Residential	
		Proposed Project		Existing Site			
Project Built-Up Area (ac.)		52.1 ac.		N/A ac.			
Typical Cross Section Description:		46' Grass median, 2@12' paved inside shoulders, 2@12' lanes each direction, 12' paved outside shoulder, grass roadway ditches.		N/A			
Annual Avg Daily Traffic (veh/hr/day):		Design/Future: 19,980		Year: 2036		Existing: N/A	
General Project Narrative: (Description of Minimization of Water Quality Impacts)		R-3421B is an interchange and bypass project (US220 Bypass, I-73/I-74) which will include a 46' grass median with 2@12' travel lanes in each direction. The project also includes grass lined roadway ditches. The proposed project includes 1 major drainage structure (3 barrel RCBC), which will convey an unnamed tributary to Cartledge Creek. The culvert will include sills and utilize Low Flow Benches to maintain low flow in two barrels. Rip Rapped Energy Dissipators will be utilized at the outlets of a 30" pipe and a 36" pipe to prevent erosion at the outlets.					
Waterbody Information							
Surface Water Body (1):		Un-named Trib to Cartledge Creek		NCDWR Stream Index No.:		UT to 13 - 35	
NCDWR Surface Water Classification for Water Body		Primary Classification:		Class C			
		Supplemental Classification:					
Other Stream Classification:		None					
Impairments:		None					
Aquatic T&E Species?		No		Comments:			
NRTR Stream ID:				Buffer Rules in Effect:		N/A	
Project Includes Bridge Spanning Water Body?		No		Deck Drains Discharge Over Buffer?		N/A	
Deck Drains Discharge Over Water Body?		N/A		(If yes, provide justification in the General Project Narrative)		(If yes, describe in the General Project Narrative; if no, justify in the General Project Narrative)	
(If yes, provide justification in the General Project Narrative)							



FOR NCDOT PROJECTS

Page 2 of 3

The design for R-3421B includes typical grassed cut ditches within the roadway footprint. These ditches are collecting runoff from the impervious roadway surfaces and transporting to inlets and pipes. The geometry of the typical cut ditches contain side slopes ranging from 2:1 to 8:1 and mild longitudinal slopes. Although no grassed swale treatment credit is claimed for this project or required many reaches of the grassed ditches/swales will meet the criteria for grassed swale treatment.

Revised 7/30/19



Page 3 of 3

Additional Comments


* Refer to the NCDOT Best Management Practices Toolbox (2014), NCDOT Standards, the Federal Highway Administration (FHWA) Hydraulic Engineering Circular No. 14 (HEC-14), Third Edition, Hydraulic Design of Energy Dissipators for Culverts and Channels (July 2006), as applicable, for design guidance and criteria.

Revised 7/30/19

09/08/99

TIP PROJECT: R-3421B

See Sheet 1-A For Index of Sheets
See Sheet 1-B For Conventional Symbols

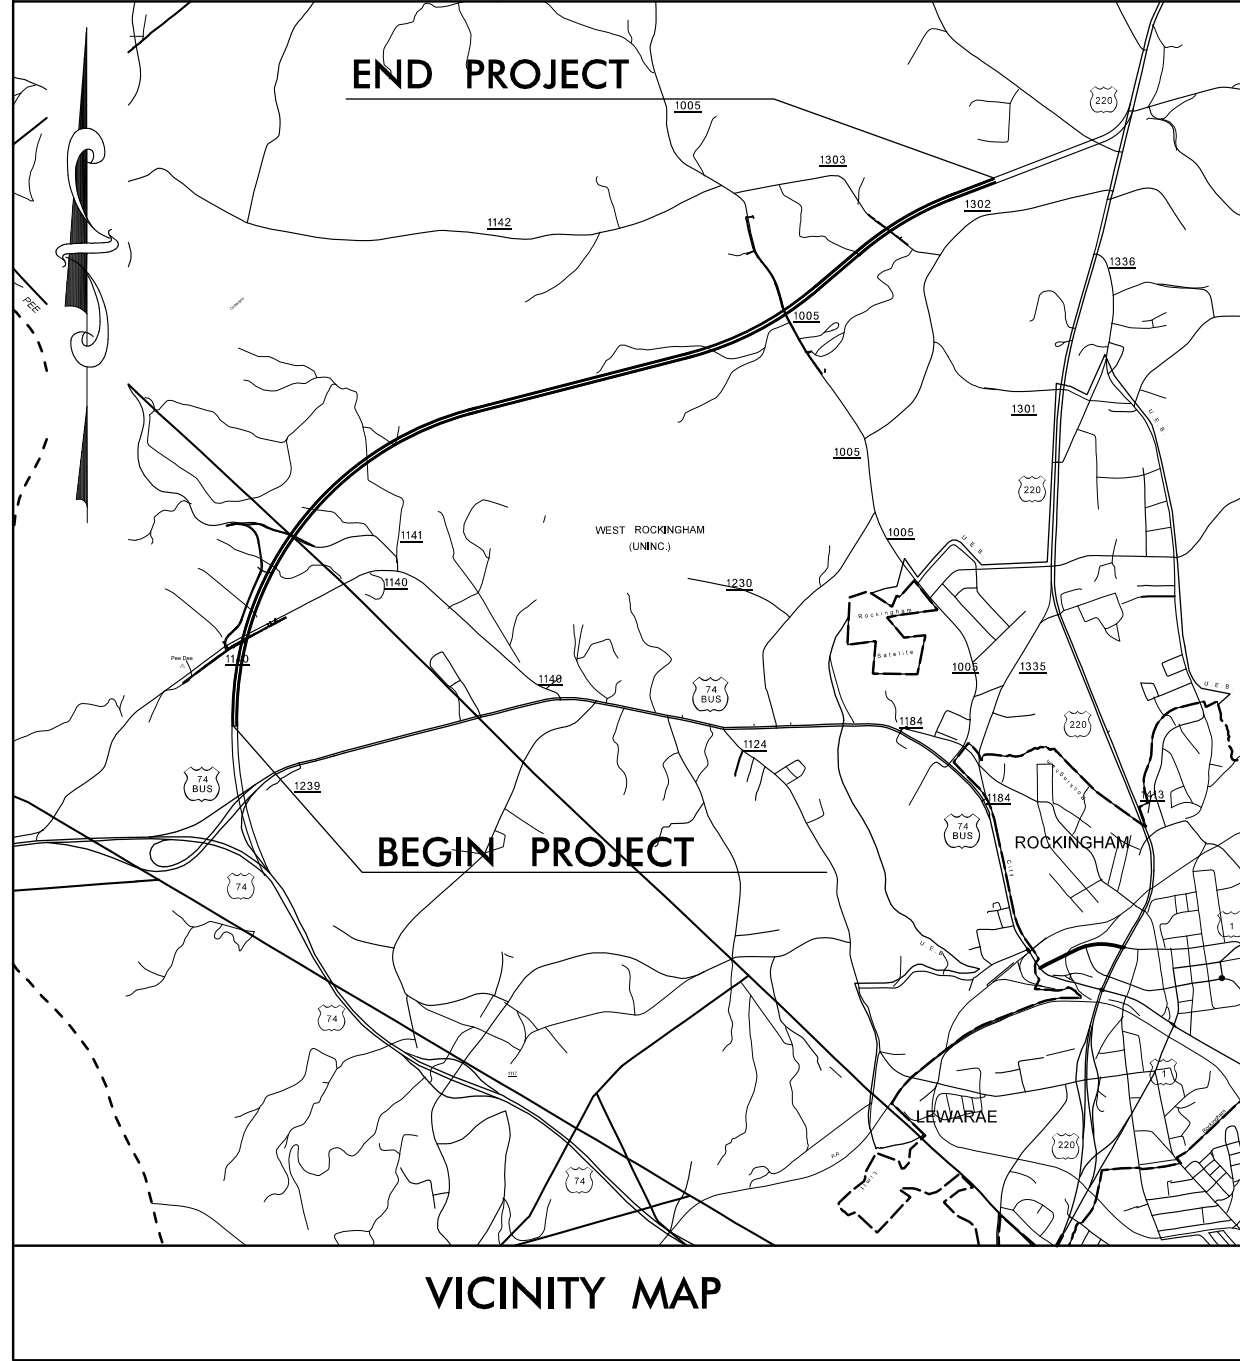

VICINITY MAP



STATE OF NORTH CAROLINA DIVISION OF HIGHWAYS RICHMOND COUNTY

LOCATION: I-7374 FROM 0.3 MILES SOUTH OF SR 1140 (OLD CHARLOTTE HIGHWAY) TO 0.2 MILES SOUTHWEST OF SR 1304 (HARRINGTON ROAD)

TYPE OF WORK: GRADING, PAVING, DRAINAGE, CULVERTS, STRUCTURES, MSE RETAINING WALLS, AND SIGNING

WETLAND AND SURFACE WATER IMPACTS PERMIT

PERMIT DRAWING
SHEET 1 OF 71

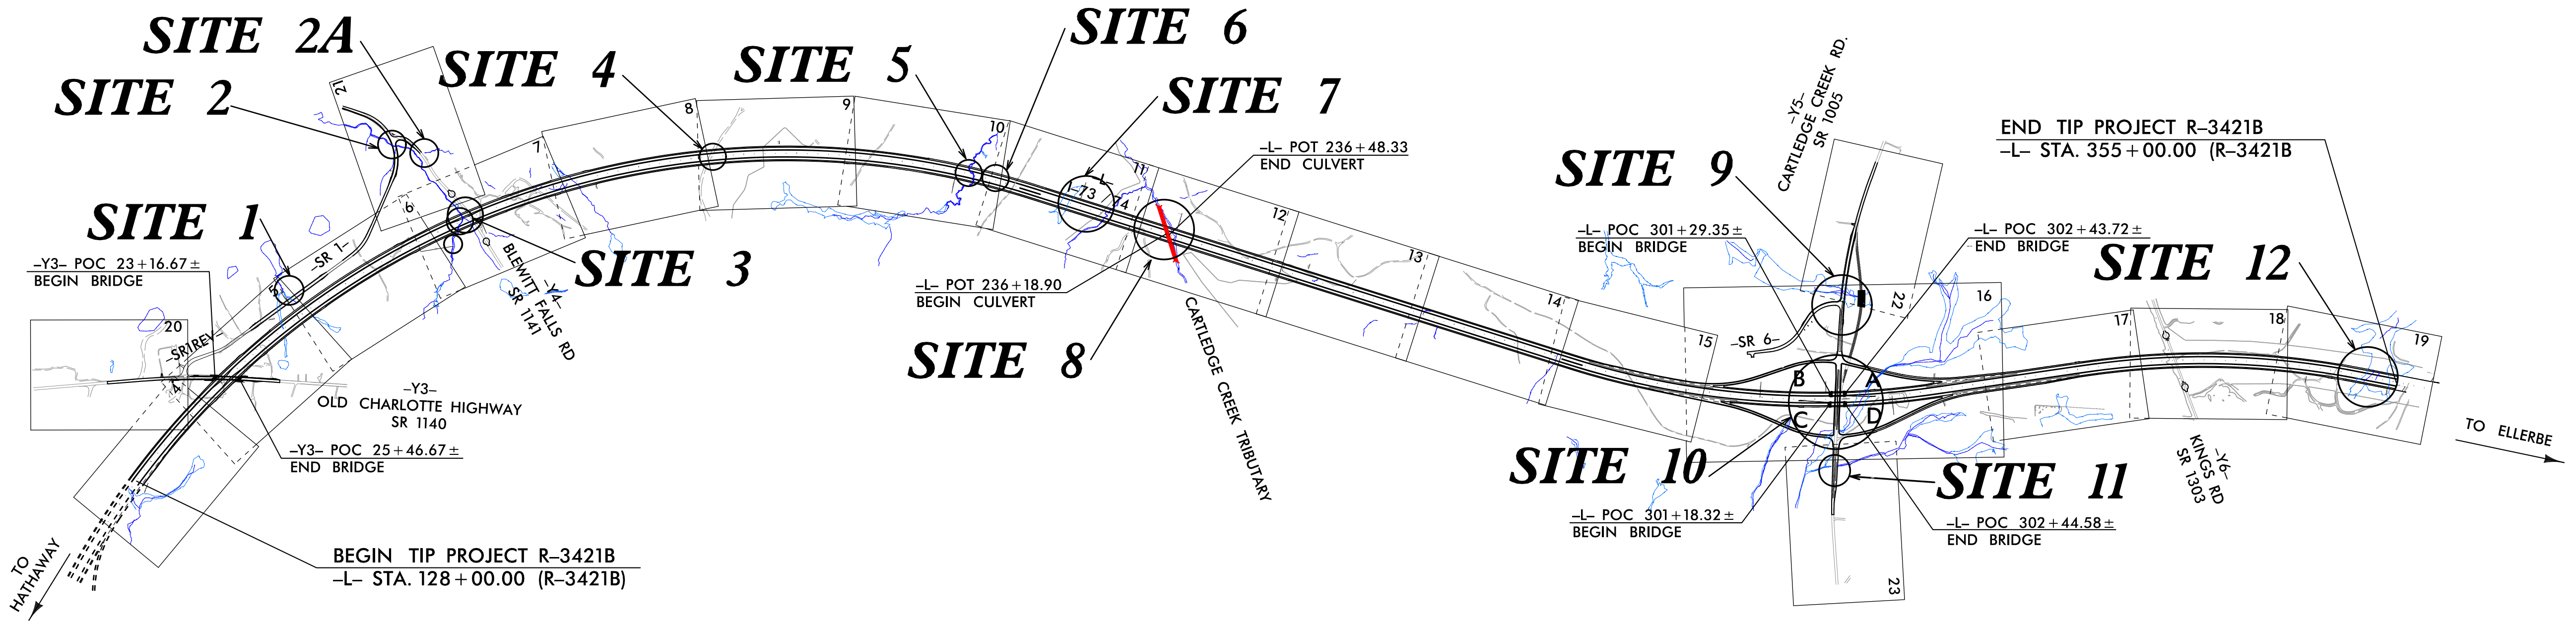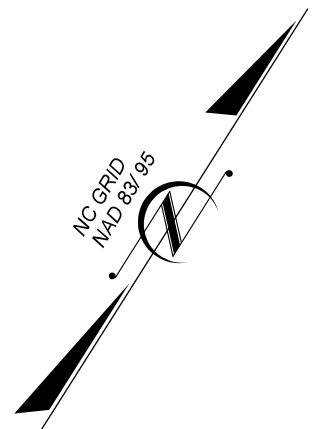

MULKEY
ENGINEERS & CONSULTANTS
PO BOX 323127
RALEIGH, N.C. 27636
(919) 851-1512
(919) 851-1518 (FAX)
WWW.MULKEY-INC.COM

NOTE:
THIS PROJECT IS A CONTROLLED ACCESS PROJECT
WITH ACCESS LIMITED TO THE INTERCHANGE.

GRAPHIC SCALES



PLANS



PROFILE (HORIZONTAL)



PROFILE (VERTICAL)

DESIGN DATA

ADT 2016 = 10,400
ADT 2036 = 19,980

K = 10%
D = 60%
T = 26% *
V = 70 mph

* (Duals = 9% + TTST = 17%)
Functional Class.: Interstate
statewide ties

PROJECT LENGTH

LENGTH ROADWAY TIP PROJECT R-3421B = 4.270 MILES

LENGTH STRUCTURES TIP PROJECT R-3421B = 0.029 MILES

TOTAL LENGTH TIP PROJECT R-3421B = 4.299 MILES

-L- LINE USED FOR PROJECT LENGTH

Prepared in the Office of:
Mulkey Engineers & Consultants
FOR THE NORTH CAROLINA DEPARTMENT OF TRANSPORTATION

2012 STANDARD SPECIFICATIONS

RIGHT OF WAY DATE:
SEPTEMBER 23, 2009

LETTING DATE:
FEB 16, 2016
(PRODUCTION)

NCDOT CONTACT: REKHA PATEL, PE
ROADWAY DESIGN - PROJECT ENGINEER

JOHNNY BANKS
MULKEY E & C
PROJECT MANAGER

STEVE BROWDE, PE
MULKEY E & C
PROJECT DESIGN ENGINEER


HYDRAULICS ENGINEER

SIGNATURE: _____ P.E.

ROADWAY DESIGN
ENGINEER

SIGNATURE: _____ P.E.

DIVISION OF HIGHWAYS STATE OF NORTH CAROLINA

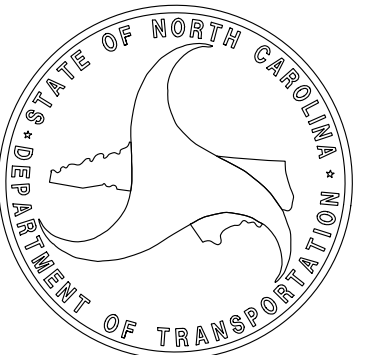

STATE HIGHWAY DESIGN ENGINEER

SDATES
SUSERS
SFILES
12:30 AM
R:\Hydraulics\PERMITS_Environmental\Drawings\R3421B\R3421B_Hyd_Tsh_20150902.dgn
rrobol

8/17/99

7/2/96 AM
R:\Hydraulics\PERMITS\Environmental\Drawings\R3421B\Hyd.prm_wet.psh05_20150701.dgn

SDATES
SUSSENAMEJS
SFILELS

REVISIONS

MATCHLINE TO SHEET 4
-L- STATION 135+00






MATCHLINE TO SHEET 20
-Y3- STATION 18+00.00

MATCHLINE TO SHEET 6
-L- STATION 149+00

PROJECT REFERENCE NO. R-3421A		SHEET NO. 5	
RW SHEET NO.			
ROADWAY DESIGN ENGINEER		HYDRAULICS ENGINEER	
INCOMPLETE PLANS DO NOT USE FOR R/W ACQUISITION			
PRELIMINARY PLANS DO NOT USE FOR CONSTRUCTION			

PERMIT DRAWING
SHEET 2 OF 71


NC GRID
NAD 83/95

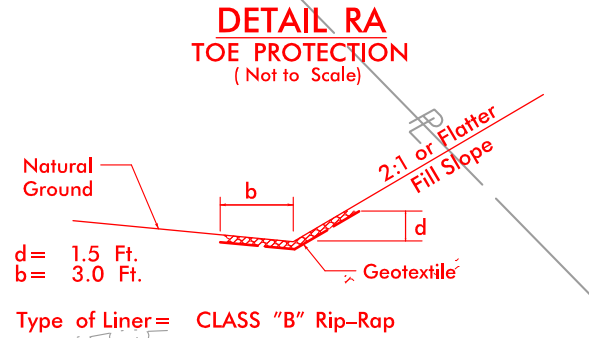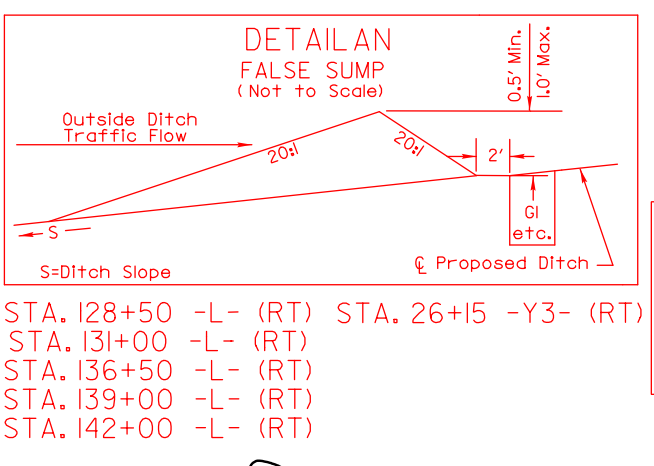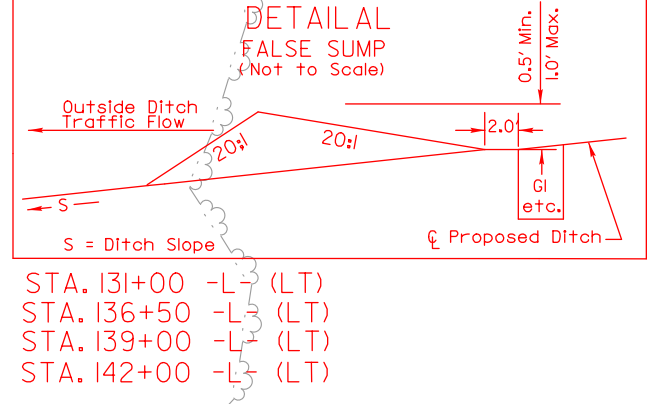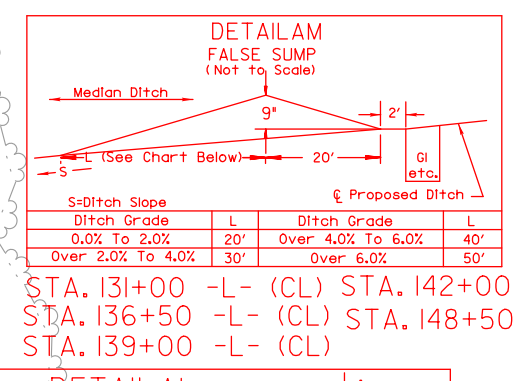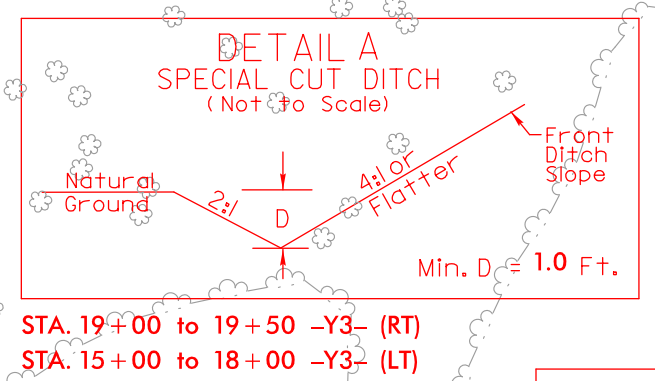


FROM STA. 12+50 -SRIREV- TO STA. 13+00 -SRIREV- LT. (Est. Qty. 27 Tons; 43 SY GEOTEXTILE)
FROM STA. 14+00 -SRIREV- TO STA. 14+50 -SRIREV- LT. (Est. Qty. 28 Tons; 47 SY GEOTEXTILE)
FROM STA. 147+43 -L- TO STA. 149+00 -L- RT. (Est. Qty. 45 Tons; 109 SY GEOTEXTILE)
FROM STA. 21+67 -SRI- TO STA. 22+71 -SRI- LT. (Est. Qty. 41 Tons; 74 SY GEOTEXTILE)



DENOTES FILL IN
WETLAND

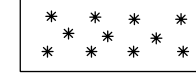

DENOTES MECHANIZED
CLEARING

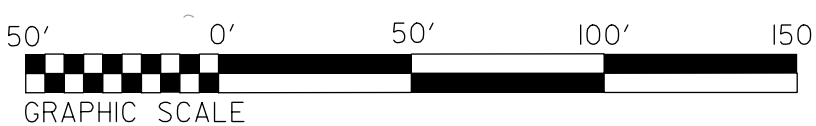

SITE 1

8/17/99

7:42:55 AM
R:\Hydraulics\PERMITS\Environmental\Drawings\R3421B\Hyd.prm_wet_psh05_20150701_con.dgn

SDATES
SUSSENAME\S
FILELS

REVISIONS

MATCHLINE TO SHEET 4
-L- STATION 135+00






MATCHLINE TO SHEET 20
-Y3- STATION 18+00.00

MATCHLINE TO SHEET 6
-L- STATION 149+00


PROJECT REFERENCE NO. R-3421A		SHEET NO. 5	
R/W SHEET NO.			
ROADWAY DESIGN ENGINEER		HYDRAULICS ENGINEER	
INCOMPLETE PLANS DO NOT USE FOR R/W ACQUISITION			
PRELIMINARY PLANS DO NOT USE FOR CONSTRUCTION			

PERMIT DRAWING
SHEET 3 OF 71

NC GRID
NAD 83/95

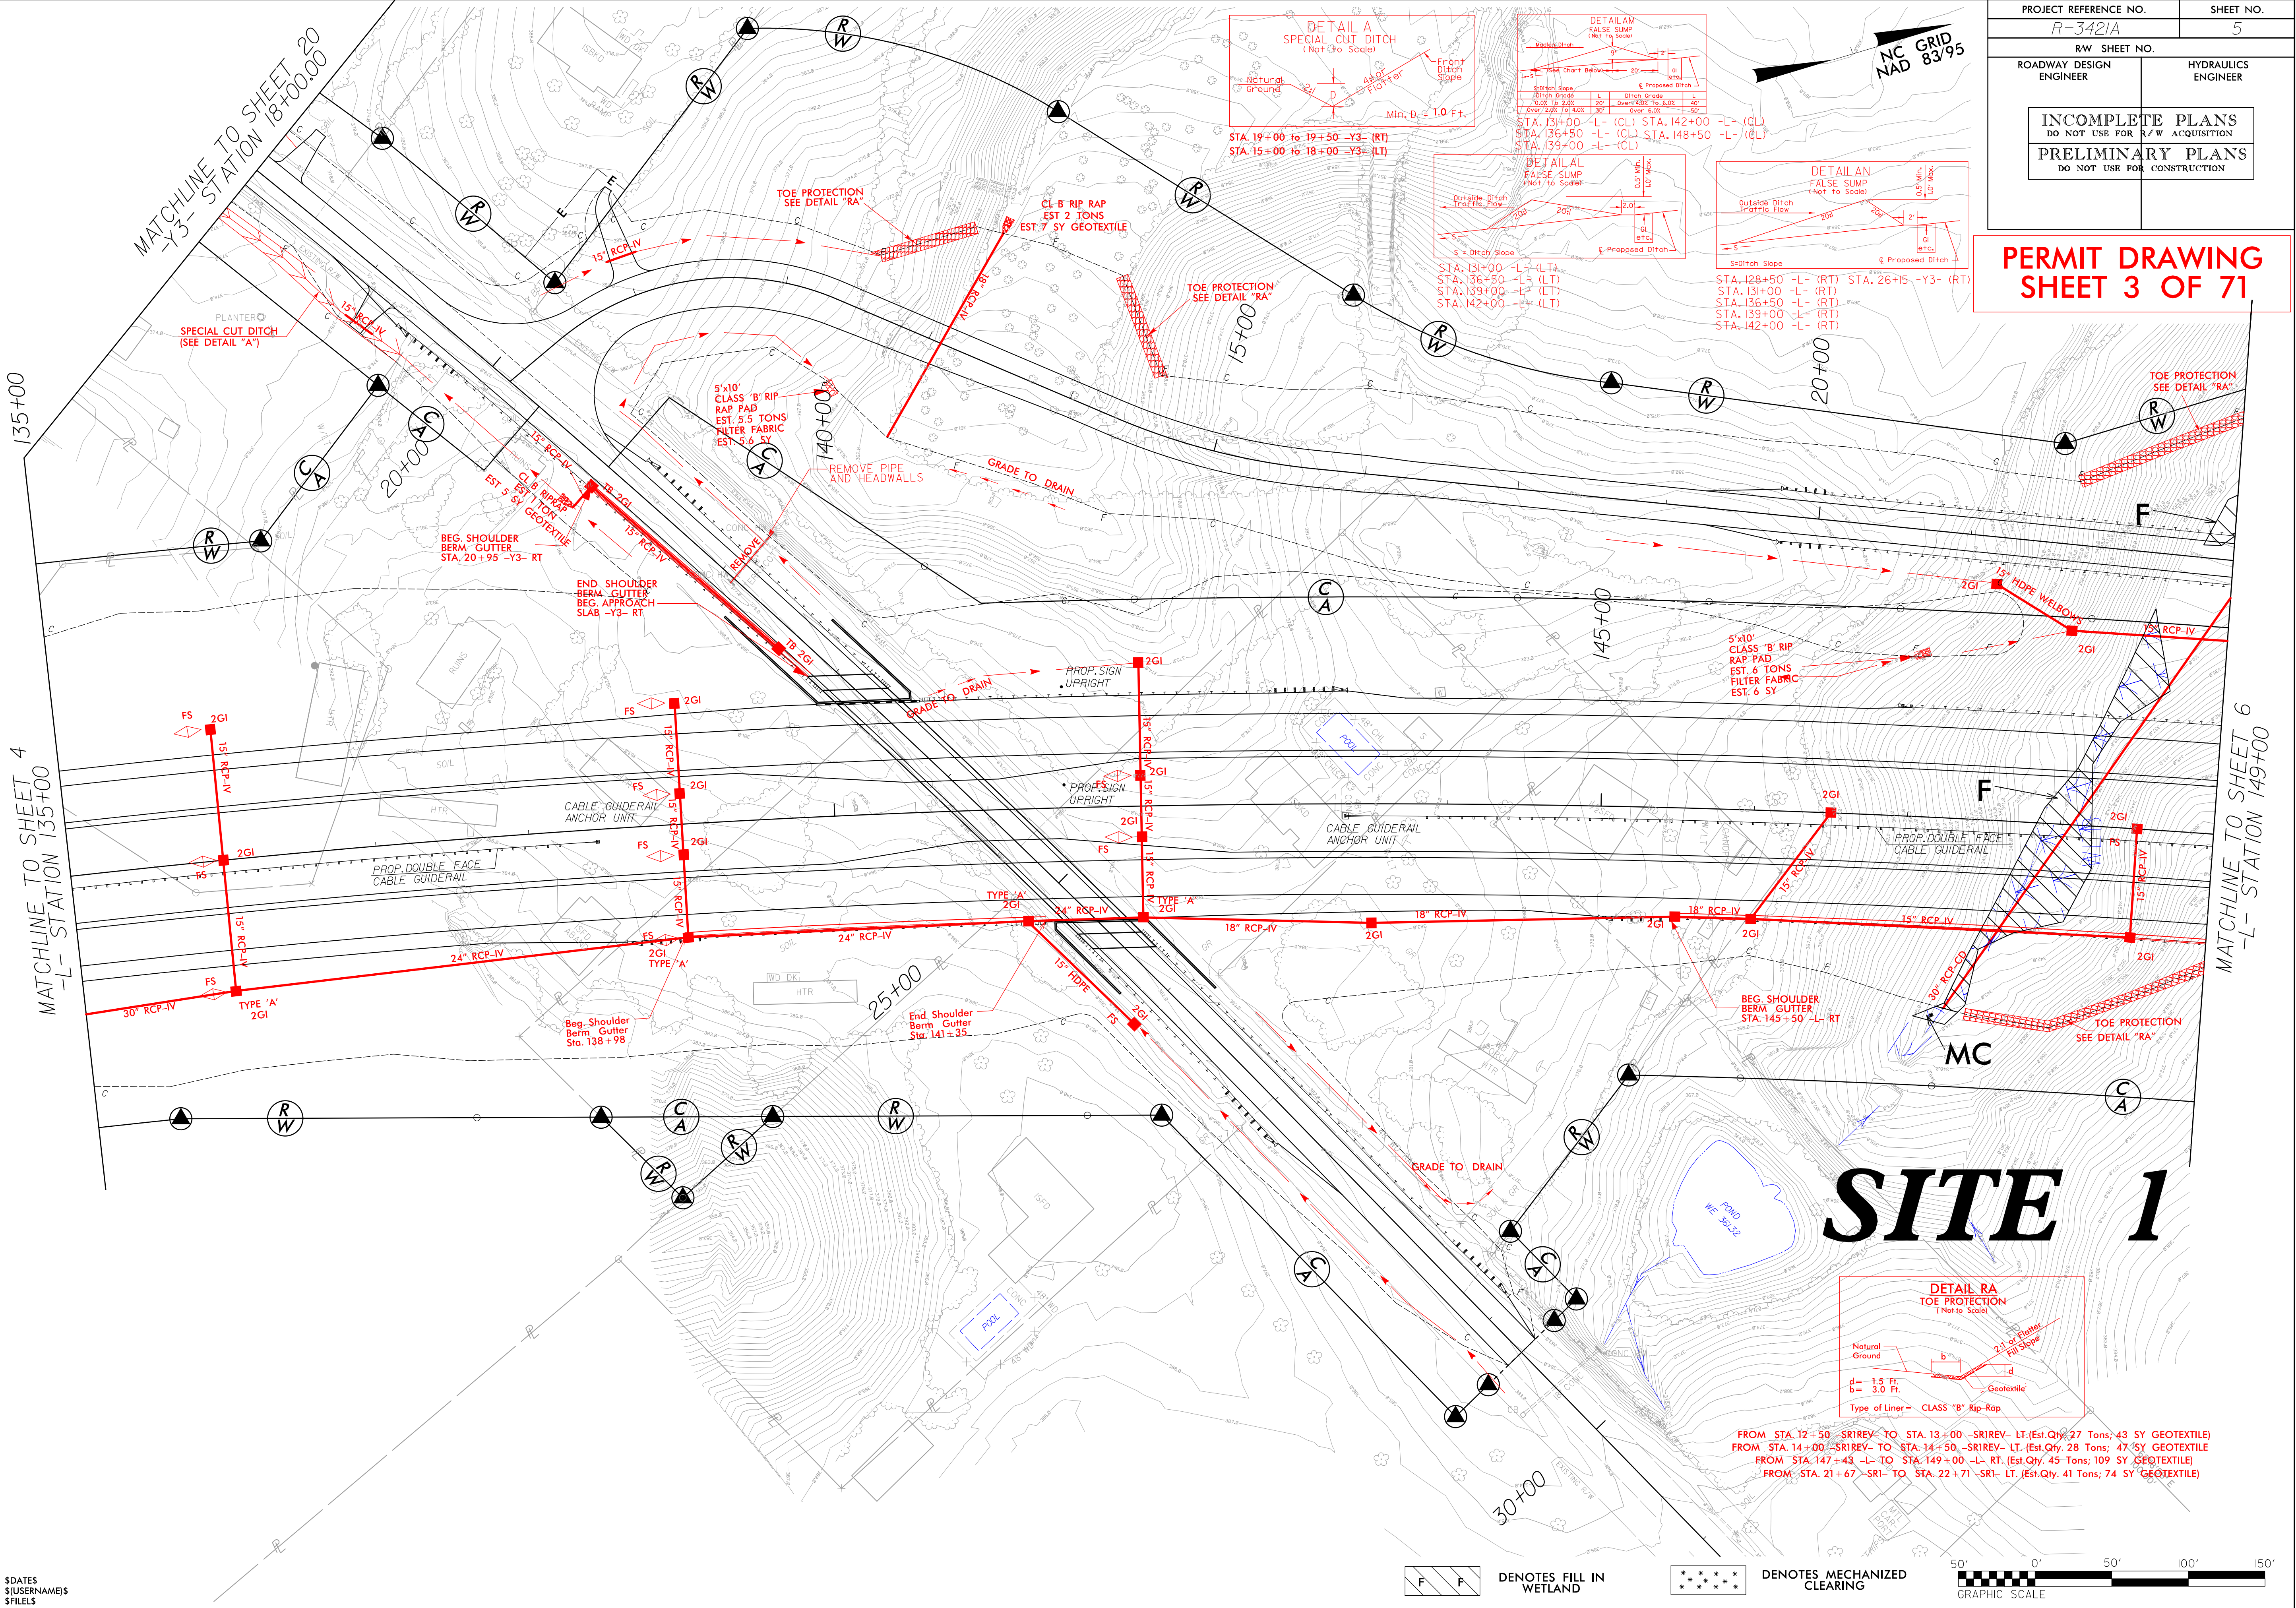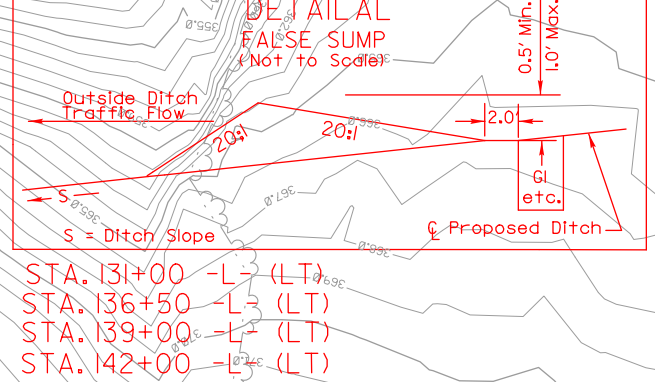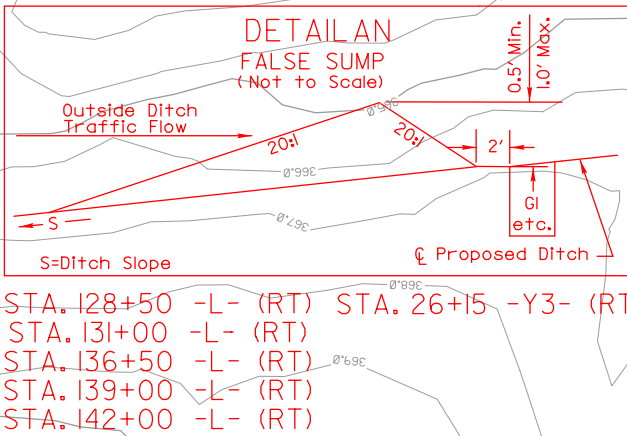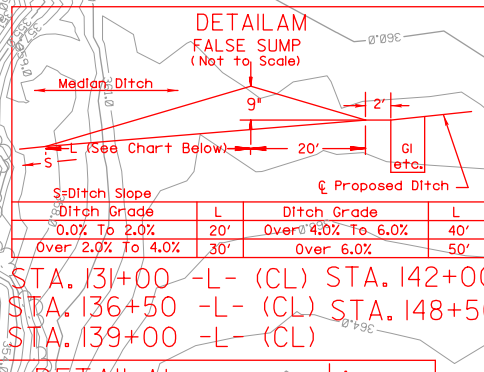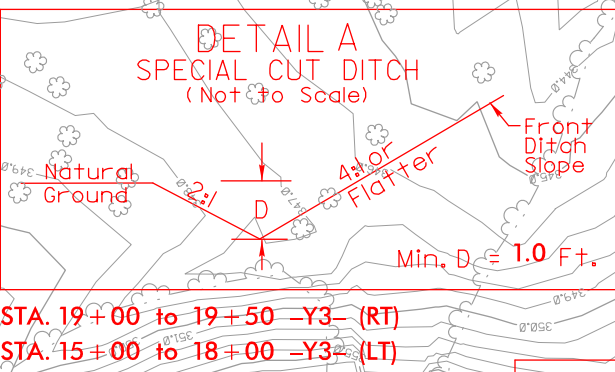


SITE 1

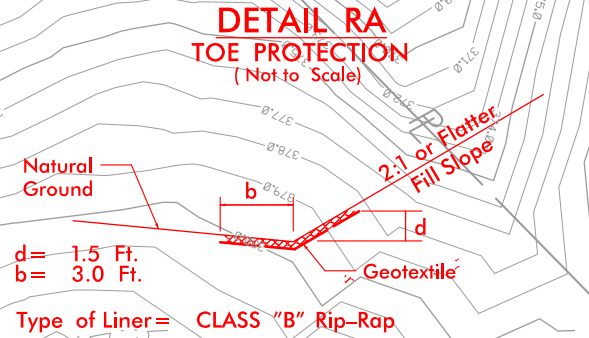


FROM STA. 12+50 -SRREV- TO STA. 13+00 -SRREV- LT. (Est.Qty. 27 Tons; 43 SY GEOTEXTILE)
FROM STA. 14+00 -SRREV- TO STA. 14+50 -SRREV- LT. (Est.Qty. 28 Tons; 47 SY GEOTEXTILE)
FROM STA. 147+43 -L- TO STA. 149+00 -L- RT. (Est.Qty. 45 Tons; 109 SY GEOTEXTILE)
FROM STA. 21+67 -SRI- TO STA. 22+71 -SRI- LT. (Est.Qty. 41 Tons; 74 SY GEOTEXTILE)



DENOTES FILL IN
WETLAND






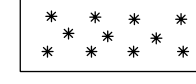


DENOTES MECHANIZED
CLEARING

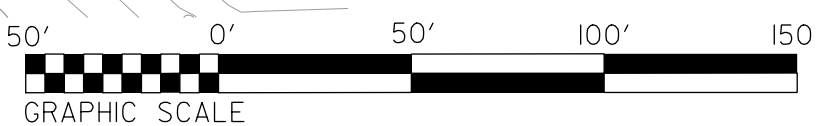

PERMIT DRAWING
SHEET 4 OF 71

SITE 1

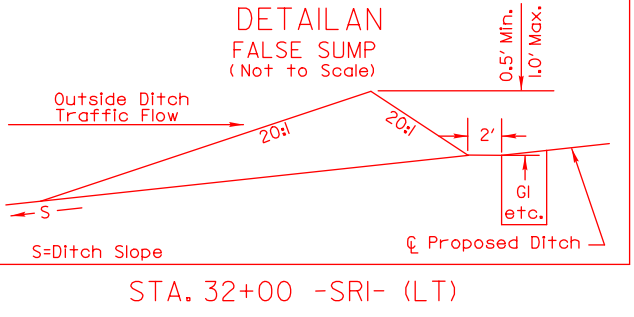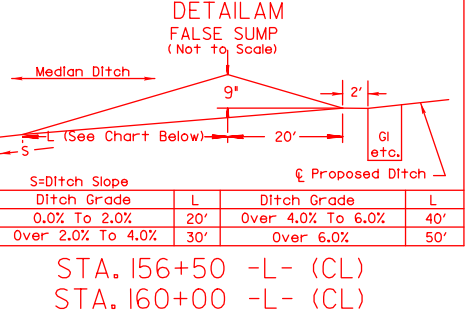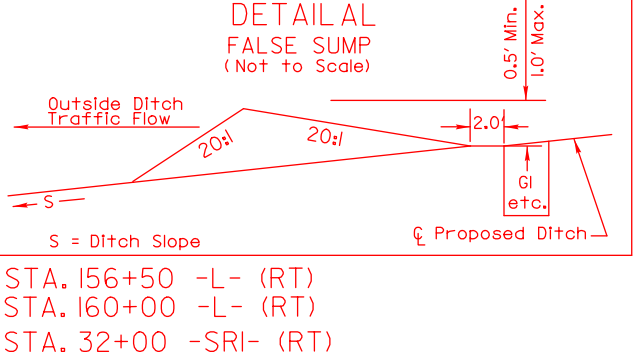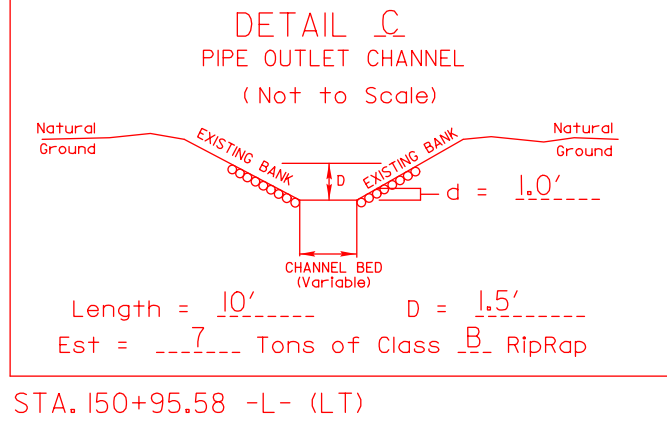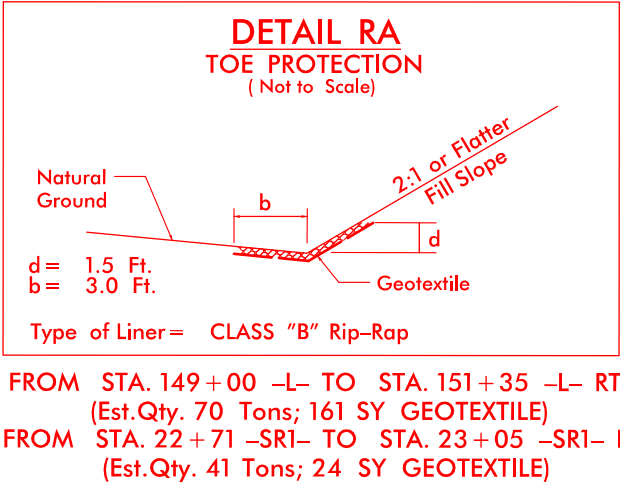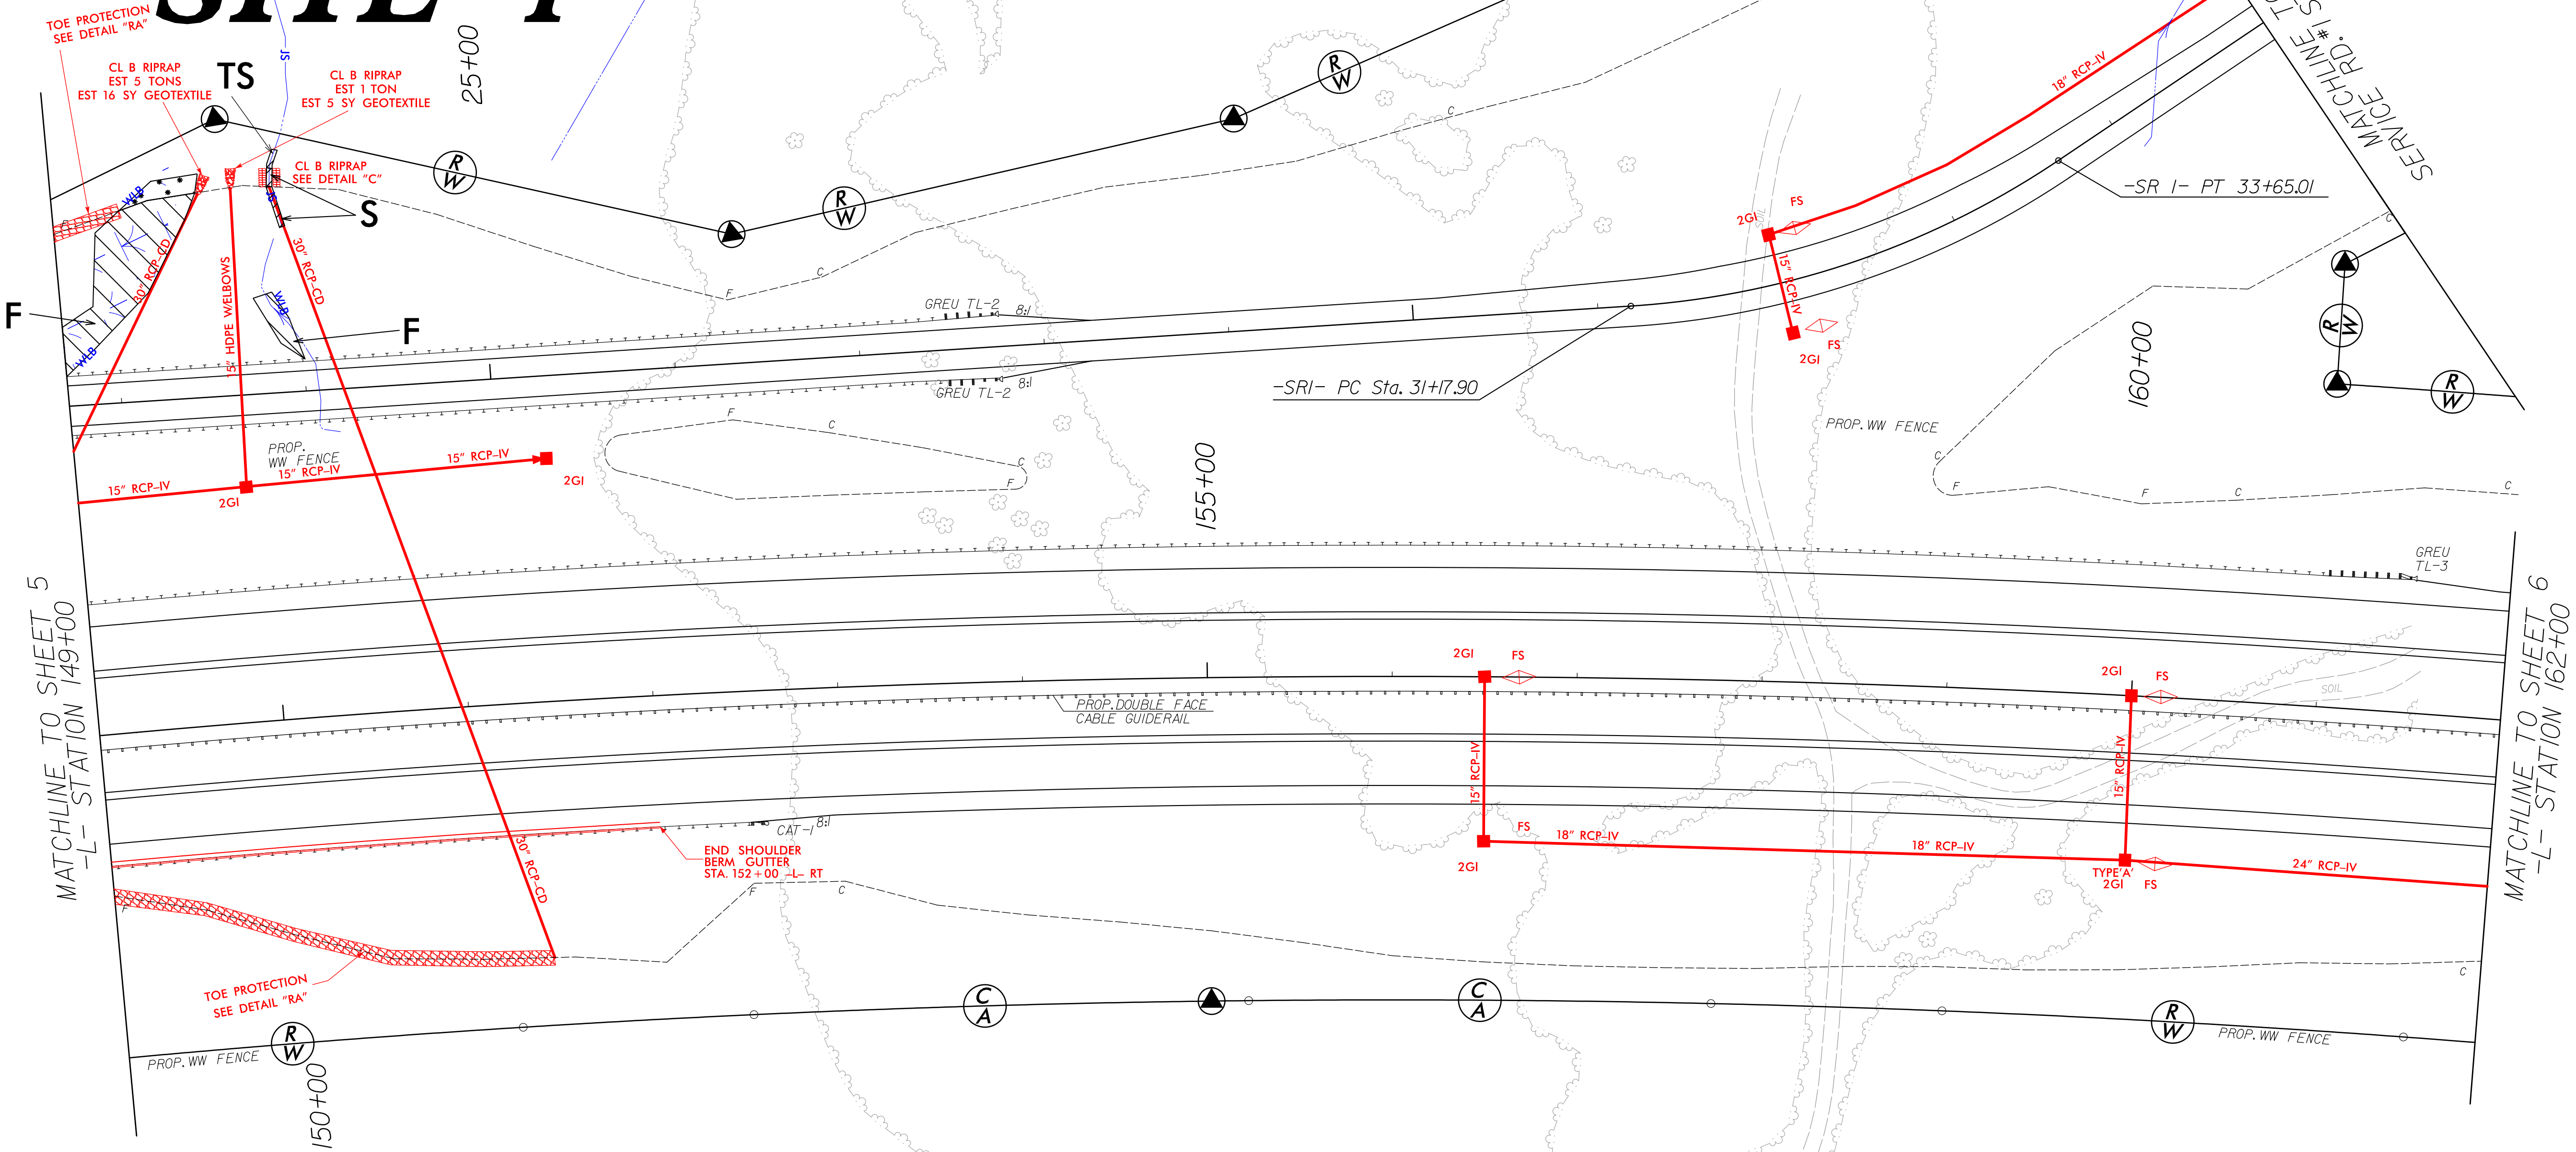

- DENOTES IMPACTS IN SURFACE WATER
- DENOTES TEMPORARY IMPACTS IN SURFACE WATER
- DENOTES FILL IN WETLAND
- DENOTES MECHANIZED CLEARING

PROJECT REFERENCE NO. <i>R-3421B</i>		SHEET NO. <i>6</i>
RW SHEET NO.		
ROADWAY DESIGN ENGINEER		HYDRAULICS ENGINEER
INCOMPLETE PLANS DO NOT USE FOR R/W ACQUISITION		
PRELIMINARY PLANS DO NOT USE FOR CONSTRUCTION		

REVISIONS



8/17/99
7:13:00 AM
R:\Hydraulics\PERMITS\Environmental\Drawings\R3421B\R3421B_Hyd_prm_wet_psh06_20150325.dgn

\$DATES
\$(USERAME)\$
\$FILES





PERMIT DRAWING
SHEET 5 OF 71

PROJECT REFERENCE NO. R-3421B		SHEET NO. 6	
RW SHEET NO.			
ROADWAY DESIGN ENGINEER		HYDRAULICS ENGINEER	
INCOMPLETE PLANS DO NOT USE FOR R/W ACQUISITION			
PRELIMINARY PLANS DO NOT USE FOR CONSTRUCTION			

SITE 1

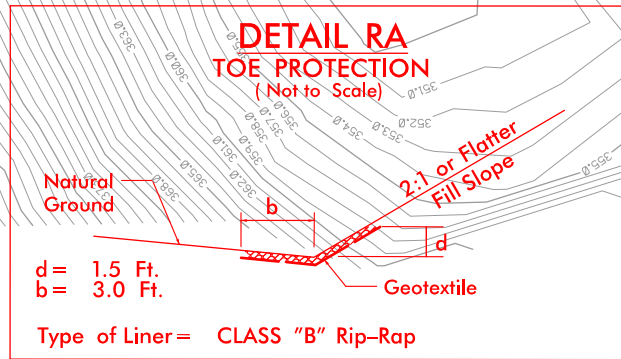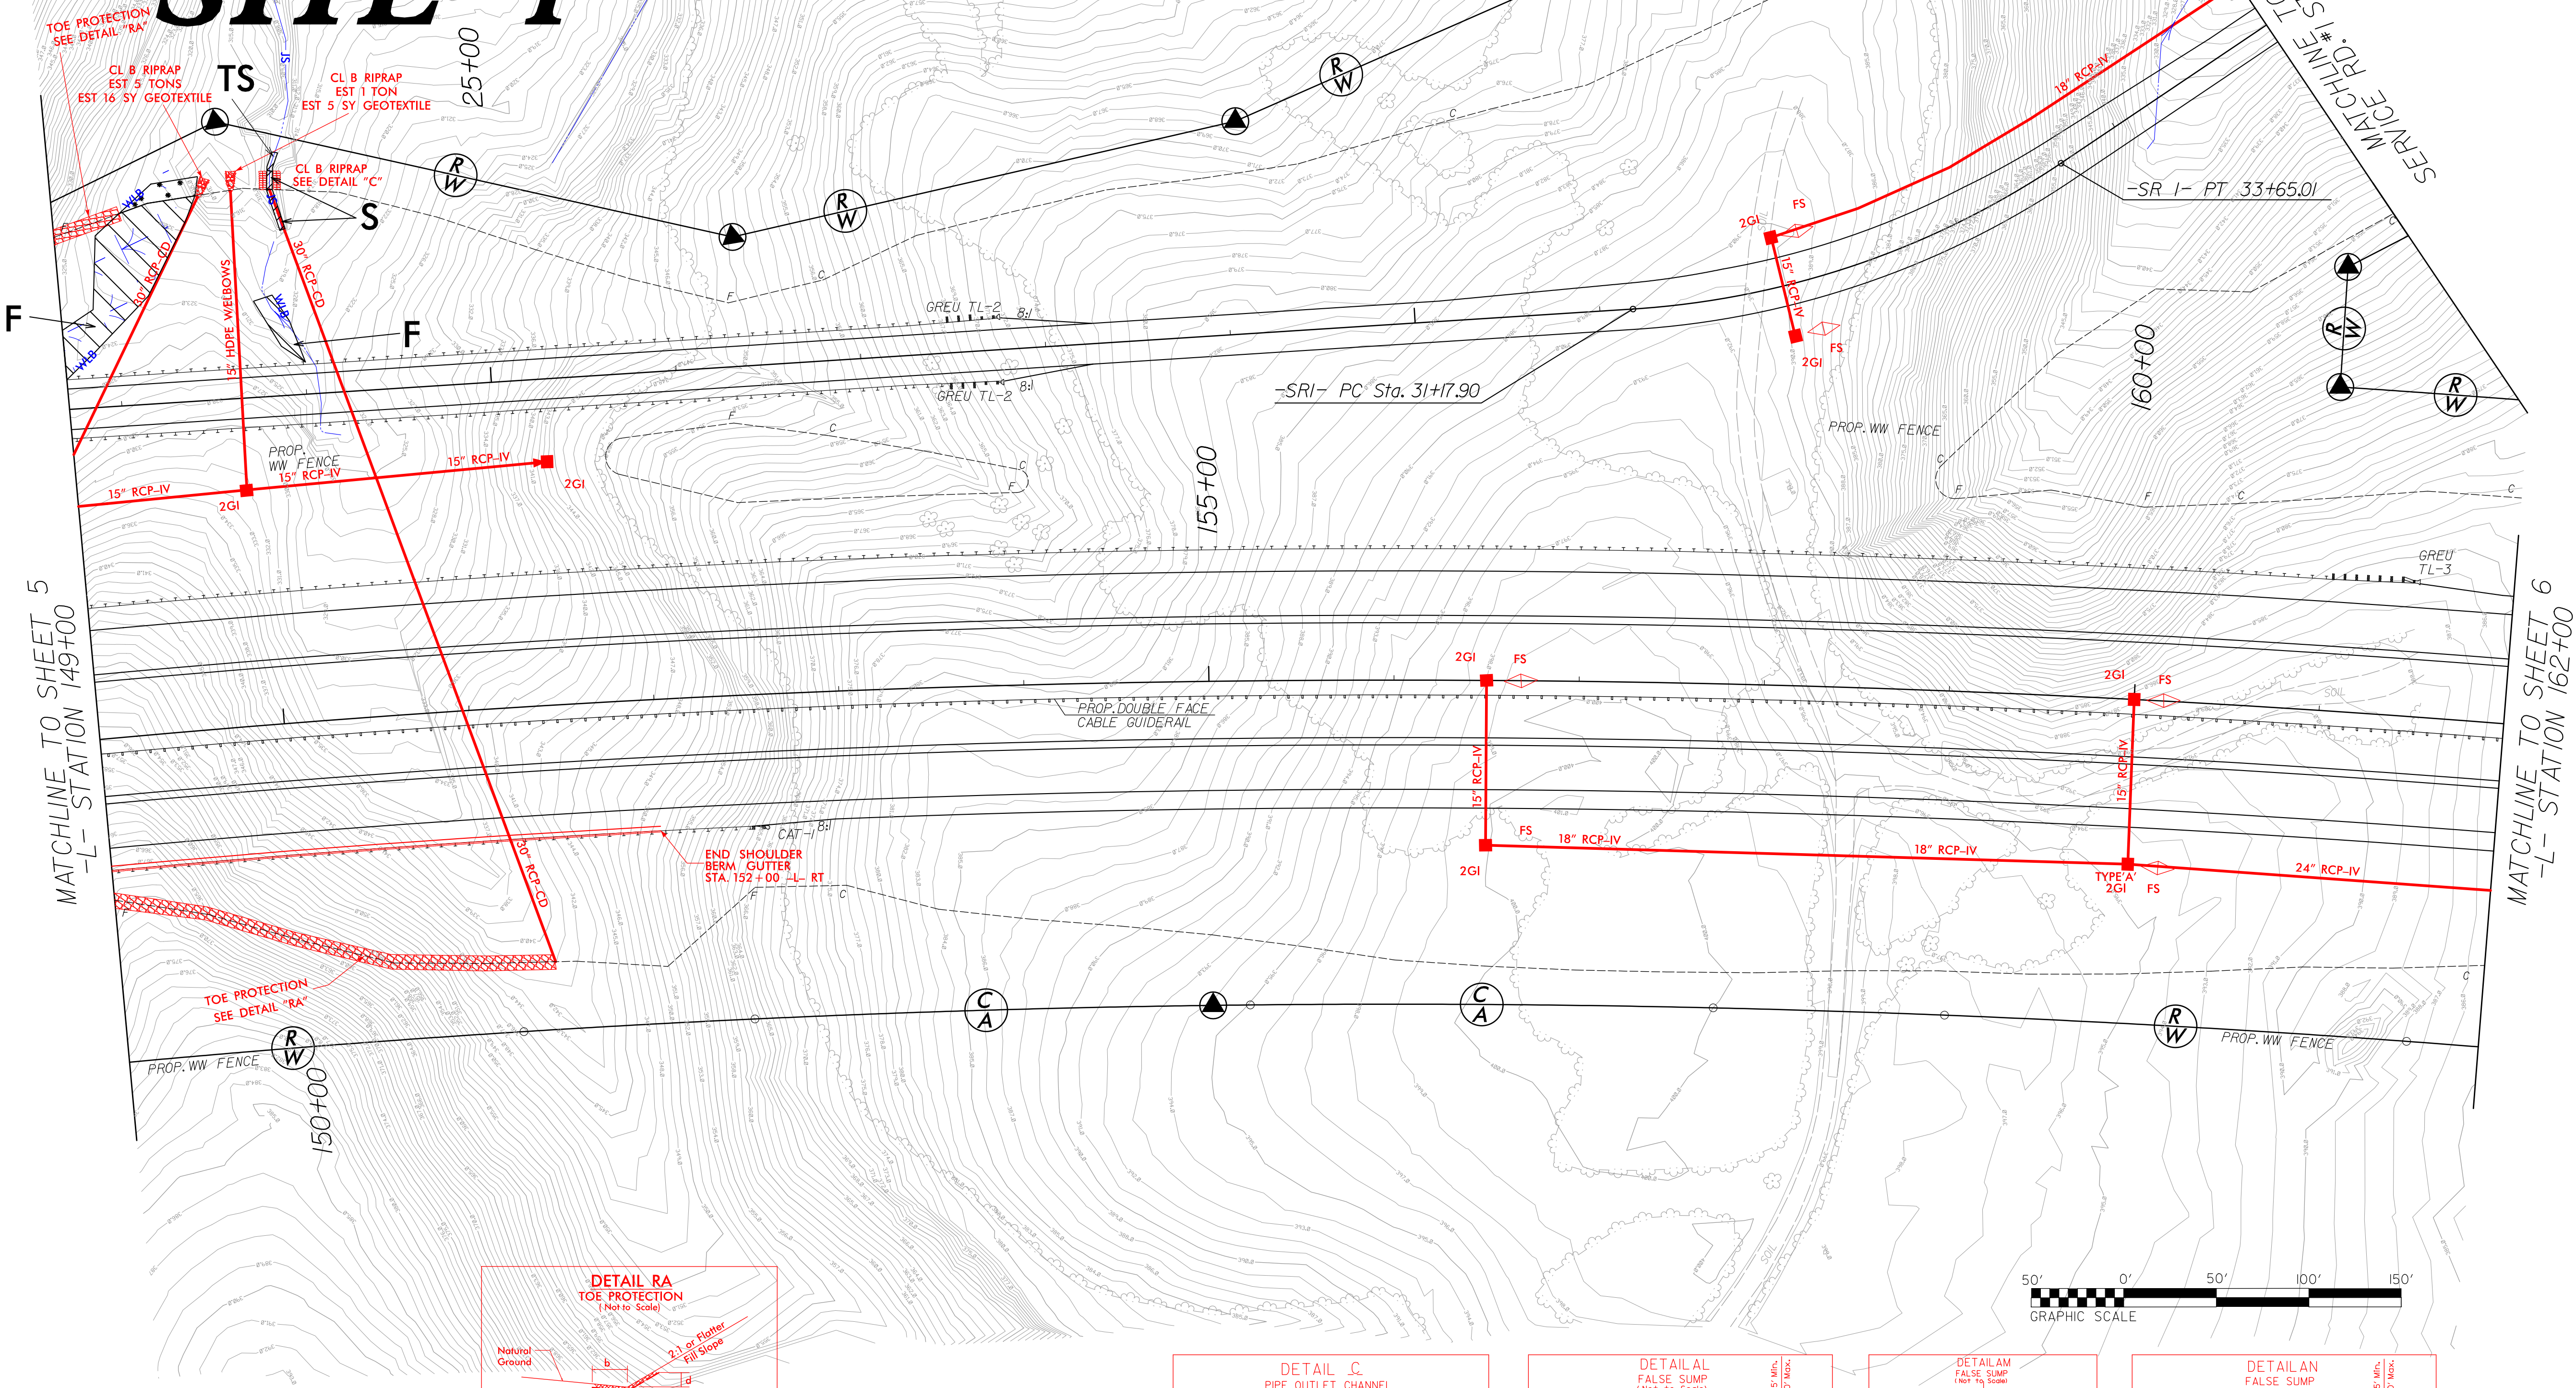


FROM STA. 149+00 -L- TO STA. 151+35 -L- RT.
(Est. Qty. 70 Tons; 161 SY GEOTEXTILE)
FROM STA. 22+71 -SRI- TO STA. 23+05 -SRI- LT.
(Est. Qty. 41 Tons; 24 SY GEOTEXTILE)

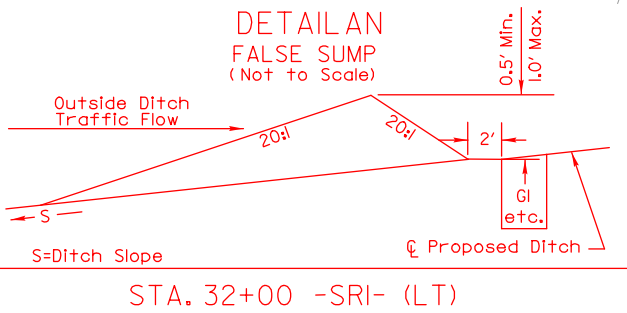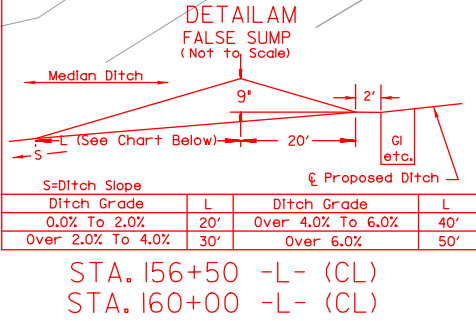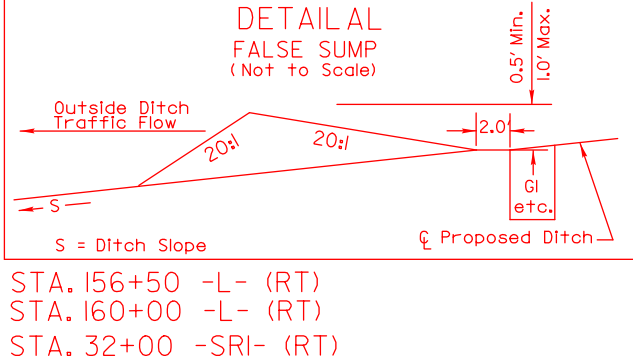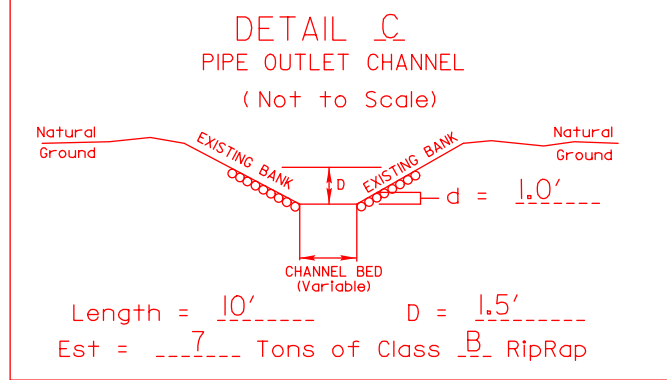

DENOTES IMPACTS IN
SURFACE WATER



DENOTES FILL IN
WETLAND

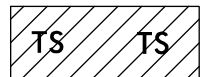

DENOTES TEMPORARY
IMPACTS IN SURFACE WATER



DENOTES MECHANIZED
CLEARING

REVISIONS

8/17/99

7/3/04 AM
R:\Hydraulics\PERMITS\Environmental\Drawings\R3421B\R3421B_Hyd_prm_wet.psh06_20150325_con.dgn



\$DATES
\$(USERAME)\$
\$FILES

8/17/99

REVISIONS


7/13/15 AM
R:\Hydraulics\PERMITS\Environmental\Drawings\R3421B\R3421B_Hyd_prm_wet_psh06.enlarge_site1.20150624_con.dgn

SDATES
S\USER\NAME\J
S\FILES

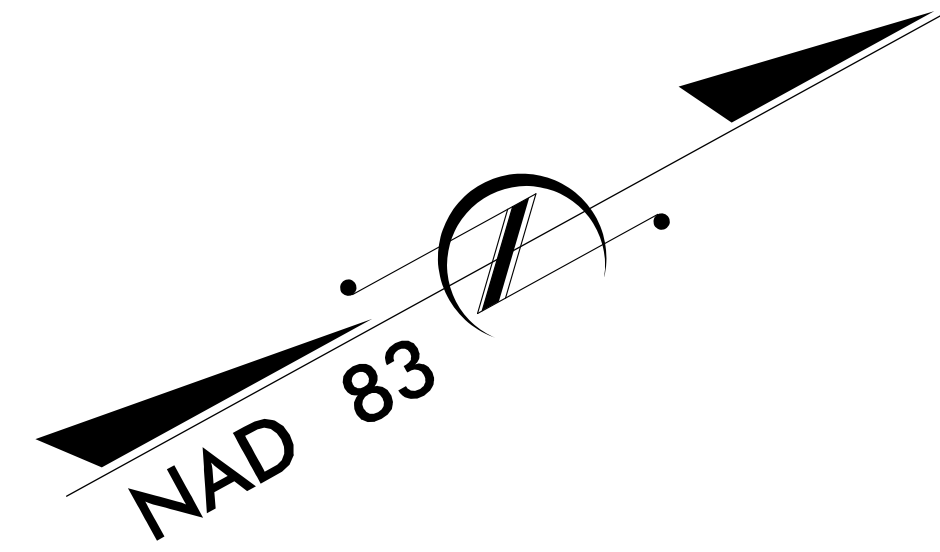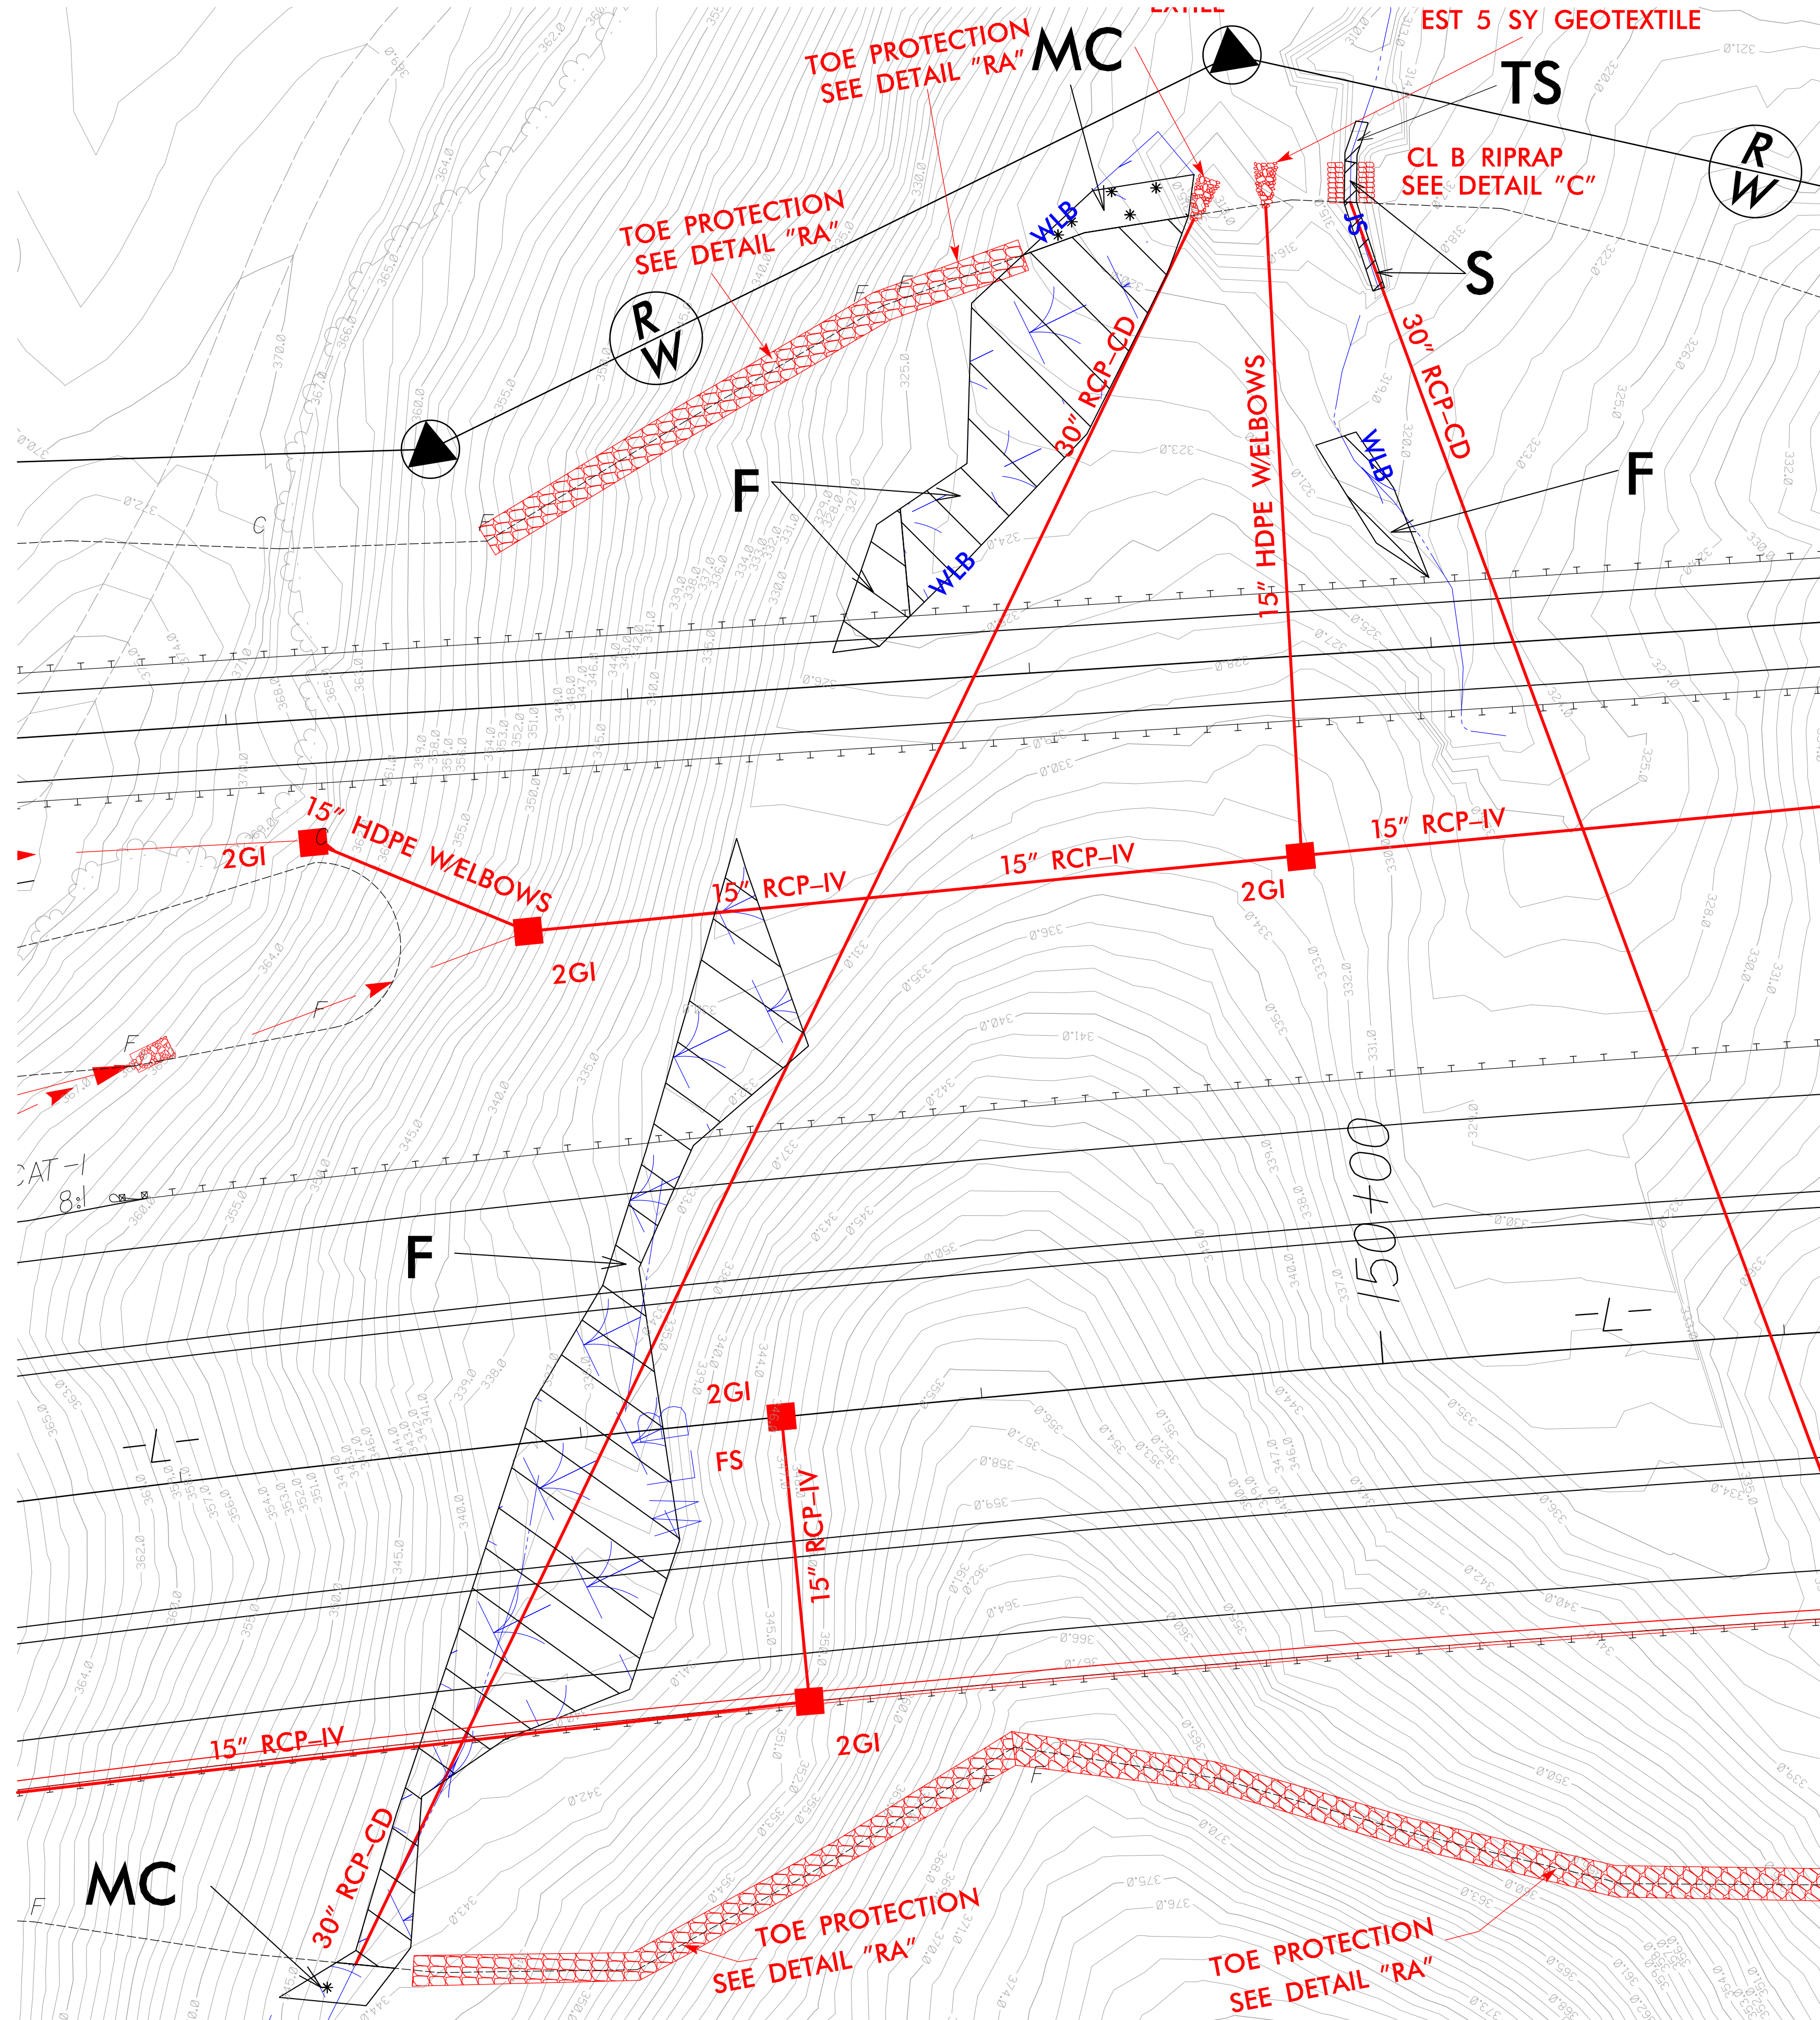

PERMIT DRAWING
SHEET 7 OF 71


SITE 1 ENLARGEMENT

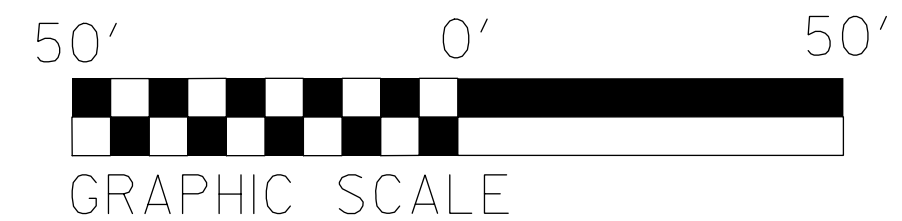


DENOTES IMPACTS IN
SURFACE WATER



DENOTES TEMPORARY
IMPACTS IN SURFACE WATER

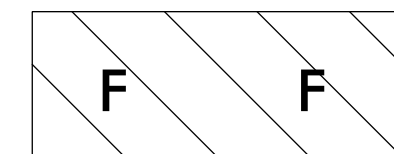


DENOTES FILL IN
WETLAND

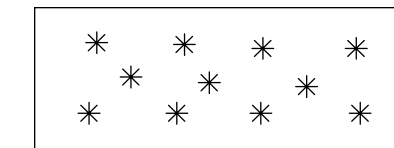


DENOTES MECHANIZED
CLEARING


SDATES
S:\08ENR\AWB5
7/15/23 3:41 AM
R:\Hydro\enr\lics\PERMITS_Environmental\Drawings\R342\IB_Hyd-prm-xpl-sitel_20150729.dgn
P:\0800

8/23/99

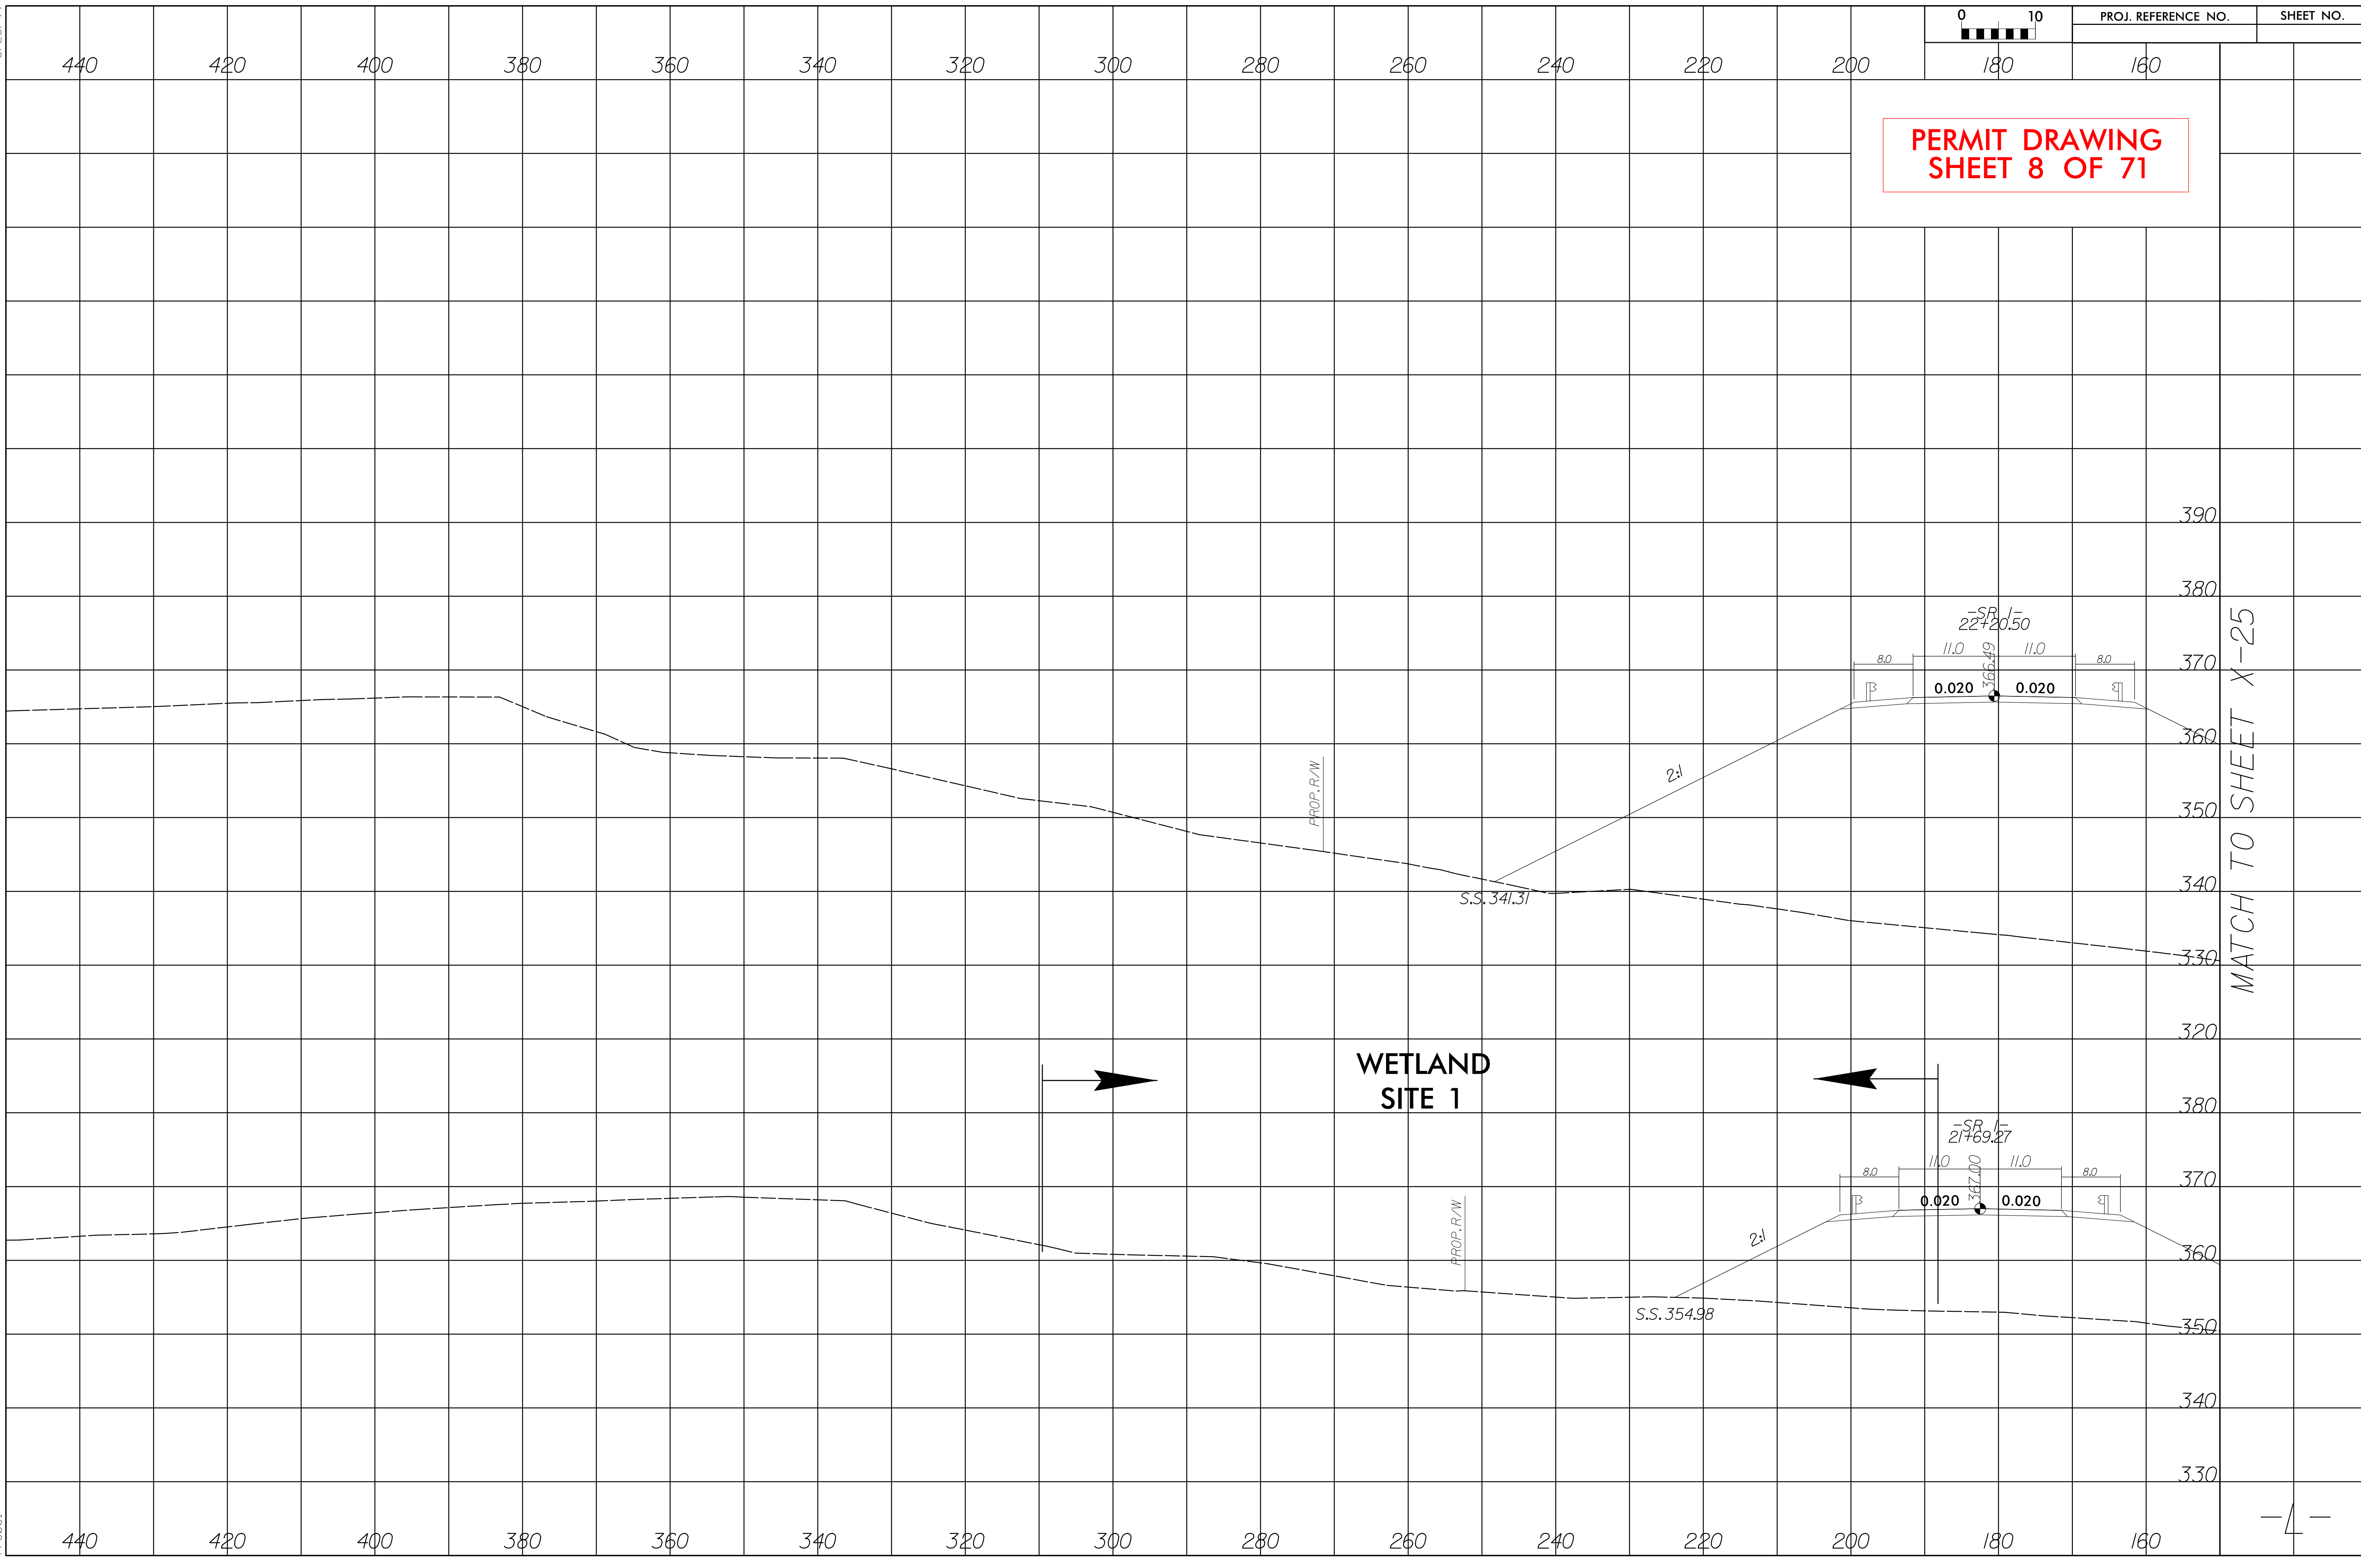






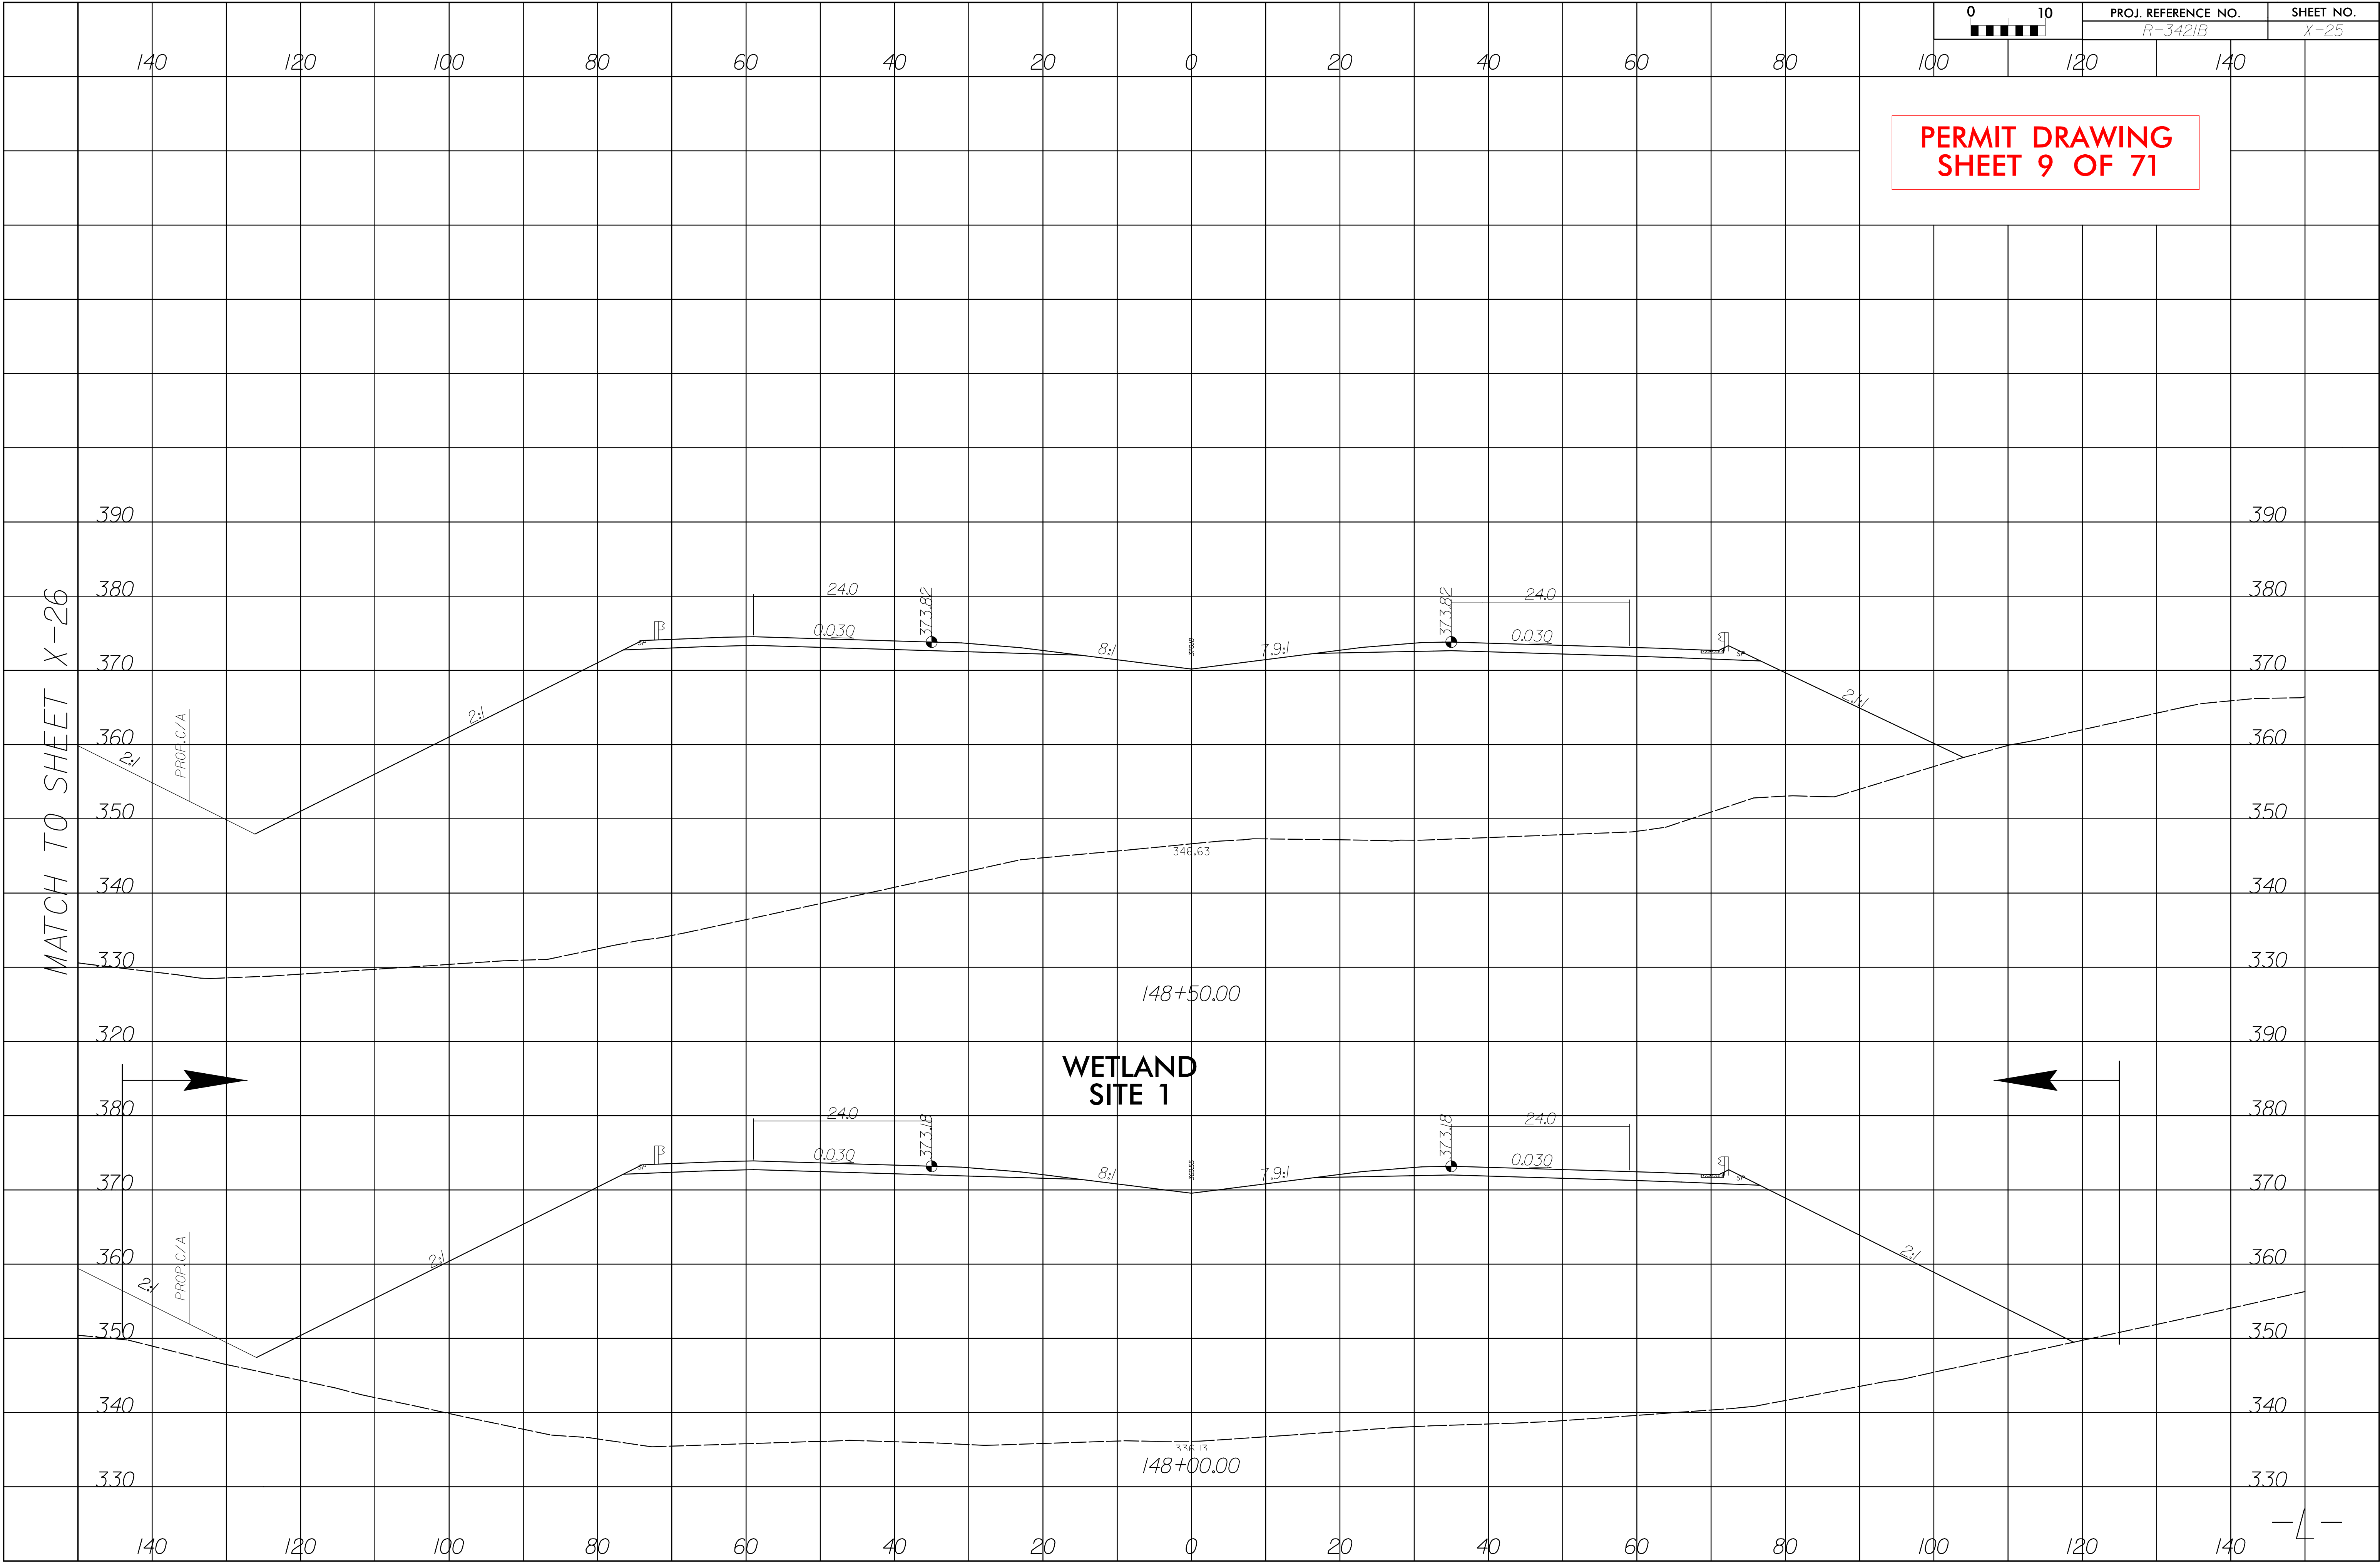


REVISIONS

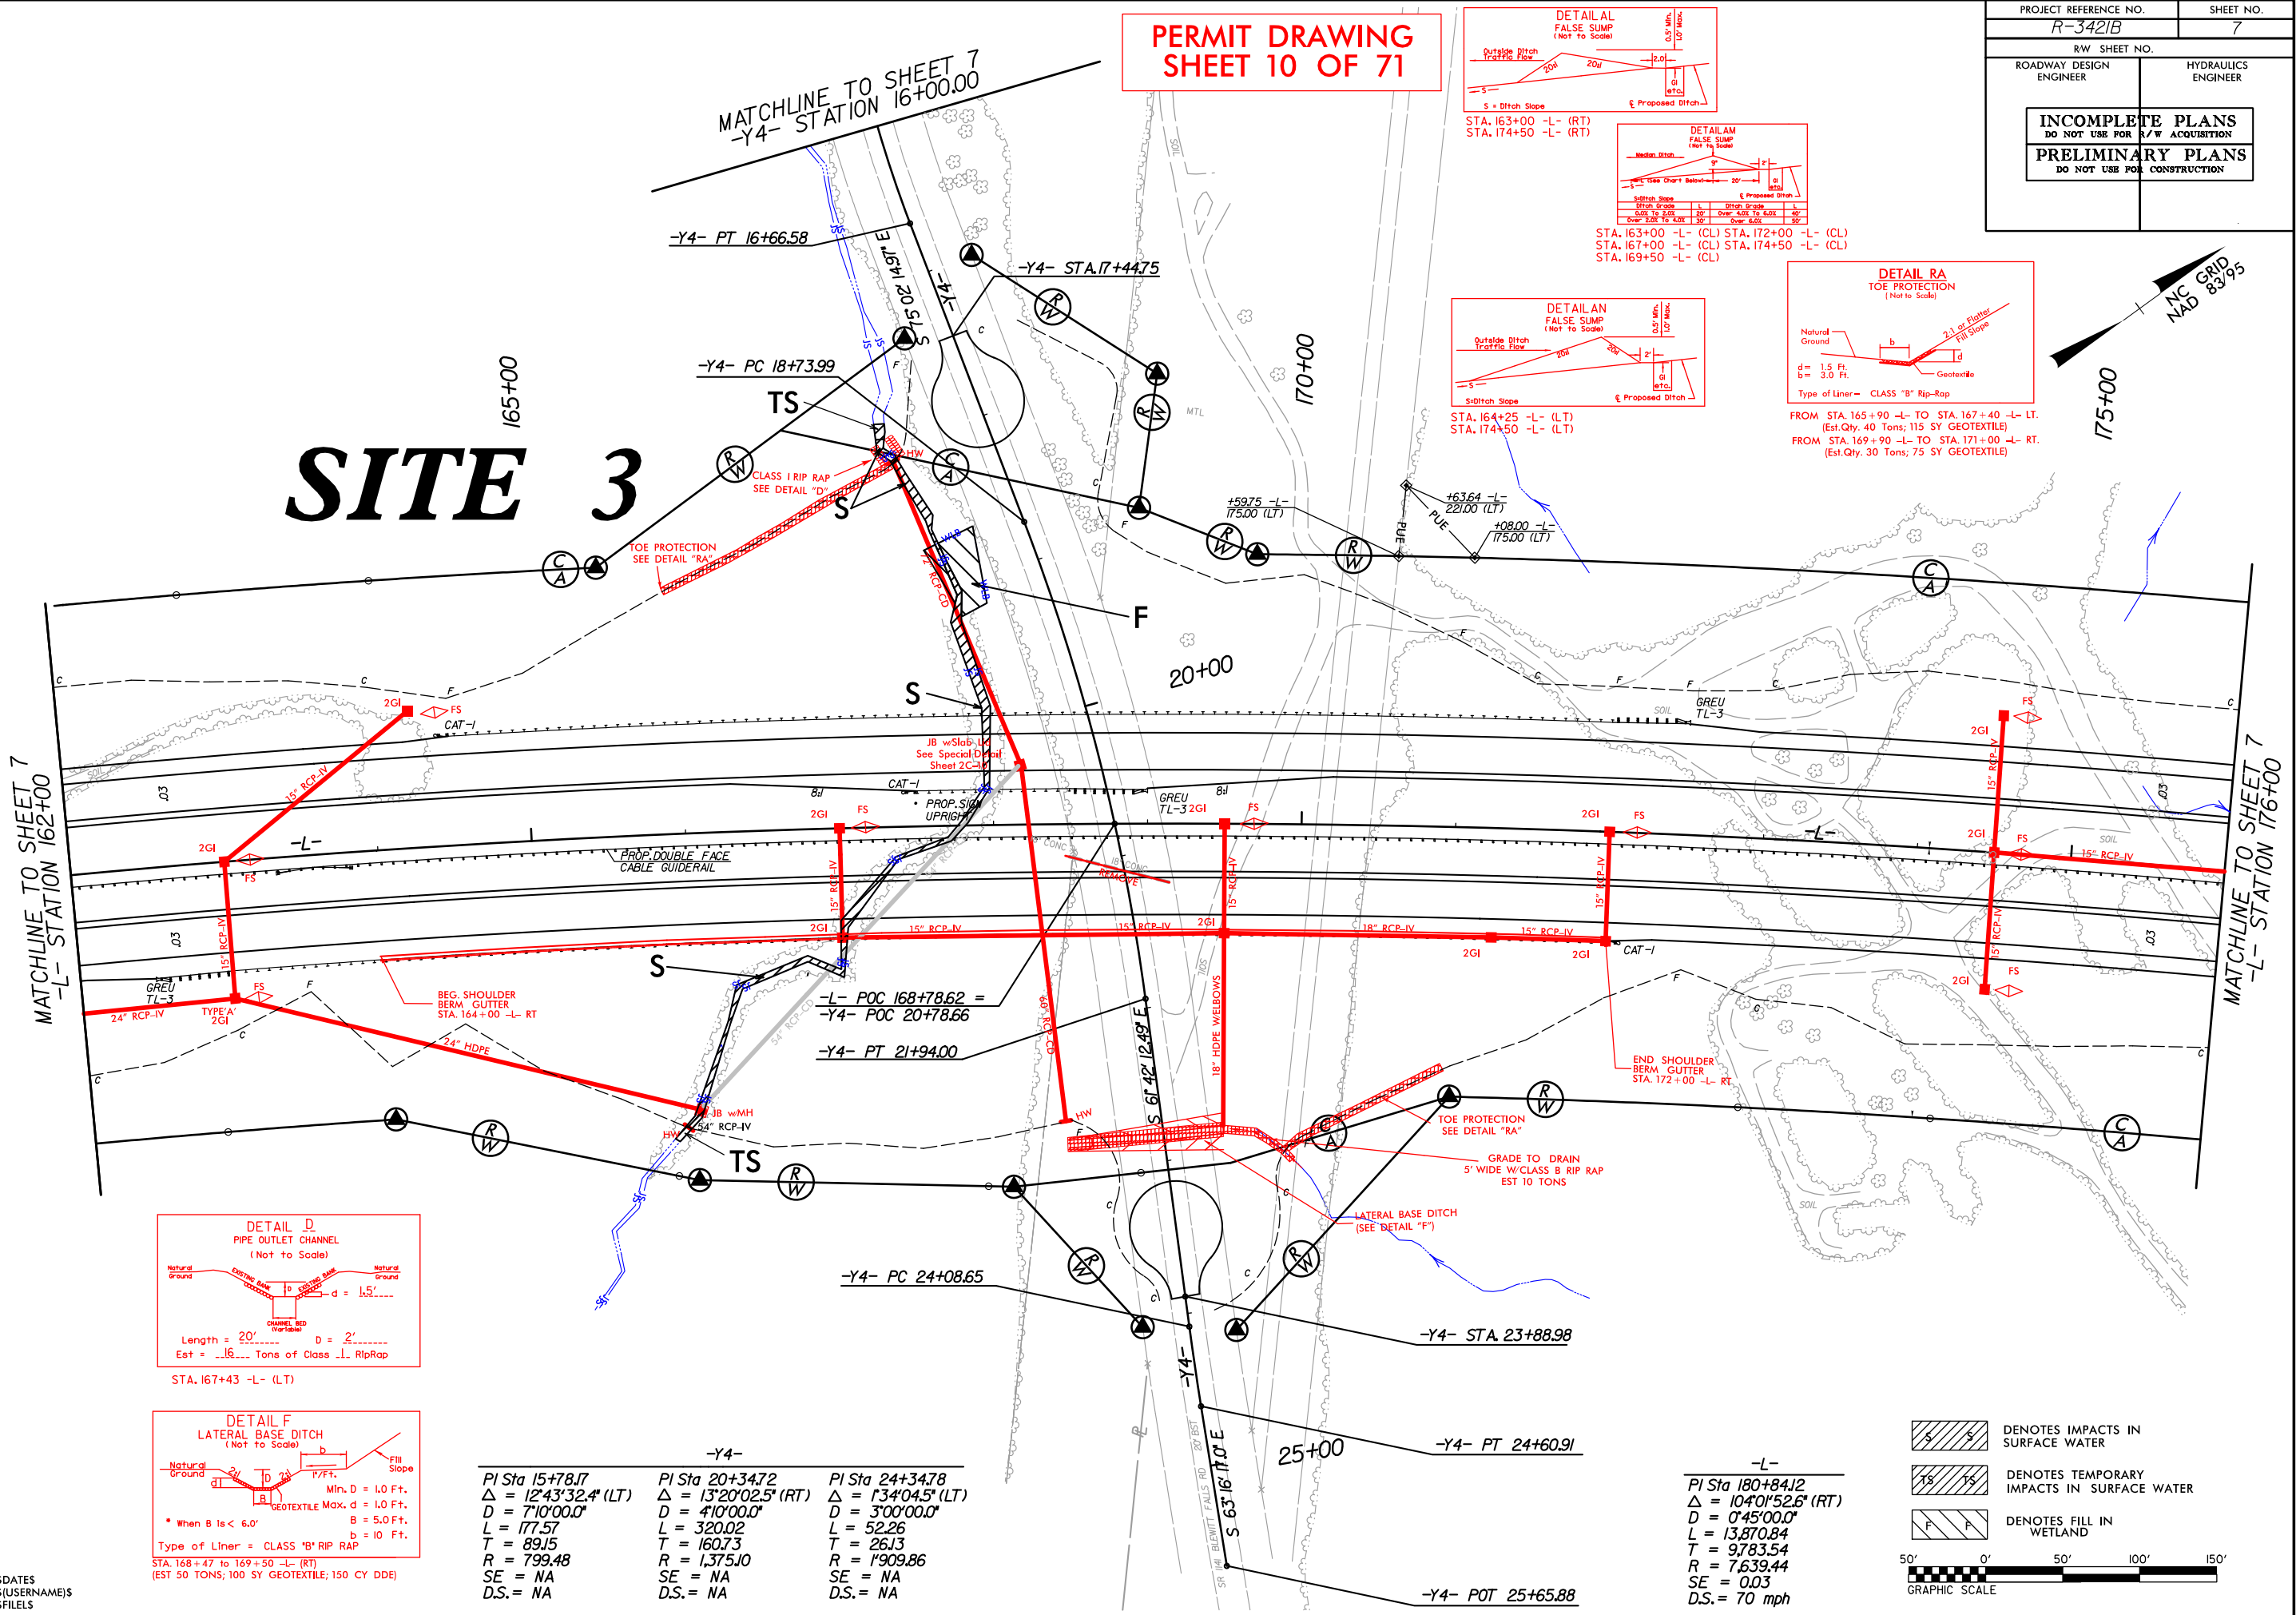


PERMIT DRAWING
SHEET 10 OF 71

PROJECT REFERENCE NO. R-3421B		SHEET NO. 7	
RW SHEET NO.			
ROADWAY DESIGN ENGINEER		HYDRAULICS ENGINEER	
INCOMPLETE PLANS DO NOT USE FOR R/W ACQUISITION			
PRELIMINARY PLANS DO NOT USE FOR CONSTRUCTION			

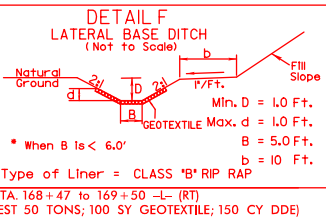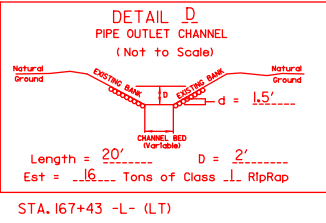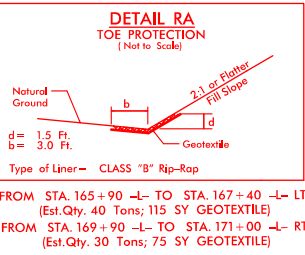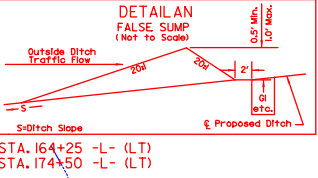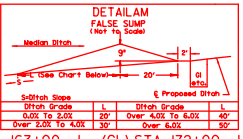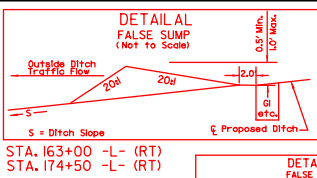

-Y4-		
PI Sta 15+78.17	PI Sta 20+347.2	PI Sta 24+347.8
$\Delta = 12^{\circ}43'32.4''$ (LT)	$\Delta = 13^{\circ}20'02.5''$ (RT)	$\Delta = 13^{\circ}40'45.4''$ (LT)
D = 710'00.0"	D = 410'00.0"	D = 310'00'00.0"
L = 177.57	L = 320.02	L = 522.26
T = 89.15	T = 160.73	T = 261.3
R = 799.48	R = 1,375.10	R = 1,909.86
SE = NA	SE = NA	SE = NA
D.S. = NA	D.S. = NA	D.S. = NA

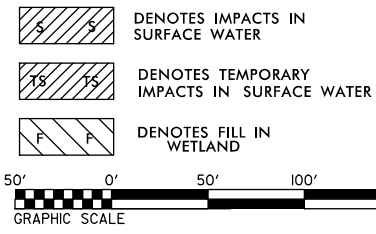

R:\Hydraulics\PERMITS-Environmental\Drawings\R3421B\R3421B-Hyd-prm-wet_psh07_20150316-con.dgn

```
$DATES
$(USERNAME)$
$FILES
```

DETAIL RA
TOE PROTECTION
 (Not to Scale)

Natural Ground

$d = 1.5 \text{ Ft.}$
 $b = 3.9 \text{ Ft.}$

b

d

2:1 or Flatter Fill Slope

Geotextile

Type of Liner = GLASS "B" Rip-Rap

NC GRID
NAD 83/95

MATCHLINE TO SHEET 7
-L- STATION 176+00

MATCHLINE TO SHEET 7
-Y4- STATION 16+00.00

DETAIL F
LATERAL BASE DITCH
(Not to Scale)

Natural Ground

2:1

2:3

b

B

1/4"

Min. D = 1.0 Ft.

GEOTEXTILE

Max. d = 1.0 Ft.

B = 5.0 Ft.

B = 10 Ft.

* When B is less than 6.0'

Fill Slope


Type of Liner = CLASS "B" RIP RAP

STA. 168+47 to 169+50 - (RT)

(EST 50 TONS; 100 SY GEOTEXTILE; 150 CY DDE)

PI Sta 24+34.78
 $\Delta = 1^{\circ}34'04.5''$ (LT)
 $D = 3^{\circ}00'00.0''$
 $L = 52.26$
 $T = 261.3$
 $R = 1^{\circ}909.86$
 $SE = NA$
 $D.S. = NA$

$PI Sta 180+84.12$
 $\Delta = 104^{\circ}01'52.6'' (RT)$
 $D = 0^{\circ}45'00.0''$
 $L = 13,870.84$
 $T = 9,783.54$
 $R = 7,639.44$
 $SE = 0.03$
 $D.S. = 70 \text{ mph}$

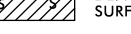
 DENOTES IMPACTS IN SURFACE WATER
 DENOTES TEMPORARY IMPACTS IN SURFACE WATER
 DENOTES FILL IN WETLAND

50' 0' 50' 100'
 GRAPHIC SCALE



Revised 8/6/19

8/17/99

REVISIONS

2:18:42 AM
C:\Users\jones\Documents\Hydraulics\Drawings\342IB\342IB_Hyd-prm-wet.psh07-enlarge site3.20150507.dgn



```
SDATES$
$(USERNAME)$
$FILES$
```

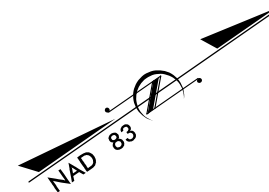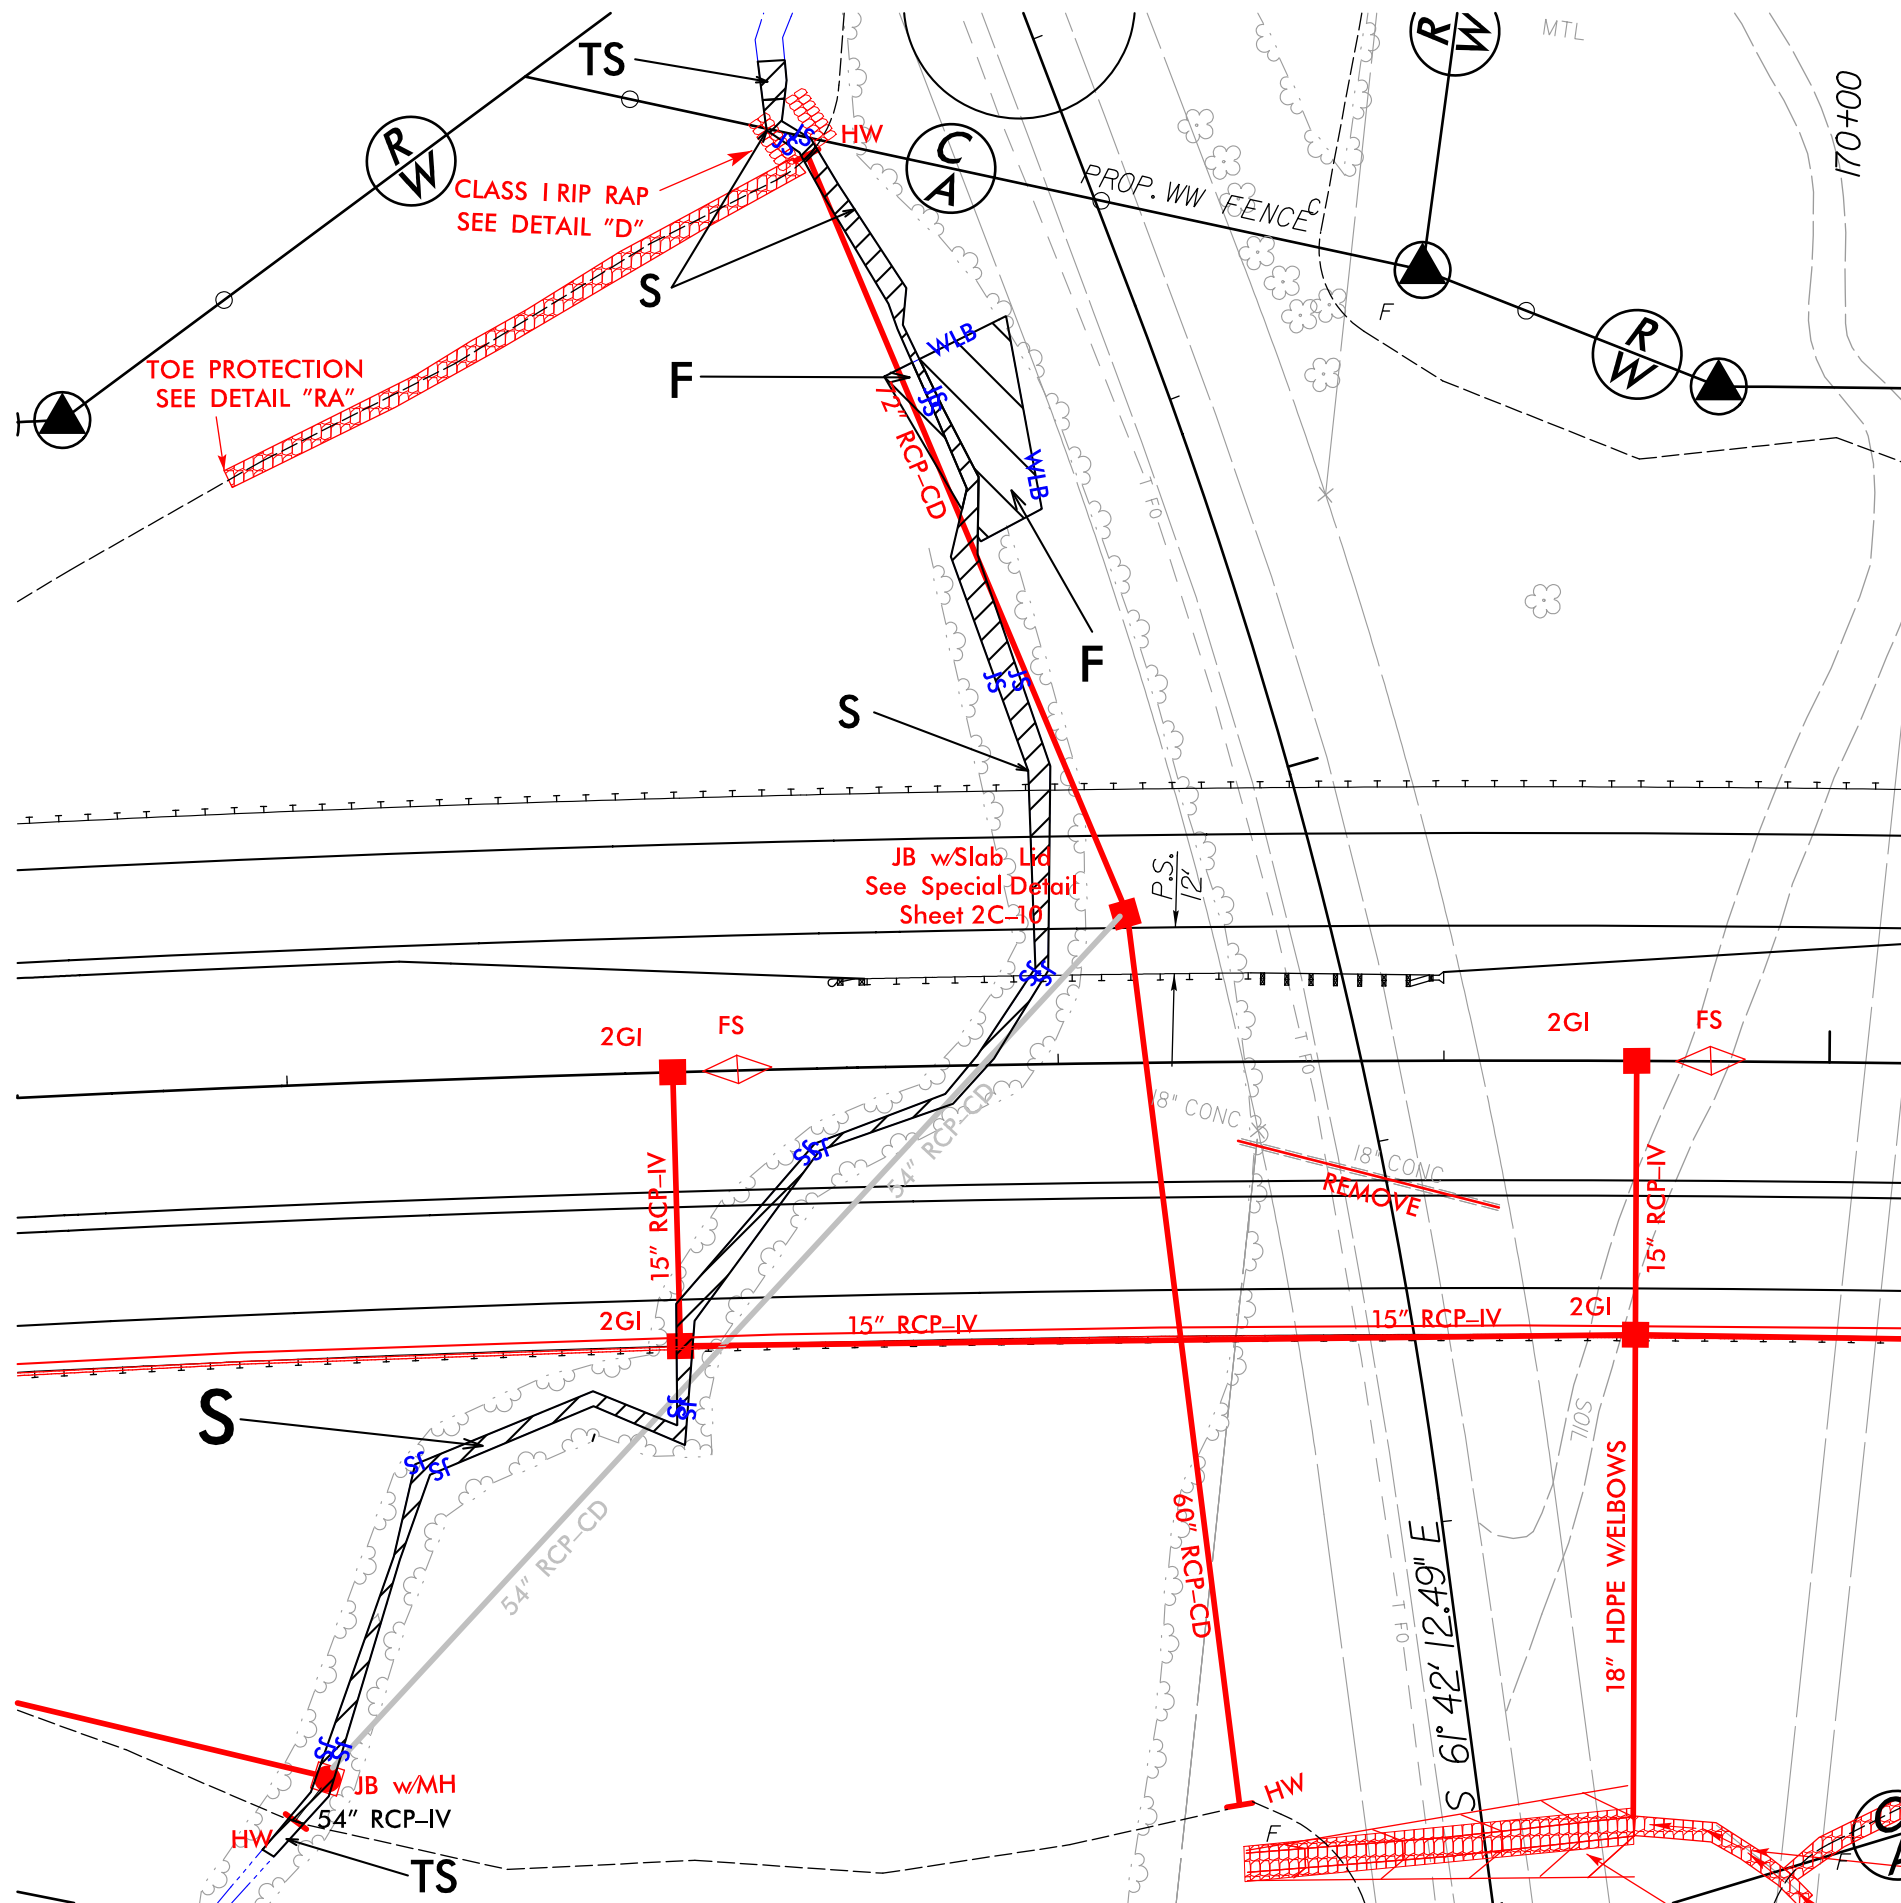

PROJECT REFERENCE NO.	SHEET NO.
R-3421B	7
R/W SHEET NO.	
ROADWAY DESIGN ENGINEER	HYDRAULICS ENGINEER
INCOMPLETE PLANS DO NOT USE FOR R/W ACQUISITION PRELIMINARY PLANS DO NOT USE FOR CONSTRUCTION	



PERMIT DRAWING
SHEET 12 OF 71

SITE 3 ENLARGEMENT

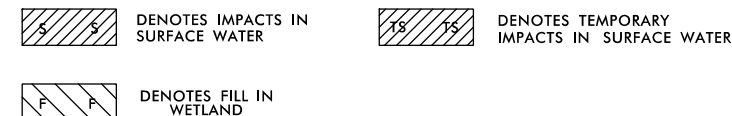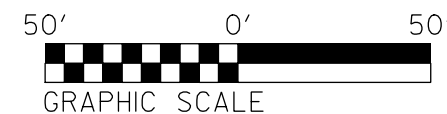

R:\Hydraulics\PERMITS_Environmental\Drawings\R3421B\Hyd_prm_wet_psh07_enlarge_site3-20150507_con.dgn


```
SDATES$
$(USERNAME)$
$FILES$
```

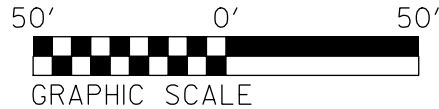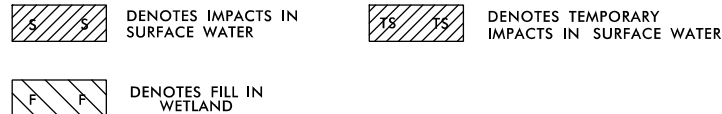


PROJECT REFERENCE NO.	SHEET NO.
R-3421B	7
R/W SHEET NO.	
ROADWAY DESIGN ENGINEER	HYDRAULICS ENGINEER
INCOMPLETE PLANS DO NOT USE FOR R/W ACQUISITION PRELIMINARY PLANS DO NOT USE FOR CONSTRUCTION	


PERMIT DRAWING
SHEET 13 OF 71

SITE 3 ENLARGEMENT

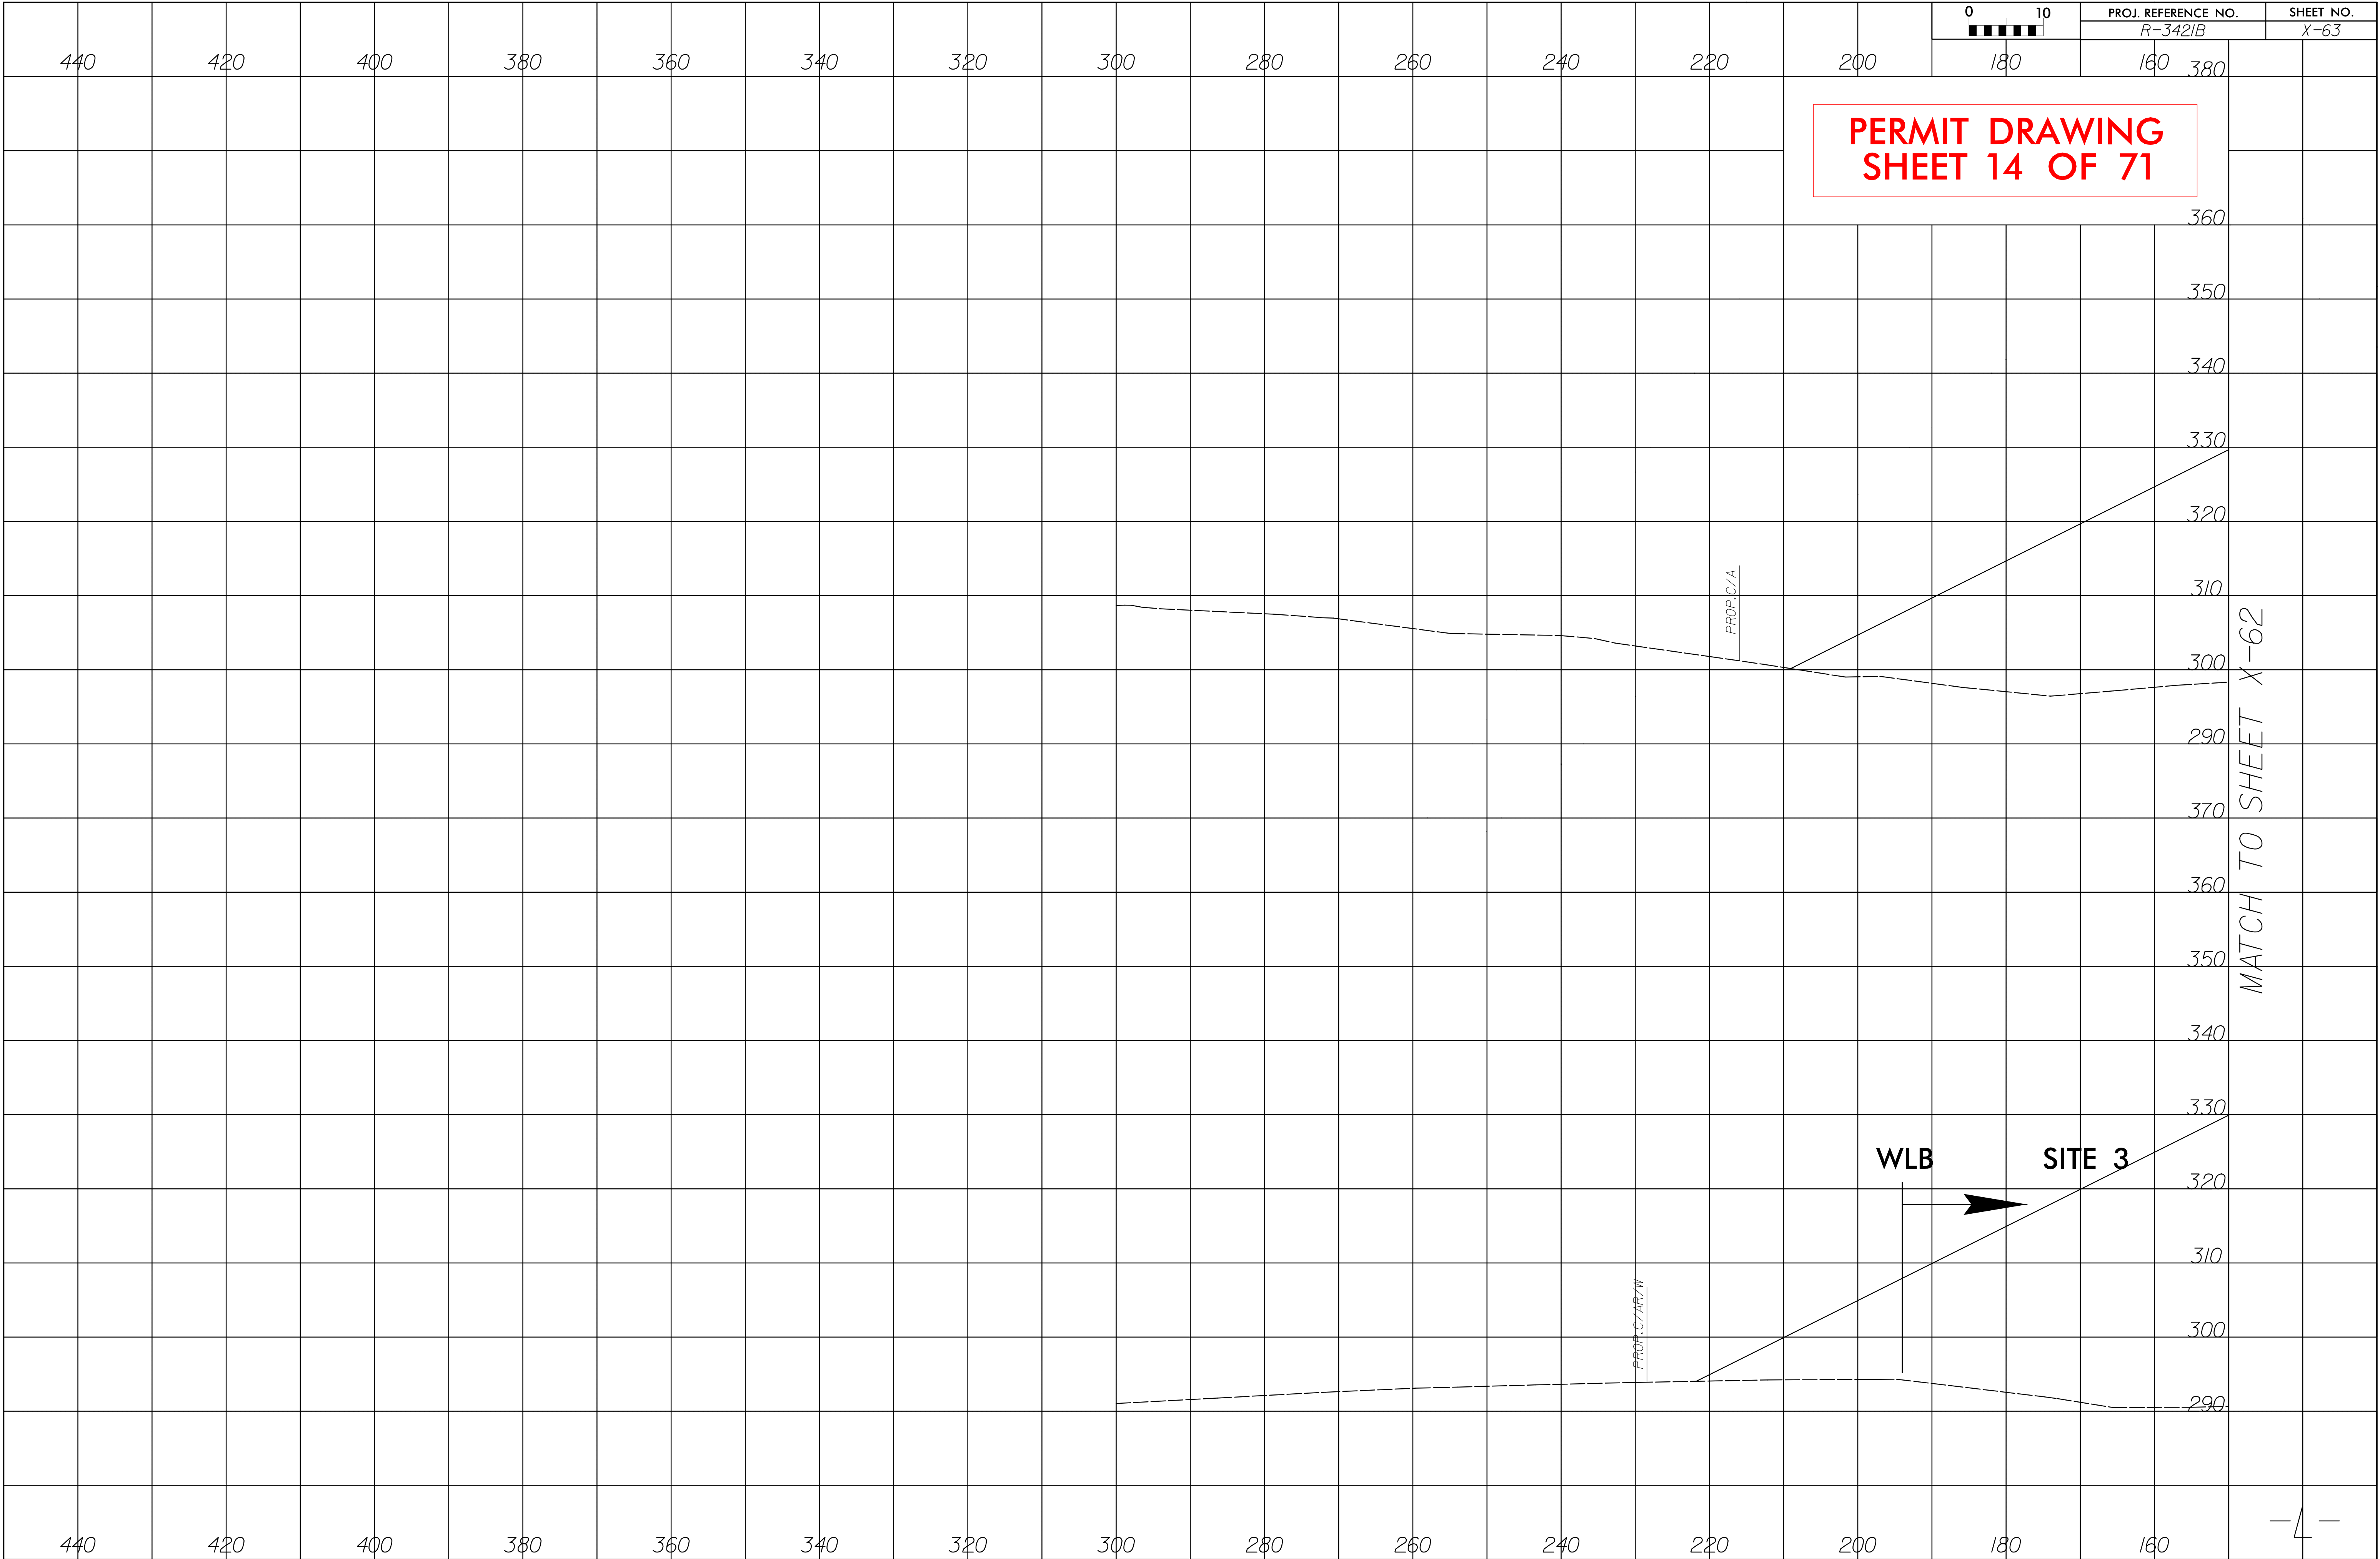

8/23/99
DATE: 7/20/06 AM
PROJECT: R342IB
SHEET: X-62
FILE: R:\Hydro\Drawings\Drawings\R342IB\Hyd-prm-xpl-site3.20150729.dgn
PROJECT: R342IB

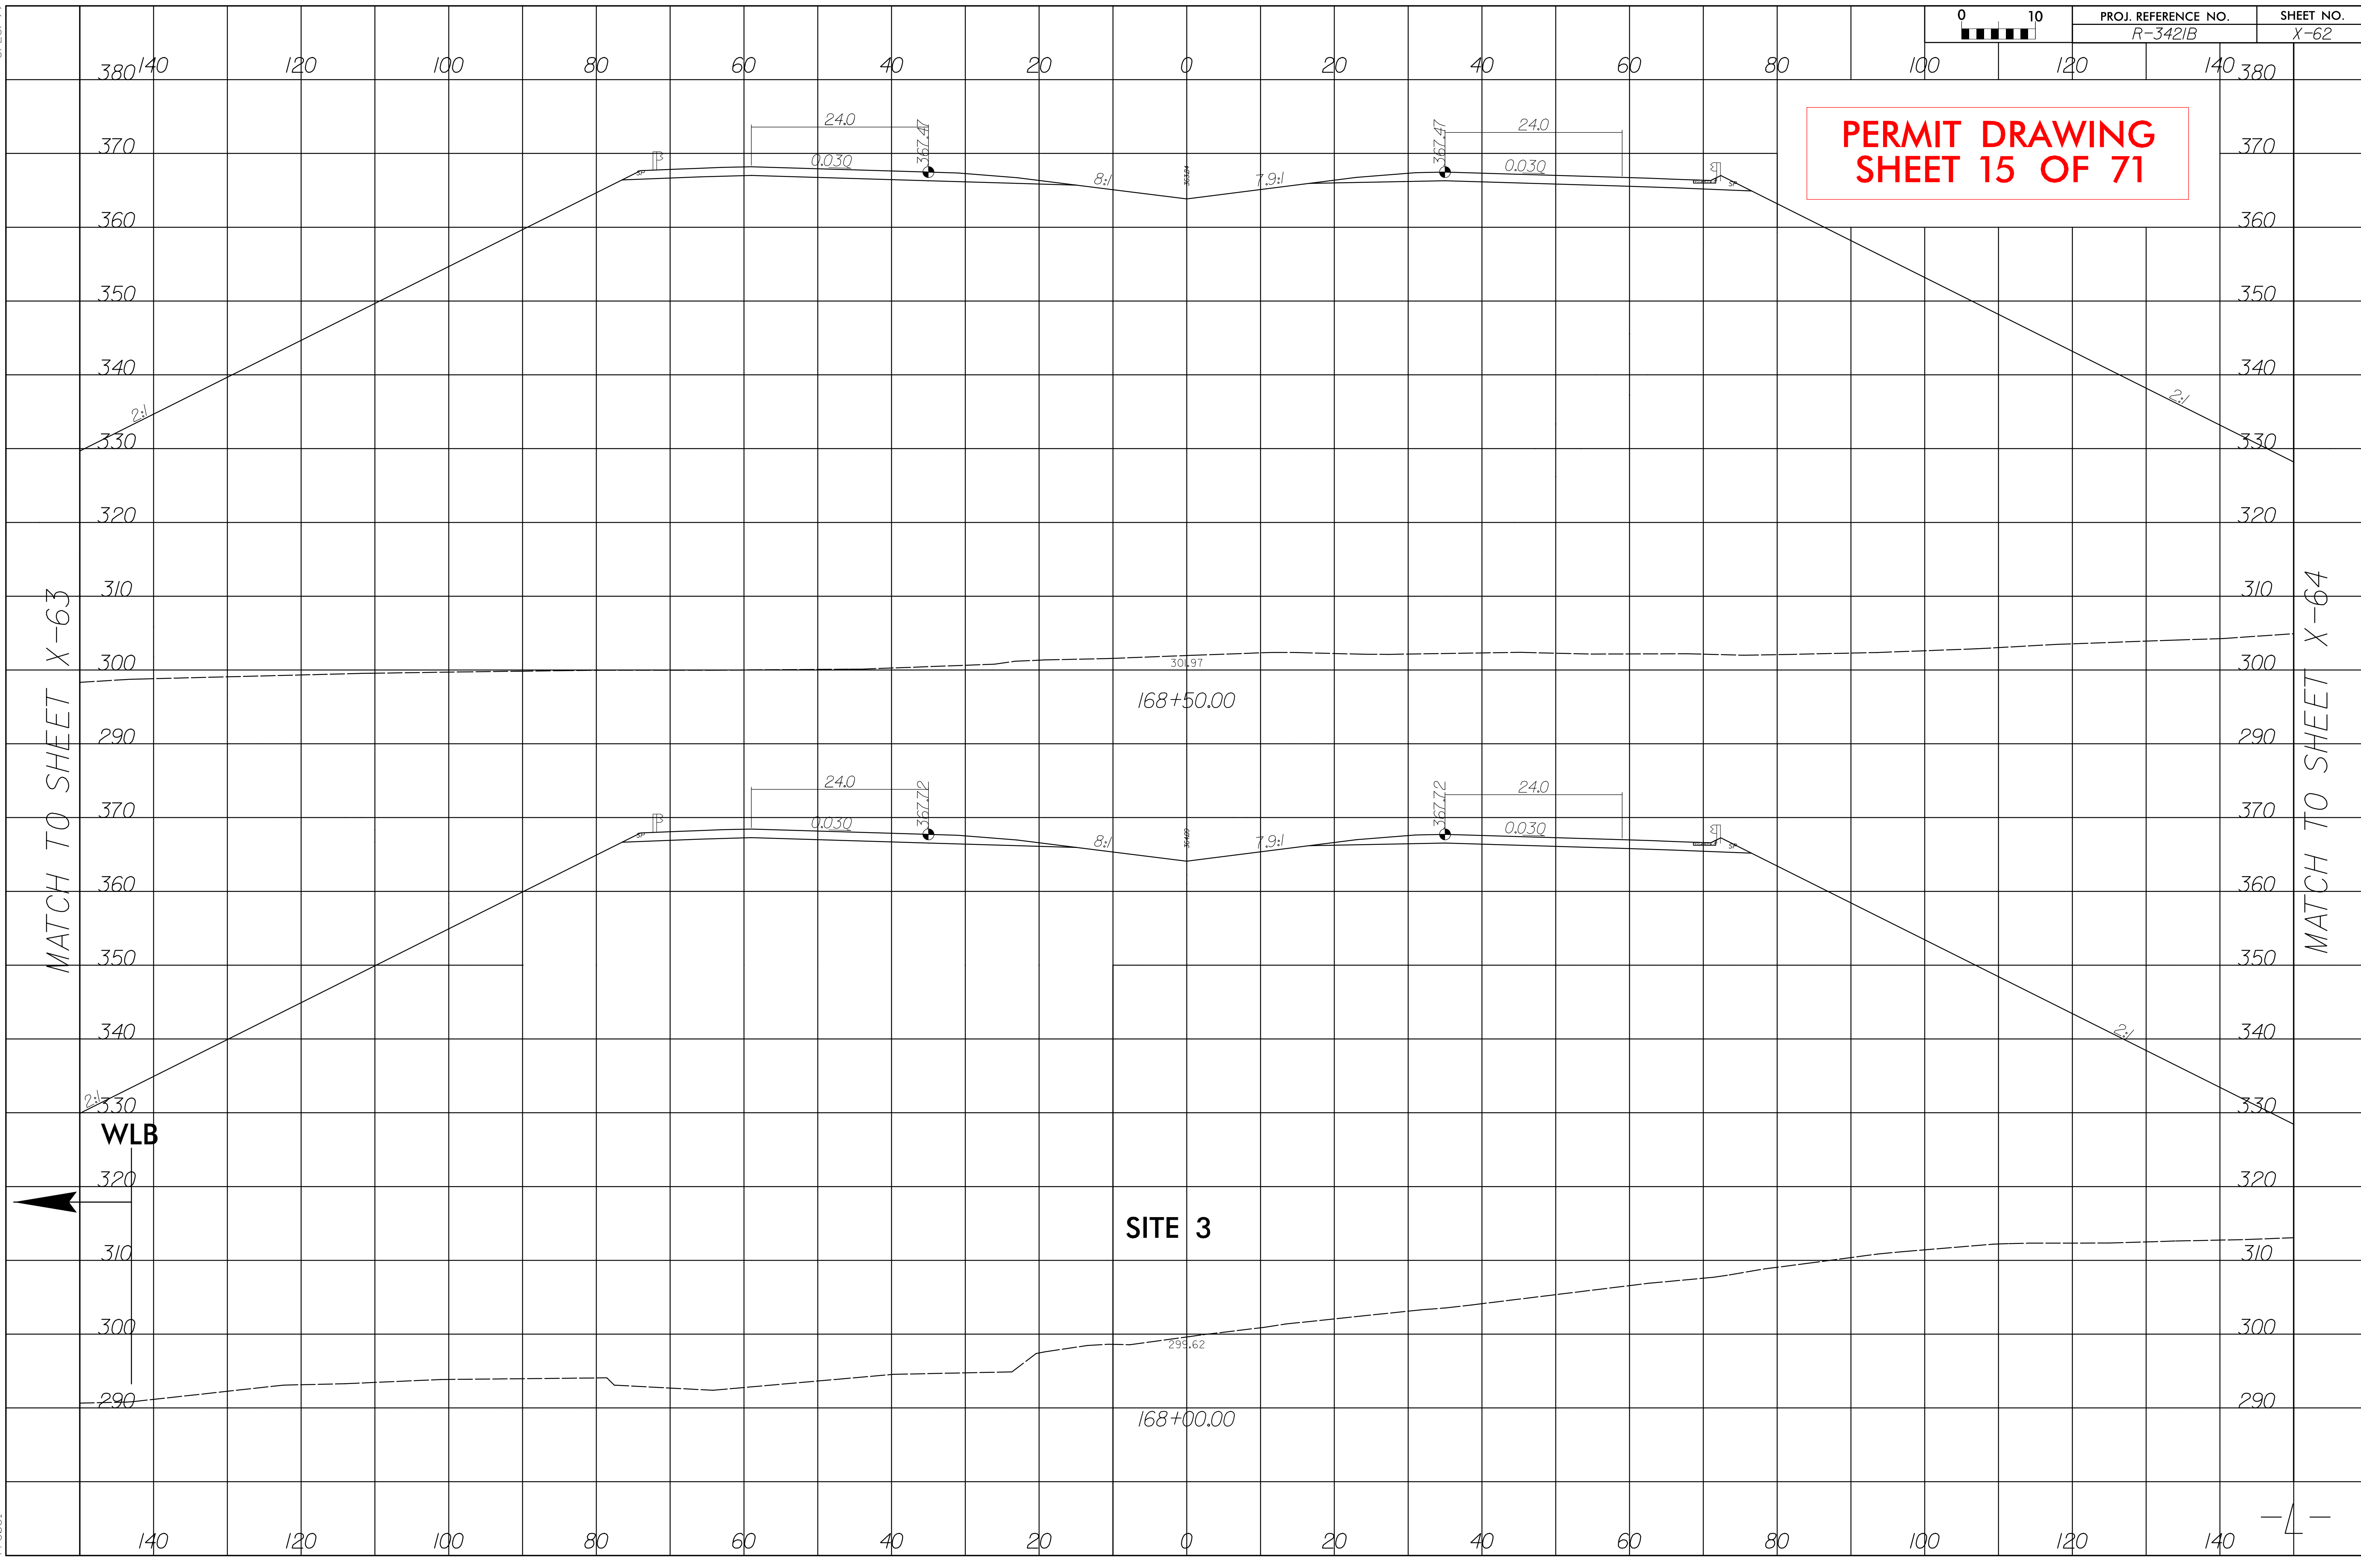

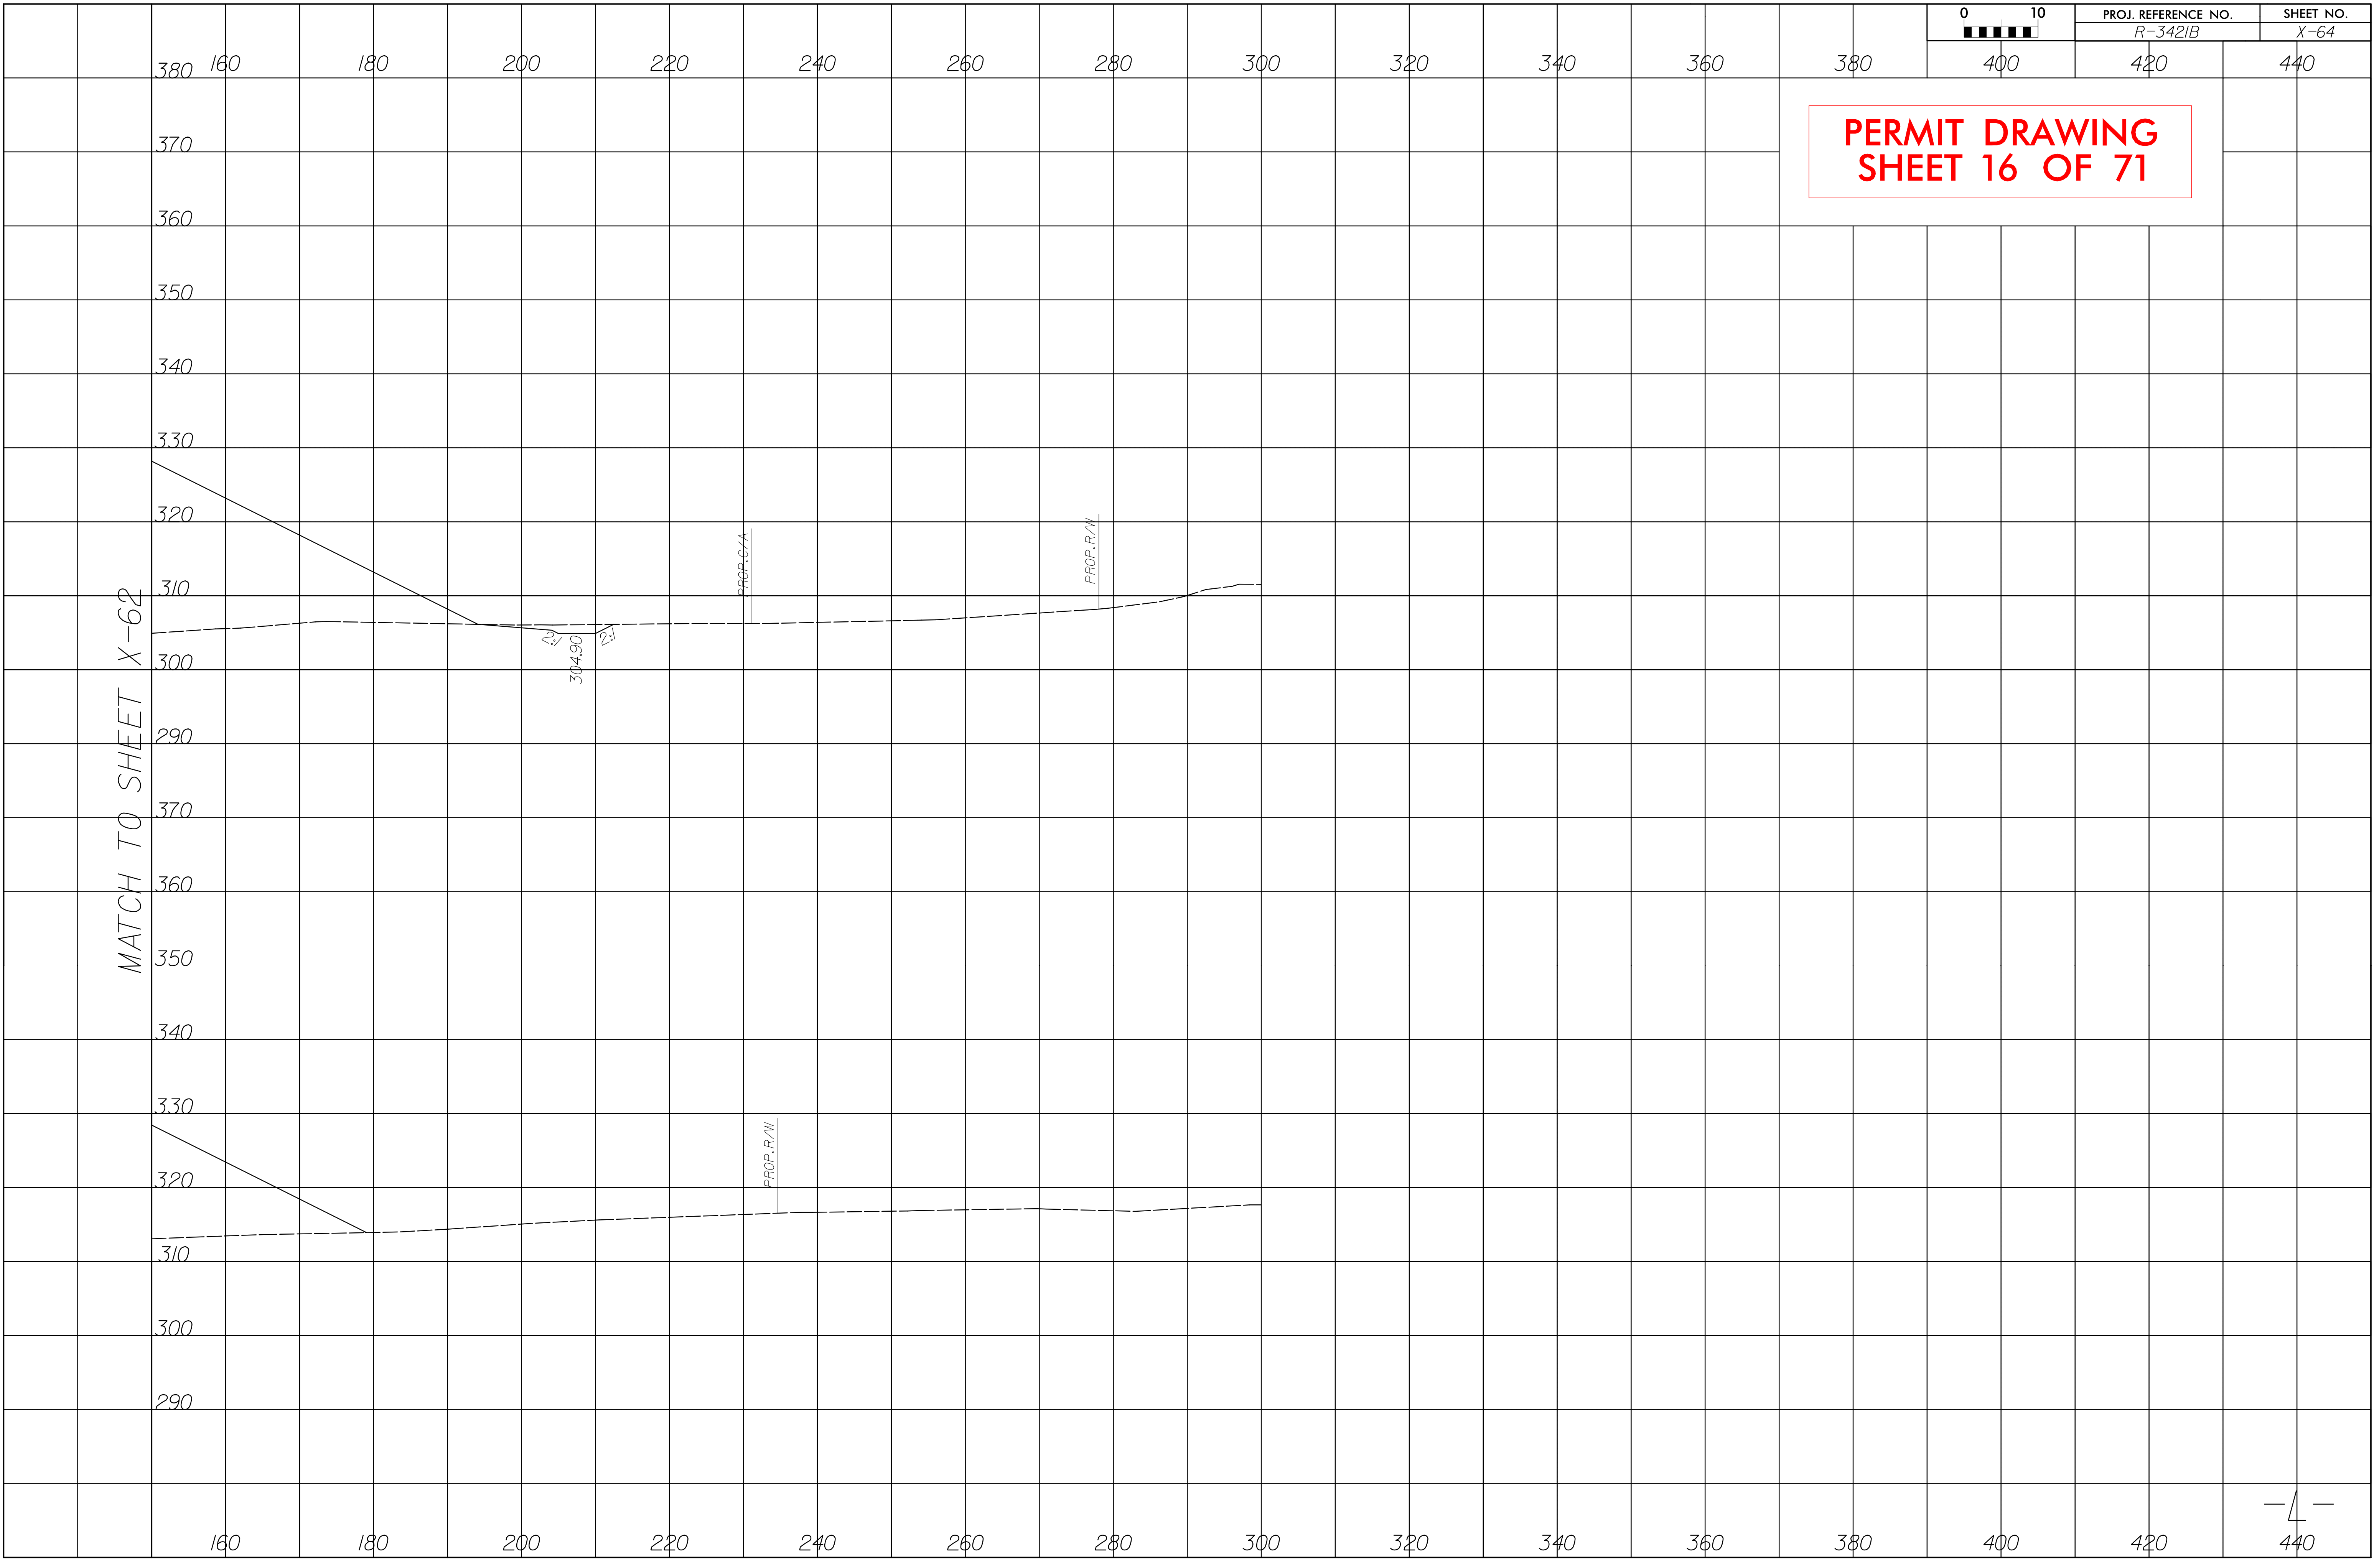


Revised 8/6/19


8/17/99

REVISIONS


9/19/36 AM
R:\Hydraulics\PERMITS\Environmental\Drawings\R3421B\Hyd_prm_wet.psh08_20150318.dgn
SDATES
S\USER\NAME\J
S\FILES

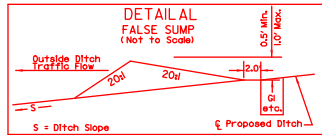


STA. 176+50 -L- (RT) STA. 190+00 -L- (RT)
STA. 183+50 -L- (RT)
STA. 187+00 -L- (RT)

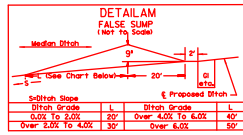


STA. 176+50 -L- (CL) STA. 183+50 -L- (CL)
STA. 179+00 -L- (CL) STA. 187+00 -L- (CL)
STA. 181+00 -L- (CL) STA. 190+00 -L- (CL)

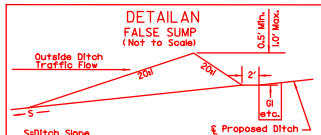

STA. 176+50 -L- (LT) STA. 190+00 -L- (LT)
STA. 183+50 -L- (LT)
STA. 187+00 -L- (LT)


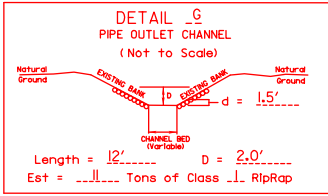


STA. 178+71.06 -L- (LT)
STA. 179+59 -L- (RT) - (25' long)



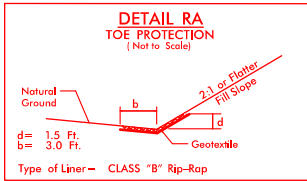


FROM STA. 178+00 -L- TO STA. 180+00 -L- LT.
(Est. Qty. 70 Tons; 147 SY GEOTEXTILE)
FROM STA. 178+25 -L- TO STA. 179+45 -L- RT.
(Est. Qty. 30 Tons; 84 SY GEOTEXTILE)

SITE 4

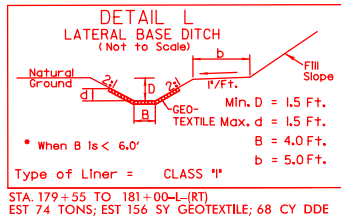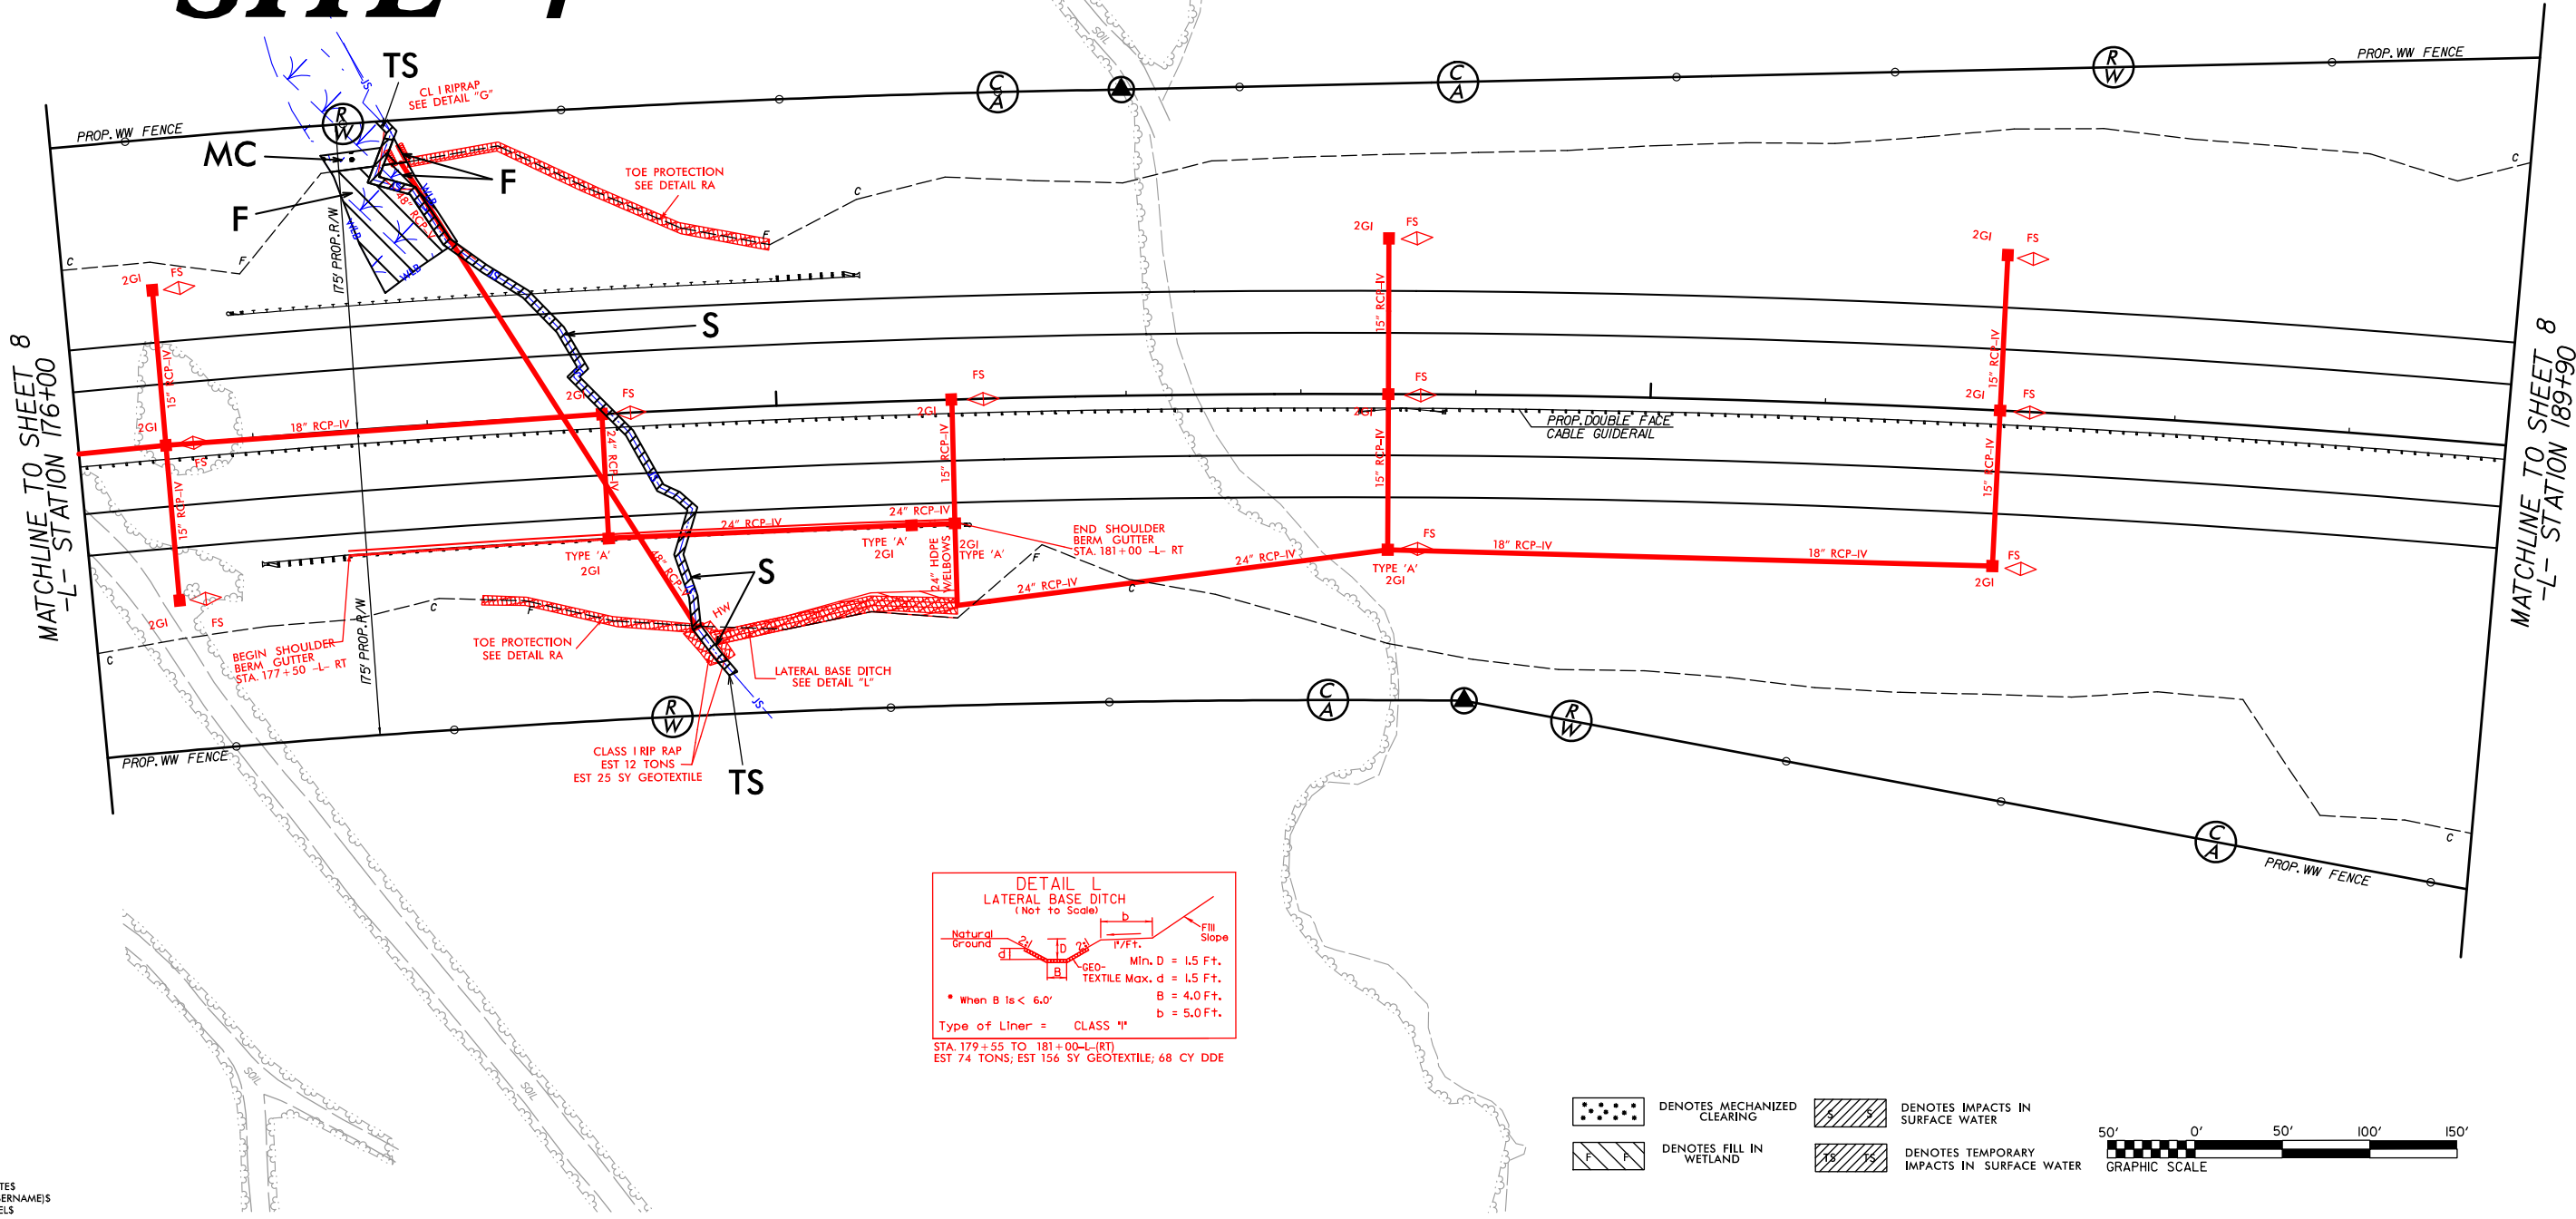


STA. 179+55 TO 181+00-L- (RT)
EST 74 TONS; EST 156 SY GEOTEXTILE; 68 CY DDE

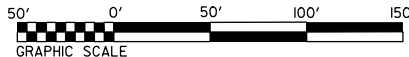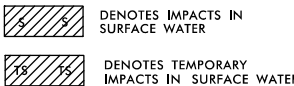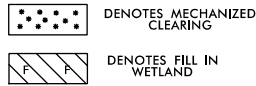

R:\Hydraulics\PERMITS-Environmental\Drawings\R3421B\R3421B-Hyd-prm-wet_psh08-20150318_con.dgn

```
SDATES
$(USERNAME)$
$FILE$
```

PERMIT DRAWING
SHEET 18 OF 71

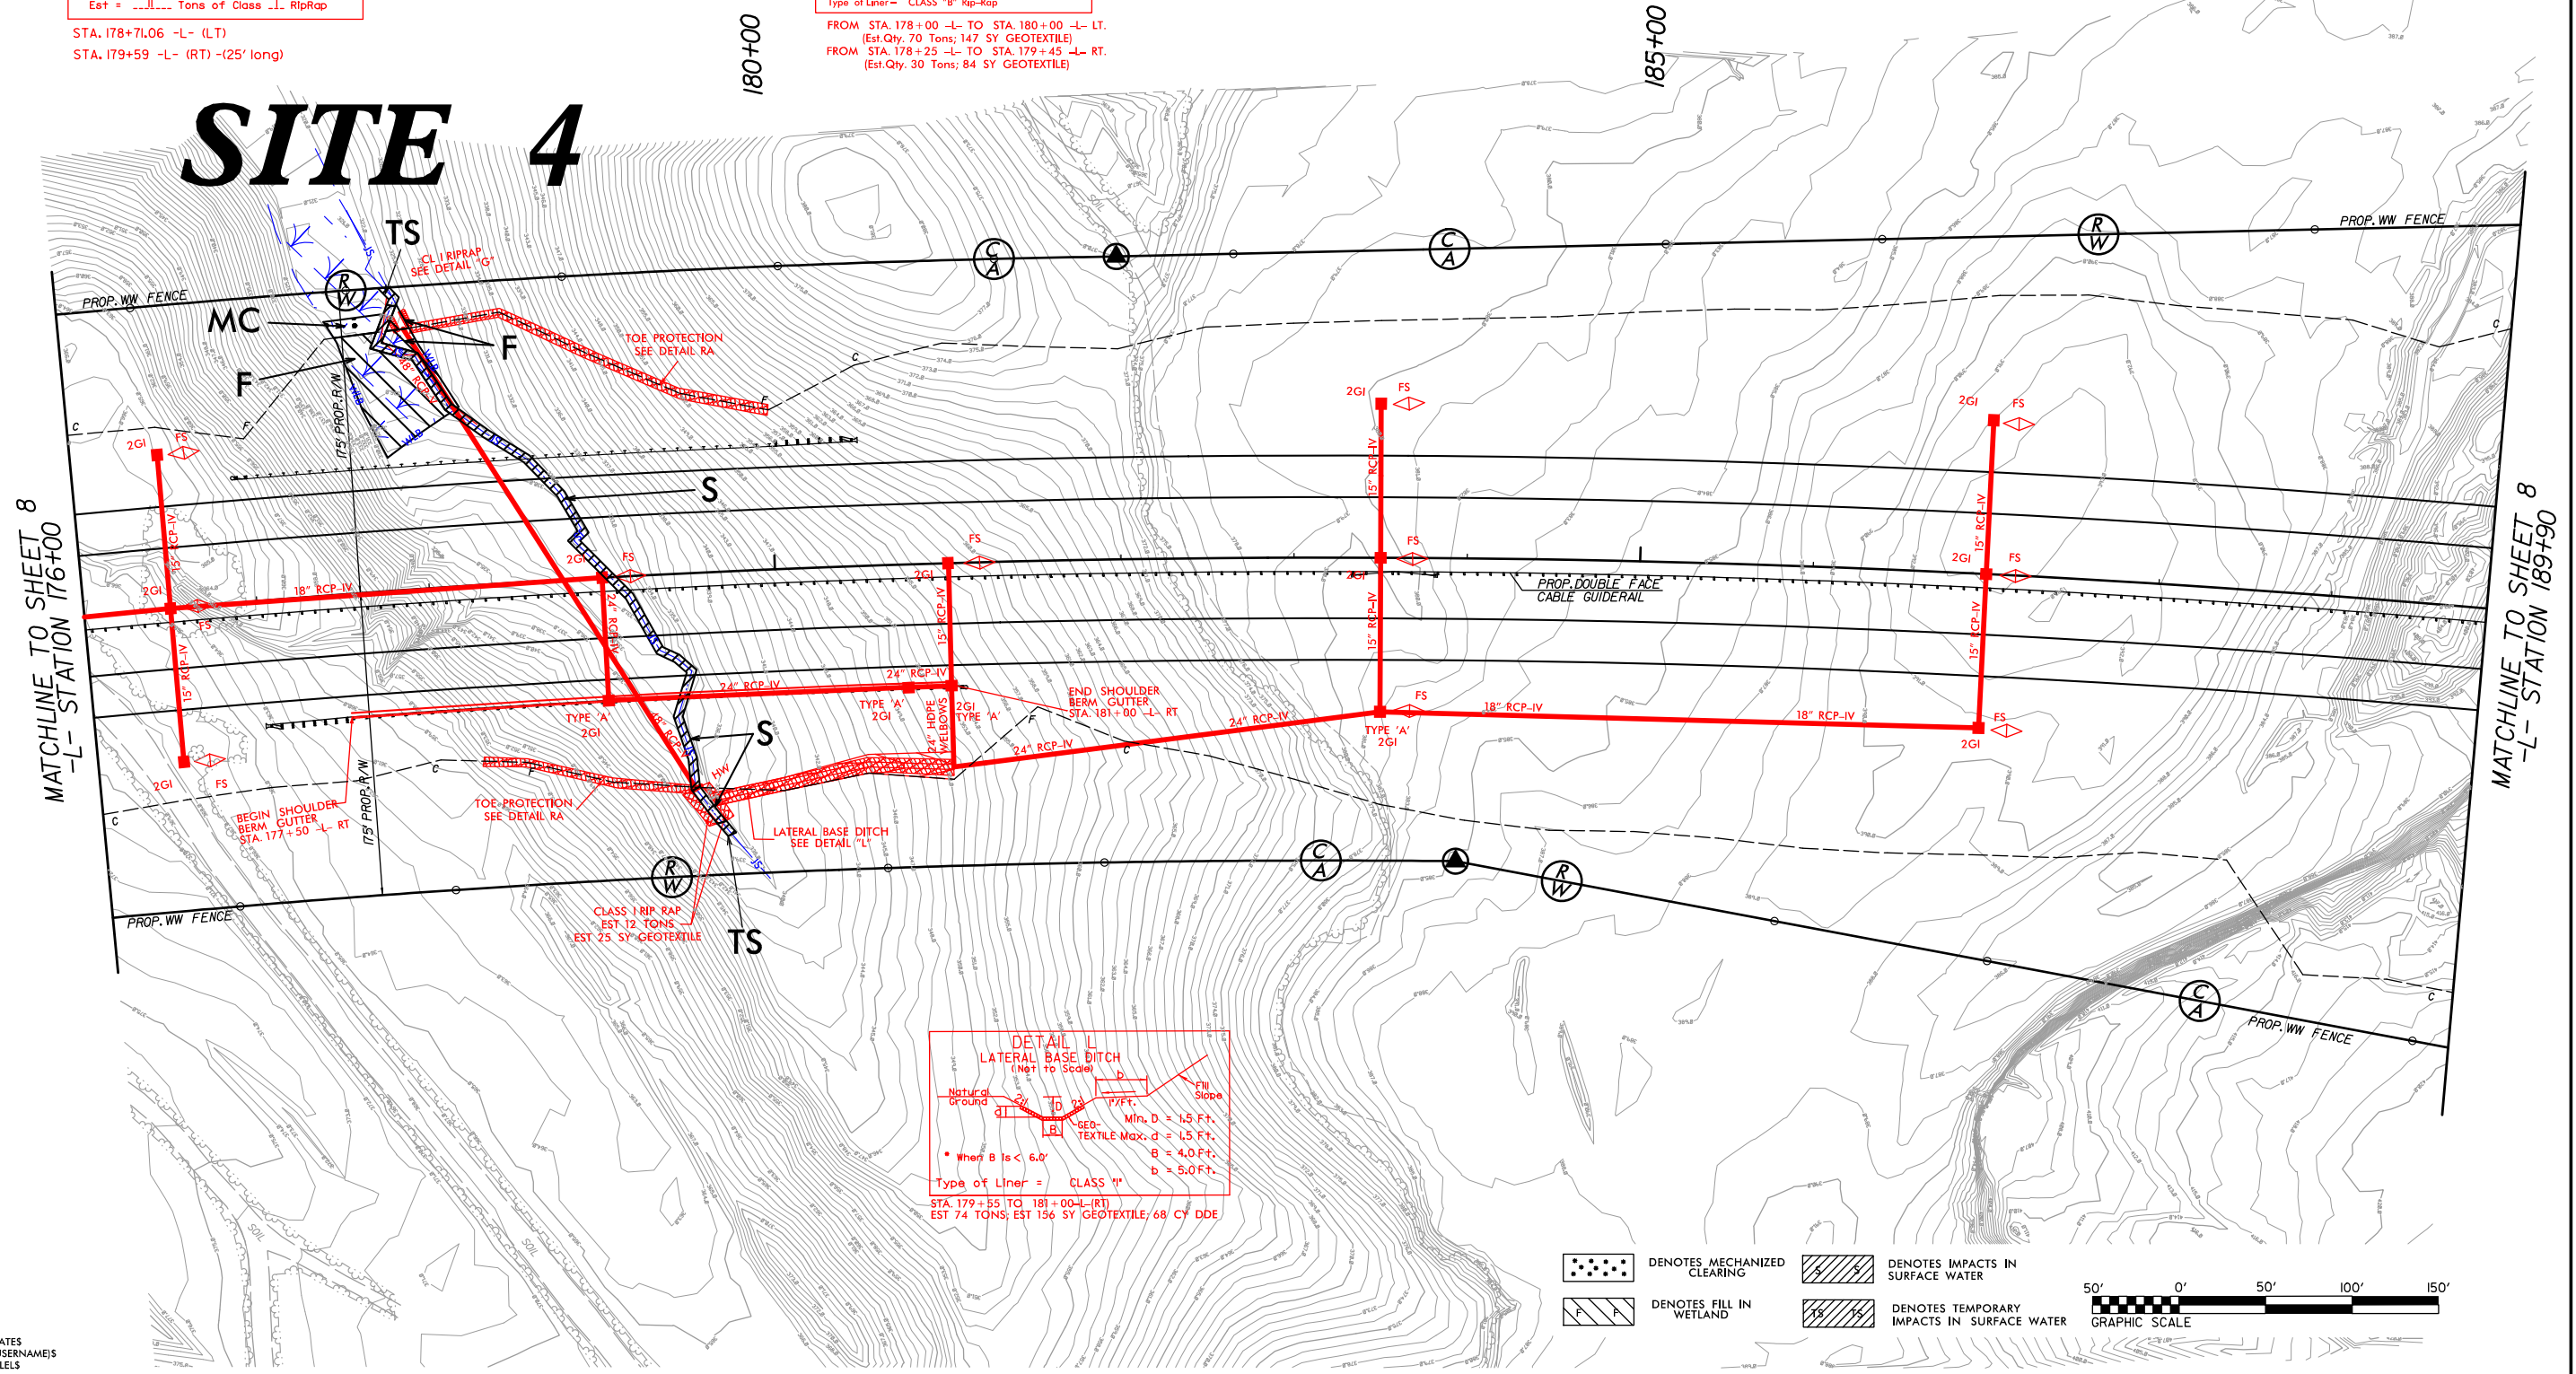

Revised 8/6/19


8/17/99

REVISIONS

9:19:52 AM R:\Hydraulics\PERMITS\Environmental\Drawings\R3421B\Hyd_prm_wet_psh08_enlarge_site4_20150318.dgn



\$DATE\$
\$(USERNAME)\$
\$FILEL\$

SITE 4 ENLARGEMENT

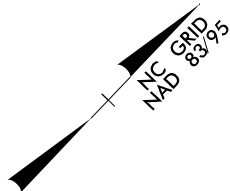

PROJECT REFERENCE NO.	SHEET NO.
R-3421B	8
R/W SHEET NO.	
ROADWAY DESIGN ENGINEER	HYDRAULICS ENGINEER
INCOMPLETE PLANS DO NOT USE FOR R/W ACQUISITION	
PRELIMINARY PLANS DO NOT USE FOR CONSTRUCTION	

PERMIT DRAWING
SHEET 19 OF 71

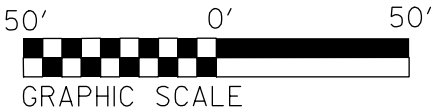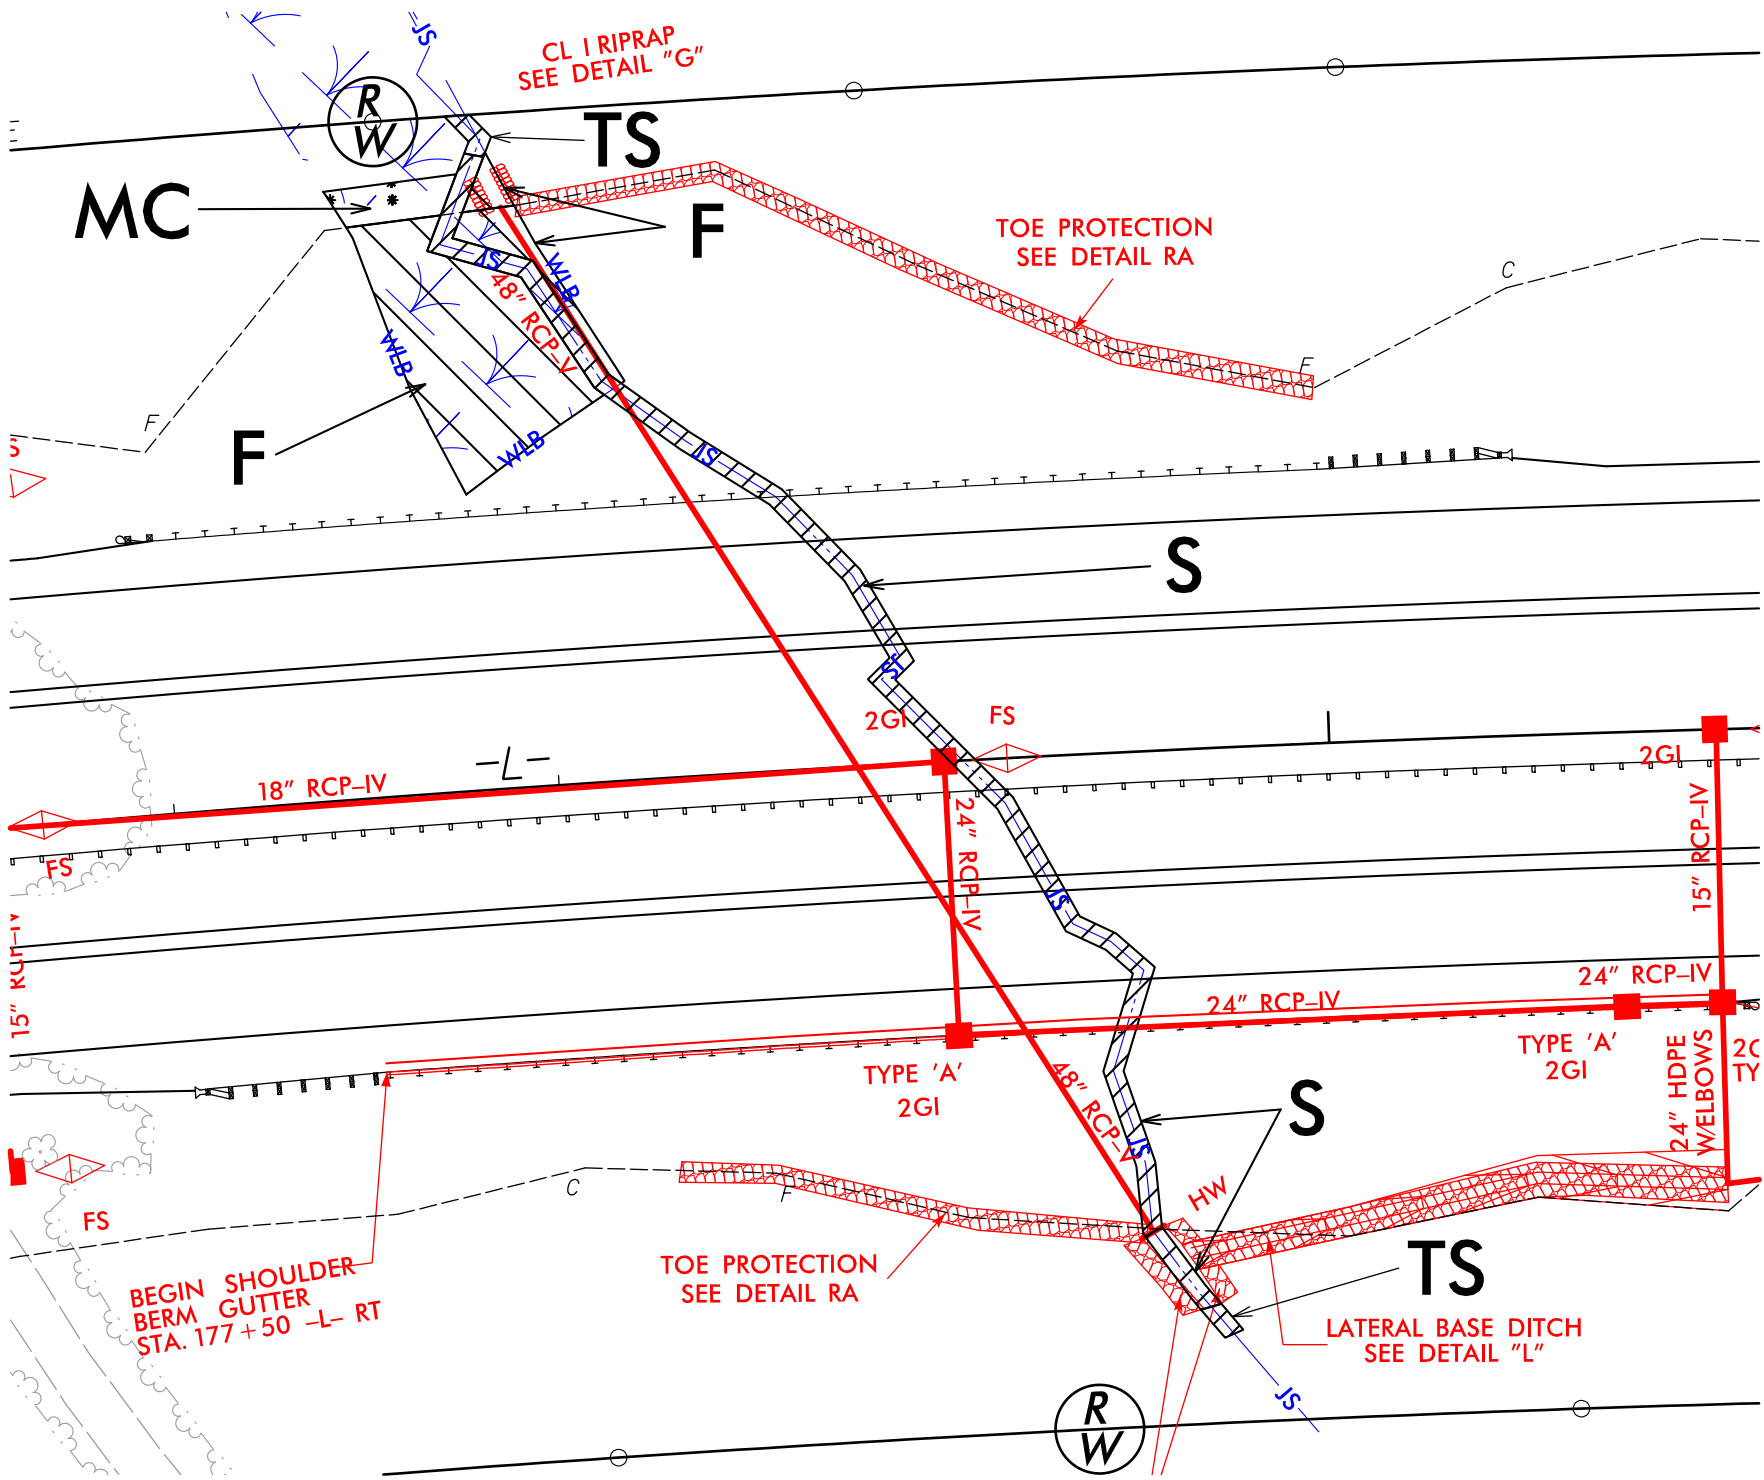

- DENOTES IMPACTS IN SURFACE WATER
- DENOTES TEMPORARY IMPACTS IN SURFACE WATER
- DENOTES MECHANIZED CLEARING
- DENOTES FILL IN WETLAND

Revised 8/6/19


8/17/99

REVISIONS

9:20:00 AM R:\Hydra\lics\PERMITS\Environmental\Drawings\R3421B\Hyd_prm_wet_psh08_enlarge site4.20150318_con.dgn



\$DATES
\$(USERNAME)\$
\$FILEL\$

SITE 4 ENLARGEMENT

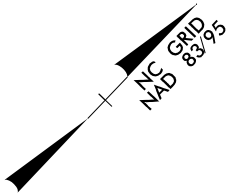



PROJECT REFERENCE NO.	SHEET NO.
R-3421B	8
R/W SHEET NO.	
ROADWAY DESIGN ENGINEER	HYDRAULICS ENGINEER
INCOMPLETE PLANS DO NOT USE FOR R/W ACQUISITION	
PRELIMINARY PLANS DO NOT USE FOR CONSTRUCTION	

PERMIT DRAWING
SHEET 20 OF 71

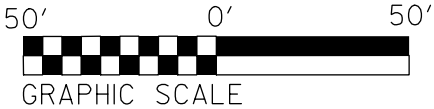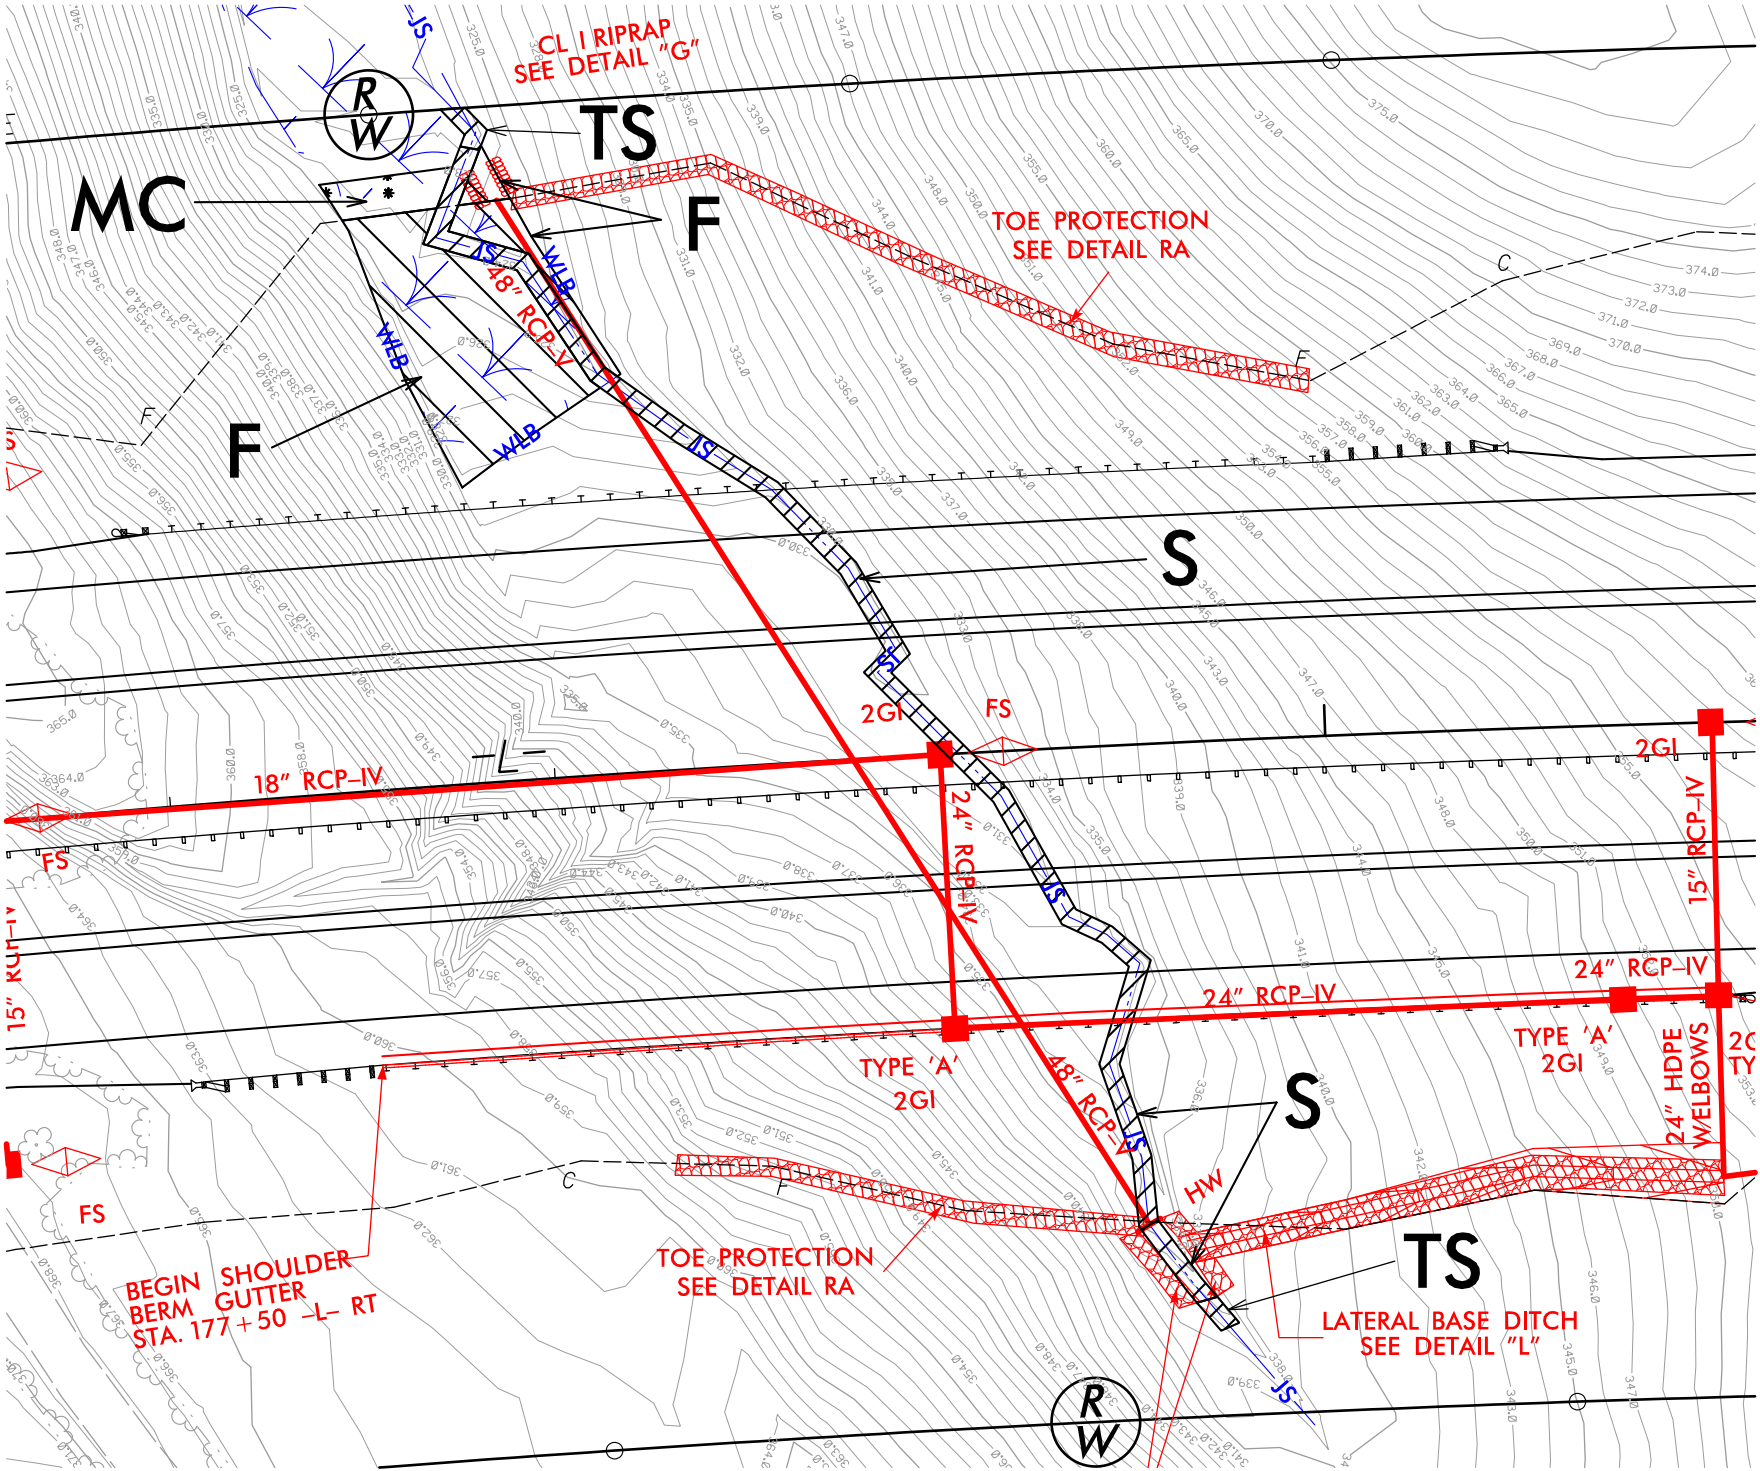

- DENOTES IMPACTS IN SURFACE WATER
- DENOTES TEMPORARY IMPACTS IN SURFACE WATER
- DENOTES MECHANIZED CLEARING
- DENOTES FILL IN WETLAND

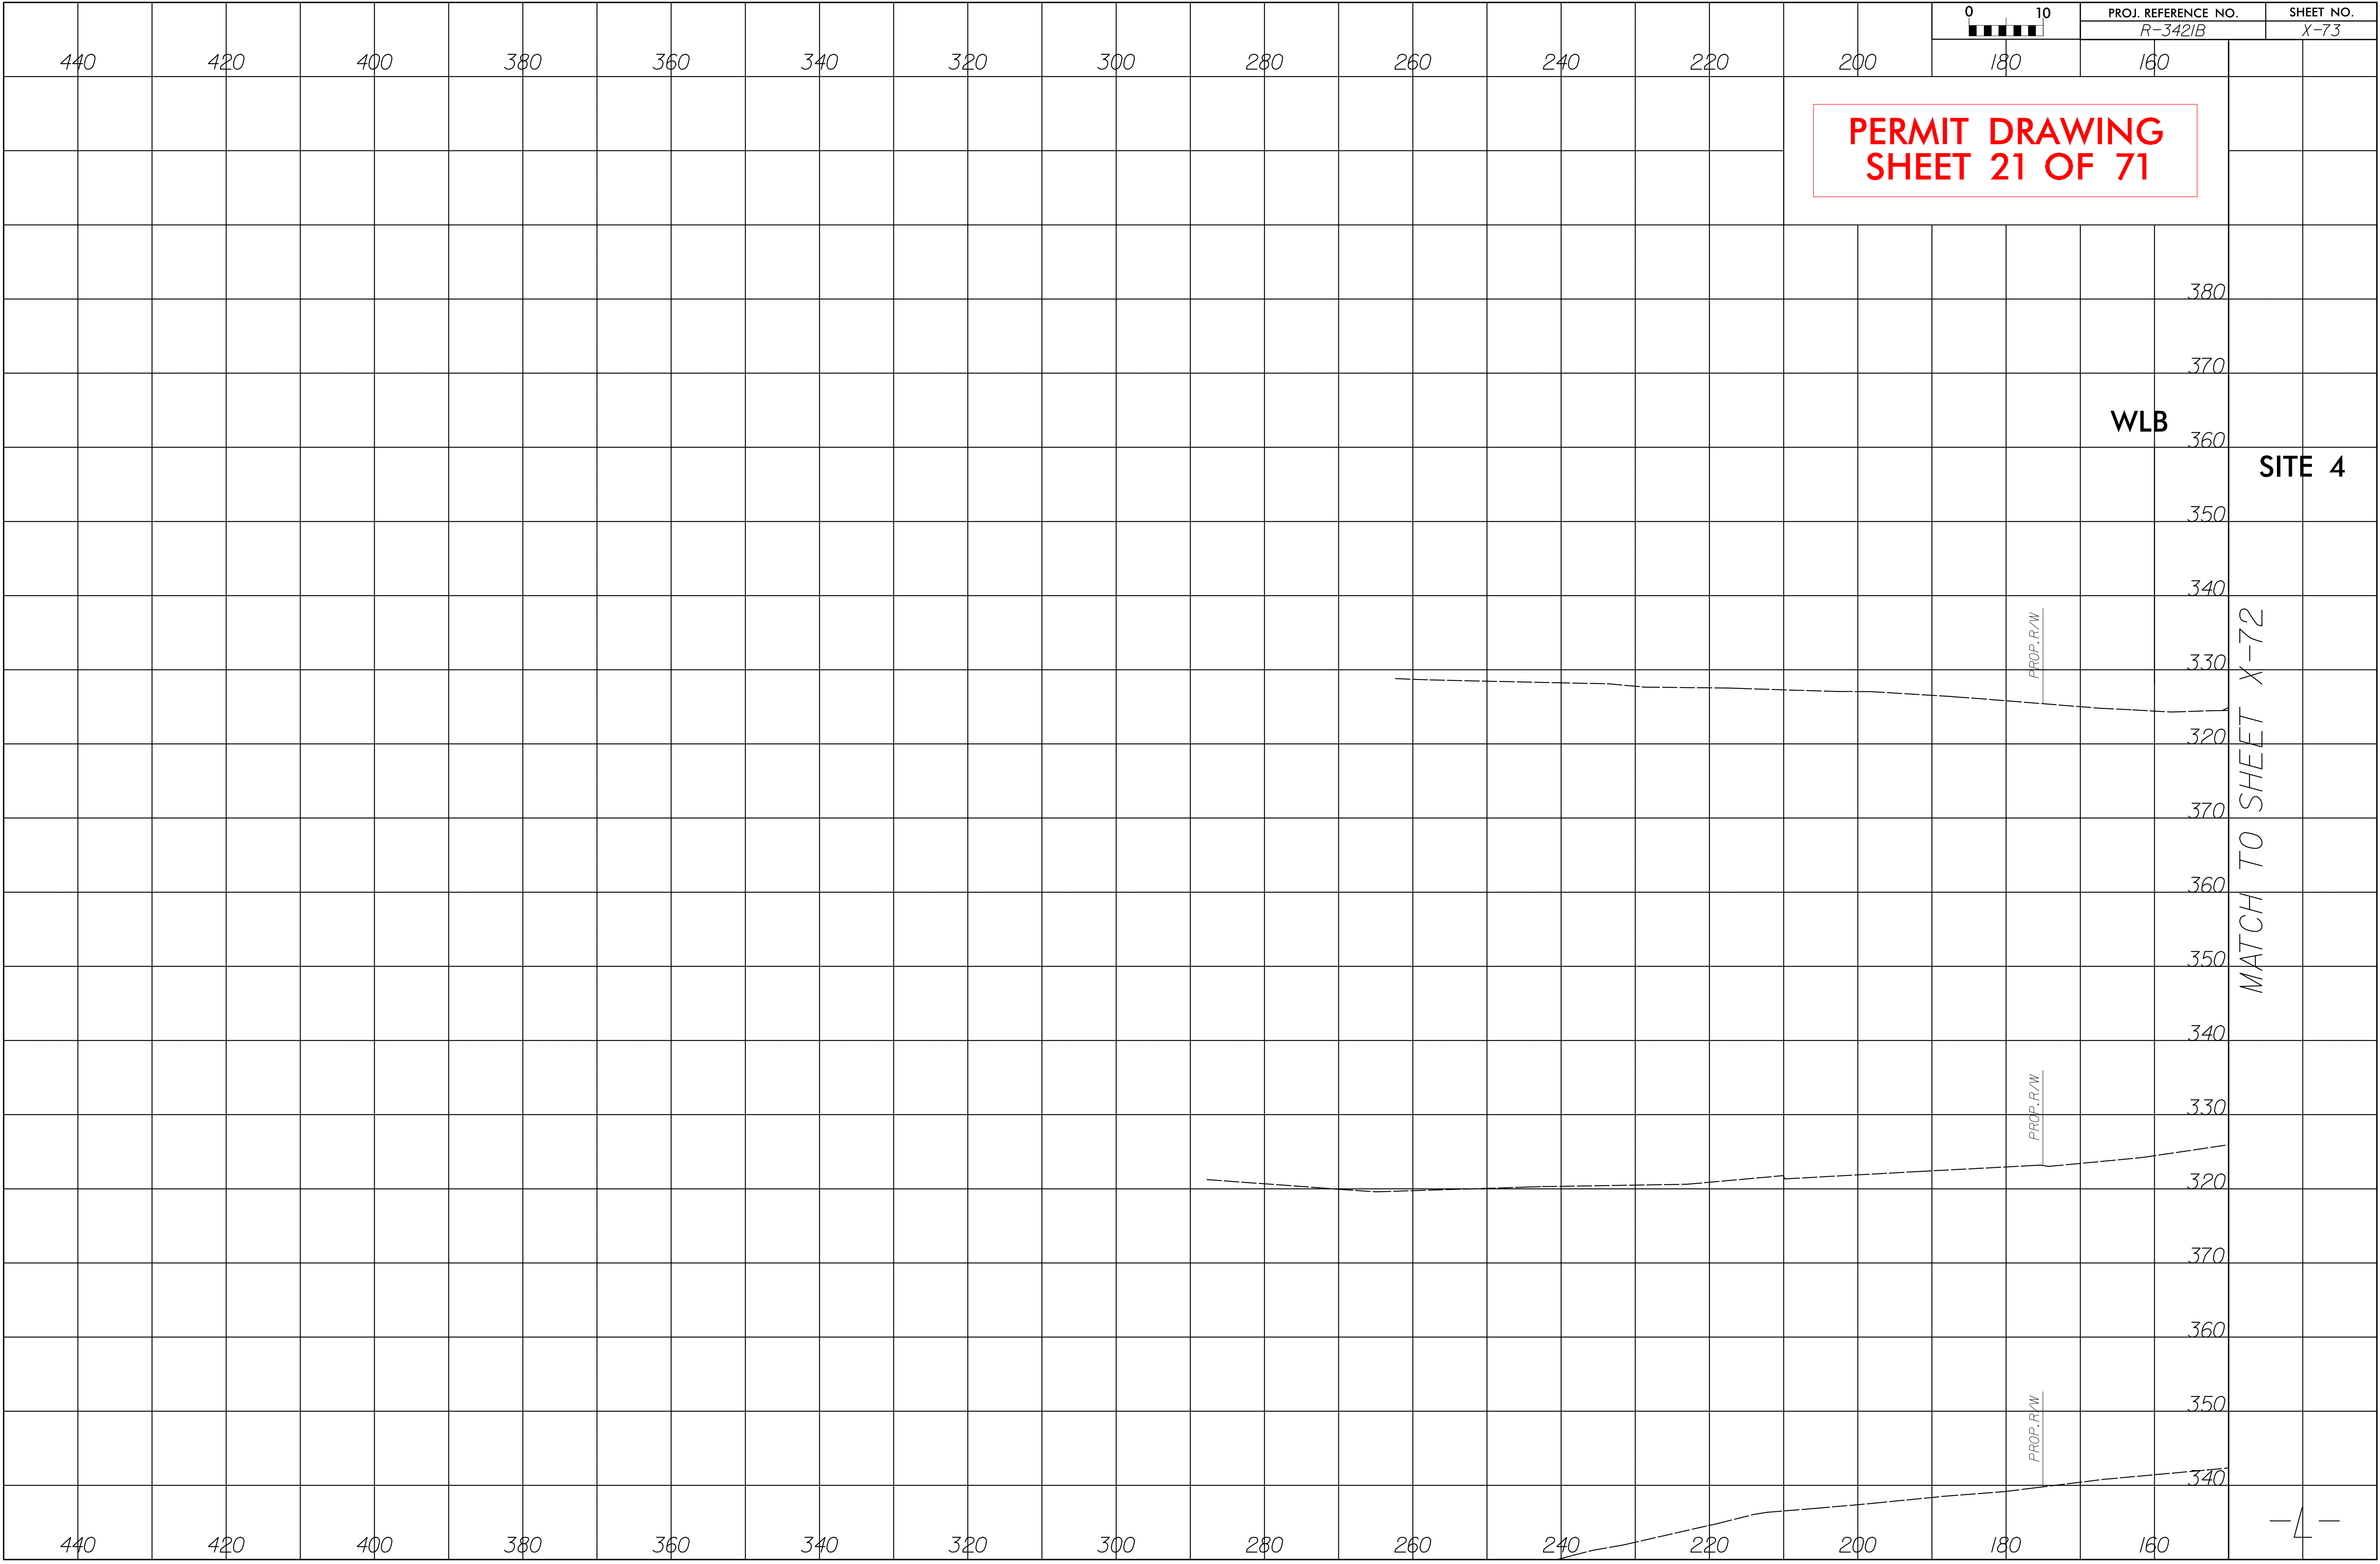

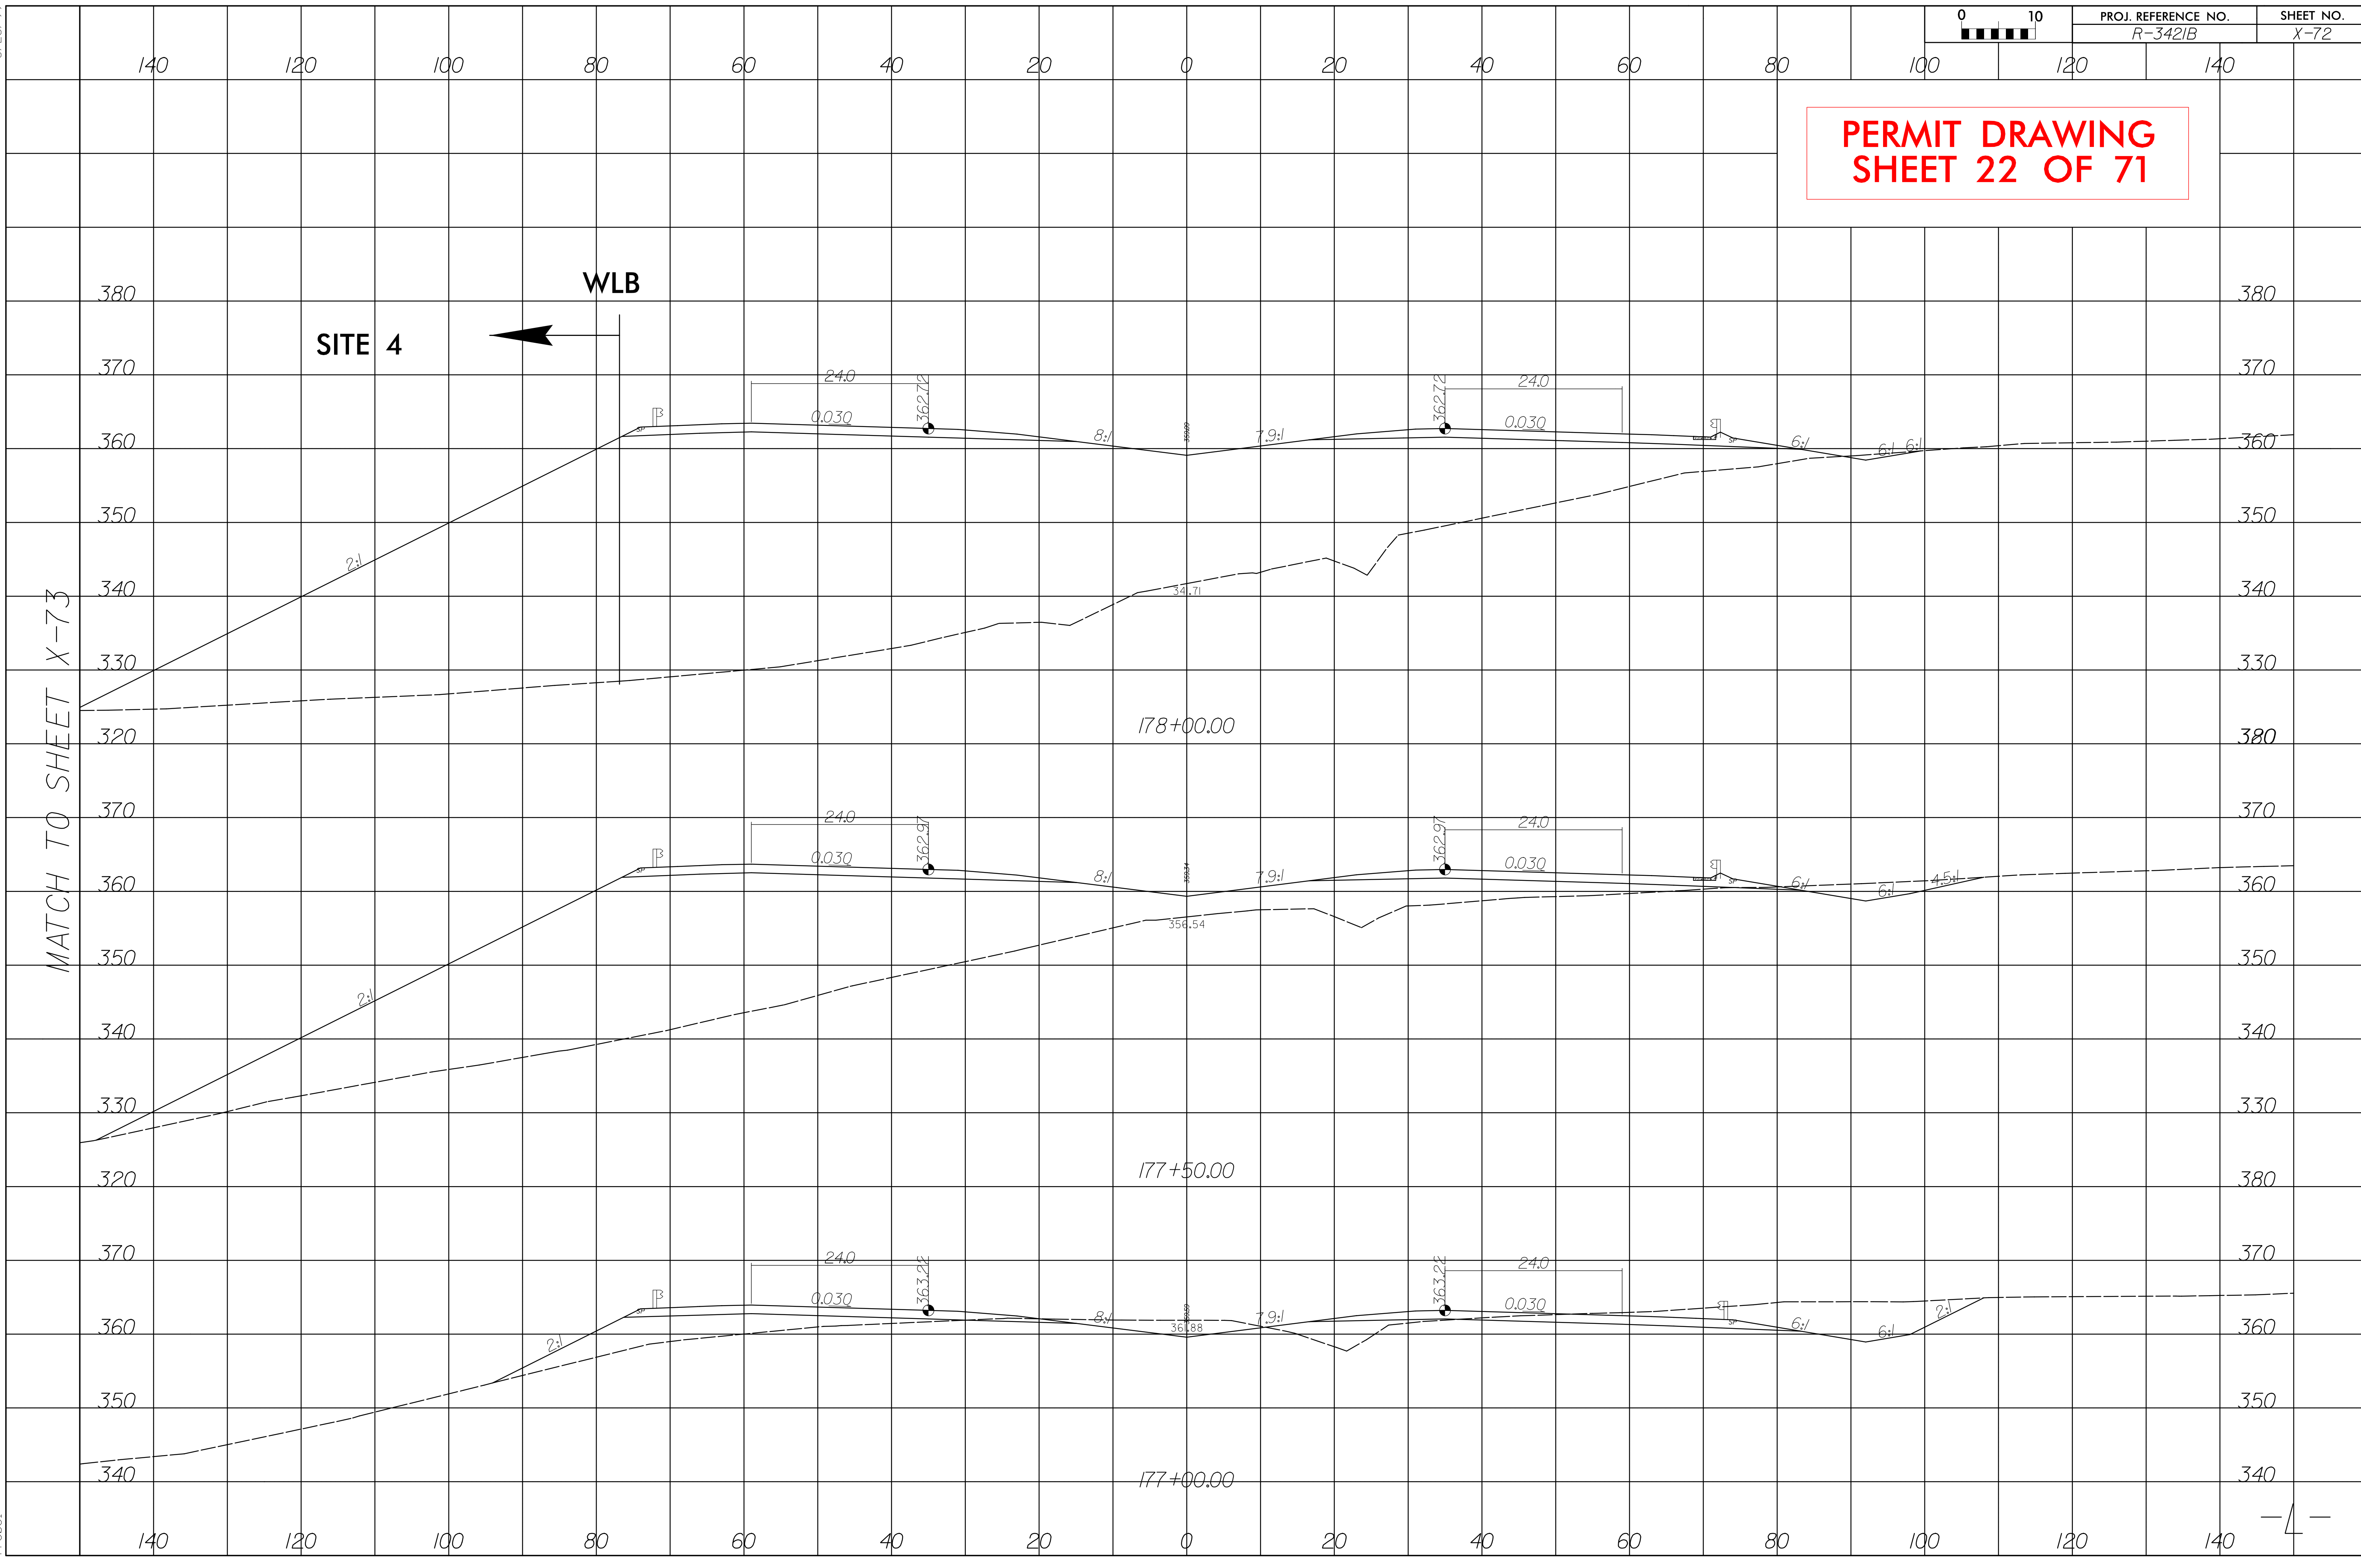


PERMIT DRAWING
SHEET 22 OF 71


8/17/99

PROJECT REFERENCE NO.	SHEET NO.
R-3421B	10
RW SHEET NO.	
ROADWAY DESIGN ENGINEER	HYDRAULICS ENGINEER
INCOMPLETE PLANS DO NOT USE FOR R/W ACQUISITION	
PRELIMINARY PLANS DO NOT USE FOR CONSTRUCTION	


PERMIT DRAWING
SHEET 23 OF 71

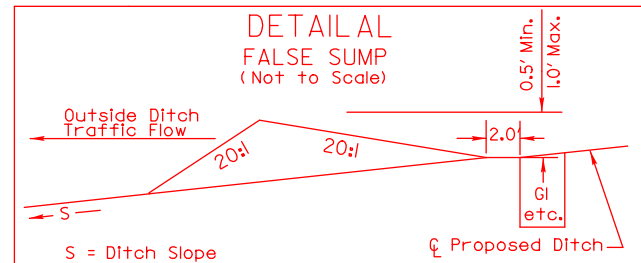


STA. 205+00 -L- (RT)
STA. 211+50 -L- (RT)

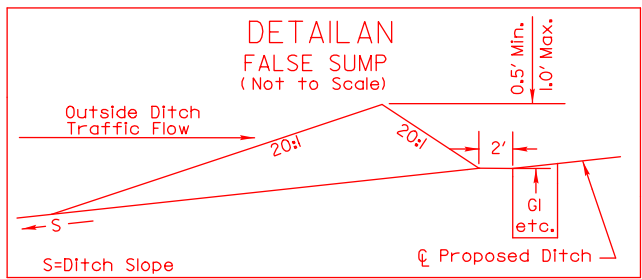


STA. 205+00-L- (LT)
STA. 211+50 -L- (LT)

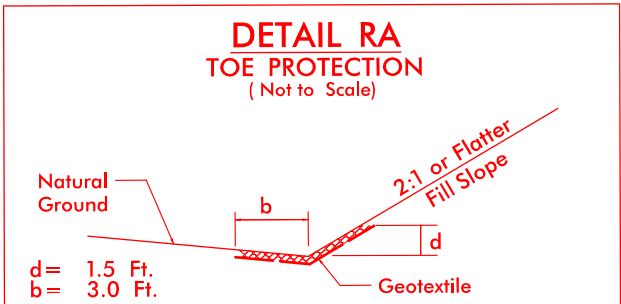

Type of Liner= CLASS "B" Rip-Rap
FROM STA. 215+50 -L- TO STA. 218+00 -L- RT.
(Est.Qty. 70 Tons; 170 SY GEOTEXTILE)

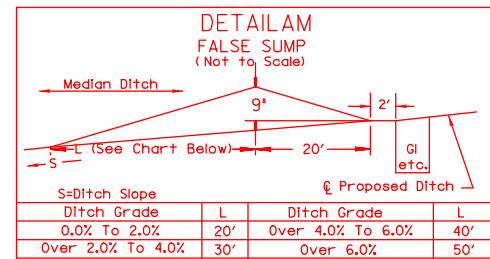


STA. 205+00 -L- (CL)
STA. 209+00 -L- (CL)
STA. 211+50 -L- (CL)
STA. 215+50 -L- (CL)

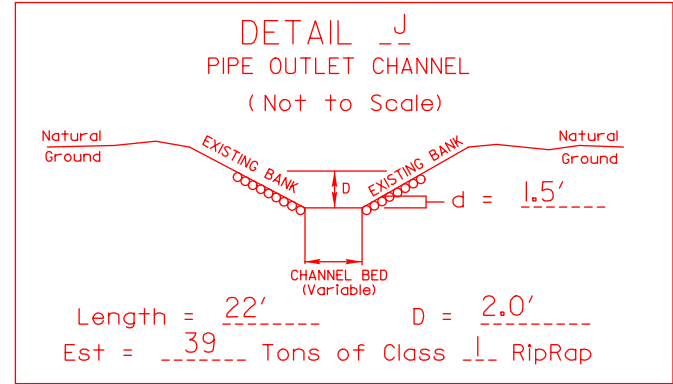

Length = 22' d = 2.0'
Est = .39 Tons of Class 1 RipRap



STA. 216+69.17 -L- (LT)

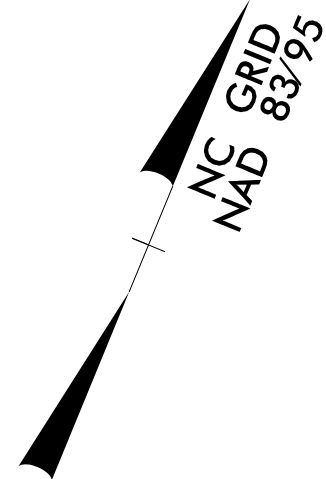

MATCHLINE TO SHEET 10
-L- STATION 204+00

MATCHLINE TO SHEET 10
-L- STATION 218+00


SITE 5

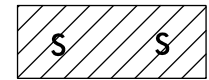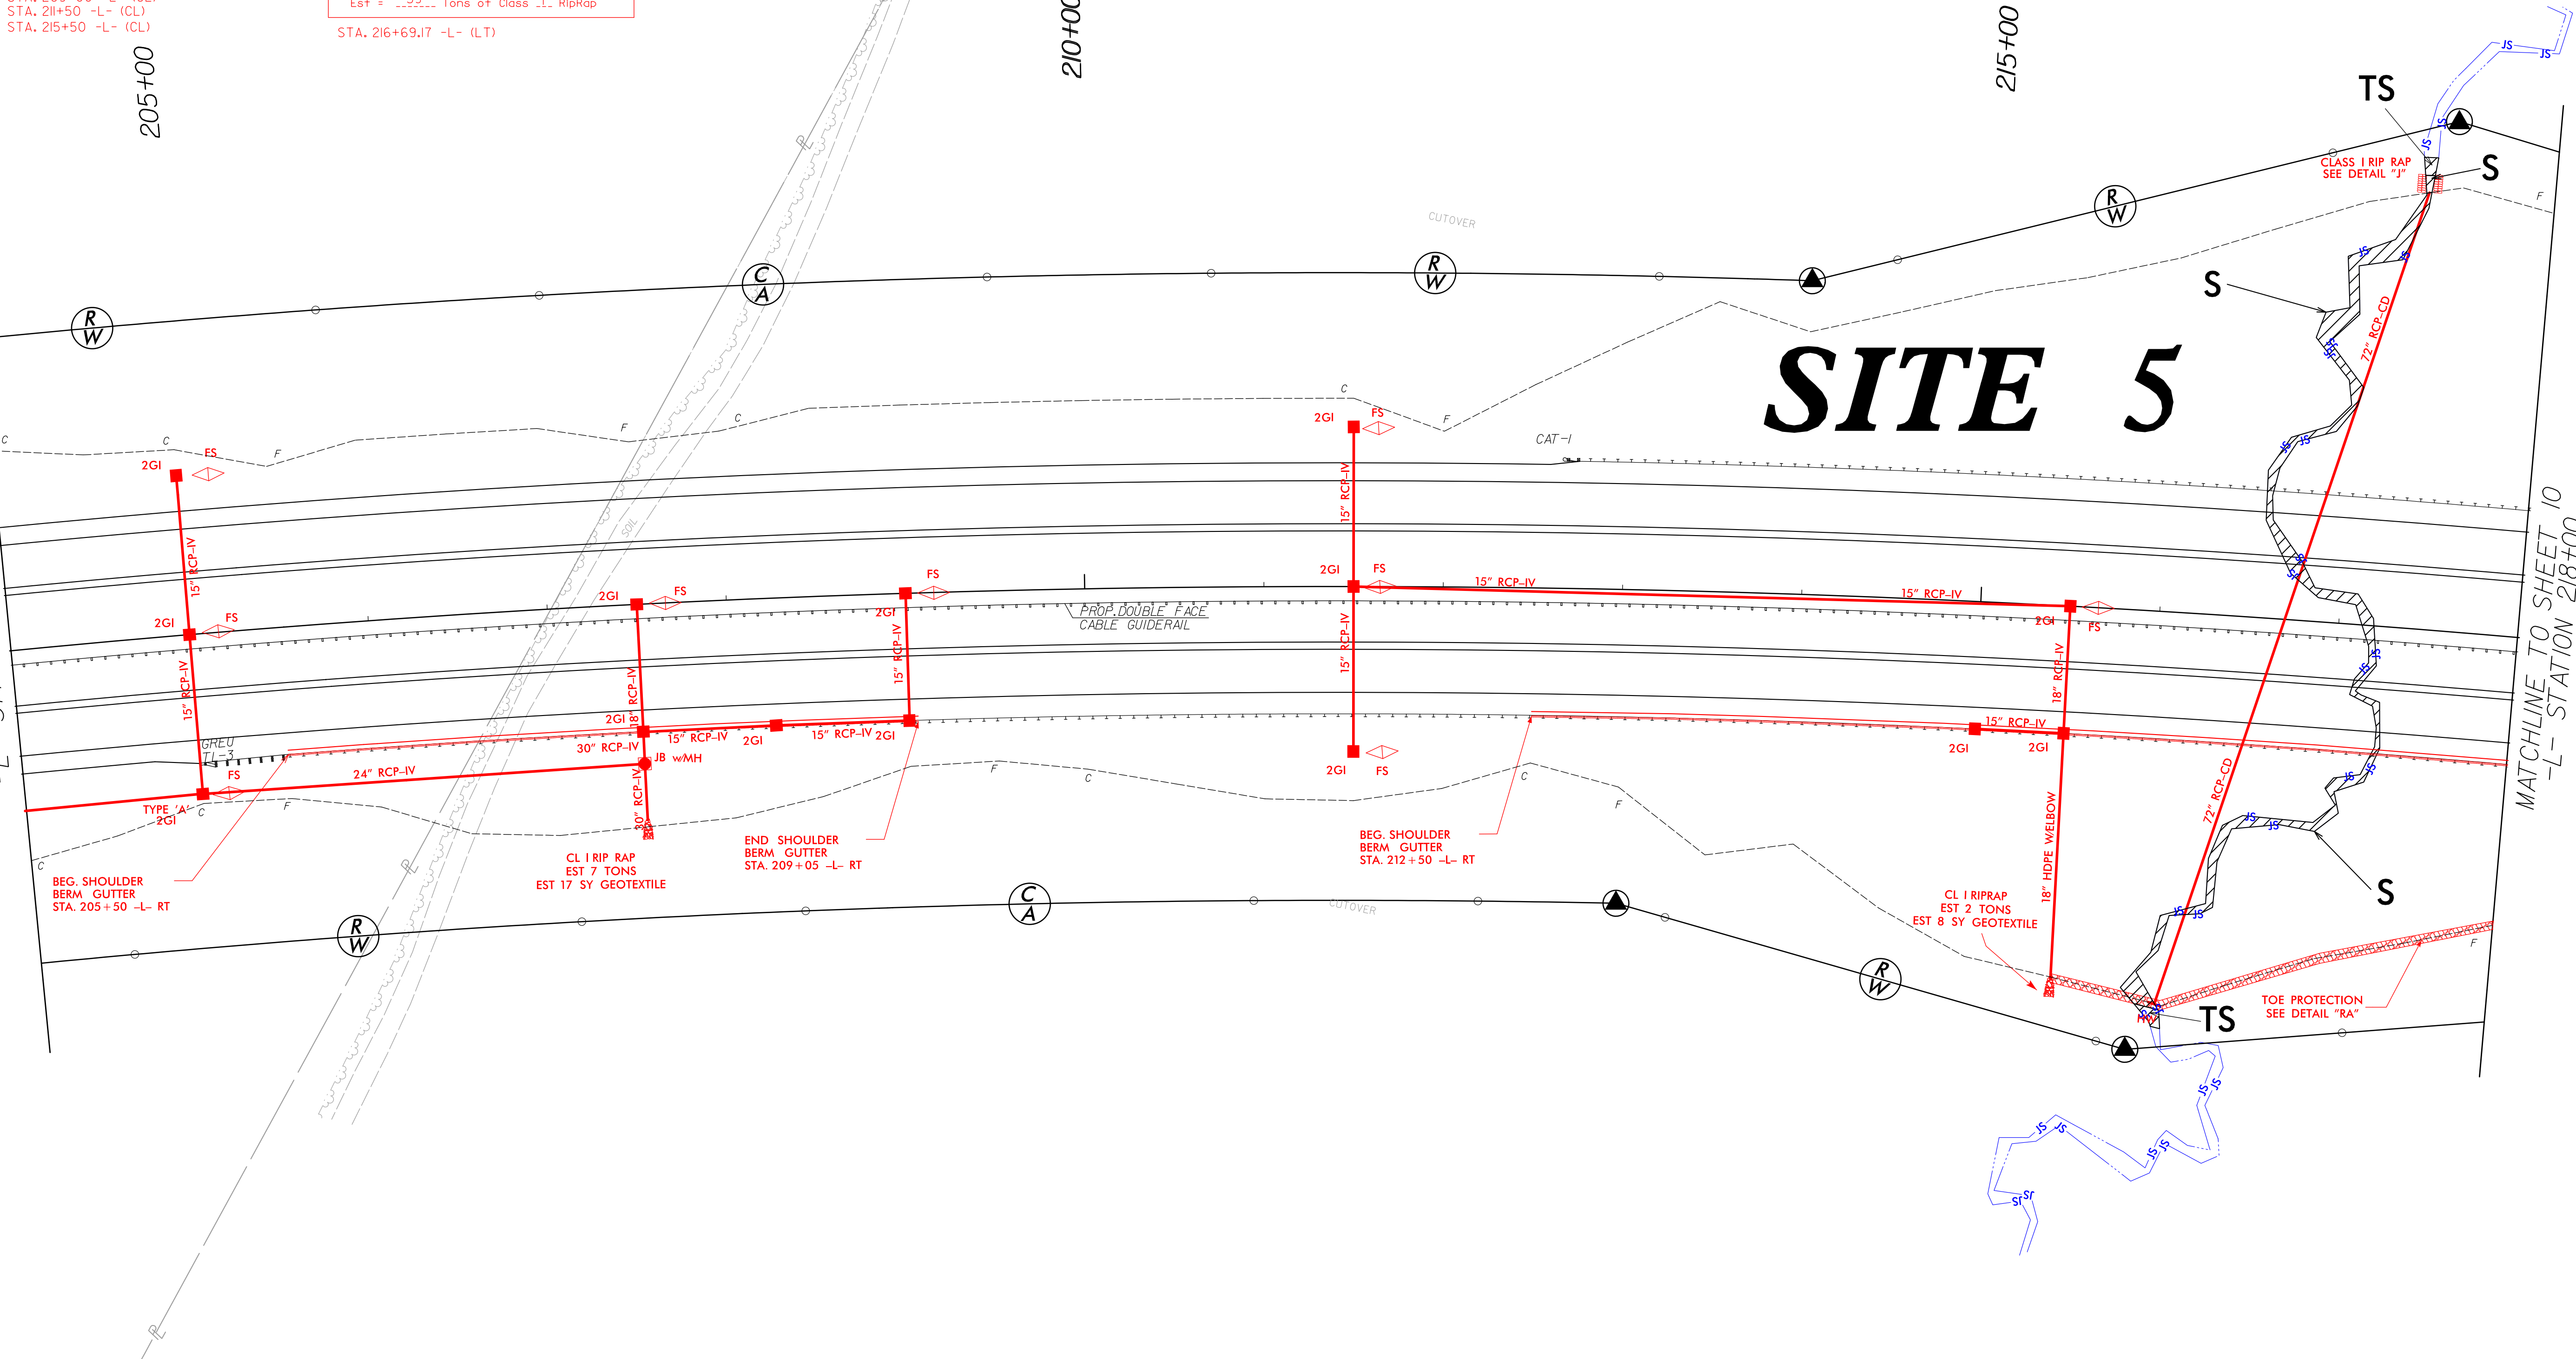

DENOTES IMPACTS IN
SURFACE WATER




DENOTES TEMPORARY
IMPACTS IN SURFACE WATER

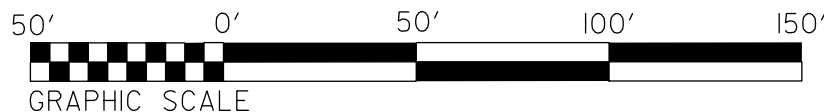


SDATES
S(USERNAME)S
SFILELS

PROJECT REFERENCE NO.	SHEET NO.
R-3421B	10
RW SHEET NO.	
ROADWAY DESIGN ENGINEER	HYDRAULICS ENGINEER
INCOMPLETE PLANS DO NOT USE FOR R/W ACQUISITION	
PRELIMINARY PLANS DO NOT USE FOR CONSTRUCTION	


PERMIT DRAWING
SHEET 24 OF 71

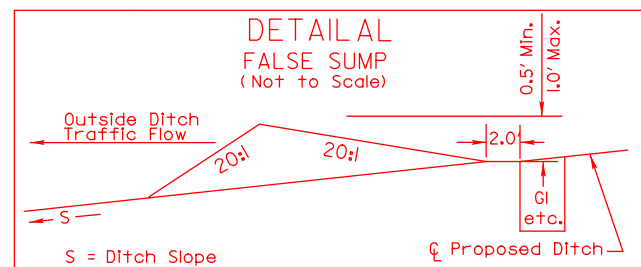


STA. 205+00 -L- (RT)
STA. 211+50 -L- (RT)

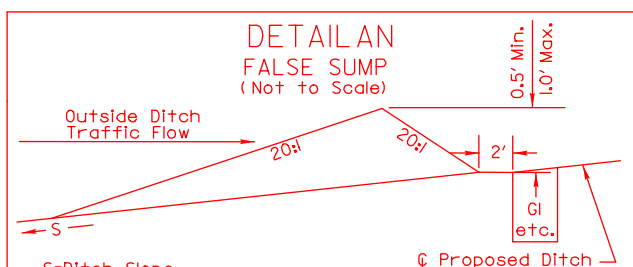


STA. 205+00-L- (LT)
STA. 211+50 -L- (LT)

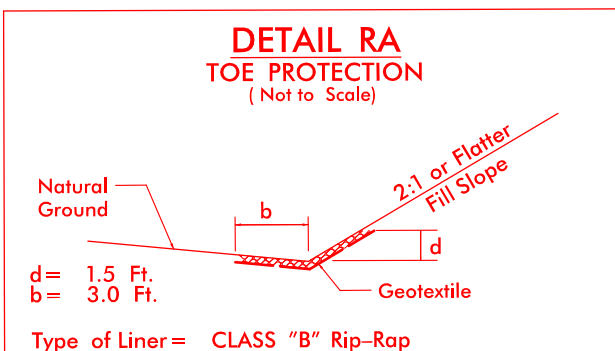

FROM STA. 215+50 -L- TO STA. 218+00 -L- RT.
(Est. Qty. 70 Tons; 170 SY GEOTEXTILE)

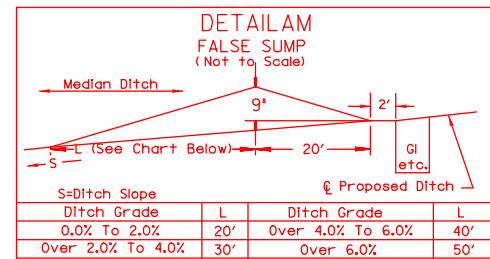

STA. 205+00 -L- (CL)
STA. 209+00 -L- (CL)
STA. 211+50 -L- (CL)
STA. 215+50 -L- (CL)

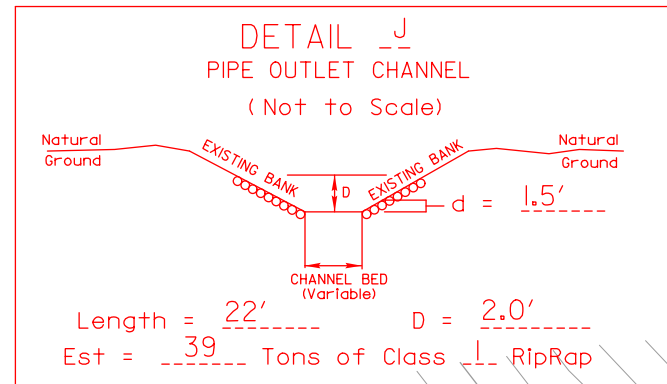


STA. 216+69.17 -L- (LT)

MATCHLINE TO SHEET 10
-L- STATION 204+00

MATCHLINE TO SHEET 10
-L- STATION 218+00


SITE 5

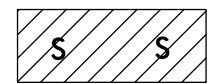

DENOTES IMPACTS IN
SURFACE WATER



DENOTES TEMPORARY
IMPACTS IN SURFACE WATER

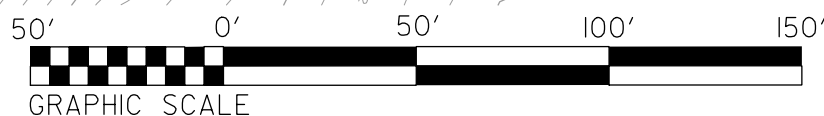



SDATES
S(USERNAME)
SFILEL

8/17/99

REVISIONS

7:24:42 AM
R:\Hydraulics\PERMITS\Environmental\Drawings\R3421B\Drawings\R3421B_Hyd_prm_wet.psh10_enlarge site5_20150720.dgn



SDATES
S(USERNAME)S
SFILELS

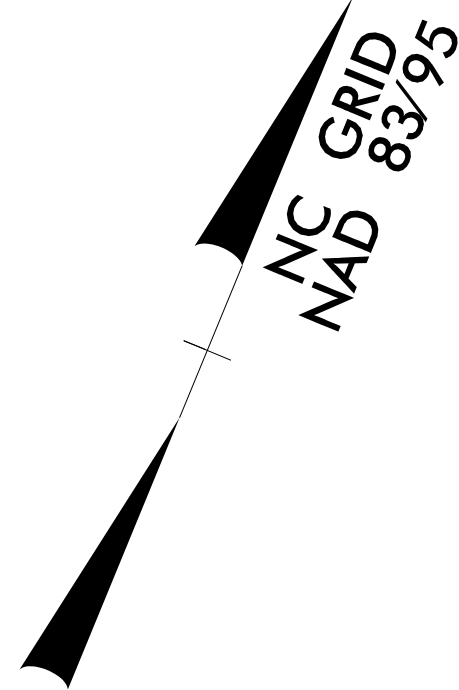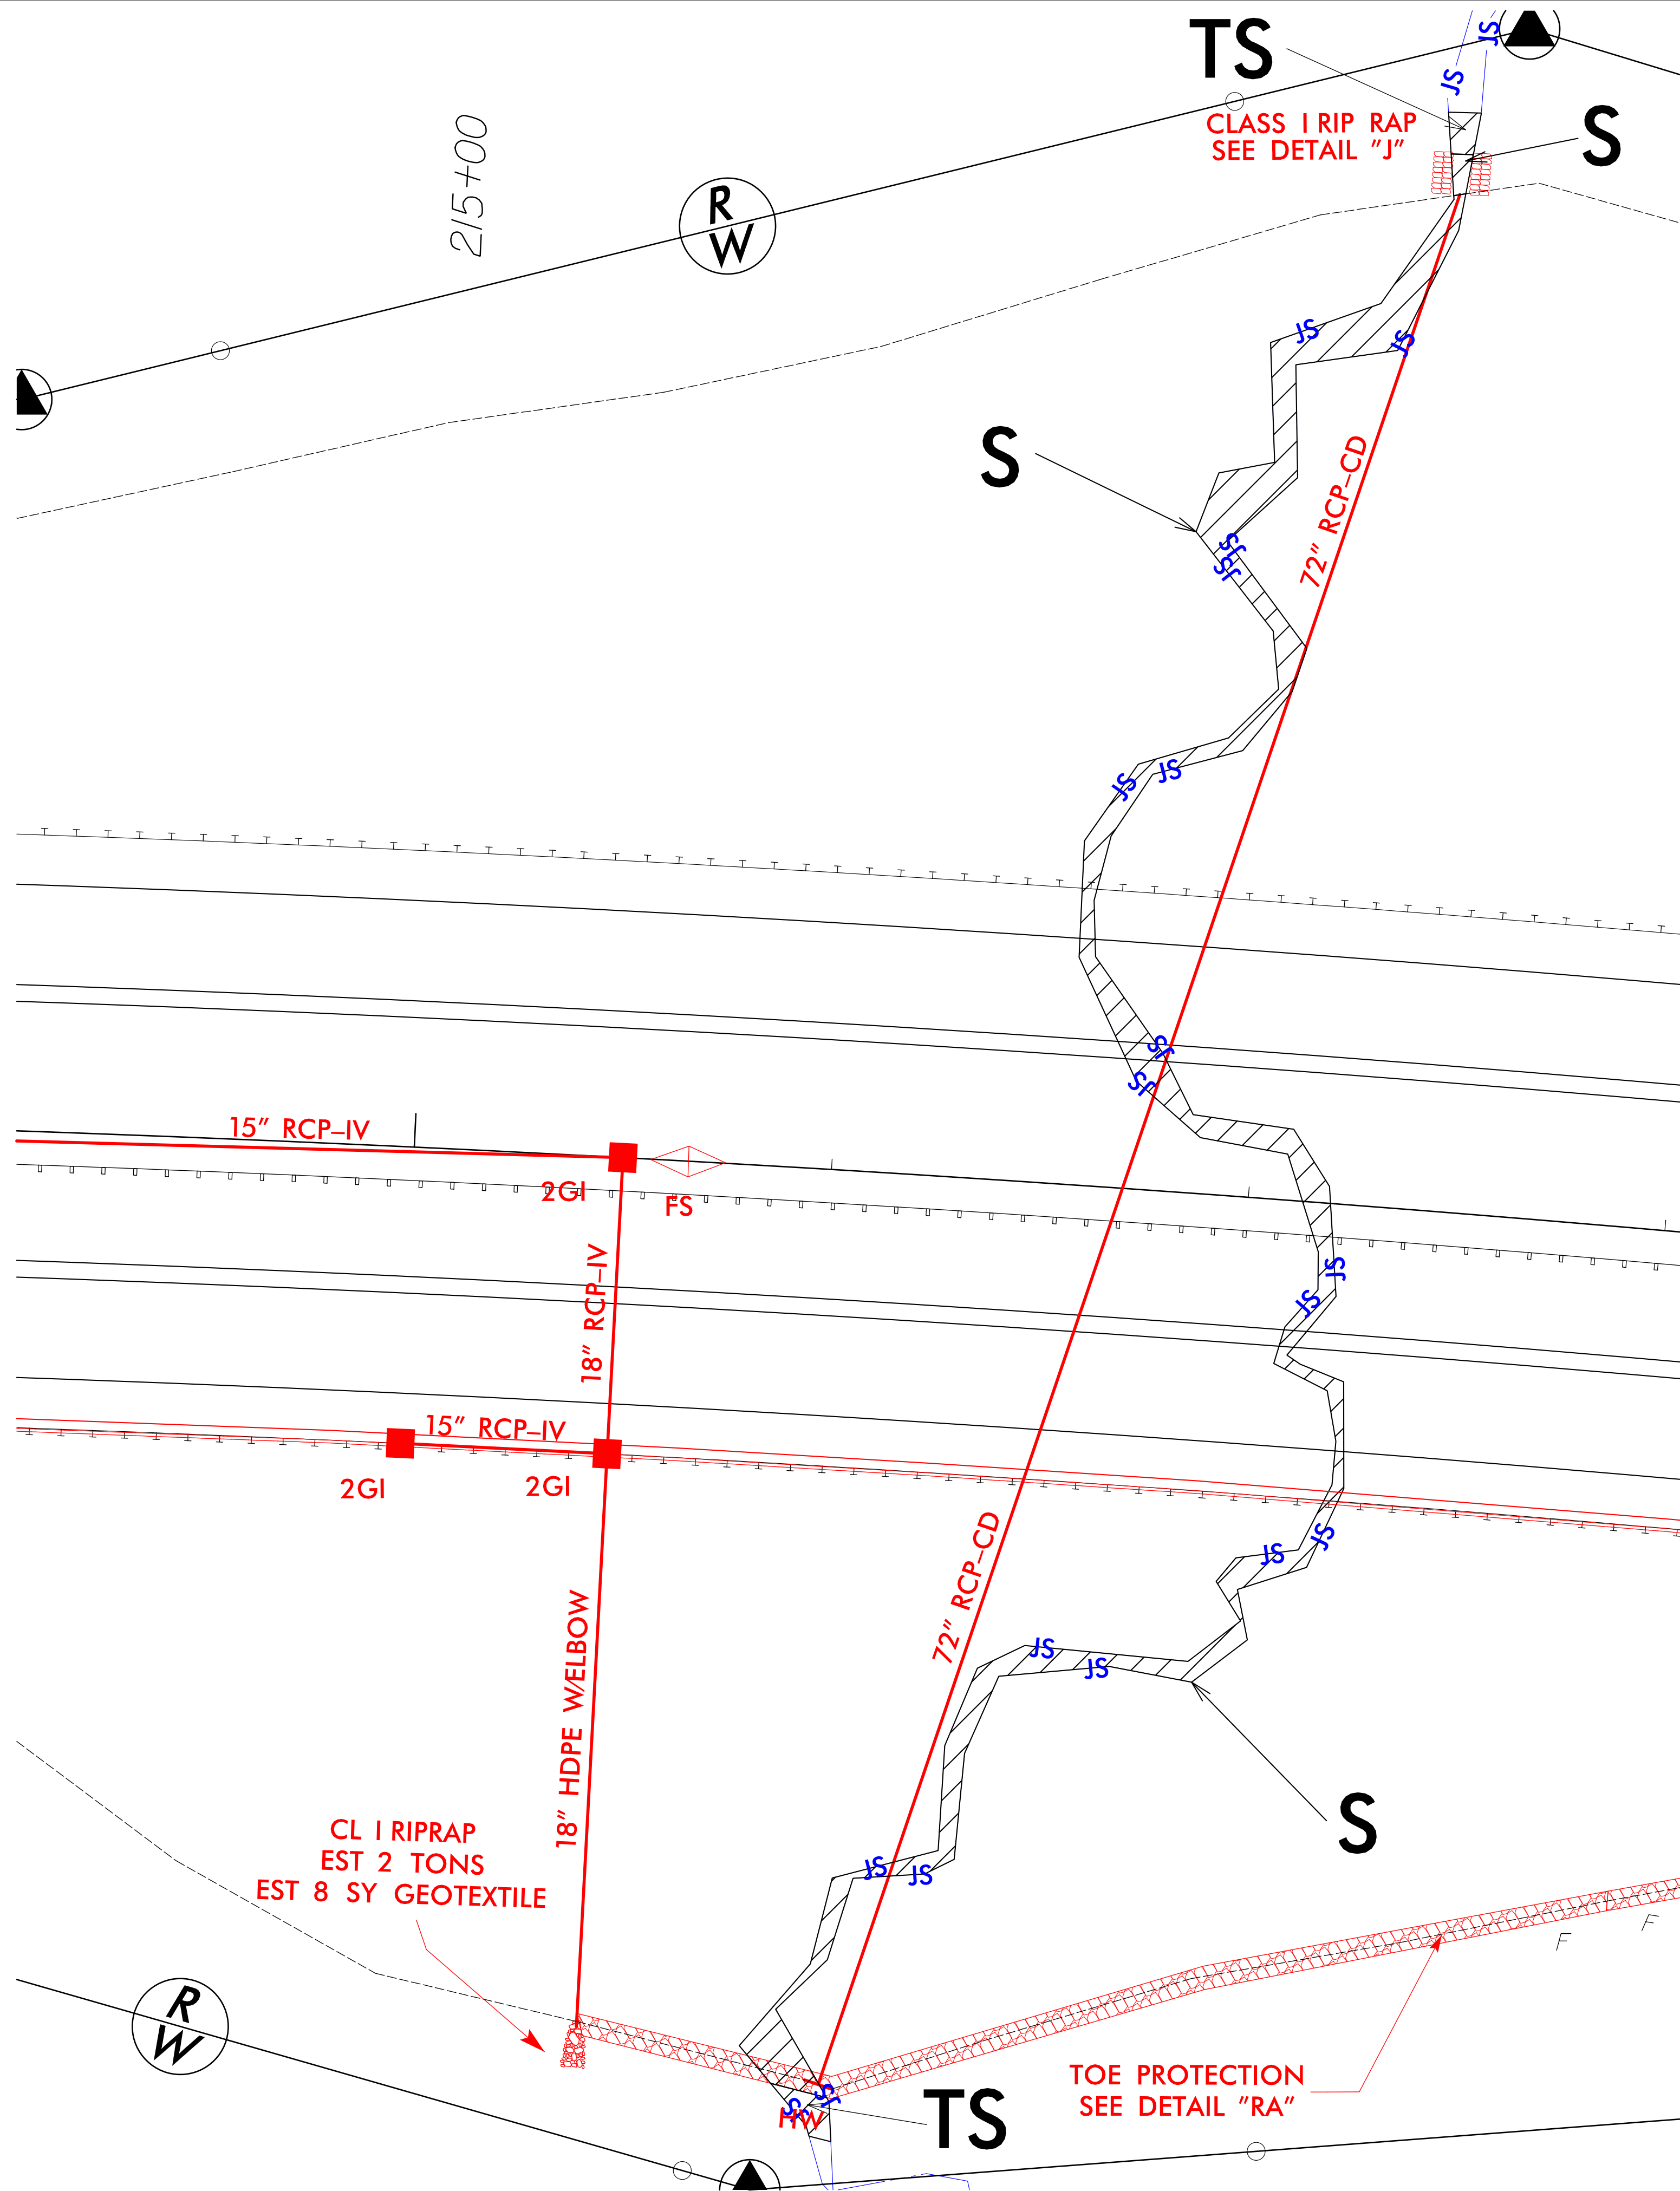


PROJECT REFERENCE NO.	SHEET NO.
R-3421B	10
RW SHEET NO.	
ROADWAY DESIGN ENGINEER	HYDRAULICS ENGINEER
INCOMPLETE PLANS DO NOT USE FOR R/W ACQUISITION	
PRELIMINARY PLANS DO NOT USE FOR CONSTRUCTION	

PERMIT DRAWING
SHEET 25 OF 71

SITE 5 ENLARGEMENT

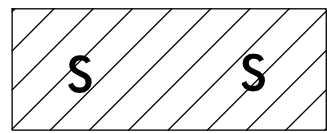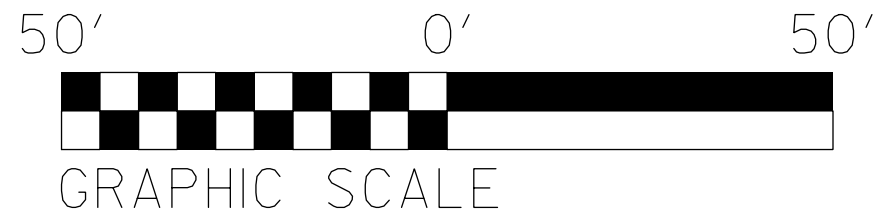

DENOTES IMPACTS IN
SURFACE WATER

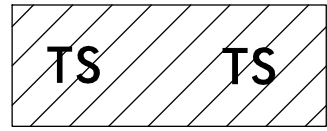





DENOTES TEMPORARY
IMPACTS IN SURFACE WATER

REVISIONS


8/17/99

7:28:17 AM R:\Hydraulics\PERMITS\Environmental\Drawings\R3421B\R3421B_Hyd_prm_wet.psh10_enlarge site5.20150720_con.dgn

SDATES
\$(USERNAME)\$
SFILELS

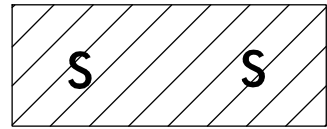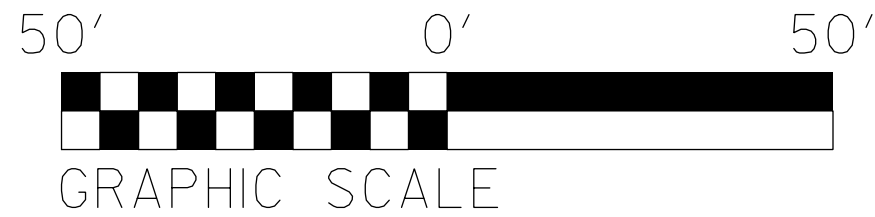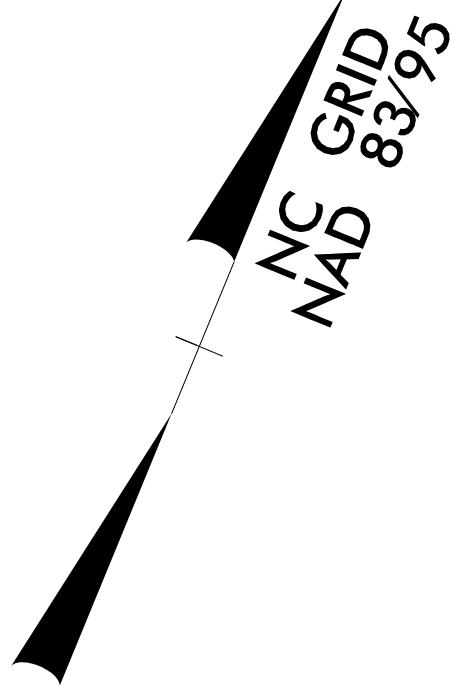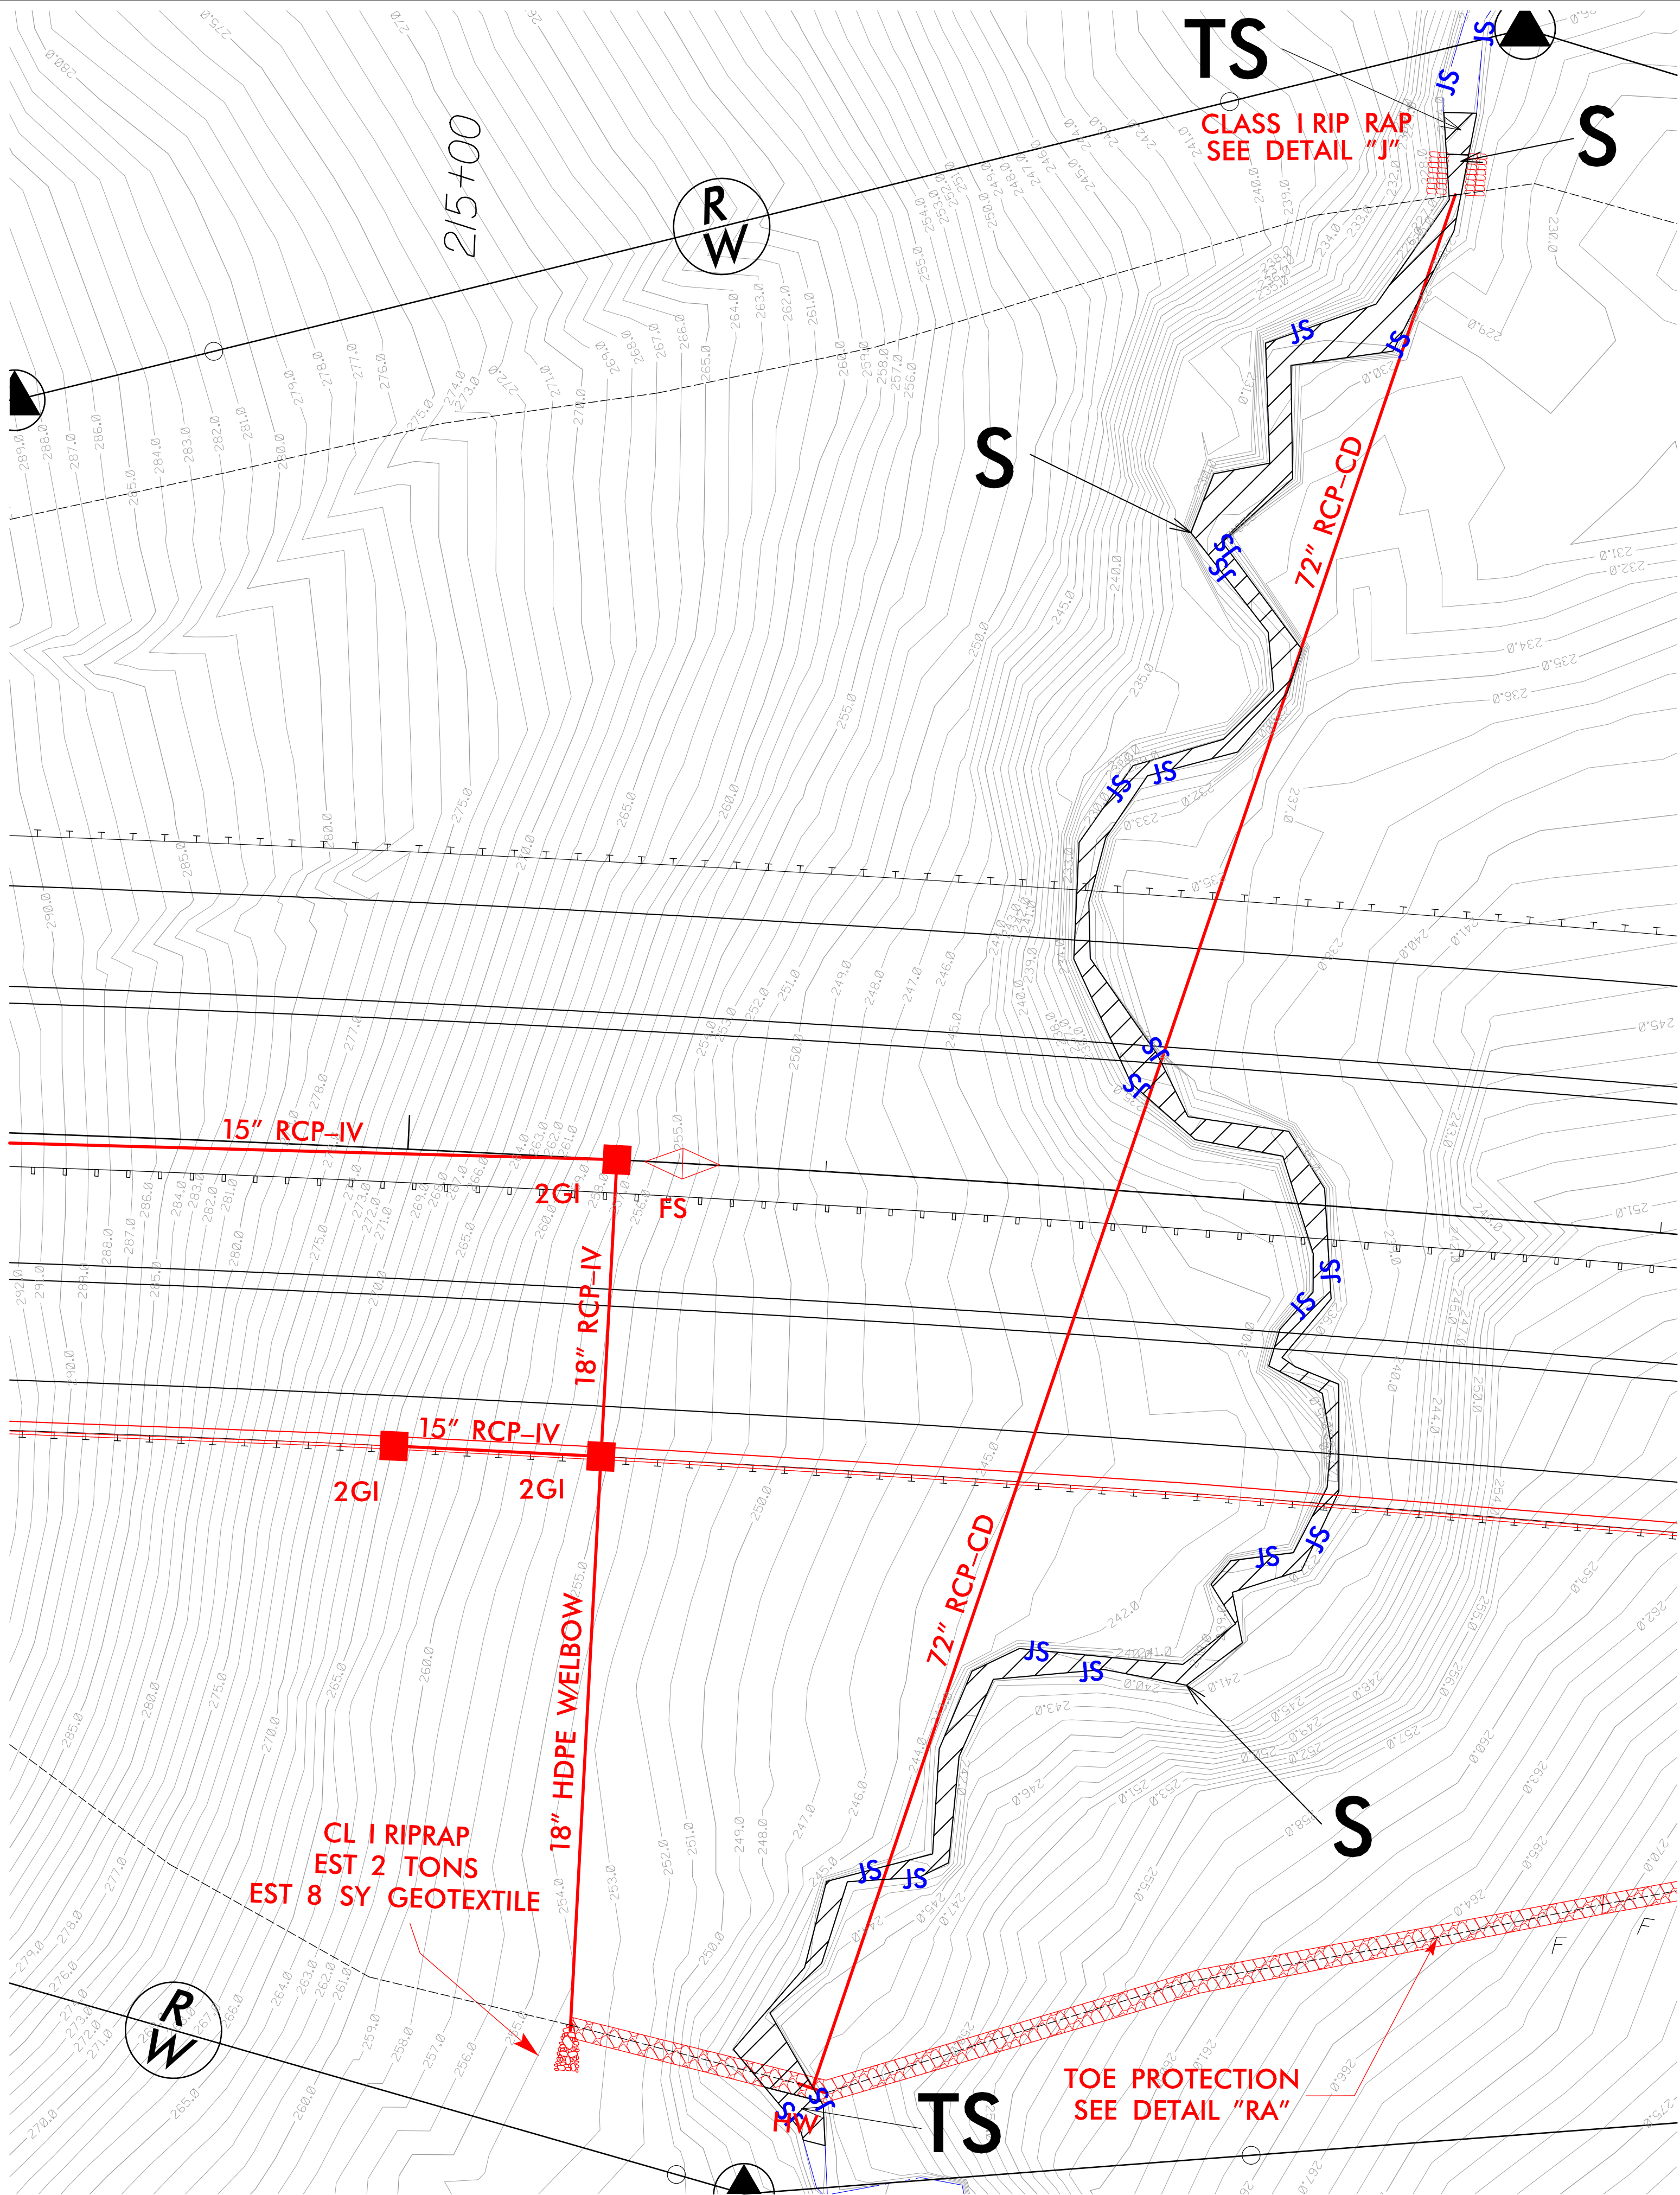

DENOTES IMPACTS IN
SURFACE WATER

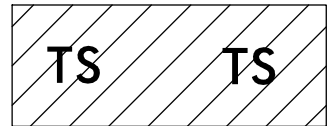



DENOTES TEMPORARY
IMPACTS IN SURFACE WATER


PERMIT DRAWING
SHEET 26 OF 71

SITE 5 ENLARGEMENT

PROJECT REFERENCE NO.	SHEET NO.
R-3421B	10
RW SHEET NO.	
ROADWAY DESIGN ENGINEER	HYDRAULICS ENGINEER
INCOMPLETE PLANS DO NOT USE FOR R/W ACQUISITION	
PRELIMINARY PLANS DO NOT USE FOR CONSTRUCTION	

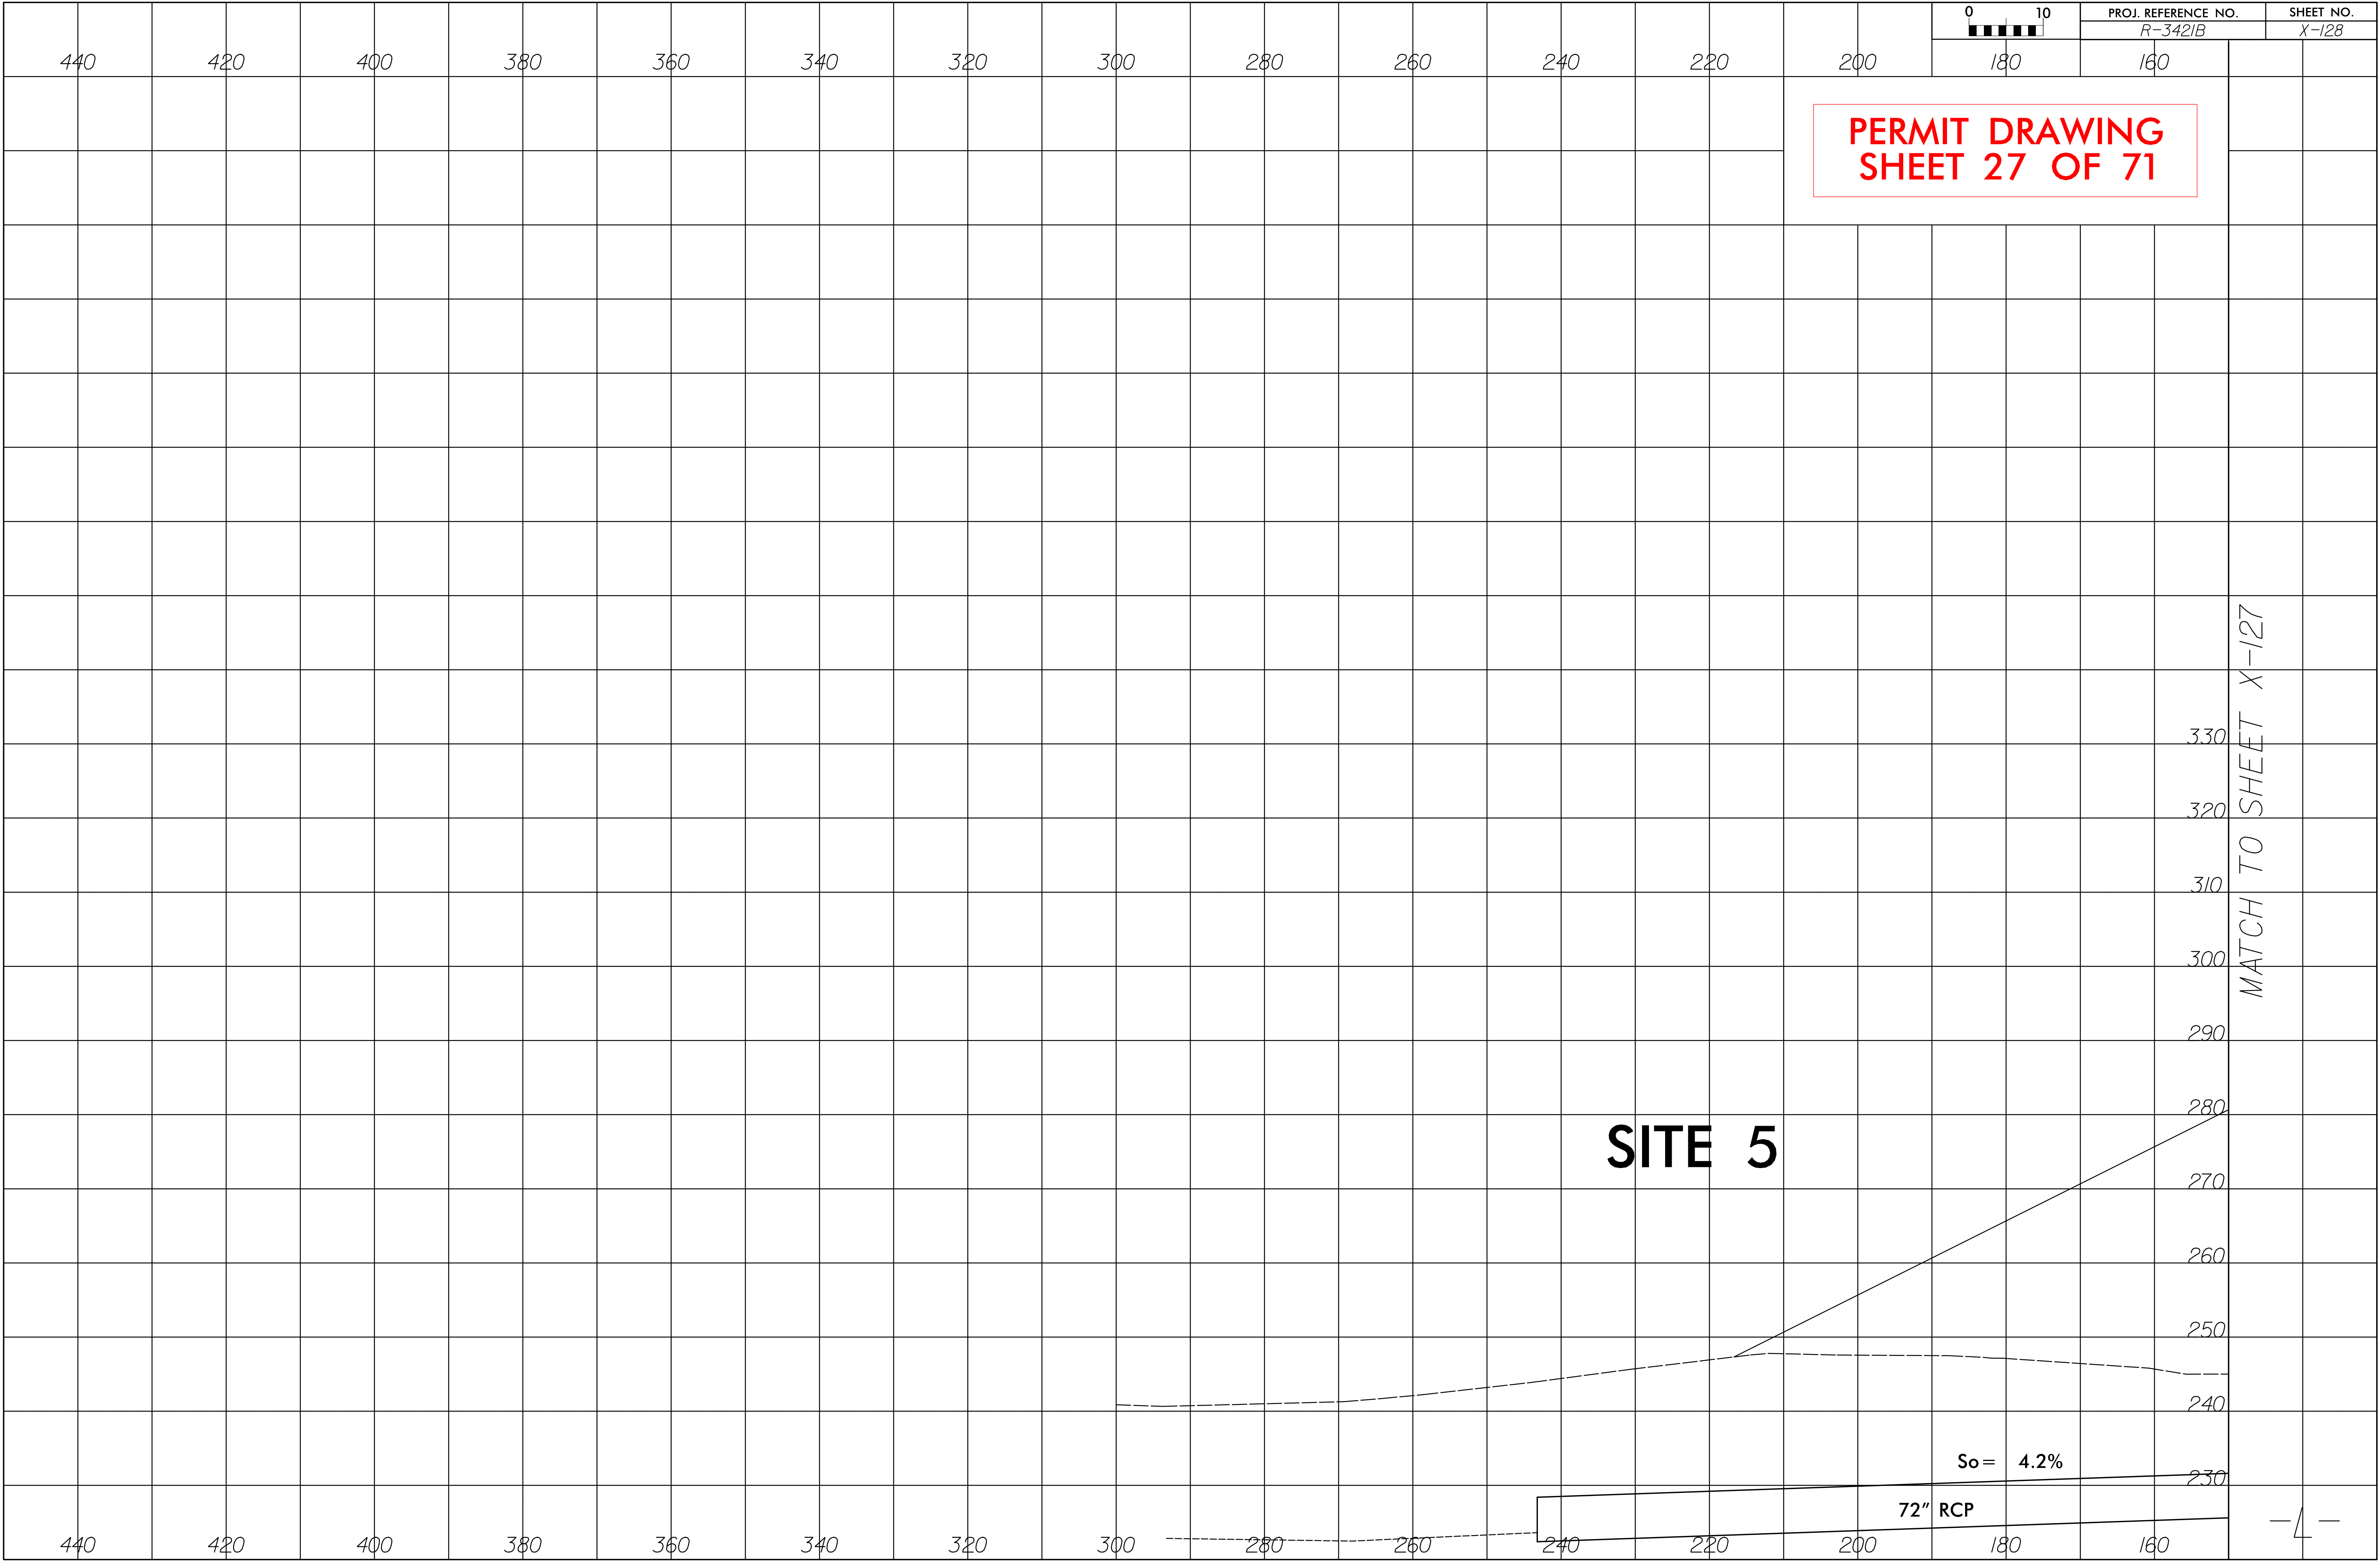

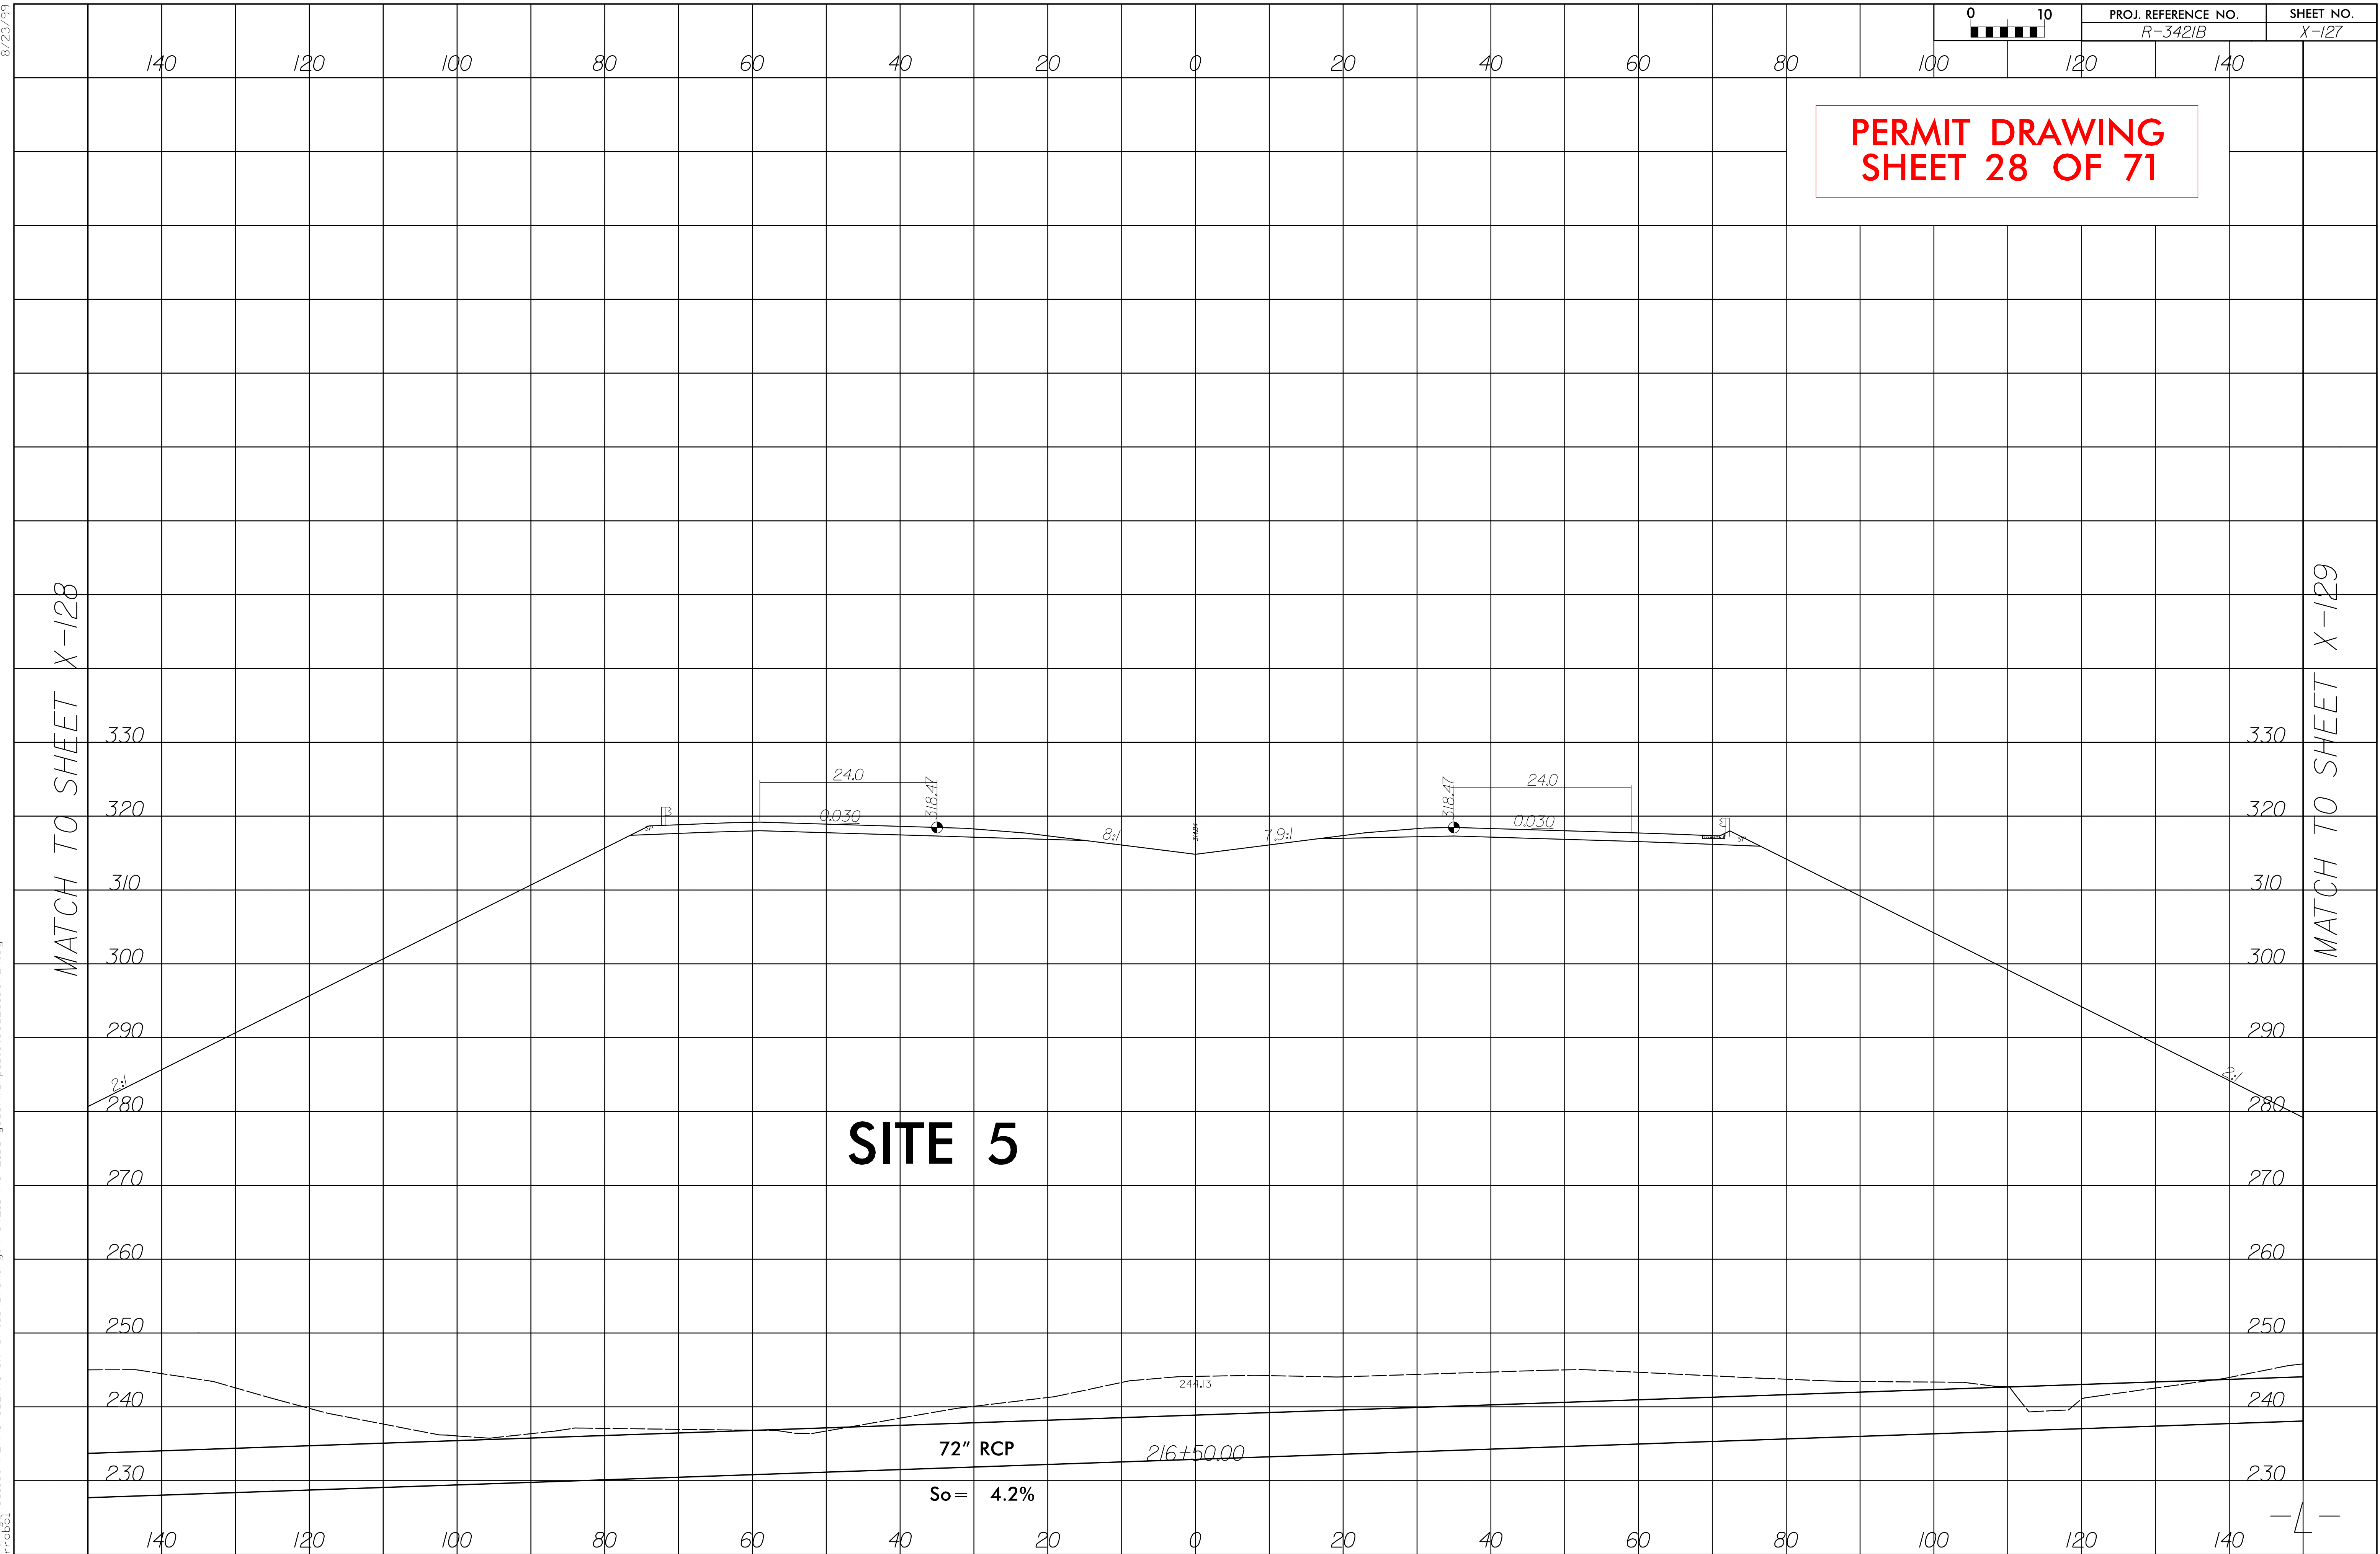

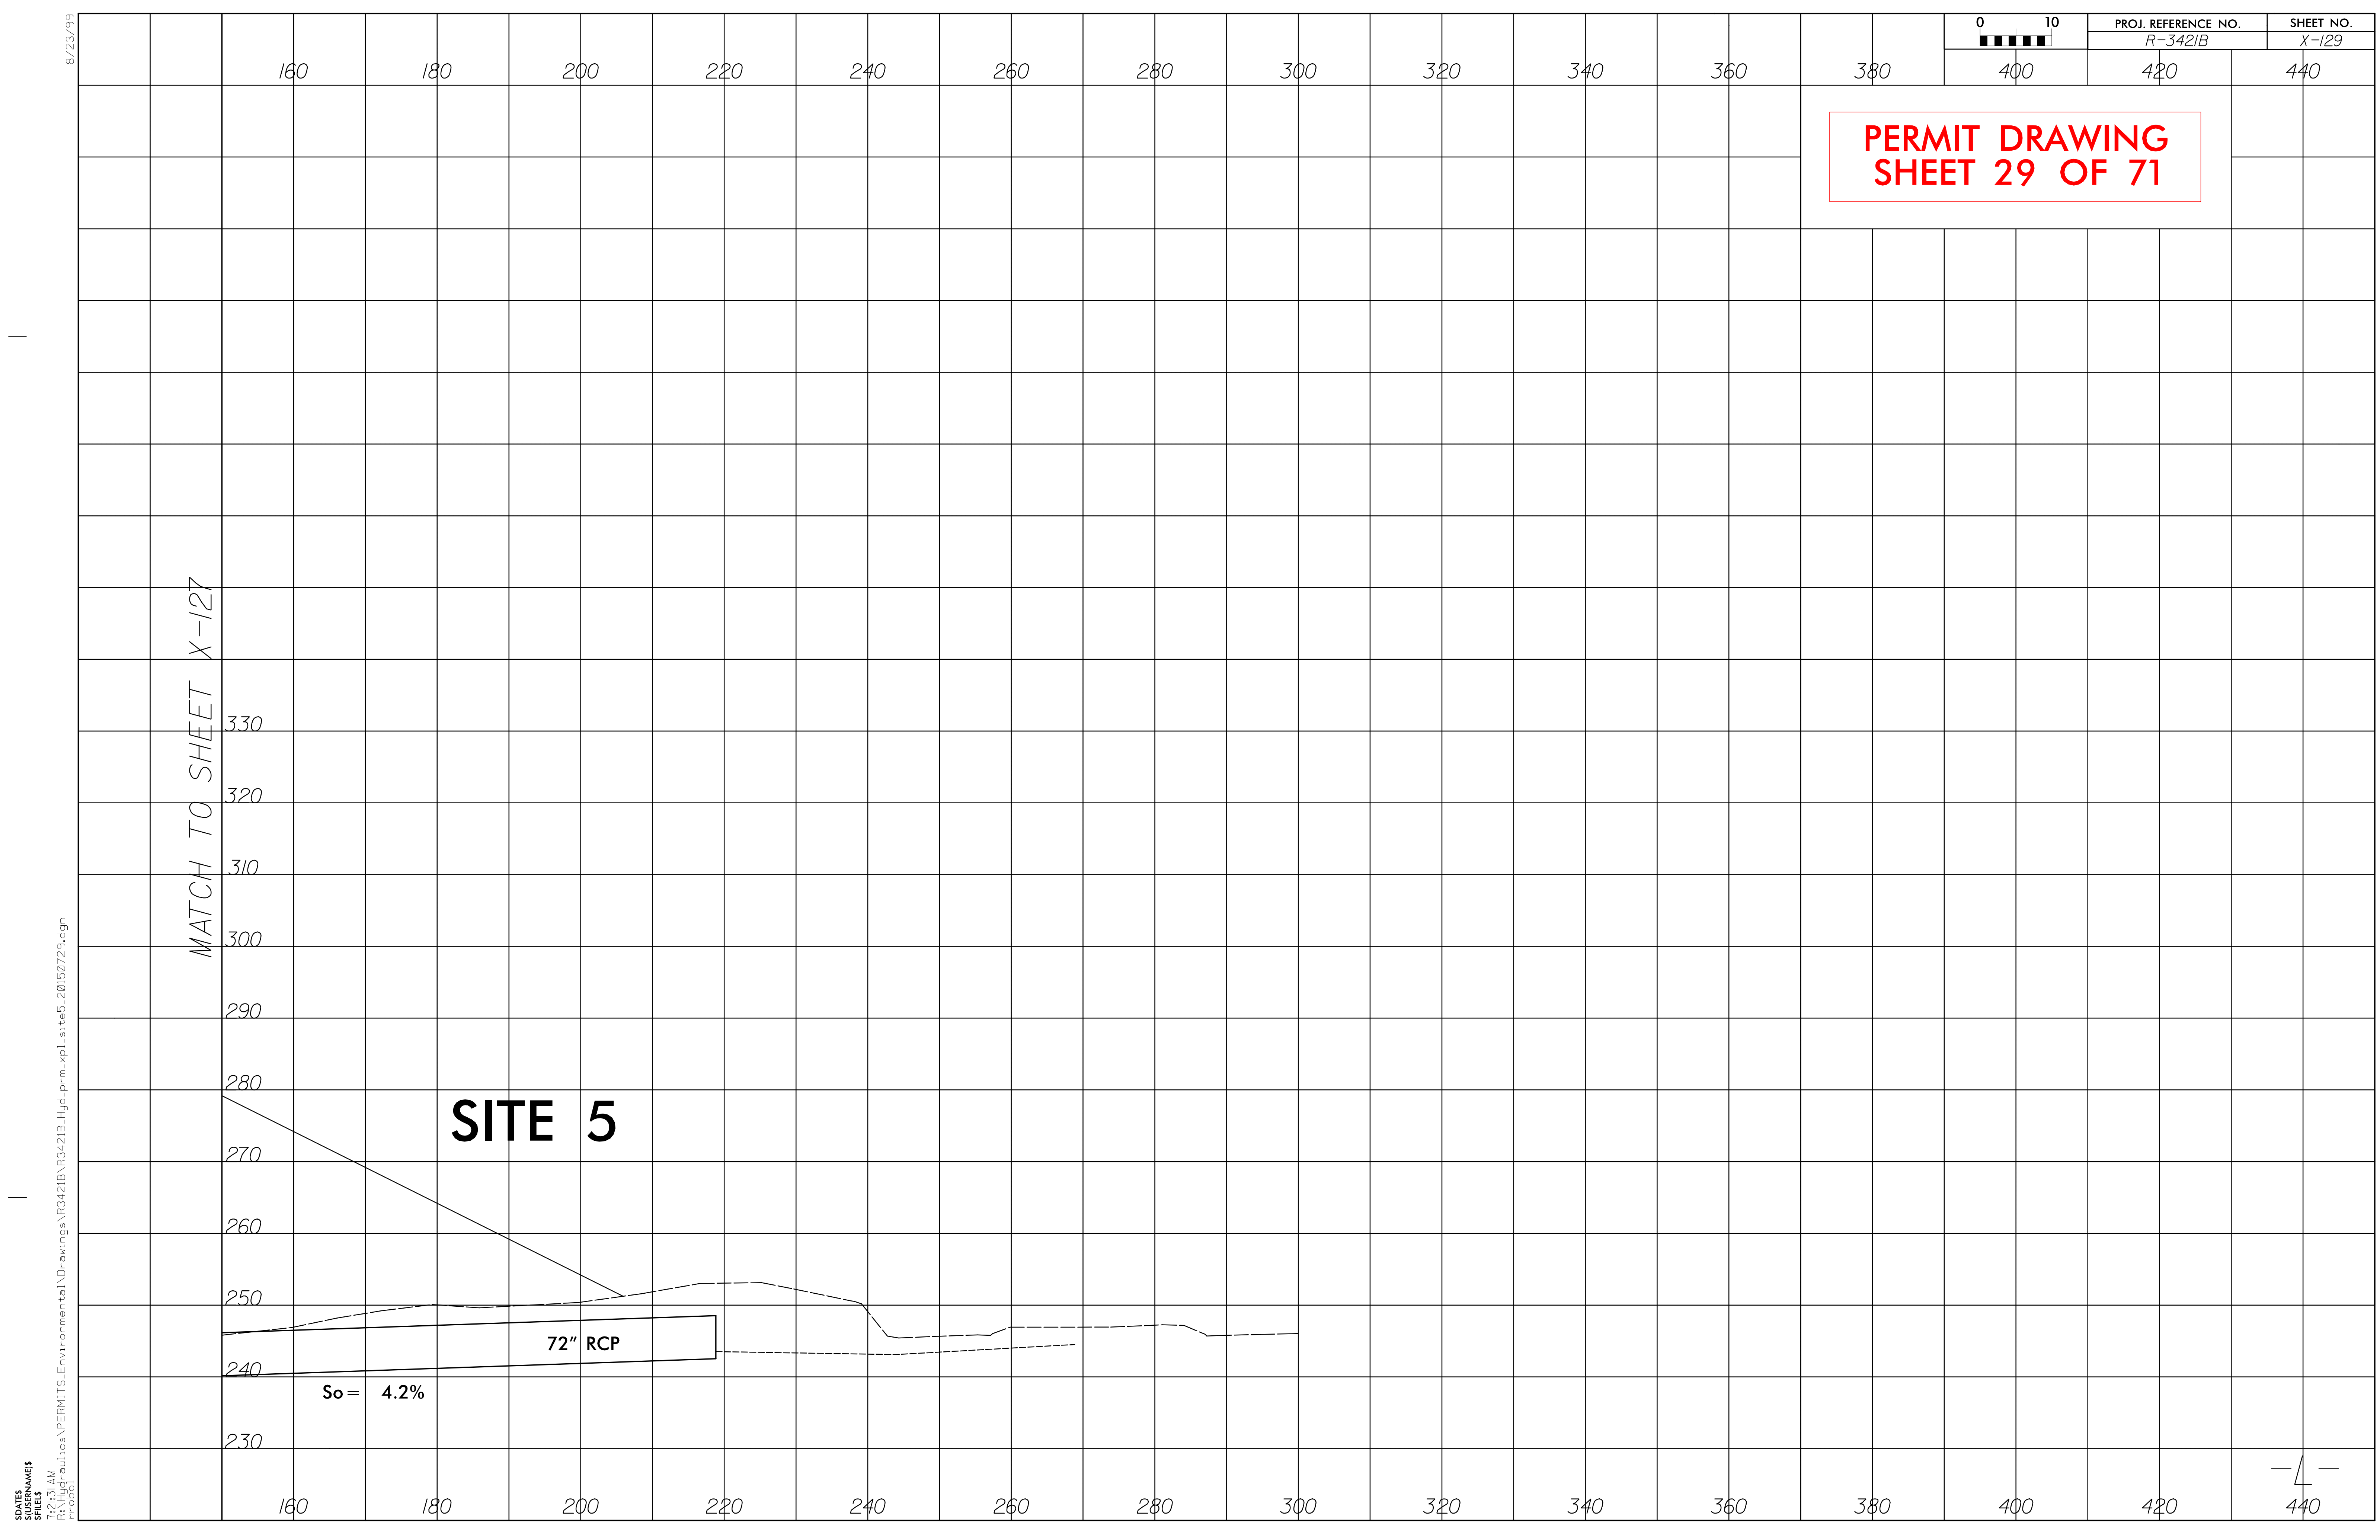


8/17/99


REVISIONS

7:20:42 AM
R:\Hydraulics\PERMITS\Environmental\Drawings\3421B\3421B_Hyd_prm_wet.psh11.20150326.dgn


SDATES
S(USERNAME)
SFILES

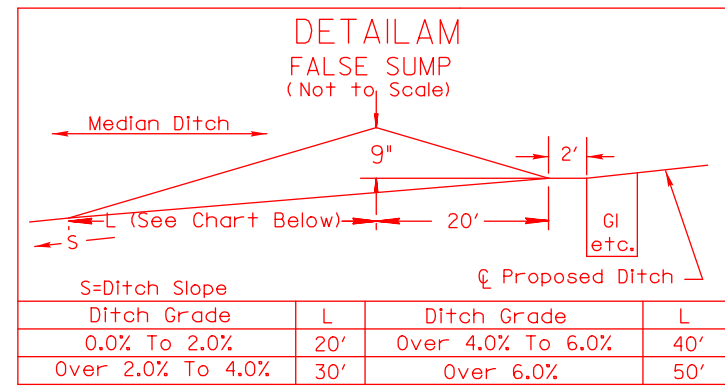


STA. 220+00 -L- (CL)
STA. 224+00 -L- (CL)
STA. 227+50 -L- (CL)
STA. 231+00 -L- (CL)

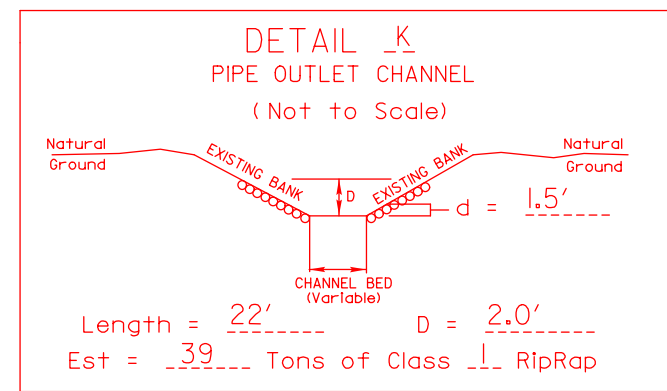


STA. 229+81.52 -L- (LT)

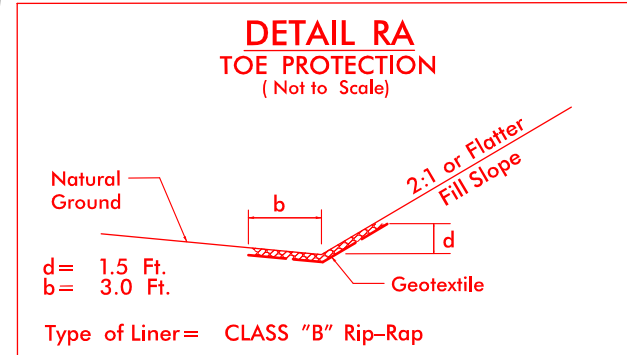

FROM STA. 218+00 -L- TO STA. 219+00 -L- RT.
(Est.Qty. 25 Tons; 67 SY GEOTEXTILE)
FROM STA. 228+65 -L- TO STA. 231+50 -L- RT.
(Est.Qty. 90 Tons; 193 SY GEOTEXTILE)

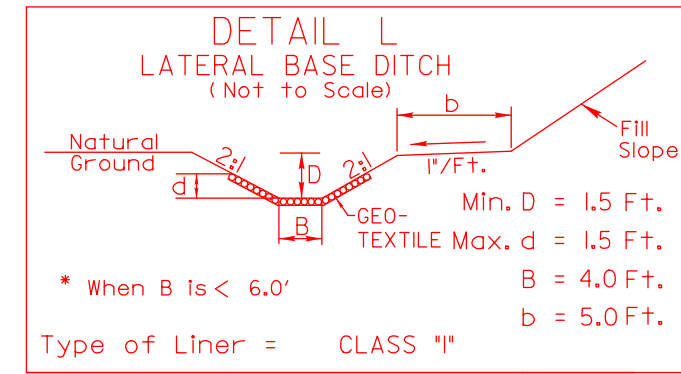

STA. 224+50 TO 226+20-L-(RT)
(EST 94 TONS; EST 200 SY GEOTEXTILE)

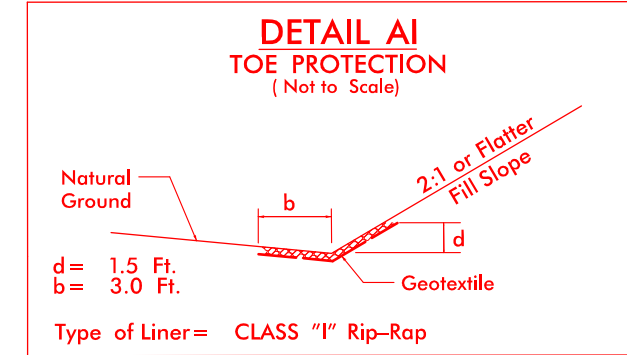


FROM STA. 223+00 -L- TO STA. 224+45 -L- RT.
(Est.Qty. 50 Tons; 83 SY GEOTEXTILE)

PROJECT REFERENCE NO. <i>R-3421B</i>		SHEET NO. <i>II</i>	
RW SHEET NO.		HYDRAULICS ENGINEER	
ROADWAY DESIGN ENGINEER		HYDRAULICS ENGINEER	
INCOMPLETE PLANS DO NOT USE FOR R/W ACQUISITION		PRELIMINARY PLANS DO NOT USE FOR CONSTRUCTION	

**PERMIT DRAWING
SHEET 30 OF 71**

MATCHLINE TO SHEET II
-L- STATION 218+00

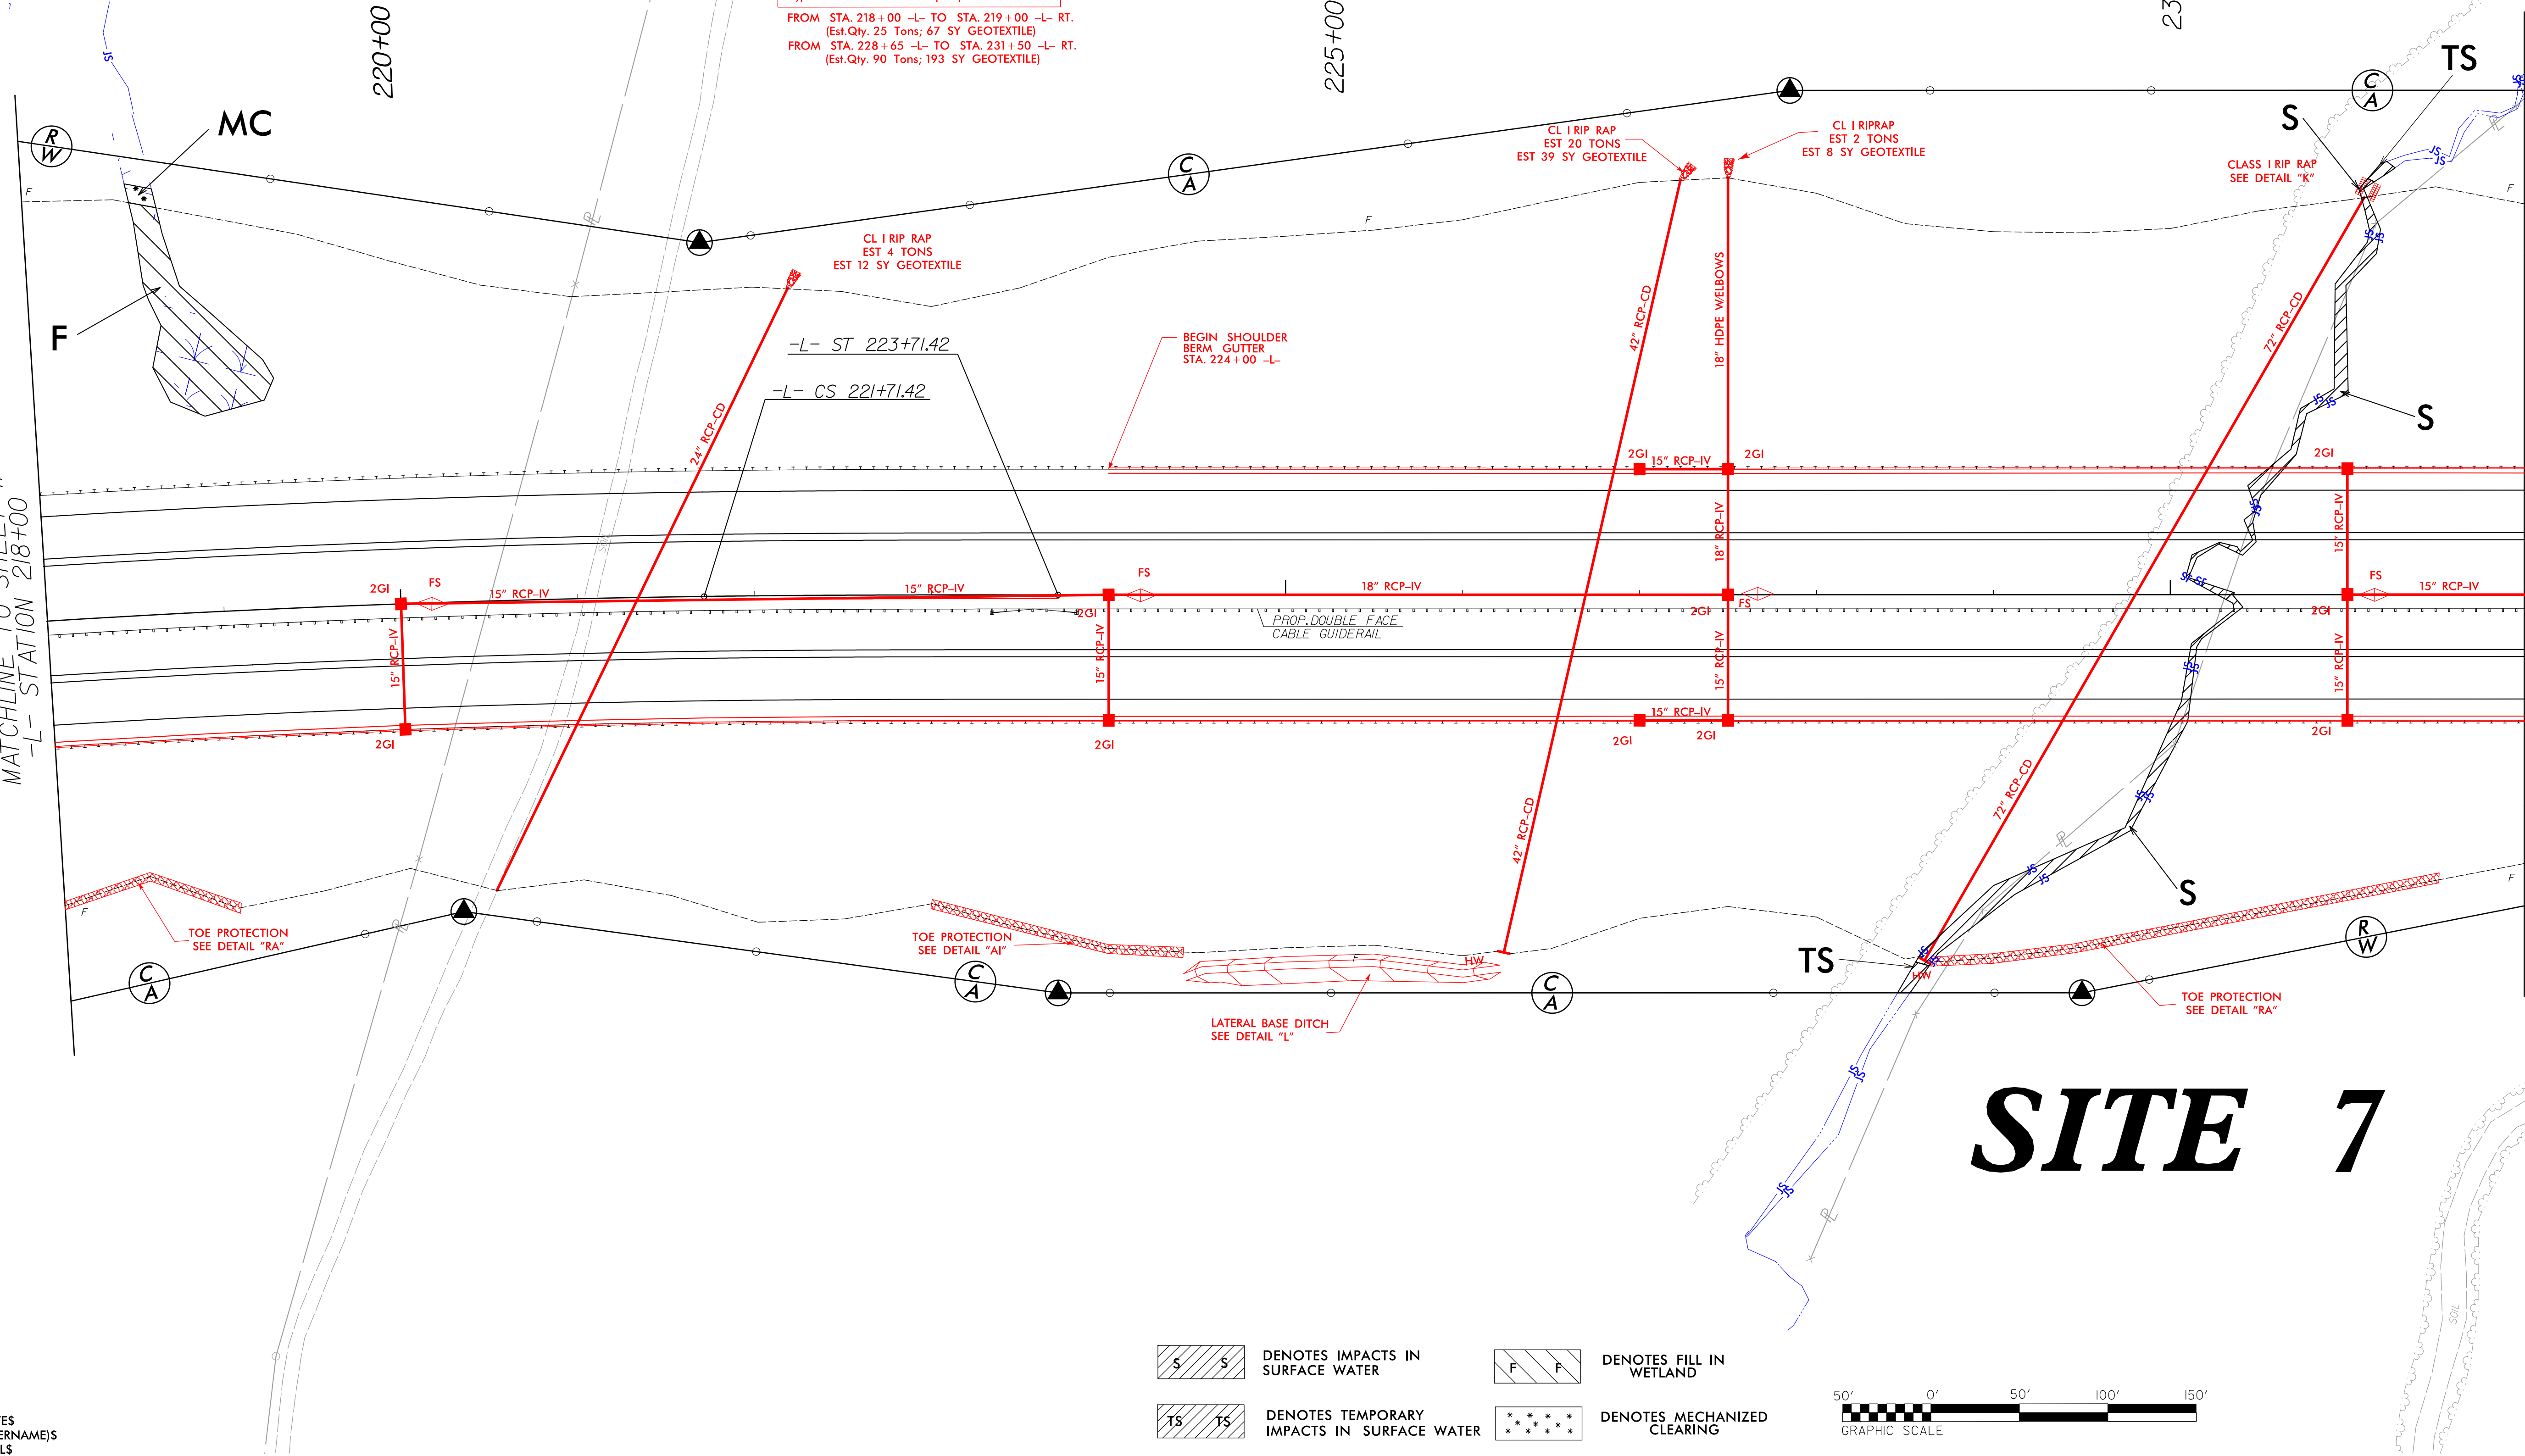

MATCHLINE TO SHEET II
-L- STATION 232+00




DENOTES IMPACTS IN
SURFACE WATER




DENOTES FILL IN
WETLAND



DENOTES TEMPORARY
IMPACTS IN SURFACE WATER

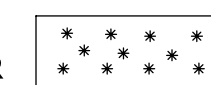


DENOTES MECHANIZED
CLEARING

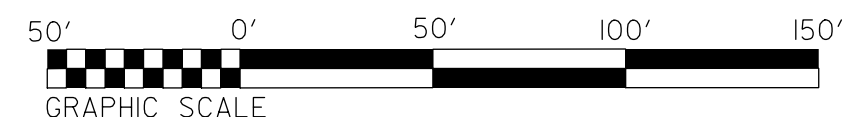





PROJECT REFERENCE NO.		SHEET NO.
R-3421B		11
R/W SHEET NO.		
ROADWAY DESIGN ENGINEER		HYDRAULICS ENGINEER
INCOMPLETE PLANS DO NOT USE FOR R/W ACQUISITION		
PRELIMINARY PLANS DO NOT USE FOR CONSTRUCTION		


PERMIT DRAWING
SHEET 31 OF 71

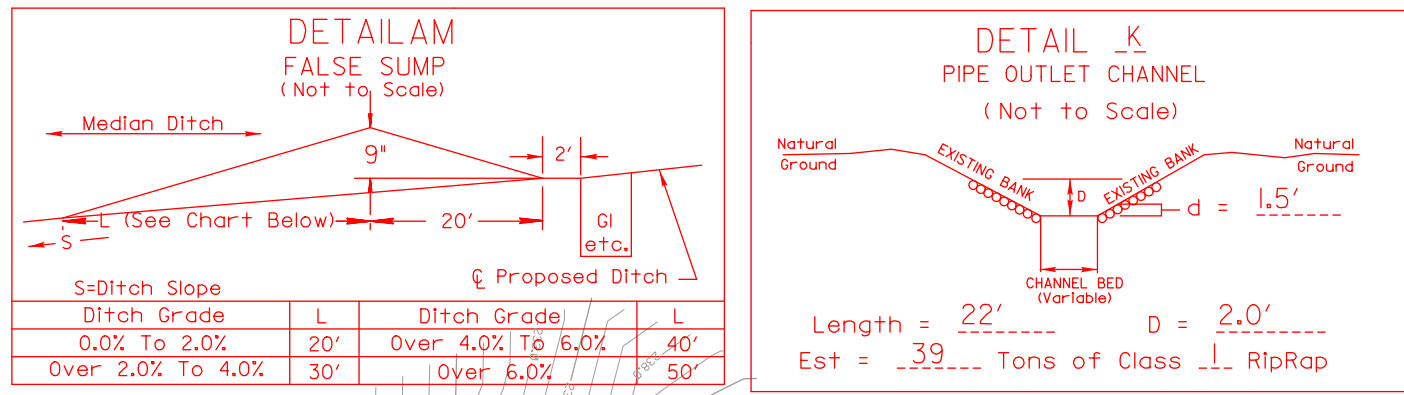


STA. 220+00 -L- (QL)
STA. 224+00 -L- (QL)
STA. 227+50 -L- (QL)
STA. 231+00 -L- (QL)

STA. 229+81.52 -L- (LT)

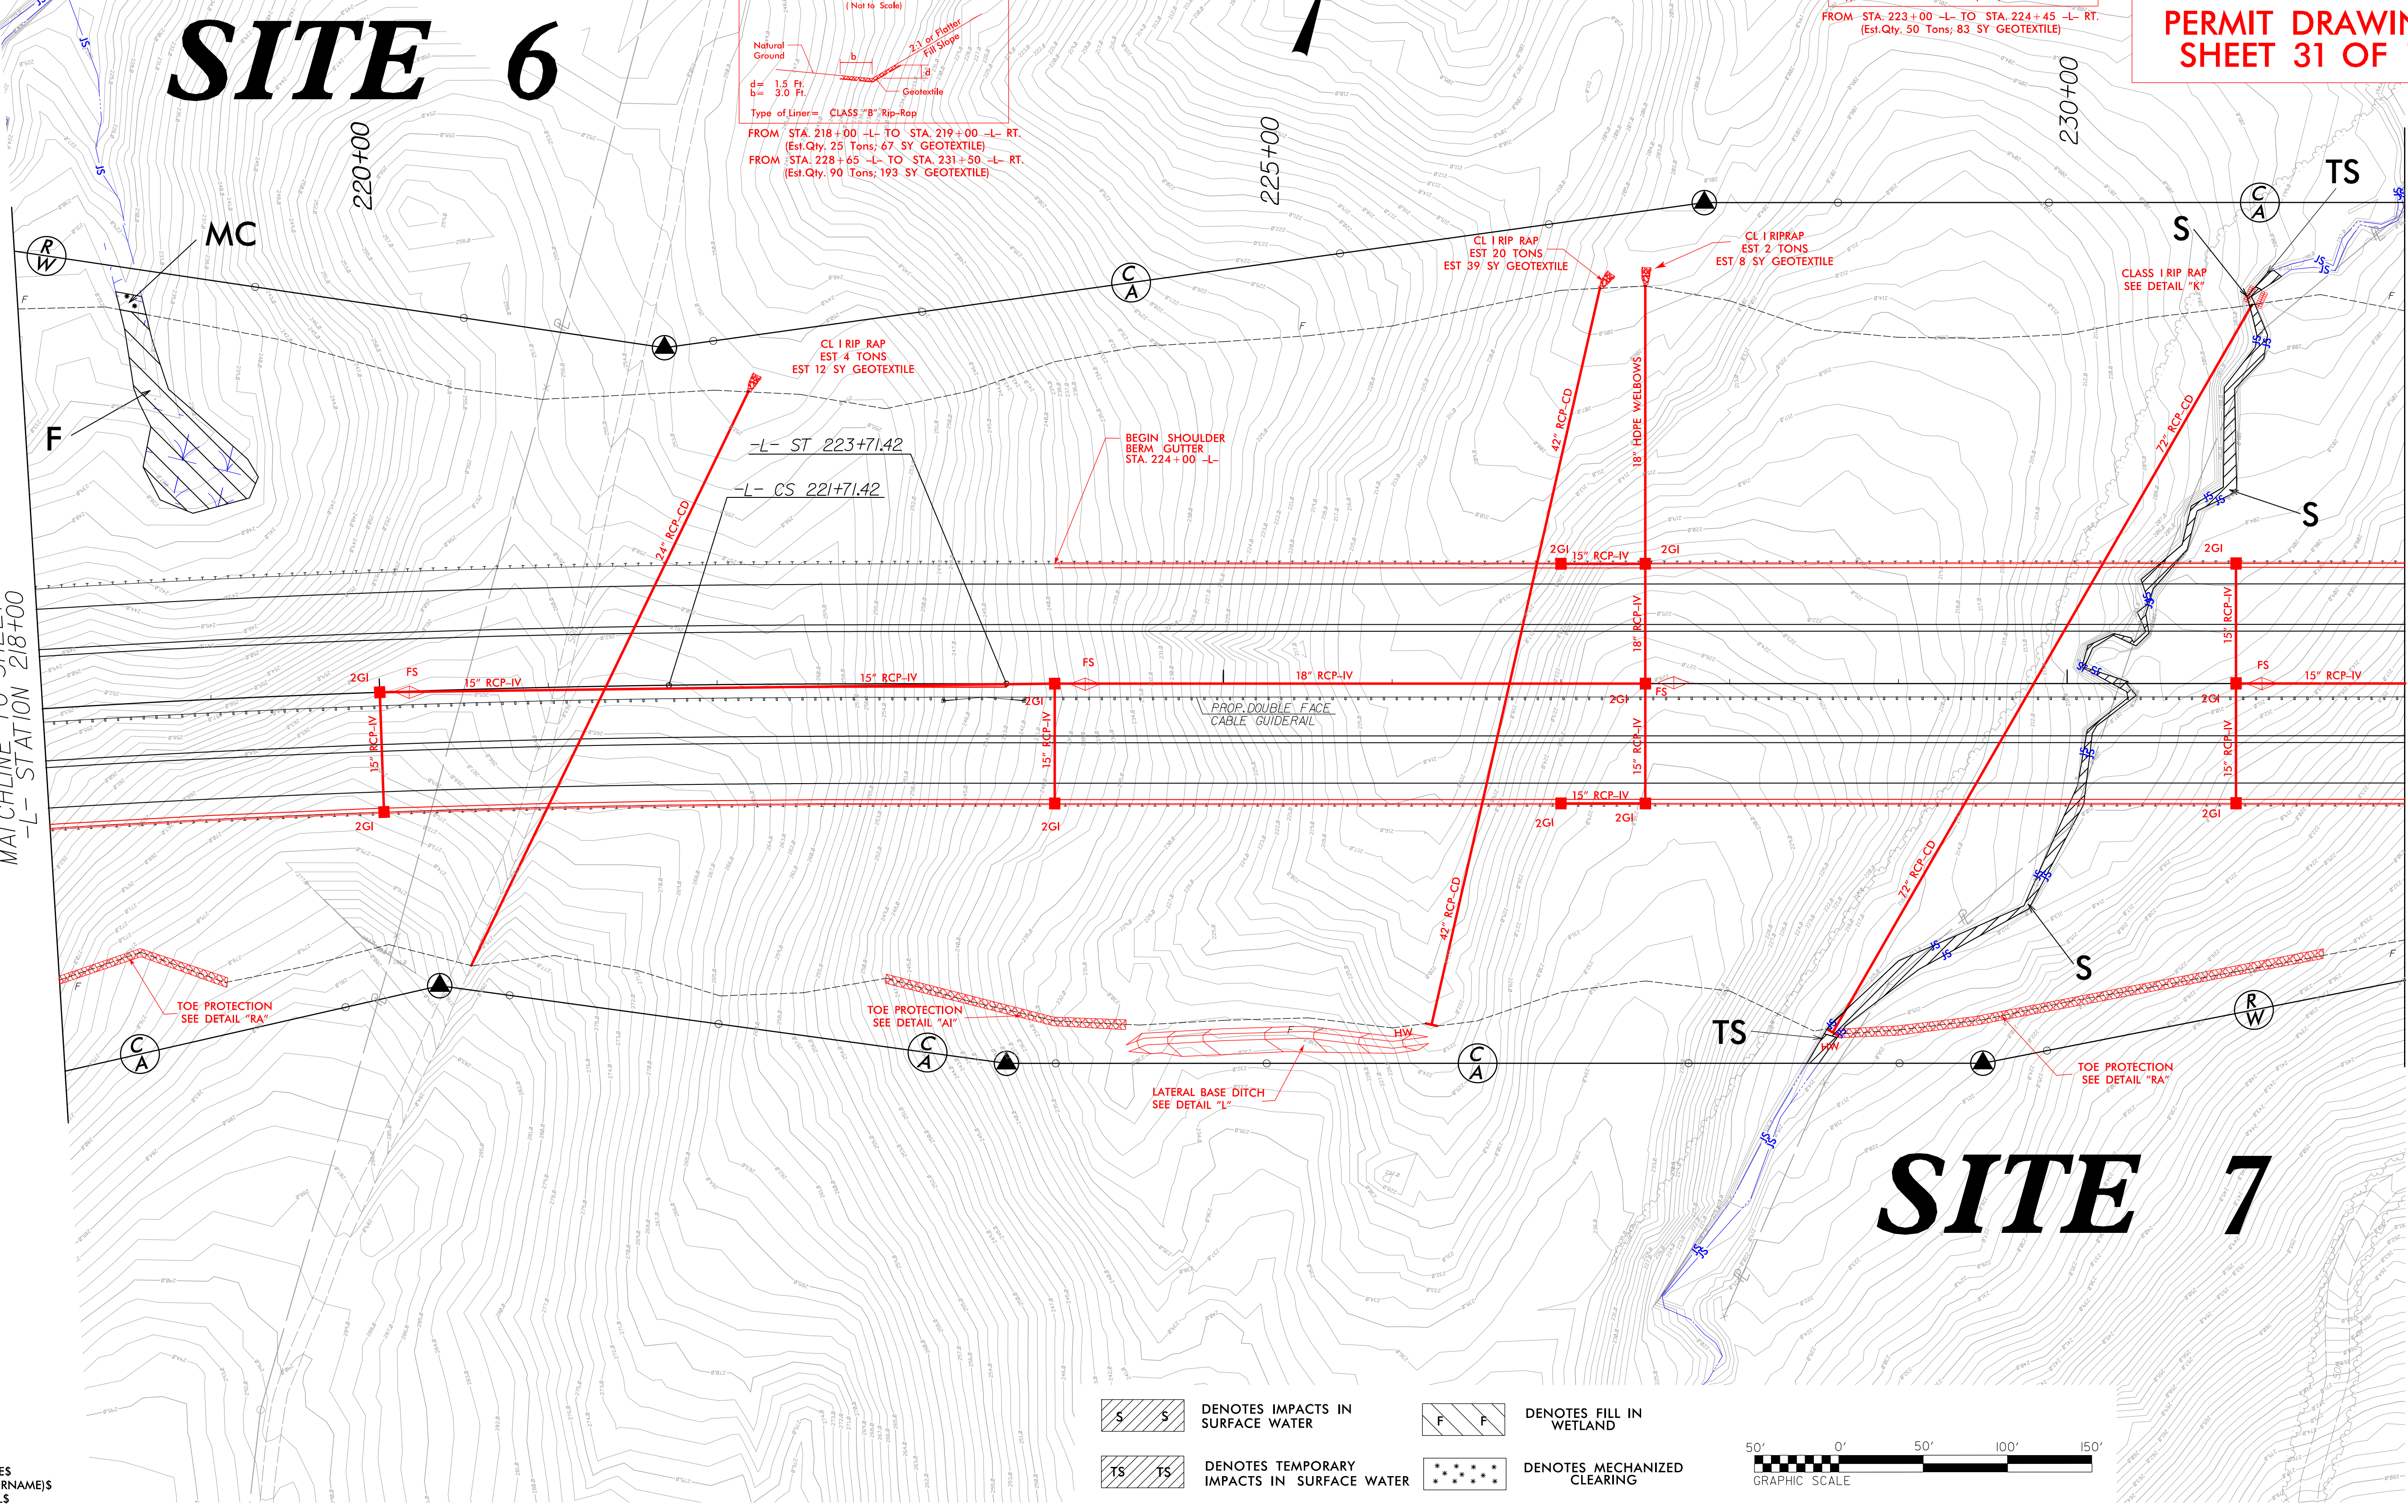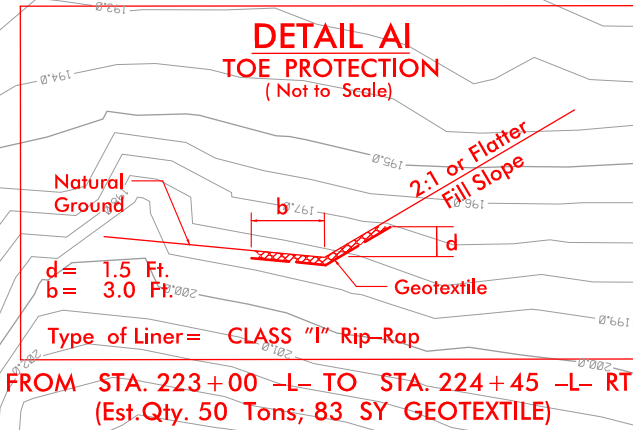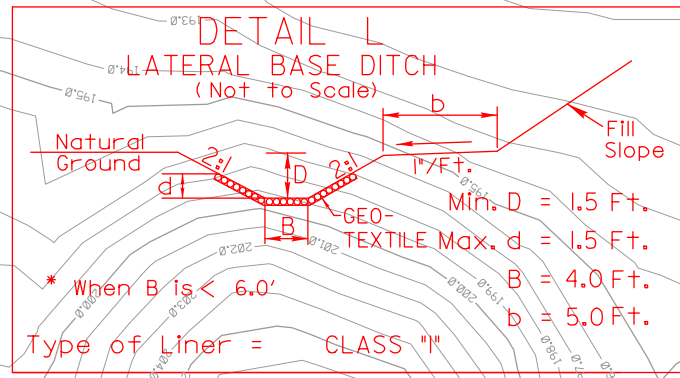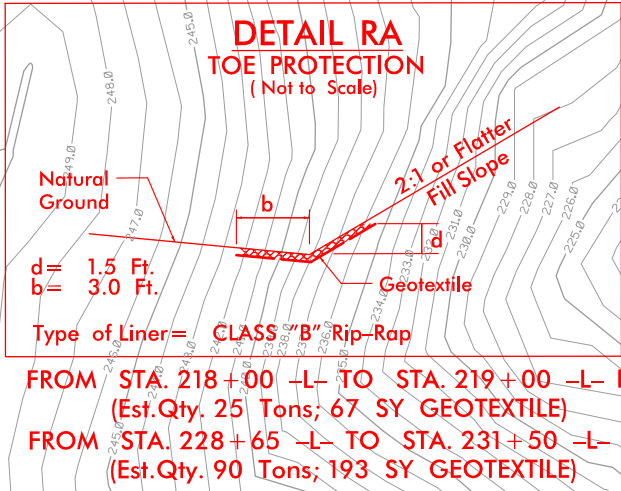


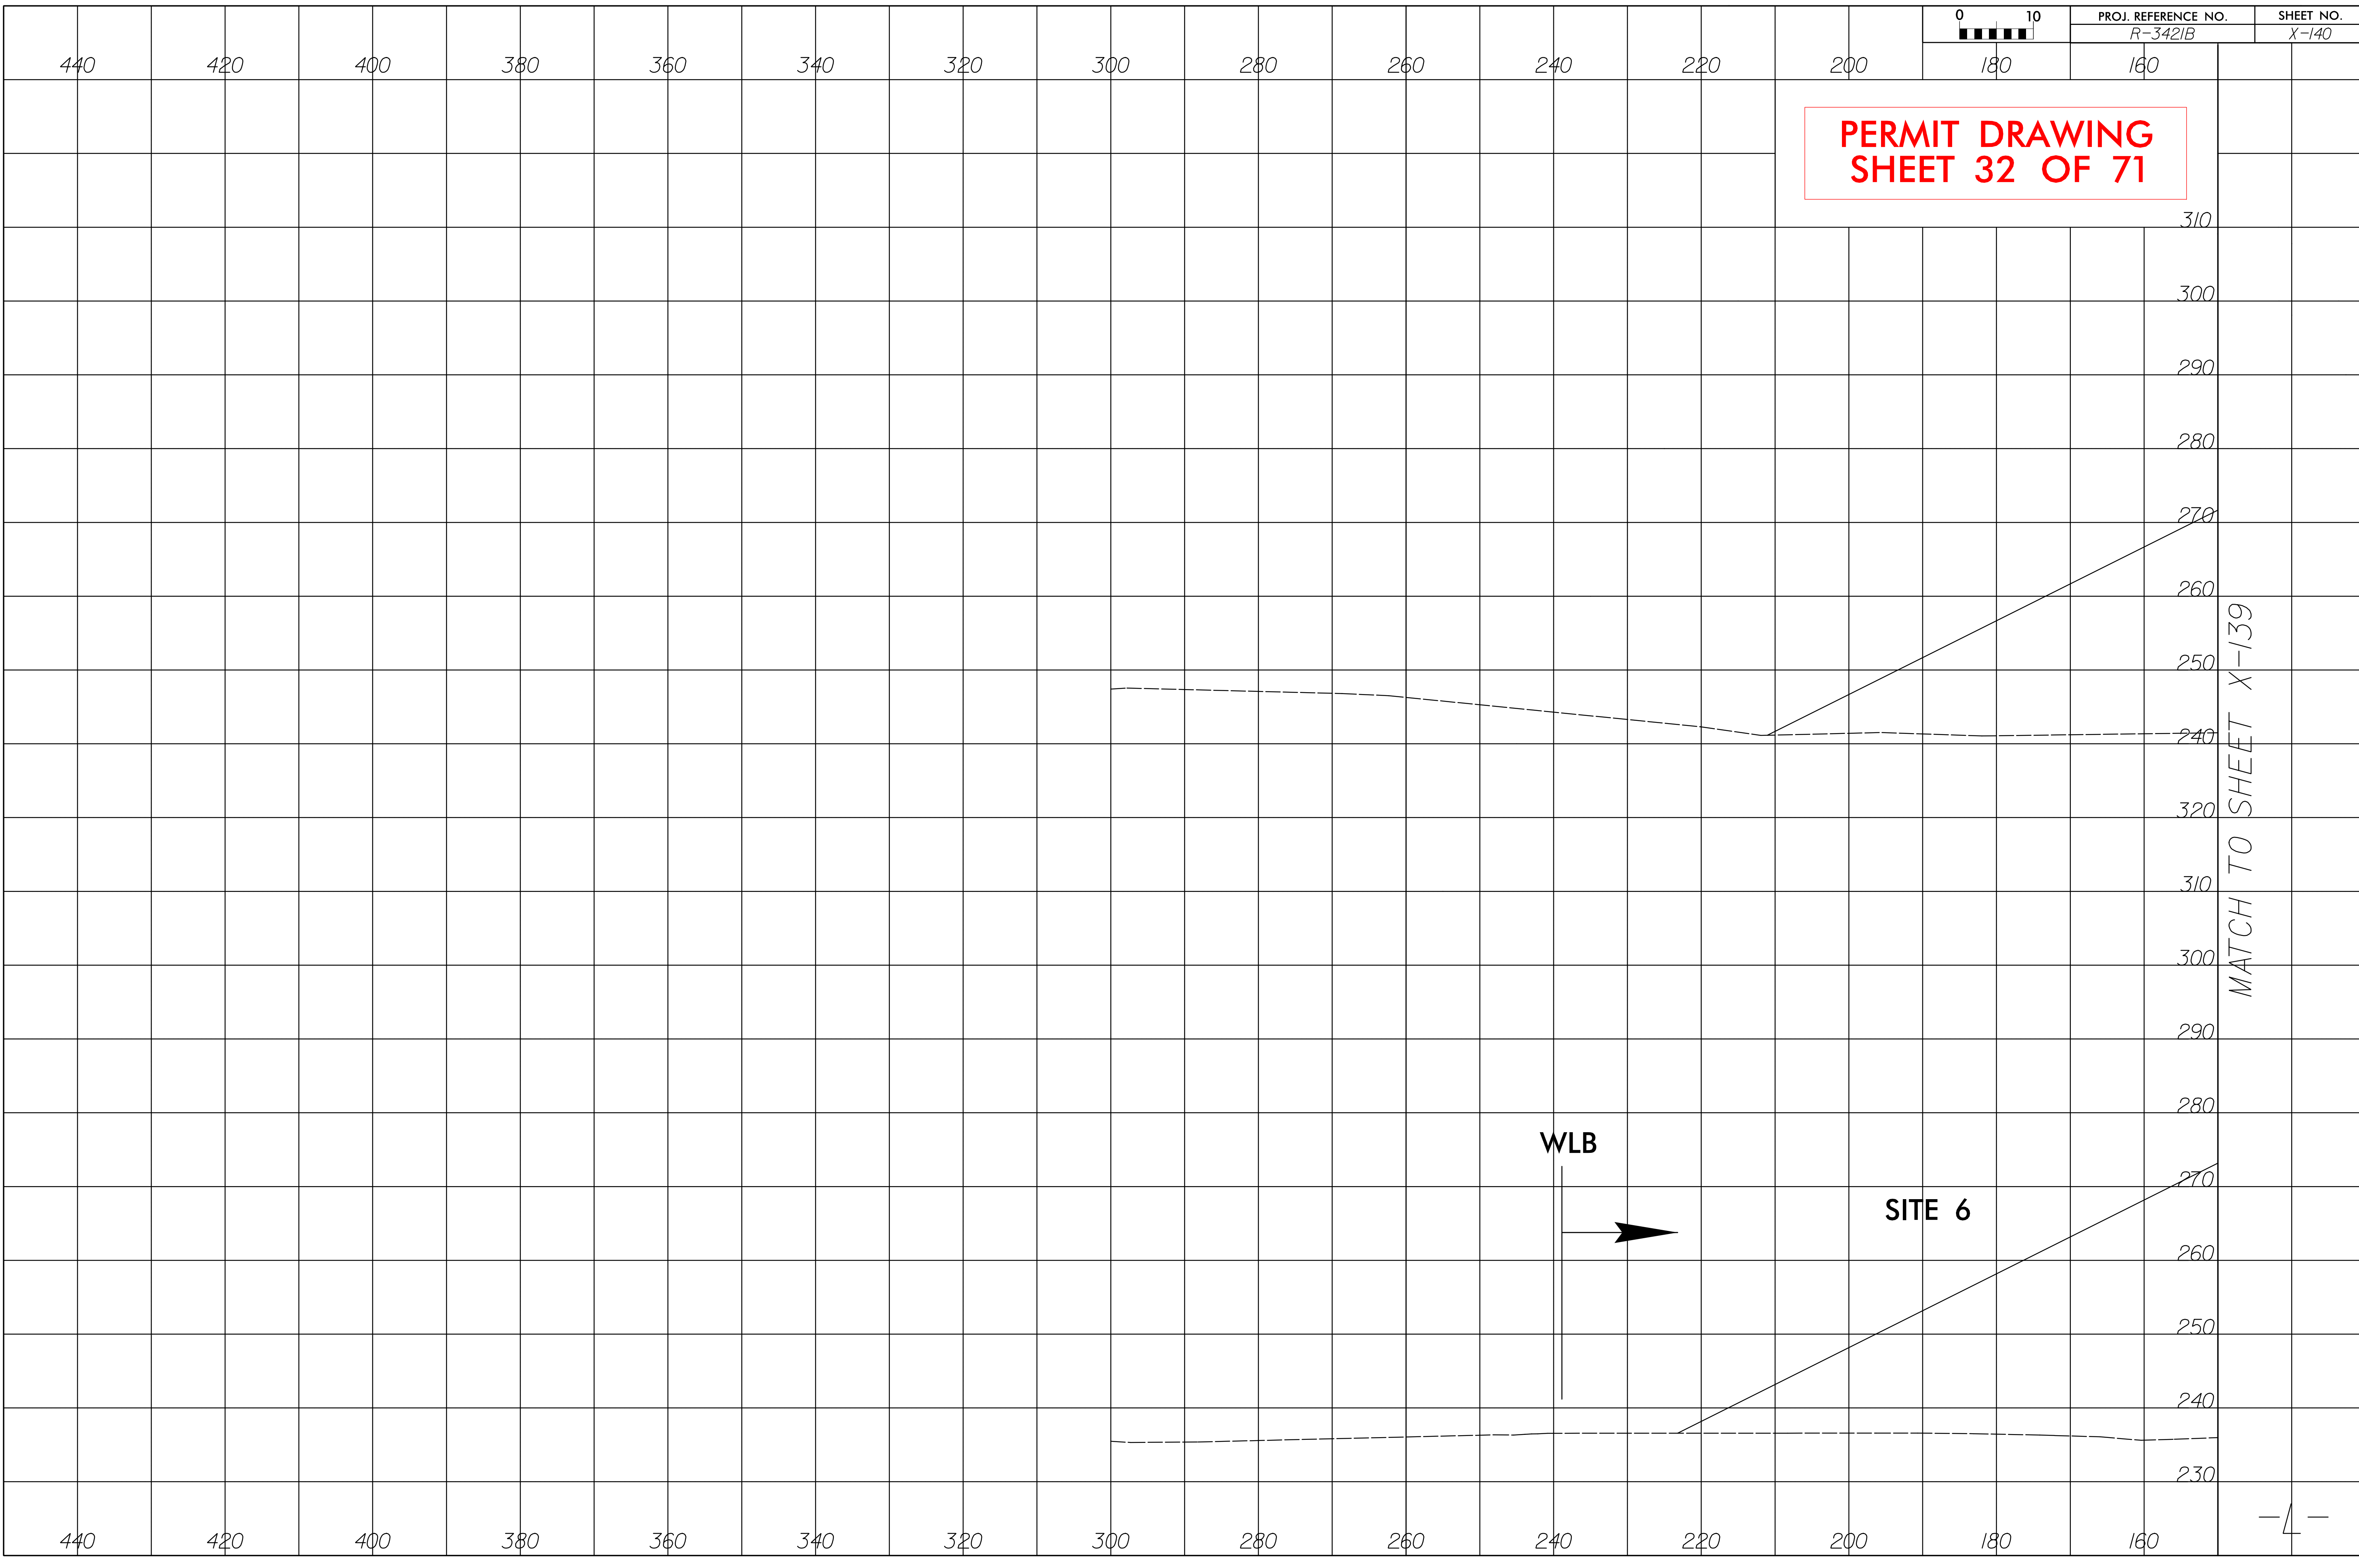


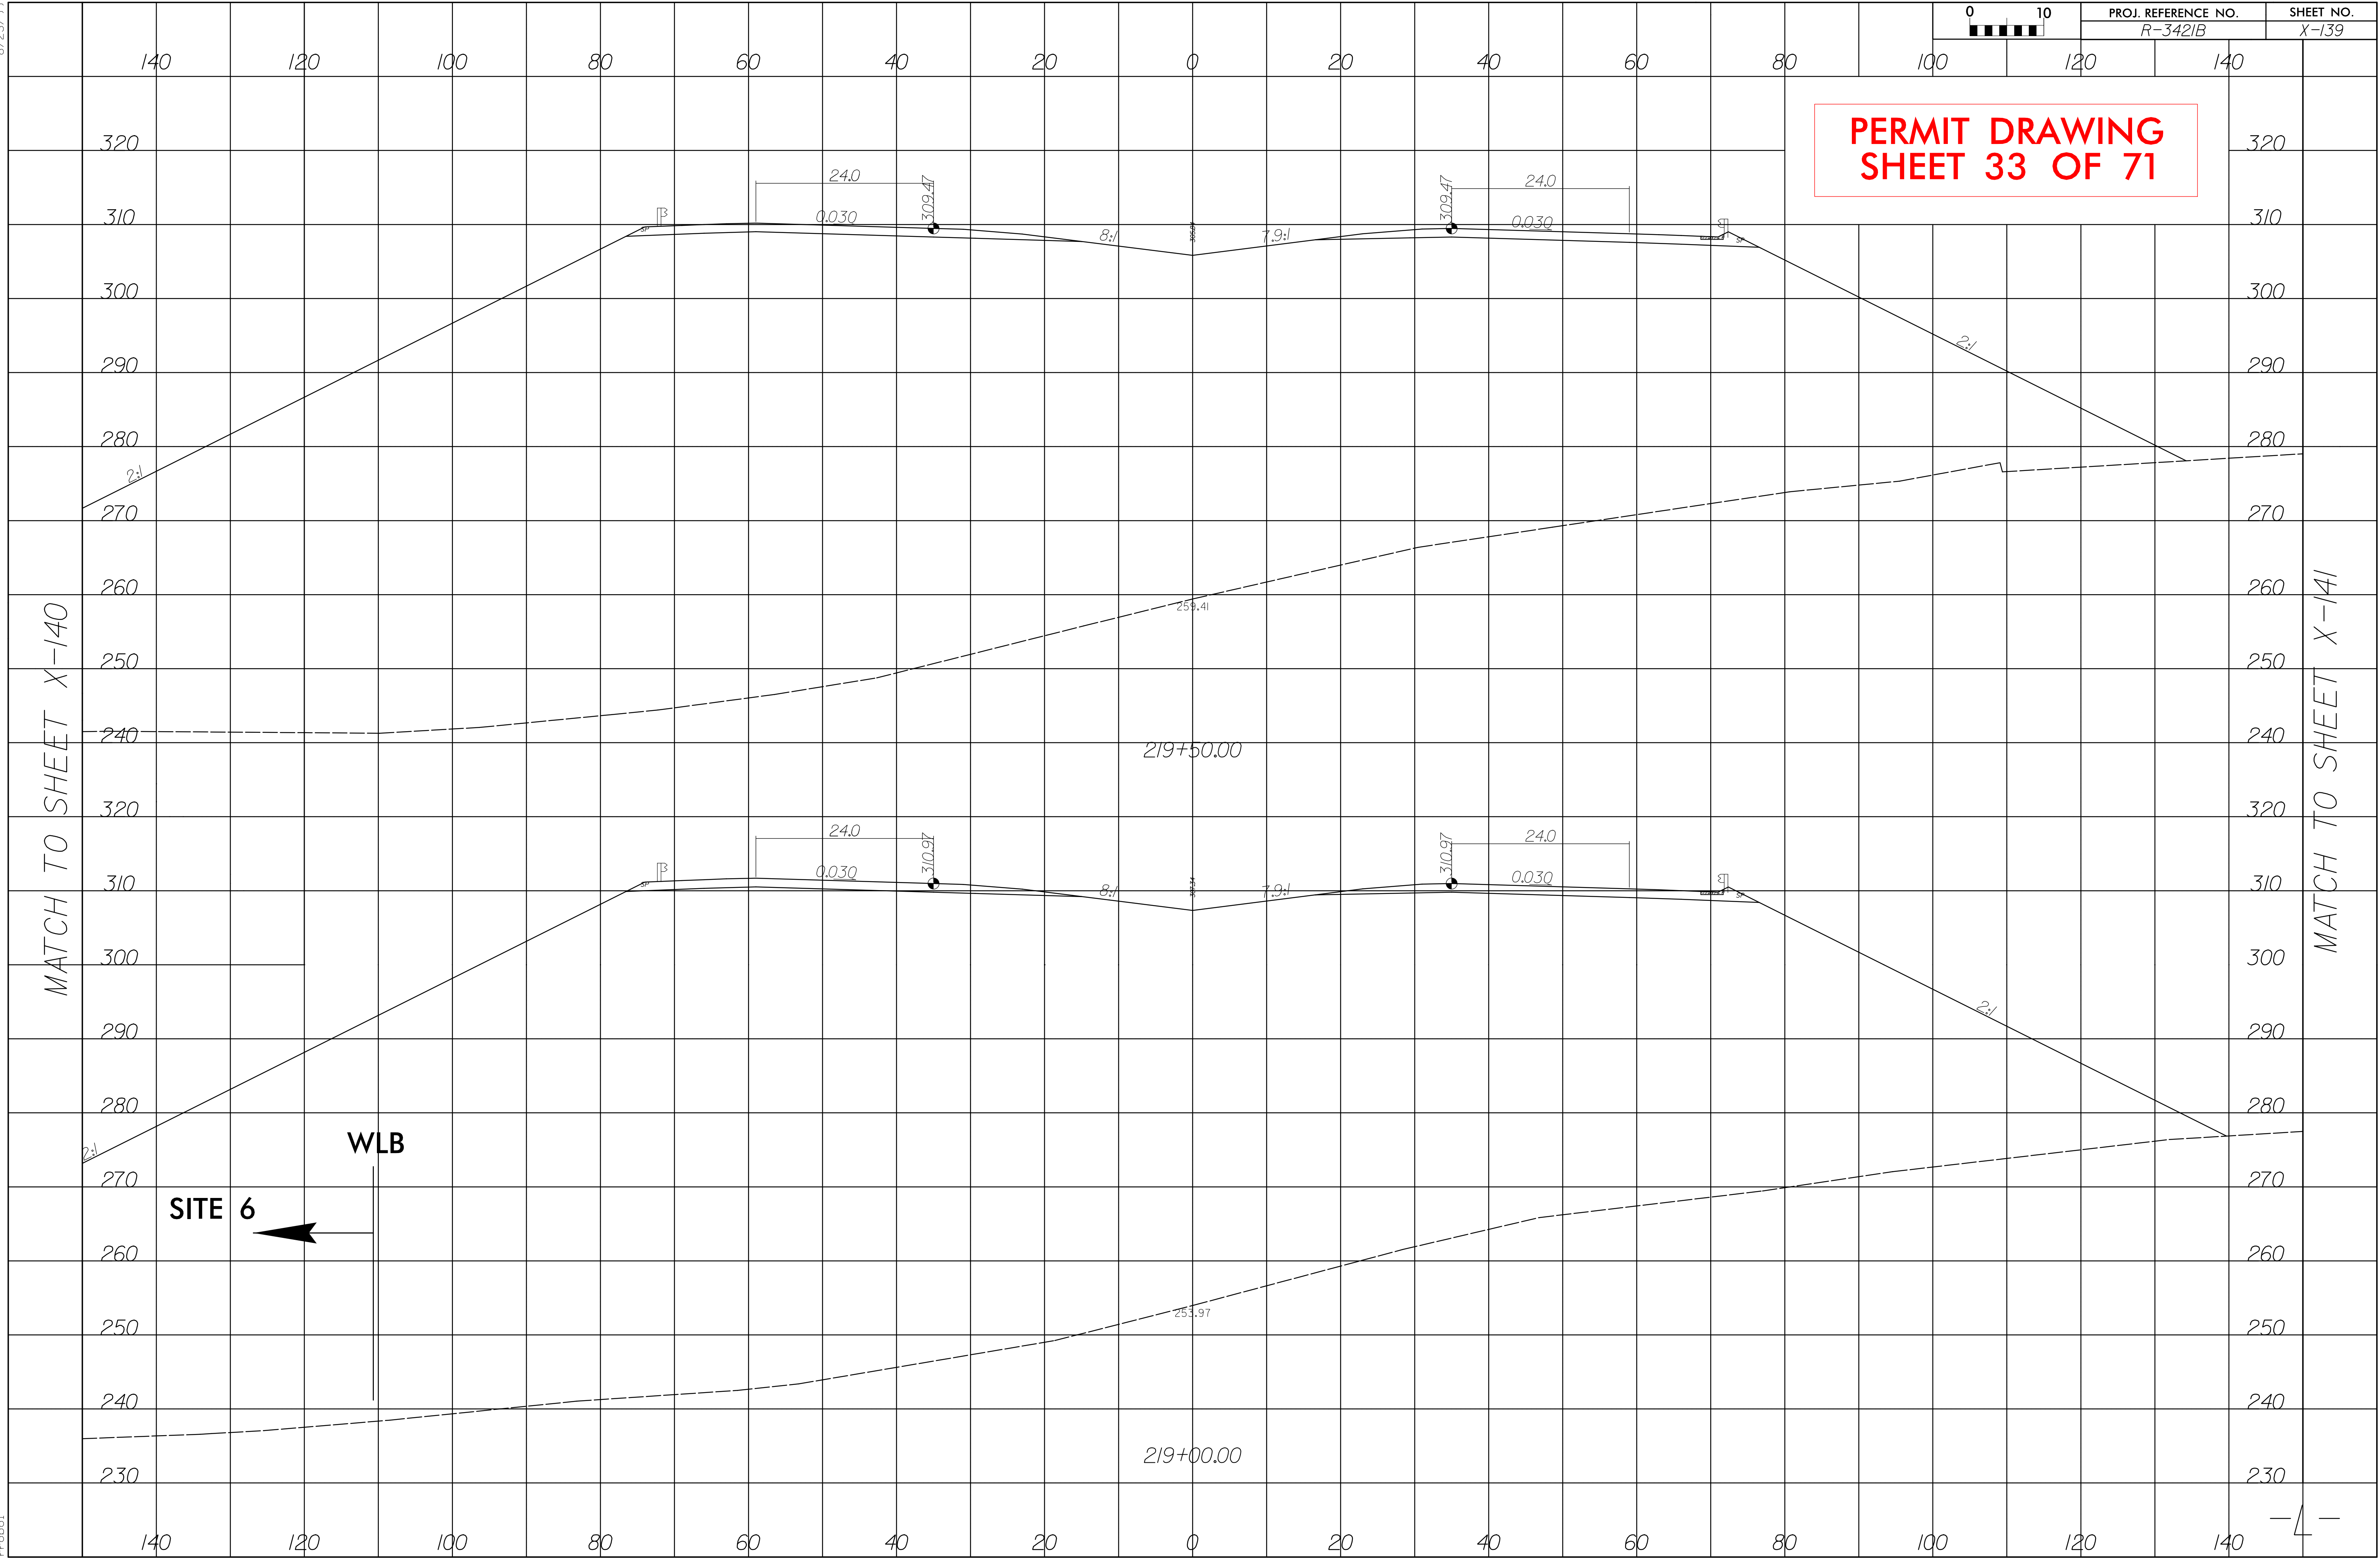

8/17/99

REVISIONS


7/22/03 AM
R:\Hydraulics\PERMITS\Environmental\Drawings\R3421B\R3421B_Hyd_prm_wet_psh11_enlarge site7_20150720.dgn

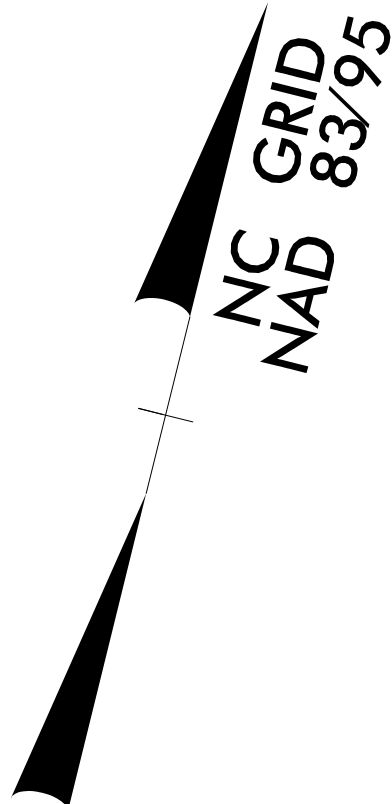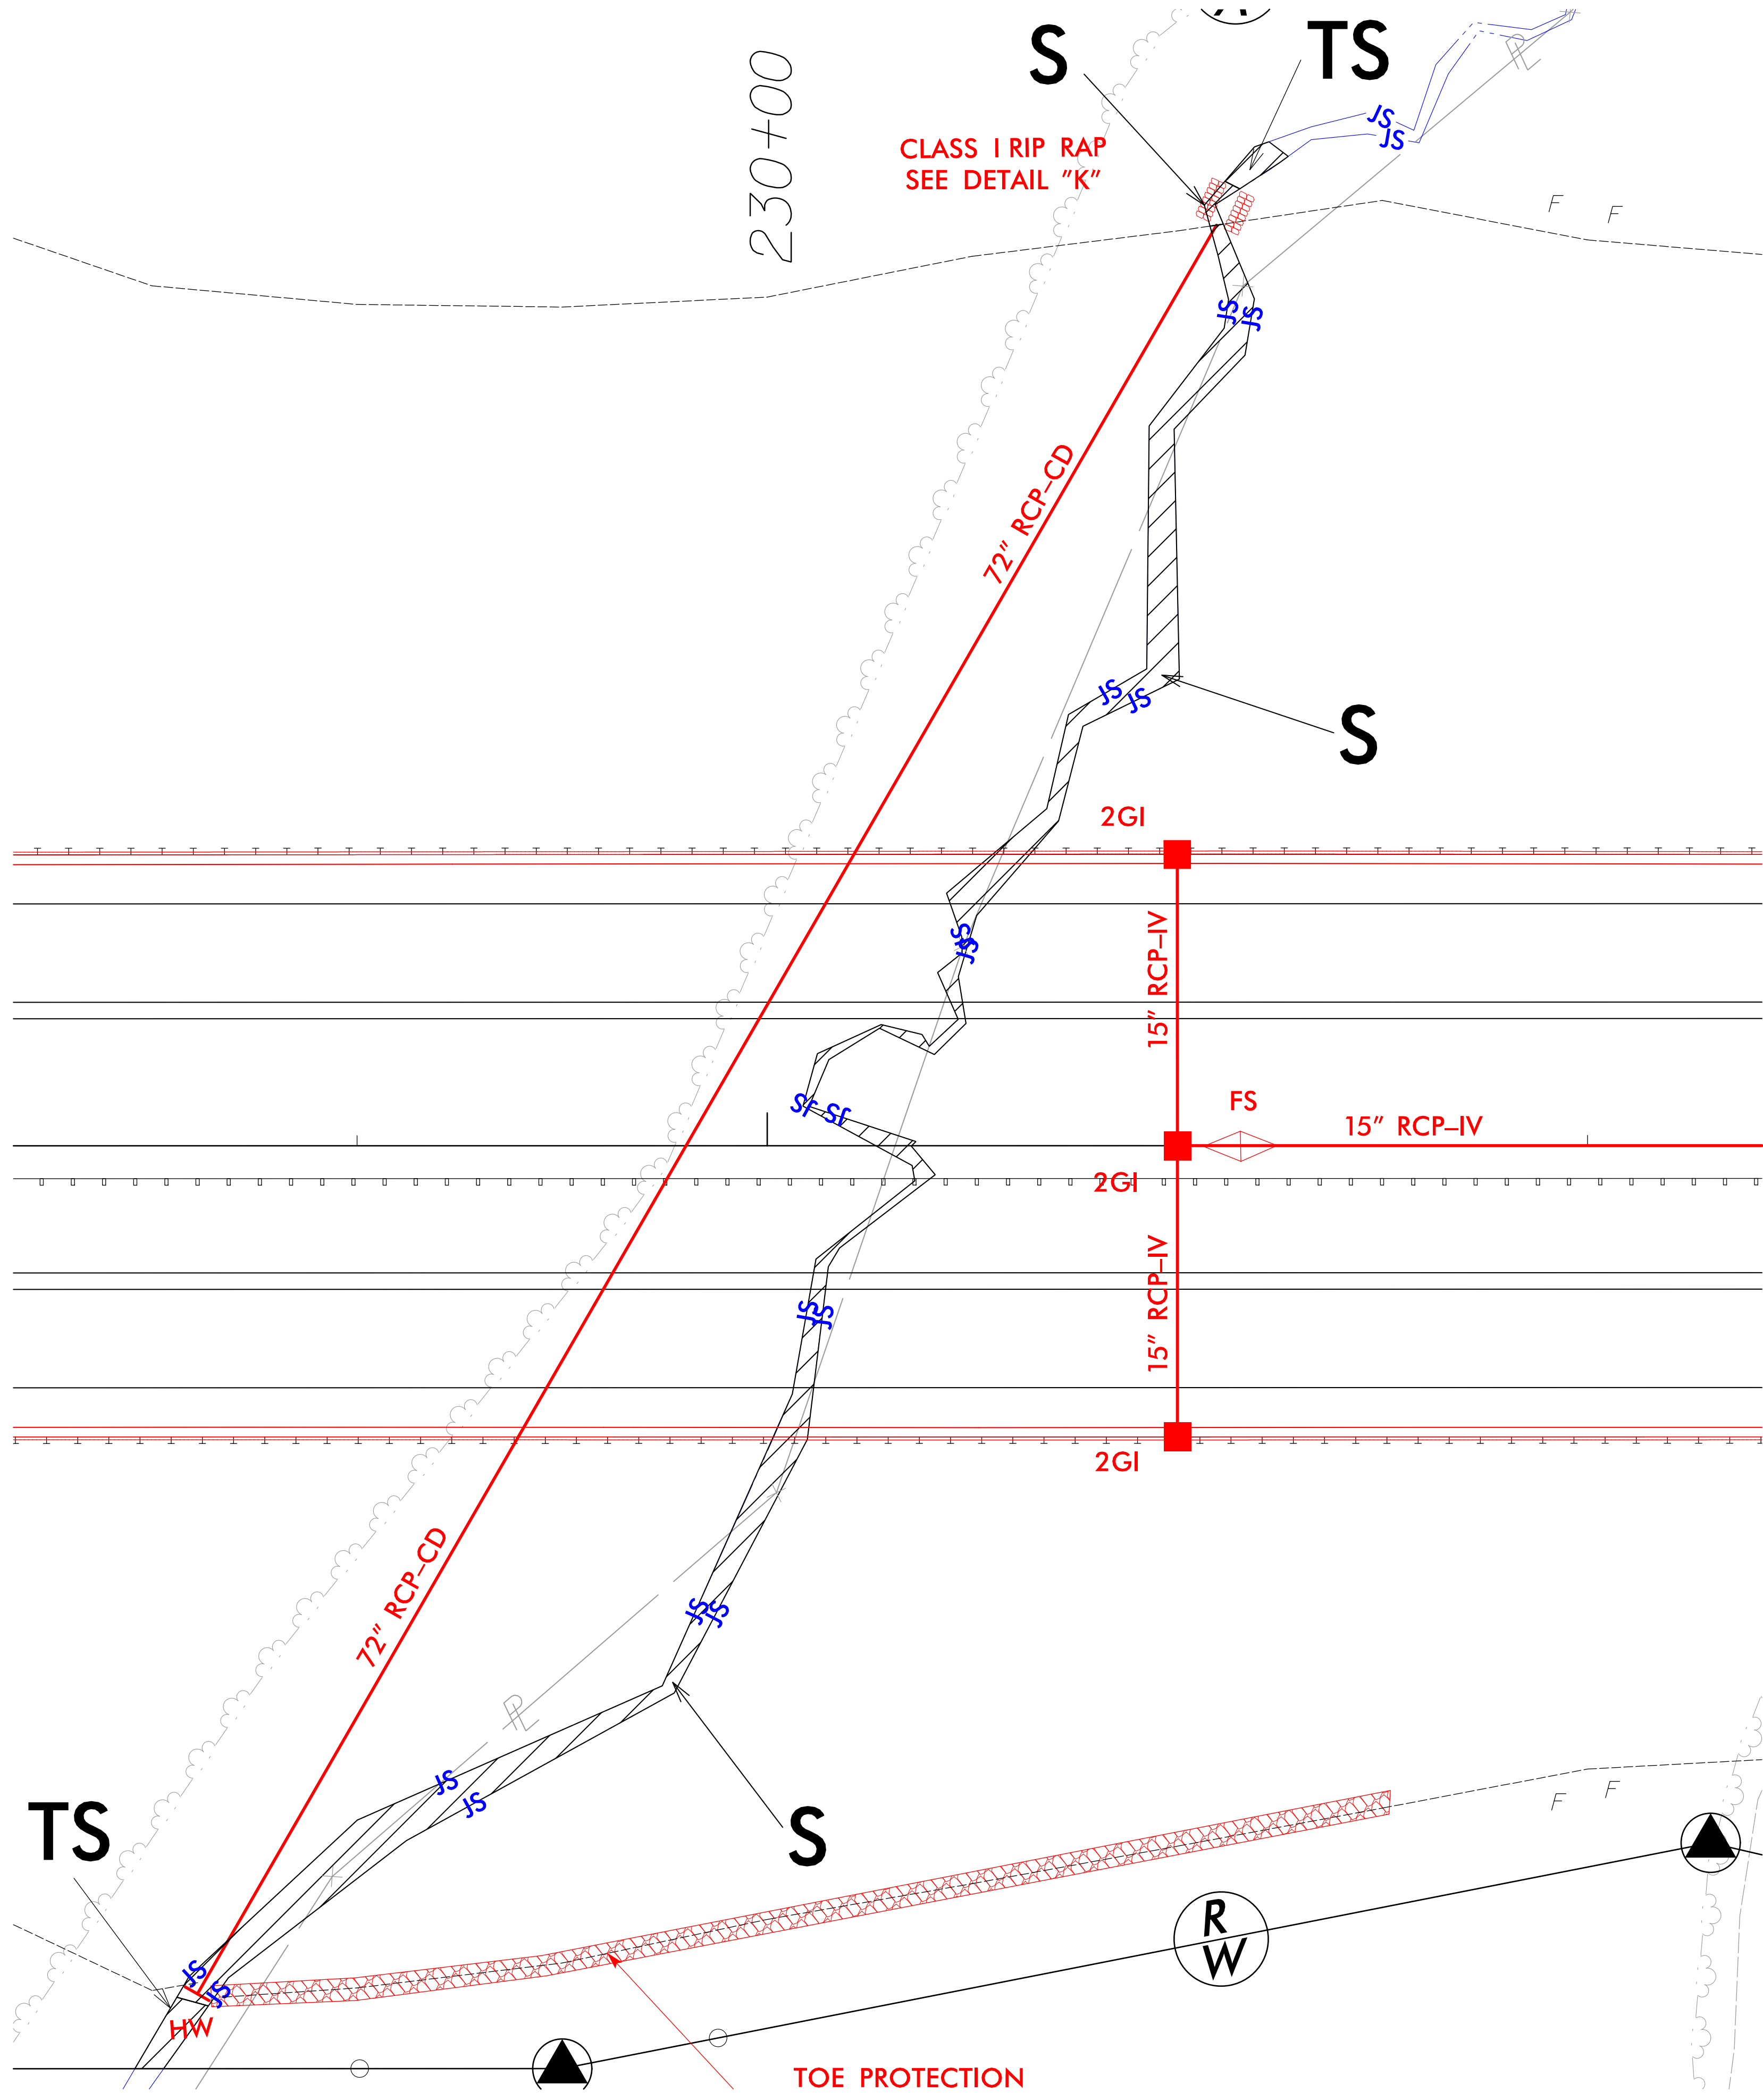


PROJECT REFERENCE NO.		SHEET NO.	
-3421B		11	
R/W SHEET NO.			
ROADWAY DESIGN ENGINEER		HYDRAULICS ENGINEER	
INCOMPLETE PLANS DO NOT USE FOR R/W ACQUISITION			
PRELIMINARY PLANS DO NOT USE FOR CONSTRUCTION			

PERMIT DRAWING
SHEET 34 OF 71

SITE 7 ENLARGEMENT

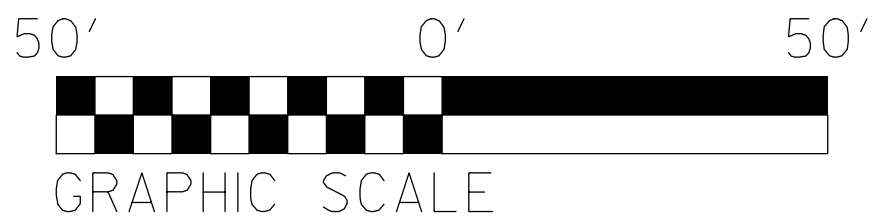

DENOTES IMPACTS IN
SURFACE WATER


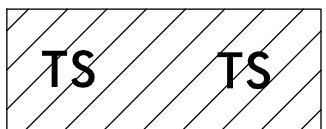


DENOTES TEMPORARY
IMPACTS IN SURFACE WATER

8/17/99

REVISIONS


7:22:07 AM
R:\Hydraulics\PERMITS\Environmental\Drawings\R3421B\R3421B_Hyd_prm_wet_psh11_enlarge site7_20150720.con.dgn

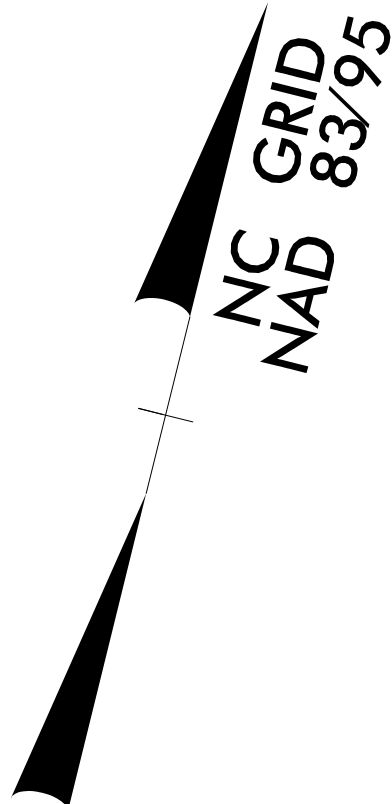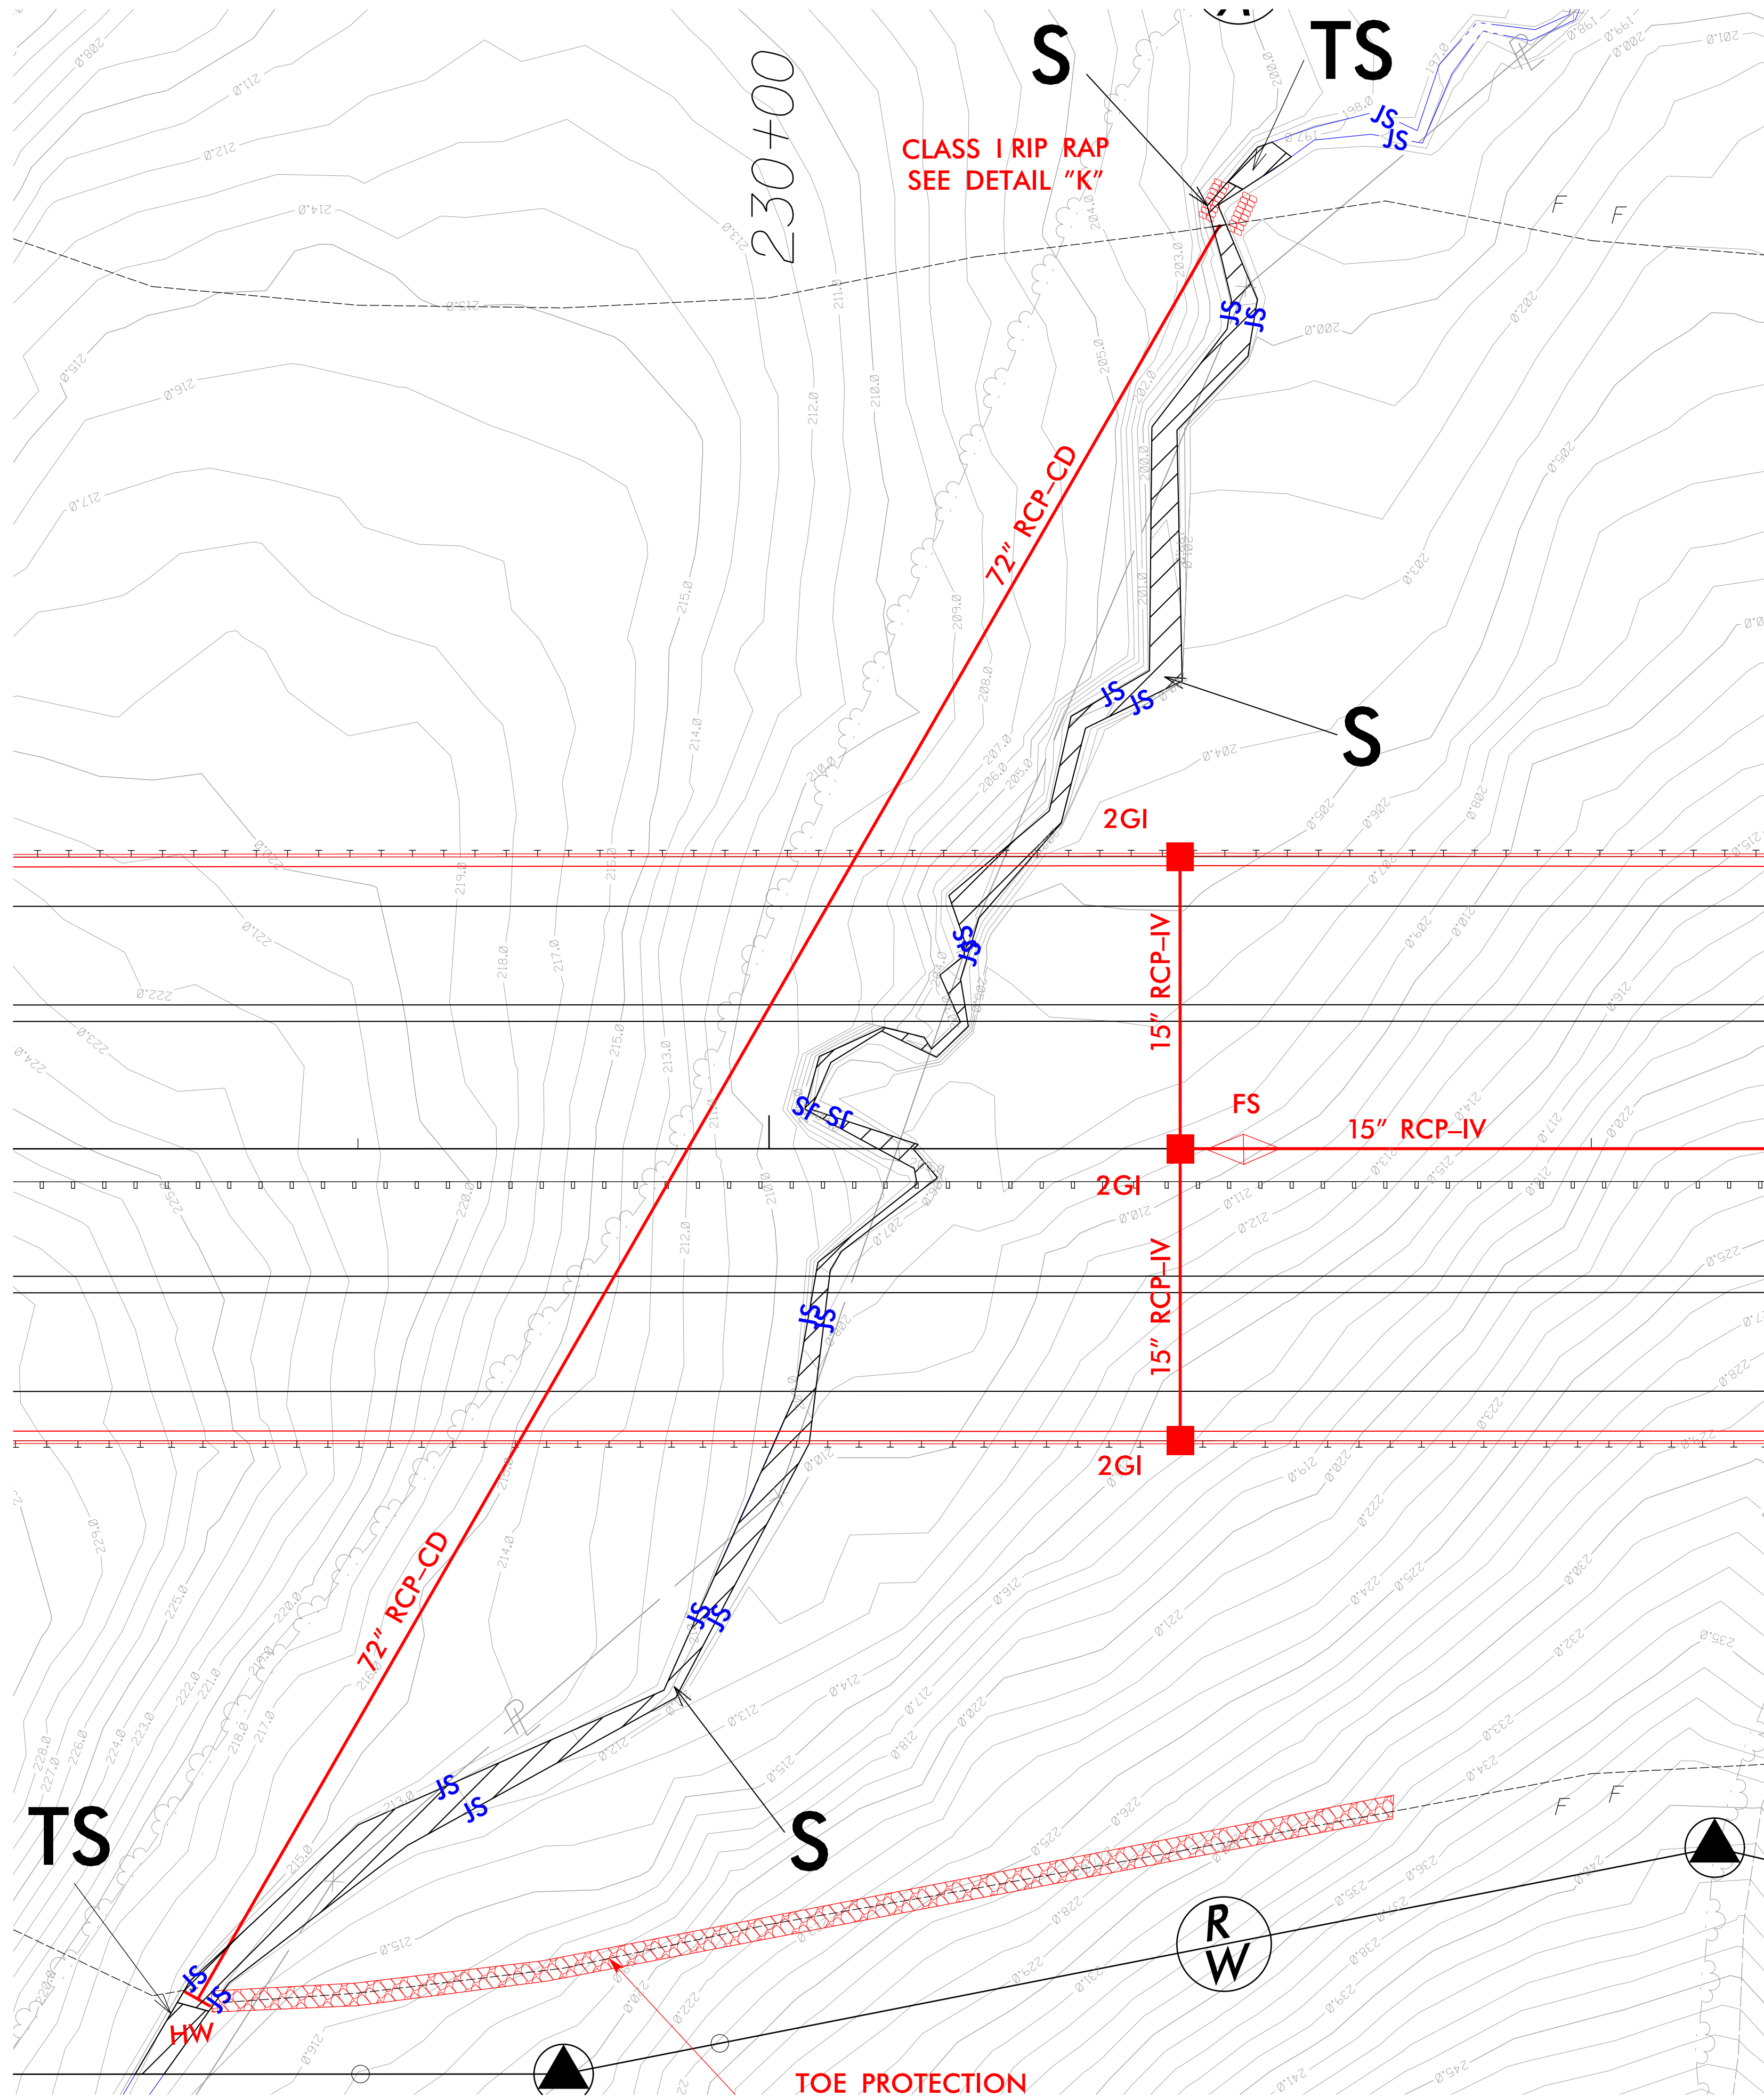



PROJECT REFERENCE NO.		SHEET NO.	
-3421B		11	
R/W SHEET NO.			
ROADWAY DESIGN ENGINEER		HYDRAULICS ENGINEER	
INCOMPLETE PLANS DO NOT USE FOR R/W ACQUISITION			
PRELIMINARY PLANS DO NOT USE FOR CONSTRUCTION			


PERMIT DRAWING
SHEET 35 OF 71


SITE 7 ENLARGEMENT

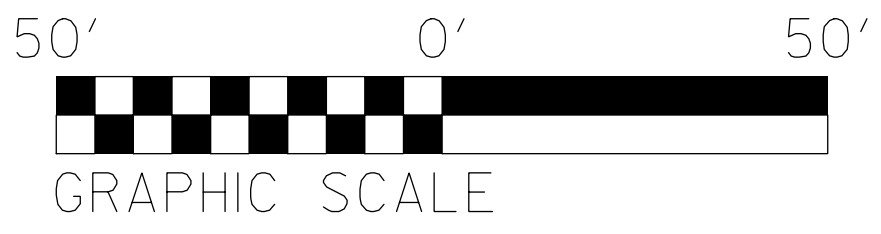

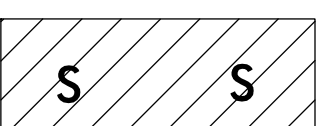-  DENOTES IMPACTS IN SURFACE WATER
-  DENOTES TEMPORARY IMPACTS IN SURFACE WATER

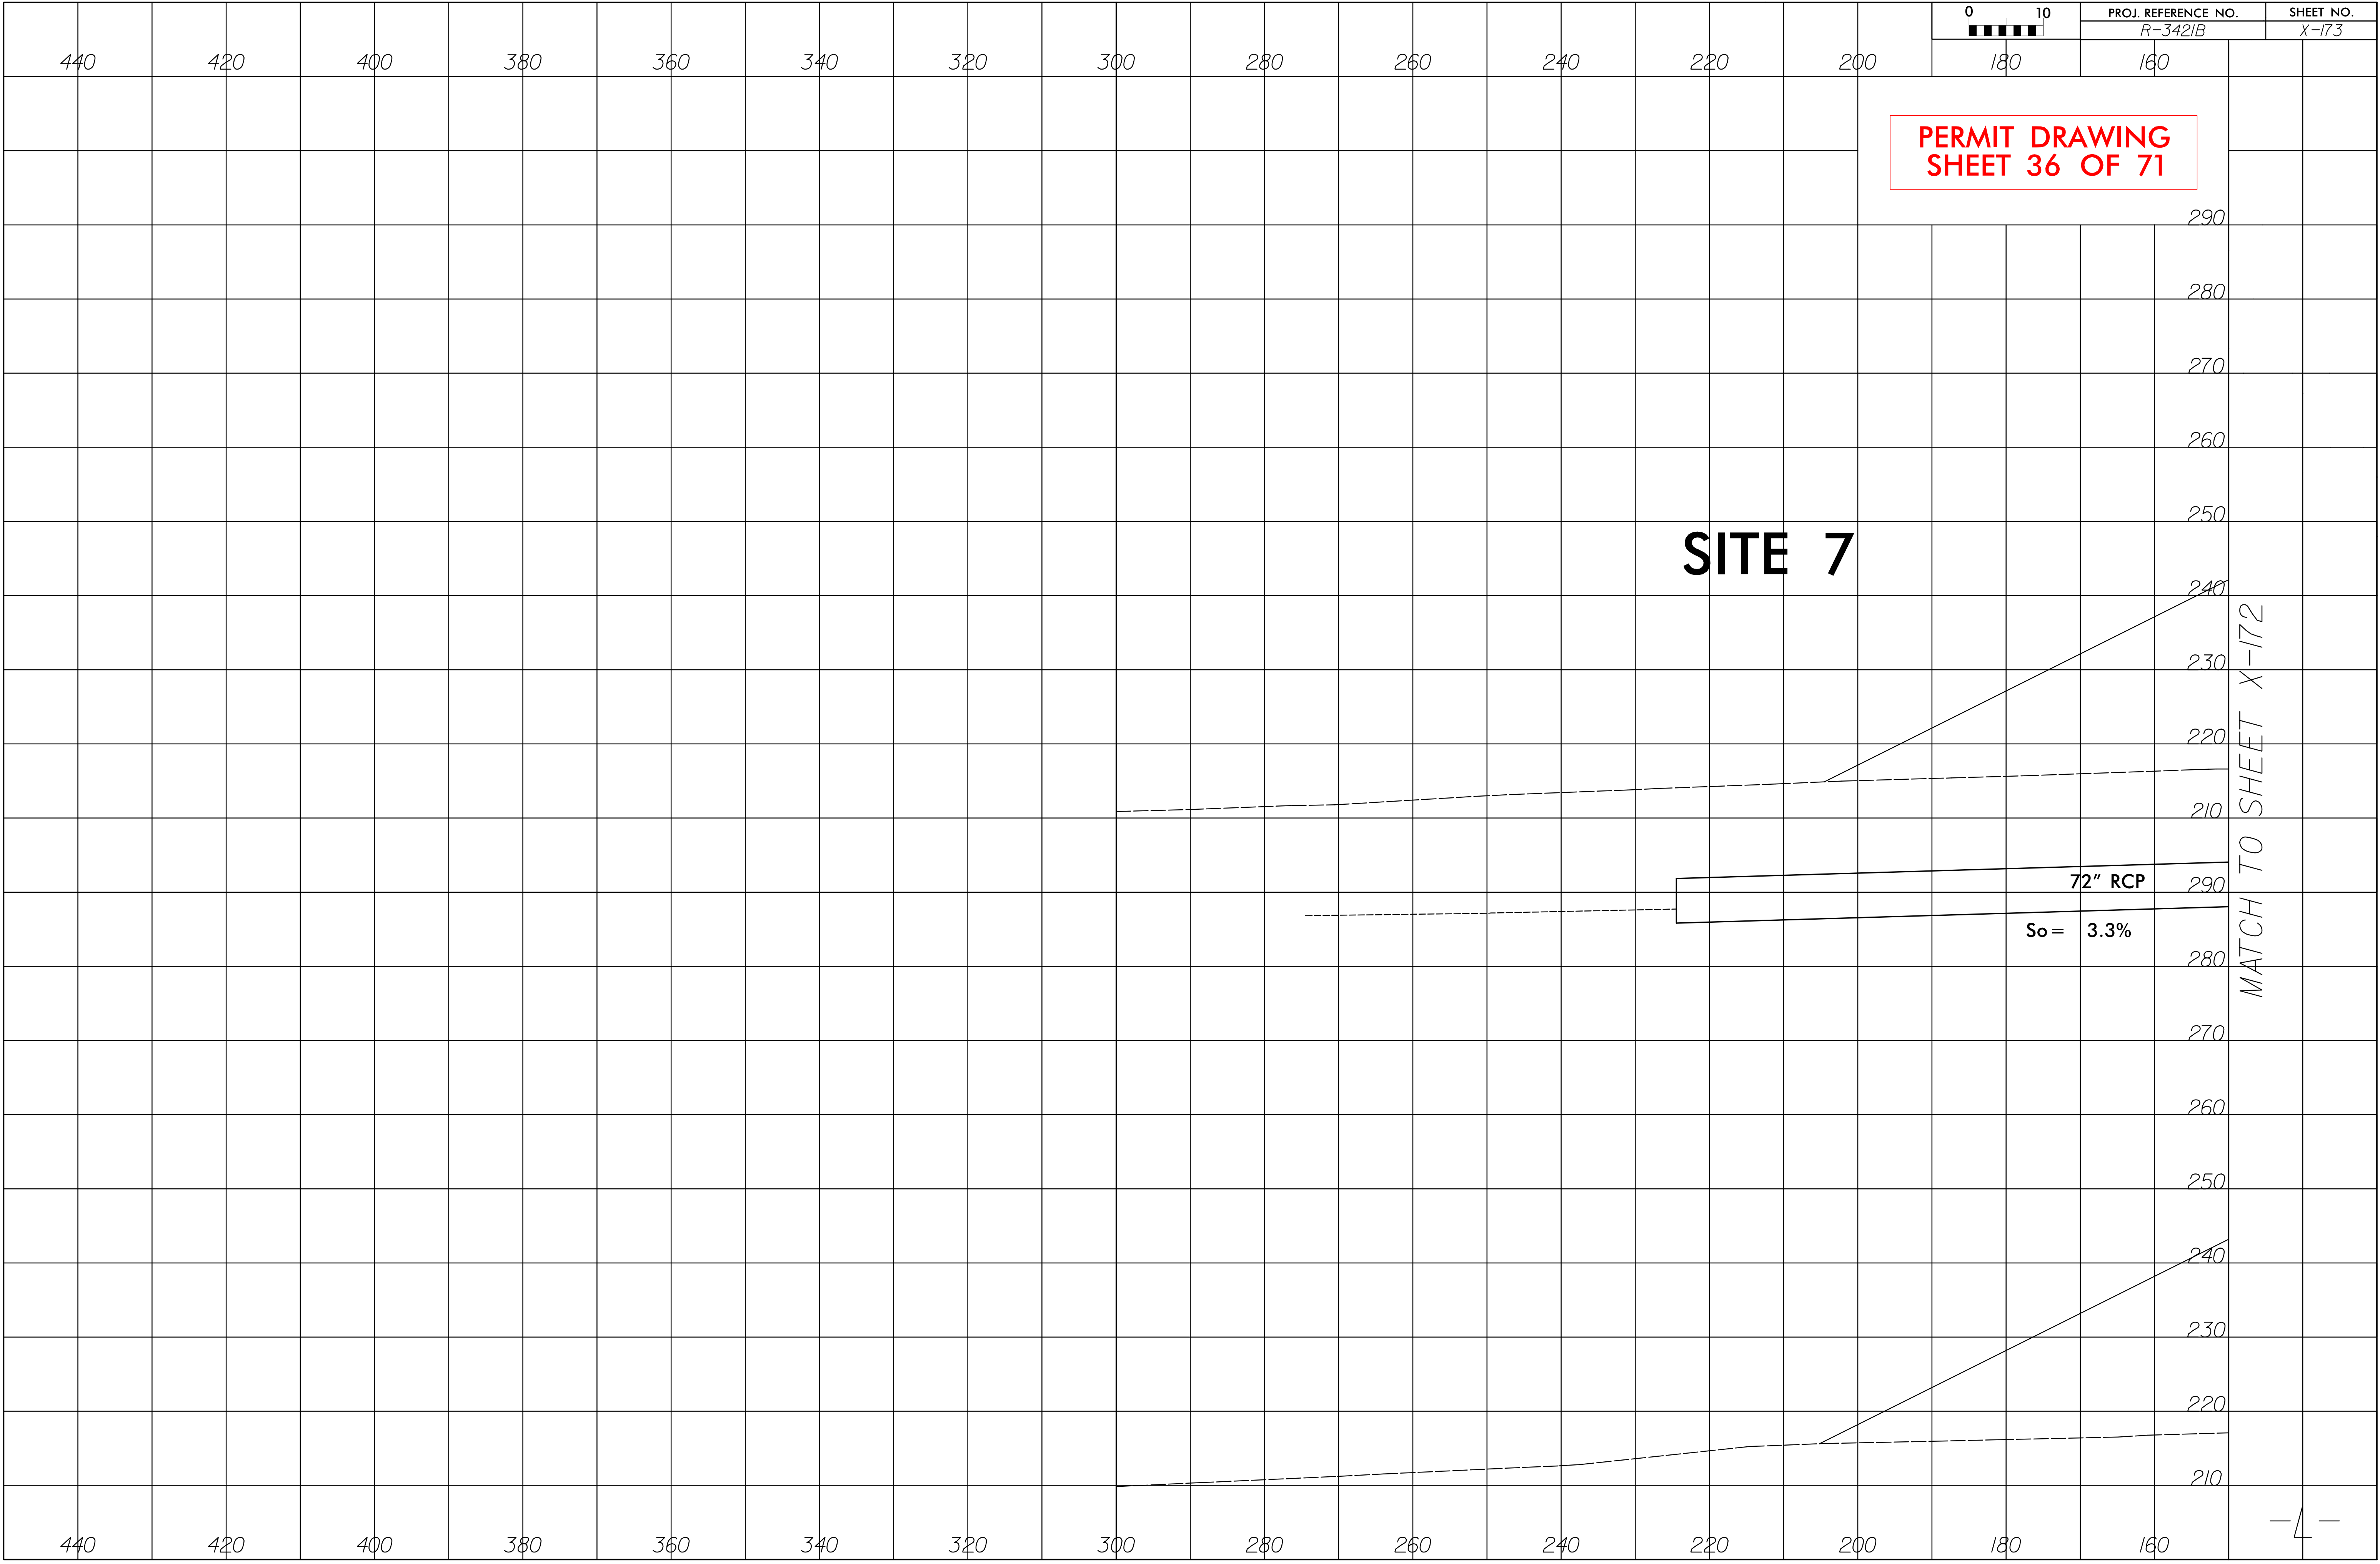

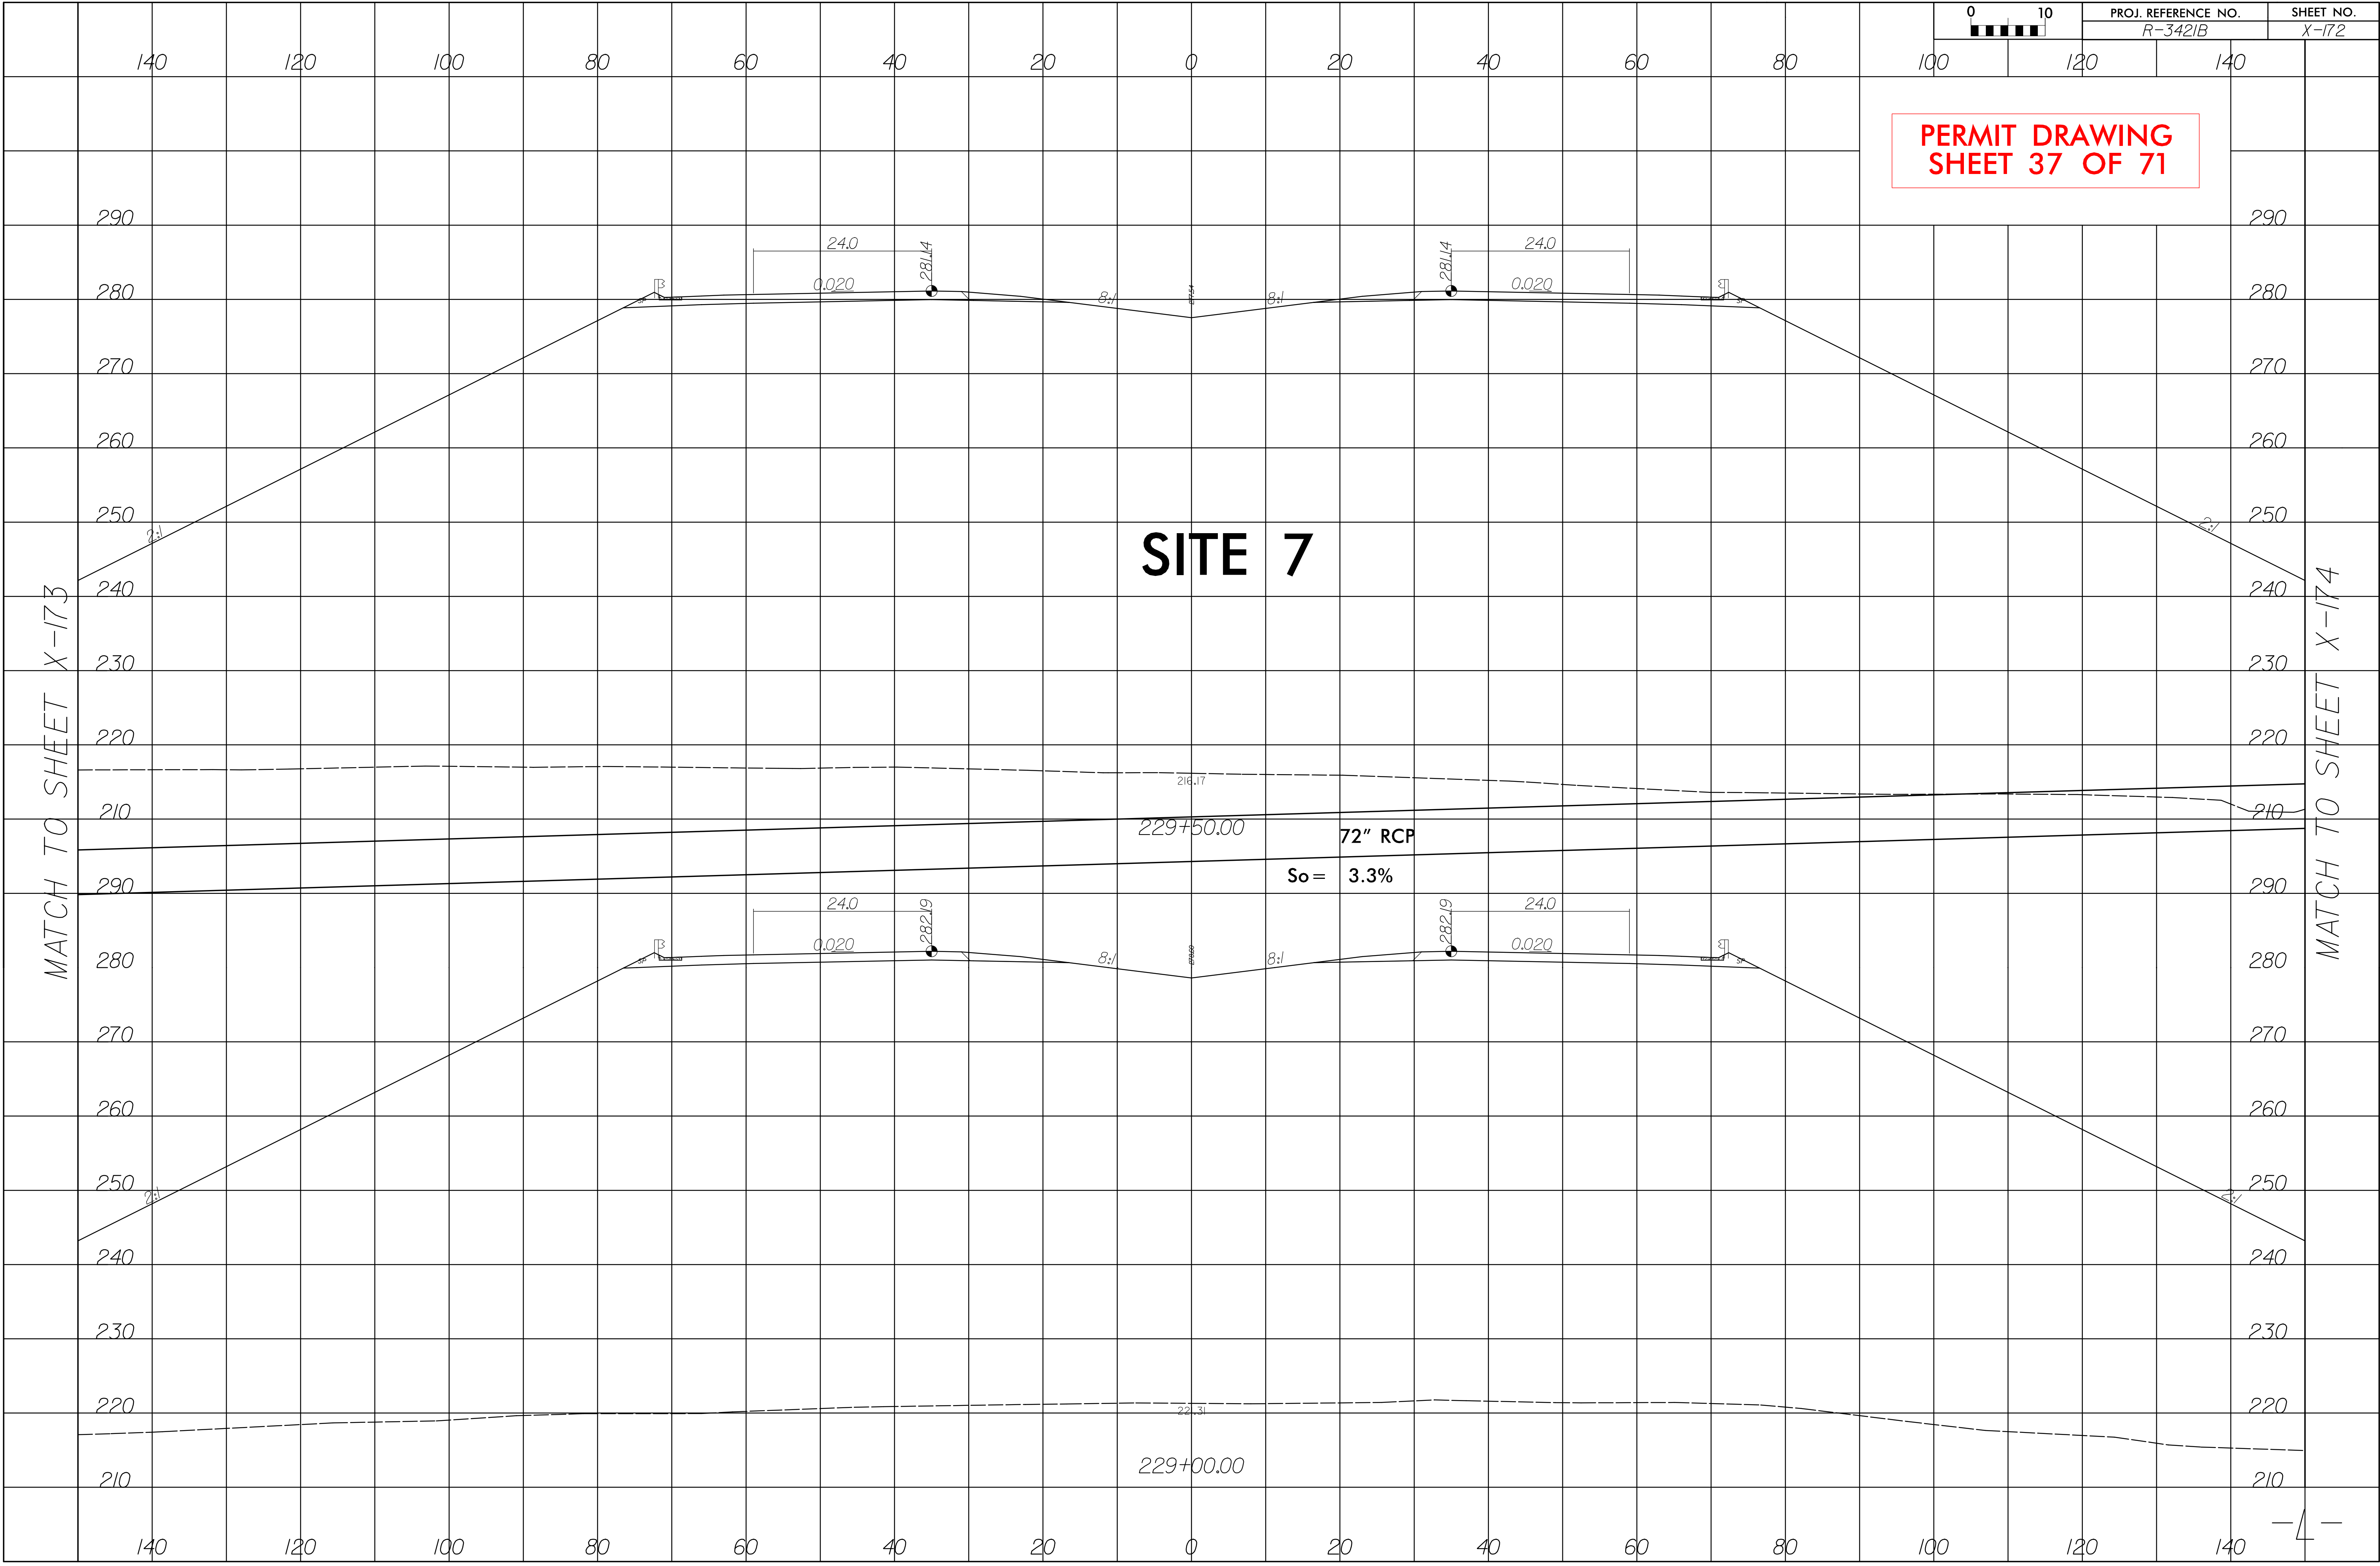

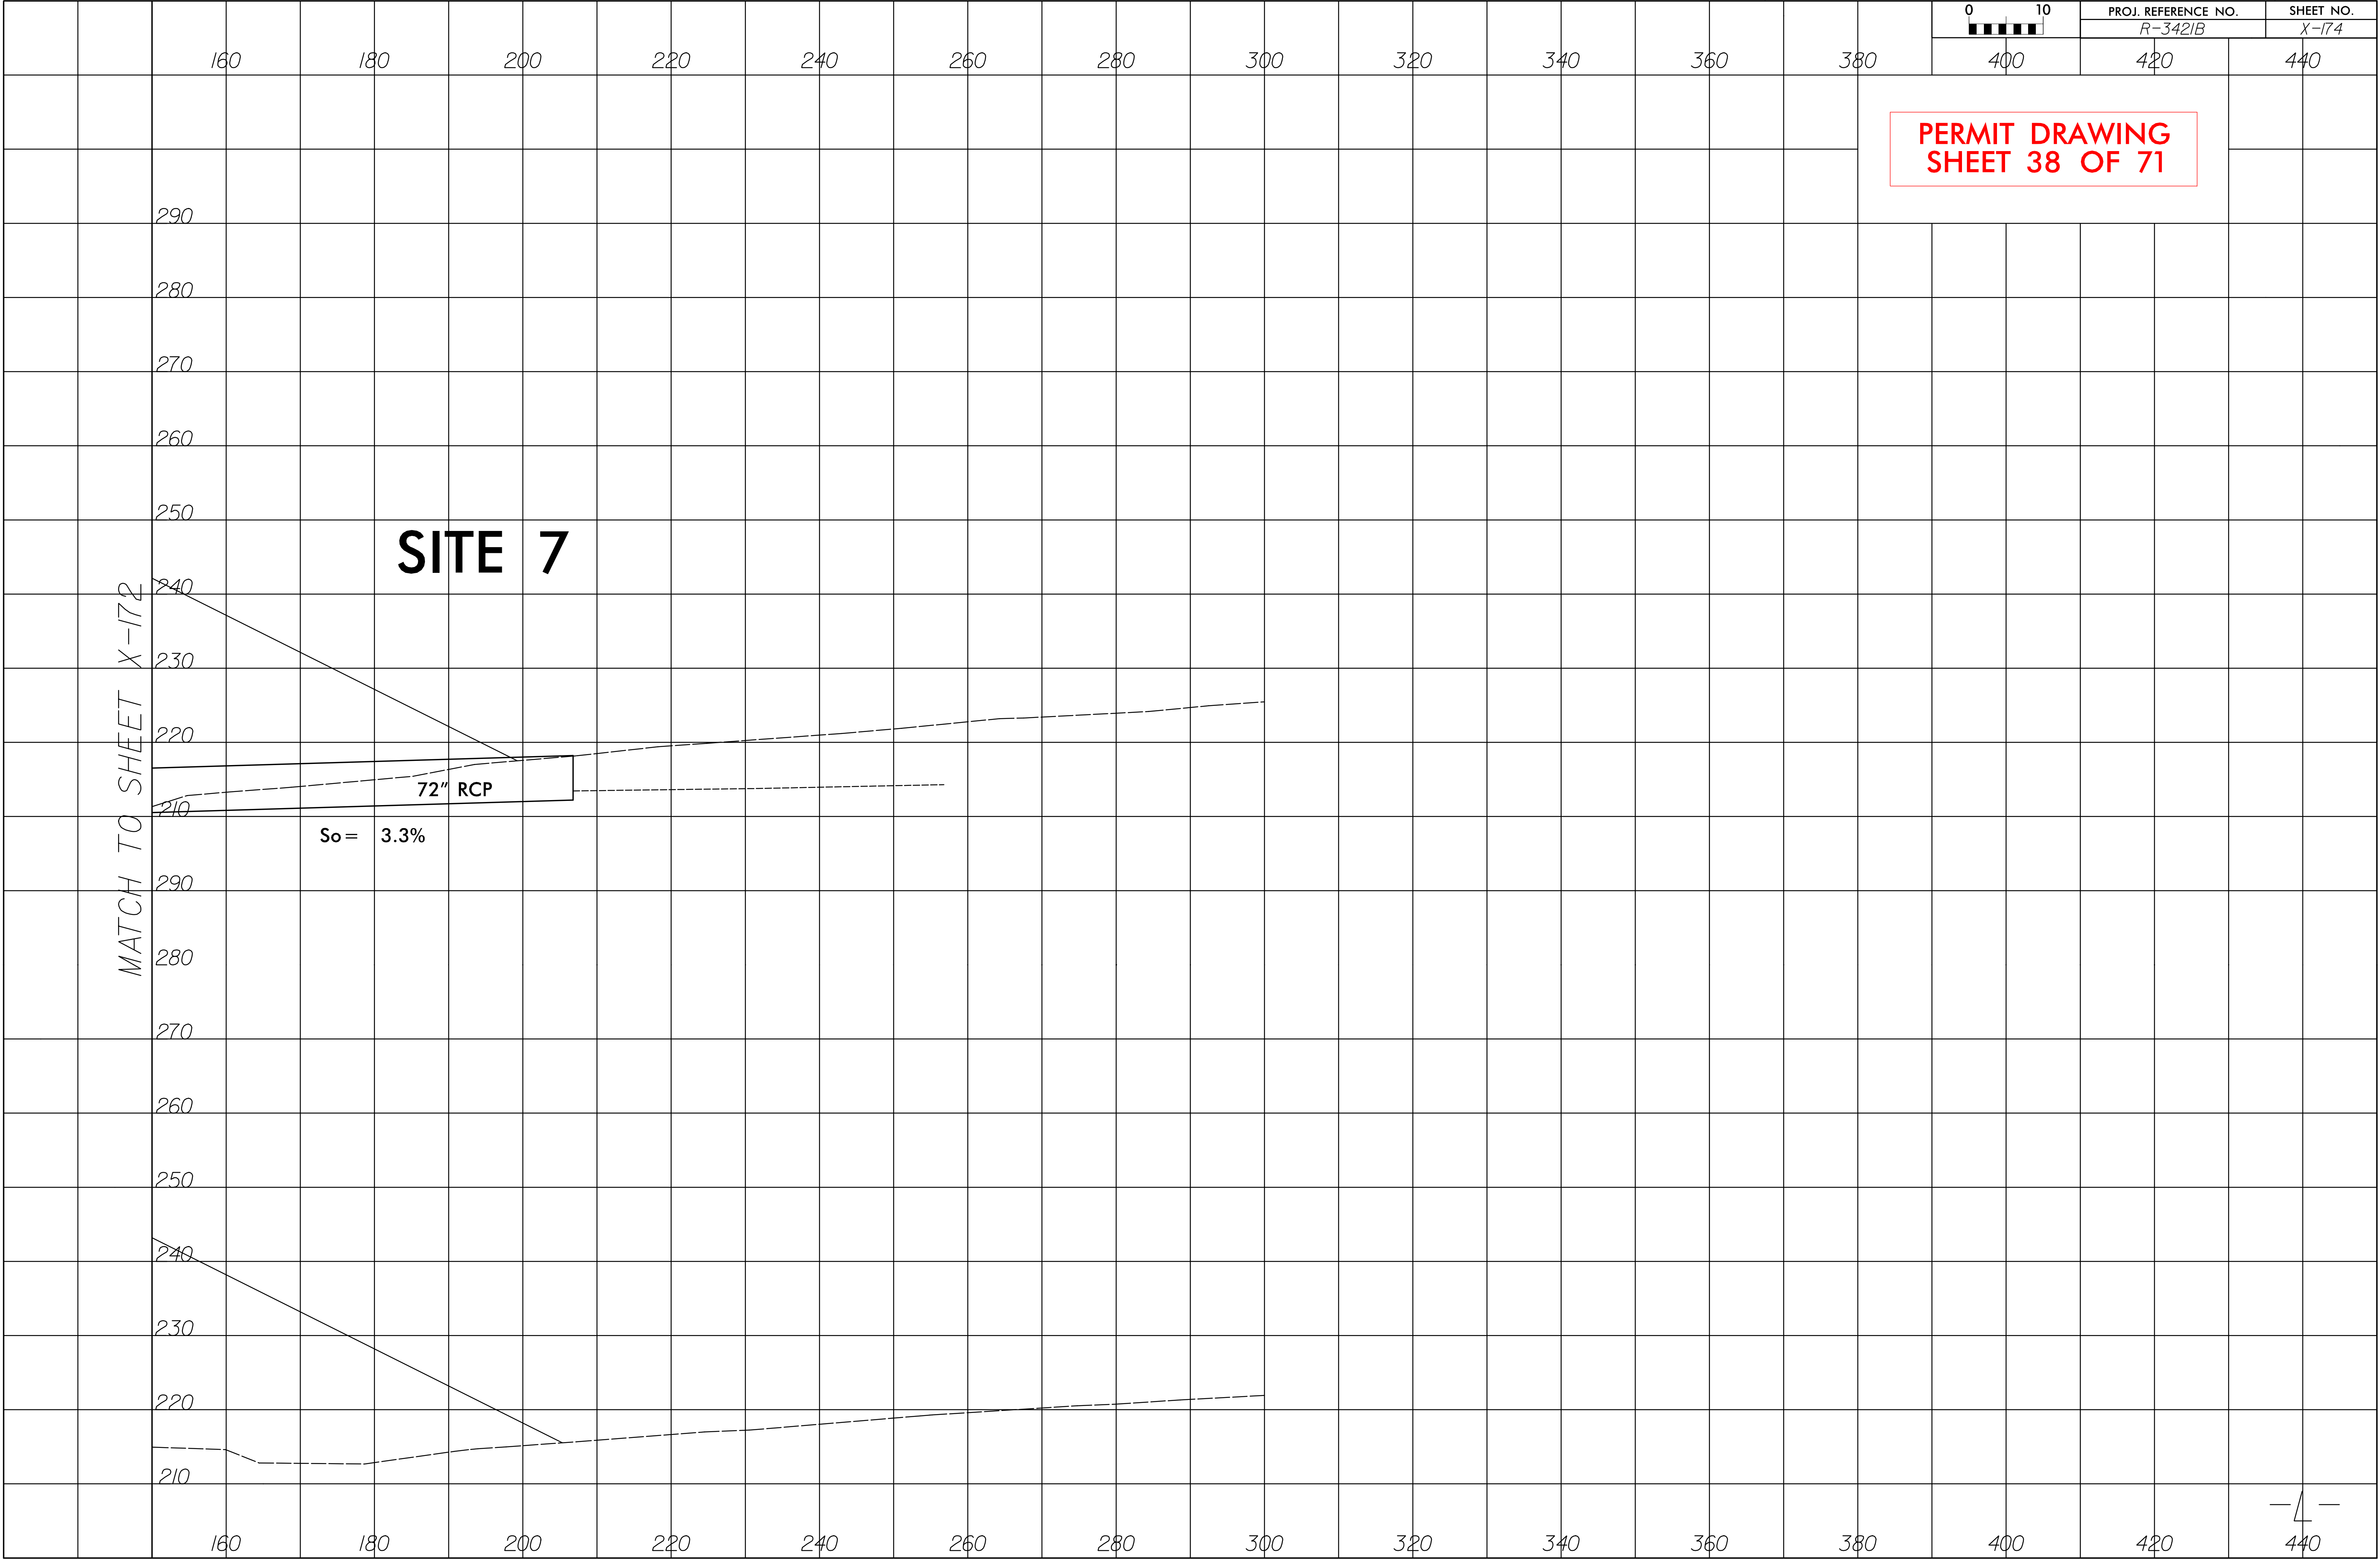






Revised 8/6/19

8/17/99

9/22/50 AM
R:\Hydro-a\lics\PERMITS\Environmental\Drawings\R3421B\R3421B_Hyd_prm_wet_psh12_20150326.dgn

REVISIONS

MATCHLINE TO SHEET 12
-L- STATION 232+00

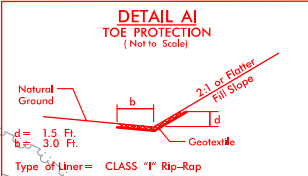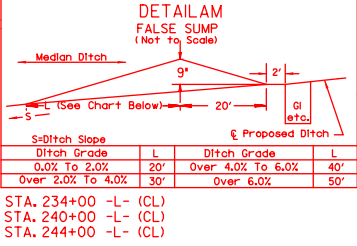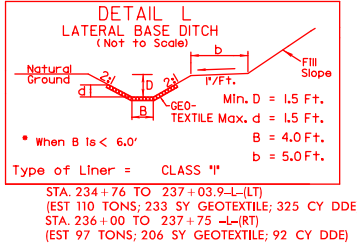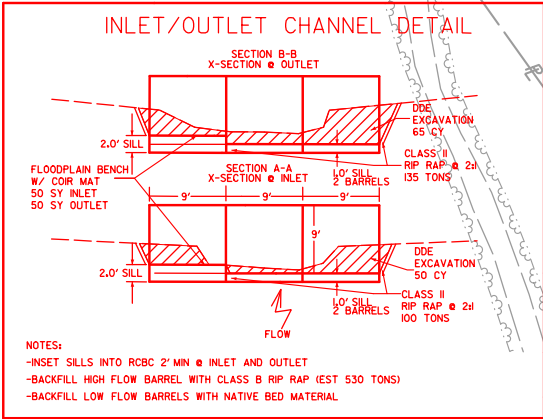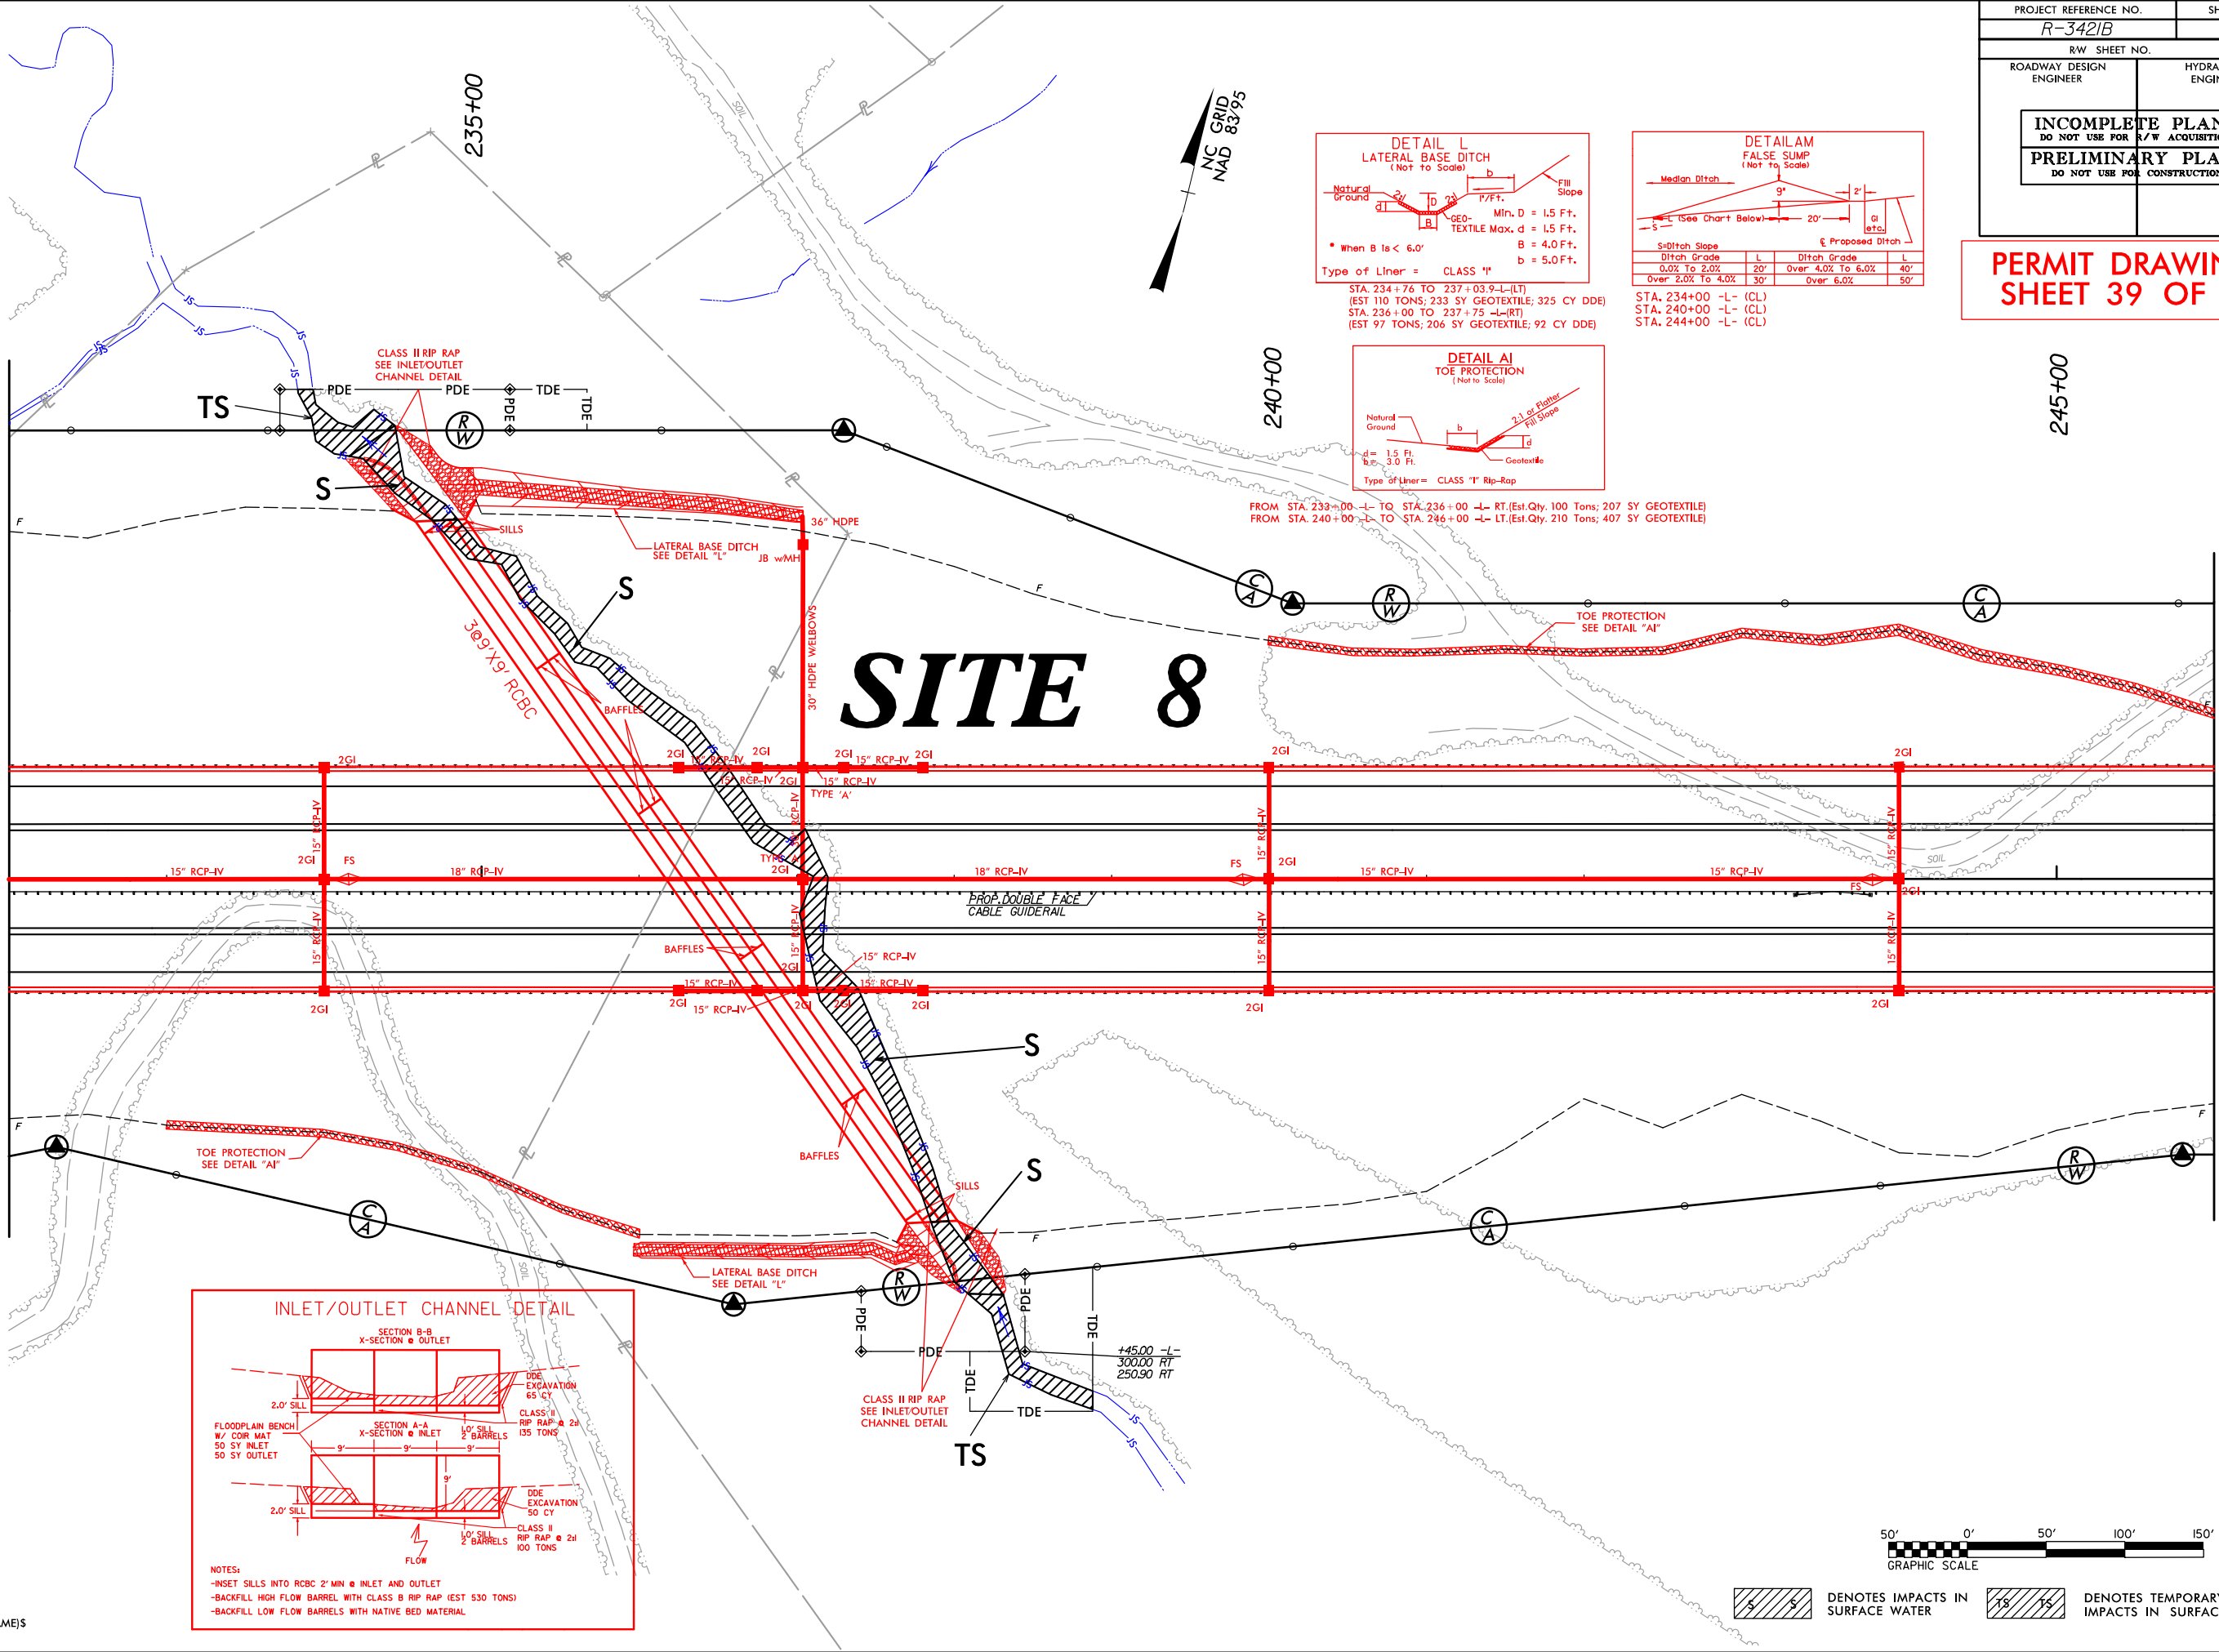

**PERMIT DRAWING
SHEET 39 OF 71**



50' 0' 50' 100' 150'
GRAPHIC SCALE

15 15 DENOTES IMPACTS IN SURFACE WATER

15 15 DENOTES TEMPORARY IMPACTS IN SURFACE WATER

Revised 8/6/19






8/17/99

REVISIONS

9/22/57 AM R:\Hydro\autocad\Drawings\3421B\3421B_Hyd.prm_wet.psh12.20150326.con.dgn

SDATES
S(USERNAME)S
SFIELDS

MATCHLINE TO SHEET 12
-L- STATION 232+00

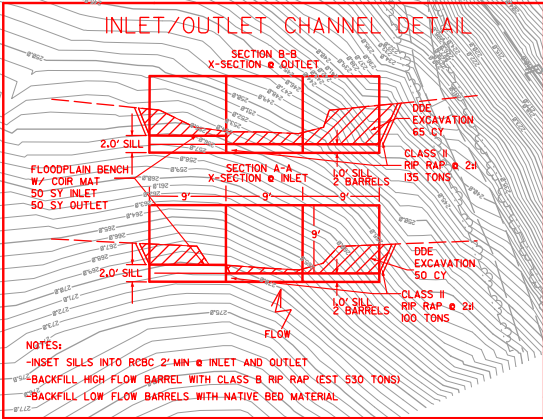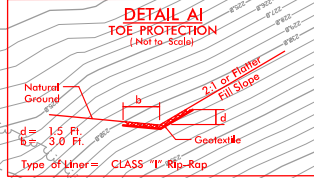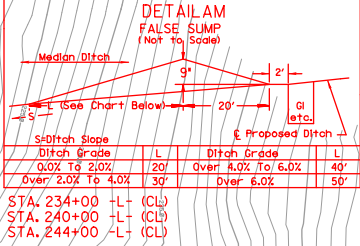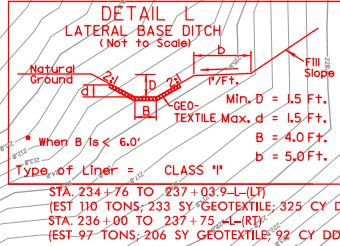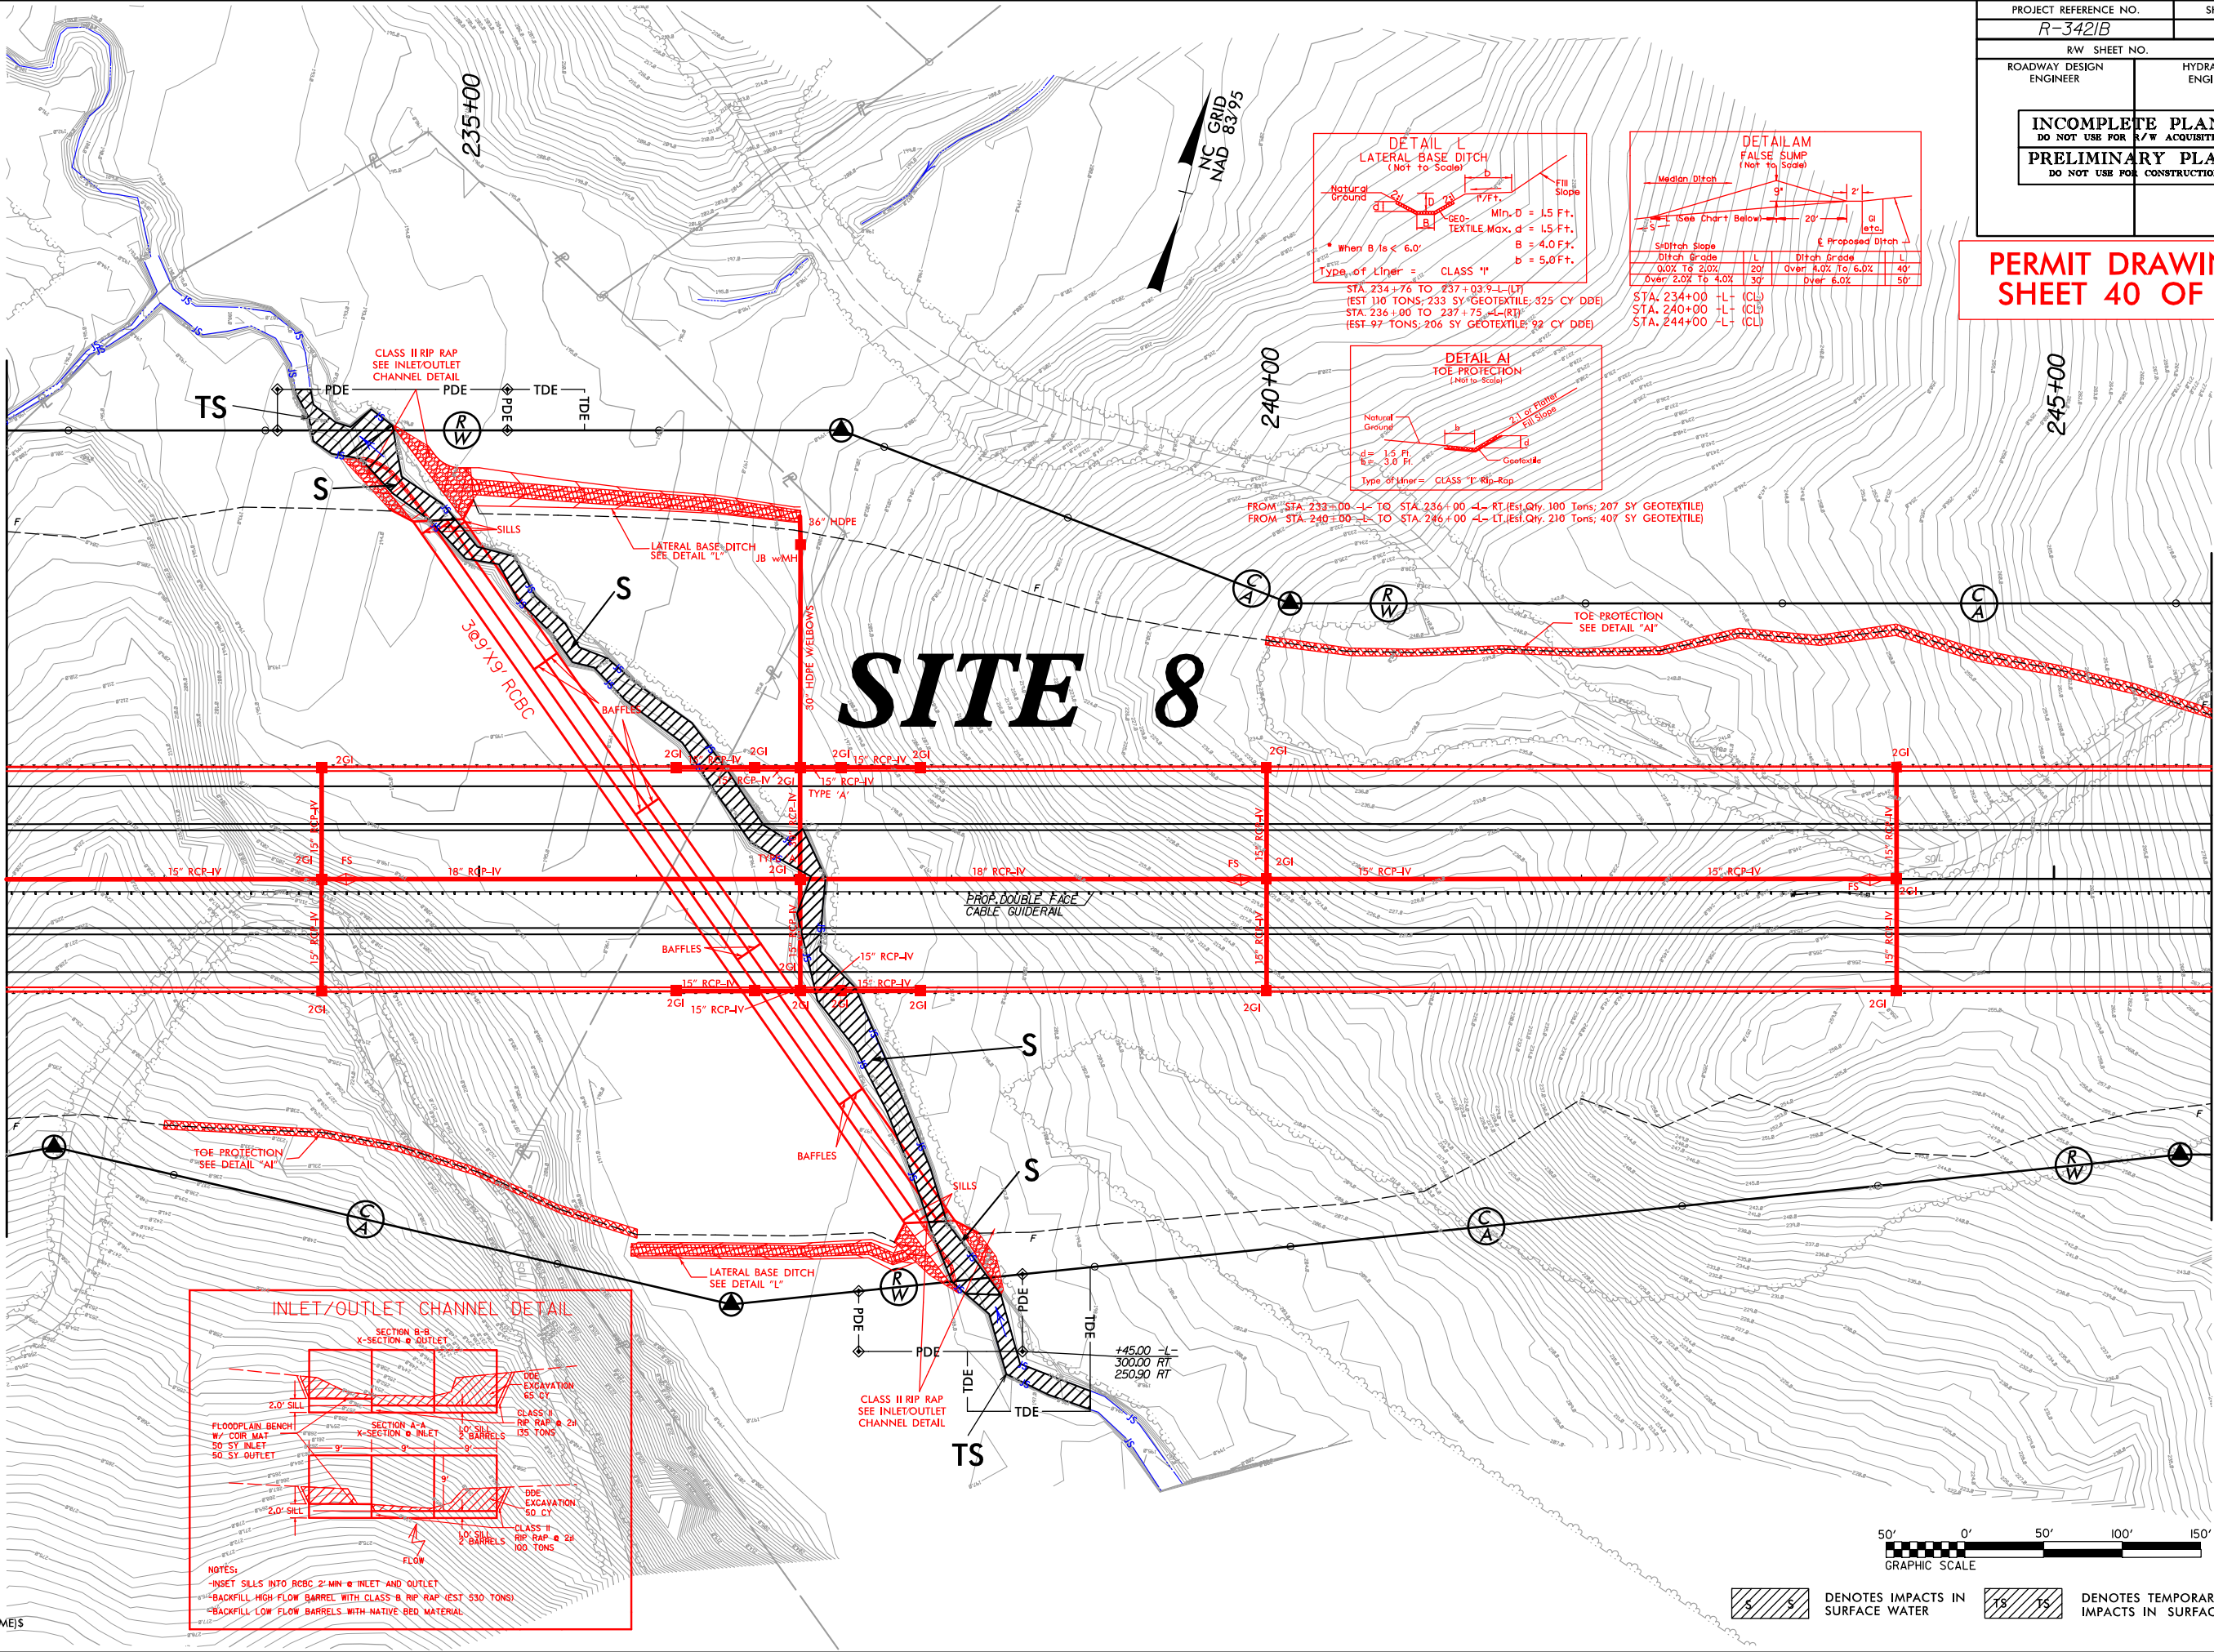

Denotes Impacts in Surface Water

Denotes Temporary Impacts in Surface Water


PROJECT REFERENCE NO. R-3421B		SHEET NO. 12
RW SHEET NO.		
ROADWAY DESIGN ENGINEER	HYDRAULICS ENGINEER	
INCOMPLETE PLANS DO NOT USE FOR R/W ACQUISITION		
PRELIMINARY PLANS DO NOT USE FOR CONSTRUCTION		

PERMIT DRAWING
SHEET 40 OF 71

MATCHLINE TO SHEET 12
-L- STATION 246+00

5/14/99

7:22:35 AM
R:\Hydro\Public\PERMITS\Environmental\Drawings\R342IB\R342IB_Hyd.prm_xpl_site8.20150630.dgn
P:\Hydro\Public\PERMITS\Environmental\Drawings\R342IB\R342IB_Hyd.prm_xpl_site8.20150630.dgn
P:\Hydro\Public\PERMITS\Environmental\Drawings\R342IB\R342IB_Hyd.prm_xpl_site8.20150630.dgn

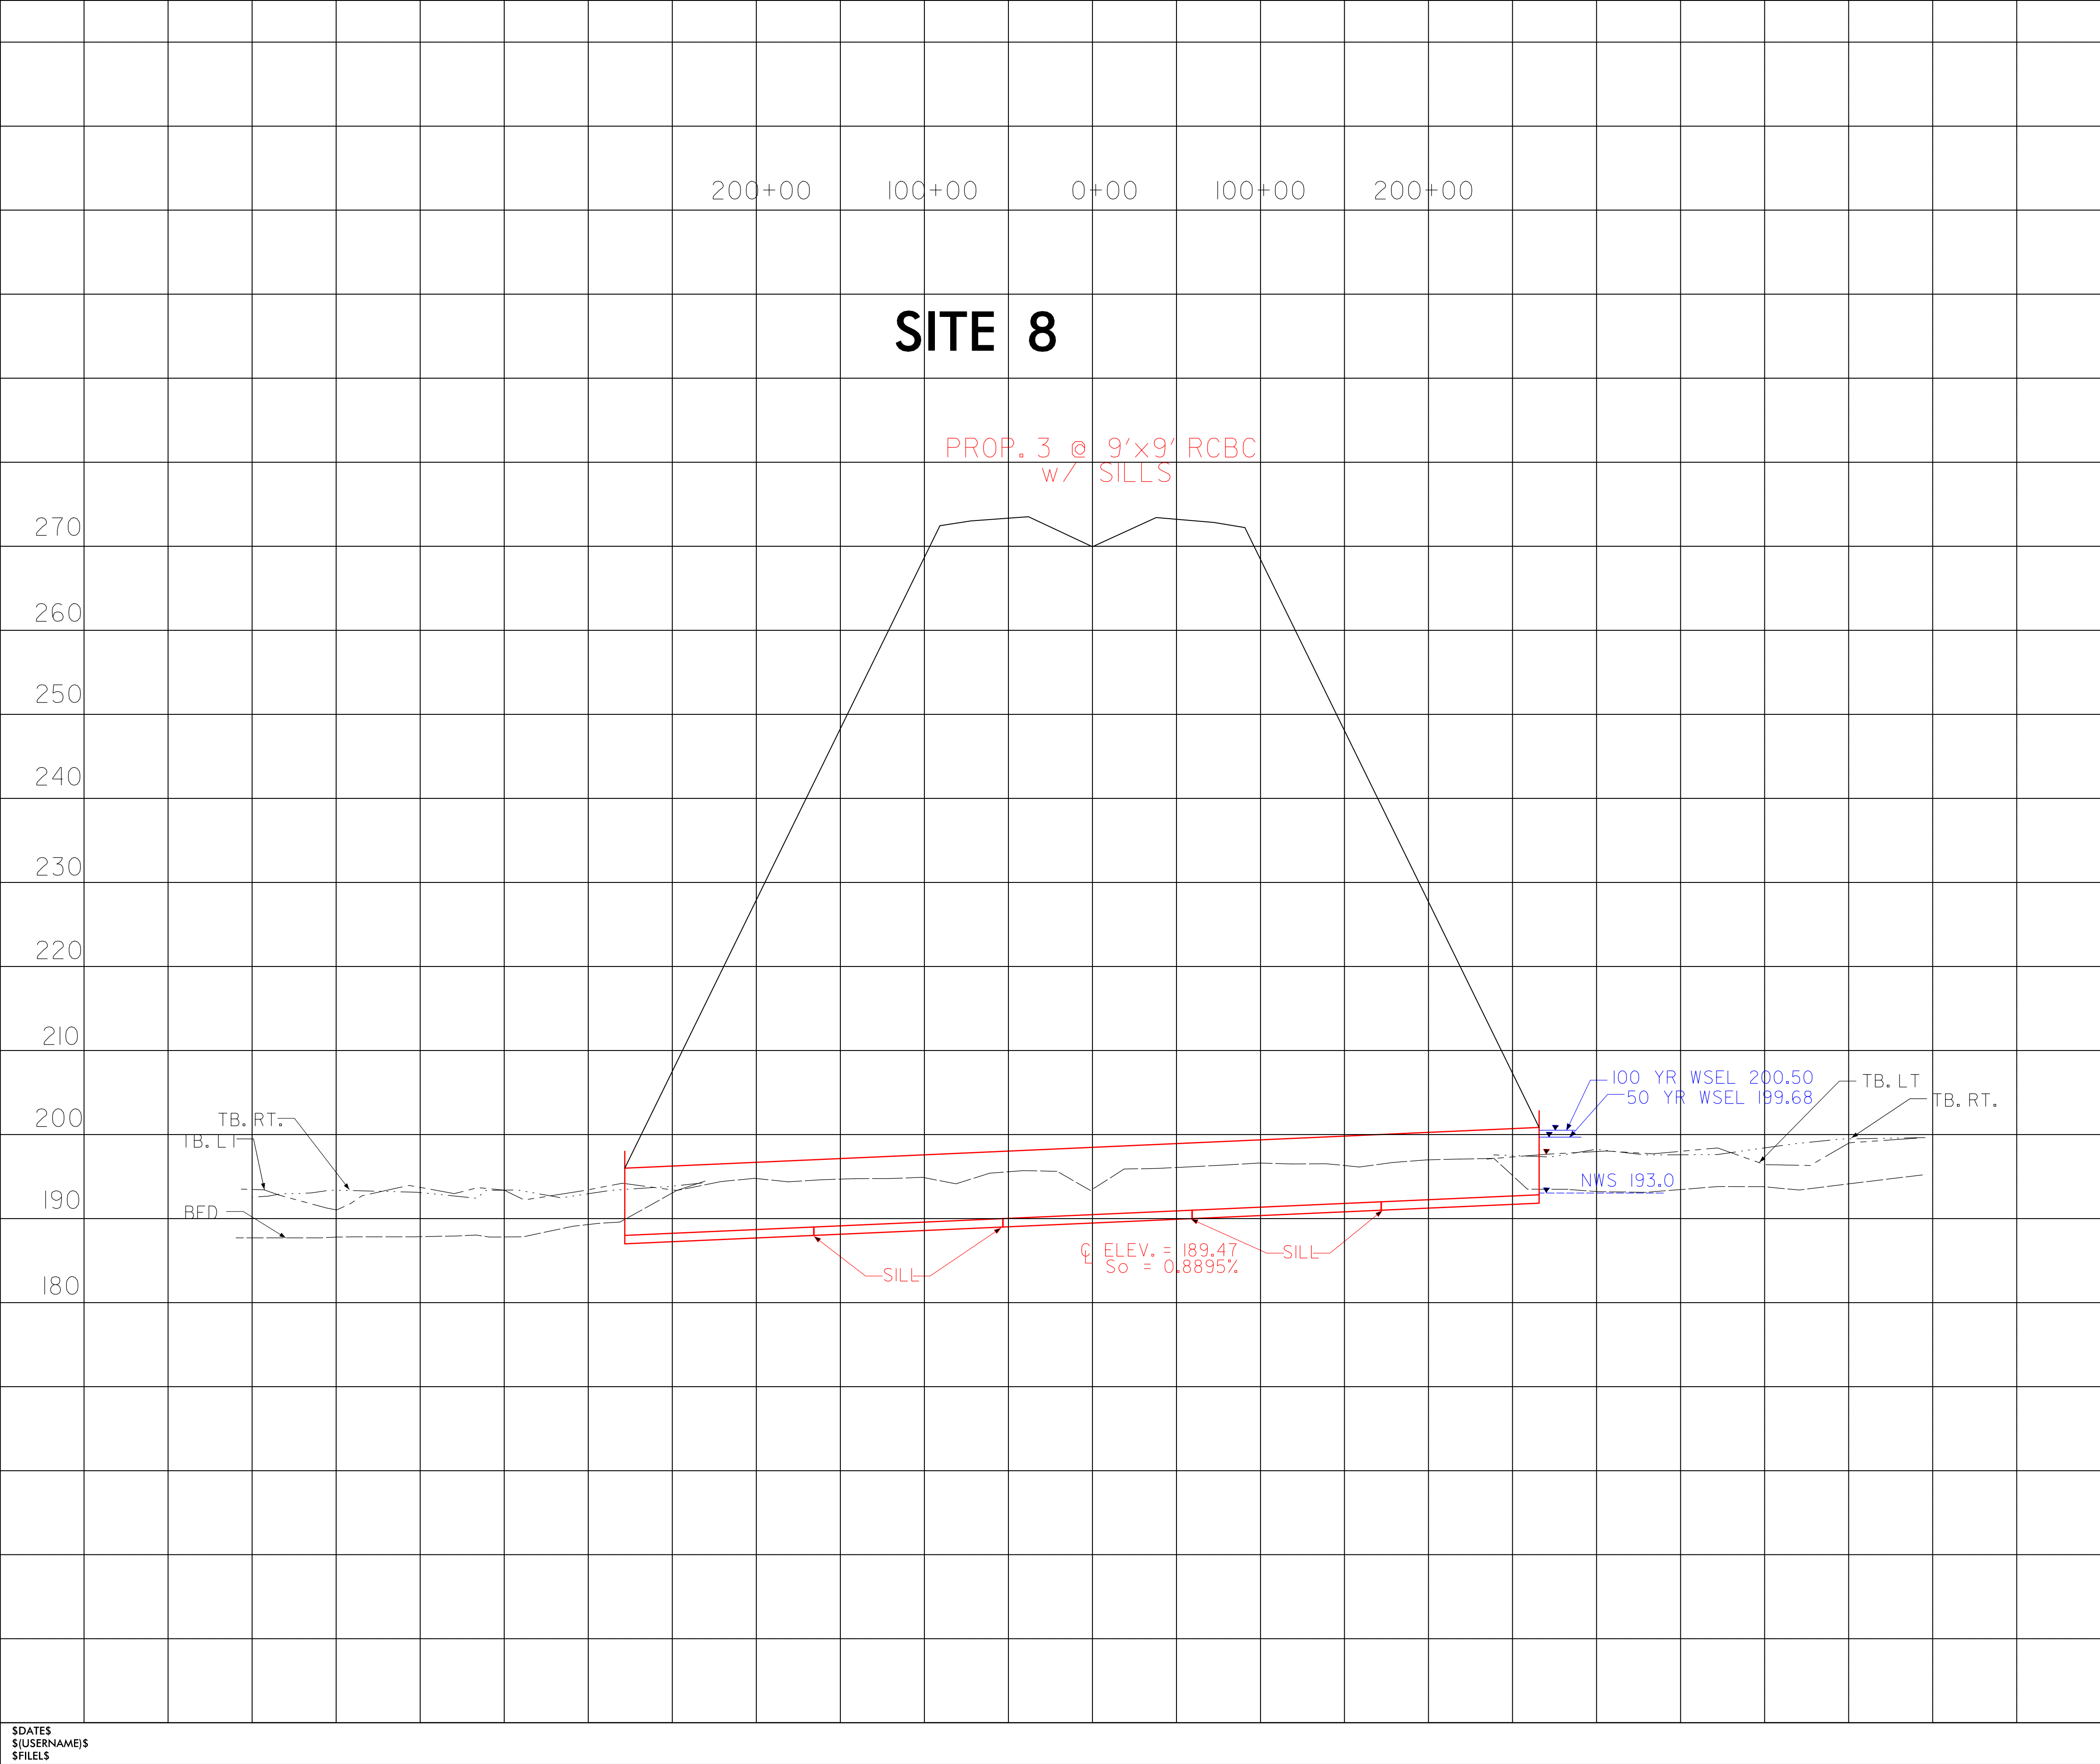

PROJECT REFERENCE NO.		SHEET NO.	
R-342IB			
ROADWAY DESIGN ENGINEER		HYDRAULICS ENGINEER	
INCOMPLETE PLANS DO NOT USE FOR R/W ACQUISITION		PRELIMINARY PLANS DO NOT USE FOR CONSTRUCTION	




PERMIT DRAWING
SHEET 41 OF 71

SDATES
\$(USERNAME)
\$(FILE)

PROJECT REFERENCE NO.		SHEET NO.
R-3421B		16
R/W SHEET NO.		
ROADWAY DESIGN ENGINEER		HYDRAULICS ENGINEER
INCOMPLETE PLANS DO NOT USE FOR R/W ACQUISITION		
PRELIMINARY PLANS DO NOT USE FOR CONSTRUCTION		

PERMIT DRAWING
SHEET 42 OF 71

REVISIONS

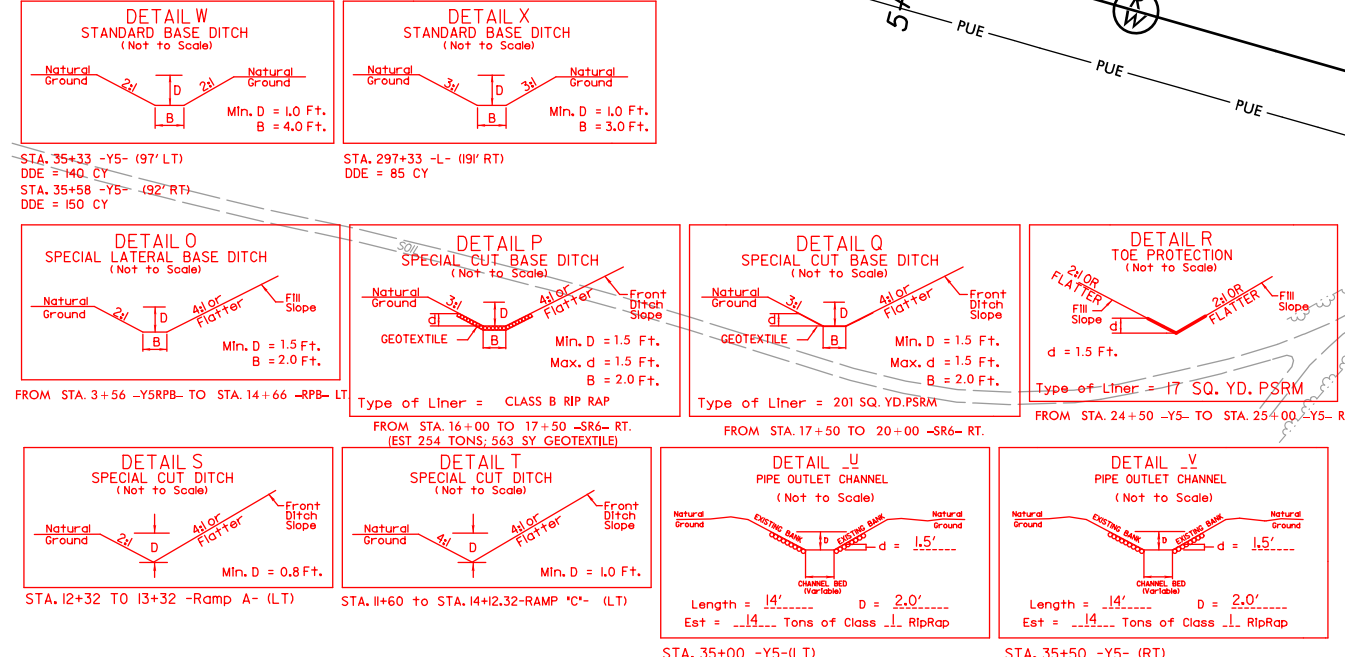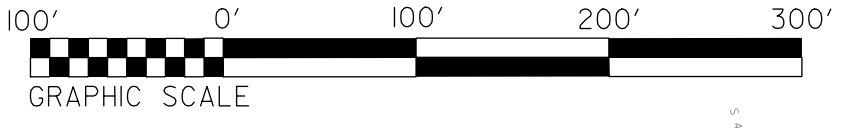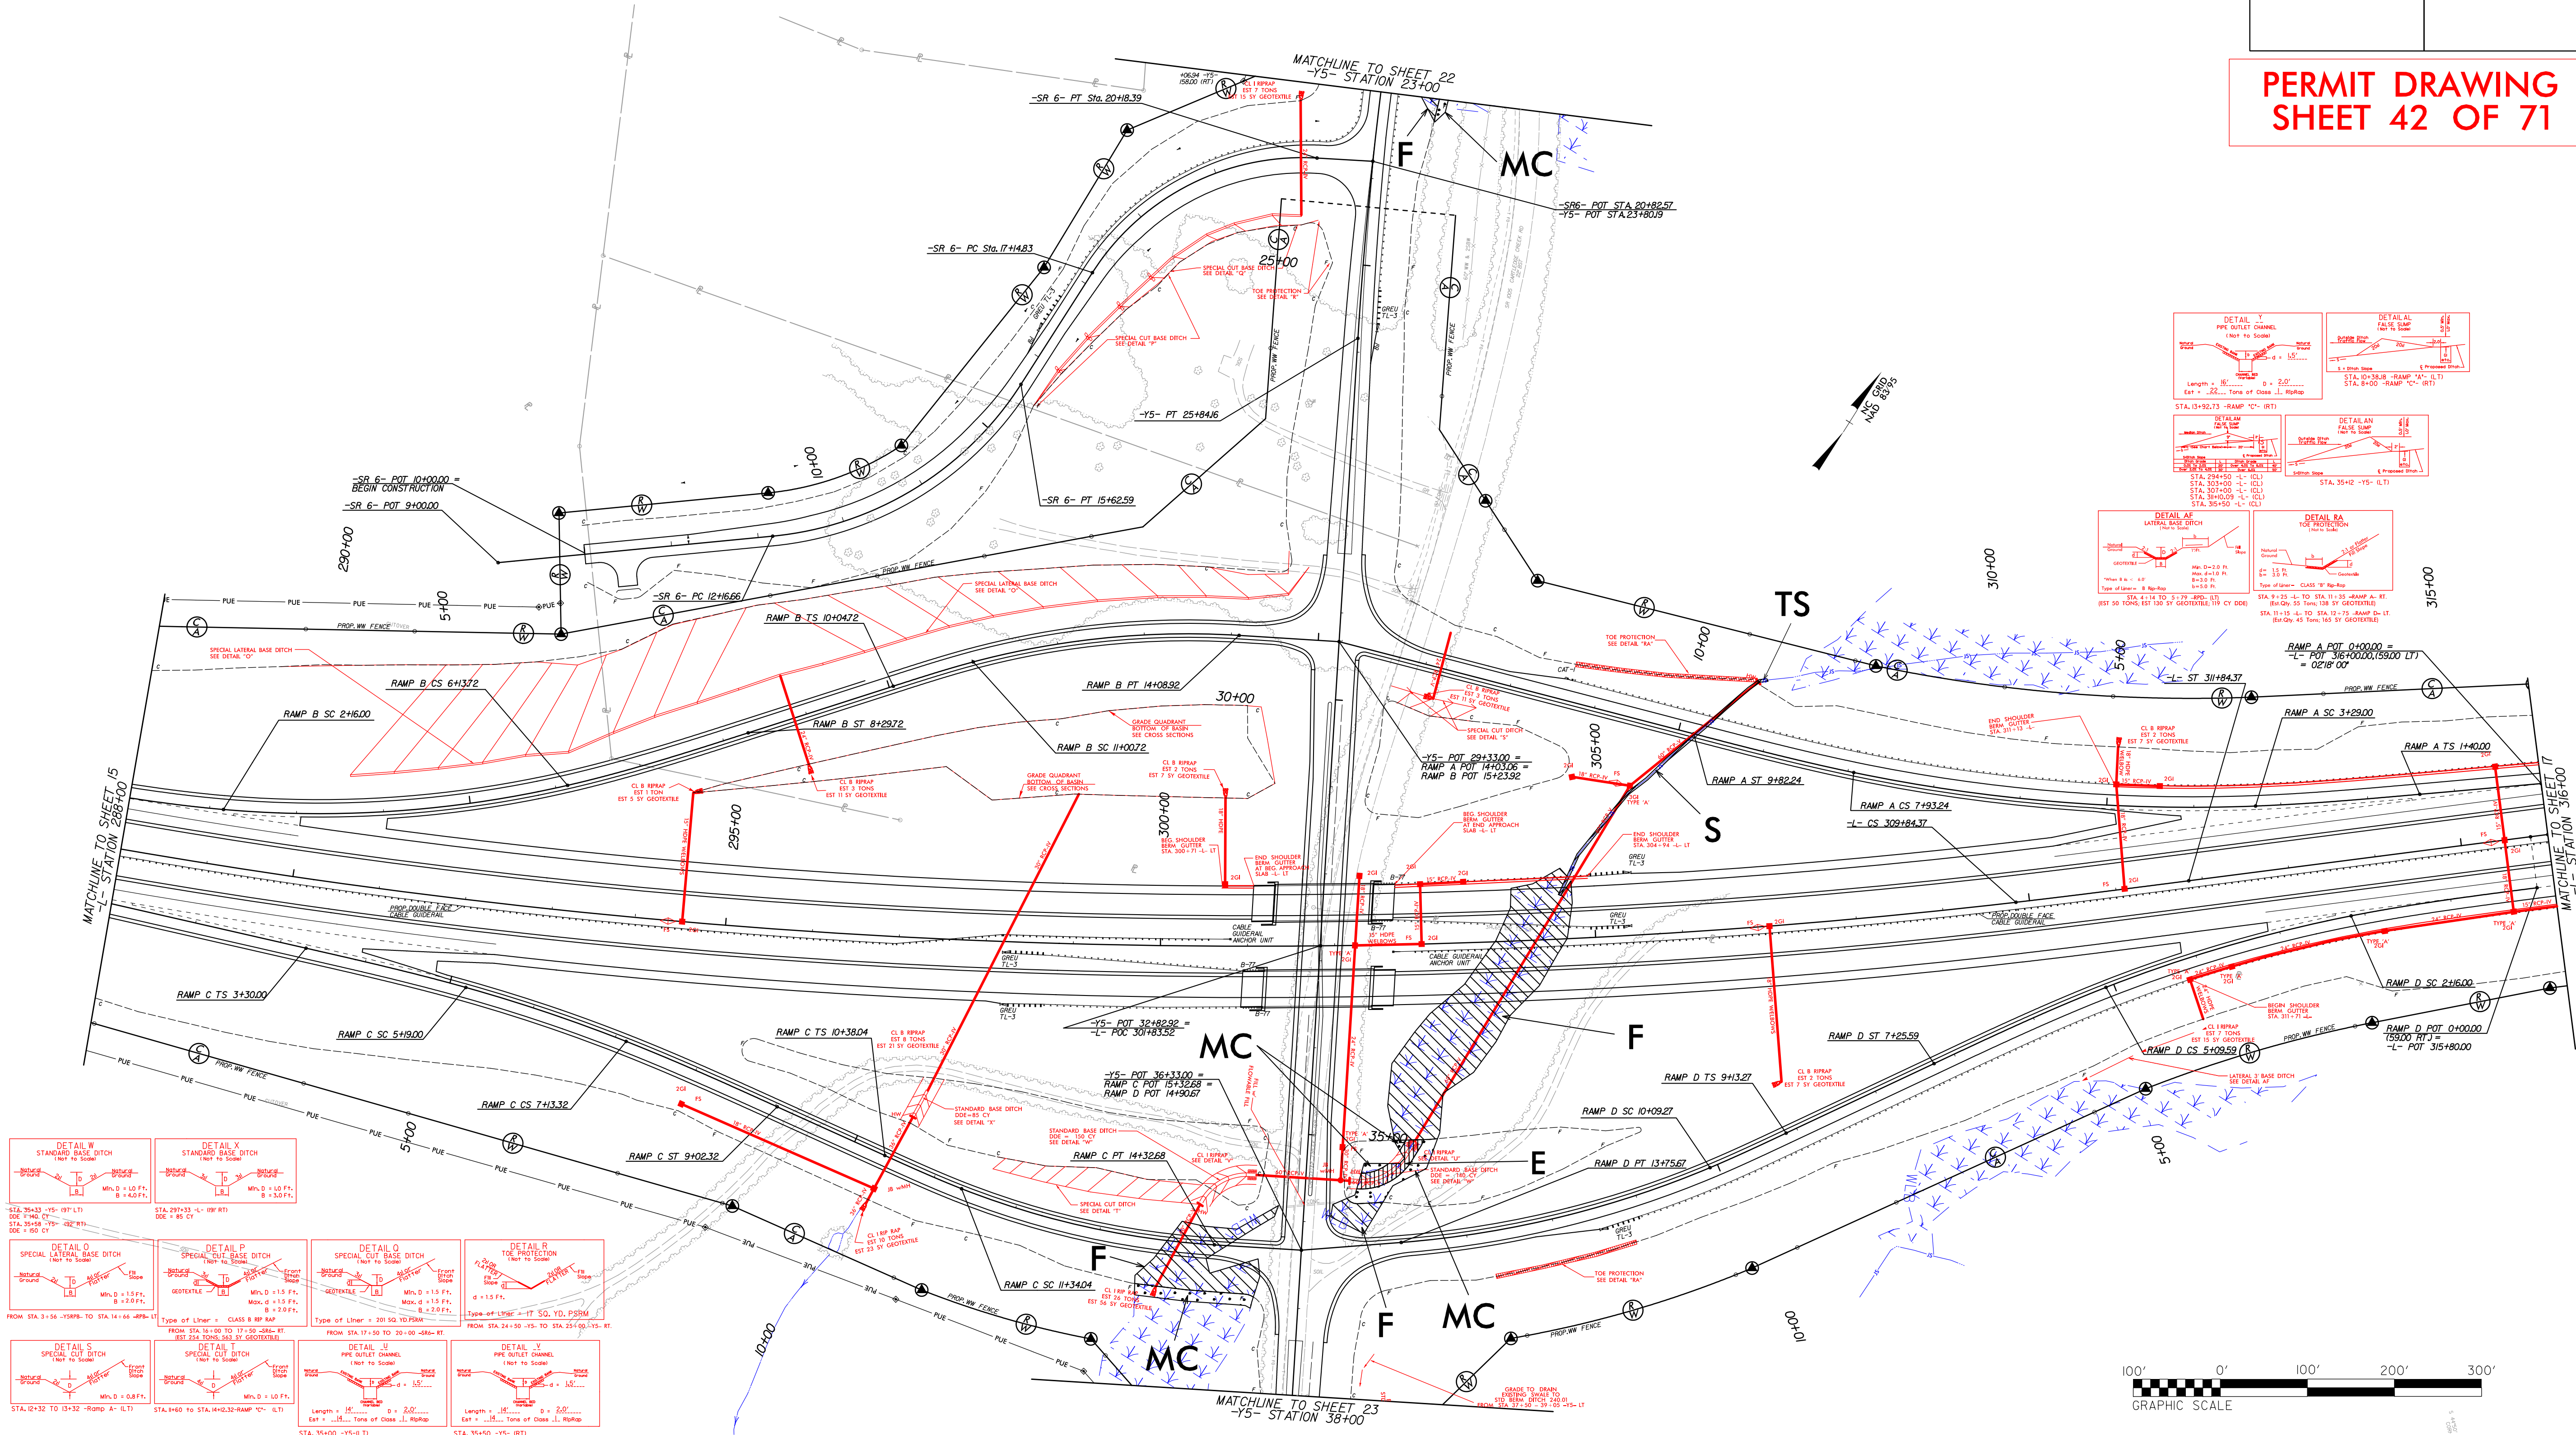



SITE 10

- DENOTES IMPACTS IN SURFACE WATER
- DENOTES TEMPORARY IMPACTS IN SURFACE WATER
- DENOTES FILL IN WETLAND
- DENOTES MECHANIZED CLEARING
- DENOTES EXCAVATION IN WETLAND

PROJECT REFERENCE NO.		SHEET NO.
R-3421B		16
R/W SHEET NO.		
ROADWAY DESIGN ENGINEER		HYDRAULICS ENGINEER
INCOMPLETE PLANS DO NOT USE FOR R/W ACQUISITION		
PRELIMINARY PLANS DO NOT USE FOR CONSTRUCTION		

PERMIT DRAWING
SHEET 43 OF 71

REVISIONS

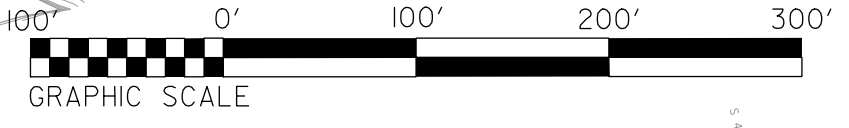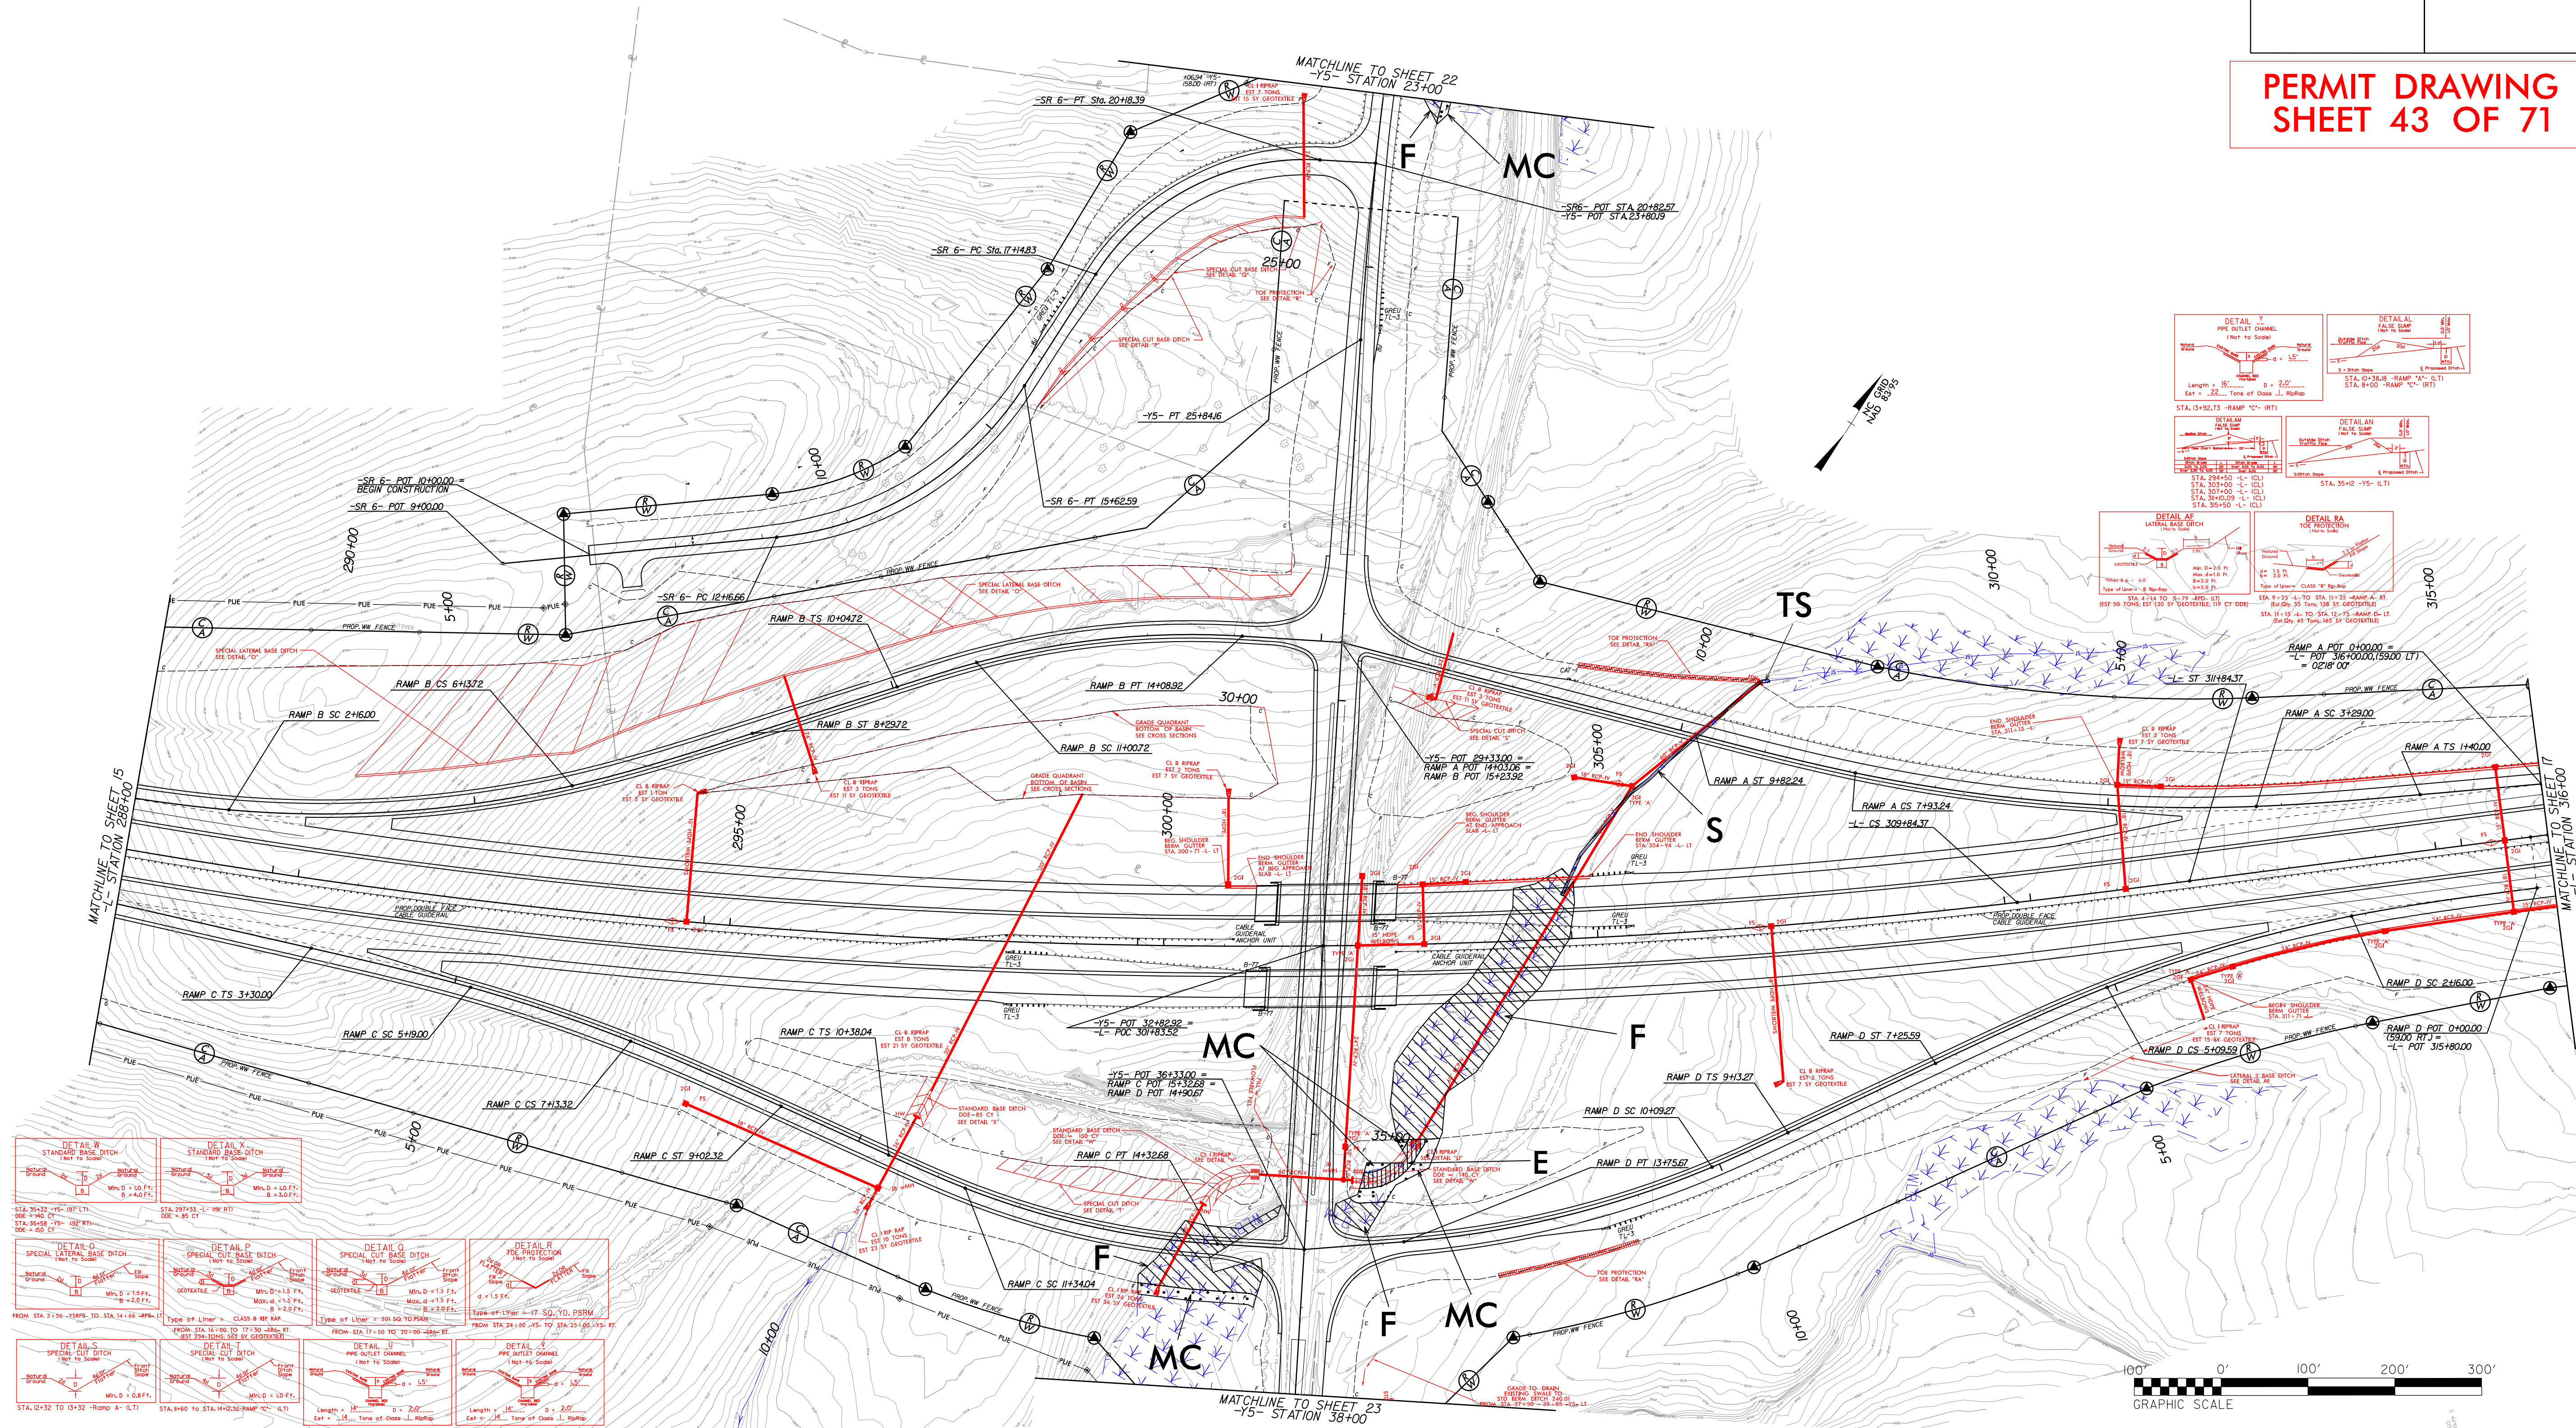

SITE 10

- DENOTES IMPACTS IN SURFACE WATER
- DENOTES TEMPORARY IMPACTS IN SURFACE WATER
- DENOTES FILL IN WETLAND
- DENOTES MECHANIZED CLEARING
- DENOTES EXCAVATION IN WETLAND

7:42:55 AM
R:\Hydraulics\PERMITS\Environmental\Drawings\R3421B\R3421B_Hyd_prm_wet.psh16.20150326.con.dgn




SDATES
\$(USERAME\$)
\$FILE\$

SITE 9 ENLARGEMENT


NC GRID
NAD 83/95

PROJECT REFERENCE NO.	SHEET NO.
R-3421B	16
RW SHEET NO.	
ROADWAY DESIGN ENGINEER	HYDRAULICS ENGINEER
INCOMPLETE PLANS DO NOT USE FOR R/W ACQUISITION	
PRELIMINARY PLANS DO NOT USE FOR CONSTRUCTION	

PERMIT DRAWING
SHEET 44 OF 71

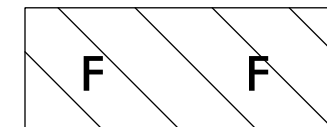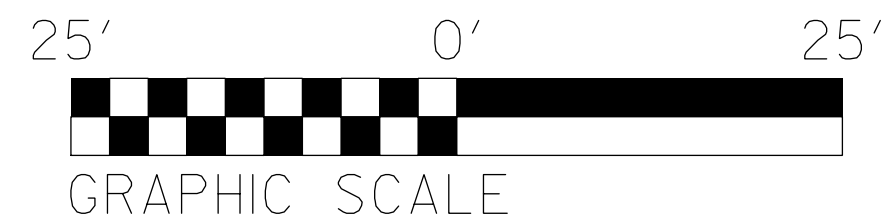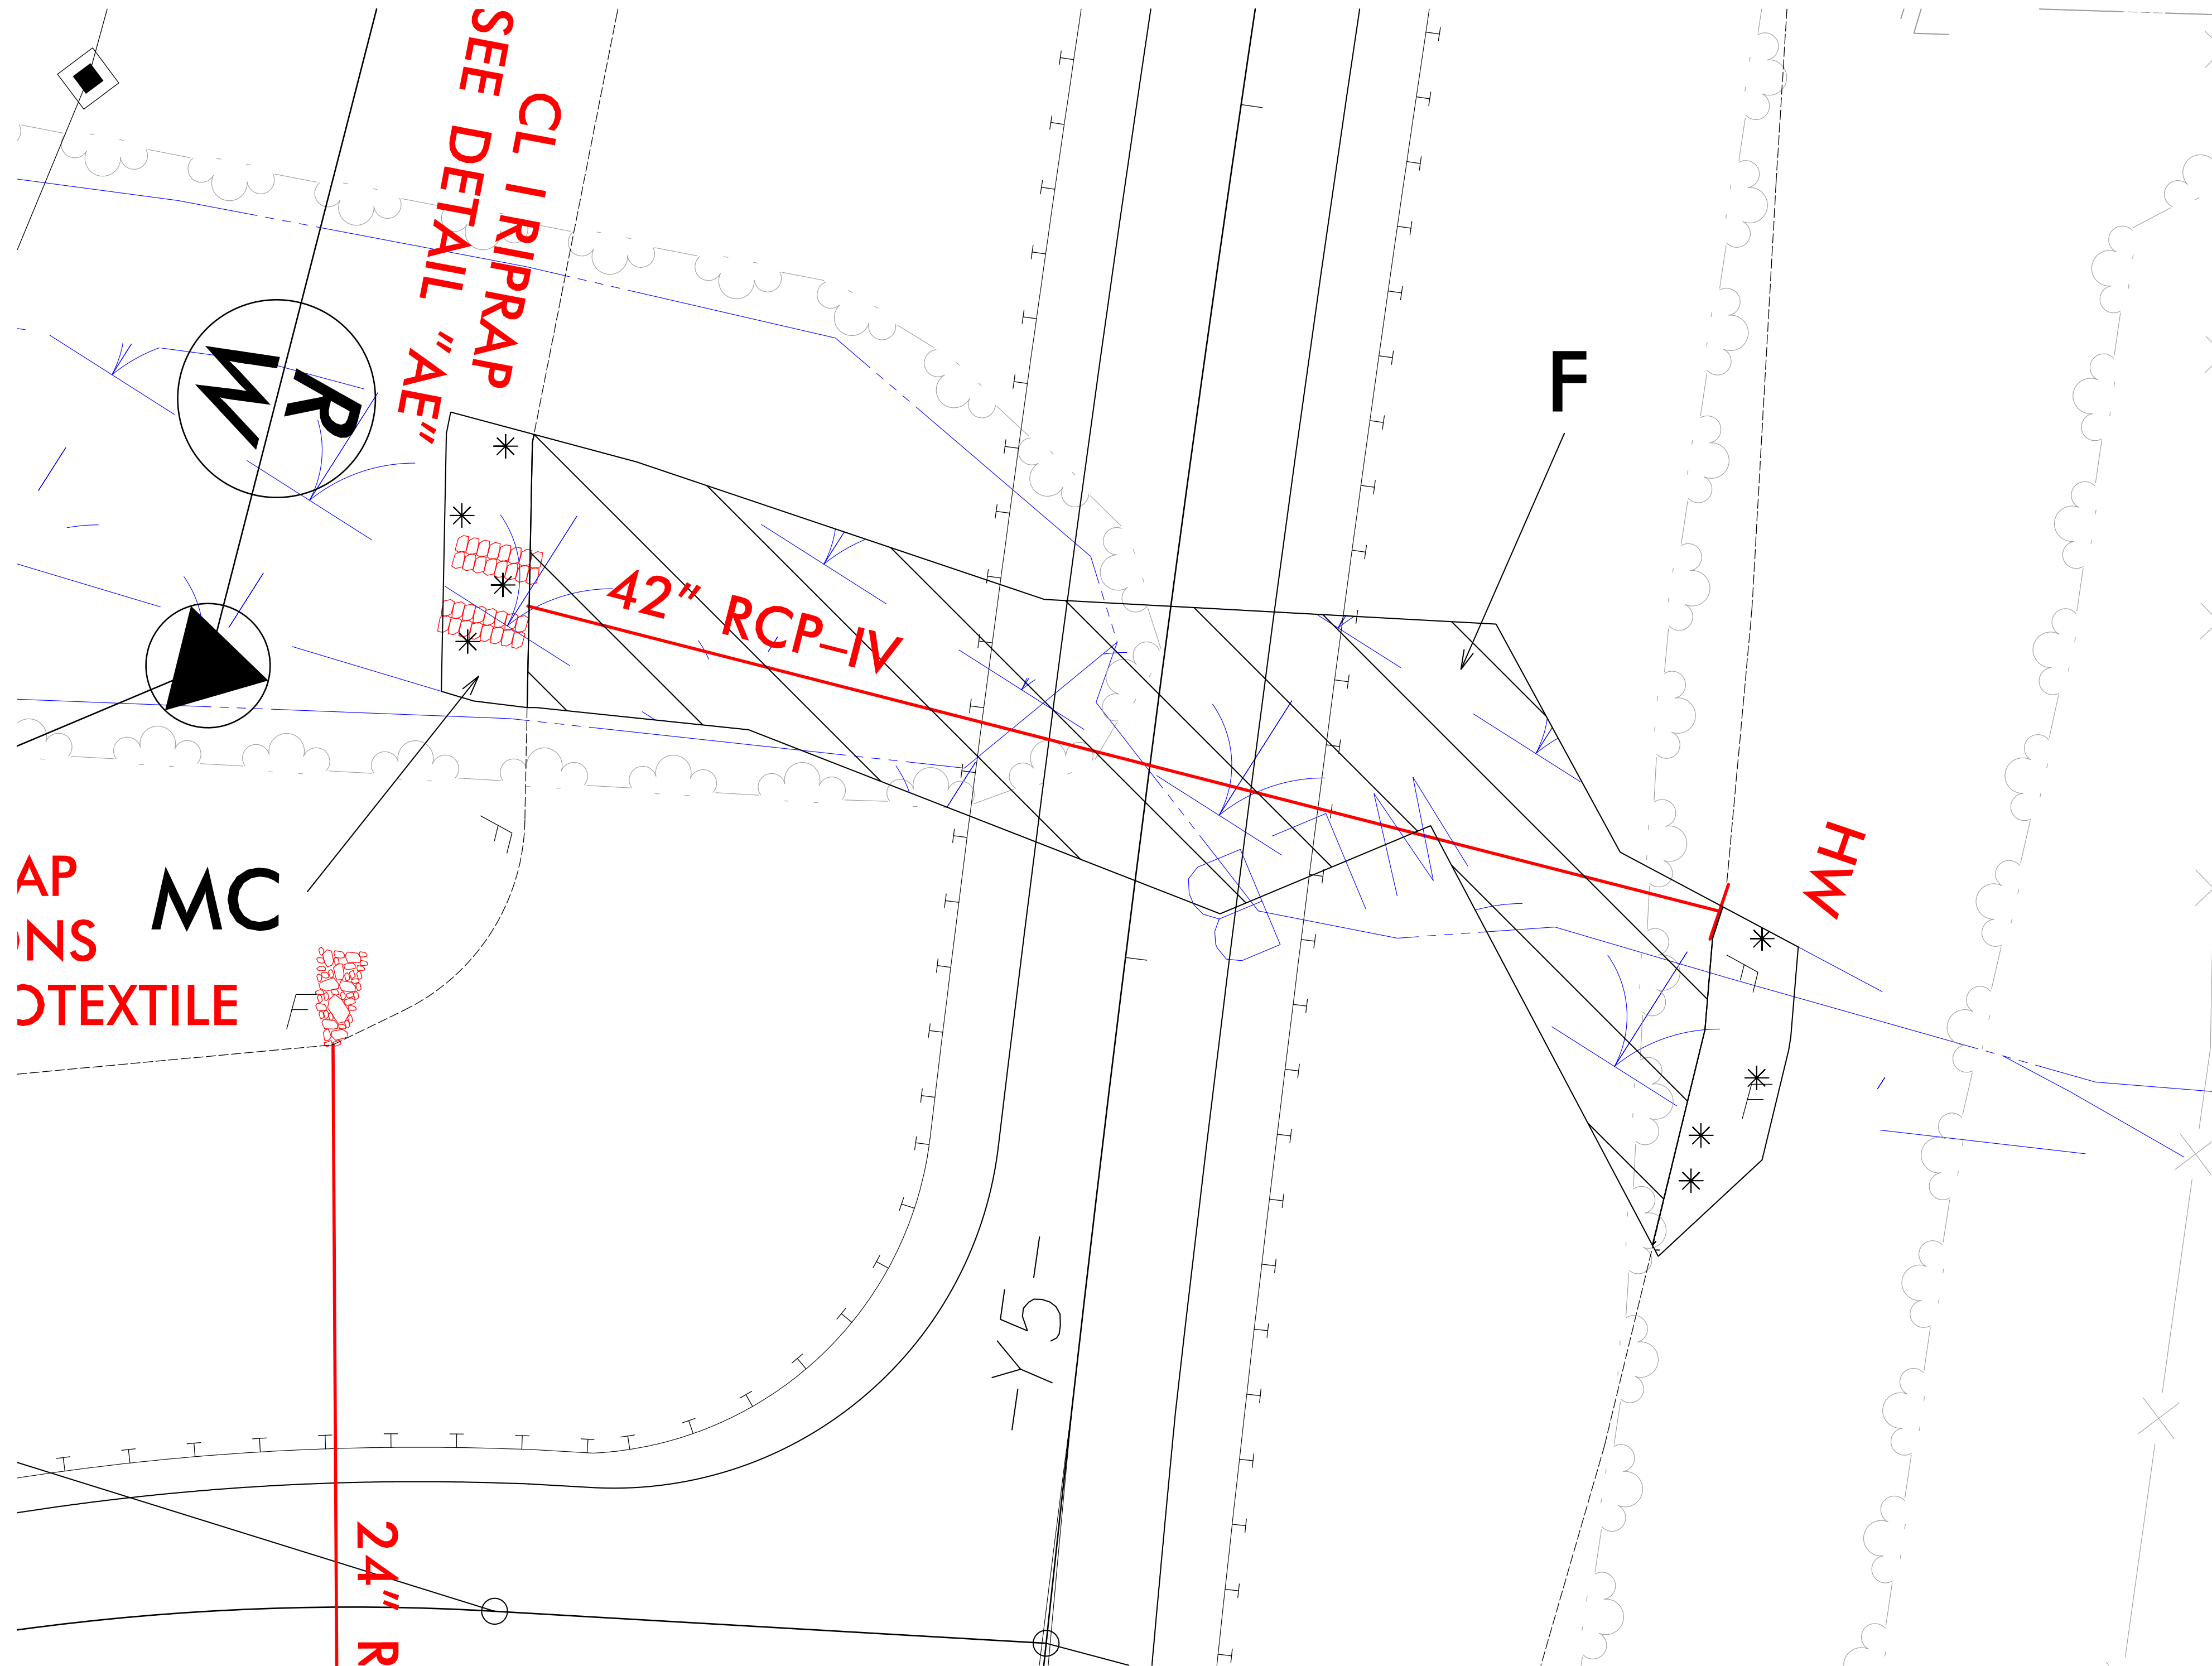

DENOTES FILL IN
WETLAND

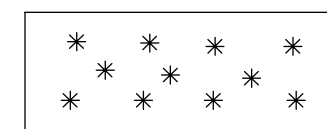

DENOTES MECHANIZED
CLEARING

SITE 9 ENLARGEMENT

R-342/B	16
---------	----

16

ROADWAY DESIGN ENGINEER


HYDRAULICS
ENGINEER

DO NOT USE FOR R/W ACQUISITION

PRELIMINARY PLANS	
-------------------	--

PERMIT DRAWING
SHEET 45 OF 71

NC
NAD GRID 83/95

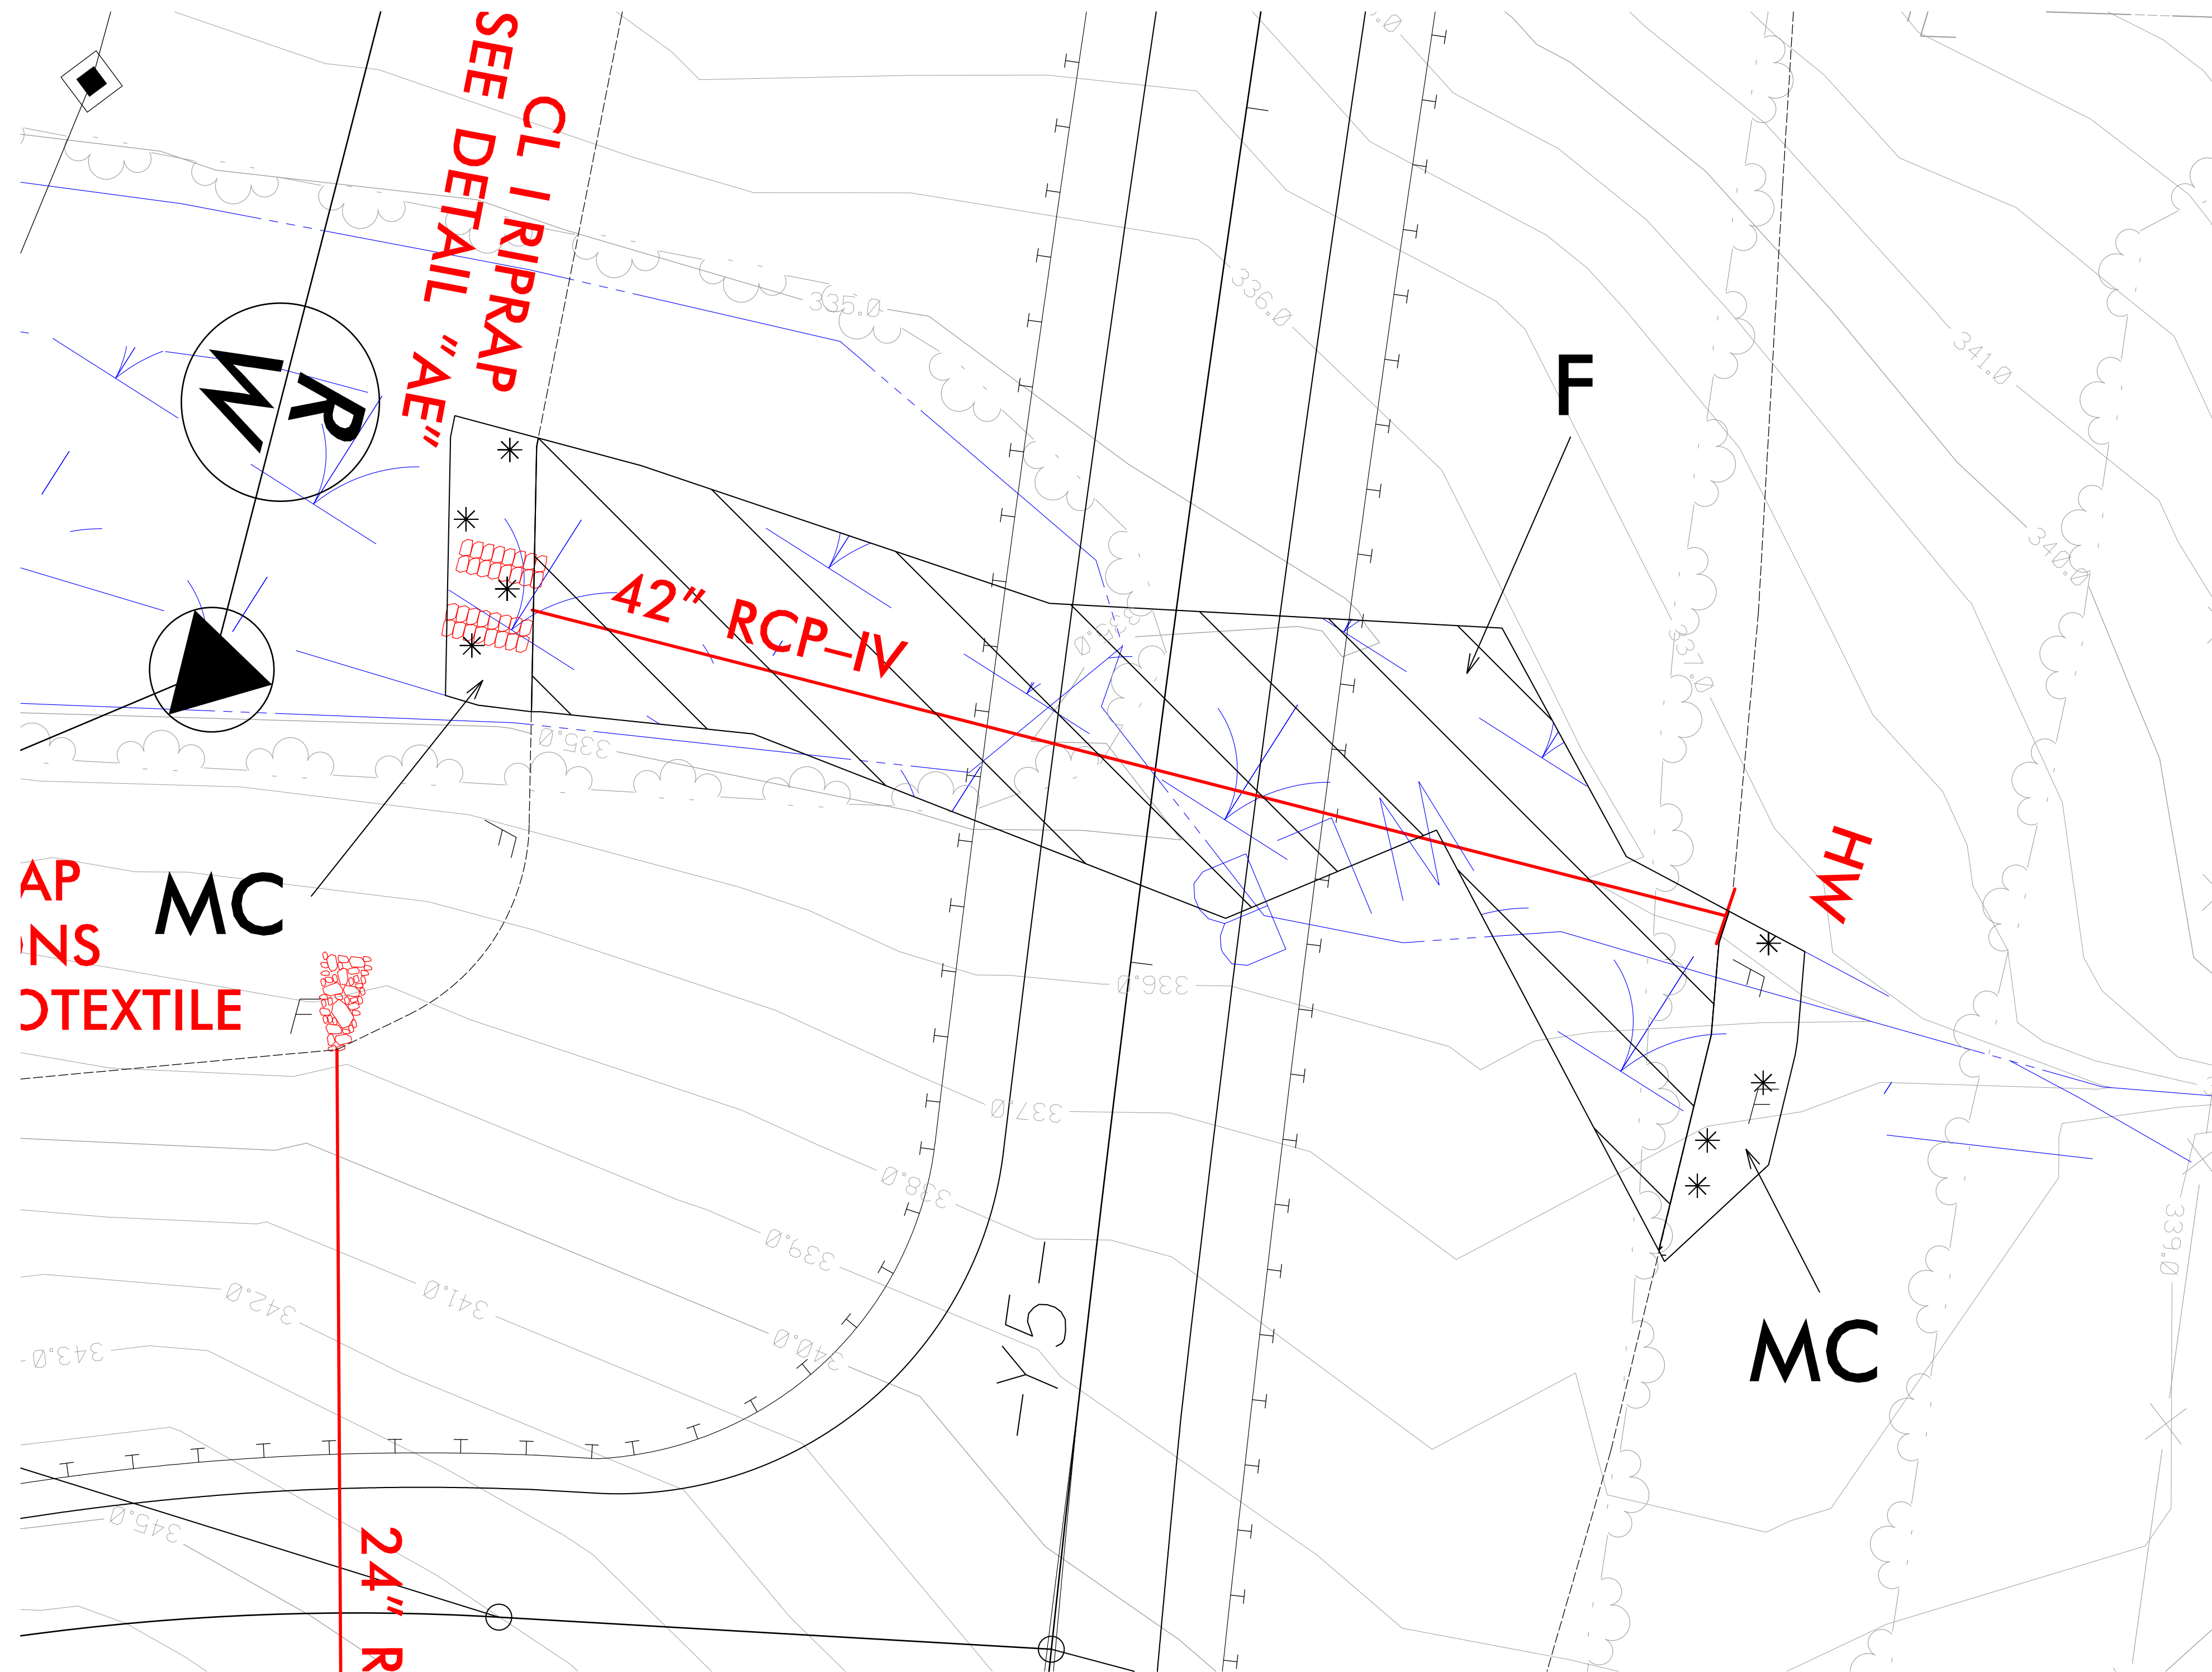

25' 0' 25'



GRAPHIC SCALE


DENOTES FILL IN
WETLAND

DENOTES MECHANIZED
CLEARING

REVISIONS

7:23:05 AM
 R:\Hydraulics\PERMITS_Environmental\Drawings\R3421b.Hjd_prm_wet_pshf6_enlarge site9_20150720_con.dgn


```
$DATE$
$(USERNAME)$
$FILE$
```

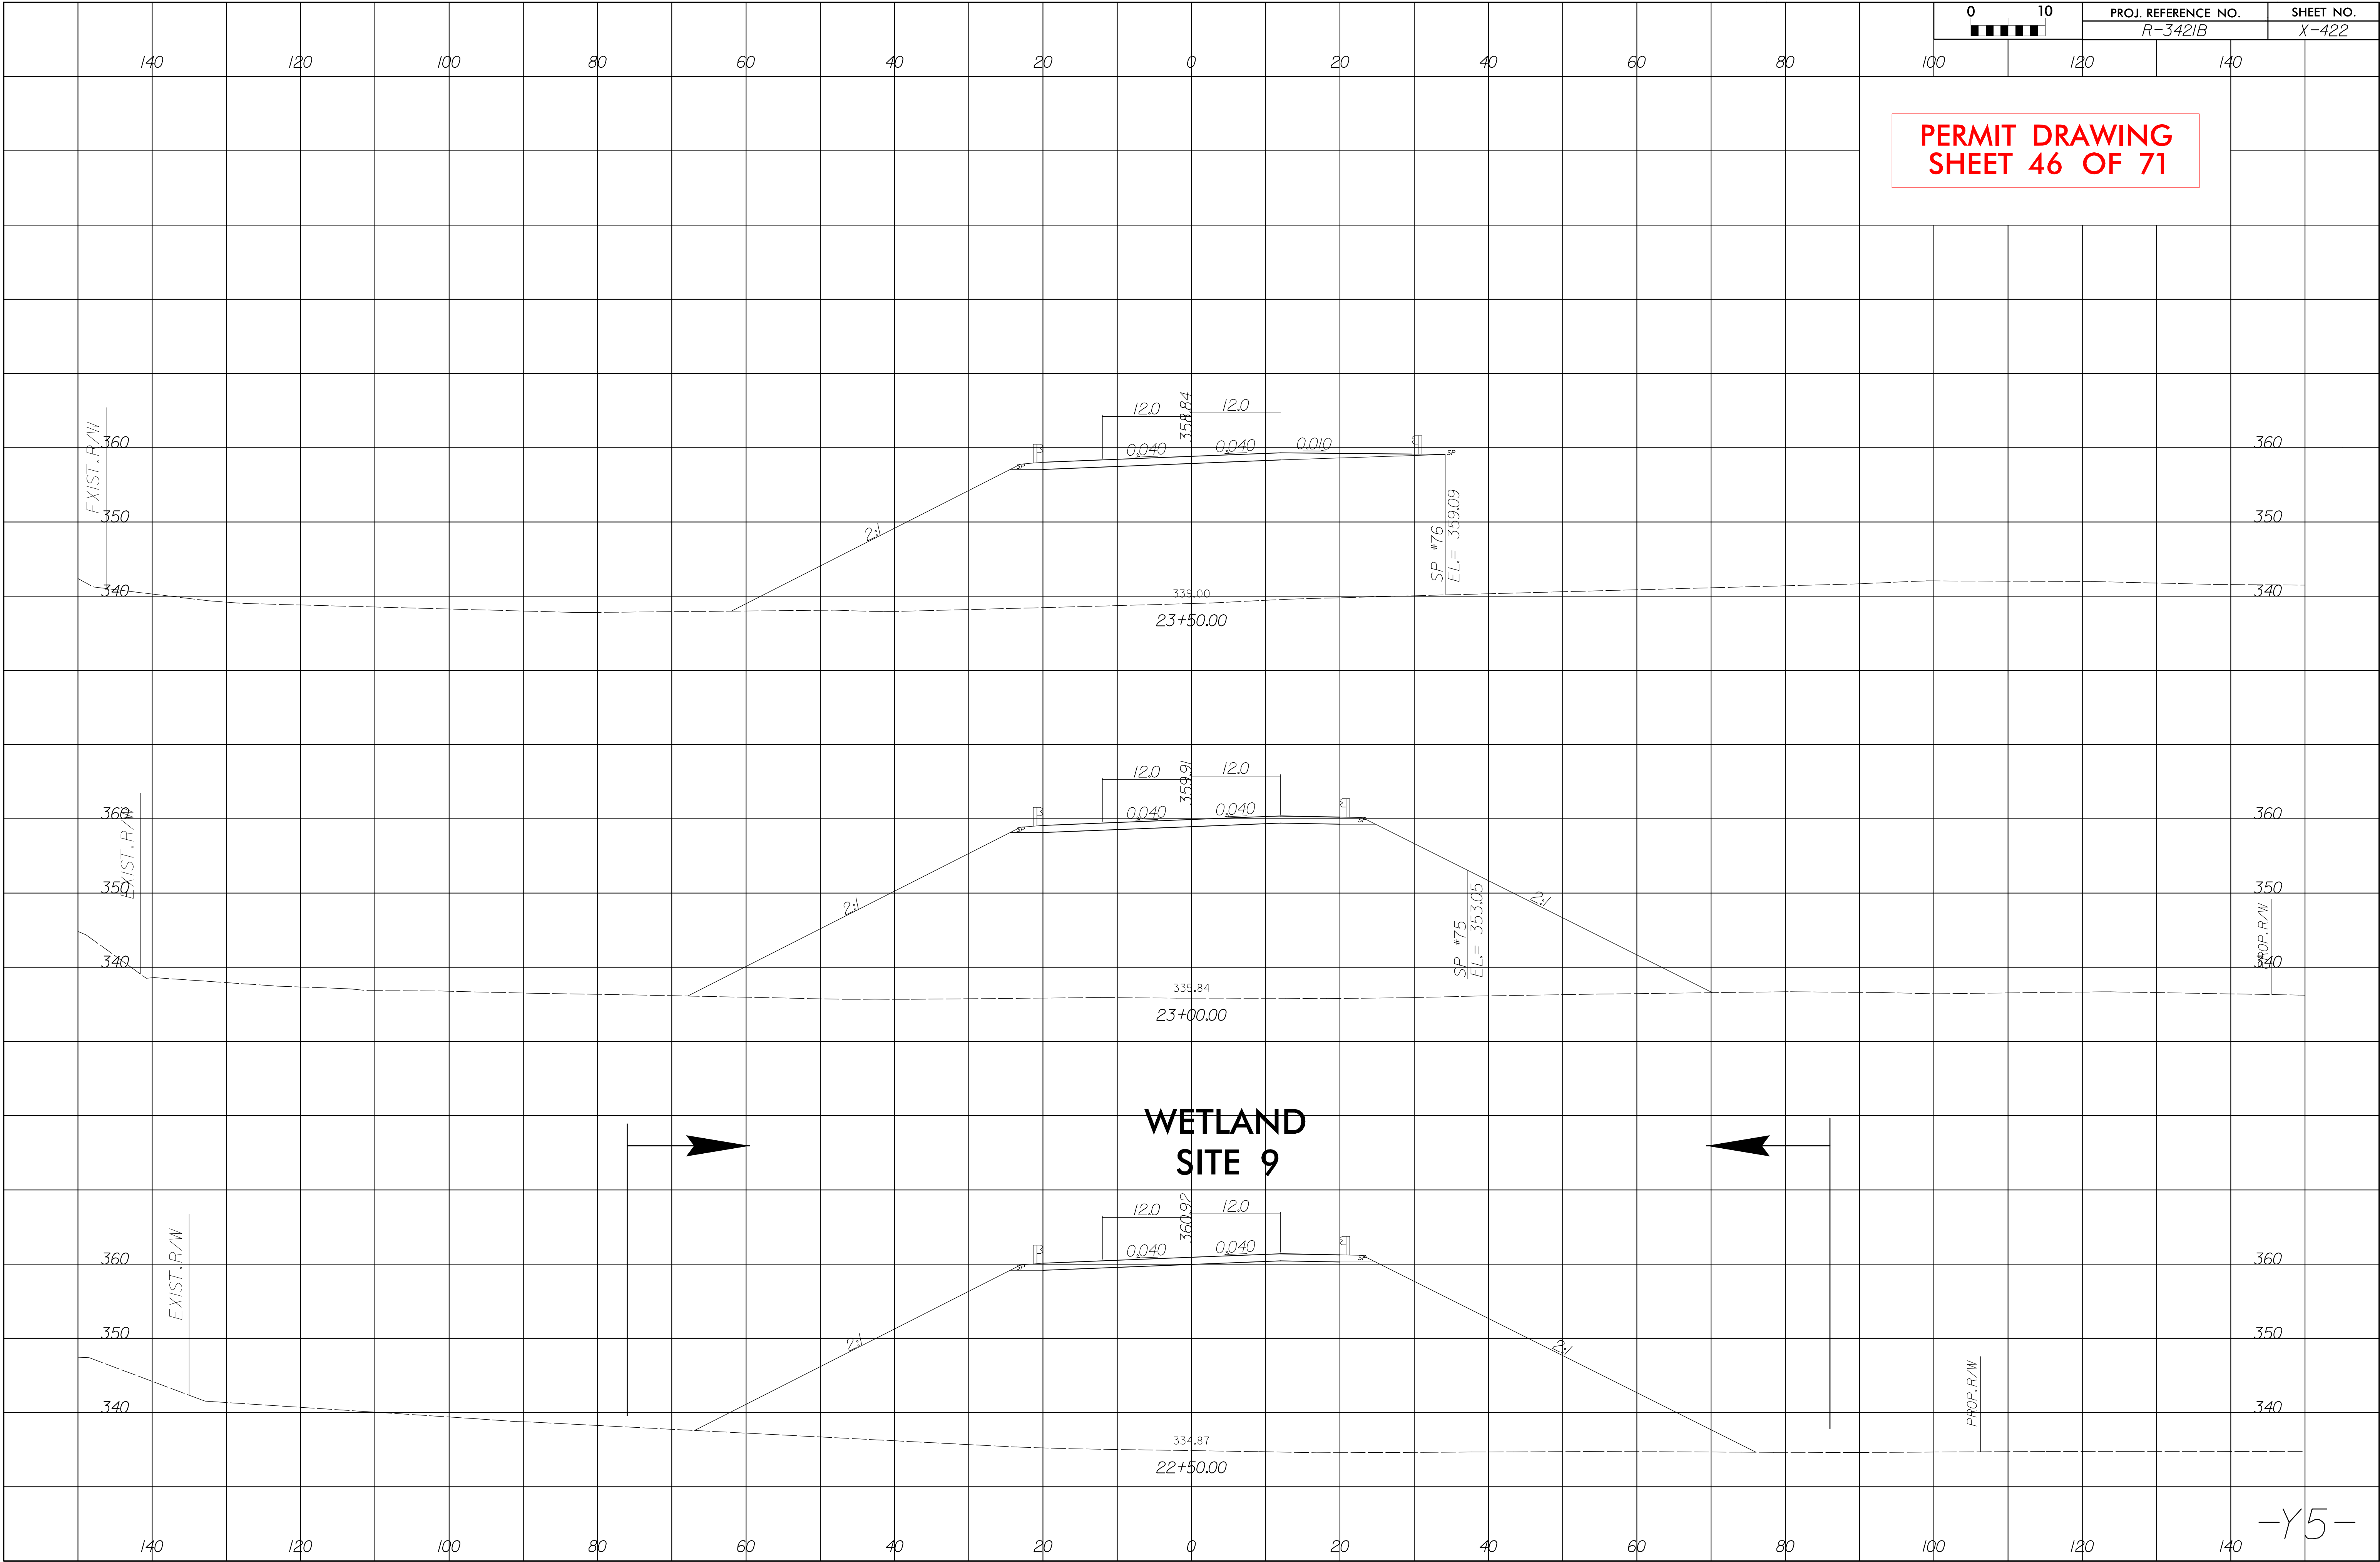PERMIT DRAWING
SHEET 46 OF 71




SITE 10 ENLARGEMENT

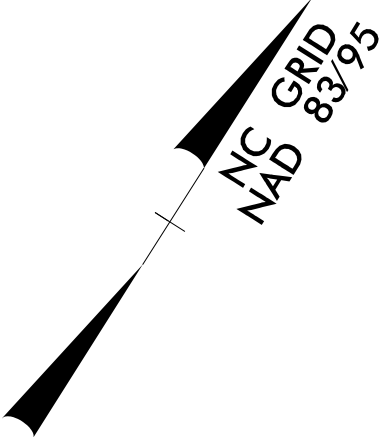


PROJECT REFERENCE NO.		SHEET NO.	
R-3421B		16	
R/W SHEET NO.			
ROADWAY DESIGN ENGINEER		HYDRAULICS ENGINEER	
INCOMPLETE PLANS DO NOT USE FOR R/W ACQUISITION			
PRELIMINARY PLANS DO NOT USE FOR CONSTRUCTION			

PERMIT DRAWING
SHEET 47 OF 71

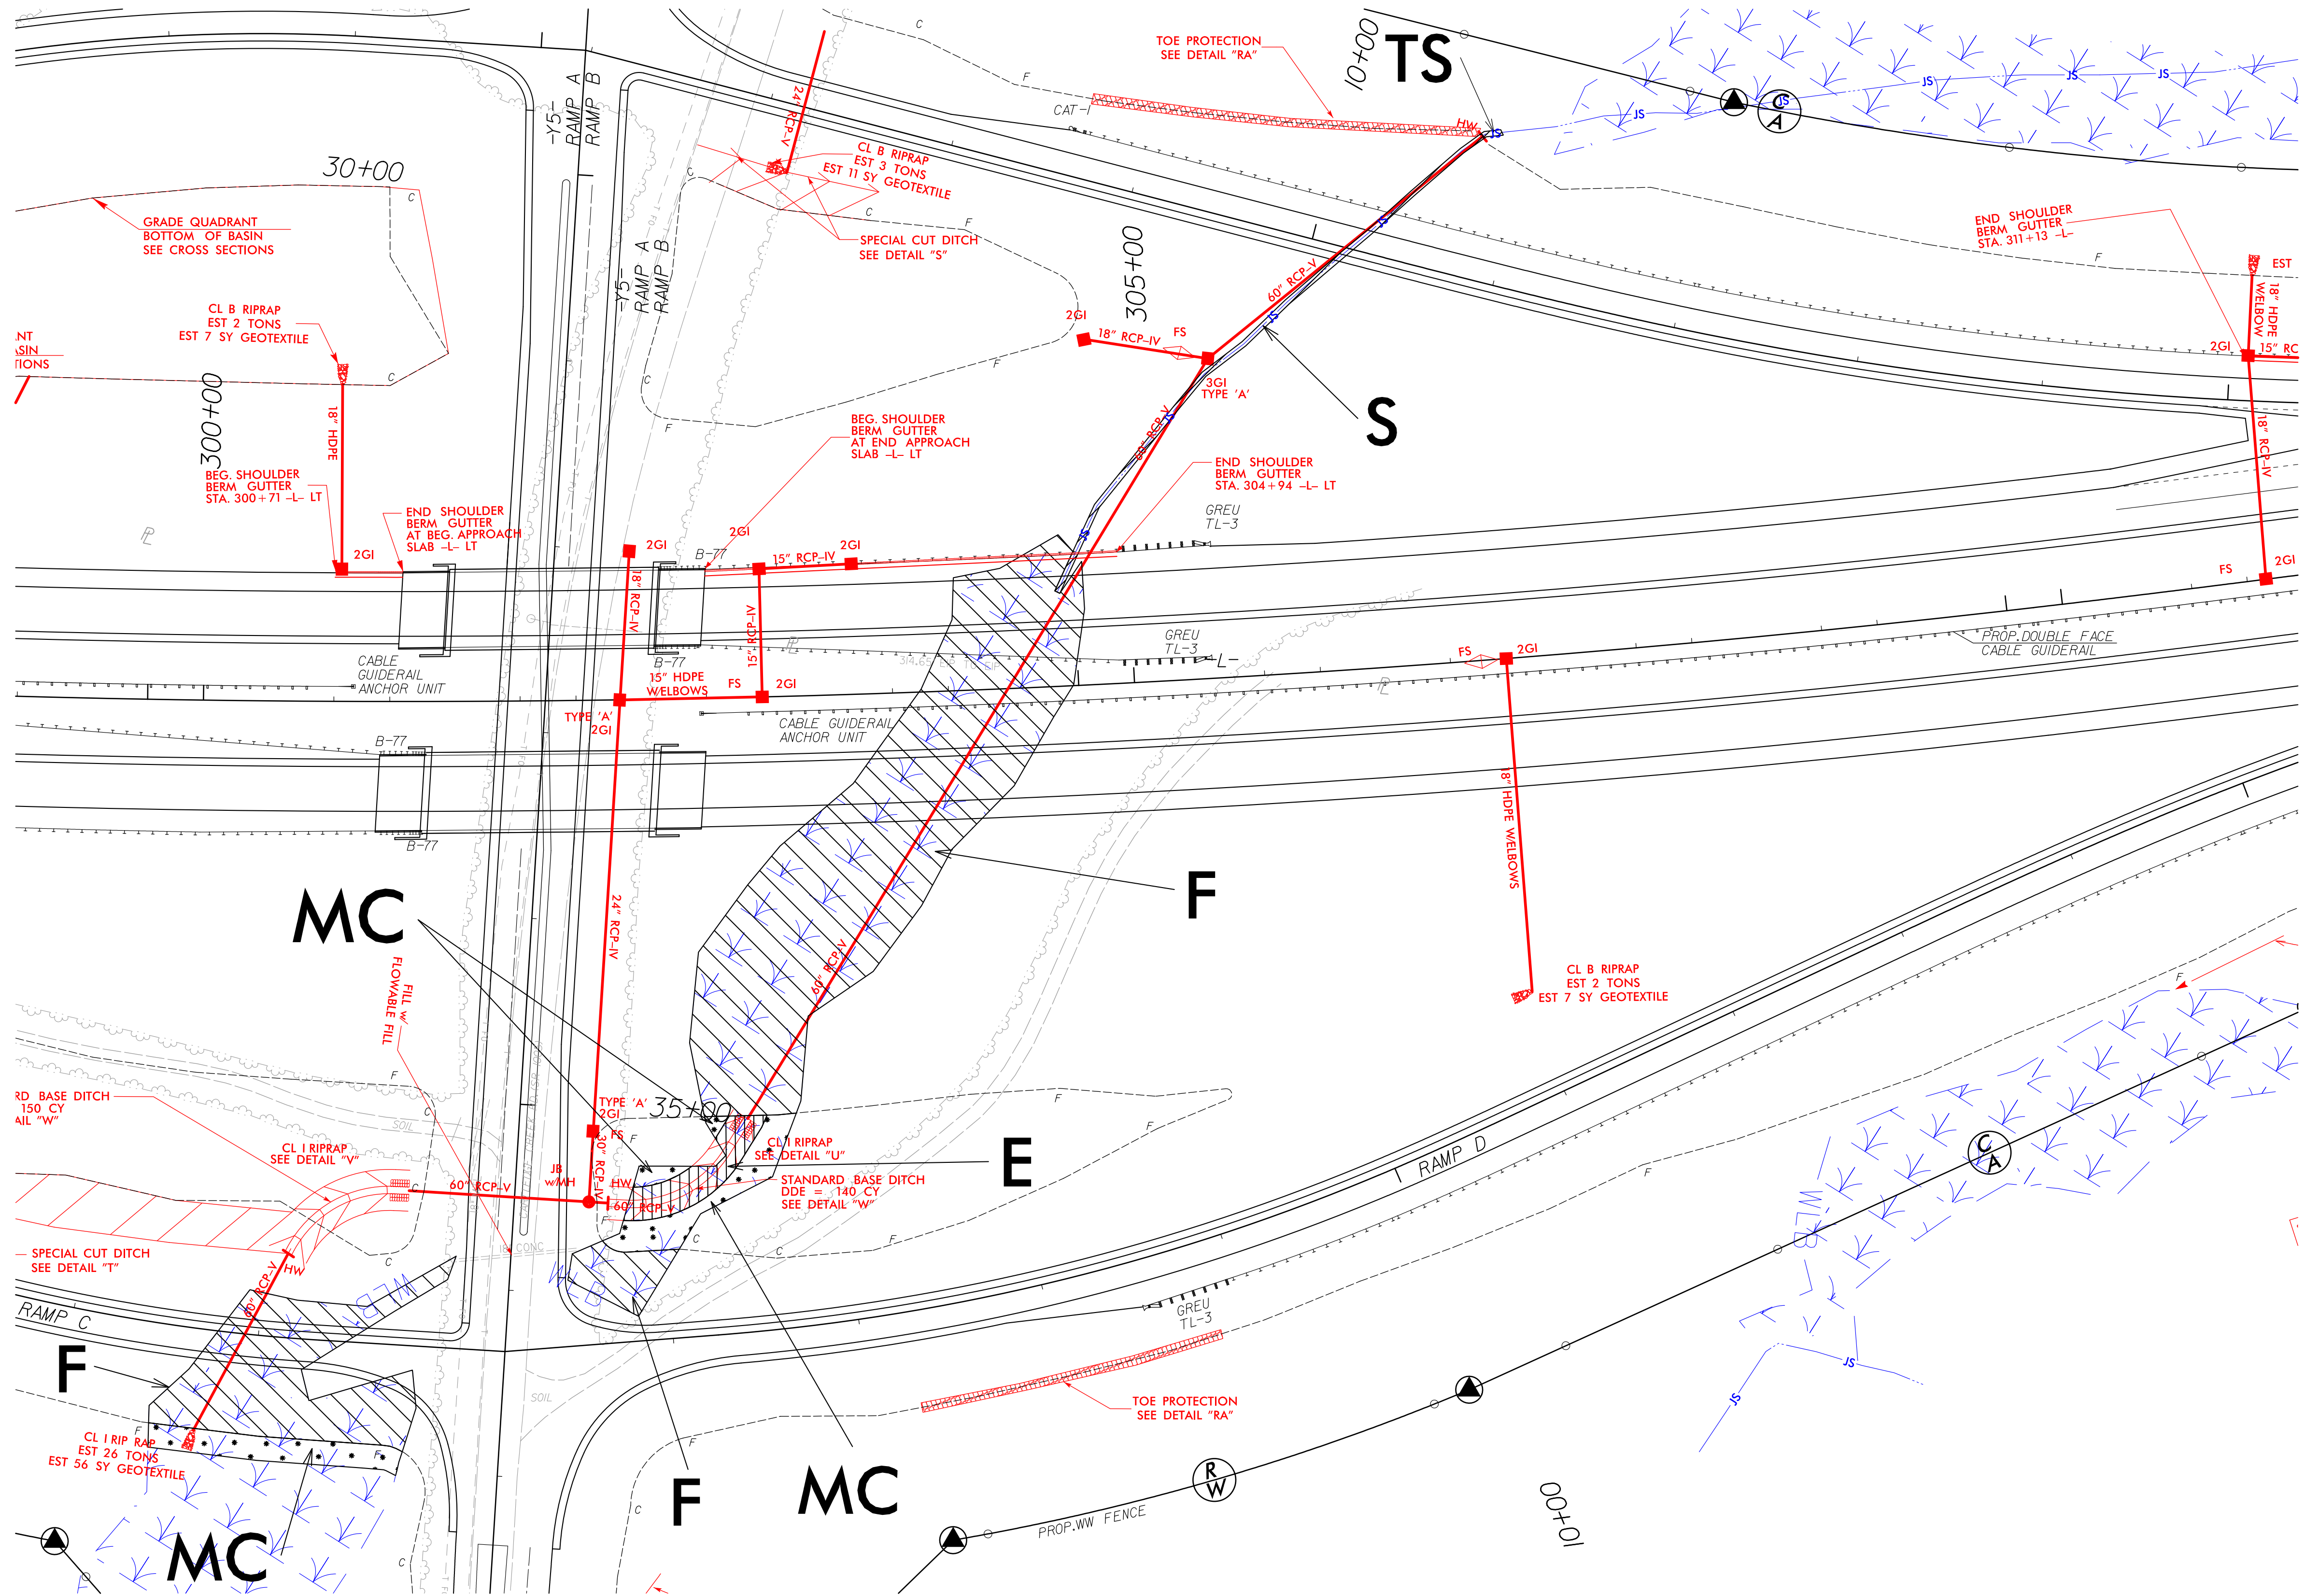


- DENOTES IMPACTS IN SURFACE WATER
- DENOTES TEMPORARY IMPACTS IN SURFACE WATER
- DENOTES FILL IN WETLAND
- DENOTES MECHANIZED CLEARING
- DENOTES EXCAVATION IN WETLAND

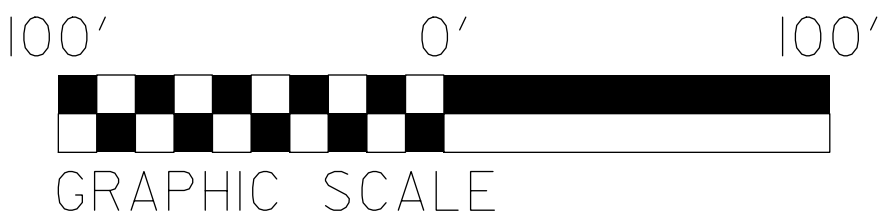



7/23/26 AM
R:\Hydrolics\Drawings\R3421B\R3421b_Hyd_prm_wet_psh16.enlarge.sst10-20150720_con.dgn


PERMIT DRAWING
SHEET 48 OF 71

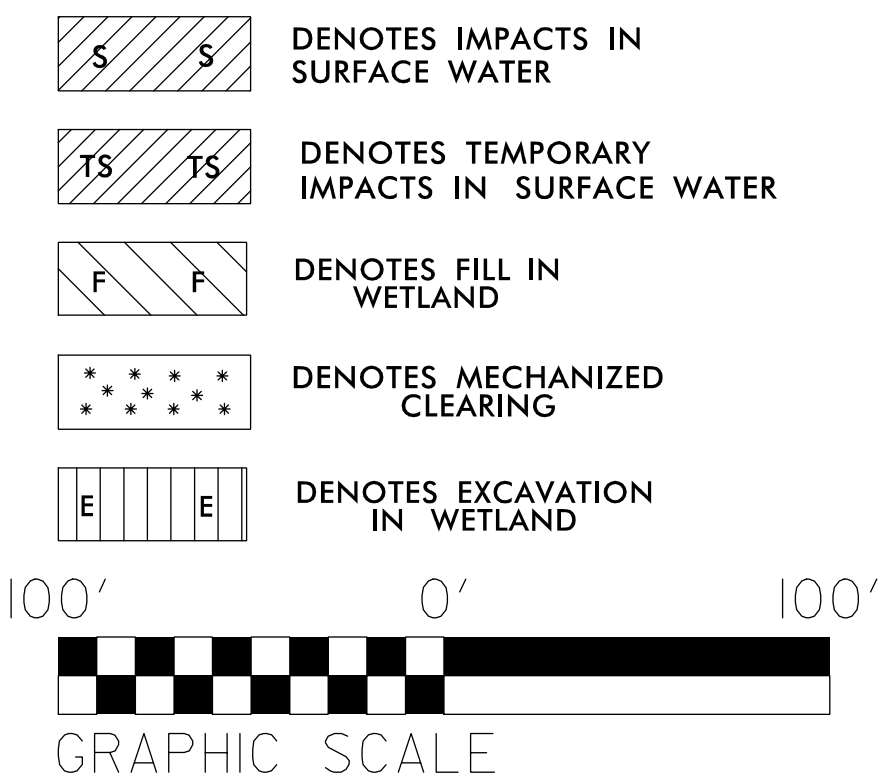



```
$DATES
$(USERNAME)$
$FILE$
```

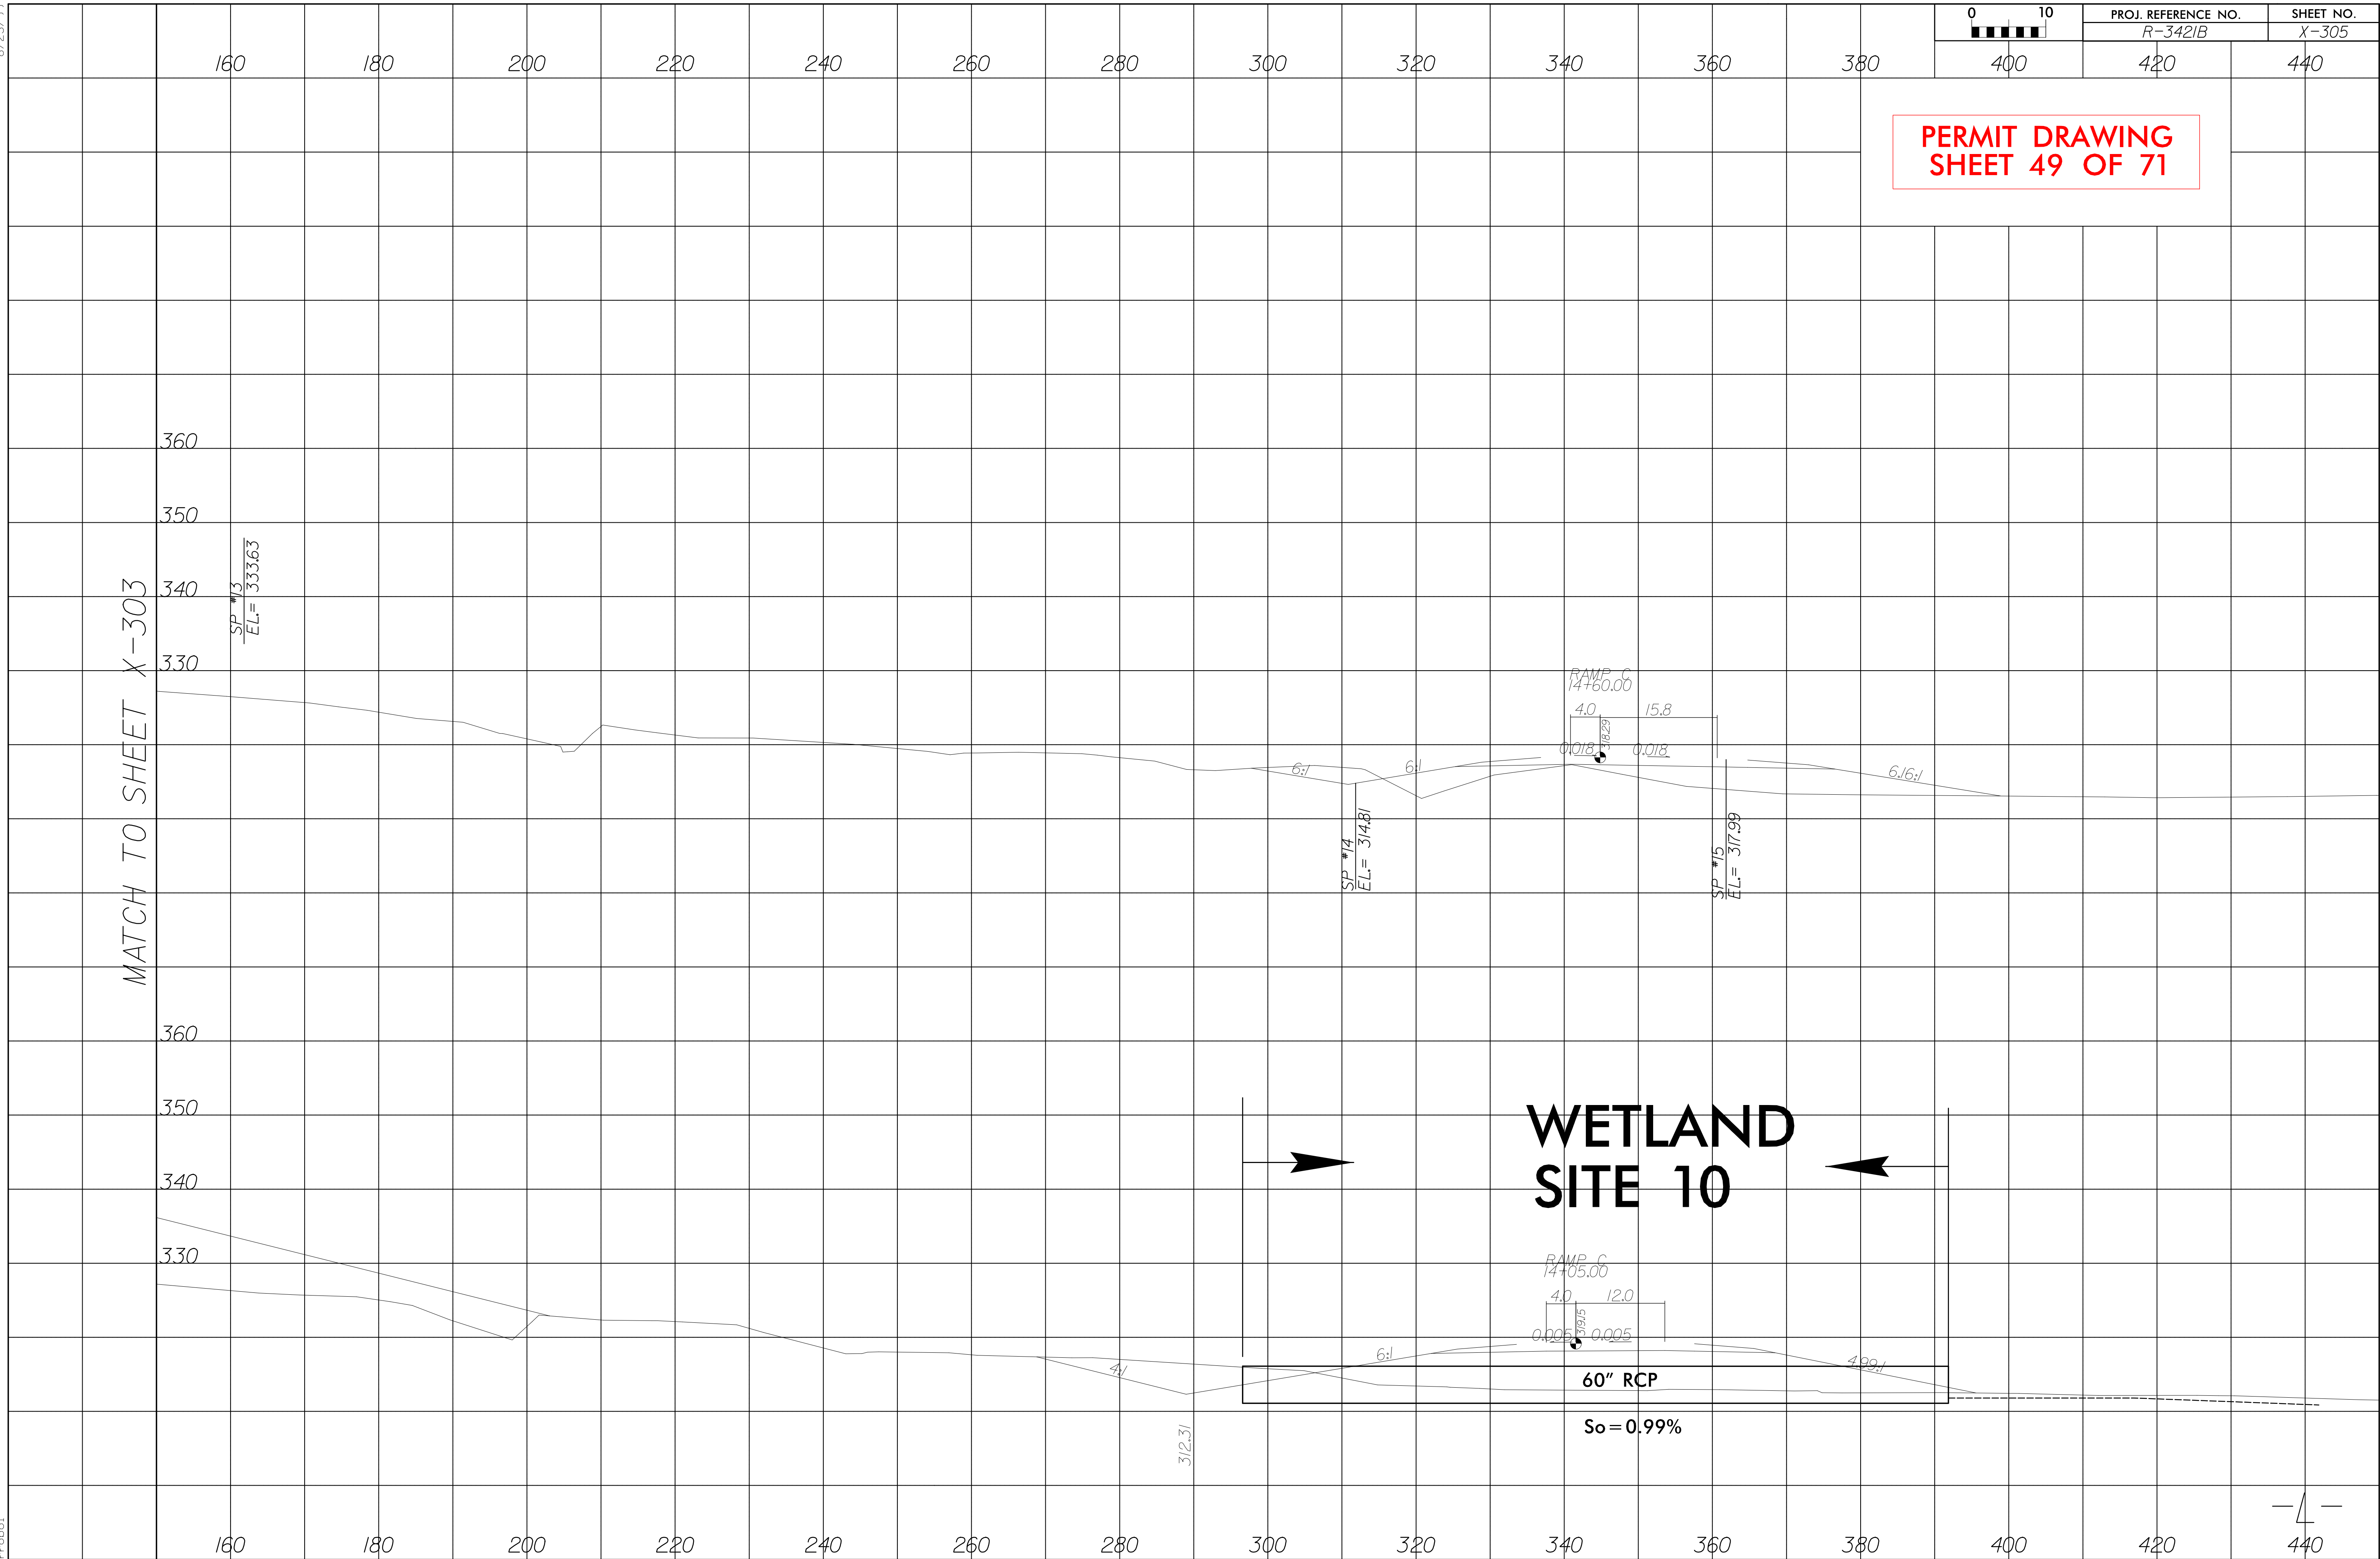


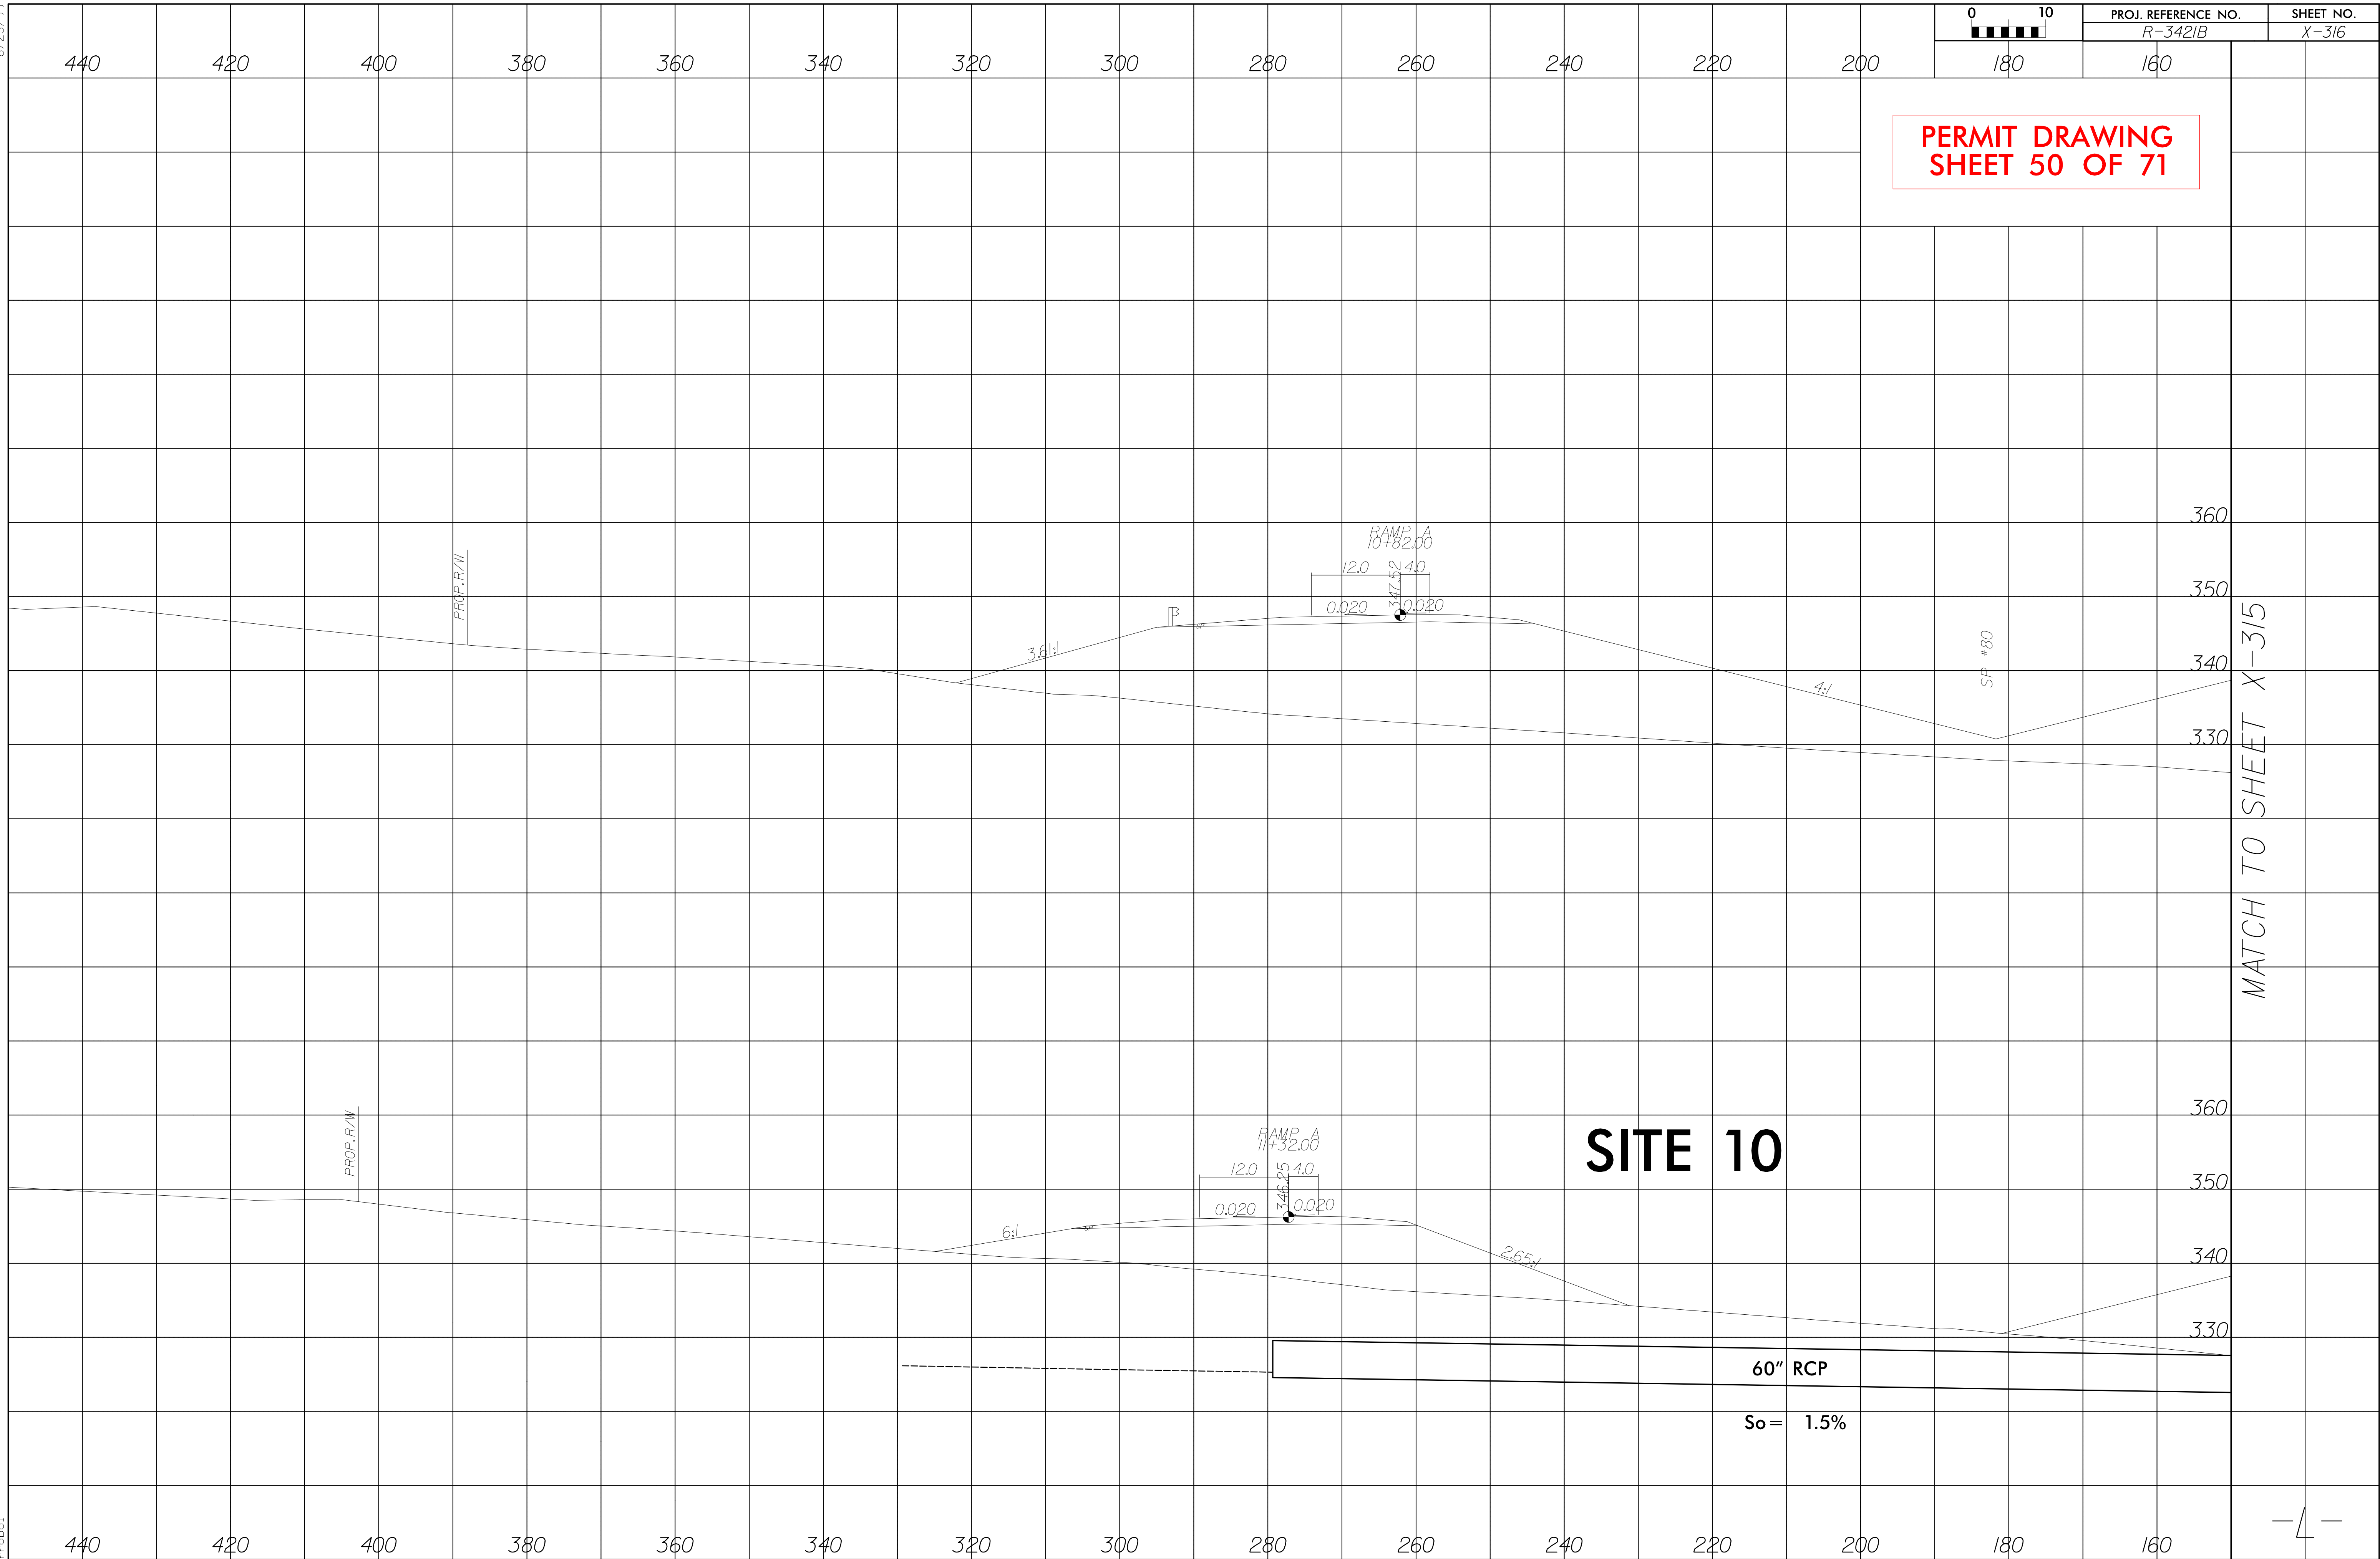
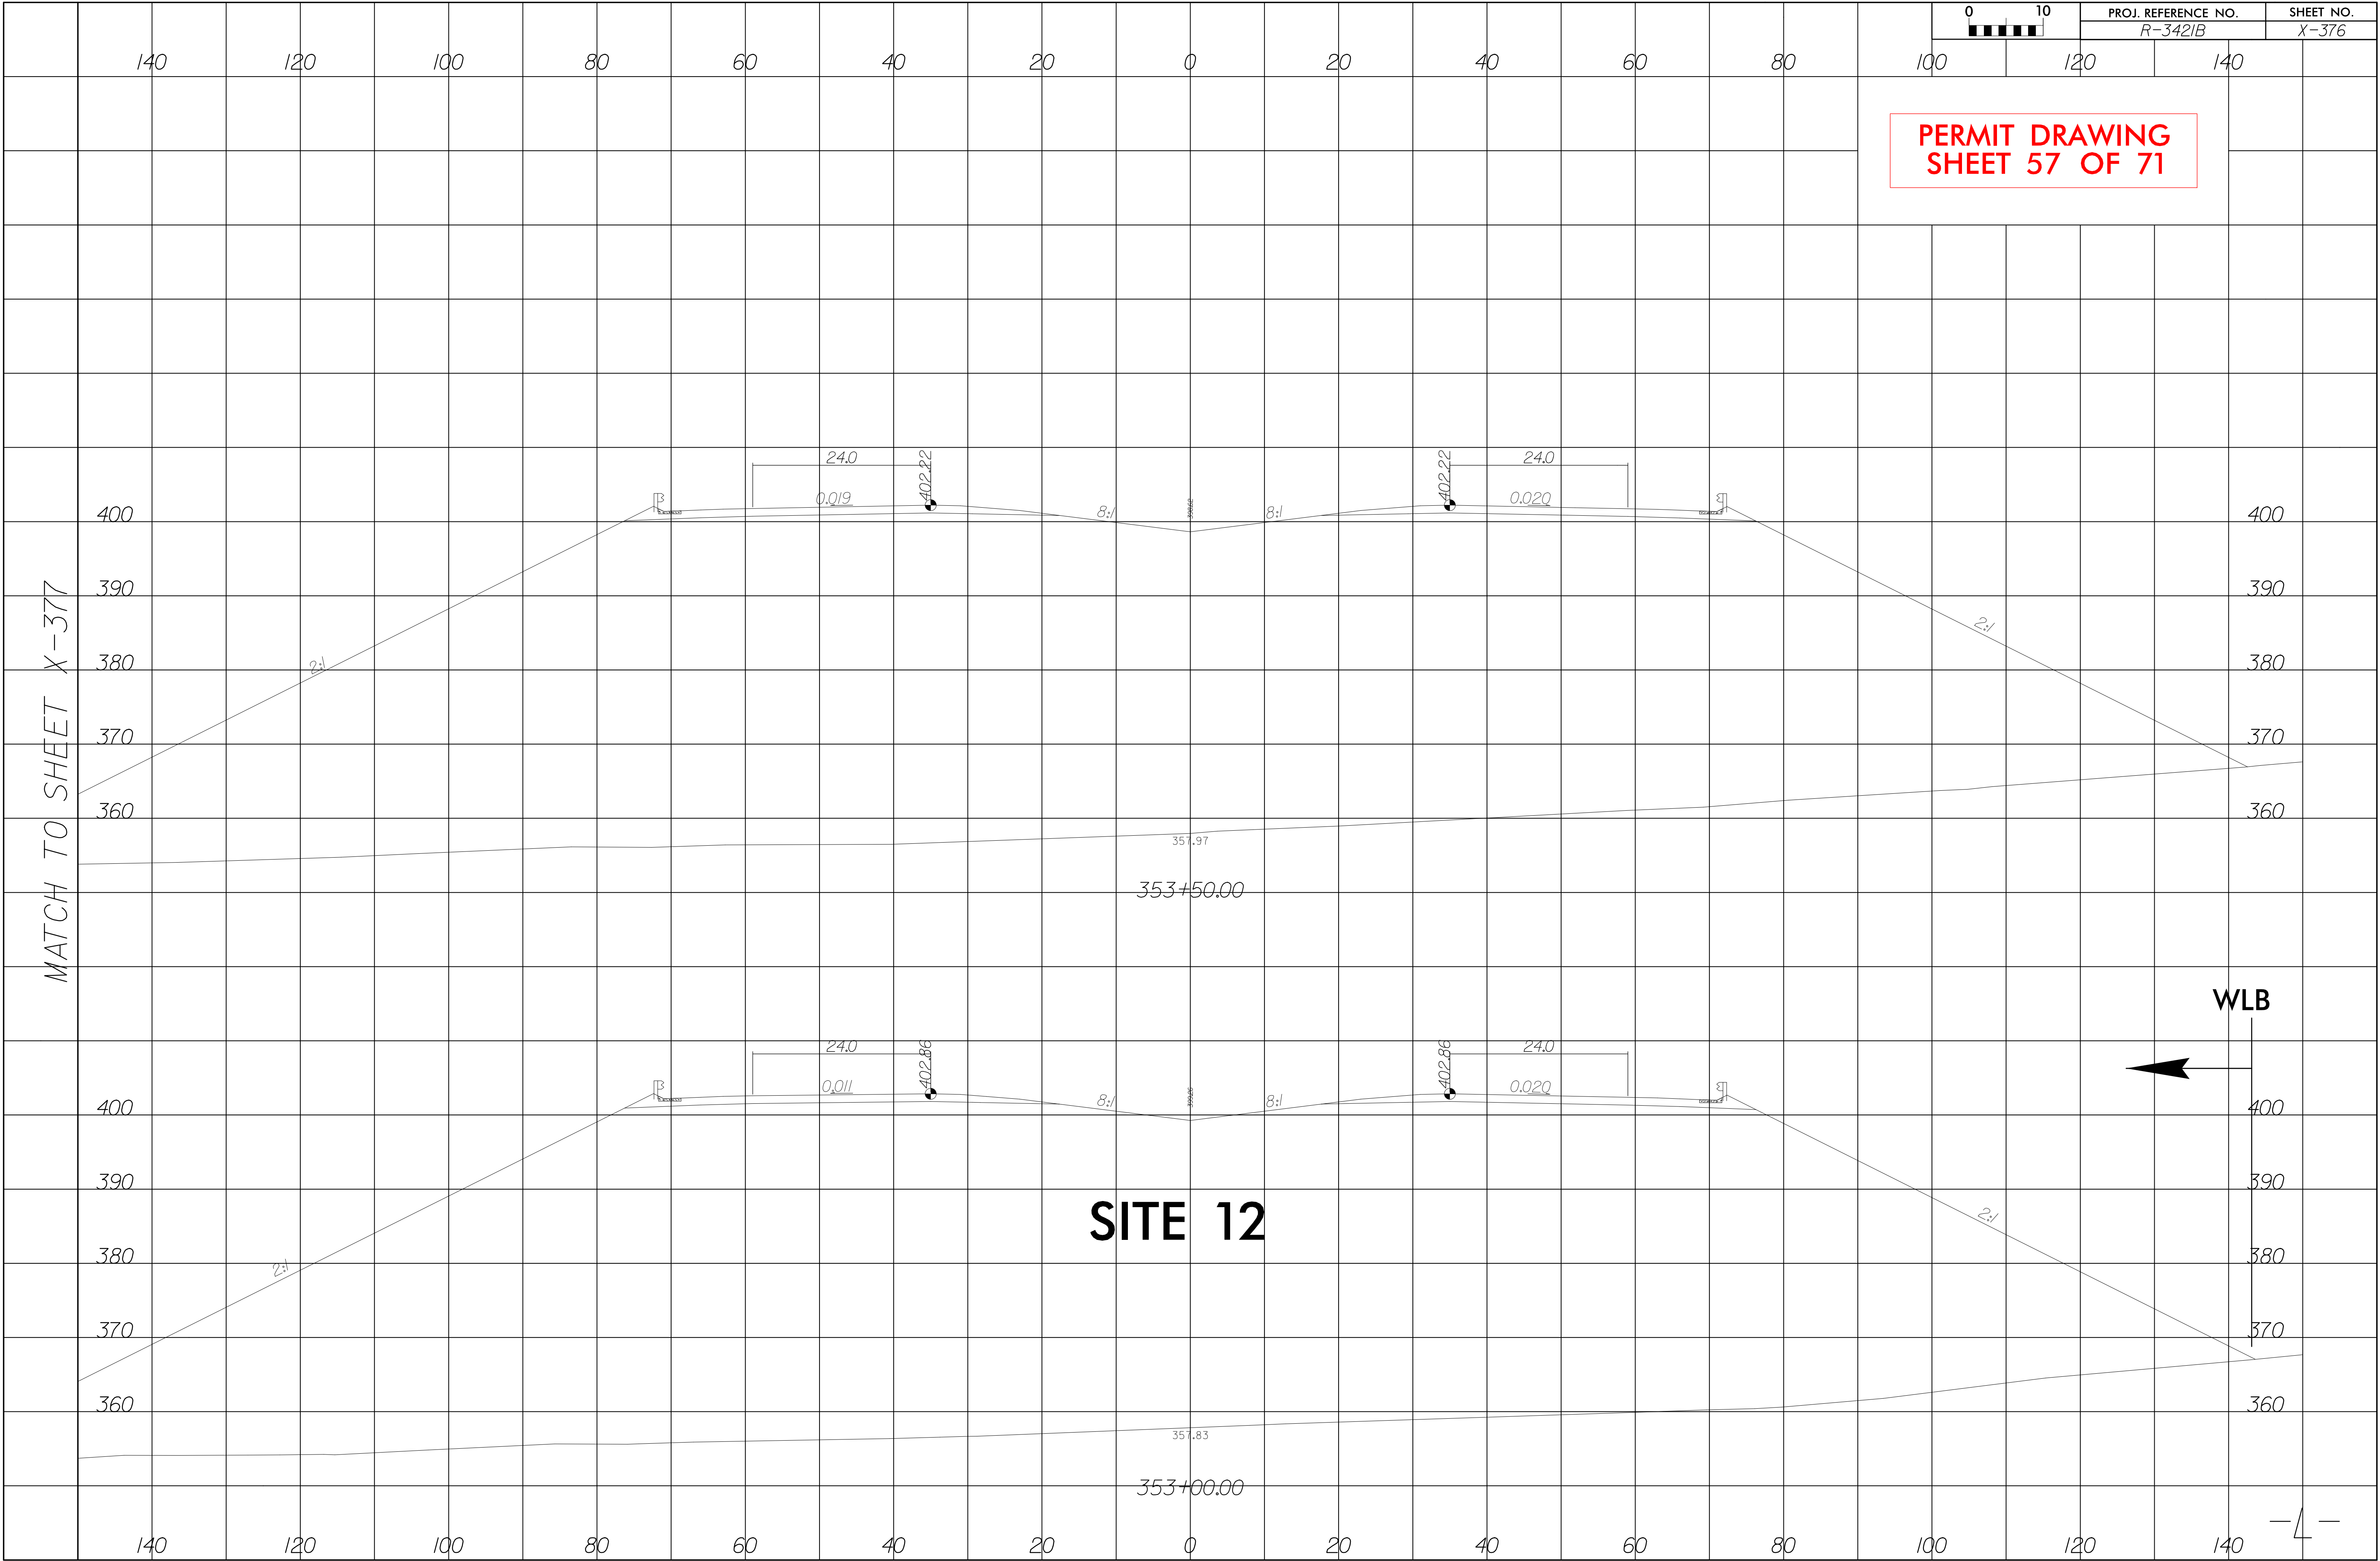


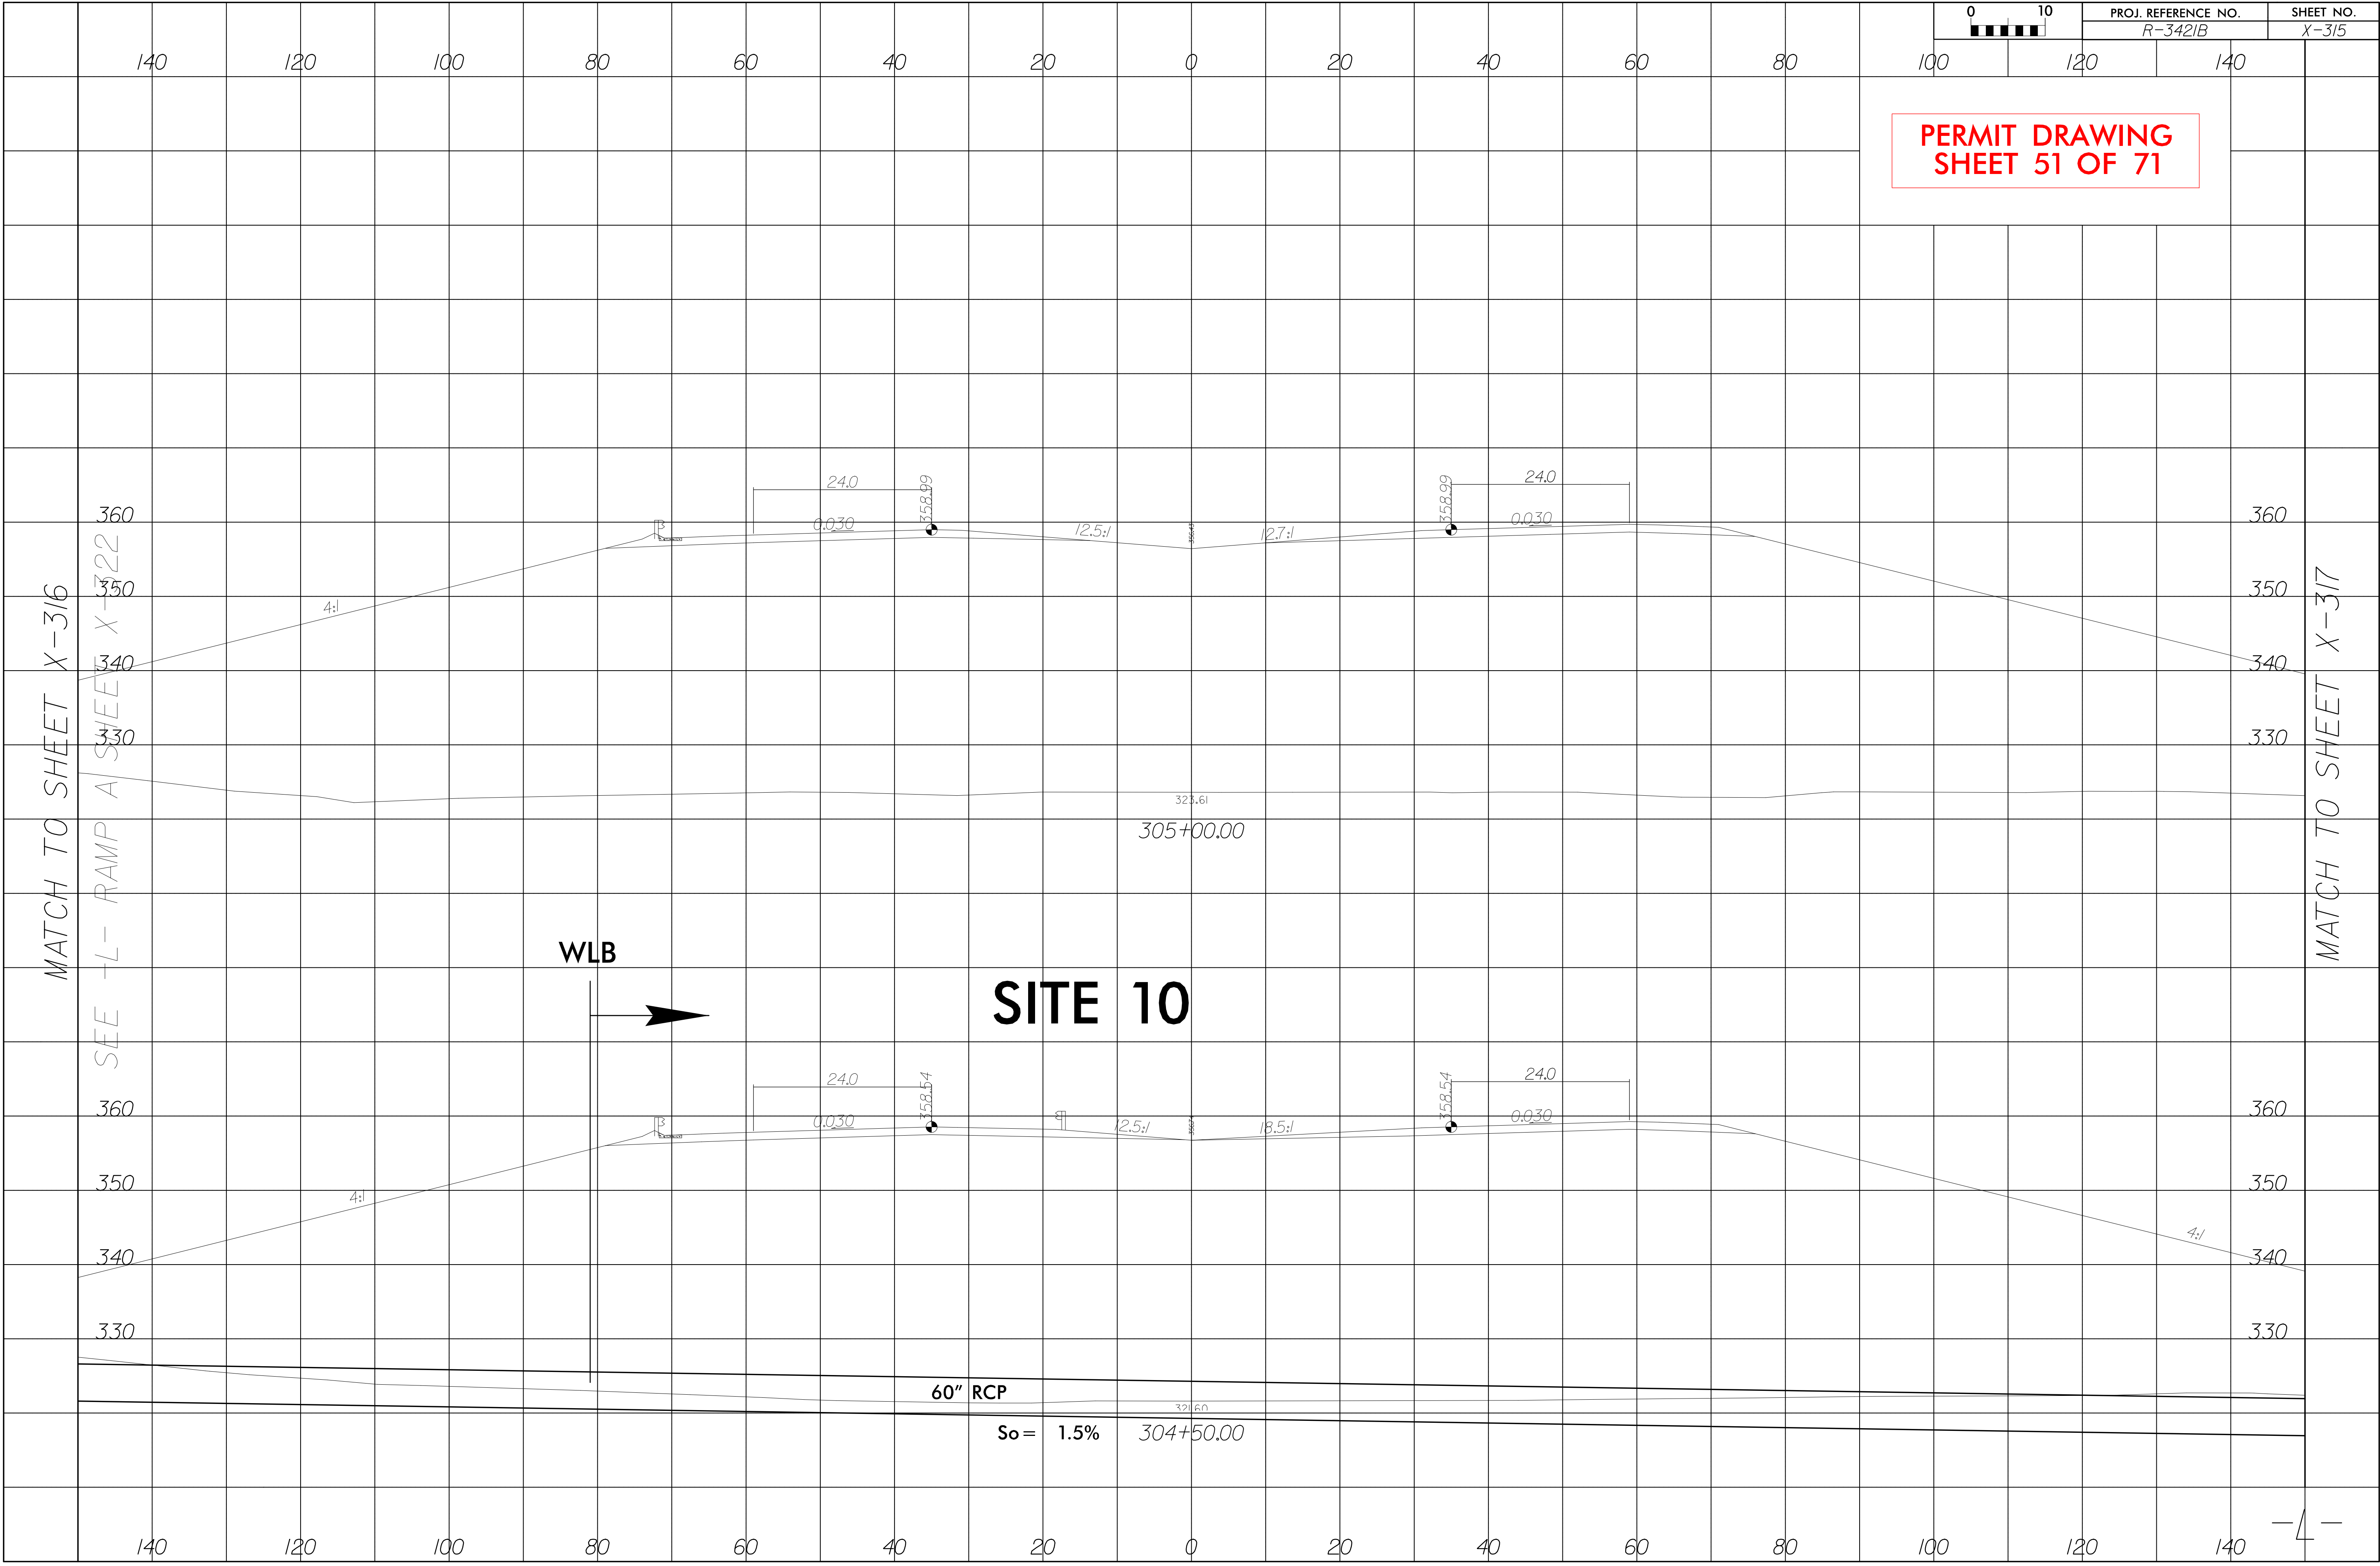

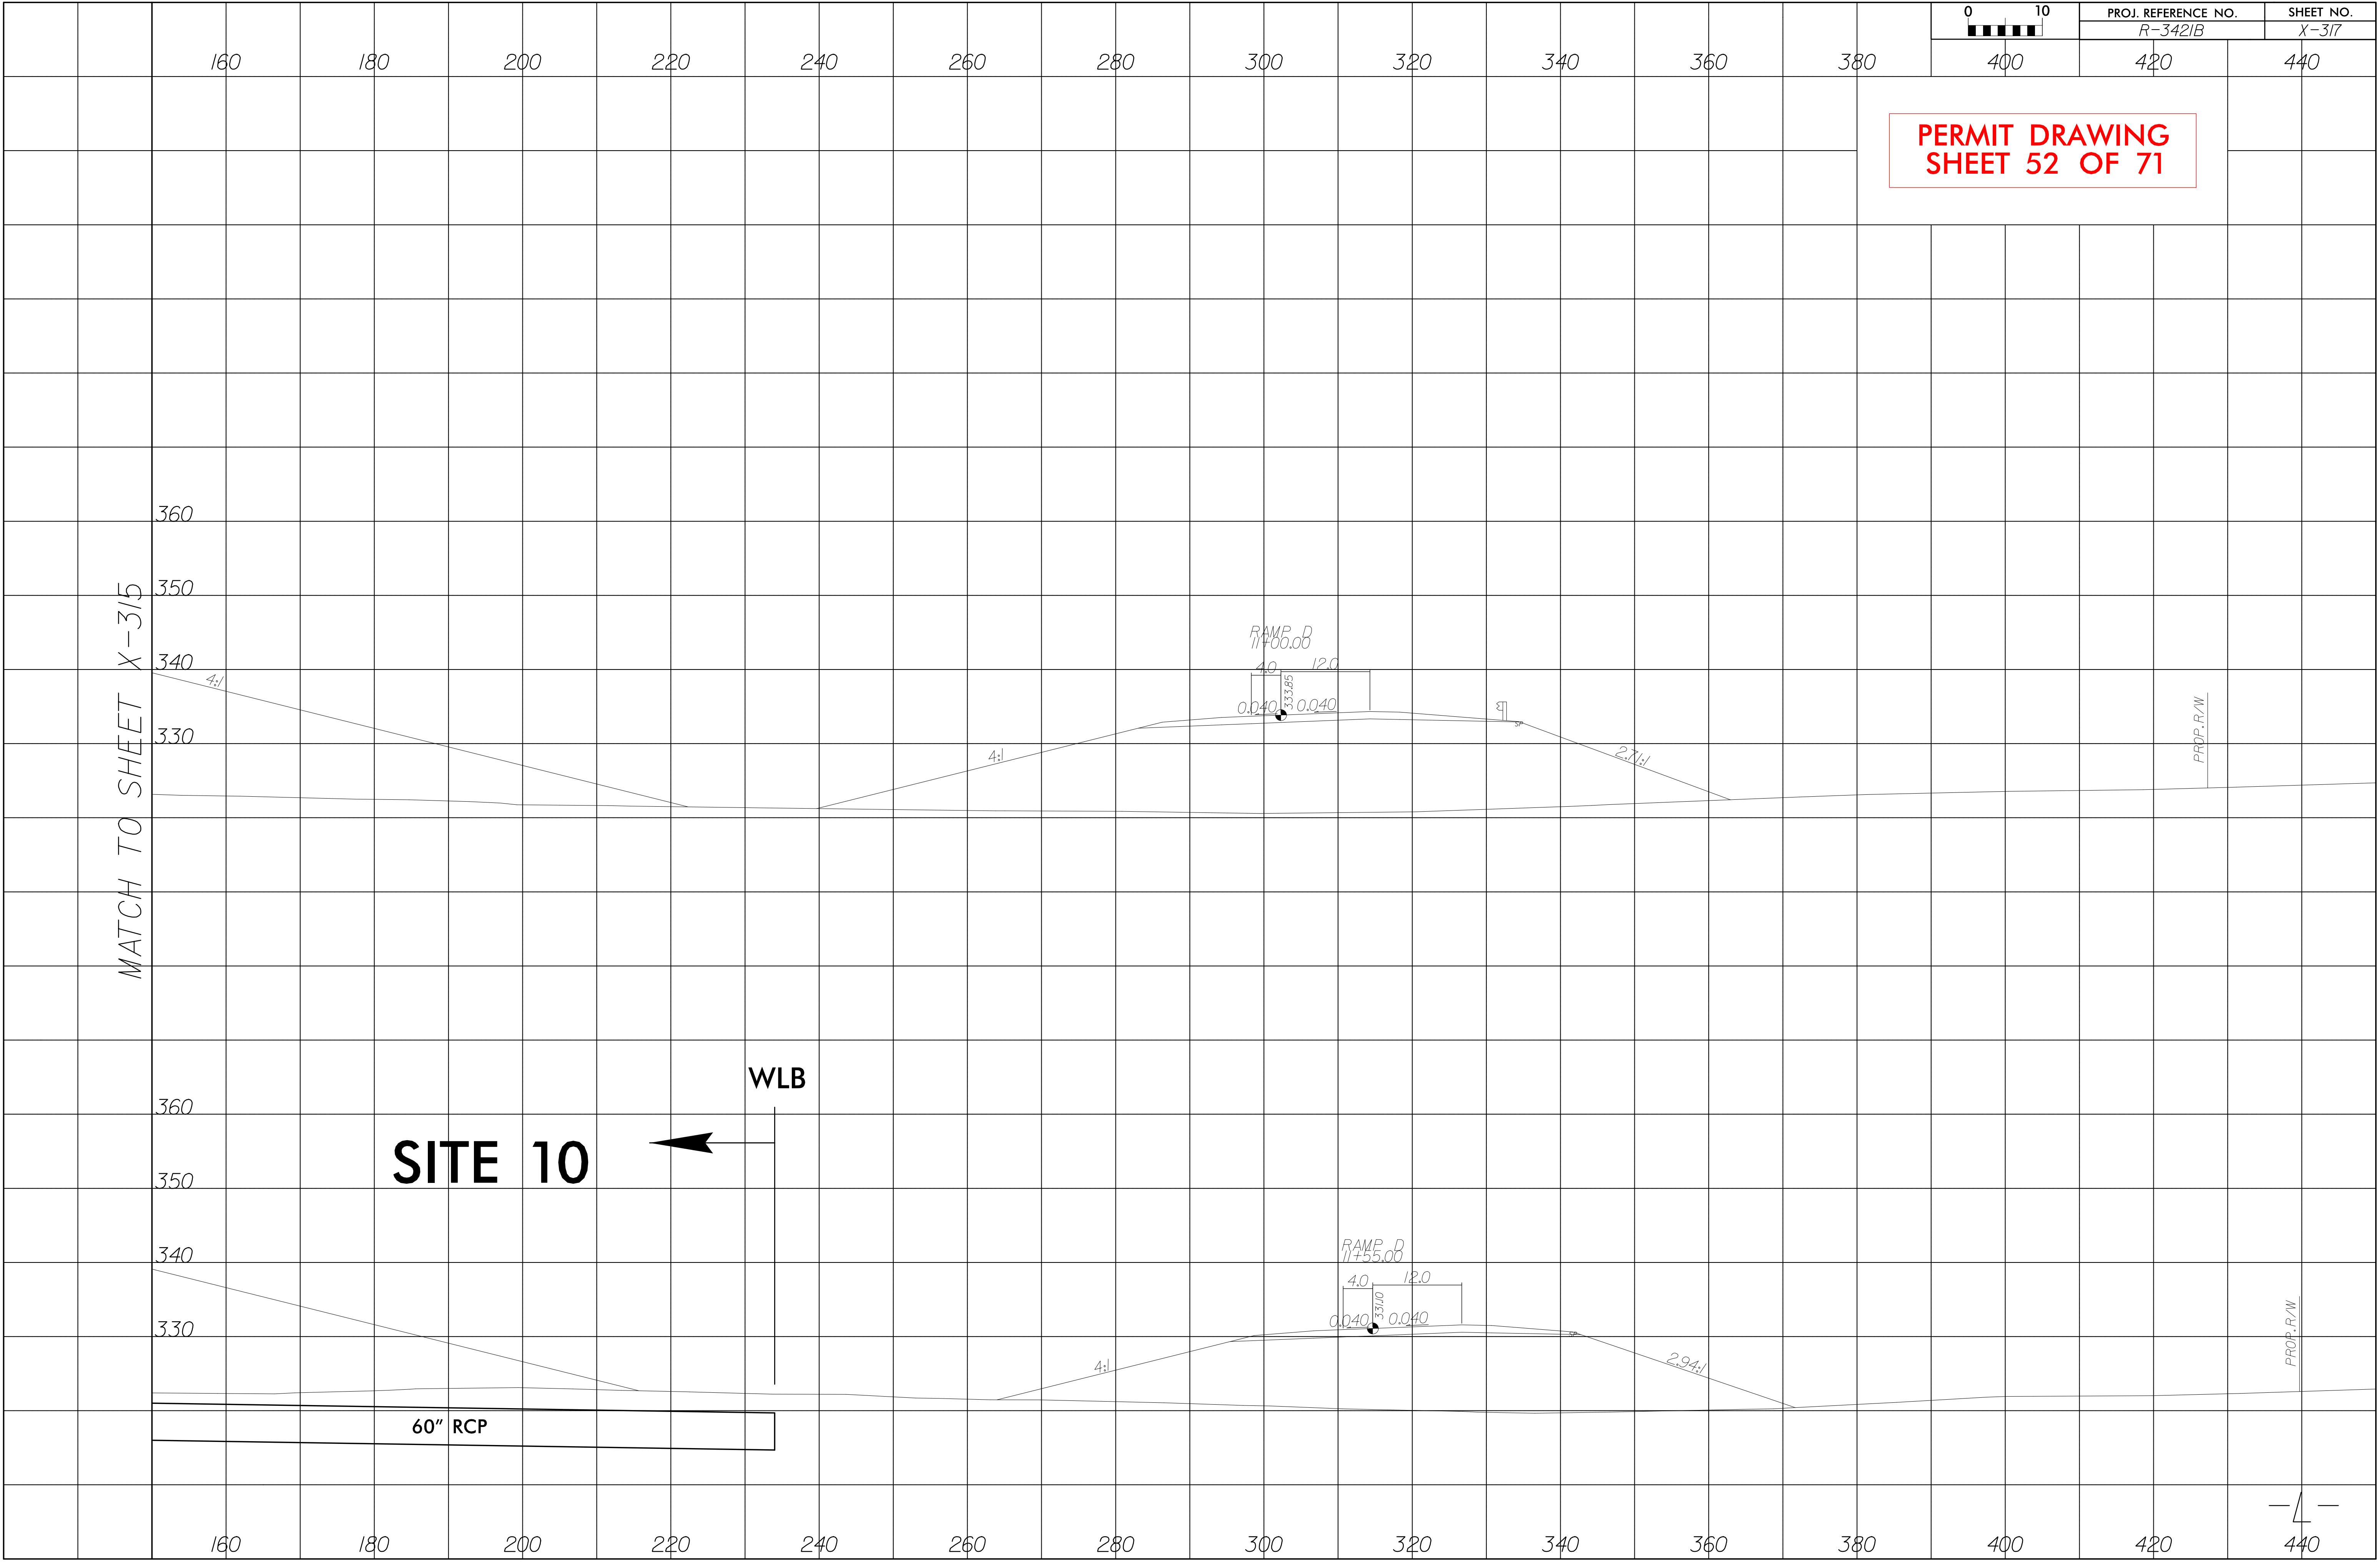

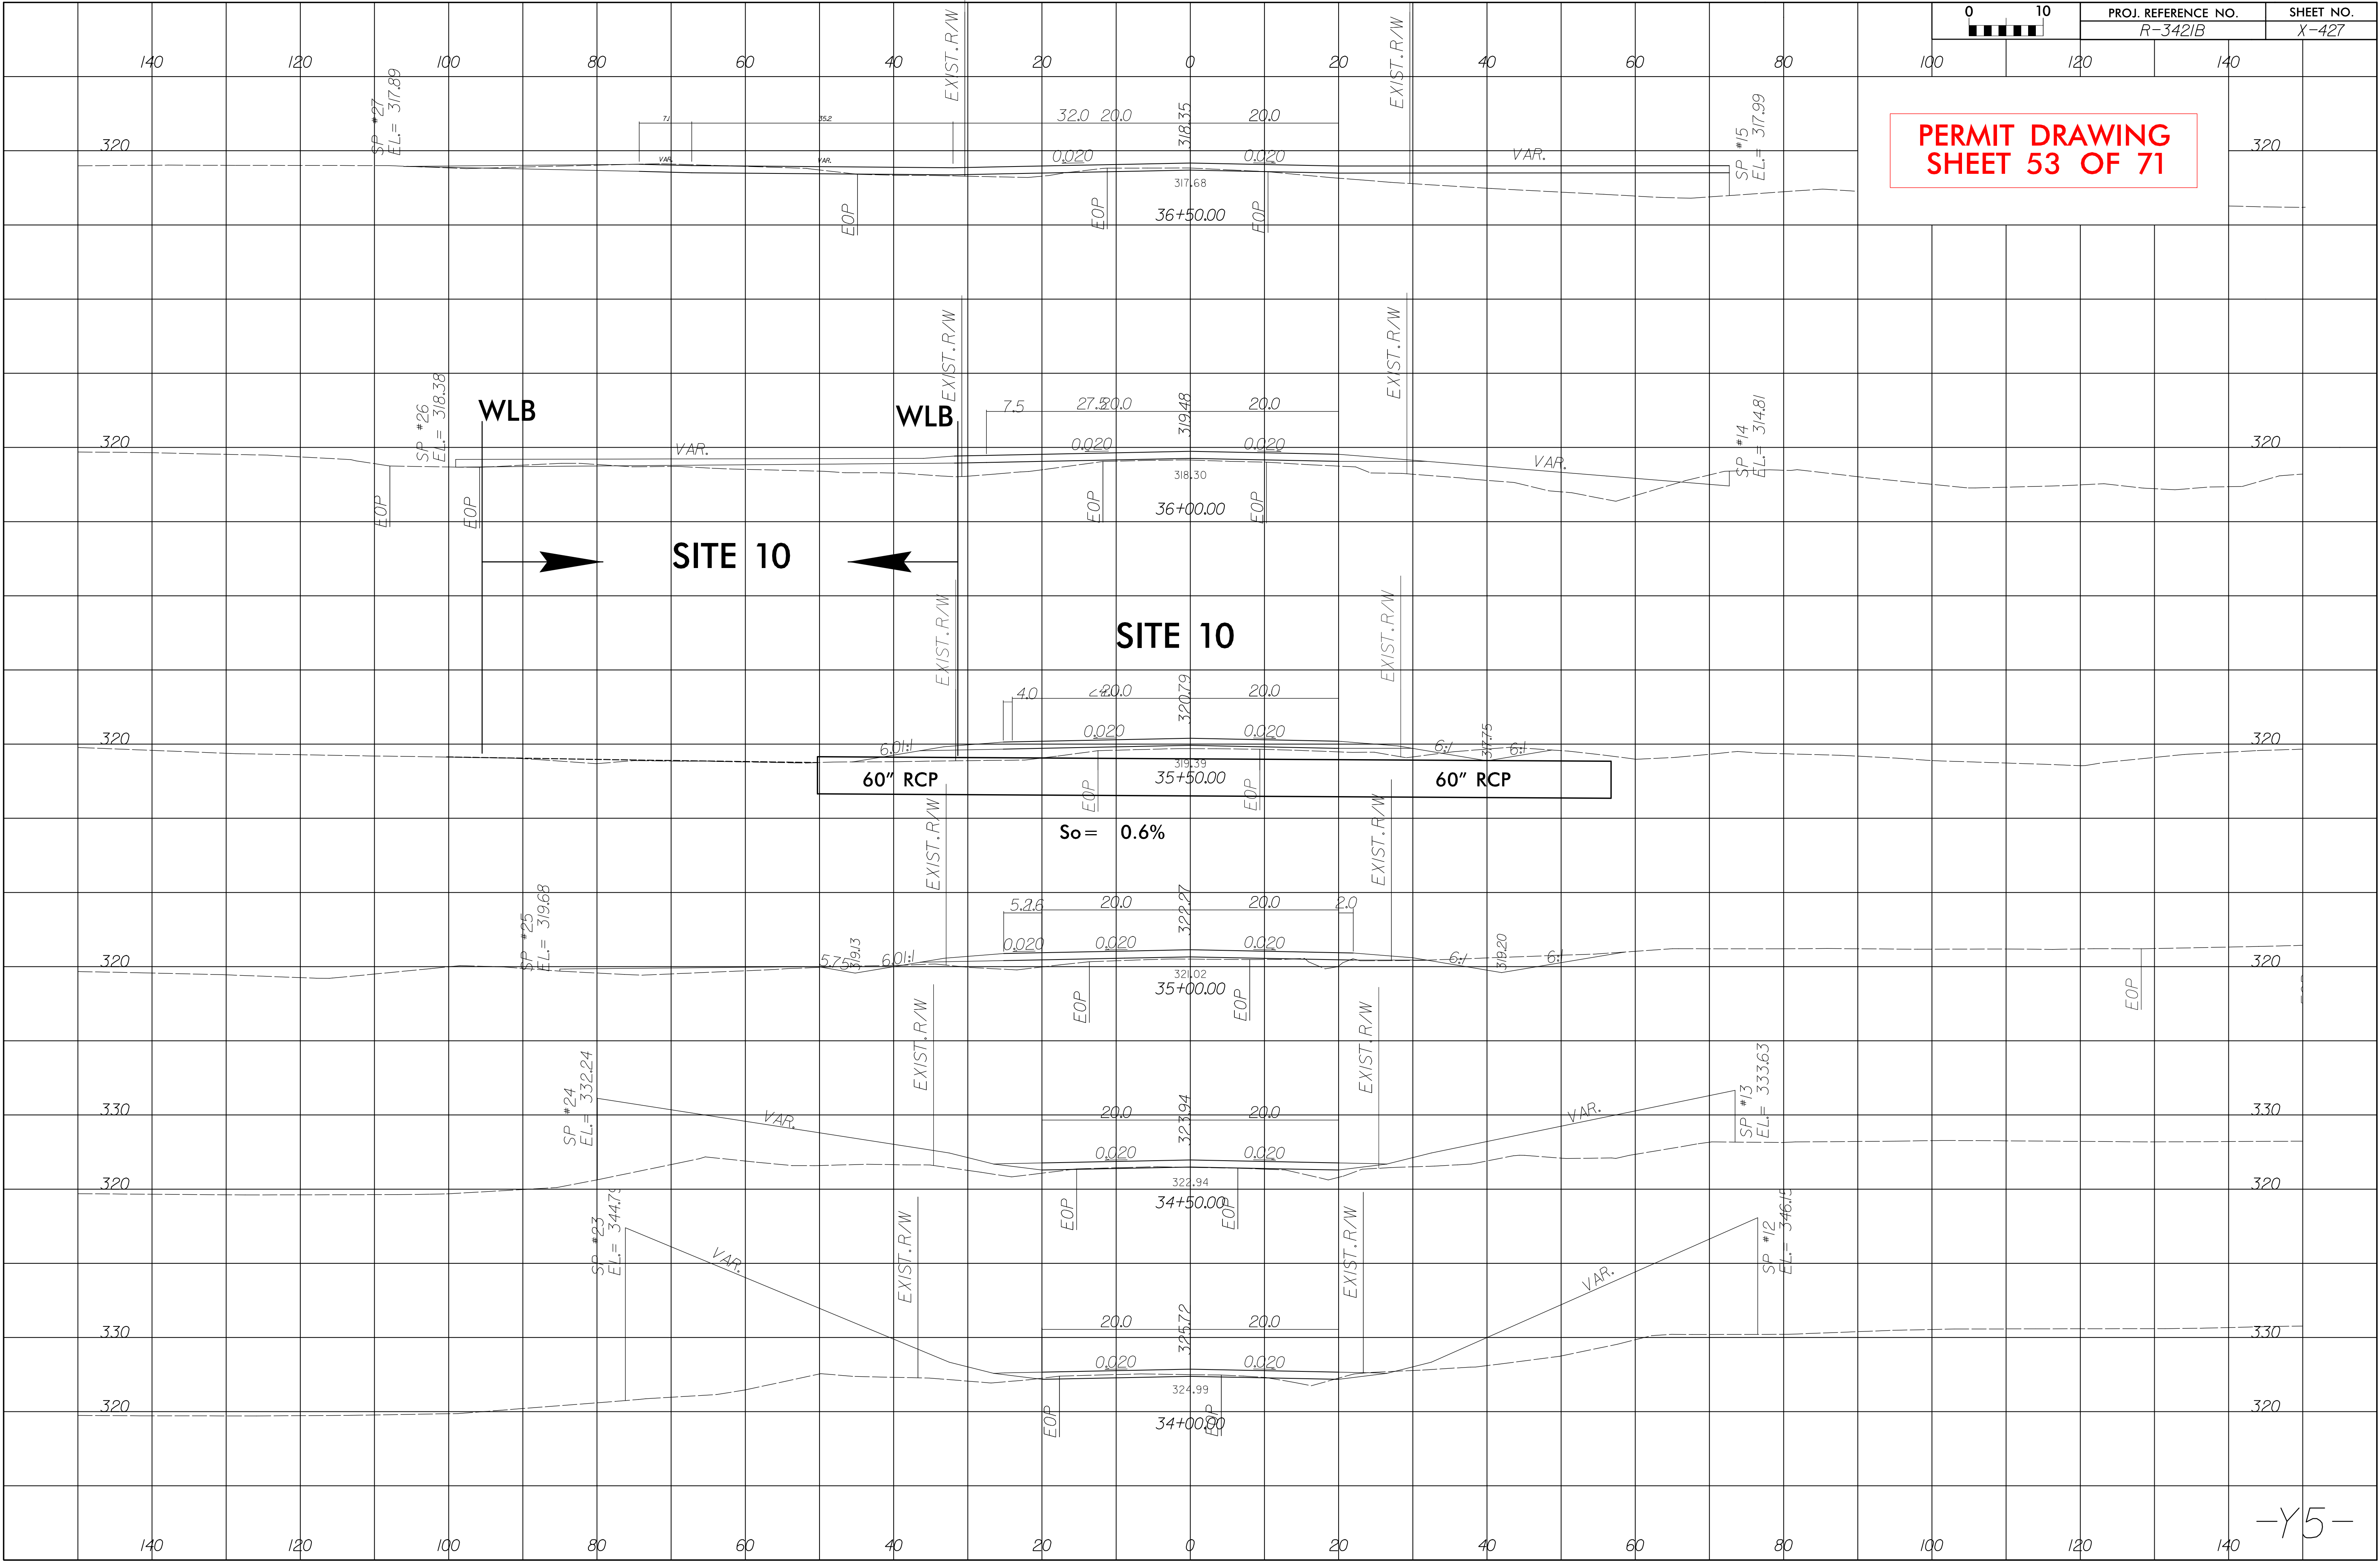

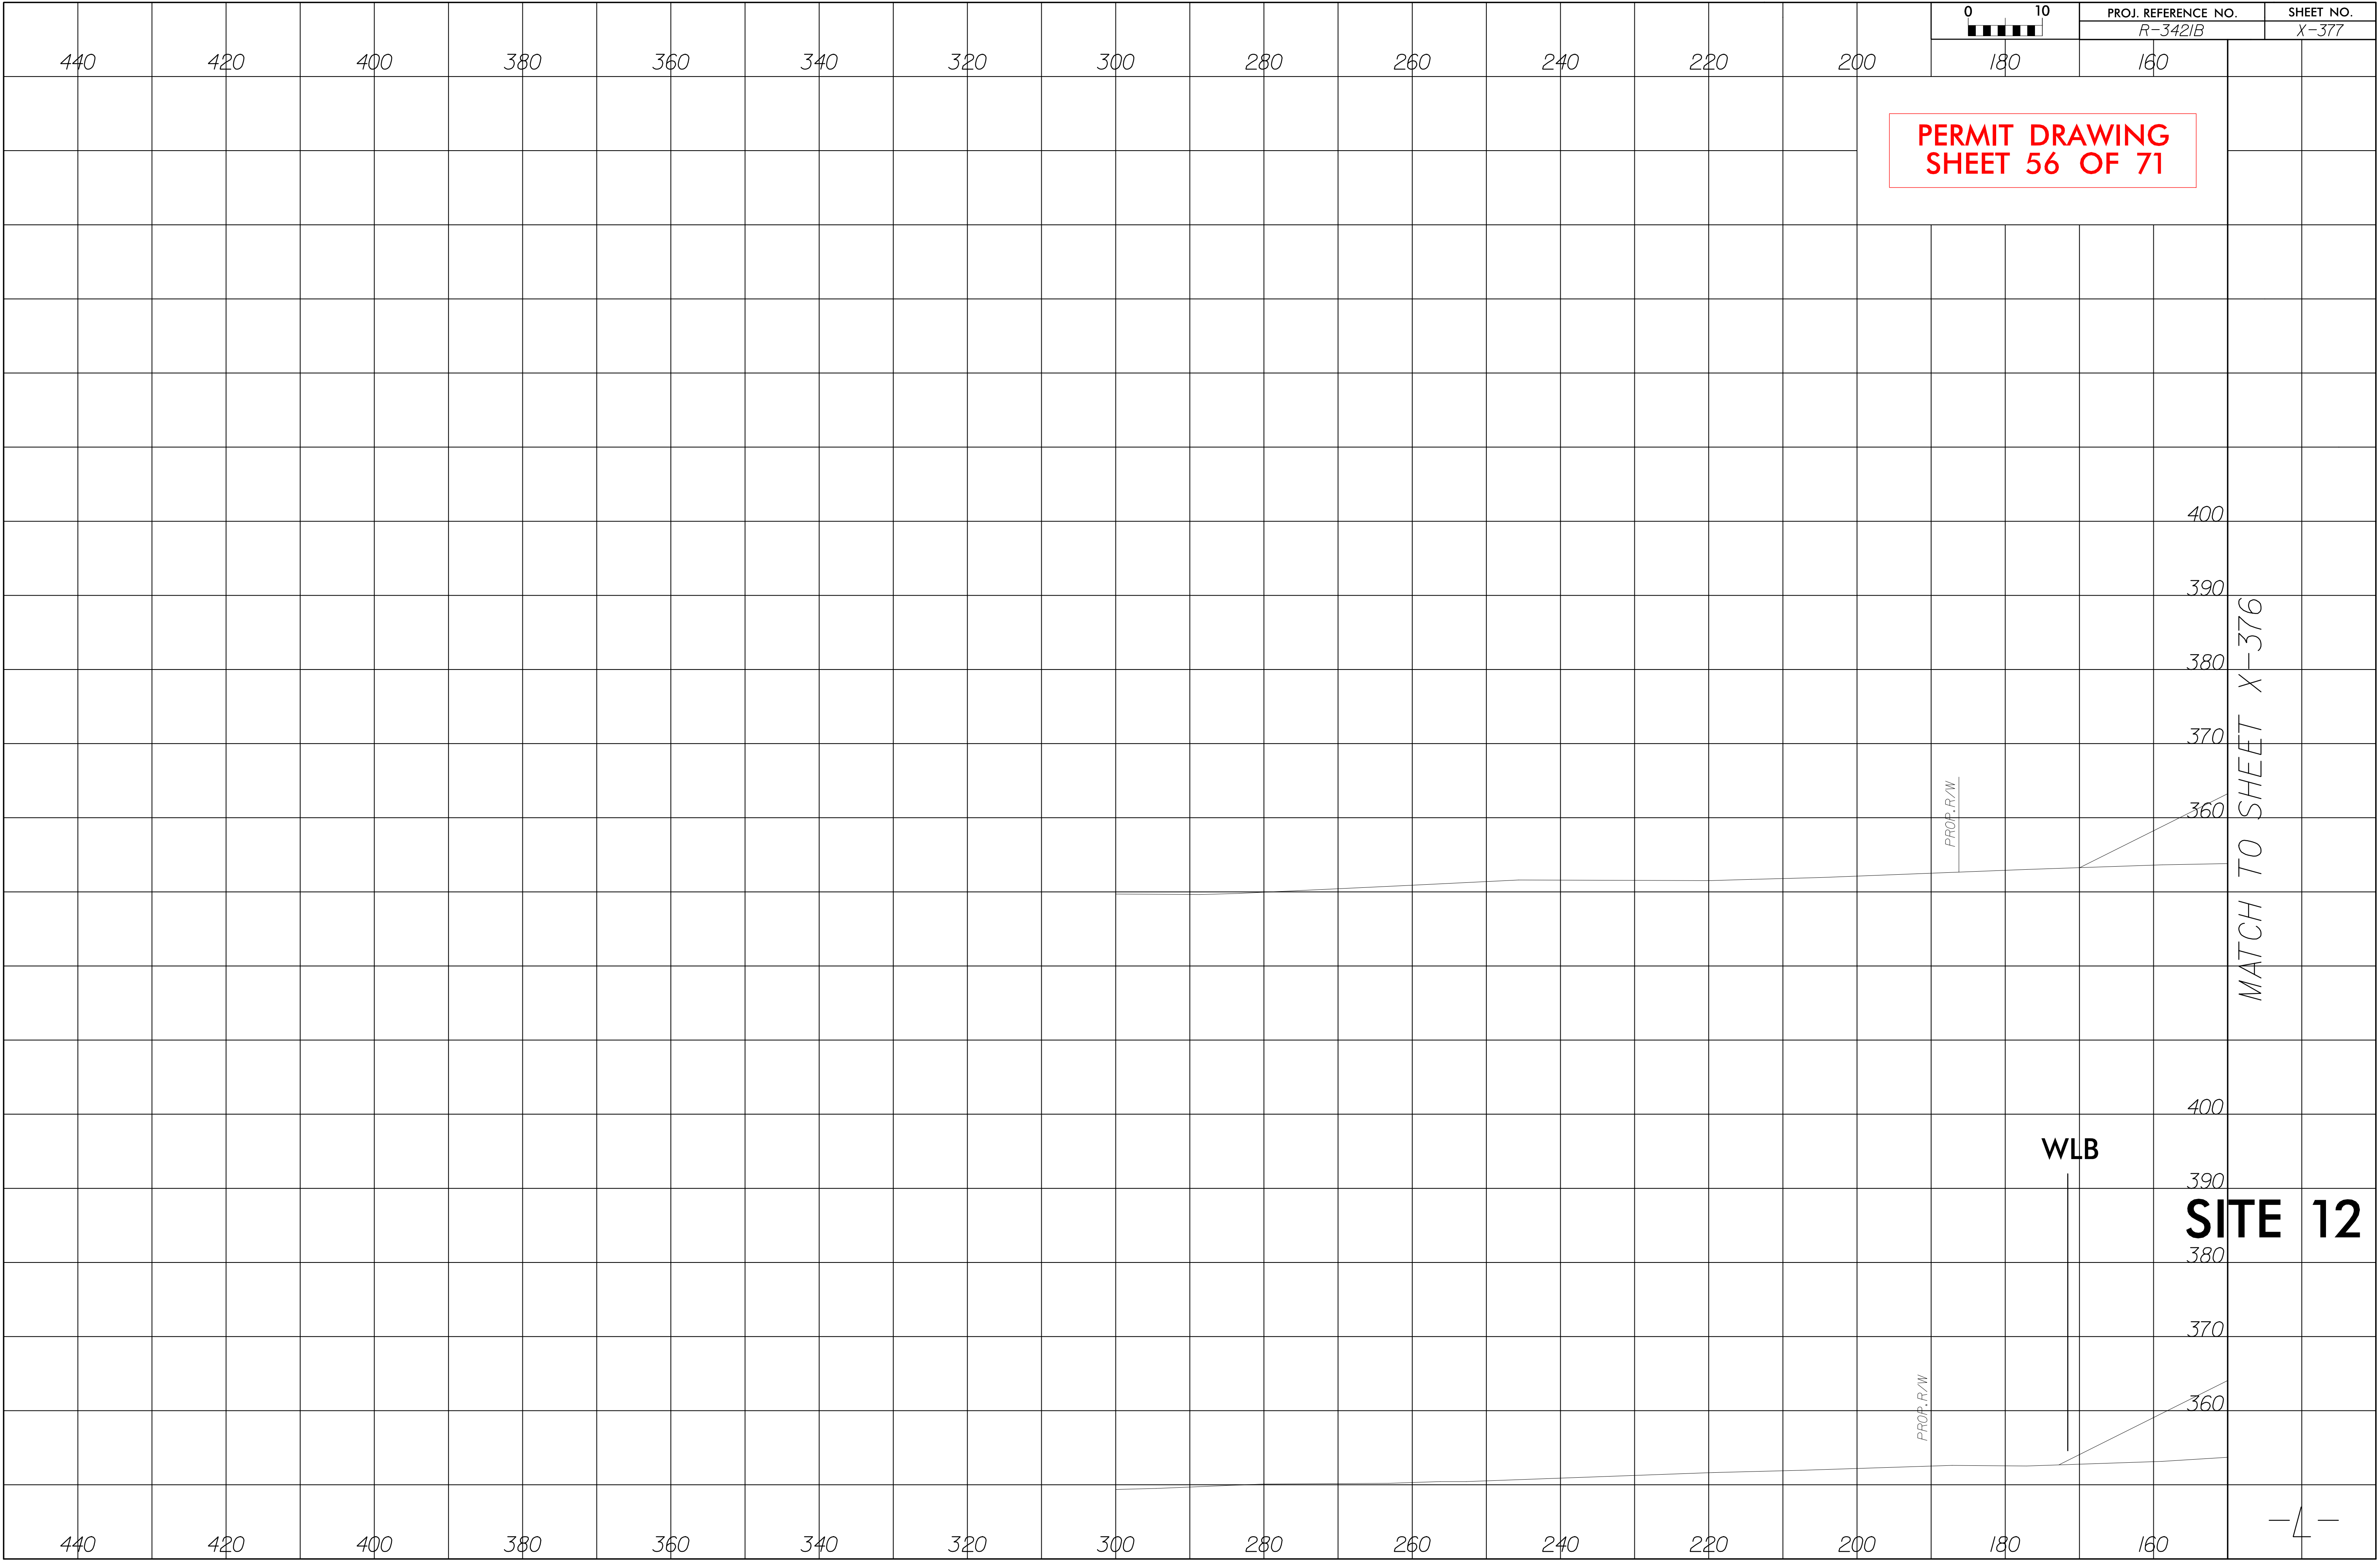



PERMIT DRAWING
SHEET 57 OF 71



PROJ. REFERENCE NO.	SHEET NO.
R-342IB	X-376







8/17/99

REVISIONS

7:24:30 AM
R:\Hydraulics\PERMITS-Environmental\Drawings\R3421B\Drawings\R3421B_Hyd_prm_wet.psh21.enlarge site2.20150902.dgn
probol

\$DATES
\$(USERNAME)\$
\$FILEL\$

SITE 2 ENLARGEMENT

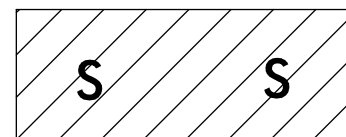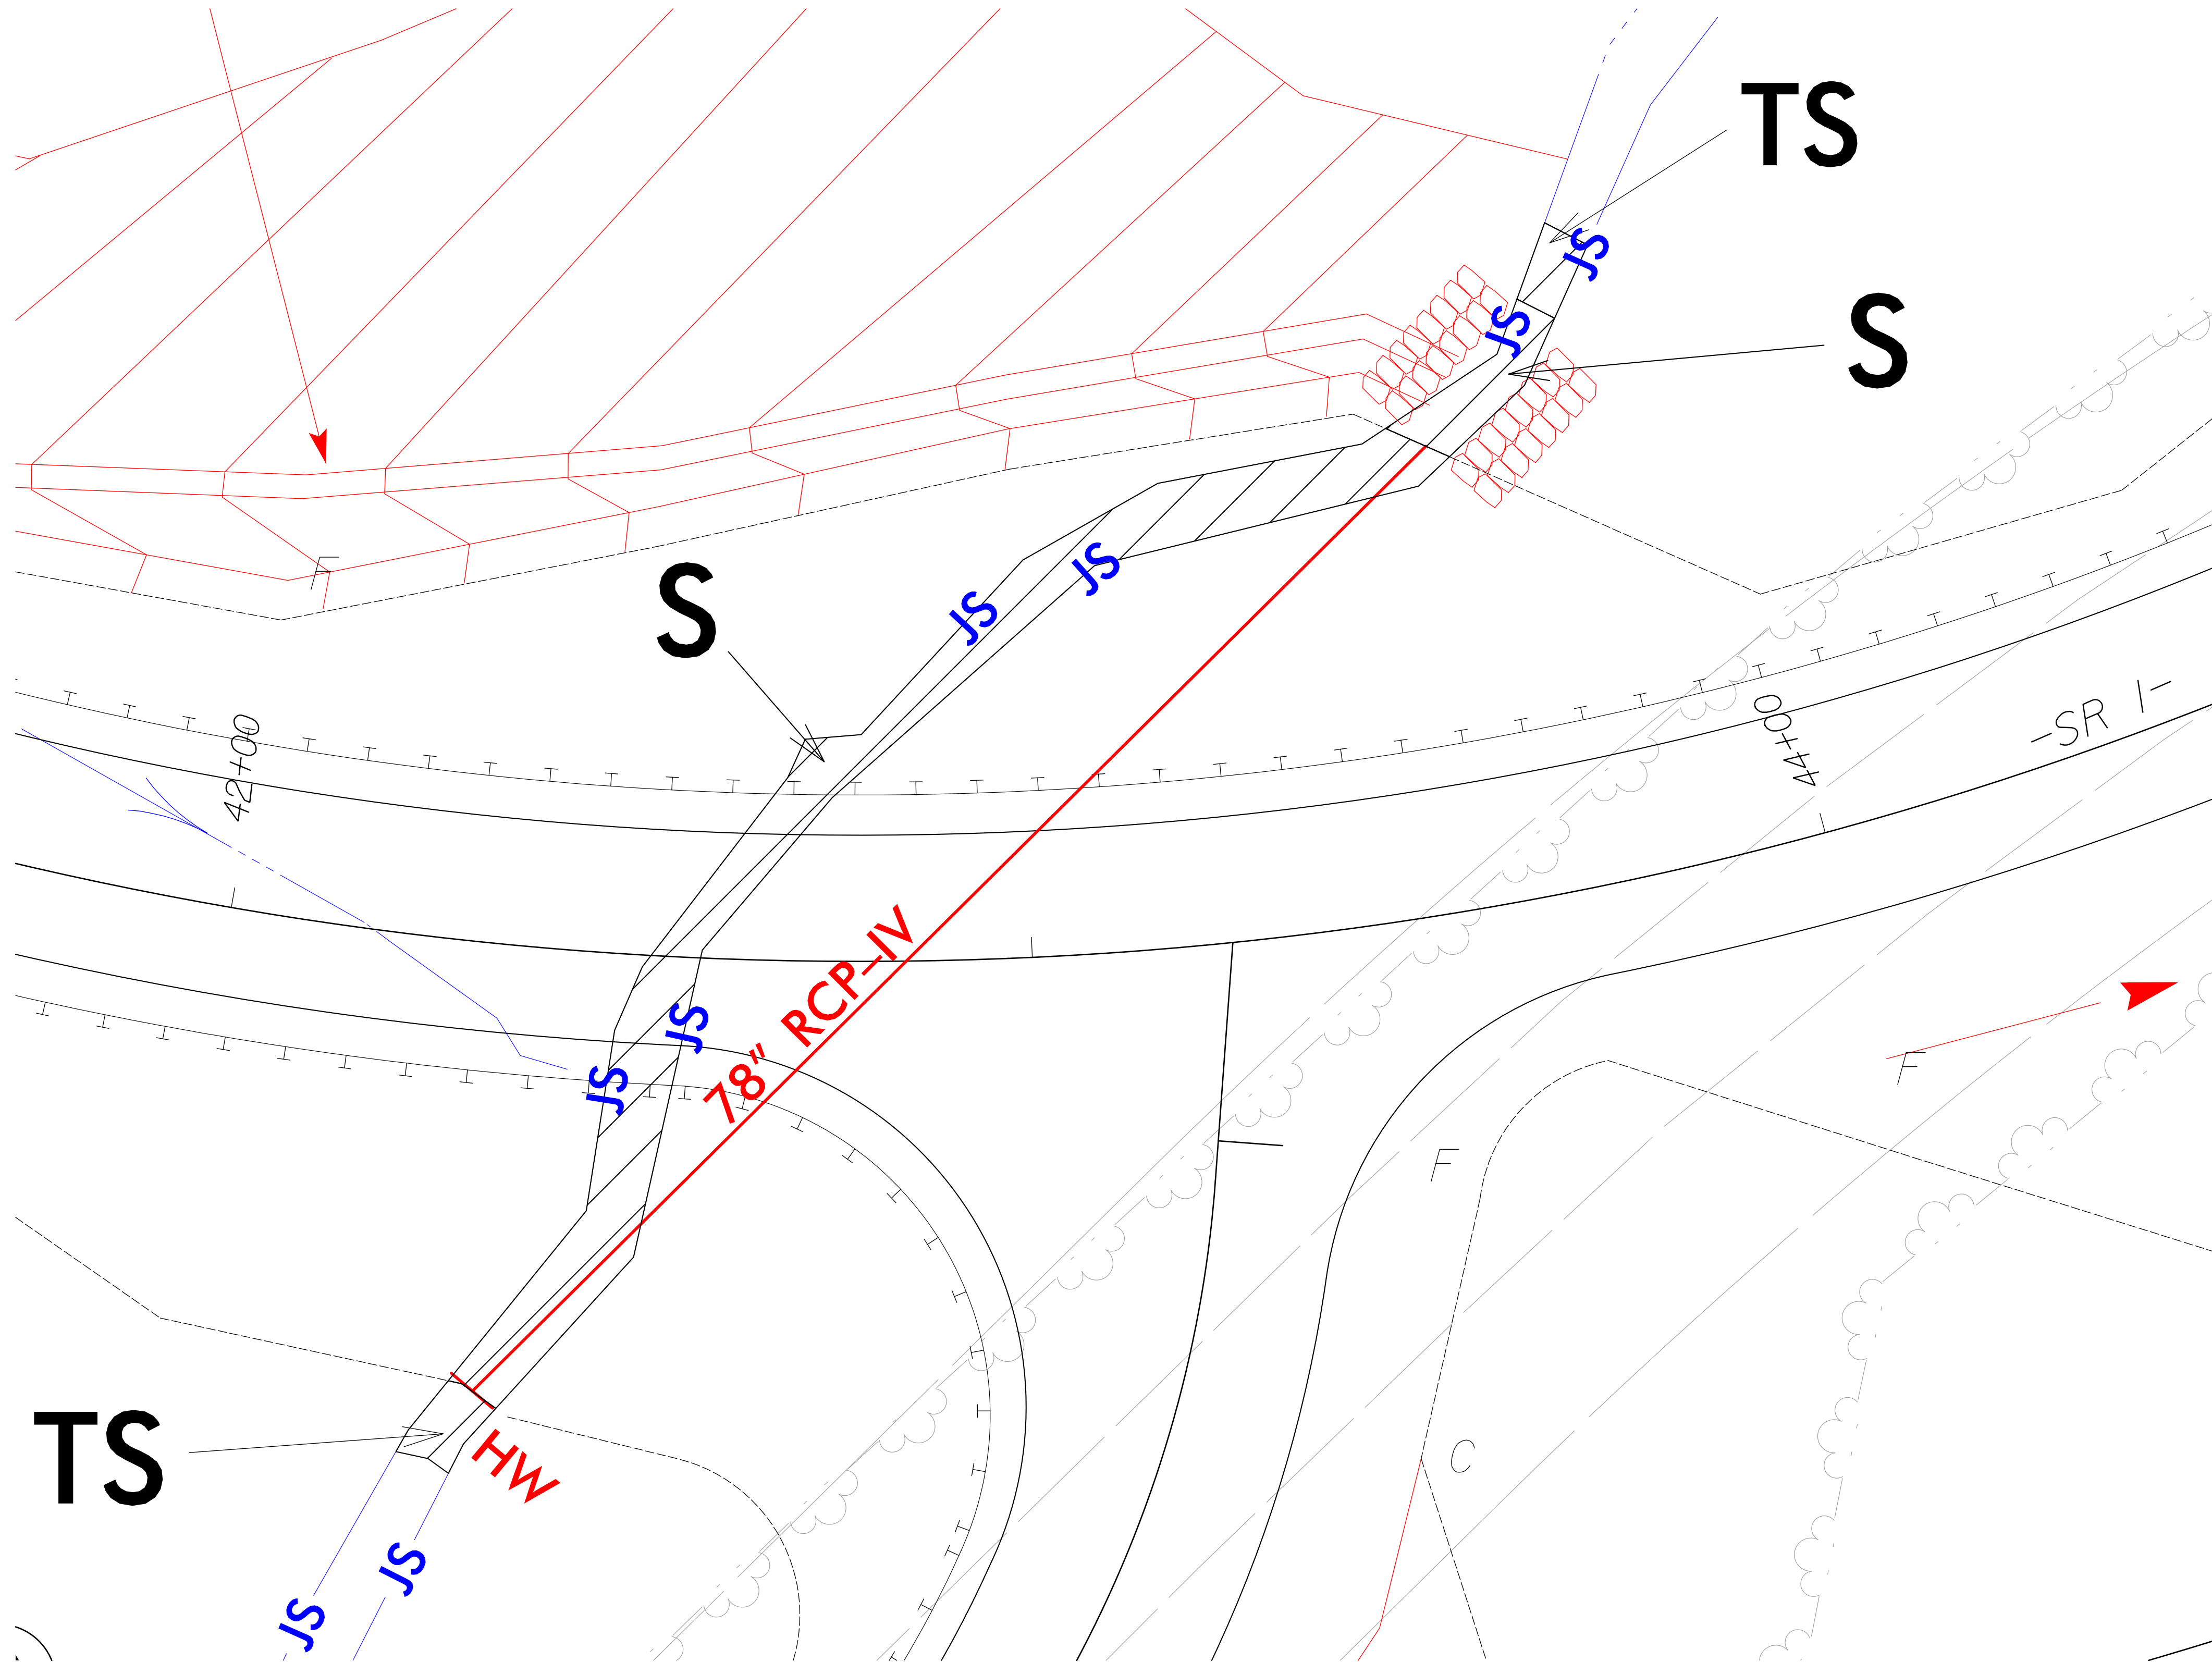

DENOTES IMPACTS IN
SURFACE WATER



DENOTES TEMPORARY
IMPACTS IN SURFACE WATER

PERMIT DRAWING
SHEET 60 OF 71


PROJECT REFERENCE NO.	SHEET NO.
R-3421B	21
RW SHEET NO.	
ROADWAY DESIGN ENGINEER	HYDRAULICS ENGINEER
INCOMPLETE PLANS DO NOT USE FOR R/W ACQUISITION	
PRELIMINARY PLANS DO NOT USE FOR CONSTRUCTION	

SITE 2


ENLARGEMENT

PROJECT REFERENCE NO.	SHEET NO.
R-3421B	21
RW SHEET NO.	
ROADWAY DESIGN ENGINEER	HYDRAULICS ENGINEER
INCOMPLETE PLANS DO NOT USE FOR R/W ACQUISITION	
PRELIMINARY PLANS DO NOT USE FOR CONSTRUCTION	

PERMIT DRAWING
SHEET 61 OF 71

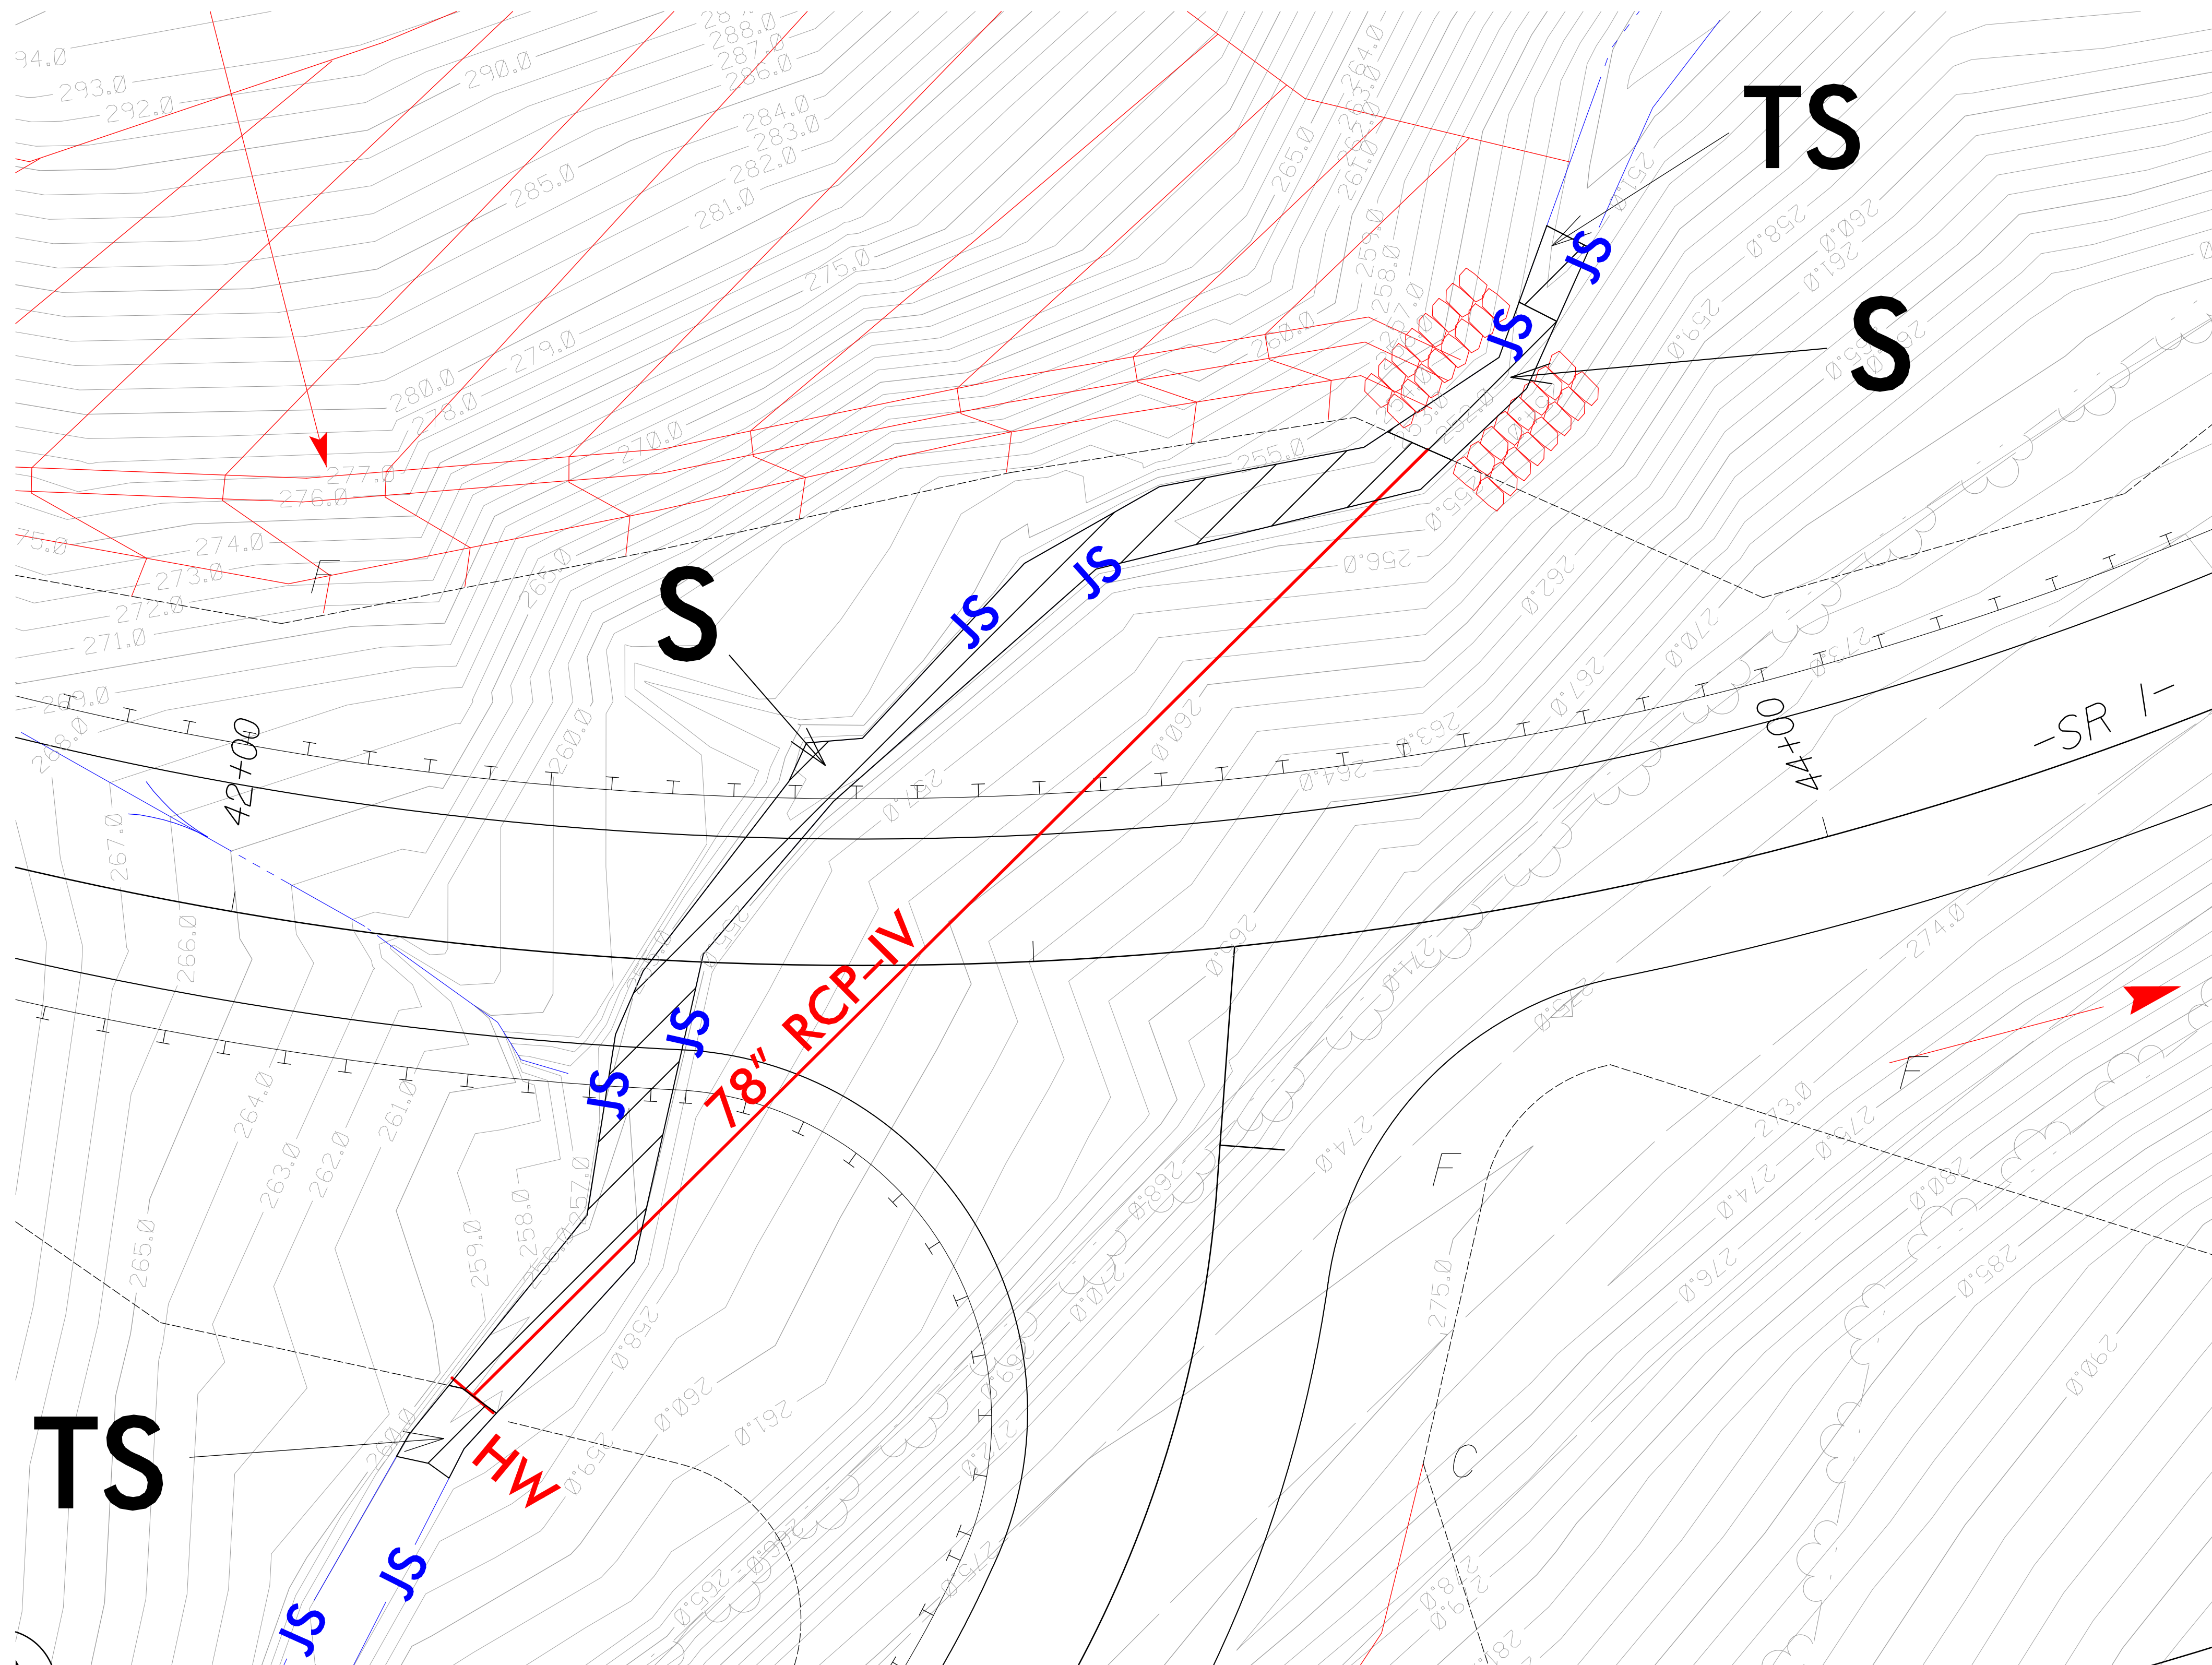


\$DATES
\$(USERNAME)\$
\$FILEL\$

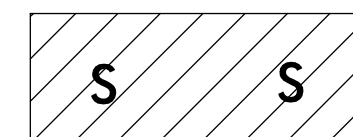

DENOTES IMPACTS IN
SURFACE WATER



DENOTES TEMPORARY
IMPACTS IN SURFACE WATER

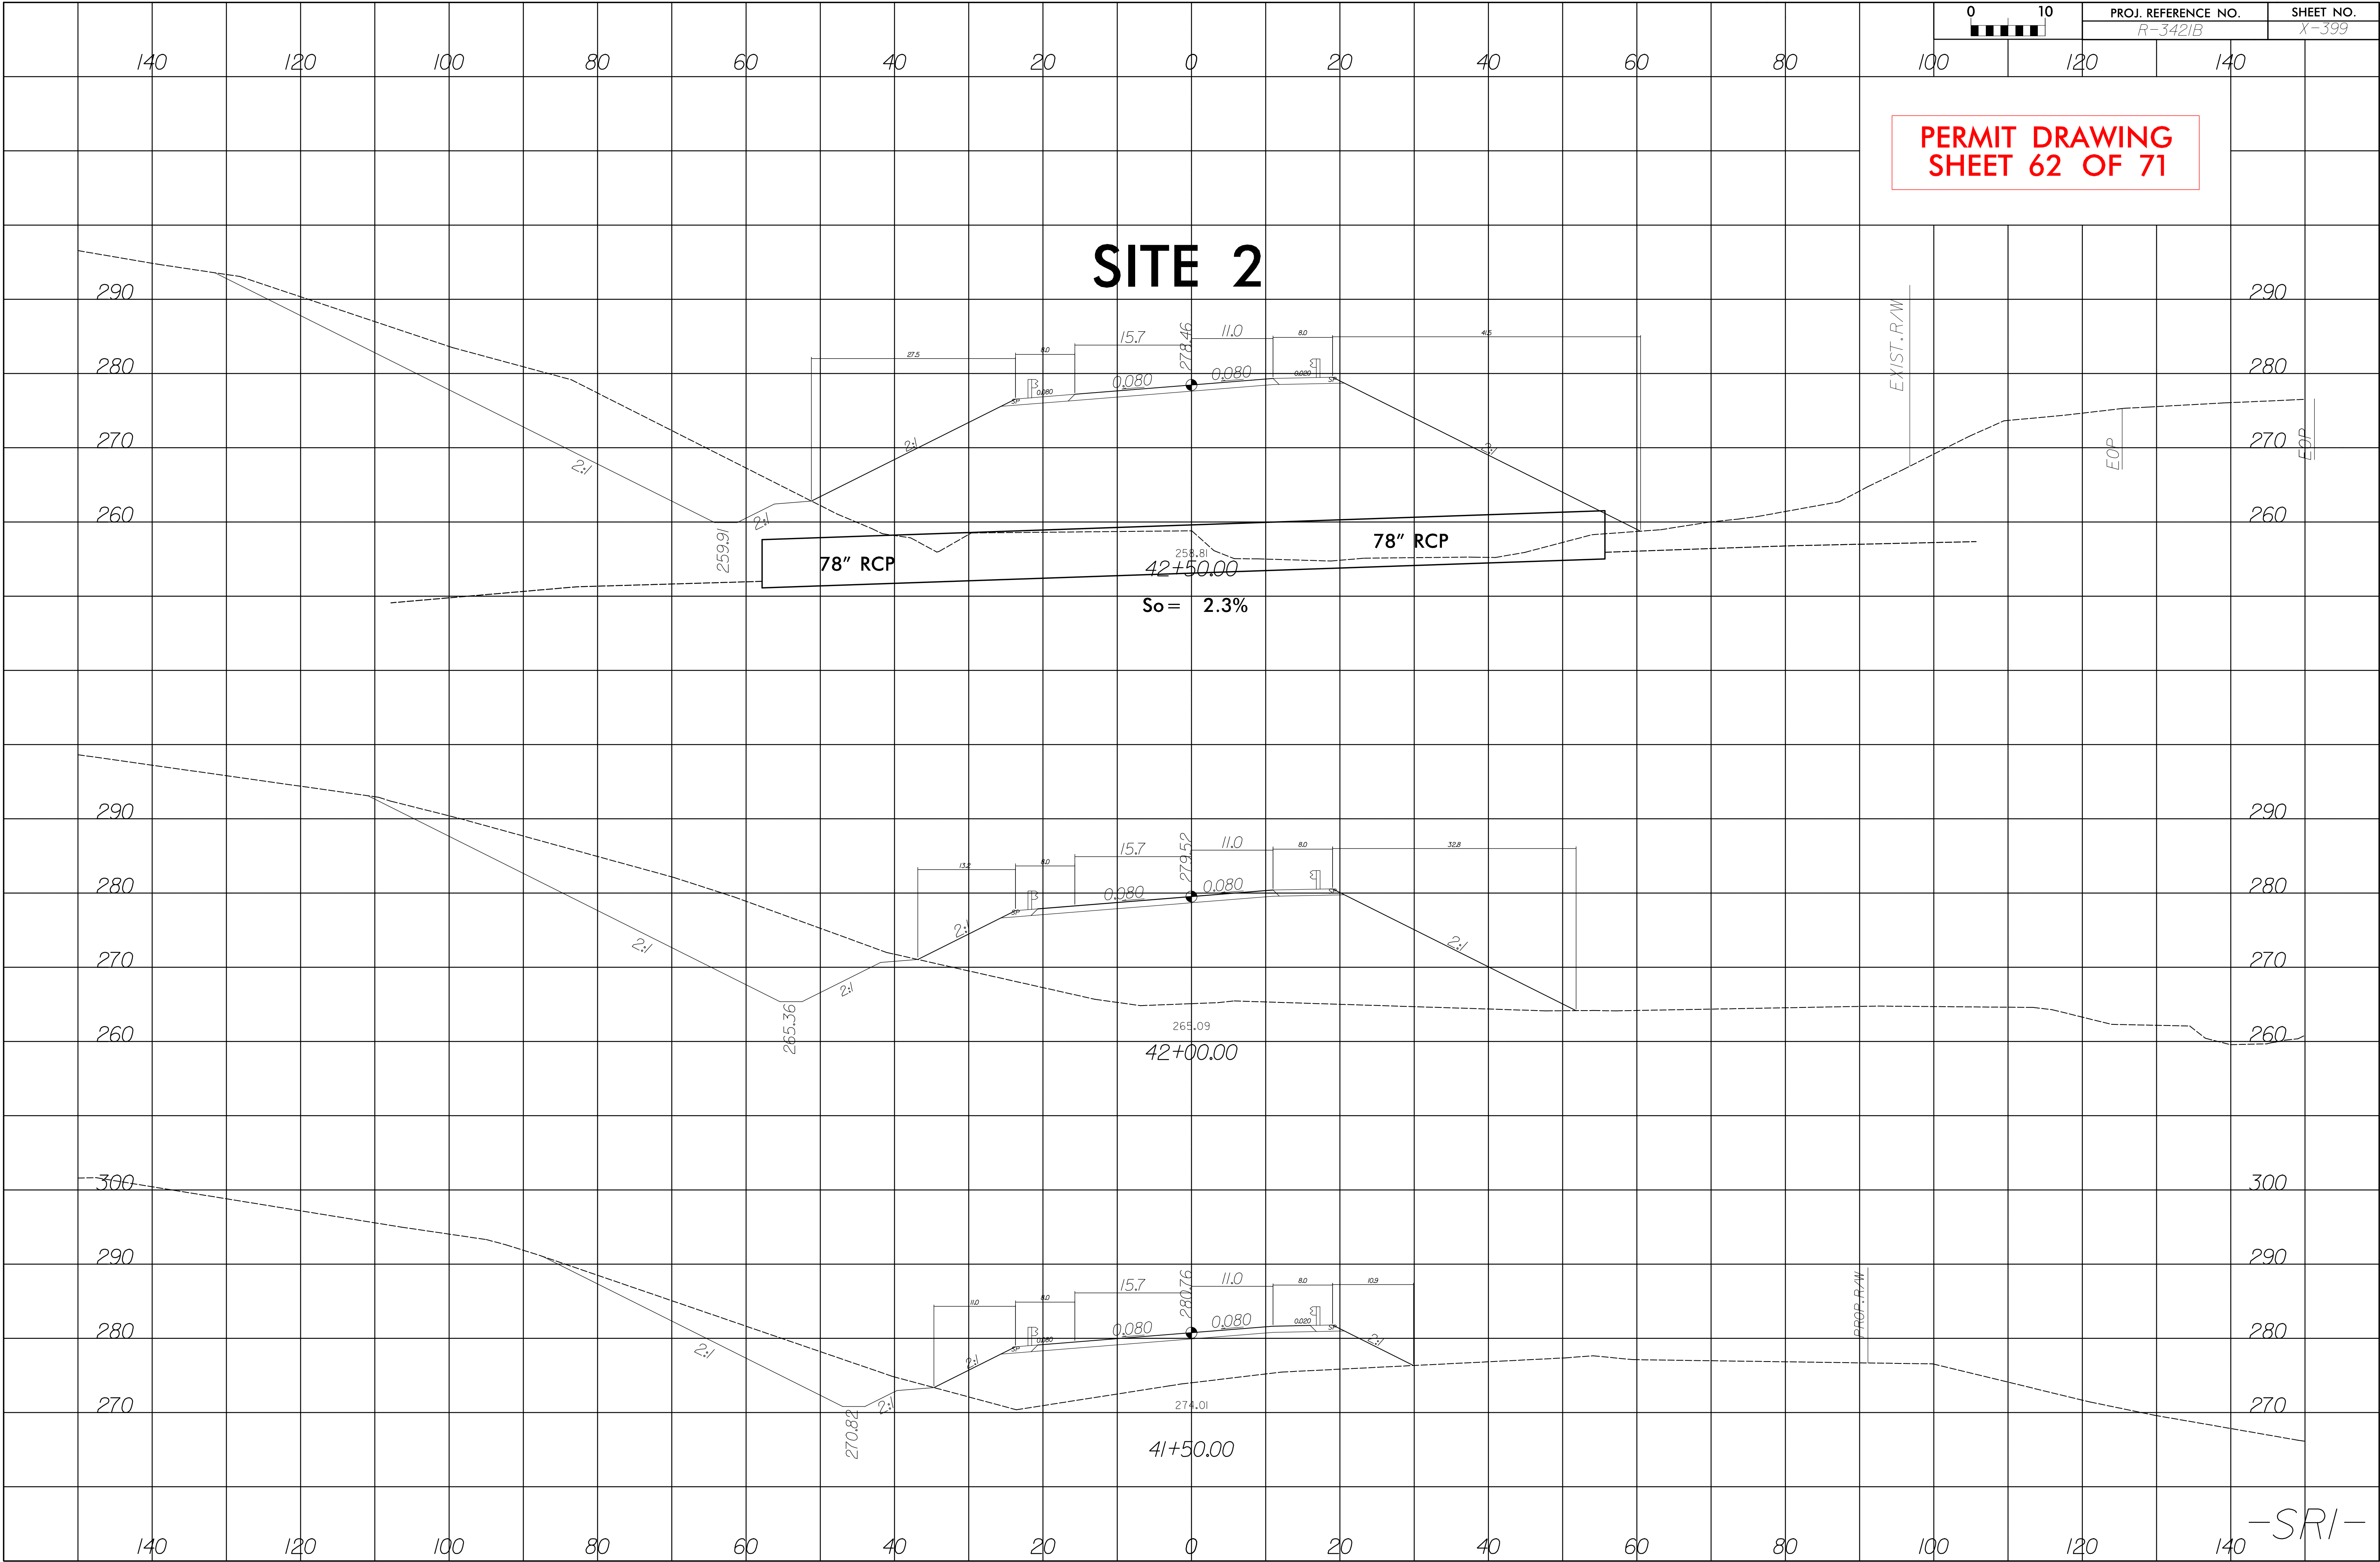

SITE 2A

ENLARGEMENT

STANDARD BASE DITCH
SEE DETAIL "AH"

REMOVE

MH


66" RCP-IV

TS

TS

TOE PROTECTION

PERMIT DRAWING
SHEET 63 OF 71

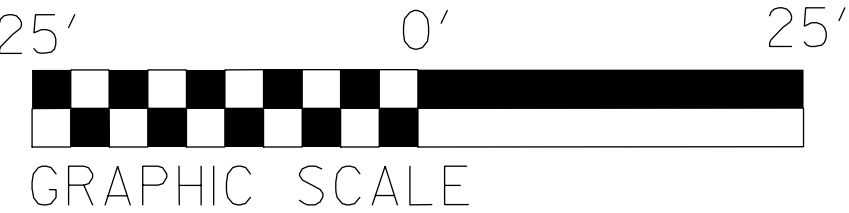

DENOTES TEMPORARY
IMPACTS IN SURFACE WATER

NAD 83
GRID 95

REVISIONS

8/17/99

7:24:46 AM R:\Hydraulics\PERMITS\Environmental\Drawings\R3421B\Drawings\R3421B_Hyd_prm_wet_psh2L_enlarge_site2a_20150902.dgn


\$DATE\$
\$(USERNAME)\$
\$FILE\$

SITE 2A



ENLARGEMENT

PROJECT REFERENCE NO.	SHEET NO.
R-3421B	21
RW SHEET NO.	
ROADWAY DESIGN ENGINEER	HYDRAULICS ENGINEER
INCOMPLETE PLANS DO NOT USE FOR R/W ACQUISITION	
PRELIMINARY PLANS DO NOT USE FOR CONSTRUCTION	

PERMIT DRAWING
SHEET 64 OF 71

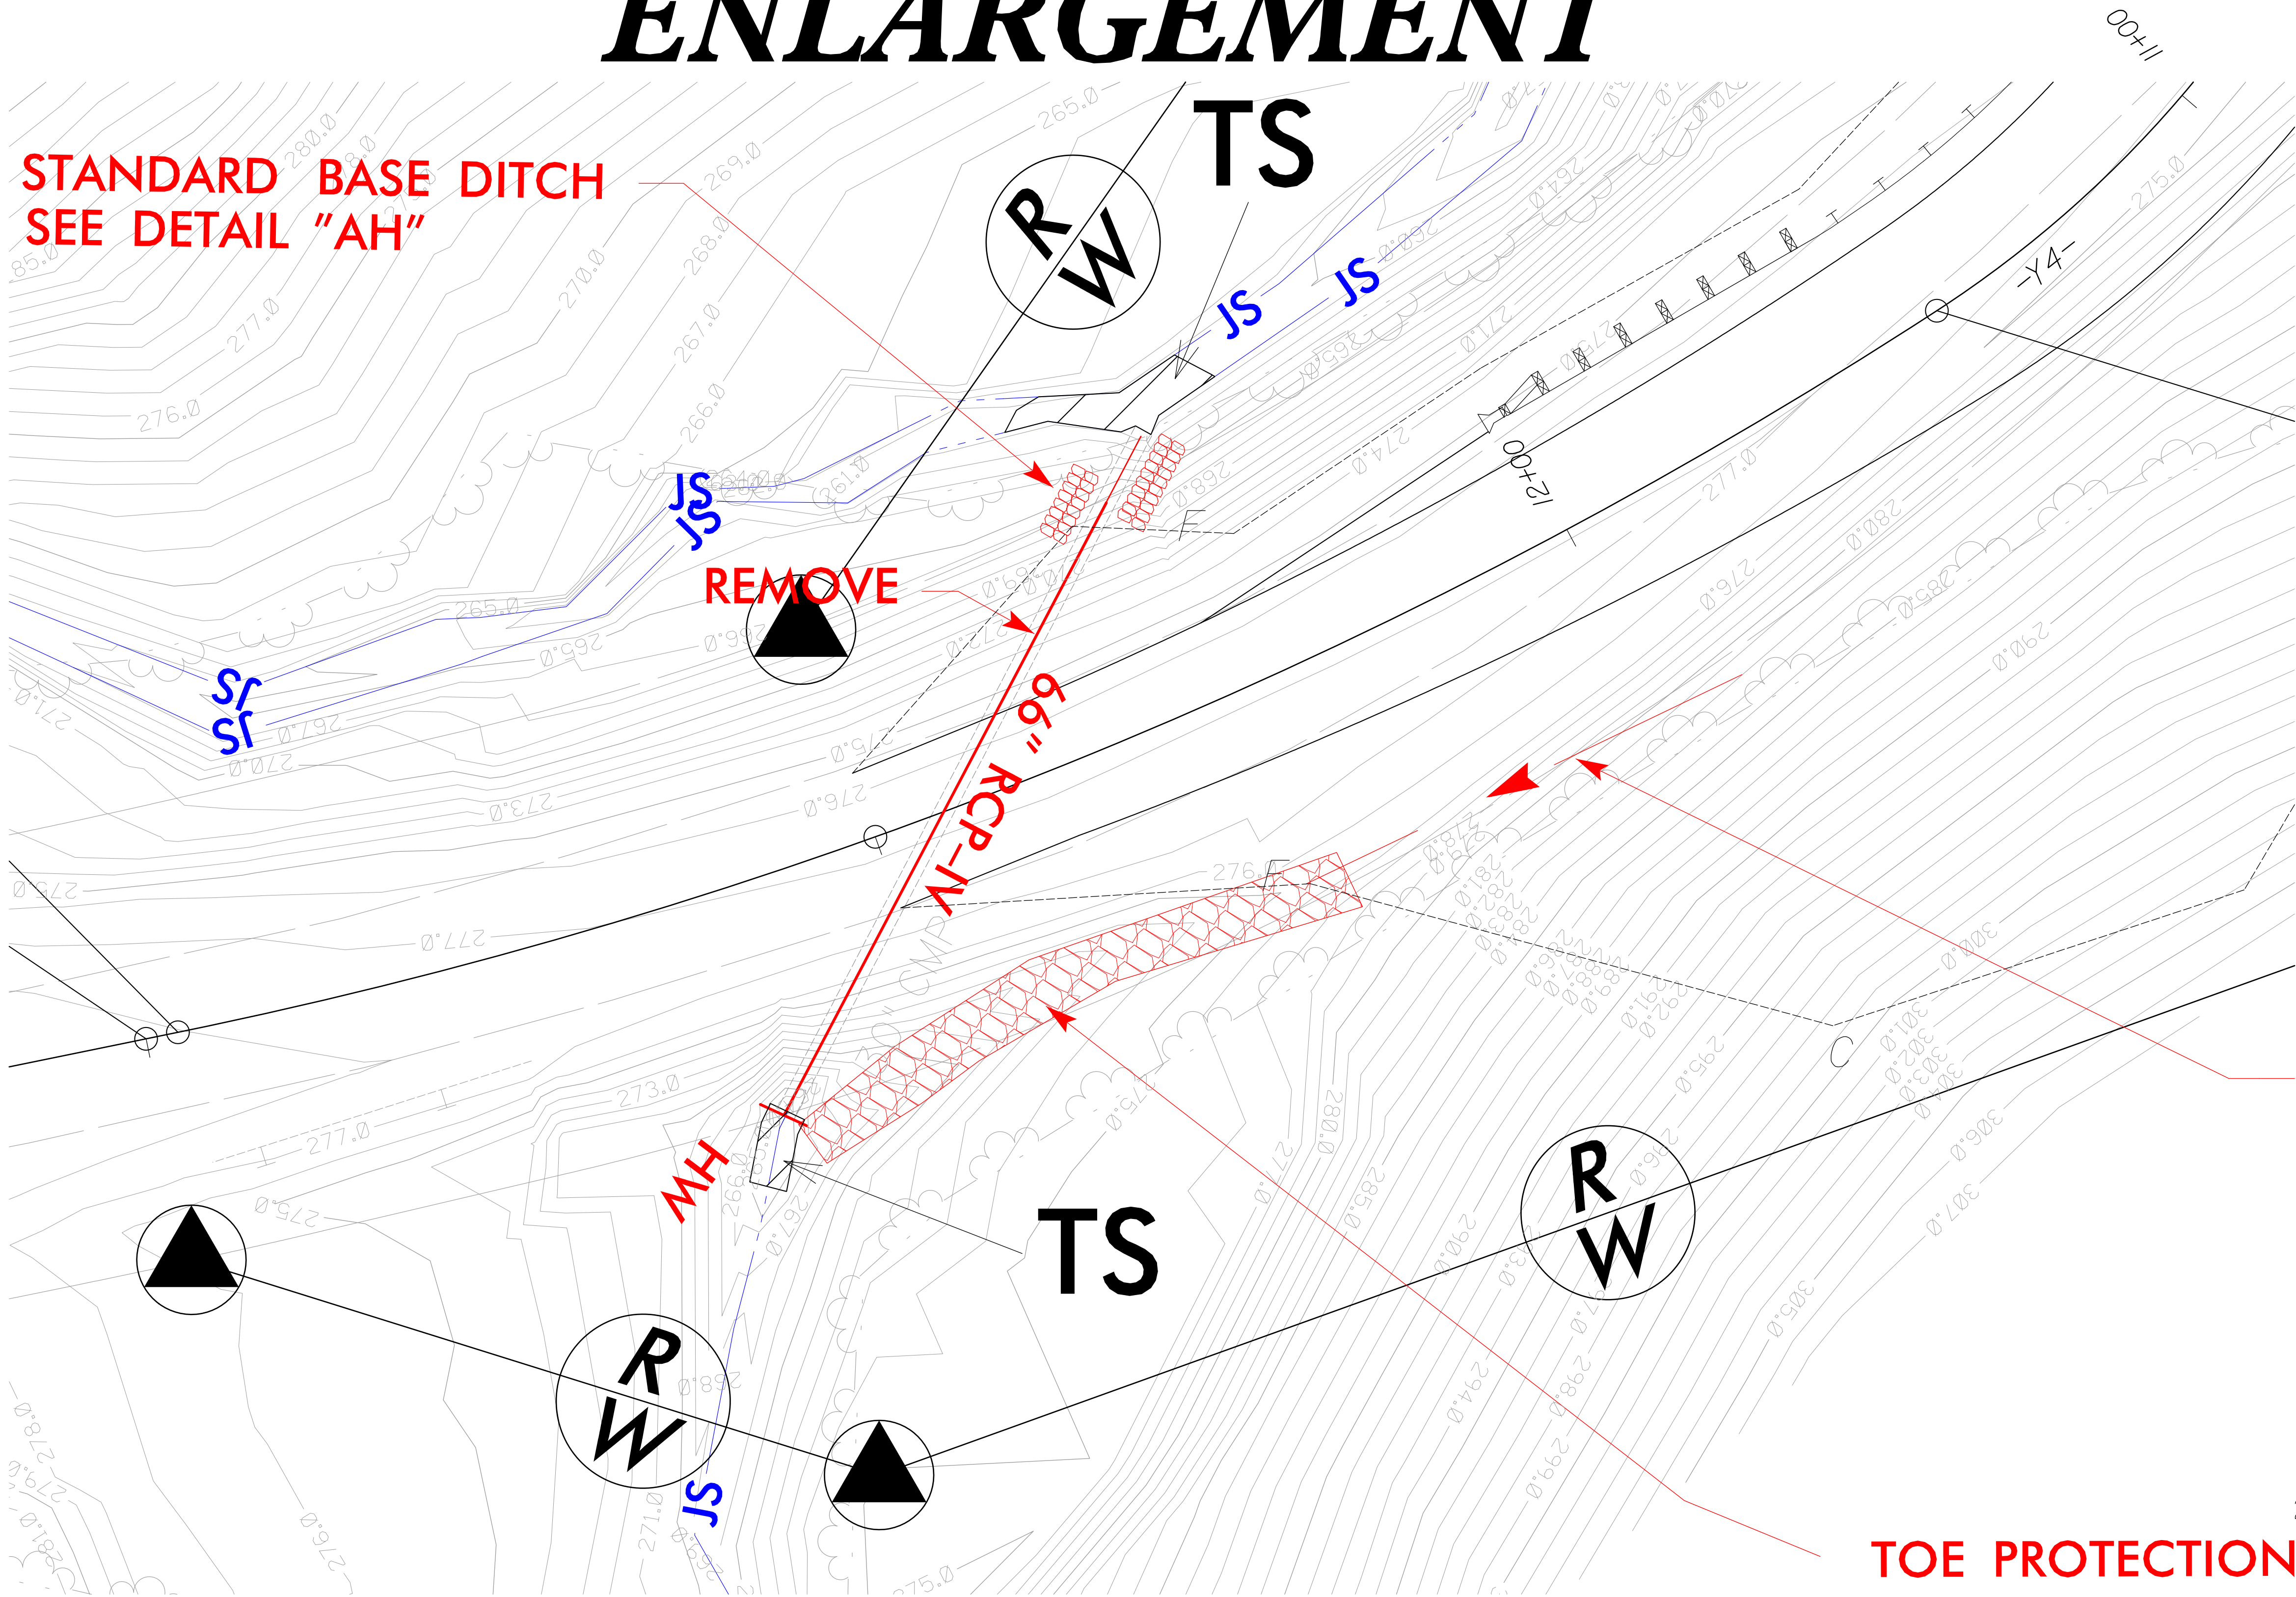


TOE PROTECTION

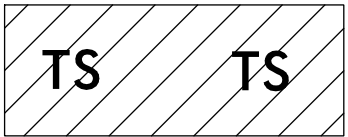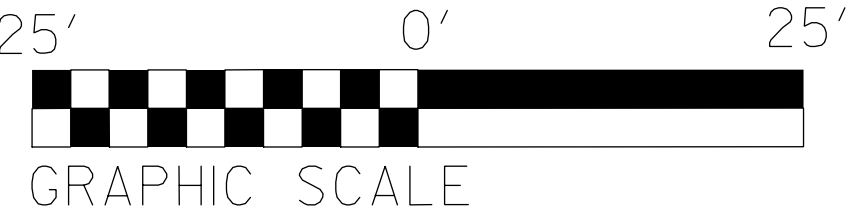

DENOTES TEMPORARY
IMPACTS IN SURFACE WATER

REVISIONS

\$DATES\$
\$(USERNAME)\$
\$FILE\$

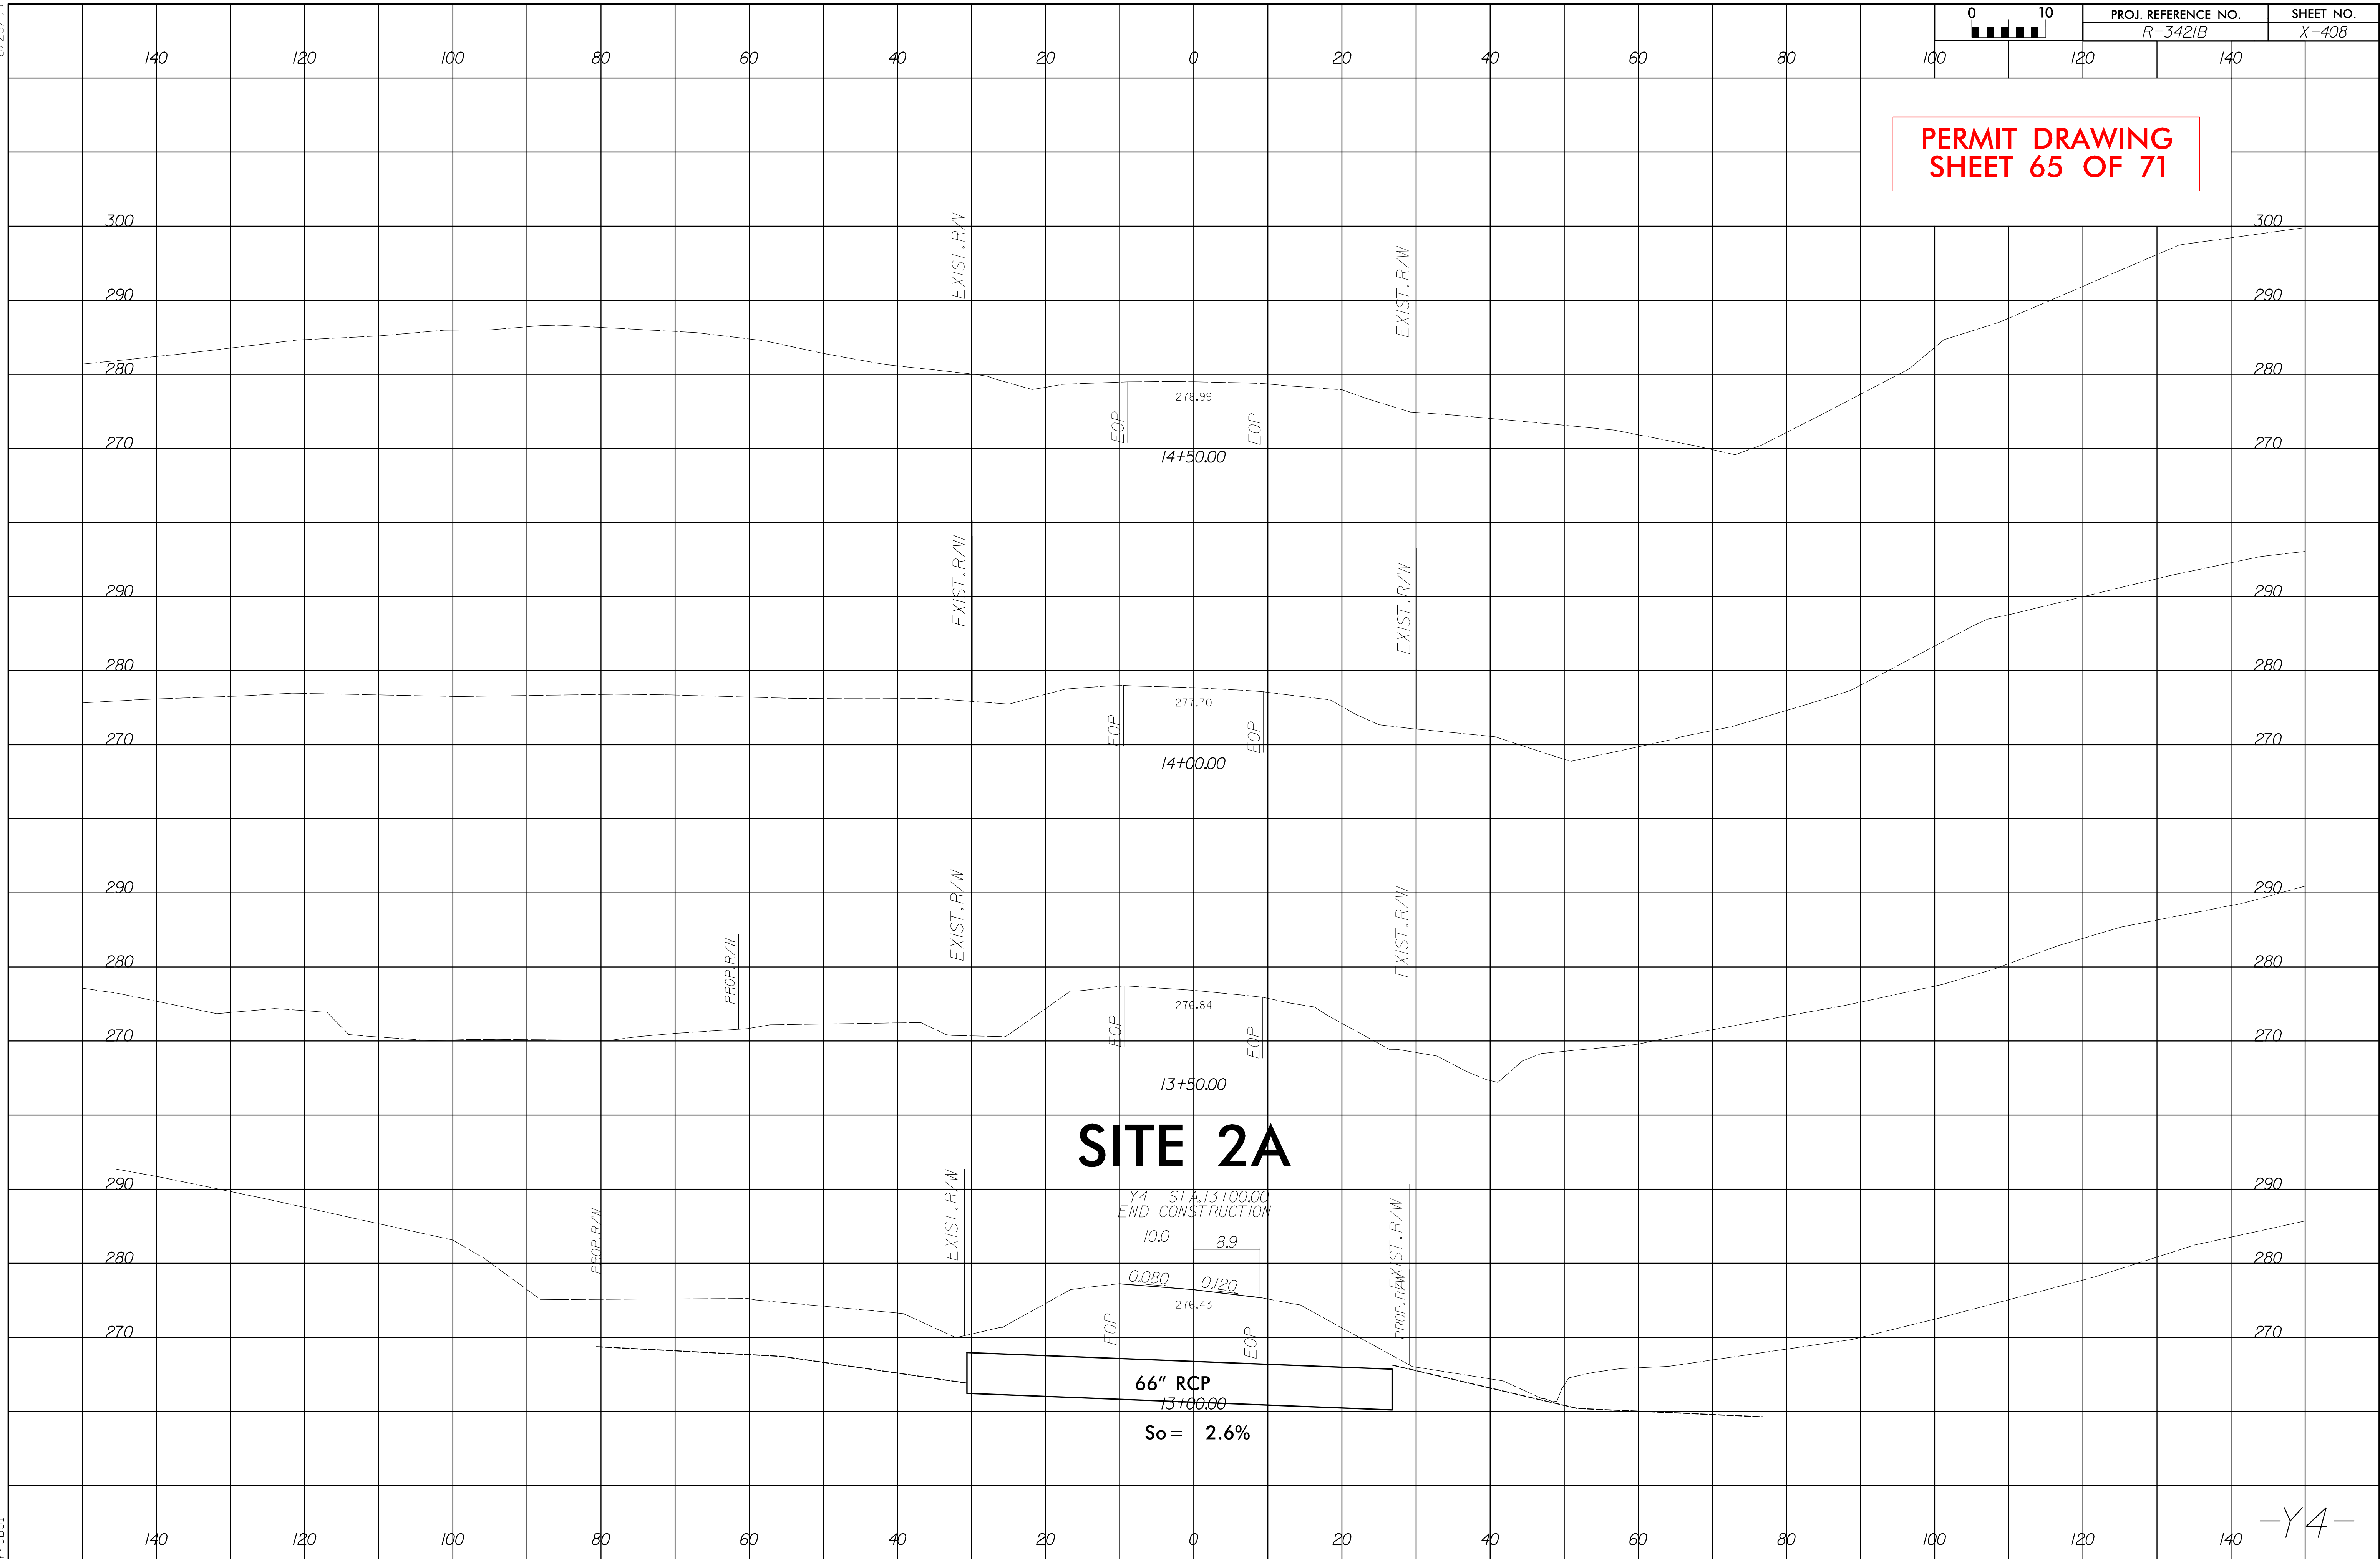

8/17/99

7:25:07 AM
R:\Hydraulics\PERMITS\Environmental\Drawings\R3421B\R3421B_Hyd_prm_wet_psh23_20150327_con.dgn

SDATES
S(USERNAME)S
SFILES

REVISIONS

MULKEY
ENGINEERS & CONSULTANTS
PO Box 33127
Raleigh, N.C. 27636
919 851-1111
919 851-1918 (FAX)
WWW.MULKEYINC.COM

PROJECT REFERENCE NO. SHEET NO.

R-3421B 23

R/W SHEET NO.


ROADWAY DESIGN
ENGINEER

HYDRAULICS
ENGINEER

INCOMPLETE PLANS
DO NOT USE FOR R/W ACQUISITION

PRELIMINARY PLANS
DO NOT USE FOR CONSTRUCTION

PERMIT DRAWING
SHEET 67 OF 71

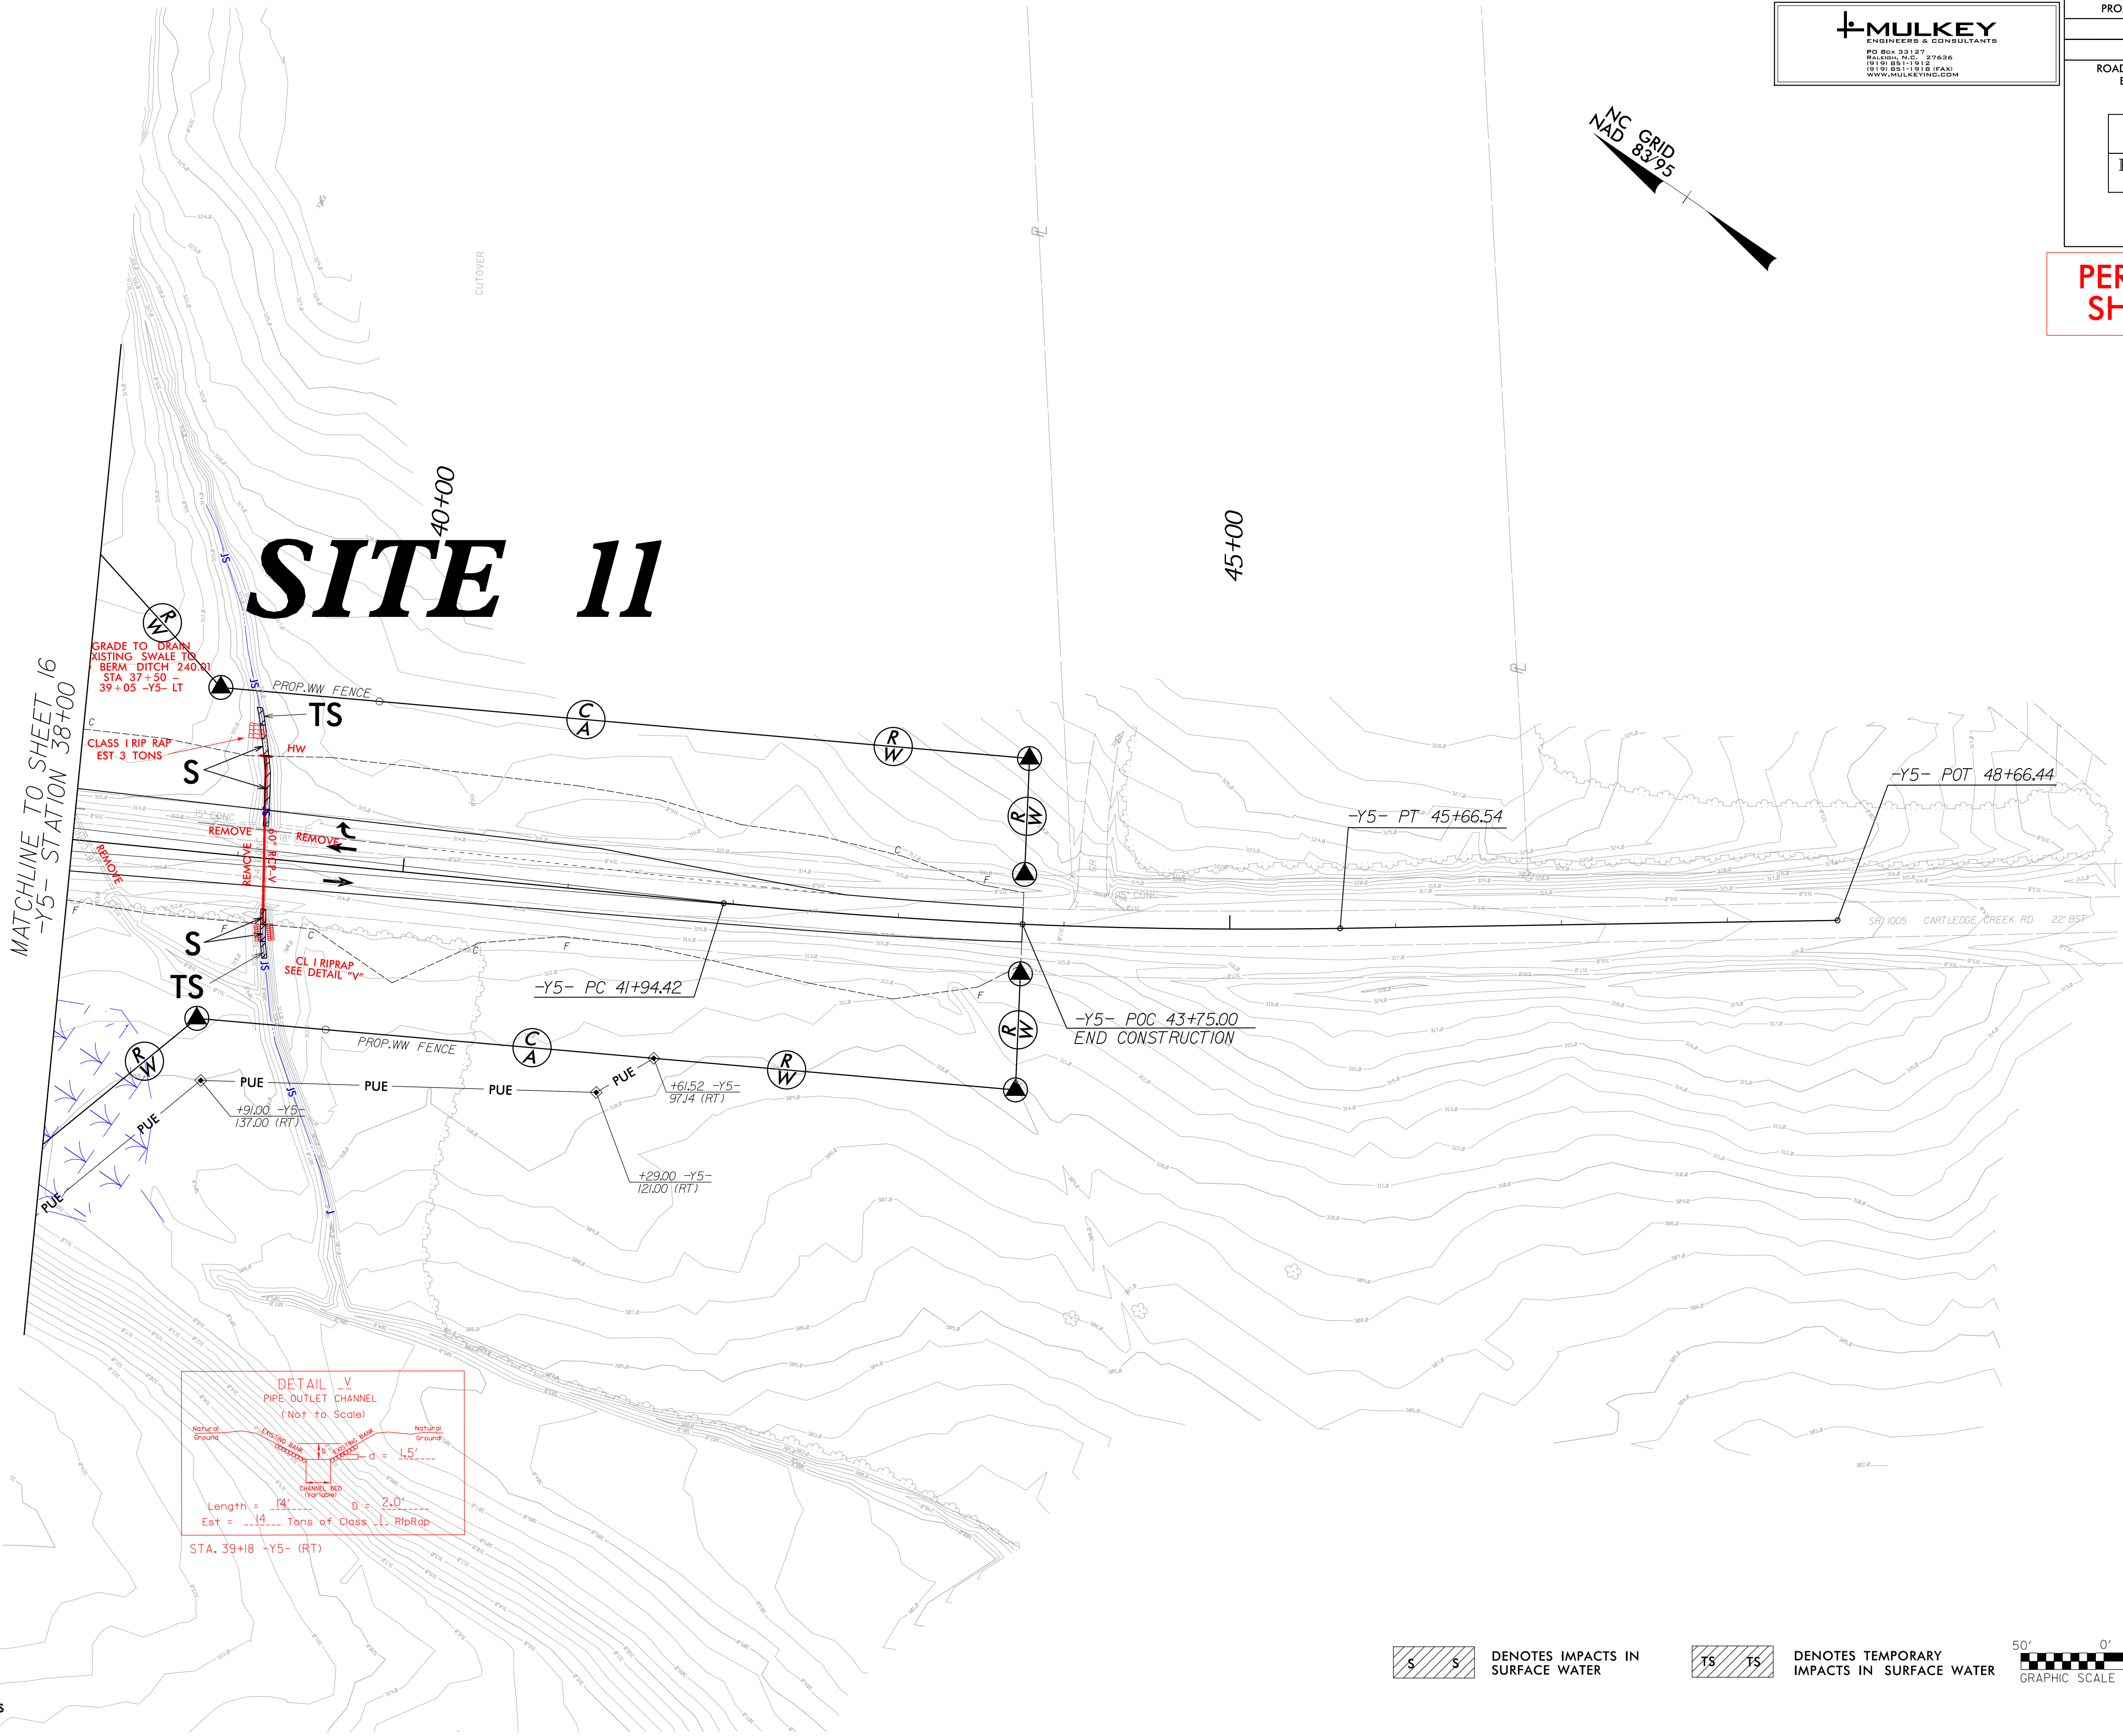

8/17/99

REVISIONS

7:25:11 AM R:\Hydraulics\PERMITS-Environmental\Drawings\R3421B\Drawings\R3421B_Hyd_prm_wet_psh23.enlarge sitell.20150624.dgn




\$DATE\$
\$(USERNAME)\$
\$FILEL\$

SITE 11 ENLARGEMENT


NC GRID
NAD 83/95

PROJECT REFERENCE NO.	SHEET NO.
R-3421B	23
RW SHEET NO.	
ROADWAY DESIGN ENGINEER	HYDRAULICS ENGINEER
INCOMPLETE PLANS DO NOT USE FOR R/W ACQUISITION	
PRELIMINARY PLANS DO NOT USE FOR CONSTRUCTION	

PERMIT DRAWING
SHEET 68 OF 71

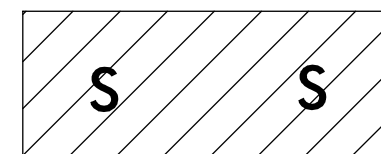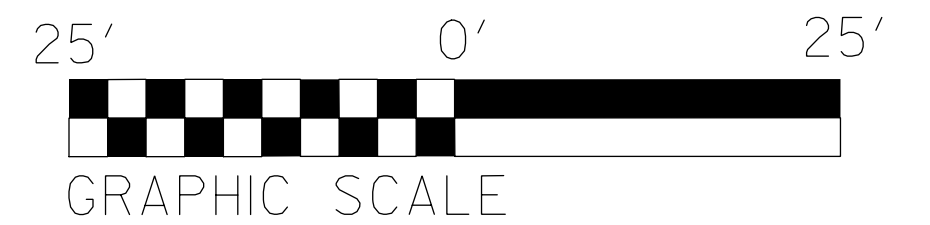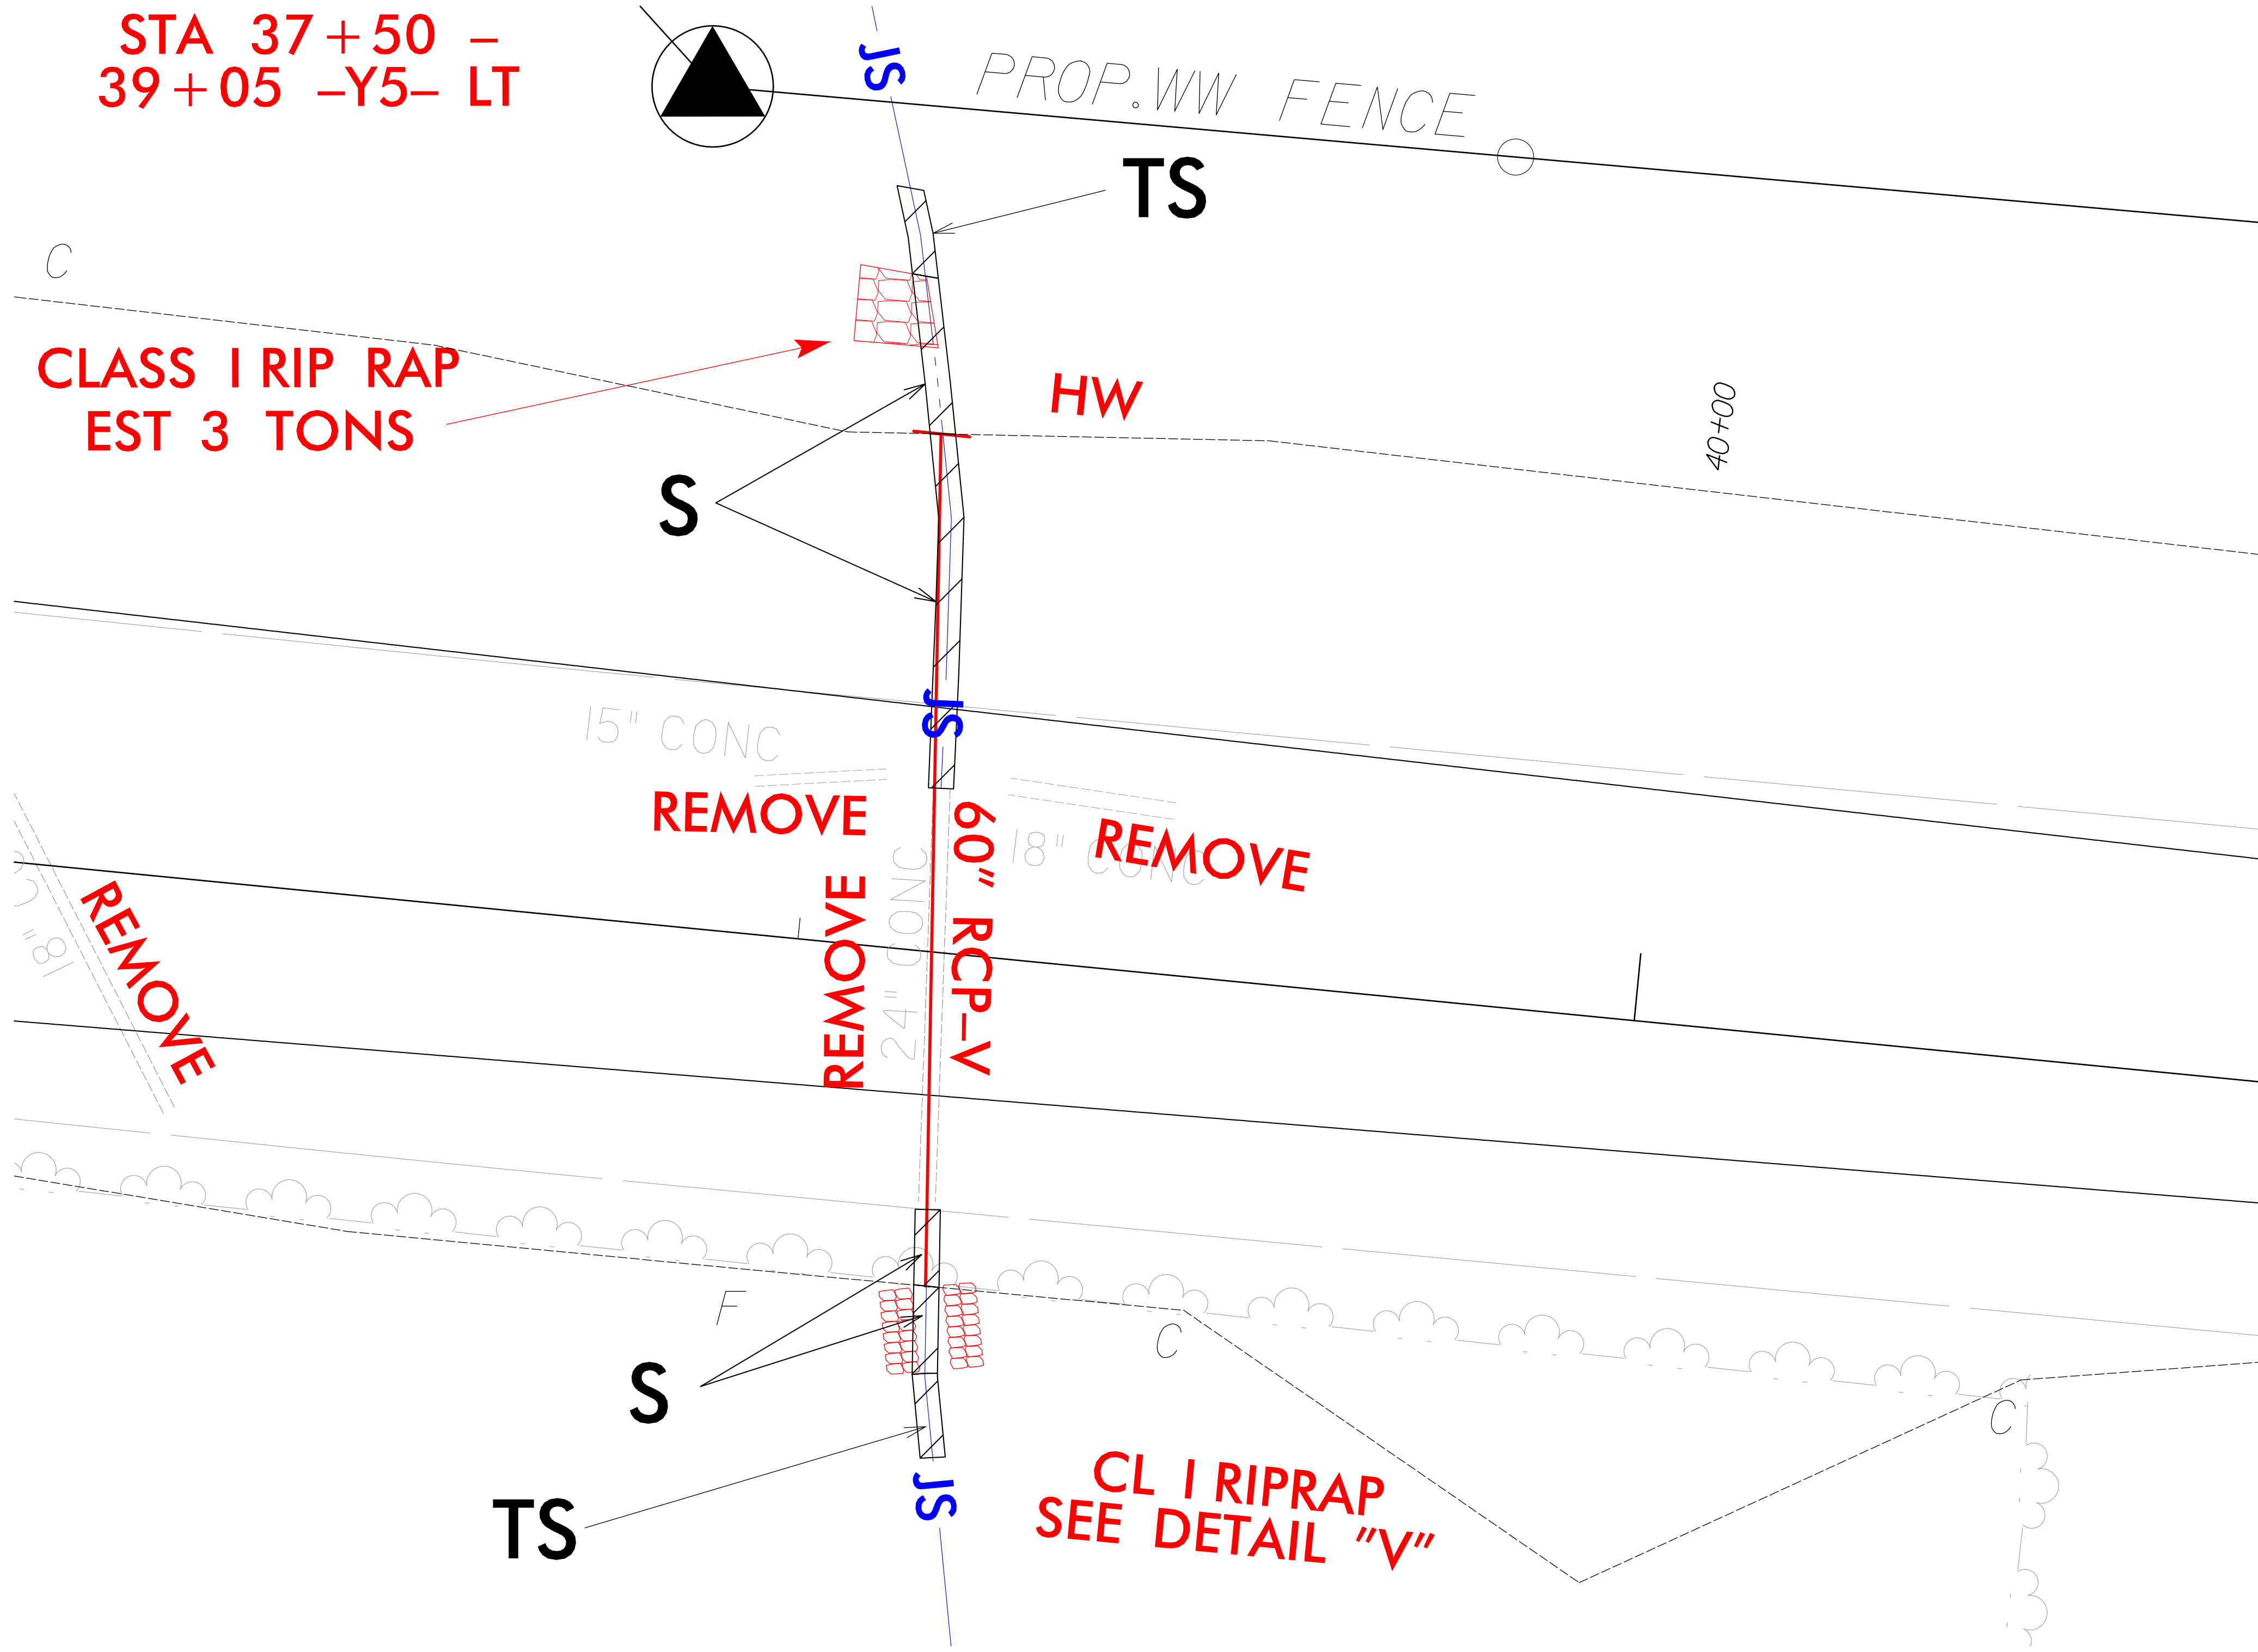

DENOTES IMPACTS IN
SURFACE WATER

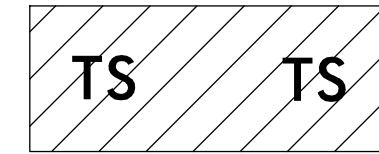

DENOTES TEMPORARY
IMPACTS IN SURFACE WATER

8/17/99

REVISIONS

7:25:15 AM R:\Hydraulics\PERMITS\Environmental\Drawings\R3421B\Drawings\R3421B_Hyd_prm_wet_psh23.enlarge sitel1.20150624.con.dgn




\$DATES\$
\$(USERNAME)\$
\$FILEL\$

SITE 11 ENLARGEMENT

NC GRID
NAD 83/95

PROJECT REFERENCE NO.	SHEET NO.
R-3421B	23
RW SHEET NO.	
ROADWAY DESIGN ENGINEER	HYDRAULICS ENGINEER
INCOMPLETE PLANS DO NOT USE FOR R/W ACQUISITION	
PRELIMINARY PLANS DO NOT USE FOR CONSTRUCTION	


PERMIT DRAWING
SHEET 69 OF 71

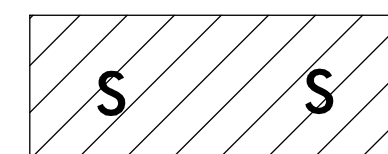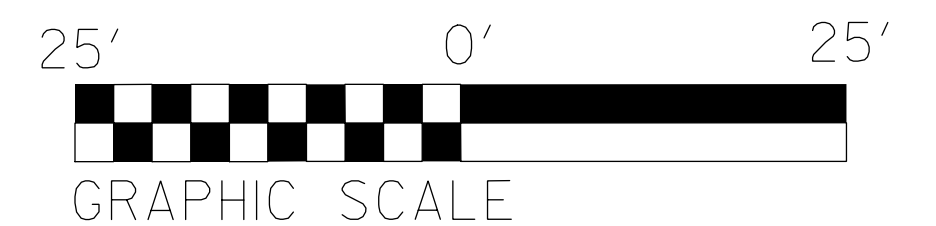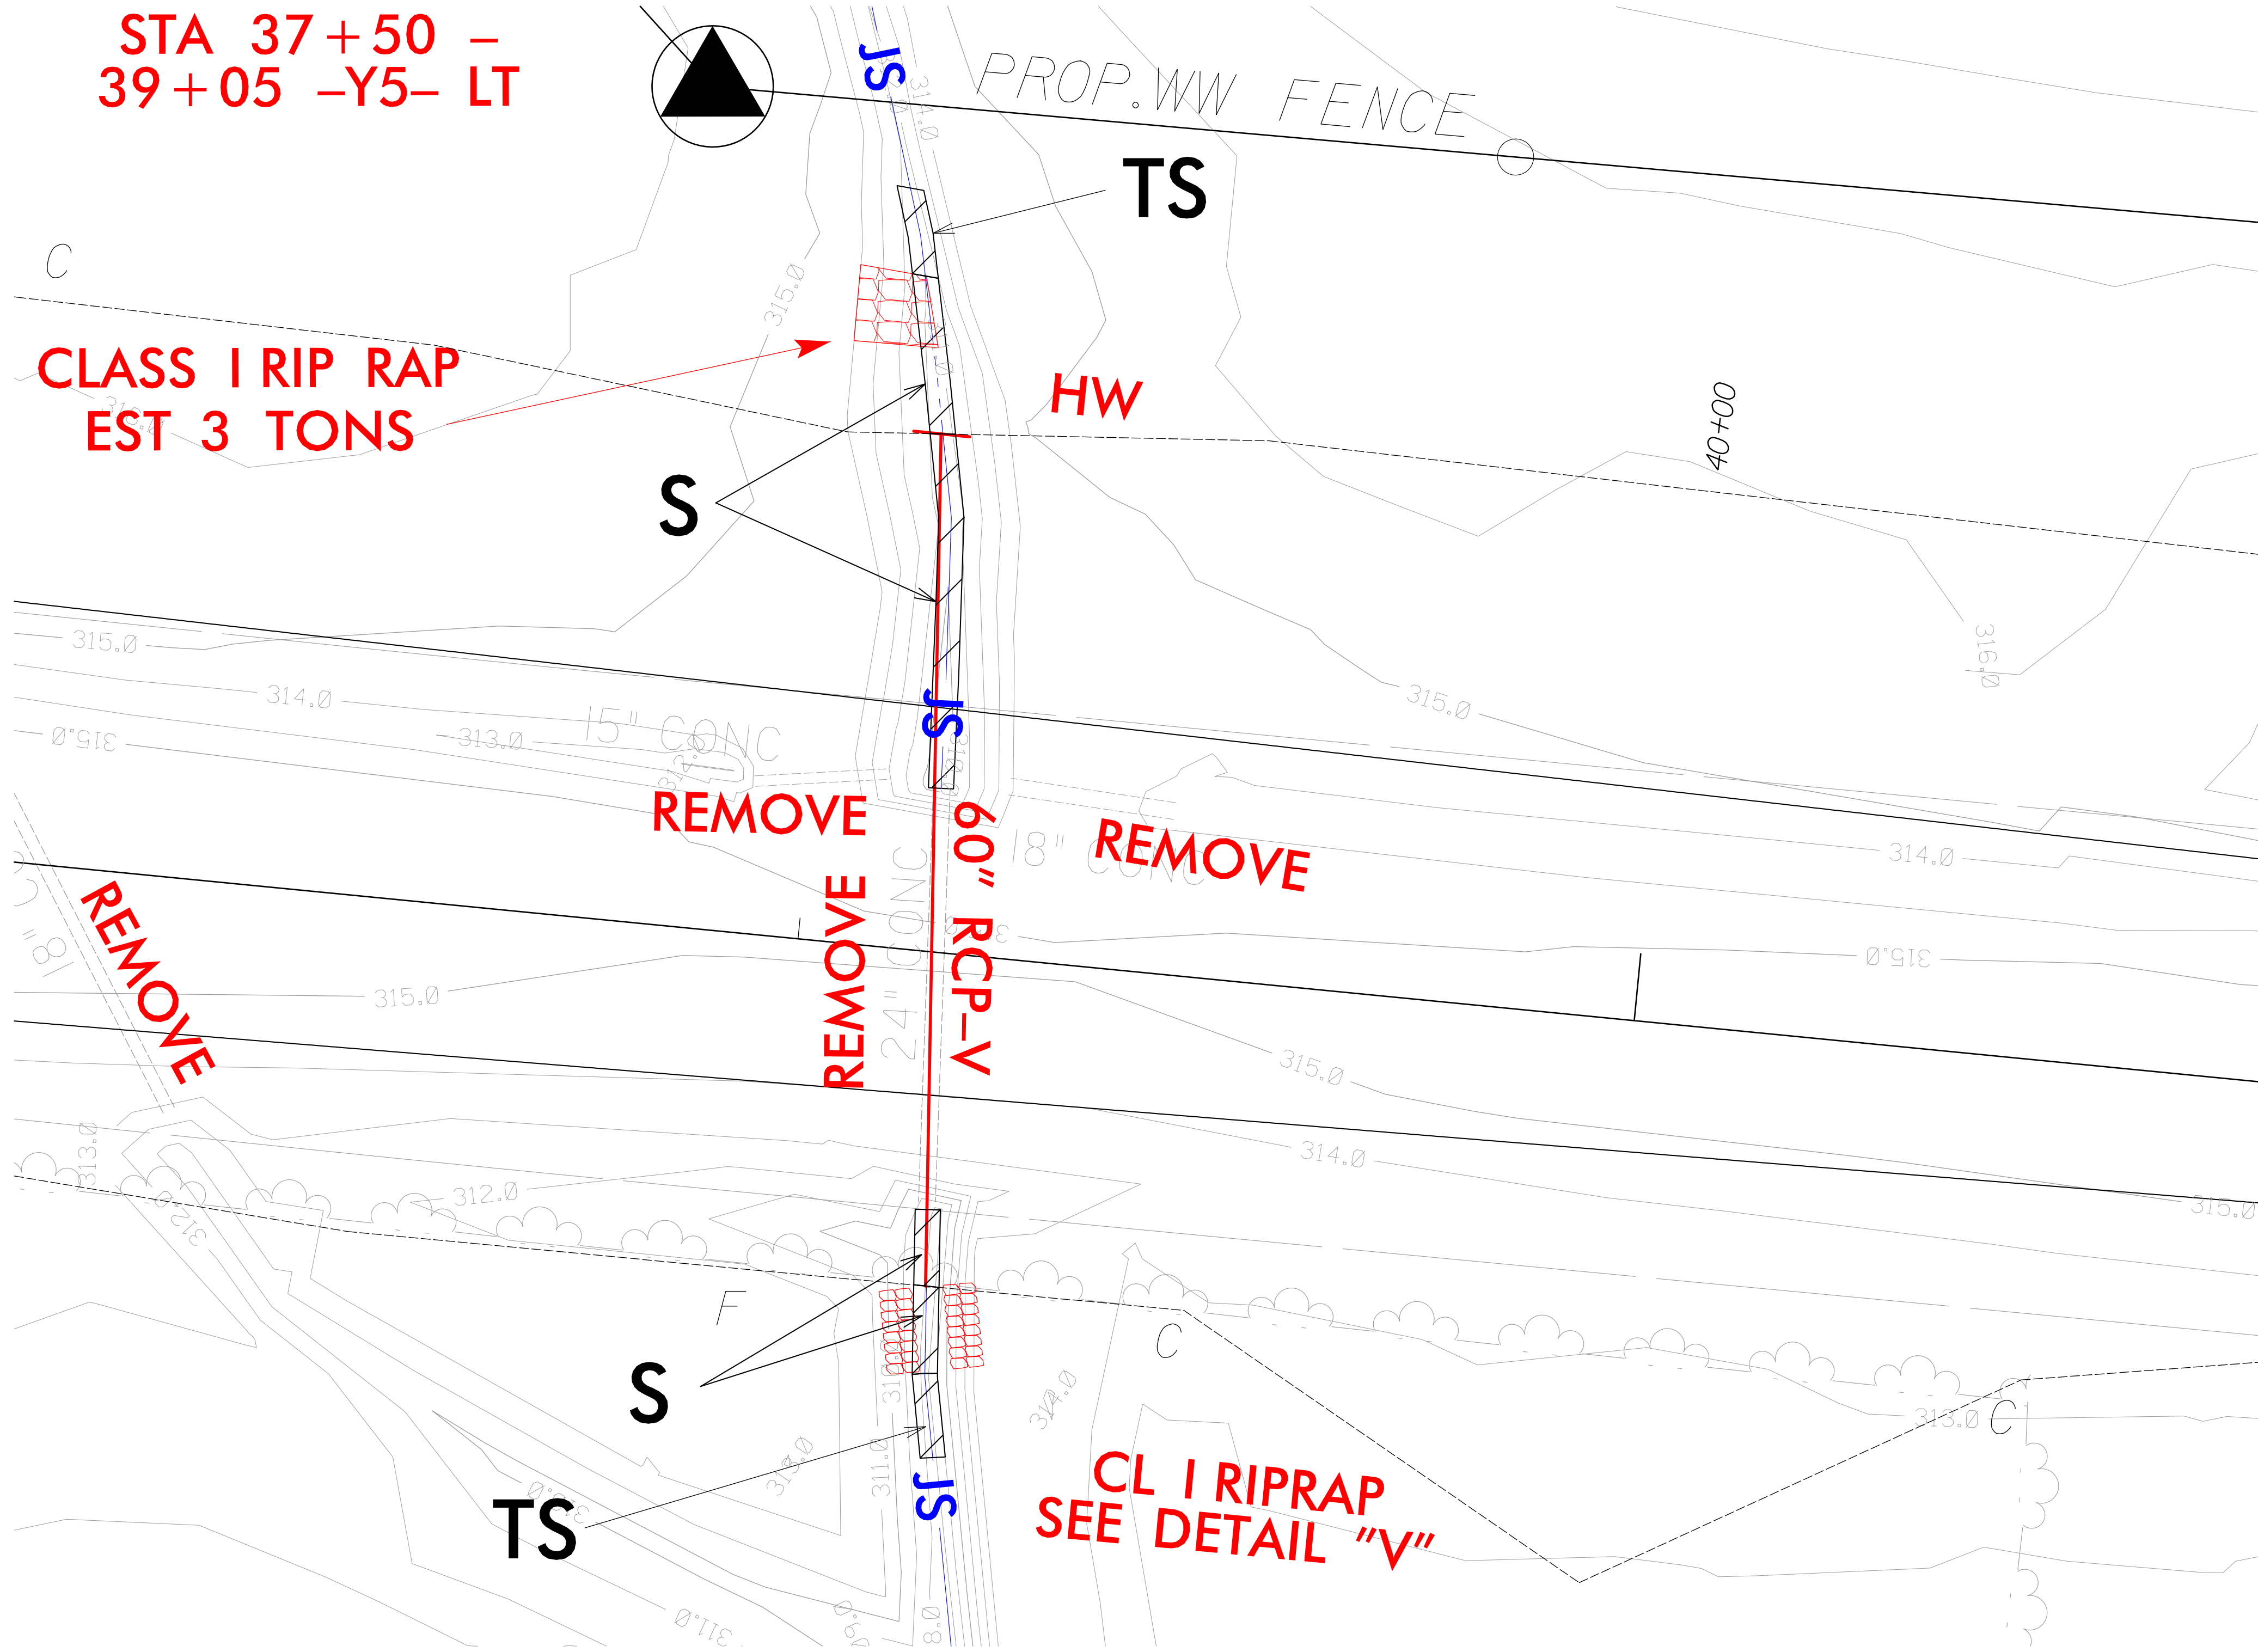

DENOTES IMPACTS IN
SURFACE WATER



DENOTES TEMPORARY
IMPACTS IN SURFACE WATER

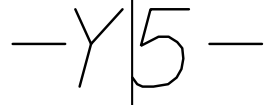

Revised 8/6/19

WETLAND AND SURFACE WATER IMPACTS SUMMARY												
Site No.	Station (From/To)	Structure Size / Type	WETLAND IMPACTS					SURFACE WATER IMPACTS				
			Permanent Fill In Wetlands (ac)	Temp. Fill In Wetlands (ac)	Excavation in Wetlands (ac)	Mechanized Clearing in Wetlands (ac)	Hand Clearing in Wetlands (ac)	Permanent SW impacts (ac)	Temp. SW impacts (ac)	Existing Channel Impacts Permanent (ft)	Existing Channel Impacts Temp. (ft)	Natural Stream Design (ft)
1	147+09 / 150+26 -L-	PROP 30" RCP	0.23			0.01		< 0.01	< 0.01	23	10	
	150+12 / 150+21 -L-	BANK STABILIZATION						< 0.01		10		
2	42+28 / 43+89 -SR1-	PROP 78" RCP						0.03	< 0.01	178	20	
	43+54 / 43+81 -SR1-	BANK STABILIZATION						< 0.01		23		
2A	12+29 / 13+29 -Y4-	PROP 66" RCP							< 0.01		36	
3	165+85 / 167+99 -L-	PROP PIPE SYSTEM	0.03					0.05	< 0.01	560	21	
	167+30 / 167+43 -L-	BANK STABILIZATION						< 0.01		18		
4	177+50 / 179+71 -L-	PROP 48" RCP	0.06			< 0.01		0.04	< 0.01	372	22	
	179+46 / 179+65 -L-	BANK STABILIZATION						< 0.01		25		
5	215+90 / 217+35 -L-	PROP 72" RCP						0.08	< 0.01	659	23	
	217+29 / 217+34 -L-	BANK STABILIZATION						< 0.01		10		
6	218+57 / 219+34 -L-	ROADWAY FILL	0.09			< 0.01						
7	228+51 / 231+25 -L-	PROP 72" RCP						0.07	< 0.01	598	34	
	231+07 / 231+15 -L-	BANK STABILIZATION						< 0.01		12		
8	233+83 / 238+88 -L-	PROP 3@9'X9' RCBC						0.17	0.05	578	161	
	234+16 / 238+31 -L-	BANK STABILIZATION						0.05		125		
9	22+48 / 23+27 -Y5-	PROP 42" RCP	0.10			0.01						
10	299+77 / 310+33 -L-	PROP PIPE SYSTEM	0.76		0.03	0.08		0.02	< 0.01	339	11	
11	39+03 / 39+23 -Y5-	PROP 60" RCP						< 0.01	< 0.01	51	21	
	39+05 / 39+22 -Y5-	BANK STABILIZATION						< 0.01		30		
12	350+69 / 355+83 -L-	ROADWAY FILL & RIP RAP PADS	2.25			0.14						
TOTALS*:			3.51		0.03	0.26		0.53	0.07	3611	359	0

*Rounded totals are sum of actual impacts


NOTES:

NC DEPARTMENT OF TRANSPORTATION
DIVISION OF HIGHWAYS
7/30/2019
RICHMOND COUNTY
R-3421B

SHEET71OF71

TIP PROJECT: R-3421B

CONTRACT: C204368

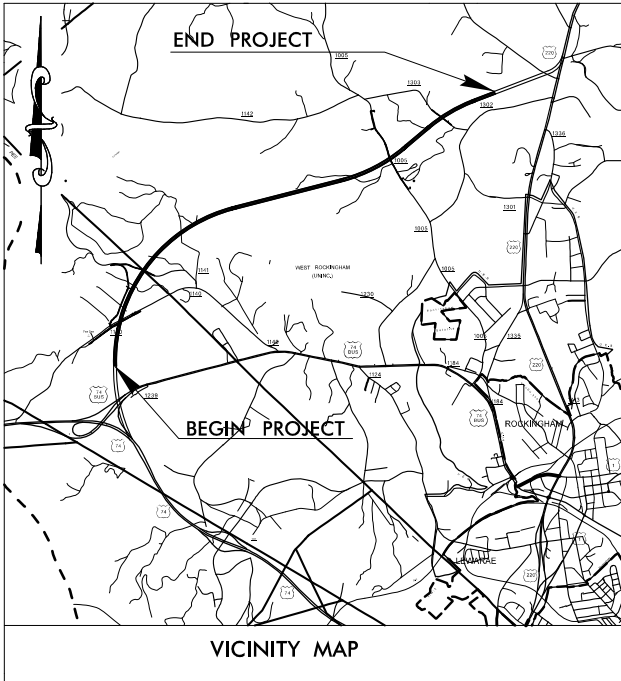

VICINITY MAP

STATE OF NORTH CAROLINA
DIVISION OF HIGHWAYS




RICHMOND COUNTY

LOCATION: I-73/74 FROM 0.3 MILES SOUTH OF SR 1140 (OLD
CHARLOTTE HIGHWAY) TO 0.2 MILES SOUTHWEST
OF SR 1304 (HARRINGTON ROAD)


TYPE OF WORK: GRADING, PAVING, DRAINAGE, CULVERTS & STRUCTURES

WETLAND AND SURFACE WATER UTILITY IMPACTS PERMIT

STATE	STATE PROJECT REFERENCE NO.	SHEET NO.	TOTAL SHEETS
N.C.	R-3421B	1	5
WBS NO.	F.A. PROJ. NO.	DESCRIPTION	
34542.1.FR3	NHF-0220(76)	P.E.	
34542.2.3	NHF-0220(43)	R /W & UTIL.	
34542.3.7	NHF-0220(43)	CONST.	

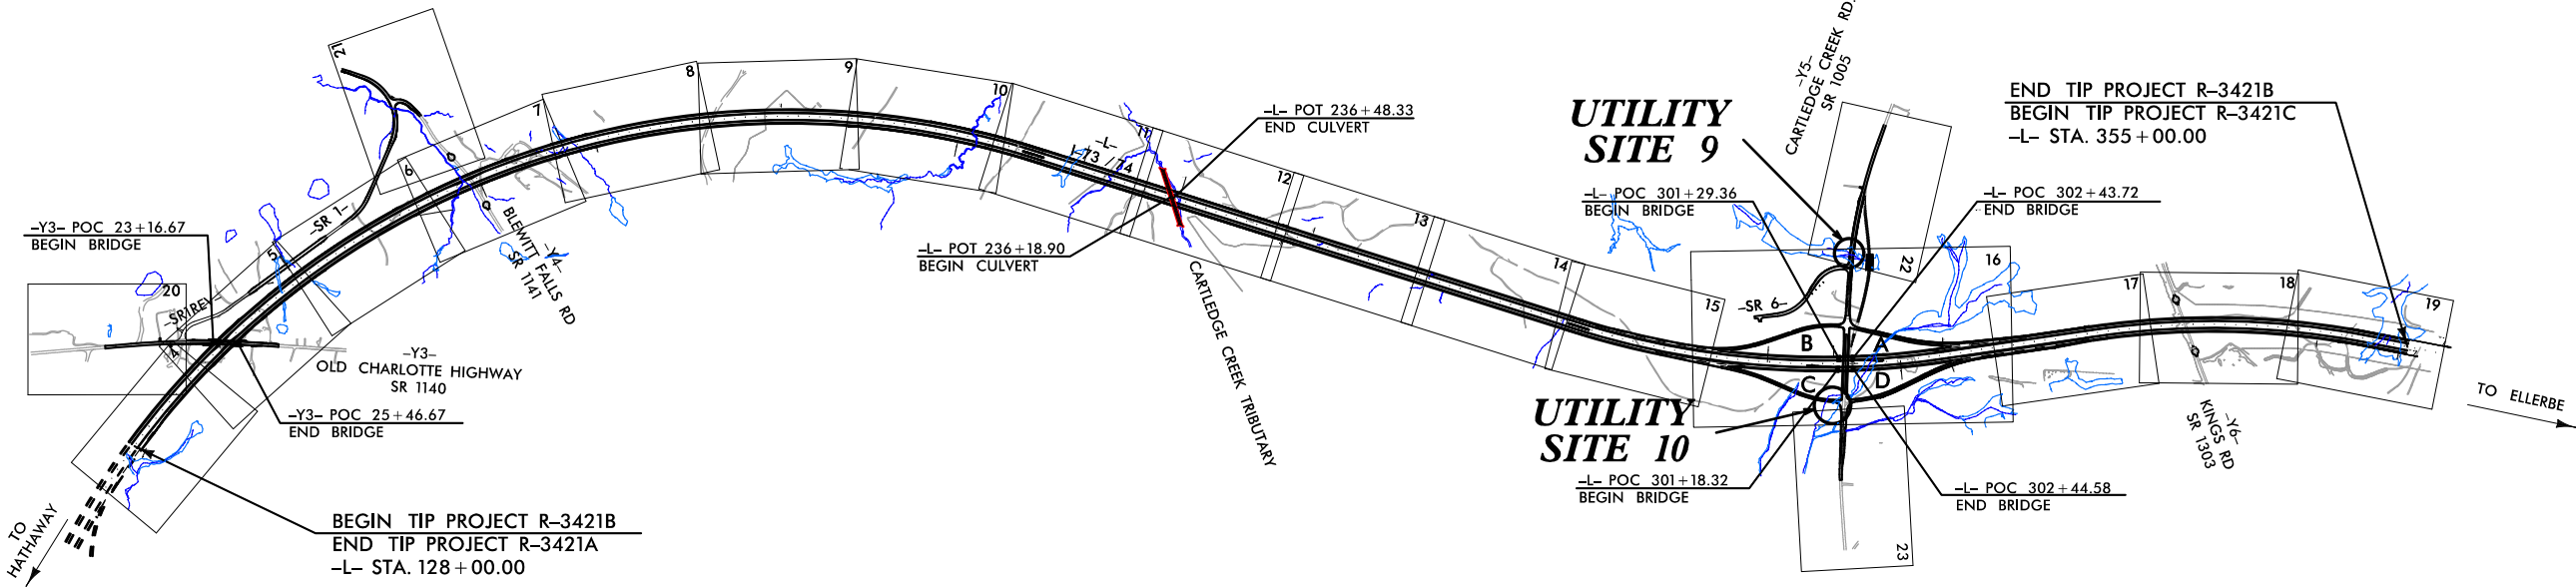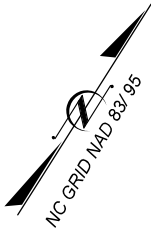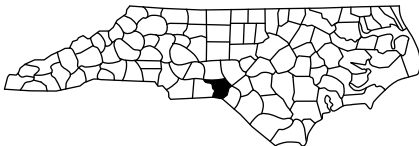

NOTE:
THIS PROJECT IS A CONTROLLED ACCESS PROJECT
WITH ACCESS LIMITED TO THE INTERCHANGE.

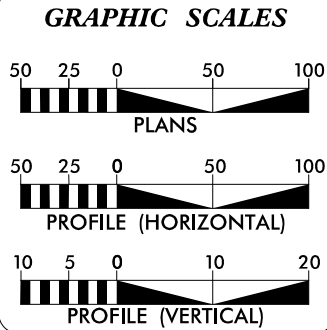

DESIGN DATA	
ADT 2019 =	11,850
ADT 2040 =	21,900
K =	10 %
D =	60 %
T =	26 % *
V =	70 MPH
* 17% TTST +	9% DUAL
FUNC CLASS =	
INTERSTATE	
STATEWIDE TIER	

PROJECT LENGTH	
LENGTH ROADWAY TIP PROJECT R-3421B	= 4.270 MILES
LENGTH STRUCTURES TIP PROJECT R-3421B	= 0.029 MILES
TOTAL LENGTH TIP PROJECT R-3421B	= 4.299 MILES

Prepared in the Office of:
CALYX
ENGINEERS & CONSULTANTS
FOR THE NORTH CAROLINA DEPARTMENT OF TRANSPORTATION
2018 STANDARD SPECIFICATIONS

RIGHT OF WAY DATE:
SEPTEMBER 23, 2009

LETTING DATE:
OCTOBER 2019

NCDOT CONTACT: GREGORY S. DAVIS, PE
PROJECT MANAGER

JOHNNY BANKS
CALYX E & C
PROJECT MANAGER


STEPHEN C. BROWDE, PE
CALYX E & C
PROJECT DESIGN ENGINEER

HYDRAULICS ENGINEER

SIGNATURE: P.E.

ROADWAY DESIGN ENGINEER

SIGNATURE: P.E.

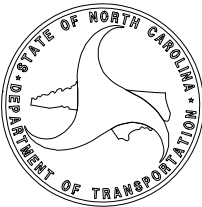

8/17/99

REVISIONS

3:33:33 PM
R:\Hydro\Utilities\PERMITS\Environmental\Drawings\R3421B\Utility Impact Drawings\R3421B-utility.prm-psht6.dgn
ender


SDATES
\$(USERAME\$)
SFILES



HC
HC
DENOTES HAND
CLEARING

WETLAND AND SURFACE WATER UTILITY IMPACTS SHEET 2 OF 5

PROJECT REFERENCE NO.		SHEET NO.
R-3421B		16
RW SHEET NO.		
ROADWAY DESIGN ENGINEER		HYDRAULICS ENGINEER

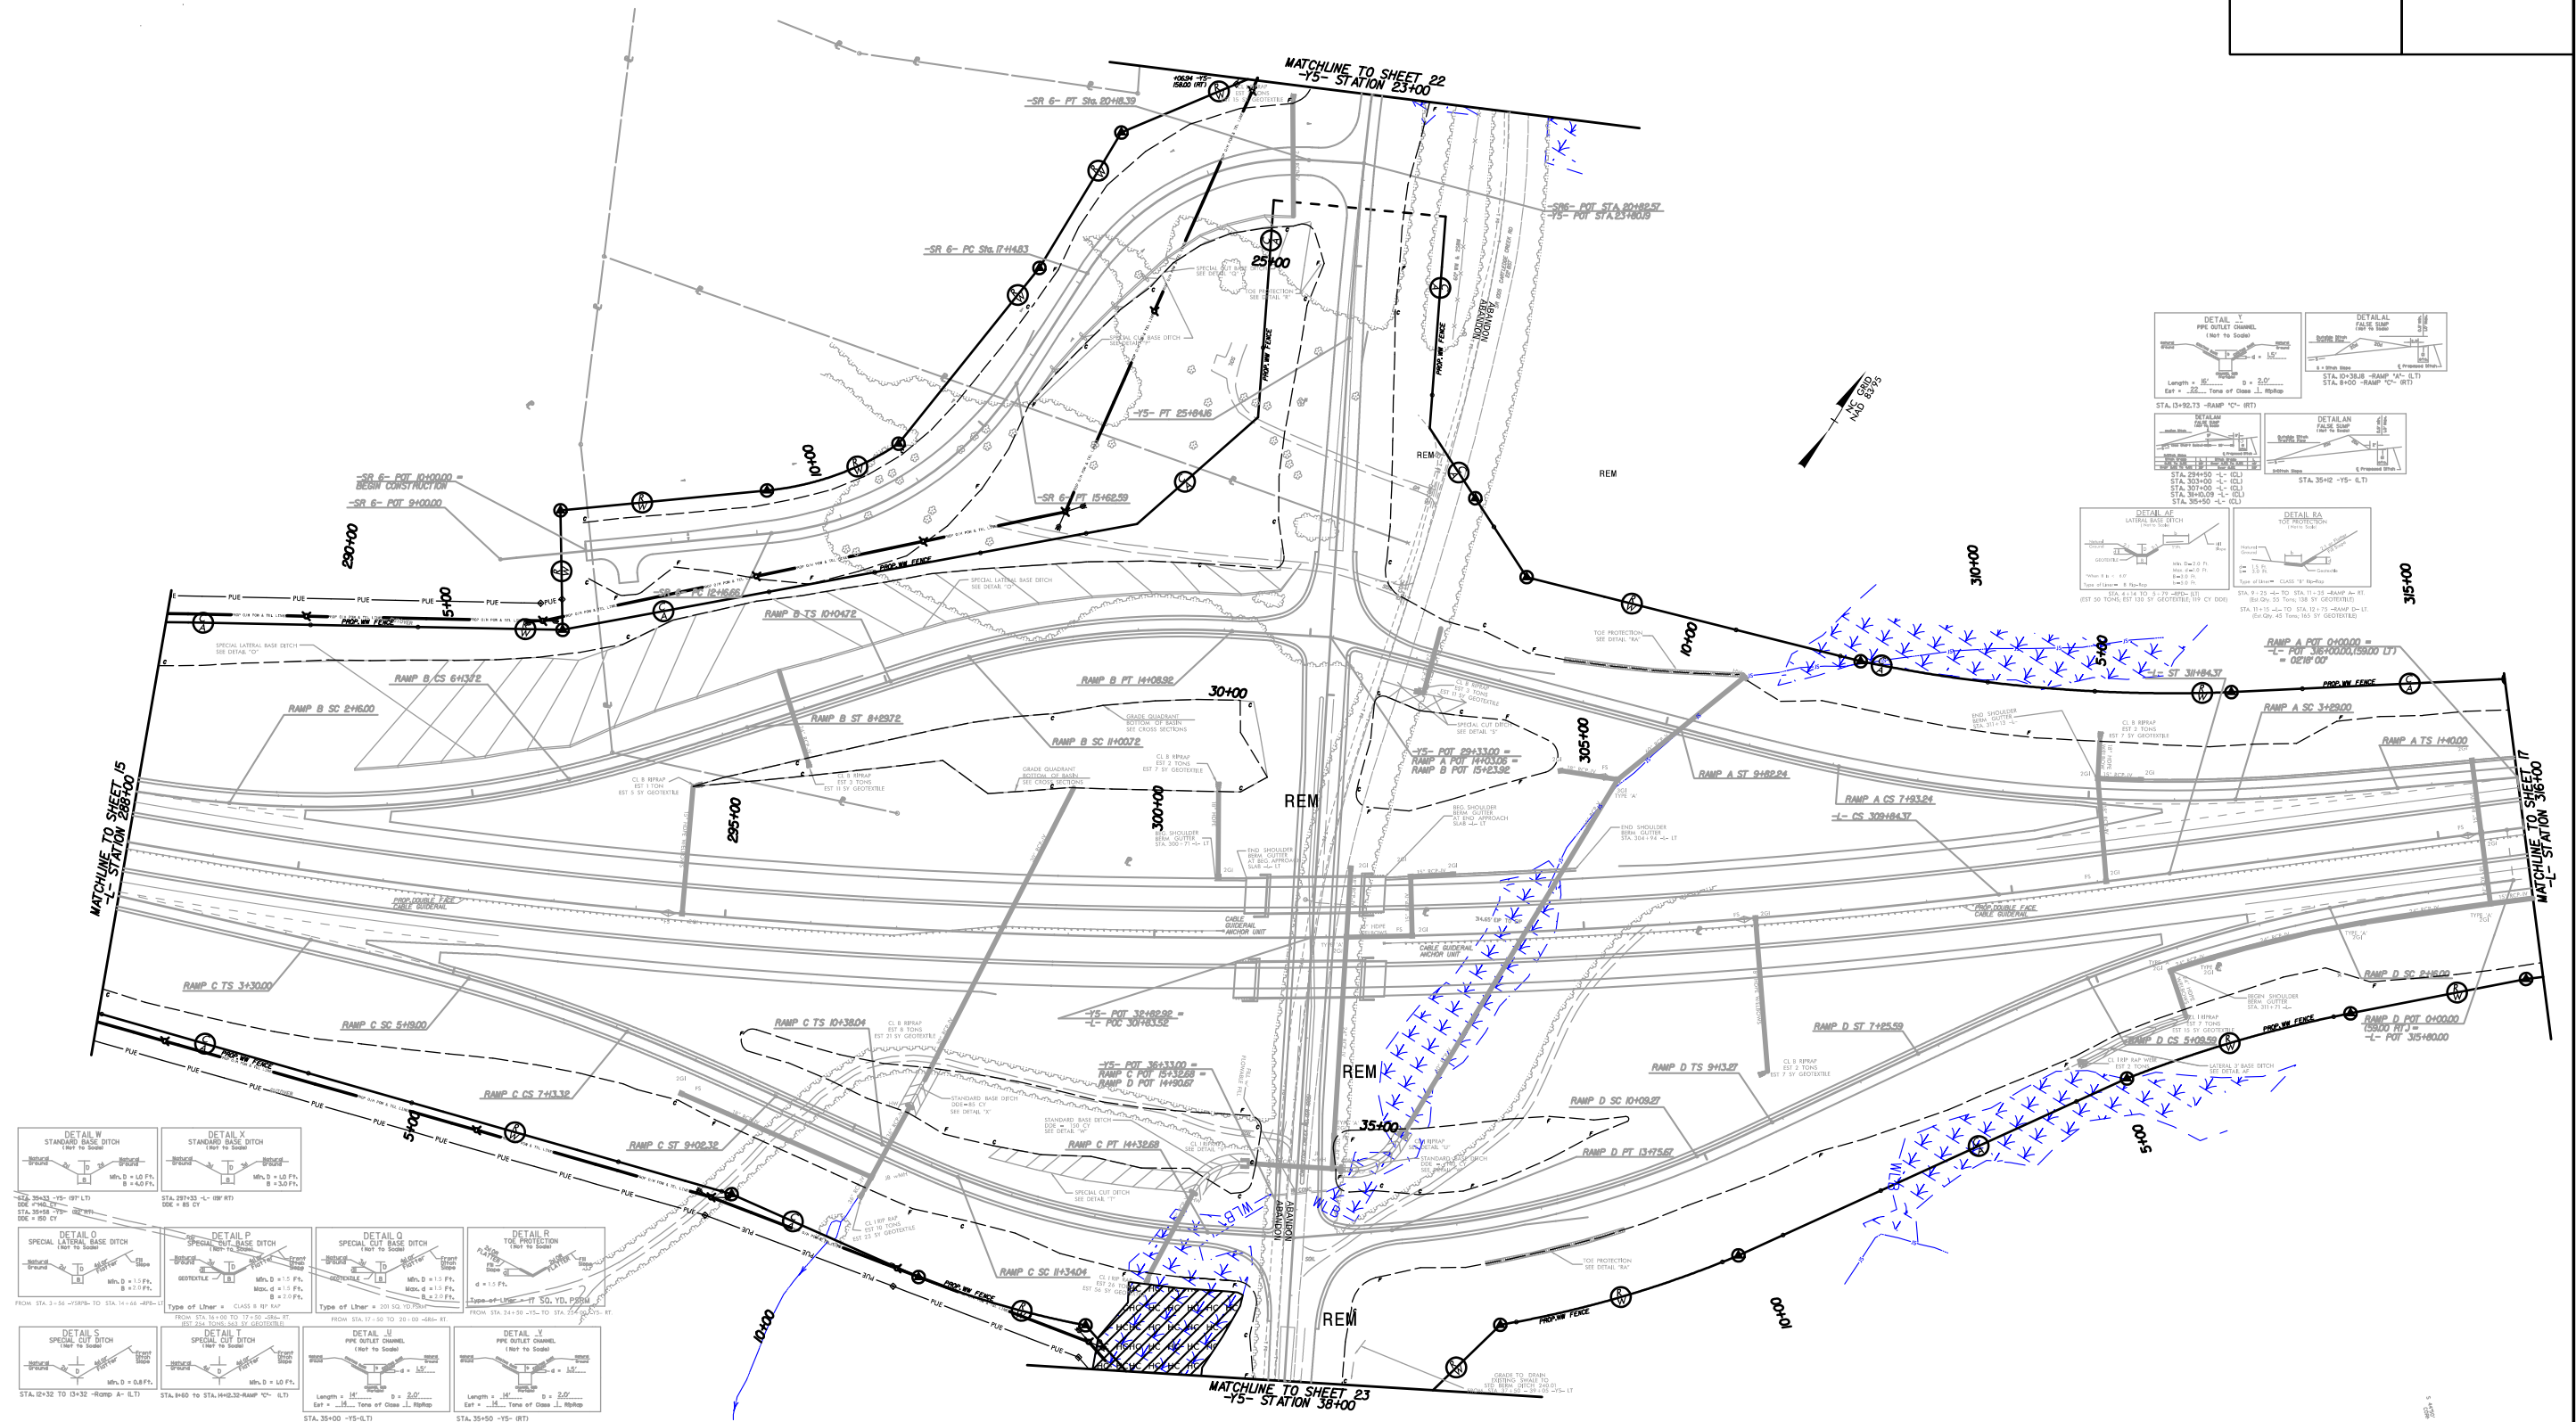

SITE 10

SEE PSH 23 FOR CONTINUATION OF SITE 10

NYC GRID
NAD 83 95

3421B\Utility Impact Drawings\R3421B_utility-prm_psh23.dgn



3:34:17 PM
R:\Hydraulics\PERMITS.Environmental\Drawings\R3421B\Utility.prm.psh23.dgn
8/17/99

WETLAND AND SURACE WATER IMPACTS SUMMARY												
			WETLAND IMPACTS					SURFACE WATER IMPACTS				
Site No.	Station (From/To)	Structure Size / Type	Permanent Fill In Wetlands (ac)	Temp. Fill In Wetlands (ac)	Excavation in Wetlands (ac)	Mechanized Clearing in Wetlands (ac)	Hand Clearing in Wetlands (ac)	Permanent SW impacts (ac)	Temp. SW impacts (ac)	Existing Channel Impacts Permanent (ft)	Existing Channel Impacts Temp. (ft)	Natural Stream Design (ft)
9	22+48/22+79 -Y5-						0.04					
10	299+40/301+03 -L-						0.44					
TOTALS*:							0.48			0	0	0

NOTES:

34542.2.3