



STATE OF NORTH CAROLINA
DEPARTMENT OF TRANSPORTATION

JOSH STEIN
GOVERNOR

November 7, 2025

DANIEL H. JOHNSON
SECRETARY

U. S. Army Corps of Engineers
Regulatory Field Office
151 Patton Avenue, Room 208
Asheville, NC 28805

NC Division of Water Resources
Transportation Permitting Branch
2090 U.S. 70 Highway
Swannanoa, NC 28778-8211

ATTN: Ms. Crystal Amschler,
NCDOT Coordinator

Ms. Amy Annino,
NCDOT Coordinator

Subject: **1) Section 404 Nationwide Permit 3/33 & 401 Individual Water Quality Certification** for the “Upper Section” of NC 9 (from “Station 37” to the Buncombe County Line).
2) Modification to Site 1 of the previously issued permits for the “Lower Section” (NC 9 from US 74A to Station 37).
3) Additional Information pursuant to questions from the September 5, 2025 project “walk-thru”
Henderson County, Division 14, WBS 18314.1045061.

Reference: 404 Permit; Action ID: SAW-2025-00325, dated 8/8/2025.
401 Certification; Project No. 20250664, dated 8/4/2025.

Dear Madams:

The North Carolina Department of Transportation (NCDOT) provides the following supplemental information, provided to answer question and provide additional information after the September 5, 2025 “virtual walk-thru” for the above referenced project.

Please find Walkthrough Comments, questions and NCDOT responses noted below.
Additionally, drawings have been revised as appropriate.

General
Amy Annino (DWR): Please include the dewatering detail(s) that will be used for the project. The detail(s) do not have to be site specific.
Response: The pump around operation detail for dewatering is included with the Erosion Control Plan Set. A pdf printout of the detail has been included with the supplemental packet for convenience.
Amy Annino (DWR): Please show the path of proposed stream channel along with the post-Helene stream channel or pre-Helene stream channel - differentiate by feature color or label.
Response: Estimated pre-Helene stream channel has been added to the drawings along with the suspected location of existing pipes using pre-storm LiDAR from NC Spatial Data. A legend has been added to the drawings to indicate the line style and color of the pre-Helene stream channel and existing pipe crossings.


Site 1

David McHenry (NC WRC): What is the proposed fill material shown in 1st screenshot along and across the river at site 1?


Response: All river material will consist of previously harvested river material which was deposited in upland areas and temporarily used to re-stabilize NC 9, on Sheet 4.

David McHenry (NC WRC): The application mentions the river bed is bedrock, but it also notes; All river material will consist of previously harvested river material which was deposited in upland areas and temporarily used to re-stabilize NC 9, on Sheet 4. Specifically, where is that material coming from? Is it the excavated road bed material in the attached picture (left side) where the single lane NC 9 has been (may still be)? I haven't been down there in a while so I'm not sure what other changes may have occurred down there in last 2-3 months.

Response: Here's an excerpt of the attached in-stream construction detail. Boulders will be harvested on-site along the river including using what's remaining of the temporary berm that was built right after the storm that allowed them to build the temporary gravel "road" right after the storm. Coincidentally, the stream morphologists recommended that these boulders be removed because they were causing a high energy concentration that wasn't present in the river pre-Helene so they will be beneficially used to stabilize the river.

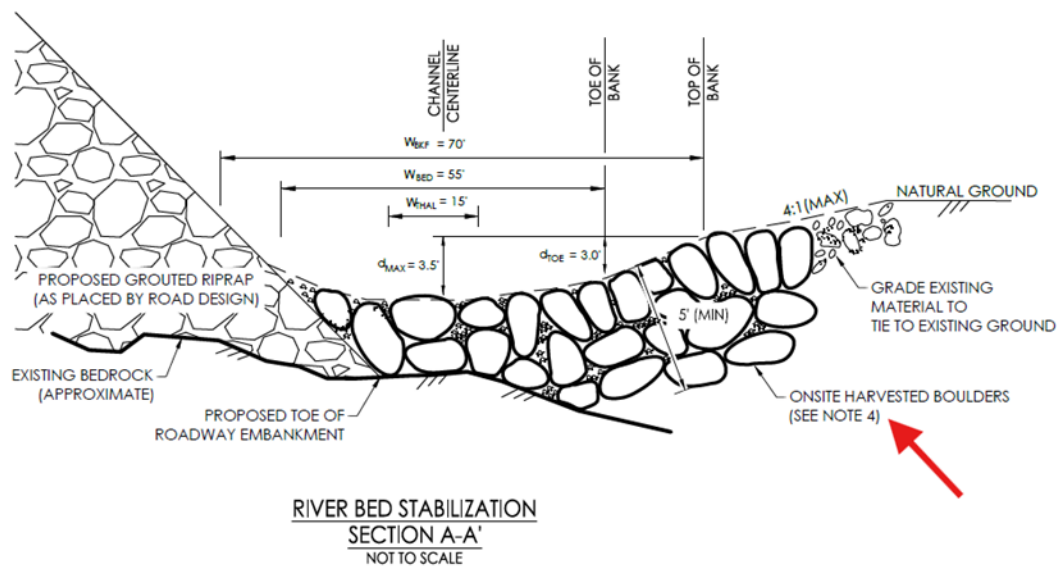

Boulders outlined in red below will be used in Site 1.

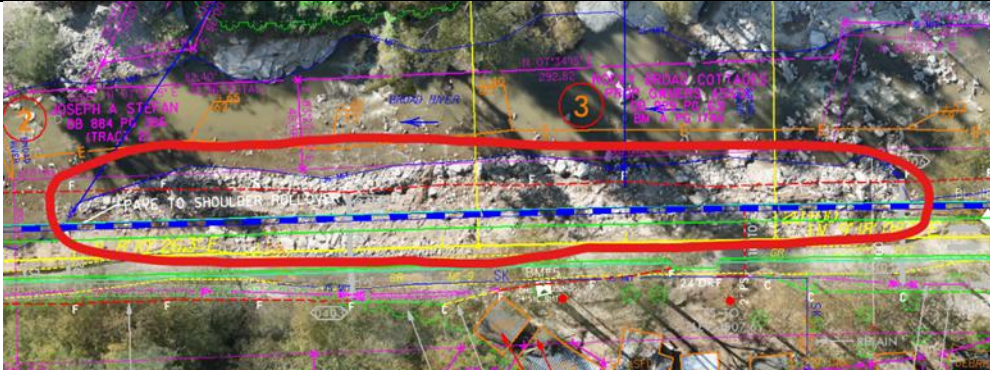

Note 4 will allow the contractor to use non-native boulders in the lower layer topped with the harvested layer if there are not enough harvested boulders.

NOTES:

- 1) DIMENSIONS ARE APPROXIMATE AND MAY BE SUBJECT TO CHANGE BASED ON FILED CONDITIONS AND THE DIRECTION OF THE ENGINEER AND/OR THE CLIENT REPRESENTATIVE.
- 2) CONSTRUCT RUN STRUCTURE BEGINNING AT THE DOWNSTREAM END AND MOVING IN THE UPSTREAM DIRECTION.
- 3) PLACE BOULDERS SO THEY ARE TOUCHING AND ORIENTED WITH THEIR DOWNSTREAM END PITCHED UP INTO THE FLOW AS SHOWN.
- 4) NON-NATIVE CLASS VII AND LARGER RIP RAP AND BOULDERS CAN BE USED IN NON-EXPOSED LOWER LAYERS OF THE IN-STREAM CONSTRUCTION WHEN A SUFFICIENT AMOUNT OF ONSITE HARVESTED BOULDERS ARE NOT AVAILABLE.

Crystal Amschler (USACE): How is the stream modification tie-in working?

Response: As discussed in the meeting, the tie-in was left vague since the River Morphologist Engineer would be on site to direct how to tie-in to the existing channel.

Scott Jones (USACE): Where is the debris near the stream mod from?

Response: The debris near the stream modification is all-natural consisting of rocks, trees, and other similar material.

Amy Annino (DWR): No comments on Site 1 from DWR.

David McHenry (NC WRC): Part of my confusion was I didn't notice any rock berm before. I still didn't notice it earlier this week when they were constructing what looks like a construction access and/or embankment base (see photos).

Response: We have been coordinating with Grant Ginn, a River Restoration Engineer hired by NCDOT, to oversee repairs of riverbeds like these damaged by Helene. He was in Bat Cave in September 2025, coordinating with Mike Patton, resident engineer for the projects in the area, and Wright Brothers who is constructing the first 1/4 mile of the project along the river. During his visit, he scouted the river and reported that he believes that there will be enough native boulders to do the in-stream construction. Grant worked directly with our engineers at Stantec to develop the In-Stream construction detail to move the thalweg over at Site 1.

continued

Berm in February 2025:



David McHenry (NC WRC): This week they were bringing in rock, I think, but maybe they had already pulled the berm under the embankment (?).

Response: Wright Brothers has a quarry nearby and the roadway embankment came from there.

David McHenry (NC WRC): I did request in my comments leaving some scattered large rock along that wall (aka embankment). That would provide flow disruption and offer some aquatic habitat heterogeneity and channel roughness (at least for awhile), which are particularly needed when hardened walls (in this case grouted rock) are constructed to line a river bank. I still recommend that, and that would be exposed boulders rather than rock that is fully embedded in the “smooth-ish” channel base (presumably also not grouted) as shown in the cross section.

Response: Cory Anderson and Chris Plummer, two stream engineers from Stantec, will be in the Broad River once the permit is approved, directing Wright Brothers to construct the stream realignment alongside Grant Ginn. They will be able to direct Wright Brothers to leave/place boulders along the grouted embankment as requested.

David McHenry (NC WRC): Per note 4, I hope they can obtain enough native alluvial material to top this channel with, much of which is under the road. That would be good if they could recoup some of that as the top-dressing.

Response: As noted above, Grant Ginn believes that there is enough.

Site 2

No comments.

Site 3

No comments.

Site 4


No comments.

Site 5
Amy Annino (DWR): Please identify and differentiate the LF of proposed impact types (ex. rip rap fill, additional culvert pipe, channel relocation) and include the total LF for each in the impact table. Please differentiate temporary impact types (ex. rip rap fill, culvert pipe, dewatering) and include the total LF for each in the impact table. Please indicate approximate LF of pre-Helene culvert pipe and proposed LF of culvert pipe. Please include a detail showing the stream channel dimensions at the culvert outlet and how this stream will connect to the off-site 24" CMP.
Response: See detail 35. For the quantities, they have been broken out for both the inlet and outlet ends. Changed the verbiage from "Channel Relocation" to "Channel Replacement" since the proposed configuration is establishing the pre-storm streamline as best as possible considering the current existing conditions. The pre-Helene existing LF of the existing culvert has been added as a line item in the summary table. Please note that this estimated value is based solely on LiDAR obtained from NC Spatial Data. We do not have inlet/outlet locations for pipes, therefore, this value is speculative.
Crystal Amschler (USACE) & Amy Annino (DWR): Add outlet channel detail to maintain 2' width.
Response: See detail 35. A note has been added to in the detail to key-in the supplemental rip rap to maintain the existing stream bed.
Revise clip boundary on Section 329/330 sheets to show full sheet instead of only Section 329.
Response: Clip boundary revised to show full sheet.
Site 6
Amy Annino (DWR): Please identify and differentiate the LF of proposed impact types (ex. rip rap fill, additional culvert pipe, channel relocation) and include the total LF for each in the impact table. Please differentiate temporary impact types (ex. rip rap fill, culvert pipe, dewatering) and include the total LF for each in the impact table. Please indicate approximate LF of pre-Helene culvert pipe and proposed LF of standard base ditch.
Response: Additional line items added to summary table to denote the different impact types. Existing approximate LF of pre-Helene culvert pipe has been added as a separate line item. Please note that this reported value is based solely on LiDAR obtained from NC Spatial Data. We do not have inlet/outlet locations for pipes, therefore, this value is speculative. The standard base ditch along the flow path of the ditch as shown in the plans is 150 LF, but the existing streamline distance is 131 LF.

Site 7

David McHenry (NC WRC): Also, at site 7, is that short class II section the fill planned to fix to the RCBC perch (and stabilize the right bank)? Attached is a picture of this area.

Response: At the Inlet, we proposed to place Class II Rip Rap behind the wingwall to repair some Helene erosion.

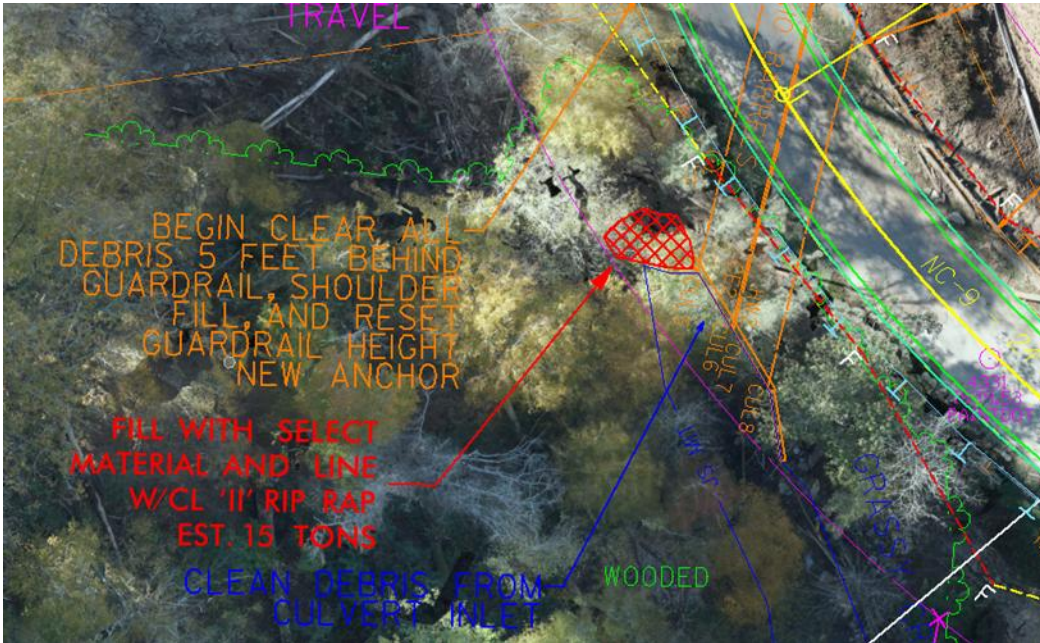


At the Outlet, we propose to place Class II Rip Rap in the creek to repair the perched culvert. As requested in the meeting, we have prepared a detail that will direct the contractor to channelize this rip rap.



David McHenry (NC WRC): And, what is the stabilization material and the profile (x-secs available?) proposed to extend 400 feet or so downstream? I didn't see (but may have missed) a description/detail.

Response: Downstream from the outlet will be repaired using the same method we used along the Broad River. The stabilization material will be grouted Class VII rip rap at the toe of the slope and Class II rip rap on up the slope where it is Rock Plating as detailed in the Geotechnical portion of the plans. See below for a typical cross section at station 62+50.

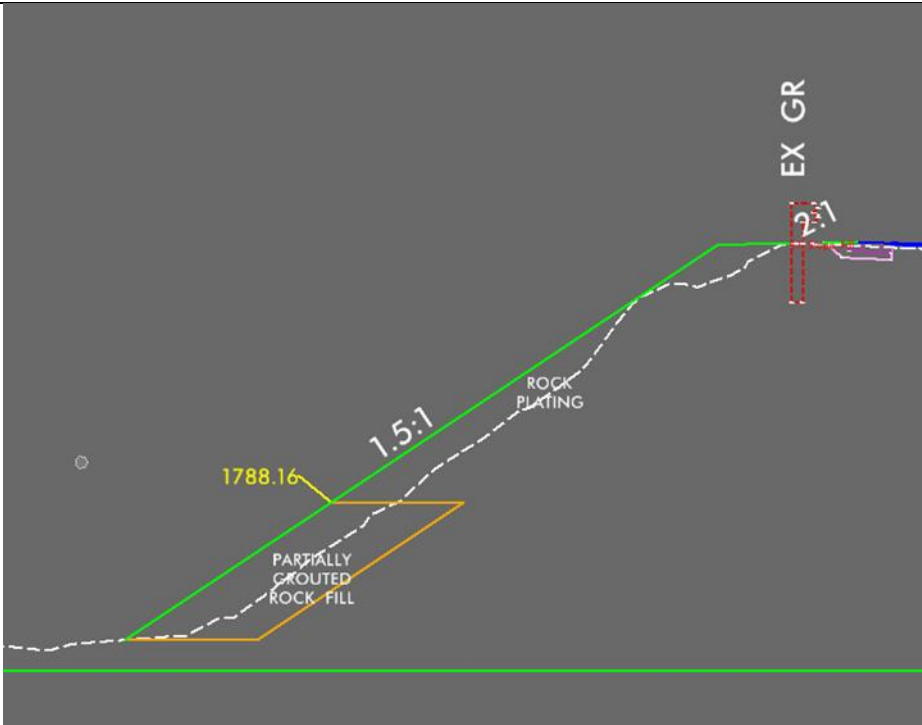

David McHenry (NC WRC): There wasn't rock slope there before and the toe of the fill slope washed-out, but there's still decent width shoulder along much of this area.

Response: There was a little rock at the toe of the slope before in this area but our designs place more, adds grout, and armors the upslope as requested to make it more resilient.



Amy Annino (DWR): Please include a cross section and a detail showing the proposed fill in the stream channel at the culvert outlet where the scour hole will be addressed.

Response: Detail 32 has been added and plan view callout updated.

Crystal Amschler (USACE) & Amy Annino (DWR): Need cross section (ditch detail typical for culvert outlet stabilization) showing the rip-rap at the culvert outlet.

Response: Detail 32 has been added and plan view callout updated.

Crystal Amschler (USACE): Need to break out quantities for rip-rap, pipe, etc. Add short narrative explaining what the Pre-Helene conditions looked like.

Response: Quantities have been broken out in the table and a short narrative describing how Hurricane Helene changed the area has been added to supplemental site narrative document.

David McHenry (NC WRC): I was somewhat surprised they are constructing a grouted wall on Grassy Creek site 7. For what it's worth that area was not stabilized in 2019 unless somebody went in and did that without coordinating with me – I was out there several times before and during slope construction above the road. There's a lot of bank scour right near the culvert outlet but still a decent amount of road shoulder and remaining fill slope progressing downstream, and the road never washed-out (see attached grassy creek photos). Seems like it is already "resilient" there from that standpoint. Really, a conventional rock fill would certainly be more environmentally benign (and sufficient?) than another grouted rock embankment since the roughness of plain stone would better temper the stream velocity and over time allow some vegetation to grow up through the rock. As many theorize the Broad system is going to cook for awhile, particularly if vegetation can't creep back in naturally and provide some shade where solid structures are on the banks.

Response: Matt Lauffer, NCDOT, and his stream modeling teams reached a decision to grout the embankment along Grassy Creek after extensive stream modeling was completed. See attached response from Matt justifying the grout.

From: Lauffer, Matthew S <mslauffer@ncdot.gov>

Sent: Wednesday, October 1, 2025 1:59 PM

To: Sarvis, Dean <Dean.Sarvis@stantec.com>; David Markwood, PE <david.markwood@summitde.com>

Subject: RE: [External] RE: Helene NC 9 | Henderson | Application and Modification | SAW-2025-00325 and 20250664

Hi Dean,

Please include this statement.

Statement for partially grouted rock fill:

Partially grouted rock fill is specified for this section to increase the effective median stone size (D50), thereby enhancing resistance to the elevated velocities and shear stresses produced by the steep channel gradient. With an average slope of approximately six percent between the culvert outlet and the downstream waterfall, hydraulic forces are significant. The partially grouted treatment provides additional stability, protects the banks from erosion, and ensures long-term performance and protection of habitat under these high-energy flow conditions.

Best Regards,

Matt

Matthew (Matt) Lauffer, PE, CPM


State Hydraulics Engineer

Hydraulics Unit

Department of Transportation

David McHenry (NC WRC): Anyway, if they go with another grouted embankment here, they should replace those very abundant boulders that are in the active channel (see photos) to retain some existing habitat complexity, like the approach recommended at site 1. I'd hate to see that converted to ditch-like cross-section.

Response: As shown in the cross section at Station 62+00 below, it is not NCDOT's intention to disturb the boulders that are in the stream bed of Grassy Creek shown in your photos, only stabilize the roadside fill slope and not go beyond the pre-Helene edge of creek. From your pictures, we believe grass has grown from the hydroseeding and that grass is hiding some of the damage that needs to be repaired underneath. See photos below. The roadway and geotechnical engineers believe that these unstable areas need to be protected with rip rap.

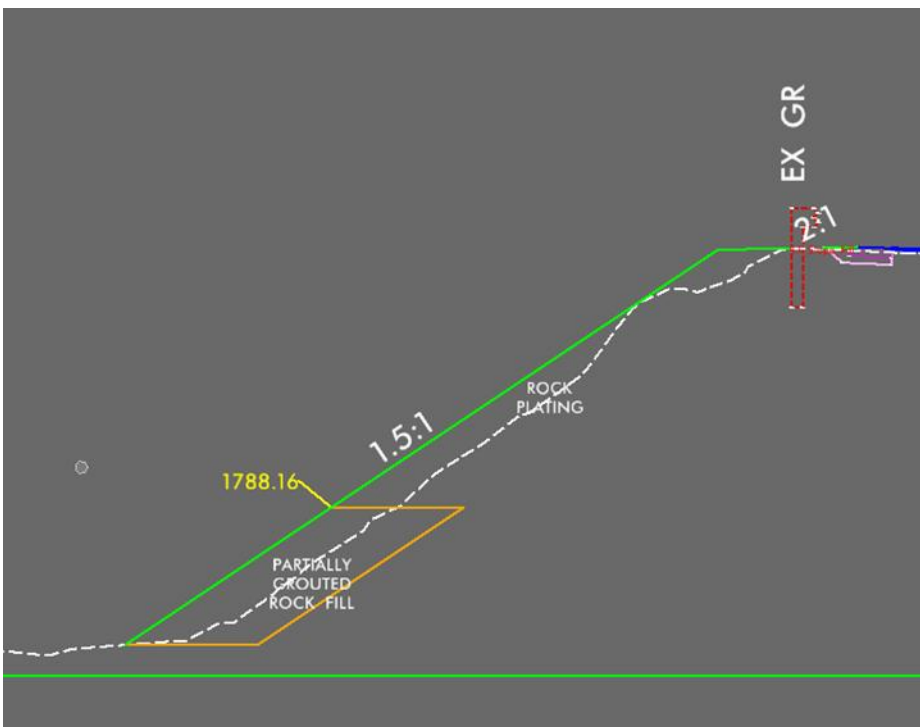



Eroded bank along Grassy Creek looking downstream (11/12/2024).



Eroded bank along Grassy Creek looking upstream (11/12/2024).

Site 8
Amy Annino (DWR): Please identify and differentiate the LF of proposed impact types (ex. rip rap fill, additional culvert pipe, channel relocation) and include the total LF for each in the impact table. Please differentiate temporary impact types (ex. rip rap fill, culvert pipe, dewatering) and include the total LF for each in the impact table. Please indicate approximate LF of pre-Helene culvert pipe and proposed LF of culvert pipe. Please include a cross section at the culvert outfall showing how the two culverts will interface with the stream channel.
Response: The impact summary table has been broken out to better illustrate the different impact types. The temporary impact types have been separated out as separate line items. Please see supplemental detail 28A for the cross section at the existing culvert outfall.
Look at/remove dual line in XSC view.
Response: The dual line is a top bank line but has been removed for clarity.
Site 9
Amy Annino (DWR): Please identify and differentiate the LF of proposed impact types (ex. rip rap fill, additional culvert pipe, channel relocation) and include the total LF for each in the impact table. Please differentiate temporary impact types (ex. rip rap fill, culvert pipe, dewatering) and include the total LF for each in the impact table. Please indicate approximate LF of pre-Helene culvert pipe and proposed LF of culvert pipe.
Response: Site 9 in the summary table has been broken out as requested. Since the approximate LF of pre-Helene culvert pipe is included with site 8, the line item is missing from this site to avoiding counting it twice.
Site 10
Amy Annino (DWR): The JS cannot be filled without a culvert pipe installed to carry stream flow to downstream waters. Please show how the JS will be placed in a culvert and verify that the stream will be connected to downstream waters located off project.
Response: Please see the response to the "Why is this a JS?" comment below for explanation on the change to the JS line extents for the site. Using the revised JS line, the stream is currently in a stable condition conveying flow down the slope. Therefore, geocells are no longer needed over the footprint of the channel. I reached out to Geotech for confirmation, and they have confirmed that the geocells can wrap around the existing channel footprint leaving the stream undisturbed. In lieu of geocells filling in the channel, supplemental rip rap has been proposed to compliment the boulders currently located along the stream banks.

Amy Annino (DWR): Why is this a JS?

Response: Pre-Helene, this general area has been the site of historical manipulation including spring boxes, channel re-routes, old road alignments, etc. In September 2024 Helene caused a major slump in this valley and continued to be bare through the winter. The original delineation was completed for this project in February 2025 when the site was still bare and somewhat freshly disturbed. Seeps and drainage had begun to carve channels across the slope below the road and Stream SO appeared to begin in a parallel section along NC-9. To better assess this site due to questions regarding geotechnical activities here. Stantec's biologist revisited site 10 on September 15, 2025 (stream SO).

After the effects of a full growing season and some vegetation establishment it appears that the short section parallel to the road is actually a scour channel and does not carry flow sufficient enough to form a jurisdictional intermittent channel. That section does not appear to be fed by groundwater. The current origin of the stream appears to be from a seep downslope from the outlet of the 18" temporary pipe.

The portion of the stream parallel to the roadway alignment has been removed from the plan set and the impacts associated with that portion have been removed as well.

Site 11

Include cross section at outlet of 2 existing 48" pipes to show how pipes will tie-in with the channel.

Response: Please see supplemental detail 26A for the cross section at the existing 2@48" CMP outfall. Quantities in impact summary table have been broken out for clarification between reasoning for temporary and permanent impacts.

Site 12

Amy Annino (DWR): Any permanent fill placed in the stream (as part of the energy dissipation pad at stream culvert outlet) must be properly keyed into the stream bed flowing from the culvert AND in the receiving stream, so as not to disrupt stream flow or block aquatic passage of either stream. Please provide a detail showing how energy dissipator pad will interface with both stream channels. Please indicate whether the culvert will be buried to meet low flow and aquatic passage requirements (Condition 11 of DWR GC 7466).

Response: Both inlet and outlet pipes have been upsized to account for the burial depth of the pipe. The proper callouts have been added to the plan view for the burial depths. Detail 33 has been added to the detail sheet to show how the pipe will interact with the stream. The detail indicates that the rip rap shall be keyed-in to not disrupt the natural channel dimensions. The quantities provided in the impact summary table have been broken out to show the differences between impacts caused by the rip rap pad versus temporary dewatering for the installation.

Site 13
Amy Annino (DWR): Please include the LF of additional culvert pipe proposed / LF loss of channel.
Response: This site has been broken out in the summary table for the inlet/outlet locations where the proposed pipe network is causing permanent impacts. The temporary impacts for dewatering has been moved to separate line item as well.

Revised Regulatory Break-Down Tables:

Impact Site	Impact Category	Permanent Fill	Bank Stabilization	Temporary Impacts	Permit Proposed / Impact Description
Site 5 UT to Broad River	Maintenance Exemption	>>>>	--	--	The estimated, pre-Helene length of pipe of 115 lf has been noted in the summary table. This estimated value is based solely on LiDAR from NC Spatial Data.
	Non-Notifying	--	--	--	--
	Notification Required (Not After the Fact)	65 lf (26'+39')	62 lf (inlet: 19' Outlet: 43')	--	NWP 3: Hurricane Helene re-routed this stream system. Prior to the storm, the stream was conveyed through a 42" CMP which was subsequently buried. A temporary 24" HDPE was installed after Helene and currently conveys the stream. A 48" pipe is proposed for the permanent restoration of this crossing. The restoration will result in 65 lf (26 + 39) of channel replacement and 62 lf (19 + 43) of outlet stabilization impacts.
	Notification Required (After the Fact)	--	--	32 lf	A temporary/ emergency 24" HDPE, 32 lf in length was installed to temporary handle this stream.
Site 6 UT to Broad River	Maintenance Exemption	>>>>	--	--	The estimated, pre-Helene length of pipe of 166 lf has been noted in the summary table. This estimated value is based solely on LiDAR from NC Spatial Data.
	Non-Notifying	--	--	--	--
	Notification Required (Not After the Fact)	6 lf	125 lf	--	NWP 3 Prior to the storm, this site was conveyed by an existing 42" CMP that would bypass the pipe and overflow to site 5 during high rainfall events. After the storm, this stream flows within the overflow channel/roadside ditch to flow under NC-9 in the temporary 24" HDPE. The existing 42" CMP was buried by the storm. Upon the hydraulic analysis of the 2 pipes/streams (Site 5 and 6), the drainage area could be consolidated to one crossing (48" CSP). By using a single crossing, the ditch backslopes avoided cutting into the mountainside (the team was asked by NCDOT to avoid cutting into the mountainside where possible). The confluence with site 5 also maintains the existing drainage patterns that are currently present at the site.
		--	--	26 lf	NWP 33 We anticipate the contractor using dewatering techniques to construct this site. To account for dewatering, impacts are shown to the PDE line.
	Notification Required (After the Fact)	--	--	--	--

Impact Site	Impact Category	Permanent Fill	Bank Stabilization	Temporary Impacts	Permit Proposed / Impact Description
Site 7 Grassy Creek	Maintenance Exemption	19 lf	379 lf	--	This site includes Grassy Creek impacts. Hurricane Helene caused the creek to widen into the existing fill slope on NC-9 due to erosion during the high flow periods experienced during the storm. The team was tasked with using the proposed fill slope to recreate the pre-Helene stream banks. The impacts for this are the “rip rap embankment” and “dewatering” line items in the summary table. The team was also asked to repair a scour issue at the outlet of the existing 2@8’x10’ RCBC. The impact for this improvement is the “outlet rip rap” line item in the summary table (19 lf).
	Non-Notifying	--	--	--	--
	Notification Required (Not After the Fact)	--	--	207 lf	NWP 3: This temporary impact is to accomplish the work noted above.
	Notification Required (After the Fact)	--	--	--	--

Impact Site	Impact Category	Permanent Fill	Bank Stabilization	Temporary Impacts	Permit Proposed / Impact Description
Site 8 UT to Grassy Creek	Maintenance Exemption	>>>>	--	--	The pre-Helene existing LF of the existing culvert (48 lf) has been added as a line item in the summary table.
	Non-Notifying	--	--	--	--
	Notification Required (Not After the Fact)	41 lf (Inlet: 11 Outlet: 30)	81 lf (Inlet: 44 Outlet: 37)--	37 lf (Inlet: 17 Outlet: 20)	NWP 3: The pre-Helene existing drainage pattern included a confluence point between site 8 and site 9 streams on the upstream side of the road. This confluence point was a large 6'-12' hole at the inlet of the existing 36" CMP. Hurricane Helene filled this hole in by about 7 feet. Since the storm, crews were able to dig down to expose the inlet and make it functional until proposed repairs were complete. Upon analysis of this site, the water from the inlet channel currently flows along a moderately steep slope, then drops down into the excavated hole. NCDOT proposes to create a drop structure to provide a more stable transition down to the pipe invert. Due to the steepness of the pipe, burial is not proposed to avoid head cut issues. On the outlet end of the existing 36" CMP, the pre-Helene condition flowed into a roadside channel just as it turned offsite to a downstream driveway crossing eventually flowing into Grassy Creek (Site 7). Hurricane Helene brought much destruction to this area to the point it was unrecognizable. By the start of the project, relief efforts had been made to repair the downstream driveway crossing. In an internal meeting with NCDOT, it was decided the repairs for the channel flowing offsite downstream of NC-9 would be part of a separate stream restoration contract. Therefore, the proposed outlet channel was designed to tie-in to the post-storm channel.
	Notification Required (After the Fact)	--	--	--	--

Impact Site	Impact Category	Permanent Fill	Bank Stabilization	Temporary Impacts	Permit Proposed / Impact Description
Site 9 UT to Grassy Creek	Maintenance Exemption	--	--	--	--
	Non-Notifying	--	--	--	--
	Notification Required (Not After the Fact)	44 ft 13 lf 2 lf	56 lf	--	NWP 3: In the pre-Helene condition, the channel met the stream from Site 8 at the existing 36" CMP inlet. Hurricane Helene brought much soil and debris from higher in the watershed and deposited it here. Based on the analysis of the drainage area, an additional proposed pipe crossing is needed. To fit the pipe underneath NC-9 with appropriate cover, the proposed 54" WSP would require lowering the channel elevation at the inlet side. To ensure a smooth and stable transition to a lower elevation, a drop structure is proposed. NCDOT does not propose mitigation for the 59 feet of stream in this scenario. There are no transportation improvements proposed to NC 9, and the resulting loss of water impacts are the result of Hurricane Helene and the sizing of pipes using modern drainage recommendations. Additionally, as the previous pipe was undersized, this site corrects deficiencies and provides a more stable hydraulic situation for this stream. Furthermore, this stream valley contains a significant amount of loose material well outside of NCDOT's purview. NCDOT is constructing an area to help contain this upstream material to help ensure system stability.
		--	--	24 ft	NWP 33: Dewatering for the installation of the above-described impacts.
	Notification Required (After the Fact)	--	--	--	--

Impact Site	Impact Category	Permanent Fill	Bank Stabilization	Temporary Impacts	Permit Proposed / Impact Description
Site 10 UT to Grassy Creek	Maintenance Exemption	--	--	--	--
	Non-Notifying	--	--	--	--
	Notification Required (Not After the Fact)	--	46 lf	--	NWP 3: In the pre-Helene condition, most of the flow for the stream came from a wet weather seepage in the slope as well as very minimal non-jurisdictional flow coming from the poorly functioning 18" cross pipe underneath NC-9. A soil nail wall is being proposed at the existing crossing. Pipes cannot be installed in areas where soil nail walls are present due to the location of the nails not being known until they are built in the field. The nails typically extend all the way across the road where it is being placed. Though the existing crossing could not be replaced, the existing drainage pattern for the area did not change as the existing pipe does not function as intended with most of the mountainside non-jurisdictional flow bypassing the existing cross pipe and continuing downhill along NC-9. The proposed drainage pattern follows the behavior of the existing condition and continues to direct the stormwater to flow along NC-9. The proposed slope stake lines beyond the soil nail wall show the extents of the proposed geocells to be installed to protect an unstable slope caused by a landslide that occurred during Hurricane Helene. After consultation with Geotech, the geocells will be able to be wrapped around the footprint of the channel. Supplemental rip rap has been included to compliment the boulders along the stream banks for stability in lieu of the geocells filling in the channel.
	Notification Required (After the Fact)	--	--	--	--

Impact Site	Impact Category	Permanent Fill	Bank Stabilization	Temporary Impacts	Permit Proposed / Impact Description
Site 11 Grassy Creek	Maintenance Exemption	51 lf	--	--	In the pre-Helene condition, the existing 2 @ 48" CMP was perched above the existing bed at the outlet indicating scour issues. Hurricane Helene worsened the scour issues and increased the perched elevation between the existing bed and the existing pipe outlet inverts. The existing crossing was analyzed, and the existing pipes were determined to be sized appropriately and in good condition. The team was asked to help mitigate the scour issues by raising the streambed by filling in the existing scour hole with rip rap. Detail 26A has been added to the detail sheet to show how the outlet of the existing 2 @ 48" CMP will tie-in with the scour hole repair. The detail includes verbiage to key-in the rip rap.
	Non-Notifying	--	--	--	--
	Notification Required (Not After the Fact)	--	--	16 lf	NWP 33: It is anticipated the contractor will either use impervious dikes or a pump around operation to dewater the site. To account for this activity, impacts are shown to the PDE line.
	Notification Required (After the Fact)	--	--	--	--

Impact Site	Impact Category	Permanent Fill	Bank Stabilization	Temporary Impacts	Permit Proposed / Impact Description
Site 12 UT to Broad River	Maintenance Exemption	--	--	--	--
	Non-Notifying	--	--	--	--
	Notification Required (Not After the Fact)	--	4 lf	15 lf	In the pre-Helene condition, the existing 24" CMP had remnants of an older rip rap pad at the outlet. Hurricane Helene further washed out the existing rip rap pad. For the proposed condition, the crossing was analyzed and the existing 24" CMP was found to be undersized. The crossing was analyzed as a 36" RCP and was upsized to a 42" RCP to account for the burial depth. Burying the proposed outlet of the system ensures the crossing would be compliant with Condition 11 of DWR GC 7466. At the proposed outlet, a rip rap pad was proposed for energy dissipation. Detail 33 has been added to indicate how the pipe will interact with the stream. The detail specifies that the rip rap must be keyed-in.
	Notification Required (After the Fact)	--	--	--	--

Impact Site	Impact Category	Permanent Fill	Bank Stabilization	Temporary Impacts	Permit Proposed / Impact Description
Site 13 UT to Broad River	Maintenance Exemption	--	--	--	--
	Non-Notifying	--	--	--	--
	Notification Required (Not After the Fact)	13 lf (3 lf on the inlet side of the 36" pipe & 42" pipe, and 10 lf on the inlet side of the 36" pipe)	--	--	NWP 3: In the pre-Helene condition, the existing 24" CMP behaved as a normal driveway pipe. Hurricane Helene did not destroy the channel, but it did bring excessive debris that piled up on the inlet side. Analyzing the crossing indicated that the existing pipe was undersized. The pipe was analyzed as a 30" unburied and was upsized to a 36" to account for the burial depth. Burying the proposed inlet of the system ensures the crossing would be compliant with Condition 11 of DWR GC 7466. The impacts shown for the portion of the stream in between the existing 24" driveway pipe and the 24" pipe under NC-9 (Site 12) has been added as a line item for this site. NCDOT does not propose mitigation for the 13 feet of stream in this scenario. There are no improvements proposed to NC 9, and the resulting loss of water impacts are the result of Hurricane Helene and the sizing of pipes using modern drainage recommendations.
		--	--	10 lf	NWP 33: It is anticipated the contractor will use dewatering techniques for the site. To account for the dewatering, impacts have been extended past the area needed for installation.
	Notification Required (After the Fact)	--	--	--	

		Permanent Fill	Bank Stabilization	Temporary Impacts	
Category Totals	Maintenance Exemption	Site 7: 19 Site 11: 51 70 lf	Site 7: 379 379 lf	--	
		449 lf		--	
	Non-Notifying	--	--	--	
	Notification Required (Not After the Fact)	Site 5: 65 Site 6: 6 Site 8: 41 Site 9: 59 Site 13: 13 184 lf	Site 5: 62 Site 6: 125 Site 8: 81 Site 9: 56 Site 10: 46 Site 12: 4 374 lf	Site 6: 26 Site 7: 207 Site 8: 37 Site 9: 24 Site 11: 16 Site 12: 15 Site 13: 10 335 lf	
		558 lf			
	Notification Required (After the Fact)	--	--	Site 5: 32 5 lf*	
NC 9 Upper Section Totals		254 lf	753 lf	340 lf	
		1,007 lf			
NC 9 Lower Section Totals		1,821 lf		1,200 lf	
NC 9 Project Totals		2,828 lf		1,540 lf*	

*When comparing this table with the Impact Summary Table, there is a 5 lf difference, as the “after the fact” impact is not shown in Impact Summary Table

The information above is provided in accordance with the " US Army Corps of Engineers, Wilmington District' s Information for Hurricane Helene Recovery and Repair Work Conducted by the North Carolina Dept of Transportation in Waters of the US " dated February 10, 2025.

The total permanent and temporary impacts at Site 1 remain 2,295 linear feet of stream impact. However, the division of impacts has changed. **New values are shown in red.**

Impact Site	Impact Category	Permanent Fill	Bank Stabilization	Temporary Impacts	Permit Proposed / Impact Description
Site 1 Broad River	Maintenance Exemption	—	1,073 lf (0.278 ac) 1,129 ft (0.300 ac)	--	See above explanation for in channel work.
	Non-Notifying	--	--	--	--
	Notification Required (Not After the Fact)			1,222 lf (1.029) 1,166 lf (1.064 ac)	NWP 33: This impact includes an update to impacts requested within the original permit. Adjustments are based on the stream stabilization measures.
	Notification Required (After the Fact)	--	--	--	--

The remaining sites on the lower section (Sites S2, S3 and S4) have not changed.

Endangered Species Act: Protected Species listed from IPaC¹ as of the date of this application:

Common Name	Habitat Present	Survey Dates ²	Proposed Biological Conclusion	FWS Concurrence Remarks
Gray bat Northern long-eared bat Tricolored bat (Proposed)	Yes	2/24/2025	May Affect, Likely to Adversely Affect (under PBO/PCO) ³	Concur ⁴
Bog turtle	No	n/a	Not Required	n/a
Monarch butterfly (Proposed) ⁵	Unknown	n/a	n/a	n/a
Rock gnome lichen	No	n/a	No Effect	n/a
White irisette	No	2/24/2025	No Effect	n/a
Small whorled pogonia	No	2/24/2025	No Effect	n/a

1 IPaC – Information for Planning and Consultation (US Fish and Wildlife Service)

2 Original delineation and habitat survey conducted 2/24/2025.

3 There is a total of 0.34 acre of tree clearing over the entire project.

4 Section 7 consultation was completed for the entire project on July 7, 2025, and included using the NCDOT Bat Programmatic Biological Opinion.

5 Due to the recent listings of monarch butterfly within the proposed action area, NCDOT does not have complete information at this time. It is anticipated that construction will be complete by the timeframes proposed for full listing, should the species be formally listed.

Historic Resources Summary (documentation included)

106 Topic	Findings	
Historic Architecture	No Historic Properties Present	
Archaeology	No Surveys Required	
Tribal Coordination	Tribe	Response
Tribal Coordination Letters were sent to the following Tribes on March 10, 2025:	Catawba Indian Nation	March 27, 2025
	Cherokee Nation	<i>No response received</i>
	Eastern Band of Cherokee Indians	<i>No response received</i>
	Muscogee (Creek) Nation	<i>No response received</i>
	United Keetoowah Band of Cherokee Indians in Oklahoma	<i>No response received</i>

Based on this additional information, NCDOT requests resumption of the processing of the environmental permits for this project.

If you have any questions or need additional information, please contact Michael Turchy, at maturchy@ncdot.gov or (919) 707-6157.

Sincerely,

 Digitally
signed by
Michael
Turchy

Michael A. Turchy
Environmental Coordination and Permitting Group Leader



North Carolina Department of Transportation

Highway Stormwater Program
STORMWATER MANAGEMENT PLAN

FOR NCDOT PROJECTS



(Version 3.02; Released April 23, 2024)

WBS Element: 18314.1045 TIP/Proj No: NC-9 County(ies): Henderson Page 1 of 2

General Project Information

WBS Element:	18314.1045035	TIP Number:	NC-9	Project Type:	Roadway Widening	Date:	5/1/2025
NCDOT Contact:	Josh Deyton			Contractor / Designer:	Sungate Design Group, PA		
Address:	253 Webster Road Sylva, NC 28779			Address:	905 Jones Franklin Rd Raleigh, NC 27606		
	Phone: 828-331-5211				Phone: 919-859-2243		
	Email: jbdeyton@ncdot.gov				Email: jdalton@sungatedesign.com		
City/Town:	Bat Cave			County(ies):	Henderson		
River Basin(s):	Broad			CAMA County?	No		
Wetlands within Project Limits?	No						

Project Description

Project Length (lin. miles or feet):	1.97	Surrounding Land Use:	Residential, Wooded, Conservation Forest					
	Proposed Project		Existing Site					
Project Built-Upon Area (ac.)	14.0	ac.	5.8	ac.				
Typical Cross Section Description:	NC-9: Southbound lane includes a 10' paved lane with 4' shoulders (2' paved + 2' grass from 10+12 to 91+00 -L-)(4' grass from 91+00 to 113+77 -L-). Northbound lane includes a 10' paved lane with 3' shoulders (2' paved + 1' grass from 10+12 to 91+00 -L-)(3' grass from 91+00 to 113+77 -L-). Varying cut and fill slopes (see XSC file for detailed information).			Existing NC-9: 10' paved lane with 3' shoulders (1' paved + 2' grass) in each direction. Varying cut and fill slopes.				
Annual Avg Daily Traffic (veh/hr/day):	Design/Future:	1000	Year:	2025	Existing:	1000	Year:	2025

General Project Narrative:
(Description of Minimization of Water
Quality Impacts)

The North Carolina Department of Transportation (NCDOT) has proposed repairs to NC-9 from US 74 ALT to the Henderson County Line. The project, NC-9, was proposed in response to the damage caused by Hurricane Helene (09/2024). There is one major structure within the limits of the project (2@8'x10' RCBC) that is not being impacted by the proposed design. There have been 2 repiars proposed to the structure fixing erosion issues on either end of the culvert (see PSH 08 for inlet/outlet improvements). Erosion and Sediment Control measures to preserve water quality for instream construction activities will include floating turbidity curtains and/or impervious dikes. Rip rap has been added to outlets in jurisdictional features in order to dissipate energy and reduce velocities.



North Carolina Department of Transportation

Highway Stormwater Program
STORMWATER MANAGEMENT PLAN
FOR NCDOT PROJECTS

(Version 3.02; Released April 23, 2024)

WBS Element: 18314.1045

TIP/Proj No.: NC-9

County(ies): Henderson

Page 2 of 2

General Project Information

Waterbody Information


Surface Water Body (1):	Broad River	NCDWR Stream Index No.:	9-(1)
NCDWR Surface Water Classification for Water Body	Primary Classification:	Class C	
	Supplemental Classification:	Trout Waters (Tr)	
Other Stream Classification:	None		
Impairments:	None		
Aquatic T&E Species?	Comments:		
NRTR Stream ID:	Broad River	Buffer Rules in Effect:	N/A
Project Includes Bridge Spanning Water Body?	No	Deck Drains Discharge Over Buffer?	N/A
Deck Drains Discharge Over Water Body?	N/A	(If yes, provide justification in the General Project Narrative)	Dissipator Pads Provided in Buffer?
(If yes, provide justification in the General Project Narrative)			(If yes, describe in the General Project Narrative; if no, justify in the General Project Narrative)
Surface Water Body (2):	Grassy Creek	NCDWR Stream Index No.:	9-13
NCDWR Surface Water Classification for Water Body	Primary Classification:	Class C	
	Supplemental Classification:	Trout Waters (Tr)	
Other Stream Classification:	None		
Impairments:	None		
Aquatic T&E Species?	Comments:		
NRTR Stream ID:	Grassy Creek	Buffer Rules in Effect:	N/A
Project Includes Bridge Spanning Water Body?	No	Deck Drains Discharge Over Buffer?	N/A
Deck Drains Discharge Over Water Body?	N/A	(If yes, provide justification in the General Project Narrative)	Dissipator Pads Provided in Buffer?
(If yes, provide justification in the General Project Narrative)			(If yes, describe in the General Project Narrative; if no, justify in the General Project Narrative)
Surface Water Body (3):		NCDWR Stream Index No.:	
NCDWR Surface Water Classification for Water Body	Primary Classification:		
	Supplemental Classification:		
Other Stream Classification:			
Impairments:			
Aquatic T&E Species?	Comments:		
NRTR Stream ID:		Buffer Rules in Effect:	
Project Includes Bridge Spanning Water Body?		Deck Drains Discharge Over Buffer?	Dissipator Pads Provided in Buffer?
Deck Drains Discharge Over Water Body?		(If yes, provide justification in the General Project Narrative)	(If yes, describe in the General Project Narrative; if no, justify in the General Project Narrative)
(If yes, provide justification in the General Project Narrative)			

09/08/99

PROJECT: NC-9

CONTRACT: C205121

See Sheet 1A For Index of Sheets
See Sheet 1B For Conventional Symbols

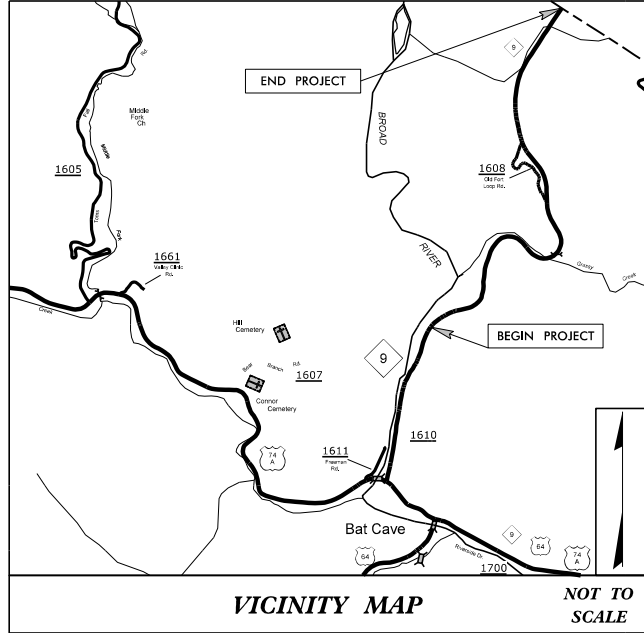

STATE OF NORTH CAROLINA
DIVISION OF HIGHWAYS

HENDERSON COUNTY

**LOCATION: NC-9 FROM 2700' NORTH OF THE
US 74A /NC-9 INTERSECTION TO THE
BUNCOMBE COUNTY LINE**

**TYPE OF WORK: GRADING, DRAINAGE,
PAVING, AND RETAINING WALLS**

WETLAND AND SURFACE WATER IMPACTS PERMIT

BEGIN WBS SITE 330
-L- STATION 37+00.00


END WBS SITE 330
BEGIN WBS SITE 331
-L- STATION 47+00.00

END WBS SITE 331
BEGIN WBS SITE 332
-L- STATION 57+00.00

END WBS SITE 333
BEGIN WBS SITE 334
-L- STATION 74+00.00

END WBS SITE 334
BEGIN WBS SITE 560
-L- STATION 91+00.00

END WBS SITE 560
-L- STATION 113+77.00

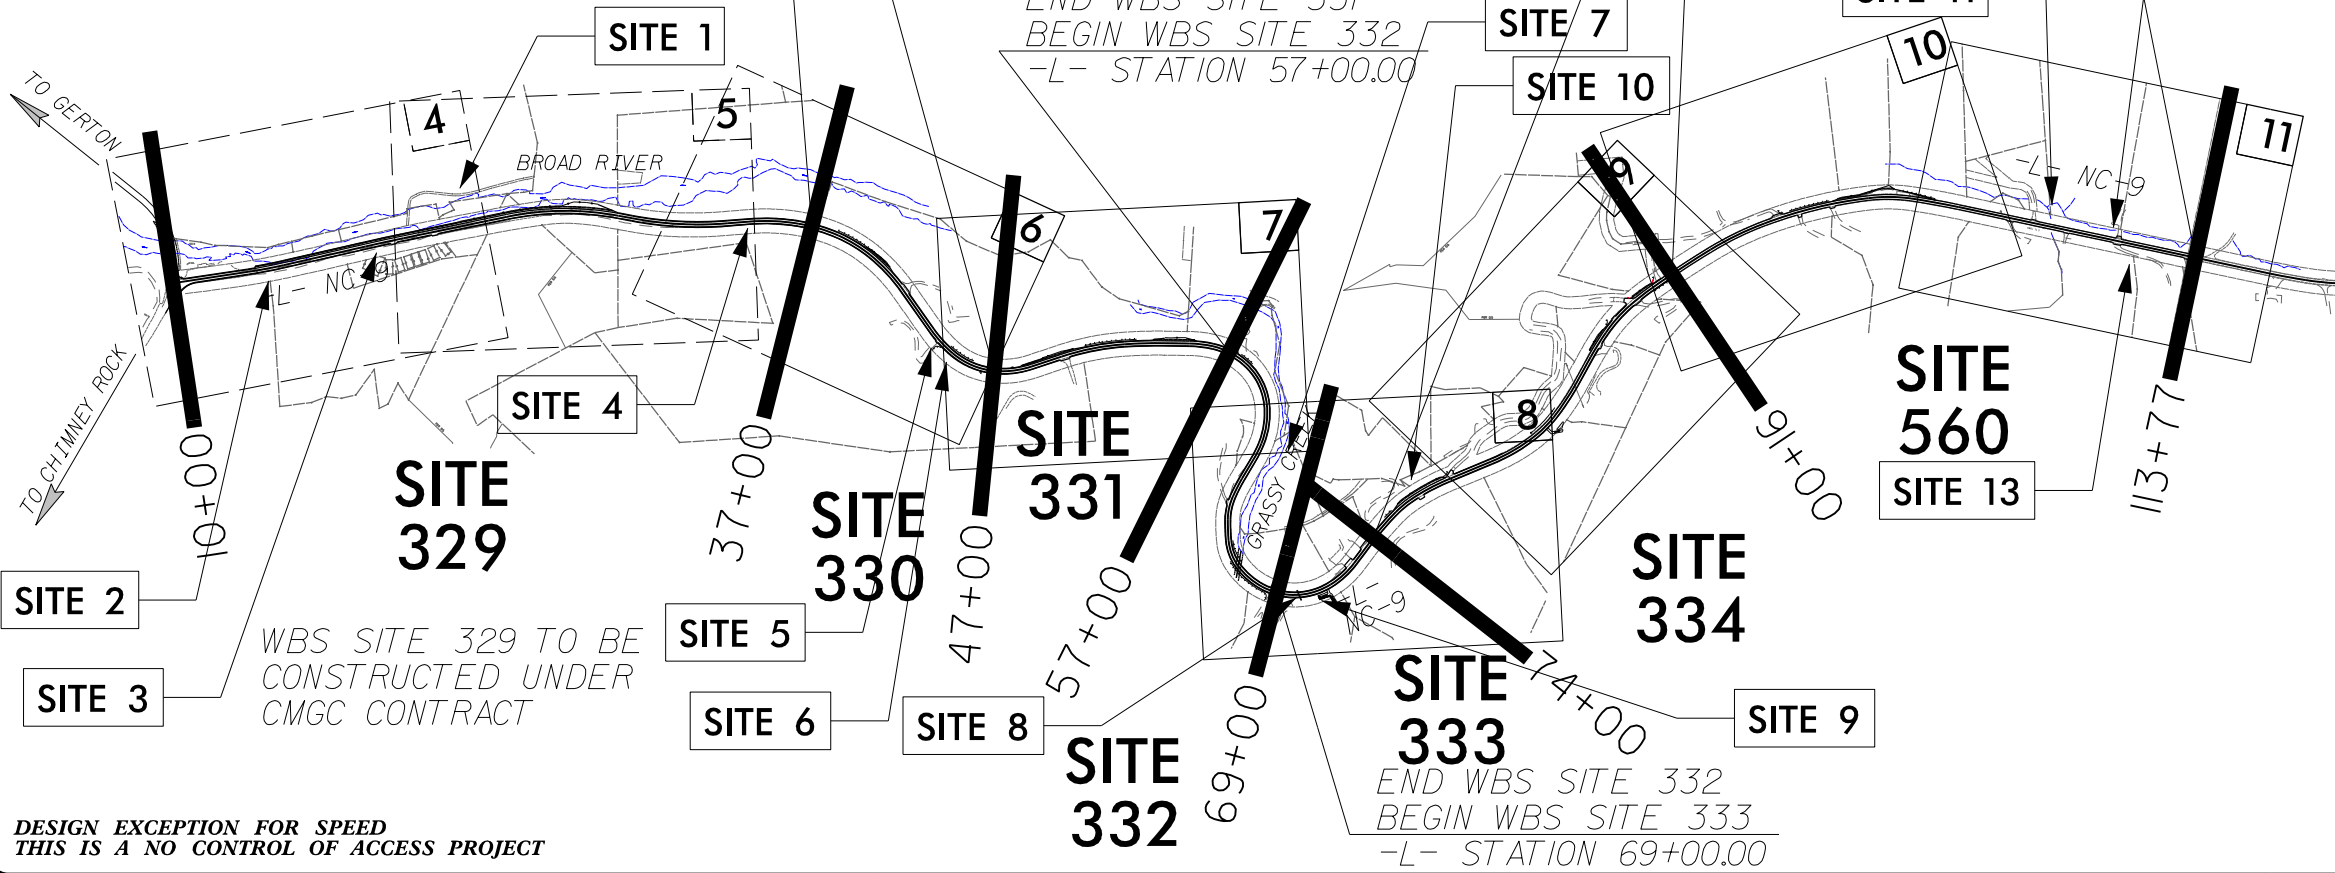

SITE 12

SITE 11

SITE 7

SITE 10

SITE 560
SITE 13

SITE 334

SITE 333

SITE 332

SITE 331

SITE 330

SITE 329


SITE 2

SITE 3

DESIGN EXCEPTION FOR SPEED
THIS IS A NO CONTROL OF ACCESS PROJECT

DOCUMENT NOT CONSIDERED FINAL
UNLESS ALL SIGNATURES COMPLETED

GRAPHIC SCALES

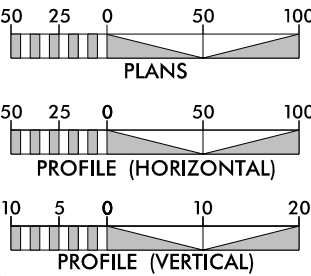

DESIGN DATA


ADT 2025 = 1000
K = N/A
D = N/A
T = 7%
V = 45 MPH

FUNC CLASSIFICATION =
MAJOR COLLECTOR
REGIONAL TIER

PROJECT LENGTH

LENGTH ROADWAY PROJECT NC-9 = 1.963 MILES
TOTAL LENGTH PROJECT NC-9 = 1.963 MILES

PREPARED IN THE OFFICES OF:

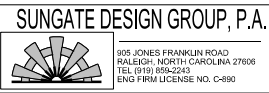

FOR THE NORTH CAROLINA DEPARTMENT OF TRANSPORTATION

2024 STANDARD SPECIFICATIONS
3R GUIDELINES

RIGHT OF WAY DATE:
FEBRUARY 6, 2025

LETTING DATE:
AUGUST 12, 2025

A. DEAN SARVIS, P.E.
PROJECT ENGINEER


JOSH B DEYTON, P.E.
NCDOT DIVISION 14 CONTACT

HYDRAULICS ENGINEER

SIGNATURE: P.E.


ROADWAY ENGINEER

SIGNATURE: P.E.

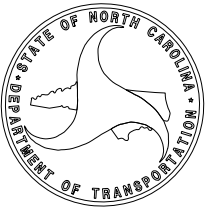


ROADWAY FINAL PLAN SET

10/20/2025
NC-9_Hyd-prm_wet_psh_01.dgn
JStanovich

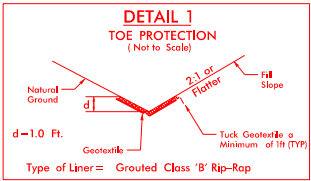


Type of Liner = Grouted Class 'B' Rip-Rap


FROM STA. 10+50 TO STA. 11+28 -L- RT
FROM STA. 11+34 TO STA. 13+50 -L- RT
FROM STA. 53+00 TO STA. 56+80 -L- RT
FROM STA. 73+50 TO STA. 75+50 -L- RT
FROM STA. 77+68 TO STA. 80+00 -L- RT

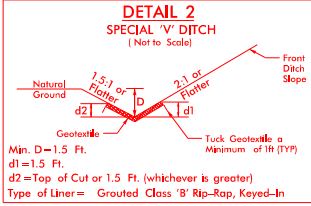


FROM STA. 14+00 TO STA. 17+50 -L- RT

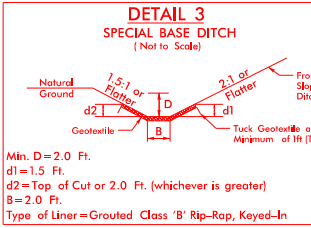


FROM STA. 17+50 TO STA. 18+30 -L- RT

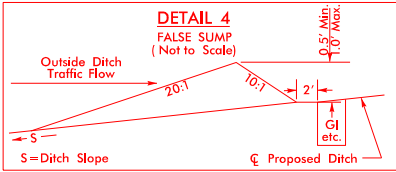


STA. 19+75 -L- RT
STA. 29+80 -L- RT
STA. 39+57 -L- RT
STA. 64+86 -L- RT
STA. 81+76 -L- RT
STA. 82+50 -L- RT

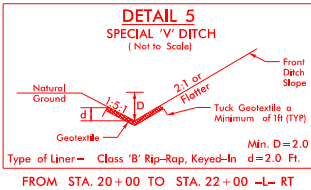


FROM STA. 20+00 TO STA. 22+00 -L- RT

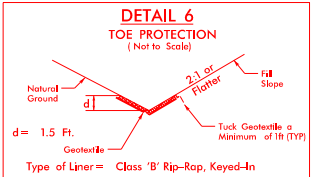


FROM STA. 22+00 TO STA. 22+50 -L- RT
FROM STA. 32+50 TO STA. 33+50 -L- RT
FROM STA. 86+50 TO STA. 87+14 -L- LT

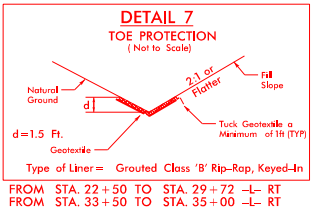


FROM STA. 22+50 TO STA. 29+72 -L- RT
FROM STA. 33+50 TO STA. 35+00 -L- RT

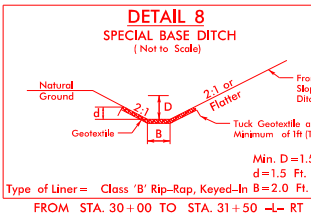


FROM STA. 30+00 TO STA. 31+50 -L- RT

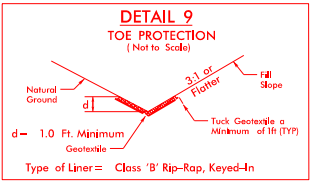


FROM STA. 31+50 TO STA. 32+50 -L- RT

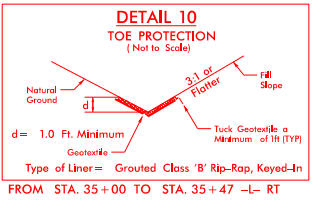


FROM STA. 35+00 TO STA. 35+47 -L- RT

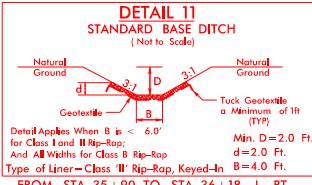


FROM STA. 35+90 TO STA. 36+18 -L- RT

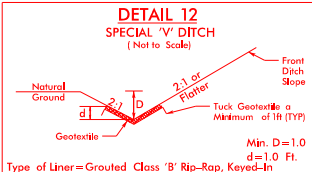


FROM STA. 41+67 TO STA. 42+00 -L- RT

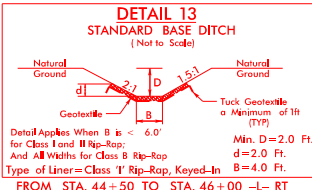


FROM STA. 44+50 TO STA. 46+00 -L- RT

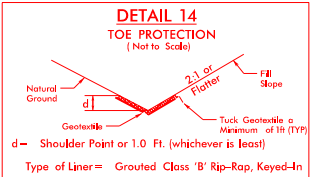


FROM STA. 50+25 TO STA. 52+40 -L- RT

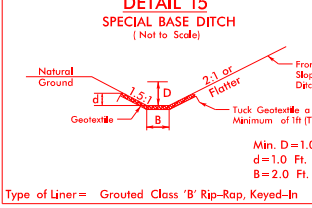


FROM STA. 52+50 TO STA. 53+00 -L- RT
FROM STA. 73+28 TO STA. 73+50 -L- RT

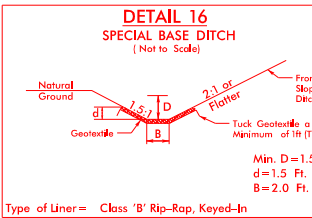


FROM STA. 59+00 TO STA. 63+50 -L- RT

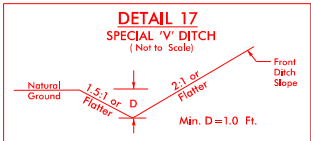


FROM STA. 64+41 TO STA. 65+00 -L- RT
FROM STA. 95+50 TO STA. 97+36 -L- RT
FROM STA. 99+00 TO STA. 101+50 -L- RT

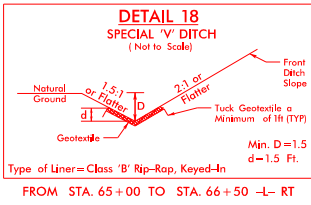


FROM STA. 65+00 TO STA. 66+50 -L- RT

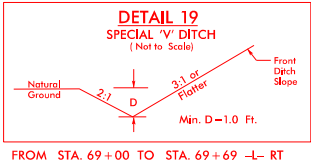


FROM STA. 69+00 TO STA. 69+69 -L- RT

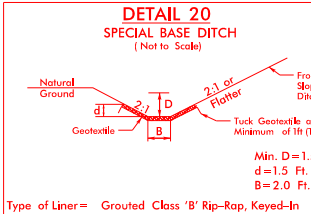


FROM STA. 70+50 TO STA. 72+15 -L- RT

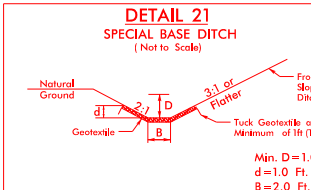


FROM STA. 75+50 TO STA. 77+68 -L- RT

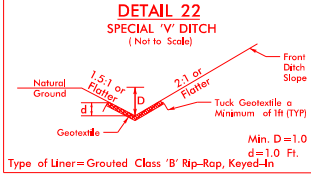


FROM STA. 80+00 TO STA. 82+00 -L- RT
FROM STA. 83+00 TO STA. 85+50 -L- RT

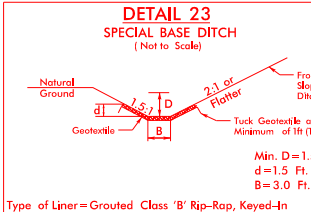


FROM STA. 82+75 TO STA. 83+00 -L- RT

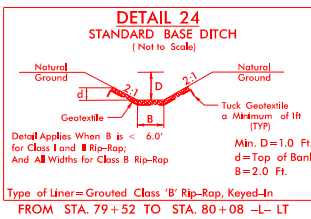


FROM STA. 79+52 TO STA. 80+08 -L- LT

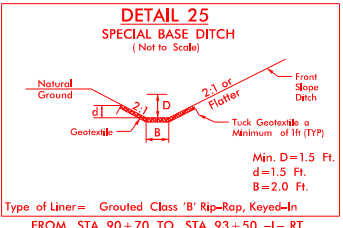


FROM STA. 90+70 TO STA. 93+50 -L- RT

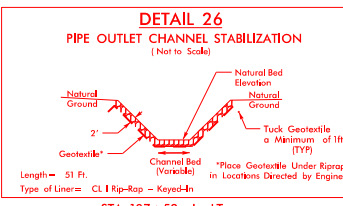


STA. 107+52 -L- LT

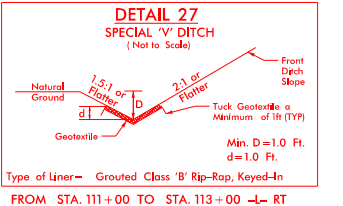

FROM STA. 111+00 TO STA. 113+00 -L- RT

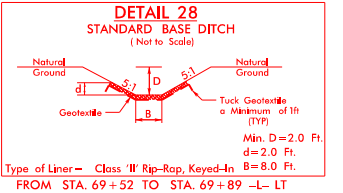

FROM STA. 69+52 TO STA. 69+89 -L- LT

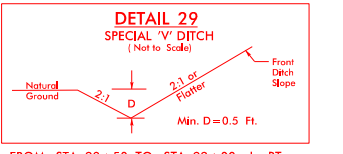

FROM STA. 98+50 TO STA. 99+00 -L- RT

PERMIT DRAWING SHEET 2 OF 25

DATE: 10/20/2025

PROJECT REFERENCE NO. SHEET NO.

NC-9

20-1

ROADWAY DESIGN
ENGINEER

HYDRAULICS
ENGINEER



DOCUMENT NOT CONSIDERED FINAL
UNLESS ALL SIGNATURES COMPLETED

SUNGATE DESIGN GROUP, P.A.









905 JONES FRANKLIN ROAD
RALEIGH, NORTH CAROLINA 27606
TEL: (919) 858-2243
ENG FIRM LICENSE NO. C-690

PROJECT REFERENCE NO.		SHEET NO.	
NC-9		2D-2	
ROADWAY DESIGN ENGINEER		HYDRAULICS ENGINEER	
DOCUMENT NOT CONSIDERED FINAL UNLESS ALL SIGNATURES COMPLETED			
SUNGATE DESIGN GROUP, P.A.			
		905 JONES FRANKLIN ROAD RALEIGH, NORTH CAROLINA 27606 TEL (919) 858-2243 ENG FIRM LICENSE NO. C-890	
PERMIT DRAWING SHEET 3 OF 25			
DATE: 10/20/2025			

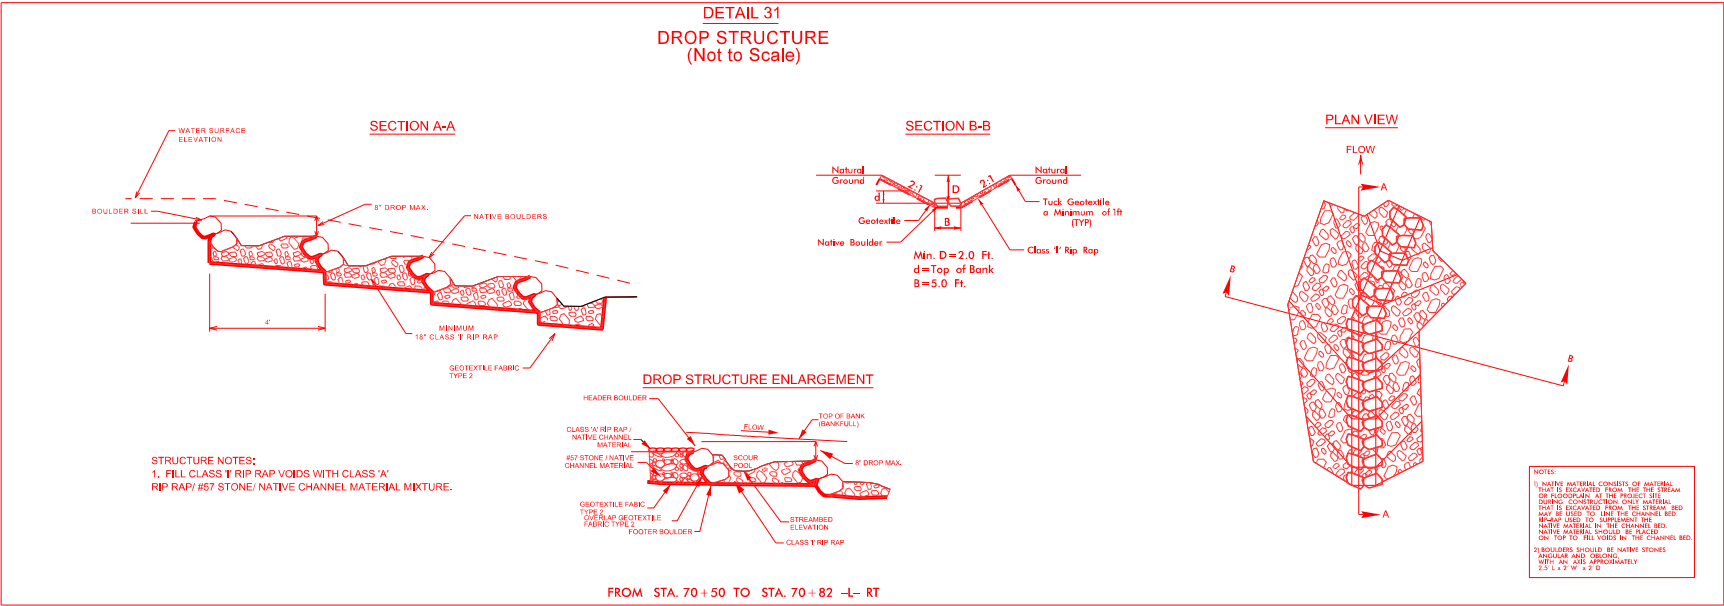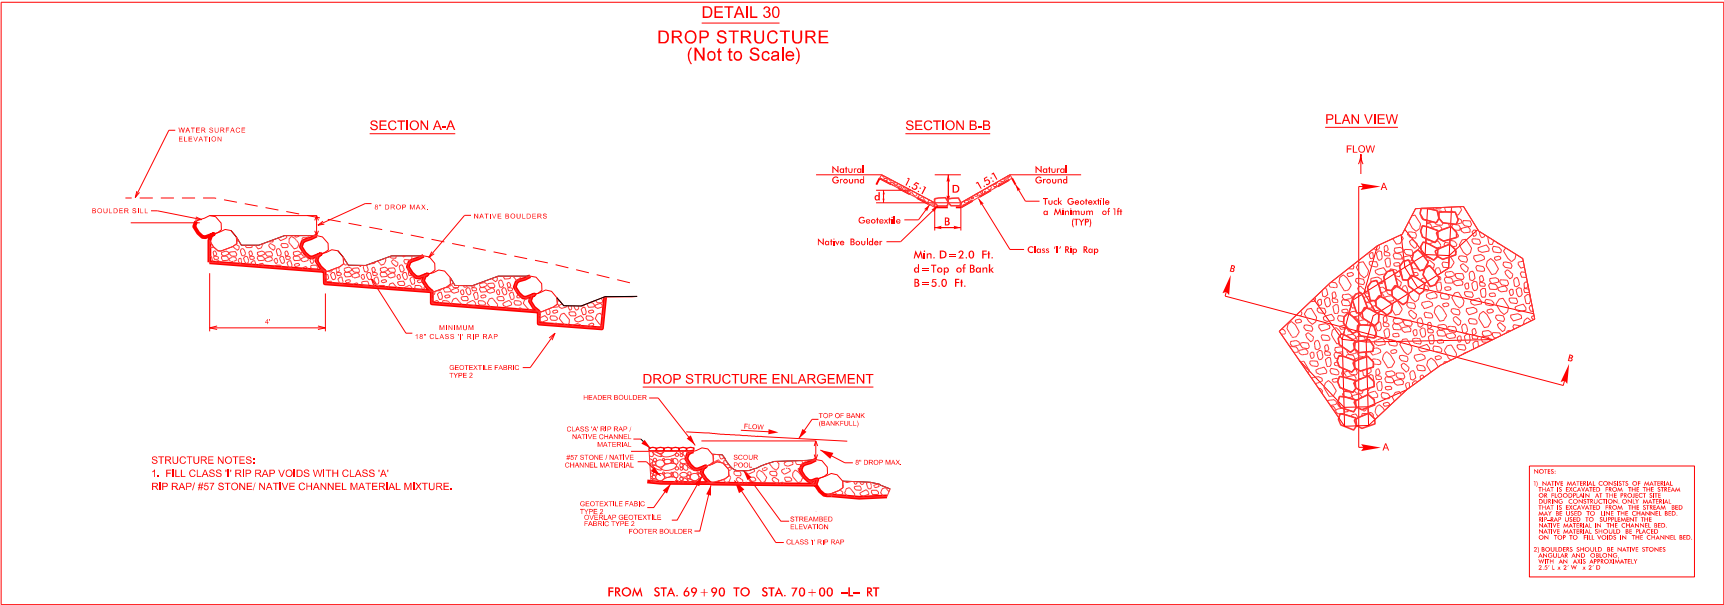

SUPPLEMENTAL DITCH DETAILS FOR PERMITTING

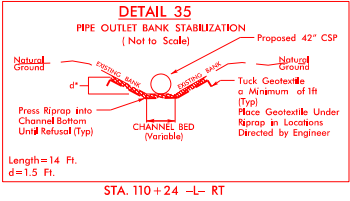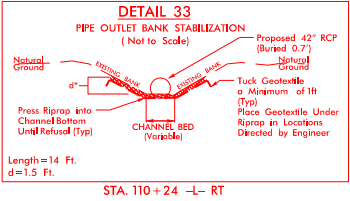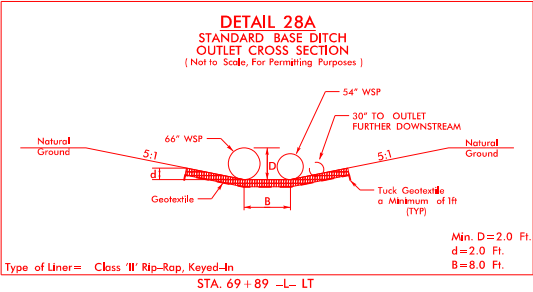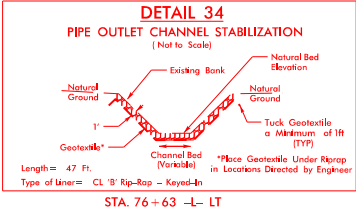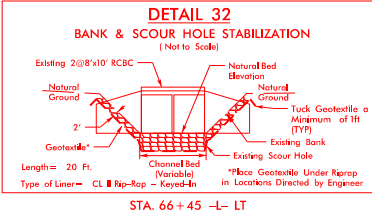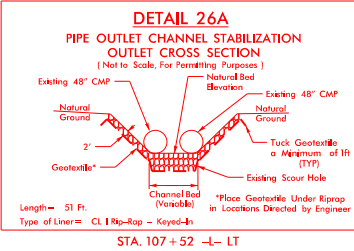

8/17/99


10/20/2025
NC-9_Hyd.prm_wet_pah_04.dgn
JStonovich



SURFACE WATER IMPACTS



TEMPORARY SURFACE WATER IMPACTS

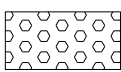


EXEMPT SURFACE WATER IMPACTS



PRE-HELENE STREAM CHANNEL




PRE-HELENE ASSUMED
EX STORM PIPES

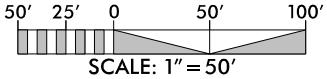

PROJECT REFERENCE NO. NC-9		SHEET NO. 4	
ROADWAY DESIGN ENGINEER		HYDRAULICS ENGINEER	
DOCUMENT NOT CONSIDERED FINAL UNLESS ALL SIGNATURES COMPLETED			
SUNGATE DESIGN GROUP, P.A.			
		905 JONES FRANKLIN ROAD RALEIGH, NORTH CAROLINA 27606 TEL: (919) 859-2243 ENG FIRM LICENSE NO. C-890	

PERMIT DRAWING
SHEET 4 OF 25
DATE: 10/20/2025

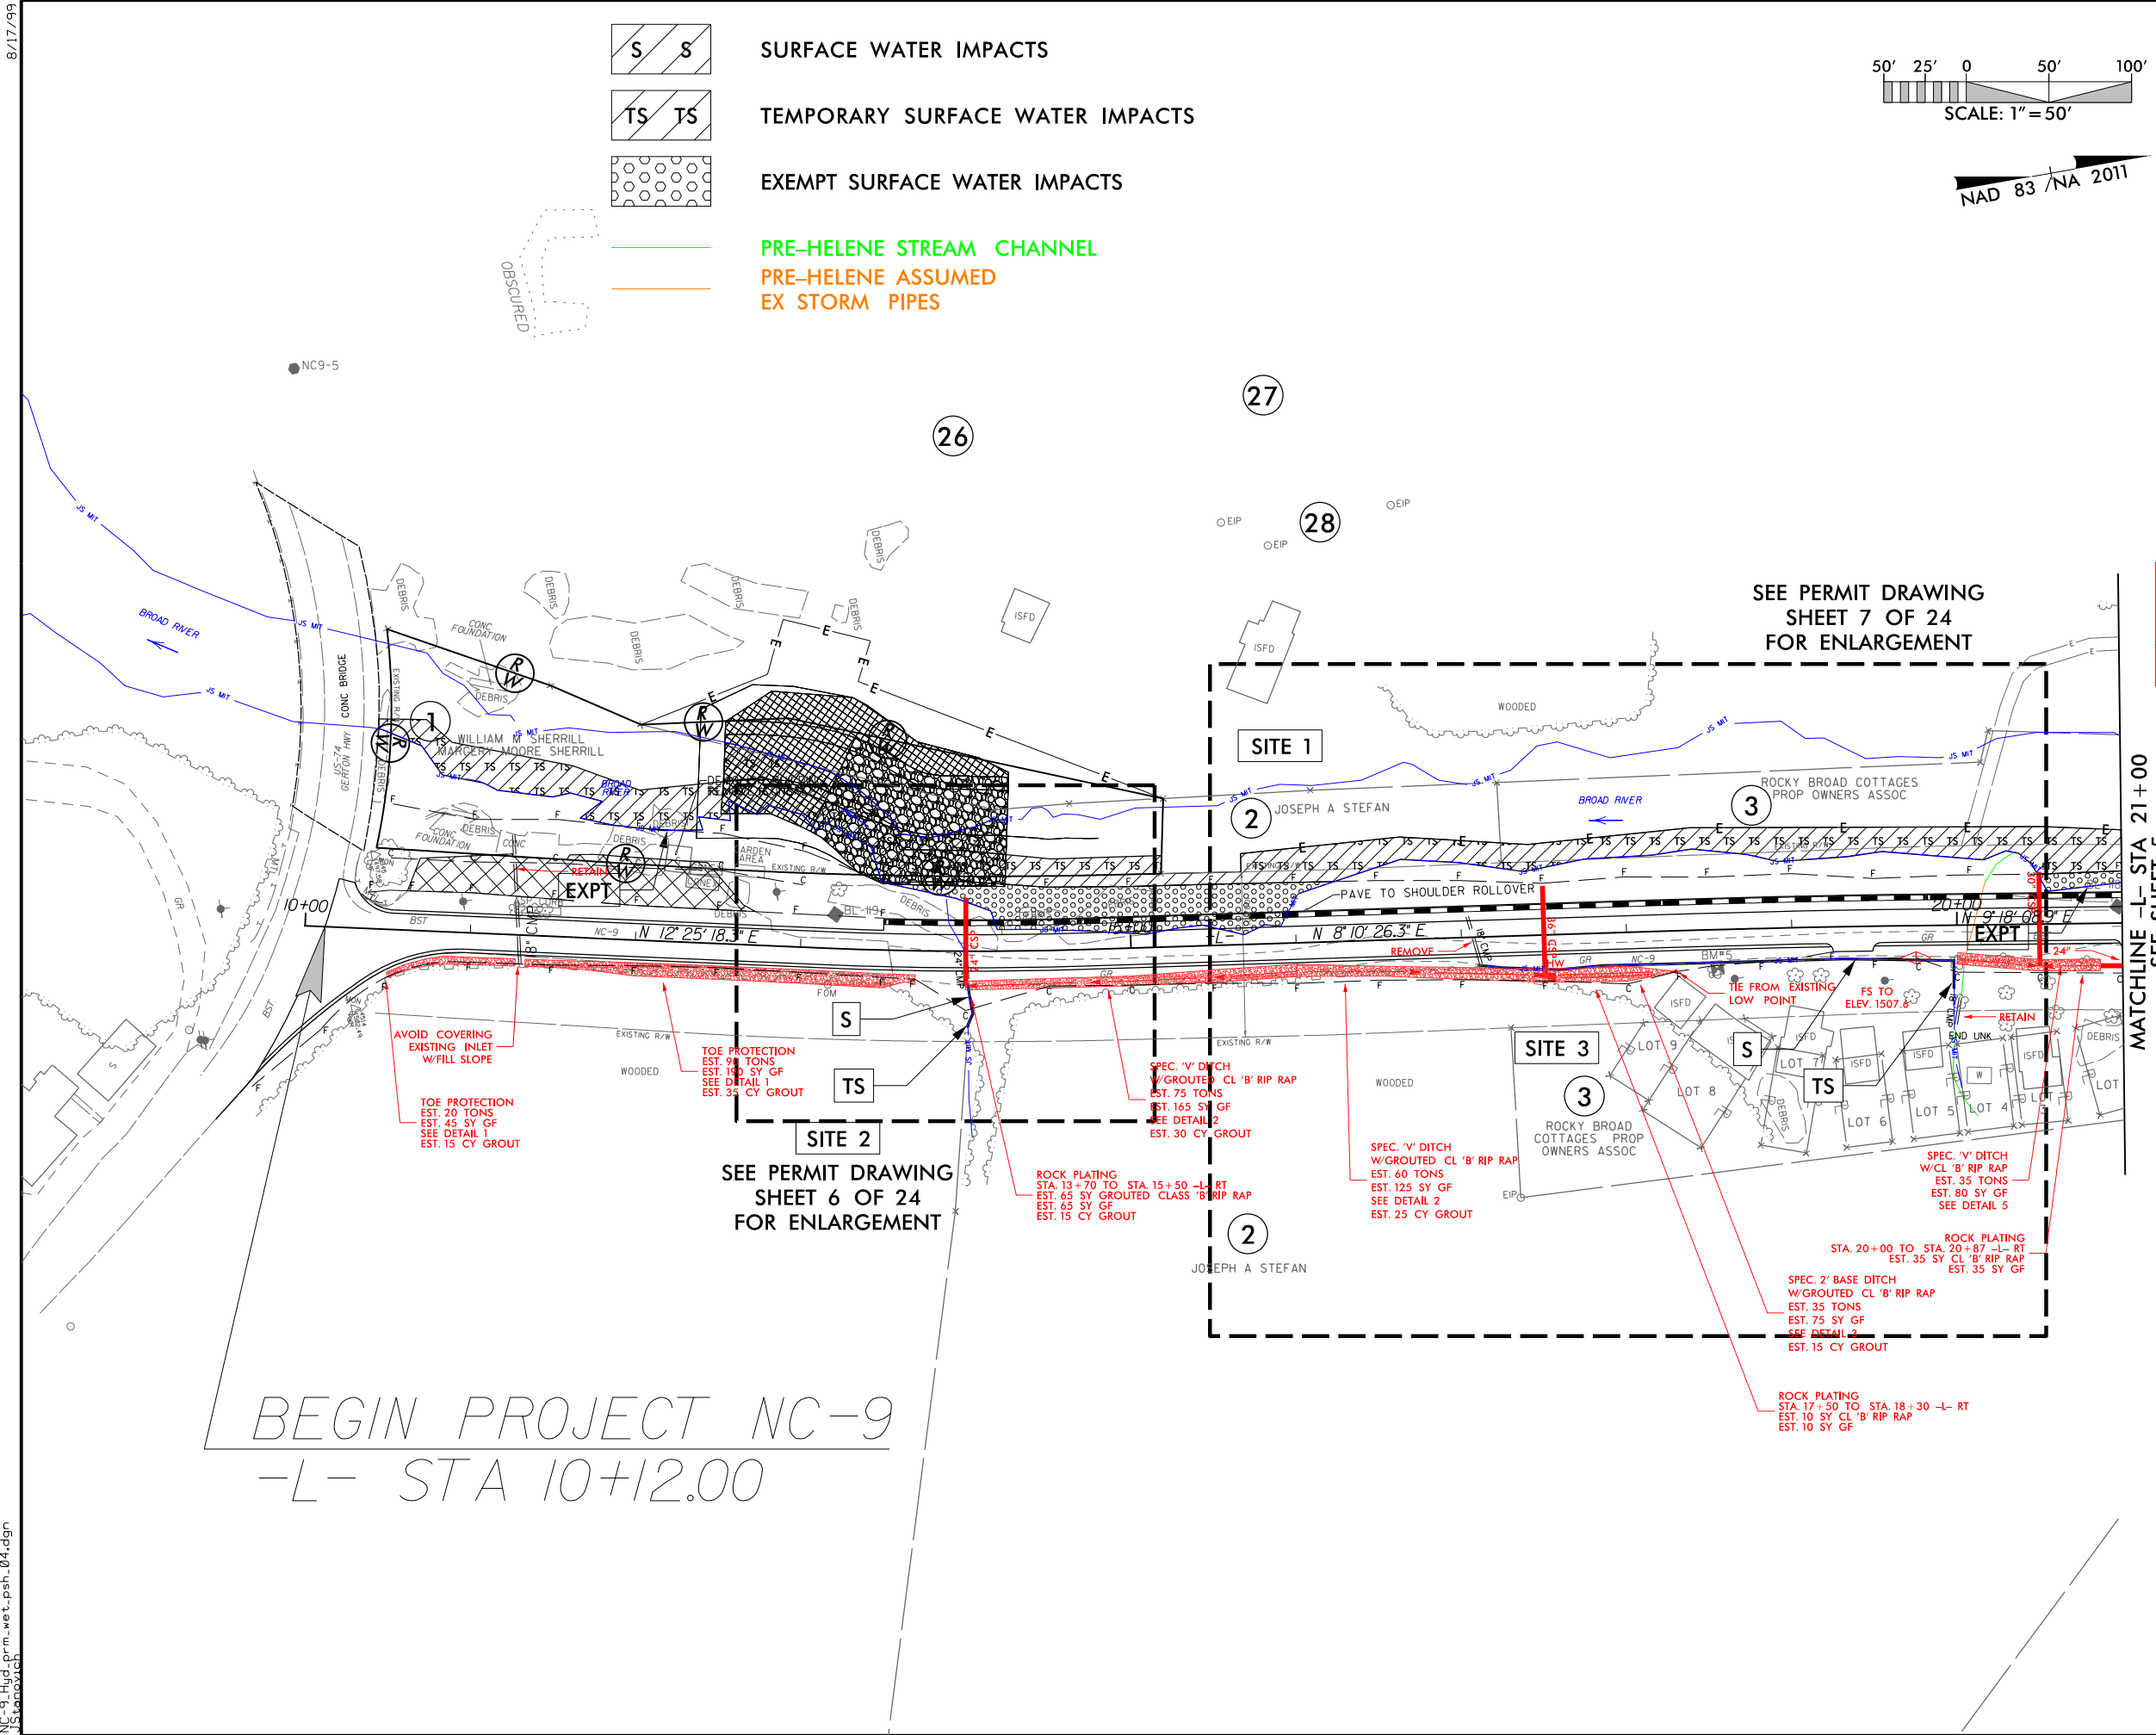


8/17/99



SURFACE WATER IMPACTS



TEMPORARY SURFACE WATER IMPACTS

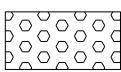


EXEMPT SURFACE WATER IMPACTS



PRE-HELENE STREAM CHANNEL



PRE-HELENE ASSUMED
EX STORM PIPES

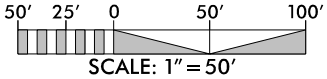

PROJECT REFERENCE NO.	SHEET NO.
NC-9	4

ROADWAY DESIGN ENGINEER	HYDRAULICS ENGINEER
----------------------------	------------------------

DOCUMENT NOT CONSIDERED FINAL
UNLESS ALL SIGNATURES COMPLETED


SUNGATE DESIGN GROUP, P.A.

905 JONES FRANKLIN ROAD
RALEIGH, NORTH CAROLINA 27606
TEL: (919) 858-2243
ENG FIRM LICENSE NO. C-690

PERMIT DRAWING
SHEET 5 OF 25

DATE: 10/20/2025



10/20/2025
NC-9_Hyd.prm_wet_pah_04-1.dgn
stonovich

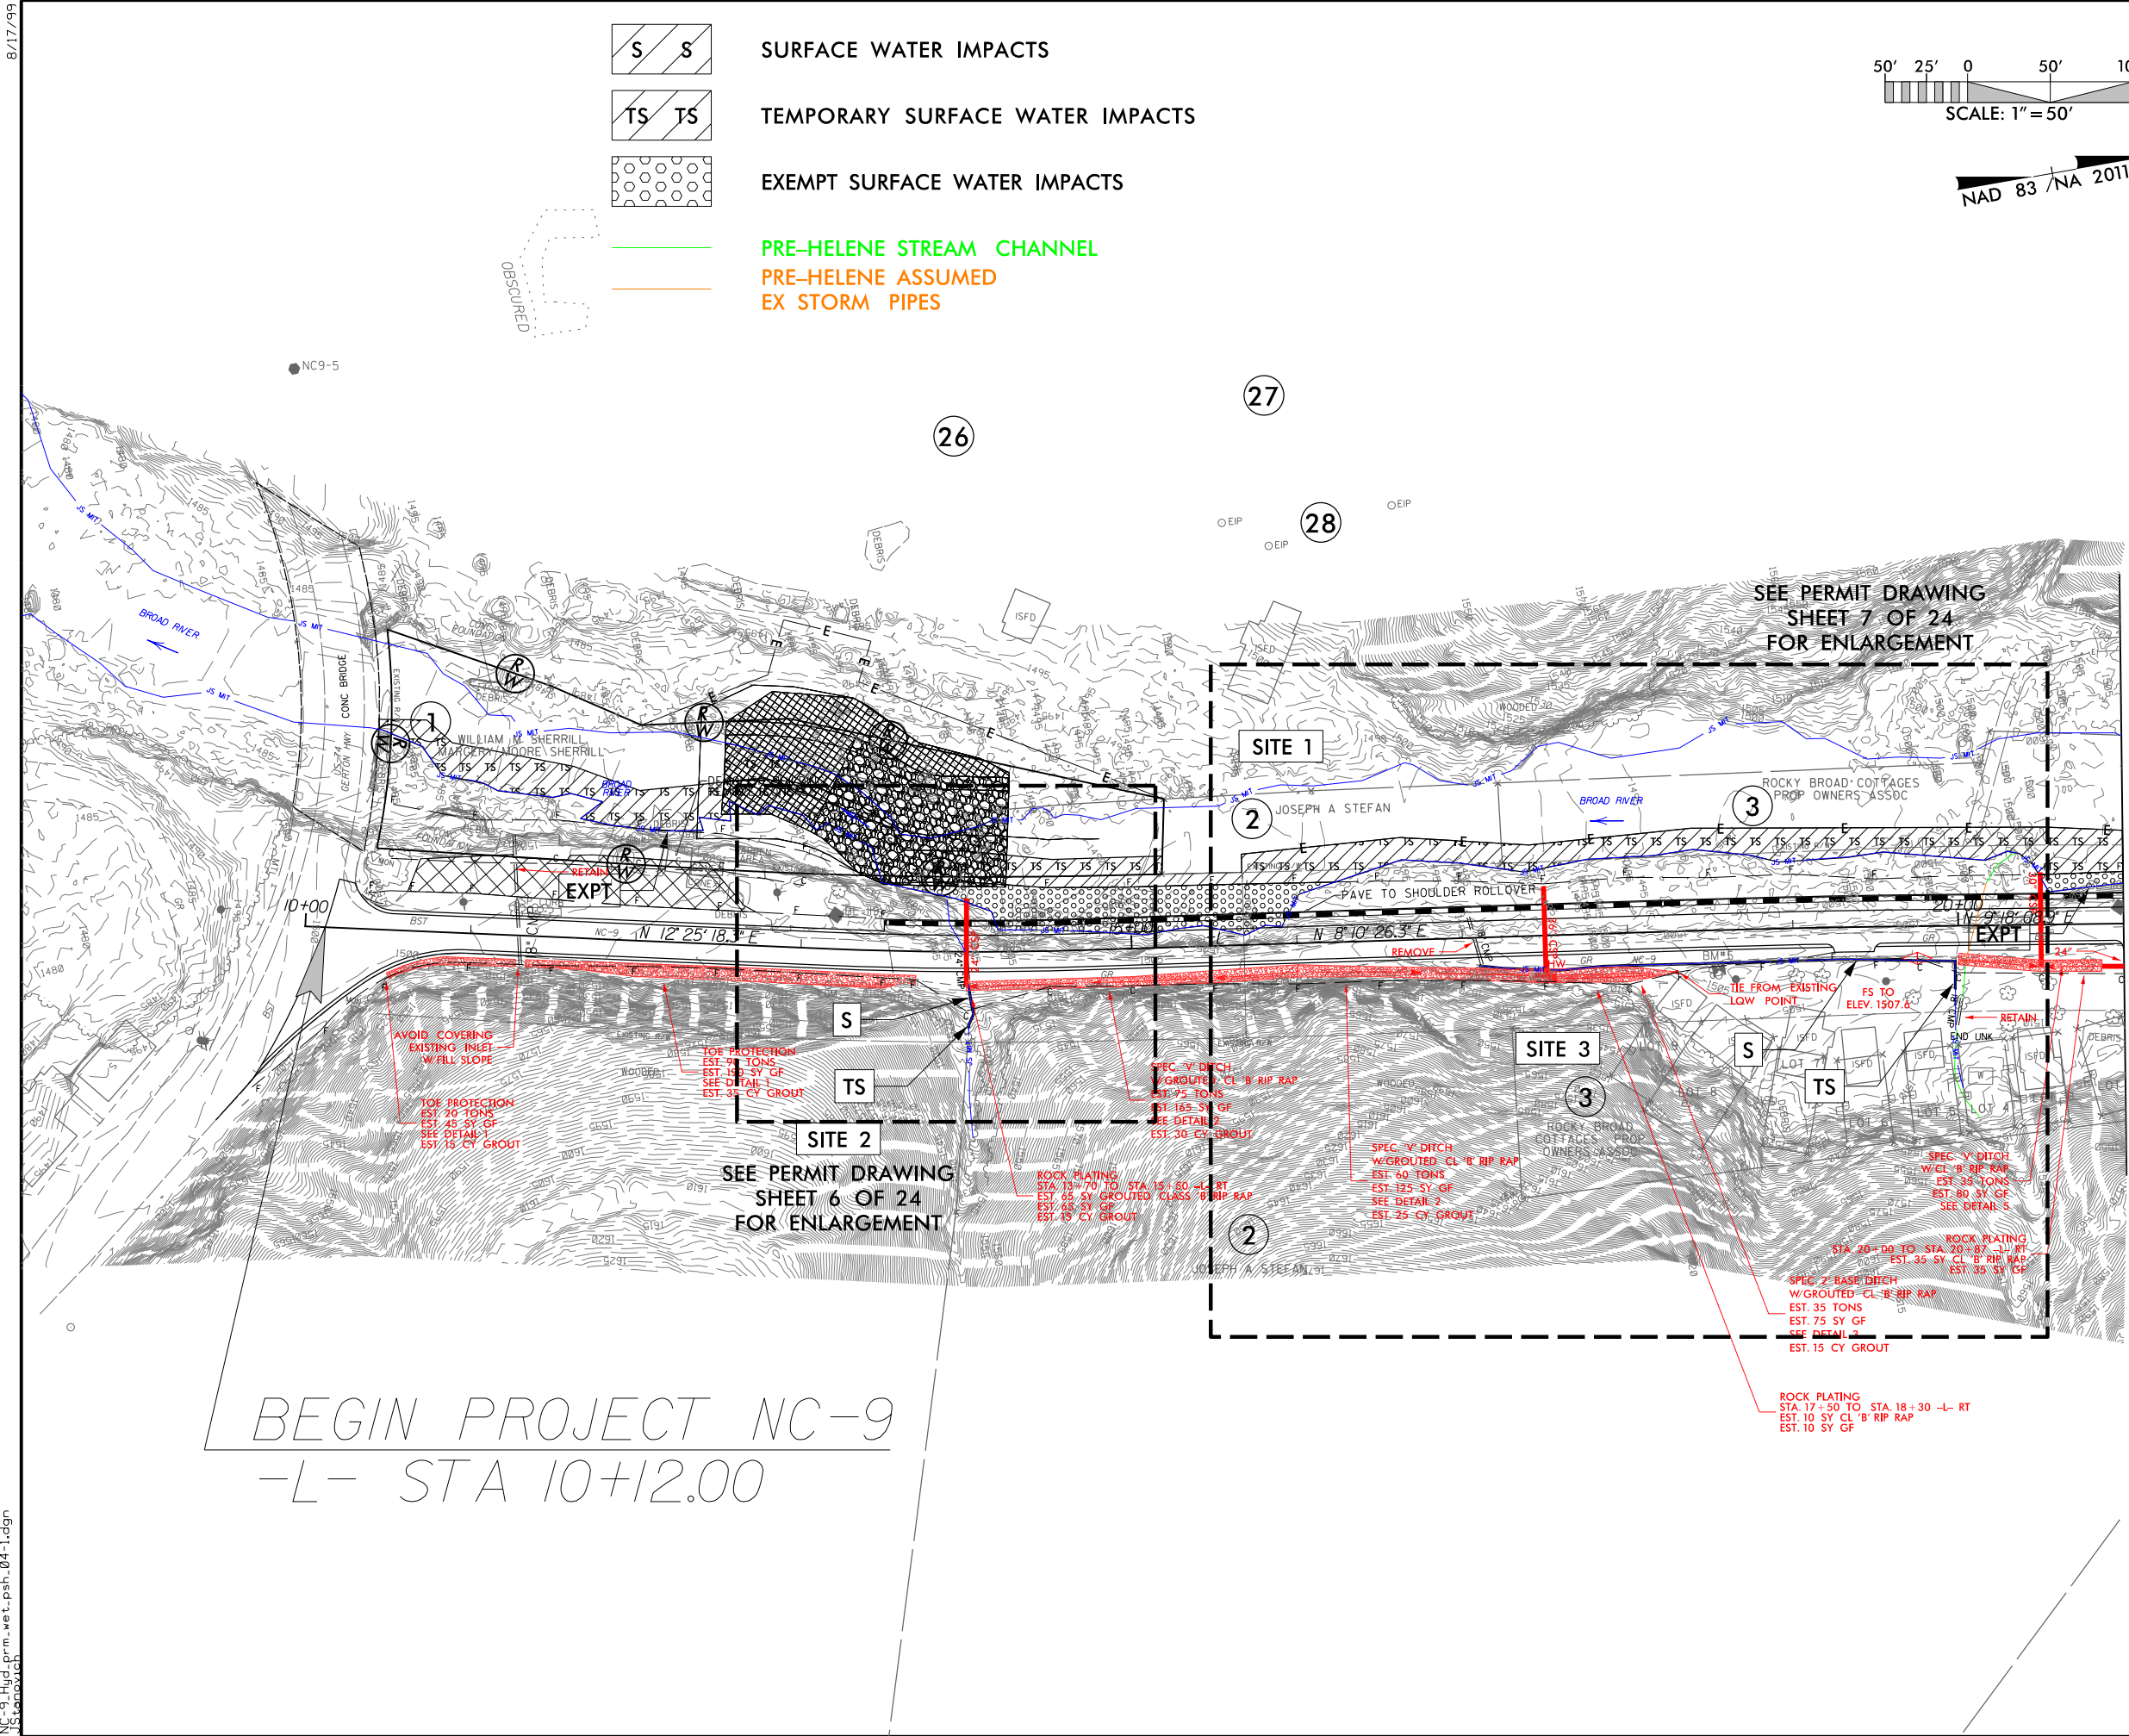

MATCHLINE -L- STA 21+00
SEE SHEET 5

8/17/99

10/20/2025
NC-9_Hyd_perm_wet_psh_04-2-View1.dgn
J.Stonovich

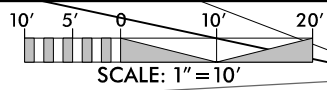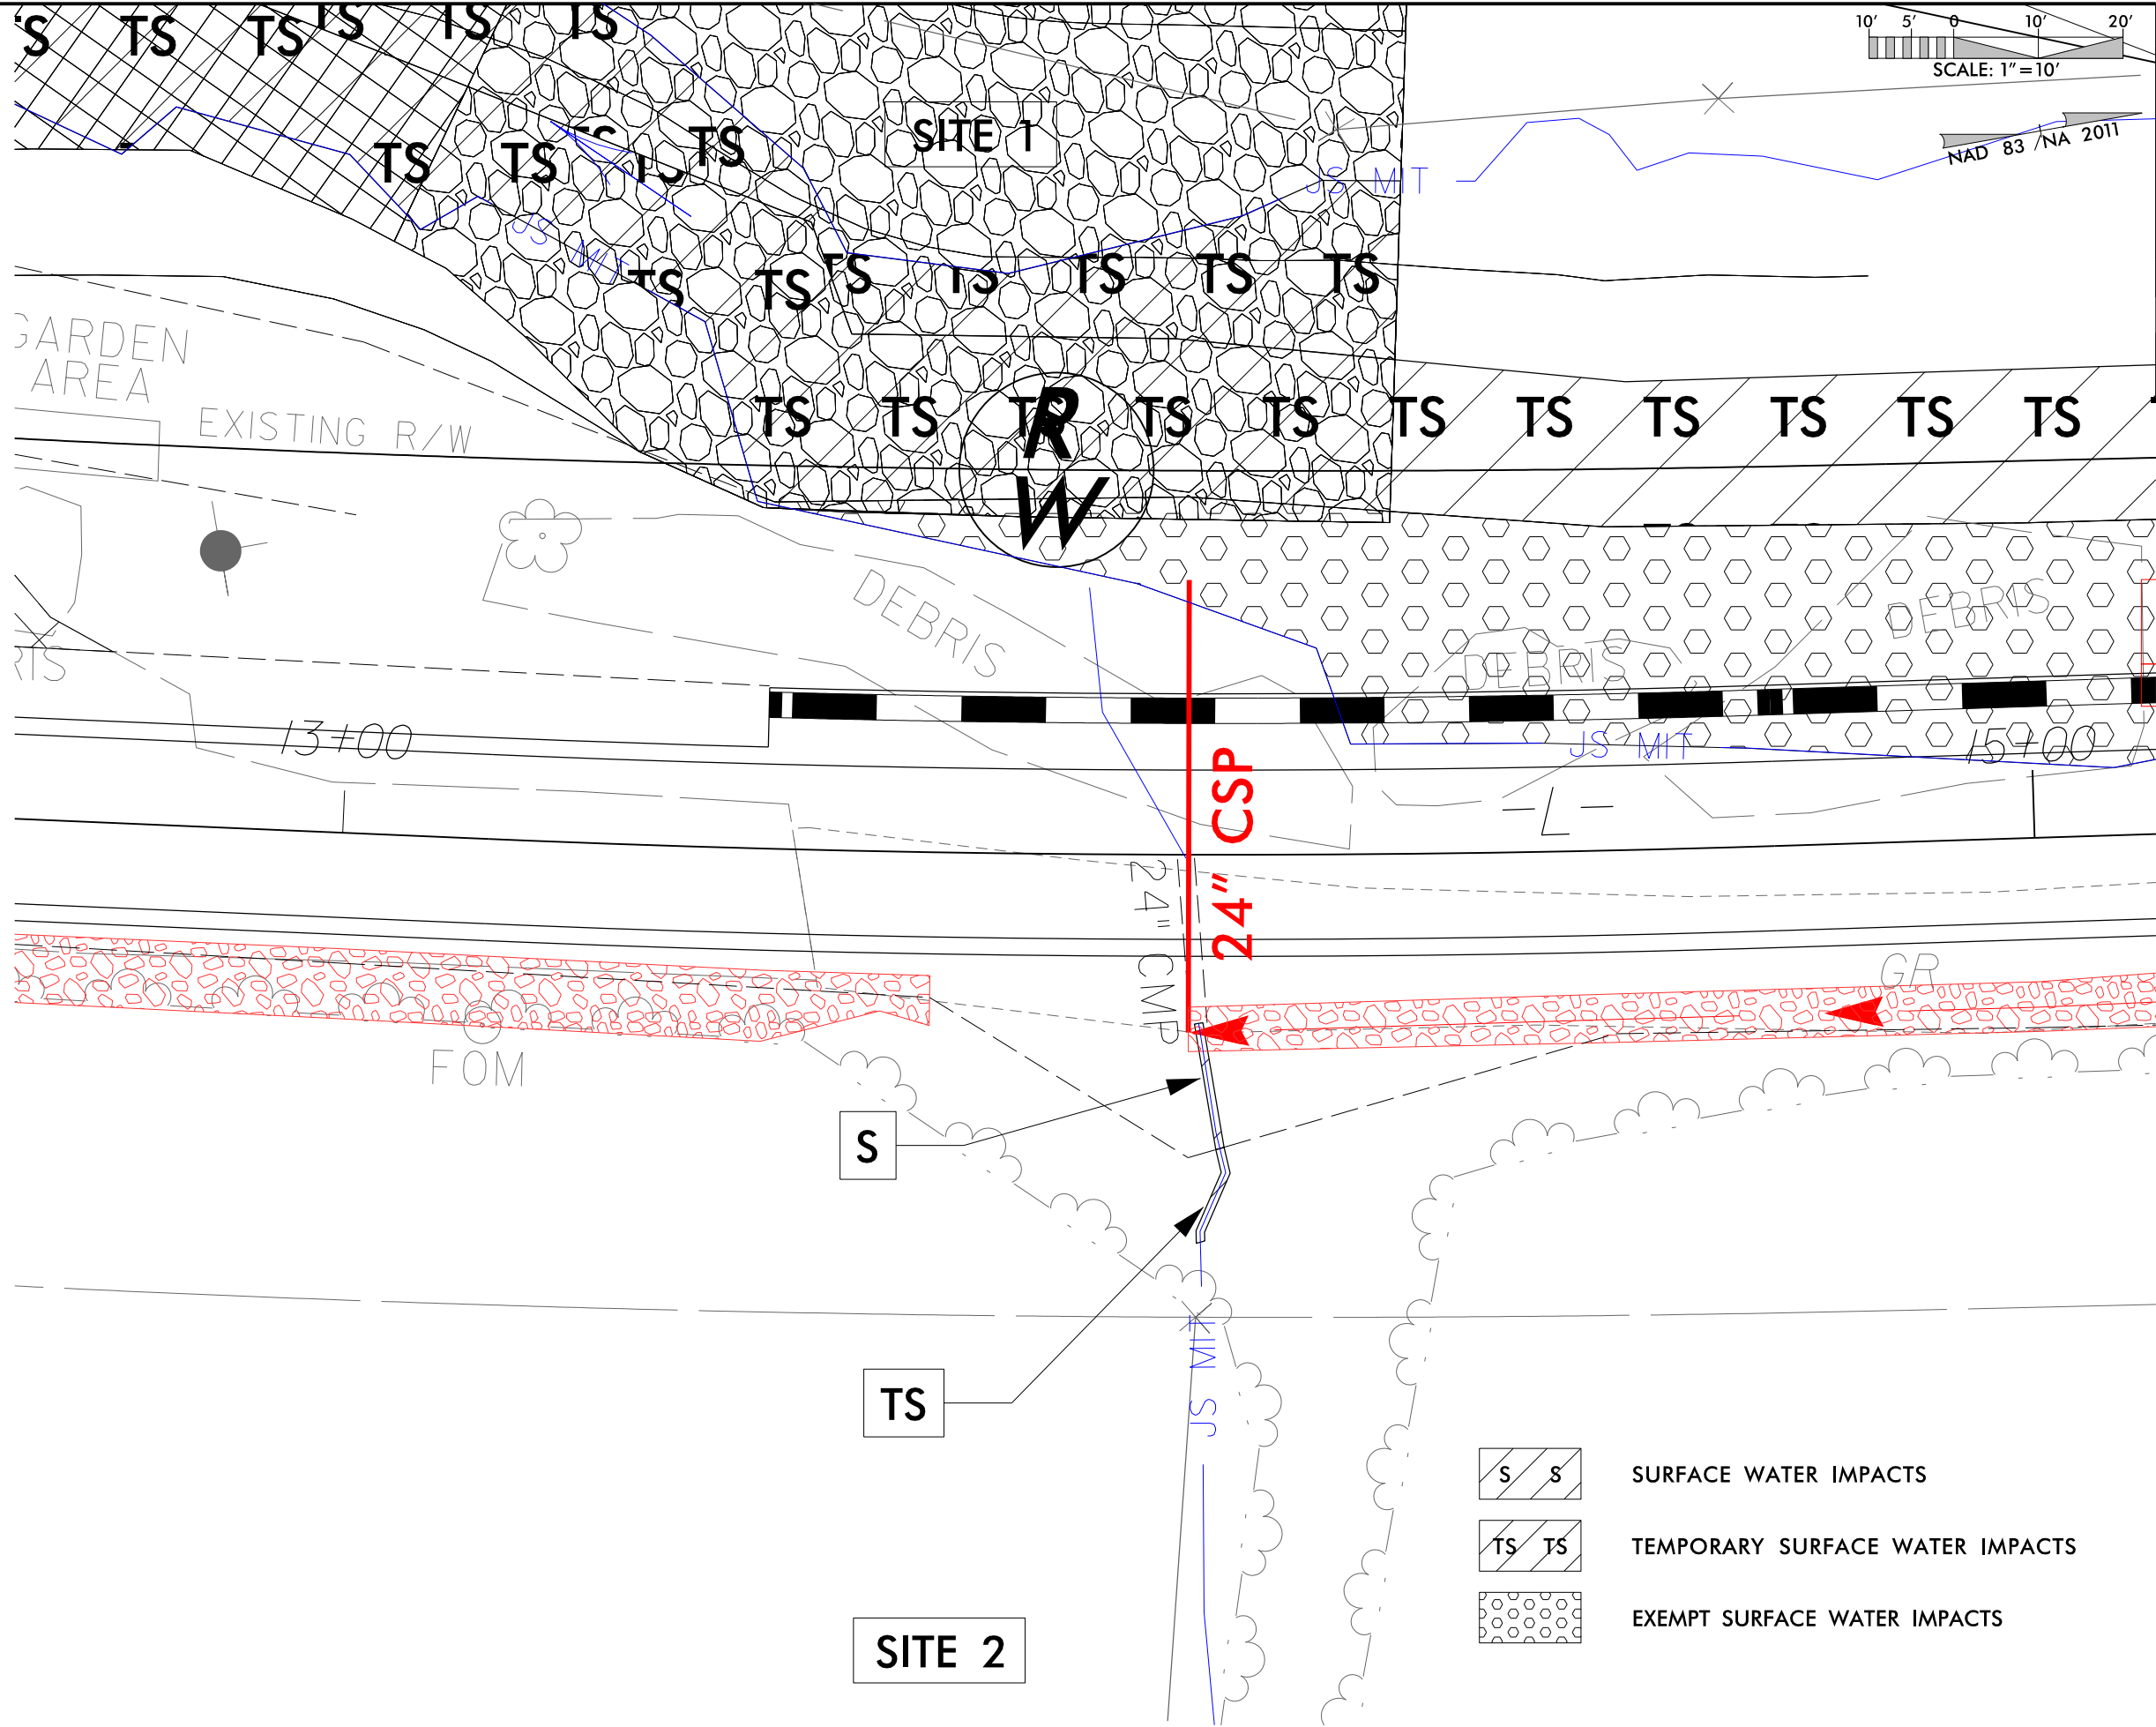


NAD 83 / NA 2011

PROJECT REFERENCE NO. NC-9		SHEET NO.	
ROADWAY DESIGN ENGINEER		HYDRAULICS ENGINEER	
DOCUMENT NOT CONSIDERED FINAL UNLESS ALL SIGNATURES COMPLETED			
SUNGATE DESIGN GROUP, P.A.			
		905 JONES FRANKLIN ROAD RALEIGH, NORTH CAROLINA 27606 TEL (919) 858-2243 ENG FIRM LICENSE NO. C-690	


PERMIT DRAWING
SHEET 6 OF 25

DATE: 10/20/2025

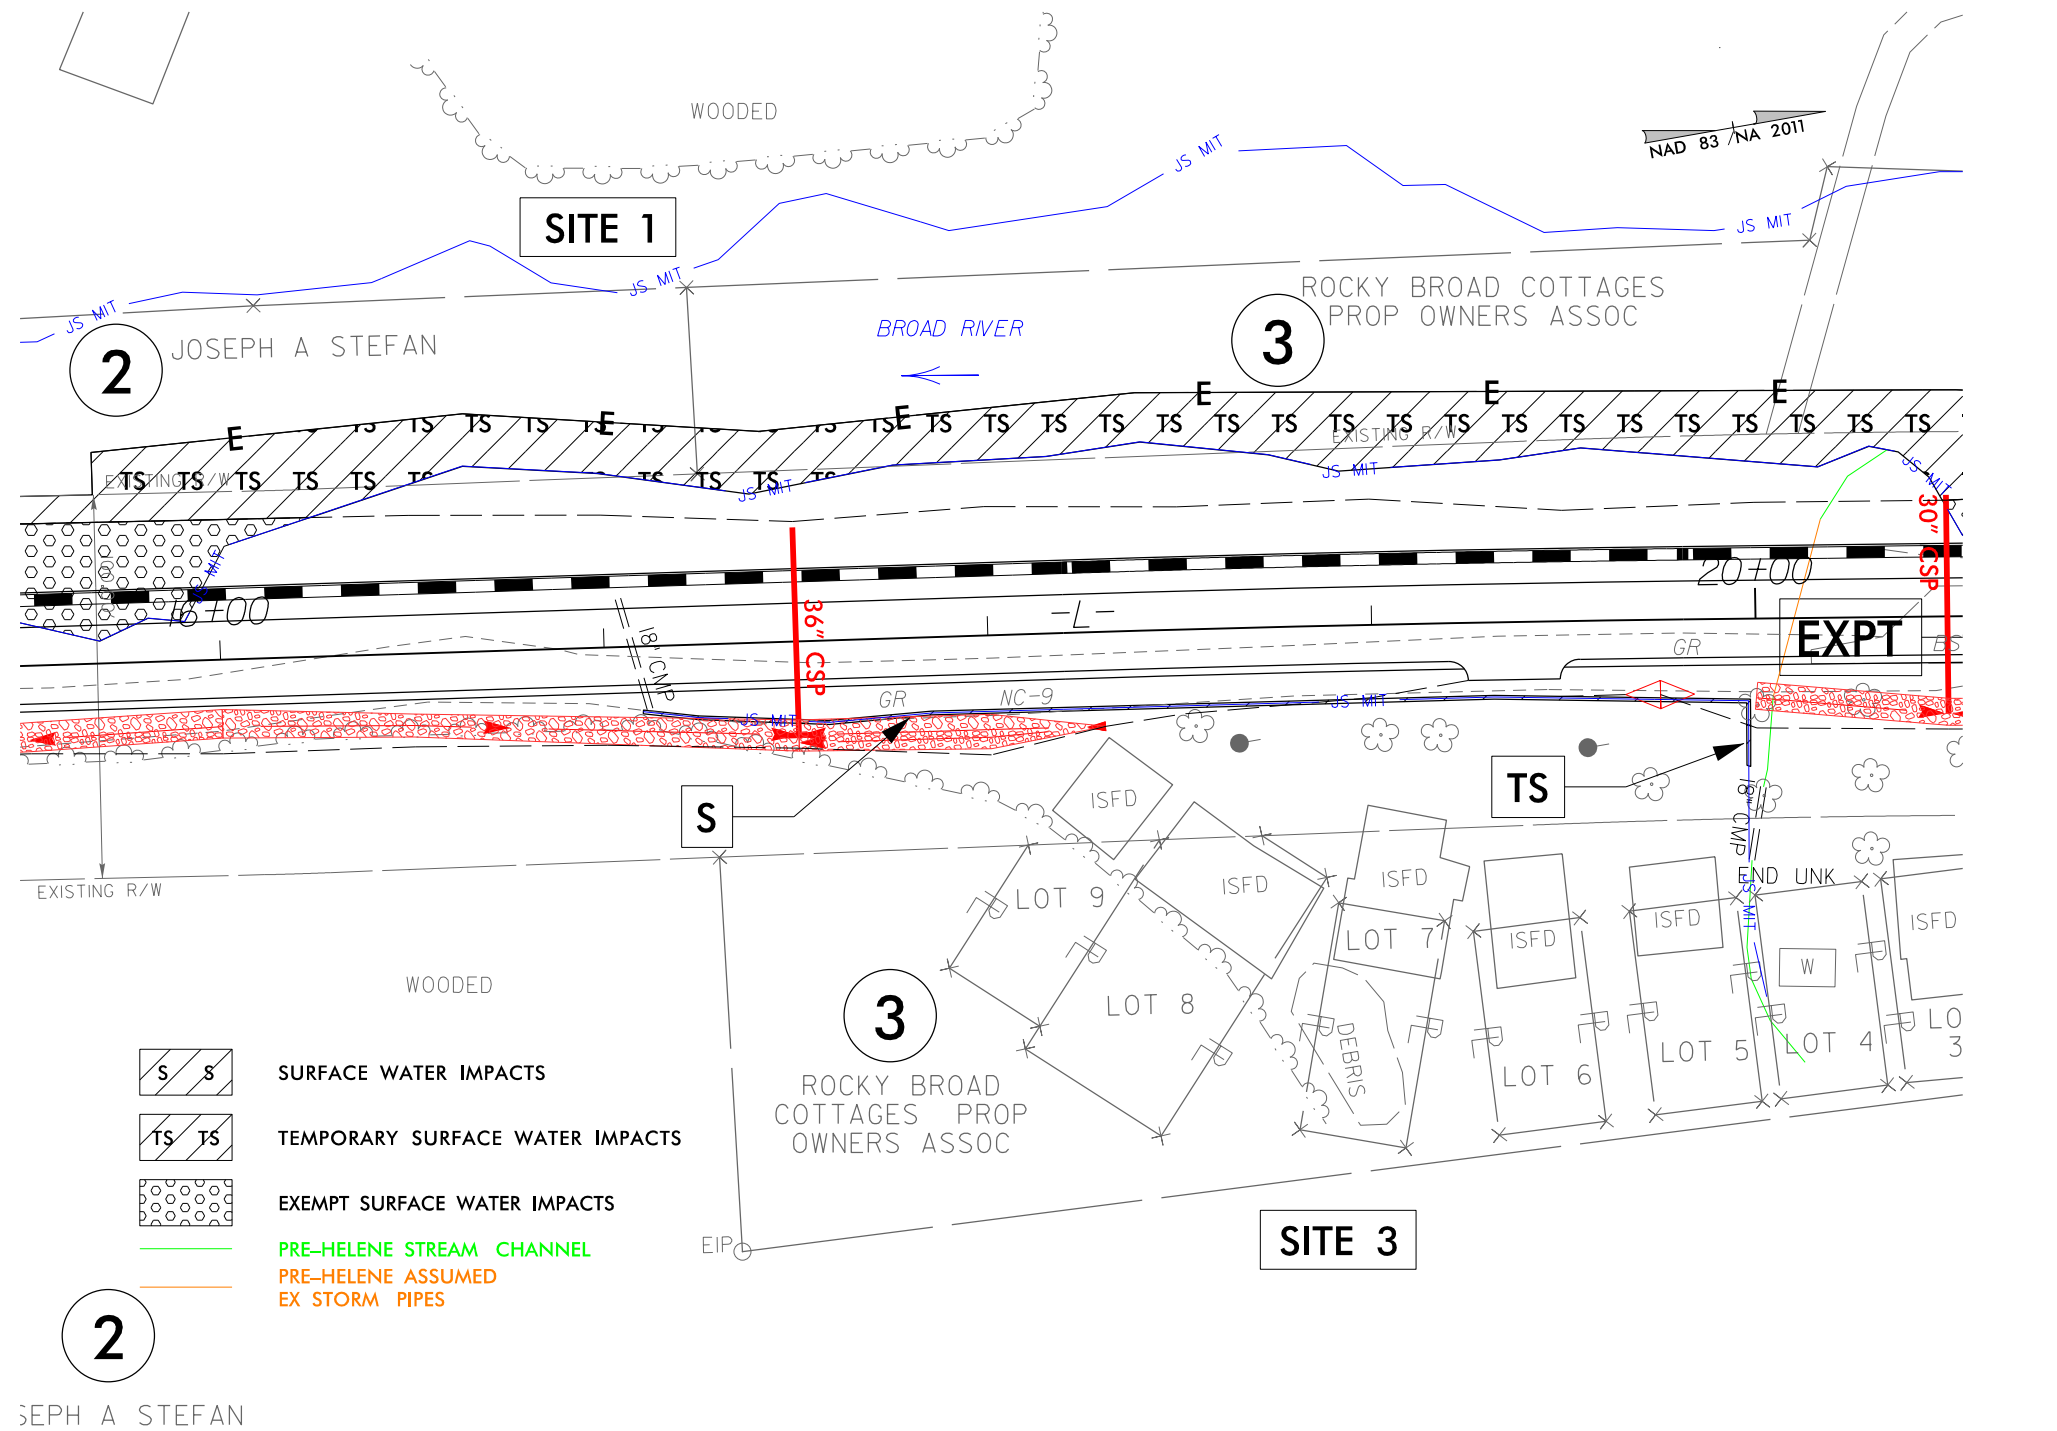

PROJECT REFERENCE NO.		SHEET NO.	
NC-9			
ROADWAY DESIGN ENGINEER		HYDRAULICS ENGINEER	
DOCUMENT NOT CONSIDERED FINAL UNLESS ALL SIGNATURES COMPLETED			
SUNGATE DESIGN GROUP, P.A.			
		905 JONES FRANKLIN ROAD RALEIGH, NORTH CAROLINA 27606 TEL (919) 858-2243 ENG FIRM LICENSE NO. C-890	

PERMIT DRAWING
SHEET 7 OF 25
DATE: 10/20/2025

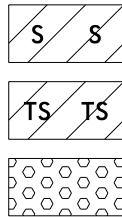


SURFACE WATER IMPACTS

TEMPORARY SURFACE WATER IMPACTS


EXEMPT SURFACE WATER IMPACTS


NAD 83 /NA 2011

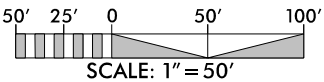

PROJECT REFERENCE NO. NC-9		SHEET NO. 5	
ROADWAY DESIGN ENGINEER		HYDRAULICS ENGINEER	
DOCUMENT NOT CONSIDERED FINAL UNLESS ALL SIGNATURES COMPLETED			
SUNGATE DESIGN GROUP, P.A.			
		905 JONES FRANKLIN ROAD RALEIGH, NORTH CAROLINA 27606 TEL: (919) 858-2243 ENG FIRM LICENSE NO. C-890	

PERMIT DRAWING
SHEET 8 OF 25
DATE: 10/20/2025

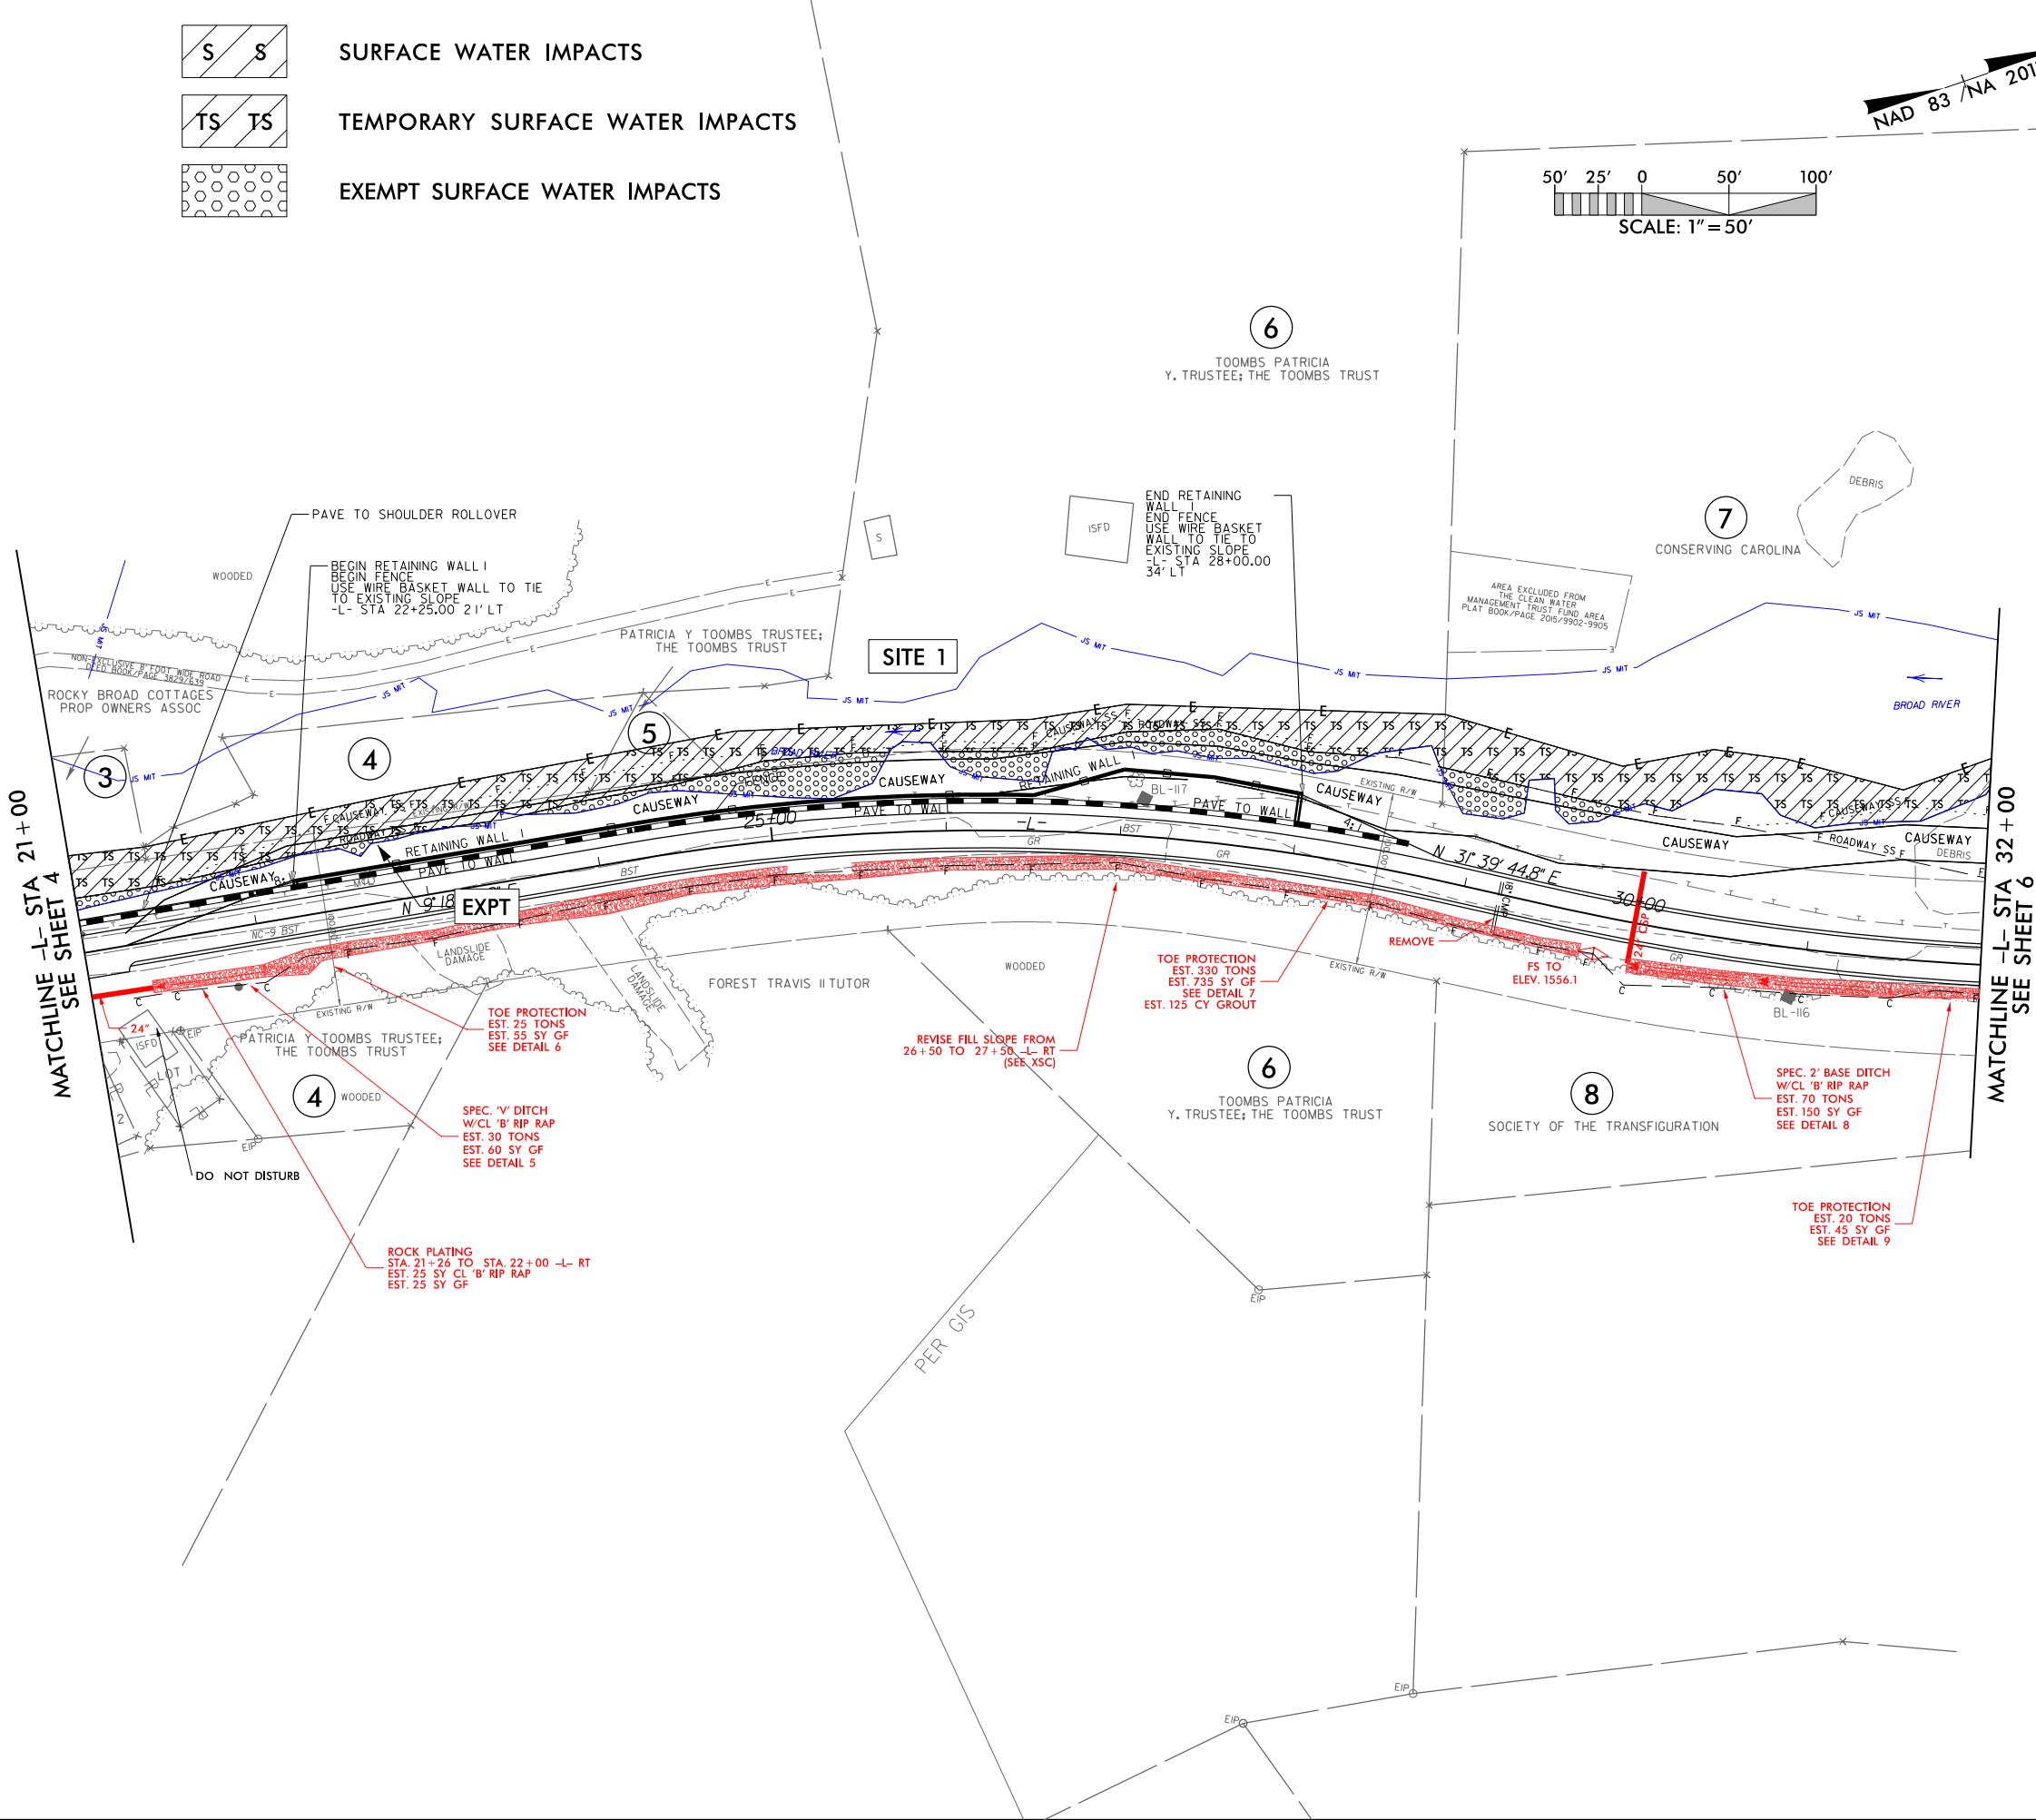

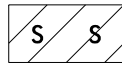

SURFACE WATER IMPACTS




TEMPORARY SURFACE WATER IMPACTS



EXEMPT SURFACE WATER IMPACTS


NAD 83 / N.A. 2011

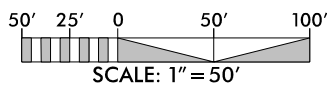

PROJECT REFERENCE NO.		SHEET NO.	
NC-9		5	
ROADWAY DESIGN ENGINEER		HYDRAULICS ENGINEER	
DOCUMENT NOT CONSIDERED FINAL UNLESS ALL SIGNATURES COMPLETED			
SUNGATE DESIGN GROUP, P.A.			
		905 JONES FRANKLIN ROAD RALEIGH, NORTH CAROLINA 27606 TEL (919) 856-2243 ENG FIRM LICENSE NO. C-890	

PERMIT DRAWING
SHEET 9 OF 25

DATE: 10/20/2025

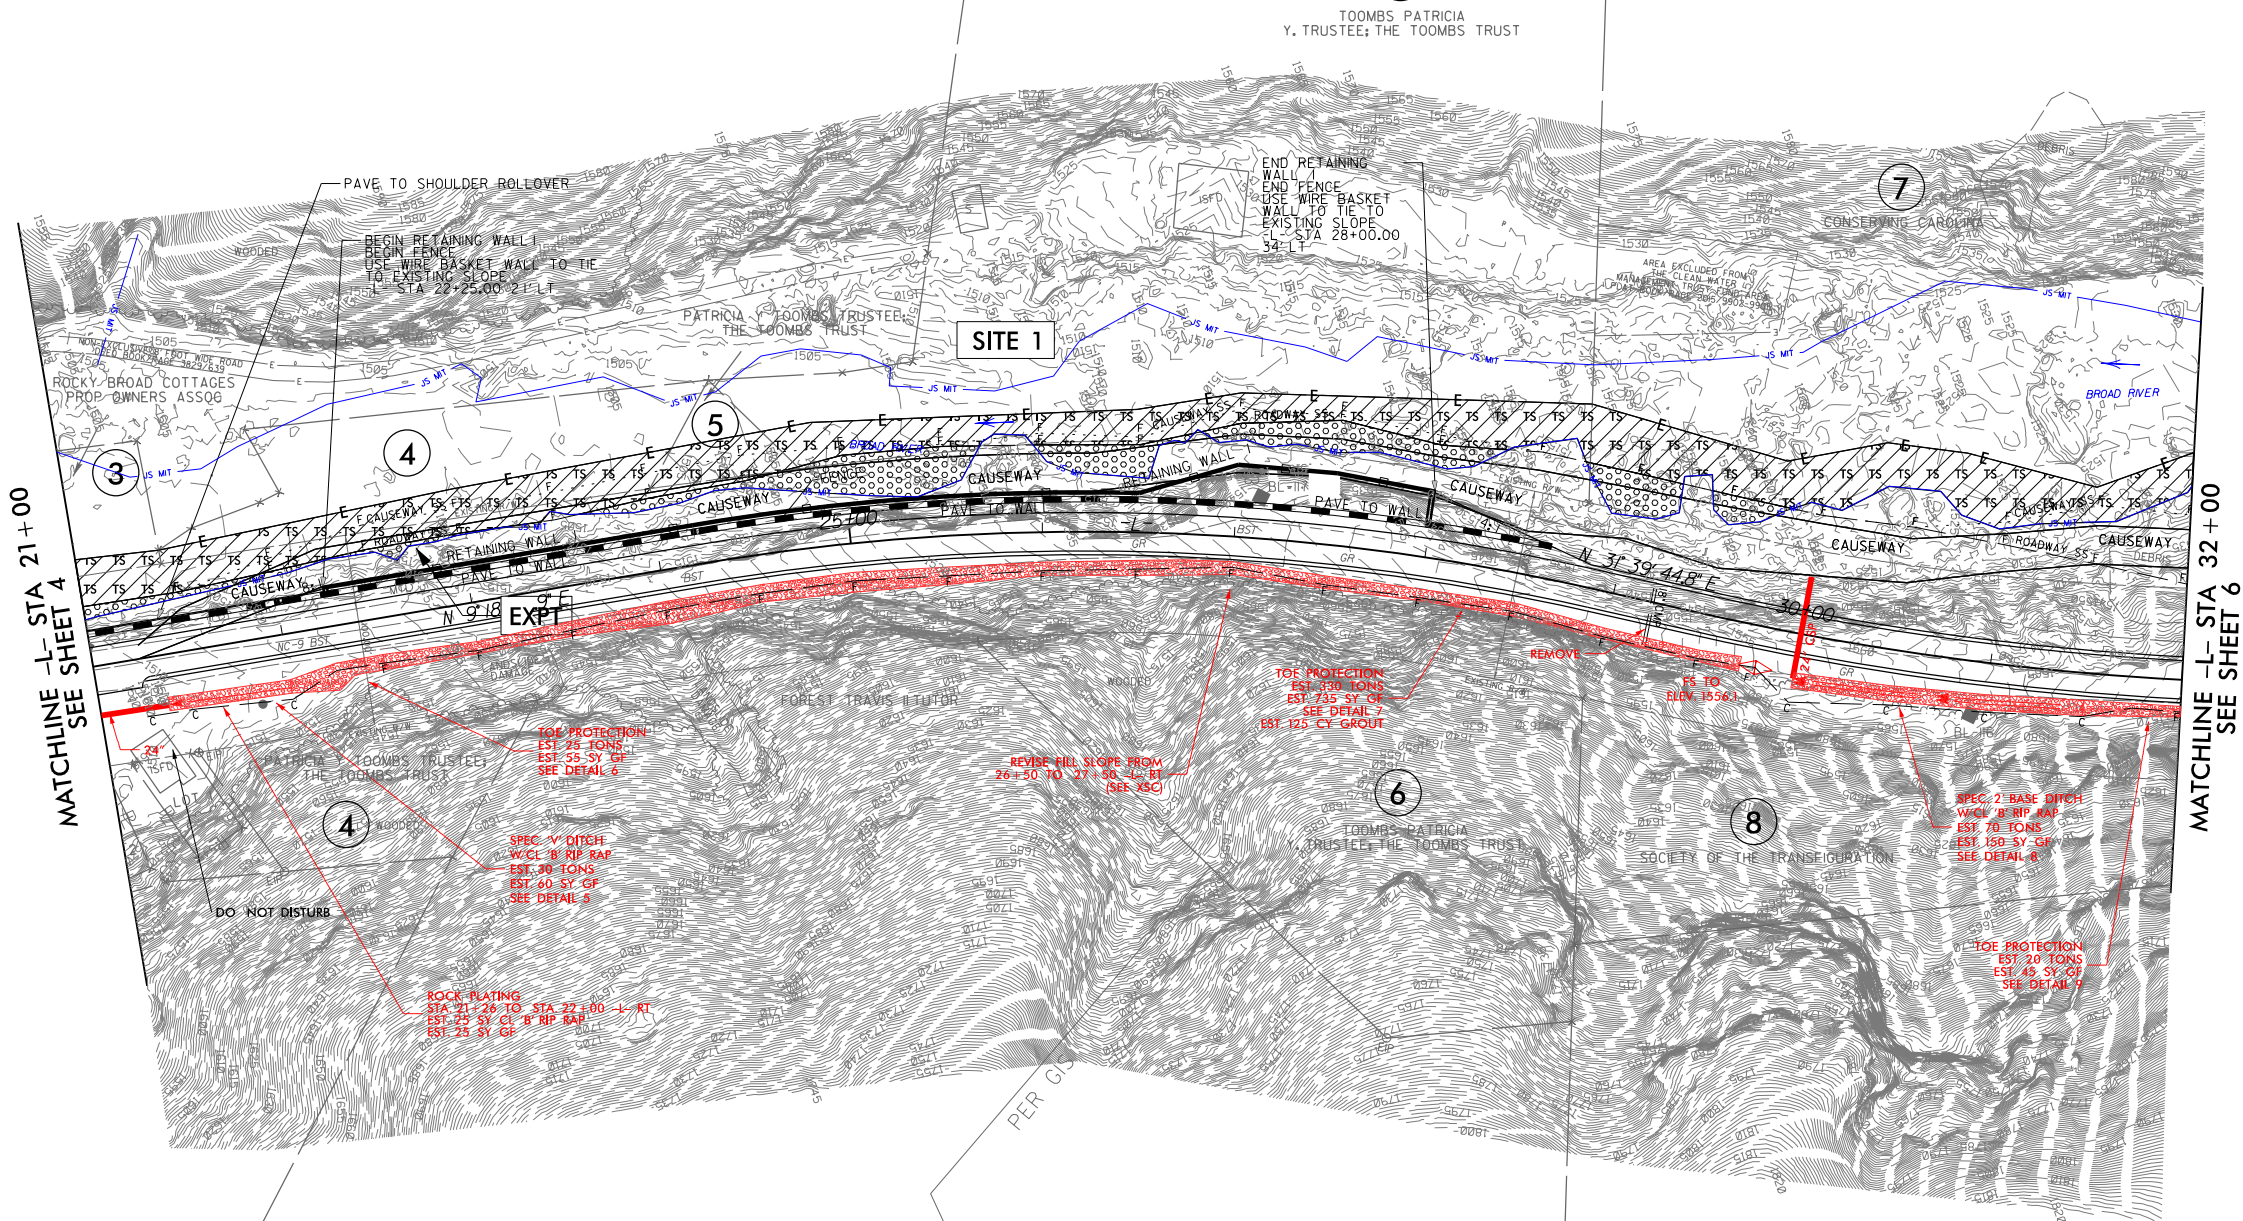


8/17/99

10/20/2025
NC-9_Hyd.prm_wet_pah_06.dgn
J.Stonovich


PERMIT DRAWING
SHEET 10 OF 25

DATE: 10/20/2025

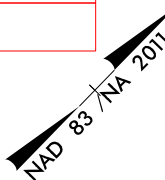

- SURFACE WATER IMPACTS
- TEMPORARY SURFACE WATER IMPACTS
- PRE-HELENE STREAM CHANNEL
- PRE-HELENE ASSUMED EX STORM PIPES

PROJECT REFERENCE NO. NC-9		SHEET NO. 6
ROADWAY DESIGN ENGINEER		HYDRAULICS ENGINEER
DOCUMENT NOT CONSIDERED FINAL UNLESS ALL SIGNATURES COMPLETED		
SUNGATE DESIGN GROUP, P.A.		
 905 JONES FRANKLIN ROAD RALEIGH, NORTH CAROLINA 27606 TEL (919) 858-2243 ENG FIRM LICENSE NO. C-890		

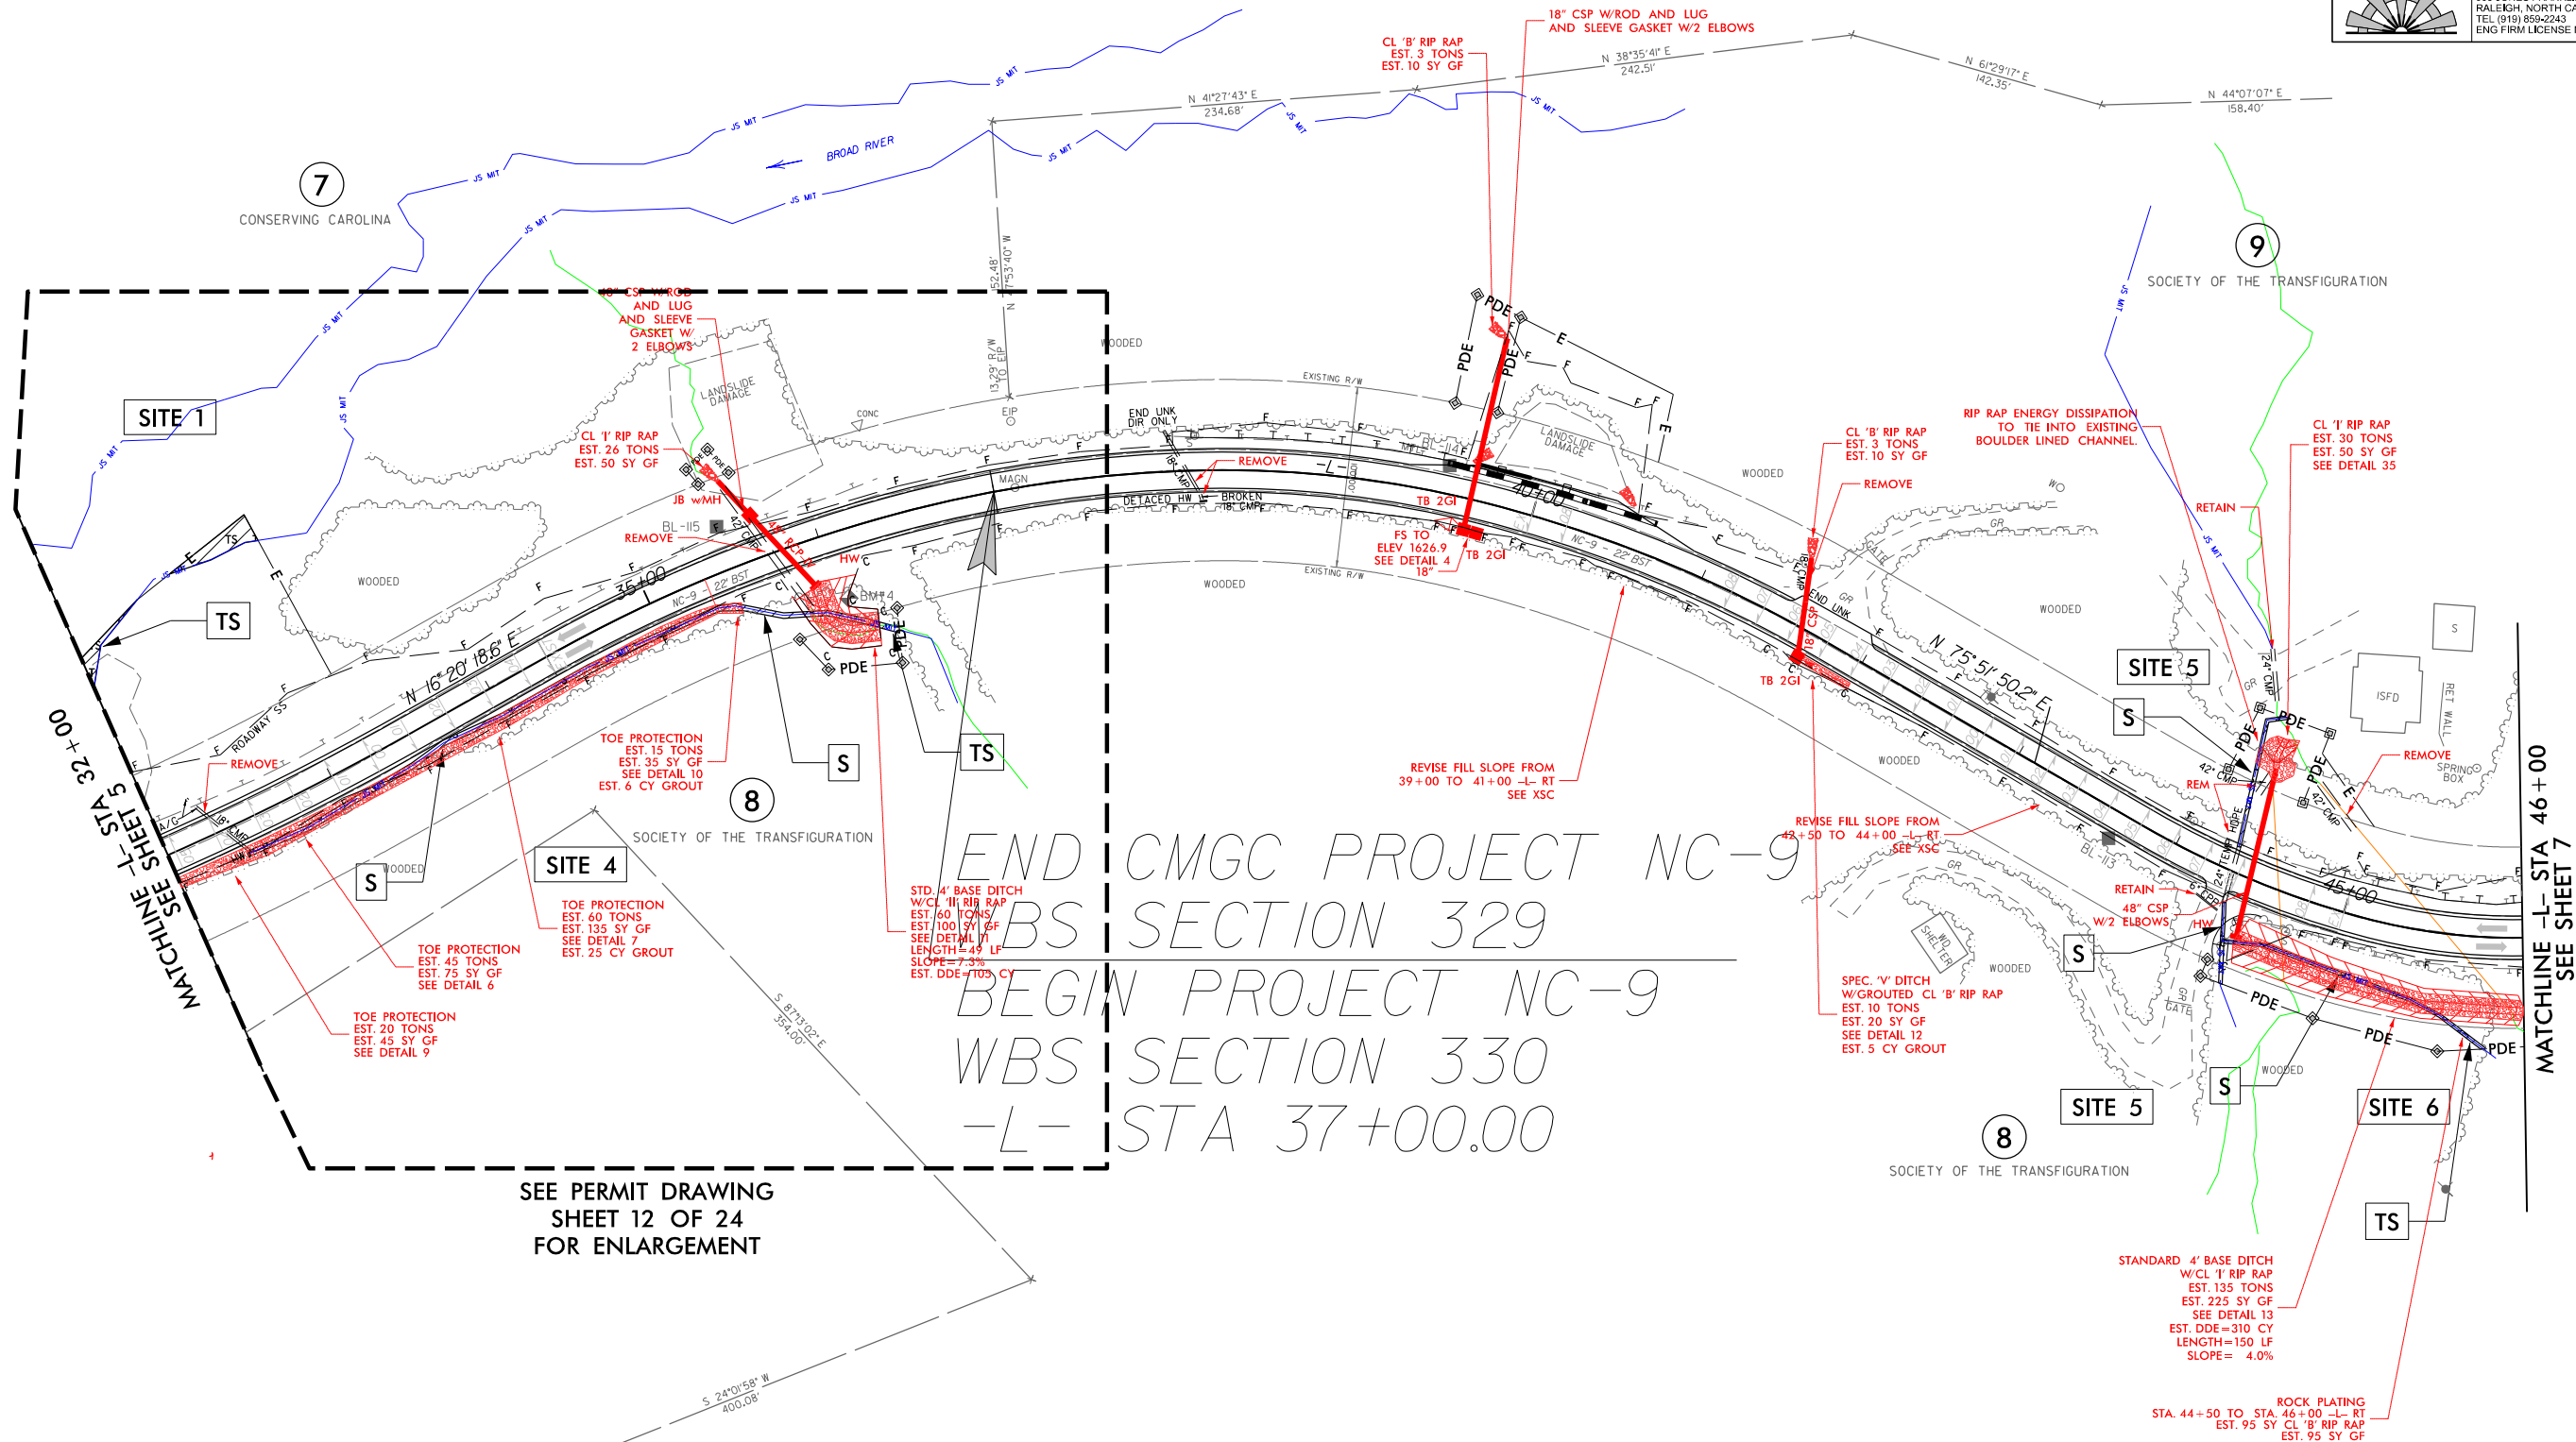

SEE PERMIT DRAWING
SHEET 12 OF 24
FOR ENLARGEMENT

NAD 83 / NA 2011



905 JONES FRANKLIN ROAD
RALEIGH, NORTH CAROLINA 27606
TEL (919) 859-2243
ENG FIRM LICENSE NO. C-890


SEE PERMIT DRAWING
SHEET 13 OF 25
FOR ENLARGEMENT

STANDARD 4' BASE DITCH
W/CL 1' RIP RAP
EST. 135 TONS
EST. 225 SY GF
SEE DETAIL T3
EST. DDE=310 CY
LENGTH=150 LF
SLOPE= 4.0%

ROCK PLATING
STA. 44+50 TO STA. 46+00 -L- RT -
EST. 95 SY CL 'B' RIP RAP
EST. 95 SY GF


8/17/99




10/20/2025
NC-9_Hyd.prm_wet_psh_06-2-ViewIndgn
JStonovich

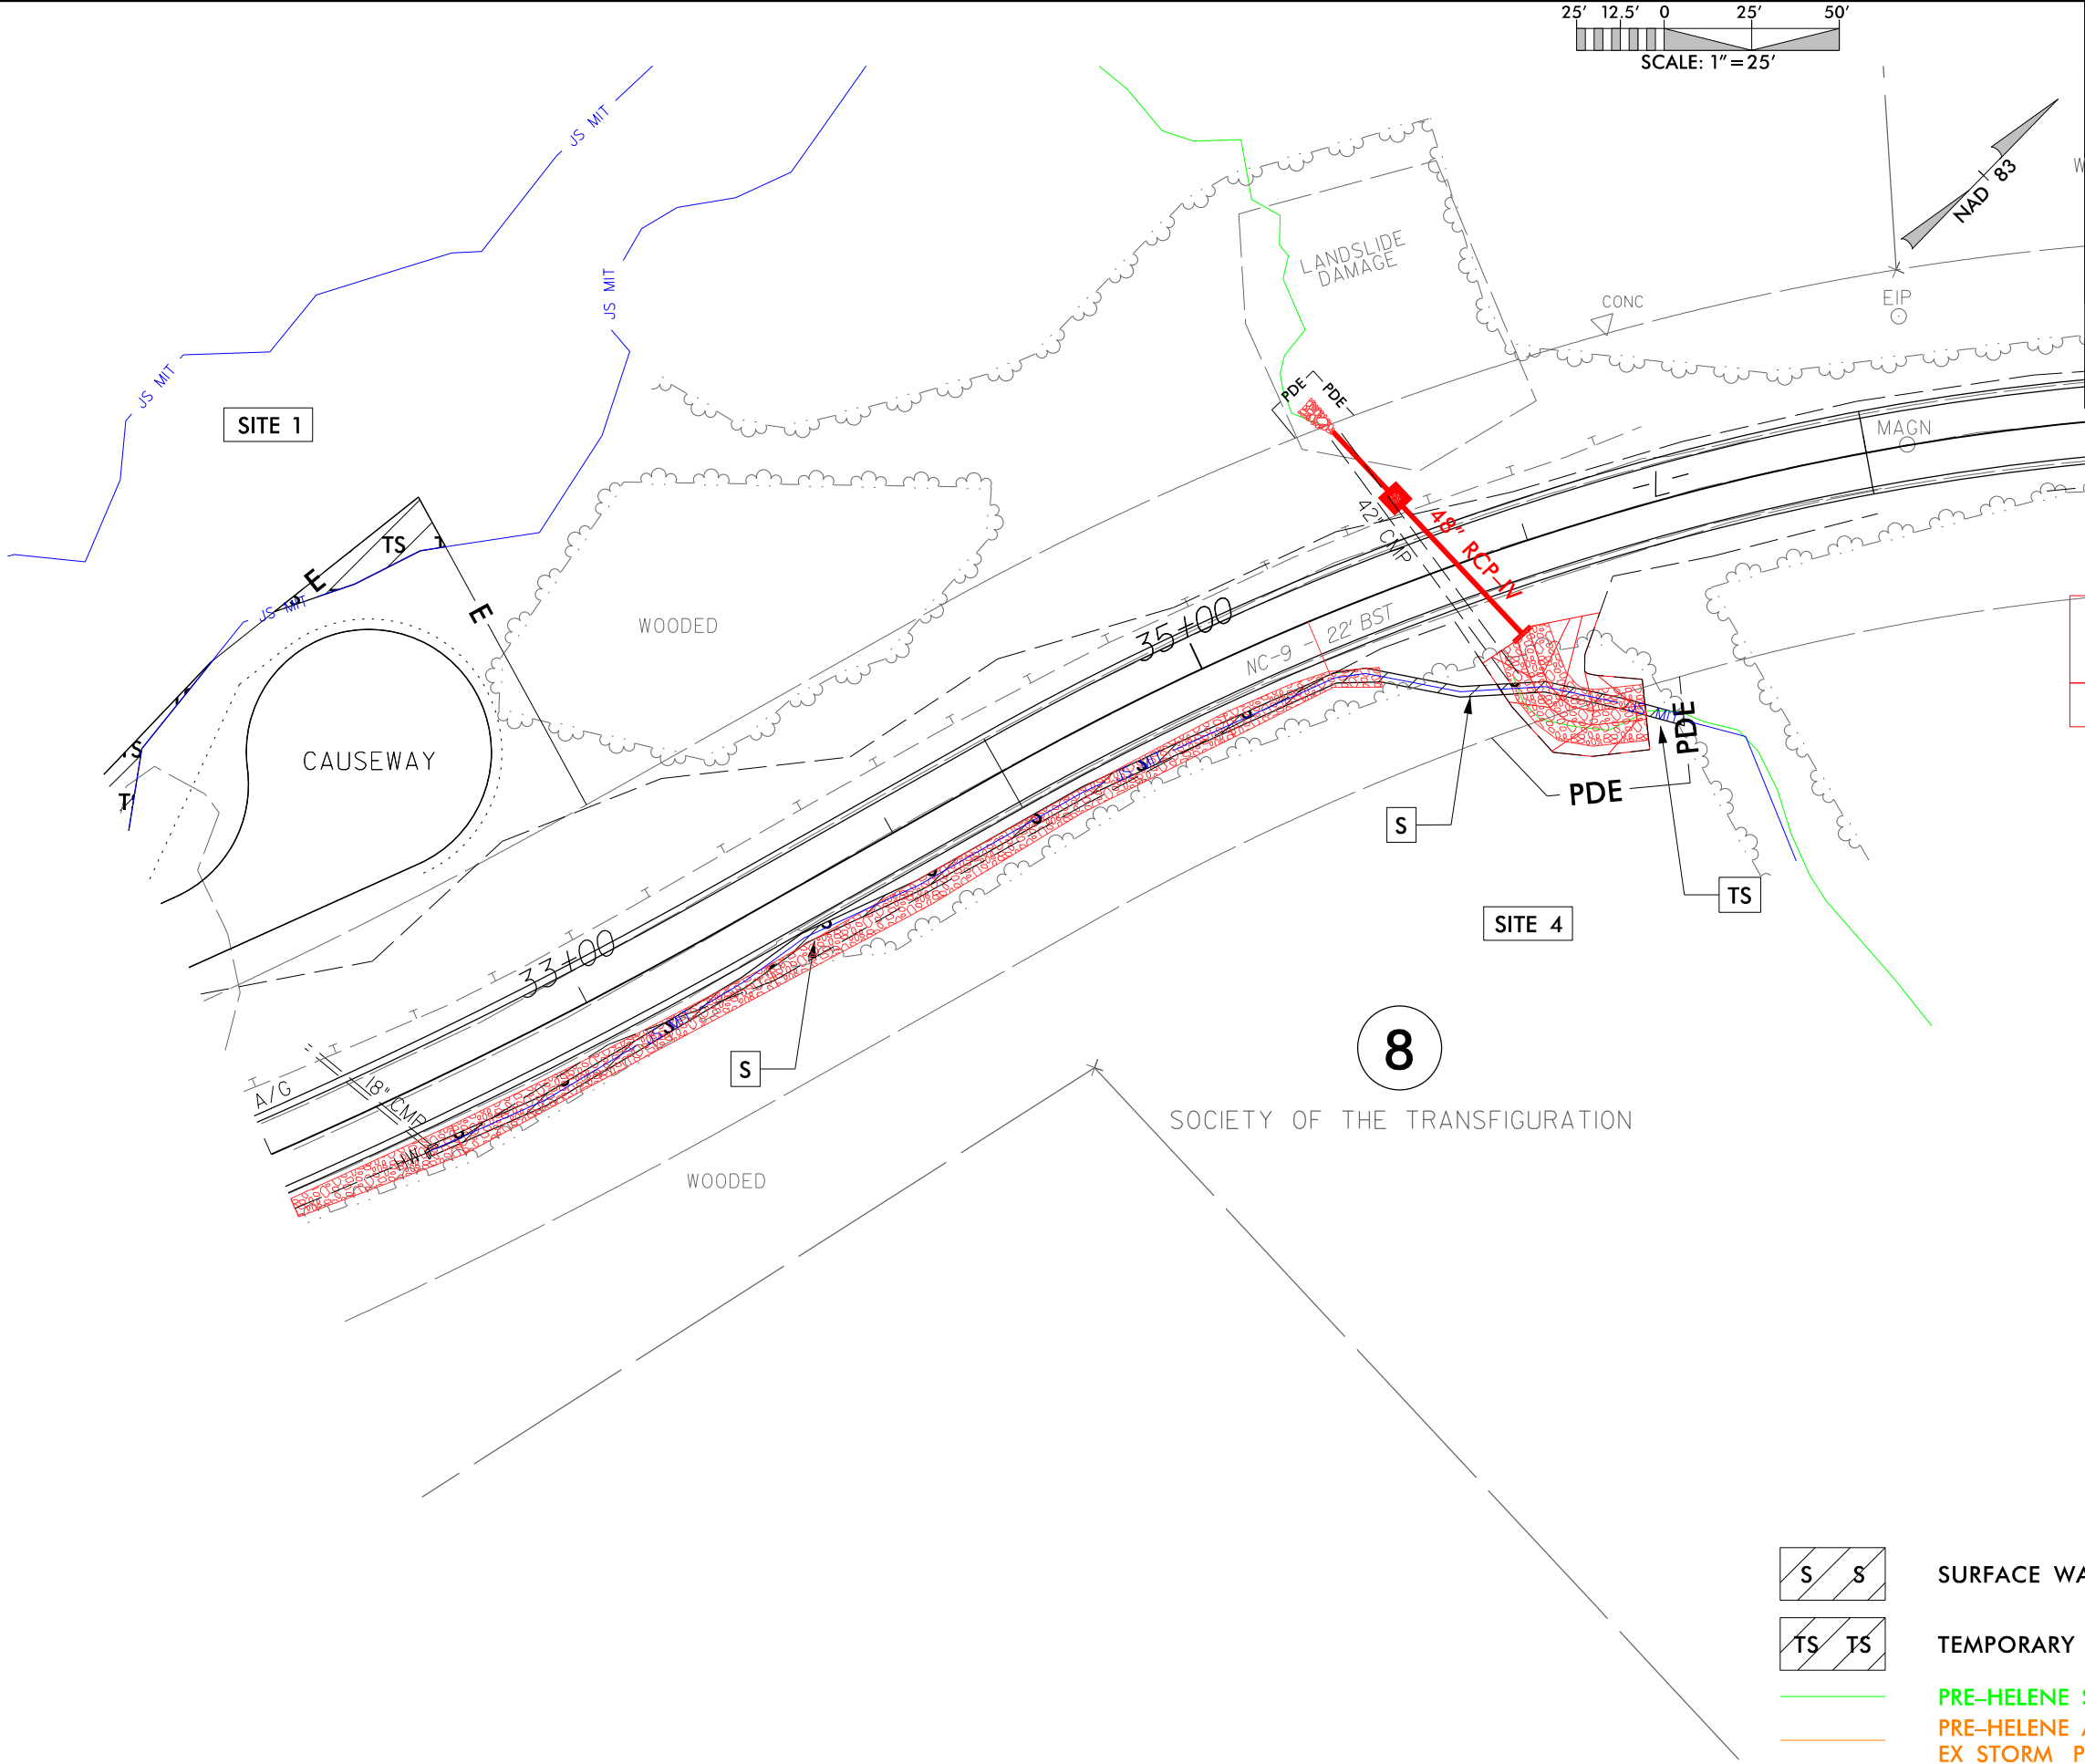

PROJECT REFERENCE NO. NC-9		SHEET NO.
ROADWAY DESIGN ENGINEER	HYDRAULICS ENGINEER	
DOCUMENT NOT CONSIDERED FINAL UNLESS ALL SIGNATURES COMPLETED		
SUNGATE DESIGN GROUP, P.A.		
 905 JONES FRANKLIN ROAD RALEIGH, NORTH CAROLINA 27606 TEL: (919) 858-2243 ENG FIRM LICENSE NO. C-890		


**PERMIT DRAWING
SHEET 12 OF 25**
DATE: 10/20/2025

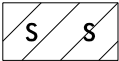-  SURFACE WATER IMPACTS
-  TEMPORARY SURFACE WATER IMPACTS
-  PRE-HELENE STREAM CHANNEL
-  PRE-HELENE ASSUMED EX STORM PIPES

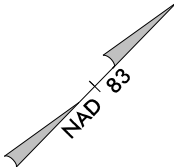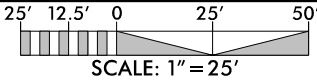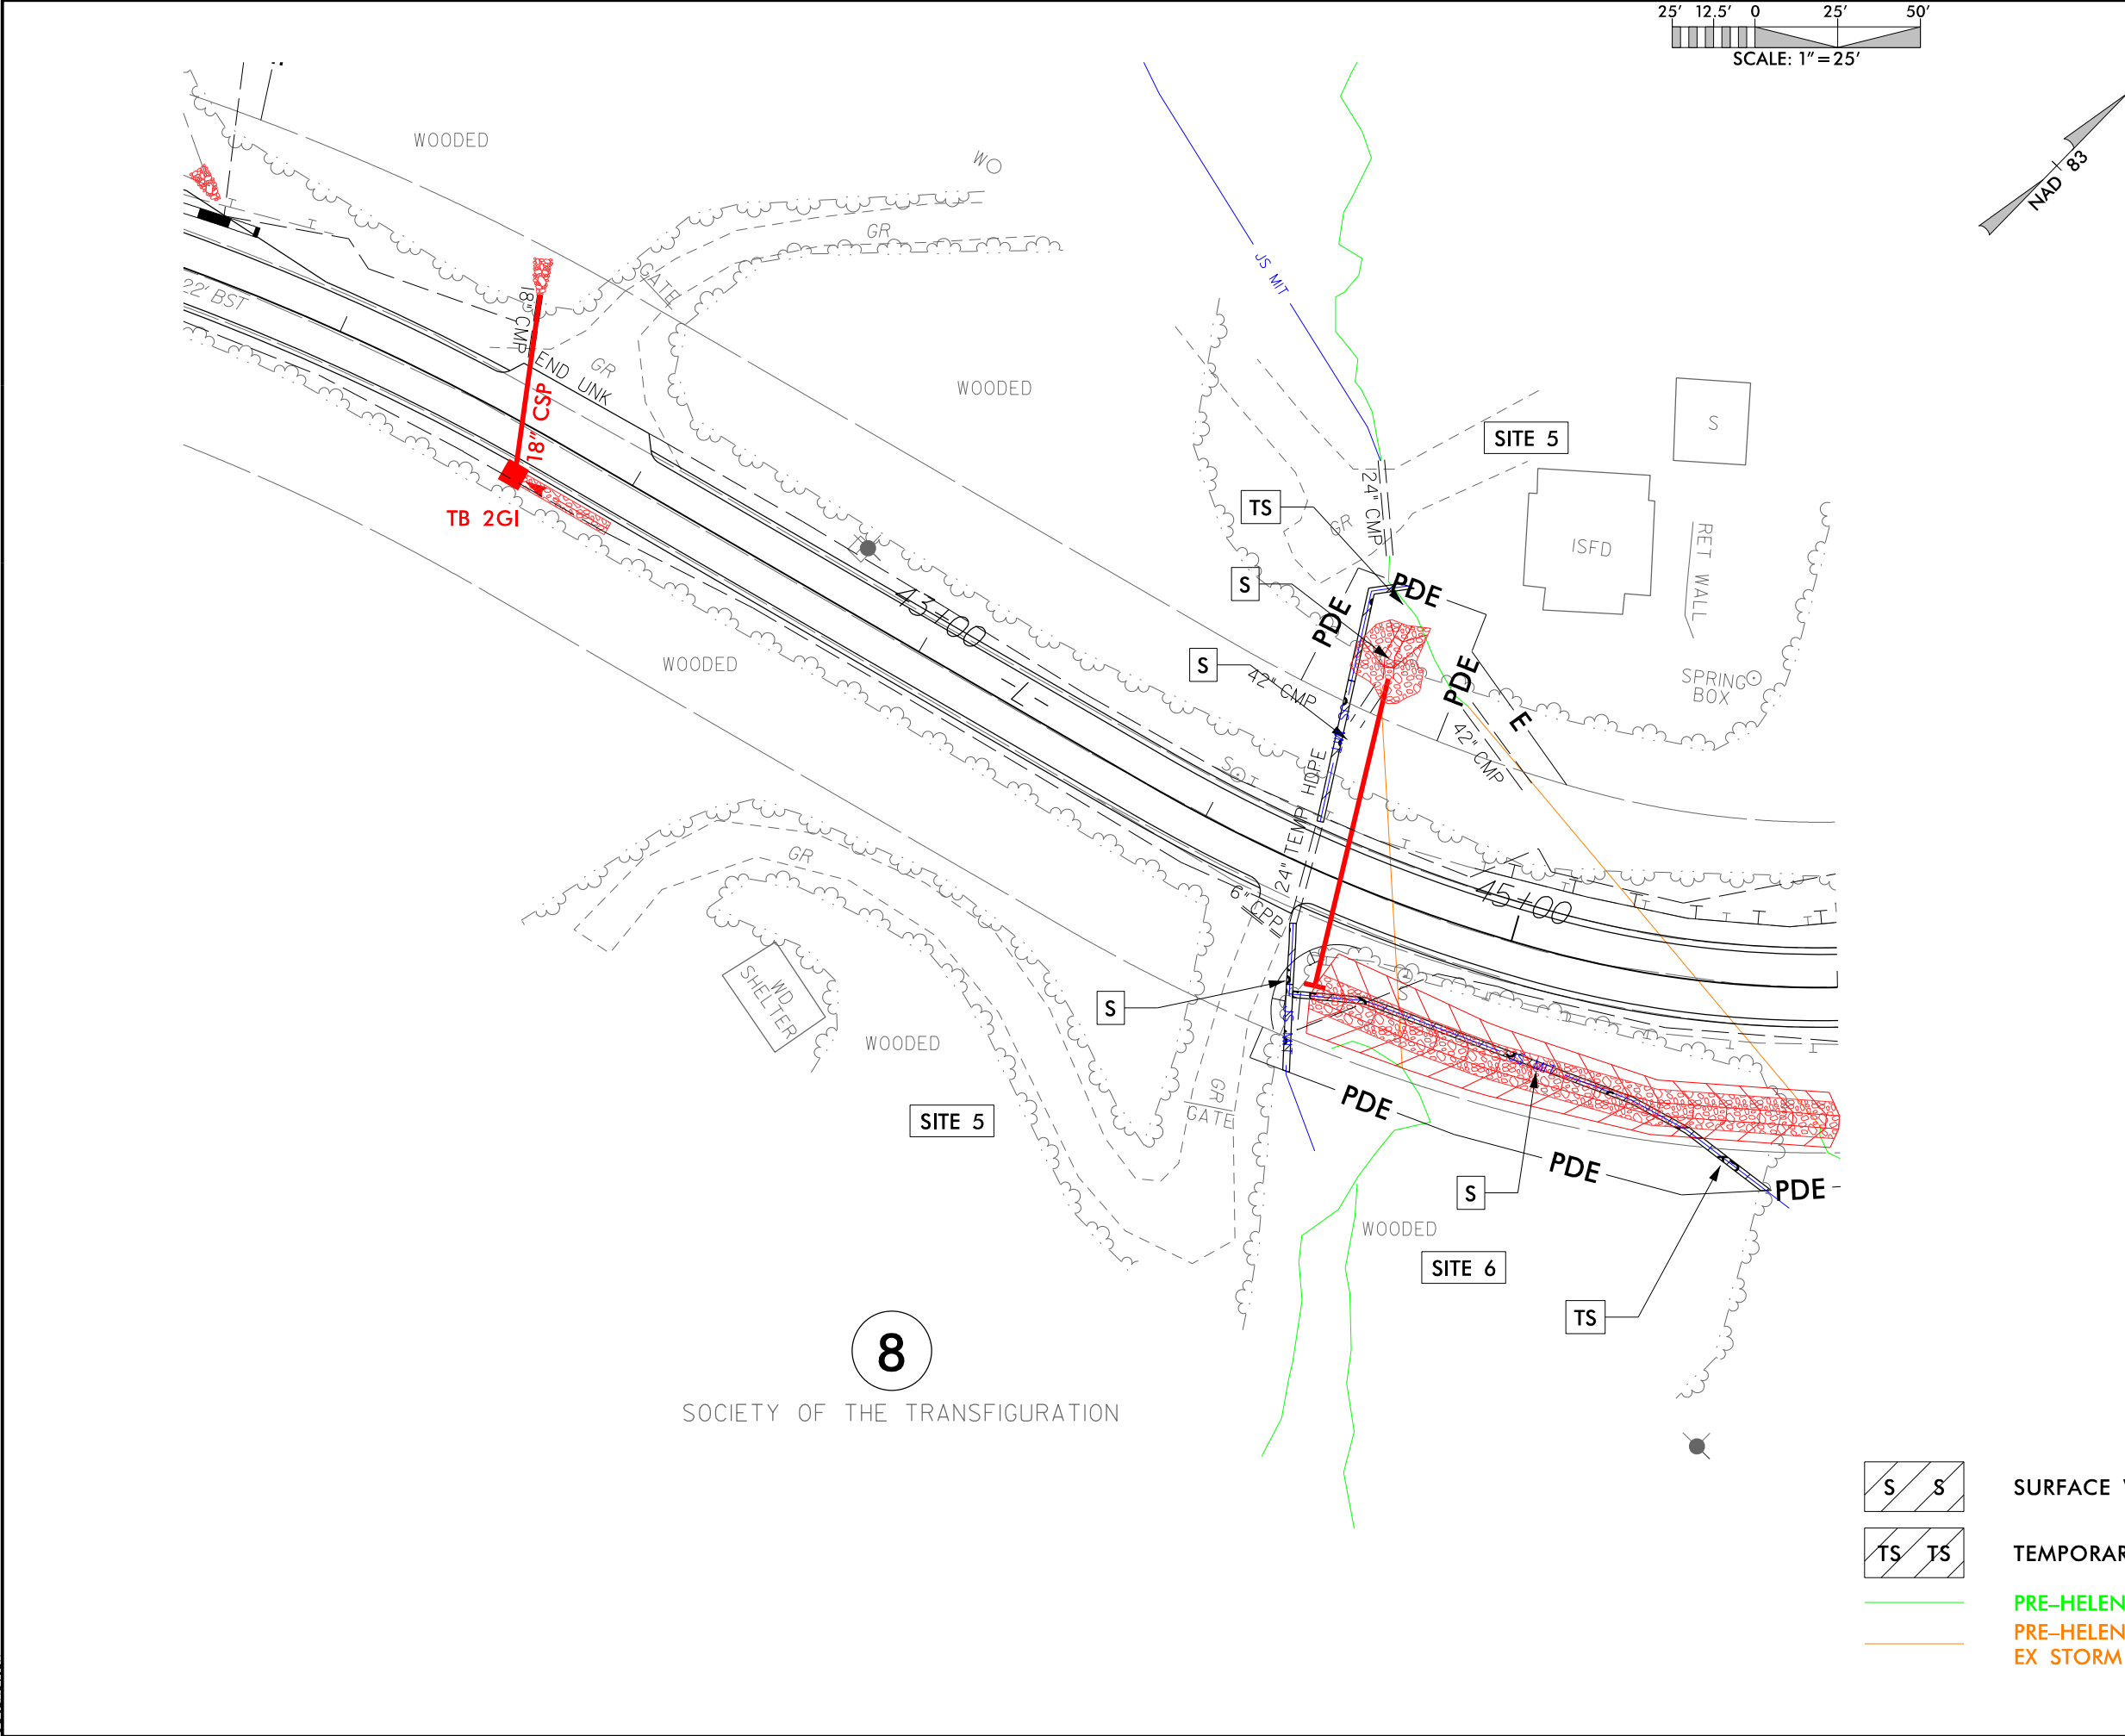

PROJECT REFERENCE NO.		SHEET NO.
NC-9		
ROADWAY DESIGN ENGINEER	HYDRAULICS ENGINEER	
DOCUMENT NOT CONSIDERED FINAL UNLESS ALL SIGNATURES COMPLETED		
SUNGATE DESIGN GROUP, P.A.		
		
905 JONES FRANKLIN ROAD RALEIGH, NORTH CAROLINA 27606 TEL: (919) 858-2243 ENG FIRM LICENSE NO. C-890		

PERMIT DRAWING
SHEET 13 OF 25
DATE: 10/20/2025

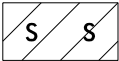- 

SURFACE WATER IMPACTS
- 

TEMPORARY SURFACE WATER IMPACTS
- 

PRE-HELENE STREAM CHANNEL
- 

PRE-HELENE ASSUMED
EX STORM PIPES

8/17/99

10/20/2025
NC-9 Hyd. prj. wet. pah.08.dgn
J. Stonovich

MATCHLINE -L- STA 60+00 SEE SHEET 7



NOTE: FOR -L- PROFILE SEE SHEET 13 & 14

PROJECT REFERENCE NO. NC-9		SHEET NO. 8
ROADWAY DESIGN ENGINEER		HYDRAULICS ENGINEER
DOCUMENT NOT CONSIDERED FINAL UNLESS ALL SIGNATURES COMPLETED		
SUNGATE DESIGN GROUP, P.A.		
905 JONES FRANKLIN ROAD RALEIGH, NORTH CAROLINA 27606 TEL: (919) 858-2243 ENG FIRM LICENSE NO. C-890		

PERMIT DRAWING
SHEET 14 OF 25

DATE: 10/20/2025

50' 25' 0 50' 100'
SCALE: 1" = 50'

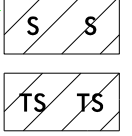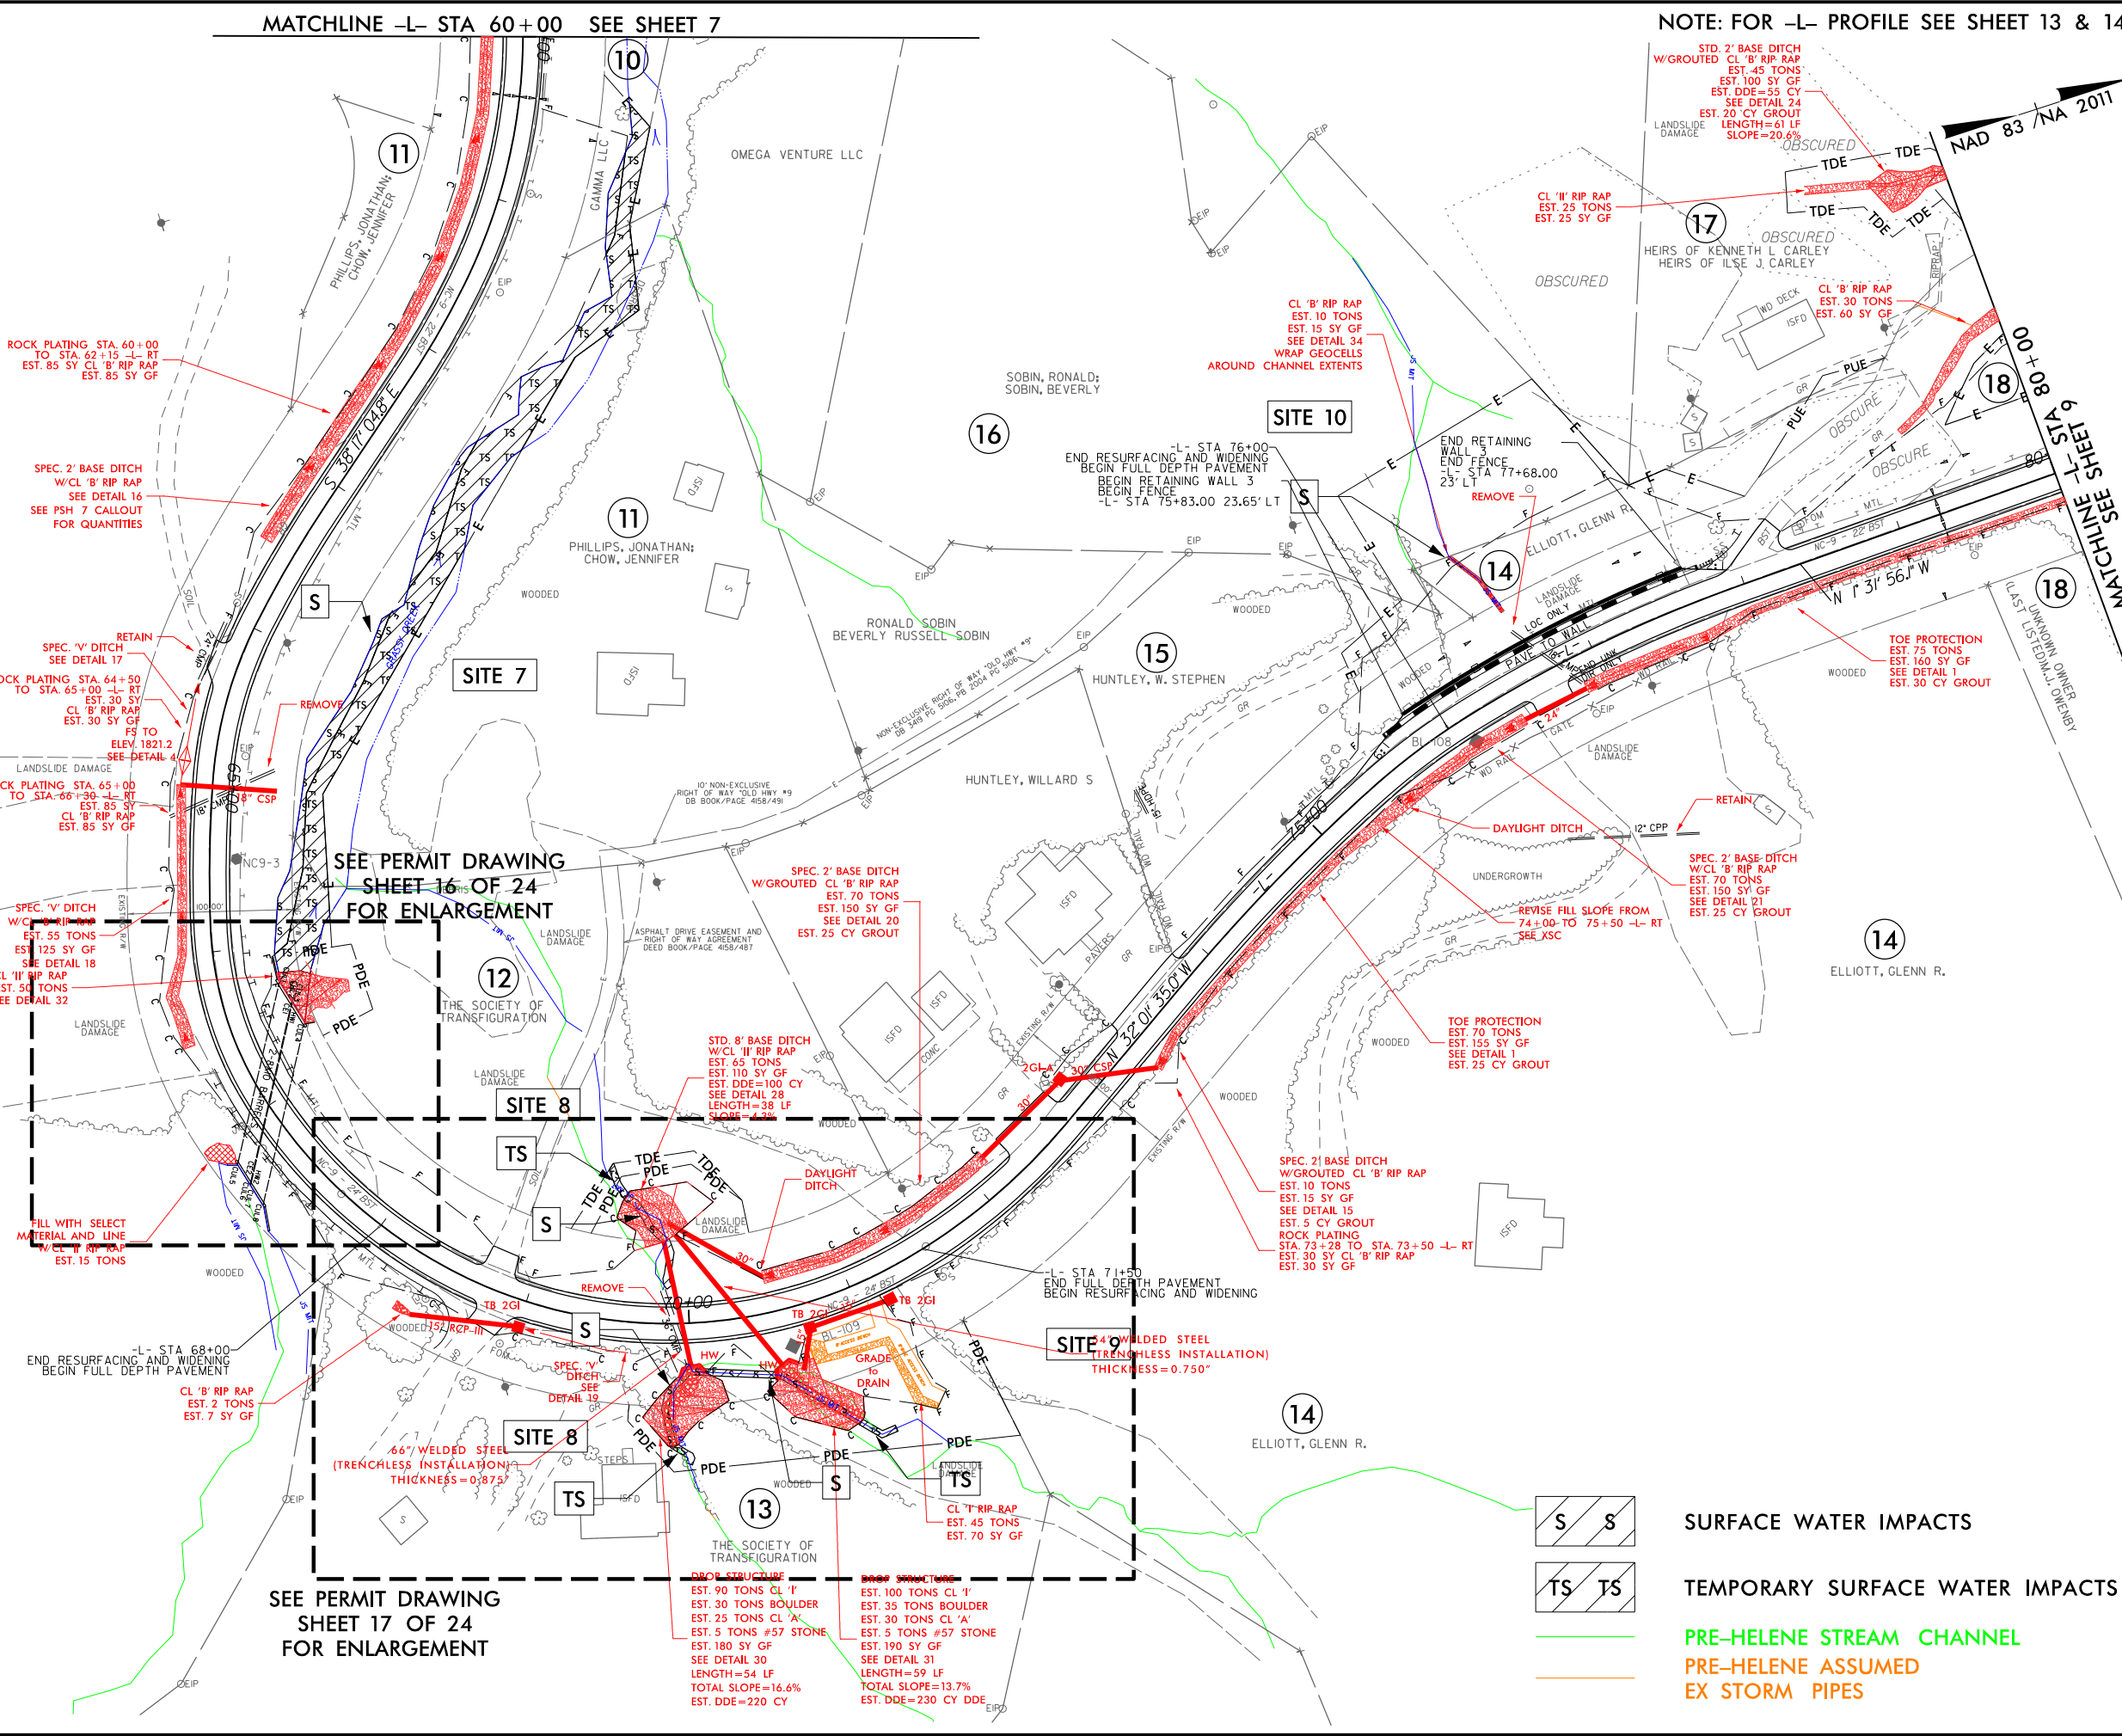

- SURFACE WATER IMPACTS
- TEMPORARY SURFACE WATER IMPACTS
- PRE-HELENE STREAM CHANNEL
- PRE-HELENE ASSUMED
- EX STORM PIPES

8/17/99

10/20/2025
NC-9 Hyd.prm_wet.pah.08-1.dgn
JSTONOUGH




MATCHLINE -L- STA 60+00 SEE SHEET 7

NOTE: FOR -L- PROFILE SEE SHEET 13 & 14

PROJECT REFERENCE NO. NC-9		SHEET NO. 8	
ROADWAY DESIGN ENGINEER		HYDRAULICS ENGINEER	
DOCUMENT NOT CONSIDERED FINAL UNLESS ALL SIGNATURES COMPLETED			
SUNGATE DESIGN GROUP, P.A.			
		905 JONES FRANKLIN ROAD RALEIGH, NORTH CAROLINA 27606 TEL (919) 858-2243 ENG FIRM LICENSE NO. C-690	

PERMIT DRAWING
SHEET 15 OF 25

DATE: 10/20/2025

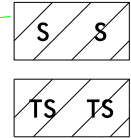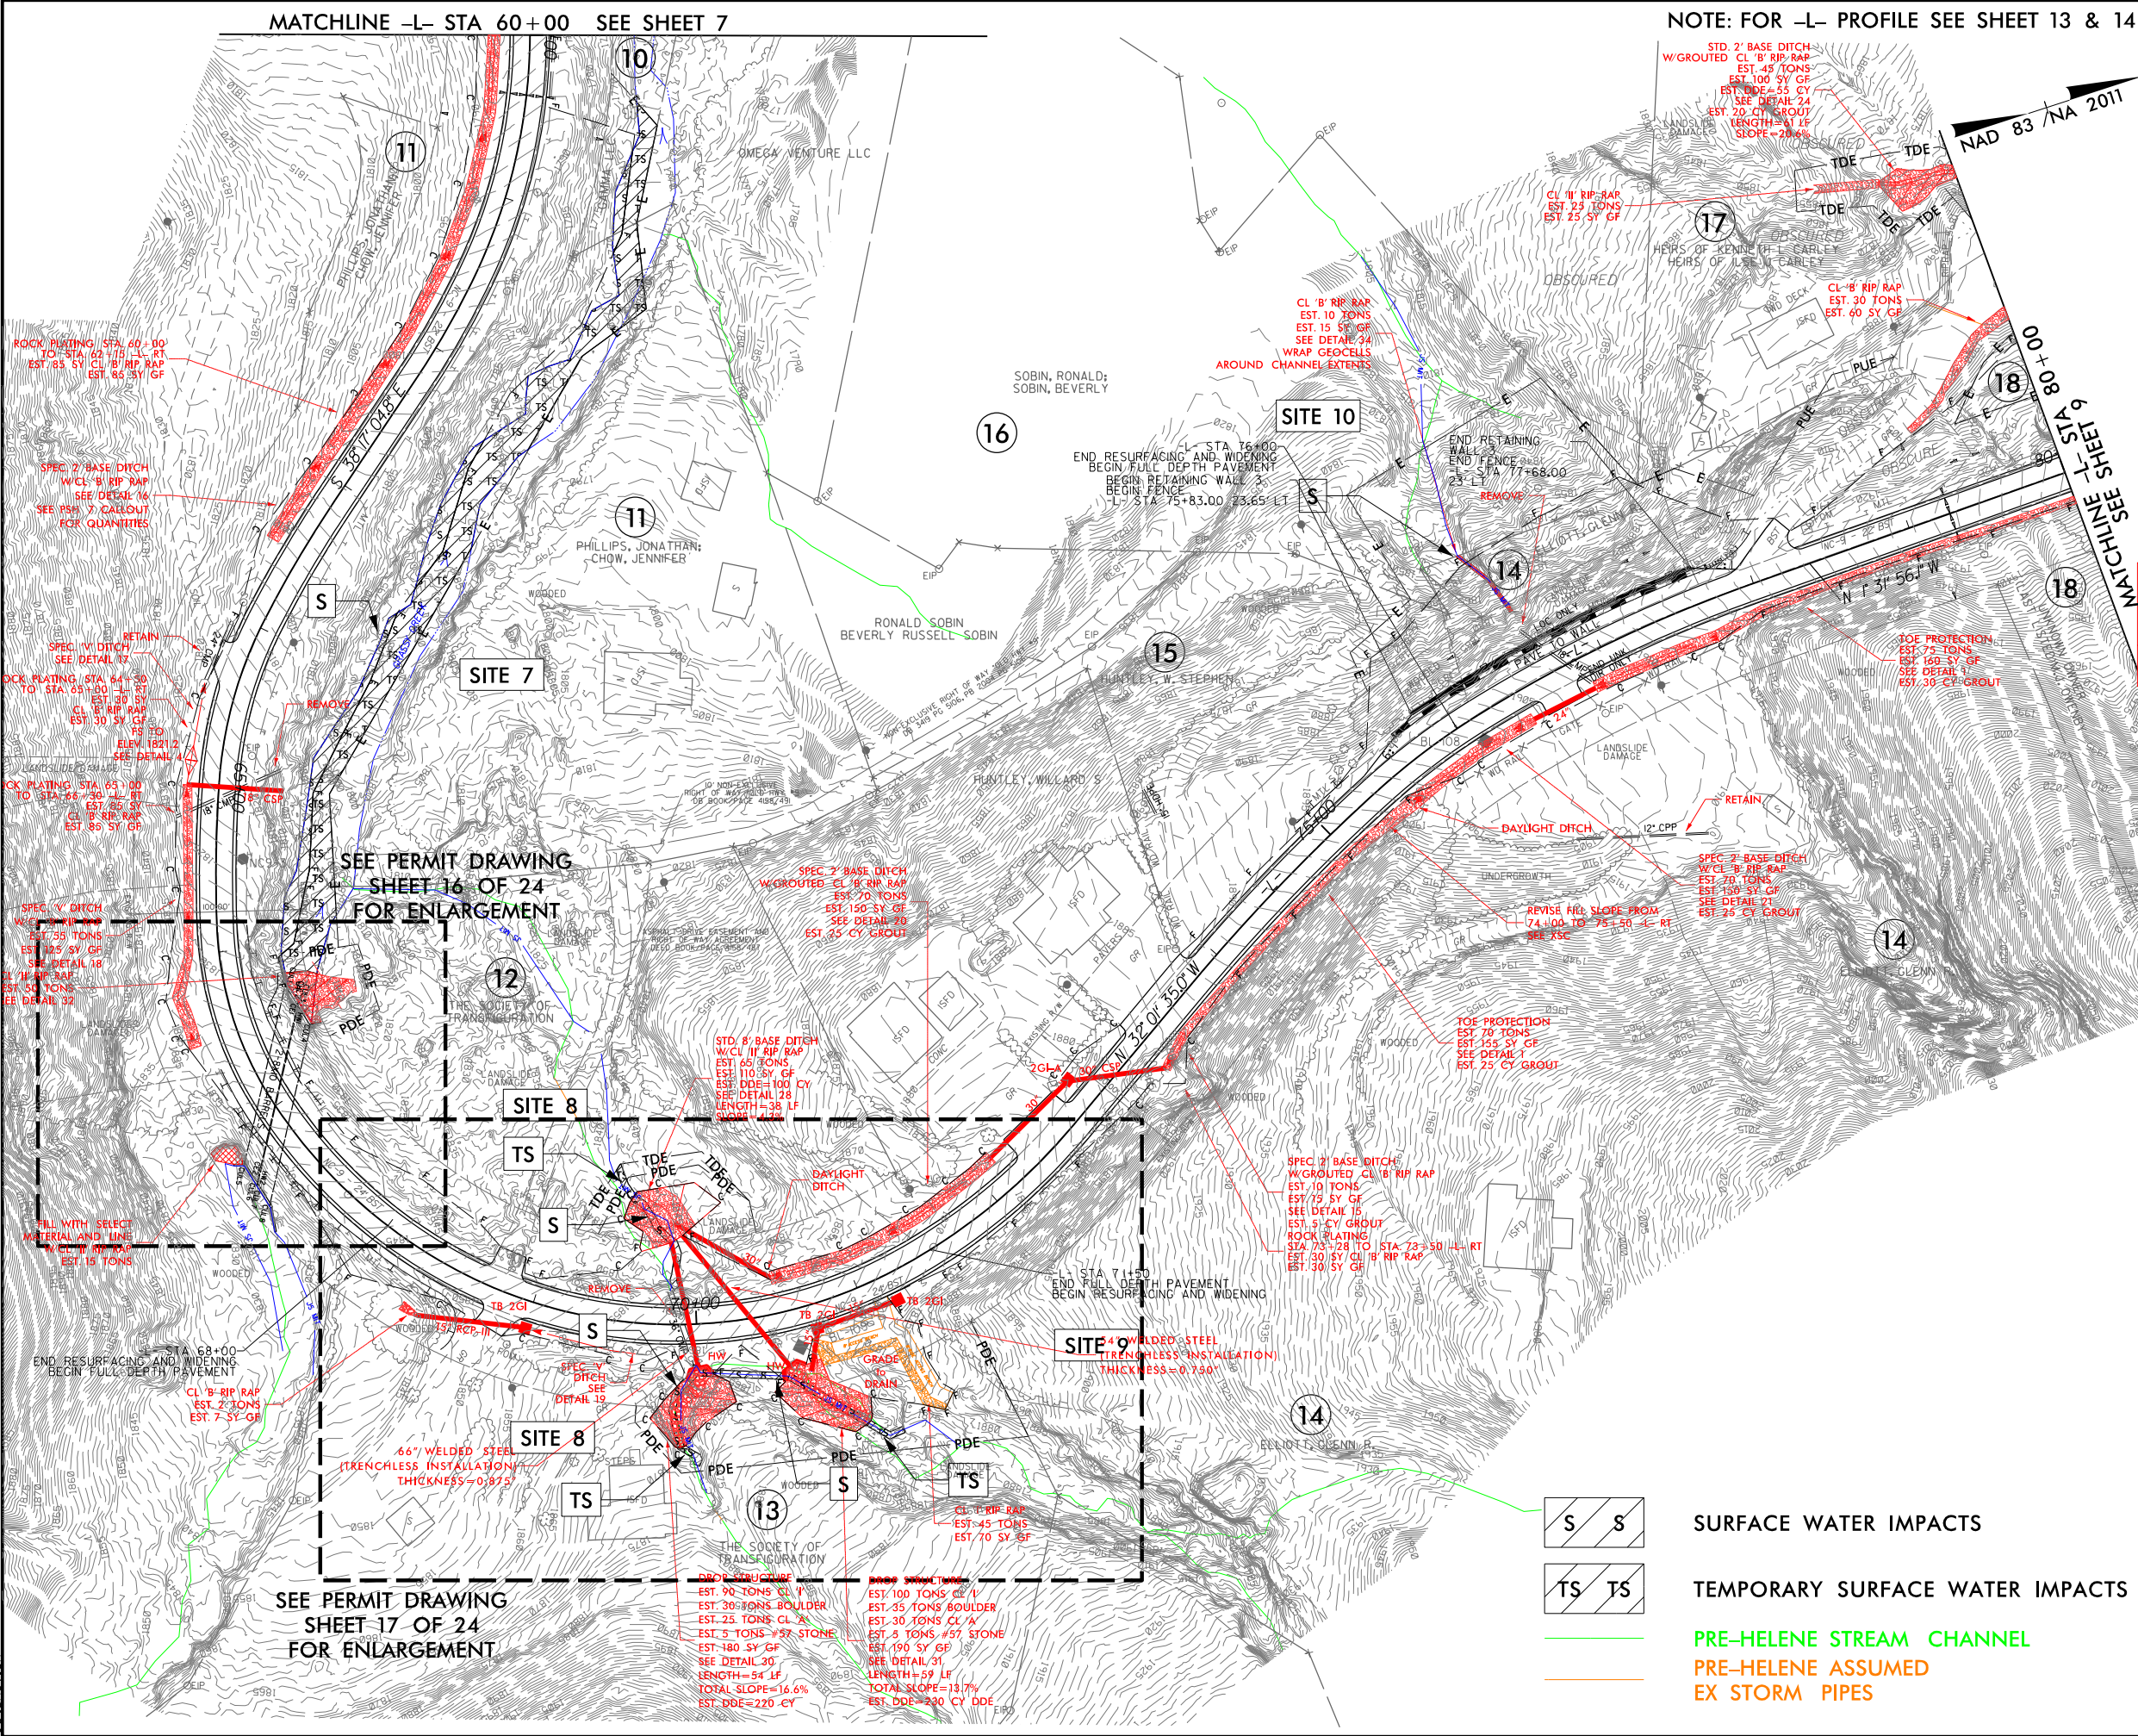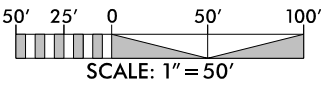



SURFACE WATER IMPACTS

TEMPORARY SURFACE WATER IMPACTS

PRE-HELENE STREAM CHANNEL

PRE-HELENE ASSUMED

EX STORM PIPES

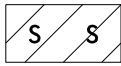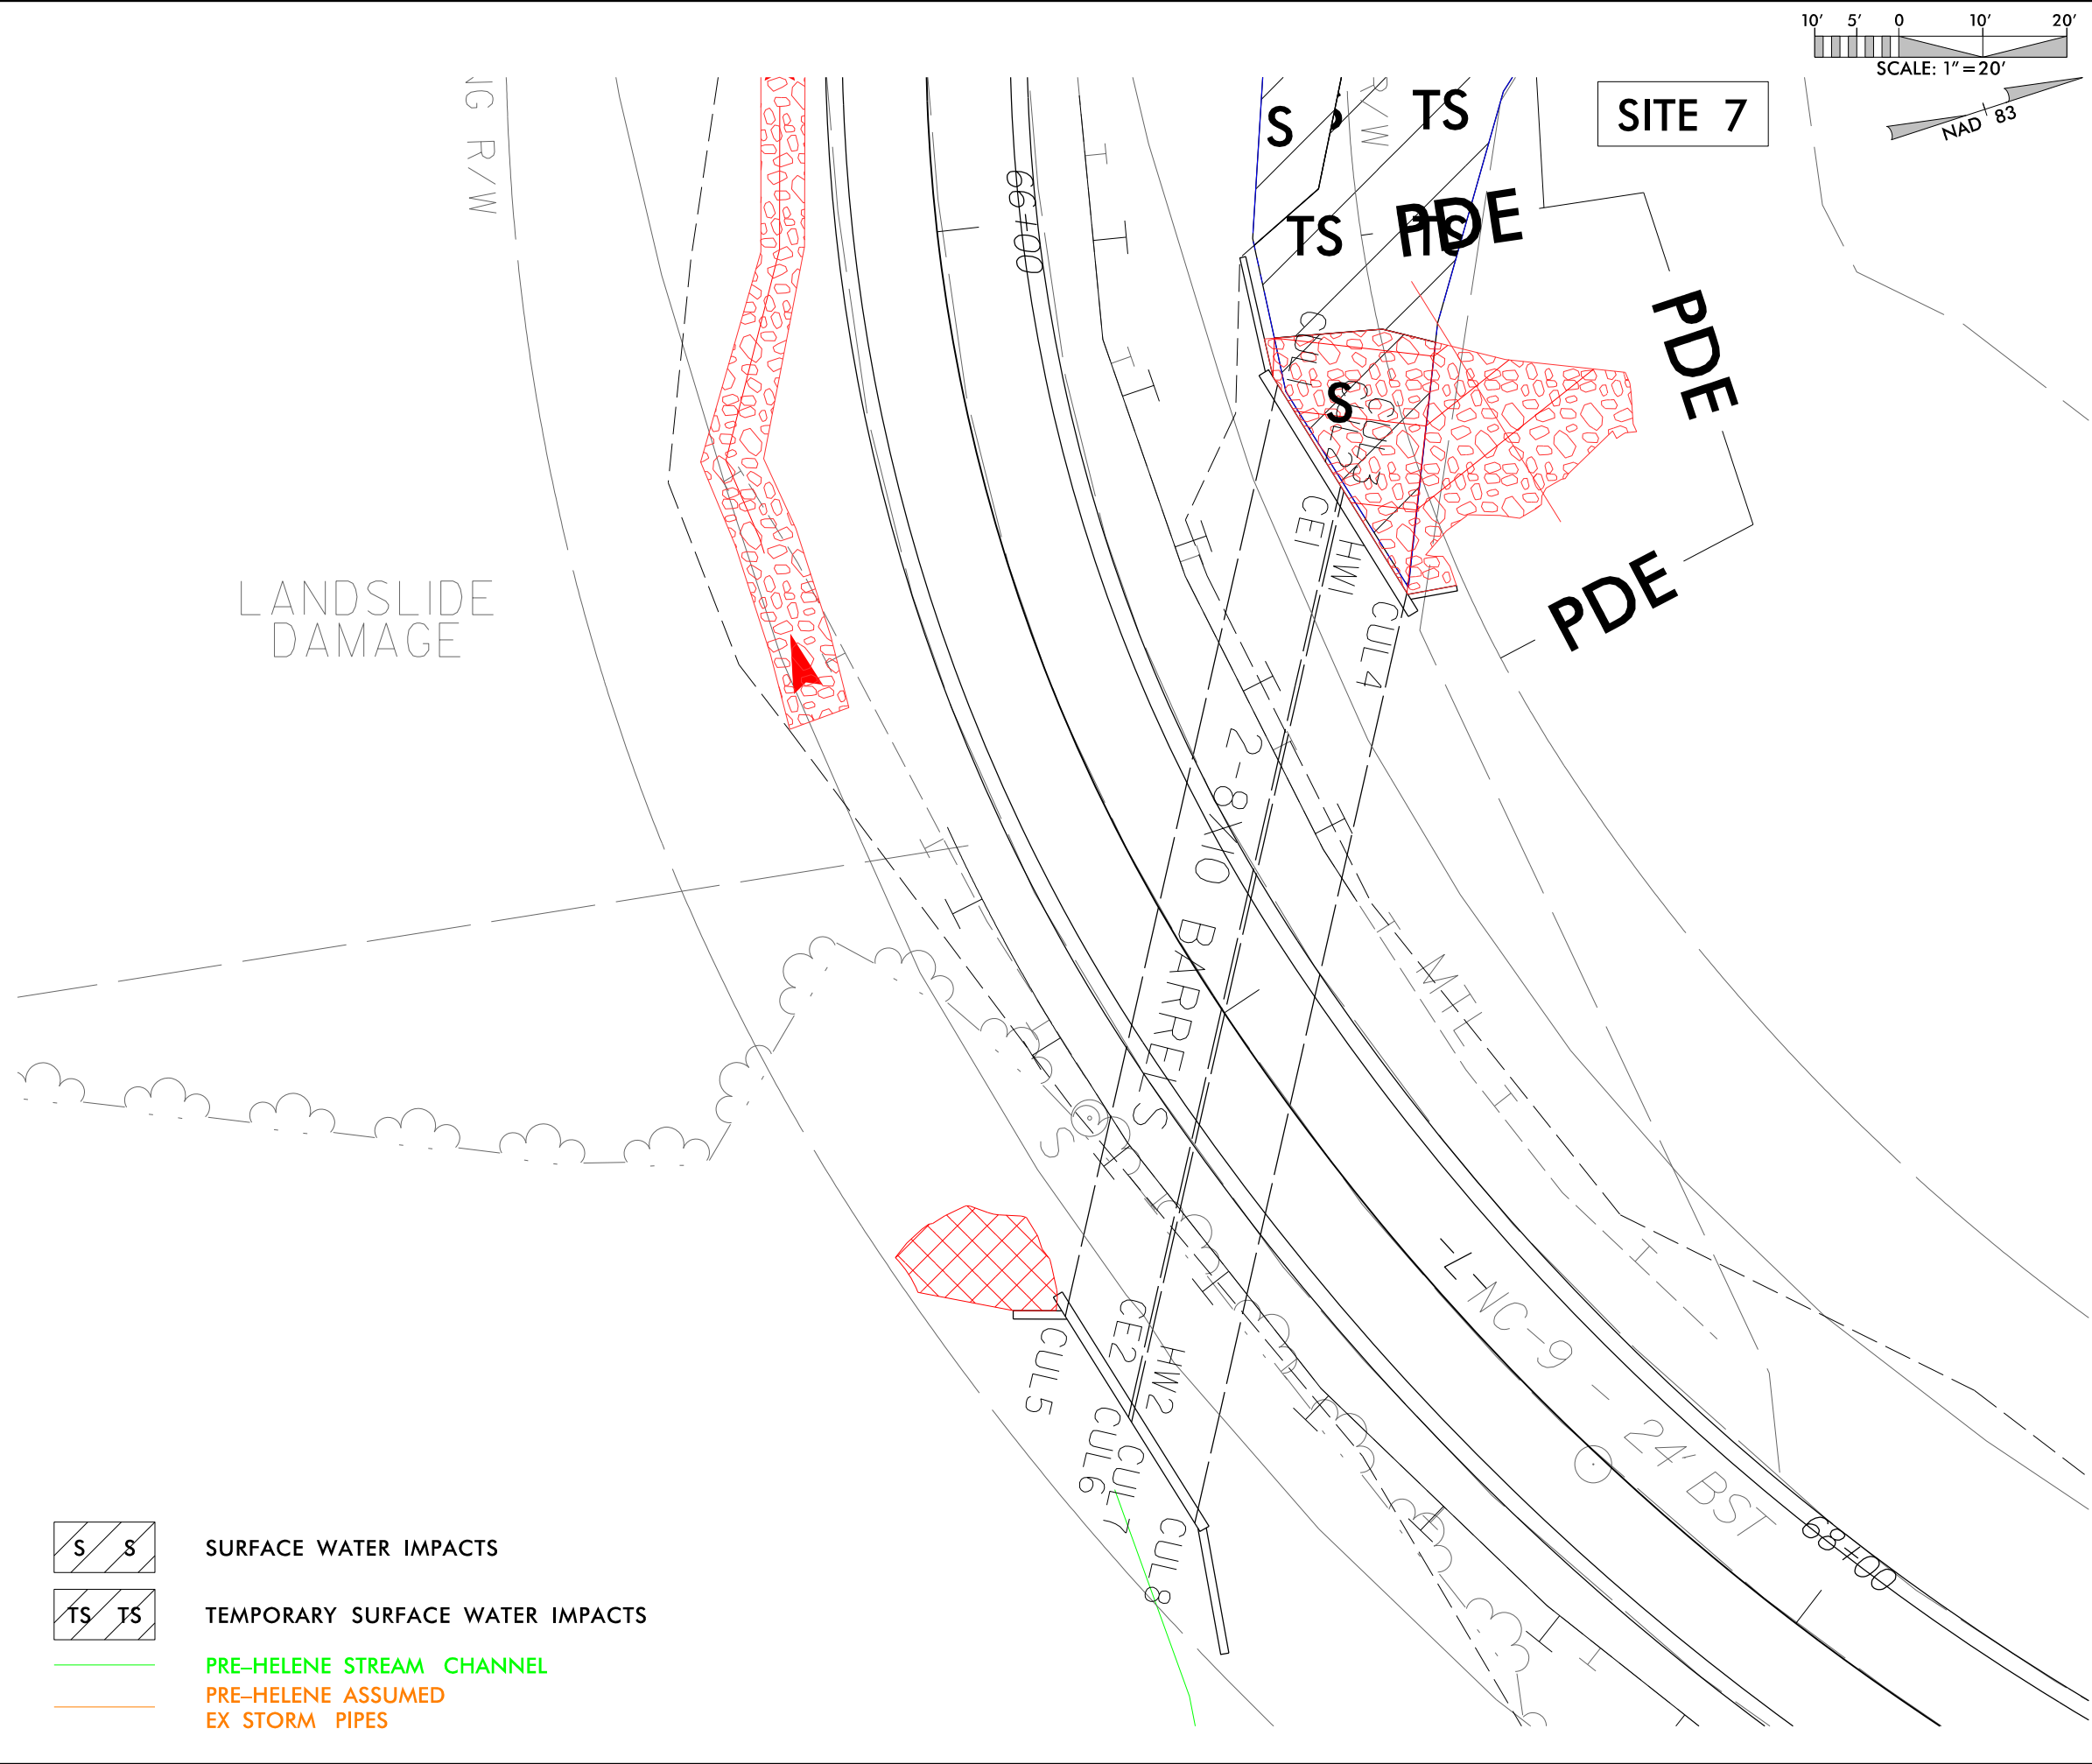

SURFACE WATER IMPACTS



TEMPORARY SURFACE WATER IMPACTS



PRE-HELENE STREAM CHANNEL




PRE-HELENE ASSUMED
EX STORM PIPES

PROJECT REFERENCE NO.		SHEET NO.			
NC-9					
ROADWAY DESIGN ENGINEER		HYDRAULICS ENGINEER			
DOCUMENT NOT CONSIDERED FINAL UNLESS ALL SIGNATURES COMPLETED					
SUNGATE DESIGN GROUP, P.A.					
		905 JONES FRANKLIN ROAD RALEIGH, NORTH CAROLINA 27606 TEL (919) 859-2243 ENG FIRM LICENSE NO. C-690			


PERMIT DRAWING
SHEET 16 OF 25


DATE: 10/20/2025

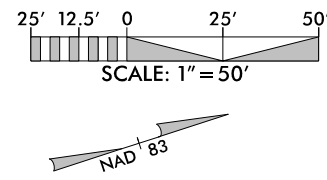

PROJECT REFERENCE NO.		SHEET NO.	
NC-9			
ROADWAY DESIGN ENGINEER		HYDRAULICS ENGINEER	
DOCUMENT NOT CONSIDERED FINAL UNLESS ALL SIGNATURES COMPLETED			
SUNGATE DESIGN GROUP, P.A.			
		905 JONES FRANKLIN ROAD RALEIGH, NORTH CAROLINA 27606 TEL: (919) 858-2243 ENG FIRM LICENSE NO. C-890	


PERMIT DRAWING
SHEET 17 OF 25
DATE: 10/20/2025

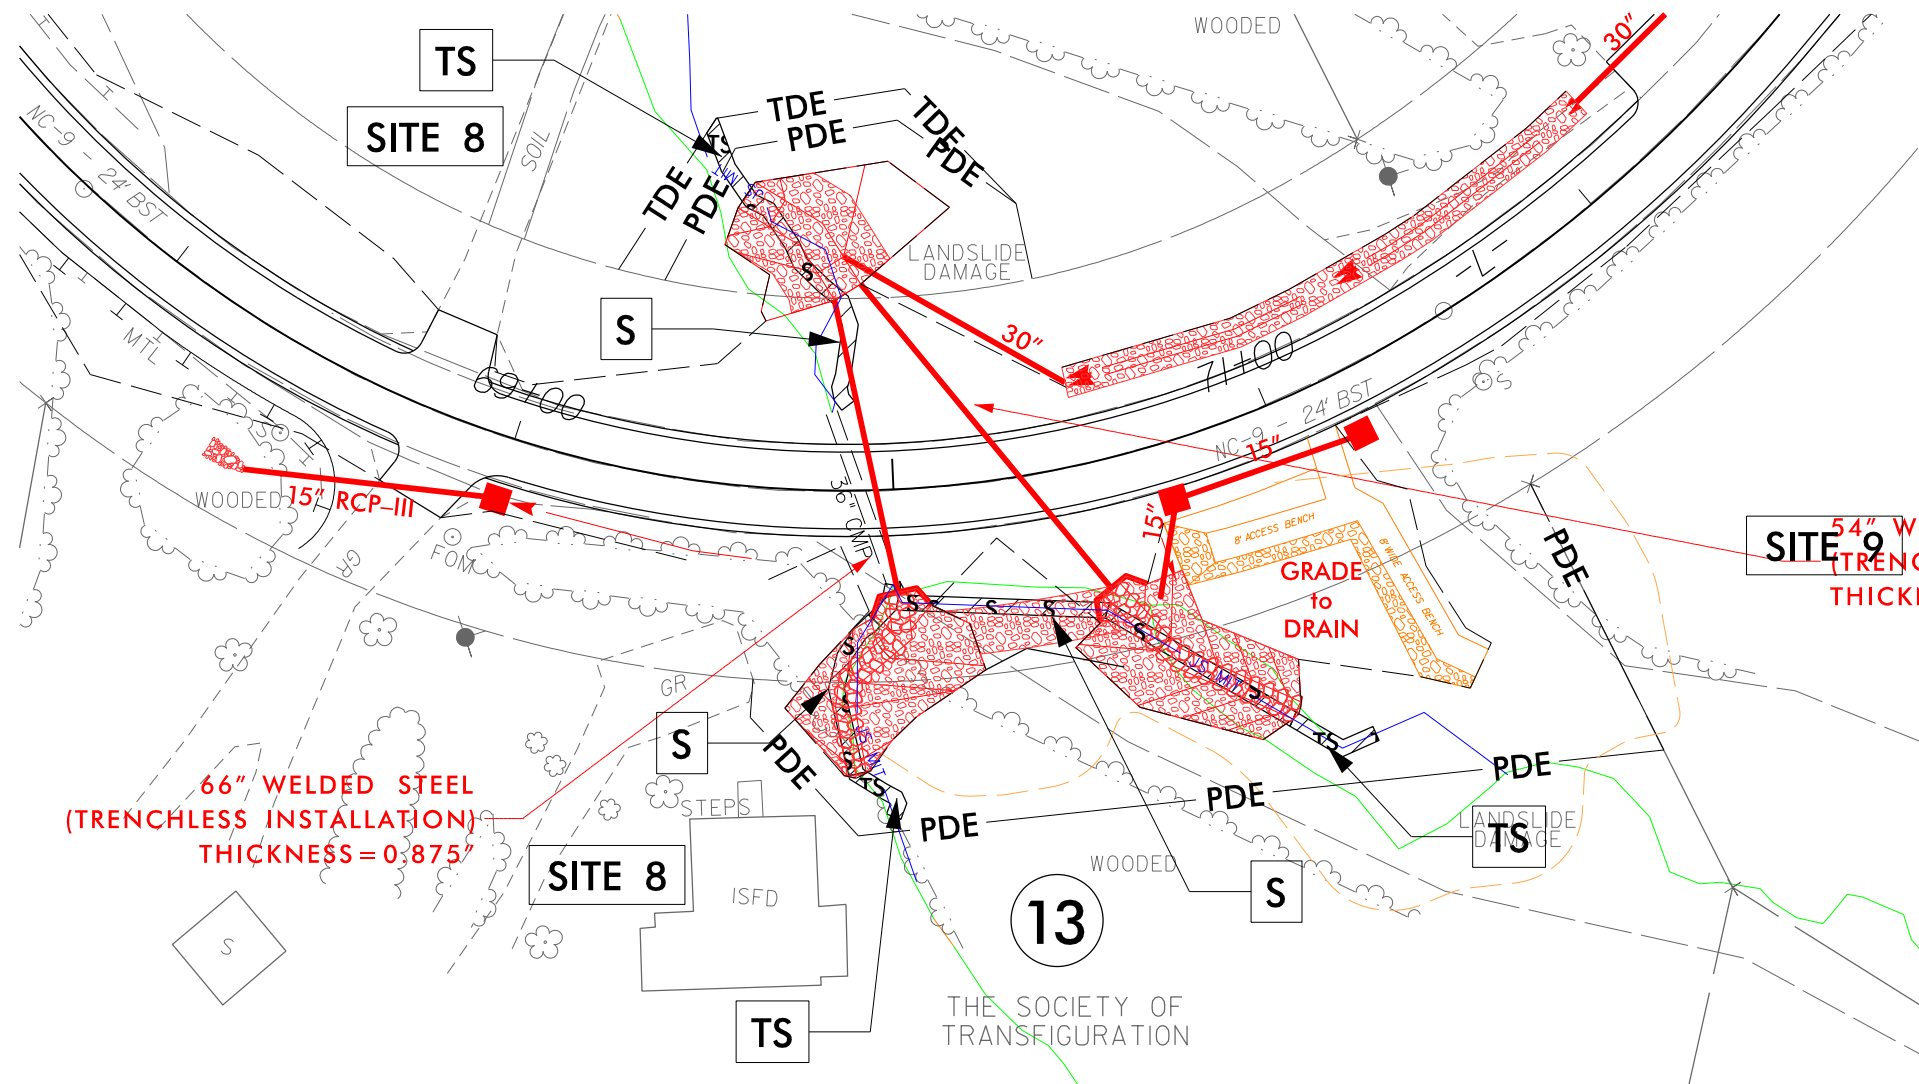


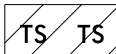-  SURFACE WATER IMPACTS
-  TEMPORARY SURFACE WATER IMPACTS
-  PRE-HELENE STREAM CHANNEL
-  PRE-HELENE ASSUMED EX STORM PIPES

012.525

PROJ. REFERENCE NO.	SHEET NO.
NC-9	
PERMIT DRAWING SHEET 18 OF 25	
DATE: 10/20/2025	

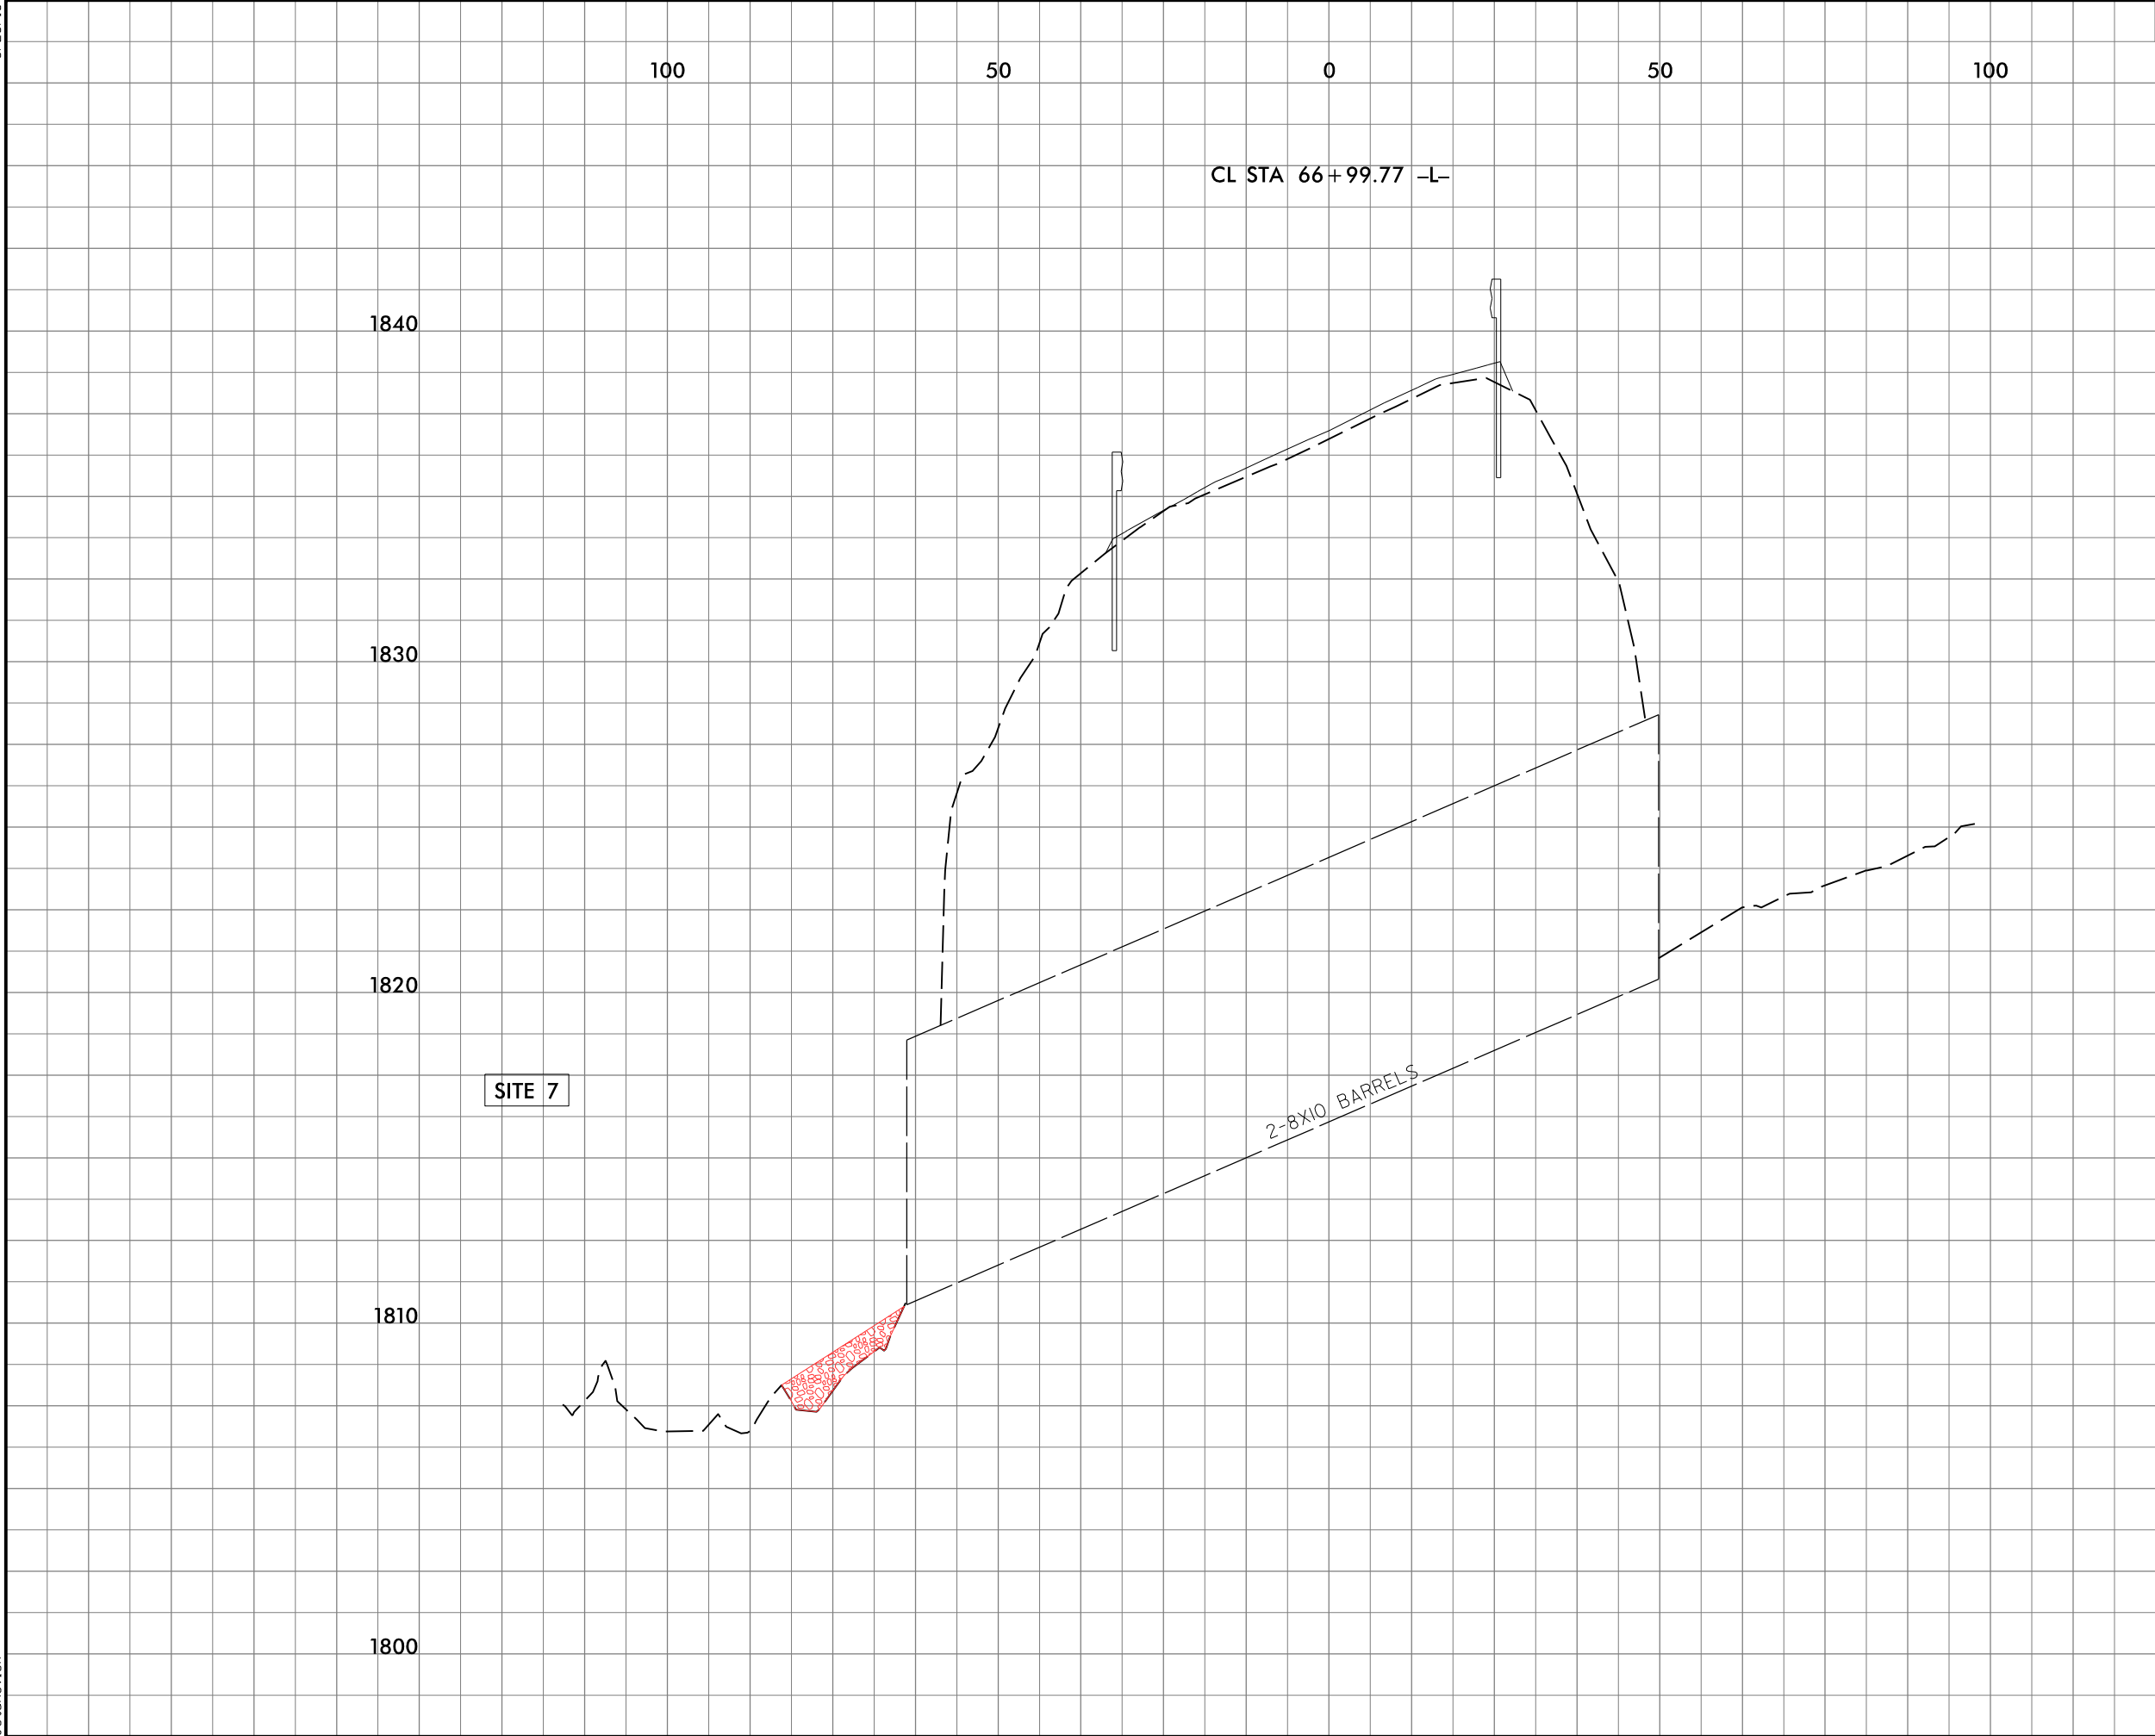

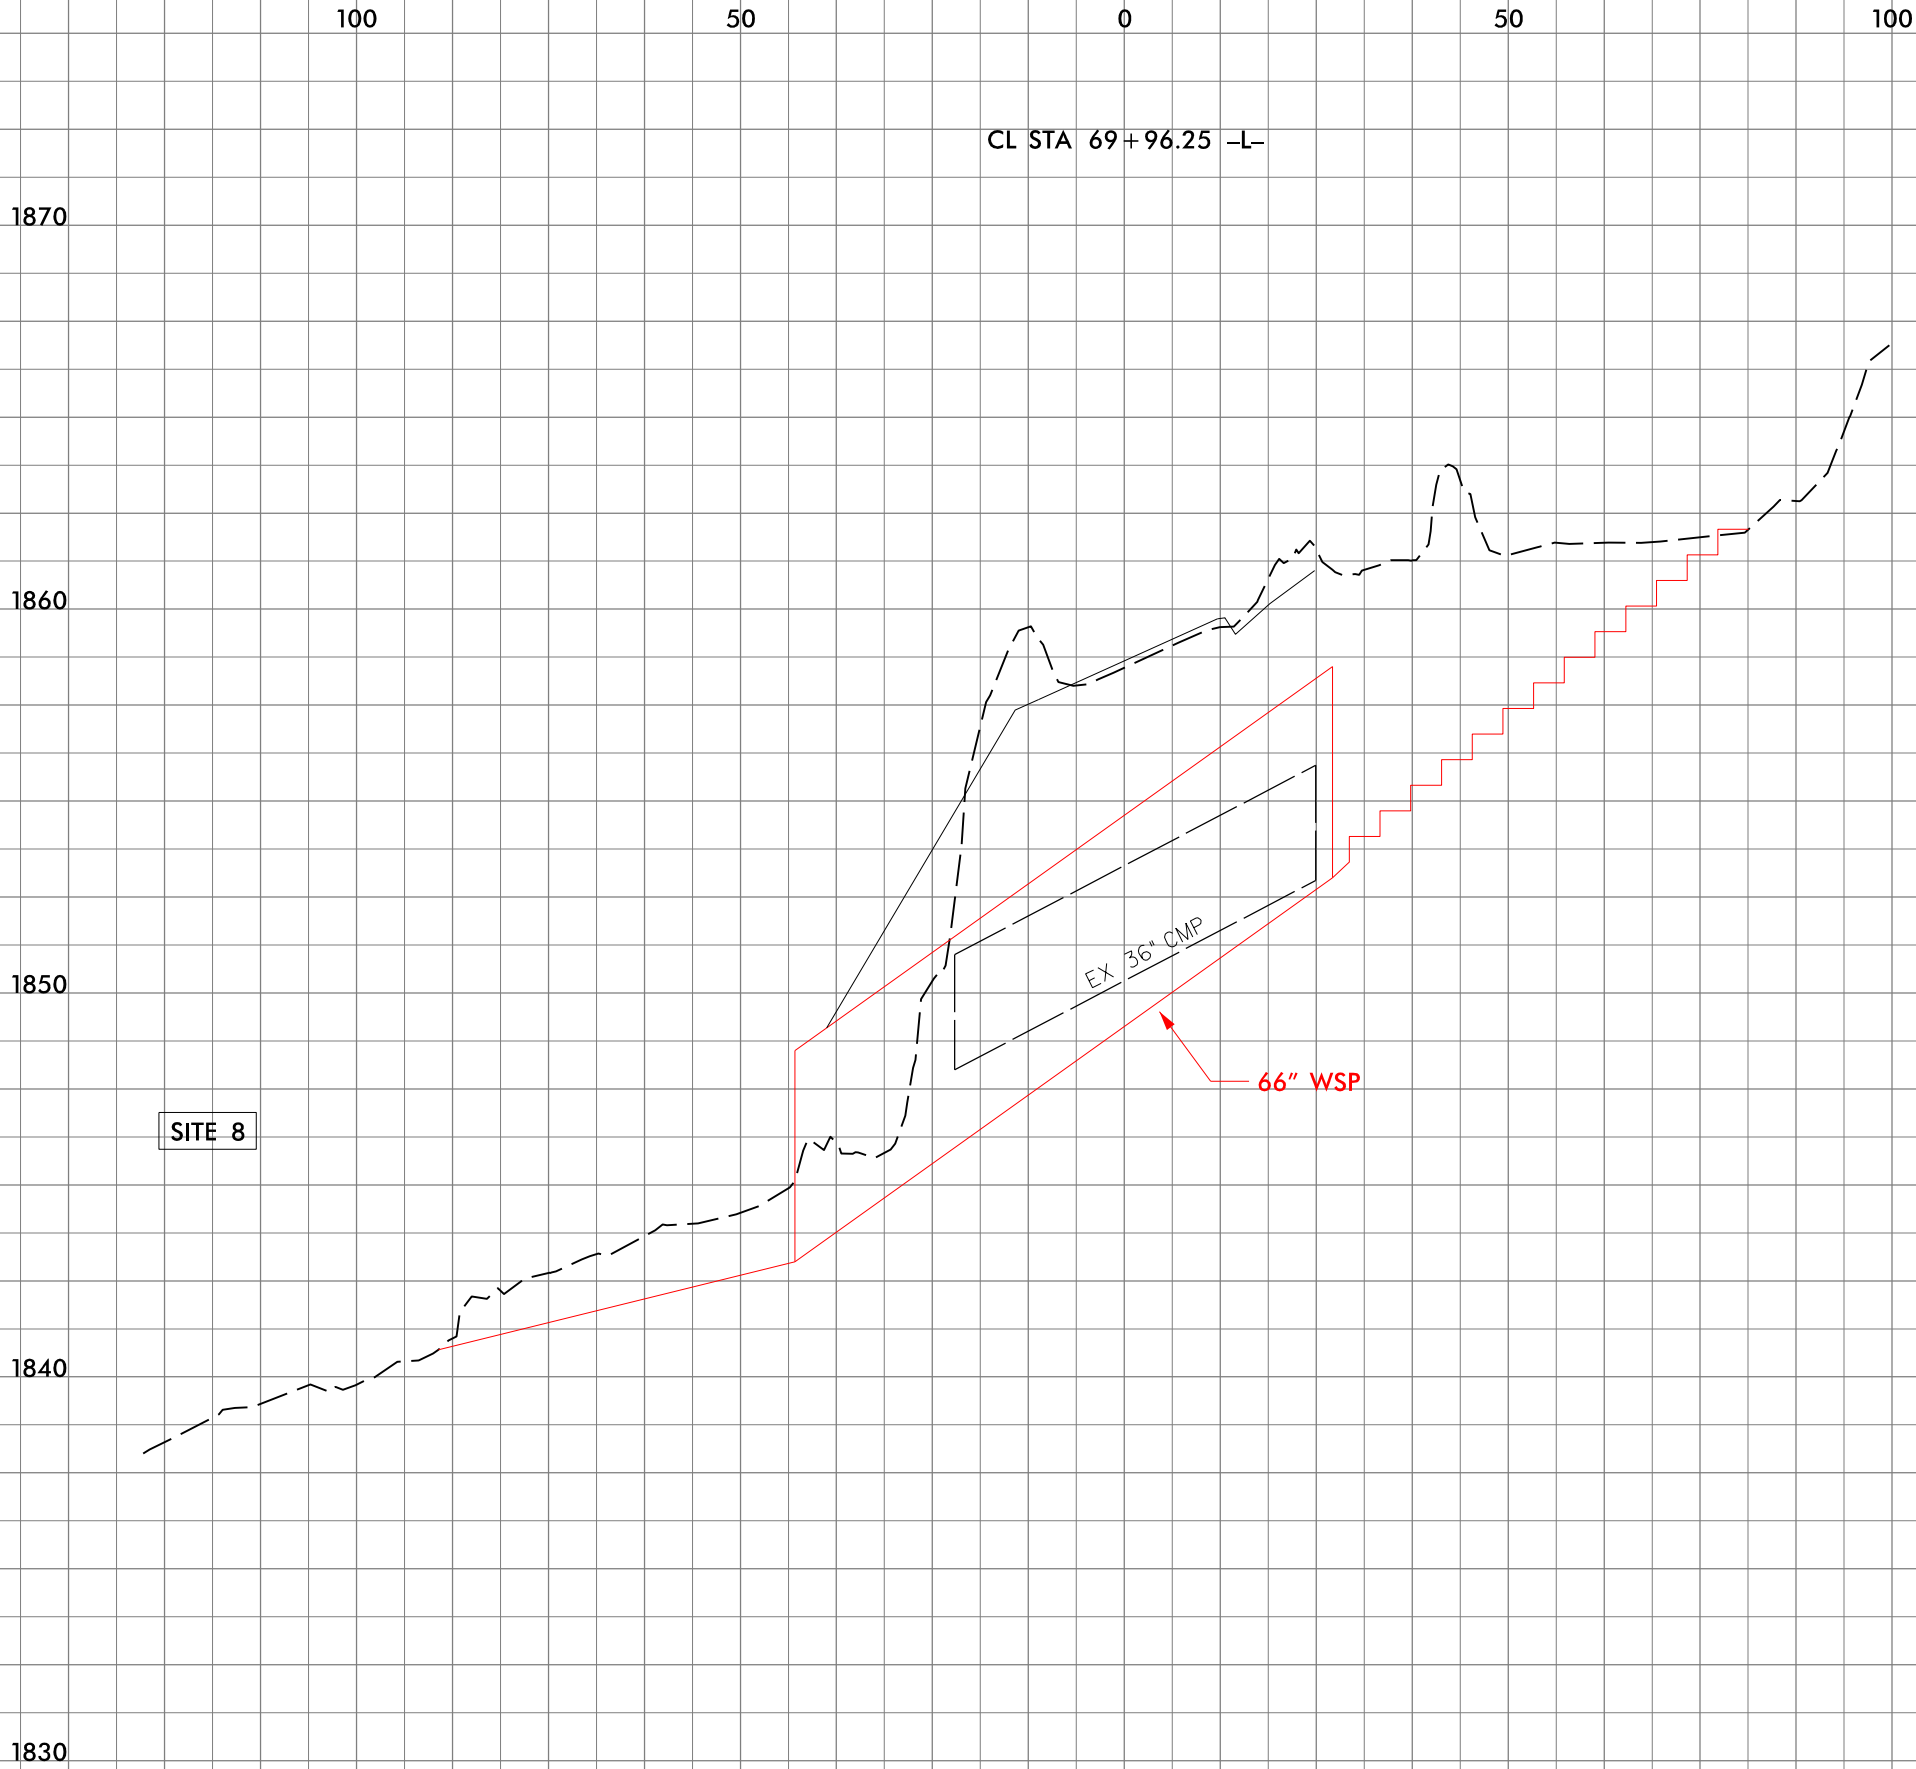

SITE 8

CL STA 69+96.25 -L-



EX 36" CMP

66" WSP

8/17/99

10/20/2025
NC-9_Hyd.prm_wet_pah.11dgn
J.Stonovich


MATCHLINE -L- STA 103+00
SEE SHEET 10

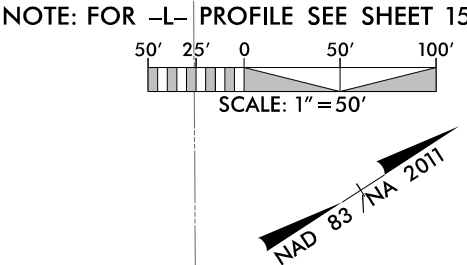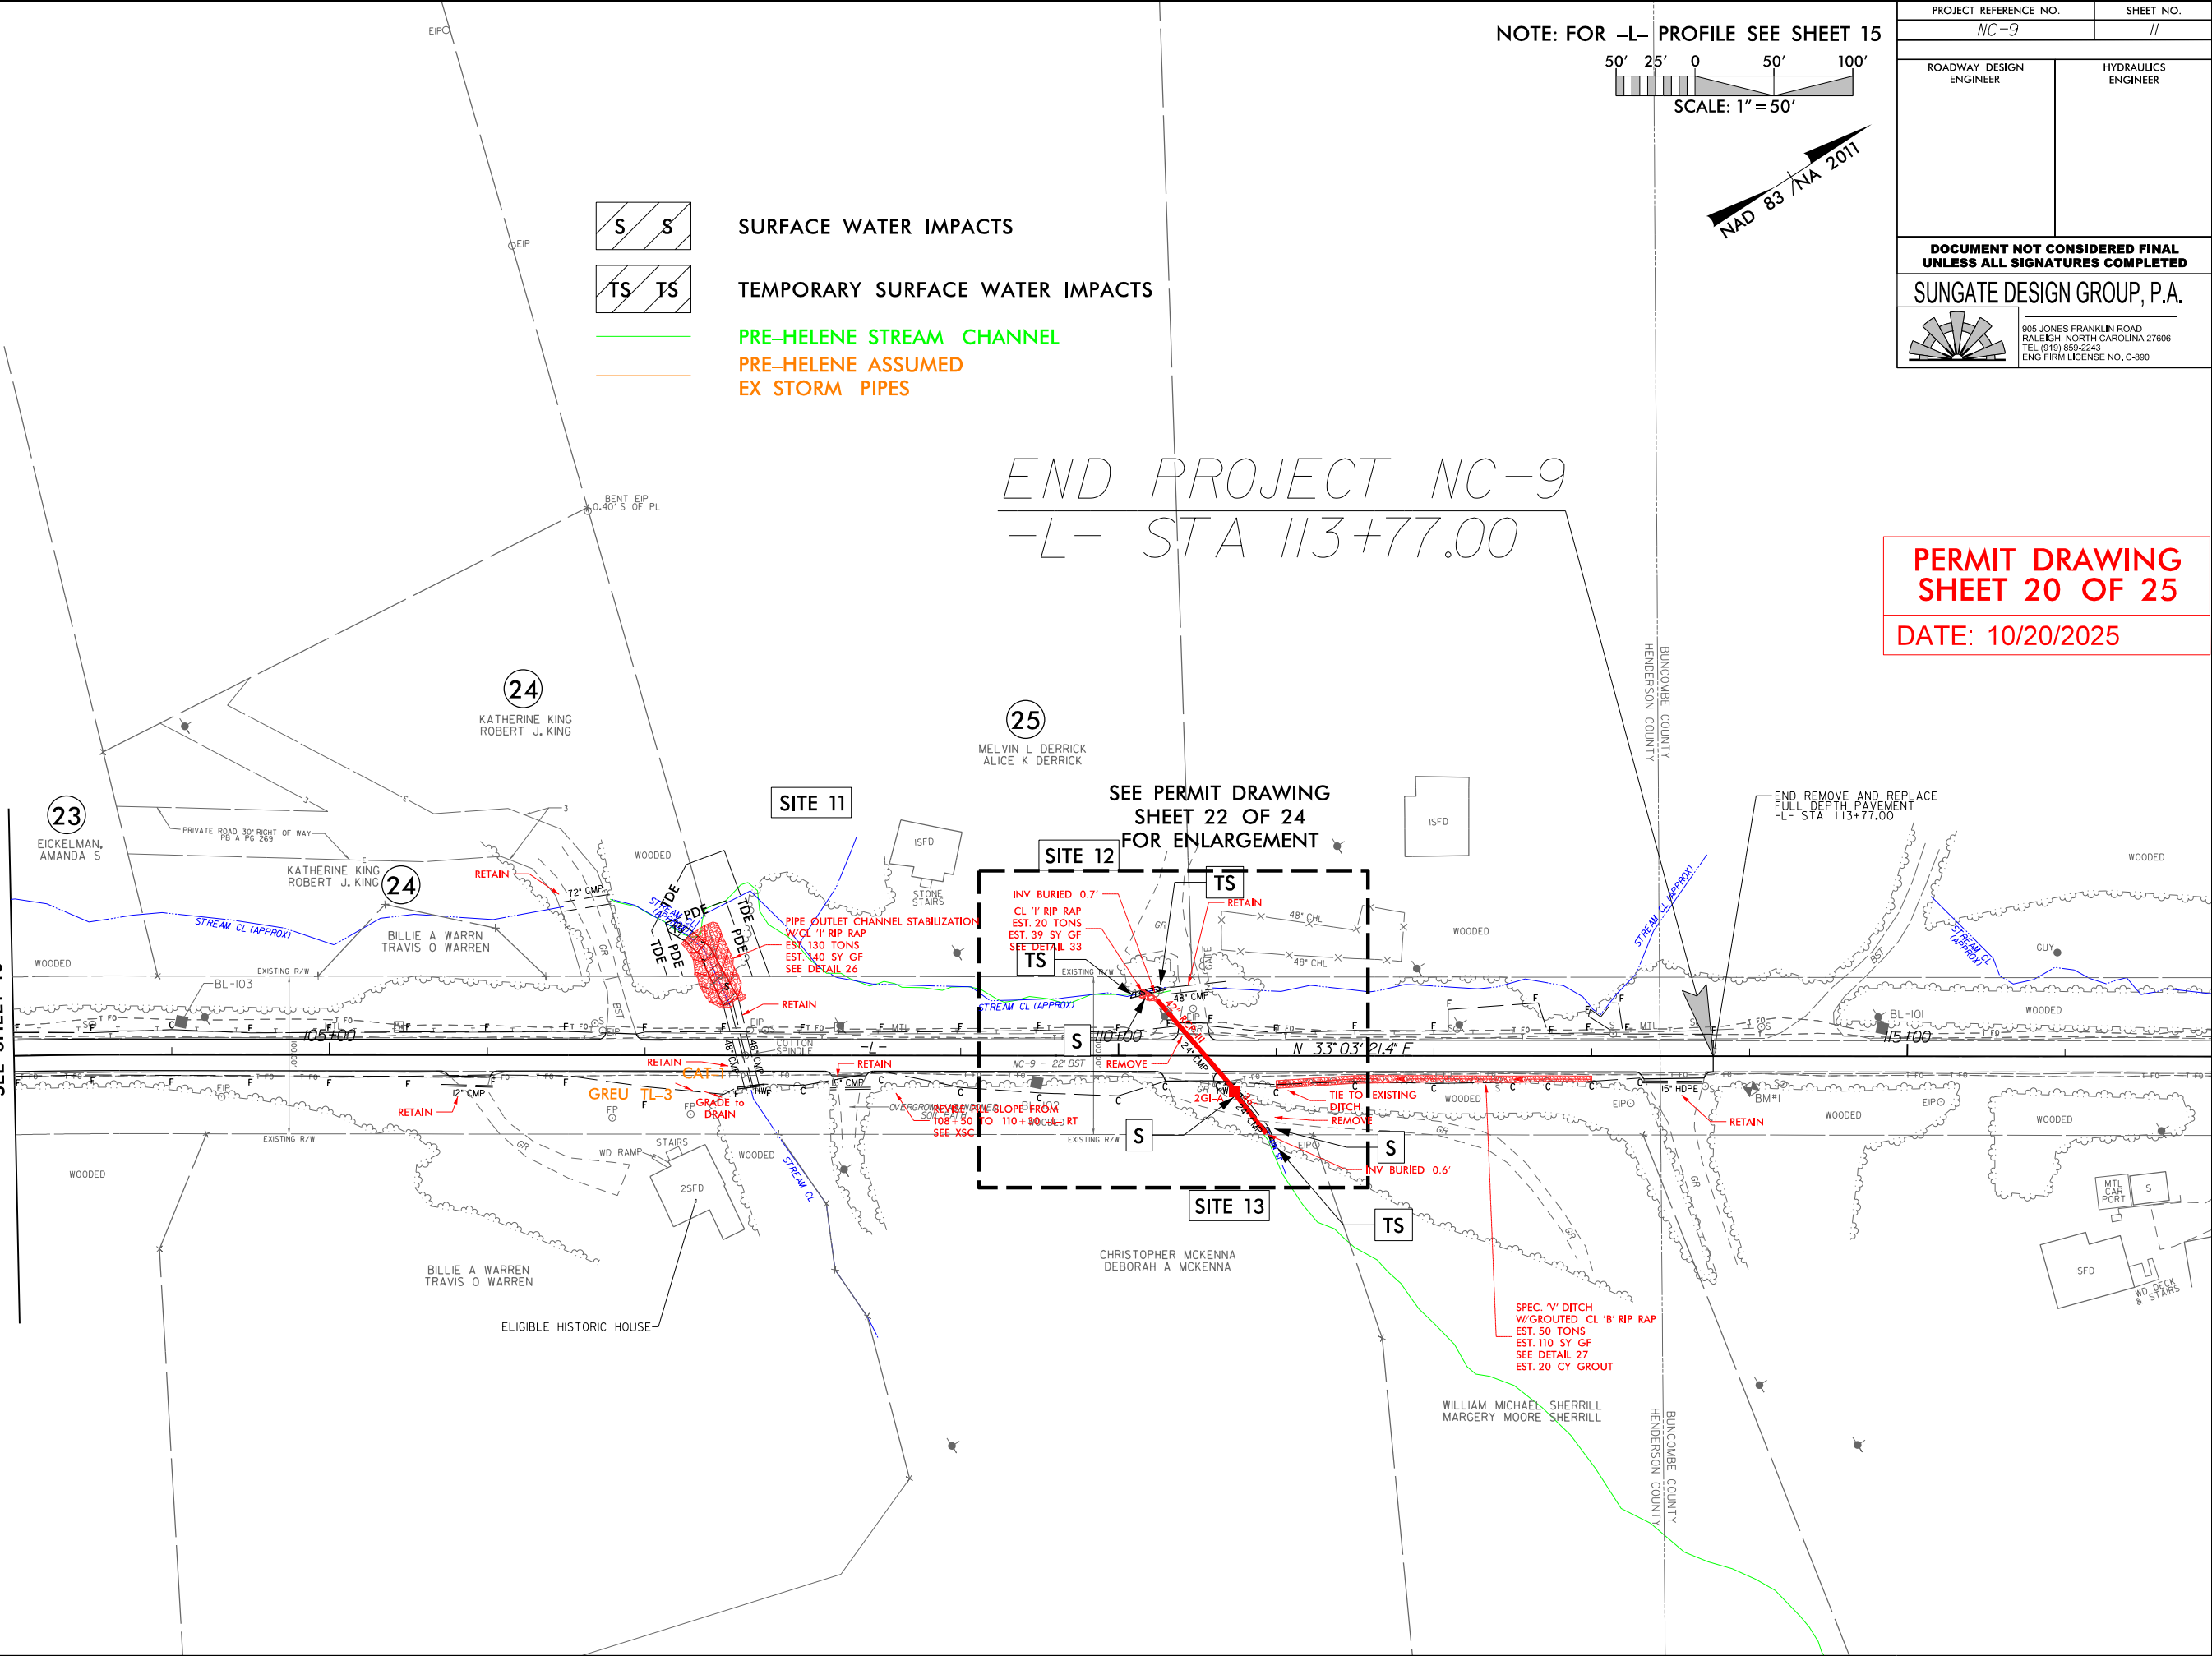

- SURFACE WATER IMPACTS
- TEMPORARY SURFACE WATER IMPACTS
- PRE-HELENE STREAM CHANNEL
- PRE-HELENE ASSUMED EX STORM PIPES

PROJECT REFERENCE NO. NC-9		SHEET NO. 11	
ROADWAY DESIGN ENGINEER		HYDRAULICS ENGINEER	
DOCUMENT NOT CONSIDERED FINAL UNLESS ALL SIGNATURES COMPLETED			
SUNGATE DESIGN GROUP, P.A.			
		905 JONES FRANKLIN ROAD RALEIGH, NORTH CAROLINA 27606 TEL: (919) 858-2243 ENG FIRM LICENSE NO. C-890	


PERMIT DRAWING
SHEET 20 OF 25
DATE: 10/20/2025

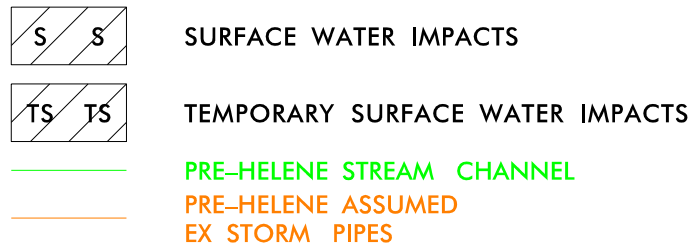

END PROJECT NC-9
-L- STA 113+77.00



8/17/99

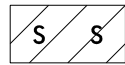

SURFACE WATER IMPACTS





TEMPORARY SURFACE WATER IMPACTS



PRE-HELELE STREAM CHANNEL



PRE-HELELE ASSUMED
EX STORM PIPES

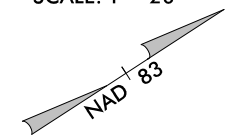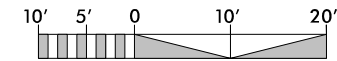

SITE 12

TS

S

TS

EXISTING R/W

STREAM CL (APPROX)

42" RCP III

48" CMP

24" CMP

GR

HW

FO

FO

SITE 13

S

TS

TIE TO
DITCH

PROJECT REFERENCE NO.		SHEET NO.			
NC-9					
ROADWAY DESIGN ENGINEER		HYDRAULICS ENGINEER			
DOCUMENT NOT CONSIDERED FINAL UNLESS ALL SIGNATURES COMPLETED					
SUNGATE DESIGN GROUP, P.A.					
		905 JONES FRANKLIN ROAD RALEIGH, NORTH CAROLINA 27606 TEL: (919) 858-2243 ENG FIRM LICENSE NO. C-890			

PERMIT DRAWING
SHEET 22 OF 25

DATE: 10/20/2025

10/20/2025
NC-9_Hyd.prm_wet_psh.11-2-ViewIn.dgn
JStonovich

WETLAND AND SURFACE WATER IMPACTS SUMMARY												
			WETLAND IMPACTS					SURFACE WATER IMPACTS				
Site No.	Station (From/To)	Structure Size / Type	Permanent Fill In Wetlands (ac)	Temp. Fill In Wetlands (ac)	Excavation in Wetlands (ac)	Mechanized Clearing in Wetlands (ac)	Hand Clearing in Wetlands (ac)	Permanent SW impacts (ac)	Temp. SW impacts (ac)	Existing Channel Impacts Permanent (ft)	Existing Channel Impacts Temp. (ft)	Natural Stream Design (ft)
1	10+40 to 33+27-L-LT	ROADWAY FILL							1.006		1166	
	12+01 to 29+83-L-LT	EXEMPT ROADWAY FILL						0.300		1129		
	12+49 to 14+25 -L- LT	STREAM MODIFICATION							0.058			
2	14+01 to 14+05-L-RT	ROADWAY FILL						0.001	0.001	15	12	
3	17+10 to 19+98-L-RT	ROADWAY FILL						0.007	0.001	295	11	
4	32+41 to 36+29-L-RT	ROADWAY FILL						0.024	0.001	340		
		PIPE INLET						0.003		42	11	
SHEET TOTALS*:			0.000	0.000	0.000	0.000	0.000	0.335	1.067	1821	1200	0

*Rounded totals are sum of actual impacts

NOTES:

The linear feet of temporary existing channel impacts not included for Site 1 Stream Modification due to already being accounted for under Site 1 Roadway Fill.

NC DEPARTMENT OF TRANSPORTATION
DIVISION OF HIGHWAYS
10-20-2025
HENDERSON COUNTY
NC-9
18314.4045135
SHEET 23 OF 25

WETLAND AND SURFACE WATER IMPACTS SUMMARY												
			WETLAND IMPACTS					SURFACE WATER IMPACTS				
Site No.	Station (From/To)	Structure Size / Type	Permanent Fill In Wetlands (ac)	Temp. Fill In Wetlands (ac)	Excavation in Wetlands (ac)	Mechanized Clearing in Wetlands (ac)	Hand Clearing in Wetlands (ac)	Permanent SW impacts (ac)	Temp. SW impacts (ac)	Existing Channel Impacts Permanent (ft)	Existing Channel Impacts Temp. (ft)	Natural Stream Design (ft)
5	44+36 to 45+21-L-RT	CHANNEL REPLACEMENT						0.001		26		
		PIPE INLET						0.001		19		
	44+14 to 44+33-L-LT	PIPE OUTLET						0.002		43		
		CHANNEL REPLACEMENT						0.002		39		
6	44+45 to 45+82-L-RT	DEWATERING							0.001		26	
		INLET CHANNEL BACKSLOPE						0.001		6		
		INLET CHANNEL RIP RAP						0.006		125		
7	60+34 to 66+62-L-LT	RIP RAP EMBANKMENT						0.052		379		
	60+34 to 66+62-L-LT	DEWATERING							0.194		207	
	66+21 to 66+62-L-LT	OUTLET RIP RAP						0.008		19		
8	69+84 to 70+01-L-RT	PIPE INLET						0.001		11		
		INLET CHANNEL RIP RAP						0.004		44		
		DEWATERING							0.002		17	
	69+42 to 69+91-L-LT	PIPE CULVERT						0.003		30		
		OUTLET CHANNEL RIP RAP						0.003		37		
		DEWATERING							0.002		20	
SHEET TOTALS*:			0.000	0.000	0.000	0.000	0.000	0.084	0.199	778	270	0

*Rounded totals are sum of actual impacts

NOTES:

Site 5: Existing Pipe Culvert: 115 LF
Site 6: Existing Pipe Culvert: 166 LF
Site 8: Existing Pipe Culvert: 48 LF

NC DEPARTMENT OF TRANSPORTATION
DIVISION OF HIGHWAYS
10-20-2025
HENDERSON COUNTY
NC-9
18314.4045135

SHEET24OF25

WETLAND AND SURFACE WATER IMPACTS SUMMARY												
			WETLAND IMPACTS					SURFACE WATER IMPACTS				
Site No.	Station (From/To)	Structure Size / Type	Permanent Fill In Wetlands (ac)	Temp. Fill In Wetlands (ac)	Excavation in Wetlands (ac)	Mechanized Clearing in Wetlands (ac)	Hand Clearing in Wetlands (ac)	Permanent SW impacts (ac)	Temp. SW impacts (ac)	Existing Channel Impacts Permanent (ft)	Existing Channel Impacts Temp. (ft)	Natural Stream Design (ft)
9	70+01 to 70+86-L-RT	RESILIENCY						0.004		44		
		PIPE INLET						0.001		13		
	70+46 to 70+86-L-RT	INLET CHANNEL RIP RAP						0.005		56		
		PIPE INLET						0.001		2		
		DEWATERING							0.001		24	
10	76+27 to 76+64-L-LT	SUPPLEMENTAL RIP RAP						0.002		46		
11	107+13 to 107+59-L-LT	OUTLET RIP RAP						0.010		51		
		DEWATERING							0.003		16	
12	110+08 to 110+30-L-LT	OUTLET RIP RAP						0.001		4		
		DEWATERING							0.001		15	
13	110+93 to 111+00-L-RT	PIPE INLET						0.001		3		
		DEWATERING							0.001		10	
	110+70 to 110+79-L-RT	PIPE OUTLET						0.001		10		
	TOTAL SHEET	23 OF 25						0.335	1.067	1821	1200	
	TOTAL SHEET	24 OF 25						0.084	0.199	778	270	
PROJECT TOTALS*:			0.000	0.000	0.000	0.000	0.000	0.445	1.272	2828	1535	0

*Rounded totals are sum of actual impacts
NOTES:

NC DEPARTMENT OF TRANSPORTATION
DIVISION OF HIGHWAYS
10-20-2025
HENDERSON COUNTY
NC-9
18314.4045135

SHEET25OF25